

HORIZONTAL CONTROL

THE BASIS OF HORIZONTAL CONTROL FOR THIS PROJECT WAS DERIVED FROM GPS OBSERVATIONS PERFORMED BY DOT/PPF ON PAIRS OF CENTERLINE MONUMENTS AT REVILLA ROAD AND AT WHIPPLE CREEK. A TRAVERSE WAS RUN BY TONER-NORDLING AND ASSOCIATES BETWEEN SAID PAIRS AND ADJUSTED BY TNA. CONTROL TRAVERSE WAS THEN SCALED TO GROUND DISTANCES AND ROTATED TO GEODETIC BEARINGS.

FOR THIS PHASE OF THIS PROJECT THE CONTROL BASE IS OUTLINED IN COORDINATE TABLES. THESE COORDINATES ARE NOT TRUE STATE PLANE BUT RATHER A LOCAL SYSTEM NEAR STATE PLANE VALUES.

TRANSFORMATION PARAMETERS RELATING THE LOCAL GROUND BASED COORDINATE SYSTEM TO ALASKA STATE PLANE ZONE 1 US FEET WERE COMPUTED POST TRAVERSE BY DOT/PPF. OPUS WAS USED TO CONTROL THE BASE STATION ON POINT #435 AND SIX GPS TIES TO NETWORK CONTROL CONFIRMED THE FOLLOWING TRANSFORMATION VALUES.
 GRID SCALE FACTOR : 0.99990085
 ROTATION TO GRID NORTH : 1°35'14"
 LOCAL NORTHING: 1,316,047.0920'
 LOCAL EASTING: 3,079,528.5740'
 AKSPC GRID NORTHING: 1,315,746.0455'
 AKSPC GRID EASTING: 3,079,408.2788'

CONTROL MONUMENTS

POINT	STATION	OFFSET	NORTHING	EASTING	ELEVATION	DESCRIPTION	REMARKS
22	N/A	N/A	1317918.0721	3077515.6684	59.43	ALCTRL2_NT-22	DO NOT REPLACE OR RESET IF DISTURBED
23	223+87.16	51.25 L	1318326.7387	3076592.1186	98.25	ALCTRL2_NT-23	
24	N/A	N/A	1319447.2601	3075855.0778	100.29	ALCTRL2_NT-24	


PROPERTY MONUMENTS

POINT	STATION	OFFSET	NORTHING	EASTING	DESCRIPTION	REMARKS
900	N/A	N/A	1317993.5146	3077457.7512	PRIMARY_MON	
901	N/A	N/A	1318010.0110	3077284.5475	SECONDARY_MON	
902	219+40.06	48.27 L	1318120.8129	3077002.5799	PRIMARY_MON	
903	220+10.09	13.96 L	1318178.4168	3076950.0226	CL_MON	DO NOT REPLACE
904	220+36.00	16.51 L	1318185.5510	3076924.9784	CL_MON	DO NOT REPLACE
905	221+65.27	68.54 L	1318189.2183	3076782.1450	IRON_PIPE	
906	222+21.88	16.28 R	1318291.1548	3076769.4026	SECONDARY_MON	
907	224+08.41	89.18 L	1318310.9588	3076550.8462	PRIMARY_MON	
908	225+27.24	52.81 L	1318422.7076	3076480.9920	SECONDARY_MON	
909	225+07.38	25.63 R	1318464.3673	3076550.4358	SECONDARY_MON	
910	226+39.29	2.89 R	1318545.2402	3076446.0699	CL_MON	DO NOT REPLACE
911	227+80.49	30.90 L	1318643.0343	3076336.4923	SECONDARY_MON	
912	230+44.32	39.46 L	1318864.4561	3076192.7436	SECONDARY_MON	
913	230+41.61	153.74 L	1318803.0510	3076096.3261	SECONDARY_MON	
914	231+44.27	41.64 L	1318948.8877	3076139.1948	SECONDARY_MON	
915	N/A	N/A	1319061.9029	3076067.1779	SECONDARY_MON	
916	N/A	N/A	1319097.6681	3076056.9792	PRIMARY_MON	
917	N/A	N/A	1319114.9126	3076038.3509	SECONDARY_MON	
918	N/A	N/A	1319213.7933	3075975.9917	SECONDARY_MON	
919	N/A	N/A	1319316.4890	3075919.6090	SECONDARY_MON	
920	N/A	N/A	1319312.8230	3075913.6933	SECONDARY_MON	
921	N/A	N/A	1319412.3645	3075850.9871	SECONDARY_MON	

VERTICAL CONTROL

THE BASIS OF VERTICAL CONTROL IS A BRASS CAP MONUMENT FOUND IN THE NE BRIDGE ABUTMENT OF WHIPPLE CREEK BRIDGE. THE ACCEPTED ELEVATION OF THIS POINT IS 135.79' ABOVE MLLW.

LEVELS WERE RUN THROUGH THE CONTROL NETWORK AND AS SUCH ALL CONTROL MONUMENTS HAVE VALID ELEVATIONS REFERENCED IN THE CONTROL TABLE.

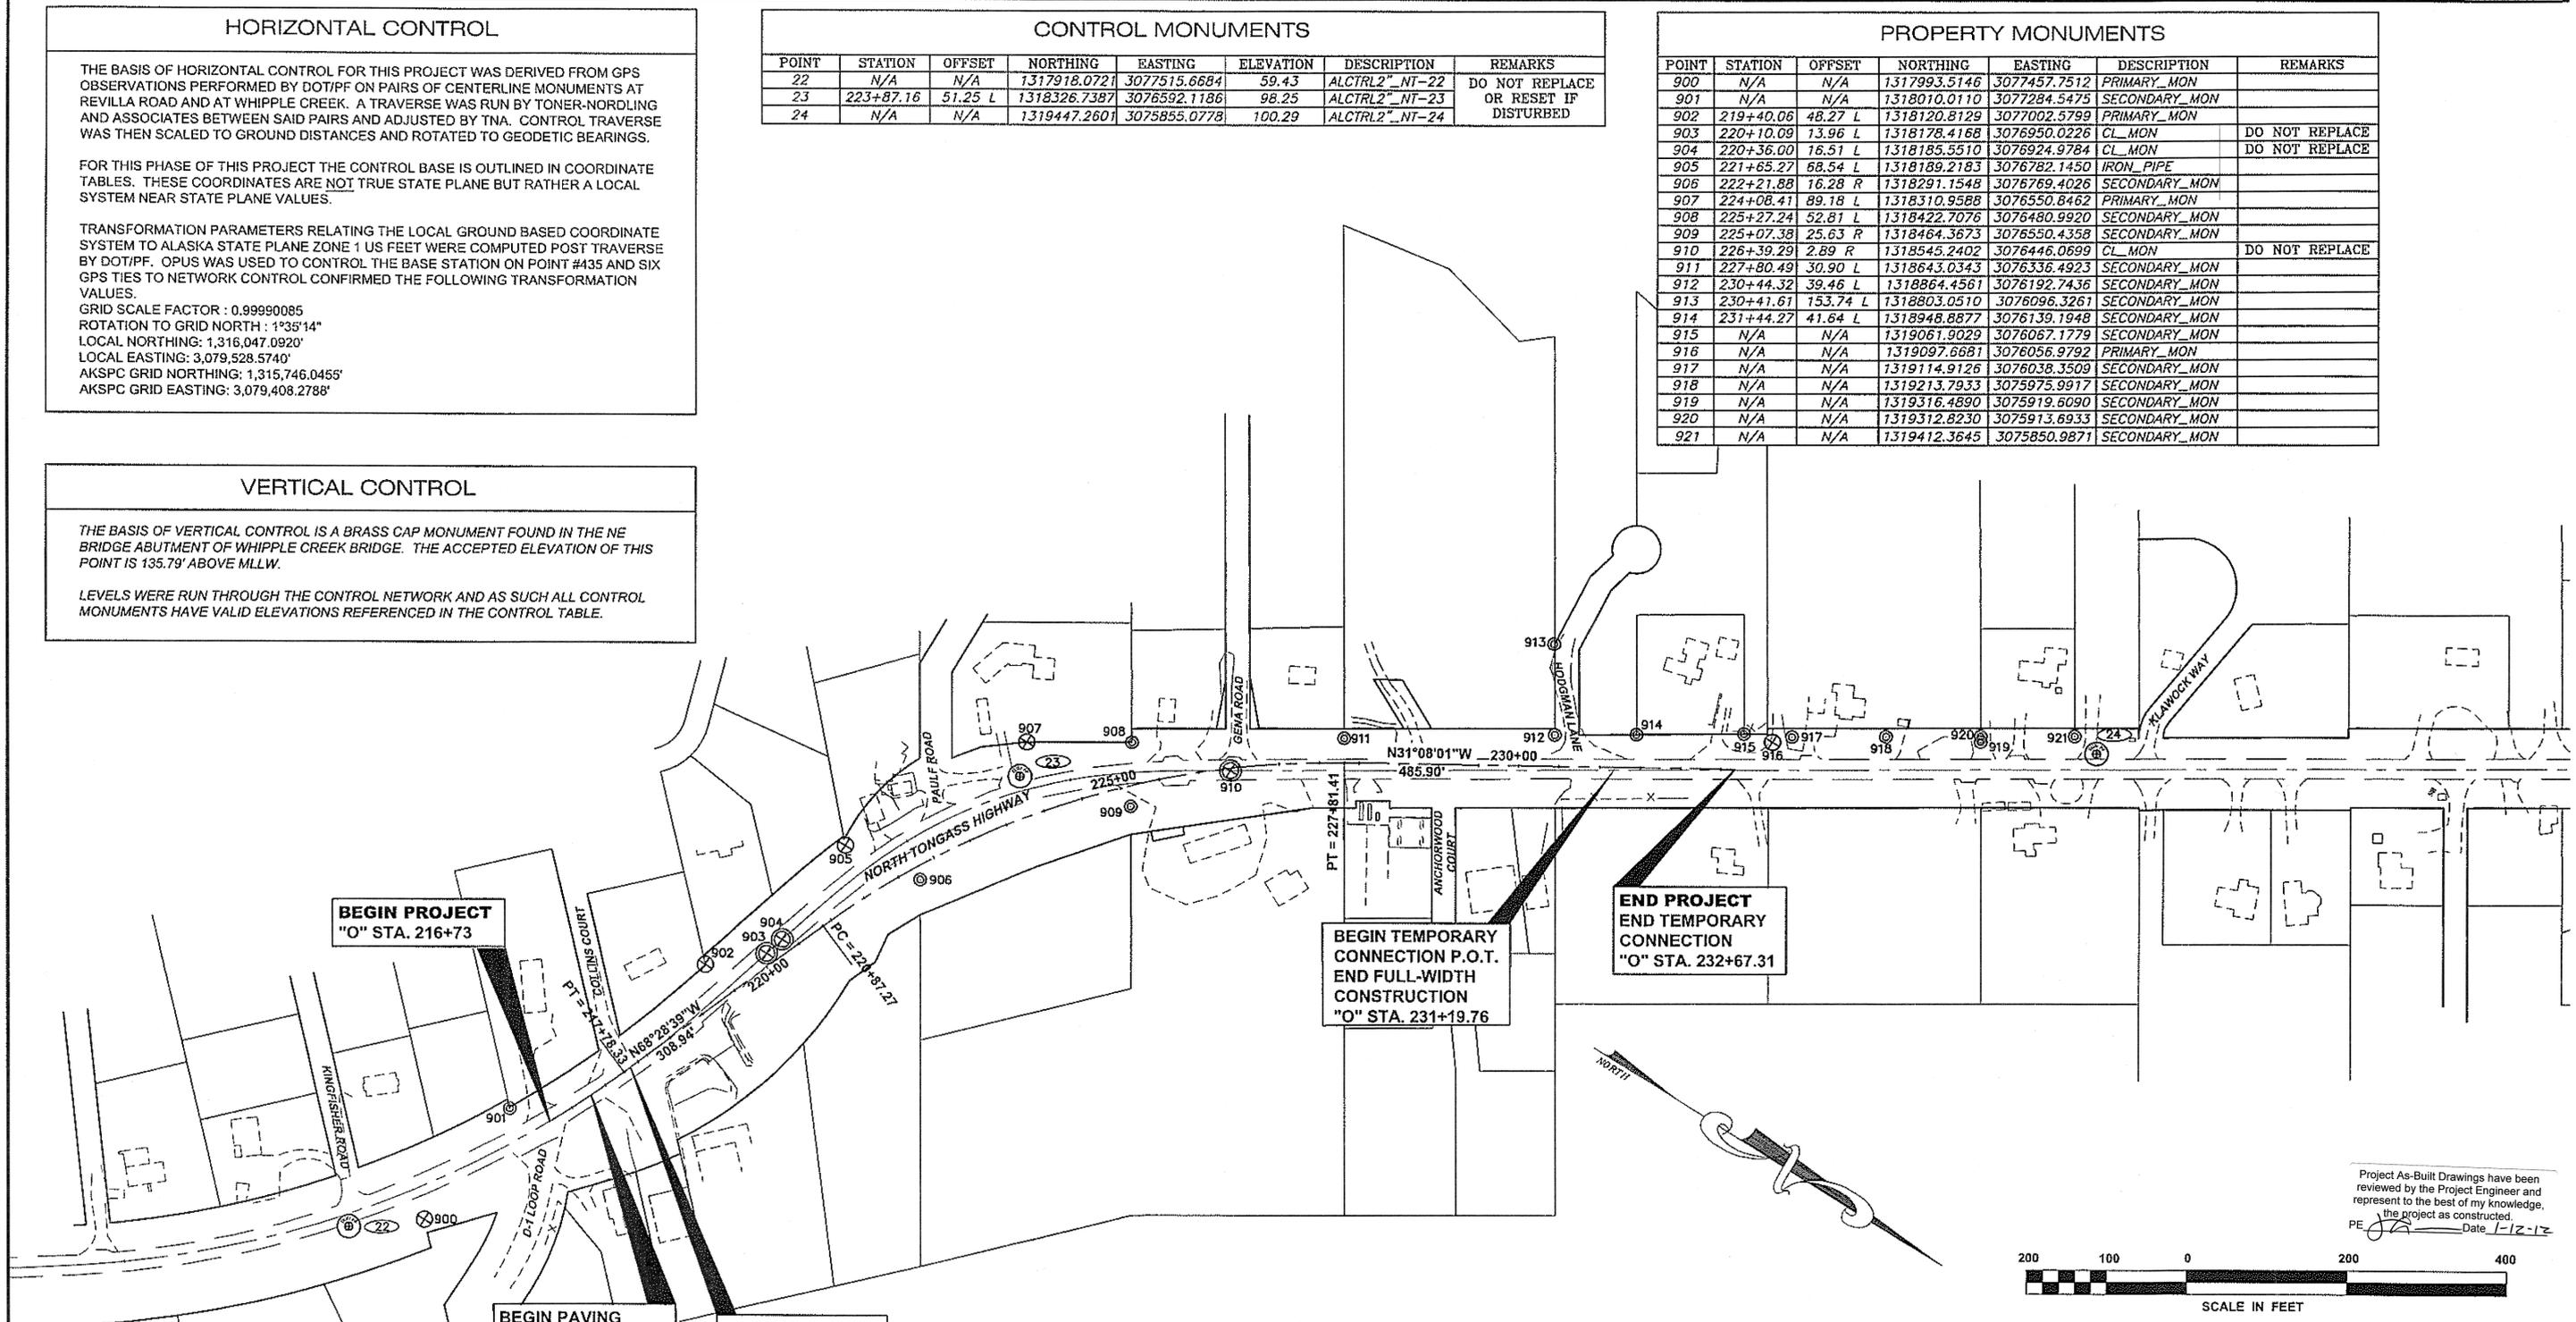

CONTROL NOTES


- If any pair of control points disagrees from published value by more than 1:10,000 horizontally or vertically then a third network point must be tied to ascertain which point is in error or has been disturbed.
- Whether listed or not, all monuments or property markers or accessories which will be disturbed or buried shall be referenced prior to being disturbed and re-established in their original position and a record of monument form in accordance with A.S.34.65.040 shall be submitted to the construction engineer for review prior to recording. Coordinate values listed are for informational purposes and should be used to reset monuments only as a last resort.

Project As-Built Drawings have been reviewed by the Project Engineer and represent to the best of my knowledge, the project as constructed.
 PE [Signature] Date 1-12-12




DO NOT SCALE FROM THESE DRAWINGS USE DIMENSIONS

	STATE OF ALASKA DEPARTMENT OF TRANSPORTATION & PUBLIC FACILITIES SOUTHEAST REGION	
	KTN - NORTH TONGASS HWY. SAFETY IMPROVEMENTS PROJECT # 67423	
SURVEY CONTROL PLAN		
DESIGNED BY:	PROJECT DESIGNATION	
DRAWN BY:	HHE-0920(24)	
PA TH: Q:\KTN\67423\PLANSET\67423_A2_CNTRL.DWG	YEAR	SHEET NO.
TAB: A2	2009	A2
REVISIONS	PROJECT DESIGNATION	TOTAL SHEETS
NO. DATE DESCRIPTION	67423	25
	WILSON, BRIAN G (DOT)	

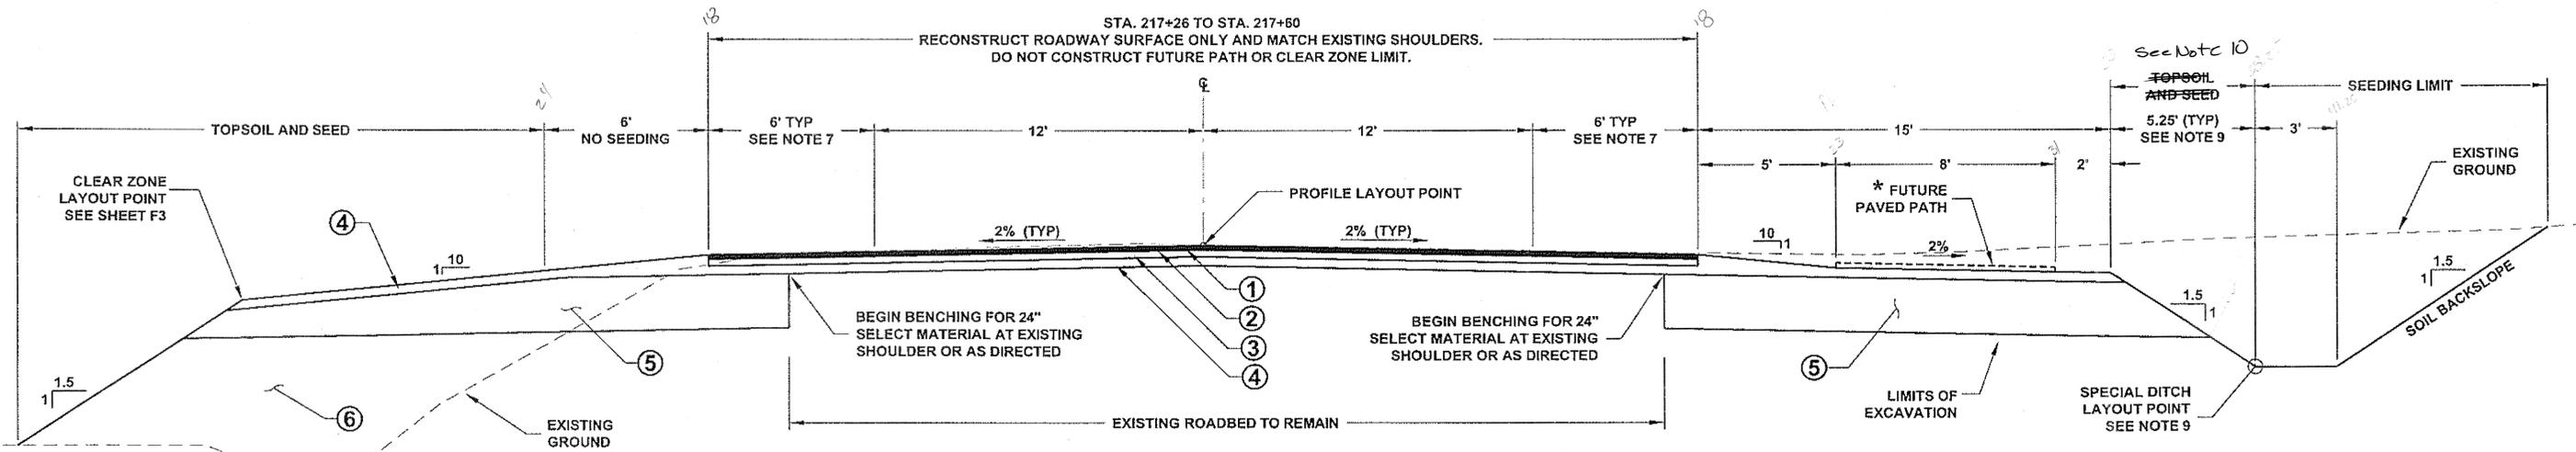


TYPICAL SECTION
STA. 217+26 TO STA. 219+80
STA. 227+40 TO STA. 231+19.76
 SEE SHEET G5 FOR SWALE AT UNDERGROUND FUEL TANKS,
 STA 228+60, AND FOR ANCHORWOOD COURT ACCESS


* BUILDOUT FOR FUTURE PATH
 WILL END AT STA. 228+55

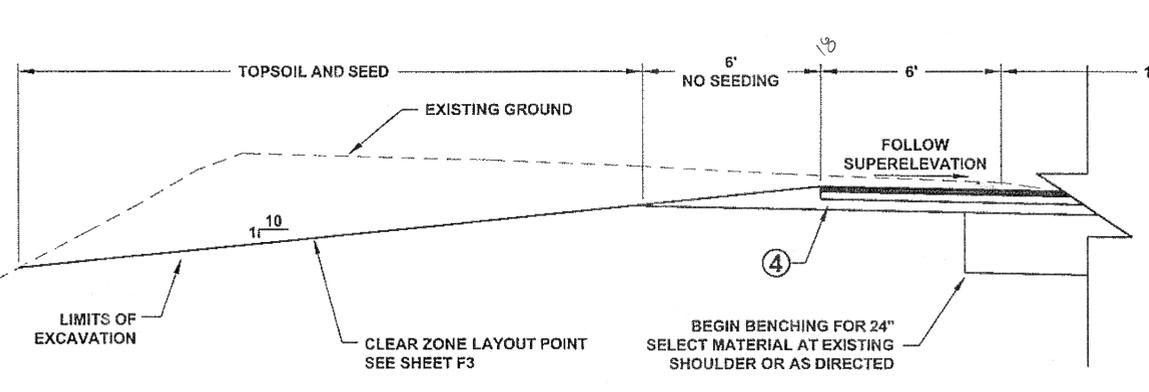

TYPICAL LEFT CUT SECTION
STA. 219+80 TO STA. 221+80

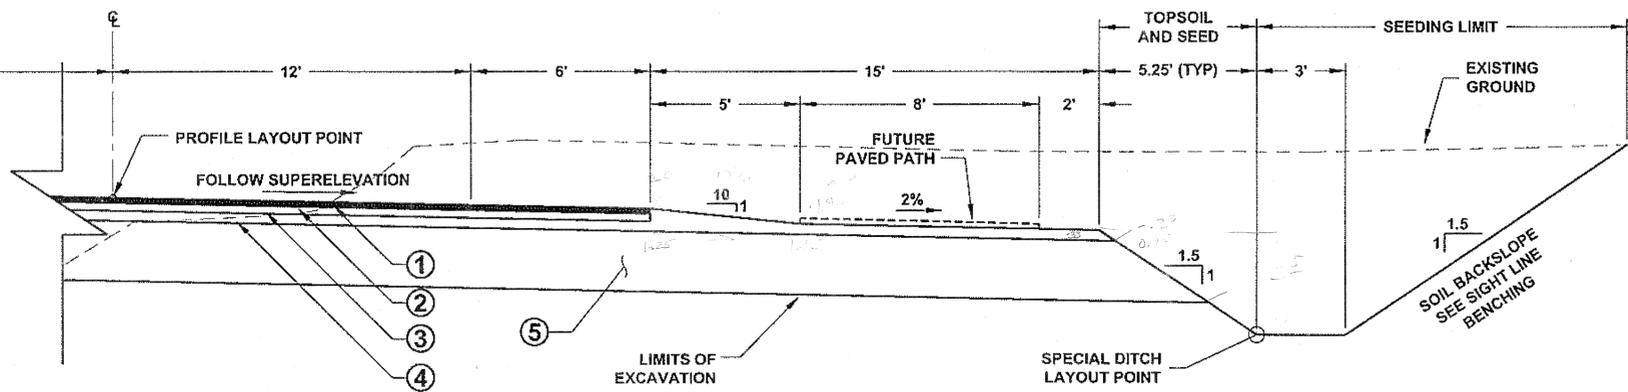

TYPICAL SECTION
STA. 219+80 RT TO STA. 221+80 RT
STA. 224+00 RT TO STA. 227+40 RT

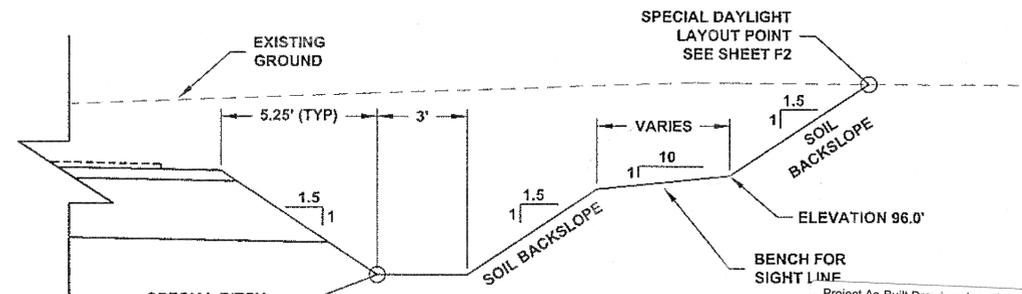

SIGHT LINE BENCHING
STA. 224+00 RT TO STA. 226+00 RT
 DO NOT SCALE FROM THESE DRAWINGS USE DIMENSIONS

TYPICAL SECTION NOTES:

- NO EXISTING ROAD PAVEMENT SHALL BE REMOVED WITHOUT WRITTEN APPROVAL FROM THE ENGINEER.
- CUT SOIL SLOPES ARE NOT REQUIRED TO BE COVERED WITH TOPSOIL. NON-BEDROCK CONSTRUCTION SLOPES THAT ARE STEEPER THAN 1.5:1 (H:V) WILL BE EVALUATED FOR SLOPE STABILIZATION MEASURES. BEDROCK SLOPES SHALL NOT RECEIVE TOPSOIL OR SEEDING. DO NOT SEED FUTURE PATH AREA.
- CLEARING AND GRUBBING LIMITS SHALL BE THE LIMITS BELOW, OR AS DIRECTED BY THE ENGINEER.


CLEARING AND GRUBBING LIMITS
 CLEARING AND GRUBBING LIMITS SHALL BE FROM THE EDGE OF MAINTAINED DITCH/FORESLOPE TO THE PROPOSED CUTFILL SLOPE LIMITS.

CLEARING LIMITS
 CLEARING LIMITS SHALL BE TO A POINT 5' BEYOND THE PROPOSED CUTFILL SLOPE LIMITS OR TO THE RIGHT-OF-WAY, WHICHEVER IS CLOSER TO CENTERLINE. FROM STA. 226+00 TO STA. 227+50, CLEAR TO THE ROW TO PROVIDE SIGHT DISTANCE FOR ANCHORWOOD CT.
- THE AVERAGE THICKNESS OF EXISTING PAVEMENT IS 3".
- WHERE THE ROADWAY IS REALIGNED, CONSTRUCT 24" OF SELECTED MATERIAL TYPE A IN AREAS OUTSIDE OF THE EXISTING ROADWAY. THE MINIMUM NEW PAVEMENT SECTION CONSISTS OF 2" ASPHALT CONCRETE, 3" ATB, AND 4" AGGREGATE BASE COURSE, GRADING D-1. AGGREGATE BASE COURSE, GRADING D-1 MAY BE PLACED DIRECTLY ON EXISTING ROADWAY EMBANKMENT AS GRADE AND ALIGNMENT ALLOW.
- FILL SLOPE RATIOS DEPICTED ON ALL "B" SHEETS ARE THE MINIMUM. SLOPES MAY BE CONSTRUCTED FLATTER IF APPROVED. DITCHES SHALL BE CONSTRUCTED AS SHOWN ON THE TYPICAL SECTIONS.
- BEGINNING STA. 217+60, CONSTRUCT FULL 6' SHOULDERS AND BUILD-OUT FOR FUTURE PATH AS SHOWN IN THE TYPICAL.
- FLATTEN THE DITCH FORESLOPE TO ACHIEVE THE NECESSARY OFFSET AND ELEVATION OF THE SPECIAL DITCH LAYOUT POINT.
- FROM STATION 218+03 TO 218+70 RT, DITCH DEPTH SHALL BE 1 FOOT WHILE MAINTAINING THE 5.25' FORESLOPE DISTANCE.
- Topsoil & Seeding Deleted from all D-1 & Shot Rock covered areas.


LEGEND

- ① 2" ASPHALT CONCRETE PAVEMENT, TYPE II, CLASS B
- ② STE-1 ASPHALT FOR TACK COAT
- ③ 3" ASPHALT TREATED BASE COURSE
- ④ 4" AGGREGATE BASE COURSE, GRADING D-1
- ⑤ 24" SELECTED MATERIAL, TYPE A
- ⑥ SELECTED MATERIAL, TYPE B


CHECKED BY: C. HOWARD 		STATE OF ALASKA DEPARTMENT OF TRANSPORTATION & PUBLIC FACILITIES SOUTHEAST REGION KTN - NORTH TONGASS HWY. SAFETY IMPROVEMENTS PROJECT # 67423	
DESIGNED BY: J. WEAVER DRAWN BY: J.W./R.S.		TYPICAL SECTIONS	
PATH: Q:\KTN\67423\PLANS\SET1\67423_B1_TYPS.DWG TAB: B1		PROJECT DESIGNATION HHE-0920(24) 67423	YEAR 2009
REVISIONS NO. DATE DESCRIPTION		SHEET NO. B1	TOTAL SHEETS 25

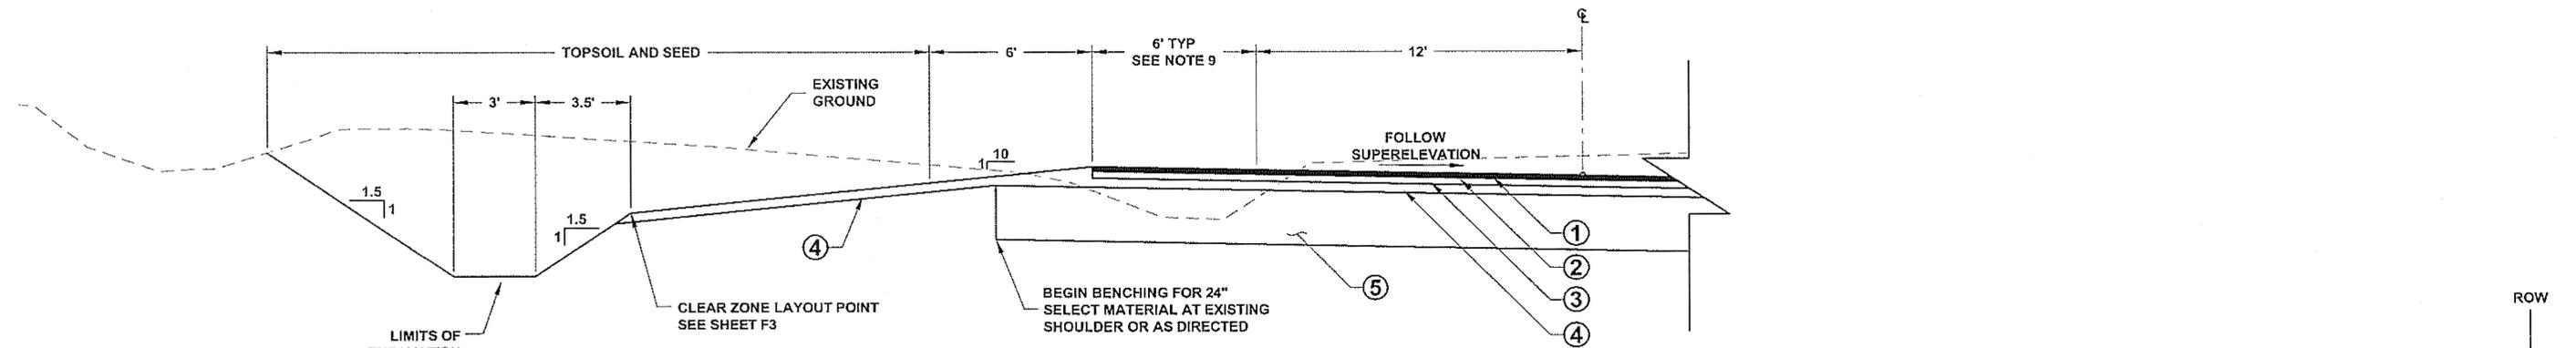


LEFT DITCH SECTION
STA. 221+80 LT TO STA. 225+50 LT

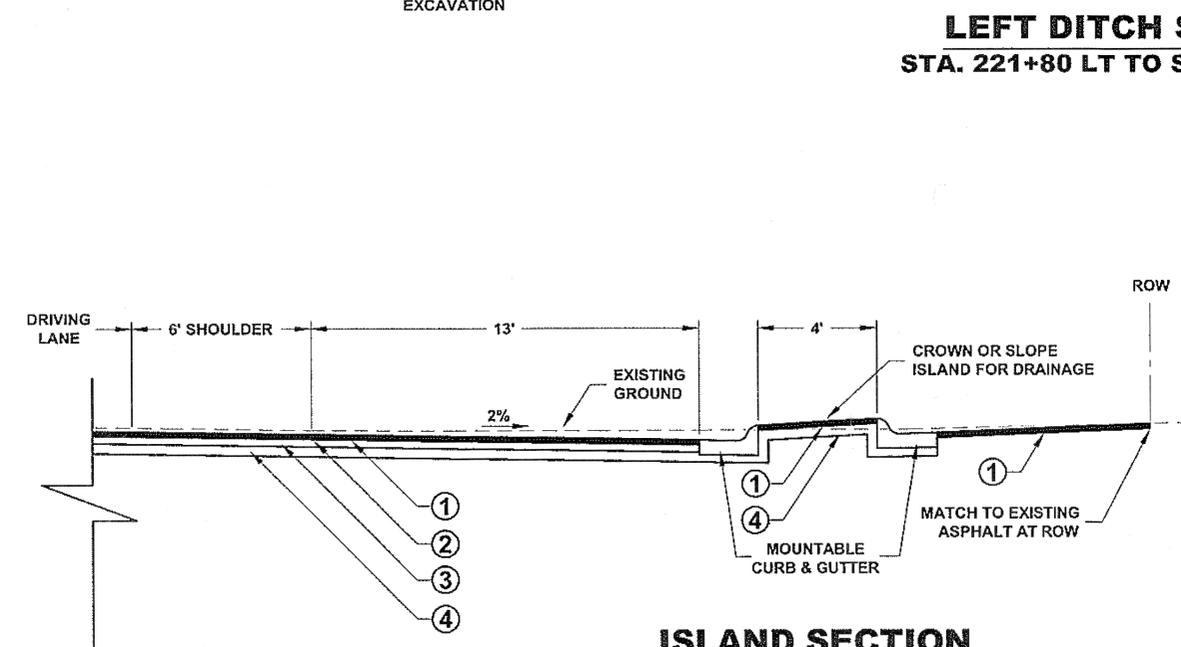

ISLAND SECTION
STA. 229+28 TO STA. 230+01
 SEE SHEET G5 FOR ISLAND LAYOUT

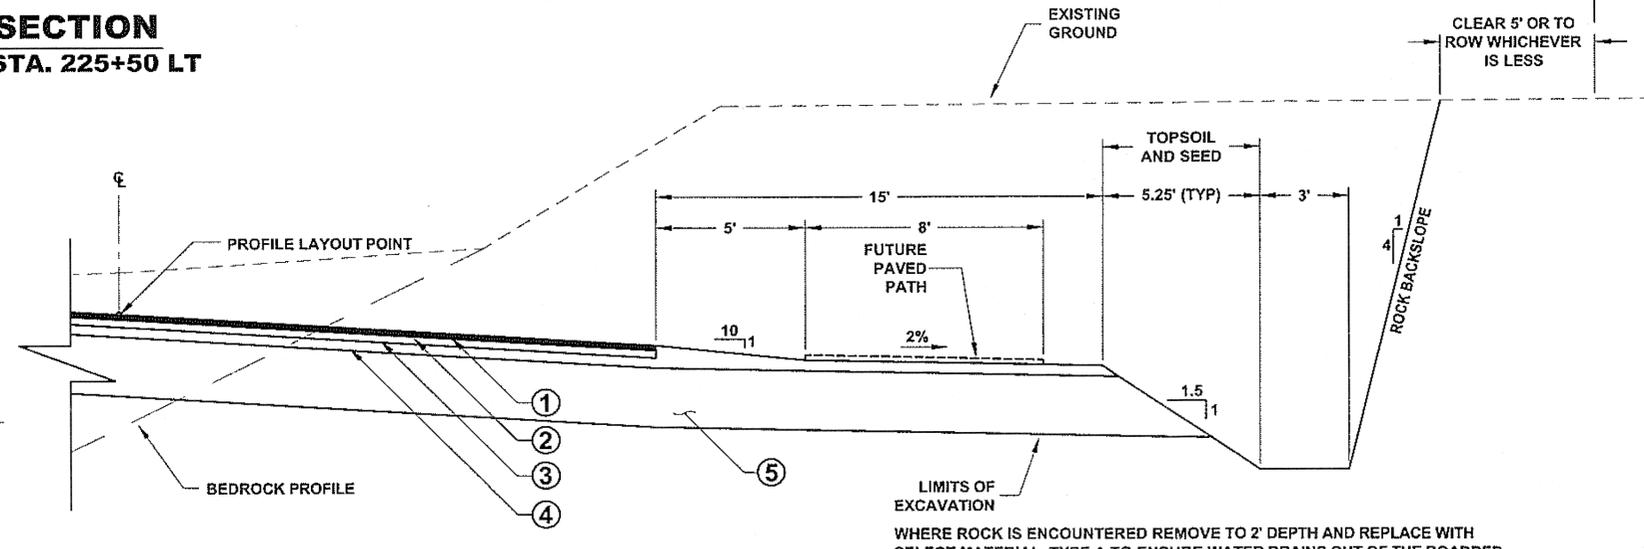

ROCK CUT DETAIL
STA. 221+80 TO STA. 224+00

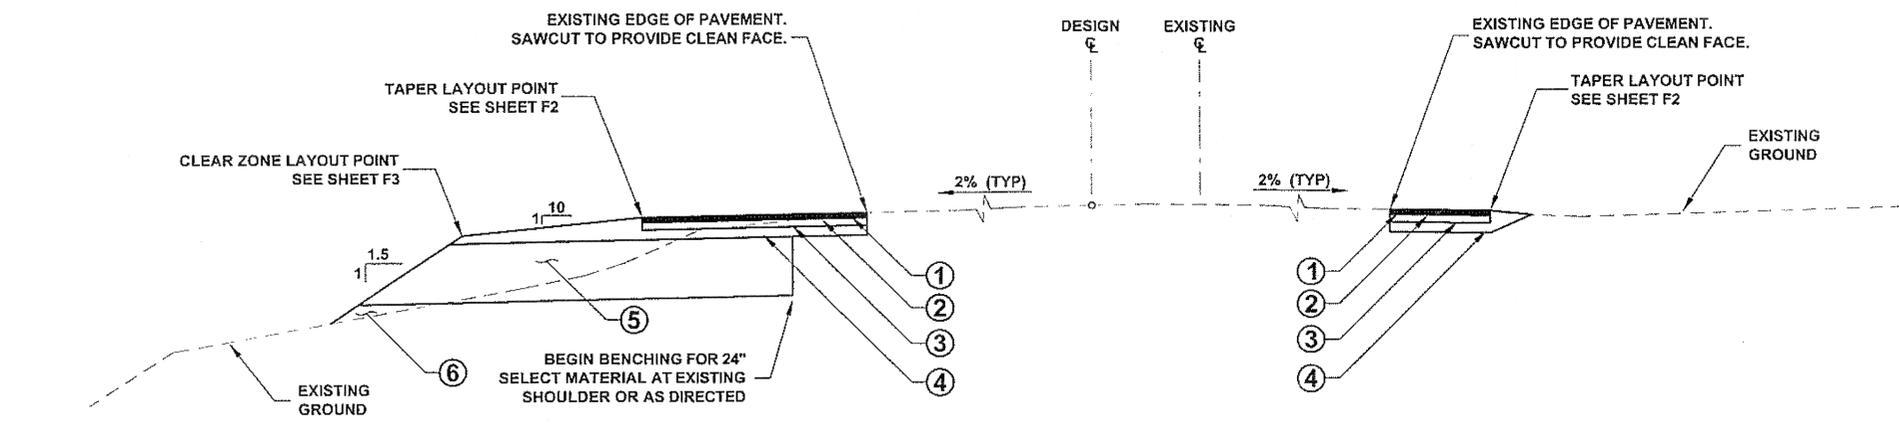


TYPICAL SECTION
STA. 231+19.76 TO E.O.P.

LEGEND

- ① 2" ASPHALT CONCRETE PAVEMENT, TYPE II, CLASS B
- ② STE-1 ASPHALT FOR TACK COAT
- ③ 3" ASPHALT TREATED BASE COURSE
- ④ 4" AGGREGATE BASE COURSE, GRADING D-1
- ⑤ 24" SELECTED MATERIAL, TYPE A
- ⑥ SELECTED MATERIAL, TYPE B

DO NOT SCALE FROM THESE DRAWINGS USE DIMENSIONS

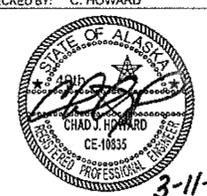CHECKED BY: C. HOWARD  DESIGNED BY: J. WEAVER DRAWN BY: J.W. / R.S.	STATE OF ALASKA DEPARTMENT OF TRANSPORTATION & PUBLIC FACILITIES SOUTHEAST REGION KTN - NORTH TONGASS HWY. SAFETY IMPROVEMENTS PROJECT # 67423 TYPICAL SECTIONS
PATH: Q:\KTN\67423\PLANSET\167423_B1_TYPS.DWG TAB: 82 PROJECT DESIGNATION: HHE-0920(24) 67423 YEAR: 2009 SHEET NO.: B2 TOTAL SHEETS: 25	

Project As-Built Drawings have been reviewed by the Project Engineer and represent to the best of my knowledge, the project as constructed.
 PE: [Signature] Date: 1-10-12

ESTIMATE OF QUANTITIES			
ITEM NO.	ITEM DESCRIPTION	PAY UNIT	QUANTITY
201 (3B)	CLEARING AND GRUBBING	LUMP SUM	ALL REQUIRED
202 (1)	REMOVAL OF STRUCTURES AND OBSTRUCTIONS	LUMP SUM	ALL REQUIRED
202 (2)	REMOVAL OF PAVEMENT	SQUARE YARD	5,930 5398.7
202 (4)	REMOVAL OF CULVERT PIPE	LINEAR FOOT	424 482.1
202 (10)	SINGLE MAIL BOX INSTALLATION	EACH	2 3
202 (11)	MULTIPLE MAIL BOX INSTALLATION	EACH	2 3
203 (3)	UNCLASSIFIED EXCAVATION	CUBIC YARD	13,850 12,002.81
203 (5)	BORROW, TYPE A	CUBIC YARD	700 58.34
203 (19)	CONTROL OF INVASIVE PLANTS	LUMP SUM	ALL REQUIRED
301 (1)	AGGREGATE BASE COURSE, GRADING D-1 - Deleted CO#3	TON	2,700 2837.33
306 (1)	ATB	TON	1,140 984.14
401 (1)	ASPHALT CONCRETE, TYPE II; CLASS B	TON	990 1153.28
401 (2)	ASPHALT CEMENT, GRADE PG 58-28	TON	444 101.95
402 (1)	STE-1 ASPHALT FOR TACK COAT	TON	3 0.89
603 (1)-12	12 INCH CSP	LINEAR FOOT	20 20.7
603 (21)-18	18 INCH CORRUGATED POLYETHYLENE PIPE	LINEAR FOOT	343 357.10
603 (21)-24	24 INCH CORRUGATED POLYETHYLENE PIPE	LINEAR FOOT	160 167.77
604 (5)	INLET, TYPE A	EACH	5
609 (2)	CURB AND GUTTER, TYPE 1	LINEAR FOOT	206 276.0
611 (3)	RIPRAP, CLASS 1	SQUARE YARD	10 14
615 (2)	REMOVE AND RELOCATE EXISTING SIGN	EACH	6
618 (1)	SEEDING	ACRE	1.5 0.309
620 (1)	TOPSOIL	SQUARE YARD	7,260 ITEM NOT USED
633 (1)	SILT FENCE	LINEAR FOOT	1,440 641.9
639 (1)	RESIDENCE DRIVEWAY	EACH	8
639 (2)	COMMERCIAL DRIVEWAY	EACH	6
640 (1)	MOBILIZATION AND DEMOBILIZATION	LUMP SUM	ALL REQUIRED
640 (4)	WORKER MEALS AND LODGING, OR PER DIEM	LUMP SUM	ALL REQUIRED
641 (1)	EROSION, SEDIMENT AND POLLUTION CONTROL ADMINISTRATION	LUMP SUM	ALL REQUIRED
641 (2)	TEMPORARY EROSION, SEDIMENT AND POLLUTION CONTROL	LUMP SUM	ALL REQUIRED
641 (7)	INLET PROTECTION	EACH	5 8
641 (8)	ROCK CHECK DAM	EACH	5 7
642 (1)	CONSTRUCTION SURVEYING	LUMP SUM	ALL REQUIRED
643 (2)	TRAFFIC MAINTENANCE	LUMP SUM	ALL REQUIRED
643 (15)	FLAGGING	CONTINGENT SUM	ALL REQUIRED

ESTIMATE OF QUANTITIES (CONTINUED)			
ITEM NO.	ITEM DESCRIPTION	PAY UNIT	QUANTITY
643 (25)	TRAFFIC CONTROL	CONTINGENT SUM	ALL REQUIRED
660 (3)	HIGHWAY LIGHTING SYSTEM COMPLETE	LUMP SUM	ALL REQUIRED
670 (1)	PAINTED TRAFFIC MARKINGS	LUMP SUM	ALL REQUIRED
670 (8)	RECESSED PAVEMENT MARKER	EACH	25 36
202(4A)	P. 205 Grout Cement Fill	Lump Sum	All Required
643(29)	Reduce Speed Signs	Lump Sum	All Required
301(1)	Aggregate Base Course, Grading D-1	Lump Sum	All Required
615(5)	Flexible Delineators	Each	8
670(14)	Striping + Access Changes	Lump Sum	All Required
605(8)	8" Perforated Corrugated Polyethylene Pipe	Linear Foot	348.1
605(8A)	Extra Work Associated w/Perforated Pipe Install	Lump Sum	All Required

CO #1
CO #2
CO #3
CO #4
CO #4
CO #5 270
CO #5

BASIS OF ESTIMATE		
ITEM NO.	ITEM DESCRIPTION	ESTIMATING FACTOR
201 (3B)	CLEARING AND GRUBBING	1.7 ACRES
203 (3)	UNCLASSIFIED EXCAVATION	9800 CY COMMON; 4050 CY ROCK
203	PRE-BLAST SURVEY	15 HOMES
301 (1)	AGGREGATE BASE COURSE, GRADING D-1	1.95 TON/CY
306 (1)	ATB	120 LB/SY/IN
401 (1)	ASPHALT CONCRETE, TYPE II; CLASS B	120 LB/SY/IN
401 (2)	ASPHALT CEMENT, GRADE PG 58-28	4.5% OF ITEM 306(1), 6% OF ITEM 401(1)
402 (1)	STE-1 ASPHALT FOR TACK COAT	0.1 GAL/SY; 243 GAL/TON

Project As-Built Drawings have been reviewed by the Project Engineer and represent to the best of my knowledge, the project as constructed.
PE [Signature] Date 1-10-12

DO NOT SCALE FROM THESE DRAWINGS USE DIMENSIONS

CHECKED BY: C. HOWARD	STATE OF ALASKA DEPARTMENT OF TRANSPORTATION & PUBLIC FACILITIES SOUTHEAST REGION			
DESIGNED BY: J. WEAVER	KTN - NORTH TONGASS HWY. SAFETY IMPROVEMENTS PROJECT # 67423			
DRAWN BY: R. SNYDER				
PATH: Q:\KTN\67423\PLANSET\67423_C1_EST.DWG	ESTIMATE OF QUANTITIES			
TAB: C1				
REVISIONS	PROJECT DESIGNATION	YEAR	SHEET NO.	TOTAL SHEETS
NO. DATE DESCRIPTION	HHE-0920(24) 67423	2009	C1	25

202 (1) REMOVAL OF STRUCTURES AND OBSTRUCTIONS

DESCRIPTION	STA	OFFSET	REMARKS
FIELD INLET	218+09	23 RT	
ROCKERY WALL	218+40	RT	±90' ENGINEER WILL DIRECT LIMITS OF REMOVAL
METAL GATE	218+90	RT	ACROSS KTN WELDING DRIVEWAY
ROCKERY WALL	219+20	RT	±75' REMOVE ENTIRE ROCKERY
INLET	226+07	32 RT	REMOVE OR ABANDON. SEE SEC. 202 OF SPECIAL PROVISIONS
INLET	227+83	31 RT	
INLET	228+46	30 RT	
INLET	229+00	32 RT	

202 (1) SHALL INCLUDE, BUT NOT BE LIMITED TO, THE ABOVE

202 (4) REMOVAL OF CULVERT PIPE

PIPE NO.	STA	OFFSET	DIA.	LENGTH	TYPE	REMARKS
UNLABELED	217+97	58.6 RT	12"	38' 37.7	CSP	SAWCUT AND REMOVE DOWNSTREAM SEGMENT TO STRUCTURE
UNLABELED	217+30-218+09	24 RT	12"	80' 60.0	CSP	
P-203	219+62	44 LT-16 RT	18"	50' 60.3	CSP	
P-204	226+15	34 LT-32 RT	30"	67' 67	CSP	SEE SECTION 202 OF SPECIAL PROVISIONS
UNLABELED	227+83	40.4 RT	12"	9' 11.5	CSP	SAWCUT PIPE TO MATCH BACKSLOPE AND REMOVE DOWNSTREAM SEGMENT
P-204A	227+84-228+46	30 RT	18"	84' 63.7	CSP	
P-204B	228+46-229+00	31 RT	18"	54' 54.0	CSP	
P-205	228+46	18 LT-30 RT	18"	77' 77	CSP	Filled w/ Grout per CO #1
Unlabeled	229+86 1/2	12"		76.0	CuP	Pipe Shown / No Replacement Planned - Replace w/ 8" pipe see F2

604 (5) INLET, TYPE A

STRUCTURE NO.	STA	OFFSET	TOP OF CASTING ELEV.	REMARKS
S-1	218+03.4	39.7 RT	72.27	FIELD INLET
S-2	227+83.2	36.0 RT	93.90	FIELD INLET
S-3	228+46.6 228+22.6	36.0 RT	93.26 93.5	FIELD INLET
S-4	229+00.1	34.0 RT	95.22	FIELD INLET
S-5	229+34	38.0 RT	95.59	MOUNTABLE CURB INLET

STATION AND OFFSET TAKEN TO CENTER OF STRUCTURE.

DRIVEWAY CULVERT SUMMARY

PIPE NO.	INLET			OUTLET			LENGTH	REMARKS
	STA	OFFSET	ELEV	STA	OFFSET	ELEV		
P-254A	S-1		69.2	217+44.2	39.8 RT	67.4	63' 68.0'	18" CPP
P-254B	217+96.7	58.6 RT	MATCH EXISTING	S-1		69.7	20' 20.7'	12" CSP
P-203A	223+03.5	49.4 LT	89.6	222+62.3	49.6 LT	88.6	43' 41.0'	18" CPP
P-203B	223+90.0	46.2 LT	91.8	223+57.3	47.9 LT	91.0	34' 40.0'	18" CPP
P-203C	225+77.9	39.8 RT	92.4	225+20.6	39.7 RT	91.4	55' 59.9'	18" CPP
P-205A	S-2		90.8	S-3		89.5 90.0	63' 38.0'	18" CPP
P-205B	S-4		91.5	S-3		89.7 90.2	51' 77.5'	18" CPP
P-206	S-5		91.9	S-4		91.6	34' 32.7'	18" CPP

ROADWAY CROSS CULVERT SUMMARY

PIPE NO.	INLET			OUTLET			LENGTH	REMARKS
	STA	OFFSET	ELEV	STA	OFFSET	ELEV		
P-203	219+62.5	38.3 RT	75.60	219+59.6	50.0 LT	66.45	90' 90.1'	24" CPP, CLASS I RIPRAP AT OUTLET
P-205	S-3		89.8 89.28	228+22.6 228+46.7	44.0 LT 34.0 LT	84.5 87.82	70' 77.6'	24" CPP, CLASS I RIPRAP AT OUTLET
CO #	227+86-50 RT			229+86	23 LT		72.4	Replace existing culvert w/ 8" CPP. Per CO #1
CO #	229+25 to 229+35	29.36		S-5	see ASBlt		41.7	8" CPP. Per CO #1 to drain into S-5

202 (10) SINGLE MAIL BOX INSTALLATION

STA	OFFSET	REMARKS
219+44	RT	10540 NTH (KTN WELDING). INSTALL BETWEEN SHOULDER AND FUTURE PATH.
Not used 230+95 230+95	RT	Relocated after Redesign of Parking lot access & addition of Traffic Island

SEE STANDARD DRAWING M-20.12

202 (11) MULTIPLE MAIL BOX INSTALLATION

STA	OFFSET	REMARKS
217+16	RT	3 BOXES. INSTALL BETWEEN SHOULDER AND FUTURE PATH.
227+24	RT	5 BOXES. INSTALL BETWEEN SHOULDER AND FUTURE PATH.


SEE STANDARD DRAWING M-23.12

230+45

RT

2 Boxes between child & path

DO NOT SCALE FROM THESE DRAWINGS USE DIMENSIONS

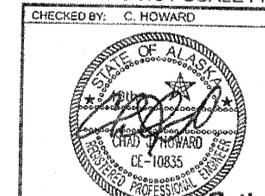

STATE OF ALASKA
DEPARTMENT OF TRANSPORTATION
& PUBLIC FACILITIES
SOUTHEAST REGION

KTN - NORTH TONGASS HWY.
SAFETY IMPROVEMENTS
PROJECT # 67423

SUMMARIES

CHECKED BY: C. HOWARD
DESIGNED BY: J. WEAVER
DRAWN BY: J. WEAVER

PATH: Q:\KTM67423\PLANSET\67423_D1-2_SUMS.DWG
TAB: D1 DLESTER

NO.	DATE	DESCRIPTION

PROJECT DESIGNATION
HHE-0920(24)
67423

YEAR: 2009
SHEET NO: D1
TOTAL SHEETS: 25

Project As-Built Drawings have been reviewed by the Project Engineer and represent to the best of my knowledge, the project as constructed.
PE [Signature] Date 1-12-12

639 (1) RESIDENCE DRIVEWAY						
DRIVEWAY	STA	R1/R2	WIDTH	LENGTH OF PAVING	AREA OF PAVING (SY)	REMARKS
COLLINS CT.	217+67.24	40' / 20'	14'	20'	79	SEE SHEET G1
PAULF ROAD	222+71.63	40'	20'	20'	121	SEE SHEET G1
10641 NTH	223+65	20'	14'	20'	52	
10681 NTH	225+70	20'	20'	20'	65	
GENA ROAD	226+50.00	20'	20'	20'	65	SEE SHEET G2
10690 NTH HOUSE	227+50	20'	30'	20'	87	
10741 NTH	228+72.00	20'	14'	20'	53	SEE SHEET G4
HODGMAN LANE	230+78.45	20'	20'	20'	65	SEE SHEET G2

639 (2) COMMERCIAL DRIVEWAY						
DRIVEWAY	STA	R1/R2	WIDTH	LENGTH OF PAVING	AREA OF PAVING (SY)	REMARKS
10526 NTH	217+74.14	40'	30'	35.9'	195	SEE SHEET G3
KTN WELDING	218+93.38	40'	30'	31.1'	175	SEE SHEET G3
10690 NTH WAREHOUSE	225+56.20	40'	30'	51.5'	259	SEE SHEET G4
LIGHTHOUSE TESORO	228+50	-	-	-	424	SEE SHEET G5
ANCHORWOOD CT	229+06.81	40' / -	28'	-	154	SEE SHEET G5
LIGHTHOUSE GROCERY	230+25	40'	30'	35'	192	


SEE DRIVEWAY DETAIL ON SHEET J1

611 (3) RIPRAP, CLASS I		
PIPE OUTLET	AREA (SY)	REMARKS
P-203	5	
P-205	5	

SEE DETAIL ON SHEET T3

Project As-Built Drawings have been reviewed by the Project Engineer and represent to the best of my knowledge, the project as constructed.
 PE *[Signature]* Date 1/2/12

DO NOT SCALE FROM THESE DRAWINGS USE DIMENSIONS

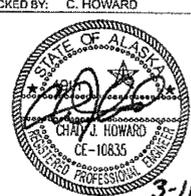CHECKED BY: C. HOWARD 		STATE OF ALASKA DEPARTMENT OF TRANSPORTATION & PUBLIC FACILITIES SOUTHEAST REGION KTN - NORTH TONGASS HWY. SAFETY IMPROVEMENTS PROJECT # 67423	
DESIGNED BY: J. WEAVER DRAWN BY: J. WEAVER		SUMMARIES	
PATH: Q:\KTN\67423\PLANSET\67423_D1-2_SUMS.DWG TAB: D2		PROJECT DESIGNATION HHE-0920(24) 67423	
REVISIONS NO. DATE DESCRIPTION	YEAR 2009	SHEET NO. D2	TOTAL SHEETS 25

PATH:
Q:\KTN\67423\PLANSET\67423_F1-3_PLAN.DWG




TAB: F1 WILSON, BRIAN C

ADDENDUM NUMBER

ATTACHMENT NUMBER

RECORD OF REVISIONS

No.	DATE	DESCRIPTION

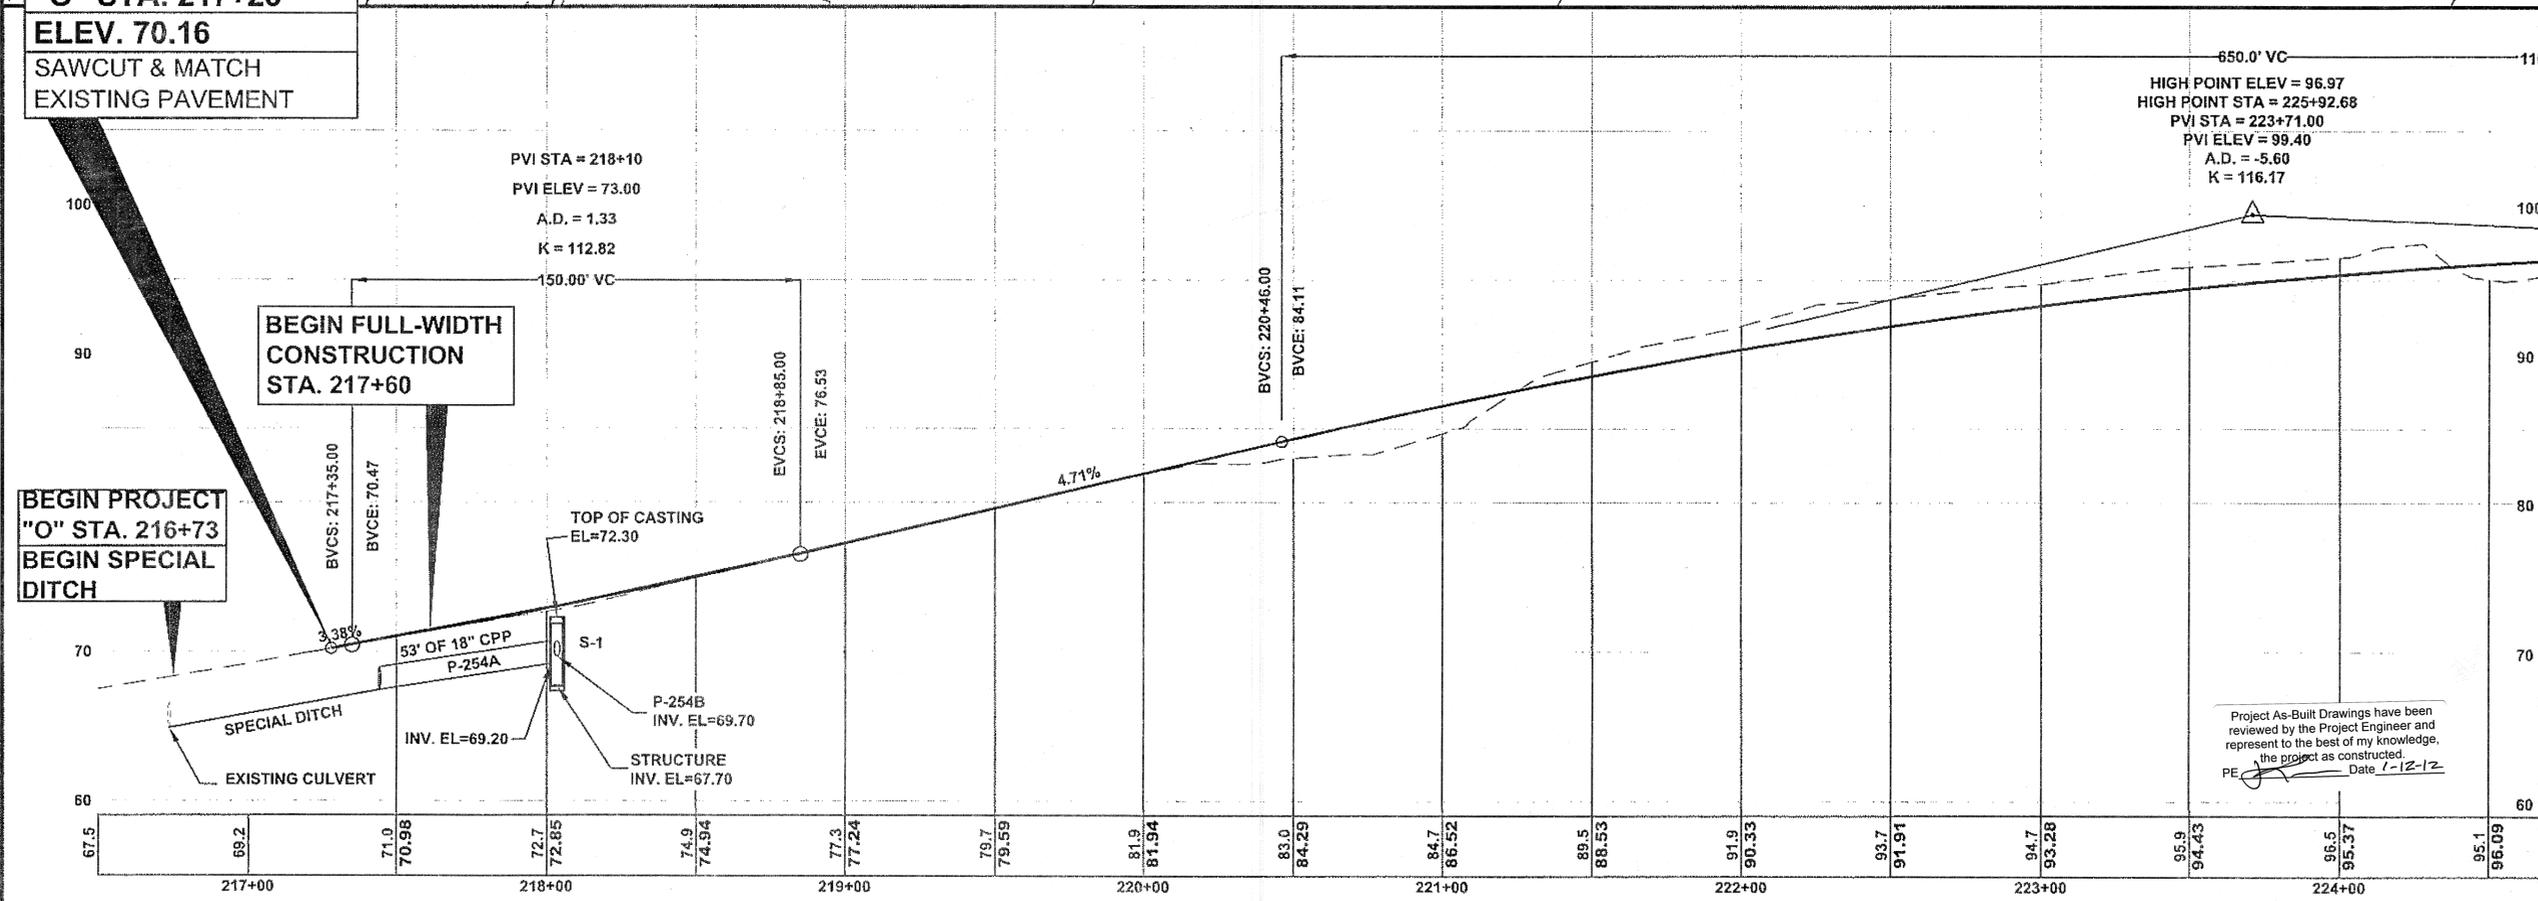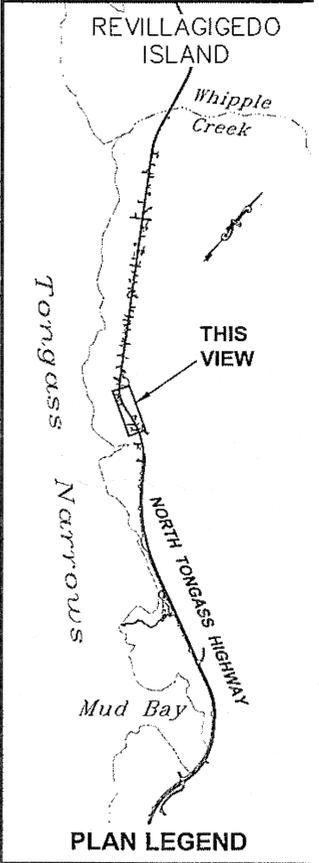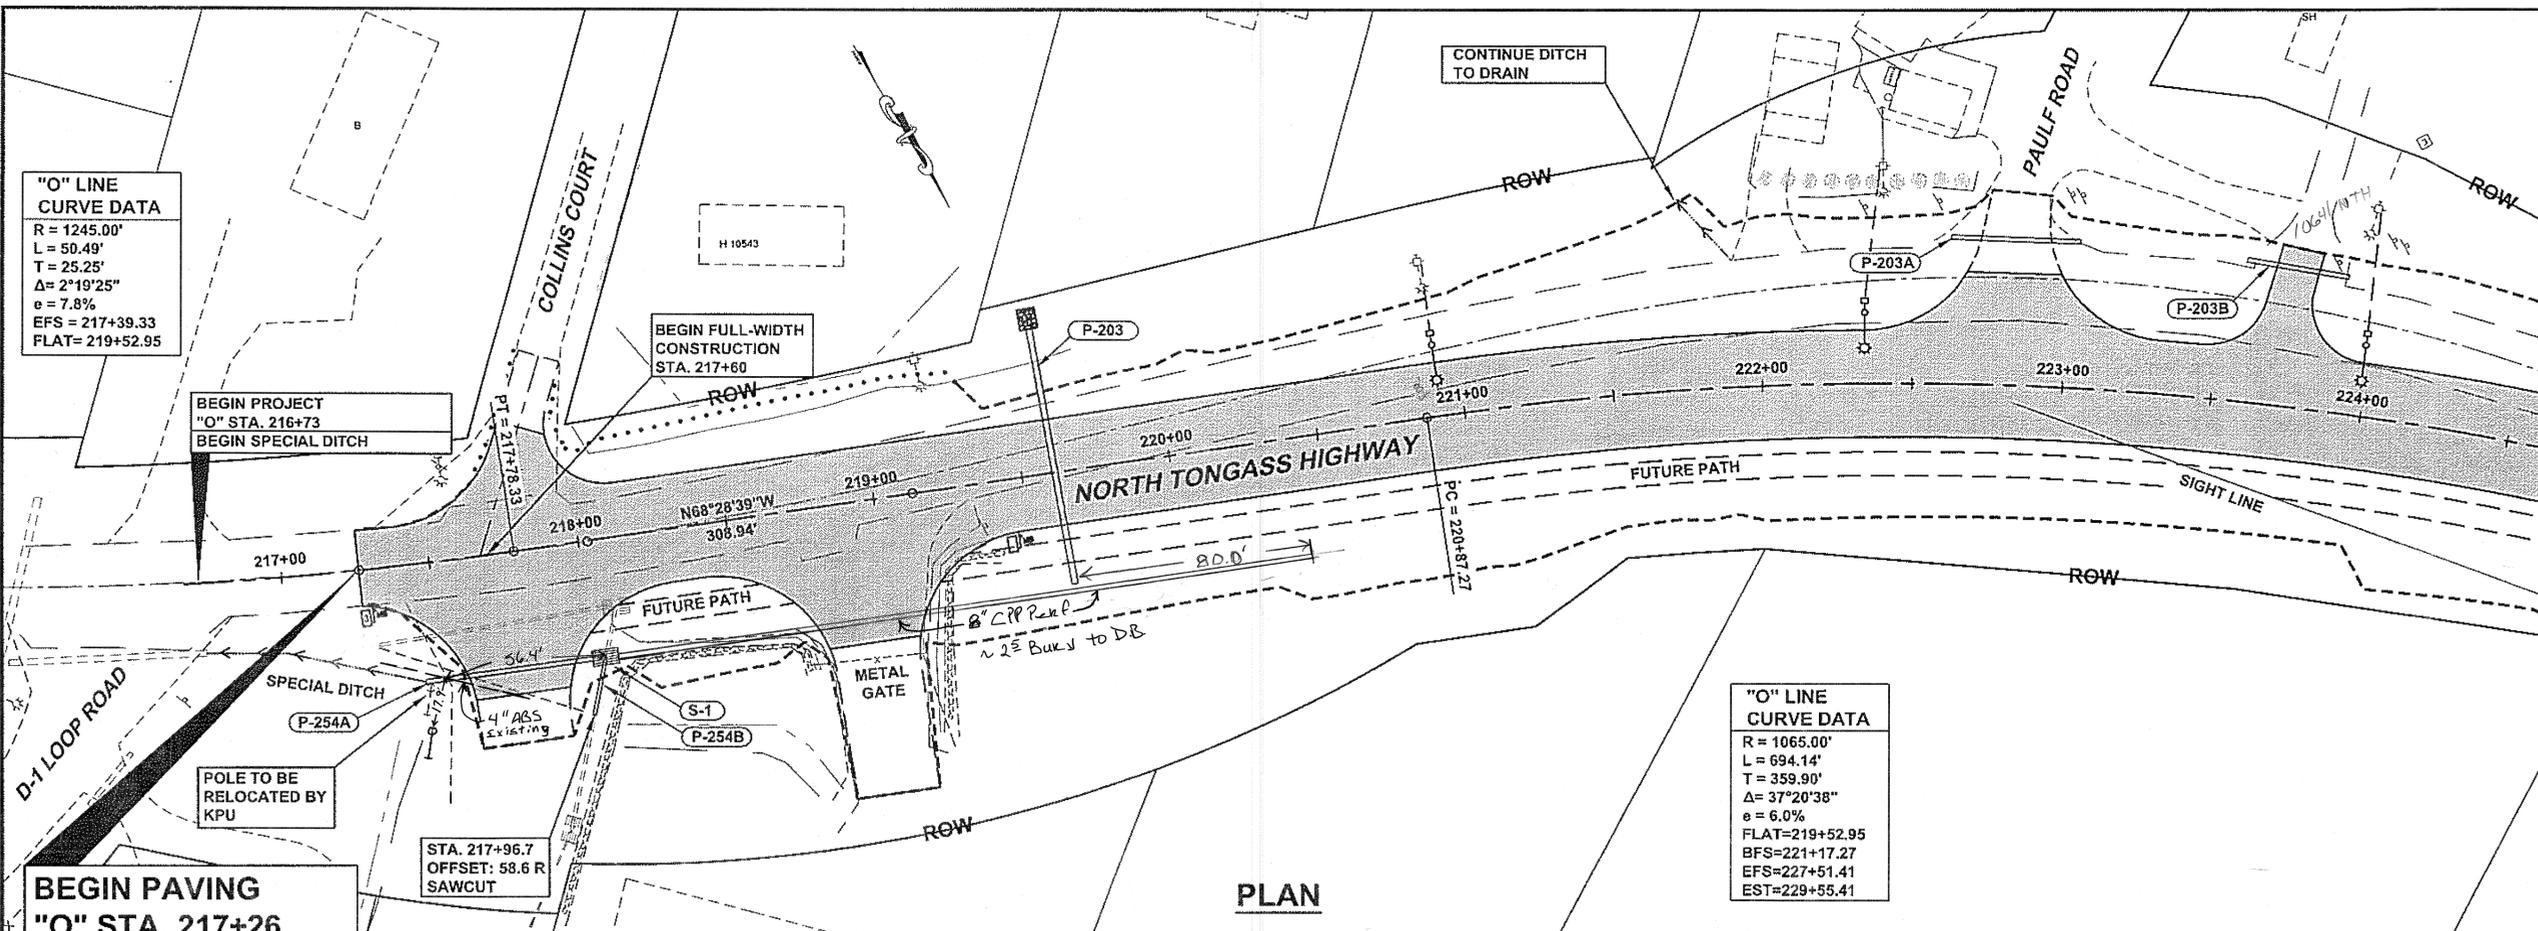

CHECKED BY: C. HOWARD

DESIGNED BY: J. WEAVER
 DRAWN BY: R. SNYDER

STATE OF ALASKA
 DEPARTMENT OF TRANSPORTATION & PUBLIC FACILITIES
 DESIGN & ENGINEERING SERVICES
 DIVISION-SOUTHEAST REGION

KTN - NORTH TONGASS HWY. SAFETY IMPROVEMENTS PROJECT #67423

PLAN & PROFILE


PROJECT DESIGNATION
HHE-0920(24) / 67423

STATE	YEAR
ALASKA	2009
SHEET NUMBER	TOTAL SHEETS
F1	25

PROFILE **DO NOT SCALE FROM THESE DRAWINGS USE DIMENSIONS**

0 10 20 30 40 50 75 100

LIGHTHOUSE
GROCERY

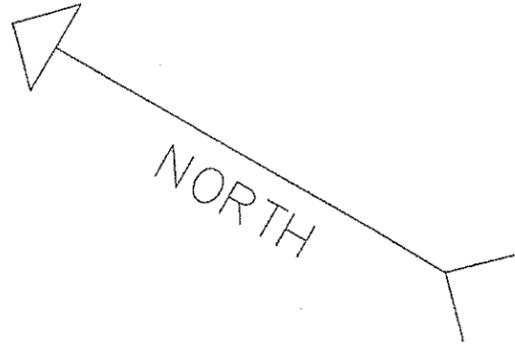

NORTH

ANCHORWOOD CT.

B 10730
STATION
GAS

CD #4 New Island & Striping

END ISLAND AT EDGE OF PAVEMENT.
OPEN ENTIRE GUTTER PAN
AWAY FROM ISLAND FOR
DRAINAGE.

4" DOUBLE YELLOW

PERMANENT DELINEATORS
AT EACH ISLAND END

12'

16'

8' MULTI-USE PATH

14'

8' MULTI-USE PATH

18" SOLID WHITE
CHEVRON, 12' O.C.
45° ANGLE

4" SOLID WHITE

TEMPORARY DELINEATORS
AT EACH STRIPED CORNER

4" SOLID WHITE BROKEN FOR
ENTRANCE/ EXIT

NORTH TONGASS HWY

Sheet 3
of 3
Sheet 13

20'38"
22'48"
15'
%

RESU
CONS
STA.
SAWC
EXIST

DRIVEWAY 10741

HODGMAN LANE

228+00

229+00

230+00

N31°08'01"W

486.90'

STA: 230+58.00
RESUME FULL MA
PATH CONSTRUCT

NORTH TONGASS HIGHWAY

New S-3 & P-205
Locations

PT = 227+81.42

P-205

S-3

New 8" CPP Rent
Pipe - See Swims Tie Draw

PAVE ISLAND
CENTER. PAID AS
ASPHALT SIDEWALK


ANCHORWOOD CT.

Existing 10" CMP Rent

N TONGASS HWY 10730

100




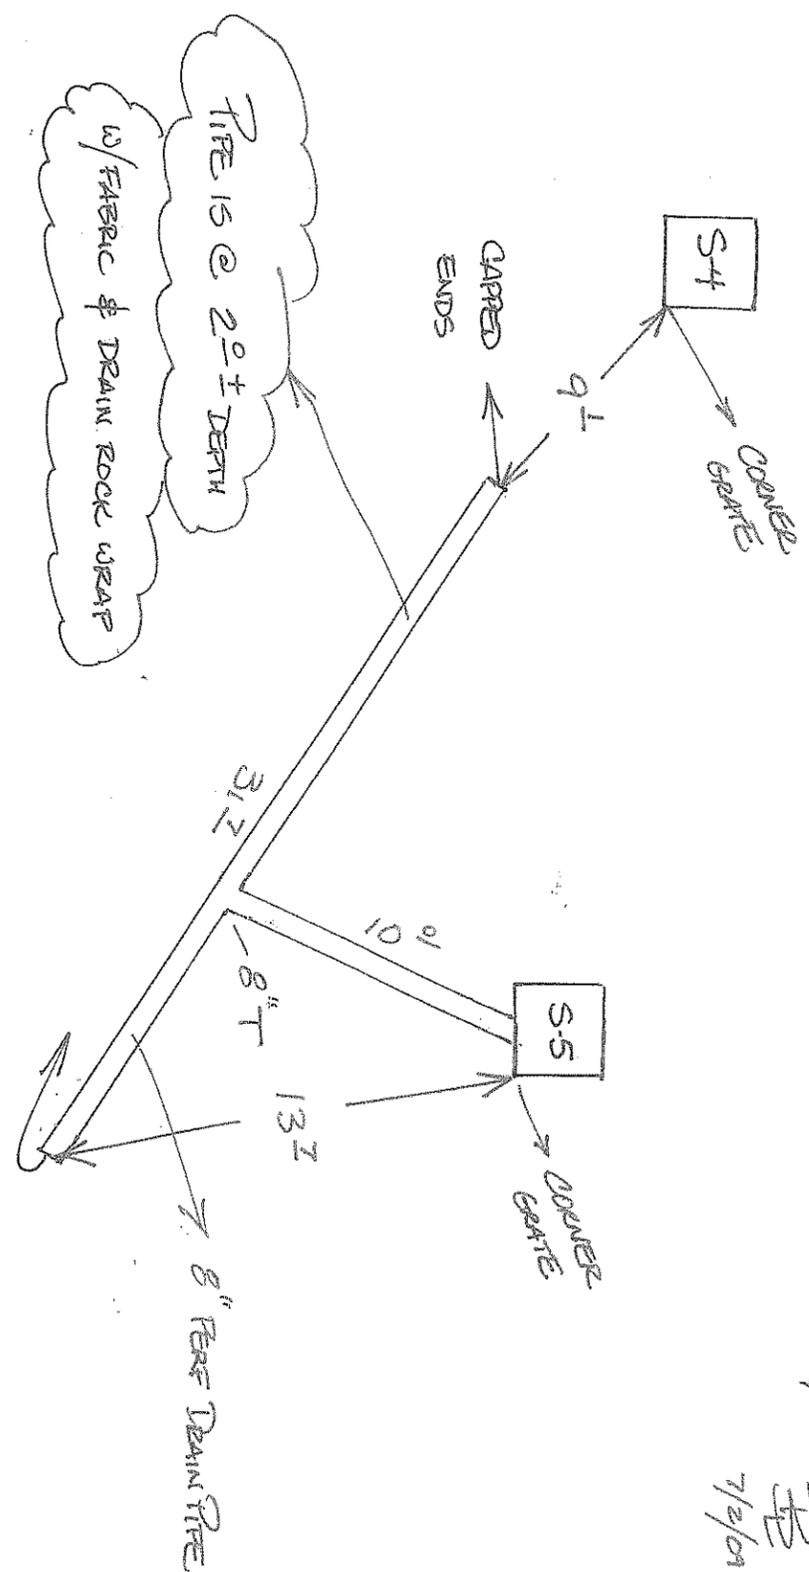


Art pipe: 31.7' + 10.0' = 41.7 LF

Not To Scale!!
 7/2/04
 Sheet 3 of 3

N. TONGASS

71 674423
 SWING TIES TO FEED DRAIN


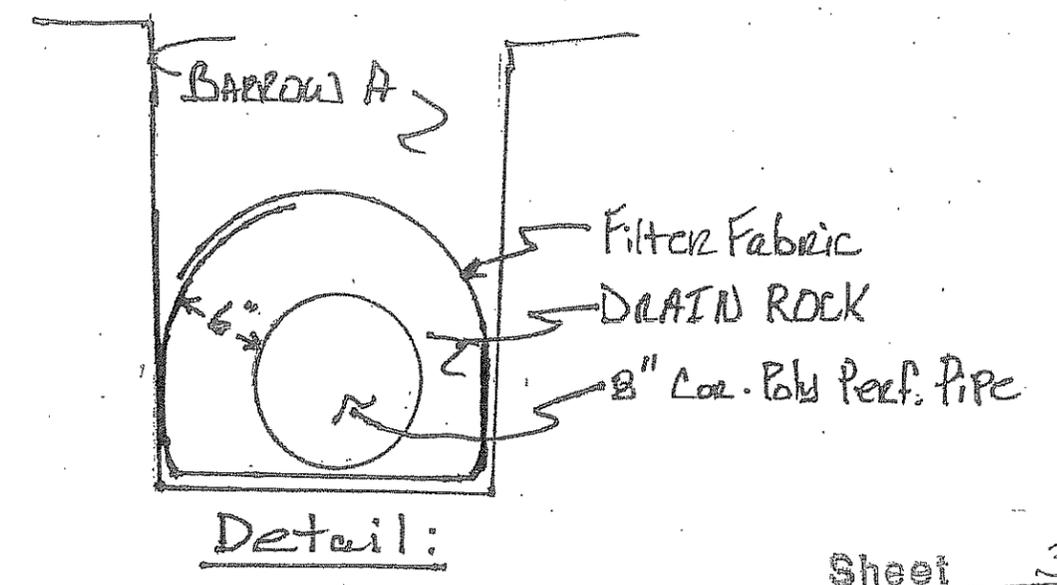
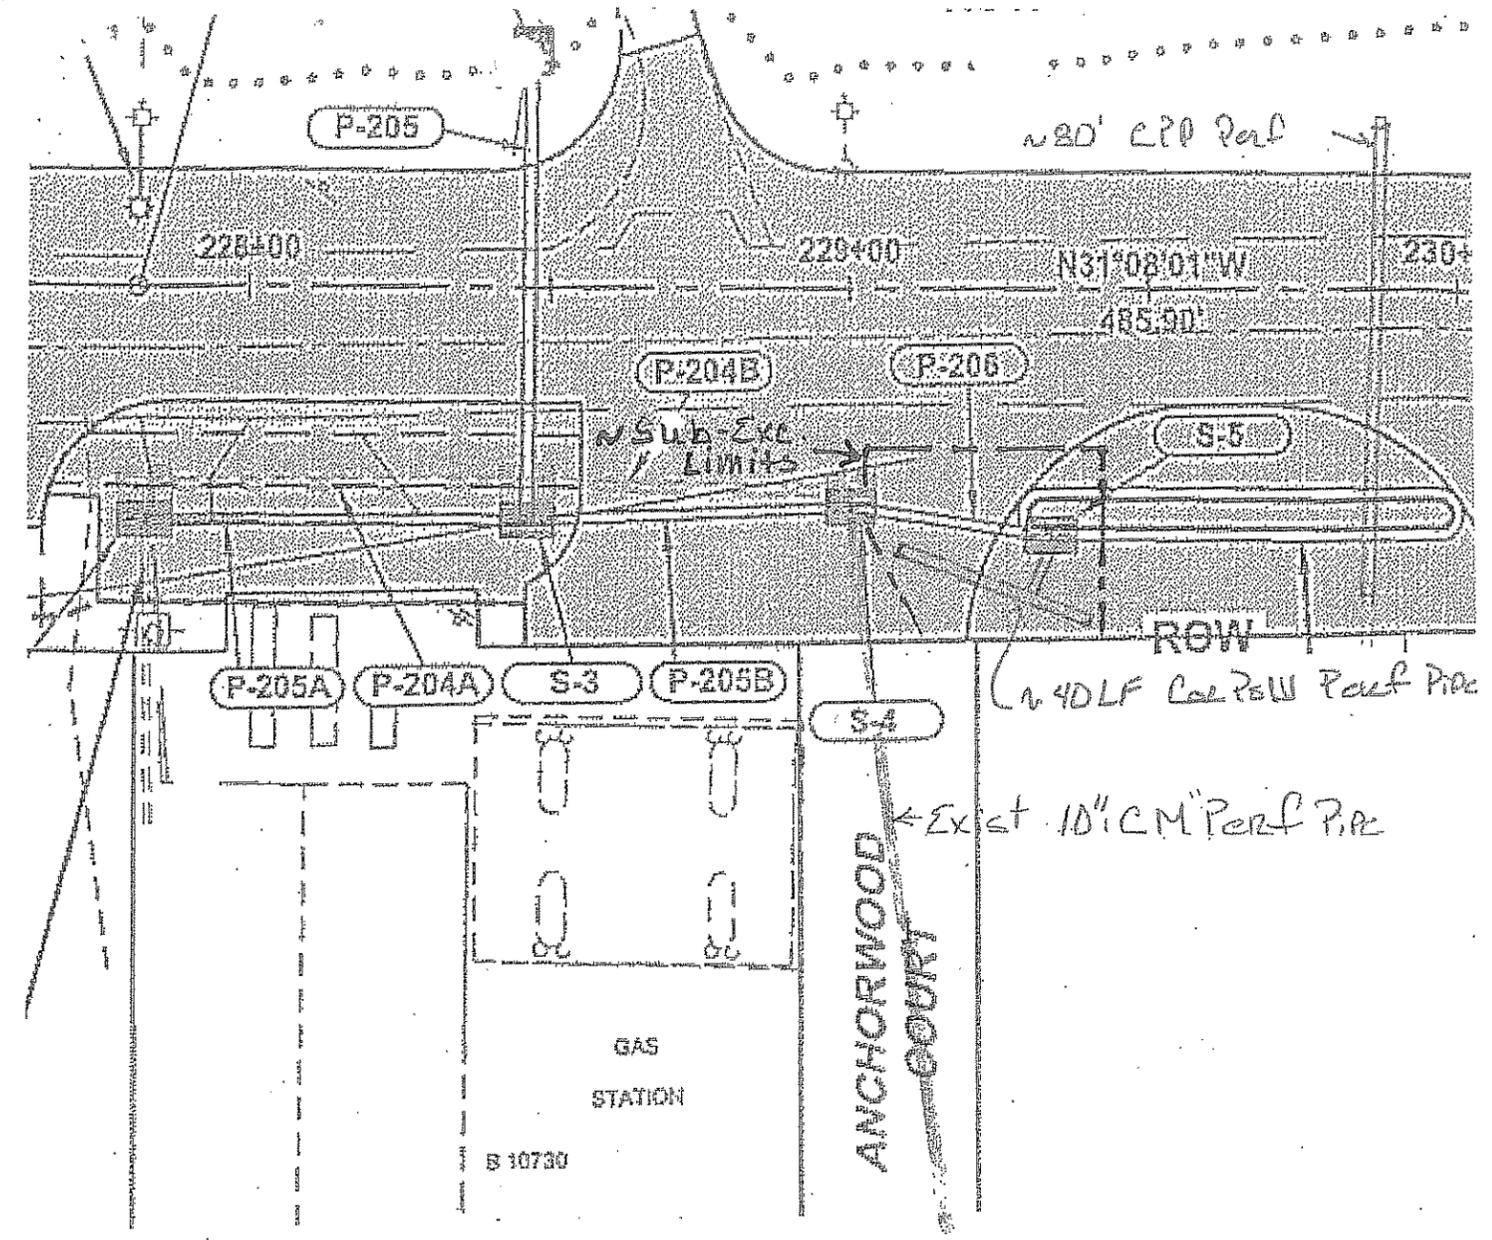


"O" LINE CURVE DATA
 R = 1065.00'
 L = 694.14'
 T = 359.90'
 Δ = 37°20'38"
 e = 6.0%
 FLAT = 219+52.95
 BFS = 221+17.27
 EFS = 227+51.41
 EST = 229+55.41

PATH:
Q:\KTN\167423\PLANSET\167423_F1-3_PLAN.DWG

TAB: F2 WILSON, BRIAN C

ADDENDUM NUMBER		
ATTACHMENT NUMBER		
RECORD OF REVISIONS		
No.	DATE	DESCRIPTION

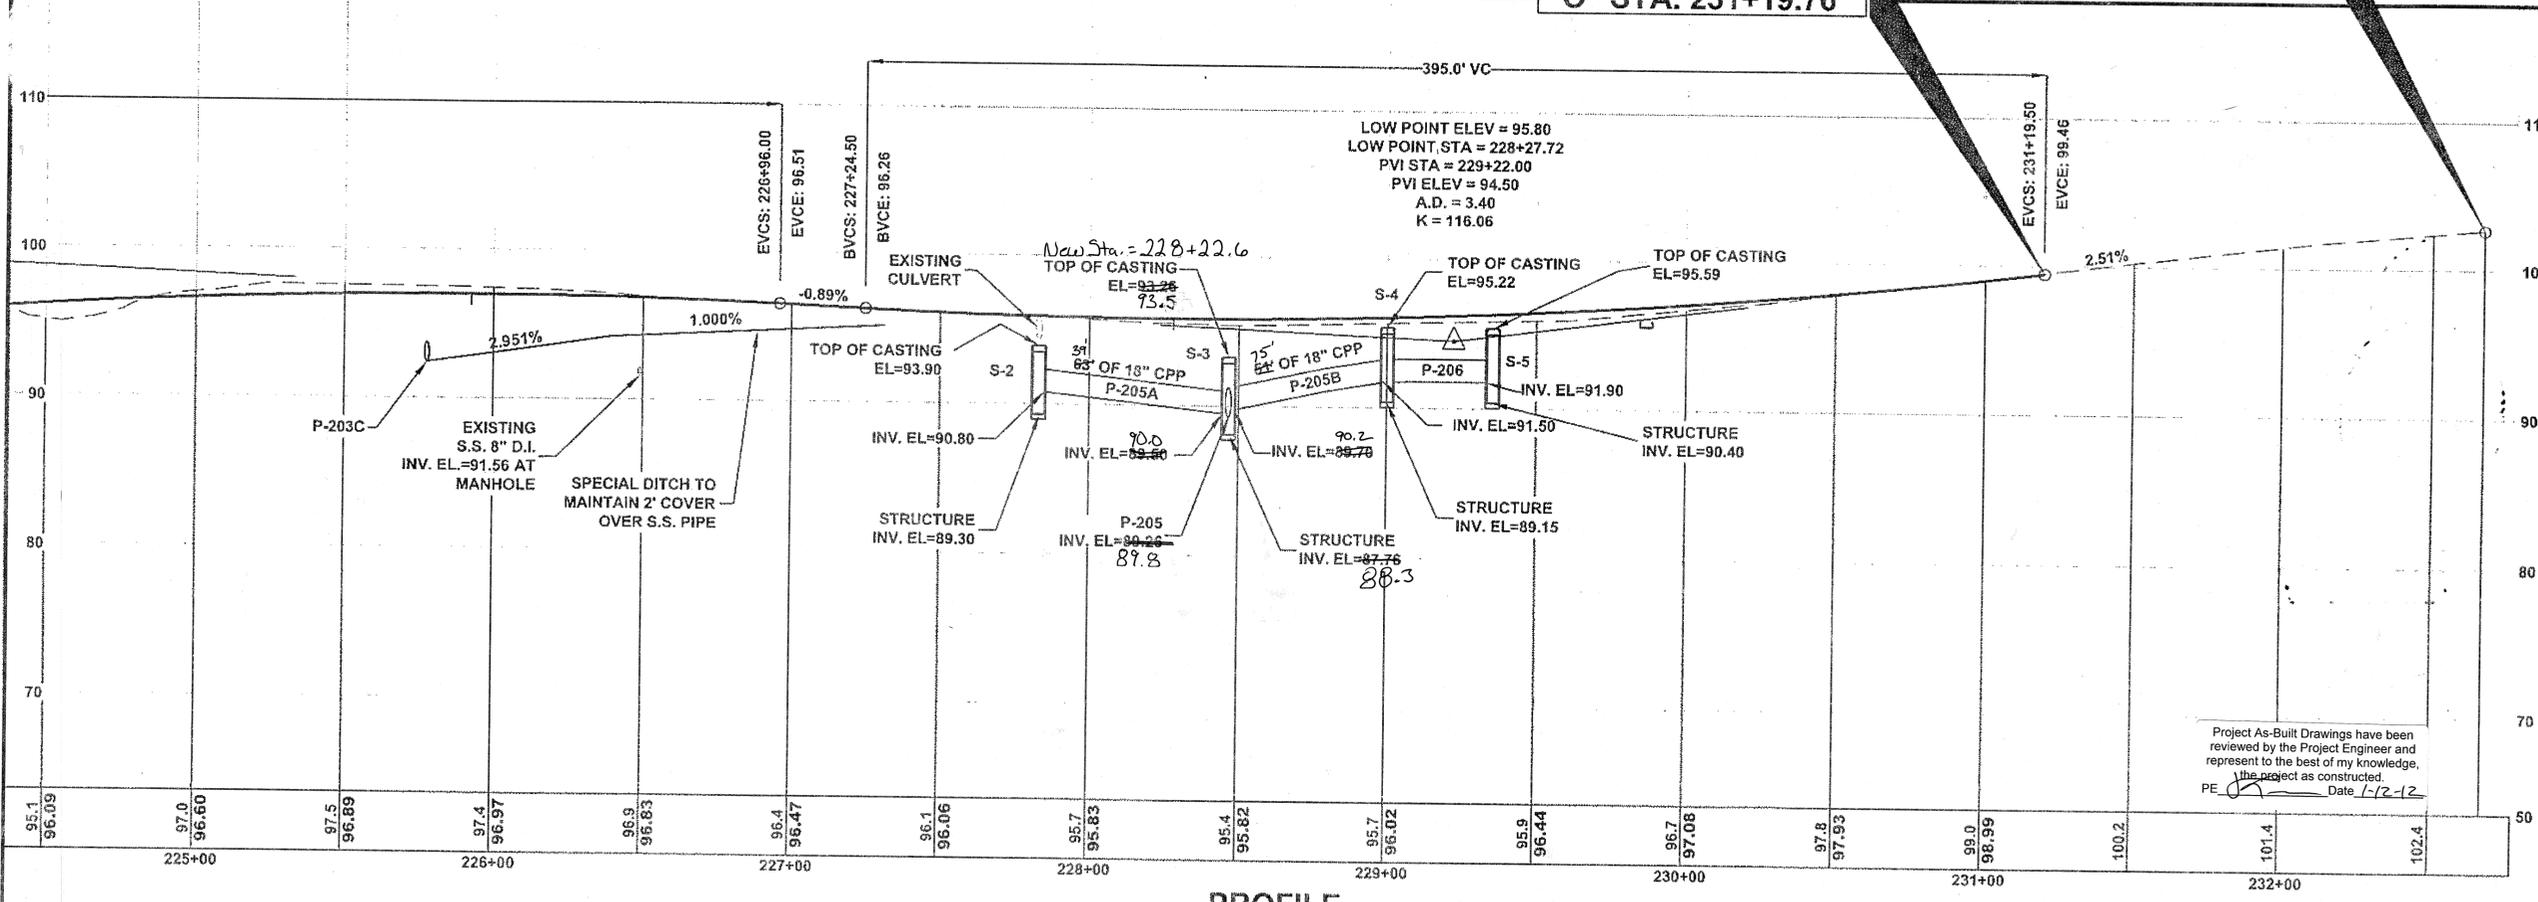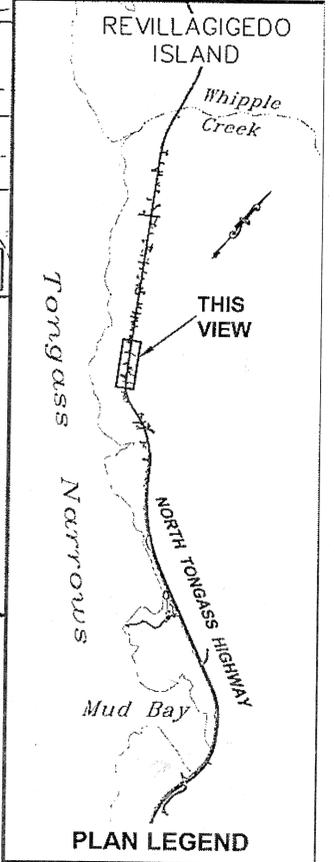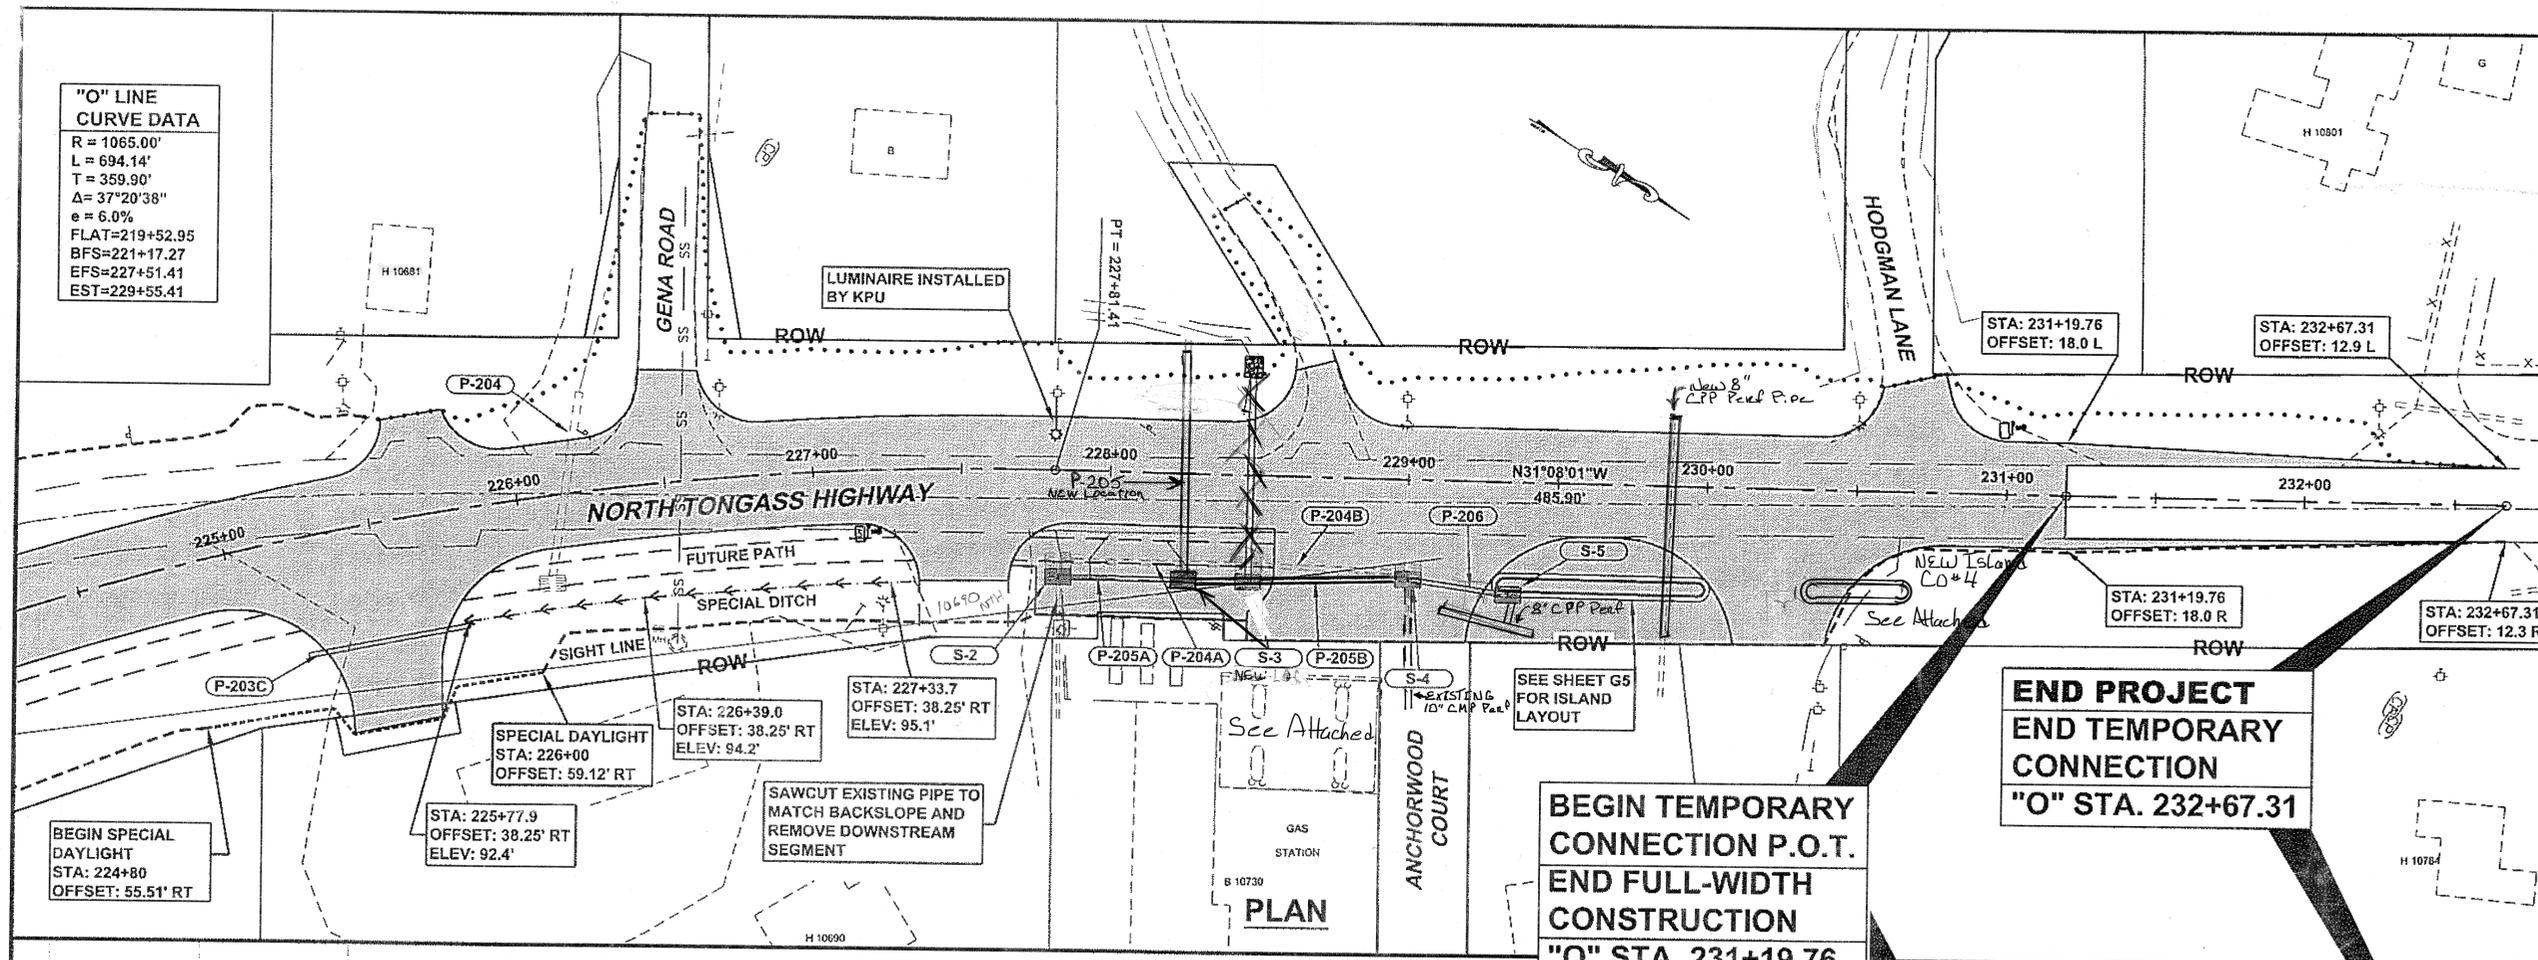

CHECKED BY: C. HOWARD

STATE OF ALASKA
 DEPARTMENT OF TRANSPORTATION & PUBLIC FACILITIES
 DESIGN & ENGINEERING SERVICES
 DIVISION - SOUTHEAST REGION
 CHAD J. HOWARD
 CE-10835
 3-11-09

DESIGNED BY: J. WEAVER
 DRAWN BY: R. SNYDER

STATE OF ALASKA
 DEPARTMENT OF TRANSPORTATION & PUBLIC FACILITIES
 DESIGN & ENGINEERING SERVICES
 DIVISION - SOUTHEAST REGION
 KTN - NORTH TONGASS HWY.
 SAFETY IMPROVEMENTS
 PROJECT #67423

PLAN & PROFILE


PROJECT DESIGNATION
HHE-0920(24) / 67423

STATE	YEAR
ALASKA	2009
SHEET NUMBER	TOTAL SHEETS
F2	25


Project As-Built Drawings have been reviewed by the Project Engineer and represent to the best of my knowledge, the project as constructed.
 PE: [Signature] Date: 1-12-12

DO NOT SCALE FROM THESE DRAWINGS USE DIMENSIONS

RECORD OF REVISIONS		
No.	DATE	DESCRIPTION

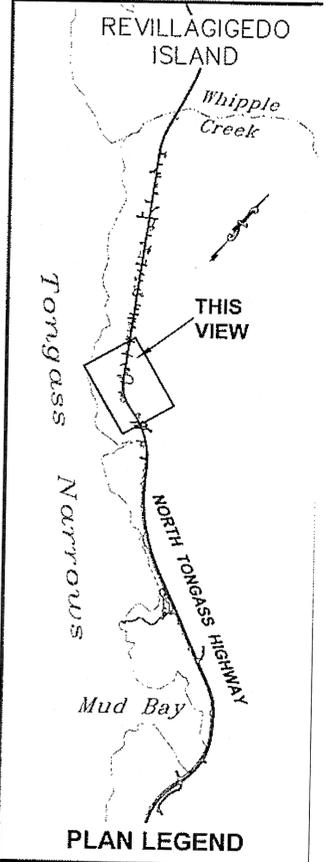

CHECKED BY: C. HOWARD

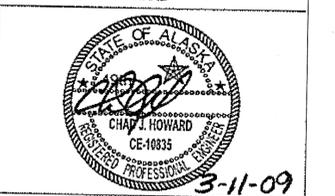

DESIGNED BY: J. WEAVER


DRAWN BY: R. SNYDER

STATE OF ALASKA
DEPARTMENT OF TRANSPORTATION
& PUBLIC FACILITIES
DESIGN & ENGINEERING SERVICES
DIVISION-SOUTHEAST REGION
KTN - NORTH TONGASS HWY.
SAFETY IMPROVEMENTS
PROJECT #67423

CLEAR ZONE LAYOUT PLAN

PROJECT DESIGNATION
HHE-0920(24) / 67423

STATE	YEAR
ALASKA	2009
SHEET NUMBER	TOTAL SHEETS
F3	25


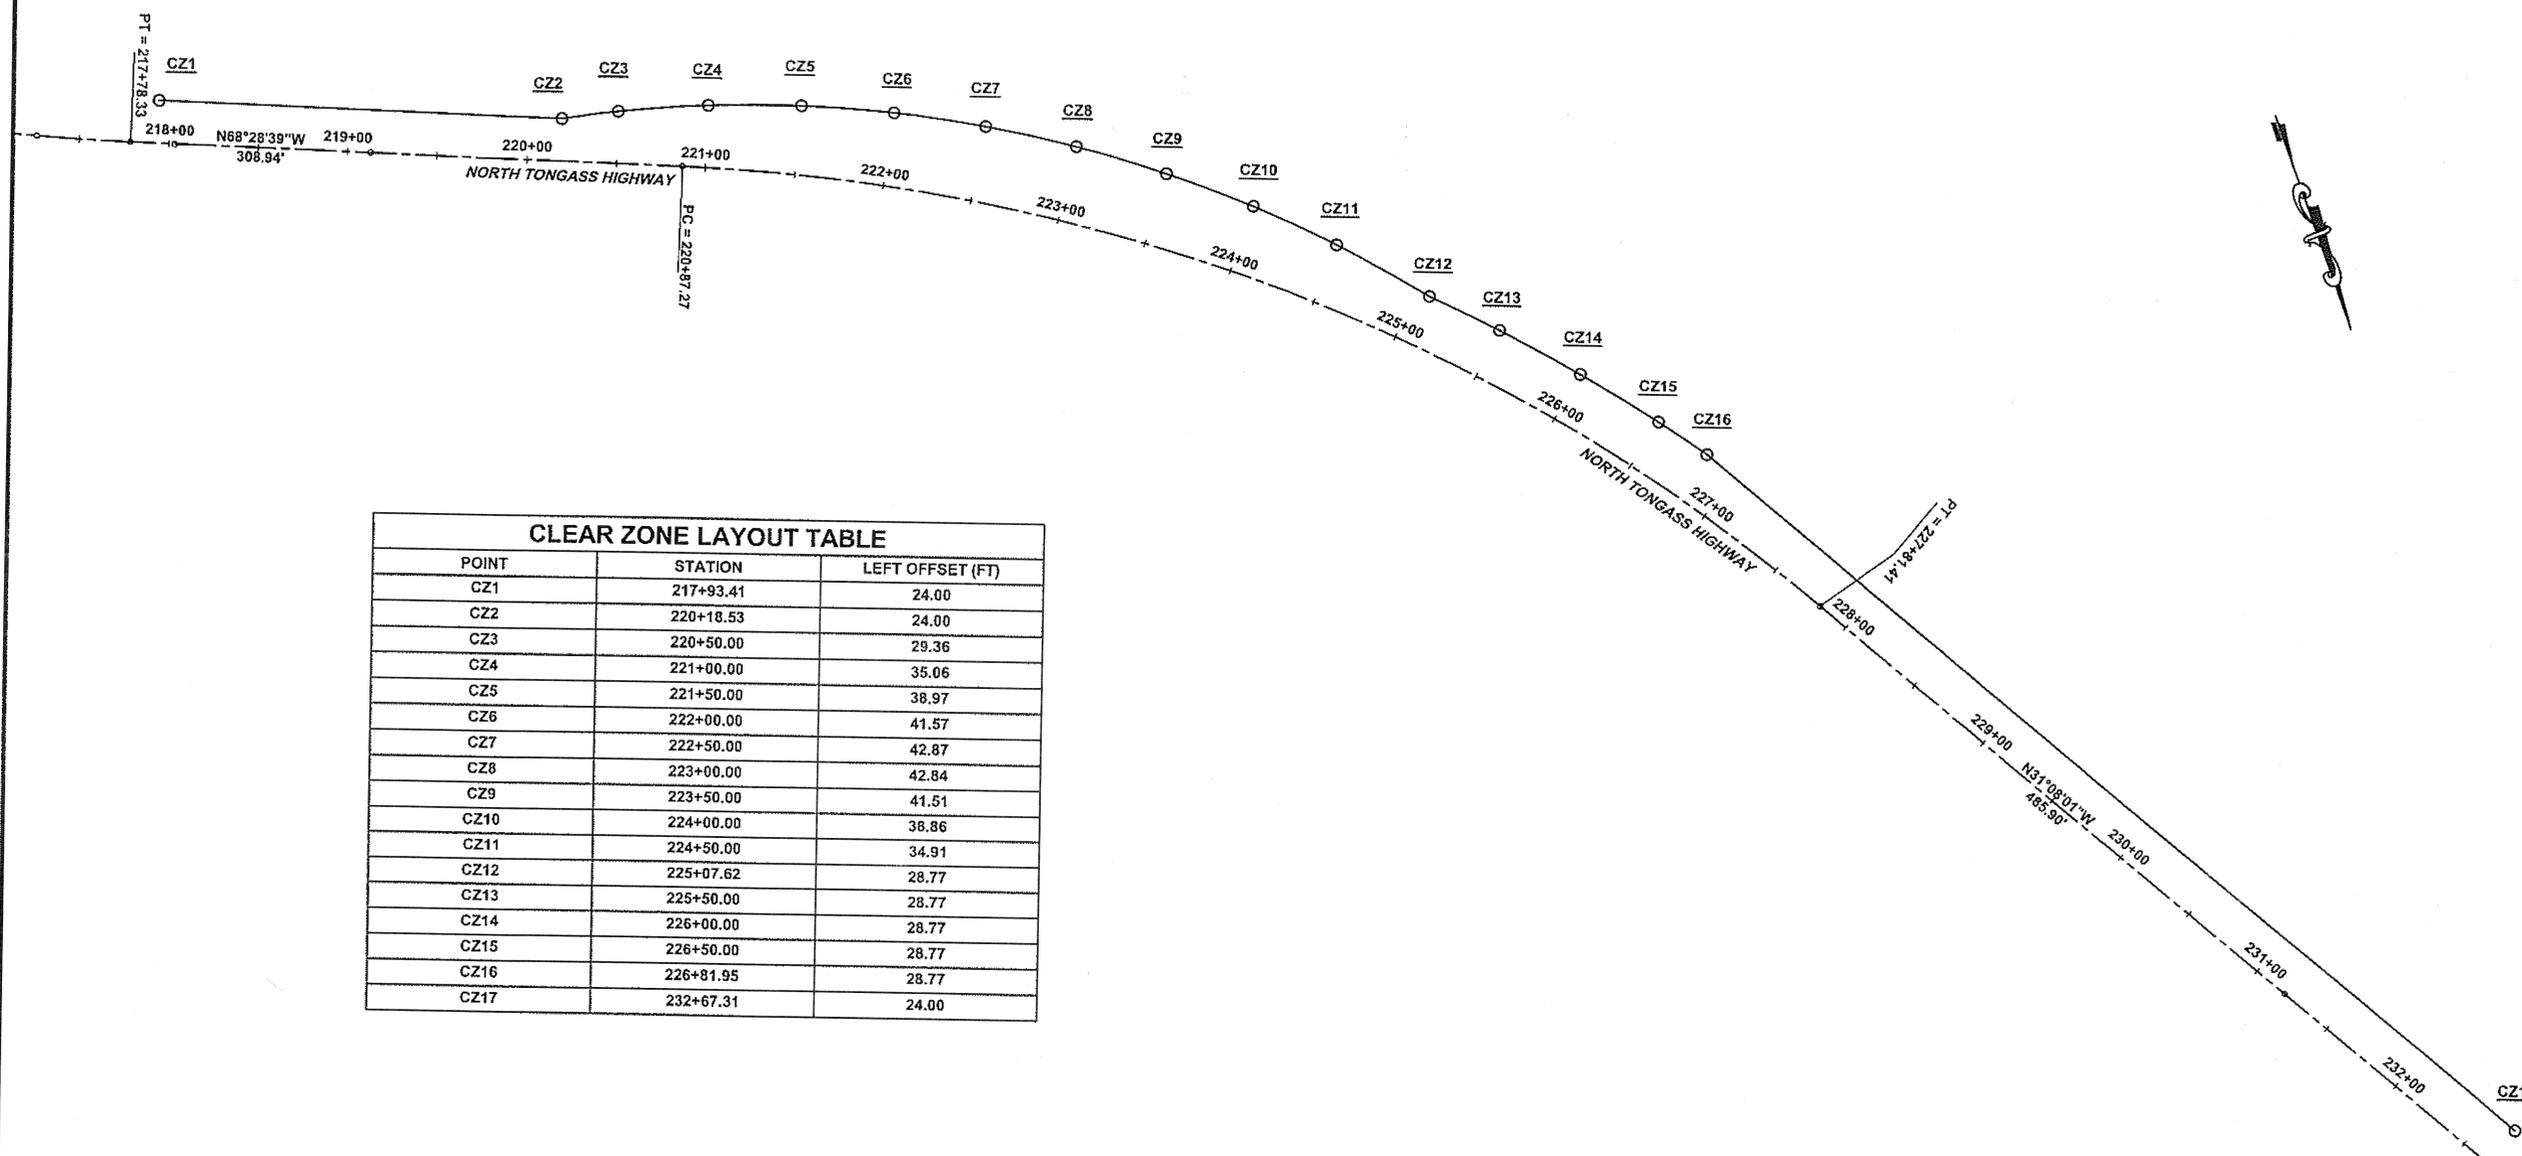


POINT	STATION	LEFT OFFSET (FT)
CZ1	217+93.41	24.00
CZ2	220+18.53	24.00
CZ3	220+50.00	29.36
CZ4	221+00.00	35.06
CZ5	221+50.00	38.97
CZ6	222+00.00	41.57
CZ7	222+50.00	42.87
CZ8	223+00.00	42.84
CZ9	223+50.00	41.51
CZ10	224+00.00	38.86
CZ11	224+50.00	34.91
CZ12	225+07.62	28.77
CZ13	225+50.00	28.77
CZ14	226+00.00	28.77
CZ15	226+50.00	28.77
CZ16	226+81.95	28.77
CZ17	232+67.31	24.00


Project As-Built Drawings have been reviewed by the Project Engineer and represent to the best of my knowledge, the project as constructed.
Date 1-12-12

DO NOT SCALE FROM THESE DRAWINGS USE DIMENSIONS


TAB: G1	WILSON, BRIAN C	
ADDENDUM NUMBER		
ATTACHMENT NUMBER		
RECORD OF REVISIONS		
No.	DATE	DESCRIPTION

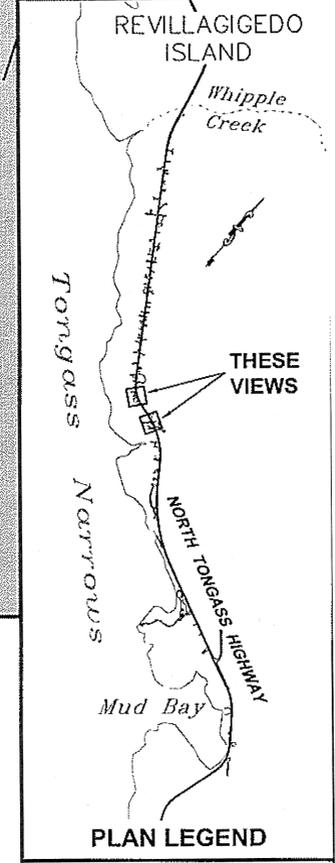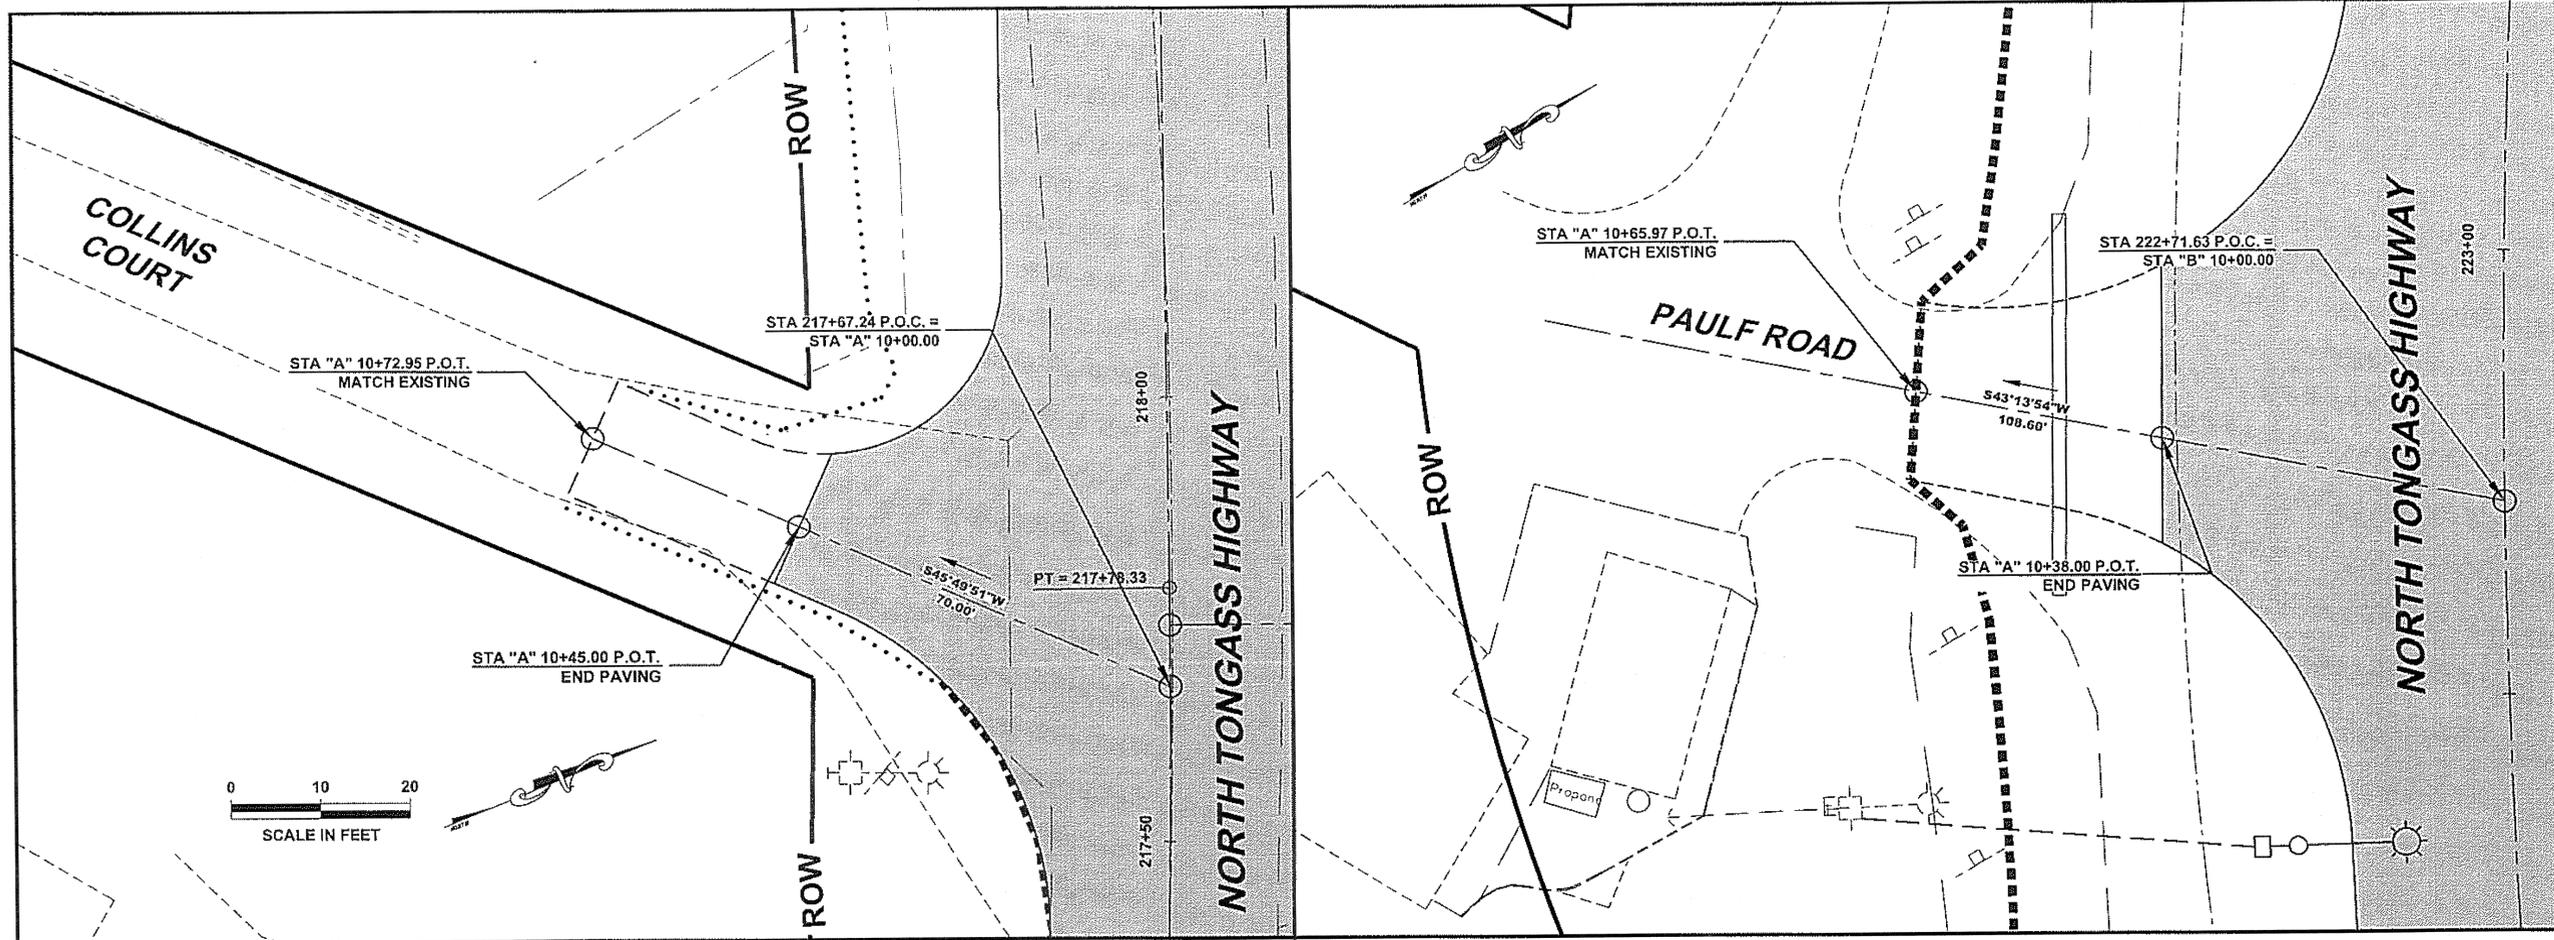

ALL VPI SHALL BE ROUNDED PER NOTE 6 ON SHEET J1

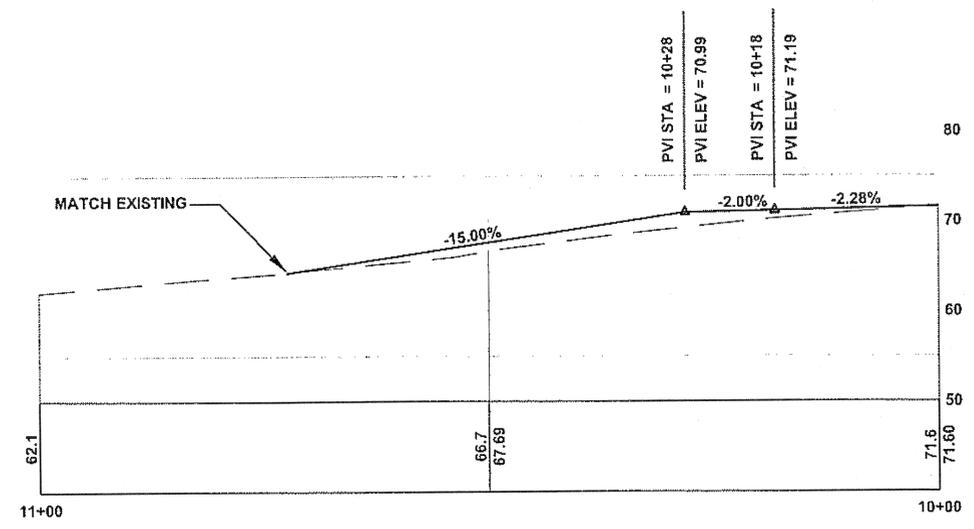

COLLINS COURT

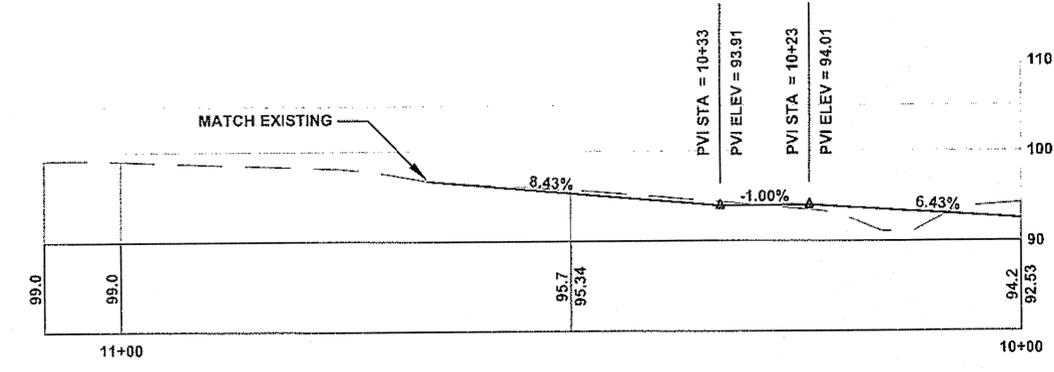

PAULF ROAD

SEE SHEET J1 FOR DRIVEWAY DETAILS
DO NOT SCALE FROM THESE DRAWINGS USE DIMENSIONS

Project As-Built Drawings have been reviewed by the Project Engineer and represent to the best of my knowledge, the project as constructed.
PE: [Signature] Date: 1-12-12

CHECKED BY: C. HOWARD




DESIGNED BY: J. WEAVER
DRAWN BY: J. WEAVER

STATE OF ALASKA
DEPARTMENT OF TRANSPORTATION & PUBLIC FACILITIES
DIVISION-SOUTHEAST REGION
DESIGN & ENGINEERING SERVICES
KTN - NORTH TONGASS HWY. SAFETY IMPROVEMENTS
PROJECT #67423

APPROACH PLAN & PROFILE

PROJECT DESIGNATION
HHE-0920(24) / 67423

STATE	YEAR
ALASKA	2009
SHEET NUMBER	TOTAL SHEETS
G1	25

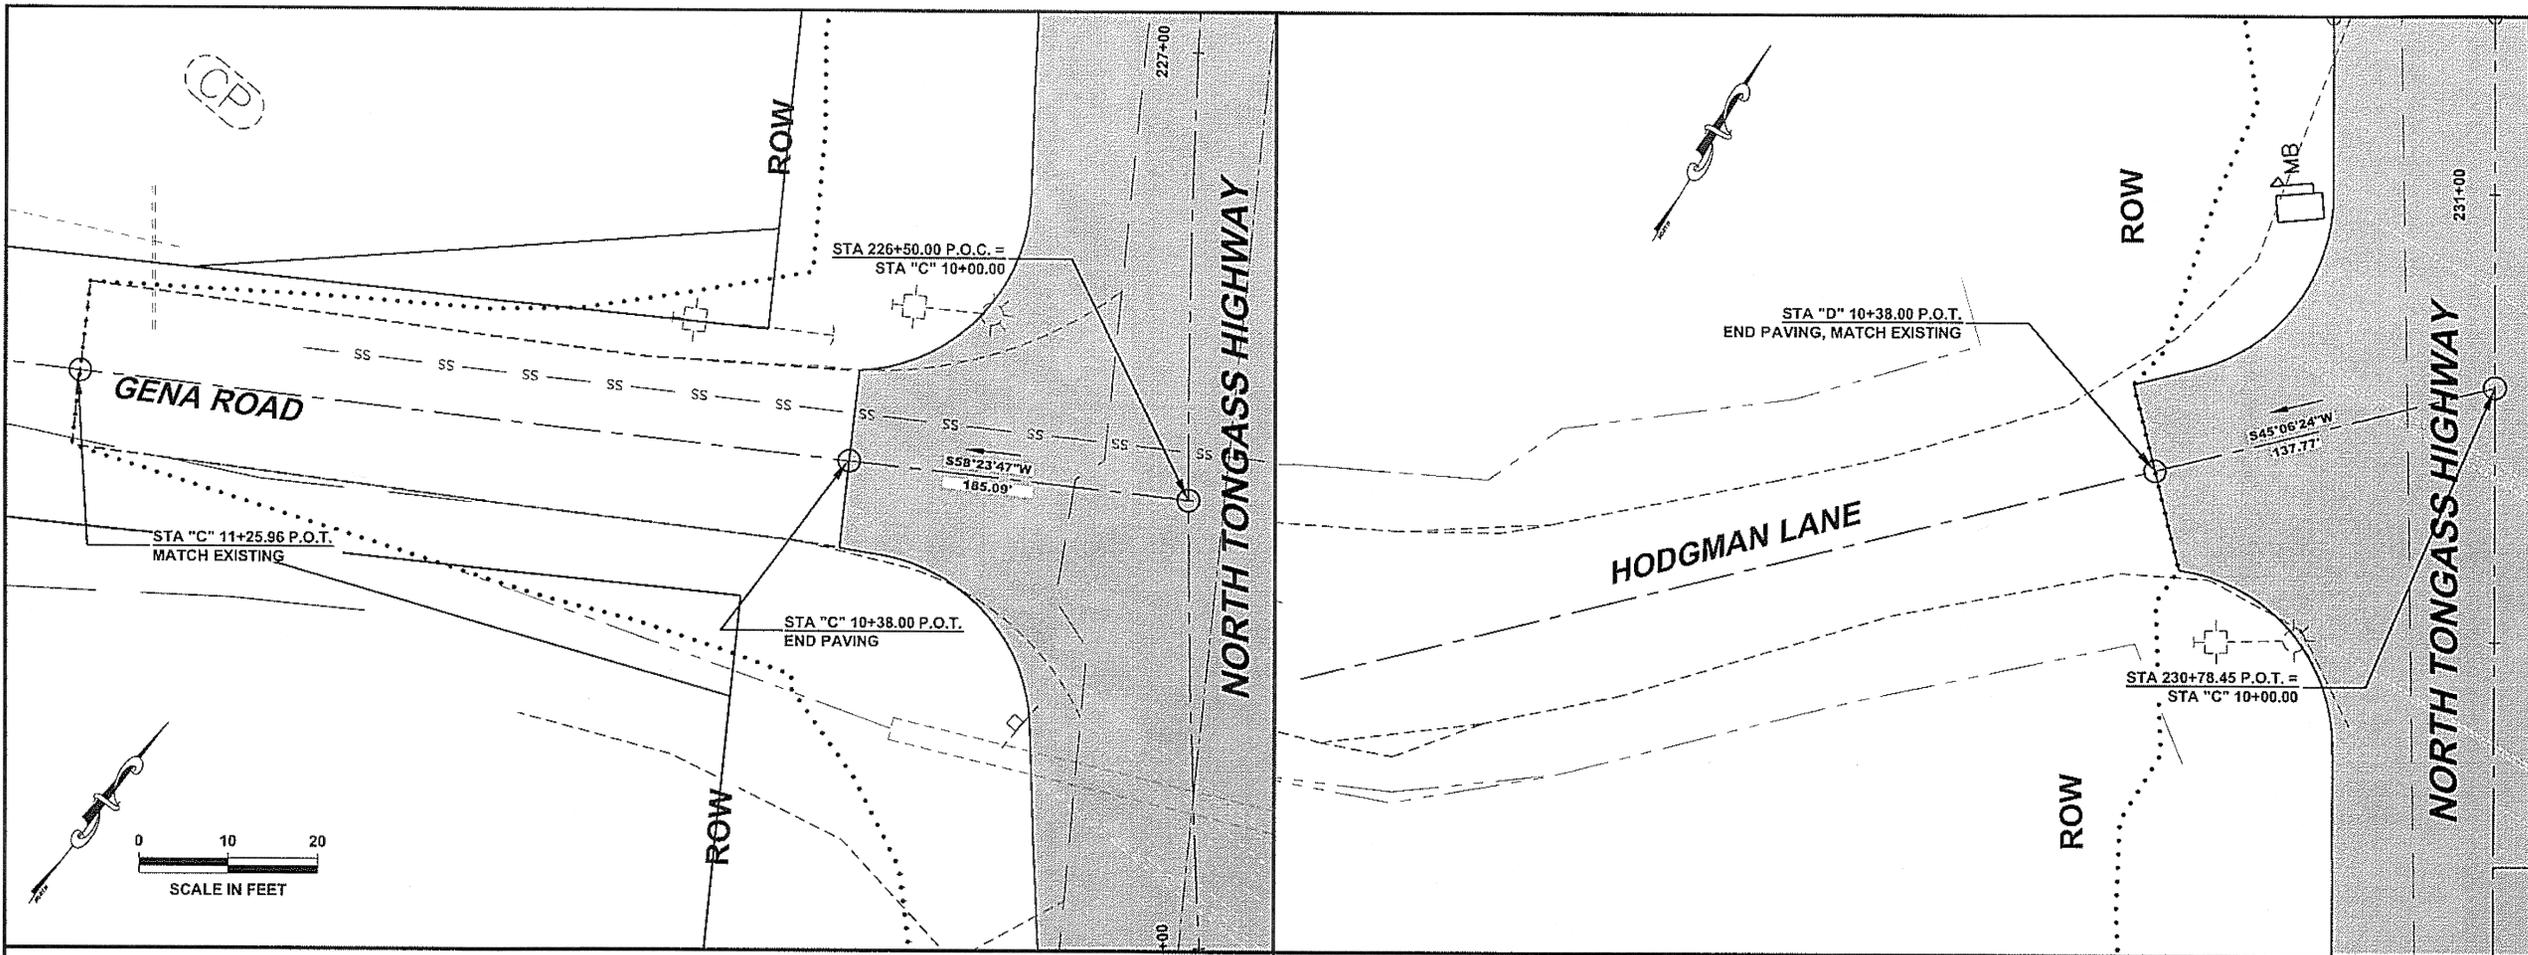

PATH:
Q:\KTN\67423\PLANSET\67423_G1-5_APPROACHES


TAB: G2 WILSON, BRIAN

ADDENDUM NUMBER


ATTACHMENT NUMBER

RECORD OF REVISIONS


No.	DATE	DESCRIPTION

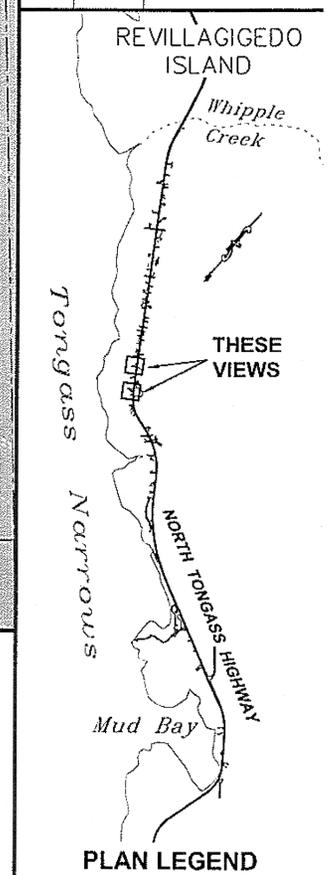

ALL VPI SHALL BE ROUNDED PER NOTE 6 ON SHEET J1

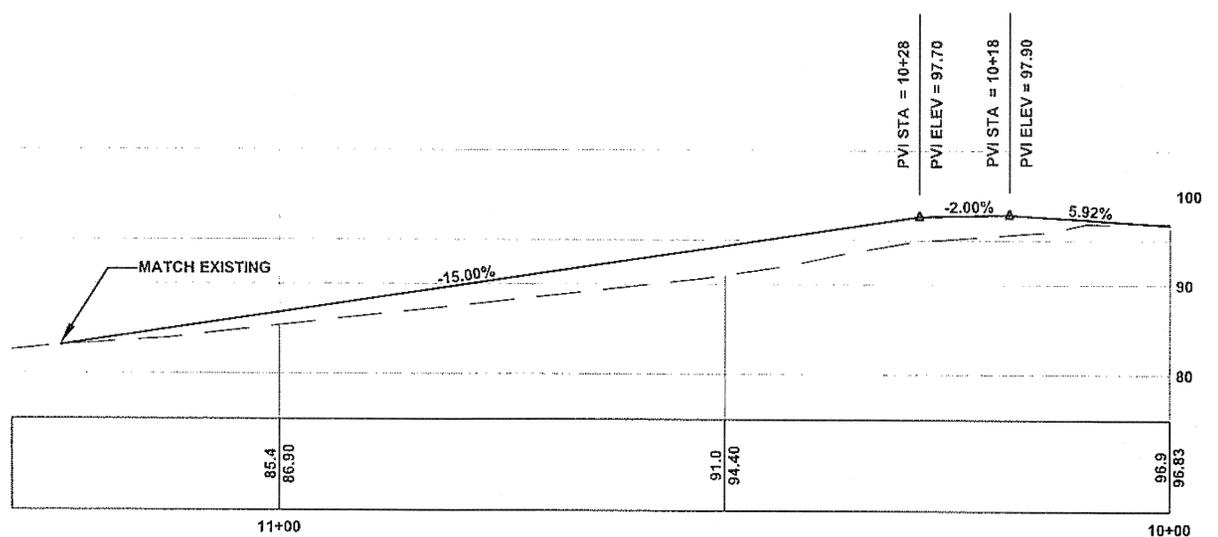

GENA ROAD

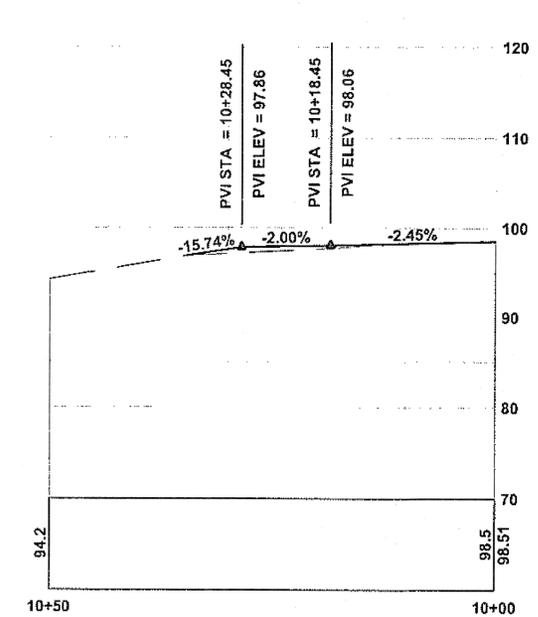

HODGMAN LANE

SEE SHEET J1 FOR DRIVEWAY DETAILS
DO NOT SCALE FROM THESE DRAWINGS USE DIMENSIONS

Project As-Built Drawings have been reviewed by the Project Engineer and represent to the best of my knowledge, the project as constructed.
PE [Signature] Date 1-12-12

CHECKED BY: C. HOWARD




DESIGNED BY: J. WEAVER
DRAWN BY: J. WEAVER

STATE OF ALASKA
DEPARTMENT OF TRANSPORTATION & PUBLIC FACILITIES
DESIGN & ENGINEERING SERVICES
DIVISION - SOUTHEAST REGION
KTN - NORTH TONGASS HWY.
SAFETY IMPROVEMENTS
PROJECT #67423

APPROACH
PLAN & PROFILE

PROJECT DESIGNATION
HHE-0920(24) / 67423

STATE	YEAR
ALASKA	2009
SHEET NUMBER	TOTAL SHEETS
G2	25

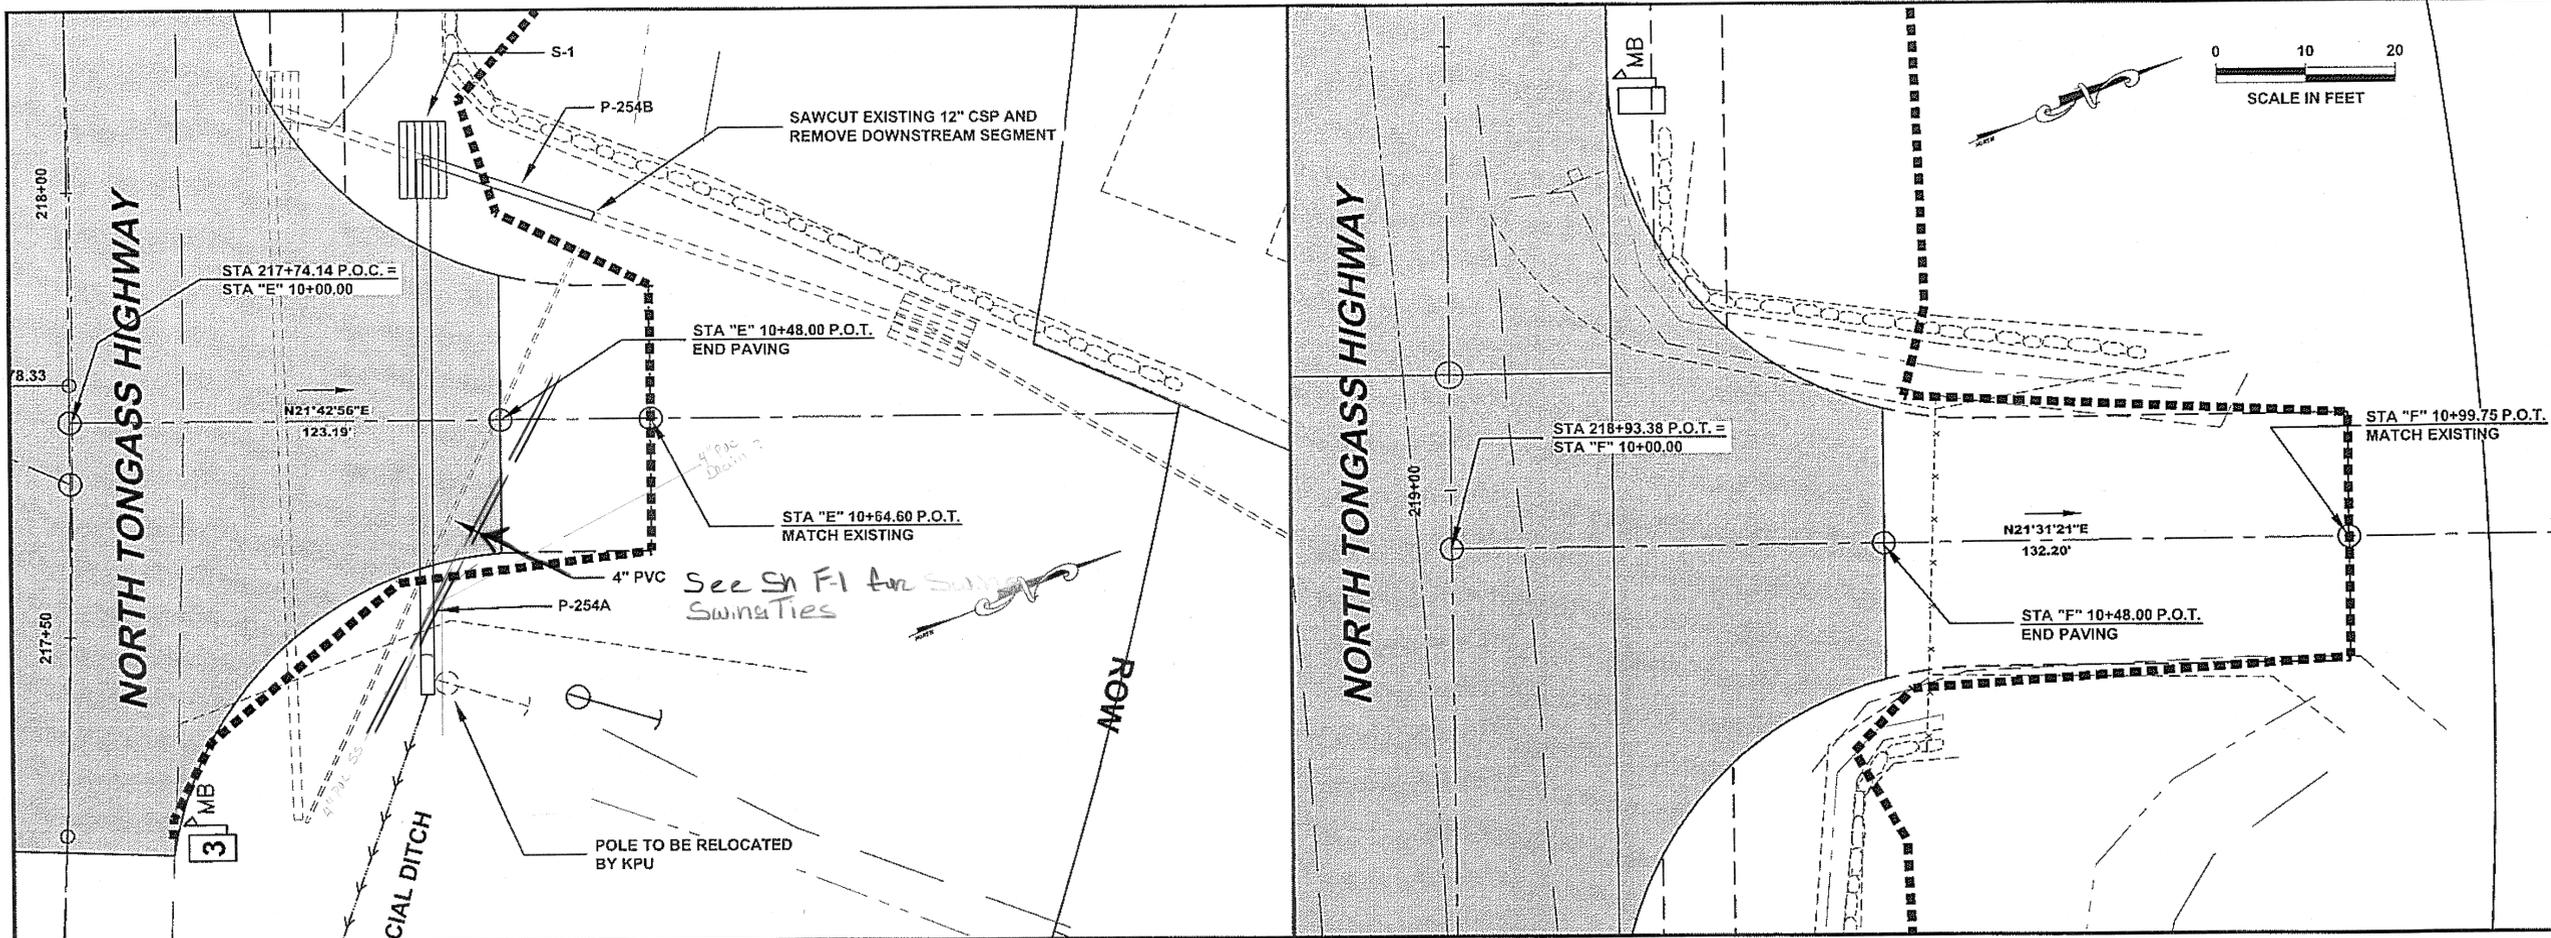

PATH:
Q:\KTN\67423\PLANSET\67423_G1-5_APPROACHES


TAB: G3 WILSON, BRIAN

ADDENDUM NUMBER


ATTACHMENT NUMBER

RECORD OF REVISIONS


No.	DATE	DESCRIPTION

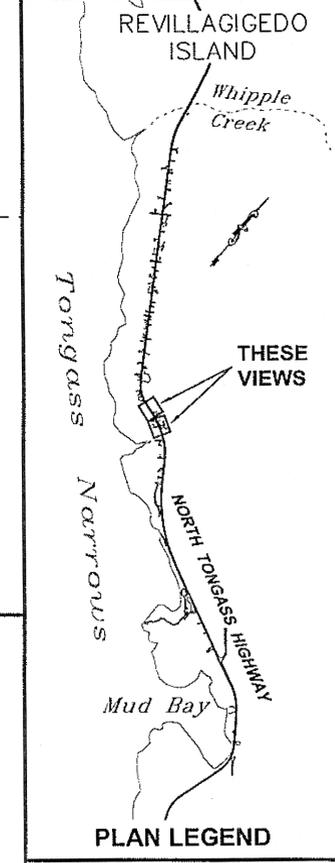

ALL VPI SHALL BE ROUNDED PER NOTE 6 ON SHEET J1

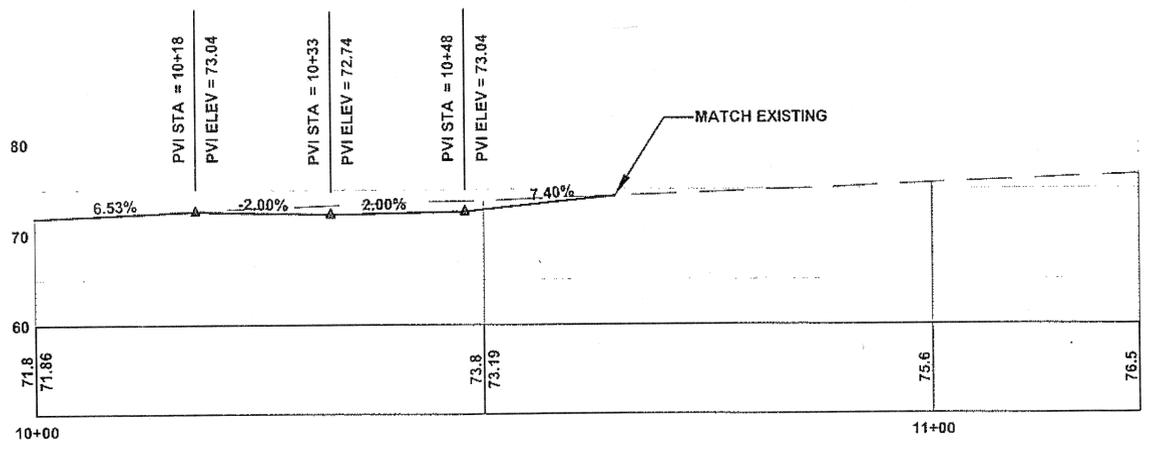

10526 NORTH TONGASS HIGHWAY

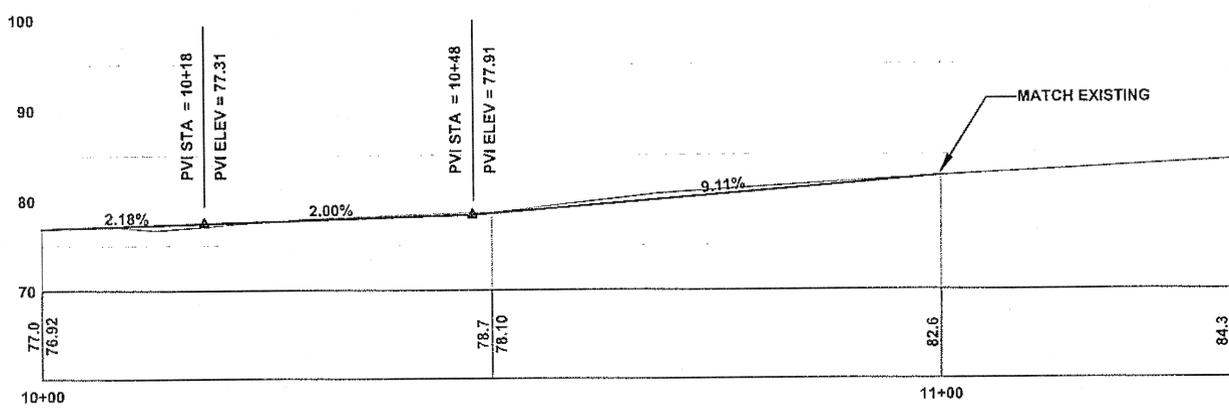

KETCHIKAN WELDING

SEE SHEET J1 FOR DRIVEWAY DETAILS
DO NOT SCALE FROM THESE DRAWINGS USE DIMENSIONS

Project As-Built Drawings have been reviewed by the Project Engineer and represent to the best of my knowledge, the project as constructed.
PE: [Signature] Date: 1-12-12

CHECKED BY: C. HOWARD

DESIGNED BY: J. WEAVER
DRAWN BY: J. WEAVER

STATE OF ALASKA
DEPARTMENT OF TRANSPORTATION & PUBLIC FACILITIES
DESIGN & ENGINEERING SERVICES
DIVISION - SOUTH EAST REGION
KTN - NORTH TONGASS HWY. SAFETY IMPROVEMENTS PROJECT #67423

APPROACH PLAN & PROFILE

PROJECT DESIGNATION
HHE-0920(24) / 67423

STATE	YEAR
ALASKA	2009
SHEET NUMBER	TOTAL SHEETS
G3	25

PATH:
Q:\KTN167423\PLANSET\167423_G1-5_APPROACHES


TAB: G4 WILSON, BRIAN C

ADDENDUM NUMBER

ATTACHMENT NUMBER

RECORD OF REVISIONS

No.	DATE	DESCRIPTION

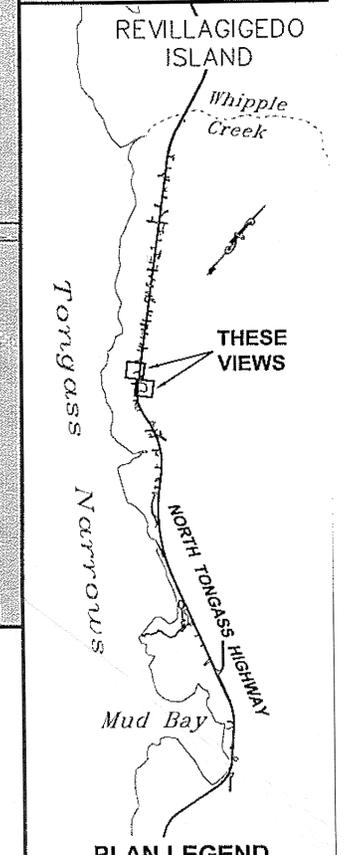

CHECKED BY: C. HOWARD

DESIGNED BY: J. WEAVER

DRAWN BY: J. WEAVER

STATE OF ALASKA
DEPARTMENT OF TRANSPORTATION & PUBLIC FACILITIES
DESIGN & ENGINEERING SERVICES
DIVISION - SOUTHEAST REGION
KTN - NORTH TONGASS HWY.
SAFETY IMPROVEMENTS
PROJECT #67423



3-11-09

APPROACH
PLAN & PROFILE


PROJECT DESIGNATION
HHE-0920(24) / 67423

STATE	YEAR
ALASKA	2009


SHEET NUMBER	TOTAL SHEETS
G4	25

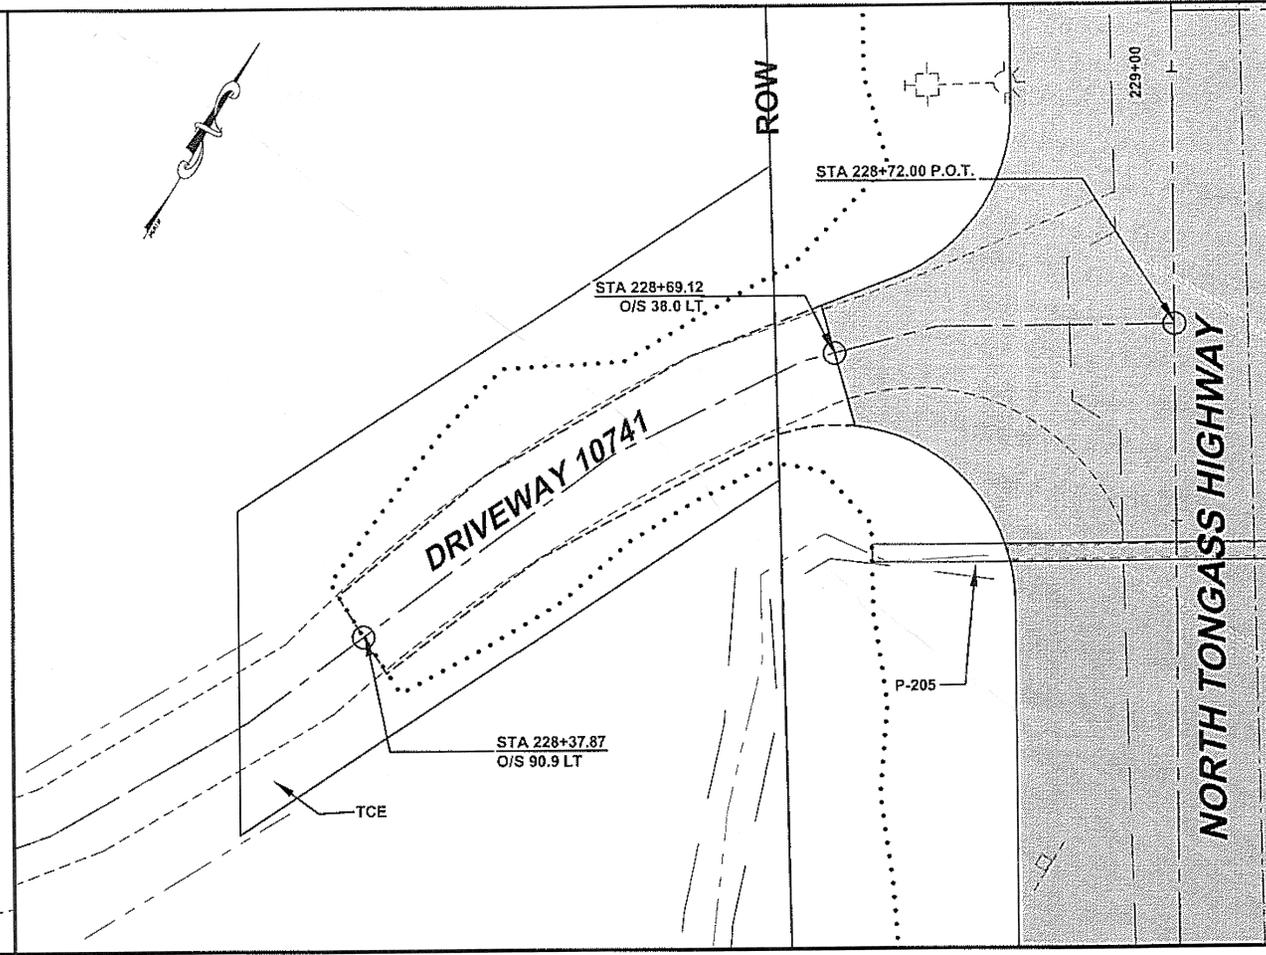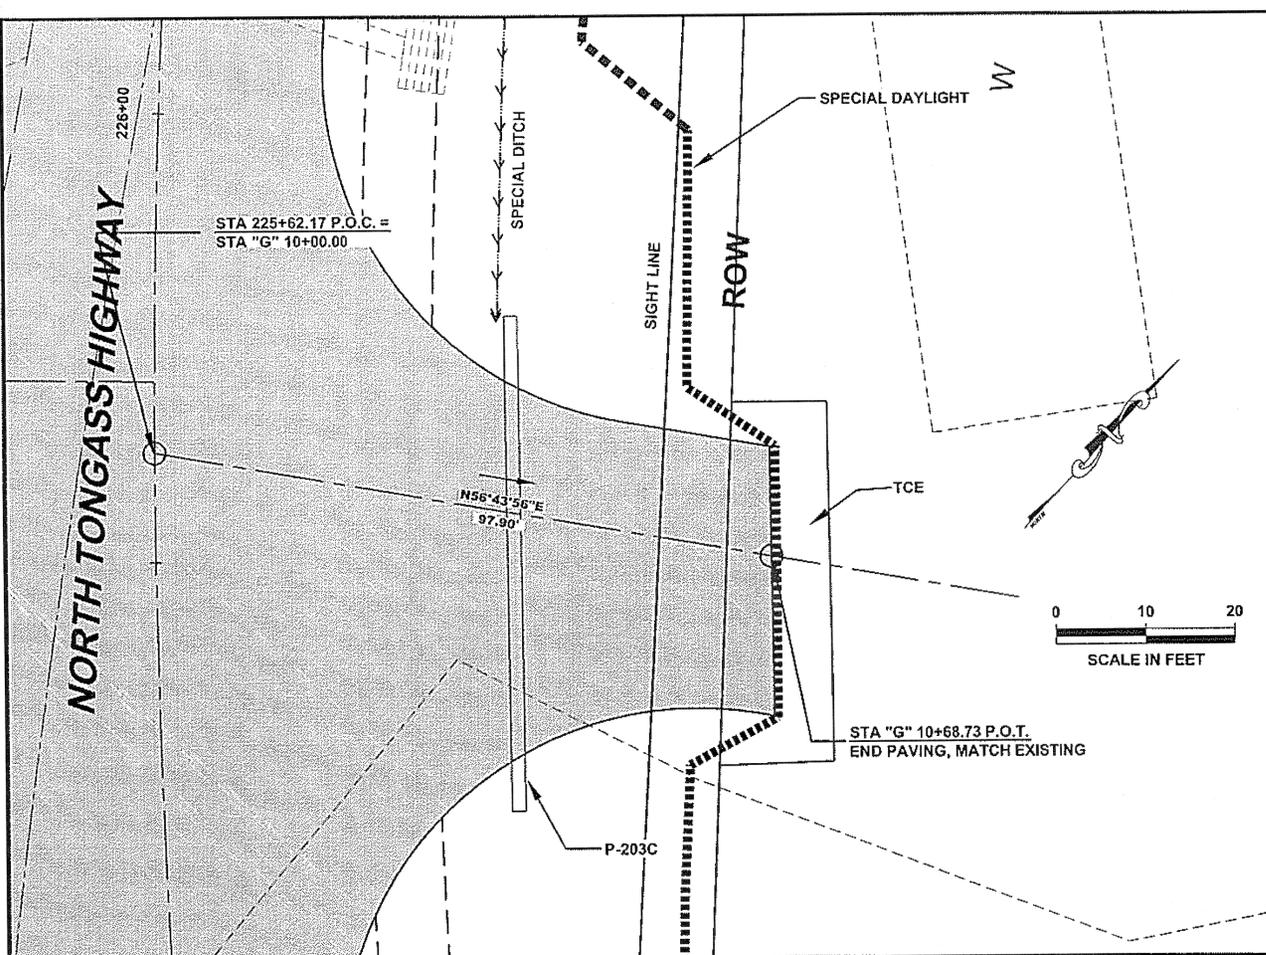

ALL VPI SHALL BE ROUNDED PER NOTE 6 ON SHEET J1

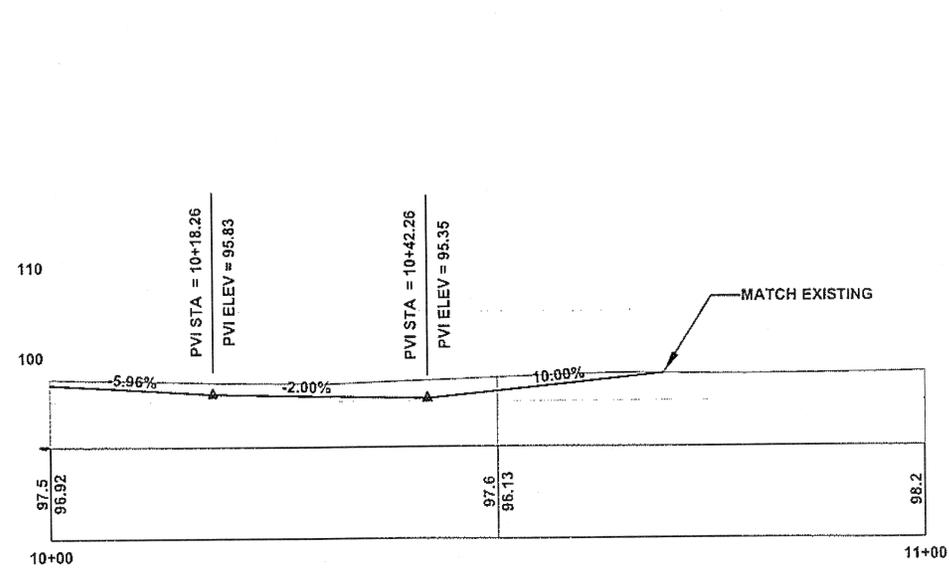



10690 NORTH TONGASS HIGHWAY
WAREHOUSE ENTERANCE

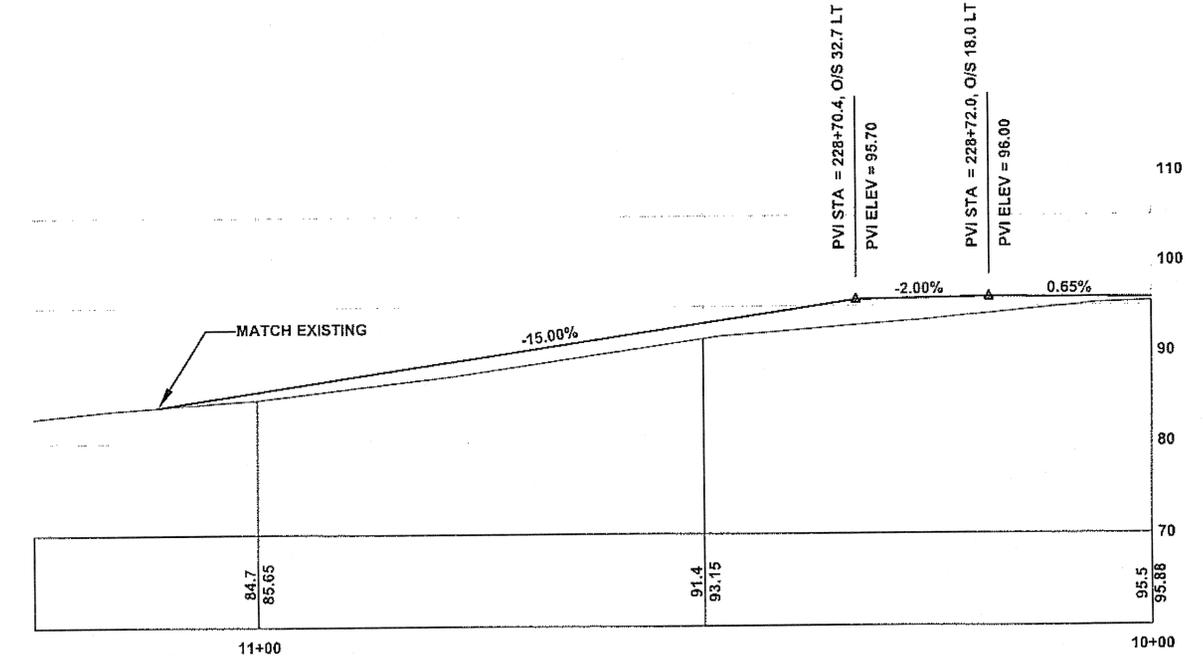

10741 NORTH TONGASS HIGHWAY


Project As-Built Drawings have been reviewed by the Project Engineer and represent to the best of my knowledge, the project as constructed.
Date 1-12-12

SEE SHEET J1 FOR DRIVEWAY DETAILS
DO NOT SCALE FROM THESE DRAWINGS USE DIMENSIONS

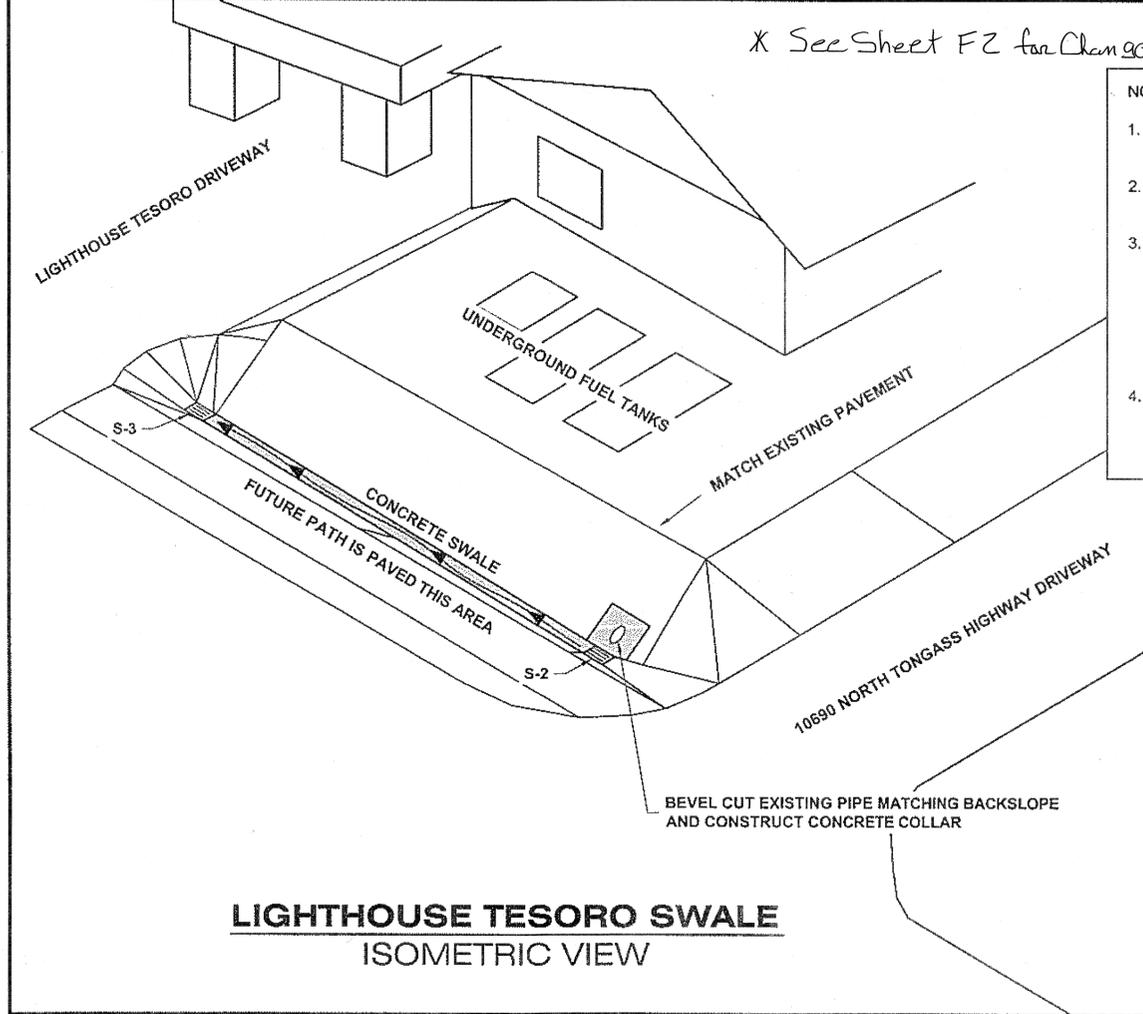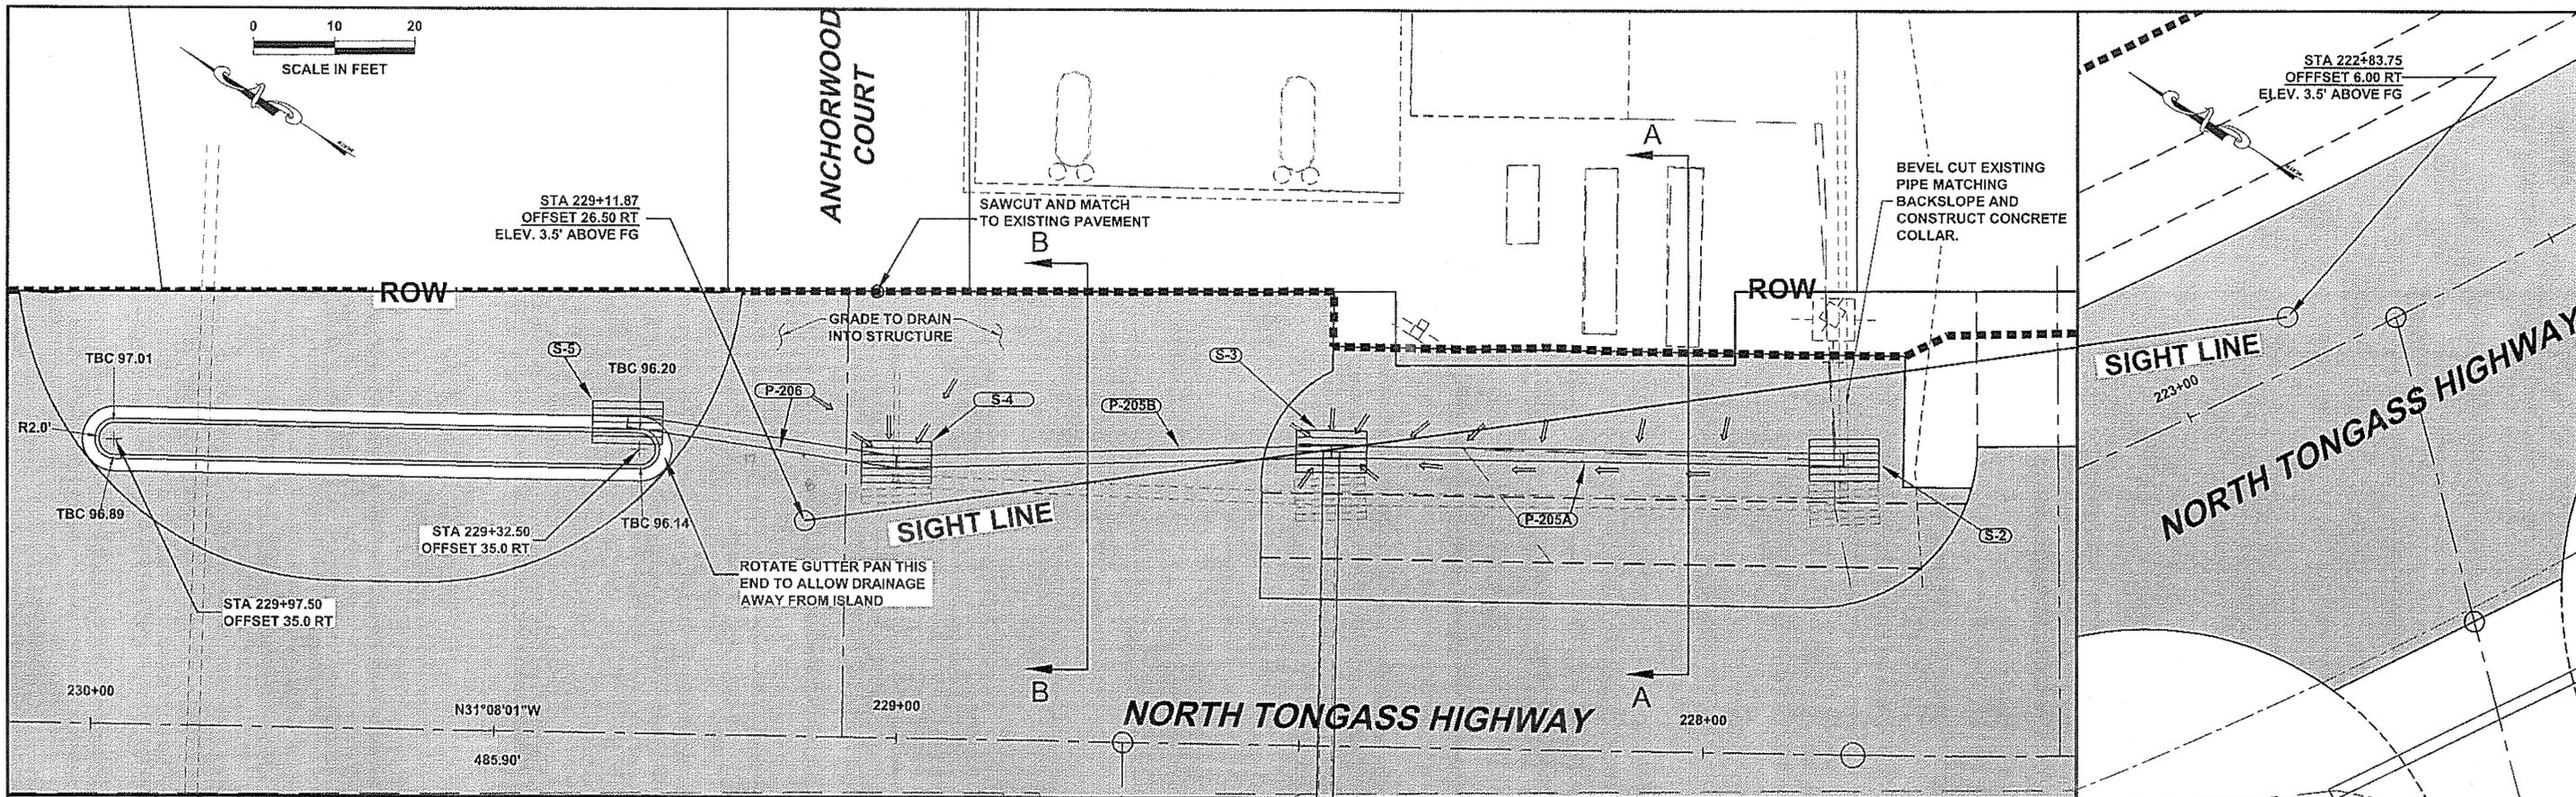

X See Sheet FZ for Changes to Drainage & Access


- NOTES:
1. THE CONTRACTOR SHALL USE CAUTION WHILE EXCAVATING IN THE VICINITY OF THE FUEL TANKS.
 2. CEASE WORK AND INFORM THE PROJECT ENGINEER IMMEDIATELY IF THE FUEL TANKS ARE DAMAGED.
 3. THE LIMIT OF EXCAVATION IS THAT WHICH WILL PROVIDE THE UNOBSTRUCTED SIGHT LINE SHOWN. THIS SIGHT LINE SHALL PROVIDE AN UNINTERRUPTED VIEW ALONG ITS LENGTH, TAKING INTO ACCOUNT AN ELEVATION PROVIDED AT EACH END OF 3.5' ABOVE FINISHED GRADE, AFTER THE COVER OVER THE FUEL TANKS IS IN ITS FINAL, PAVED CONDITION.
 4. IF IT BECOMES EVIDENT THAT THE REQUIRED SIGHT LINE CAN NOT BE EXCAVATED, INFORM THE PROJECT ENGINEER WHO WILL CONTACT AK DOT&PF DESIGN.

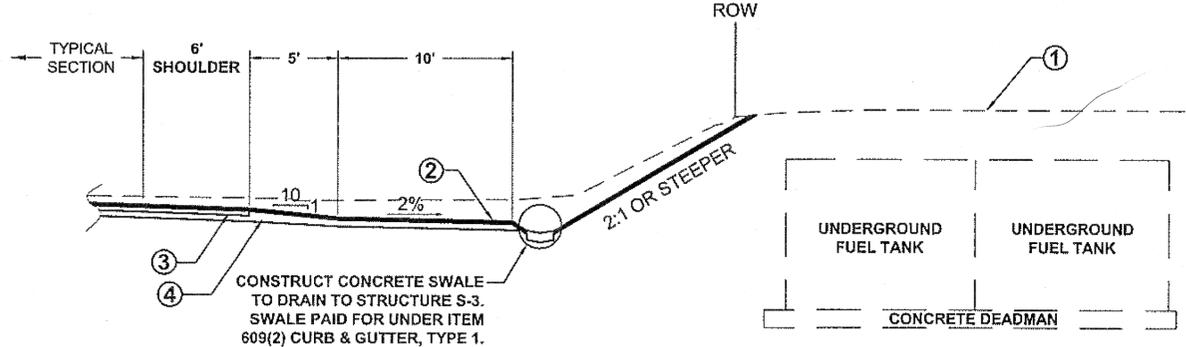

SECTION A-A
TYPICAL SECTION OVER UNDERGROUND FUEL TANKS

LEGEND

- ① EXISTING GROUND
- ② 2" ASPHALT CONCRETE PAVEMENT, TYPE II, CLASS B
- ③ 3" ATB
- ④ 4" AGGREGATE BASE COURSE, GRADING D-1

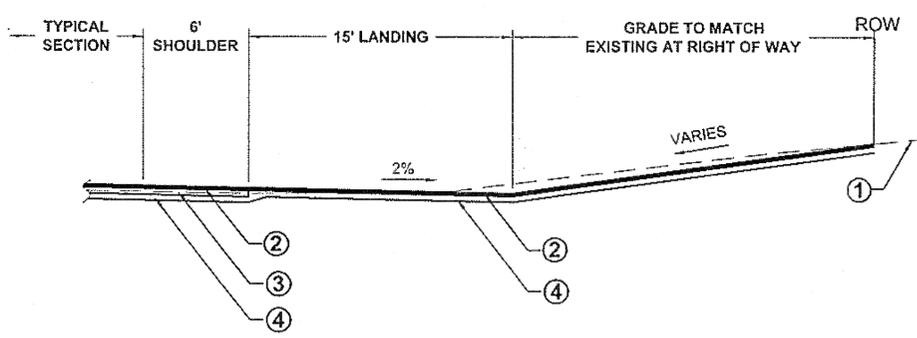

SECTION B-B
TYPICAL DRIVEWAY SECTION

DO NOT SCALE FROM THESE DRAWINGS USE DIMENSIONS

CHECKED BY: C. HOWARD

STATE OF ALASKA
DEPARTMENT OF TRANSPORTATION & PUBLIC FACILITIES
SOUTHEAST REGION

KTN - NORTH TONGASS HWY. SAFETY IMPROVEMENTS
PROJECT # 67423
ANCHORWOOD CT. AND LIGHTHOUSE TESORO


DESIGNED BY: J. WEAVER
DRAWN BY: J. WEAVER

DATE: 3-11-09


PROJECT DESIGNATION: HHE-0920(24) 67423

NO.	DATE	REVISIONS DESCRIPTION	YEAR	SHEET NO	TOTAL SHEETS
			2009	G5	25


Project As-Built Drawings have been reviewed by the Project Engineer and represent to the best of my knowledge, the project as constructed.
Date: 1-12-11

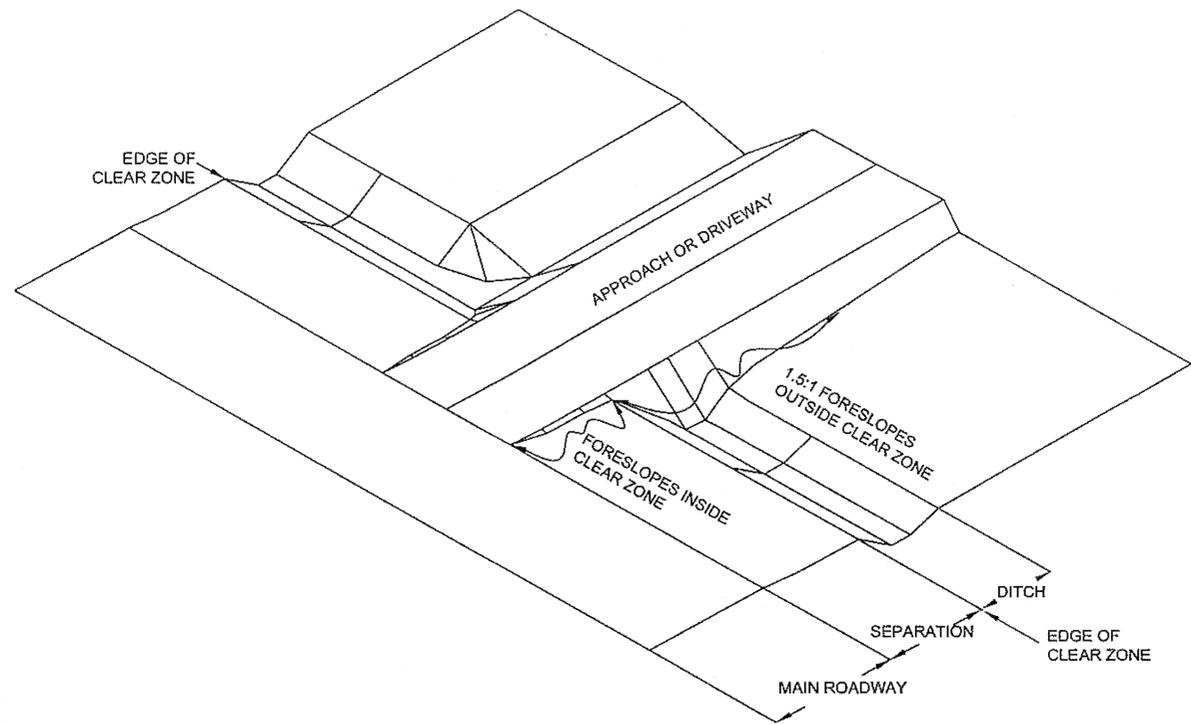


APPROACH/DRIVEWAY SLOPES ③

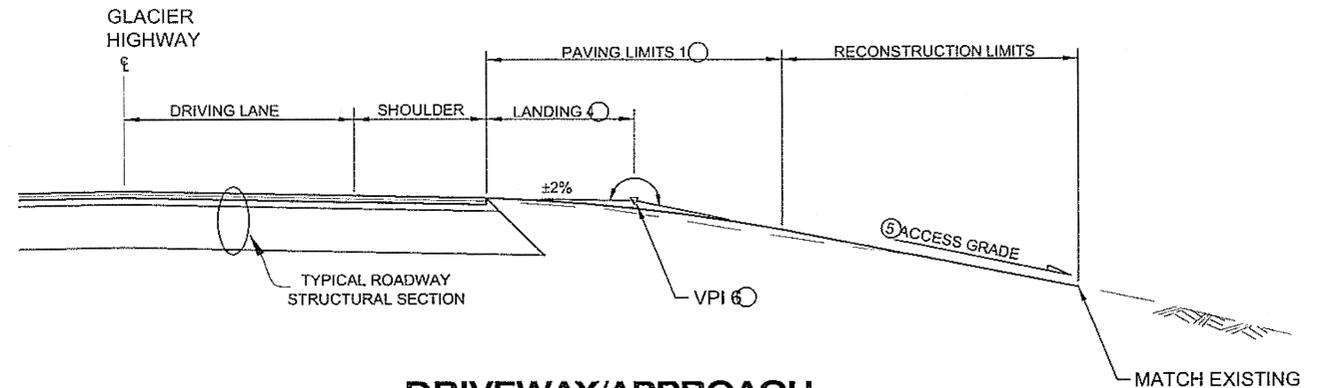

DRIVEWAY/APPROACH TYPICAL PROFILE

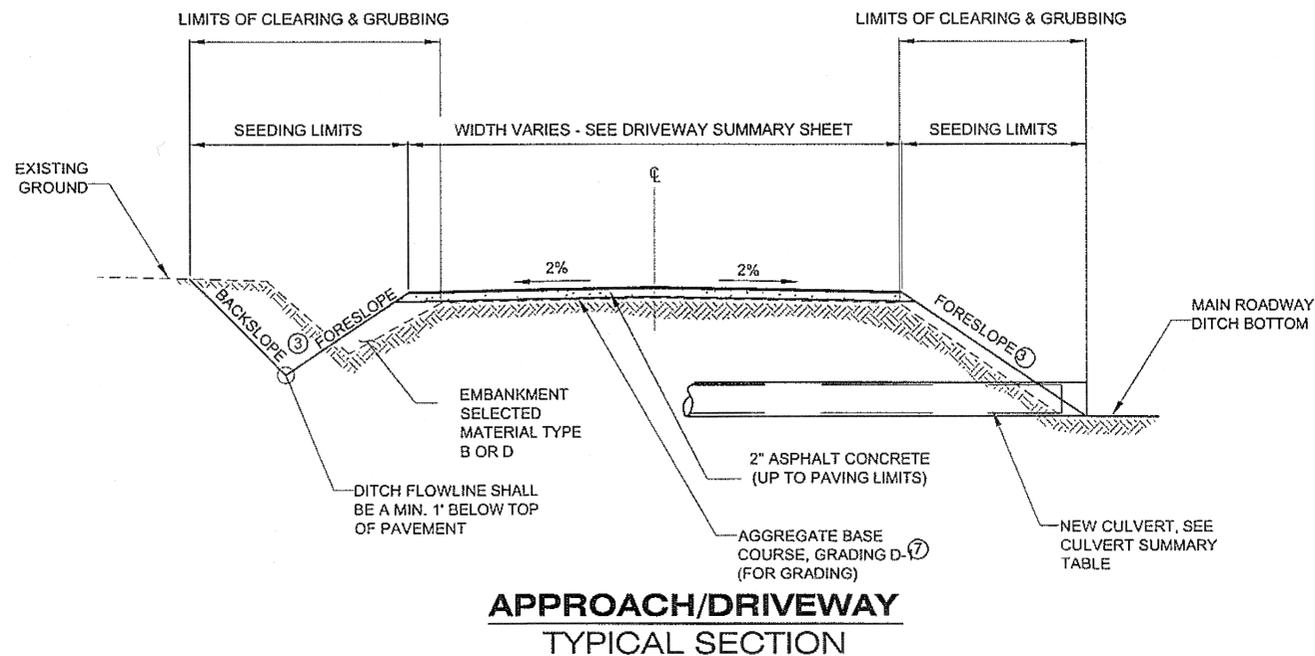

APPROACH/DRIVEWAY TYPICAL SECTION

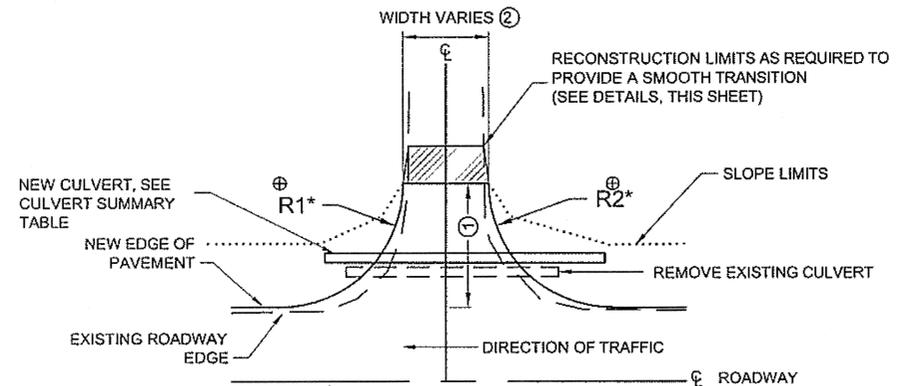

*RADIUS VARIES, SEE DRIVEWAY SUMMARY TABLE SHEET D2

APPROACH / DRIVEWAY / APRON PLAN VIEW



NOTES

1. LENGTH OF PAVING VARIES. SEE SHEET D2 FOR DRIVEWAY SUMMARY TABLES
2. WIDTH OF APPROACH/DRIVEWAY VARIES. SEE SHEET D2 FOR DRIVEWAY SUMMARY TABLES
3. APPROACH/DRIVEWAY FORESLOPES OR DITCH BACKSLOPES SHALL BE 6:1 OR FLATTER INSIDE THE CLEAR ZONE. BEYOND THE CLEAR ZONE THE SLOPE SHALL BE 1.5:1
4. UNLESS SPECIFIED, THE LANDING SHALL BE 10' FOR RESIDENTIAL DRIVEWAYS AND 30' FOR COMMERCIAL DRIVEWAYS
5. UNLESS SPECIFIED, THE ALGEBRAIC DIFFERENCE BETWEEN THE LANDING GRADE AND THE ACCESS GRADE SHALL NOT EXCEED 15% FOR RESIDENTIAL OR 8% FOR COMMERCIAL DRIVEWAYS
6. ALL VPI SHALL BE SMOOTHED WITH A VERTICAL CURVE. VERTICAL CURVES SHALL NOT HAVE HUMPS OR DEPRESSIONS THAT EXCEED 3 1/2" IN A 10' CHORD
7. SUPPLEMENT EXISTING DRIVEWAY BASE COURSE, AS REQUIRED, TO PROVIDE 4" OF AGGREGATE BASE COURSE, GRADING D-1 UNDER THE ASPHALT CONCRETE

Project As-Built Drawings have been reviewed by the Project Engineer and represent to the best of my knowledge, the project as constructed.
 PE *[Signature]* Date 1-12-12

DO NOT SCALE FROM THESE DRAWINGS USE DIMENSIONS


CHECKED BY: C. HOWARD 		STATE OF ALASKA DEPARTMENT OF TRANSPORTATION & PUBLIC FACILITIES SOUTHEAST REGION KTN - NORTH TONGASS HWY. SAFETY IMPROVEMENTS PROJECT # 67423	
DESIGNED BY: J. WEAVER DRAWN BY: J. WEAVER		DRIVEWAY DETAILS	
P.A.T.H.: Q:\KTN\67423\PLANSET\67423_J1-2_DETAILS.DWG TAB: J1		PROJECT DESIGNATION HHE-0920(24) 67423	
REVISIONS NO. DATE DESCRIPTION		YEAR 2009	SHEET NO. J1
		TOTAL SHEETS 25	

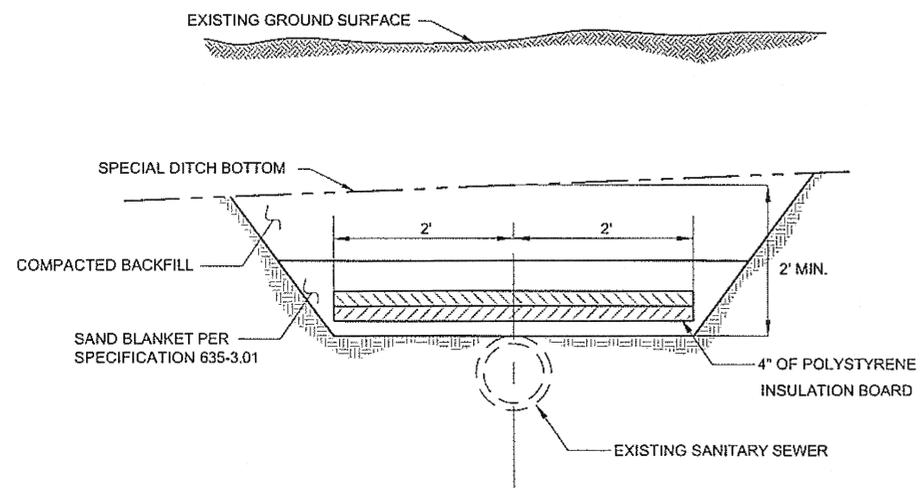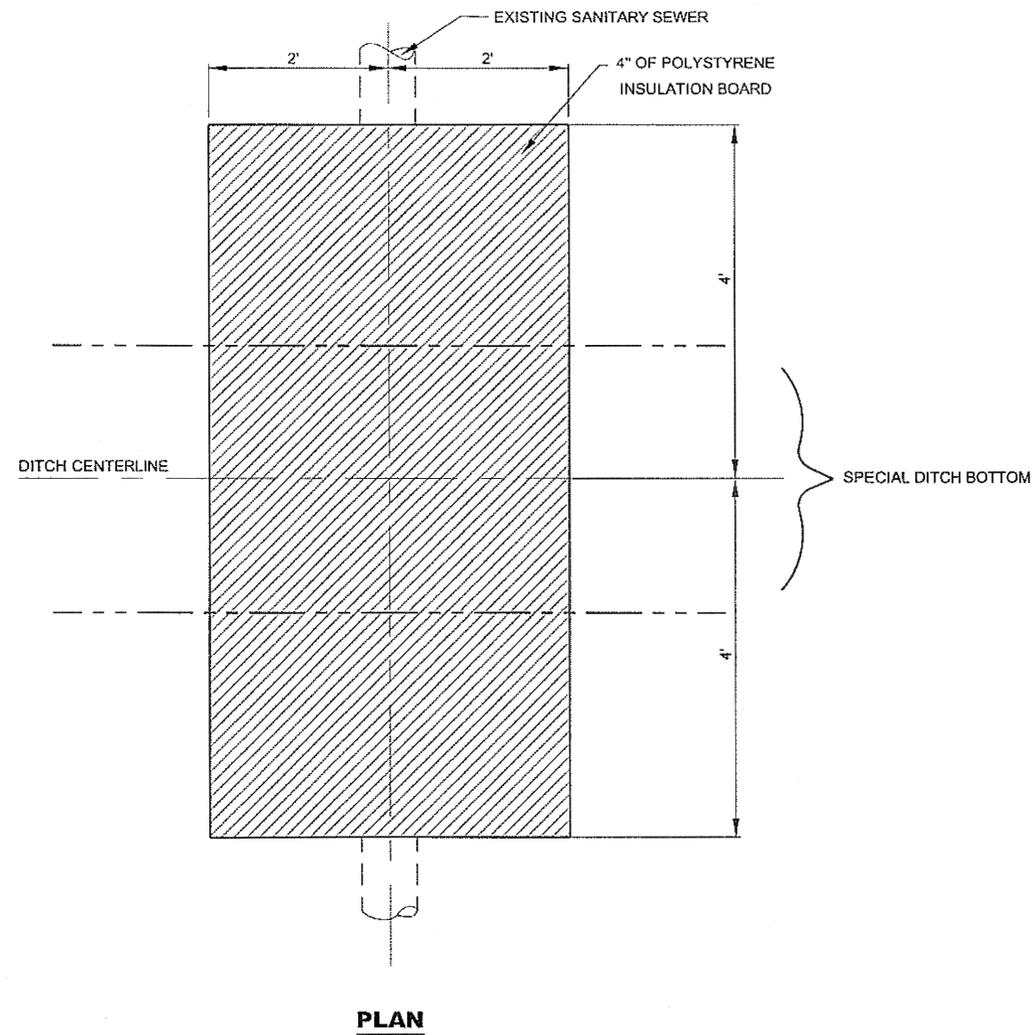


SECTION RIGID INSULATION
SANITARY SEWER AT STA 226+55.4
N.T.S.

INSULATION NOTES:

1. INSTALL INSULATION AS SHOWN.
2. INSULATION IS INCIDENTAL TO OTHER ITEMS OF WORK AND WILL NOT BE MEASURED FOR PAYMENT.

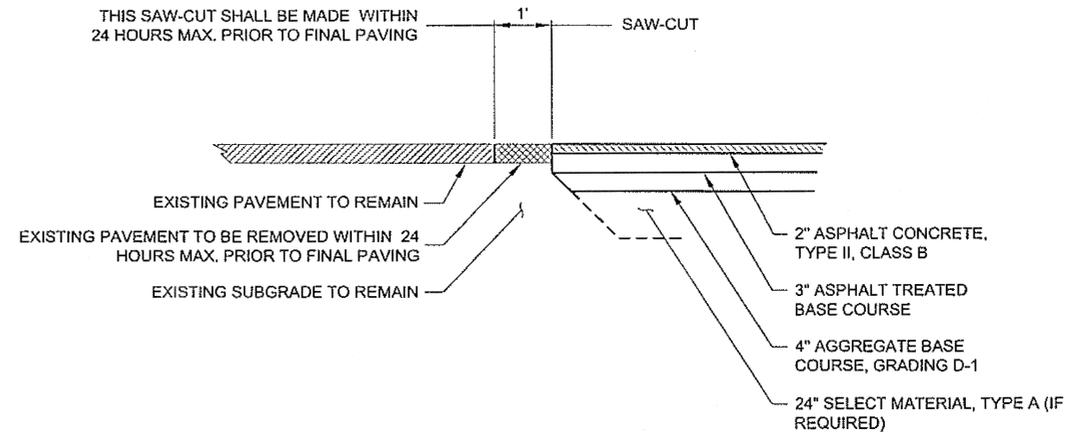

PAVEMENT MATCH JOINT DETAIL
N.T.S.

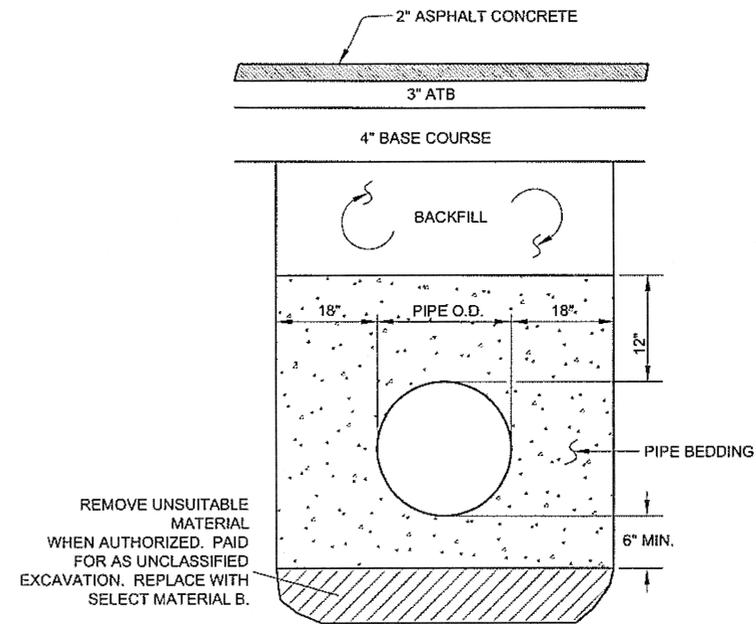


CULVERT BEDDING/BACKFILL DETAIL
N.T.S.

Project As-Built Drawings have been reviewed by the Project Engineer and represent to the best of my knowledge, the project as constructed.
 Date 1-12-12
 PE [Signature]

DO NOT SCALE FROM THESE DRAWINGS USE DIMENSIONS

CHECKED BY: C. HOWARD  DESIGNED BY: J. WEAVER DRAWN BY: J. WEAVER DATE: 3-11-09		STATE OF ALASKA DEPARTMENT OF TRANSPORTATION & PUBLIC FACILITIES SOUTHEAST REGION KTN - NORTH TONGASS HWY. SAFETY IMPROVEMENTS PROJECT # 67423 MISCELLANEOUS DETAILS			
PATH: Q:\KTN\67423\PLANSET\67423_J1-2_DETAILS.DWG TAB: J2 WILSON, BRIAN G (DOT)		PROJECT DESIGNATION HHE-0920(24) 67423	YEAR 2009	SHEET NO. J2	TOTAL SHEETS 25

No.	DATE	DESCRIPTION

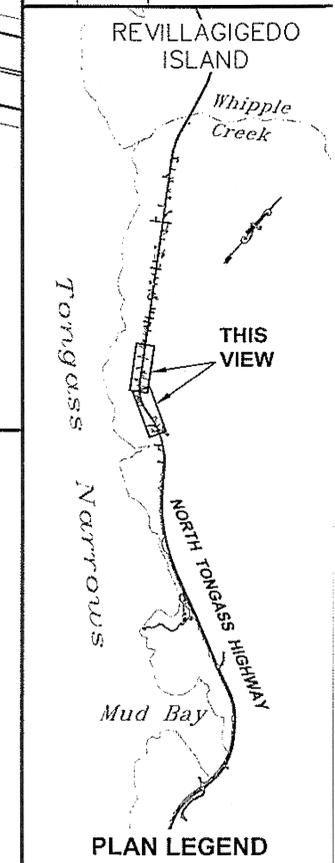

CHECKED BY: C. HOWARD



DESIGNED BY: J. WEAVER

DRAWN BY: R. SNYDER

STATE OF ALASKA
DEPARTMENT OF TRANSPORTATION & PUBLIC FACILITIES
DESIGN & ENGINEERING SERVICES
DIVISION-SOUTHEAST REGION
KTN - NORTH TONGASS HWY. SAFETY IMPROVEMENTS PROJECT #67423

SIGNING AND STRIPING


PROJECT DESIGNATION
HHE-0920(24) / 67423

STATE	YEAR
ALASKA	2009

SHEET NUMBER	TOTAL SHEETS
P1	25


SIGNING NOTE:

CONTACT ADOT&PF TRAFFIC AND SAFETY SECTION ONE WEEK PRIOR TO STRIPING TO FIELD VERIFY THE STRIPING LAYOUT.

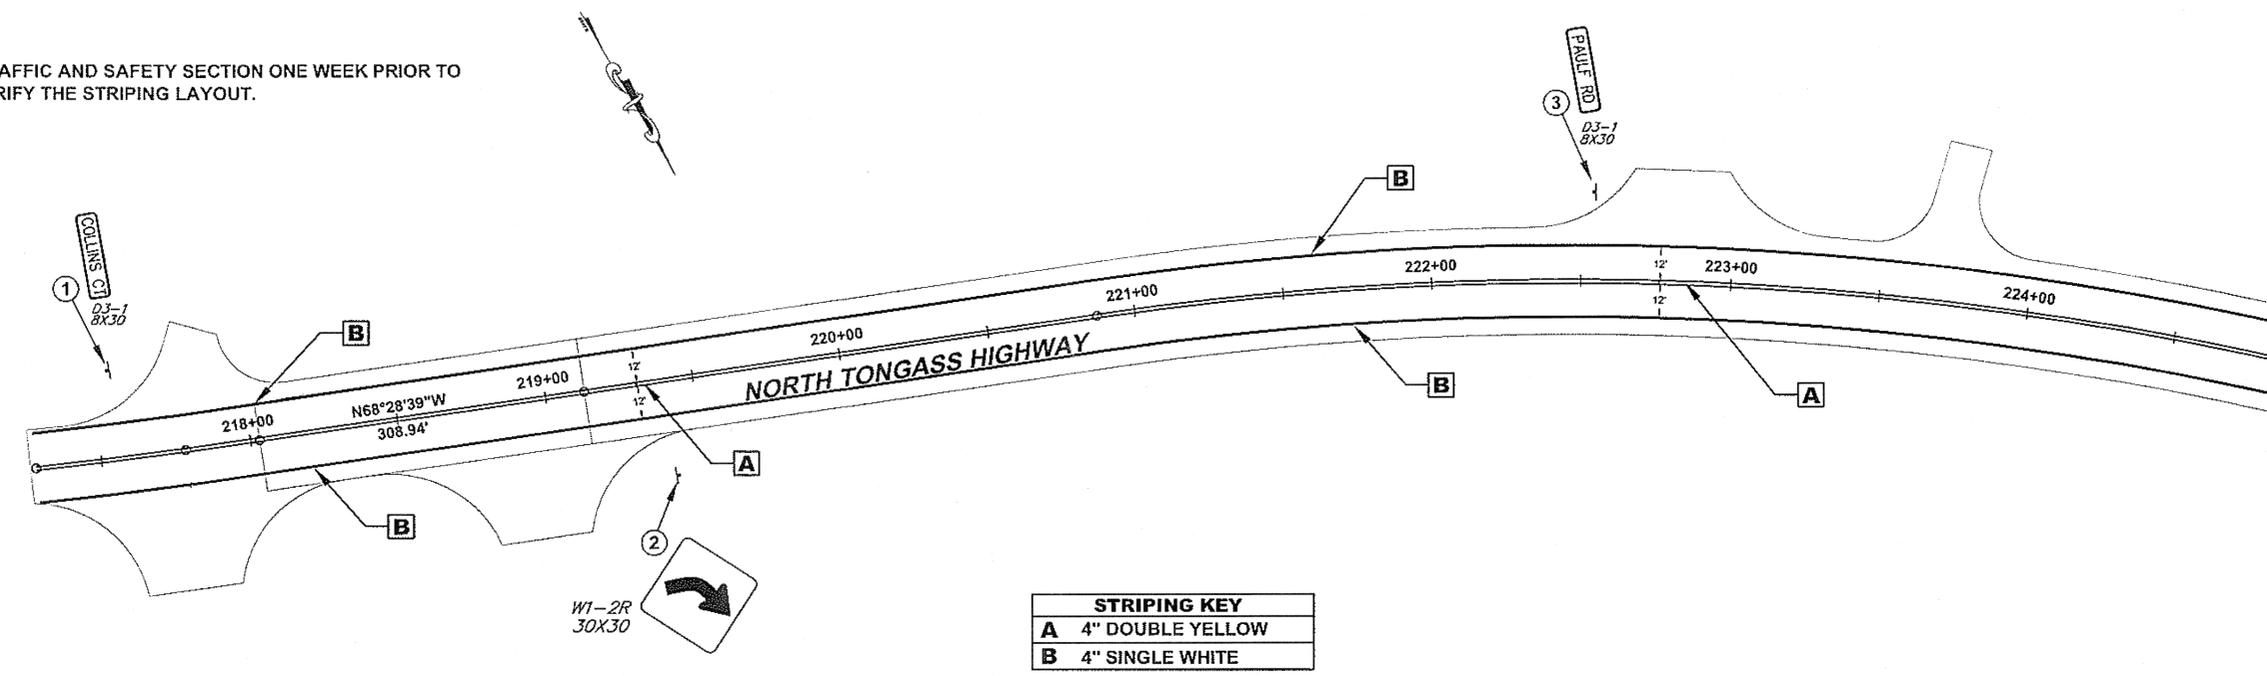

STRIPING KEY

A	4" DOUBLE YELLOW
B	4" SINGLE WHITE

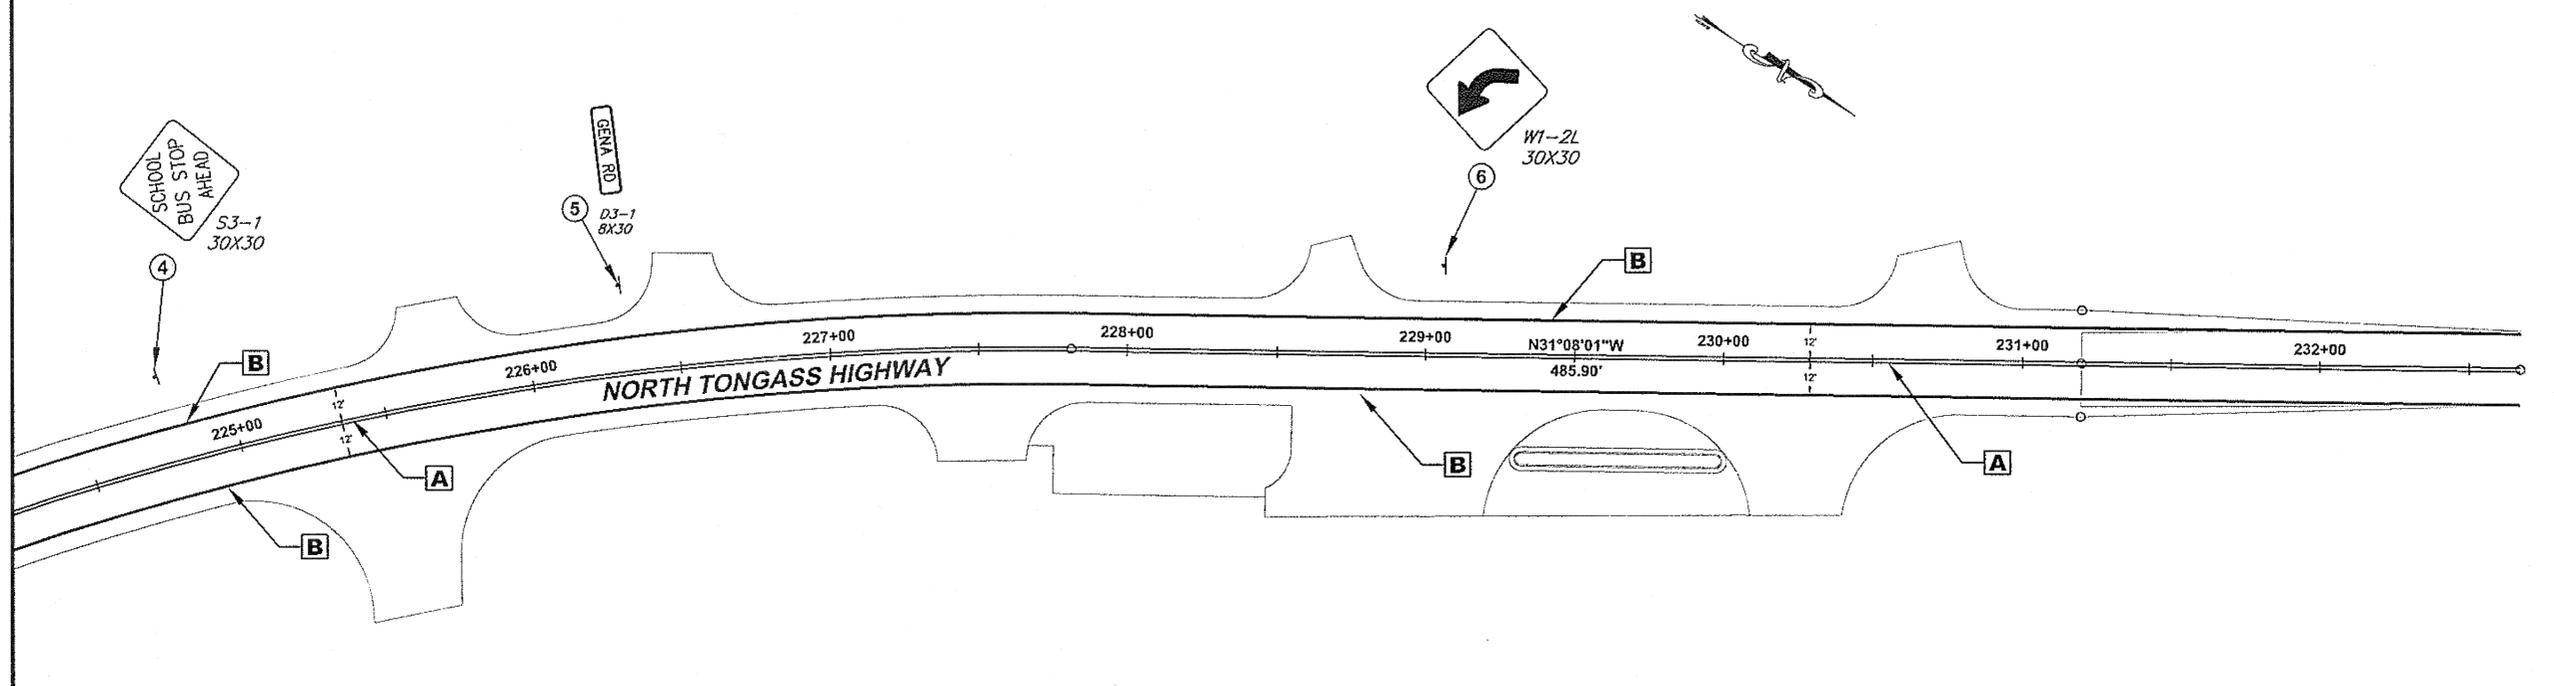

615 (2) REMOVE AND RELOCATE EXISTING SIGN

NUMBER	STATION	OFFSET	DESCRIPTION	ASDS CODE	DIM (HXW)	POST	REMARKS
1	217+56	30' LT	COLLINS CT	D3-1	8X30	2.5 PST	
2	219+40	33' RT	CURVE (ARROW)	W1-2R	30X30	2.5 PST	TAKE FUTURE PATH INTO ACCOUNT FOR MOUNTING HEIGHT
3	222+54	30' LT	PAULF RD	R3-1	8X30	2.5 PST	
4	224+78	30' LT	SCHOOL BUS STOP AHEAD	S3-1	36X36	2.5 PST	
5	226+32	30' LT	GENA RD	D3-1	8X30	2.5 PST	
6	229+06	30' LT	CURVE (ARROW)	W1-2L	30X30	2.5 PST	

NOTES

- SIGN SIZES ARE GIVEN ONLY AS A REFERENCE. USE THE EXISTING SIGN.
- SEE "S" SERIES STANDARD DRAWINGS FOR SIGN AND POST DETAILS.
- LOCATIONS ARE APPROXIMATE AND ARE SUBJECT TO MINOR REVISIONS BY THE ENGINEER.

Project As-Built Drawings have been reviewed by the Project Engineer and represent to the best of my knowledge, the Project as constructed.
Date 1-12-12



DO NOT SCALE FROM THESE DRAWINGS USE DIMENSIONS

NOTES:

1. CONTACT CHRIS BREWTON OF KETCHIKAN PUBLIC UTILITIES (907) 228-5447 TO DISCONNECT LUMINAIRES FROM UTILITY POLES AS SHOWN ON THIS SHEET.

PATH: Q:\KTN167423\PLANSET167423_R1_ILLUMINATION.I
 TAB: R2 WILSON, BRIAN
 ADDENDUM NUMBER
 ATTACHMENT NUMBER
 RECORD OF REVISIONS

No.	DATE	DESCRIPTION

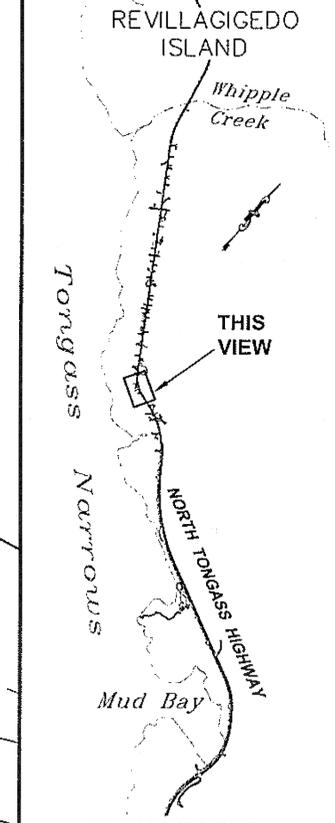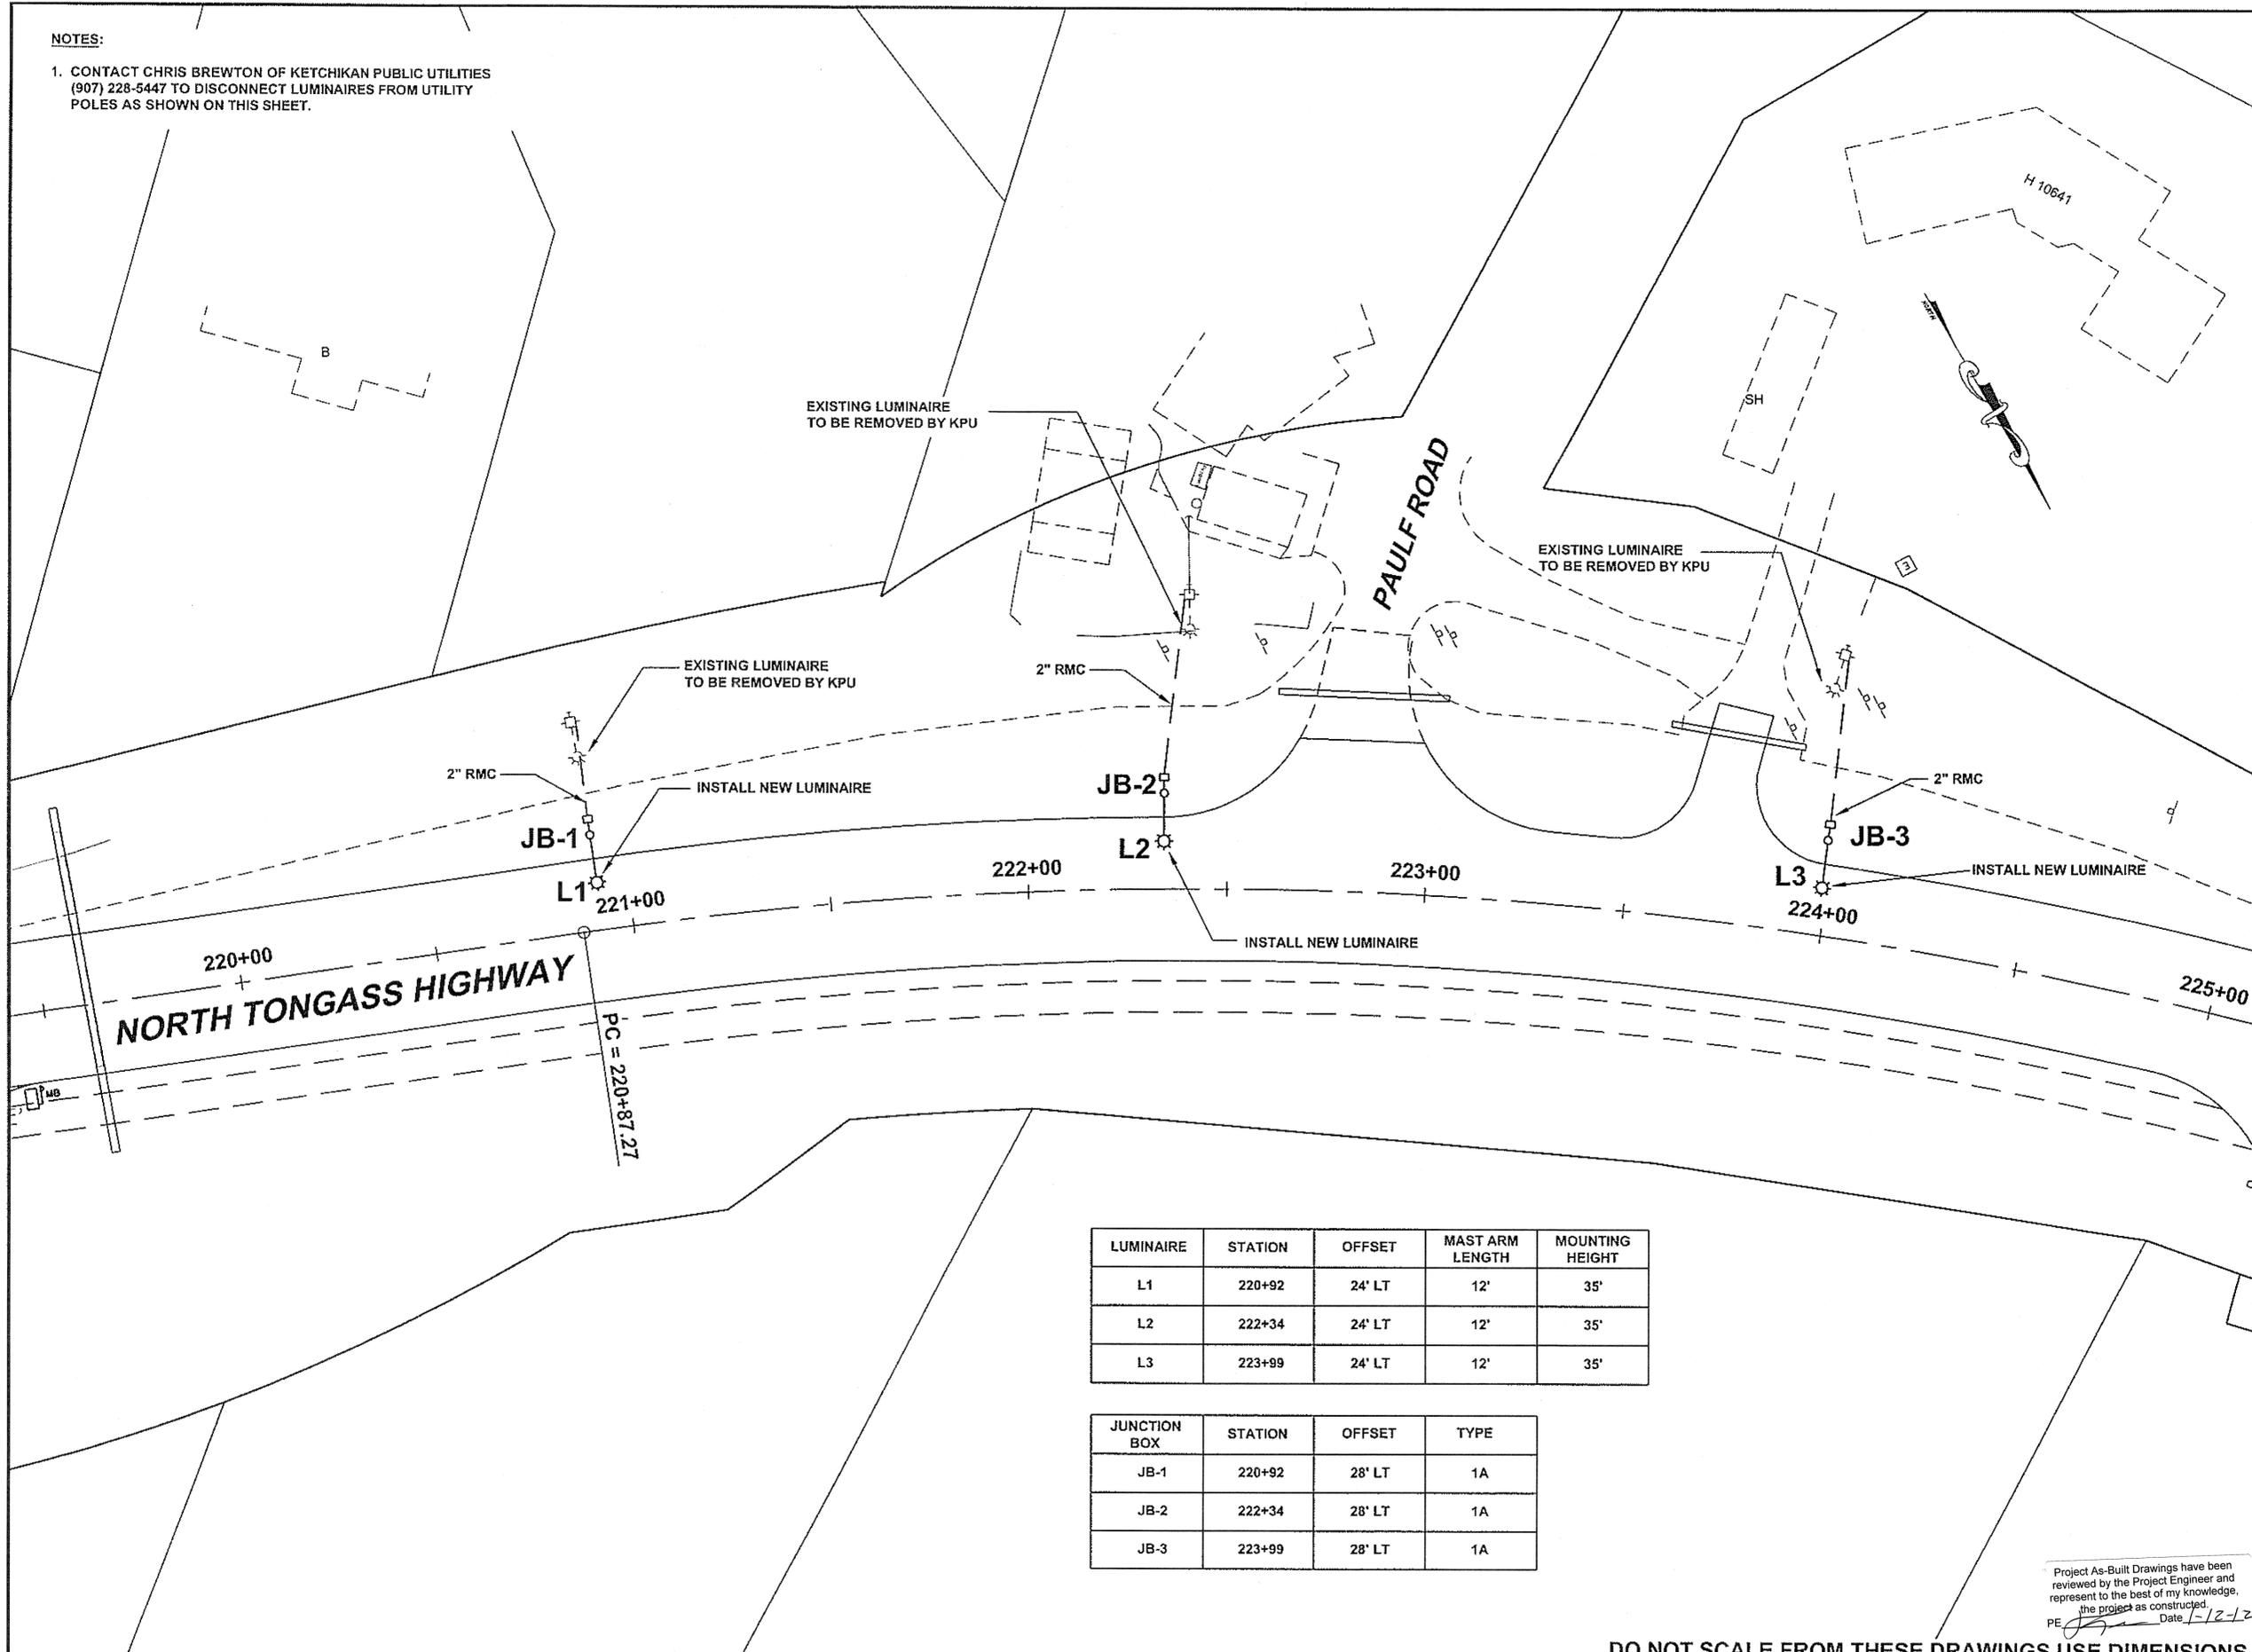

CHECKED BY: C. MOREHOUSE

 DESIGNED BY: D. FAGNANT
 DRAWN BY: D. FAGNANT

LUMINAIRE	STATION	OFFSET	MAST ARM LENGTH	MOUNTING HEIGHT
L1	220+92	24' LT	12'	35'
L2	222+34	24' LT	12'	35'
L3	223+99	24' LT	12'	35'

JUNCTION BOX	STATION	OFFSET	TYPE
JB-1	220+92	28' LT	1A
JB-2	222+34	28' LT	1A
JB-3	223+99	28' LT	1A

Project As-Built Drawings have been reviewed by the Project Engineer and represent to the best of my knowledge, the project as constructed.
 PE Date 1-12-12

DO NOT SCALE FROM THESE DRAWINGS USE DIMENSIONS

STATE OF ALASKA
 DEPARTMENT OF TRANSPORTATION & PUBLIC FACILITIES
 DESIGN & ENGINEERING SERVICES
 DIVISION-SOUTHEAST REGION
KTN - NORTH TONGASS HWY. SAFETY IMPROVEMENTS PROJECT #67423

ILLUMINATION LAYOUT


PROJECT DESIGNATION
HHE-0920(24) / 67423

STATE	YEAR
ALASKA	2009

SHEET NUMBER	TOTAL SHEETS
R2	25

TRAFFIC CONTROL NOTES

1. IT IS THE INTENT OF THIS TRAFFIC CONTROL PLAN (TCP) TO ILLUSTRATE SOME BUT NOT ALL OF THE TRAFFIC CONTROL CONFIGURATIONS THAT WILL BE REQUIRED BY THIS PROJECT. TRAFFIC CONTROL PLANS FOR CONFIGURATIONS NOT COVERED BY THIS TCP SHALL BE DEVELOPED AND SUBMITTED FOR APPROVAL BY THE ENGINEER PRIOR TO USE.
2. TWO LANES SHALL BE MAINTAINED ALONG NORTH TONGASS HIGHWAY AT ALL TIMES THE CONTRACTOR IS NOT ACTIVELY WORKING. FLAGGERS MUST BE PRESENT FOR ANY LANE CLOSURES.
3. TRAFFIC LANES SHALL BE A MINIMUM OF 10 FEET WIDE.
4. ACCESS TO BUSINESSES AND HOMES WILL BE MAINTAINED AT ALL TIMES.
5. KEEP THE PUBLIC INFORMED OF CONSTRUCTION ACTIVITIES. SEE SECTION 643-3.03 OF THE SPECIAL PROVISIONS.
6. CONSTRUCTION ACTIVITIES WILL NOT BE ALLOWED BETWEEN THE HOURS OF 11:00P.M. AND 6:00A.M. WITHOUT WRITTEN APPROVAL OF THE ENGINEER.
7. ALL TRAFFIC CONTROL PLANS SUBMITTED BY THE CONTRACTOR SHALL BE NUMBERED. ALL TRAFFIC CONTROL PLANS THAT USE A TYPICAL APPLICATION AS DESCRIBED IN THE MUTCD SHALL REFERENCE THE TYPICAL APPLICATION. EXAMPLE: TCP 3, MUTCD TA-10.
8. ORANGE CONSTRUCTION SIGNS SHALL USE TYPE VIII OR IX FLOURESCENT SHEETING AS DETAILED IN SECTION 615-2.01.
9. DELAYS SHALL NOT EXCEED 5 MINUTES UNLESS APPROVED BY THE ENGINEER.
10. WHEN ROAD CLOSURES ARE REQUIRED FOR BLASTING EVENTS AND RELATED WORK, THEY SHALL NOT BE LONGER THAN 2 HOURS IN DURATION.
11. SEE SECTION 201-3.01 OF THE SPECIAL PROVISIONS FOR LIMITATIONS ON PAVEMENT REMOVAL AND REPAVING. REPAVED SECTIONS REQUIRE INTERIM PAVEMENT MARKINGS PER SECTION 643-3.09 OF THE SPECIAL PROVISIONS.
12. ALL PAVED SECTIONS OF ROADWAY SHALL BE SWEEPED CLEAN BEFORE OPENING TO TRAFFIC.

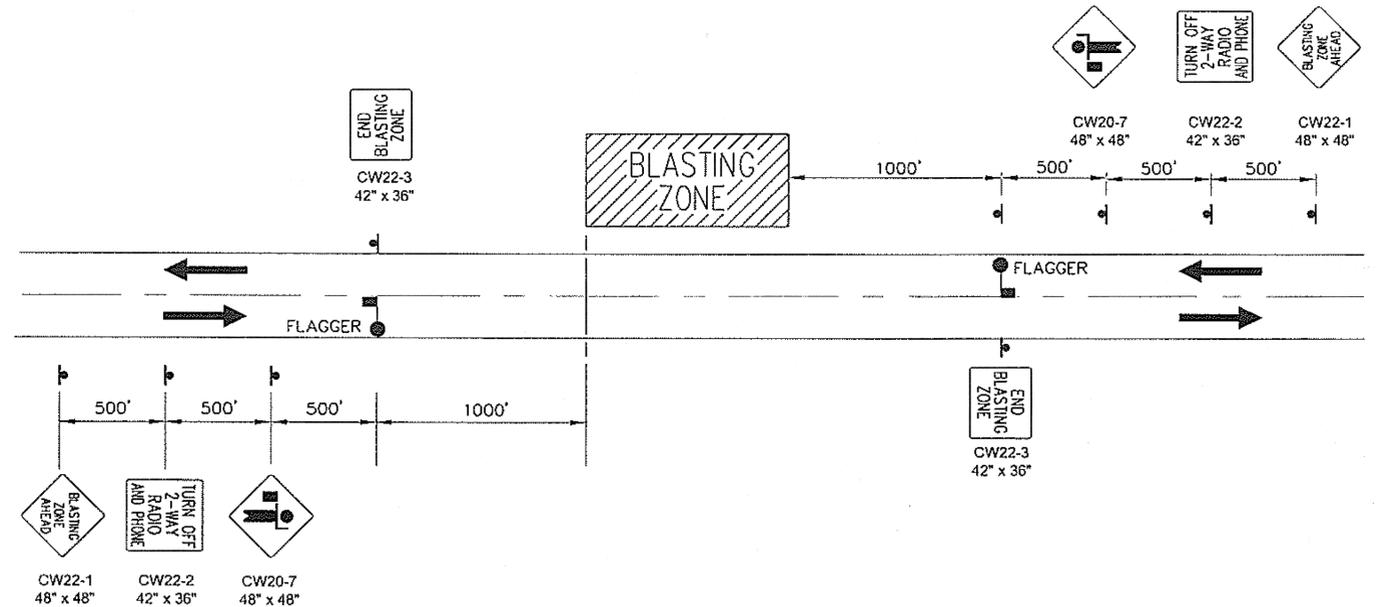

TYPICAL BLASTING ZONE PLAN



SIGN FOR 48 HOUR ADVANCED NOTICE OF BLASTING

SIGNS SHALL BE ORANGE BACKGROUND WITH BLACK BORDER AND TEXT. SIGNS SHALL INCLUDE THE DATE OF CLOSURE, BEGINNING TIME OF CLOSURE, AND EXPECTED TIME THE ROAD WILL REOPEN. SIGNS SHALL BE IN PLACE A MINIMUM OF 48 HOURS PRIOR TO ROAD CLOSURE.

LEGEND

- SIGN
- CONE
- DRUM
- TYPE III BARRICADE
- FLAGGING STATION
- HI-LEVEL WARNING DEVICE

FORMULAS FOR L (TAPER LENGTH)

40 MPH OR LESS $L = \frac{W \times S^2}{60}$


45 MPH OR GREATER $L = W \times S$

WHERE W= WIDTH OF OFFSET

S= POSTED SPEED LIMIT OR ANTICIPATED OPERATING SPEED

MAXIMUM DRUM OR CONE SPACING = S (IN FEET) FOR TAPERS
= 2S (IN FEET) FOR TANGENTS


MIN. BUFFER S	LENGTH
20	115
25	115
30	200
35	250
40	305
45	360
50	425
55	495
60	570
65	645

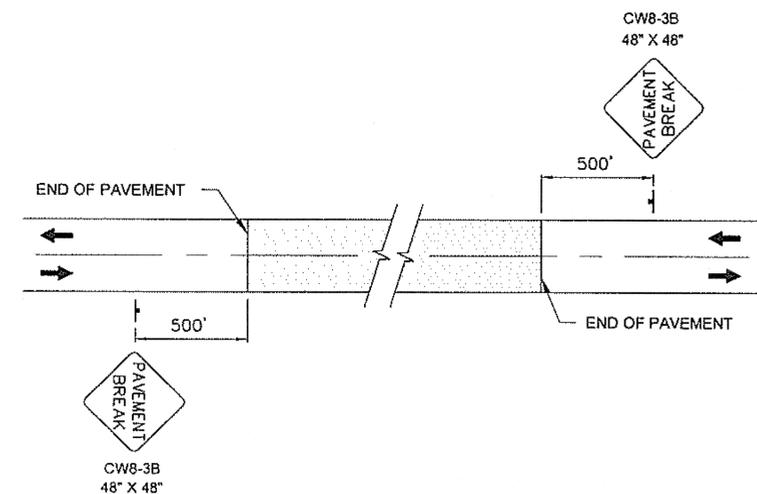

SIGNING FOR UNPAVED AREA

DO NOT SCALE FROM THESE DRAWINGS USE DIMENSIONS

<p>CHECKED BY: C. HOWARD</p> <p>DESIGNED BY: J. WEAVER DRAWN BY: R. SNYDER</p> <p>PATH: Q:\KTN\67423\PLANSET\67423_S1-2_TCP.DWG TAB: S1</p>	<p>STATE OF ALASKA DEPARTMENT OF TRANSPORTATION & PUBLIC FACILITIES SOUTHEAST REGION</p> <p>KTN - NORTH TONGASS HWY. SAFETY IMPROVEMENTS PROJECT # 67423</p> <p>TRAFFIC CONTROL PLAN</p>																		
<p>Project As-Built Drawings have been reviewed by the Project Engineer and represent to the best of my knowledge, the project as constructed. Date: 1-12-12</p>	<table border="1" style="width: 100%; border-collapse: collapse;"> <thead> <tr> <th colspan="3">REVISIONS</th> <th>YEAR</th> <th>SHEET NO.</th> <th>TOTAL SHEETS</th> </tr> <tr> <th>NO.</th> <th>DATE</th> <th>DESCRIPTION</th> <th></th> <th></th> <th></th> </tr> </thead> <tbody> <tr> <td></td> <td></td> <td></td> <td>2009</td> <td>S1</td> <td>25</td> </tr> </tbody> </table> <p>PROJECT DESIGNATION HHE-0920(24) 67423</p>	REVISIONS			YEAR	SHEET NO.	TOTAL SHEETS	NO.	DATE	DESCRIPTION							2009	S1	25
REVISIONS			YEAR	SHEET NO.	TOTAL SHEETS														
NO.	DATE	DESCRIPTION																	
			2009	S1	25														

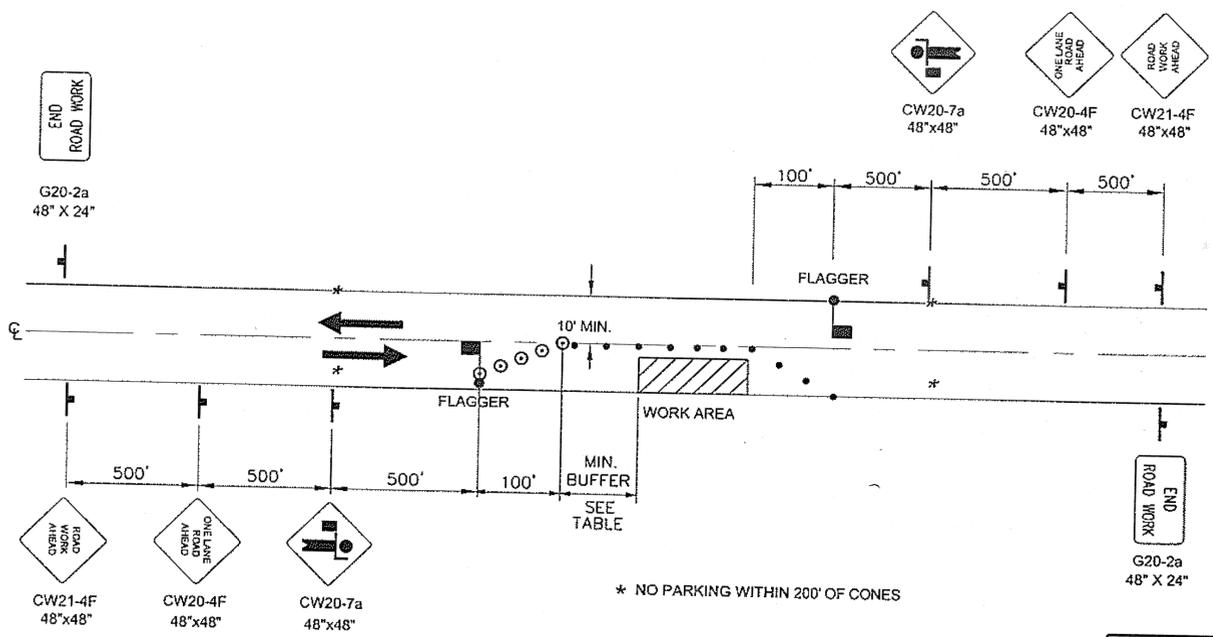

TWO LANE ROAD - SINGLE LANE CLOSURE
DOUBLE FLAGGER

LEGEND

- SIGN
- CONE
- DRUM
- TYPE III BARRICADE
- FLAGGING STATION
- HI-LEVEL WARNING DEVICE

FORMULAS FOR L (TAPER LENGTH)

40 MPH OR LESS $L = \frac{W \times S^2}{60}$


45 MPH OR GREATER $L = W \times S$

WHERE W = WIDTH OF OFFSET

S = POSTED SPEED LIMIT OR ANTICIPATED OPERATING SPEED


MAXIMUM DRUM OR CONE SPACING = S (IN FEET) FOR TAPERS
= 2S (IN FEET) FOR TANGENTS

S	MIN. BUFFER LENGTH
20	115
25	115
30	200
35	250
40	305
45	360
50	425
55	495
60	570
65	645

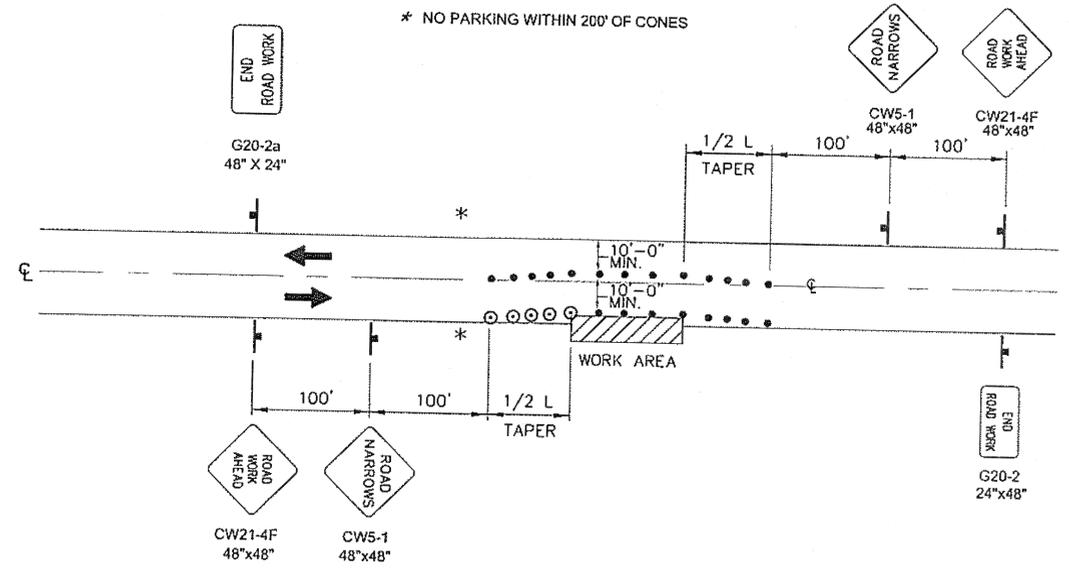

ROADWAY ENCROACHMENT

NOTE:
IF ONLY ONE LANE IS AFFECTED BY ROAD WORK (THAT IS, THE CONES ALONG THE WORK AREA ARE NO CLOSER THAN 10' TO CENTERLINE) THE CENTERLINE CONES FOR THE OPPOSING LANE SHALL BE DELETED.

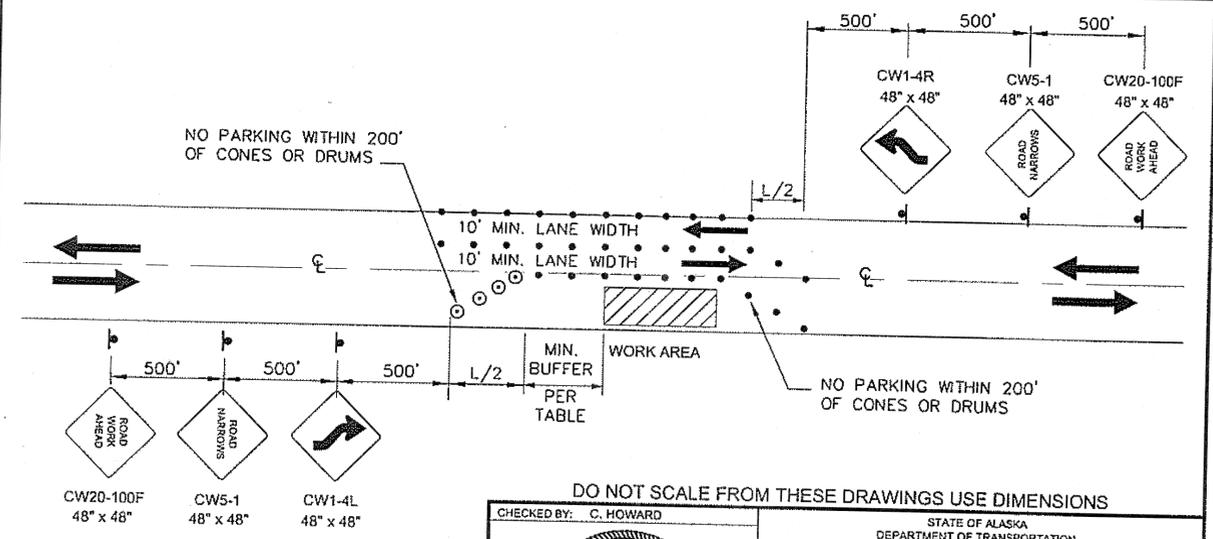

TWO-WAY TRAFFIC

DO NOT SCALE FROM THESE DRAWINGS USE DIMENSIONS

CHECKED BY: C. HOWARD

DESIGNED BY: J. WEAVER
DRAWN BY: R. SNYDER

PA TH: Q:\KTM67423\PLANSE\167423_S1-2_TCP.DWG
TAB: S2 WILSON, BRIAN G (DOT)

PROJECT DESIGNATION: HHE-0920(24) 67423

YEAR: 2009

SHEET NO: S2

TOTAL SHEETS: 25


STATE OF ALASKA
DEPARTMENT OF TRANSPORTATION & PUBLIC FACILITIES
SOUTHEAST REGION

KTN - NORTH TONGASS HWY.
SAFETY IMPROVEMENTS
PROJECT # 67423

TRAFFIC CONTROL PLAN


Project As-Built Drawings have been reviewed by the Project Engineer and represent to the best of my knowledge, the project as constructed.
Date: 1-12-12

REVILLAGIGEDO ISLAND

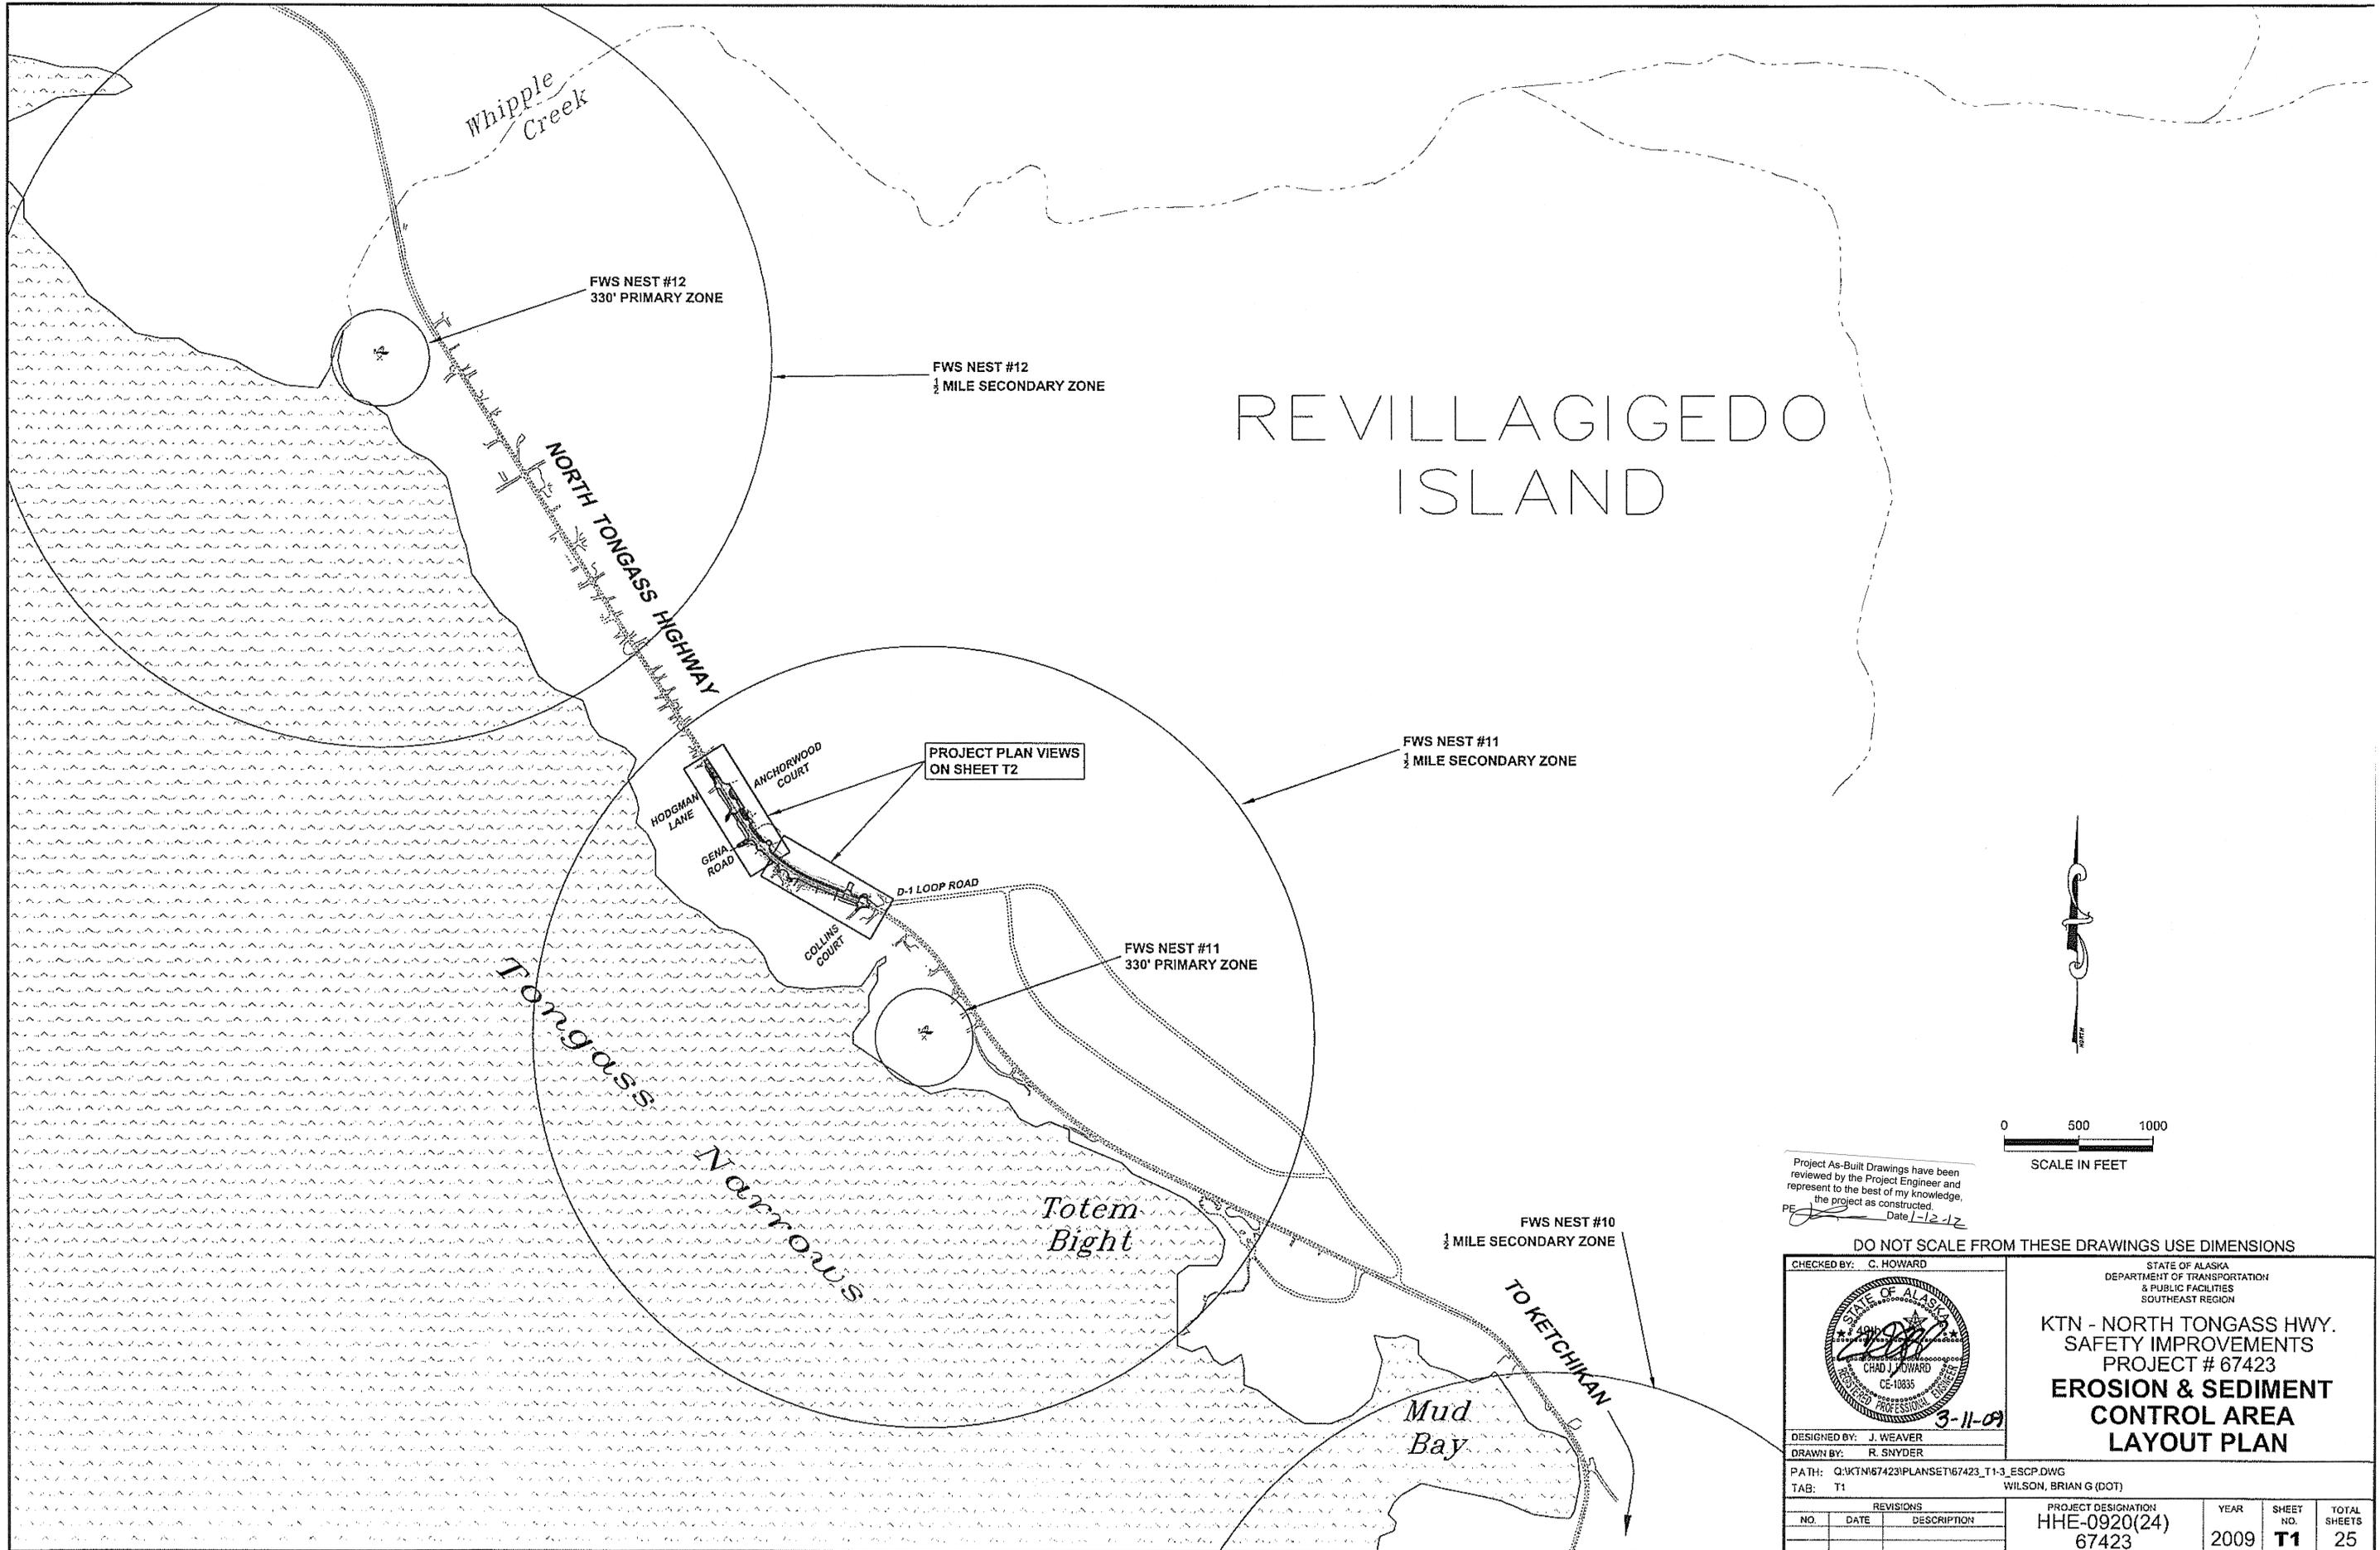

Project As-Built Drawings have been reviewed by the Project Engineer and represent to the best of my knowledge, the project as constructed.
 PE *[Signature]* Date 1-12-12

DO NOT SCALE FROM THESE DRAWINGS USE DIMENSIONS

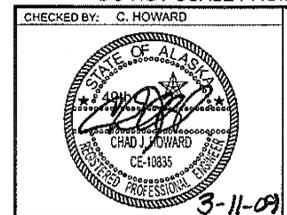


CHECKED BY: C. HOWARD
 DESIGNED BY: J. WEAVER
 DRAWN BY: R. SNYDER

STATE OF ALASKA
 DEPARTMENT OF TRANSPORTATION
 & PUBLIC FACILITIES
 SOUTHEAST REGION

**KTN - NORTH TONGASS HWY.
 SAFETY IMPROVEMENTS
 PROJECT # 67423
 EROSION & SEDIMENT
 CONTROL AREA
 LAYOUT PLAN**

WILSON, BRIAN G (DOT)

REVISIONS			PROJECT DESIGNATION HHE-0920(24) 67423	YEAR 2009	SHEET NO. T1	TOTAL SHEETS 25
NO.	DATE	DESCRIPTION				

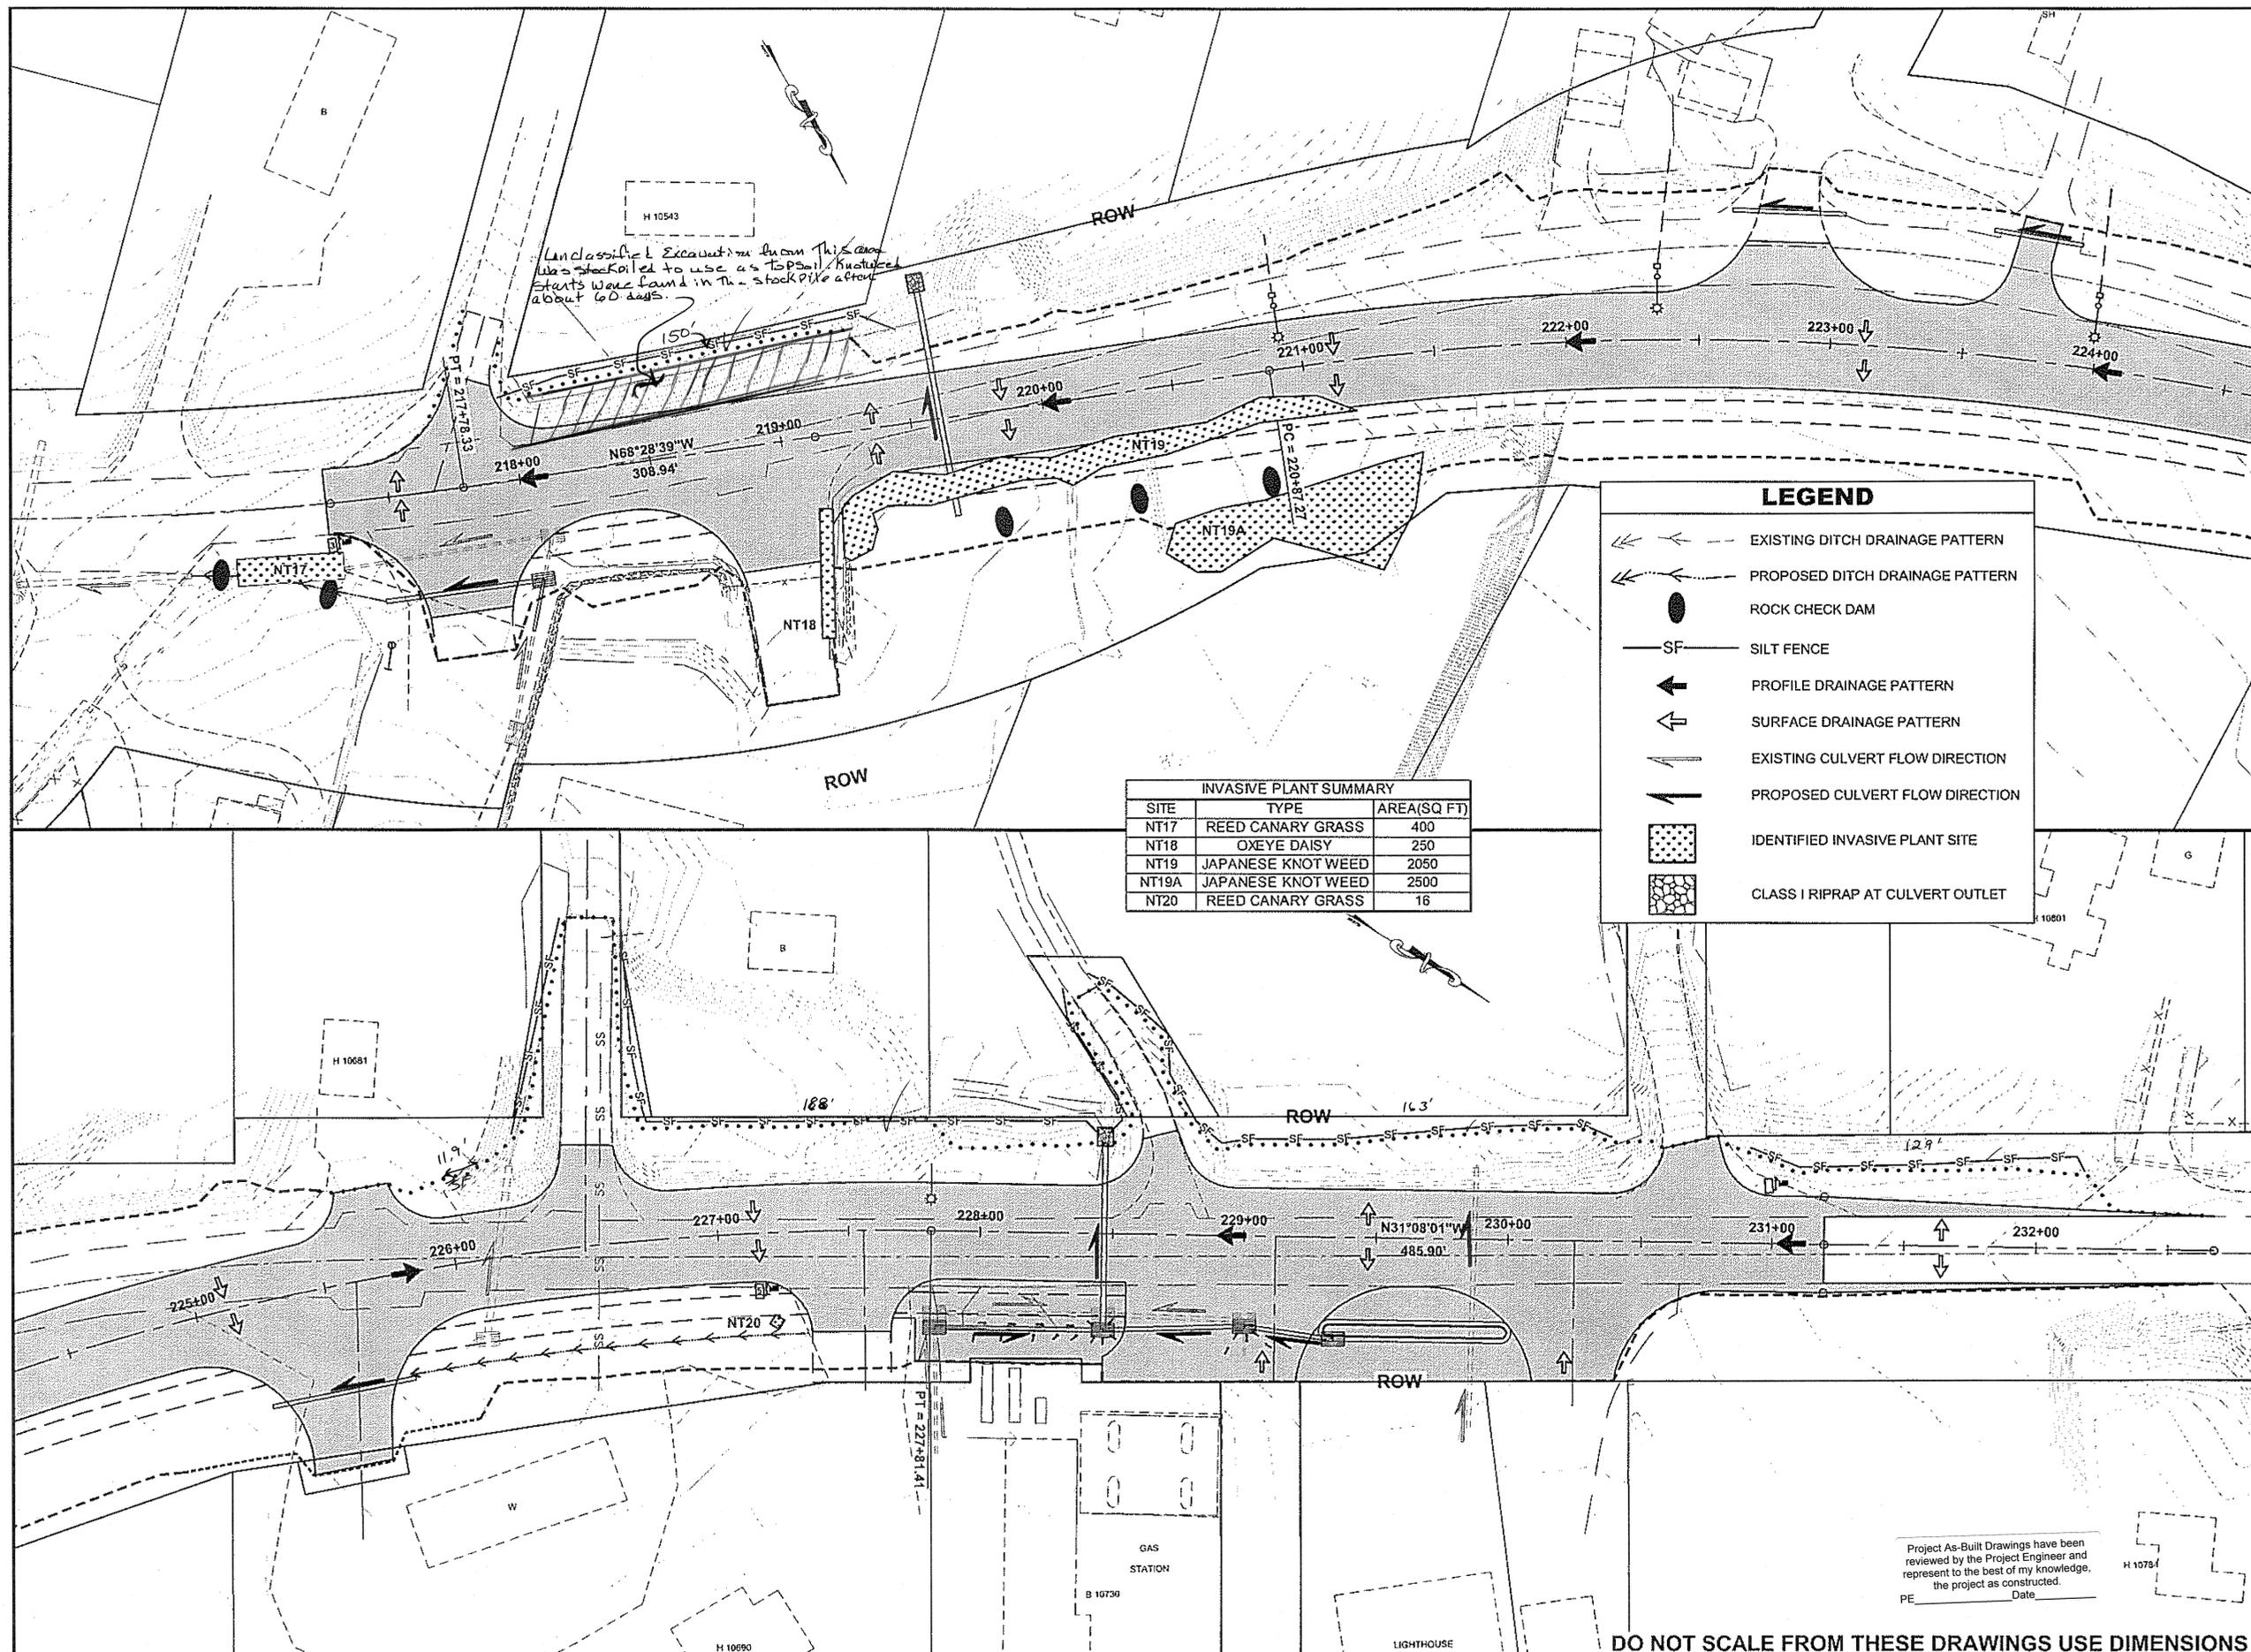

INVASIVE PLANT SUMMARY

SITE	TYPE	AREA(SQ FT)
NT17	REED CANARY GRASS	400
NT18	OXEYE DAISY	250
NT19	JAPANESE KNOT WEED	2050
NT19A	JAPANESE KNOT WEED	2500
NT20	REED CANARY GRASS	16

LEGEND

- EXISTING DITCH DRAINAGE PATTERN
- PROPOSED DITCH DRAINAGE PATTERN
- ROCK CHECK DAM
- SILT FENCE
- PROFILE DRAINAGE PATTERN
- SURFACE DRAINAGE PATTERN
- EXISTING CULVERT FLOW DIRECTION
- PROPOSED CULVERT FLOW DIRECTION
- IDENTIFIED INVASIVE PLANT SITE
- CLASS I RIPRAP AT CULVERT OUTLET

**KTN - NORTH TONGASS HIGHWAY
SAFETY IMPROVEMENTS
PROJECT # 67423**

**EROSION & SEDIMENT
CONTROL PLAN**

PLAN LEGEND

CHECKED BY: C. HOWARD

DESIGNED BY: J. WEAVER

DRAWN BY: R. SNYDER

STATE OF ALASKA
DEPARTMENT OF TRANSPORTATION
& PUBLIC FACILITIES
DESIGN & ENGINEERING SERVICES
DIVISION-SOUTHEAST REGION

**KTN - NORTH TONGASS HWY.
SAFETY IMPROVEMENTS
PROJECT #67423**

**EROSION &
SEDIMENT
CONTROL PLAN**


PROJECT DESIGNATION
HHE-0920(24) / 67423

STATE	YEAR
ALASKA	2009


SHEET NUMBER	TOTAL SHEETS
T2	25

Project As-Built Drawings have been reviewed by the Project Engineer and represent to the best of my knowledge, the project as constructed.
PE _____ Date _____


DO NOT SCALE FROM THESE DRAWINGS USE DIMENSIONS

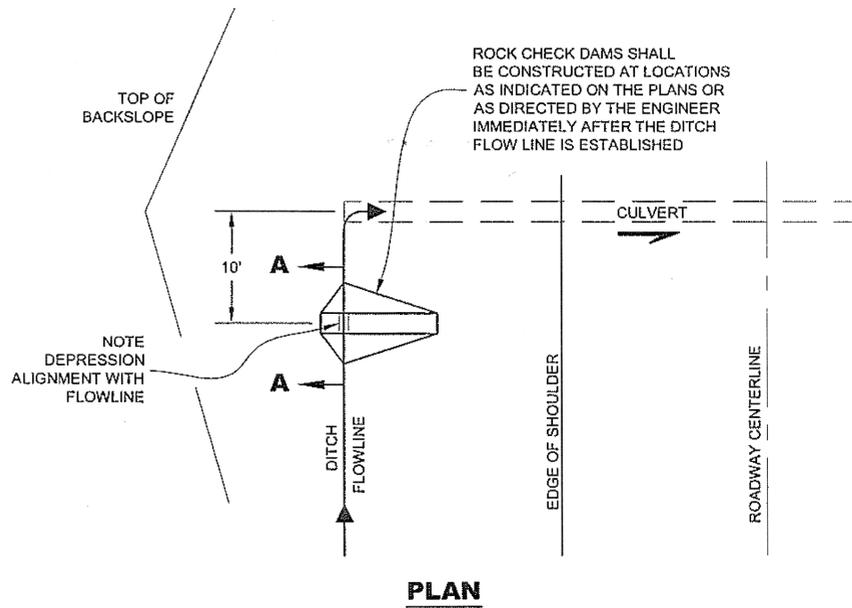


PLAN

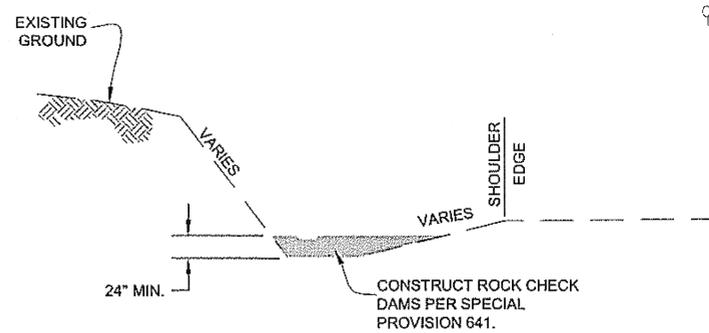


ELEVATION

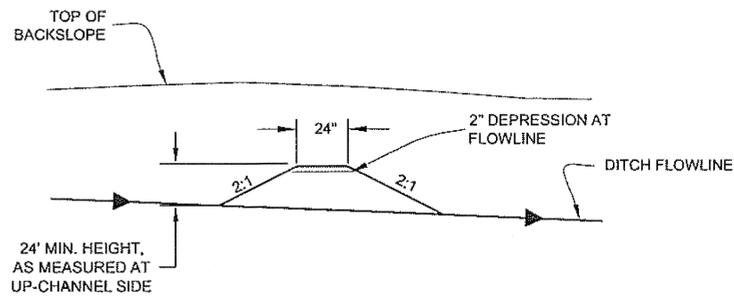


SECTION A-A
TEMPORARY CHECK DAM DETAILS

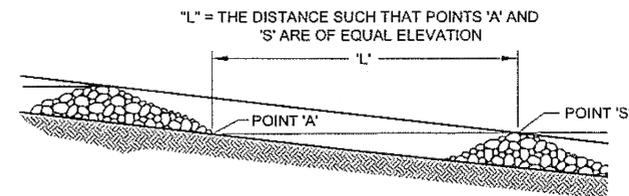

SPACING BETWEEN CHECK DAMS

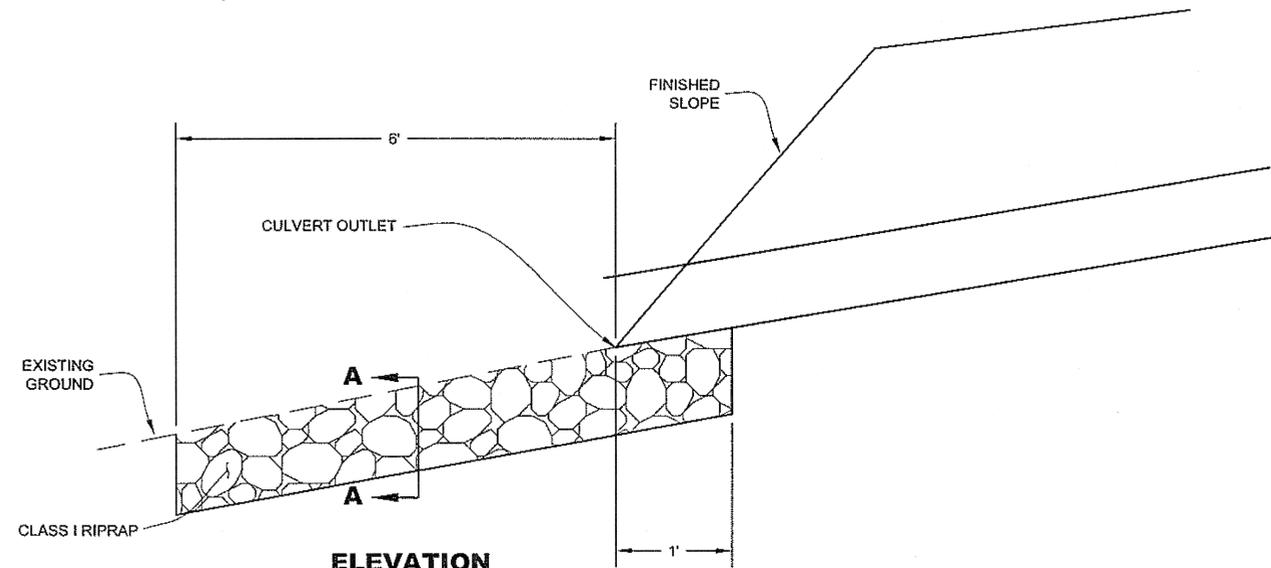

ELEVATION

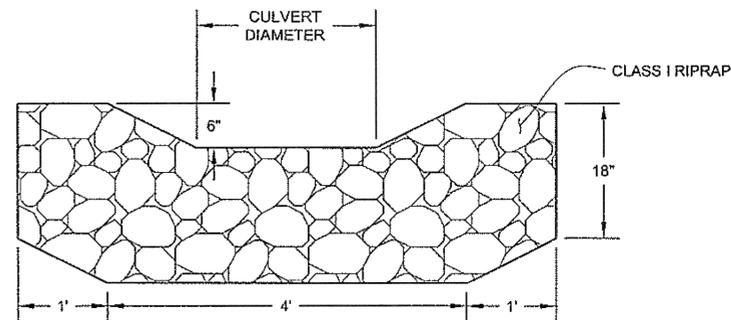

SECTION A-A
CULVERT OUTLET DETAILS

EROSION AND SEDIMENT CONTROL NOTES:

1. REFER TO APPENDIX B OF THE CONTRACT DOCUMENTS FOR THE ENVIRONMENTAL COMMITMENTS, PERMITS, AND EROSION AND SEDIMENT CONTROL PLAN.
2. INSTALL EROSION AND SEDIMENT CONTROL DEVICES BEFORE EARTH DISTURBING ACTIVITIES.
3. EROSION AND SEDIMENT CONTROL DEVICES REQUIRE INSPECTION AND MAINTENANCE TO INSURE THEY ARE FUNCTIONING. SEE SECTION 641 OF THE SPECIAL PROVISIONS.
4. IF INSPECTION REVEALS SEDIMENT IS DISCHARGING BEYOND THE PROJECT WORK LIMITS, IMMEDIATELY IMPLEMENT CORRECTIVE ACTION. ADDITIONAL EROSION OR SEDIMENT CONTROL DEVICES MAY BE REQUIRED.
5. STABILIZE DISTURBED GROUND AS SOON AS POSSIBLE. UNSTABILIZED SURFACES MUST BE TEMPORARILY STABILIZED WITH SEEDING OR OTHER EFFECTIVE MEASURES WITHIN 14 DAYS OF CESSATION OF LAND DISTURBING ACTIVITIES IN THE VICINITY. SEE SECTION 641-3.01 OF THE SPECIAL PROVISIONS. MAINTAIN EROSION AND SEDIMENT CONTROL UNTIL PROJECT WORK AREAS ARE SEEDED AND HAVE ACHIEVED 70% VEGETATIVE COVER.

Project As-Built Drawings have been reviewed by the Project Engineer and represent to the best of my knowledge, the project as constructed.
PE *[Signature]* Date 1-12-12

DO NOT SCALE FROM THESE DRAWINGS USE DIMENSIONS

CHECKED BY: C. HOWARD  3-11-09		STATE OF ALASKA DEPARTMENT OF TRANSPORTATION & PUBLIC FACILITIES SOUTHEAST REGION KTN - NORTH TONGASS HWY. SAFETY IMPROVEMENTS PROJECT # 67423 EROSION & SEDIMENT DETAILS	
DESIGNED BY: J. WEAVER DRAWN BY: R. SNYDER		PROJECT DESIGNATION HHE-0920(24) 67423	
PATH: Q:\KTM67423\PLANSET\T167423_T1-3_ESCP.DWG TAB: T3		YEAR 2009	SHEET NO. T3
		TOTAL SHEETS 25	

0.2412
 0.2412
 0.2412