


# CRAIG NORTH COVE HARBOR EXPANSION

PROJECT NO. 70649A


## INDEX OF SHEETS

SHEET NO.	DESCRIPTION
1	TITLE SHEET
2	ESTIMATE OF QUANTITIES
3	FLOAT LAYOUT
4	STRINGER LAYOUT
5	10' TIMBER FLOAT
6	6'X50' STALL FLOAT
7	3'-2 1/2" X 40' STALL FLOAT
8	HINGE CONNECTION DETAILS
9	PILE COLLAR DETAILS
10	FLOAT RECONSTRUCTION DETAILS
11-14	WATERLINE LAYOUT & DETAILS
15-17	ELECTRICAL

DESIGNED BY  
THE STATE OF ALASKA  
D.O.T./P.F. - S.E. REGION  
FOR  
THE CITY OF CRAIG, ALASKA

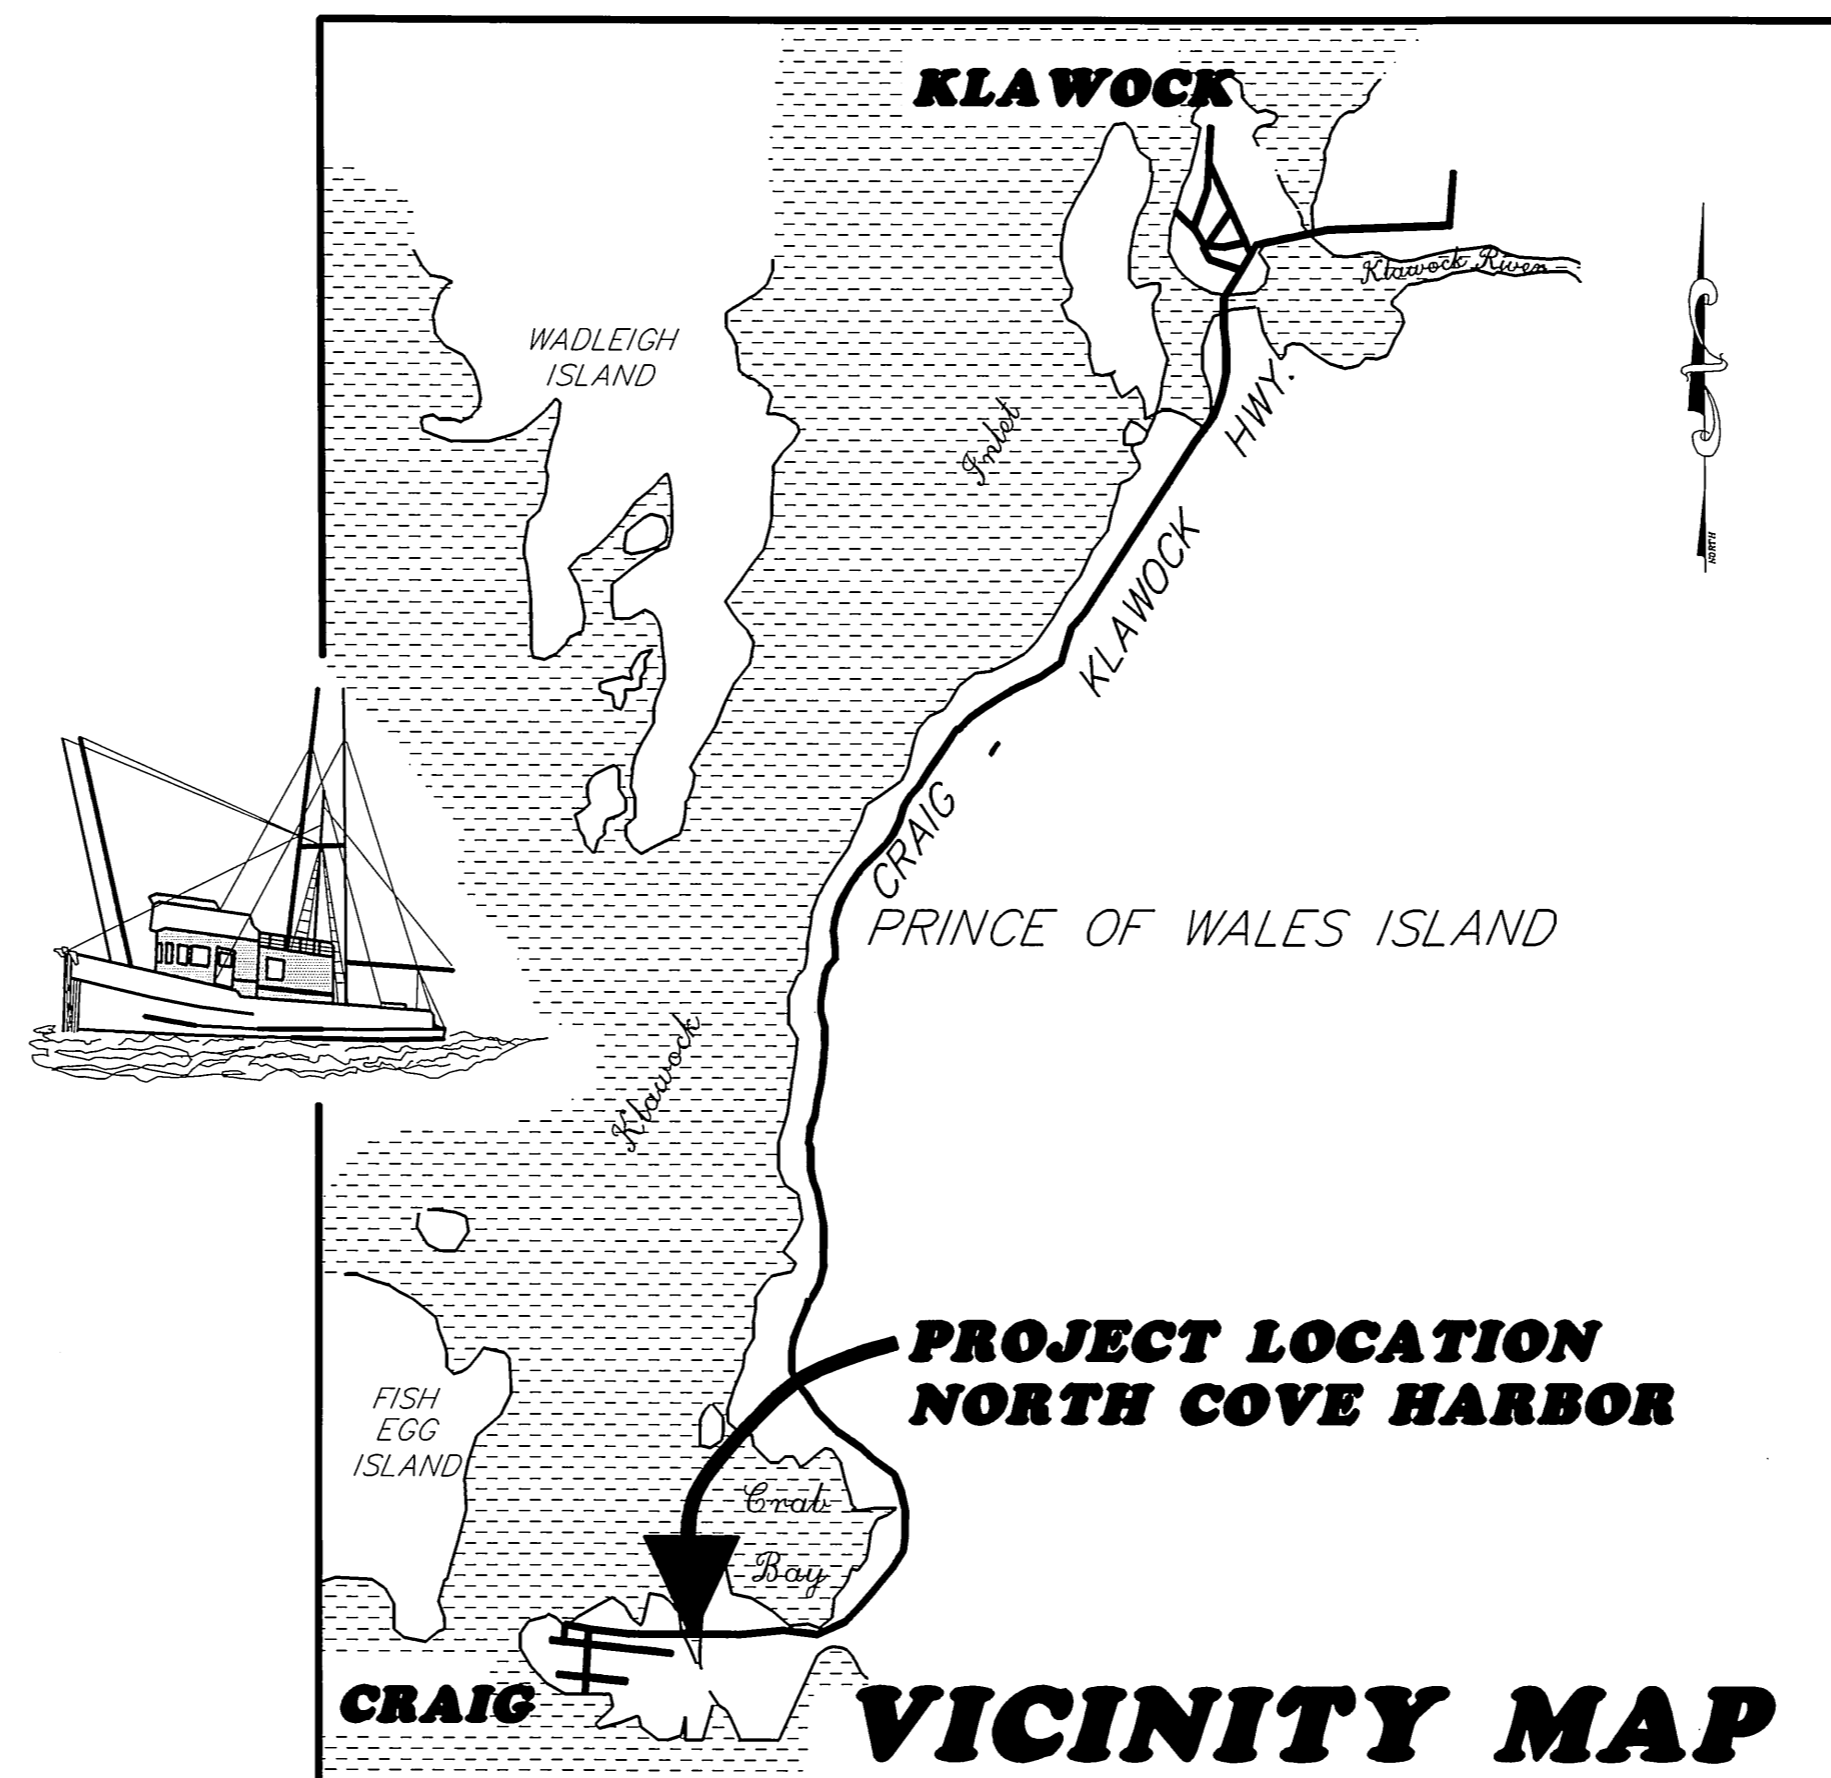

PROJECT NUMBER:  
70649A  
DATE:  
JULY 1992  
SHEET 1 OF 17

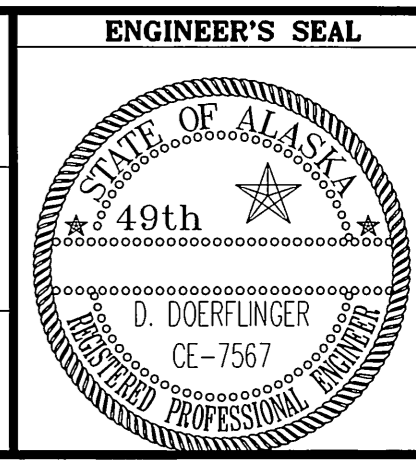

# ESTIMATE OF QUANTITIES

NO.	PAY ITEM	UNIT	QUANT.
110(1)	MOBILIZATION & DEMOBILIZATION	L.S.	ALL REQ'D.
112(1)	CONSTRUCTION SURVEYING BY THE CONTRACTOR	L.S.	ALL REQ'D.
121(1)	DBE INCENTIVE	C.S.	ALL REQ'D.
201(1)	SALVAGE EXISTING STEEL PILES	EA.	27.00
301(1)	FURNISH 12 3/4" DIA. X 3/8" STEEL PILES	L.F.	3,252.00
301(2)	DRIVE PILES	EA.	60.00
311(1A)	10' X 175' TIMBER MAIN FLOAT	L.S.	ALL REQ'D.
311(1B)	10' X 137.5' TIMBER FINGER FLOAT	L.S.	ALL REQ'D.
311(1C)	10' X 175' TIMBER FINGER FLOAT	L.S.	ALL REQ'D.
311(2)	6' X 50' STALL FLOAT	EA.	6.00
311(3)	3'-2 1/2" X 40' STALL FLOAT	EA.	6.00
311(4)	RELOCATE EXIST. 10' X 125' TIMBER FLOAT	L.S.	ALL REQ'D.
311(5)	RELOCATE EXIST. 12' X 300' LOG FLOAT	L.S.	ALL REQ'D.
402((1)	WATER SYSTEM	L.S.	ALL REQ'D.
660(5)	ELECT. LIGHTING, THAW WIRE & POWER SYSTEM	L.S.	ALL REQ'D.



# PILING SUMMARY

PILE NO.	PENETRATION *	ORIG. GRND. ELEVATION	PILE CUTOFF ELEVATION	PILE LENGTH **
1	40'	-26'	+32	98'
2	35'	-23'	+32	90'
3	35'	-27'	+32	94'
4	35'	-24'	+32	76'
5	25'	-19'	+32	76'
6	25'	-24'	+32	81'
7	20'	-21'	+32	73'
8	20'	-15'	+32	67'
9	20'	-17'	+32	69'
10	20'	-19'	+32	71'
11	20'	-14'	+32	66'
12	20'	-16'	+32	68'
13	20'	-16'	+32	68'
14	20'	-18'	+32	70'
15	20'	-19'	+32	71'
16	20'	-22'	+32	74'
17	20'	-25'	+32	77'
18	20'	-25'	+32	77'
19	25'	-26'	+32	83'
20	25'	-27'	+32	84'
21	30'	-29'	+32	91'
22	40'	-32'	+32	104'
23	40'	-30'	+32	102'
24	40'	-31'	+32	103'
25	40'	-33'	+32	105'
26	40'	-34'	+32	106'
27	35'	-31'	+32	98'
28	30'	-26'	+32	88'
29	30'	-27'	+32	89'
30	30'	-30'	+32	92'
31	30'	-31'	+32	93'
32	25'	-27'	+32	84'
33	20'	-20'	+32	72'
34	20'	-22'	+32	74'
35	20'	-25'	+32	77'
36	20'	-26'	+32	78'
37	20'	-21'	+32	73'
38	40'	-32'	+32	104'
39	40'	-33'	+32	105'
40	40'	-33'	+32	105'
41	40'	-34'	+32	106'
42	40'	-34'	+32	106'
43	40'	-36'	+32	107'
44	40'	-36'	+32	107'
45	25'	-24'	+32	81'
46	25'	-25'	+32	82'
47	25'	-27'	+32	84'
48	30'	-30'	+32	92'
49	30'	-31'	+32	93'
50	35'	-33'	+32	100'
51	40'	-37'	+32	109'
52	40'	-37'	+32	109'
53	40'	-37'	+32	109'
54	40'	-38'	+32	110'
55	40'	-37'	+32	109'
56	40'	-37'	+32	109'
57	35'	-35'	+32	102'
58	30'	-31'	+32	93'
59	30'	-31'	+32	93'
60	30'	-29'	+32	91'
TOTAL =				5368
*** REUSABLE EXIST. PILING =				2116
NET TOTAL =				3252

# GENERAL NOTES

- ALL STEEL HARDWARE SHALL BE HOT DIP GALVANIZED UNLESS OTHERWISE NOTED ON THE PLANS.
- ALL BOLTS IN CONTACT WITH WOOD SURFACE SHALL HAVE ECONOMY HEAD BOLTS. A MALLEABLE IRON WASHER SHALL BE PLACED BETWEEN ALL NUTS AND WOOD SURFACES.
- COUNTERSINK ALL BOLT HEADS FACING DECKING.
- ALL TIMBER SHALL BE S4S EXCEPT FOR DECKING (MILLED S1S2E)& SIDING (RESAWN).
- SEE SHEET 4 FOR THE NUMBERING SYSTEM OF STEEL PILING.
- AS-BUILT DRAWINGS SHOWING LENGTHS OF EXISTING PILINGS ARE AVAILABLE UPON REQUEST.
- SEE SPECIAL PROVISION FOR CONSTRUCTION RESTRICTIONS AS STATED IN THE ISSUED PERMITS.
- CONTRACTOR'S OPERATION SHALL NOT CONFLICT WITH BOAT TRAFFIC TO EXISTING FACILITY. BOAT ACCESS TO FLOAT FACILITY SHALL REMAIN ACCESSIBLE AT ALL TIMES EXCEPT AT THE FLOATS THAT WILL BE RELOCATED.

## LEGEND

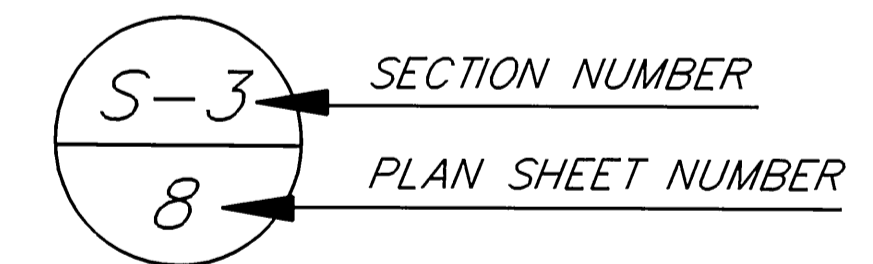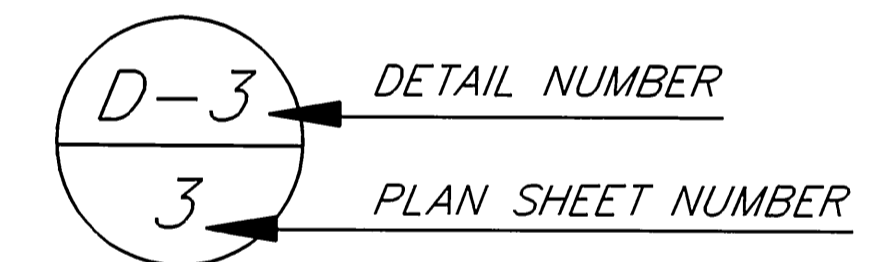

\*PENETRATION IS APPROXIMATE, MAY VARY FROM A MINIMUM OF 20' TO A MAXIMUM OF 40'

\*\*PILE LENGTHS ARE APPROXIMATE, ONLY FOR ESTIMATING PURPOSES.

\*\*\*PILINGS FROM EXISTING FLOATS TO BE RELOCATED.

NOTE: DO NOT SCALE FROM THESE PLANS-USE DIMENSIONS

BY:	DATE:	DESCRIPTION OF CHANGE:

STATE OF ALASKA  
DEPARTMENT OF TRANSPORTATION  
AND PUBLIC FACILITIES  
SOUTHEAST REGION DESIGN & CONSTRUCTION


CRAIG

ESTIMATE OF QUANTITIES

ALASKA

DESIGNED BY: D. SALDIVAR  
DRAWN BY: AUTOCADD/C. Anderson  
CHECKED BY: D. DOERFLINGER

PROJECT NO. 70469A  
DATE: JULY, 1992  
SHEET 2 OF 17

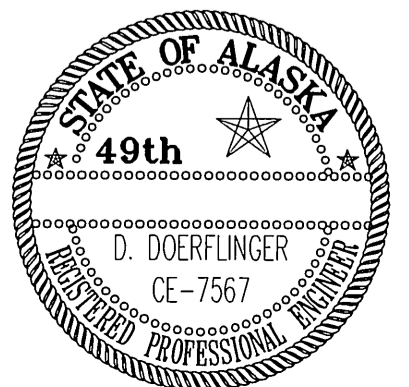

### Basis of Control

The basis of horizontal control is the alignment of existing main float.  
The new float shall match existing alignment. Finger float shall be aligned perpendicular to the main float.


The basis of vertical control is CS-8 with an elevation of +10.63 above MLLW.



TIDAL DATA	
EHW	14.0
EHT	12.8
MHHW	10.0
MHW	9.2
MTL	5.3
MLLW	0.0
ELW	-4.0

CS-9  
# 5 rebar with  
DOT&PF plastic cap  
N 32,330.4977  
E 94,910.6562  
ELEV. 10.01

CS-8  
# 5 rebar with  
DOT&PF plastic cap  
N 32,031.0100  
E 94,849.6349  
ELEV. 10.63

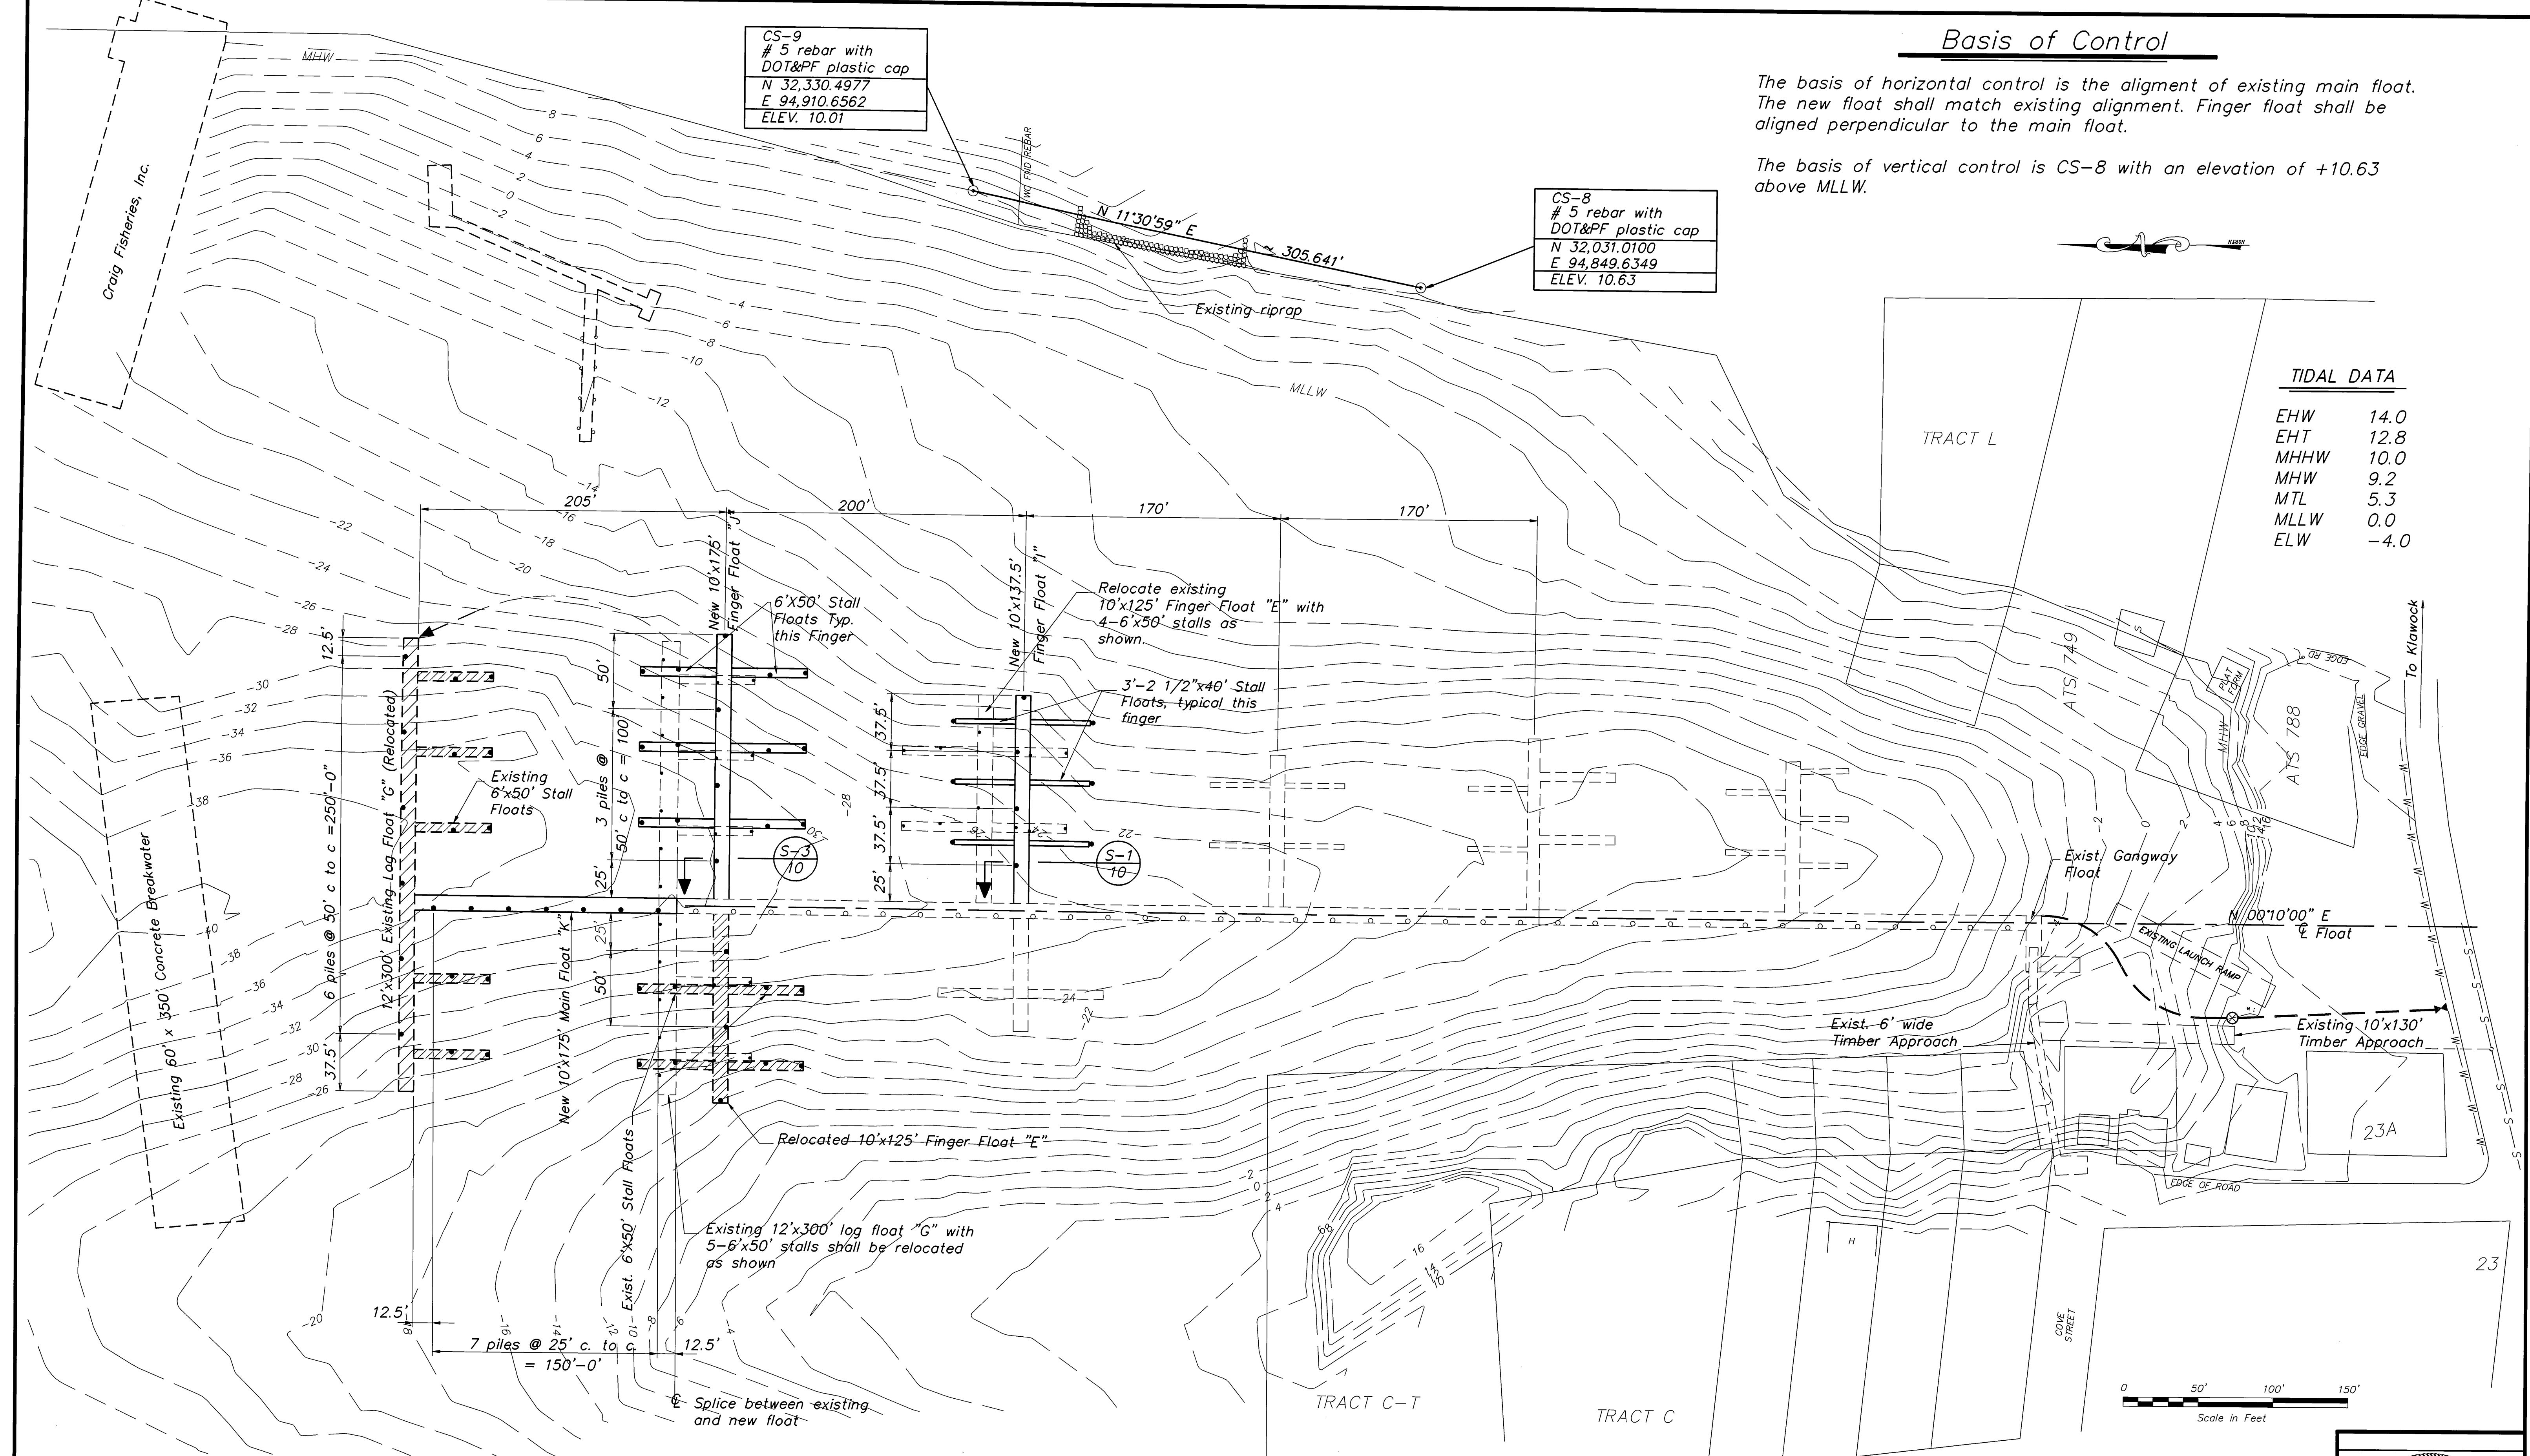

BY:	DATE:	DESCRIPTION OF CHANGE:



**RECORD OF REVISIONS**


STATE OF ALASKA  
DEPARTMENT OF TRANSPORTATION  
AND PUBLIC FACILITIES  
SOUTHEAST REGION DESIGN & CONSTRUCTION

CRAIG

## FLOAT LAYOUT

ALASKA	DESIGNED BY: D.D. Saldivar	PROJECT No. 70649A
	DRAWN BY: AutoCAD / BWB	DATE: JULY 1992
	CHECKED BY: D.F. Doerflinger	SHEET 3 OF 17

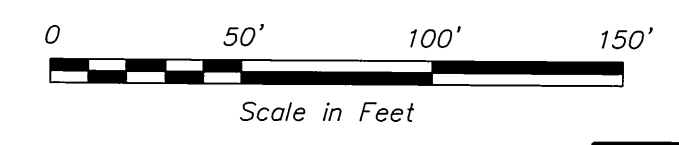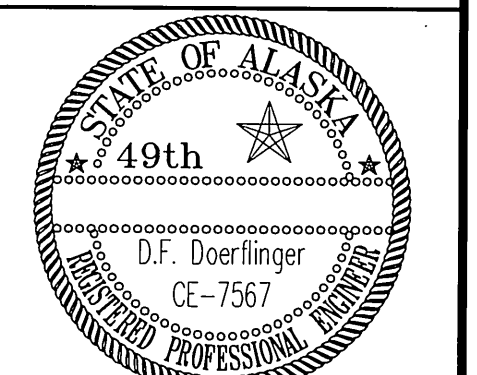

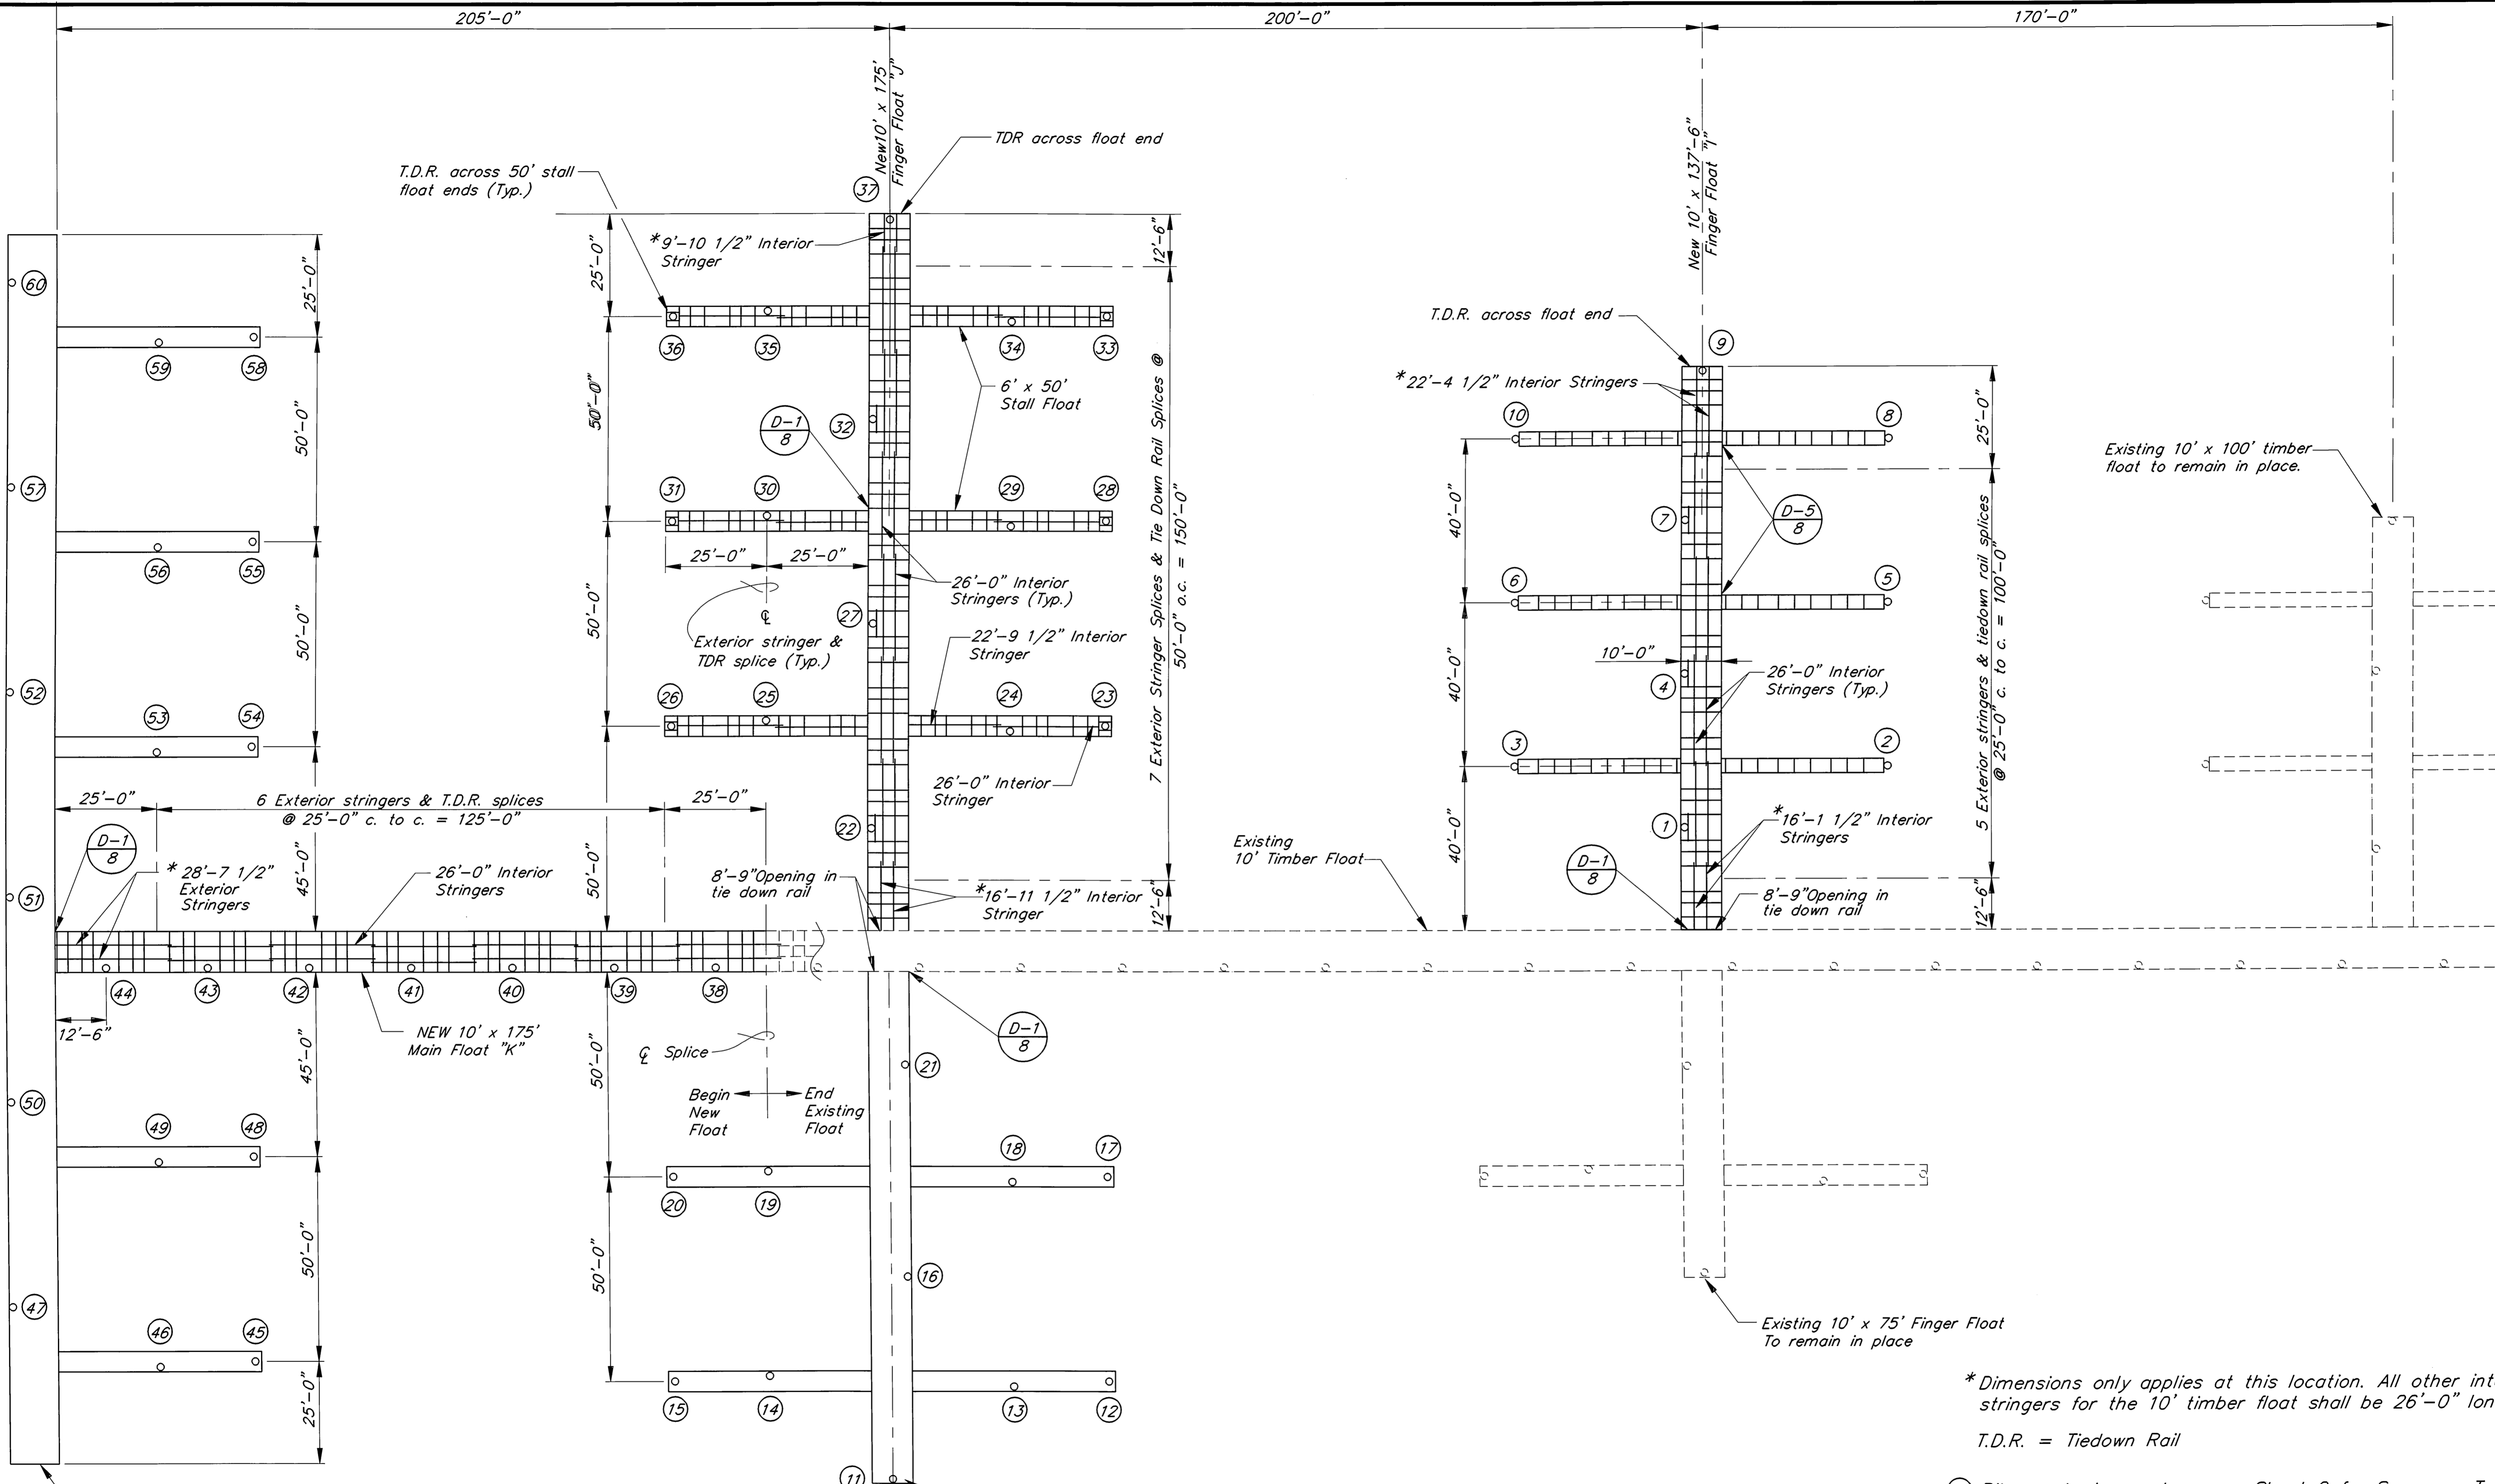

\* Dimensions only applies at this location. All other interior stringers for the 10' timber float shall be 26'-0" long.  
T.D.R. = Tiedown Rail  
(No) Pile numbering system, see Sheet 2 for Summary Table.

NOTE: DO NOT SCALE FROM THESE PLANS-USE DIMENSIONS

BY:	DATE:	DESCRIPTION OF CHANGE:


RECORD OF REVISIONS

STATE OF ALASKA  
DEPARTMENT OF TRANSPORTATION  
AND PUBLIC FACILITIES  
SOUTHEAST REGION DESIGN & CONSTRUCTION




Craig

# STRINGER LAYOUT

DESIGNED BY: D. SALDIVAR	PROJECT NO. 70649 A
DRAWN BY: AUTOCAD/R. SNYDER	DATE: JULY 1992
CHECKED BY: D. DOERFLINGER	SHEET 4 OF 17



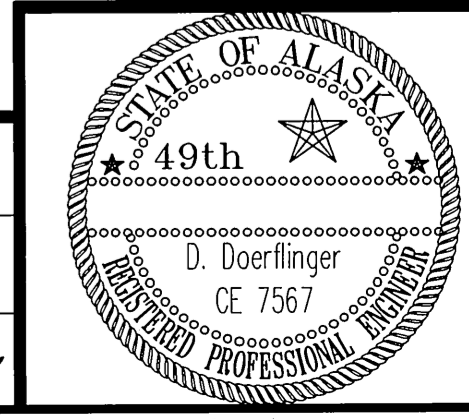


SEE FLOAT LAYOUT FOR  
TIMBER FLOAT WITH 50'  
PILE SPACING

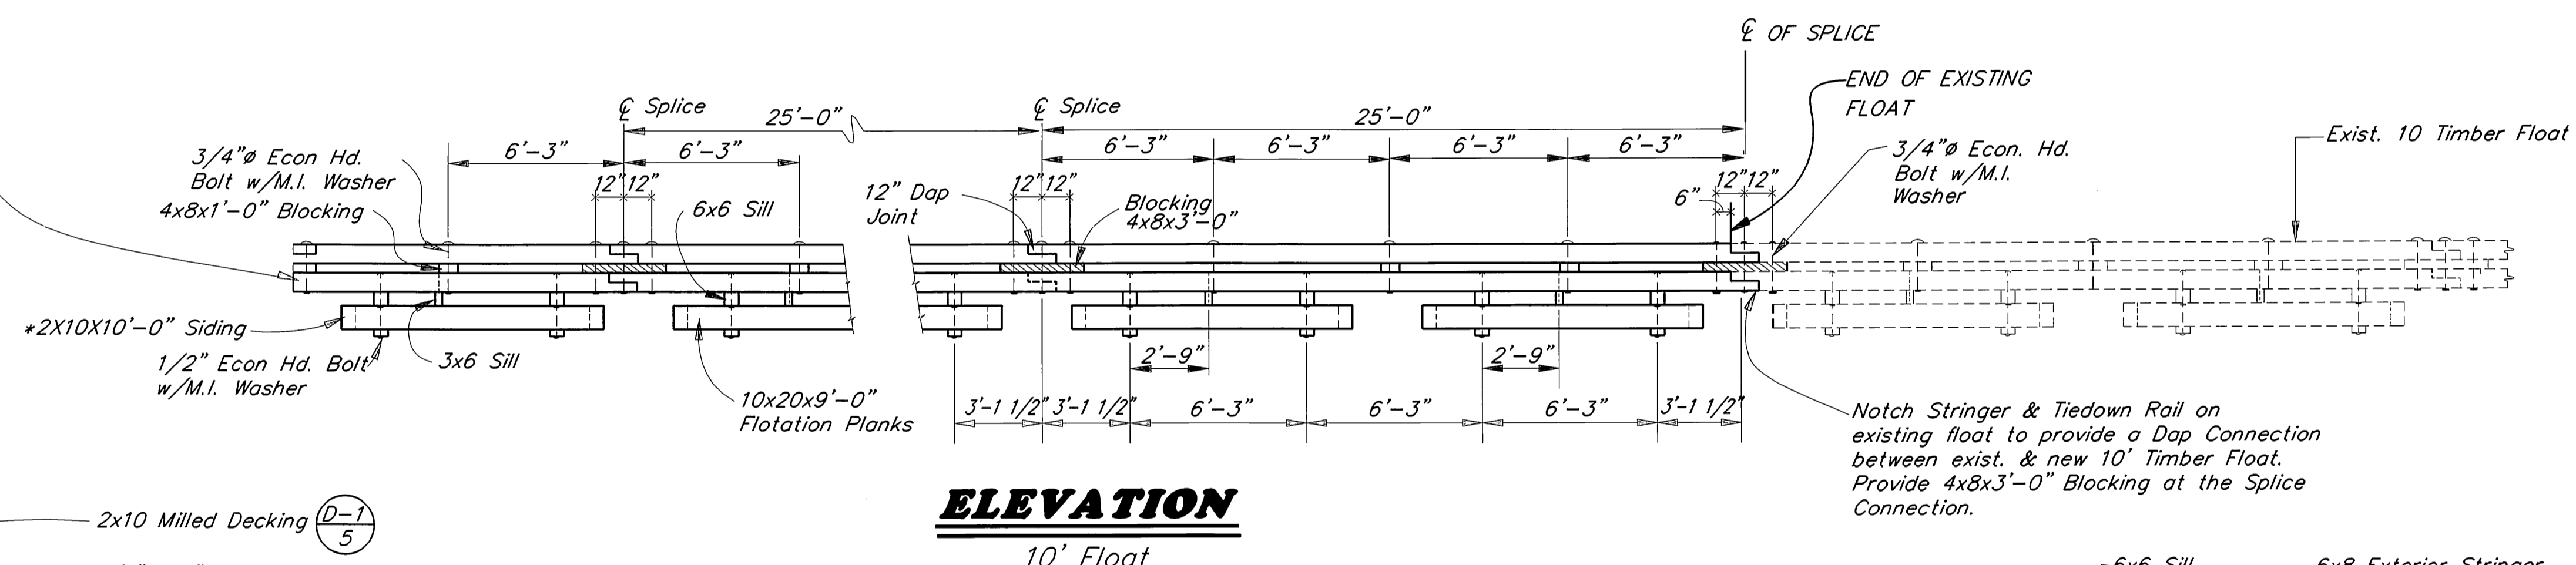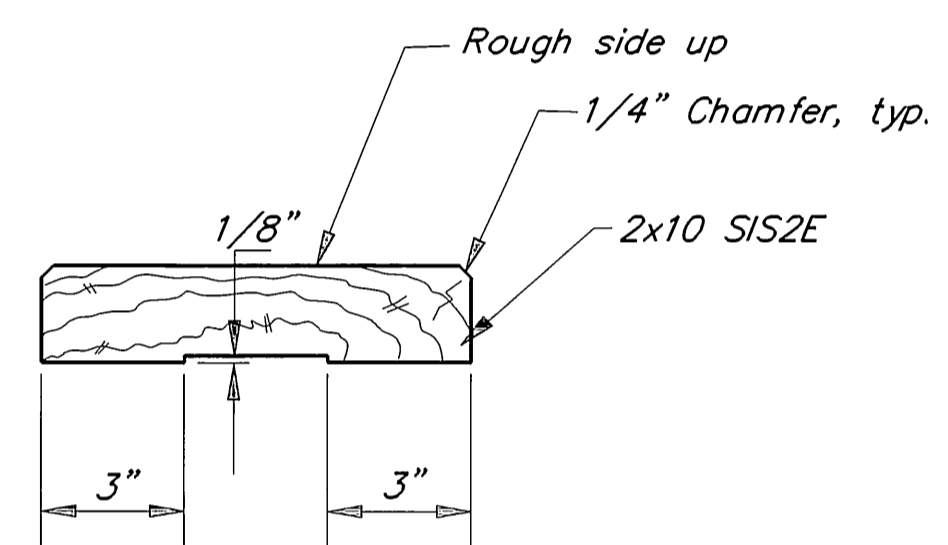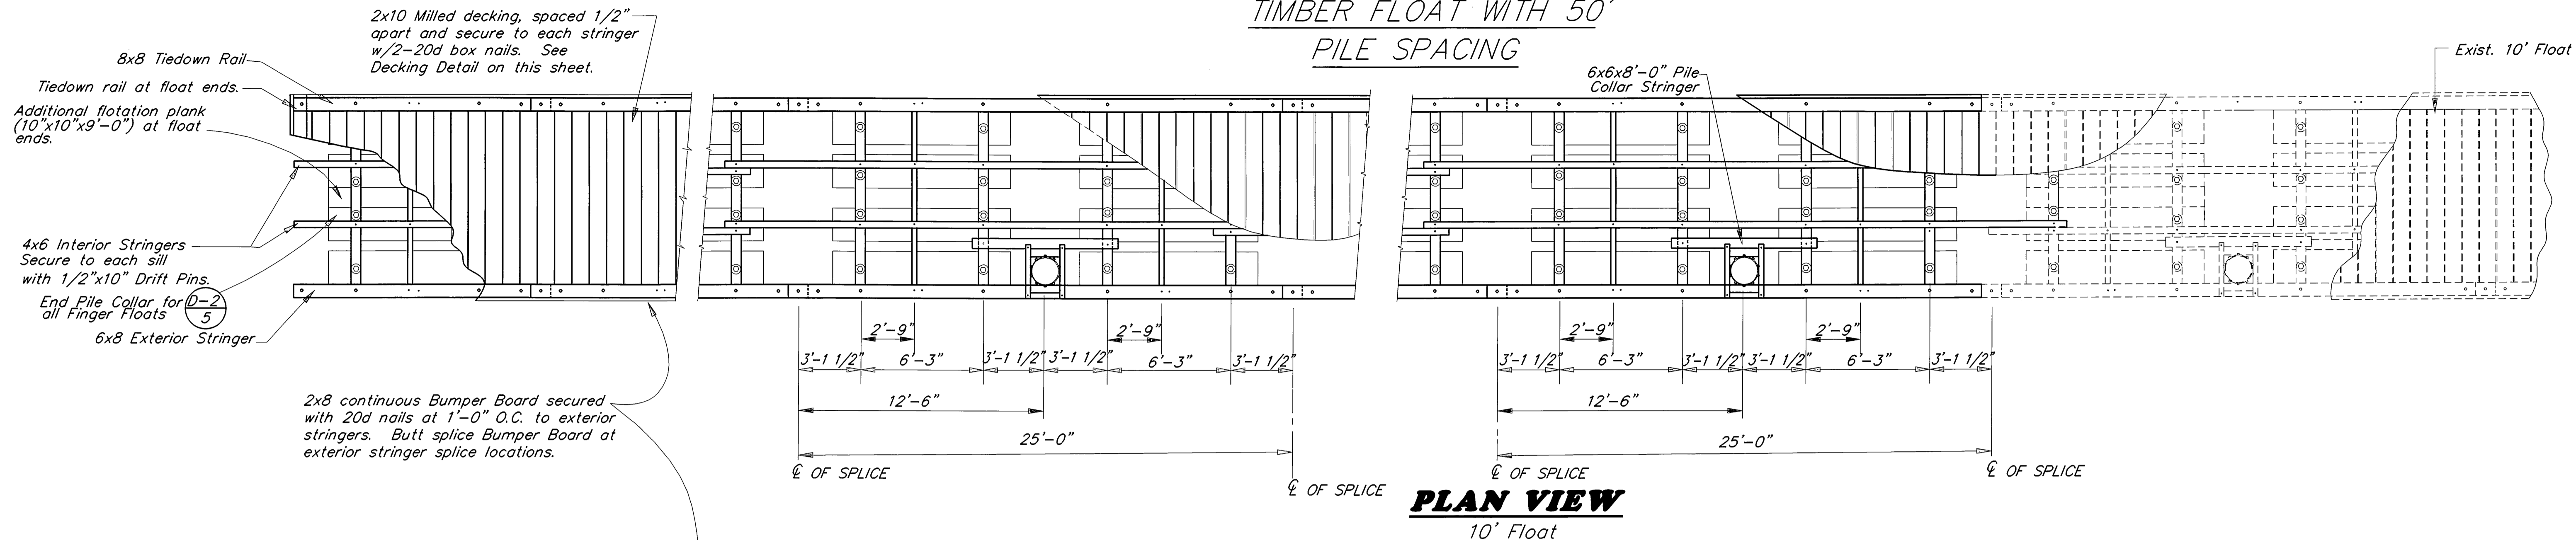

**MILLED DECKING DETAIL** (1)

On Float ends, interior 10"x20"x9'-0" flotation planks shall be shifted to allow insertion of additional half planks (10"x10"x9'-0")

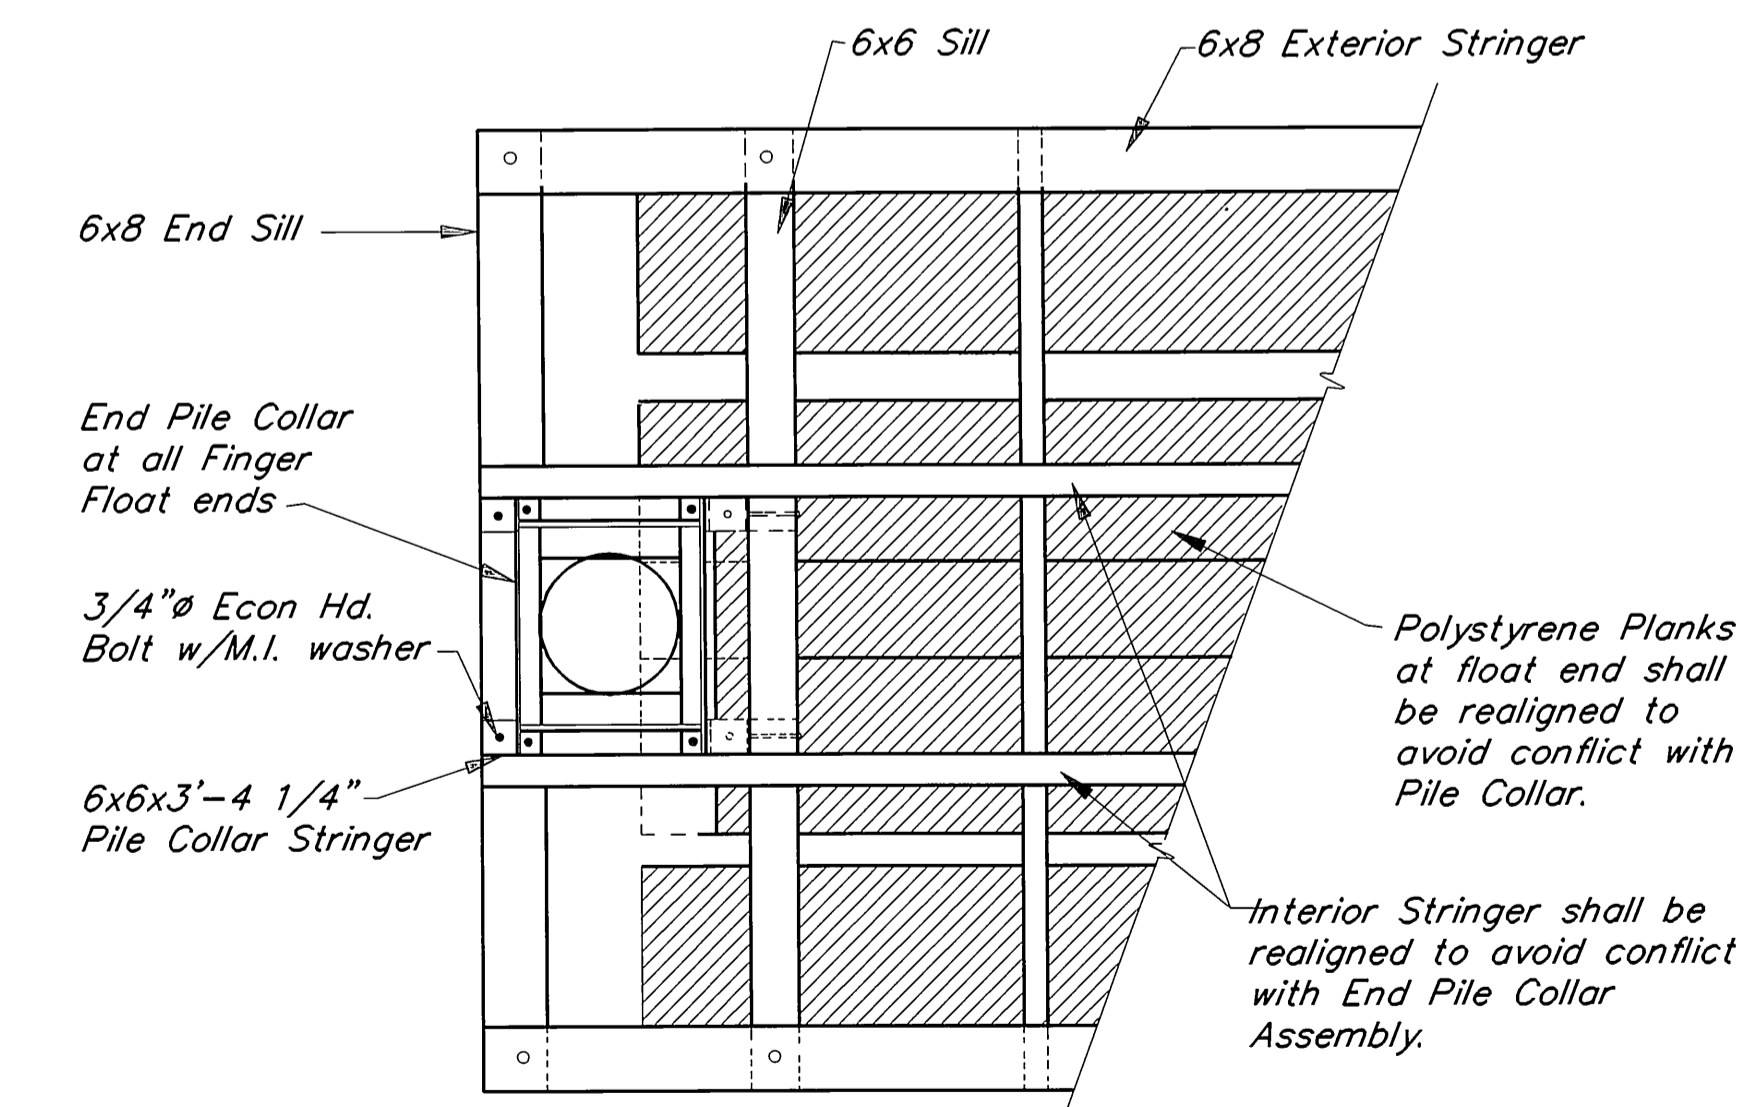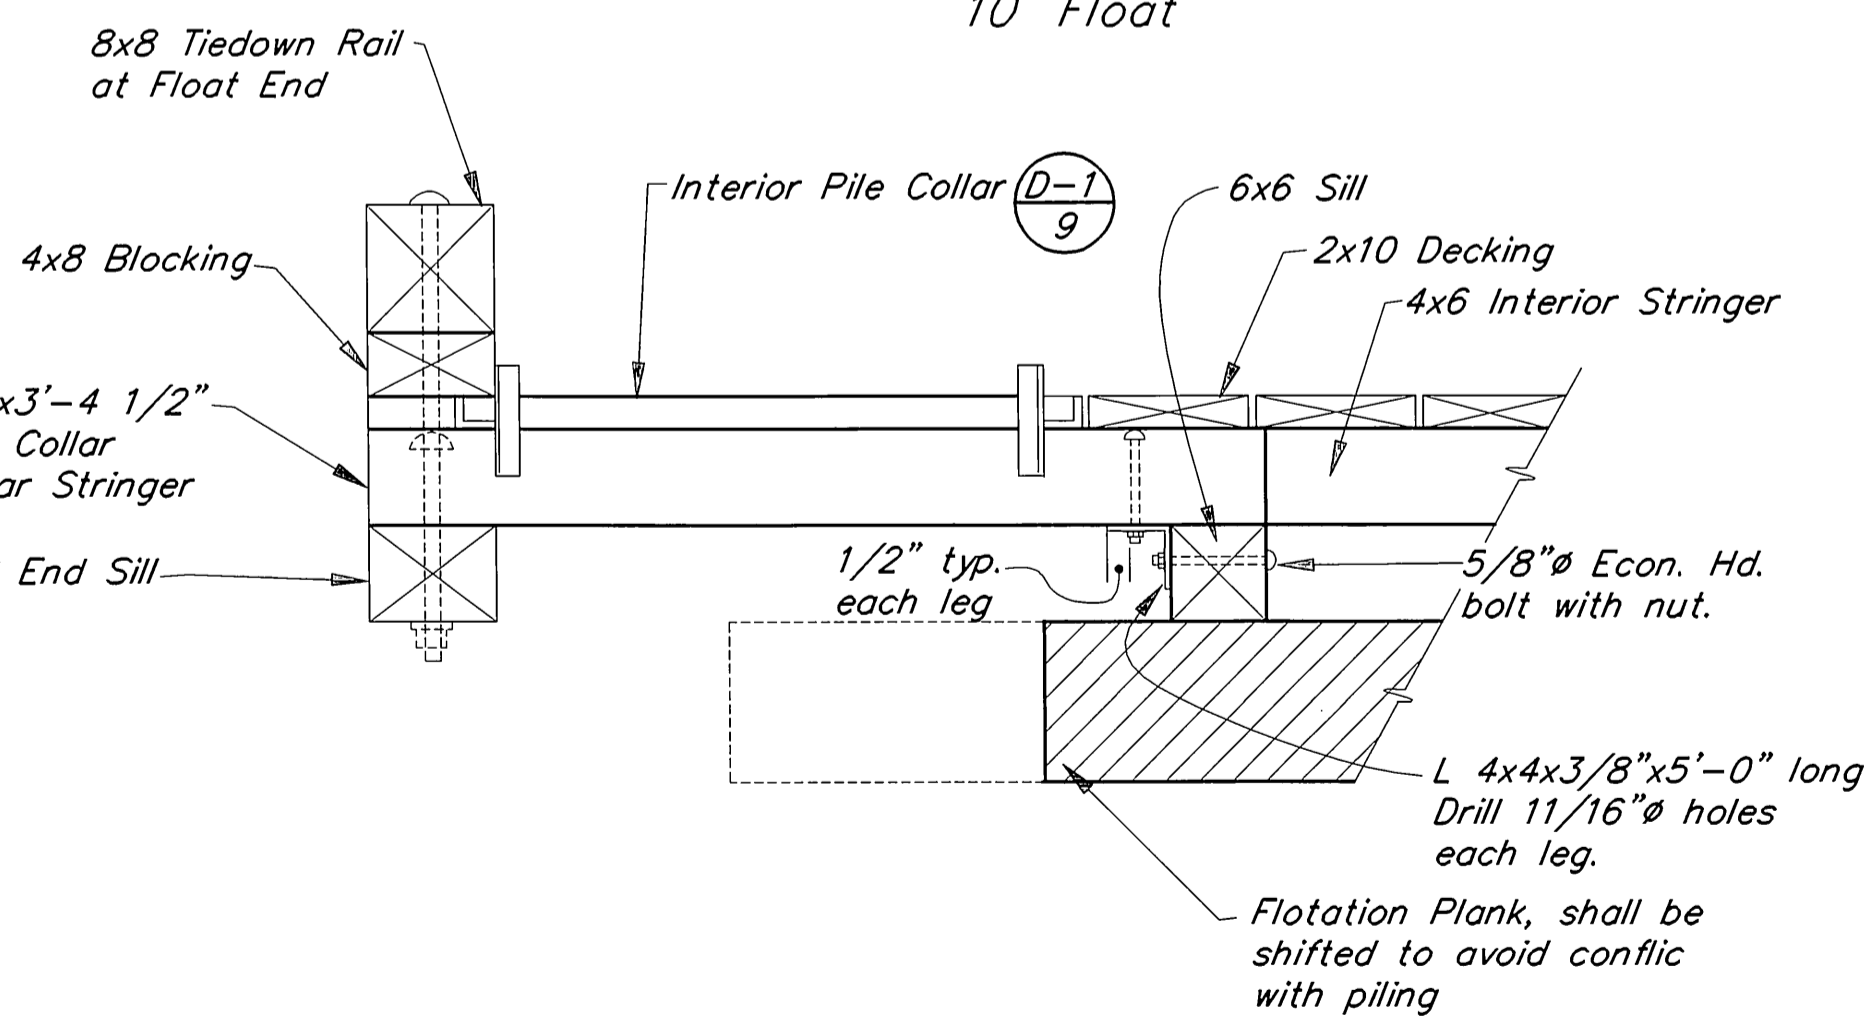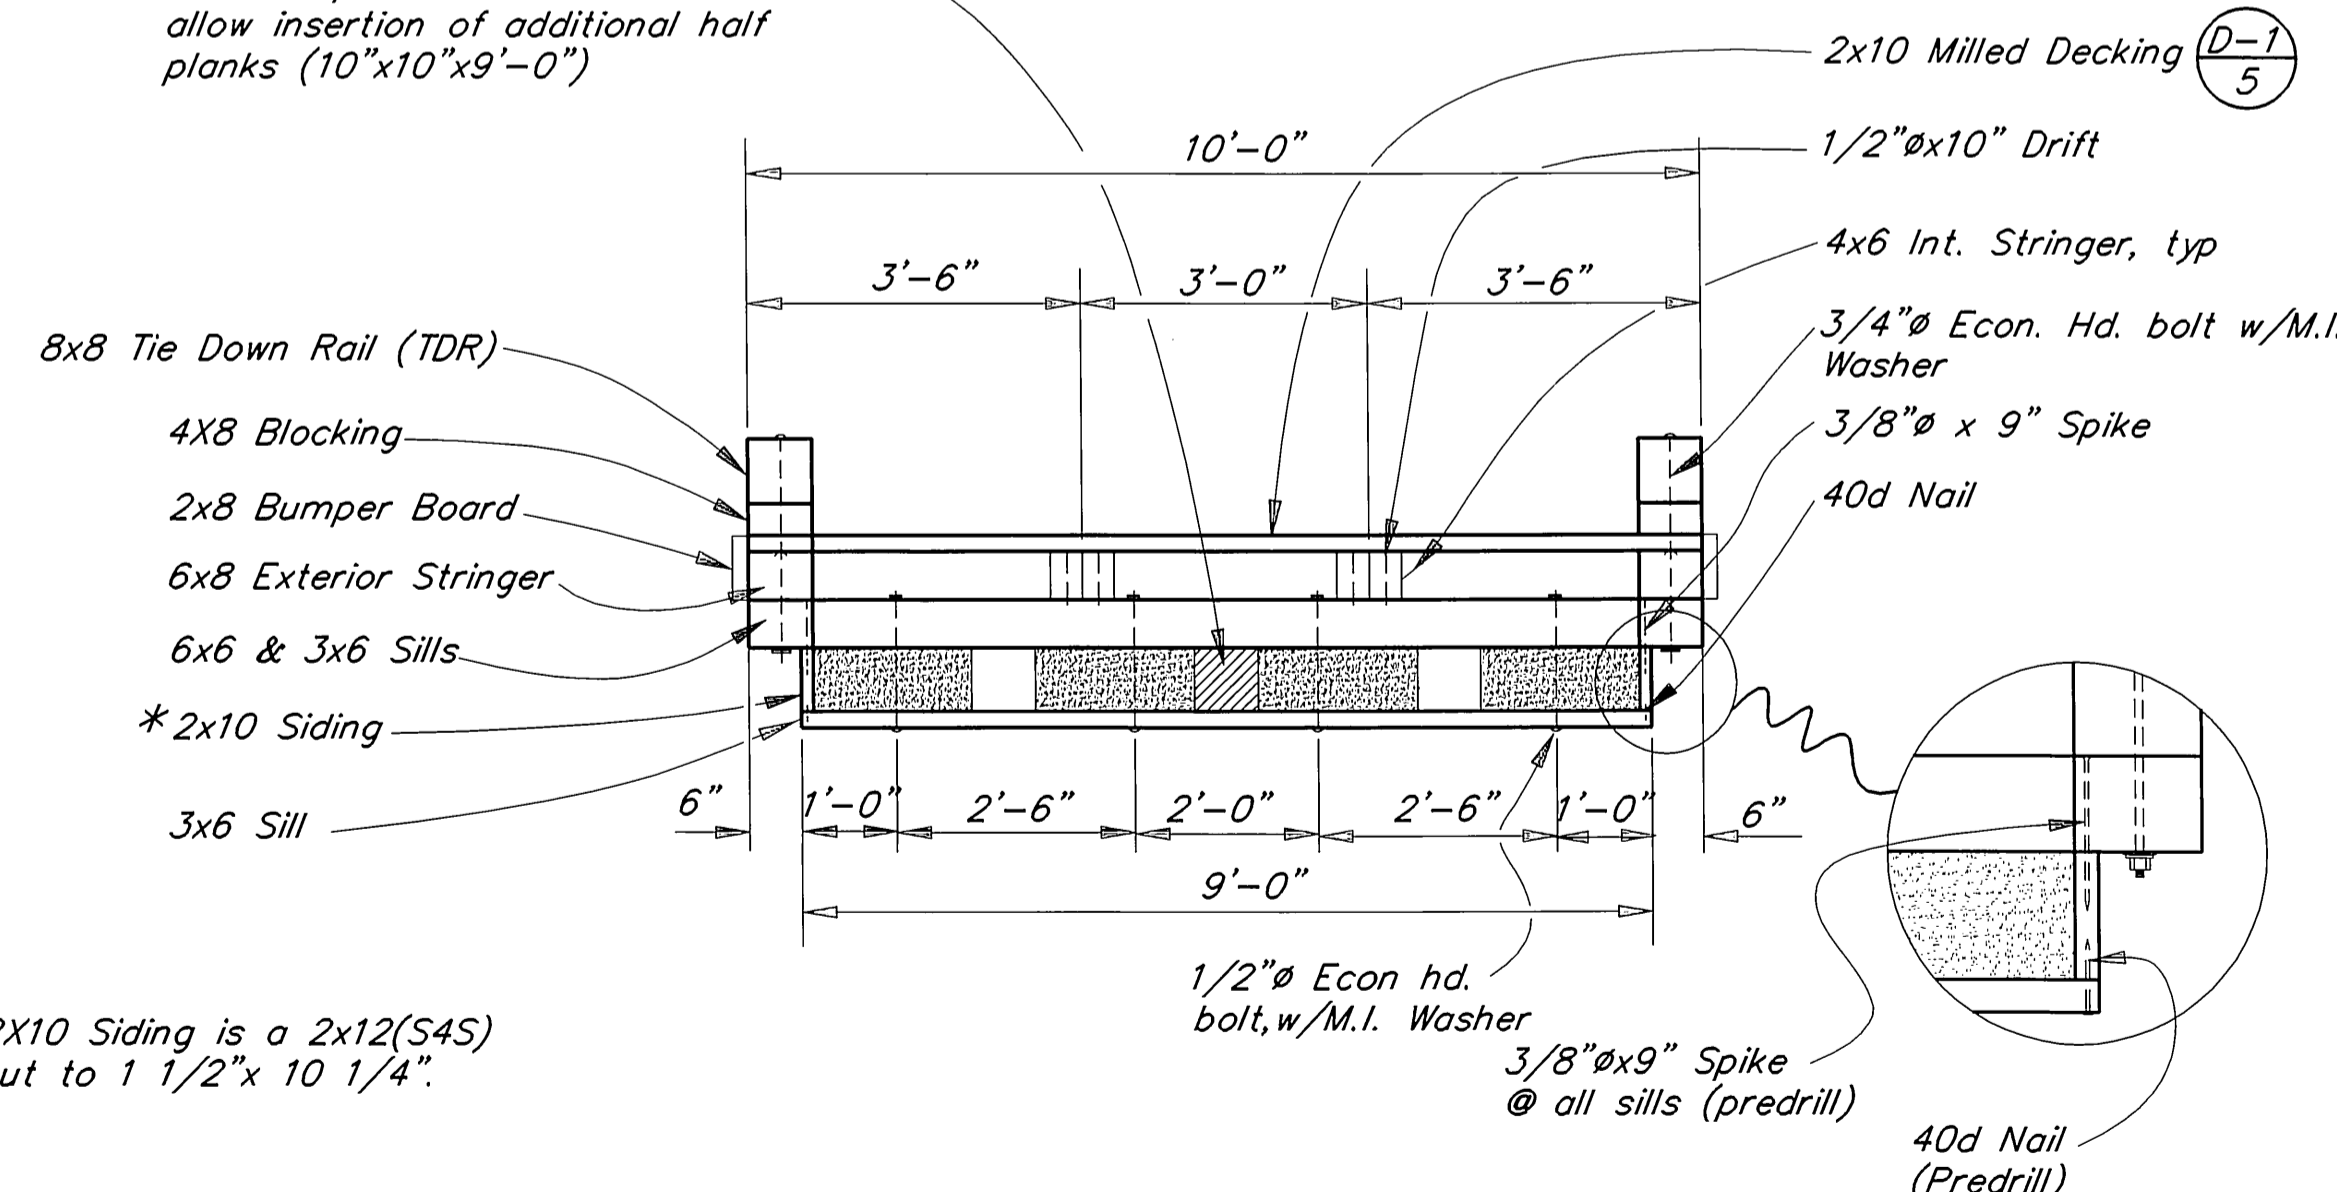

NOTE: DO NOT SCALE FROM THESE PLANS-USE DIMENSIONS

BY:	DATE:	DESCRIPTION OF CHANGE:


RECORD OF REVISIONS





STATE OF ALASKA  
DEPARTMENT OF TRANSPORTATION  
AND PUBLIC FACILITIES  
SOUTHEAST REGION DESIGN & CONSTRUCTION

Craig

10' TIMBER FLOAT

DESIGNED BY: D. SALDIVAR	PROJECT NO. 70649A
DRAWN BY: AUTOCADD/CSA	DATE: JULY, 1992
CHECKED BY: D. DOERFLINGER	SHEET 5 OF 17

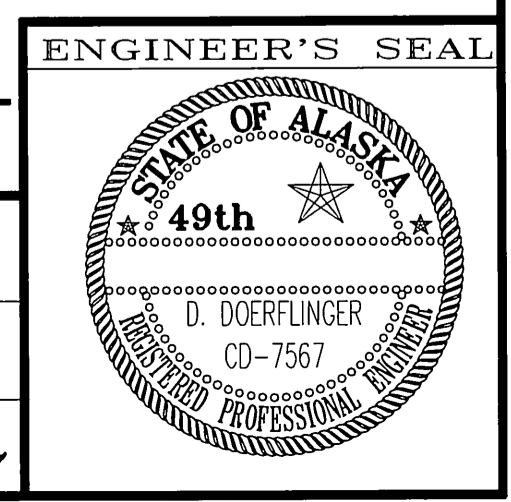

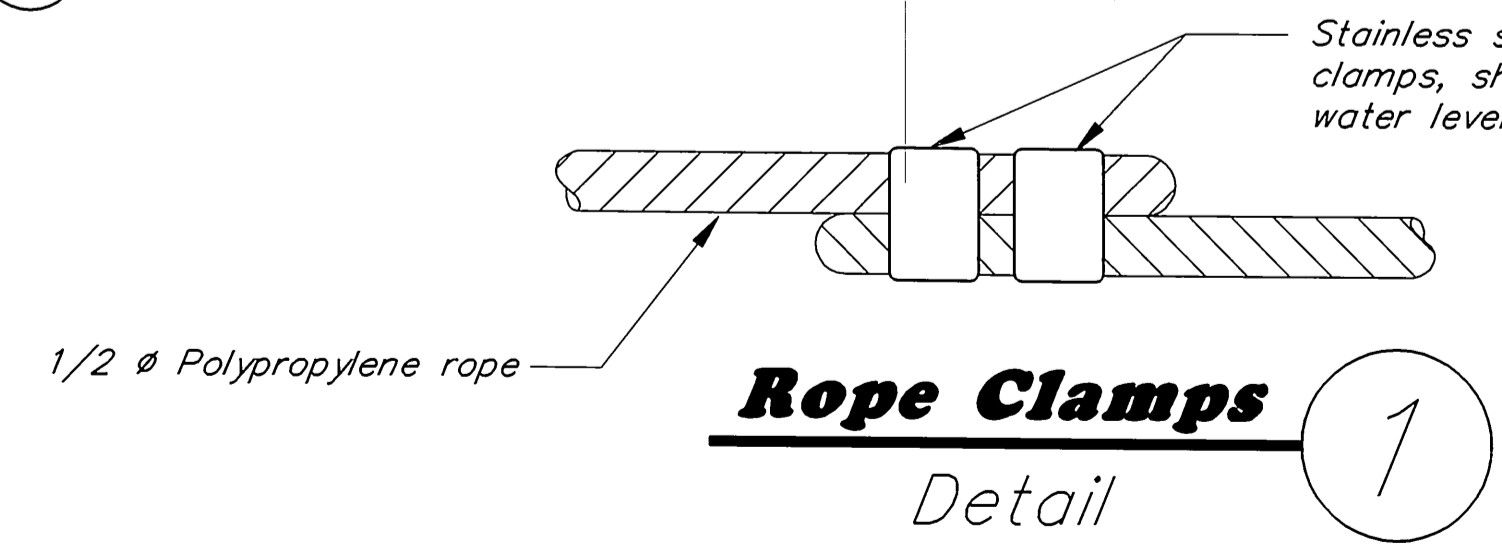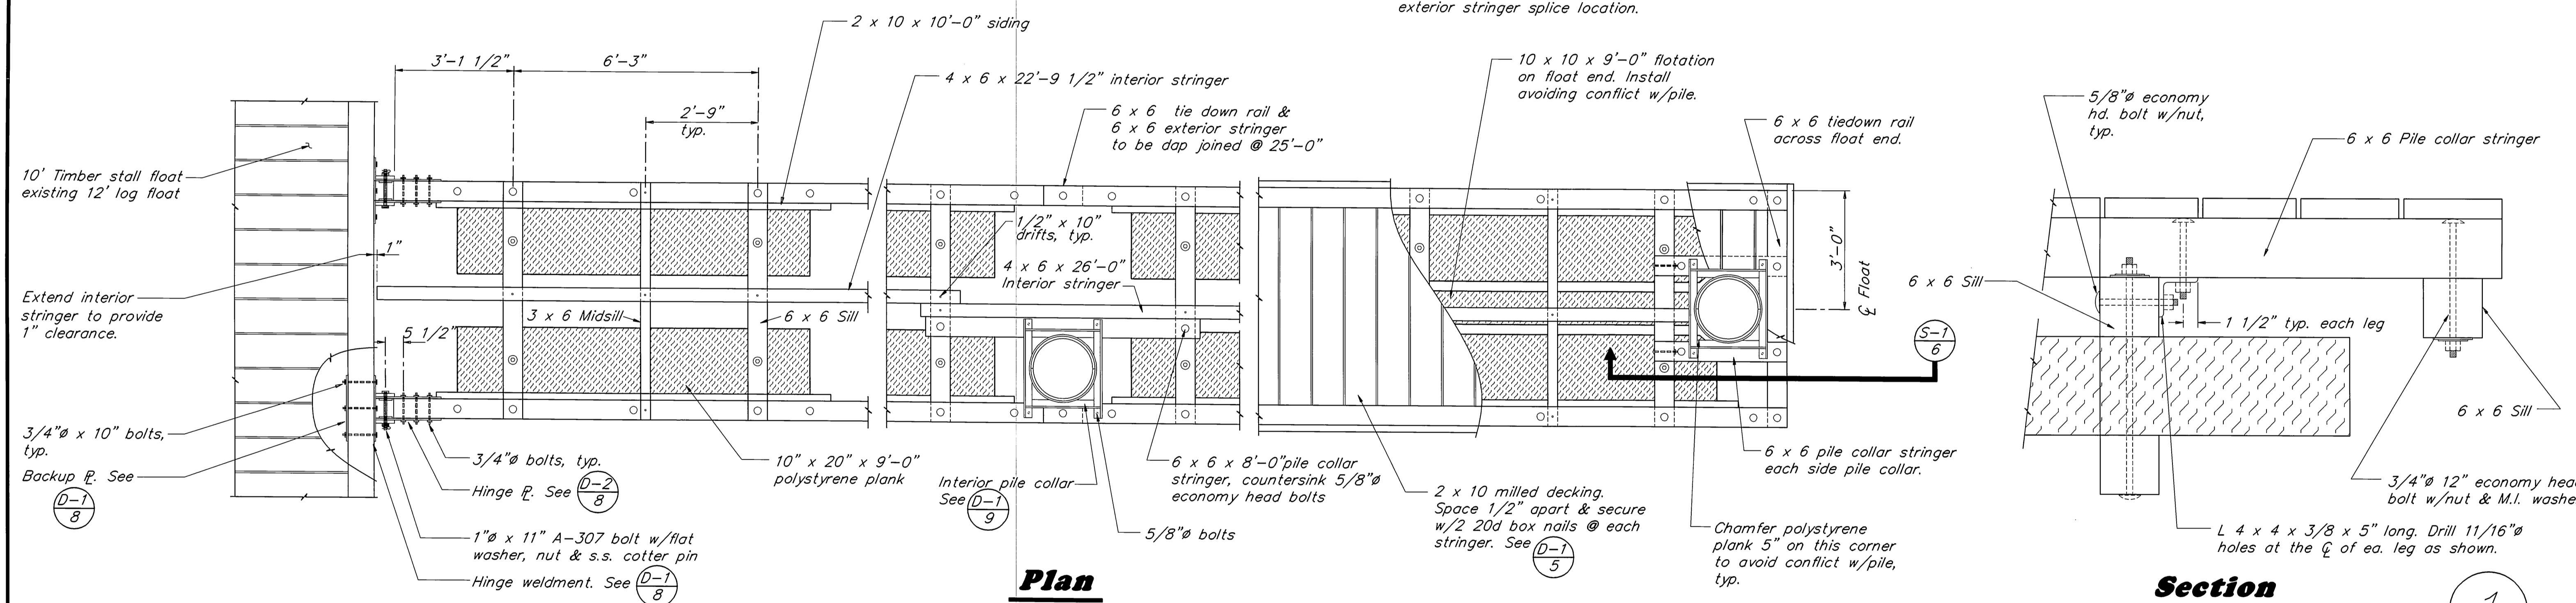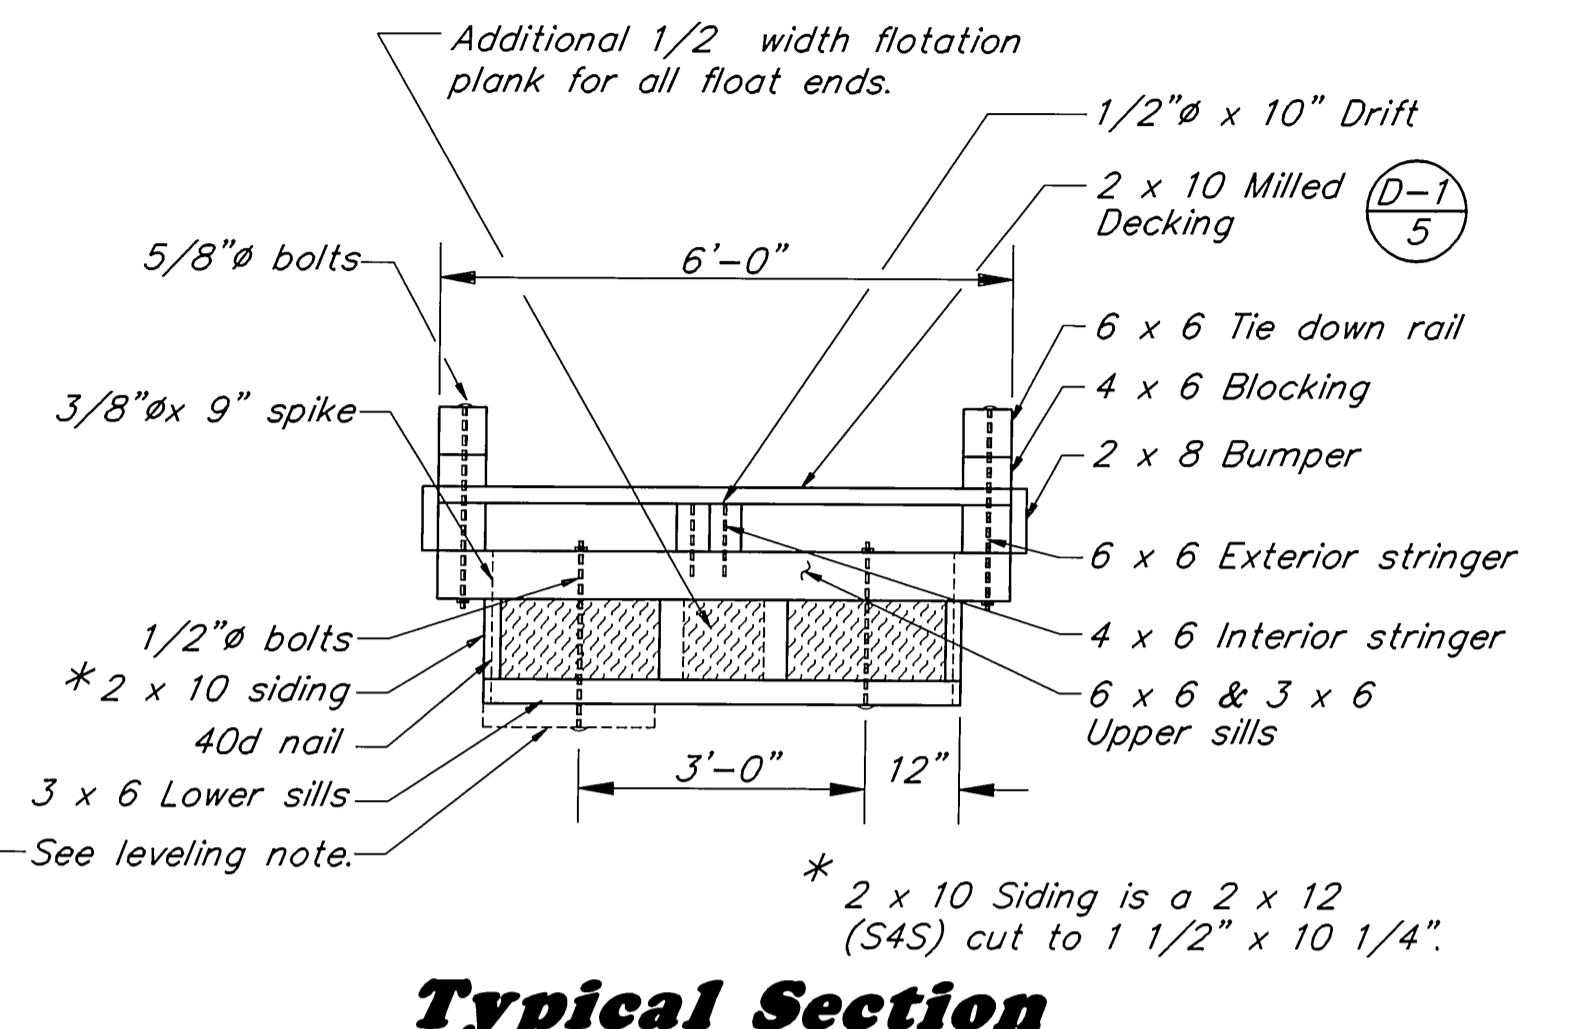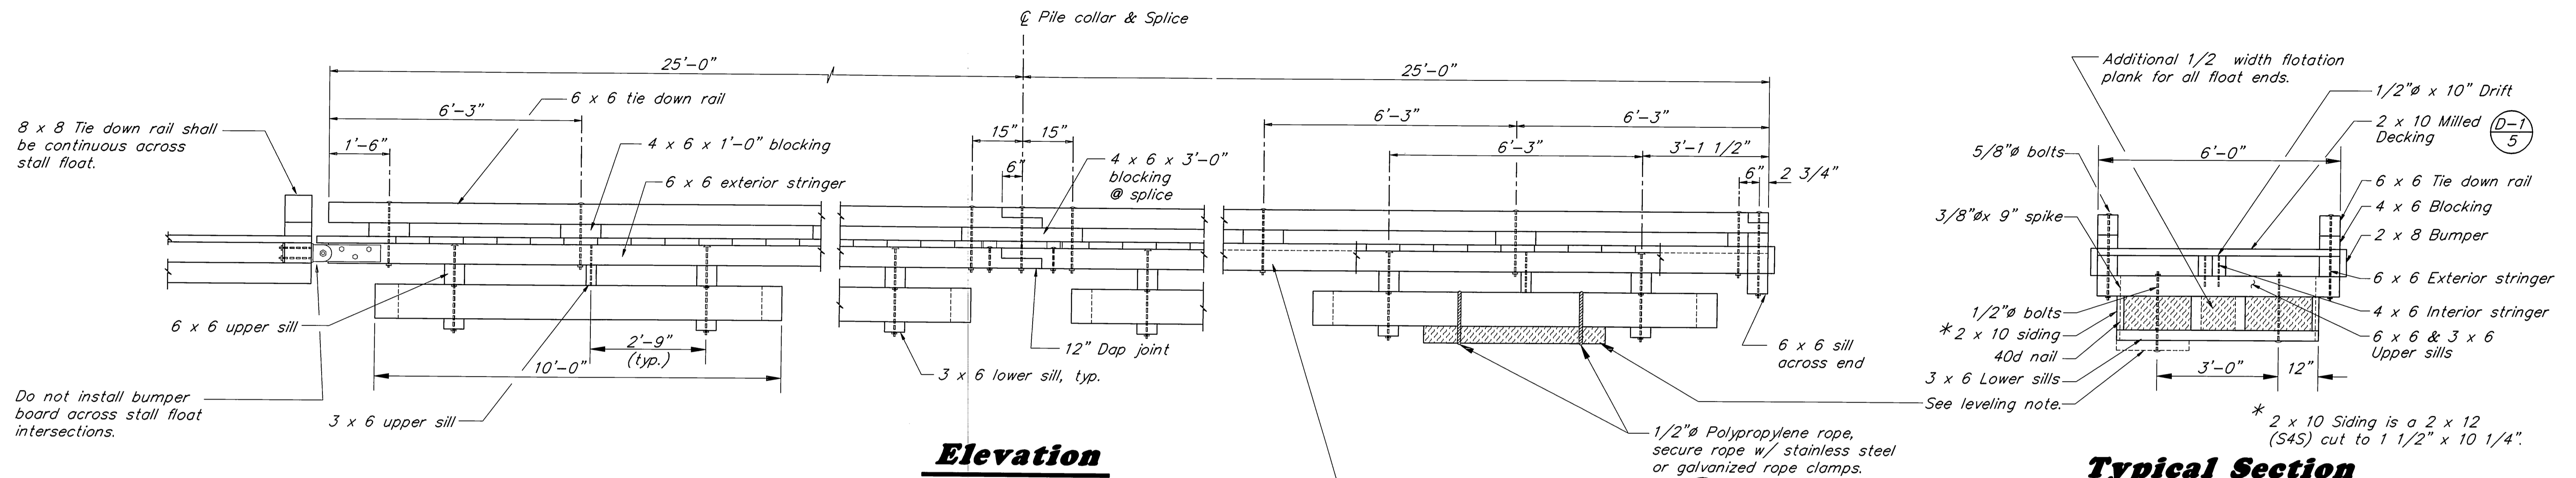

**LEVELING NOTE**  
 For leveling, provide twenty five 5" x 20" x 4'-6" coated polystyrene planks. Where leveling is required, place leveling plank between lower sill members. Secure each leveling plank with two 1/2" polypropylene rope. Unused leveling planks shall be given to the City of Craig Harbormaster.

BY:	DATE:	DESCRIPTION OF CHANGE:


RECORD OF REVISIONS


STATE OF ALASKA  
 DEPARTMENT OF TRANSPORTATION  
 AND PUBLIC FACILITIES  
 SOUTHEAST REGION DESIGN & CONSTRUCTION

Craig  
 Alaska  
**6' x 50' STALL FLOAT**


NOTE: DO NOT SCALE FROM THESE PLANS—USE DIMENSIONS

DESIGNED BY: D. SALDIVAR	PROJECT NO. 70649 A
DRAWN BY: AUTOCAD/R. SNYDER	DATE: JULY 1992
CHECKED BY: D. DOERFLINGER	SHEET 6 OF 17

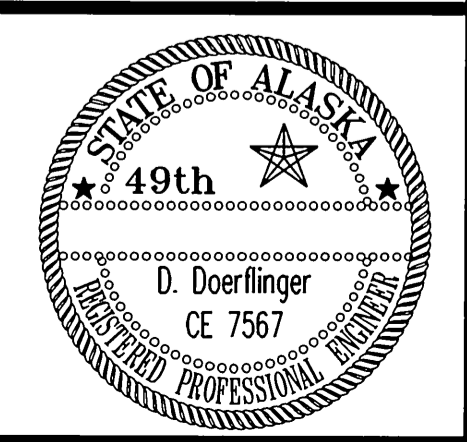

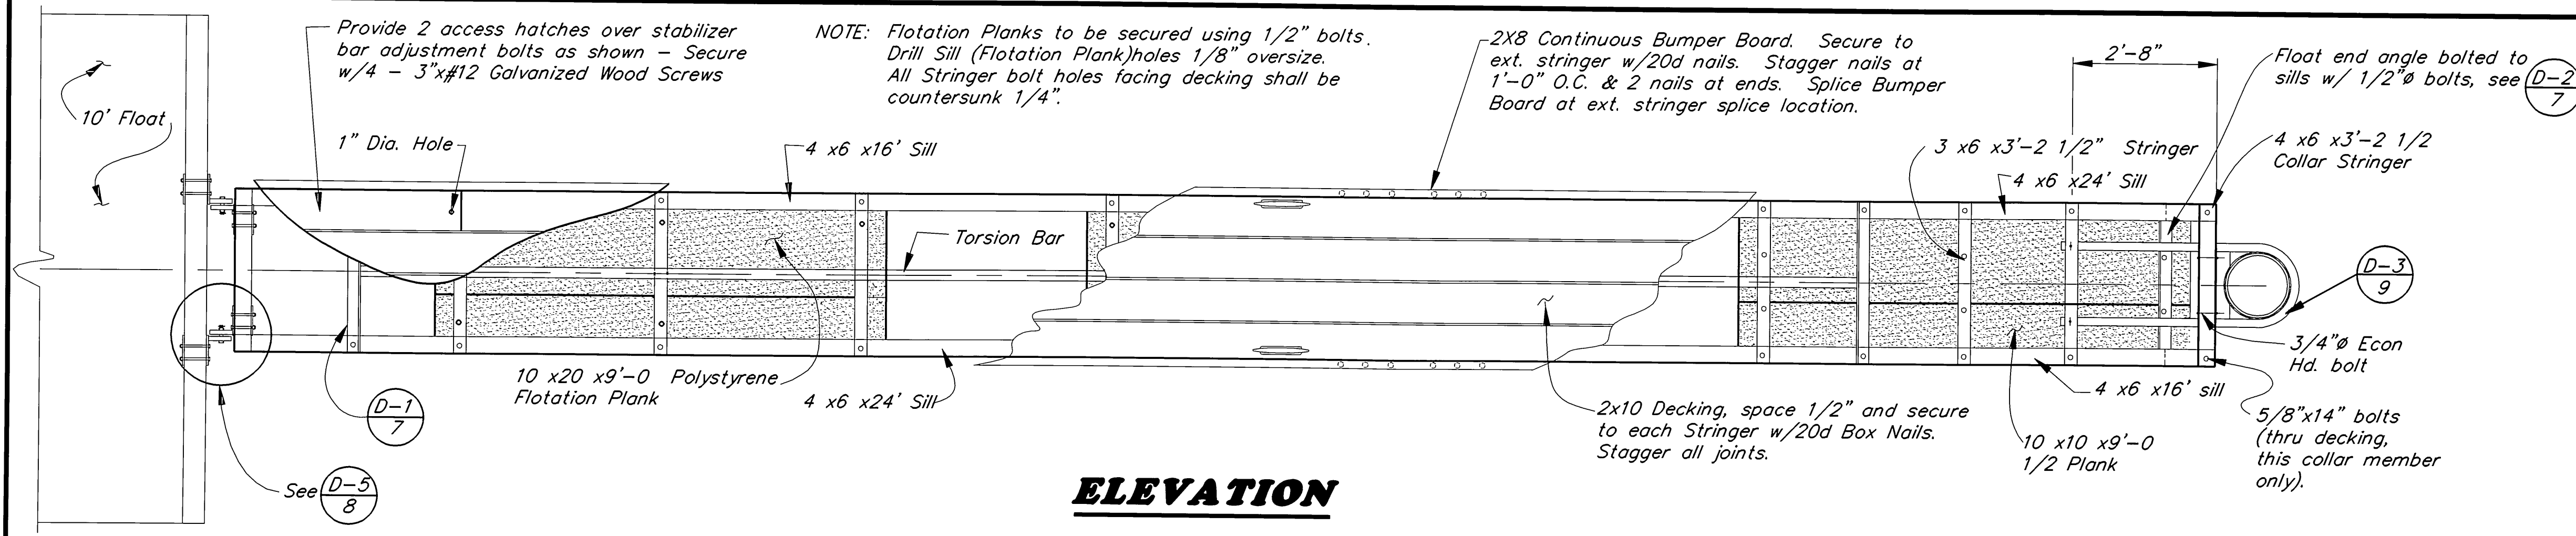


**ELEVATION**

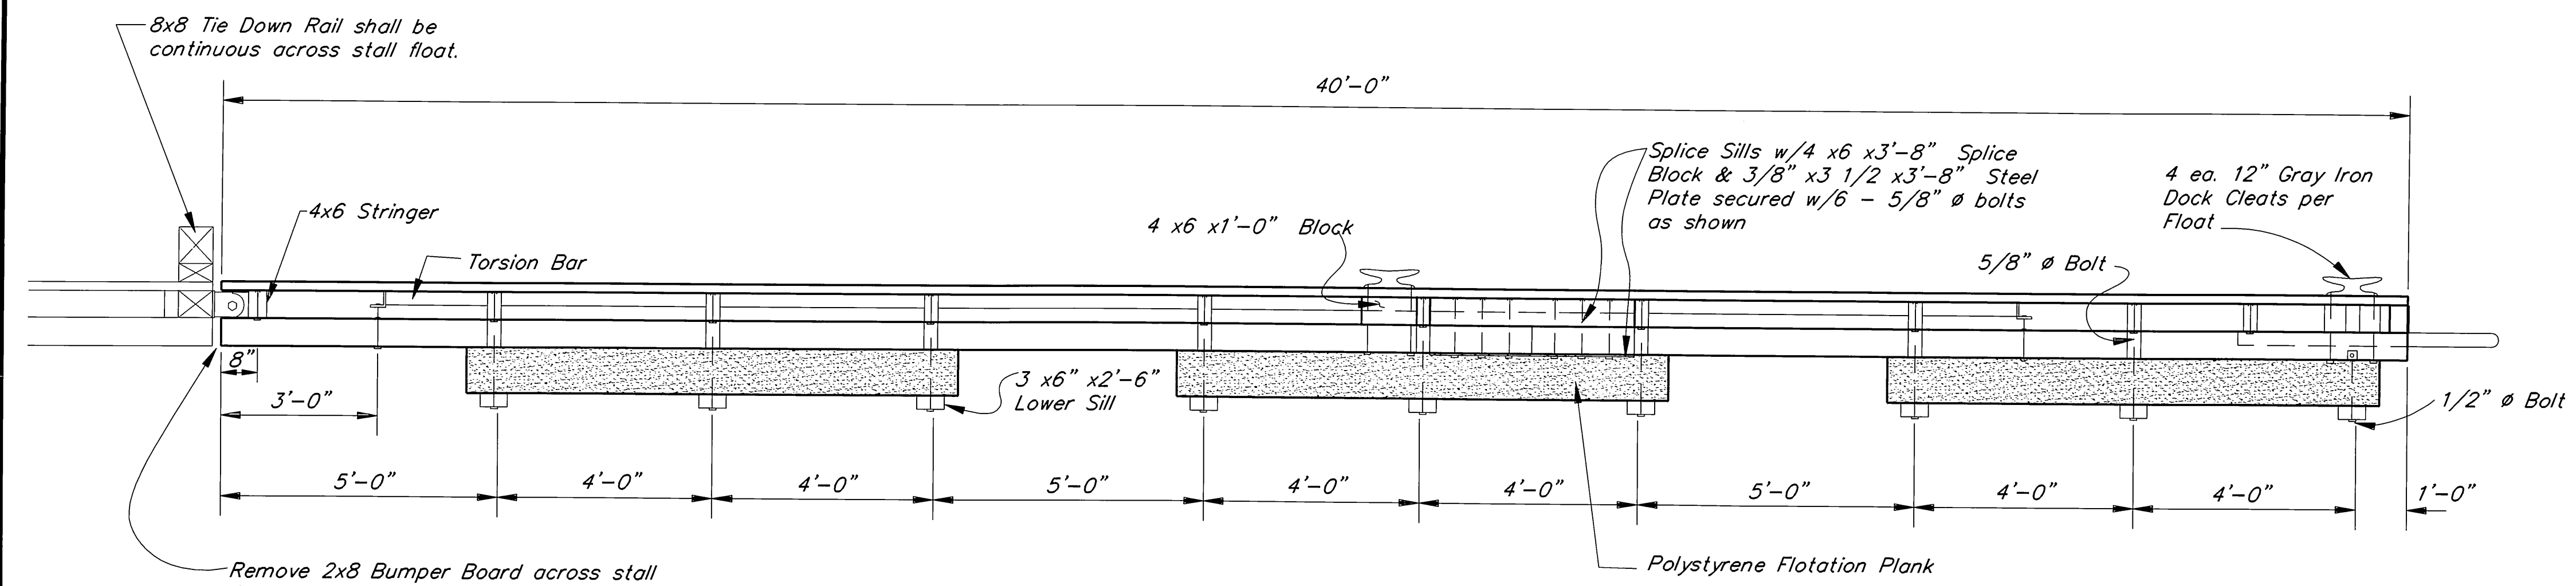



**PLAN**

3'-2 1/2" X 40'-0" STALL FLOAT

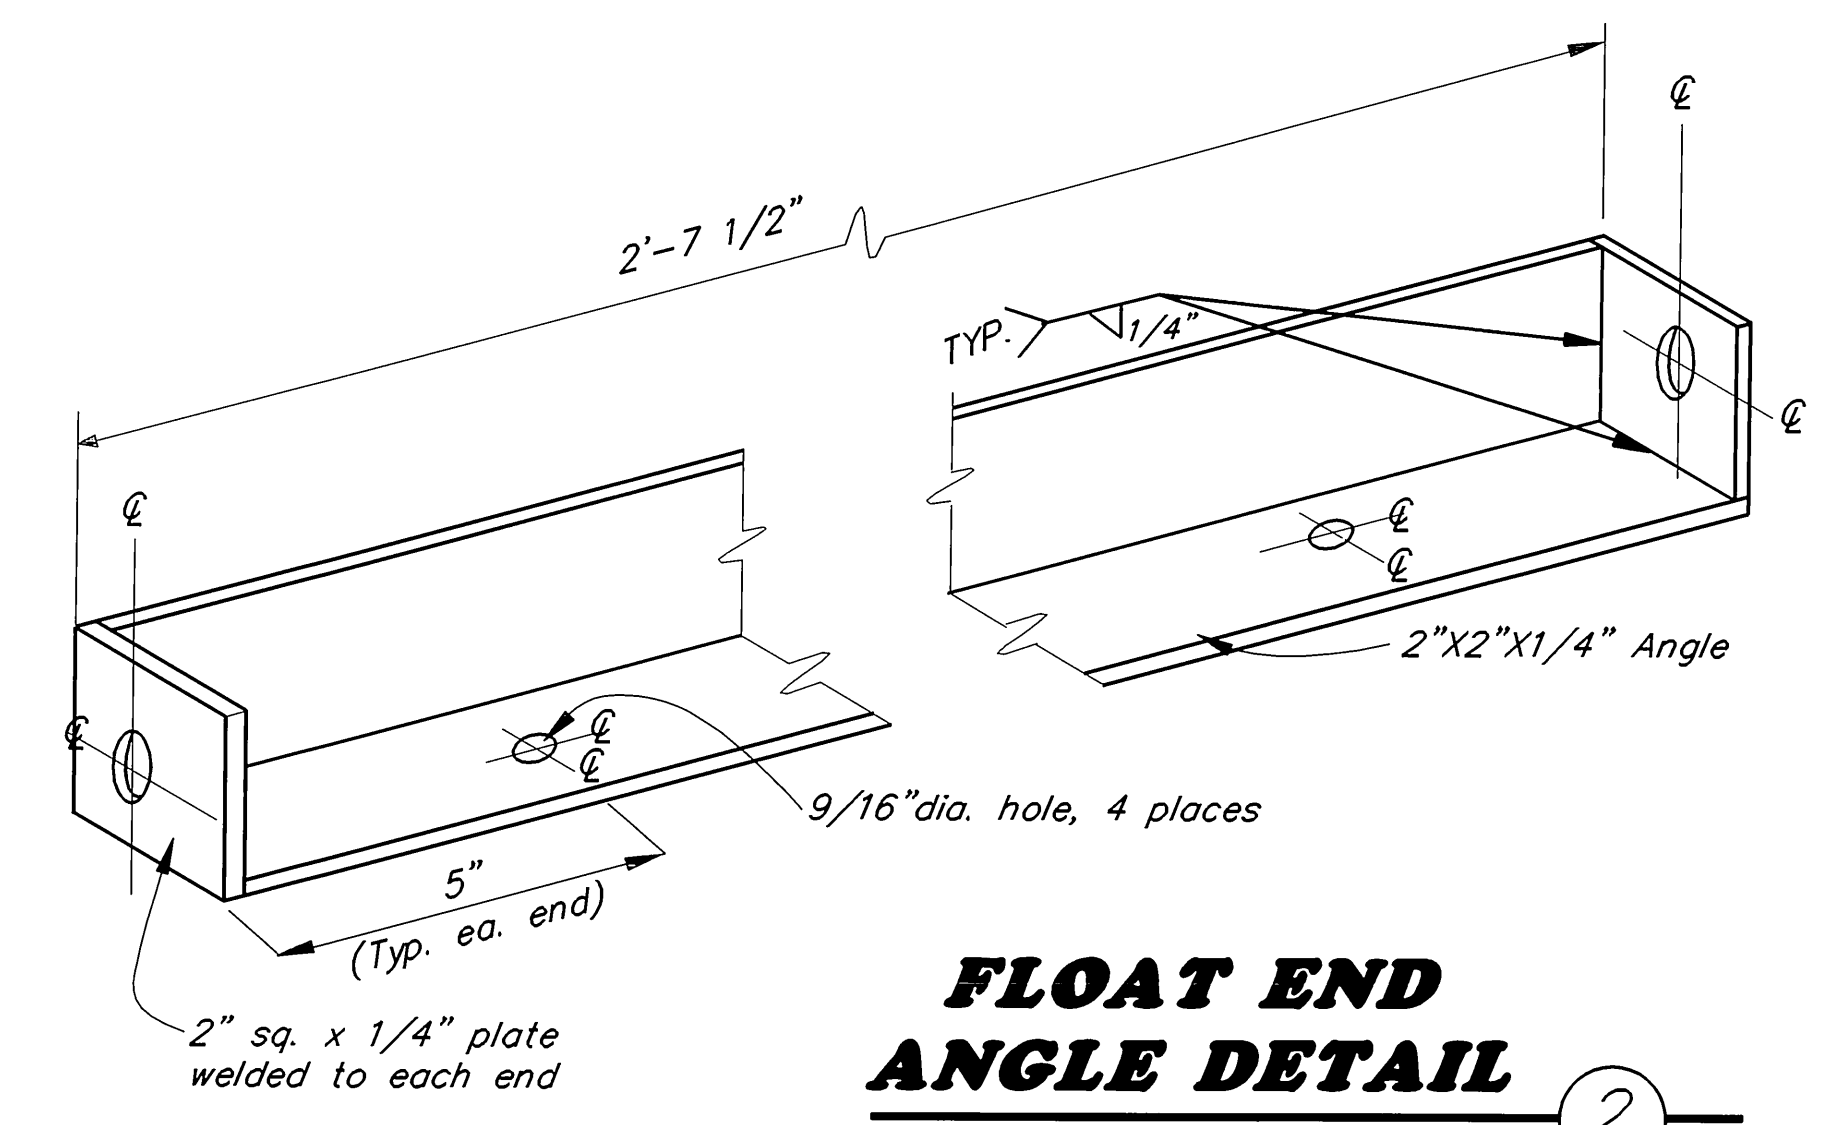

**FLOAT END ANGLE DETAIL**

**STALL FLOAT STABILIZER DETAILS**

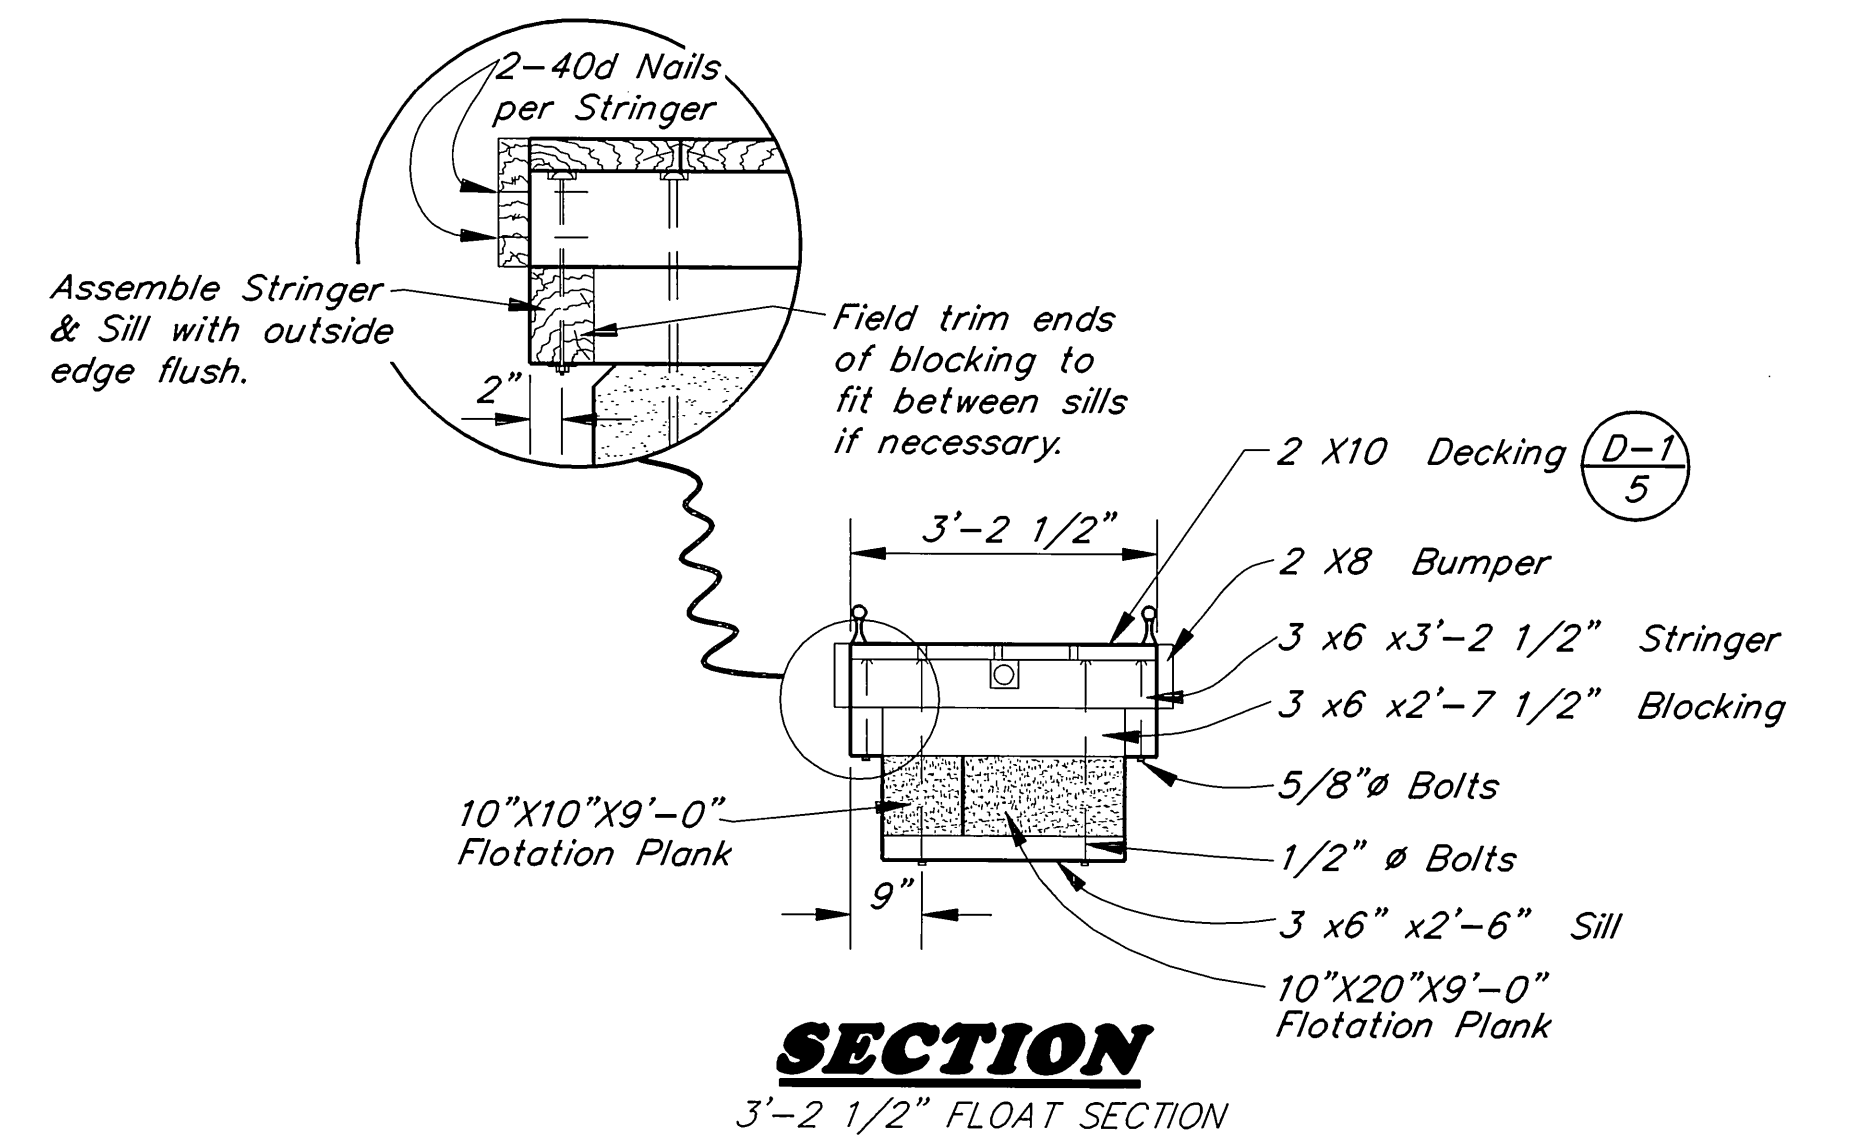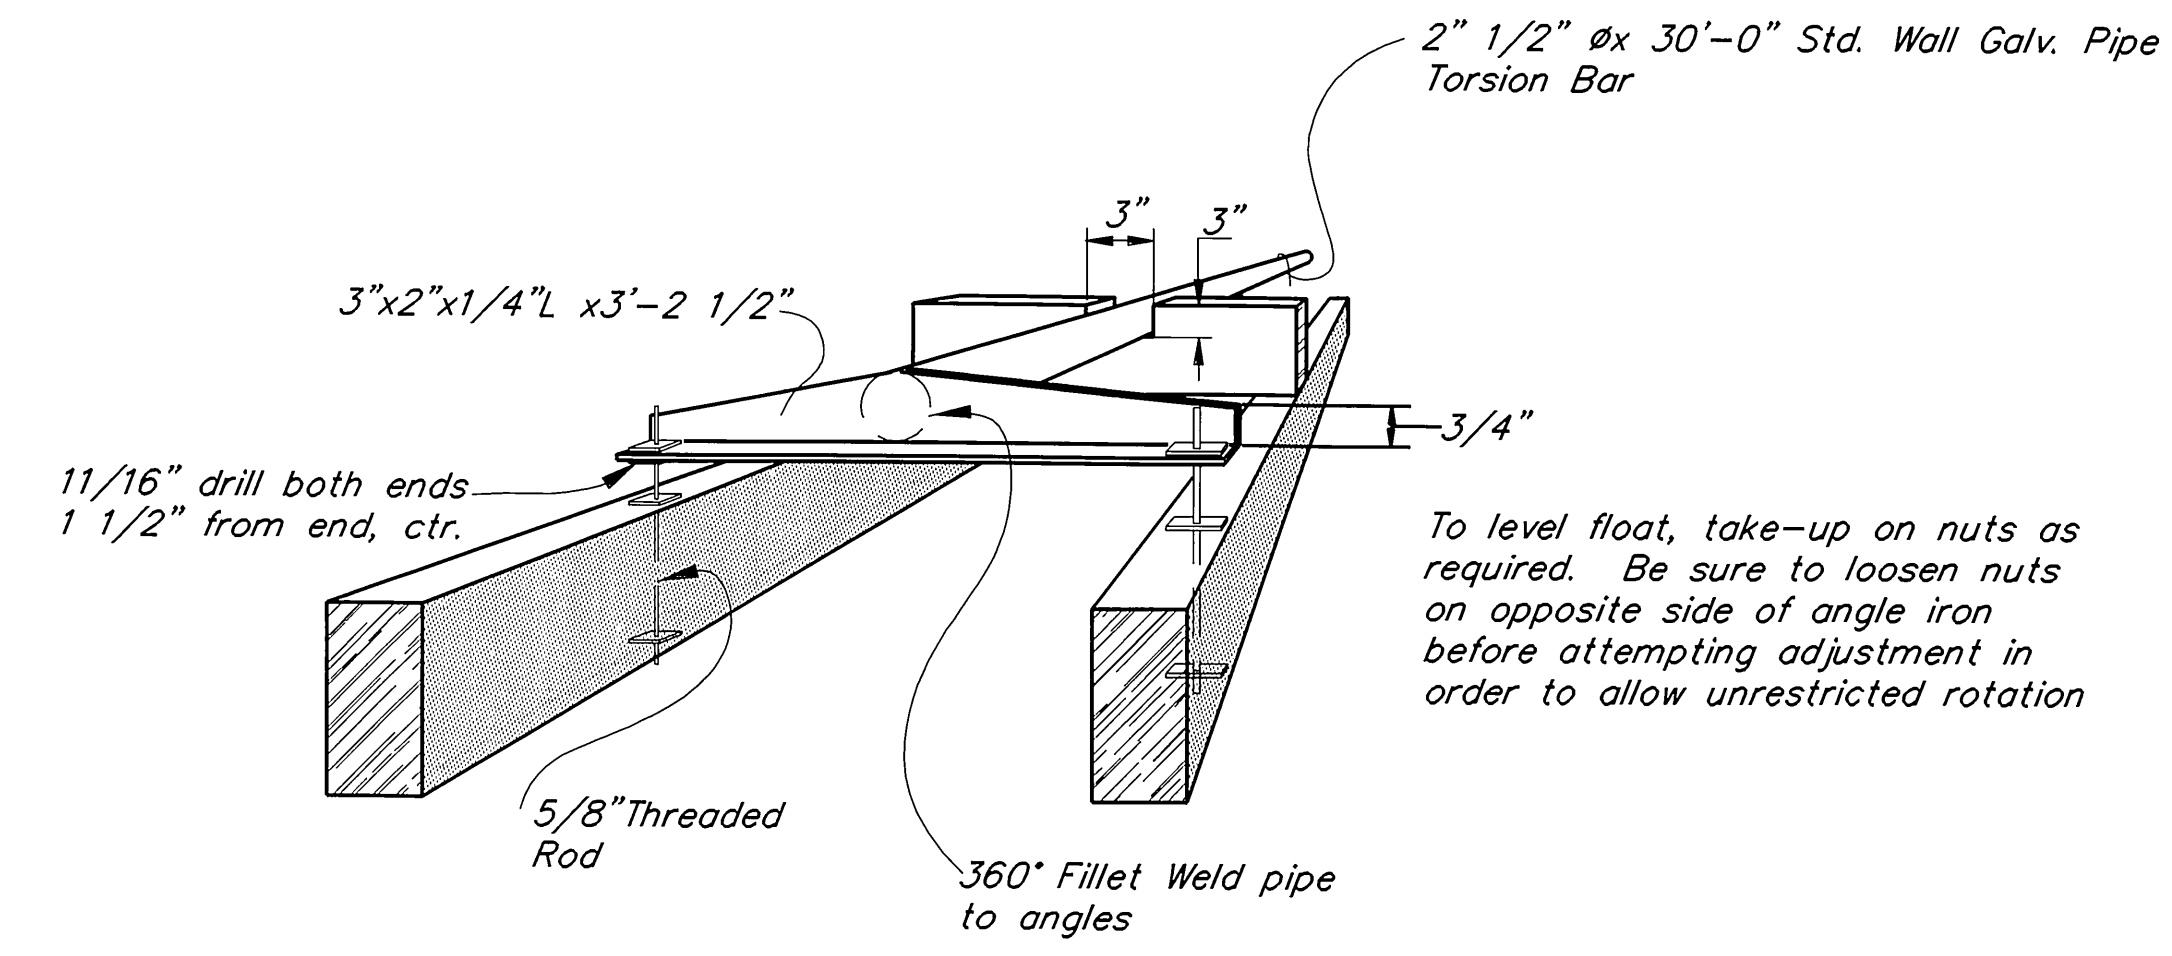

**SECTION**

3'-2 1/2" FLOAT SECTION

BY:	DATE:	DESCRIPTION OF CHANGE:


RECORD OF REVISIONS

STATE OF ALASKA  
DEPARTMENT OF TRANSPORTATION  
AND PUBLIC FACILITIES  
SOUTHEAST REGION DESIGN & CONSTRUCTION

Craig


NOTE: DO NOT SCALE FROM THESE PLANS-USE DIMENSIONS

ALASKA	DESIGNED BY: D. SALDIVAR	PROJECT NO. 70469A
	DRAWN BY: AUTOCADD/CSA	DATE: JULY 1992
	CHECKED BY: D. DOERFLINGER	SHEET 7 OF 17



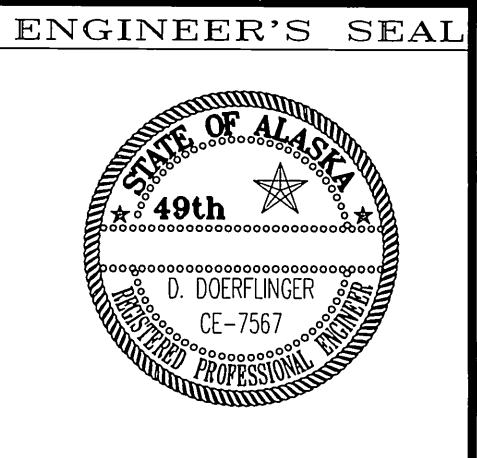


3'-2 1/2" x 40' STALL FLOAT

8x8 Tie Down Rail shall be continuous across stall float. 8'-9" opening at intersection between 10' Main Float & 10' Finger Float.

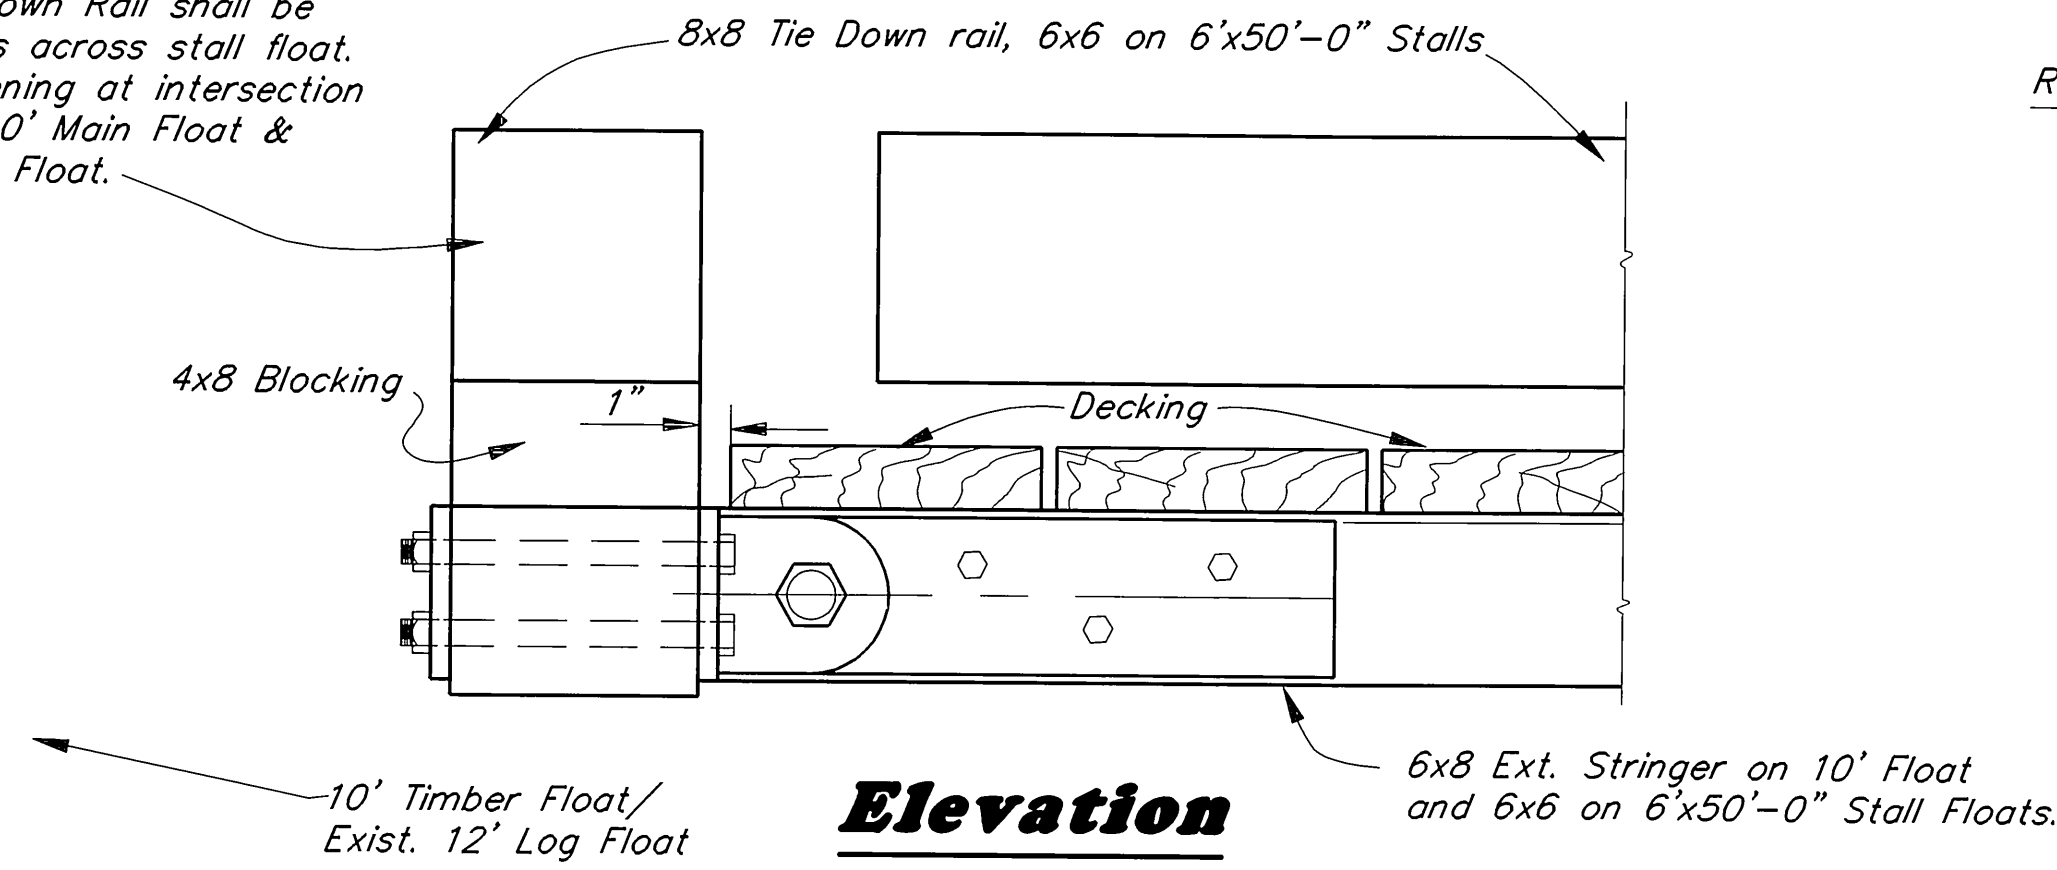


**Elevation**

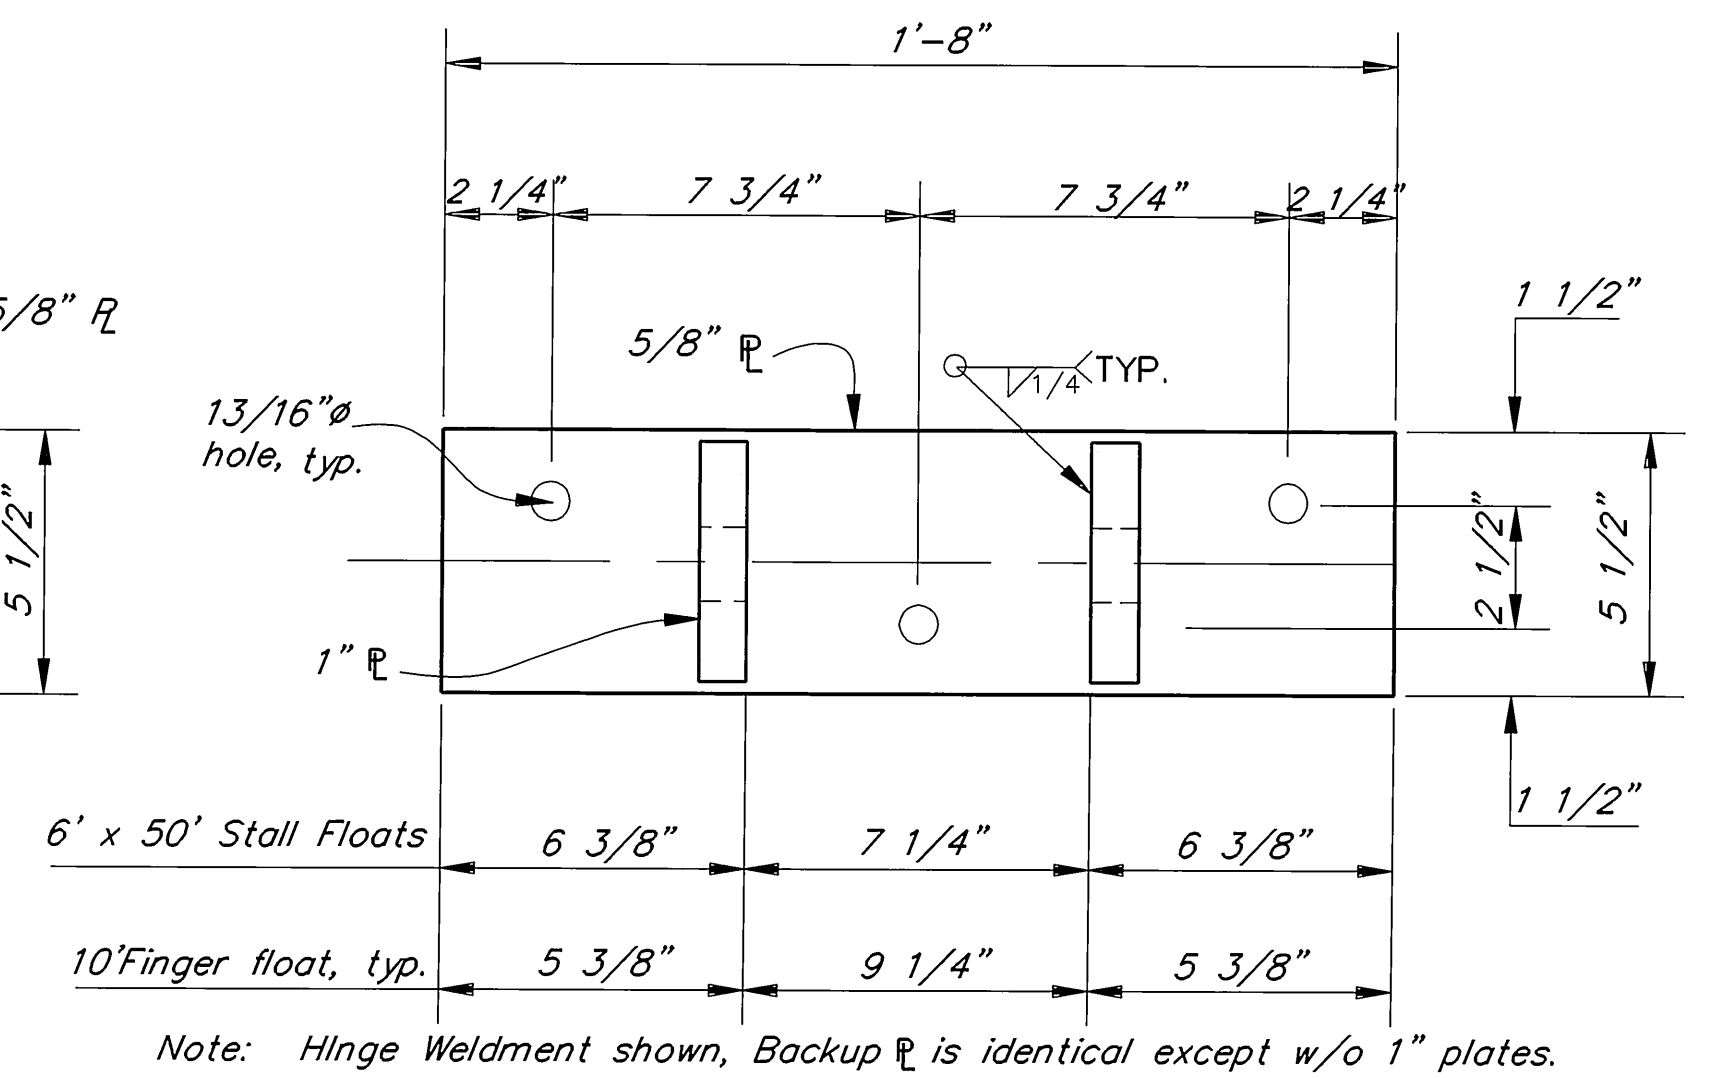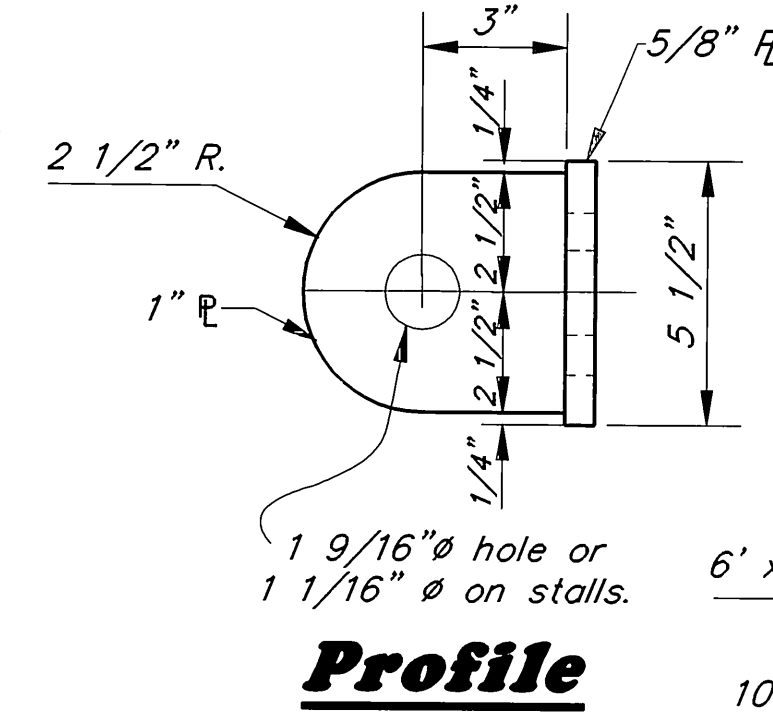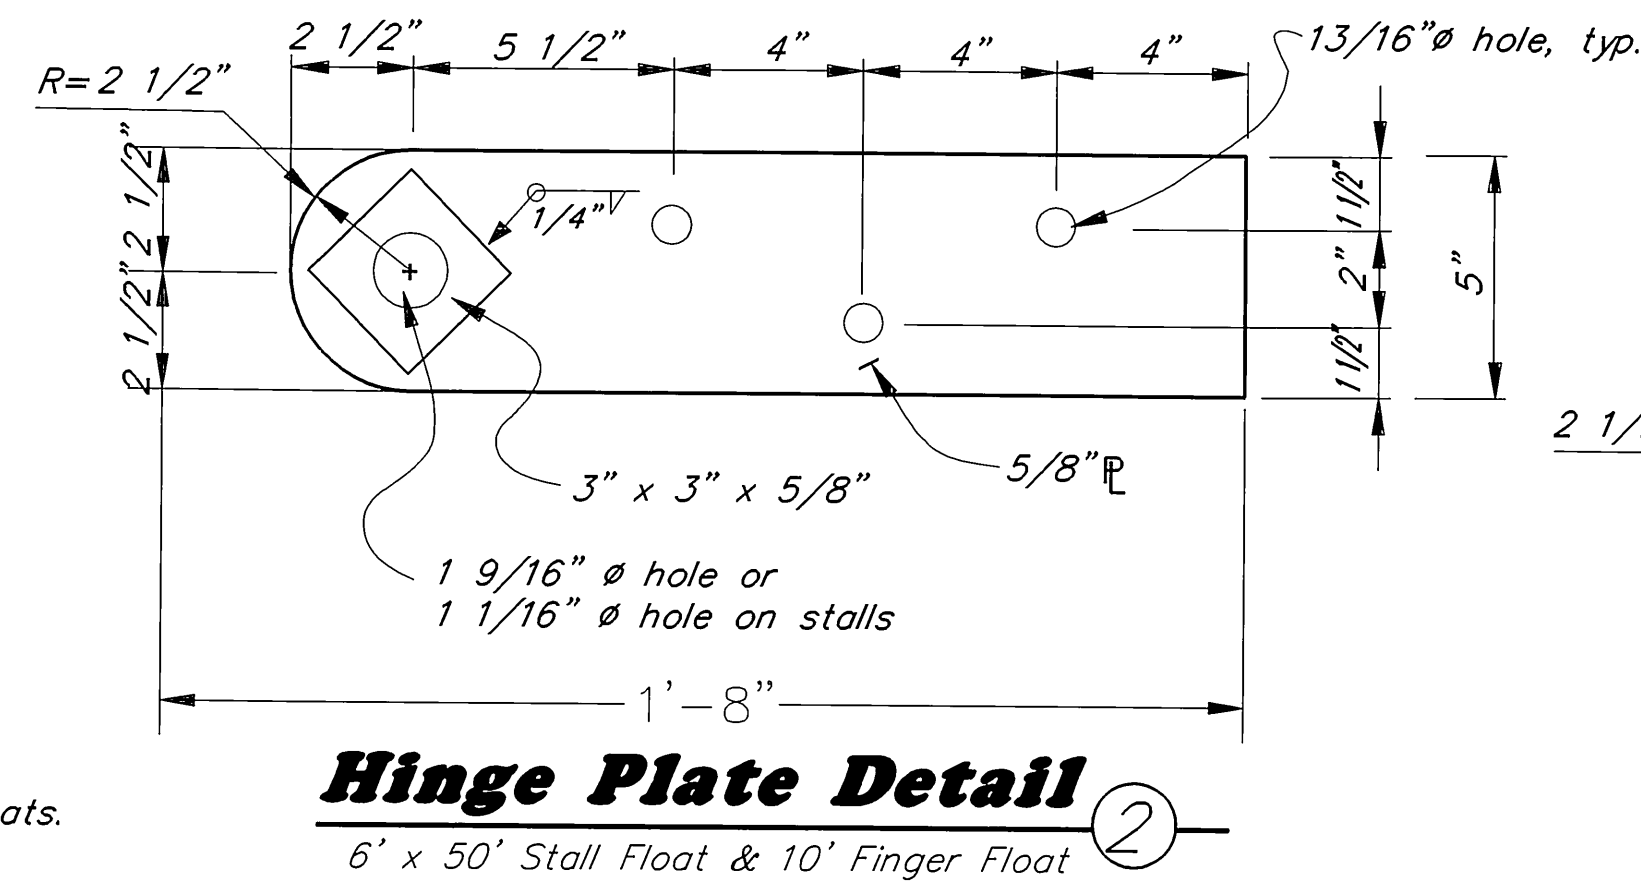

**Elevation**

**HINGE WELDMENT & BACKUP PLATE**


6' x 50' Stall Float & 10' Finger Float

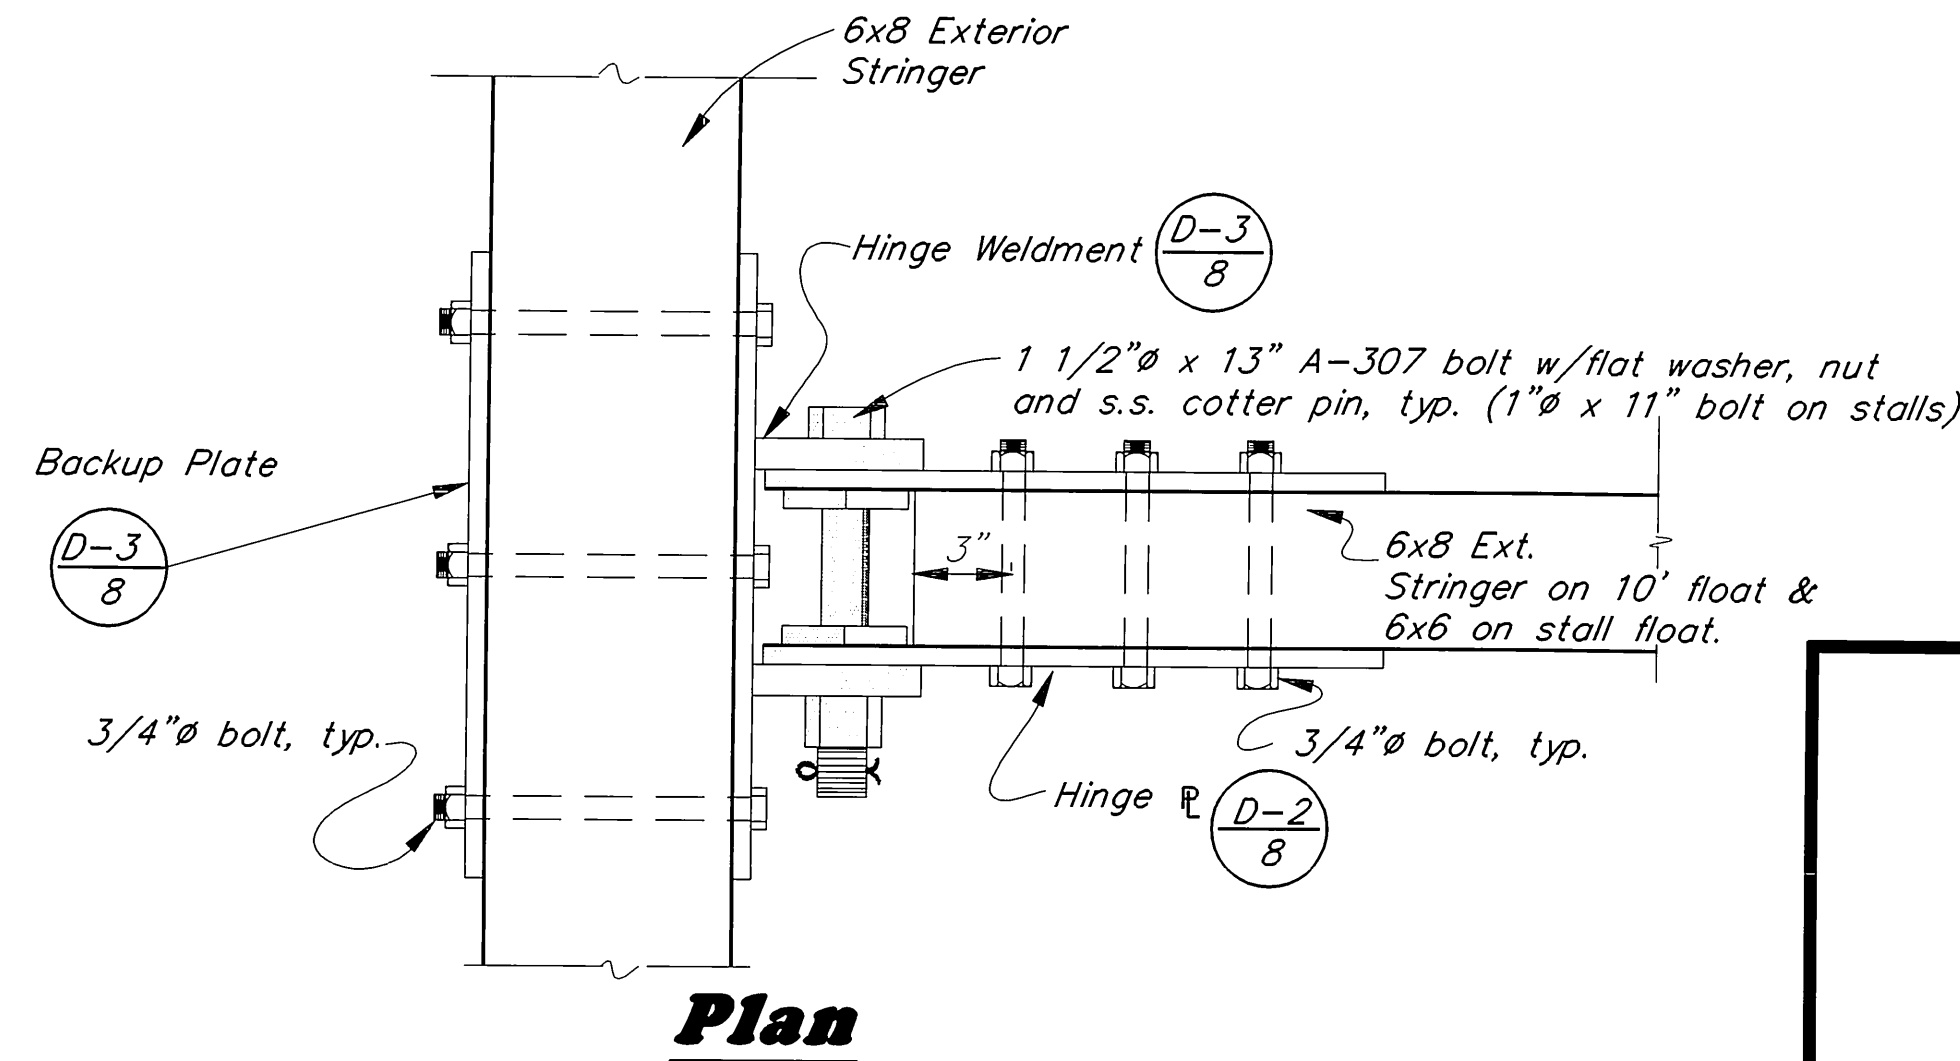

**Plan**

**HINGE CONNECTION DETAIL**


6' x 50' Stall Float 10' Finger Float

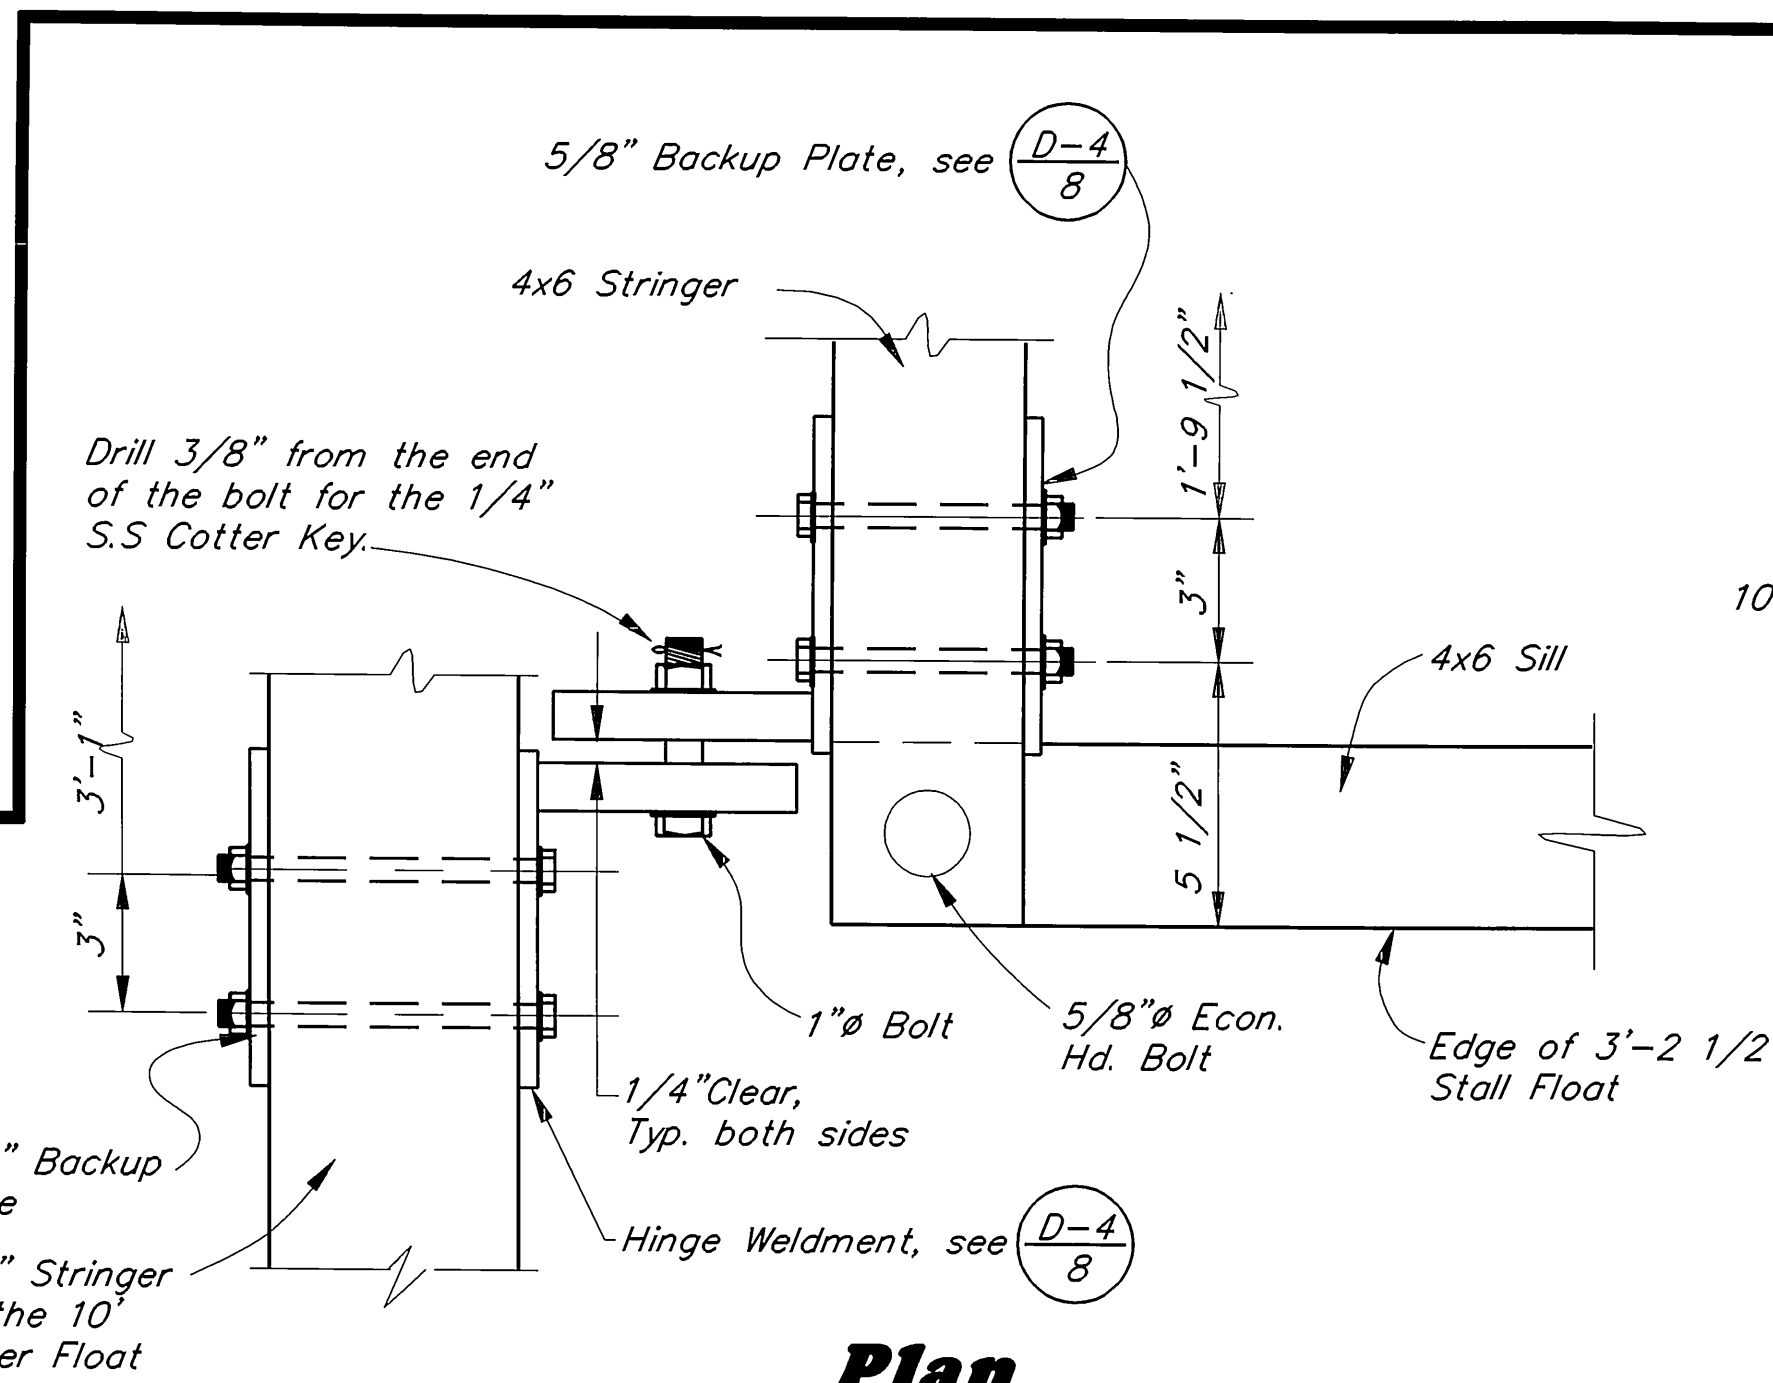

**Plan**

**HINGE CONNECTION DETAIL**

3'-2 1/2" X 40' Stall Float

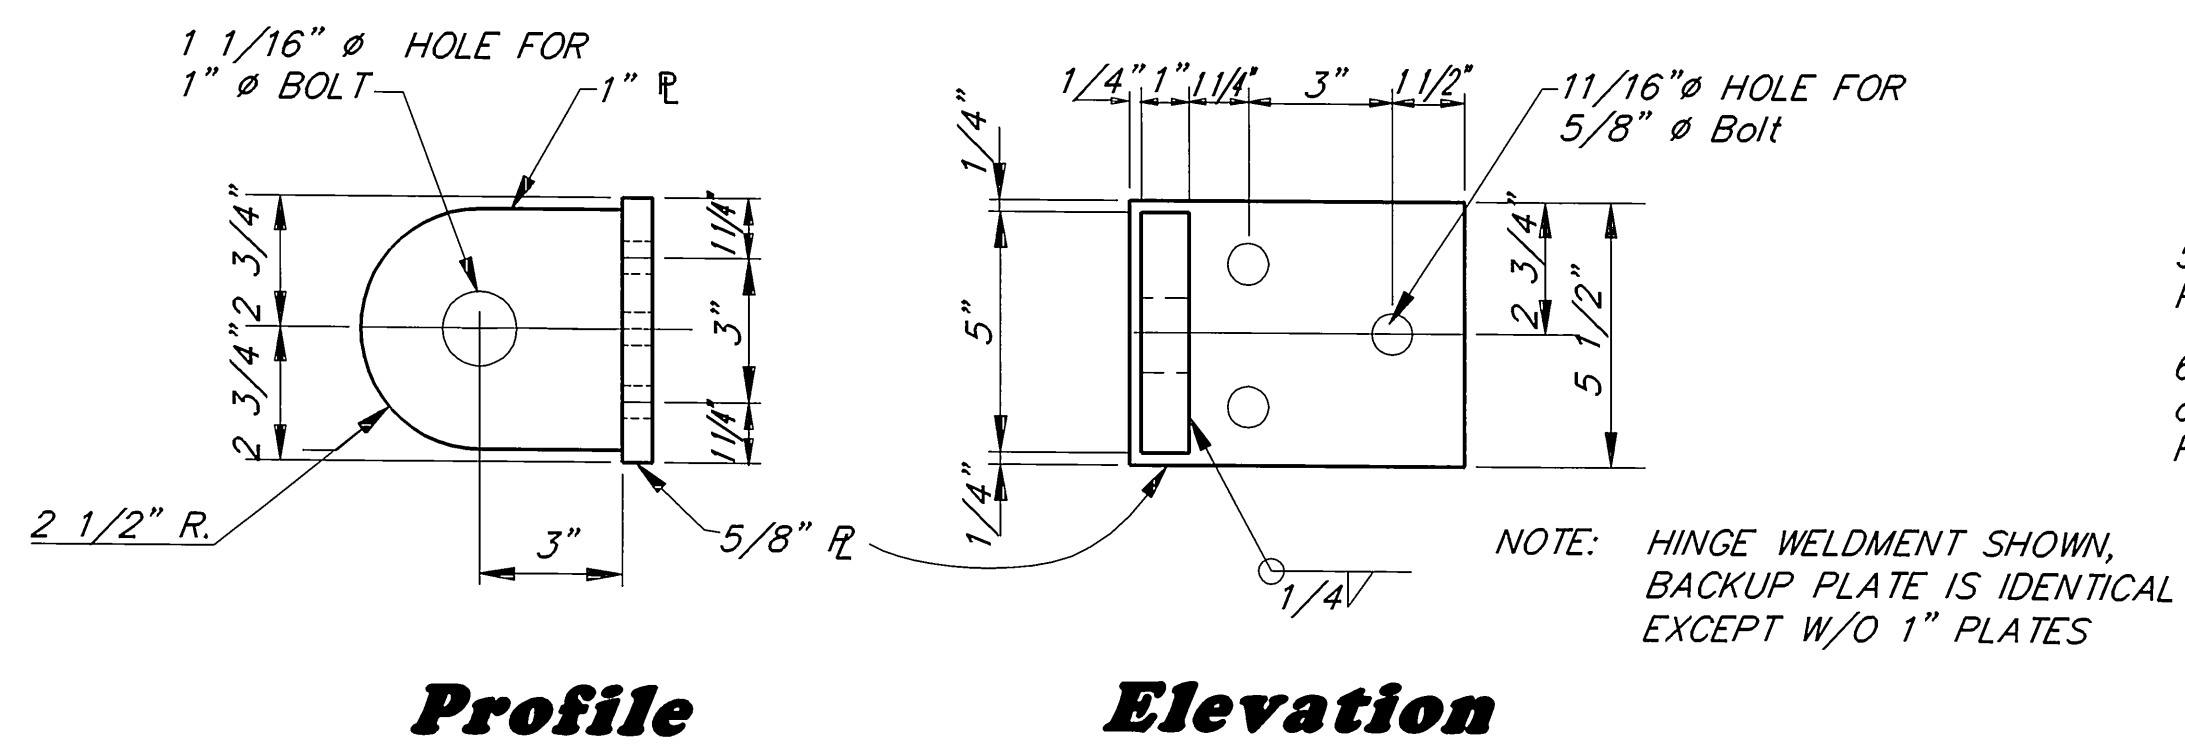


**Profile**

**Elevation**

**HINGE WELDMENT & BACKUP PLATE**

3'-2 1/2" X 40' Stall Float

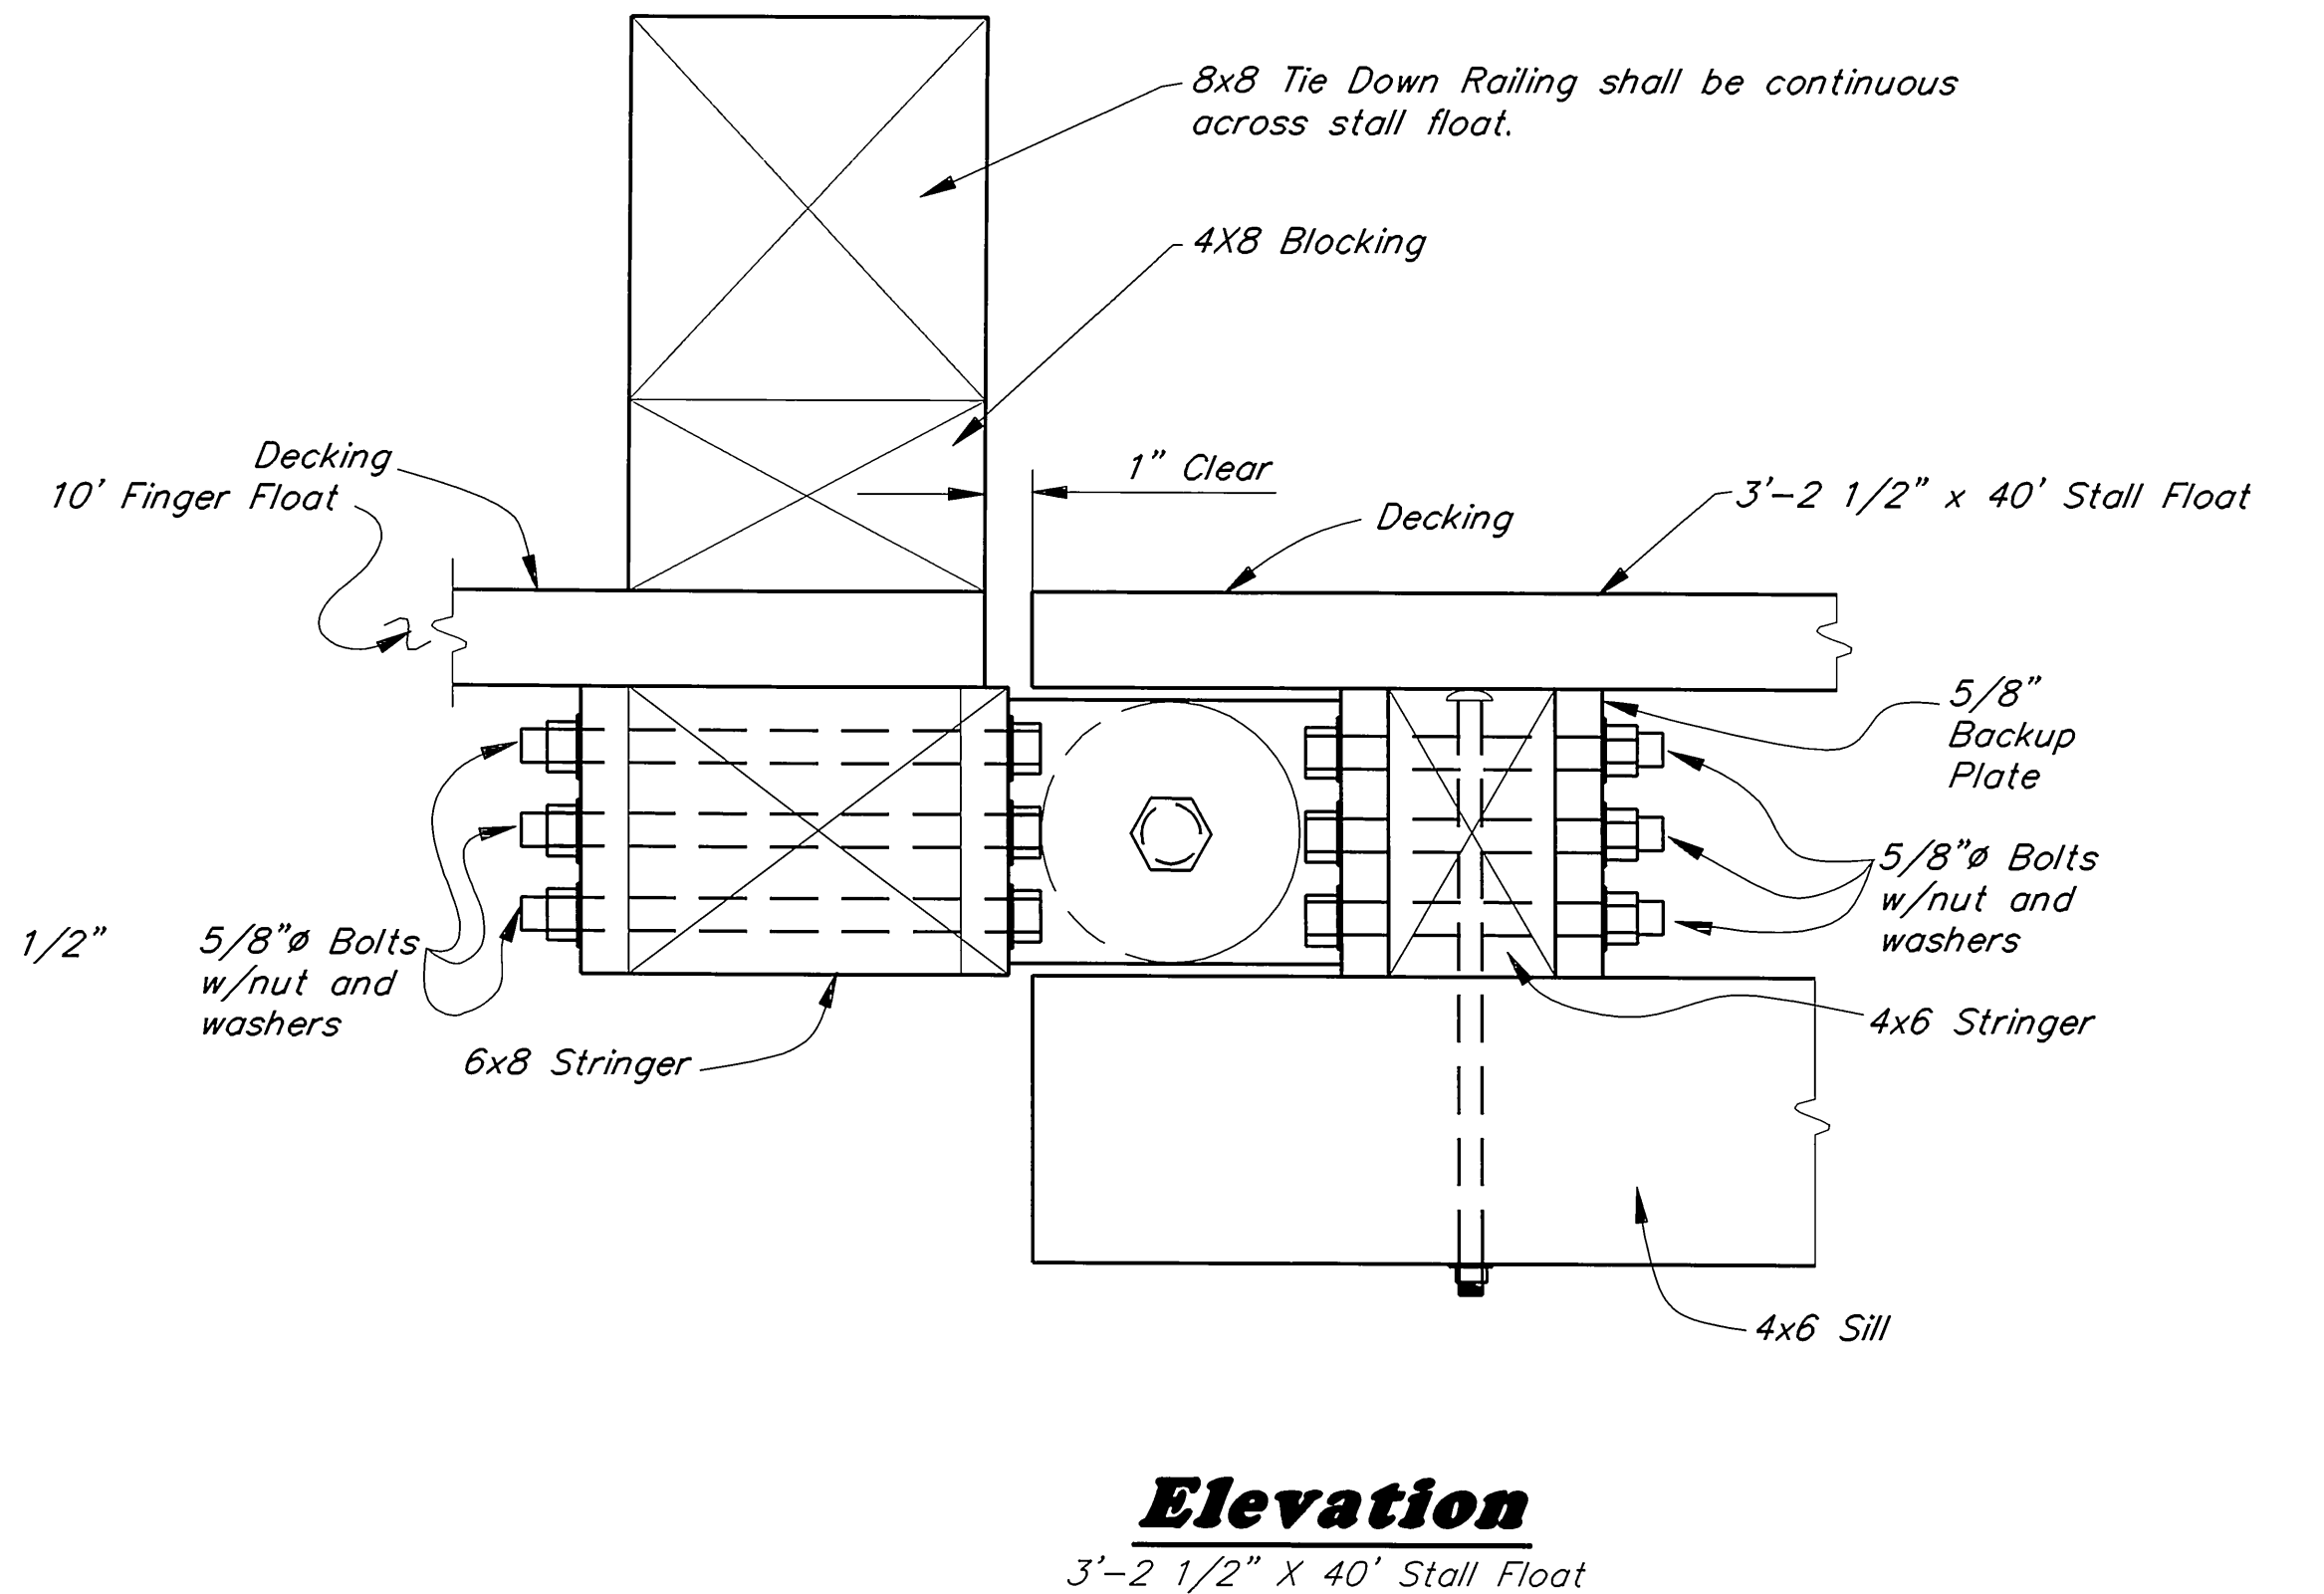

**Elevation**

3'-2 1/2" X 40' Stall Float

**HINGE CONNECTION DETAIL**

3'-2 1/2" X 40' Stall Float

NOTE: DO NOT SCALE FROM THESE PLANS—USE DIMENSIONS

BY:	DATE:	DESCRIPTION OF CHANGE:

RECORD OF REVISIONS

STATE OF ALASKA  
DEPARTMENT OF TRANSPORTATION  
AND PUBLIC FACILITIES  
SOUTHEAST REGION DESIGN & CONSTRUCTION


Craig


HINGE CONNECTION DETAILS

Alaska

DESIGNED BY: D. SALDIVAR  
DRAWN BY: AUTOCADD/CSA  
CHECKED BY: D. DOERFLINGER


PROJECT NO. 70649A  
DATE: JULY 1992  
SHEET 8 OF 17

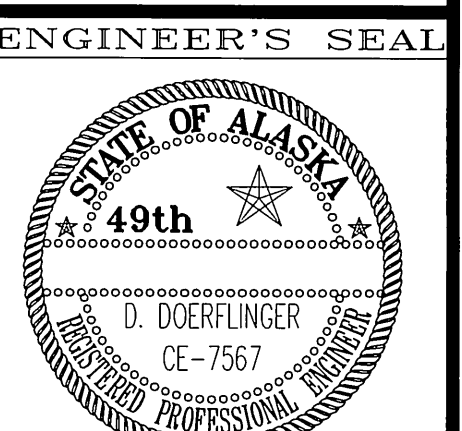

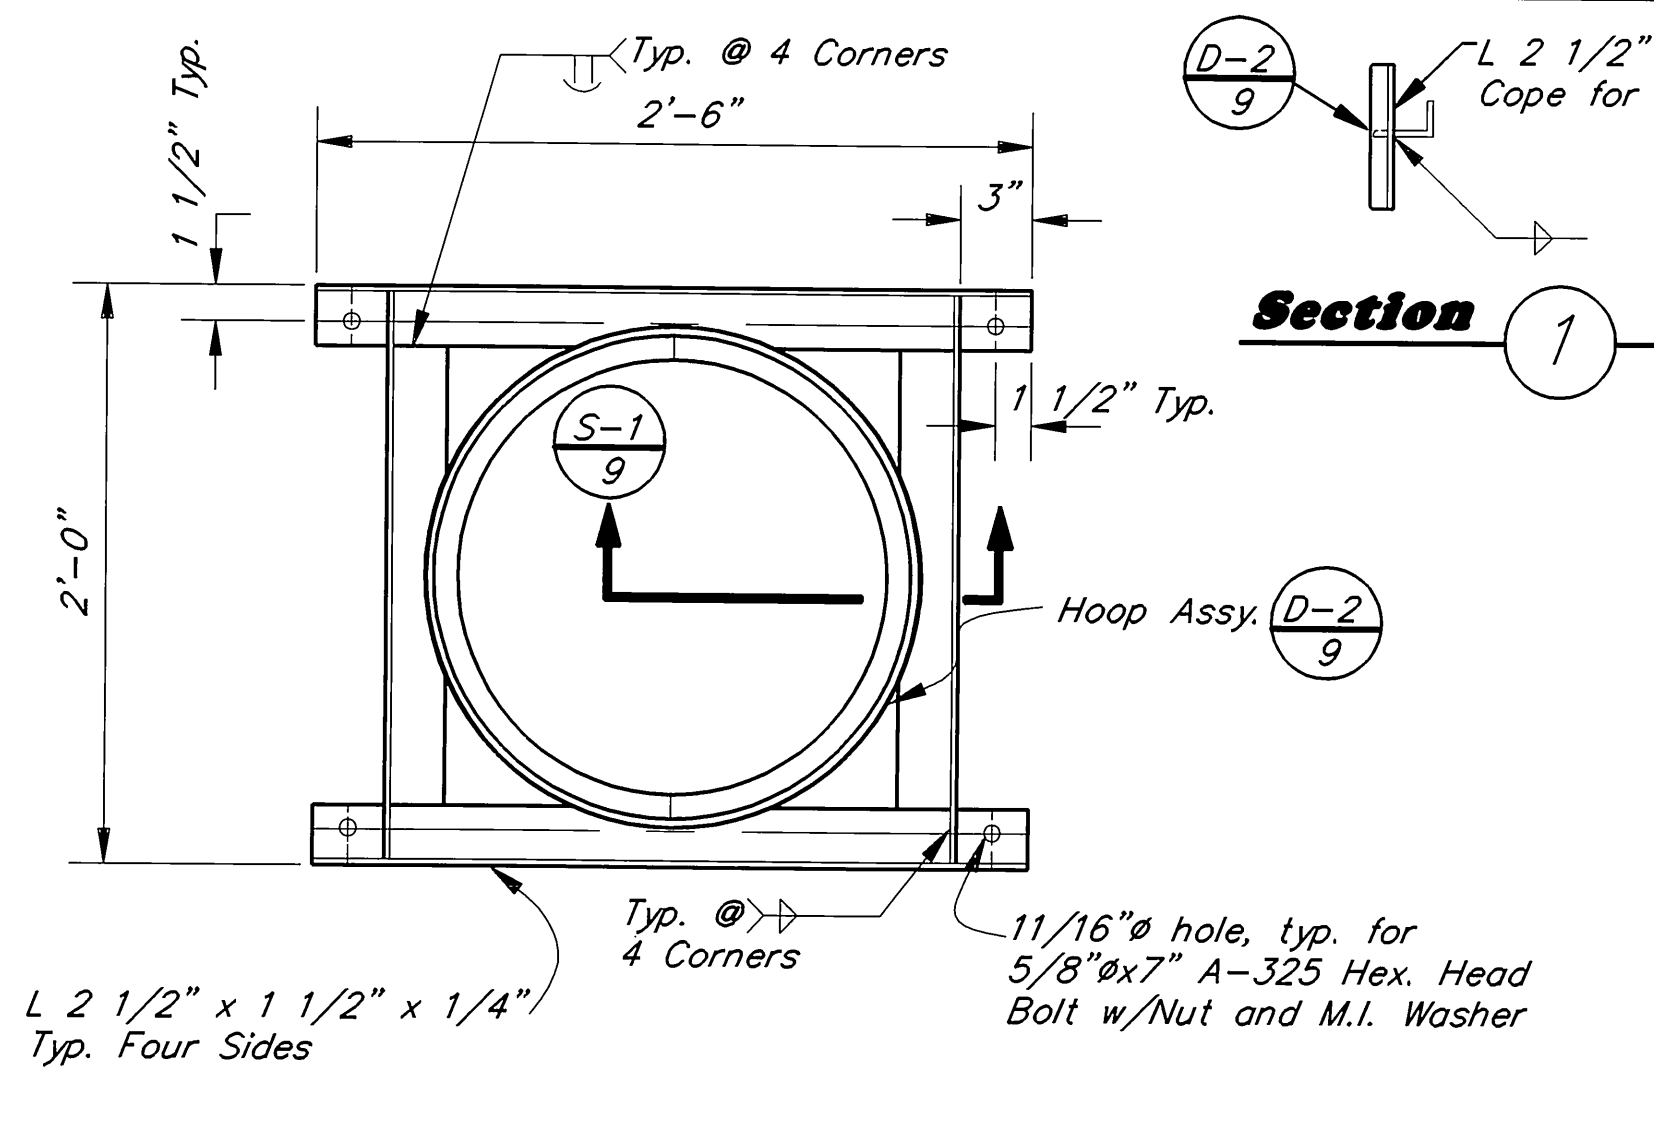


**INTERIOR PILE COLLAR DETAIL**

1

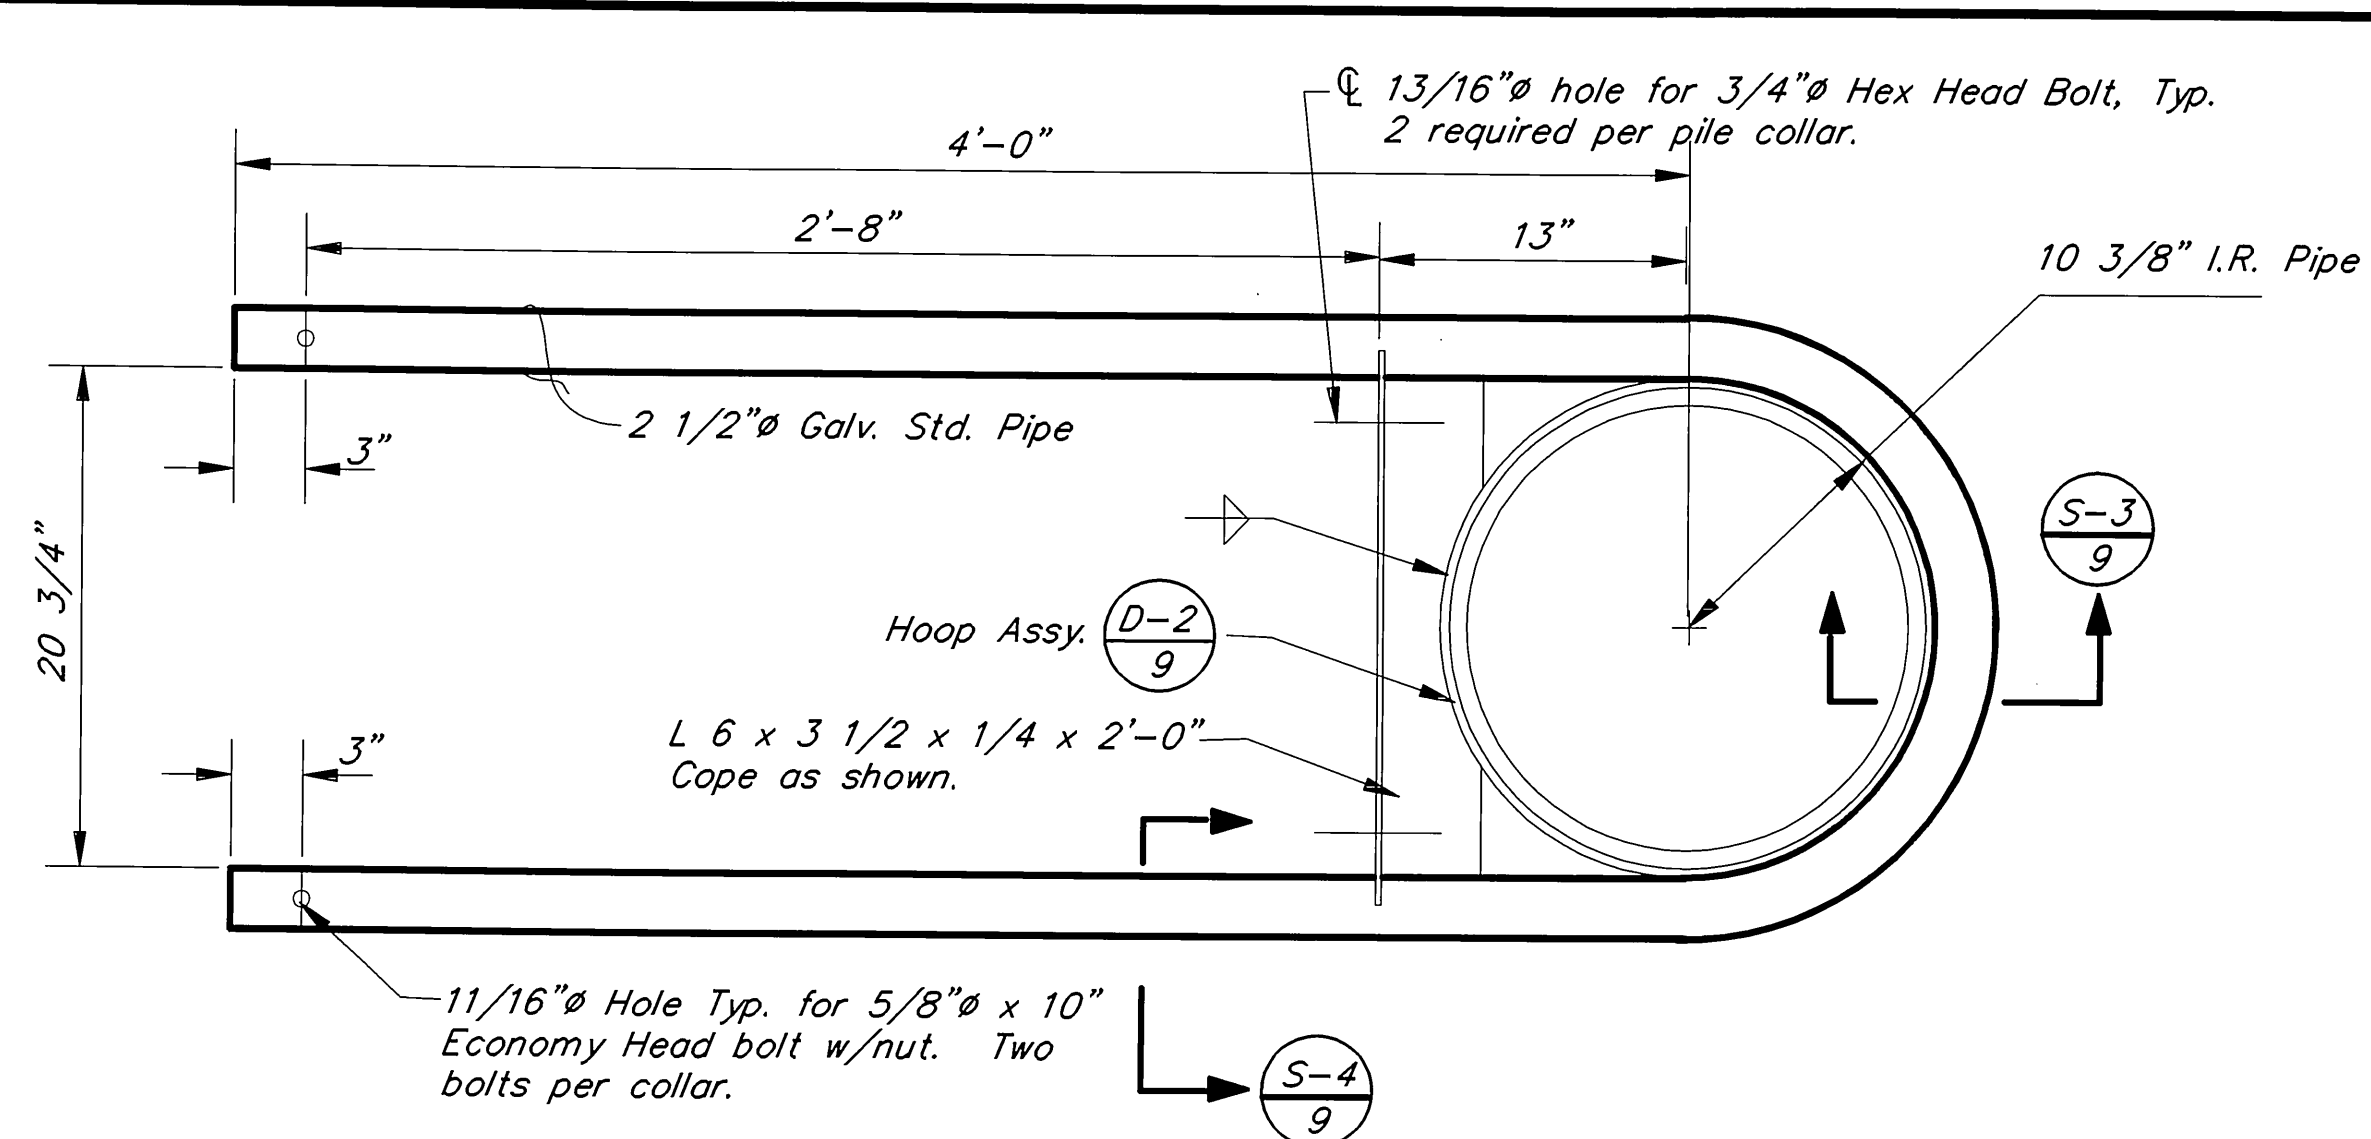


**EXTERIOR PILE COLLAR DETAILS**

3

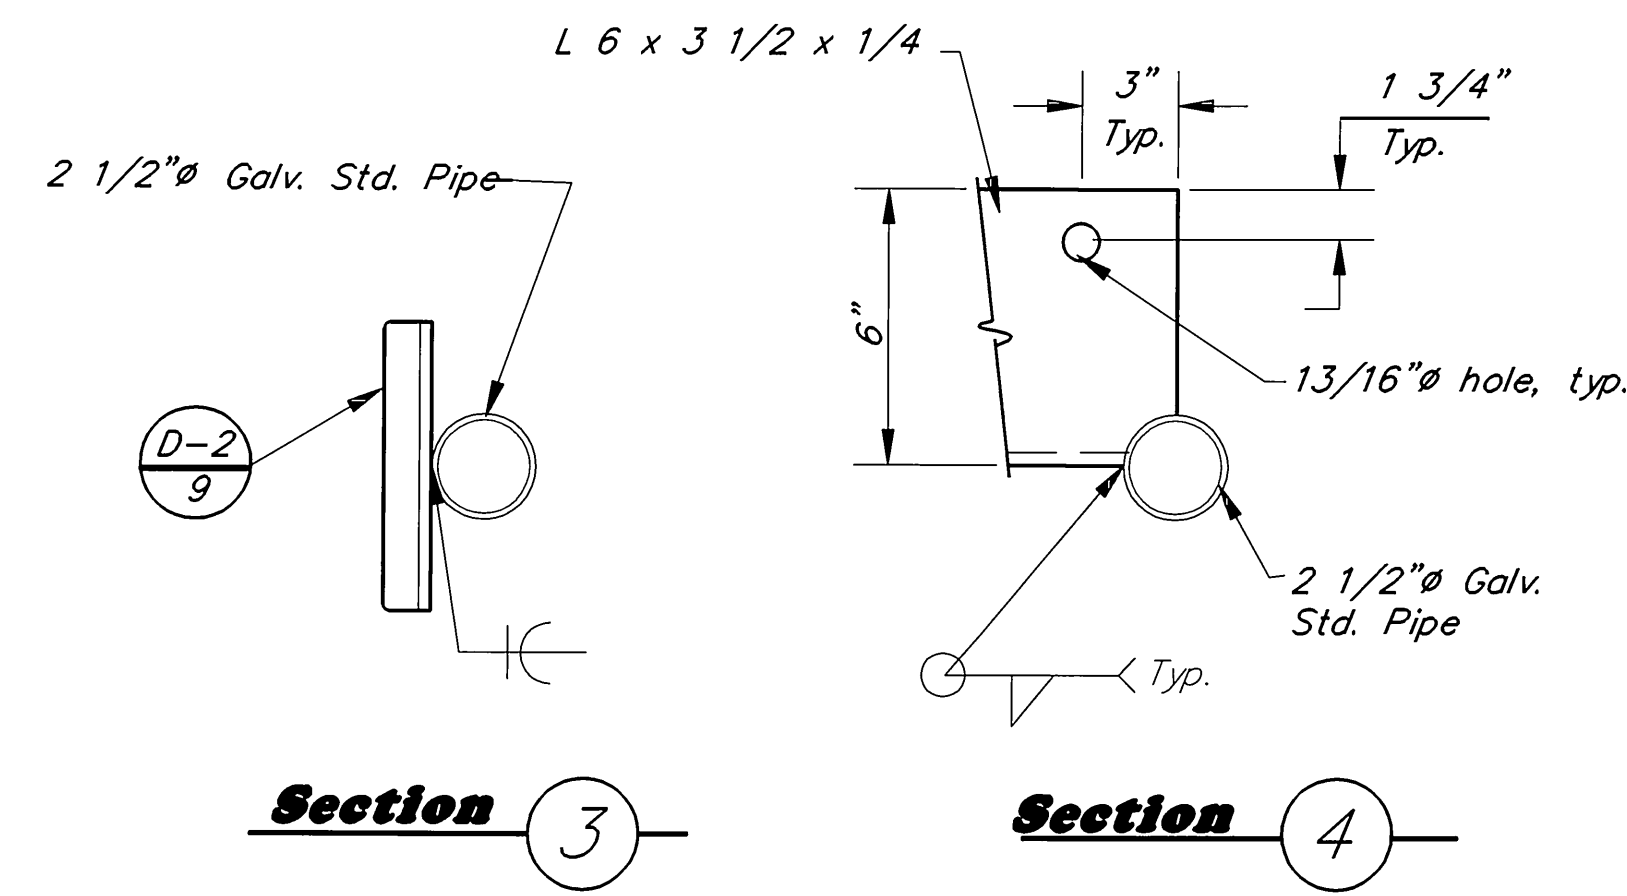

**Section 3**


**Section 4**

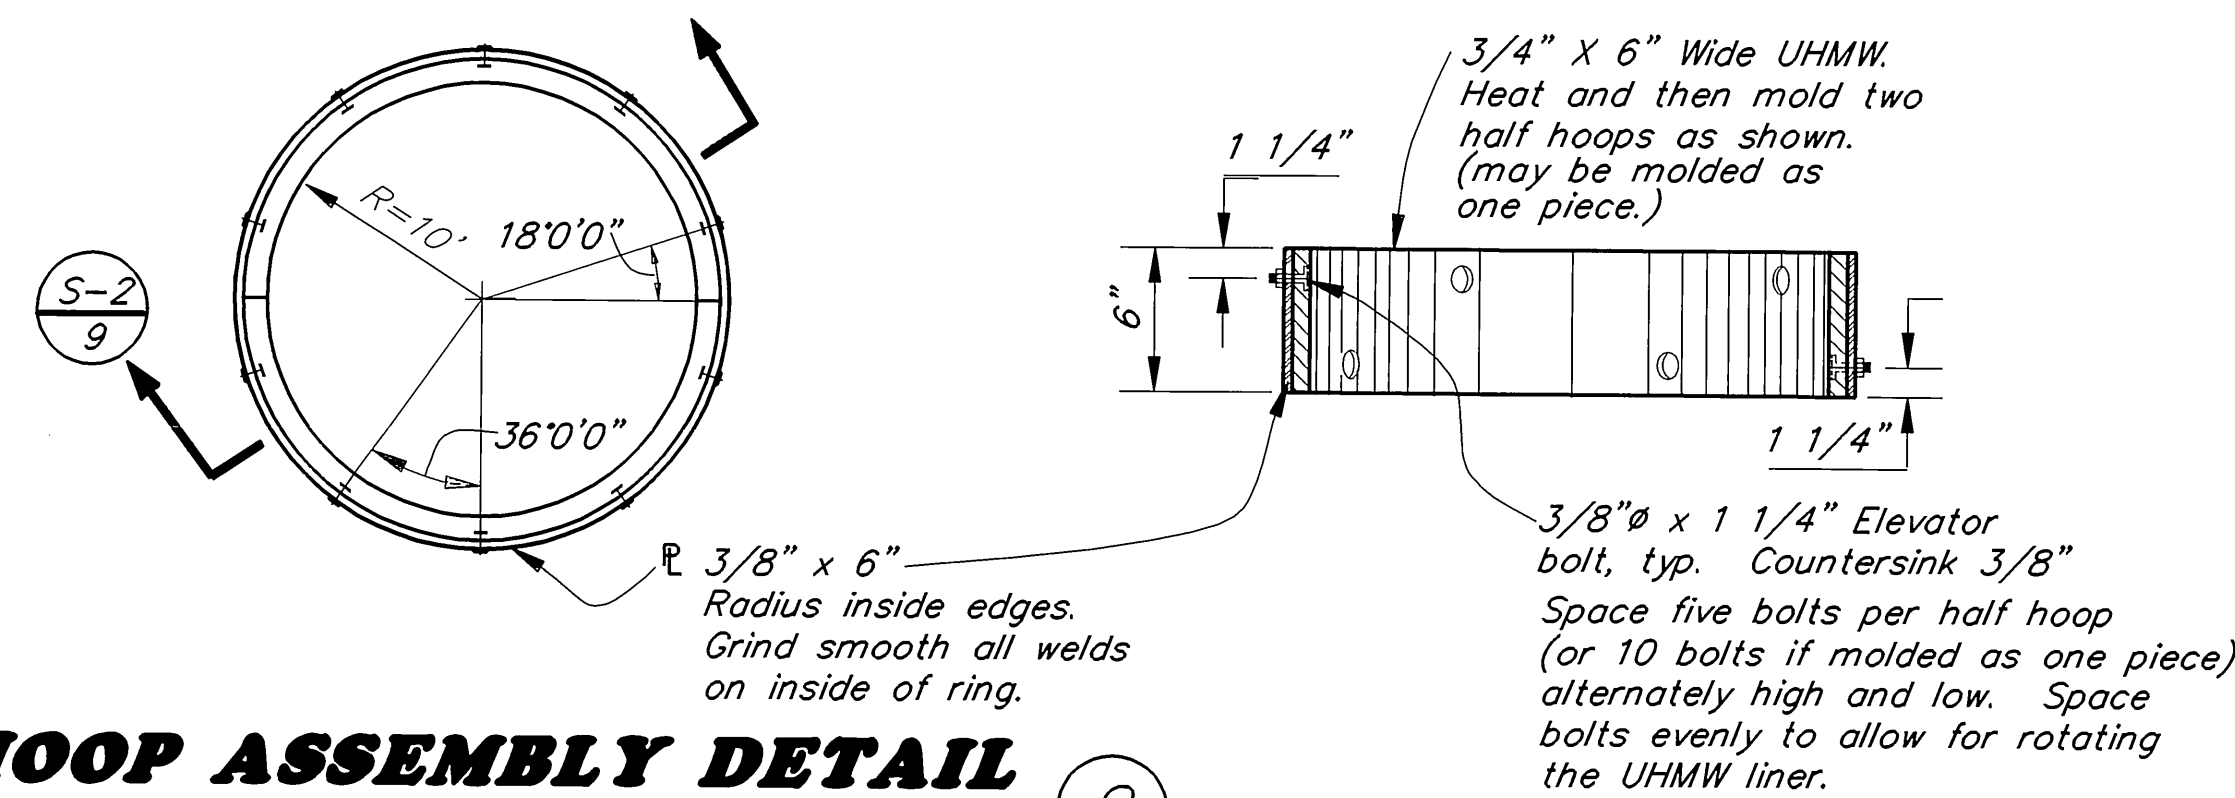

**HOOP ASSEMBLY DETAIL**

2

**Section 2**

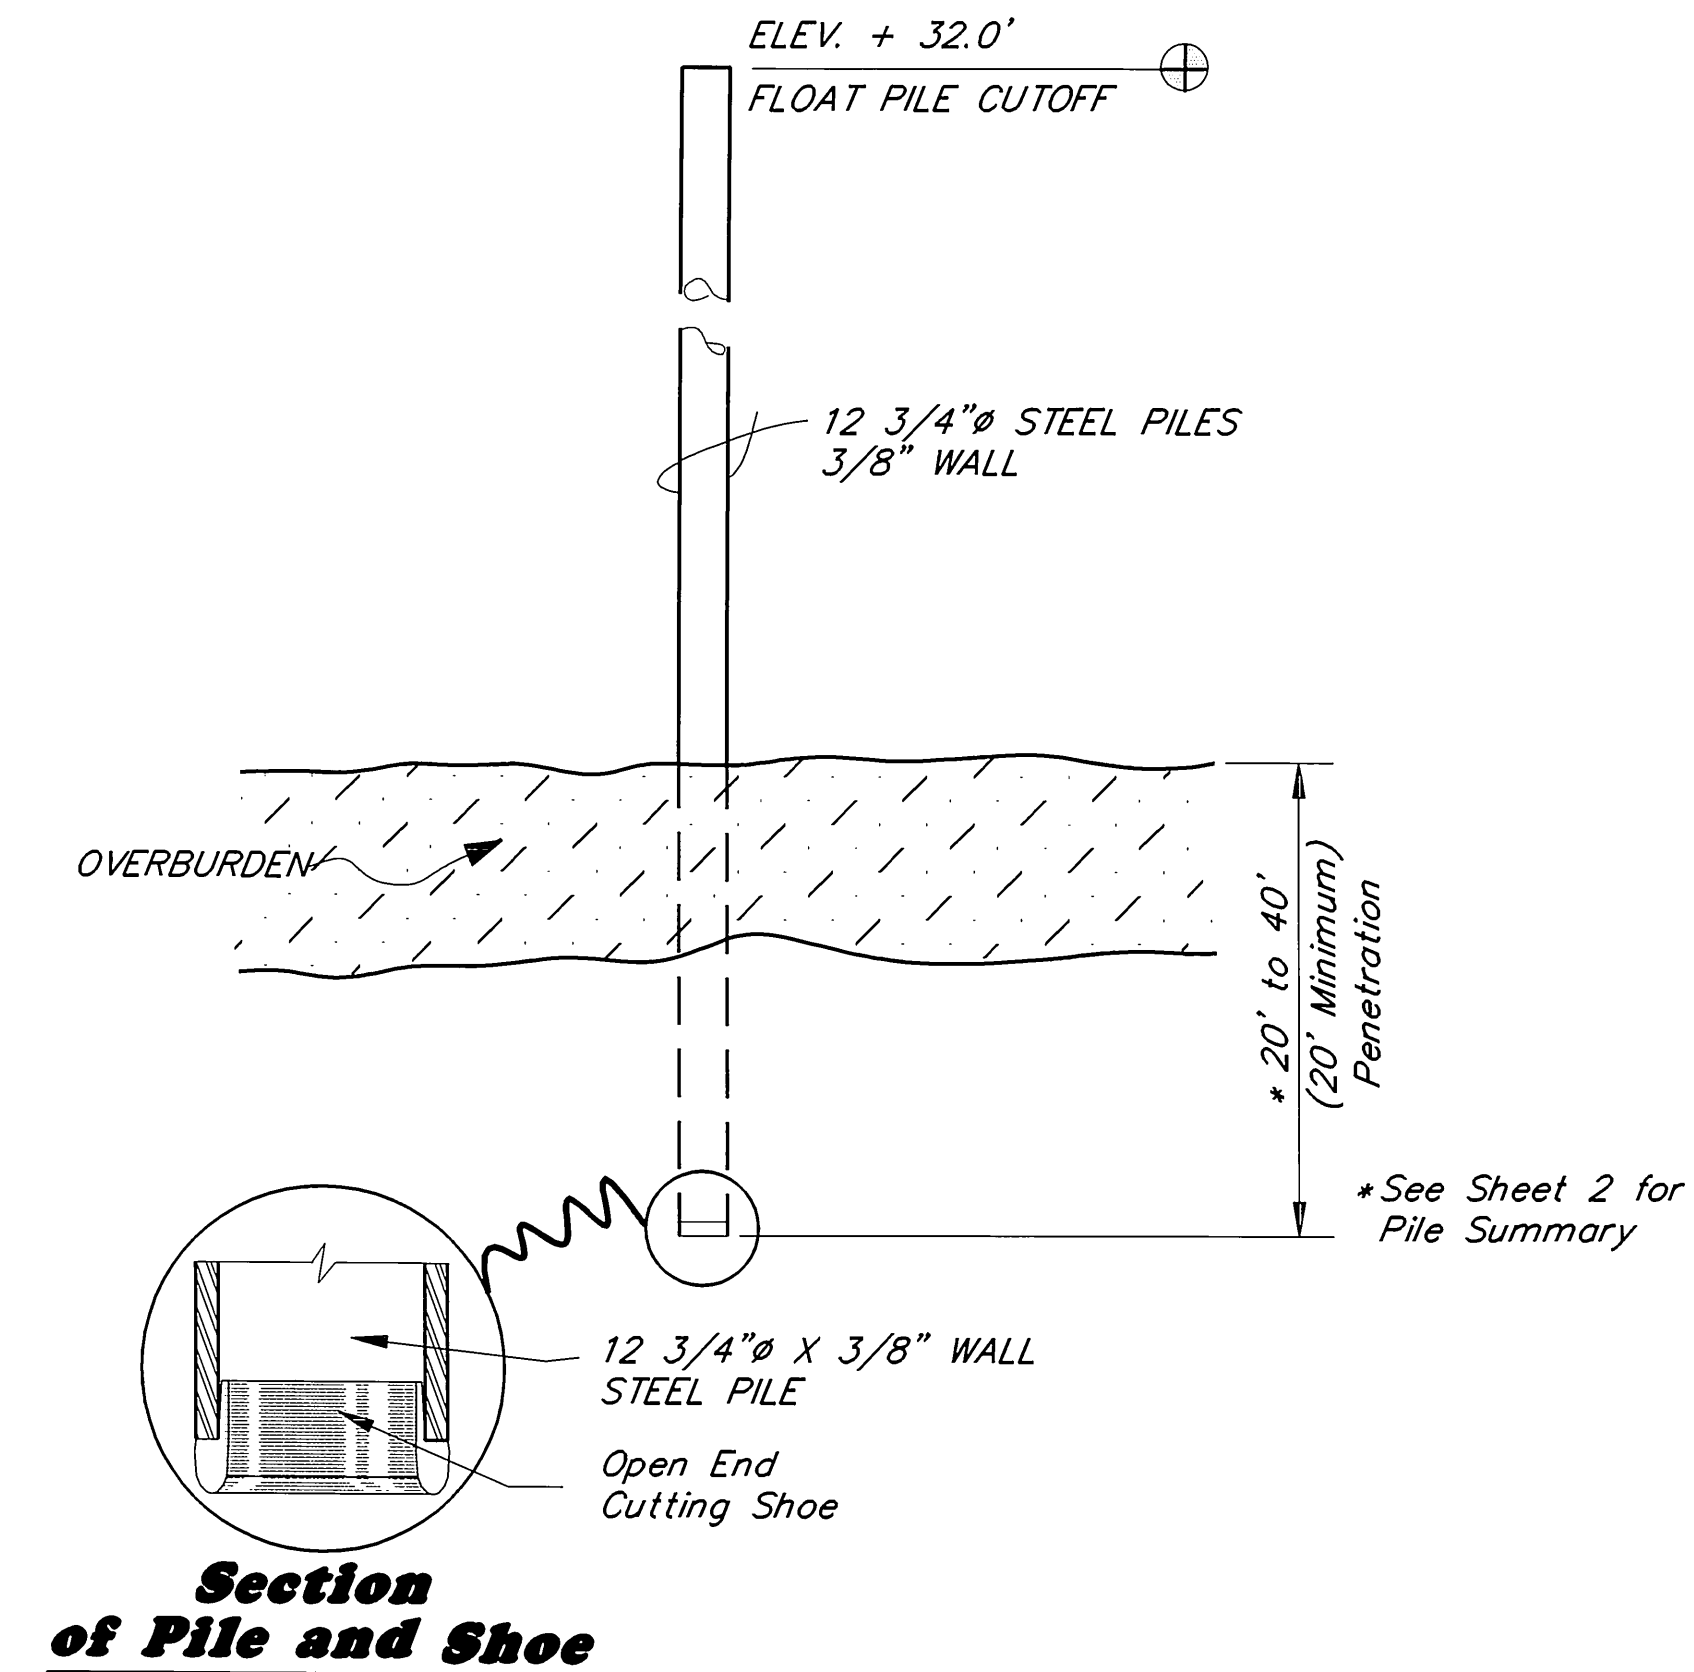

**Section of Pile and Shoe**

**STEEL PILE DETAIL**

4

BY:	DATE:	DESCRIPTION OF CHANGE:


STATE OF ALASKA  
DEPARTMENT OF TRANSPORTATION  
AND PUBLIC FACILITIES  
SOUTHEAST REGION DESIGN & CONSTRUCTION


Craig

**PILE COLLAR DETAILS**

NOTE: DO NOT SCALE FROM THESE PLANS—USE DIMENSIONS


DESIGNED BY: D. SALDIVAR	PROJECT NO. 70649A
DRAWN BY: AUTOCADD/CSA	DATE: JULY 1992
CHECKED BY: D. DOERFLINGER	SHEET 9 OF 17

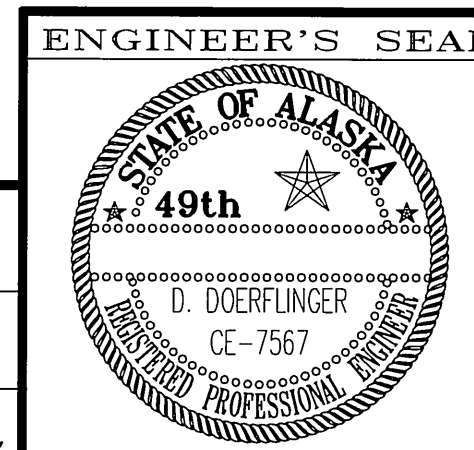

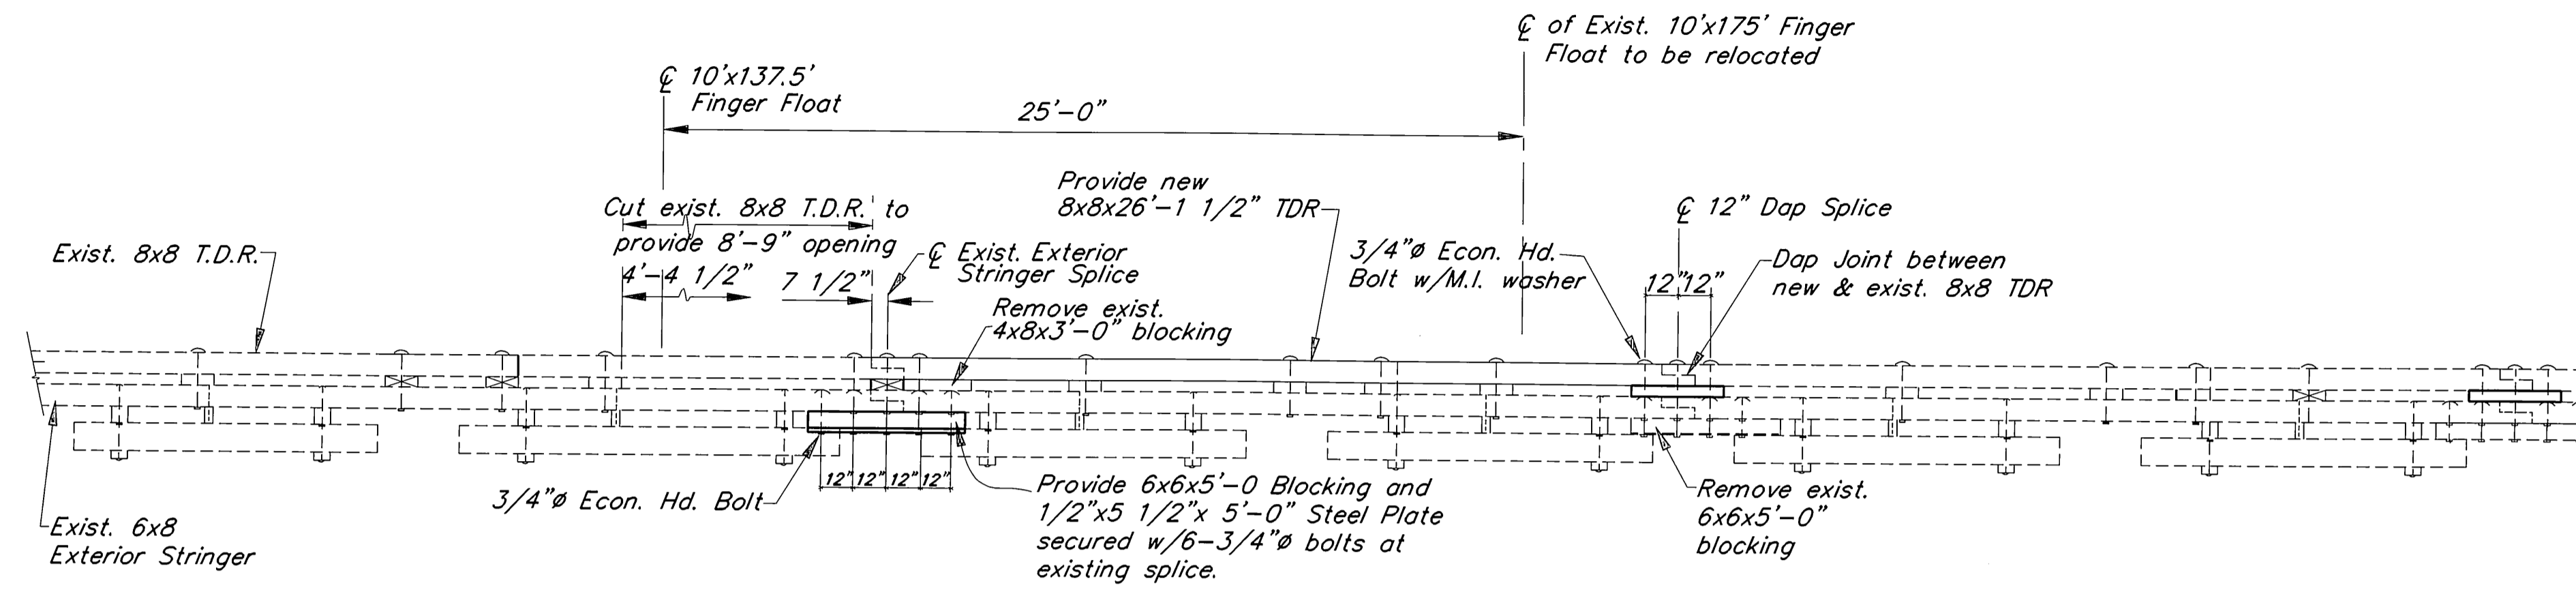


**SECTION 1**

NOTE: All holes left by the removal of existing bolts shall be treated and plugged as described in the specifications.

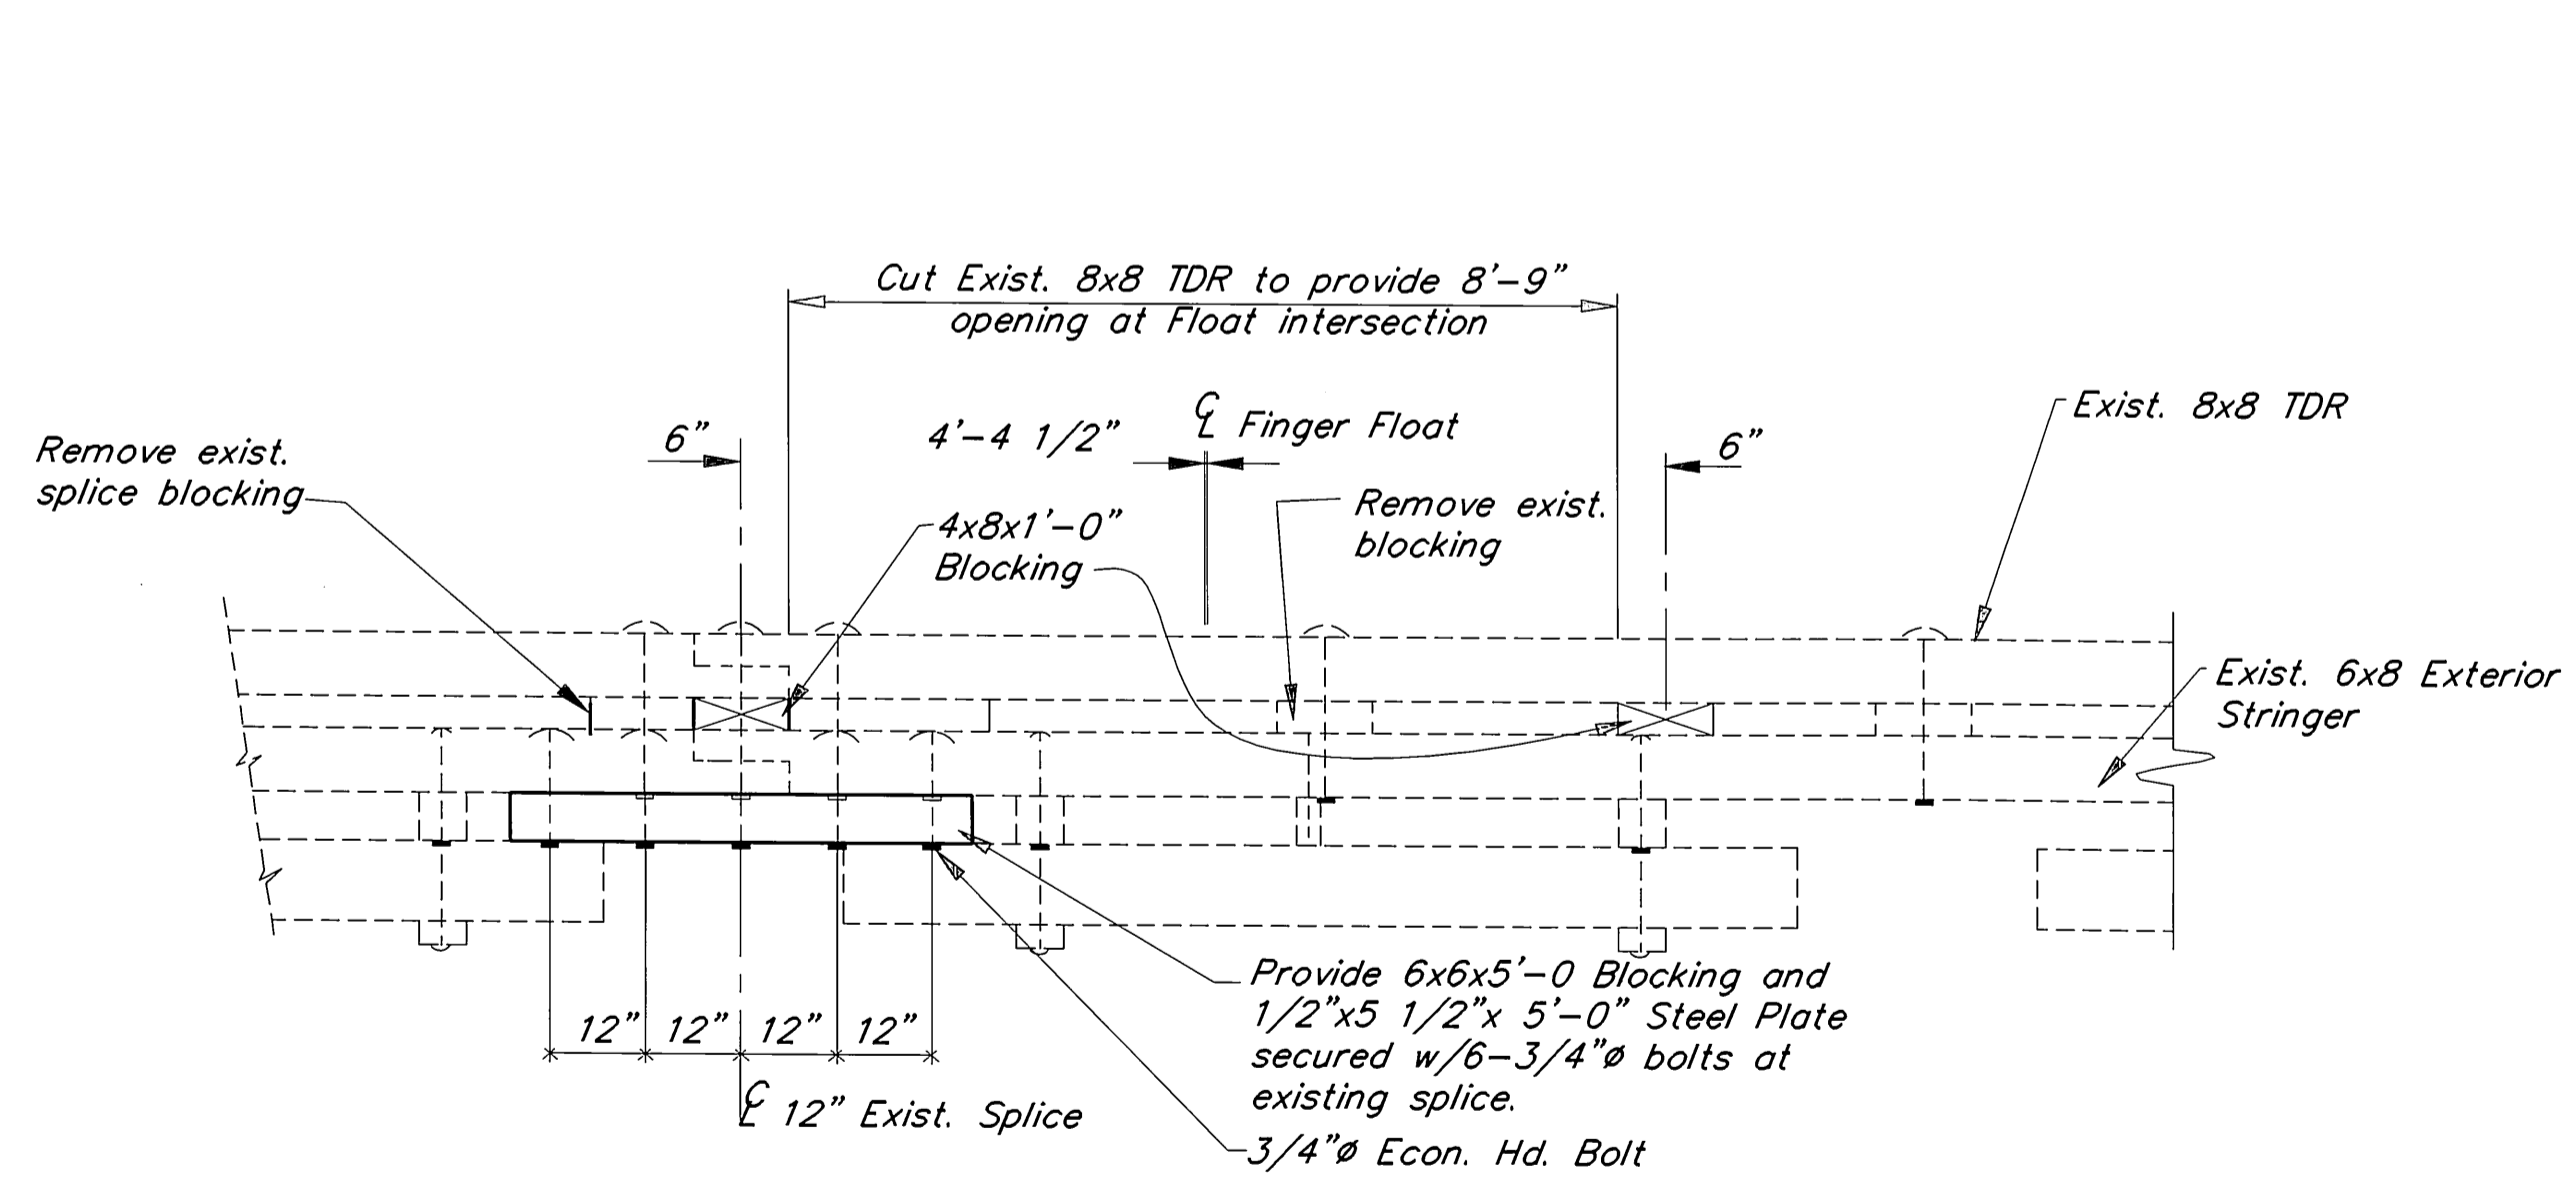

**SECTION 2**

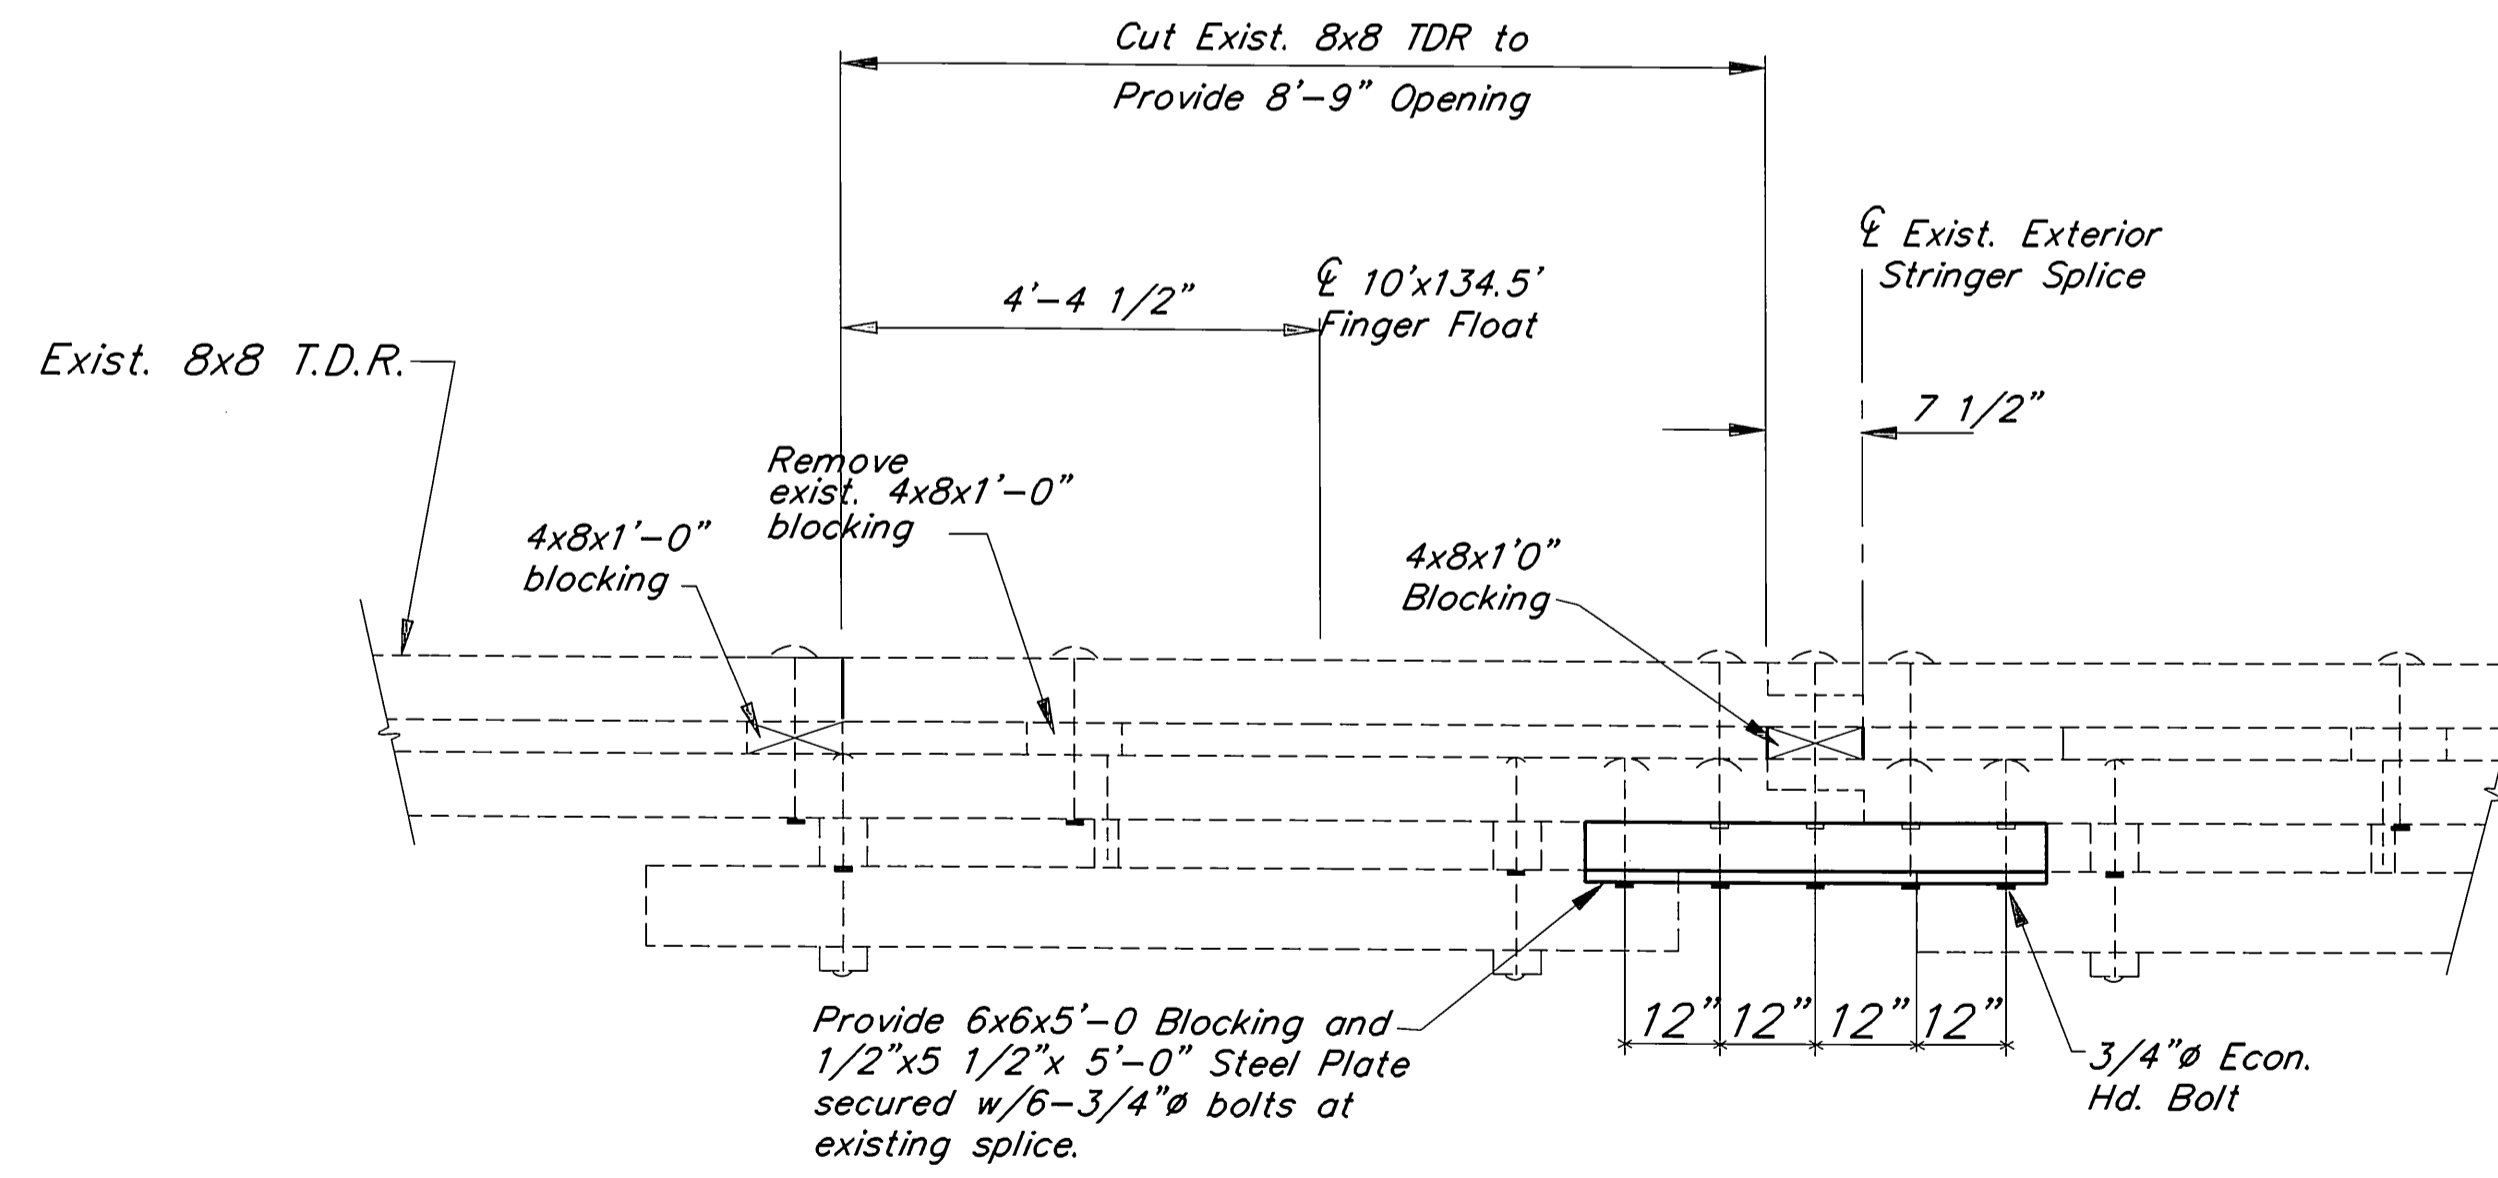

**SECTION 5**

NOTE: DO NOT SCALE FROM THESE PLANS—USE DIMENSIONS

BY:	DATE:	DESCRIPTION OF CHANGE:


STATE OF ALASKA  
 DEPARTMENT OF TRANSPORTATION  
 AND PUBLIC FACILITIES  
 SOUTHEAST REGION DESIGN & CONSTRUCTION


Craig

**FLOAT RECONSTRUCTION DETAILS**

Alaska

DESIGNED BY: D. SALDIVAR	PROJECT NO. 70649A
DRAWN BY: AUTOCADD/CSA	DATE: JULY 1992
CHECKED BY: D. DOERFLINGER	SHEET 10 OF 17

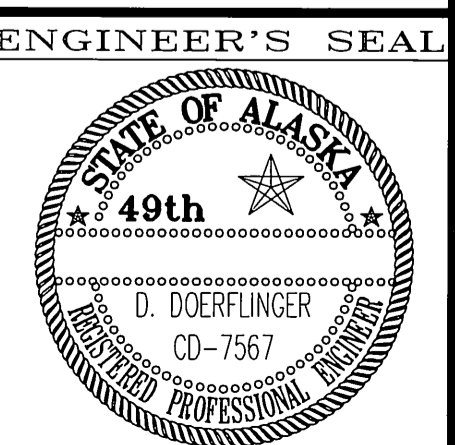

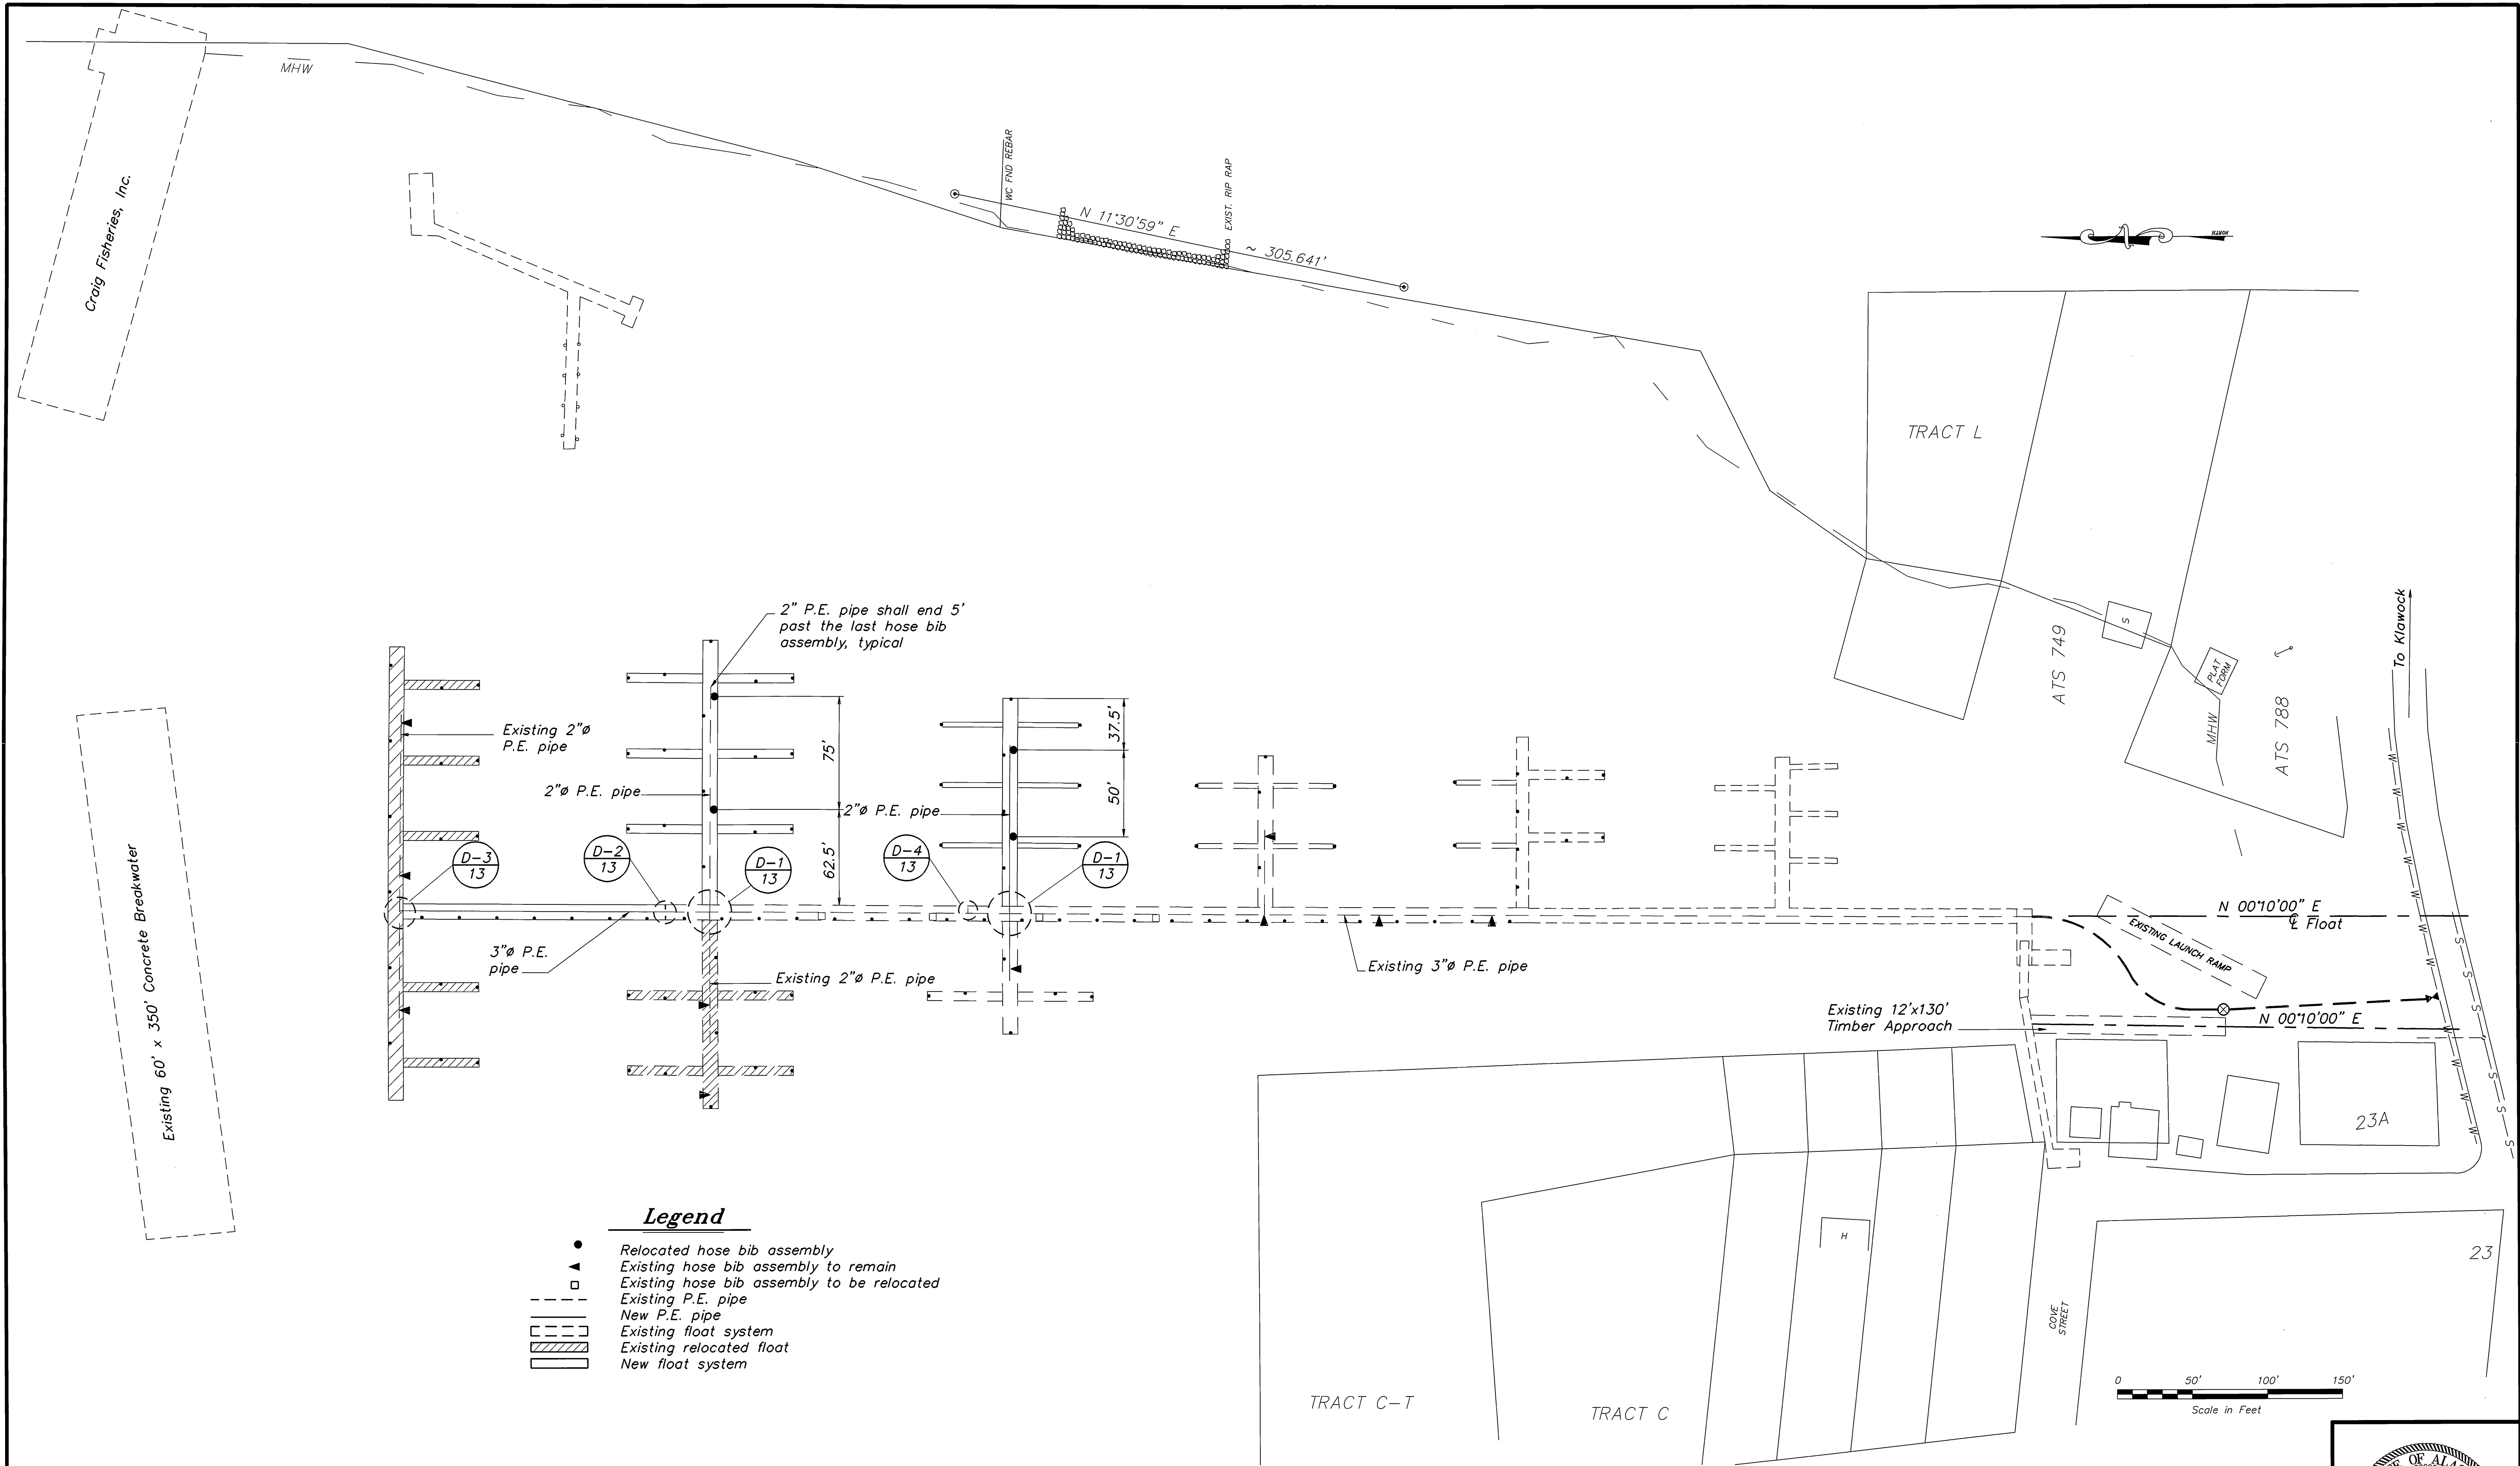

- Legend**
- Relocated hose bib assembly
  - ▲ Existing hose bib assembly to remain
  - ◻ Existing hose bib assembly to be relocated
  - - - Existing P.E. pipe
  - New P.E. pipe
  - - - Existing float system
  - ▨ Existing relocated float
  - ▭ New float system

BY:	DATE:	DESCRIPTION OF CHANGE:

**RECORD OF REVISIONS**



STATE OF ALASKA  
 DEPARTMENT OF TRANSPORTATION  
 AND PUBLIC FACILITIES  
 SOUTHEAST REGION DESIGN & CONSTRUCTION


CRAIG

**WATERLINE LAYOUT**

ALASKA  
 DESIGNED BY: DDS  
 DRAWN BY: AutoCAD / BWB  
 CHECKED BY: DFD


PROJECT No. 70649A  
 DATE: JULY 1992  
 SHEET 11 OF 17

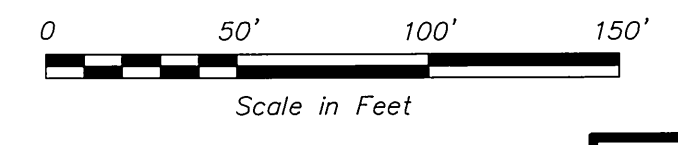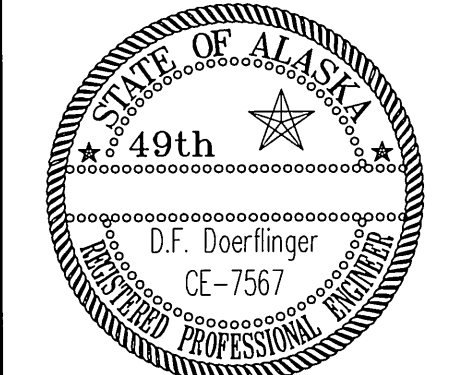

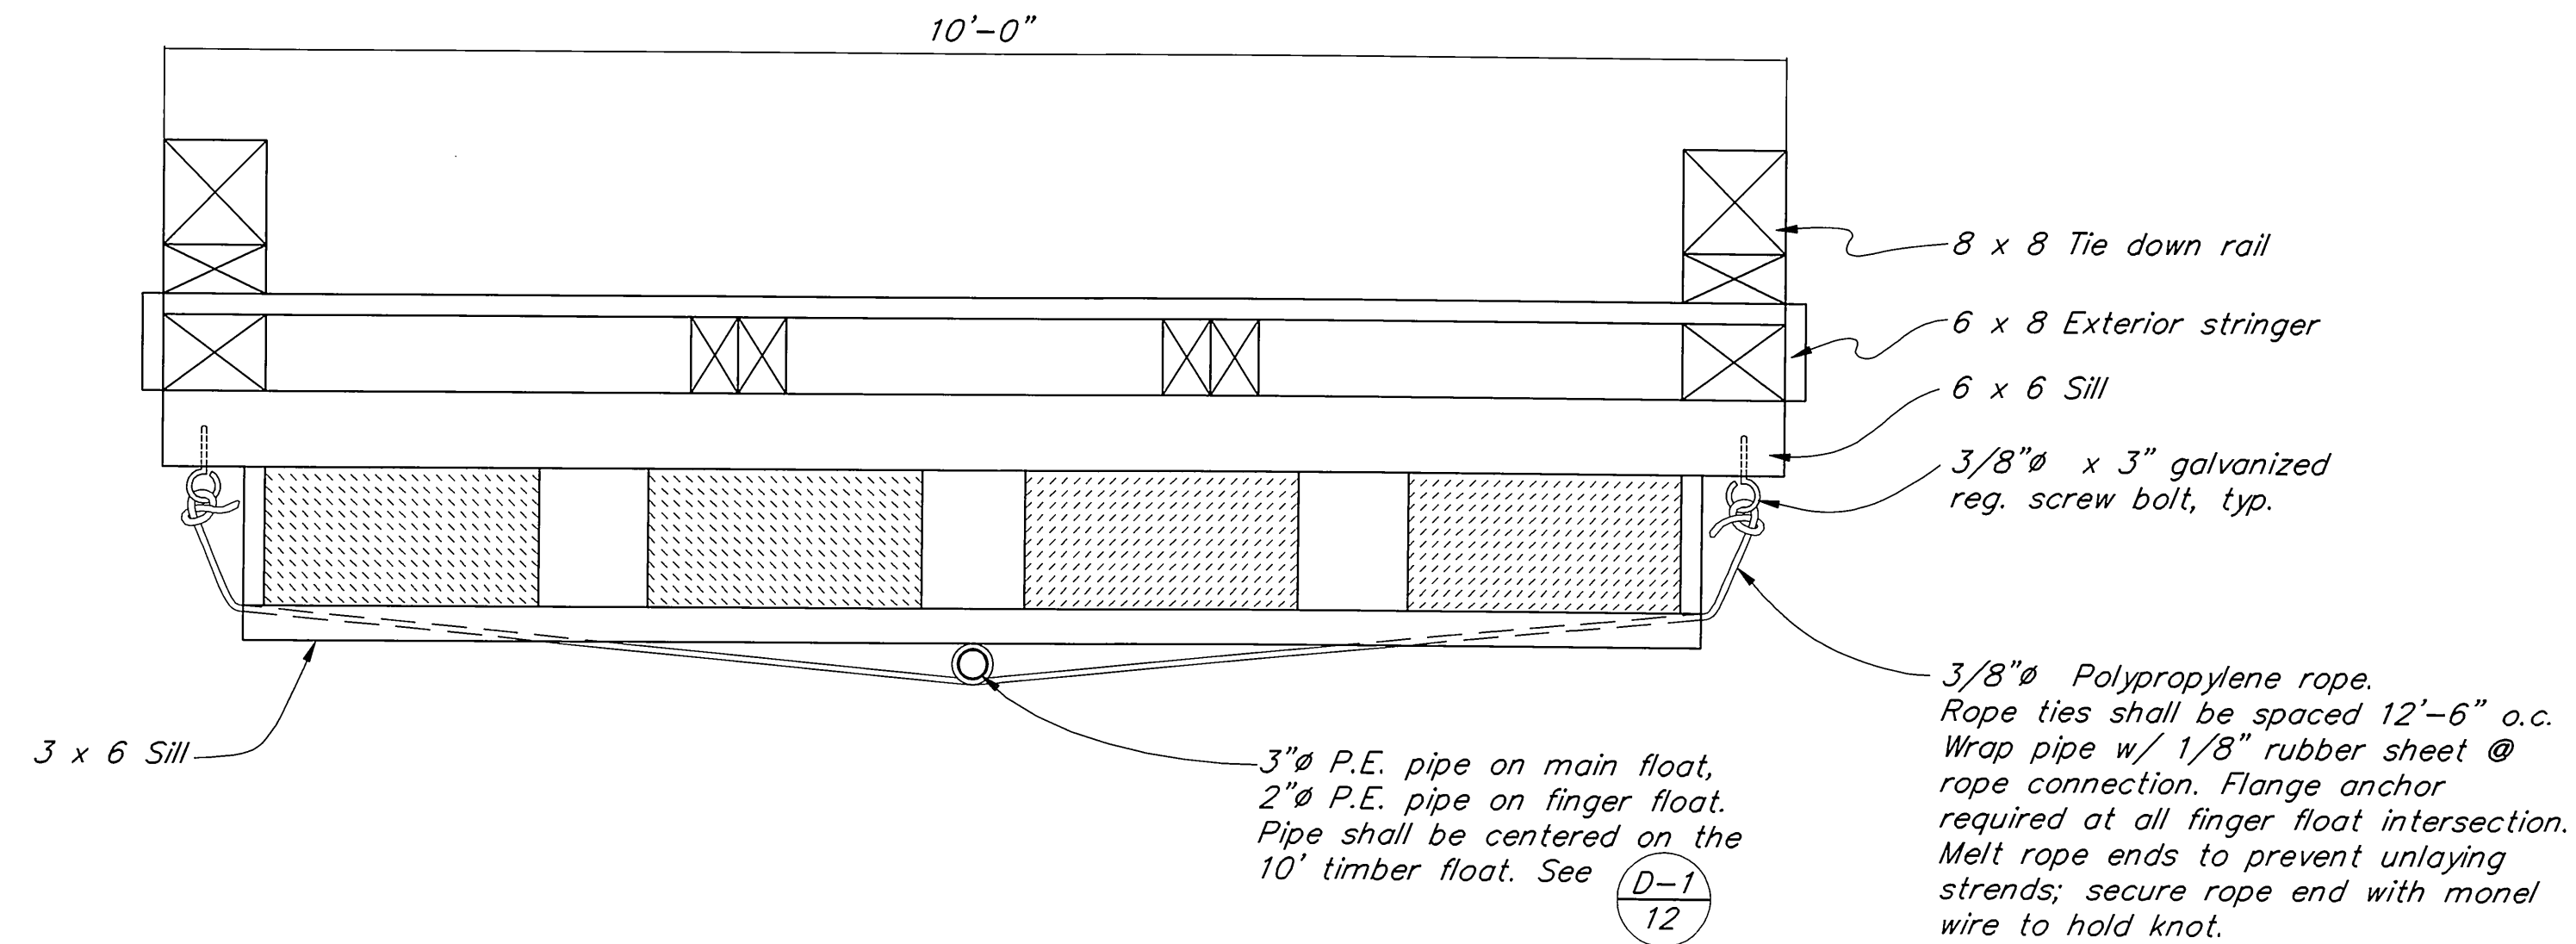

**Waterline Installation**


10' Timber Float

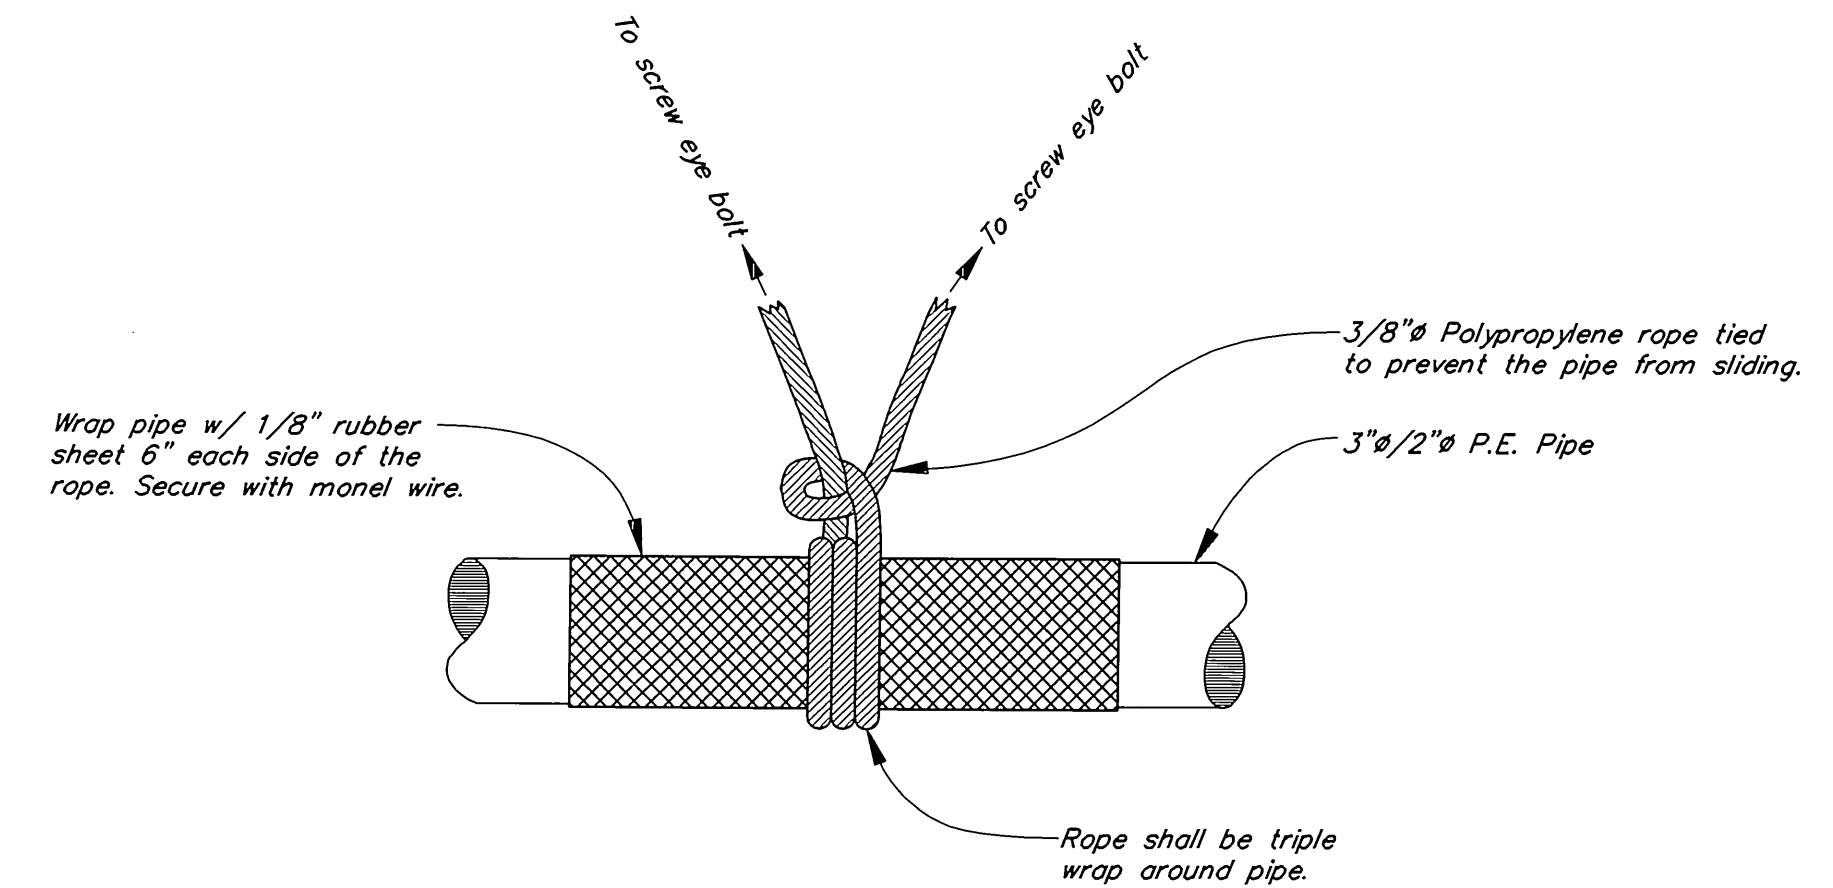

**Typical Rope Attachment**

Detail

1

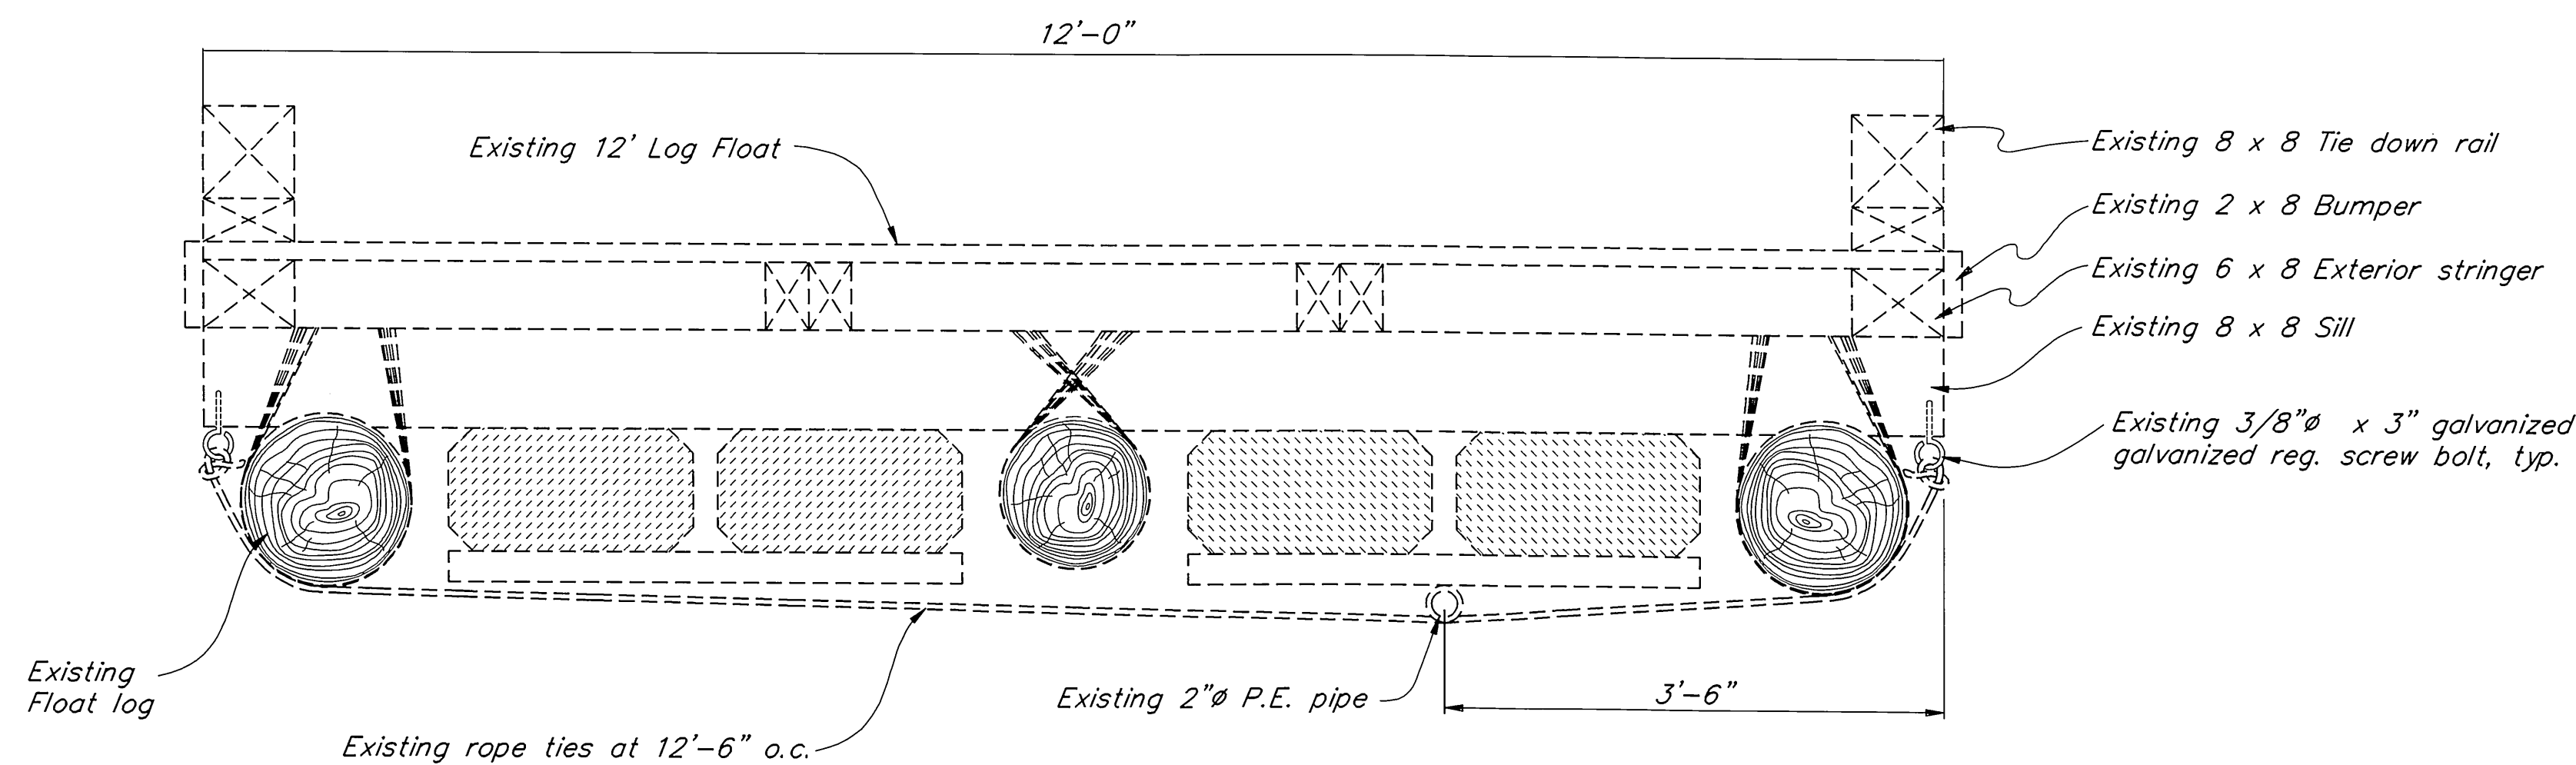

**As-Built Waterline Installation**

Existing 12' Finger Float

BY:	DATE:	DESCRIPTION OF CHANGE:

STATE OF ALASKA  
DEPARTMENT OF TRANSPORTATION  
AND PUBLIC FACILITIES  
SOUTHEAST REGION DESIGN & CONSTRUCTION


Craig


**WATERLINE DETAILS**

NOTE: DO NOT SCALE FROM THESE PLANS—USE DIMENSIONS



Alaska

DESIGNED BY:	D. SALDIVAR	PROJECT NO.	70649 A
DRAWN BY:	AUTOCAD/R. SNYDER	DATE:	JULY 1992
CHECKED BY:	D. DOERFLINGER	SHEET	12 OF 17

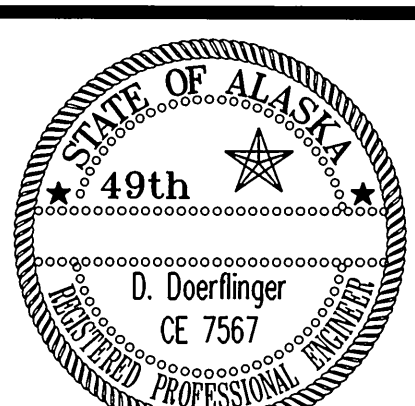


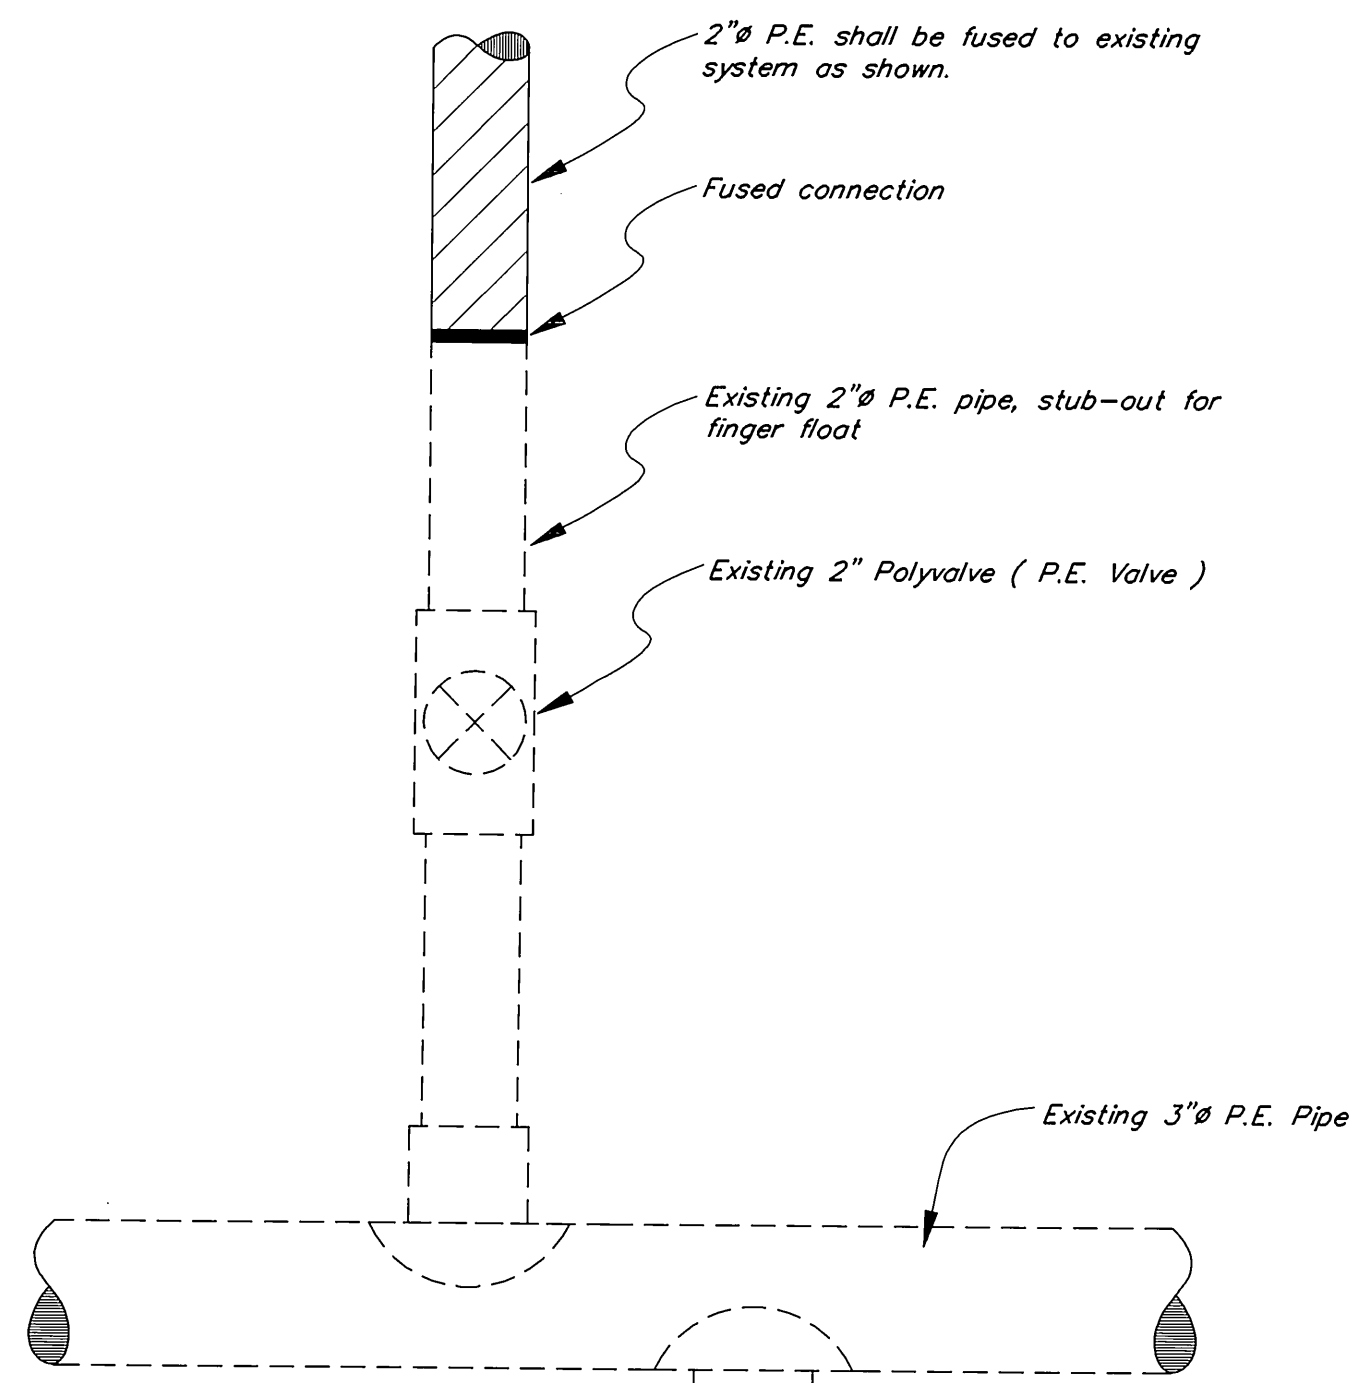


**Detail** ①

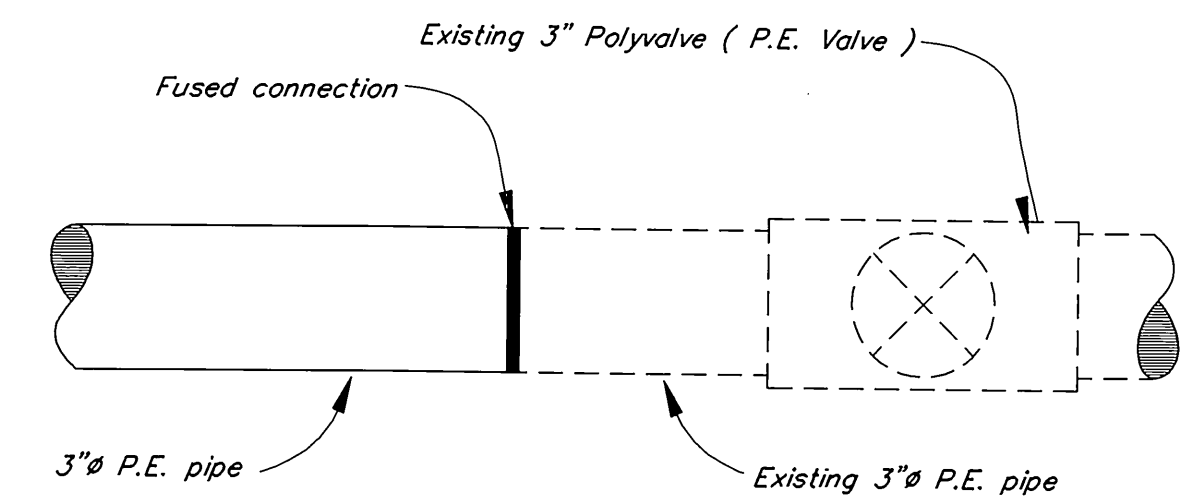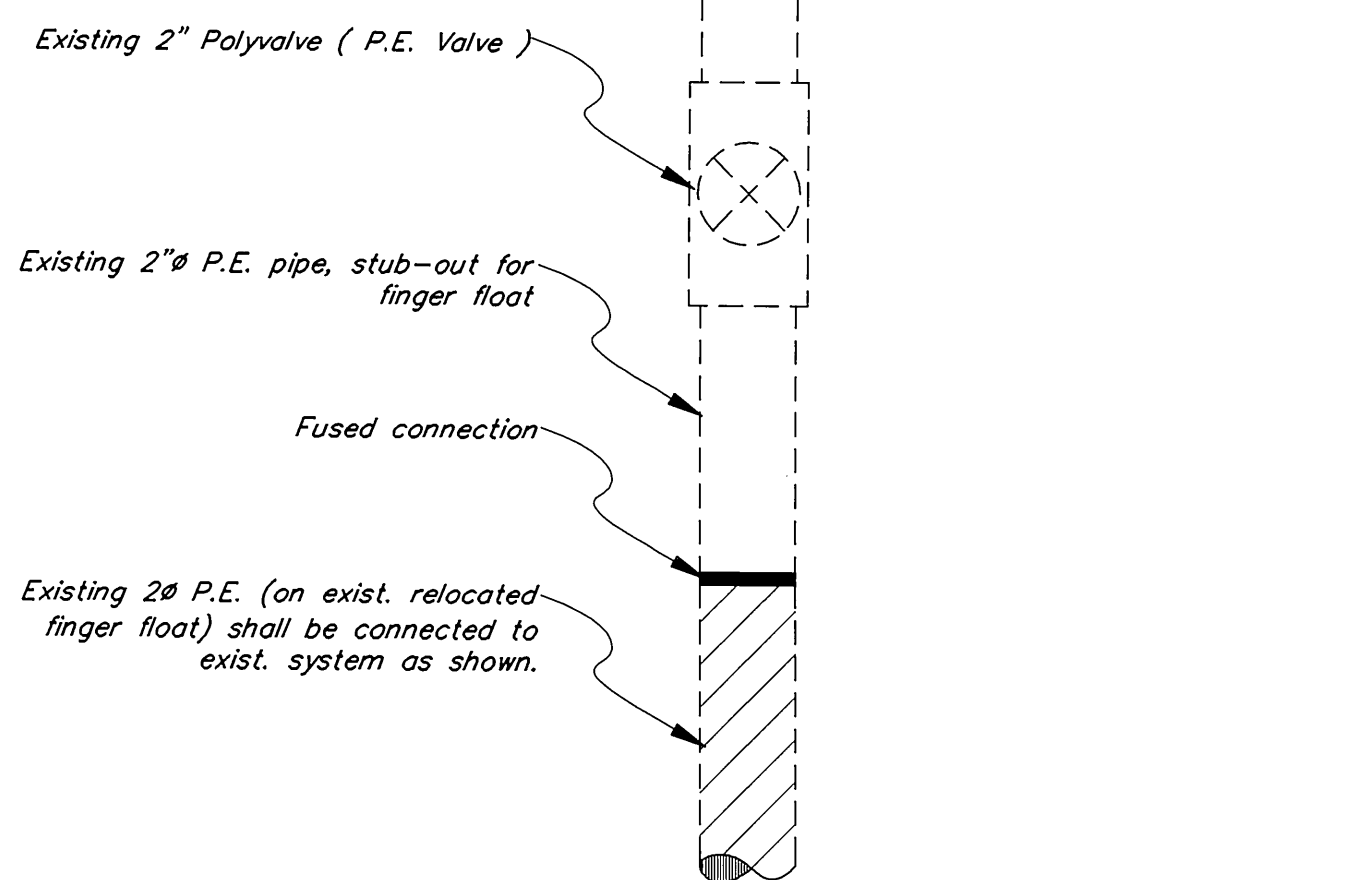

**Detail** ②

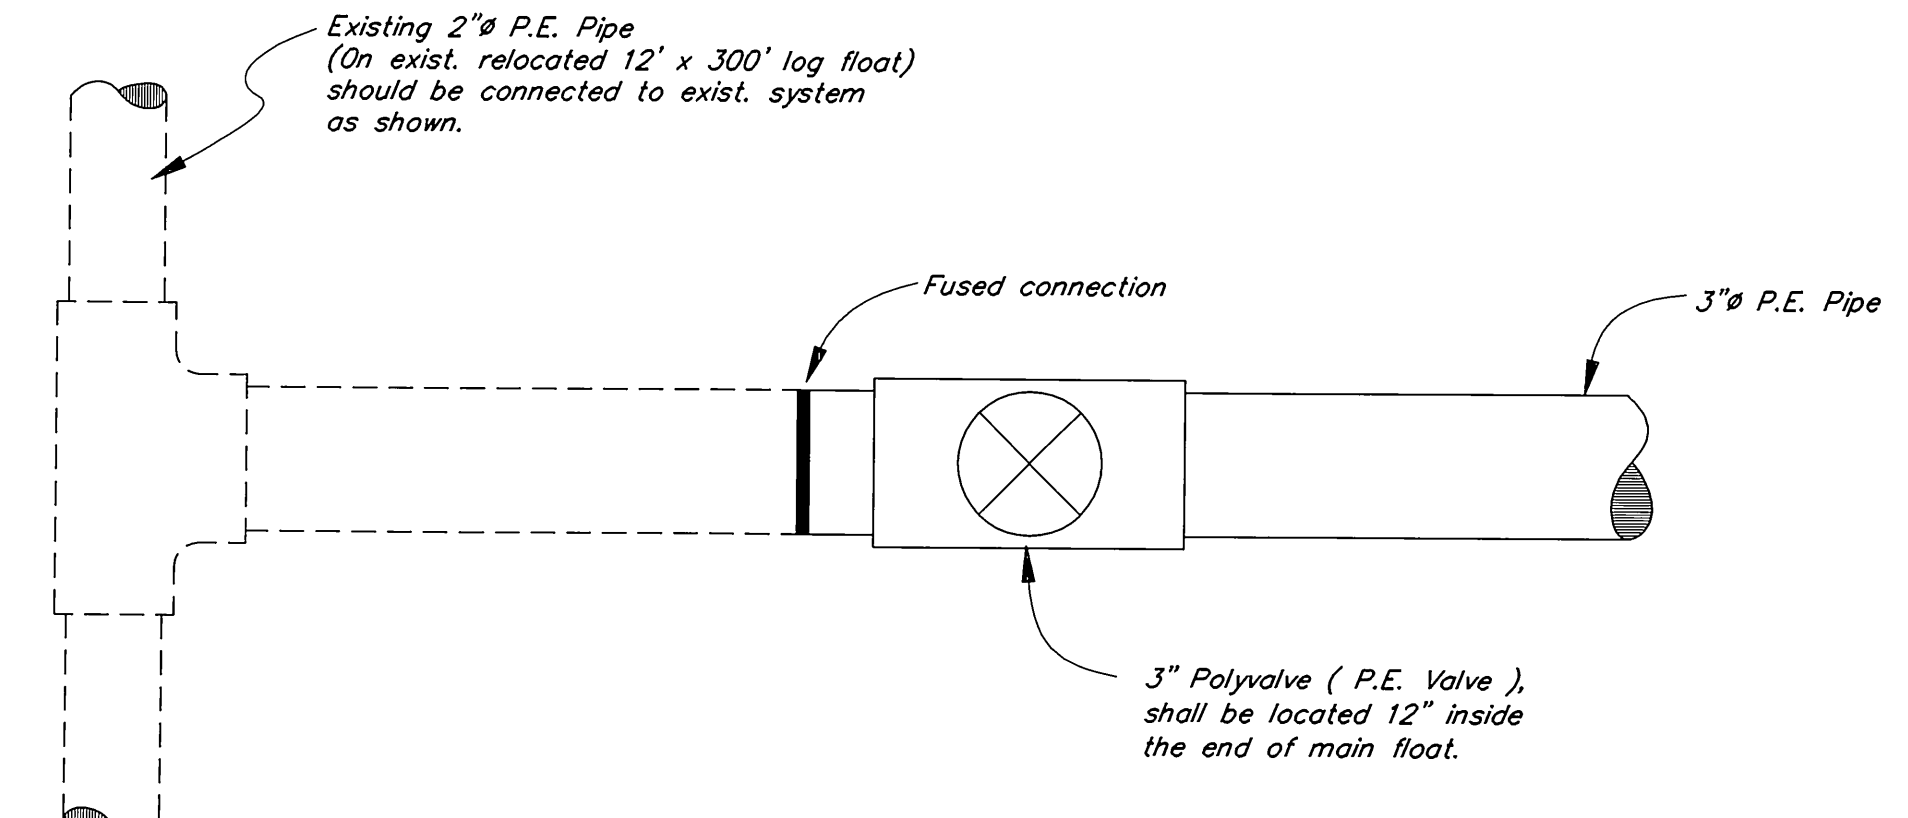

**Detail** ③

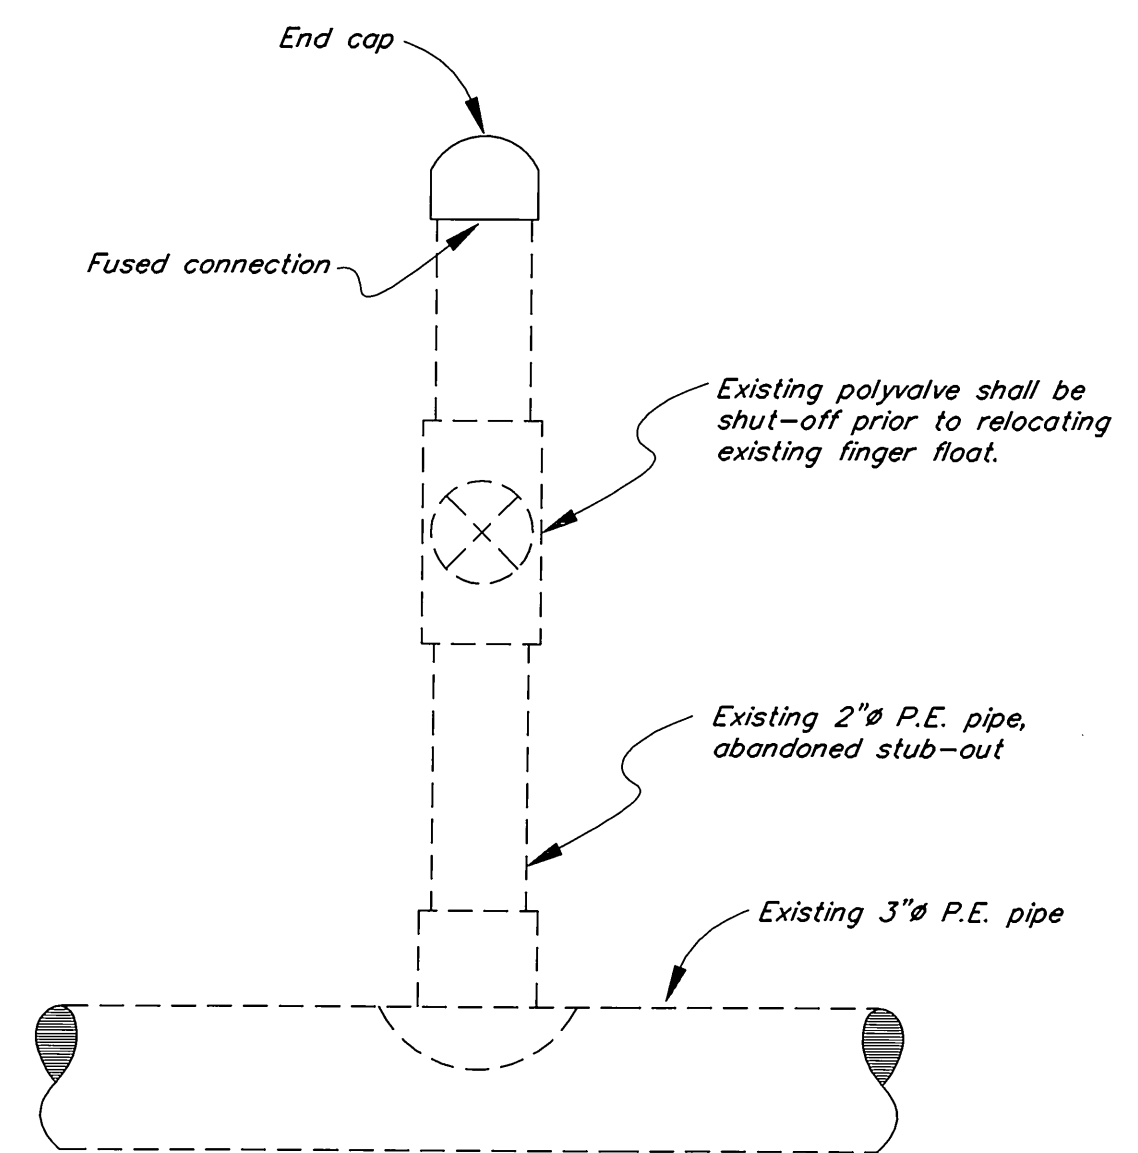

**Detail** ④

BY:	DATE:	DESCRIPTION OF CHANGE:

**RECORD OF REVISIONS**


STATE OF ALASKA  
 DEPARTMENT OF TRANSPORTATION  
 AND PUBLIC FACILITIES  
 SOUTHEAST REGION DESIGN & CONSTRUCTION

Craig

**WATERLINE DETAILS**

NOTE: DO NOT SCALE FROM THESE PLANS—USE DIMENSIONS



DESIGNED BY: <i>D. SALDIVAR</i>	PROJECT NO. 70649 A
DRAWN BY: <i>AUTOCAD/R. SNYDER</i>	DATE: JULY 1992
CHECKED BY: <i>D. DOERFLINGER</i>	SHEET 13 OF 17

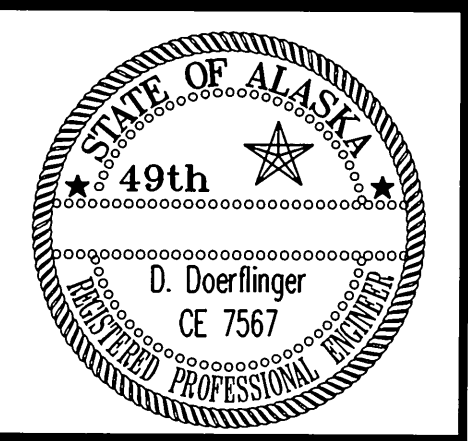




NOTES:

- ① REMOVE EXISTING LIGHTING AND OVERHEAD TRIPLEX ON FLOATS E & G, REINSTALL LIGHTING AND CABLE WHEN THE FLOATS HAVE BEEN RELOCATED. PROVIDE A NEW OVERHEAD FEED FROM THE EXISTING ADJACENT MAIN FLOAT LUMINAIRE AS SHOWN.
- ② DISCONNECT EXISTING HOSE BIBS ON FLOATS E & G FROM THAW WIRE FEEDER SYSTEM. PROVIDE NEW CABLE & JUNCTION BOXES AS REQUIRED TO MAKE REQUIRED RECONNECTIONS TO THE THAW WIRE FEEDER SYSTEM AFTER THE FLOATS HAVE BEEN RELOCATED. PROVIDE NEW CABLE AND JUNCTION BOXES AS REQUIRED TO RECONNECT RELOCATED HOSE BIBS ON FLOATS I & J TO THAW WIRE SYSTEM.
- ③ SEE CIVIL DRAWING 14 OF 17 FOR HOSE BIB DETAIL. ROUTE NEW TYPE W FEEDER CABLES UNDER FLOAT DECK ON TOP OF SILLS.
- ④ EXISTING HOSE BIB JUNCTION BOXES MAY REMAIN TO PROVIDE CONTINUITY OF EXISTING FEEDER CABLE.

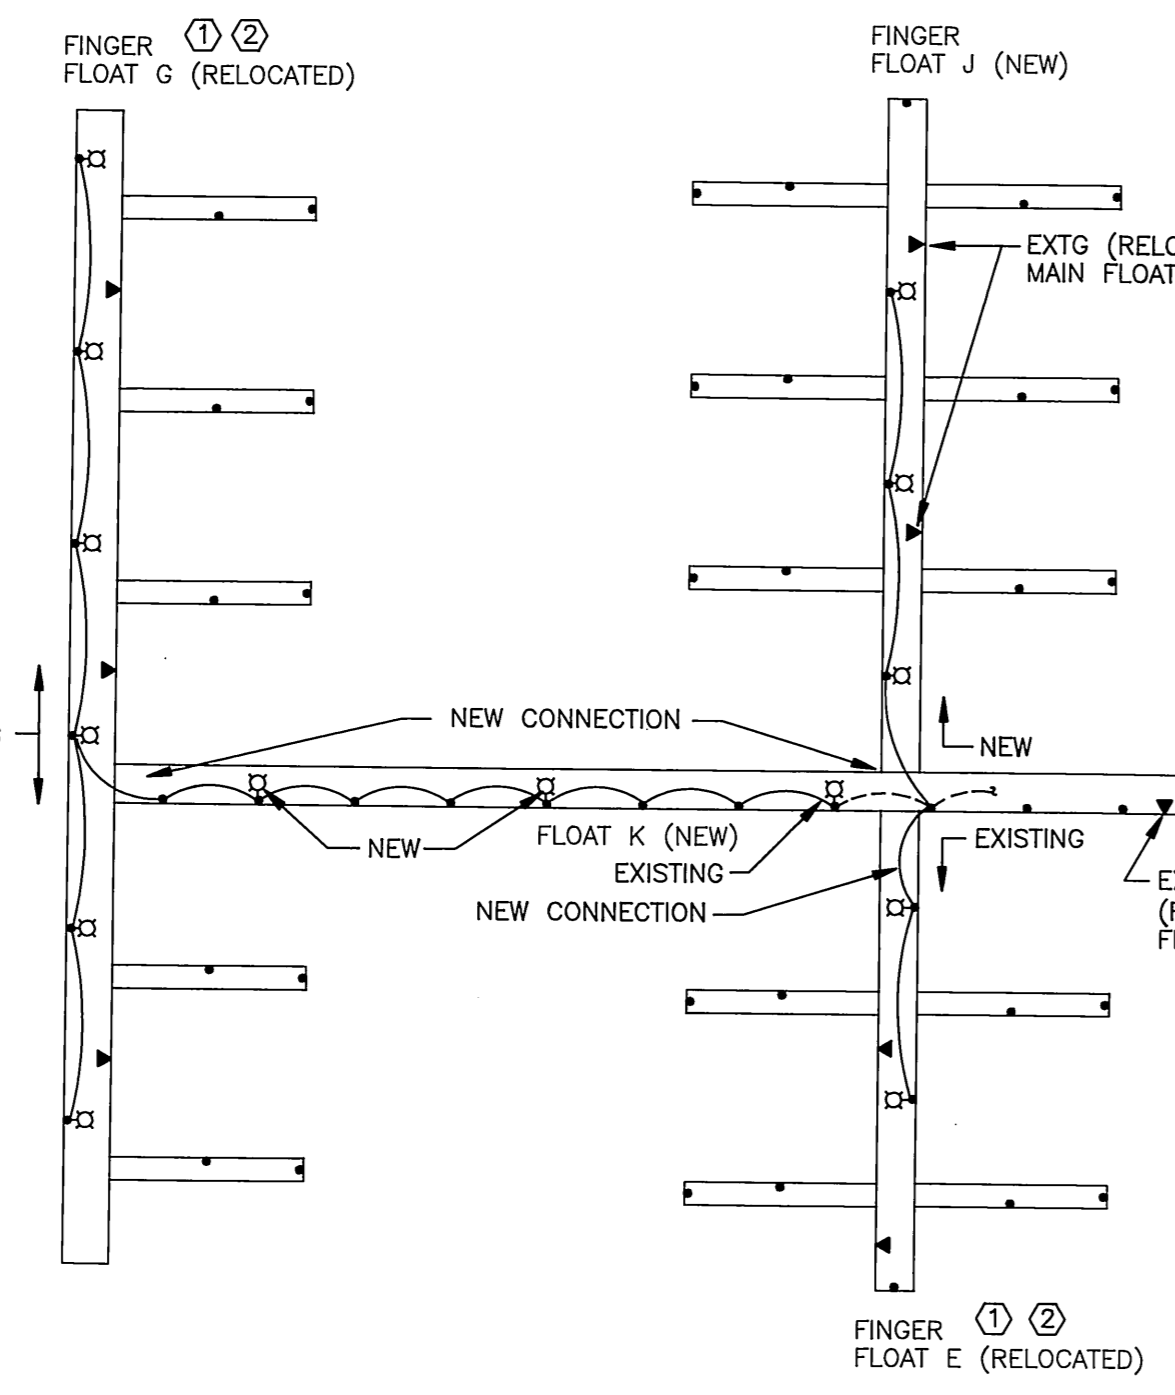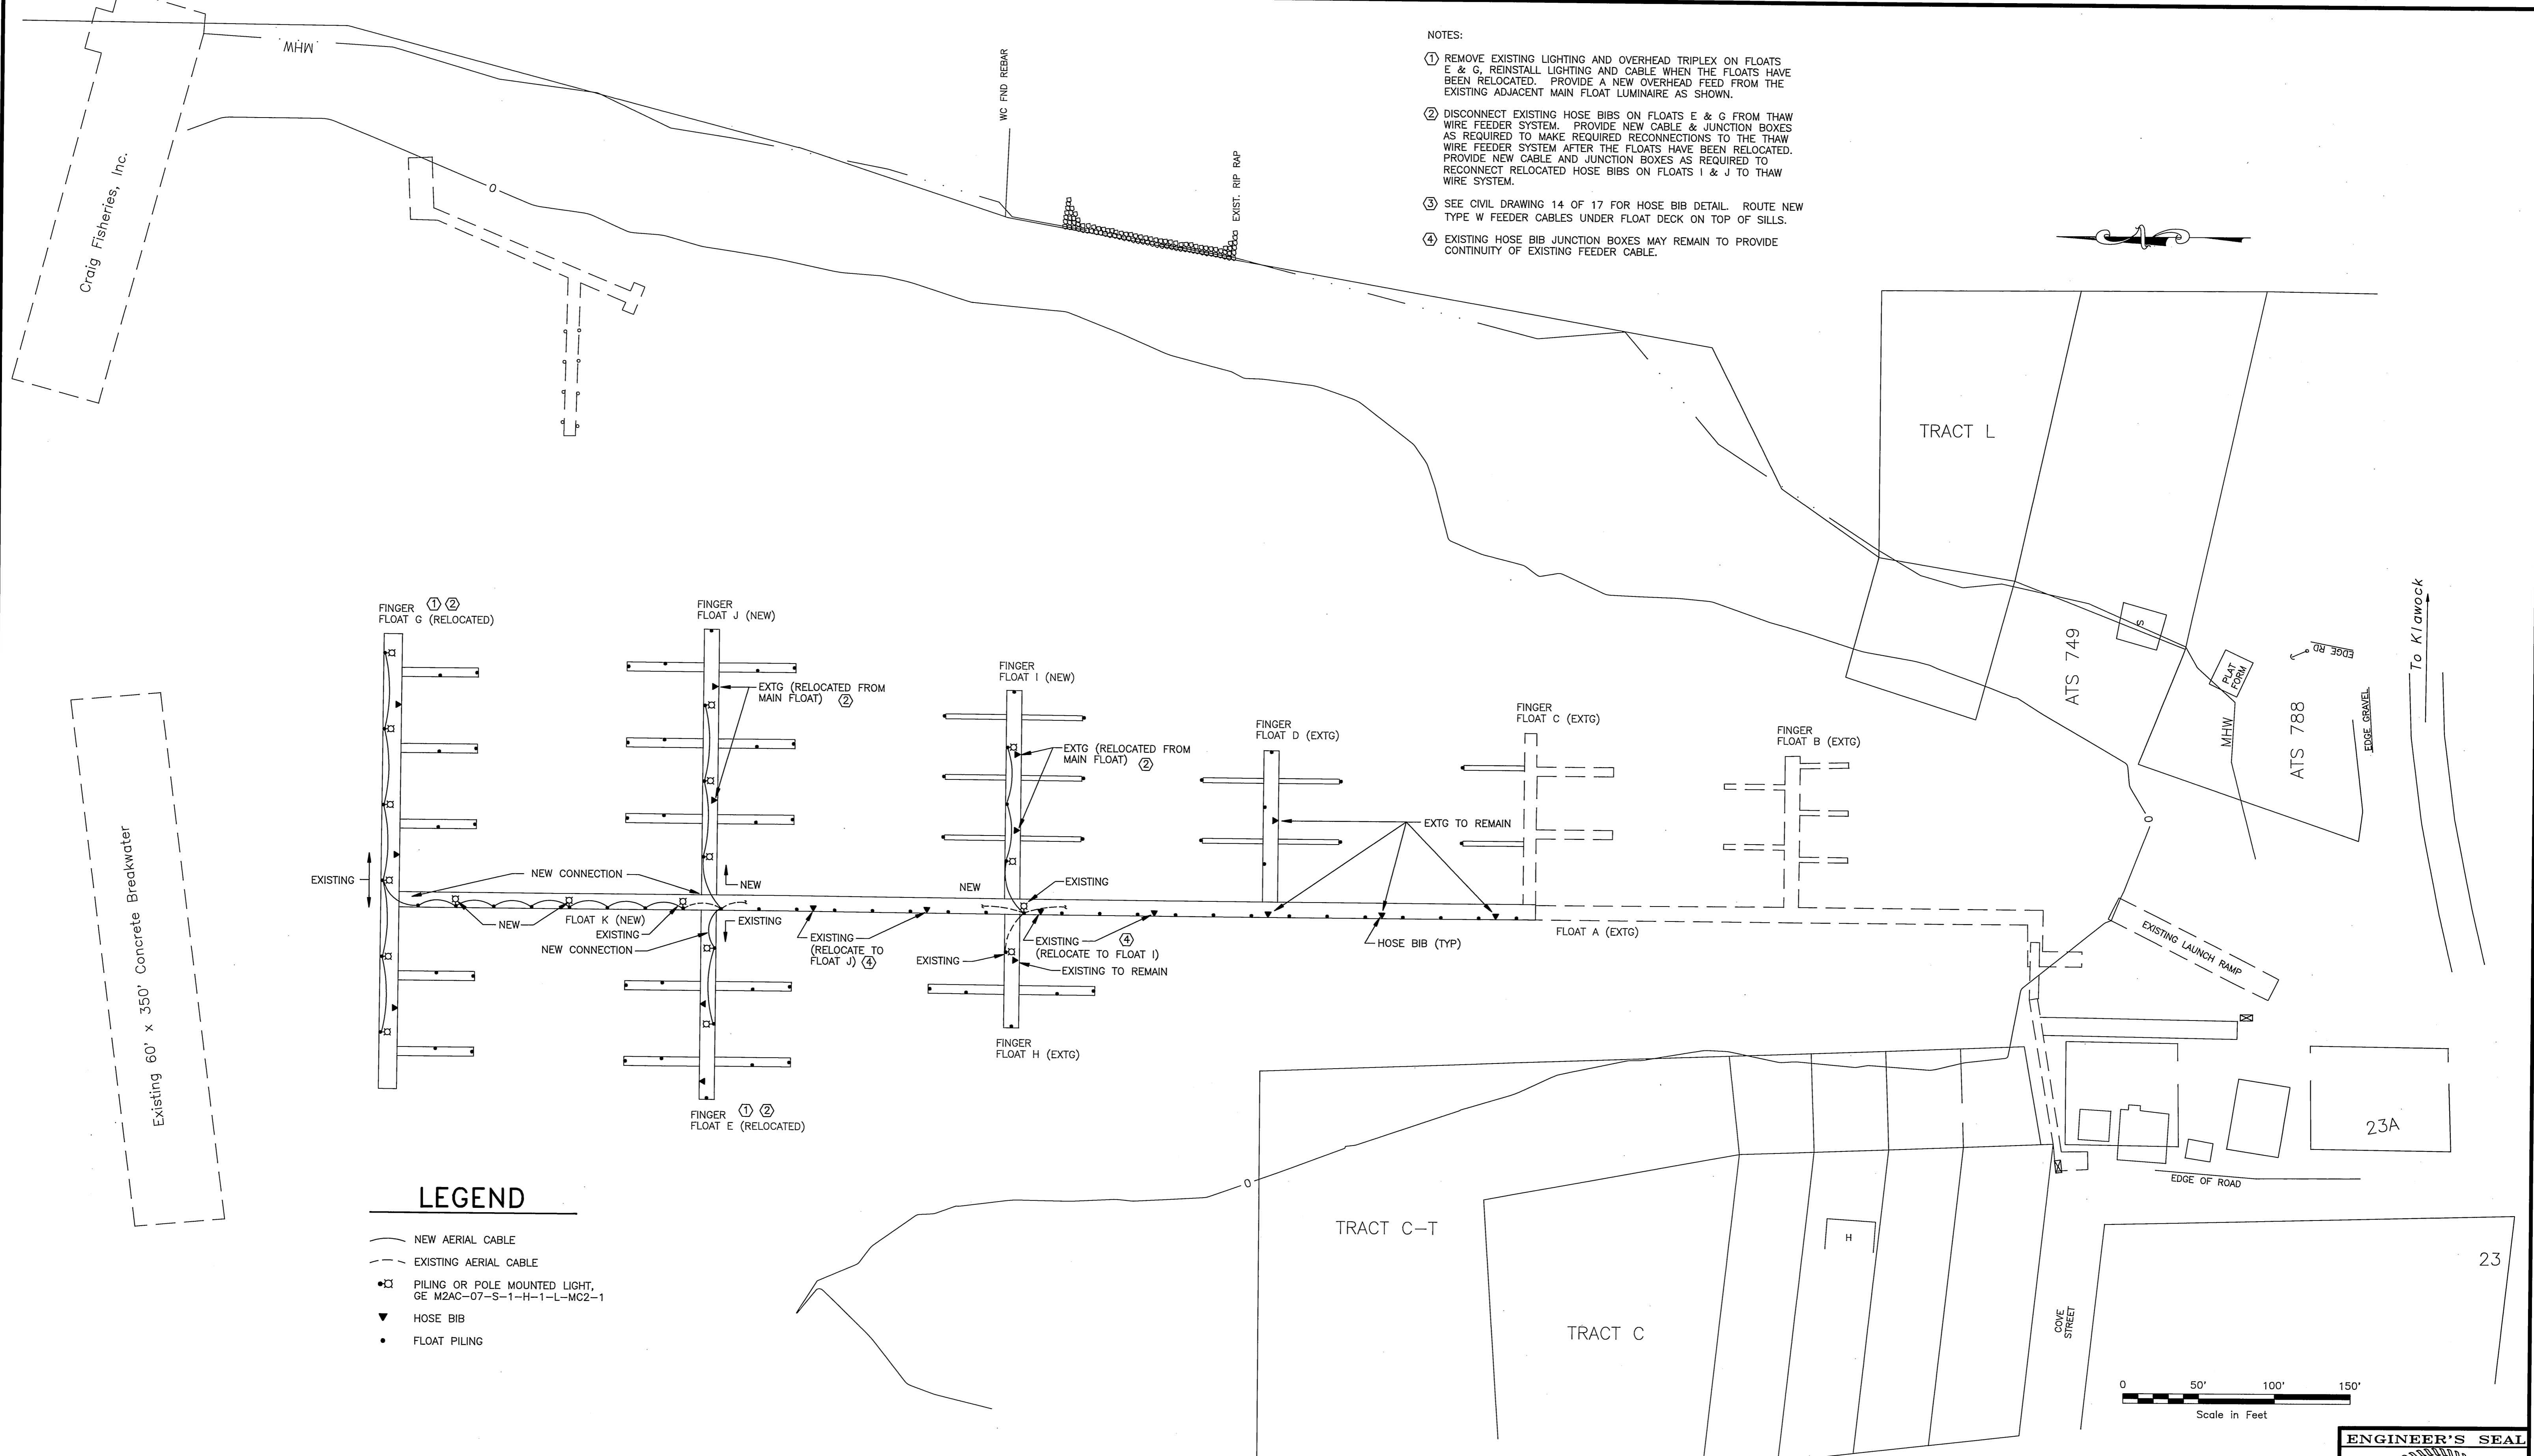

**LEGEND**

- NEW AERIAL CABLE
- - - EXISTING AERIAL CABLE
- PILING OR POLE MOUNTED LIGHT, GE M2AC-07-S-1-H-1-L-MC2-1
- ▼ HOSE BIB
- FLOAT PILING

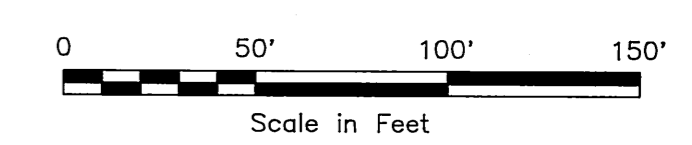


BY:	DATE:	DESCRIPTION OF CHANGE:

**RECORD OF REVISIONS**


STATE OF ALASKA  
 DEPARTMENT OF TRANSPORTATION  
 AND PUBLIC FACILITIES  
 SOUTHEAST REGION DESIGN & CONSTRUCTION

CRAIG  
 ALASKA  
**ELECTRICAL - LIGHTING, THAW WIRE & POWER**

DESIGNED BY:	TSM	PROJECT No.	70649A
DRAWN BY:	PEL	DATE:	JULY 17, 1992
CHECKED BY:	BCH	SHEET	15 OF 17

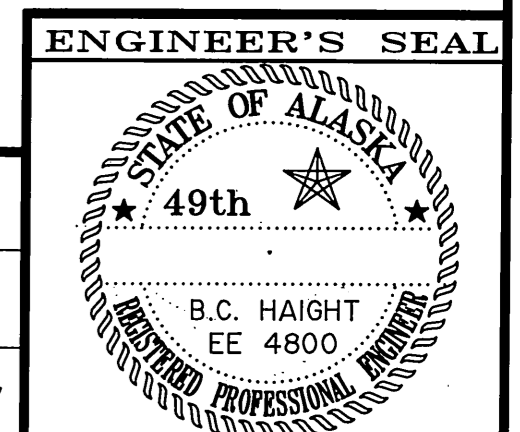

NOTES:  
 ① REMOVE EXISTING HOME RUNS FOR FLOATS E & G. PROVIDE NEW HOME RUNS FROM THE RELOCATED FLOATS TO PANEL P1 & P2 AFTER THEY HAVE BEEN RELOCATED. THE POWER PEDESTALS AND CABLES WITHIN FLOATS ARE TO REMAIN AS IS. PROVIDE NEW PEDESTALS & CABLE FOR THE NEW FLOATS AS SHOWN.

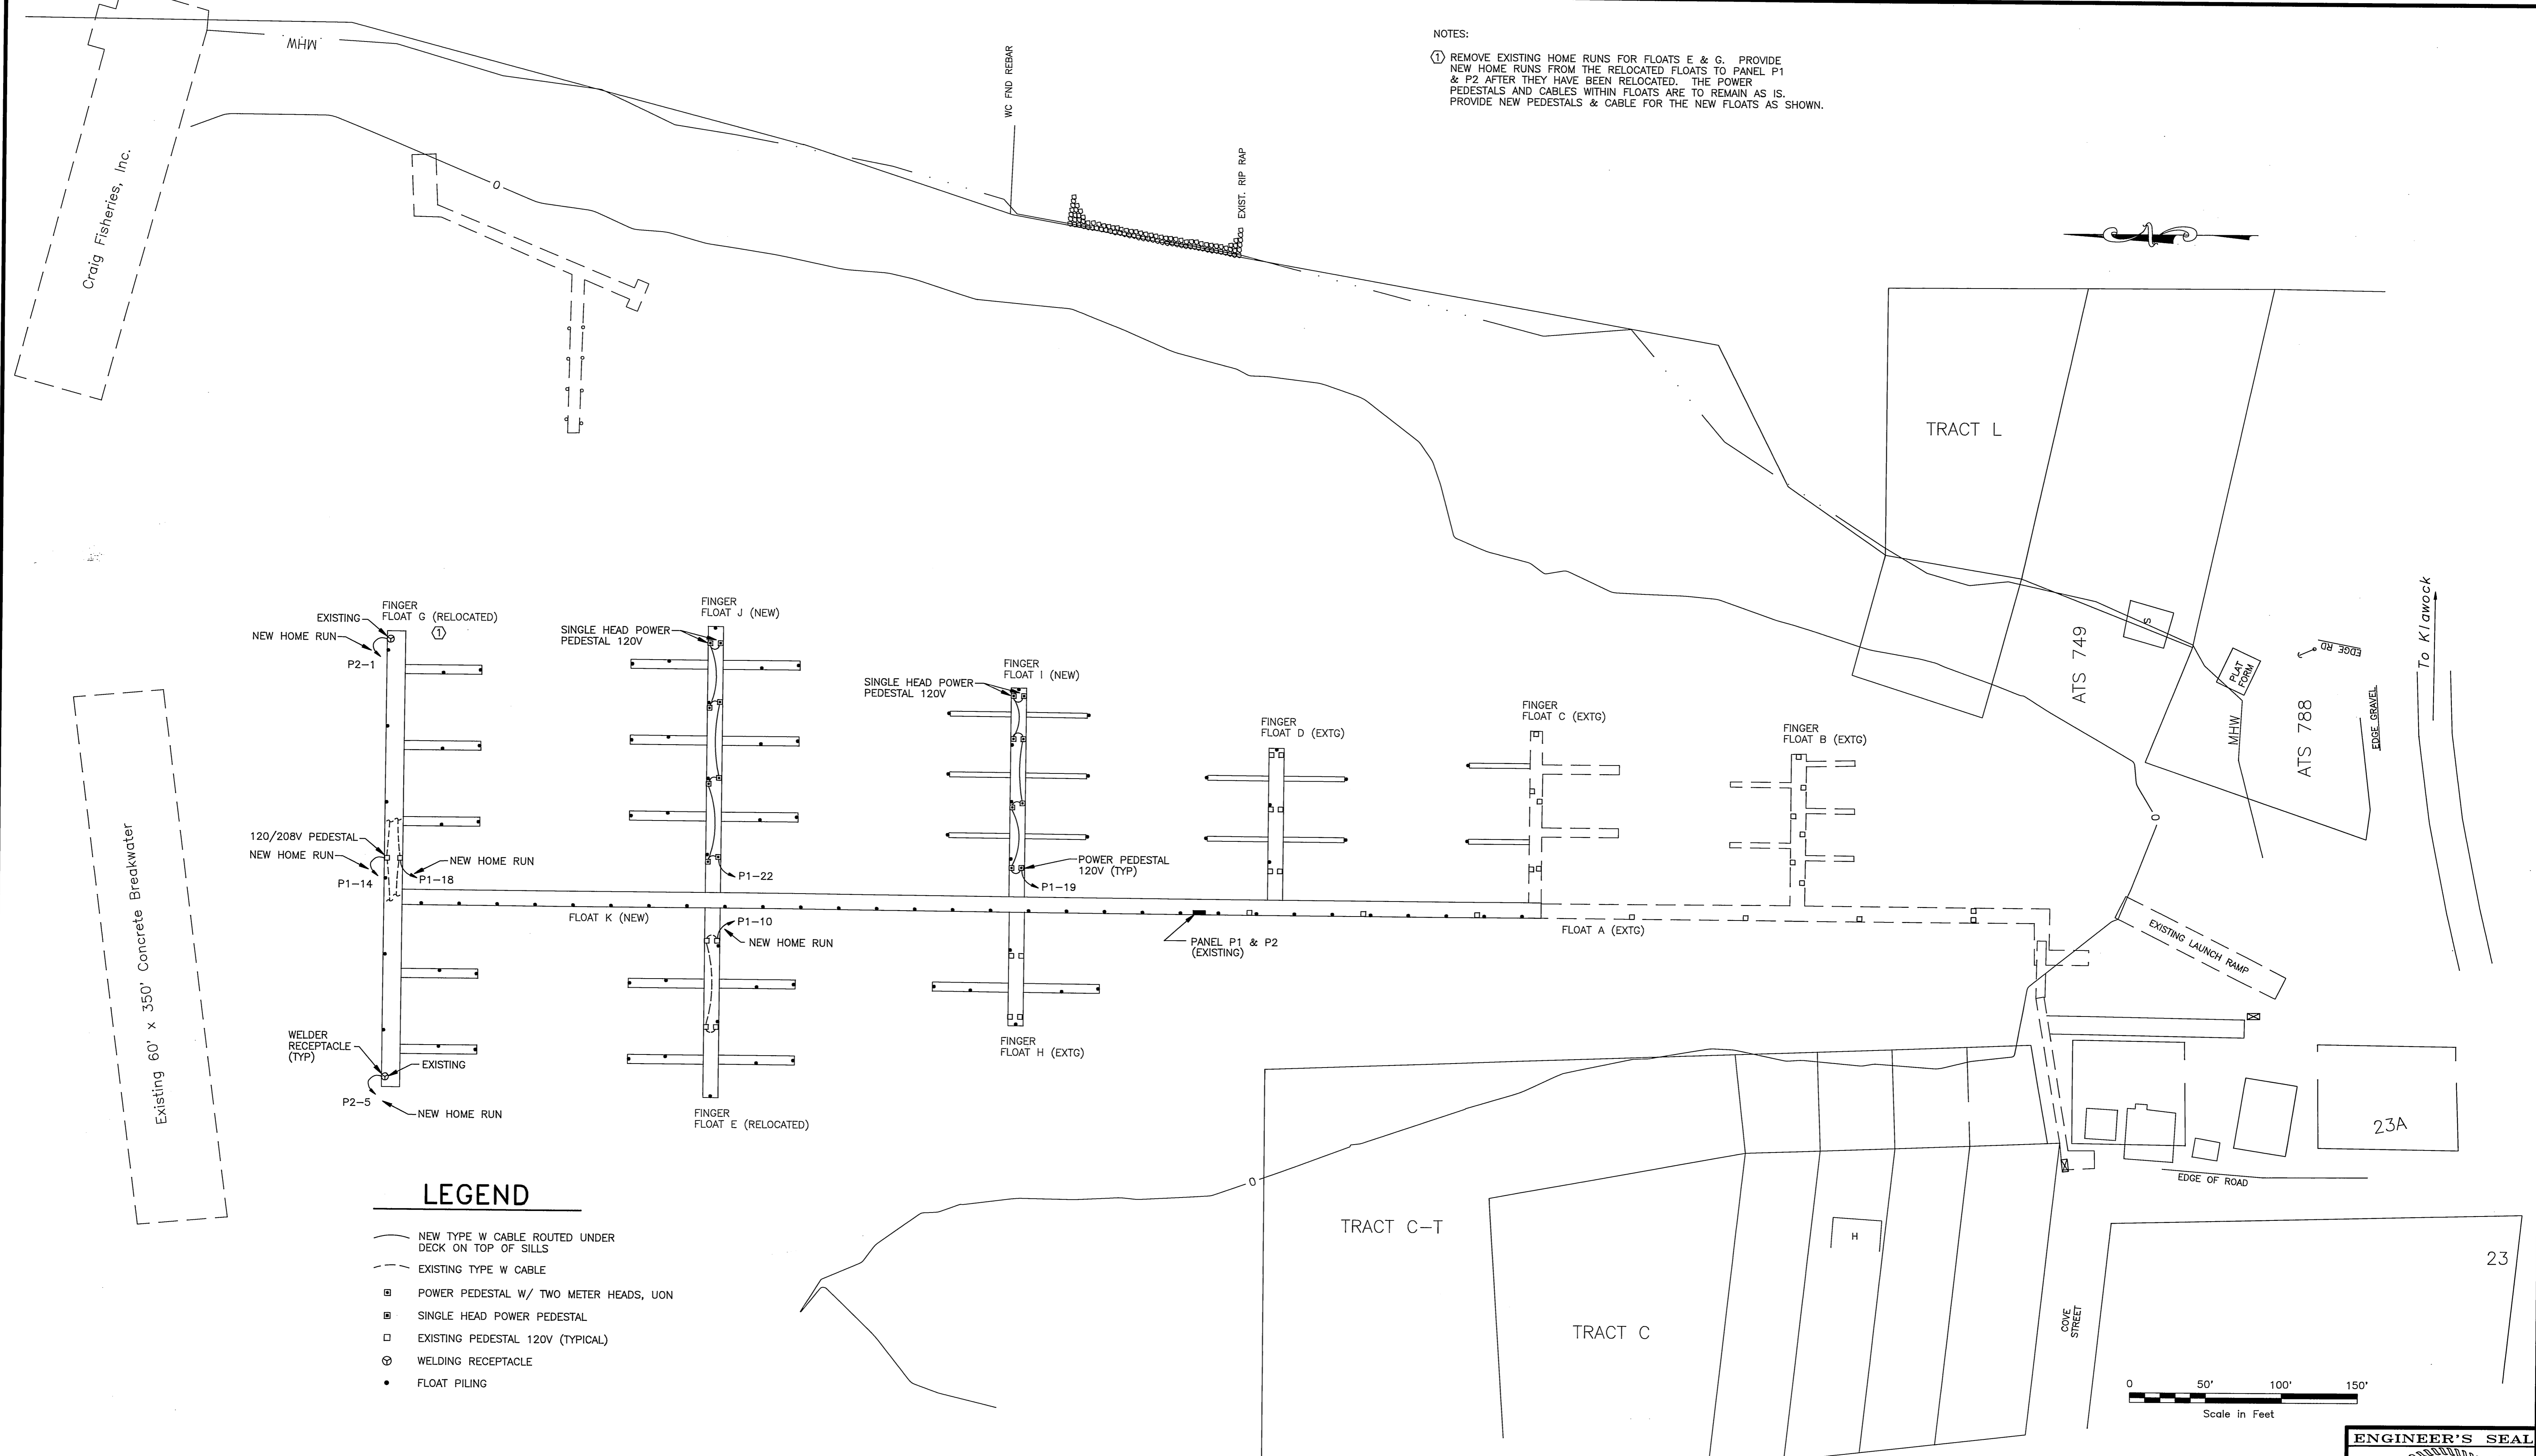

- LEGEND**
- NEW TYPE W CABLE ROUTED UNDER DECK ON TOP OF SILLS
  - - - EXISTING TYPE W CABLE
  - POWER PEDESTAL W/ TWO METER HEADS, UON
  - SINGLE HEAD POWER PEDESTAL
  - EXISTING PEDESTAL 120V (TYPICAL)
  - ⊕ WELDING RECEPTACLE
  - FLOAT PILING


BY:	DATE:	DESCRIPTION OF CHANGE:


**RECORD OF REVISIONS**

STATE OF ALASKA  
 DEPARTMENT OF TRANSPORTATION  
 AND PUBLIC FACILITIES  
 SOUTHEAST REGION DESIGN & CONSTRUCTION


CRAIG  
 ALASKA  
**ELECTRICAL - LIGHTING, THAW WIRE & POWER**

DESIGNED BY: TSM	PROJECT No. 70649A
DRAWN BY: PEL	DATE: JULY 17, 1992
CHECKED BY: BCH	SHEET 16 OF 17

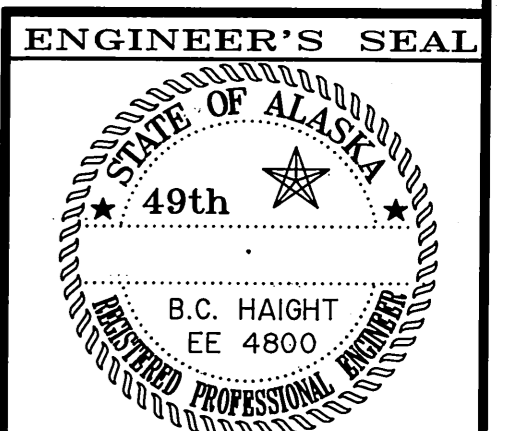

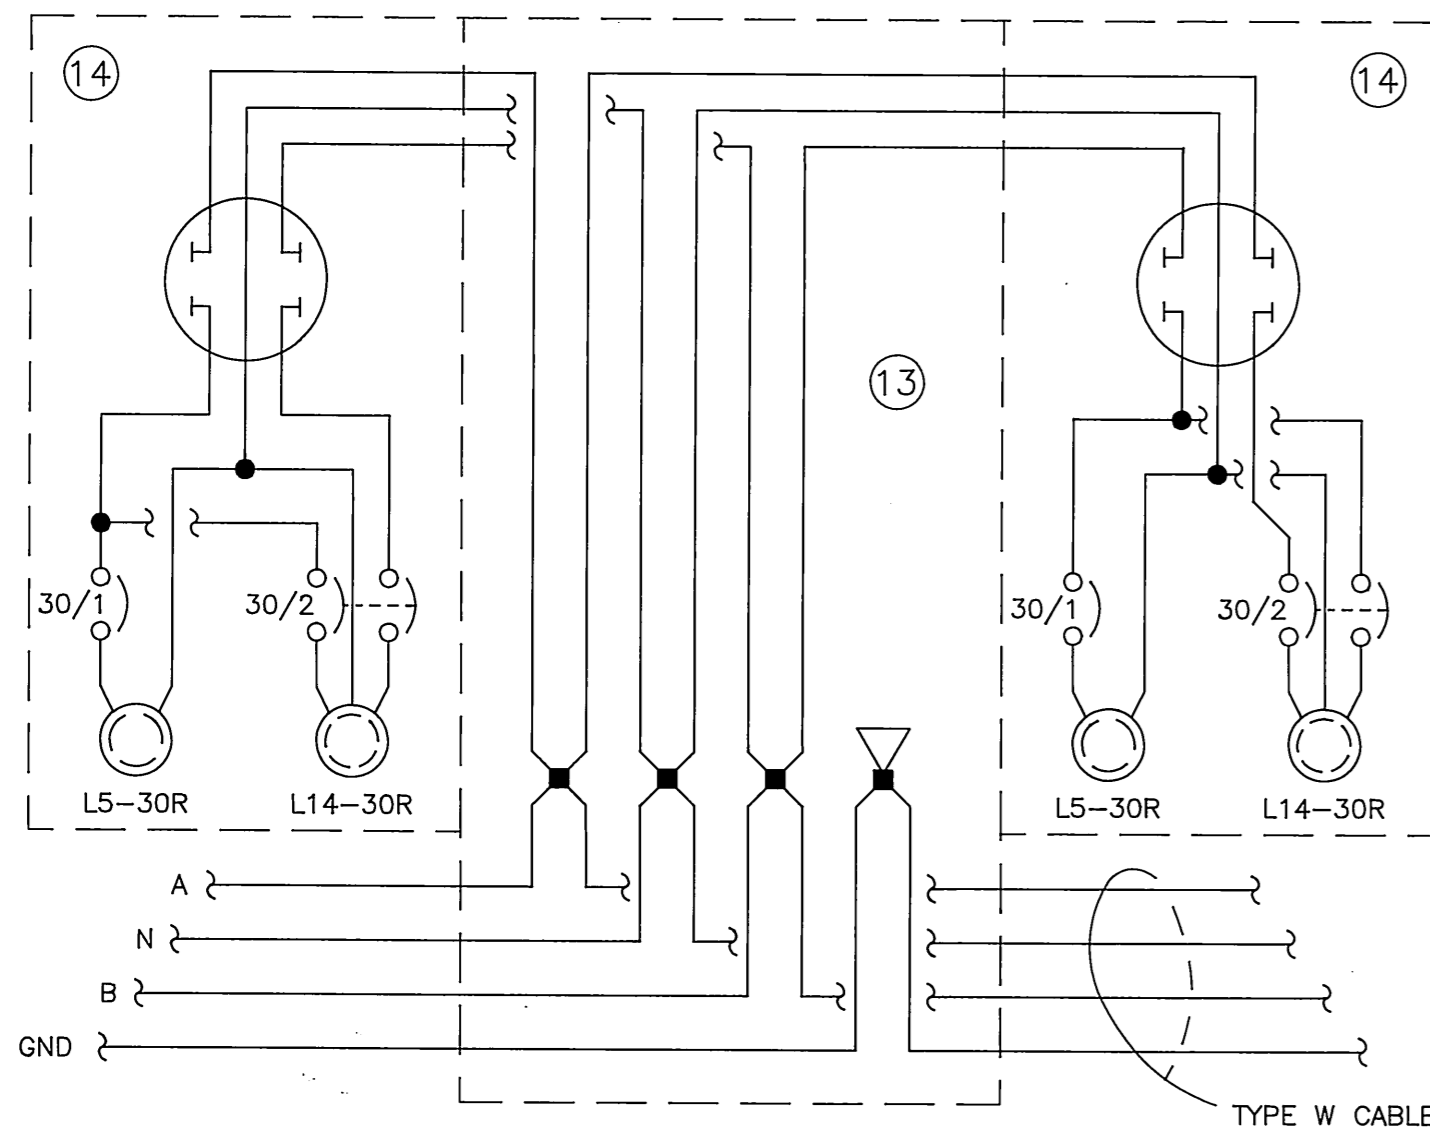

**RISER DIAGRAM - 120/240 VOLT PEDESTAL**  
NO SCALE

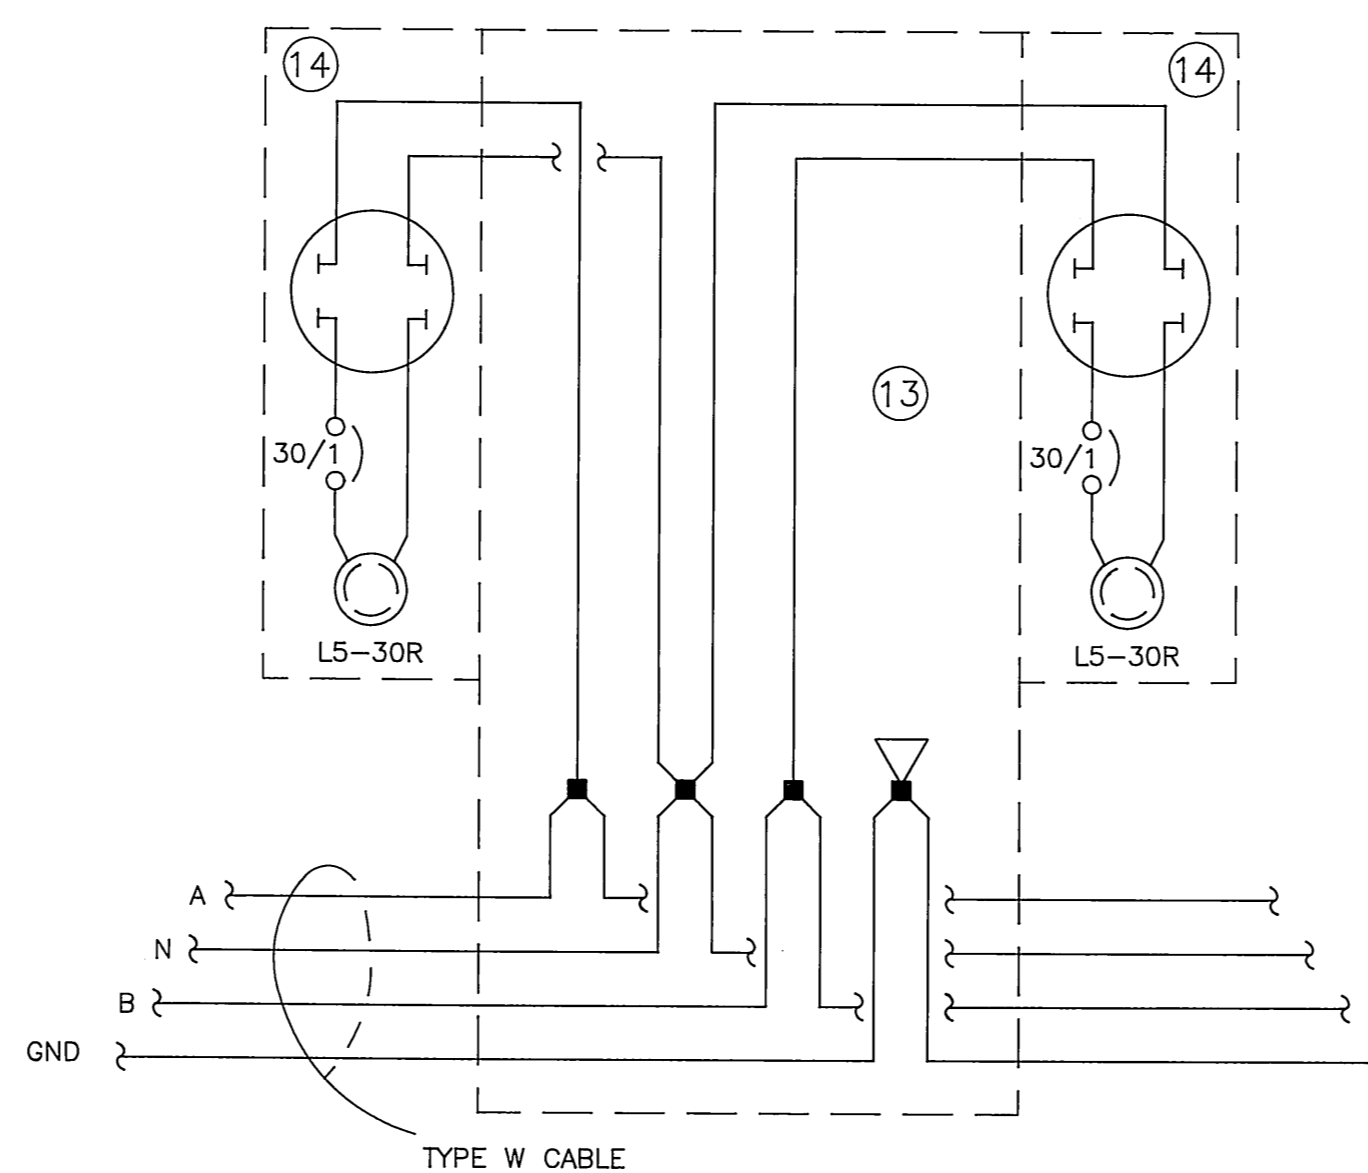


**RISER DIAGRAM - 120 VOLT PEDESTAL**  
NO SCALE



C.K.T. NO.	WIRE NO./SIZE	DESCRIPTION	BREAKER AMP/POLE	VOLTS/PHASE				BREAKER AMP/POLE	DESCRIPTION	LOCATION	MOUNT SURFACE	
				400 AMPS	120/208V, 3 PH							MAIN LUGS ONLY
			KVA									
			CKT	AØ	BØ	CØ	CKT					
1	4/4	FLOAT C SHORETIES EXISTING	60/2	5.0	10.0		5.0	60/2	FLOAT D SHORETIES EXISTING		4/4	
3				5.0	10.0		5.0				4	
5	4/2	FLOAT A SHORETIES	60/2	4.2		11.7	7.5	100/2	MAIN & H FLOAT SHORETIES		4/1/0	
7				4.2	11.7		7.5				8	
9	4/2	FLOAT B SHORETIES	60/2	6.0		12.3	6.3	80/2	FLOAT E SHORETIES		4/2	
11				6.0		12.3	6.3				12	
13					3.8		3.8	60/2	FLOAT G NORTH SHORETIES		4/2	
15	4/4	PANEL P2	100/2	7.2		11.0	3.8				16	
17				6.6		14.1	7.5	100/2	FLOAT G SOUTH SHORETIES		4/1/0	
19	4/1/0	FLOAT I SHORETIES	100/2	7.0	14.5		7.5				20	
21				7.0		13.3	6.3	80/2	FLOAT J SHORETIES		4/2	
23							6.3	6.3			24	
25											26	
27											28	
29											30	
31											32	
33											34	
35											36	
37											38	
39											40	
41											42	
TOTAL CONNECTED LOAD = 135.2 KVA / 375.6 AMPS				44.2	46.6	44.4						

C.K.T. NO.	WIRE NO./SIZE	DESCRIPTION	BREAKER AMP/POLE	VOLTS/PHASE				BREAKER AMP/POLE	DESCRIPTION	LOCATION	MOUNT SURFACE	
				100 AMPS	120/208V, 1 PH							MAIN LUGS ONLY
			KVA									
			CKT	AØ	BØ	CØ	CKT					
1	4/4	WELDER RECEPTACLE (EXTG)	50/2	3.3	3.9		0.6	20/1*	UTILITY RECEPTACLE (EXTG)		2/12	
3				3.3	3.3						4	
5	4/4	WELDER RECEPTACLE (EXTG)	50/2	3.3	3.3						6	
7				3.3	3.3						8	
9											10	
11											12	
13											14	
15											16	
17											18	
19											20	
21											22	
23											24	
TOTAL CONNECTED LOAD = 13.8 KVA / 38 AMPS				7.2	6.6							

\* GROUND FAULT INTERRUPTER

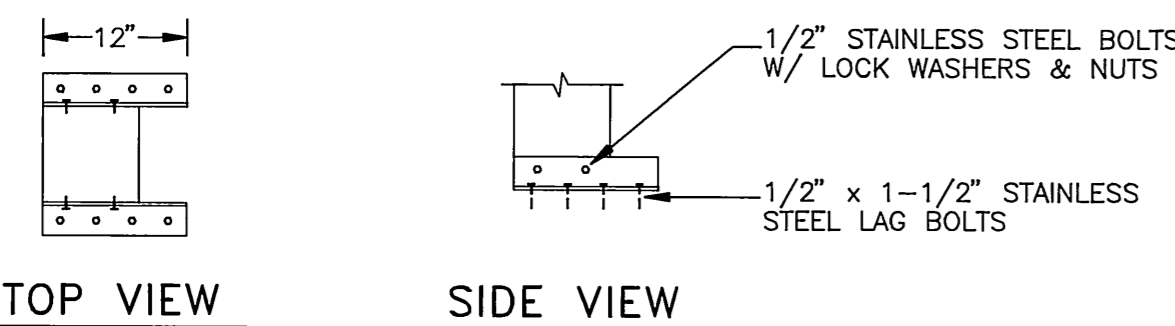

**DETAIL - PEDESTAL BASE**

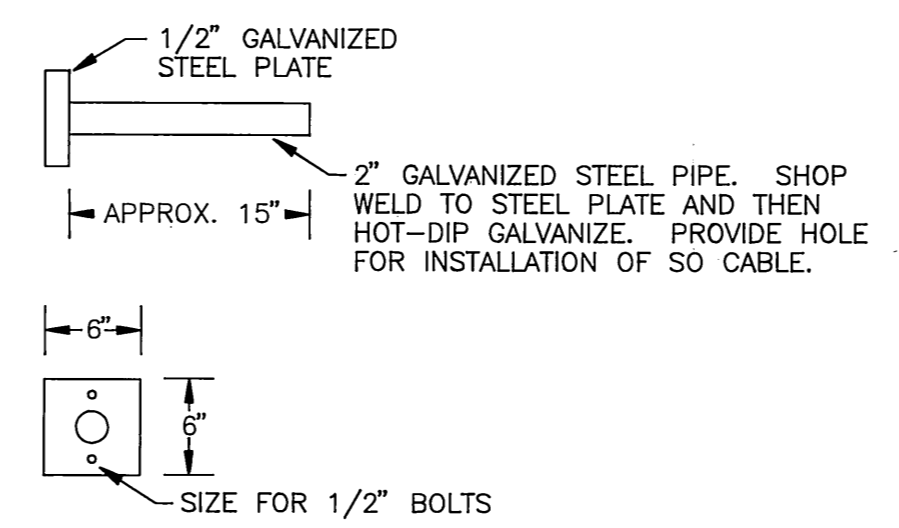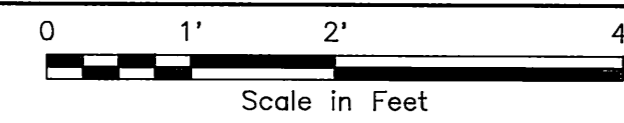


**DETAIL - PILING BRACKET**  
NO SCALE

**EQUIPMENT SCHEDULE:**



- ① 2"x10" DECKING
- ② 8"x8" BULLRAIL
- ③ 4"x8" BLOCKING
- ④ 4"x8"x20" SPACER (NEW)
- ⑤ 2"x8" BUMPER BOARD
- ⑥ 6"x8" STRINGER
- ⑦ 4"x6" STRINGER
- ⑧ 6"x6" & 3"x6" SILLS
- ⑨ 2"x10" SIDING
- ⑩ 3"x6" SILL
- ⑪ 10"x20"x9" FLOTATION PLANKS
- ⑫ PEDESTAL BASE - 2-1/2"H x 4"W x 12", 1/4" STAINLESS STEEL ANGLE IRON (SEE DETAIL)
- ⑬ 8x10 PEDESTAL - 14 GA. STAINLESS STEEL (316)
- ⑭ POWER HEAD W/ METER BASE, CIRCUIT BREAKER, & RECEPTACLE & LOCKABLE COVER - 16 GA. STAINLESS STEEL (316)
- ⑮ TYPE W CABLES (TYP)
- ⑯ 1/2" x 6" STAINLESS STEEL LAG BOLT

**EQUIPMENT / NOTES:**

- ① STEEL PILING WITH AERIAL LINE SUPPORT
- ② CLEVIS & INSULATOR: JOSLYN J93 & J151.
- ③ AERIAL CABLE: #6 QUADRUPEX CU WITH ACSR MESSENGER.
- ④ 5/8" GALVANIZED BOLT.
- ⑤ STEEL PILING WITH AERIAL LINE SUPPORT & LUMINAIRE.
- ⑥ LUMINAIRE: GE M2AC-07-S-1-H-1-L-MC2-1, 70 WATT HIGH PRESSURE SODIUM.
- ⑦ LUMINAIRE PILING BRACKET, GALVANIZED. SEE DETAIL THIS SHEET.
- ⑧ 3/8" GALVANIZED BOLTS.
- ⑨ MAKE CONNECTION FROM AERIAL CABLE TO LUMINAIRE WITH 10/3 SO CABLE (BLACK). UTILIZE MECHANICAL TYPE CABLE TAPS, THOMAS & BETTS CT2 OR EQUAL, W/ INSULATING BOOT CT2C. TAPE OVER BOOT W/ TWO LAYERS OF ELECTRICIANS TAPE. TY-RAP TO MESSENGER.
- ⑩ MOUNT CLEVIS TO FACE CONDUCTOR BEING TERMINATED IN DEADEND CONFIGURATION.

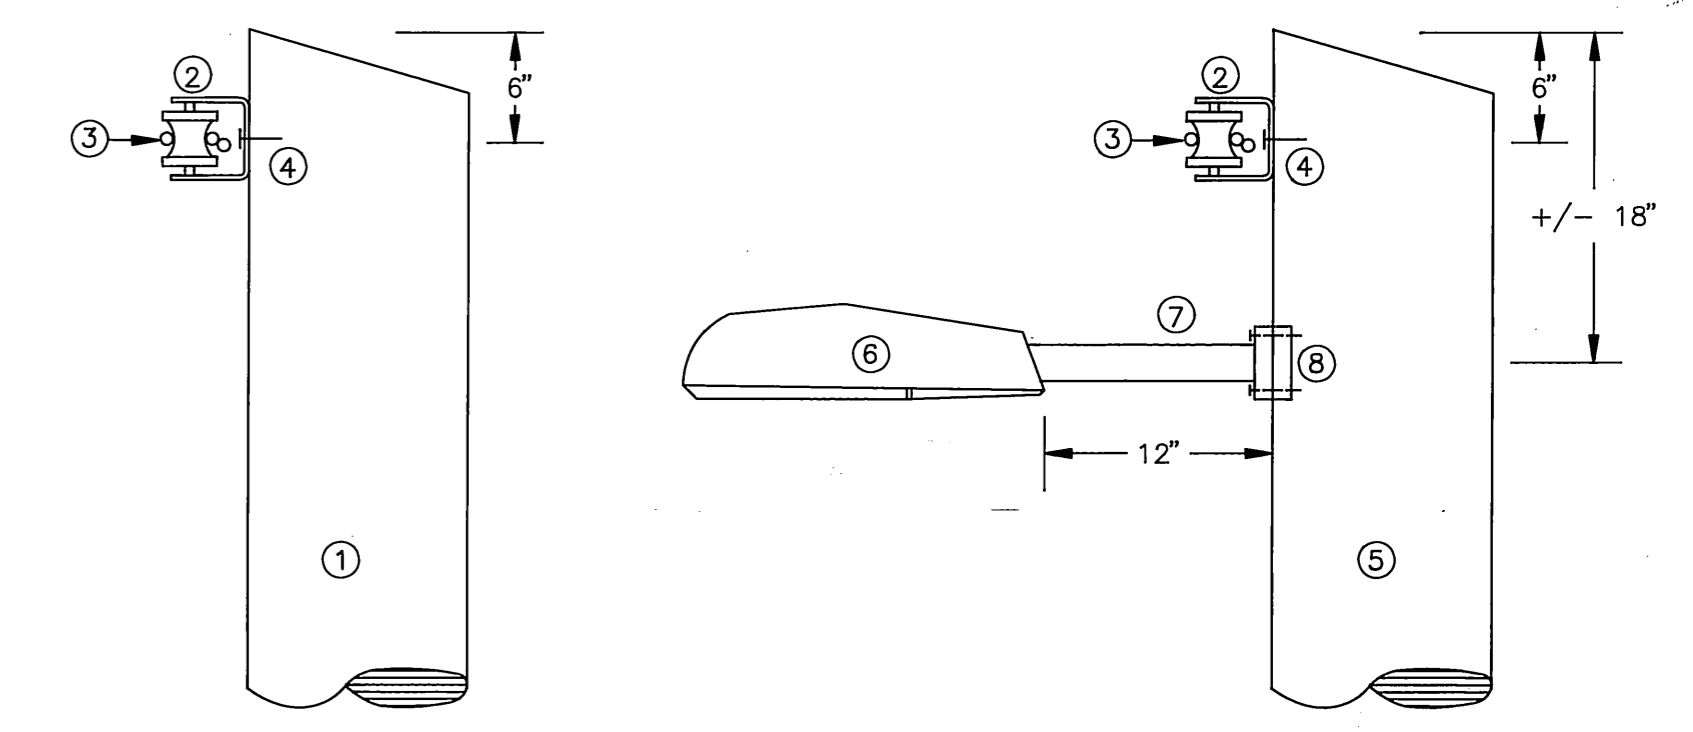

**DETAIL - FLOAT LIGHTING / AERIAL LINE**  
NO SCALE

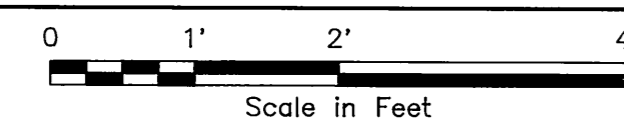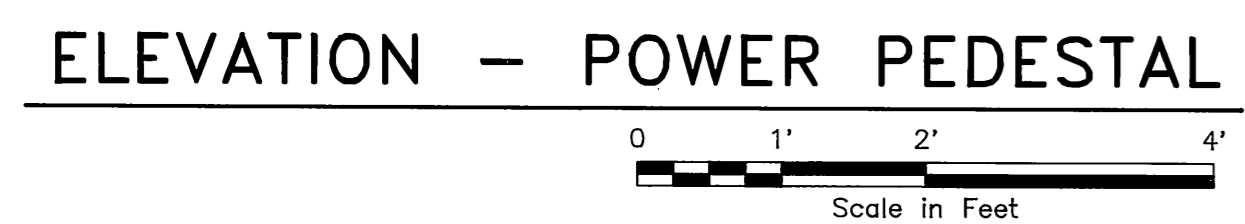

BY:	DATE:	DESCRIPTION OF CHANGE:

STATE OF ALASKA  
DEPARTMENT OF TRANSPORTATION  
AND PUBLIC FACILITIES  
SOUTHEAST REGION DESIGN & CONSTRUCTION

CRAIG  
ALASKA  
DESIGNED BY: TSM  
DRAWN BY: PEL  
CHECKED BY: BCH  
**ELECTRICAL - LIGHTING, THAW WIRE & POWER**

PROJECT No. 70649A  
DATE: JULY 17, 1992  
SHEET 17 OF 17

