

Estimate of Quantities

Item No.	Item	Unit	Quantity
110 (1)	Mobilization and Demobilization	L.S.	All Req'd.
120 (1)	DBE Adjustment	C.S.	All Req'd.
202 (1)	Removal and Relocation of Seaplane Float	L.S.	All Req'd.
301 (1)	12 3/4" dia. x 1/2" Wall Steel Pile, Furnished	L.F.	342.1 420 ^{As Built}
301 (2)	12 3/4" dia. x 1/2" Wall Steel Pile, Driven	Each	4
301 (3)	16" dia. x 1/2" Wall Steel Pile, Furnished	L.F.	149.2 200 ^{As Built}
301 (4)	16" dia. x 1/2" Wall Steel Pile, Driven	Each	2
301 (5)	100# Anode Bracelet	Each	6
301 (6) 301 (6)	Pile sockets	L.S.	As Built
311 (1)	Seaplane Float (56' x 56')	L.S.	All Req'd.
311 (2)	Log Reinforced Float (12' x 50')	L.S.	All Req'd.
311 (3)	Standard Signs	S.F.	15.0
311 (4)	Wind Cone	Each	1
315 (1)	6,000# Stockless Type Anchor	Each	1
315 (2)	Rock Anchor	Each	1
315 (3)	1 3/8" Stud Link Chain	L.F.	140 130 ^{As Built}
315 (4)	1 3/4" Stud Link Chain	L.F.	214 250 ^{As Built}
662 (1)	20# Fire Extinguisher and Container	Each	1
Additive Alternate I			
312 (1)	Pile Realignment	L.S.	All Req'd.
312 (2)	Pile Collar Replacement	Each	3
312 (3)	Flotation Billets, Furnished	Each	8
312 (4)	Flotation Billets, Installed	Each	8

LEGEND:


- Detail Number (Numerical)
- Sheet Number
- Section Number (Letter)
- Sheet Number
- Dashed line for Existing Structure
- Solid line for New Structure

PILE DRIVING LOG

Hammer Weight = 7000 lb./5000 lb.
 Hammer Type = Steam/Air
 Pile Type = Timber, Cut-off Elevation = +26.0

Pile No.	Penetration	Remarks
1	21'	Good driving-soft
2	13'	Good driving-pile split
3	18'	Good driving-pile split
* 4	5'	Rock refusal
* 5	23'	Good driving-soft
* 6	8'	Rock refusal
7	17'	Good driving-soft
8	19'	Good driving-soft
9	18'	Good driving-soft
10	17'	Good driving-soft
11	16'	Good driving-soft
12	16'	Good driving-soft
13	14'	Rock @ cut-off
14	15'	Rock @ cut-off
15	14'	Rock @ cut-off
16	15'	Rock @ cut-off
17	15'	Rock @ cut-off

* Variable driving depth at this location.

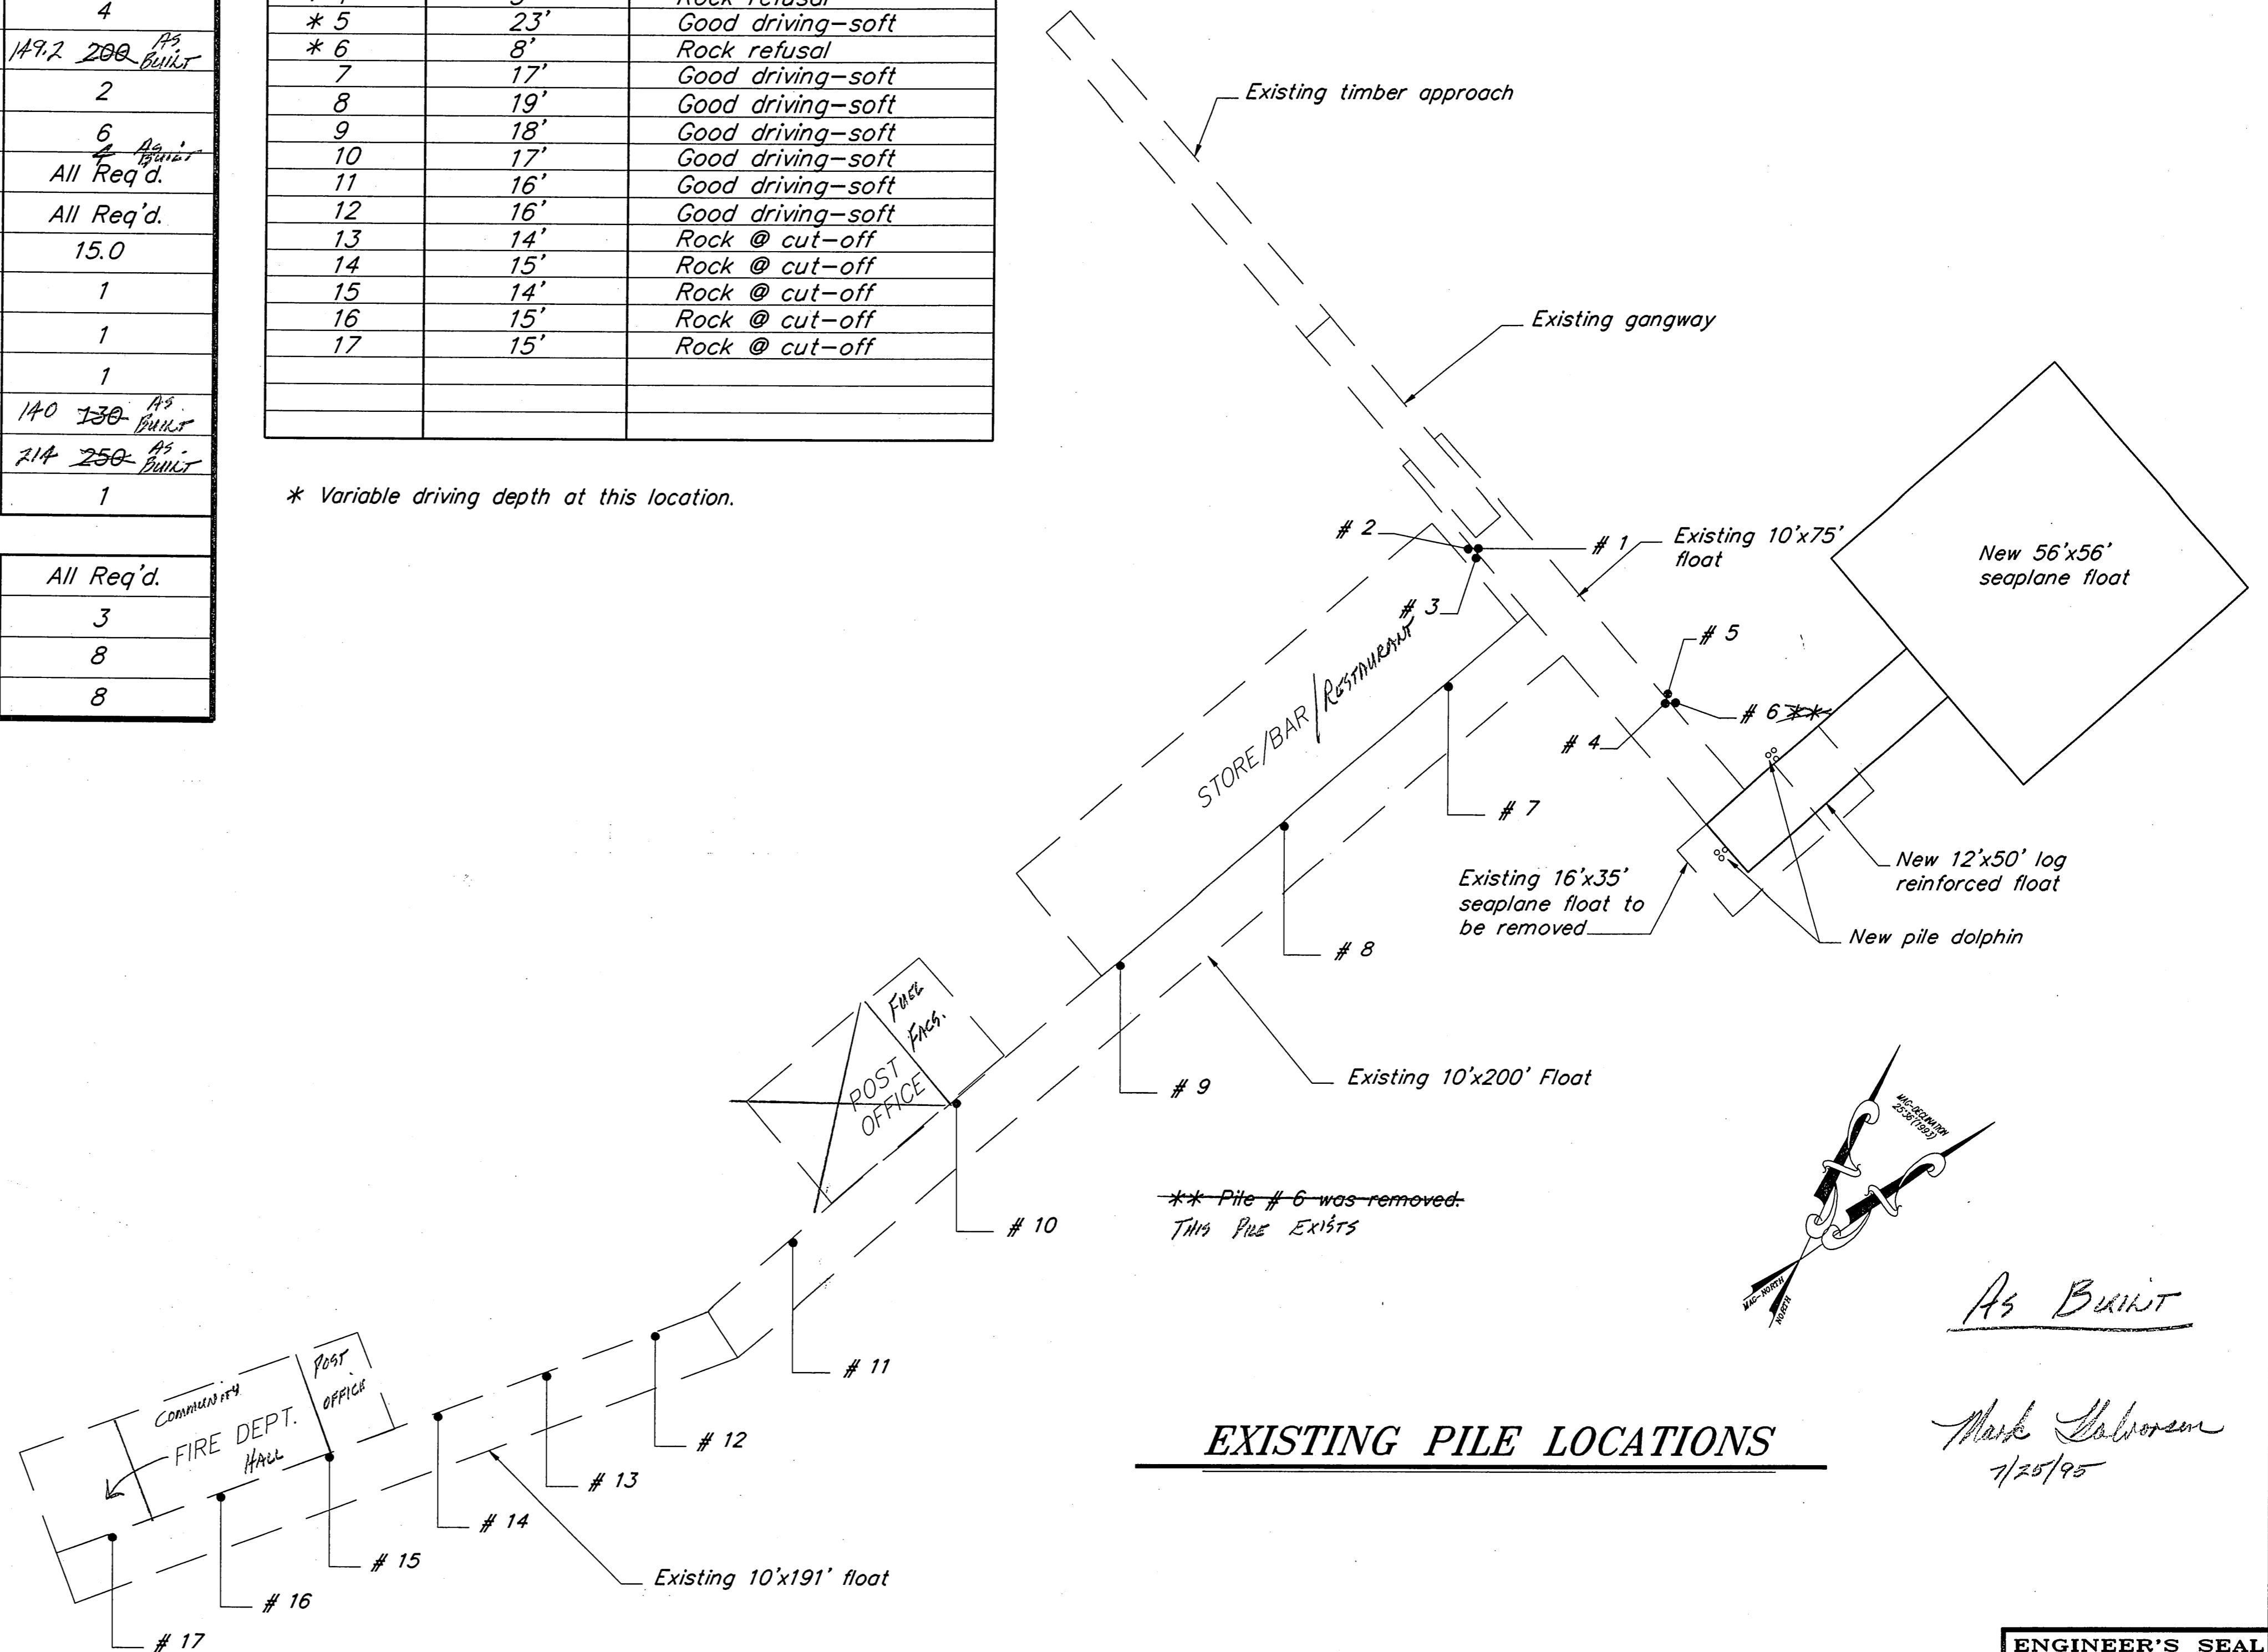

EXISTING PILE LOCATIONS

NOTE: DO NOT SCALE FROM THESE PLANS-USE DIMENSIONS

BY	DATE	DESCRIPTION OF CHANGE

RECORD OF REVISIONS

STATE OF ALASKA
 DEPARTMENT OF TRANSPORTATION
 AND PUBLIC FACILITIES
 SOUTHEAST REGION DESIGN & CONSTRUCTION

POINT BAKER

PRINCE OF WALES ISLAND
 POINT BAKER SEAPLANE FLOAT
 A.I.P. # 3-02-0423-01
 Estimate of Quantities

ALASKA

DESIGNED BY: D.D.S.	PROJECT NO. 71135
DRAWN BY: B.W.B.	DATE: APRIL, 1994
CHECKED BY: J.D.B.	SHEET 2 OF 20

ENGINEER'S SEAL



BASIS OF CONTROL

HORIZONTAL CONTROL:


THE PROJECT BASIS OF BEARING IS THE CENTERLINE OF EXISTING MAIN FLOAT. NEW FLOAT SHALL BE ATTACHED PERPENDICULAR TO THE END OF EXISTING MAIN FLOAT.

VERTICAL CONTROL:

THE BASIS OF VERTICAL CONTROL IS THE TOP OF EXISTING MONUMENT "WCMC" (2" GALVANIZED PIPE) WITH AN ASSUMED ELEVATION OF +13.59 ABOVE MLLW.

ADDITIVE ALTERNATE 1 WORK

- Work No. 1 Realign existing piling by pulling piling under pile cap. See sheet 20 for details.
- Work No. 2 Remove existing iron bark rub strip & install new pile collar. See sheet 19 for details.
- Work No. 3 Balance existing float by installing flotation billets under float. See sheet 20 for details.

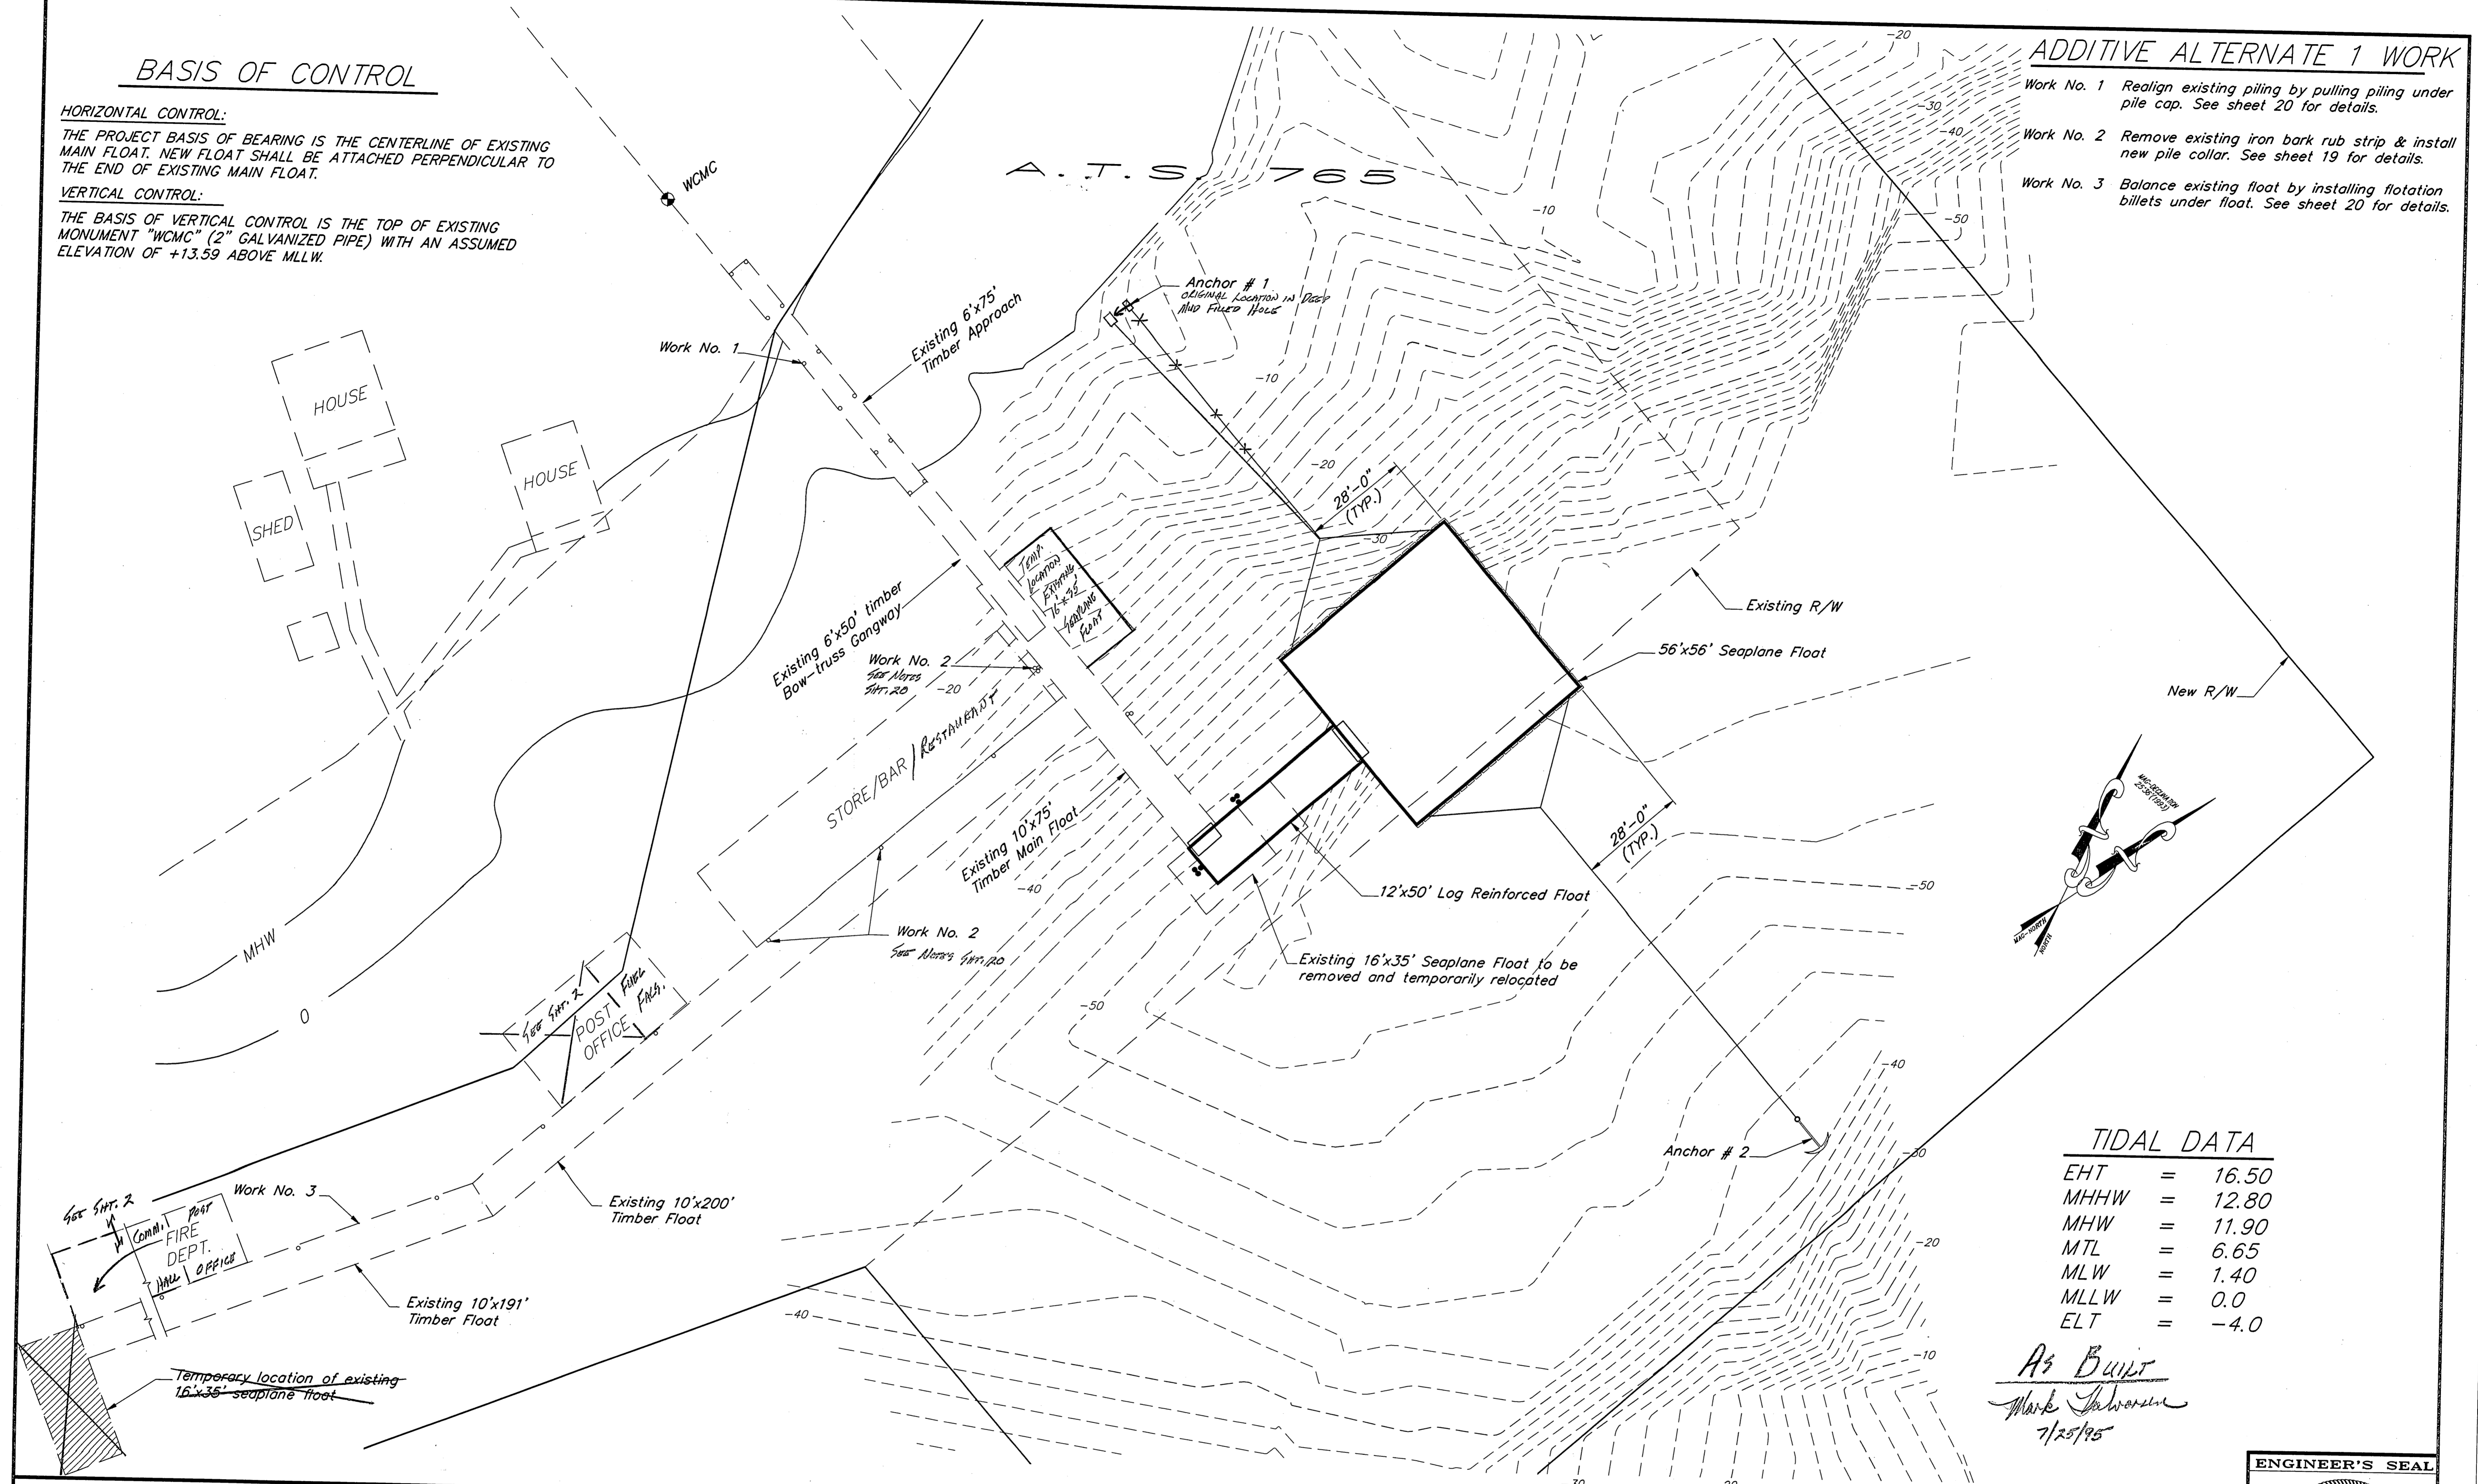

TIDAL DATA

EHT	=	16.50
MHHW	=	12.80
MHW	=	11.90
MTL	=	6.65
MLW	=	1.40
MLLW	=	0.0
ELT	=	-4.0

As Built
Mark Johnson
7/25/95

PATH: P:\POW\PTBAKER\DR\SH73.dwg < 1=30 >

BY	DATE	DESCRIPTION OF CHANGE


RECORD OF REVISIONS

STATE OF ALASKA
DEPARTMENT OF TRANSPORTATION
AND PUBLIC FACILITIES
SOUTHEAST REGION DESIGN & CONSTRUCTION

POINT BAKER
PRINCE OF WALES ISLAND
POINT BAKER SEAPLANE FLOAT
A.I.P. # 3-02-0423-01
Site Layout

NOTE: DO NOT SCALE FROM THESE PLANS-USE DIMENSIONS


DESIGNED BY: D.D.S.	PROJECT NO. 71135
DRAWN BY: B.W.B.	DATE: APRIL, 1994
CHECKED BY: J.D.B.	SHEET 3 OF 20

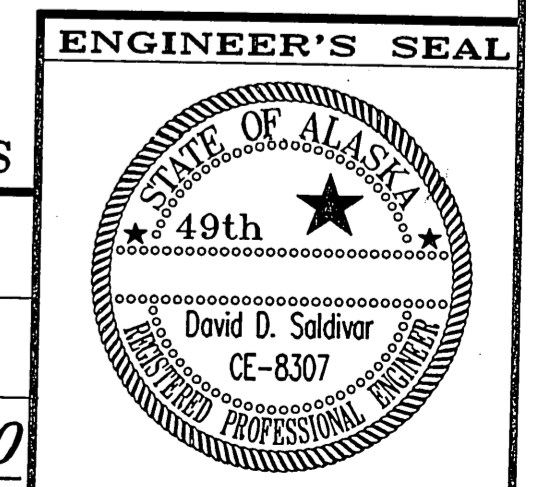


NOTES:

1. 2x10 decking milled S1S2E rough side up. Milled side shall be towards the center of the tree. See sheet 9 for details.
2. Decking shall be spaced 1/4" apart and secured with 2~20d galvanized box nails at 4-ft. maximum spacing and at 4" from decking ends. Decking shall be predrilled as required to prevent splitting.
3. Glulam sub-decking shall be combination 5. Glulam stringers shall be combination 24F-V4.
4. Pile locations may be moved ±2 feet from the plan location to avoid rock or boulder.
5. All steel members and bolts shall be galvanized.
6. All bolts shall conform to ASTM A307 unless otherwise noted.

Each run of decking shall consist of 3 lengths of 2x10 milled decking. Every other run shall consist of 20'-0", 20'-0" and 16'-5" long each and install in this order. The other runs shall consist of 16'-5", 20'-0" and 20'-0" long each and installed in this order.

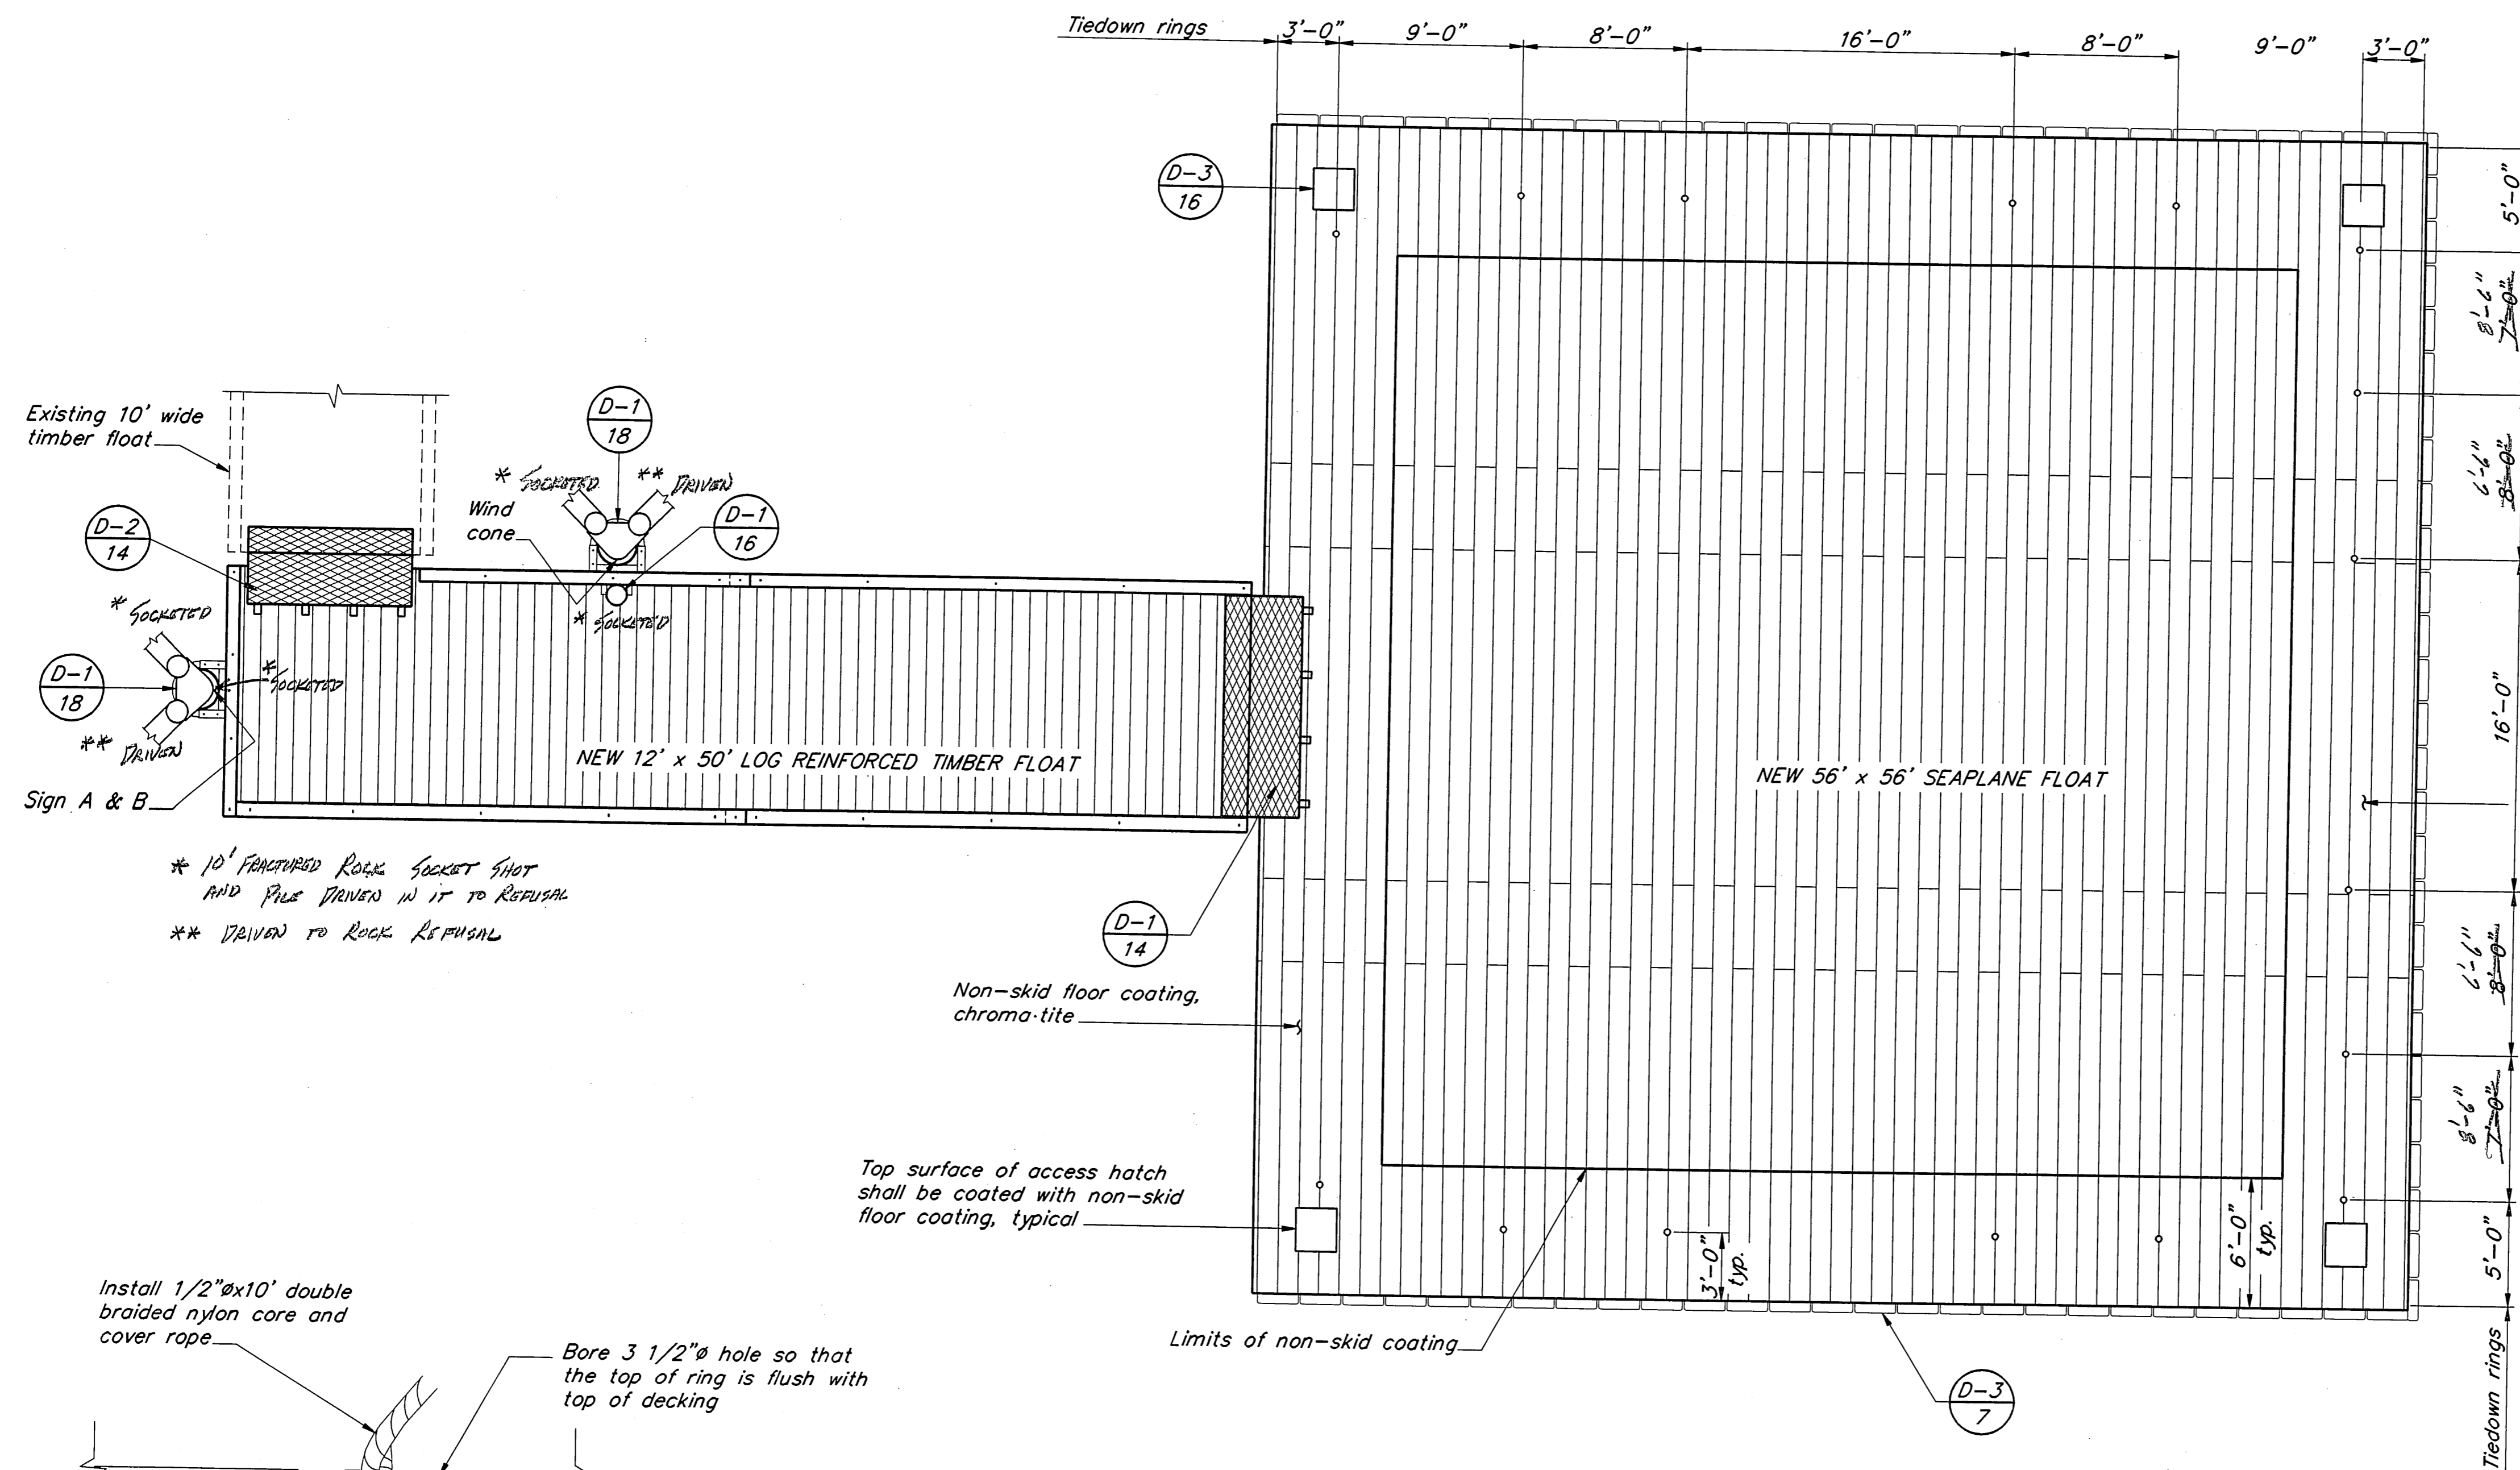

FLOAT LAYOUT

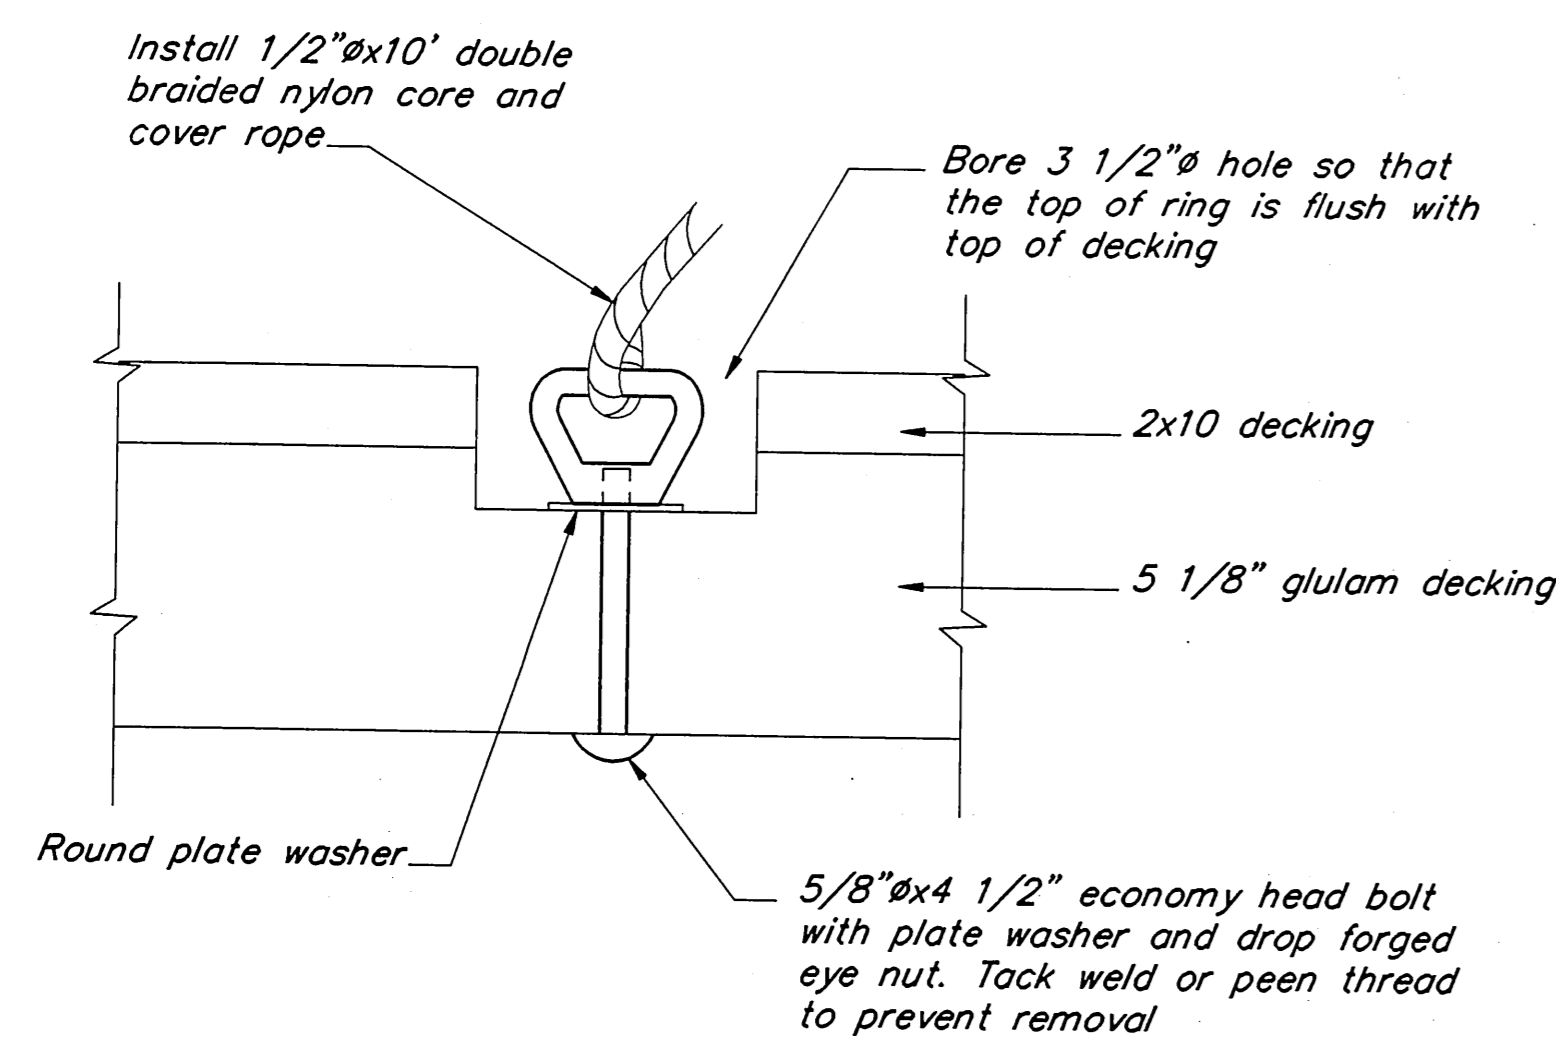

TIE-DOWN RING DETAIL
(16 REQUIRED)

As Built
Mark Johnson
7/25/95

PATH: P:\POW\PTBAKER\DR\SH4.dwg < 1=64 >		
BY	DATE	DESCRIPTION OF CHANGE
RECORD OF REVISIONS		

STATE OF ALASKA
DEPARTMENT OF TRANSPORTATION
AND PUBLIC FACILITIES
SOUTHEAST REGION DESIGN & CONSTRUCTION


POINT BAKER


PRINCE OF WALES ISLAND
POINT BAKER SEAPLANE FLOAT
A.I.P. # 3-02-0423-01

Float Layout

NOTE: DO NOT SCALE FROM THESE PLANS-USE DIMENSIONS


DESIGNED BY: D.D.S.	PROJECT NO. 71135
DRAWN BY: B.W.B.	DATE: APRIL, 1994
CHECKED BY: J.D.B.	SHEET 4 OF 20

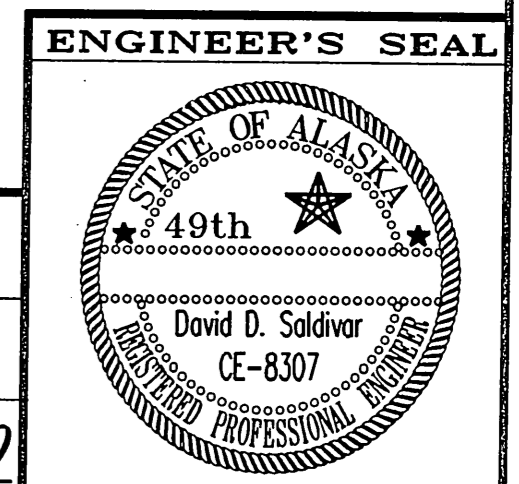

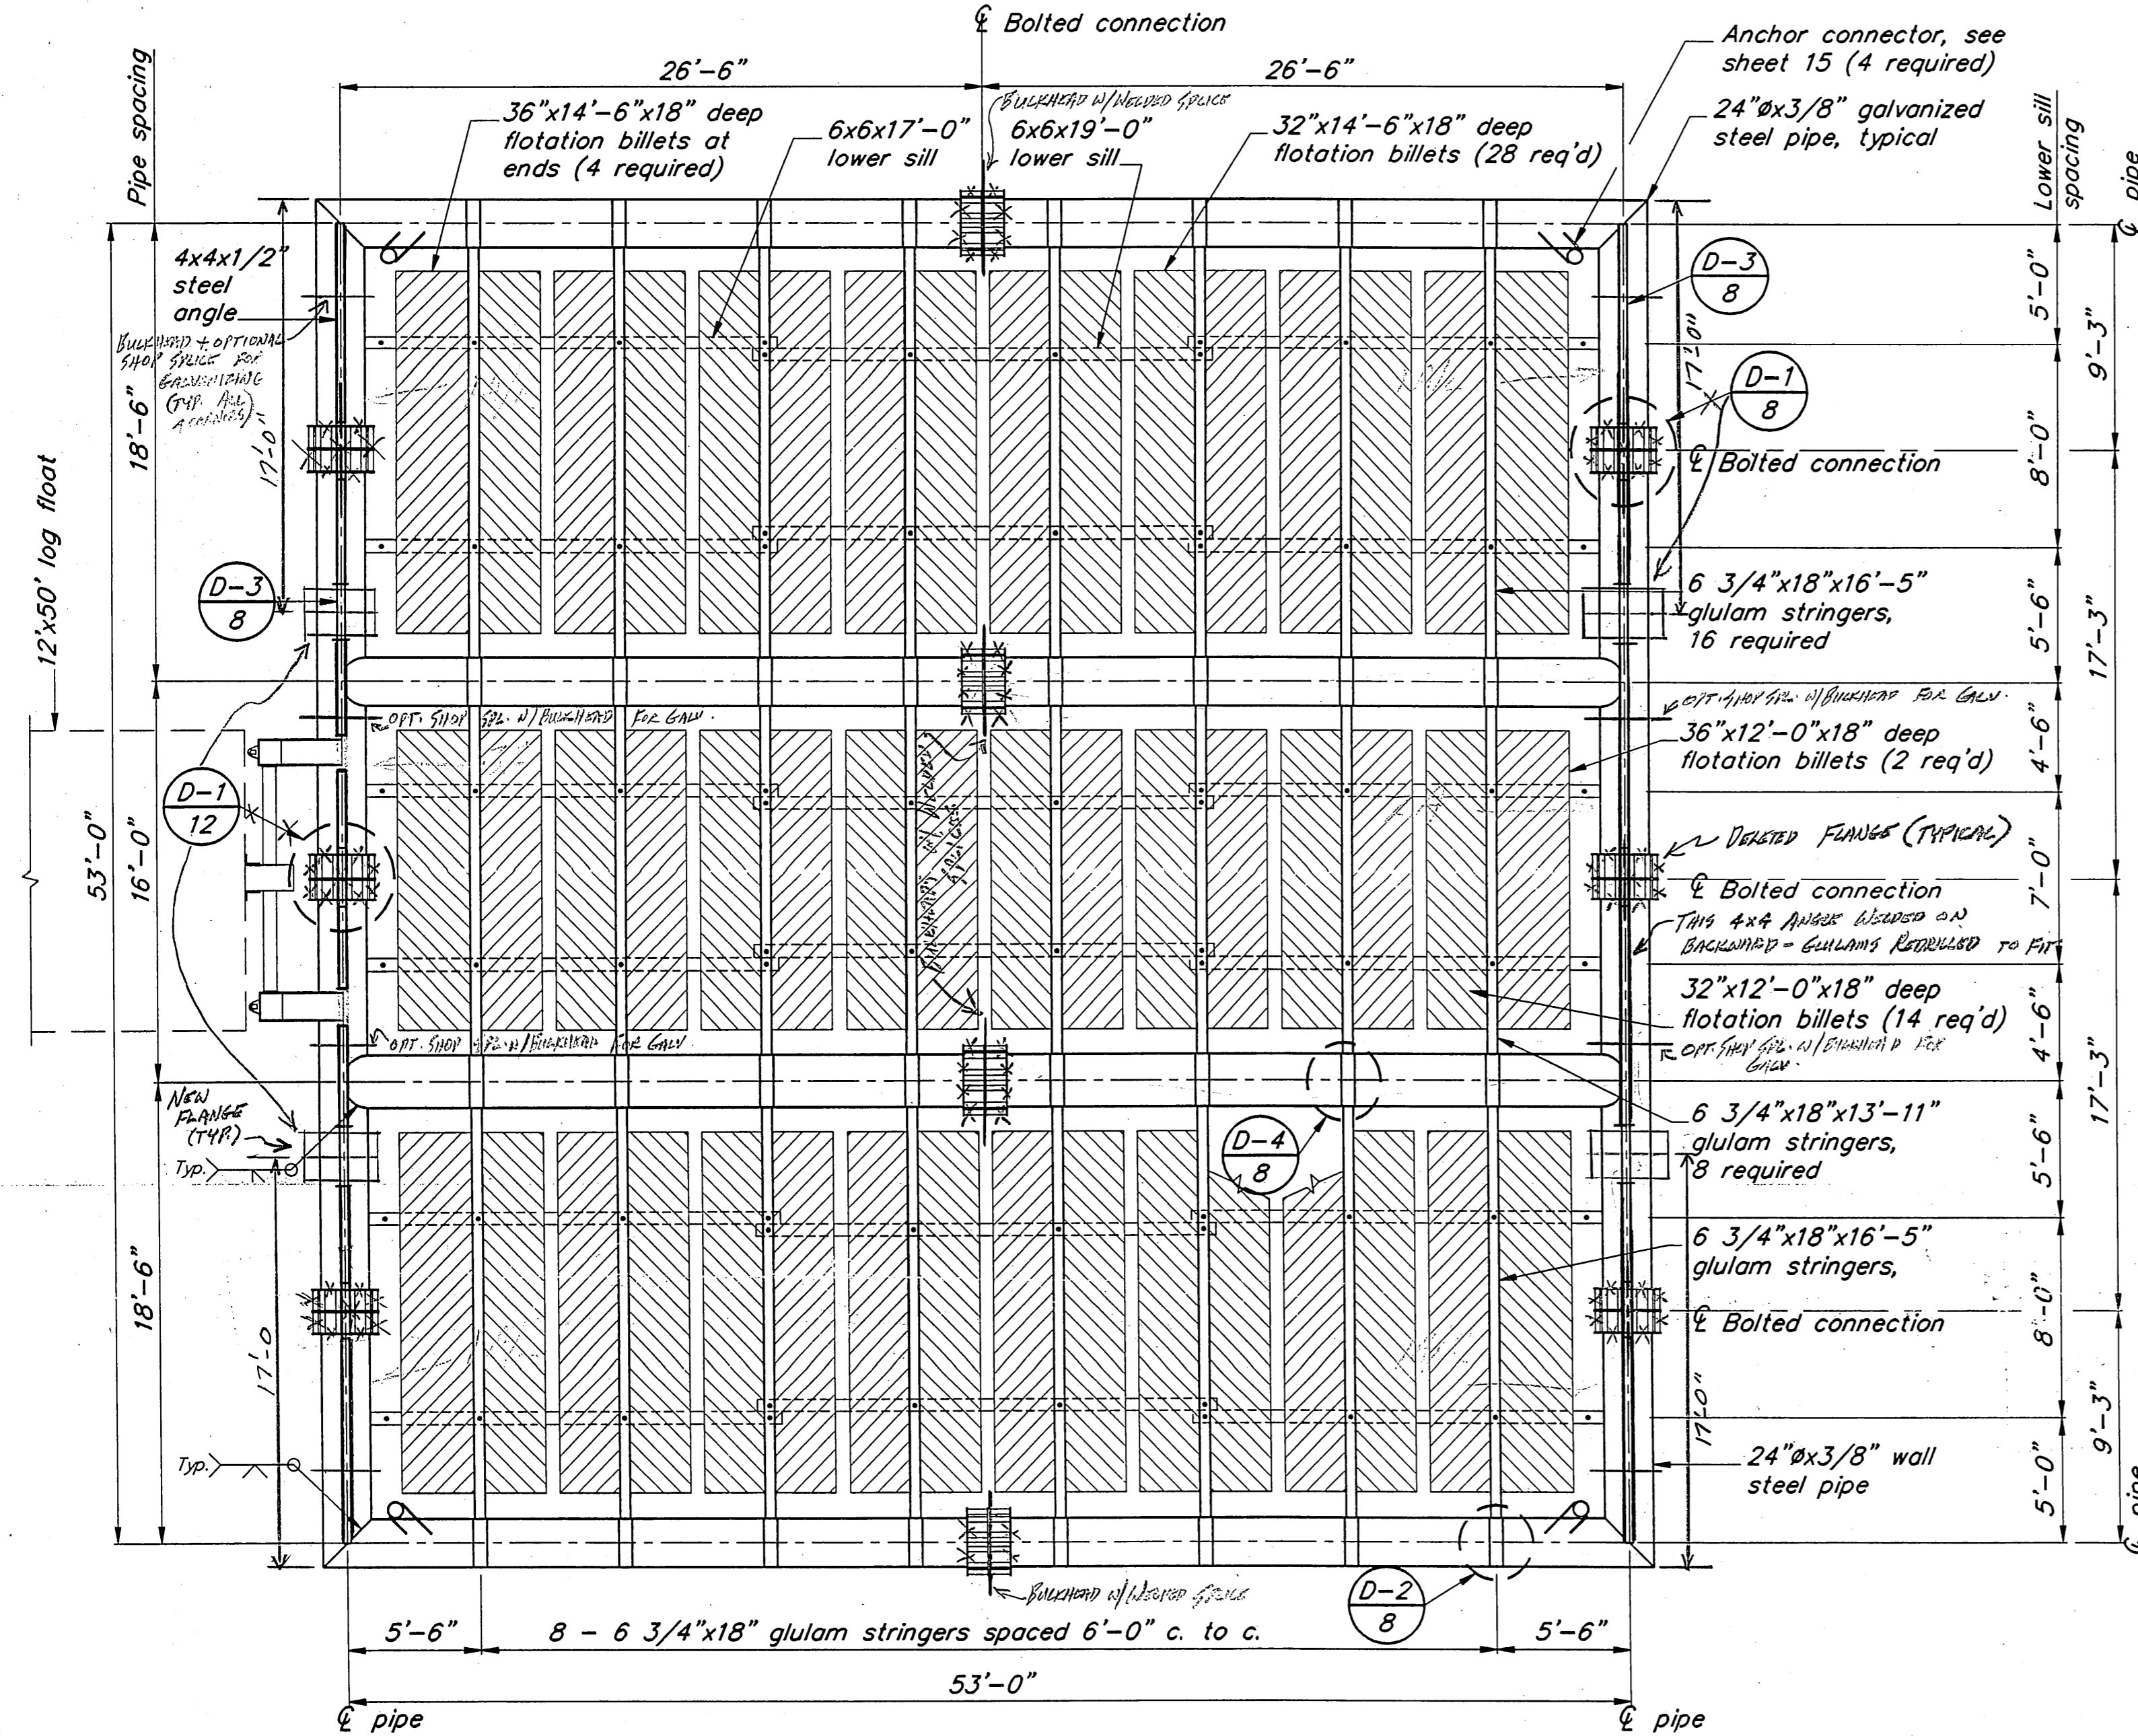

PIPE/GLULAM STRINGER LAYOUT

3/16" = 1'-0"

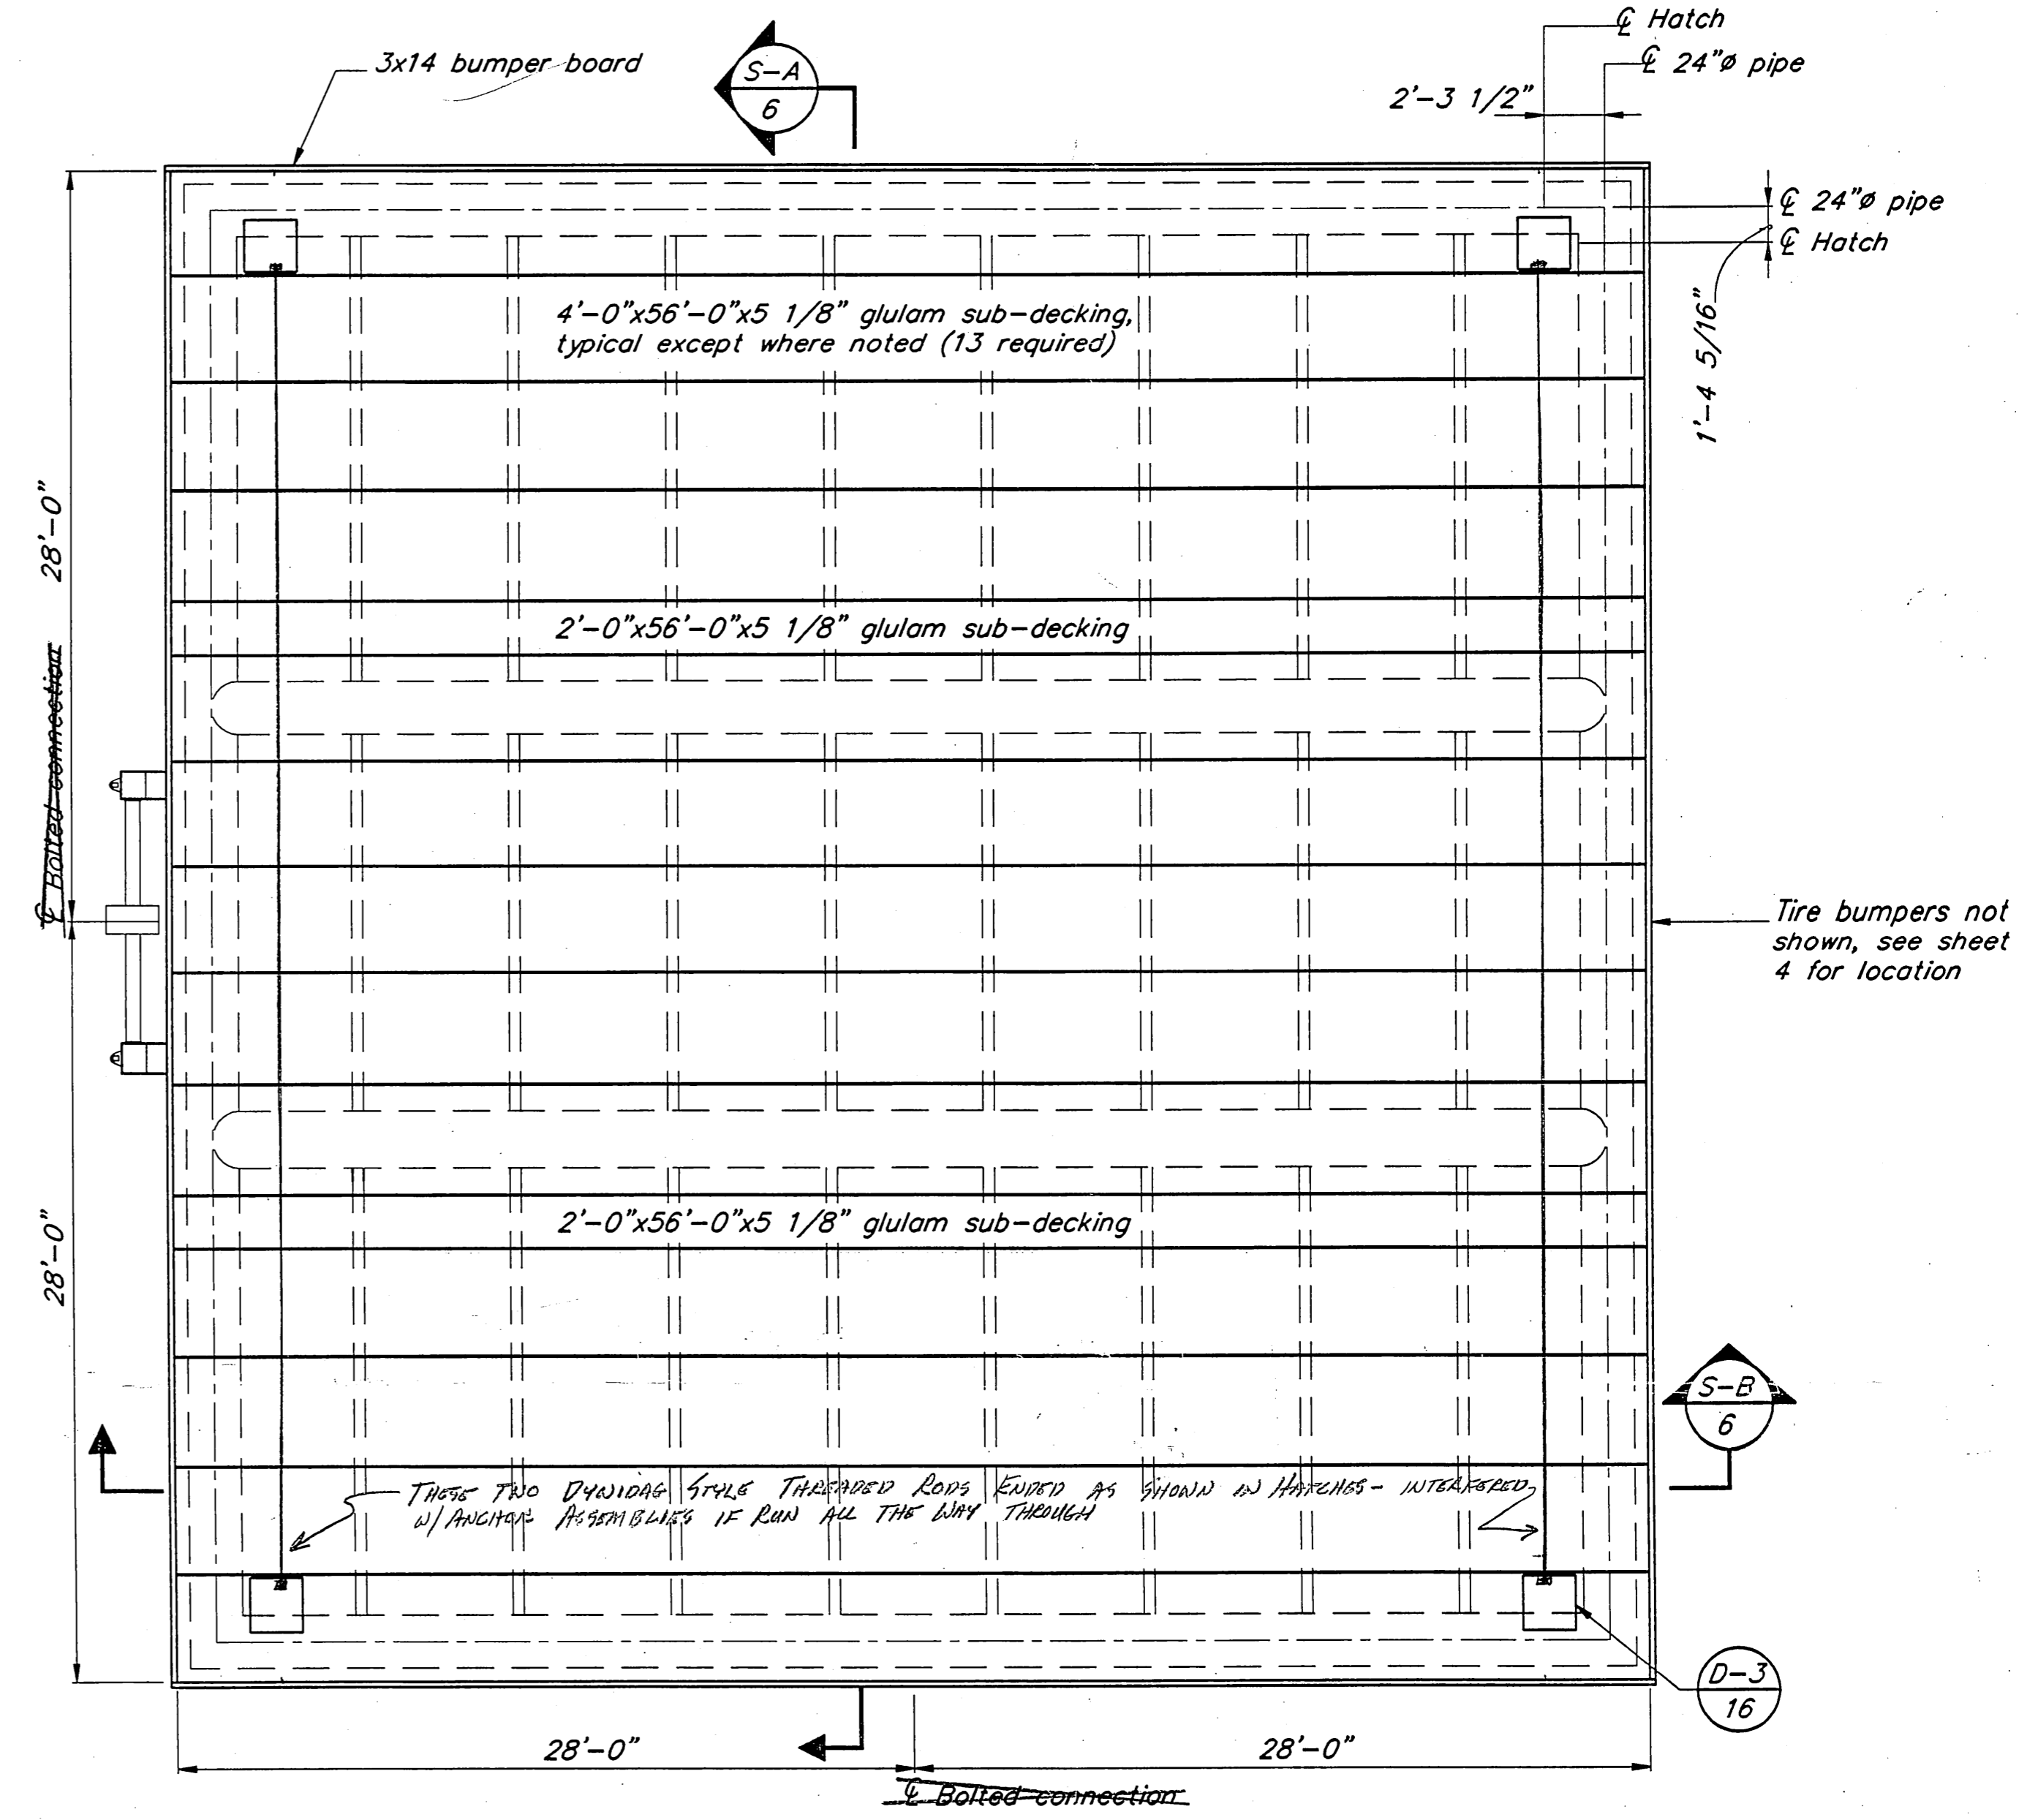

5 1/8" GLULAM SUB-DECKING LAYOUT

3/16" = 1'-0"

NOTE:
See sheet 7 for post-tensioned
threadbar installation.

As BUILT
Mark Salomon
1/25/95

PATH: P:\POW\PTBAKER\DR\SH75.dwg < 1=96 >		
BY	DATE	DESCRIPTION OF CHANGE
RECORD OF REVISIONS		

STATE OF ALASKA
DEPARTMENT OF TRANSPORTATION
AND PUBLIC FACILITIES
SOUTHEAST REGION DESIGN & CONSTRUCTION


POINT BAKER


PRINCE OF WALES ISLAND
POINT BAKER SEAPLANE FLOAT
A.I.P. # 3-02-0423-01

Pipe/Stringer/Decking Layout

NOTE: DO NOT SCALE FROM THESE PLANS-USE DIMENSIONS


DESIGNED BY: D.D.S.	PROJECT NO. 71135
DRAWN BY: B.W.B.	DATE: APRIL, 1994
CHECKED BY: J.D.B.	SHEET 5 OF 20

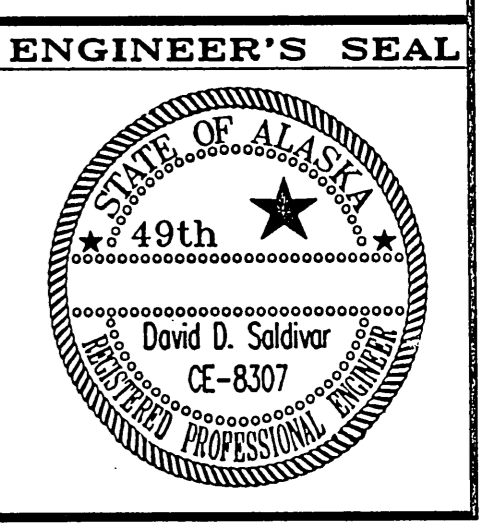

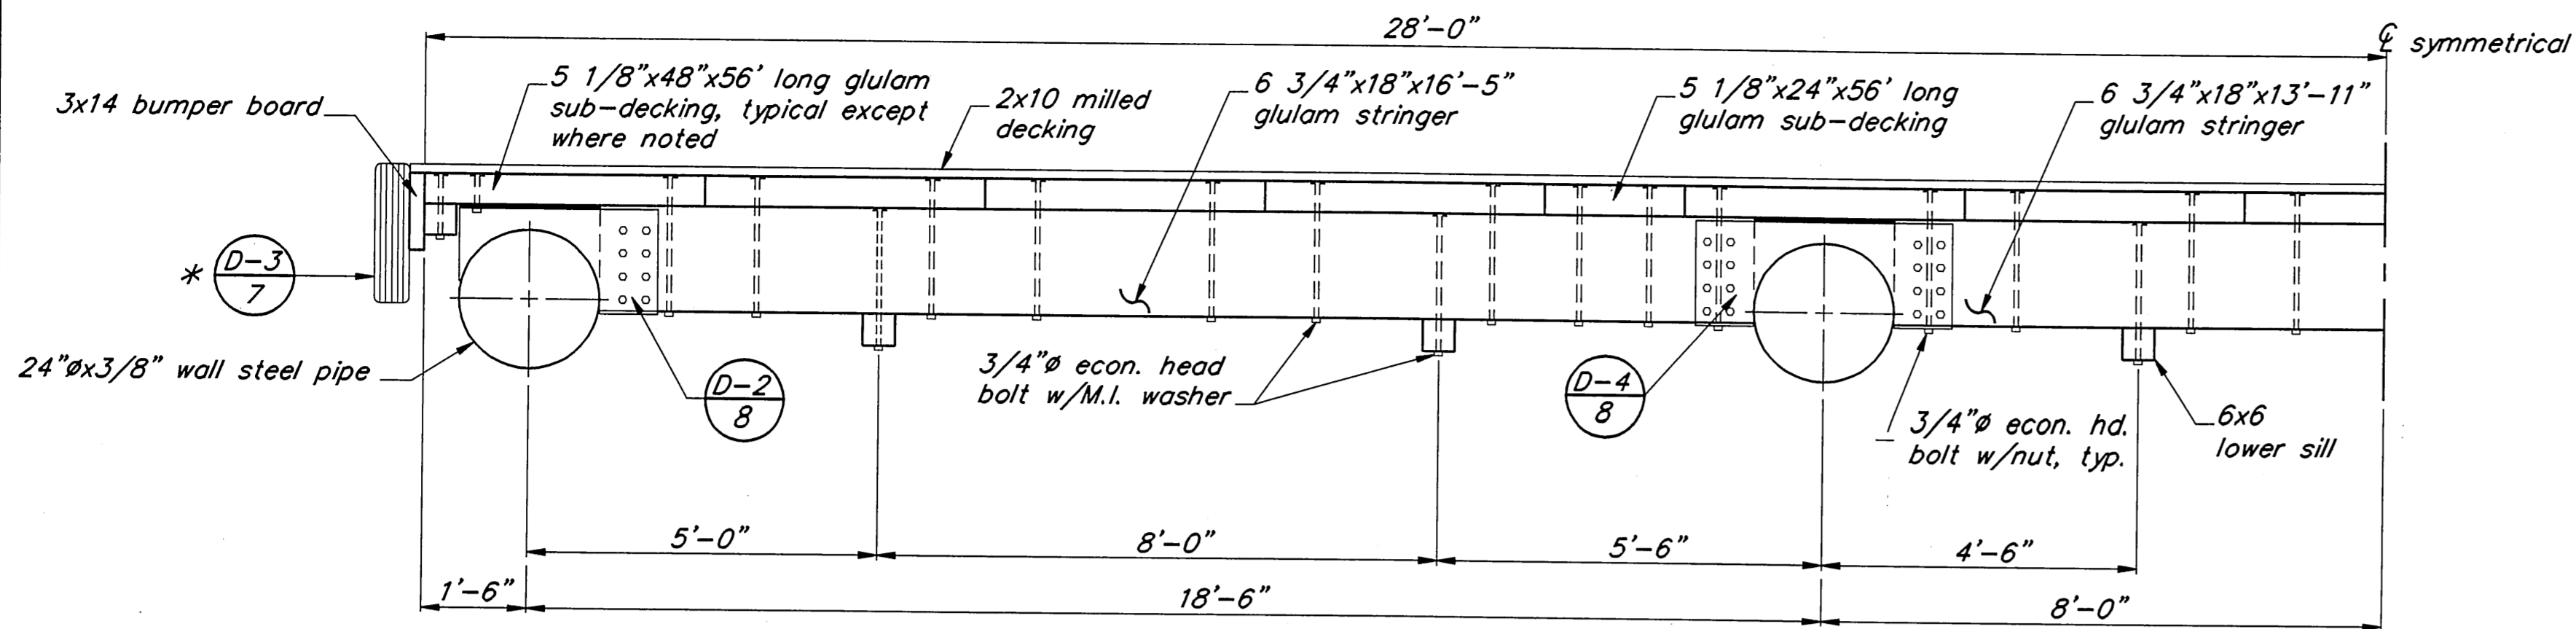


* See sheet 4 for location of tire bumpers.

SECTION A

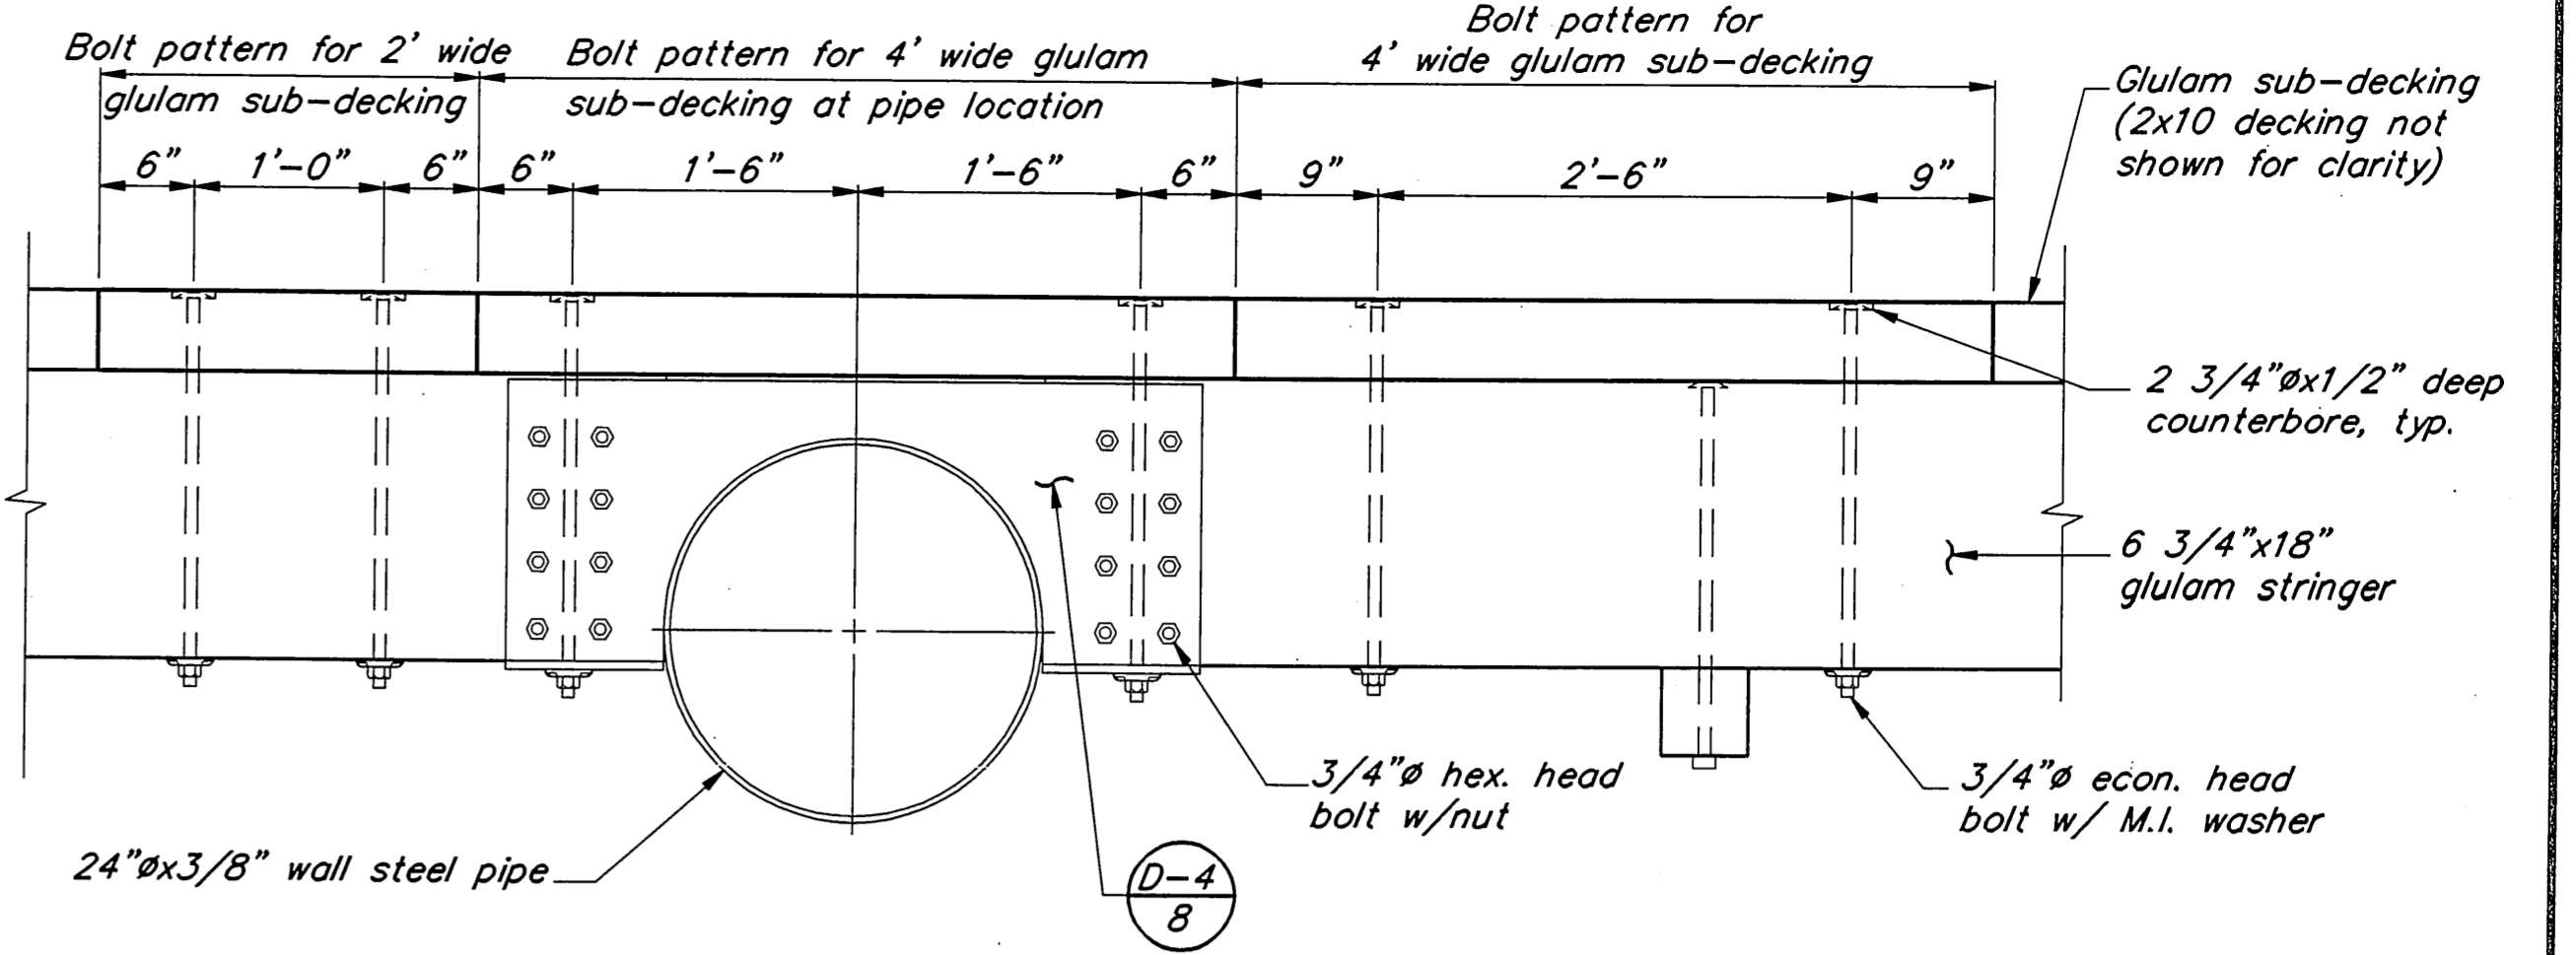


INSIDE BOLT PATTERN DETAIL 1

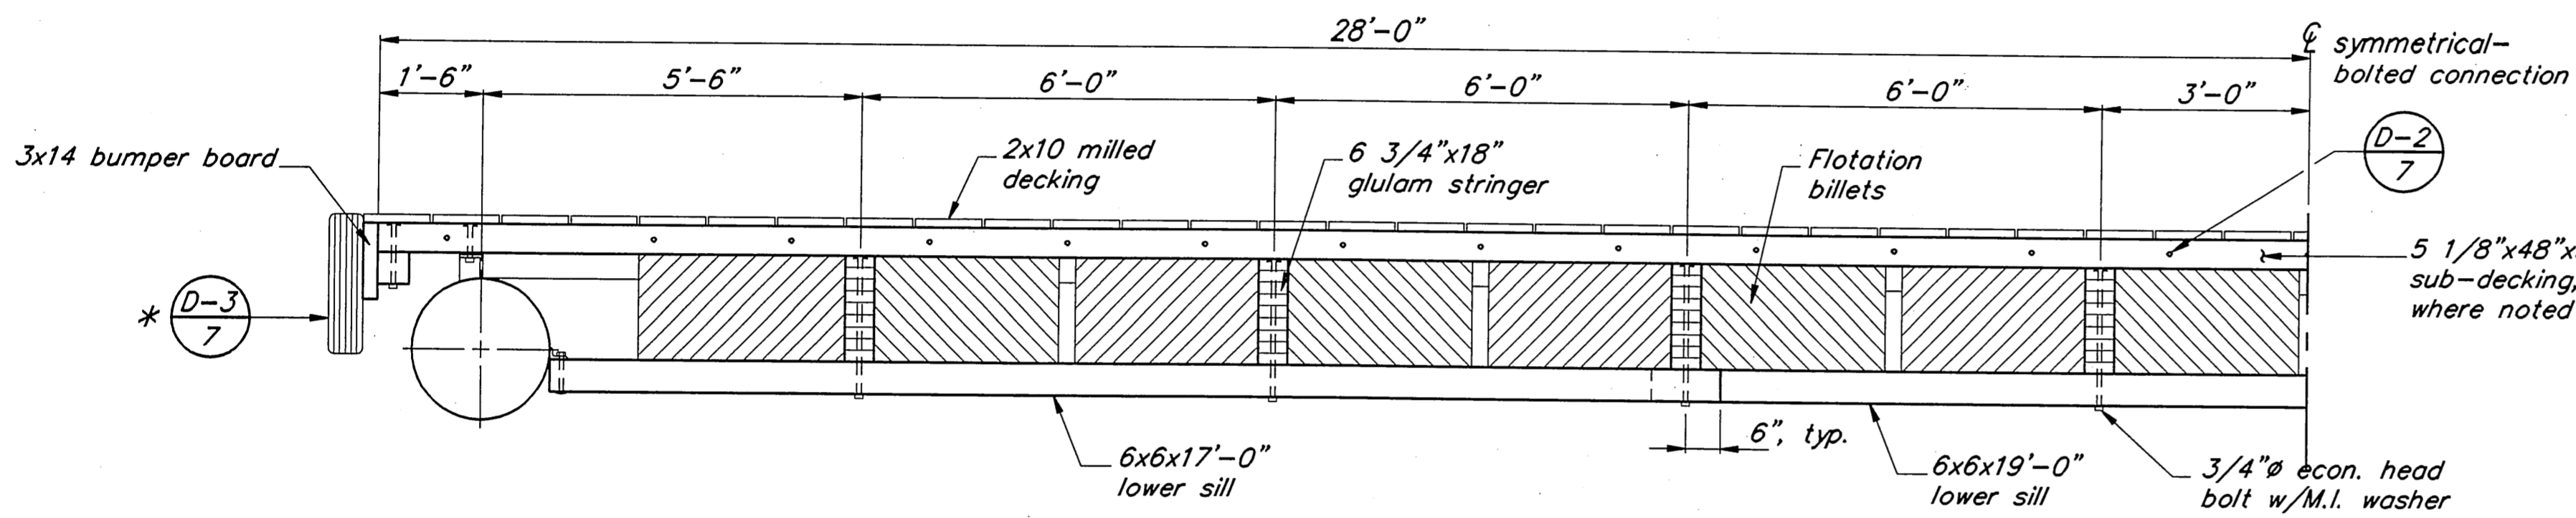


SECTION B

NOTES:


- 3x14 bumper board shall be continuous except at the bumper slide connection.
- 3x14 bumper board shall be secured with 30d common nails every 12" staggered high and low. Bumper board shall be a minimum of 18' long except at the bumper slide connection.
- Glulam sub-decking shall be combination 5. Glulam stringers shall be combination 24F-V4.

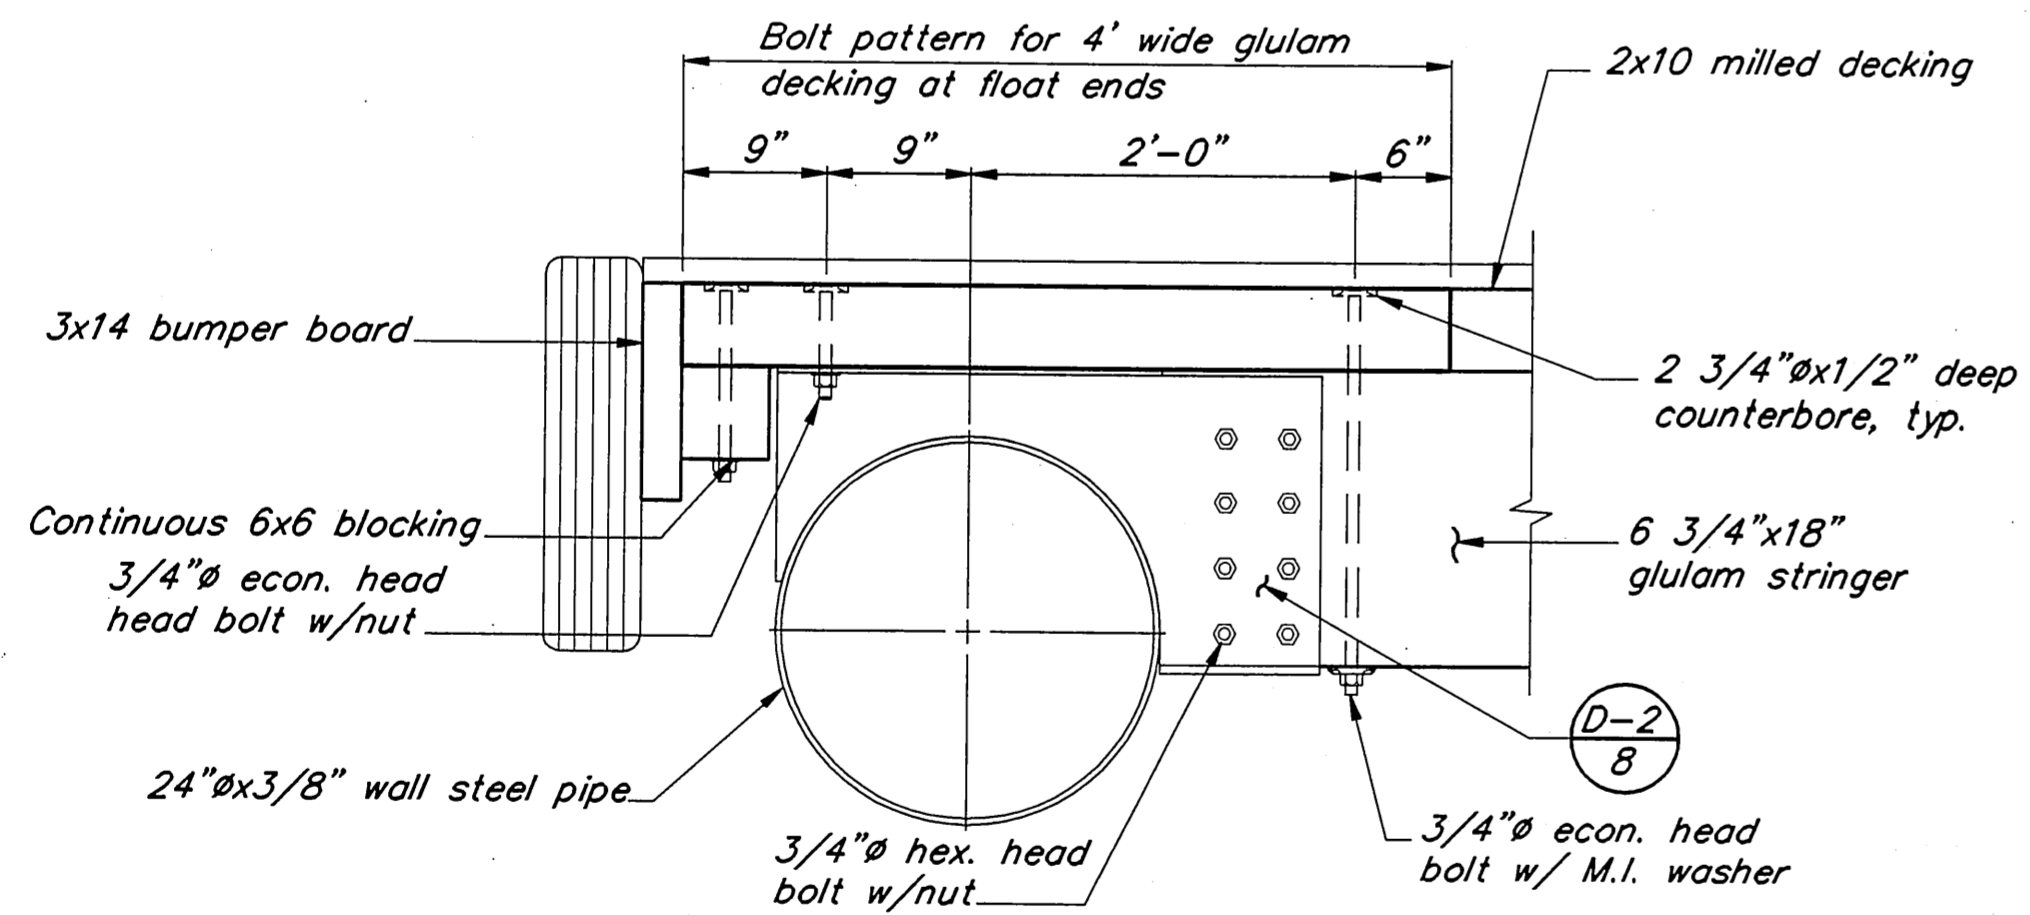

OUTSIDE BOLT PATTERN DETAIL 2

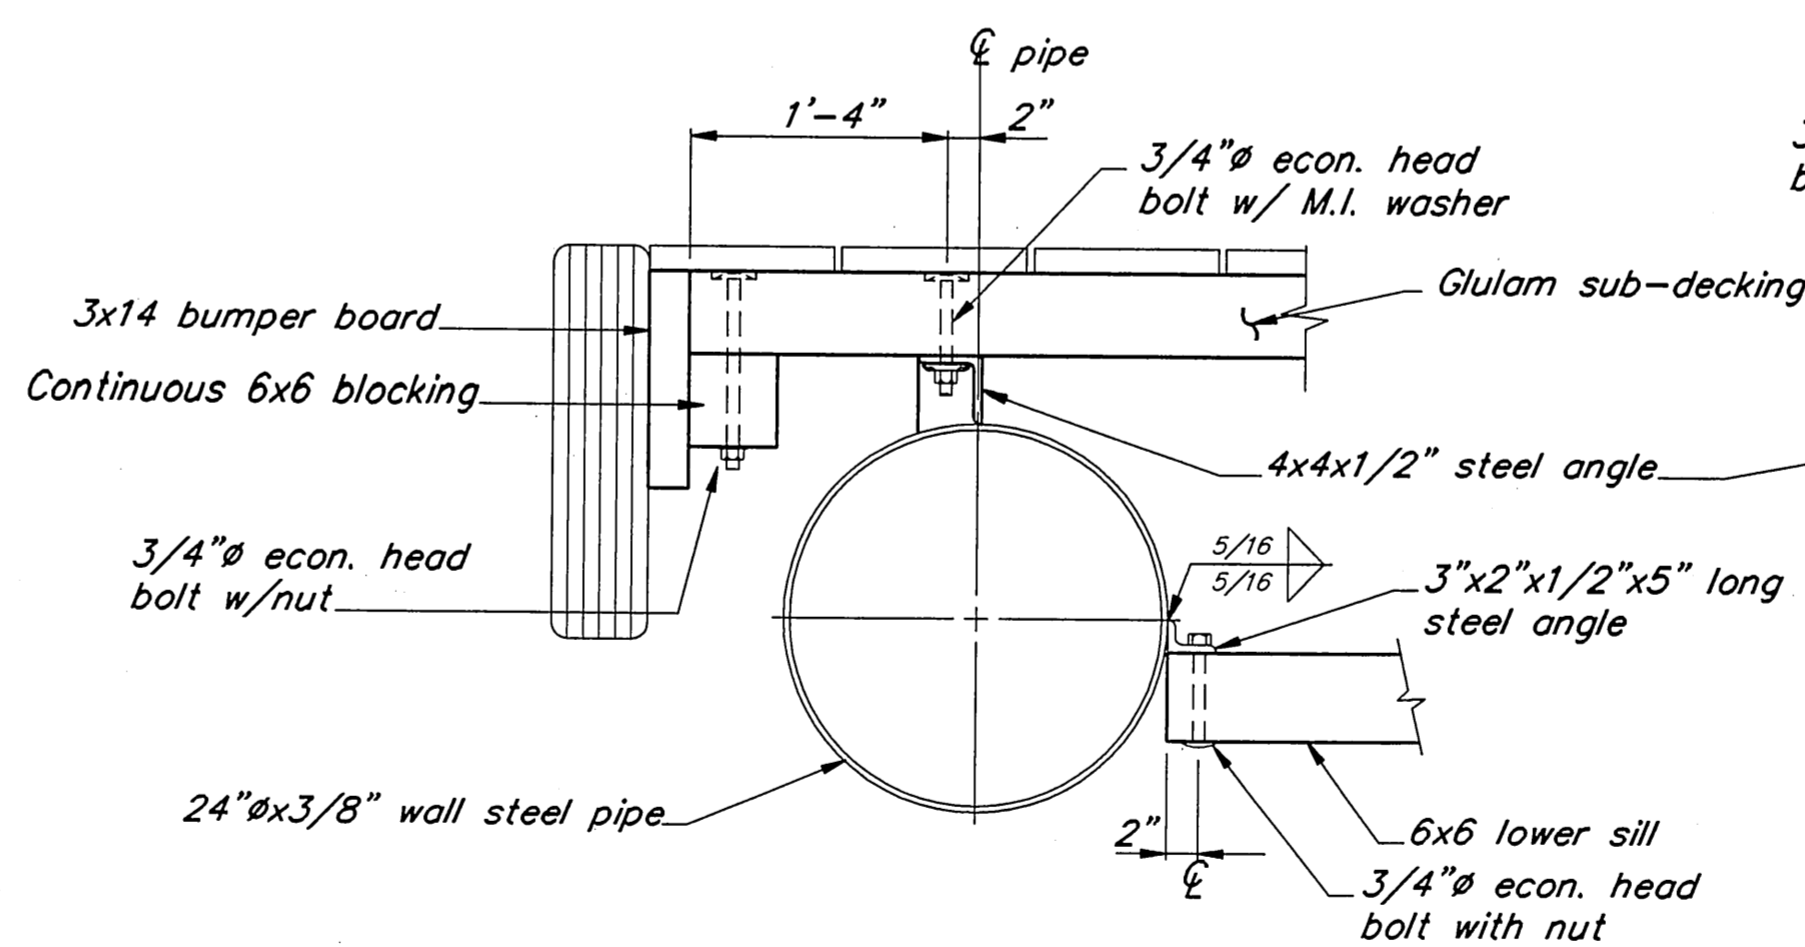

SECTION

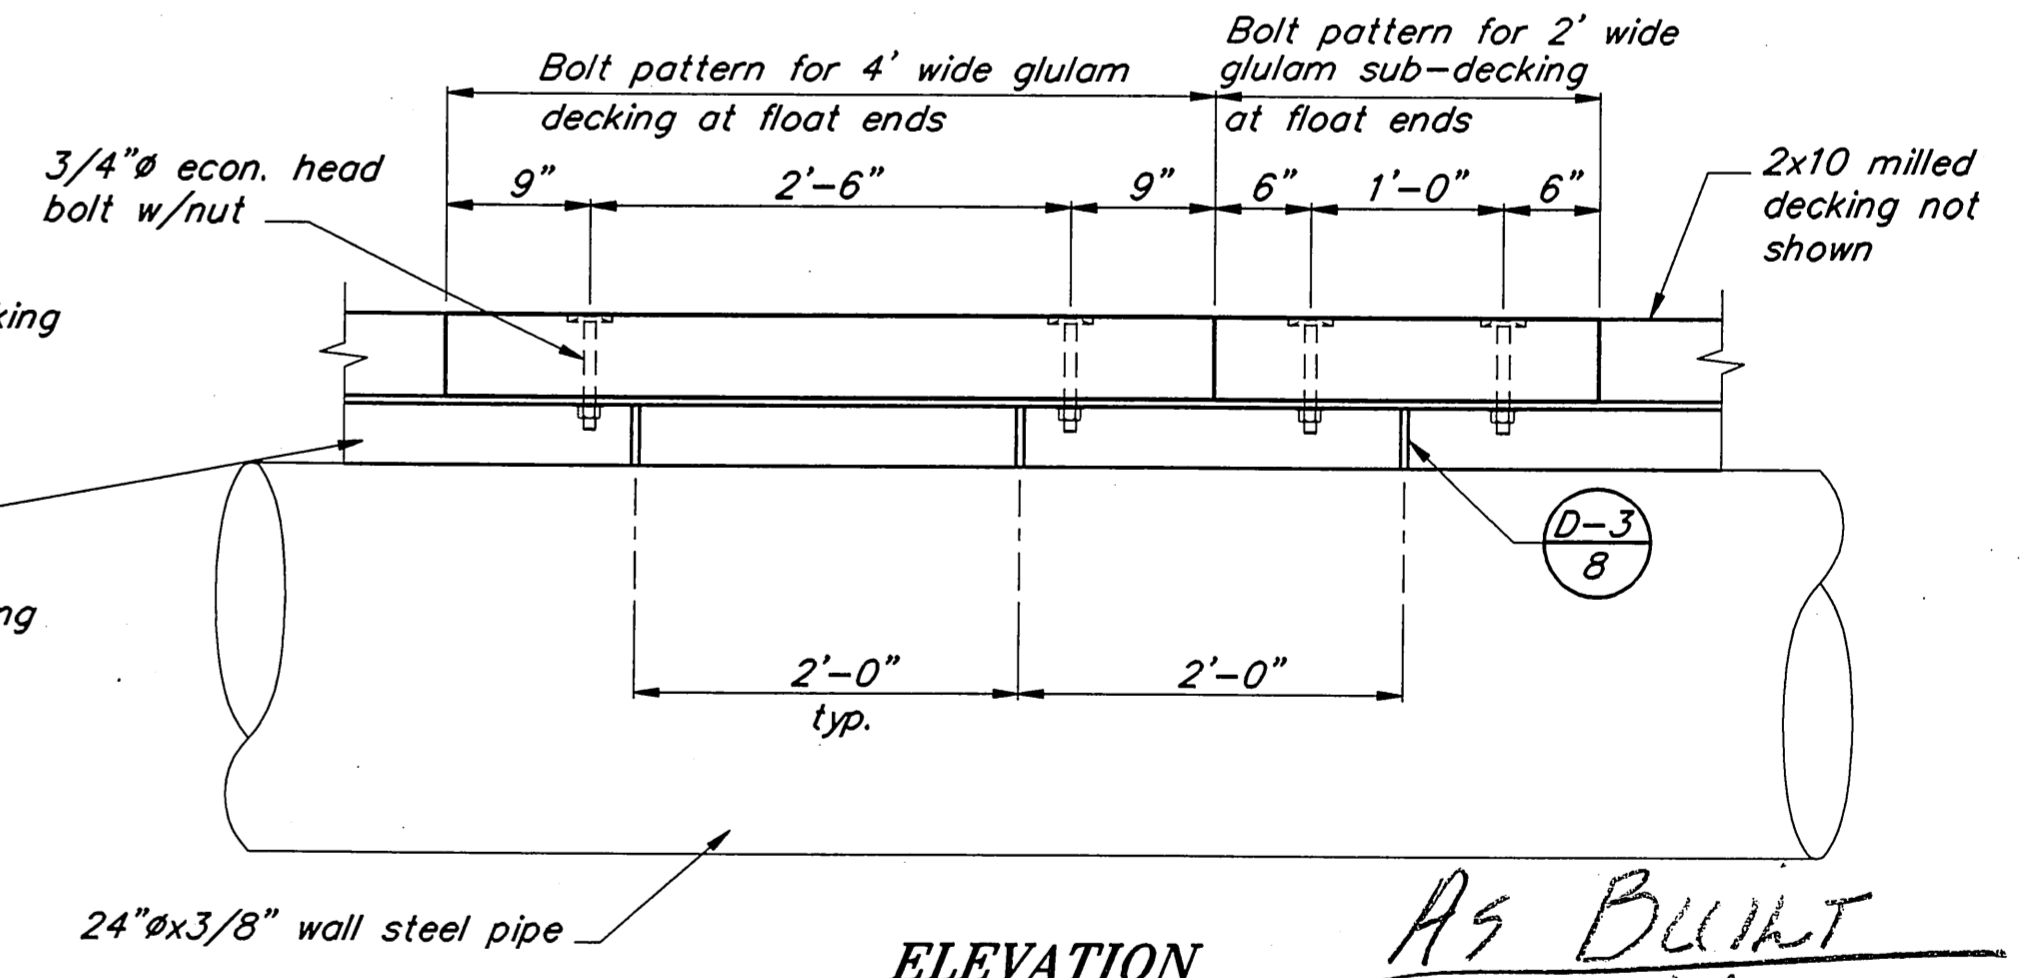

BOLT PATTERN DETAIL 3

ELEVATION

As BUILT
Mark Salvo
7/25/95

PATH: P:\POW\PTBAKER\DR\SH76.dwg < 1=24 >		
BY	DATE	DESCRIPTION OF CHANGE
RECORD OF REVISIONS		

STATE OF ALASKA
DEPARTMENT OF TRANSPORTATION
AND PUBLIC FACILITIES
SOUTHEAST REGION DESIGN & CONSTRUCTION

POINT BAKER

PRINCE OF WALES ISLAND
POINT BAKER SEAPLANE FLOAT
A.I.P. # 3-02-0423-01


Float Sections


NOTE: DO NOT SCALE FROM THESE PLANS-USE DIMENSIONS

ALASKA


DESIGNED BY: D.D.S.	PROJECT NO. 71135
DRAWN BY: B.W.B.	DATE: APRIL, 1994
CHECKED BY: J.D.B.	SHEET 6 OF 20

ENGINEER'S SEAL

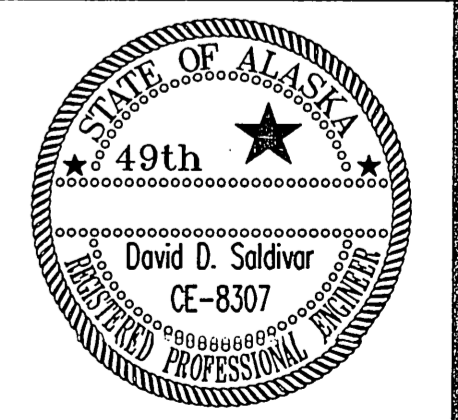


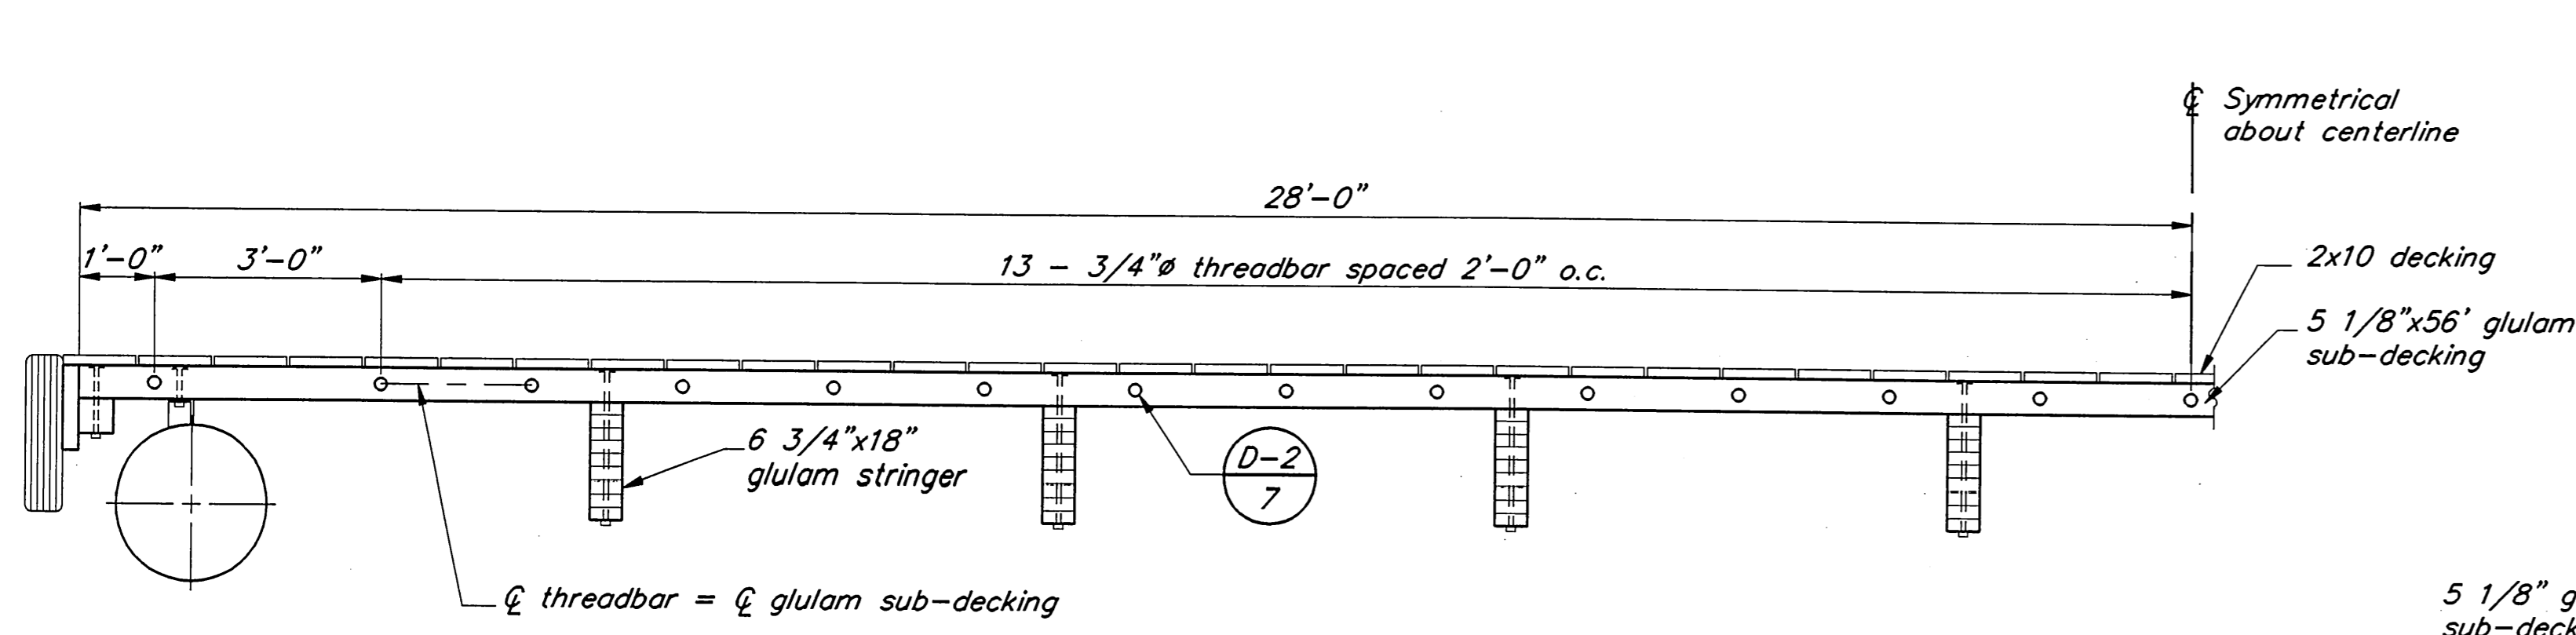

POST-TENSIONED THREADBAR SPACING ①

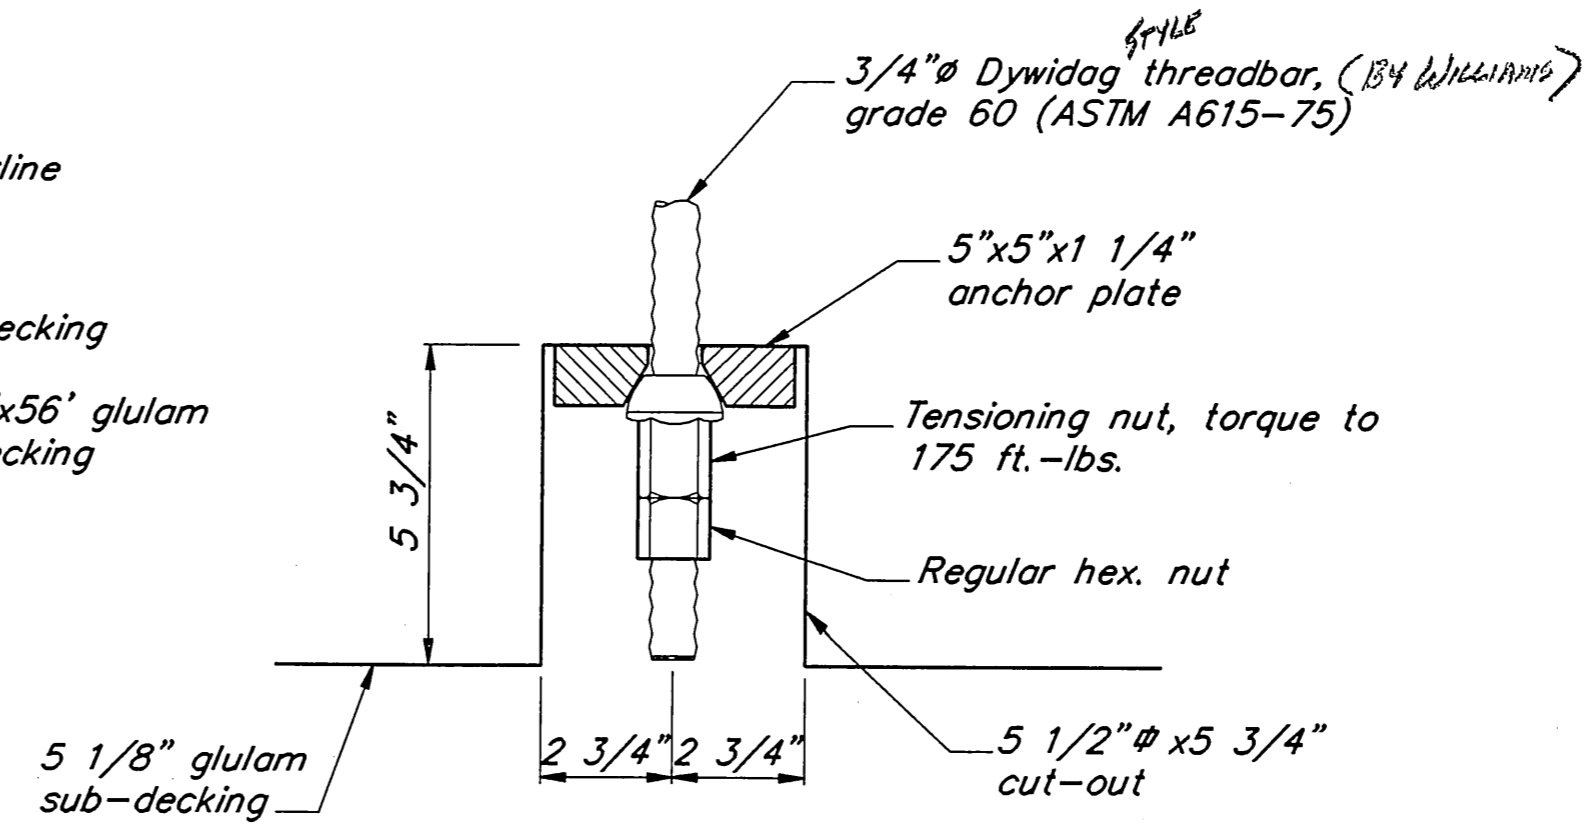


PLAN

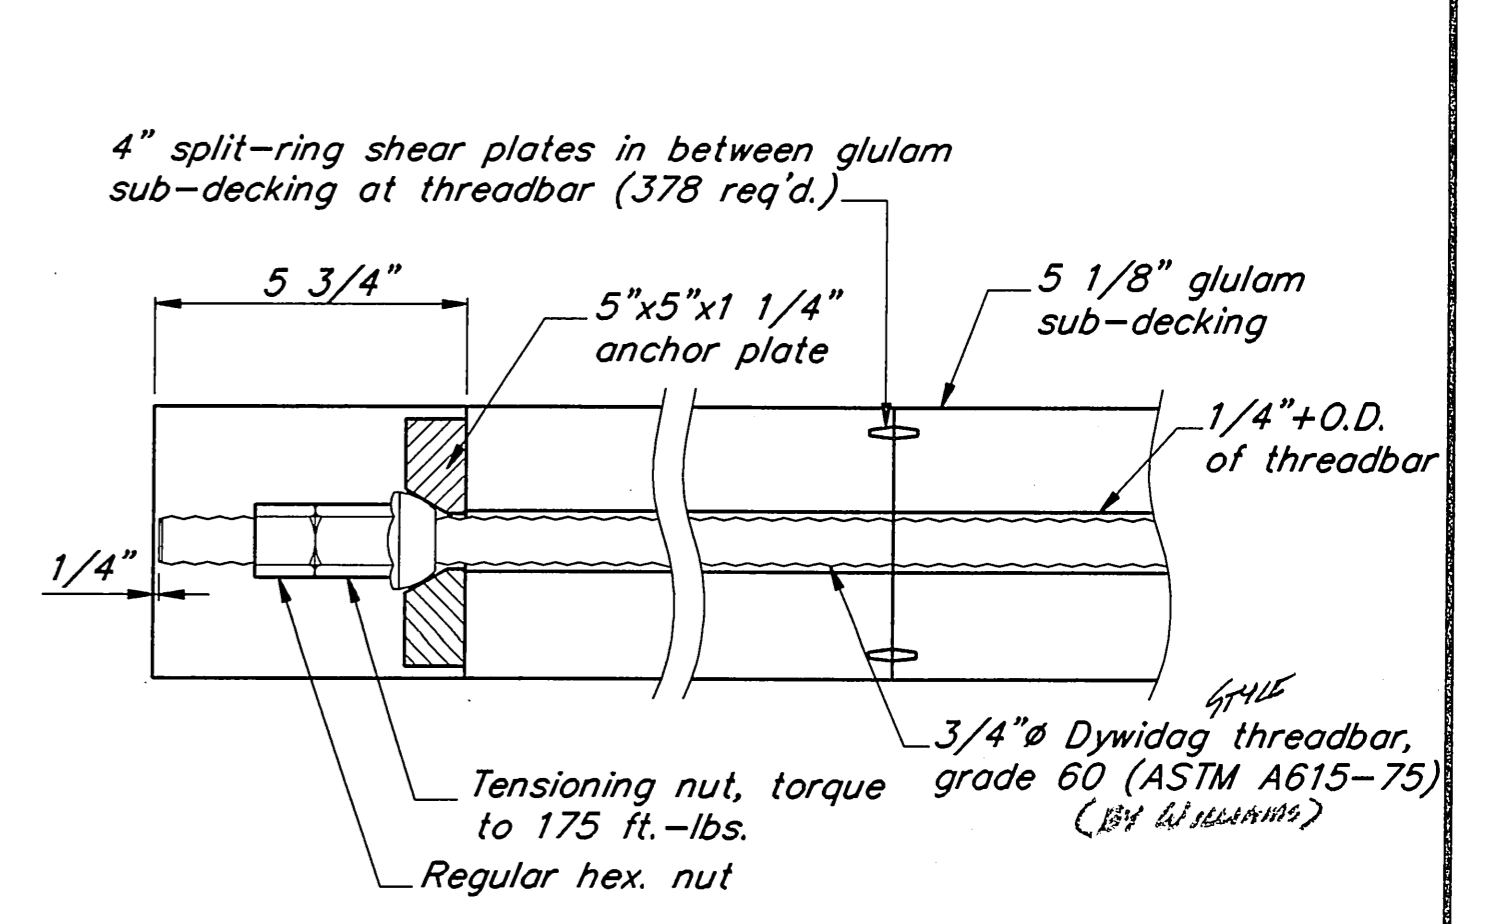

SECTION


THREADBAR INSTALLATION DETAILS ②

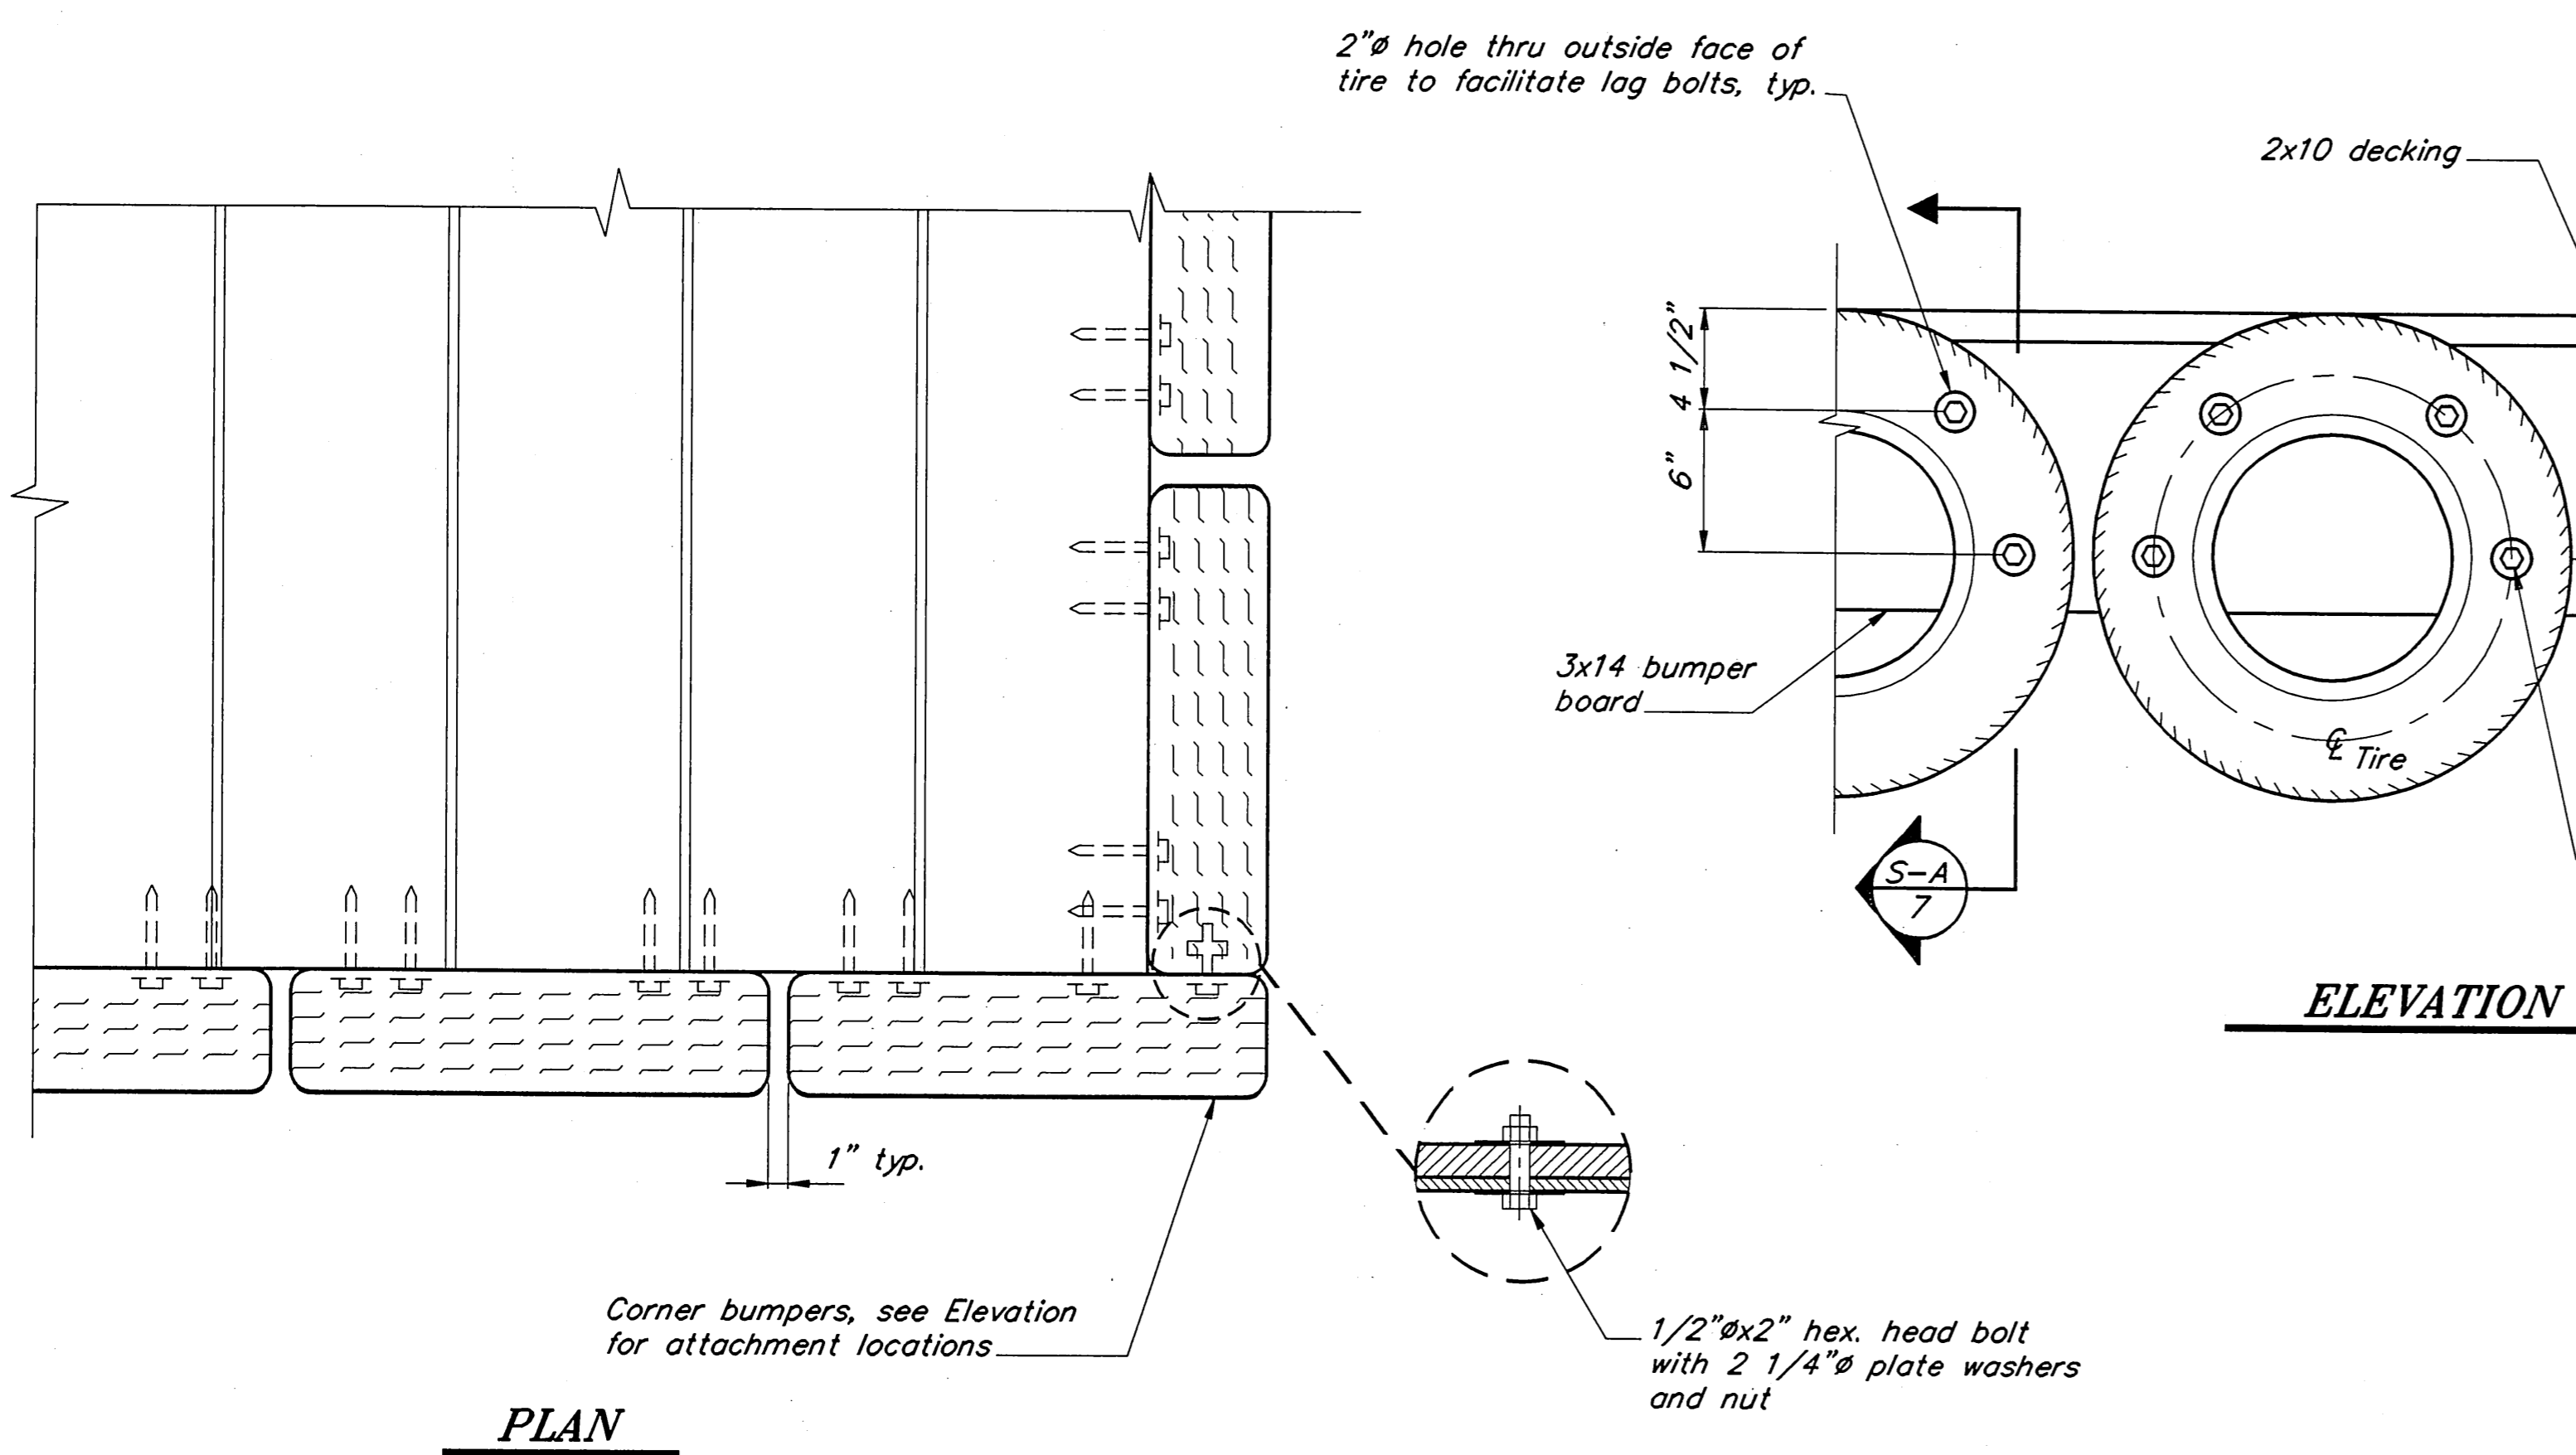

ELEVATION

PLAN

- NOTES:**
1. Tires shall be used 13" series tires with a minimum 1/8" deep summer or all season tread, no heavy lugs or studs.
 2. All of the tires shall be the same width with a maximum allowable variation of 1/2".
 3. Paint tires white per specification.

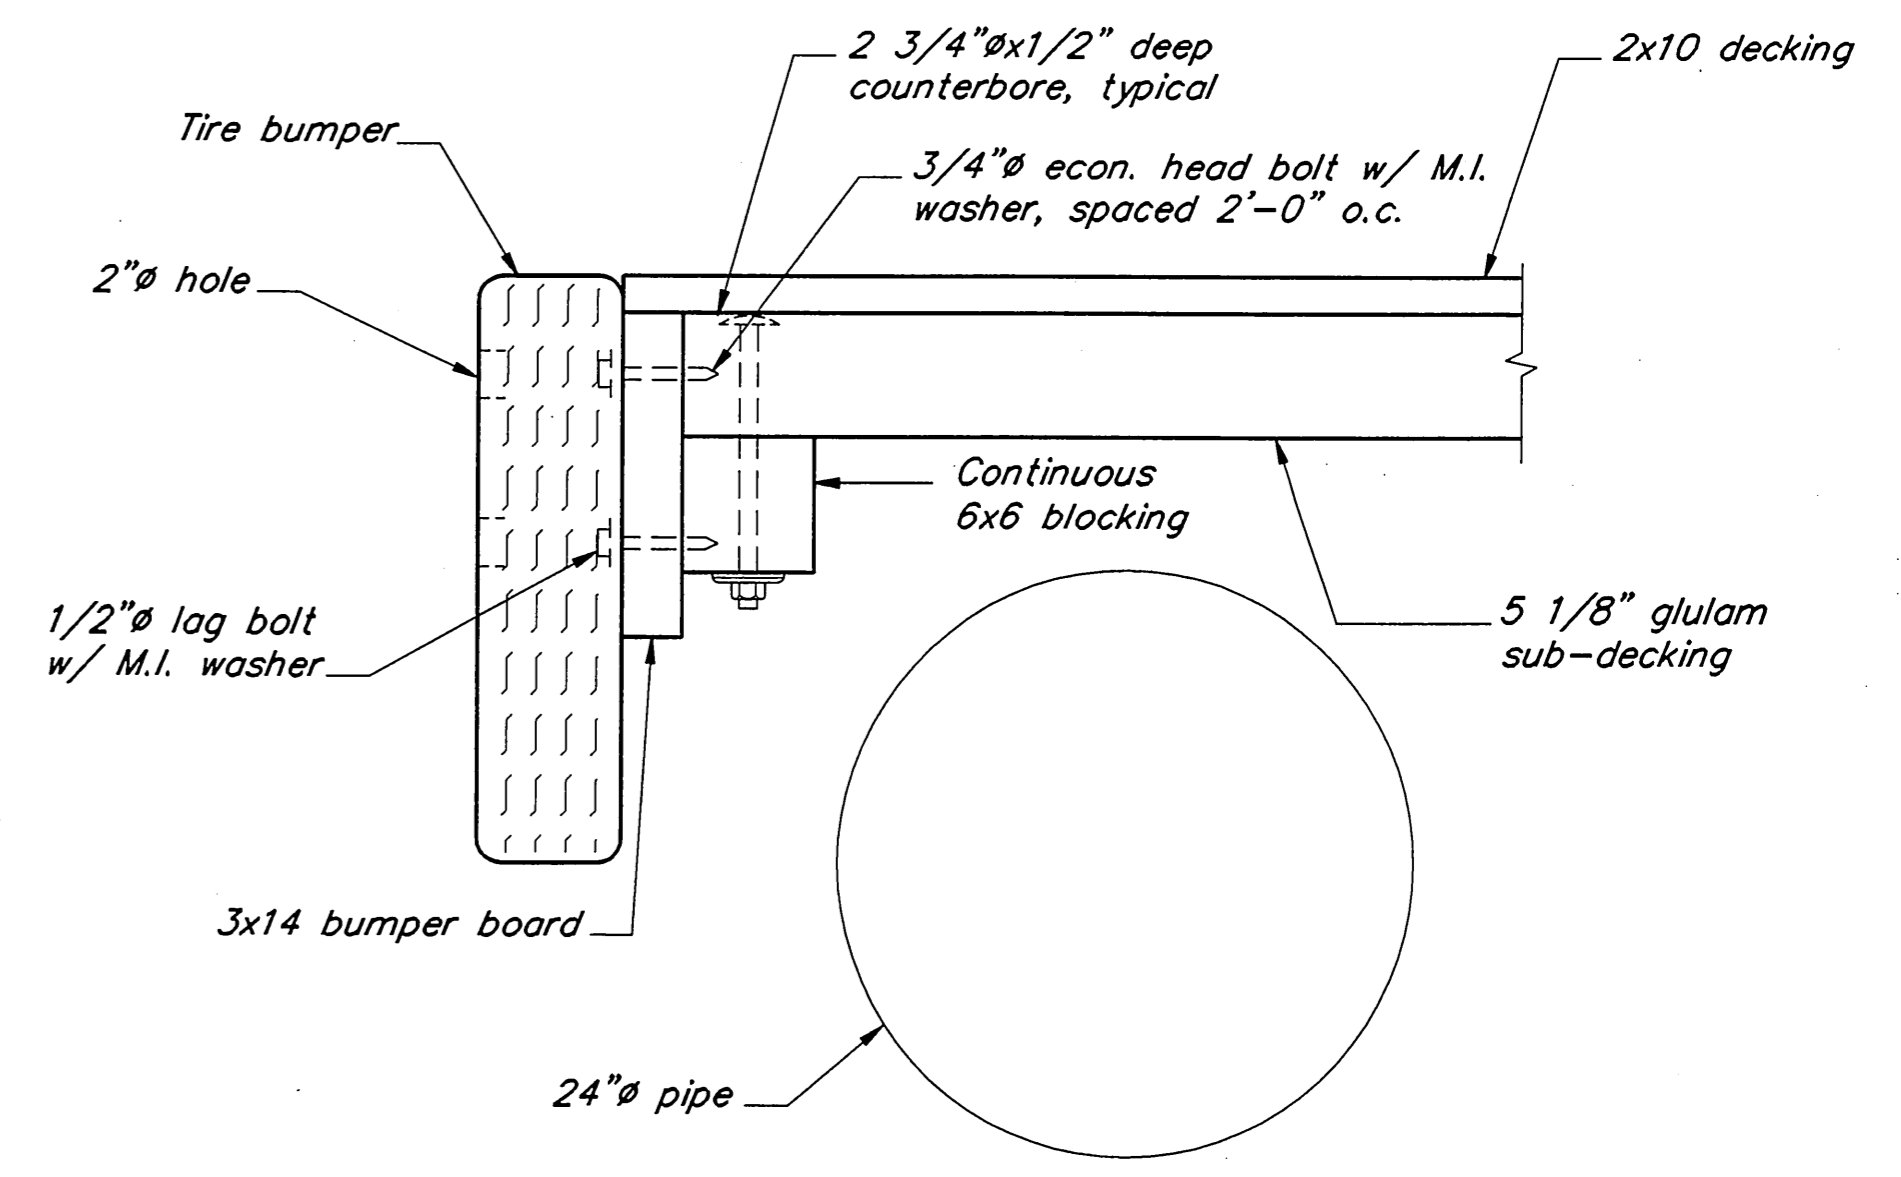

SECTION A

TIRE BUMPER DETAILS ③

As Built
Mark Salvo
 7/25/95

PATH: P:\POW\PTBAKER\DR\SH77.dwg < 1=24 >

BY	DATE	DESCRIPTION OF CHANGE


RECORD OF REVISIONS


STATE OF ALASKA
 DEPARTMENT OF TRANSPORTATION
 AND PUBLIC FACILITIES
 SOUTHEAST REGION DESIGN & CONSTRUCTION

POINT BAKER
 PRINCE OF WALES ISLAND
 POINT BAKER SEAPLANE FLOAT
 A.I.P. # 3-02-0423-01
 Post Tension/Tire Bumper Details

NOTE: DO NOT SCALE FROM THESE PLANS-USE DIMENSIONS


DESIGNED BY: D.D.S.	PROJECT NO. 71135
DRAWN BY: B.W.B.	DATE: APRIL, 1994
CHECKED BY: J.D.B.	SHEET 7 OF 20

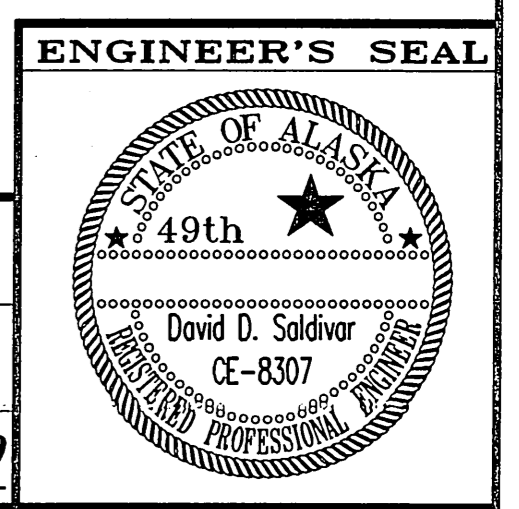


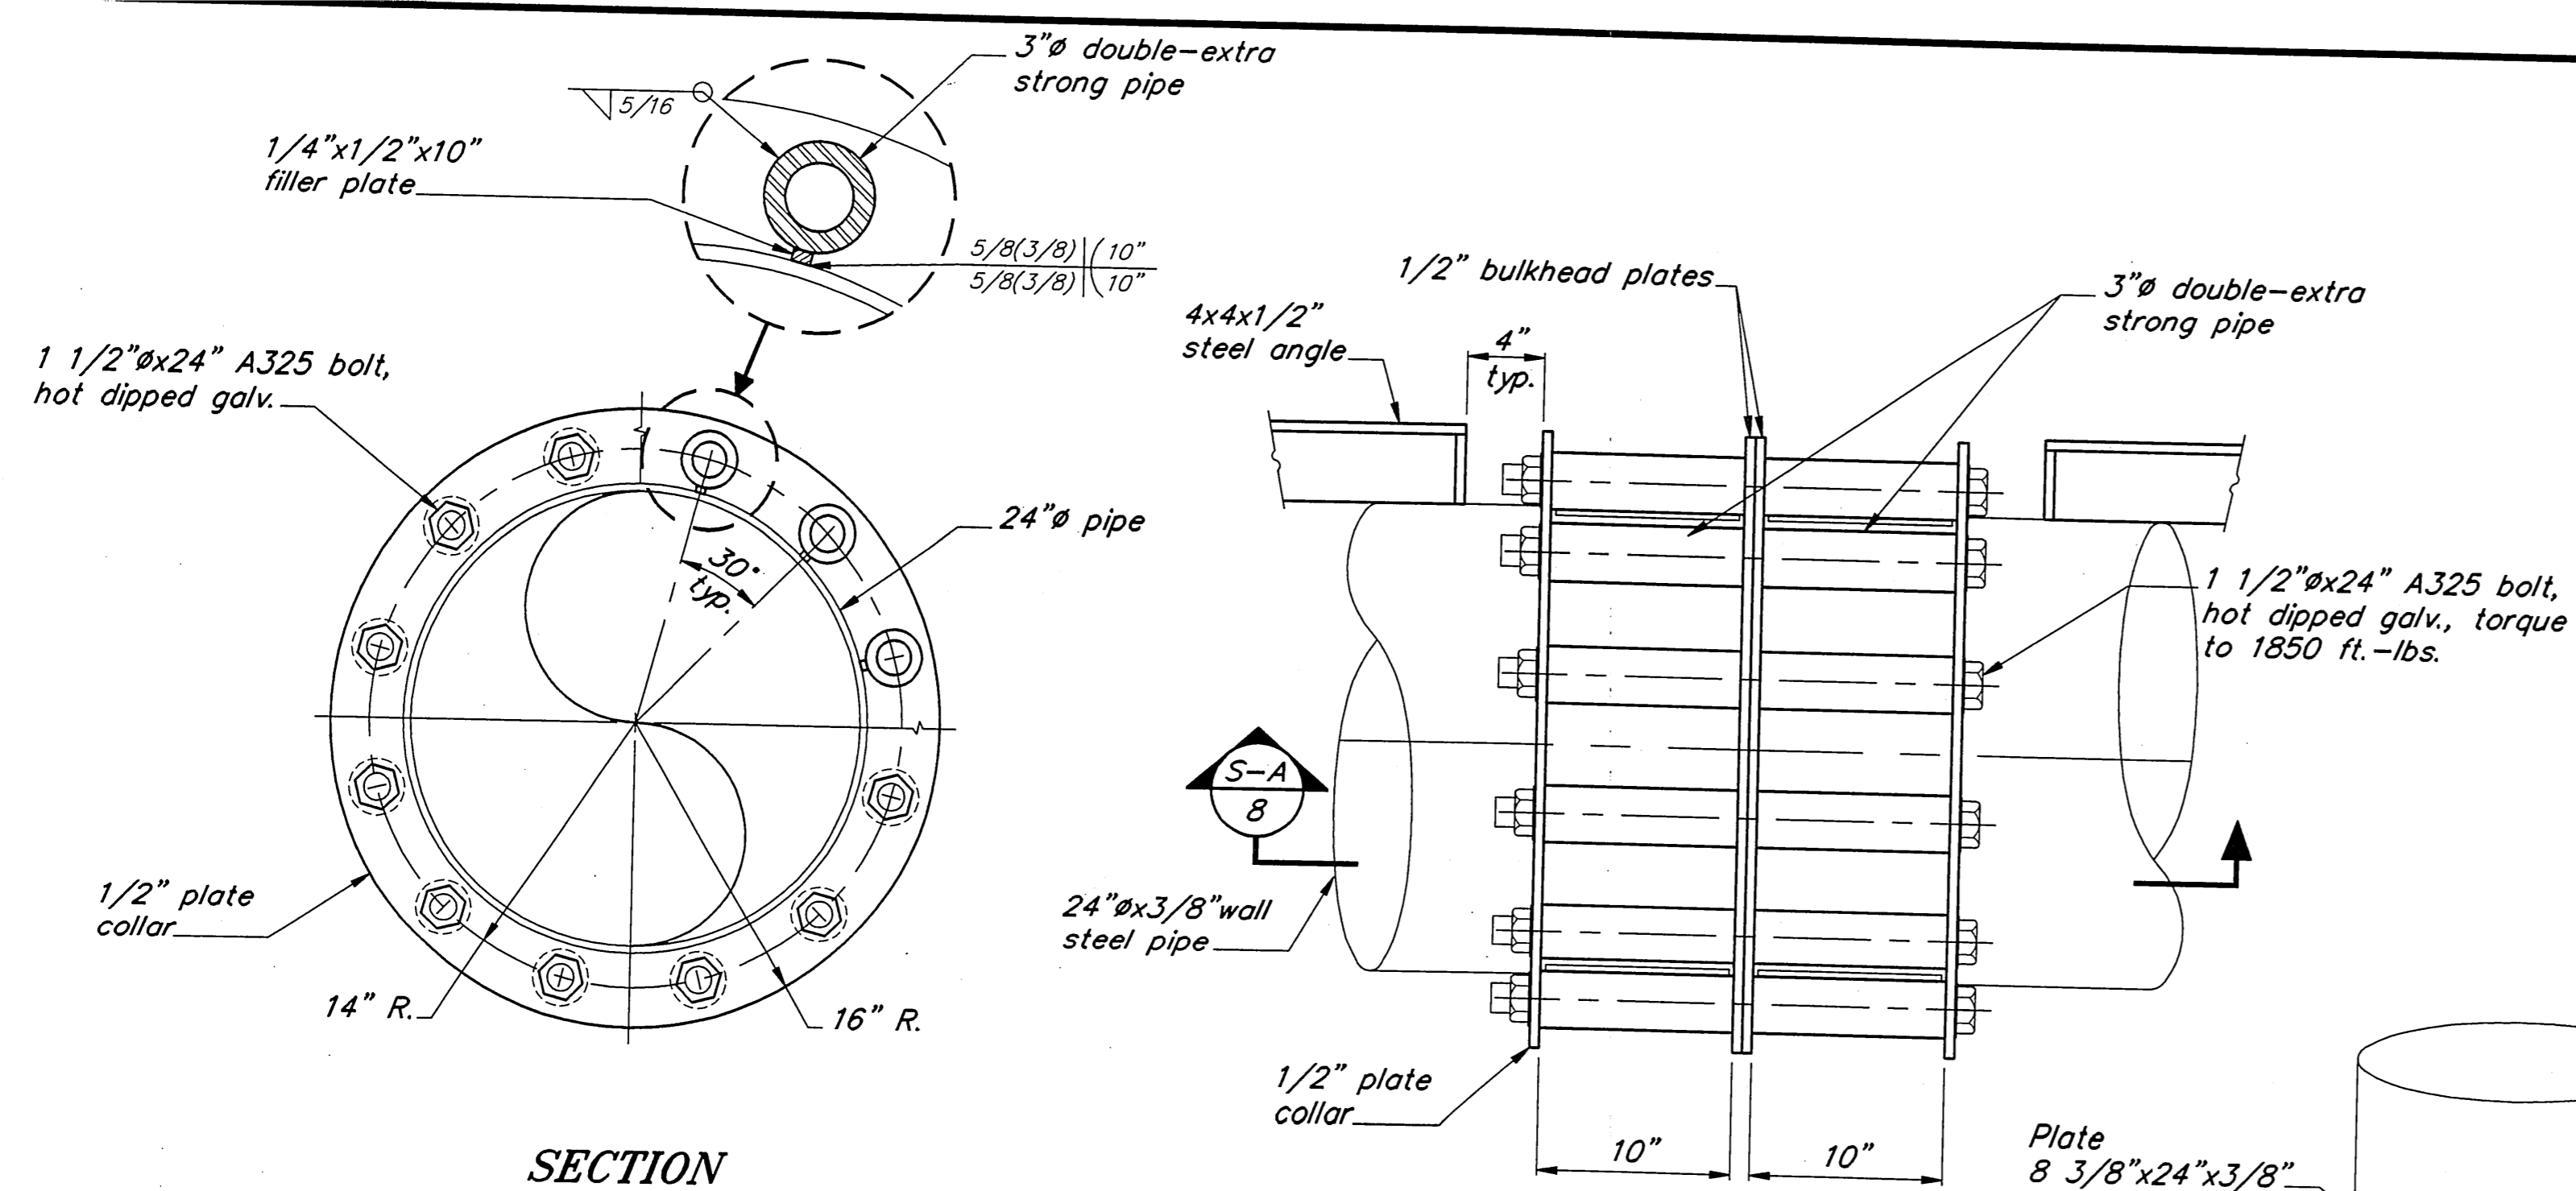


BOLTED CONNECTION DETAIL

1

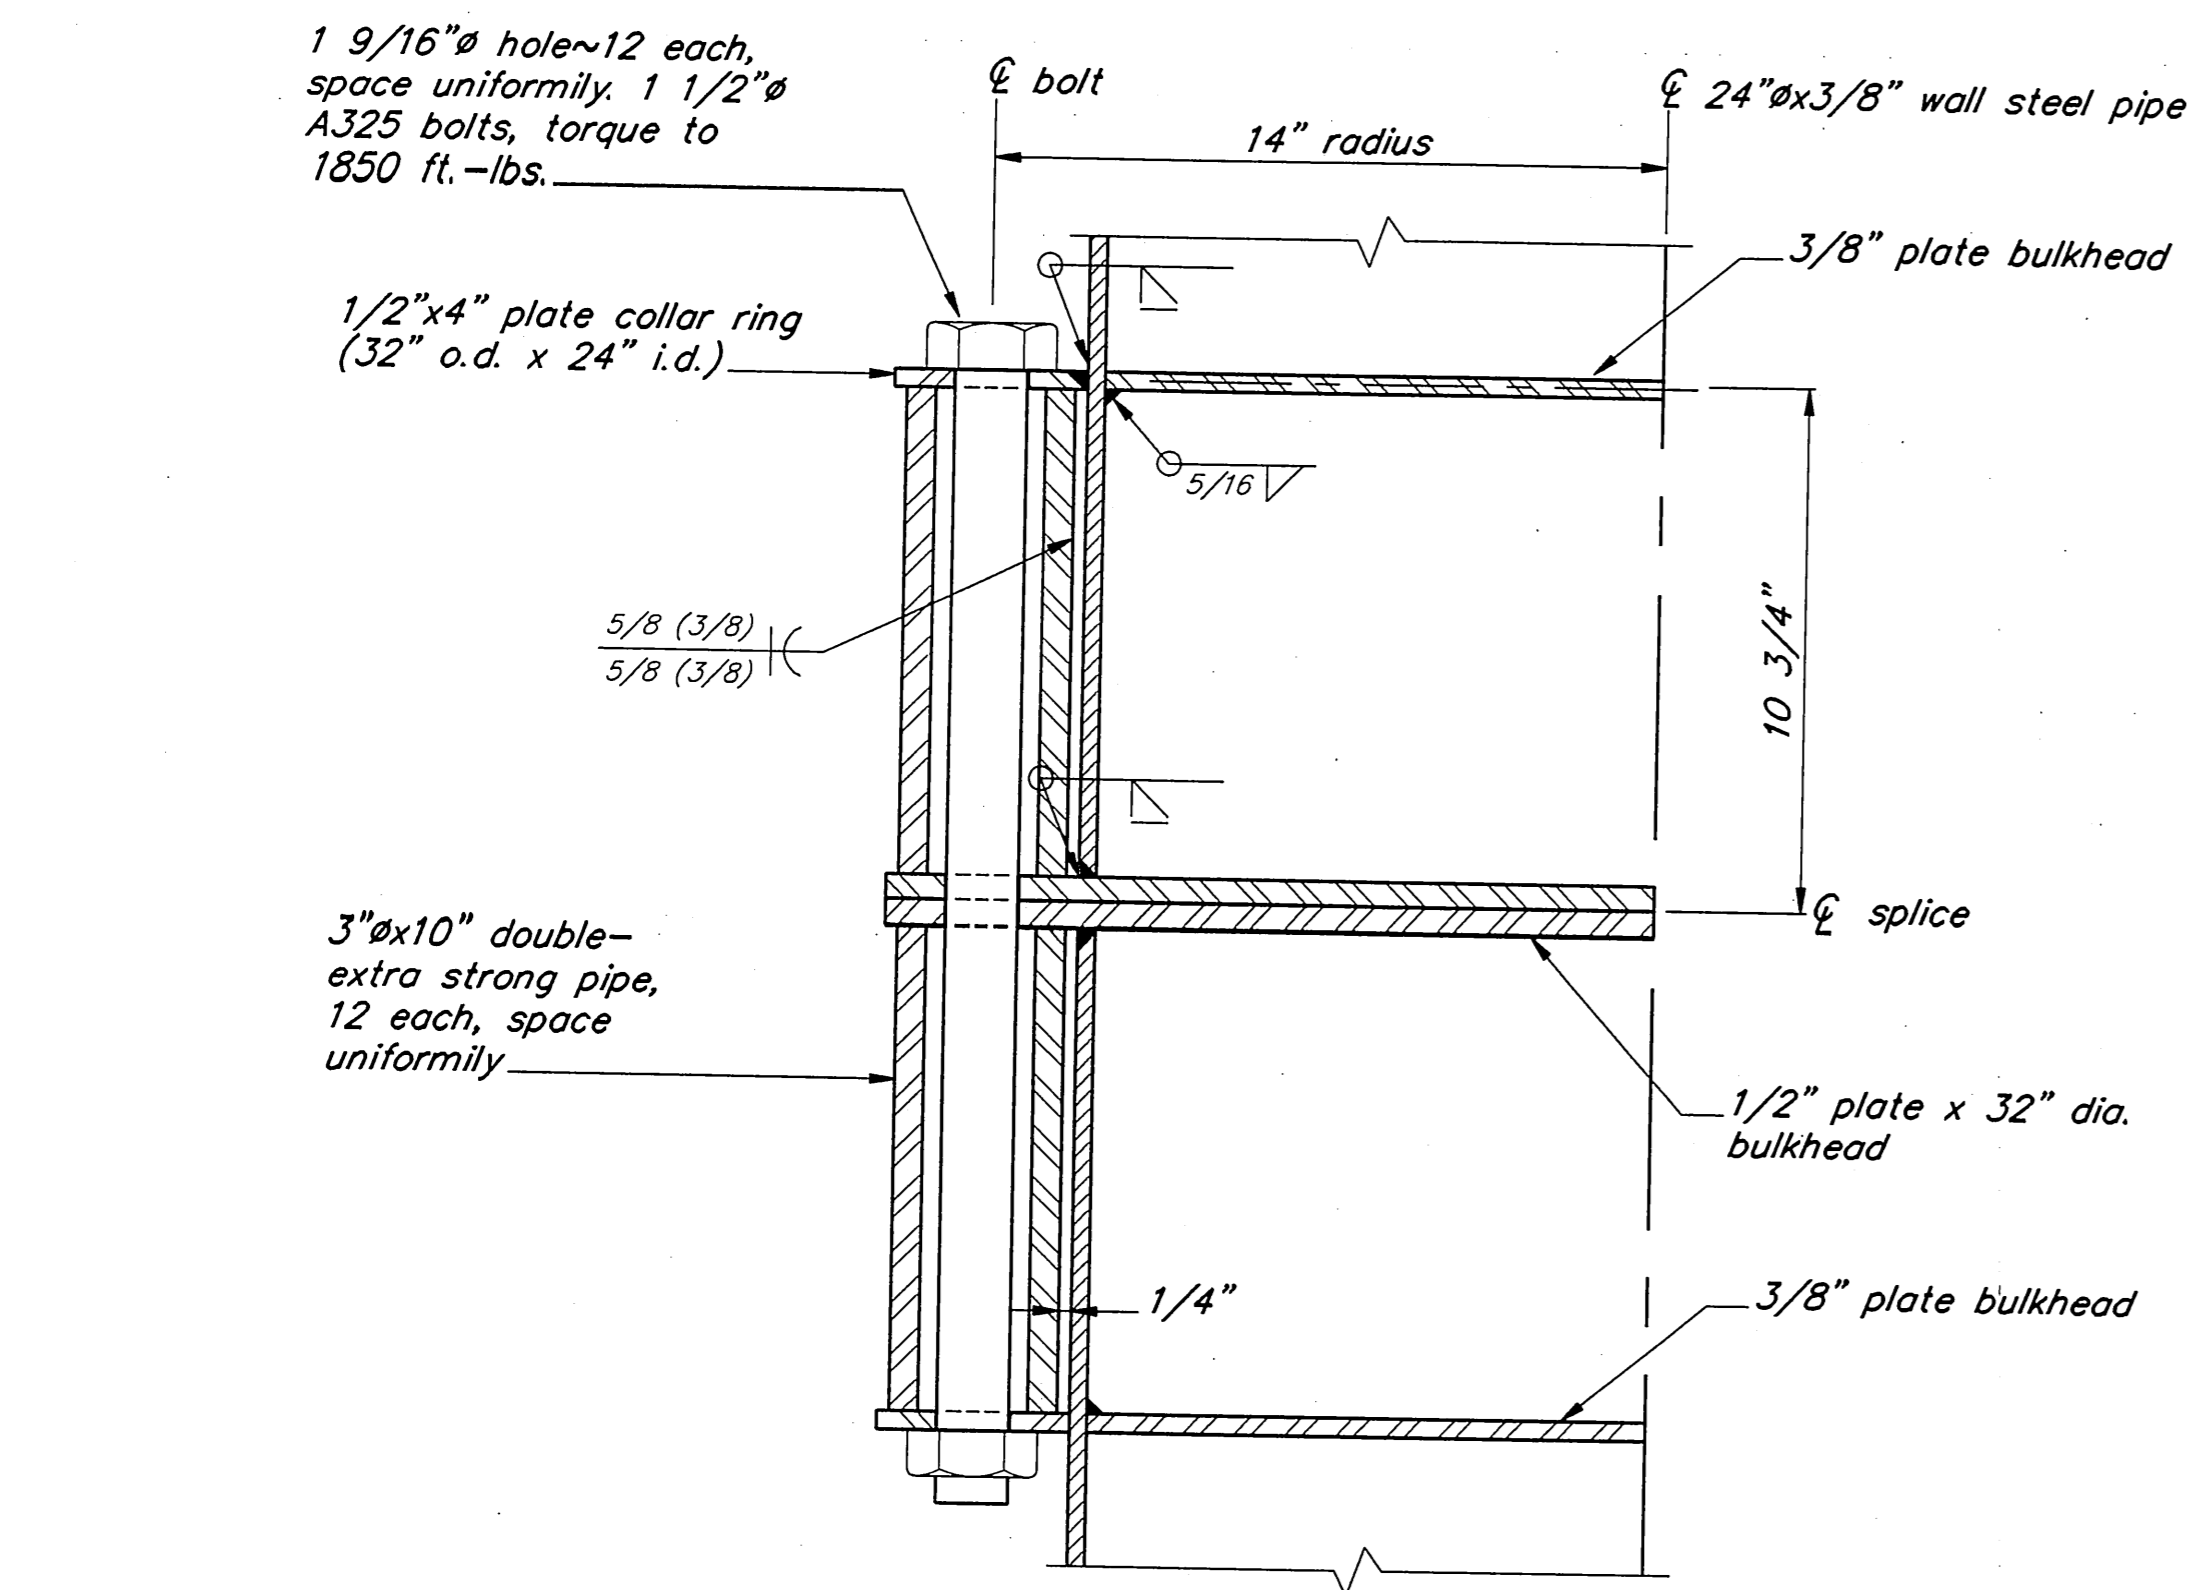


SECTION A

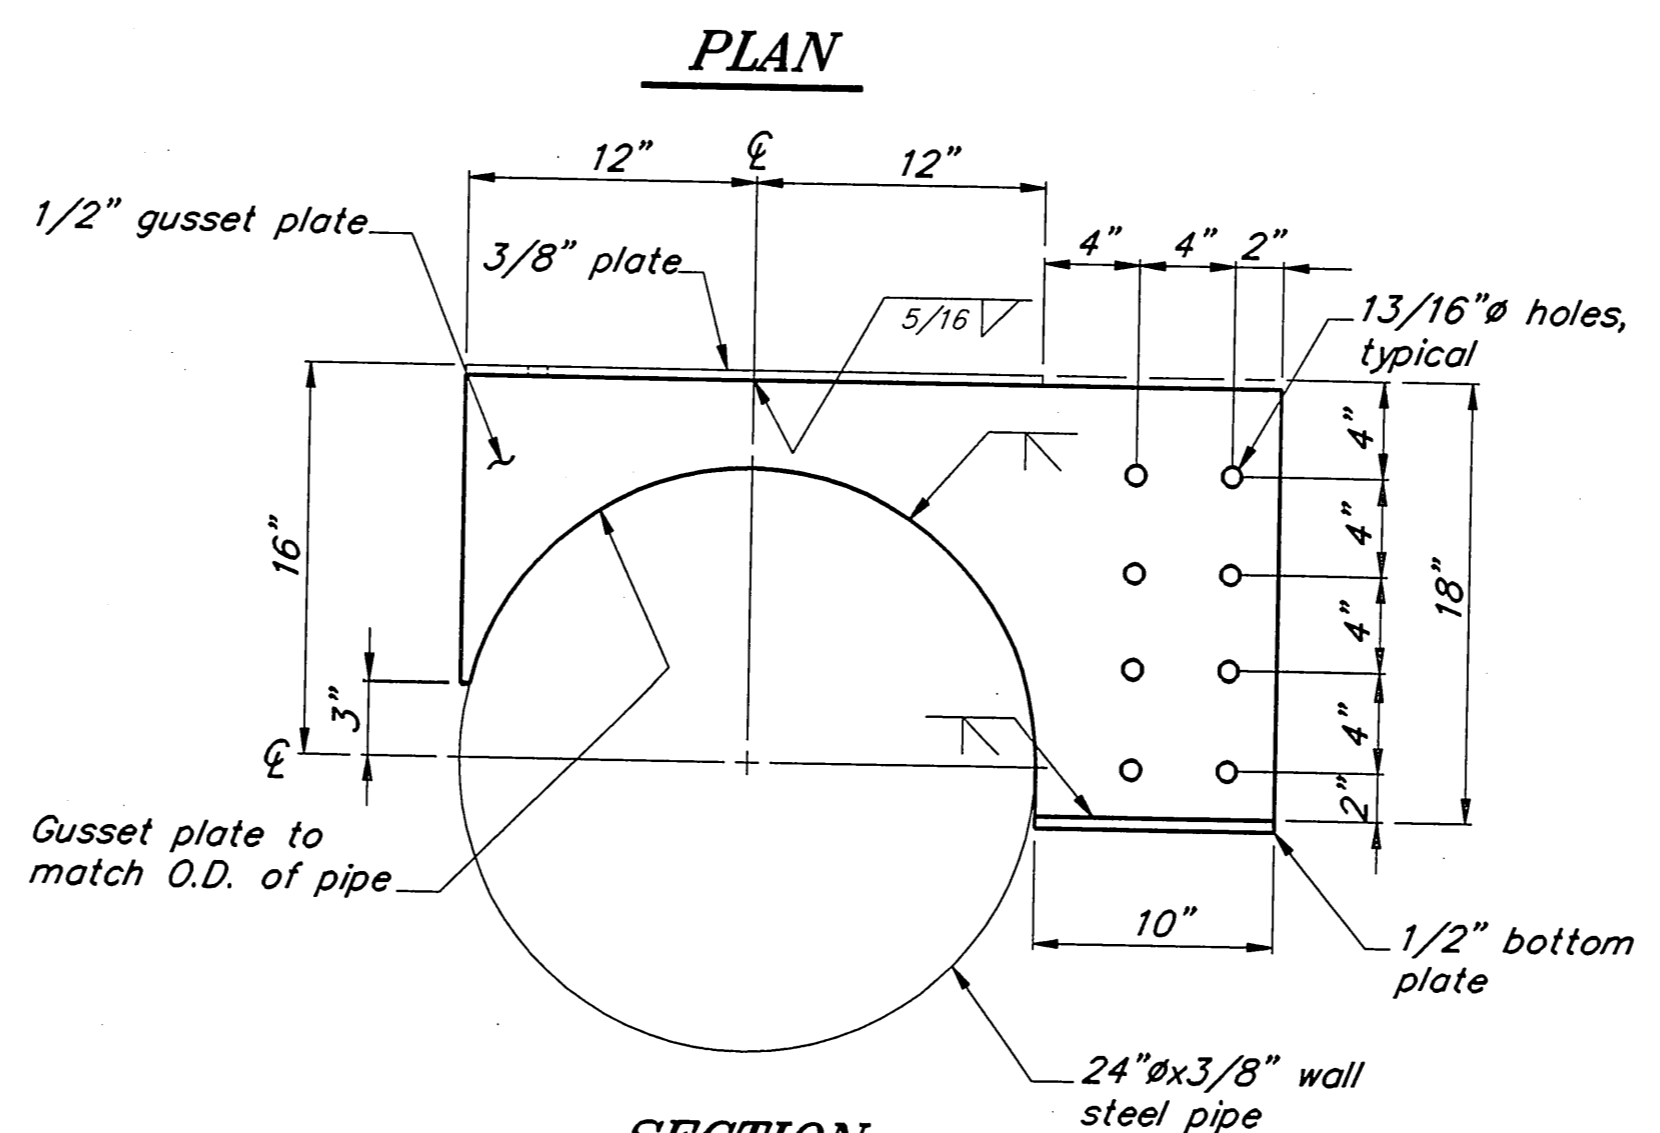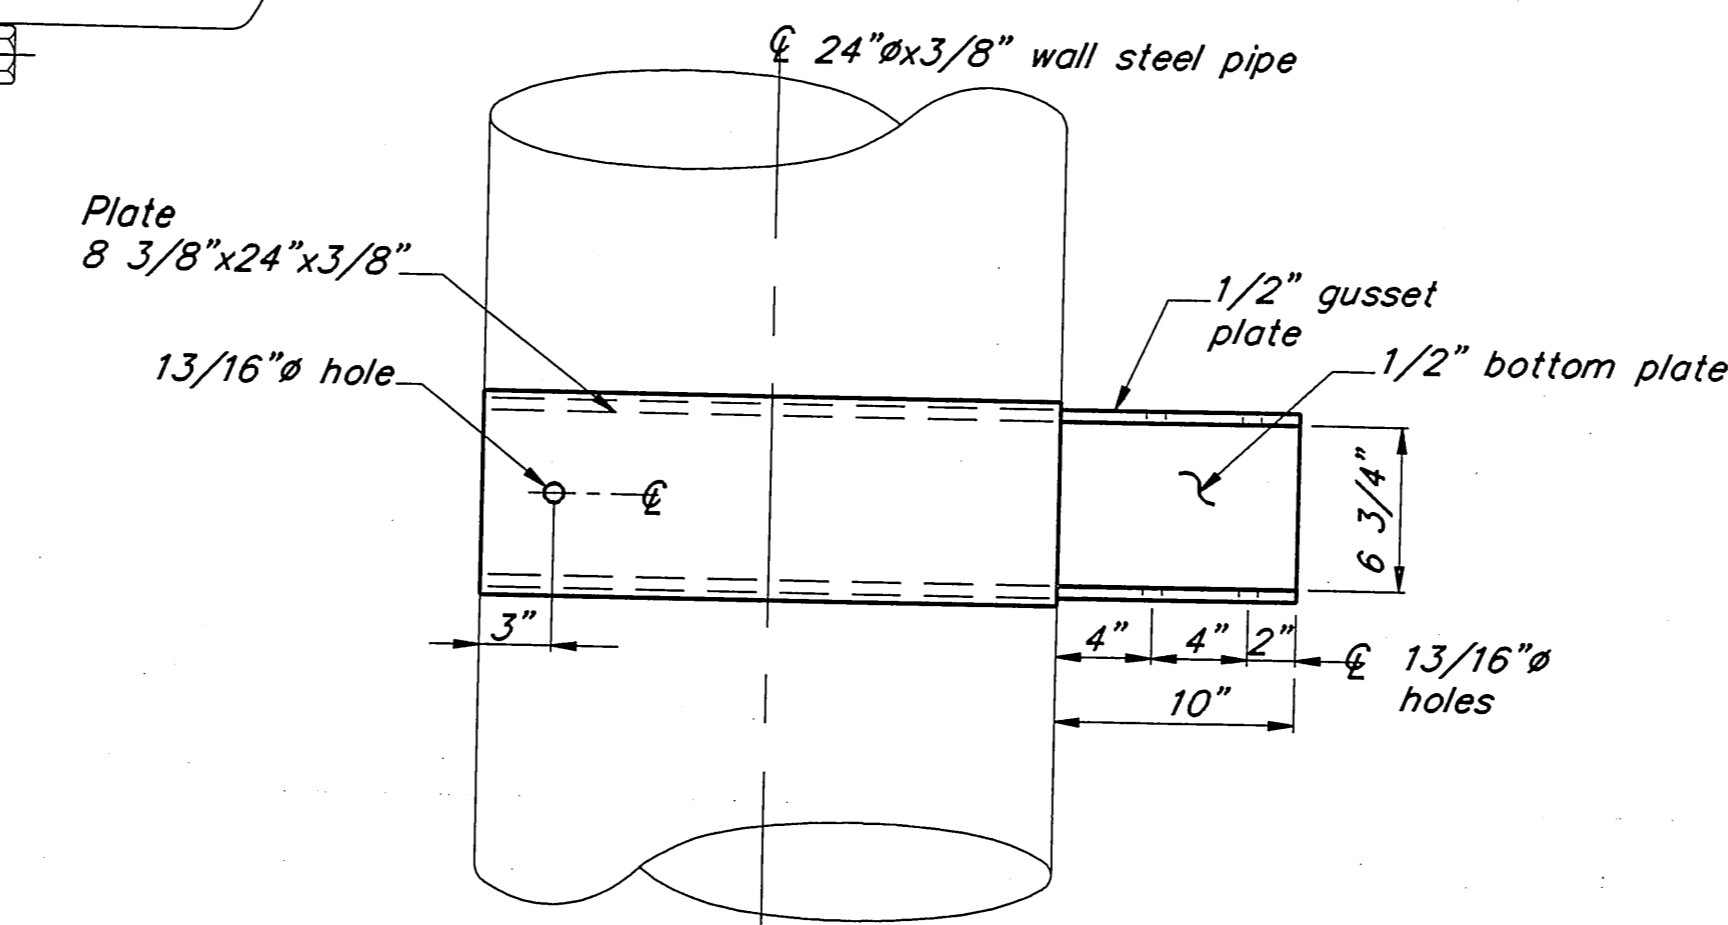



OUTSIDE PIPE HANGER DETAIL

2

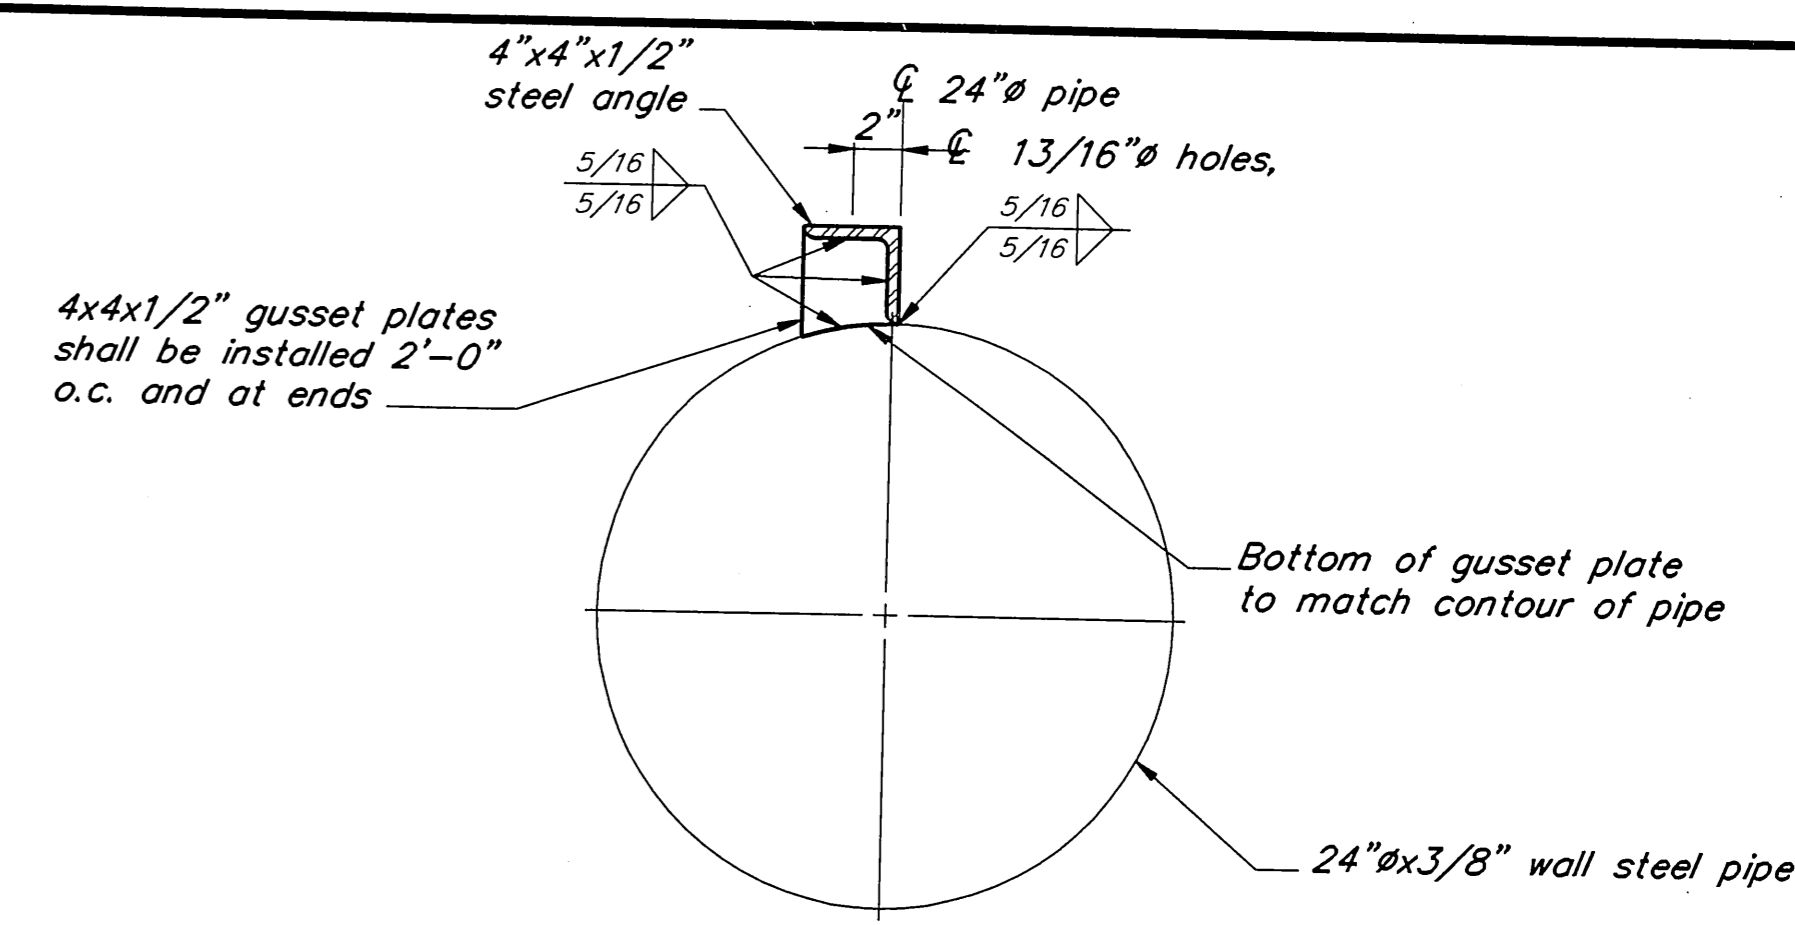

EXTERNAL DECK SUPPORT DETAIL

3

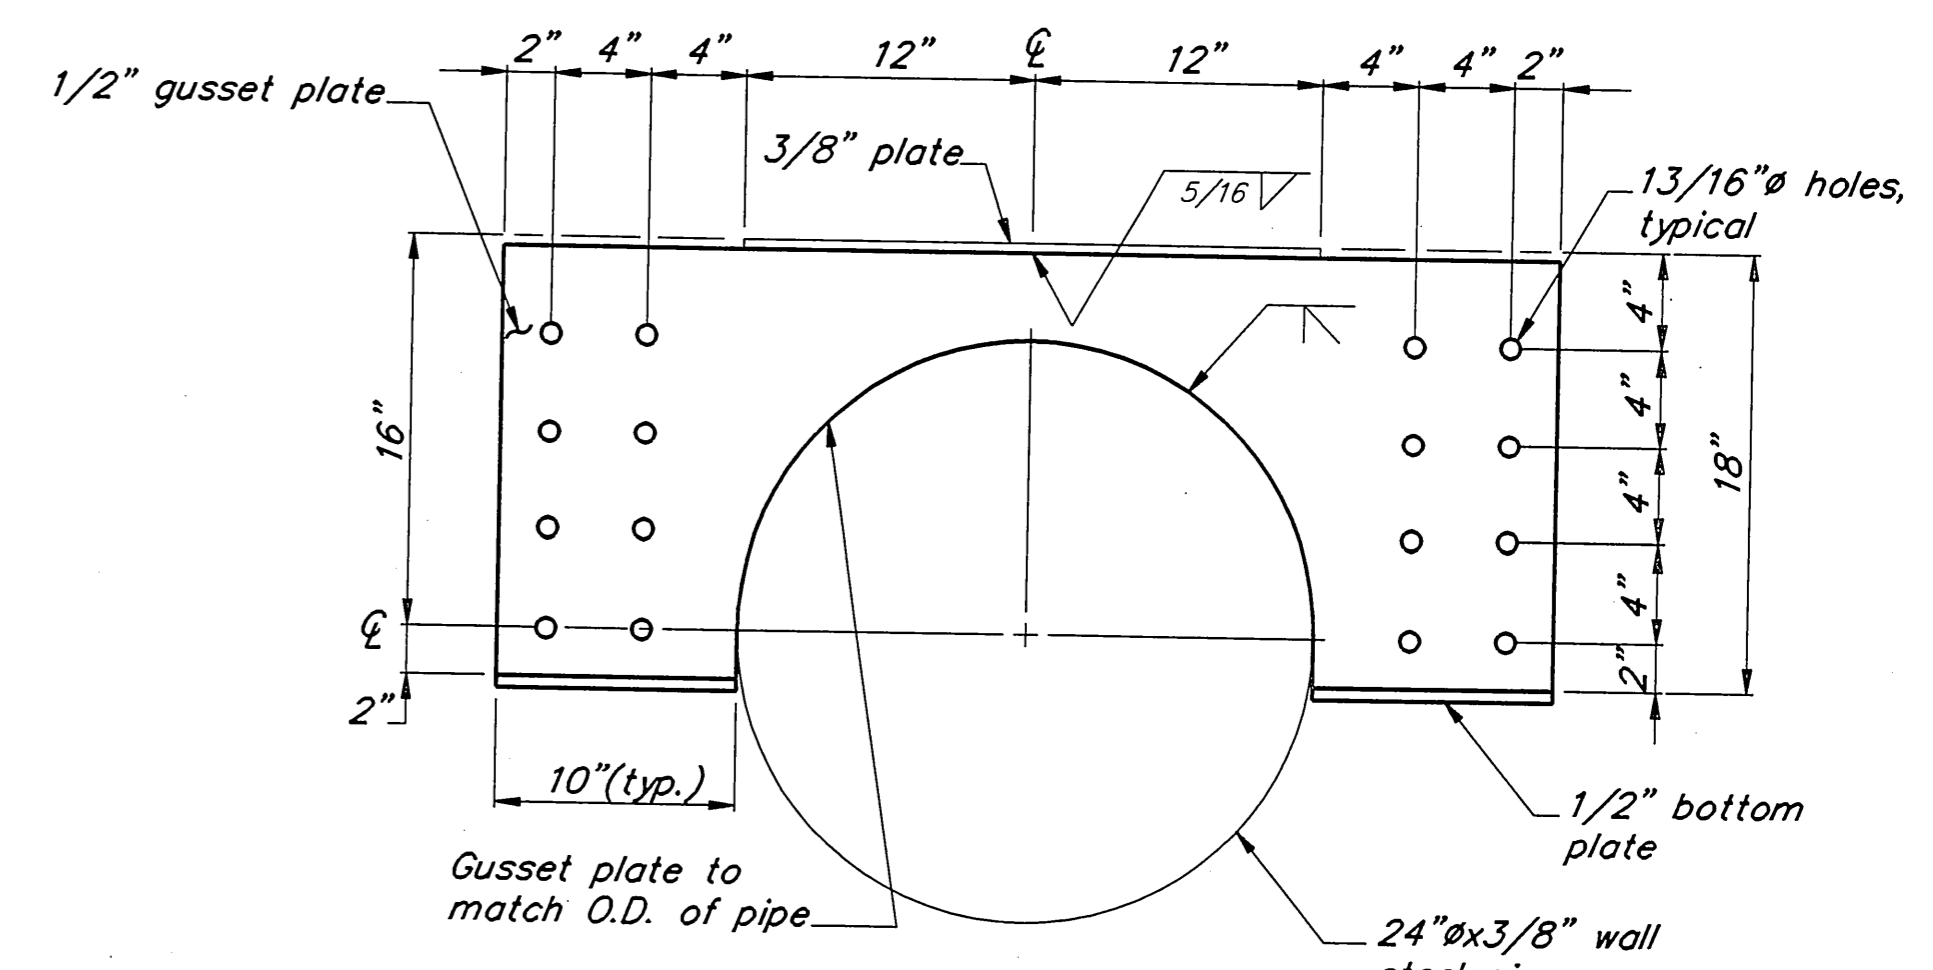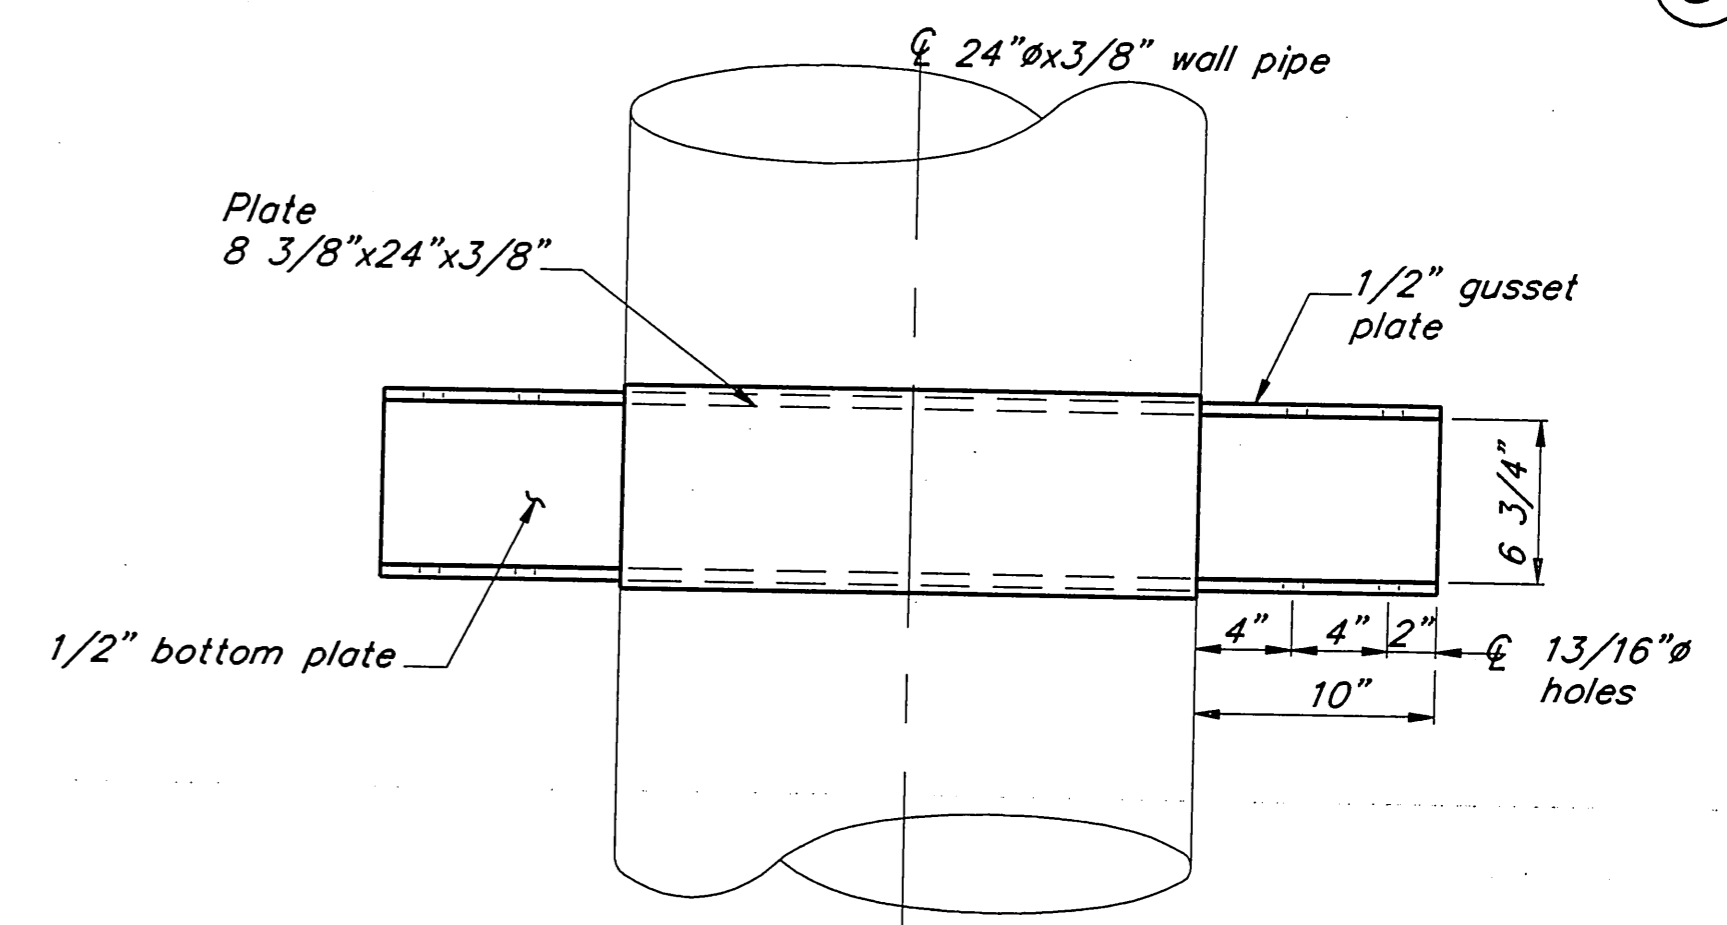

INSIDE PIPE HANGER DETAIL

4

As BUILT
Mark Saldorin
7/25/95


BY	DATE	DESCRIPTION OF CHANGE
RECORD OF REVISIONS		


STATE OF ALASKA
DEPARTMENT OF TRANSPORTATION
AND PUBLIC FACILITIES
SOUTHEAST REGION DESIGN & CONSTRUCTION

POINT BAKER
PRINCE OF WALES ISLAND
POINT BAKER SEAPLANE FLOAT
A.I.P. # 3-02-0423-01
Pipe Connection Details

NOTE: DO NOT SCALE FROM THESE PLANS-USE DIMENSIONS

DESIGNED BY: D.D.S.	PROJECT NO. 71135
DRAWN BY: B.W.B.	DATE: APRIL, 1994
CHECKED BY: J.D.B.	SHEET 8 OF 20

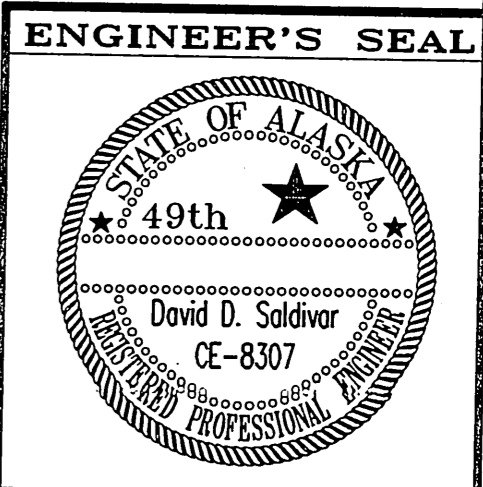

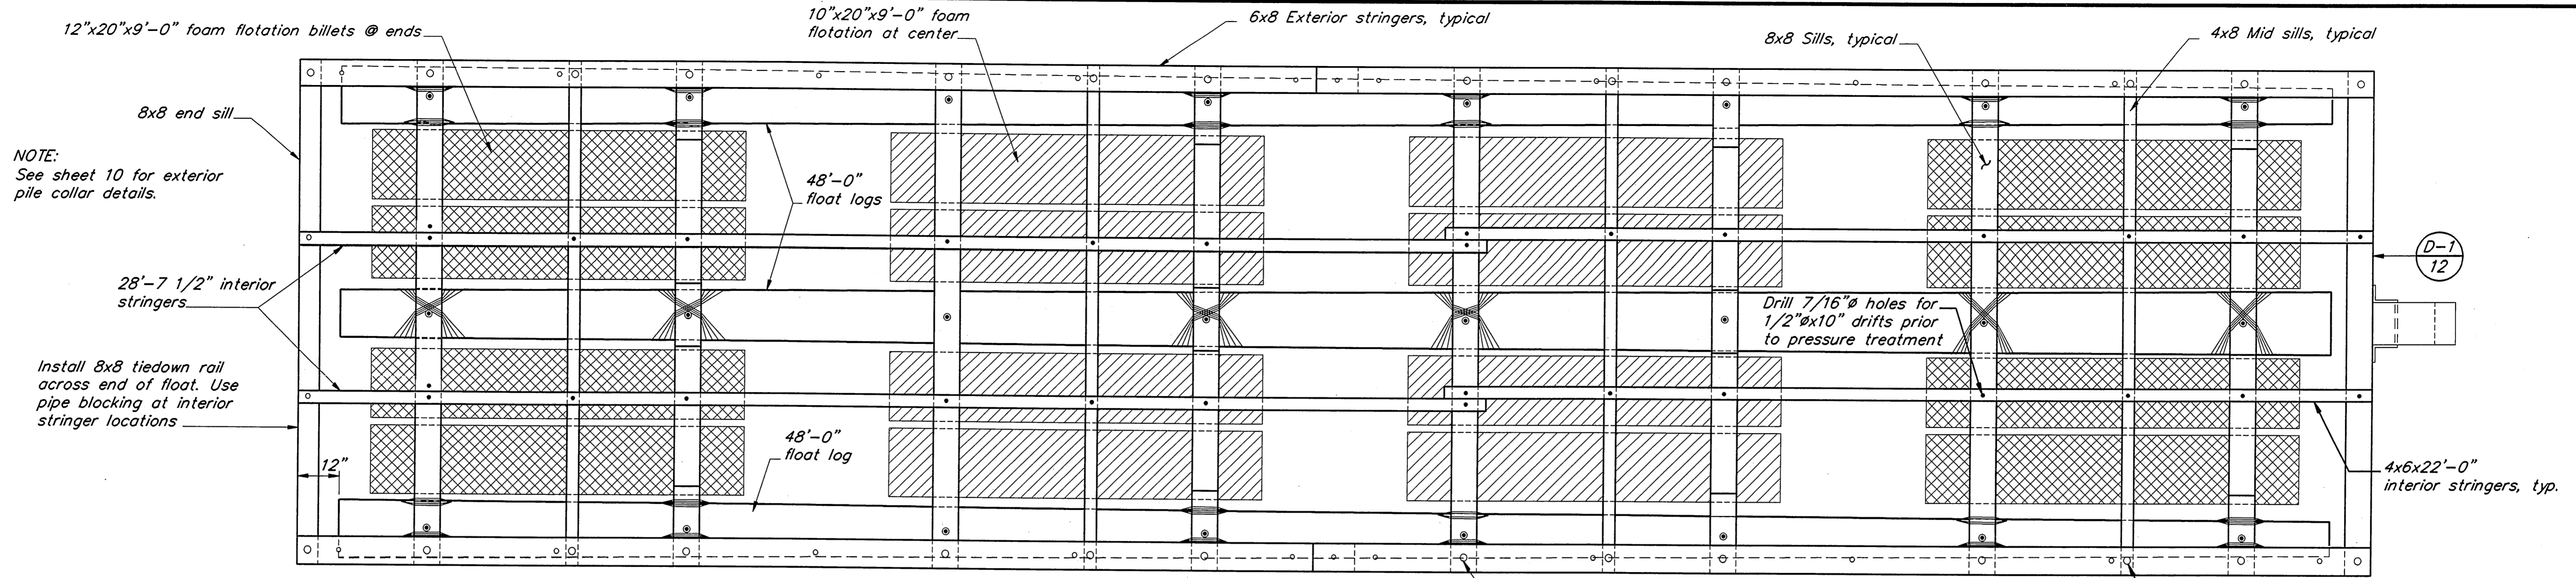

PLAN

NOTE:
See sheet 10 for exterior pile collar details.


Install 8x8 tiedown rail across end of float. Use pipe blocking at interior stringer locations

2x8 bumper board, both sides continuous. Secure with 20d galvanized box nails 12" on center staggered high and low, 2 nails at ends. Butt splice bumper board at centerline of exterior stringer splice.

Drill 13/16" hole thru and counterbore 2 3/4"x3/8" deep for 3/4" economy head bolts

NOTE:
DECKING AND TIEDOWN RAIL NOT SHOWN IN PLAN VIEW.


Drill 9/16" hole thru and counterbore 2 1/4"x3/8" deep for 1/2" economy head bolts

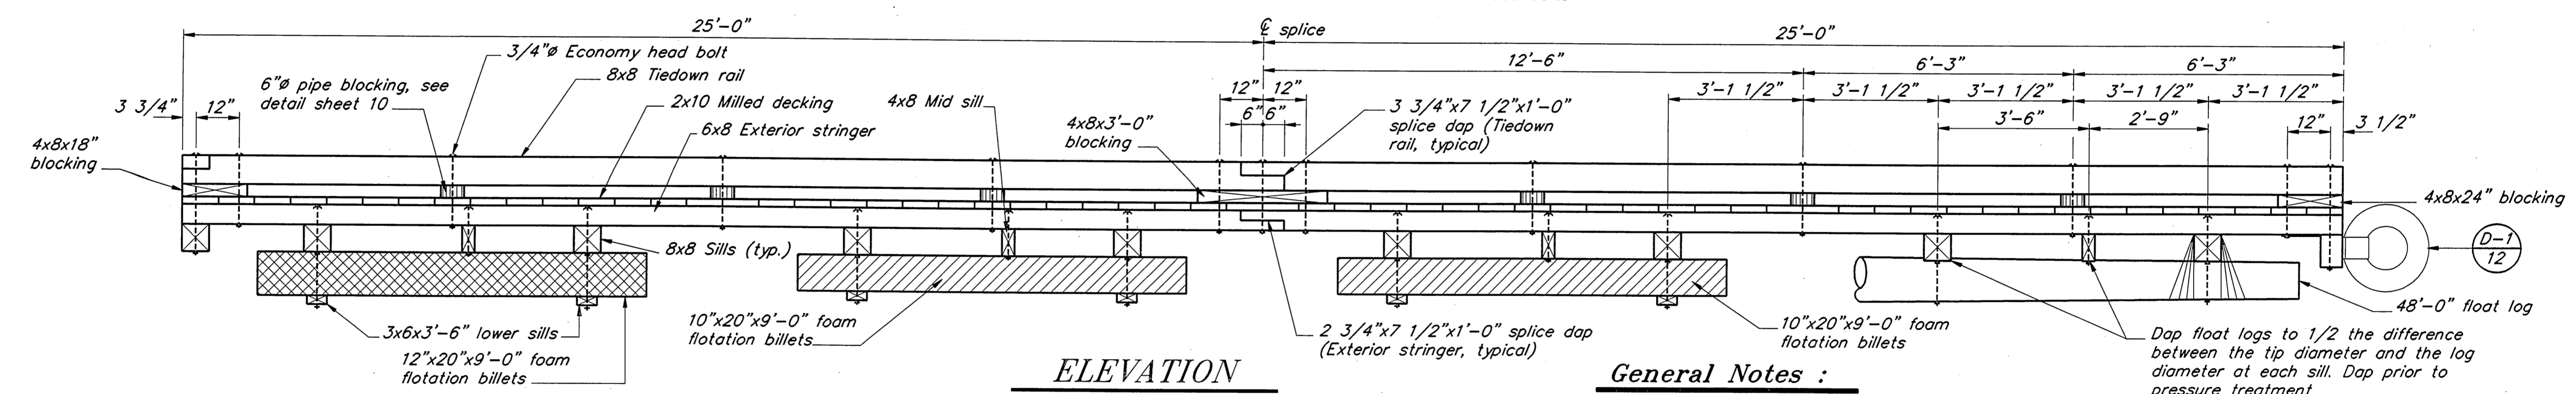

ELEVATION

General Notes:


Lash all logs where shown with 4 turns 1/2" galvanized cable. Secure with 3" galvanized trap staples each turn. Return bend and staple cable ends.
All holes to be drilled and daps to be cut prior to pressure treatment (except where specified).
Float logs shall have a minimum tip circumference of 31 1/2" (10" dia.) and a maximum butt circumference of 56 1/2" (18" diameter).
Contractor to furnish and install as needed, where directed by the Engineer, 5 - 5"x20"x4'-6" flotation billets to balance the float. *NOTE: FORM USED TO RAISE AND LEVEL HEAD OF EXISTING 10'x15' FLOAT WHICH MEETS THIS FLOAT*

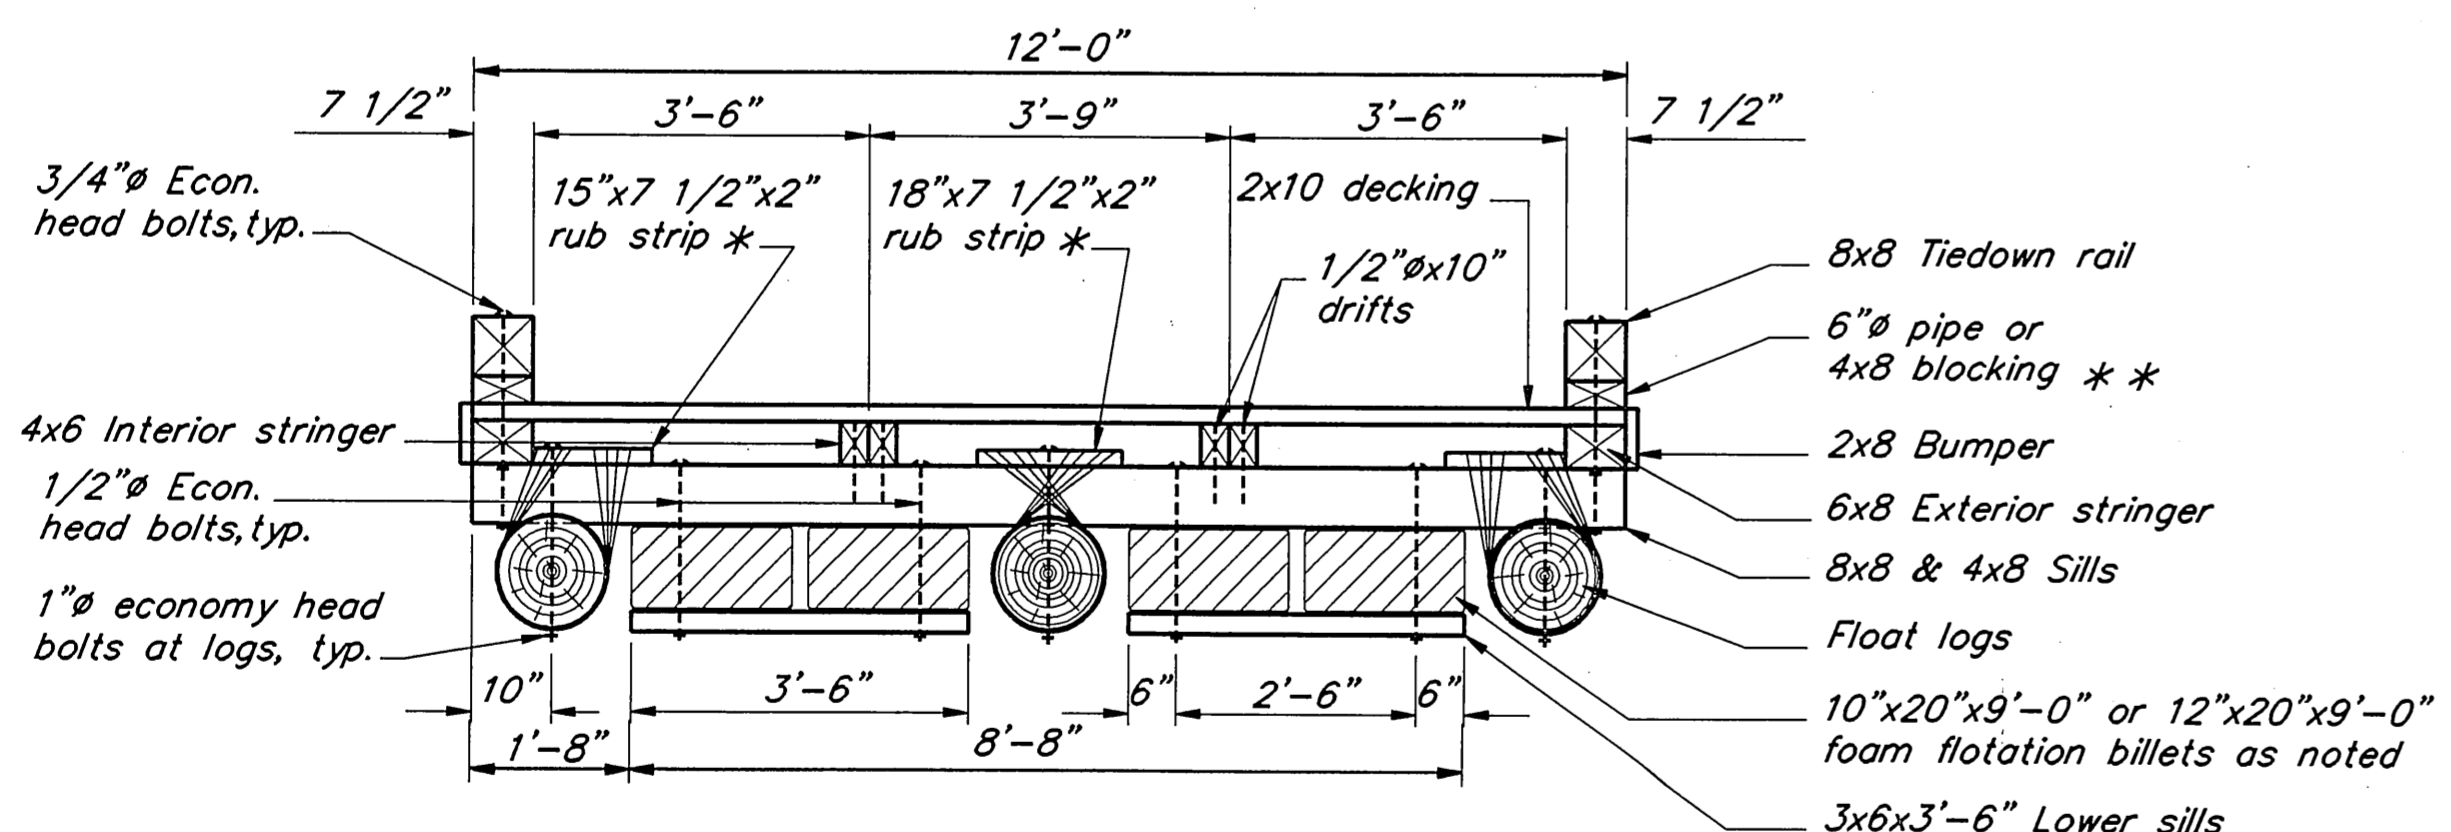

TYPICAL SECTION

* Rub strip to be Ekki or iron bark.

** All blocking shall be 6" diameter except where noted.

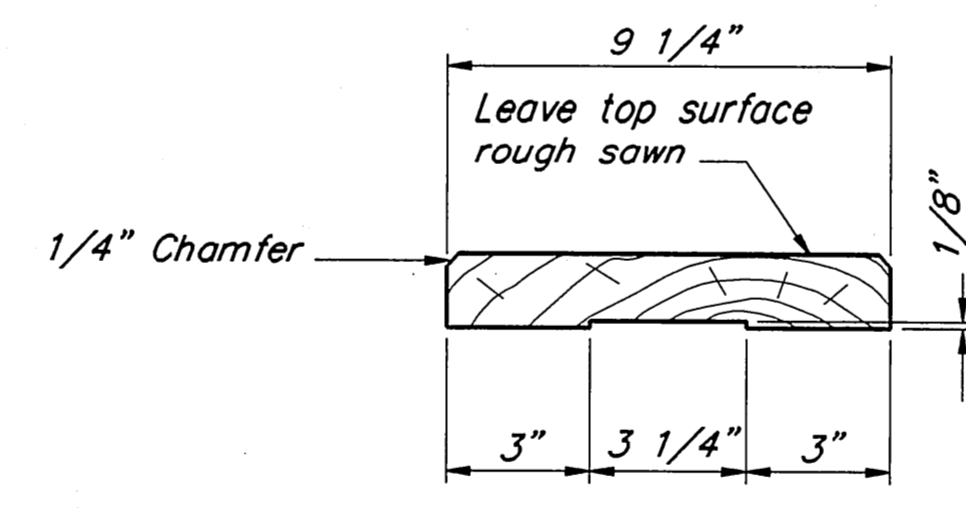

MILLED DECKING DETAIL

DECKING NOTES:

2x10 Decking milled S1S2E rough side up. Milled side shall be towards the center of the tree. Space 1/4" and secure with 2-20d galv. box nails at each stringer, predrill to prevent splitting if required.

Pressure Treated Timber Materials (See Specifications for Treatment & Retention)		
Item	Dressing	Notes
8x8 Tiedown Rails	S4S	Shop drill all holes.
4x8 Blocking	S4S	Shop drill all holes with shear plates.
2x10 Decking	Milled S1S2E	Field drill ends to prevent splitting if req'd.
2x8 Bumpers	S4S	Field drill ends to prevent splitting if req'd.
6x8 Exterior Stringers	S4S	Shop drill all holes.
4x6 Interior Stringers	S4S	Shop drill all holes.
8x8 Sills	S4S	Shop drill all holes except @ int. stringers
4x8 Mid Sills	S4S	Shop drill all holes except @ int. stringers
3x6 Lower Sills	S4S	Shop drill all holes.
Float Logs	A.S.T.M. D25	Cut daps & drill holes prior to treatment

As Built
Mark Johnson
7/25/95

ENGINEER'S SEAL



PATH: P:\POW\PTBAKER\DR\SH19.dwg < 1=24 >


BY	DATE	DESCRIPTION OF CHANGE

RECORD OF REVISIONS



STATE OF ALASKA
DEPARTMENT OF TRANSPORTATION
AND PUBLIC FACILITIES
SOUTHEAST REGION DESIGN & CONSTRUCTION

POINT BAKER
PRINCE OF WALES ISLAND
POINT BAKER SEAPLANE FLOAT
A.I.P. # 3-02-0423-01
12'x50' Log Reinforced Float


ALASKA	DESIGNED BY: D.D.S.	PROJECT NO. 71135
	DRAWN BY: B.W.B.	DATE: APRIL, 1994
	CHECKED BY: J.D.B.	SHEET 9 OF 20

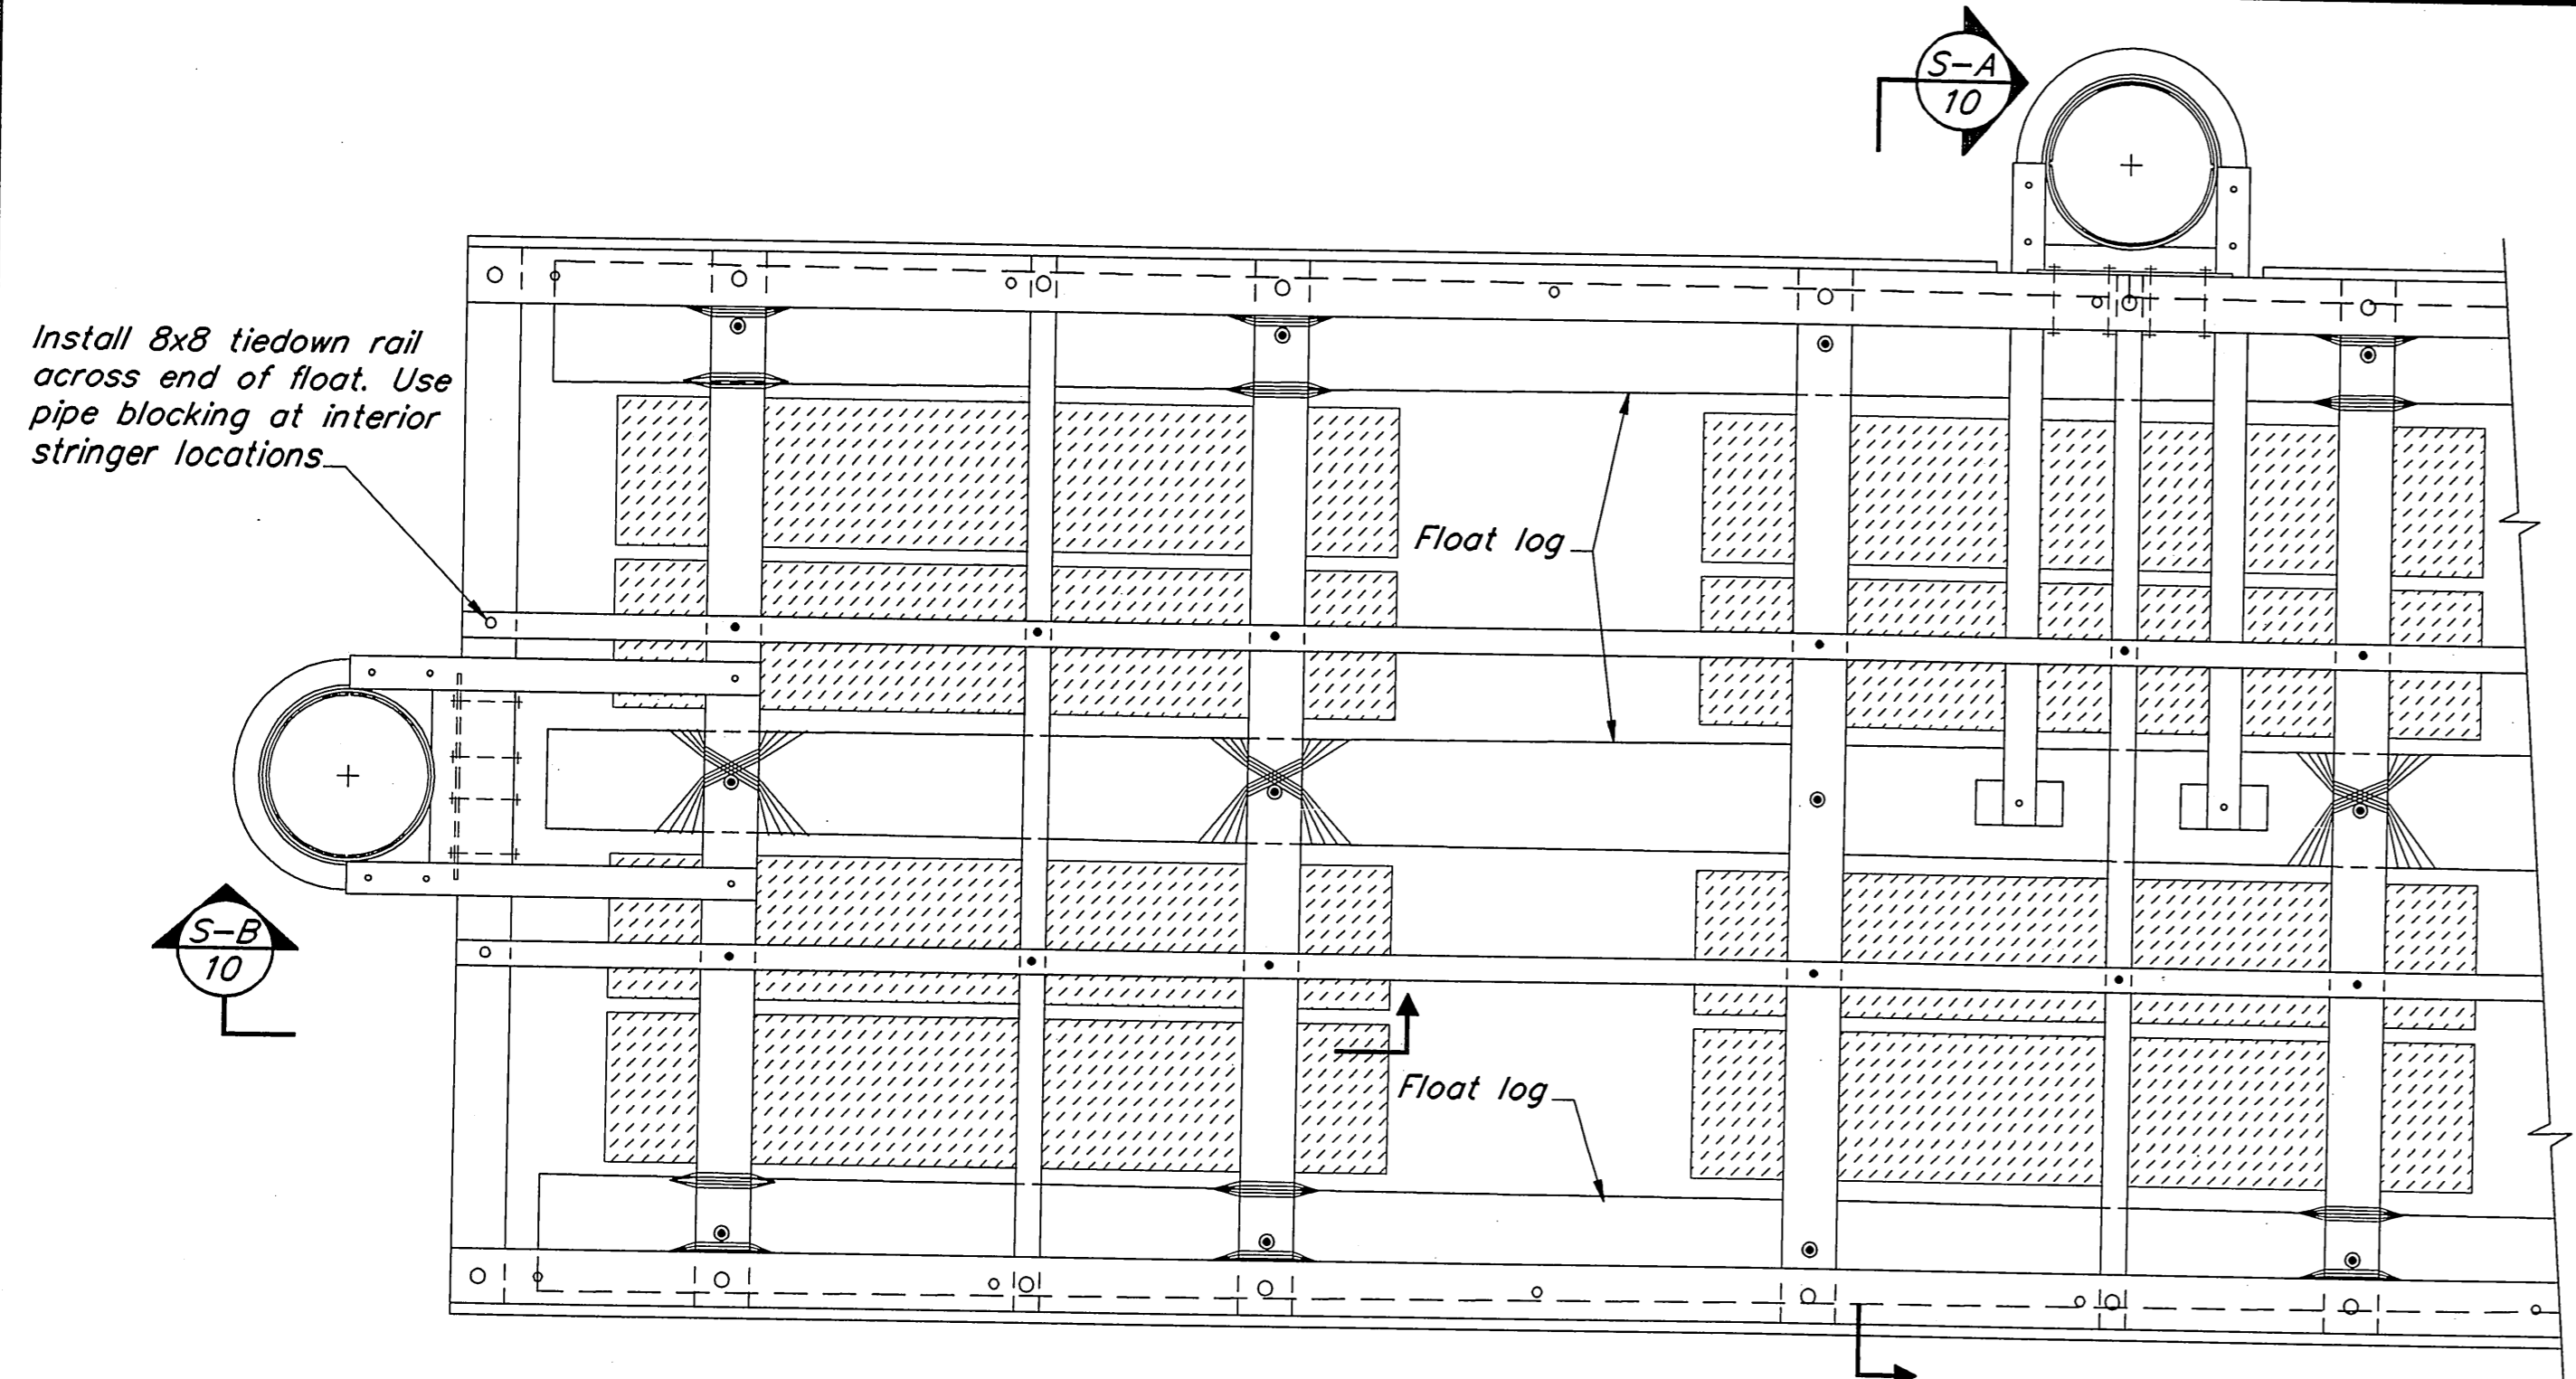


EXTERIOR PILE COLLAR ASSEMBLY

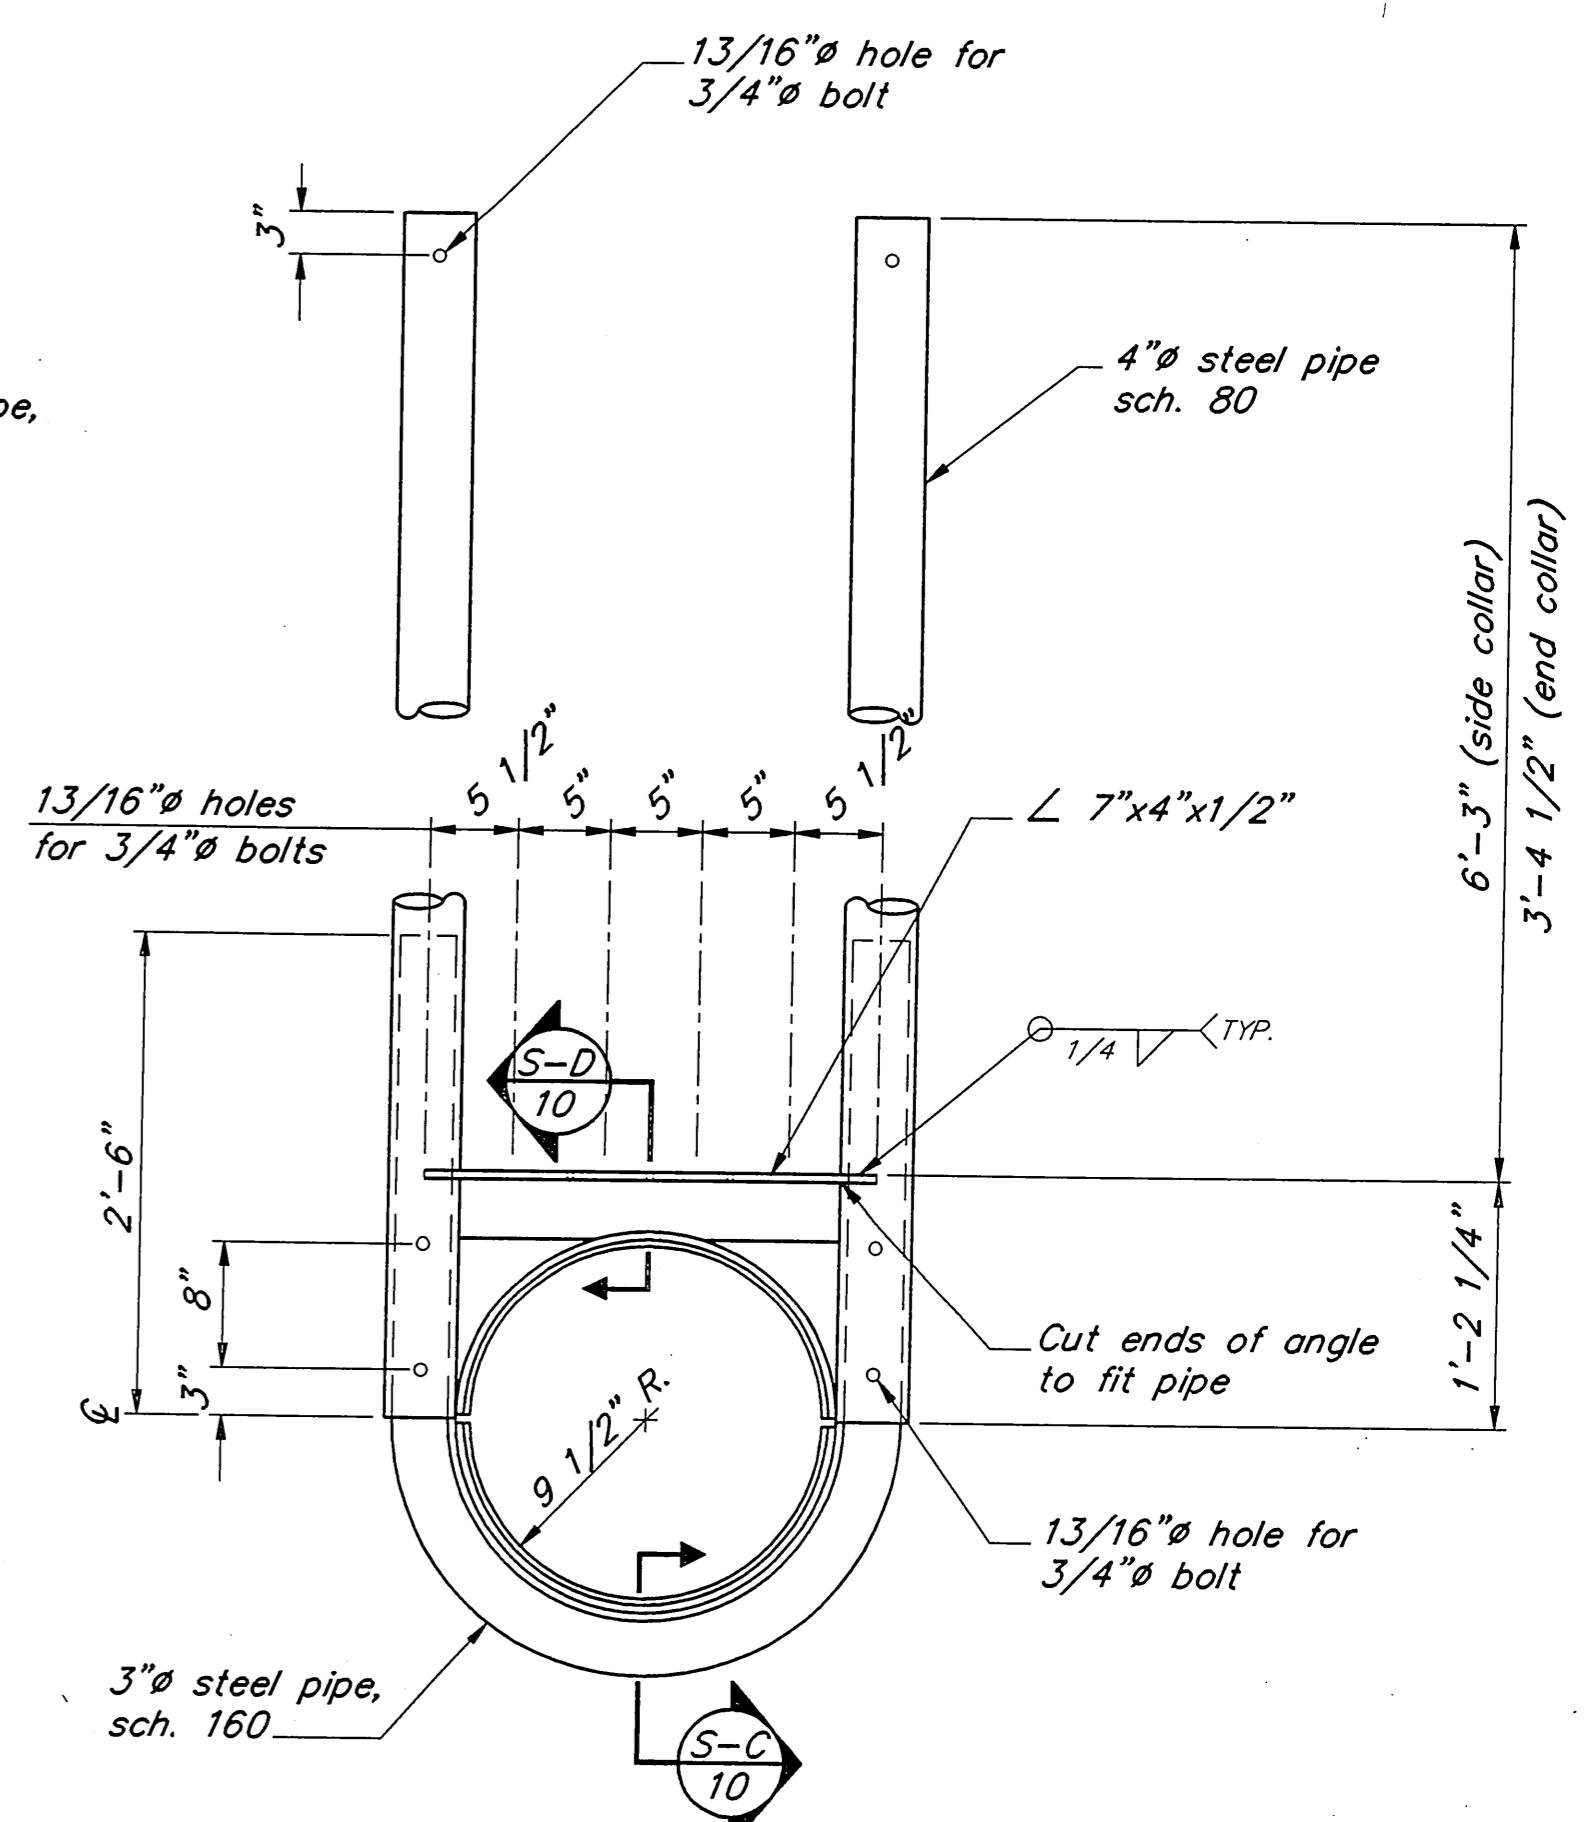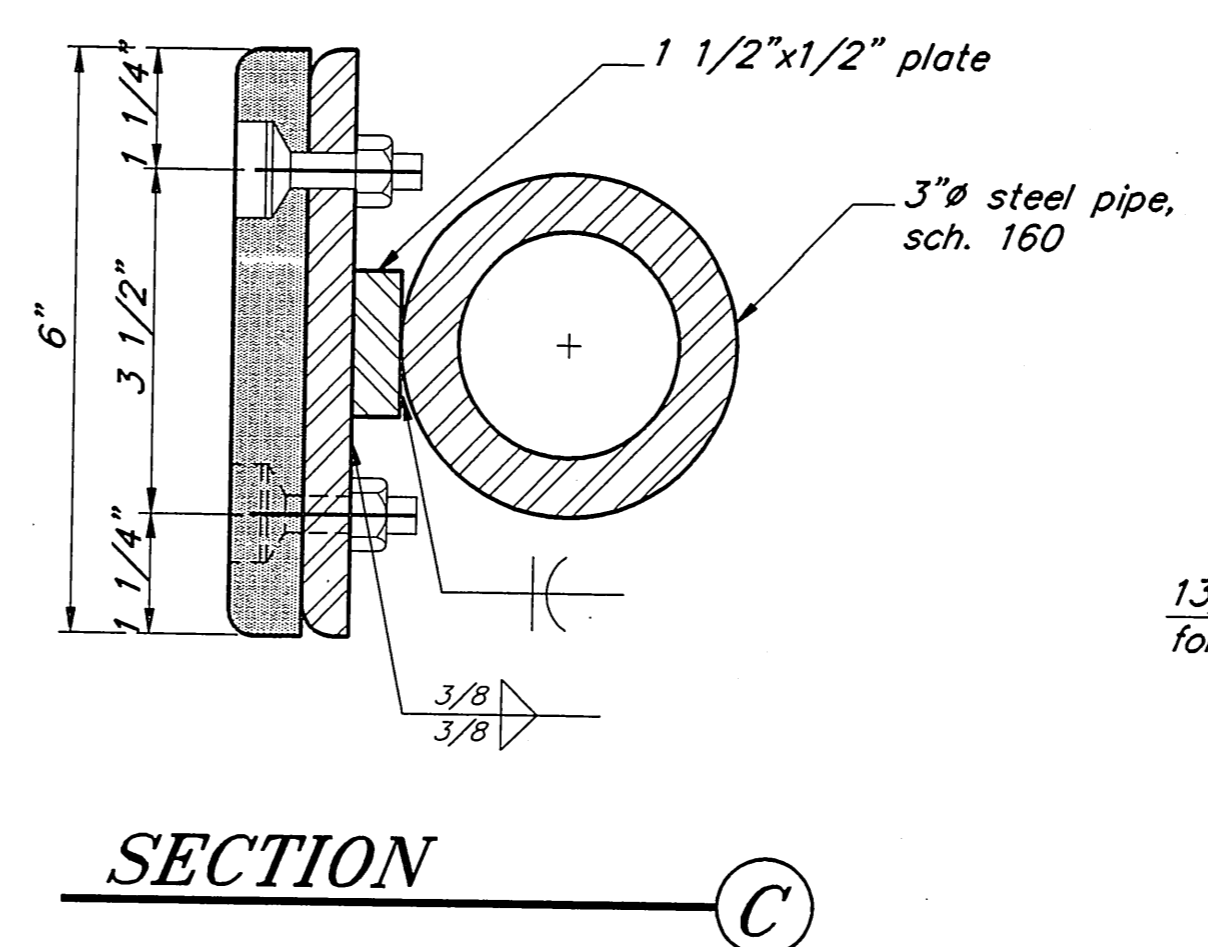


EXTERIOR PILE COLLAR DETAIL

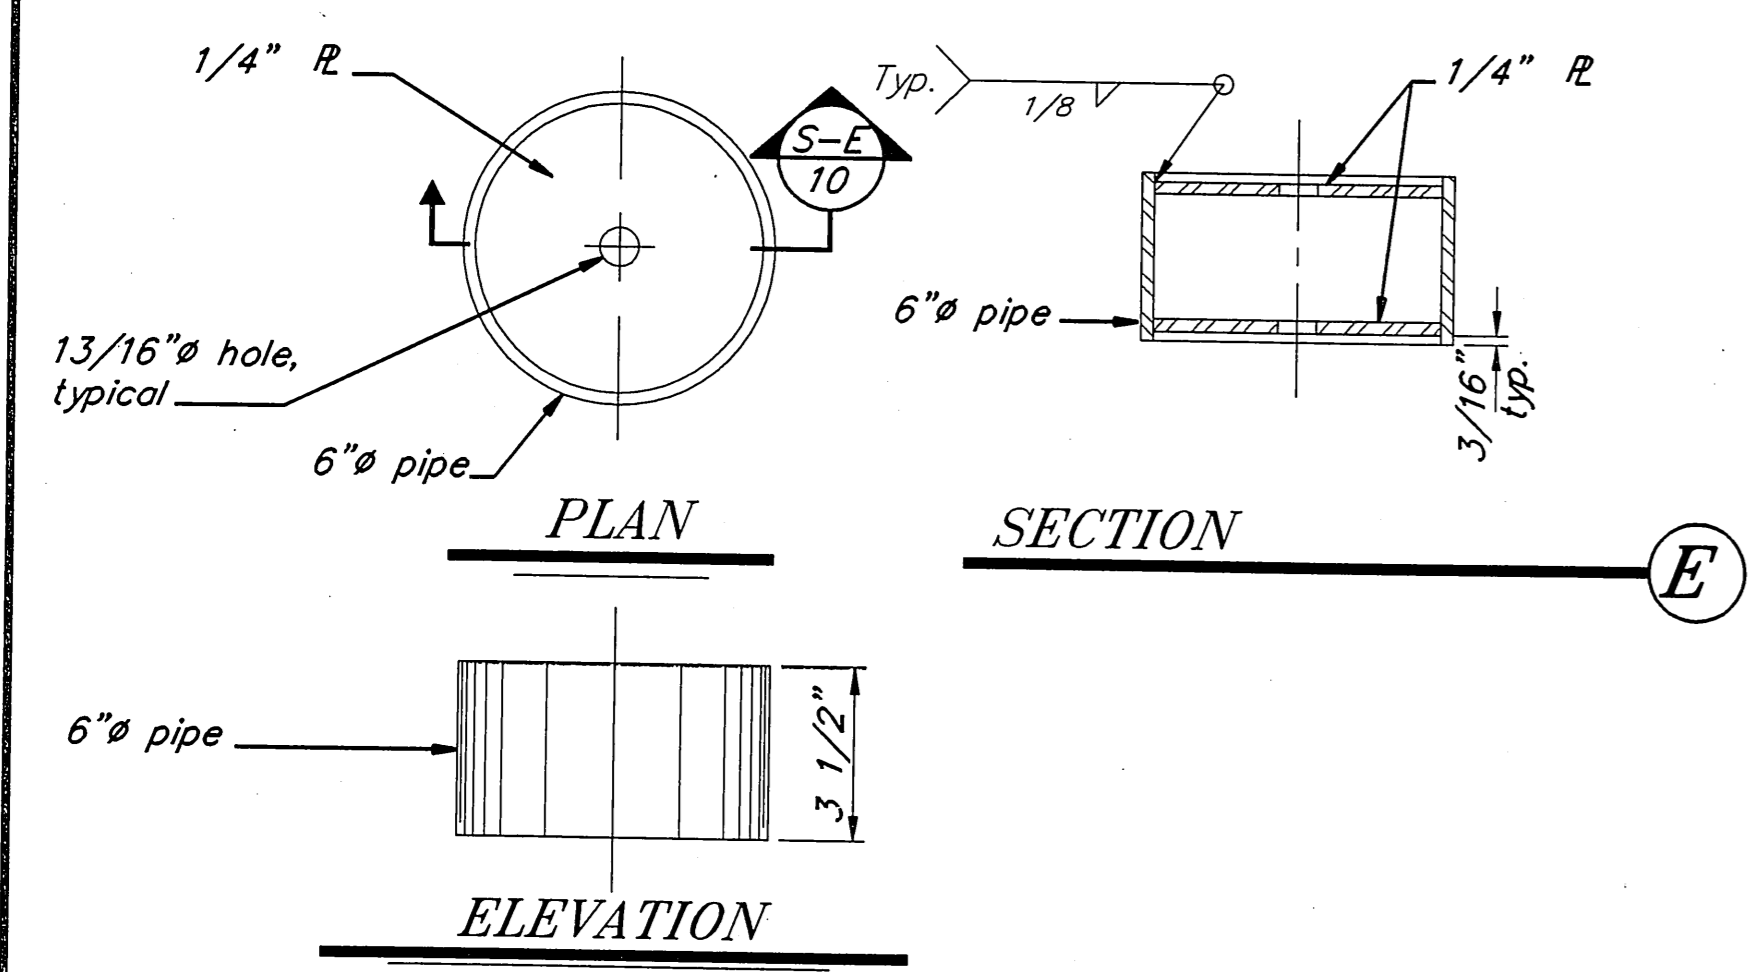


PIPE BLOCKING DETAILS

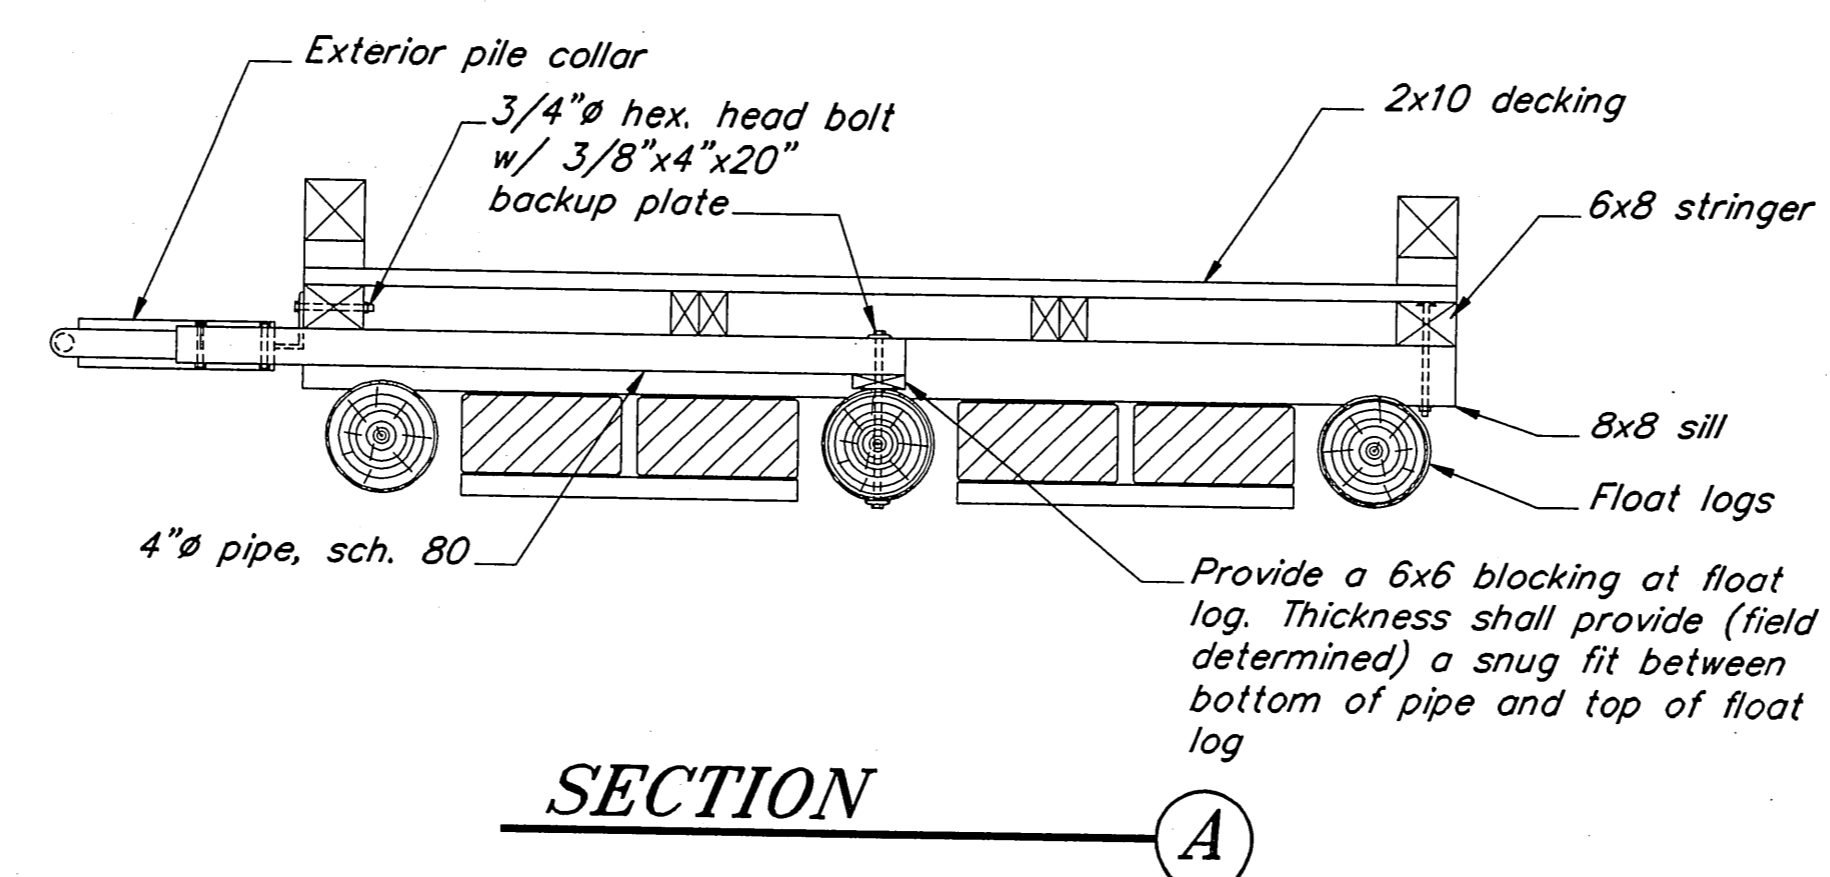

SECTION A

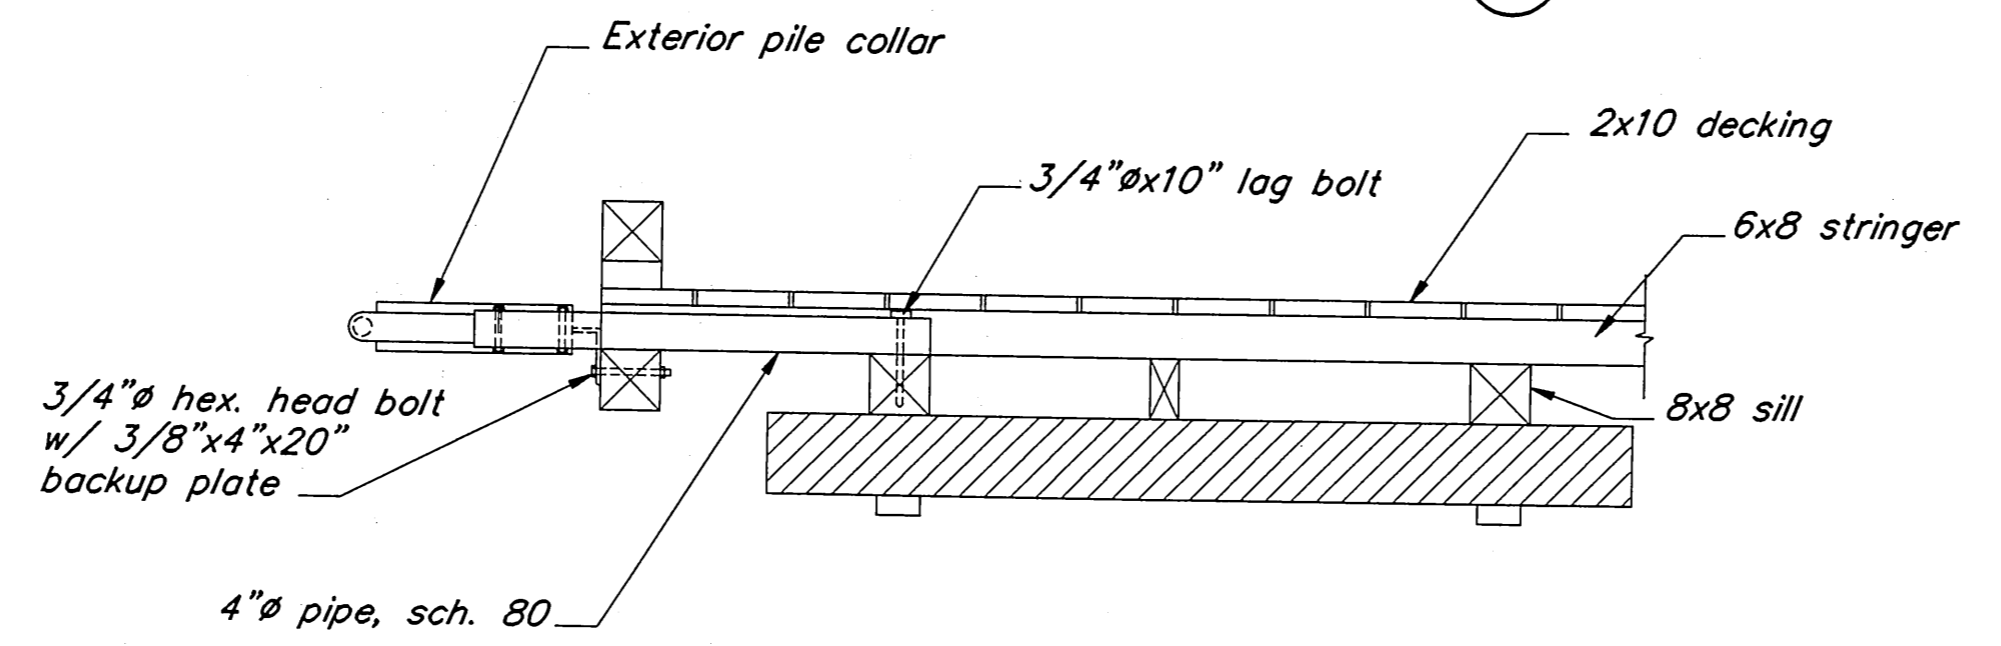

SECTION B

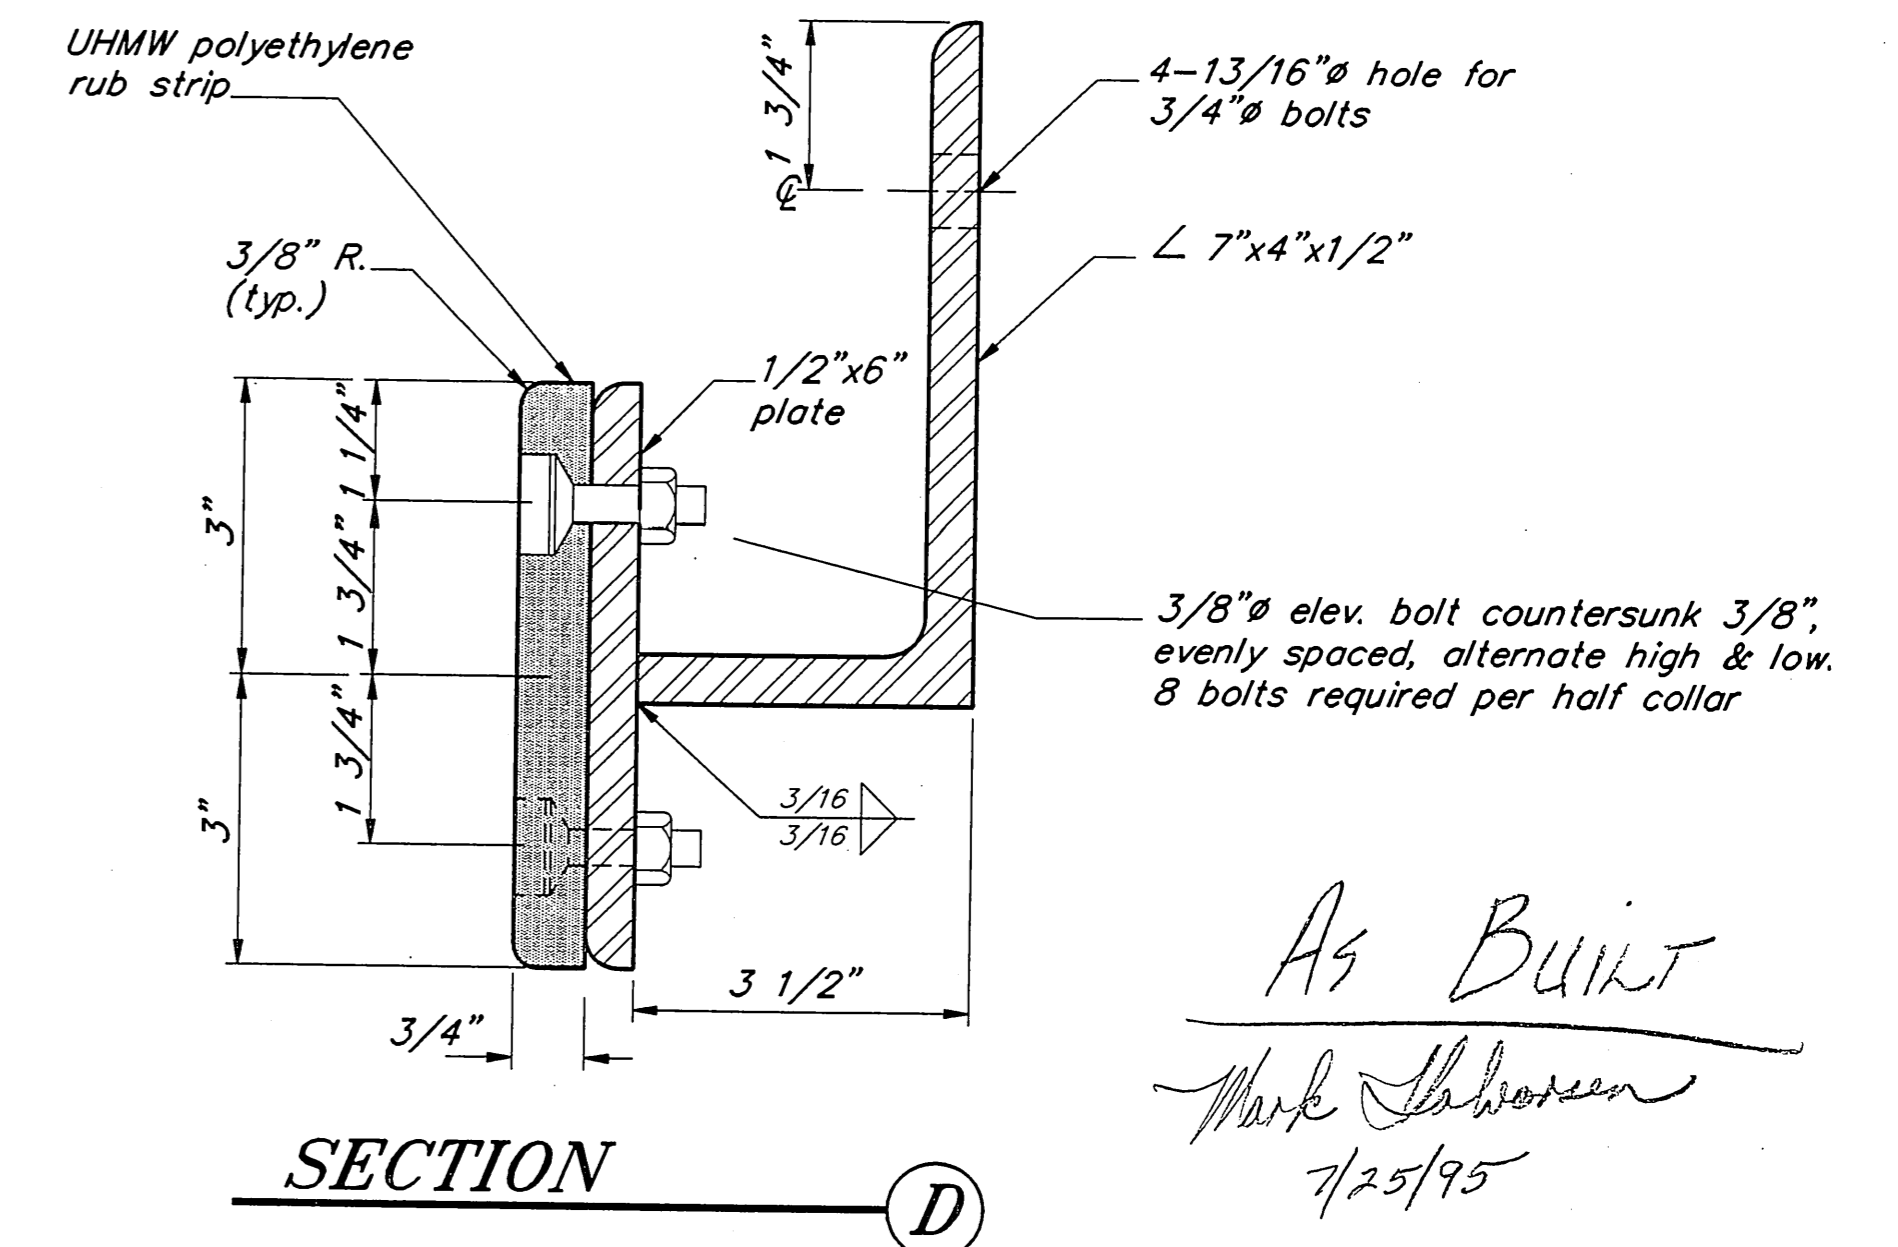

SECTION D

As Built
Mark Johnson
 7/25/95

RECORD OF REVISIONS		
BY	DATE	DESCRIPTION OF CHANGE

STATE OF ALASKA
 DEPARTMENT OF TRANSPORTATION
 AND PUBLIC FACILITIES
 SOUTHEAST REGION DESIGN & CONSTRUCTION


POINT BAKER


PRINCE OF WALES ISLAND
 POINT BAKER SEAPLANE FLOAT
 A.I.P. # 3-02-0423-01

Pile Collar Details

NOTE: DO NOT SCALE FROM THESE PLANS-USE DIMENSIONS


DESIGNED BY: D.D.S.	PROJECT NO. 71135
DRAWN BY: B.W.B.	DATE: APRIL, 1994
CHECKED BY: J.D.B.	SHEET 10 OF 20

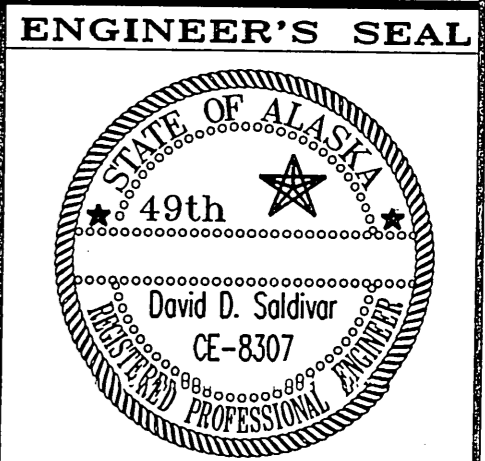

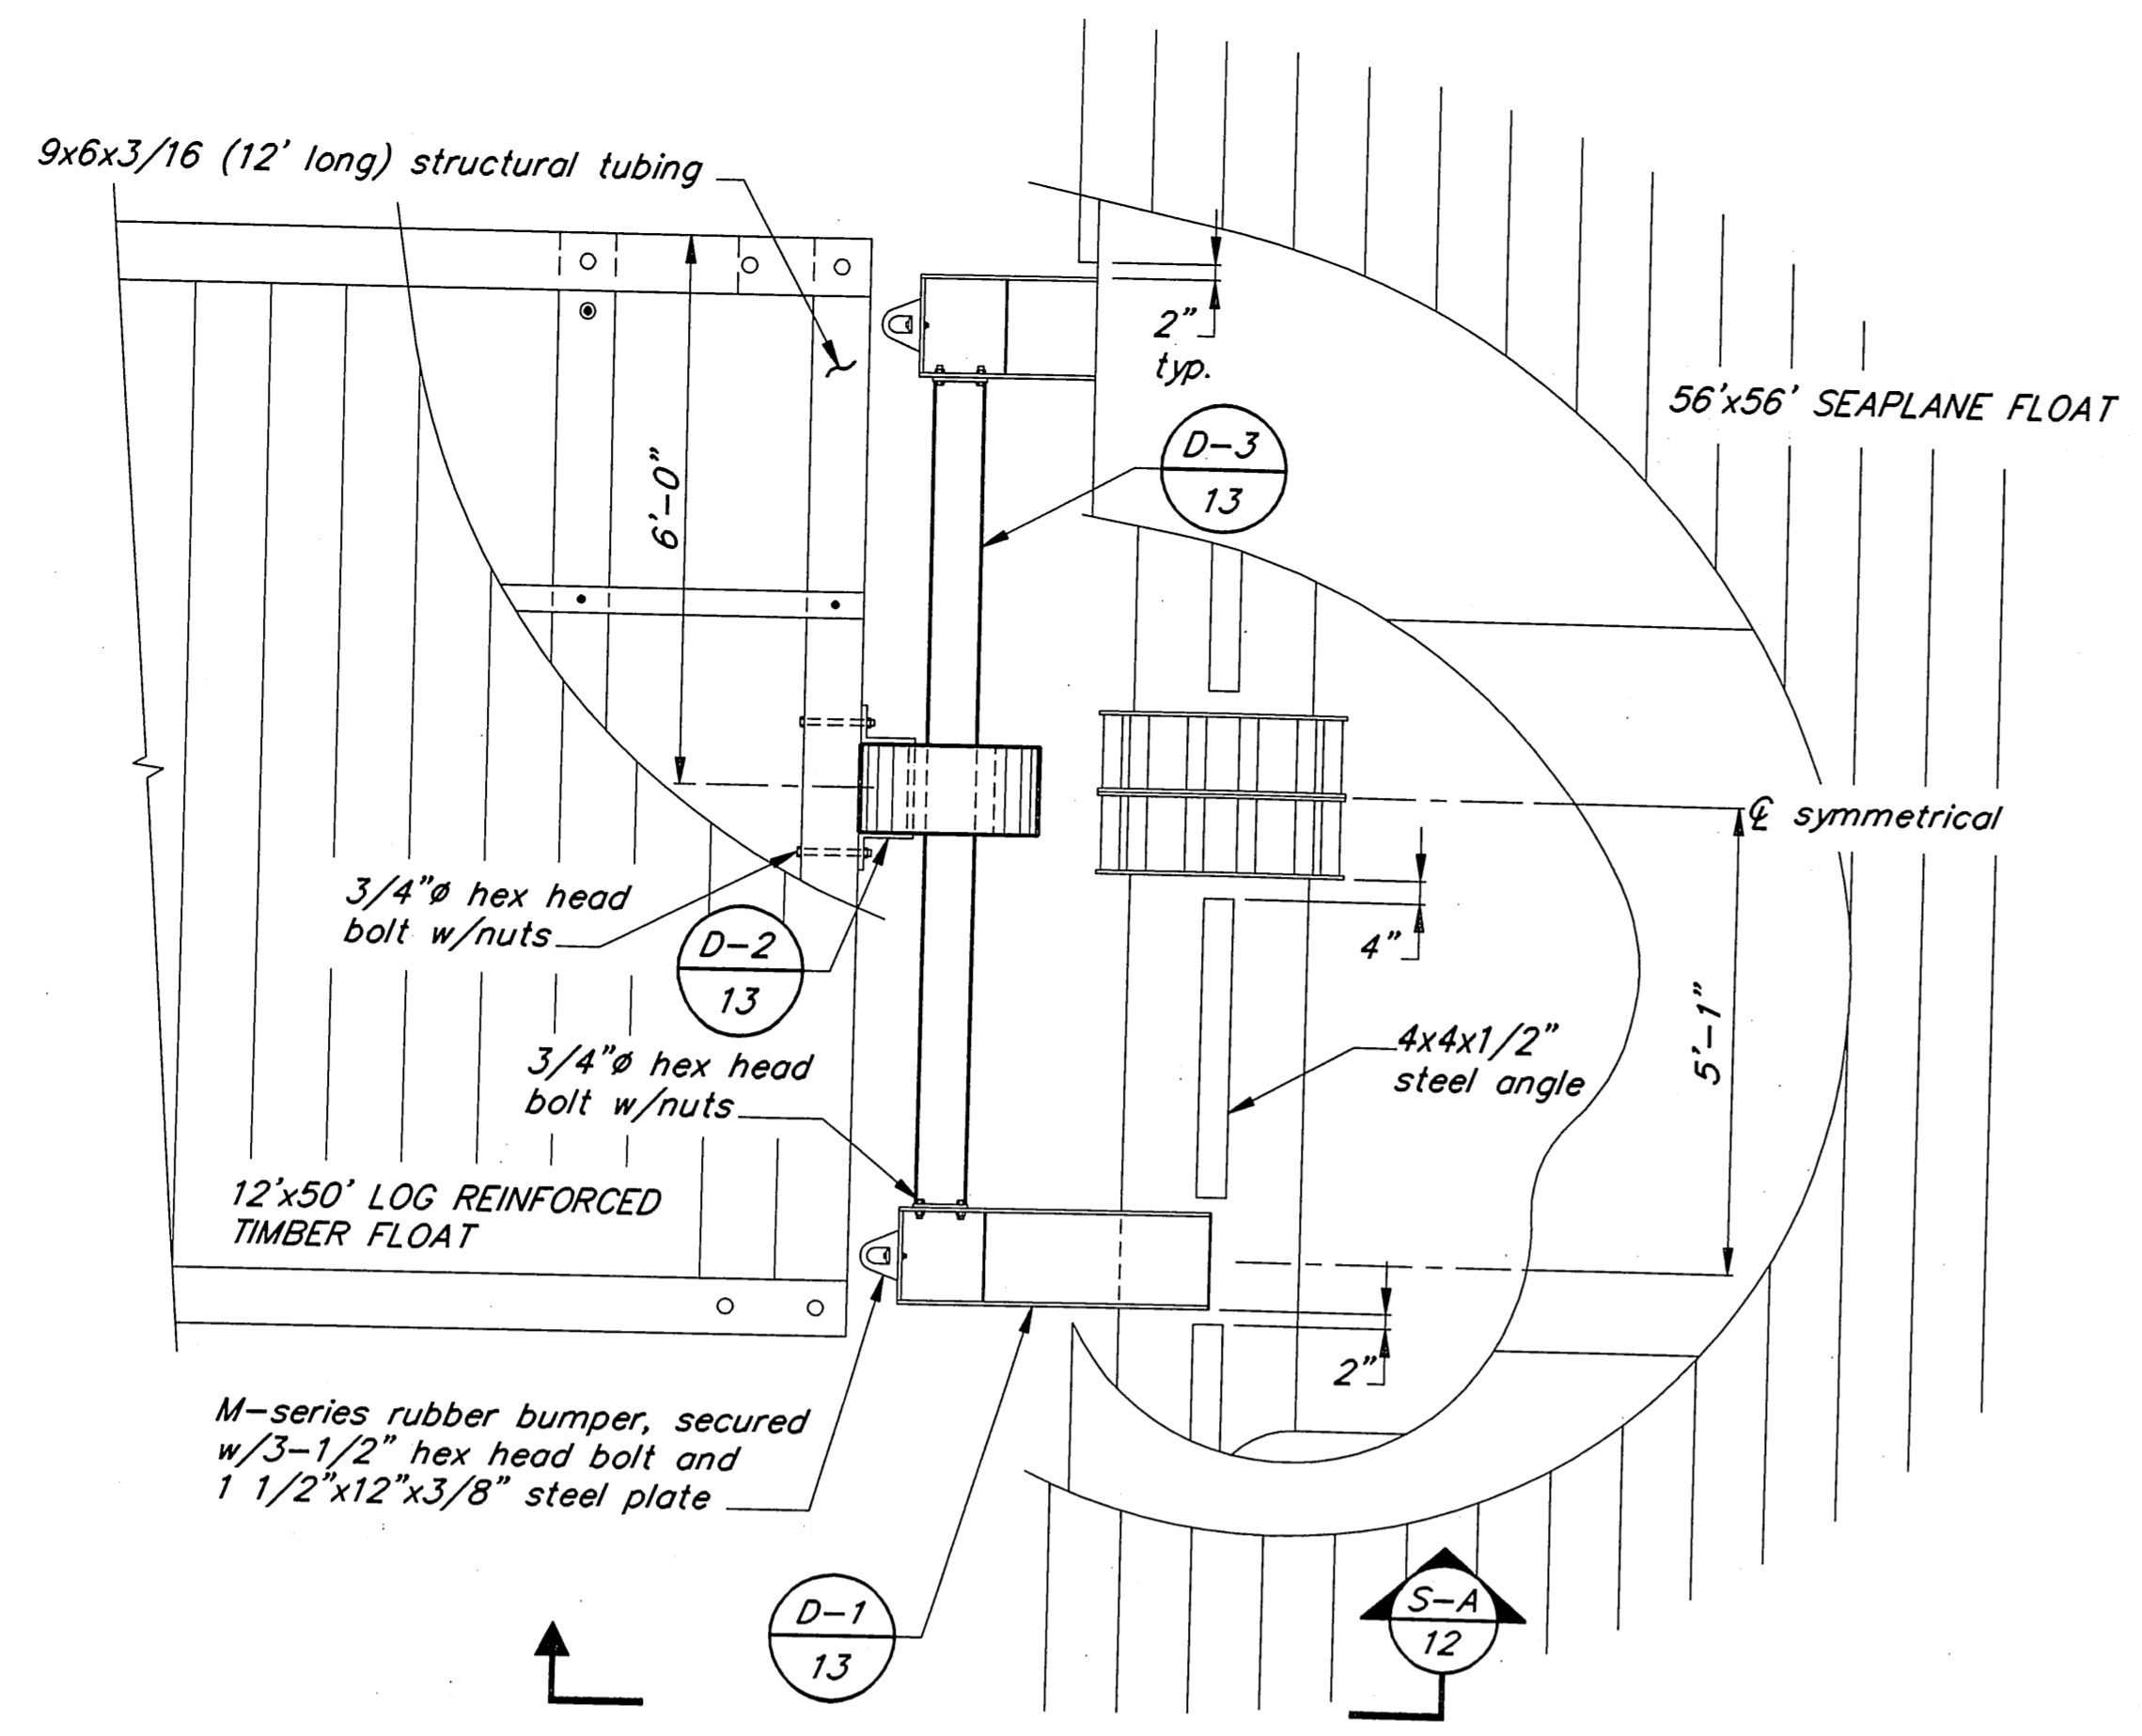


BUMPER SLIDE INSTALLATION DETAIL

1

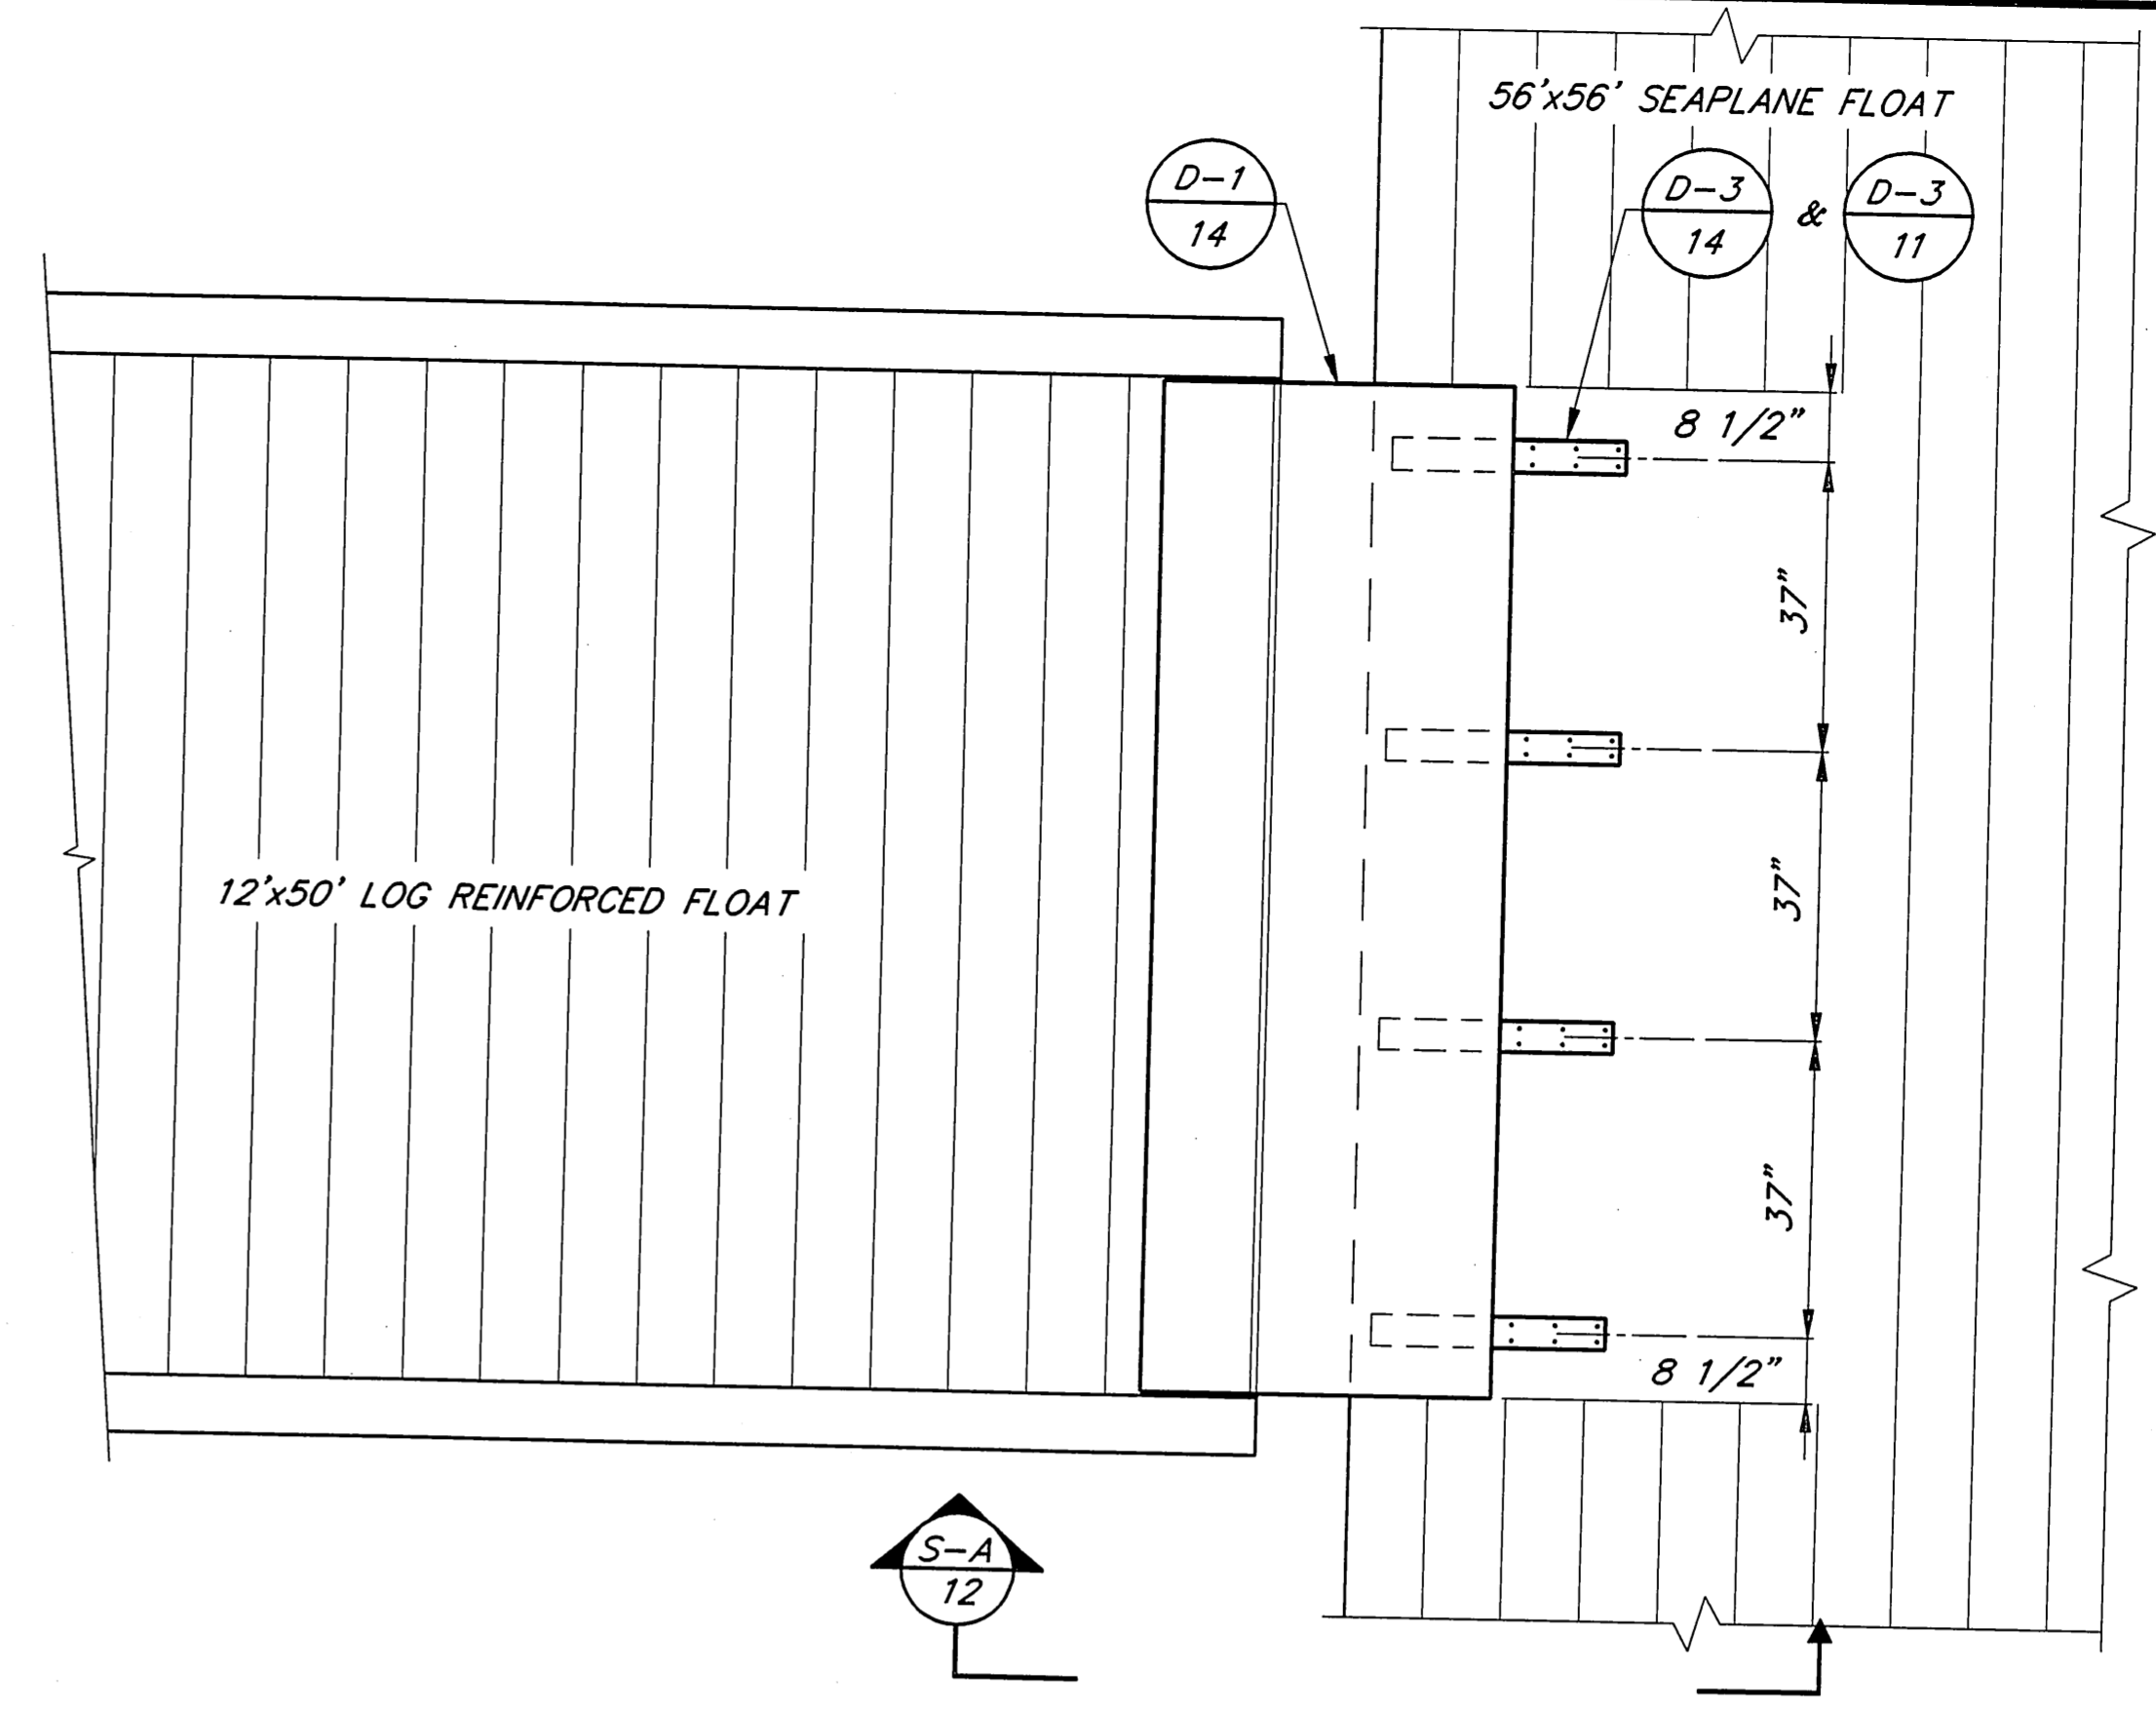

PLAN DETAIL

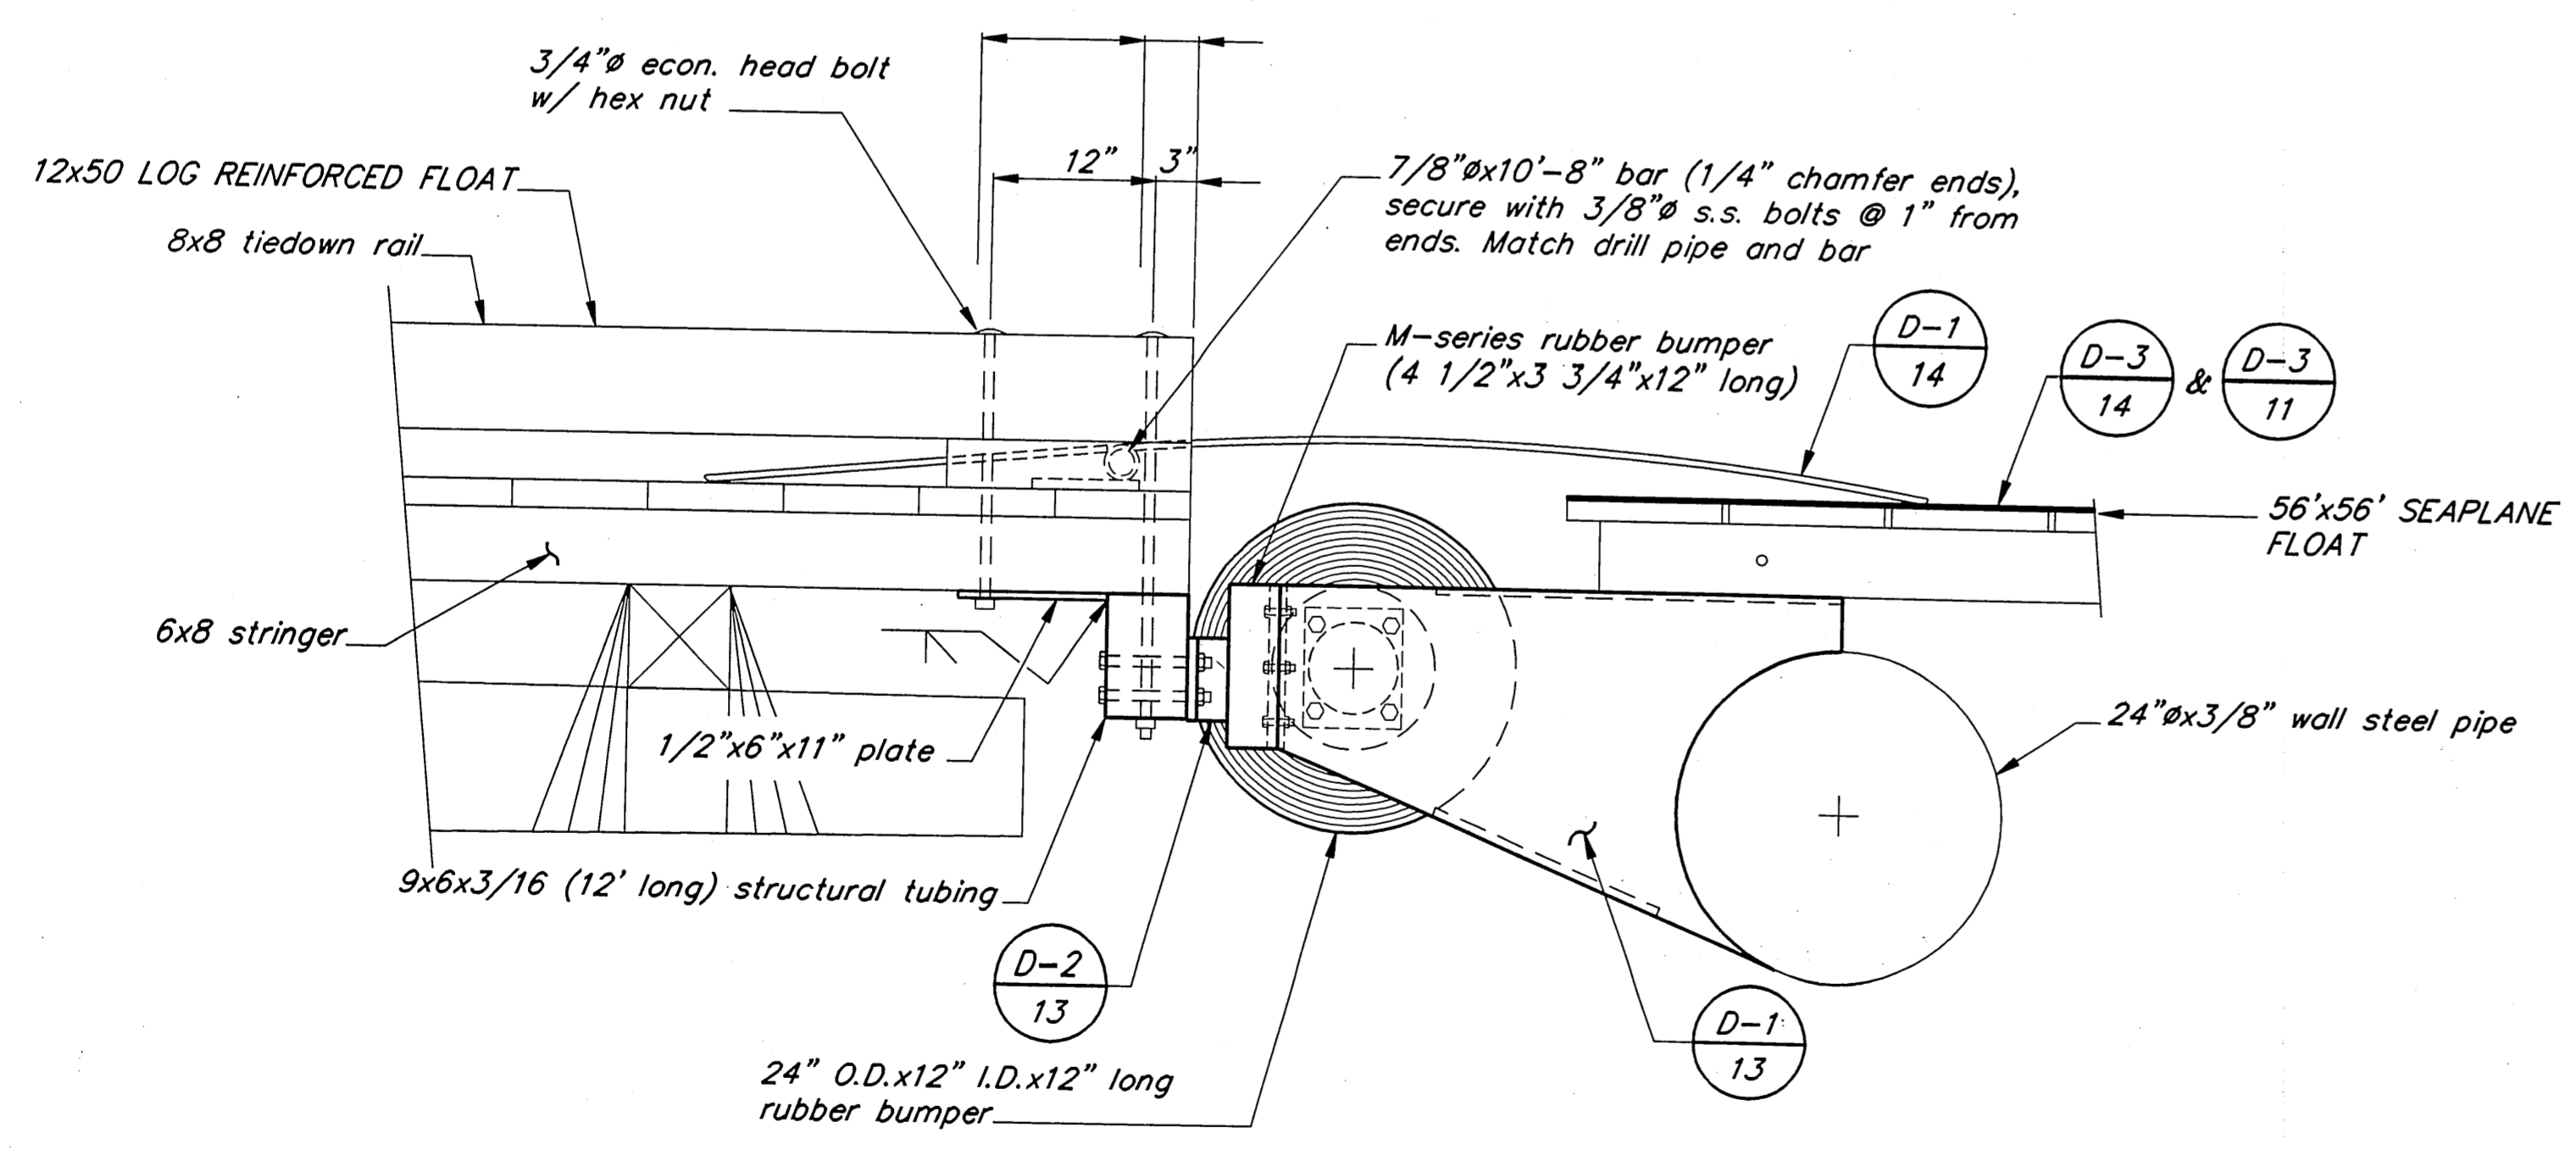

SECTION A

As BUILT
Mark Johnson
 7/25/95

PATH: P:\POW\PTBAKER\DR\SH12.dwg < 1=24 >

BY	DATE	DESCRIPTION OF CHANGE


RECORD OF REVISIONS

STATE OF ALASKA
 DEPARTMENT OF TRANSPORTATION
 AND PUBLIC FACILITIES
 SOUTHEAST REGION DESIGN & CONSTRUCTION


POINT BAKER
 PRINCE OF WALES ISLAND
 POINT BAKER SEAPLANE FLOAT
 A.I.P. # 3-02-0423-01
 ALASKA

NOTE: DO NOT SCALE FROM THESE PLANS-USE DIMENSIONS


DESIGNED BY: D.D.S.	PROJECT NO. 71135
DRAWN BY: E.W.B.	DATE: APRIL, 1994
CHECKED BY: J.D.B.	SHEET 12 OF 20

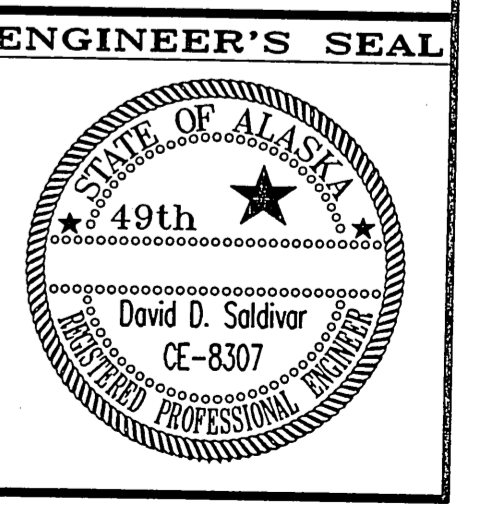


Float Connection Details

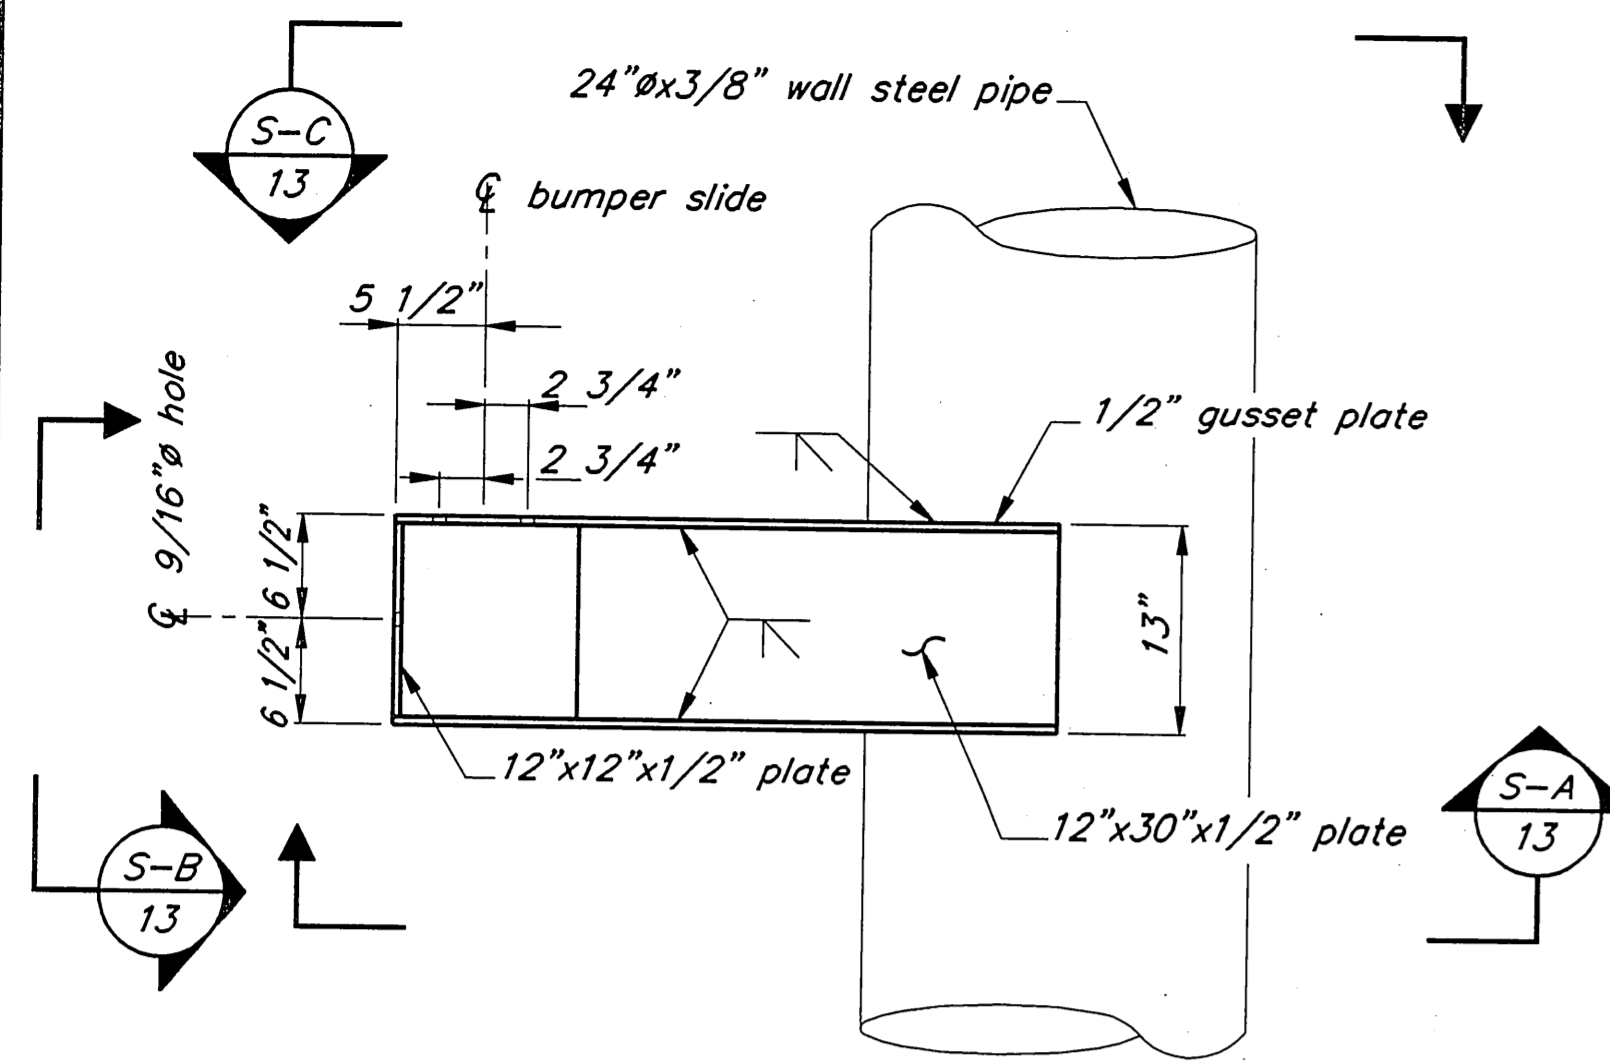


GUSSET PLATE ASSEMBLY ①

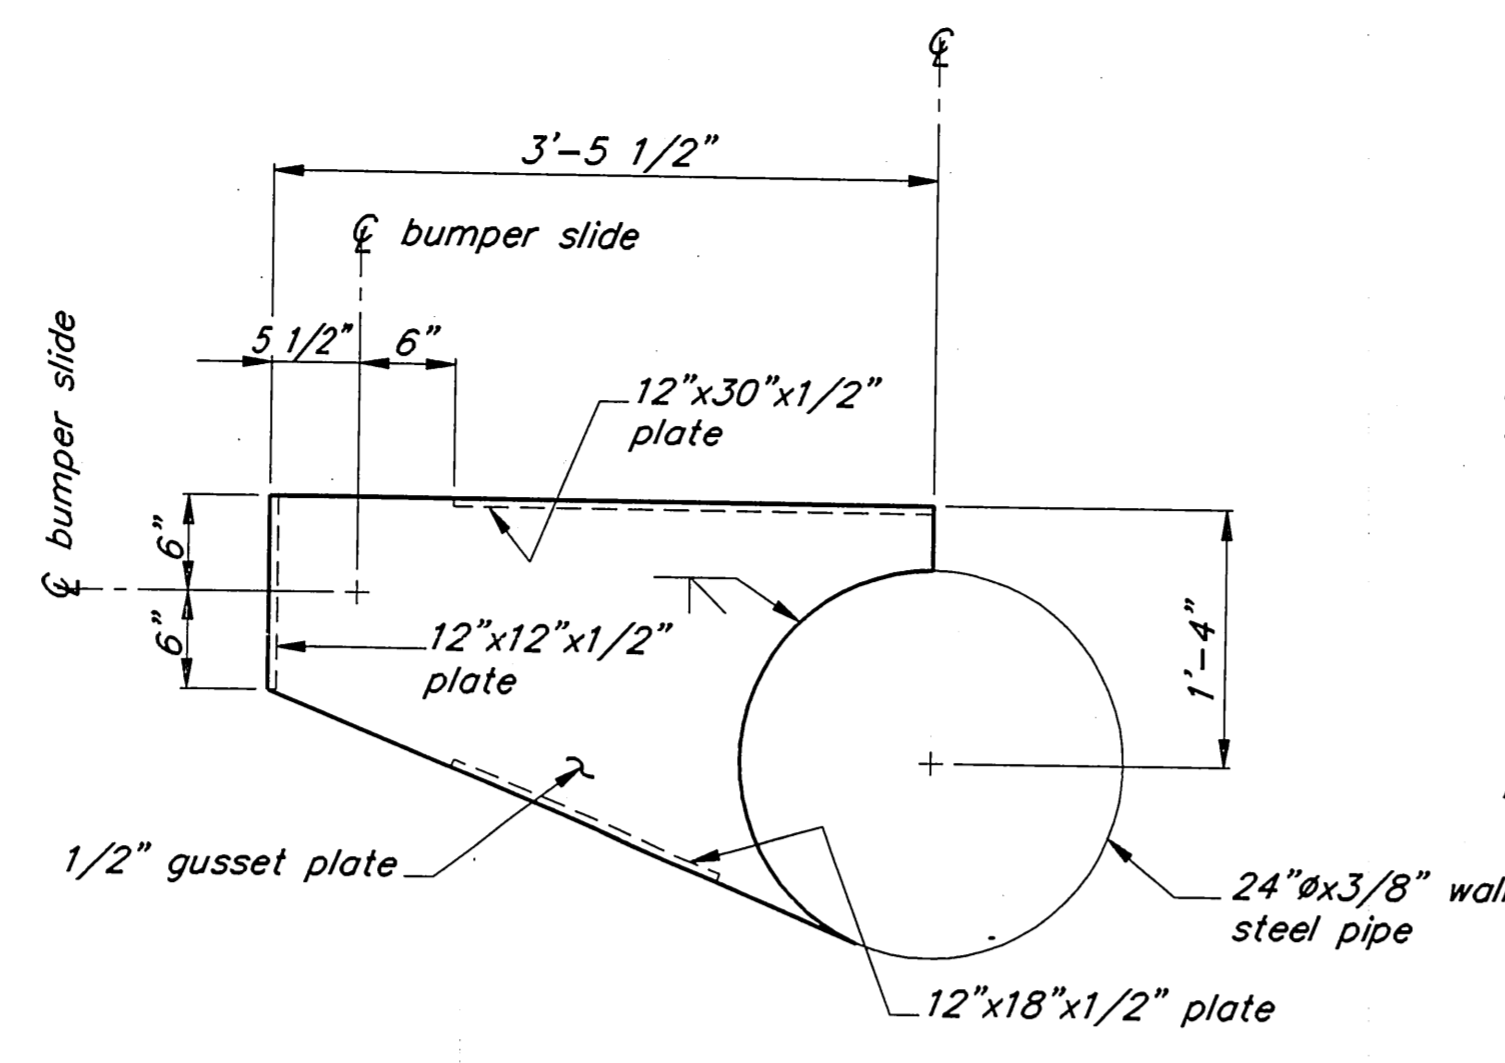


SECTION A

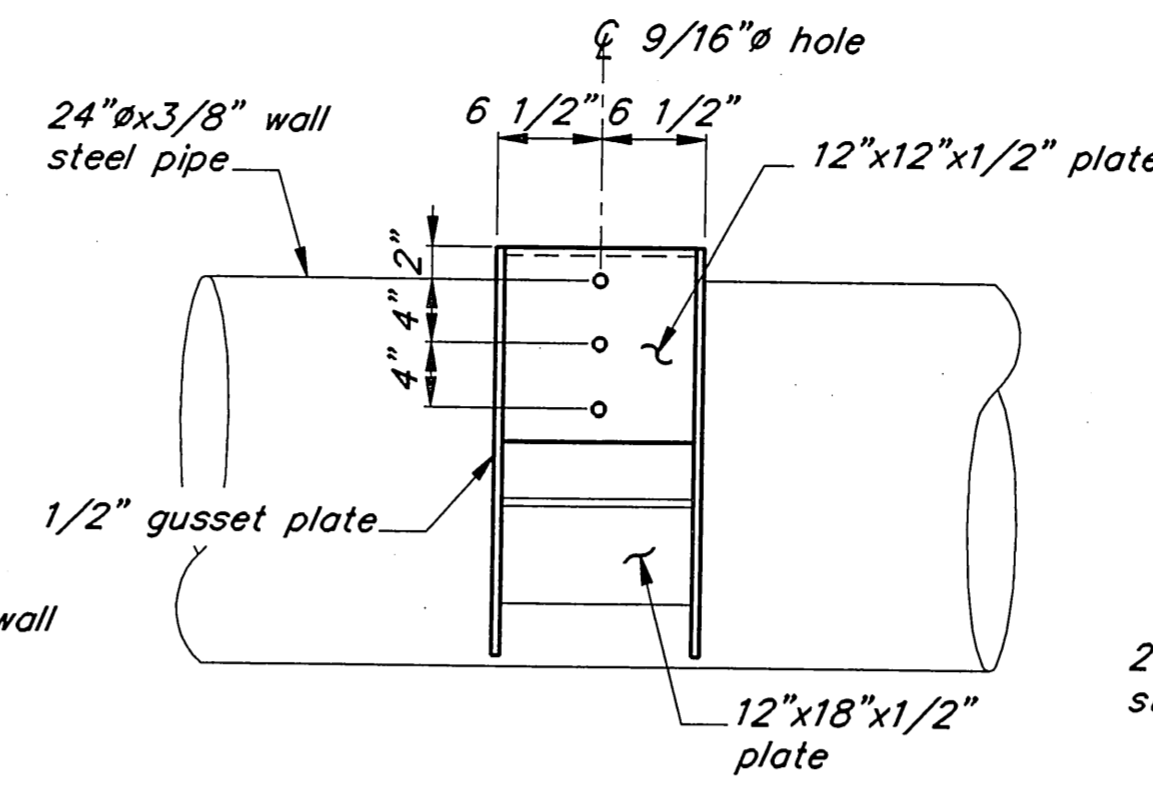


SECTION B

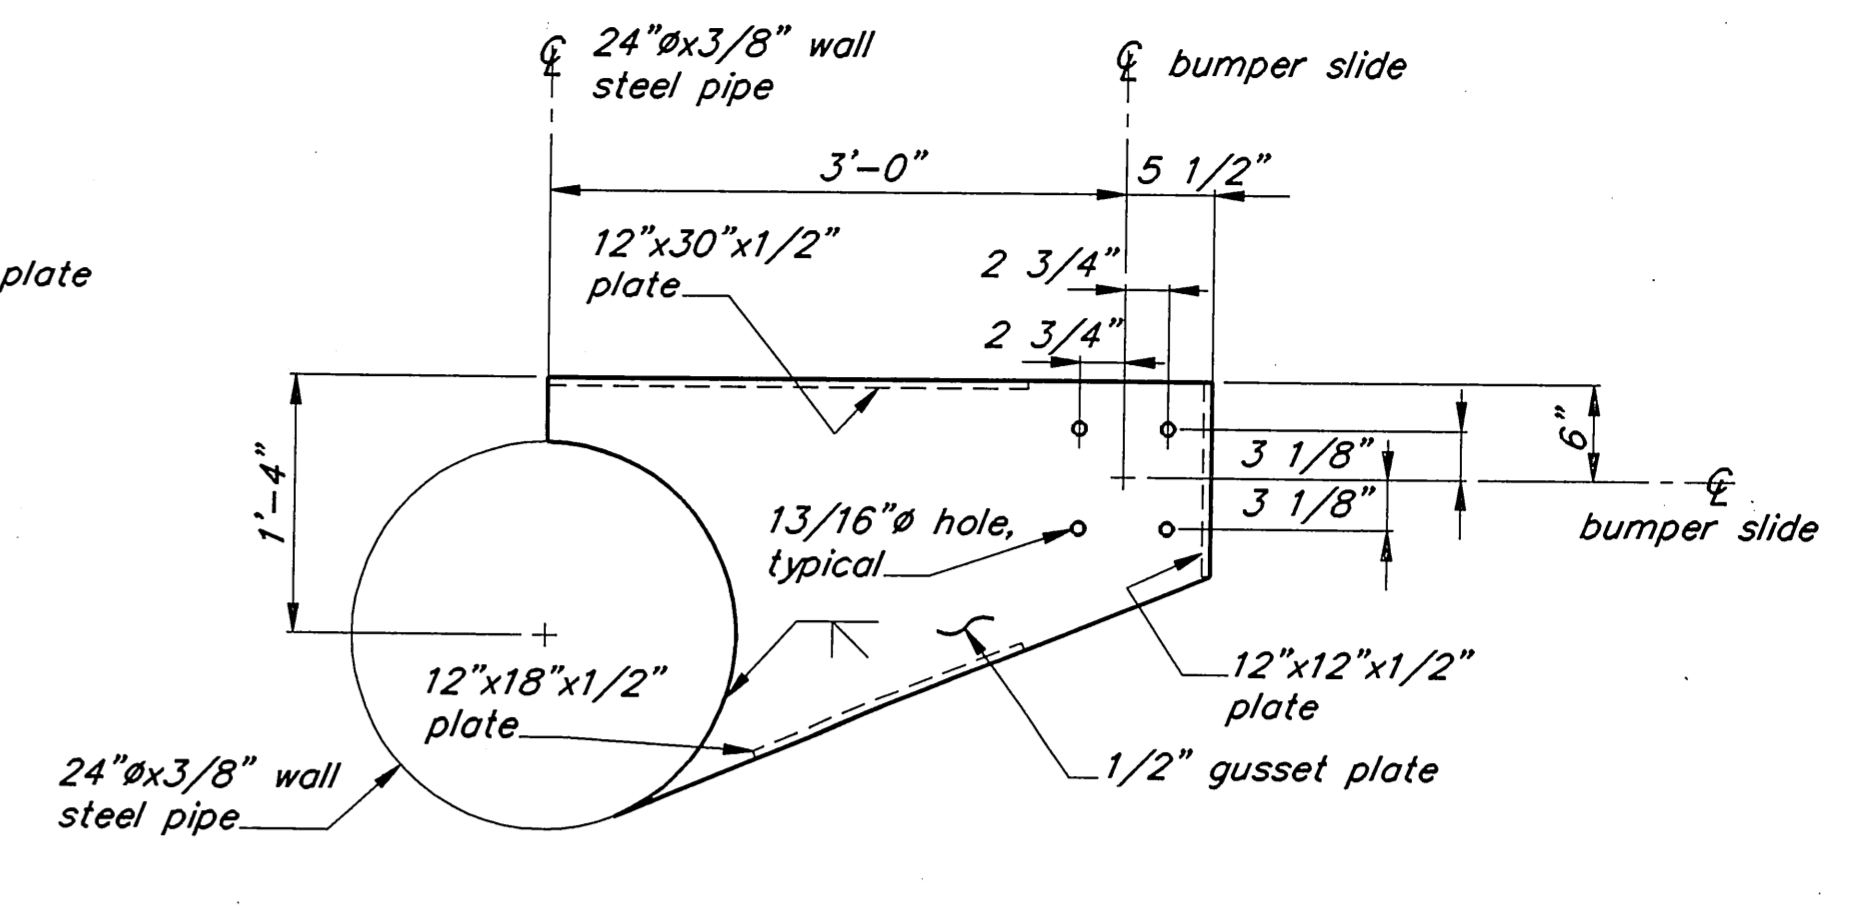

SECTION C

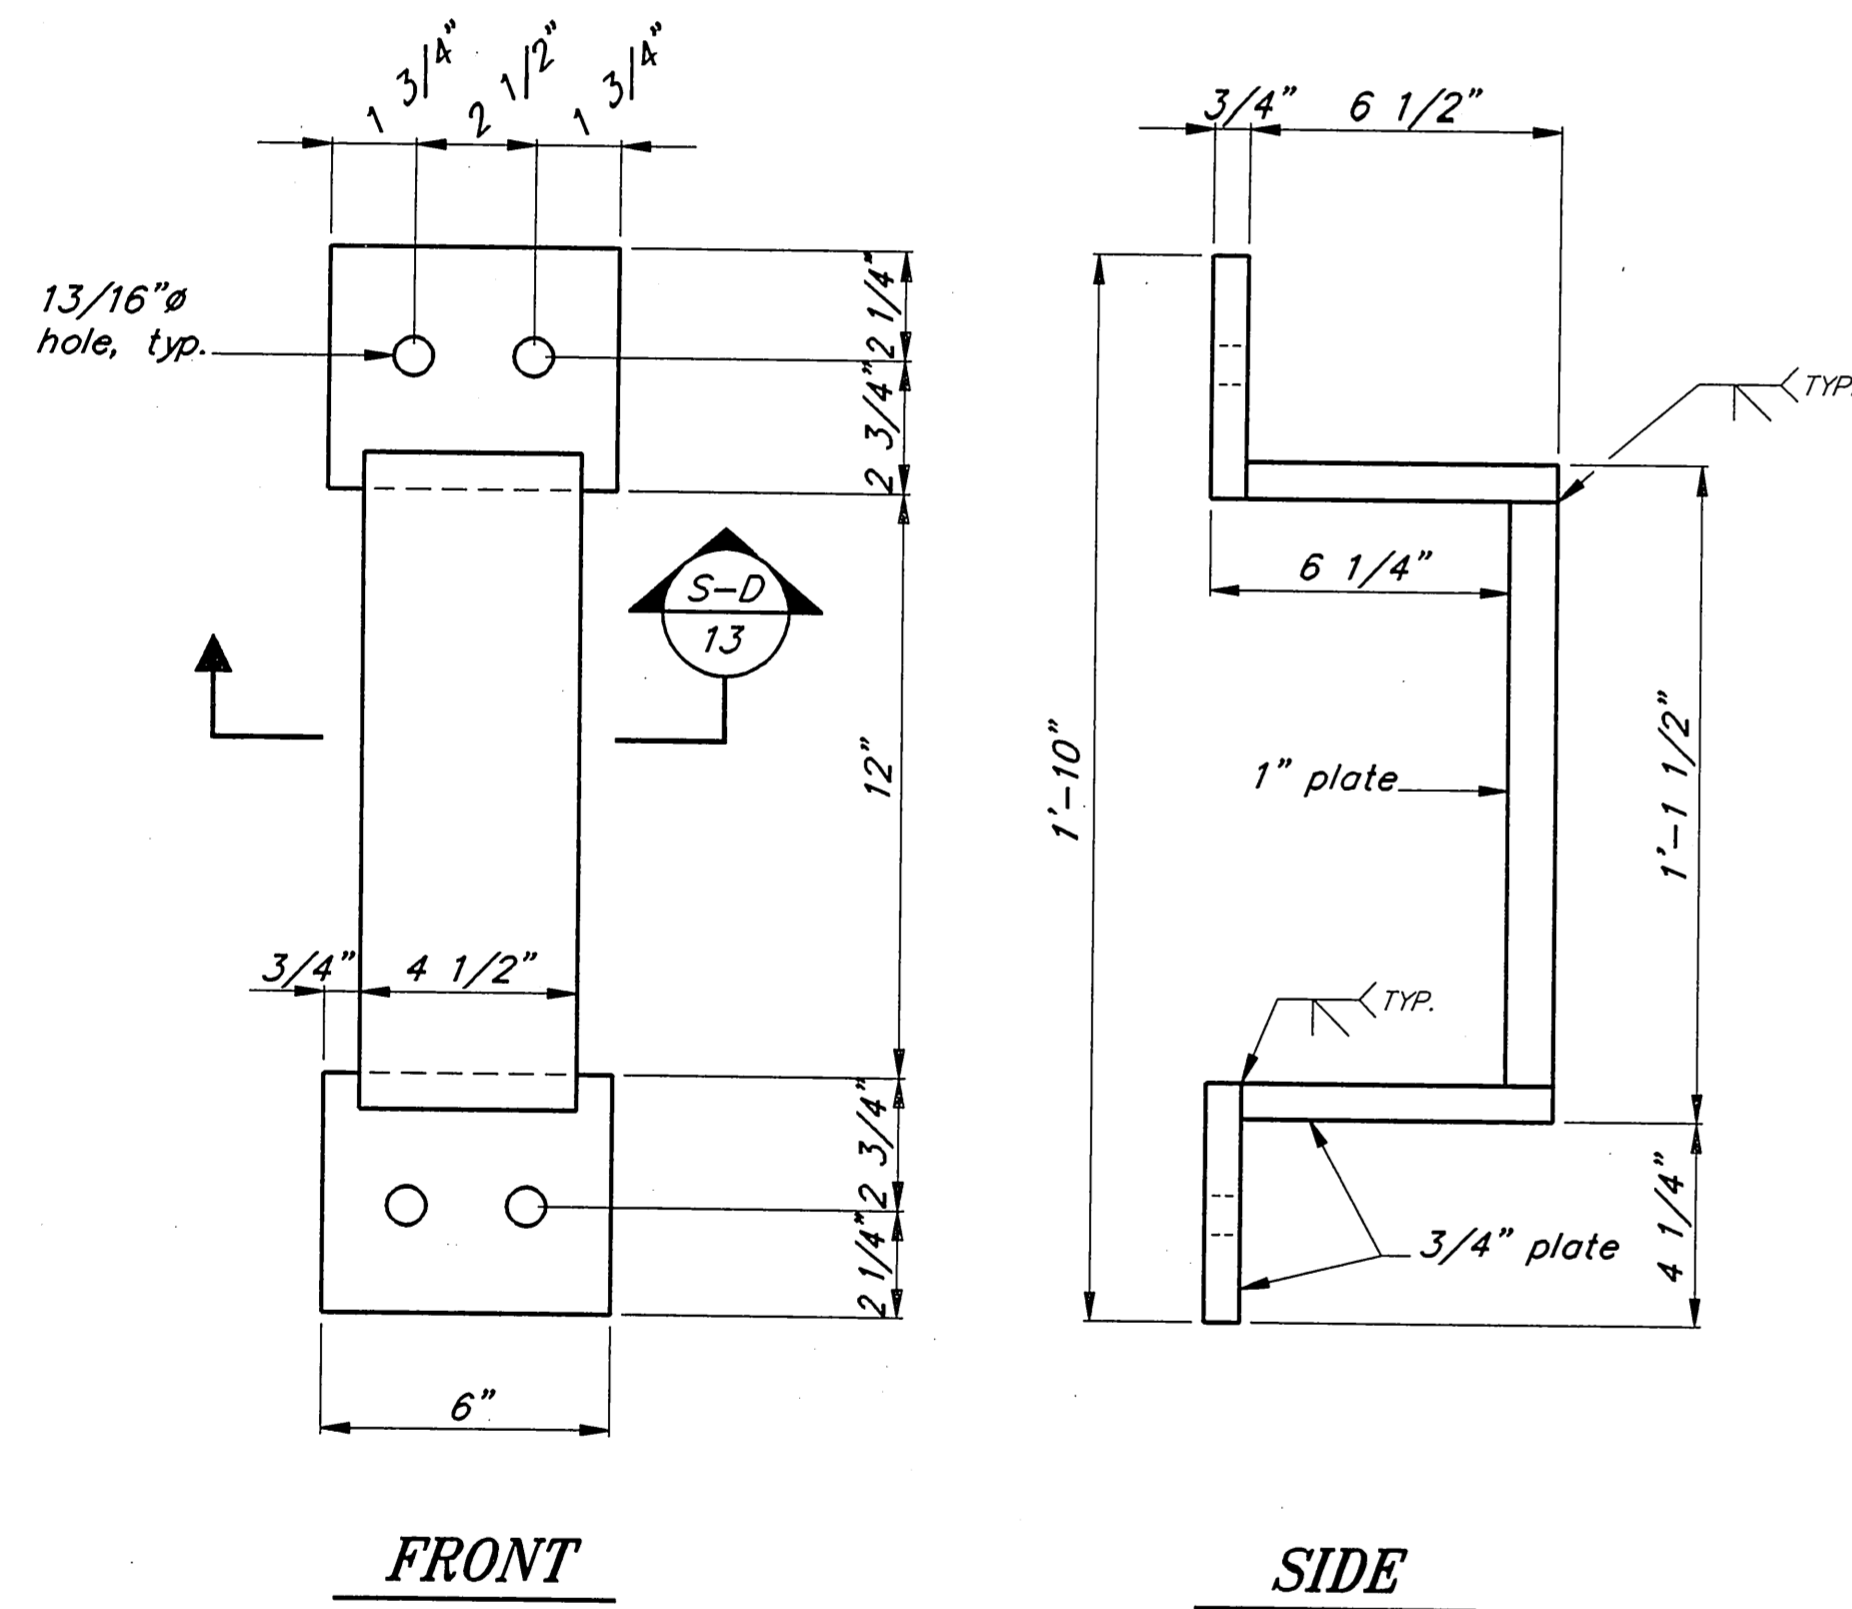


BUMPER BRACKET DETAIL ②

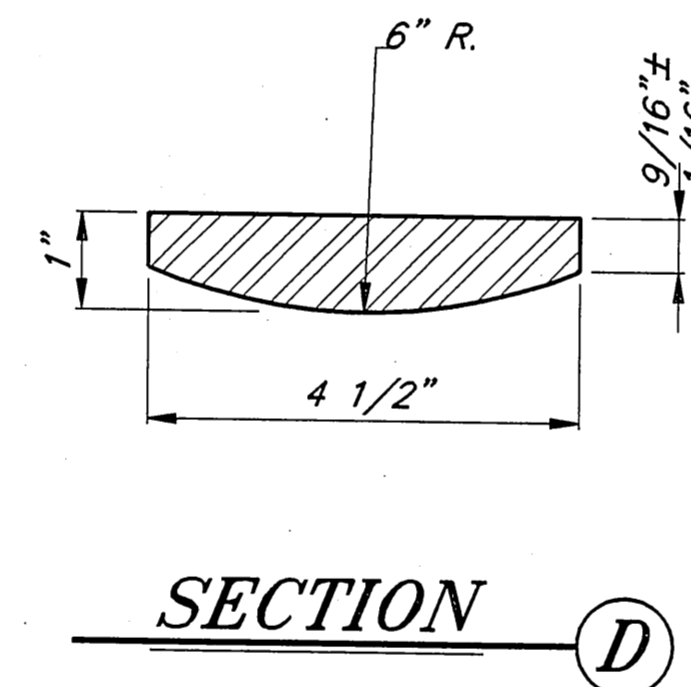


SECTION D

NOTE:
CONTRACTOR MAY FABRICATE THIS COMPONENT FROM
12 3/4" x 1/2" WALL PIPE WITH APPROPRIATE STIFFENER.
SHOP DRAWING SUBMITTED REQUIRED.

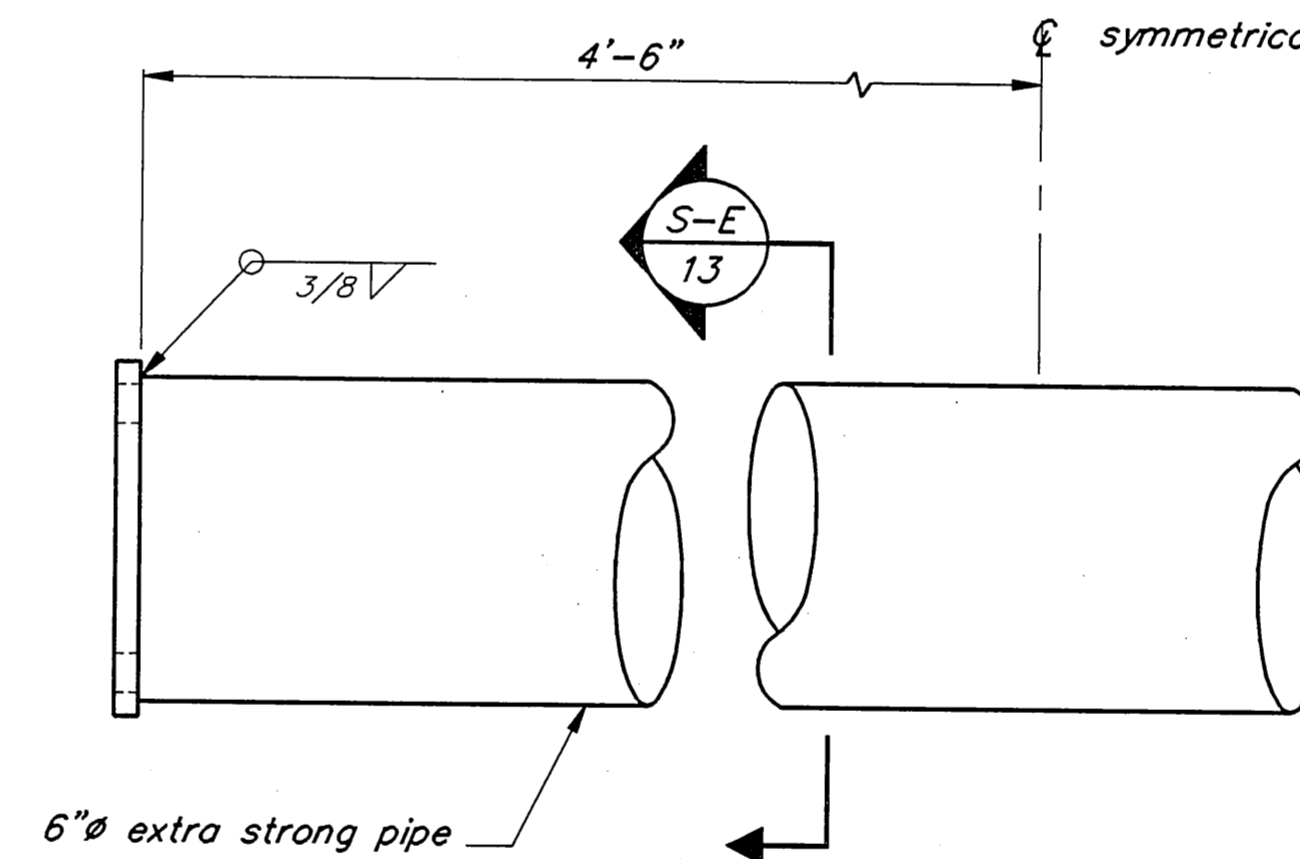

BUMPER SLIDE DETAIL ③

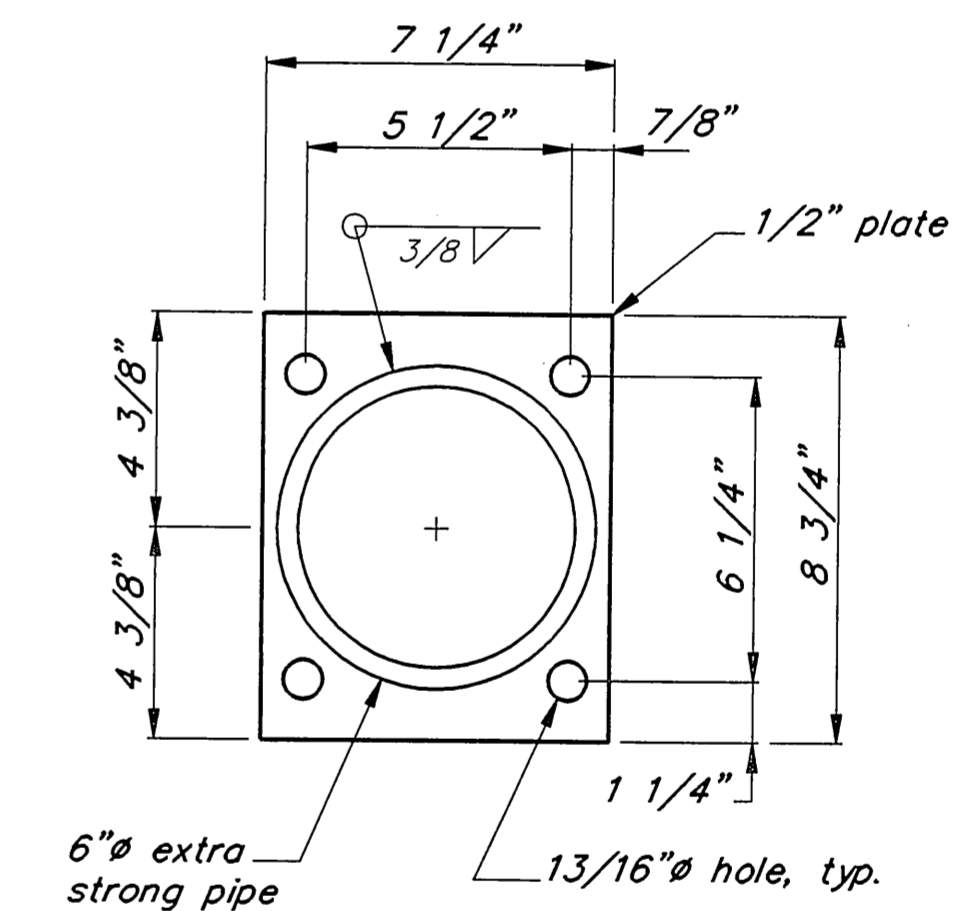

SECTION E

As Built
Mark Johnson
7/25/95

PATH: P:\POW\PTBAKER\DR\SH13.dwg < 1=12 >		
BY	DATE	DESCRIPTION OF CHANGE
RECORD OF REVISIONS		

STATE OF ALASKA
DEPARTMENT OF TRANSPORTATION
AND PUBLIC FACILITIES
SOUTHEAST REGION DESIGN & CONSTRUCTION

POINT BAKER


PRINCE OF WALES ISLAND
POINT BAKER SEAPLANE FLOAT
A.I.P. # 3-02-0423-01
Float Connection Details

NOTE: DO NOT SCALE FROM THESE PLANS-USE DIMENSIONS

DESIGNED BY: D.D.S.	PROJECT NO. 71135
DRAWN BY: B.W.B.	DATE: APRIL, 1994
CHECKED BY: J.D.B.	SHEET 13 OF 20


ENGINEER'S SEAL



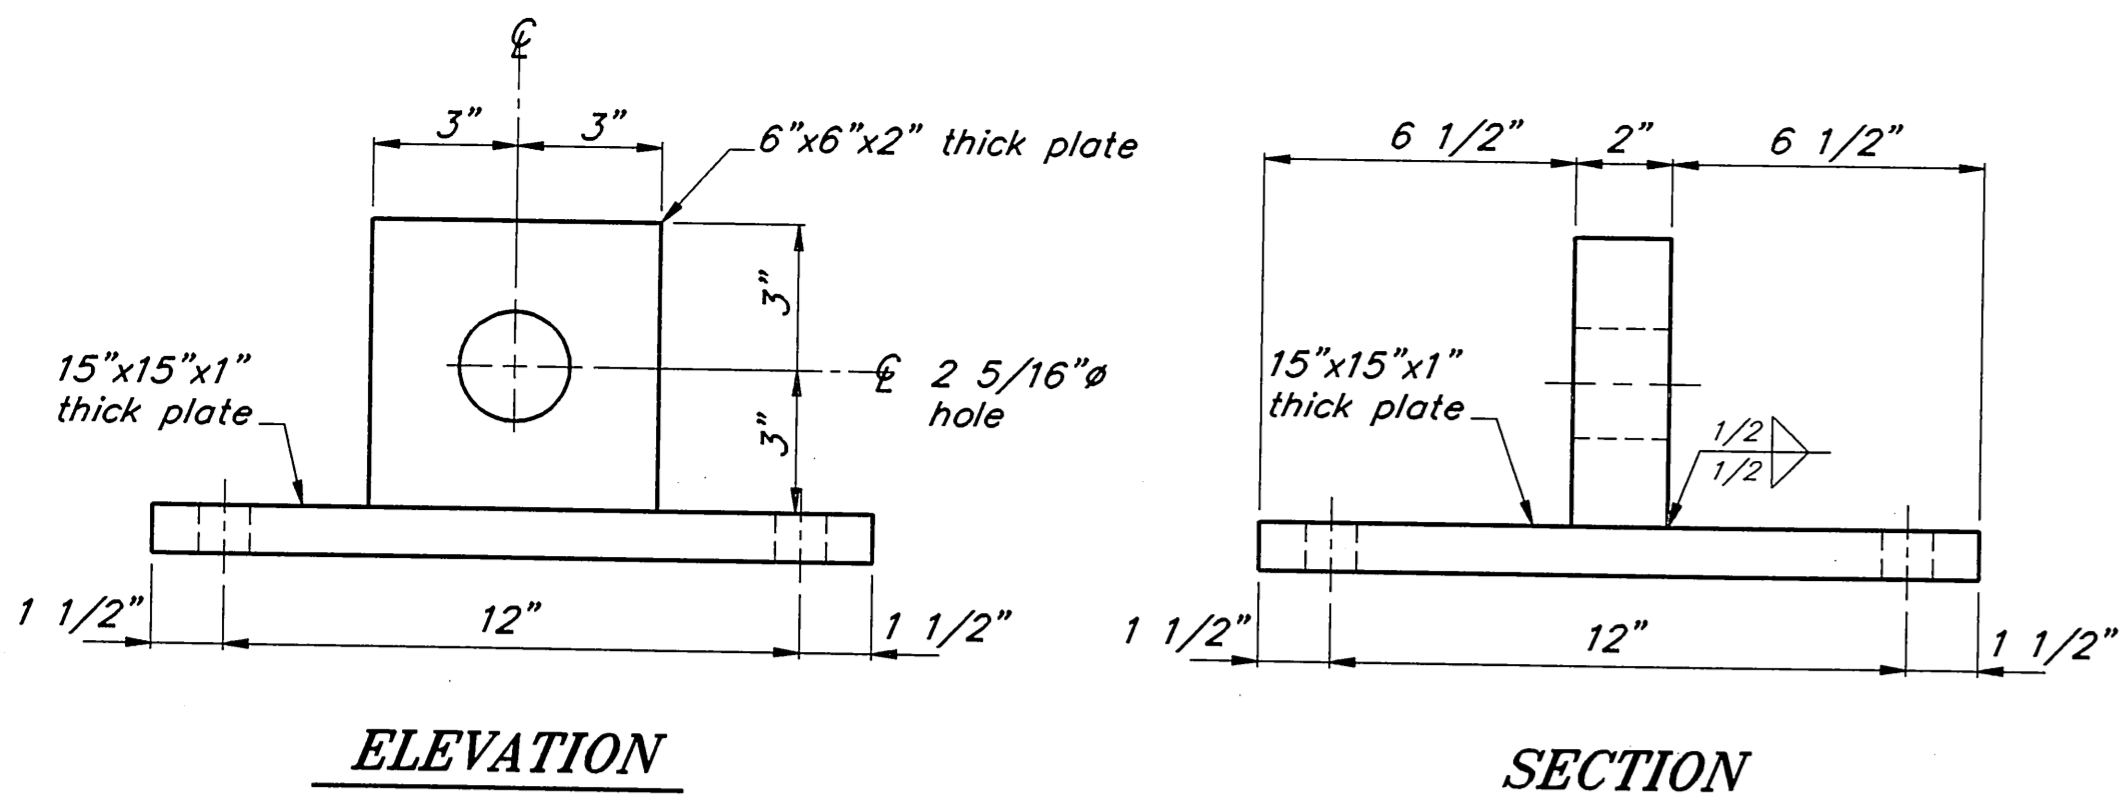


ROCK ANCHOR DETAIL

ANCHOR # 1

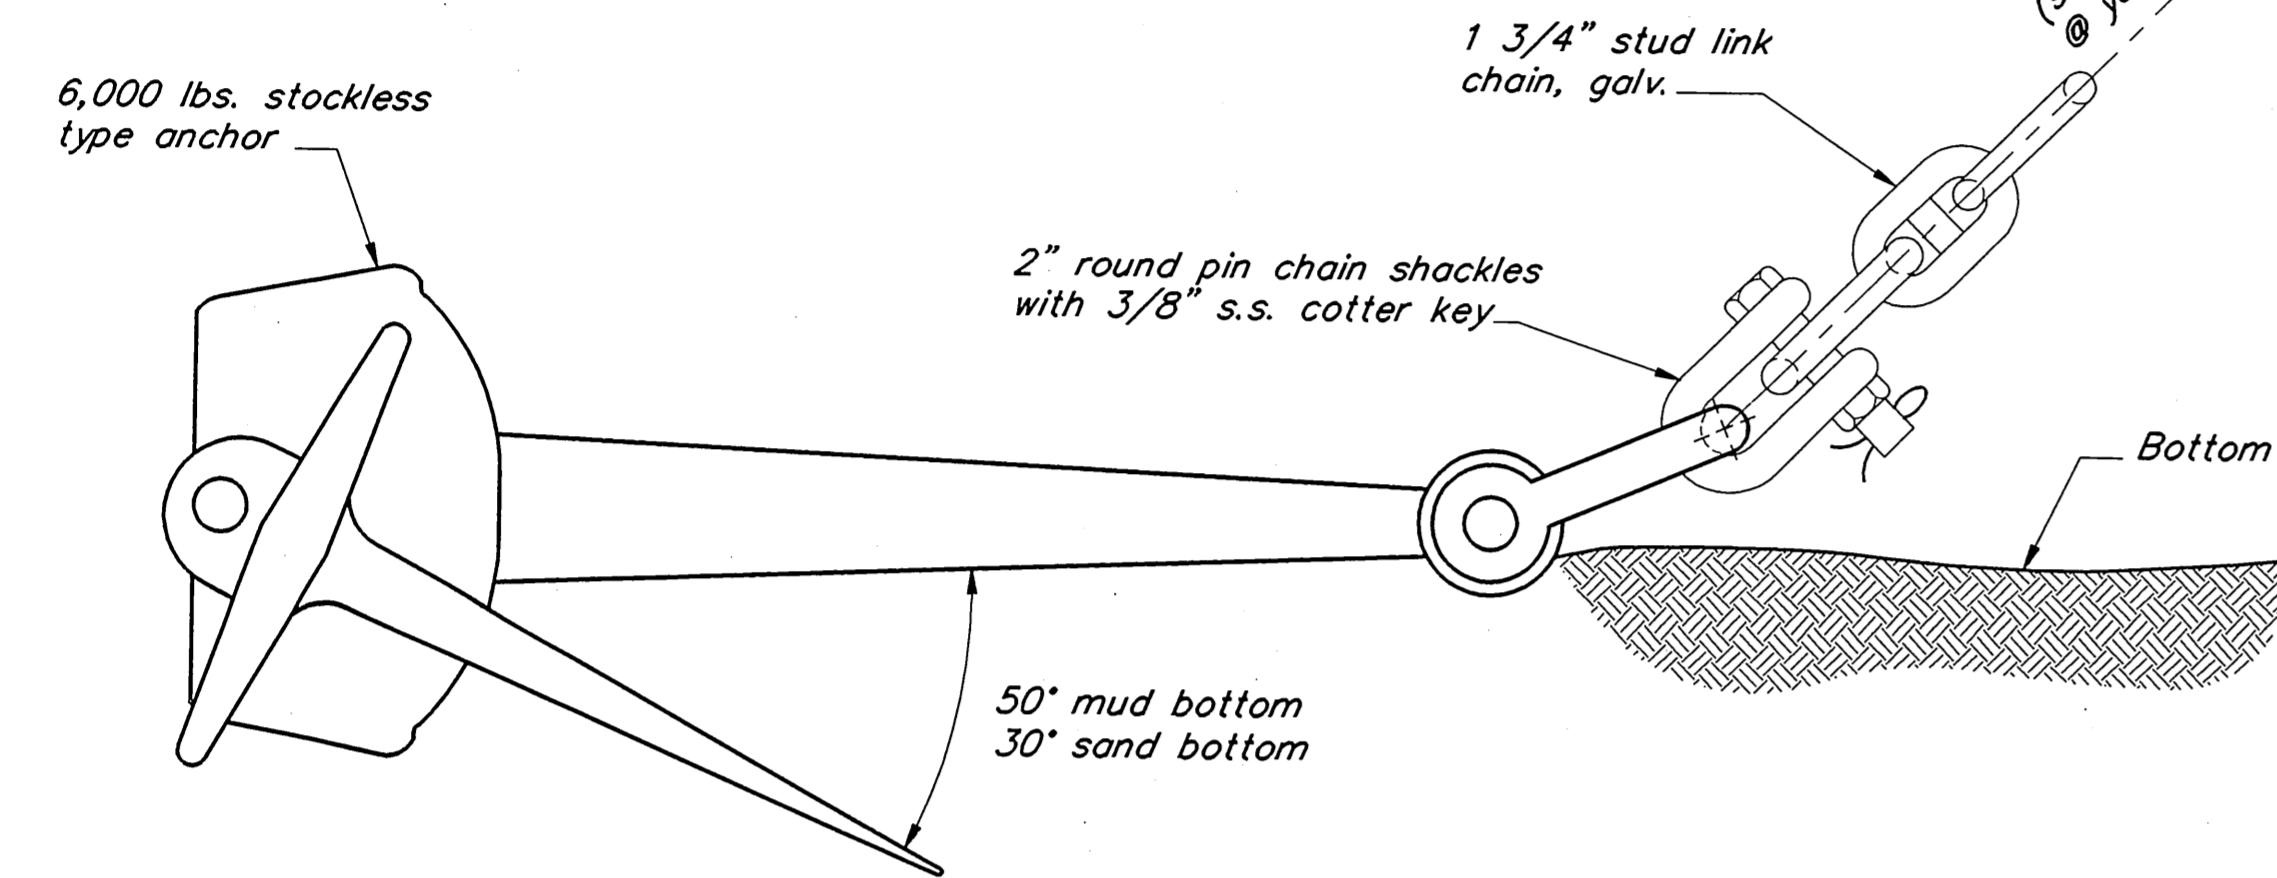

STOCKLESS ANCHOR DETAIL

ANCHOR # 2

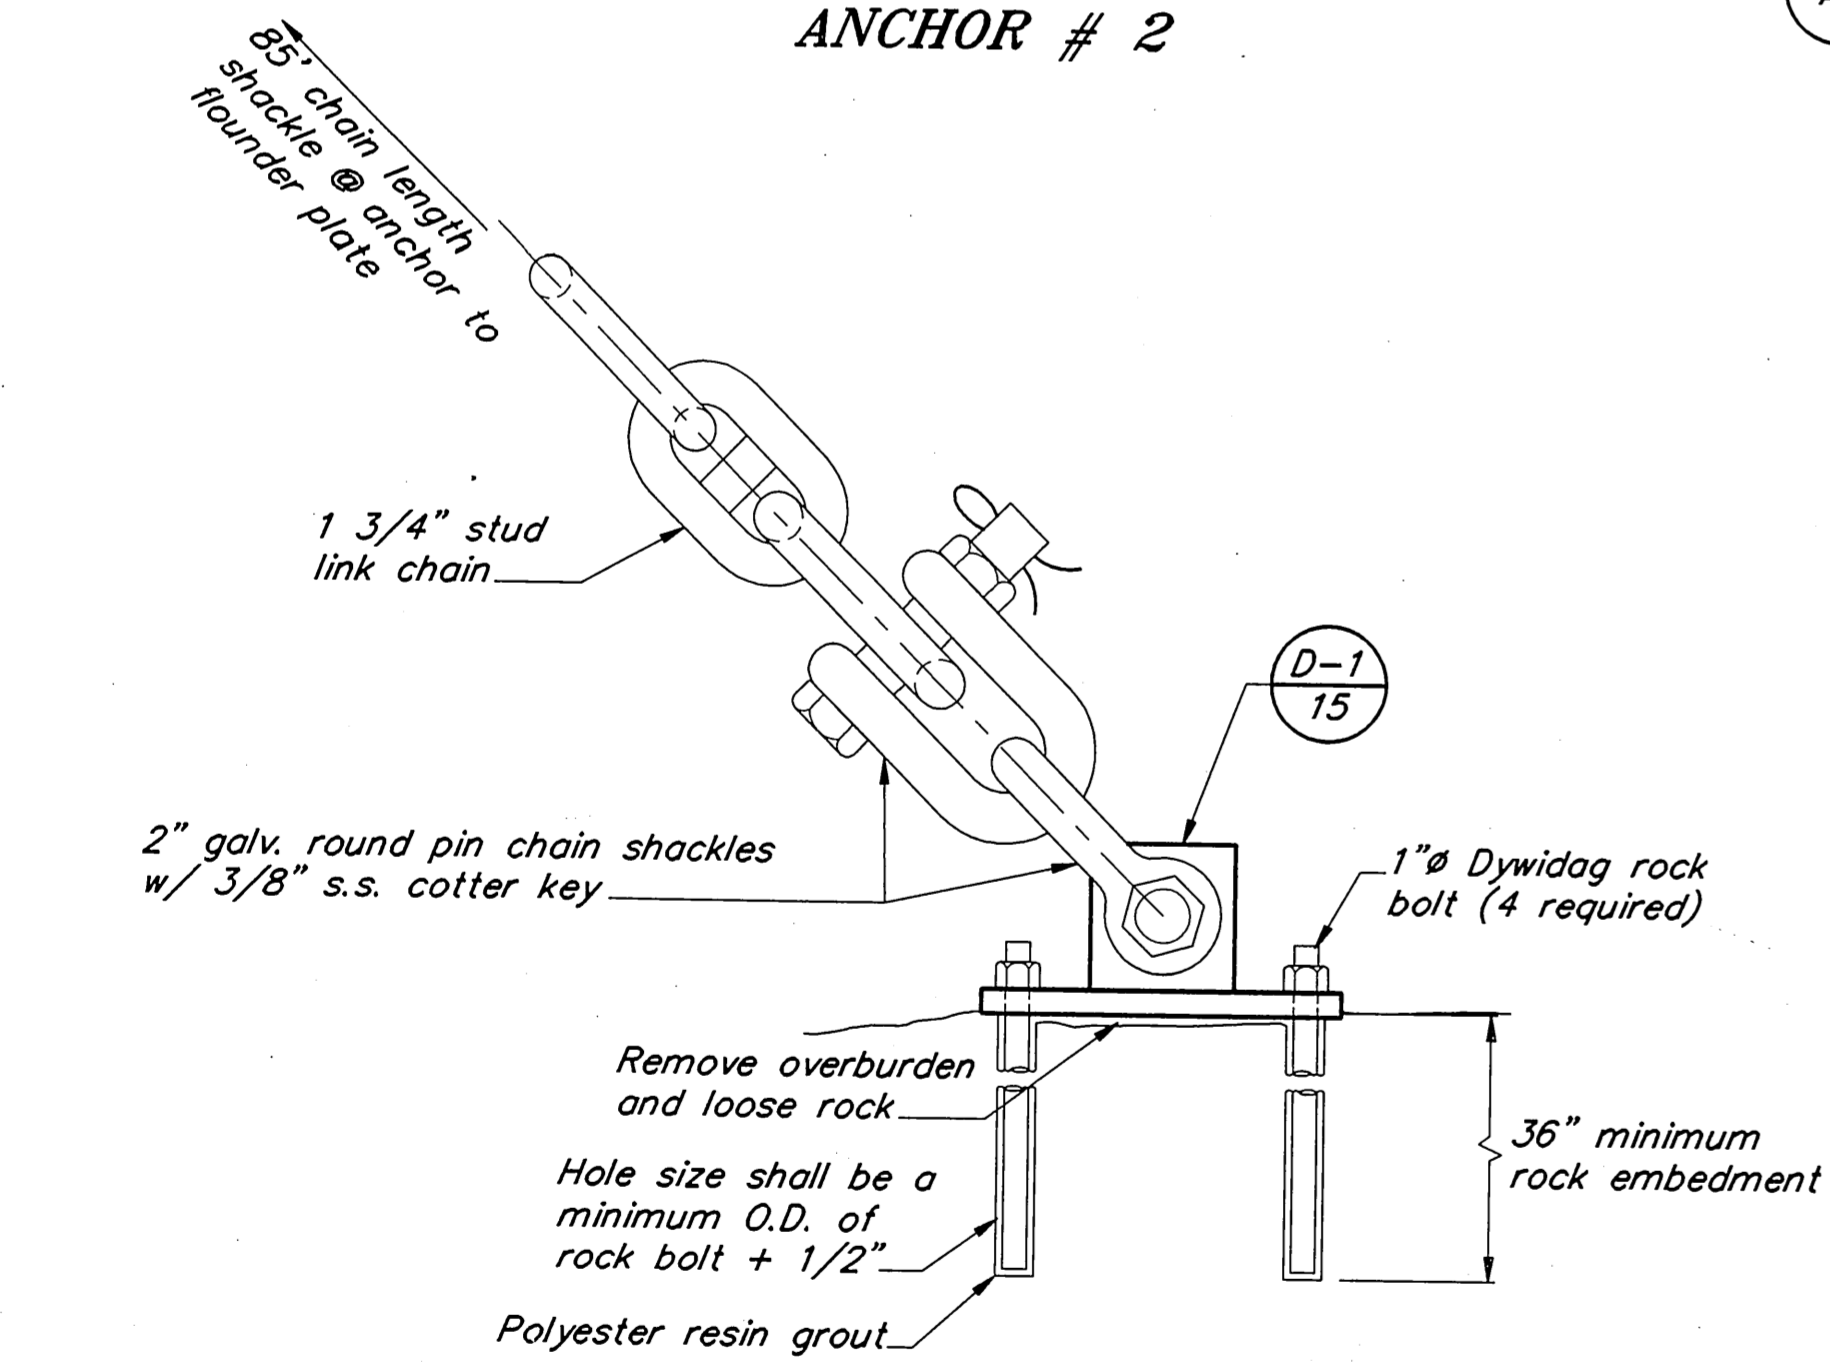


ROCK ANCHOR INSTALLATION DETAIL

3

* SHORTENED UP SW. CORNER 1/8" CHAIN BY TWO LINKS FOR ADJUSTMENT - EXTRA LINKS ABOVE CHAIN KEEPER

ANCHOR #	CHAIN LENGTH	CHAIN SIZE	TENSION @ TIDE 16.5	TENSION @ TIDE 0	HORIZONTAL DISTANCE
ANCHOR # 1	± 35.0' ①	1 3/8"	2510 lbs.	1456 lbs.	95'
	* Chain A ± 30.0' ③	1 3/8"	2510 lbs.	1456 lbs.	
	Chain B ± 35.0' ④	1 3/4"	VARIED	VARIED	
ANCHOR # 2	± 35.0' ①	1 3/8"	2988 lbs.	1889 lbs.	130'
	Chain A ± 30.0' ③	1 3/8"	2988 lbs.	1884 lbs.	
	Chain B ± 35.0' ④	1 3/4"	VARIED	VARIED	

- ① Stud link chain, galvanized
- ② Horizontal distance is measured from chain keeper to shackle @ anchor (perpendicular).
- ③ Chain length is measured from flounder plate to chain keeper, chain lengths are approximate and maybe adjusted to better fit field conditions.
- ④ Chain length is measured from flounder plate to shackle @ anchor, chain lengths are approximate and maybe adjusted to better fit field conditions.
- ⑤ Tension forces are approximate and maybe adjusted to better fit field conditions.

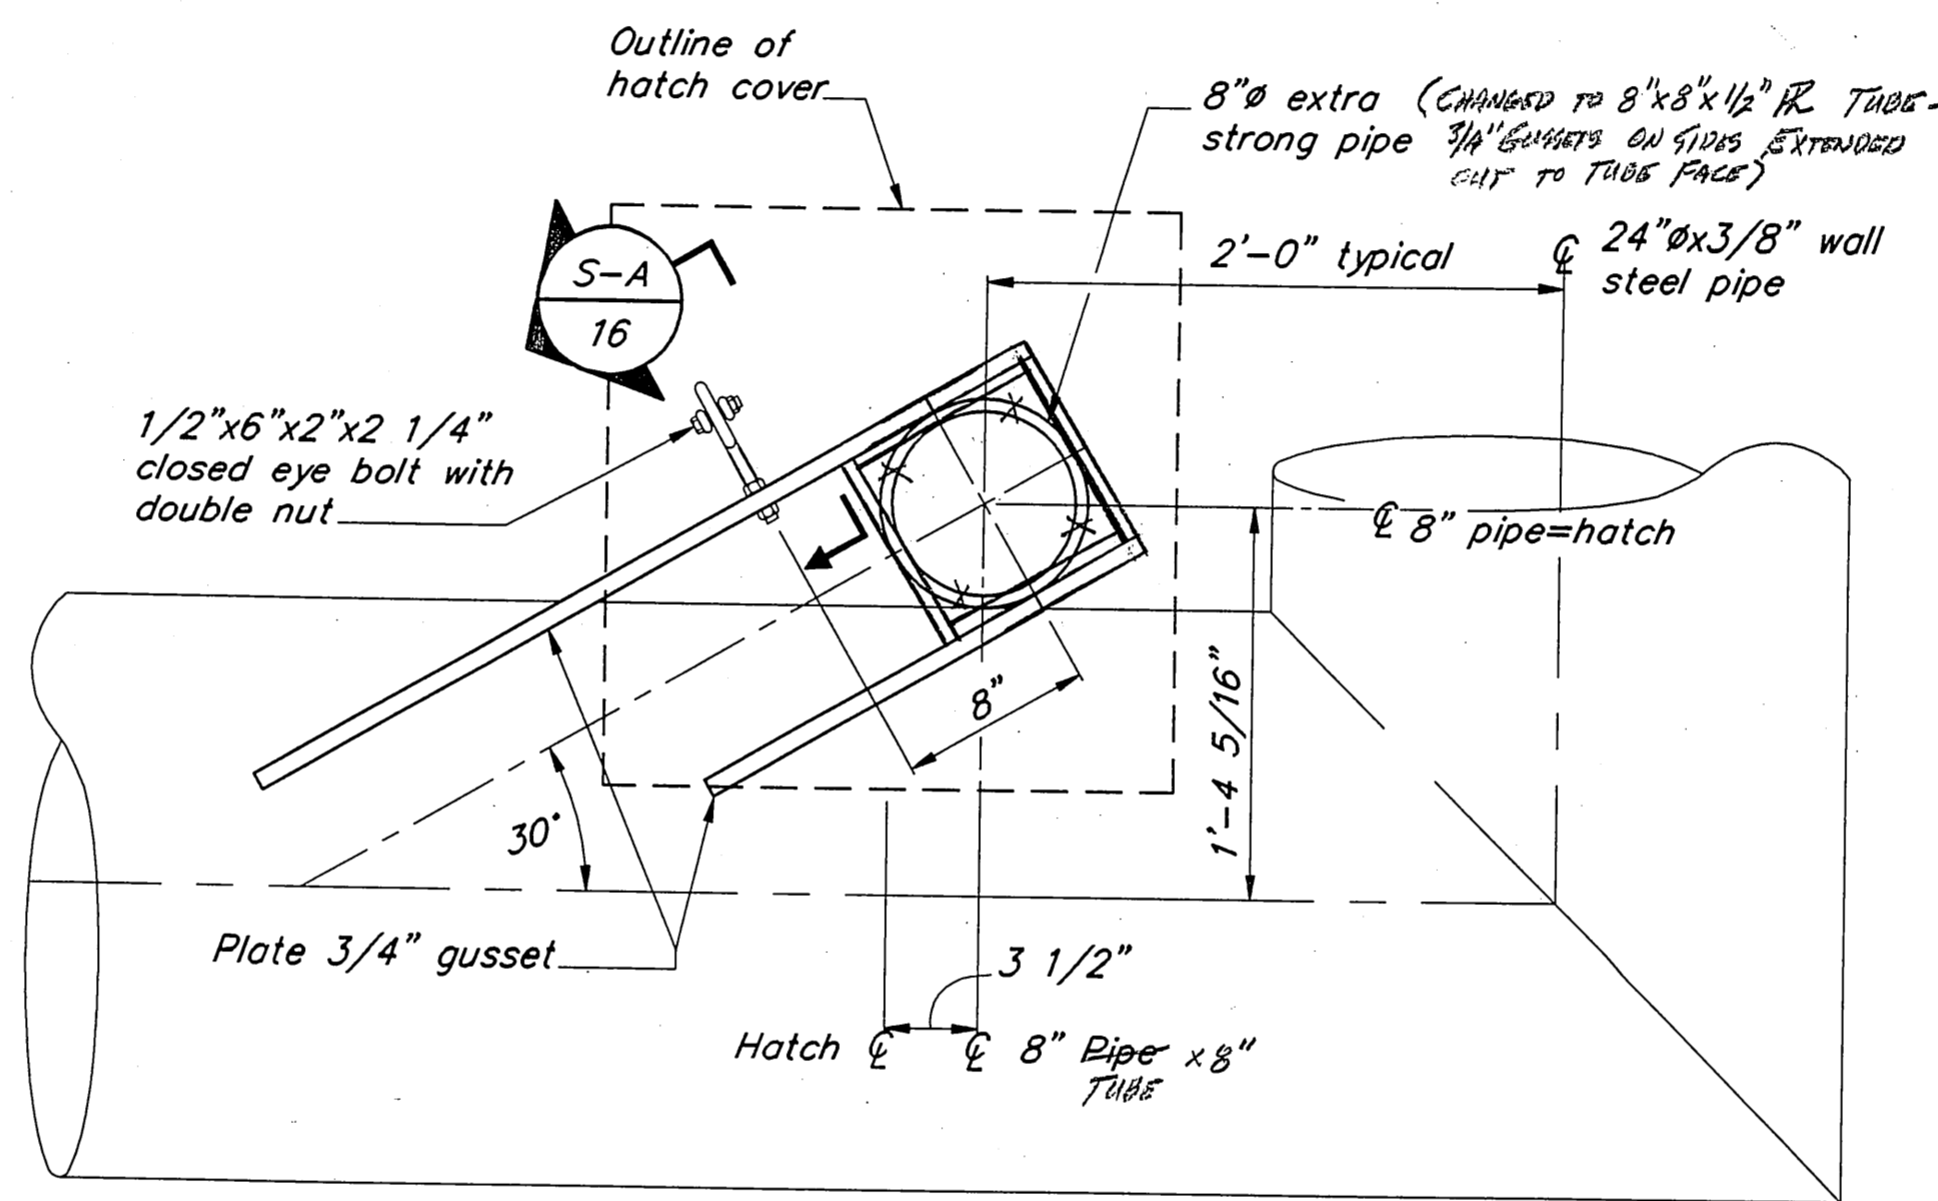


ANCHOR CONNECTOR DETAIL

4

ROCK ANCHOR INSTALLATION NOTES:

1. After drilling, each bore hole must be cleaned before the resin cartridge is installed.
2. Use slow setting resin. Provide the required amount of resin cartridge to fully encapsulate the length of rock bolt.
3. Insert the Dywidag rock bolt by spinning the bolt at about 100 RPM. Continue to spin for 30 to 60 seconds after reaching the bottom of hole. Total spinning time should not exceed gel time.
4. Rock bolt shall not be loaded until the resin has fully set as recommended by the manufacturer.

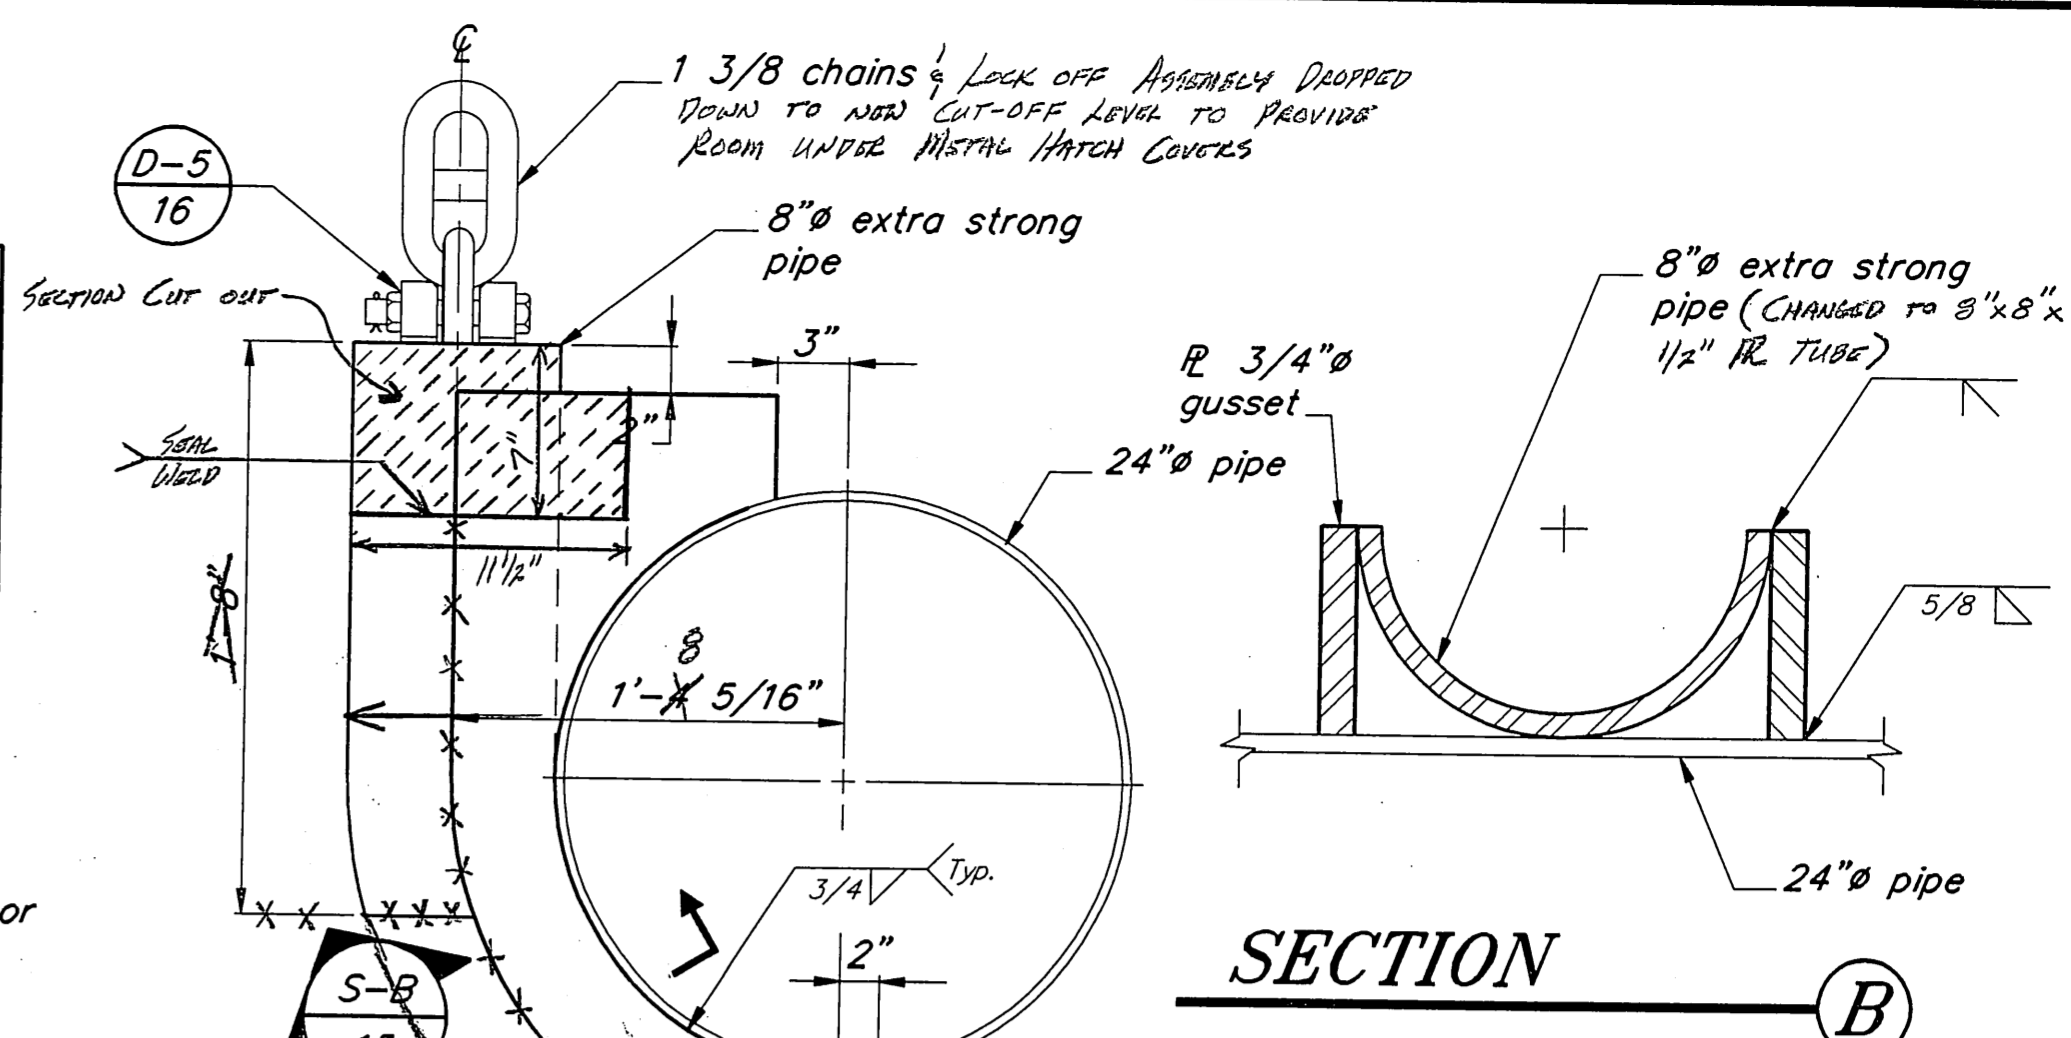

ANCHOR YOKE DETAIL

5

As Built
Mark Johnson
7/25/95

PATH: P:\POW\PTBAKER\DR\SHT15.dwg < 1-8 >

BY	DATE	DESCRIPTION OF CHANGE


RECORD OF REVISIONS


STATE OF ALASKA
DEPARTMENT OF TRANSPORTATION
AND PUBLIC FACILITIES
SOUTHEAST REGION DESIGN & CONSTRUCTION

POINT BAKER
PRINCE OF WALES ISLAND
POINT BAKER SEAPLANE FLOAT
A.I.P. # 3-02-0423-01
Anchor Details

NOTE: DO NOT SCALE FROM THESE PLANS-USE DIMENSIONS

DESIGNED BY: D.D.S.	PROJECT NO. 71135
DRAWN BY: B.W.B.	DATE: APRIL, 1994
CHECKED BY: J.D.B.	SHEET 15 OF 20

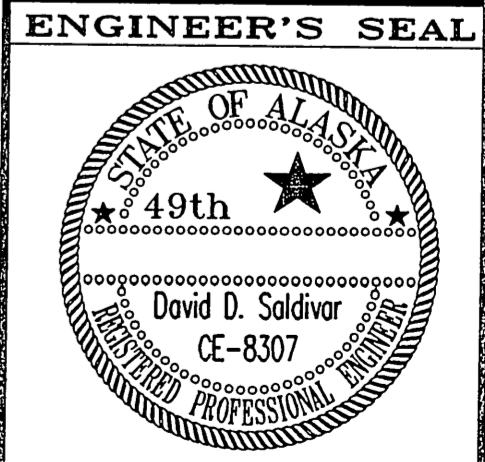


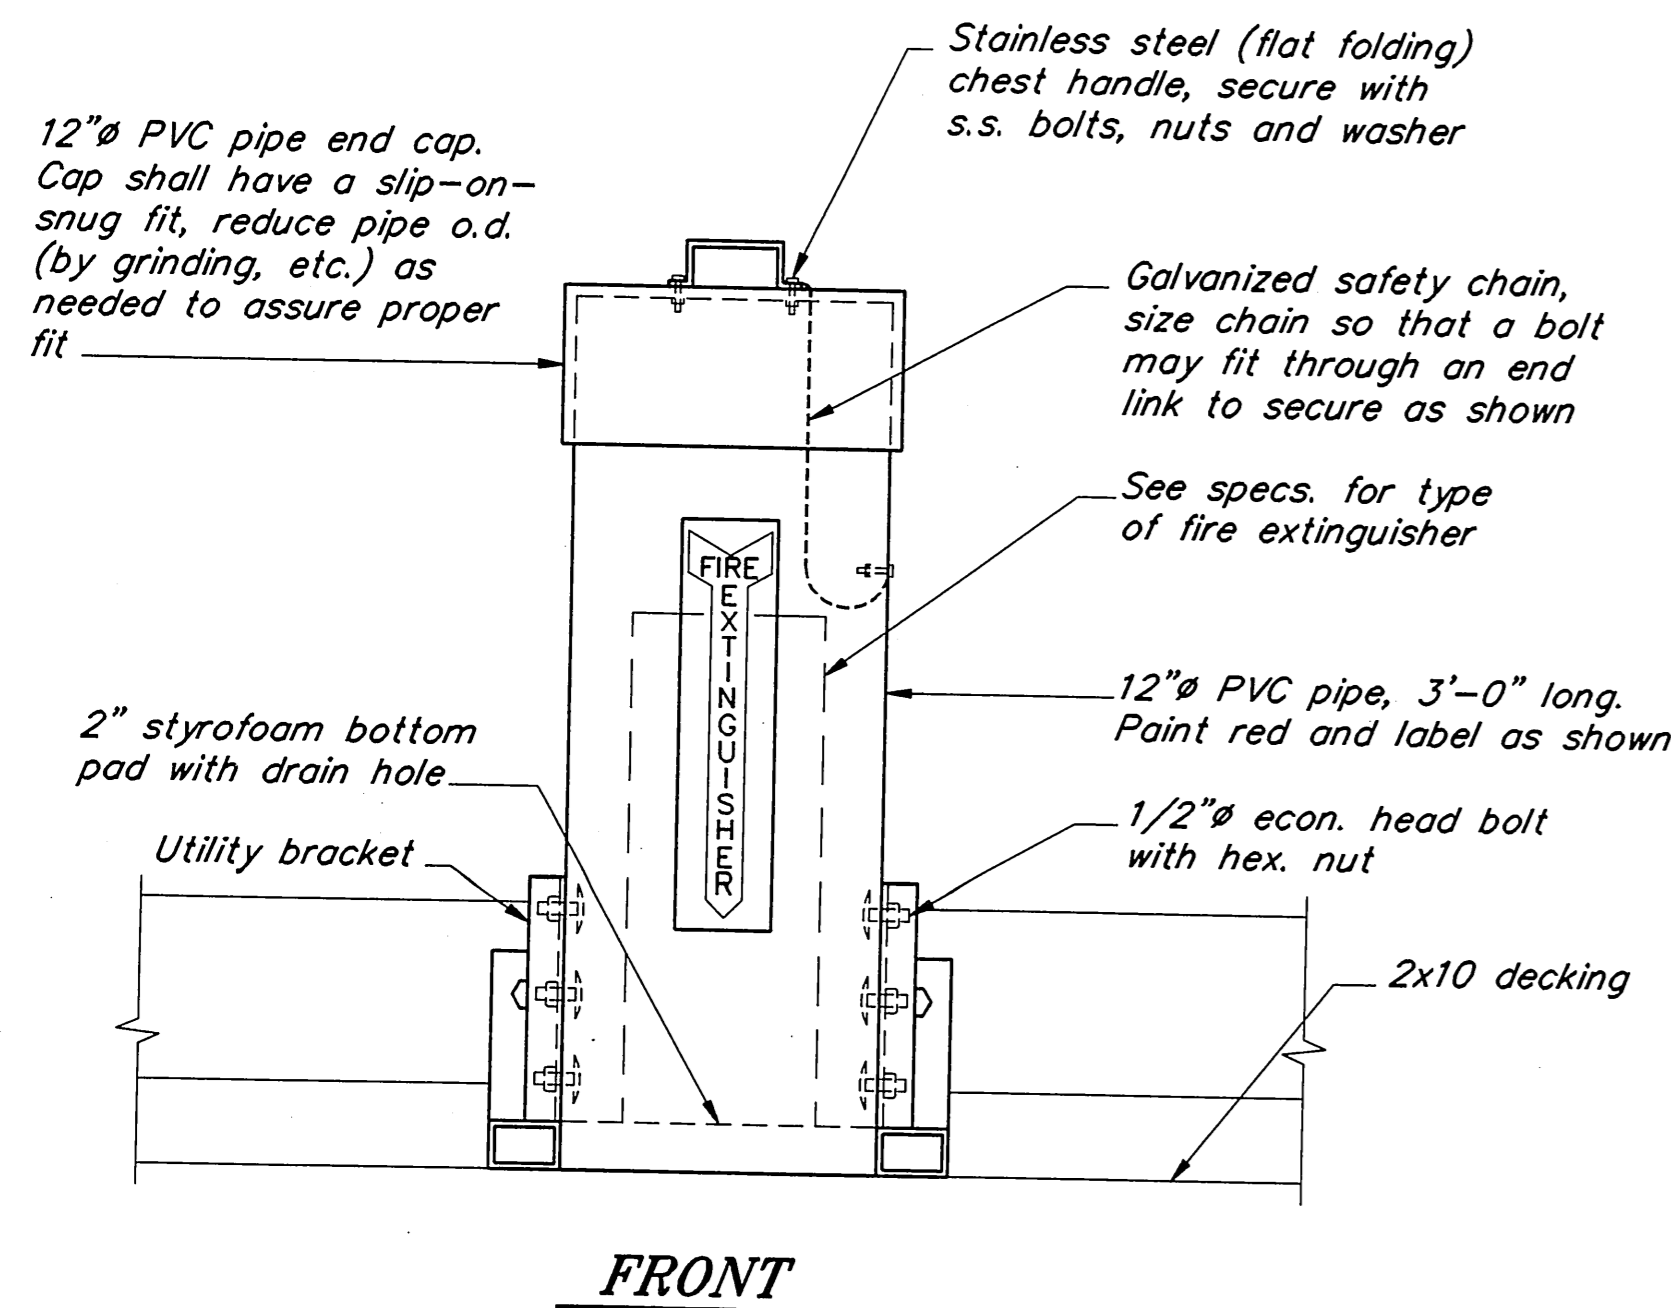


FRONT

FIRE EXTINGUISHER & CONTAINER

(1 REQUIRED)

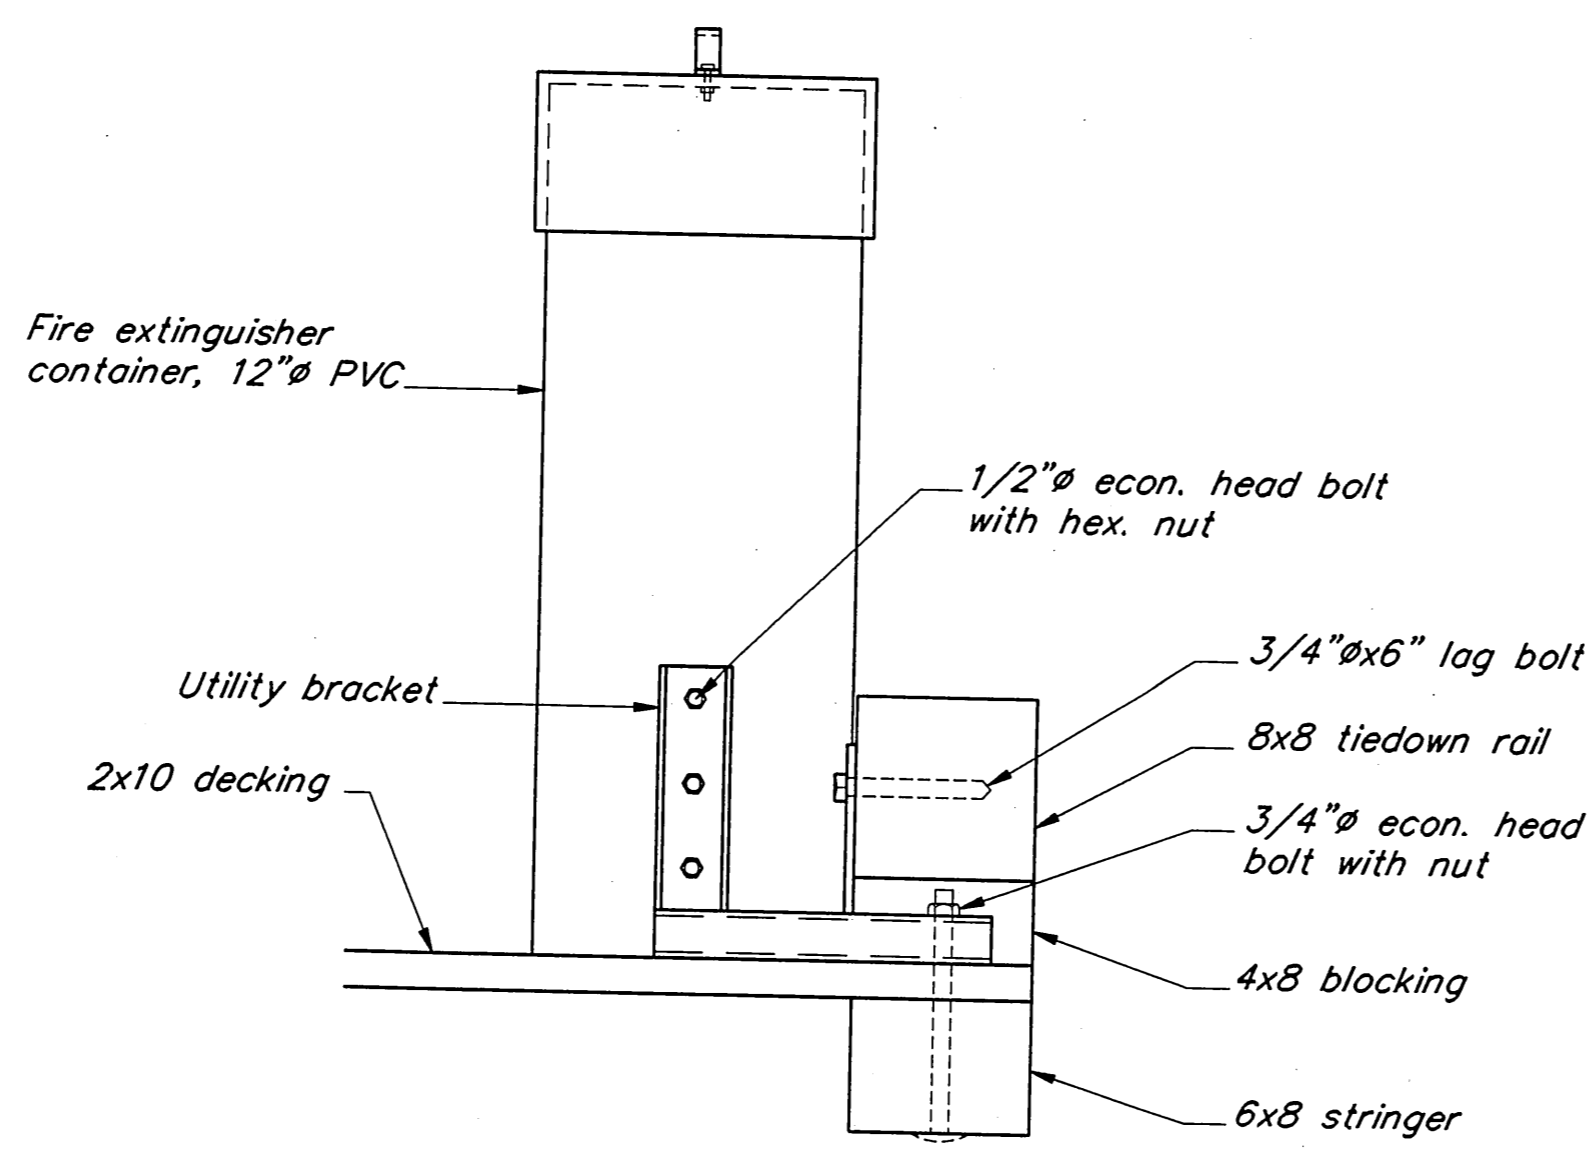

SIDE

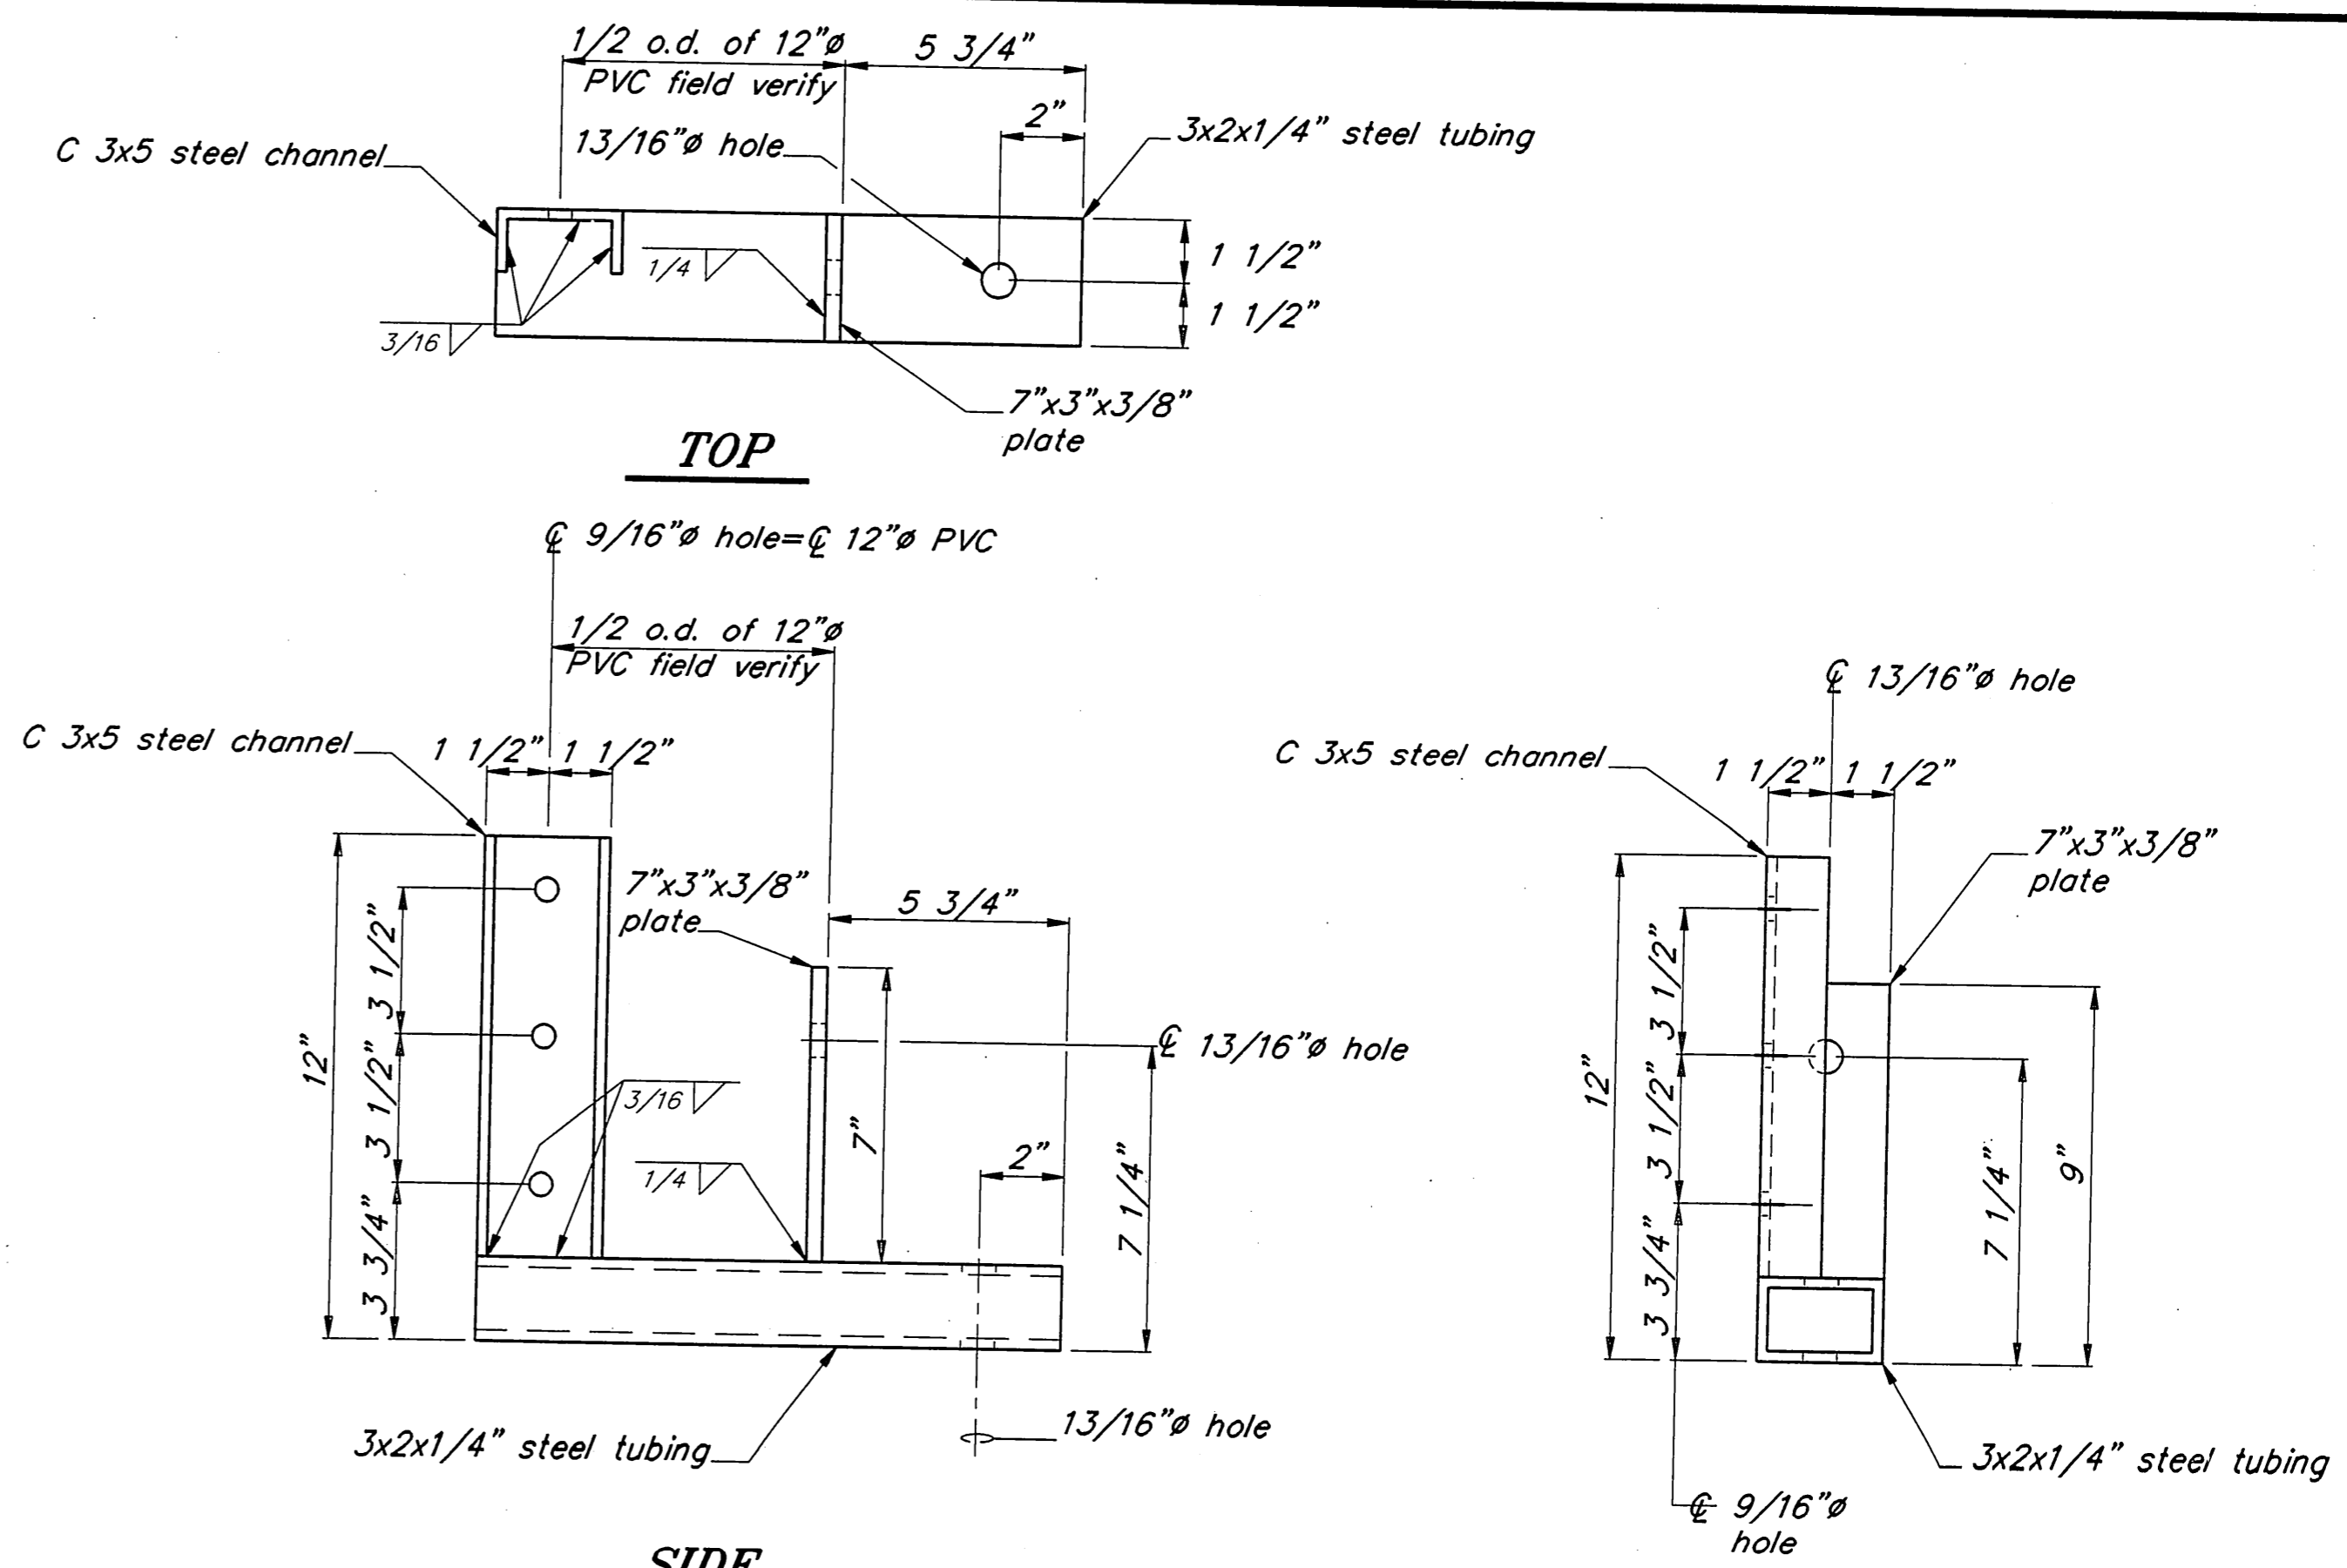


SIDE

FRONT


UTILITY BRACKET DETAIL

(2)

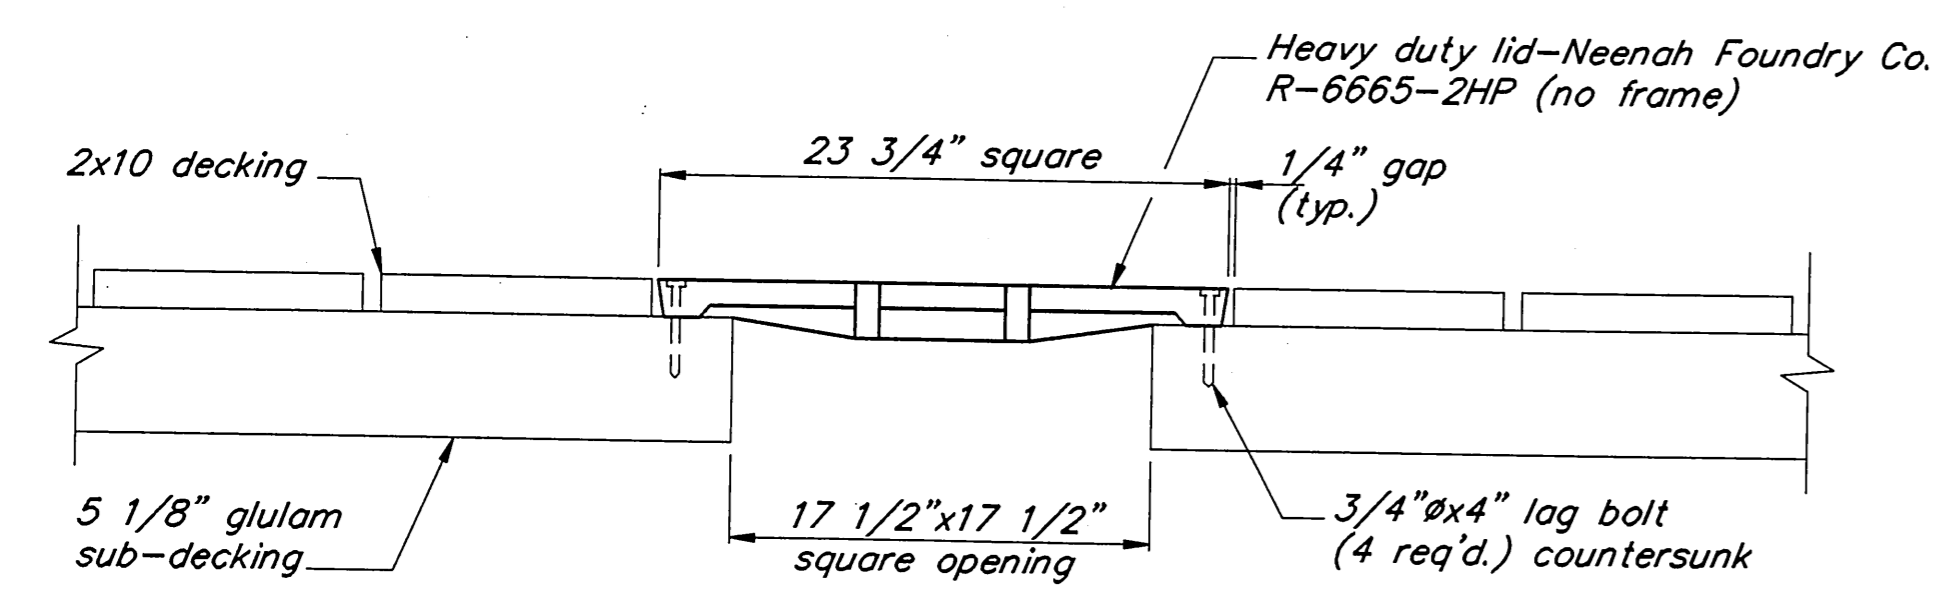

ACCESS HATCH DETAIL


(4 REQUIRED)

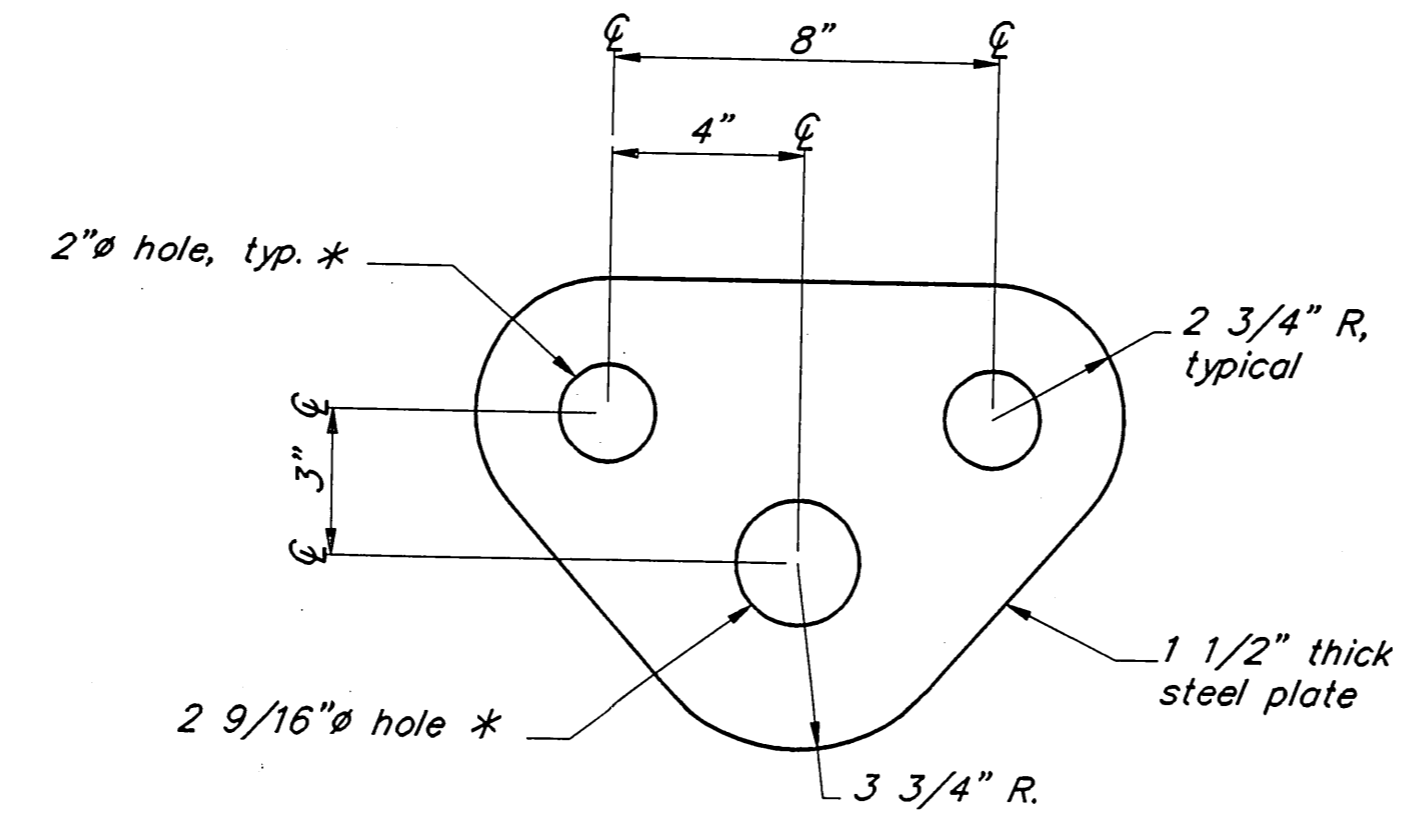

FLOUNDER PLATE DETAIL

(4)

* Hole size are approximate, exact hole size will be determined by the actual dimension of the detachable chain connecting link (O.D. +1/16").

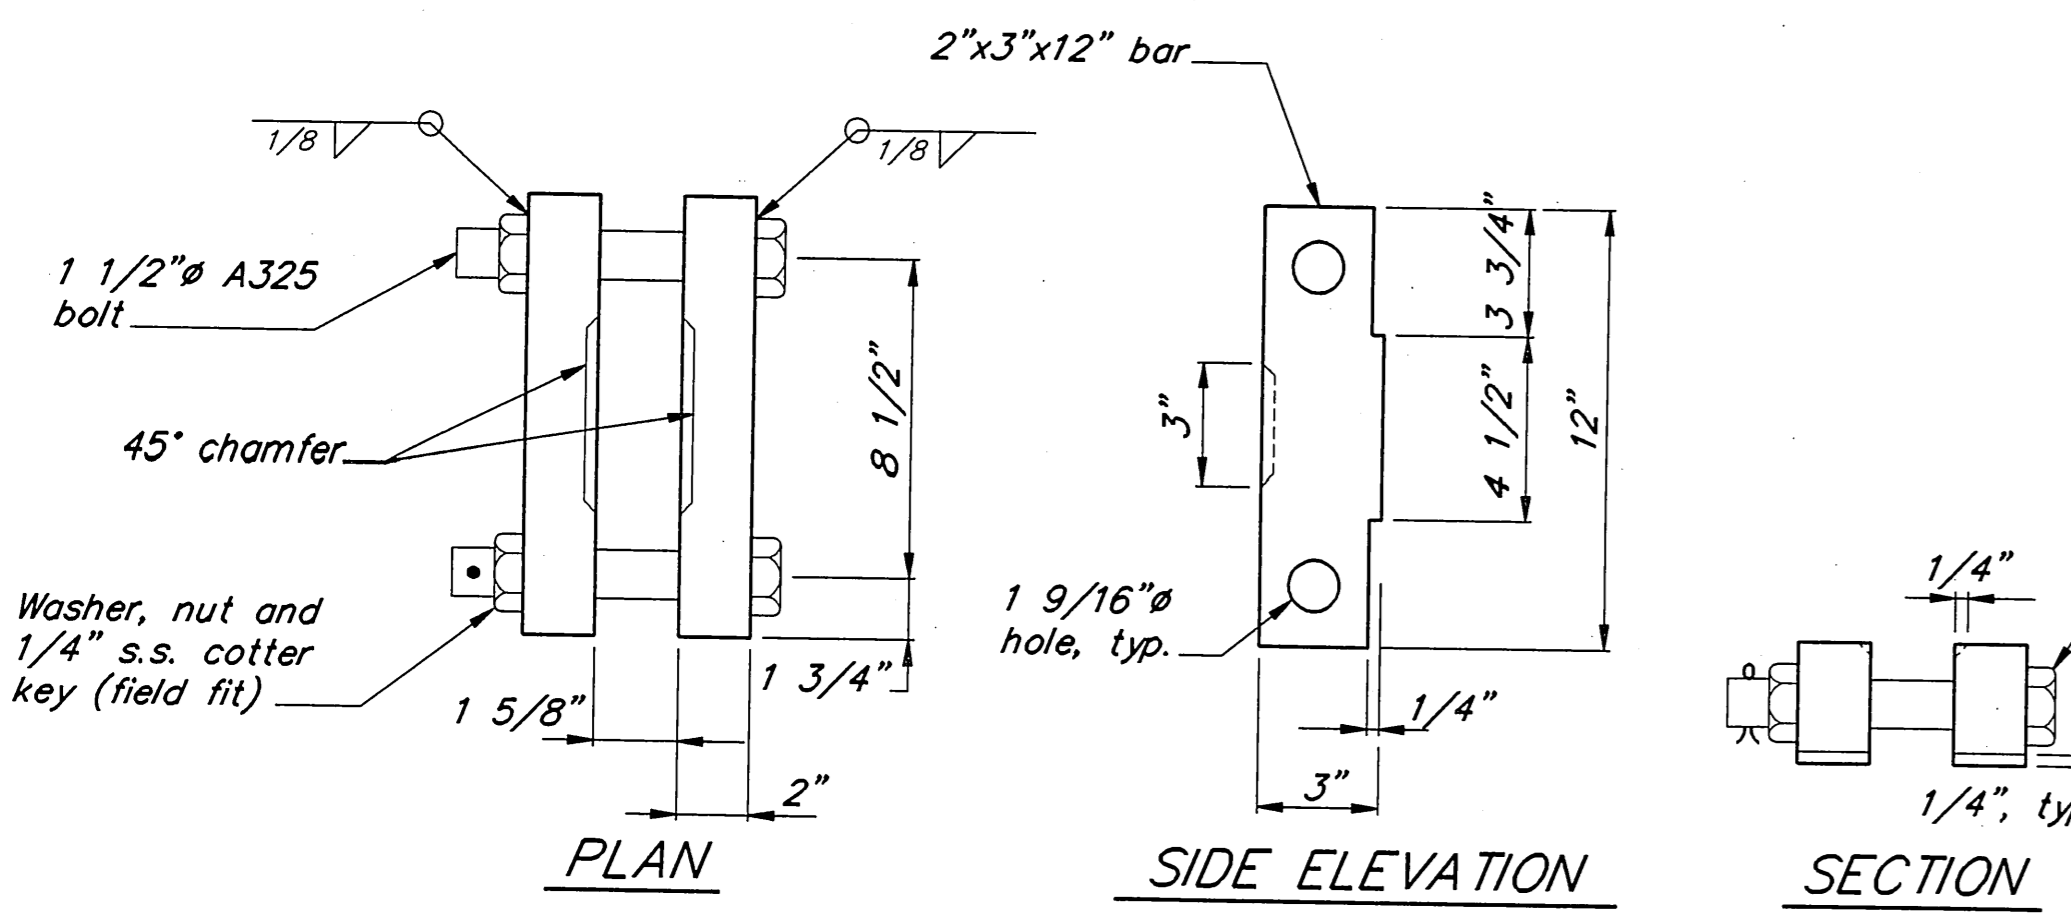


PLAN

SIDE ELEVATION

SECTION

CHAIN KEEPER DETAIL

(5)

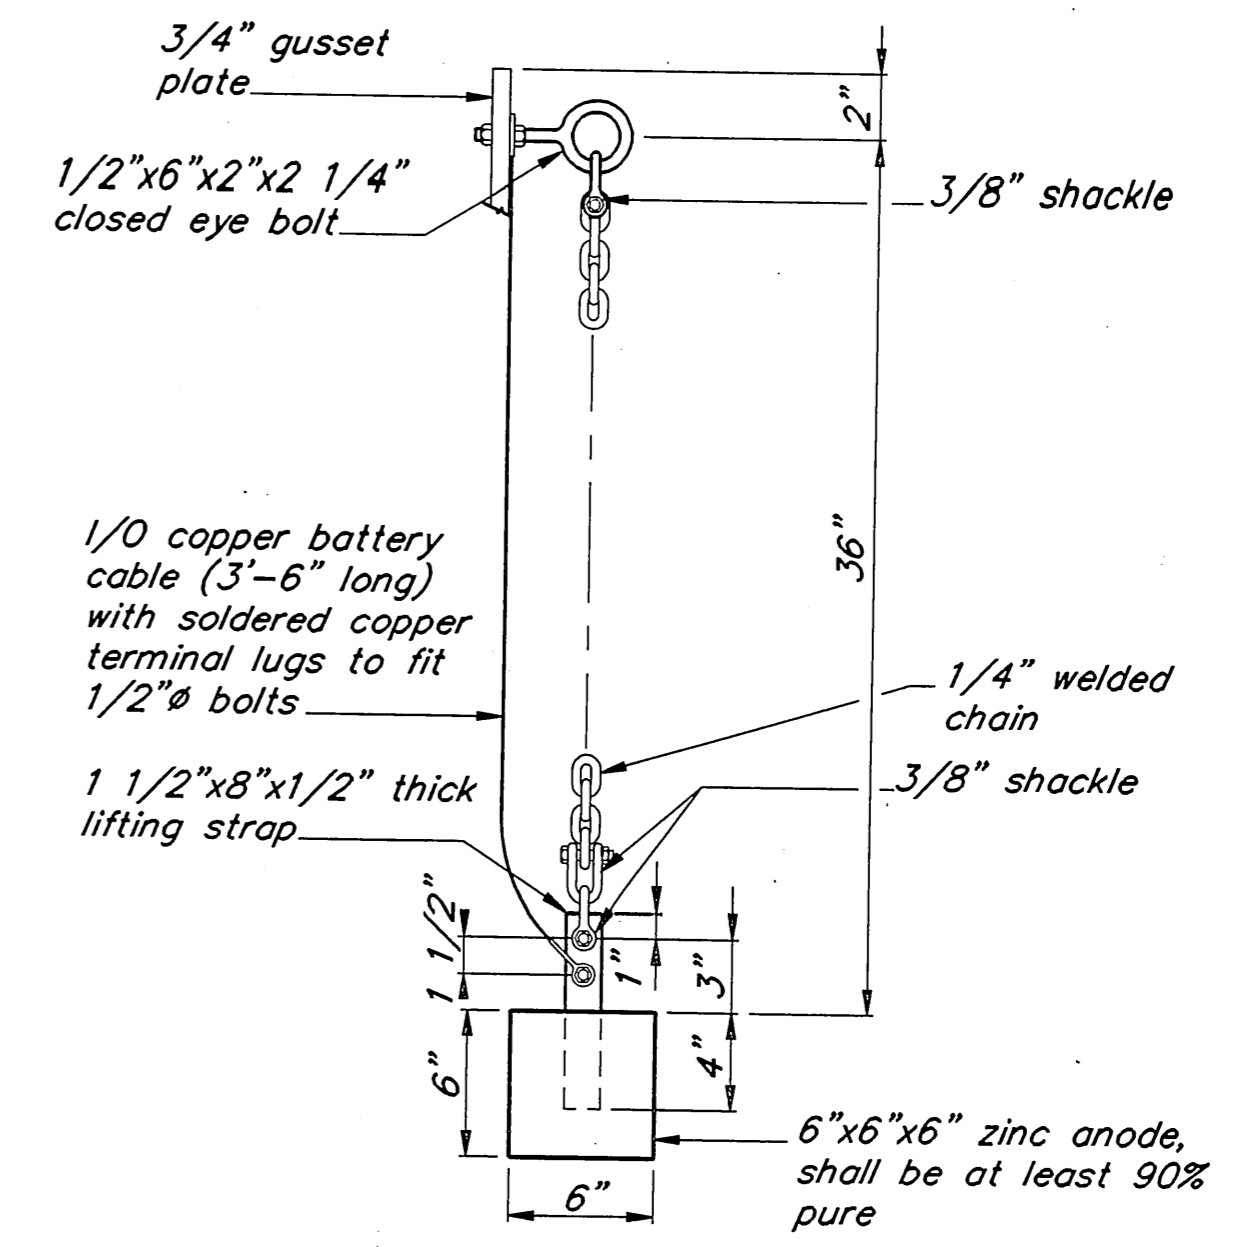

SECTION

(A)

As Built
Mark Salvo
7/26/95


PATH: P:\POW\PTBAKER\DR\SH16.dwg < 1-8 >		
BY	DATE	DESCRIPTION OF CHANGE
RECORD OF REVISIONS		

STATE OF ALASKA
DEPARTMENT OF TRANSPORTATION
AND PUBLIC FACILITIES
SOUTHEAST REGION DESIGN & CONSTRUCTION

POINT BAKER
PRINCE OF WALES ISLAND
POINT BAKER SEAPLANE FLOAT
A.I.P. # 3-02-0423-01
ALASKA
Fire Extinguisher & Container Details

NOTE: DO NOT SCALE FROM THESE PLANS-USE DIMENSIONS

DESIGNED BY: D.D.S.	PROJECT NO. 71135
DRAWN BY: B.W.B.	DATE: APRIL, 1994
CHECKED BY: J.D.B.	SHEET 16 OF 20

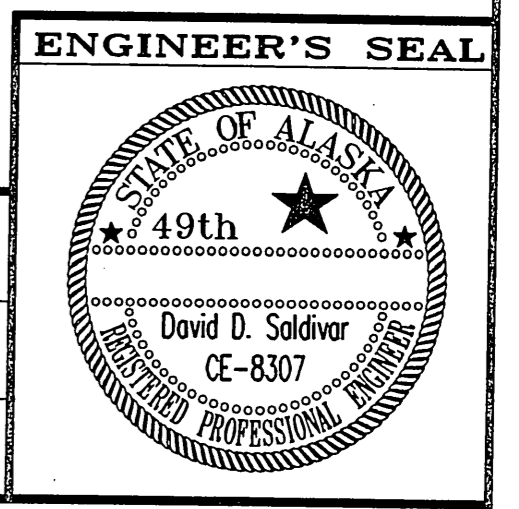



SIGN "A"
1 REQUIRED




SIGN "B"
1 REQUIRED


SIGN NOTES :

Align top of sign "A" with top of float pile with top of sign "B" 3" below the bottom of sign "A". Secure the signs by welding the heads of two-1/2" stainless steel bolts to piling. Place the sign and install flat stainless steel washers and nuts.


Signs shall have white background with black legend. Sign shall conform to Alaska Sign Design Specification. Lettering shall be as shown on the plans.

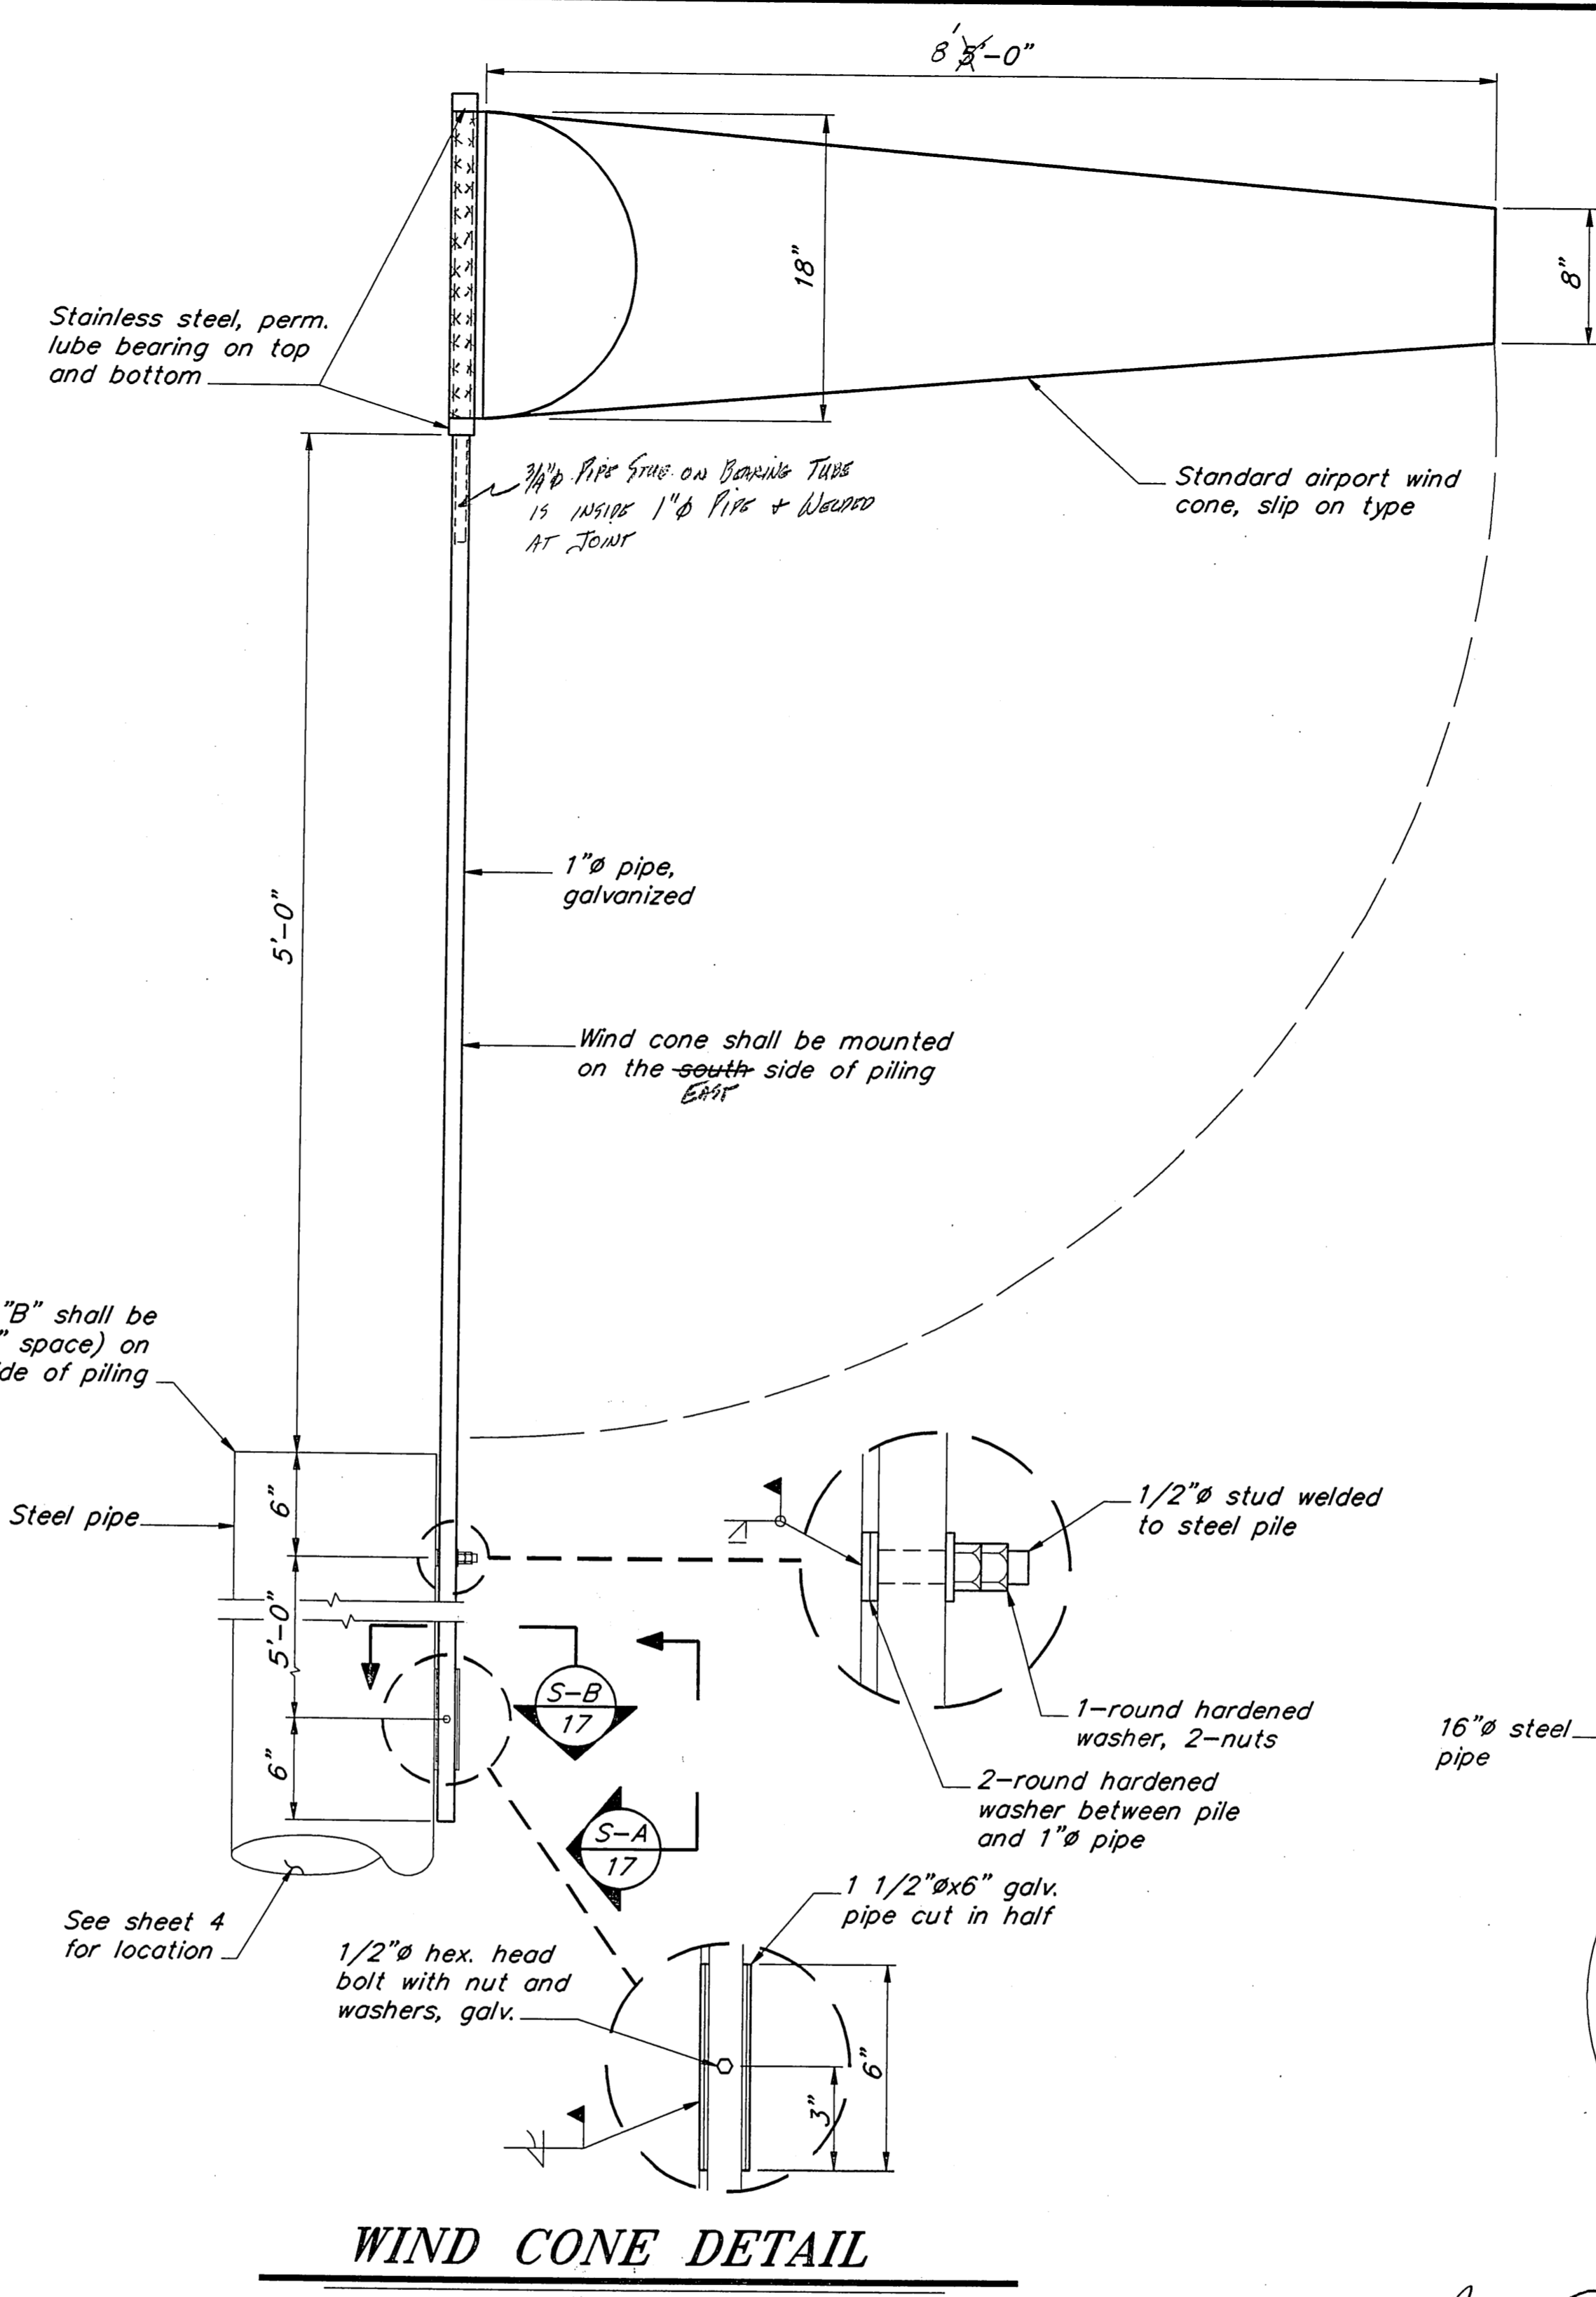

WIND CONE DETAIL
1 REQUIRED

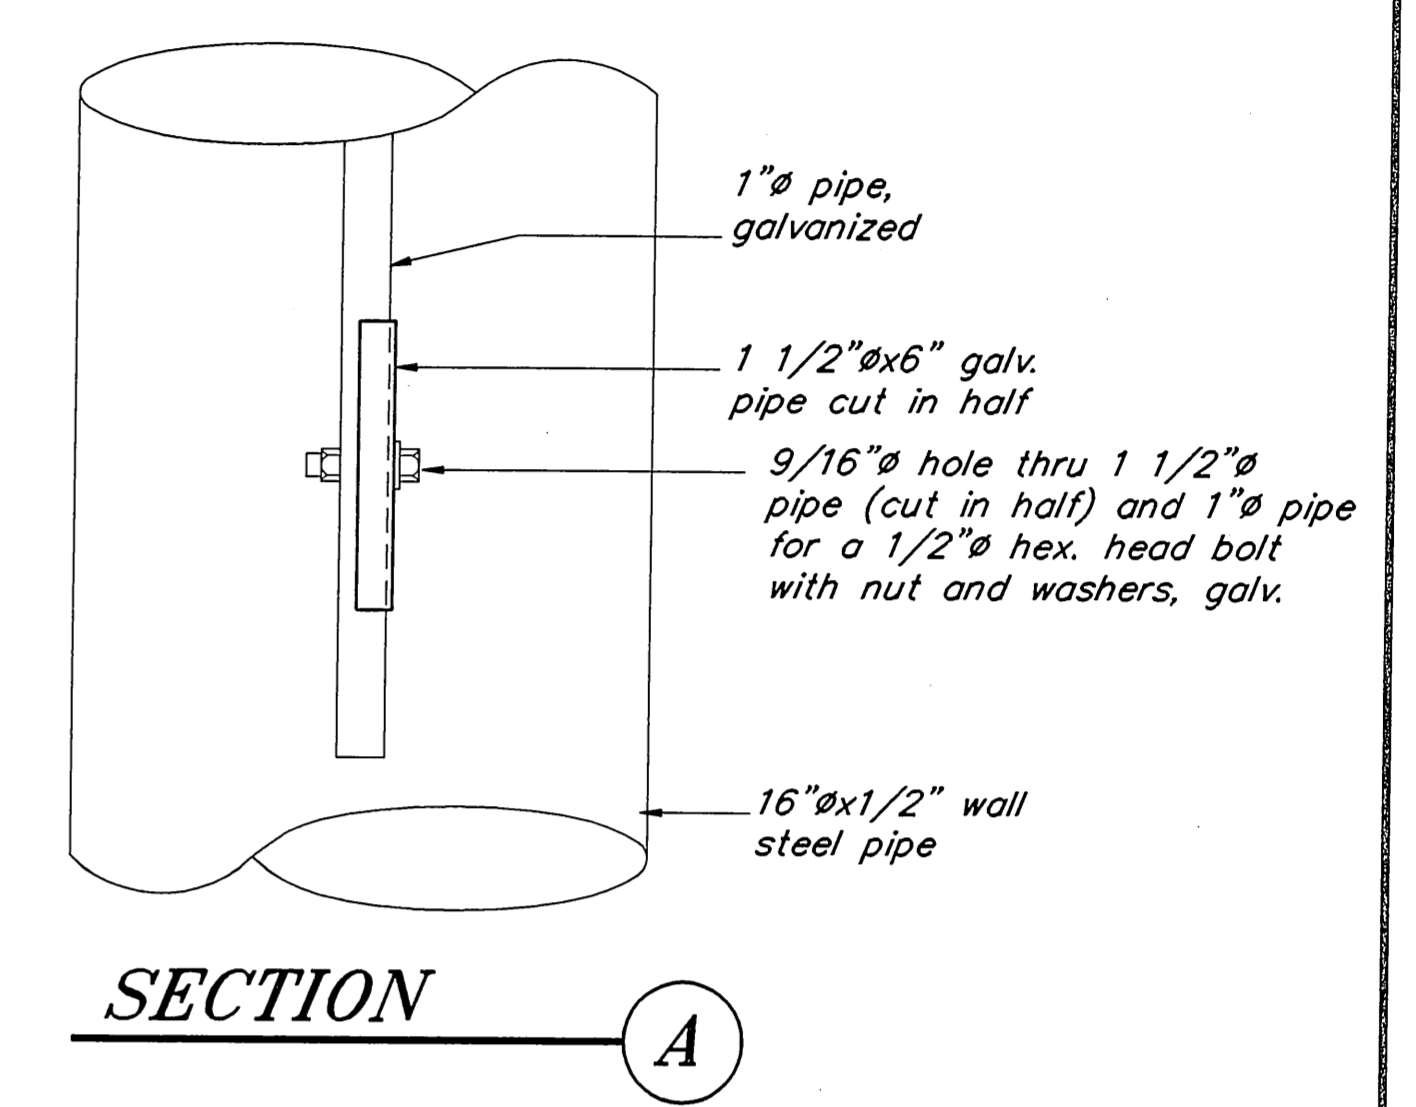

SECTION A

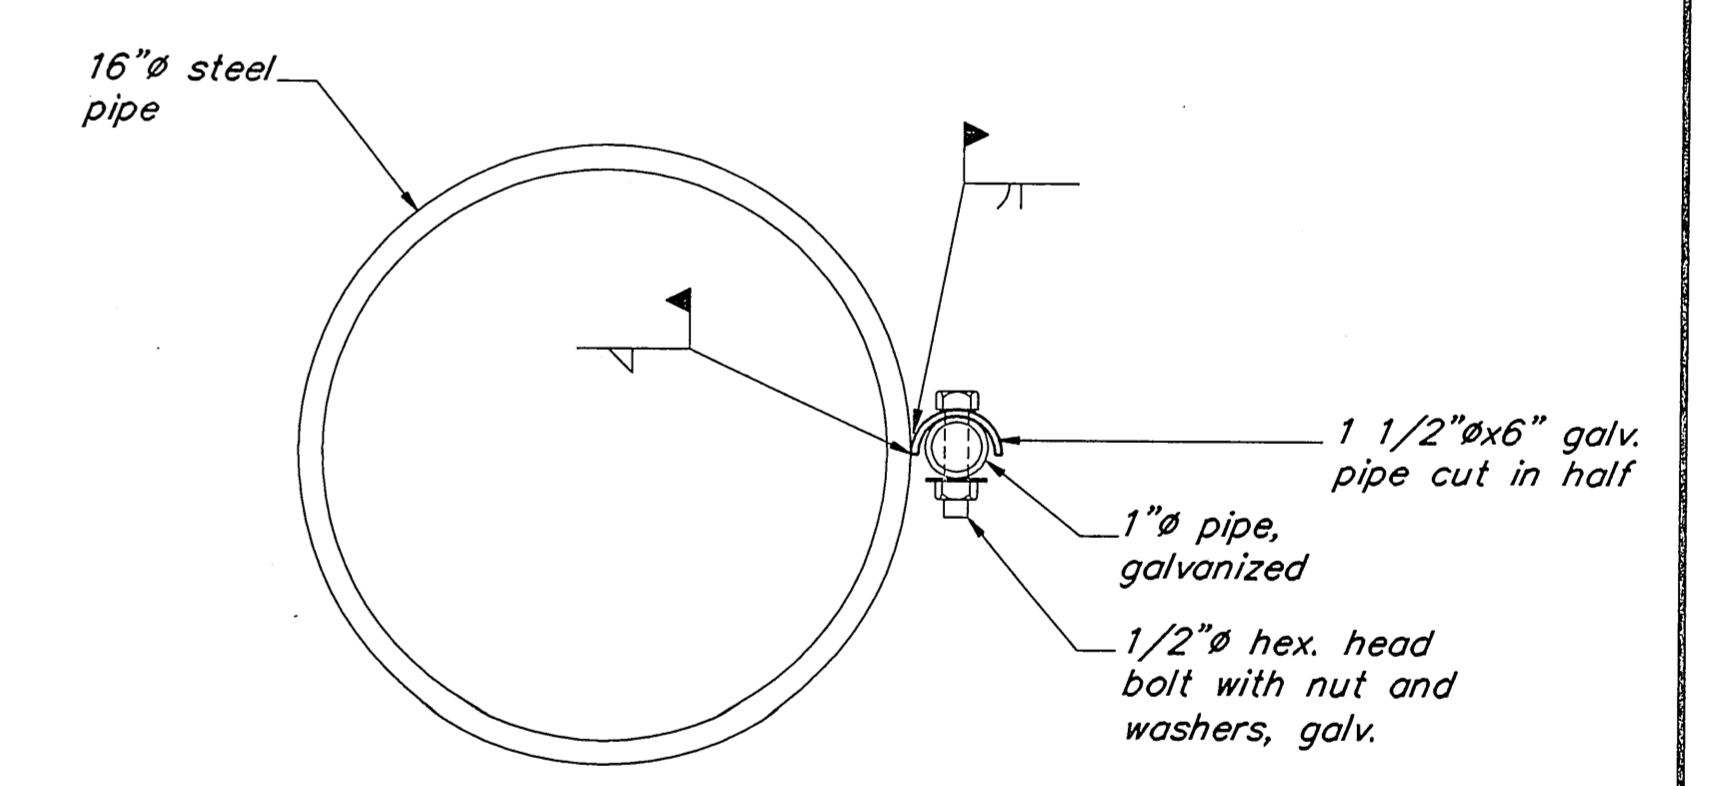

SECTION B

As Built
Mark Salvo
7/26/95

* "B" SERIES LETTERING
** "C" SERIES LETTERING
*** "D" SERIES LETTERING


PATH: P:\POW\PTBAKER\DR\SH17.dwg < 1=4 >		
BY	DATE	DESCRIPTION OF CHANGE
RECORD OF REVISIONS		




STATE OF ALASKA
DEPARTMENT OF TRANSPORTATION
AND PUBLIC FACILITIES
SOUTHEAST REGION DESIGN & CONSTRUCTION

POINT BAKER
PRINCE OF WALES ISLAND
POINT BAKER SEAPLANE FLOAT
A.I.P. # 3-02-0423-01
Signs & Wind Cone Details


NOTE: DO NOT SCALE FROM THESE PLANS-USE DIMENSIONS

DESIGNED BY: D.D.S.	PROJECT NO. 71135
DRAWN BY: B.W.B.	DATE: APRIL, 1994
CHECKED BY: J.D.B.	SHEET 17 OF 20

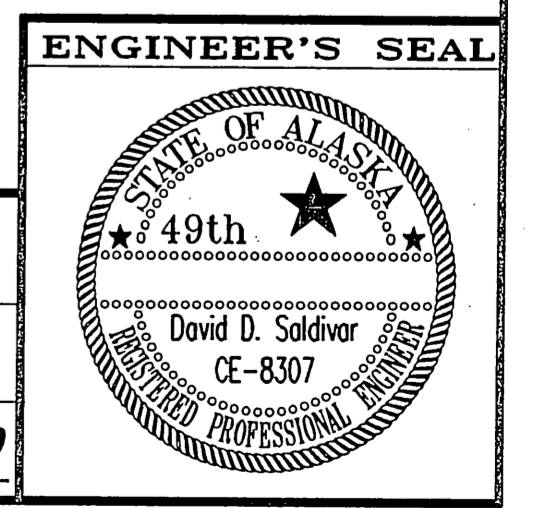


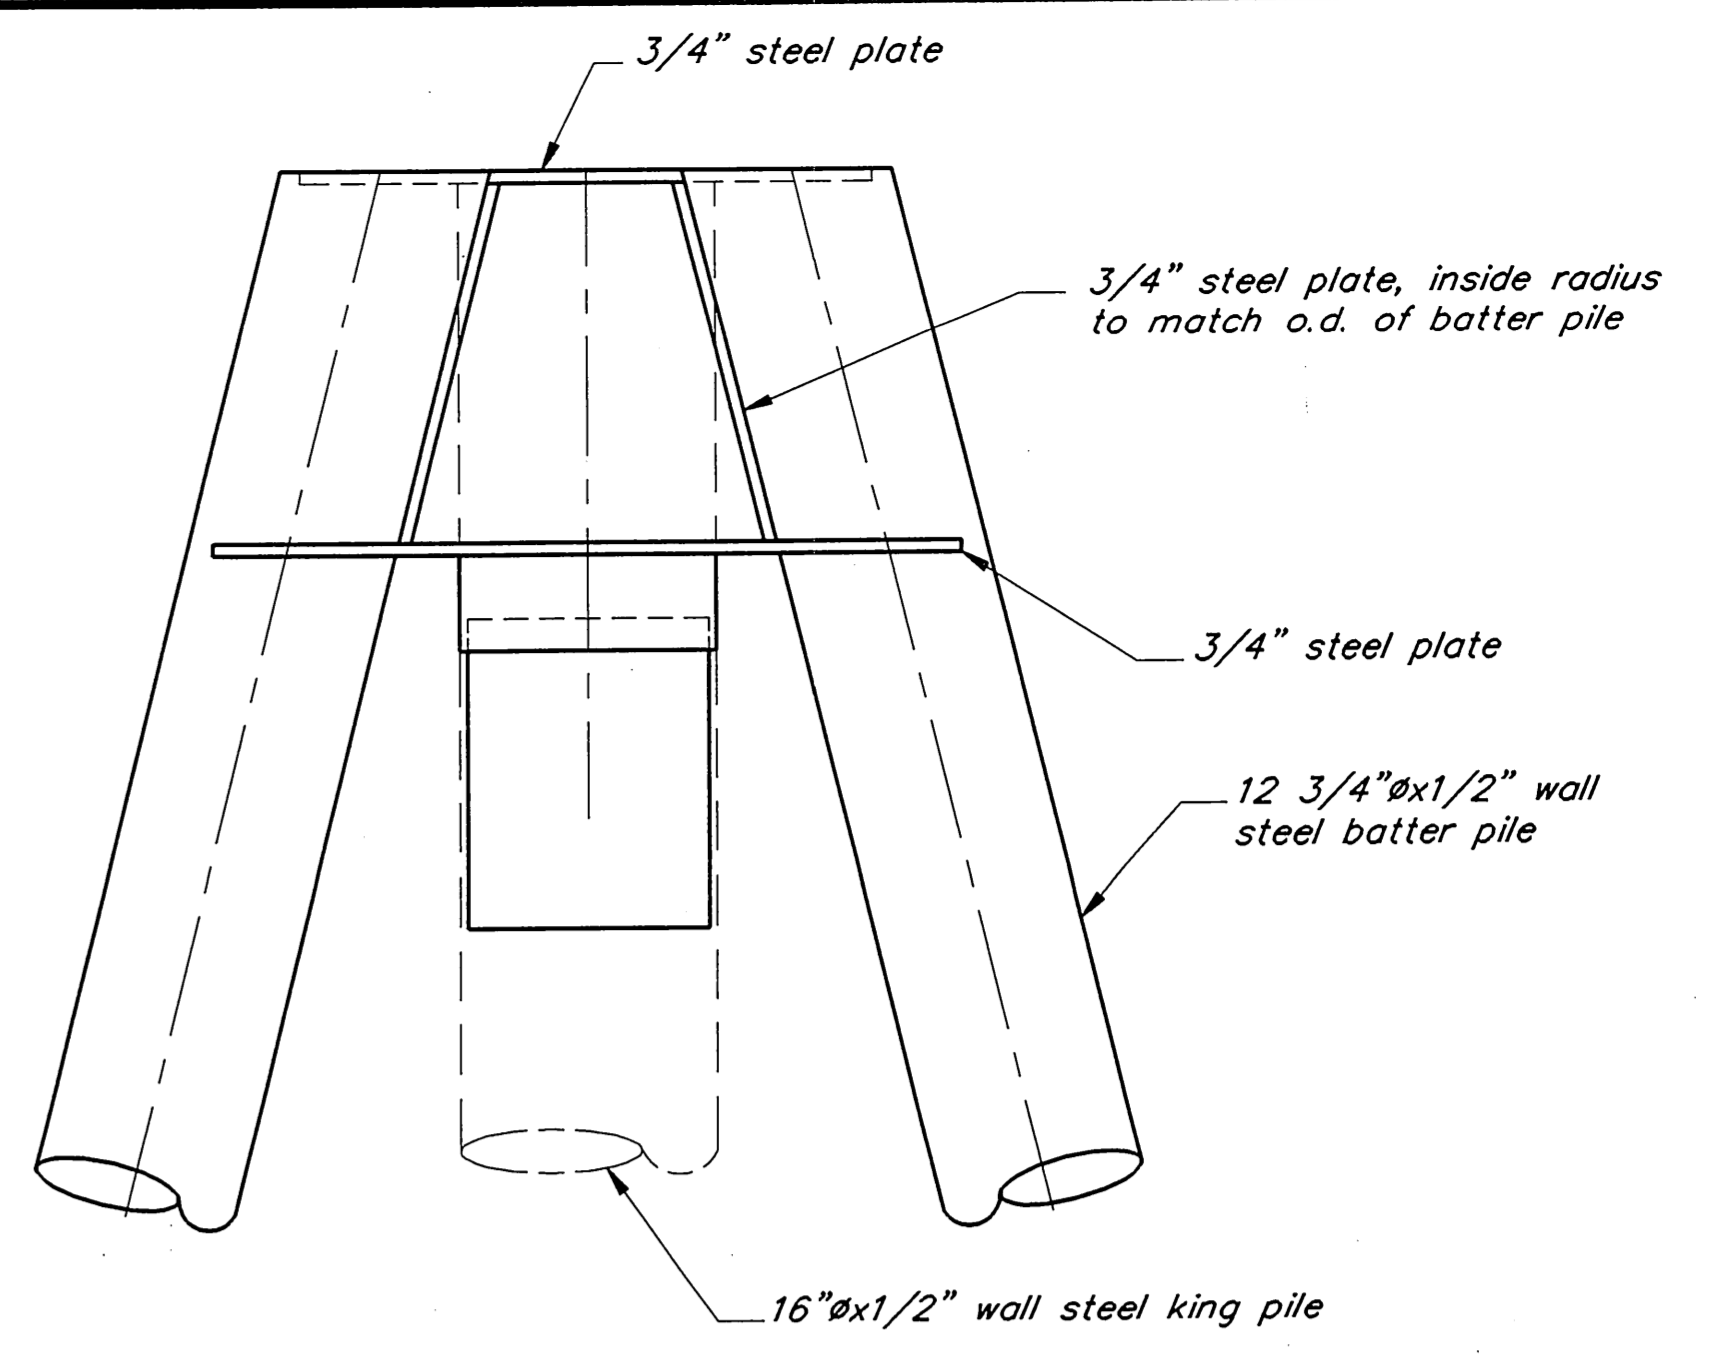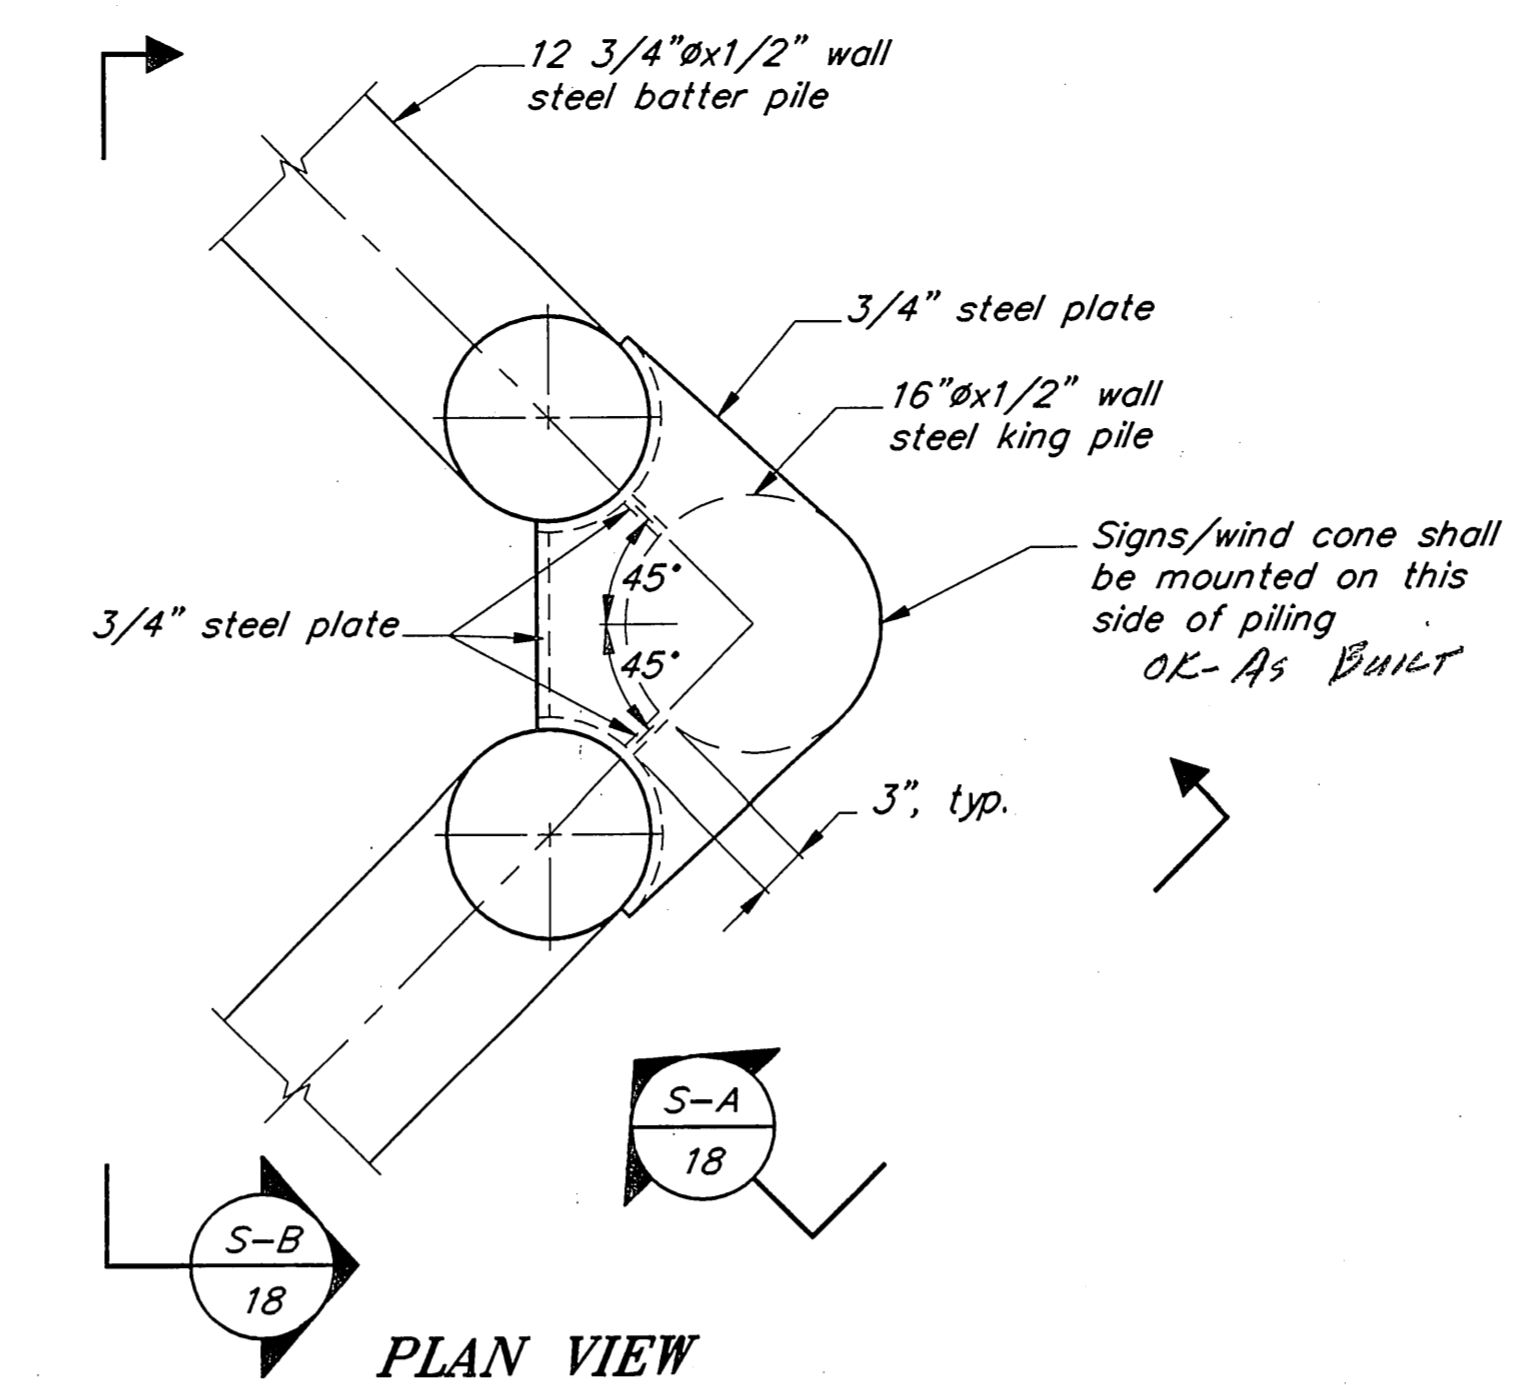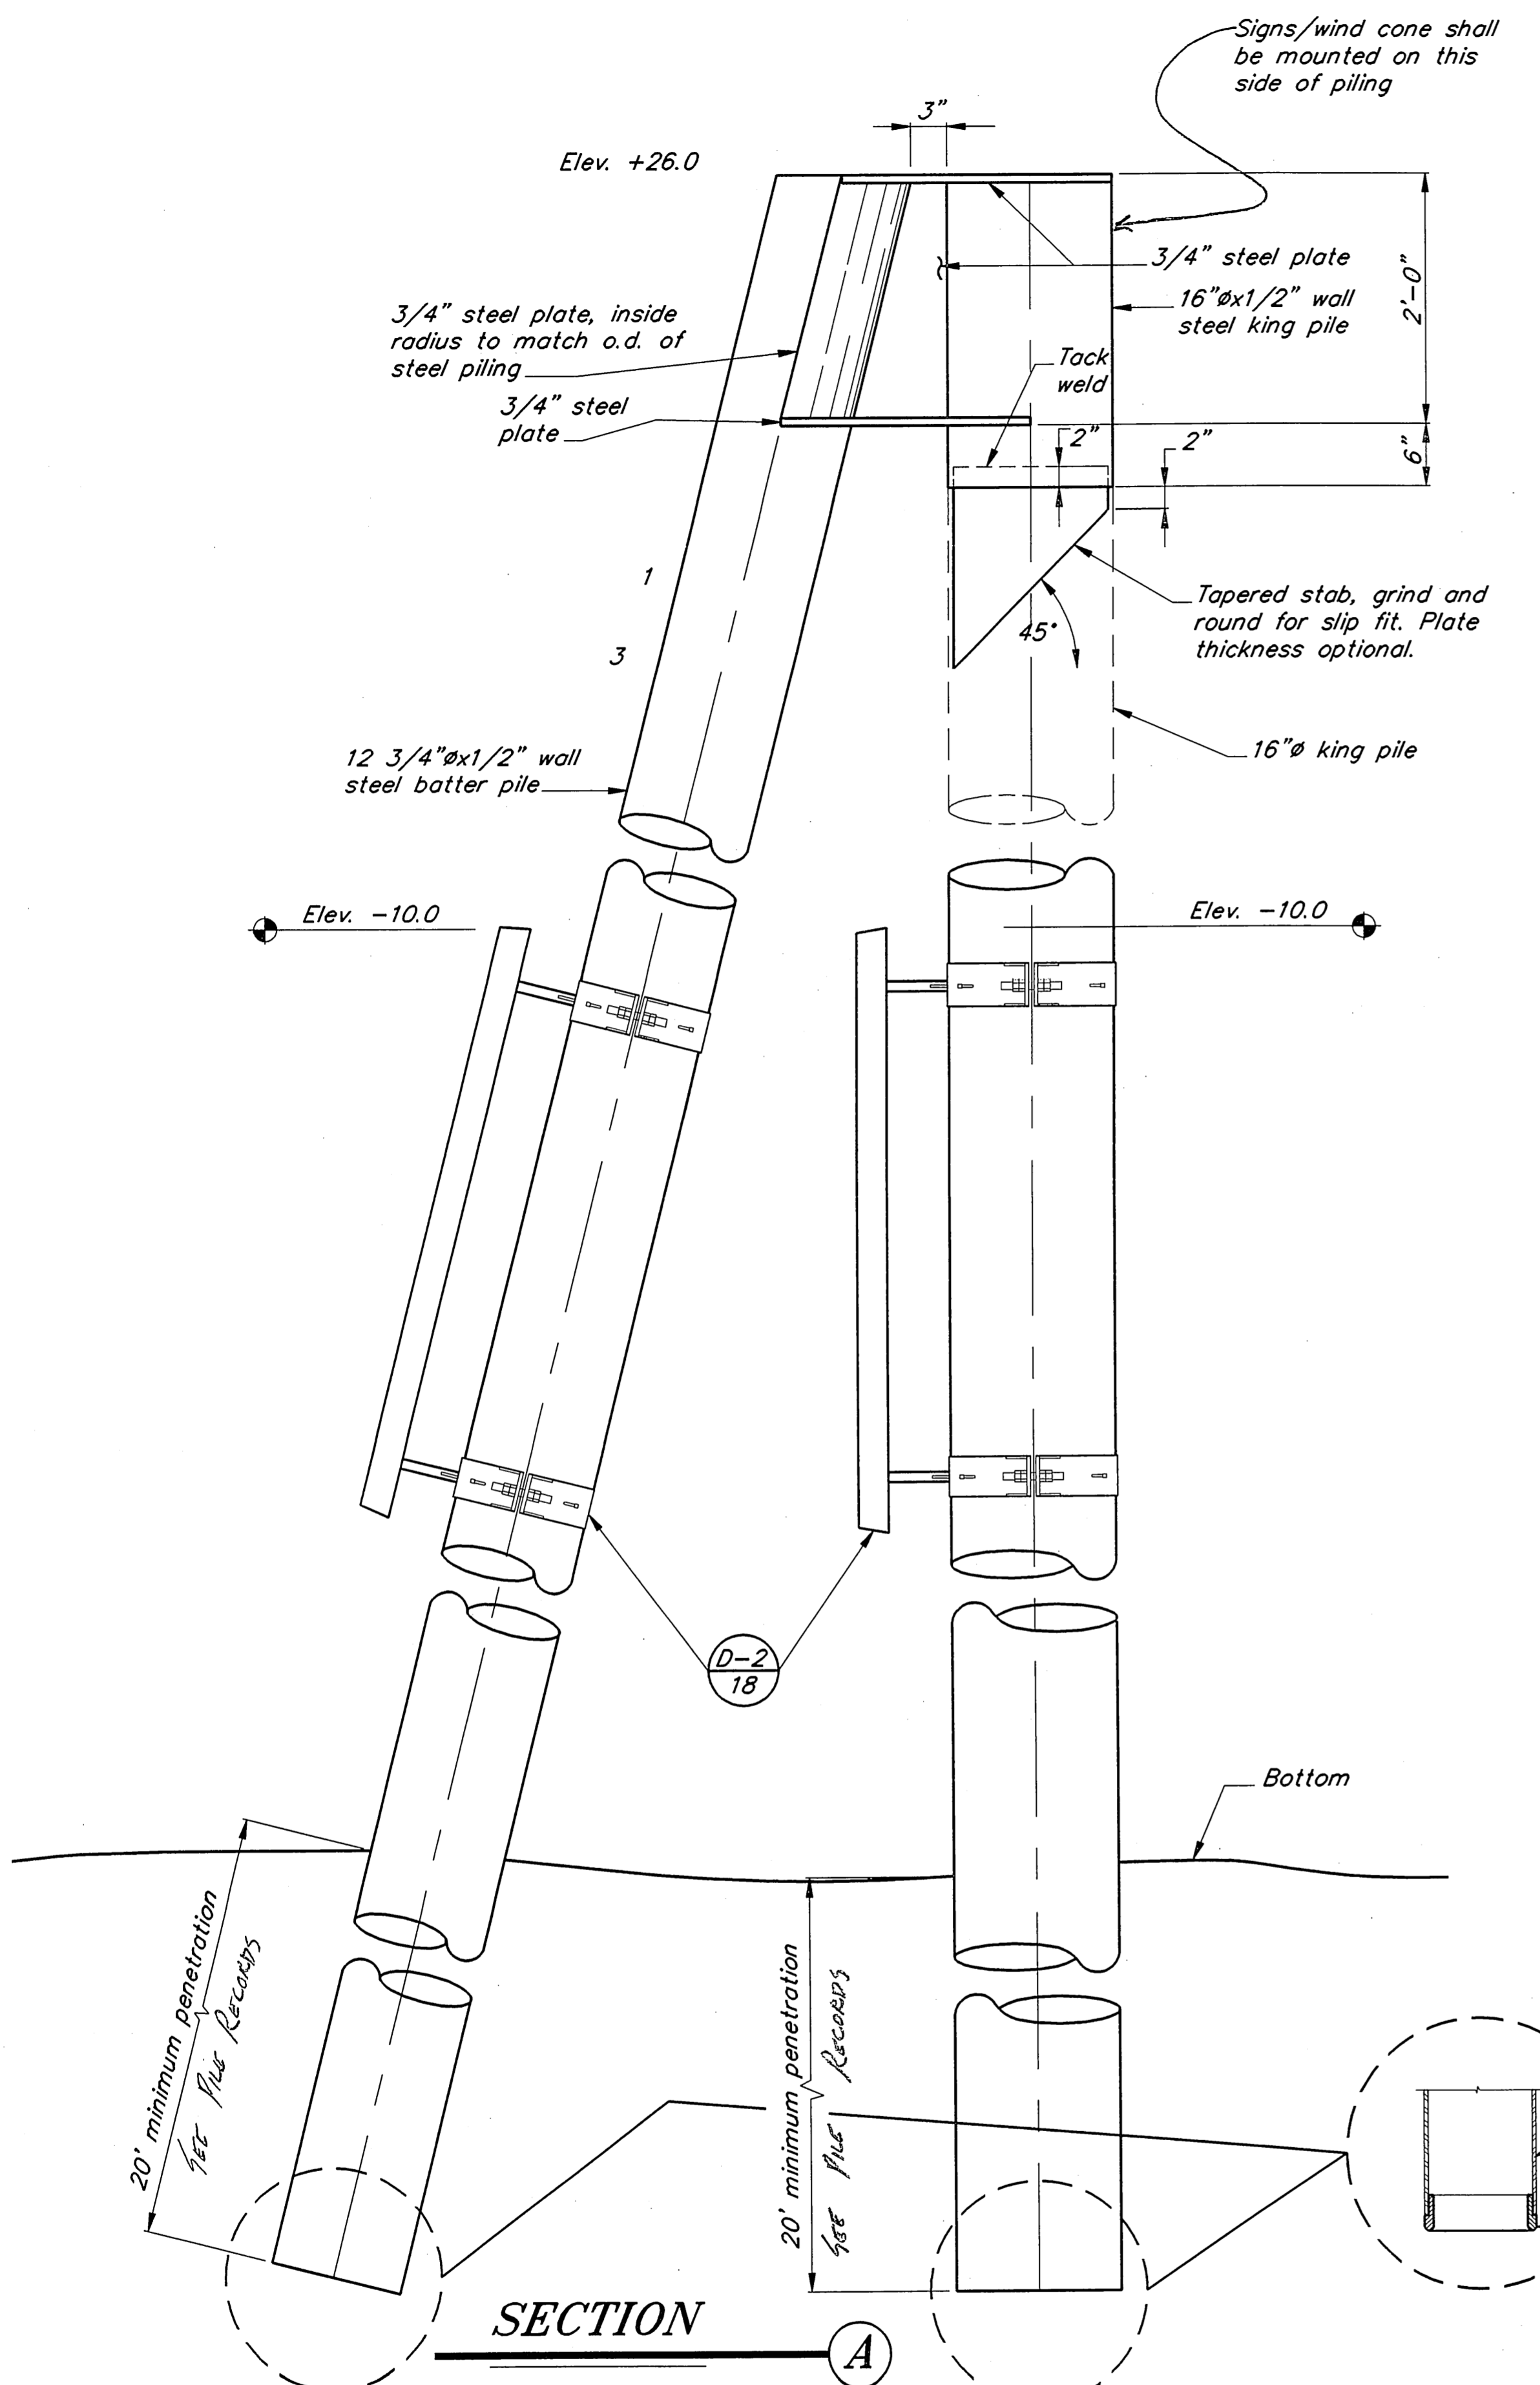

3 PILE DOLPHIN DETAIL
(2 REQUIRED)

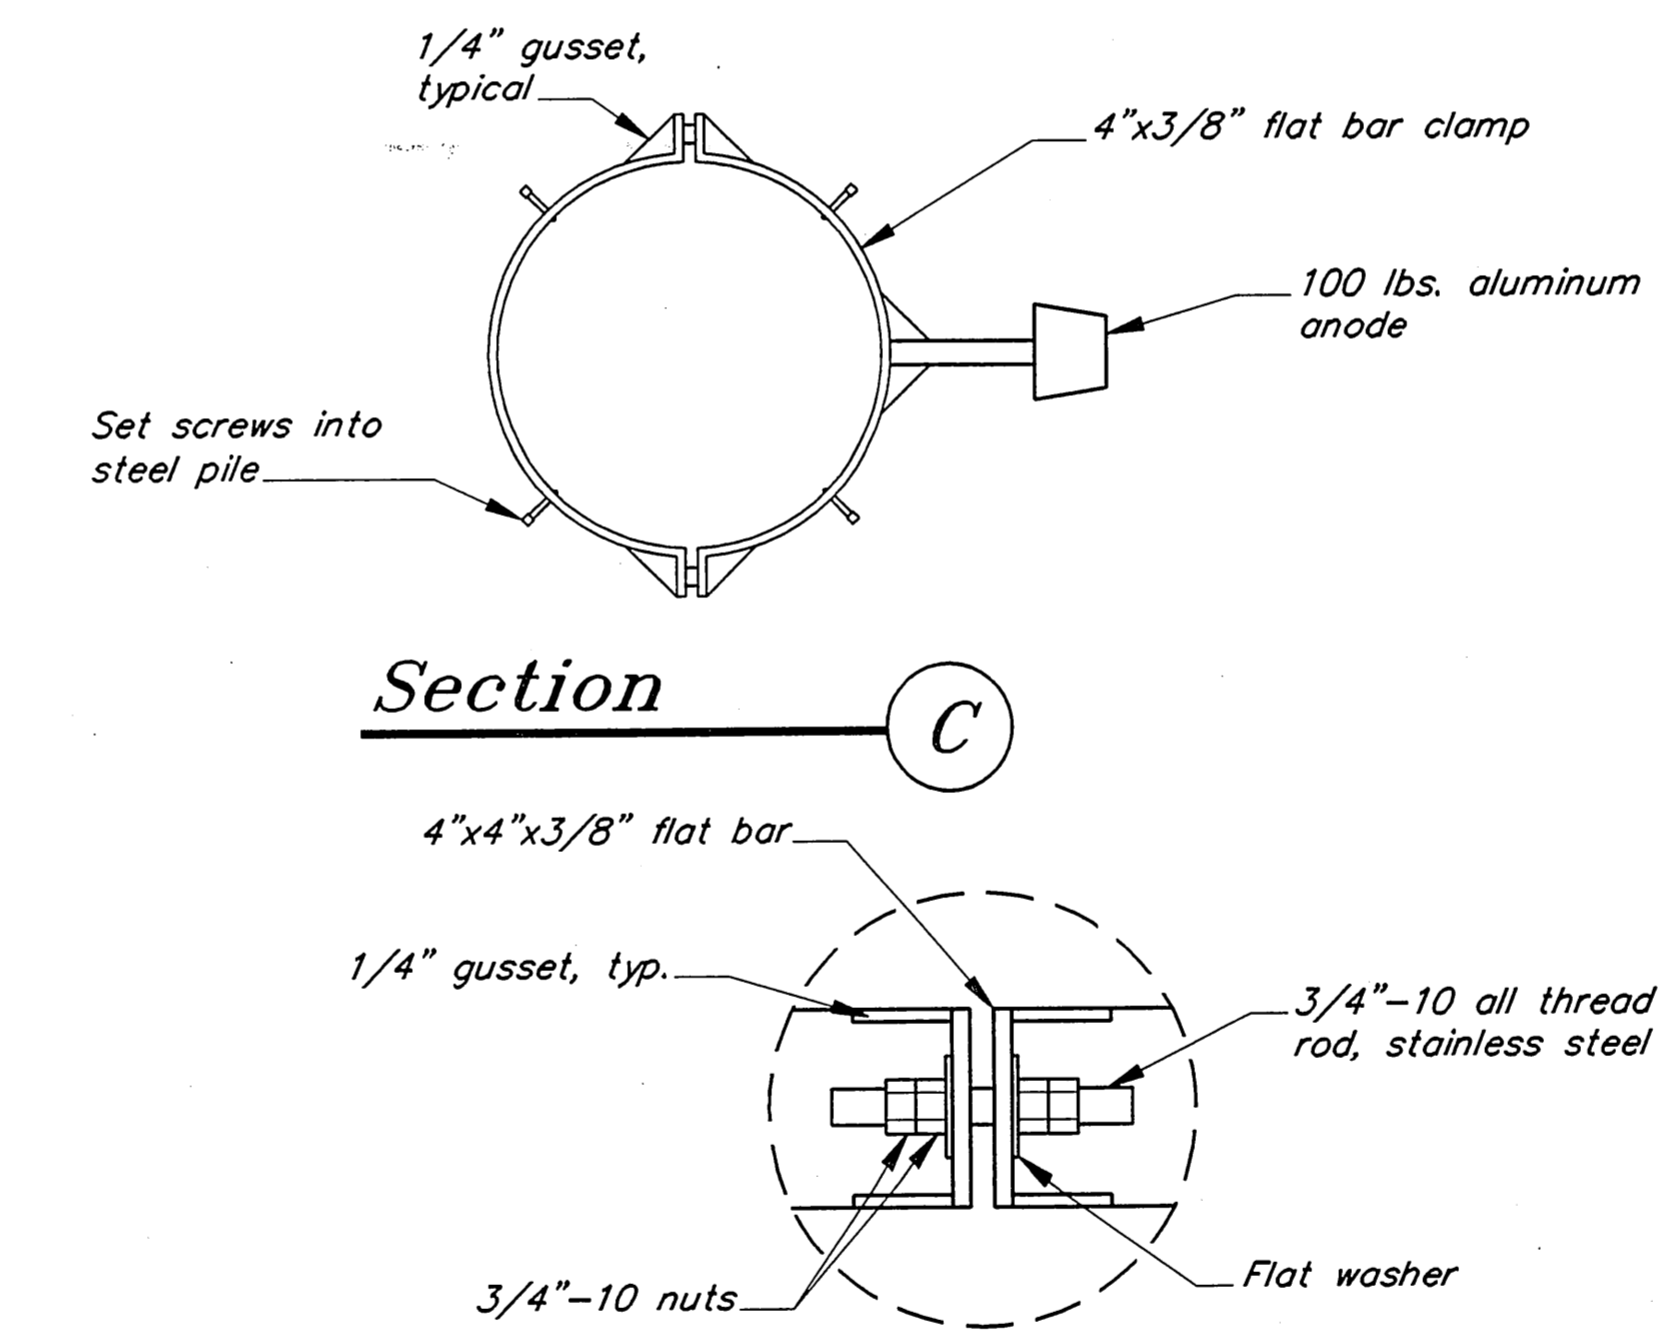

Clamp Connection Detail
(3)

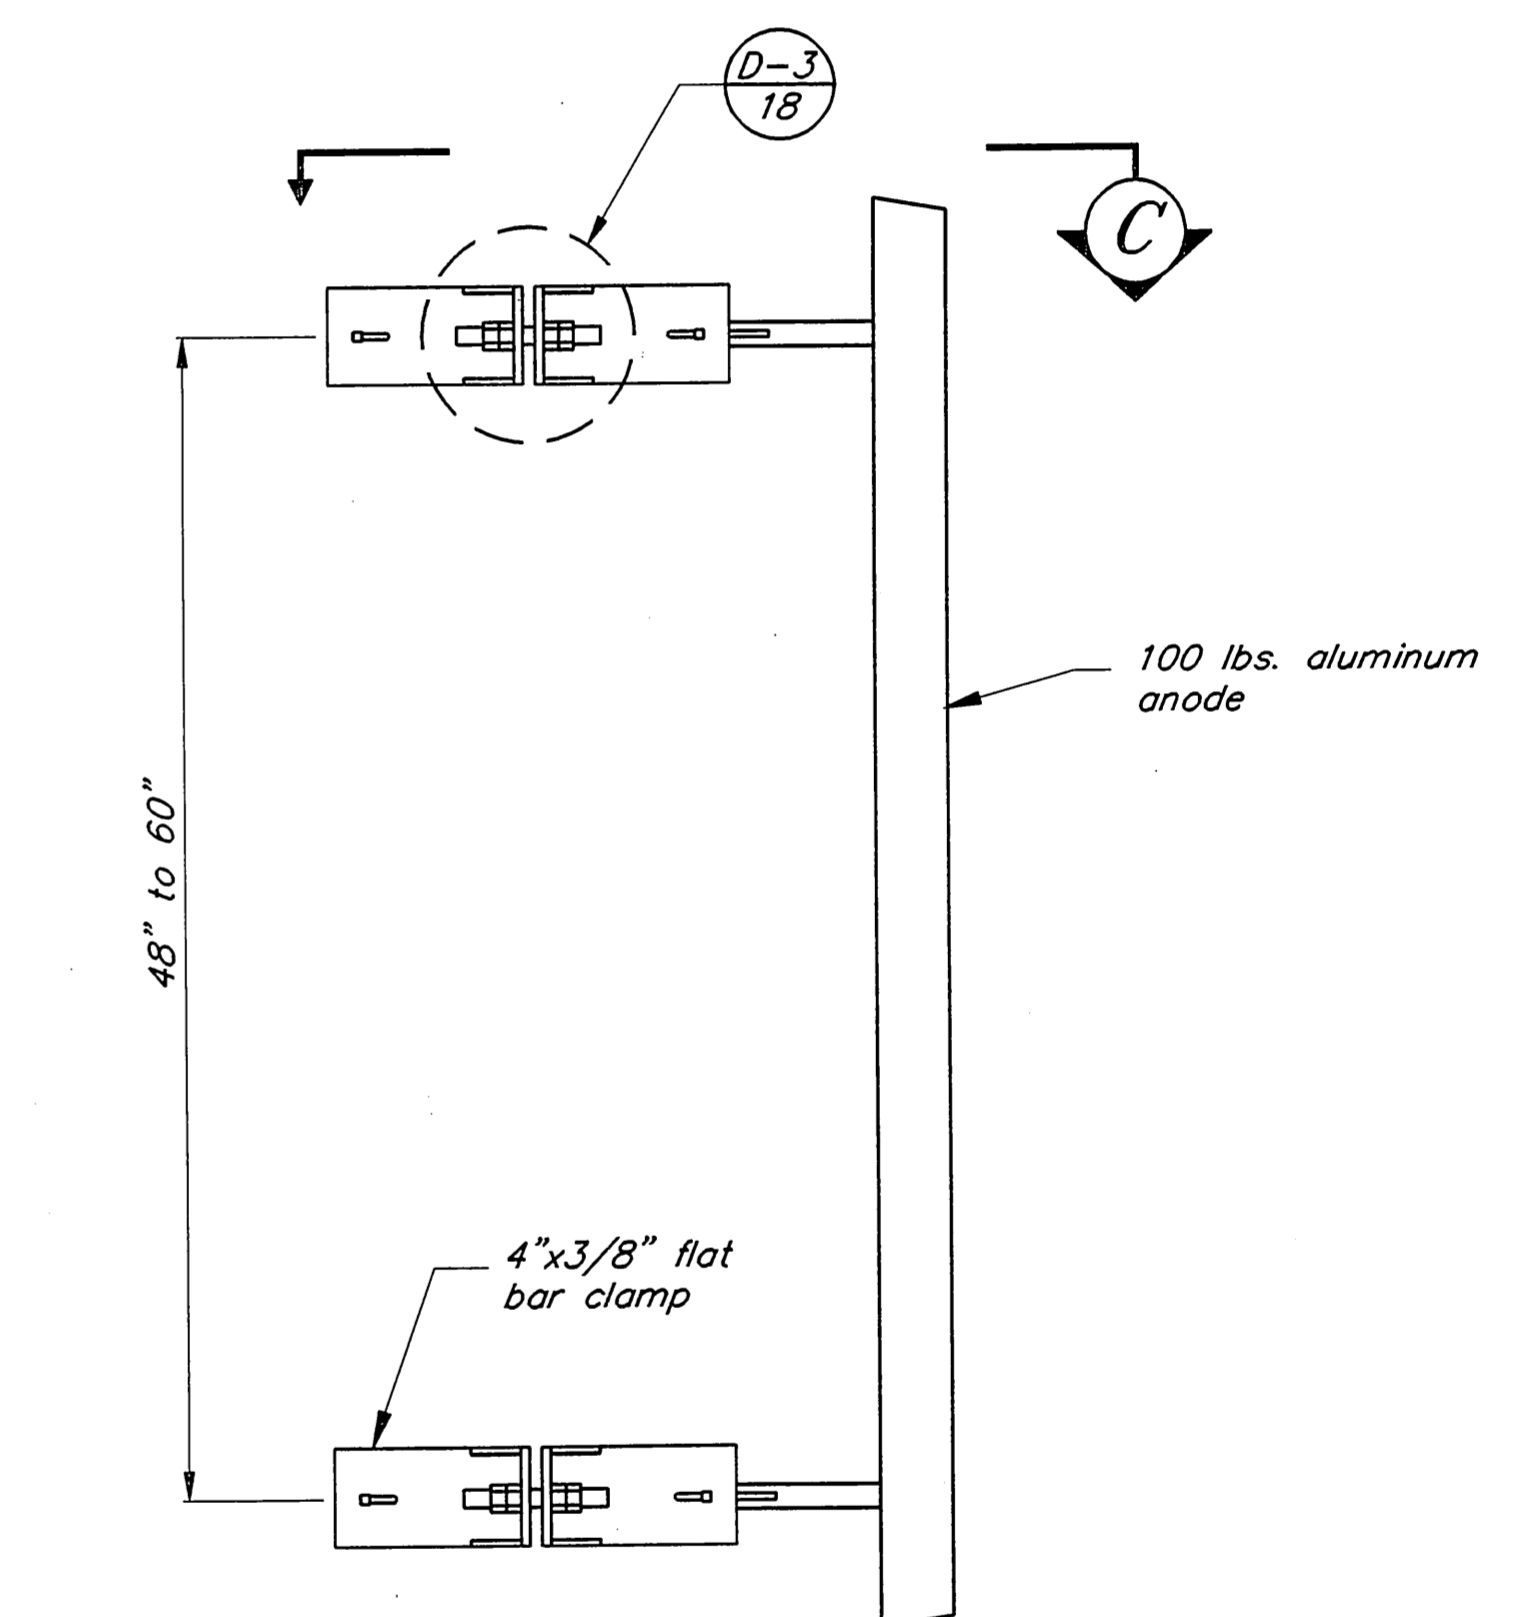


Anode Bracelet Detail
(6 REQUIRED)

RECORD OF REVISIONS		
BY	DATE	DESCRIPTION OF CHANGE


STATE OF ALASKA
DEPARTMENT OF TRANSPORTATION
AND PUBLIC FACILITIES
SOUTHEAST REGION DESIGN & CONSTRUCTION

POINT BAKER
PRINCE OF WALES ISLAND
POINT BAKER SEAPLANE FLOAT
A.I.P. # 3-02-0423-01
Dolphin Details

DESIGNED BY: D.D.S.	PROJECT NO. 71135
DRAWN BY: B.W.B.	DATE: APRIL, 1994
CHECKED BY: J.D.B.	SHEET 18 OF 20

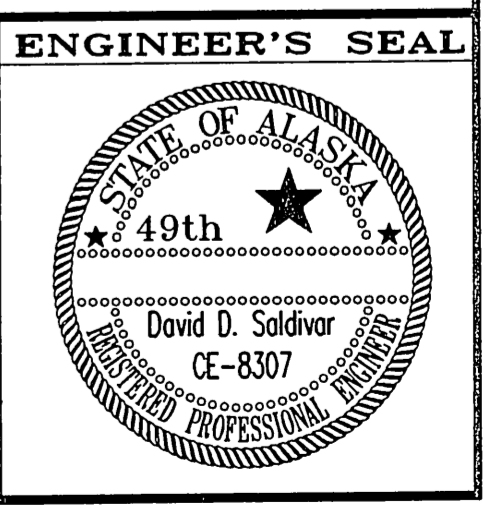

NOTE: DO NOT SCALE FROM THESE PLANS—USE DIMENSIONS

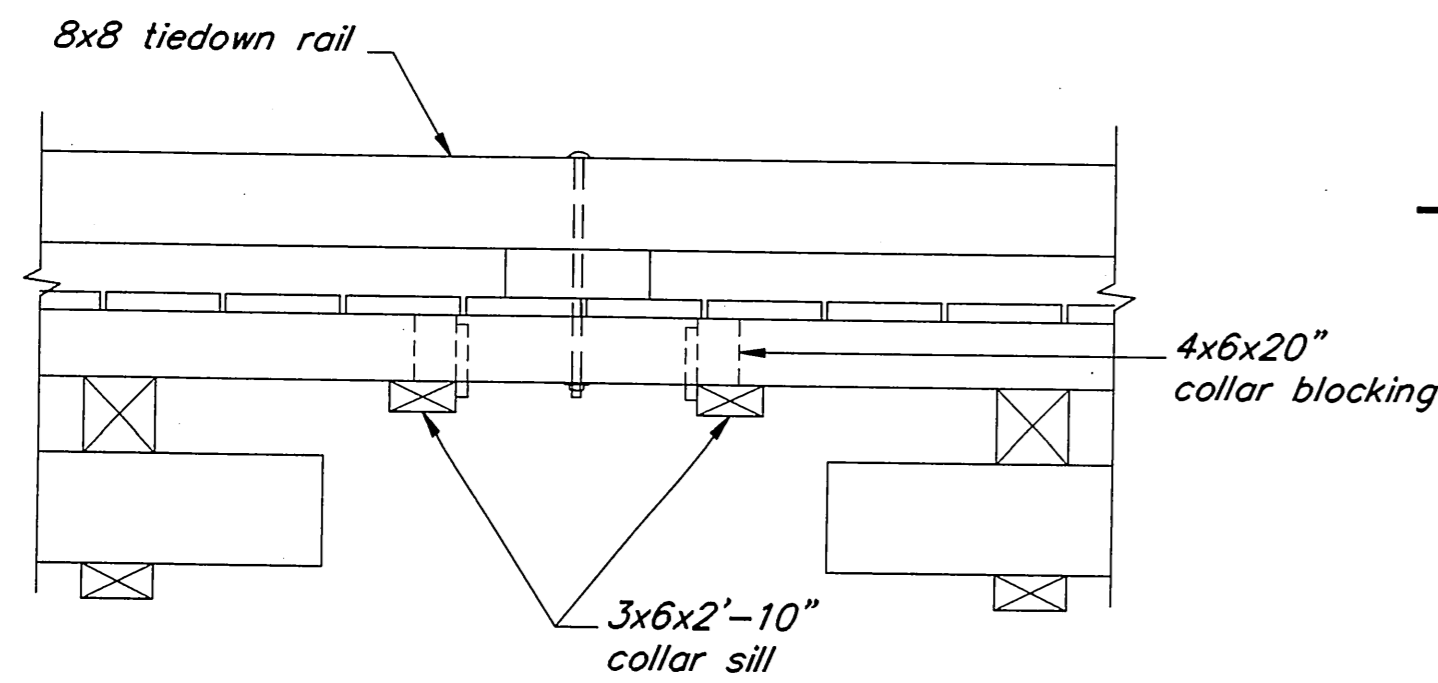


ELEVATION

EXISTING PILE COLLAR


PILE COLLAR REPLACEMENT NOTES:

1. Remove iron bark and nails from stringers.
2. Replace two collar sills and blocking at each location. Supply 5/8" economy head bolts and hex head bolts with M.I. washers and nuts required to secure sills, blocking and pile collar.
3. Existing decking may have to be removed and replaced to access the bolts holding the collar sill.
4. Put new steel pile collars in position.
5. Field drill 11/16" holes through deck, blocking and collar sills, treat holes per specification and secure collar with bolts.
6. See sheet 3 for locations of pile collars to be replaced.

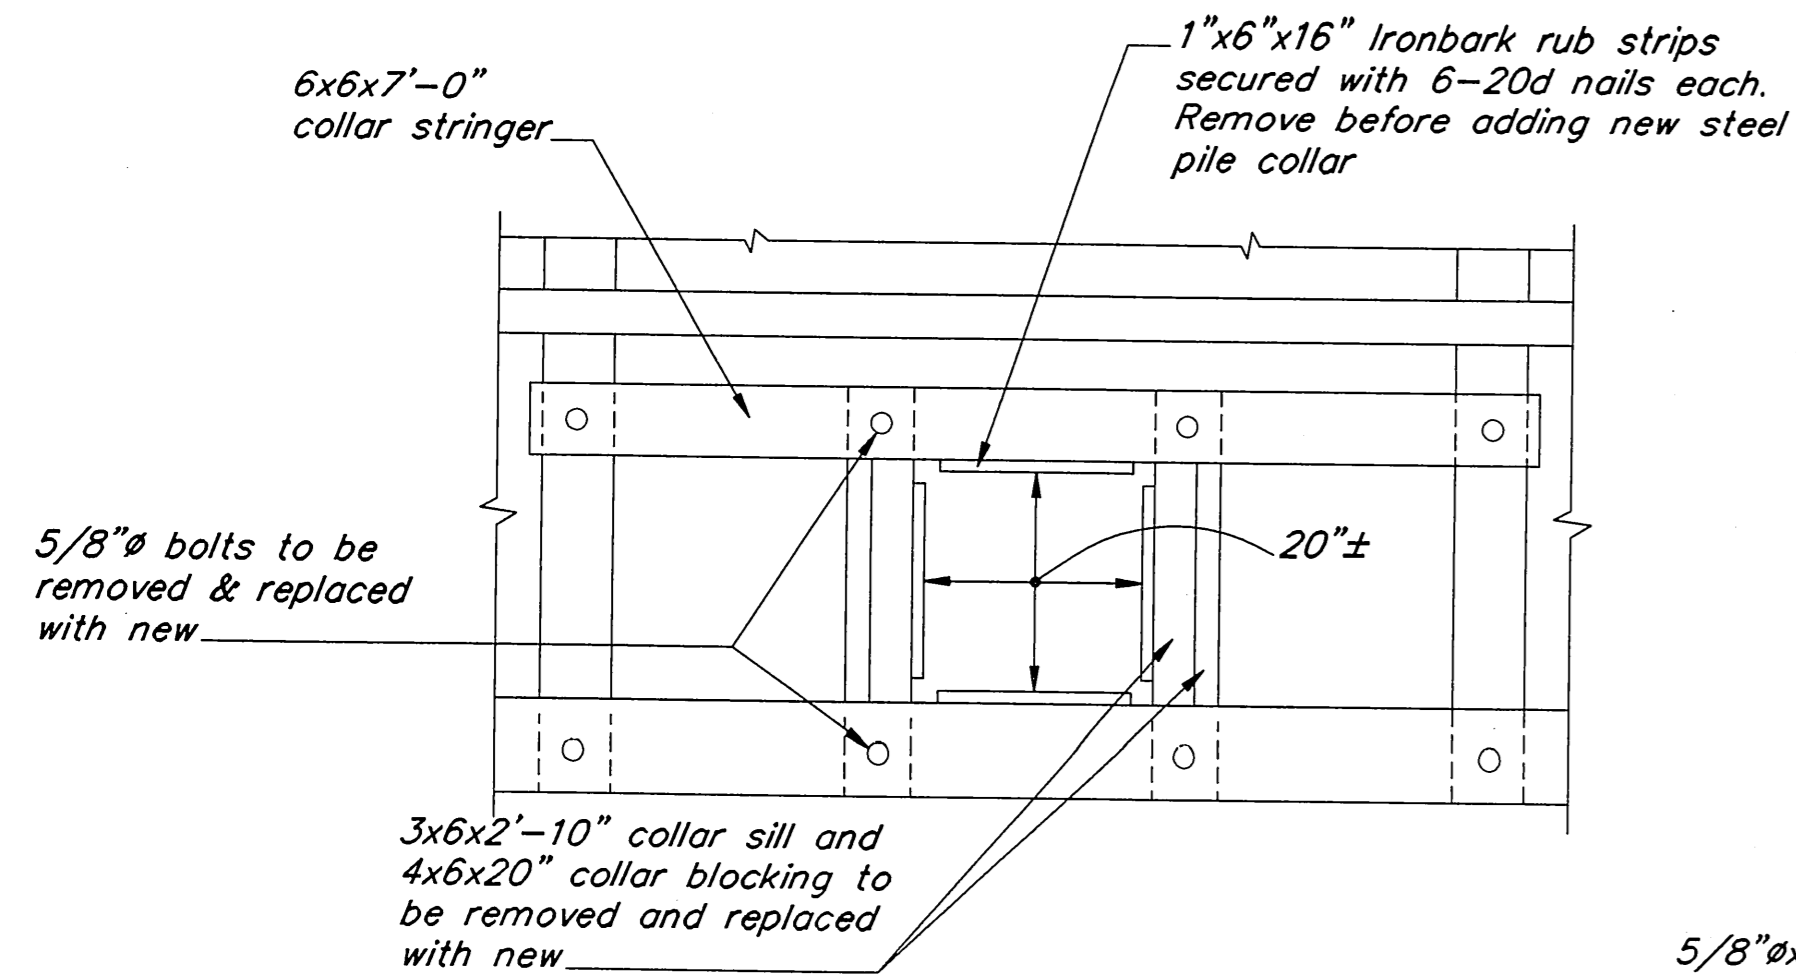

PLAN


EXISTING PILE COLLAR

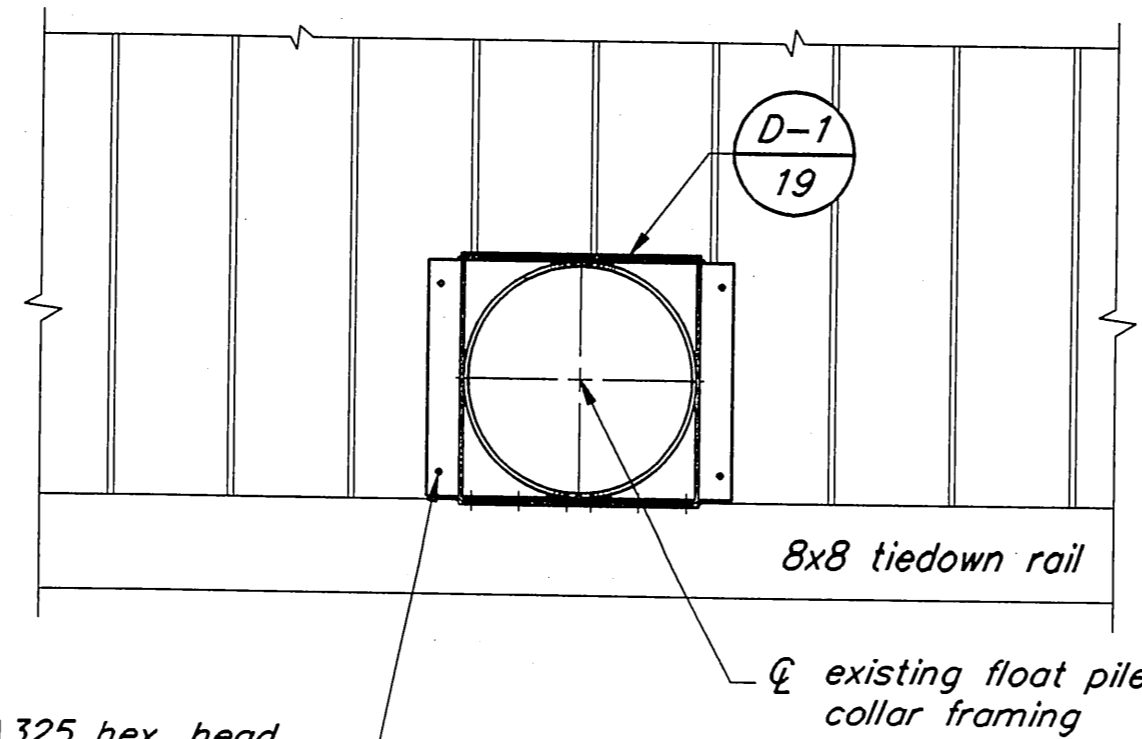

PLAN


REPLACEMENT PILE COLLAR IN PLACE

WORK No. 2

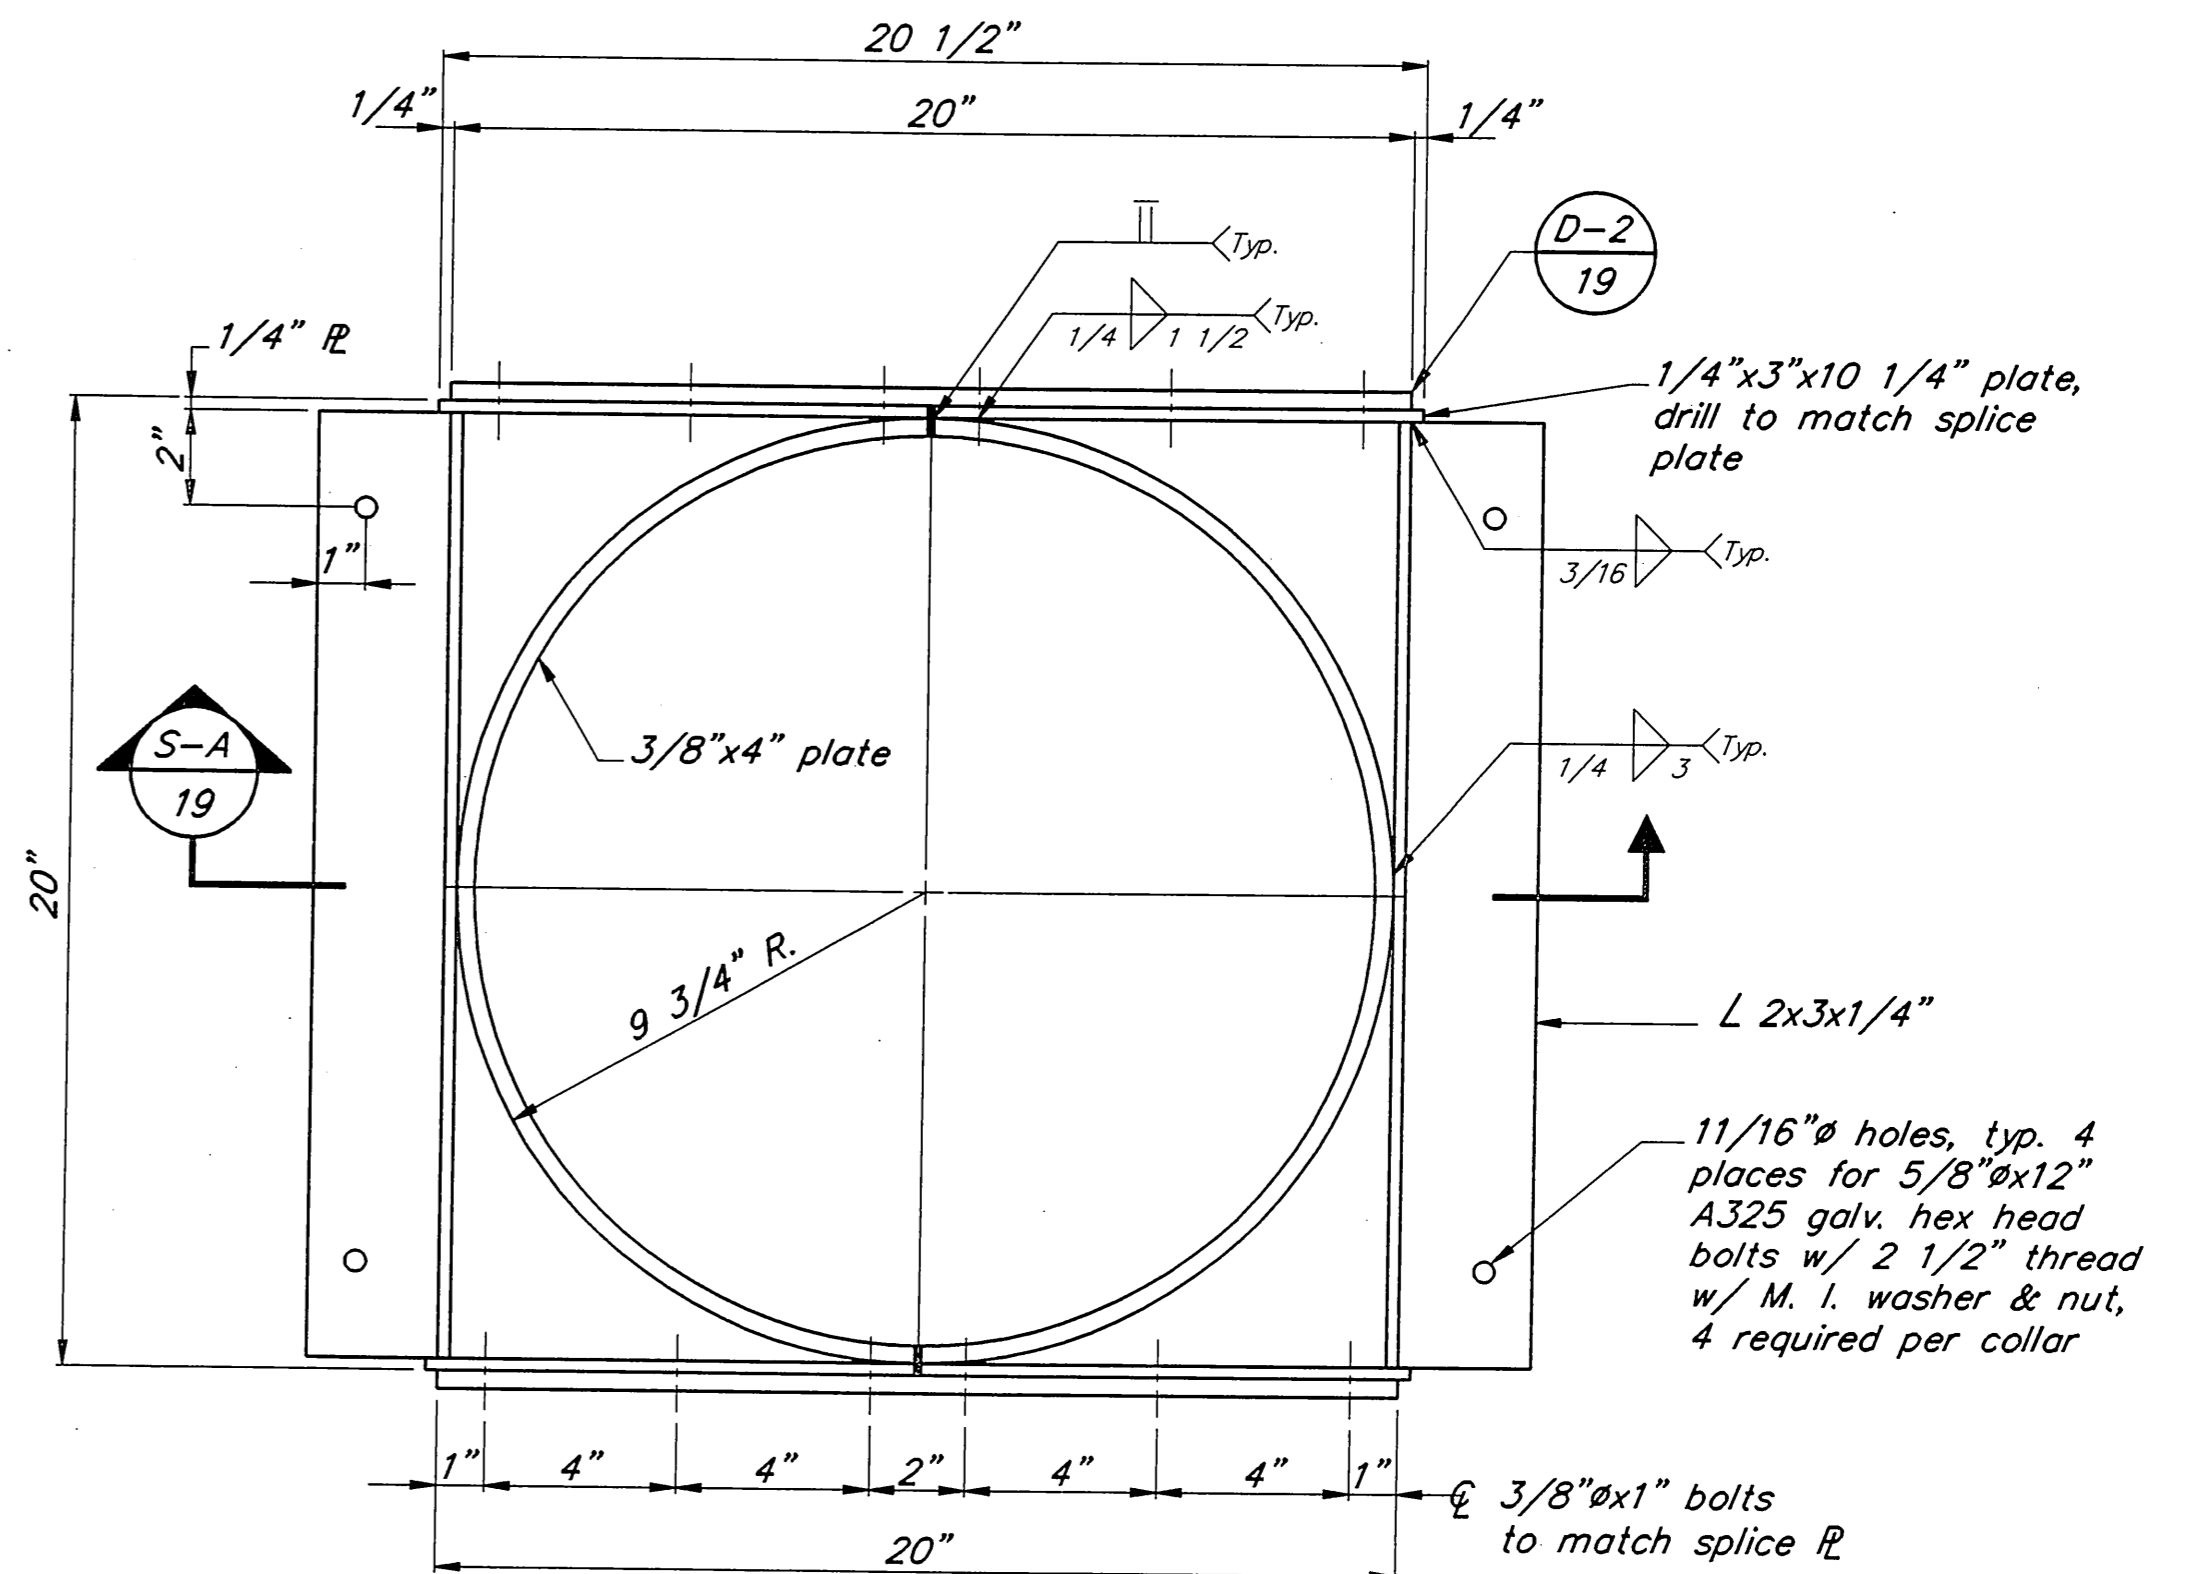


SPLIT PILE COLLAR

3 REQUIRED

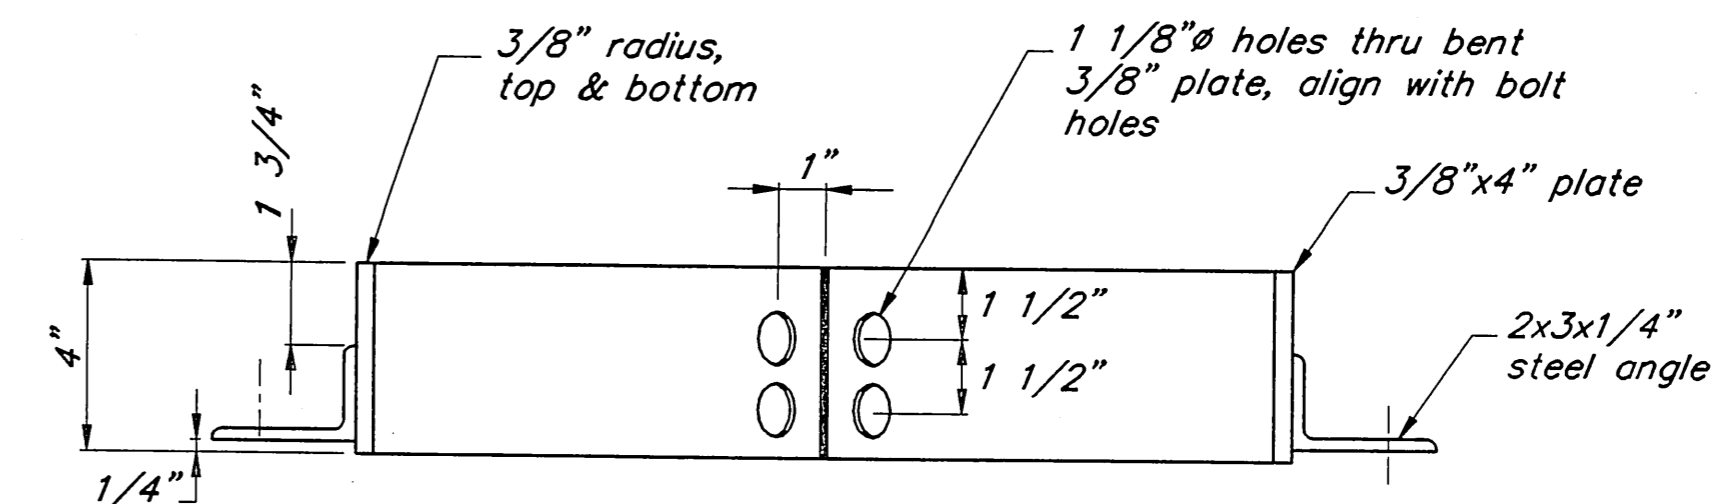

SECTION

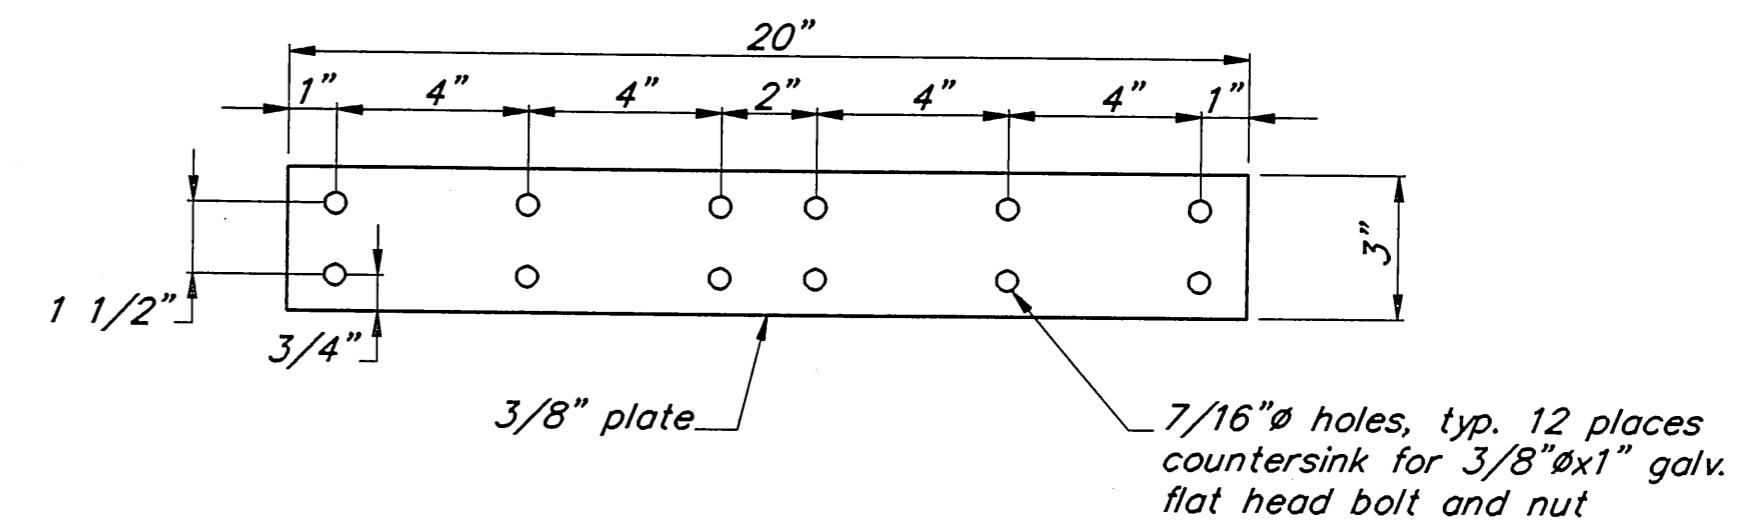

SPLICE PLATE DETAIL

NEW TIMBERS NOT NECESSARY ON THE TWO COLLARS FOR THE EXISTING 10'x 200' FLOAT
 PILE COLLAR ON 10'x 75' FLOAT MOVED BACK TOWARD GANGWAY APPROX. 6" AND COMPLETELY REBUILT - COLLAR MOVED TO BETTER BEAR ON PILE ALONG WITH FILE OF OTHER PORTION OF THIS FLOAT

As BUILT
 Mark Johnson
 7/26/95

PATH: P:\POW\PTBAKER\DR\SH119.dwg < 1=12 >		
BY	DATE	DESCRIPTION OF CHANGE
RECORD OF REVISIONS		

STATE OF ALASKA
 DEPARTMENT OF TRANSPORTATION
 AND PUBLIC FACILITIES
 SOUTHEAST REGION DESIGN & CONSTRUCTION


POINT BAKER

PRINCE OF WALES ISLAND
 POINT BAKER SEAPLANE FLOAT
 A.I.P. # 3-02-0423-01

Pile Collar Replacement




NOTE: DO NOT SCALE FROM THESE PLANS-USE DIMENSIONS

ALASKA	DESIGNED BY: D.D.S.	PROJECT NO. 71135
	DRAWN BY: B.W.B.	DATE: APRIL, 1994
	CHECKED BY: J.D.B.	SHEET 19 OF 20

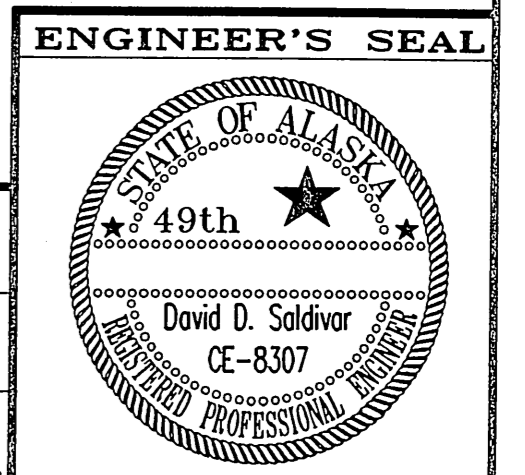

FLOAT BALANCING NOTES:


1. Contractor shall supply a minimum of 8-20"x5"x4"-6" balancing billets. Balancing billets shall be installed at locations directed by the Engineer.
2. Unused balancing billets shall become the property of the State and shall be stored at a location on the project site as directed by the Engineer. - ALL USED
3. Existing 2x10 decking shall be removed as necessary to drive the 1/2"x14" wooden dowels (treated) thru the existing flotation billets. *NOTED - EXISTING JOEKING WAS INSTALLED THROUGH & MORE DAMAGE TO IT WOULD OCCUR WITH ITS REMOVAL THAN NECESSARY - PILES NOT NECESSARY*
4. Installation of balancing billets may not be accessible on the listing side because of the existing floating building. - WORK W/ILE TO GET BETWEEN BUILDING AND FLOAT
5. See sheet 3 for approximate location.

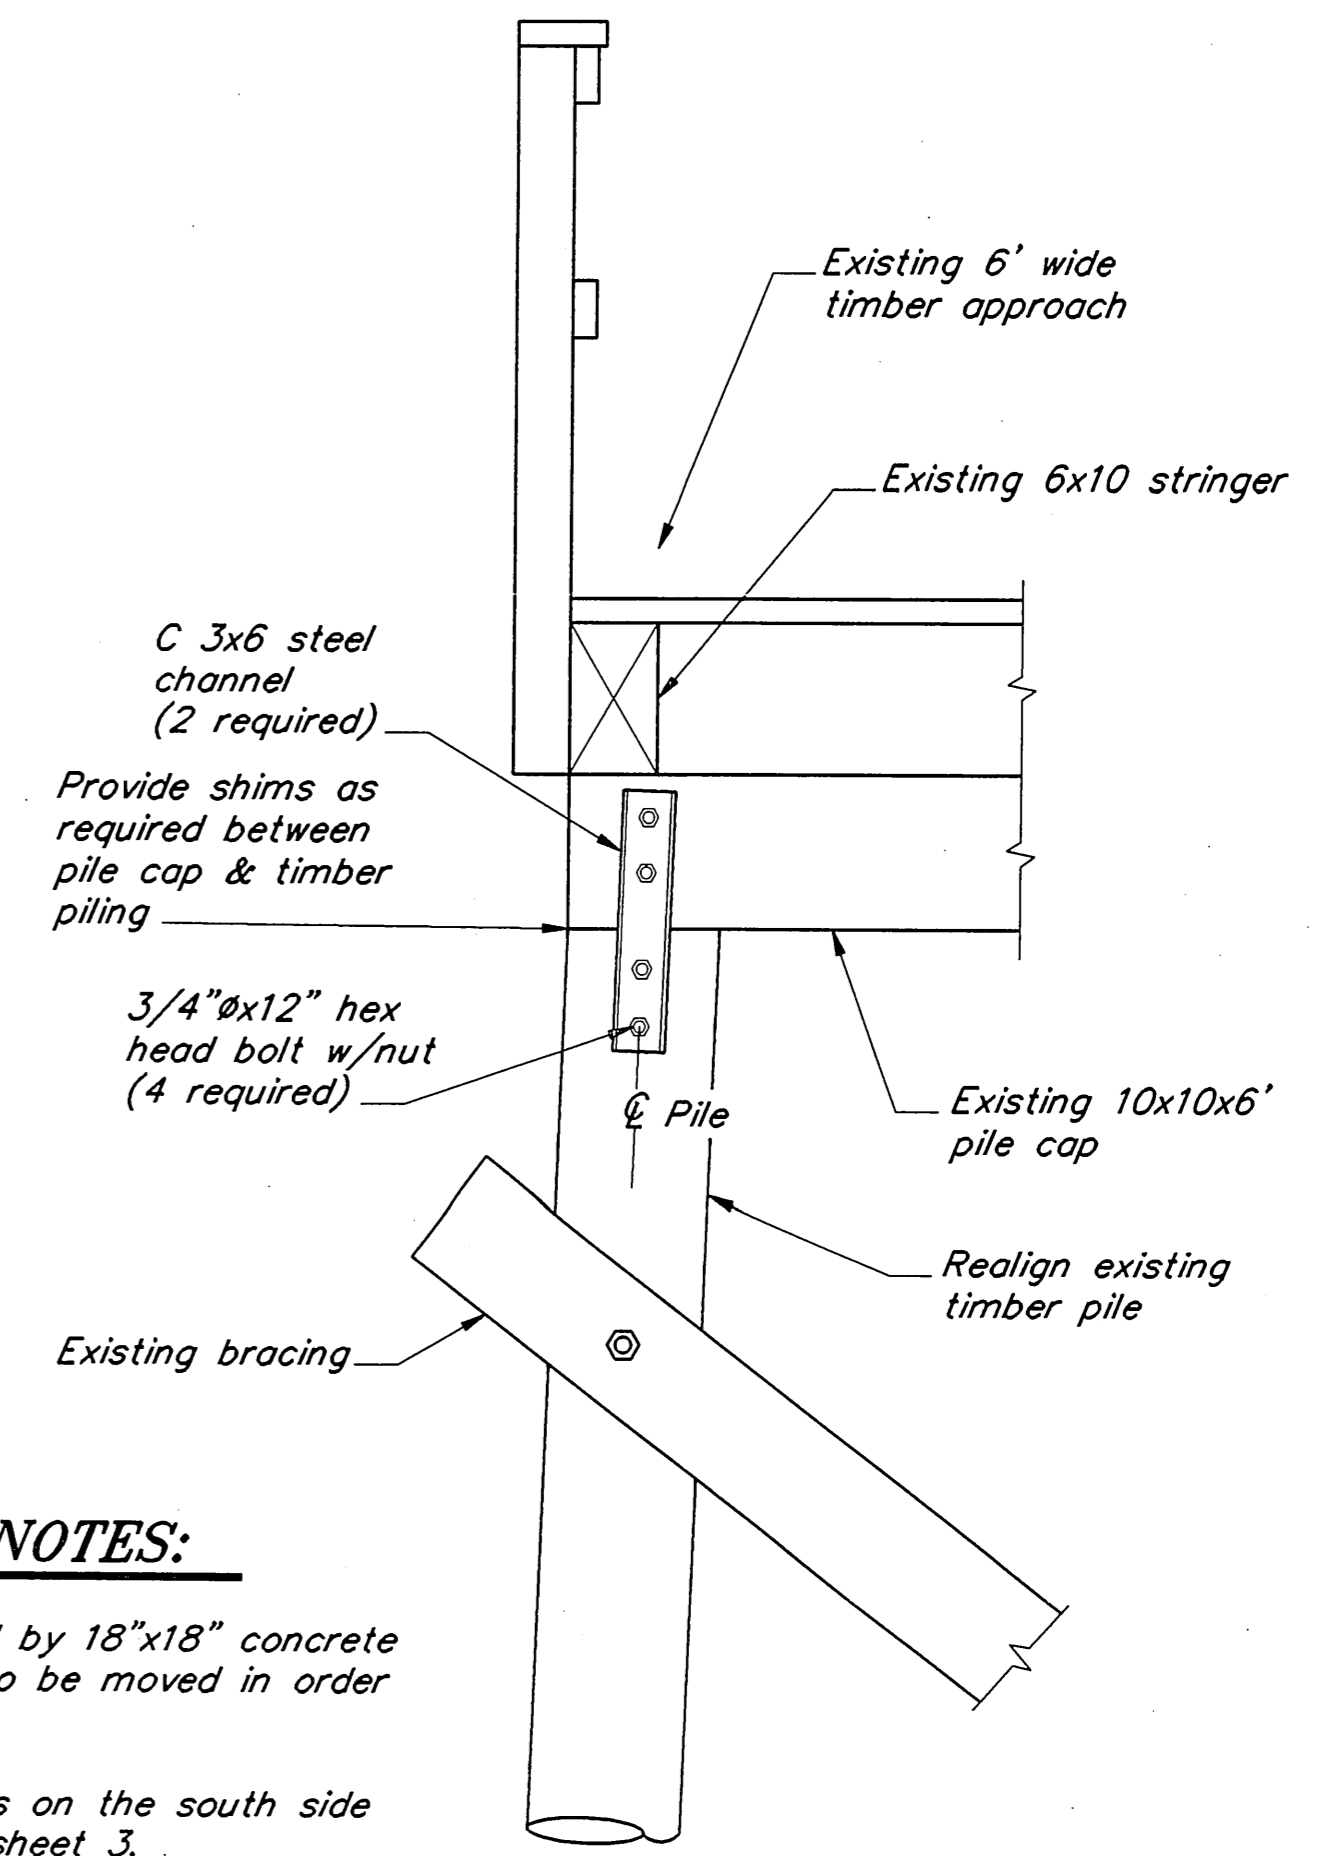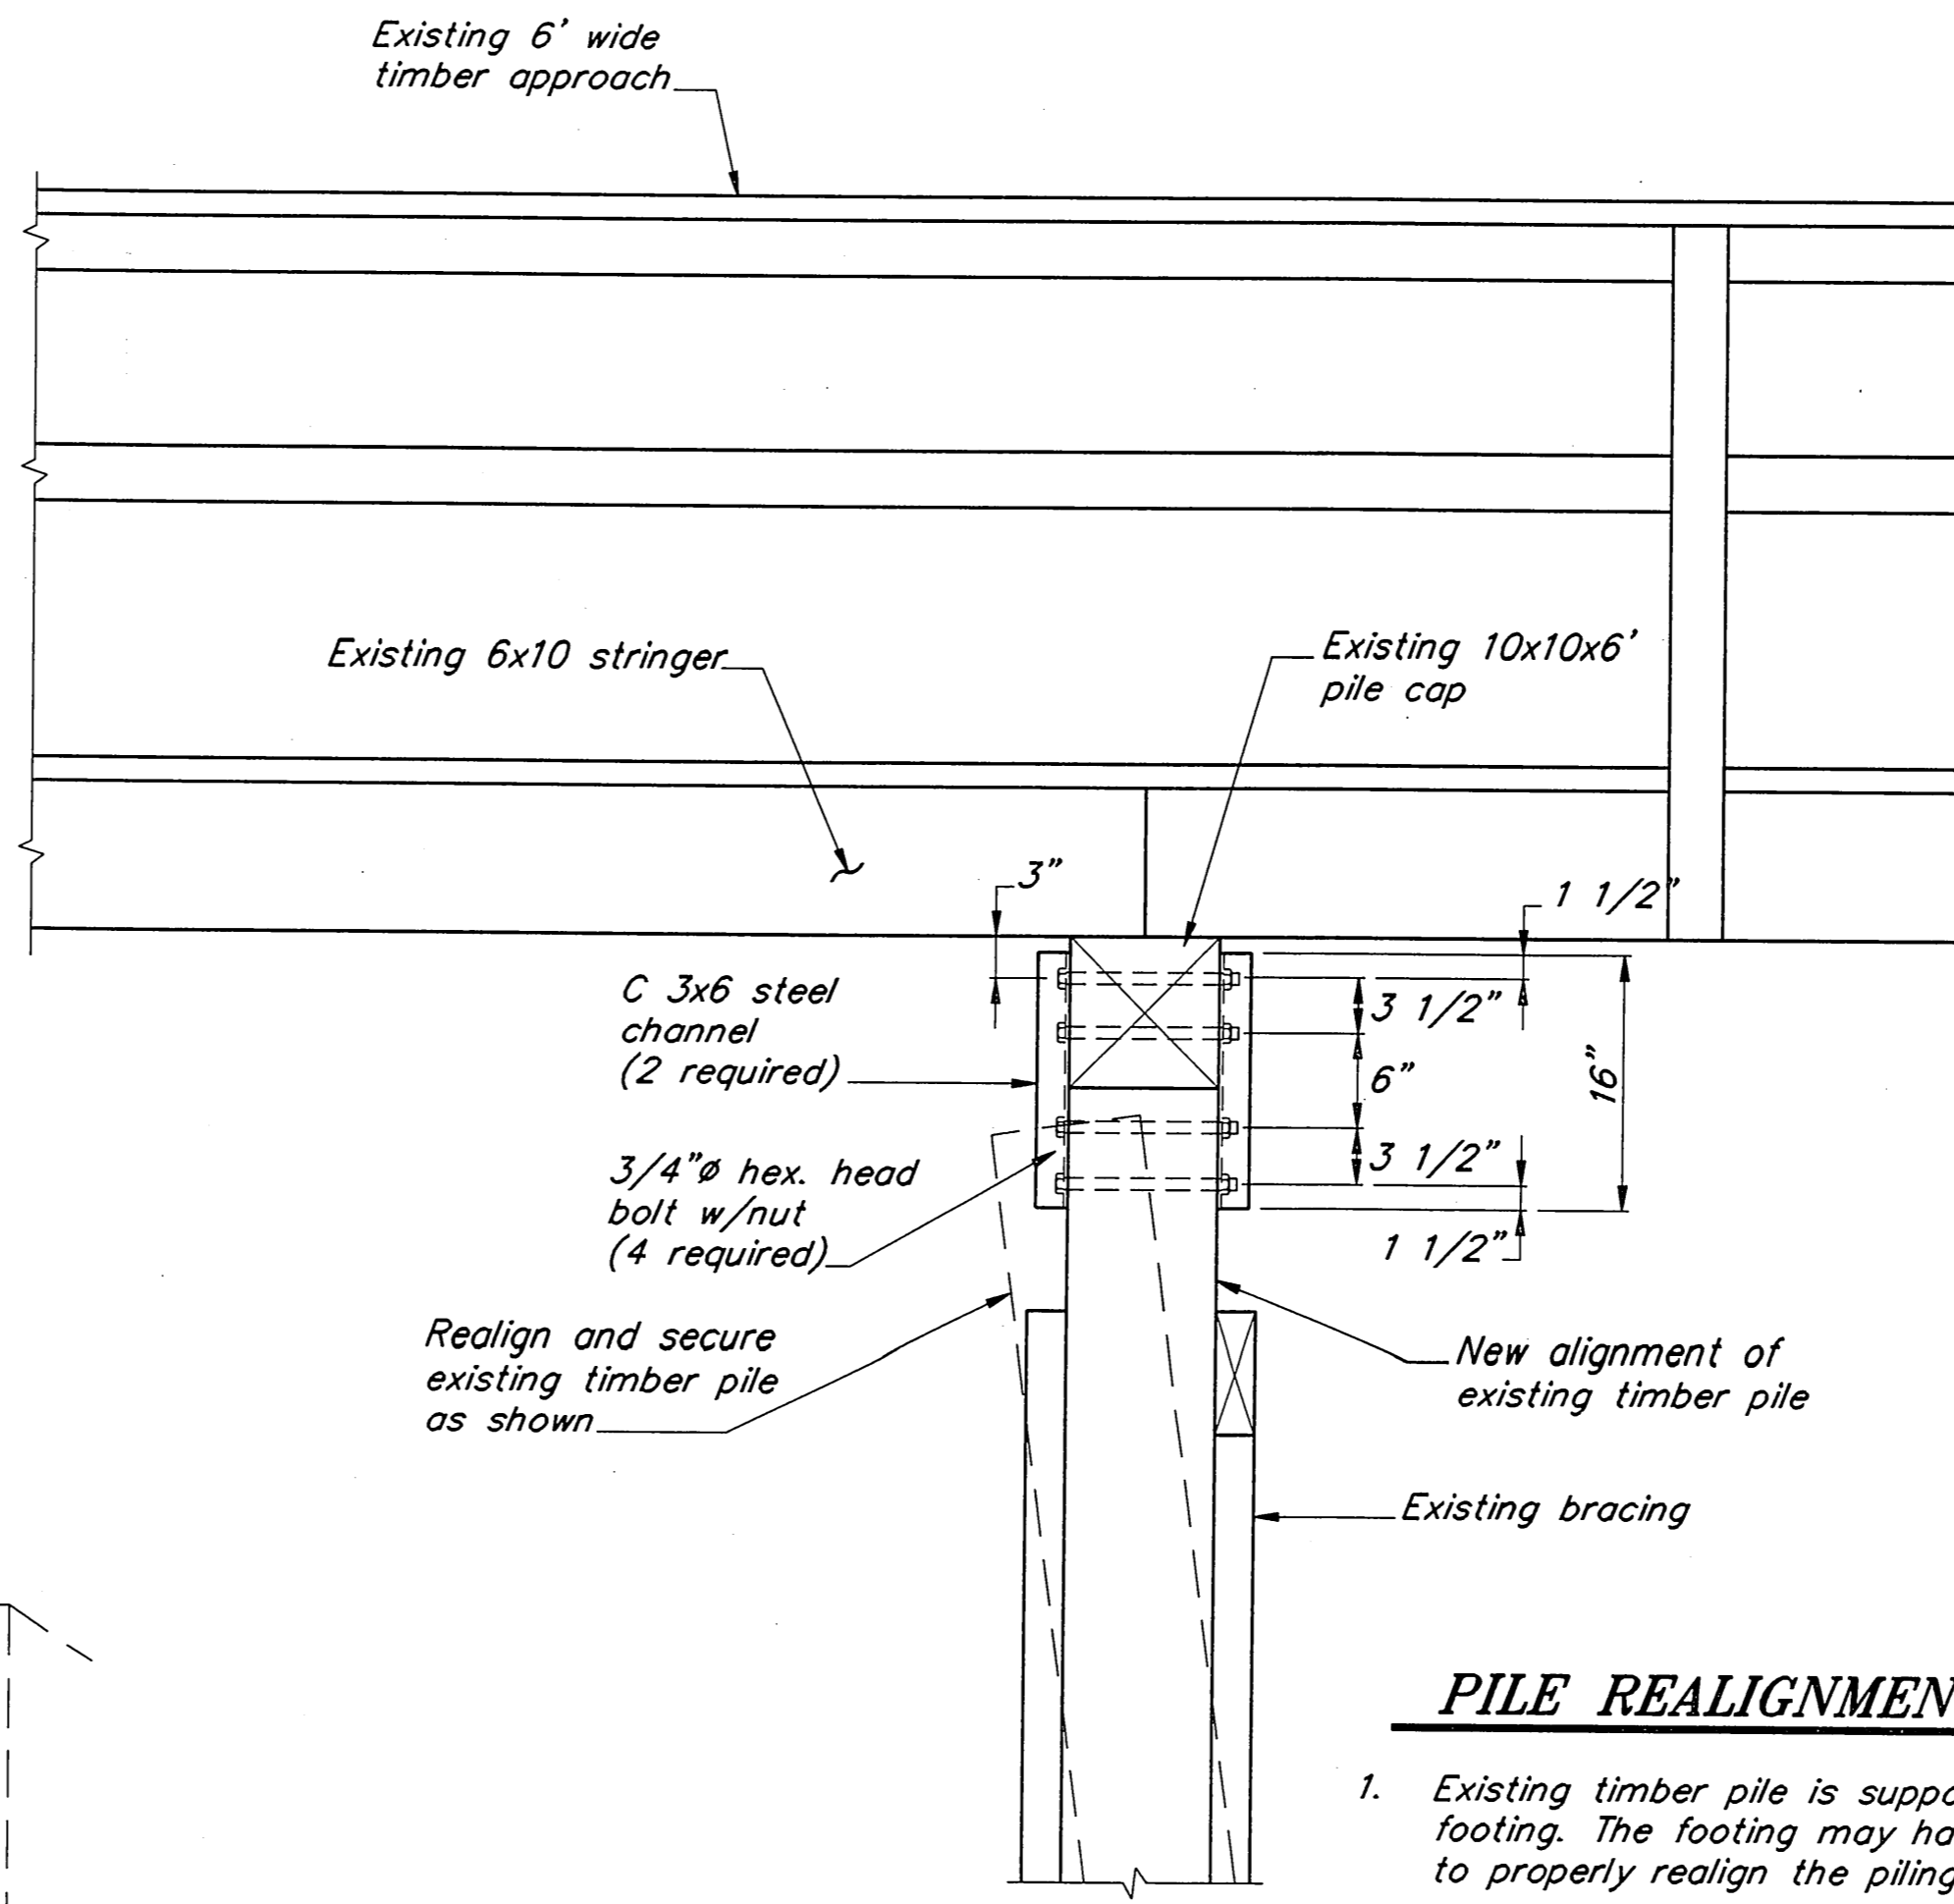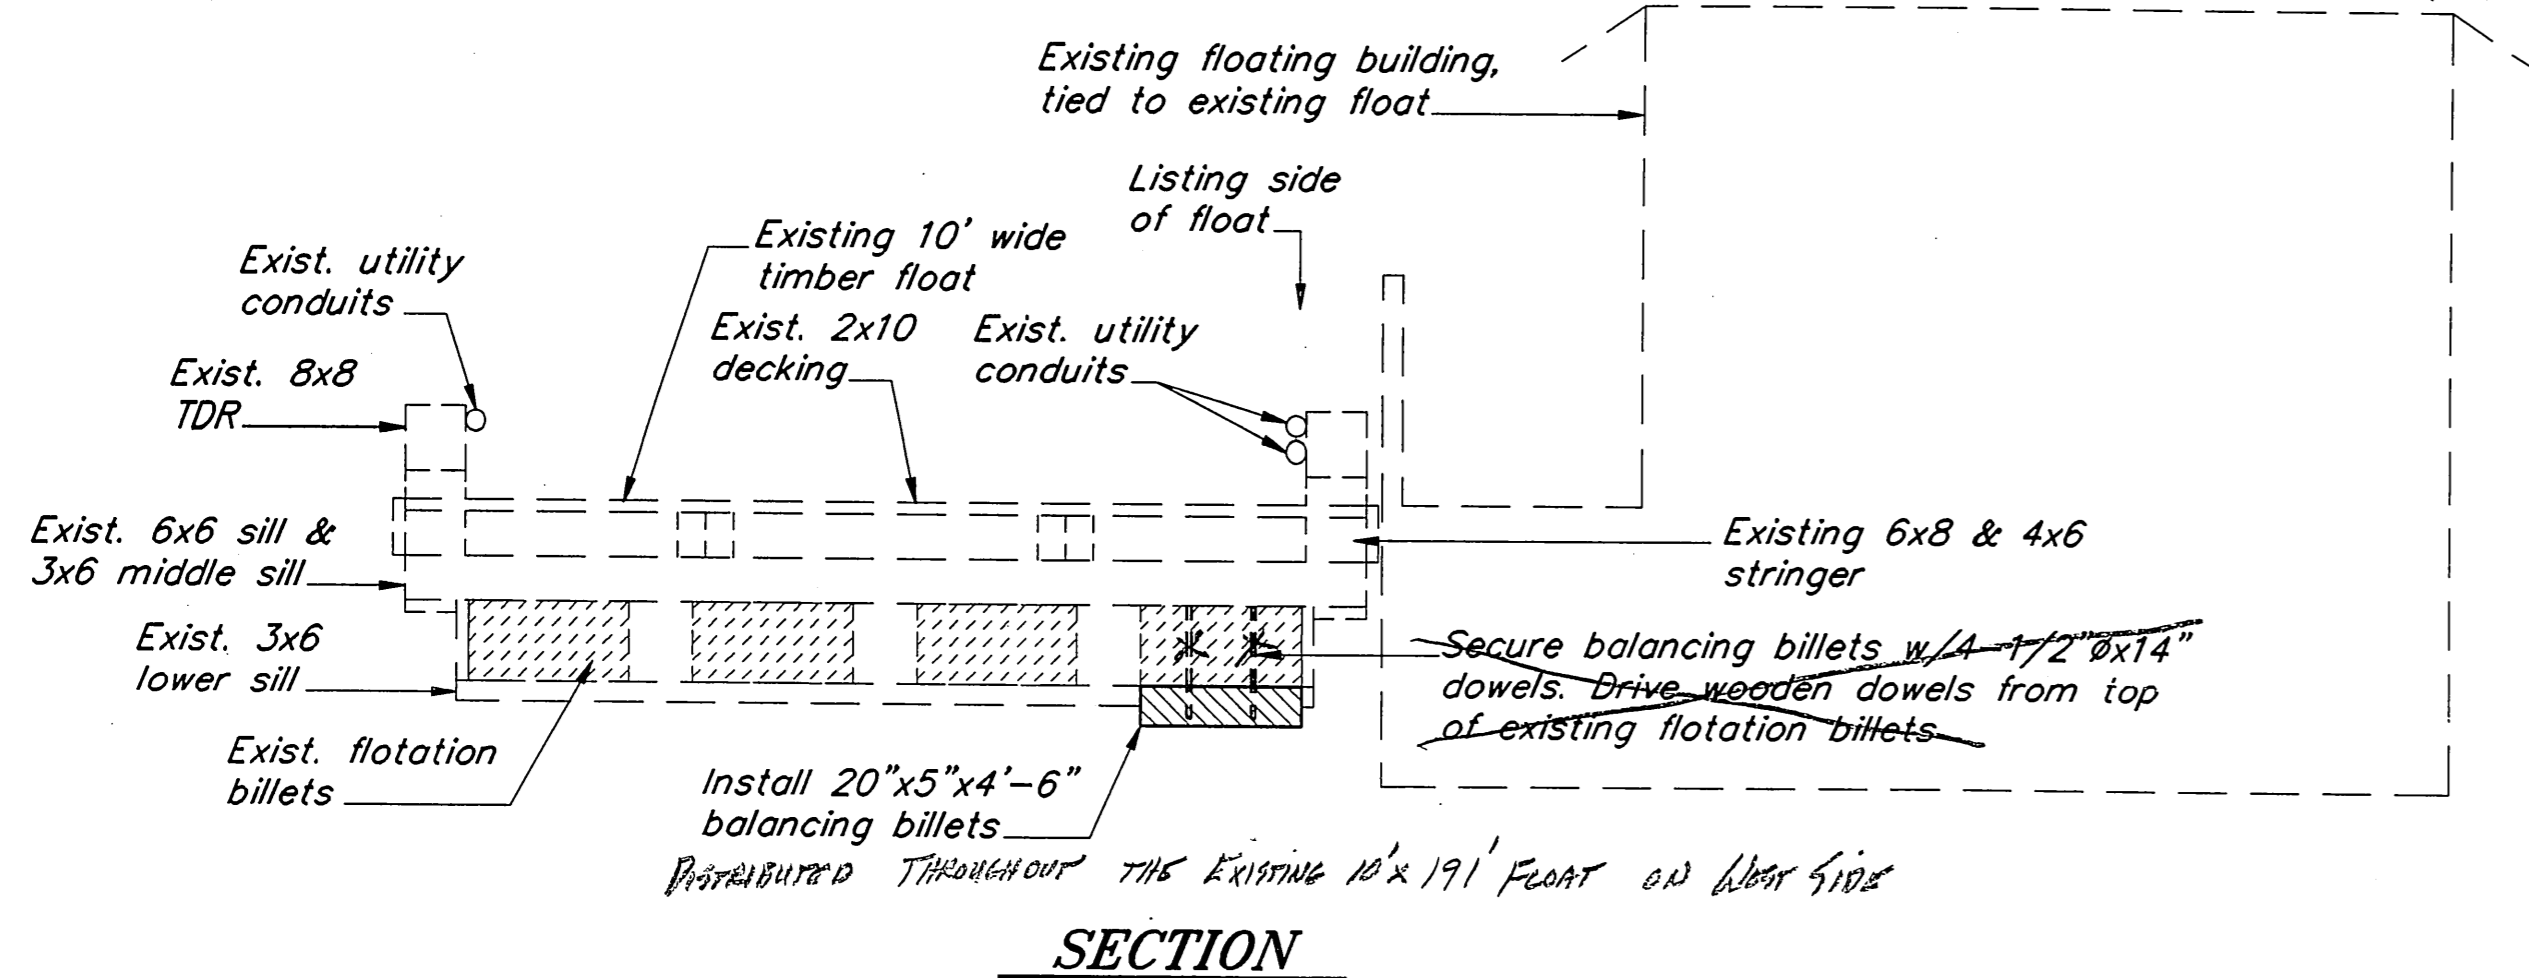

PILE REALIGNMENT NOTES:

1. Existing timber pile is supported by 18"x18" concrete footing. The footing may have to be moved in order to properly realign the piling.
2. The single pile to be realigned is on the south side of the third bent as shown on sheet 3.

PILE REALIGNMENT WORK No. 1

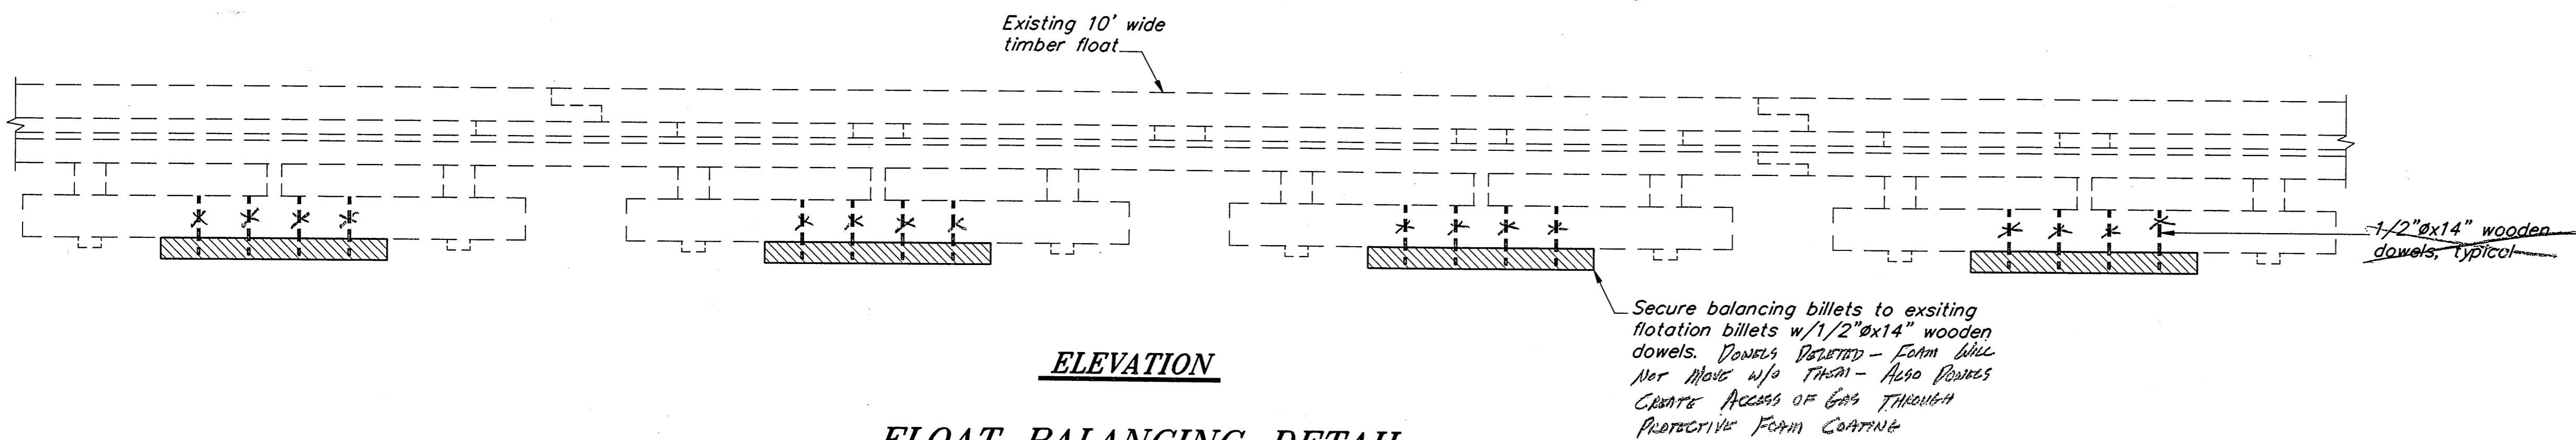

FLOAT BALANCING DETAIL WORK No. 3

As BUILT
Mark Johnson
7/24/95

PATH: P:\POW\PTBAKER\DR\SHT20.dwg < 1=24 >		
BY	DATE	DESCRIPTION OF CHANGE
RECORD OF REVISIONS		

STATE OF ALASKA
DEPARTMENT OF TRANSPORTATION AND PUBLIC FACILITIES
SOUTHEAST REGION DESIGN & CONSTRUCTION

POINT BAKER

PRINCE OF WALES ISLAND
POINT BAKER SEAPLANE FLOAT
A.I.P. # 3-02-0423-01

ALASKA

Pile Realignment/Float Balancing

NOTE: DO NOT SCALE FROM THESE PLANS-USE DIMENSIONS

DESIGNED BY: D.D.S.	PROJECT NO. 71135
DRAWN BY: E.W.B.	DATE: APRIL, 1994
CHECKED BY: J.D.B.	SHEET 20 OF 20

