

AK USFS 2060(1) Naukati Road Reconstruction

Contract No: DTFH7016C00005

Southeast Roadbuilders, Inc.

Award Date: November 19, 2015



Asbuilt Drawings

Index

- A. General Information**
- B. Summary of Quantities**
- C. Typical Sections**
- D. Plan and Profile**
- E. Approach Road Quantities**
- F. Erosion and Sediment Control**
- G. Drainage**
- H. Reinforced Soil Slopes**
- I. Safety Features**
- J. Temporary Traffic Control**
- K. Permanent Traffic Control**

Amendment A003

- APPROVED
- APPROVED AS NOTED
- RETURNED FOR CORRECTION

Date: JUL 08 2017 By: Jim Jozovich

FEDERAL HIGHWAY ADMINISTRATION
Federal Lands Highway

See FAR 52.236-21(e) for limitations of Government's
responsibility in approving this document.

STATE	PROJECT	SHEET NUMBER
AK	USFS 2060(1)	A.2

INDEX TO SHEETS

A. GENERAL INFORMATION

- A.1 TITLE SHEET
- A.2 INDEX TO SHEETS
- A.3 PLAN SYMBOLS AND ABBREVIATIONS
- A.4 VICINITY MAP

B. SUMMARIES

- △ B.1-3 SUMMARY OF QUANTITIES

C. TYPICAL SECTIONS

- C.1 TABULATION OF TYPICAL SECTION QUANTITIES
- C.2 TYPICAL SECTION
- C.3-4 EMBANKMENT CONSTRUCTION DETAILS
- C.5 SETTLEMENT PLATE DETAILS

D. PLAN-PROFILE

- D.1-2 TABULATION OF PLAN QUANTITIES
- D.3-7 PLAN AND PROFILE
- D.8 FH-43 INTERSECTION DETAIL
- D.9 SURVEY CONTROL
- D.10 GUY POLE PAD DETAIL

E. APPROACH ROAD QUANTITIES

- E.1 TABULATION OF APPROACH ROAD QUANTITIES
- E.2-7 APPROACH ROADS PLAN AND PROFILE

F. EROSION/SEDIMENT CONTROL

- F.1 TABULATION OF EROSION/SEDIMENT CONTROL PLAN QUANTITIES
- F.2-10 SEDIMENTATION AND EROSION CONTROL PLANS
- F.11-12 SETTLEMENT WATTLE DETAILS
- F.13 STABILIZED CONSTRUCTION ENTRANCE/EXIT DETAILS

G. DRAINAGE

- G.1-2 TABULATION OF DRAINAGE QUANTITIES
- G.3 STATION 13+50 - 60" DIAMETER CULVERT
- G.4 STATION 57+76 - 84" DIAMETER CULVERT
- G.5 STATION 66+74 - 108" DIAMETER CULVERT
- G.6 STATION 130+93 - 72" DIAMETER CULVERT
- G.7-8 DRAINAGE DETAILS
- G.9 SIMULATED STREAM CULVERT TREATMENT
- G.10 ENERGY DISSIPATOR DETAILS
- G.11 RSS SLOPE CULVERT AND RIPRAP DITCH DETAILS
- G.12 STD DRWG 602-1 - METAL PIPE CULVERT
- G.13 STD DRWG 602-2 - METAL PIPE CULVERT COUPLING BAND
- G.14 STD DRWG 602-3 - METAL AND PLASTIC PIPE CULVERT BEDDING
- G.15 STD DRWG 602-5 - PLASTIC PIPE CULVERT
- G.16 STD-DRWG 602-6 - PIPE CULVERT INLET TREATMENT IN CUT SLOPES

H. REINFORCED SOIL SLOPES

- H.1 TABULATION OF REINFORCED SOIL SLOPE QUANTITIES
- H.2 REINFORCED SOIL SLOPE TYPICAL SECTION
- H.3 REINFORCED SOIL SLOPE PLAN AND PROFILE 88+50 TO 90+05
- H.4-6 REINFORCED SOIL SLOPE PLAN AND PROFILE 97+50 TO 100+60

I. SAFETY FEATURES

- I.1 STD DRWG 617-10 G4 W-BEAM GUARDRAIL WOOD POSTS
- I.2 STD DRWG 617-20 G4 W-BEAM GUARDRAIL TYPE TANGENT TERMINAL

J. TEMPORARY TRAFFIC CONTROL PLAN

- J.1 TABULATION OF TEMP TRAFFIC CONTROL QUANTITIES
- J.2 STD DRWG 635-1 TEMPORARY TRAFFIC CONTROL ADVANCE SIGNING
- J.3 STD DRWG 635-5 TEMPORARY TRAFFIC CONTROL ROAD CLOSURE LAYOUT (WITH FLAGGERS)
- J.4 STD DRWG 635-6 TEMPORARY TRAFFIC CONTROL SINGLE LANE CLOSURE LAYOUT (WITH FLAGGERS)
- J.5 STD DRWG 635-13 TEMPORARY TRAFFIC CONTROL ROAD CLOSURE LAYOUT (WITH TEMPORARY BARRIER)
- STD DRWG 635-13 TEMPORARY TRAFFIC CONTROL SIGN INSTALLATION WOOD POSTS

K. PERMANENT TRAFFIC CONTROL

- K.1 TABULATION OF PERMANENT TRAFFIC CONTROL QUANTITIES
- K.2-4 PERMANENT TRAFFIC CONTROL PLAN
- K.5 PERMANENT SIGN DETAIL
- K.6 STD DRWG W633-7 PERMANENT SIGN INSTALLATION WOOD POSTS



- APPROVED
- APPROVED AS NOTED
- RETURNED FOR CORRECTION

Date: JUL 10 2017 By: Jim Jozovich

FEDERAL HIGHWAY ADMINISTRATION
Federal Lands Highway

See FAR 52.236-21(e) for limitations of Government's responsibility in approving this document.

△ Amendment A003

INDEX TO SHEETS

04/2013 Checked by:

C.Conrad

Designed by:

c:\myfiles\pw_production\0199356\ak-206001\ab.dgn [US_Sur_02D]

21 August 2015 7:42 AM

SUMMARY OF QUANTITIES - Schedule A

STATE	PROJECT	SHEET NUMBER
AK	USFS 2060(1)	B.1

A M E N D	Line Item No.	Pay Item Number	Pay Item Description	Unit	Sheet and Description													Estimated Quantities		Remarks and/or Determination of Estimated Quantity	
					Section C	Section D	Section E	Section F	Section G	Section H	Section I	Section J	Section K					ALLOWANCE	Bid Schedule		
					Typical Section	Plan & Profile	Approach Roads	Erosion Control	Drainage	Reinforce d Soil Slopes	Safety Features	Temporar y Traffic Control	Permanent Traffic Control								
	A0020	15101-0000	MOBILIZATION	LPSM															ALL		
	A0040	15201-0000	CONSTRUCTION SURVEY AND STAKING	LPSM																ALL	
	A0060	15301-0010	CONTRACTOR QUALITY CONTROL AND ASSURANCE	LPSM																ALL	
	A0080	15401-0000	CONTRACTOR TESTING	LPSM																ALL	
	A0100	15501-0000	CONSTRUCTION SCHEDULE	LPSM																ALL	
	A0120	15702-1000	SOIL EROSION CONTROL, TEMPORARY DIVERSION CHANNEL	LPSM																ALL	
	A0140	15705-1500	SOIL EROSION CONTROL, SEDIMENT WATTLE(CHECK DAMS)	LNFT				2,510												2,510	
	A0160	15705-1500	SOIL EROSION CONTROL, SEDIMENT WATTLE(SLOPE PROTECTION)	LNFT				29,884												29,884	
	A0180	15705-1500	SOIL EROSION CONTROL, SEDIMENT WATTLE	LNFT				11,636												11,636	
	A0200	15706-1600	SOIL EROSION CONTROL, STABILIZED CONSTRUCTION ENTRANCE	EACH				1												1	
	A0220	15707-1000	SOIL EROSION CONTROL, TEMPORARY TURF ESTABLISHMENT	SLRY				54												54	
	A0240	15801-0000	WATERING FOR DUST CONTROL	MGAL				2,250												2,250	
	A0260	20101-0000	CLEARING AND GRUBBING	ACRE		24.0														24.0	
	A0280	20301-1900	REMOVAL OF PIPE CULVERT	EACH					31											31	
	A0300	20301-2400	REMOVAL OF SIGN	EACH										2						2	
	A0320	20401-0000	ROADWAY EXCAVATION	CUYD		117,072	5,919										6,209		129,200		
	A0340	20402-0000	SUBEXCAVATION	CUYD		2,252											118		2,370		
	A0360	20410-0000	SELECT BORROW(GUY POLE PAD)	CUYD		110													110		
	A0380	20411-0000	SELECT BORROW	TON	31,028	14,021	3,095										2,456		50,600	1.97 TONS/CUYD	
	A0400	20450-1000	BORROW, ROCK(SUBEX BACKFILL)	CUYD		2,252											118		2,370		
	A0420	20450-1000	BORROW, ROCK	CUYD		30,463											1,537		32,000		
	A0440	20701-0700	EARTHWORK GEOTEXTILE, TYPE II-A	SQYD		34,966											1,734		36,700		
	A0460	20701-1200	EARTHWORK GEOTEXTILE, TYPE IV-A	SQYD		32,308											1,692		34,000		
	A0480	20703-2000	GEOGRID, BIAXIAL	SQYD		34,966											1,734		36,700		
	A0500	21101-2000	ROADWAY OBLITERATION, METHOD 2	SQYD		3,407													3,407		
	A0520	25101-2000	PLACED RIPRAP, CLASS 2(ENERGY DISSIPATOR)	CUYD					99								21		120		

C:\Users\kurtis.jorgensen\Desktop\Naukati Road Engineers Estimate A003.xlsx\SHEET
20-Oct-2015 4:36 PM

SUMMARY OF QUANTITIES - Schedule A

STATE	PROJECT	SHEET NUMBER
AK	USFS 2060(1)	B.2

A M E N D	Line Item No.	Pay Item Number	Pay Item Description	Unit	Sheet and Description												Estimated Quantities		Remarks and/or Determination of Estimated Quantity	
					Section C	Section D	Section E	Section F	Section G	Section H	Section I	Section J	Section K					ALLOWANCE		Bid Schedule
					Typical Section	Plan & Profile	Approach Roads	Erosion Control	Drainage	Reinforce d Soil Slopes	Safety Features	Temporar y Traffic Control	Permanent Traffic Control							
	A0540	25101-2000	PLACED RIPRAP, CLASS 2(RIPRAP HEADWALL)	CUYD						267								33	300	
	A0560	25120-2000	RIPRAP DITCH, CLASS 2	LNFT		3,405												342	3,747	
	A0580	27201-1000	REINFORCED SOIL SLOPE, GEOGRID	SQFT						6,948									6,948	
	A0600	30101-2000	AGGREGATE BASE GRADING D(4-INCH COMPACTED DEPTH)	TON	11,338		2,772											1,390	15,500	1.97 TONS/CUYD
	A0620	30901-2000	EMULSIFIED ASPHALT TREATED AGGREGATE BASE, GRADING D(4-INCH COMPACTED DEPTH)	TON	10,726													1,074	11,800	
	A0640	30905-1200	EMULSIFIED ASPHALT, GRADE CSS-1	TON	215													21	236	
	A0660	40301-0000	HOT ASPHALT CONCRETE PAVEMENT	TON			230											11	241	
	A0680	40910-0800	SURFACE TREATMENT, DESIGNATION 2C	SQYD	47,646													4,754	52,400	
	A0700	40940-1300	EMULSIFIED ASPHALT, GRADE CRS-2P	TON	199													20	219	
	A0720	60201-0800	24-INCH PIPE CULVERT	LNFT					1,922										1,922	
	A0740	60201-1000	36-INCH PIPE CULVERT	LNFT					616										616	
	A0760	60201-1400	60-INCH PIPE CULVERT	LNFT					114										114	
	A0780	60201-1600	72-INCH PIPE CULVERT	LNFT					74										74	
	A0800	60201-1800	84-INCH PIPE CULVERT	LNFT					62										62	
	A0820	60201-2200	108-INCH PIPE CULVERT	LNFT					88										88	
	A0840	61701-1250	GUARDRAIL SYSTEM G4, TYPE 2, CLASS A WOOD POSTS	LNFT															3,925	
	A0860	61702-0800	TERMINAL SECTION TYPE TANGENT	EACH			14												14	
	A0880	62101-0000	MONUMENT(SETTLEMENT PLATE ASSEMBLY)	EACH	6														6	
	A0900	62201-0250	DUMP TRUCK, 10 CUBIC YARD MINIMUM CAPACITY	HOUR			80												80	
	A0920	62201-1000	WHEEL LOADER, 4 CUBIC YARD MINIMUM RATED CAPACITY	HOUR			40												40	
	A0940	62201-1250	BULLDOZER, 120HP MINIMUM FLYWHEEL POWER	HOUR			40												40	
	A0960	62201-3100	HYDRAULIC EXCAVATOR, 3.0 CUBIC YARD MINIMUM CAPACITY, 165HP MINIMUM FLYWHEEL POWER	HOUR			80												80	
	A0980	62201-3750	CHAIN SAW	HOUR			20												20	
	A1000	62301-0000	GENERAL LABOR	HOUR			40												40	
	A1020	62405-0300	PLACING CONSERVED TOPSOIL, 4-INCH DEPTH	SQYD			18,097											1,803	19,900	

C:\Users\kurtis.jorgensen\Desktop\Naukati Road Engineers Estimate A003.xlsx\Sheet (2) 20-Oct-2015 4:36 PM

SUMMARY OF QUANTITIES - Schedule A

STATE	PROJECT	SHEET NUMBER
AK	USFS 2060(1)	B.3

A M E N D	Line Item No.	Pay Item Number	Pay Item Description	Unit	Sheet and Description													Estimated Quantities	Remarks and/or Determination of Estimated Quantity		
					Section C	Section D	Section E	Section F	Section G	Section H	Section I	Section J	Section K					ALLOWANCE		Bid Schedule	
					Typical Section	Plan & Profile	Approach Roads	Erosion Control	Drainage	Reinforced Soil Slopes	Safety Features	Temporary Traffic Control	Permanent Traffic Control								
	A1040	62503-0000	TURF ESTABLISHMENT	SLRY		54														54	
	A1060	63302-0000	SIGN SYSTEM	SQFT									53							53	
	A1080	63502-0600	TEMPORARY TRAFFIC CONTROL, BARRICADE TYPE 3	EACH								4								4	
	A1100	63502-1000	TEMPORARY TRAFFIC CONTROL, CONE, TYPE 36-INCH	EACH								150								150	
	A1120	63502-1300	TEMPORARY TRAFFIC CONTROL, DRUM	EACH								60								60	
	A1140	63503-0400	TEMPORARY TRAFFIC CONTROL, CONCRETE BARRIER	LNFT								1,170								1,170	
	A1160	63504-1000	TEMPORARY TRAFFIC CONTROL, CONSTRUCTION SIGN	SQFT								241								241	
	A1180	63509-1000	TEMPORARY TRAFFIC CONTROL, FLAGGER	X HR RA								7,000								7,000	
A003	A1182	63701-0000	FIELD OFFICE	EACH														1		1	
A003	A1184	63704-0000	VEHICLE	EACH														2		2	
	A1200	64631-0000	ROADSIDE DEVELOPMENT(BIOFILTRATION SWALE)	LNFT								1,628								1,628	
	A1220	64703-6000	MITIGATION, FISH PASSAGE BOULDER	EACH								46								46	
	A1240	64704-1000	MITIGATION, STREAMBED MATERIAL	CUYD								355								355	

C:\Users\curtis.jorgensen\Desktop\Naukati Road Engineers Estimate A003.xlsx(Sheet: 3)
20-Oct-2015 4:36 PM

STATE	PROJECT	SHEET NUMBER
AK	USFS 2060(1)	A.1

U. S. DEPARTMENT OF TRANSPORTATION FEDERAL HIGHWAY ADMINISTRATION




PLANS FOR PROPOSED PROJECT
AK USFS 2060(1)

NAUKATI ROAD RECONSTRUCTION

PRINCE OF WALES-HYDER CENSUS AREA
TONGASS NATIONAL FOREST
PRINCE OF WALES ISLAND
ALASKA

LENGTH 2.494 MILES

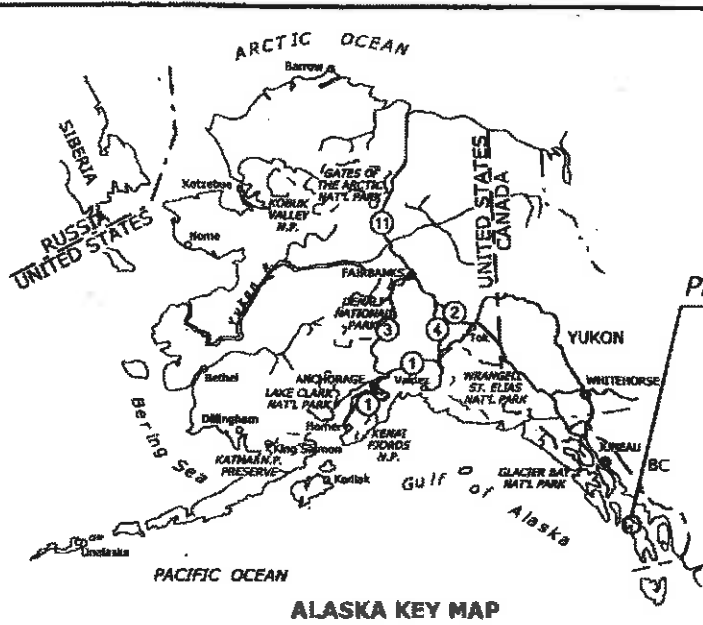

Project Location

SECTION INDEX
A. GENERAL INFORMATION
B. SUMMARIES
C. TYPICAL SECTIONS
D. PLAN-PROFILE
E. APPROACH ROAD QUANTITIES
F. EROSION/SEDIMENT CONTROL
G. DRAINAGE
H. REINFORCED SOIL SLOPES
I. SAFETY FEATURES
J. TEMPORARY TRAFFIC CONTROL PLAN
K. PERMANENT TRAFFIC CONTROL

TYPE OF CONSTRUCTION:

Grading, drainage, and base

DESIGN DESIGNATION:

ADT (2014) <100
ADT (2034) NO DATA AVAILABLE
V 30 MPH
e(max) 0.060

SPECIFICATION:


Standard Specifications for Construction of Roads and Bridges on Federal Highway Projects, FP-03 US Customary Units



PLANS PREPARED BY
U.S. DEPARTMENT OF TRANSPORTATION
FEDERAL HIGHWAY ADMINISTRATION
WESTERN FEDERAL LANDS HIGHWAY DIVISION
VANCOUVER, WASHINGTON

PROJECT MANAGER
N. CHRISTENSEN

BEGIN PROJECT
10+13.42

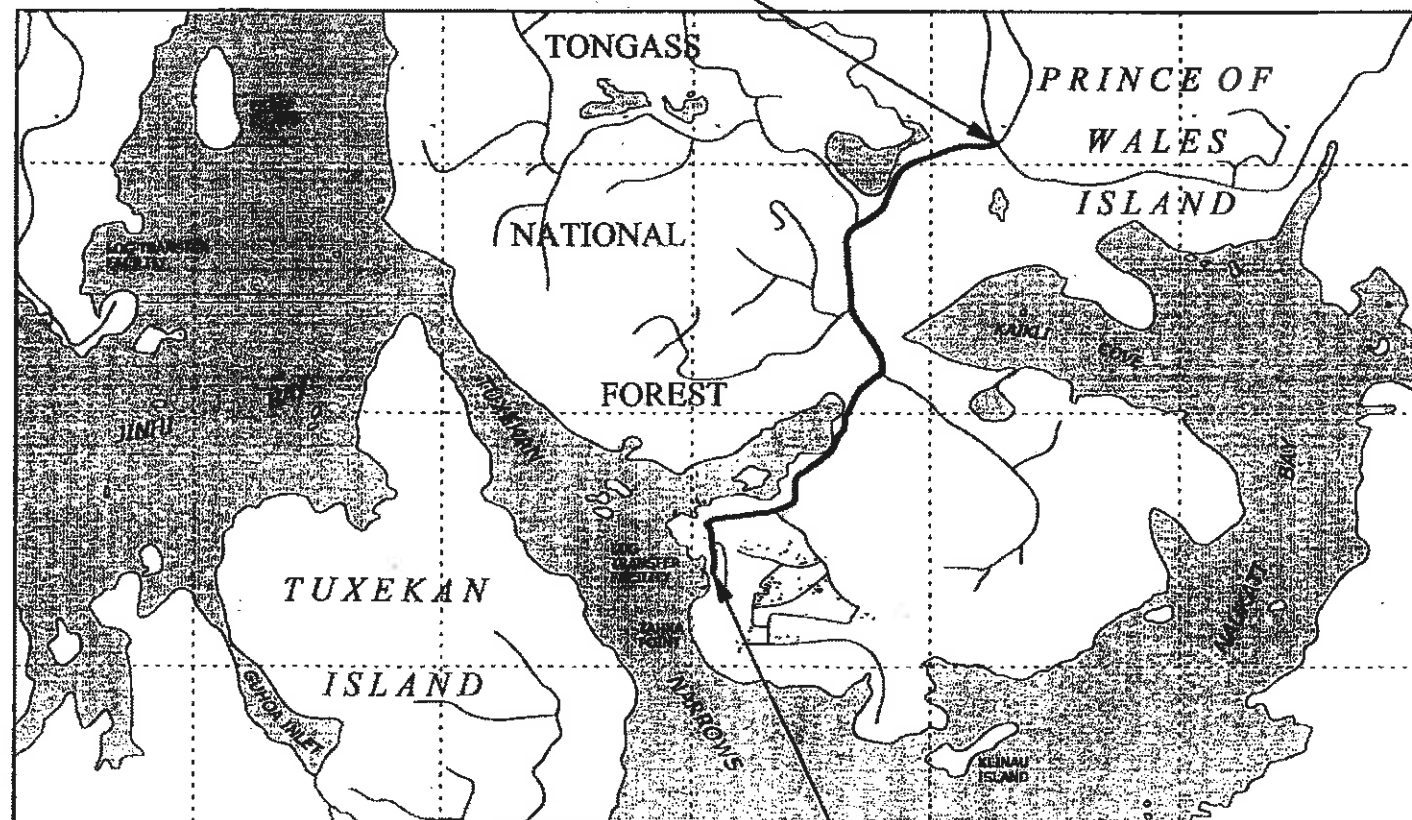

END PROJECT
141+80



See Sheet A.2 for Index to Sheets

RECEIVED
JUL 08 2017
BY PROJECT ENGINEER

APPROVED:

[Signature]
Director, Project Delivery,
Western Federal Lands Highway Division

DATE 8/21/15

Checked by: 04/2013
Designed by: C. Conrad
8/21/2015
...\\s-220601aa.dgn [U.S. Sur. D2D]

INDEX TO SHEETS

A. GENERAL INFORMATION

- A.1 TITLE SHEET
- A.2 INDEX TO SHEETS
- A.3 PLAN SYMBOLS AND ABBREVIATIONS
- A.4 VICINITY MAP

B. SUMMARIES

- B.1-2 SUMMARY OF QUANTITIES

C. TYPICAL SECTIONS

- C.1 TABULATION OF TYPICAL SECTION QUANTITIES
- C.2 TYPICAL SECTION
- C.3-4 EMBANKMENT CONSTRUCTION DETAILS
- C.5 SETTLEMENT PLATE DETAILS

D. PLAN-PROFILE

- D.1-2 TABULATION OF PLAN QUANTITIES
- D.3-7 PLAN AND PROFILE
- D.8 FH-43 INTERSECTION DETAIL
- D.9 SURVEY CONTROL
- D.10 GUY POLE PAD DETAIL

E. APPROACH ROAD QUANTITIES

- E.1 TABULATION OF APPROACH ROAD QUANTITIES
- E.2-7 APPROACH ROADS PLAN AND PROFILE

F. EROSION/SEDIMENT CONTROL

- F.1 TABULATION OF EROSION/SEDIMENT CONTROL PLAN QUANTITIES
- F.2-10 SEDIMENTATION AND EROSION CONTROL PLANS
- F.11-12 SETTLEMENT WATTLE DETAILS
- F.13 STABILIZED CONSTRUCTION ENTRANCE/EXIT DETAILS

G. DRAINAGE

- G.1-2 TABULATION OF DRAINAGE QUANTITIES
- G.3 STATION 13+50 - 60" DIAMETER CULVERT
- G.4 STATION 57+76 - 84" DIAMETER CULVERT
- G.5 STATION 66+74 - 108" DIAMETER CULVERT
- G.6 STATION 130+93 - 72" DIAMETER CULVERT
- G.7-8 DRAINAGE DETAILS
- G.9 SIMULATED STREAM CULVERT TREATMENT
- G.10 ENERGY DISSIPATOR DETAILS
- G.11 RSS SLOPE CULVERT AND RIPRAP DITCH DETAILS
- G.12 STD DRWG 602-1 - METAL PIPE CULVERT
- G.13 STD DRWG 602-2 - METAL PIPE CULVERT COUPLING BAND
- G.14 STD DRWG 602-3 - METAL AND PLASTIC PIPE CULVERT BEDDING
- G.15 STD DRWG 602-5 - PLASTIC PIPE CULVERT
- G.16 STD-DRWG 602-6 - PIPE CULVERT INLET TREATMENT IN CUT SLOPES

H. REINFORCED SOIL SLOPES

- H.1 TABULATION OF REINFORCED SOIL SLOPE QUANTITIES
- H.2 REINFORCED SOIL SLOPE TYPICAL SECTION
- H.3 REINFORCED SOIL SLOPE PLAN AND PROFILE 88+50 TO 90+05
- H.4-6 REINFORCED SOIL SLOPE PLAN AND PROFILE 97+50 TO 100+60

I. SAFETY FEATURES

- I.1 STD DRWG 617-10 G4 W-BEAM GUARDRAIL WOOD POSTS
- I.2 STD DRWG 617-20 G4 W-BEAM GUARDRAIL TYPE TANGENT TERMINAL

J. TEMPORARY TRAFFIC CONTROL PLAN

- J.1 TABULATION OF TEMP TRAFFIC CONTROL QUANTITIES
- J.2 STD DRWG 635-1 TEMPORARY TRAFFIC CONTROL ADVANCE SIGNING
- J.3 STD DRWG 635-5 TEMPORARY TRAFFIC CONTROL ROAD CLOSURE LAYOUT (WITH FLAGGERS)
- J.4 STD DRWG 635-6 TEMPORARY TRAFFIC CONTROL SINGLE LANE CLOSURE LAYOUT (WITH FLAGGERS)
- J.5 STD DRWG 635-13 TEMPORARY TRAFFIC CONTROL ROAD CLOSURE LAYOUT (WITH TEMPORARY BARRIER)
STD DRWG 635-13 TEMPORARY TRAFFIC CONTROL SIGN INSTALLATION WOOD POSTS

K. PERMANENT TRAFFIC CONTROL

- K.1 TABULATION OF PERMANENT TRAFFIC CONTROL QUANTITIES
- K.2-4 PERMANENT TRAFFIC CONTROL PLAN
- K.5 PERMANENT SIGN DETAIL
- K.6 STD DRWG W633-7 PERMANENT SIGN INSTALLATION WOOD POSTS

INDEX TO SHEETS

Δ	total central angle
Δc	curve central angle
\emptyset	diameter
$\emptyset s$	spiral central angle
abut.	abutment
ADT	average daily traffic
AH	ahead
appr.	approach
BK	back
BM	bench mark
BP	balance point
br.	bridge
brg.	bearing
cc or c. to c.	center to center
ξ	centerline
clr.	clear
CMP	corrugated metal pipe
col.	column
conc.	concrete
conn.	connection
constr. jt.	construction joint
cont.	continuous
CS	point of curve to spiral
ctrs.	centers
CUFT	cubic foot (feet)
culv.	culvert
CUYD	cubic yard(s)
D	diameter
DHV	design hourly volume
dia.	diameter
diag.	diagonal
diaph.	diaphragm
dist.	distance
drwg(s).	drawing(s)
E	east
e	superelevation rate
El. 94.16 ft	elevation with number
elev.	elevation
emb.	embankment
EP	edge of pavement
EQ or eq.	equation
ER	edge of road
EW	edge of water
exc.	excavation
exp. jt.	expansion joint
fin.	finish
flg.	flange
ft ²	square foot
ft ³	cubic foot (feet)
ftg.	footing
ga.	gage (gauge)
galv.	galvanized
hdwl.	headwall
hex.	hexagon
HW	high water
ID	inside diameter
jt.	joint
L	length of curve
lam.	lamination
lat.	latitude
LNFT	linear foot (feet)
long.	longitudinal
LPSM	lump sum
Ls	length of spiral
lt. or LT	left
LW	low water

M.L.	main line
M.P.	mile post
matl.	material
max.	maximum
MGAL	thousand gallon
min.	minimum
mon.	monument
N	north
NC	normal crown
o. c.	on center
o. to o.	out to out
OD	outside diameter
OG	original ground
PC	point of curve
PCC	point of compound curve
PCCS	point of curve to spiral
PI	point of intersection
pl.	plate
POC	point on curve
POS	point on spiral
POT	point on tangent
PS	point of tangent to spiral
PSC	point of spiral to curve
PST	point of spiral to tangent
PT	point of tangent
pvmt.	pavement
R	radius
R.	range
R/W	right-of-way
rdwy.	roadway
reinf.	reinforcement
reqd.	required
rt. or RT	right
rte.	route
S	south
SADT	seasonal average daily traffic
SC	section
sec.	section
shldr.	shoulder
SLRY	slurry unit
spa.	spacing, spaces or spaced
SQFT	square foot
SQYD	square yard
SRS	point of spiral to reverse spiral
SS	point of spiral to spiral (no curve)
ST	point of spiral to tangent
STA, Sta.	station
std.	standard
stgr.	stringer
stiff.	stiffener
struc.	structural
STS	point of spiral to tangent spiral
sym.	symmetrical
T	tangent distance
T.	township
TBM	temporary bench mark
thd.	thread
TS	point of tangent to spiral
Ts	tangent distance (spiraled curve)
typ.	typical
V	design speed
vph	vehicles per hour
VPI	vertical point of intersection
W	west
yd ²	square yard
yd ³	cubic yard(s)

National Boundary	
State Boundary	
County Boundary	
City Boundary	
Township or Range Line	
Section Line	
Section Corner (Found, Projected)	
1/4 Section Line	
1/4 Section Corner (Found, Projected)	
1/16 Section Line	
1/16 Section Corner (Found, Projected)	
Property Line w/Found Property Corner	
Parcel Number	
National Park Boundary	
National Forest Boundary	
National Wildlife Refuge Boundary	
BLM Lands Boundary	
Indian Reservation Boundary	
Existing Roadway (Road, Paved, Gravel)	
Railroad	
Trail	
Wattle	
Silt Fence	
Intermittent Drainage or Small Creek	
Large Creek or River	
Lake, Pond or Reservoir; Marshland	
Spring or Seep	
Treeline; Individual Trees	
Material Source; Bore Hole; Test Pit	
Spot Elevation; Coordinate Grid Tick	
Above Ground Tank; Underground Tank	
Boulder; Well; Satellite Dish; Grave	
Cooking Grate; Garbage Can; Picnic Table	
Flagpole; Fire Hydrant	
Gas & Water Meter; Gas & Water Valve	
Control Point (Terrestrial and GPS); Jump Hub	

North Arrow	
Slope Stake Limits	
Fence	
Gate with Fence	
Cattleguard	
Guardrail	
Concrete Barrier	
Retaining Wall	
Signs (single, double post; portable)	
Delineators	
Pipe Culvert (arrow shows flow)	
Pipe Culvert with End Section	
Pipe Culvert with Headwall	
Pipe Culvert with Drop Inlet	
Box Culvert	
Underdrain	
Overhead/Above Ground Utilities	
Underground Utilities	
<p>FM = force main, FO = fiber optic, G = gas, IRR = irrigation, O = oil, P = power, SA = sanitary sewer, SD = storm drain, SS = storm sewer, STEAM = steam, T = telephone, TV = CATV, W = water</p>	
Poles (Power, Telephone, Joint Use, Light, Support w/Anchor)	
Miscellaneous Utility Features	
Building	
Right-of-Way Line with Monument	
Permanent Easement	
Construction Easement	
Riprap	

NOTE:
 1. Other symbols used in the plans will be shown in a legend on the appropriate plan sheet.

U.S. DEPARTMENT OF TRANSPORTATION
 FEDERAL HIGHWAY ADMINISTRATION
 WESTERN FEDERAL LANDS HIGHWAY DIVISION

U.S. CUSTOMARY DETAIL

PLAN SYMBOLS AND ABBREVIATIONS


DETAIL APPROVED FOR USE 11/2001
 REVISIONS: 9/2005 1/2007 10/2009

DETAIL W101-1


NO SCALE

c:\myfiles\pw_production\10199256\ak-r206001\w101.dgn [USC] 14 August 2014 1:44 PM

STATE	PROJECT	SHEET NUMBER
AK	USFS 2060(1)	A.4

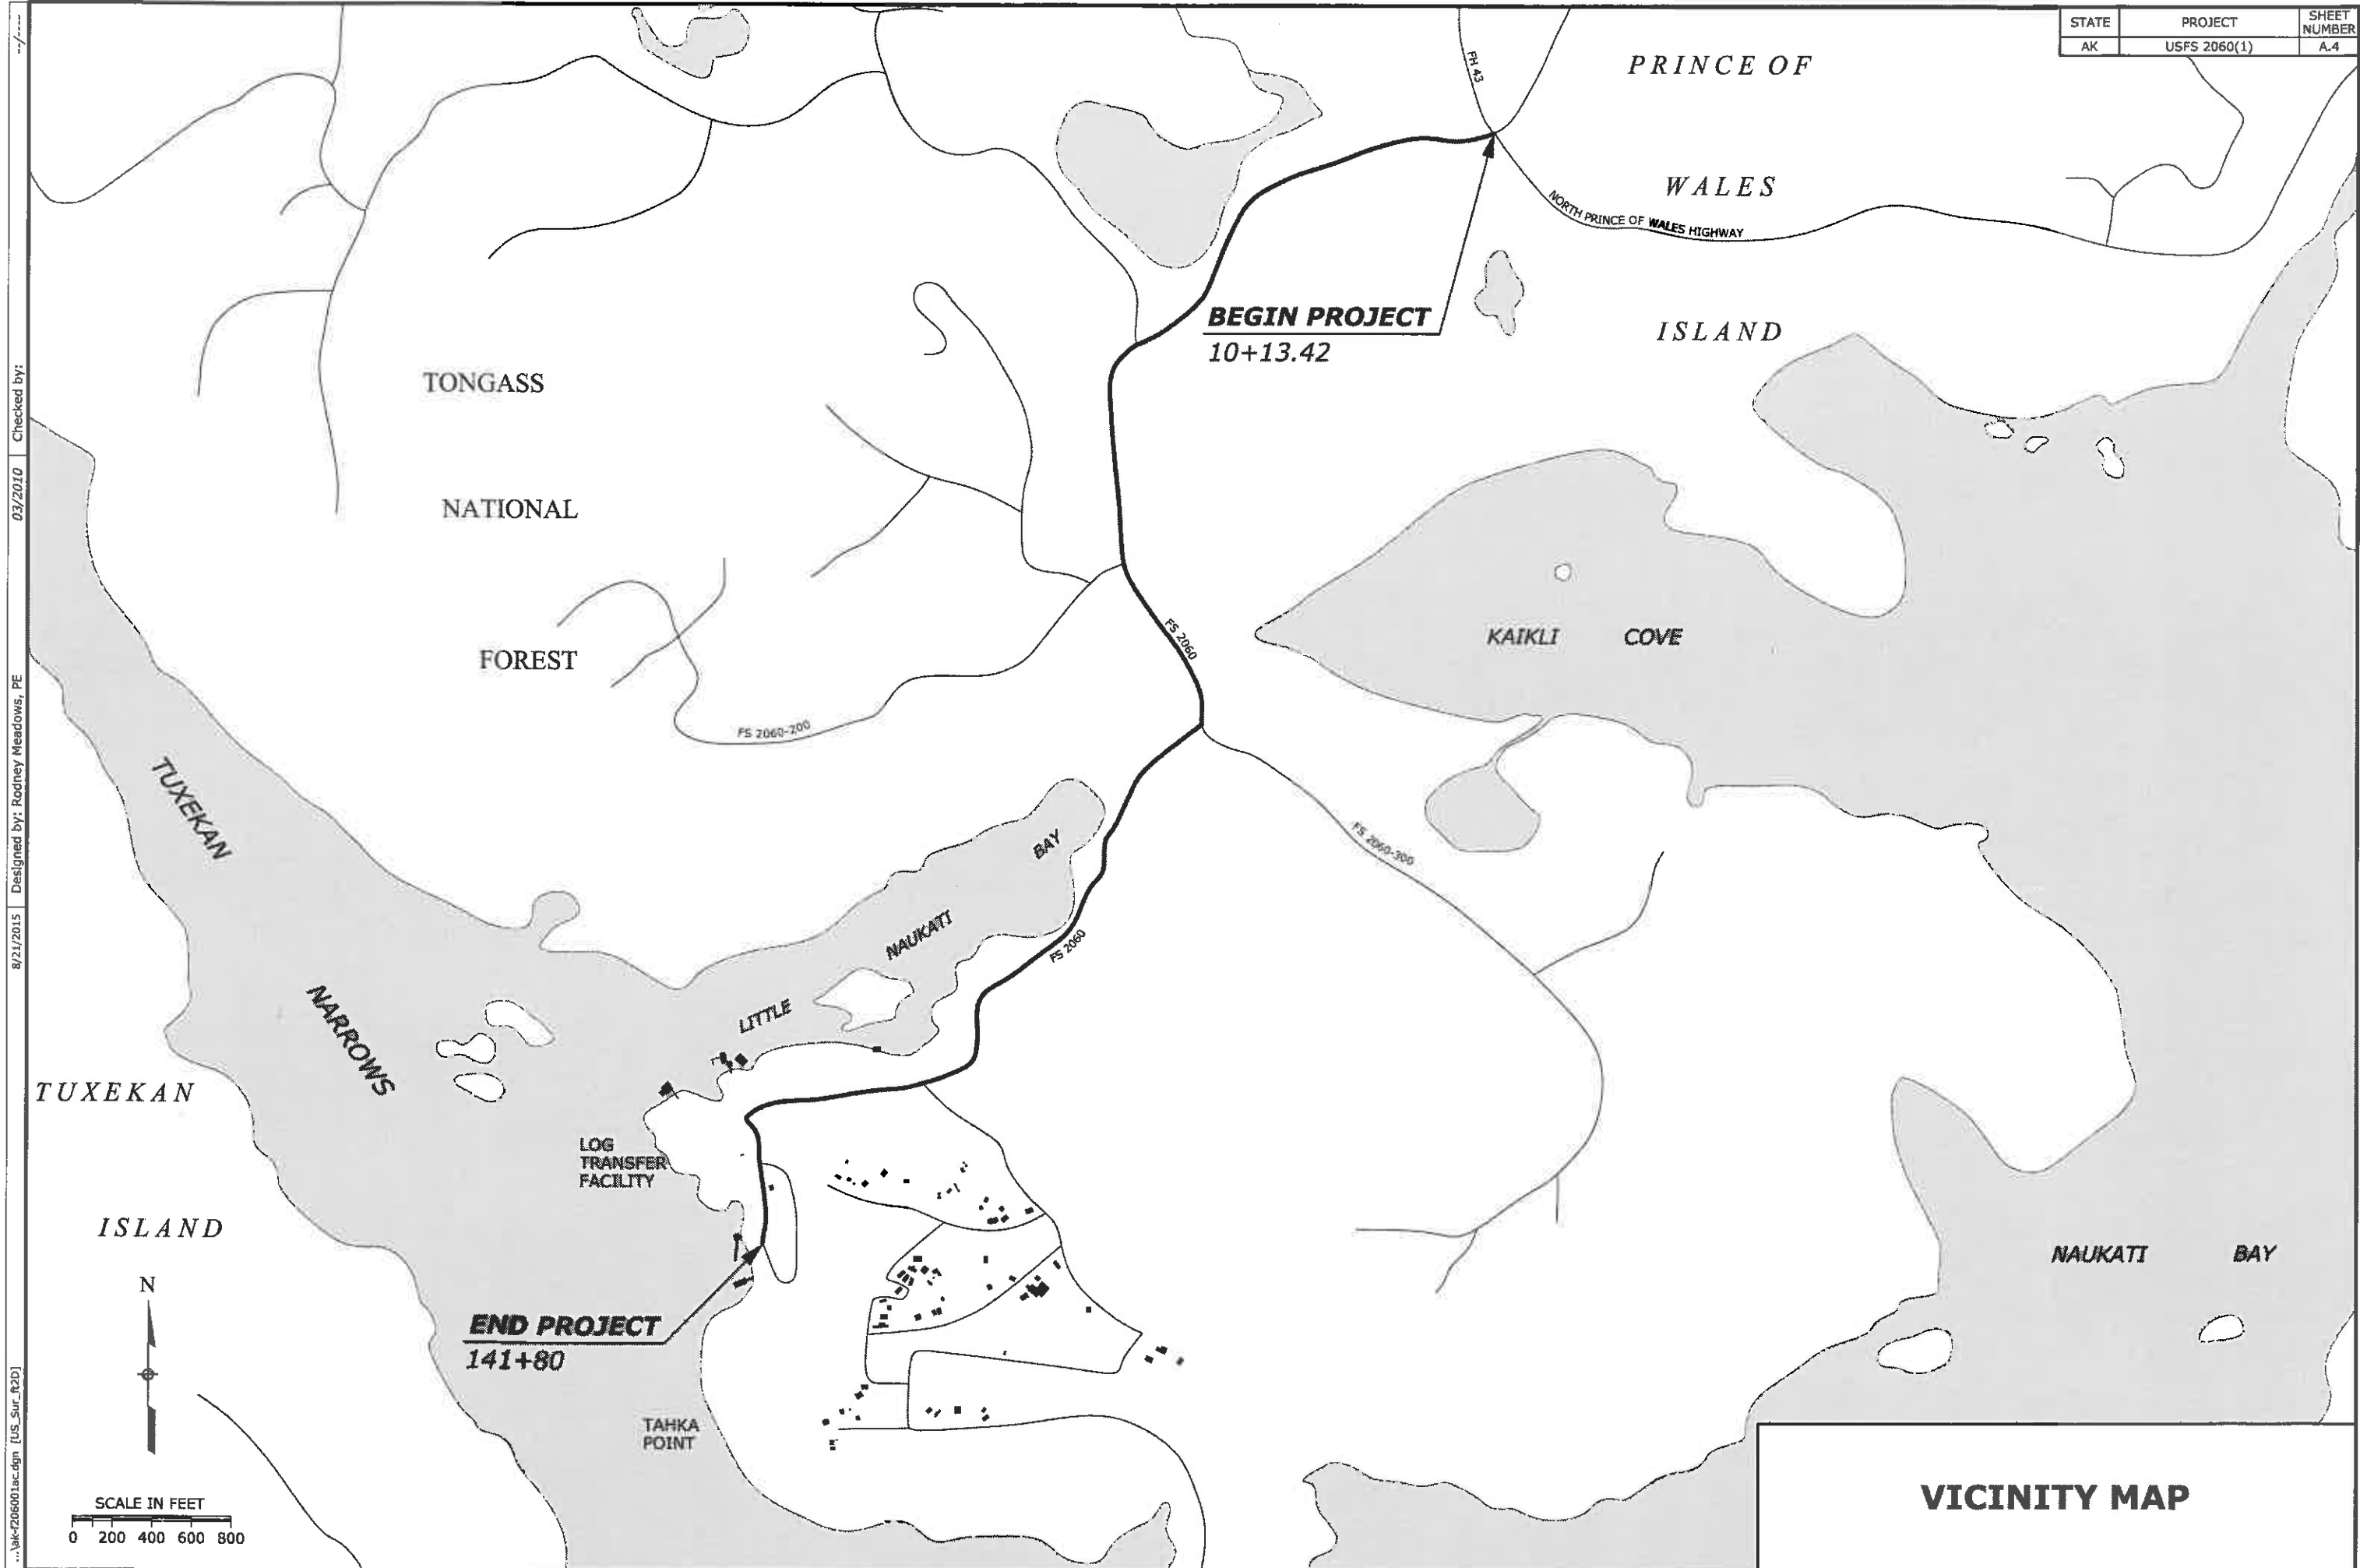

03/2010 Checked by:
 8/21/2015 Designed by: Rodney Meadows, PE
 ...lak-206001ac.dgn [US_Sur_02D]

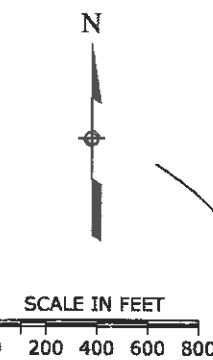

VICINITY MAP

SUMMARY OF QUANTITIES - Schedule A

STATE	PROJECT	SHEET NUMBER
AK	USFS 2060(1)	B.1

A M E N D	Line Item No.	Pay Item Number	Pay Item Description	Unit	Sheet and Description										Estimated Quantities		Remarks and/or Determination of Estimated Quantity	
					SECTION C	SECTION D	SECTION E	SECTION F	SECTION G	SECTION H	SECTION I	SECTION J	SECTION K	-	Bid Schedule			
					TYPICAL SECTIONS	PLAN & PROFILE	APPROACH ROADS	EROSION SEDIMENT CONTROL	DRAINAGE	REINFORCED SOIL SLOPES	SAFETY FEATURES	TEMPORARY TRAFFIC CONTROL PLAN	PERMANENT TRAFFIC CONTROL	ALLOWANCE				
	A0020	15101-0000	MOBILIZATION	LPSM													ALL	
	A0040	15201-0000	CONSTRUCTION SURVEY AND STAKING	LPSM													ALL	
	A0060	15301-0010	CONTRACTOR QUALITY CONTROL AND ASSURANCE	LPSM													ALL	
	A0080	15401-0000	CONTRACTOR TESTING	LPSM													ALL	
	A0100	15501-0000	CONSTRUCTION SCHEDULE	LPSM													ALL	
	A0120	15702-1000	SOIL EROSION CONTROL, TEMPORARY DIVERSION CHANNEL	LPSM													ALL	
	A0140	15705-1500	SOIL EROSION CONTROL, SEDIMENT WATTLE (CHECK DAMS)	LNFT				2,510									2,510	
	A0160	15705-1500	SOIL EROSION CONTROL, SEDIMENT WATTLE (SLOPE PROTECTION)	LNFT				29,884									29,884	
	A0180	15705-1500	SOIL EROSION CONTROL, SEDIMENT WATTLE	LNFT				11,636									11,636	
	A0200	15706-1600	SOIL EROSION CONTROL, STABILIZED CONSTRUCTION ENTRANCE	EACH				1									1	
	A0220	15707-1000	SOIL EROSION CONTROL, TEMPORARY TURF ESTABLISHMENT	SLRY				54									54	
	A0240	15801-0000	WATERING FOR DUST CONTROL	MGAL				2,250									2,250	
	A0260	20101-0000	CLEARING AND GRUBBING	ACRE			24.0										24.0	
	A0280	20301-1900	REMOVAL OF PIPE CULVERT	EACH					31								31	
	A0300	20301-2400	REMOVAL OF SIGN	EACH									2				2	
	A0320	20401-0000	ROADWAY EXCAVATION	CUYD			117,072	5,919							6,209		129,200	
	A0340	20402-0000	SUBEXCAVATION	CUYD			2,252								118		2,370	
	A0360	20410-0000	SELECT BORROW (GUY POLE PAD)	CUYD			110										110	
	A0380	20411-0000	SELECT BORROW	TON	31,028	14,021	3,095								2,456		50,600	1.97 TONS/CUYD
	A0400	20450-1000	BORROW, ROCK (SUBEX BACKFILL)	CUYD			2,252								118		2,370	
	A0420	20450-1000	BORROW, ROCK	CUYD			30,463								1,537		32,000	
	A0440	20701-0700	EARTHWORK GEOTEXTILE, TYPE II-A	SQYD			34,966										36,700	
	A0460	20701-1200	EARTHWORK GEOTEXTILE, TYPE IV-A	SQYD			32,308								1,692		34,000	
	A0480	20703-2000	GEOGRID, BIAXIAL	SQYD			34,966								1,734		36,700	
	A0500	21101-2000	ROADWAY OBLITERATION, METHOD 2	SQYD			3,407										3,407	
	A0520	25101-2000	PLACED RIPRAP, CLASS 2 (ENERGY DISSIPATOR)	CUYD					99						21		120	
	A0540	25101-2000	PLACED RIPRAP, CLASS 2 (RIPRAP HEADWALL)	CUYD					267						33		300	
	A0560	25120-2000	RIPRAP DITCH, CLASS 2	LNFT			3,405								342		3,747	
	A0580	27201-1000	REINFORCED SOIL SLOPE, GEOGRID	SQFT						6,948							6,948	
	A0620	30101-2000	AGGREGATE BASE GRADING D (4-INCH COMPACTED DEPTH)	TON	11,338			2,772							1,390		15,500	1.97 TONS/CUYD
	A0640	30901-2000	EMULSIFIED ASPHALT TREATED AGGREGATE BASE, GRADING D (4 INCH COMPACTED DEPTH)	TON	10,726										1,074		11,800	
	A0680	30905-1200	EMULSIFIED ASPHALT, GRADE CSS-1	TON	215										21		236	
	A0700	40301-0000	HOT ASPHALT CONCRETE PAVEMENT	TON				230							11		241	

MileStone: 100%
Date Completed: 09/02/15
Report Date: 09/02/15

SUMMARY OF QUANTITIES - Schedule A

STATE	PROJECT	SHEET NUMBER
AK	USFS 2060(1)	B.2

A M E N D	Line Item No.	Pay Item Number	Pay Item Description	Unit	Sheet and Description										Estimated Quantities	Remarks and/or Determination of Estimated Quantity	
					SECTION C	SECTION D	SECTION E	SECTION F	SECTION G	SECTION H	SECTION I	SECTION J	SECTION K	-			
					TYPICAL SECTIONS	PLAN & PROFILE	APPROACH ROADS	EROSION SEDIMENT CONTROL	DRAINAGE	REINFORCED SOIL SLOPES	SAFETY FEATURES	TEMPORARY TRAFFIC CONTROL PLAN	PERMANENT TRAFFIC CONTROL	ALLOWANCE	Bid Schedule		
	A0720	40910-0800	SURFACE TREATMENT, DESIGNATION 2C	SQYD	47,646										4,754	52,400	
	A0740	40940-1300	EMULSIFIED ASPHALT, GRADE CRS-2P	TON	199										20	219	
	A0760	60201-0800	24-INCH PIPE CULVERT	LNFT					1,922							1,922	
	A0780	60201-1000	36-INCH PIPE CULVERT	LNFT					616							616	
	A0800	60201-1400	60-INCH PIPE CULVERT	LNFT					114							114	
	A0820	60201-1600	72-INCH PIPE CULVERT	LNFT					74							74	
	A0840	60201-1800	84-INCH PIPE CULVERT	LNFT					62							62	
	A0860	60201-2200	108-INCH PIPE CULVERT	LNFT					88							88	
	A0880	61701-1250	GUARDRAIL SYSTEM G4, TYPE 2, CLASS A WOOD POSTS	LNFT			3,925									3,925	
	A0900	61702-0800	TERMINAL SECTION TYPE TANGENT	EACH			14									14	
	A0920	62101-0000	MONUMENT (SETTLEMENT PLATE ASSEMBLY)	EACH	6											6	
	A0940	62201-0250	DUMP TRUCK, 10 CUBIC YARD MINIMUM CAPACITY	HOUR			80									80	
	A0960	62201-1000	WHEEL LOADER, 4 CUBIC YARD MINIMUM RATED CAPACITY	HOUR			40									40	
	A0980	62201-1250	BULLDOZER, 120HP MINIMUM FLYWHEEL POWER	HOUR			40									40	
	A1000	62201-3100	HYDRAULIC EXCAVATOR, 3.0 CUBIC YARD MINIMUM CAPACITY, 165HP MINIMUM FLYWHEEL POWER	HOUR			80									80	
	A1020	62201-3750	CHAIN SAW	HOUR			20									20	
	A1040	62301-0000	GENERAL LABOR	HOUR			40									40	
	A1060	62405-0300	PLACING CONSERVED TOPSOIL, 4-INCH DEPTH	SQYD			18,097								1,803	19,900	
	A1080	62503-0000	TURF ESTABLISHMENT	SLRY			54									54	
	A1100	63302-0000	SIGN SYSTEM	SQFT									53			53	
	A1120	63502-0600	TEMPORARY TRAFFIC CONTROL, BARRICADE TYPE 3	EACH								4				4	
	A1140	63502-1000	TEMPORARY TRAFFIC CONTROL, CONE, TYPE 36-INCH	EACH								150				150	
	A1160	63502-1300	TEMPORARY TRAFFIC CONTROL, DRUM	EACH								60				60	
	A1180	63503-0400	TEMPORARY TRAFFIC CONTROL, CONCRETE BARRIER	LNFT								1,170				1,170	
	A1200	63504-1000	TEMPORARY TRAFFIC CONTROL, CONSTRUCTION SIGN	SQFT								241				241	
	A1220	63509-1000	TEMPORARY TRAFFIC CONTROL, FLAGGER	FXHR								7,000				7,000	
	A1240	64631-0000	ROADSIDE DEVELOPMENT (BIOFILTRATION SWALE)	LNFT					1,628							1,628	
	A1260	64703-6000	MITIGATION, FISH PASSAGE BOULDER	EACH					46							46	
	A1280	64704-1000	MITIGATION, STREAMBED MATERIAL	CUYD					355							355	

A7070 20410-0000 Select Borrow Contract Quantity (plangty) CUYD
 A7071 63704-0000 Vehicle month
 A7080 40301-0000 Added Hot Asphalt Concrete Pavement TON
 A7081 63400-0000 Permanent Pavement Markings LPSM
 A0600 30101-2000 Aggregate Base Grading D TON



APPROVED
 APPROVED AS NOTED
 RETURNED FOR CORRECTION

Date: JUL 10 2017 By: Jim Jozovich


FEDERAL HIGHWAY ADMINISTRATION
 Federal Lands Highway

See FAR 52.236-21(e) for limitations of Government's responsibility in approving this document.

24439 CM006
 1 CM006
 5937 CM007
 1 CM007
 5900 CM007

c:\myfiles\pwr_production\00199359\ak-f206001-summary-wf.xlsx Sheet (2) 2-Sep-2015 3:15 PM

MileStone: 100%
 Date Completed: 09/02/15
 Report Date: 09/02/15

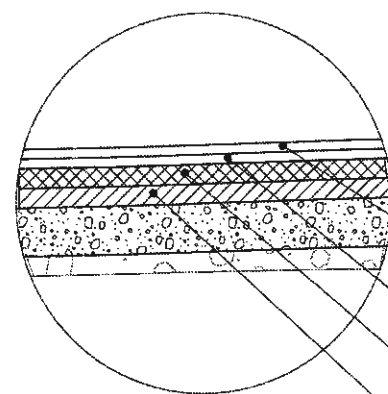


Surface treatment aggregates - 2nd application - grading-D
 Surface treatment aggregates - 1st application - grading-B
 Emulsified asphalt treated base, grading-D, 4" compacted depth
 Aggregate base, grading-D, 4" compacted depth

~~Detail A~~
 Deleted CM0007


Detail A: See CM0007

~~2 1/2" Hot Asphalt Pavement~~
~~5 1/2" Aggregate Base Grading D~~
~~10" Select Borrow~~

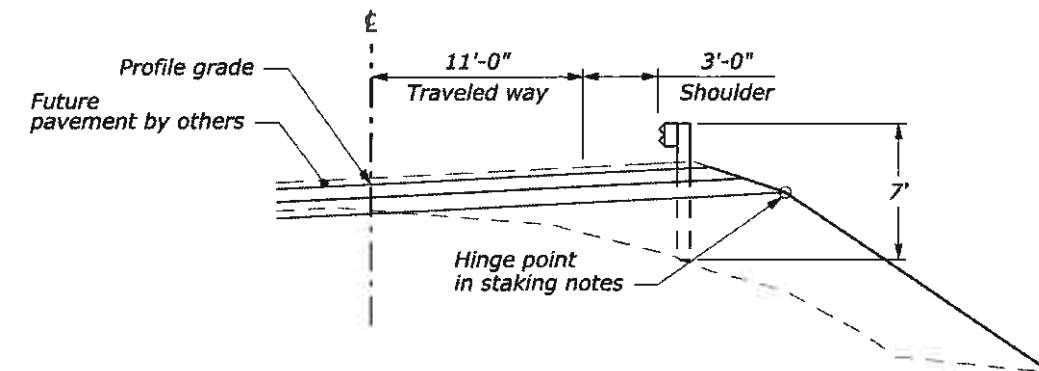

GUARDRAIL TYPICAL DETAIL

Mainline Typical Section changed to show Hot Asphalt Pavement modification; See CM0007

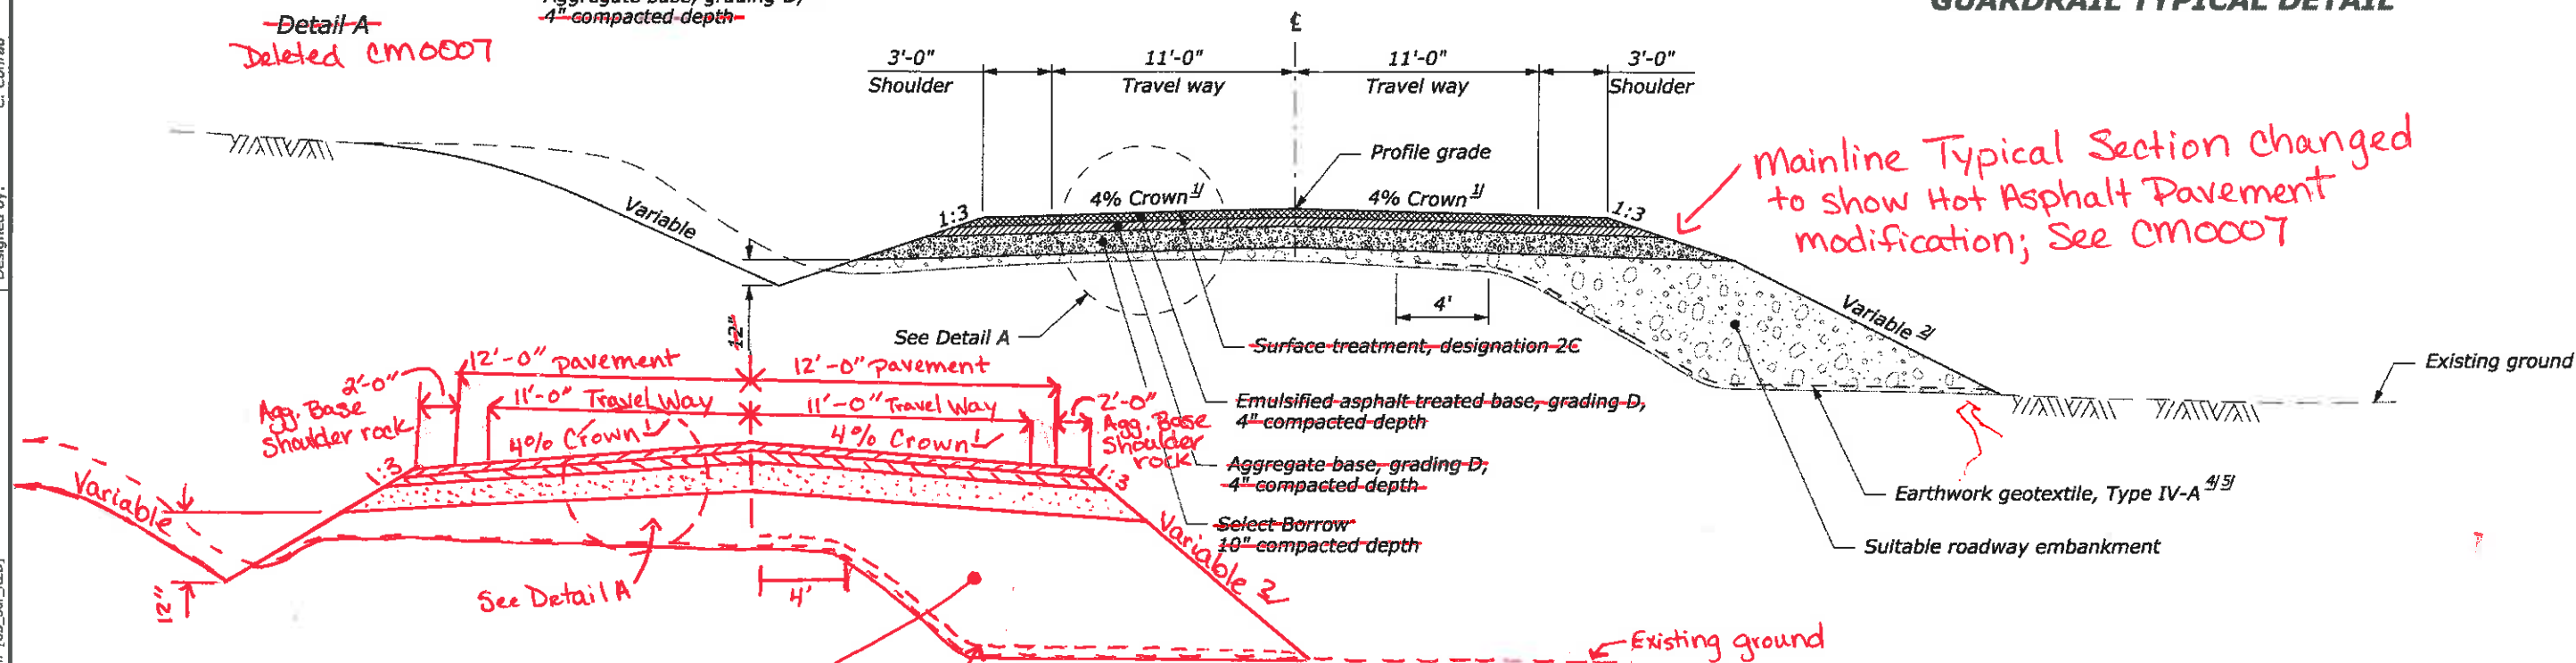

AK USFS 2060
 MAINLINE TYPICAL SECTION
 See CM0007

NOTE:

1. Curve widening is reflected in the field notes. See Sheet C.3

FOOTNOTE:


1) Superelevate roadway on curves at the rate 'e' as indicated on the plan and profile curve data. See Sheets D.3-7.

2) Construct slopes as shown in the Staking Report.


3) For cut heights less than "B" reduce "B" to the cut height dimension and reduce the front slope rounding distance proportionally.

4) Extend geotextile, Type IV-A, 4-feet beyond existing shoulder hinge point.

5) See Sheet D.2 for locations and quantities.

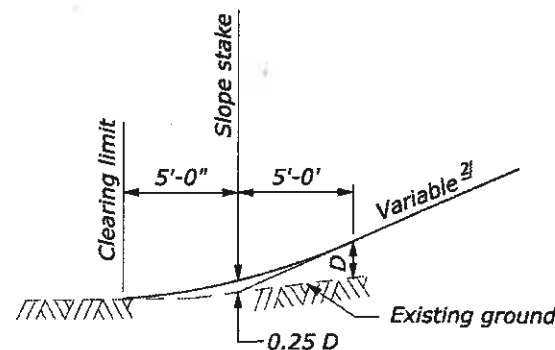

FILL SLOPE ROUNING DETAIL

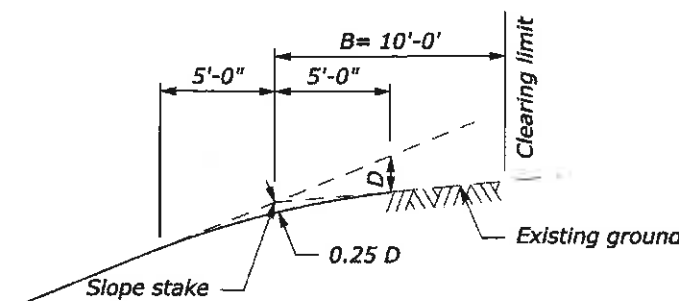

CUT SLOPE ROUNING DETAIL

✓ TYPICAL SECTION

NO SCALE


Checked by: 04/2013

Designed by: C. Conrad


04/2013

c:\myfiles\jw_production\10199360\akr-206001.cad.dgn [US_Sur_102D]

19 August 2015 10:49 AM

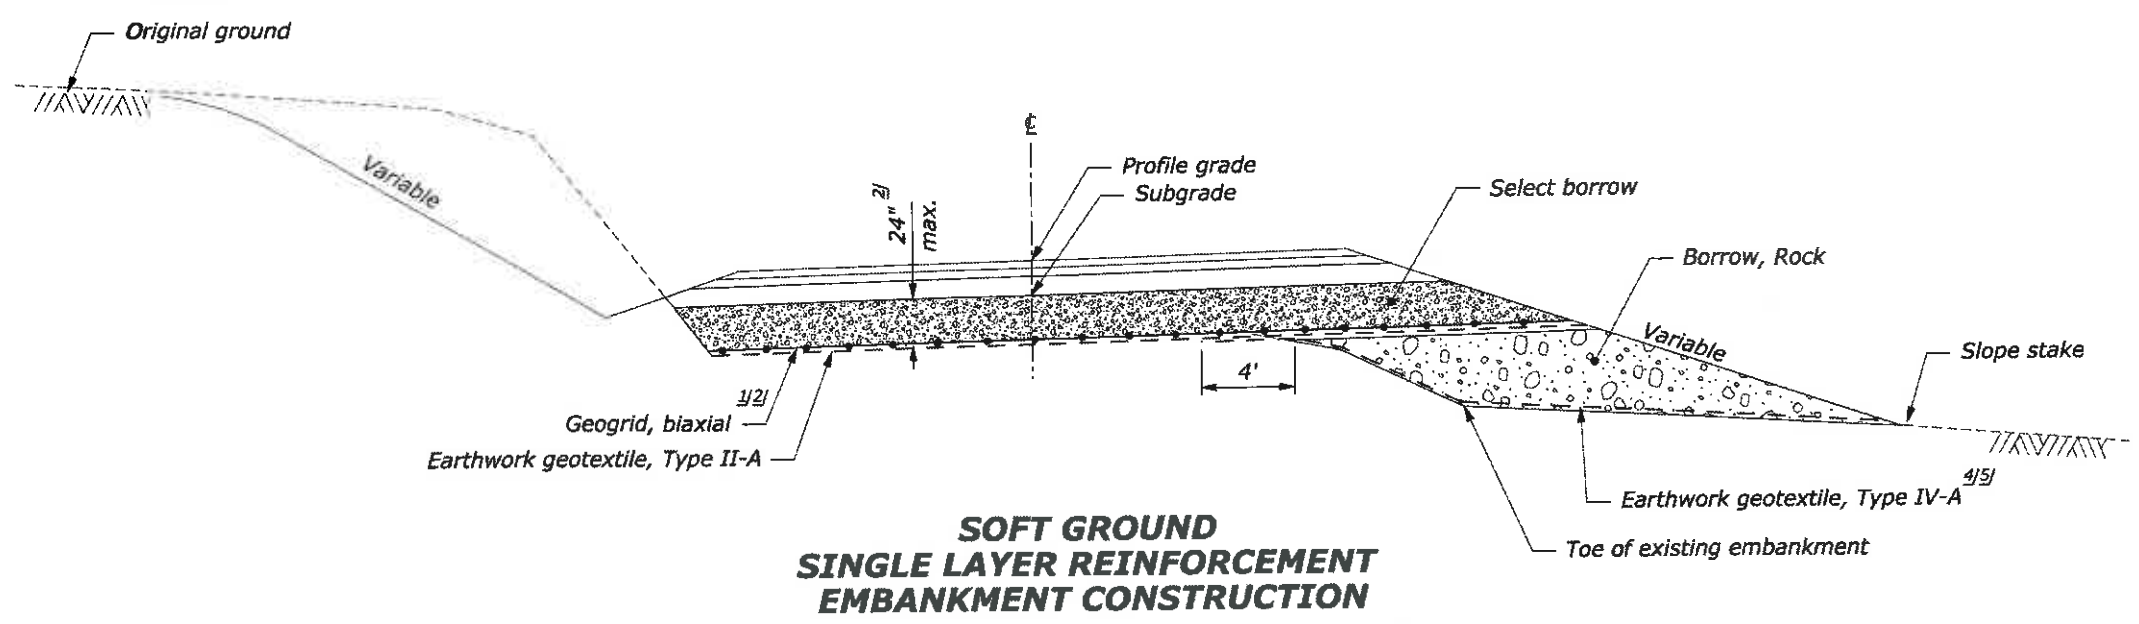

STATION TO STATION	GEOGRID
13+00 to 13+90	Full width
25+50 to 27+50	Full width ✓
29+50 to 40+25	Full width ✓
40+25 to 44+20	LT of CL ✓
53+50 to 55+50	Full width ✓
66+00 to 66+80	Full width ✓
88+75 to 90+10	RT of CL
90+10 to 95+00	RT of CL and Full width
97+50 to 103+00 100+00	RT of CL and Full width ✓
113+50 to 115+75 ^{5/}	Full width ✓
127+00 to 131+50	LT of CL ✓

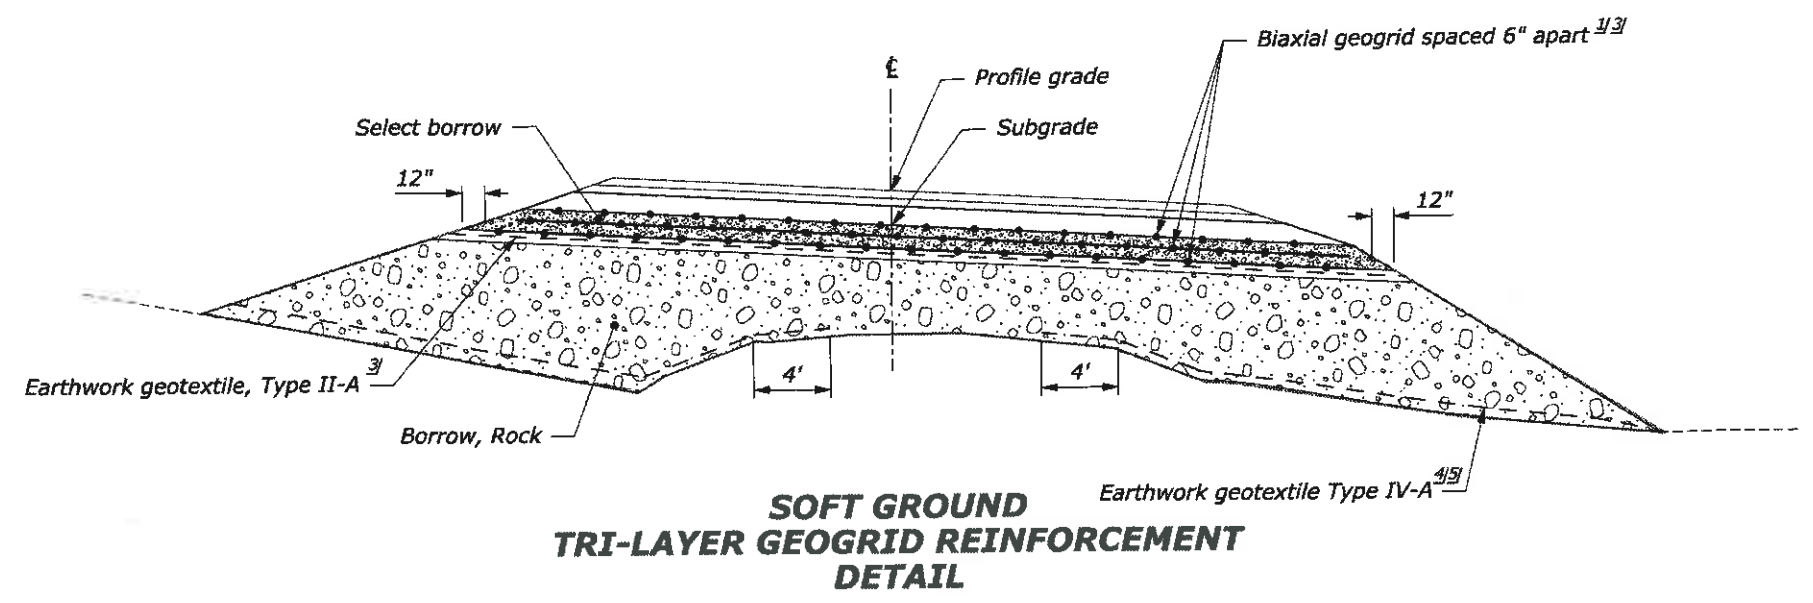

STATION TO STATION	GEOGRID
21+75 to 23+50 ^{5/}	Full width ✓
40+25 to 44+50	RT of CL ✓
44+50 to 45+75	Full width RT of CL ✓
48+00 to 53+50 ^{5/}	Full width ✓
55+50 to 60+50 ^{5/}	Full width ✓
60+50 to 61+30	LT of CL ✓

- NOTE:**
1. See Mainline Typical Section for proposed surfacing structure.
 2. Construct slopes in the Staking Report.
 3. See Section 204.

- FOOTNOTE:**
- ^{1/} Extend geogrid to within 1-foot of embankment slope in fill sections and to original ground in cut sections.
 - ^{2/} Place geotextile, Type II-A no greater than 24-inches below subgrade. Lay geogrid directly on top of geotextile.
 - ^{3/} Place geotextile Type II-A 22-inches below bottom of surface course. Lay geogrid directly on top of geotextile. Follow with two additional layers of geogrid placed in 6-inch lifts of select borrow.
 - ^{4/} Extend geotextile, Type IV-A, 4-feet beyond existing shoulder hinge point.
 - ^{5/} See Sheet D.2 for locations and quantities.
 - ^{6/} See Sheet C.4.


EMBANKMENT CONSTRUCTION DETAILS ✓

NO SCALE

Checked by: _____
 Designed by: _____
 c:\myfiles\paw_production\01199360\ak-r206001\ce.dgn [US_Sur_R2D]
 19 August 2015 10:50 AM


11/2010 M. JOHNSON
 11/2010 Checked by:
 C. KNUTH
 8/21/2015 Designed by:
 ...\\fr-2206001.ctf.dgn [US:R2D]

STATE	PROJECT	SHEET NUMBER
AK	USFS 2060(1)	C.4

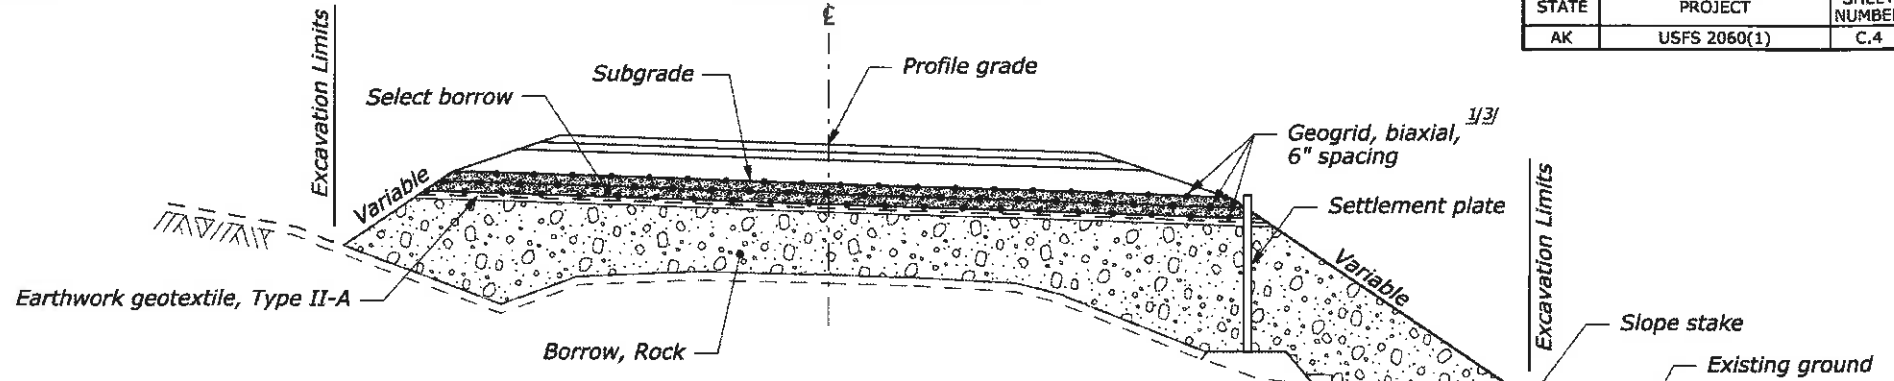


KEYED IN TRI-LAYER REINFORCEMENT EMBANKMENT CONSTRUCTION WITH SETTLEMENT PLATE

21+75 to 23+50
 SETTLEMENT PLATE LOCATION
 22+75, 22' RT

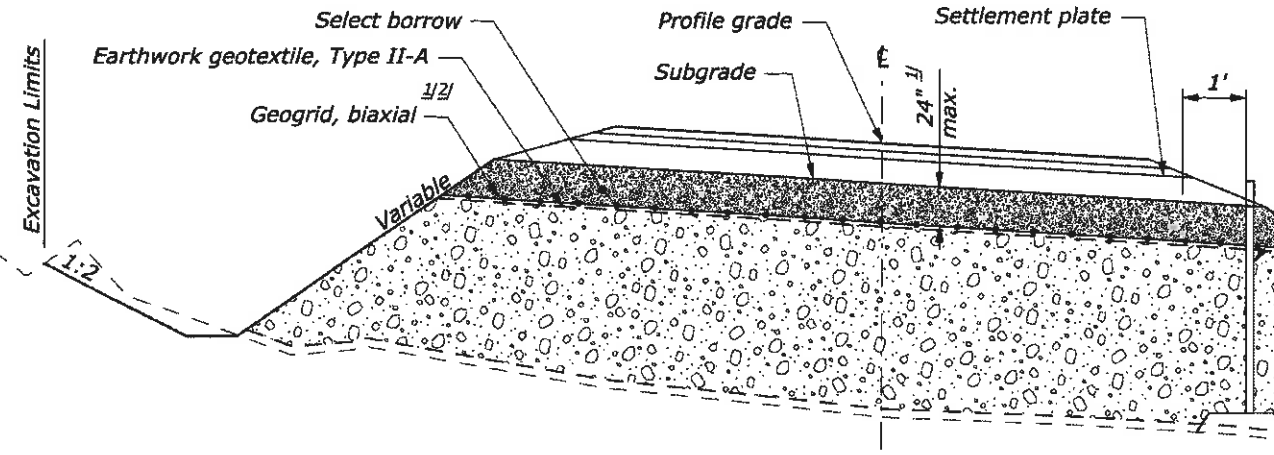

KEYED IN SINGLE REINFORCEMENT EMBANKMENT CONSTRUCTION WITH SETTLEMENT PLATE

113+50 to 115+75
 SETTLEMENT PLATE LOCATION
~~114+25, 30' RT~~
~~114+75, 30' RT~~

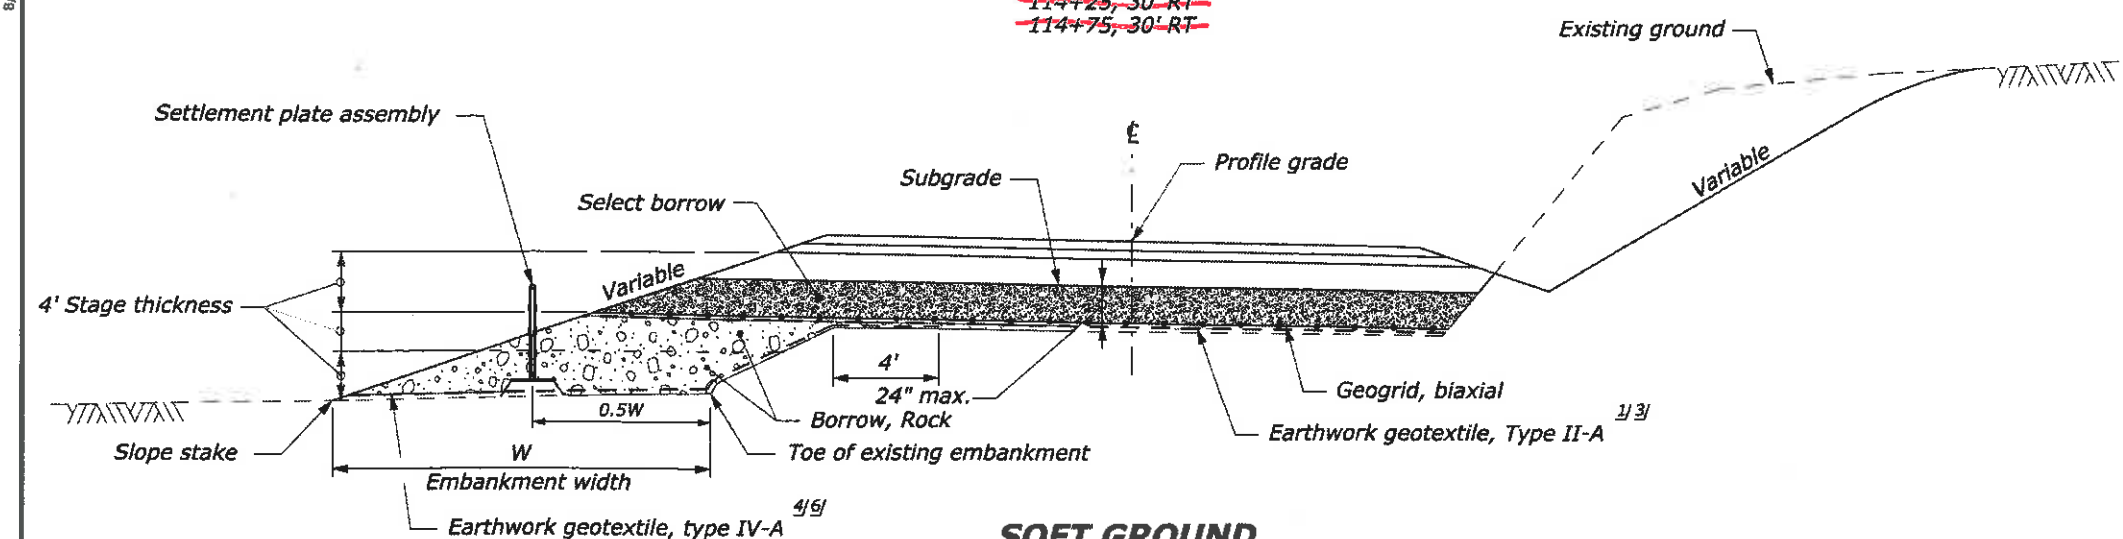

SOFT GROUND STAGED EMBANKMENT CONSTRUCTION WITH SETTLEMENT PLATE

48+50 to 53+50
 58+50 to 60+50
 SETTLEMENT PLATE LOCATIONS
 49+00, 0.5W ✓
 51+00, 0.5W ✓
 59+00, 0.5W ✓

NOTE:

1. See mainline typical section for proposed surfacing structure.
2. Construct slopes as shown in the Staking Report.
3. See Section 204.

FOOTNOTE:


- 1/ Extend geogrid to within 1-foot of embankment slope in fill sections and to original ground in cut sections.
- 2/ Place geotextile, Type II-A no greater than 24-inches below subgrade. Lay geogrid directly on top of geotextile.
- 3/ Place geotextile, Type II-A 22-inches below bottom of surface course. Lay geogrid directly on top of geotextile. Follow with two additional layers of geogrid placed in 6 inch lifts of select borrow.
- 4/ Extend geotextile, Type IV-A, 4-feet beyond existing shoulder hinge point.
- 5/ Extend geotextile, Type IV-A, under entire embankment.
- 6/ See sheet D.2 for locations and quantities.

✓ **EMBANKMENT** ✓
CONSTRUCTION DETAILS

NO SCALE

STATE	PROJECT	SHEET NUMBER
AK	USFS 2060(1)	C.5

11/2010 11/2010 11/2010 8/21/2015
 M. JOHNSON
 Checked by:
 C. KNUTH
 Designed by:
 ...\\k-206001\eg.dgn [US_Sur2D]

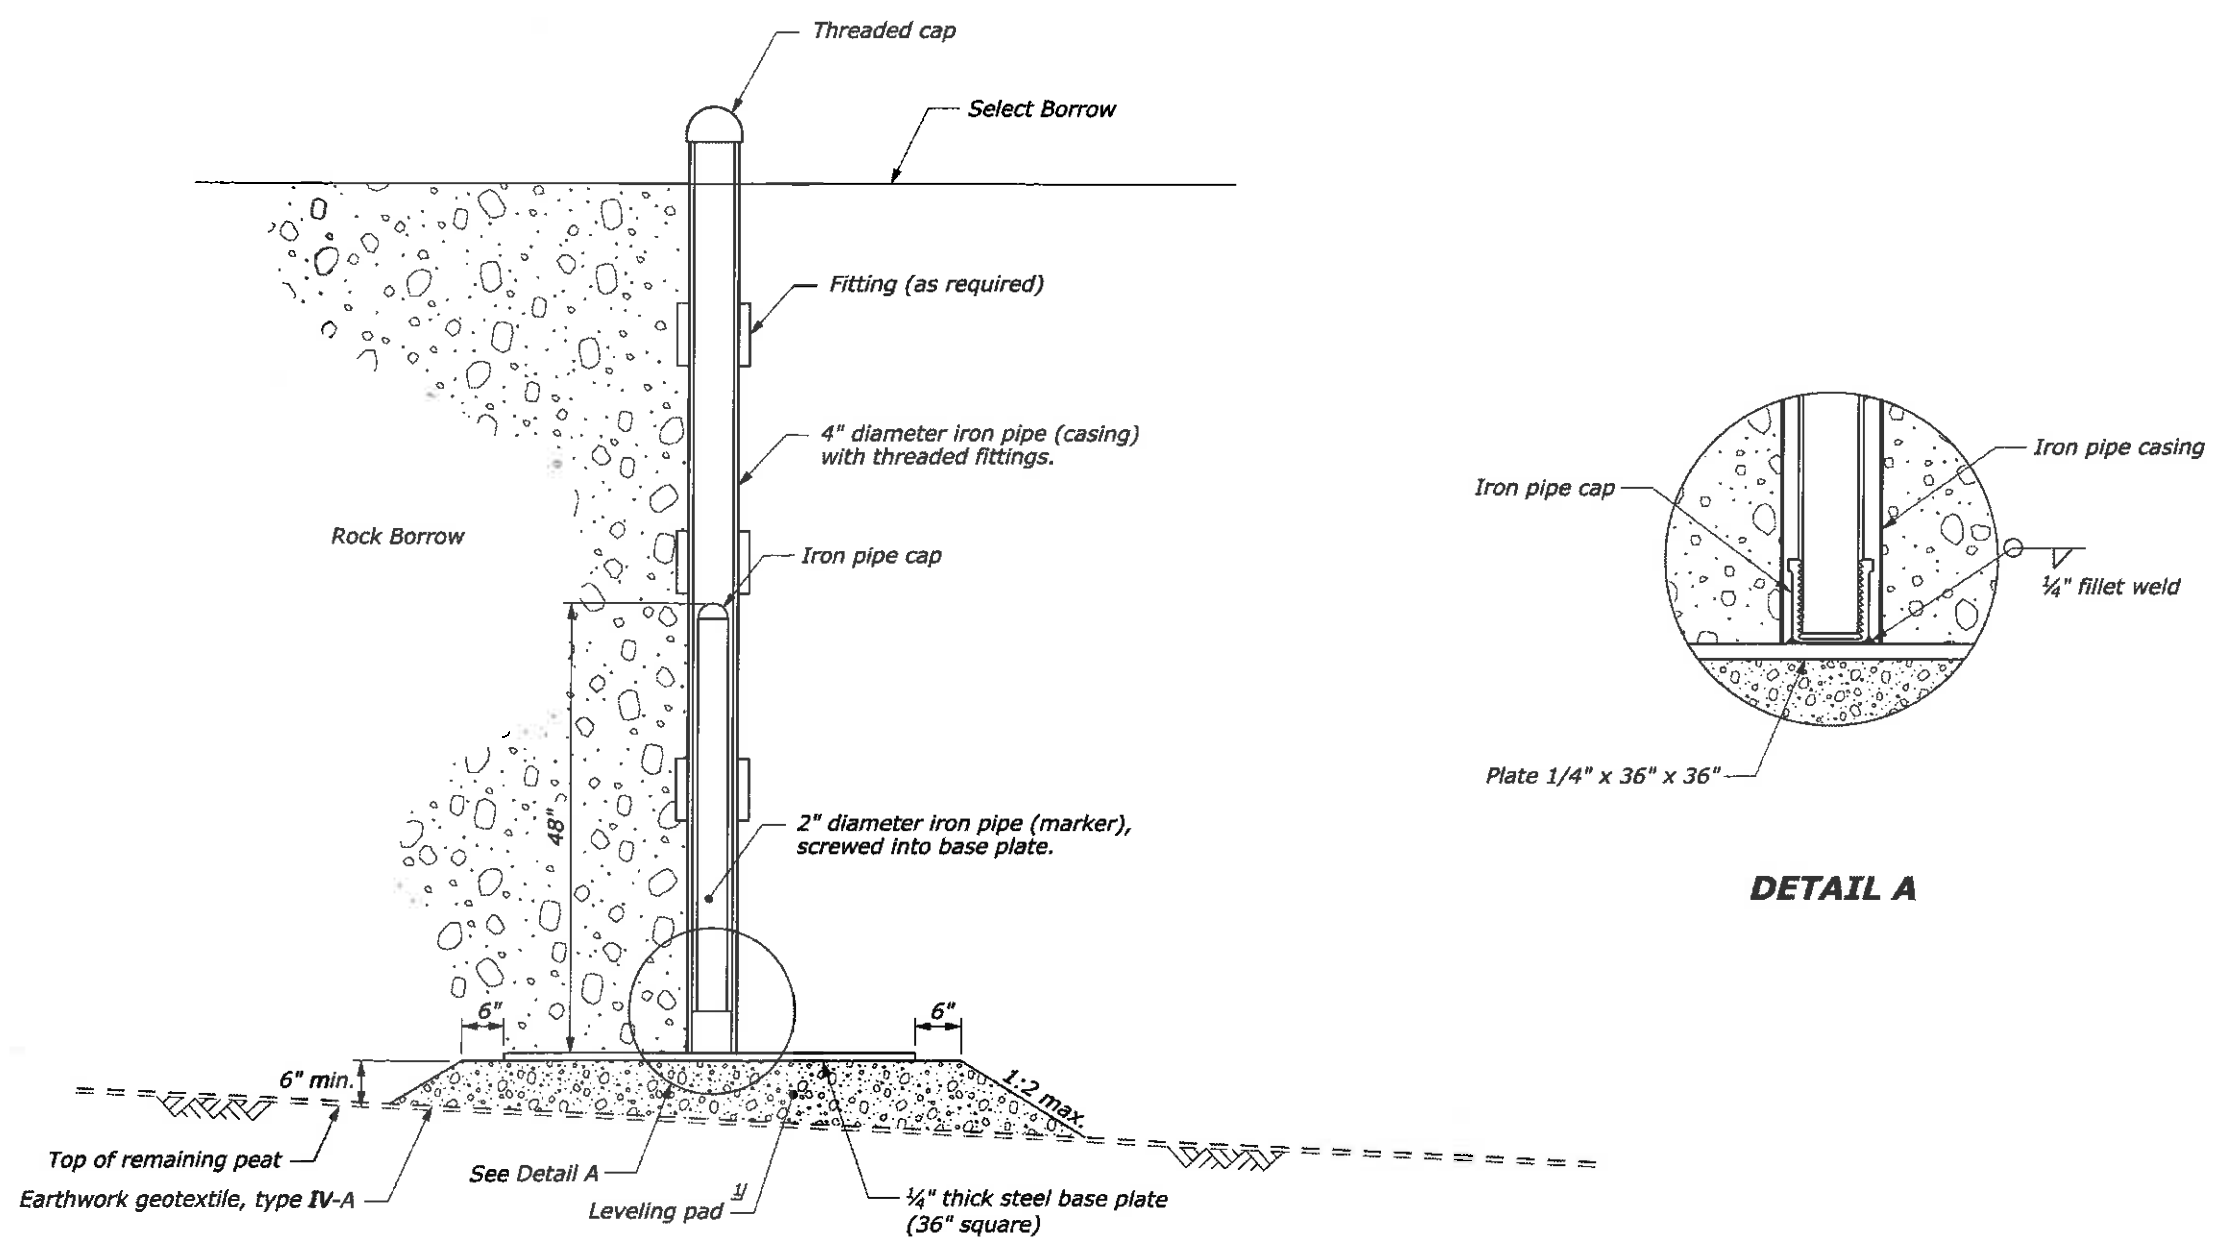

DETAIL A

SETTLEMENT PLATE ASSEMBLY

NOTE:
 1. See Subsection 621.03A.

FOOTNOTE:
 1/2 Construct an aggregate leveling pad to provide a level, stable foundation for the settlement plate assembly.

**SETTLEMENT PLATE
 DETAILS ✓**

ROADWAY QUANTITIES

20101-0000 CLEARING AND GRUBBING (ACRE)	20401-0000 ROADWAY EXCAVATION (CUYD)	20402-0000 SUBEXCAVATION (CUYD)	20450-1000 BORROW, ROCK, (SUBEX BACKFILL) (CUYD)	EMBANKMENT ^{1/} (CUYD)	CONSERVED ^{2/} TOPSOIL (CUYD)	62503-0000 TURF ESTABLISHMENT (SLRY)
24	117,072	601	601	51,440	5,230	54



SOFT GROUND SINGLE LAYER REINFORCEMENT EMBANKMENT QUANTITIES

STATION	SIDE	20402-0000 SUBEXCAVATION (CUYD)	20411-0000 SELECT BORROW (TON)	20450-1000 BORROW, ROCK (CUYD)	20450-1000 BORROW ROCK (SUBEX BACKFILL) (CUYD)	20703-0700 GEOTEXTILE, TYPE IIA (SQYD)	20703-2000 GEOGRID, BIAXIAL (SQYD)
13+00 to 13+90	Full width		577	403		583	583
25+50 to 27+50	Full width		922	174		1,031 888.89	1,031 888.89 ✓
29+50 to 40+25	Full width		2,443	1,253		4,318 4658.34	4,318 4658.34 ✓
40+25 to 44+20 44+50	Left of CL		459	63		921 1038.89	921 1038.89 ✓
53+50 to 55+50	Full width		597	23		738 920	738 920 ✓
66+00 to 66+80	Full width		382	58		437 313.33	437 313.33 ✓
88+75 to 90+10	Right of CL		95	8		127	127 ✓
90+10 to 95+00	Full width		2,384	8,874		2,543	2,543 ✓
97+50 to 103+00 100+00	Full width		221	453		1,627 1000	1,627 1000 ✓
113+50 to 115+75	Full width	1,286	1,704	10,706	1,286	1,361 1150	1,361 1150 ✓
127+00 to 131+50	Left of CL		749	168		1,160 937.78	1,160 937.78 ✓
TOTALS		1,286	10,533	22,183	1,286	14,846 10,967.23	14,846 10,967.23

20411-0000 SELECT BORROW (GUY POLE PAD)		
LOCATION	SIDE	VOLUME (CUYD)
18+65	LT	55 ✓
45+61	LT	55 ✓
TOTAL		110

APPROVED
 APPROVED AS NOTED
 RETURNED FOR CORRECTION

Date: JUL 10 2017 By: Jim Jozovich

FEDERAL HIGHWAY ADMINISTRATION
Federal Lands Highway

See FAR 52.236-21(e) for limitations of Government's responsibility in approving this document.

SOFT GROUND TRI-LAYER REINFORCEMENT EMBANKMENT QUANTITIES

STATION	SIDE	20402-0000 SUBEXCAVATION (CUYD)	20411-0000 SELECT BORROW (TON)	20450-1000 BORROW, ROCK (CUYD)	20450-1000 BORROW ROCK (SUBEX BACKFILL) (CUYD)	20703-0700 GEOTEXTILE, TYPE IIA (SQYD)	20703-2000 GEOGRID, BIAXIAL (SQYD)
21+75 to 23+50	Full width	365	534	2,733	365	2,514 797.22	2,514 2274.99 ✓
40+25 to 44+50	Right of CL		473	797		2,022 826.39	2,022 2452.93 ✓
49+50 to 45+75	Full width RT of CL		213	228		1,014 243.06	1,014 756.95 ✓
48+00 to 53+50	Full width		581	2,382		7,021 2536.11	7,021 7241.67 ✓
55+50 to 60+50	Full width		1,527	1,875		6,853 2343.43	6,853 6793.93 ✓
60+50 to 61+30	Left of CL		160	265		696 213.33	696 508.27 ✓
TOTALS		365	3,488	8,280	365	20,120 6,959.54	20,120 20,018.64

FOOTNOTE:

^{1/} Quantity Includes:
13,861 Cuyd Normal Embankment - Not measured for payment. Information only quantity
7,116 Cuyd (14,021 Ton) Select Borrow (Section D) - Pay Item 20102-0000
30,463 Cuyd Rock Borrow (Section D) - Pay Item 20450-1000

^{2/} Not measured for payment. Information only quantity.

TABULATION OF PLAN QUANTITIES ✓

21 August 2015 9:19 AM
 C:\myfiles\pww_production\0199361\ak-206001fa.dgn [US_Sur_112D]
 Designed by: C. Conrad
 04/2013 Checked by:

ITEM 20701-1200 GEOTEXTILE TYPE IV-A

LEFT	AREA (SQYD)	RIGHT	AREA (SQYD)
10+13 to 11+06	409	10+13 to 12+11	870
11+33 to 13+86	491	21+75 to 23+50	884.33
21+50 to 22+75	309	22+52 to 23+80	3,995
43+50 to 44+25	737	24+55 to 27+75	829
47+25 to 54+28	1,054	29+75 to 45+98	4,962
55+25 to 61+43	1,403	47+75 to 49+50	533
64+65 to 67+43	256	55+76 to 59+51	754.0
71+06 to 75+70	122	62+50 to 66+40	1,788.34
75+86 to 77+33	1,011	66+40 to 66+90	187.6
113+24 to 118+00	1,334	80+50 to 83+00	742
127+02 to 131+03	920	86+25 to 88+50	261
135+00 to 136+66	725	90+05 to 95+10	4,780
		101+75 to 103+50	750
		112+90 to 120+36	3,800
		130+08 to 132+50	445
		140+21 to 141+60	549
SUBTOTAL LT.	8,951	SUBTOTAL RT.	23,457
TOTAL		32,308	

21101-1000 ROADWAY OBILITERATION, METHOD 2

LOCATION	SIDE	AREA (SQYD)
67+32 to 71+07	LT	700
94+17 to 95+25	LT	195
95+48 to 97+31	RT	499
113+61 to 117+07	LT	2013
TOTAL		3,407

83+00 to 88+00 RT 955.56 ✓
 105+35 to 113+00 RT 1741.7 ✓
 122+70 to 124+20 LT 90.56 ✓
Total 6,190.09 ✓

25120-2000 RIPRAP DITCH, CLASS 2

LOCATION LEFT	Length (LNFT)	LOCATION RIGHT	Length (LNFT)
21+25 to 21+50	26	47+50 to 47+67	17
44+33 to 46+28	192	49+50 to 49+75	27.53
62+56 to 64+50	183	54+06 to 54+25	19.70
69+00 to 69+96	96	63+31 to 64+50	125
91+50 to 93+78	228	69+00 to 69+50	50
94+65 to 95+20	55	71+05 to 71+94	91.89
96+92 to 97+45	53	74+00 to 80+50	630
110+32 to 113+42	310	95+20 to 95+75	53.55
117+90 to 118+98	108	96+75 to 97+25	50
122+75 to 124+34	157	110+75 to 112+65	210
132+75 to 133+25	50	123+35 to 123+65	30
137+35 to 138+00	65	127+06 to 128+00	100
138+60 to 140+68	194	136+90 to 138+00	120
		138+75 to 140+22	165
SUBTOTAL LT.	1,718	SUBTOTAL RT.	1,687
TOTAL		3,405	

133+88 95 1,753 ✓ 3,713 ✓

31+40 to 40+52 2288.34 ✓ 43+77 to 45+75 710.6 ✓
 81+40 to 82+00 100 ✓ 500+20 to 501+50 390 ✓
 120+28 to 122+50 518 ✓ Subtotal RT 22,317.53 ✓
 Subtotal LT 10,840.69 ✓
Total 33,158.22 ✓

GUARDRAIL QUANTITIES

LOCATION	LT/RT	61701-1250 GUARDRAIL SYSTEM G4, TYPE 2, CLASS A WOOD POSTS	61702-0800 TERMINAL SECTION TYPE TANGENT (EACH)
31+38 to 38+31	RT	325	2
59+00 to 61+50	LT	250	2
87+50 to 95+00	RT	700	2
97+46 to 110+00	RT	1,250	2
112+08 to 119+98	RT	700	2
113+71 to 116+65	LT	300	2
124+38 to 128+38	LT	400	2
TOTALS		3,925	14

62405-0300 PLACING CONSERVED TOPSOIL, 4" DEPTH

LOCATION LEFT	AREA (SQYD)	LOCATION RIGHT	AREA (SQYD)
10+13 to 13+75	477	10+13 to 27+75	2,858
21+50 to 22+52	147	29+54 to 45+68	2,325
47+24 to 62+56	1,338	47+58 to 49+57	245
66+05 to 68+00	103	55+76 to 59+51	222
69+93 to 81+23	694	80+49 to 83+27	333
113+41 to 115+52	513	86+26 to 88+50	121
120+19 to 122+50	365	90+04 to 95+10	3,598
124+35 to 131+04	638	97+47 to 104+89	1,115
135+43 to 136+53	73	109+40 to 110+50	80
		112+90 to 120+50	2,230
		130+00 to 132+50	167
		133+53 to 134+35	156
		134+58 to 136+02	110
		140+22 to 141+78	189
SUBTOTAL LEFT	4,348	SUBTOTAL RIGHT	13,749
TOTAL		18,097	

See CMO04

25104-5000 Keyed Riprap, Class 4 (Riprap Blanket)

Location Left	Volume (CUYD)	Location Right	Volume (CUYD)
14+00 to 17+75	620.37	50+94 to 51+06	5.33
18+02 to 19+50	127.48	52+40 to 52+85	80
20+25 to 20+69	31.78	54+50 to 55+50	200
26+06 to 24+60	260.74	59+84 to 60+08	9.33
26+93 to 27+50	30.52	61+00 to 64+50	833.33
29+25 to 39+75	1545.38	69+80 to 70+20	60.74
40+64 to 40+83	8.44		
70+71 to 71+07	25		
141+40 to 141+80	35.56		
Subtotal LT.	2685.27	Subtotal RT	1188.73
TOTAL		3,874	

TABULATION OF PLAN QUANTITIES ✓

21 August 2015 9:04 AM
 c:\myfiles\p\production\0199361\ak-r206001b.dgn [US_Sur_R2D]
 Designed by: C. Conrad
 04/2013 Checked by:

STATE	PROJECT	SHEET NUMBER
AK	USFS 2060(1)	D.3

STATE OF ALASKA
1 1/2 IN.
SECTION 17
QCD 2010-001377-0


UTILITY CONTACT INFORMATION

ALASKA POWER AND TELEPHONE
Glen D. Martin
Mgr. Permitting/Licensing/Compliance
Alaska Power & Telephone Company
P.O. Box 3222
Port Townsend, WA 98368
Office: (360) 385-1733 x122
Cell: (360) 808-4518
Fax: (360) 385-7538
email: glen.m@aptalaska.com




BEGIN PROJECT
AK USFS 2060(1)
10+13.42
N=1483462.32
E=2784316.88
El= 75.29


LEGEND:
⊙ Tangent terminal

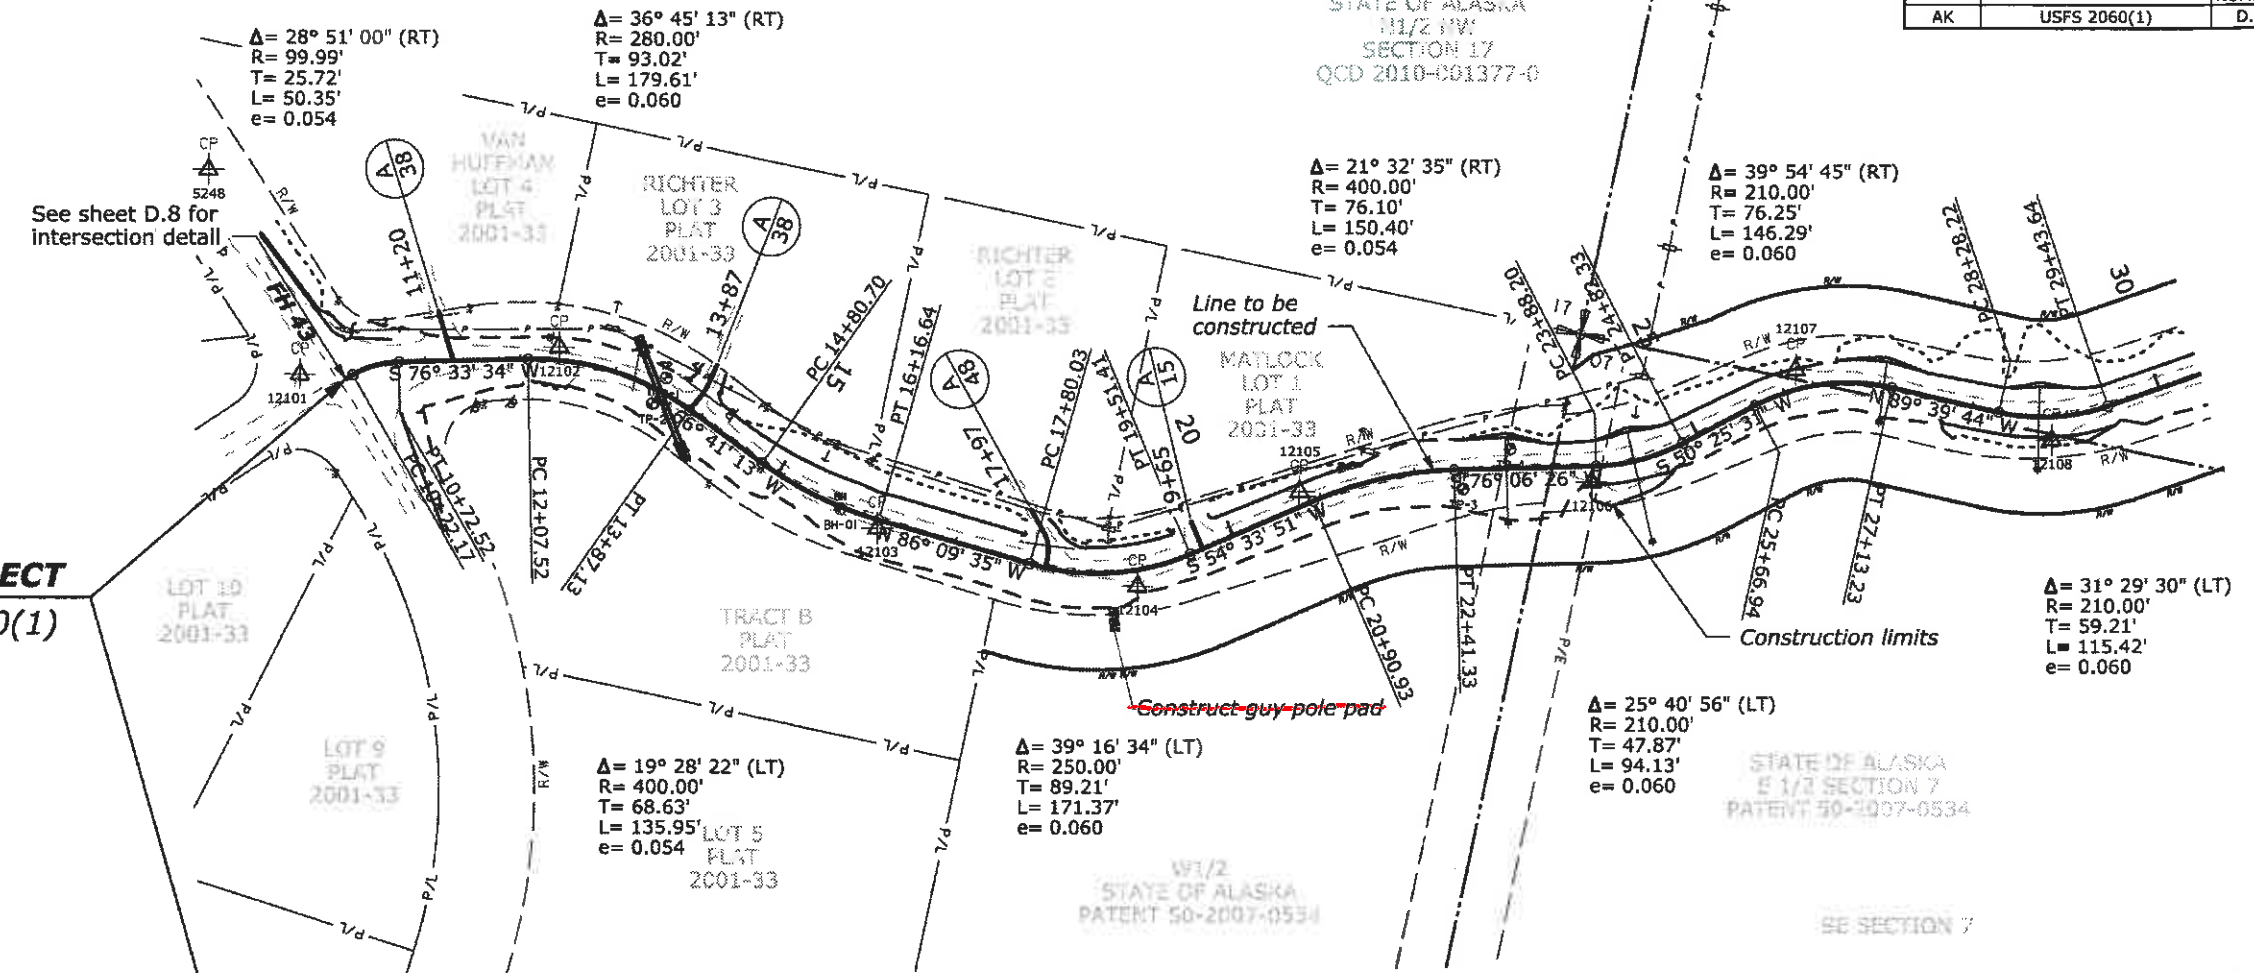

Checked by: C. Conrad
Designed by: C. Conrad
26 August 2015 2:40 PM c:\myfiles\pw production\d01993611\ak-f206001fc.dgn [US Sur ft2D] IUS Sur ft2D

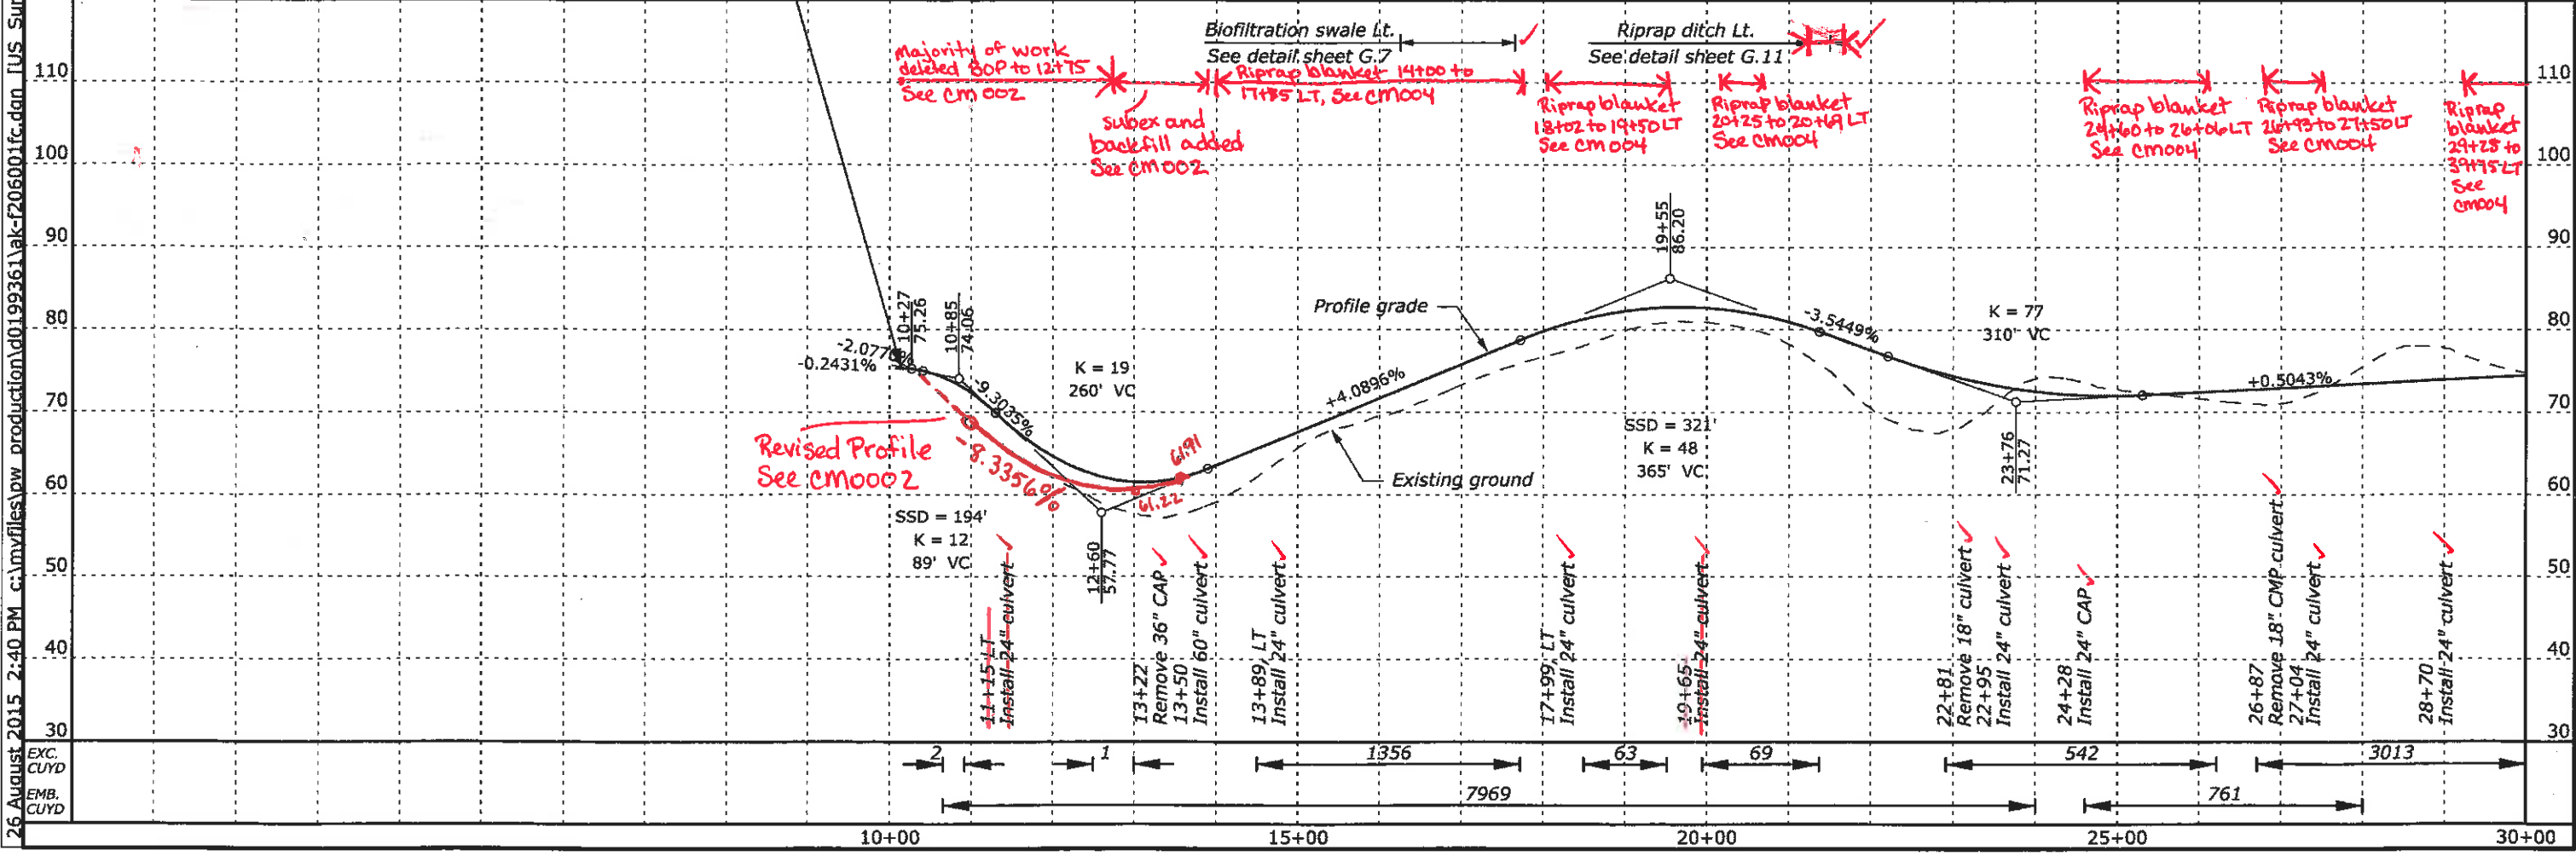

STATE	PROJECT	SHEET NUMBER
AK	USFS 2060(1)	D.4

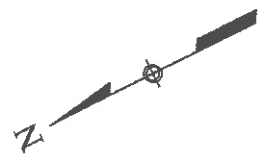

STATE OF ALASKA
N1/2 NE
SECTION 18
PATENT 50-2007-0534

$\Delta = 64^\circ 19' 04''$ (RT)
R = 231.00'
T = 145.24'
L = 259.31'
e = 0.060

$\Delta = 66^\circ 41' 59''$ (LT)
R = 350.00'
T = 230.34'
L = 407.45'
e = 0.056

$\Delta = 13^\circ 13' 59''$ (RT)
R = 350.00'
T = 40.60'
L = 80.84'
e = 0.056

$\Delta = 7^\circ 39' 05''$ (LT)
R = 1,525.00'
T = 101.98'
L = 203.65'
e = 0.028

$\Delta = 28^\circ 57' 02''$ (LT)
R = 350.00'
T = 90.35'
L = 176.85'
e = 0.056

$\Delta = 24^\circ 05' 10''$ (LT)
R = 500.00'
T = 106.67'
L = 210.19'
e = 0.050

$\Delta = 19^\circ 31' 14''$ (LT)
R = 300.00'
T = 51.60'
L = 102.21'
e = 0.058

STATE OF ALASKA
FDR 2060
100' R/W RESERVED TO USA
SECTIONS 7, 8, 18
PATENT 50-2007-0534


STATE OF ALASKA
N1/2 NE
SECTION 18
PATENT 50-2007-0534

STATE OF ALASKA
S1/2 NE
SECTION 18
BOOK 131 PAGE 2077

LEGEND:

Ⓣ Tangent terminal

Designed by: C. Conrad
Checked by:

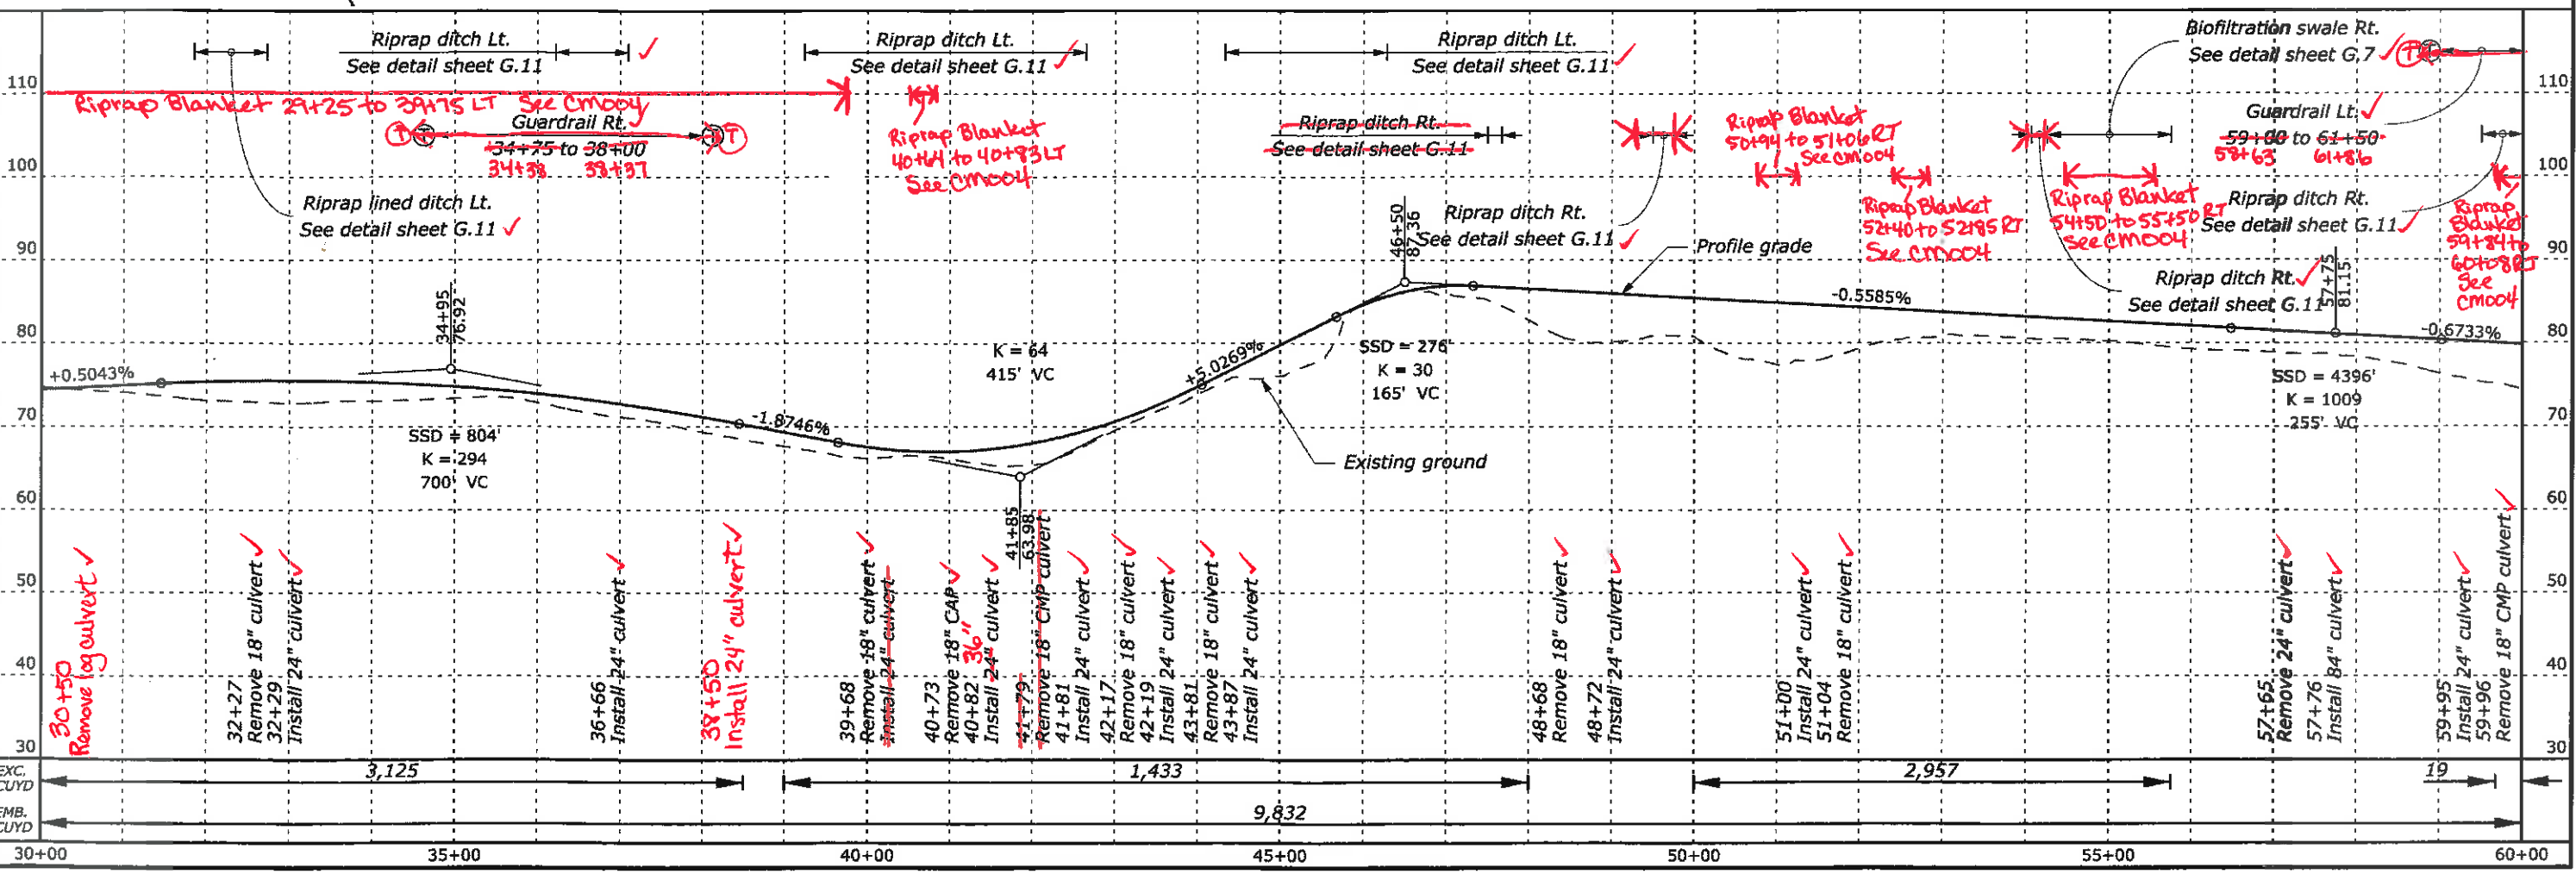

21 August 2015 8:45 AM
c:\myfiles\pw_production\0199361\ak-f206001\dgn [US_Sur_R2D]

STATE	PROJECT	SHEET NUMBER
AK	USFS 2060(1)	D.5

STATE OF ALASKA
SECTION 15
QCD 2010-001377-0

*Realignment CMO04
82+00 to 116+70.46
See FHWA survey notes
See CMO04*

*Roadway
obliteration
83+00 to 88+00 RT*

*Steepen rock cut slope
T3+00 to T7+00 RT
From 1v:1h to 1v:.5h
See CMO03*



STATE OF ALASKA
S1/2 NE
SECTION 10
BOOK 131 PAGE 2077

STATE OF ALASKA
GOVT LOT 3
SECTION 18
QCD 2010-001377-0

STATE OF ALASKA
NW SE
SECTION 18

STATE OF ALASKA
GOVT LOT 7
SECTION 18

STATE OF ALASKA
GOVT LOT 7
SECTION 18

STATE OF ALASKA
NW SE
SECTION 18

$\Delta = 42^\circ 45' 17''$ (RT)
R = 300.00'
T = 117.43'
L = 223.86'
e = 0.058

$\Delta = 23^\circ 36' 48''$ (LT)
R = 231.00'
T = 48.29'
L = 95.20'
e = 0.060

$\Delta = 42^\circ 41' 16''$ (LT)
R = 260.00'
T = 101.60'
L = 193.71'
e = 0.060

$\Delta = 12^\circ 28' 45''$ (LT)
R = 600.00'
T = 65.60'
L = 130.68'
e = 0.050



$\Delta = 7^\circ 41' 05''$ (RT)
R = 1,500.00'
T = 100.74'
L = 201.18'
e = 0.028

$\Delta = 42^\circ 20' 51''$ (RT)
R = 400.00'
T = 154.94'
L = 295.64'
e = 0.054

$\Delta = 37^\circ 49' 09''$ (RT)
R = 400.00'
T = 137.03'
L = 264.03'
e = 0.054



$\Delta = 37^\circ 38' 02''$ (LT)
R = 400.00'
T = 136.30'
L = 262.73'
e = 0.054

LEGEND:
⊕ Tangent terminal

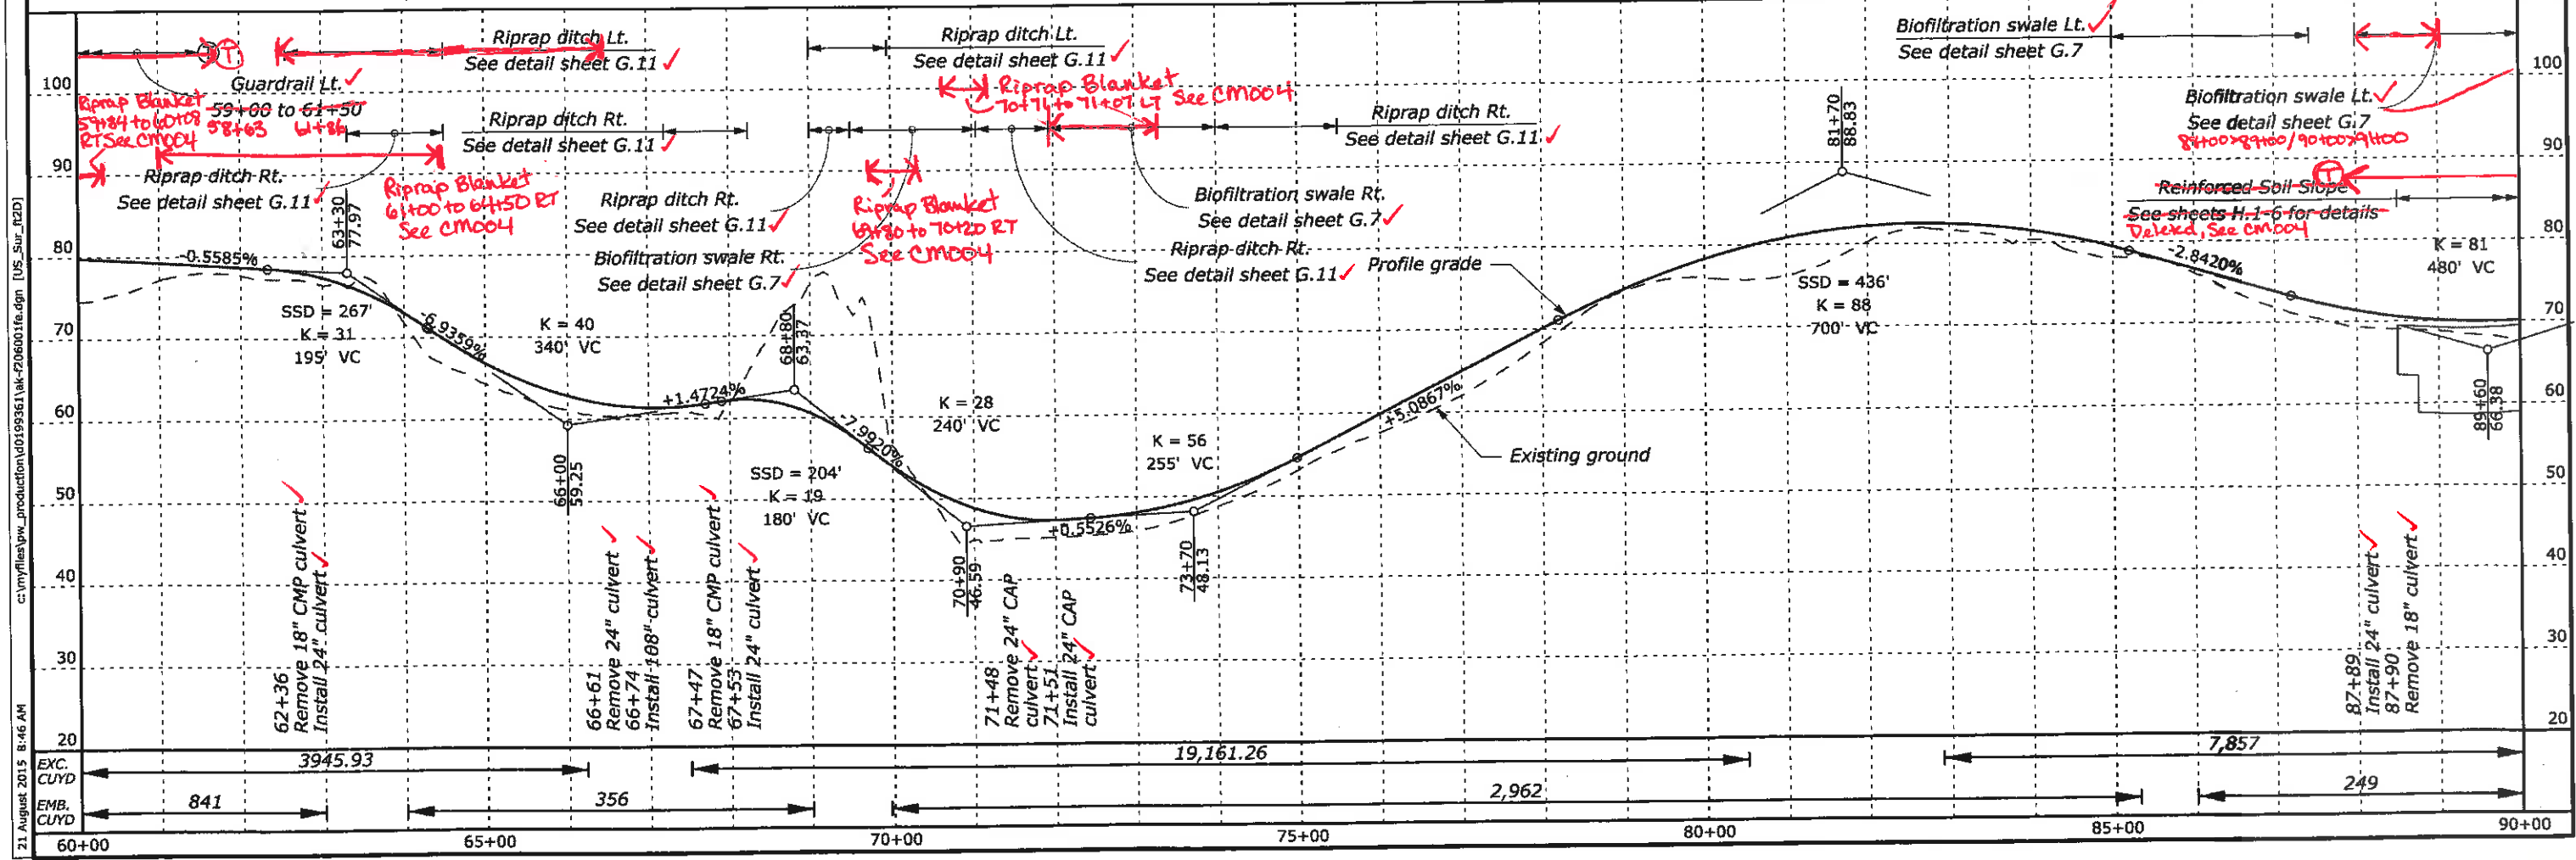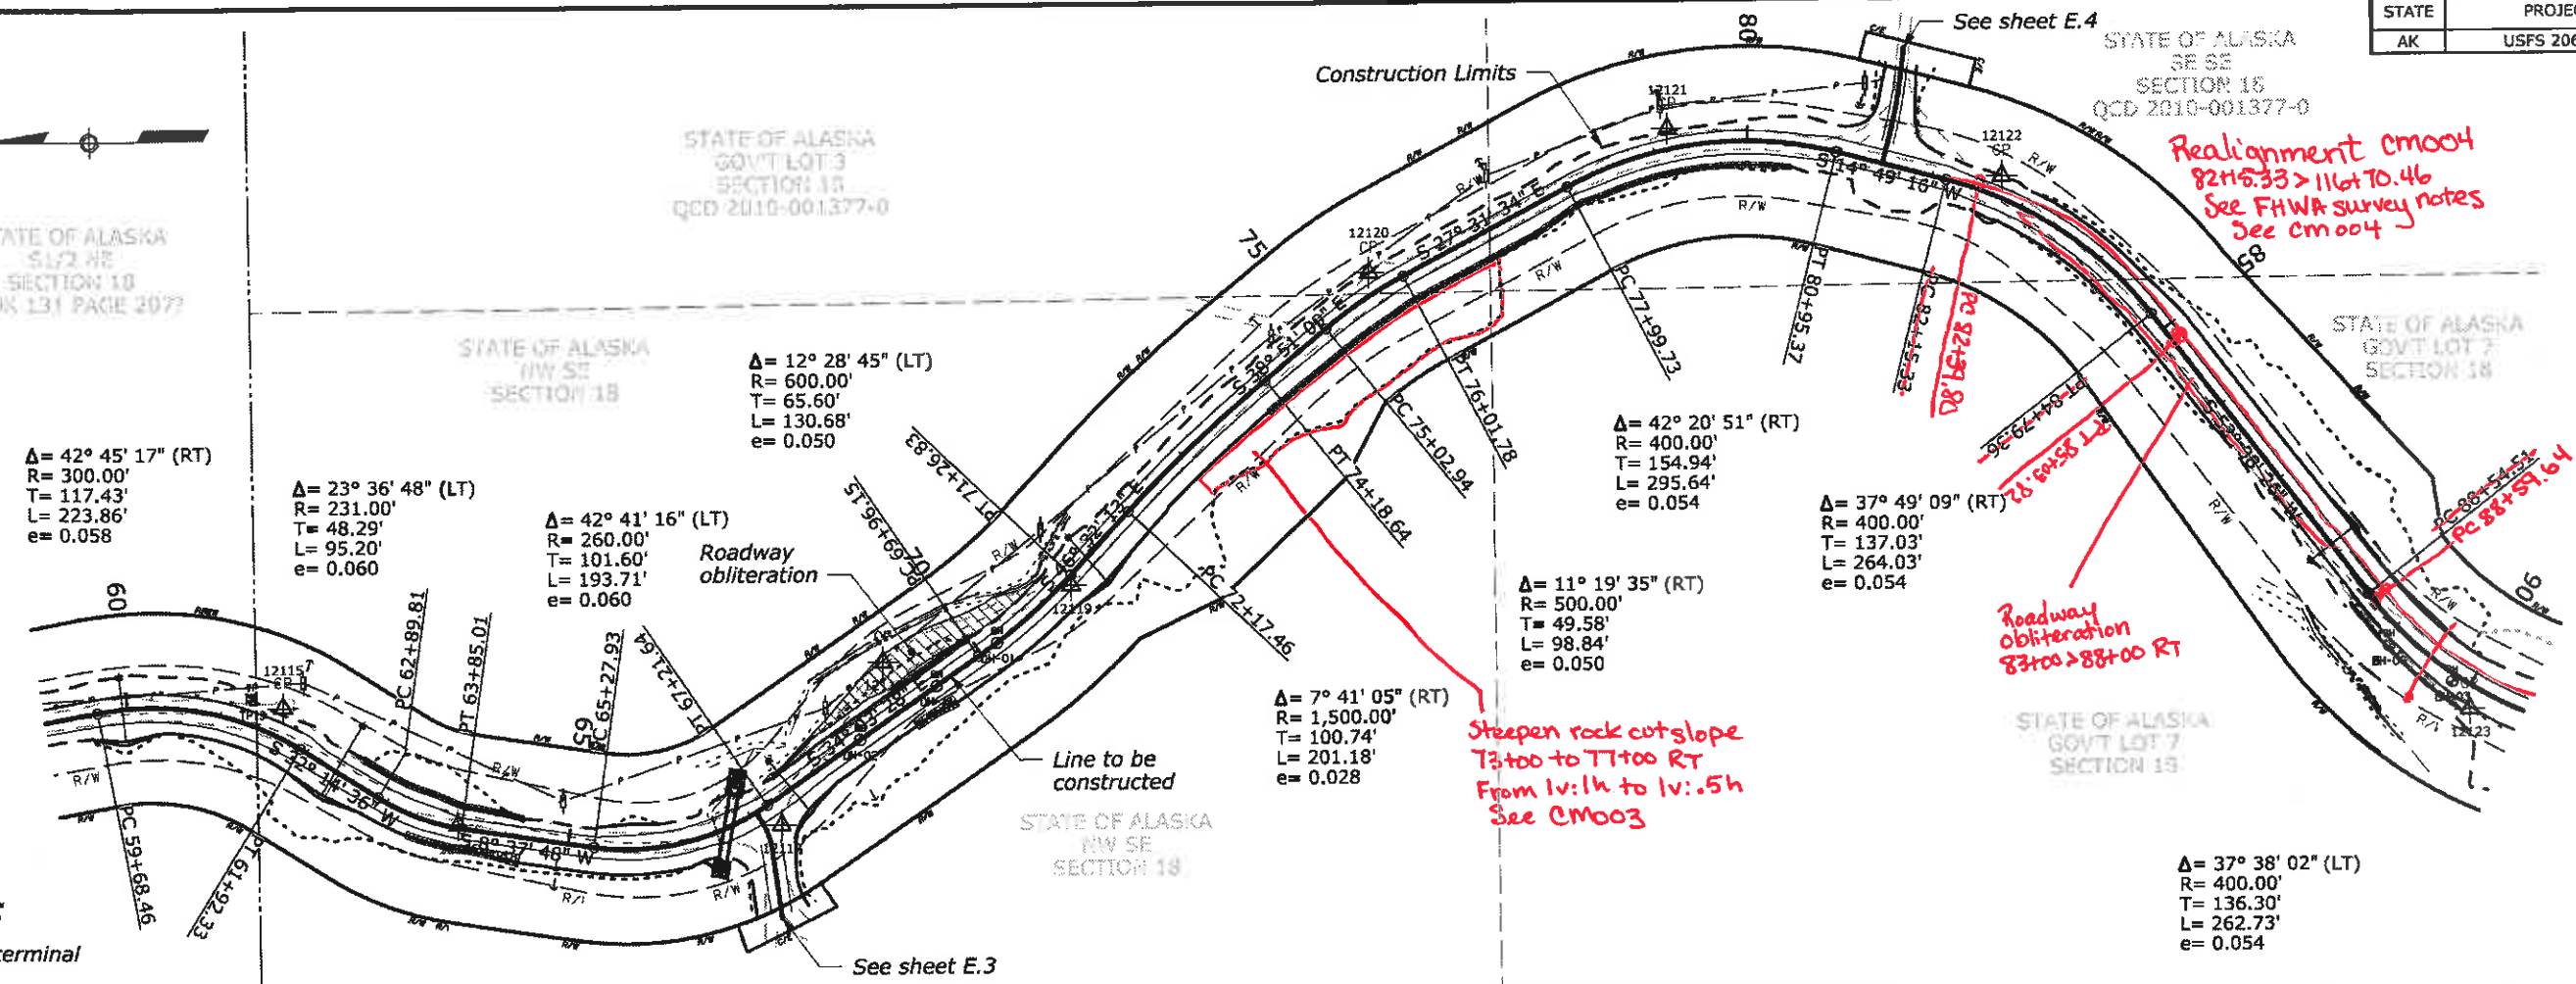

21 August 2015 8:46 AM
 c:\myfiles\pww_production\0199361\ak-206001\fe.dgn [US_Sur_B2D]
 Designed by: C. Conrad
 Checked by:

STATE	PROJECT	SHEET NUMBER
AK	USFS 2060(1)	D.6

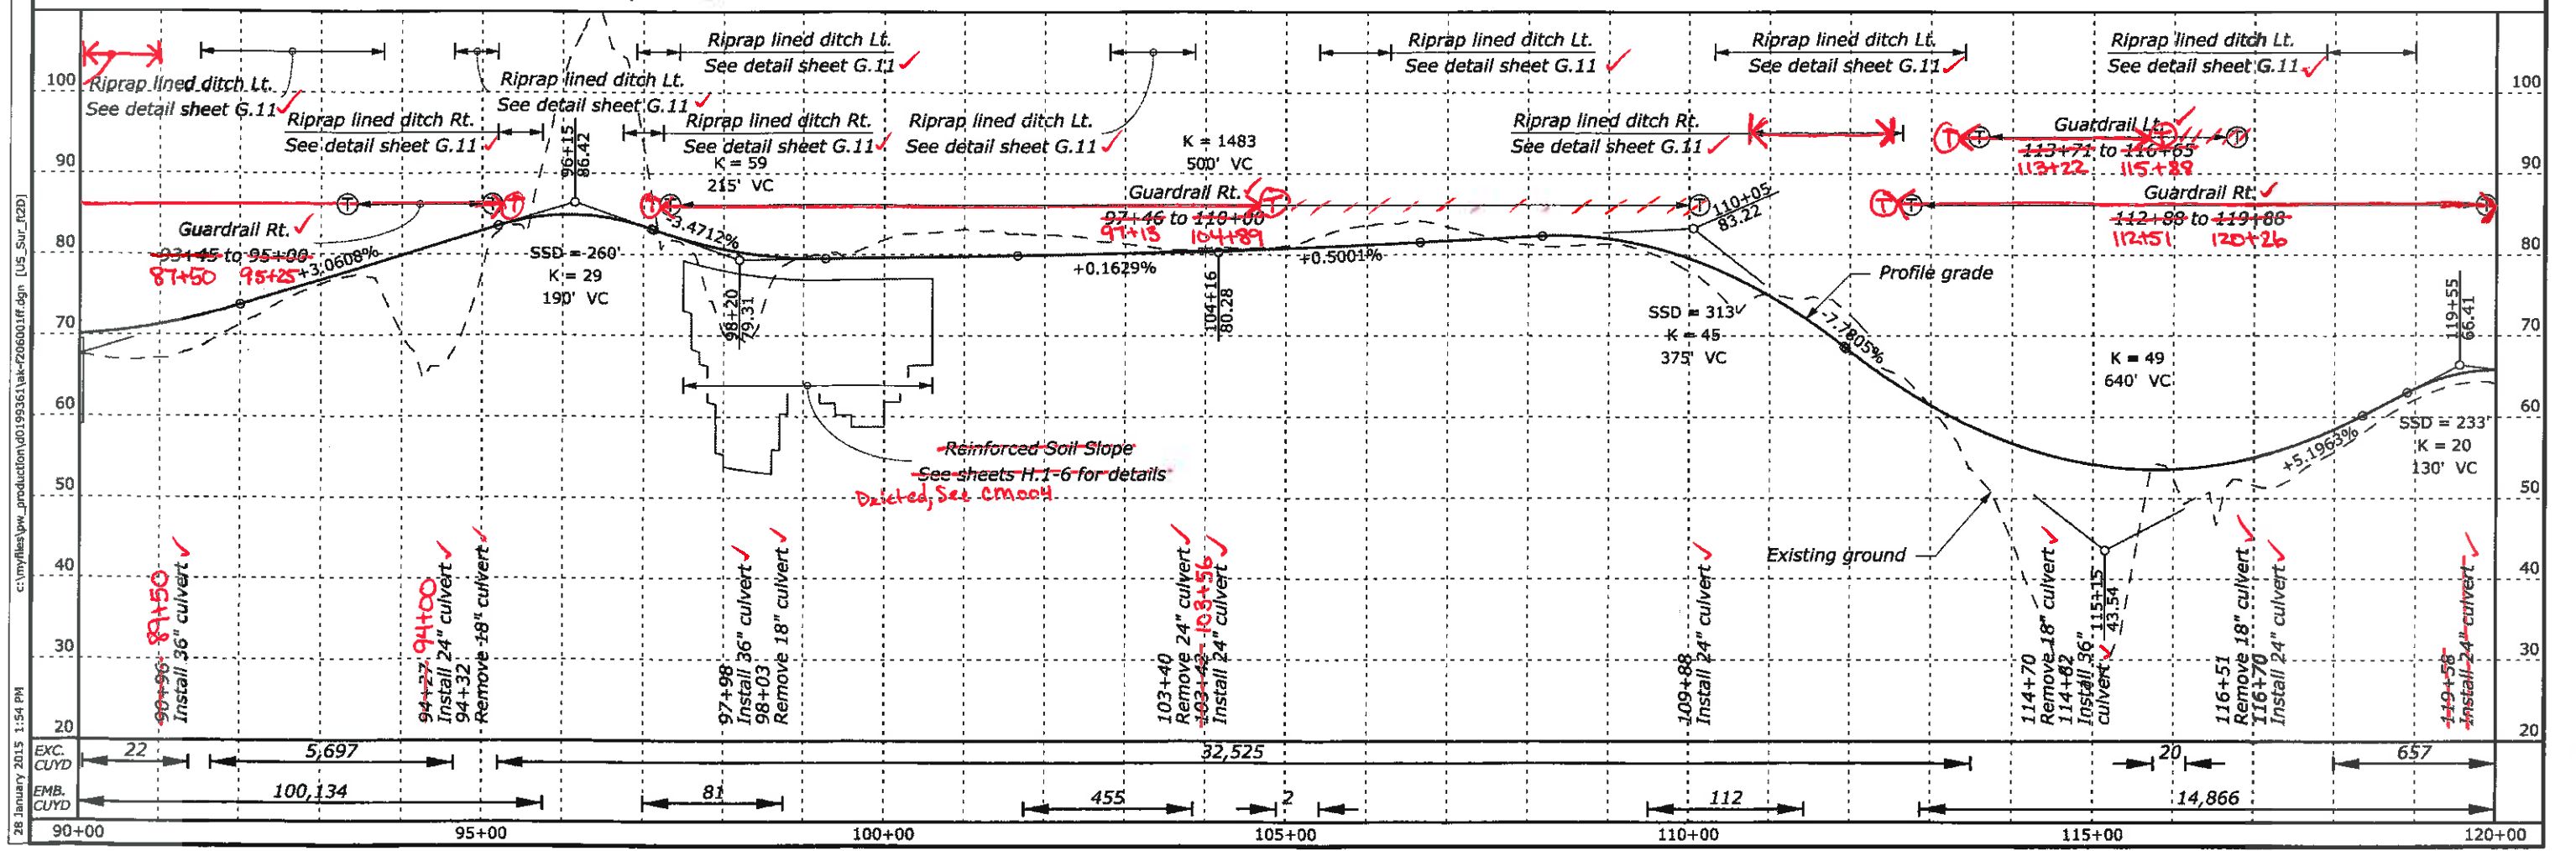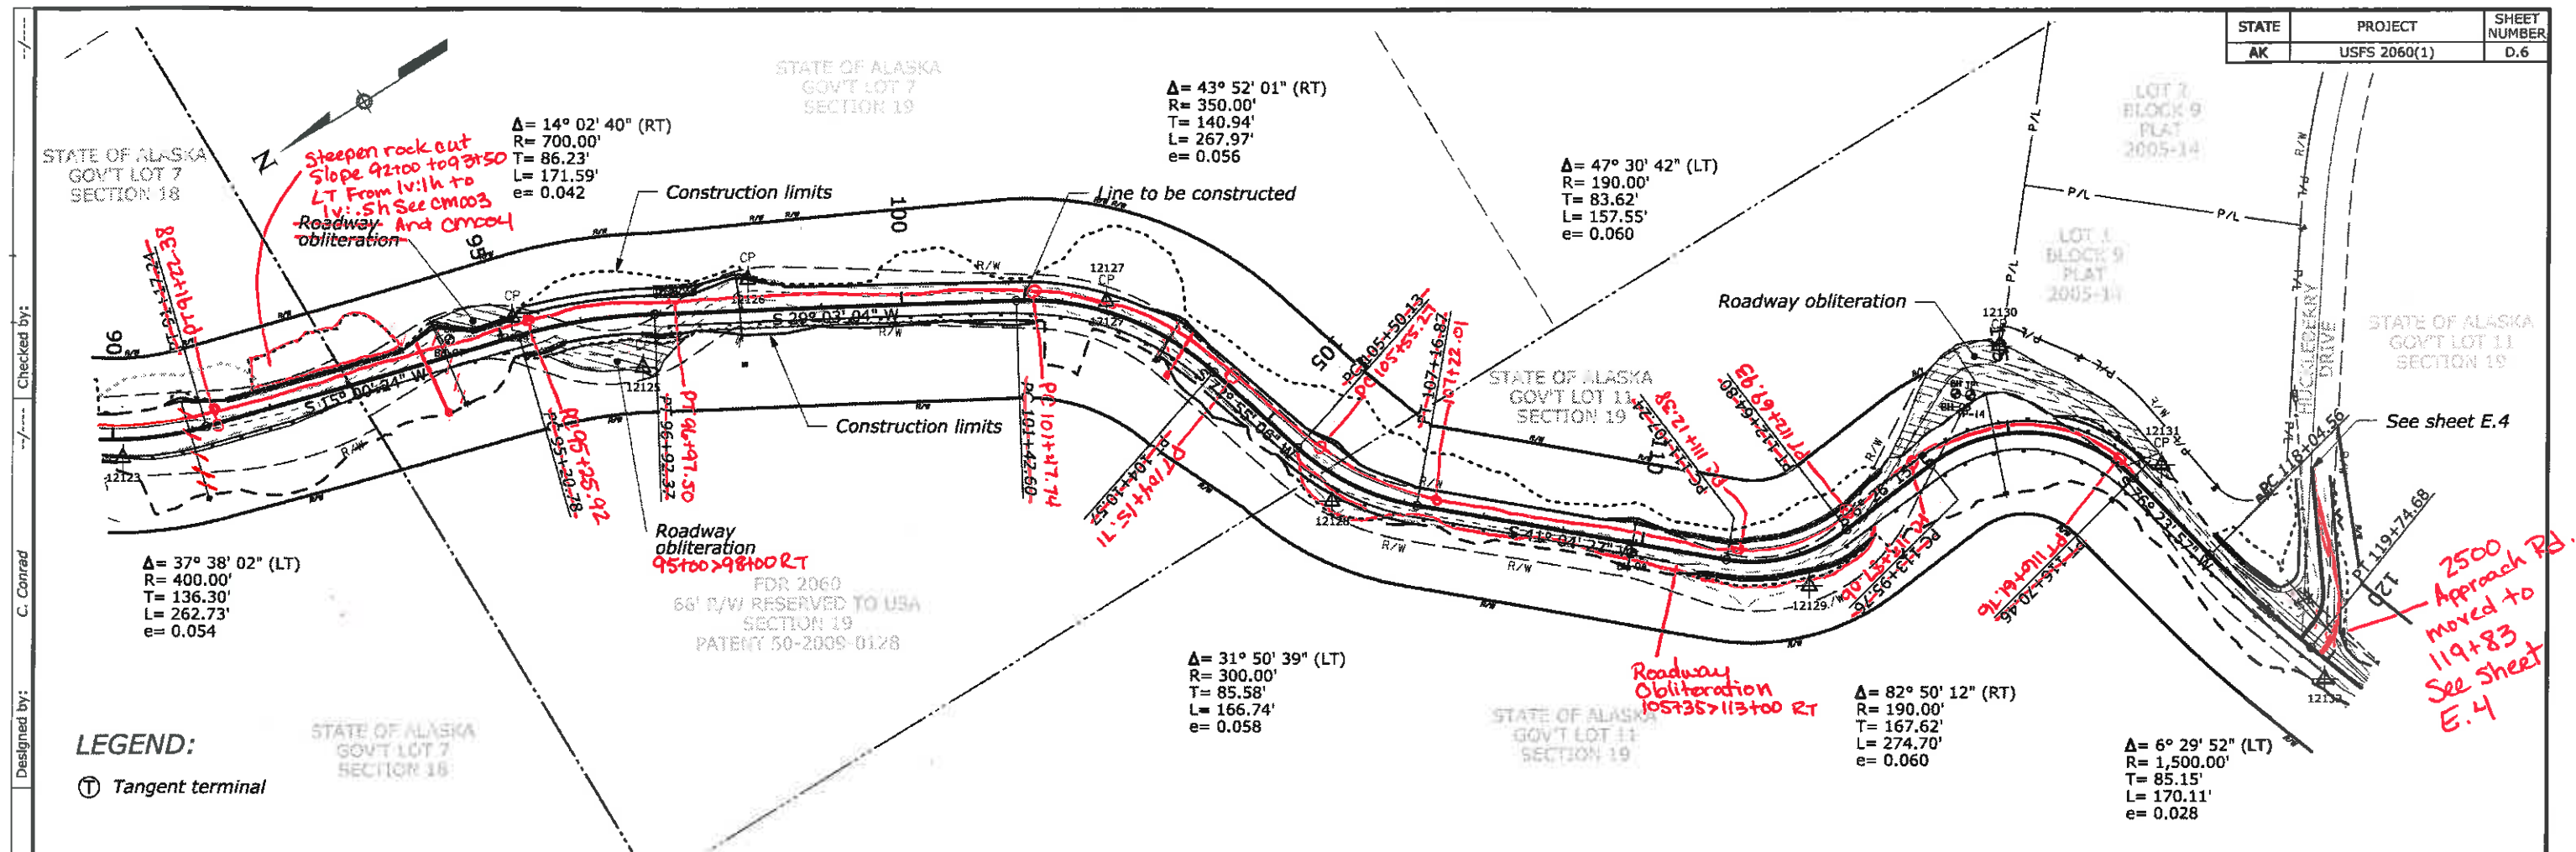



Station	Exc. CUYD	Emb. CUYD
90+00	22	100,134
95+00		
100+00	81	
105+00	455	
110+00	2	
115+00	112	
120+00	20	14,866
657		

Designed by: C. Conrad
 Checked by:


c:\myfiles\jw_production\0199361\ak-2060(1).dgn [US_Sur_12D]

28 January 2015 1:54 PM

STATE	PROJECT	SHEET NUMBER
AK	USFS 2060(1)	D.7

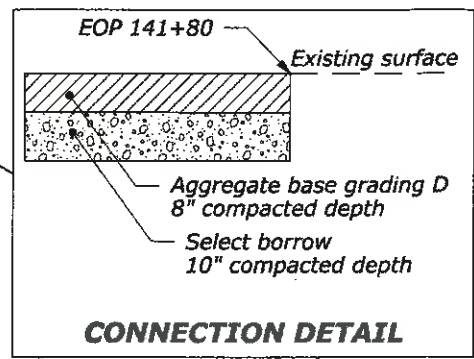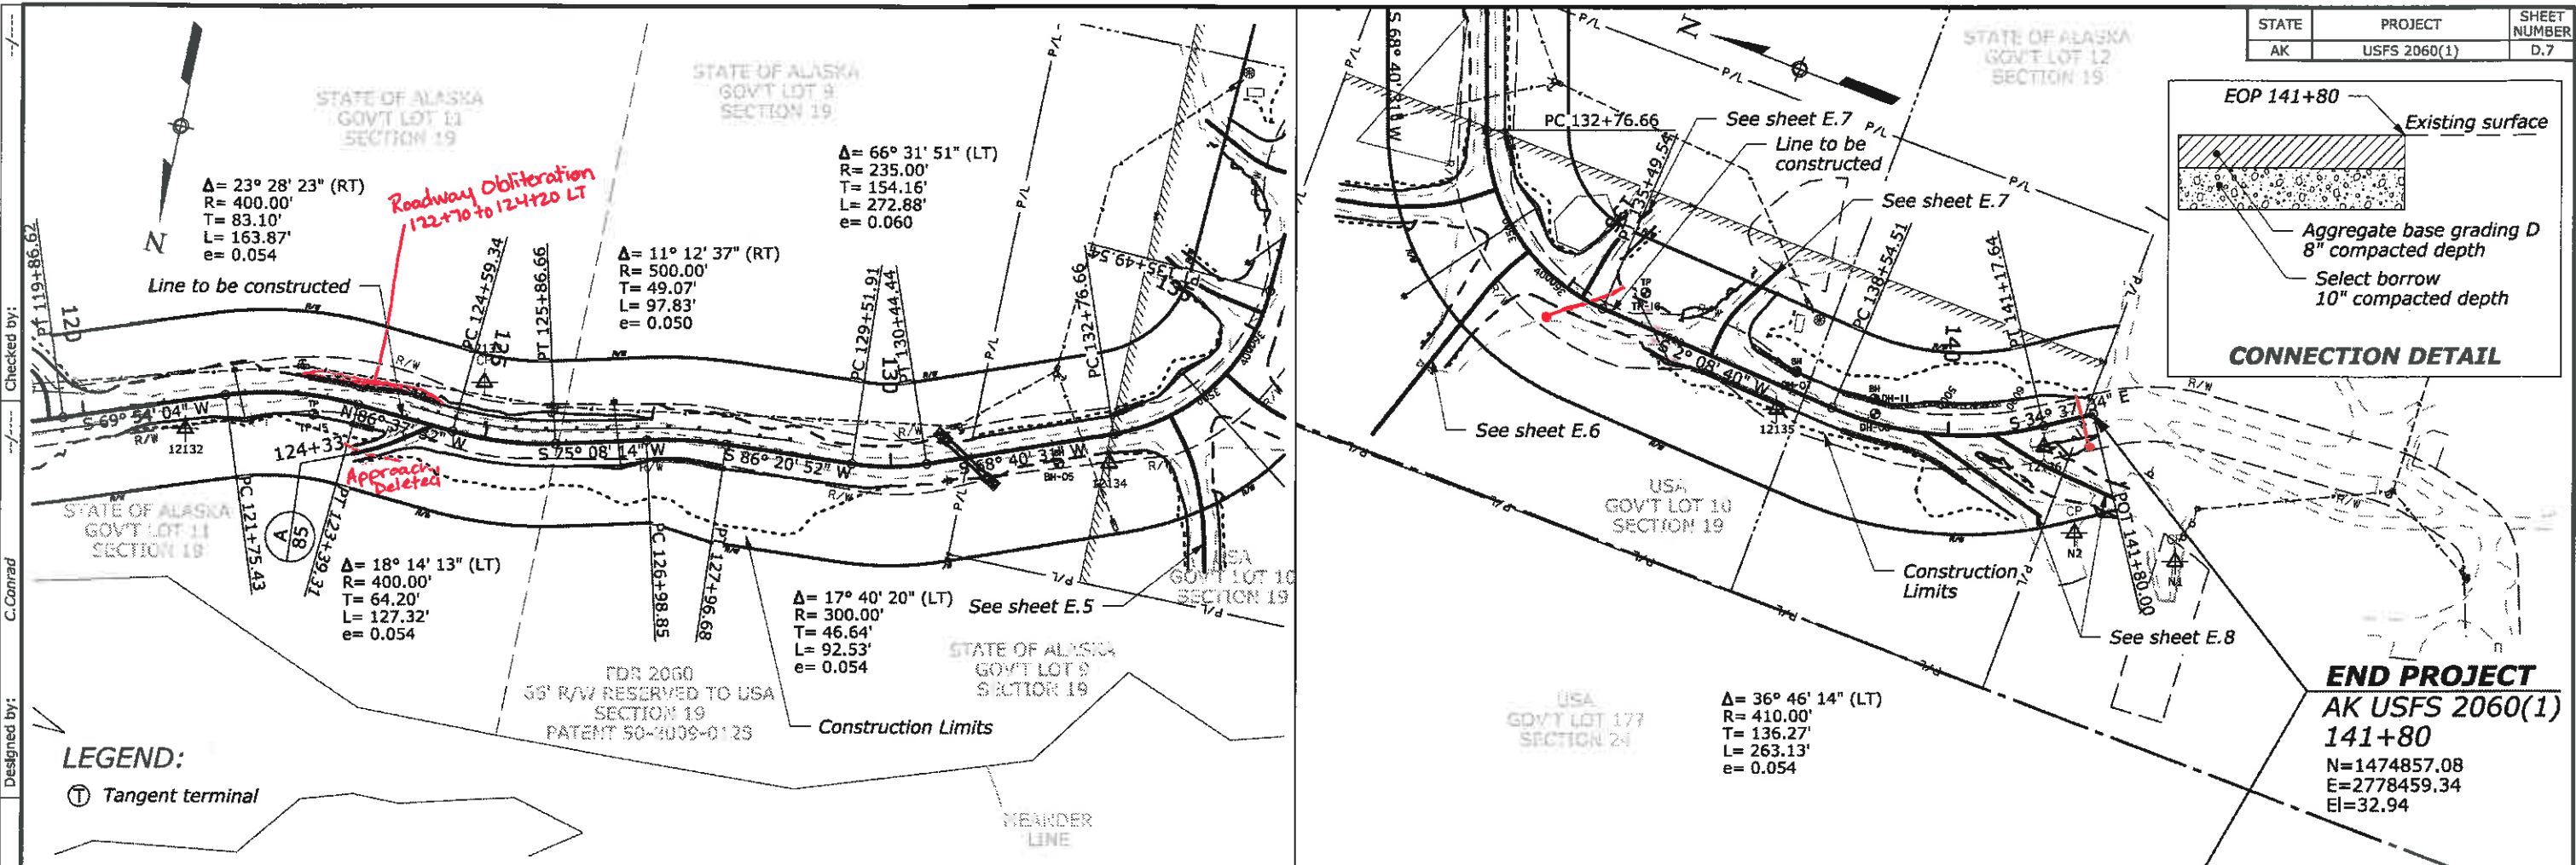

END PROJECT
AK USFS 2060(1)
141+80
 N=1474857.08
 E=2778459.34
 El=32.94

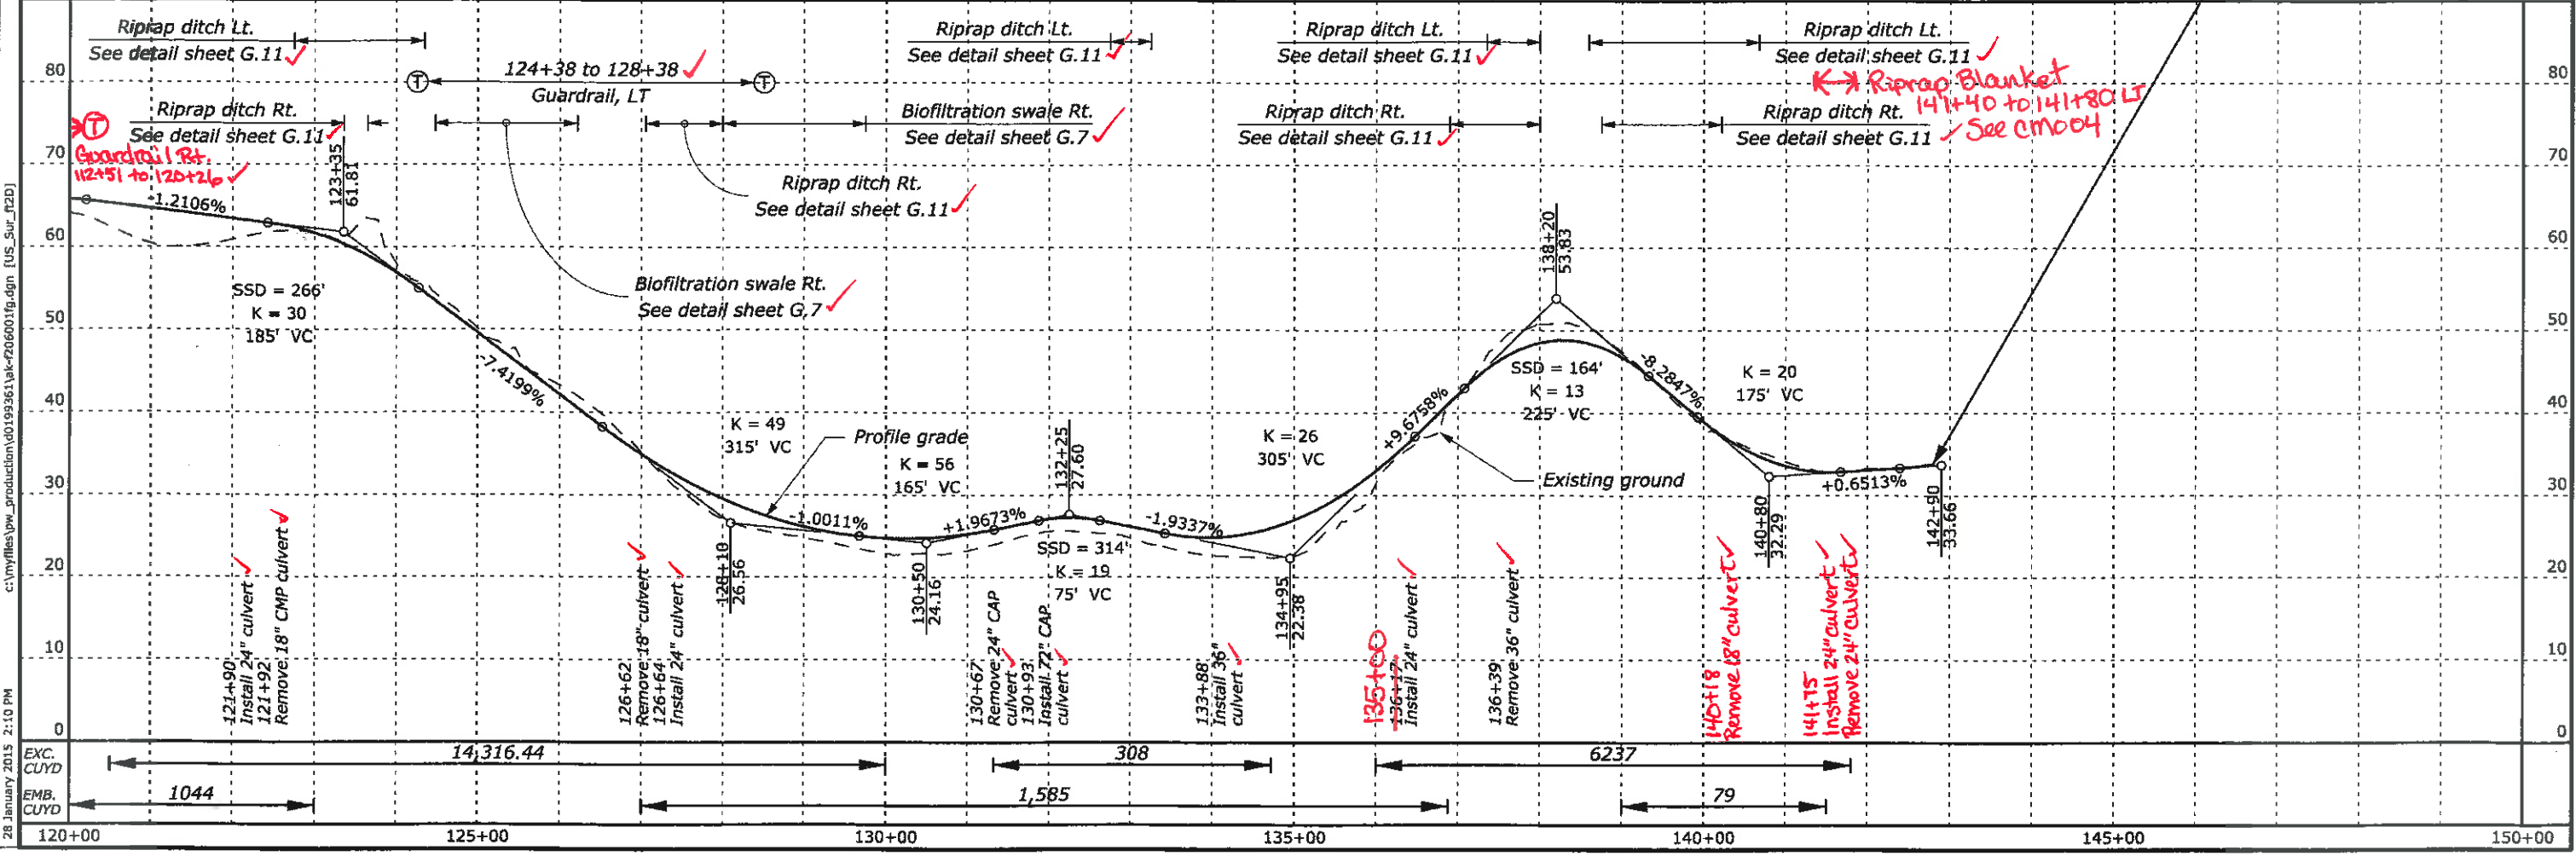

Checked by: C. Conrad
 Designed by: C. Conrad

28 January 2015 2:10 PM
 c:\myfiles\pww_production\0199361\ak-206001\fig.dgn [US_Sur_12D]

STATE	PROJECT	SHEET NUMBER
AK	USFS 2060(1)	D.8

BEGIN PROJECT

AK USFS 2060(1)


10+13.42

N=1483462.32

E=2784316.88

El= 75.29

CP
12101

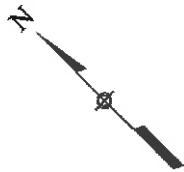

Centerline FH-43

Edge of traveled way

15:1 Taper

15:1 Taper

R=30'


Hot asphalt concrete pavement apron

See plan sheet C.2
See CMOO07
~~Surface treatment designation 2C~~

~~Emulsified asphalt treated base, grading D 4" compacted depth~~

~~Aggregate base, grading D 4" compacted depth~~

BOP 10+13.42
FH 43 Edge of travel way

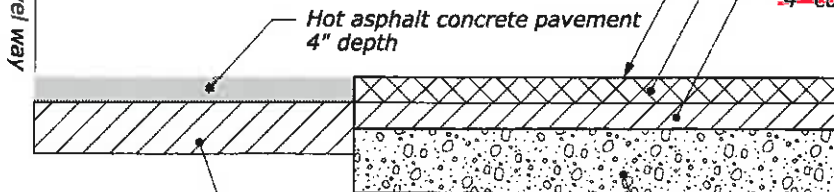

FH 43 CONNECTION DETAIL


FH-43 INTERSECTION DETAIL

Checked by:

Designed by:

c:\myfiles\jw_production\00199361\ak-f206001fh.dgn [US_Sur_h2D]

19 August 2015 11:03 AM

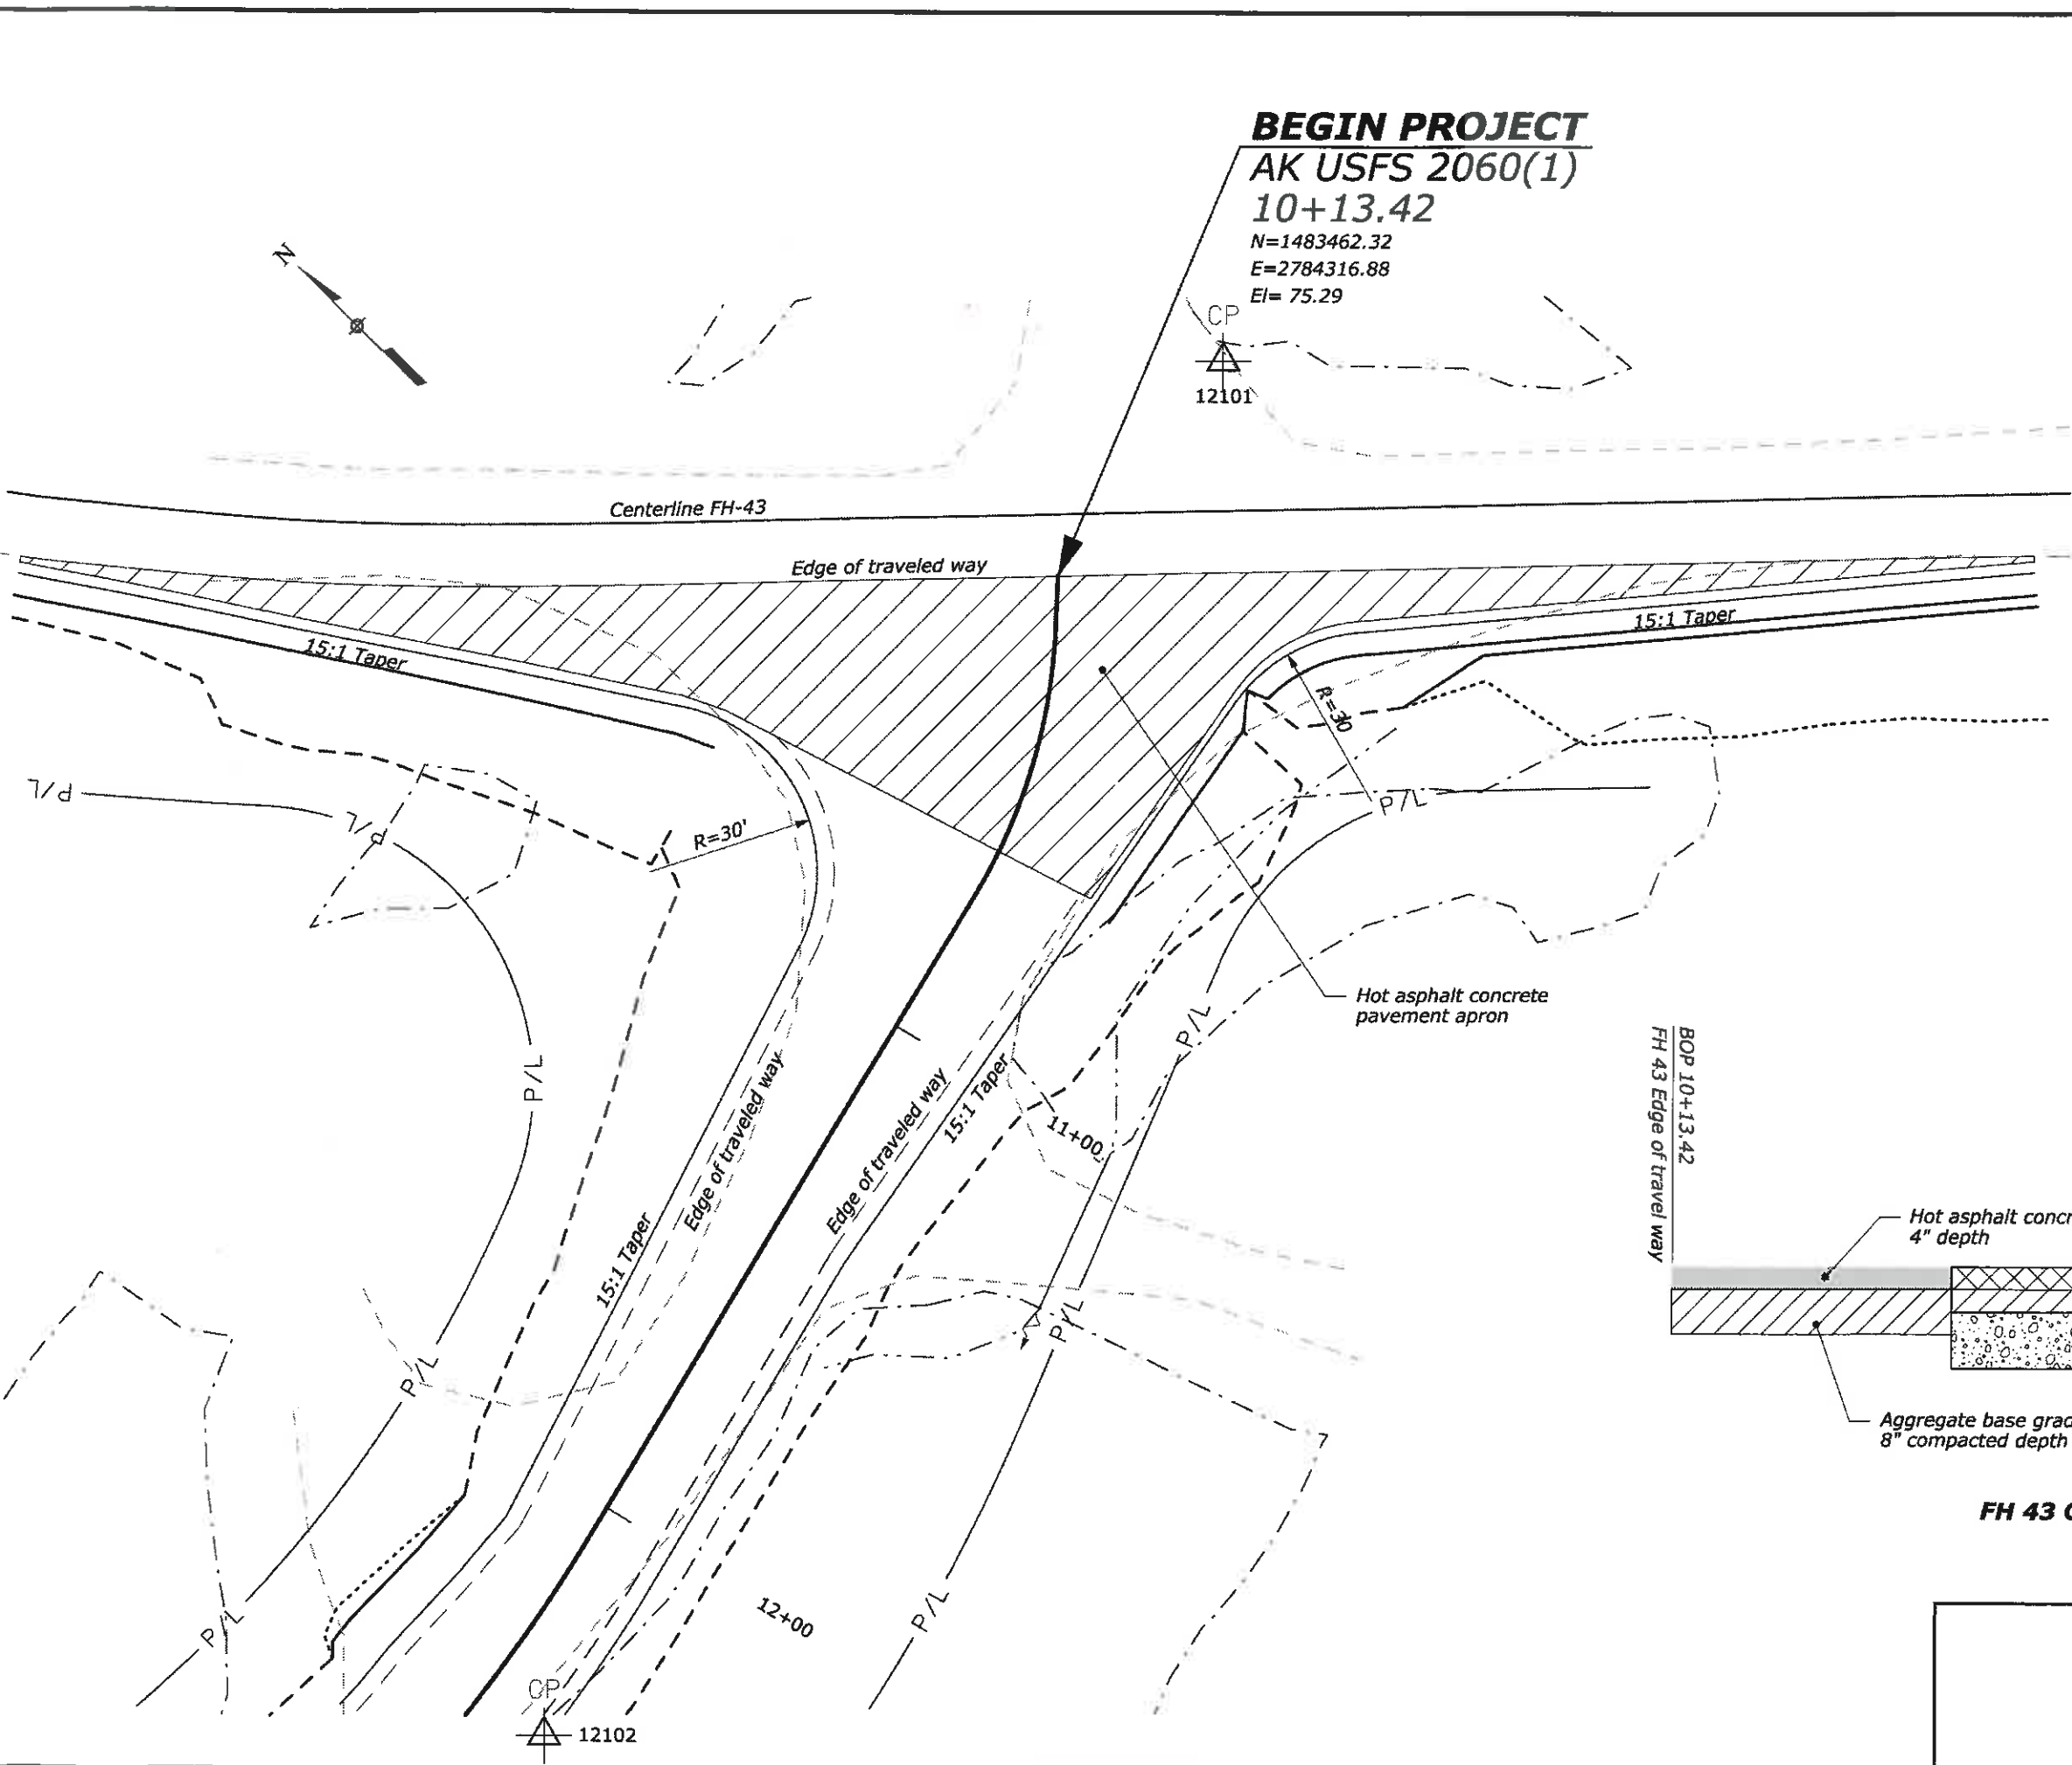

CP
12102

PROJECT : Naukati Road
 DATE OF FIELD WORK : 10/2012

PROJECT UNITS : US SURVEY FOOT
 COORDINATE SYSTEM : Alaska SPCS zone 1 (5001) NAD83 (2011)
 EPOCH DATE : 2010.000
 VERTICAL DATUM : NAVD88 based on GEOID 12A

STATE	PROJECT	SHEET NUMBER
AK	USFS 2060(1)	D.9


POINT NUMBER	PROJECT COORDINATES			GEO COORDINATES			COMBINED FACTOR	DESCRIPTION
	NORTH	EAST	ELEVATION	LATITUDE	LONGITUDE	ELLIPSOID HEIGHT		
5248	1483282.148	2784502.904	99.130	55°53'39.81377"N	133°11'11.45477"W	89.465	0.99992611	Found 1" YPC CP 197
12101	1483468.082	2784364.684	75.956	55°53'41.65589"N	133°11'13.85613"W	66.294	0.99992721	Set RPA RPC on rebar
12102	1483382.963	2784105.679	58.274	55°53'40.83494"N	133°11'18.40955"W	48.613	0.99992815	Set RPA RPC on rebar
12103	1483494.280	2783741.422	68.407	55°53'41.95723"N	133°11'24.78487"W	58.75	0.99992775	Set RPA RPC on rebar
12104	1483495.175	2783463.746	78.401	55°53'41.98518"N	133°11'29.65519"W	68.747	0.99992736	Set RPA RPC on rebar
12105	1483363.524	2783319.705	77.456	55°53'40.69758"N	133°11'32.19776"W	67.801	0.99992747	Set RPA RPC on rebar
12106	1483289.591	2783025.791	73.574	55°53'39.98908"N	133°11'37.36196"W	63.921	0.99992776	Set RPA RPC on rebar
12107	1483131.689	2782842.942	70.919	55°53'38.44536"N	133°11'40.58830"W	61.266	0.99992798	Set RPA RPC on rebar
12108	1483145.583	2782566.418	77.160	55°53'38.60118"N	133°11'45.43671"W	67.51	0.99992776	Set RPA RPC on rebar
12109	1482933.148	2782237.467	71.864	55°53'36.52988"N	133°11'51.23204"W	62.215	0.99992816	Set RPA RPC on rebar
12110	1482661.891	2782082.452	72.884	55°53'33.86698"N	133°11'53.98365"W	63.235	0.99992822	Set RPA RPC on rebar
12111	1482142.344	2782017.224	66.489	55°53'28.75091"N	133°11'55.19037"W	56.837	0.99992867	Set RPA RPC on rebar
12112	1481887.940	2781529.741	85.614	55°53'26.27655"N	133°12'03.77053"W	75.965	0.99992796	Set RPA RPC on rebar
12113	1481596.216	2781282.254	79.667	55°53'23.41808"N	133°12'08.14588"W	70.019	0.99992838	Set RPA RPC on rebar
12114	1481088.743	2781352.738	78.509	55°53'18.41184"N	133°12'06.97057"W	68.856	0.99992853	Set RPA RPC on rebar
12115	1480459.841	2781414.142	78.087	55°53'12.20943"N	133°12'05.96913"W	68.427	0.99992868	Set RPA RPC on rebar
12116	1480275.083	2781289.241	73.325	55°53'10.39692"N	133°12'08.18154"W	63.665	0.99992899	Set RPA RPC on rebar
12117	1479929.964	2781285.217	60.449	55°53'06.99580"N	133°12'08.29342"W	50.786	0.99992968	Set RPA RPC on rebar
12118	1479819.442	2781455.311	58.576	55°53'05.89508"N	133°12'05.32399"W	48.91	0.99992974	Set RPA RPC on rebar
12119	1479617.864	2781533.104	43.422	55°53'03.90314"N	133°12'03.98405"W	33.753	0.99993049	Set RPA RPC on rebar
12120	1479296.152	2781857.410	55.750	55°53'00.71053"N	133°11'58.33603"W	46.075	0.99992987	Set RPA RPC on rebar
12121	1478976.771	2782004.385	74.500	55°52'57.55285"N	133°11'55.79738"W	64.82	0.99992901	Set RPA RPC on rebar
12122	1478622.154	2781949.379	80.326	55°52'54.06158"N	133°11'56.80462"W	70.643	0.99992883	Set RPA RPC on rebar
12123	1478131.918	2781381.150	65.618	55°52'49.26834"N	133°12'06.82665"W	55.937	0.99992982	Set RPA RPC on rebar
12124	1477629.228	2781278.778	81.391	55°52'44.32087"N	133°12'08.68174"W	71.707	0.99992921	Set RPA RPC on rebar
12125	1477521.391	2781143.330	85.706	55°52'43.26716"N	133°12'11.06940"W	76.022	0.99992907	Set RPA RPC on rebar
12126	1477353.703	2781168.165	77.906	55°52'41.61281"N	133°12'10.65403"W	68.22	0.99992948	Set RPA RPC on rebar
12127	1476986.145	2780913.155	81.114	55°52'38.00738"N	133°12'15.16878"W	71.427	0.99992949	Set RPA RPC on rebar
12128	1476873.632	2780557.935	85.408	55°52'36.92225"N	133°12'21.40984"W	75.724	0.99992942	Set RPA RPC on rebar
12129	1476421.325	2780161.036	71.510	55°52'32.49090"N	133°12'28.42169"W	61.825	0.99993031	Set RPA RPC on rebar
12130	1476068.432	2780292.484	46.415	55°52'29.00414"N	133°12'26.15905"W	36.724	0.99993155	Set RPA RPC on rebar
12131	1475972.025	2780063.172	51.837	55°52'28.06923"N	133°12'30.19046"W	42.145	0.99993139	Set RPA RPC on rebar
12132	1475934.407	2779732.223	62.295	55°52'27.72043"N	133°12'35.99665"W	52.605	0.999931	Set RPA RPC on rebar
12133	1475800.762	2779387.107	59.308	55°52'26.42607"N	133°12'42.06244"W	49.619	0.99993128	Set RPA RPC on rebar
12134	1475730.979	2778618.056	24.510	55°52'25.78883"N	133°12'55.55239"W	14.826	0.9999332	Set RPA RPC on rebar
12135	1475219.549	2778326.156	51.042	55°52'20.76739"N	133°13'00.72884"W	41.355	0.99993215	Set RPA RPC on rebar
12136	1474899.504	2778400.866	29.140	55°52'17.60824"N	133°12'59.45635"W	19.448	0.99993324	Set RPA RPC on rebar
N1	1474699.636	2778328.401	14.225	55°52'15.64313"N	133°13'00.74980"W	4.531	0.99993402	Found 2" AC marked "N1 4382S AKDOT"
N2	1474826.672	2778316.334	9.454	55°52'16.89594"N	133°13'00.94659"W	-0.238	0.99993422	Found 2" AC marked "N2 4382S AKDOT"

Note: To precisely check distances between points as measured on the ground, inverse the state plane coordinates and divide the computed distance by a mean combined factor of the two points.


SURVEY CONTROL

10/2012 Checked by: RPA 12-Aug-2014 1:57 PM Designed by: c:\myfiles\pww_production\00232913\Naukati_ContrlSheet.xls Sheet

STATE	PROJECT	SHEET NUMBER
AK	USFS 2060(1)	D.10

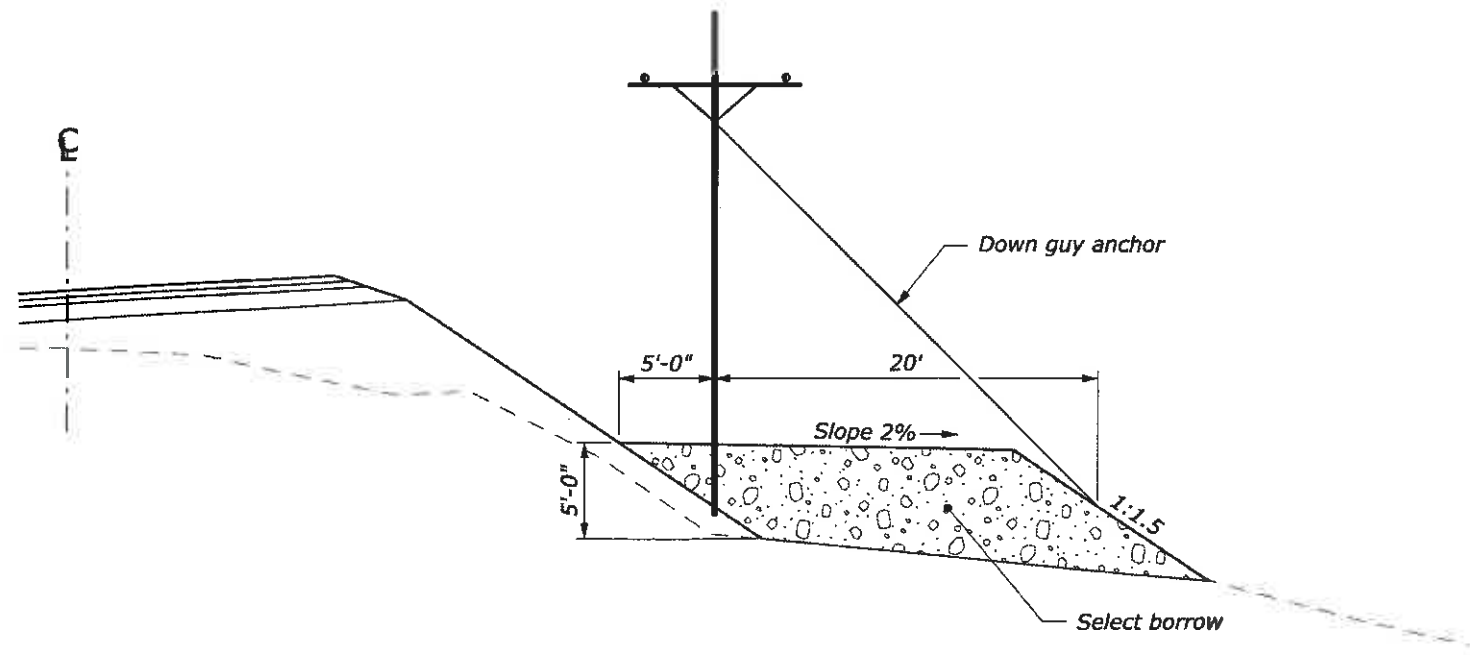

**GUY POLE PAD DETAIL
PROFILE VIEW**

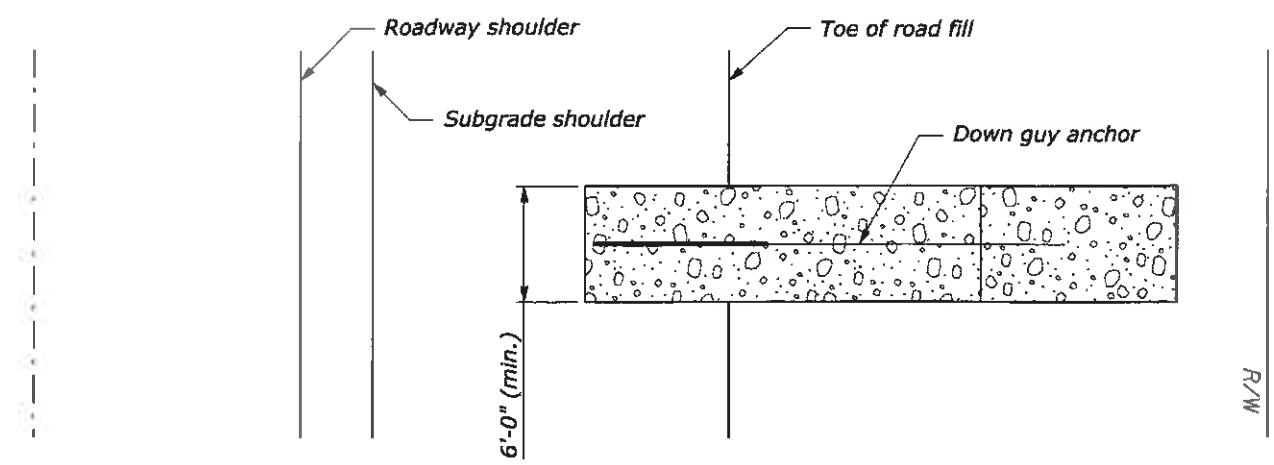

**GUY POLE PAD DETAIL
PLAN VIEW**

NOTES

1. Construct pad for placement of guy pole.
2. Stockpile 5 cuyd of select borrow at a location directed by CO.
3. Remain within right of way and clearing limits.

~~**GUY POLE PAD DETAIL**~~


21 August 2015 9:32 AM
 c:\myfiles\pww_production\d0199361\ak-r206001.r\dgn [US_Sur.rzd]
 Designed by:
 Checked by:

RECEIVED
 JUL 08 2017
 BY PROJECT ENGINEER

DRIVEWAY AND APPROACH ROAD QUANTITIES

STATION	20401-0000 ROADWAY EXCAVATION (CUYD)	20411-0000 SELECT BORROW (TON)	30101-2000 AGGREGATE BASE GRADING D (TON)	40301-0000 HOT ASPHALT CONCRETE PAVEMENT (TON)	EMBANKMENT ^{1/} (CUYD)
FH43	993	-	518	230	739
11+20 LT	3/	3/	3/	-	3/
13+87 LT	19	54	32	-	20
17+97 LT	51	62	44	-	5
19+65 LT	13	33	23	-	-
46+08 RT	106	245	170	-	36
67+08 RT	114	203	146	-	15
81+46 LT	139	183	128	-	27
119+58 LT	1,625	455	329	-	-
124+33 LT	541	37	96	-	1
133+49 RT	196	440	312	-	187
134+35 RT	53	415	297	-	578
135+21 LT	115	233	168	-	32
136+93 LT	354	255	182	-	6
139+68 RT	1,516	210	144	-	82
140+55 RT	83	270	183	-	236
TOTALS	5,919	3,095	2,772	230	3,254

40+00 LT

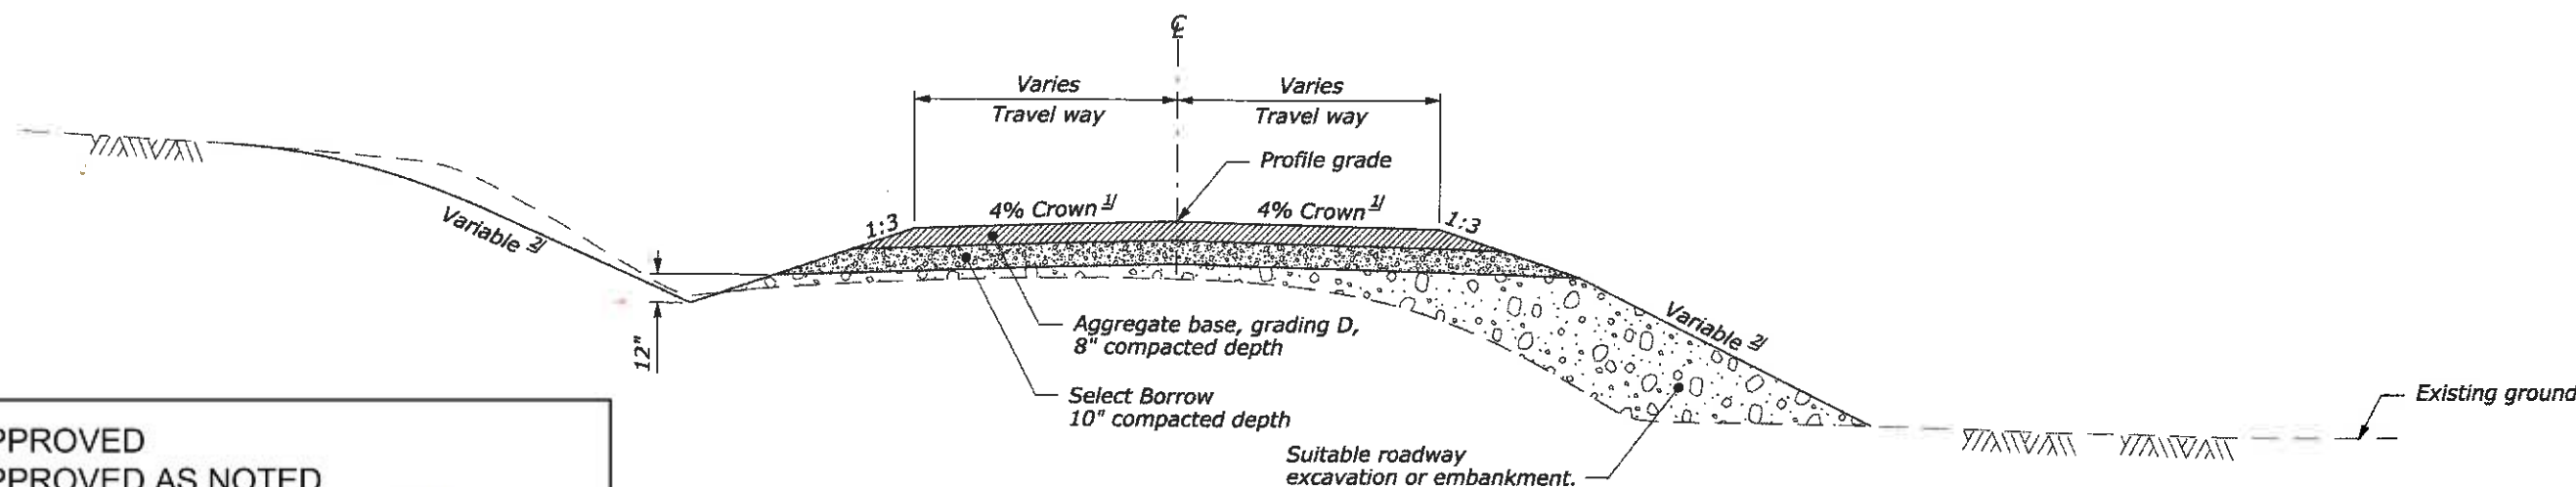

- APPROVED
- APPROVED AS NOTED
- RETURNED FOR CORRECTION

Date: JUL 10 2017 By: Jim Jozovich

FEDERAL HIGHWAY ADMINISTRATION
 Federal Lands Highway

See FAR 52.236-21(e) for limitations of Government's responsibility in approving this document.

APPROACH ROAD TYPICAL

46+08 RT, 67+08 RT,
 81+46 LT, ~~119+58 LT~~, 119+83 LT
 133+49 RT, 134+35 RT,
 135+21 LT, 136+93 LT,
 139+68 RT, 140+55 RT

FOOTNOTE:

- ^{1/} For information only. Not measured for payment.
- ^{2/} Construct slopes as shown in the Staking Report.
- ^{3/} Quantities to be measured in field.

**TABULATION OF
 APPROACH ROAD
 QUANTITIES**


07/2014 Checked by:

C. CONRAD


Designed by:

c:\vnyfiles\pww_production\0229149\ak-r20600.gsa.dgn [US_Sur_ft2D]

26 August 2015 1:27 PM

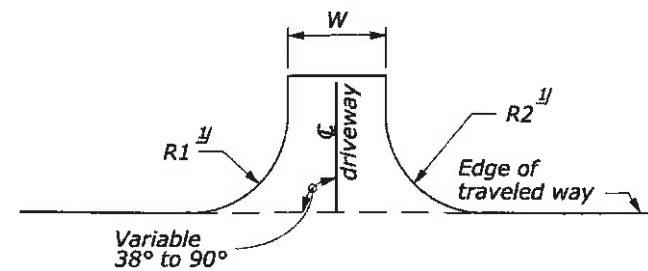


**Existing Driveway Approach Type A
Plan Detail**

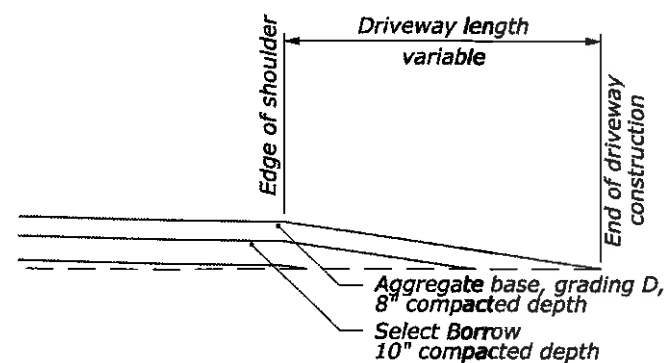

**Existing Driveway Approach Type A
Profile**

DRIVEWAY APPROACH TABLE			
MAINLINE STATION	W	R1	R2
11+20 LT	MATCH EXISTING	MATCH EXISTING	MATCH EXISTING
13+87 LT	14	17	17
17+97 LT	14	12	42
19+65 LT	18	15	15
124+33 RT	14	90	10



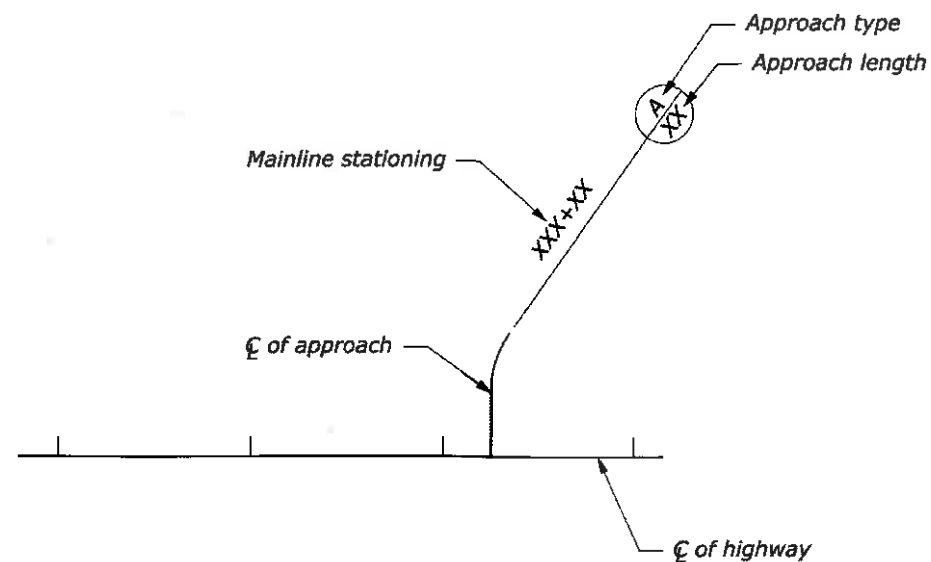


DRIVEWAY APPROACH ROAD LOCATION SYMBOL

FOOTNOTE:




^{1/} Continue approach radius as required if connection is at an angle.

**TABULATION OF
DRIVEWAY APPROACH
QUANTITIES ✓**

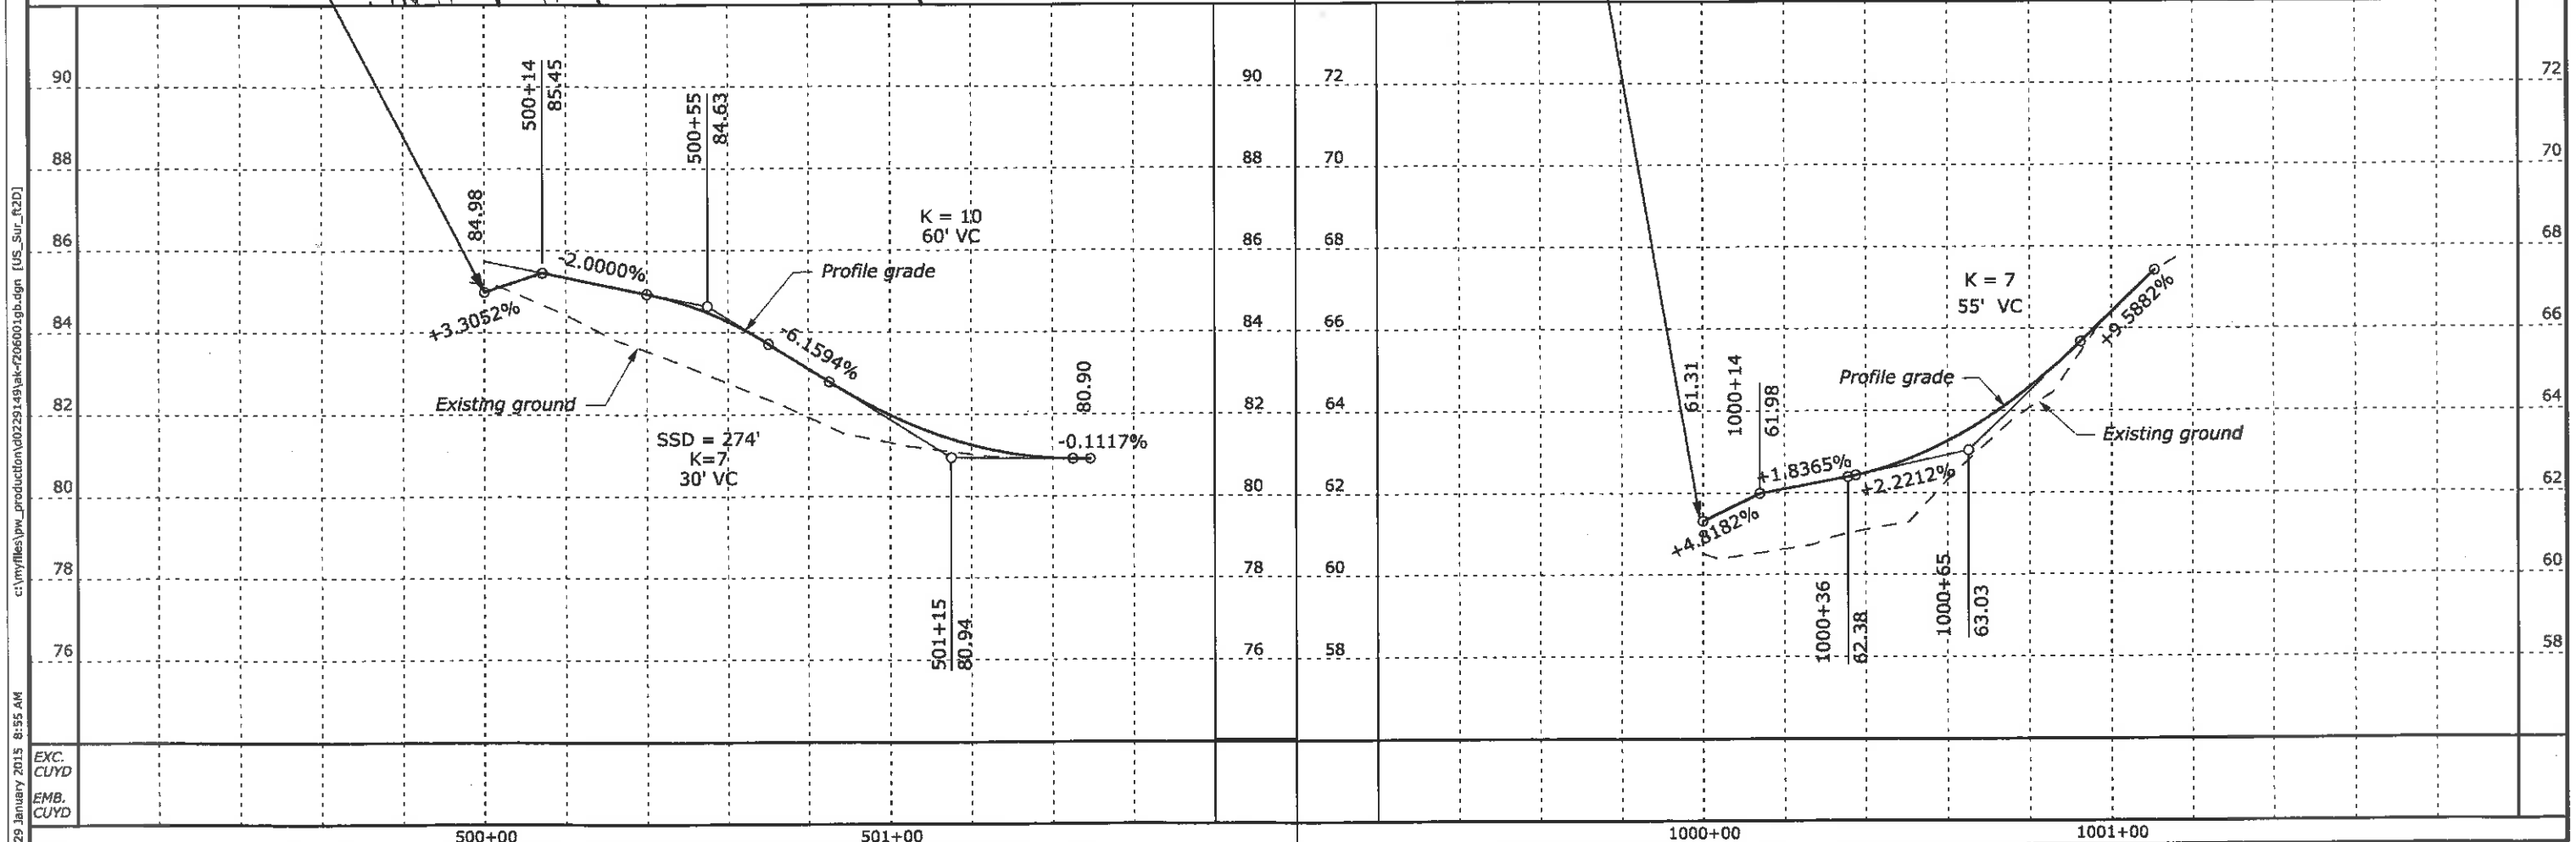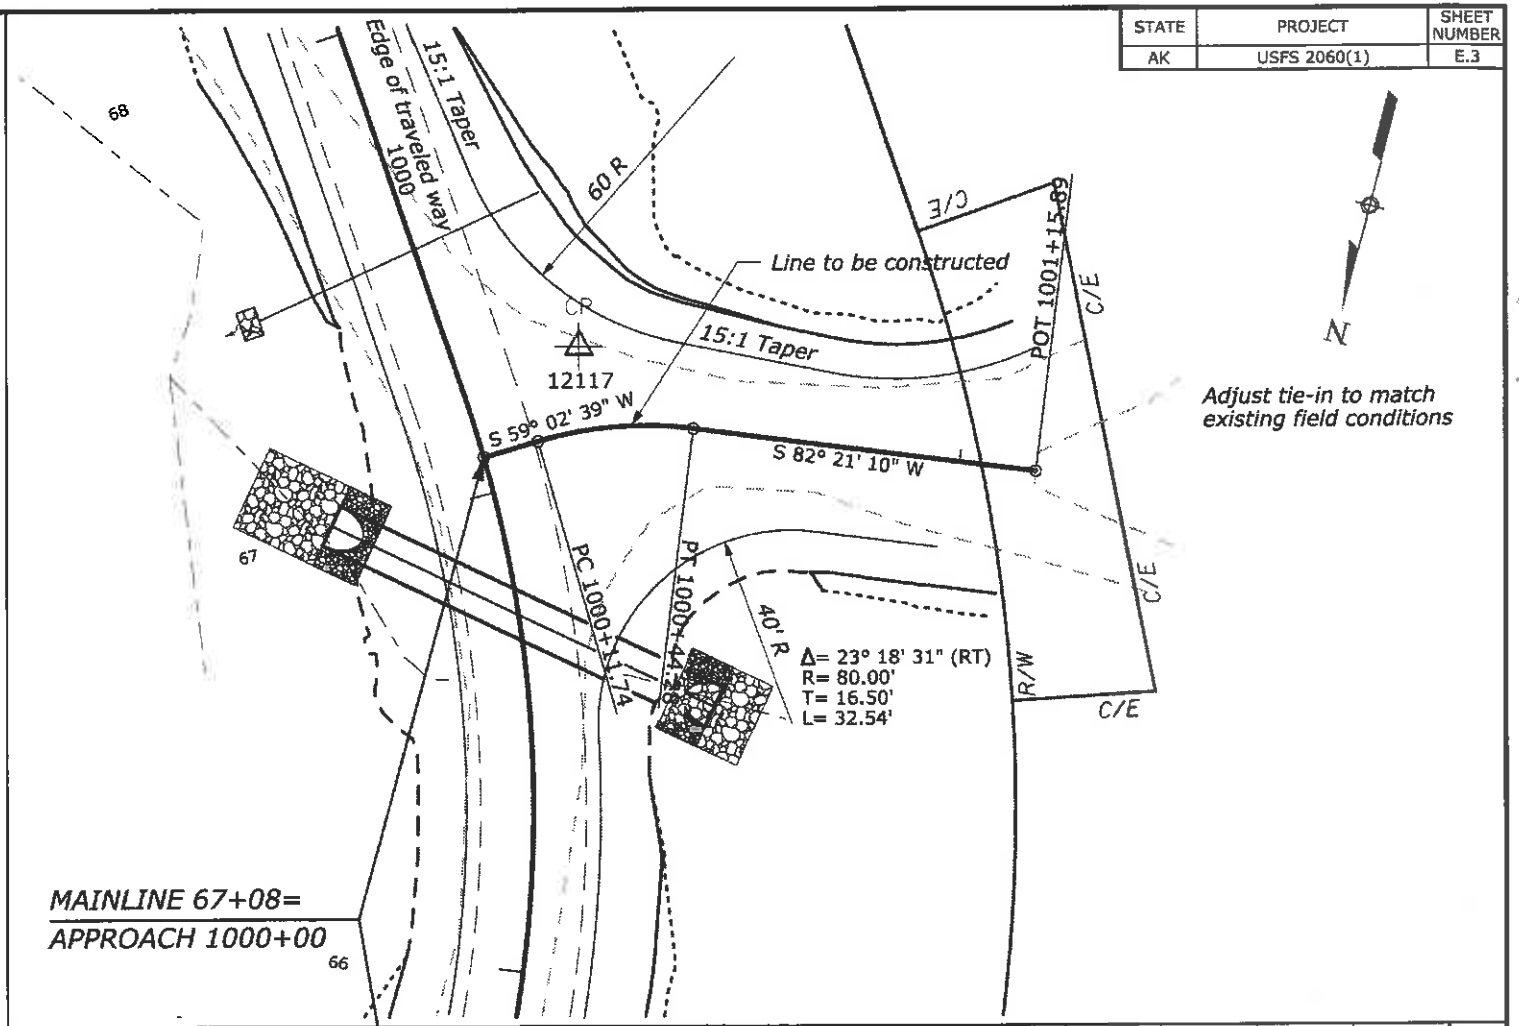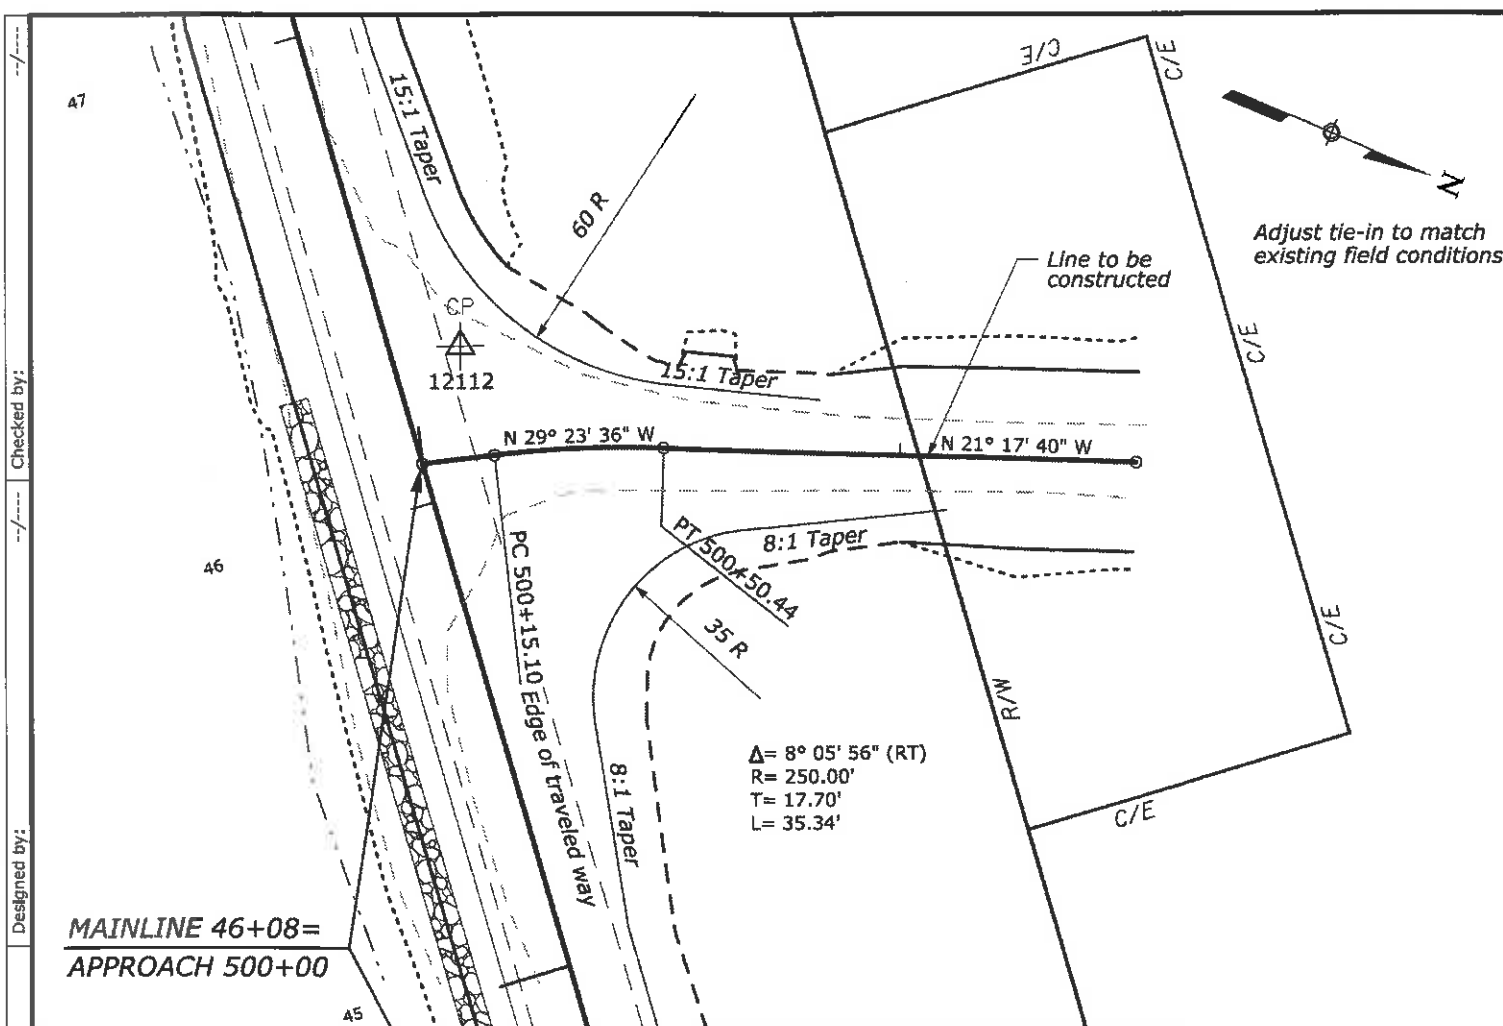

29 January 2015 8:55 AM
 c:\myfiles\pww_production\0229149\ak-206001\pb-dgn [US_Sur_R2D]
 Designed by:
 Checked by:



EXC.
 CUYD
 EMB.
 CUYD

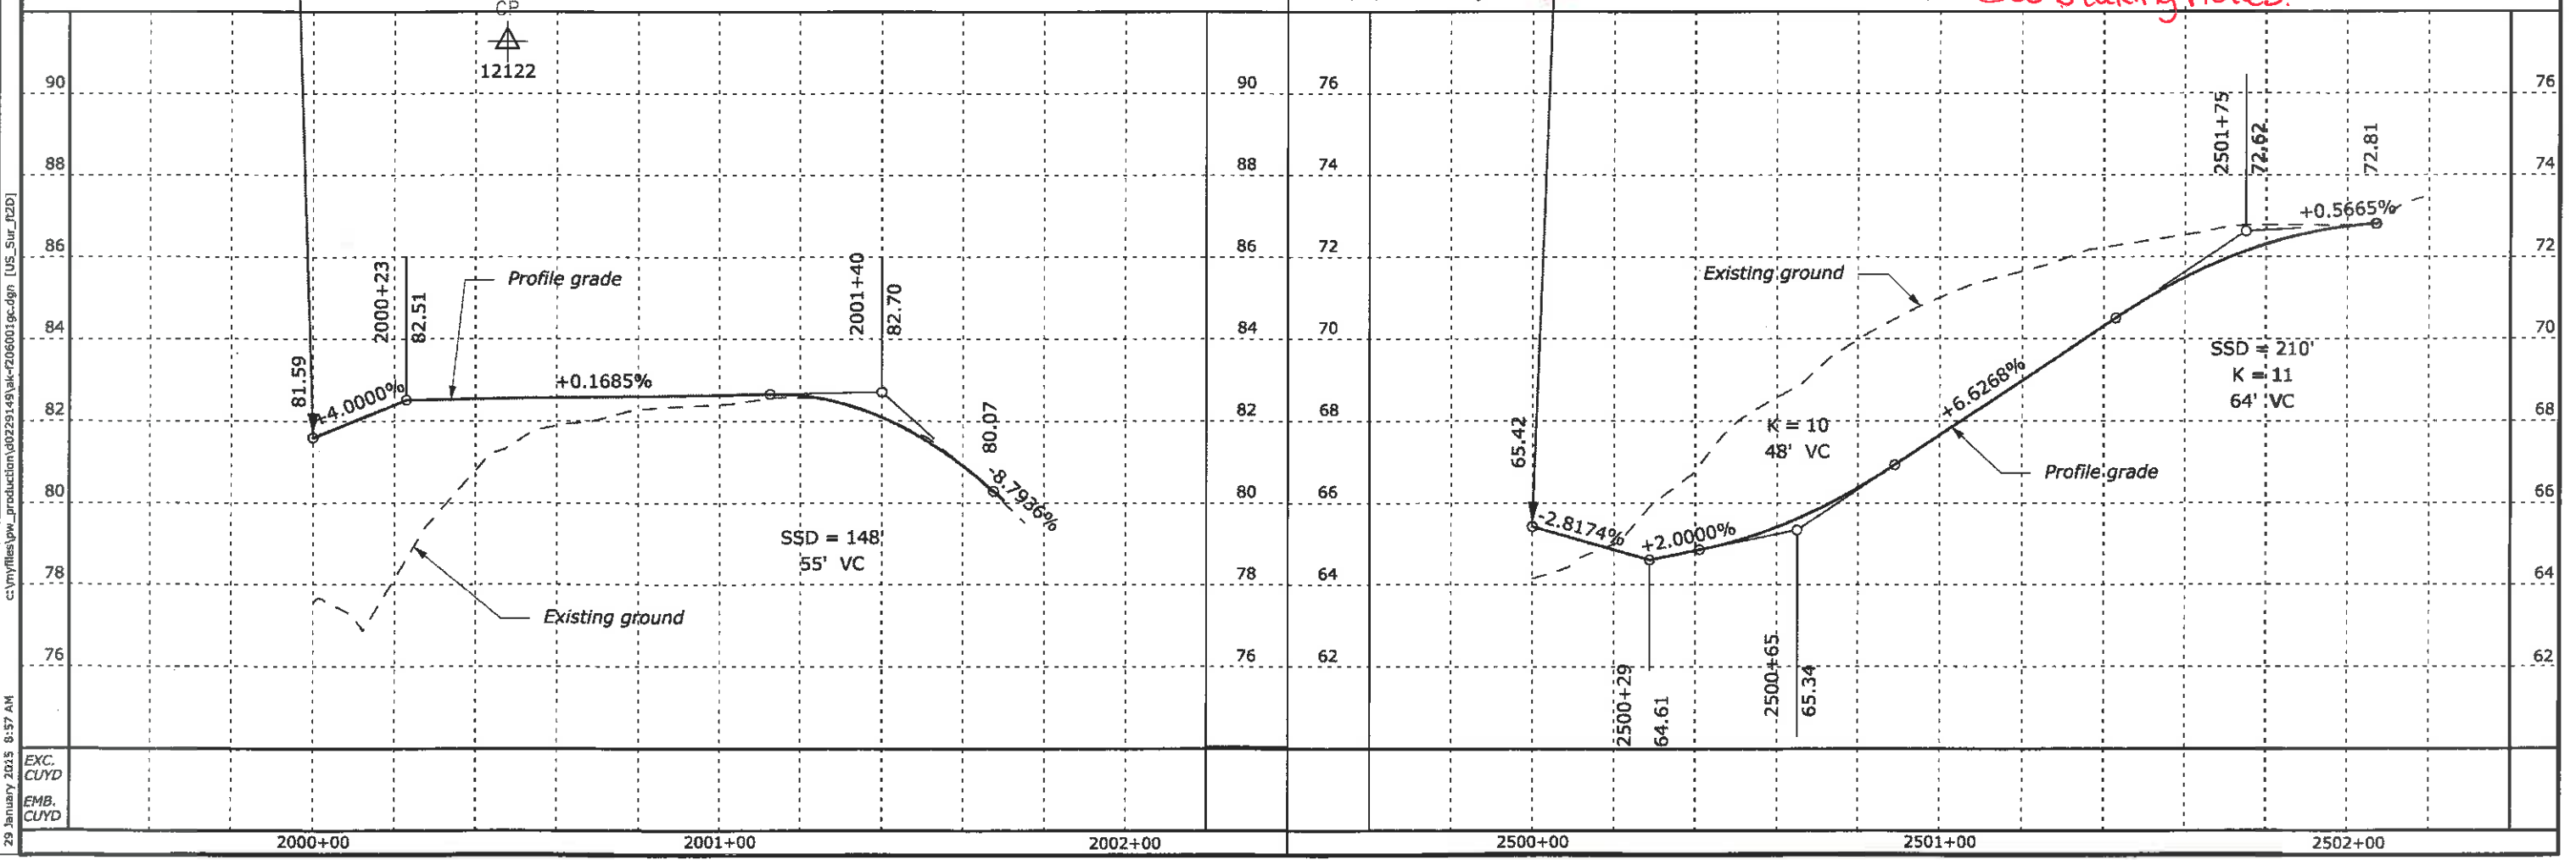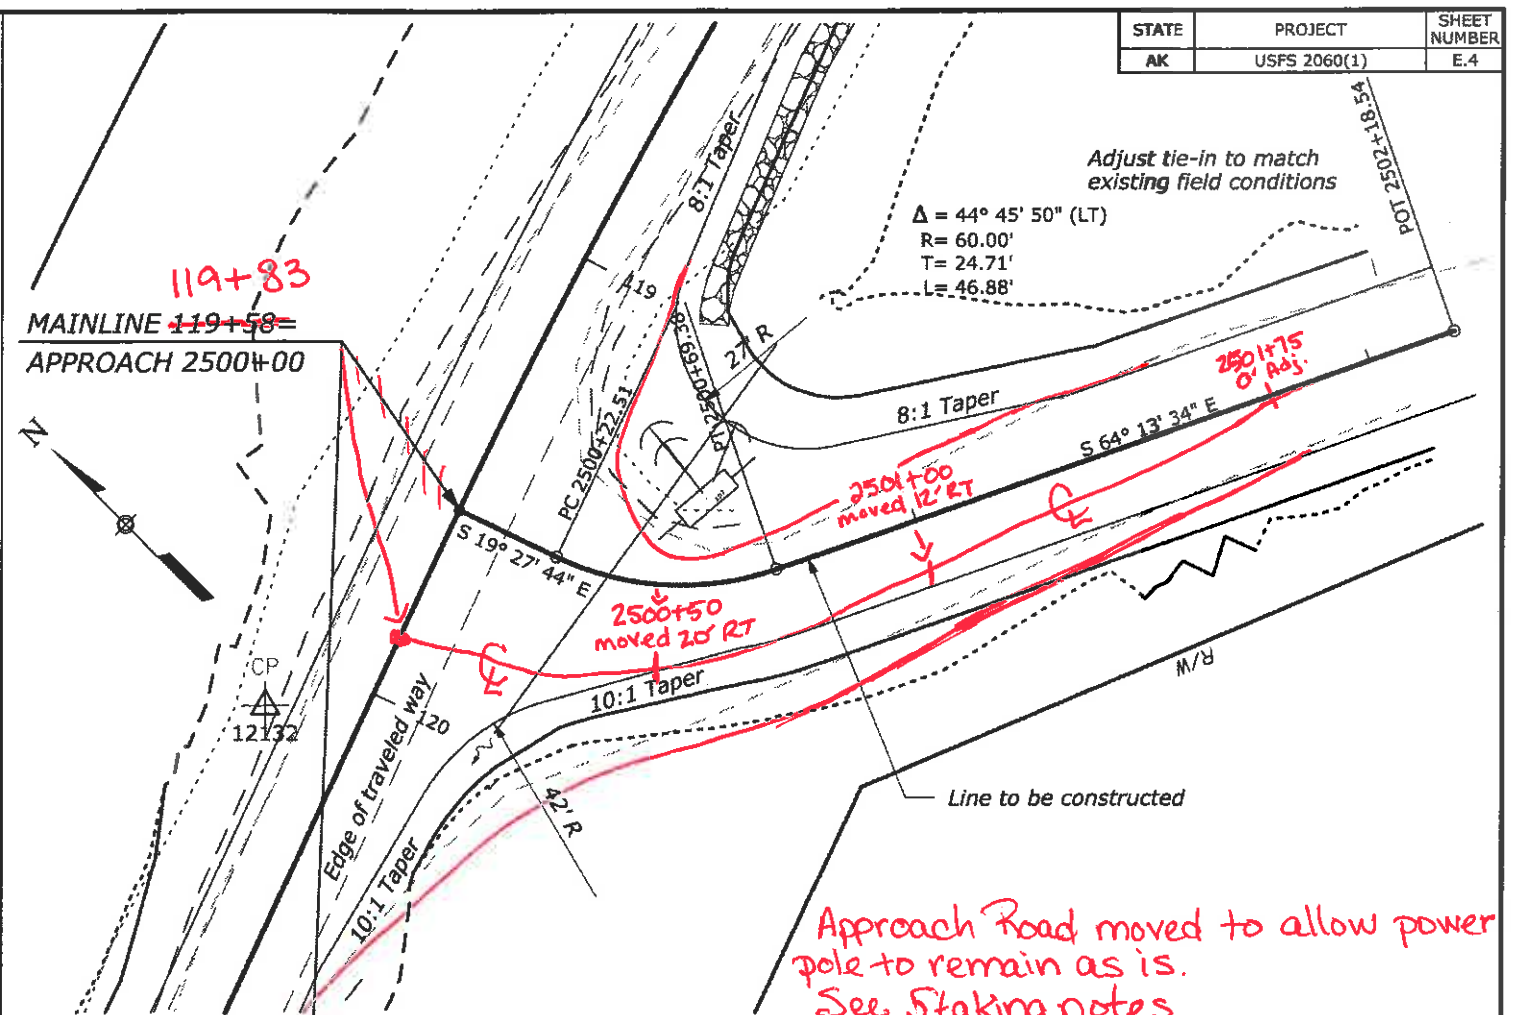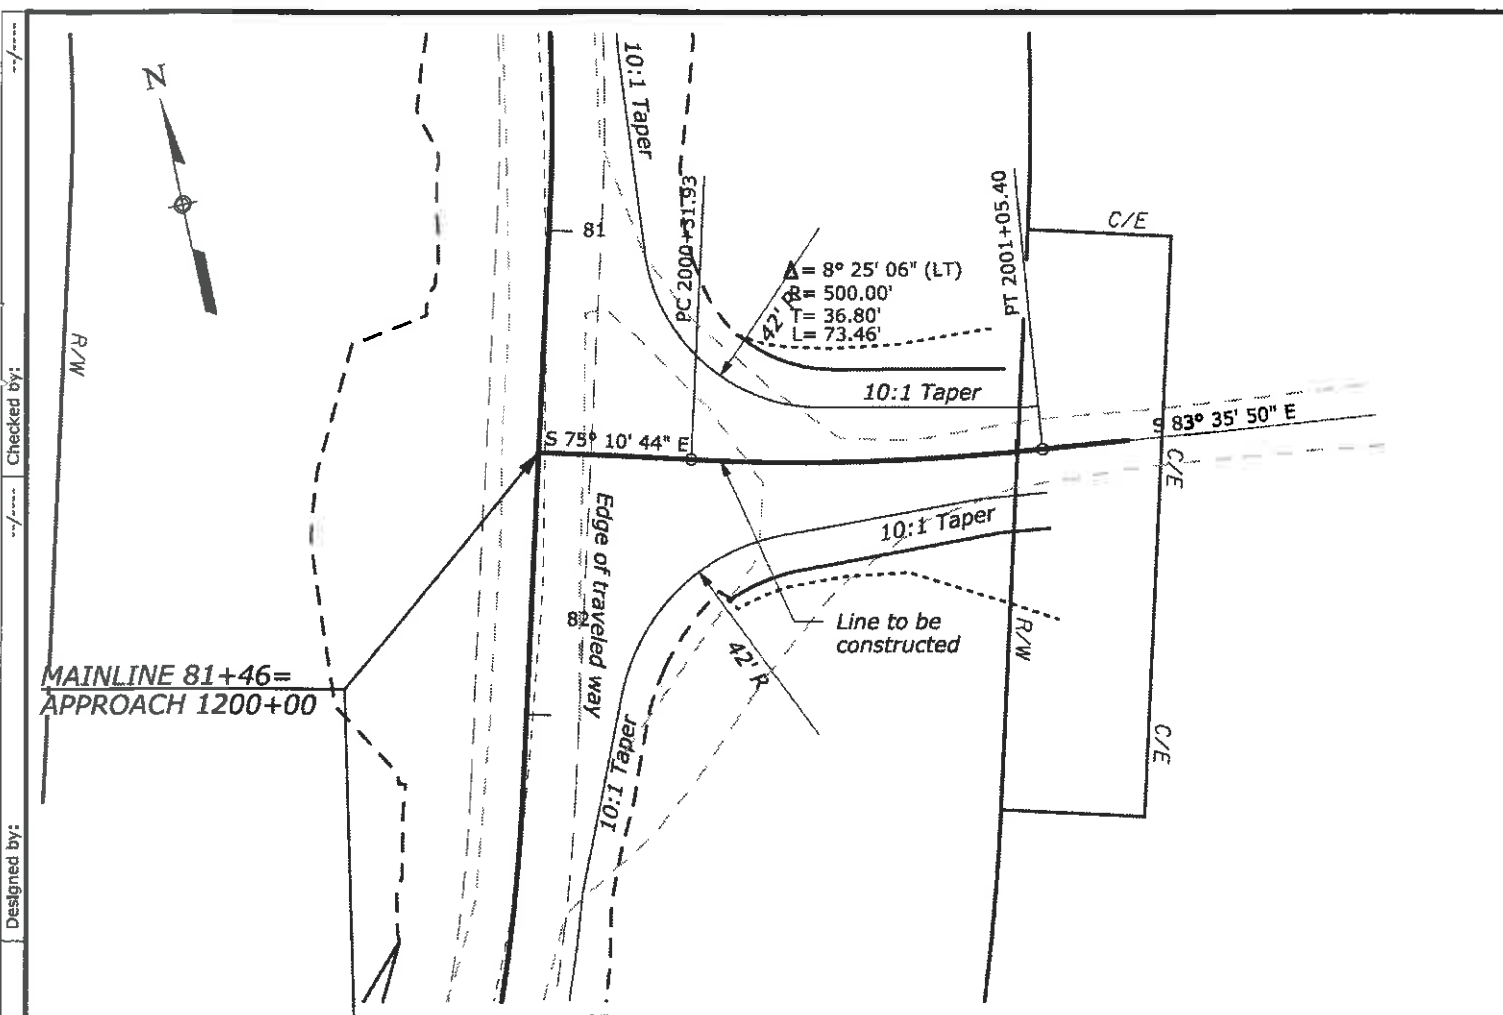

29 January 2025 8:57 AM
 EXC. CUYD
 EMB. CUYD
 c:\myfiles\pw_production\00229149\ak-206001gc.dgn [US_Sur_H2D]



Designed by:
 Checked by:

Checked by: _____
 Designed by: _____
 c:\myfiles\pww_production\0229149\ak-206001.gd.dgn [US_Sur_R2D]
 30 January 2015 11:04 AM

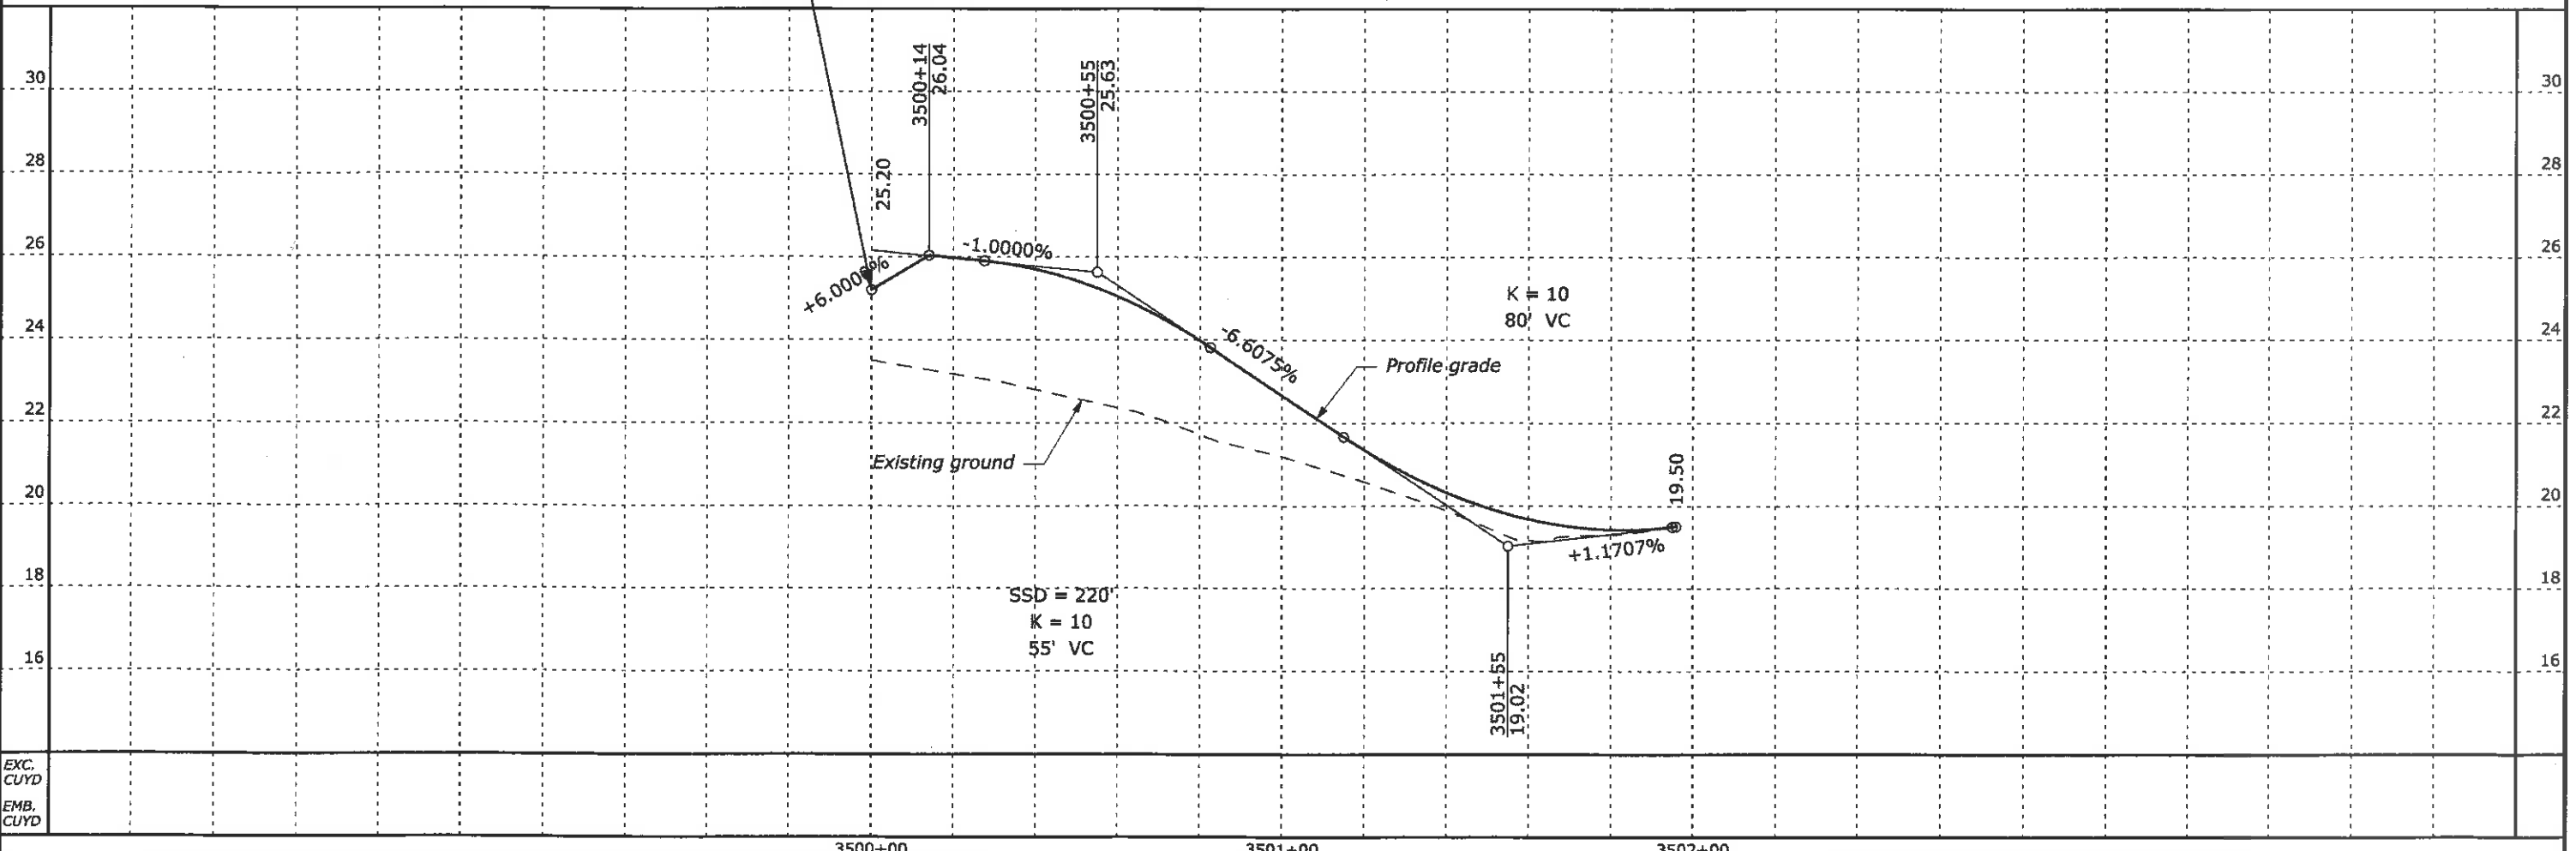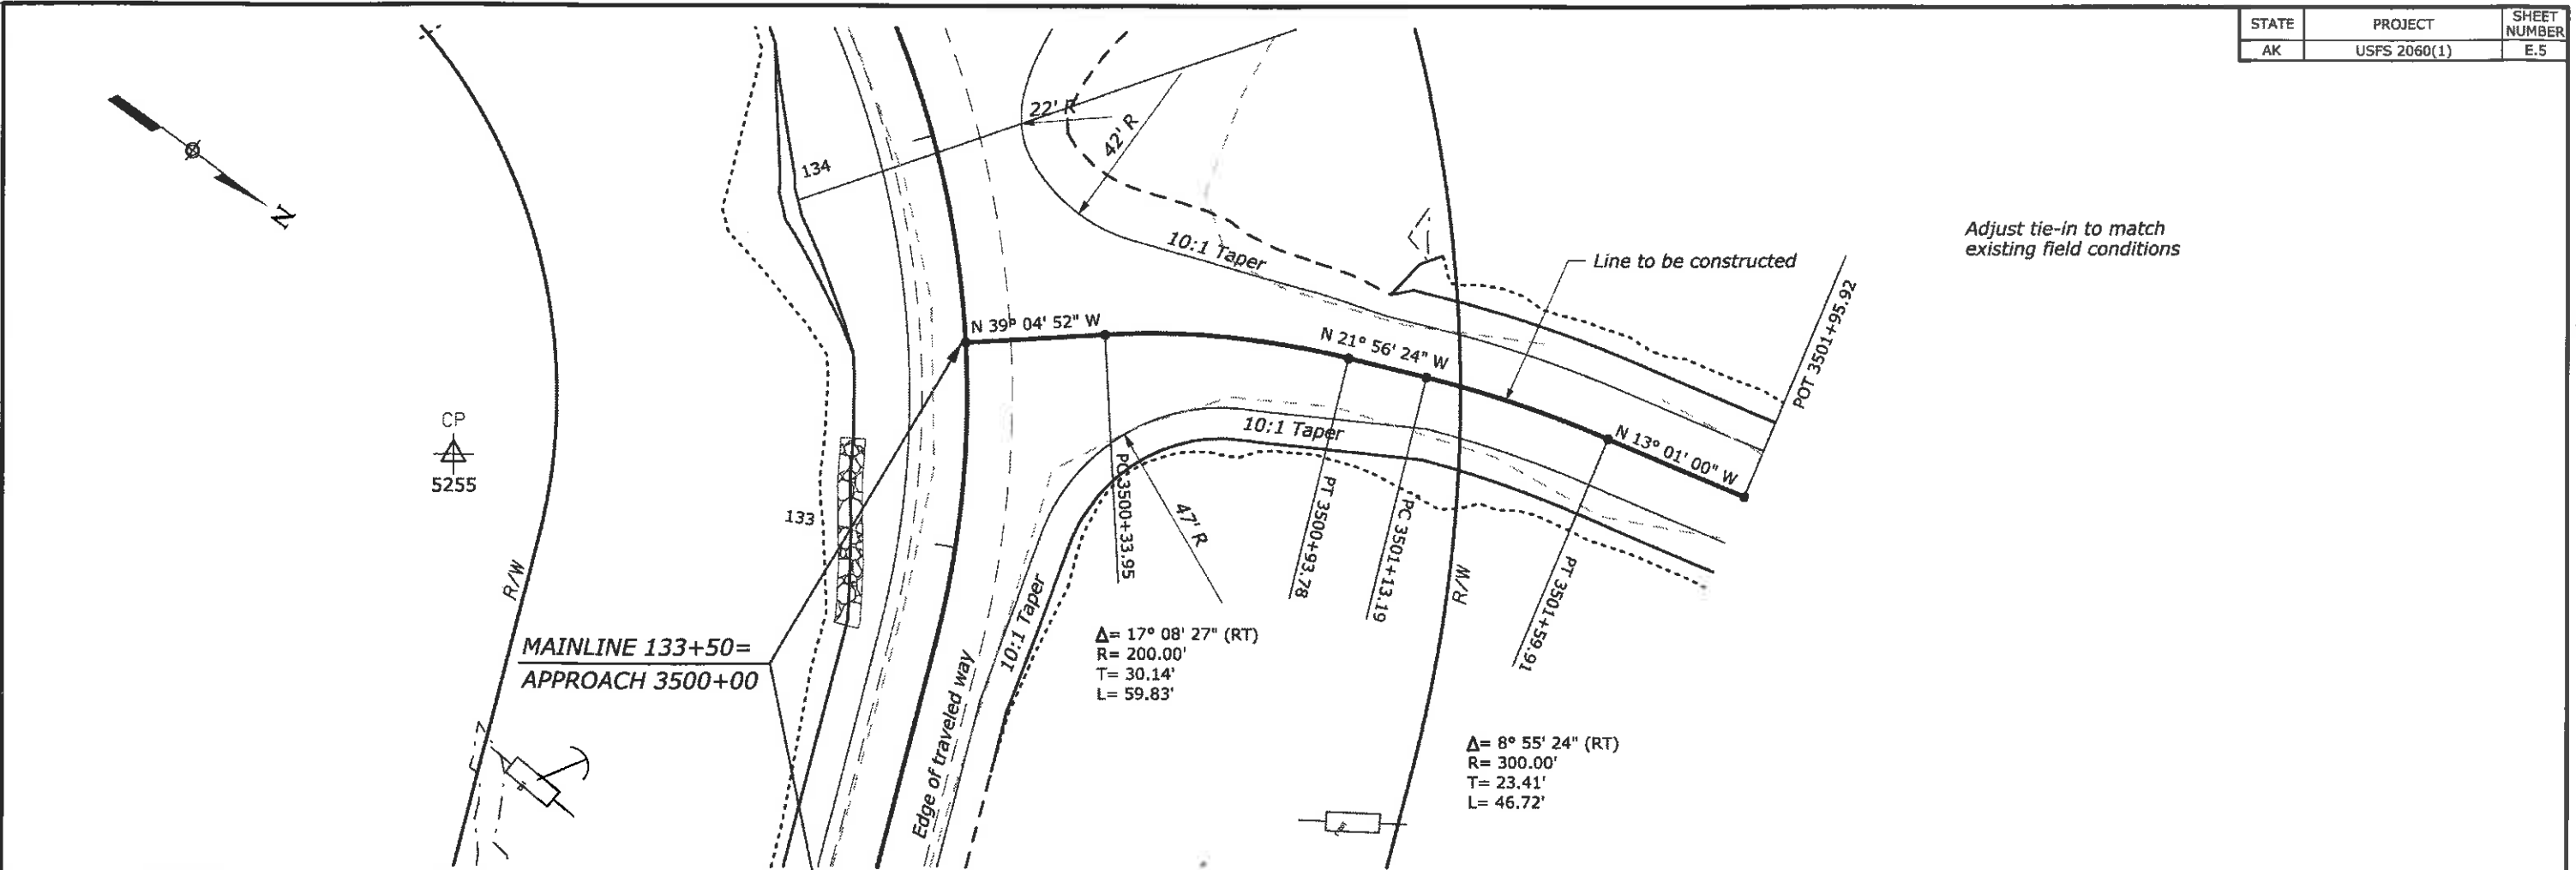




EXC.
 CUYD
 EMB.
 CUYD

STATE	PROJECT	SHEET NUMBER
AK	USFS 2060(1)	E.6

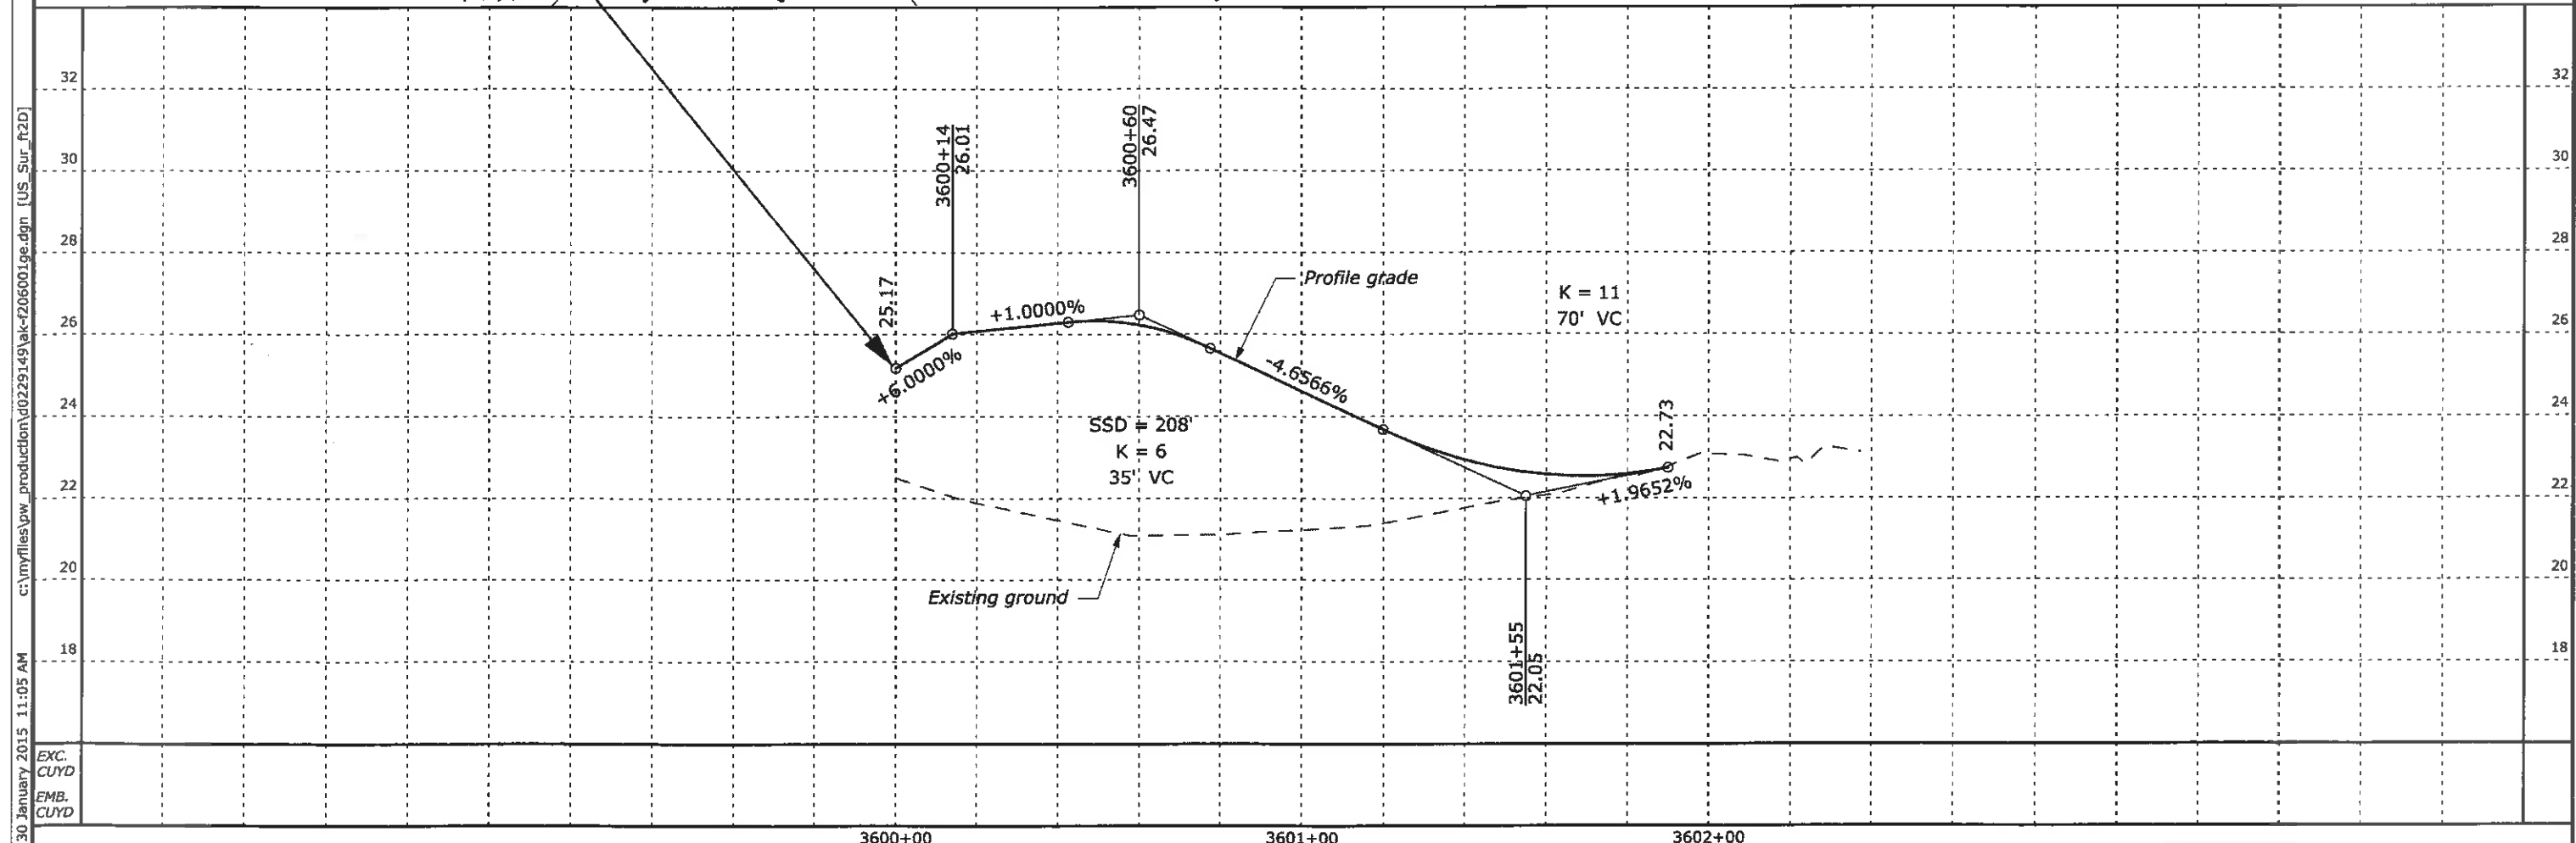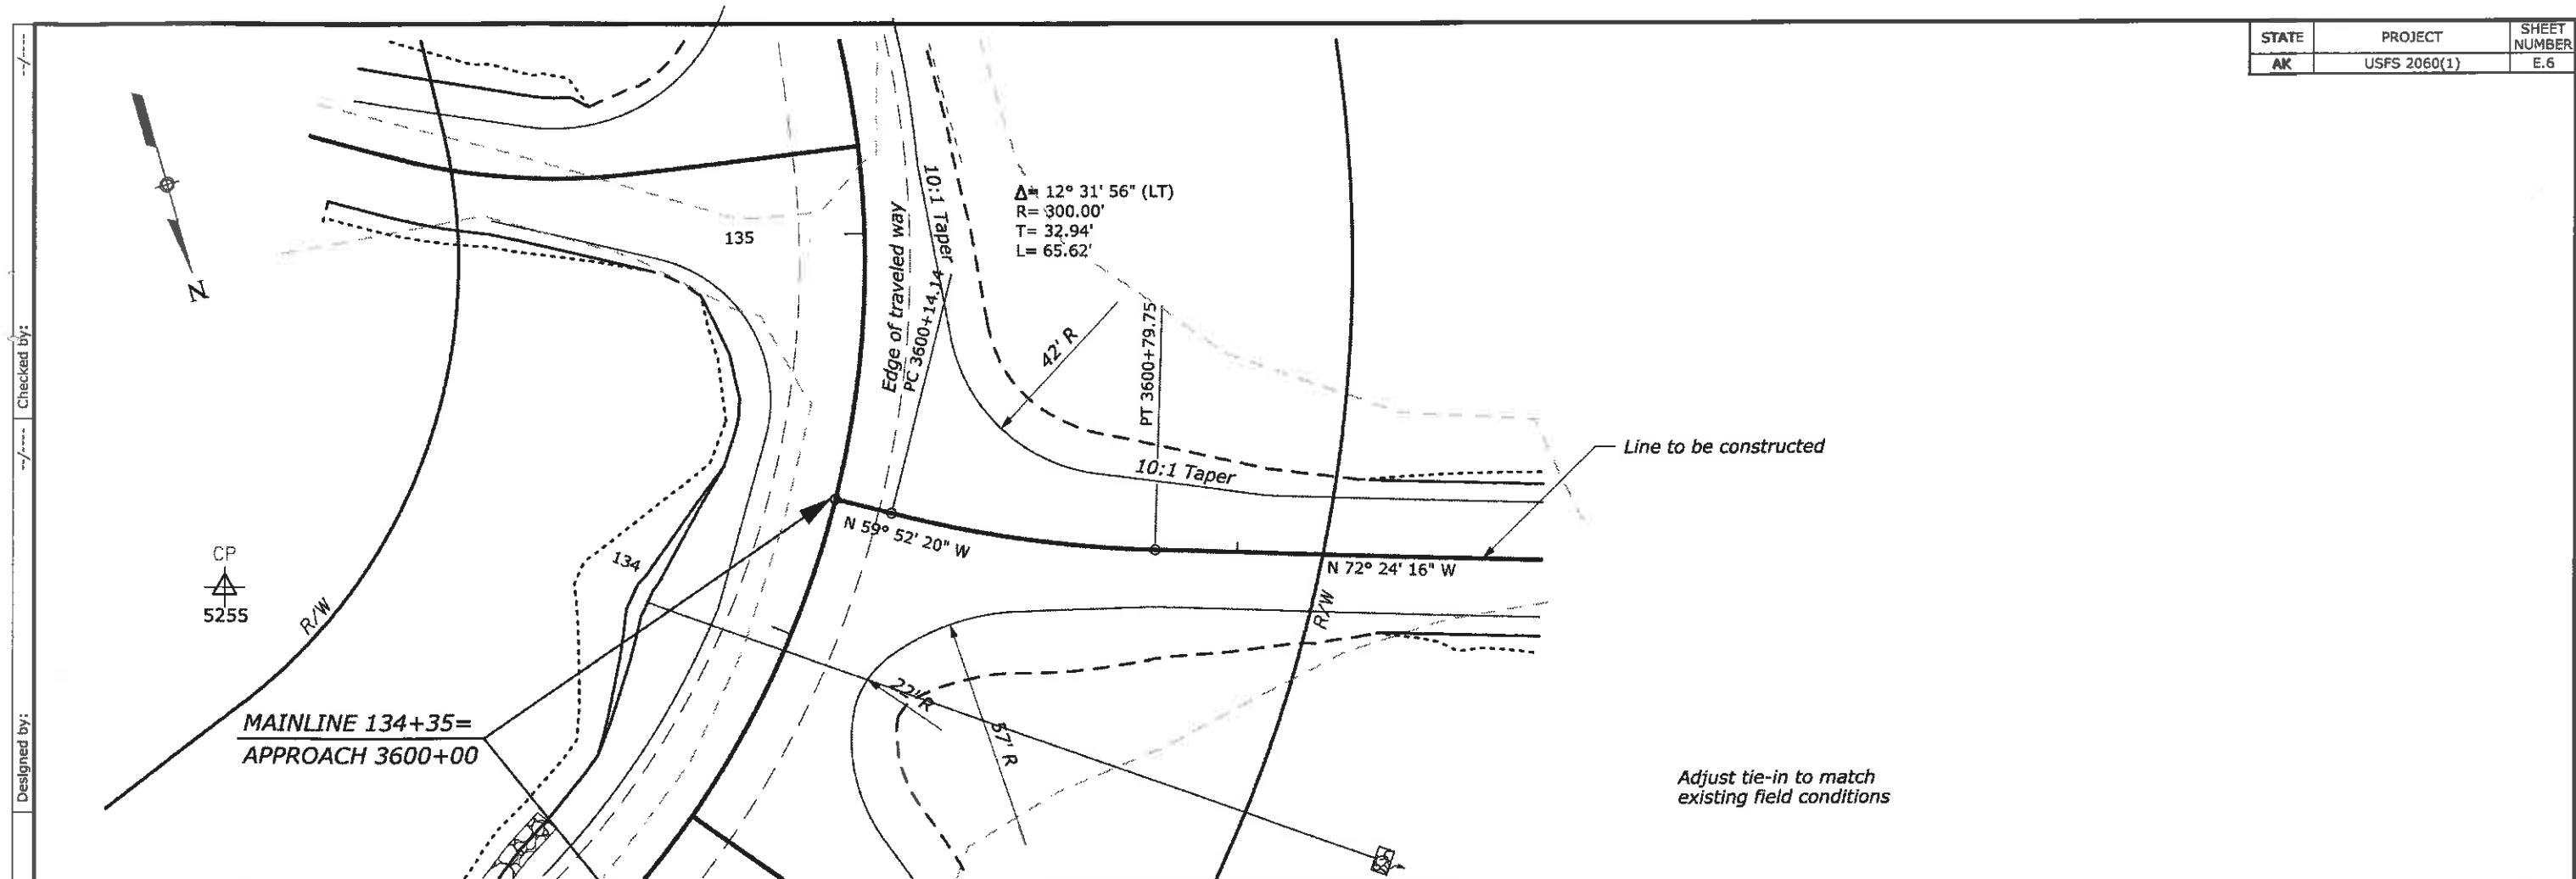

30 January 2015 11:05 AM
 c:\myfiles\pw_production\00229149\ak-r206001.ge.dgn [US_Sur_r2D]
 Designed by:
 Checked by:




EXC.
 CUYD
 EMB.
 CUYD

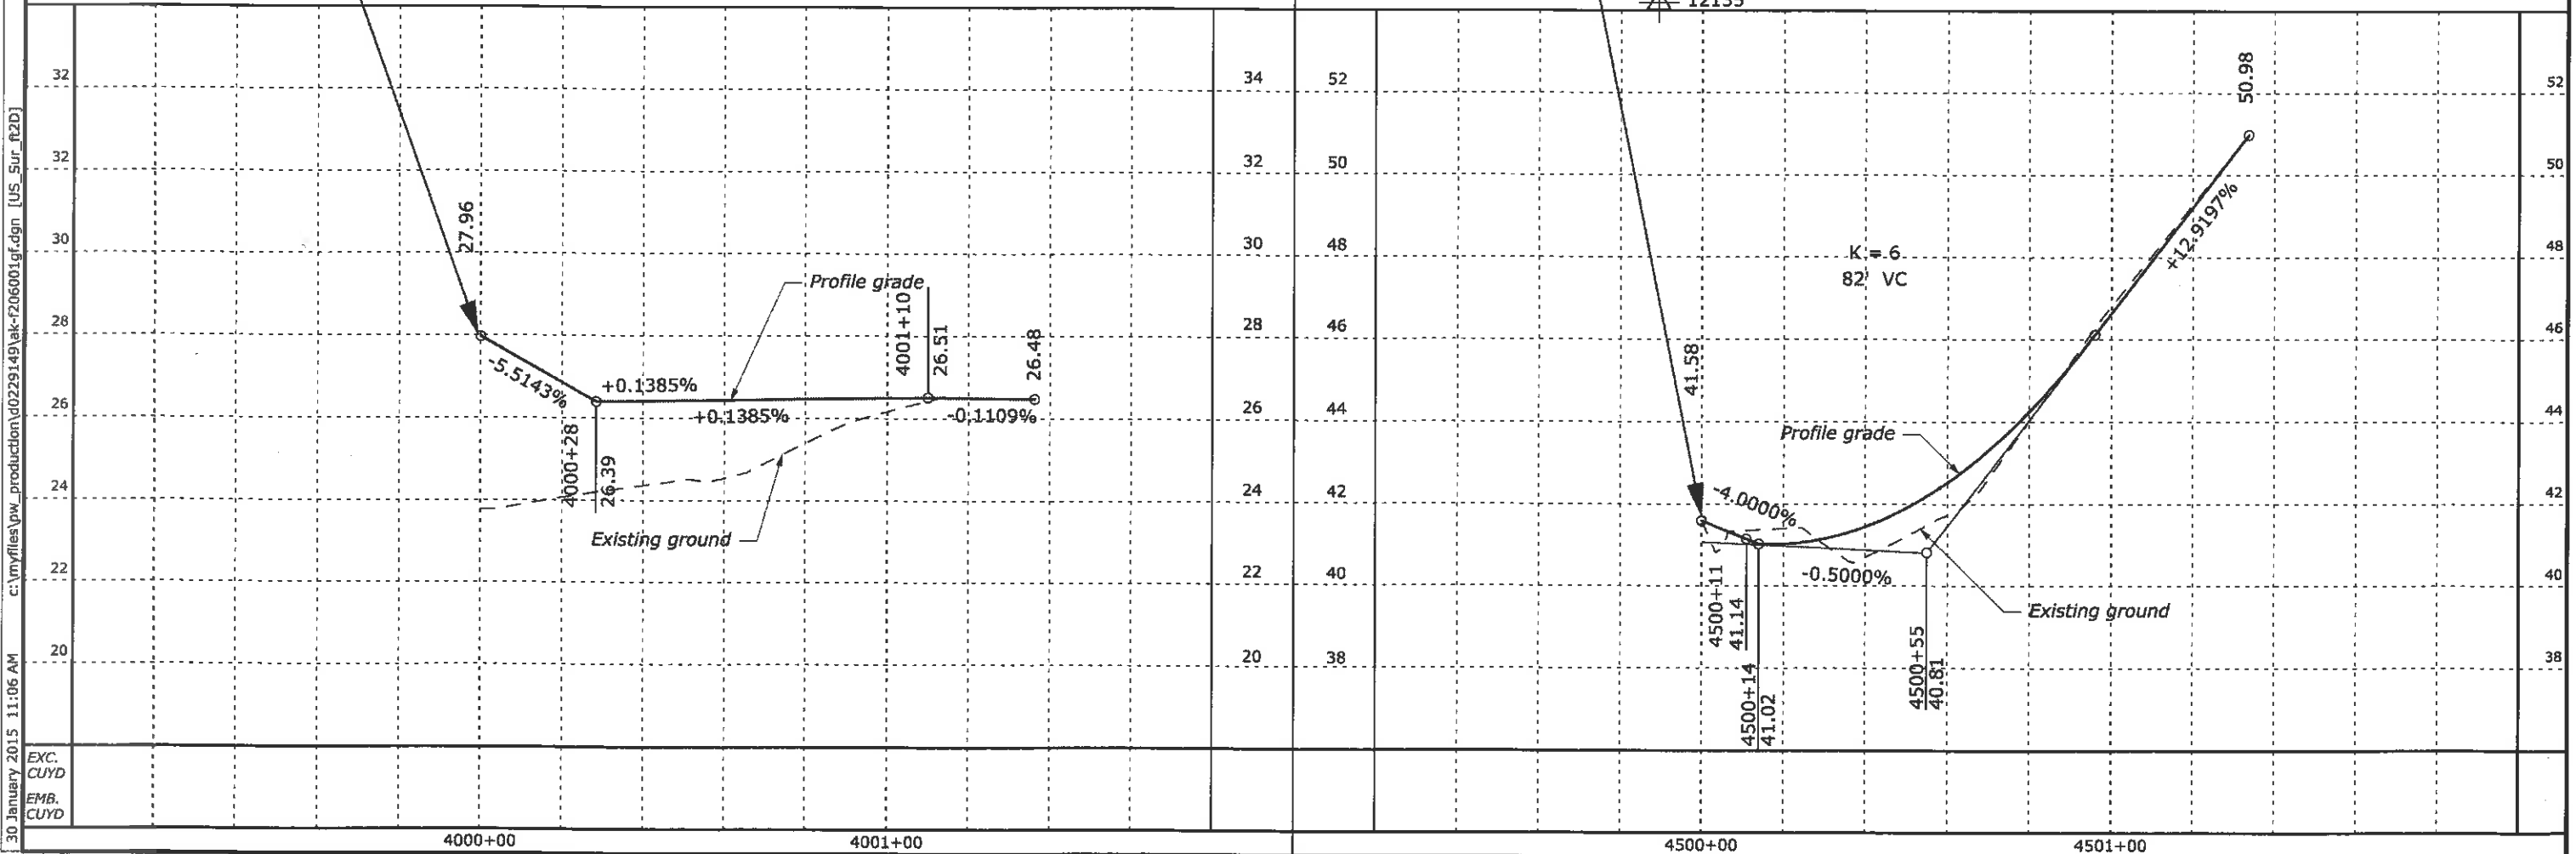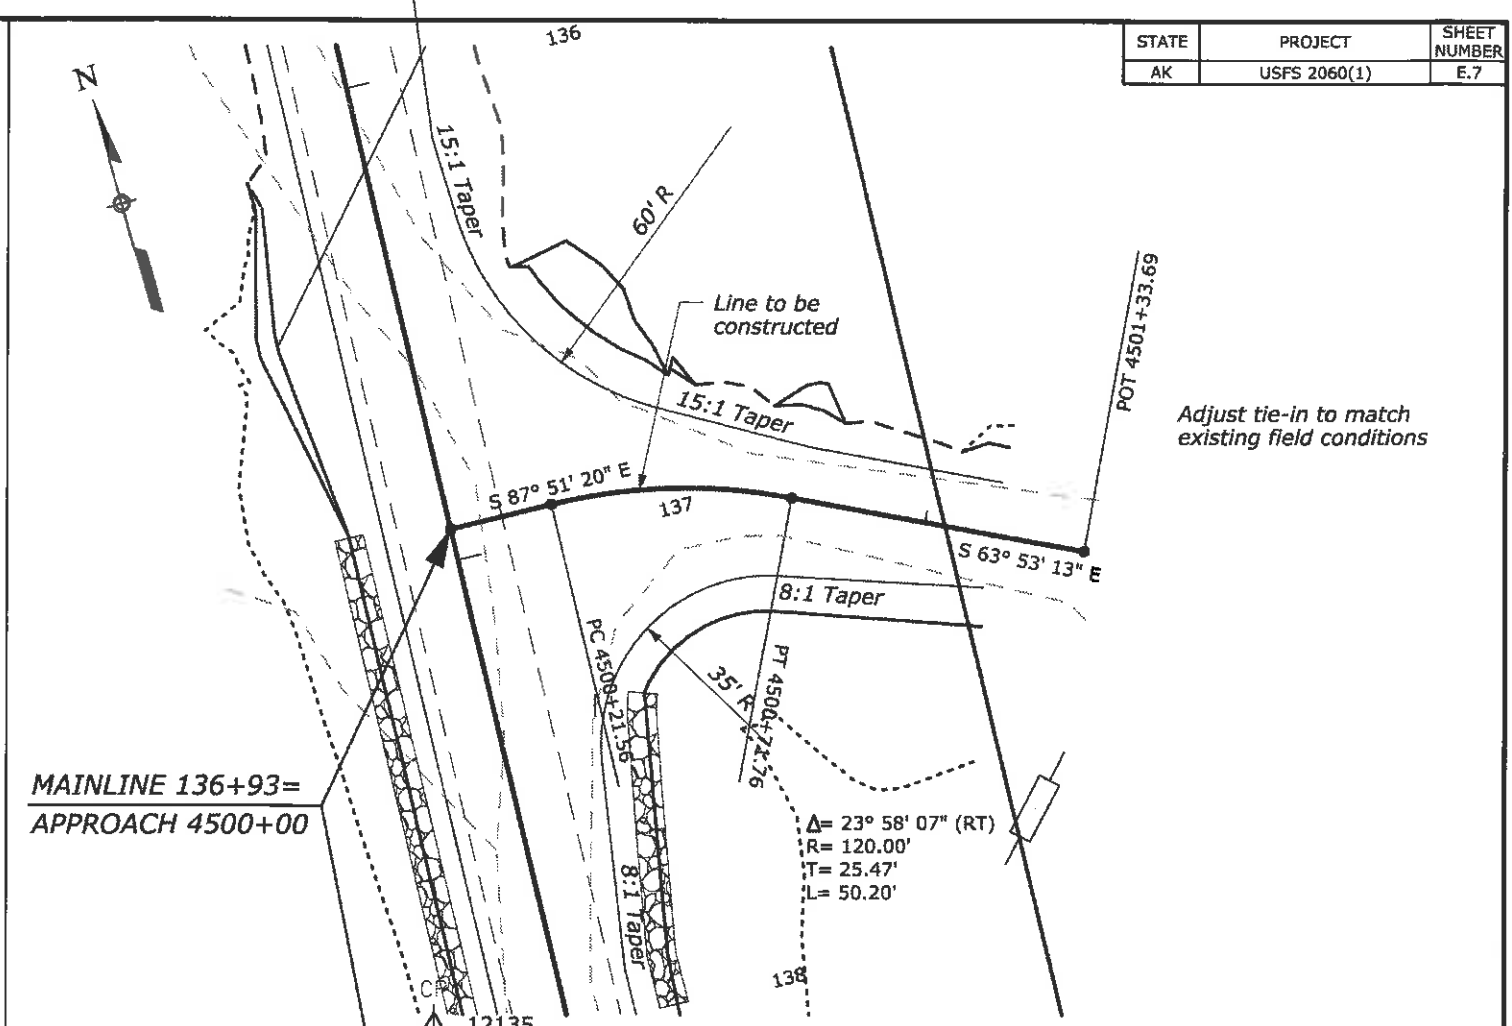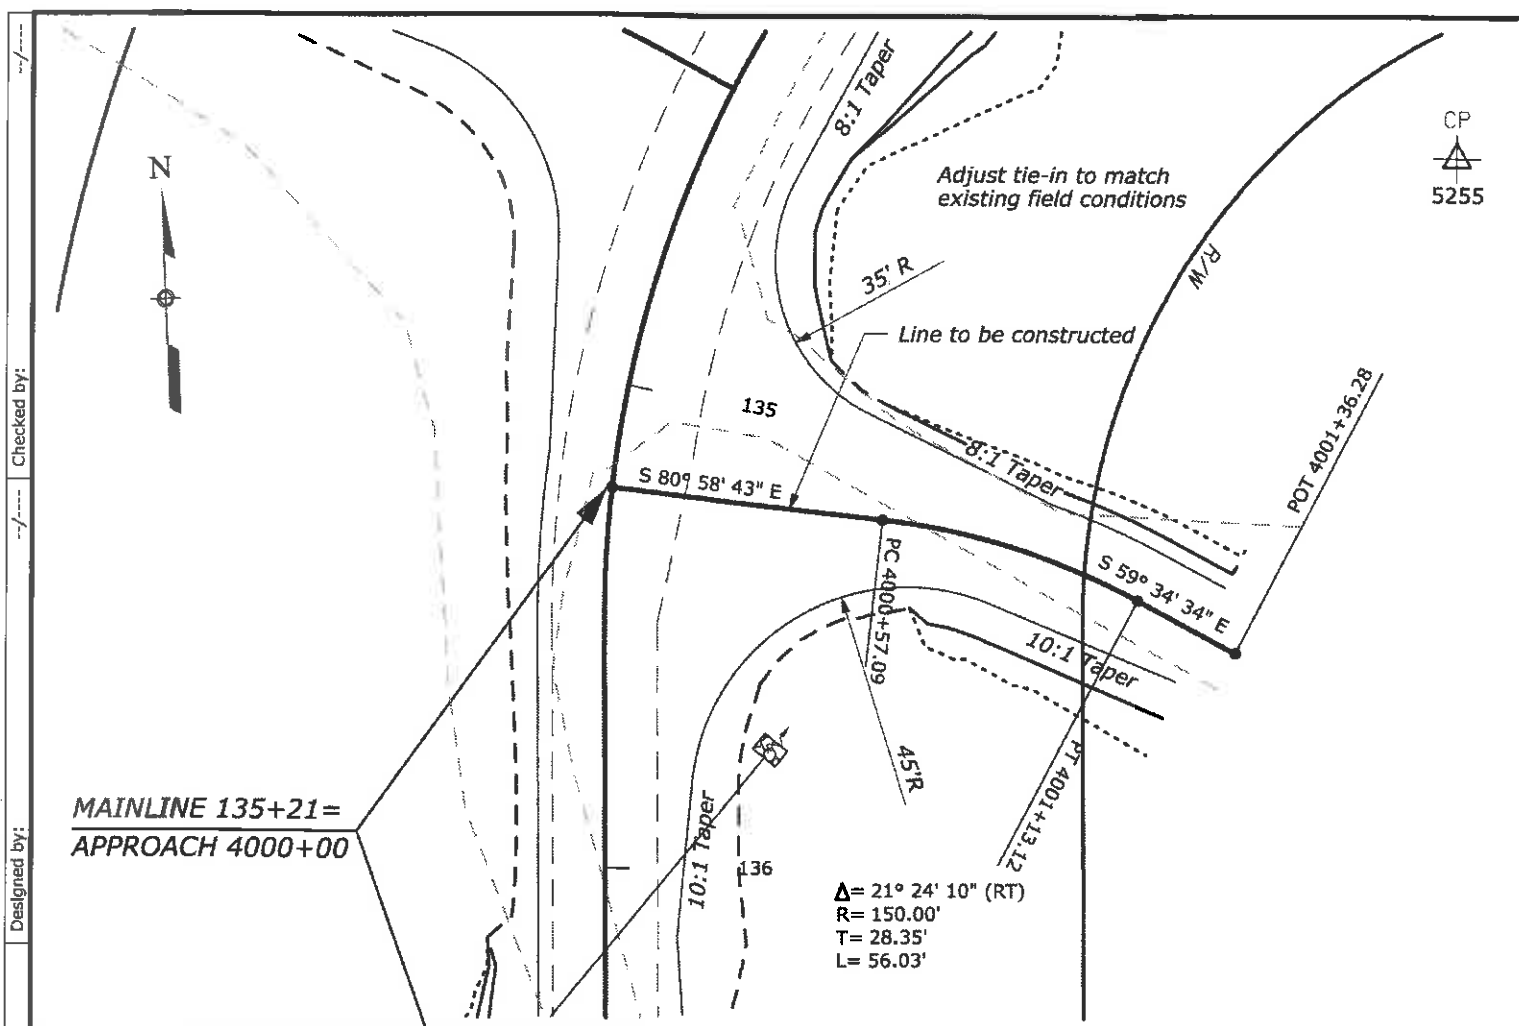

30 January 2015 11:06 AM
 c:\myfiles\pw_production\d0229149\ak-r206001\gt.dgn [US_Sur_r2D]
 Designed by:
 Checked by:

EXC.
 CUYD
 EMB.
 CUYD

STATE	PROJECT	SHEET NUMBER
AK	USFS 2060(1)	E.8

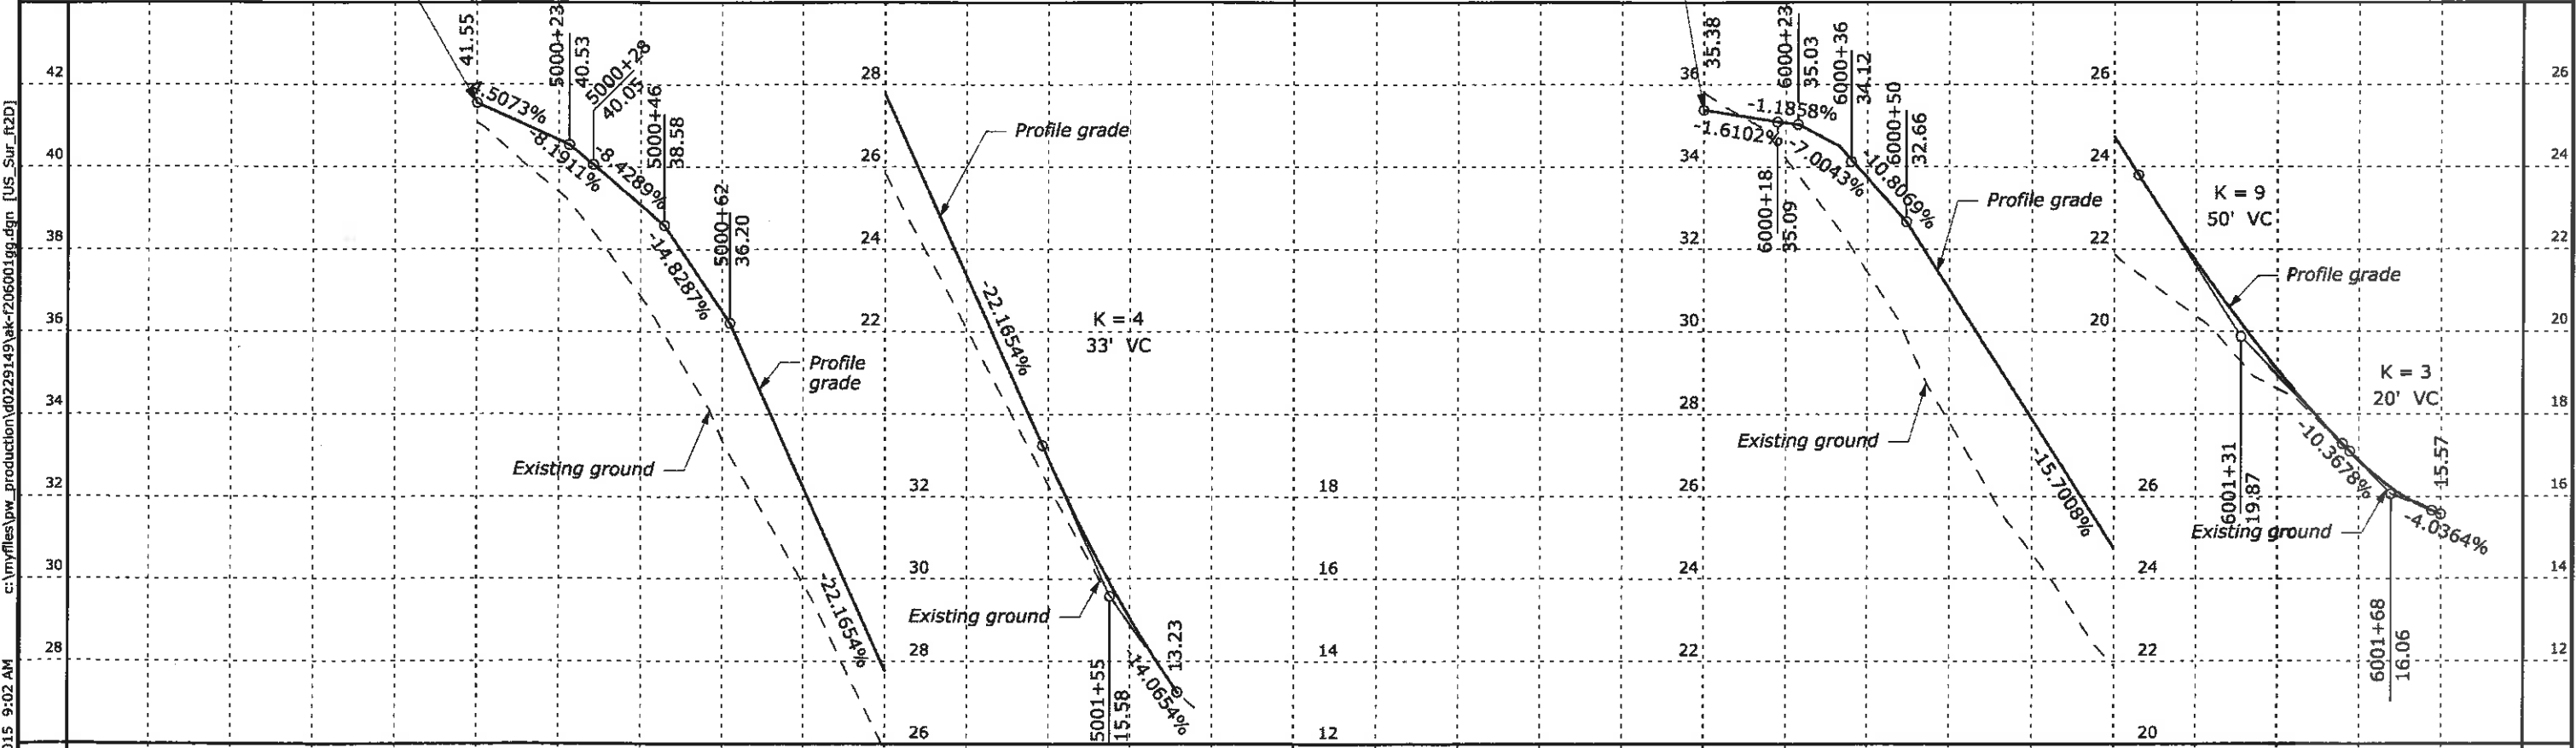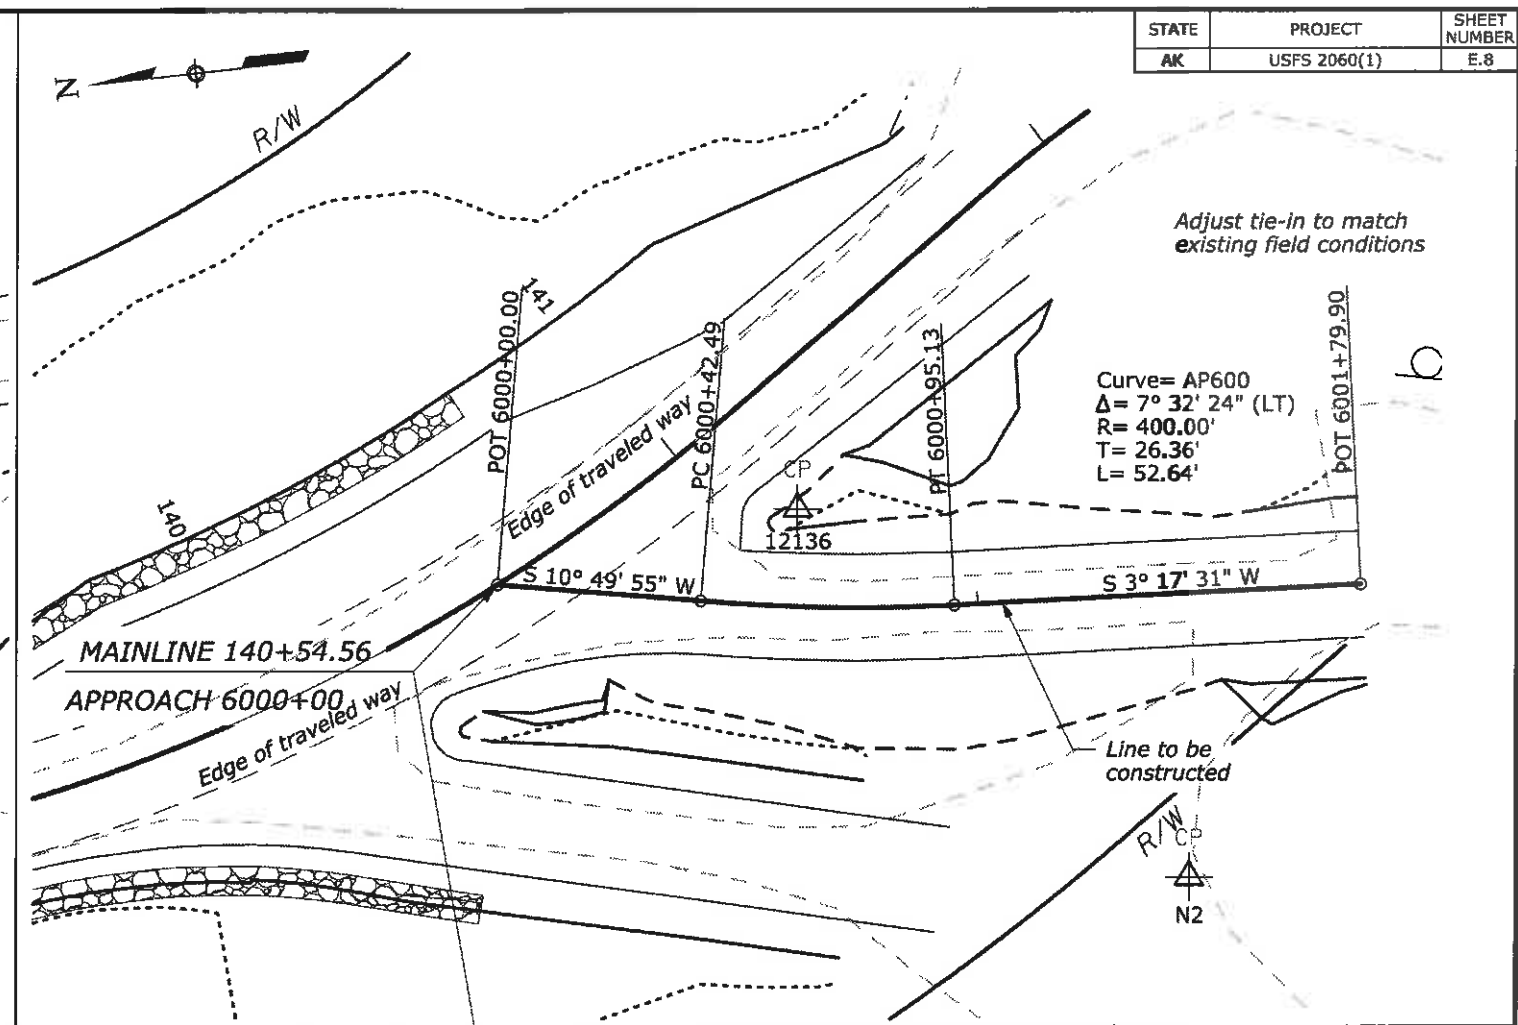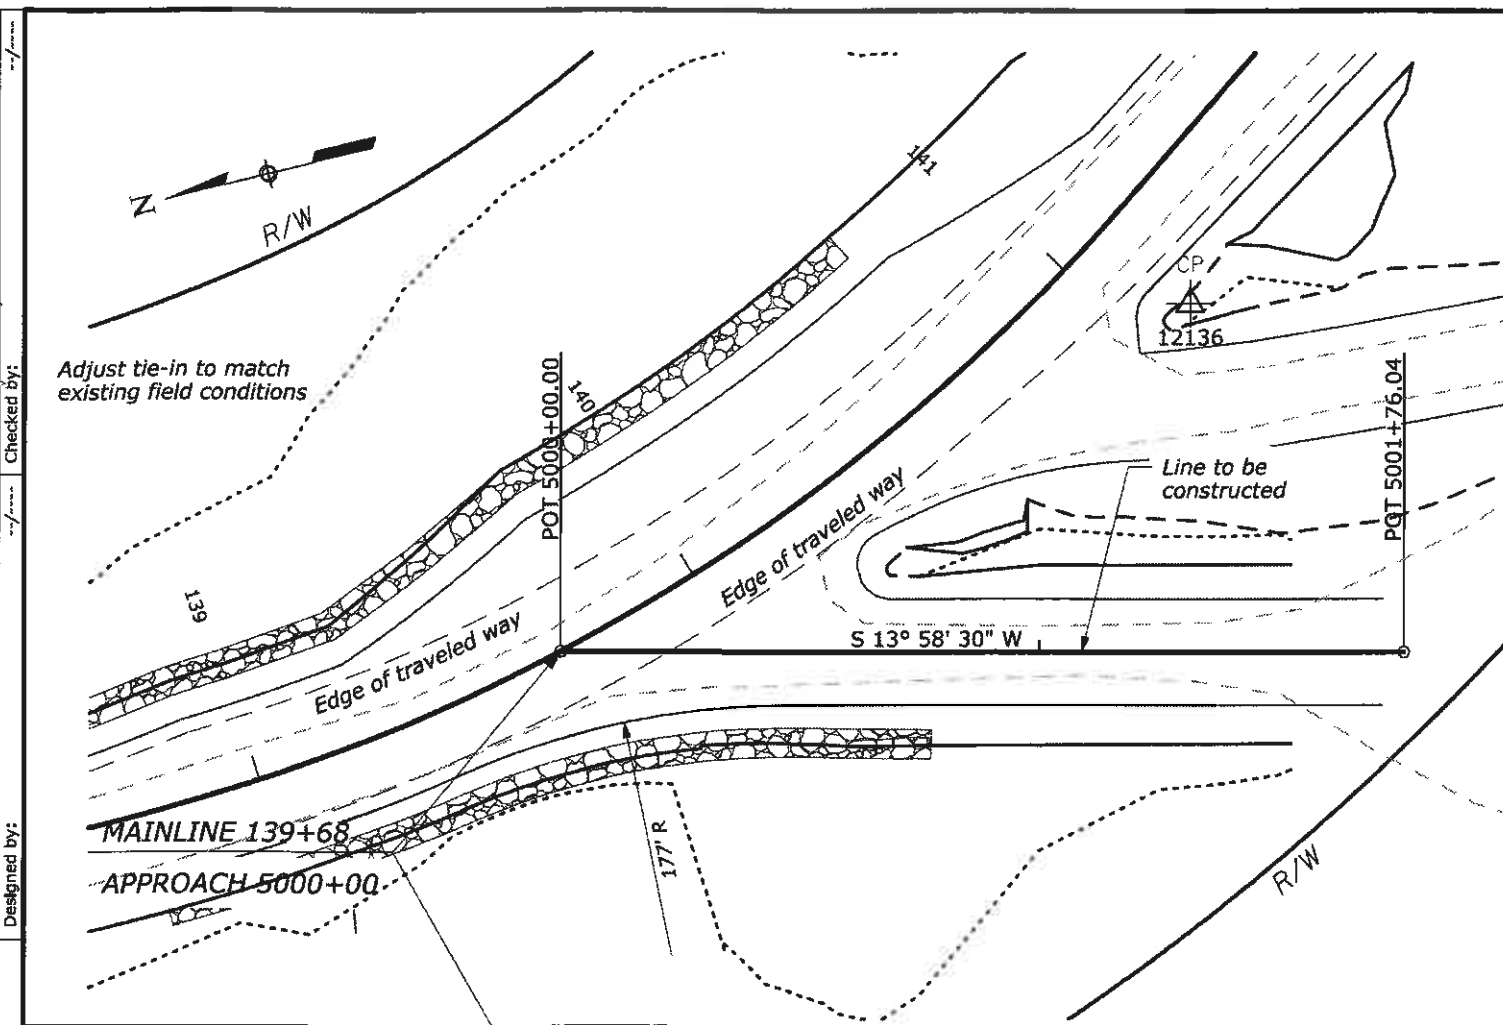

Station	Exc. CUYD	Emb. CUYD
41.55		
5000+23		
5000+46		
5000+62		
5001+55		
6000+18		
6000+23		
6000+36		
6000+50		
6001+31		
6001+68		

29 January 2015 9:02 AM
 c:\myfiles\pw_production\d0229149\ak-r206001\gg.dgn [US_Sur_f12D]
 Designed by:
 Checked by:

RECEIVED
 JUL 08 2017
 BY PROJECT ENGINEER

EROSION CONTROL QUANTITIES

ITEM NO	DESCRIPTION
15702-1000	SOIL EROSION CONTROL, TEMPORARY DIVERSION CHANNEL
15706-1600	SOIL EROSION CONTROL, STABILIZED CONSTRUCTION ENTRANCE
15707-1000	SOIL EROSION CONTROL, TEMPORARY TURF ESTABLISHMENT
15801-0000	WATERING FOR DUST CONTROL

- APPROVED
- APPROVED AS NOTED
- RETURNED FOR CORRECTION

Date: JUL 10 2017 By: Jim Jozovich
 FEDERAL HIGHWAY ADMINISTRATION
 Federal Lands Highway

See FAR 52.236-21(e) for limitations of Government's responsibility in approving this document.

MGAL 2,250

STATE	PROJECT	SHEET NUMBER
AK	USFS 2060(1)	F.1

**ITEM 15705-1500
 SOIL EROSION CONTROL,
 SEDIMENT WATTLE
 (CHECK DAMS) TEMPORARY**

LOCATION LEFT	QUANTITY (LNFT)	LOCATION RIGHT	QUANTITY (LNFT)
10+18 to 10+40	40	27+75 to 29+14	30
14+31 to 16+25	80	32+27 to 32+28	80
17+80 to 19+45	60	51+44 to 54+10	60
19+85 to 21+25	60	60+40 to 63+31	60
23+39 to 23+85	20	67+00 to 67+27	30
24+72 to 28+27	130	68+25 to 69+00	40
29+14 to 31+85	60	83+00 to 86+25	130
32+73 to 36+22	80	95+75 to 96+75	40
37+10 to 39+24	50	105+40 to 107+00	40
42+65 to 43+50	30	120+35 to 123+35	60
46+28 to 47+25	40	123+52 to 124+45	50
67+43 to 69+00	60	132+50 to 133+54	80
81+20 to 82+49	100	138+00 to 138+75	20
83+00 to 85+00	80	140+33 to 141+34	140
95+25 to 96+92	180	39+68 to 40+15	
98+65 to 102+81	90	41+79	
103+87 to 105+41	40	44+00	
106+29 to 109+84	80		
115+52 to 116+25	20		
118+98 to 120+18	140		
131+00 to 132+75	40		
133+25 to 135+00	50		
135+00 to 135+50	20		
137+20 to 137+34	30		
138+00 to 138+60	20		
140+75 to 141+80	50		
SUBTOTAL LT	-1,650	SUBTOTAL RT	-860
TOTAL	-2,510		

✓ 38+50

**ITEM 15705-1500
 SOIL EROSION CONTROL,
 SEDIMENT WATTLE**

TEMPORARY

LOCATION LEFT	QUANTITY (LNFT)	LOCATION RIGHT	QUANTITY (LNFT)
10+13 to 13+73	540	10+13.42 to 13+33	364
43+49 to 58+60	1,490	19+00 to 21+60	260
61+30 to 62+56	133	25+25 to 35+75	1,095
64+50 to 81+20	1,700	37+50 to 45+73	886
120+19 to 122+50	243	46+00 to 46+46	74
124+35 to 134+58	1,040	47+68 to 49+50	196
135+43 to 137+02	250	55+77 to 59+51	382
42+20 to 44+00		60+25 to 66+68	108
48+36 to 57+76		80+49 to 81+18	67
60+00		82+13 to 83+00	85
66+30 to 72+60		86+25 to 90+05	400
128+50 to 131+00		97+43 to 101+75	425
		102+45 to 105+39	310
		107+00 to 110+50	355
		116+55 to 117+12	60
		119+88 to 120+35	55
		130+00 to 132+50	490
		133+25 to 134+30	229
		134+58 to 136+01	262
		140+22 to 140+48	32
		141+08 to 141+78	105
SUBTOTAL LT	-5,396	SUBTOTAL RT	-6,240
TOTAL	-11,636		

**ITEM 15705-1500
 SOIL EROSION CONTROL,
 SEDIMENT WATTLE
 (SLOPE PROTECTION)**

LOCATION LEFT	QUANTITY (LNFT)	LOCATION RIGHT	QUANTITY (LNFT)
14+68 to 17+71	647	10+61 to 10+93	148
19+90 to 20+75	117	13+33 to 19+00	692
22+52 to 26+25	598	21+60 to 24+55	466
26+60 to 38+48	2,682	24+75 to 25+25	60
38+84 to 41+13	452	35+75 to 37+50	276
41+25 to 43+12	501	50+56 to 51+75	137
58+62 to 61+30	262	52+74 to 55+77	1,226
62+65 to 64+25	288	59+51 to 60+39	83
85+00 to 90+00	1,793	60+47 to 65+00	916
90+70 to 91+38	91	67+15 to 77+00	3,918
91+85 to 93+70	874	81+18 to 82+13	149
93+78 to 94+66	116	90+05 to 95+10	2,157
95+25 to 98+40	912	95+10 to 97+43	169
99+85 to 100+75	375	101+80 to 102+45	232
101+76 to 113+42	3,511	105+50 to 107+00	173
113+75 to 115+26	263	112+90 to 116+54	808
117+90 to 119+09	319	117+12 to 119+88	526
137+19 to 141+80	1,086	122+39 to 123+75	188
		124+18 to 129+85	1,960
		136+20 to 140+23	643
		140+47 to 141+08	71
SUBTOTAL LT	-14,887	SUBTOTAL RT	-14,997
TOTAL	-29,884		

66+60 to 66+80

**TABULATION OF
 EROSION/SEDIMENT
 CONTROL QUANTITIES**

30 January 2015 10:21 AM
 c:\myfiles\pwr_production\00199362\ak-r20600da.dgn [US_Sur_r20]
 Designed by: C. Conrad
 04/2013
 Checked by:

STATE	PROJECT	SHEET NUMBER
AK	USFS 2060 (1)	F.2


001

STATE OF ALASKA
DEPT. OF NATURAL RESOURCES
N½ NE¼
SECTION 18
PATEND 50-2007-0534

STATE OF ALASKA
DEPT. OF NATURAL RESOURCES
N½ NW¼
SECTION 17
QCD 2010-001377-0



02/25/14 Checked by: C. Conrad
 Designed by: C:\myfiles\pw_production\0199362\ak-f206000b.dgn [US_Sur_F20]
 28 July 2015 8:19 AM

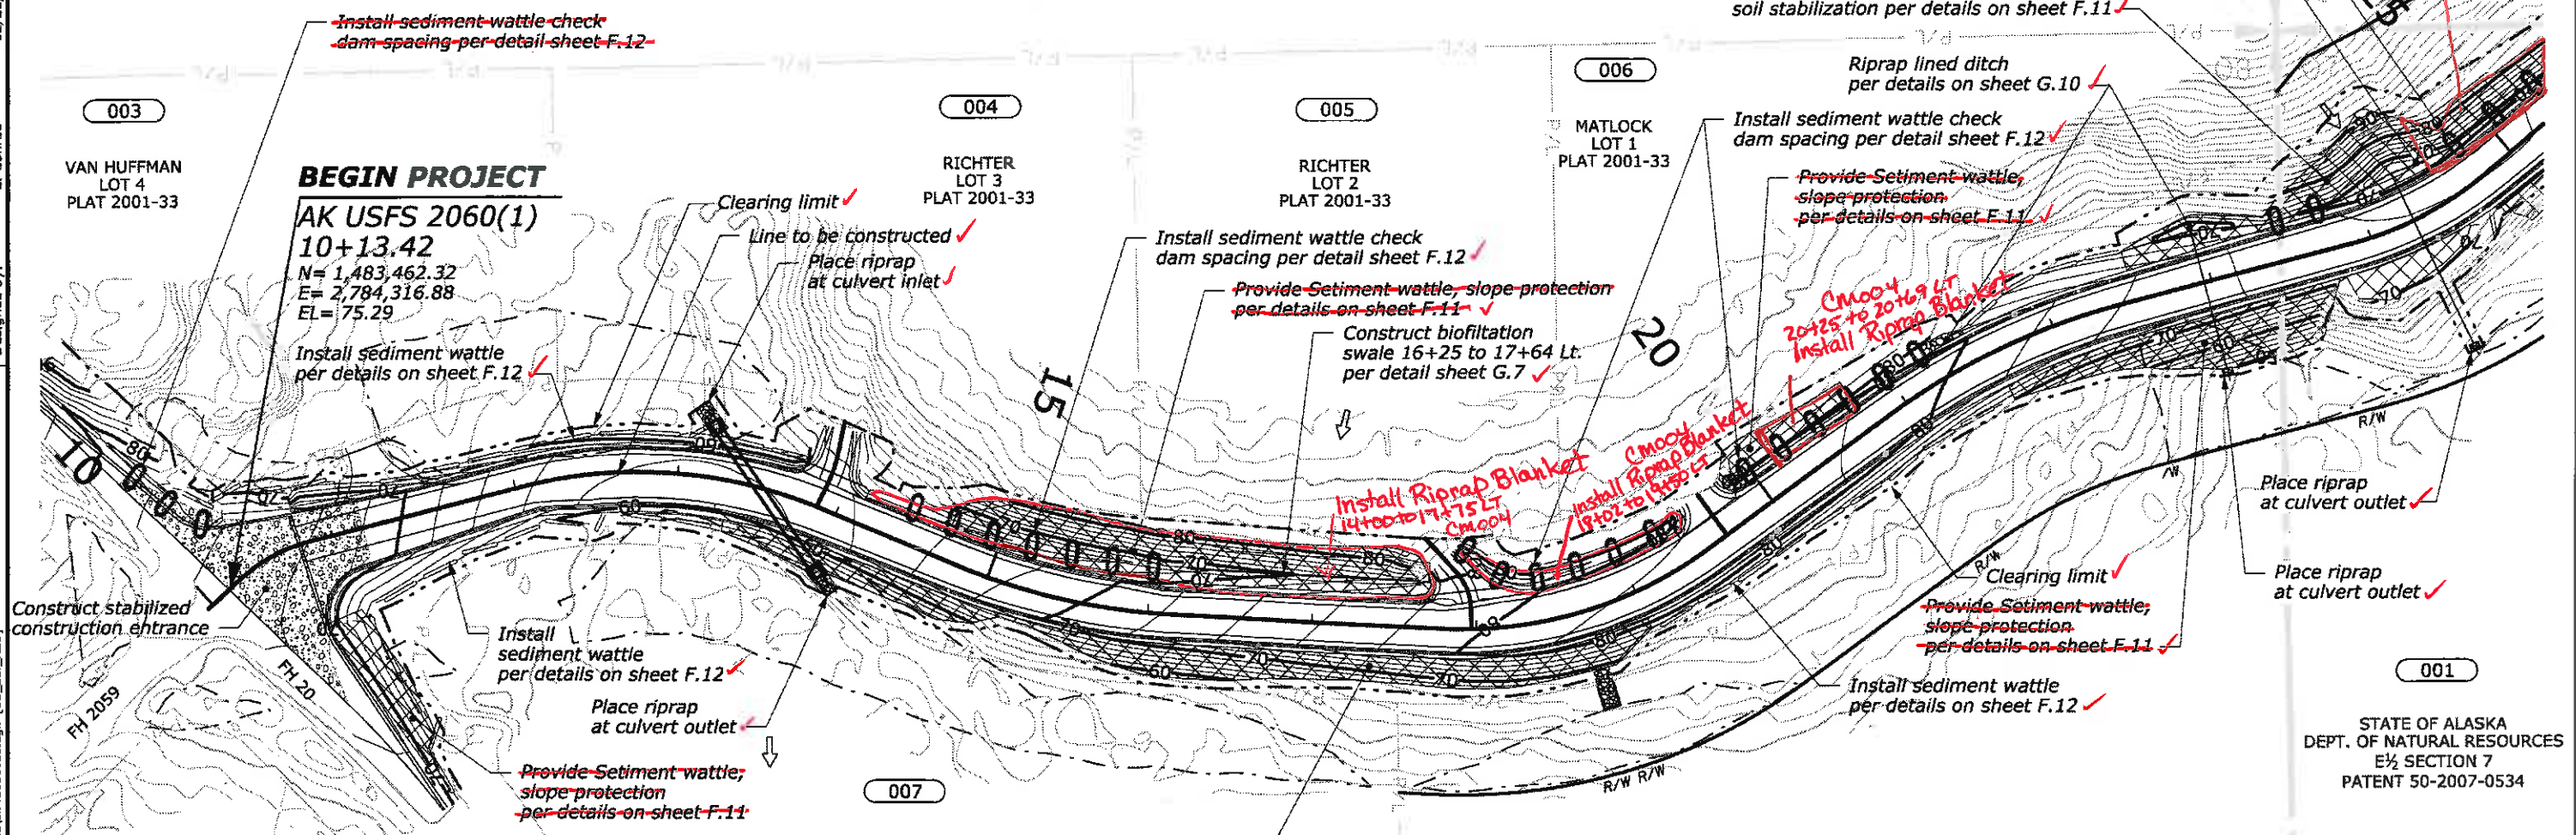

003

VAN HUFFMAN
LOT 4
PLAT 2001-33

BEGIN PROJECT

AK USFS 2060(1)
10+13.42
N= 1,483,462.32
E= 2,784,316.88
EL= 75.29

004

RICHTER
LOT 3
PLAT 2001-33

005

RICHTER
LOT 2
PLAT 2001-33

006

MATLOCK
LOT 1
PLAT 2001-33

007

TRACT B
PLAT 2001-33

001

STATE OF ALASKA
DEPT. OF NATURAL RESOURCES
W½ SECTION 08
PATENT 50-2007-0534

001

STATE OF ALASKA
DEPT. OF NATURAL RESOURCES
E½ SECTION 7
PATENT 50-2007-0534

- LEGEND :**
- Check Dam
 - Sediment Wattle
 - Slope Protection
 - Storm Water Flow
 - Existing Wetland

NOTE:

1. Sediment wattle lines shown are for illustration only. See Sediment Wattle Detail drawings for location installation details.
2. Apply temporary slope protection w/in 14 days where construction activities have ceased.

**SEDIMENTATION AND
EROSION CONTROL PLANS
10+13.42 TO 25+00**

STATE	PROJECT	SHEET NUMBER
AK	USFS 2060 (1)	F.3

001

STATE OF ALASKA
DEPT. OF NATURAL RESOURCES
N½ NW¼
SECTION 17
QCD 2010-001377-0

001

STATE OF ALASKA
DEPT. OF NATURAL RESOURCES
N½ NE¼
SECTION 18
PATEND 50-2007-0534

Provide Sediment wattle, slope protection
per details on sheet F.11 ✓

Provide Sediment wattle, slope protection
per details on sheet F.11 ✓

Riprap lined ditch
per details on sheet G.10 ✓

Install sediment wattle check dam
spacing per detail sheet F.12 ✓

Provide Sediment wattle,
slope protection
per details on sheet F.11 ✓

Install sediment wattle check dam
spacing per detail sheet F.12 ✓

Install Riprap Blanket
29+25 to 39+75 LT
Cm 004

Provide Sediment wattle, slope protection
per details on sheet F.11 ✓

Install sediment wattle check dam
spacing per detail sheet F.12 ✓

Provide Sediment wattle,
slope protection
per details on sheet F.11 ✓

Place riprap
at culvert outlet ✓

Install sediment wattle
per details on sheet F.12 ✓

Install sediment wattle
per details on sheet F.12 ✓

Provide Sediment wattle, slope protection
per details on sheet F.11 ✓

Place riprap
at culvert outlet ✓

001

STATE OF ALASKA
DEPT. OF NATURAL RESOURCES
E½ SECTION 7
PATENT 50-2007-0534

001


STATE OF ALASKA
DEPT. OF NATURAL RESOURCES
N½ NE¼
SECTION 18
PATENT 50-2007-0534

**SEDIMENTATION AND
EROSION CONTROL PLANS
25+00 TO 40+00**

02/25/14 Checked by: C. Conrad
 Designed by: C. Conrad
 c:\myfiles\paw_production\0199362\ak-2060\00c.dgn [US_Sur_F2D]
 28 July 2015 8:17 AM

STATE	PROJECT	SHEET NUMBER
AK	USFS 2060(1)	F.4

02/25/14 Checked by: C. Conrad
 Designed by: C. Conrad
 c:\myfiles\pwr_production\0199362\ak-206000\dd.dgn [US_Sur_112D]
 28 July 2015 8:20 AM

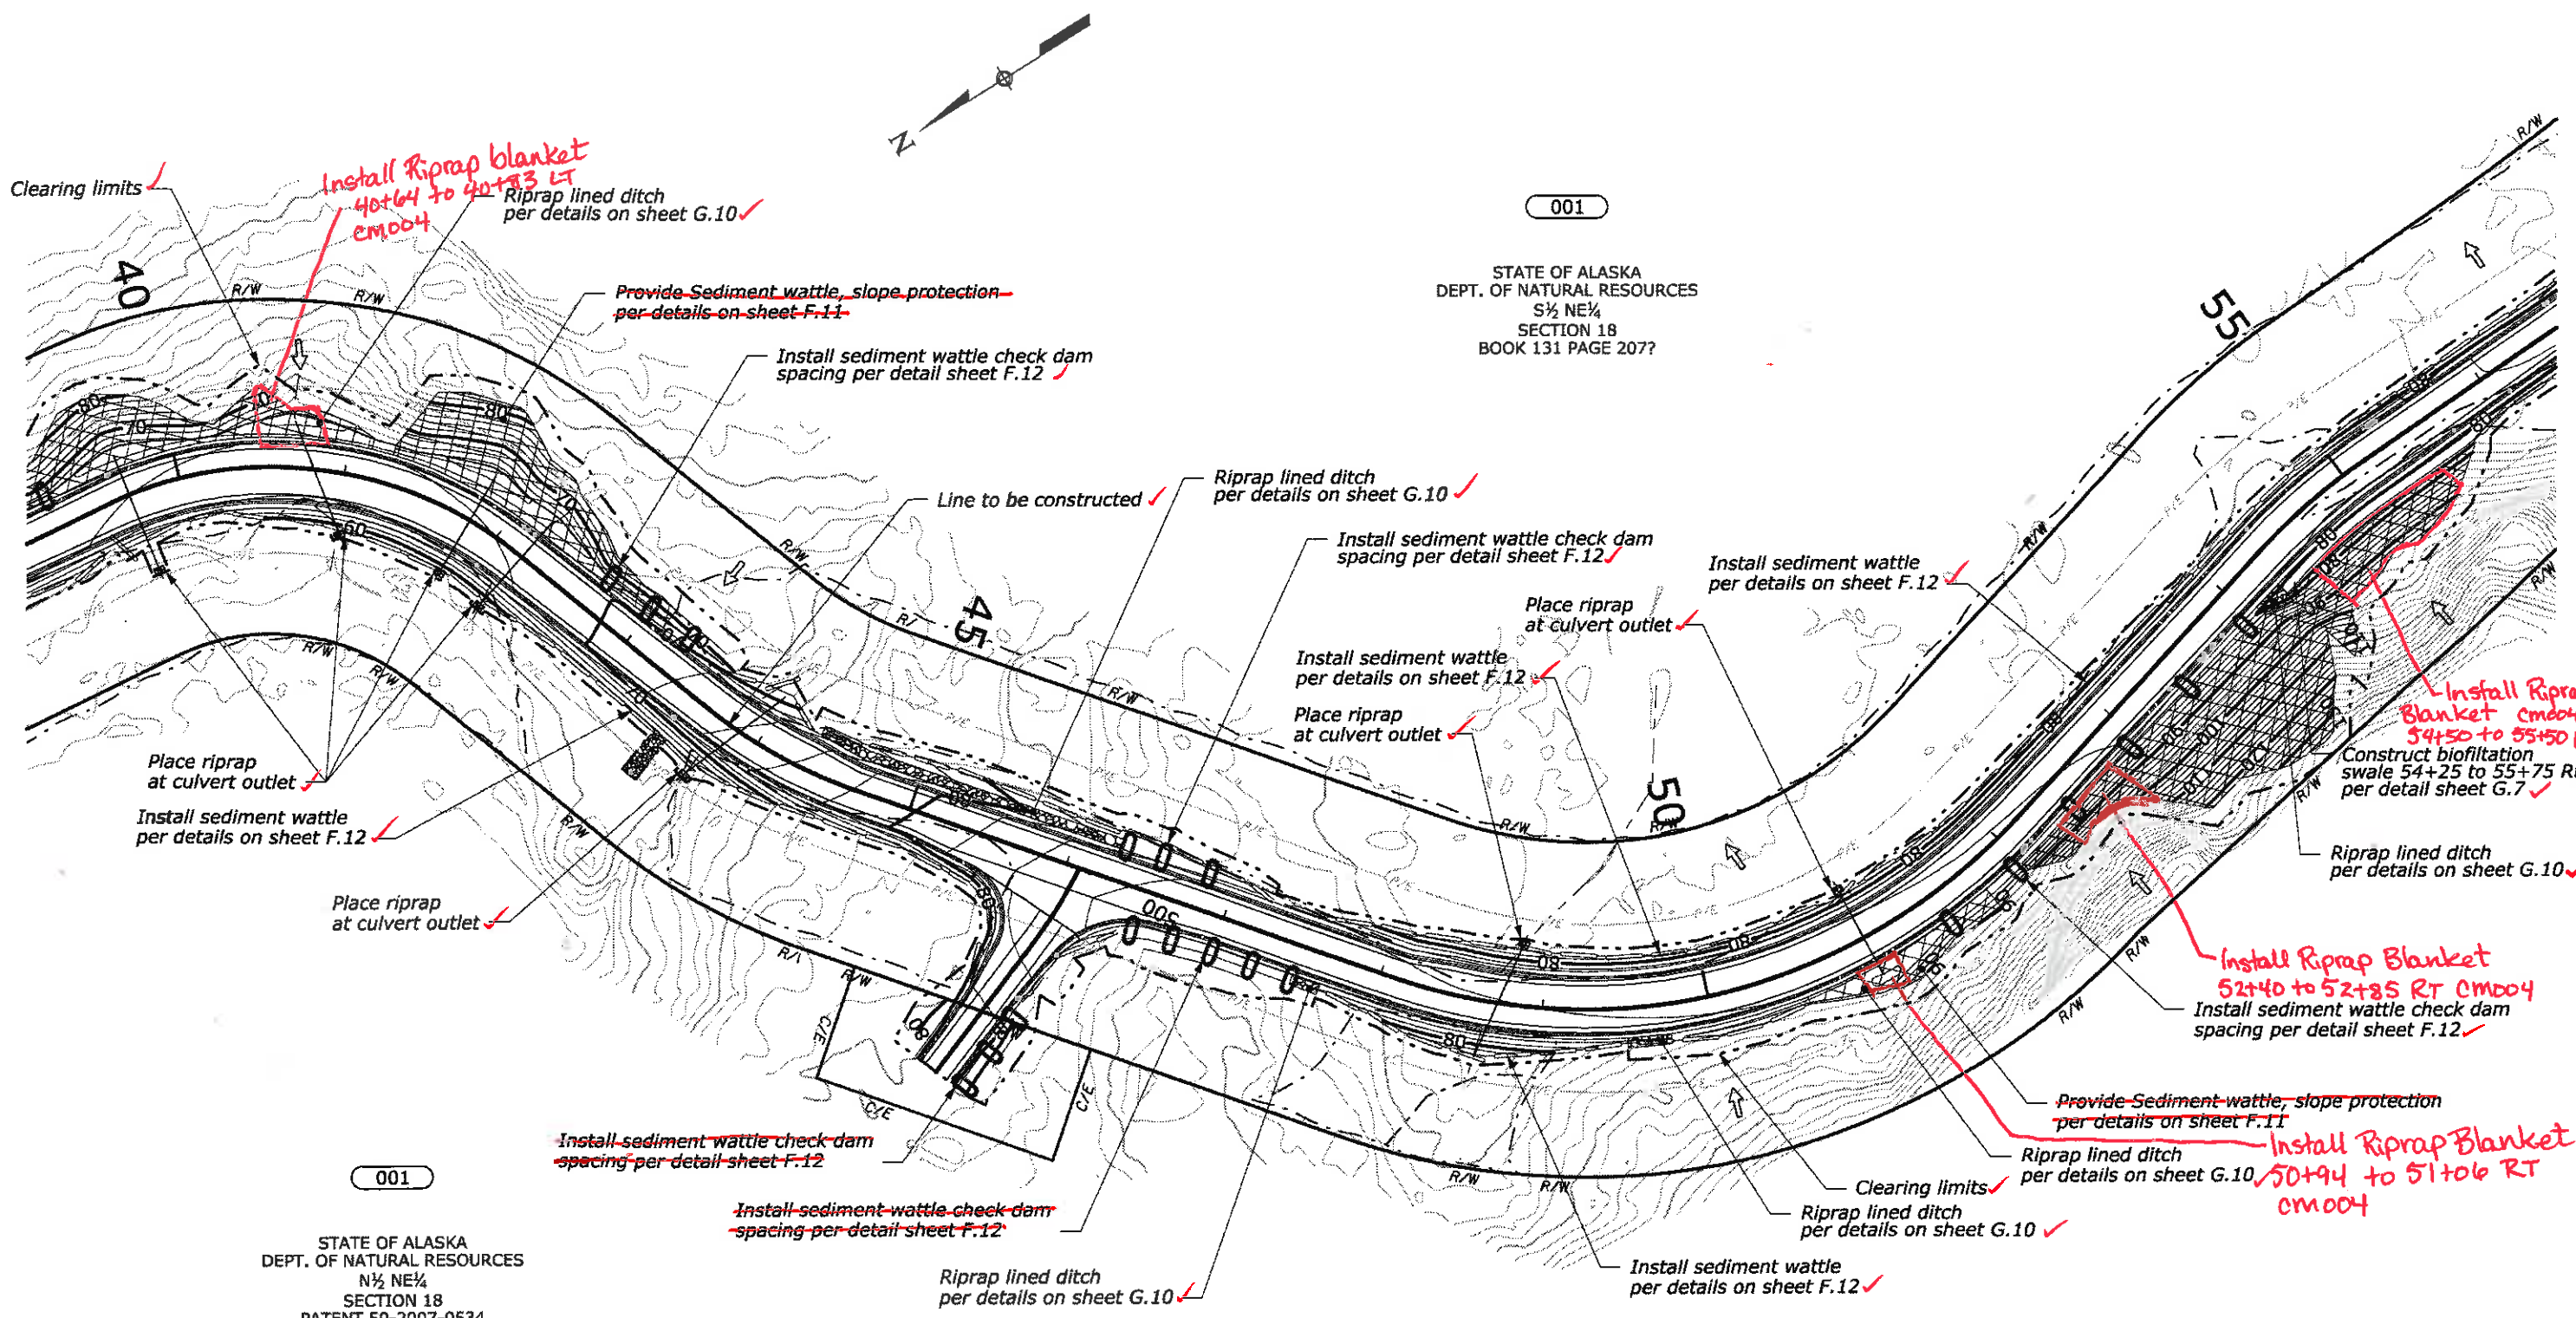

**SEDIMENTATION AND
EROSION CONTROL PLANS
40+00 TO 55+00**

STATE	PROJECT	SHEET NUMBER
AK	USFS 2060 (1)	F.5

STATE OF ALASKA
DEPT. OF NATURAL RESOURCES
GOV'T LOT 3
SECTION 18
QCD 2010-001377-0


001

STATE OF ALASKA
DEPT. OF NATURAL RESOURCES
S½ NE¼
SECTION 18
BOOK 131 PAGE 2077



001

STATE OF ALASKA
DEPT. OF NATURAL RESOURCES
NW¼ SE¼
SECTION 18

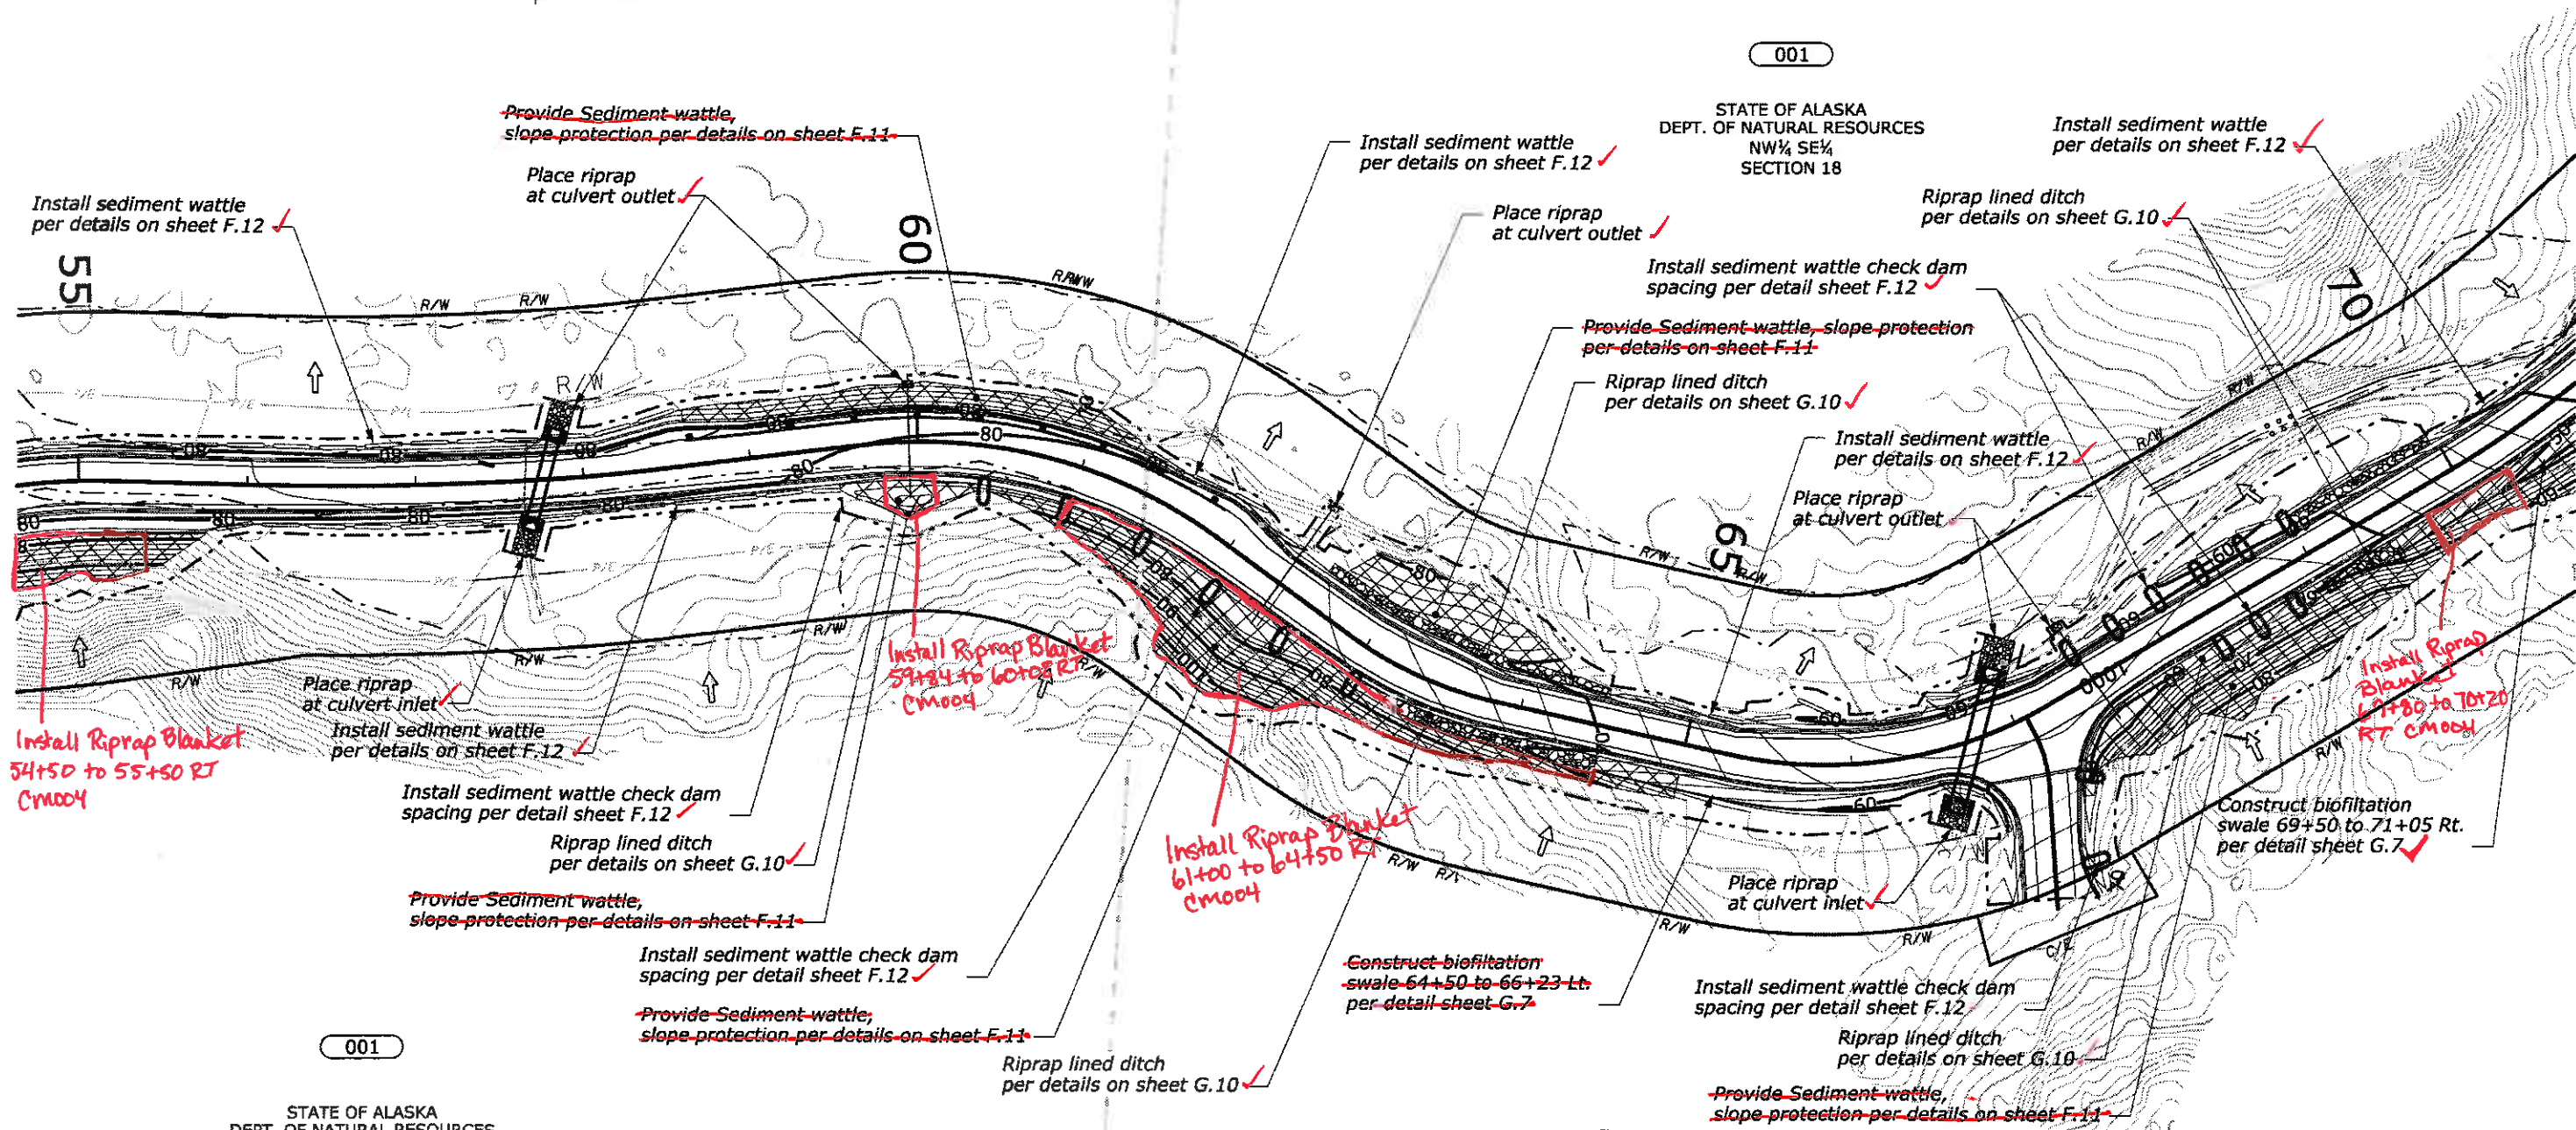

001

STATE OF ALASKA
DEPT. OF NATURAL RESOURCES
S½ NE¼
SECTION 18
BOOK 131 PAGE 2077

001

STATE OF ALASKA
DEPT. OF NATURAL RESOURCES
NW SE
SECTION 18

**SEDIMENTATION AND
EROSION CONTROL PLANS
55+00 TO 70+00**

02/25/14 Checked by: [redacted]
 Designed by: [redacted]
 c:\myfiles\pw_production\0199362\ak-20600de.dgn [US_Sur_120]
 28 July 2015 8:22 AM

STATE	PROJECT	SHEET NUMBER
AK	USFS 2060 (1)	F.6



001

STATE OF ALASKA
DEPT. OF NATURAL RESOURCES
GOV'T LOT 3
SECTION 18
QCD 2010-001377-0

001

STATE OF ALASKA
DEPT. OF NATURAL RESOURCES
SE 1/4 SE 1/4
SECTION 18
QCD 2010-001377-0

001

STATE OF ALASKA
DEPT. OF NATURAL RESOURCES
NW 1/4 SE 1/4
SECTION 18


001

STATE OF ALASKA
DEPT. OF NATURAL RESOURCES
GOV'T LOT 7
SECTION 18

001

STATE OF ALASKA
DEPT. OF NATURAL RESOURCES
NW 1/4 SE 1/4
SECTION 18

28 July 2015 8:23 AM
 c:\myfiles\pw_production\0199362\ak-r2060001.dgn [US_Sur_R2D]
 Designed by: C. Conrad
 Checked by: 02/25/14

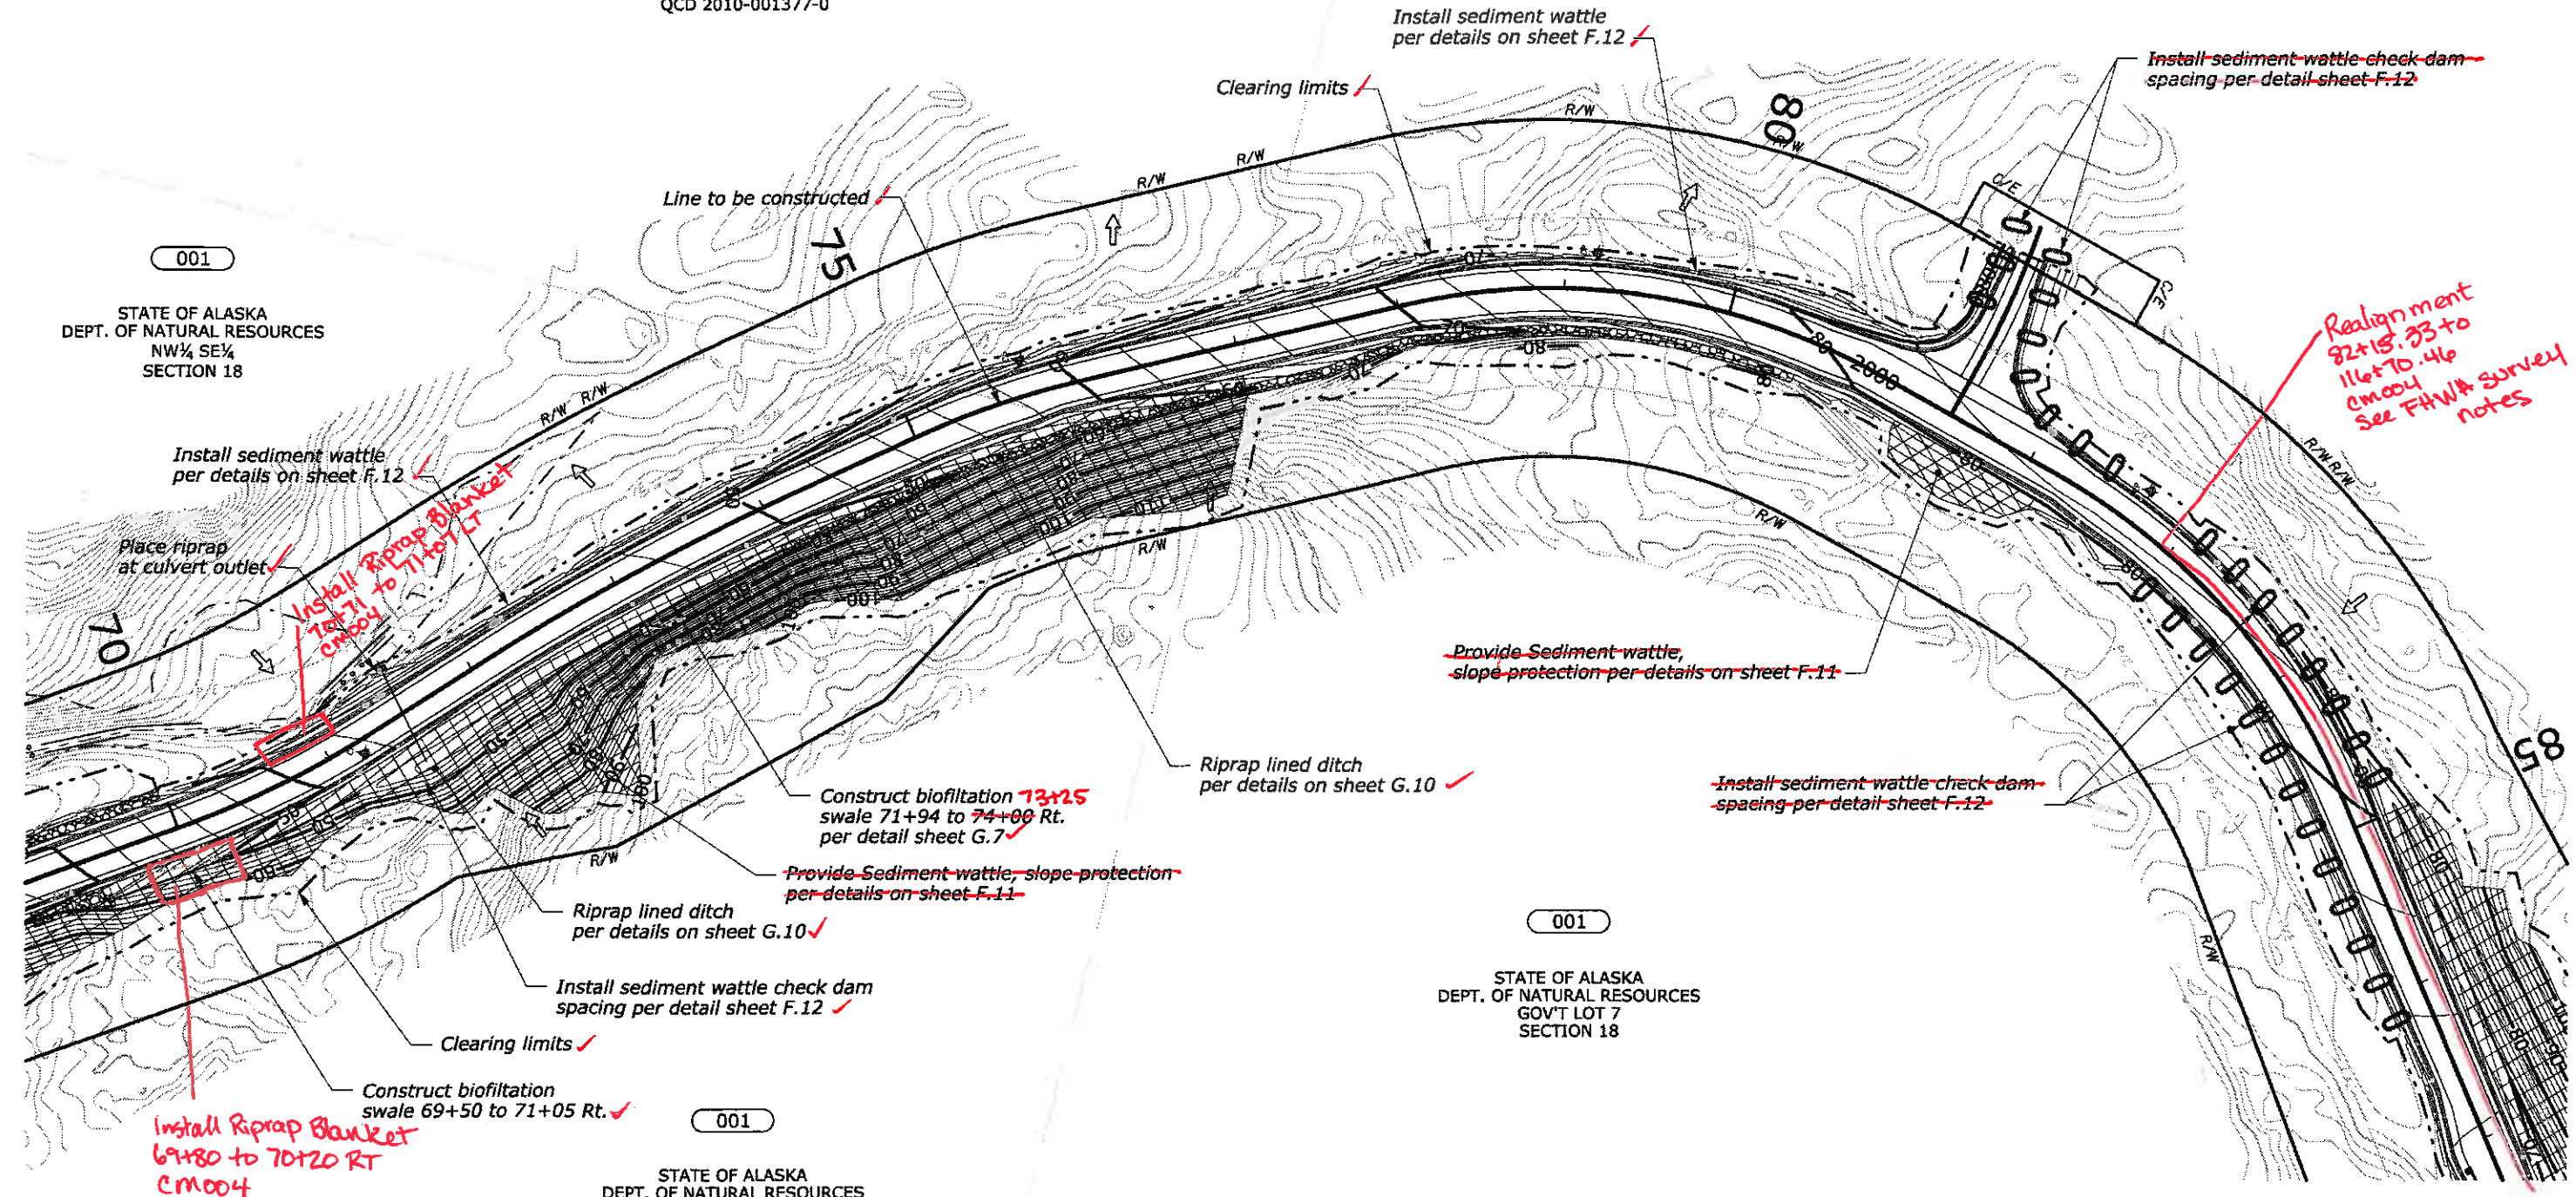

*Realignment
82+15.33 to
116+70.46
C.M.O.O.Y.
See FHWA survey
notes*

*Install Riprap Blanket
69+80 to 70+20 RT
C.M.O.O.Y.*

**SEDIMENTATION AND
EROSION CONTROL PLANS
70+00 TO 85+00**

STATE	PROJECT	SHEET NUMBER
AK	USFS 2060 (1)	F.7

001
STATE OF ALASKA
DEPT. OF NATURAL RESOURCES
SE ¼ SE ¼
SECTION 18
QCD 2010-001377-0

001
STATE OF ALASKA
DEPT. OF NATURAL RESOURCES
GOV'T LOT 7
SECTION 19


001
STATE OF ALASKA
DEPT. OF NATURAL RESOURCES
GOV'T LOT 7
SECTION 18

001
STATE OF ALASKA
DEPT. OF NATURAL RESOURCES
GOV'T LOT 7
SECTION 19

001
STATE OF ALASKA
DEPT. OF NATURAL RESOURCES
GOV'T LOT 7
SECTION 18

**SEDIMENTATION AND
EROSION CONTROL PLANS
85+00 TO 100+00**

02/25/14 Checked by: C. Conrad
 Designed by: C. Conrad
 c:\myfiles\proj_production\0199362\ale-206000.dgn [US_Sir_f20]

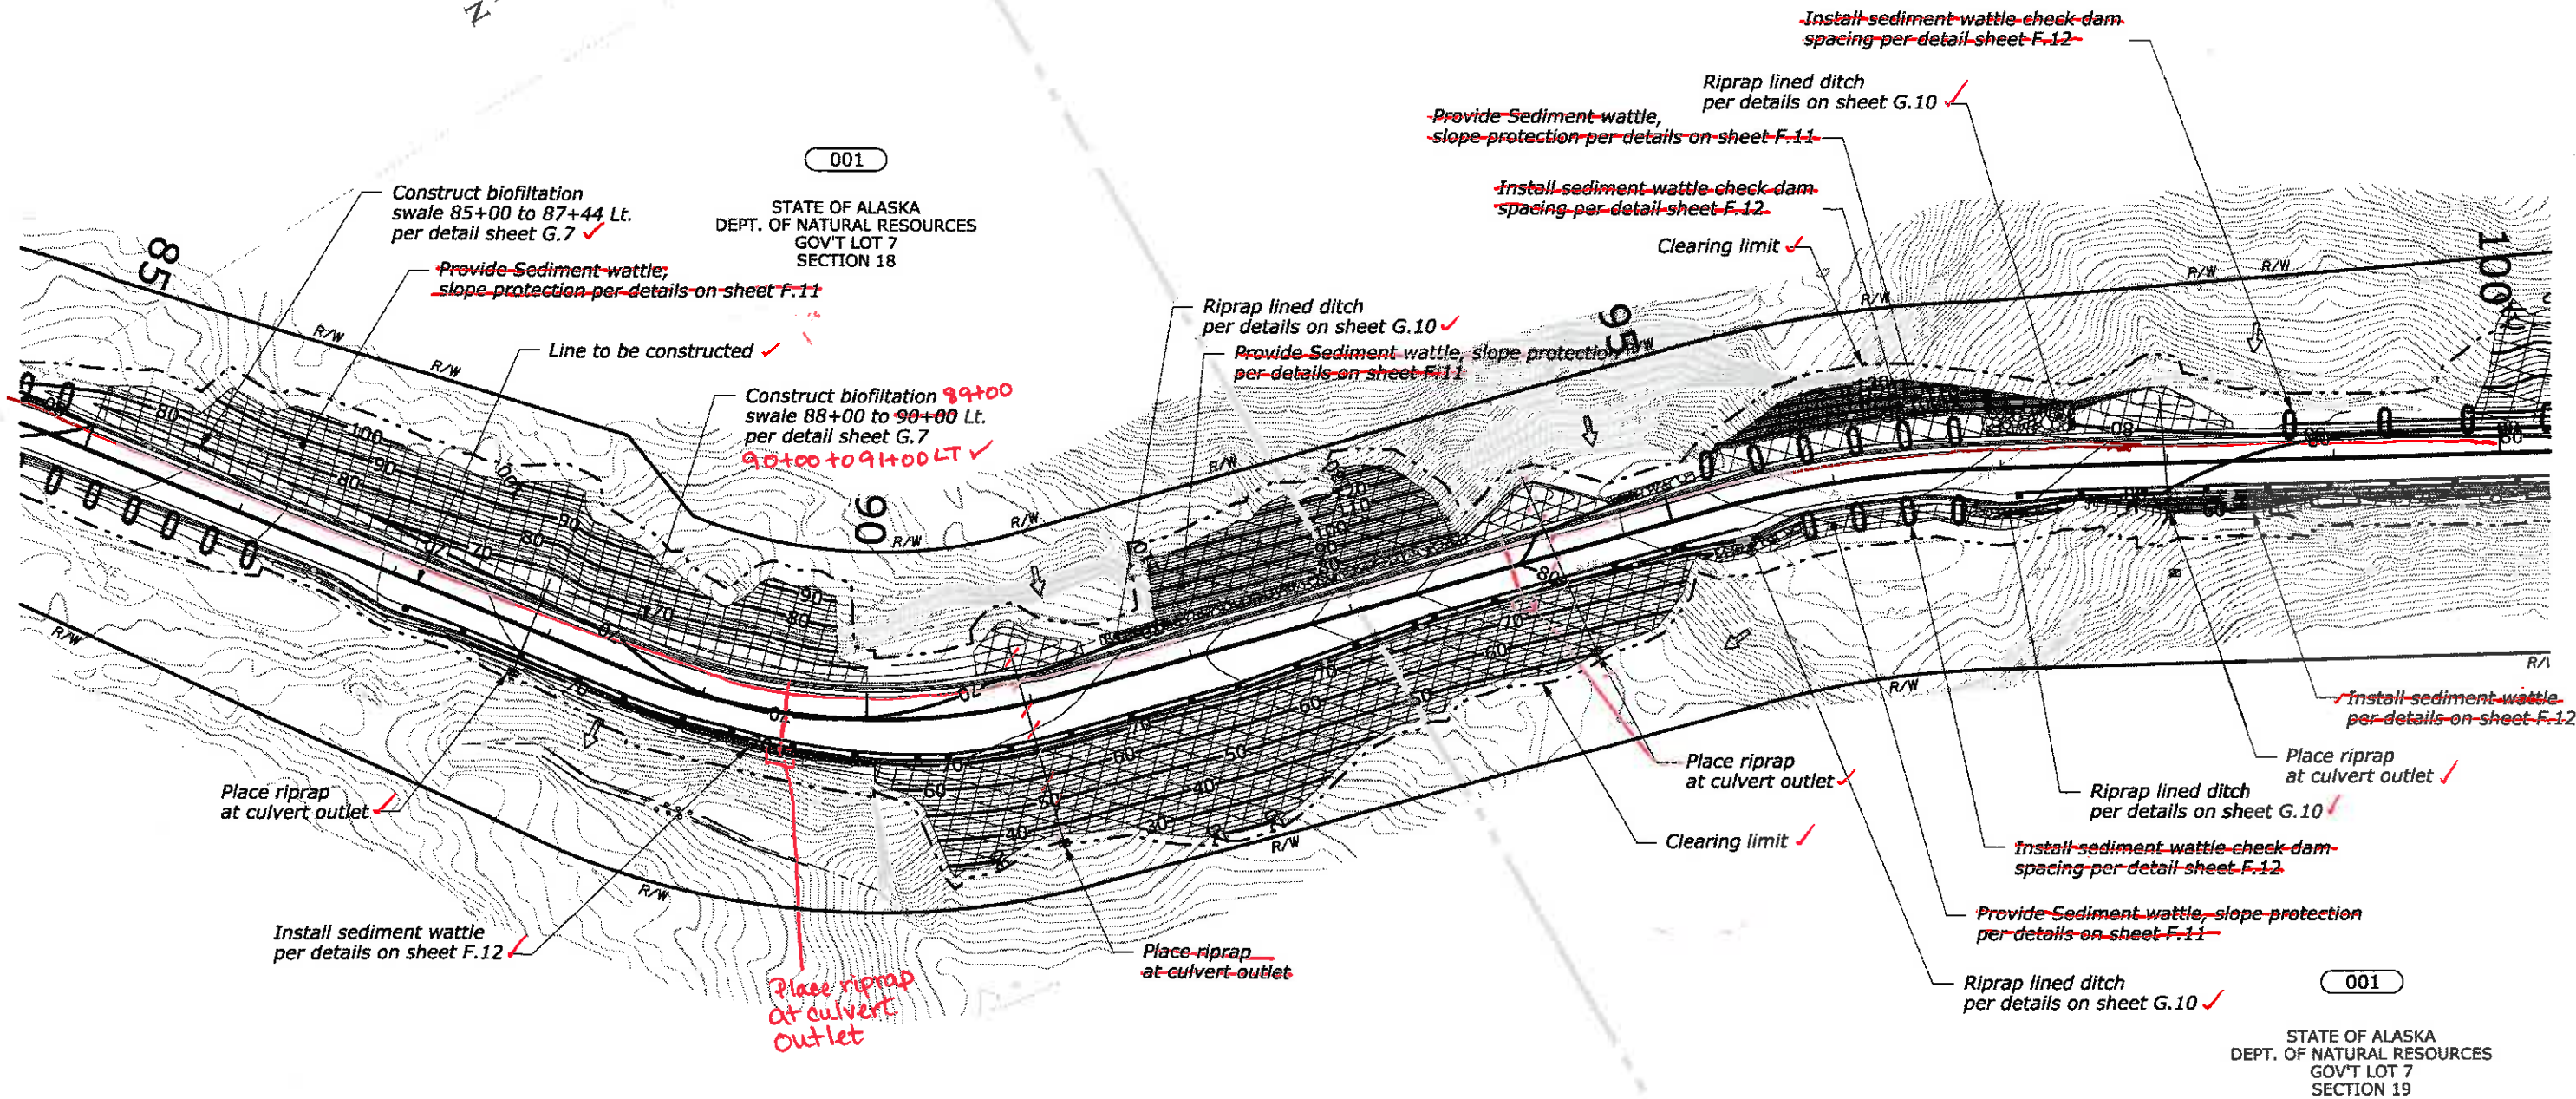

Construct biofiltration swale 85+00 to 87+44 Lt. per detail sheet G.7 ✓
~~Provide Sediment wattle, slope protection per details on sheet F.11~~

Construct biofiltration swale 88+00 to 90+00 Lt. per detail sheet G.7 ✓
 90+00 to 91+00 Lt. ✓

Riprap lined ditch per details on sheet G.10 ✓
~~Provide Sediment wattle, slope protection per details on sheet F.11~~

~~Install sediment wattle check dam spacing per detail sheet F.12~~
 Riprap lined ditch per details on sheet G.10 ✓
~~Provide Sediment wattle, slope protection per details on sheet F.11~~

~~Install sediment wattle check dam spacing per detail sheet F.12~~

Clearing limit ✓

Place riprap at culvert outlet ✓

Install sediment wattle per details on sheet F.12 ✓

Place riprap at culvert outlet

Place riprap at culvert outlet

Place riprap at culvert outlet ✓

Clearing limit ✓

~~Install sediment wattle check dam spacing per detail sheet F.12~~

~~Provide Sediment wattle, slope protection per details on sheet F.11~~

Riprap lined ditch per details on sheet G.10 ✓

~~Install sediment wattle per details on sheet F.12~~

Place riprap at culvert outlet ✓

Riprap lined ditch per details on sheet G.10 ✓

STATE	PROJECT	SHEET NUMBER
AK	USFS 2060 (1)	F.8


LOT 2
BLOCK 9
PLAT 2005-14

001
STATE OF ALASKA
DEPT. OF NATURAL RESOURCES
GOV'T LOT 7
SECTION 19

001
STATE OF ALASKA
DEPT. OF NATURAL RESOURCES
GOV'T LOT 11
SECTION 19

Realignment
82+15.33 to 116+70.46
Cm 004
See FHWA
Survey notes
008
LOT 1
BLOCK 9
PLAT 2005-14


02/25/14 Checked by: C. Conrad
 Designed by: C. Conrad
 c:\myfiles\pww_production\10199362\ak-f20600dn.dgn [US_Sur_f20] 28 July 2015 8:25 AM

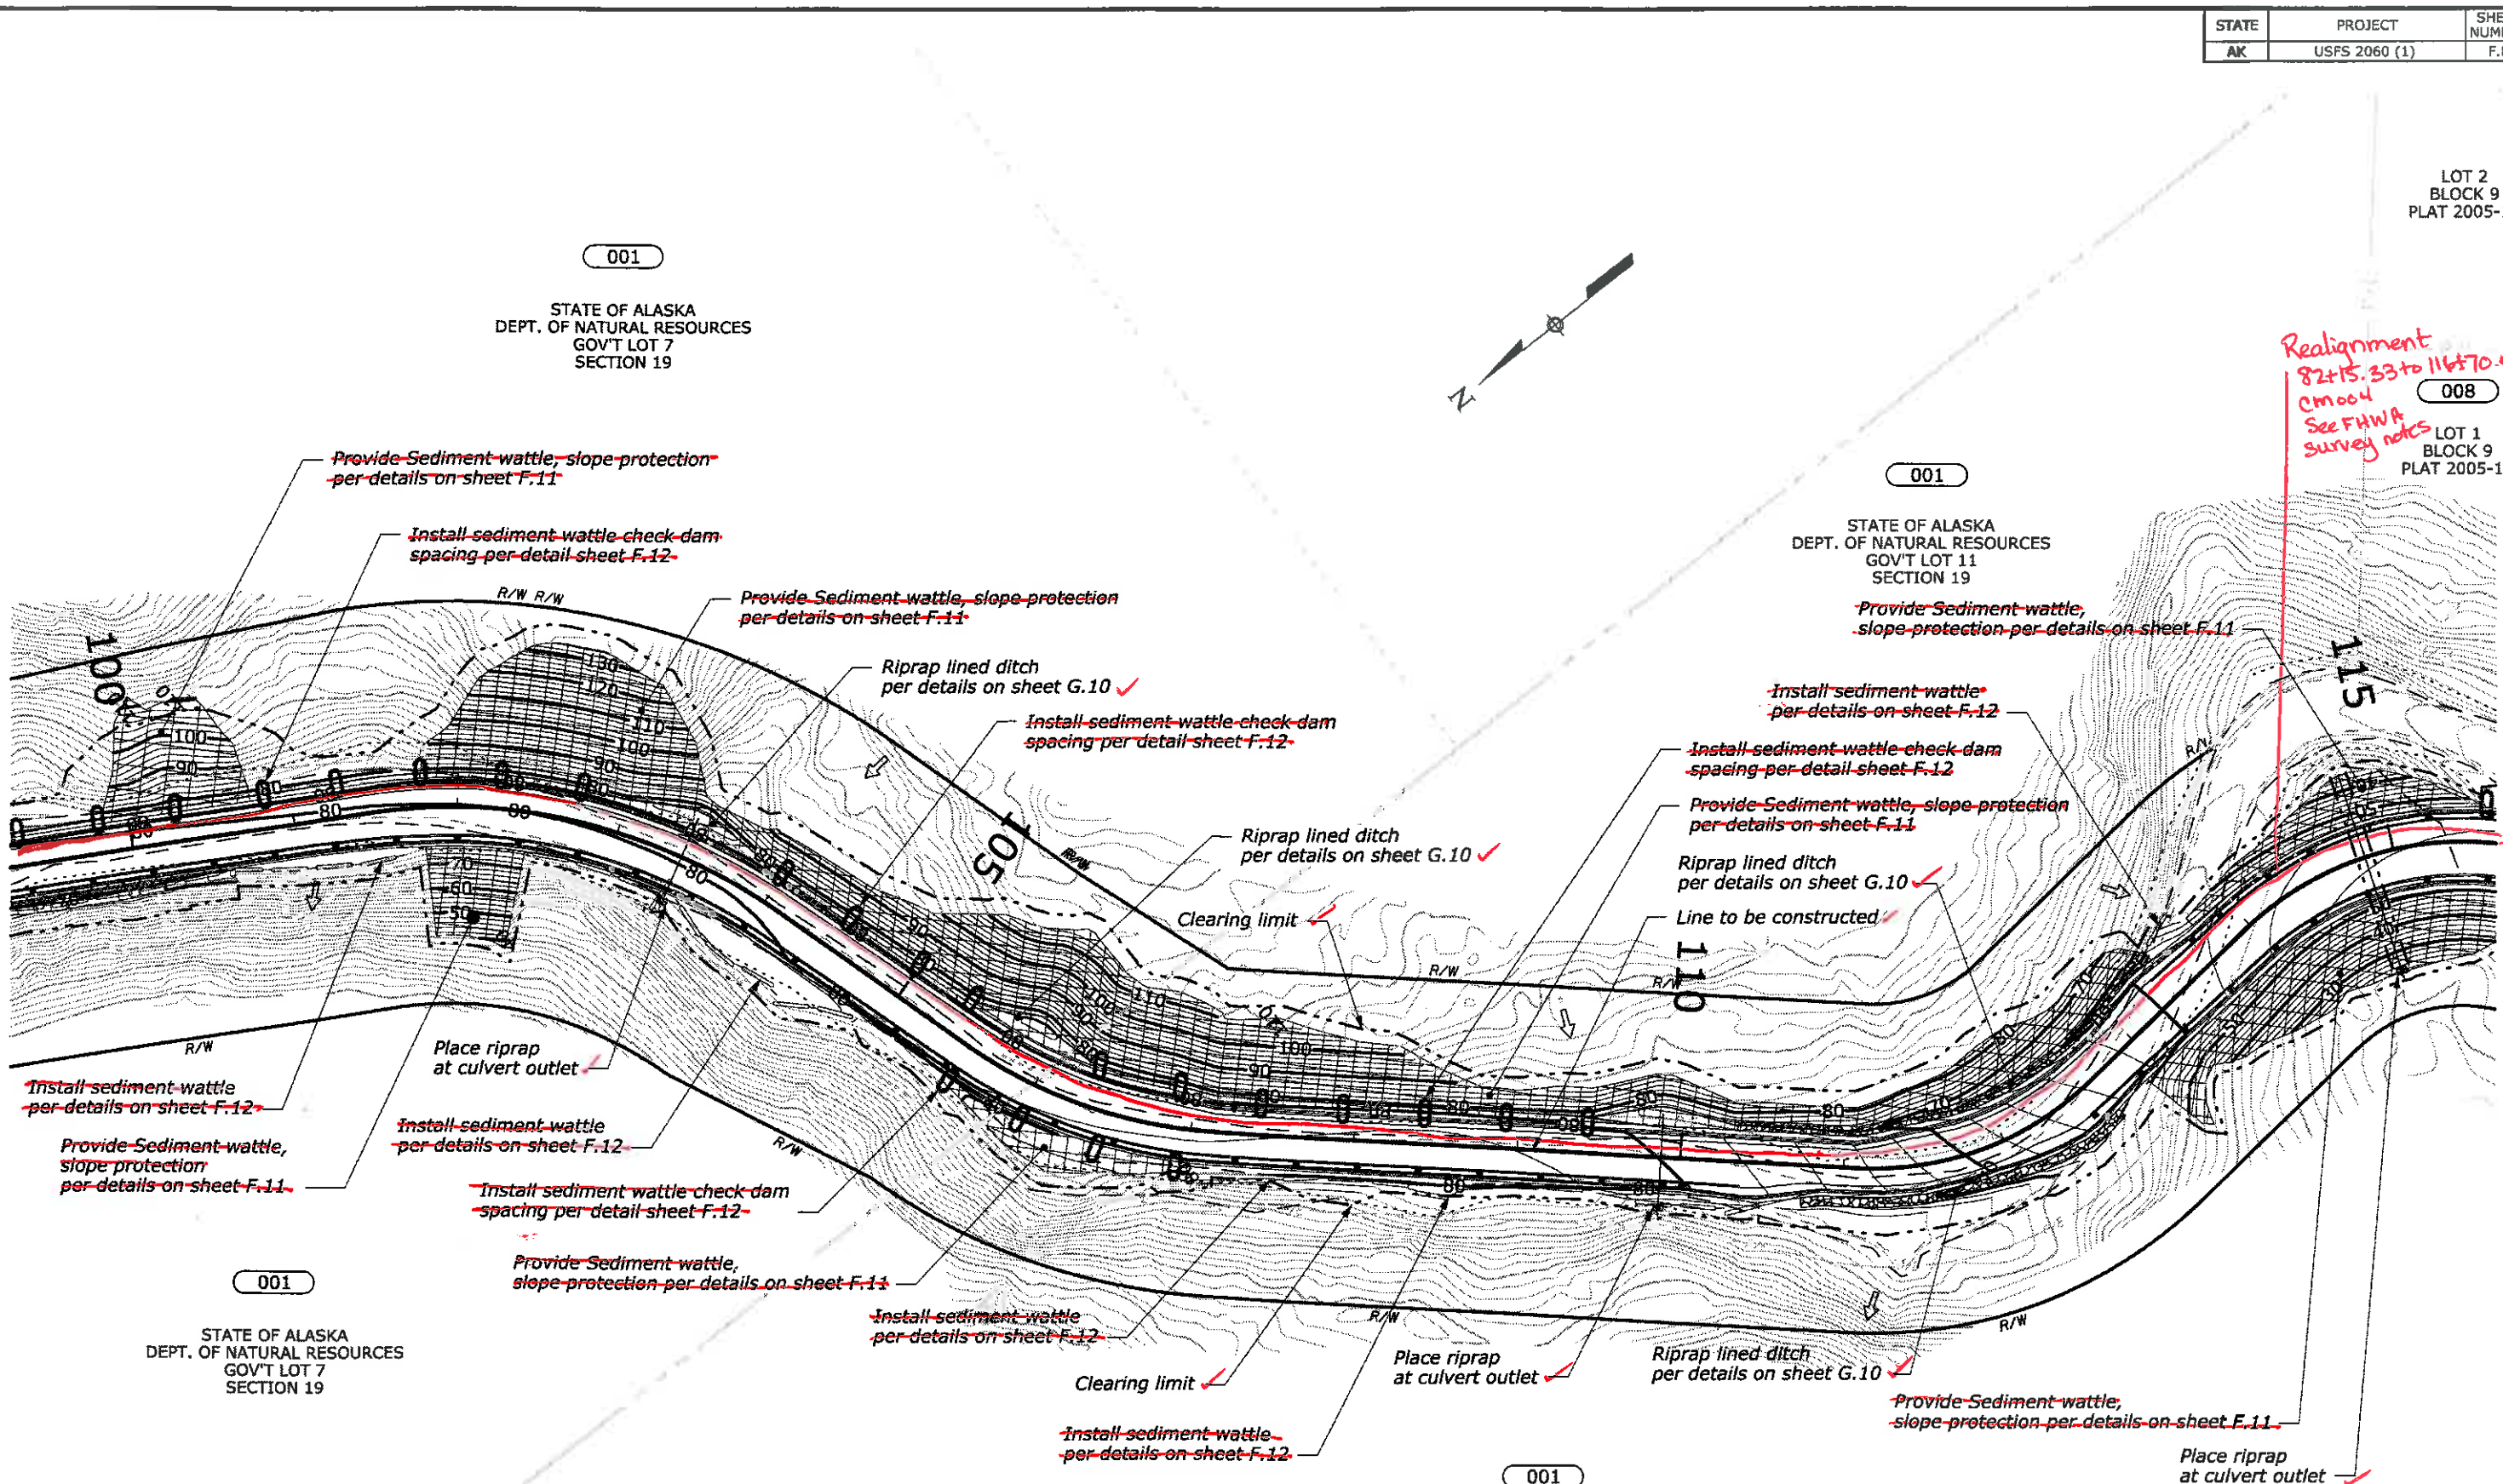

**SEDIMENTATION AND
EROSION CONTROL PLANS
100+00 TO 115+00**


STATE	PROJECT	SHEET NUMBER
AK	USFS 2060 (1)	F.9

28 July 2015 8:26 AM
 c:\myfiles\jw_production\0199362\ak-r-2060\01.dgn [US_Sur_R2D]
 Designed by: C. Conrad
 Checked by: 02/25/14

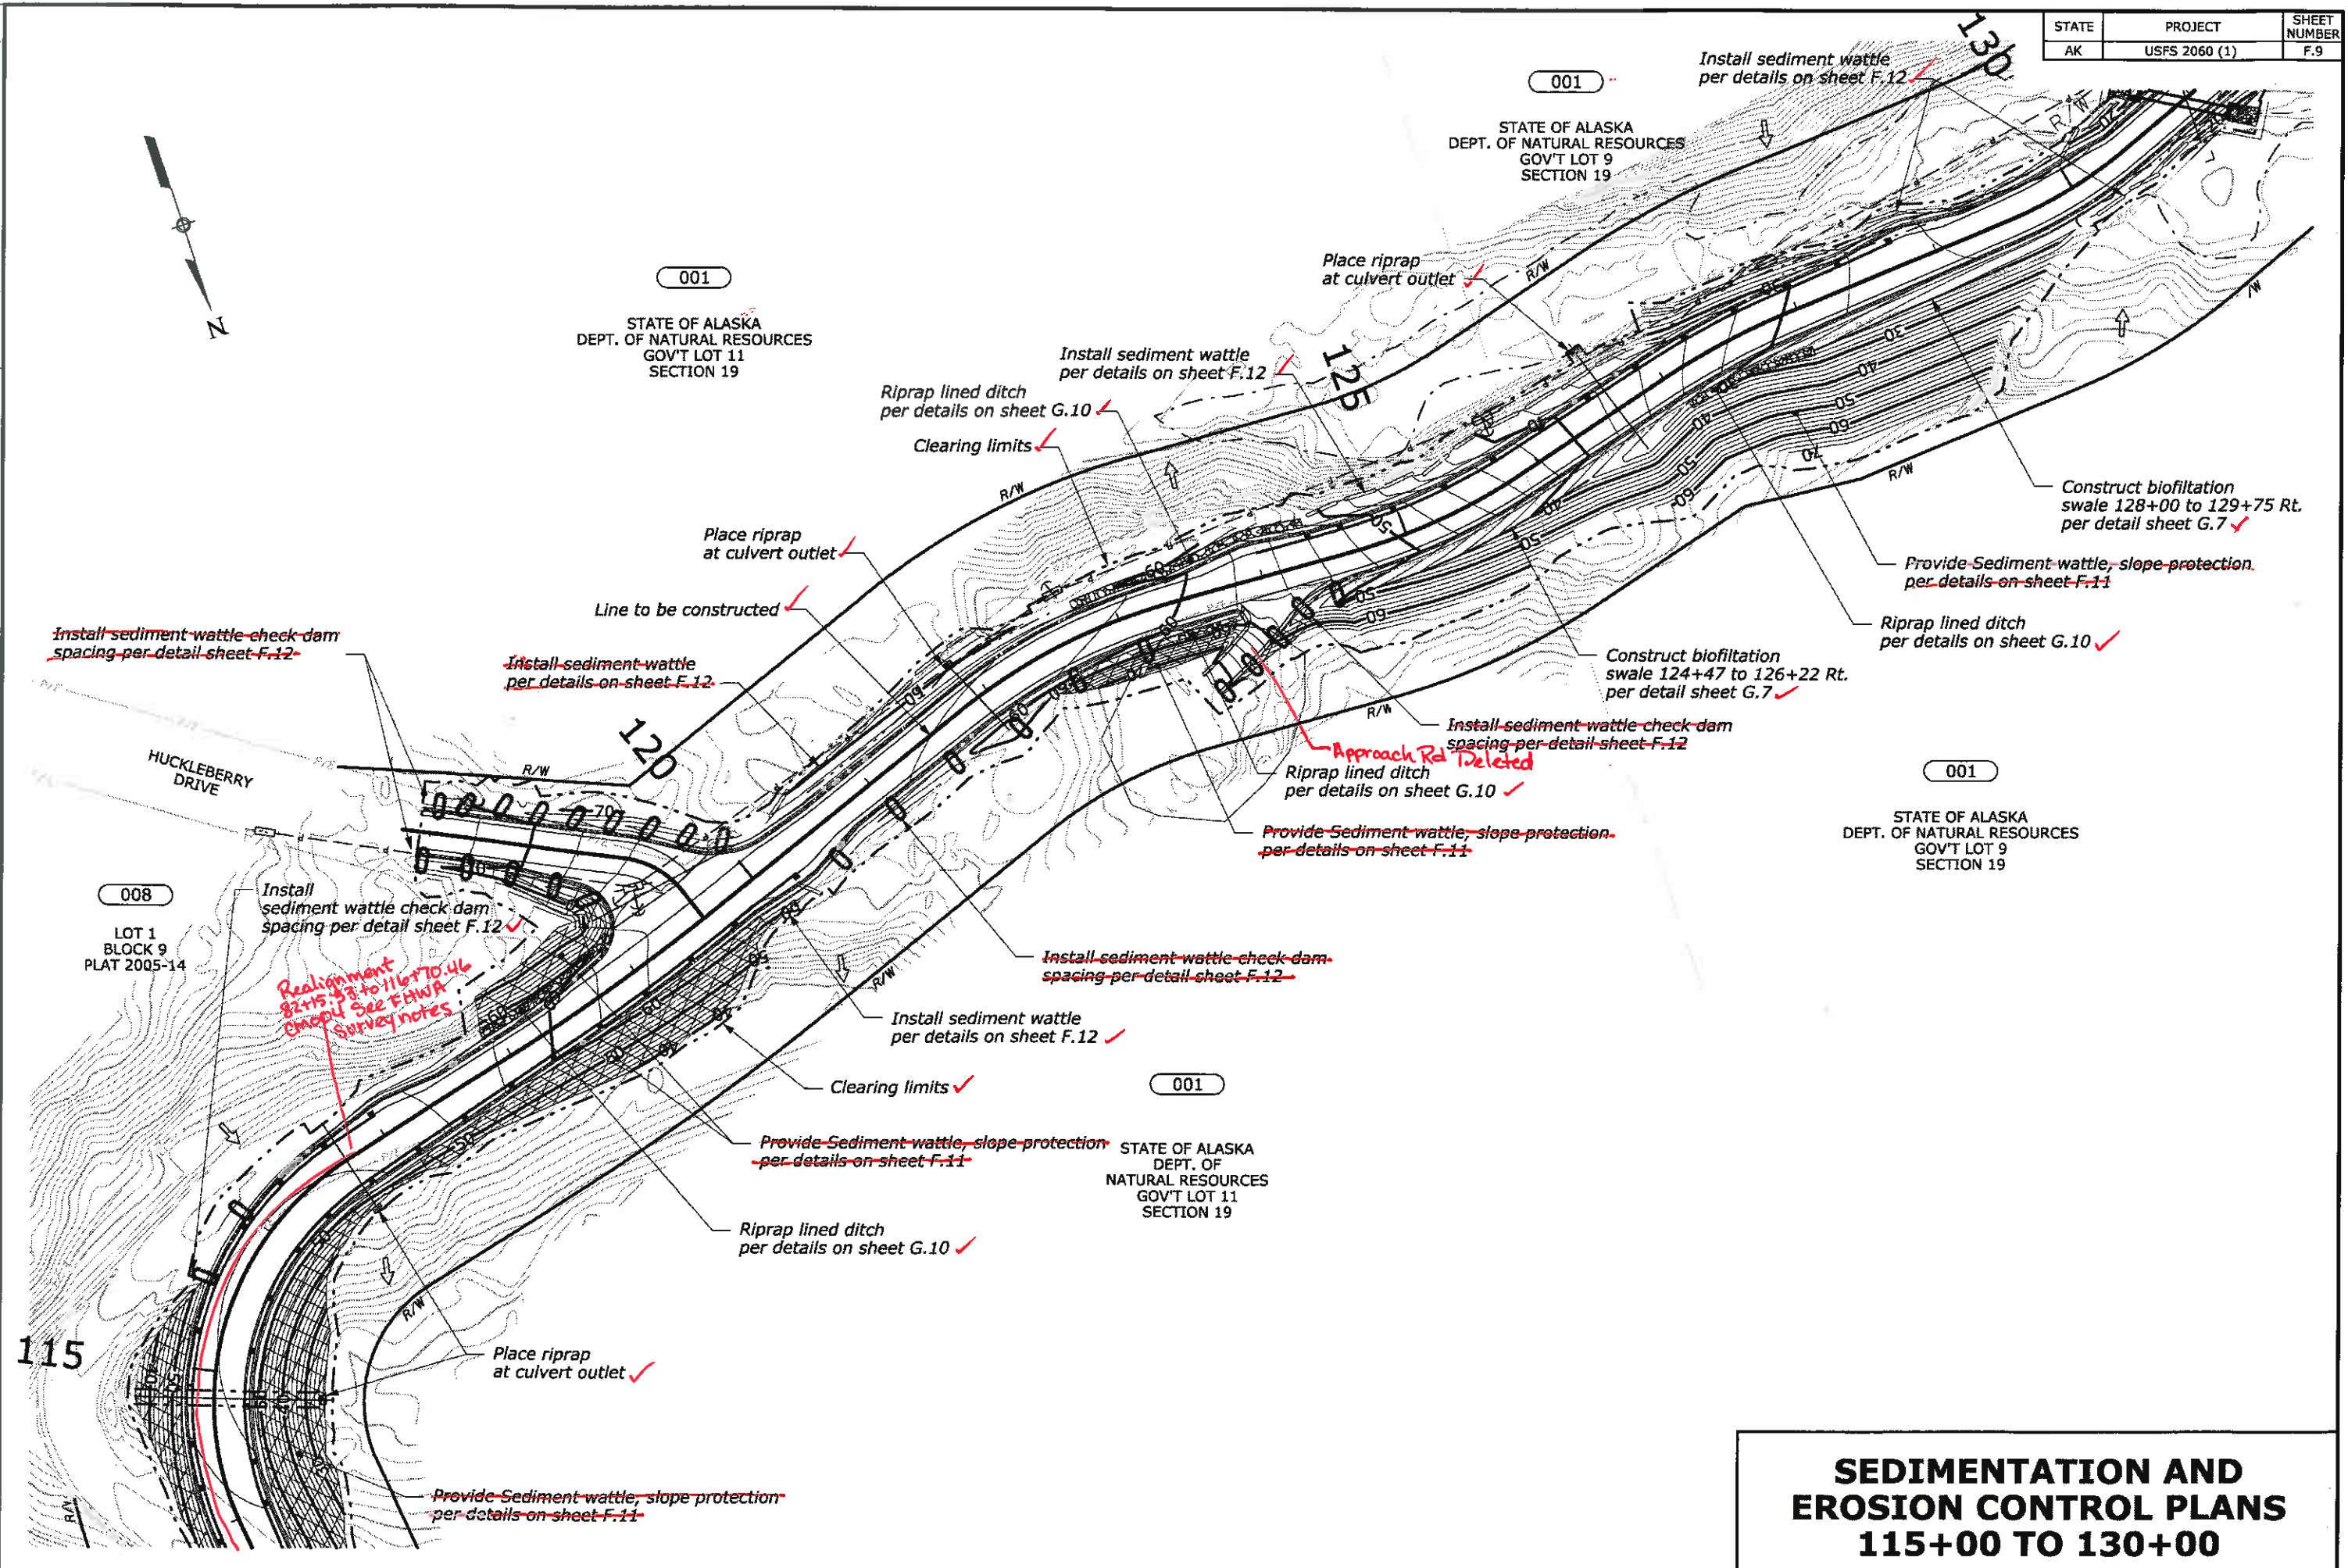

**SEDIMENTATION AND
 EROSION CONTROL PLANS
 115+00 TO 130+00**

STATE	PROJECT	SHEET NUMBER
AK	USFS 2060 (1)	F.10

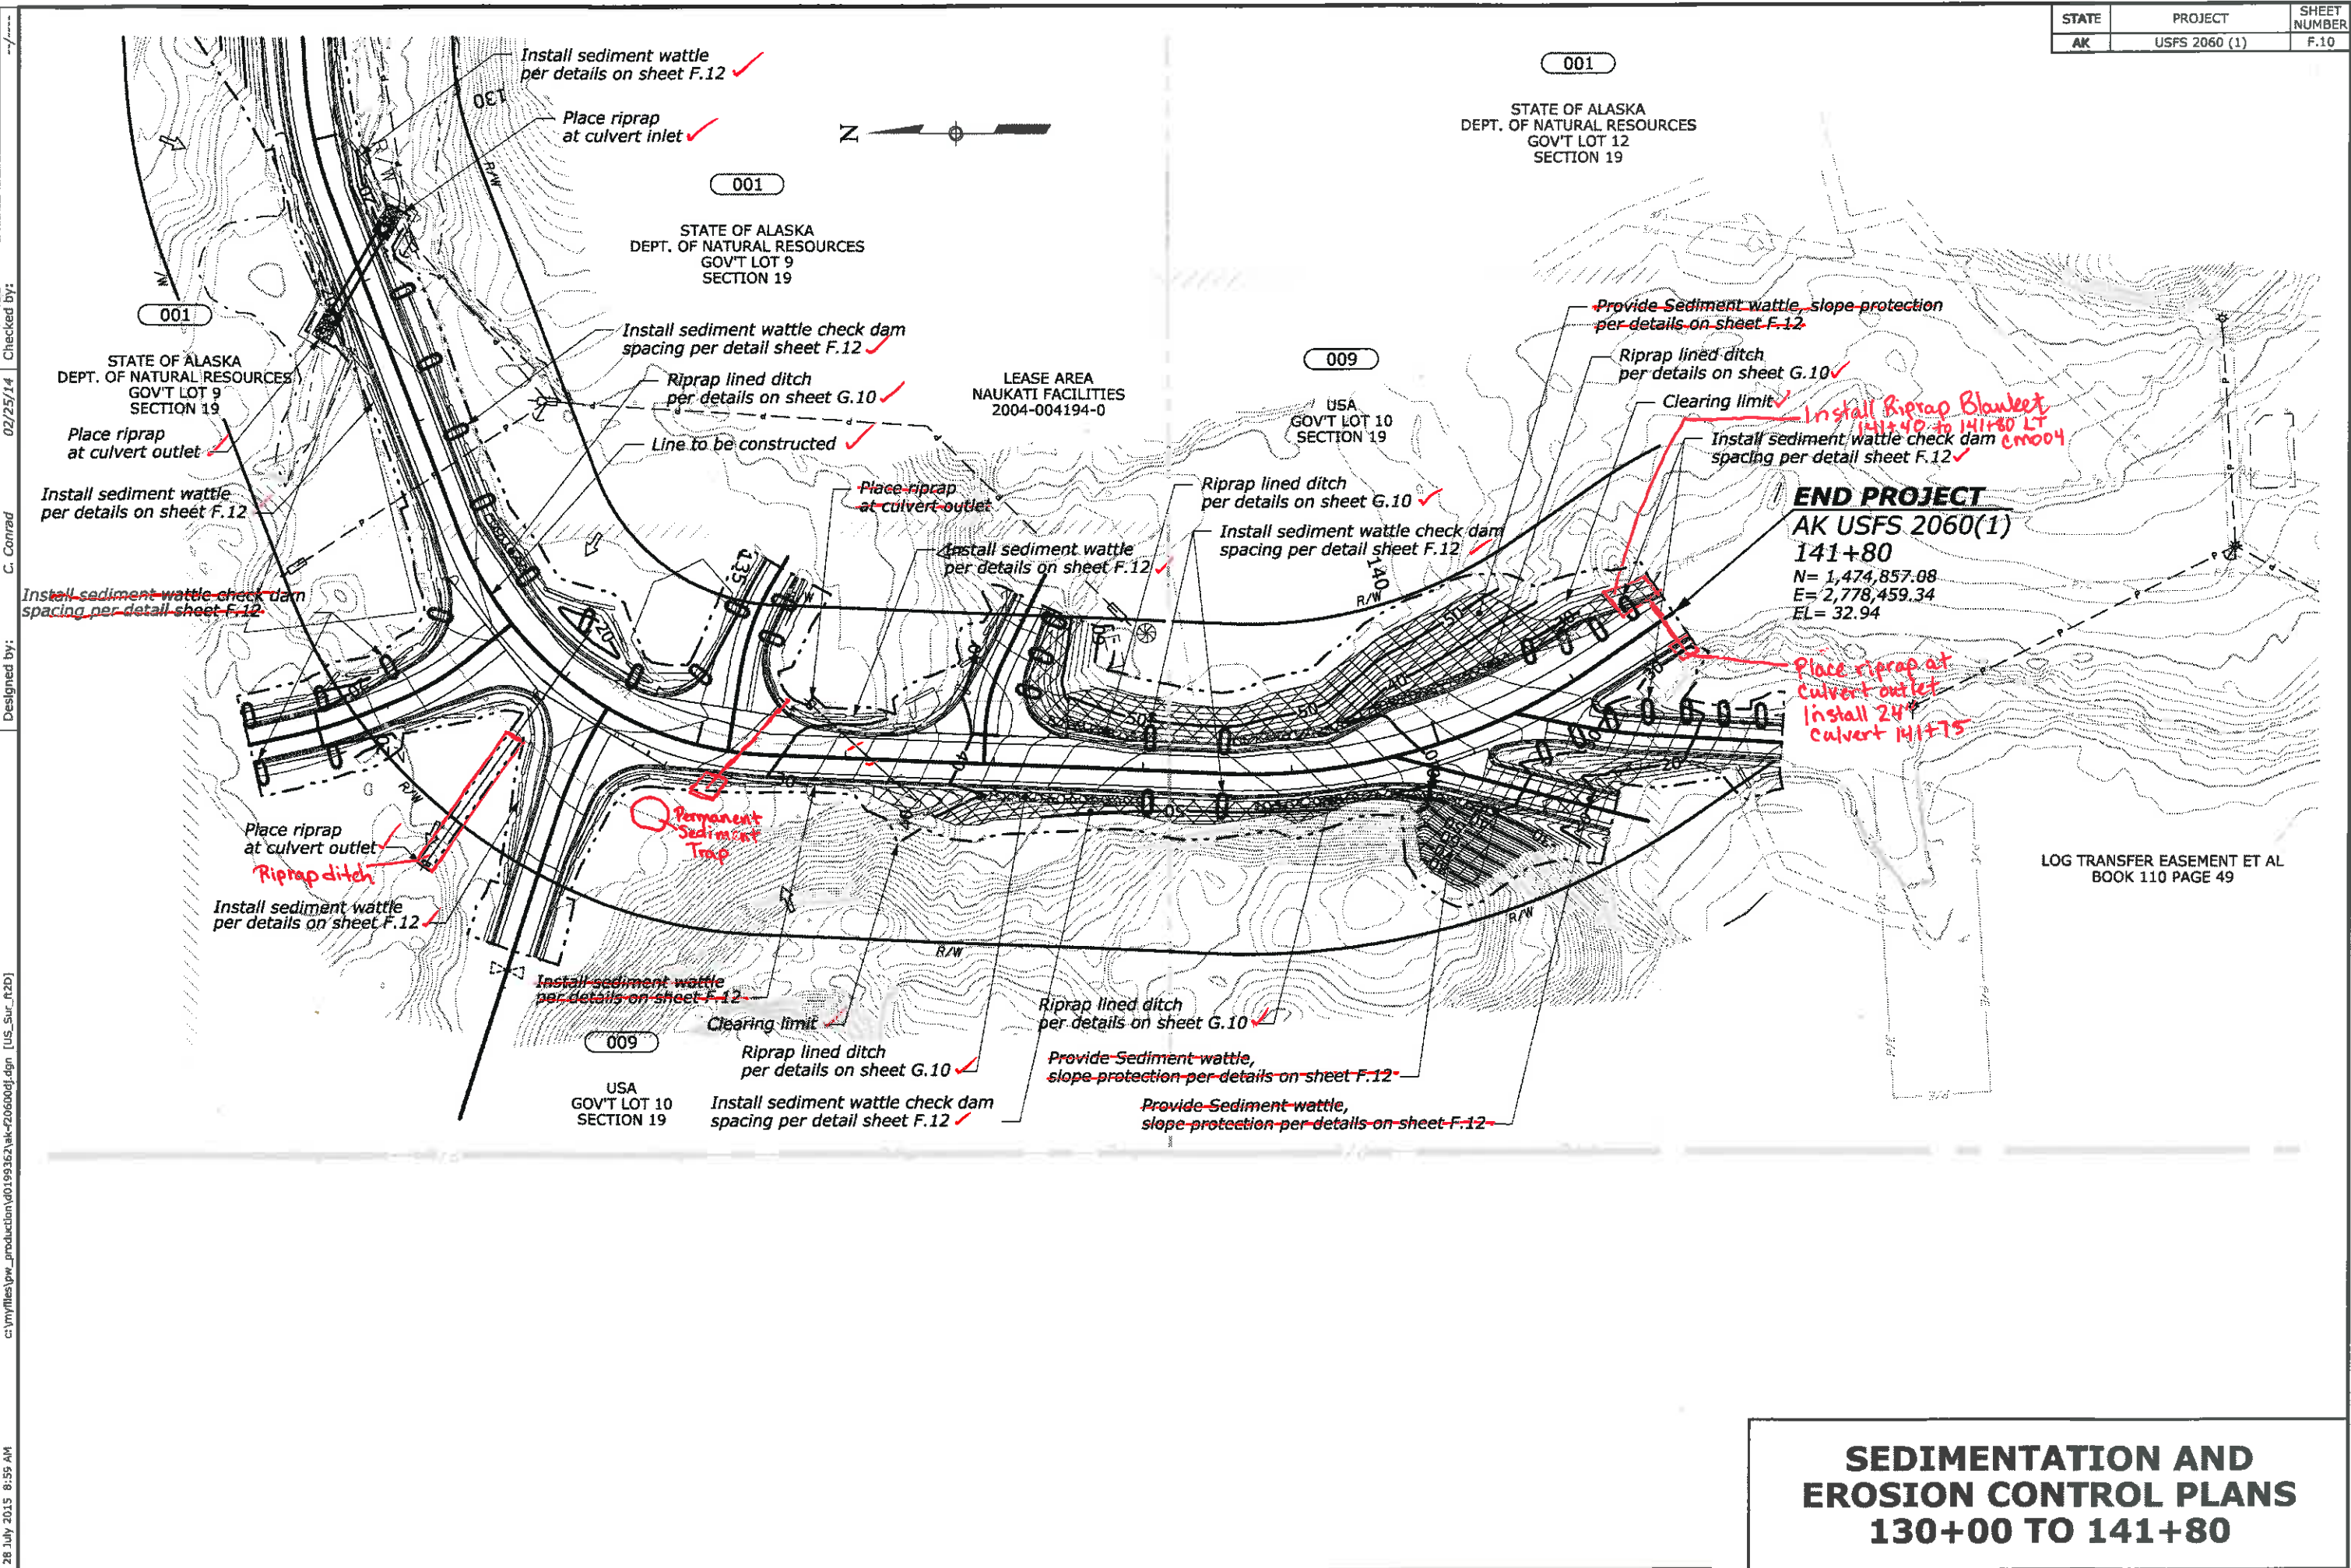

001
STATE OF ALASKA
DEPT. OF NATURAL RESOURCES
GOV'T LOT 12
SECTION 19

001
STATE OF ALASKA
DEPT. OF NATURAL RESOURCES
GOV'T LOT 9
SECTION 19

LEASE AREA
NAUKATI FACILITIES
2004-004194-0

009
USA
GOV'T LOT 10
SECTION 19


END PROJECT
AK USFS 2060(1)
141+80
N= 1,474,857.08
E= 2,778,459.34
EL= 32.94

LOG TRANSFER EASEMENT ET AL
BOOK 110 PAGE 49


**SEDIMENTATION AND
EROSION CONTROL PLANS
130+00 TO 141+80**

28 July 2015 8:59 AM
 c:\myfiles\pw_production\00199312\ak-2060001.dgn [Us_Sur_ft20]
 Designed by:
 C. Conrad
 02/25/14 Checked by:


02/25/14 Checked by: C. Conrad
 Designed by: C. Conrad
 c:\myfiles\pw_production\0199362\ak-r2060000\dk.dgn [US Customer]
 31 July 2014 1:54 PM

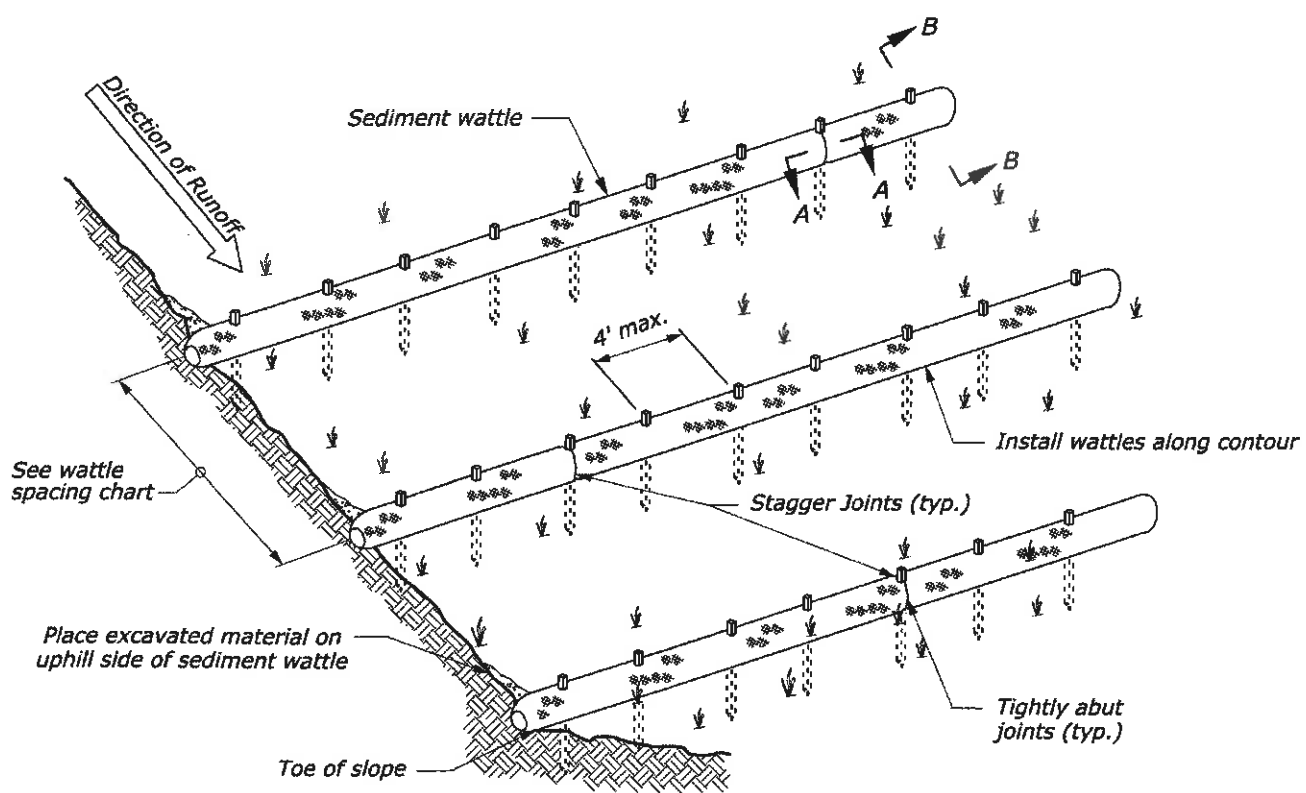


SEDIMENT WATTLE SLOPE PROTECTION INSTALLATION

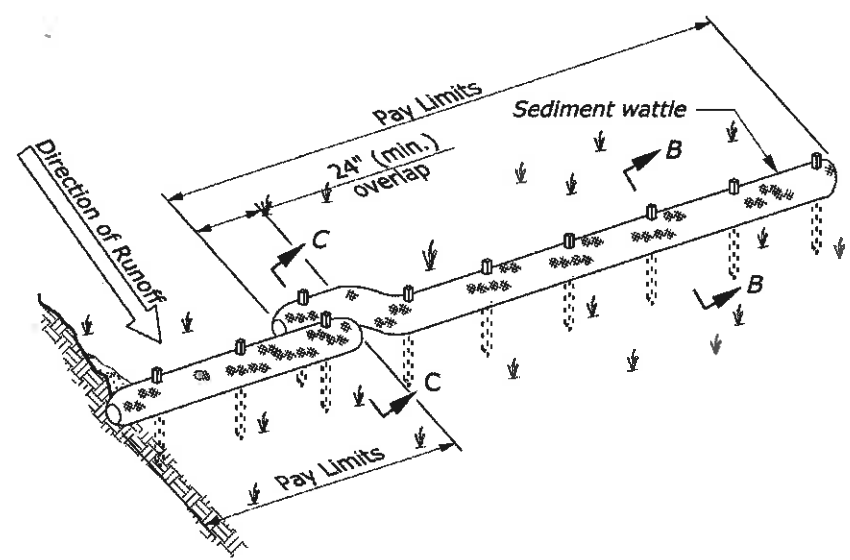


ALTERNATE WATTLE JOINT DETAIL SLOPE PROTECTION INSTALLATION

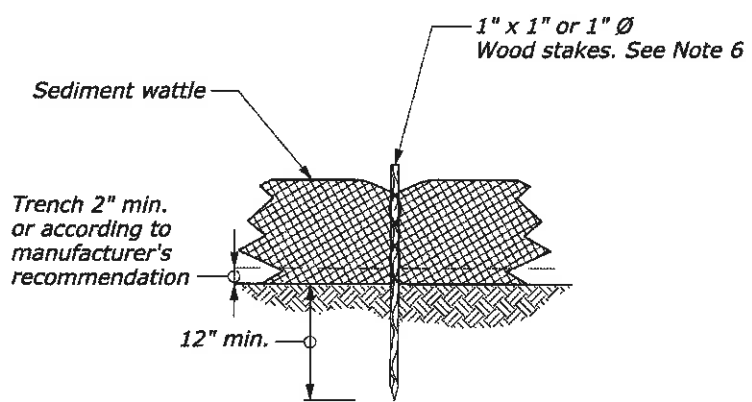

SECTION A-A WATTLE JOINT DETAIL

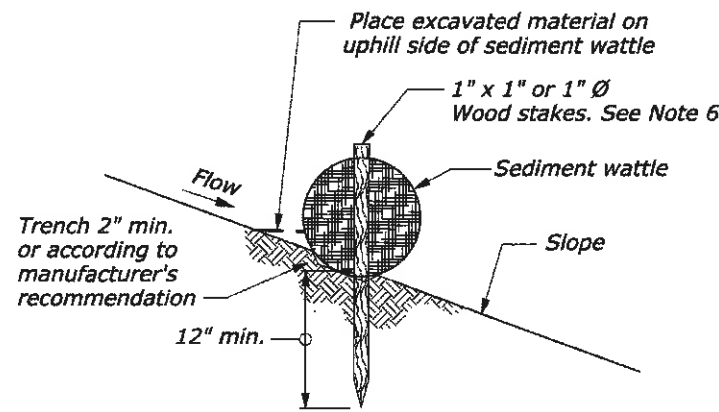

SECTION B-B STAKE DETAIL

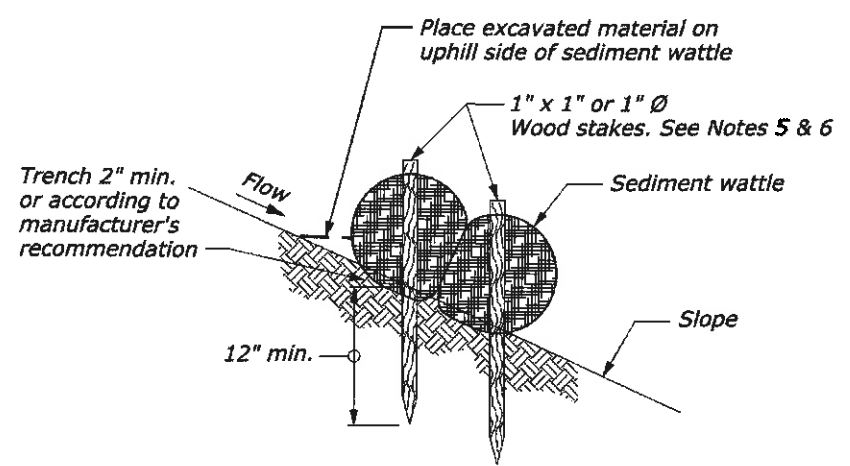

SECTION C-C WATTLE LAPPING DETAIL


ALONG SLOPE SPACING *	
SLOPE %	SPACING (FT)
1:4 or flatter	60
1:4 - 1:3	45
1:3 - 1:2	30
1:2 - 1:1	15

* Spacing calculated based on 12" Ø min. sediment wattle.


NOTE:

1. Repair any rills or gullies prior to installation.
2. For slope ratios in between those shown in the Wattle Spacing Table, apply spacing intervals per the steeper slope ratio given. Start the wattle placement at the toe of slope and then space up the slope per table.
3. Construct trenches along the slope contour and perpendicular to water flow. Remove all rocks, clods, vegetation or other obstructions to ensure wattles will have direct contact with the trenches.
4. Place sediment wattles in continuous contact with trench bottom and sides. Compact soil backfill against upstream side of wattle to ensure storm water is forced flow through wattle rather than under it. Curve terminal ends of wattles upgrade to ensure containment and prevent channeling.
5. Abut adjacent wattles tightly or overlap wattles 24" minimum to prevent sediment passing through the field joint. Drive stakes at 6" from wattle end angles towards the adjacent wattle and space stakes at 4' max. Do not crush wattle while staking.
6. Expose stakes 2" min. above top of wattle. Remove and replace crushed or damaged wattle during the installation. Place a stake on either side of the damaged area terminating the wattle segment.


NO SCALE

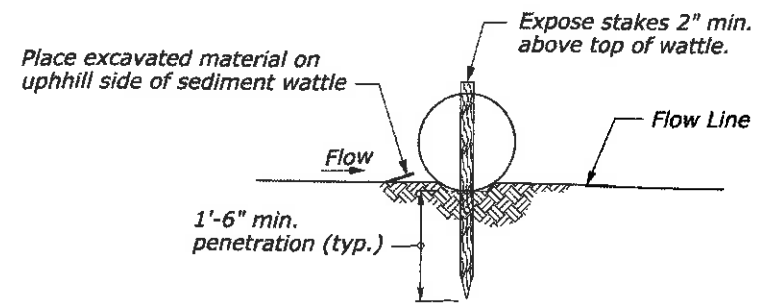


STAKING DETAIL

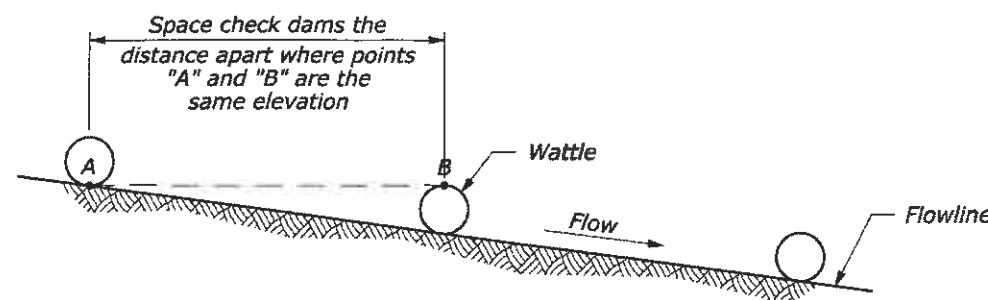


PROFILE

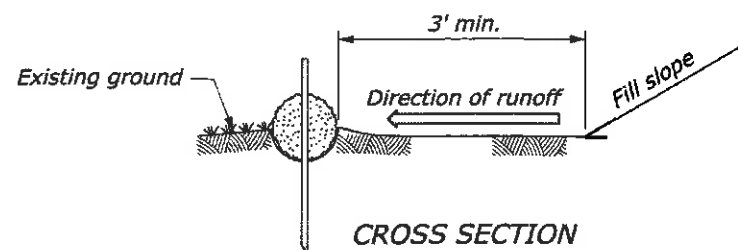

CROSS SECTION

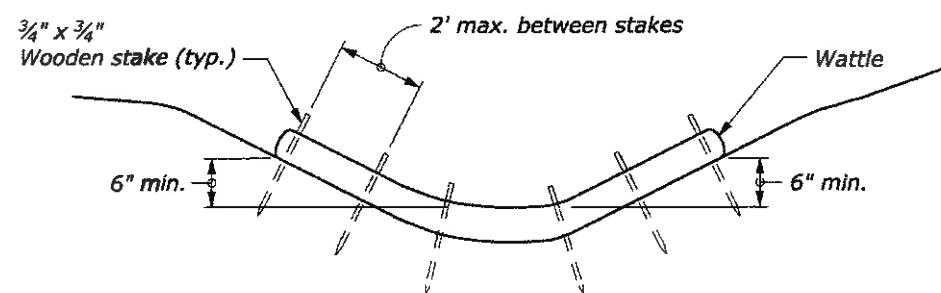


CROSS SECTION

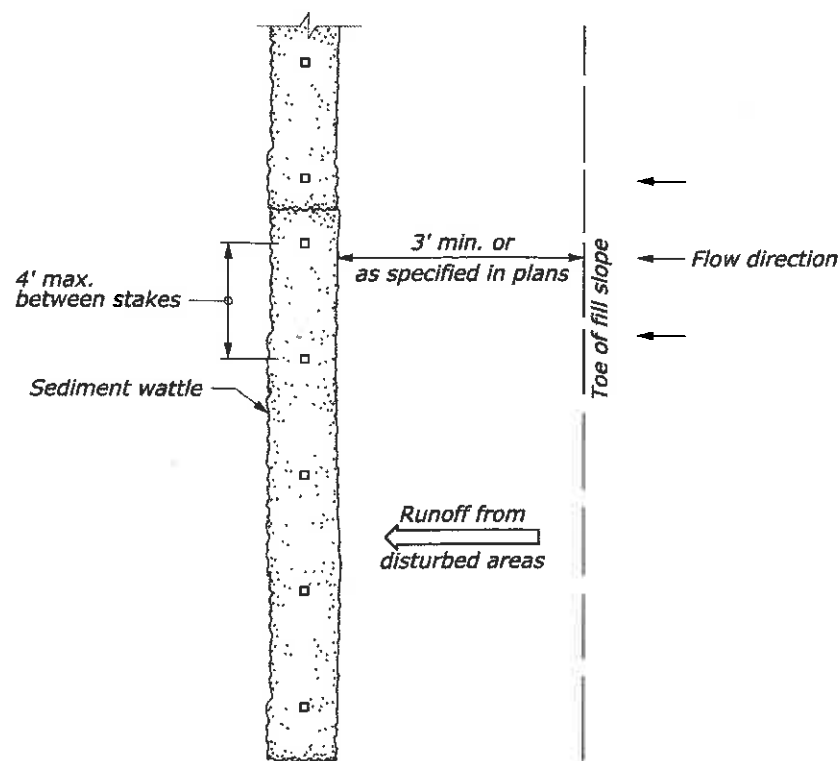

PLAN

INSTALLATION BEYOND TOE OF SLOPE

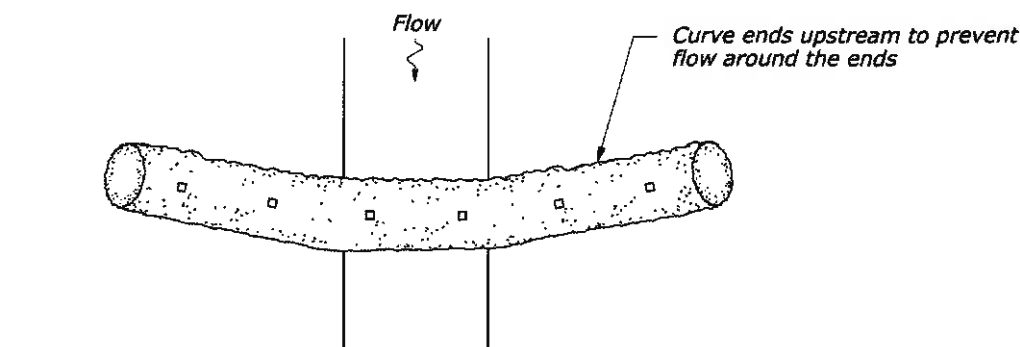

PLAN

INSTALLATION ALONG DITCH

ALONG DITCH SPACING*	
DITCH GRADE	SPACING (S) max. (FT)
1%	100
2%	50
3%	30
4%	25
5%	15
7%	10


* Spacing calculated based on 12" Ø min. sediment wattle.

NOTE:

1. Repair all rills or gullies prior to installation.
2. Install check dams in ditches perpendicular to the flowline.
3. Do not crush wattle while staking. Drive stakes at each end and at maximum space as shown.
4. For narrow ditches either cut wattles to fit ditch width and close cut ends or substitute biobags.

SEDIMENT WATTLE DETAILS

31 July 2014 2:00 PM
 c:\myfiles\pw_production\0199362\ak-f2060\01.dgn [US Customer]
 Designed by: C. Conrad
 Checked by: 02/25/14

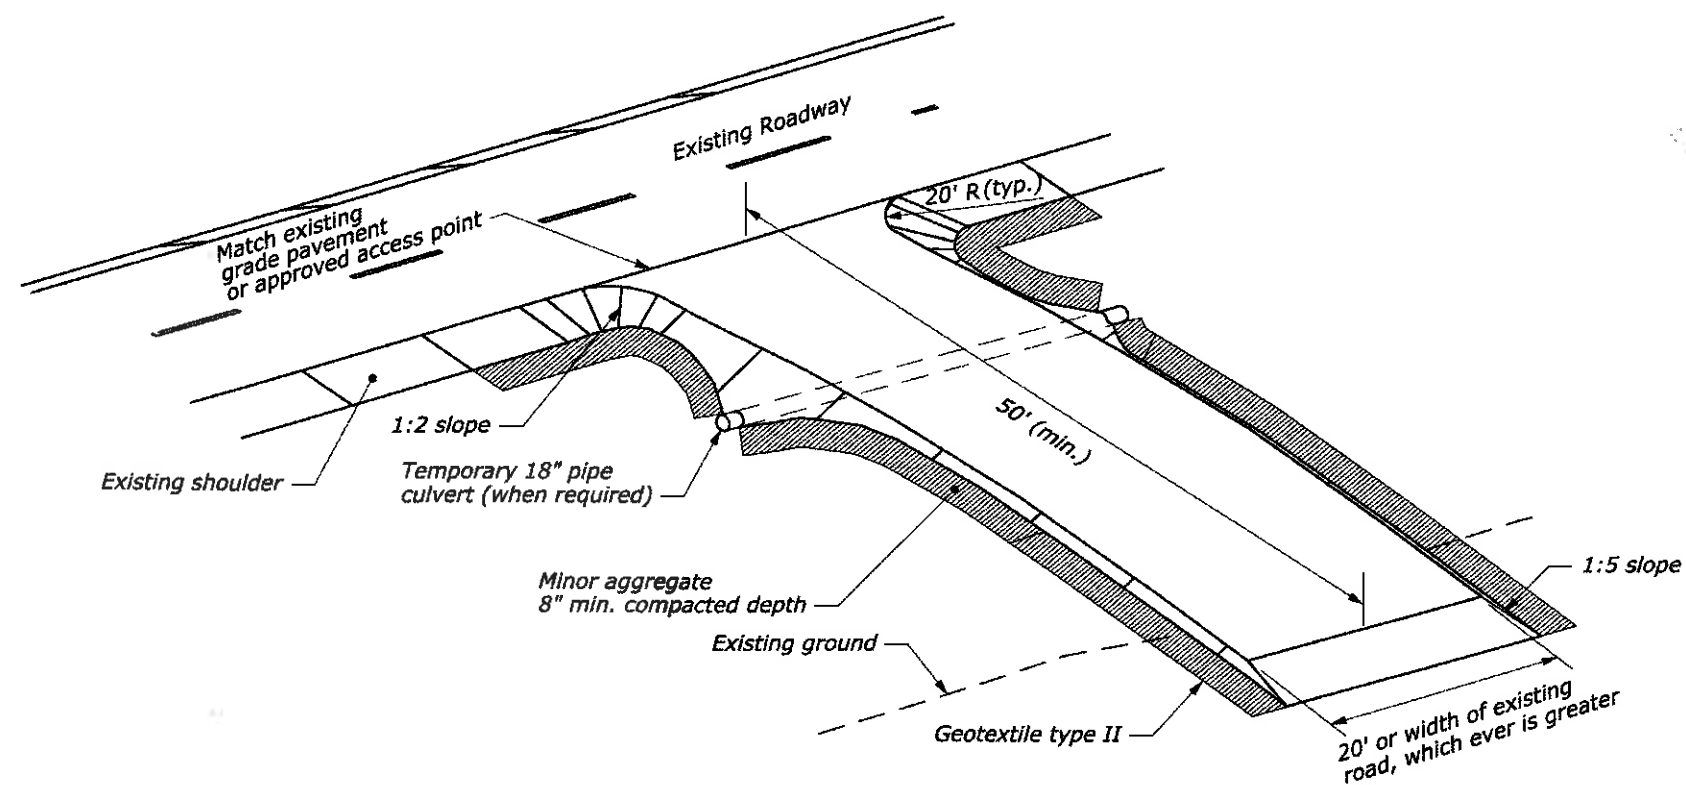

**TYPICAL STABILIZED CONSTRUCTION
ENTRANCE/ EXIT**

NOTE:

1. Modifications may be necessary to match field conditions
2. Construct drainage ditches along entrance when required. Install temporary 18-inches min. diameter pipe culverts where entrance crosses existing drainage ditches. Minimum culvert cover is 12-inches.
3. Place geotextile, type II-B, over the entire area prior to placing the aggregate base.
4. See SCR Section 157 for maintenance and clean up.

**STABILIZED CONSTRUCTION
ENTRANCE/EXIT DETAILS**

Note: The quantities shown hereon are approximate and are subject to field adjustments.

TABULATION OF DRAINAGE QUANTITIES

STATE	PROJECT	SHEET NUMBER
AK	USFS 2060(1)	G.1

Station	ESTIMATED MAXIMUM COVER FEET	STRUCTURAL EXCAVATION CUYD	20301 -1900	25101 -2000	25101 -2000	60201 -0800	60201 -1000	60201 -1400	60201 -1600	60201 -1800	60201 -2200	SKEW ANGLE	Allowable Pipe Material (See key below)	BEVELS IV:nH Lt	BEVELS IV:nH Rt	REMARKS
			REMOVAL OF PIPE CULVERT EACH	PLACED RIPRAP, CLASS 2 (RIPRAP HEADWALL) CUYD	PLACED RIPRAP, CLASS 2 (ENERGY DISSIPATOR) CUYD	24-INCH PIPE CULVERT LNFT	36-INCH PIPE CULVERT LNFT	60-INCH PIPE CULVERT LNFT	72-INCH PIPE CULVERT LNFT	84-INCH PIPE CULVERT LNFT	108-INCH PIPE CULVERT LNFT					
11+15						32							A,P			Driveway Left
✓ 13+22			1 ✓										A ✓			
✓ 13+50				35 ✓				114 ✓					A ✓			
✓ 13+89			1 ✓					36-40.5 ✓					A,P ✓			Driveway Left ✓
✓ 17+99			1 ✓					36-40.5 ✓					A,P ✓			Driveway Left ✓
19+65													A,P ✓			Driveway Left ✓
✓ 22+81			1 ✓										A,P ✓			
✓ 22+95	14	32				2.89 ✓		89-66.1 ✓					A,P ✓			
✓ 24+28	9	118				5-2.4 ✓		86-59 ✓					A,P ✓			
✓ 26+87			1 ✓										A,P ✓			
✓ 27+04	6	38				2-3.5 ✓		64-54 ✓					A,P ✓			
✓ 28+70	9	103				2.2 ✓		83-63.1 ✓					A,P ✓			
✓ 32+27			1 ✓										A,P ✓			
✓ 32+29	9	65				2-3.11 ✓		72-52.5 ✓					A,P ✓			
✓ 36+66	13	69				2-4 ✓		73-62.3 ✓					A,P ✓			
38+50													A,P ✓			
✓ 39+68	5	46	1 ✓			2-3.11 ✓		74-63.4 ✓					A,P ✓			
✓ 40+73			1 ✓										A,P ✓			
✓ 40+82	5	47				2 ✓		72-65 ✓					A,P ✓			
41+79			1 ✓										A,P ✓			
✓ 41+81	6	35	1 ✓			2		66					A,P ✓			
✓ 42+17			1 ✓										A,P ✓			
✓ 42+19	7	32				2-1.11 ✓		65-59.2 ✓					A,P ✓			
✓ 43+81			1 ✓										A,P ✓			
✓ 43+87	10	80				2-1.11 ✓		79-81.5 ✓					A,P ✓			
✓ 48+68			1 ✓										A,P ✓			
✓ 48+72	10	38				2-1.11 ✓		74-69 ✓					A,P ✓			
✓ 51+00	4	8				2-1.11 ✓		72-61.2 ✓					A,P ✓			
✓ 51+04			1 ✓										A,P ✓			
✓ 57+65			1 ✓										A ✓			
✓ 57+76				61 ✓							62 ✓		A ✓			
✓ 59+95	8	16				2-1.11 ✓		67-62 ✓					A,P ✓			
✓ 59+96			1 ✓										A,P ✓			
✓ 62+36	4	51	1 ✓			2-1.78 ✓		83-57.9 ✓					A,P ✓			
✓ 66+61			1 ✓										A ✓			
✓ 66+74				93 ✓									A ✓			
CUMULATIVE TOTAL	778	18	189	33	1223	0	114	0	62	88						

RECEIVED
 JUL 08 2017
 BY PROJECT ENGINEER

APPROVED
 APPROVED AS NOTED
 RETURNED FOR CORRECTION

Date: JUL 10 2017 By: Jim Jozovich
FEDERAL HIGHWAY ADMINISTRATION
 Federal Lands Highway
 See FAR 52.236-21(e) for limitations of Government's responsibility in approving this document.

Allowable Pipe Material
 A Aluminum
 P Plastic

NOTE:
 Plastic pipe is not allowed when final installation is exposed. Furnish metal end sections for all plastic pipe including those specified with bevels. See Std. 602-5 for acceptable cell class. ✓

→ CMO05:
 Changes outlet location of non-continuous flow cross drain/ditch relief culverts from toe-of-fill to mid-fill slope.

30-Jan-2015 10:08 | Designed by: C. Conrad | Checked by: B. Zolich | D. Checker
 c:\v\files\pw_production\00199354\ak-f206001-Drainage.xlsx | Sheet

Note: The quantities shown hereon are approximate and are subject to field adjustments.

TABULATION OF DRAINAGE QUANTITIES

STATE	PROJECT	SHEET NUMBER
AK	USFS 2060(1)	G.2

Station	PAY ITEM NUMBER		20301	25101	25101	60201	60201	60201	60201	60201	60201	SKEW ANGLE	Allowable Pipe Material (See key below)	BEVELS 1V:nH	REMARKS
	ESTIMATED MAXIMUM COVER	STRUCTURAL EXCAVATION	-1900	-2000	-2000	-0800	-1000	-1400	-1600	-1800	-2200				
FEET	CUYD	EACH	CUYD	CUYD	LNFT	LNFT	LNFT	LNFT	LNFT	LNFT	LNFT			LF	RF
PREVIOUS SHEET:	778	18	189	33	1223		114		62	88					
✓ 67+47		1 ✓													
✓ 67+53	5	50	1 ✓		2 ✓	-65	53.6 ✓						A,P ✓		
✓ 71+48		1 ✓													
✓ 71+51	5	40			2 ✓	60 ✓							A,P ✓		
✓ 87+89	7	63			102.2 ✓	72.6 ✓							A,P ✓		
✓ 87+90		1 ✓											A,P ✓		
89+50 90+96	21	328			24 ✓	121.7 ✓									
94+00 94+27	17	75			213.3 ✓	105.6 ✓							A,P ✓		
✓ 94+32		1 ✓											A,P ✓		
✓ 97+98	15	80			13 ✓	72.6 ✓							A,P ✓		
✓ 98+03		1 ✓											A,P ✓		
✓ 103+40		1 ✓													
103+56 103+42	4	39			14.2 ✓	63 ✓									
✓ 109+88	7	43			112.2 ✓	57.6 ✓							A,P ✓		
✓ 114+70		1 ✓											A,P ✓		
✓ 114+82	24	5			211.6 ✓	128.1 ✓							A,P ✓		
✓ 116+51		1 ✓											A,P ✓		
✓ 116+70	5	44			222 ✓	80.6 ✓							A,P ✓		
119+58						76							A,P ✓		Approach LT
✓ 121+90		1 ✓													
✓ 121+92	6	37			21.3 ✓	69.6 ✓							A,P ✓		
124+04															Driveway Right
✓ 126+62		1 ✓											A,P ✓		
✓ 126+64	10	113			2 ✓	77.6 ✓							A,P ✓		
✓ 130+67		1 ✓											A,P ✓		
✓ 130+93				78 ✓				74 ✓					A		
✓ 133+88	3	196											A		
135+02 136+17	3	25			21.3 ✓	80.8 ✓							A,P ✓		
✓ 136+39		1 ✓											A,P ✓		
✓ 140+18		1 ✓													
✓ 141+75		1 ✓			2.6 ✓	53.2 ✓									
PROJECT TOTAL	1916	31	267	99	1922	616	114	74	62	88					

NOTE:



Plastic pipe is not allowed when final installation is exposed. Furnish metal end sections for all plastic pipe including those specified with bevels. See Std. 602-5 for acceptable cell class. ✓

Allowable Pipe Material

- A Aluminum
- P Plastic

→ CMOOS:
Changes outlet location of non-continuous flow cross drain/ditch relief culverts from toe-of-fill to mid-fill slope.

8/2013 Checked by: D. Checker
 C. Conrad
 30-Jan-2015 10:08 Designed by:

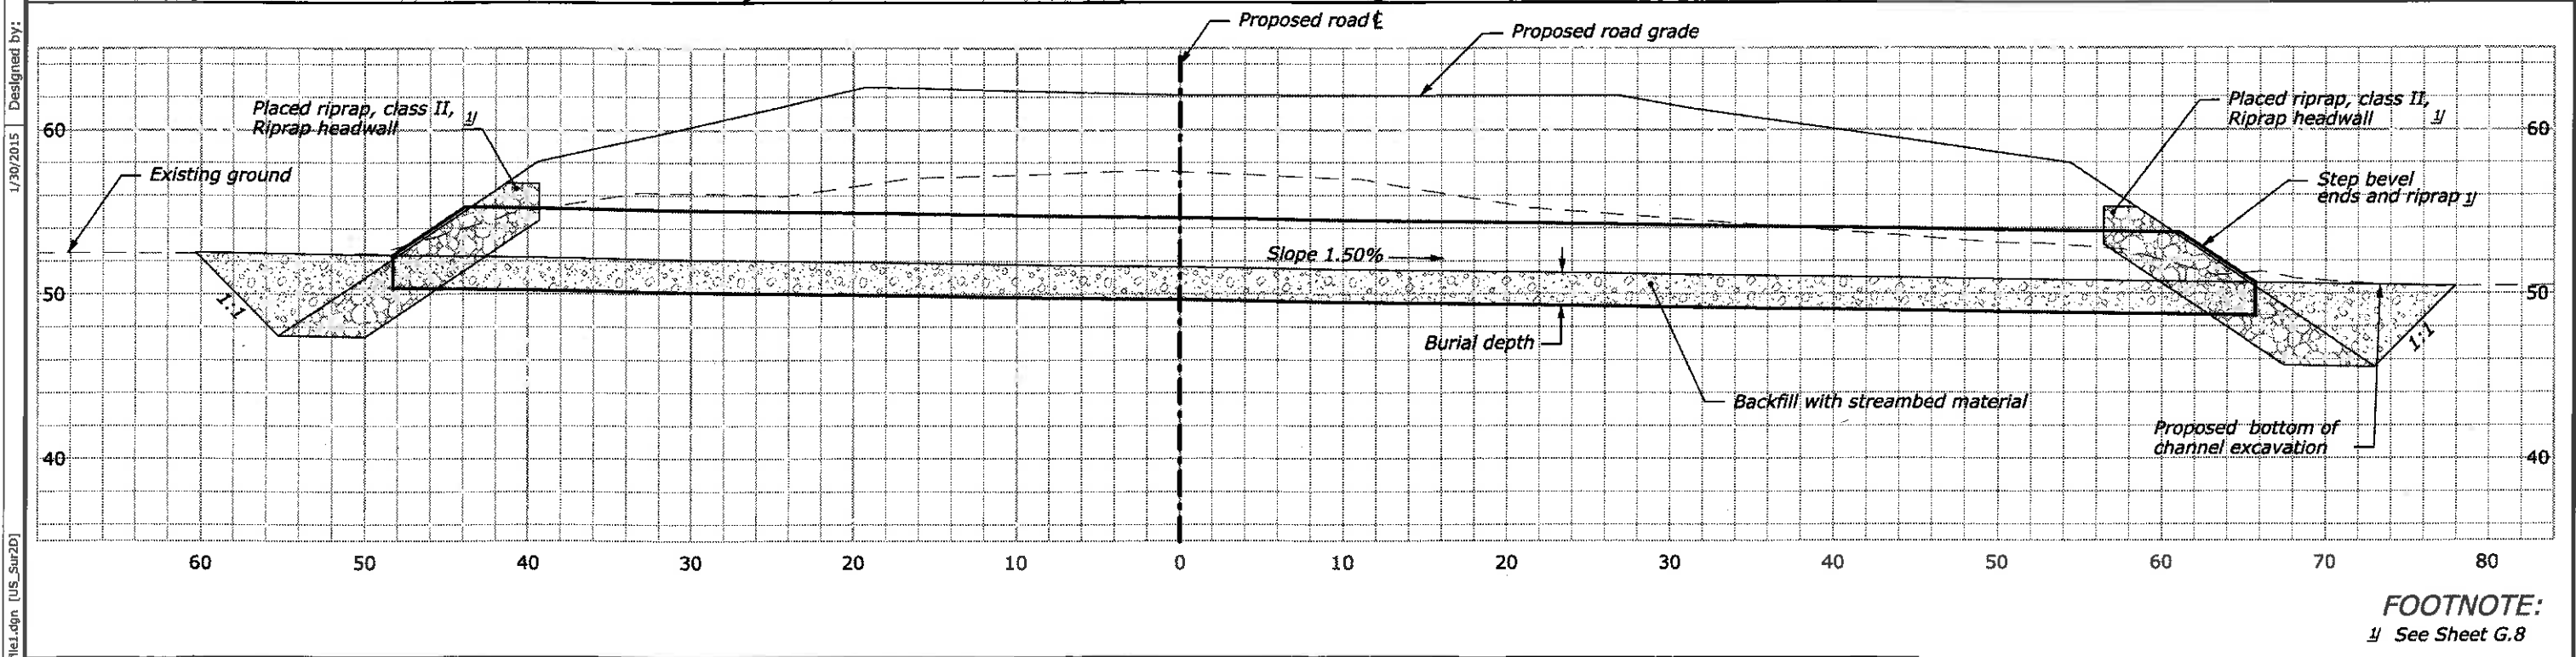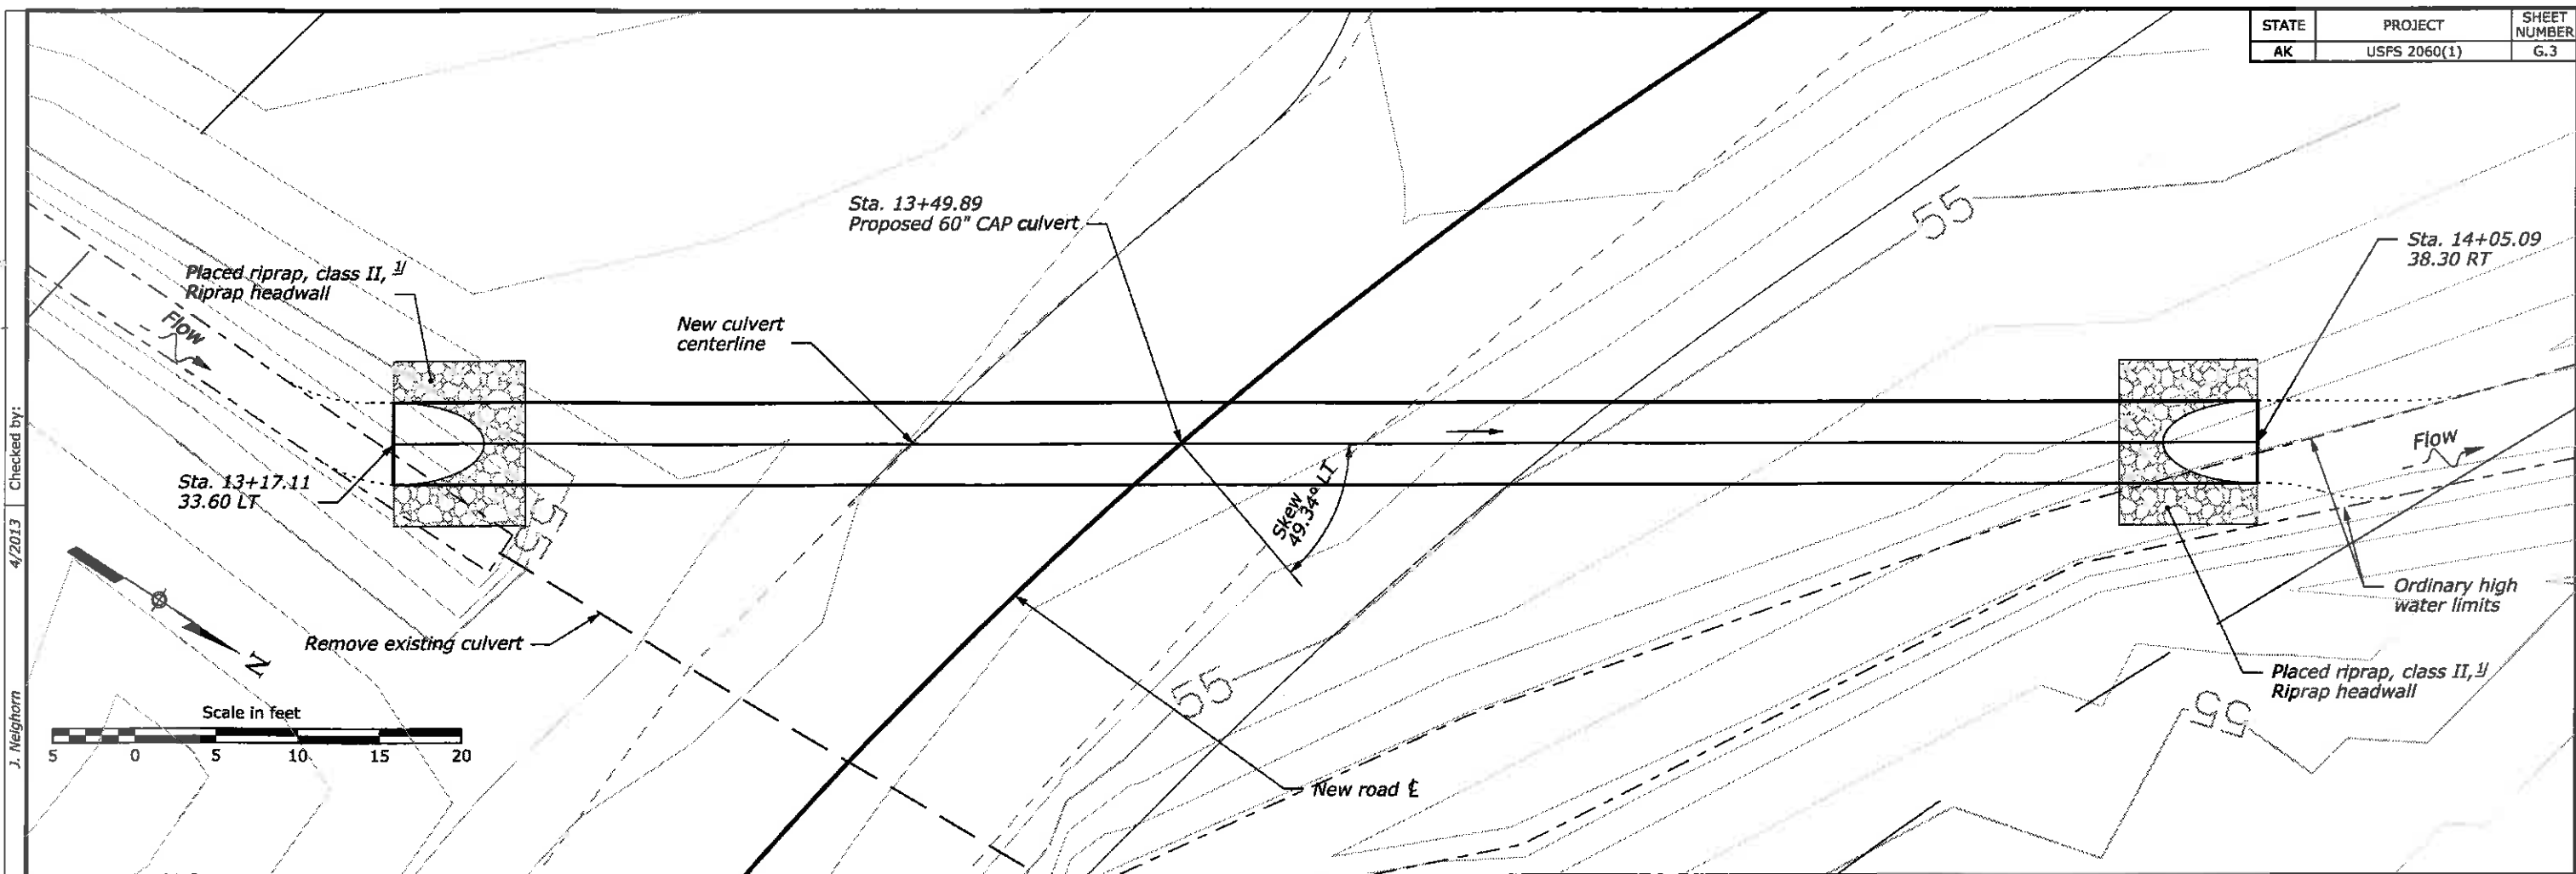



FOOTNOTE:
 1/2 See Sheet G.8

HYDRAULIC INFORMATION Q ₂ : <u>10 CFS</u> HW ₅₀ : <u>53.2 ft</u> Q ₅₀ : <u>22 CFS</u> ACTIVE CHANNEL WIDTH: <u>4.5 ft</u>	PIPE TYPE: <u>CAP, ROUND</u> SPAN: <u>60 in</u> RISE: <u>60 in</u> LENGTH: <u>114 ft</u> WALL THICKNESS: <u>0.135 in</u> PIPE SLOPE: <u>0.0150 ft/ft</u> FLOWLINE SLOPE: <u>0.0150 ft/ft</u>	INLET INV N/E/EL: <u>1483364.35/2784021.01/50.38</u> BURIAL DEPTH: <u>24 in</u> LOWER BEVEL HEIGHT: <u>24 in</u> BEVEL: <u>STEP, 1.5(h):1(v)</u> HEADWALL: <u>RIPRAP</u>	OUTLET INV N/E/EL: <u>1483459.37/2783958.02/48.67</u> BURIAL DEPTH: <u>24 in</u> LOWER BEVEL HEIGHT: <u>24 in</u> BEVEL: <u>STEP, 1.5(h):1(v)</u> HEADWALL: <u>RIPRAP</u>
--	--	--	---

STA. 13+50
60" DIAMETER CULVERT

4/2013 Checked by: J. Neighorn
 1/30/2015 Designed by: J. Neighorn
 ...\\ak-f206001\Culvert_Plan_Profile.dgn [US_Sur2D]

STATE	PROJECT	SHEET NUMBER
AK	USFS 2060(1)	G.4

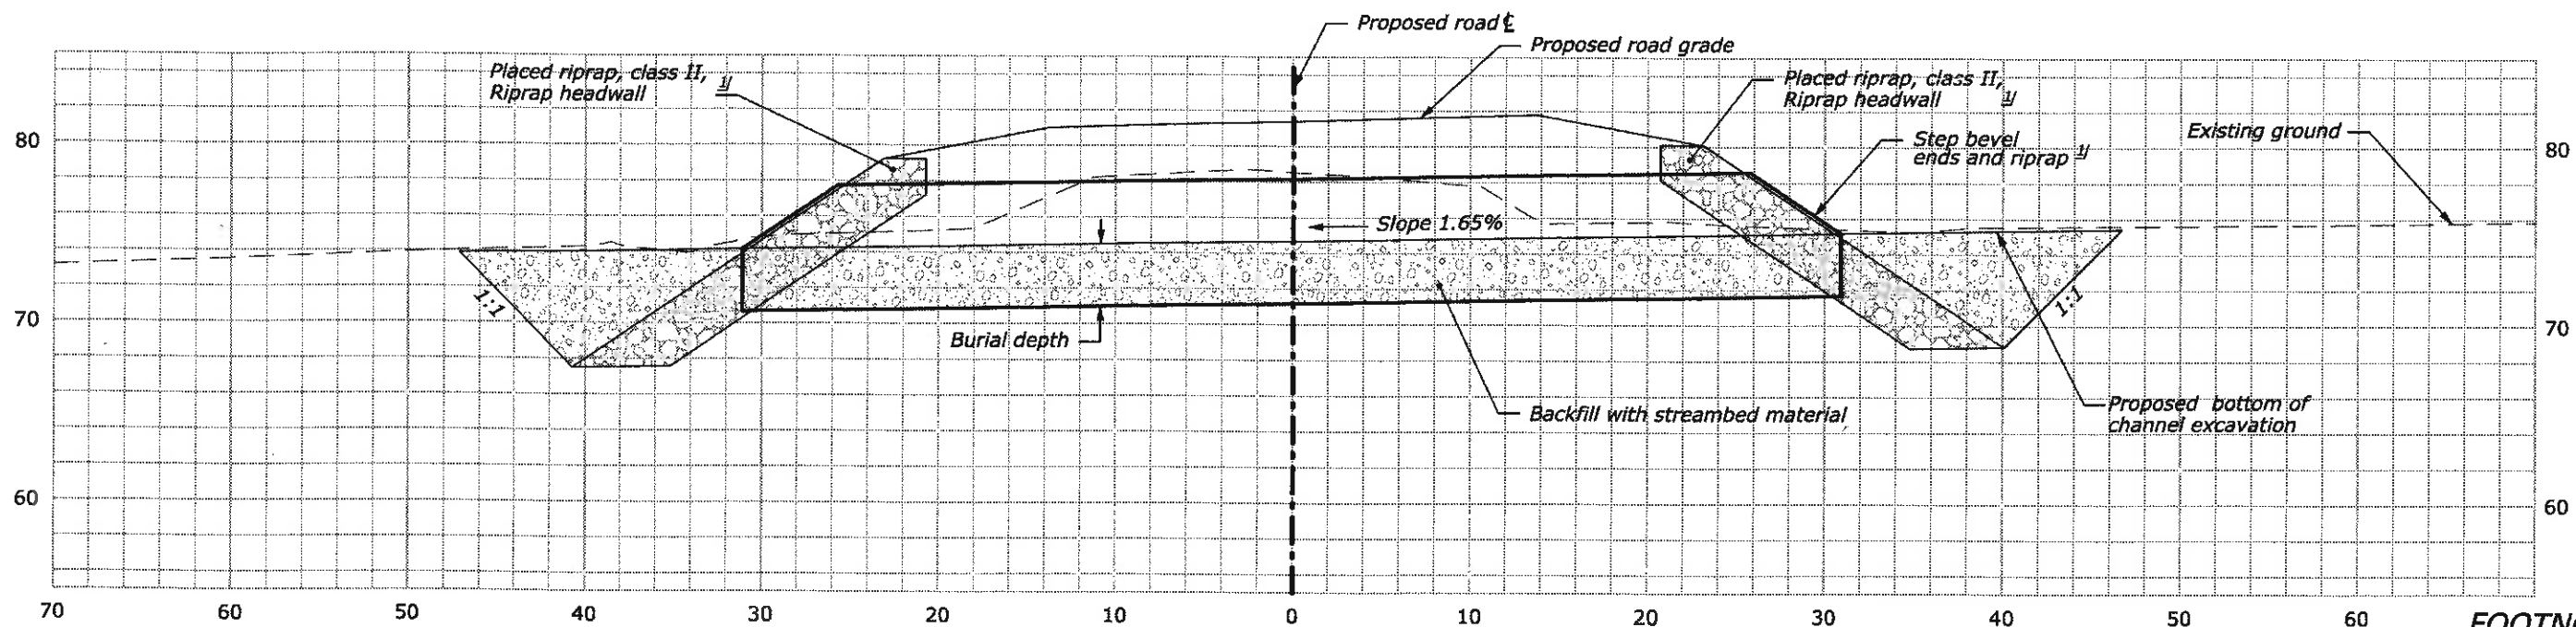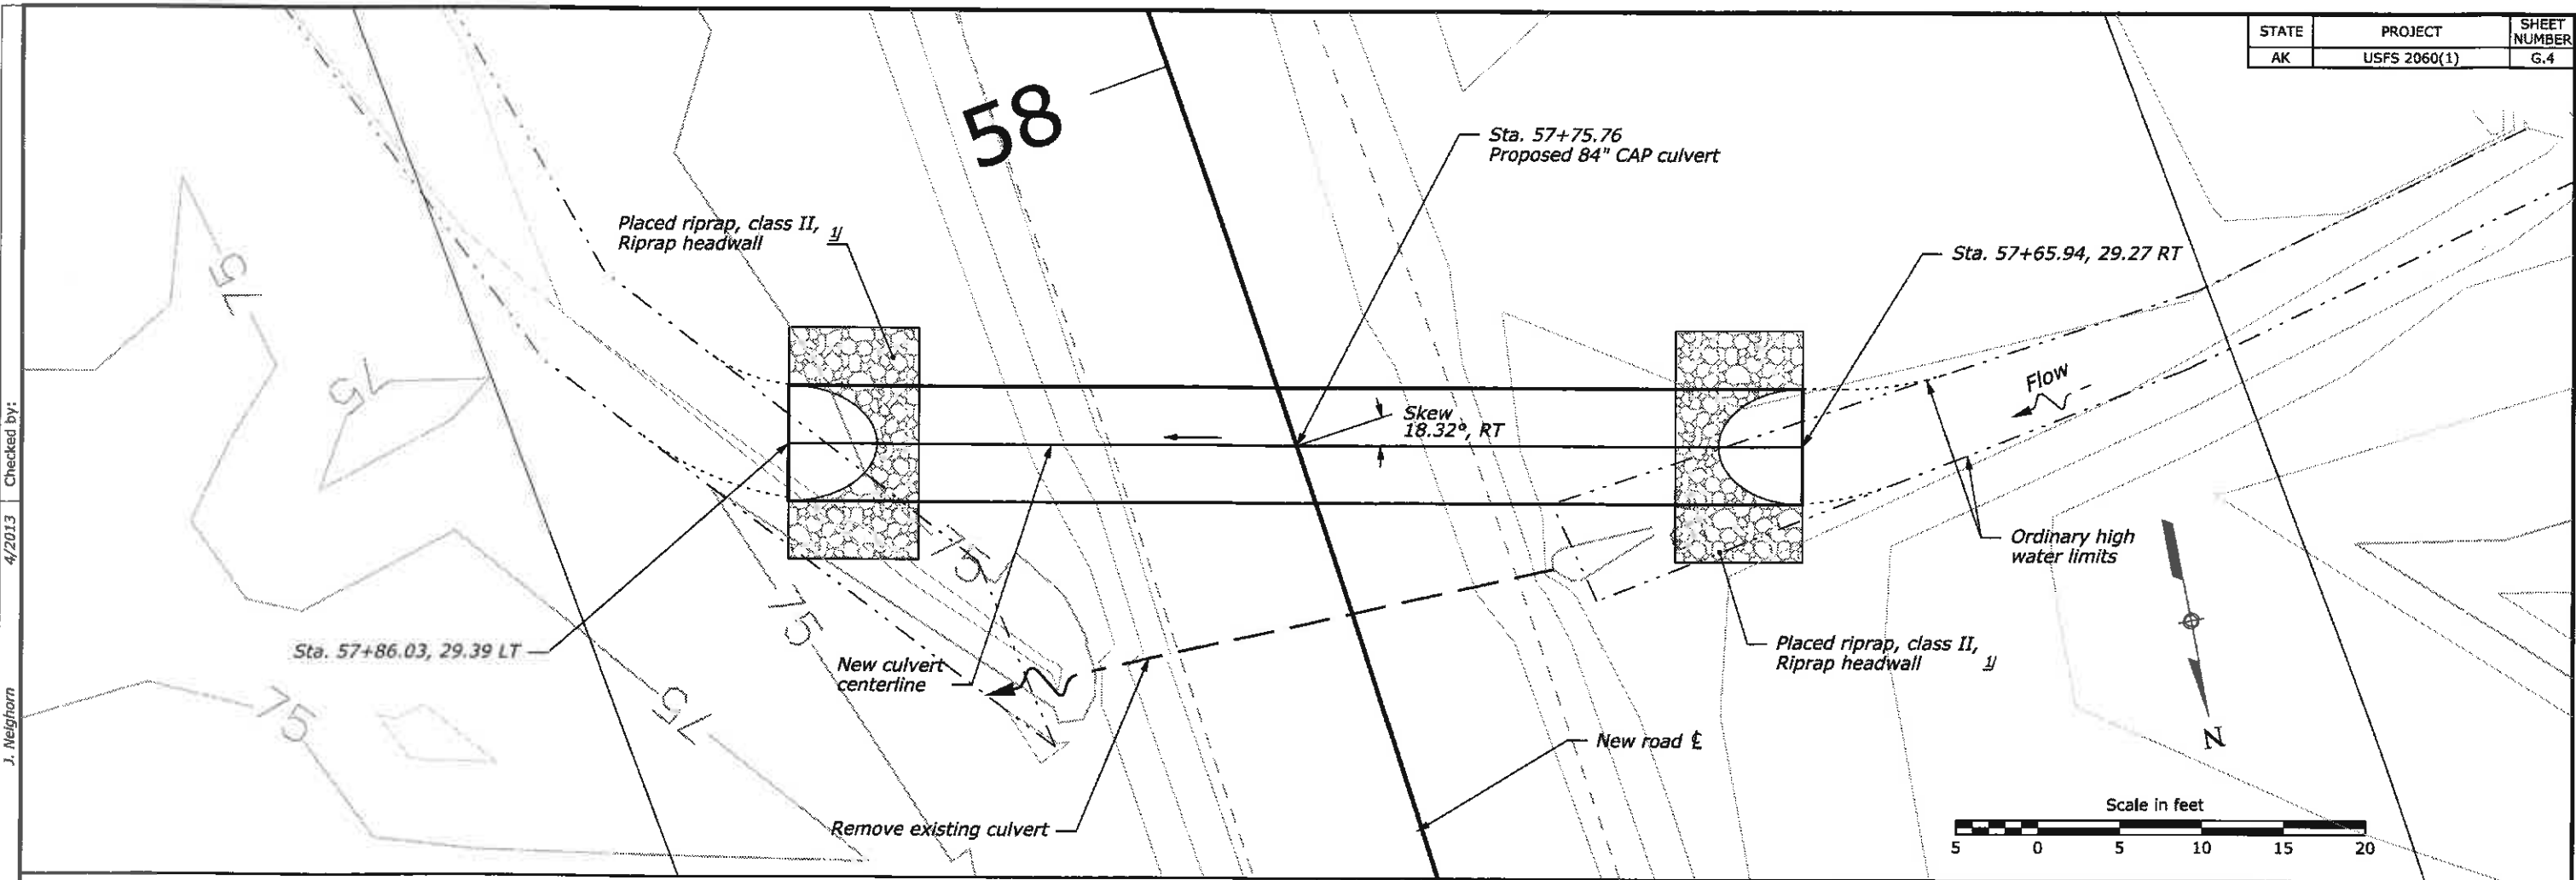

FOOTNOTE:
1/ See Sheet G.8

HYDRAULIC INFORMATION

Q₂: 18 CFS
 Q₅₀: 42 CFS
 HW₅₀: 76.9 ft
 ACTIVE CHANNEL WIDTH: 5.0 ft

PIPE

TYPE: CAP, ROUND
 LENGTH: 62 ft
 PIPE SLOPE: 0.0165 ft/ft
 SPAN: 84 in
 WALL THICKNESS: 0.105 in
 FLOWLINE SLOPE: 0.0165 ft/ft
 RISE: 84 in

INLET



INV N/E/EL: 1480852.40/2781348.04/71.68
 BURIAL DEPTH: 42 in
 LOWER BEVEL HEIGHT: 42 in
 BEVEL: STEP, 1.5(h):1(v)
 HEADWALL: RIPRAP

OUTLET

INV N/E/EL: 1480840.75/2781408.93/70.66
 BURIAL DEPTH: 42 in
 LOWER BEVEL HEIGHT: 42 in
 BEVEL: STEP, 1.5(h):1(v)
 HEADWALL: RIPRAP

STA. 57+76 ✓
84" DIAMETER CULVERT

4/2013 Checked by: J. Neighorn
 1/30/2015 Designed by: [US_Sur2D]
 ...\\ale-206001\Culvert_Plan_Profile2.dgn [US_Sur2D]

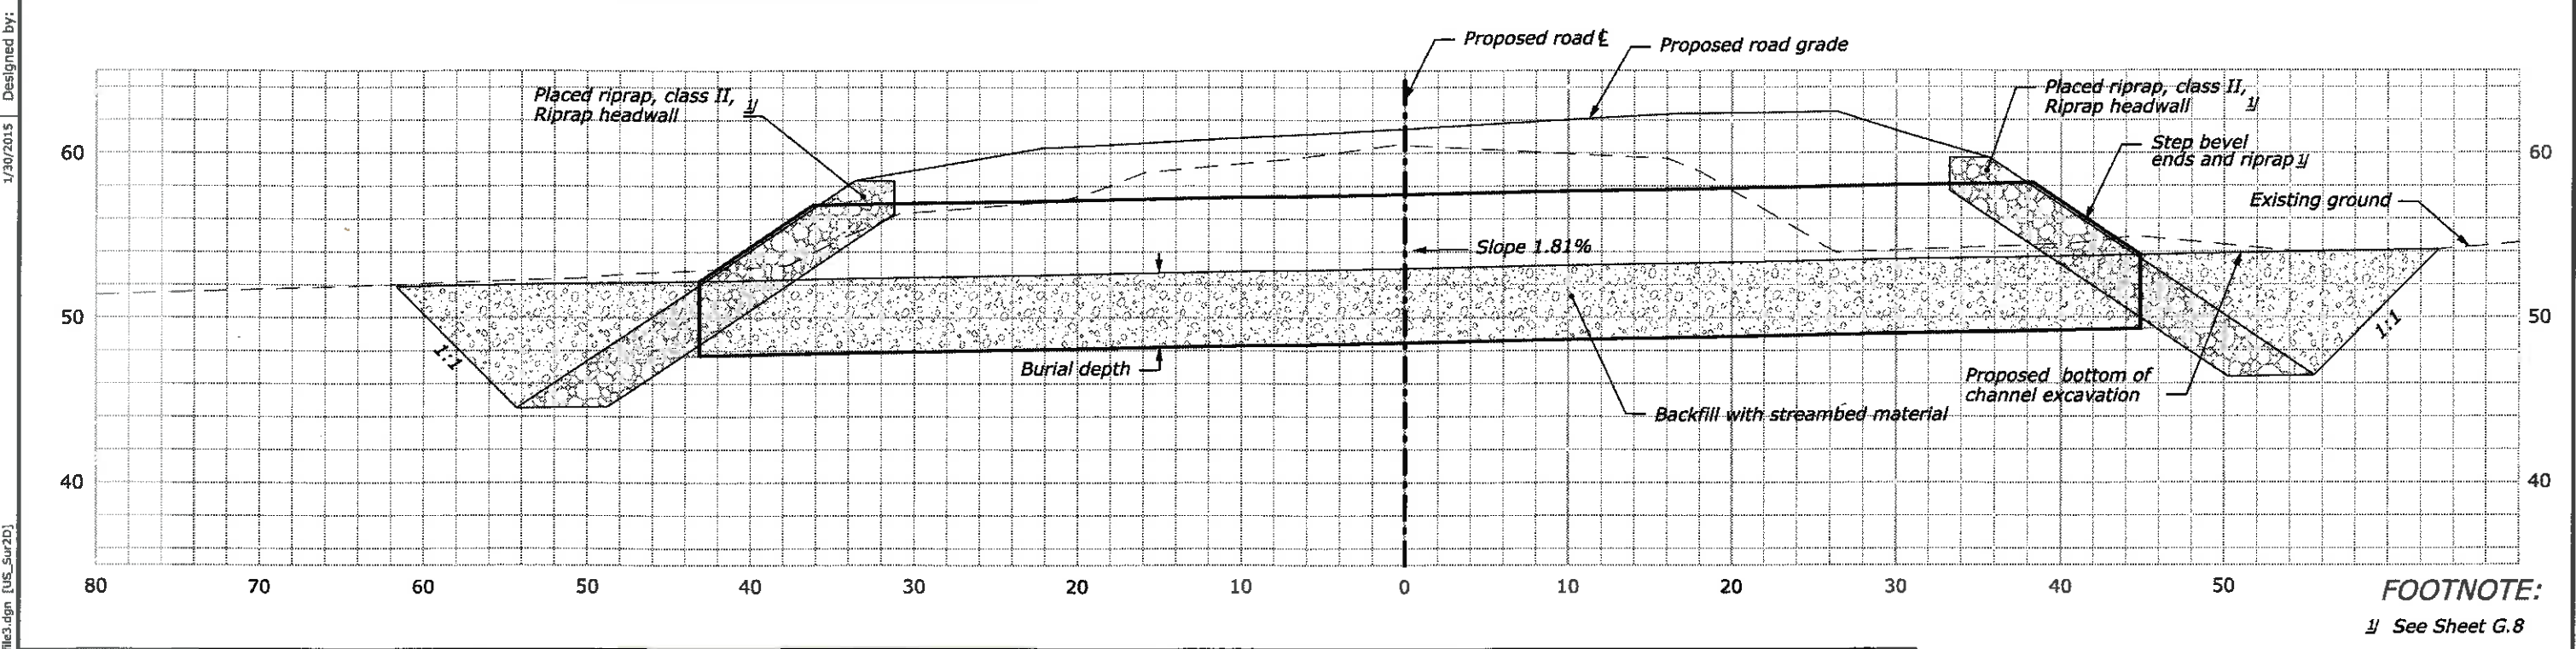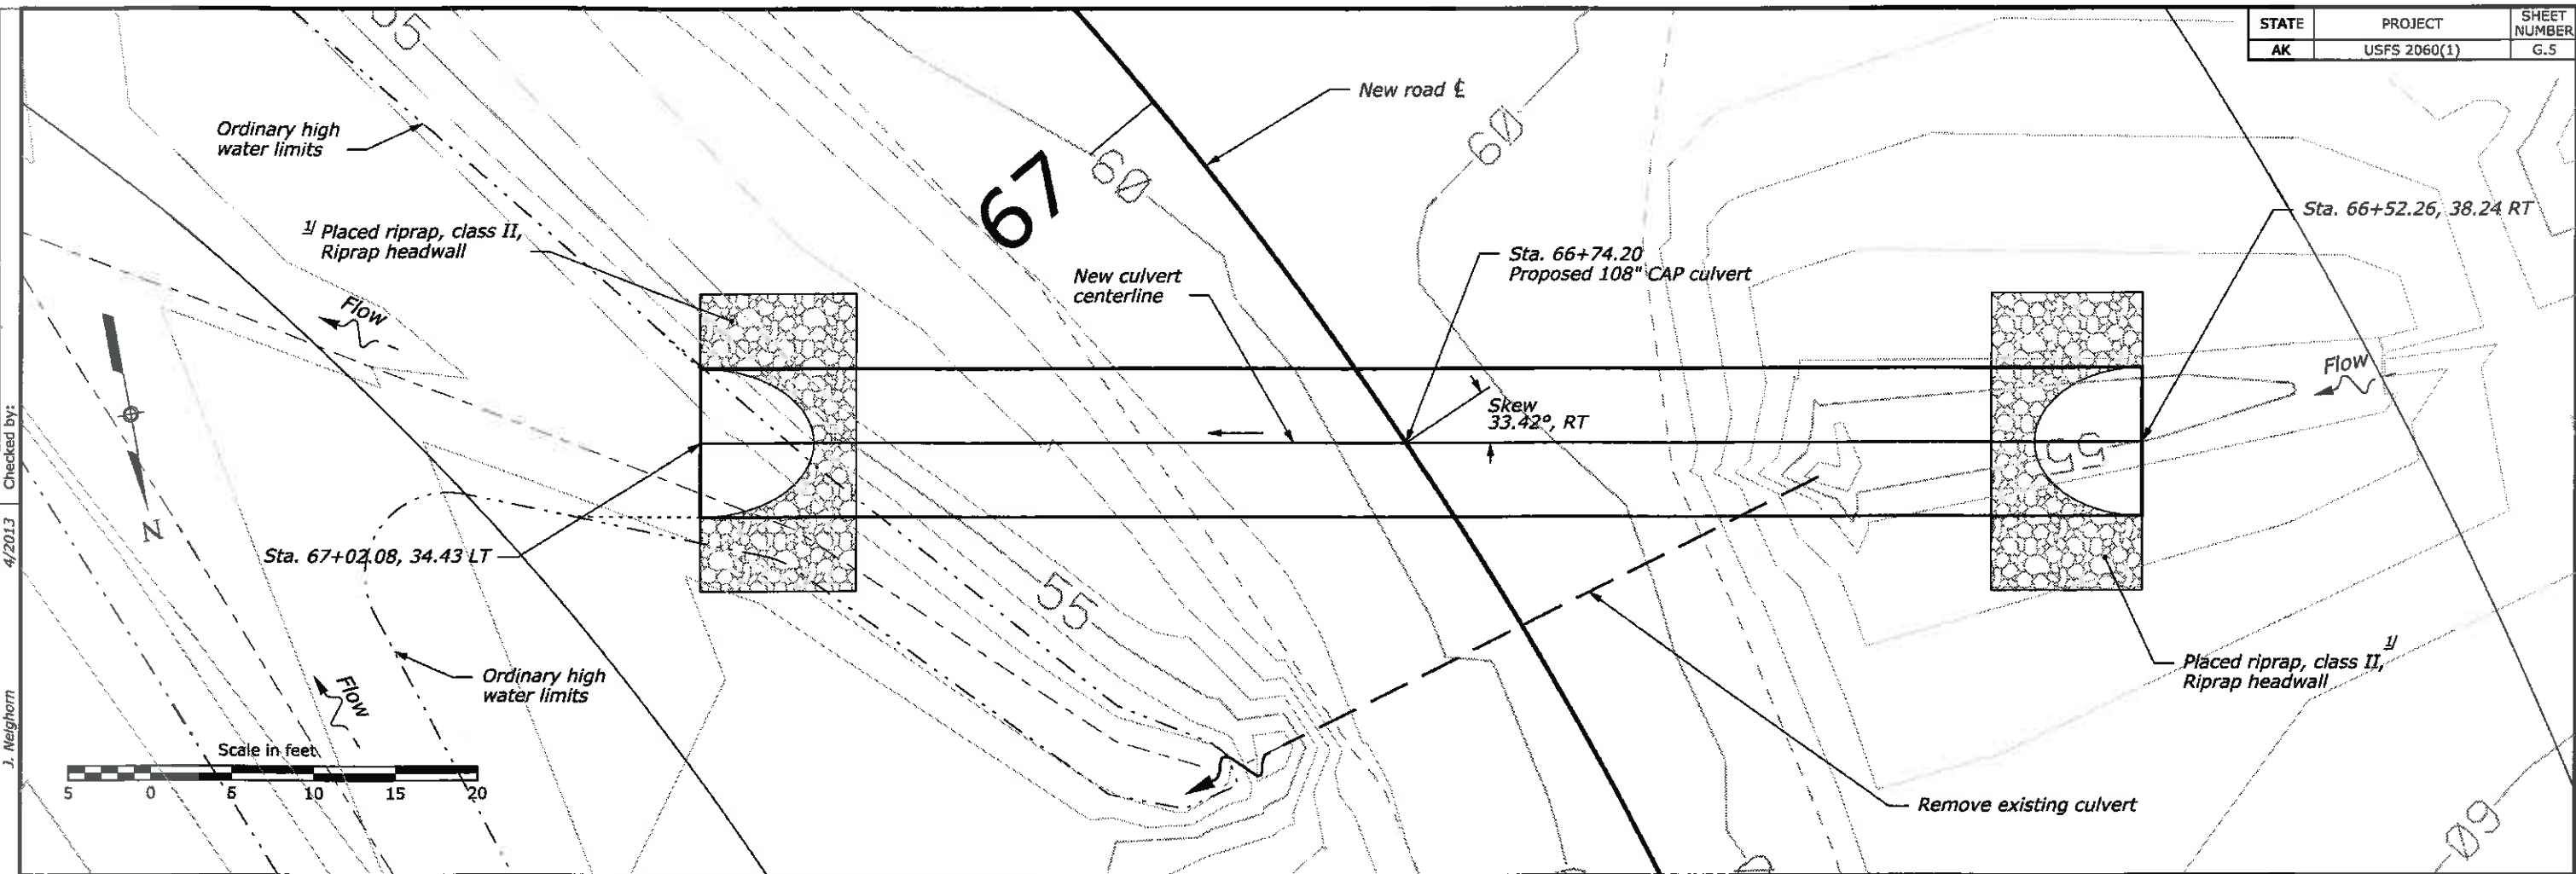



FOOTNOTE:
 1/ See Sheet G.8

HYDRAULIC INFORMATION Q ₂ : 24 CFS Q ₅₀ : 56 CFS ACTIVE CHANNEL WIDTH: 7.0 ft HW ₅₀ : 55.7 ft	PIPE TYPE: CAP, ROUND LENGTH: 88 ft PIPE SLOPE: 0.0180 ft/ft	INLET SPAN: 108 in WALL THICKNESS: 0.135 in FLOWLINE SLOPE: 0.0181 ft/ft RISE: 108 in	OUTLET INV N/E/EL: 1479978.84/2781325.70/47.72 BURIAL DEPTH: 54 in LOWER BEVEL HEIGHT: 54 in BEVEL: STEP, 1.5(h):1(v) HEADWALL: RIPRAP
---	--	--	--

STA. 66+74 ✓
108" DIAMETER CULVERT

4/2013 Checked by: J. Neighorn
 1/30/2015 Designed by: J. Neighorn
 ...\\ak-r206001\Culvert_Plan_Profile3.dgn [US_Sur2D]

STATE	PROJECT	SHEET NUMBER
AK	USFS 2060(1)	G.6



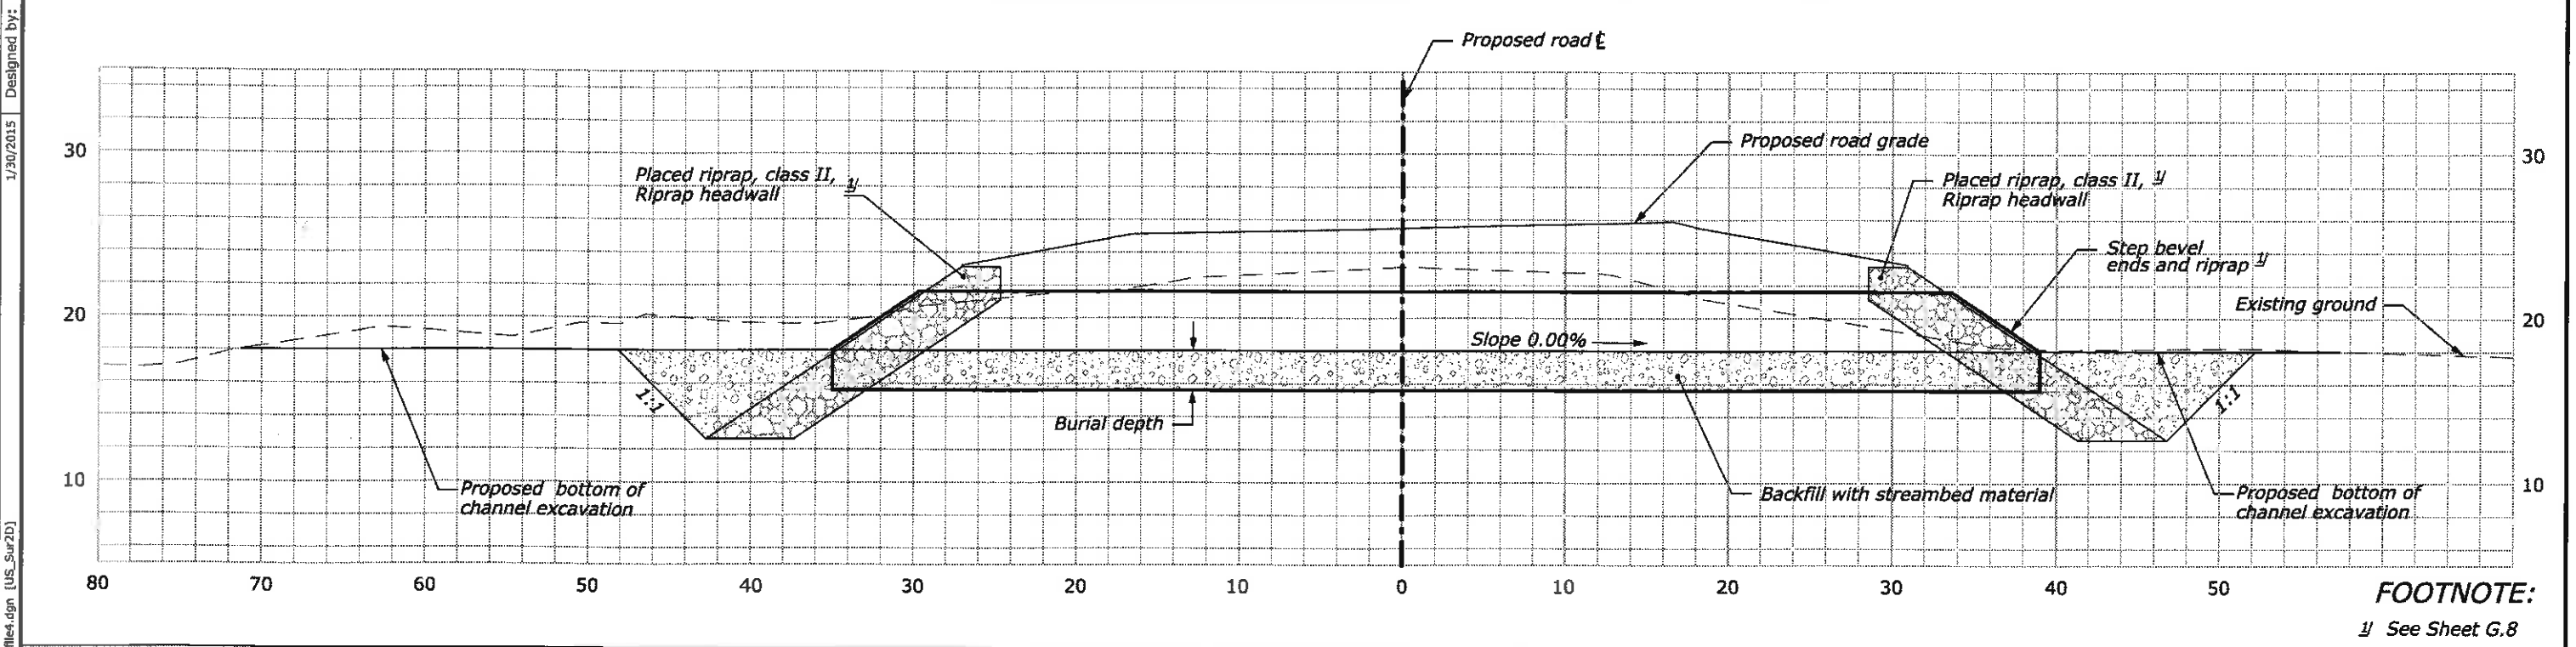
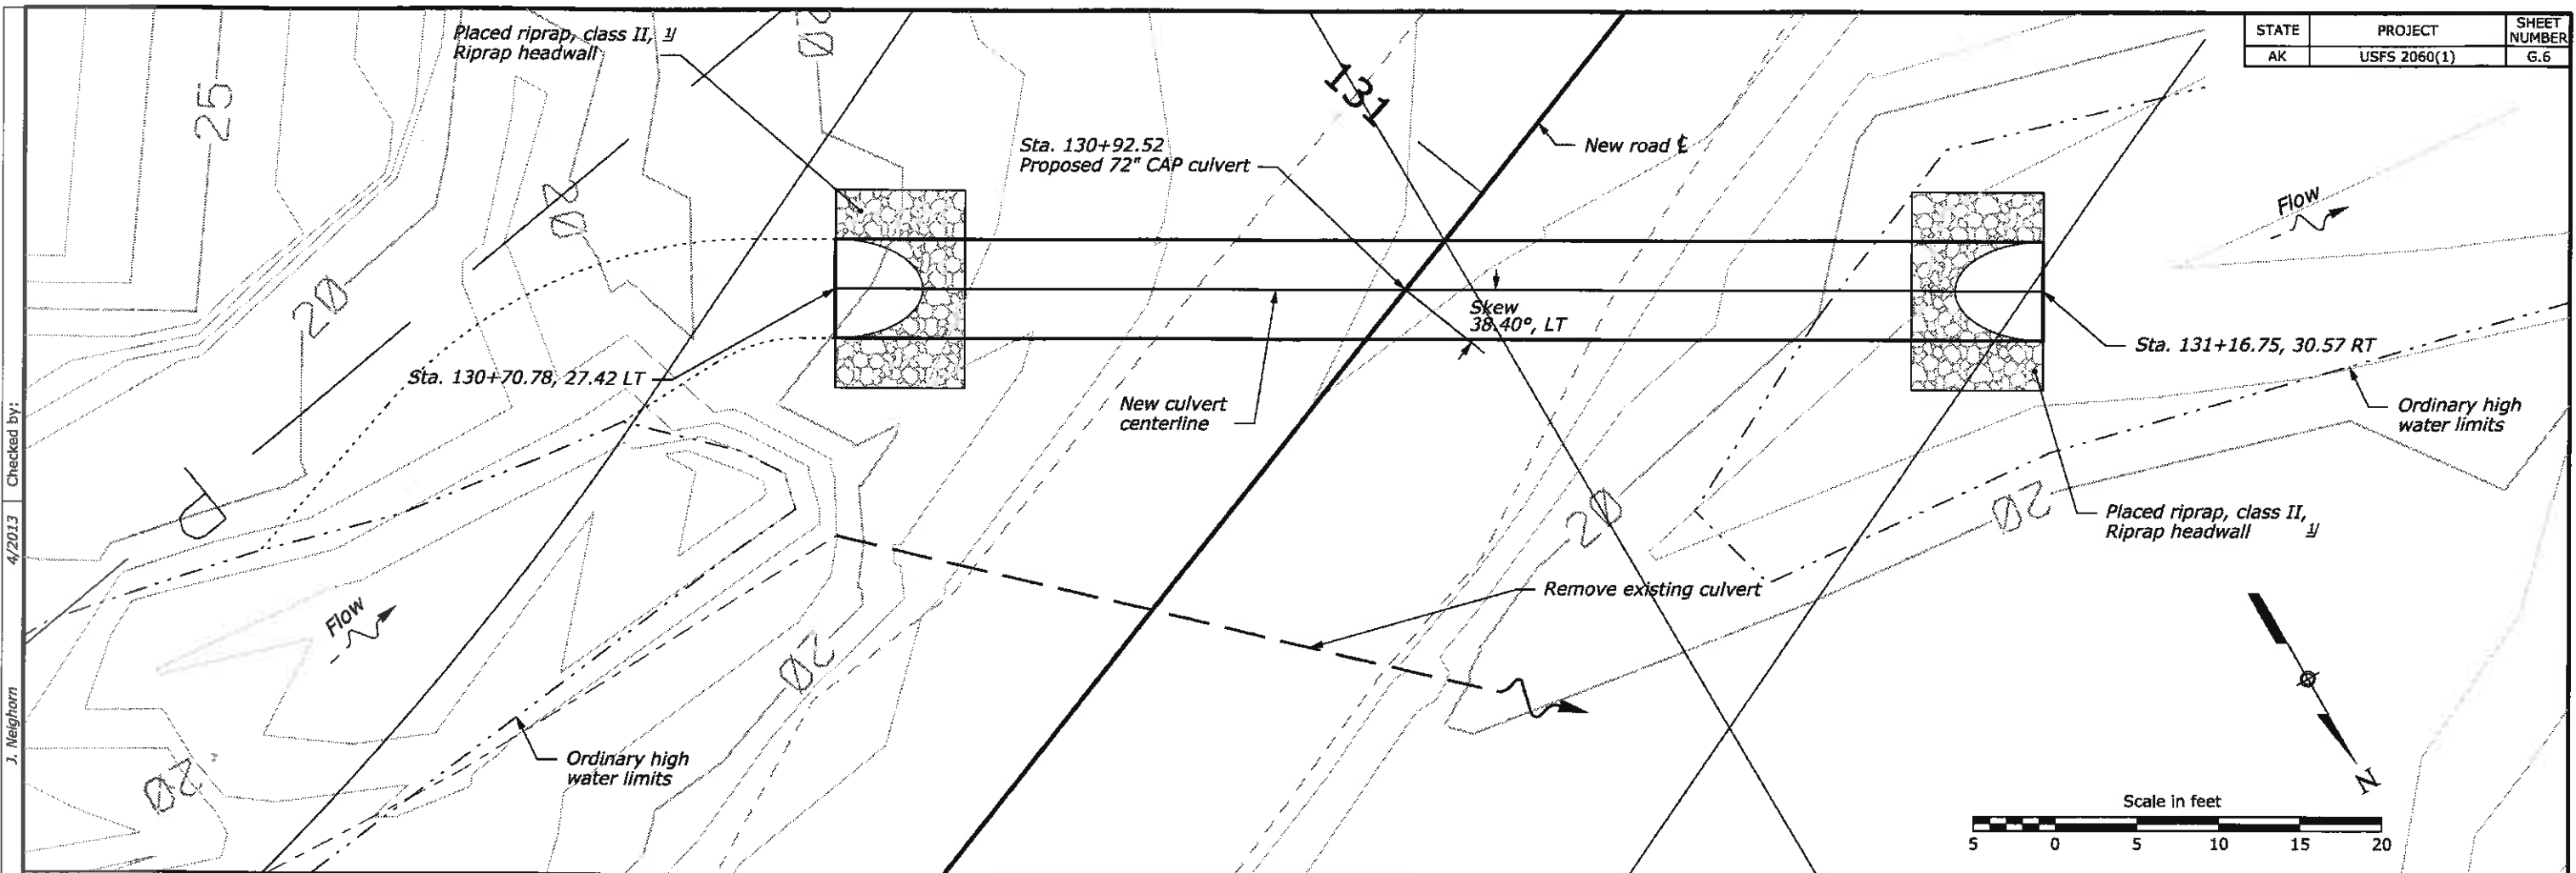


FOOTNOTE:
 1/ See Sheet G.8

HYDRAULIC INFORMATION Q_2 : 35 CFS HW_{50} : 21.7 ft Q_{50} : 84 CFS ACTIVE CHANNEL WIDTH: 6 ft		PIPE TYPE: CAP, ROUND LENGTH: 74 ft PIPE SLOPE: 0.0000 ft/ft		INLET INV N/E/EL: 1475721.27/2778713.92/15.63 BURIAL DEPTH: 29 in LOWER BEVEL HEIGHT: 29 in BEVEL: STEP, 1.5(h):1(v) HEADWALL: RIPRAP		OUTLET INV N/E/EL: 1475758.57/2778650.02/15.63 BURIAL DEPTH: 29 in LOWER BEVEL HEIGHT: 29 in BEVEL: STEP, 1.5(h):1(v) HEADWALL: RIPRAP	
		SPAN: 72 in RISE: 72 in WALL THICKNESS: 0.164 in FLOWLINE SLOPE: 0.0000 ft/ft					

STA. 130+93 ✓
72" DIAMETER CULVERT

4/2013 Checked by: J. Neighorn
 1/30/2015 Designed by: J. Neighorn
 ...\\ale-206001\Culvert_Plan_Profile.dgn [US_Sur2D]

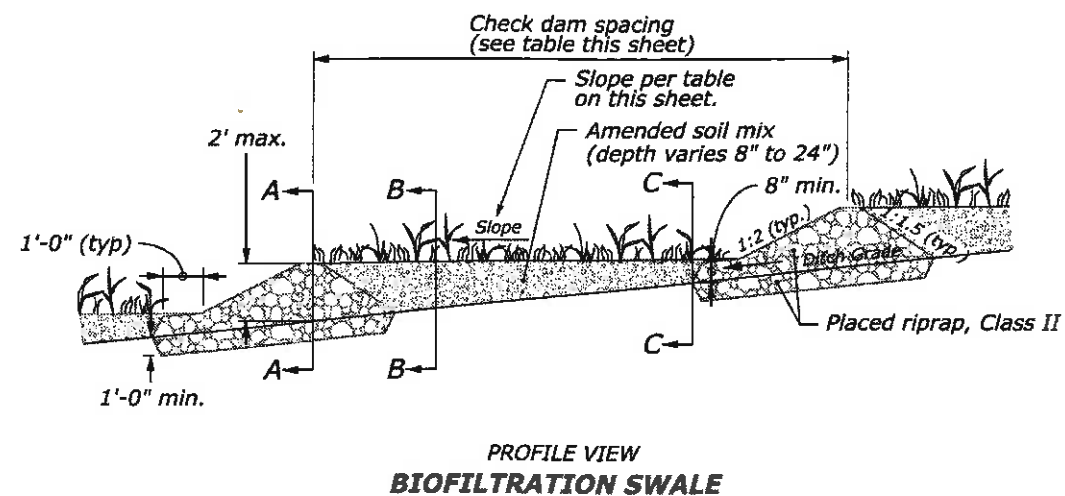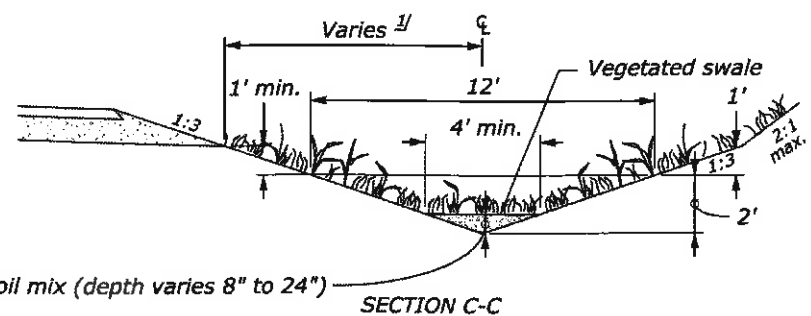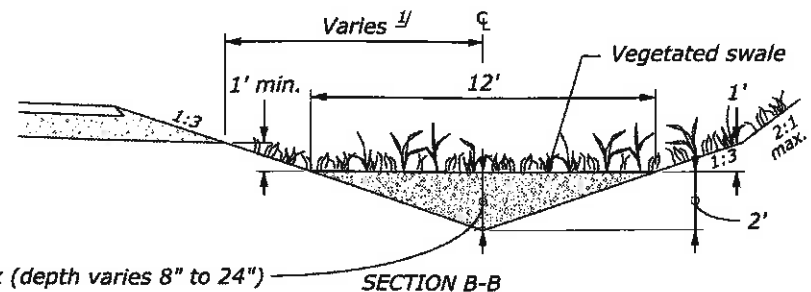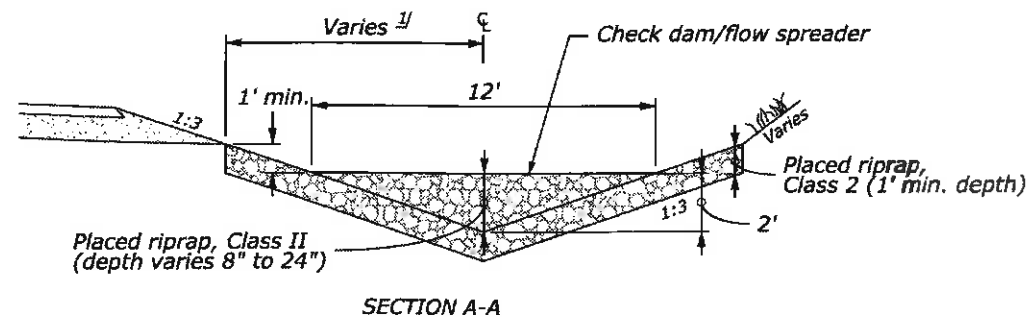



ITEM 64631-0000 ROADSIDE DEVELOPMENT (BIOFILTRATION SWALE)						
STATION RANGE	LT/RT	MIN. WIDTH (FT)	SLOPE (%)	MAX. CHECKDAM SPACING (FT)	LENGTH (LNFT)	
Begin	End					
✓ 16+25	to 17+65	LT	4	1	50	140 ✓
✓ 54+25	to 55+75	RT	4	1	50	143 150 ✓
64+50	to 66+25	RT	4	1	50	186
✓ 69+50	to 71+05	RT	4	1	50	160 155 ✓
✓ 71+94	to 74+00	RT	4	1	50	203 131 ✓
✓ 85+00	to 87+44	LT	4	1	50	245 244 ✓
✓ 88+00	to 90+00	LT	4	1	50	189 100 ✓
✓ 124+47	to 126+22	RT	4	1	50	184 175 ✓
✓ 128+00	to 129+75	RT	4	1	50	178 175 ✓
TOTAL					1,628	
✓ 90+00	to 91+00	LT	4	1	50	100 ✓

Notes:
1. Adjust check dam spacing as needed to meet minimum and maximum swale dimensions per the design ditch grade.

FOOTNOTE:

1/2 Construct ditches at locations and depths according to the staking report



DRAINAGE DETAILS

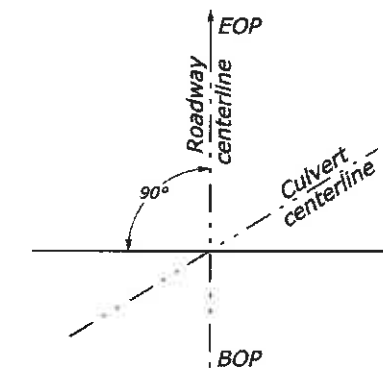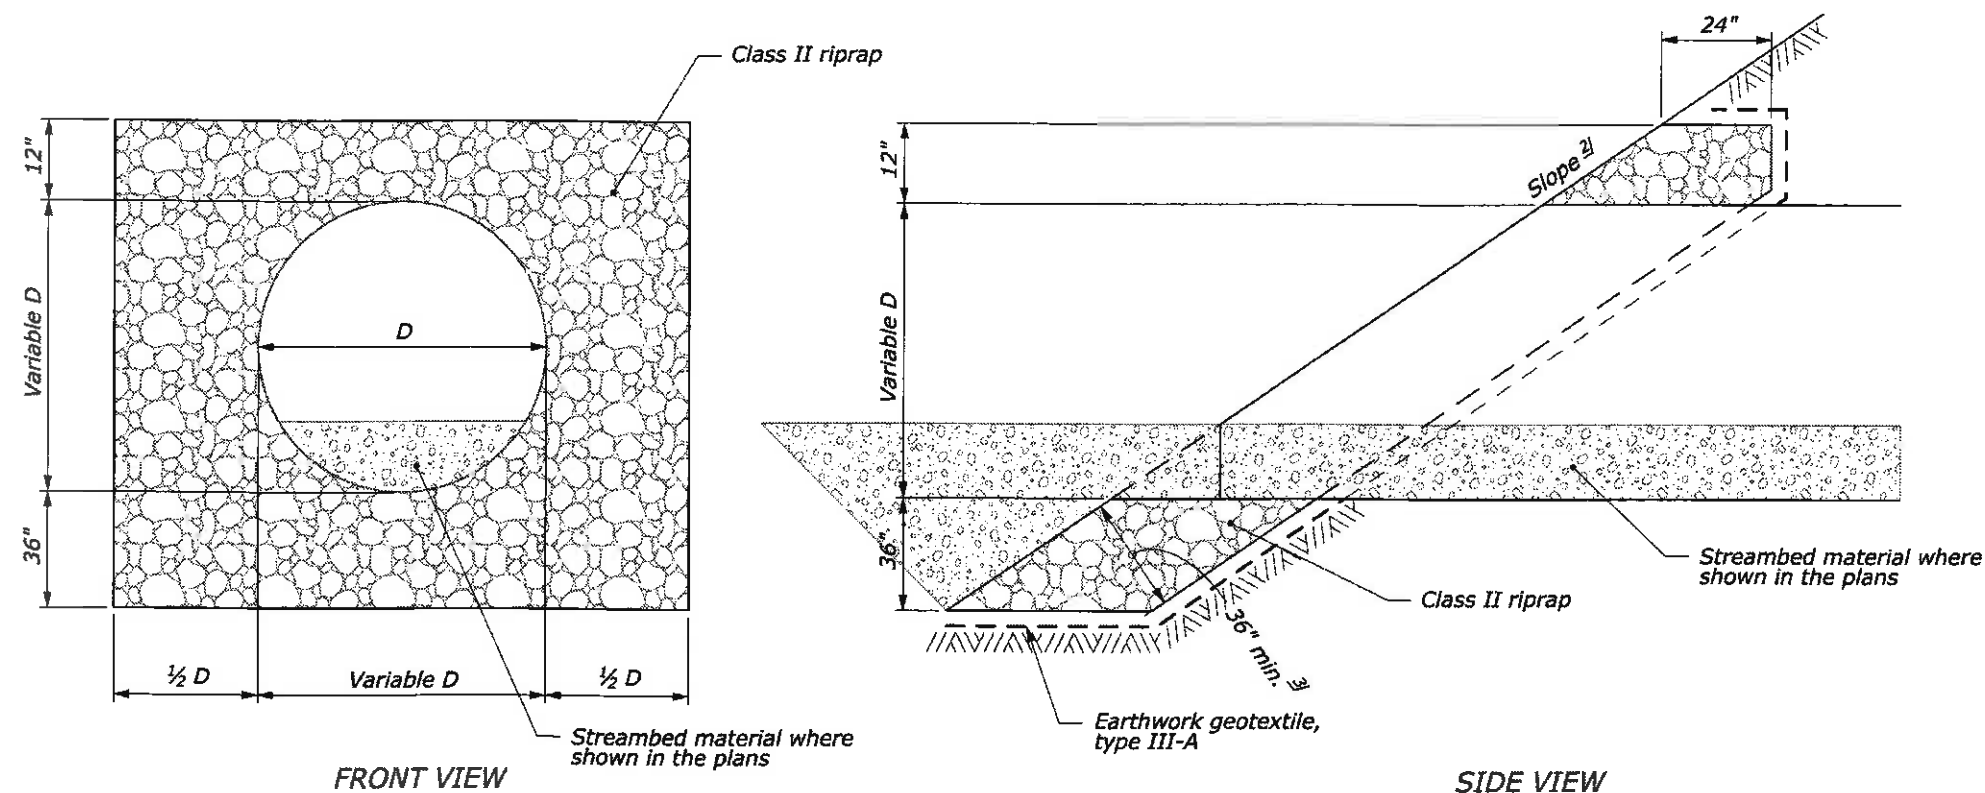

SKEW ANGLE DIAGRAM

RIPRAP HEADWALL

RIPRAP HEADWALL QUANTITIES (FOR INFORMATION ONLY)	
LOCATION	EARTHWORK GEOTEXTILE TYPE III-A (SQYD)
✓ 13+50	81
✓ 57+76	120
✓ 66+74	163
✓ 130+93	101
TOTALS	464

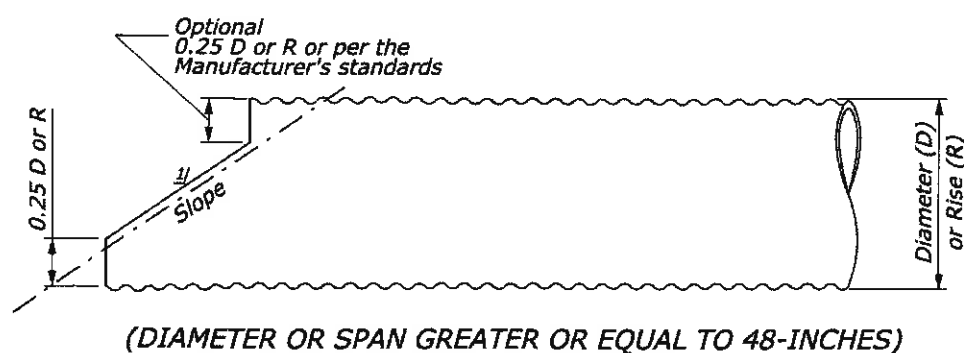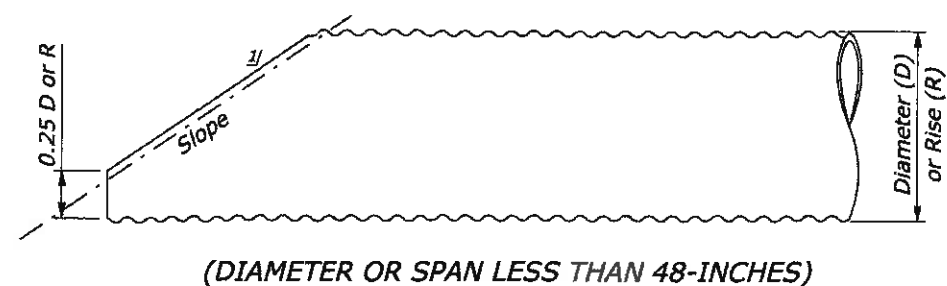

PIPE BEVEL DETAIL

NOTE:

1. Contractor to field verify all invert elevations, prior to installation.
2. Earthwork geotextile, type III-A is subsidiary to 251.
3. See sheet G.1-2 for class II riprap quantities.
4. Place earthwork geotextile between riprap and existing ground, beneath and at all sides of placed riprap.


FOOTNOTE:

- 1/ Bevel to match roadway embankment.
- 2/ Riprap end treatment slope to match roadway embankment slope.
- 3/ Construct riprap end treatment to a thickness of 36-inches or as shown on site specific details, whichever is greater.

DRAINAGE DETAILS ✓



INFILL INFORMATIONAL QUANTITIES ^{5/}

LOCATION	D (ft)	W (ft)	STREAMBED COBBLE GRADATION (in)	STREAMBED COBBLE (cuyd)	STREAMBED SEDIMENT (cuyd)	FISH PASSAGE BOULDER DIAMETER (in +/- 4)	BANK STONE (cuyd)
STA. 13+49.89	5	4.5	Class A	18	27	NA	NA
STA. 57+75.76	7	5	Class C	32	50	16	6
STA. 66+74.20	9	7	Class C	64	100	30	8
STA. 130+92.52	6	6	Class A	20	30	NA	NA
				134	207	46	14

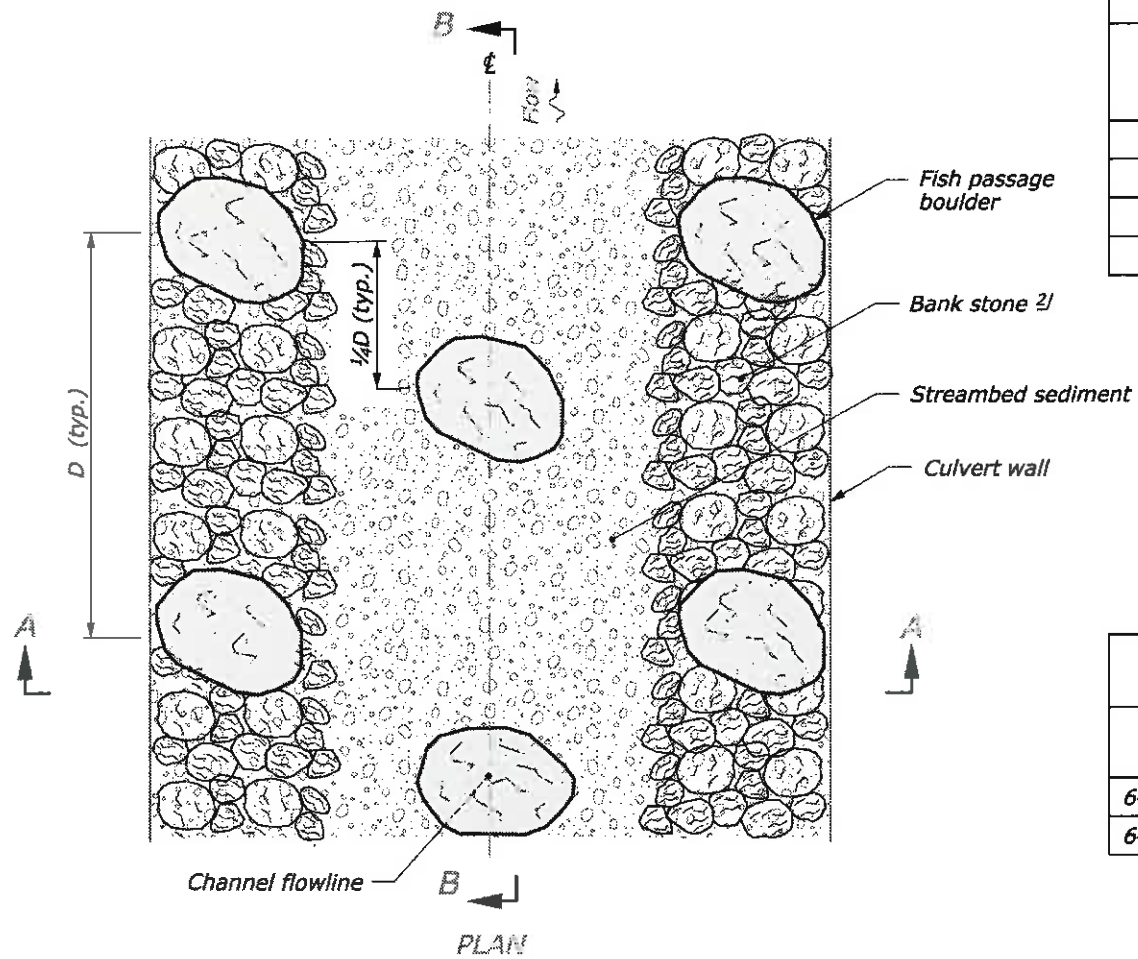

MITIGATION QUANTITIES

ITEM	DESCRIPTION	UNIT	QUANTITY
64703-6000	Fish passage boulder	each	46
64704-1000	Streambed material	cuyd	355

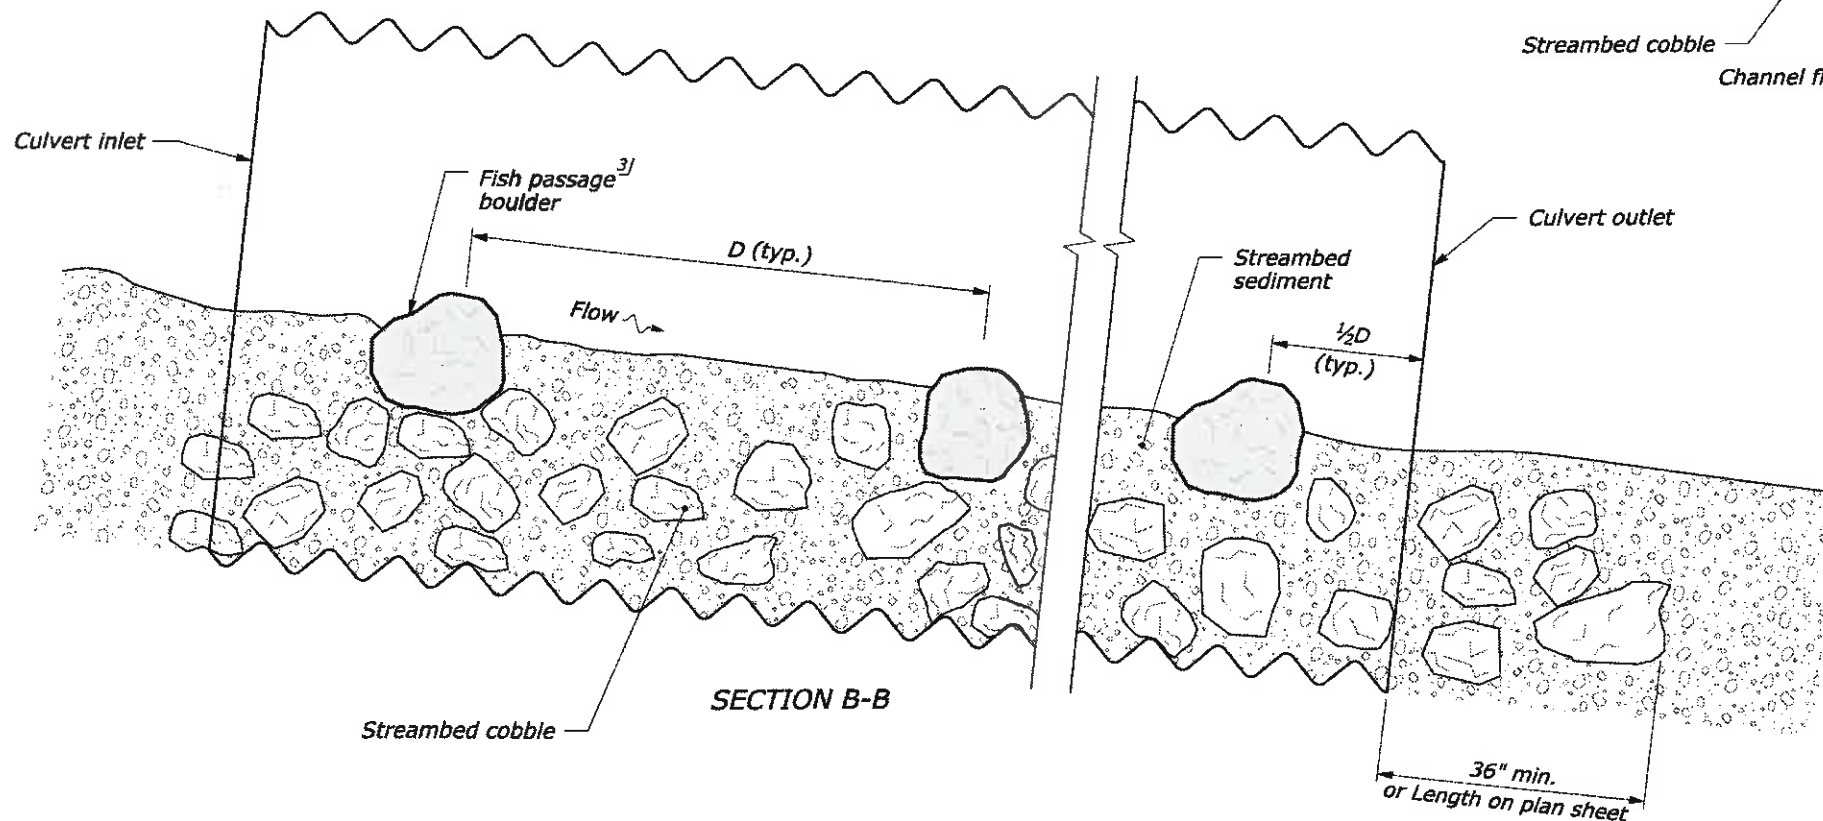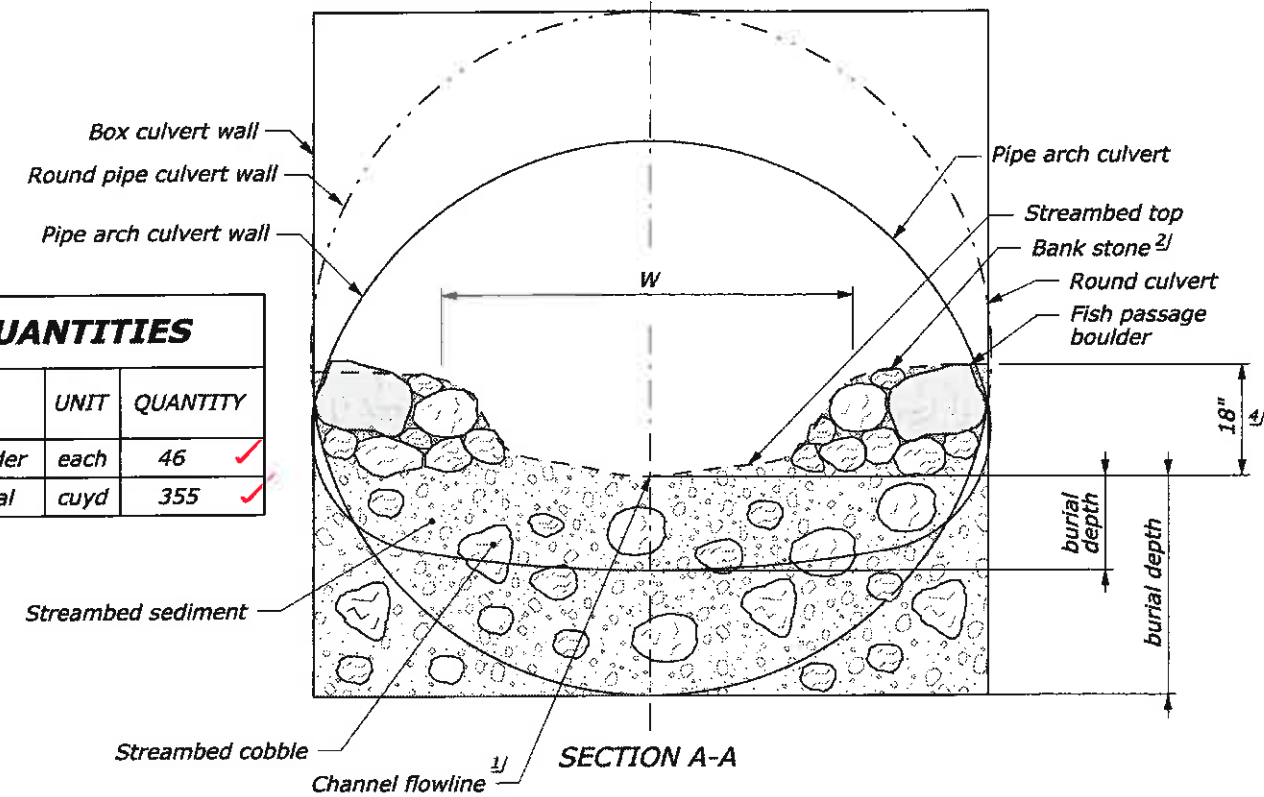

NOTE:

- Mix streambed cobbles evenly throughout streambed sediment.
- See special contract requirements for streambed sediment, streambed cobble, and bank stone gradations.
- Stagger in-channel fish passage boulder within the culvert span.

FOOTNOTE:

- ^{1/} Slope streambed aggregate towards flowline to ensure parabolic shape.
- ^{2/} Construct well defined banks with bank stone and streambed sediment where listed in the infill quantities table.
- ^{3/} Embed fish passage boulders within active channel ^{3/4} smallest dimension.
- ^{4/} 18-inches or as specified on plan sheet.
- ^{5/} Quantities included in Item 64704-1000 Mitigation, Streambed Material except Item 64703-6000 Fish Passage Boulders.

SIMULATED STREAM CULVERT TREATMENT


Not to scale

Checked by:


Designed by:

c:\myfiles\pw_production\0199358\ak-r20600.ed.dgn [us_sur_ft2d]


30 January 2015 8:26 AM

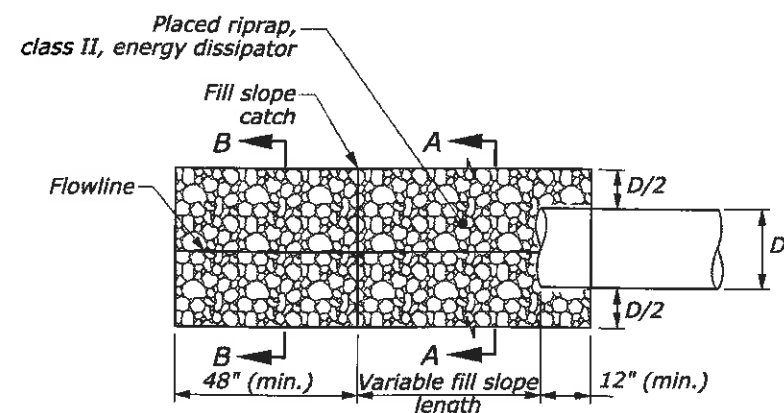


ENERGY DISSIPATOR - PLAN

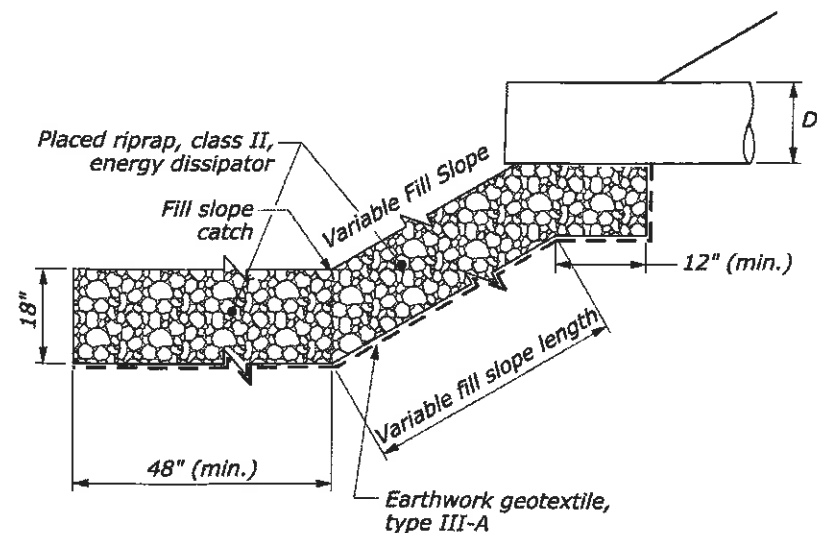

ENERGY DISSIPATOR - ELEVATION

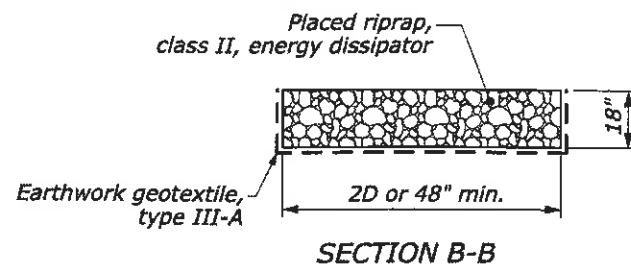

SECTION B-B

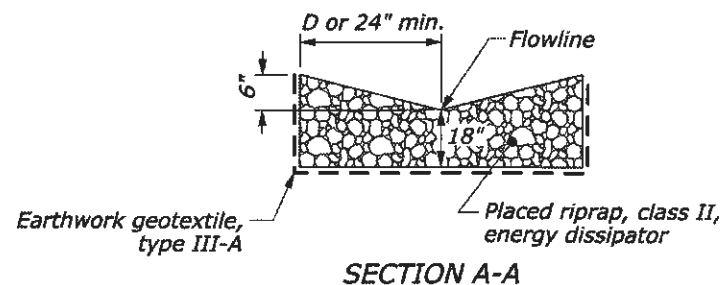

SECTION A-A

ENERGY DISSIPATOR QUANTITIES (FOR INFORMATION ONLY)			
LOCATION	EARTHWORK GEOTEXTILE TYPE III-A (SQYD)	LOCATION	EARTHWORK GEOTEXTILE TYPE III-A (SQYD)
✓ 22+95	7	✓ 62+36	6
✓ 24+28	16	✓ 67+53	6
✓ 27+04	6	✓ 71+51	6
✓ 28+70	6	✓ 87+89	33
✓ 32+29	6	✓ 90+96 89+50	8
✓ 36+66	6	✓ 94+27 94+00	8
✓ 39+68 39+50	6	✓ 97+98	38
✓ 40+82	6	✓ 103+42 103+56	45
41+81	6	✓ 109+88	34
✓ 42+19	6	✓ 114+82	8
✓ 43+87	6	✓ 116+70	6
✓ 48+72	6	✓ 121+92	6
✓ 51+00	6	✓ 126+64	6
✓ 59+95	6	✓ 136+17 136+00	6
SUBTOTAL	99	SUBTOTAL	220
		TOTALS	319

✓ 141+75

NOTE:

1. Place riprap in energy dissipators at the following rates:

Outlet Diameter	Section	Placed Riprap, Class II	Earthwork Geotextile, Type III-A
24"	A-A	0.26 cuyd/ft	0.89 sqyd/ft
24"	B-B	0.22 cuyd/ft	0.78 sqyd/ft
36"	A-A	0.39 cuyd/ft	1.11 sqyd/ft
36"	B-B	0.33 cuyd/ft	1.00 sqyd/ft
48"	A-A	0.52 cuyd/ft	1.33 sqyd/ft
48"	B-B	0.44 cuyd/ft	1.22 sqyd/ft
60"	A-A	0.65 cuyd/ft	1.56 sqyd/ft
60"	B-B	0.56 cuyd/ft	1.44 sqyd/ft
2-36"	A-A	0.71 cuyd/ft	1.67 sqyd/ft
2-36"	B-B	0.61 cuyd/ft	1.56 sqyd/ft


2. Earthwork geotextile, type III-A is subsidiary to 251.
3. See sheet G.1-2 for class II riprap quantities.

ENERGY DISSIPATOR DETAILS ✓


NO SCALE

STATE	PROJECT	SHEET NUMBER
AK	USFS 2060(1)	G.11

28 January 2015 2:51 PM
 c:\myfiles\pw_production\0199358\ak-f206001RSS.dgn [US_Sur_f2D]
 Designed by: C. Conrad
 08/2014
 Checked by:

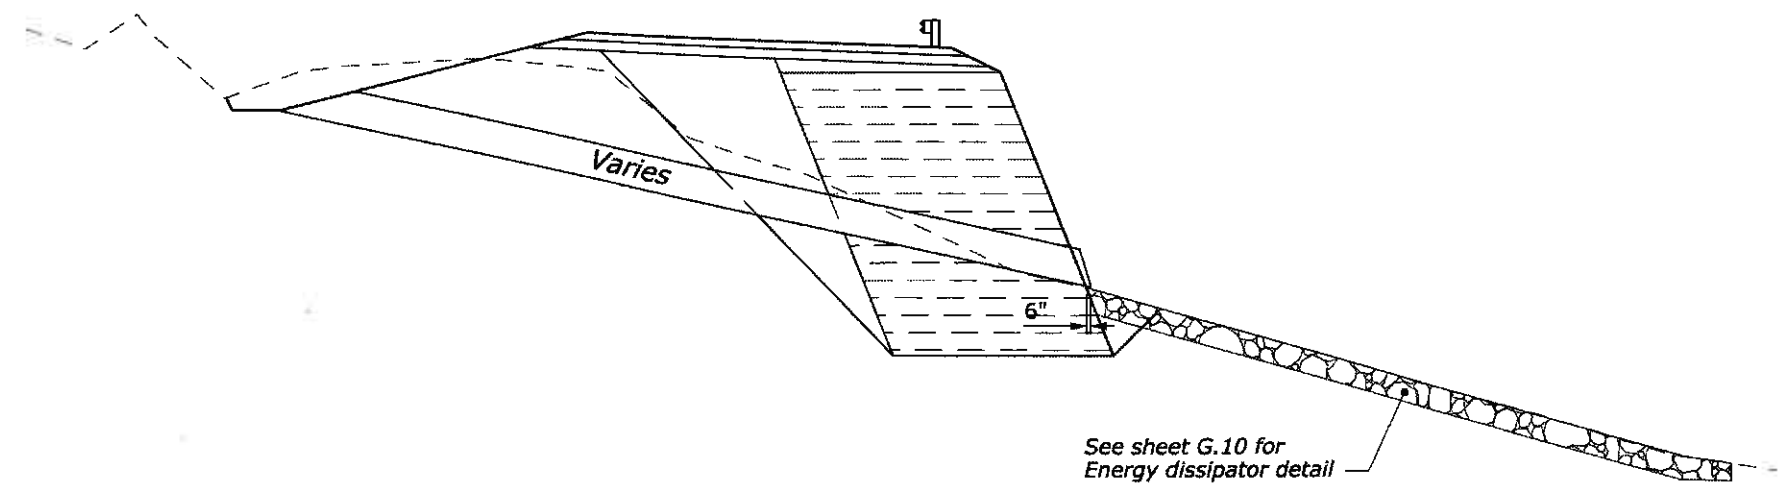

~~RSS SLOPE CULVERT DETAIL~~
 Deleted, See cmo04

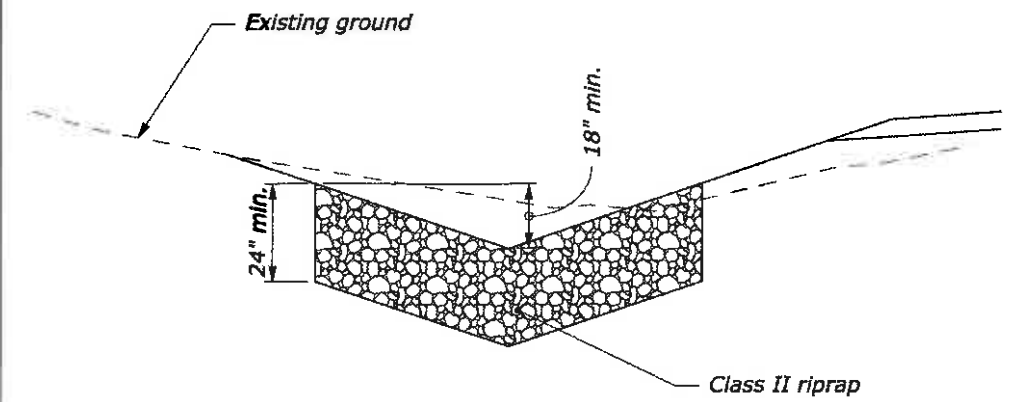

RIPRAP LINED DITCH

NOTE:

1. Place riprap in ditches at the following rates:

<u>Location</u>	<u>Riprap ditch, Class II</u>
Mainline	0.22 cuyd/ft
2. See sheet D.2 for location and quantities.
3. Grade ditch to define well established flowline.
4. Eliminate backslope portion of ditch at rocky locations.

~~RSS SLOPE CULVERT~~
AND
RIPRAP LINED DITCH DETAIL

COUPLING BANDS FOR METAL PIPE CULVERT ^{1/}

CORRUGATION SIZE ^{2/} INCHES	ROUND PIPE DIAMETER INCHES	PIPE ARCH SPAN x RISE INCHES	MINIMUM BAND WIDTH (INCHES)		
			ANNULAR CORRUGATED BANDS ^{3/}	HELICALLY CORRUGATED BANDS ^{4/}	SEMI-CORRUGATED BANDS ^{5/}
1 1/2 x 1/4	underdrain ^{6/}	-	10.5	7	10.5
	12 to 36	17 x 13 to 42 x 29	7	12	
2 2/3 x 1/2	42 to 72	49 x 33 to 83 x 57	10.5	12	
	78 to 84	-	10.5	12	10.5
3 x 1	36 to 72	60 x 46 to 81 x 59	12	14	10.5
	78 to 144	87 x 64 to 142 x 91	12	14	10.5
5 x 1	36 to 72	60 x 46 to 81 x 59	20	22	
	78 to 144	87 x 64 to 142 x 91	20	22	

^{1/} Fabricate annular, helical and semi-corrugated type coupling bands from the same metal as the connecting pipe. Provide coupling bands not more than 3 nominal sheet thicknesses thinner than the thickness of the pipe to be connected, and no thinner than 0.052 inch for steel or 0.048 inch for aluminum. Fasten coupling bands with the following diameter of bolt:

3/8" for 18" round culvert (21" x 15" pipe arch) or less
1/2" for 21" round culvert (24" x 18" pipe arch) or more


^{2/} For helically corrugated pipe with rerolled ends, the nominal corrugations size refers to the dimension of the end corrugation in the pipe.

^{3/} Use annular corrugated bands with pipes having annular corrugations or with helical pipe having rerolled end to form annular corrugations. A 10.5 inch band is acceptable on pipe ends rerolled with 2 2/3" x 1/2" corrugations. A 12 inch band is acceptable on pipe ends rerolled with 3" x 1" pipe corrugations.

^{4/} Use helical corrugated bands with pipes having helically corrugated ends.

^{5/} The minimum band widths shown for 3" x 1" and 5" x 1" corrugated sizes apply to 2 2/3" x 1/2" corrugations on rerolled pipe ends.


^{6/} Smooth sleeve-type couplers and flat bands may be used for pipe diameters of 12" or less. Use a matching metal having a nominal thickness of not less than 0.040 inch for steel, or 0.036 inch for aluminum, or a plastic with an equivalent strength to metal.

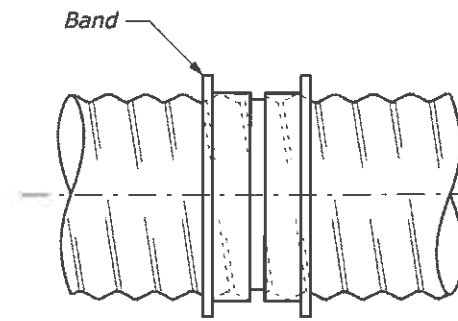


SLEEVE JOINT

Smother sleeve with center stop.
Stab type joint


SMOOTH SLEEVE BAND

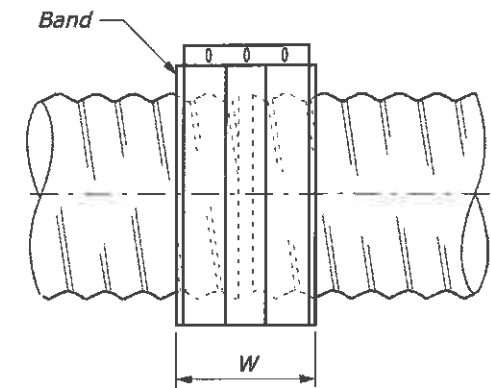


FLAT BAND

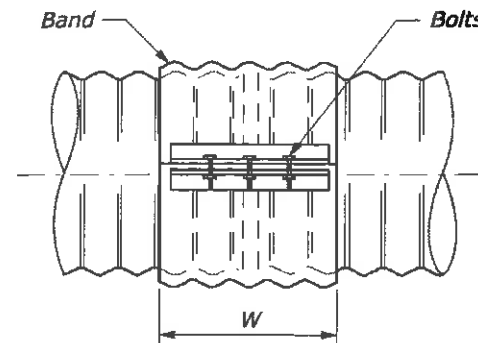


SIDE VIEW

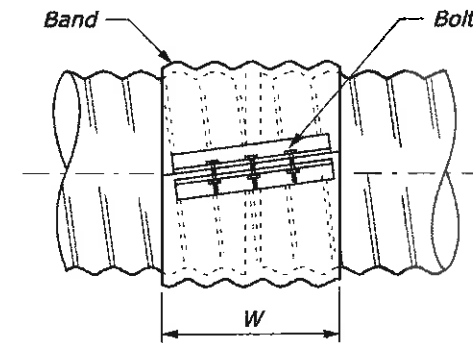


SIDE VIEW

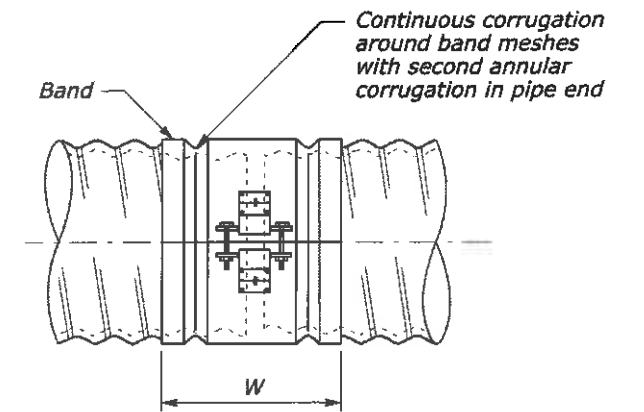

SIDE VIEW

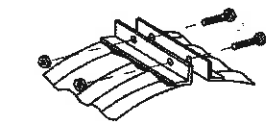


Band Angle

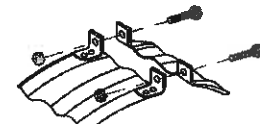


Oval Lug



Bar & Strap

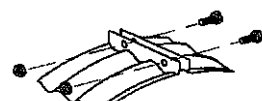


Integral Flange

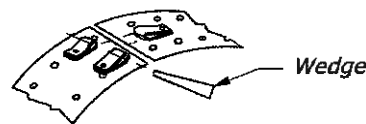

Wedge and Strap

STANDARD BAND CONNECTIONS

Rivet, spot weld, or fillet weld at crest of corrugation at heel and toe of angle

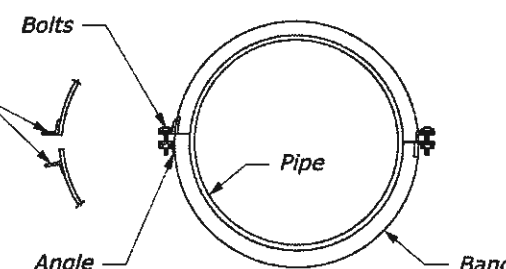


END VIEW

Second angle connection optional to 42" diameter, required above 42" diameter

ANNULAR BAND


Rivet, spot weld, or fillet weld at crest of corrugation at heel and toe of angle

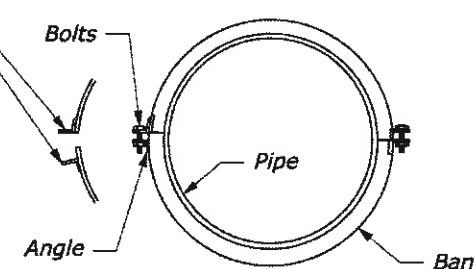

END VIEW

Second angle connection optional to 42" diameter, required above 42" diameter

HELICAL BAND

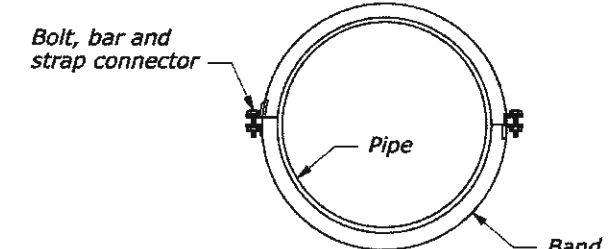


END VIEW


SEMI-CORRUGATED BAND

U.S. DEPARTMENT OF TRANSPORTATION FEDERAL HIGHWAY ADMINISTRATION FEDERAL LANDS HIGHWAY	
U.S. CUSTOMARY STANDARD	
METAL PIPE CULVERT COUPLING BAND	
STANDARD APPROVED FOR USE 12/1993	STANDARD
REVISED: 4/1994 6/2005	602-2


NO SCALE

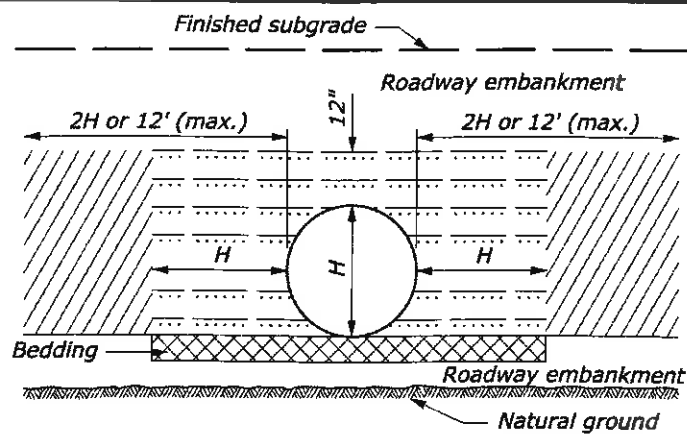


ABOVE NATURAL GROUND

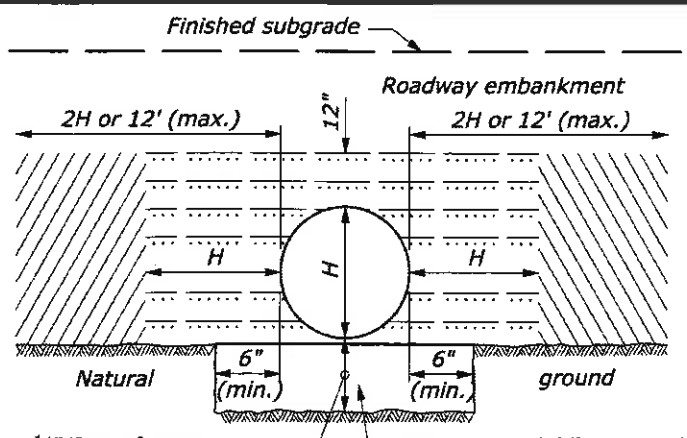


ON UNYIELDING MATERIAL

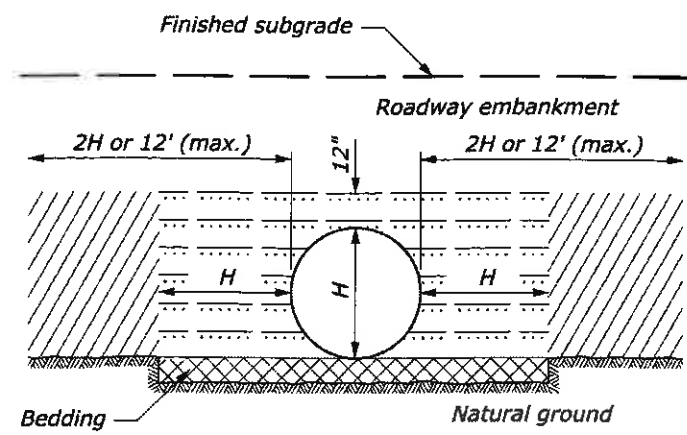


ON NATURAL GROUND

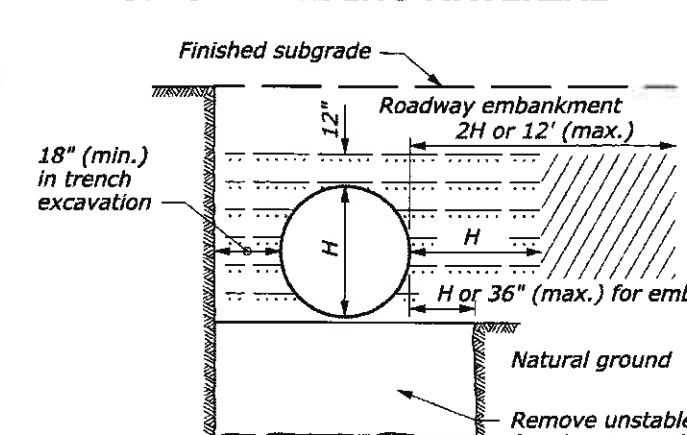

ON UNSTABLE MATERIAL

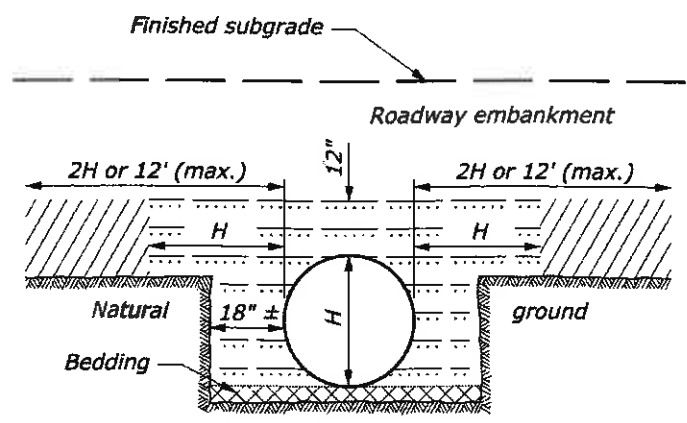


ABOVE AND BELOW NATURAL GROUND

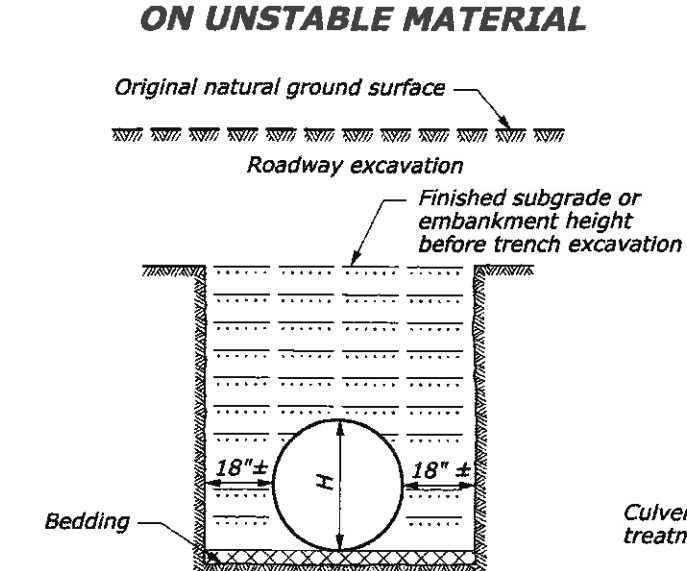

BELOW NATURAL GROUND OR TRENCH EXCAVATION IN EMBANKMENT

BEDDING DEPTH	
PIPE SIZE (H)	DEPTH
12" to 54"	4"
> 54"	6"

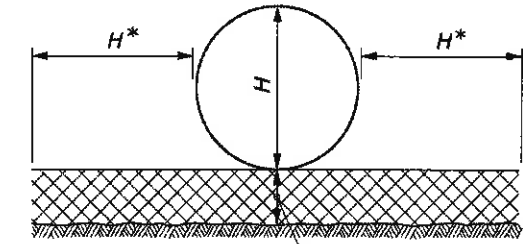


PIPE BEDDING


MINIMUM SPACING	
DIAMETER or SPAN	SPACING
UP to 48"	24"
48" and UP	Half diameter or span OR 36" whichever is less

NOTE:

1. When directed, camber pipe culverts upward from a chord through the inlet and outlet inverts an ordinate amount equal to 1% of the pipe length. Develop camber on a parabolic curve. If the midpoint elevation on the parabolic curve as designed exceeds the elevation of the inlet invert, reduce the amount of camber or increase the pipe culvert gradient.
2. H equals the diameter of all round pipe culverts or the rise dimension of all pipe arch culverts.

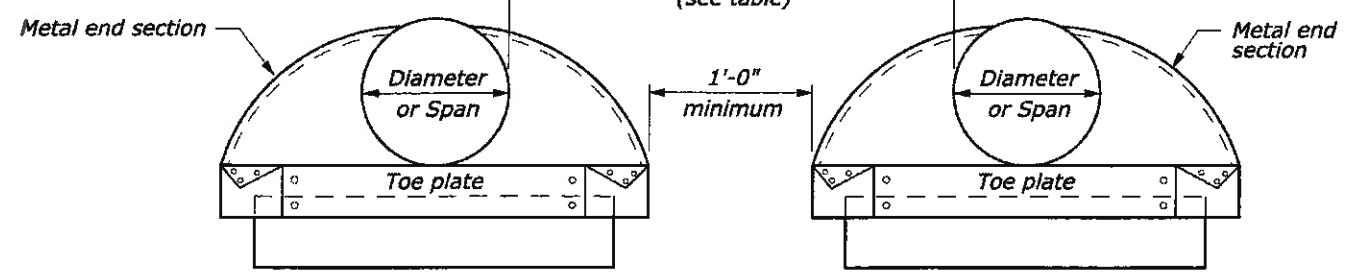

ELEVATION MULTIPLE PIPE INSTALLATION

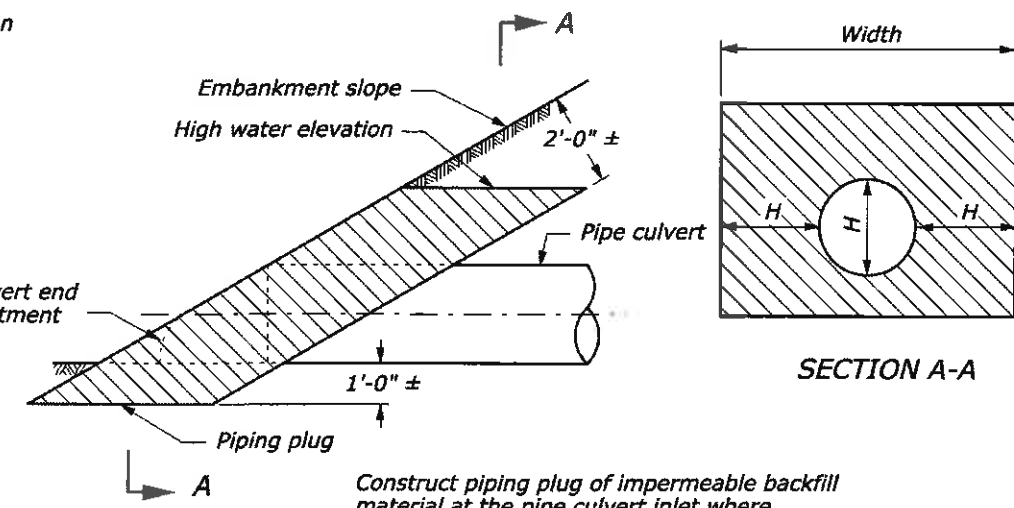

PIPING PLUG

NO SCALE

1/30/2015 ...ak-r206001.ste62033.dgn [US Customary]

- Bedding material (uncompacted)
 - Embankment material placed in layers not exceeding 6" compacted depth.
 - Compacted backfill material placed in layers not exceeding 6" compacted depth meeting the following:
 - Metal Pipe: Maximum particle size = 3"
 - Soil classification: A-1, A-2, or A-3
 - Plastic Pipe: Maximum particle size: 1 1/2"
 - Soil classification: A-1, A-2-4, A-2-5, or A-3
- Or lean concrete backfill in accordance with Section 614.

U.S. DEPARTMENT OF TRANSPORTATION
FEDERAL HIGHWAY ADMINISTRATION
FEDERAL LANDS HIGHWAY

U.S. CUSTOMARY STANDARD

**METAL AND PLASTIC
PIPE CULVERT BEDDING**

STANDARD APPROVED FOR USE 12/1993
REVISED: 4/1994 6/2005


STANDARD
602-3

POLYETHYLENE (PE) PLASTIC ROUND PIPE CULVERT															
FILL HEIGHT TABLE AND MINIMUM CELL CLASSIFICATION NUMBER PER ASTM D 3350															
SMOOTH WALL (SOLID WALL)					CORRUGATED			RIBBED							
PIPE SIZE DIAMETER INCHES	MINIMUM COVER INCHES	CELL CLASSIFICATION NUMBER 335434C						PIPE SIZE DIAMETER INCHES	MINIMUM COVER INCHES	CELL CLASS. NO. 435400C					
		MINIMUM WALL THICKNESS (INCHES)									MAXIMUM FILL HEIGHT (FEET)	PIPE SIZE DIAMETER INCHES	MINIMUM COVER INCHES	CELL CLASS. NO. 334433C	CELL CLASS. NO. 335434C
		0.607	0.857	0.923	1.154	1.385	1.292								
12	12	57						12	12	10	18	12	18	24	
18	12		52					15	12	10	24	12	22	28	
24	12			38				18	12	10	30	12	22	28	
30	12				38			24	12	10	36	12	25	31	
36	12					38		30	12	10	42	12	21	27	
42	12						27	36	12	10	48	12	21	26	
48	12						27								


NOTE:

- When directed, camber pipe culverts upward from a chord through the inlet and outlet inverts an ordinate amount equal to 1% of the pipe length. Develop camber on a parabolic curve. If the midpoint elevation on the parabolic curve as designed exceeds the elevation of the inlet invert, reduce the amount of camber or increase the pipe culvert gradient.
- Measure minimum cover from the top of the pipe culvert to the subgrade for flexible pavements, and to the top of the pavement for rigid pavements. Measure maximum fill height from the top of the pipe to the top of the pavement for both flexible and rigid pavement.


POLYVINYL CHLORIDE (PVC) PLASTIC ROUND PIPE CULVERT									
FILL HEIGHT TABLE AND MINIMUM CELL CLASSIFICATION NUMBER PER ASTM D 1784									
SMOOTH WALL (SOLID WALL)				RIBBED					
PIPE SIZE DIAMETER INCHES	MINIMUM COVER INCHES	CELL CLASS. NO. 12454		CELL CLASS. NO. 12364		PIPE SIZE DIAMETER INCHES	MINIMUM COVER INCHES		
		MINIMUM WALL THICKNESS (INCHES)						CELL CLASS. NO. 12454C	CELL CLASS. NO. 12364C
		0.358	0.438	0.358	0.438				
12	12	65		69		12	12	37	26
15	12		62		66	15	12	32	22
						18	12	33	23
						24	12	29	21
						30	12	28	20
						36	12	27	19
						42	12	26	18
						48	12	24	17

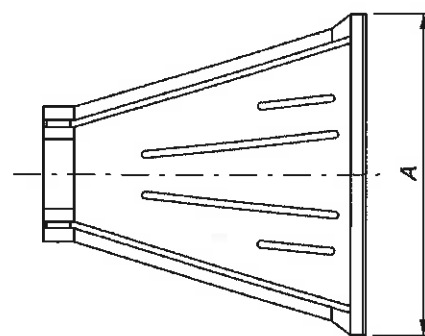

TOP

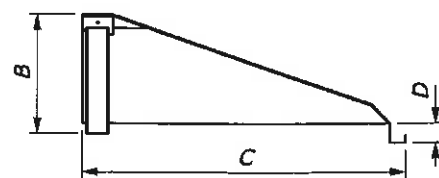

SIDE

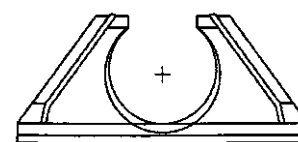

FRONT

PLASTIC PIPE END SECTION





PIPE SIZE DIAMETER INCHES	DIMENSIONS INCHES			
	A	B	C	D
12	42	14.5	33	6
15	46	24.5	45.5	6
18	54	29	55	6
24	64	37	65	6
30	88	36	63.5	6
36	88	43	66.5	6

NO SCALE

U.S. DEPARTMENT OF TRANSPORTATION FEDERAL HIGHWAY ADMINISTRATION FEDERAL LANDS HIGHWAY	
U.S. CUSTOMARY STANDARD	
PLASTIC PIPE CULVERT ✓	
STANDARD APPROVED FOR USE 12/1993	STANDARD
REVISED: 4/1994 6/2005 DRAFT 12/2008	602-5

NOTE:

1. *D* equals the diameter of all round pipe or the rise dimension of all pipe arch culverts.

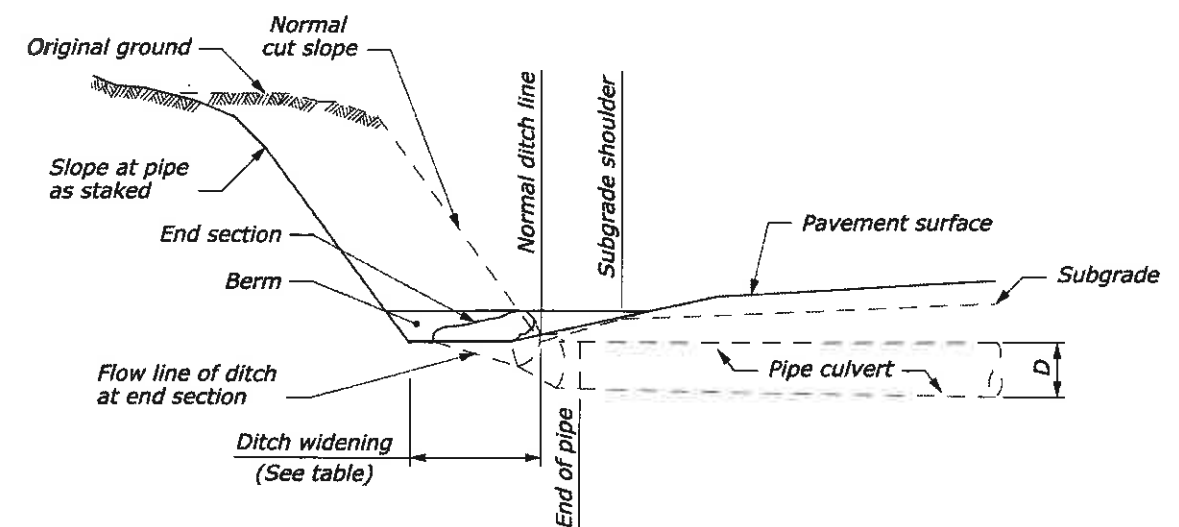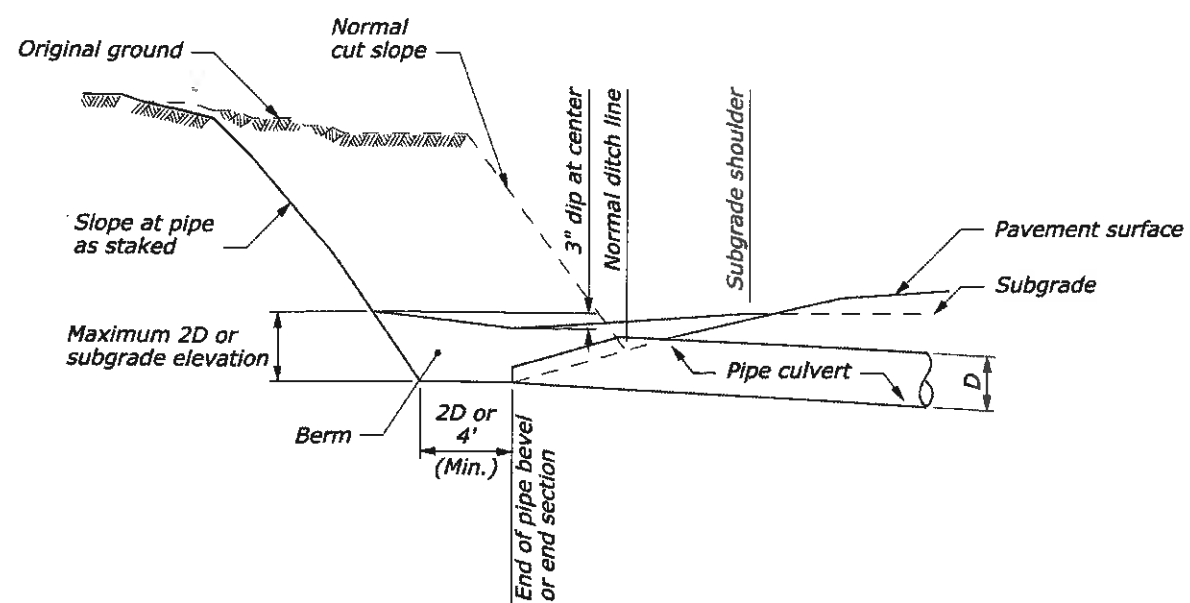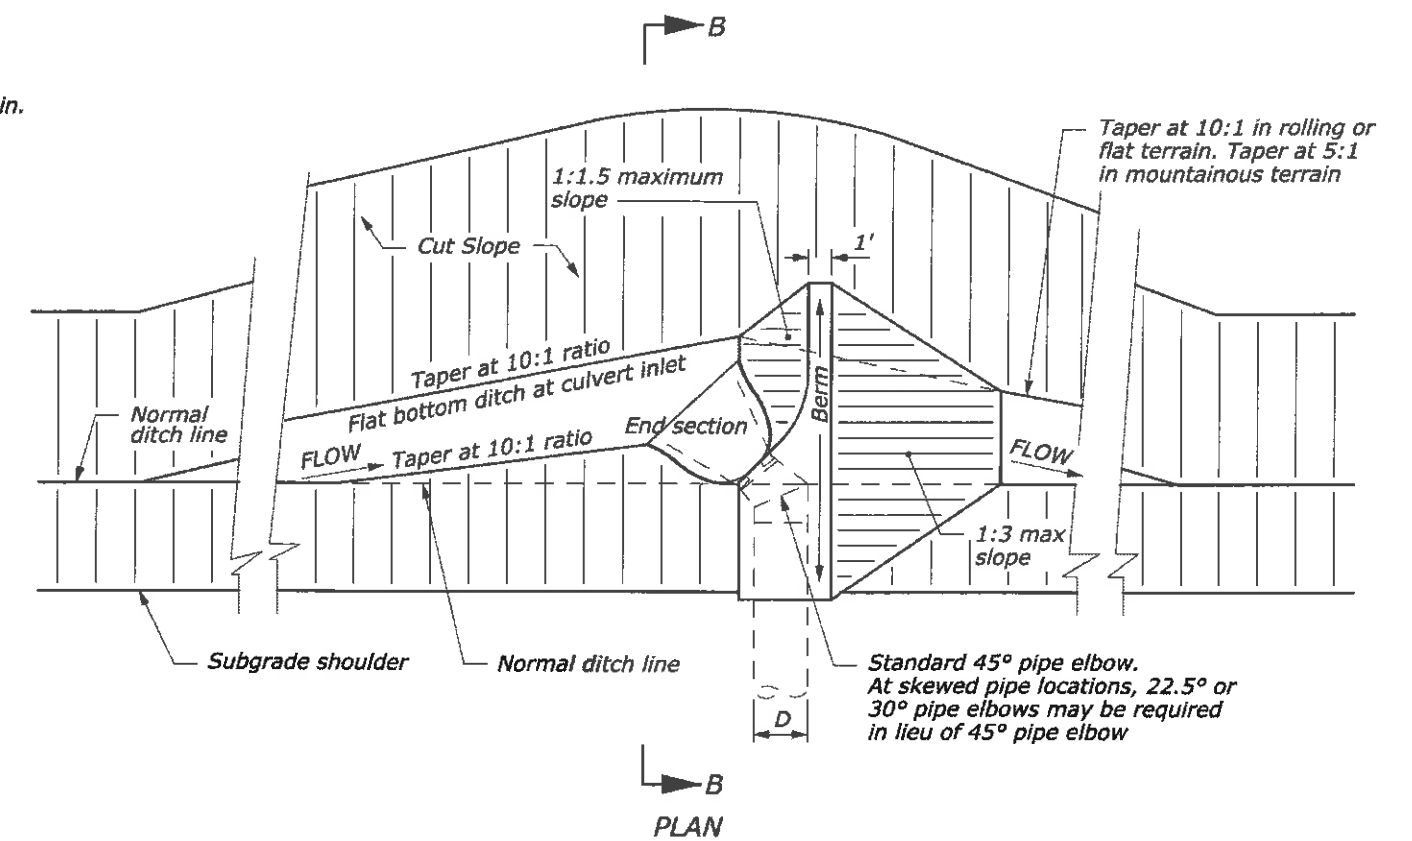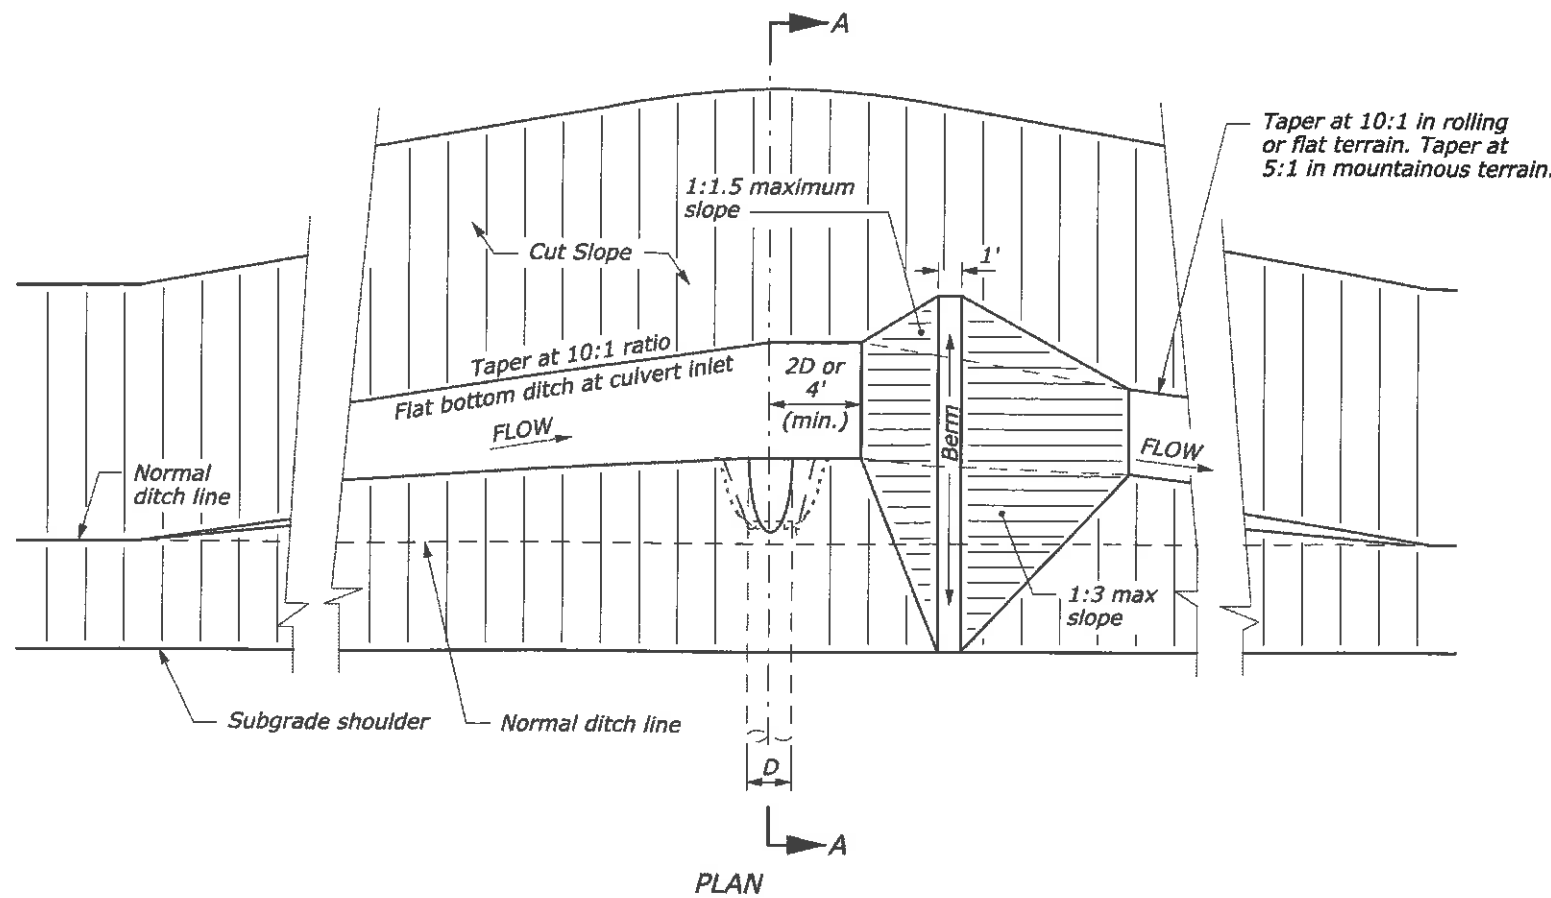

DITCH WIDENING	
PIPE SIZE (D)	WIDENING
18"	5'
24"	6'
30"	7'

**SECTION B-B
TYPE II**

NO SCALE

U.S. DEPARTMENT OF TRANSPORTATION
FEDERAL HIGHWAY ADMINISTRATION
FEDERAL LANDS HIGHWAY

U.S. CUSTOMARY STANDARD

**PIPE CULVERT INLET
TREATMENT IN CUT SLOPES**

STANDARD APPROVED FOR USE 12/1993
REVISED: 4/1994 6/2005

STANDARD
602-6

RECEIVED
 JUL 08 2017
 BY PROJECT ENGINEER

REINFORCED SOIL SLOPE QUANTITIES

Deleted, See CMOOH

STATION	27201-1000 REINFORCED SOIL SLOPE, GEOGRID (SQFT)	INFORMATIONAL QUANTITIES NOT MEASURED FOR PAYMENT									
		STRUCTURAL EXCAVATION (CUYD)	SELECT GRANULAR BACKFILL (CUYD)	UNCLASSIFIED BORROW (CUYD)	GEOGRID (SQYD)	EARTHWORK GEOTEXTILE TYPE 1-A (SQYD)	EARTHWORK GEOTEXTILE TYPE 1-B (SQYD)	ROLLED EROSION CONTROL PRODUCT TYPE 5B (SQYD)	4" SOLID OUTLET DRAIN PIPE (LNFT)	4" PERFORATED PIPE (LNFT)	GEOCOMPOSITE SHEET DRAIN (LNFT)
88+50 to 90+05	1,690	275	638	275	1,901	535	40	65	20	200	32
97+50 to 100+60	5,258	1,176	3,365	1,348	8,028	1,708	70	500	210	350	60
TOTALS	6,948	1,451	4,003	1,623	9,929	2,243	110	565	230	550	92

- APPROVED
- APPROVED AS NOTED
- RETURNED FOR CORRECTION

Date: JUL 10 2017 By: Jim Jozovich

FEDERAL HIGHWAY ADMINISTRATION
 Federal Lands Highway

See FAR 52.236-21(e) for limitations of Government's
 responsibility in approving this document.


~~**TABULATION OF
 REINFORCED SOIL SLOPE
 QUANTITIES**~~

Checked by:


Designed by:

c:\myfiles\pw_production\d0230789\ak-r206001.wa.dgn [US_Sur_f2d]


30 January 2015 10:26 AM

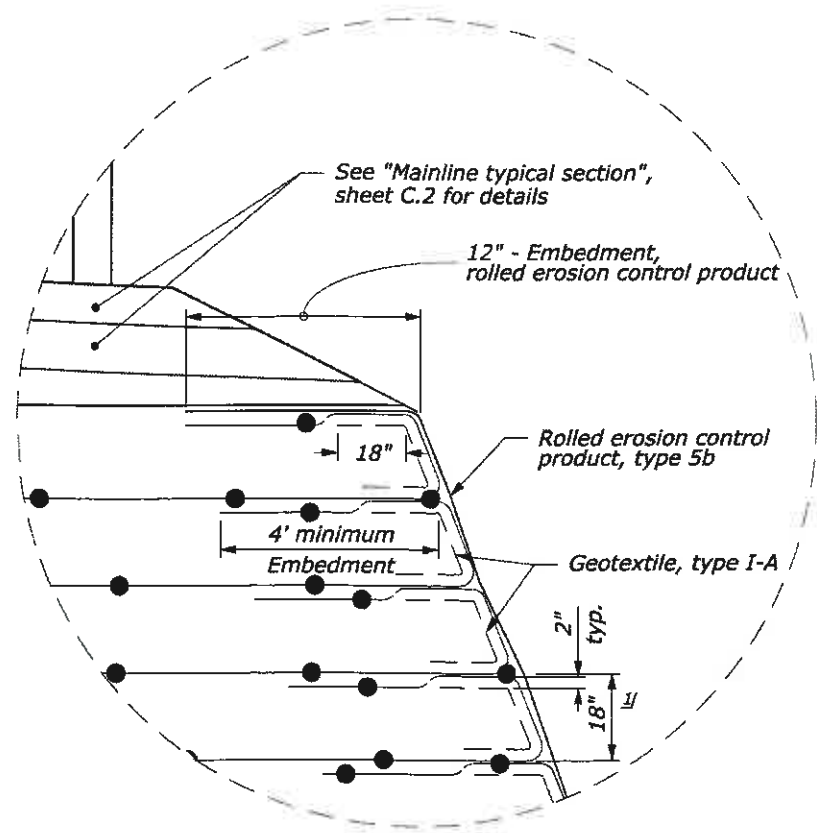

**DETAIL A
RSS FACING**

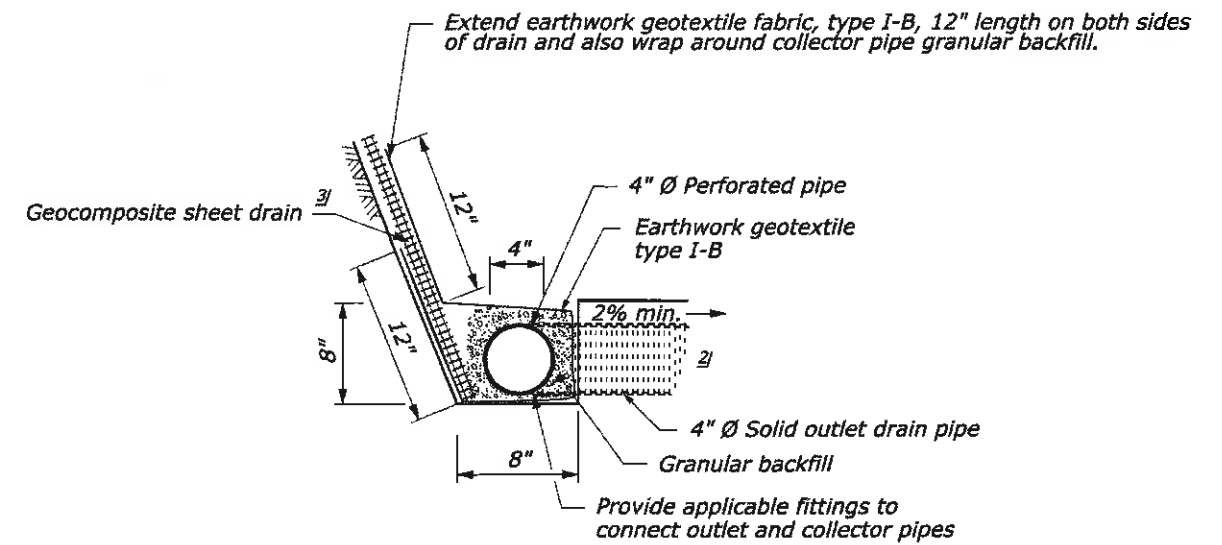

STANDARD UNDERDRAIN SYSTEM (GEOCOMPOSITE UNDERDRAIN SYSTEM)

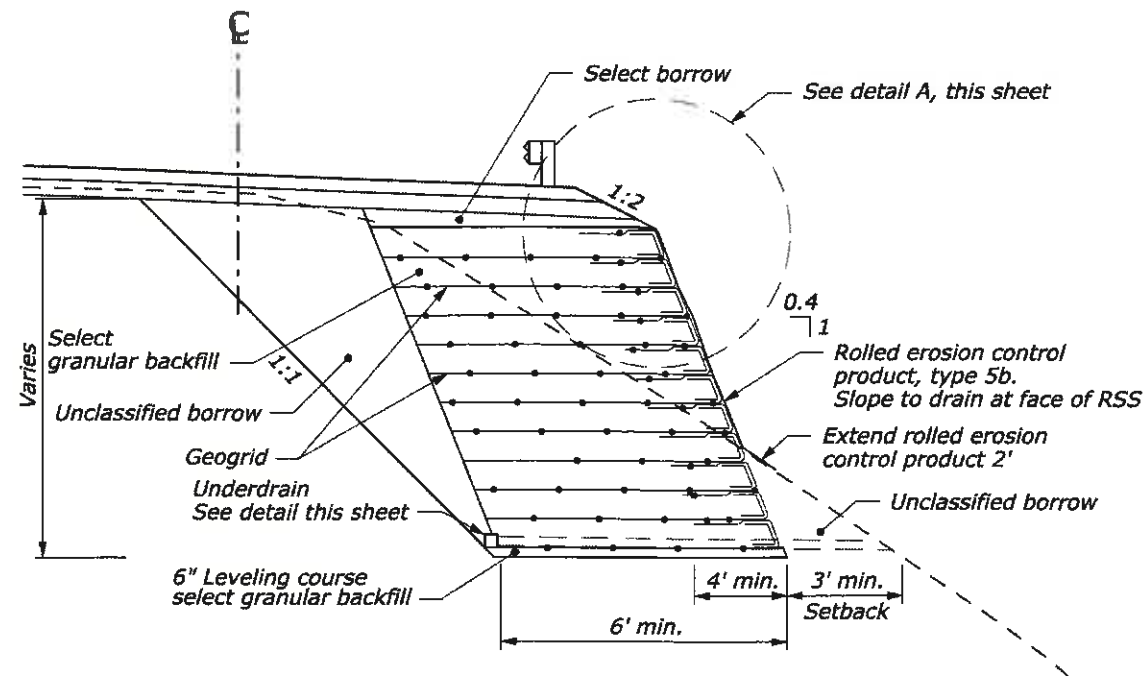

REINFORCED SOIL SLOPE (RSS)

88+50 to 90+05
97+50 to 100+60

NOTE:


1. Place permanent rolled erosion control mat, type 5B, over the face of the RSS and the disturbed ground at the toe of the RSS. Embed a minimum of 12-inch of the mat between the top layer of geogrid and bottom of aggregate base.
2. Place outlet drain pipes at all low spots along RSS and maximum 50-foot spacing.

FOOTNOTE:

- 1 Do not exceed 18-inch vertical spacing between geogrid layers.
- 2 Daylight outlet drain pipe through fill in embankment sections.
- 3 Place 4-foot wide geocomposite sheet drains at the beginning and end stations of the RSS and then place drains 10-feet on center.

Deleted, See C1004

~~**REINFORCED SOIL SLOPE
TYPICAL SECTION**~~

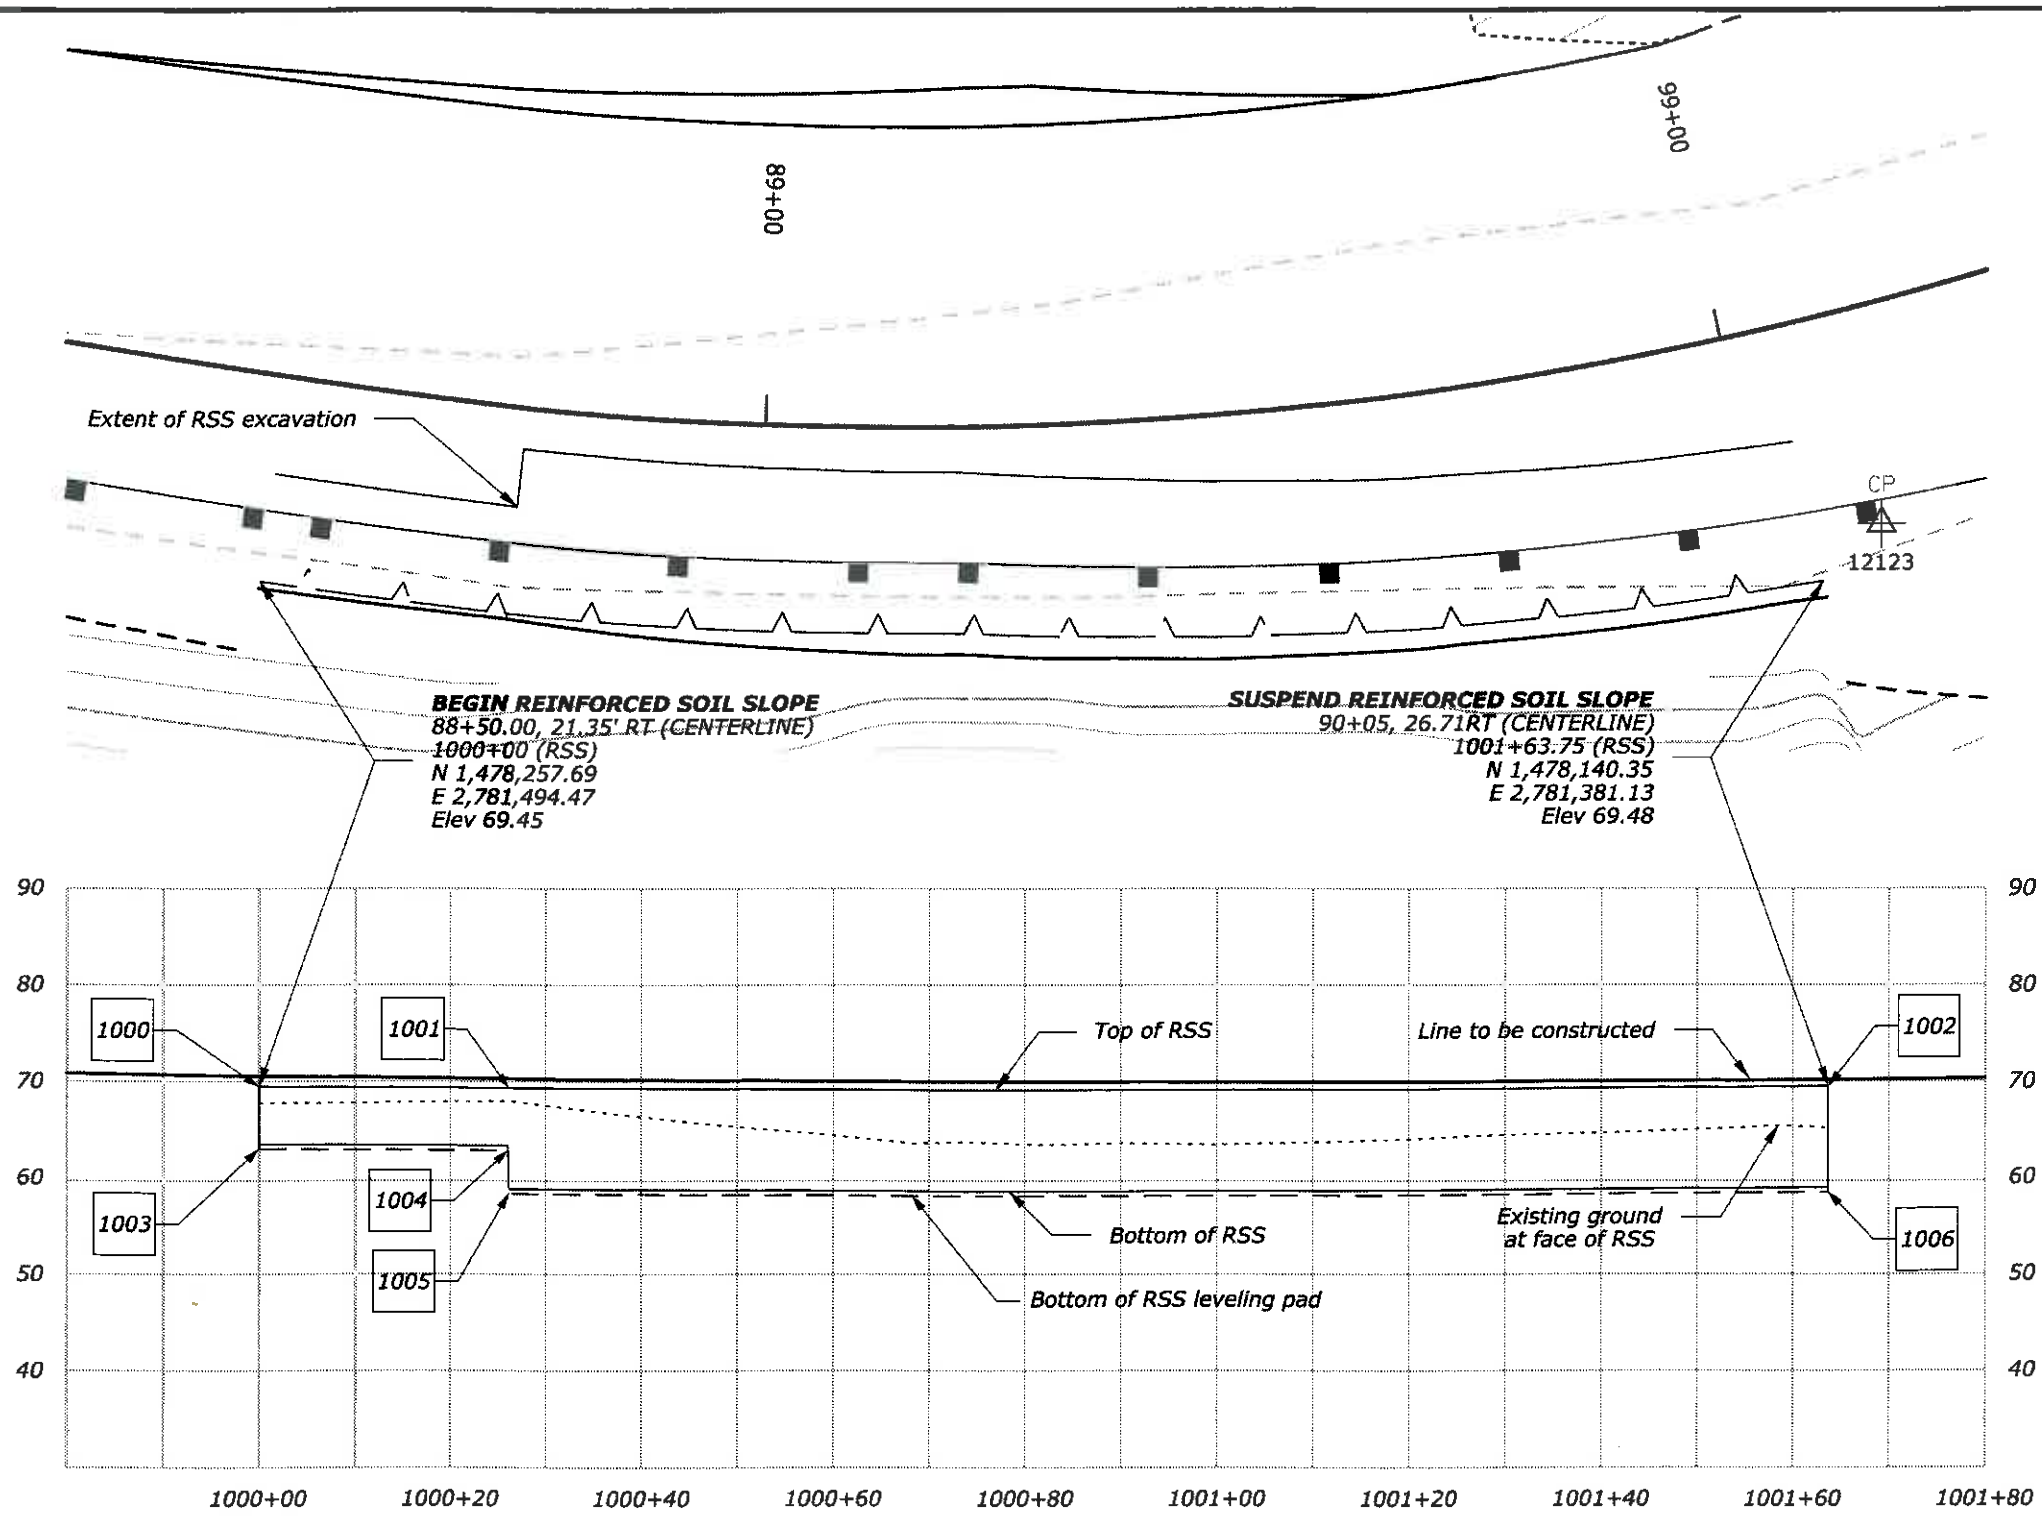

BEGIN REINFORCED SOIL SLOPE
 88+50.00, 21.35' RT. (CENTERLINE)
 1000+00 (RSS)
 N 1,478,257.69
 E 2,781,494.47
 Elev 69.45

SUSPEND REINFORCED SOIL SLOPE
 90+05, 26.71' RT. (CENTERLINE)
 1001+63.75 (RSS)
 N 1,478,140.35
 E 2,781,381.13
 Elev 69.48


POINT	NORTHING	EASTING	ELEVATION	CENTERLINE		RSS SLOPE		DESCRIPTION
				STATION	OFFSET	STATION	OFFSET	
1000	1,478,257.69	2,781,494.47	69.45	88+50.00	21.35	1000+00	0.00	TOP OF RSS SLOPE
1001	1,478,241.40	2,781,474.09	69.30	88+75.00	21.32	1000+26.09	0.00	TOP OF RSS SLOPE
1002	1,478,140.35	2,781,381.13	69.48	90+05.00	26.71	1001+63.75	0.00	TOP OF RSS SLOPE
1003	1,478,259.77	2,781,492.88	62.95	88+50.00	23.97	1000+00	2.62	BOTTOM OF LEVELING PAD
1004	1,478,243.46	2,781,472.48	62.80	88+74.90	23.94	1000+25.99	2.61	BOTTOM OF LEVELING PAD
1005	1,478,244.76	2,781,471.24	58.30	88+75.00	25.73	1000+26.09	4.41	BOTTOM OF LEVELING PAD
1006	1,478,142.72	2,781,377.41	58.48	90+04.90	31.12	1001+63.75	4.40	BOTTOM OF LEVELING PAD

Deleted, See c1004

~~REINFORCED SOIL SLOPE (RSS)~~
~~PLAN AND PROFILE~~
~~88+50 TO 90+05~~


28 October 2014 8:53 AM
 c:\myfiles\pww_production\00230789\ak-f206001\wcdgn [US_Sur_d2d]
 Designed by:
 Checked by:

STATE	PROJECT	SHEET NUMBER
AK	USFS 2060(1)	H.4

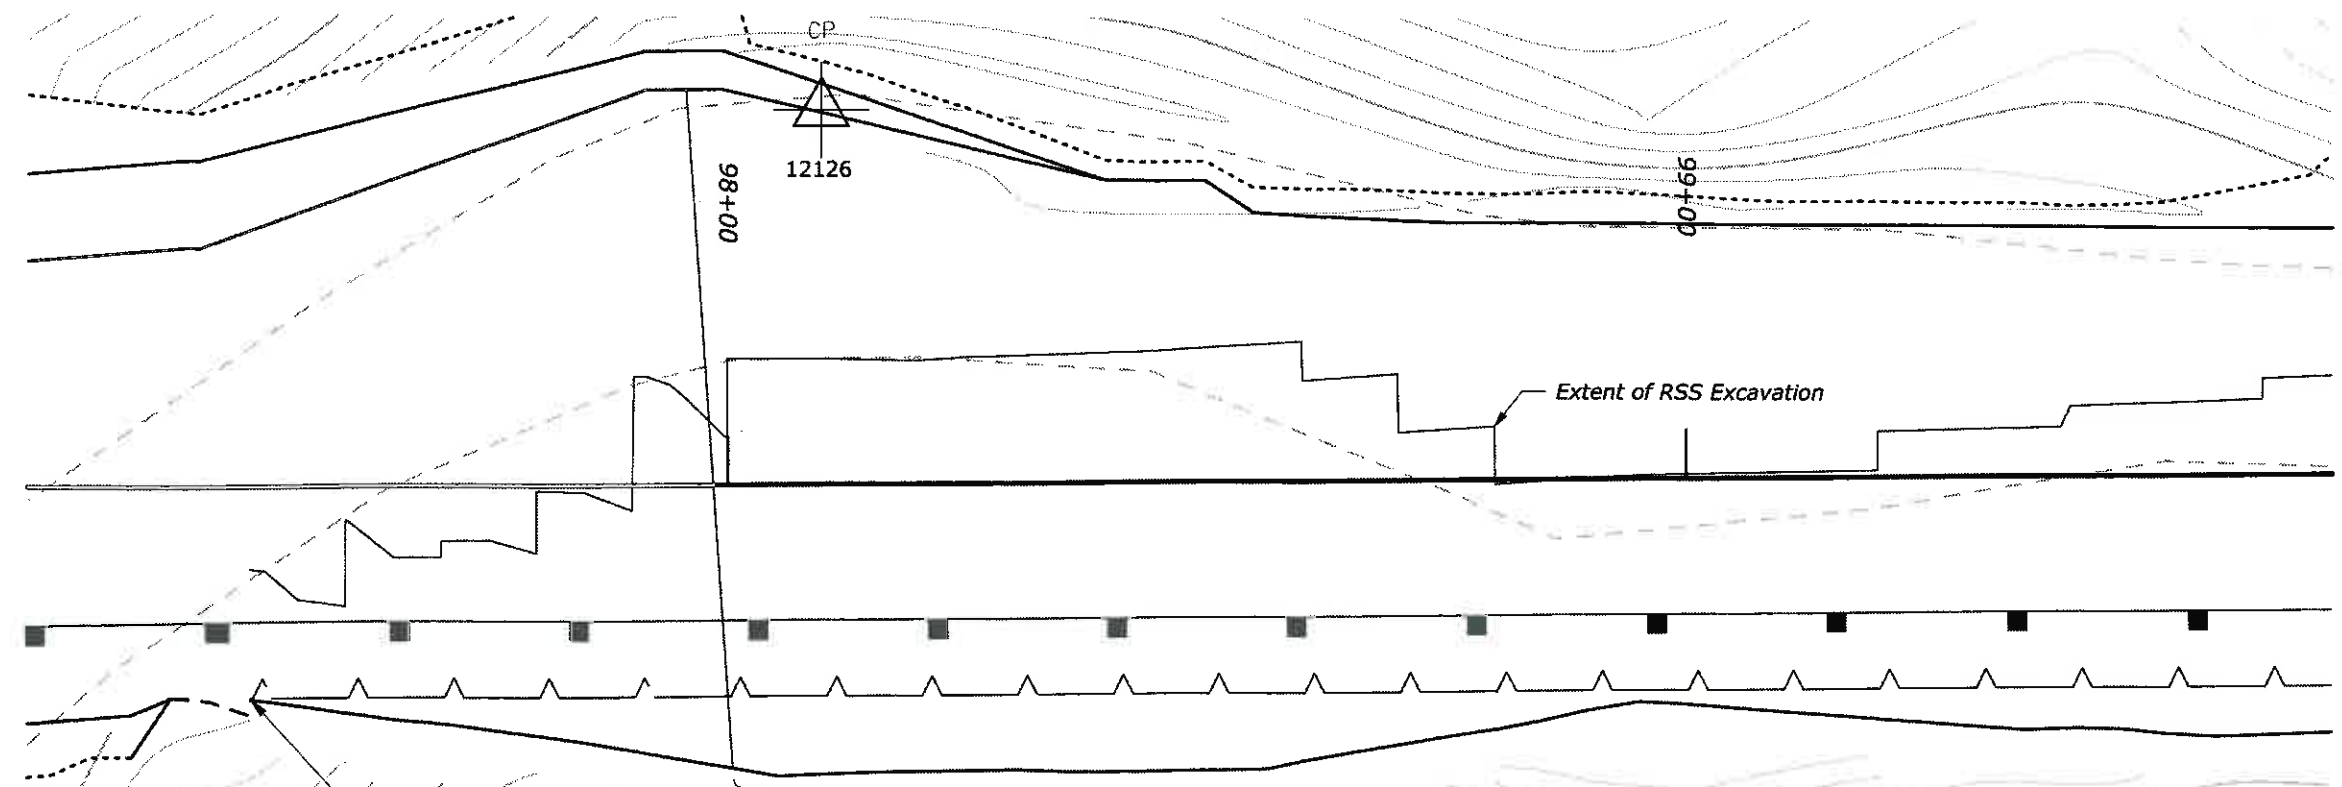

RESUME REINFORCED SOIL SLOPE
 97+50, 21.86'RT (MAIN)
 2000+00 (RSS)
 N 1,477,435.41
 E 2,781,144.42
 Elev 79.02


MATCHLINE
 99+70 (CENTERLINE)
 2002+20 (RSS)

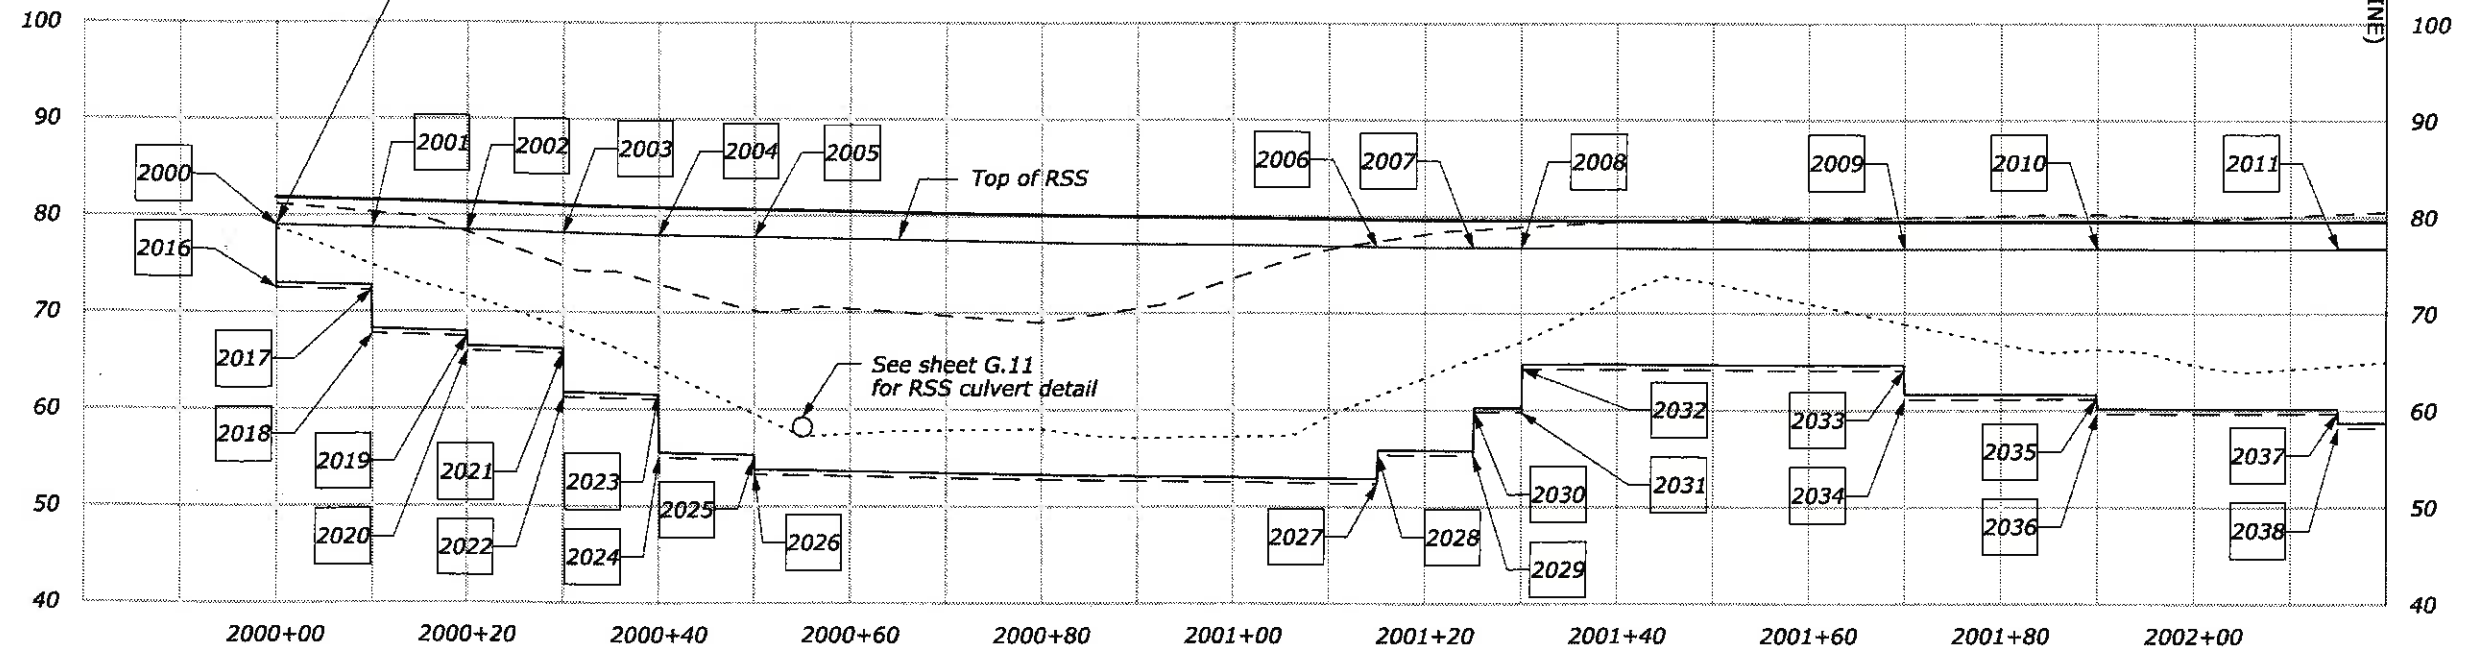

Deleted, See CMO04

~~REINFORCED SOIL SLOPE (RSS)~~
~~PLAN AND PROFILE~~
~~97+50 TO 99+70~~

28 October 2014 8:54 AM
 c:\myfiles\jw_production\02210789\ak-206001.wf.dgn [US_Sur_RCD]
 Designed by:
 Checked by:

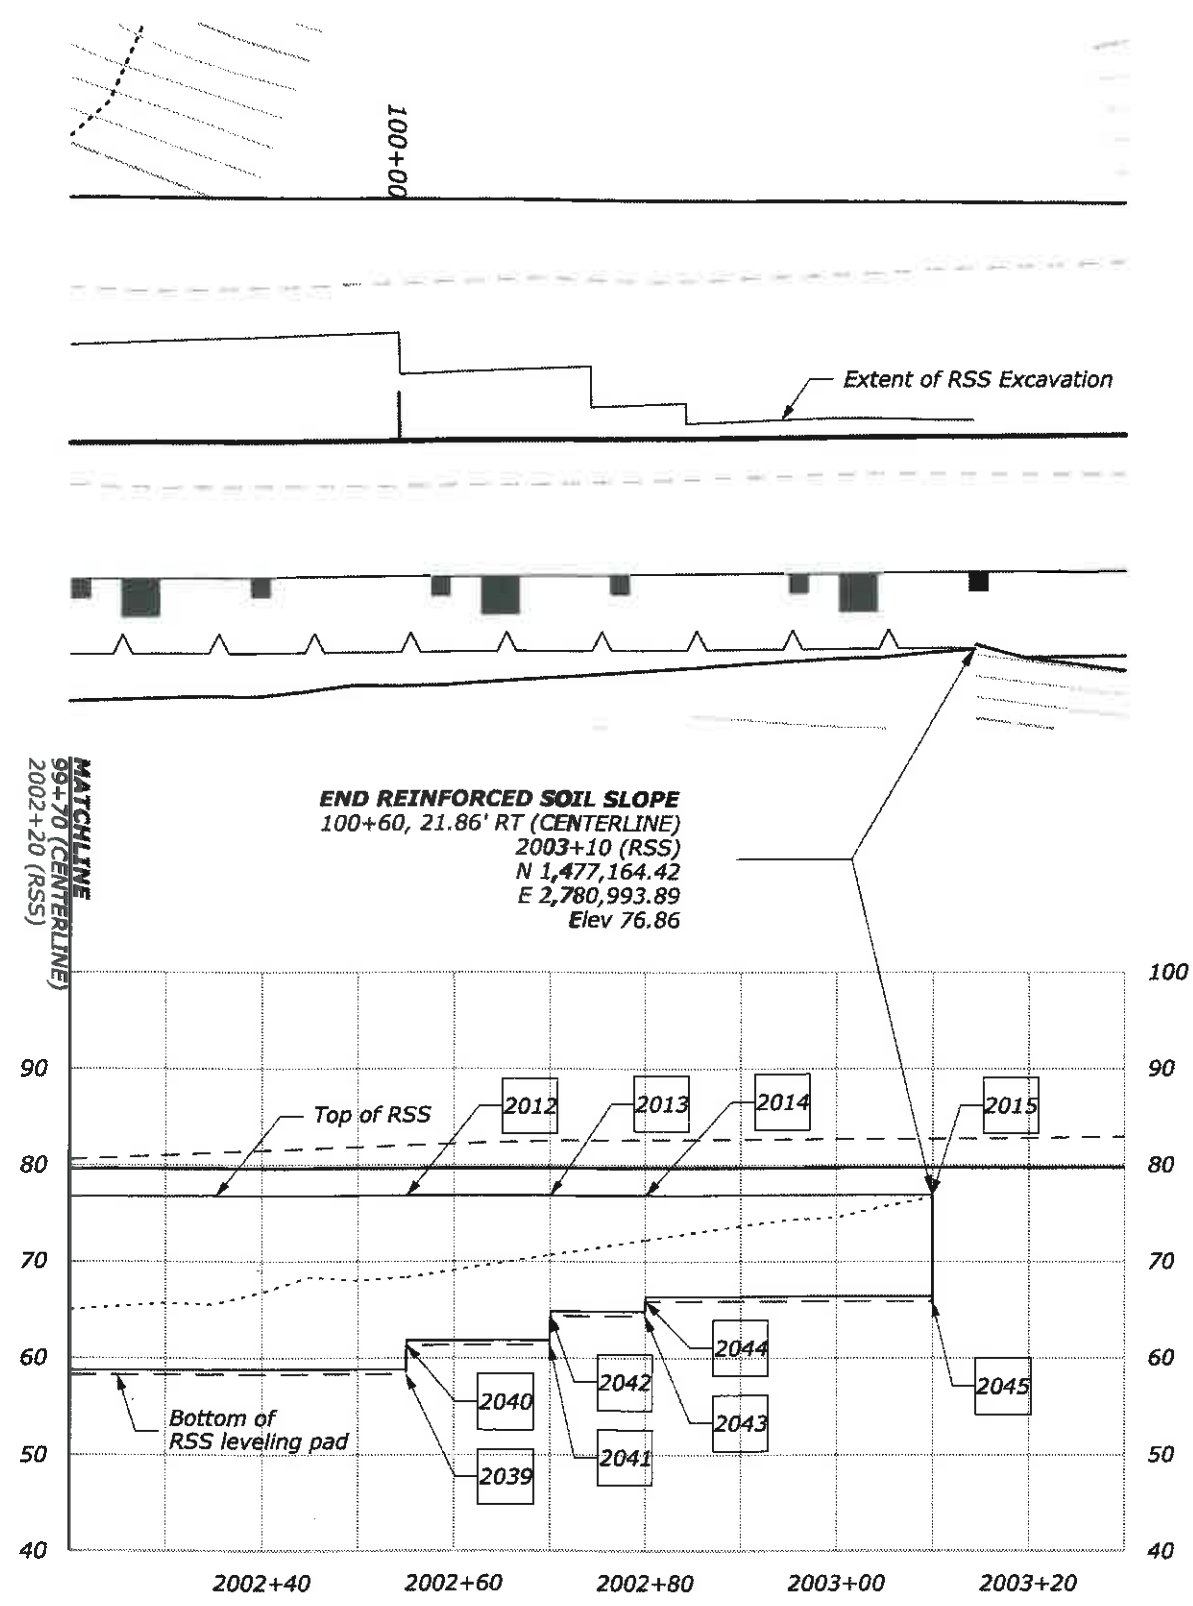

POINT	NORTHING	EASTING	ELEVATION	CENTERLINE		RSS SLOPE		DESCRIPTION
				STATION	OFFSET	STATION	OFFSET	
2000	1,477,435.41	2,781,144.42	79.02	97+50	21.86	2000+00	0	TOP OF RSS SLOPE
2001	1,477,426.67	2,781,139.57	78.75	97+60	21.86	2000+10	0	TOP OF RSS SLOPE
2002	1,477,417.93	2,781,134.71	78.49	97+70	21.86	2000+20	0	TOP OF RSS SLOPE
2003	1,477,409.19	2,781,129.86	78.25	97+80	21.86	2000+30	0	TOP OF RSS SLOPE
2004	1,477,400.45	2,781,125.00	78.02	97+90	21.86	2000+40	0	TOP OF RSS SLOPE
2005	1,477,391.70	2,781,120.15	77.81	98+00	21.86	2000+50	0	TOP OF RSS SLOPE
2006	1,477,334.88	2,781,088.58	76.88	98+65	21.86	2001+15	0	TOP OF RSS SLOPE
2007	1,477,326.14	2,781,083.73	76.80	98+75	21.86	2001+25	0	TOP OF RSS SLOPE
2008	1,477,321.77	2,781,081.30	76.76	98+80	21.86	2001+30	0	TOP OF RSS SLOPE
2009	1,477,286.80	2,781,061.87	76.64	99+20	21.86	2001+70	0	TOP OF RSS SLOPE
2010	1,477,269.32	2,781,052.16	76.67	99+40	21.86	2001+90	0	TOP OF RSS SLOPE
2011	1,477,247.46	2,781,040.02	76.71	99+65	21.86	2002+15	0	TOP OF RSS SLOPE
2012	1,477,212.50	2,781,020.60	76.77	100+05	21.86	2002+55	0	TOP OF RSS SLOPE
2013	1,477,199.38	2,781,013.32	76.80	100+20	21.86	2002+70	0	TOP OF RSS SLOPE
2014	1,477,190.64	2,781,008.46	76.81	100+30	21.86	2002+80	0	TOP OF RSS SLOPE
2015	1,477,164.42	2,780,993.89	76.86	100+60	21.86	2003+10	0	TOP OF RSS SLOPE

Deleted, See CMO04

~~REINFORCED SOIL SLOPE (RSS)
PLAN AND PROFILE
99+70 TO 100+60~~

Checked by:

Designed by:

ct:\myfiles\pw_production\0230789\ak-r206001\wg.dgn [US_Sur_R2D]

28 October 2014 9:02 AM

POINT	NORTHING	EASTING	ELEVATION	CENTERLINE		RSS SLOPE		DESCRIPTION
				STATION	OFFSET	STATION	OFFSET	
2016	1,477,436.68	2,781,142.14	72.52	97+50	24.48	2000+00	2.61	BOTTOM OF LEVELING PAD
2017	1,477,428.03	2,781,137.33	72.24	97+59.90	24.48	2000+09.90	2.62	BOTTOM OF LEVELING PAD
2018	1,477,428.81	2,781,135.71	67.75	97+60	26.28	2000+10	4.41	BOTTOM OF LEVELING PAD
2019	1,477,420.15	2,781,130.92	67.49	97+69.90	26.26	2000+19.90	4.39	BOTTOM OF LEVELING PAD
2020	1,477,420.36	2,781,130.34	65.99	97+70	26.87	2000+20	5	BOTTOM OF LEVELING PAD
2021	1,477,411.71	2,781,125.53	65.73	97+79.90	26.87	2000+29.90	5.01	BOTTOM OF LEVELING PAD
2022	1,477,412.49	2,781,123.91	61.27	97+80	28.67	2000+30	6.8	BOTTOM OF LEVELING PAD
2023	1,477,403.84	2,781,119.10	61.02	97+89.90	28.67	2000+39.90	6.81	BOTTOM OF LEVELING PAD
2024	1,477,404.91	2,781,116.96	55.02	97+90	31.06	2000+40	9.2	BOTTOM OF LEVELING PAD
2025	1,477,396.26	2,781,112.14	54.82	97+99.90	31.08	2000+49.90	9.21	BOTTOM OF LEVELING PAD
2026	1,477,396.46	2,781,111.58	53.31	98+00	31.68	2000+50	9.8	BOTTOM OF LEVELING PAD
2027	1,477,339.65	2,781,080.01	52.38	98+64.99	31.67	2001+14.99	9.81	BOTTOM OF LEVELING PAD
2028	1,477,338.97	2,781,081.02	55.38	98+65.10	30.46	2001+15.10	8.6	BOTTOM OF LEVELING PAD
2029	1,477,330.31	2,781,076.21	55.31	98+75	30.46	2001+25	8.59	BOTTOM OF LEVELING PAD
2030	1,477,329.36	2,781,077.73	59.79	98+75.10	28.67	2001+25.10	6.8	BOTTOM OF LEVELING PAD
2031	1,477,325.07	2,781,075.35	59.76	98+80	28.67	2001+30	6.8	BOTTOM OF LEVELING PAD
2032	1,477,324.11	2,781,076.88	64.26	98+80.10	26.86	2001+30.10	5	BOTTOM OF LEVELING PAD
2033	1,477,289.32	2,781,057.54	64.14	99+19.90	26.88	2001+69.90	5.01	BOTTOM OF LEVELING PAD
2034	1,477,289.81	2,781,056.46	61.14	99+20	28.06	2001+70	6.19	BOTTOM OF LEVELING PAD
2035	1,477,272.42	2,781,046.78	61.17	99+39.90	28.08	2001+89.90	6.21	BOTTOM OF LEVELING PAD
2036	1,477,272.62	2,781,046.22	59.67	99+40	28.66	2001+90	6.8	BOTTOM OF LEVELING PAD
2037	1,477,250.85	2,781,034.13	59.71	99+64.90	28.66	2002+14.90	6.8	BOTTOM OF LEVELING PAD
2038	1,477,251.06	2,781,033.55	58.21	99+65	29.27	2002+15	7.4	BOTTOM OF LEVELING PAD
2039	1,477,216.09	2,781,014.13	58.28	100+05	29.27	2002+55	7.4	BOTTOM OF LEVELING PAD
2040	1,477,215.42	2,781,015.13	61.27	100+05.10	28.07	2002+55.10	6.2	BOTTOM OF LEVELING PAD
2041	1,477,202.39	2,781,007.90	61.30	100+20	28.06	2002+70	6.19	BOTTOM OF LEVELING PAD
2042	1,477,201.72	2,781,008.90	64.30	100+20.10	26.86	2002+70.10	4.99	BOTTOM OF LEVELING PAD
2043	1,477,193.07	2,781,004.09	64.32	100+30	26.86	2002+80	5	BOTTOM OF LEVELING PAD
2044	1,477,192.69	2,781,004.56	65.81	100+30.10	26.27	2002+80.10	4.4	BOTTOM OF LEVELING PAD
2045	1,477,166.55	2,780,990.04	65.86	100+60	26.27	2003+10	4.4	BOTTOM OF LEVELING PAD

Deleted, See CM004


**REINFORCED SOIL SLOPE (RSS)
PLAN AND PROFILE
99+70 TO 100+60**

Checked by:

Designed by:


c:\myfiles\jw_production\02310789\ale-c06001\wh.dgn [U.S. Sur. R2D]

10 October 2014 12:45 PM

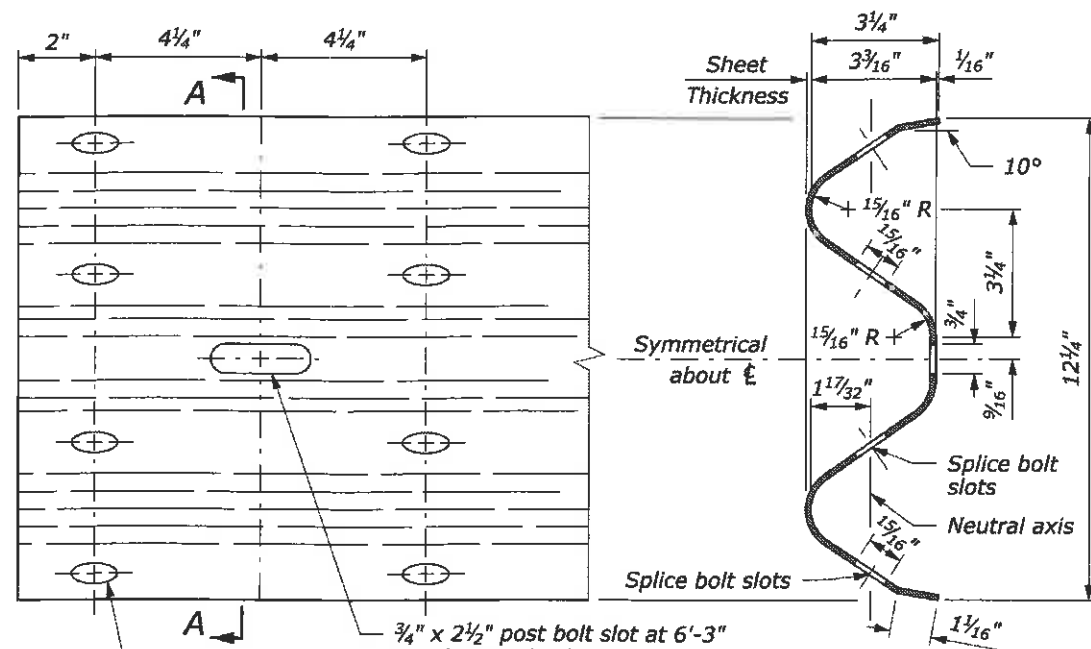


RAIL ELEVATION


W BEAM RAIL

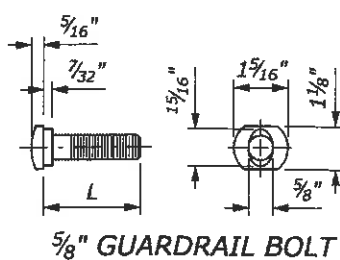

L	Thread Length
1 1/4"	1 1/8" minimum
2"	1 3/4" minimum
10"	4" minimum
18"	4" minimum
25"	4" minimum

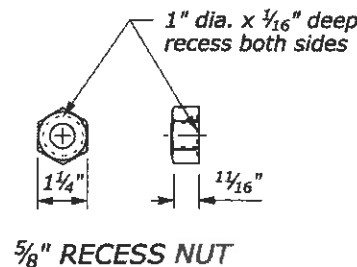


GUARDRAIL BOLT AND RECESS NUT

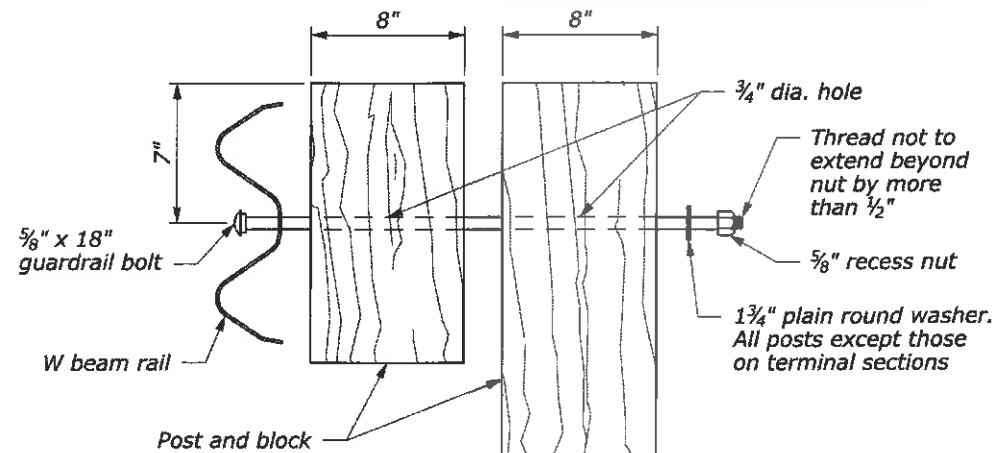

POST BOLT ASSEMBLY


NOTE:

1. When encountering impenetrable material, see Standards 617-13 or 617-24.
2. See Special Contract Requirements when 7'-0" or longer posts are specified.
3. See Special Contract Requirements when the alternative hole arrangement is specified.
4. Install reflector tab between post bolt and rail, every fourth post. Alternate reflector tab shapes are acceptable.
5. Dimensional tolerances not shown or implied are intended to be those consistent with the proper functioning of the part, including its appearance, and accepted manufacturing practices.

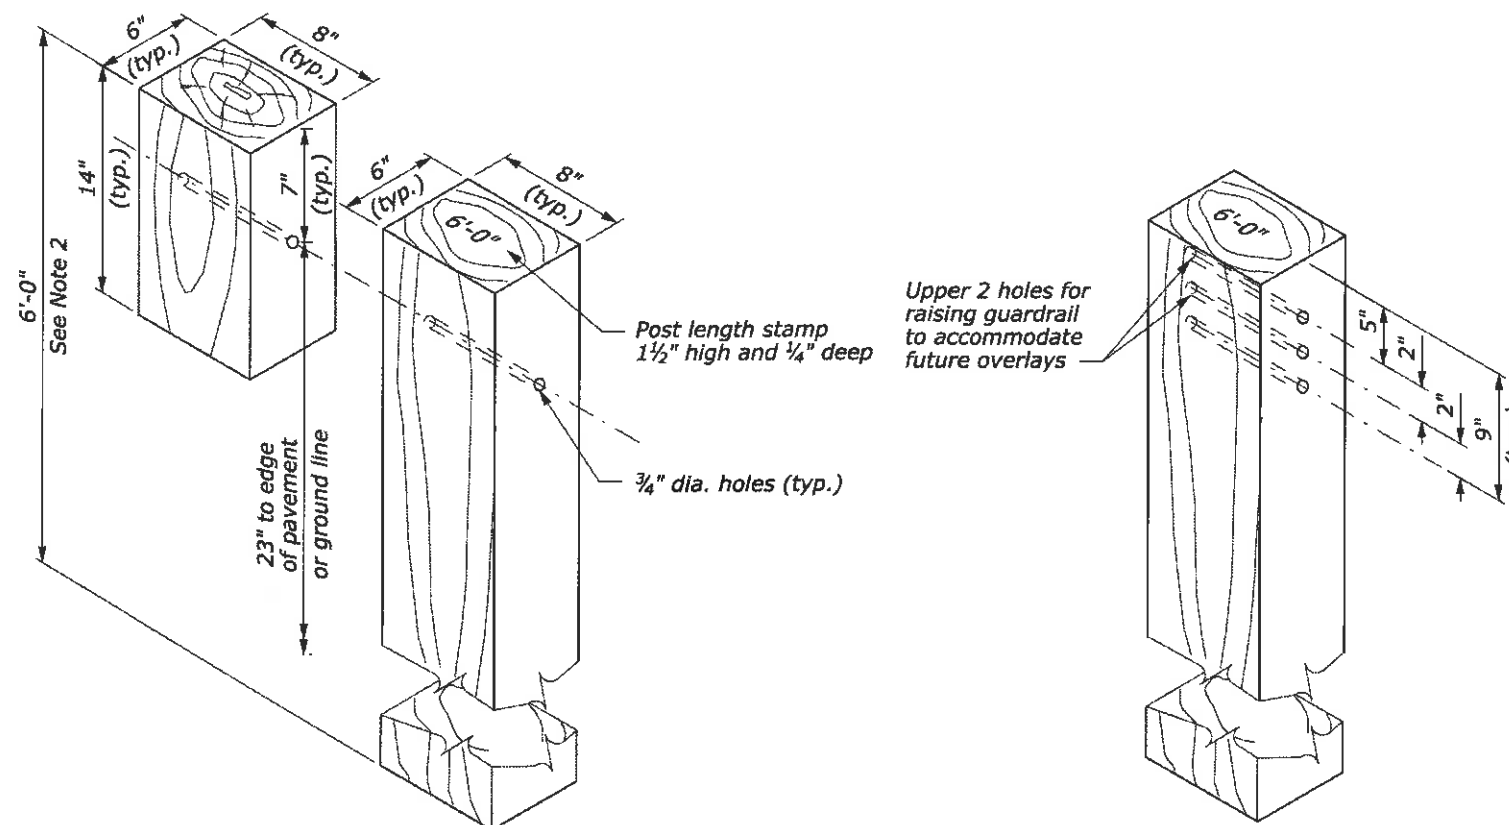


STANDARD HOLE ARRANGEMENT POST AND BLOCK DETAIL


ALTERNATE HOLE ARRANGEMENT POST AND BLOCK DETAIL

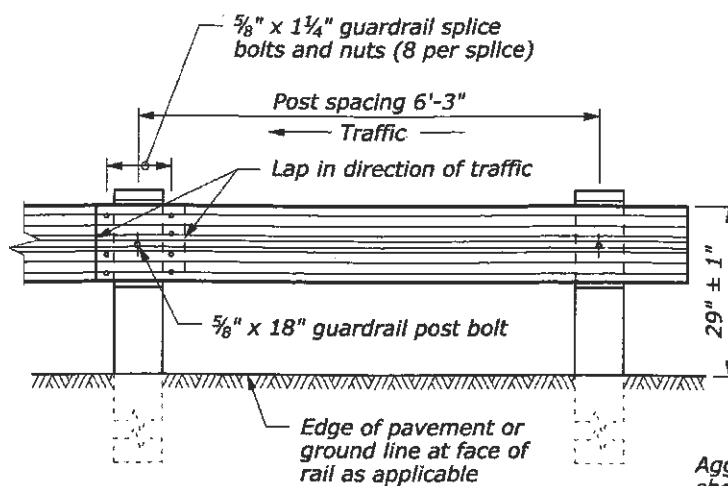

POST SPACING STANDARD POST SECTION

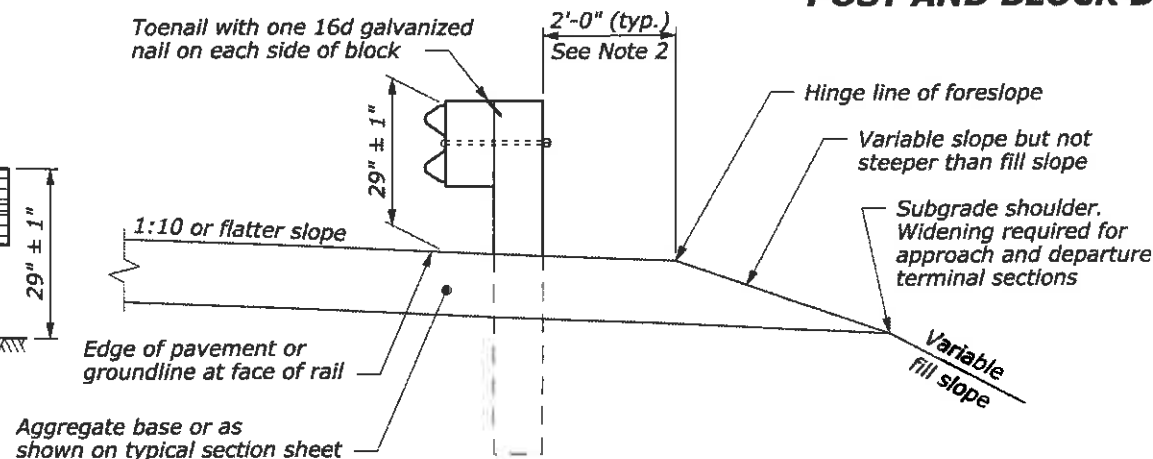

TYPICAL GUARDRAIL CROSS SECTION

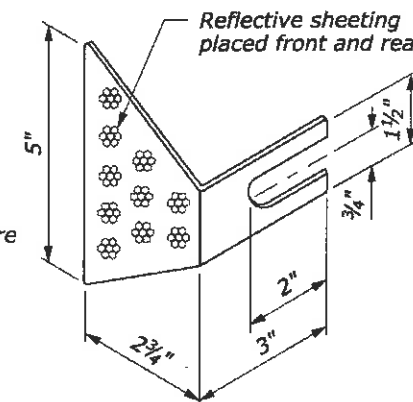


REFLECTOR TAB (See Note 4)

NO SCALE


U.S. DEPARTMENT OF TRANSPORTATION FEDERAL HIGHWAY ADMINISTRATION FEDERAL LANDS HIGHWAY	
U.S. CUSTOMARY STANDARD	
G4 W-BEAM GUARDRAIL WOOD POSTS	
STANDARD APPROVED FOR USE 1/1994	STANDARD
REVISED: 4/1994 6/2005 DRAFT: 10/2013	617-10

NOTE:

1. Install a tangent G4 W-beam guardrail terminal that meets NCHRP-350 requirements per manufacturer's recommendations. Ensure that terminal meets appropriate test level for the project.
2. Install terminal at a 1:50 taper, ensuring that end piece is entirely off shoulder.
3. See manufacturer's drawings for other details.

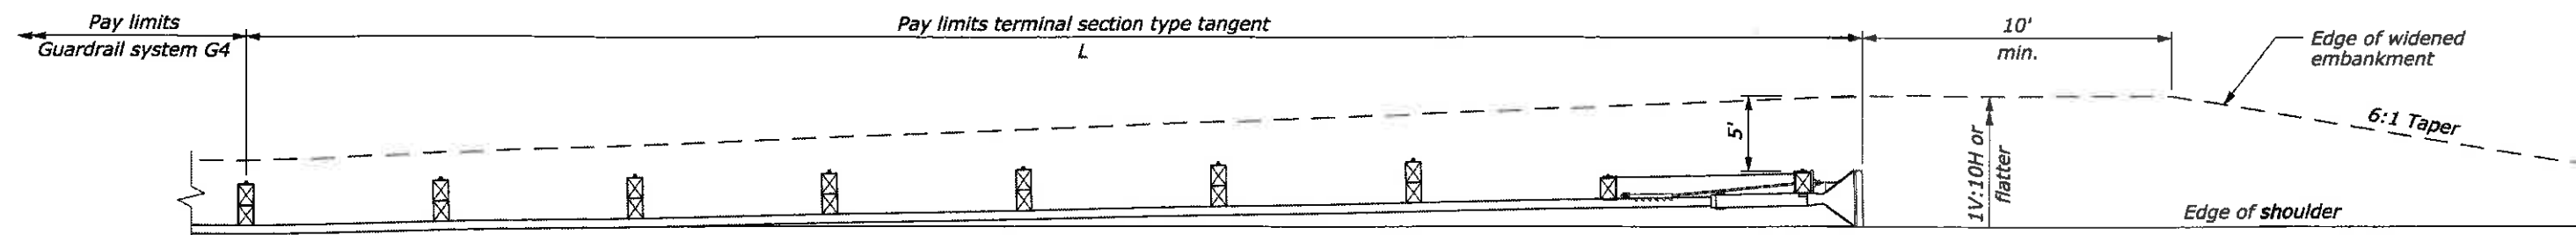

PLAN

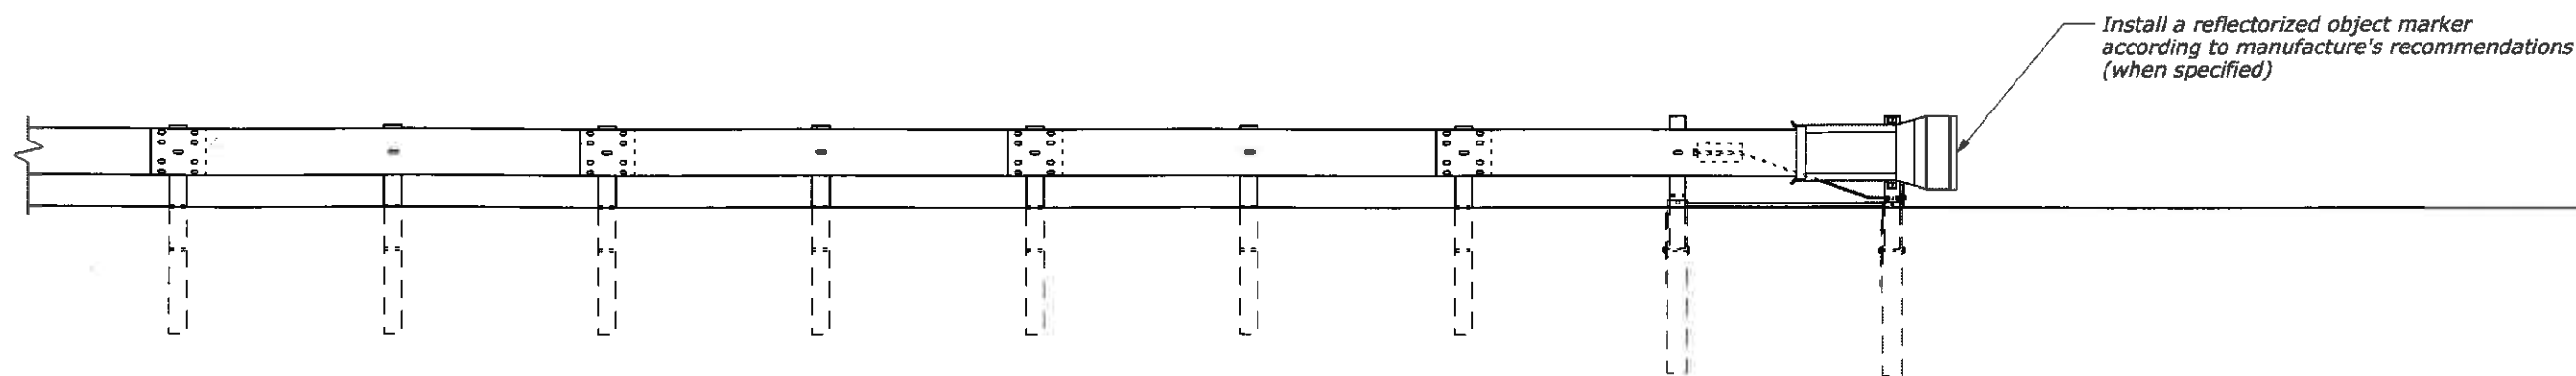

ELEVATION

TEST LEVEL	L (ft)
2 (≤ 45 mph)	25
3 (> 45 mph)	37.5 or 50

NO SCALE

U.S. DEPARTMENT OF TRANSPORTATION FEDERAL HIGHWAY ADMINISTRATION FEDERAL LANDS HIGHWAY	
U.S. CUSTOMARY STANDARD	
G4 W-BEAM GUARDRAIL TYPE TANGENT TERMINAL	
STANDARD APPROVED FOR USE 6/2005	STANDARD
REVISED: DRAFT: 2/2007	617-20

RECEIVED
 JUL 08 2017
 BY PROJECT ENGINEER

SUMMARY OF TEMPORARY TRAFFIC CONTROL QUANTITIES			
ITEM	DESCRIPTION	UNIT	QUANTITY
63502-0600	Temporary traffic control, barricade, type 3	each	4
63502-1000	Cone, type 36-inch	each	150
63502-1300	Drum	each	60
63503-0400	Temporary traffic control, concrete barrier	lnft	1,170
63509-1000	Temporary traffic control, flagger	fix hr rate	7000
63506-0600	Temporary traffic control, Pilot Car	HR	1800

✓
 ✓
 ✓
 ✓ See CMO04 ✓
 ✓ See CMO01 ✓
 ✓ See CMO01 ✓

APPROVED
 APPROVED AS NOTED
 RETURNED FOR CORRECTION

Date: JUL 10 2017 By: Jim Jozovich

FEDERAL HIGHWAY ADMINISTRATION
 Federal Lands Highway

See FAR 52.236-21(e) for limitations of Government's responsibility in approving this document.


ITEM 63504-1000 TEMPORARY TRAFFIC CONTROL, CONSTRUCTION SIGN					
SIGN NUMBER	MUTCD NUMBER	LEGEND	SIZE (In X In.)	NUMBER OF SIGNS	QUANTITY (Sqft)
1	G20-1	ROAD WORK NEXT 3 MILES	36 x 18	2	9
2	G20-2	END ROAD WORK	36 x 18	5	22.5
3	W13-1P	20 MPH	24 x 24	2	8
4	W16-2P	100 FEET	24 x 18	4	12
5	W20-1	ROAD WORK 200 FEET	36 x 36	2	18
6	W20-1	ROAD WORK 100 FEET	36 x 36	2	18
7	W20-1	ROAD WORK AHEAD	36 x 36	5	45
8	W20-4	ONE LANE ROAD AHEAD	36 x 36	4	36
9	W20-7a	FLAGGER SYMBOL	36 x 36	4	36
10	W3-4	BE PREPARED TO STOP	36 x 36	4	36
TOTAL					240.5

✓
 ✓
**TABULATION OF
 TEMPORARY TRAFFIC CONTROL
 QUANTITIES** ✓

21 October 2014 12:42 PM
 c:\myfiles\pw_production\0229143\ek-f906001.ne.dgn [US_Sur_R2D]
 Designed by: C. Conrad
 07/2014 Checked by:

ROAD TYPE	DISTANCE BETWEEN SIGNS IN FEET		
	A	B	C
Urban and Rural 30 MPH and less	100	100	100
Urban and Rural 35 MPH to 50 MPH	350	350	350
Rural greater than 50 MPH	500	500	500
Expressway / Freeway	1000	1500	2640

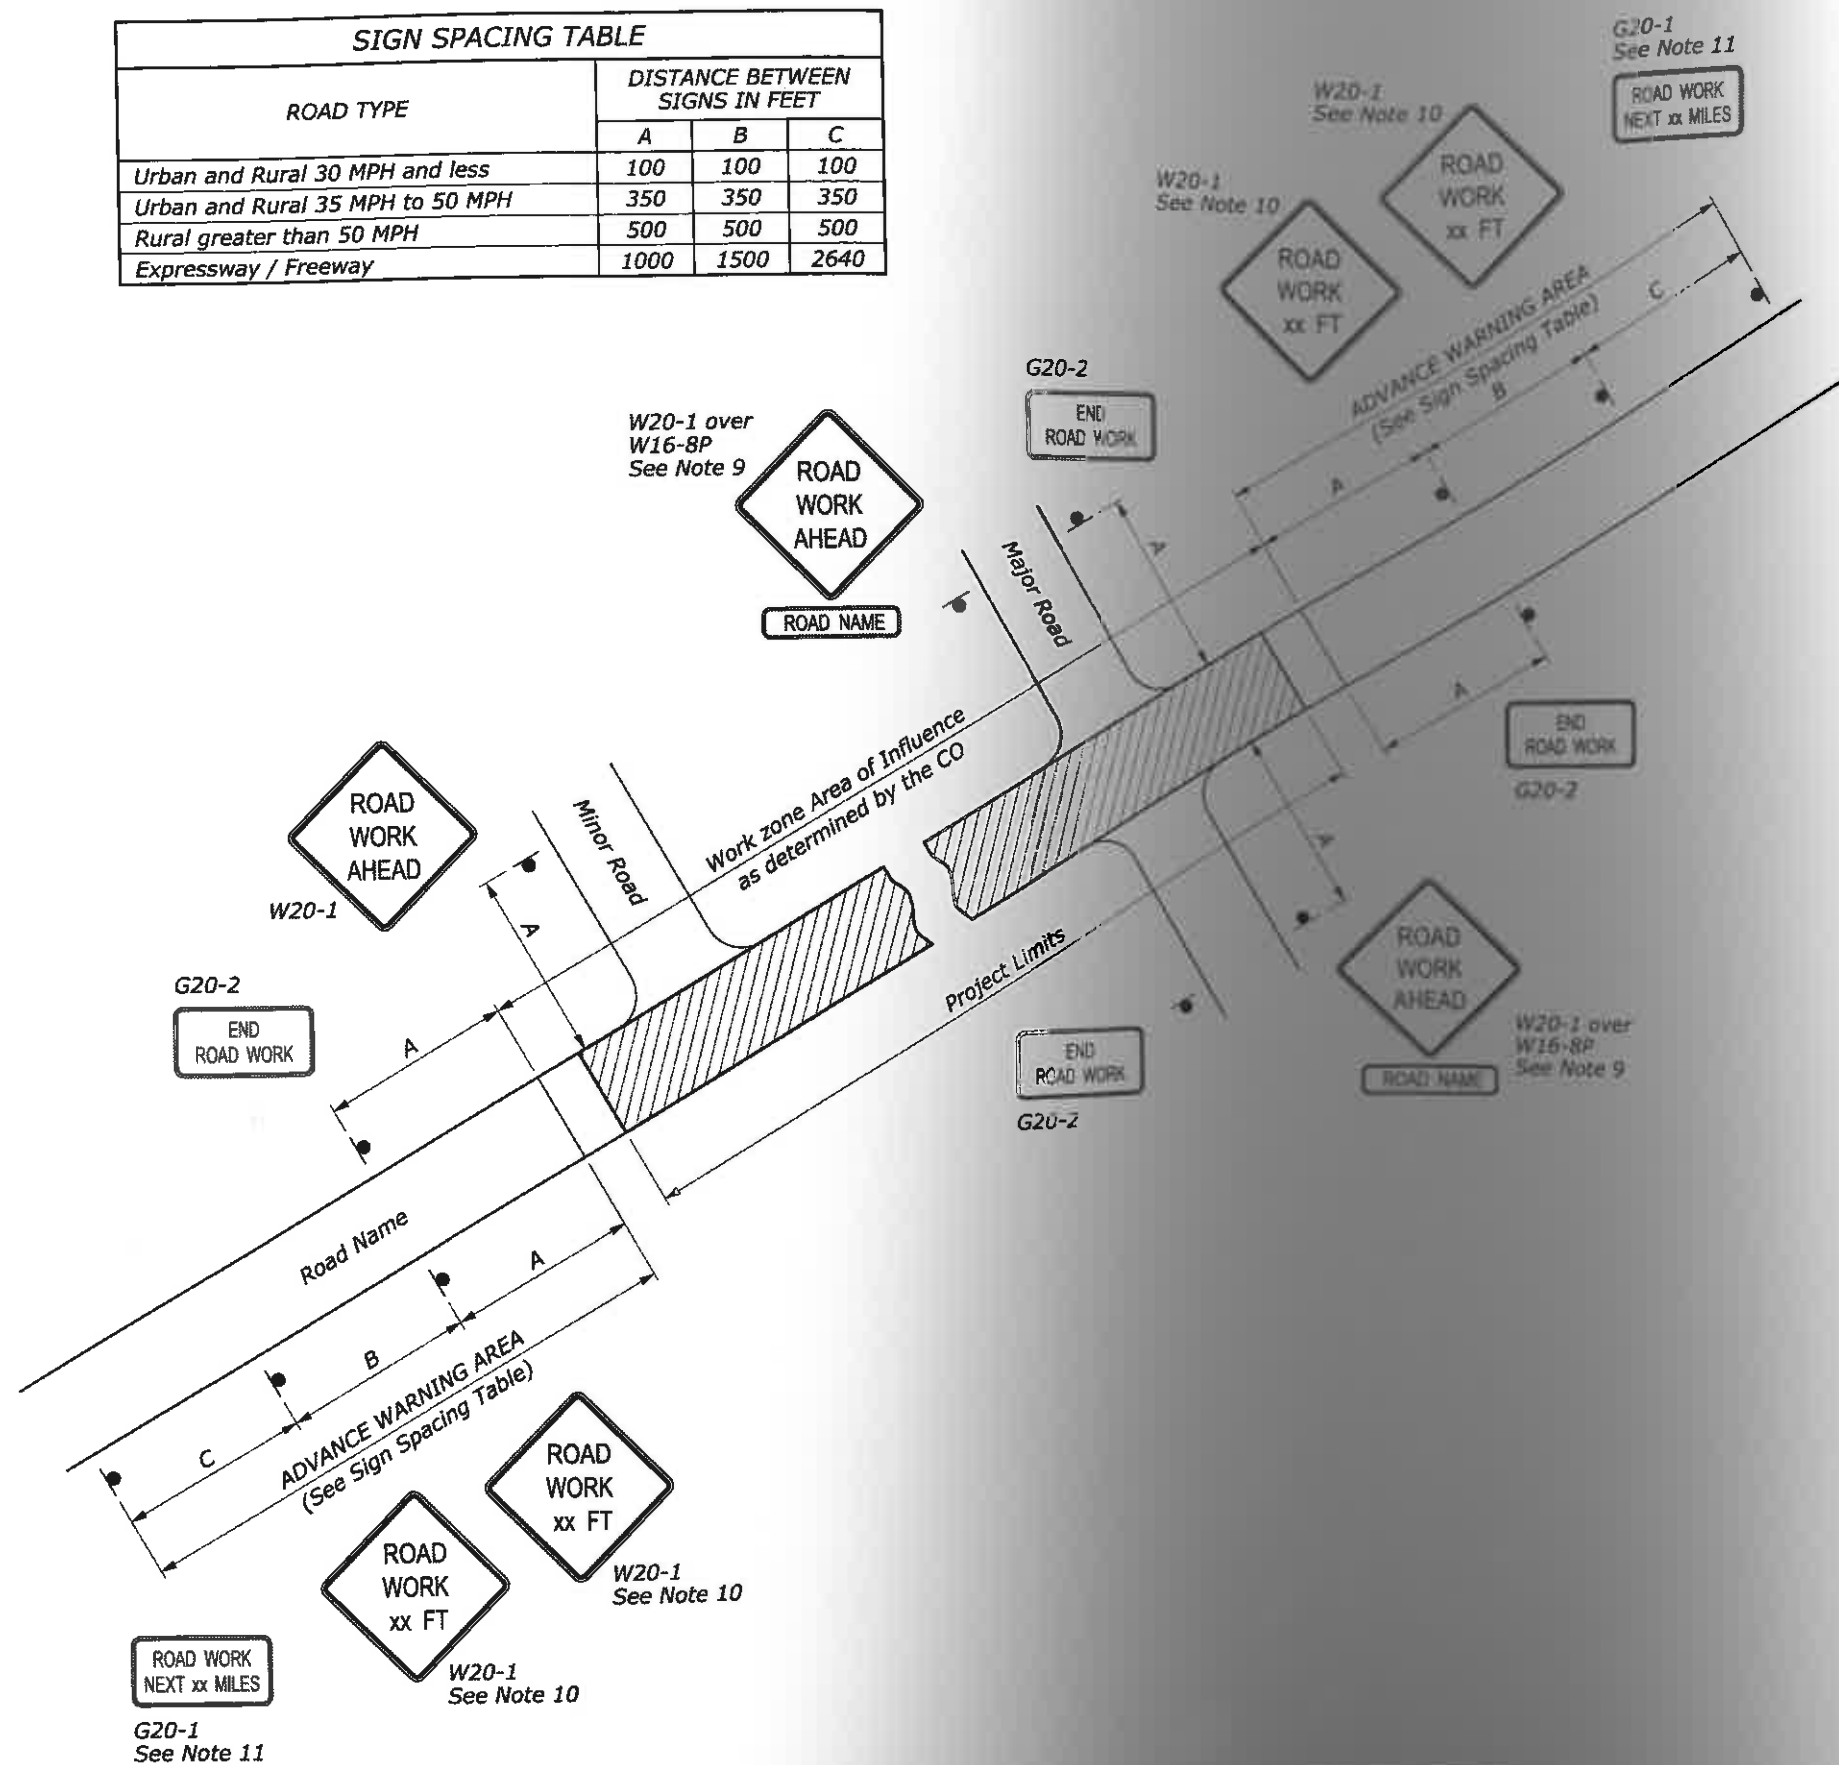

NOTE:

1. Erect all project advance warning signs before starting construction work.
2. Not all details shown on the temporary traffic control sheets may be applicable to this project. The Contractor may add or delete information and details in this traffic control plan as necessary to accommodate actual operations.
3. Where advance warning signs, placed as shown, interfere with permanent signs, locate the warning signs as determined by the CO for best results. Vary messages as required.
4. Additional or different message signs may be required to fit the actual construction conditions.
5. Install advisory speed plates under the W20 series warning signs as needed to indicate a maximum recommended speed through the construction area.
6. Ensure all sign supports exposed to impact by traffic meet the requirements of NCHRP-350 or MASH for crashworthiness.
7. Maintain two-way traffic during all non-work hours except as approved by the CO.
8. Do not store traffic control devices along the roadway when not in use. Cover post-mounted signs when not applicable.
9. If W20-1 is placed on a roadway other than that on which the actual construction work occurs, include a supplementary plaque indicating the name of the road on which the construction does occur (applies to major roads only).
10. The message on the W20-1 signs may be "ROAD WORK AHEAD" or may specify the distance to the work area in feet or in miles. Install an additional W20-1 sign when approach speeds exceed 50 MPH. When used place the two W20-1 signs "B" feet apart according to the Sign Spacing Table.
11. For work zones that are 2 miles or more in length, install G20-1 signs at each end of the project. Show the distance on the G20-1 sign to the nearest whole mile.
12. If signing on a roadway under a jurisdiction other than the client agency, verify that an encroachment permit has been obtained.
13. State standards may be used as an alternative if approved by the CO.
14. Refer to the Section 635 of the Special Contract Requirements for allowable retroreflective sheeting types.

c:\myfiles\pw_production\d0229143\ak-r206001st63501.dgn [USC] 24 July 2014 2:45 PM

NO SCALE

U.S. DEPARTMENT OF TRANSPORTATION FEDERAL HIGHWAY ADMINISTRATION FEDERAL LANDS HIGHWAY	
U.S. CUSTOMARY STANDARD	
TEMPORARY TRAFFIC CONTROL ADVANCE SIGNING	
STANDARD APPROVED FOR USE 6/2005	
REVISED: DRAFT: 9/2010	STANDARD 635-1




APPROACH SPEED*	BUFFER SPACE LENGTH
MPH	FEET
20	115
25	155
30	200
35	250
40	305
45	360
50	425
55	495
60	570
65	645
70	730

* Approach speed based on the regulatory posted speed, not the advisory speed.

ROAD TYPE	DISTANCE BETWEEN SIGNS IN FEET		
	A	B	C
Urban and Rural 30 MPH and less	100	100	100
Urban and Rural 35 MPH to 50 MPH	350	350	350
Rural greater than 50 MPH	500	500	500
Expressway / Freeway	1000	1500	2640

NOTE:

1. Signs are shown for one direction of travel only. Place devices similar to those depicted for the opposite direction of travel.
2. Final location and spacing of signs and devices may be changed to fit field conditions as approved by the CO.
3. For pilot car operation, mount the "PILOT CAR FOLLOW ME" (G20-4) sign at a conspicuous location on the rear of vehicle. Prominently display the name of the Contractor on the pilot car.
4. If closure is completely within the project limits, eliminate the "ROAD WORK AHEAD" (W20-1) and "END ROAD WORK" (G20-2) signs.
5. For night time flagging operation, provide floodlighting at flagger stations.
6. Do not allow equipment, materials, or vehicles to be parked or stored in the buffer space.

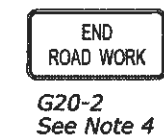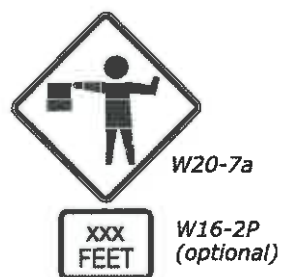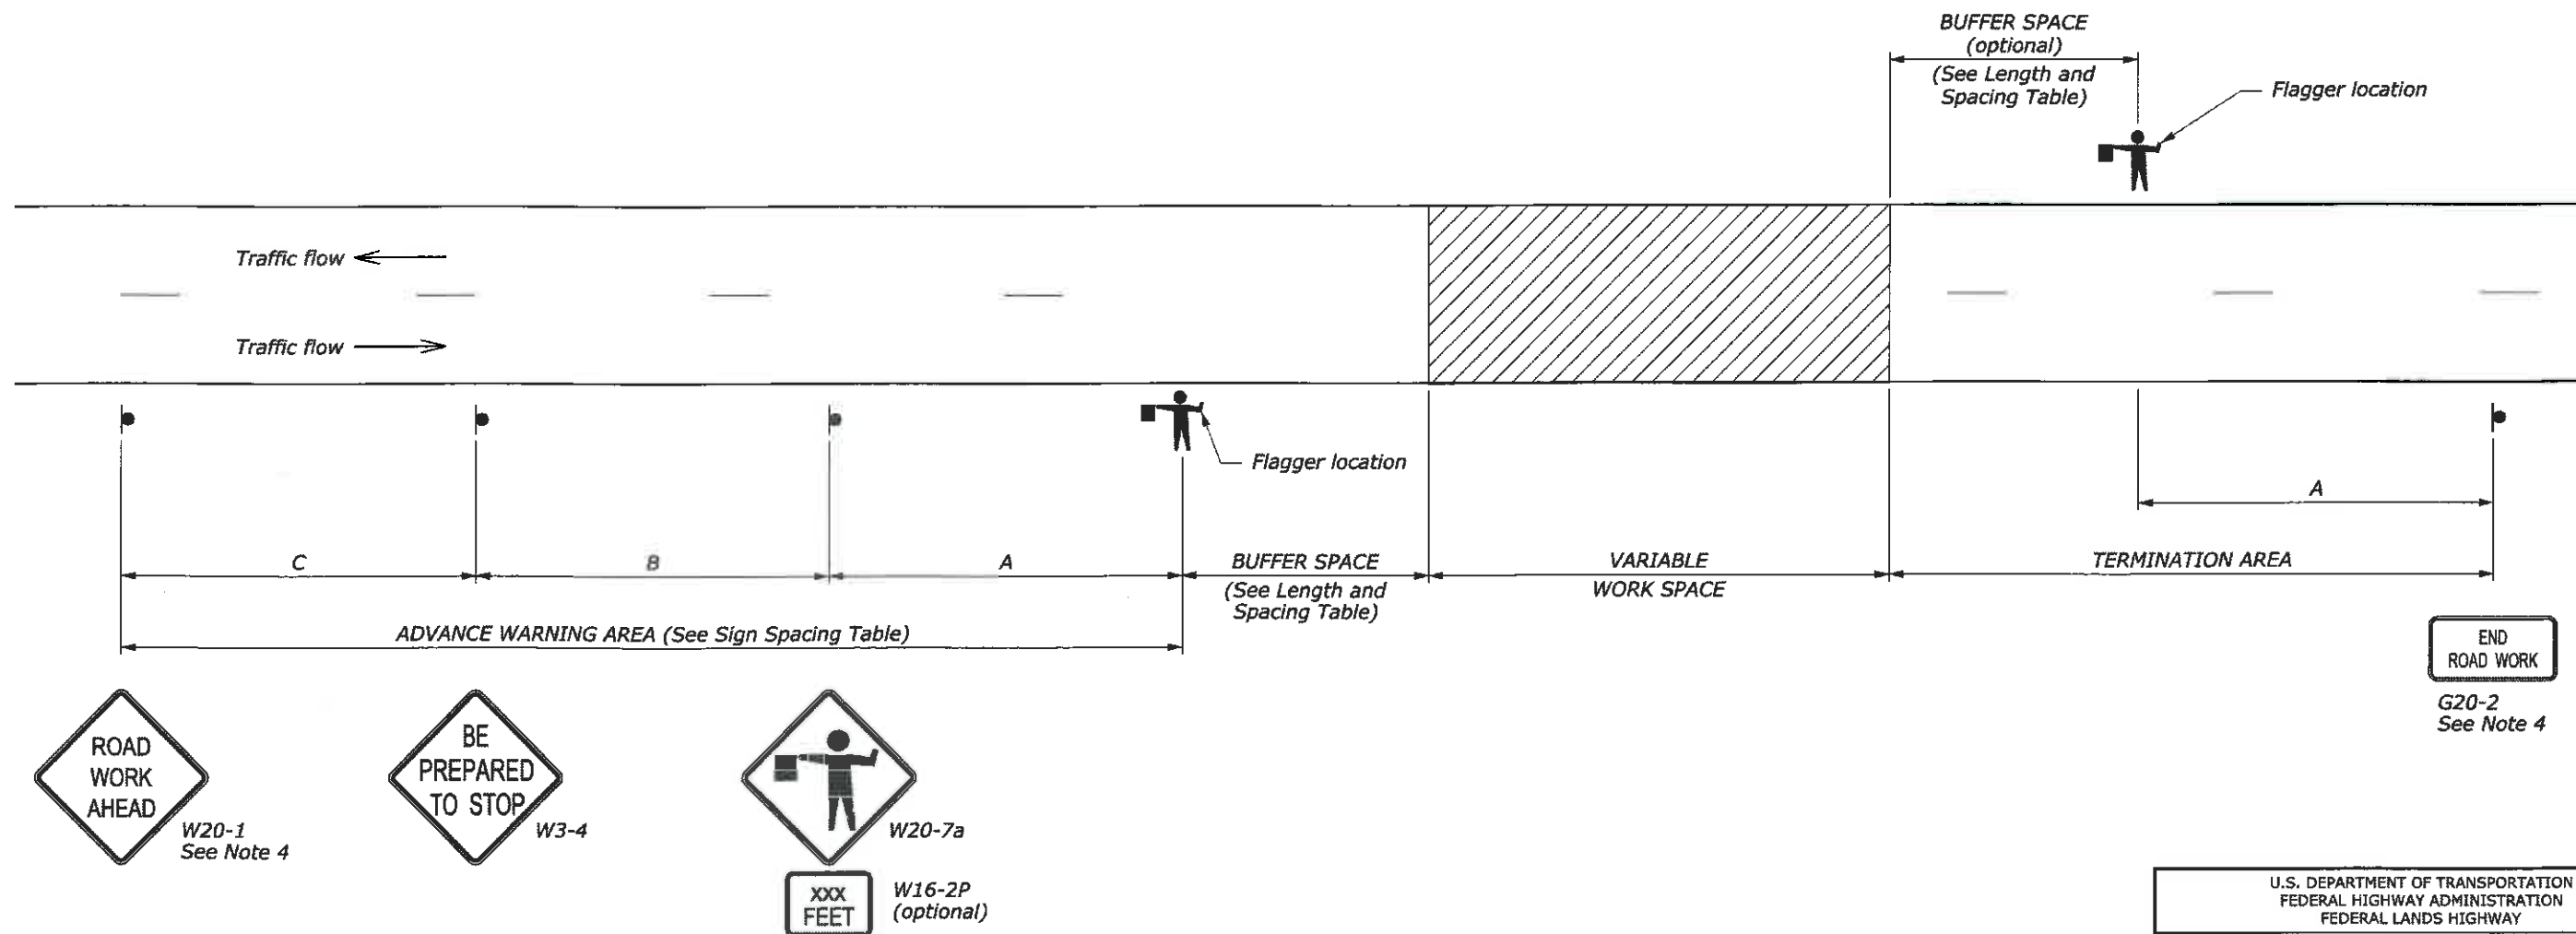

NO SCALE

U.S. DEPARTMENT OF TRANSPORTATION FEDERAL HIGHWAY ADMINISTRATION FEDERAL LANDS HIGHWAY	
U.S. CUSTOMARY STANDARD TEMPORARY TRAFFIC CONTROL ROAD CLOSURE LAYOUT (WITH FLAGGERS)	
STANDARD APPROVED FOR USE 6/2005	STANDARD
REVISED: DRAFT: 9/2010	635-5




LENGTH AND SPACING TABLE				
APPROACH SPEED*	BUFFER SPACE LENGTH	CHANNELIZING DEVICE		
		TAPER AREA	BUFFER SPACE	WORK SPACE
MPH	FEET	SPACING IN FEET		
20	115	20	40	40
25	155	20	50	50
30	200	20	60	60
35	250	20	70	70
40	305	20	80	80
45	360	20	90	90
50	425	20	100	100
55	495	20	110	110
60	570	20	120	120
65	645	20	130	130
70	730	20	140	140

* Approach speed based on the regulatory posted speed, not the advisory speed.

SIGN SPACING TABLE			
ROAD TYPE	DISTANCE BETWEEN SIGNS IN FEET		
	A	B	C
Urban and Rural 30 MPH and less	100	100	100
Urban and Rural 35 MPH to 50 MPH	350	350	350
Rural greater than 50 MPH	500	500	500
Expressway / Freeway	1000	1500	2640

NOTE:

1. Signs are shown for one direction of travel only. Place devices similar to those depicted for the opposite direction of travel.
2. Final location and spacing of signs and devices may be changed to fit field conditions as approved by the CO.
3. For pilot car operation, mount the PILOT CAR FOLLOW ME (G20-4) sign at a conspicuous location on the rear of vehicle. Prominently display the name of the contractor on the pilot car.
4. If closure is completely within the project limits, eliminate the "ROAD WORK AHEAD" (W20-1) and "END ROAD WORK" (G20-2) signs.
5. For night time flagging operation, provide floodlighting at flagger stations.
6. For project specific minimum width, refer to the Special Contract Requirements, Section 156.
7. Do not allow equipment, materials, or vehicles to be parked or stored in the buffer space.

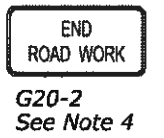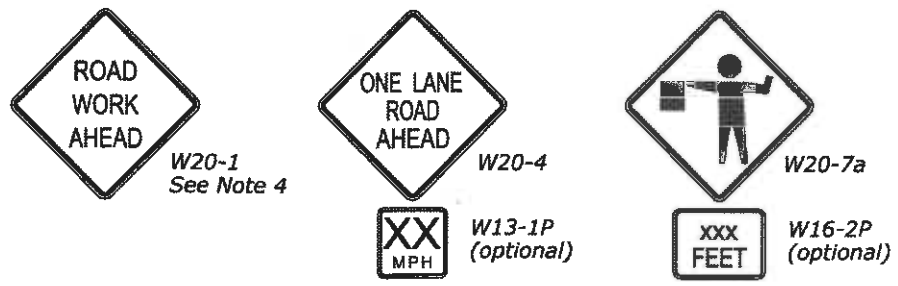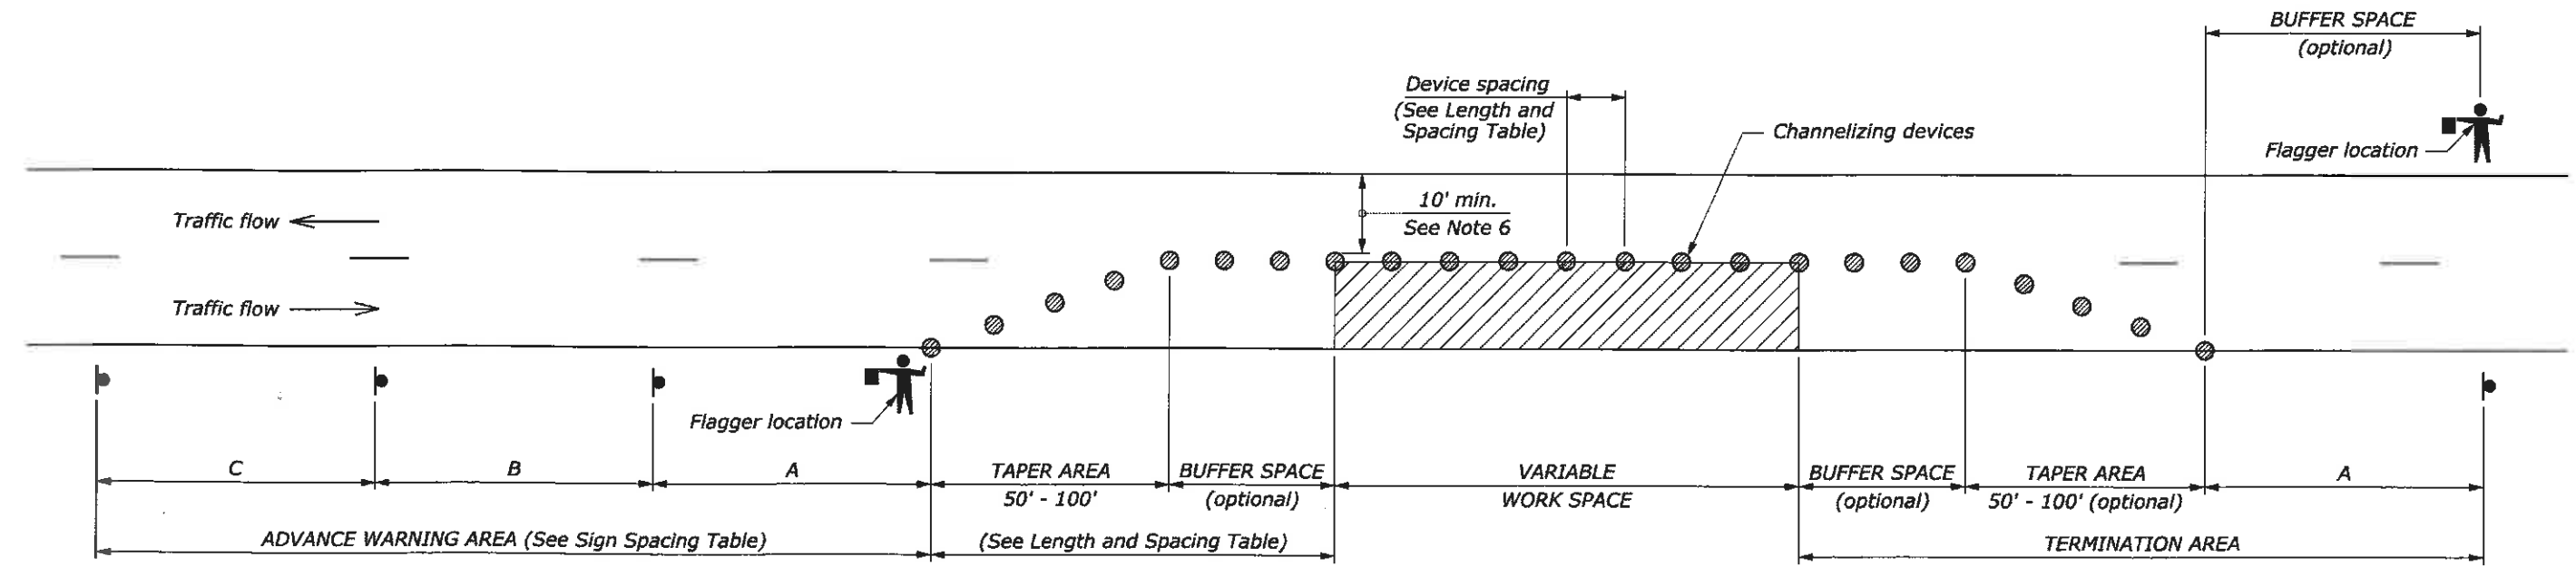

U.S. DEPARTMENT OF TRANSPORTATION
 FEDERAL HIGHWAY ADMINISTRATION
 FEDERAL LANDS HIGHWAY

U.S. CUSTOMARY STANDARD
**TEMPORARY TRAFFIC CONTROL
 SINGLE LANE CLOSURE LAYOUT
 (WITH FLAGGERS)**

STANDARD APPROVED FOR USE 6/2005

REVISOR: 9/2010
 DRAFT: 9/2010

STANDARD 635-6

NO SCALE


c:\myfiles\pw_production\0229143\ak-206001.st63506.dgn [USC] 1 August 2014 2:27 PM

LENGTH AND SPACING TABLE					
APPROACH SPEED*	BUFFER SPACE LENGTH	CHANNELIZING DEVICE			CONCRETE BARRIER FLARE RATE
		TAPER AREA	BUFFER SPACE	WORK SPACE	
MPH	FEET	SPACING IN FEET			
20	115	20	40	40	1:8
25	155	20	50	50	1:8
30	200	20	60	60	1:8
35	250	20	70	70	1:9
40	305	20	80	80	1:10
45	360	20	90	90	1:12
50	425	20	100	100	1:14
55	495	20	110	110	1:16
60	570	20	120	120	1:16
65	645	20	130	130	1:16
70	730	20	140	140	1:16

* Approach speed based on the regulatory posted speed, not the advisory speed.

NOTE:


1. Install signs and other devices for single lane closure according to Standard 635-6, 7, 8, or 9. Final location and spacing of signs and devices may be changed to fit field conditions as approved by the CO.
2. Place barrier according to the AASHTO Roadside Design Guide. Terminate barrier ends outside the clear zone or protect the ends of the barrier with a crash cushion. Include reflectors on barrier at 25' intervals.
3. For project specific minimum width, refer to Special Contract Requirements, Section 156.
4. Place channelizing devices at downstream taper during non-work hours or when access is not needed.
5. Do not allow equipment, materials, or vehicles to be parked or stored in the buffer space.
6. Reduce or eliminate drums and barrier in downstream taper if necessary to provide access to work space.

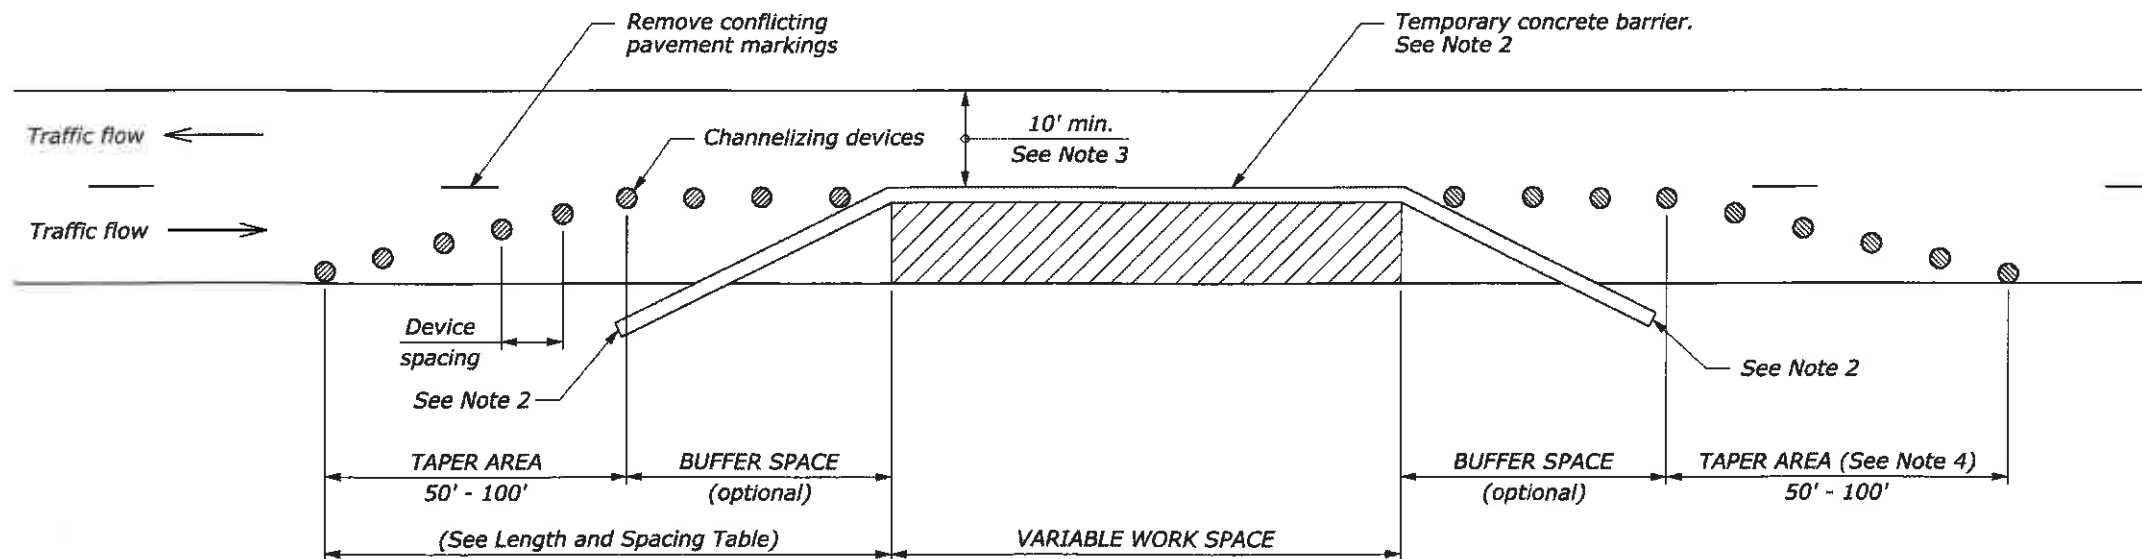


Deleted, See cm004

U.S. DEPARTMENT OF TRANSPORTATION FEDERAL HIGHWAY ADMINISTRATION FEDERAL LANDS HIGHWAY	
U.S. CUSTOMARY STANDARD	
TEMPORARY TRAFFIC CONTROL SINGLE LANE CLOSURE LAYOUT (WITH TEMPORARY BARRIER)	
STANDARD APPROVED FOR USE 6/2005	STANDARD
REVISED: DRAFT: 9/2010	635-13


NO SCALE

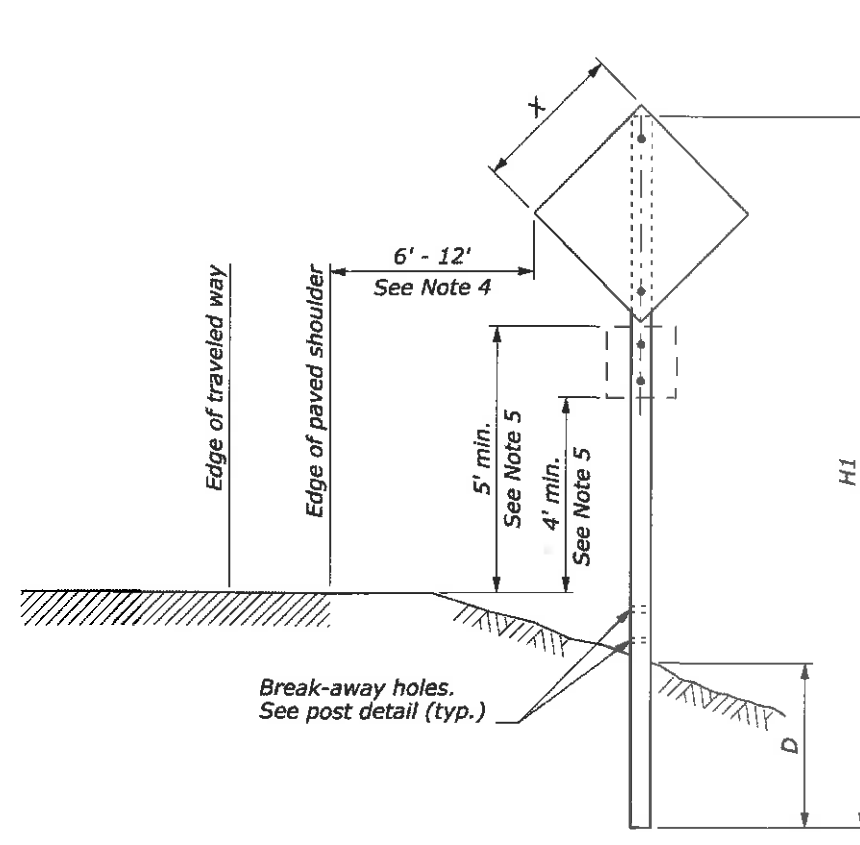

SINGLE POST SIGN

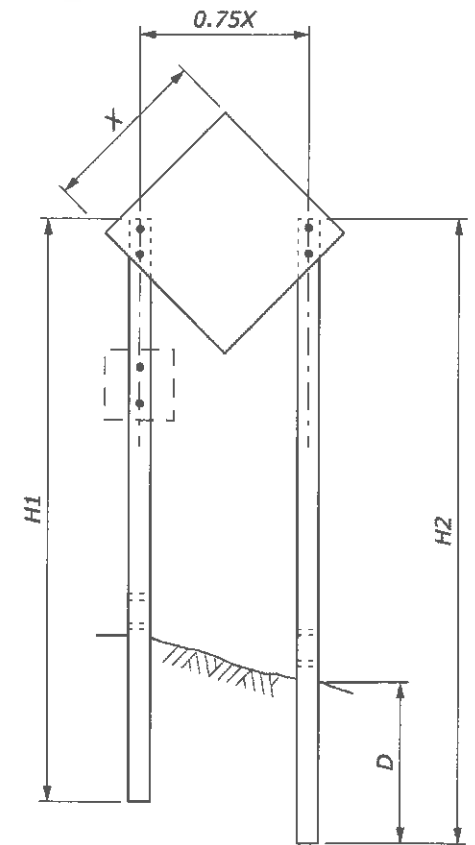


TWO POST SIGN

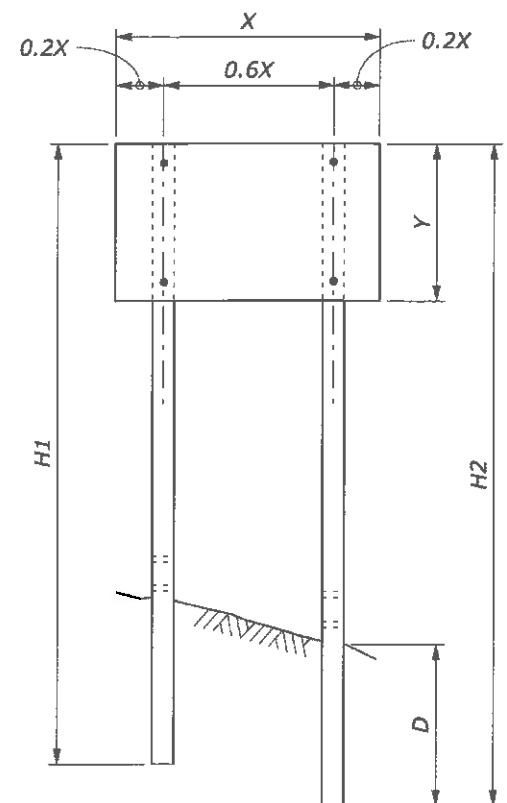


NOTE:

1. Attach sign panels with a minimum of 2 - 1/4" dia. bolts per post.
2. H1 and H2 = Overall post length. Select post lengths to fit field conditions.
3. D = Post embedment depth for average soil conditions.
4. In rural areas where lateral distance is limited, a minimum lateral offset of 2' may be used. In urban areas, a minimum lateral offset of 1' behind the face of the curb may be used.
5. In pedestrian locations, or in areas where the view is obstructed, use 7' minimum mounting height for main sign and 6' minimum mounting height for secondary sign.
6. Use 7' minimum spacing between posts for sign posts 6" x 6" or larger.
7. State standards may be used as an alternative if approved by the CO.

WOOD POST SELECTION TABLE					
WIDTH "X"	AREA (SQFT)	NUMBER OF POSTS	POST SIZE (INCH)	D (INCH)	HOLE SIZE (INCH)
Diamond ≤ 36"	< 10	1	4 x 4	36	0
Other Shapes ≤ 48"		1	4 x 6	48	1.5
Diamond ≤ 48"	10 - 20	1	6 x 6	48	2
Diamond ≤ 48"	10 - 20	2	4 x 4	36	0
Other Shapes ≤ 12'		2	4 x 6	48	1.5
> 13'	50 - 65	2	6 x 6	48	2
12' - 16'	50 - 65	3	4 x 6	48	1.5
> 17'	65 - 95	4	4 x 6	48	2
> 30'	65 - 95	3	6 x 6	48	2

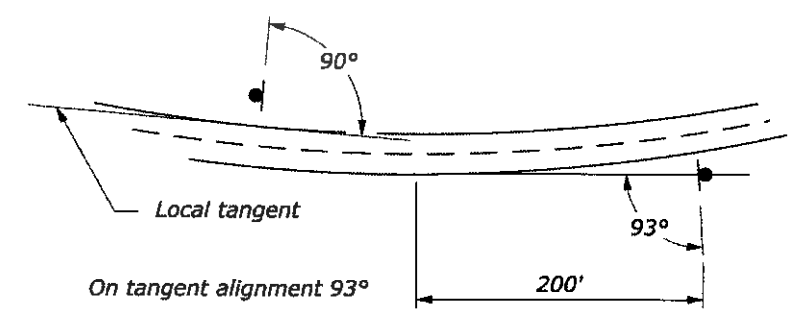

SIGN INSTALLATION ANGLE

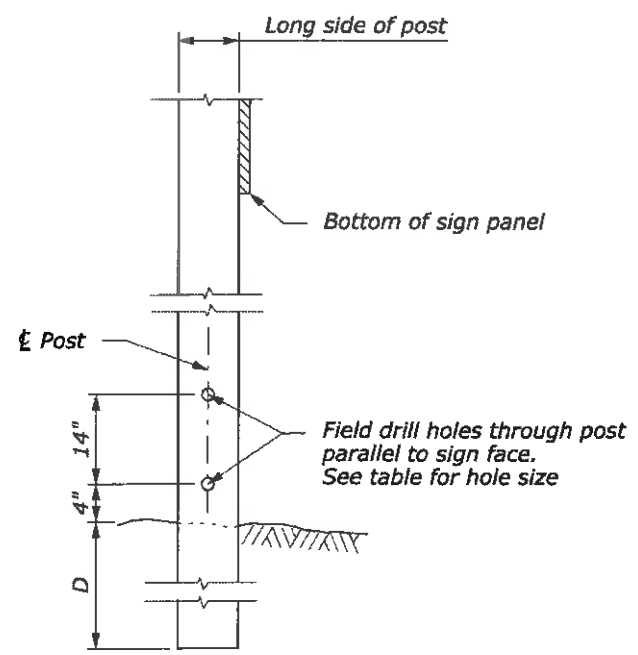

POST DETAIL

U.S. DEPARTMENT OF TRANSPORTATION
 FEDERAL HIGHWAY ADMINISTRATION
 FEDERAL LANDS HIGHWAY

U.S. CUSTOMARY STANDARD

**TEMPORARY TRAFFIC CONTROL
 SIGN INSTALLATION
 WOOD POSTS**

STANDARD APPROVED FOR USE 6/2005

REVISOR: [blank]
 DRAFT: 9/2011

STANDARD 635-14

NO SCALE

RECEIVED
 JUL 08 2017
 BY PROJECT ENGINEER

ITEM 20301-2400 REMOVAL OF SIGN		
LOCATION	SIGN LEGEND	QUANTITY (EACH)
12+29 LT	MILE 2	1 ✓
14+24 LT	Forest Doad Destination sign	1 ✓
TOTAL		2

ITEM 63302-0000 SIGN SYSTEM						
SIGN NUMBER	MUTCD NUMBER	LOCATION	SIGN LEGEND	SIZE (In X In.)	NUMBER OF SIGNS	QUANTITY (Sqft)
1	R1-1	10+18 LT	STOP	30 x 30	1	6.25 ✓
2	R2-1		SPEED LIMIT 30	24 x 30	1	5 ✓
3	W3-1	12+88 LT	Stop Ahead Symbol	30 x 30	1	6.25 ✓
4	FRD-1	14+24 LT	Forest Road Destination Sign	72 x 36	1	18 ✓
	M1-7		FOREST ROUTE 20	18 x 18	1	2.25 ✓
	M6-4		Directional arrow	21 x 15	1	2.19 ✓
	FM4-6		END	12 x 8	1	0.67 ✓
	FM1-7H		2060	12 x 8	1	0.67 ✓
5	R7-1	140+25 LT	NO PARKING ANY TIME	12 x 18	1	1.50 ✓
6	R2-1	141+80 LT	SPEED LIMIT 30	24 x 30	1	5 ✓
7	R2-1	141+80 RT	SPEED LIMIT 10	24 x 30	1	5 ✓
TOTAL						53 ✓

- APPROVED
- APPROVED AS NOTED
- RETURNED FOR CORRECTION

Date: JUL 10 2017 By: Jim Jozovich

FEDERAL HIGHWAY ADMINISTRATION
 Federal Lands Highway


See FAR 52.236-21(e) for limitations of Government's responsibility in approving this document.

**TABULATION OF
 TEMPORARY TRAFFIC CONTROL
 QUANTITIES ✓**

STATE	PROJECT	SHEET NUMBER
AK	USFS 2060(1)	K.2





← Whale Pass 25
 Thorne Bay 41
 Hollis 63 →

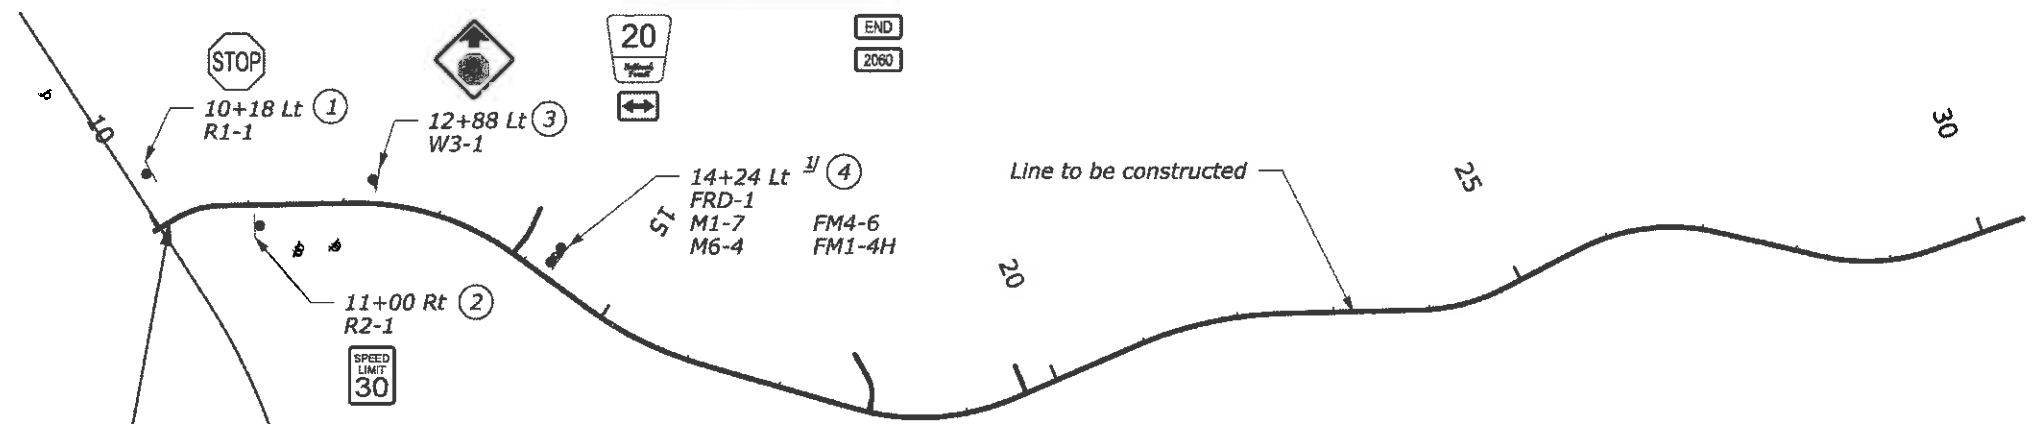

BEGIN PROJECT
 AK USFS 2060(1)
 10+13.42
 N 1,483,462.32
 E 2,784,316.88

Footnote
 ⌈ Sign colors are white legend and border on brown background.

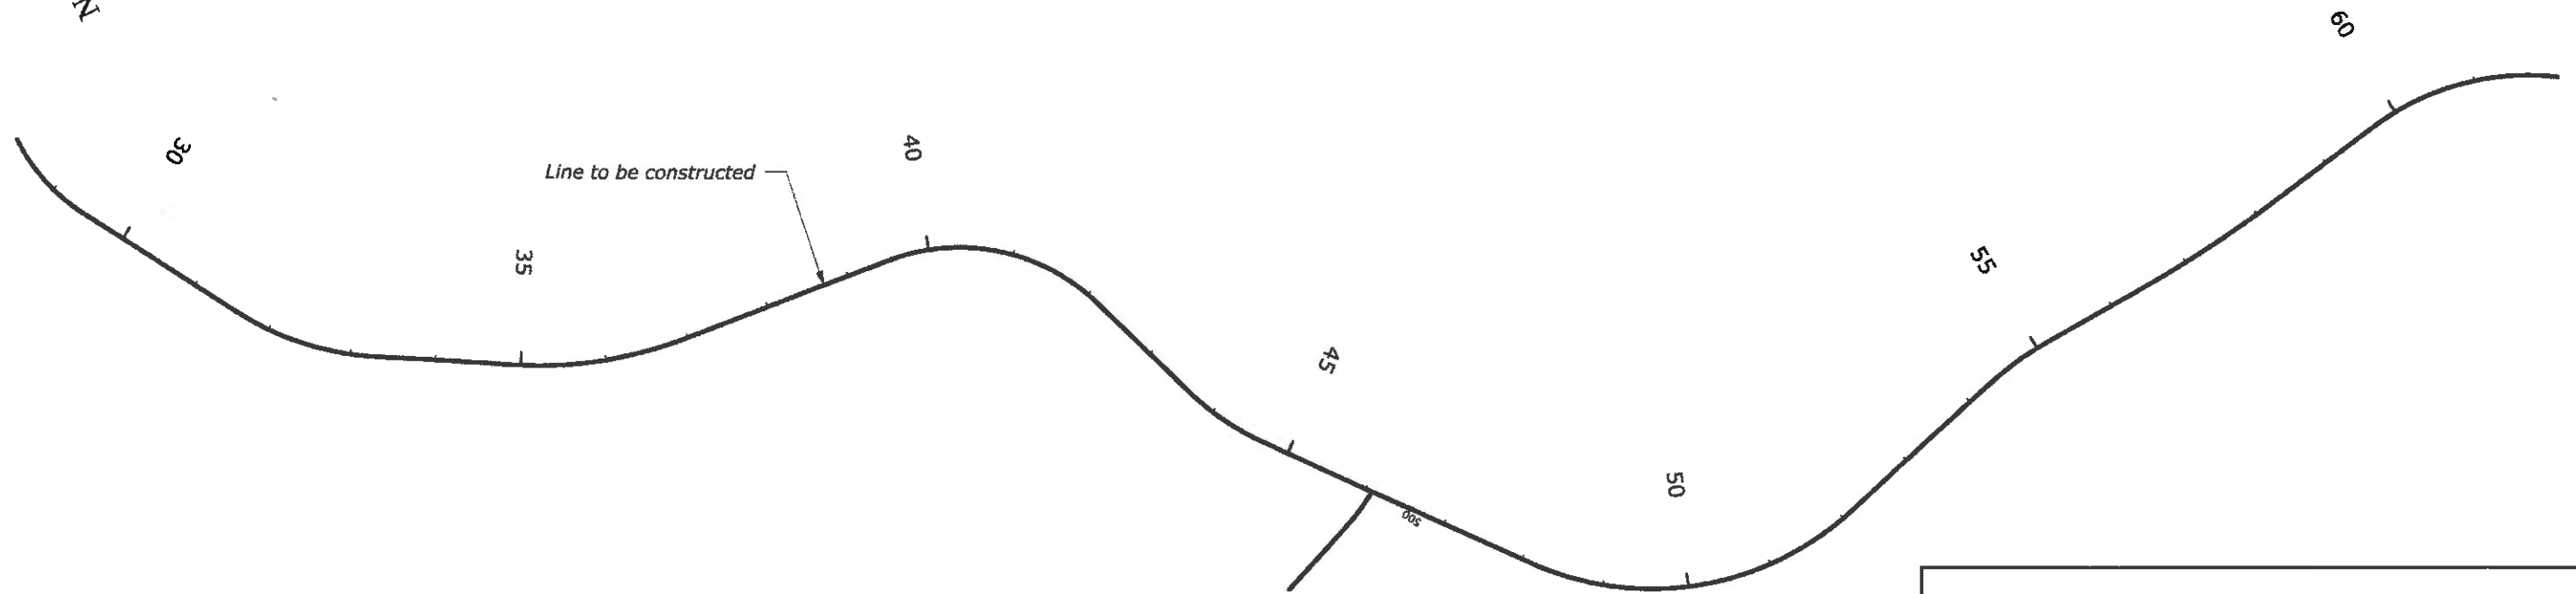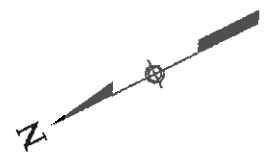

PERMANENT TRAFFIC CONTROL PLAN
10+13 TO 60+00 ✓




Checked by:

Designed by:

c:\myfiles\jw_production\0229144\ak-f206001\pb.dgn [US_Sur_R2D]

12 January 2015 1:12 PM

STATE	PROJECT	SHEET NUMBER
AK	USFS 2060(1)	K.3

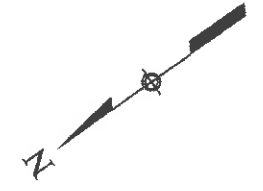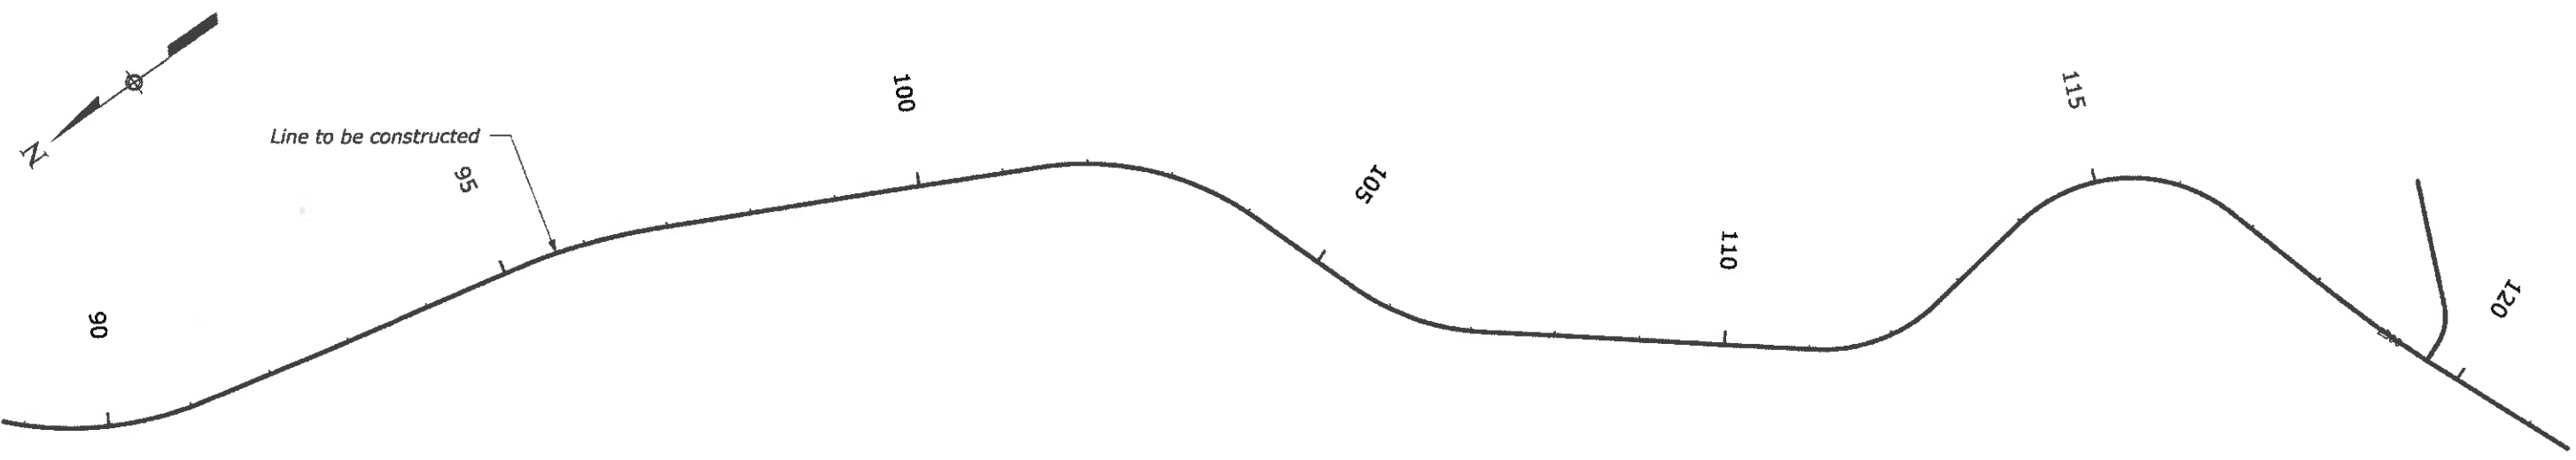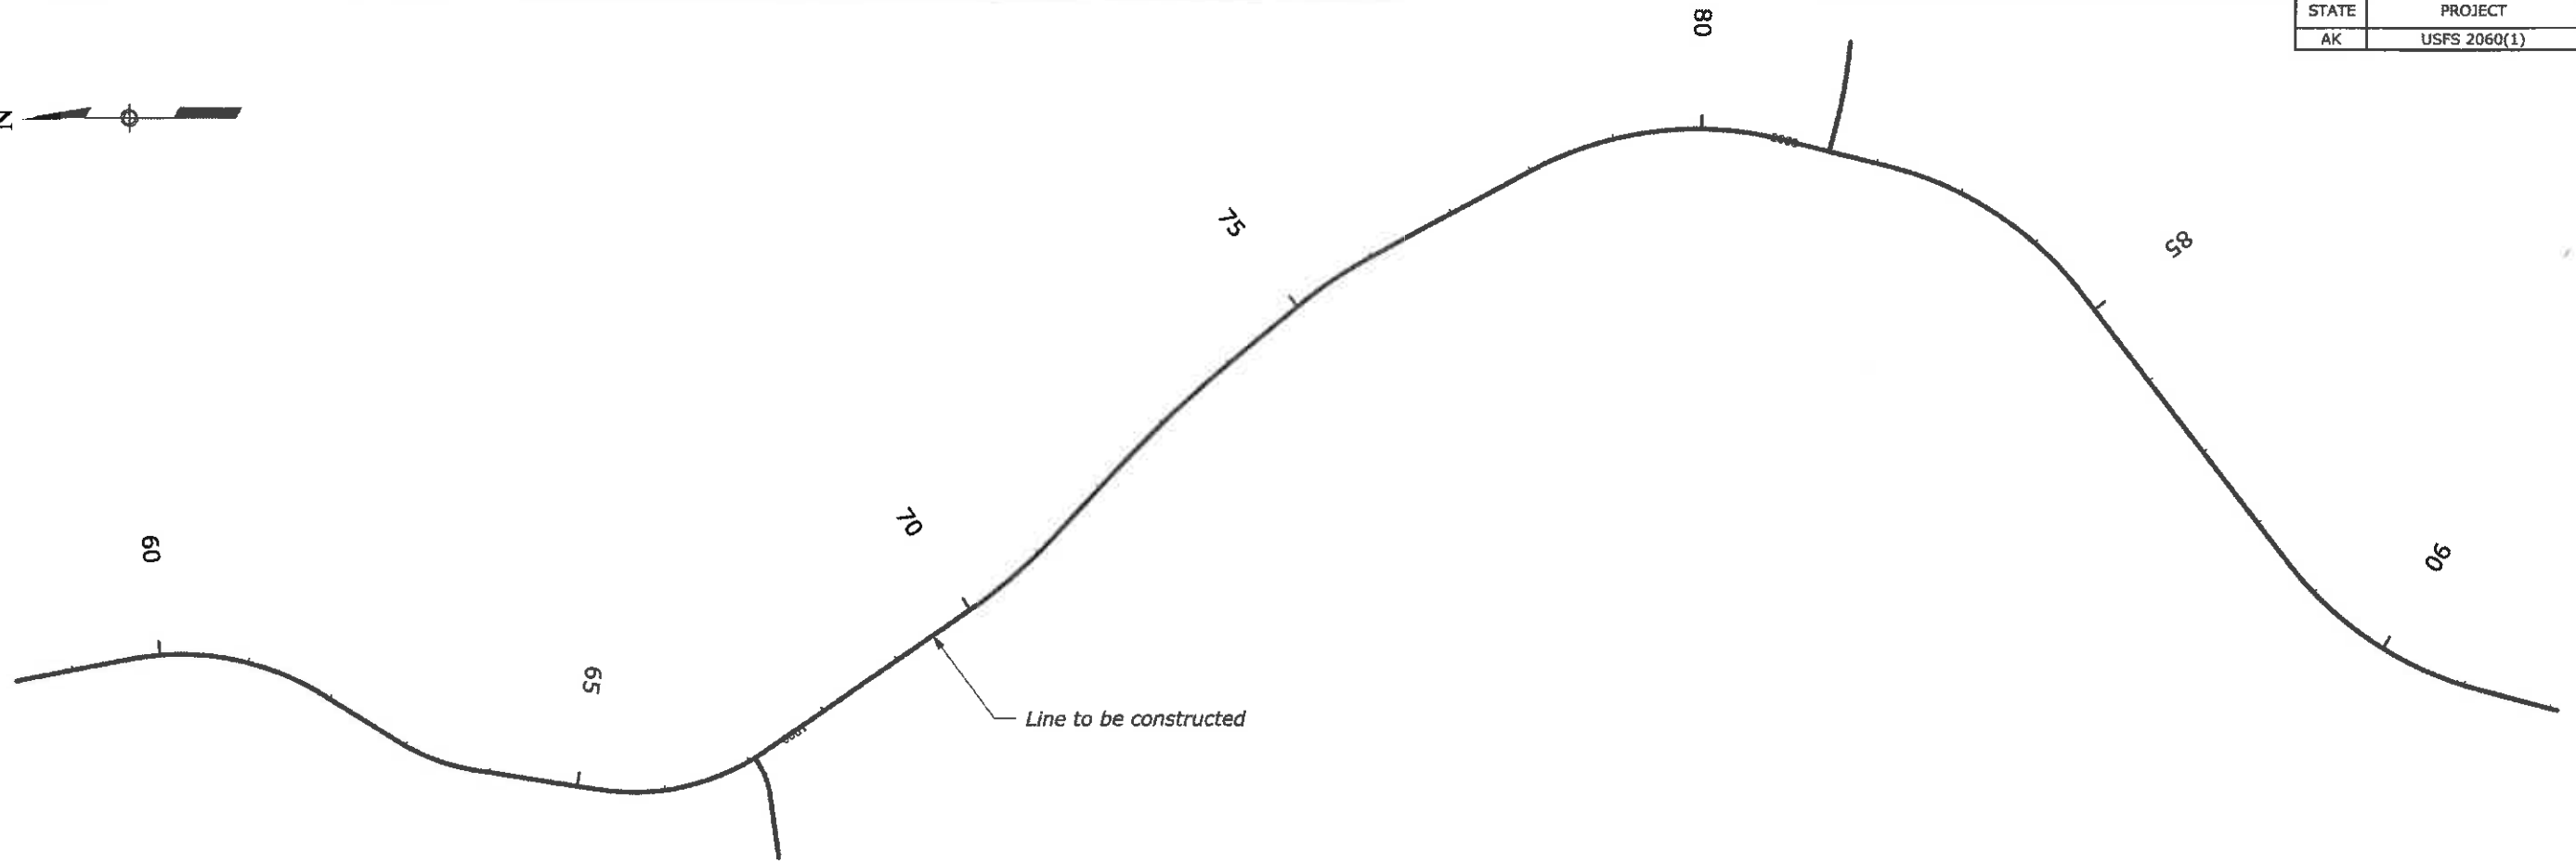


PERMANENT TRAFFIC CONTROL PLAN
60+00 TO 120+00 ✓

12 January 2015 1:12 PM
 c:\vmyfiles\pw_production\d0229144\ak-r206001.pcdgn [US_Sur_r2D]
 Designed by: _____ Checked by: _____

STATE	PROJECT	SHEET NUMBER
AK	USFS 2060(1)	K.4


END PROJECT
 AK USFS 2060(1)
 141+80
 N 1,474,857.08
 E 2,778,459.34

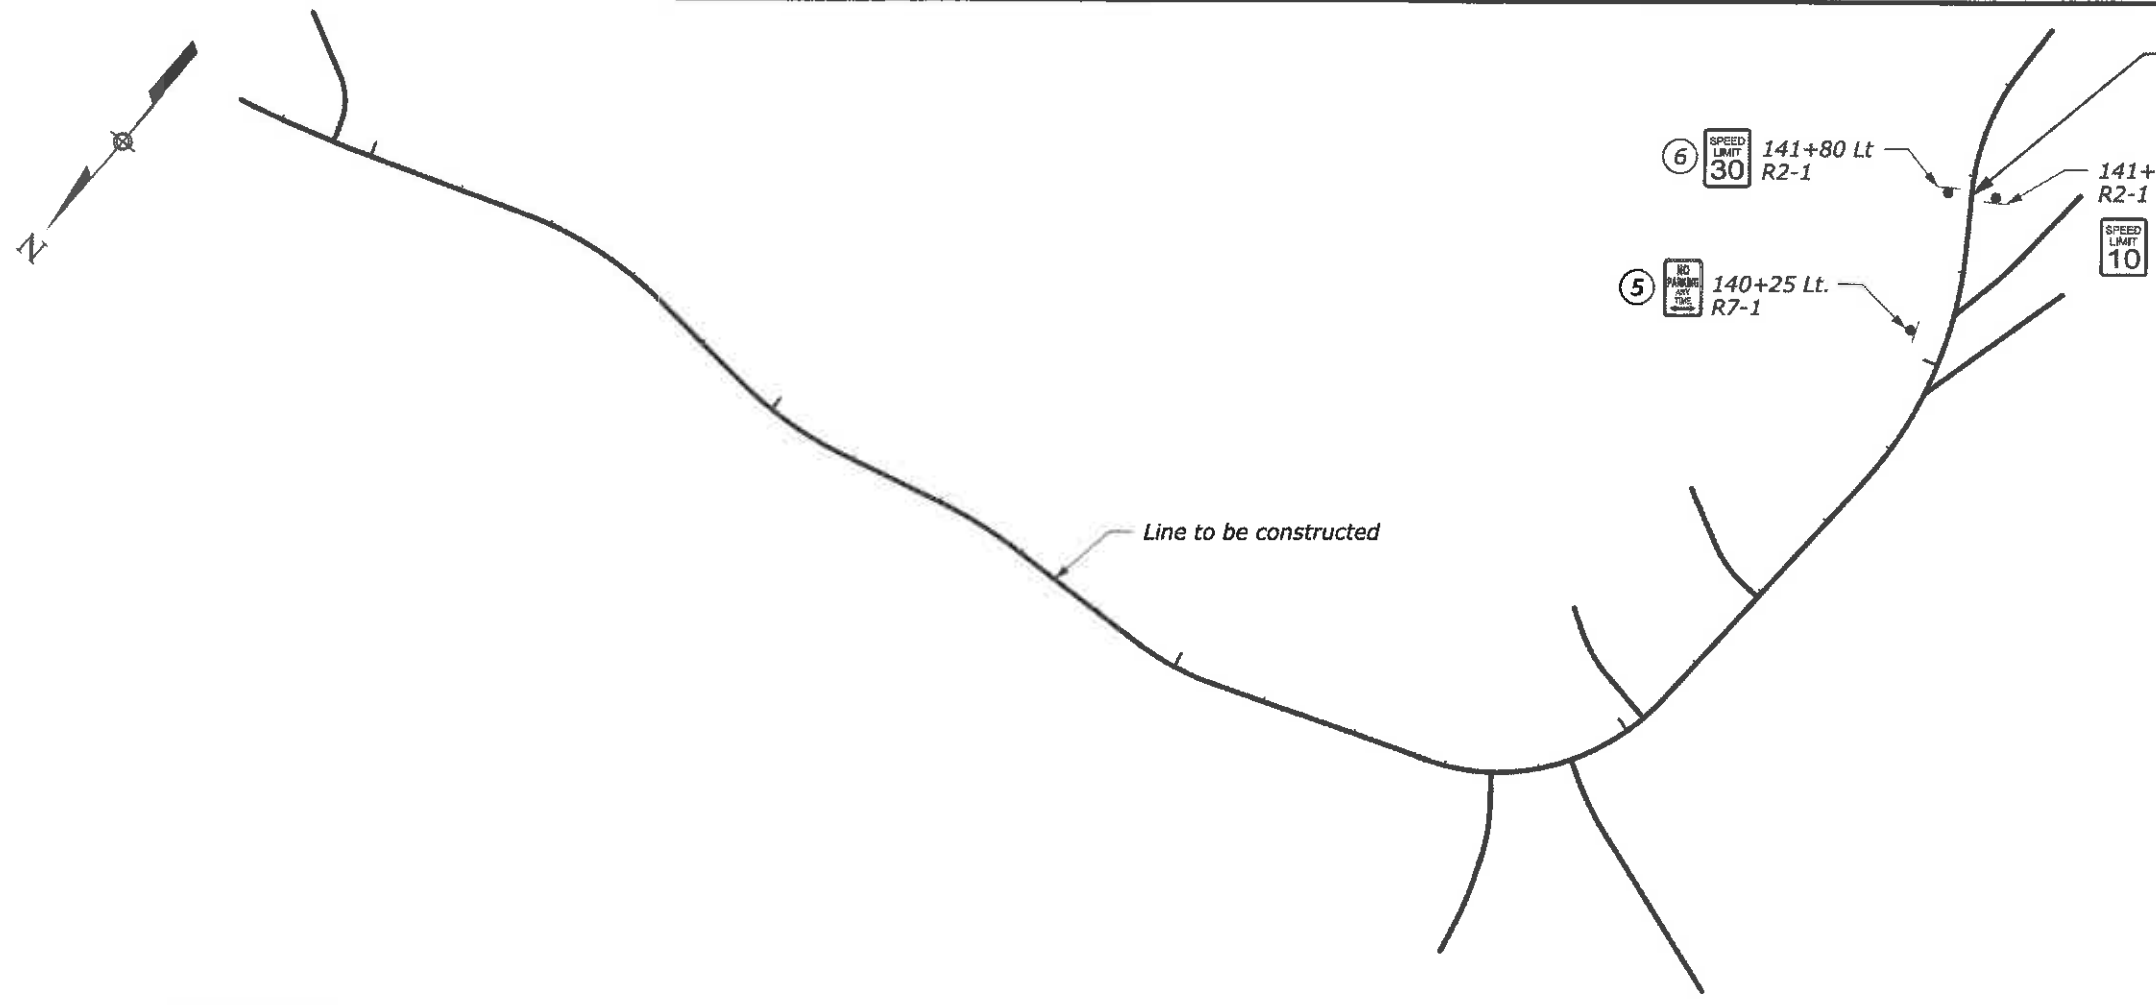

PERMANENT TRAFFIC CONTROL PLAN ✓
120+00 TO 141+80

12 January 2015 1:11 PM
 c:\myfiles\pww_production\0229144\ak-206001\pd.dgn [US_Sur_R2D]
 Designed by:
 Checked by:

STATE	PROJECT	SHEET NUMBER
AK	USFS 2060(1)	K.5

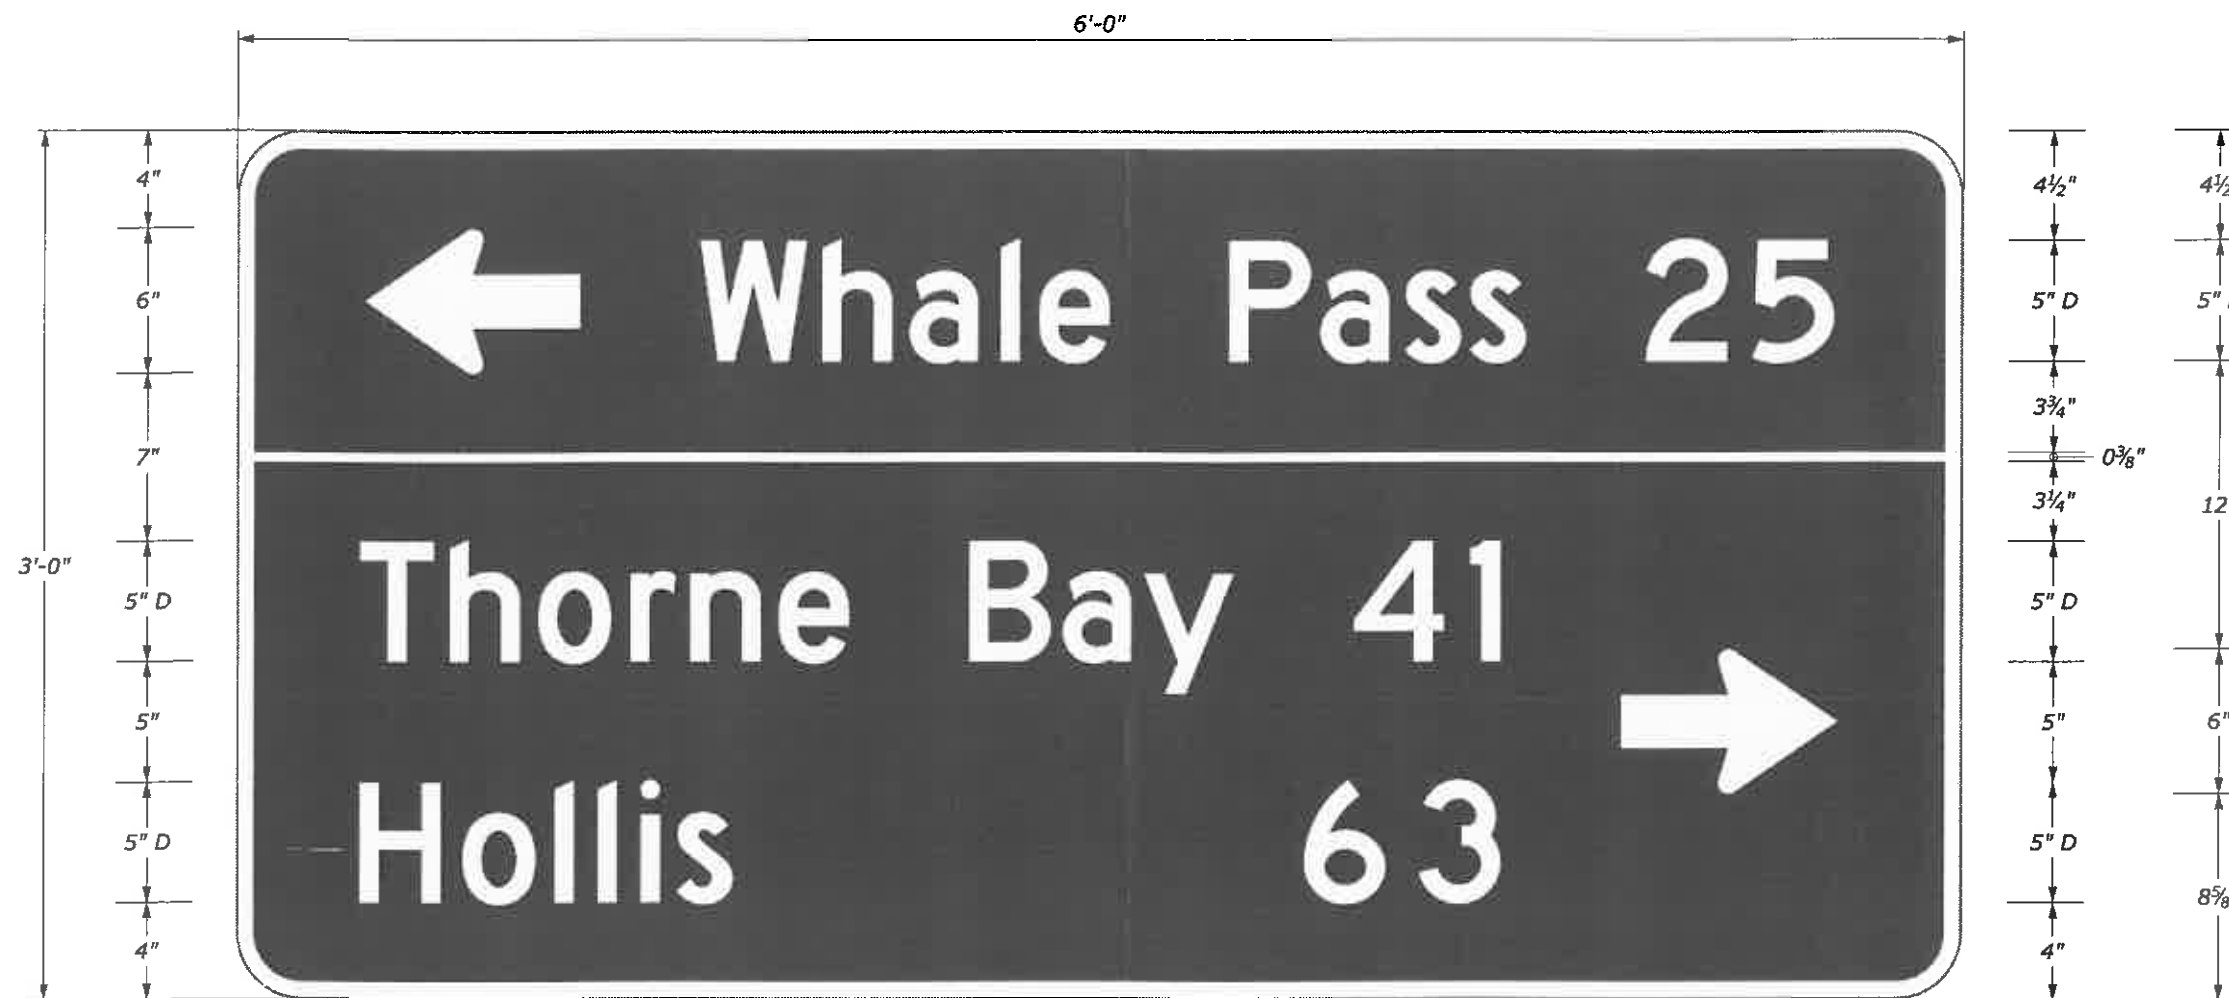

FRD-1 ^{1/2}

FOOTNOTE

^{1/2} Sign colors are white legend and border on brown background.


PERMANENT SIGN DETAIL ✓

Checked by:


Designed by:

c:\myfiles\jw_production\0229144\ak-r206001pe.dgn [US_Sur_R2D]


28 January 2015 3:24 PM

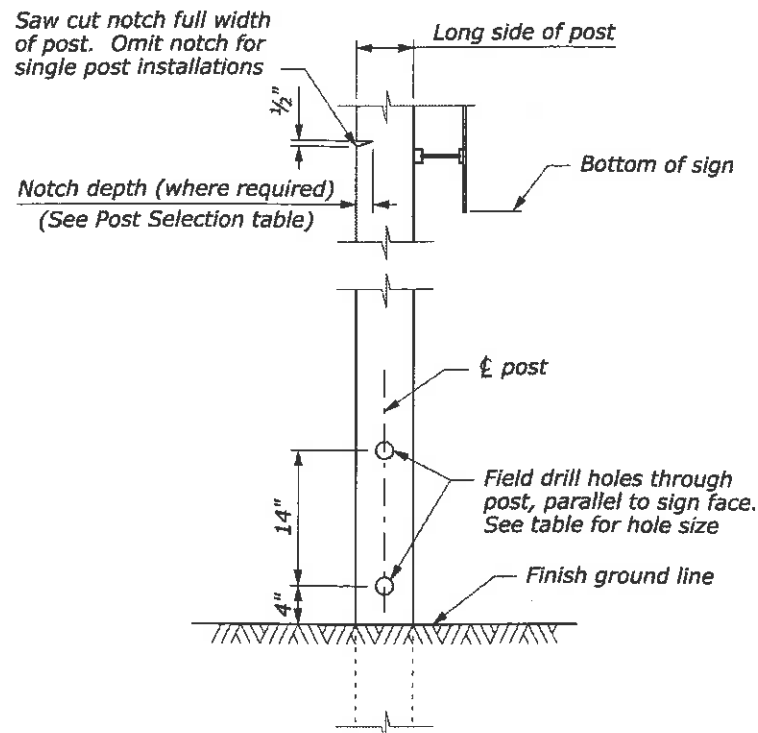


POST DETAIL

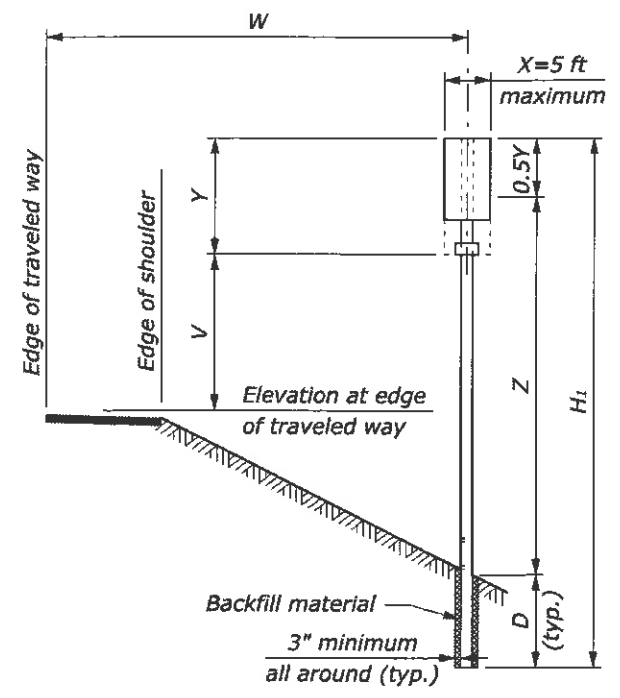

SINGLE POST SIGNS

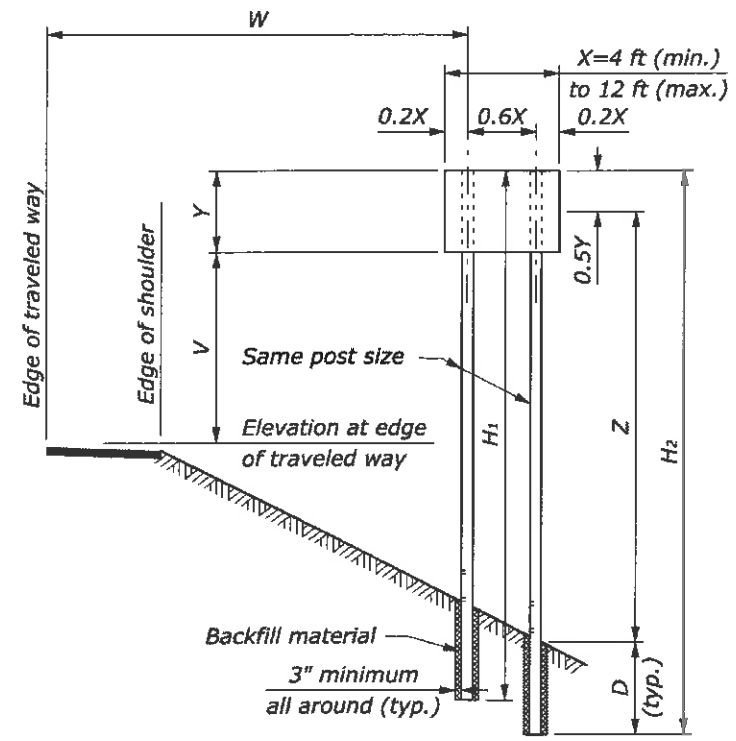

TWO POST SIGNS

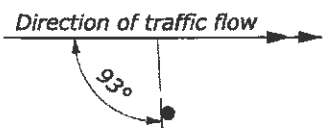


SIGN INSTALLATION ANGLE


For all retroreflectorized signs where $W > 25'$

MINIMUM DISTANCE TO SIGN		
Location	Lateral Offset (W)	Mounting Height (V)
Rural Districts	6 ft	5 ft
Business or Residence Districts	2 ft from curb	7 ft

V may be reduced by 1 foot in rural districts for a secondary sign mounted below another sign.

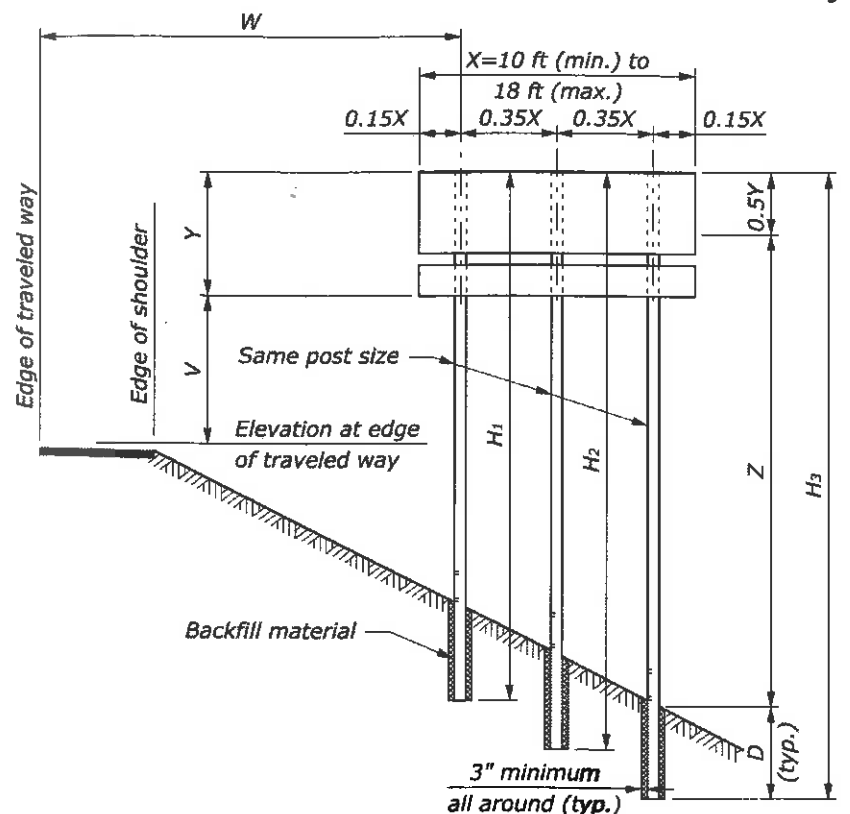


THREE POST SIGNS

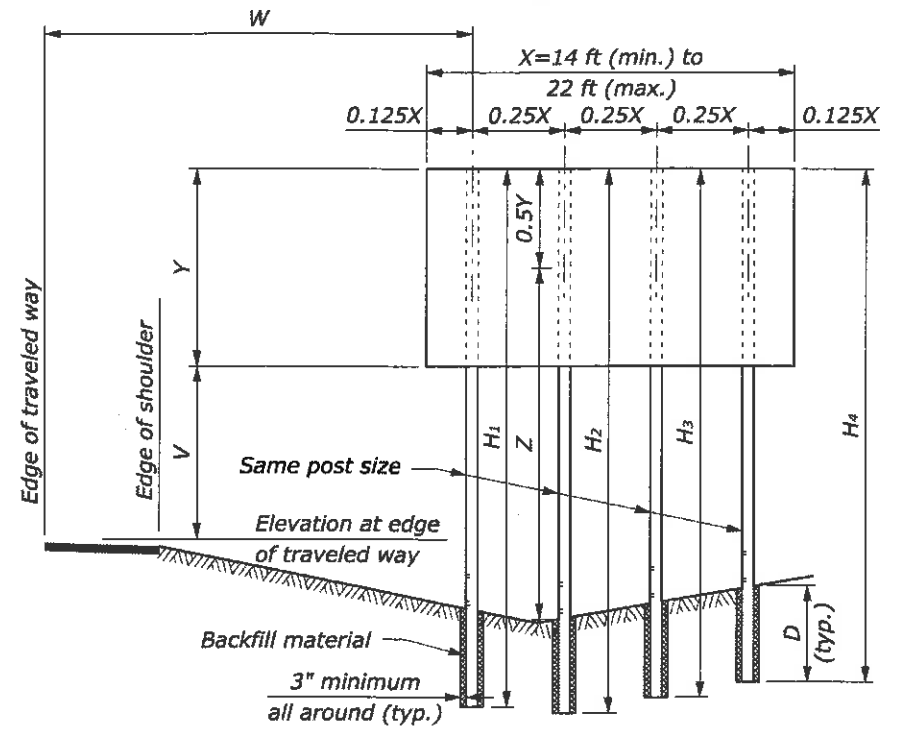

FOUR POST SIGNS

NOTE:

1. Traffic barrier protection is required for all posts larger than 6" x 8" when located within the clear zone or if the post is vulnerable to being struck when placed outside the clear zone.
2. H_1 thru H_4 indicate overall post length. Select post lengths to fit field conditions.
3. D is the minimum post embedment depth for average soil conditions. See Wood Post Selection Table below.
4. Z is the height from ground line to mid-height of sign at the longest post.
5. For the purpose of post selection X and Y are as follows:
 - Single sign, or back to back signs: X and Y are the overall dimensions of the signs.
 - Multiple sign installations: X and Y are the dimensions of a rectangle enclosing all the signs.

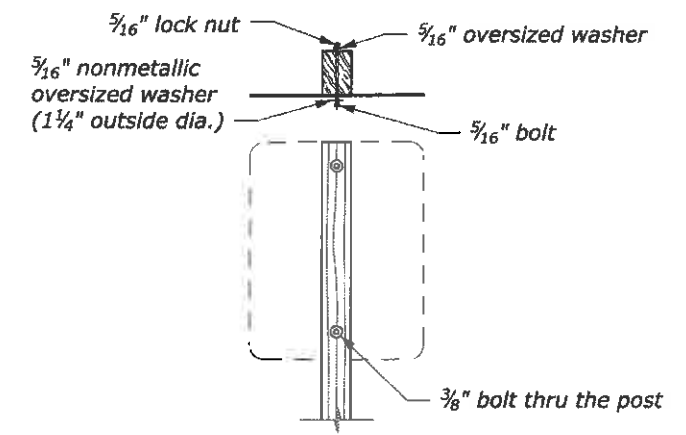

TYPICAL MOUNTING FOR SIGNS WITHOUT ANGLES

POST SIZE (inch)	NUMBER OF POSTS				D	Notch depth and hole diameter
	1	2	3	4		
	Product of X-Y-Z in CUFT					
4 x 4	80	155	235	310	3'-0"	-
4 x 6	180	385	545	725	4'-0"	1 3/4"
6 x 6	235	475	710	950	4'-0"	1 3/4"
6 x 8	300	850	1280	1700	4'-0"	2 1/2"
6 x 10	385	1180	1170	2360	5'-0"	-
8 x 10	575	1610	2410	3215	5'-0"	-
8 x 12	775	2310	3465	4620	6'-0"	-

Values shown are the maximum permitted. If the product of XYZ exceeds the limit for the largest post, use steel post installation.

U.S. DEPARTMENT OF TRANSPORTATION
FEDERAL HIGHWAY ADMINISTRATION
WESTERN FEDERAL LANDS HIGHWAY DIVISION

U.S. CUSTOMARY DETAIL
PERMANENT SIGN INSTALLATION WOOD POSTS

DETAIL APPROVED FOR USE --/----

REVISD: 2/1998
DRAFT: 10/2009

DETAIL
W633-7

NO SCALE