

**STATE OF ALASKA
DEPARTMENT OF HIGHWAYS**

PROPOSED HIGHWAY PROJECT

**FH-006-1 (I)
HARRIS RIVER TO HOLLIS
GRADING, DRAINAGE AND
AGGREGATE SURFACING**


AS BUILT PLANS

CONTRACTOR: LUNDGREN NORTHWEST & ASSOCIATES

PROJECT ENGINEER: JOHN S. MCGRATH

WORK BEGAN: AUG. 12, 1975

WORK COMPLETED: SEPT. 26, 1977

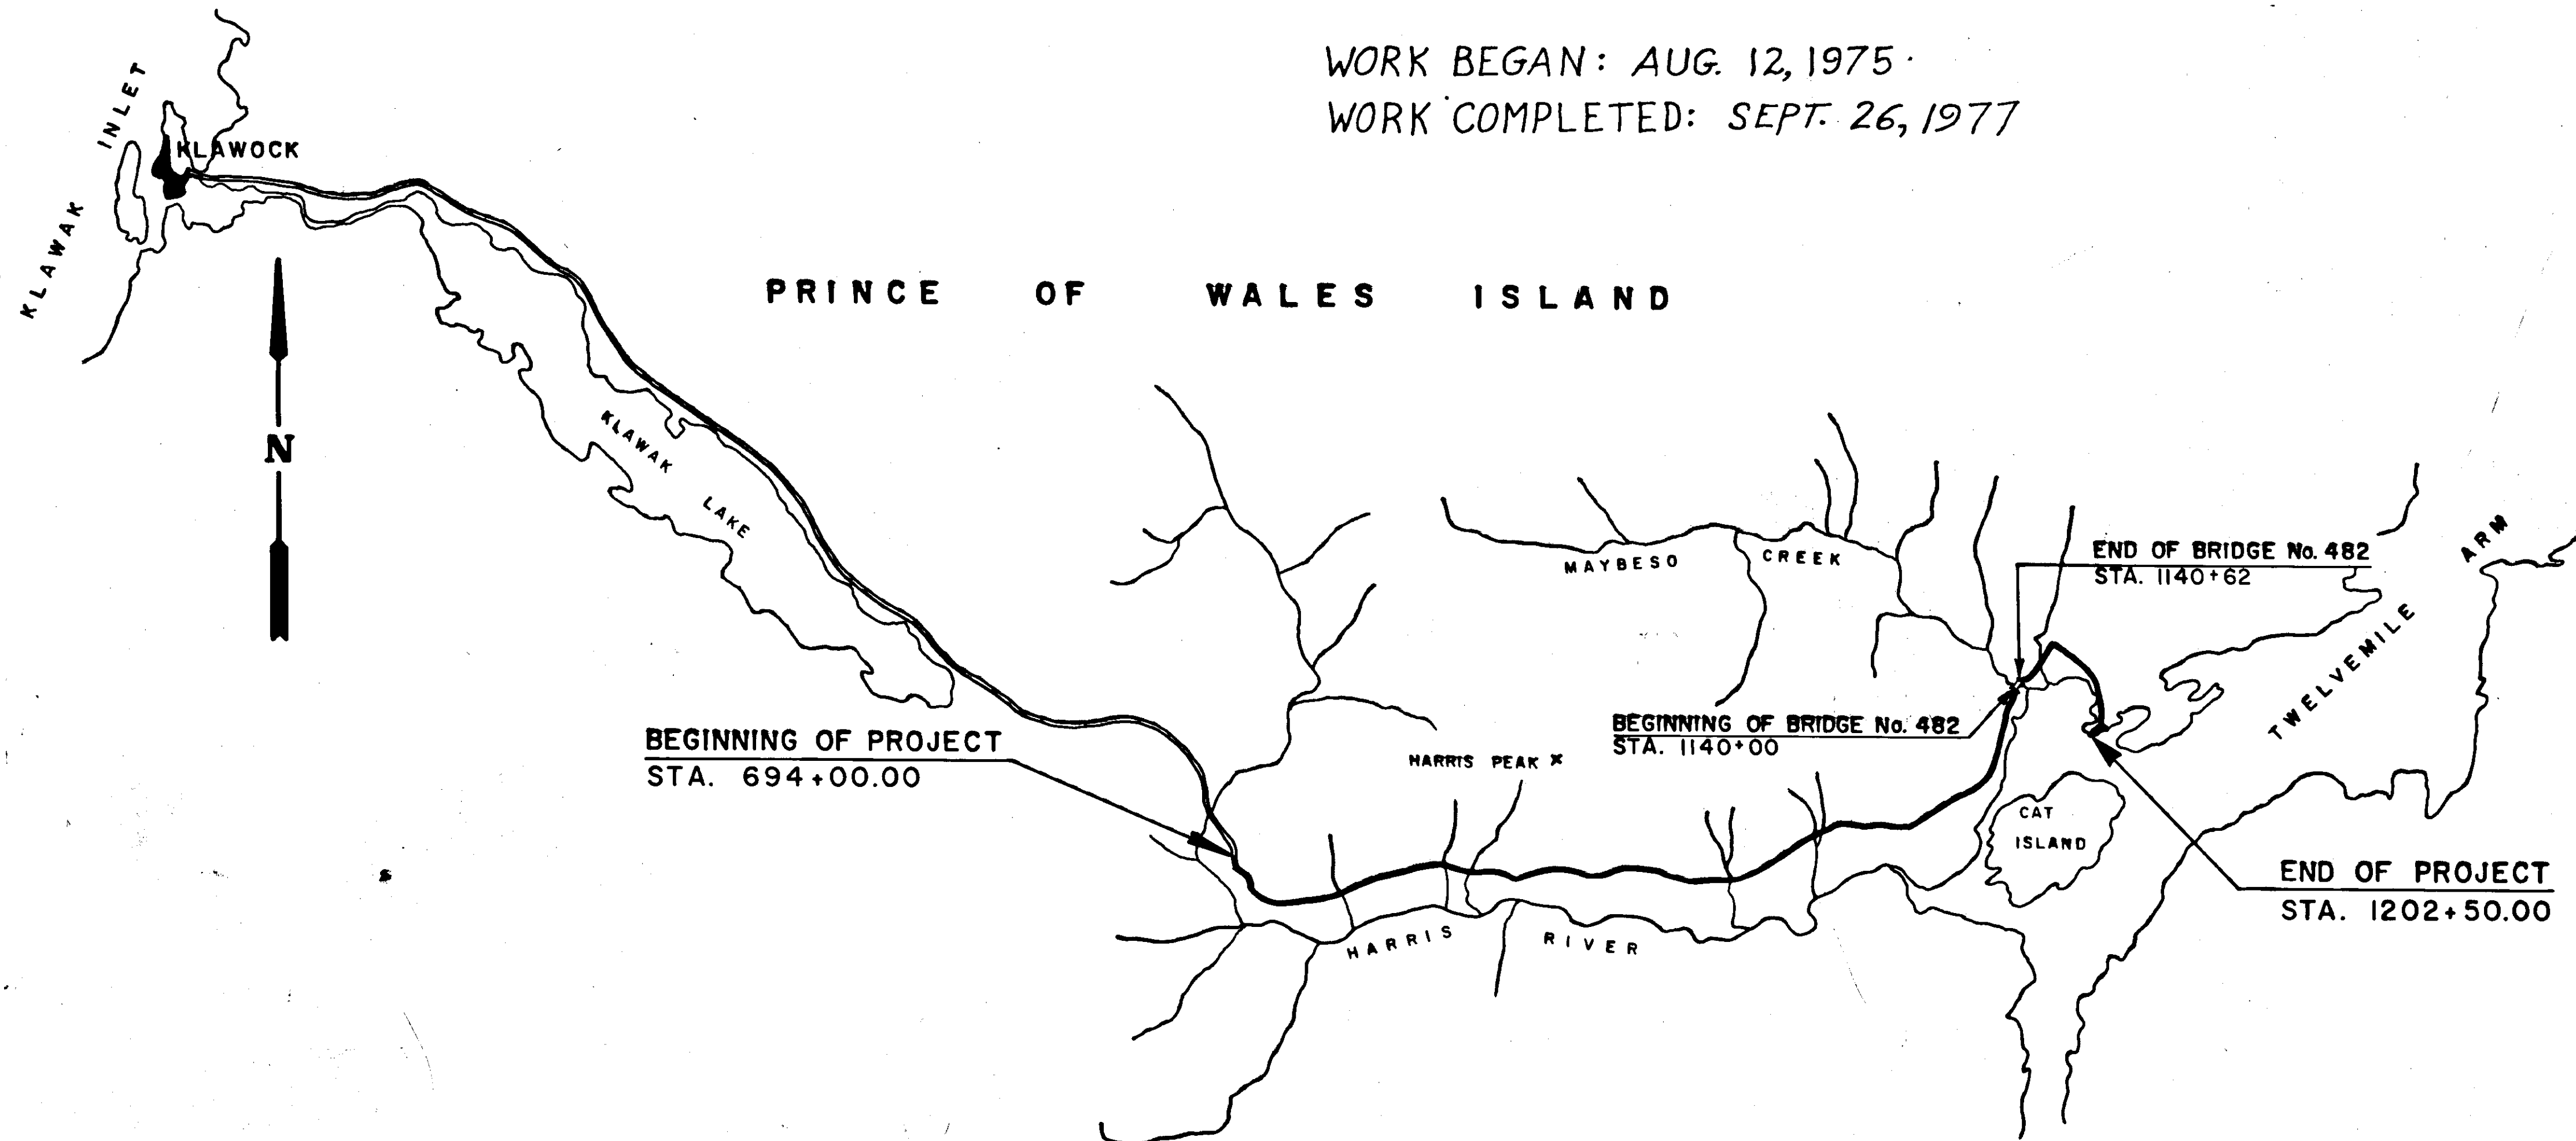

STATE	PROJECT DESIGNATION	YEAR	SHEET NO.	TOTAL SHEETS
ALASKA	FH 006-1 (I)	1975	1	1

INDEX OF SHEETS

SHEET NO.	DESCRIPTION
1	Title Sheet
2-3	Typical Section
4-6	Summaries and Estimate of Quantities
7	Materials Site
8-17	Plans
18	Bridge Modification Detail

The following standard drawings apply to this project;
A - 1, C - 00.01, C - 10.00, C - 11.01, D - 02.01, D - 03.01,
D - 09.00, G - 04.00, G - 04.11, G - 10.11, G - 30.01, G - 30.12,
I - 80.00, S - 00.10, S - 05.00, S - 20.00, S - 30.00.

DESIGN DESIGNATION

ADT 1974	= 55
ADT 1995	= 110
DHV	= 28
D	= 30-70
T	= 4%

PROJECT SUMMARY

WIDTH OF SUBGRADE	28'
LENGTH OF GRADING	53,749.56' = 10.180 mi.
LENGTH OF BRIDGE	60' = 0.011 mi.
LENGTH OF PROJECT	53,809.56' = 10.191 mi.


STATE OF ALASKA
DEPARTMENT OF HIGHWAYS

APPROVED

Harold E. Mill Date *4/22/77*
SOUTHEAST DISTRICT ENGINEER

APPROVED



Shirley For Date *7/2/77*
COMMISSIONER OF HIGHWAYS

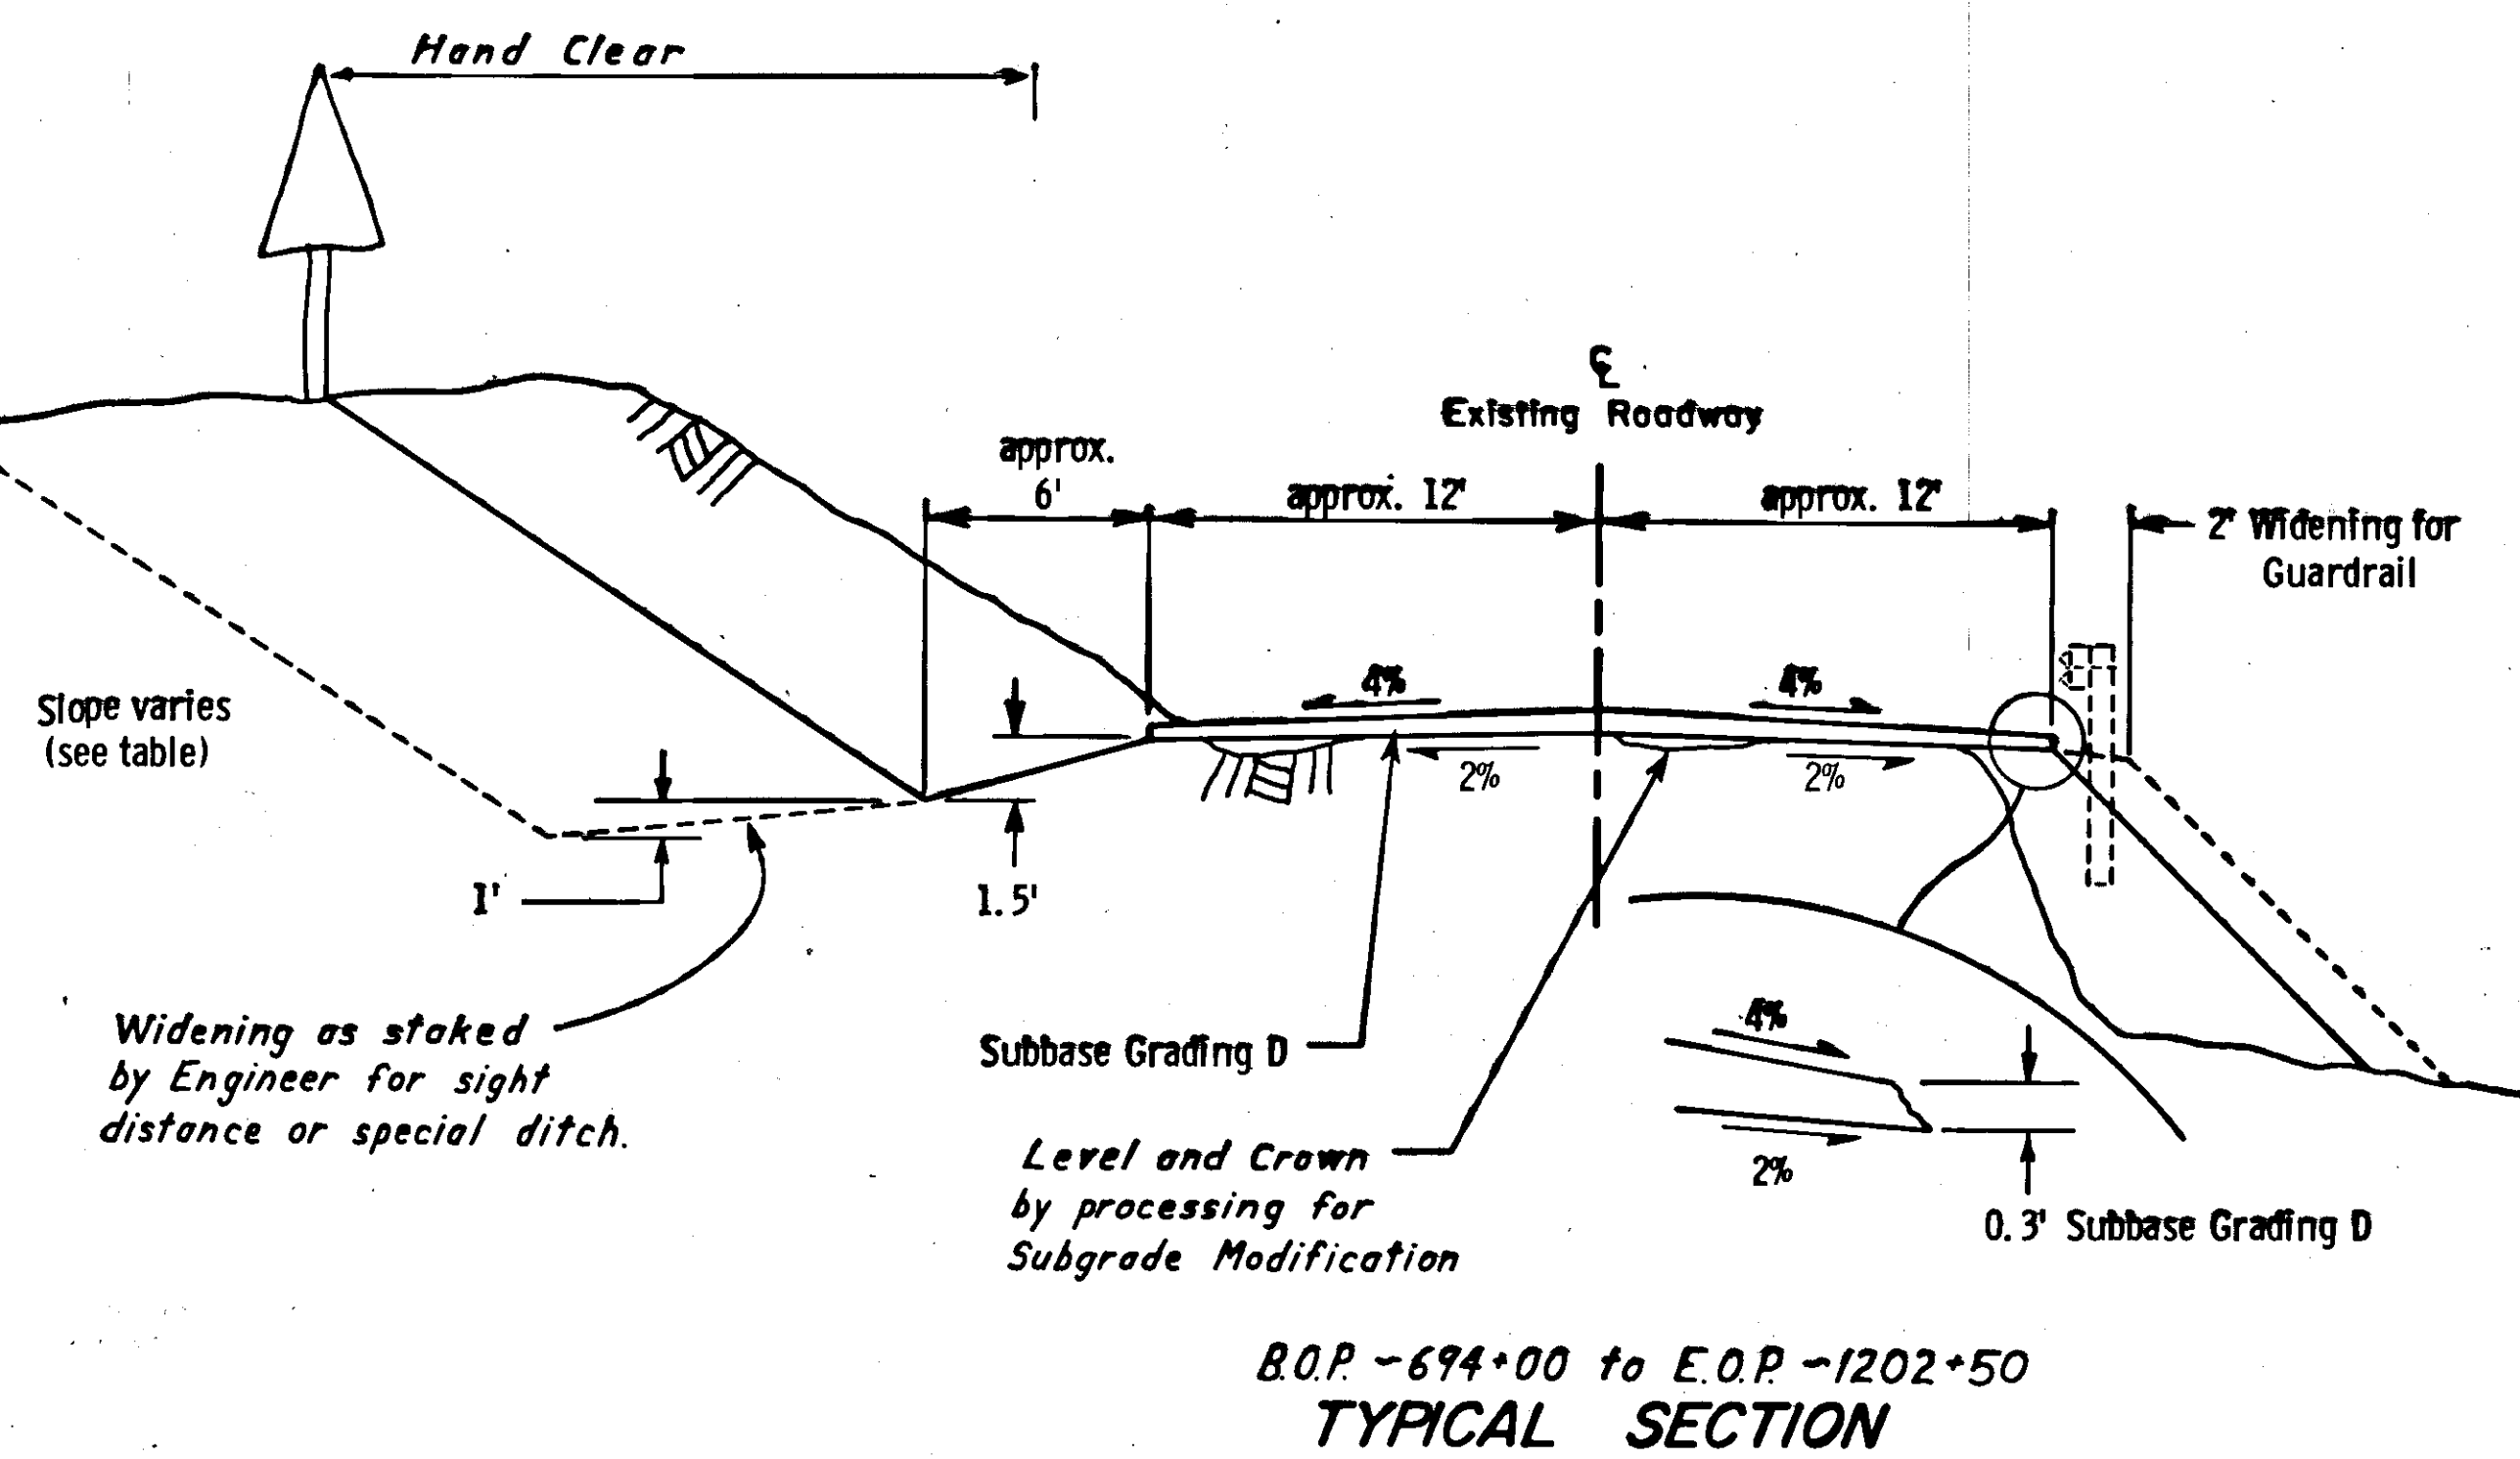



SLOPE TABLE

	ALL HEIGHTS		
	Rock	Soil	Waste
Cut	1/4 : 1	1 1/2 : 1	-
Fill	1/2 : 1	2 : 1	1 1/2 : 1 to 4 : 1 as staked



TYPICAL RIPRAP INSTALLATION

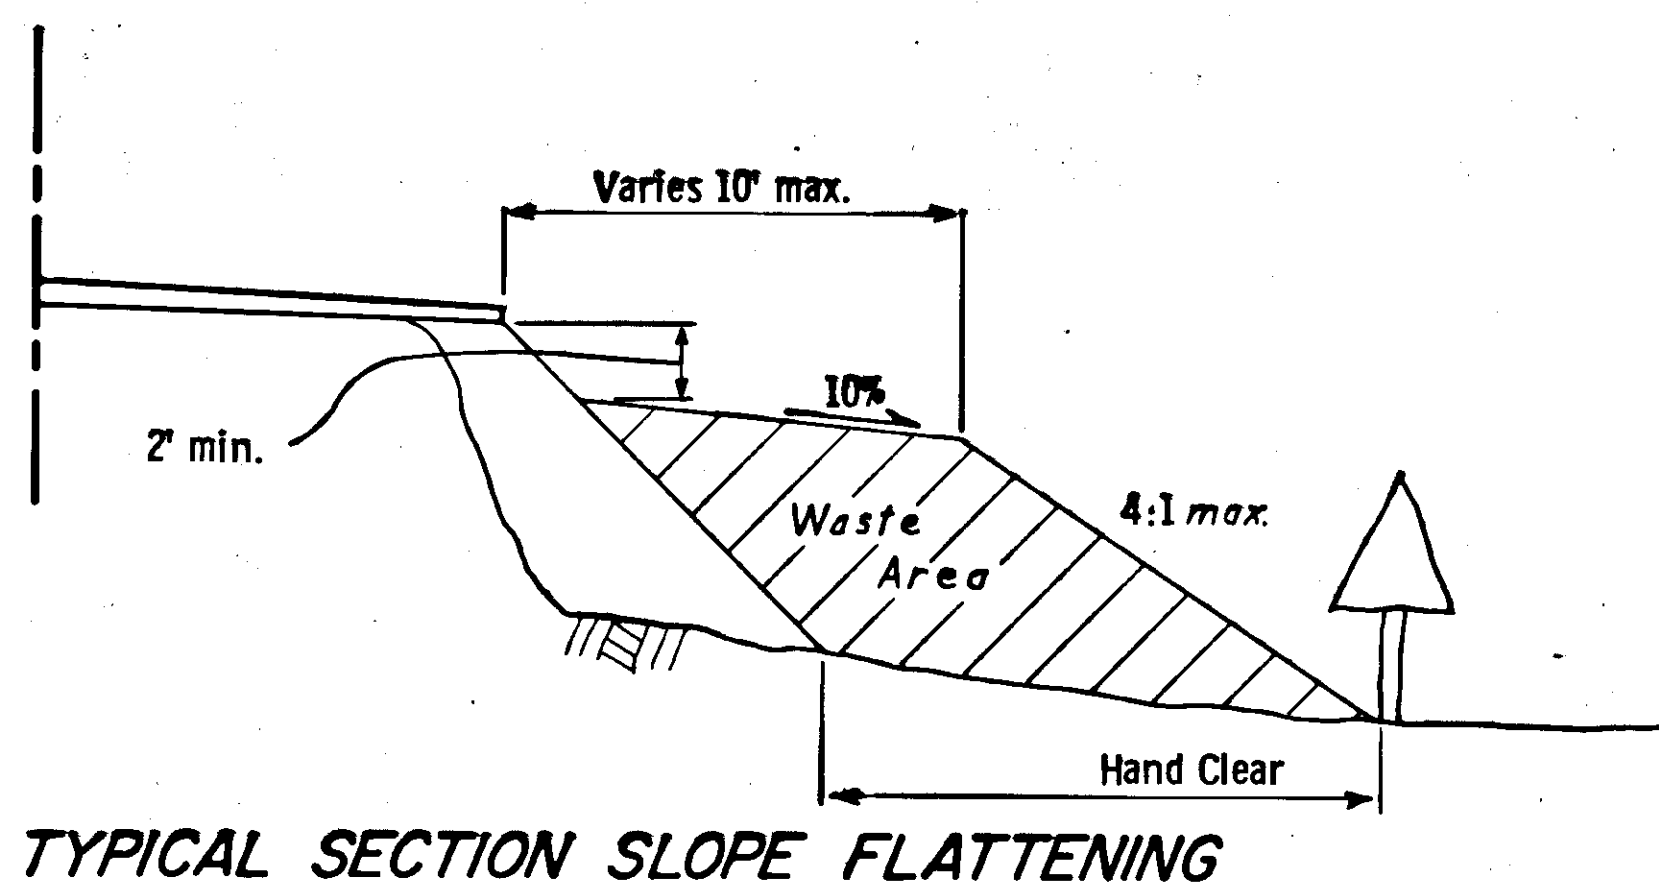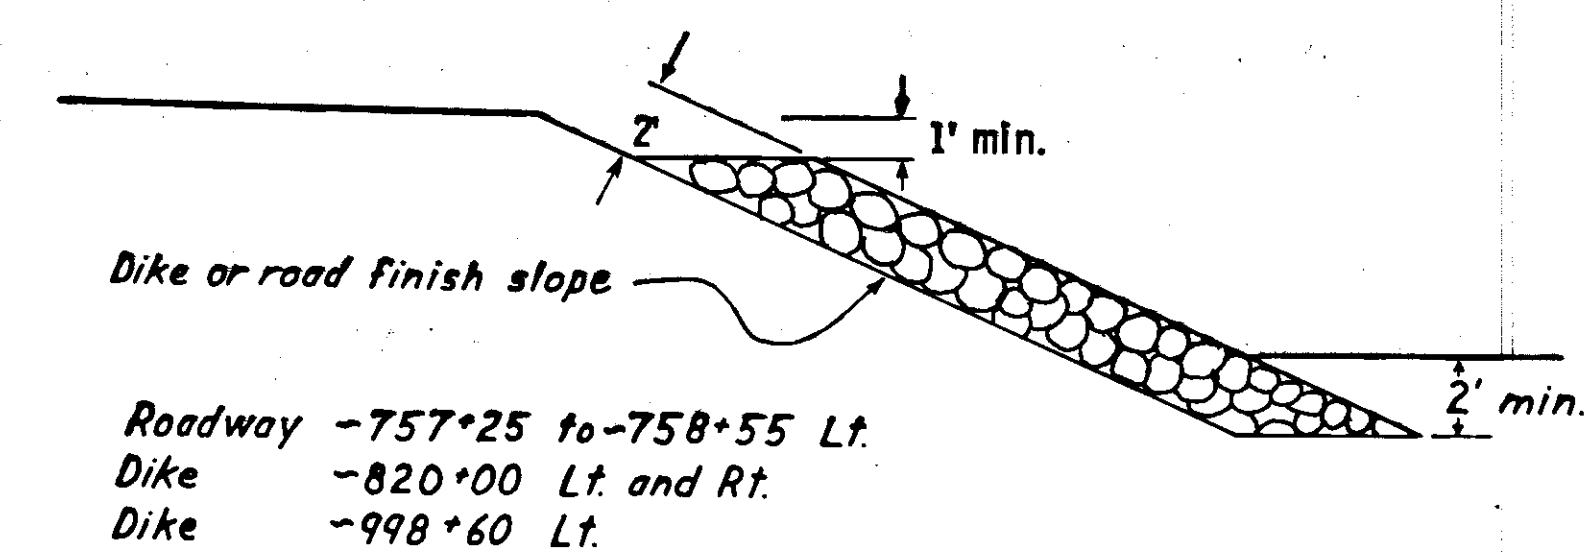

TYPICAL CULVERT END PROTECTION

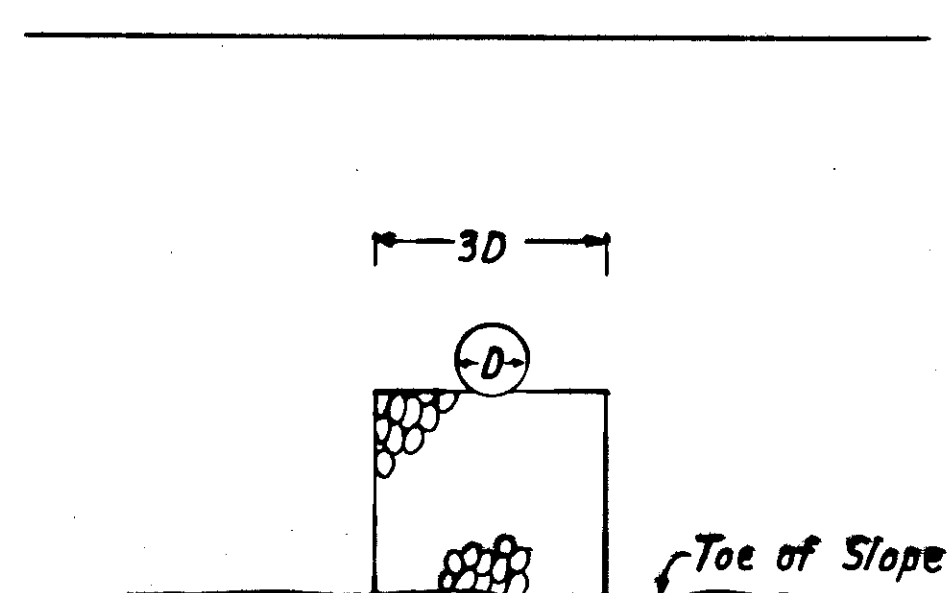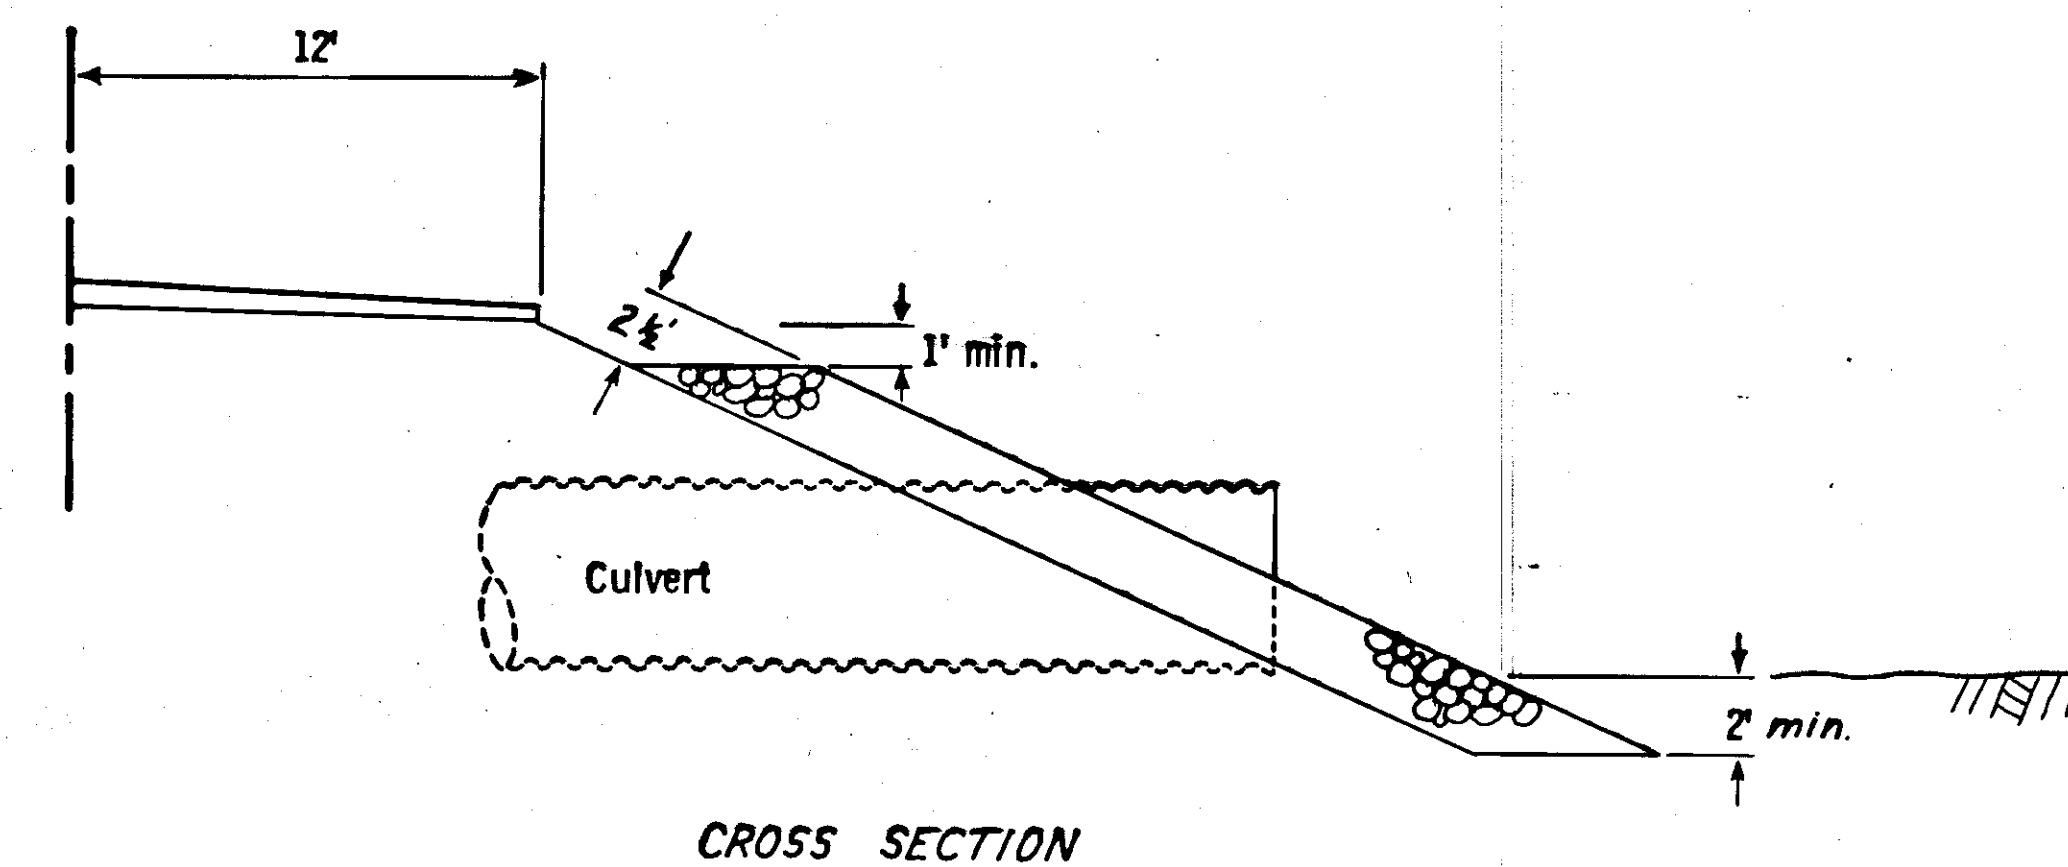


ROCK OUTLET DETAIL

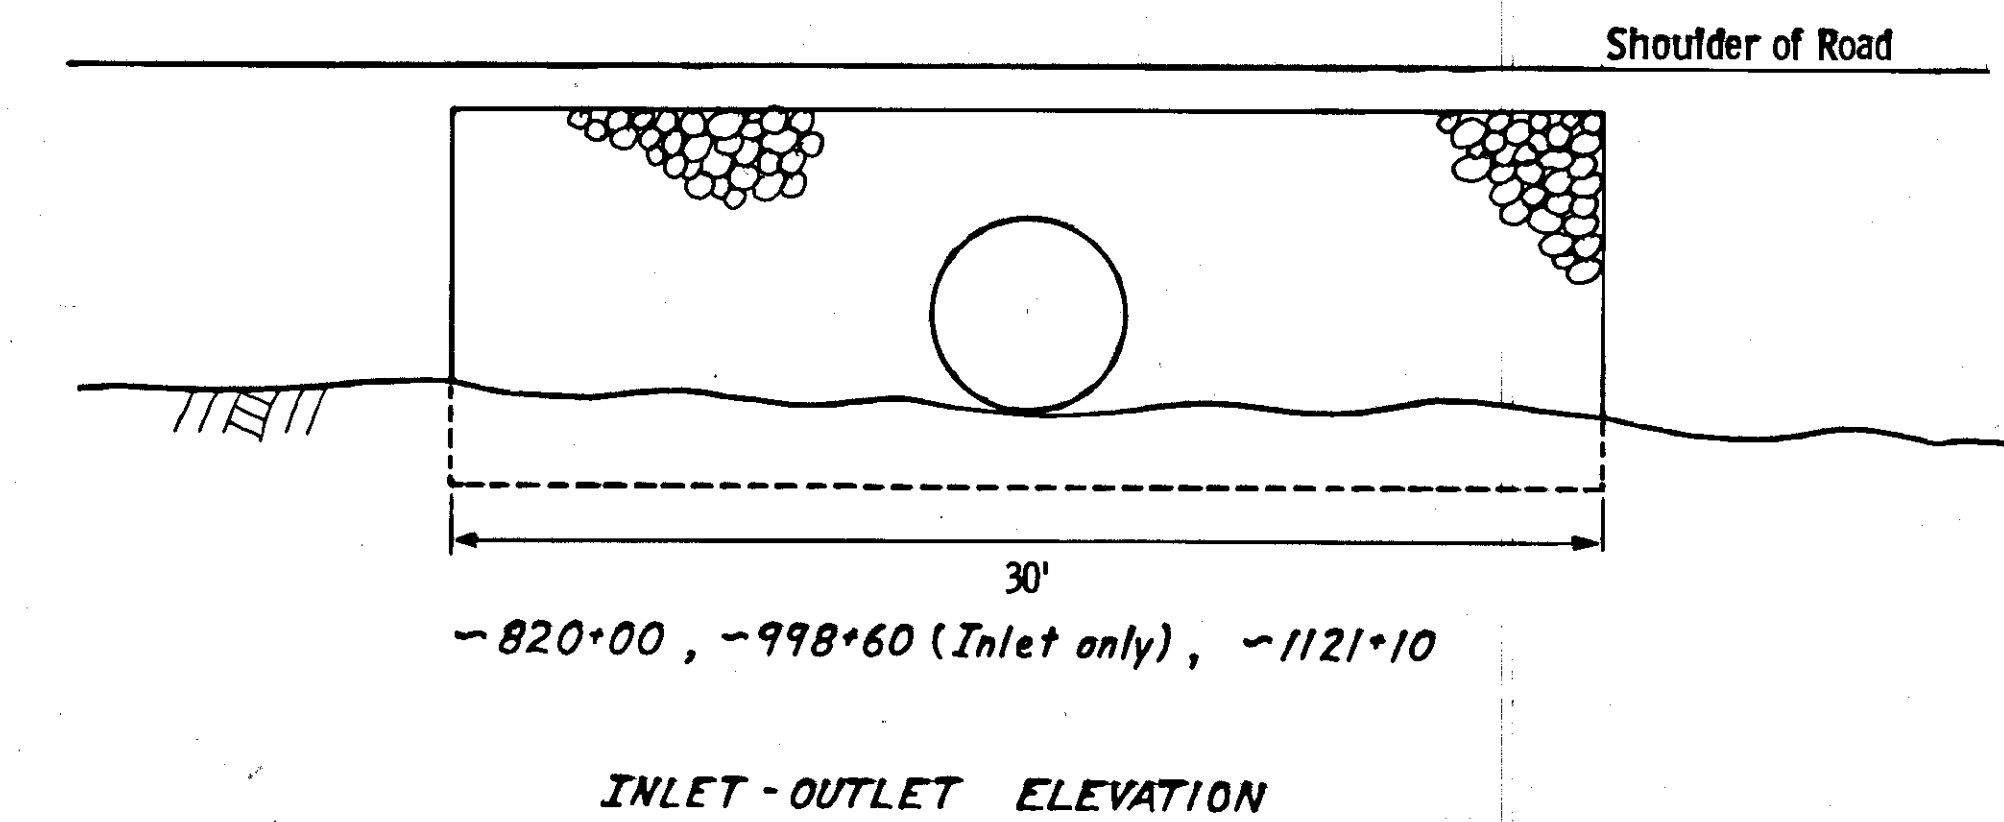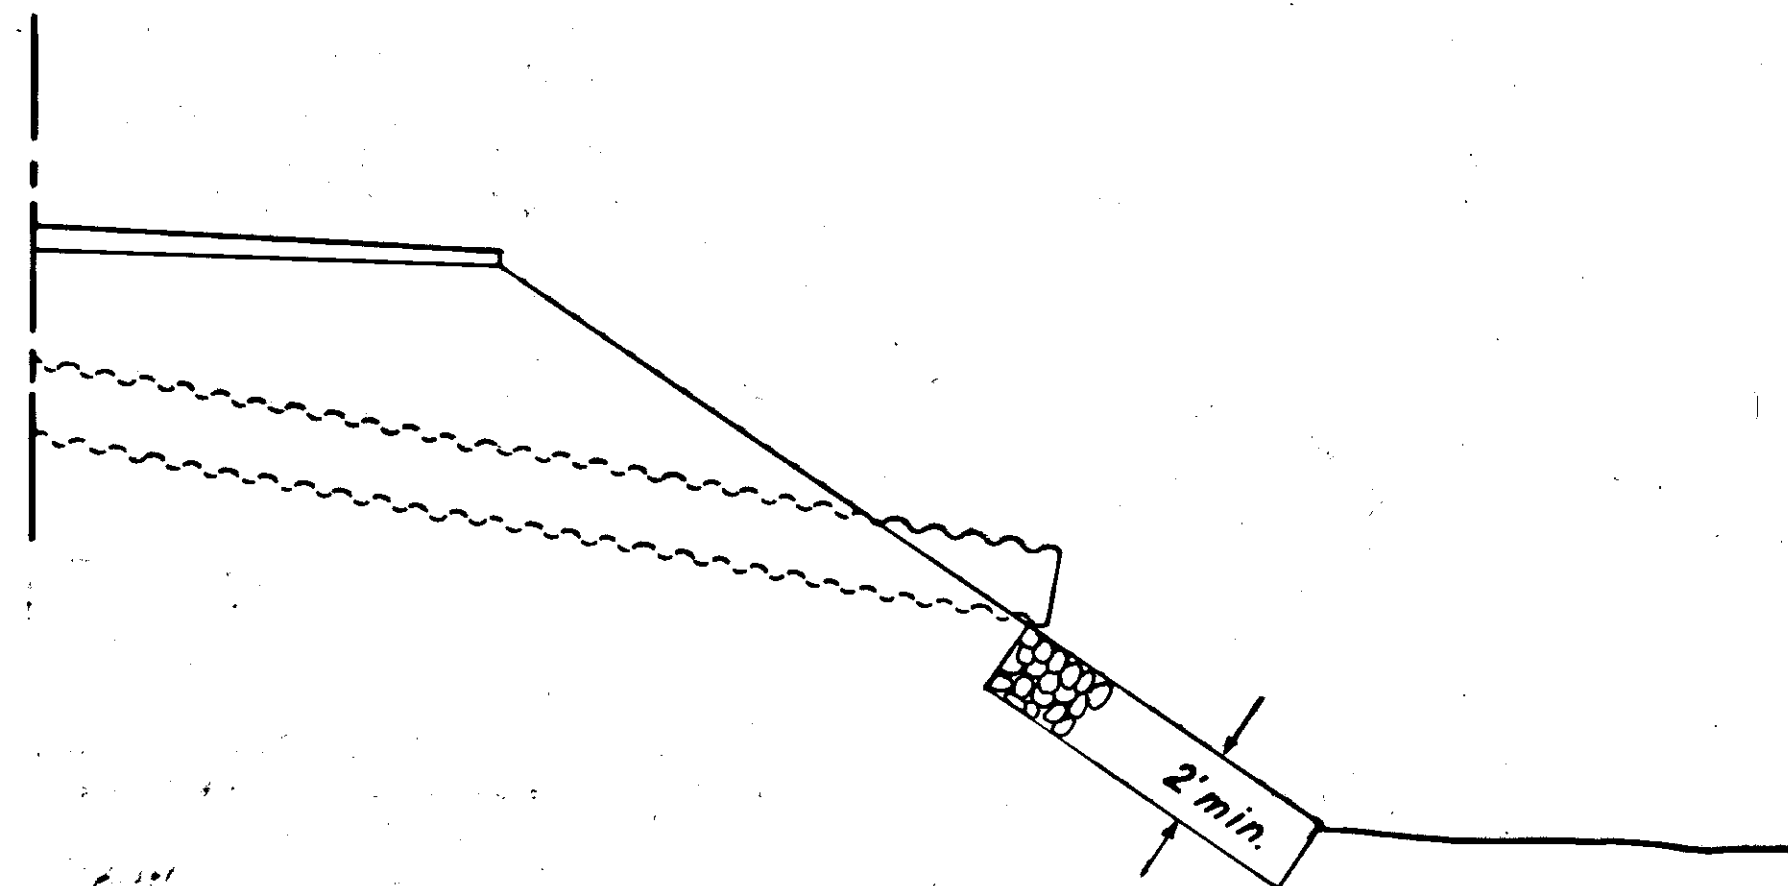


STATE	PROJECT DESIGNATION	YEAR	SHEET NO.	TOTAL SHEETS
ALASKA	FH 006 - / (1)	1975	3	18

GENERAL NOTES

1. Hand clearing must be completed in advance of excavation or waste disposal.
2. Stumps, stump butts, logs, limbed trees and brush may be buried in waste. No stumps, log or brush will be placed so as to protrude from the waste fill.
3. The variable dimension shown on the typical sections for waste berms will be used to provide a uniform width of prism where roadway width varies.
4. Rock outlet detail will be paid for under item 203 (3), unclassified excavation.
5. Excavation for culvert installation and or culvert removal work will encounter large logs, log cribs, bedrock and possible stumps. Such obstruction will be considered part of the normal excavation. Disposal in an approved area will be incidental to the item of work being performed.
6. Culverts indicated for "Removal" on the plan sheets will be removed and disposed of as in Section 202 of the specifications.
7. Processing for Subgrade Modification item 302(3) will include shaping the roadway to the template and restoring ditches along the entire project.
8. Existing signs will be removed by others.
9. Embankment widening as shown on the plans and or staked by the engineer will be constructed of materials obtained from unclassified Excavation.
10. The heavy centerline shown on the plans is the control line. The existing roadway is to be improved. Pay quantities based on the length of roadway will be calculated along the length of the existing roadway.

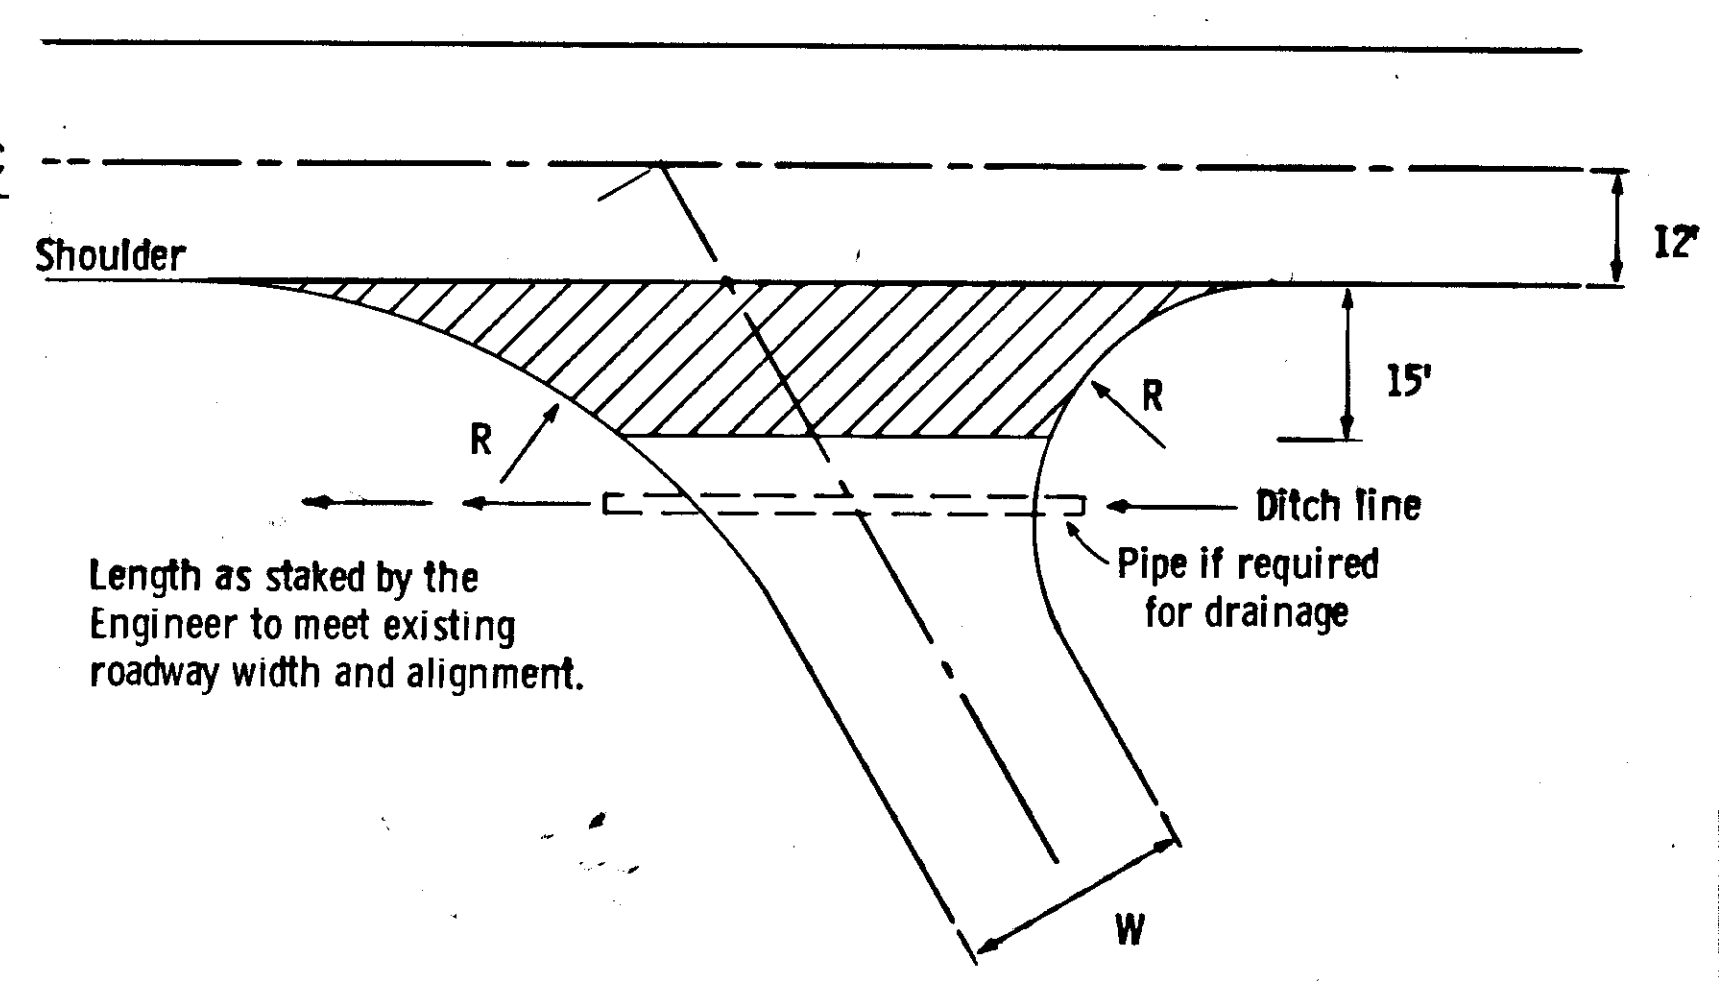


APPROACH DETAIL

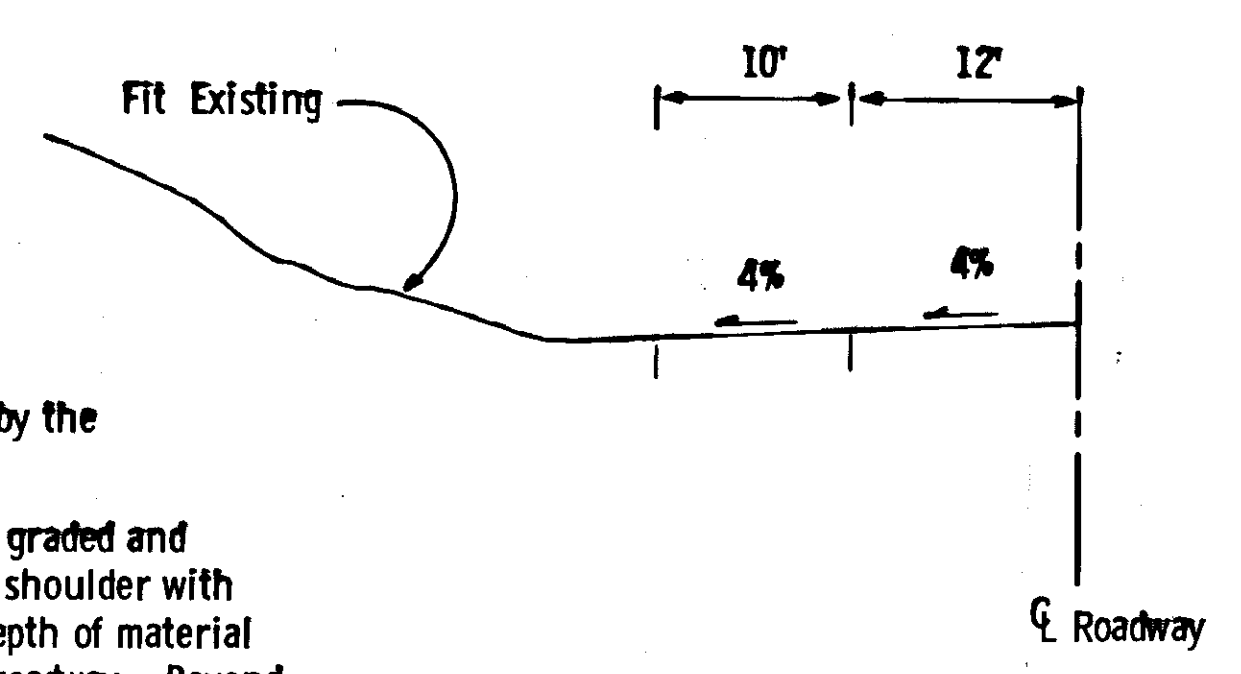


APPROACH PROFILE

NOTES
 R - Radius as staked by the Engineer
 Approaches shall be graded and surfaced 15' beyond shoulder with the same type and depth of material as specified for the roadway. Beyond this point approaches shall be surfaced the same as the connecting road. Approach side slopes shall match existing construction.
 W - Varies, construct as staked by the Engineer.

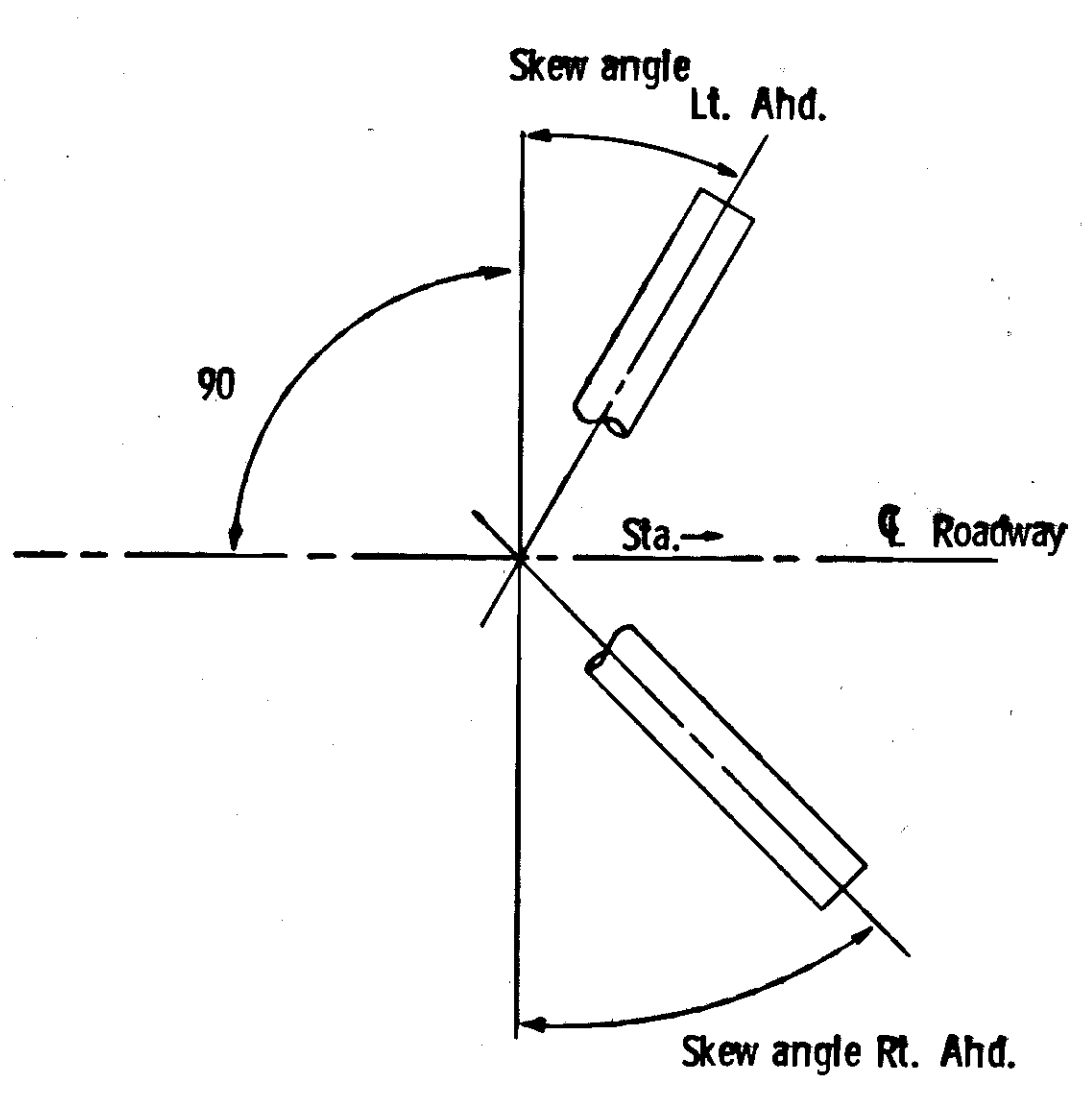

CULVERT SKEW

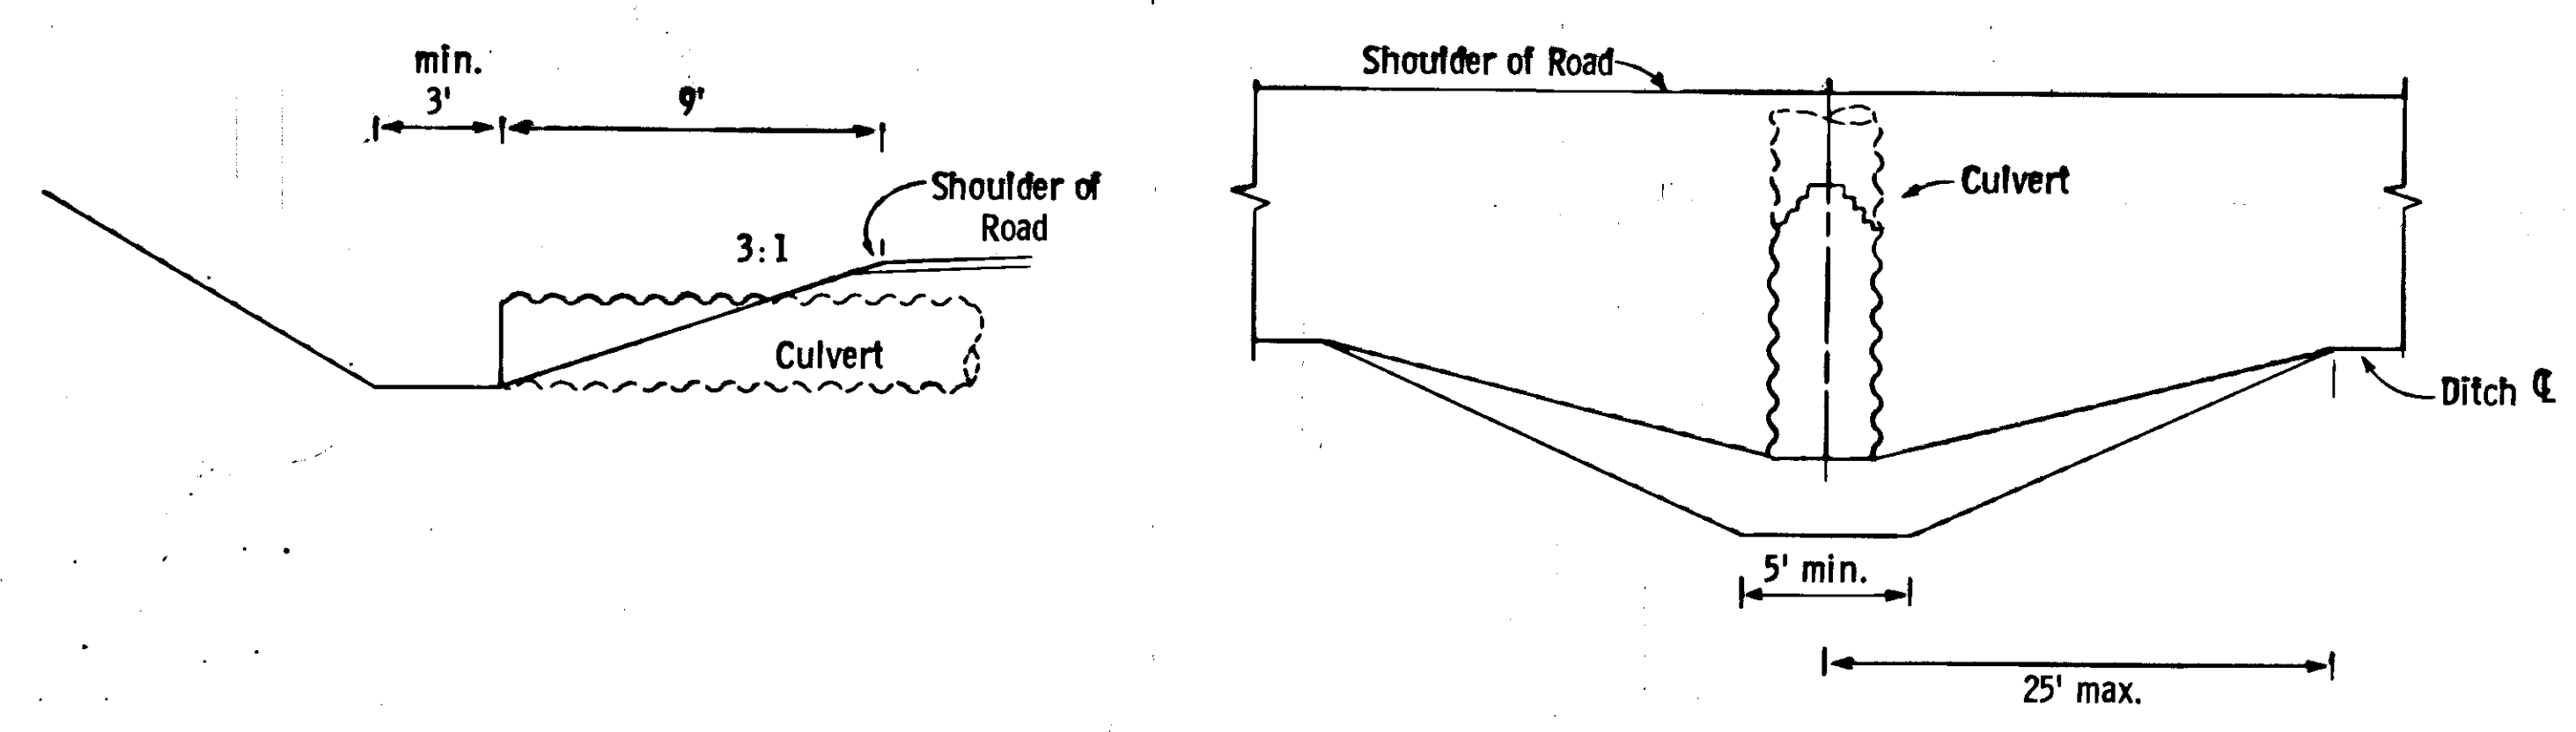

CULVERT INLET DETAIL

SIGNING SCHEDULE

STATION	LEFT/RIGHT	CODE NO.	LEGEND	SIZE
"L"690+00	Right	R2-1	35 MPH	30" X 36"
"L"872+00	Lt. & Rt.	R2-1	35 MPH	30" X 36" (2)
"L"1027+94	Right	W1-3R	Reverse Turn	36" X 36"
"L"1027+94	Right	W13-1	20 MPH	24" X 24"
"L"1037+40	Left	W1-3L	Reverse Turn	36" X 36"
"L"1037+40	Left	W13-1	20 MPH	24" X 24"
"L"1042+50	Right	W1-1L	Turn	36" X 36"
"L"1042+50	Right	W13-1	25 MPH	24" X 24"
"L"1046+50	Left	W1-1R	Turn	36" X 36"
"L"1046+50	Left	W13-1	25 MPH	24" X 24"
"L"1054+00	Lt. & Rt.	R2-1	35 MPH	30" X 36" (2)
"L"1083+00	Right	W1-3R	Reverse Turn	30" X 36"
"L"1083+00	Right	W13-1	20 MPH	24" X 24"
"L"1087+00	Left	W1-3R	Reverse Turn	36" X 36"
"L"1087+00	Left	W13-1	20 MPH	24" X 24"
"L"1105+00	Right	W1-3R	Reverse Turn	36" X 36"
"L"1105+00	Right	W13-1	20 MPH	24" X 24"
"L"1113+00	Left	W1-3L	Reverse Turn	36" X 36"
"L"1113+00	Left	W13-1	20 MPH	24" X 24"
"L"1117+90	Right	R1-1	Stop	30" X 30"
"O"1137+00	Right	W1-1R	Turn	36" X 36"
"O"1137+00	Right	W13-1	15 MPH	24" X 24"
"O"1143+00	Left	W1-1L	Turn	36" X 36"
"O"1143+00	Left	W13-1	15 MPH	24" X 24"
"O"1169+00	Right	W1-1R	Turn	36" X 36"
"O"1169+00	Right	W13-1	15 MPH	24" X 24"
"L"1173+00	Left	W1-1L	Turn	36" X 36"
"L"1173+00	Left	W13-1	15 MPH	24" X 24"
"O"1186+00	Left	R2-1	35 MPH	30" X 36"
"O"1190+00	Left	R1-1	Stop	30" X 30"
"O"1196+60	Right	R1-1	Stop	30" X 30"
"O"1196+60	Left	R1-1	Stop	30" X 30"
"O"1198+00	Right	W2-4	T Symbol	36" X 36"
"O"1199+00	Right	R1-1	Stop	30" X 30"
"O"1199+30	Left & Right	R1-1	Stop	30" X 30" (2)

NOTE: All sign posts shall be telescoping perforated steel posts. The 2" size shall be used above ground and 2 1/4" size below ground. Embedment of the 2 1/4" piece shall be 4'.

RIP RAP SUMMARY

STATION	Lt. / Rt.	QUANTITY
"L"757+25 to 758+55	Left 13.15	116 Cubic Yards
"L"820+00	Lt. & Rt. 38.59	180 Cubic Yards
"L"998+60	Left 40.98	200 Cubic Yards
"L"1120+90 to 1121+30	Lt. & Rt. 82.77	71 Cubic Yards
"O"1140+00	Lt. & Rt. 52.63	90 Cubic Yards
"O"1161+30	Lt. & Rt. 144.45	30 Cubic Yards
914+70		68.1 " "

GUARDRAIL SUMMARY

STATION	Lt. / Rt.	QUANTITY
"O"1139+25 to 1140+00	Right	75 Linear Feet
"O"1139+50 to 1140+00	Left	50 Linear Feet
"O"1140+62 to 1141+12	Right	50 Linear Feet
"O"1140+62 to 1141+37	Left	75 Linear Feet

STUMP REMOVAL SUMMARY

STATION	NUMBER	STATION	NUMBER
"L"737+00	2	"L"1004+00	1
"L"738+00	1	"L"1013+00	1
"L"743+00	2	"L"1014+00	1
"L"748+00	1	"L"1018+00	1
"L"766+00	2	"L"1103+00	1
"L"771+00	1	"L"1107+00	1
"L"781+00	2	"L"1122+00	4
"L"811+00	1	"O"1124+00	2
"L"817+00	1	"O"1133+00	1
"L"821+00	1	"O"1137+00	2
"L"823+00	1	"O"1157+00	3
"L"830+00	1	"O"1158+00	4
"L"834+00	1	"O"1162+00	1
"L"853+00	1	"O"1165+00	3
"L"893+00	2	"O"1178+00	1
"L"900+00	1	"O"1181+00	2
"L"911+00	1	"O"1191+00	2
"L"913+00	1	"L"1179+00	2
"L"940+00	1	"O"1183+00	1
"L"945+00	1		
"L"946+00	1		
"L"947+00	1		
"L"959+00	1		
"L"964+00	1		
"L"976+00	1		
"L"977+00	1		
"L"998+00	1		
		TOTAL	66

706+05 R 1	894+75 R 1	1155+75 R 1
716+50 R 1	899+65 R 1	1156+25 L 1
716+65 R 1	902+35 R 1	1156+75 L 1
721+20 R 1	908+80 R 1	1157+60 L 1
723+40 R 1	911+00 R 1	1158+00 L 1
728+40 R 2	903+48 R 1	1158+65 L 1
736+70 R 1	908+15 R 1	1161+65 L 1
737+62 R 1	916+25 R 1	1162+00 R 1
741+45 R 1	917+35 L 1	1166+00 R 1
742+30 R 1	932+10 R 1	1166+50 R 1
742+99 R 1	937+20 R 1	1170+00 L 1
745+21 R 1	945+10 R 1	1173+00 L 1
744+27 R 2	945+70 R 1	1177+95 R 1
744+35 R 2	946+50 L 1	1181+80 R 1
753+06 R 1	956+88 R 1	1192+00 R 1
753+26 R 1	960+00 R 1	1192+15 R 1
767+80 R 1	963+60 R 1	1199+00 R 1
772+00 R 1	985+62 R 1	1199+40 R 1
790+55 R 1	996+00 R 1	1181+75 L 1
781+35 R 1	998+00 R 1	1183+70 R 1
787+75 R 1	1012+70 R 1	1184+96 L 1
767+12 R 1	1013+30 R 1	903+00 R 1
811+40 R 1	1029+90 R 1	889+00 R 1
900+50 R 1	1036+50 R 1	889+50 R 1
823+15 R 1	1103+00 R 1	890+55 R 1
830+55 R 1	1120+30 L 1	879+75 R 1
908+82 R 1	1121+65 L 1	821+00 L 1
1113+00 R 1	1122+35 L 1	1077+55
836+50 R 1	1122+60 L 1	#105
840+40 R 1	1122+65 R 1	1124+00 R 1
834+14 R 1	1123+05 L 1	748+00 L 1
834+80 R 1	1123+05 R 1	1116+00 R 1
835+20 R 1	1123+15 R 1	1126+00 R 1
853+32 R 1	1124+90 R 1	1117+00 R 1
862+85 R 1	1125+05 R 1	1114+00 R 1
870+05 R 1	1130+35 R 1	1124+00 L 1
880+86 R 1	1130+80 R 1	1128+00 L 1
885+08 R 1	1133+06 R 1	1164+00 L 1
884+75	1154+30 R 1	
894+50 R 1	1154+00 R 1	

CULVERT SUMMARY

STATE	PROJECT DESIGNATION	YEAR	SHEET NO.	TOTAL SHEETS
ALASKA	FH 006-(1)	1975	5	15

STATION	Remove and Dispose of Culvert								Culvert Marker Posts	Structural Plate Pipe - Arch 12' 10" X 8' 4"	REMARKS
	L.F.		24" Pipe Conduit	30" Pipe Conduit	36" Pipe Conduit	42" Pipe Conduit	48" Pipe Conduit	60" Pipe Conduit			
"L" 700+40	3029			A240					2		
"L" 705+60	3733			A046					2		
"L" 709+80	3837					566A			1		Place rock at outlet
"L" 712+10	2035		A65A						2		Remove stumps at outlet
"L" 715+75			-30						-2		Ditch out
"L" 718+30	40		A850						1		
"L" 722+40	3875										Log crib in fill
"L" 722+50 28				50					1		
"L" 724+60 80	3640			A074					2		Excavate at inlet, Place rock at outlet See sheet no. 2
"L" 731+95	39		5458						1		
"L" 734+62	3134		3842						2		
"L" 736+34	3234		3844						2		
"L" 744+09	3433		A074						2		
"L" 747+18	30			3674					2		Excavate at inlet
"L" 747+36	30										
"L" 748+94	36		A076						2		
"L" 753+86	2526		3846						2		
"L" 758+55	2825			3844					2		Excavate at inlet
"L" 760+60	28			A074					2		
"L" 765+52	27		46	A6					2		
"L" 771+97	2830			3642					2		Excavate at outlet
"L" 775+60	2723		36	42					2		Excavate at inlet and outlet
"L" 776+80	3035		3844						2		
"L" 767+57			44								
"L" 779+20	30			A076					2		
"L" 784+24	2036		3640						2		
"L" 789+35	2838			A072					2		Excavate at inlet
"L" 791+48	3233		40						2		Do not skew
"L" 795+95	2837		3842						2		Excavate at inlet
"L" 801+76	2830					3048			1		Ditch in and out
"L" 809+38 9	3635										Do not replace
"L" 813+24	3635		42								Do not replace
"L" 816+35	A233		44	A6					2		
"L" 818+05	A643			A674					2		
"L" 820+00								76	2		See sheet no. 2
"L" 824+70	36										
"L" 826+06 825+90	28		A238						2		Excavate at outlet
"L" 828+90	A028		A238						2		
"L" 831+40	3435		A240						2		
"L" 833+50	A0		40						2		
"L" 835+90	A037		3842						2		
"L" 836+50	A237				5658				2		Skew 30 degrees Lt. Ah.
"L" 840+40	3844		3844						2		
"L" 842+81	2870		3844						2		
"L" 847+75			A672						2		
"L" 852+70	3234			A658					1		
"L" 855+20	3233		A240						2		
"L" 860+80	38			A744					2		
"L" 862+70	3040		A038						2		Excavate at outlet
"L" 863+95	3035		A438						2		Excavate at inlet
"L" 865+97 79	3437		A470						2		

STATION	Remove and Dispose of Culvert								Culvert Marker Posts	Structural Plate Pipe - Arch 9' 6" X 6' 5"	REMARKS
	L.F.		24" Pipe Conduit	30" Pipe Conduit	36" Pipe Conduit	42" Pipe Conduit	48" Pipe Conduit	60" Pipe Conduit			
"L" 868+88 58	2836					3646			2		
"L" 870+49	3640		3638						2		
"L" 873+64	2834		A038						2		
"L" 875+84	40			40					2		Skew 15 degrees Rt. Ah.
"L" 877+23	38		A470						1		
"L" 879+25			A438						2		
"L" 880+39	38										
"L" 881+74	A246		A238						2		
"L" 883+92	A043		A640						2		
"L" 886+34	A637		A640						2		Skew 10 degrees Lt. Ah.
"L" 887+12 04	A640				A240				2		Skew 5 degrees Lt. Ah.
"L" 890+55	A038		A038						2		
"L" 895+28	2838		A038						2		
"L" 896+30	3041		A038						2		
"L" 897+48	3040			A238					2		
"L" 900+00	3042		3842						2		
"L" 901+65	3048		38						2		
"L" 903+48	A038										
"L" 903+80			A236						2		
"L" 905+70	3637		38	A2					2		
"L" 910+02	3240			A238					2		
"L" 914+80	A642						A644		2		Construct Dike at Inlet
"L" 916+78	3848			48		54			1		
"L" 921+94	A635		43	A6					2		
"L" 924+54	3638			A840					1		
"L" 929+19	3225			5042					1		
"L" 932+90			A236						2		
"L" 935+25			A438						2		
"L" 936+25	3640		A638						2		
"L" 939+79	3629			5440					1		
"L" 917+50					46						
"L" 941+43	5053			A838					1		
"L" 942+80	3643				5450				1		Skew 20 degrees Lt. Ah.
"L" 945+60	3836					A846			1		
"L" 947+64	A041			42					2		
"L" 949+89	38			A640					2		
"L" 957+88	3645					A850			1		
"L" 963+50			A838						1		
"L" 964+30	24										Remove 8" C. M. P.
"L" 967+50	38		A636						2		Excavate at inlet and outlet
"L" 970+14	5030				54				1		
"L" 974+80	3040		A240						2		
"L" 976+80	3642				50				1		
"L" 978+20	3637		38	A6					2		
"L" 979+89 65	5025										Ditch to 978+20
"L" 956+50	40		46								
"L" 980+47	3634		44						2		
"L" 982+64	3645		A240						1		
"L" 983+73	A050										Ditch to 982+64
"L" 985+90	A033		A640						2		
"L" 990+00			46						2		
"L" 991+40	3641				A442				1		
"L" 994+00	3840										
"L" 995+50	3039					6056			1		Excavate at inlet
"L" 998+60	29					108			2		Construct Inlet Dikes & Place Rock at Outlet
"L" 999+00	28										

CULVERT SUMMARY

ESTIMATE OF QUANTITIES

STATE	PROJECT DESIGNATION	YEAR	SHEET NO.	TOT. SHEETS
ALASKA	FH 006 - 1(1)	1975	6	16


STATION	Remove and Dispose of Culvert	L.F.	24" Pipe Conduit	L.F.	30" Pipe Conduit	L.F.	36" Pipe Conduit	L.F.	42" Pipe Conduit	L.F.	48" Pipe Conduit	L.F.	60" Pipe Conduit	L.F.	Culvert Marker Posts	Each	Structural Plate Pipe - Arch 9' 6" X 6' 5"	L.F.	Structural Plate Pipe - Arch 12' 10" X 8' 10"	L.F.	REMARKS	
																						L.F.
" L " 1002+30		3637			5044										1							
" L " 1006+22				4638											1							
" L " 1012+00 60				4048											1							
" L " 1015+40 70		32			4042										1							Excavate at outlet
" L " 1017+00													7850		1							Skew to meet side road culvert
" L " 1019+00		4032			4640										2							
" L " 1027+60													7846		1							Excavate at inlet
" L " 1027+94		38			5060										1							Place rock at outlet see sheet no 2
" L " 1033+00 1031+00		46		44											1							
" L " 1034+20		7638													1							Remove 2 Log culverts
" L " 1037+40		4047													1							Excavate at inlet
" L " 1039+58 80				4044											2							
" L " 1041+21		44		5238											1							Excavate at inlet
" L " 1043+50				4244											2							
" L " 1046+00		3640		4438											2							
" L " 1050+50		5045		4846											1							
" L " 1055+00				5042											1							
" L " 1058+60		3640			5038										1							
" L " 1063+15		24		3660											2							Located in access road Lt.
" L " 1063+00				40											2							
" L " 1064+03		3640											4442		1							Excavate at inlet
" L " 1065+00		3641																				
" L " 1096+25				4844																		
" O " 1144+00				4640											2							
" O " 1157+80				4638											2							
" O " 1178+30		36		4638											2							Excavate at outlet
" O " 1187+00 1178+00				4648											2							Excavate at outlet
" O " 1190+60 85				40	42										2							Excavate at outlet
" L " 1181+90		4039		4440											2							
" O " 1188+60				50											2							
" O " 1196+60				42											2							Install in approach Rt.
" O " 1196+60				42											2							Install in approach Lt.
" A " 11+60				38											2							Install in approach Lt.
Total		3842		2796	1110	708	318	110	398						211		52		76			


Note: Pipe Conduit minimum gage or thickness requirements are not exceeded by height of fill.

" L " 1067+75	40	36																				
" L " 1069+50	43		42																			
" L " 1073+31	39																					
" L " 1073+76		40																				
" L " 1074+95	46		44																			
" L " 1083+92	20			46																		
" L " 1088+68	40	40																				
" L " 1091+46	40	38																				
" L " 1099+30	36																					
" L " 1101+58	35								48													
" L " 1105+91	35																					
" L " 1111+40		54	38																			
" L " 1114+40	20			66																		
" L " 1117+90		24																				
" L " 1122+22	36		46																			
" O " 1155+00	40	40																				
" O " 1161+30	40																					
" O " 1172+70	38												50									52
" O " 1184+00				40																		
" O " 1194+85	68												72									
" L " 1178+00	35	40																				
" O " 1184+30	43	44																				



Item No.	Item	Unit	Quantity
1	Furnishing and Maintaining Engineering Facilities	Lump Sum	All Required
2A	Meals	Each	5295
2B	Lodging	Each	1760
2C	Pickup	Day	566
2D	Crew Cab	Day	191
110(1)	Mobilization	Lump Sum	All Required
111(1)	Temporary Erosion and Pollution Control	Cont. Sum	All Required
112(1)	Training Program in accordance with FHWA Order, Interim 7-2(2)	Cont. Sum	All Required
113(1)	Flagging	Man Hrs	64
201(4A)	Hand Clearing	Acre	5
201(6A)	Select Tree Removal	Each	10
201(6B)	Select Stump Removal	Each	66
203 (3)	Unclassified Excavation	C.Y.	35,410
202(4)	Removal and Disposal of Culvert Pipe	Lin. Foot	3842
302(3)	Processing for Subgrade Modification	Station	546
304(2)	Subbase Grading "D"	Cubic Yard	20,850
305(1)	Stockpiled Material, Section 304(2), Grading "D"	Cubic Yard	3,000
506(1)	Untreated Timber	MBM	2.5
507(2)	Bridge Railing	Lump Sum	All Required
602(2A)	Structural Plate Pipe - Arch 9' 6" X 6' 5" (State furnished)	Lin. Foot	52
602(2B)	Structural Plate Pipe - Arch 12' 10" X 8' 4"	Lin. Foot	76
603(22G)	24" Pipe Conduit	Lin. Foot	2,796
603(22H)	30" Pipe Conduit	Lin. Foot	1,110
603(22I)	36" Pipe Conduit	Lin. Foot	708
603(22J)	42" Pipe Conduit	Lin. Foot	318
603(22K)	48" Pipe Conduit	Lin. Foot	110
603(22M)	60" Pipe Conduit	Lin. Foot	398
606(1)	Beam Type Guardrail, Type I Post	Lin. Foot	250
611(1)	Rip Rap	Cubic Yard	687
613(2)	Culvert Marker Posts	Each	211
615(1)	Standard Signs	Square Foot	247.5
618(1)	Seeding	1000 Sq. Ft.	630

STATE	PROJECT DESIGNATION	YEAR	SHEET NO.	TOTAL SHEETS
ALASKA	FH-006-1(1)	1975	8	18

 Denotes Excavation to Template or as staked by the Engineer


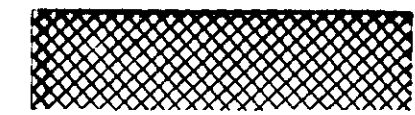
 Denotes Embankment widening

NOTE: The heavy centerline shown on the plans is the control line. The existing roadway is to be improved. Pay quantities based on the length of roadway will be calculated along the length of the existing roadway.

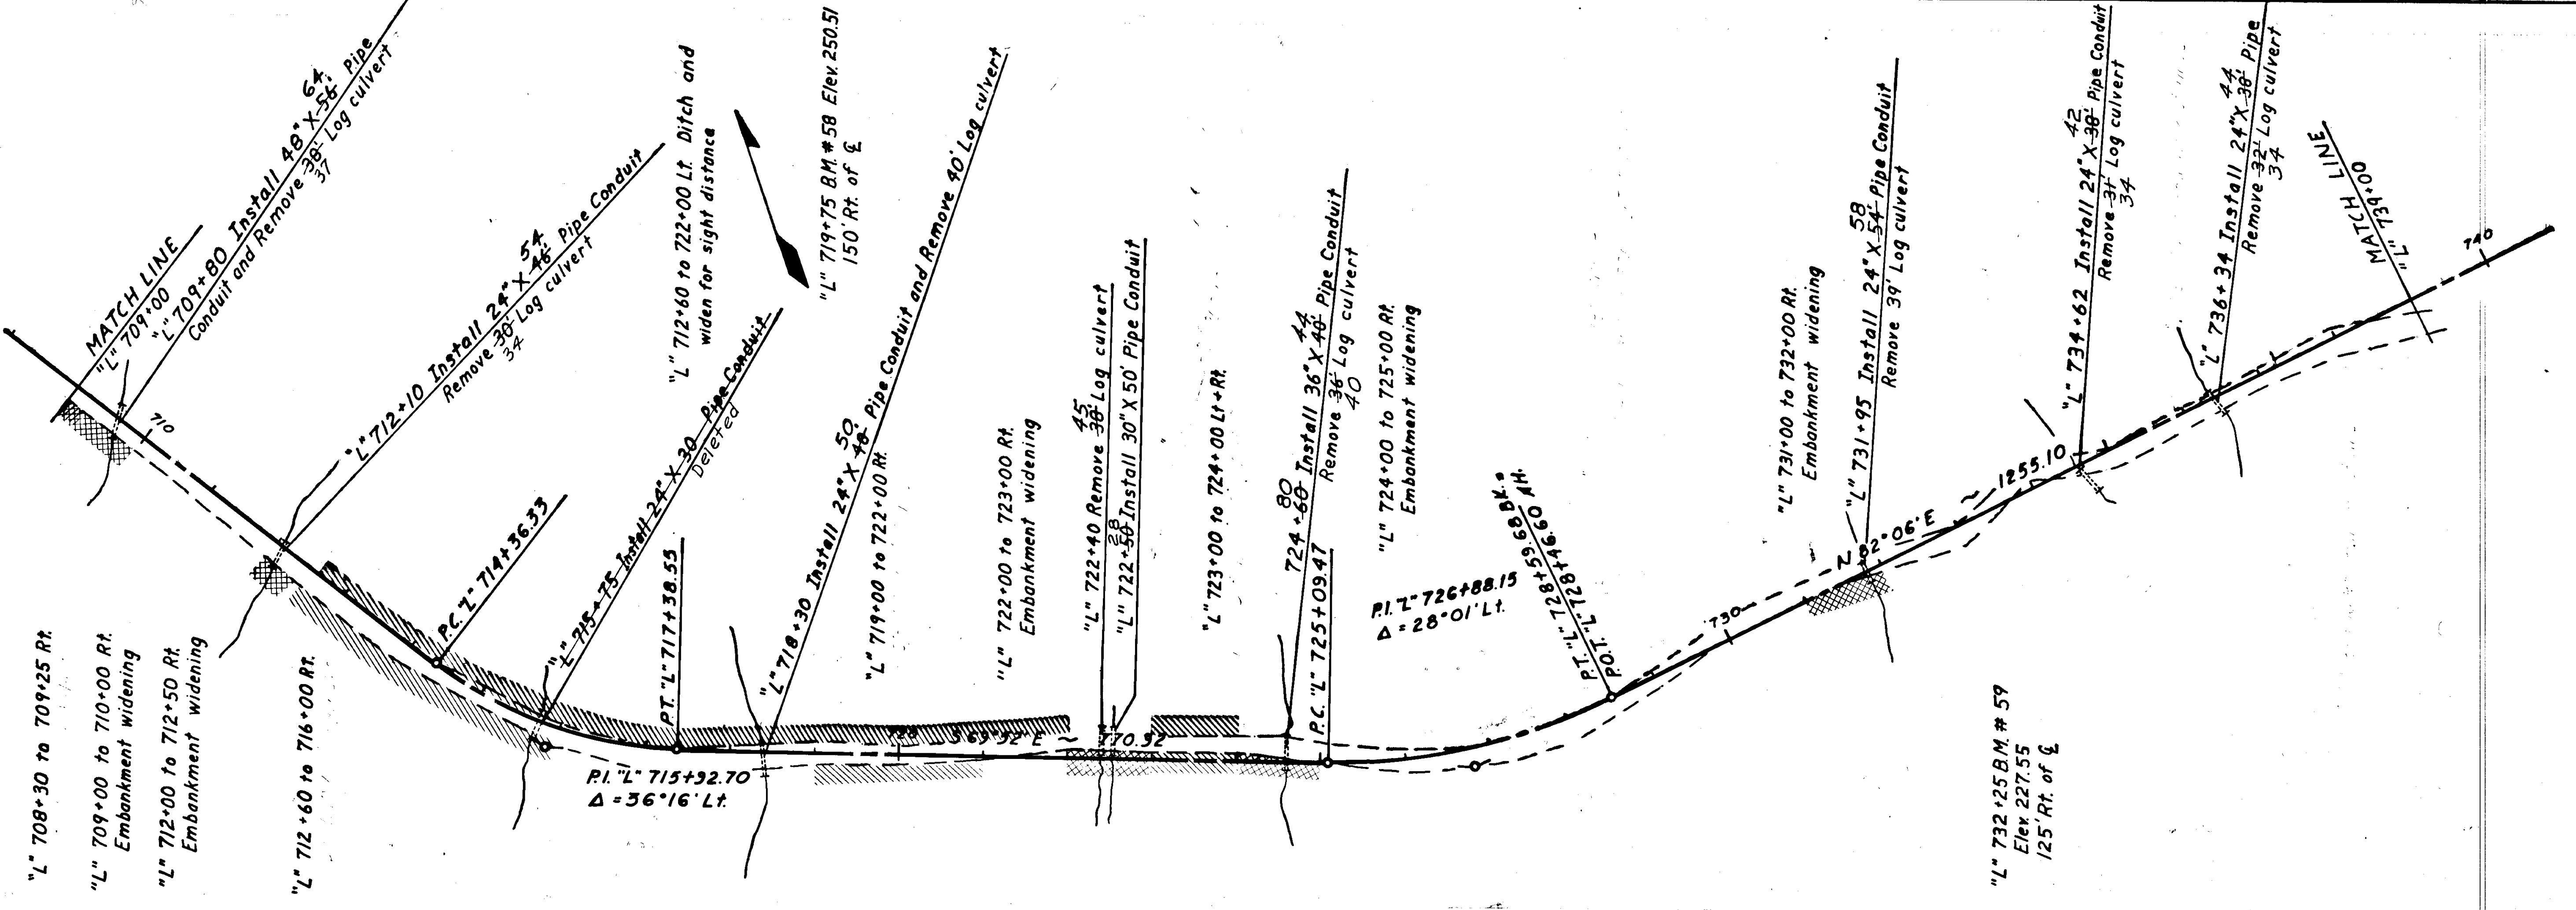
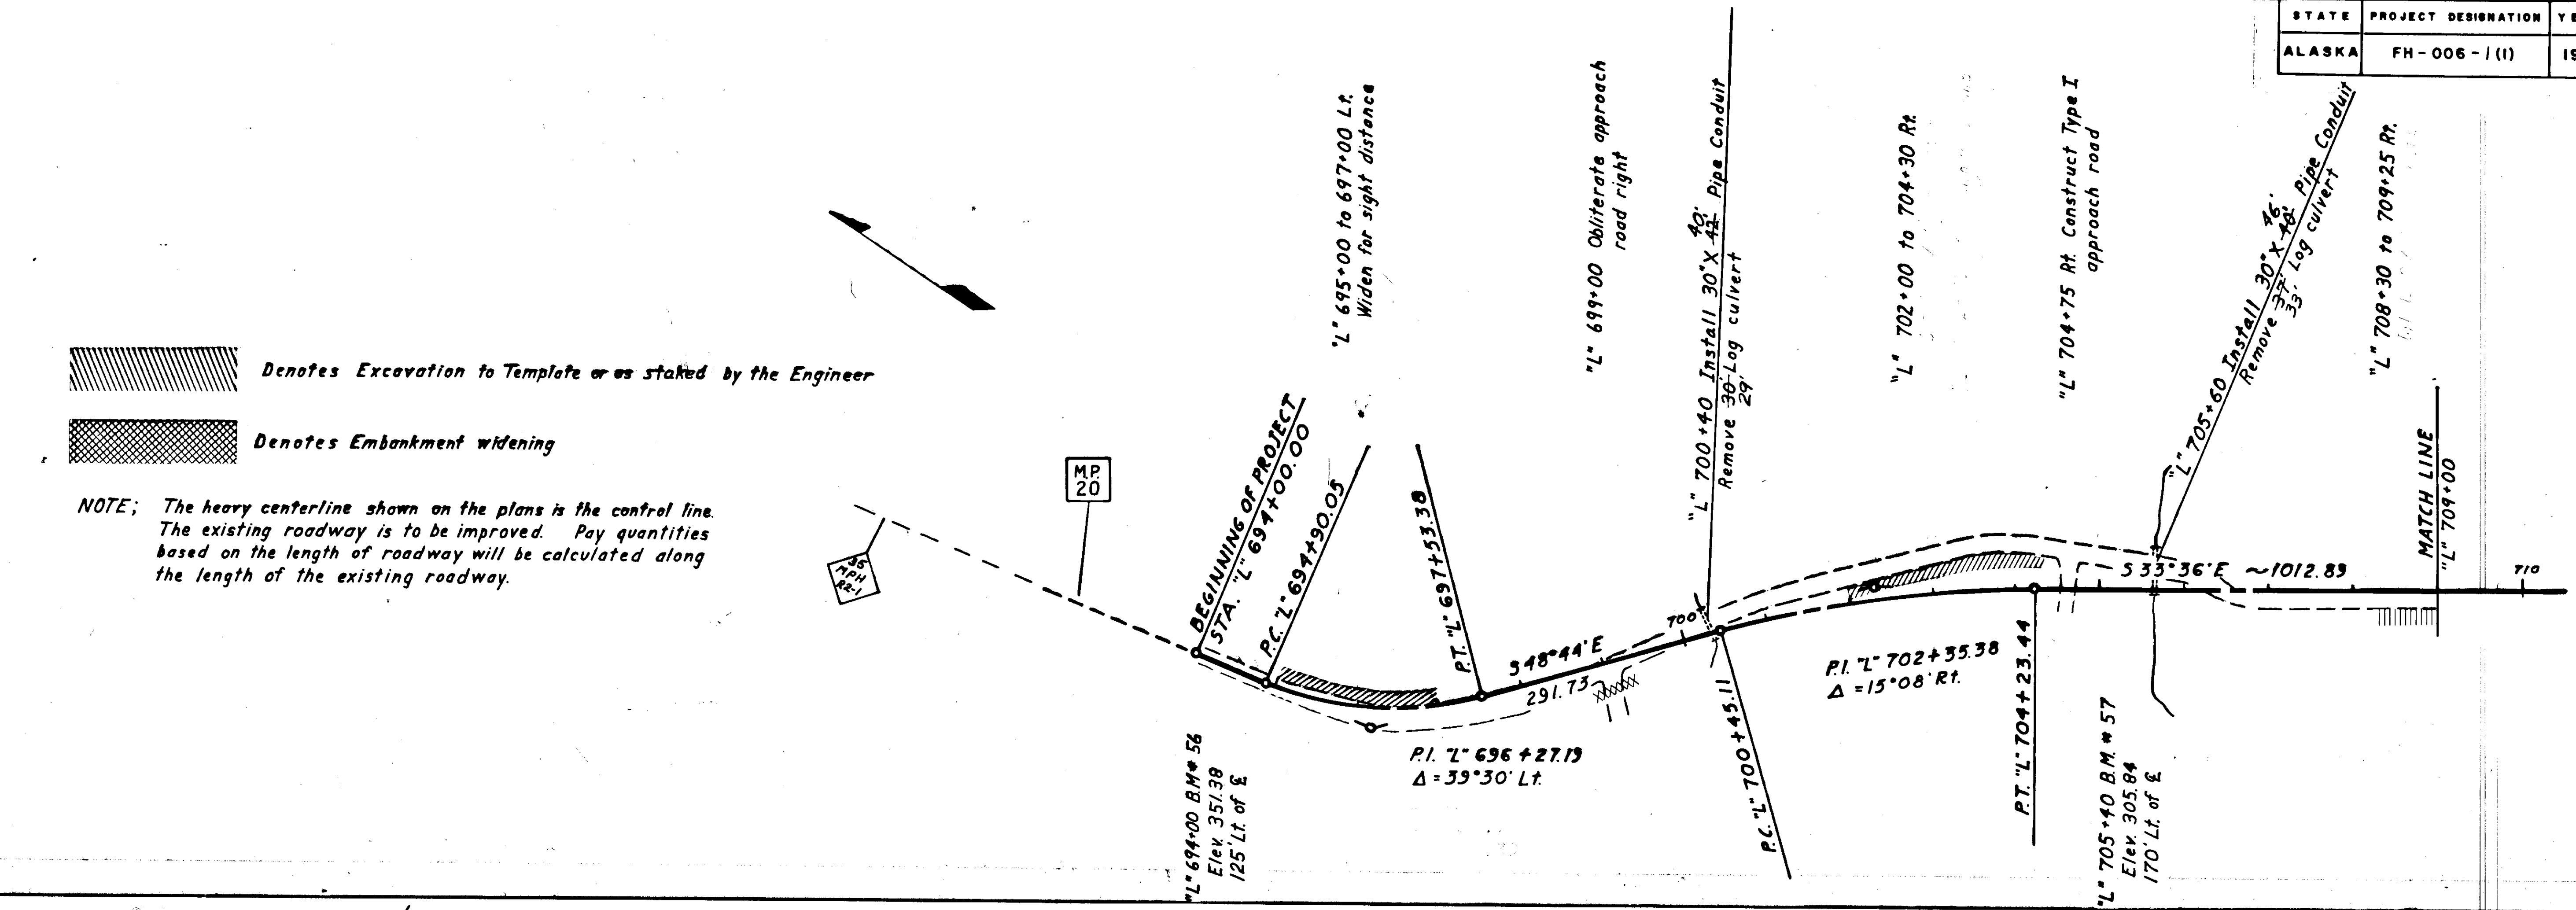


STATE	PROJECT DESIGNATION	YEAR	SHEET NO.	TOTAL SHEETS
ALASKA	FH 006 - 1 (1)	1975	10	18



Hydrological Data "L" 820+00
 Design Area - 275 Acres
 Design Freq. - 50 Year
 Design Discharge - 132 c.f.s.

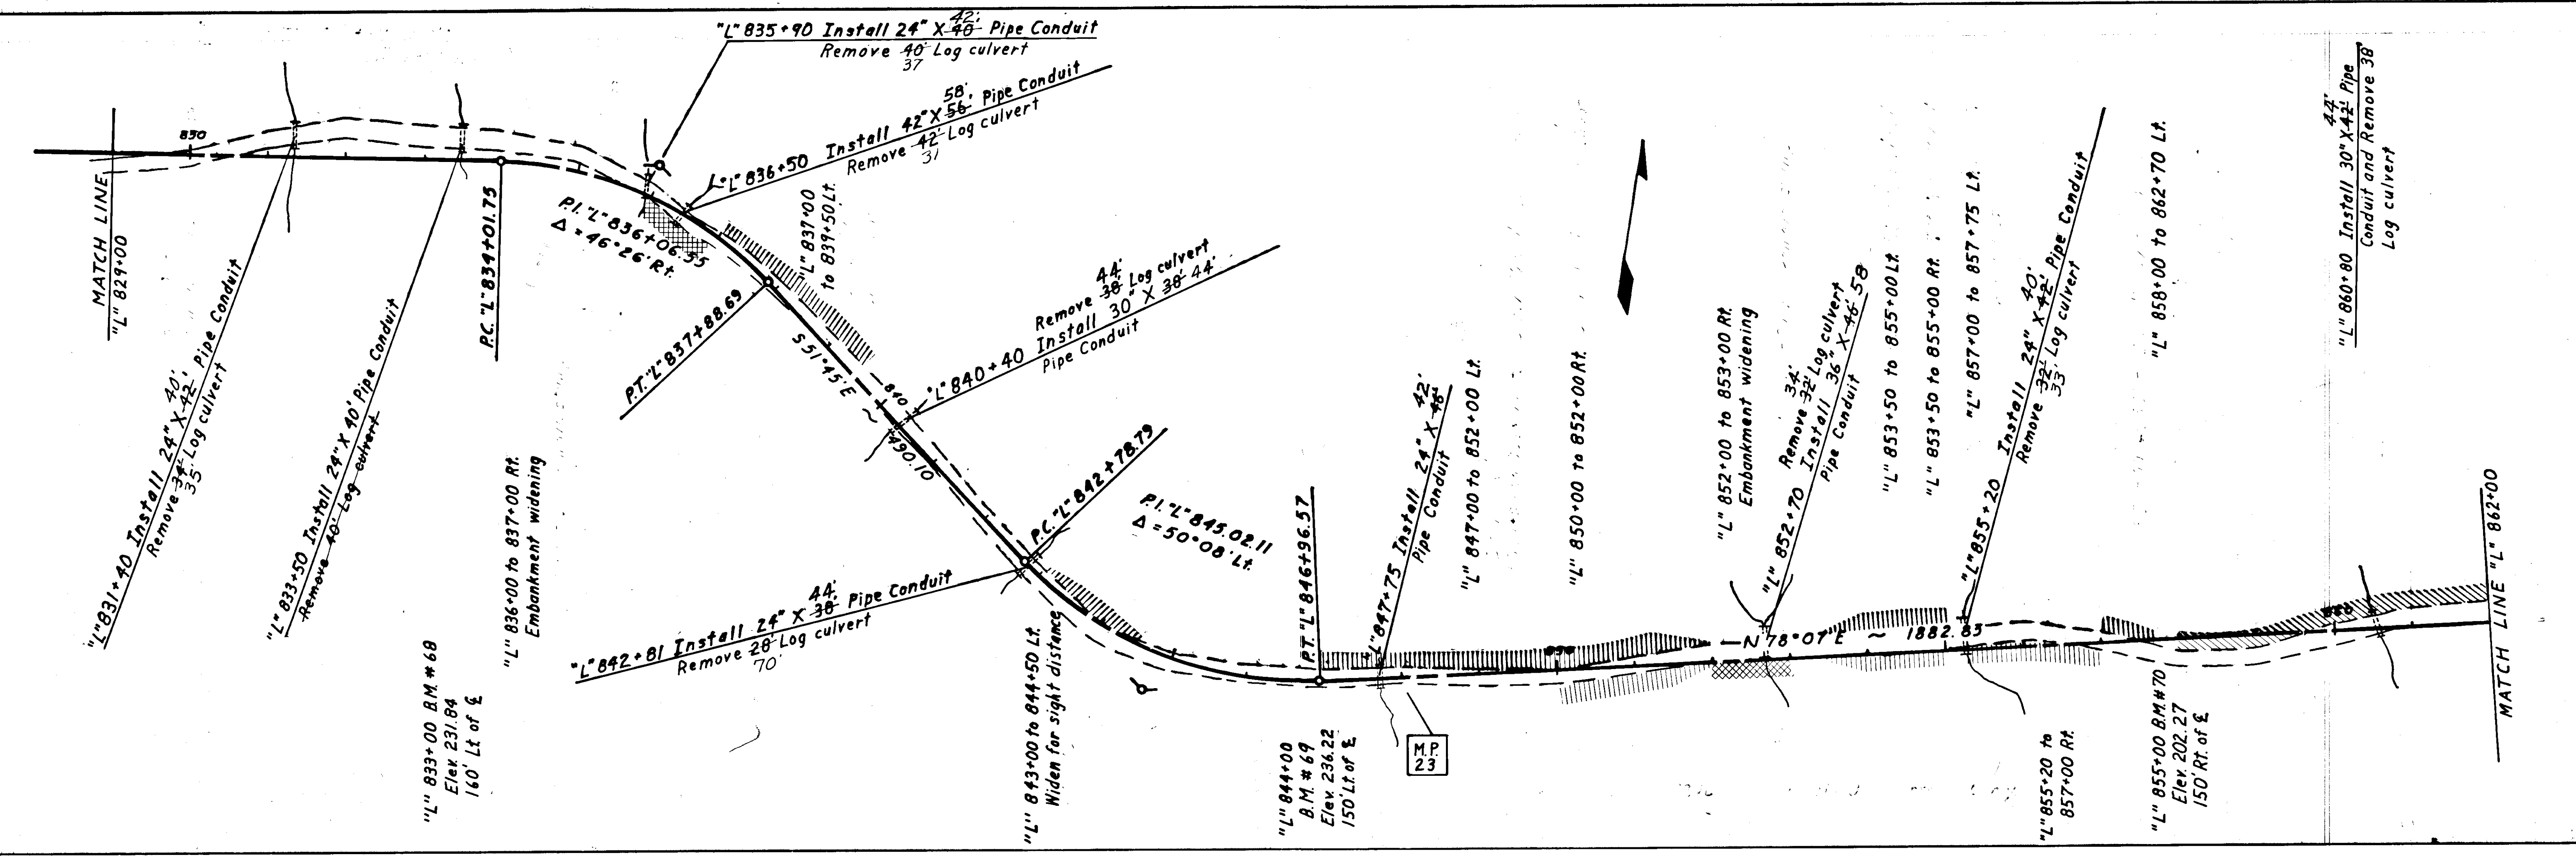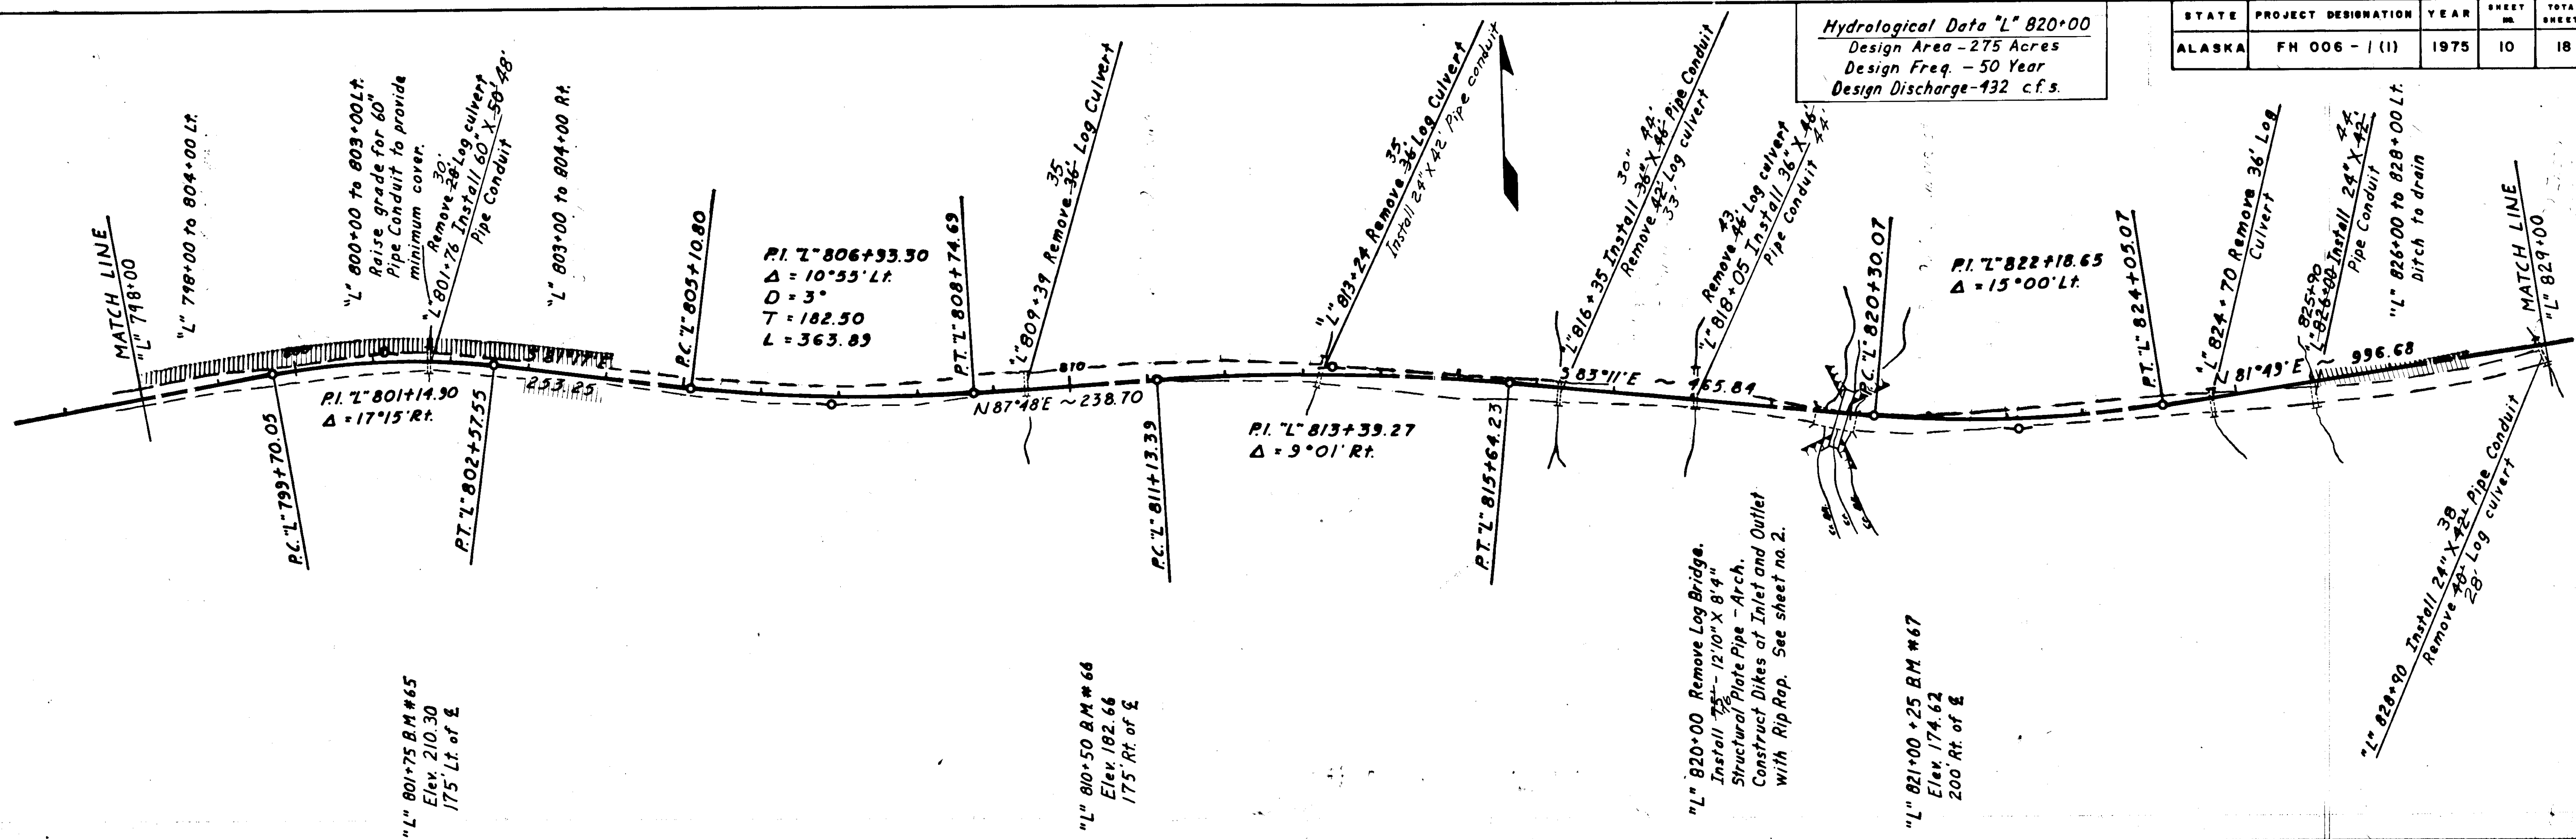


STATE	PROJECT DESIGNATION	YEAR	SHEET NO.	TOTAL SHEETS
ALASKA	FH 006 - 1(1)	1975	11	18

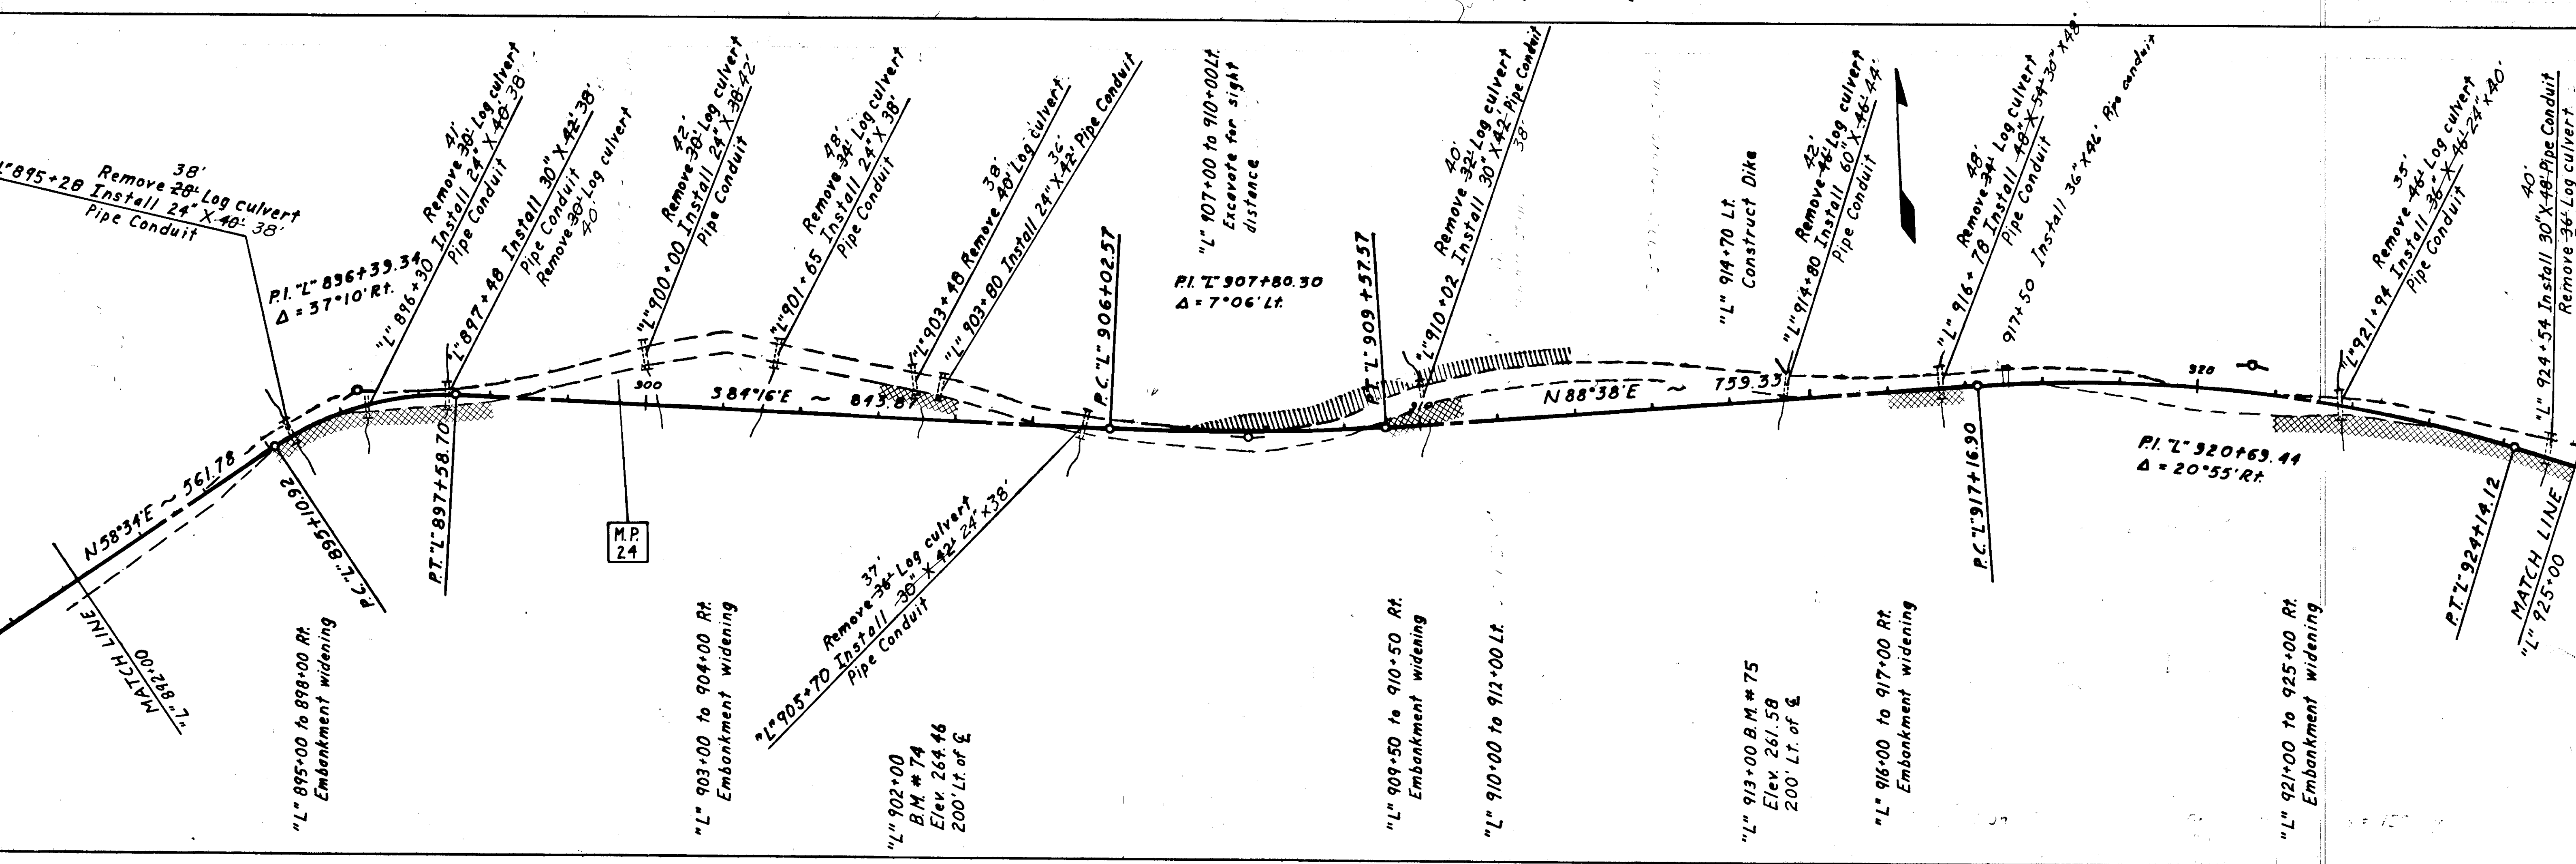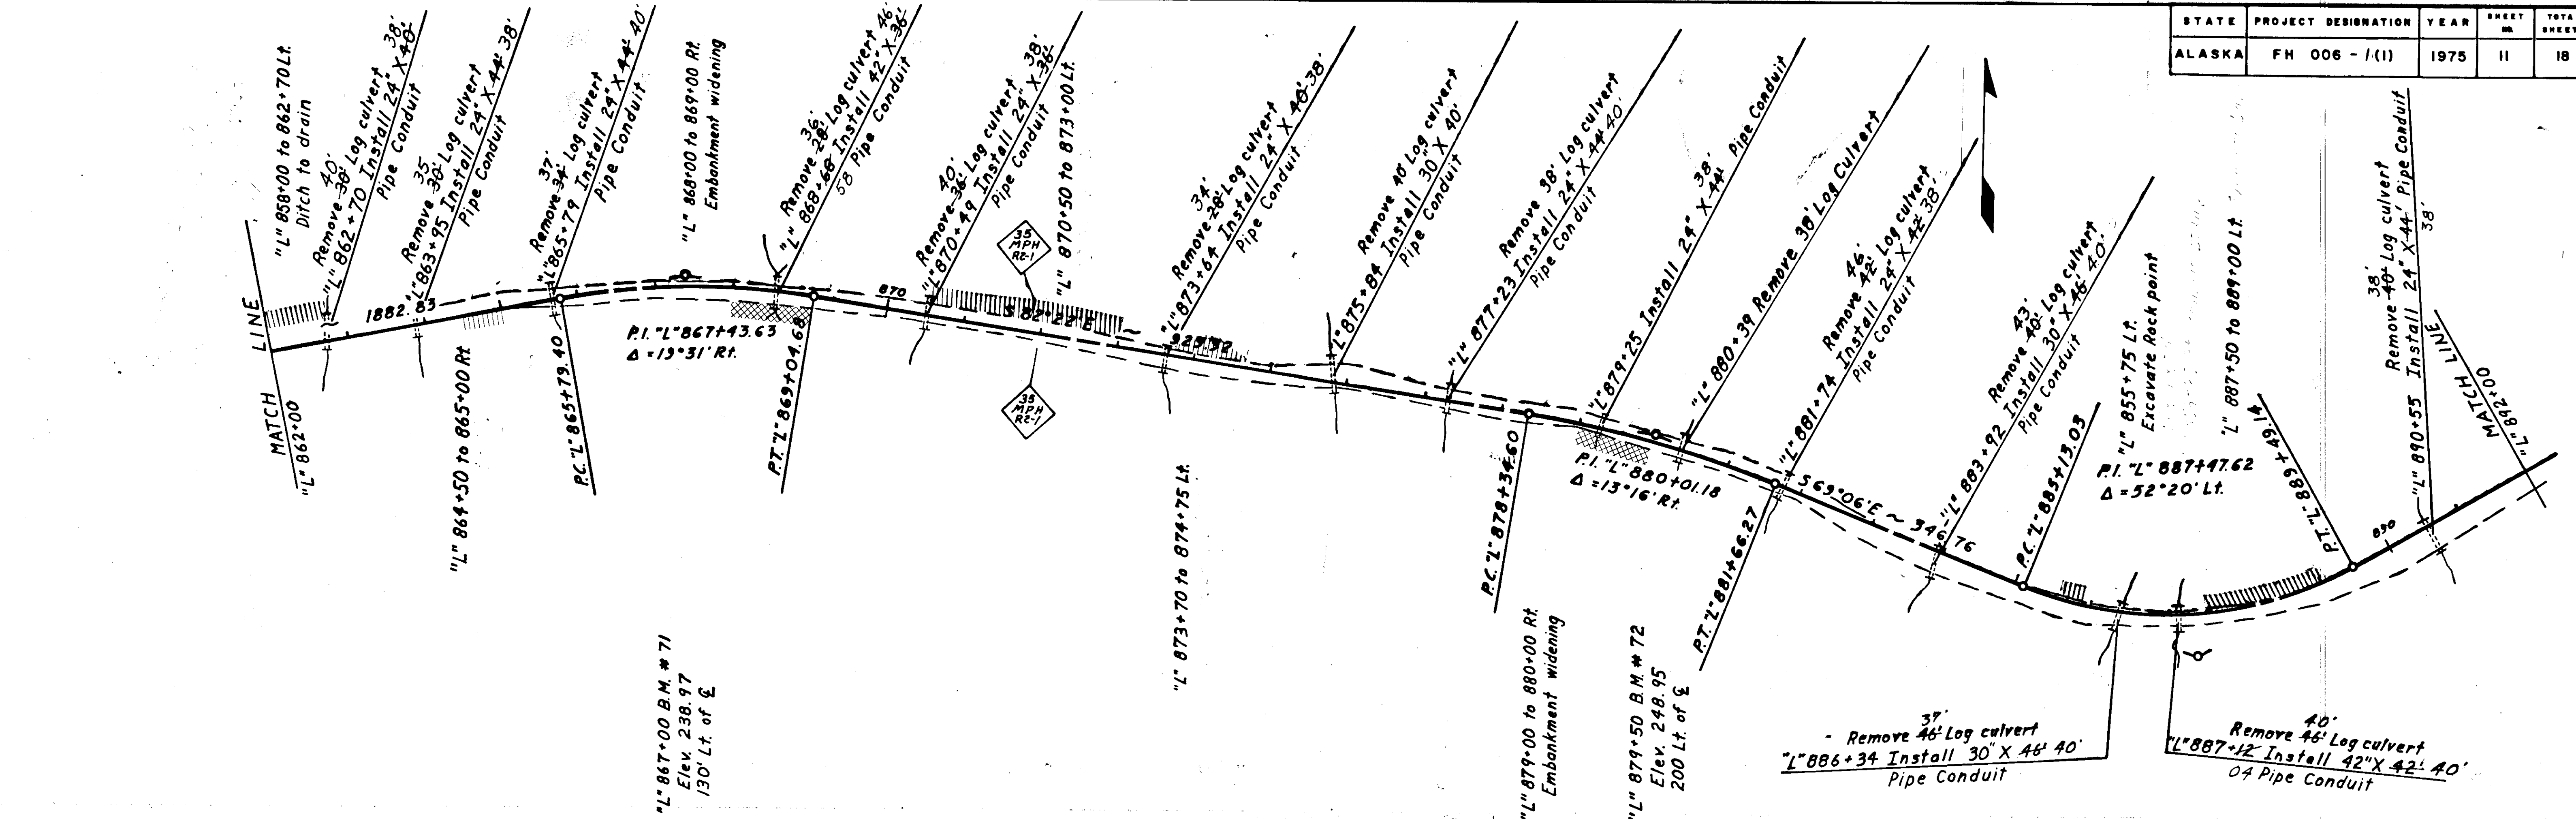


STATE	PROJECT DESIGNATION	YEAR	SHEET	TOTAL SHEETS
ALASKA	FH 006 - 1(1)	1975	12	18

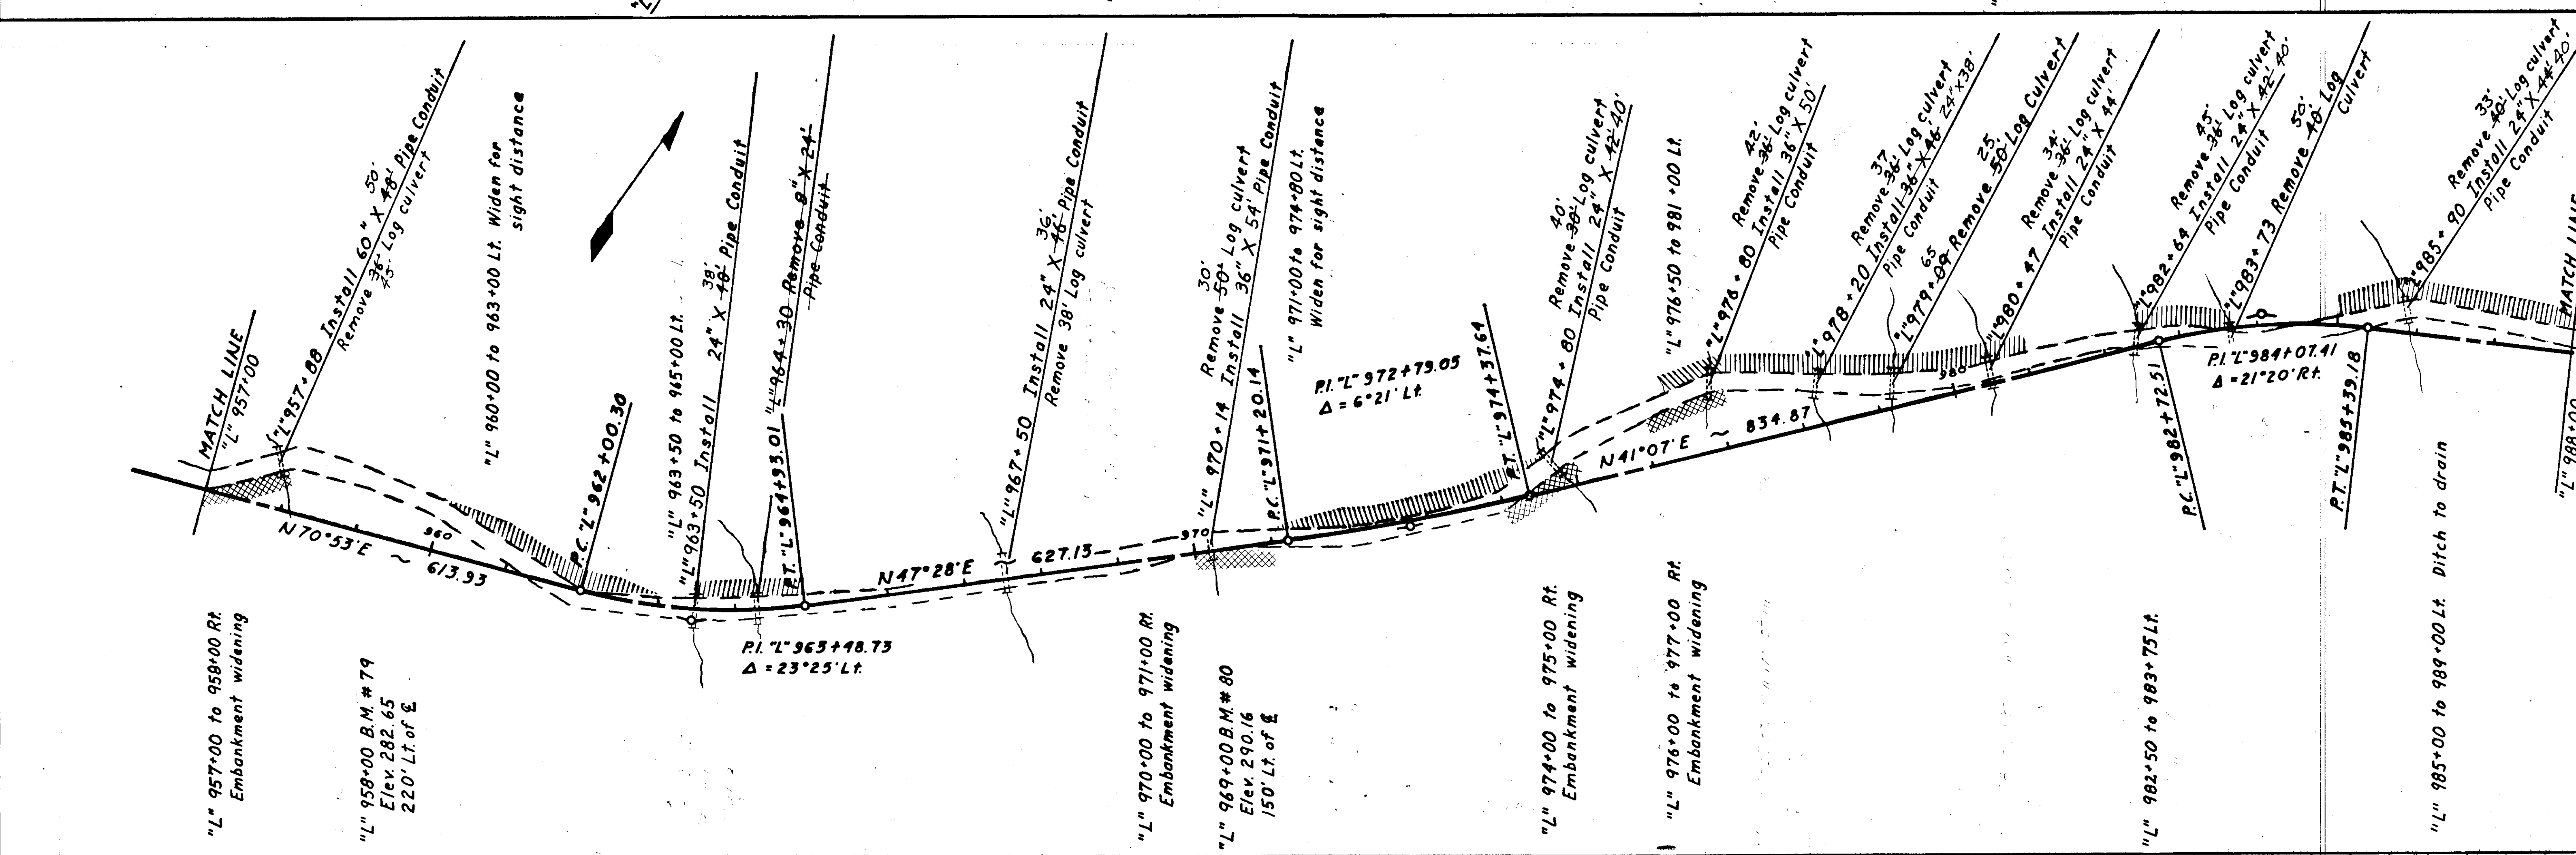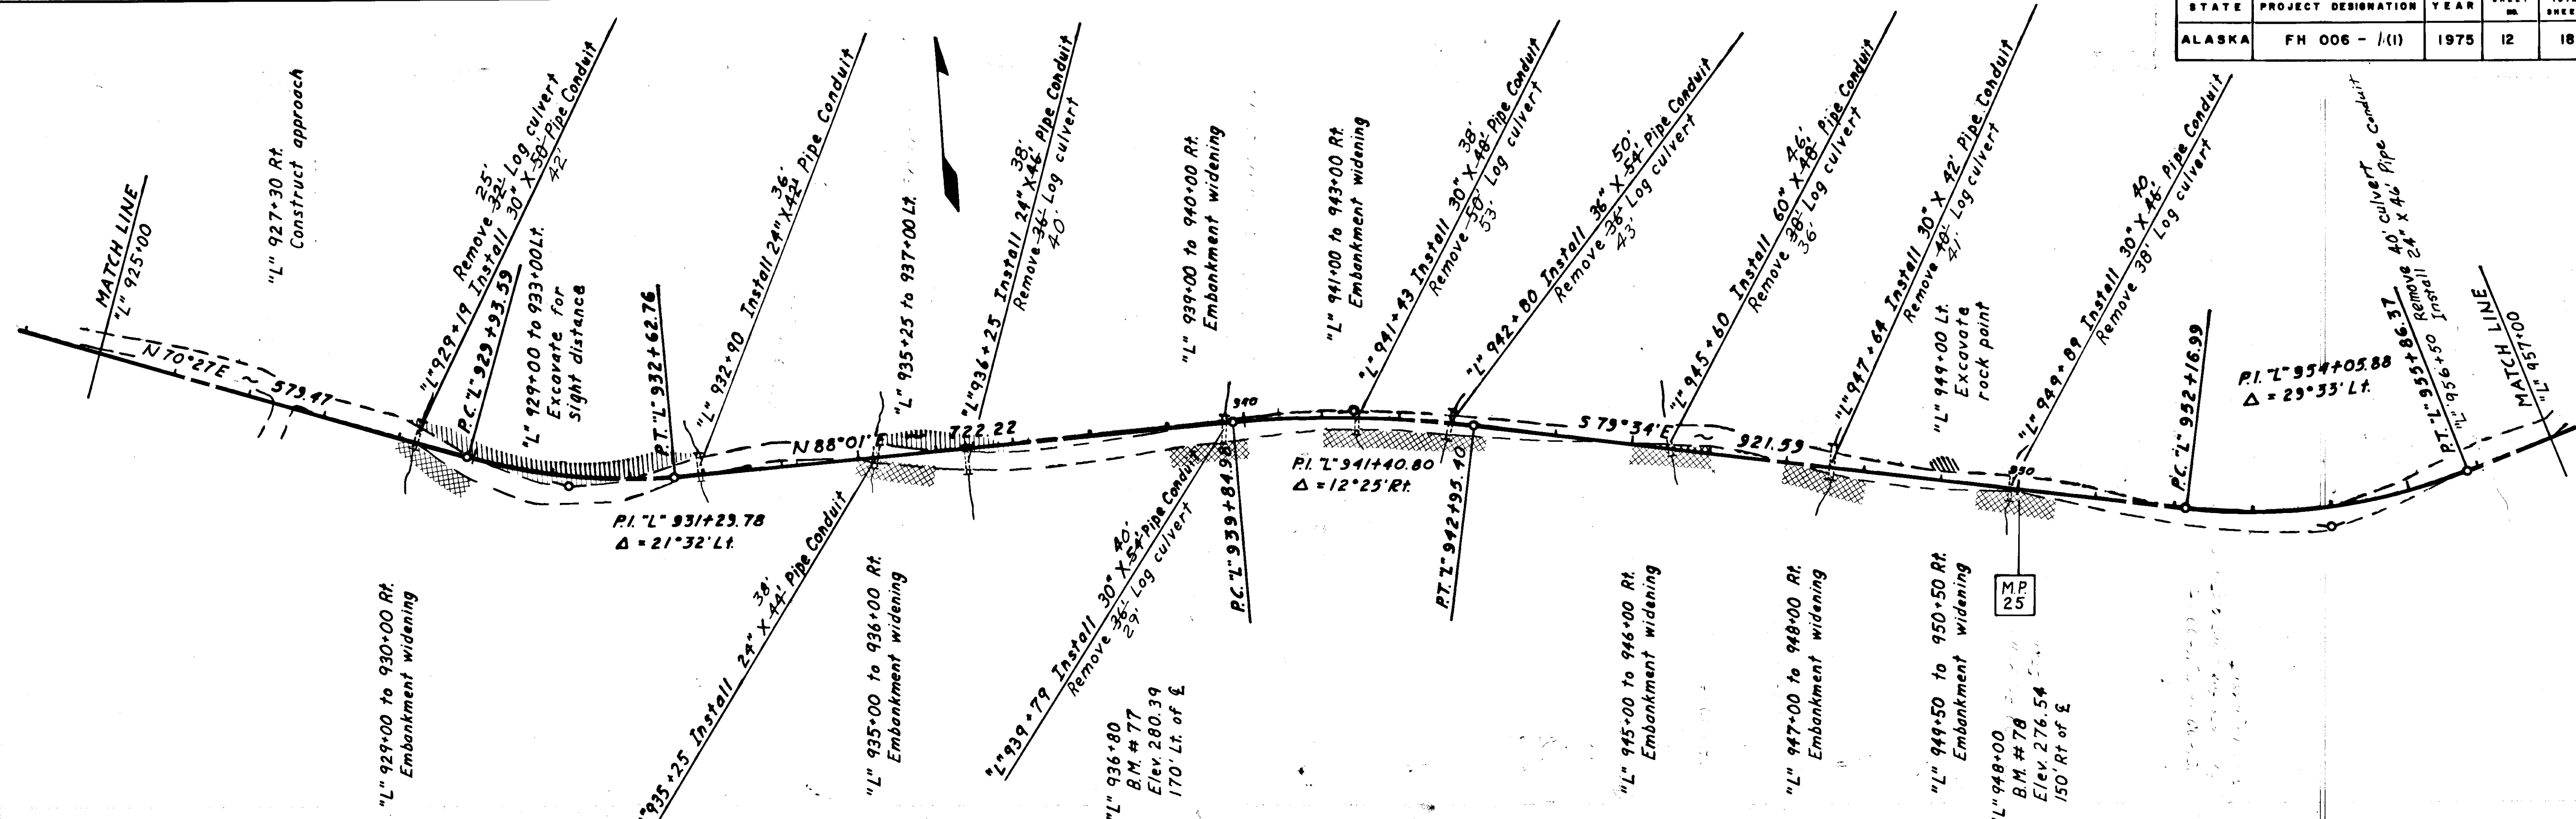

STATE	PROJECT DESIGNATION	YEAR	SHEET NO.	TOTAL SHEETS
ALASKA	FH 006 - 1(1)	1975	13	18

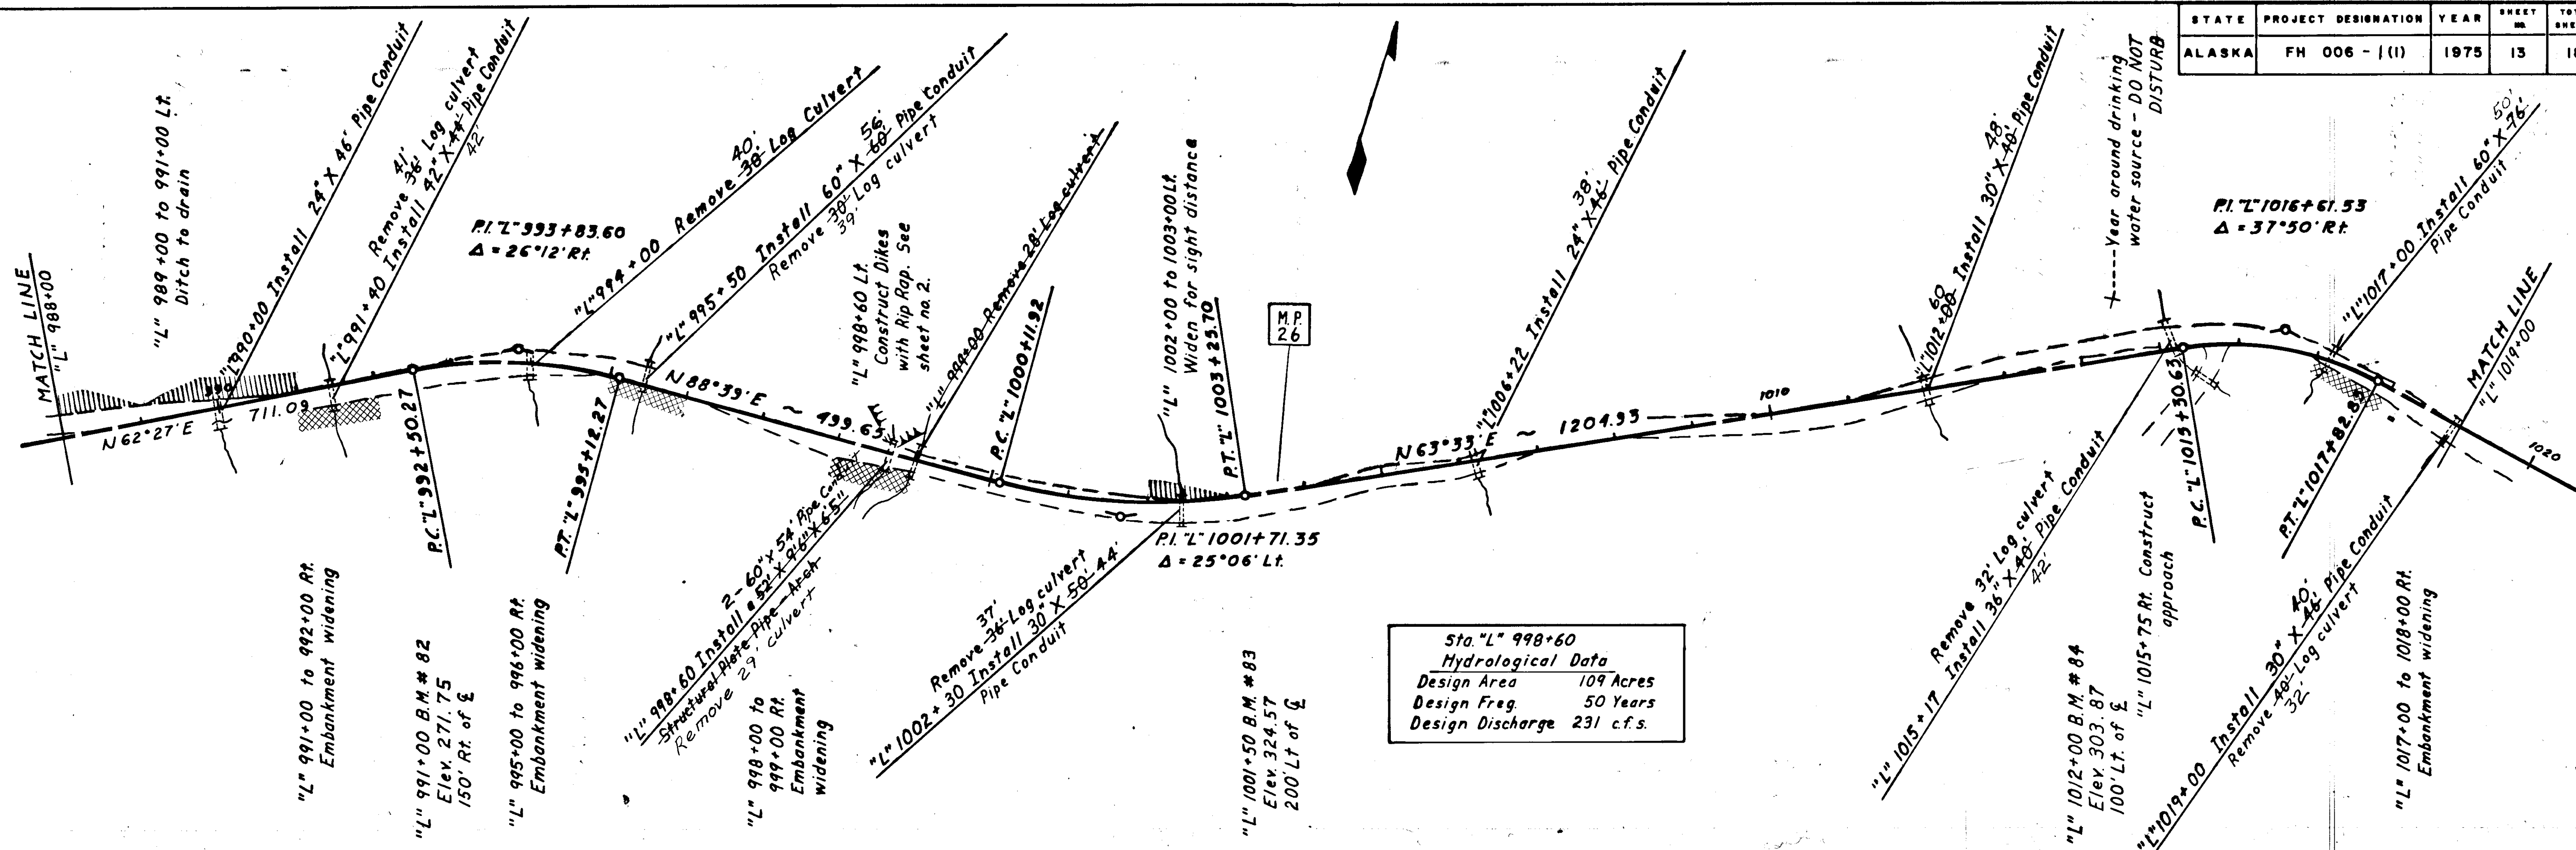

Sta. "L" 998+60
 Hydrological Data
 Design Area 109 Acres
 Design Freq. 50 Years
 Design Discharge 231 c.f.s.


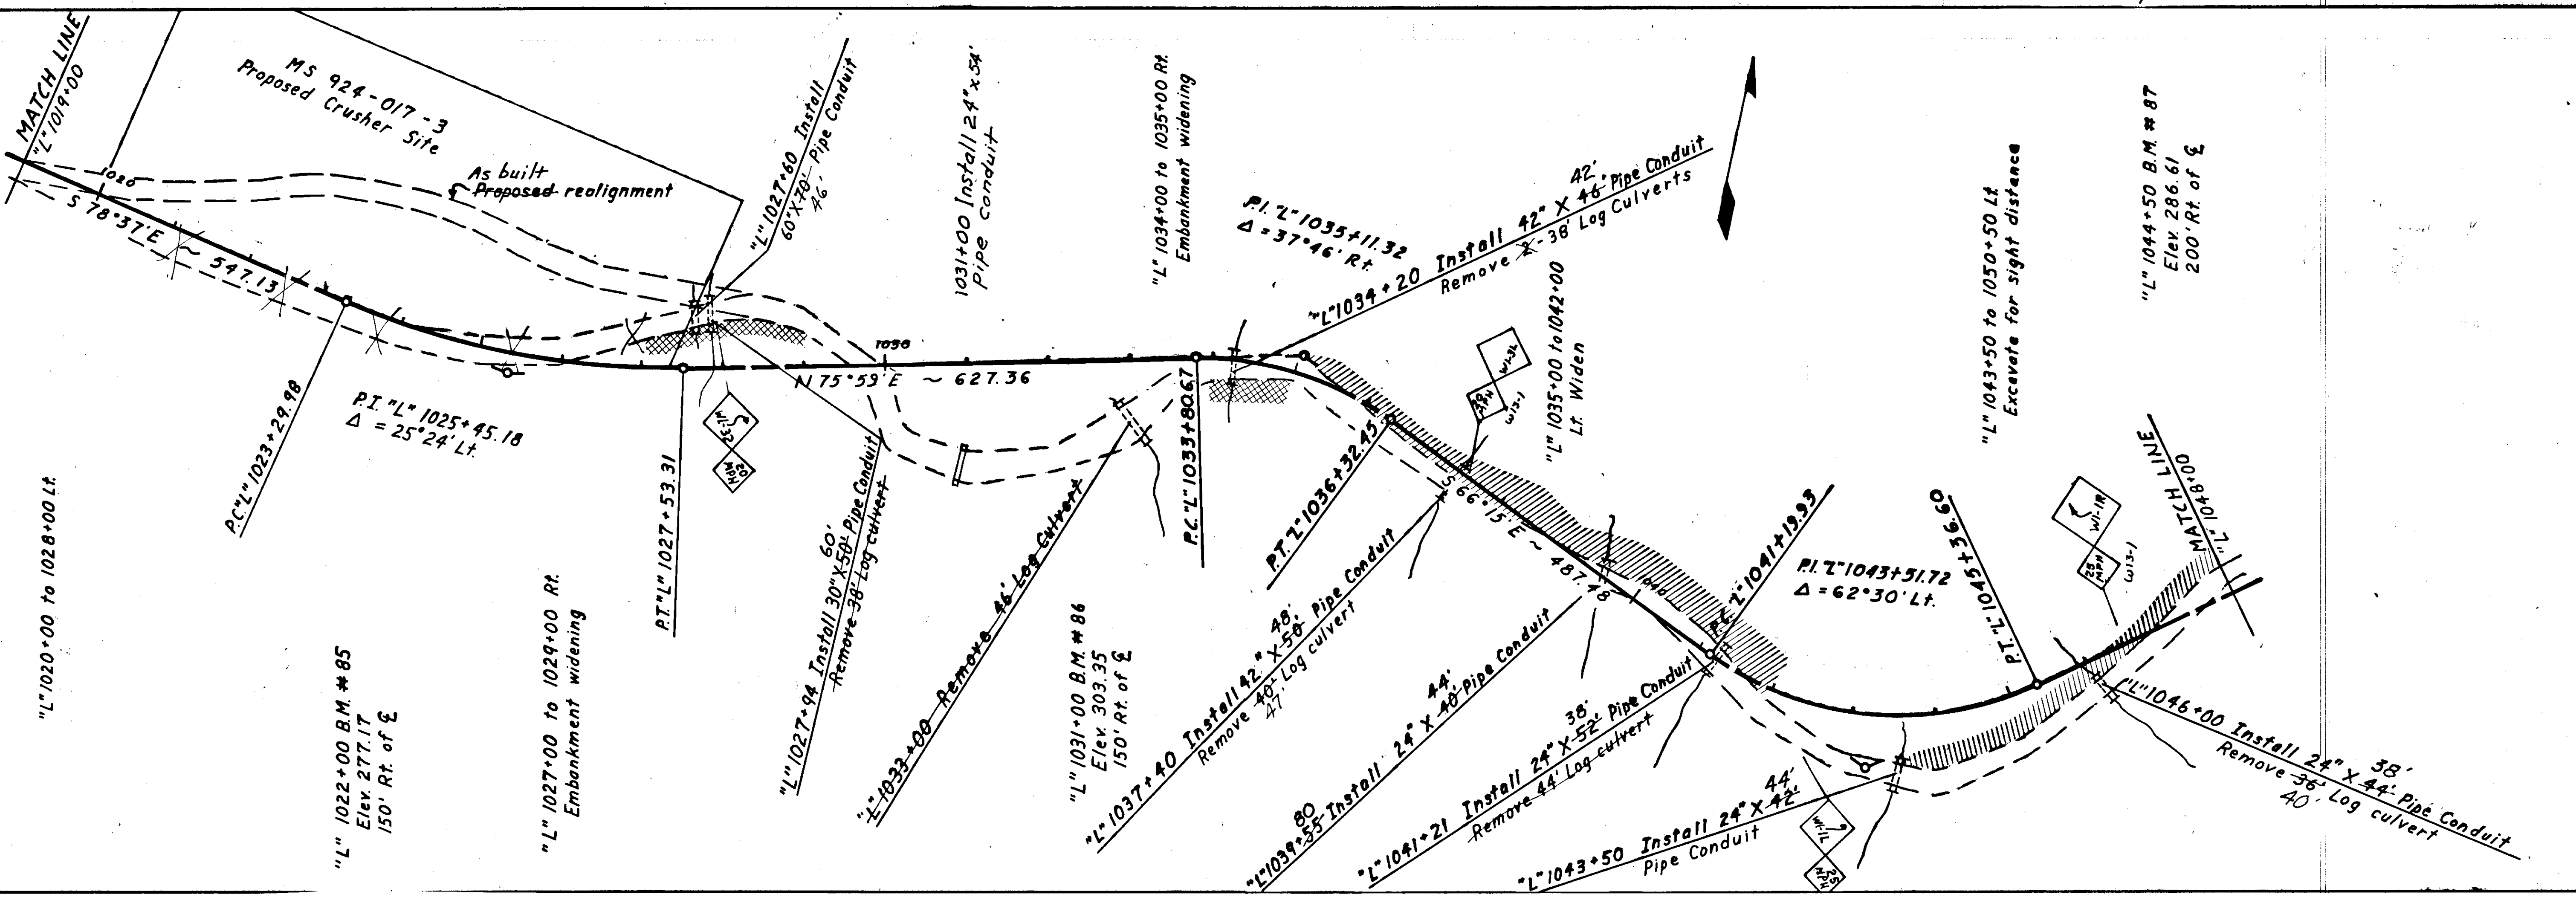


M.S. 924-017-3
 Proposed Crusher Site

As built
 Proposed realignment



"L" 1044+50 B.M. #87
 Elev. 286.61
 200' Rt. of ξ

STATE	PROJECT DESIGNATION	YEAR	SHEET NO.	TOTAL SHEETS
ALASKA	FH 006 - 1(1)	1975	14	18

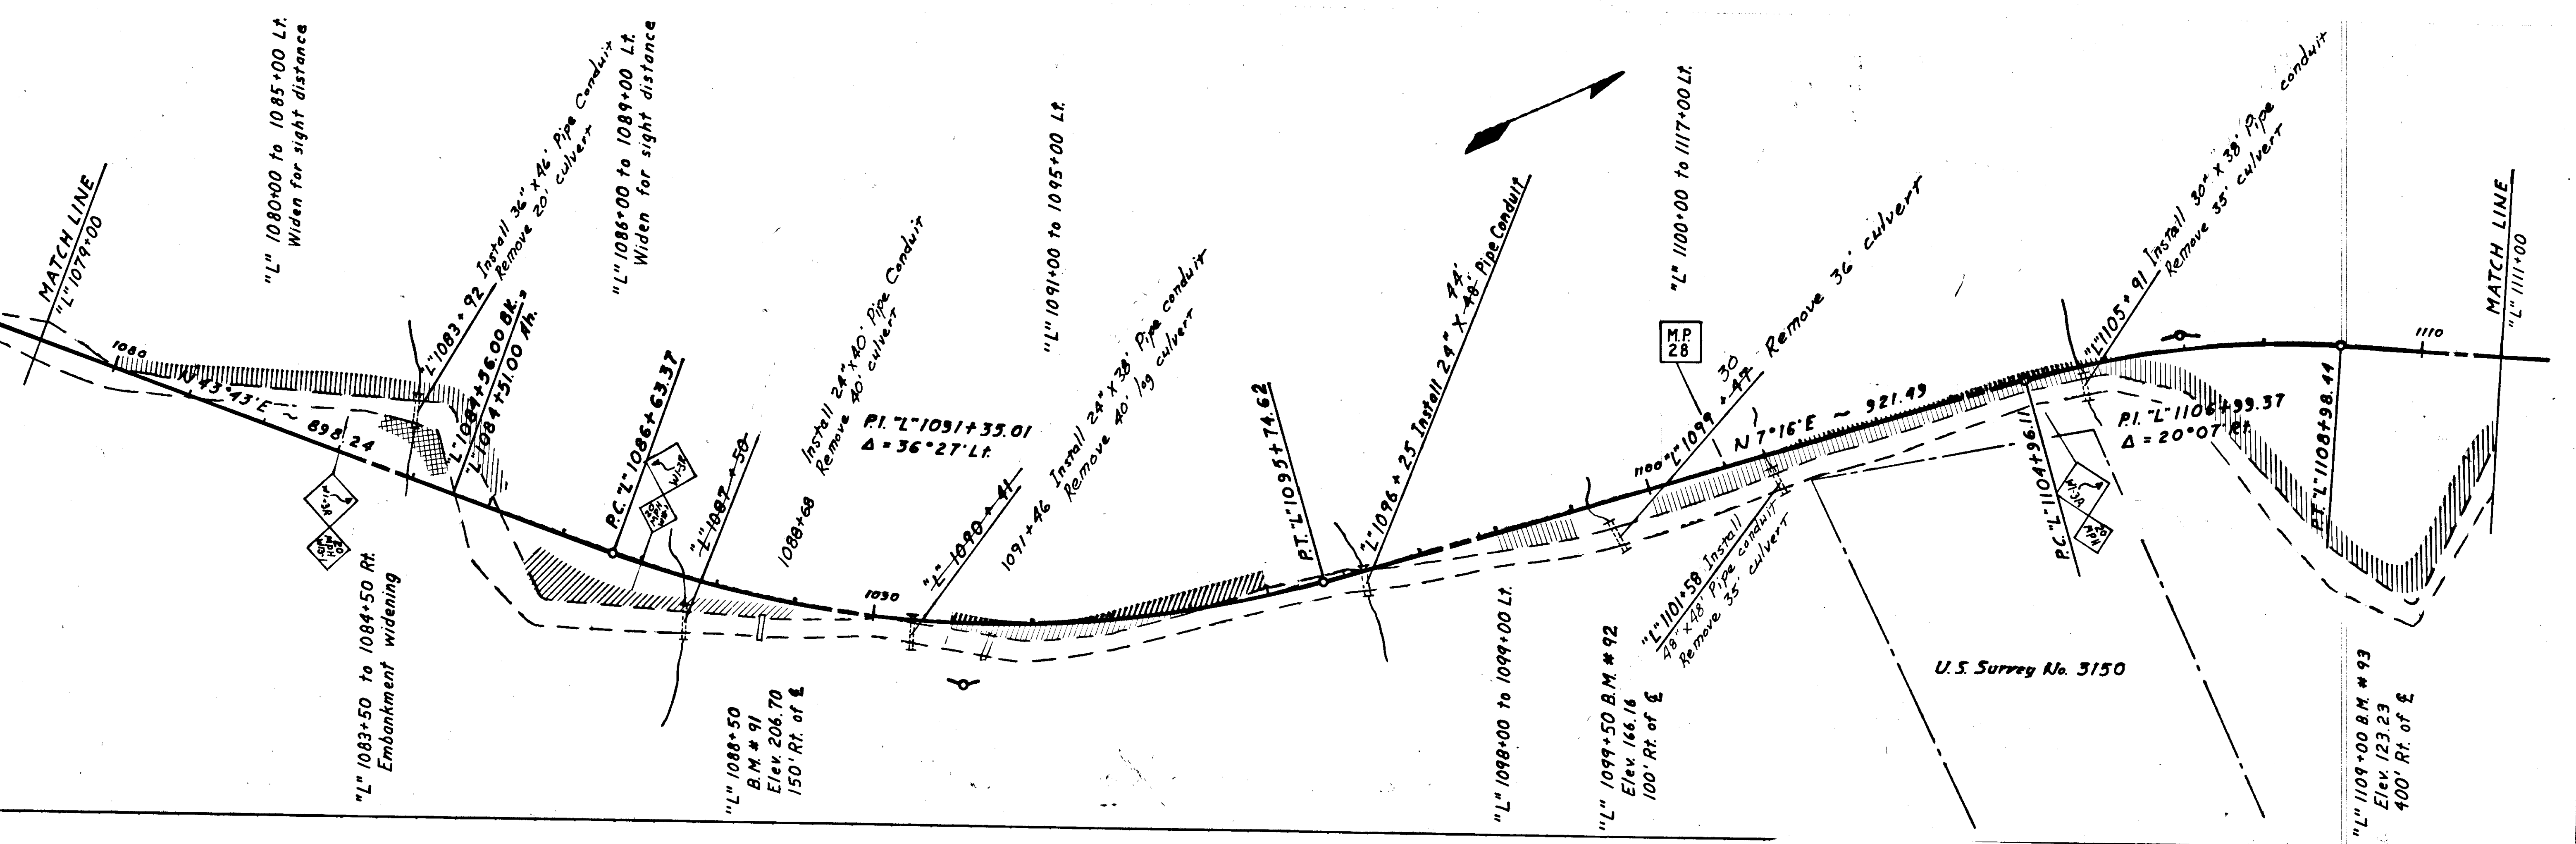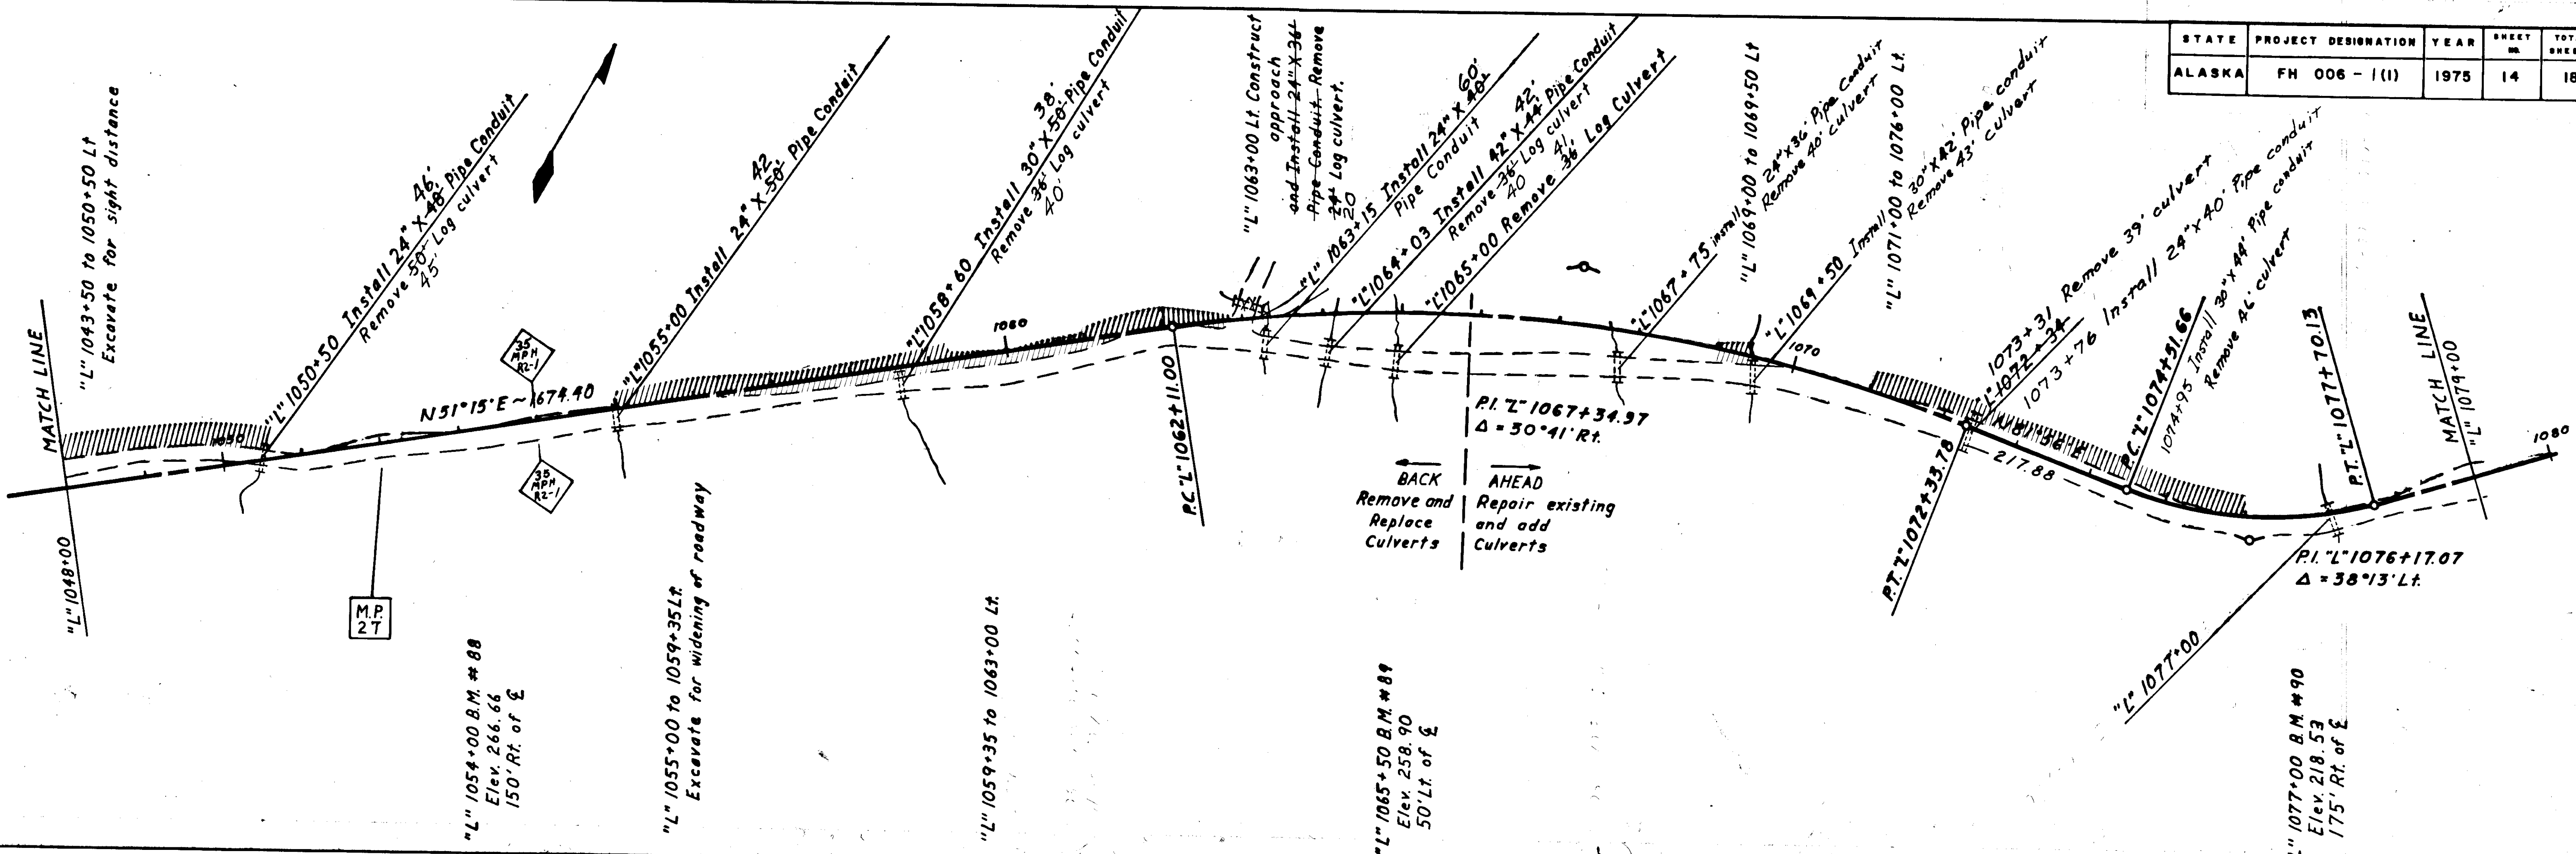


U.S. Survey No. 3150

STATE	PROJECT DESIGNATION	YEAR	SHEET NO.	TOTAL SHEETS
ALASKA	FH 006 - 1(1)	1975	15	18

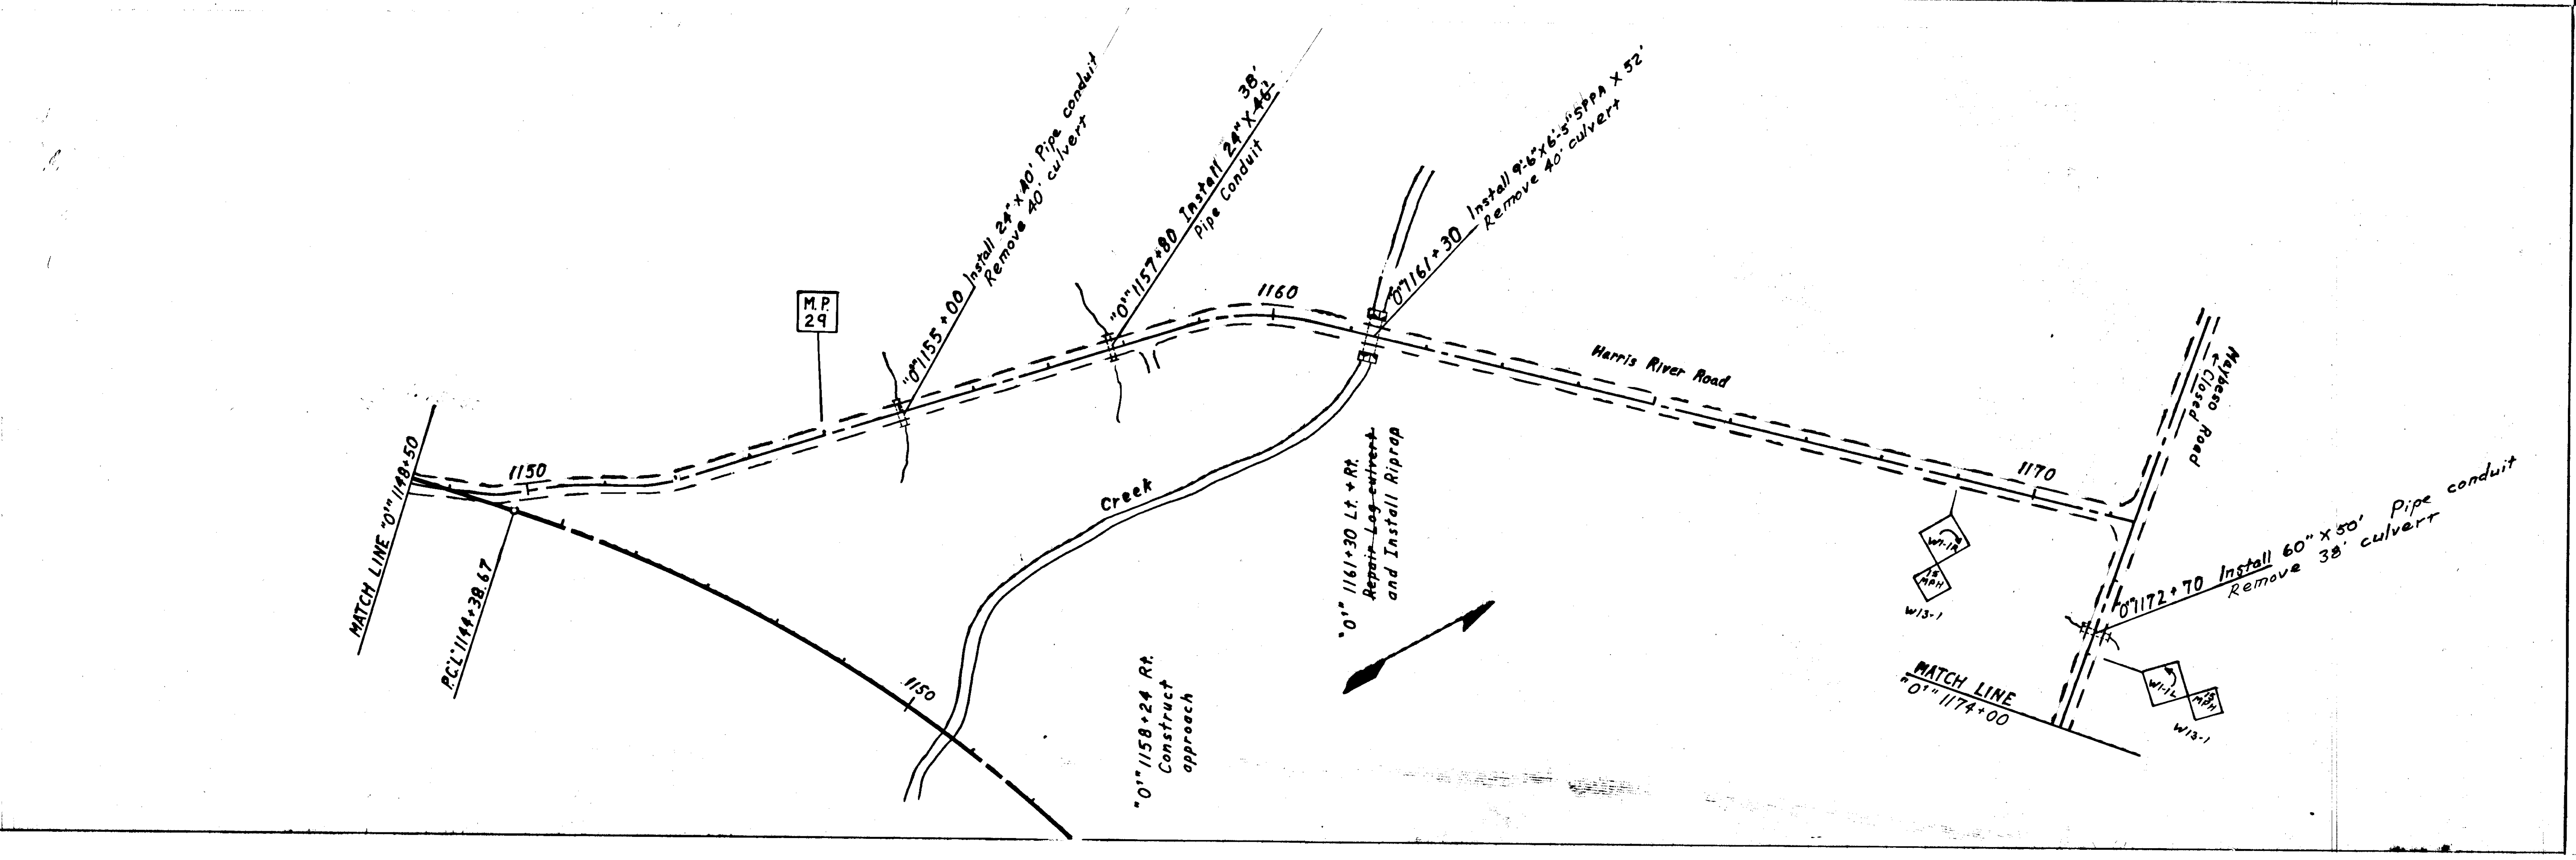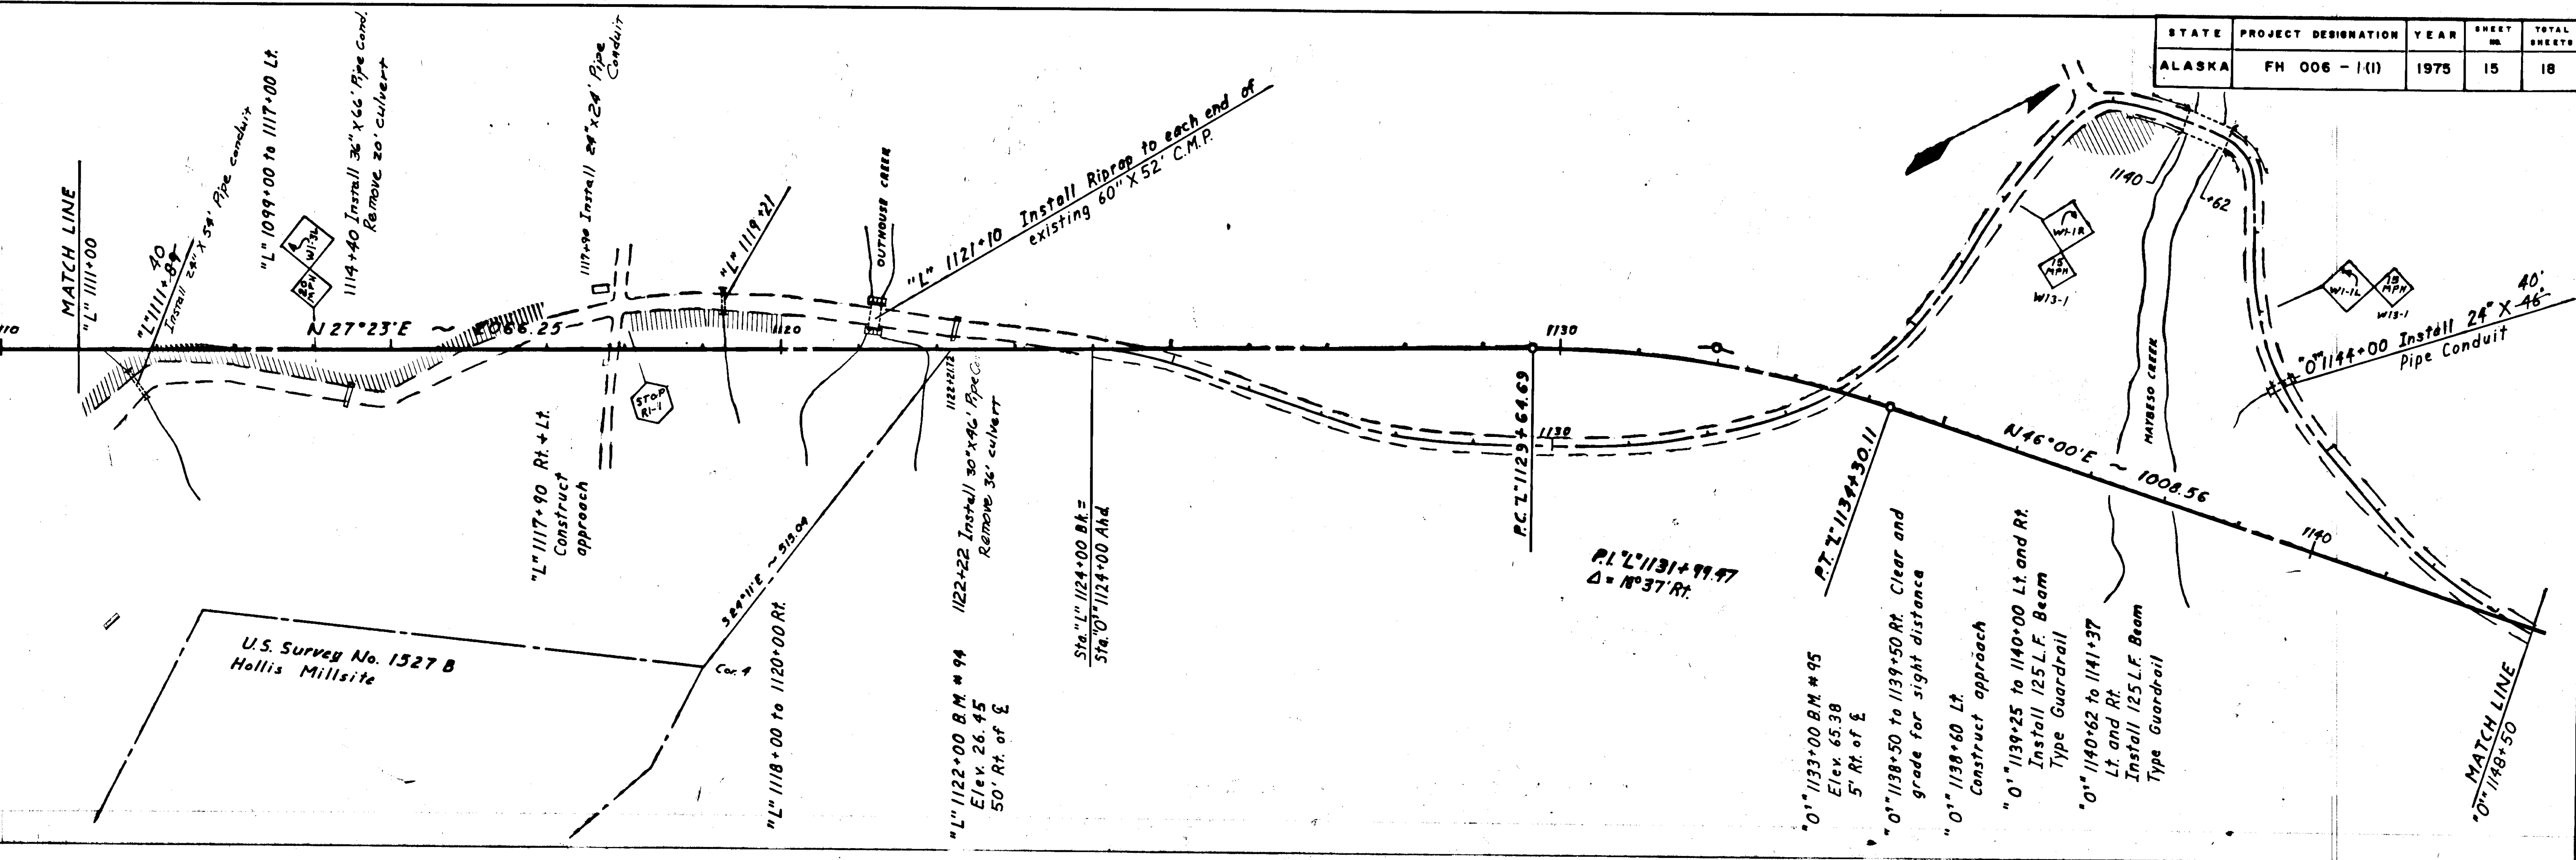


STATE	PROJECT DESIGNATION	YEAR	SHEET NO.	TOTAL SHEETS
ALASKA	FH 006 - / (1)	1975	16	18

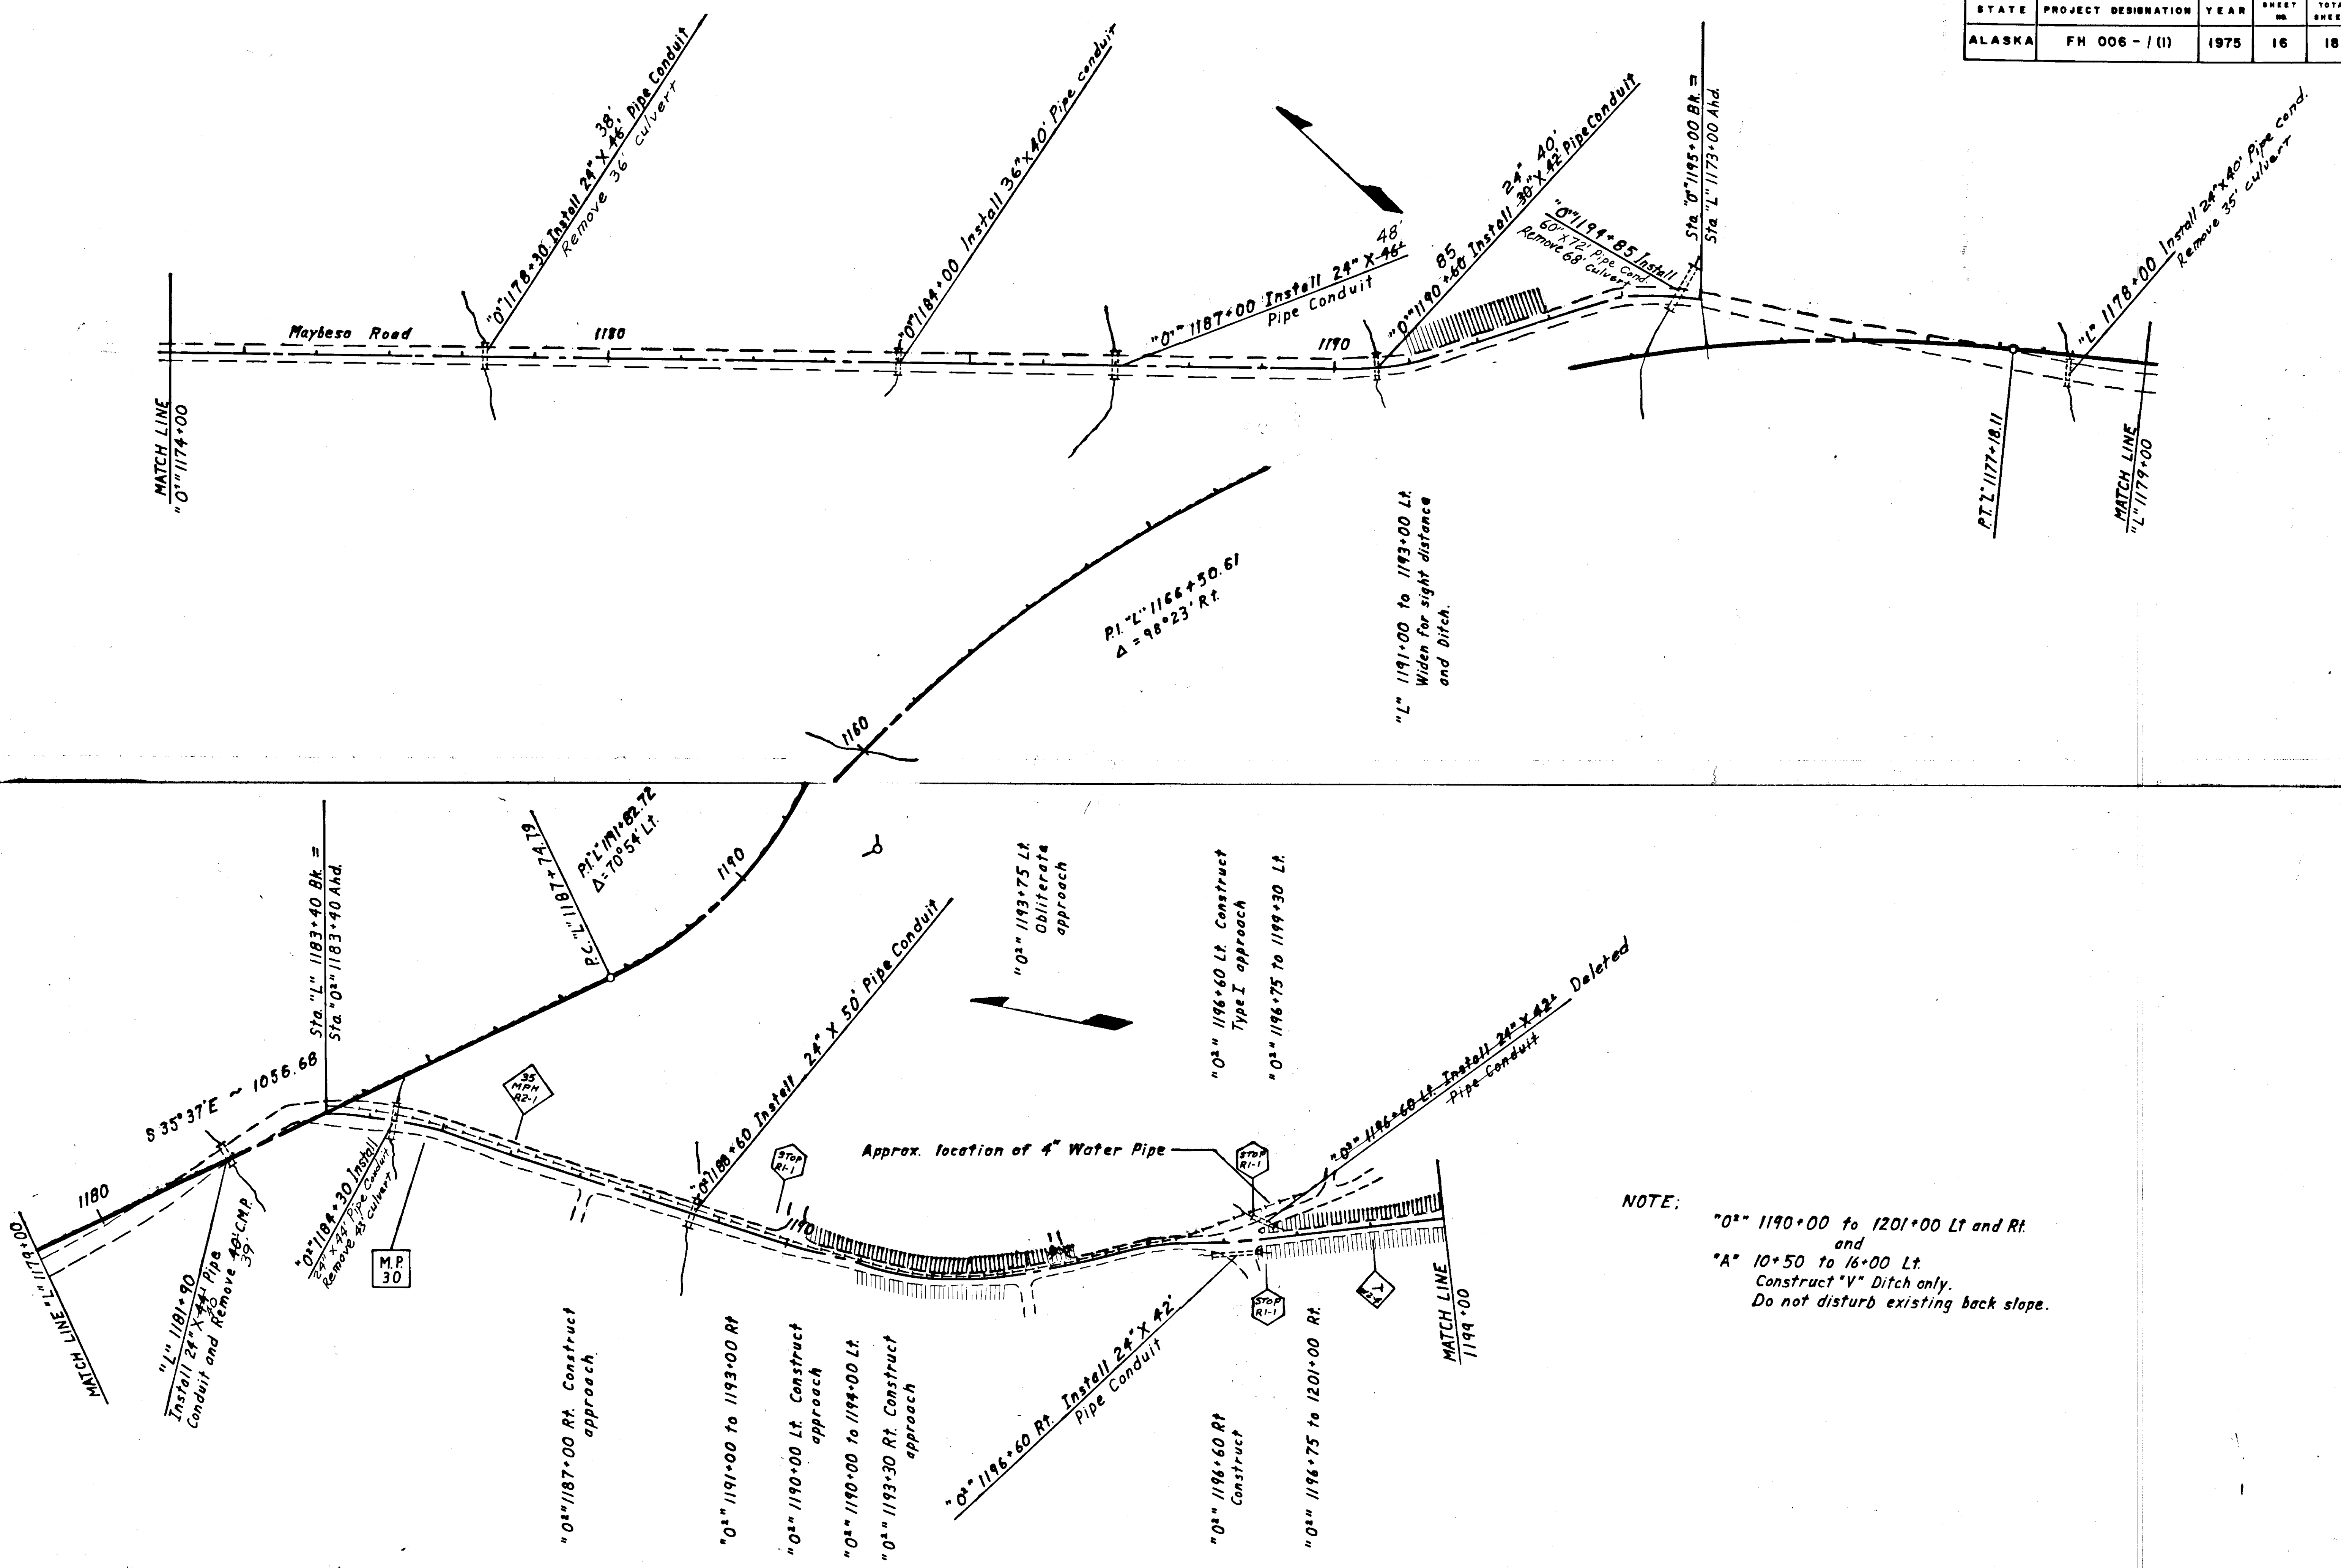

NOTE:
 "O" 1190+00 to 1201+00 Lt and Rt.
 and
 "A" 10+50 to 16+00 Lt.
 Construct "V" Ditch only.
 Do not disturb existing back slope.

STATE	PROJECT DESIGNATION	YEAR	SHEET NO.	TOTAL SHEETS
ALASKA	FH 006 - 1(1)	1975	17	18


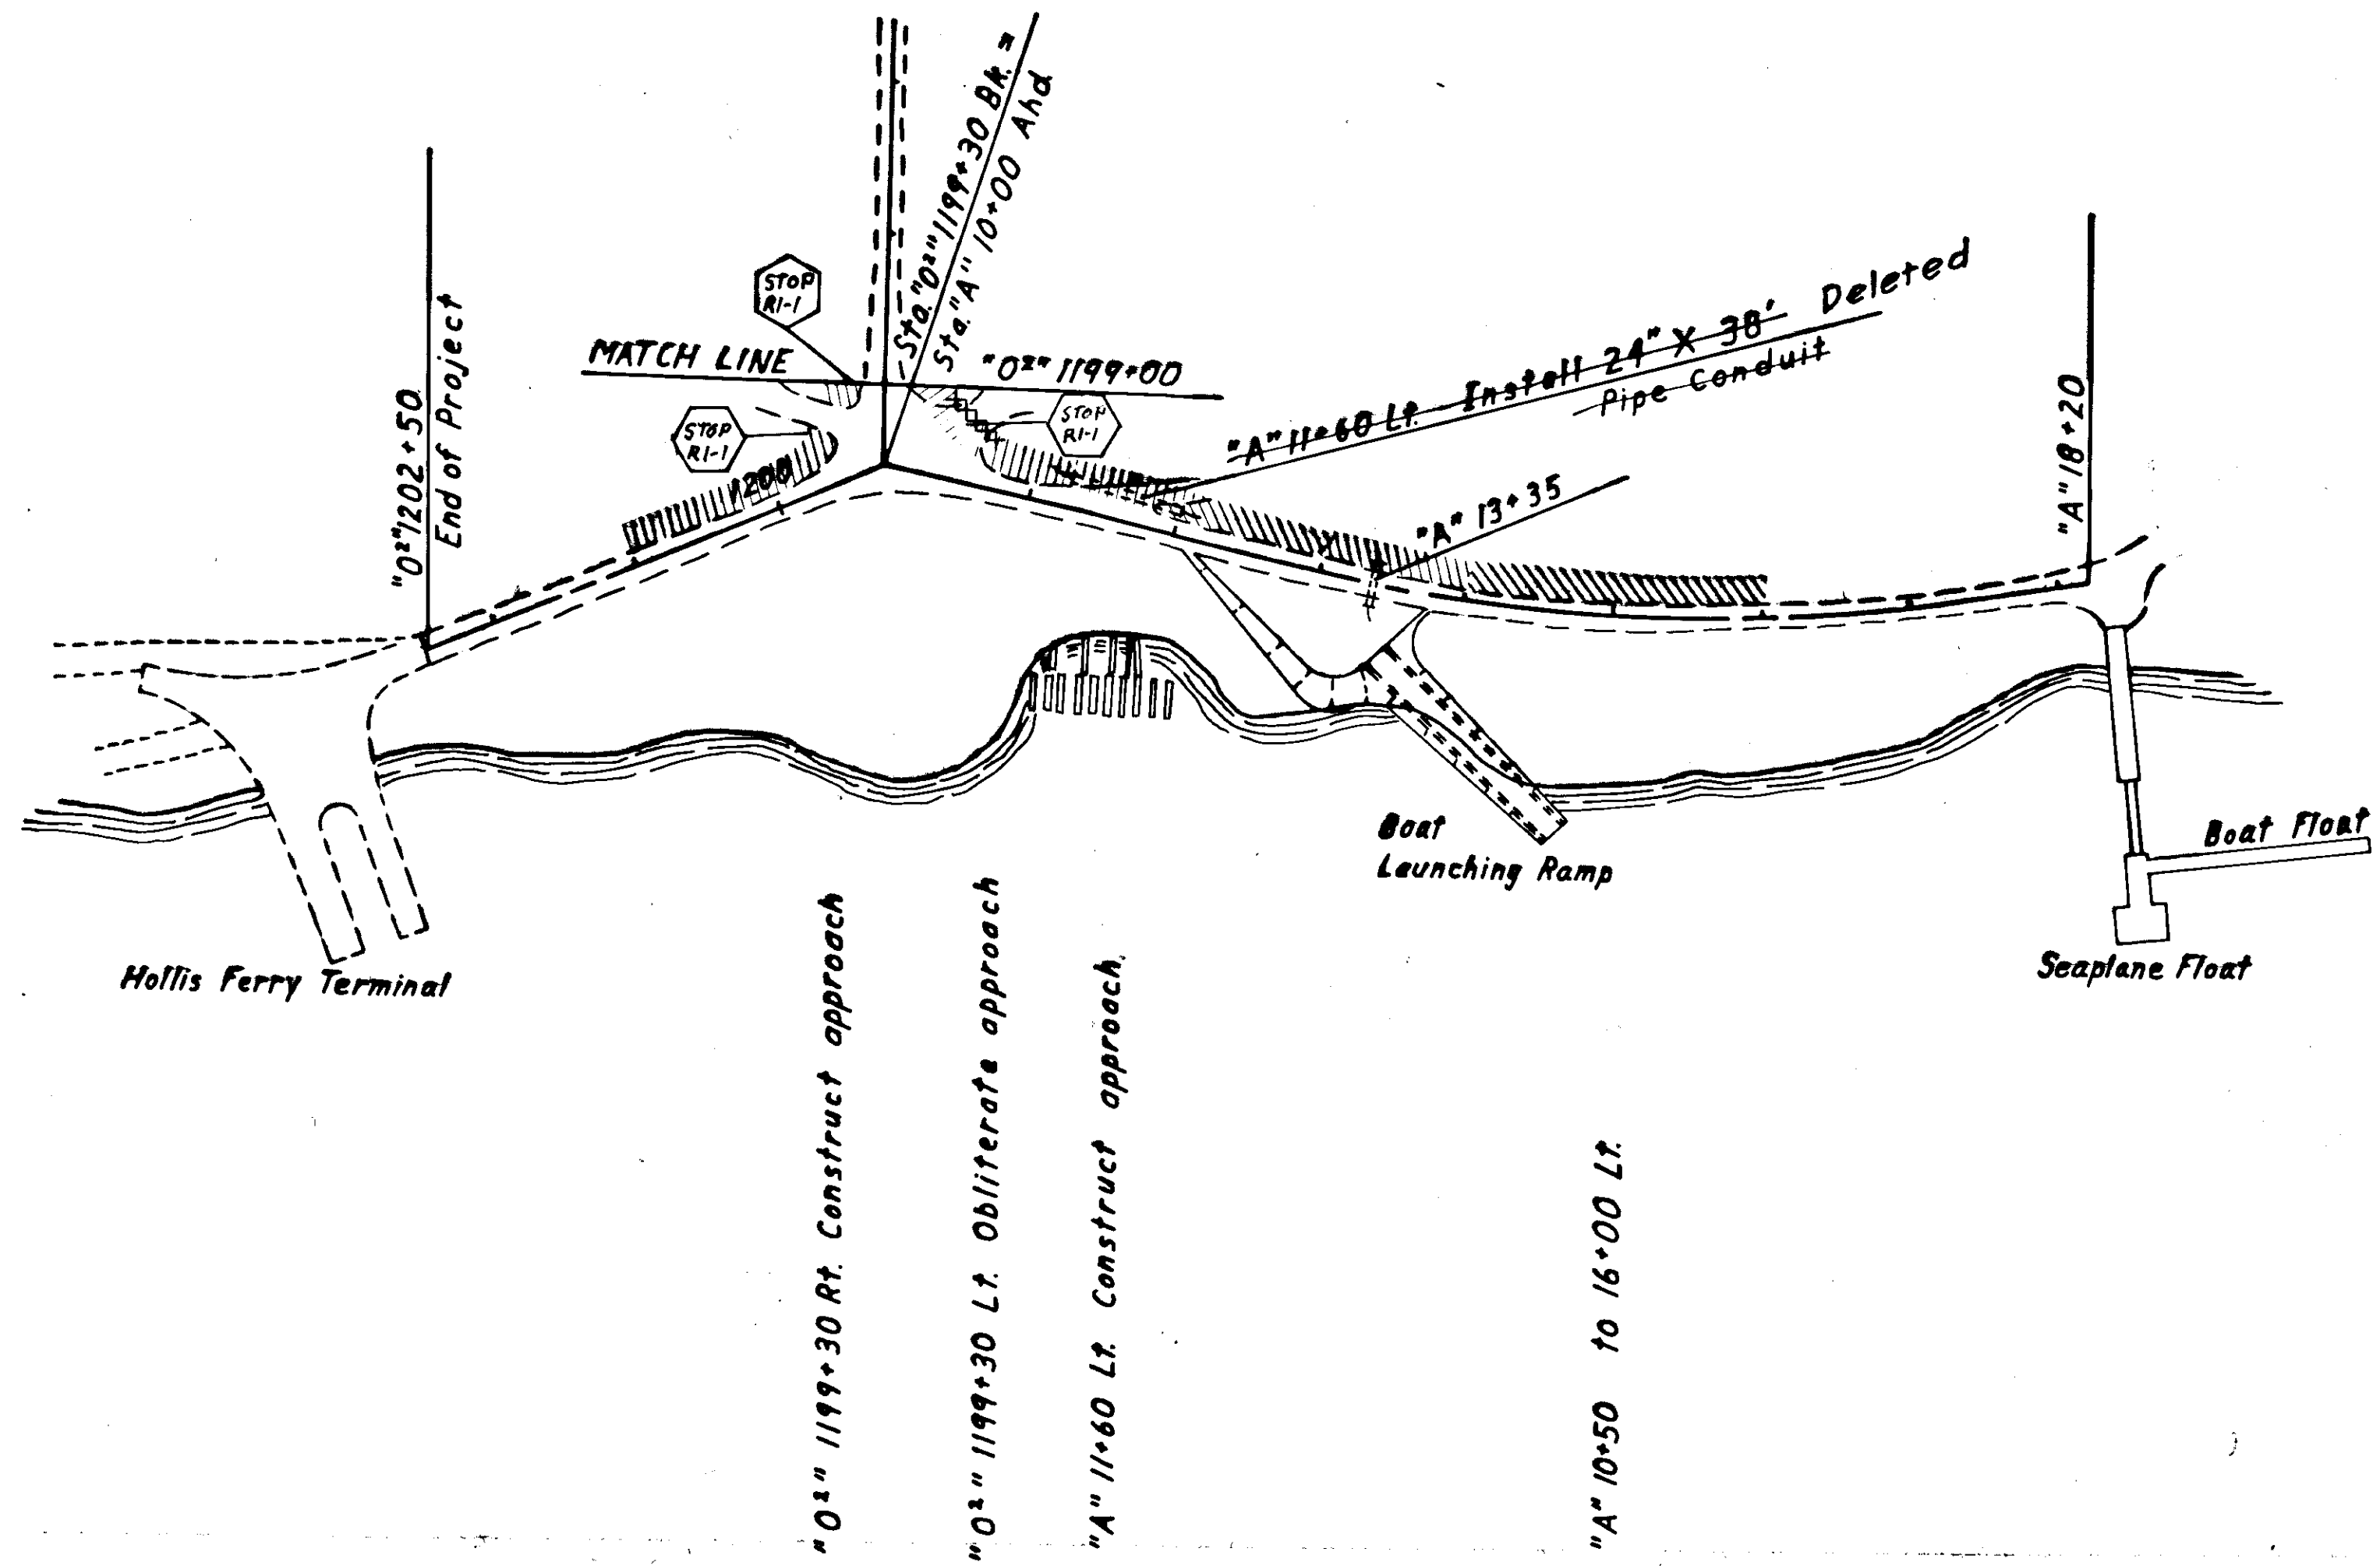


STATE	PROJECT DESIGNATION	YEAR	SHEET NO.	TOTAL SHEETS
ALASKA	FH 006 - (I)	1975	18	18


MAYBESO CREEK BRIDGE

Notes:


1. Machine place riprap at bridge ends as directed by the engineer. Rock will be from Rock Excavation. Place rock prior to relocating brow logs. The riprap work described above will be paid for under Item 611(1).
2. Hand placing of angular rock under the existing sill logs and backfilling the cavity behind the Klawock end sill log will be included in the lump sum payment of Item 507(2).
3. Roadway guardrail will be paid for under Item 606(1).
4. Add five cable wraps after relocating brow logs. One near midspan, triple wrap - all logs. Two near each abutment, double wrap - the outer two logs. Tension and staple wraps.

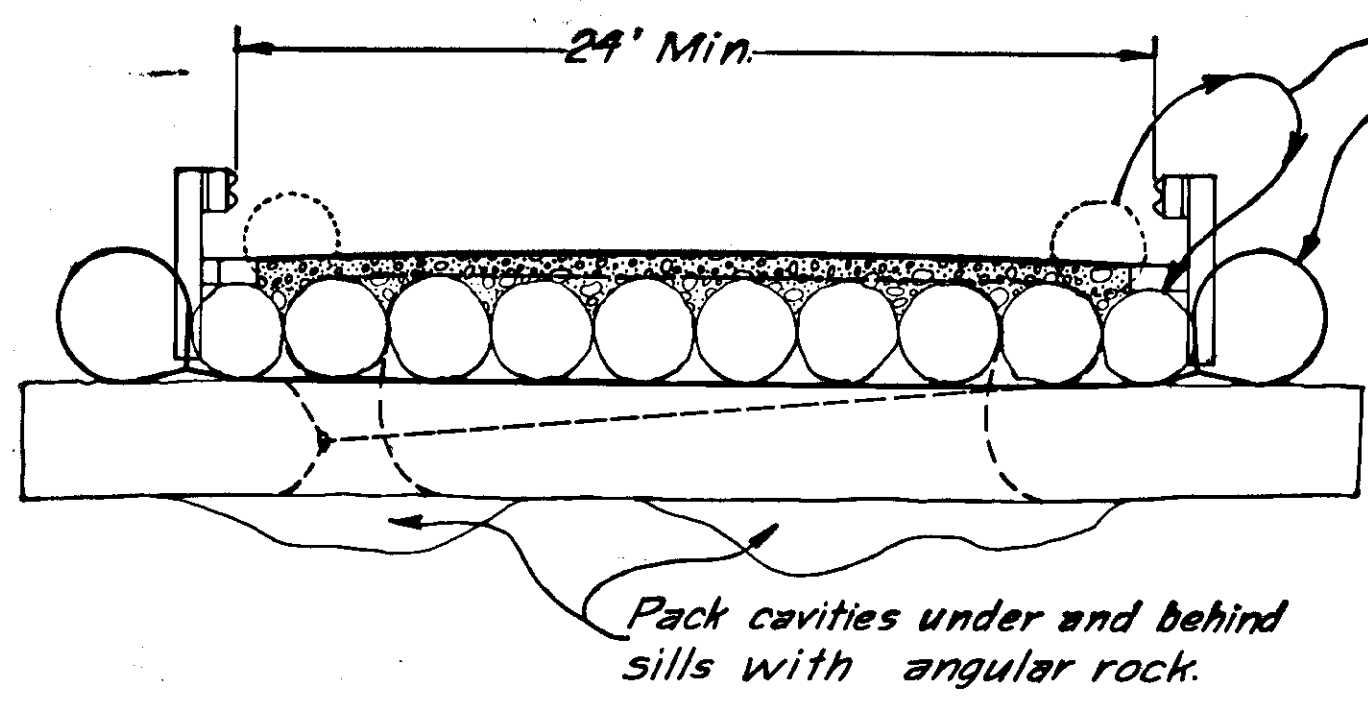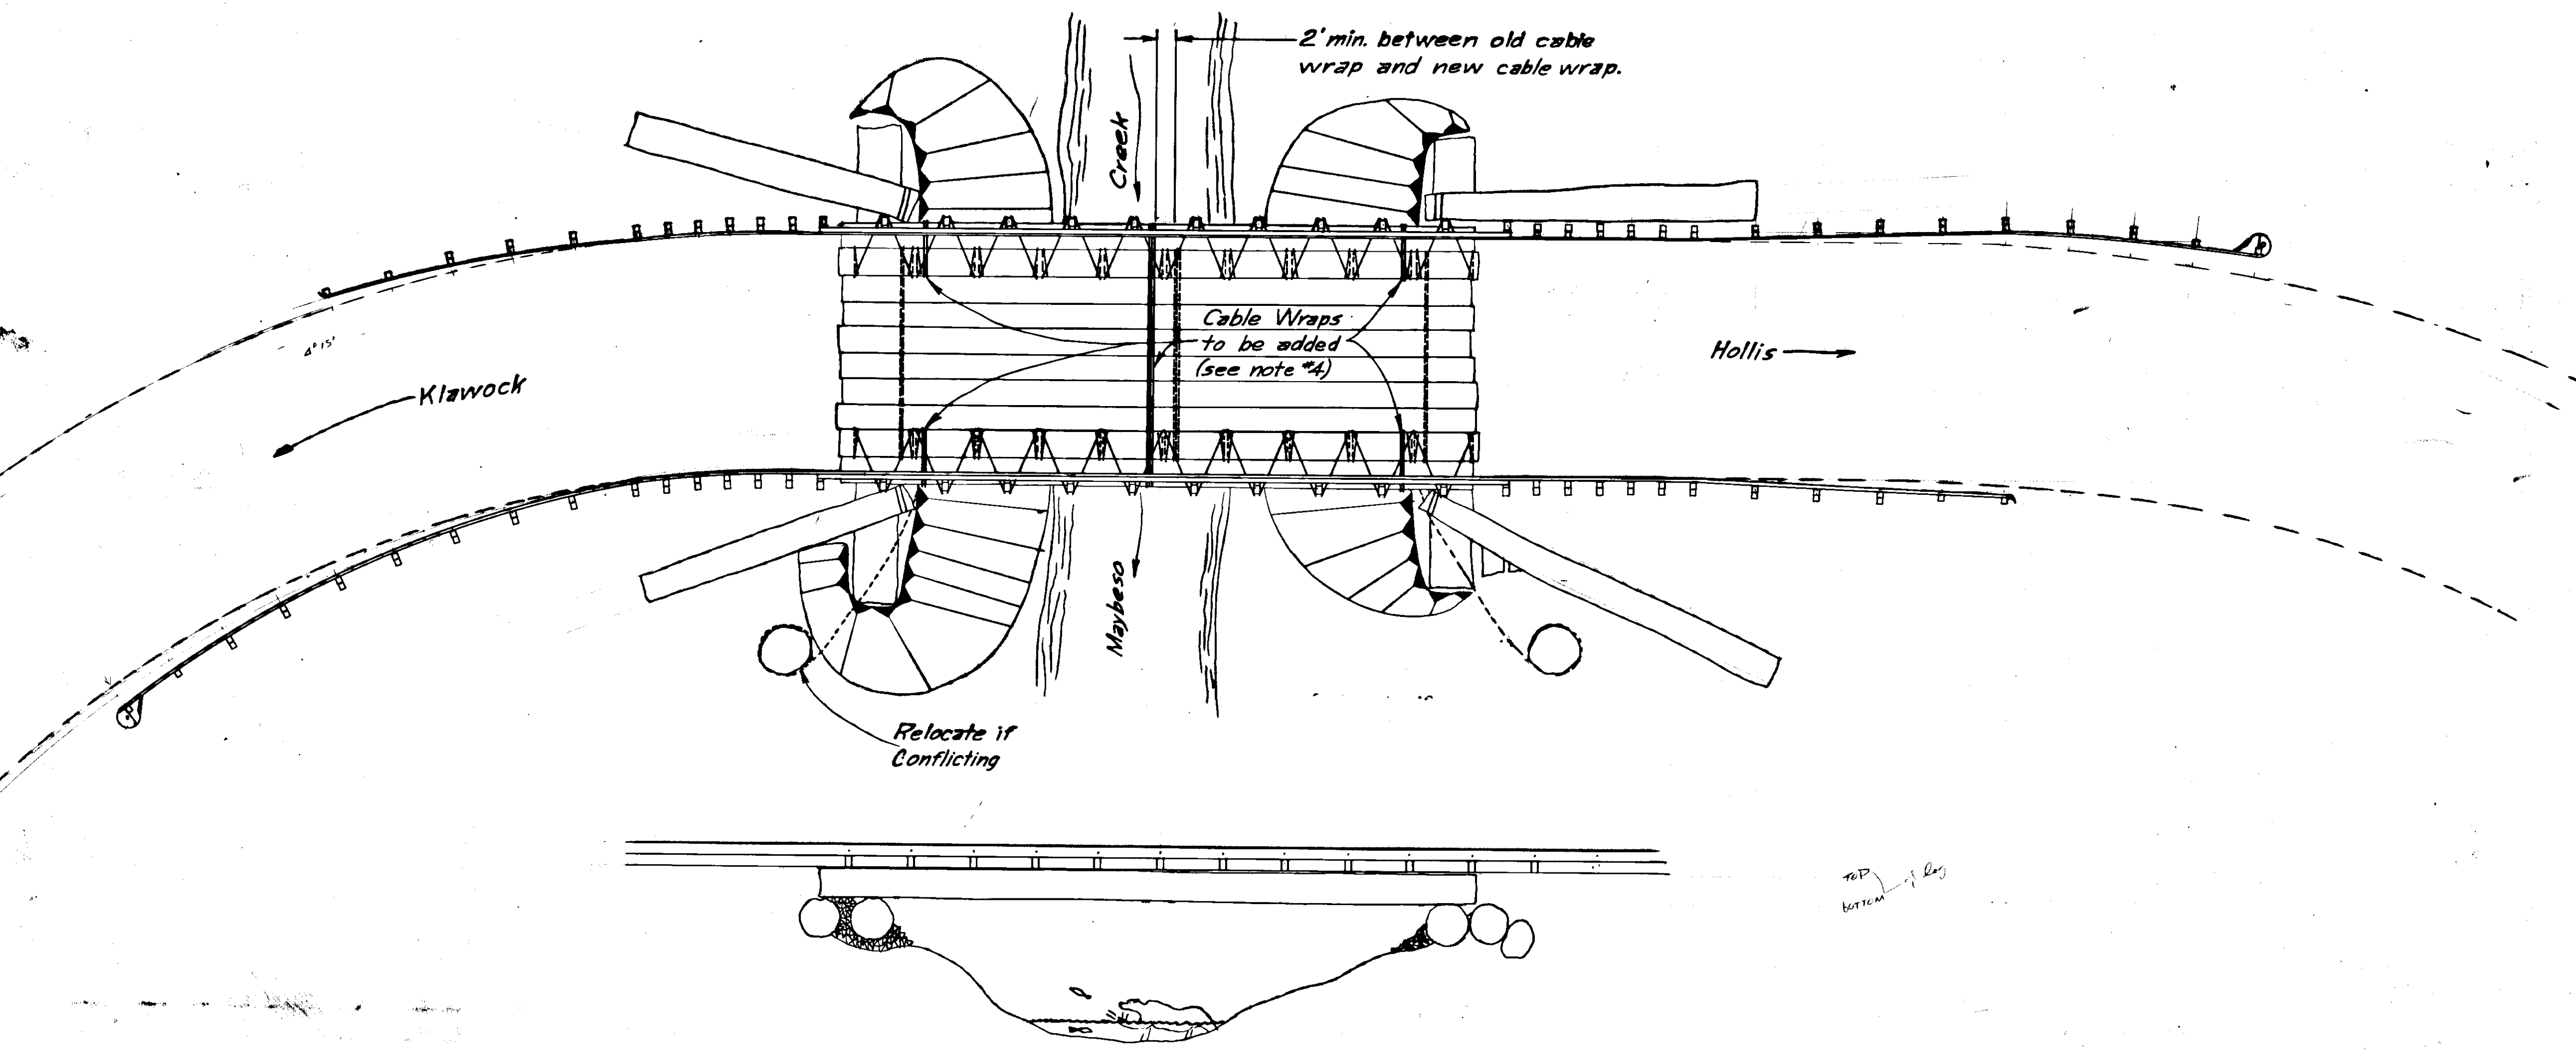


Section At Abutment

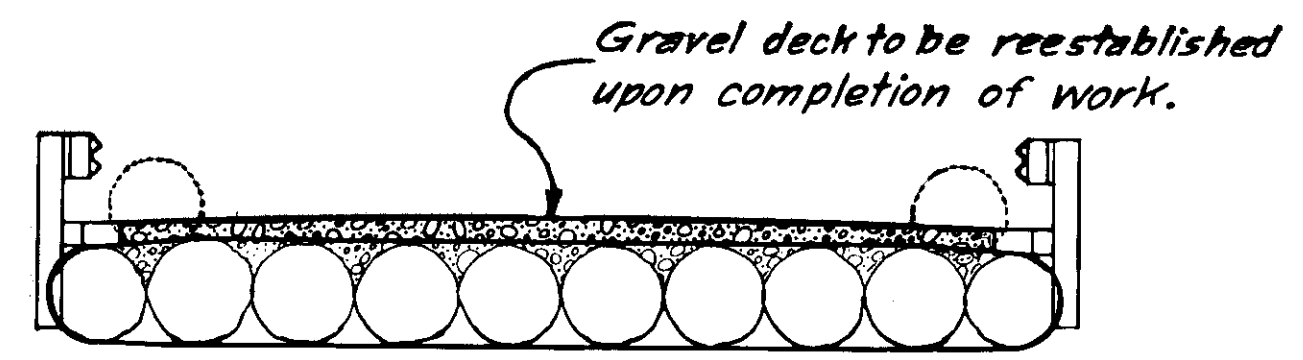




Section At Approximately Midspan

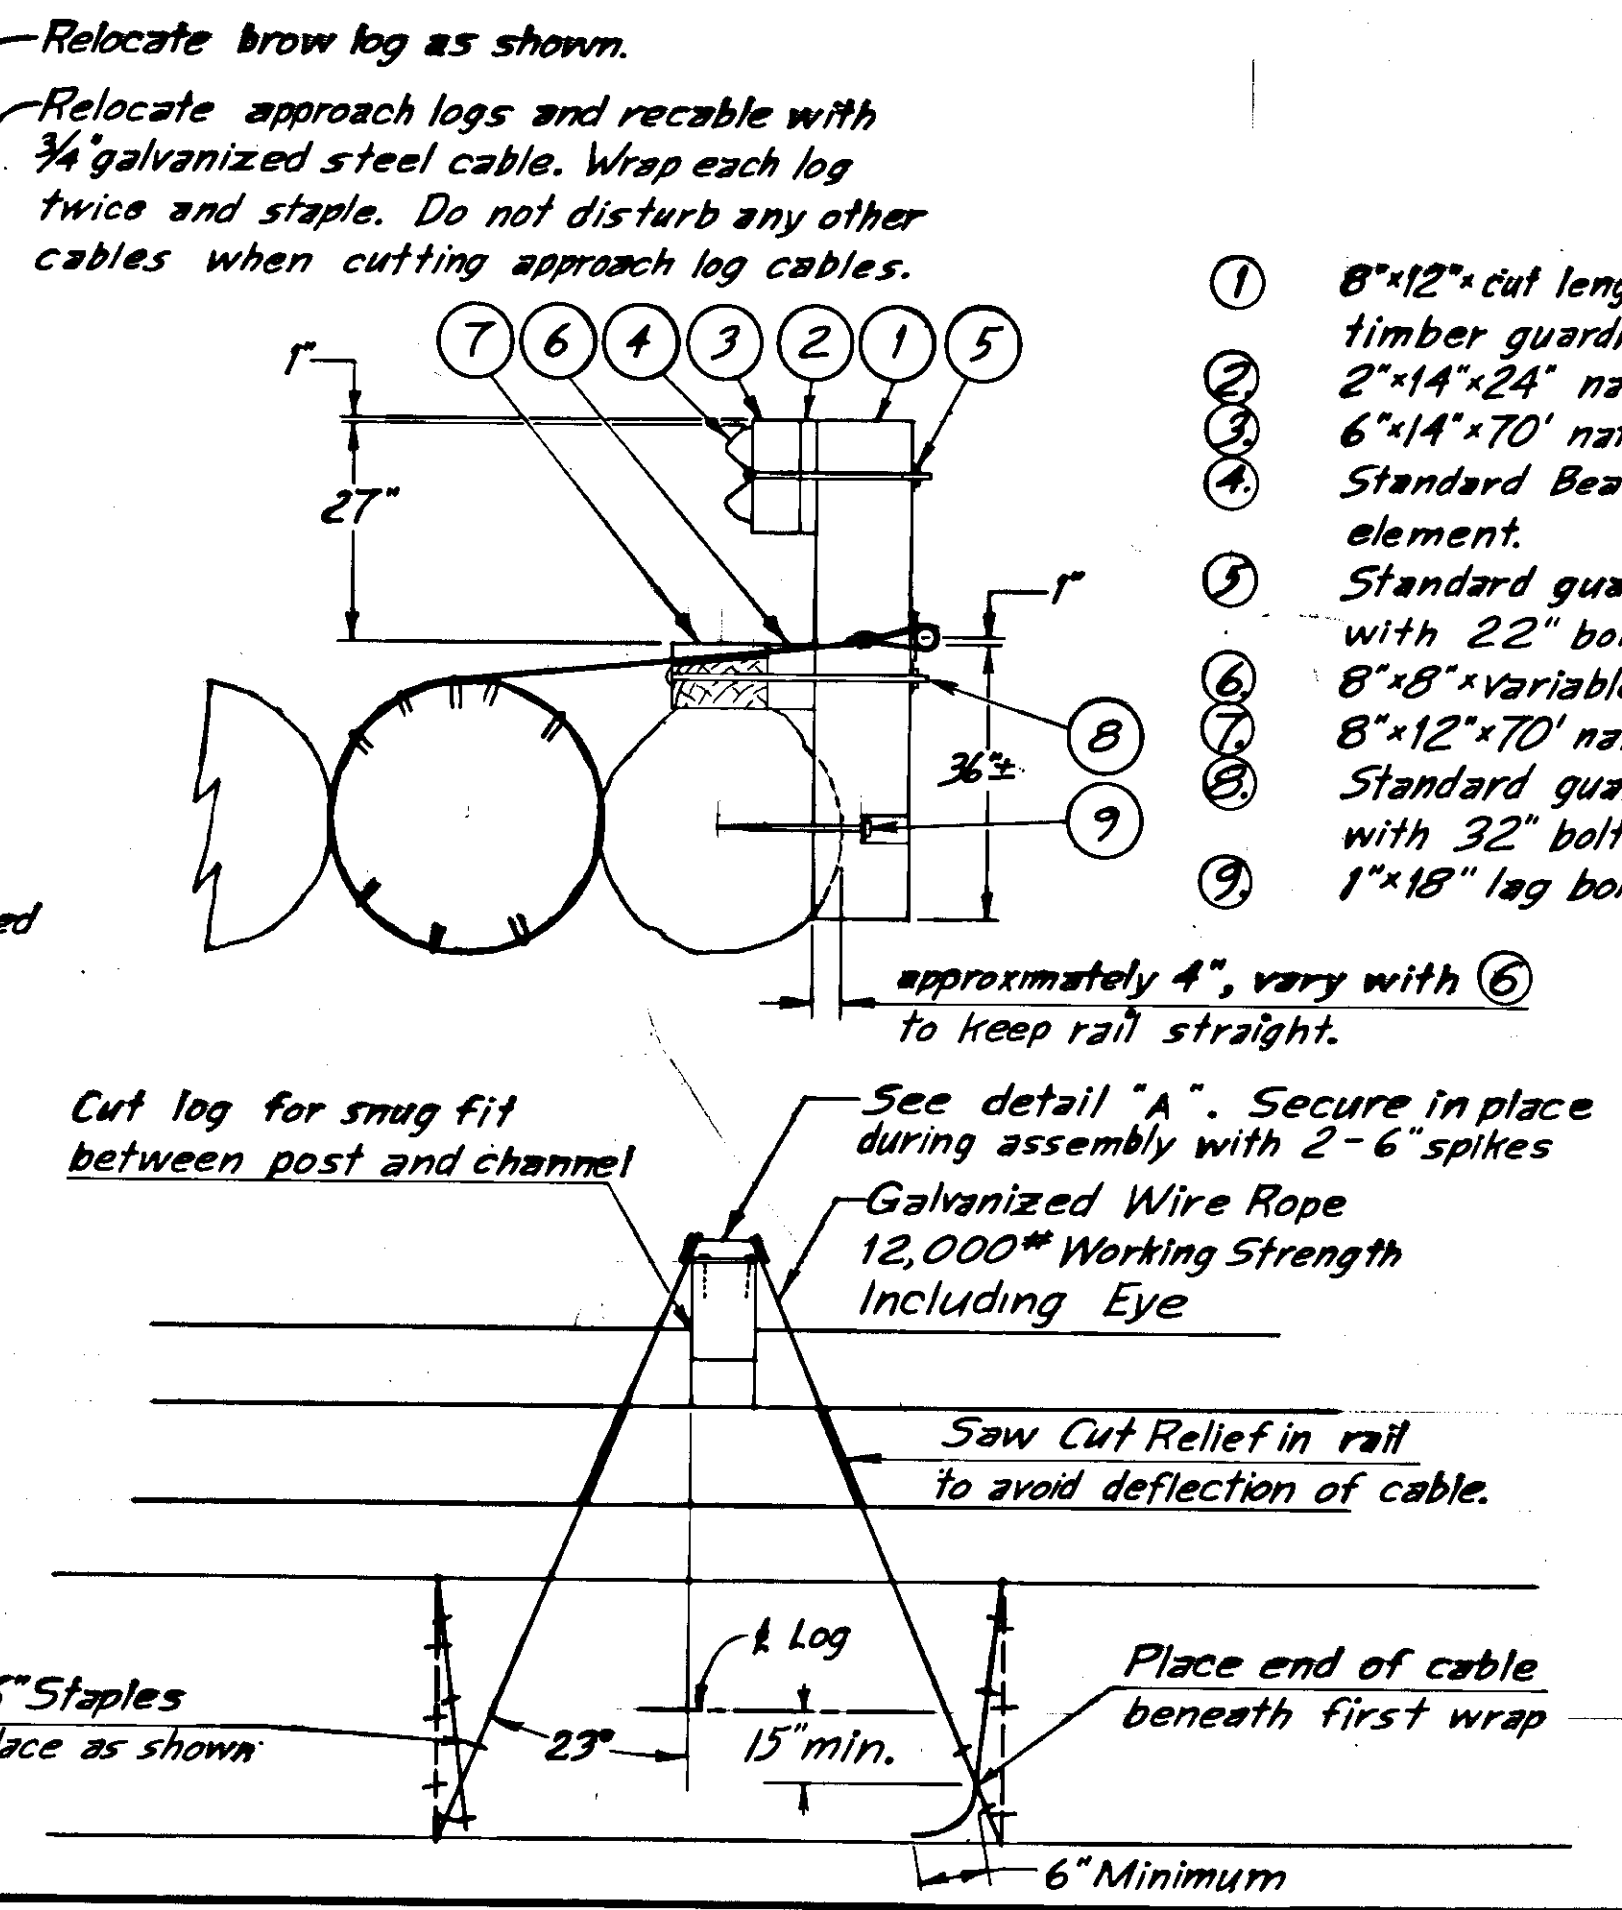

- ① 8"x12" cut length - Dense No. 1, treated timber guardrail post.
- ② 2"x14"x24" native spruce spacer.
- ③ 6"x14"x70" native spruce (each side).
- ④ Standard Beam type guardrail element.
- ⑤ Standard guardrail bolt system with 22" bolt.
- ⑥ 8"x8" variable thickness spacer.
- ⑦ 8"x12"x70" native spruce (each side).
- ⑧ Standard guardrail bolt system with 32" bolt.
- ⑨ 1"x18" lag bolt and washer

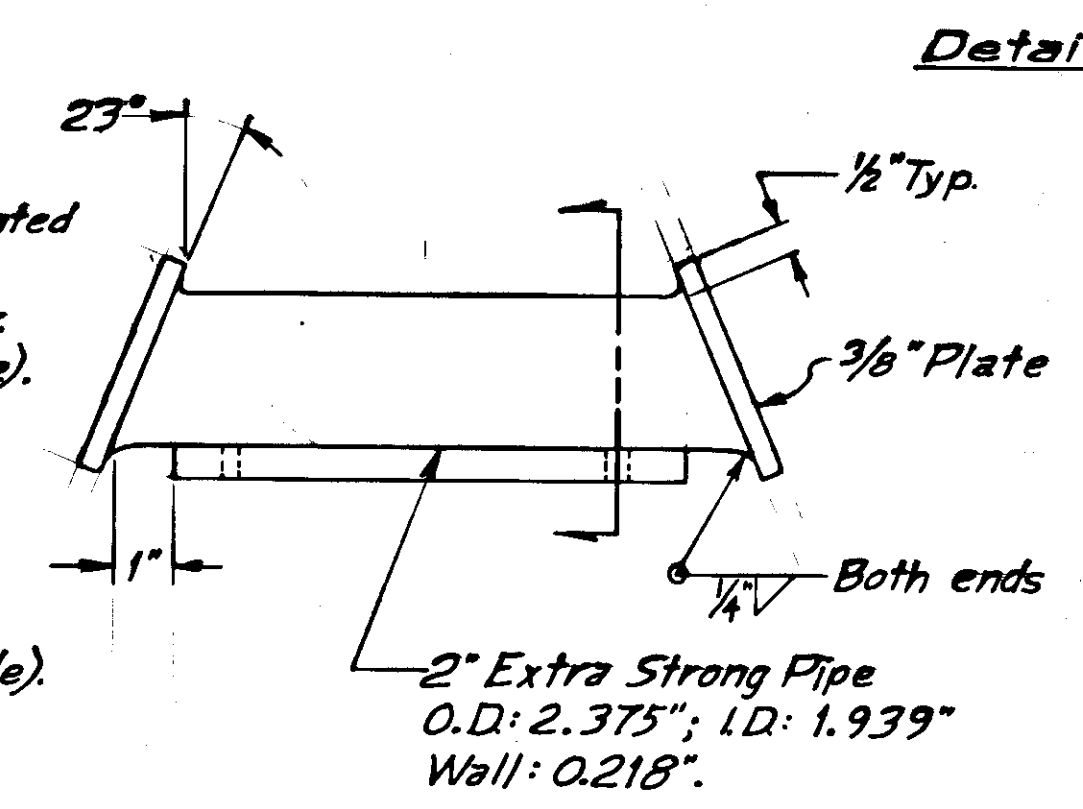

Detail A

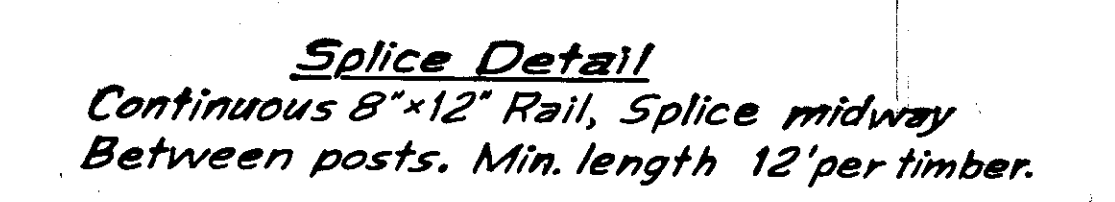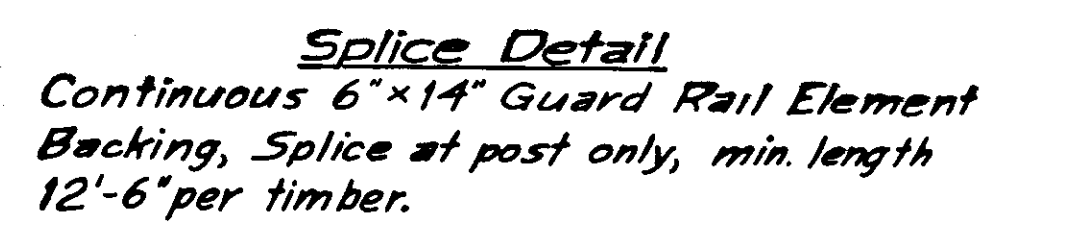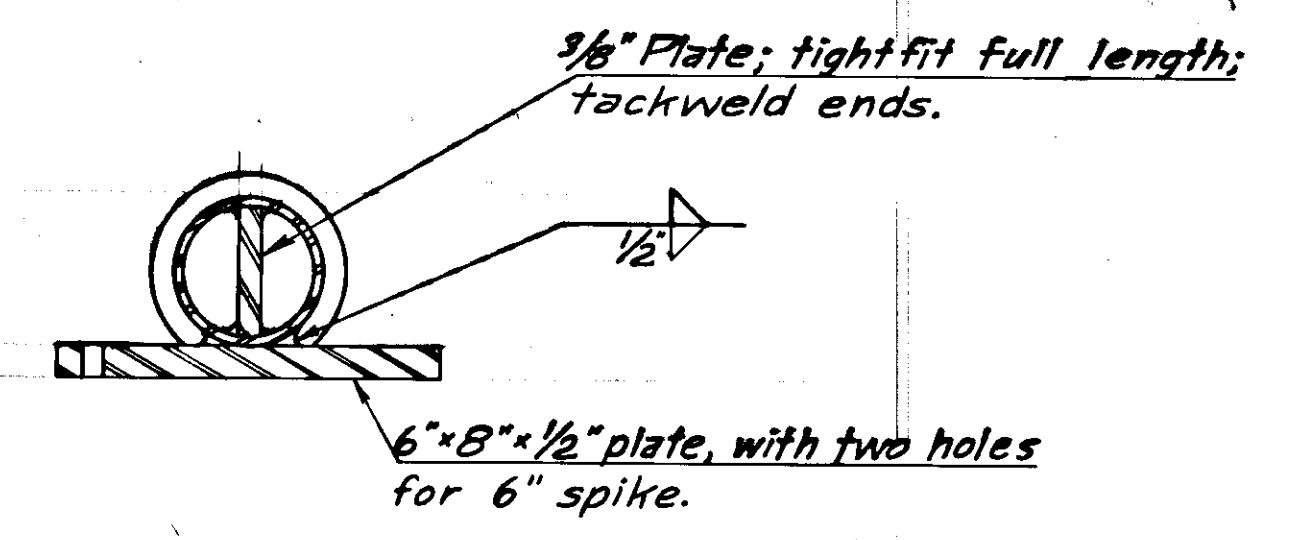

Drift pins to be located 4' O/C. Additional drift pins are to be located on each side of every splice. Drift pin size: 3/4" x 24".

