

PROJECT LOCATION
SR-0924(7), G-37049

KEY MAP

STATE OF ALASKA DEPARTMENT OF TRANSPORTATION & PUBLIC FACILITIES

PLAN AND PROFILE PROPOSED HIGHWAY PROJECT SR-0924(7) and G-37049, (B-60032) CRAIG TO KLAWOCK : DRAINAGE, GRADING, PAVING, & BRIDGE REPAIR

STATE	PROJECT	SHEET NO.	TOTAL SHEETS
ALASKA	SR - 0924(7) G-37049 R-30682	1	27

INDEX OF SHEETS	
1	TITLE SHEET
2	TYPICAL SECTION OF IMPROVEMENTS
3	SUMMARY TABLES
4	DRAINAGE DETAILS
5	TRAFFIC CONTROL PLAN
5	QUARRY PLAN
6-14	PLAN & PROFILE SHEETS
15-20	PLAN SHEETS ("K" 40+00.00 TO E.O.P.)
21-26	INTERSECTION DETAIL SHEETS
27	KLAWOCK DRAINAGE IMPROVEMENTS
A-1	SUPPLEMENTAL WORK SCHEDULE "A"
	KLAWOCK RIVER BRIDGE "AS - BUILTS"

THE FOLLOWING STANDARD DRAWING ARE INCLUDED IN THIS PROJECT: A-1, C-00.04, C-10.04, C-11.04, D-01.00, D-04.00, D-20.10, D-24.13, D-26.03, G-04.15, G-04.34, G-13.16, G-14.08, G-18.12, G-24.01, G-24.11, I-40.21, I-80.00, M-05.01, M-16.03, S-05.00, S-30.12, T-20.03, T-21.03, U-03.00


PROJECT SUMMARY

WIDTH OF PAVING	=	34' 28' 38,111.29' = 7.2180 miles
LENGTH OF PROJECT	=	36,144.69' = 6.8456 miles
LENGTH OF GRADING	=	35,843.19' = 6.7885 miles
LENGTH OF PAVING	=	35,843.19' = 6.7885 miles
LENGTH OF EXCEPTION	=	301.50' = 0.057 miles
		296.97' = 0.0562 miles

DESIGN DESIGNATION

	"K" 0+21.18 - "K" 146+00	"K" 146+00 - "K" 313+50	"K" 313+50 - "K" 348+50
V	55 MPH	55 MPH	55 MPH
ADT(1980)	330	370	380
ADT(2000)	596	636	646
DHV	(16%) 95	(15%) 96	(15%) 97
T	6.6%	6.6%	6.6%
TI	6.0	7.0	7.5

CRAIG CITY STREET PAVING
SUPPLEMENTAL WORK
SCHEDULE "A" (R-30682)

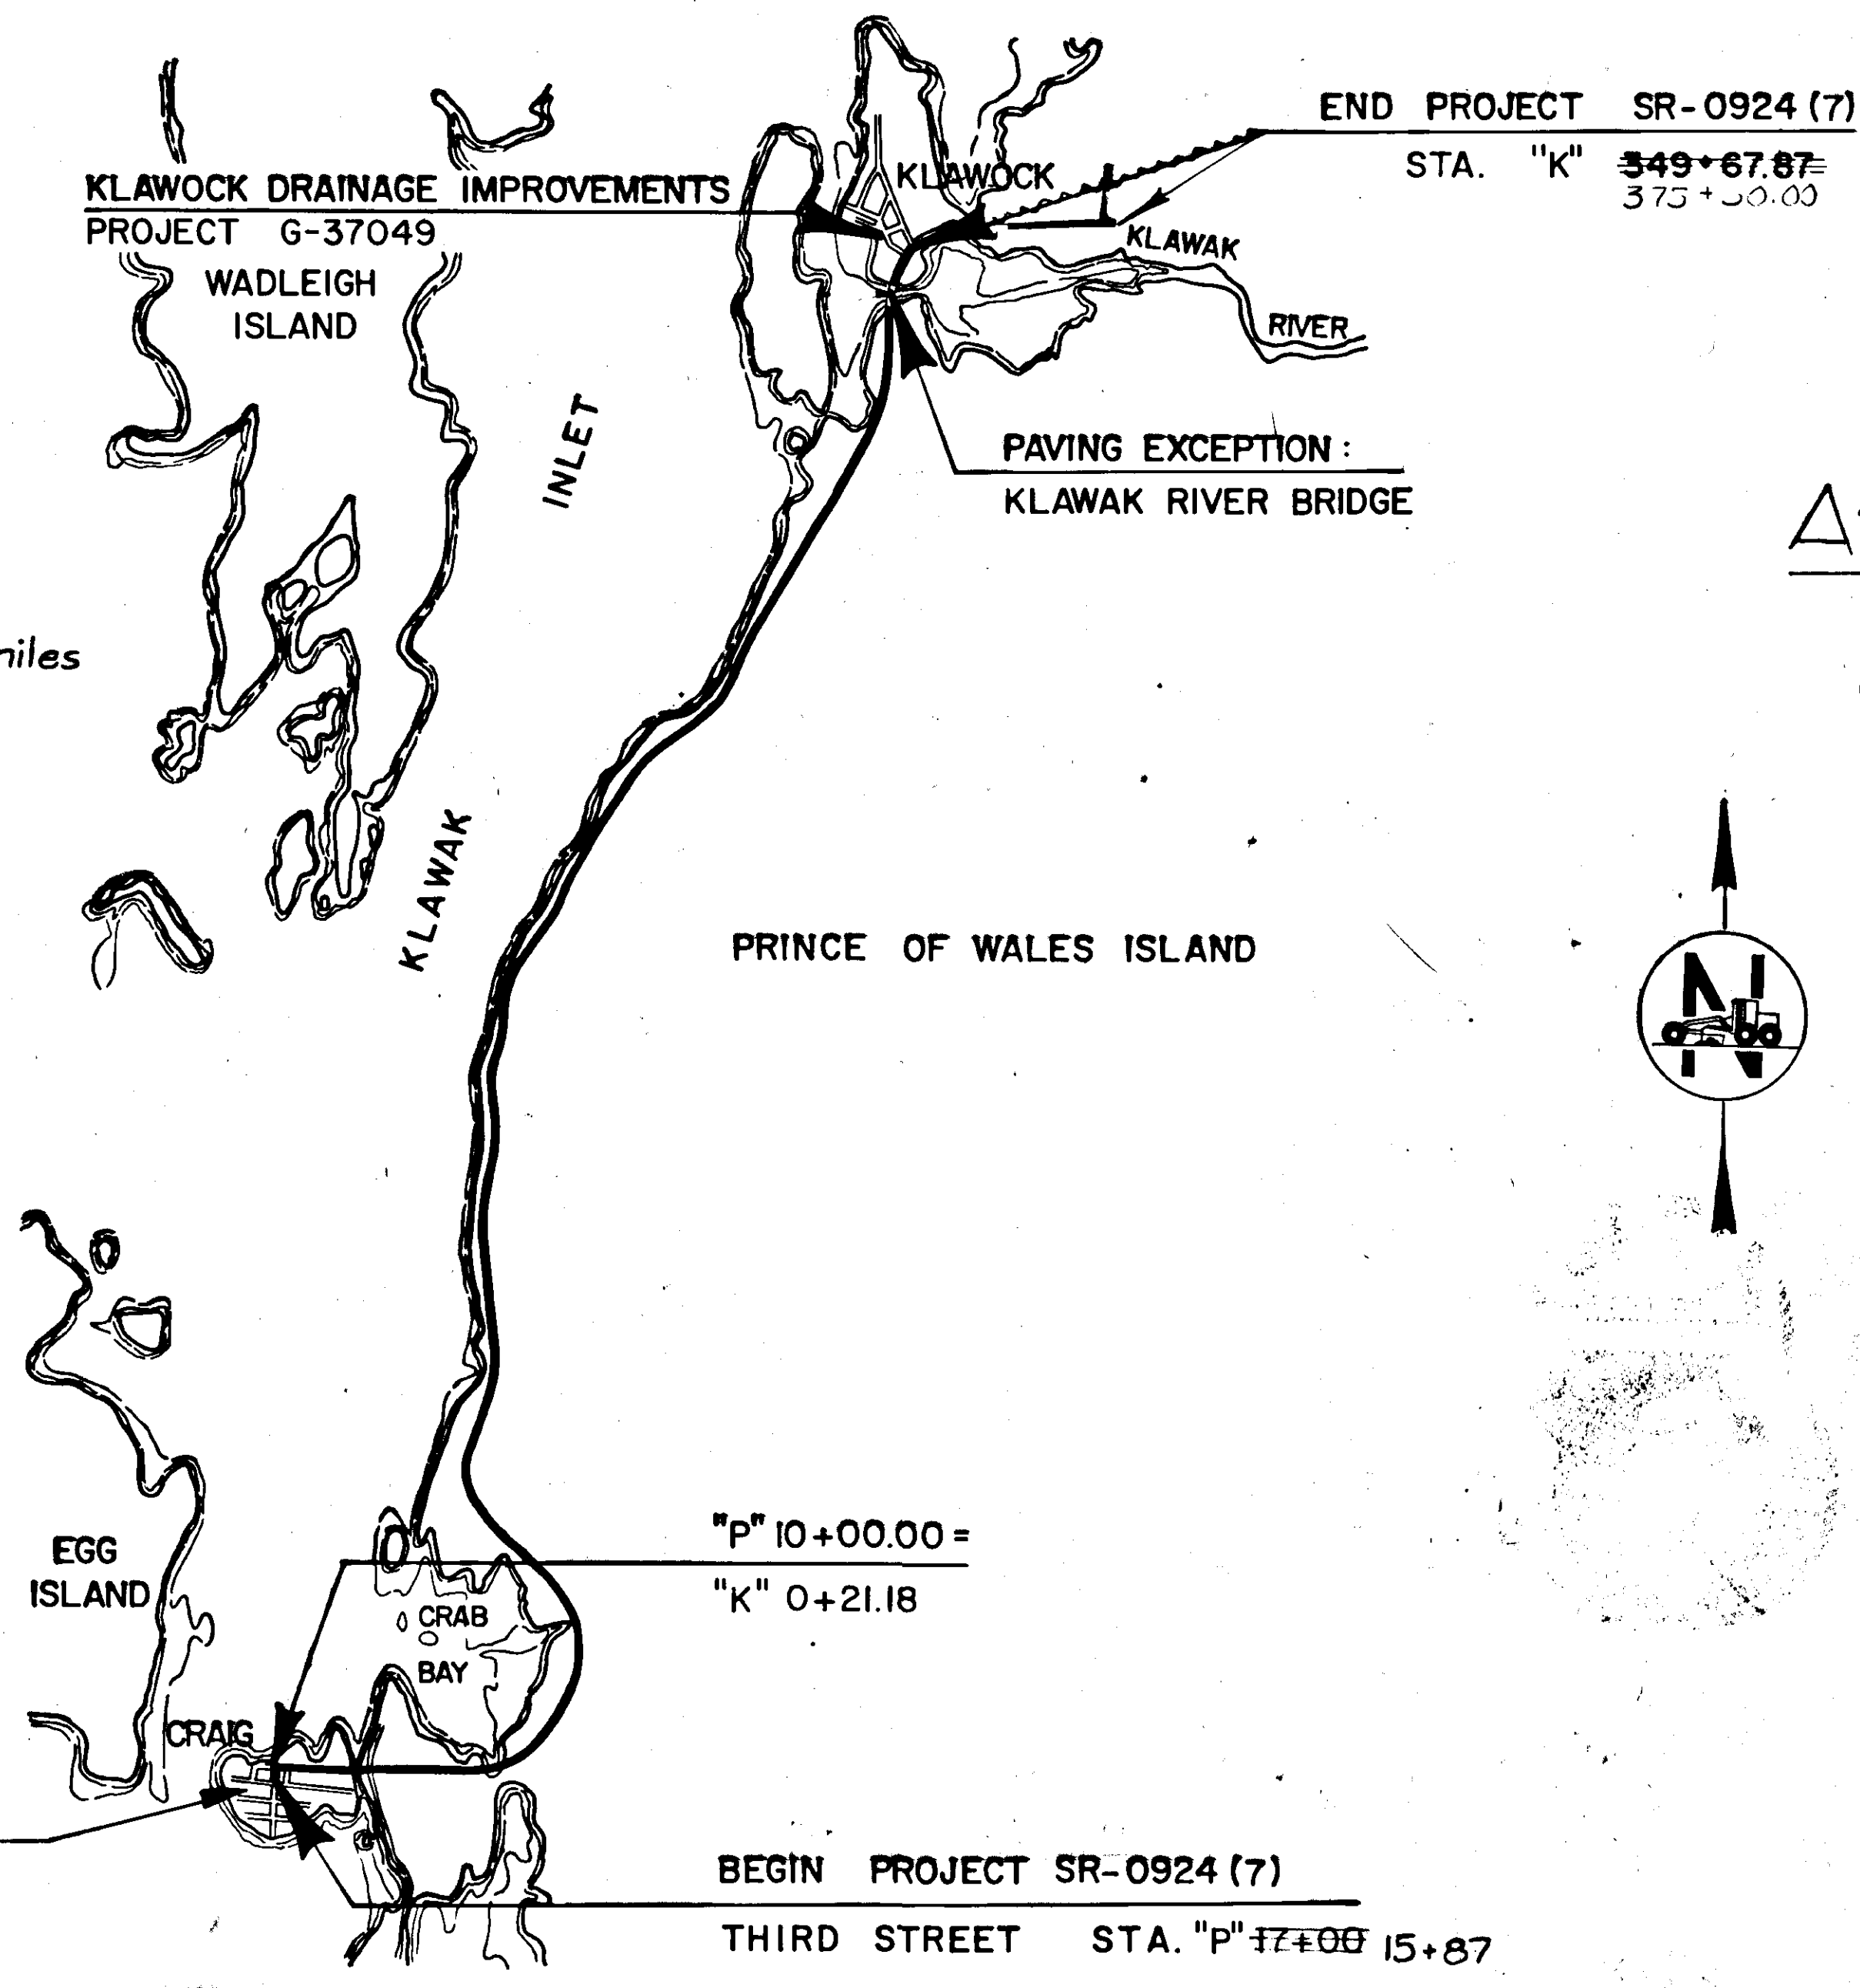

AS-BUILT PLANS

CONTRACTOR: RED SAMM CONST. INC.
PROJ. ENGR.: BRIAN BELT
NOTICE TO PROCEED: 7/1/82
COMPLETION DATE: 8/17/83

STATE OF ALASKA
DEPARTMENT OF TRANSPORTATION
&
PUBLIC FACILITIES


APPROVED
Wallace K. Williams Date 3-23-82
SOUTHEASTERN REGION
DESIGN/CONSTRUCTION ENGINEER



STATE OF ALASKA
DEPARTMENT OF TRANSPORTATION
&
PUBLIC FACILITIES


APPROVED
Charles S. Statok Date 3-23-82

BEGIN PROJECT SR-0924 (7)
THIRD STREET STA. "P" 17+00 15+87

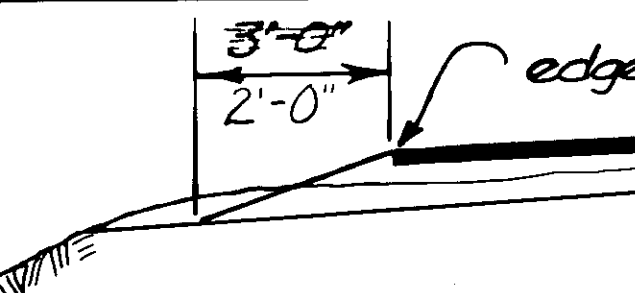

Note: Use this detail if no pavement extension is specified. (urban section only)

NOTE: Additional 1" lift of Asphalt Concrete was placed (CSS-1 Tack coat bonded) over original 1 1/2" paving on "P"-line and between 0+21.18 and 43+00 on "K"-line, and between 343+00 and 375+00 also on "K"-line; overlay also placed on Klawock Street Paving (Bayview Blvd.)

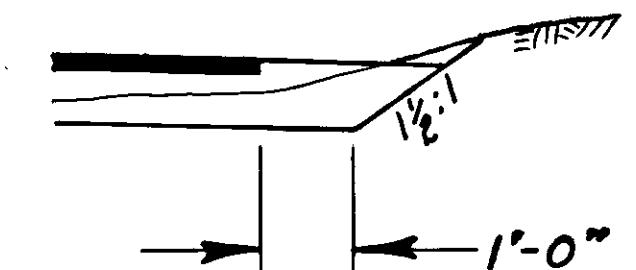


Note: Use this detail if no paved gutter pavement extension is specified. (urban section only)

TYPICAL SECTIONS OF IMPROVEMENTS

GENERAL NOTES:

- Station, line and grade shown on these plans are subject to minor revisions, as directed by the Engineer.
- Profile grade is determined by the vertical alignment shown on the Plan and Profile sheets for the "P"-Line, the detailed intersecting roadways and the "K"-Line up to station "K" 40+00. From station "K" 40+00 to the end of the project, the profile grade shall be designed by the Contractor and approved by the Engineer; finished profile grade shall be a nominal 6" above top of existing shot-rock embankment, and all changes in longitudinal rate of grade shall be accompanied by a vertical curve whose minimum length is determined by the equation:

$$L(\text{min.}) = \frac{(\text{algebraic difference in grades, percent})(\text{design speed, mph})^2}{46.5}$$
- Top of existing shot-rock embankment was constructed using a design speed of 40 mph and Case II superelevation; new construction shall be built to a design speed of 55 mph as per Case I: Std. Drg. I-80.00, e max = 0.06'/ft.
- Longitudinal cold pavement joints will not be allowed within the limits of the driving lane. All cold joints elsewhere shall be thoroughly coated with CSS-1 Emulsified Asphalt whose payment will be incidental to other paving items.
- Ditch offsets and fore-slopes may vary according to local conditions. The Contractor shall perform Ditch Cleaning operation in such a fashion as to approximate the original ditch section, or to construct a new ditch of similar dimensions shown at left which has prior approval of the Engineer.
- The Contractor shall compute, stake and construct the ditch grade required to obtain adequate drainage; all associated engineering shall be a part of Item 114.11).
- Construction of approaches shall be as detailed on the plans and on Std. Drg. I-40.21; materials needed shall be the same as mainline construction.
- The road prism shall be constructed in the following manner. Nominal depth of Base Course shall be 4" at ϵ ; where top of existing embankment (or bottom of excavation) is more than 4 inches below the bottom of proposed pavement, the base depth may be increased to a maximum thickness of 6 inches. Between the bottom of Base Course and 42 inches below the bottom of pavement, Selected Material shall be installed. Embankment placed below a depth of 42 inches shall be Borrow and/or useable Unclassified Excavation.
- ~~Pavement depth shall be 3 inches between Stations "K" 260+00 and "K" 300+00.~~
- All intersecting roadways shall be constructed to mainline specifications and section, cross-slope shall be -0.02'/ft. Payment shall be by the appropriate bid items; intersecting roadways which are detailed separately shall not be paid for as Approaches.

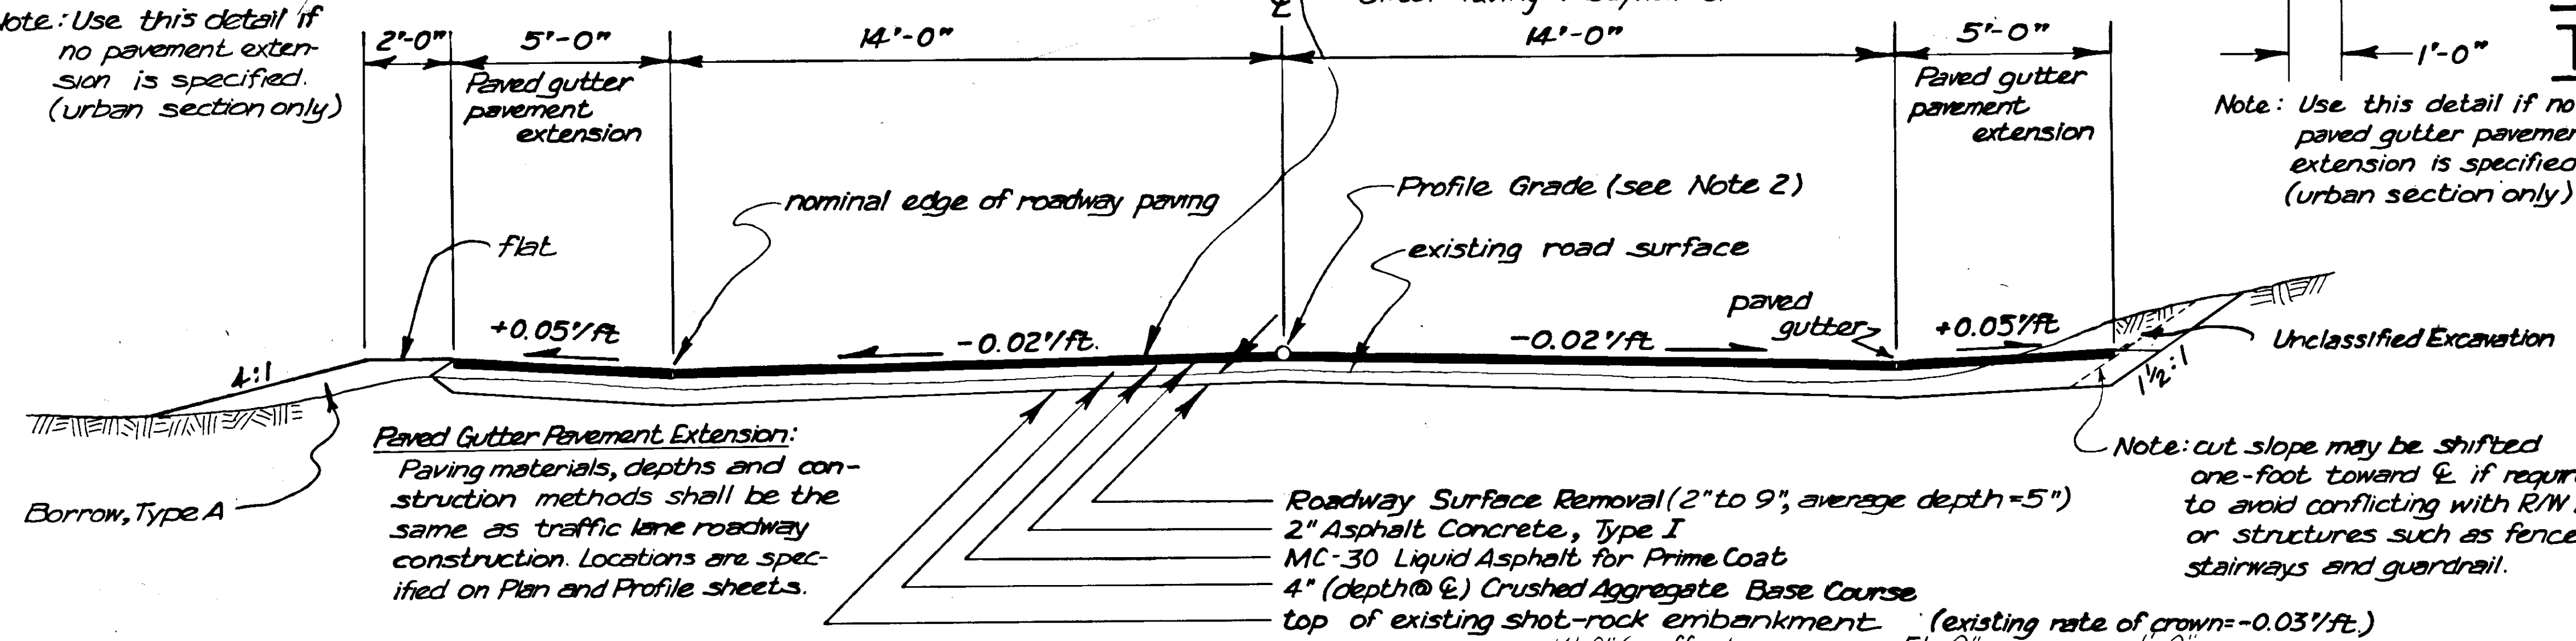



Paved Gutter Pavement Extension:
Paving materials, depths and construction methods shall be the same as traffic lane roadway construction. Locations are specified on Plan and Profile sheets.

Note: cut slope may be shifted one-foot toward ϵ if required to avoid conflicting with R/W line or structures such as fences, stairways and guardrail.


- Roadway Surface Removal (2" to 9", average depth = 5")
- 2" Asphalt Concrete, Type I
- MC-30 Liquid Asphalt for Prime Coat
- 4" (depth @ ϵ) Crushed Aggregate Base Course
- top of existing shot-rock embankment (existing rate of crown = -0.03'/ft.)

URBAN SECTION

SIDEWALK TYPICAL SECTION
SUPP. AGREEMENT No. 2 work
Begin @ "K" 1+00, Right;
End @ "K" 27+50 right

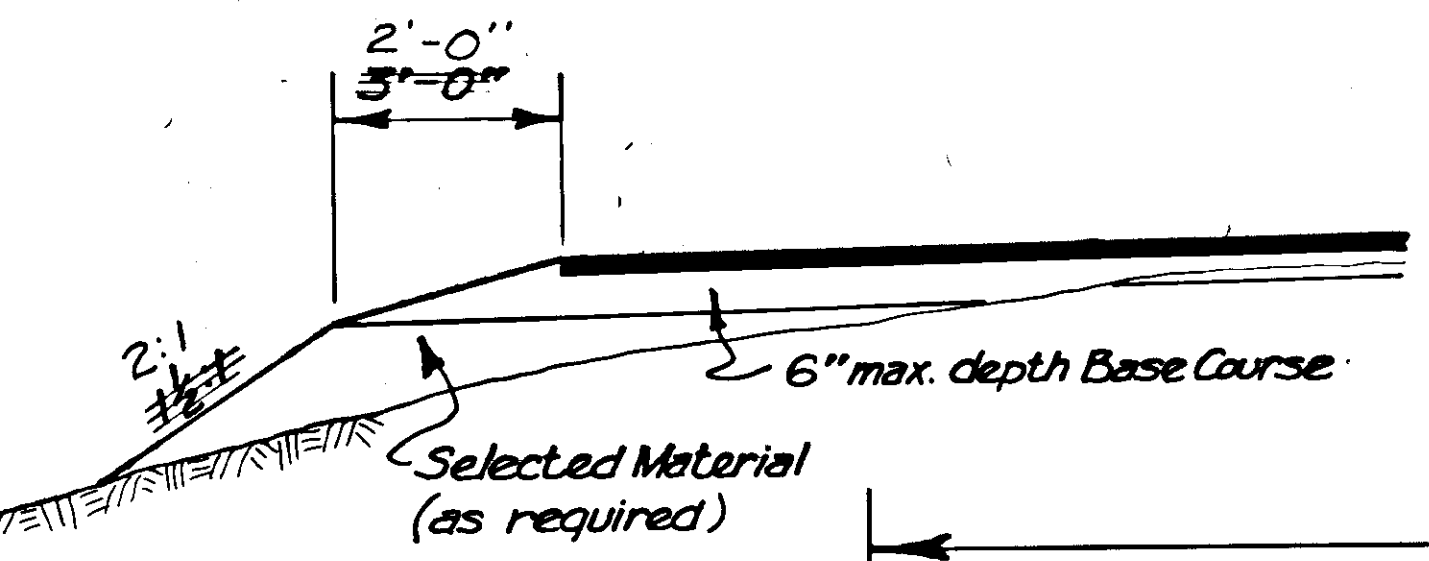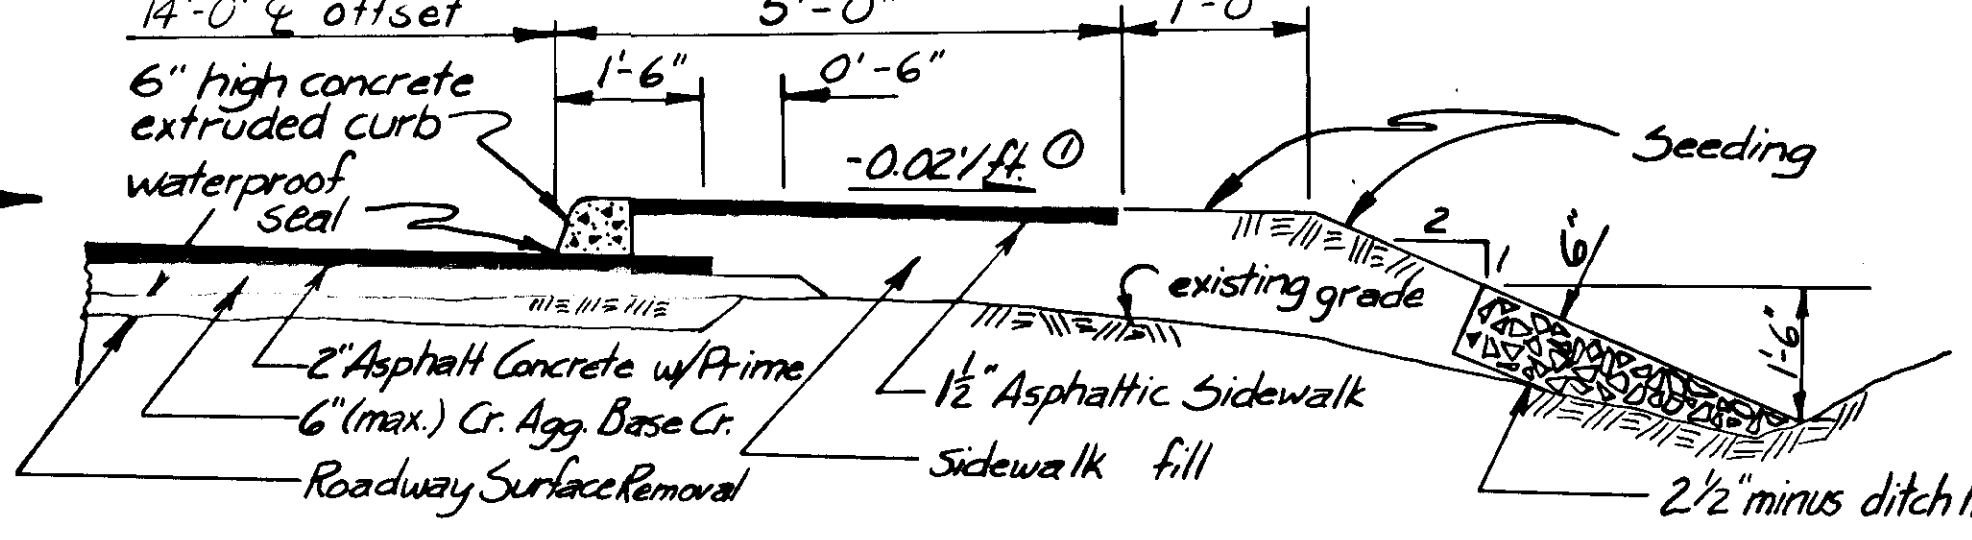


EMBANKMENT DETAIL
(see Note 8)
Pull back slope to 1 1/2 : 1 where required to catch, as directed by the Engineer

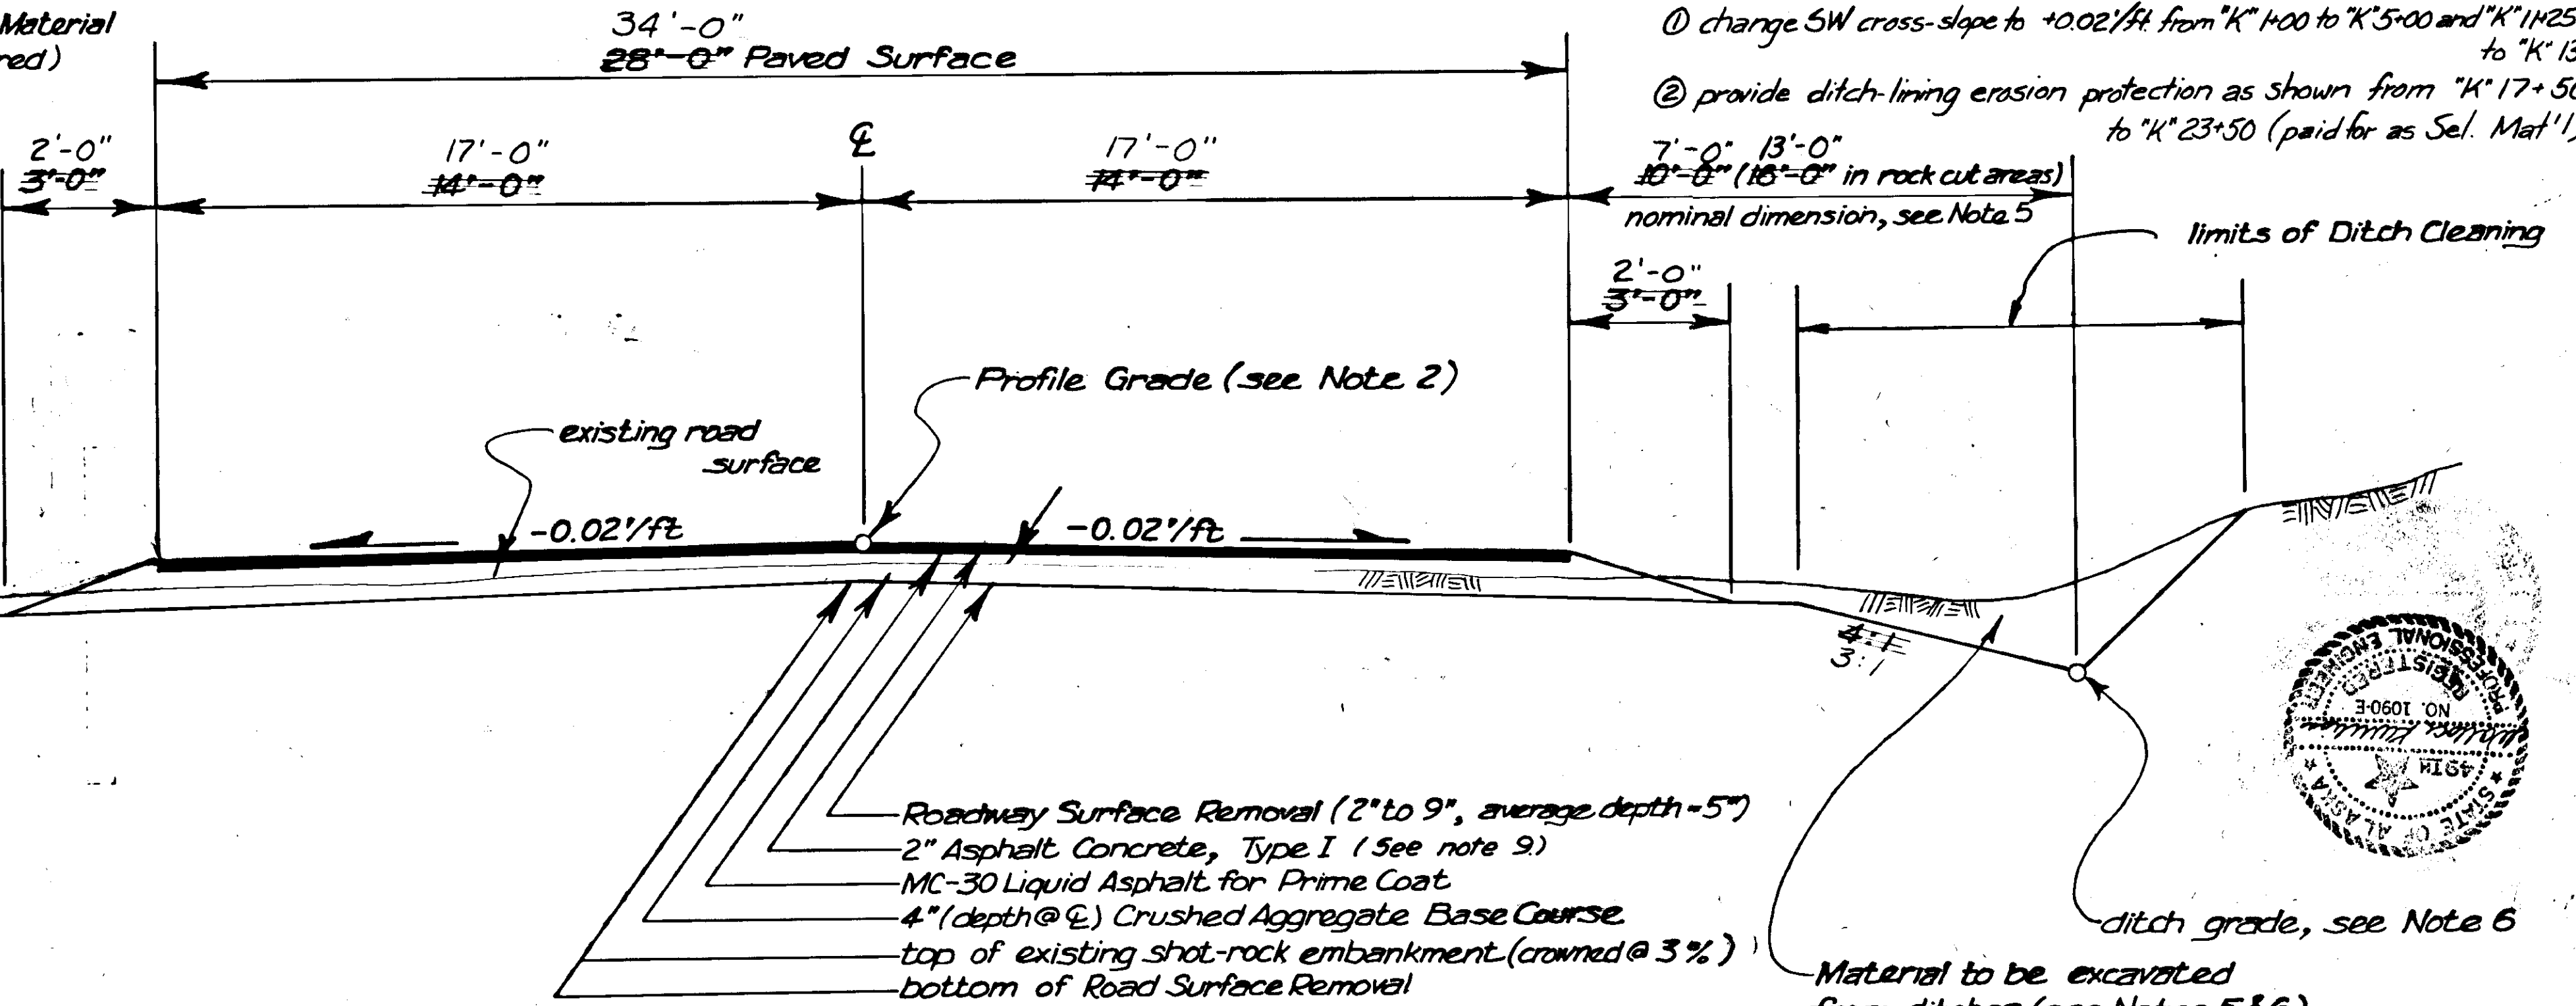

Base Course Depth:
Depth is designated as 4" at roadway centerline. At section extremities no minimum thickness is specified, but a maximum allowed depth is 6" (see also Note 8).

RURAL SECTION

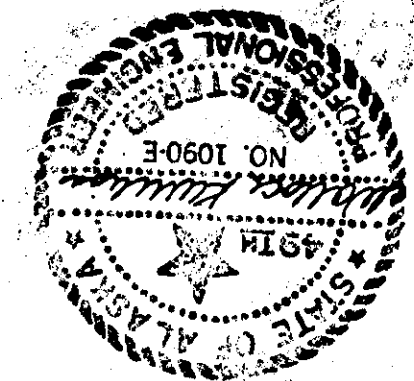

STATE	PROJECT DESIGNATION	YEAR	SHEET NO.	TOTAL SHEETS
ALASKA	SR-0924(7) G-37049	1982	3	27



ESTIMATE OF QUANTITIES

ITEM NO.	ITEM	UNIT	QUANTITY			TOTAL
			SR-0924(7)	G-37049	R-30682	
110(1)	Mobilization	lump sum	all required	all required		all required
110(1A)	Supplemental Mobilization	lump sum			all required	all required
111(1)	Temporary Erosion and Pollution Control	con't sum	all required			all required
113(1)	Flagging	Man-Hours	1,920	1,704.00		1,104.00
113(1A)	Supplemental Flagging	Man-Hours			40	40
114(1)	Construction Surveying by the Contractor	lump sum	all required	all required		all required
115(1)	Traffic Maintenance	lump sum	all required	all required		all required
115(1A)	Supplemental Traffic Maintenance	lump sum			all required	all required
115(2)	Construction Signs	lump sum	all required	all required		all required
115(2A)	Supplemental Construction Signs	lump sum			all required	all required
116(1)	Furnishing and Maintaining Field Office	lump sum	all required	all required		all required
116(2)	Furnishing and Maintaining Field Laboratory	lump sum	all required	all required		all required
116(6)	Furnishing and Maintaining Engineering Transportation	lump sum	all required	all required		all required
202(4)	Removal of Culvert Pipe	linear foot	102	197.0	92	69.0
203(3)	Unclassified Excavation	cubic yard	3,524	3,545.12		4,545.12
203(5B)	Borrow, Type A	Ton	444	579.40		444
203(8)	Roadway Surface Removal	Station	358	369.00		368.00
203(9)	Ditch Cleaning	Station	376	369.12		364.72
203(10)	Selected Material	Ton	3,565	12,624.45	100.00	12,624.45
203(11)	Excavation for Drainage	linear foot	300	302.00		302.00
301(1)	Crushed Aggregate Base Course	Ton	29,793	37,771.39	101.95	38,473.34
301(1A)	Street Base Course	Ton			596.25	596.25
401(1)	Asphalt Concrete, Type I	Ton	33,728	17,421.51	554.37	17,975.88
401(2)	Asphalt Cement, AC-5	Ton	293	294.83	29.43	104.26
403(2)	MC-30 Liquid Asphalt for Prime Coat	Ton	333	8.47		311.5
406(1)	Street Paving	Ton			312.31	312.31
506(1)	Treated Timber (deleted by C.O #2)	lump sum	all required			all required
506(2)	Untreated Timber	lump sum	all required			all required
506(6)	Reconstruct Timber Stairways	each	5			5
603(13-18)	18-Inch Corrugated Aluminum Pipe	linear foot	212	219.00	30	219.00
603(13-24)	24-Inch Corrugated Aluminum Pipe	linear foot	114	116.00	126	211.00
603(21-18)	18-Inch Lateral Wye Branch Connection	each	5			5
604(1)	Storm Sewer Manhole	each	1			1
604(4)	Adjust Existing Manhole	each	12	11.00	4.00	15.00
604(5)	Inlets	each	5	14.00		14.00
604(8)	Adjust Existing Inlet	each	6	6.00		6.00
604(9)	Reconstruct Existing Inlet	each	5	4.00		4.00
605(6)	Subdrain System	lump sum	all required			all required
606(1)	Beam Type Guard Rail, Type I Post	linear foot	5	304	3,406.25	3,406.25
606(5)	Removal and Disposal of Guard Rail	linear foot	all required	3,243.75		3,243.75
606(6)	End Anchorage	each	7	21.00		21.00
614(1)	Survey Monuments	each	62	65.00		62
614(2)	Monument Cases	each	62	66.00		62
615(1)	Standard Sign	square foot	388	203.00		203.00
615(2)	Remove and Relocate Existing Signs	each	3	3.00		3.00
627(1)	Watering	M. Gal	100	152.88		152.88
628(5)	Fire Hydrant Relocation	each	1	1.00		1.00
628(11)	Adjustment of Valve Box	each	27	21.00	6.00	27.00
639(1)	Approaches	each	7	59.00		59.00
670(8)	Traffic Markings	lump sum	all required			all required
203(12)	Ditch Construction (EWO #1)	linear foot	184.00			184.00
203(13)	Realignment Test Holes (EWO #2)	lump sum	all required			all required
203(14)	Subgrade Repair (EWO #1)	lump sum	all required			all required
203(15)	Curve 3 Realignment (EWO #15)	lump sum	all required			all required
203(16)	Royalty Payment (EWO #16)	lump sum	all required	all required	all required	all required
114(1A)	Widening Engineering (SA #1)	lump sum	all required			all required
114(1B)	Sidewalk Engineering (SA #2)	lump sum	all required			all required
110(1B)	Sidewalk Mobilization (EWO #13)	lump sum	all required			all required
115(1B)	Widening Traffic Maintenance (SA #1)	lump sum	all required			all required
115(1C)	Sidewalk Traffic Maintenance (SA #2)	lump sum	all required			all required
115(1D)	Klawock Traffic Maintenance	lump sum	all required	all required		all required
203(5B-1)	Rock Borrow (EWO #5)	Ton	13005			13005
203(8A)	Sidewalk Fill (SA #2)	Station	22.00			22.00
603(13-12)	12-inch Corrugated Aluminum Pipe	linear foot	108.00	72.00		180.00
603(30)	Drainage Revision (EWO #3)	lump sum	all required	all required		all required
603(31)	Culvert Extension (SA #3)	each	1.00			1.00
603(32)	Tea Connection (SA #2)	each	2.00			2.00
603(33)	Culvert Repairs (EWO #10)	lump sum	all required			all required
606(4)	Removal & Reconstruction of Guardrail (EWO #12)	linear foot	443.75			443.75
608(2)	Asphalt Sidewalk (SA #2)	Ton	13795			13795
609(4)	Concrete Curb (SA #2)	linear foot	2,290.00			2,290.00
618(1)	Seeding (SA #2)	MSF	11.05			11.05
639(2)	Sidewalk Approaches (SA #2)	each	6.00			6.00
670(8A)	Widening Traffic Markings (SA #1)	lump sum	all required			all required

BASIS OF ESTIMATE

ITEM NO.	ESTIMATING FACTOR
203(5B)	1.96 Tons/ Cubic Yard
203(8)	15,915 Cubic Yards over whole job
203(9)	6,000 Cubic Yards over whole job
203(1G)	1.96 Tons/ Cubic Yard
301(1) & (1A)	1.96 Tons/ Cubic Yard
401(1)	114 lb/sq. yd./inch depth
401(2)	6% of 401(1)
403(2)	0.15 @ 25 gal./sq. yd., 256 gallons/Ton
406(1)	114 lb/sq. yd./inch depth
406(1)	18 Tons of AC-5 asphalt cement (6%)
406(1)	2.7 Tons of MC-30 liquid asphalt for prime coat (25,000 sq. ft. @ 0.25 gal./sq. yd., 256 gallons/Ton)

LUMP SUM QUANTITIES

ITEM NO.	BASIS QUANTITY
115(2)	300 square feet
115(2A)	90 square feet
116(6)	2 each
506(1)	0.5 thousand board feet
506(2)	23.5 thousand board feet
506(5)	400 linear feet
670(8)	45,000 square feet

UTILITY CONSTRUCTION

Station	Offset	Remarks
"K" 0+31	24' Lt.	Adjustment of Valve Box
"K" 0+39	32' Lt.	Adjustment of Valve Box
"K" 1+66	5' Lt.	Adjustment of Valve Box
"K" 1+95	24' Lt.	Adjustment of Valve Box
"K" 3+05	27' Rt.	Fire Hydrant Relocation - done by others
"K" 4+63	6' Rt.	Adjust Existing Manhole
"K" 7+71	5' Lt.	Adjustment of Valve Box
"K" 7+87	24' Rt.	Adjustment of Valve Box
"K" 9+12	15' Lt.	Adjustment of Valve Box
"K" 13+17	25' Lt.	Fire Hydrant Relocation
"K" 13+29	7' Rt.	Adjustment of Valve Box
"K" 13+34	4' Rt.	Adjustment of Valve Box
"K" 13+34	30' Rt.	Adjustment of Valve Box - deleted
"K" 13+44	40' Rt.	Adjust Existing Manhole
"K" 13+80	6' Rt.	Adjust Existing Manhole
"K" 17+00	36' Lt.	Adjustment of Valve Box
"K" 17+03	1' Rt.	Adjust existing Manhole
"K" 20+07	1' Rt.	Adjust Existing Manhole
"K" 22+10	1' Rt.	Adjust Existing Manhole
"K" 23+37	77' Lt.	Adjustment of Valve Box - deleted
"K" 23+42	48' Lt.	Adjustment of Valve Box
"K" 25+95	4' Lt.	Adjust Existing Manhole
"P" 9+57	13' Rt.	Adjust Existing Manhole - delete
"P" 10+06	11' Rt.	Adjust Existing Manhole
"P" 10+17	8' Rt.	Adjust Existing Manhole - abandoned, delete
"P" 11+56	11' Rt.	Adjust Existing Manhole
"P" 13+00	21' Rt.	Adjustment of Valve Box
"P" 12+90	10' Lt.	Adjustment of Valve Box
"P" 15+95	5' Lt.	Adjustment of Valve Box
"P" 16+20	13' Rt.	Adjust Existing Manhole - delete
"P" 12+80	21' Lt.	Adjustment of Valve Box
"P" 11+00	7' Rt.	Adjustment of Valve Box
"K" 13+17	25' Lt.	Adjustment of Valve Box
"K" 375+00	25' Lt.	Adjustment of Valve Box
"K" 351+50	30' Lt.	Adjustment of Valve Box
Klawock City Bayview Dr. Beach Valve Box Adjustments		
"P" 13+20	15' Rt.	Adjust Existing Manhole
"K" 340+30	20' Lt.	Adjust Existing Manhole
Klawock City Bayview Dr. Beach Manhole Adjustments		
"K" 217+00	22' Lt.	SCENIC OVERLOOK

APPROACH SUMMARY

STATION	Lt.	Rt.	Wide	Radius Bk.	Radius Ahd.	Depth	STATION	Lt.	Rt.	Wide	Radius Bk.	Radius Ahd.	Depth
"P" 10+68	x		36'	6'	6'	10'	"K" 11+06	x		18'	25'	6'	10'
"P" 13+74	x		42'	6'	6'	10'	"K" 13+80	x		65'	-	-	6.5'
"P" 14+63	x		12'	6'	4'	15'	"K" 15+24	x		20'	25'	25'	20'
"P" 14+79	x	x	13'	20'	10'	10'	"K" 17+08	x		16'	35'	25'	24'
"P" 14+81	x		8'	4'	6'	15'	"K" 17+22	x	x	32'	25'	10'	12'
"P" 15+34	x		10'	6'	2.5'	15'	"K" 19+61	x		14'	20'	20'	20'
"P" 15+49	x		10'	2.5'	6'	15'	"K" 23+86	x	x	16'	20'	20'	50'
"K" 0+85	x		25'	6'	6'	11'	"K" 25+18	x		24'	20'	20'	20'
"K" 1+68	x	x	22'	6'	6'	11'	"K" 26+05	x	x	22'	30'	30'	20'
"K" 2+36	x		38'	6'	6'	6'	"K" 27+68	x	x	50'	20'	20'	20'
"K" 3+24	x		32'	6'	6'	6'	"K" 30+70	x	x	16'	20'	20'	20'
"K" 4+71	x		16'	6'	11'	11'	"K" 35+77	x	x	20'	25'	25'	25'
"K" 0+42	x		14'	10'	-	8'	"K" 49+50	x	x	24'	150'-50'-150'	150'-50'-150'	86'
"K" 6+45	x	x	14'	10'	4'	10'	"K" 145+79	x	x	24'	25'	25'	20'
"K" 6+69	x		14'	4'	10'	10'	"K" 213+75	x	x	100'	40'	40'	26'
"K" 7+70	x		18'	10'	25'	11'	"K" 298+45	x	x	24'	25'	25'	20'
"K" 8+61	x		14'	10'	10'	10'	"K" 315+50	x	x	16'	25'	25'	50'
"K" 9+24	x		15'	10'	10'	10'	"K" 315+50	x	x	24'	150'-50'-150'	150'-50'-150'	86'
"K" 10+47	x		12'	10'	10'	10'	"K" 335+45	x	x	24'	25'	25'	20'
"K" 10+48	x		14'	10'	10'	10'	"K" 348+55	x	x	24'	150'-50'-150'	150'-50'-150'	86'


Additional Approaches Constructed at:
 "K" 32+75 Lt. 40'-00 Rt. 343'-00 Lt.
 33+05 Rt. 76'-00 Rt. 346'-50 Lt.
 34+75 Rt. 310'-50 Lt. 347'-40 Lt. 353+75 Lt. 357+05 Lt. 371'-00 Lt. (Cannery approach)
 36'-00 Lt. 338'-00 Lt. 351'-50 Lt. 355+00 Lt. 369'-00 Lt. 375'-00 Lt.

* Public Road Approach as shown on Std. Drg. I-40.21

STANDARD SIGN SCHEDULE

Station	Offset	Symbol	Code	Area (sq. ft.)	Facing
"D" 0+22	0+25	DO NOT ENTER	R5-1	9.00	SB
"E" 0+25	18' Lt.	STOP	R1-1	6.25	NB
"F" 0+25	12' Lt.	STOP	R1-1	6.25	NB
"G" 0+25	12' Lt.	STOP	R1-1	6.25	NB
"H" 0+28	12' Lt.	STOP	R1-1	6.25	NB
"K" 16+95	13'-25 Rt.	STOP	R1-1	6.25	NB
"K" 17+37	25' Rt.	STOP	R1-1	6.25	NB
"K" 20+60	30' Rt.	STOP	R1-1	6.25	NB
"K" 23+20	30' Rt.	STOP	R1-1	6.25	NB
"K" 26+00	30' Lt.	STOP	R1-1	6.25	NB
"K" 26+20	25' Rt. 30' Lt.	STOP SPEED LIMIT 25	R1-1	6.25-5.00	NB
"K" 28+00	25' Rt.	STOP	R1-1	6.25	NB
"K" 29+85	26+20	STOP	R1-1	6.25	NB
"K" 35+90	32+30				

G-37049

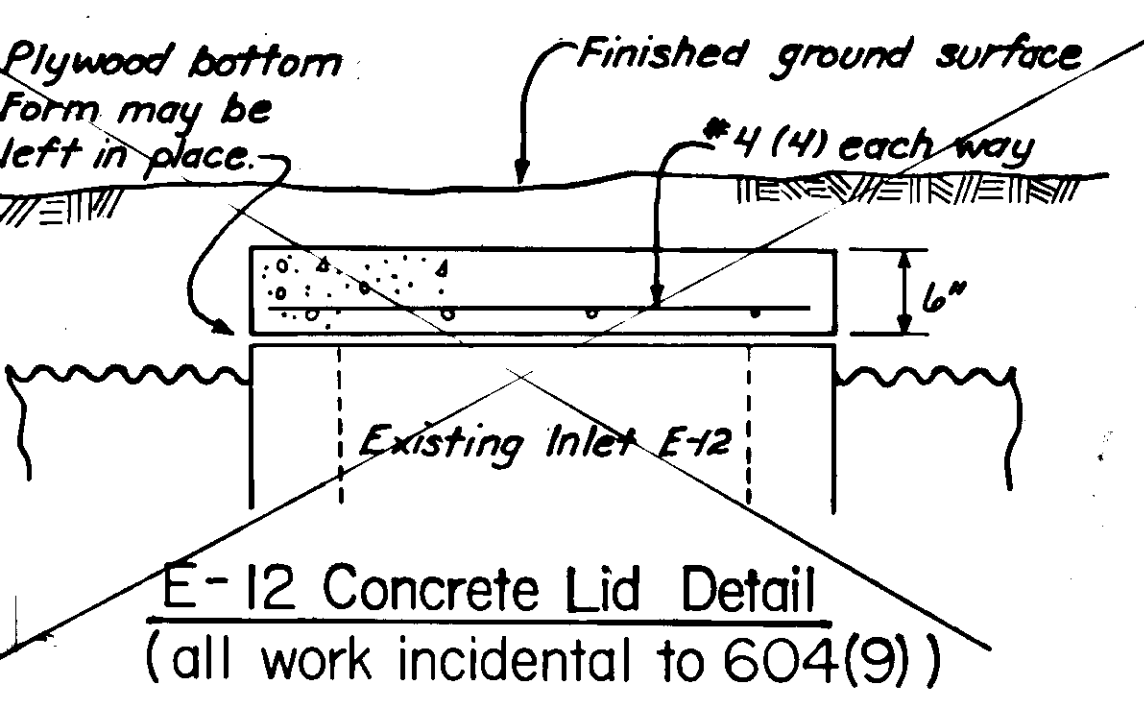

EXISTING STRUCTURE SUMMARY

Structure No.	Location		New Grade Elevation	Work to be done
	Station	Offset		
E-1	"P"12+96	13.5' Lt.	50 ²¹ ₂₈	adjust @
E-1A	"P"14+05	13.5' Lt.	59 ⁰⁰	reconstruct
E-2	"P"10+27	20.0' Lt.	22 ⁴⁸ ₇₈	adjust @
E-3	"K"0+82	18.3' Rt.	23 ¹⁹	reconstruct
E-3A	"K"2+60	17.5' Rt.	35 ⁷⁰	NO WORK adjust @
E-4	"K"2+98	18.0' Rt.	38 ⁸⁸ ₇₈	ADJUST @ reconstruct
E-5	"K"3+50	18.0' Lt.	-	remove
E-6	"K"5+10	19.0' Rt.	43 ⁰⁰	adjust @
E-7	"K"6+55	19.0' Rt.	-	(no work)
E-8	"K"7+64	19.0' Rt.	-	ADJUST (no work)
E-9	"K"11+90	18.0' Rt.	-	ADJUST (no work)
E-10	"K"11+88	21.0' Lt.	-	(no work)
E-11	"K"13+07	21.0' Lt.	-	(no work)
E-12	"K"13+08	16.5' Rt.	-	Grate raise reconstruct

DRAIN NOTES:

Begin Subdrain at "K"27+50, 28' Rt., end at "K"27+50, 28' Rt.; actual location of installation may vary as directed by the Engineer.

Excavated trench shall be shored as necessary during construction.

Aggregate shall be placed as to insure proper final position of fabric; care shall be taken to avoid tearing or punching holes in fabric during aggregate placement.

After placing aggregate within fabric, the fabric shall be lapped over the aggregate and secured adequately to insure a fit which will not allow the intrusion of soil particles through the seam.

Previously excavated silty material shall be replaced in the remainder of the trench in such a manner to render the ditch bottom impervious.

- ⓐ Continue traffic lane cross-slope over to grate, warp pavement to inlet.
- ⓑ Pour conc. lid as detailed.
- ⓒ Removed inlet (E-5) is to be moved to "K"13+08, 28' Rt.; grate elev = 18⁰⁰; paid for as Reconstruct Existing Inlet.

DRAINAGE STRUCTURE SUMMARY


Structure No.	Location		Type Structure	Top/Grate Elev.	Invert Elev.
	Station	Offset			
S-1	"P"14+50	10' Lt.	"A" Gutter Inlet	65 ⁷⁴	62 ⁷⁵
S-2	"P"13+50	10' Lt.	" "	52 ⁴⁴	49 ⁵⁰
S-3	"B"9+75	14' Lt.	" "	50 ⁹⁵	47 ⁷⁵
S-4	"P"11+25	14' Lt.	" "	36 ¹⁴	33 ⁰⁰
S-5	"P"10+65	14' Rt.	" "	28 ⁰⁴	25 ⁰⁰
S-6	"K"0+50.3	18' Rt.	" "	21 ¹⁰	18 ⁴⁰
S-7	"K"0+37	13' Rt.	Storm Sewer Manhole	(lid) 21 ⁵⁵	18 ³⁰
S-8	"K"3+02	14' Rt.	"A" Gutter Inlet	38 ¹⁸	35 ⁵⁰
S-9	"K"3+48.5	14' Lt.	" "	41 ⁸⁰ _{41⁰⁴}	38 ⁵⁵
S-10	"K"6+27	14' Rt.	" "	36 ²²	33 ⁰⁰
S-11	"K"1+10	22' Rt.	"A" Field Inlet	24 ⁷⁵	22 ⁶⁰
S-12	"K"11+50	13' Rt.	"A" Flat / Gutter	21 ⁸³	18 ³³
S-13	"K"15+50	13' Rt.	" "	16 ⁸⁰	13 ⁸⁰
S-14	"K"17+50	13' Rt.	" "	24 ³⁰	21 ³⁰
S-15	"K"20+50	13' Rt.	" "	44 ¹⁸	41 ²⁰
S-16	"K"27+30	13' Rt.	" "	51 ⁴⁸	48 ⁷⁰

- ⓐ Elevations may require minor adjusting to accommodate variations in existing drainage pipes.
- ⓑ Culvert length specified contains portion which is attributable to culvert wye assembly (see Note 4).
- ⓒ Existing culverts are Kaiser Aluminum Co. Corlix 16 ga. riveted aluminum.

DRAINAGE PIPE SUMMARY

PIPE No.	Dia.	Length	Flowing From		Flowing To	
			Location	Inv. Elev.	Location	Inv. Elev.
P-1	18"	44' ⁴⁶	S-1	62 ⁷⁵	E-1A	56 ³⁰
P-2	18"	16' ¹²	S-3	47 ⁷⁵	W-2	(existing)
P-3	18"	44' ³⁸	S-5	25 ⁰⁰	W-4	(existing)
P-4	18"	12' ¹⁴	S-6	18 ⁴⁰	S-7	18 ³⁰
P-5	18"	30' ³³	E-4	20 ⁴⁰	S-6	18 ⁴⁰
P-6	18"	8' ¹⁰	S-7	18 ³⁰	exist. pipe	(existing)
P-7	18"	10'	DELETED S-8	35 ⁵⁰	E-6	35 ⁴⁰
P-8	18"	38' ³⁶	"K"19+78, 21' Lt.	38 ⁴²	"K"19+40, 21' Lt.	36 ¹⁵
P-9	18"	10'	Relocated E-5	15 ⁰⁰	E-12	14 ⁹⁰
P-10	24"	38' ⁷²	"K"26+00	Rt.	"K"26+00	Lt.
P-11	24"	38' ⁷²	"K"29+00	Rt.	"K"29+00	Lt.



Note - See sheet no. 27 for additional drainage pipes for installation.

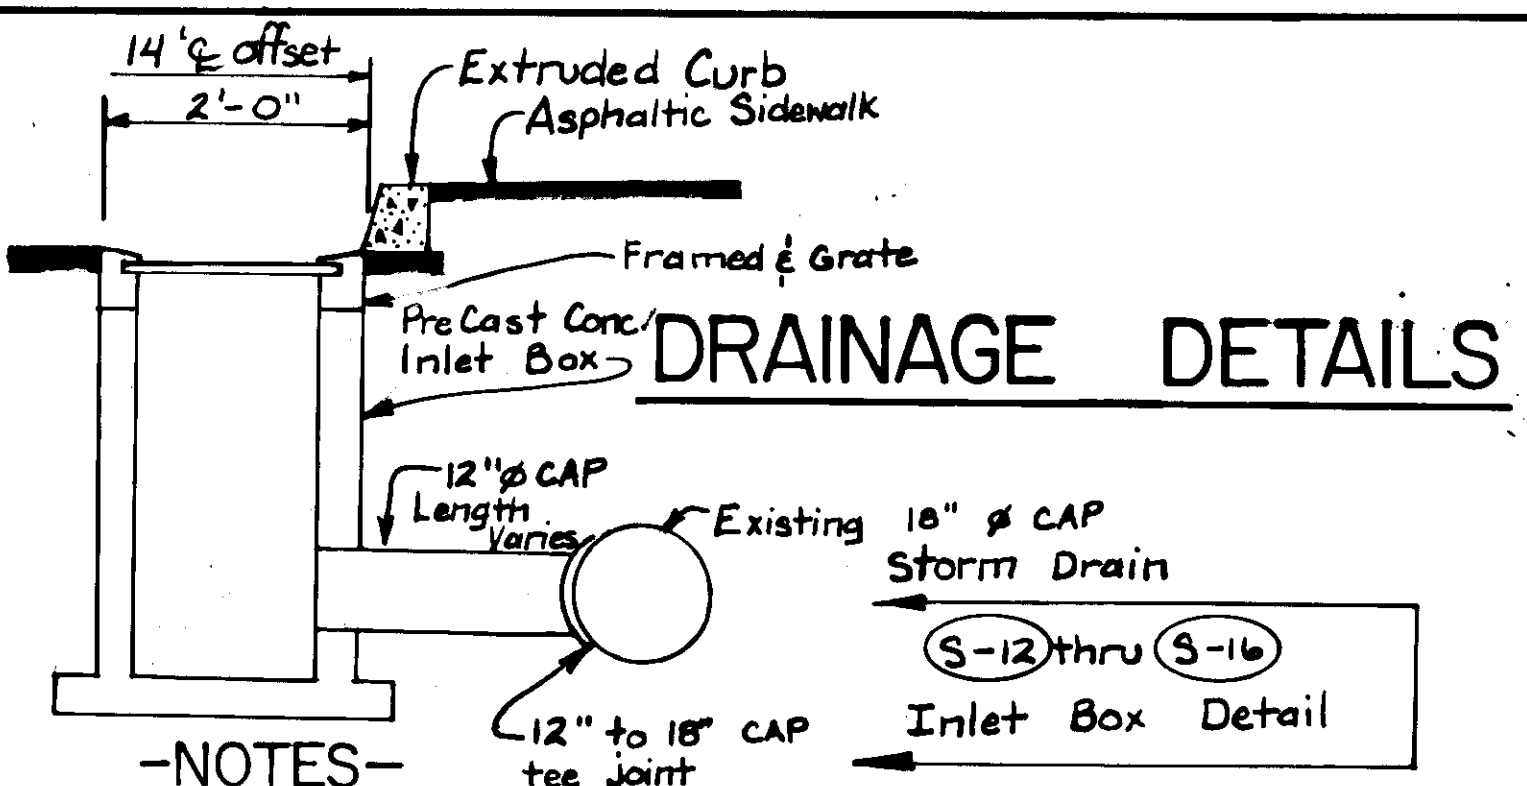

- NOTES-**
- Inlet, culverts & wyes shall be installed according to the requirements of Section 205 of the Specifications; structures shall be placed in bedding materials which conform to Section 703-2.10 of the Specifications & all bedding & backfill shall be compacted according to Standard Drawing D-0100 & Section 205 of the Specifications.
 - Inlets shall be Type "A" Inlet boxes as shown on Std. Dwg. D-26.03; frames & grates shall be Gutter Inlet frames & grates as shown on Std. Dwg. D-24.13.
 - Shop Drawings of Wye Saddle & Bands shall be submitted for approval prior to installation.
 - Each Wye Saddle, Band & Beveled end Cut shall be paid for as 603(21-18) Lateral Wye Branch Connection, all inclusive; its length to be included under this pay item is 5'-0". Additional culvert needed to meet specific installation requirements shall be paid for as 603(13-18) 18 inch Corrugated Aluminum Pipe.
 - All assemblies shall be 18" and constructed of aluminum; full round lateral connections in lieu of saddles will be permitted upon prior request by the Contractor and approval by the Engineer.



WYE STRUCTURE SUMMARY

WYE No.	Location		connection elev. @
	Station	Offset	
W-1	"P"14+47	13.5' Lt.	62 ²⁵
W-2	"P"13+13	14.0' Lt.	47 ²⁵
W-3	"P"11+23	17.0' Lt.	48 ⁵⁰
W-4	"P"10+36	18.0' Lt.	20 ⁰⁰
W-5	"K"6+30	18.5' Rt.	32 ⁶⁰

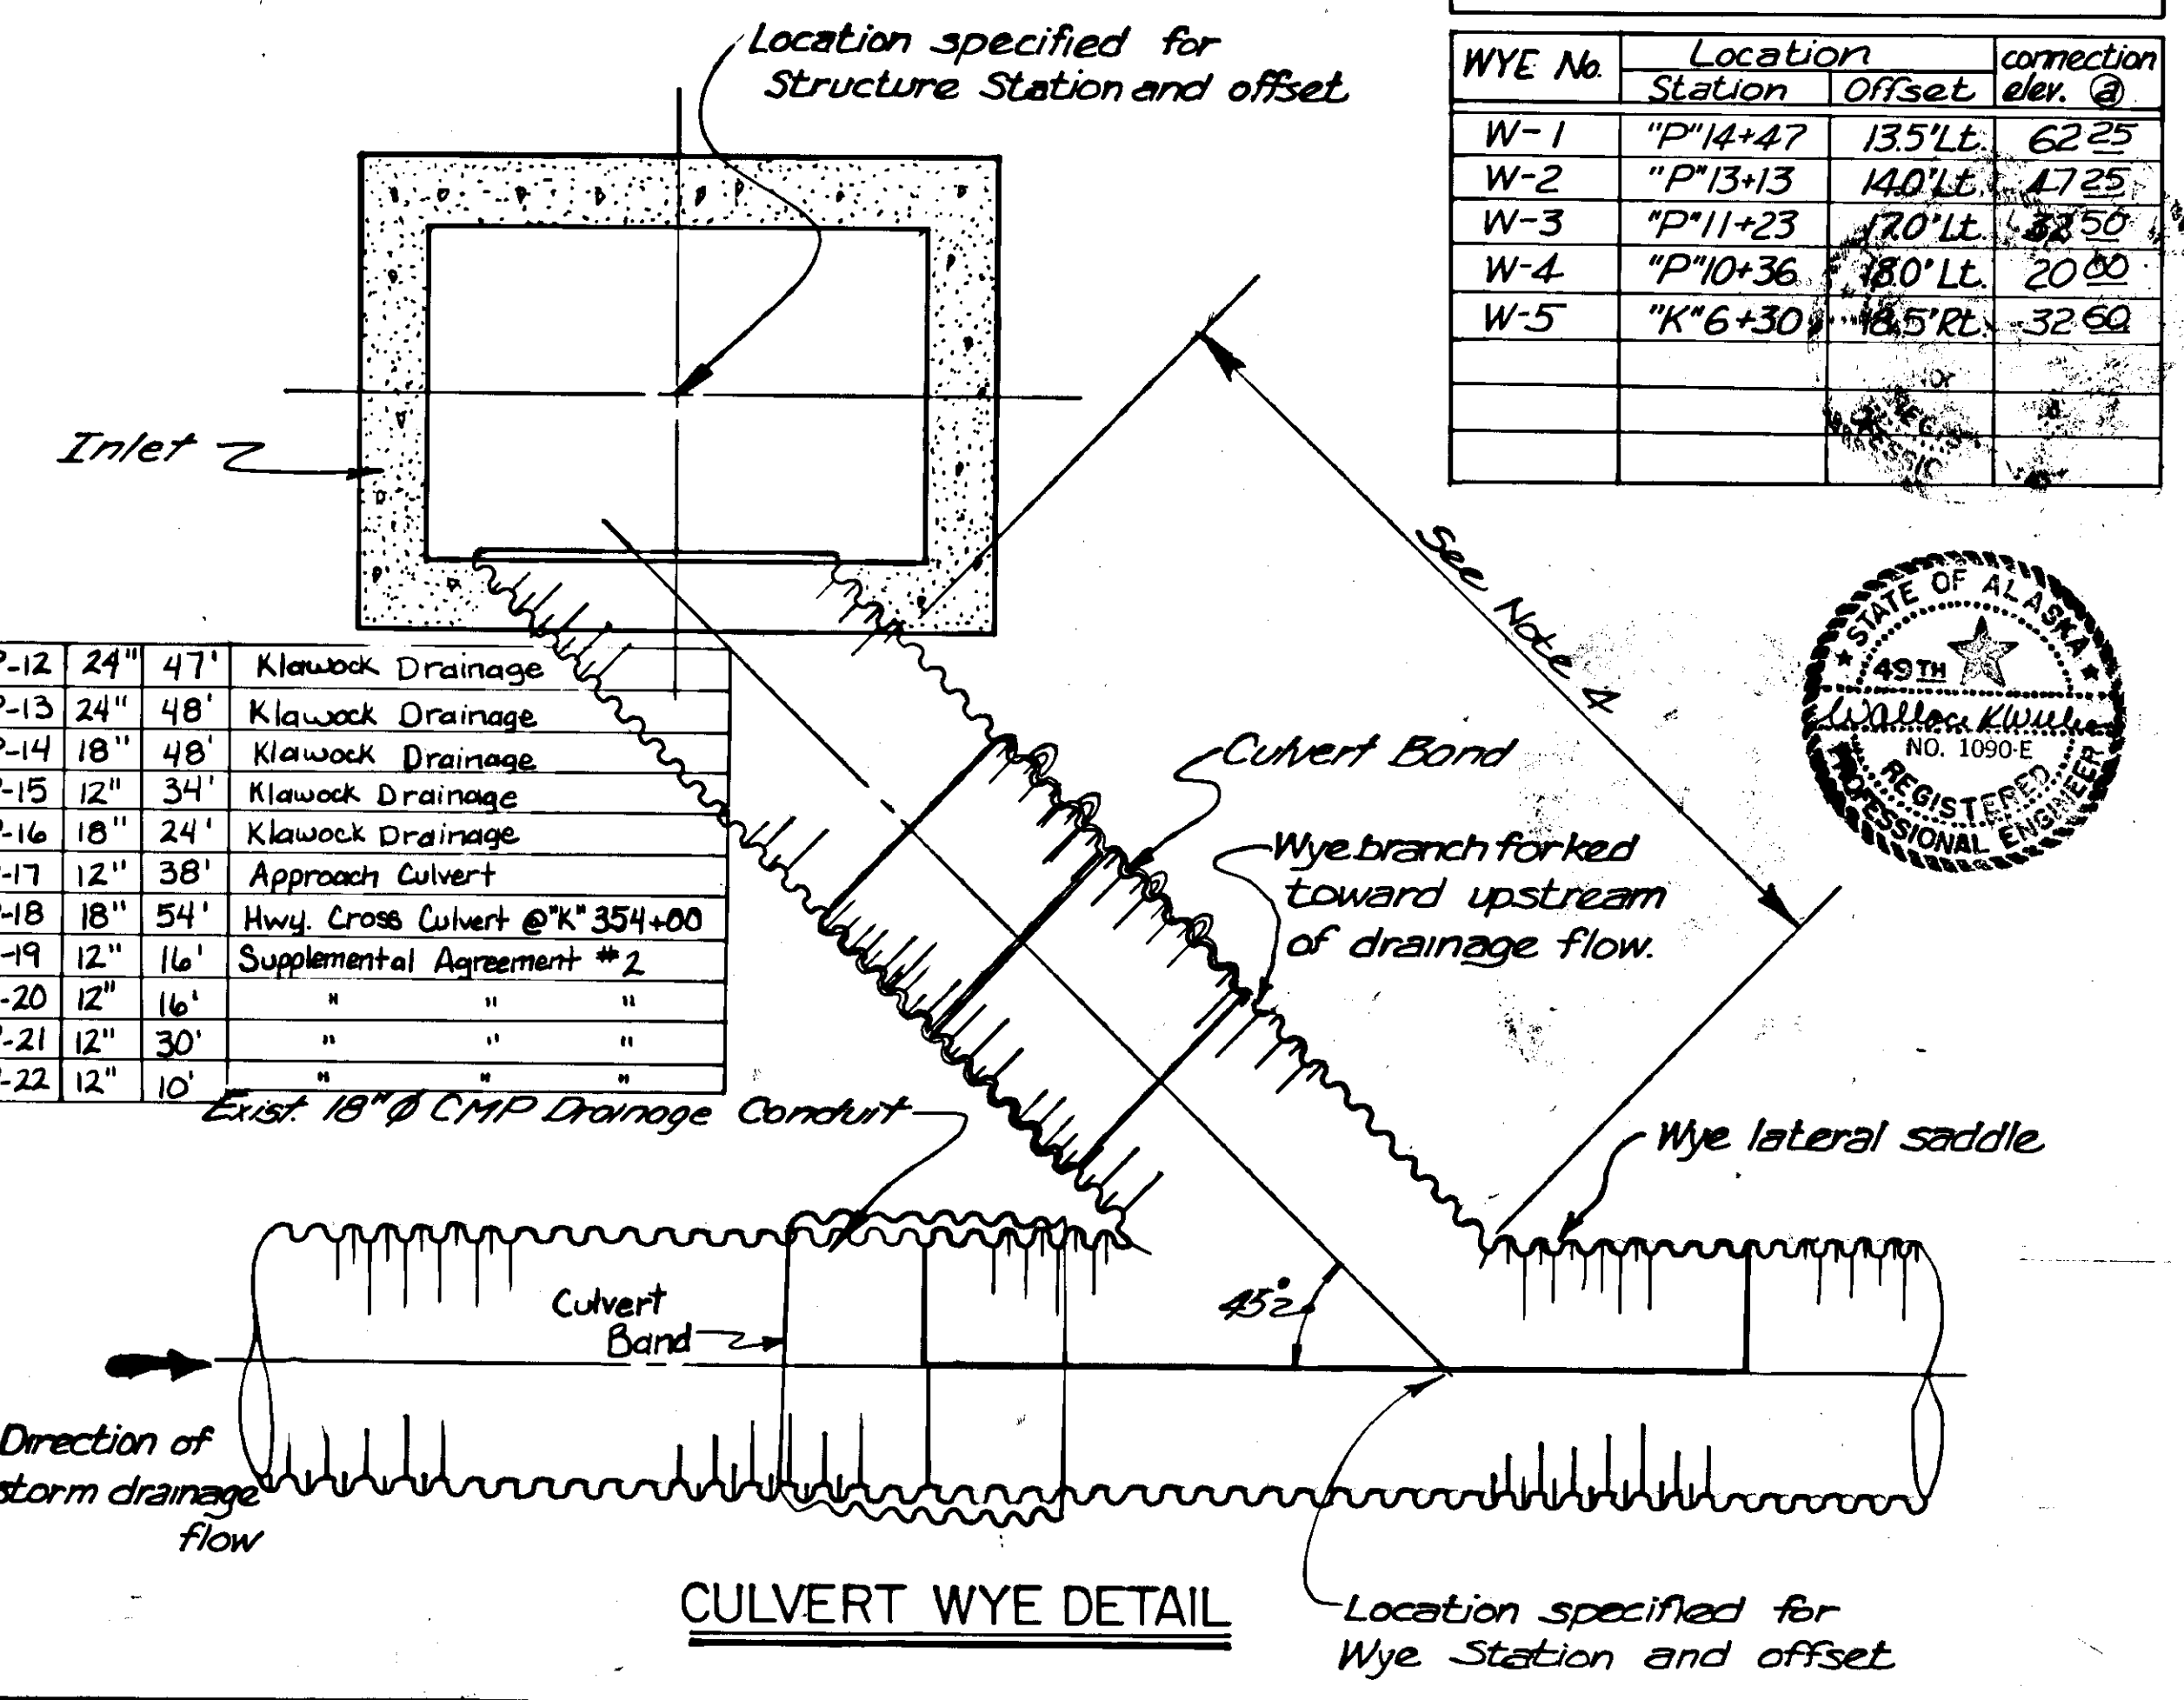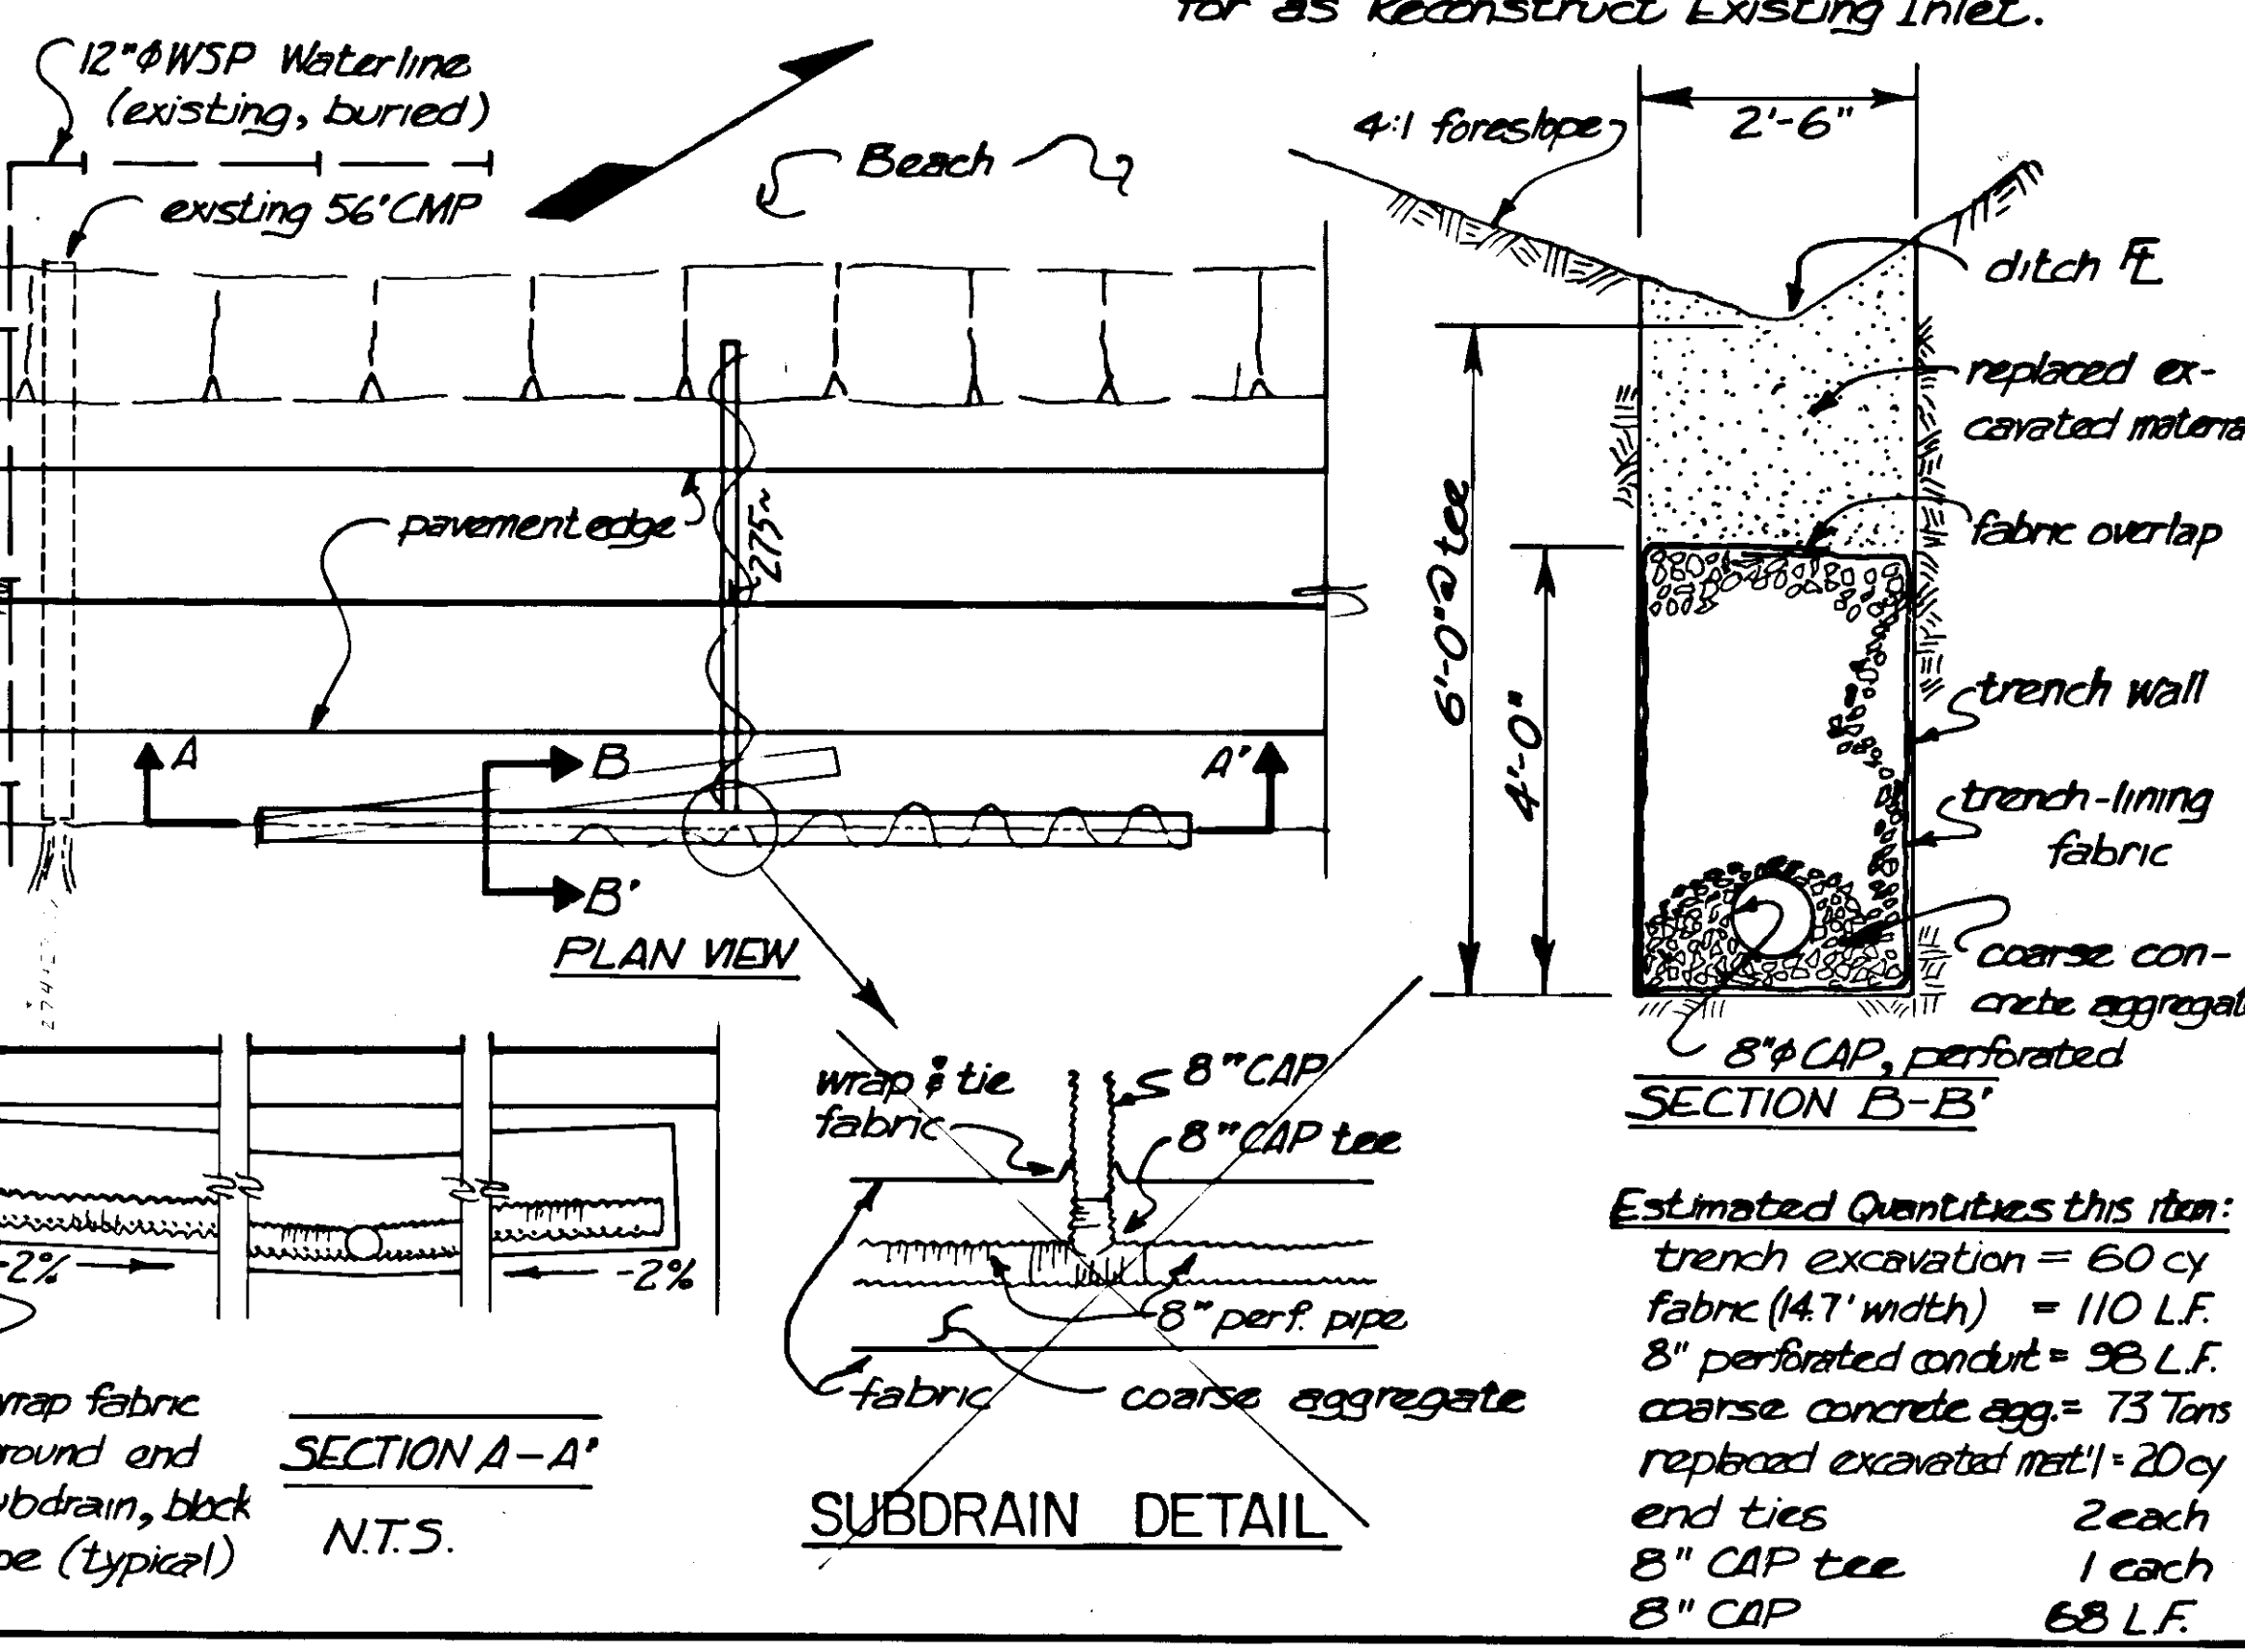


TRAFFIC CONTROL PLAN (TCP)

- Construction signing, flagging, detours and general traffic control features shall conform to the guidelines set forth in the "C" series Std. Drgs. and the applicable portions of Sections 107 and 115 of the Specifications.
- To accommodate construction sequence, the Contractor will be allowed single lane road closures limited to one-half mile in length. Further restrictions to this partial road closure are stipulated in Section 115 of the Specifications.
- All work proceeding adjacent to businesses or private property which will restrict access, shall be coordinated with the parties involved and the Engineer 24 hours in advance to the restriction.
- Urban roadway construction may be accompanied by total road closures provided acceptable detours (location and duration) can be agreed upon by the Contractor, the Engineer, and the local authorities. The Engineer will be the final authority regarding whether such closures and detours are permitted.
- Construction operations are limited by the following parameters which are further stipulated in the Plans and Specifications:
 - after any station of the roadway has been excavated to the top of existing shot-rock embankment, a maximum of thirty calendar days may elapse before the exposed embankment at that station must be covered with the next layer of construction material (see penalty clause in Section 203 of the Specifications),
 - after placement of Base Course, ten calendar days may elapse before the Base Course must be primed and paved (see penalty clause in Section 301 of the Special Provisions),
 - and, after shooting of Prime Coat, traffic must be kept off the fresh oil until sufficient absorption has occurred.
- Because of load restrictions, the work to be performed on the Klawak River Bridge shall be done so that loaded trucks are not routed on the side of the bridge that is designated as H15 capacity. Dunnage shall be placed along the leading edge of new deck timber construction to avoid damage to the new material and to lessen the bump for traffic travelling over the new work.

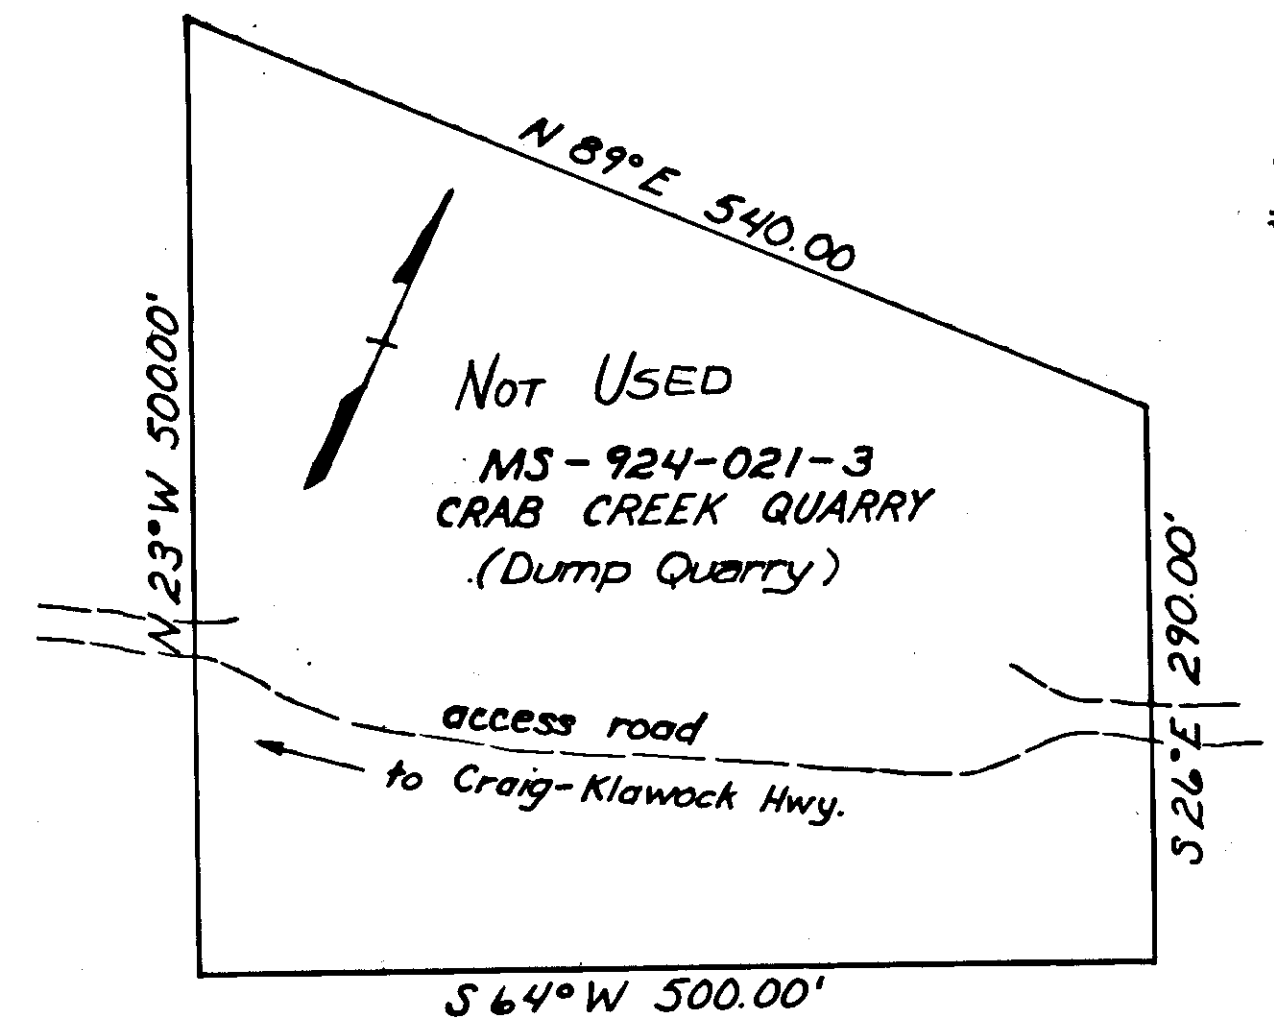
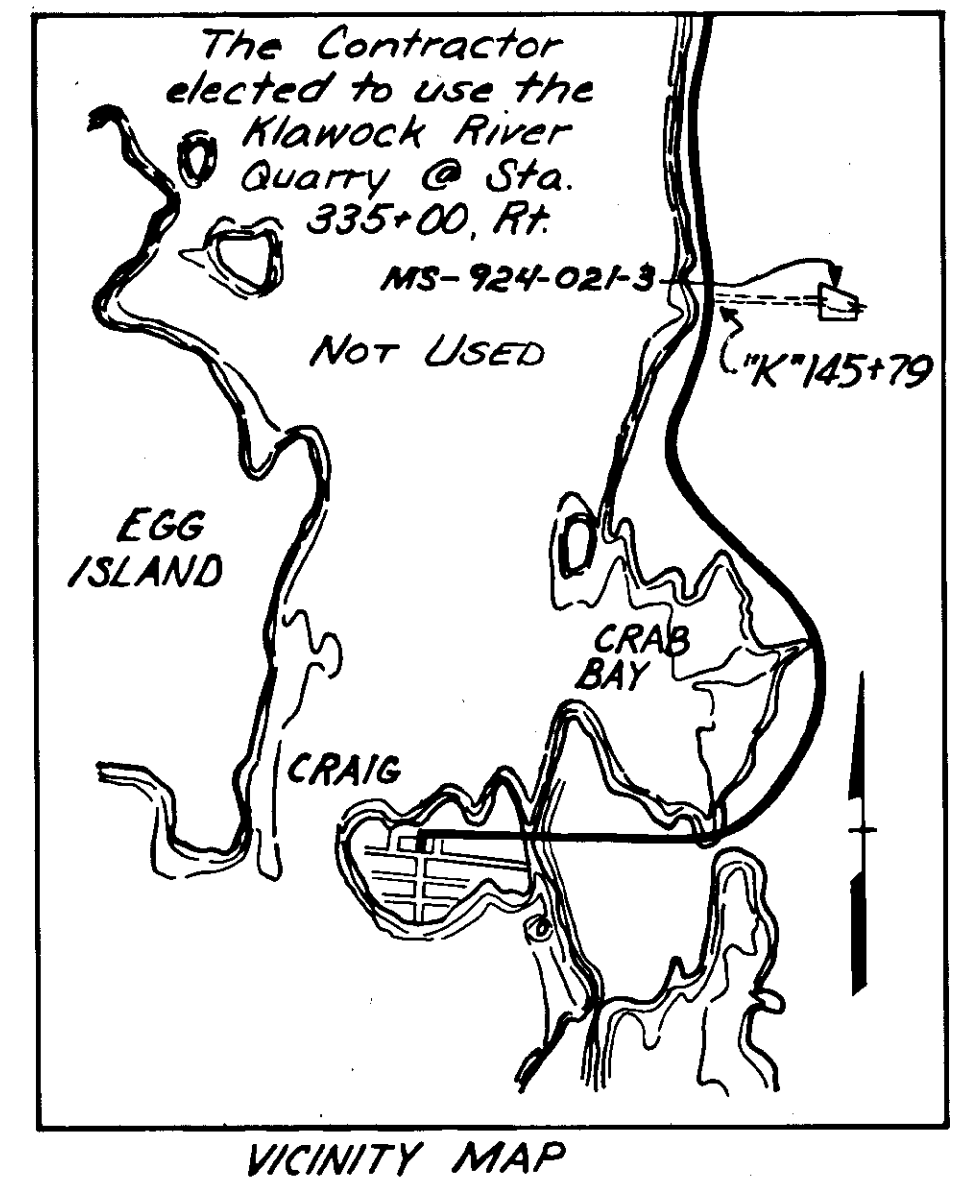


QUARRY NOTES


- If material is to be excavated in such a manner as to leave near-vertical faces, no unbenched face shall be left greater than 20 feet in height.
- Benches shall be accessible and of sufficient width to allow future development of this area as a source of material.
- No excavation shall remain upon completion of materials removal which can impound water.
- All oversized material presently in the quarry or resulting from the contractors operation shall be reprocessed to suitable size and utilized in this project if it can be made to meet specifications.
- All trees cut shall be done so with prior approval of the Engineer and shall be severed no higher than 4 1/2 feet above ground level. All trees, stumps, brush and other organic substance removed to obtain material from the pit shall be disposed of by the contractor.
- Overburden shall be placed so it does not impede future development of the materials source.
- No stockpile shall remain upon completion of materials removal unless approved by the Engineer.
- Upon completion of materials removal, no equipment or debris shall remain in the area. Cleanup shall be performed to the satisfaction of the Engineer.
- The quarry area shall be maintained in a neat and sanitary condition. Only equipment and materials involved in processing or batch plant operations shall be stored in the Quarry.
- The access road to the quarry shall be maintained to the satisfaction of the Engineer.
- The gate detail below shall be installed on the access road just above the existing sanitary land-fill. And shall remain in place after completion of construction.

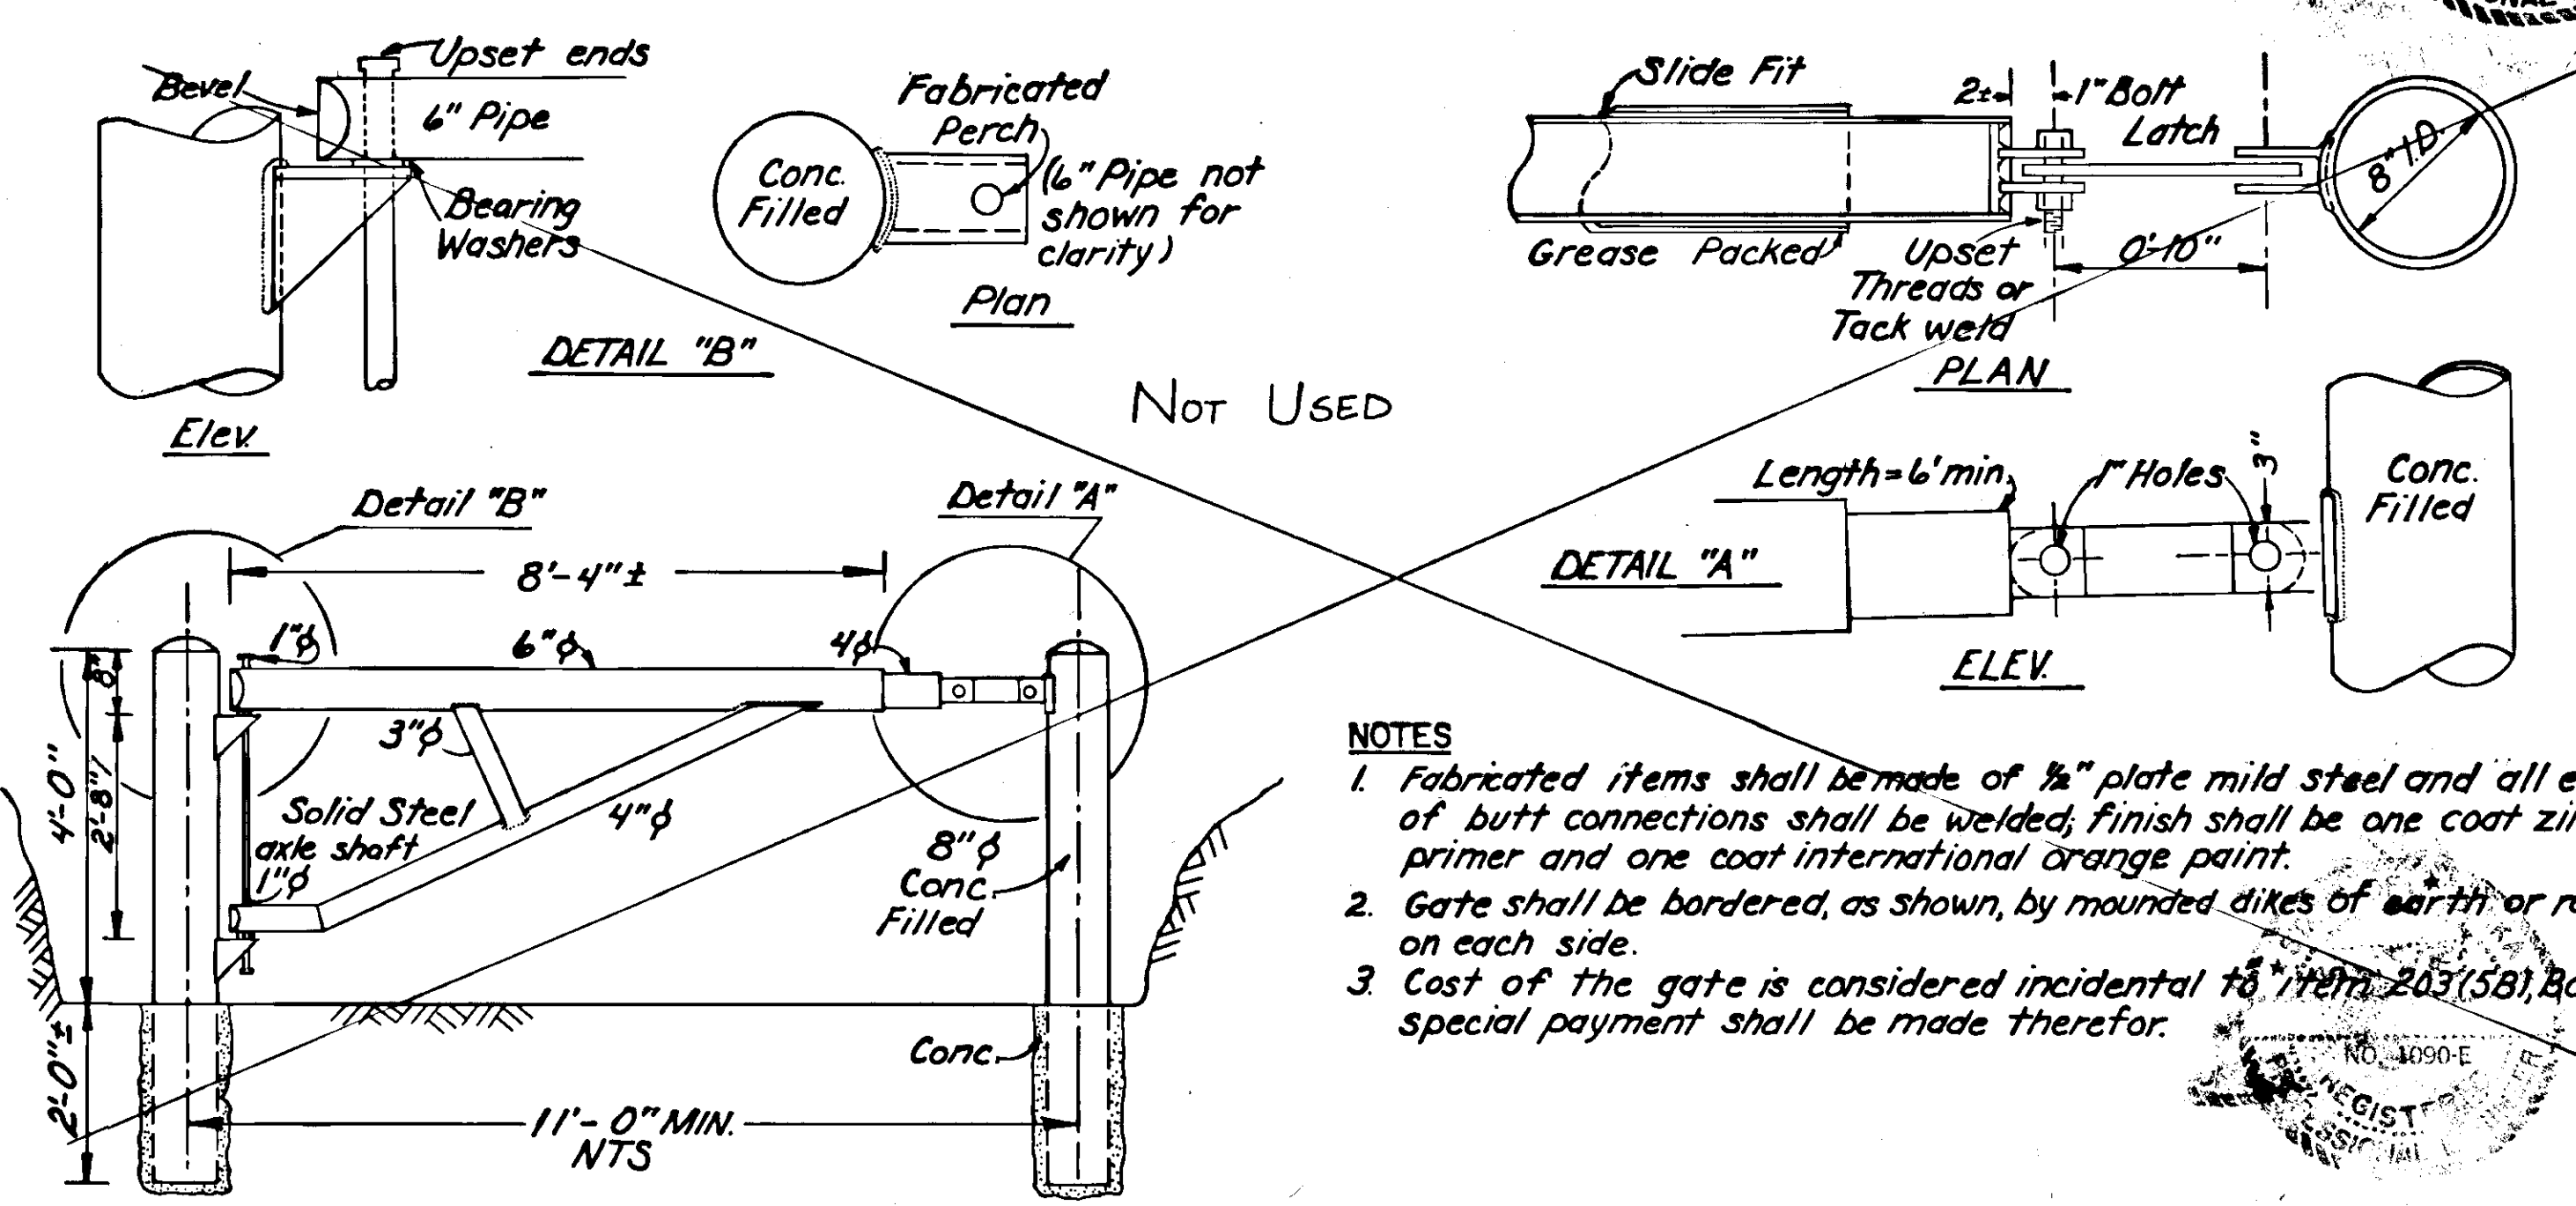


- NOTES
- Fabricated items shall be made of 1/2" plate mild steel and all exposed edges of butt connections shall be welded; finish shall be one coat zinc chromate primer and one coat international orange paint.
 - Gate shall be bordered, as shown, by mounded dikes of earth or rock as required on each side.
 - Cost of the gate is considered incidental to Section 203 (SB) Borrow, and no special payment shall be made therefor.

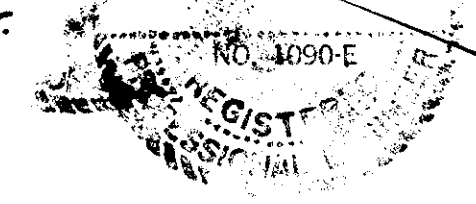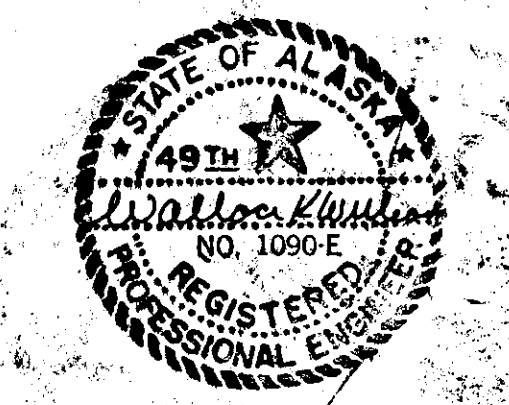

STATE	PROJECT DESIGNATION	YEAR	SHEET NO.	TOTAL SHEETS
ALASKA	SR-0924(7)	1982	6	27

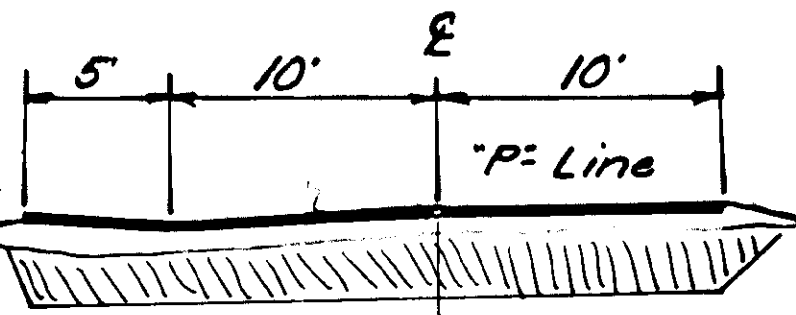

Sub-Excavated 18", replaced with shot-rock (EWO #11)
 STA. "P" 14+65 to 15+90

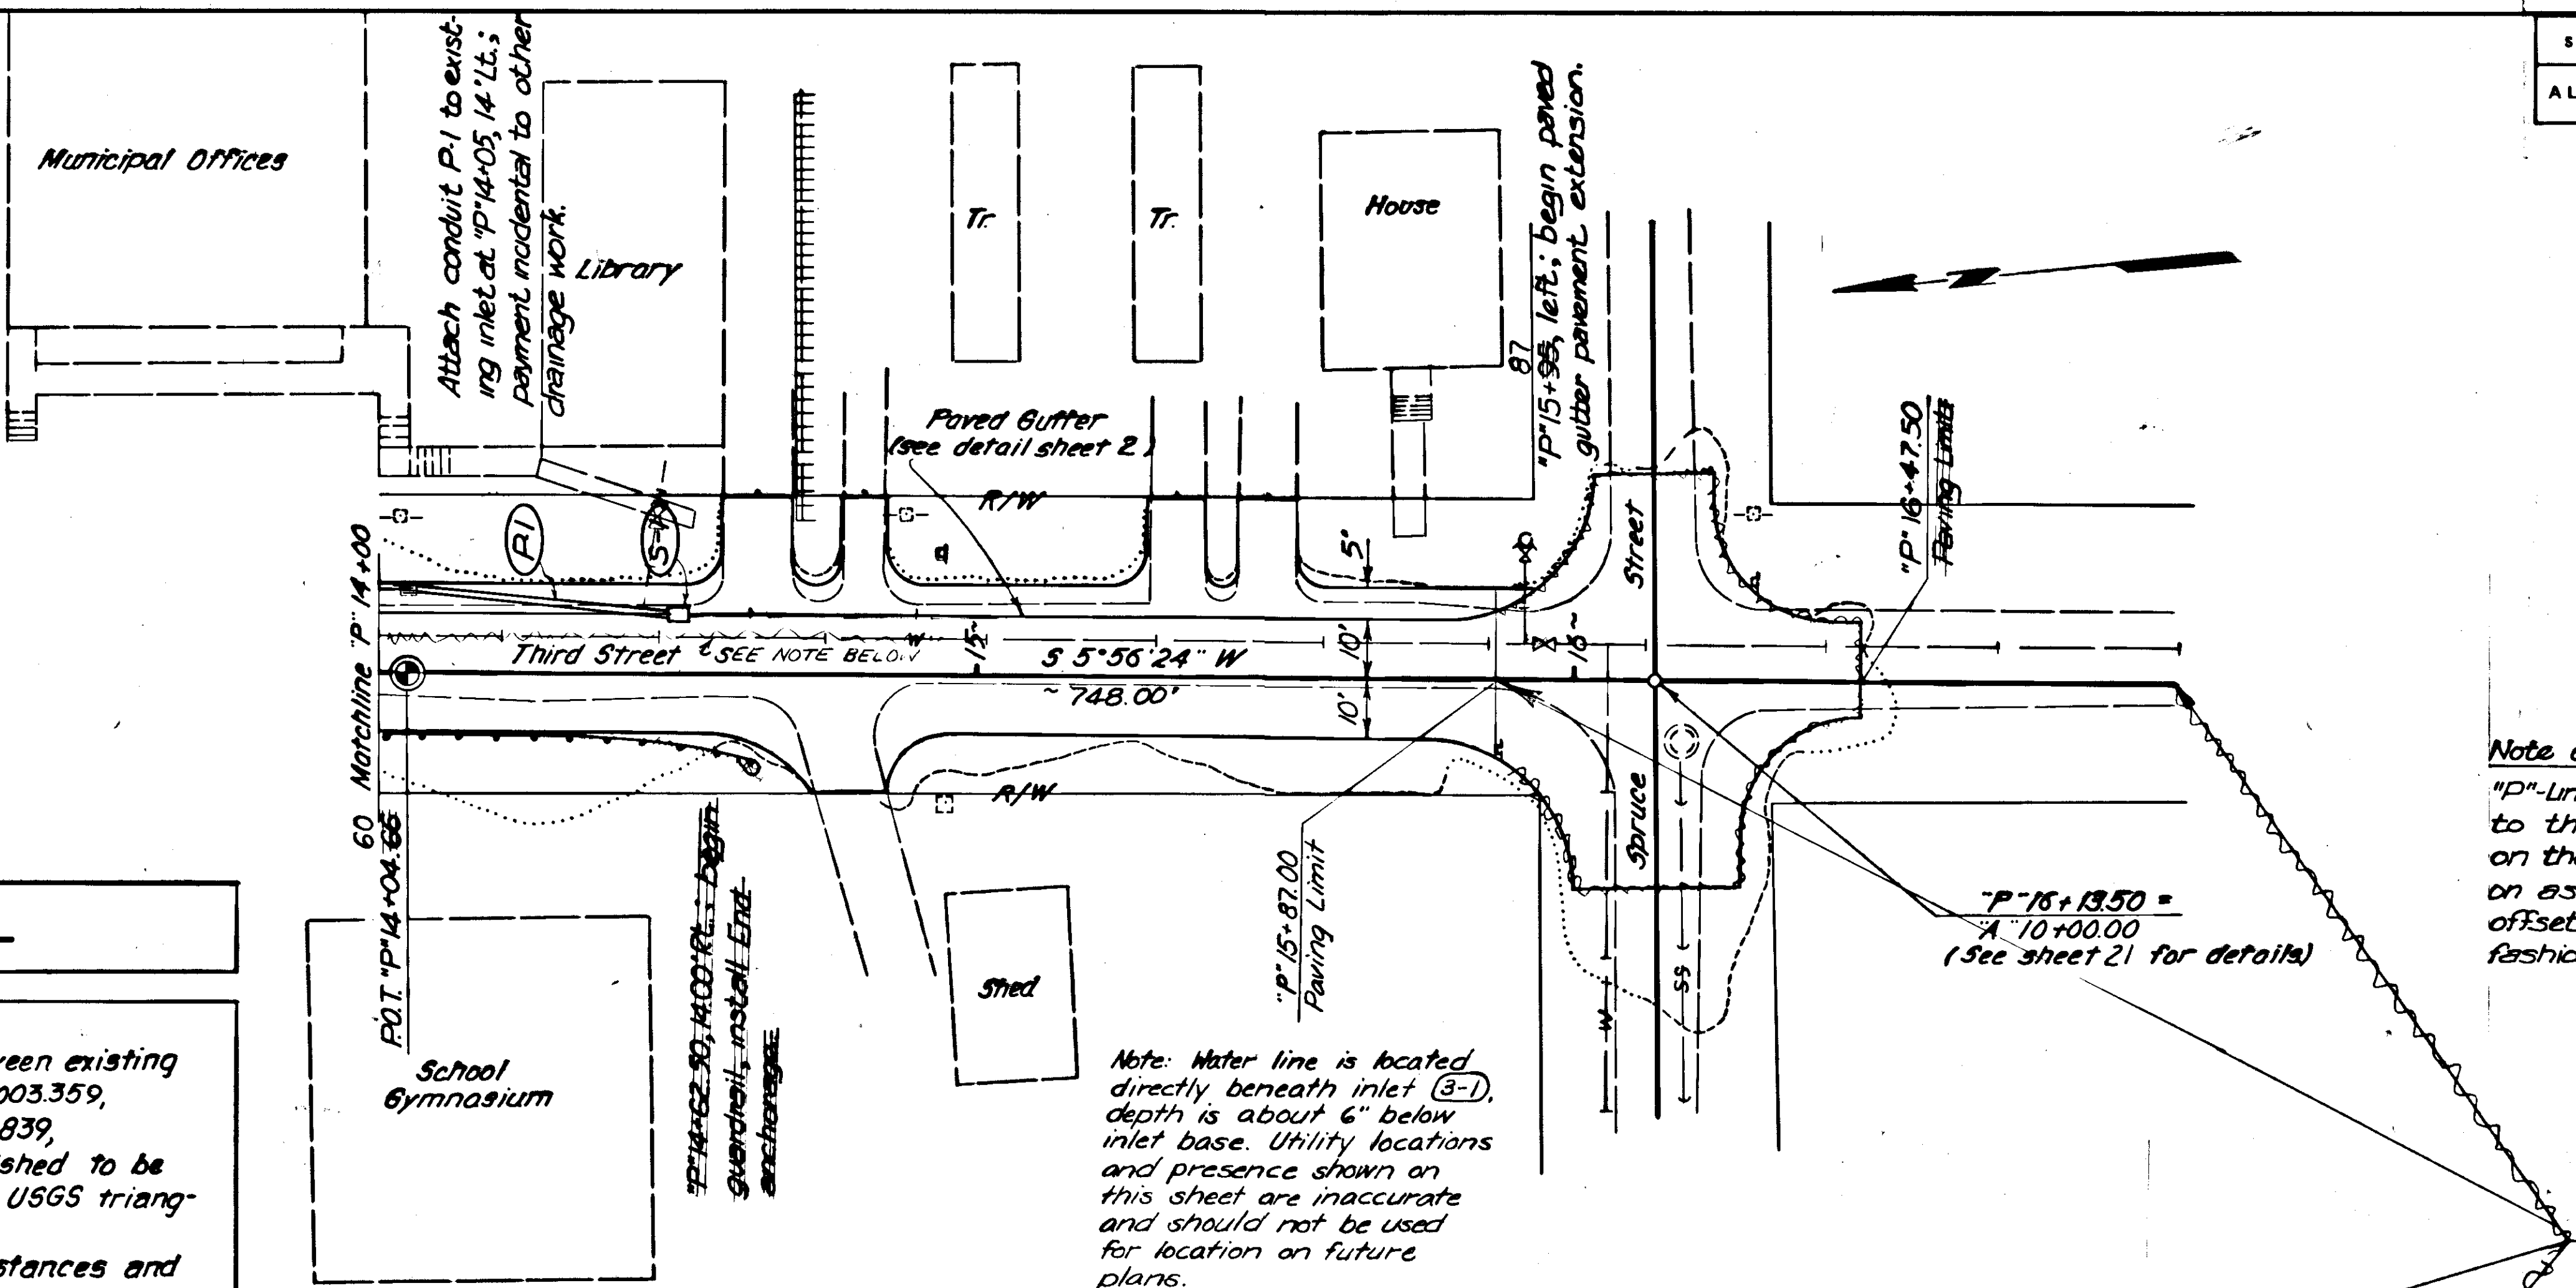

Note on Stationing:
 "P"-Line stationing decreases from the BOP to the intersection with the "K"-Line (shown on the following sheet); offsets are based on ascending reference. "K"-Line stationing, offsets and direction proceed in conventional fashion.



STATION "P" 17+00.00
 15+87.00
 Begin Project No. SR-0924 (7)

BASIS OF CONTROL

Horizontal Control:
 The basis of bearing is the line between existing buried monuments at P 14+04.66 (N 1331003.359, E 2792898.780) and P 10+00.00 (N 1331405.839, E 2792940.656); this bearing is established to be N 5°56'23.6" E and was obtained from USGS triangulation stations "Fish" and "Parida."
 Bearings shown are grid bearings, distances and stationing are geodetic distances; the mean scale factor used on this project is 0.9999718.

Vertical Control:
 All elevations are referenced to "Bench Mark 8" (1953) which is a standard disk, stamped "No. 8 1953" set in dark stone lying on beach about 4 feet inland from high water line. It is about 10 feet seaward from boardwalk, about 240 feet 55 degrees (magnetic) from northwest corner of Libby Cannery Company office and 28 feet 137 degrees (magnetic) from "Bench Mark 6." Elevation: 10.44 feet above mean lower low water.


ESTIMATED EXCAVATION & EMBANKMENT QUANTITIES THIS SHEET:
 Roadway Surface Removal = 61 cy
 Unclassified Excavation = 15 cy
 Borrow, Type A = 15 tons
 Selected Material = 18 tons

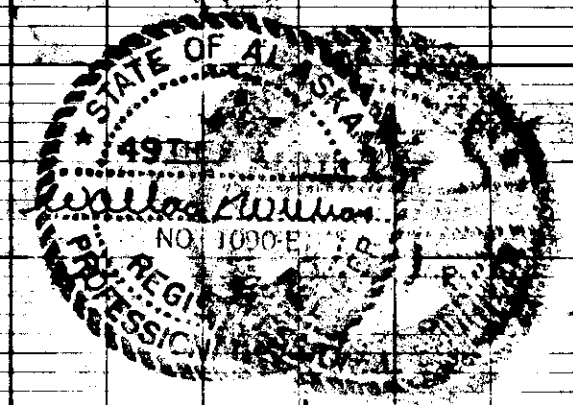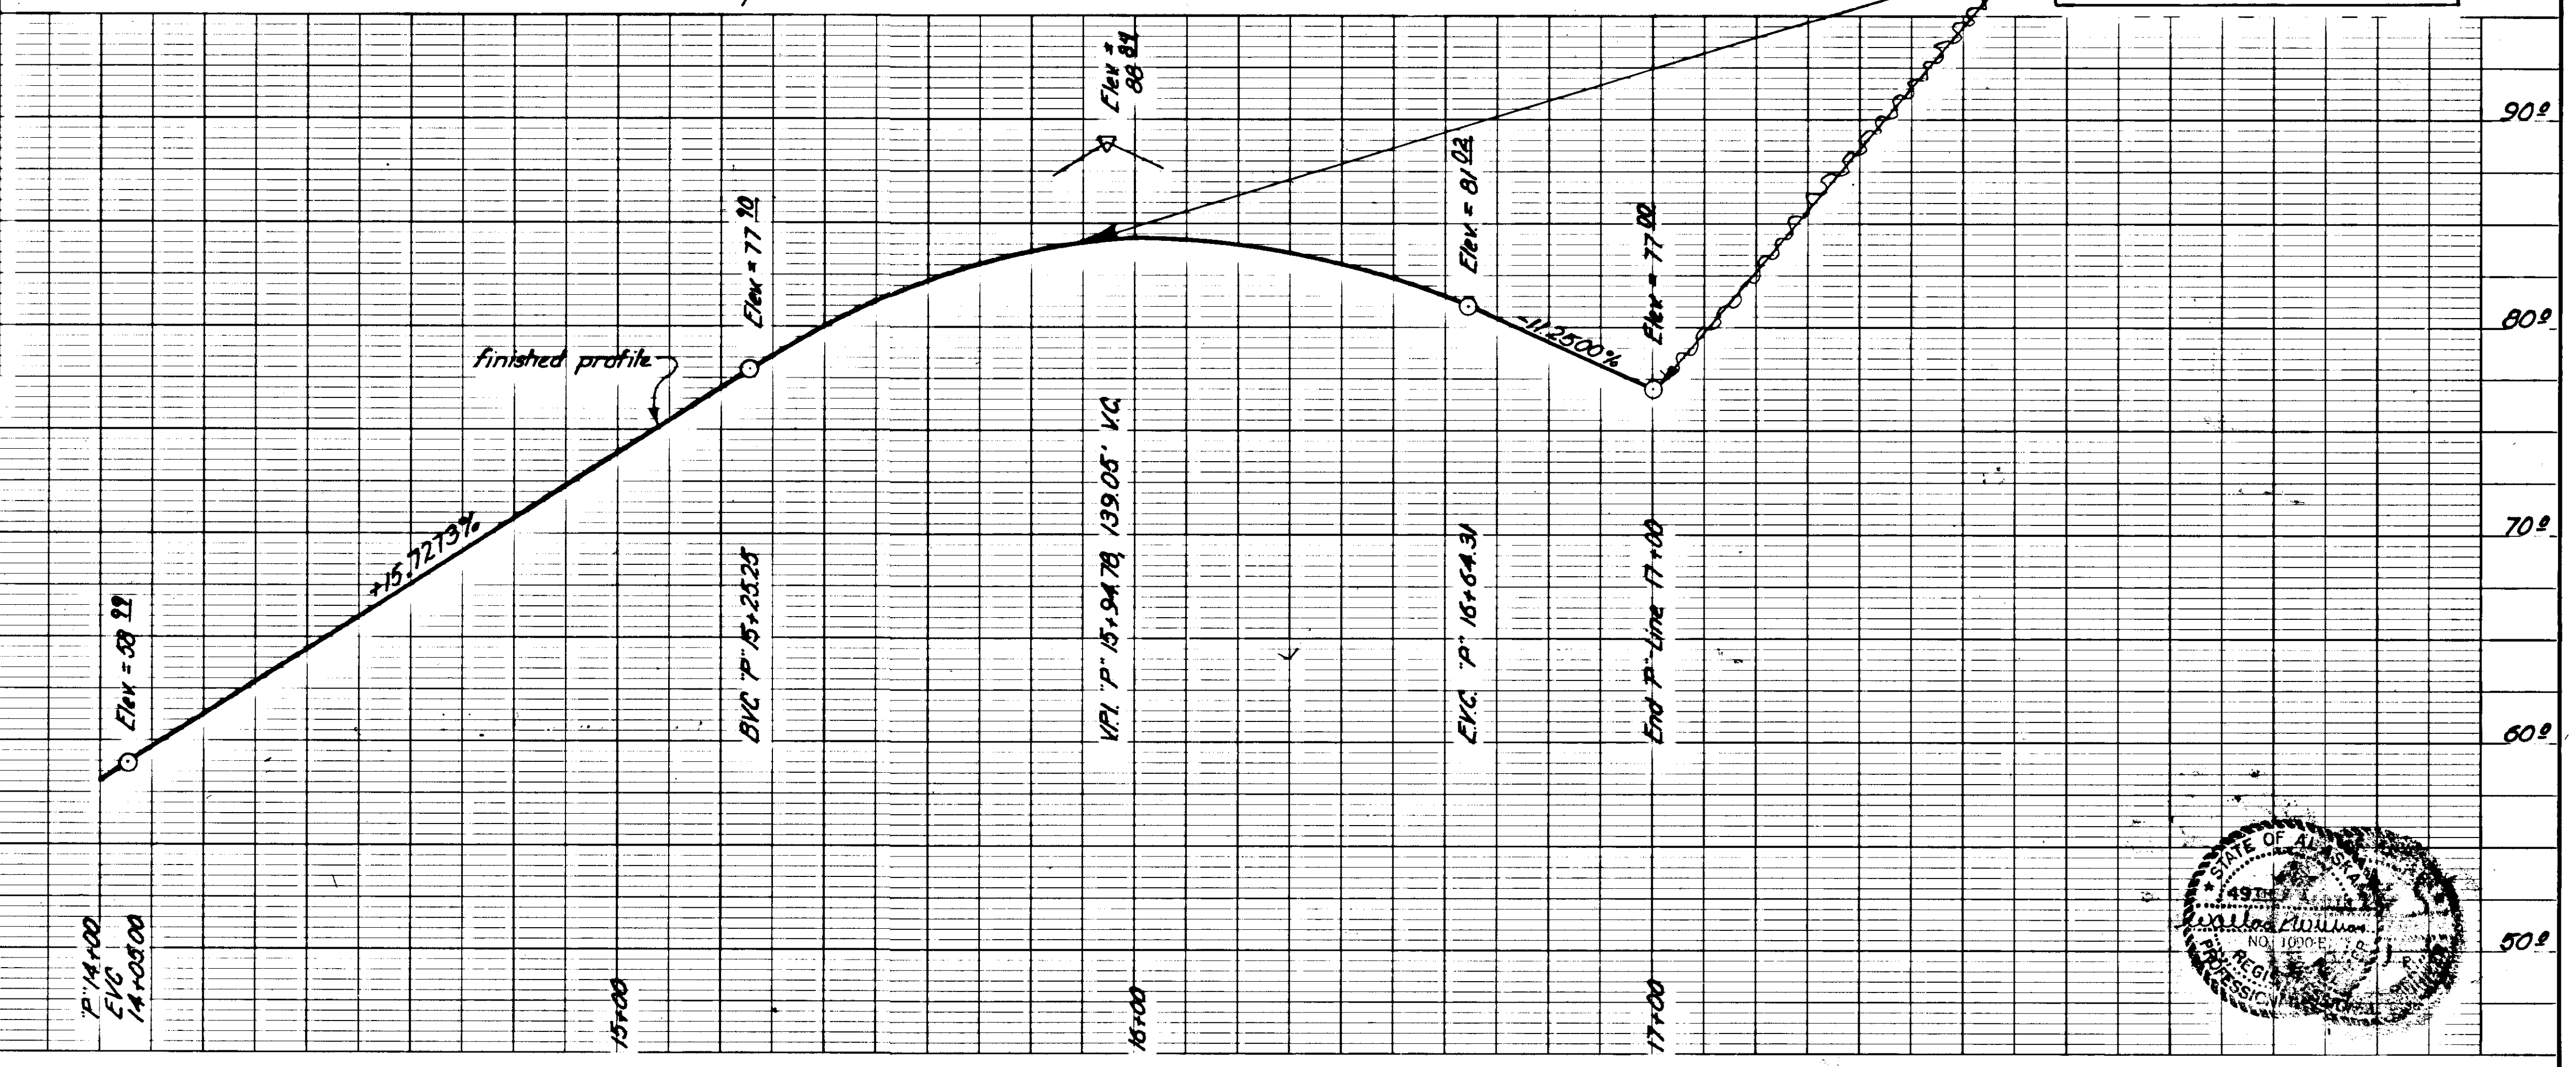

Craig City Street Paving Project R-30682



STATE	PROJECT DESIGNATION	YEAR	SHEET NO.	TOTAL SHEETS
ALASKA	SR-0924(7)	1982	7	27

Note:
See Sheet 6 for vertical alignment of the beginning of "K"-Line.


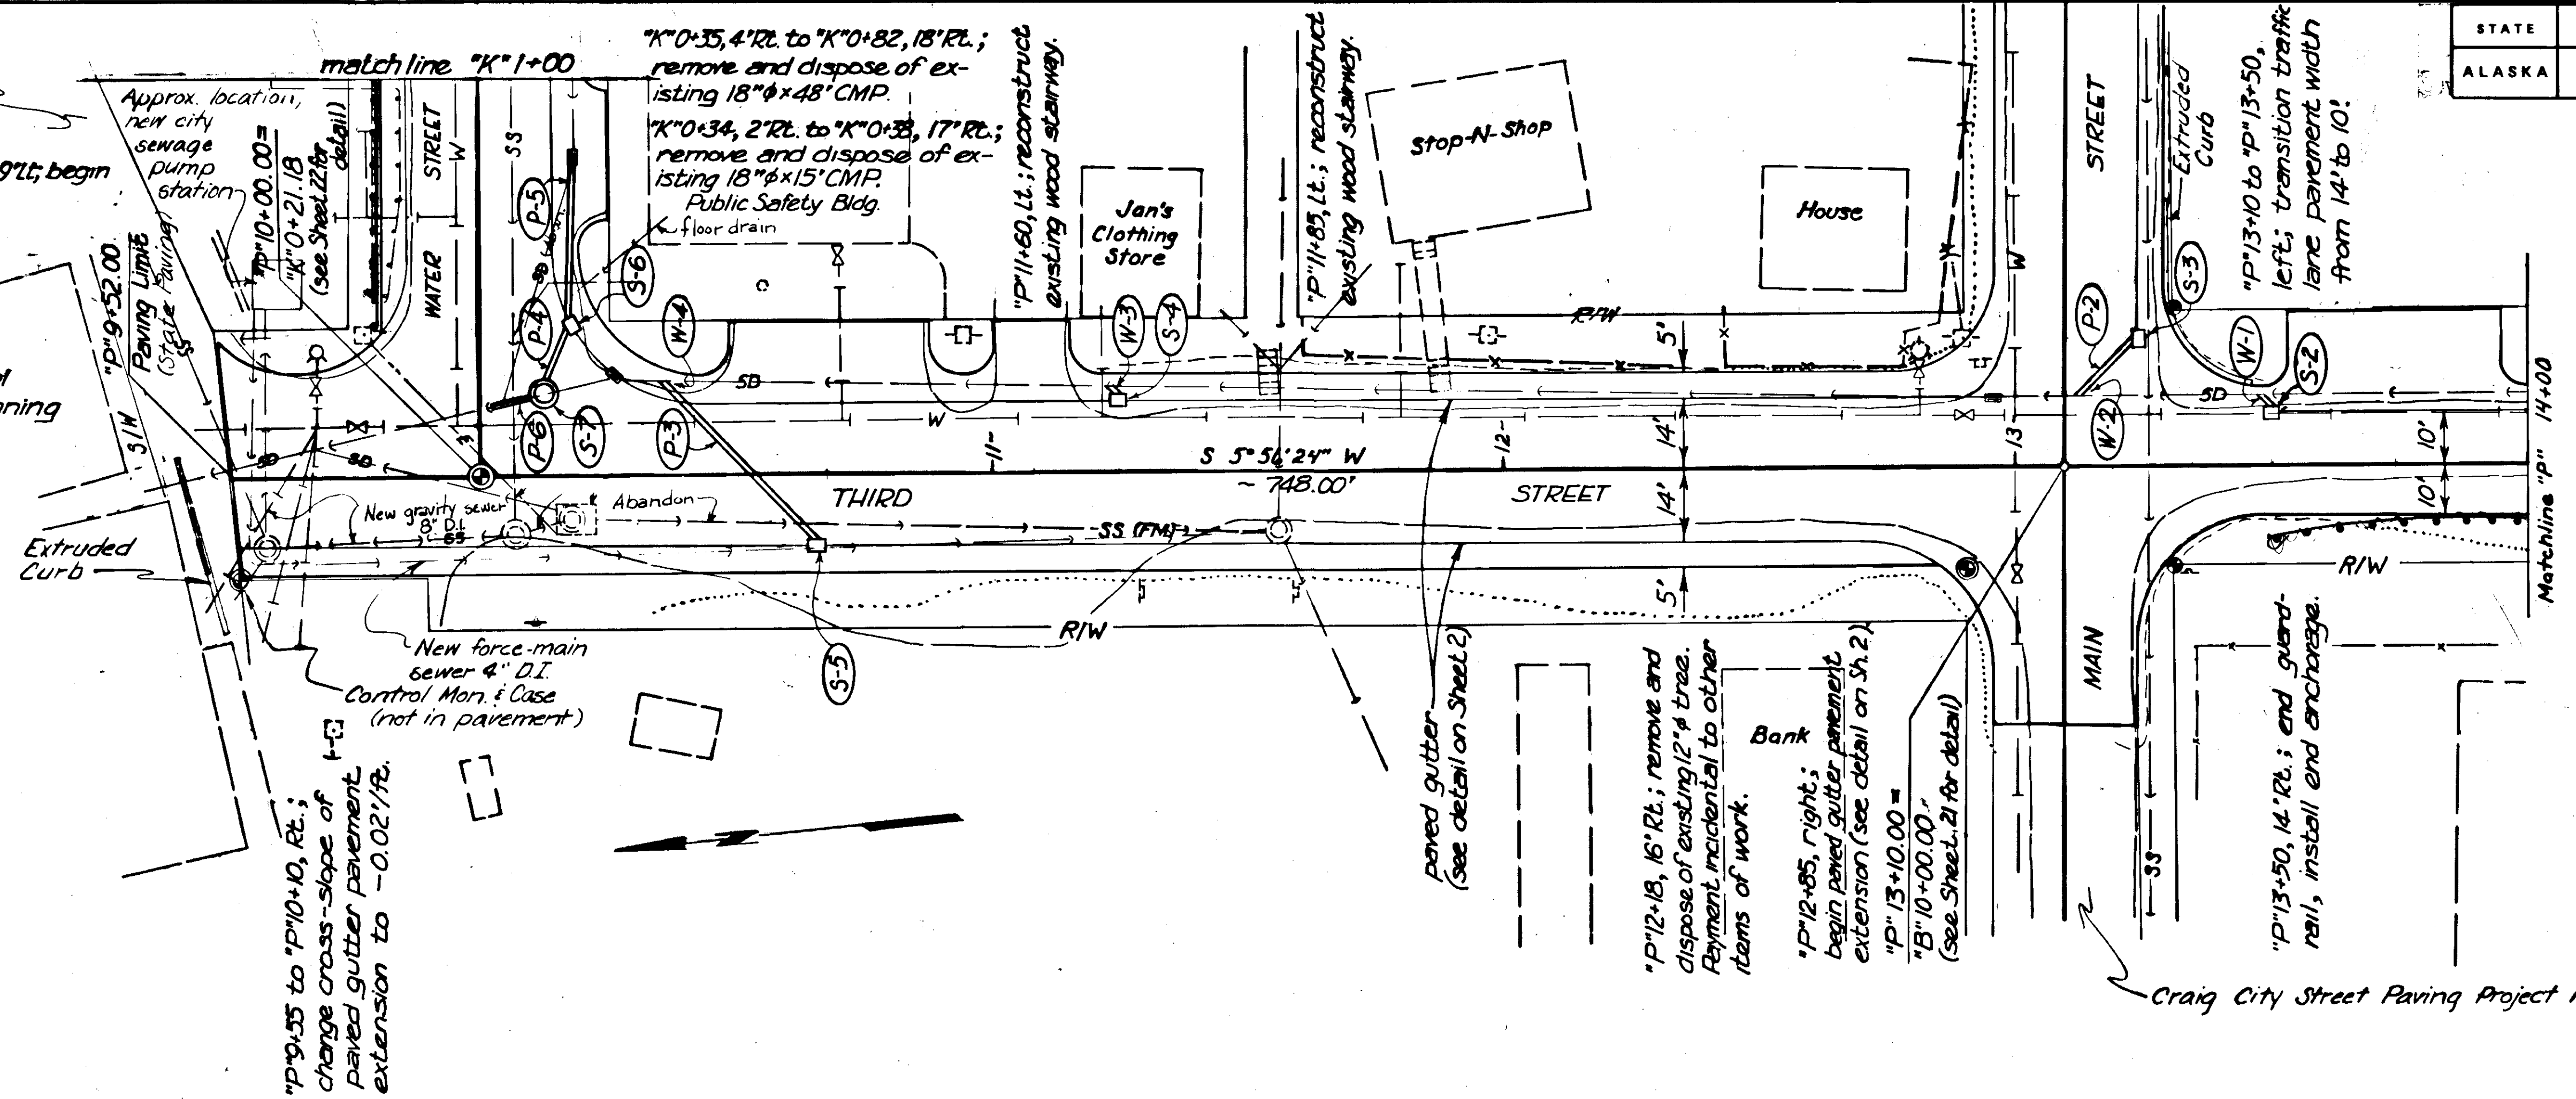


Craig City Street Paving Project R-30682



Roadway Surface Removal = 106 cy -
 Unclassified Excavation = 52 cy -
 Borrow, Type A = 52 Tons -
 Selected Material = 55 Tons -

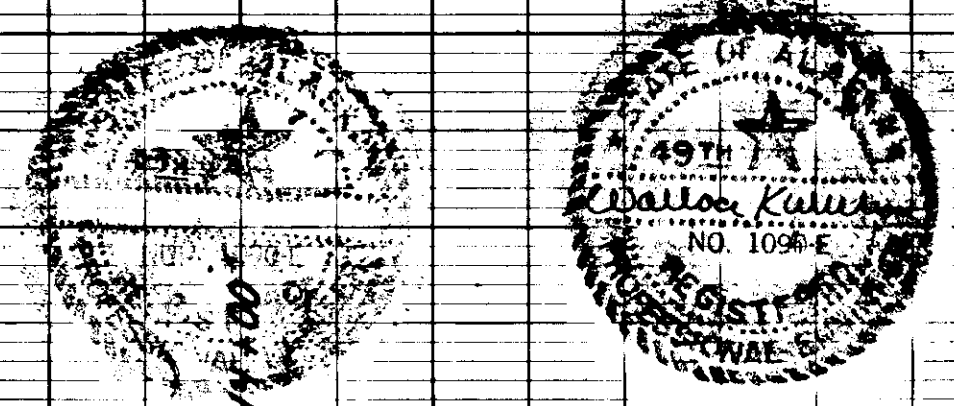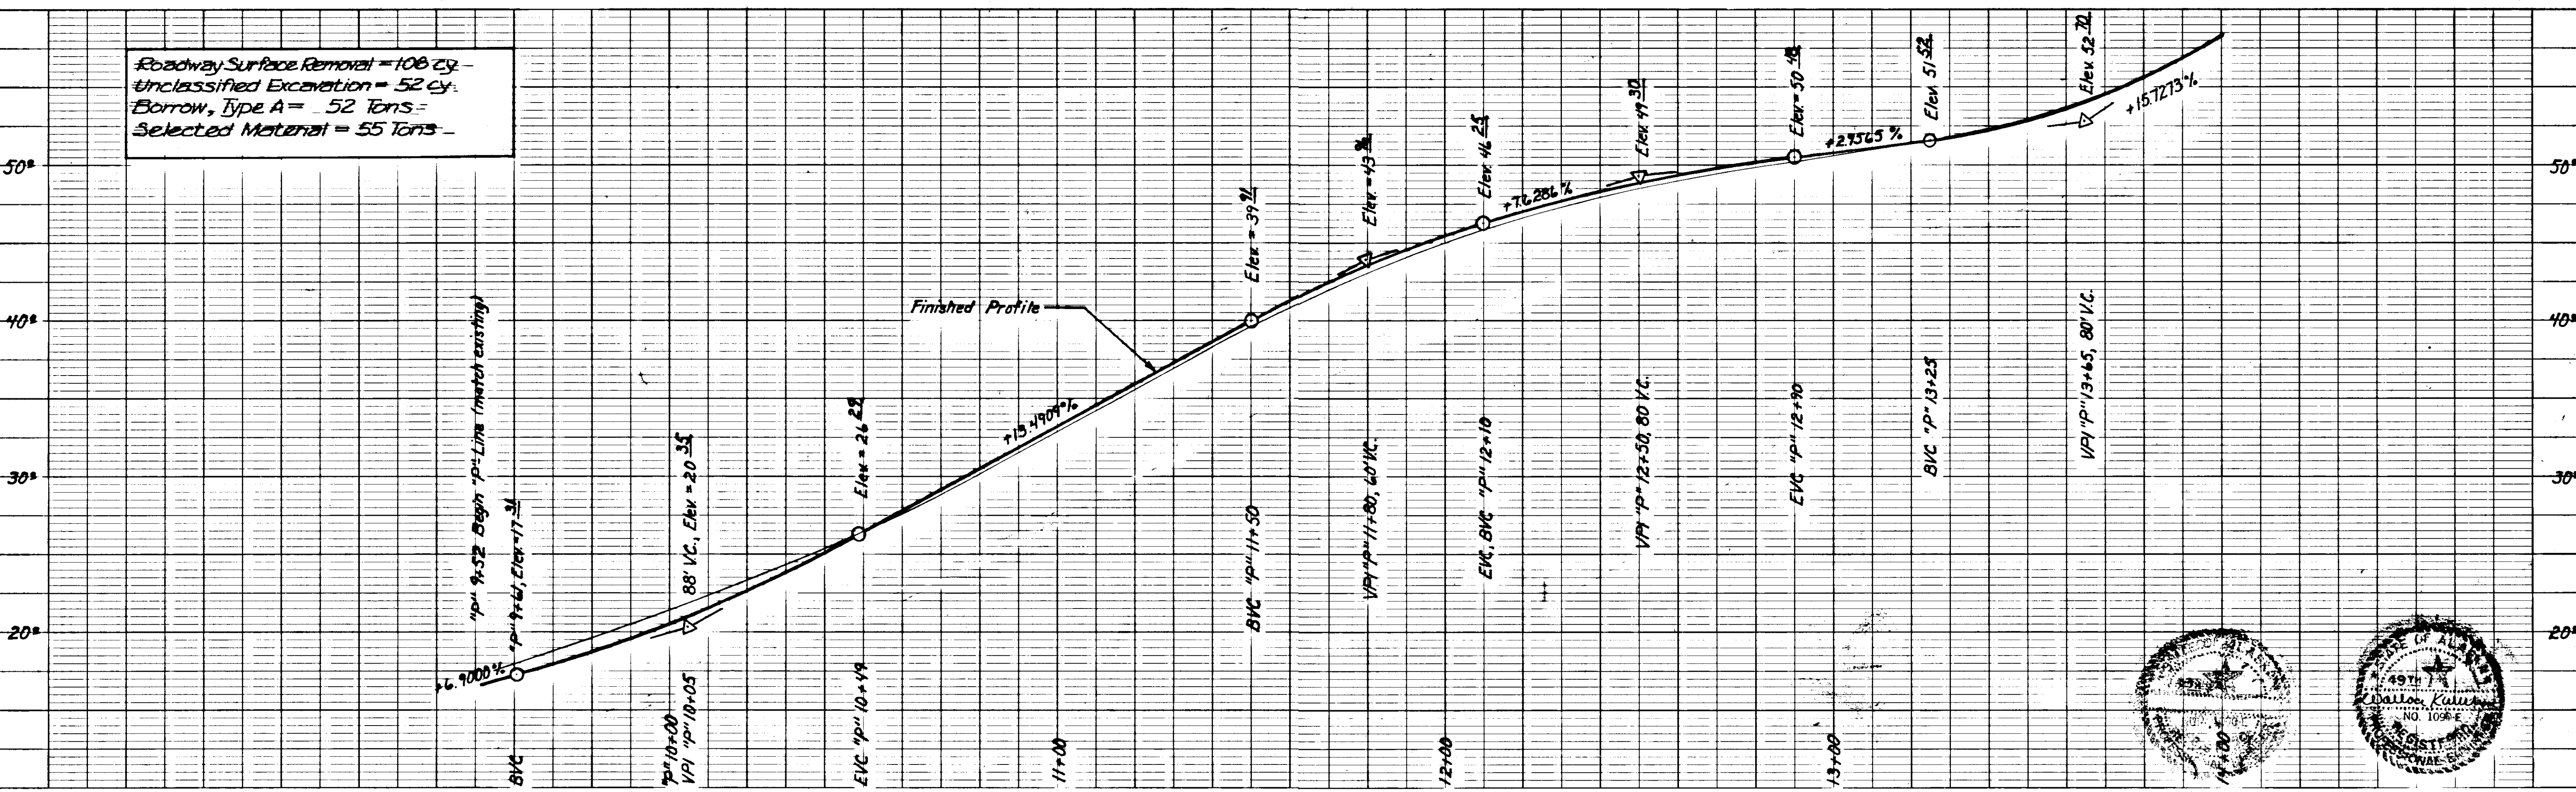





STATE	PROJECT DESIGNATION	YEAR	SHEET NO.	TOTAL SHEETS
ALASKA	SR-0924(7)	1982	8	27

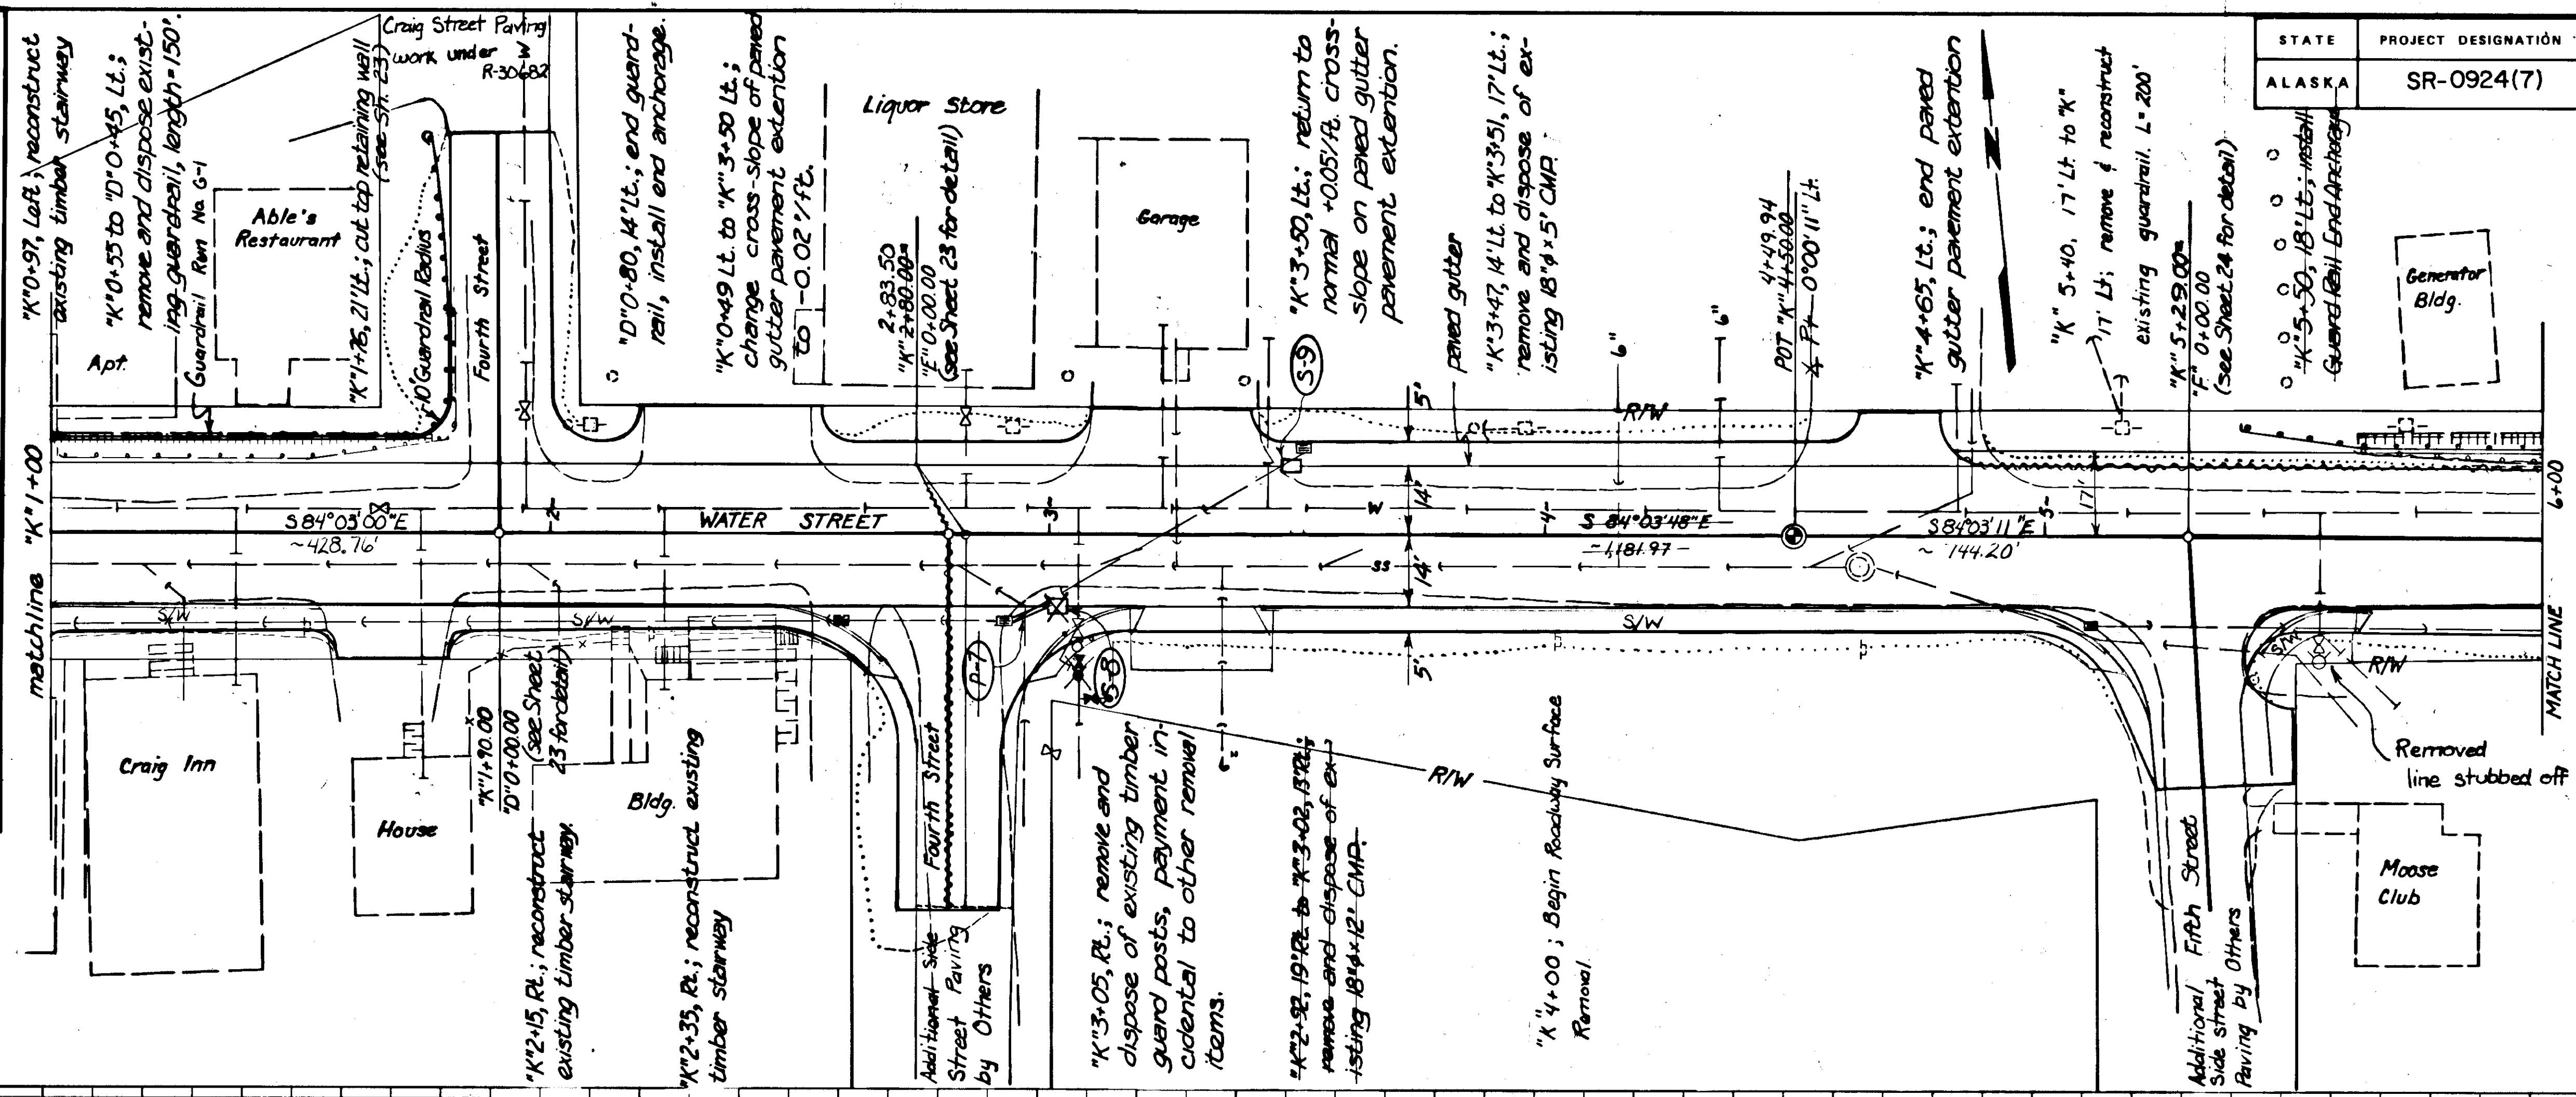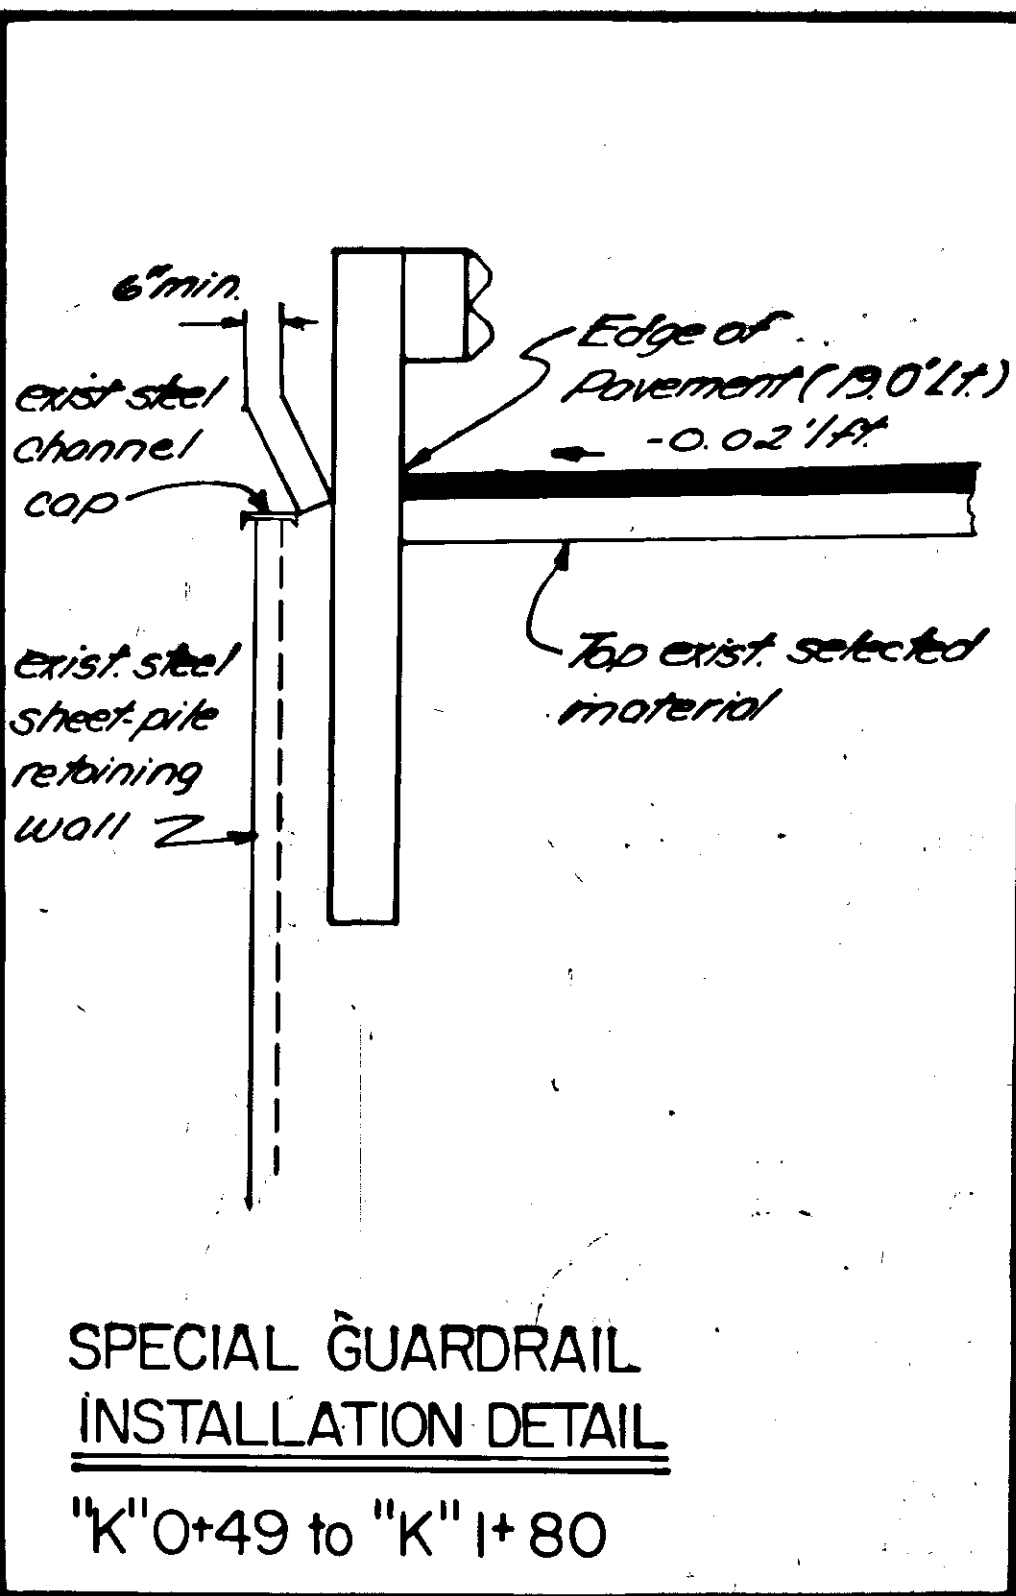




Roadway Surface Removal = 251 cy 4' ahead
 Unclassified Excavation = 7 cy
 Borrow, Type A = 11 Tons
 Selected Material = 210 Tons

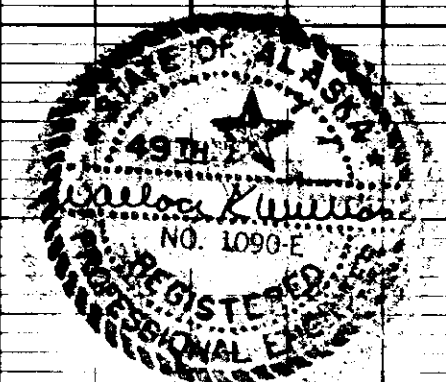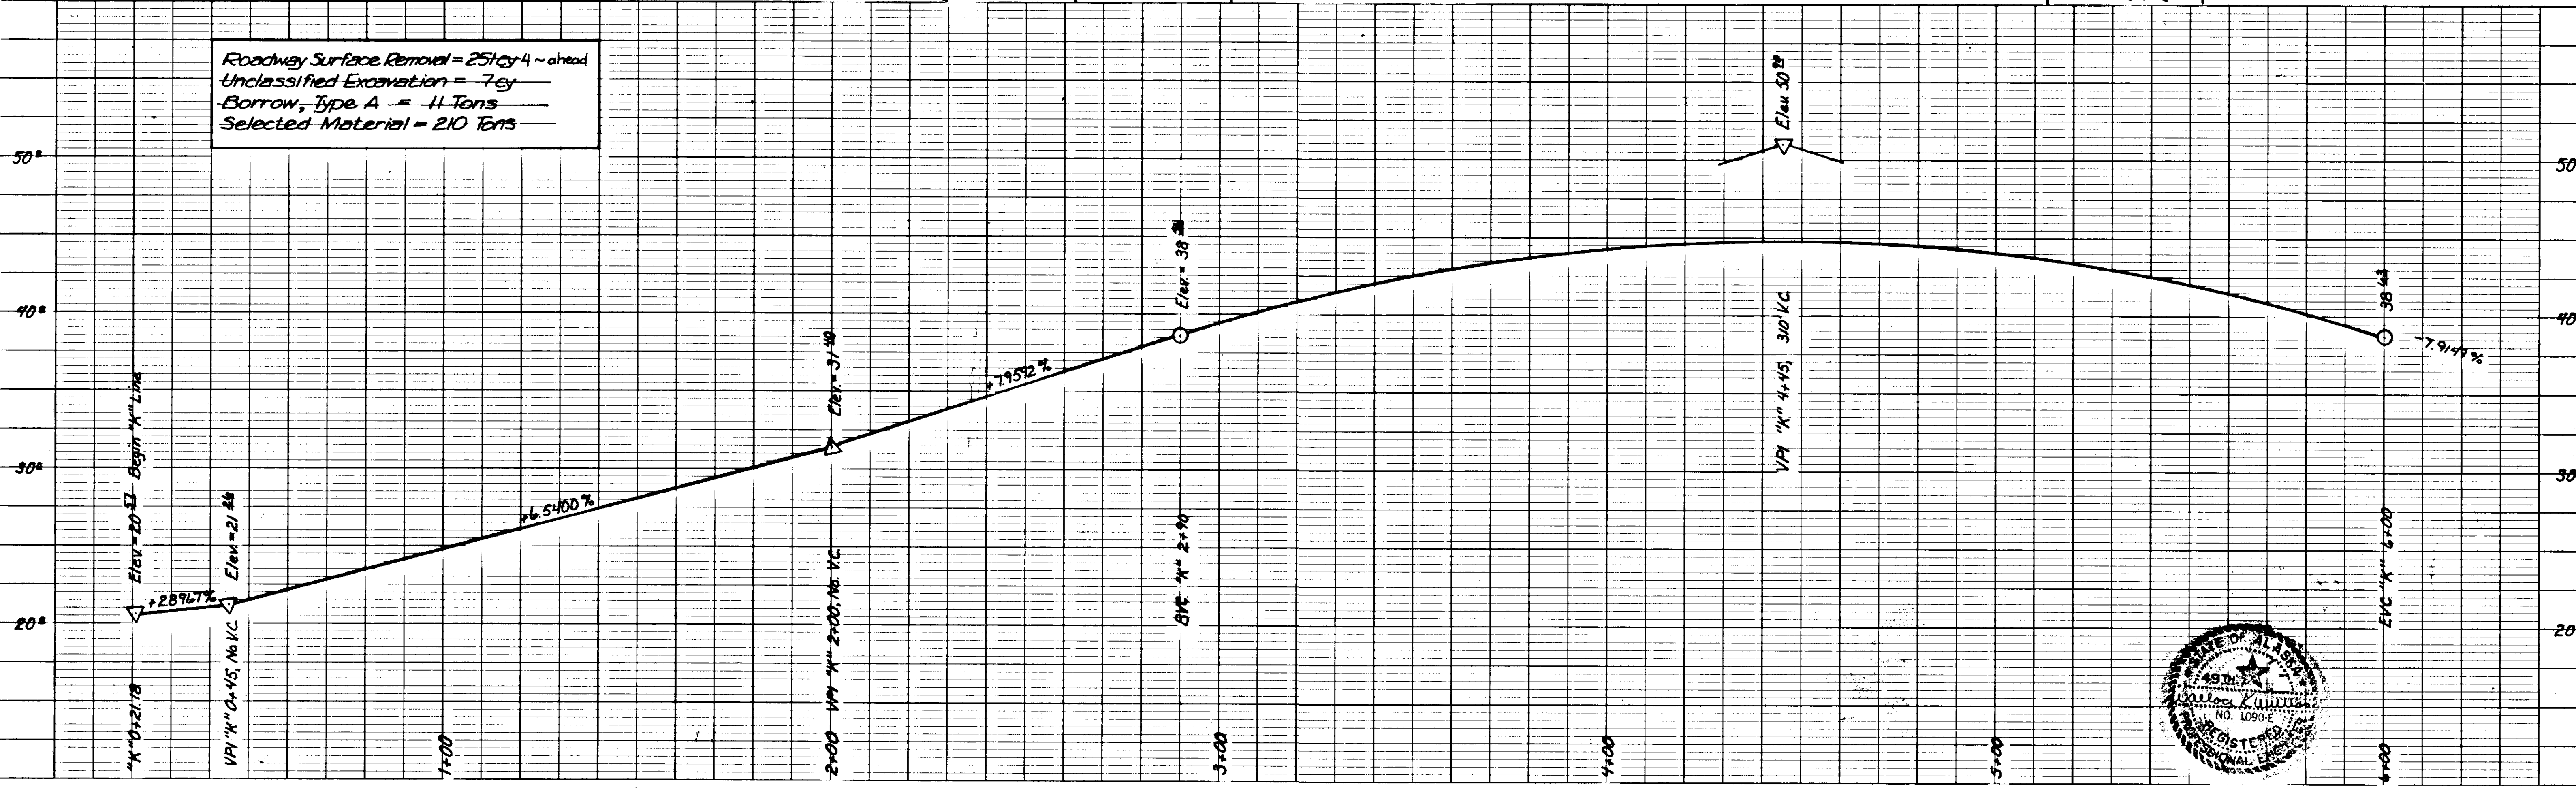




STATE	PROJECT DESIGNATION	YEAR	SHEET NO.	TOTAL SHEETS
ALASKA	SR-0924(7)	1982	9	27

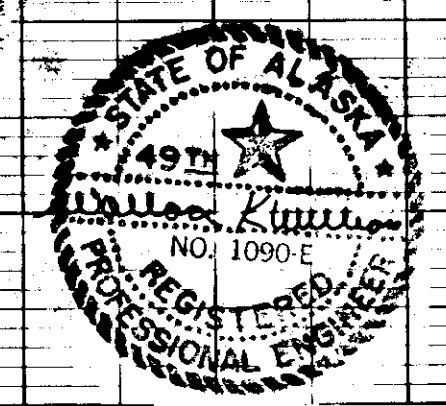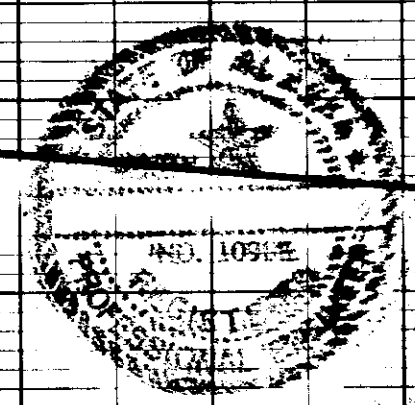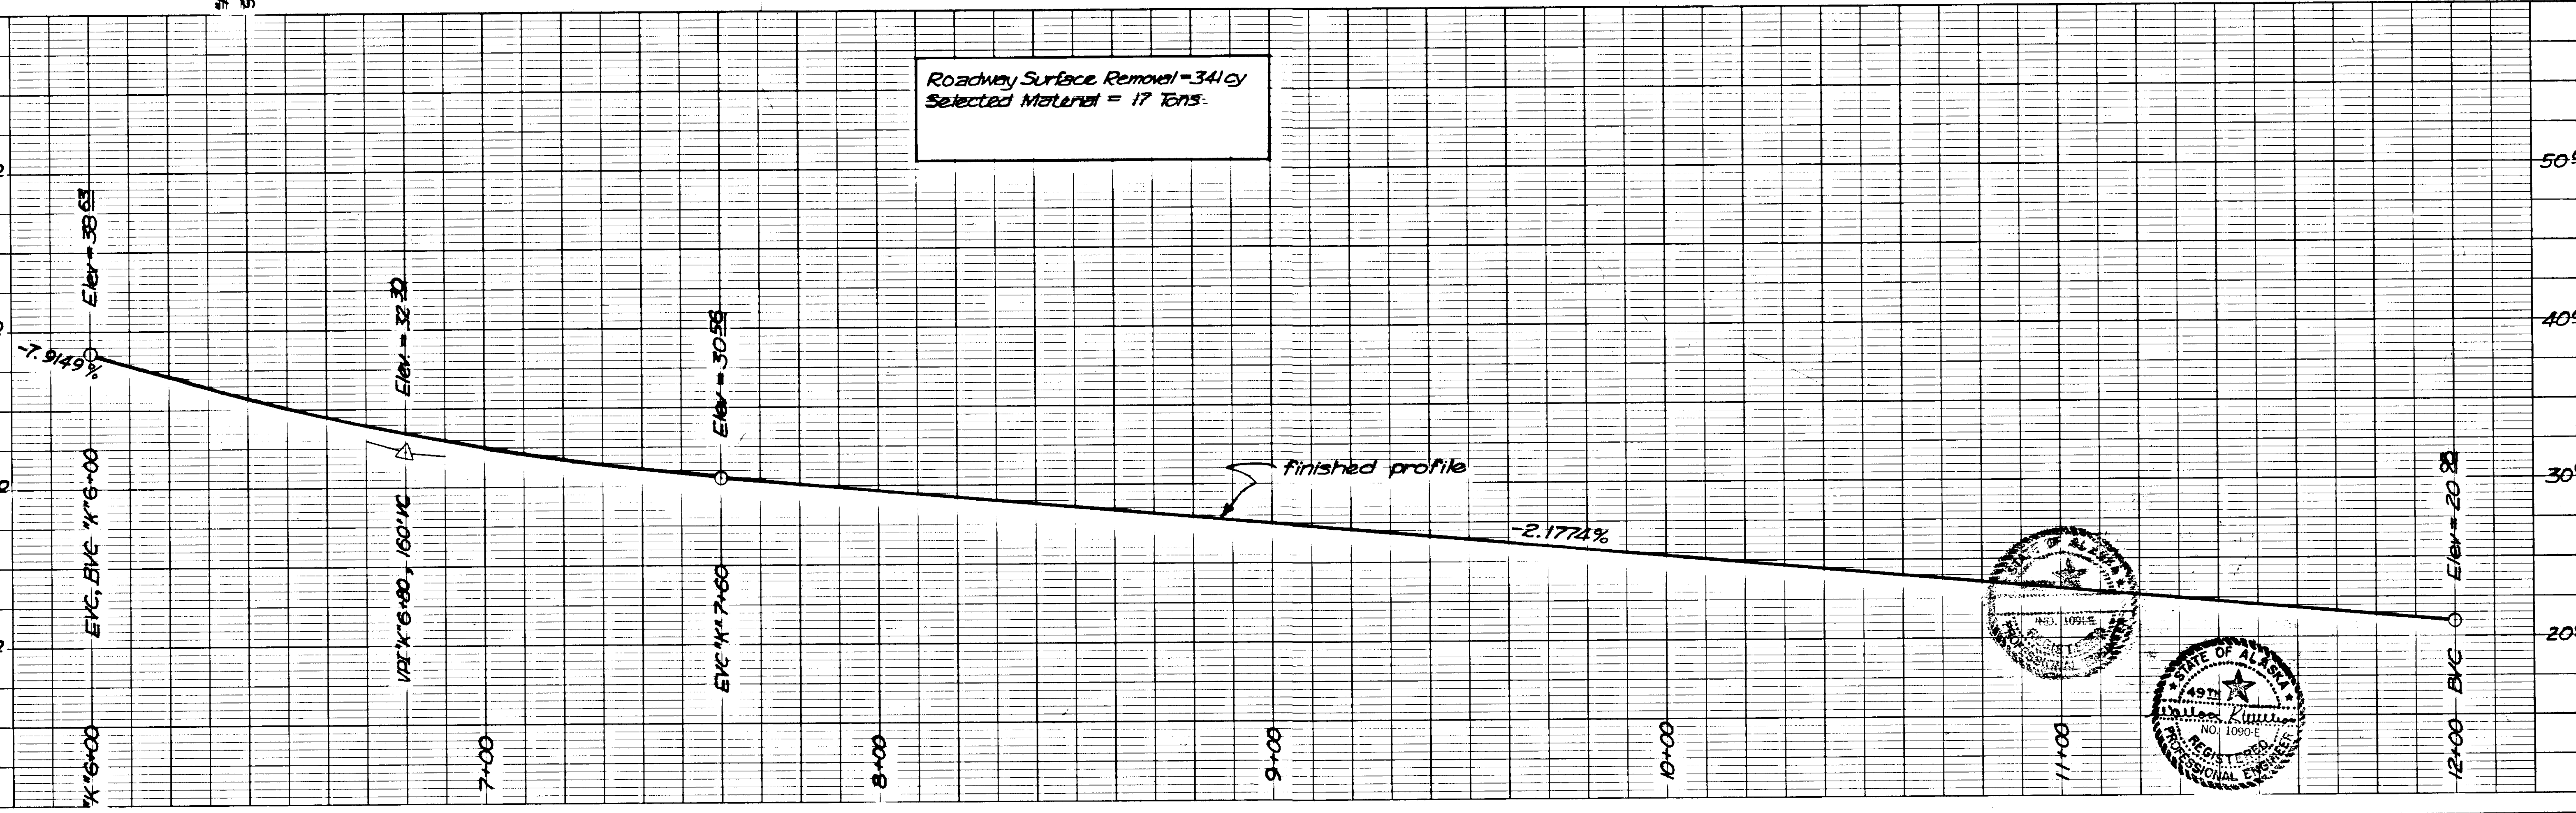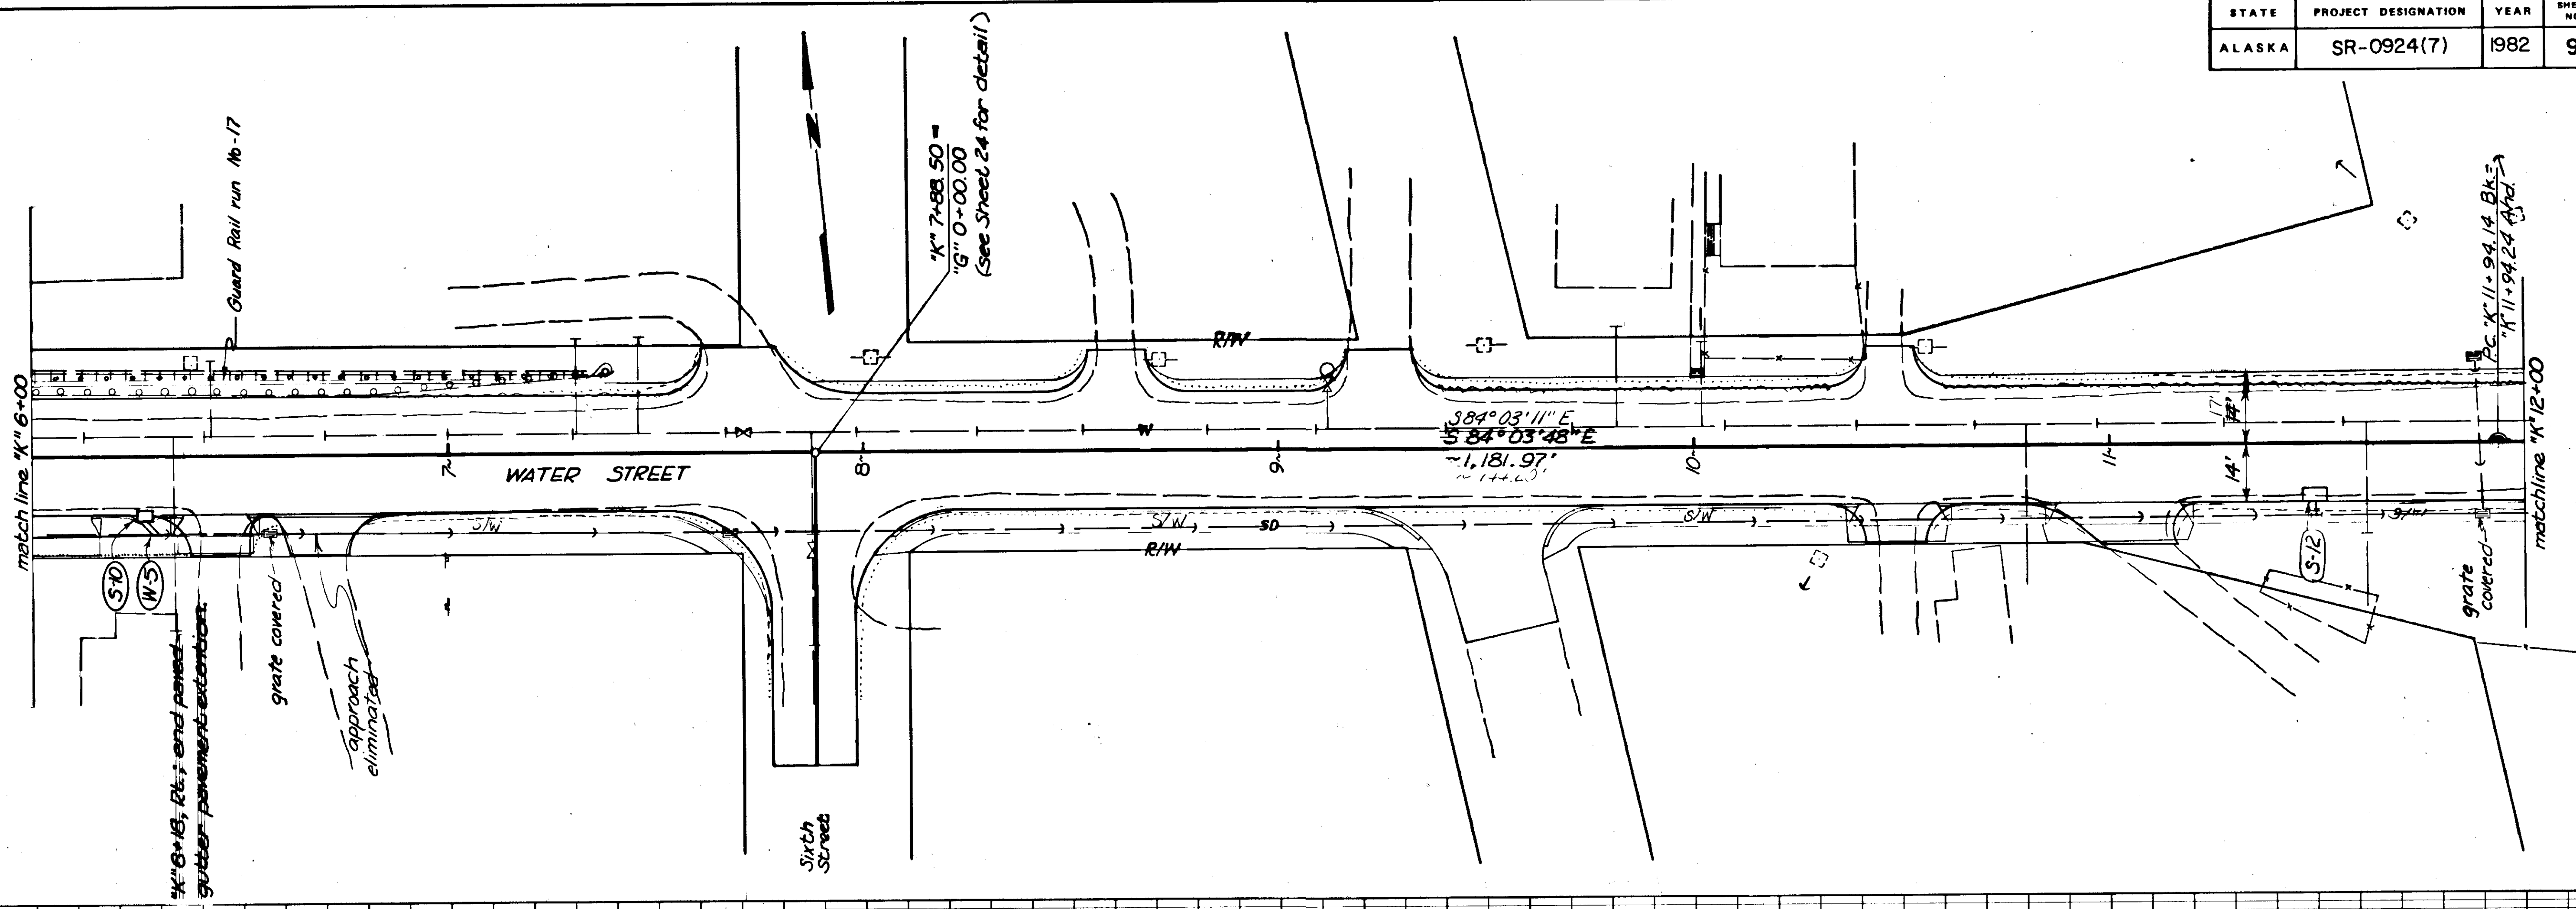




STATE	PROJECT DESIGNATION	YEAR	SHEET NO.	TOTAL SHEETS
ALASKA	SR-0924(7)	1982	11	27

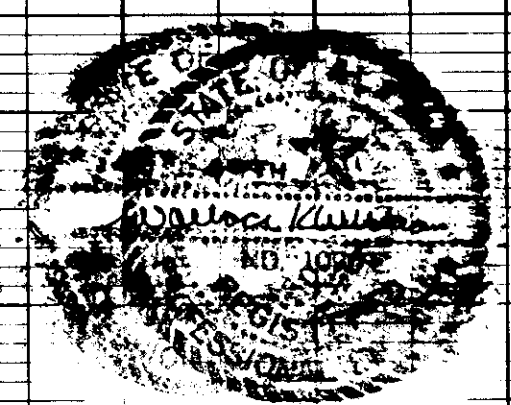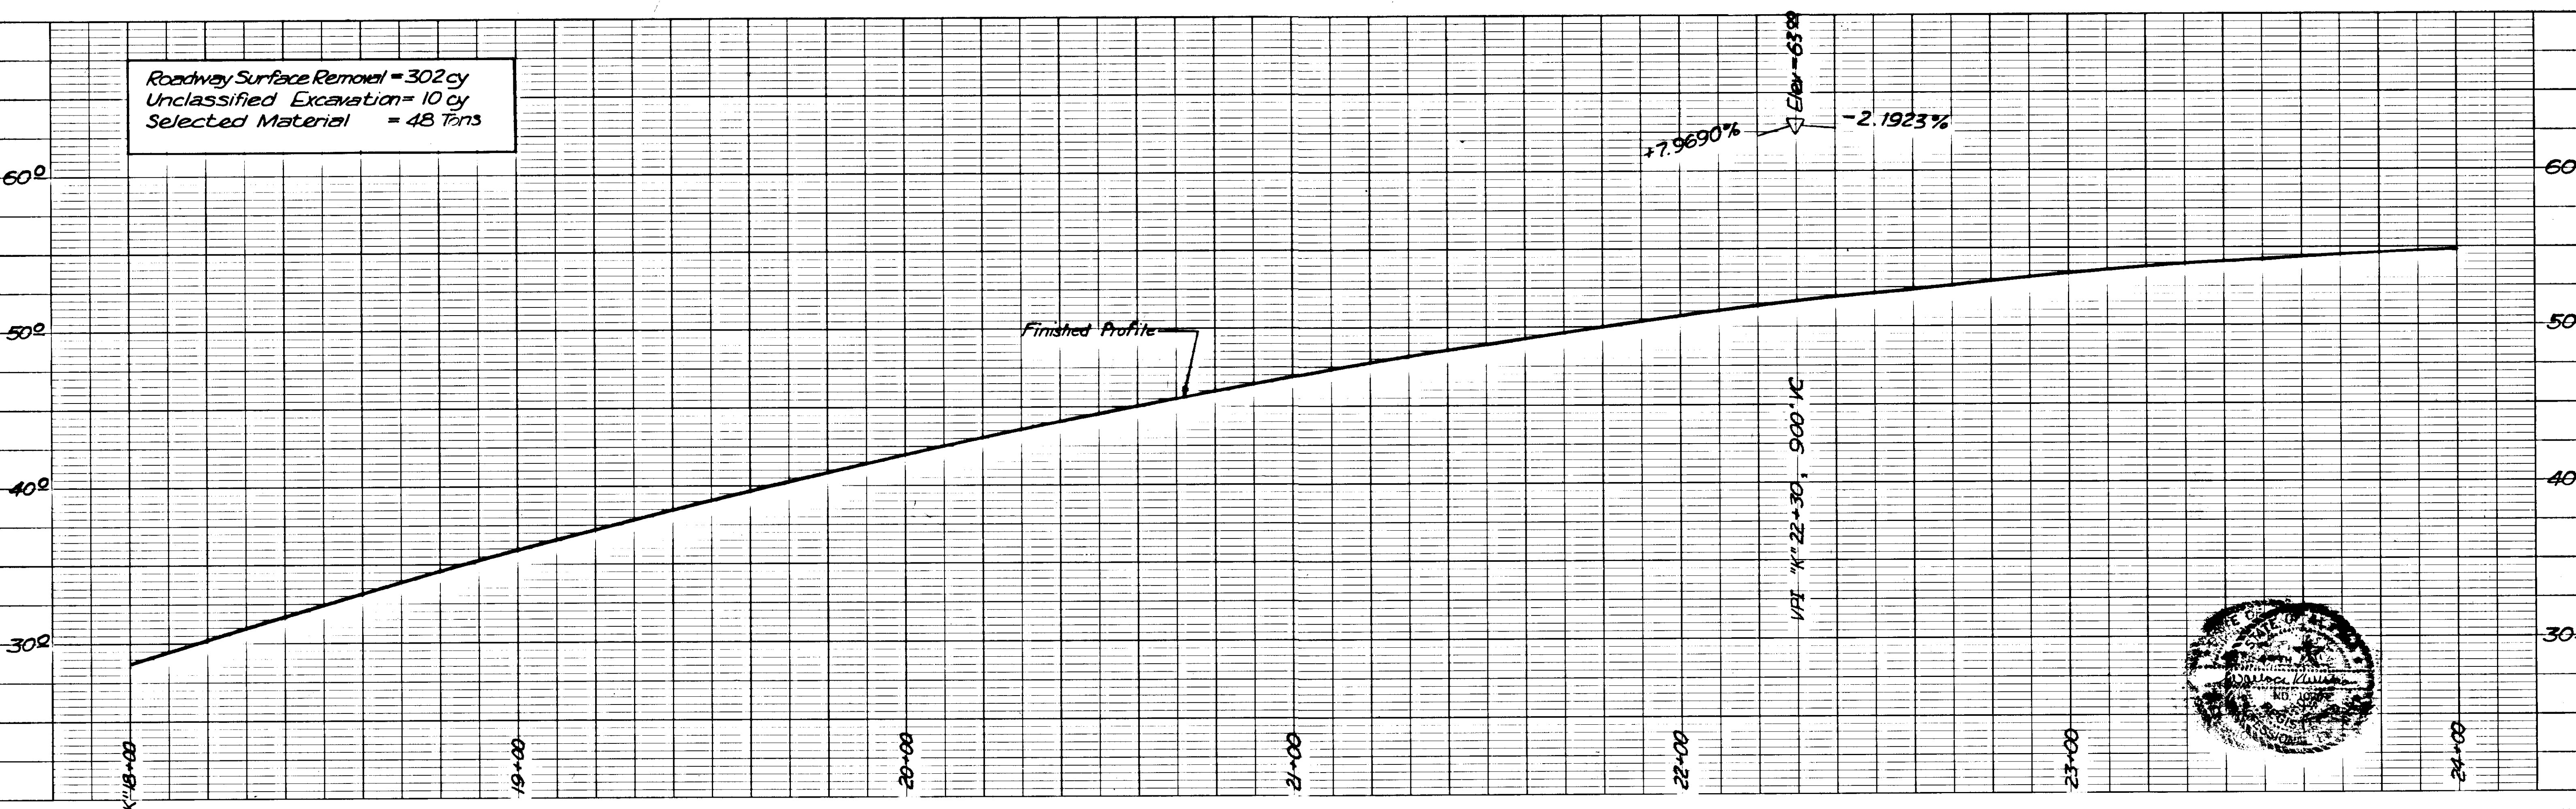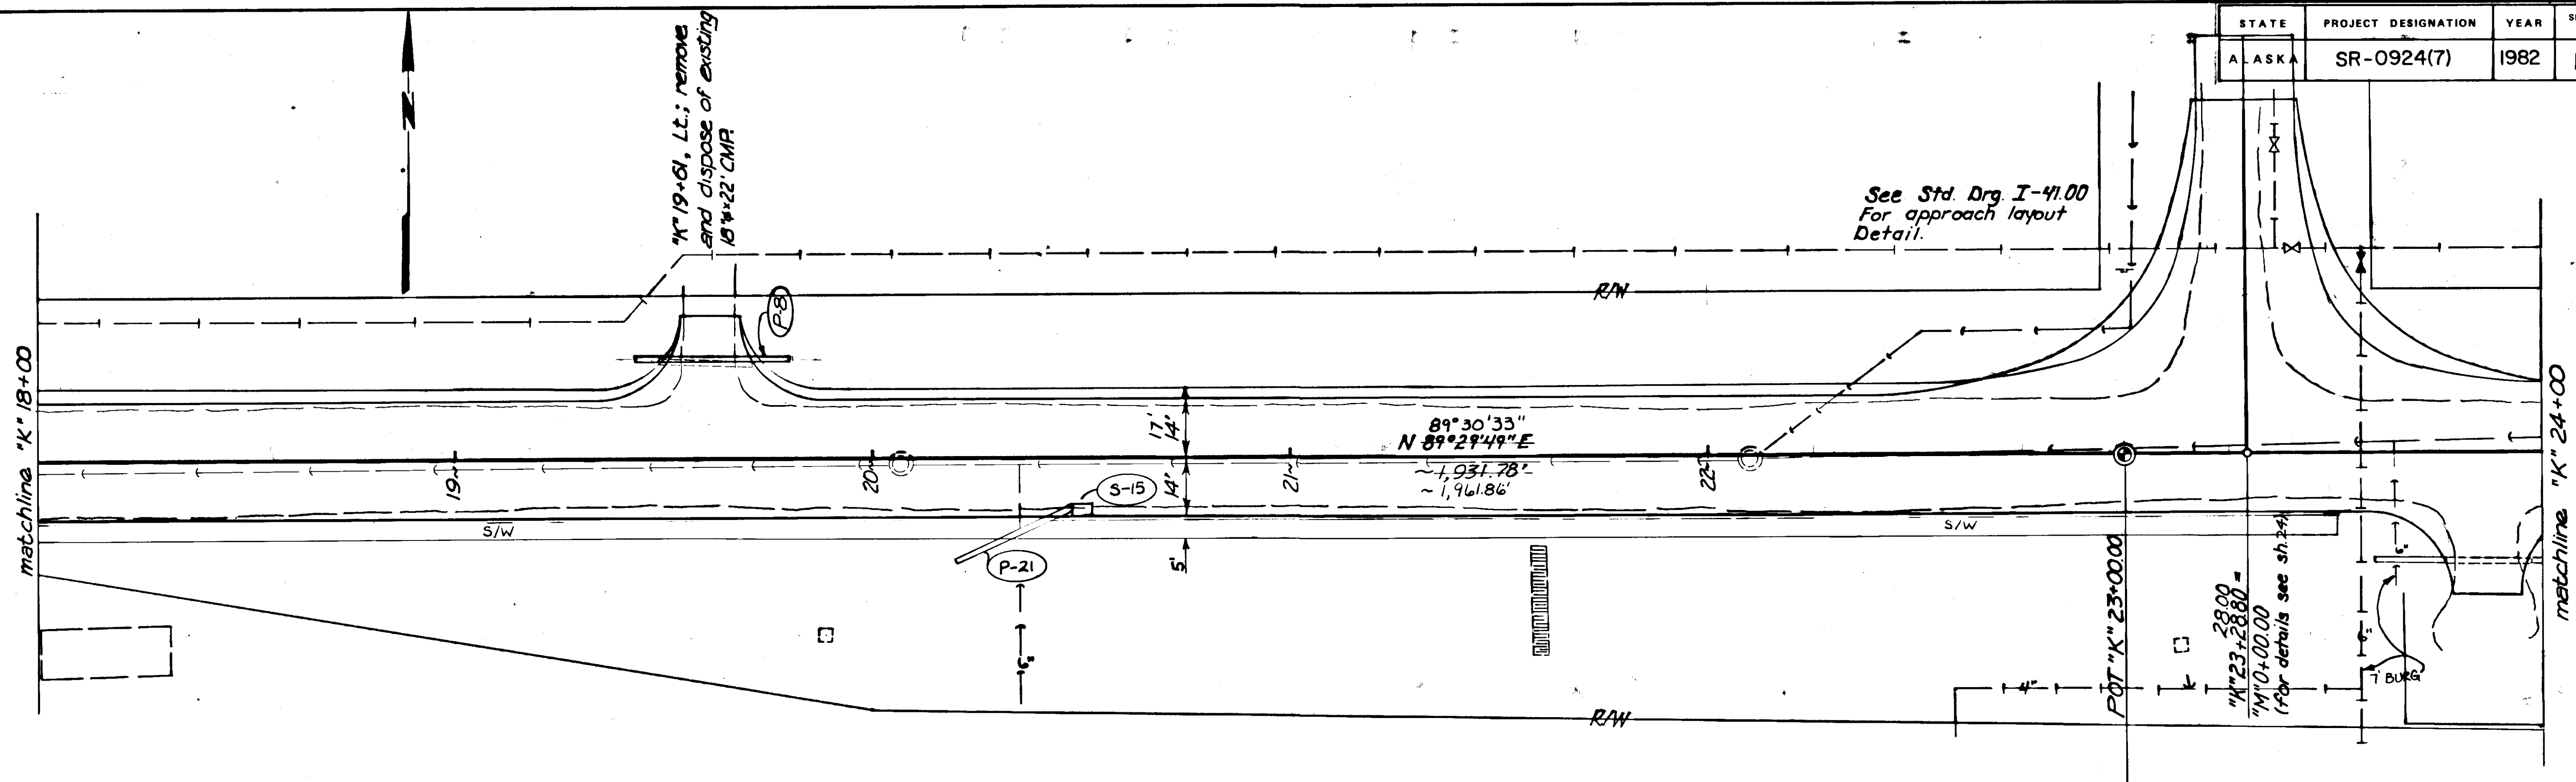




STATE	PROJECT DESIGNATION	YEAR	SHEET NO.	TOTAL SHEETS
ALASKA	SR-0924(7)	1982	12	27

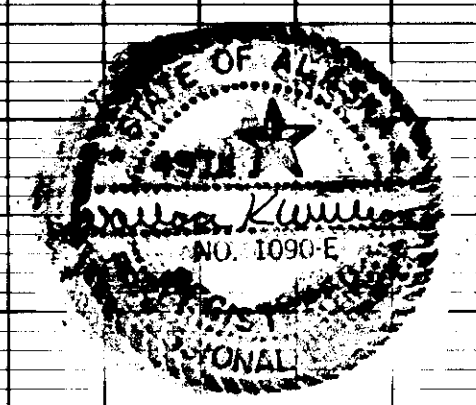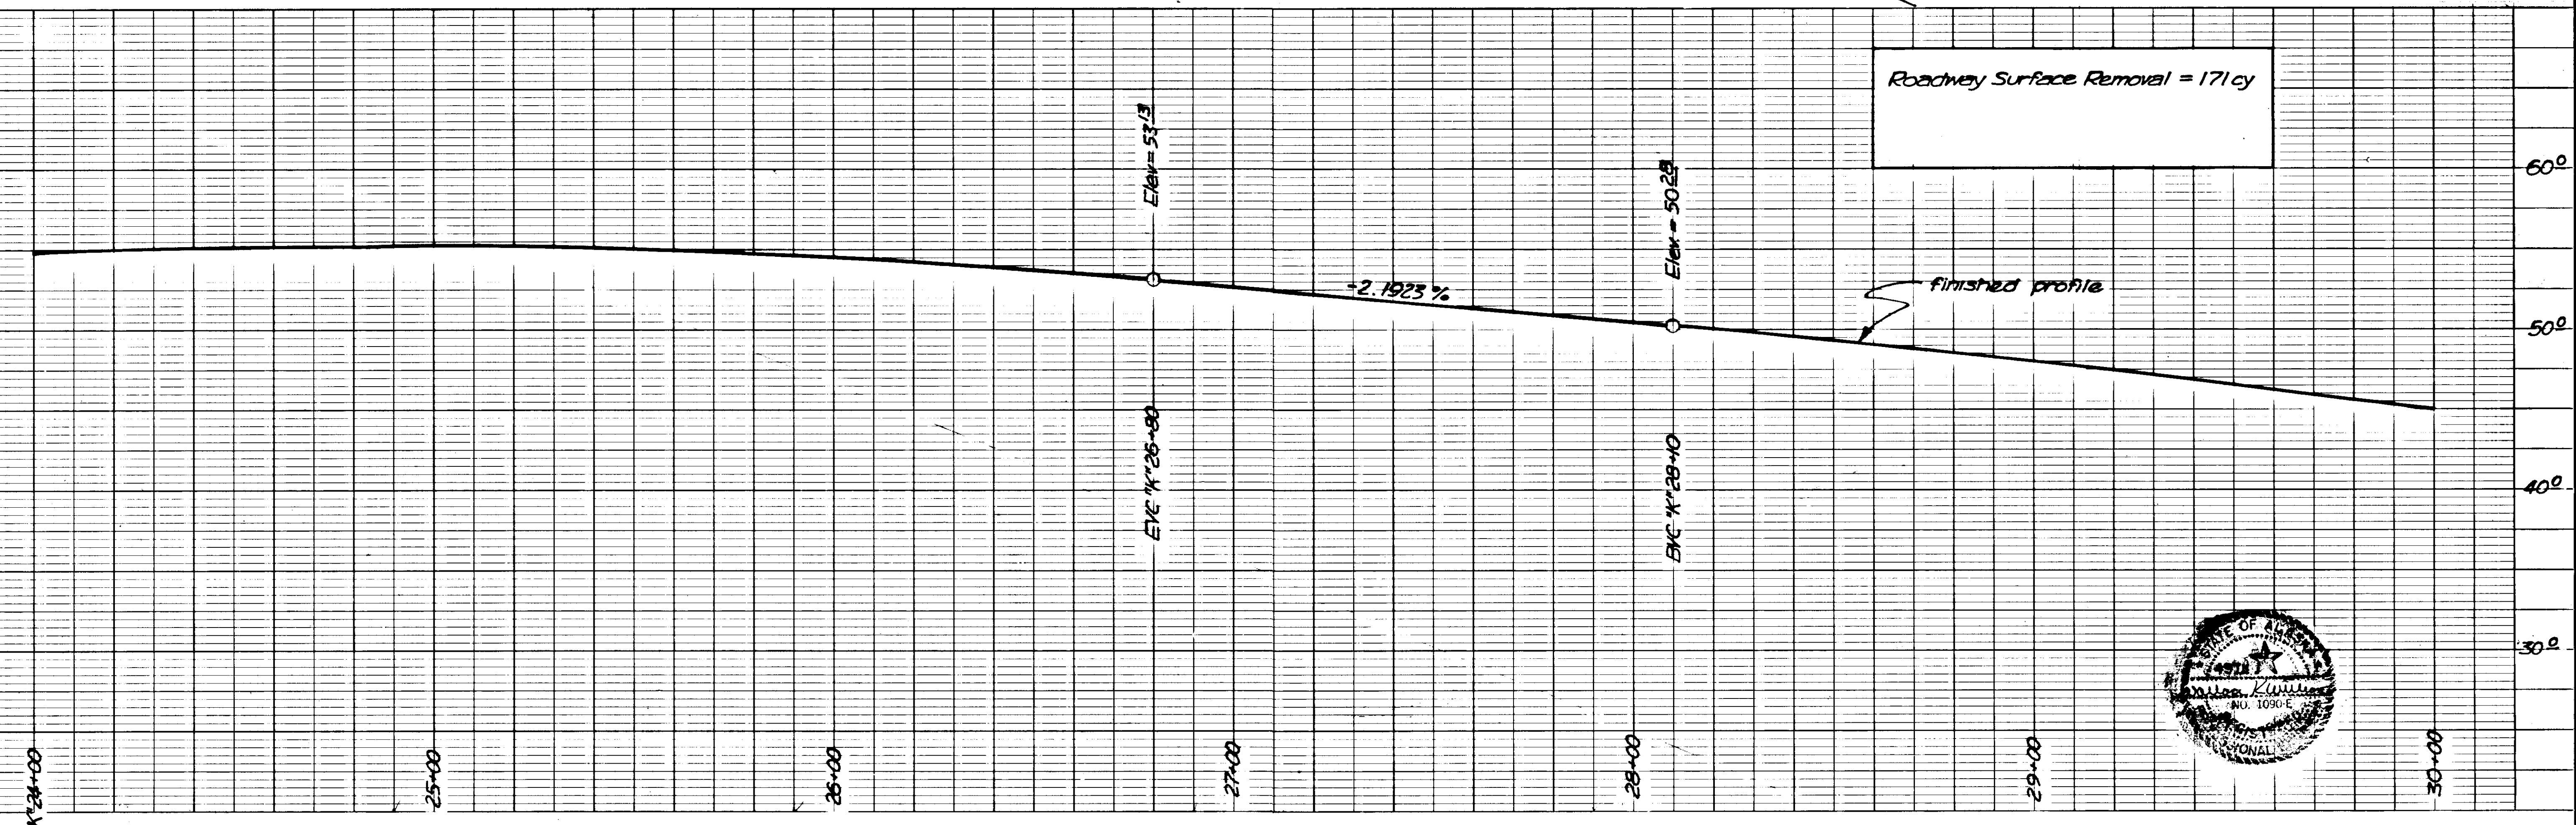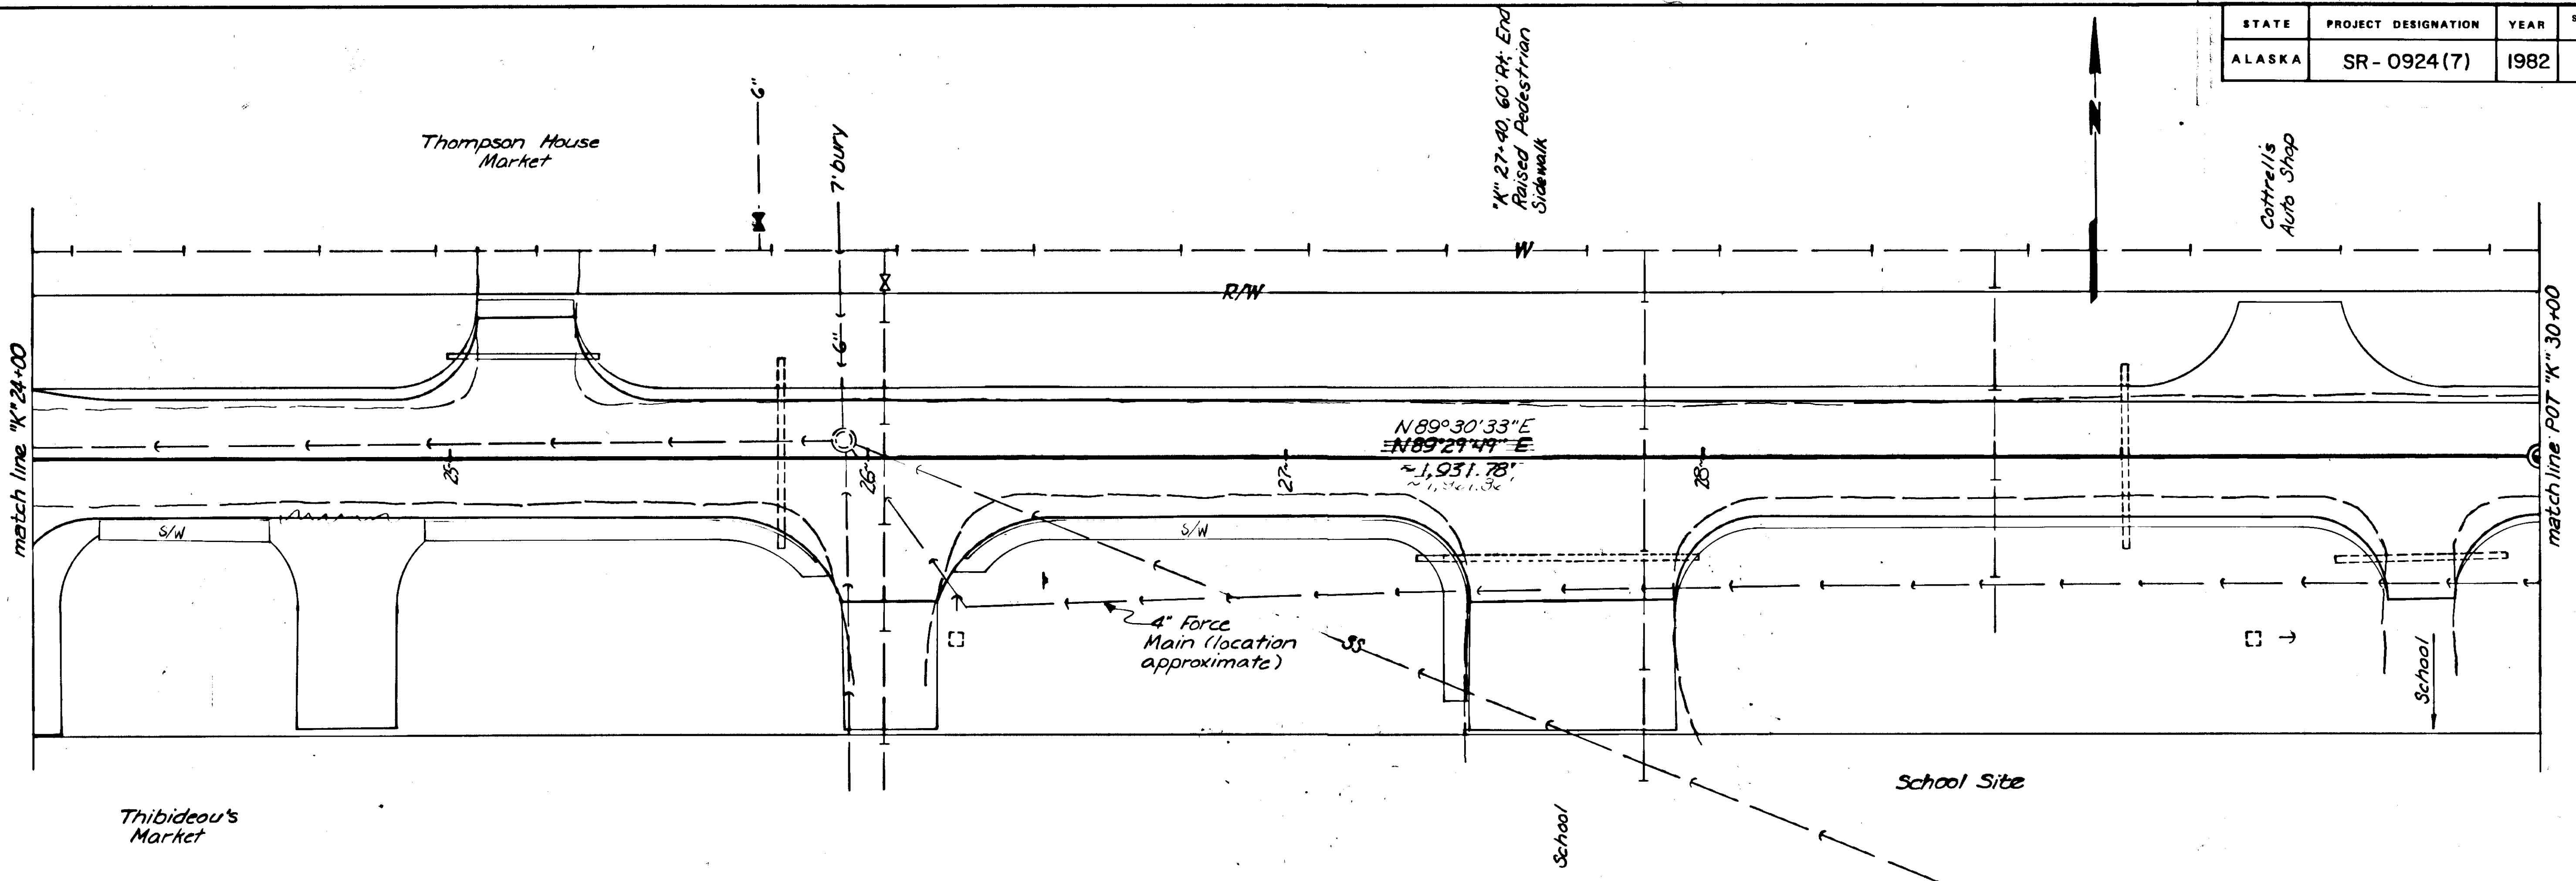


STATE	PROJECT DESIGNATION	YEAR	SHEET NO.	TOTAL SHEETS
ALASKA	SR-0924(7)	1982	13	27

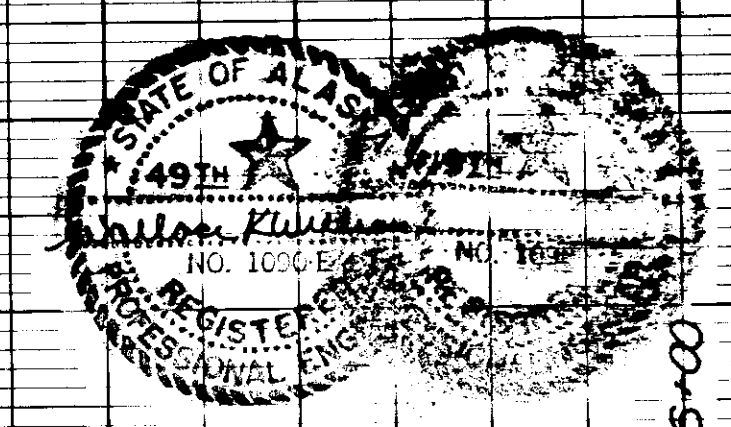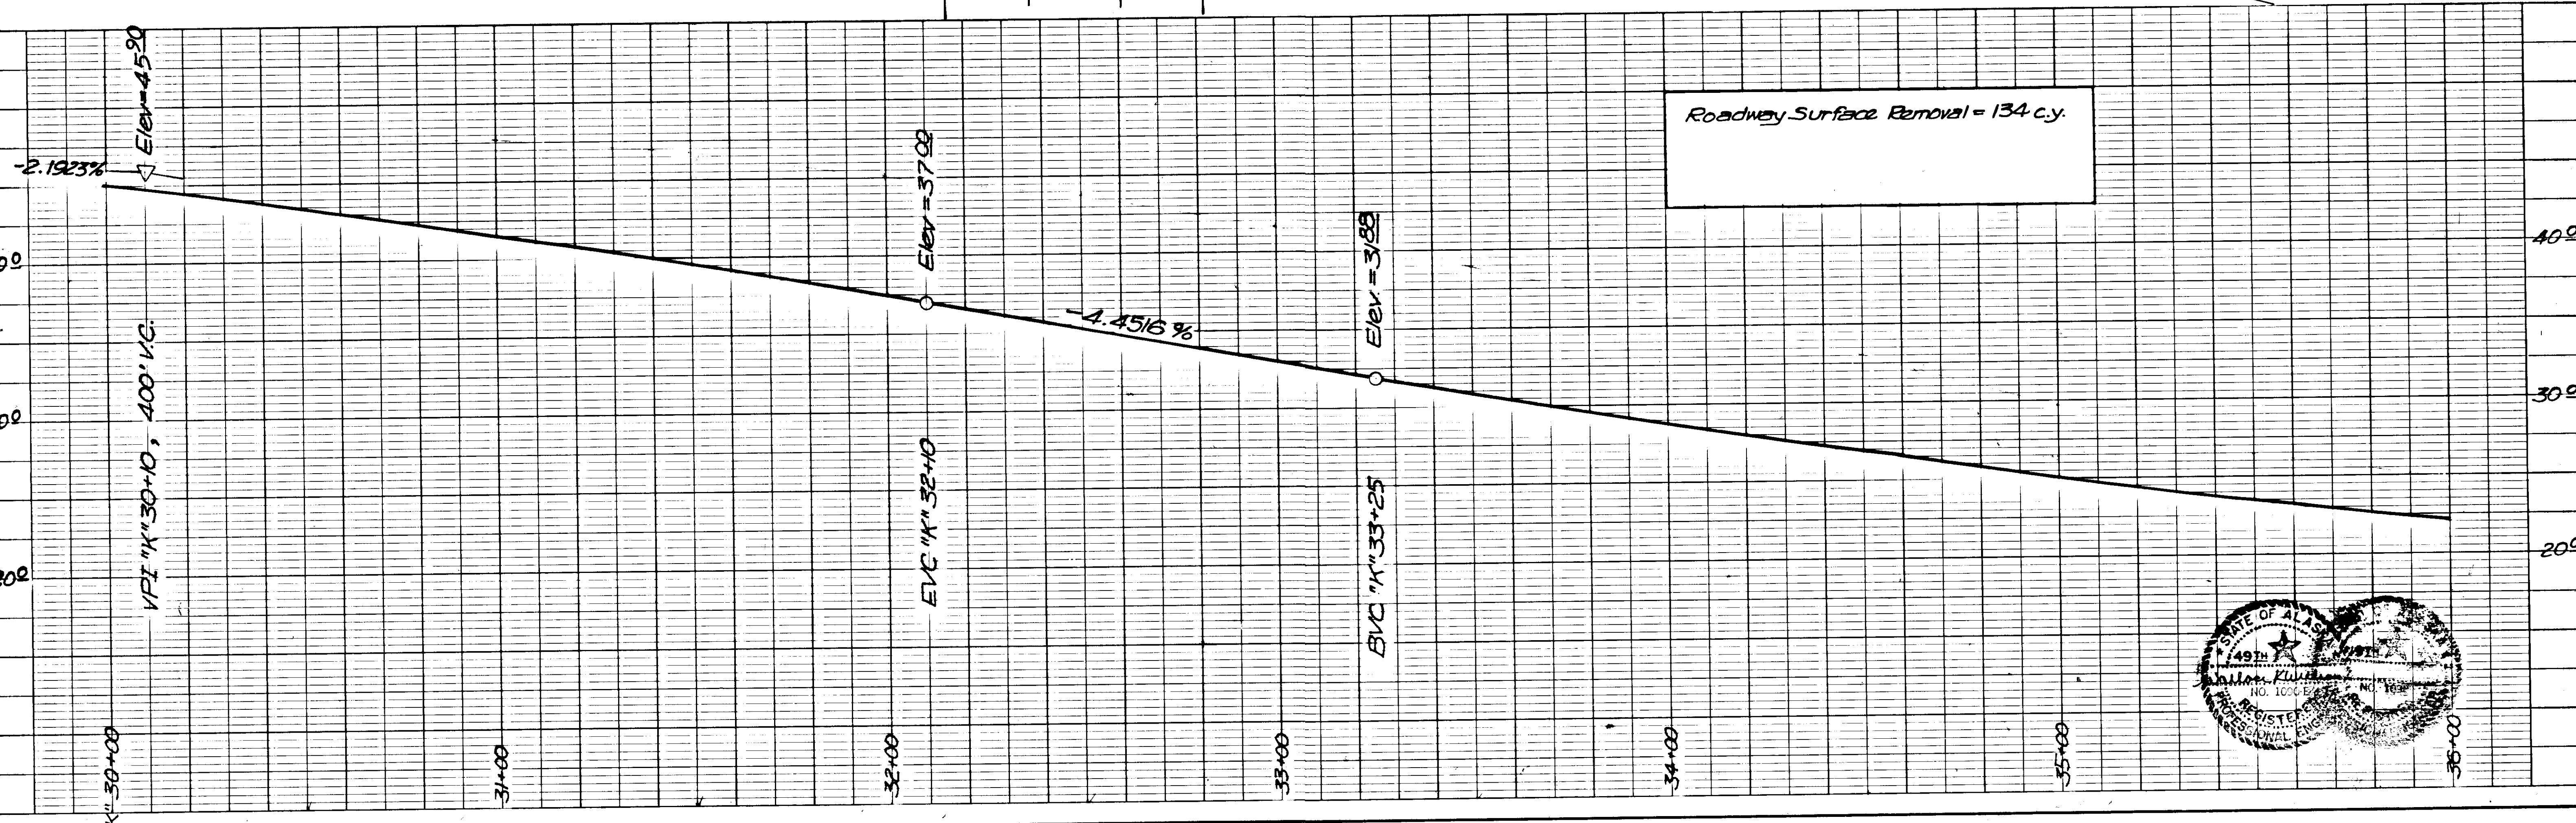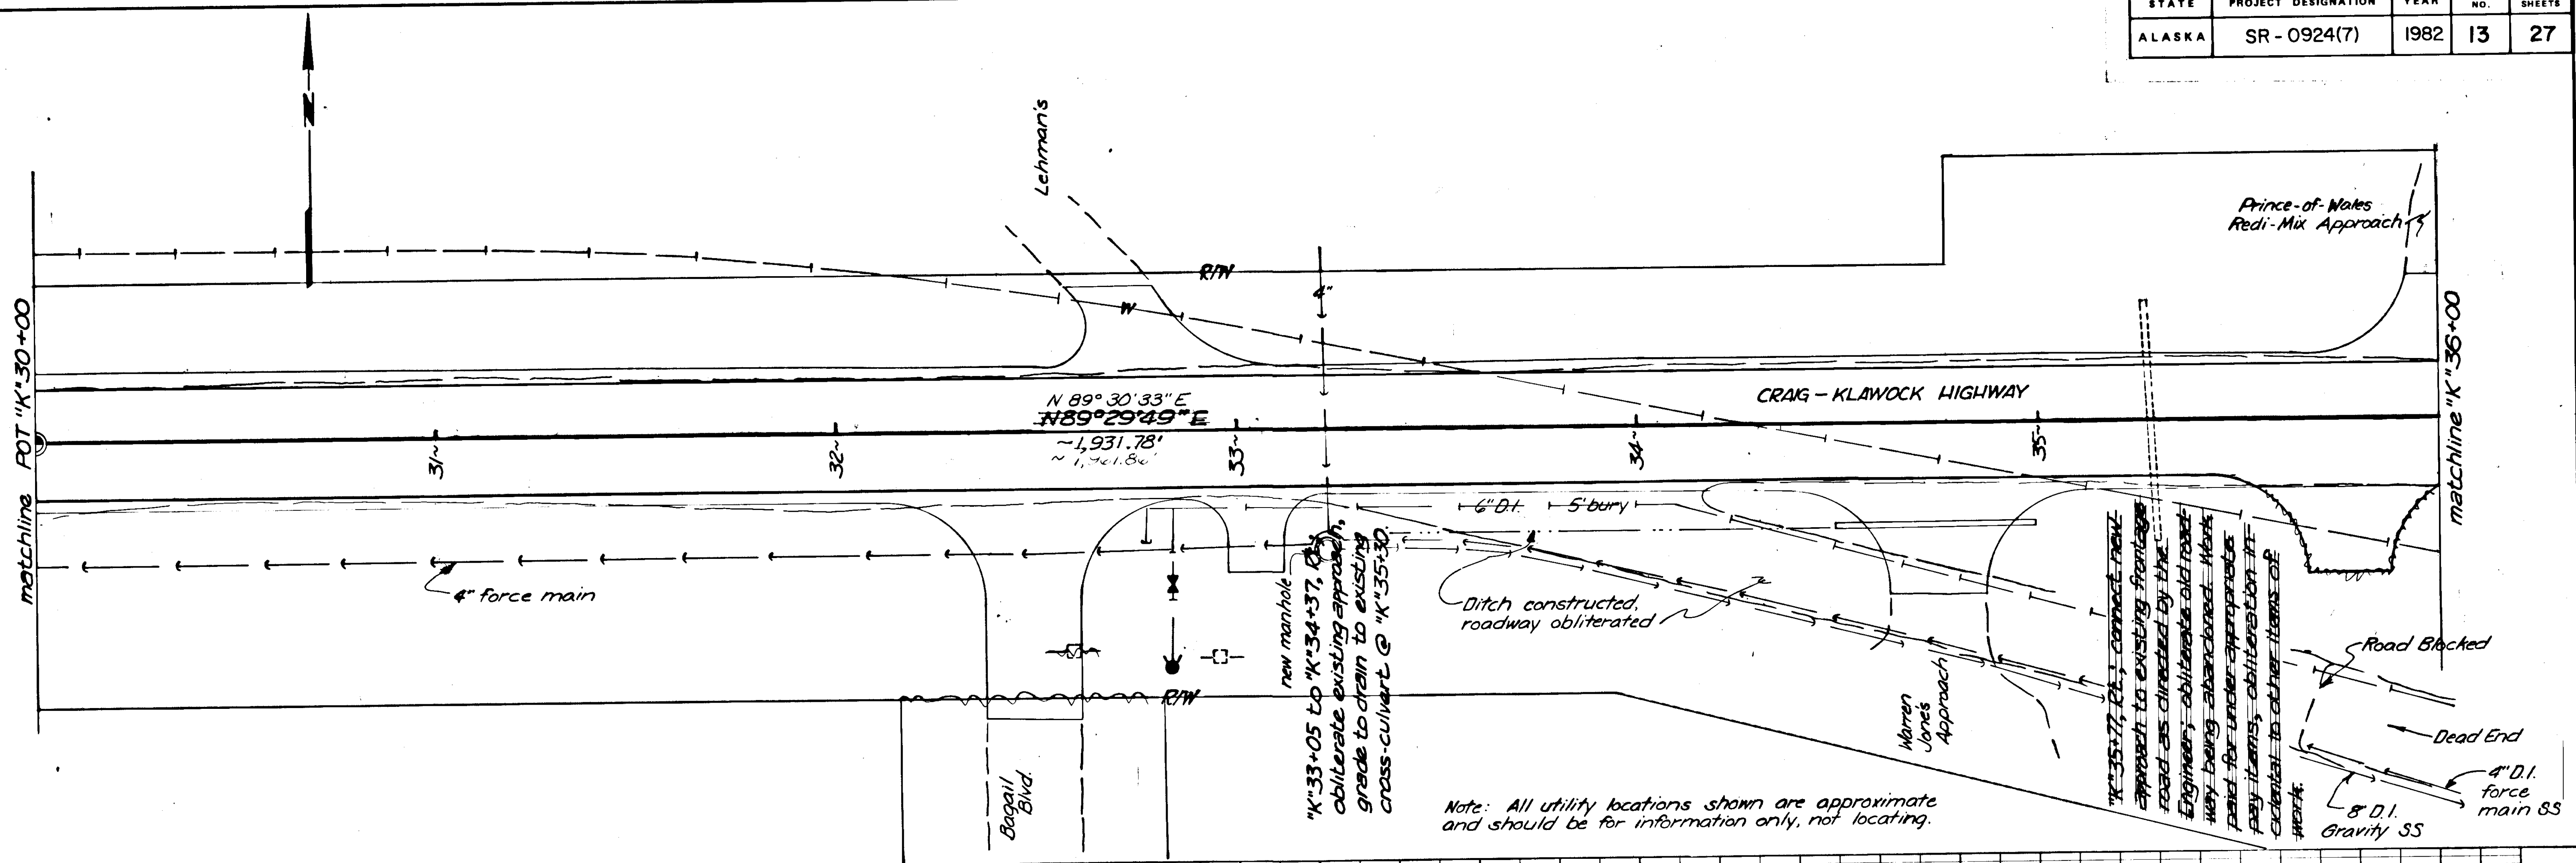

STATE	PROJECT DESIGNATION	YEAR	SHEET NO.	TOTAL SHEETS
ALASKA	SR-0924 (7)	1982	14	27

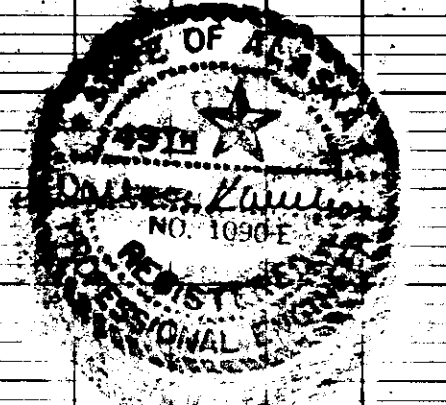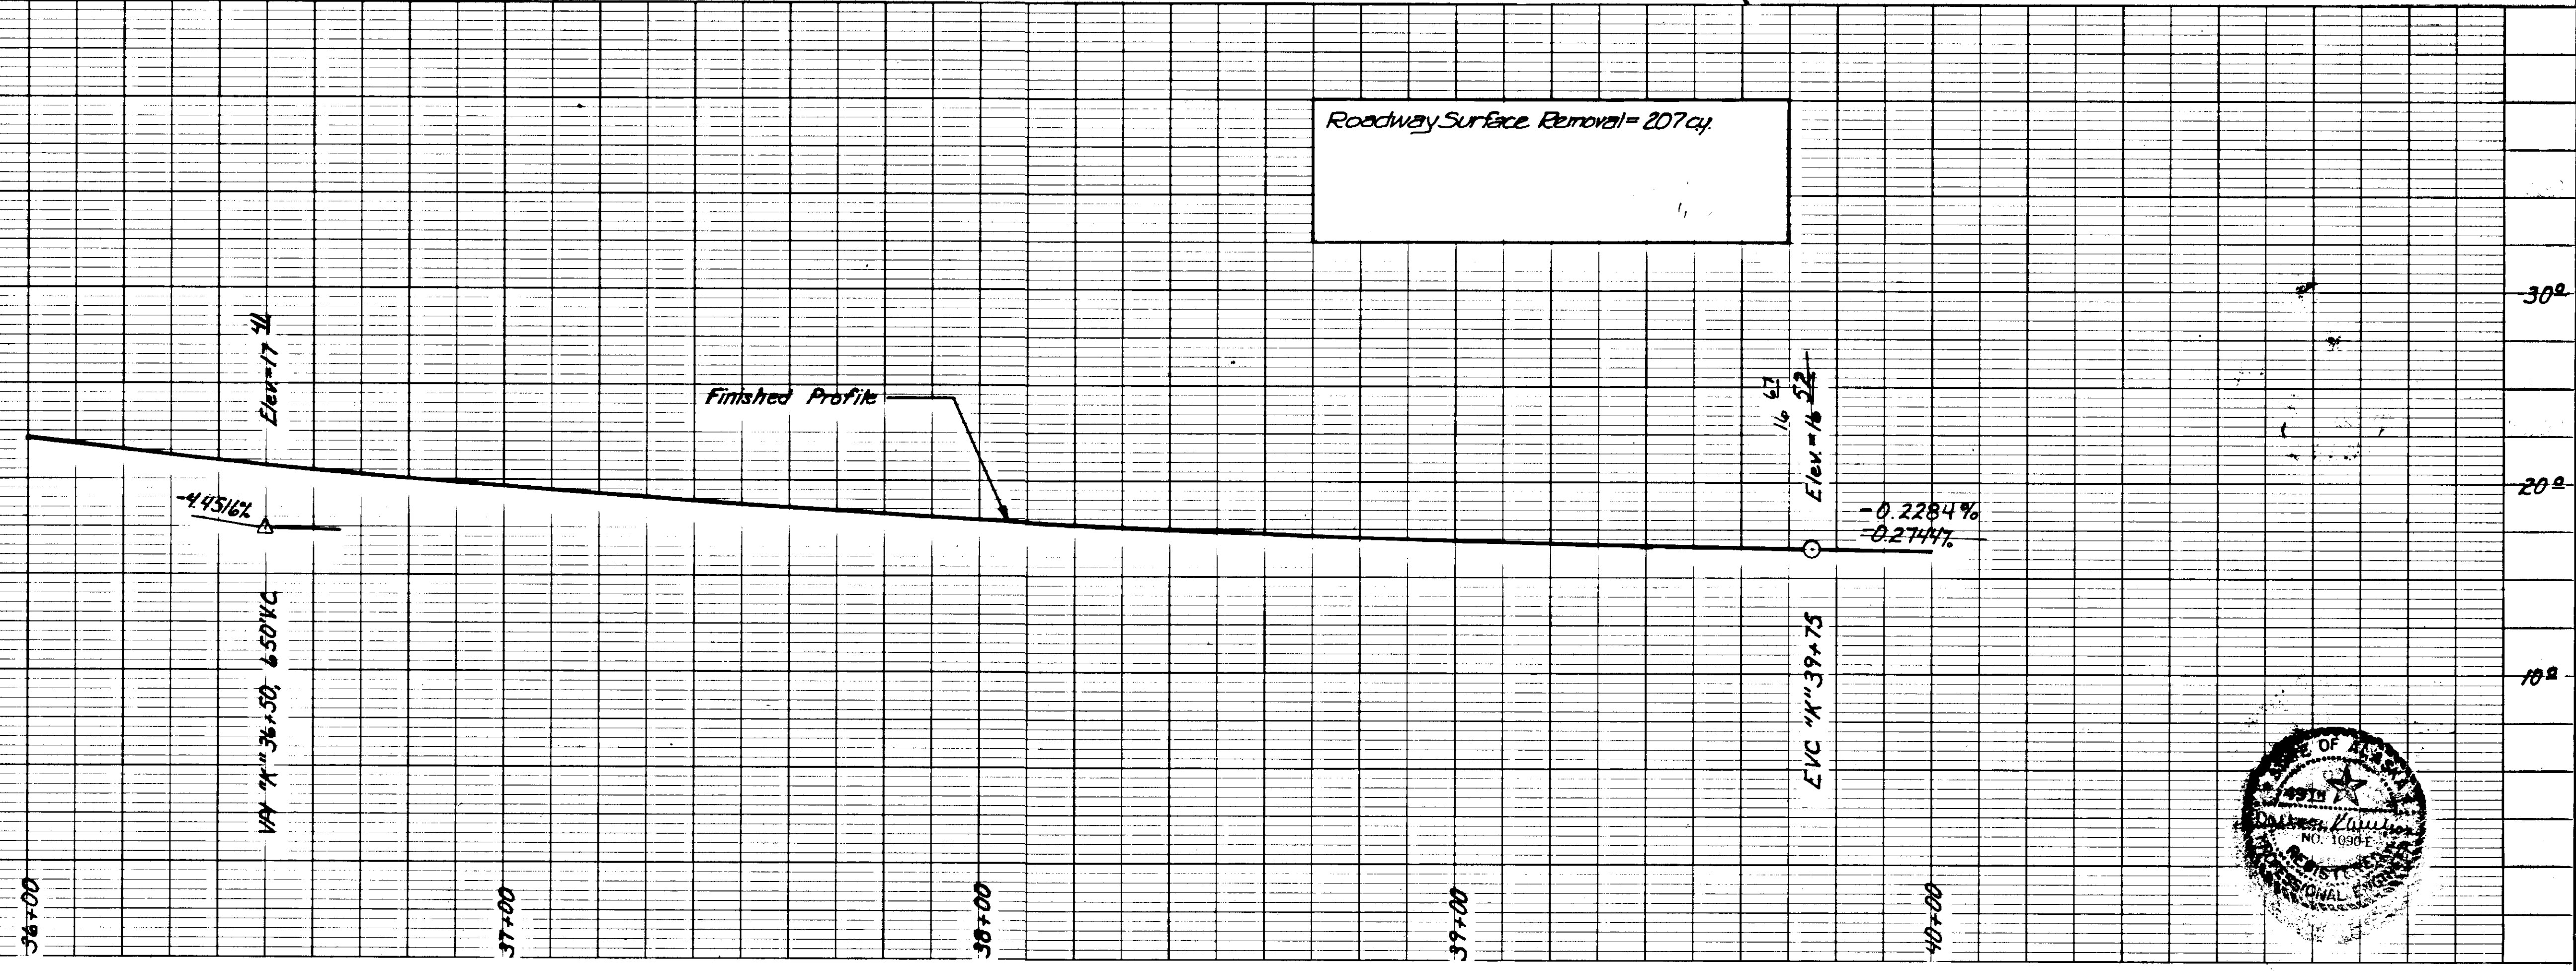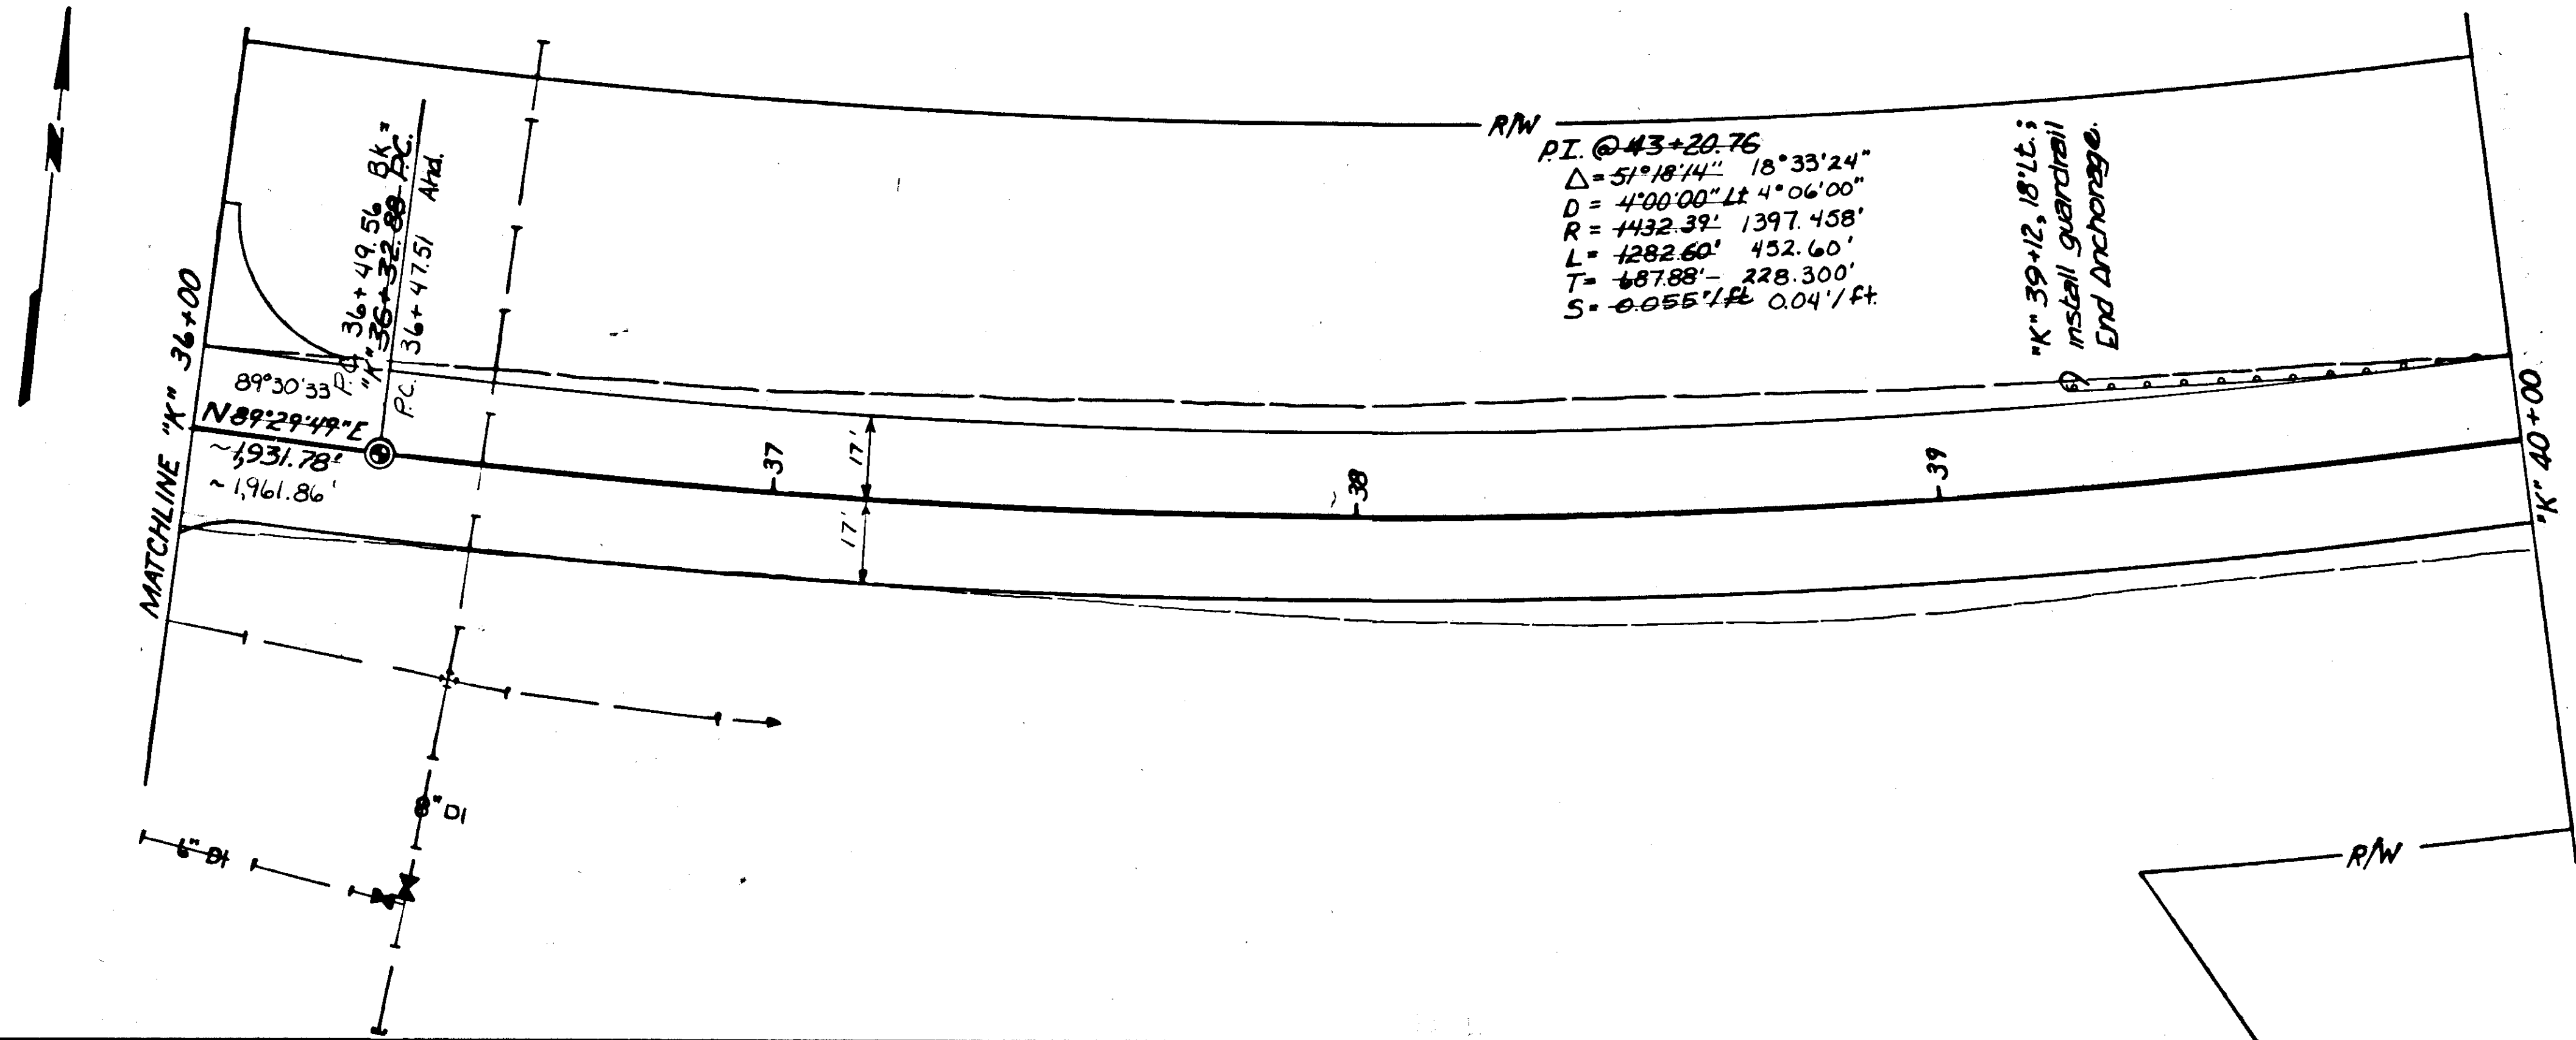

STATE	PROJECT DESIGNATION	YEAR	SHEET NO.	TOTAL SHEETS
ALASKA	SR-0924 (7)	1982	15	27

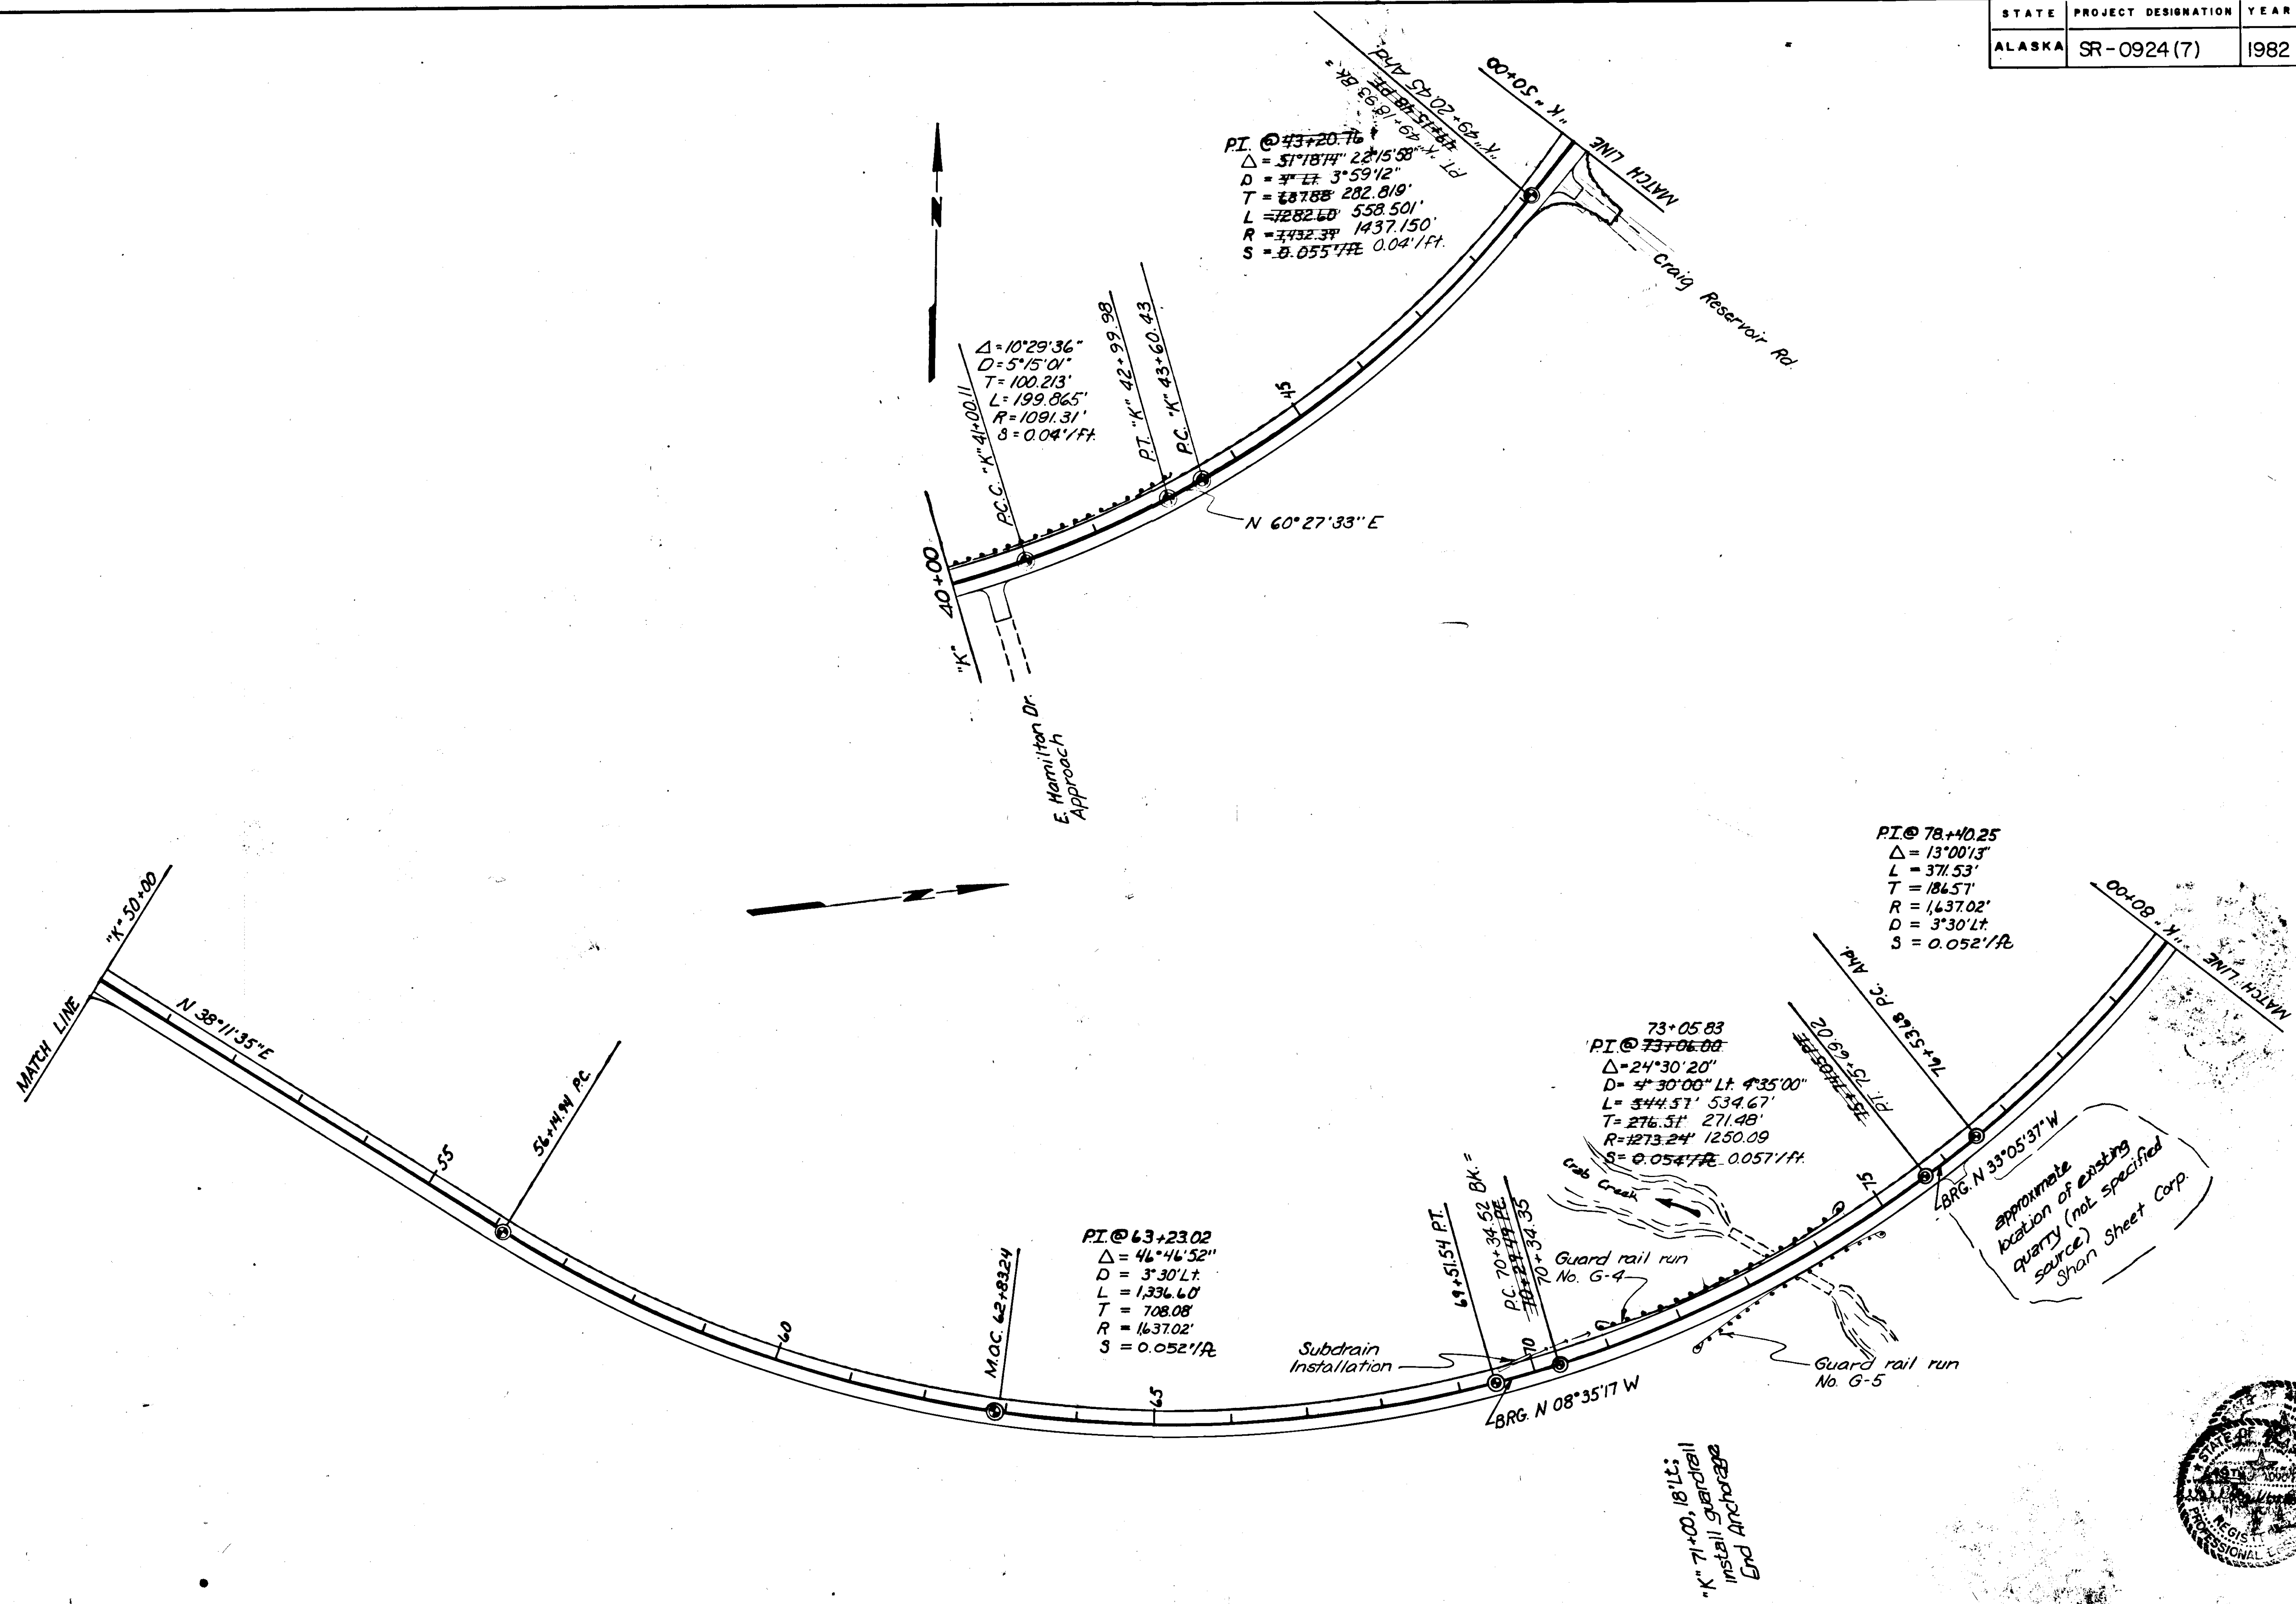

P.I. @ 43+20.76
 $\Delta = 51^{\circ}18'14''$ 22'15.58"
 $D = 4^{\circ}47'$ 3"59.42"
 $T = 487.88'$ 282.819'
 $L = 7282.60'$ 558.501'
 $R = 3432.39'$ 1437.150'
 $S = 0.055'/ft$ 0.04'/ft.

$\Delta = 10^{\circ}29'36''$
 $D = 5^{\circ}15'01''$
 $T = 100.213'$
 $L = 199.865'$
 $R = 1091.31'$
 $S = 0.04'/ft$


P.I. @ 78+40.25
 $\Delta = 13^{\circ}00'13''$
 $L = 371.53'$
 $T = 184.57'$
 $R = 1437.02'$
 $D = 3^{\circ}30'14''$
 $S = 0.052'/ft$

73+05.83
 P.I. @ 73+06.00
 $\Delta = 24^{\circ}30'20''$
 $D = 4^{\circ}30'00''$ Lt. 4'35.00"
 $L = 544.57'$ 539.67'
 $T = 276.51'$ 271.48'
 $R = 1273.24'$ 1250.09'
 $S = 0.0547'/ft$ 0.057'/ft.

P.I. @ 63+23.02
 $\Delta = 46^{\circ}46'52''$
 $D = 3^{\circ}30'17''$
 $L = 1336.60'$
 $T = 708.08'$
 $R = 1637.02'$
 $S = 0.052'/ft$

approximate location of existing quarry (not specified source) Shan Sheet Corp.


"K" 71+00, 18' Lt.
 install guardrail
 End Anchorage

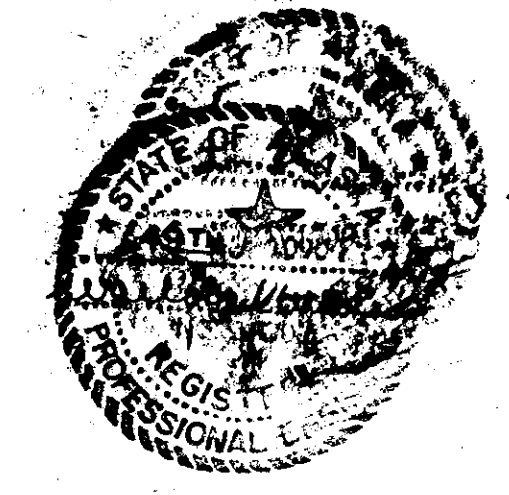



STATE	PROJECT DESIGNATION	YEAR	SHEET NO.	TOTAL SHEETS
ALASKA	SR-0924(7)	1982	16	27

"K" 85+00 to "K" 87+00: raise existing grade 6", 50' trench. Estimated quantity = 527 tons Selected Material.

PI. @ 103+45.63
 $\Delta = 62^{\circ}56'07''$ $62^{\circ}55'48''$
 $D = 5^{\circ}47'$ $5^{\circ}00'01''$
 $T = 701.33'$ $701.223'$
 $L = 1258.71'$ $1258.542'$
 $R = 1145.92'$ $1145.862'$
 $S = 0.056'/ft$

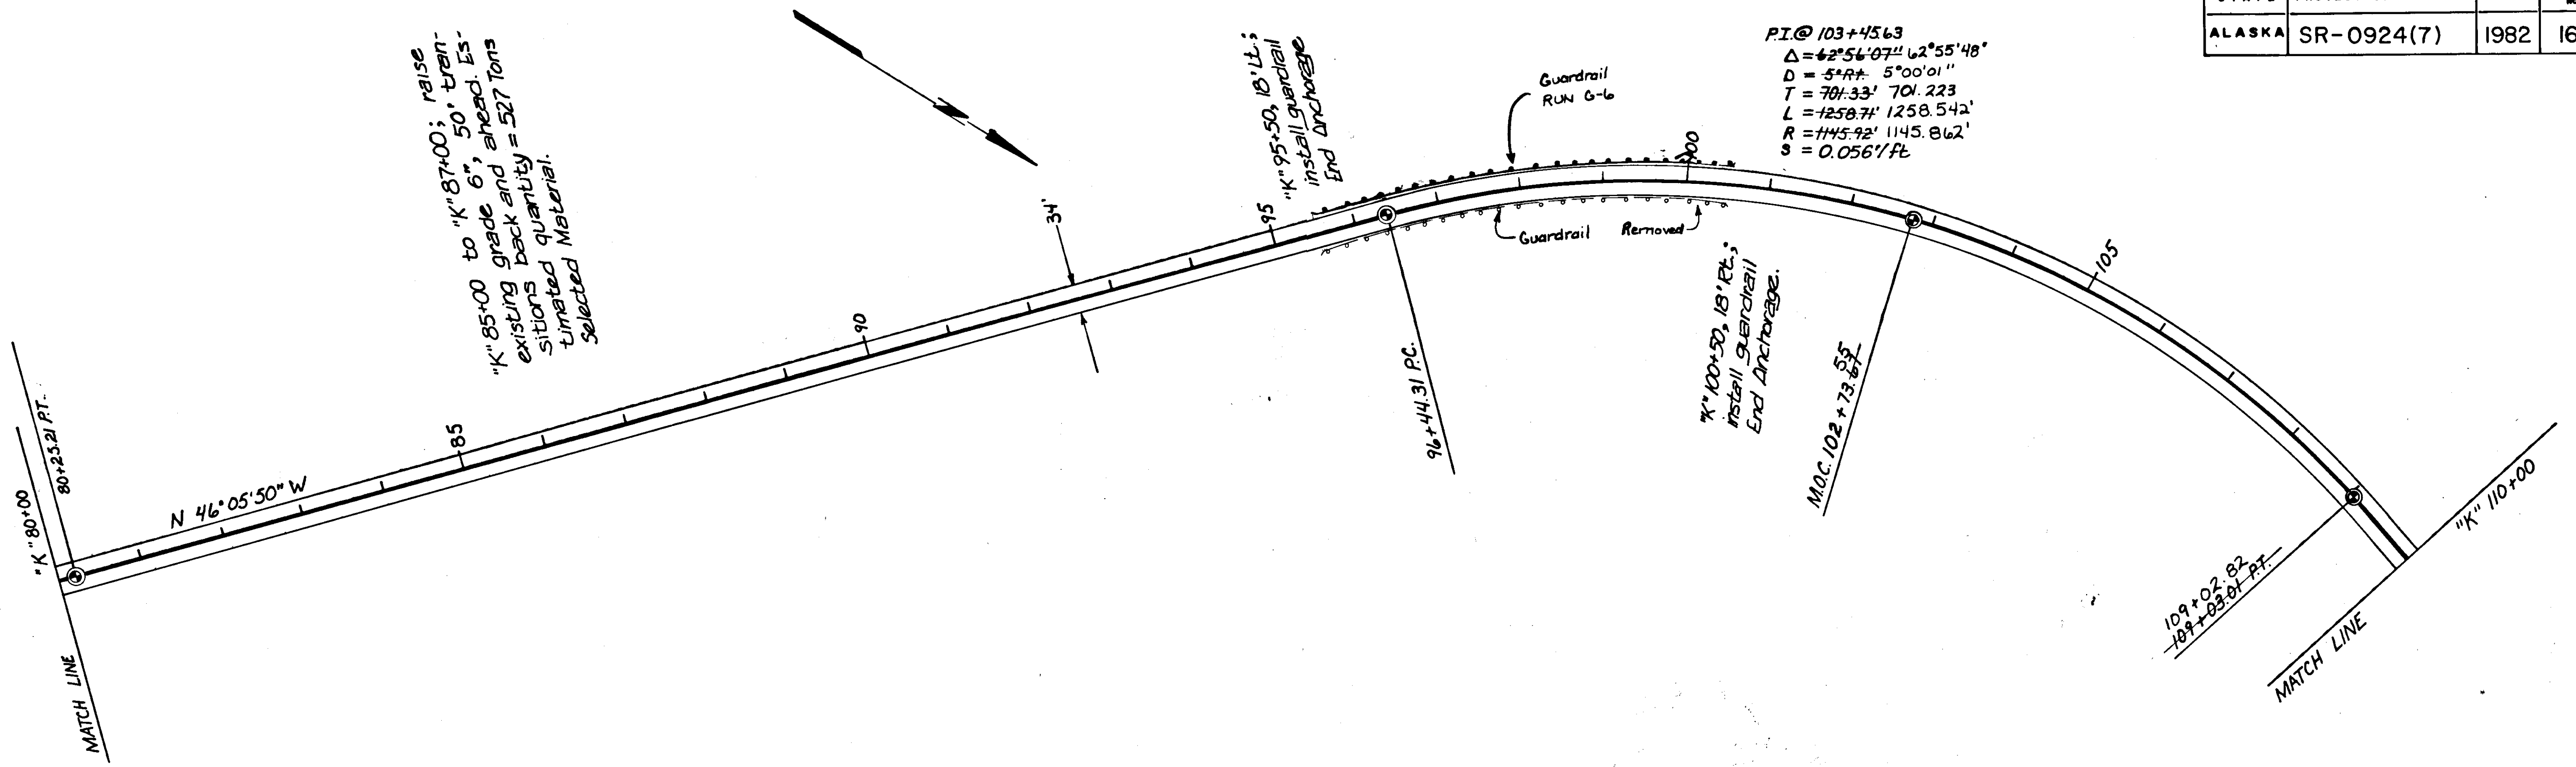


PI. @ 124+69.81
 $\Delta = 20^{\circ}44'31''$ $20^{\circ}44'50''$
 $D = 3^{\circ}47'$ $3^{\circ}00'01''$
 $T = 349.52'$ $349.599'$
 $L = 691.40'$ $691.542'$
 $R = 1909.86'$ $1909.770'$
 $S = 0.049'/ft$

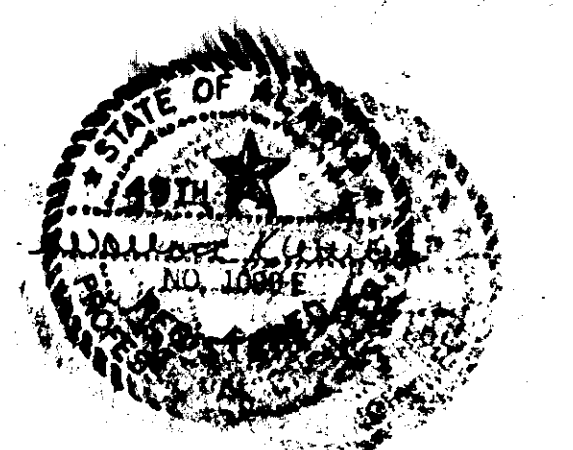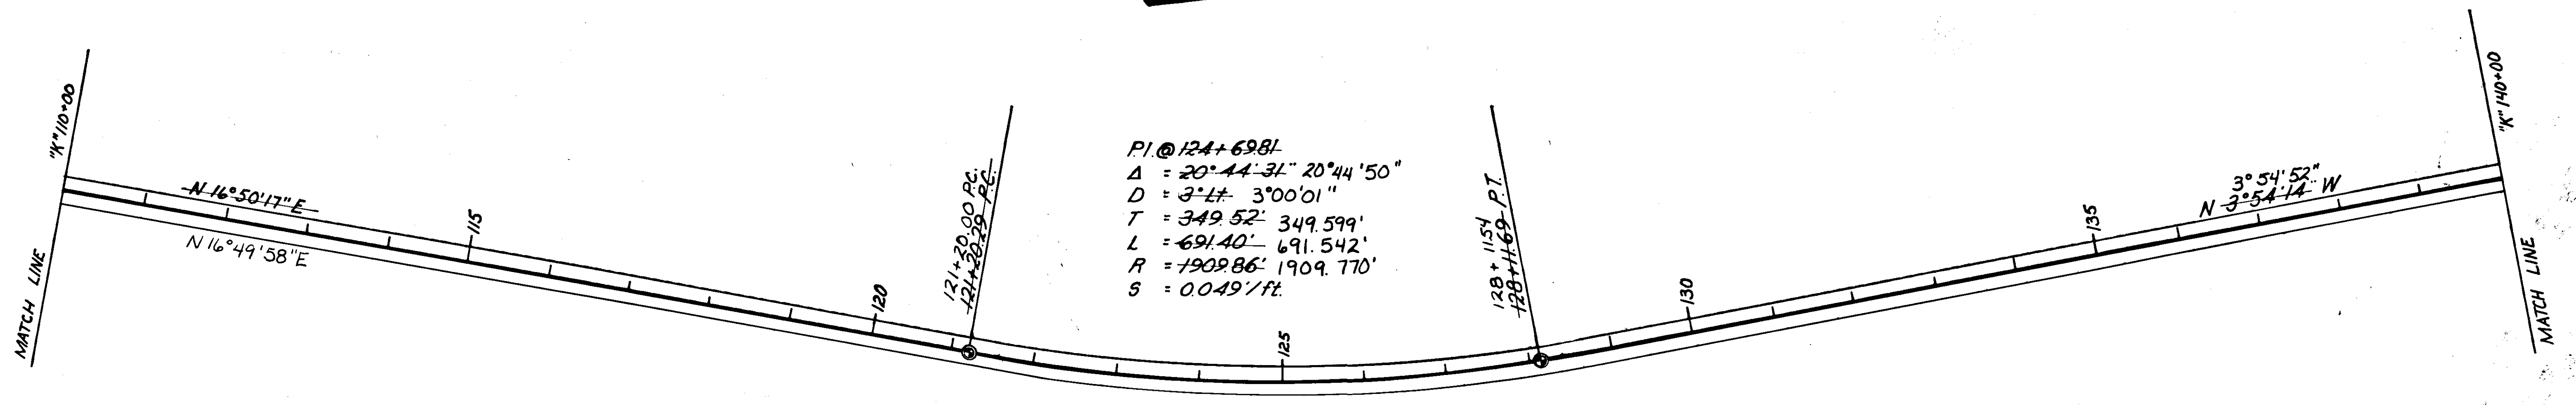

STATE	PROJECT DESIGNATION	YEAR	SHEET NO.	TOTAL SHEETS
ALASKA	SR-0924(7)	1982	17	27

P.I. @ 152+39.09
 $\Delta = 11^{\circ}42'20''$ 11'41"43"
 $D = 2^{\circ}$ Rt.
 $T = 293.66$ 293.388'
 $L = 585.28$ 584.737'
 $R = 2864.79$ 2864.656'
 $S = 0.040$ 1/ft.

Bearing Change: (angle point)
 Semi tangent brg. = N 07°46'51" E (Bk)
 tangent brg. = N 07°47'32" E Ahd.
 (0°0'41" Rt.)

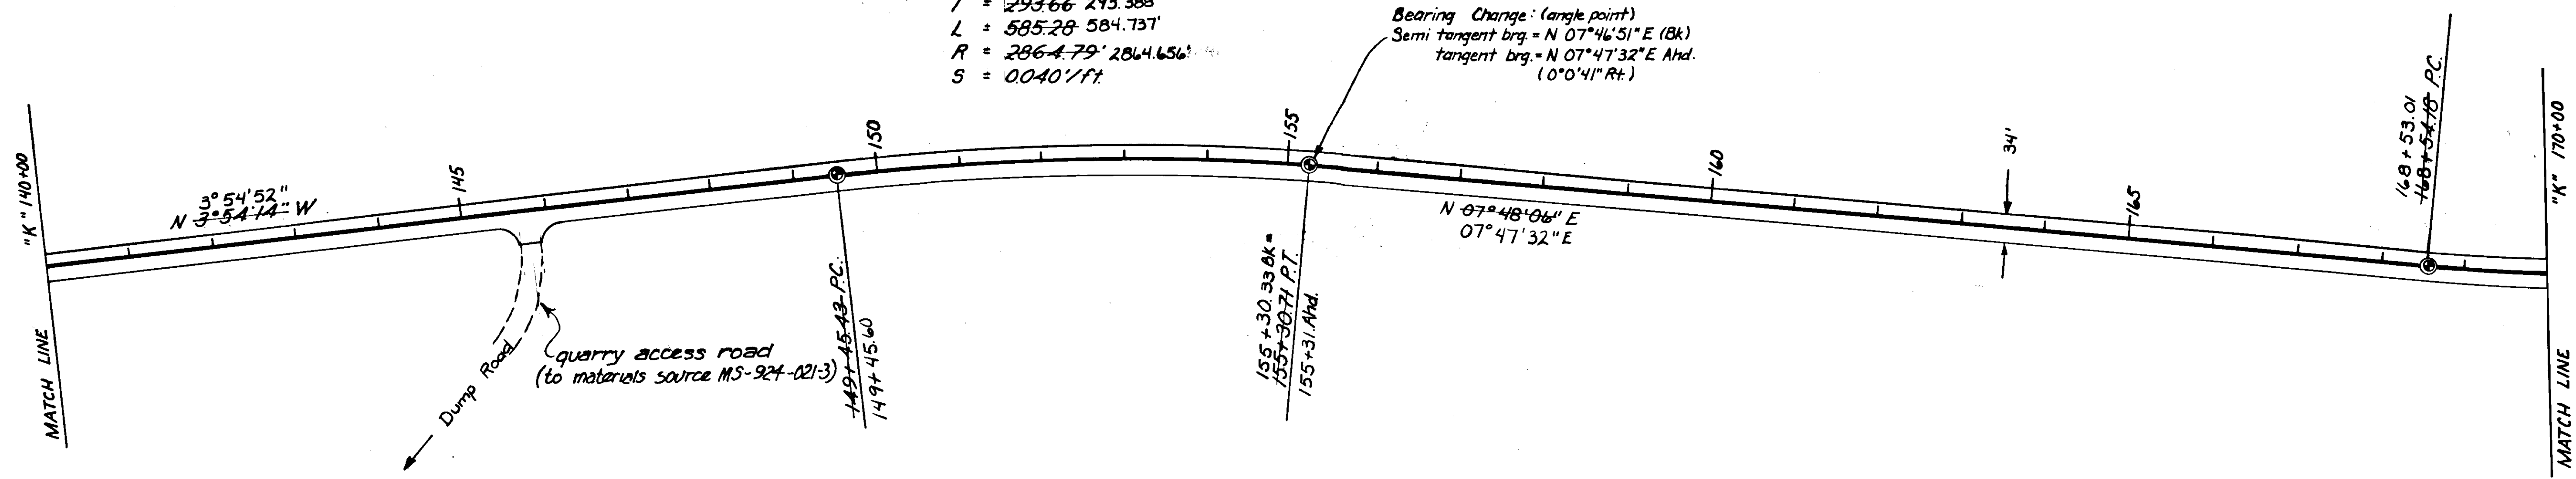


P.I. @ 179+79.05
 $\Delta = 35^{\circ}15'57''$
 $D = 5^{\circ}$ Rt.
 $T = 364.23'$
 $L = 705.32'$
 $R = 1145.92'$
 $S = 0.056$ 1/ft.


P.I. @ 192+27.70
 $\Delta = 21^{\circ}01'41''$
 $D = 7^{\circ}$ Rt.
 $T = 151.91'$
 $L = 300.40'$
 $R = 818.51'$
 $S = 0.060$ 1/ft.

P.I. @ 187+45.57
 $\Delta = 22^{\circ}52'30''$
 $D = 7^{\circ}$ Lt.
 $T = 165.60'$
 $R = 818.51'$
 $L = 326.78'$
 $S = 0.060$ 1/ft.

$\Delta = 20^{\circ}01'20''$
 $D = 5^{\circ}00'00''$
 $T = 202.285'$
 $L = 400.444'$
 $R = 1145.916'$

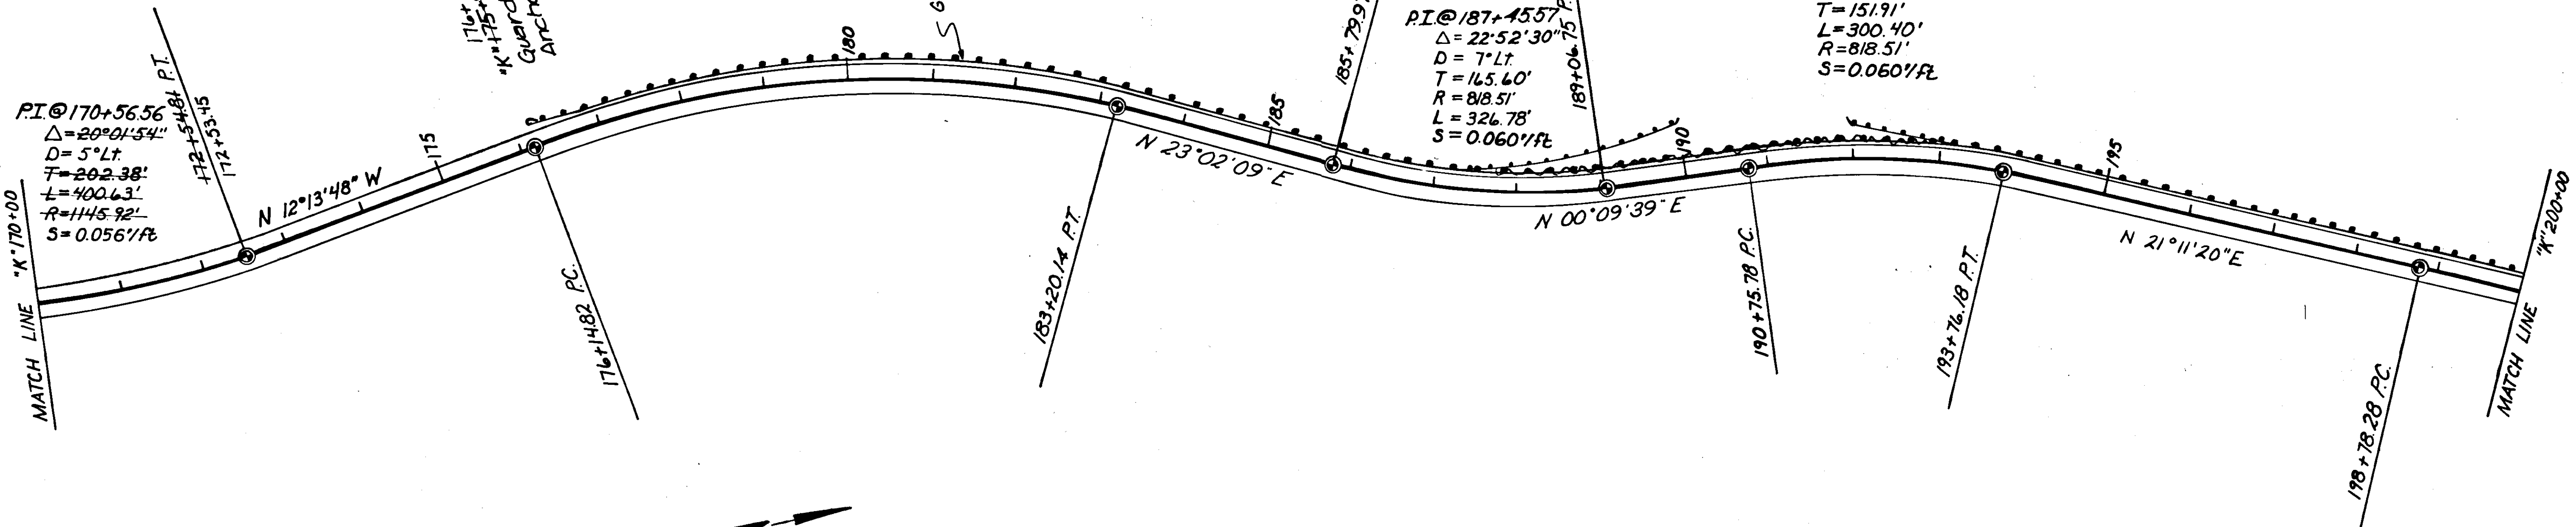

STATE	PROJECT DESIGNATION	YEAR	SHEET NO.	TOTAL SHEETS
ALASKA	SR-0924(7)	1982	18	27

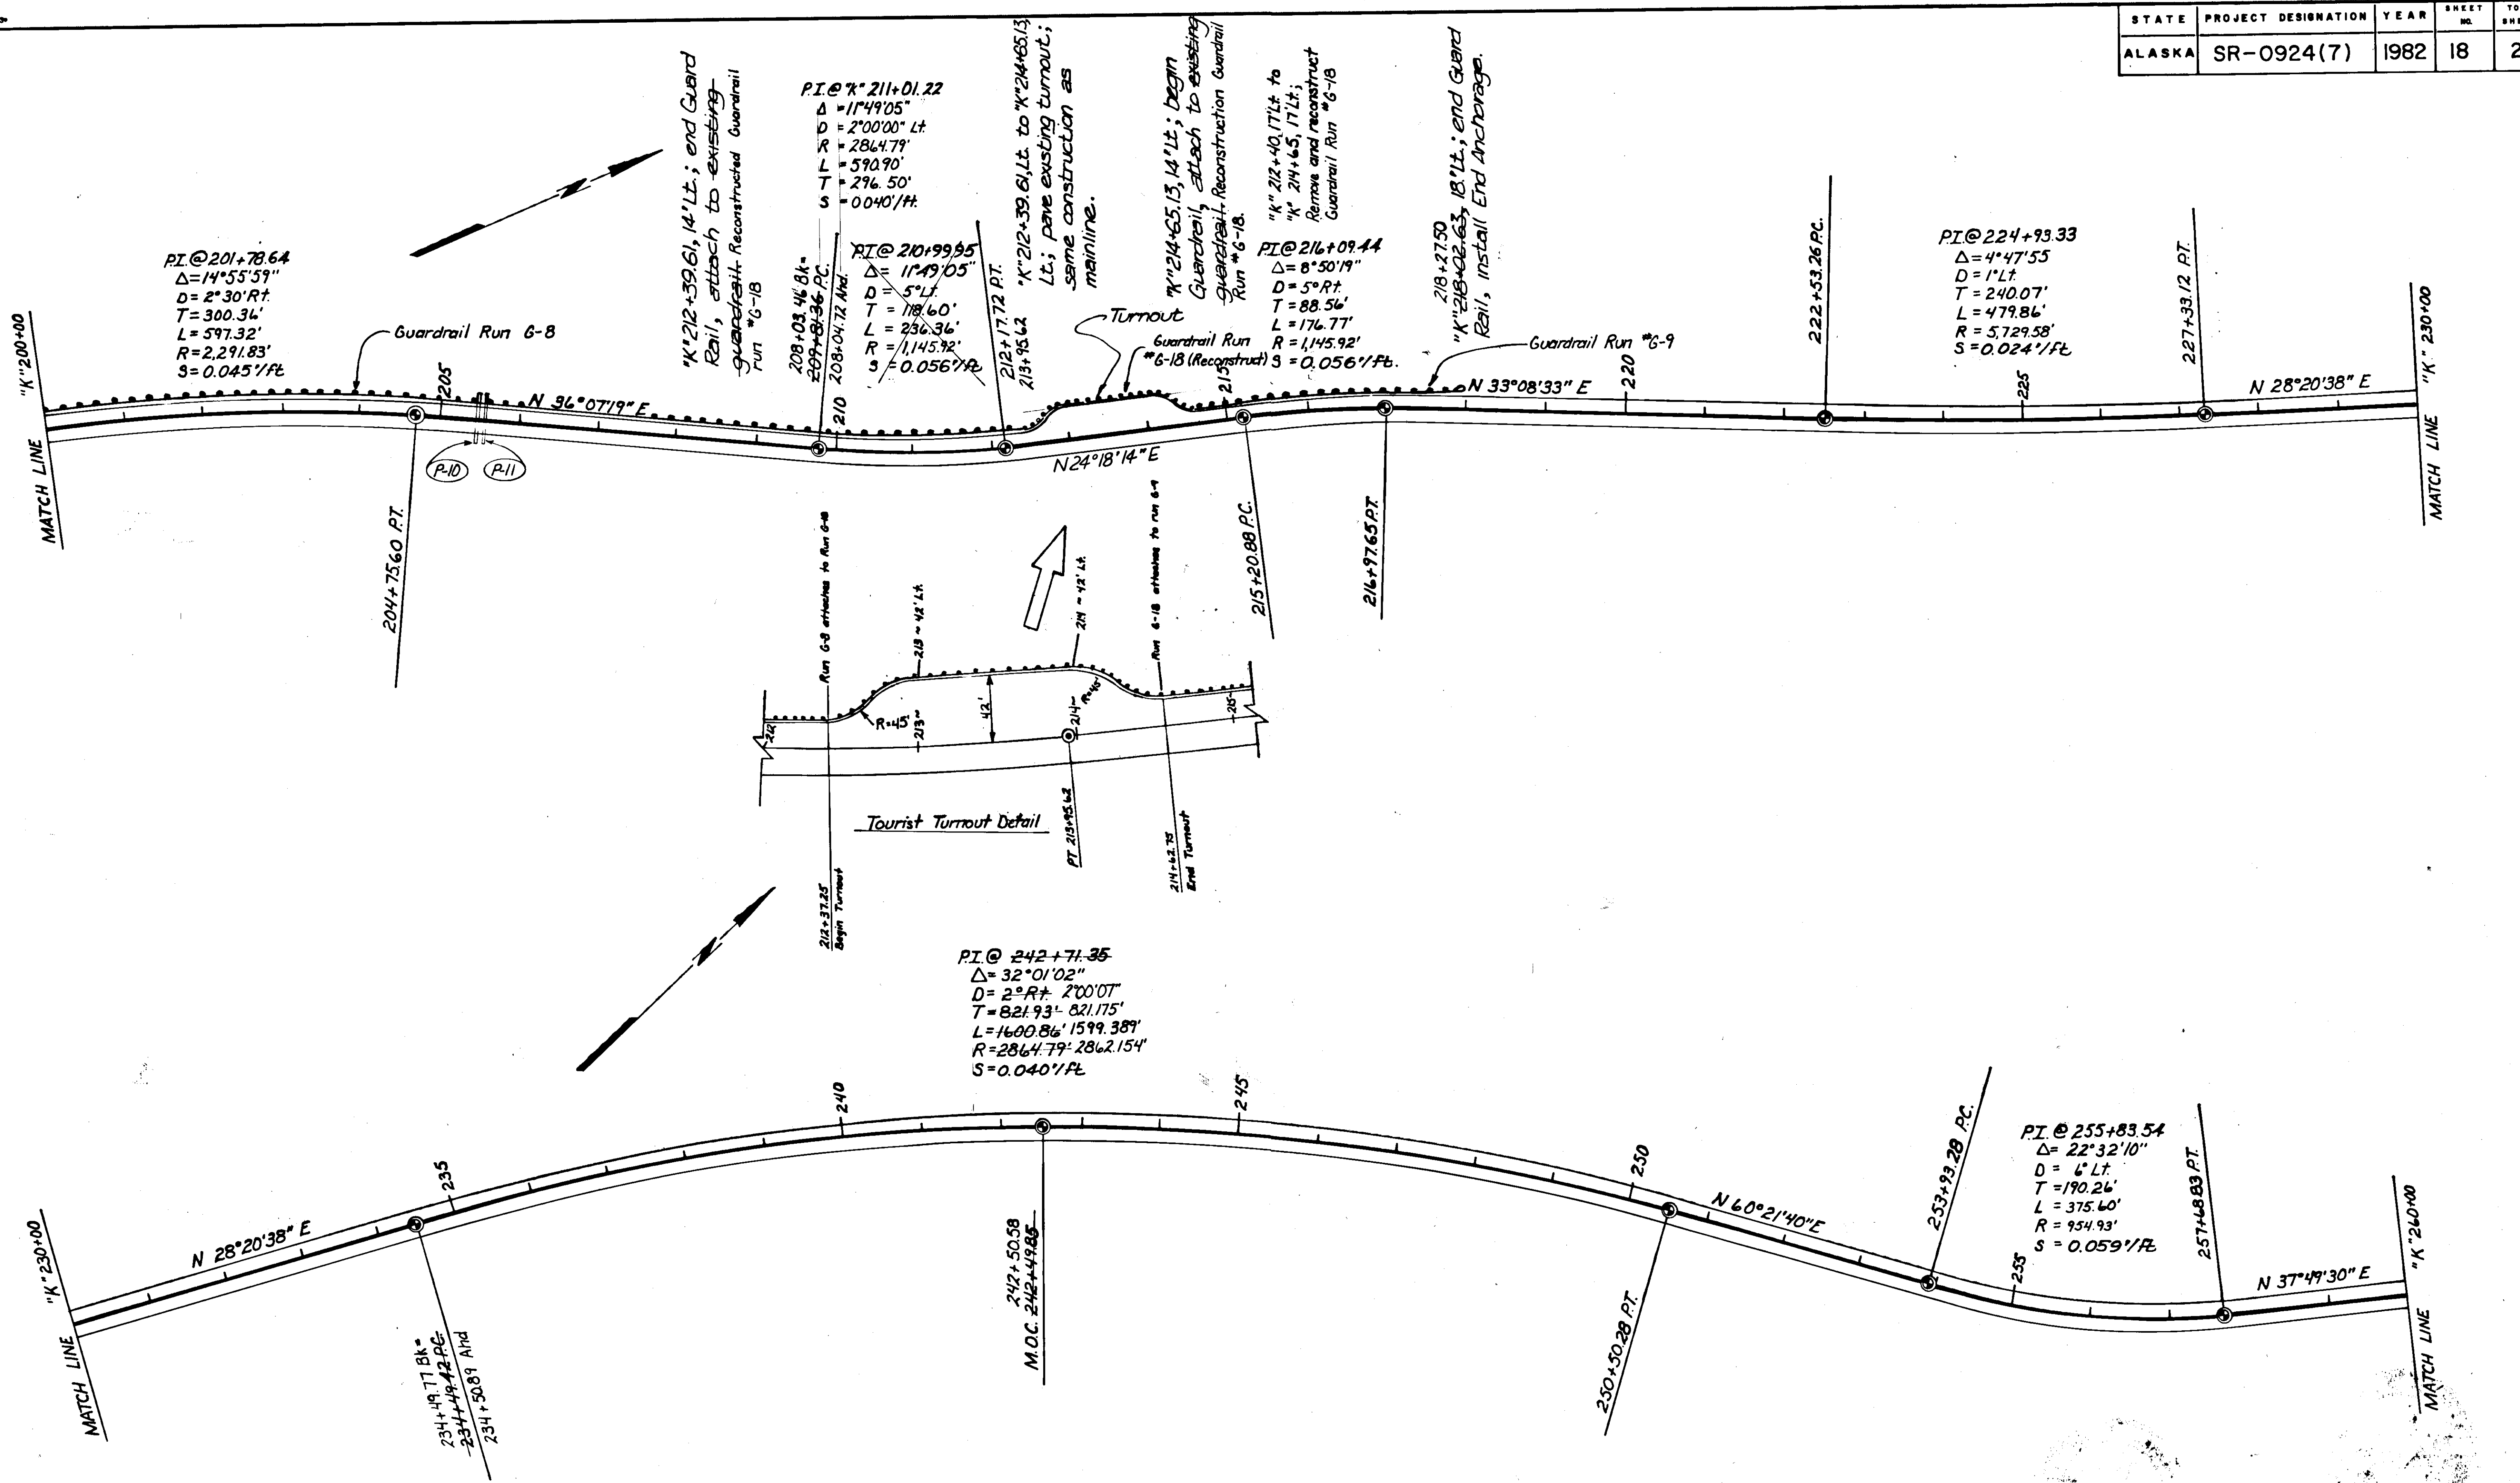

PI @ 201+78.64
 $\Delta = 14^\circ 55' 59''$
 $D = 2^\circ 30' R$
 $T = 300.34'$
 $L = 597.32'$
 $R = 2,291.83'$
 $S = 0.045'/ft$

"K" 212+39.61, 14' Lt.; end Guard Rail, attach to existing guardrail. Reconstruct Guardrail Run #6-18

PI @ 211+01.22
 $\Delta = 11^\circ 49' 05''$
 $D = 2^\circ 00' 00'' L$
 $R = 2864.79'$
 $L = 590.90'$
 $T = 296.50'$
 $S = 0.040'/ft$

PI @ 210+99.95
 $\Delta = 11^\circ 49' 05''$
 $D = 5^\circ L$
 $T = 188.60'$
 $L = 236.36'$
 $R = 1,145.92'$
 $S = 0.056'/ft$

"K" 212+39.61 Lt. to "K" 214+65.13 Lt.; pave existing turnout; same construction as mainline.

Turnout
 Guardrail Run #6-18 (Reconstruct)

PI @ 216+09.44
 $\Delta = 8^\circ 50' 19''$
 $D = 5^\circ R$
 $T = 88.56'$
 $L = 176.77'$
 $R = 1,145.92'$
 $S = 0.056'/ft$

"K" 212+40.17 Lt. to "K" 214+65.13 Lt.; Remove and reconstruct Guardrail Run #6-18



PI @ 224+93.33
 $\Delta = 4^\circ 47' 55''$
 $D = 1^\circ L$
 $T = 240.07'$
 $L = 479.86'$
 $R = 5,729.58'$
 $S = 0.024'/ft$

PI @ 242+71.35
 $\Delta = 32^\circ 01' 02''$
 $D = 2^\circ R$
 $T = 821.93' - 821.175'$
 $L = 1600.86' - 1599.389'$
 $R = 2864.79' - 2862.154'$
 $S = 0.040'/ft$

PI @ 255+83.54
 $\Delta = 22^\circ 32' 10''$
 $D = 6^\circ L$
 $T = 190.26'$
 $L = 375.60'$
 $R = 954.93'$
 $S = 0.059'/ft$



STATE	PROJECT DESIGNATION	YEAR	SHEET NO.	TOTAL SHEETS
ALASKA	SR-0924(7)	1982	19	27

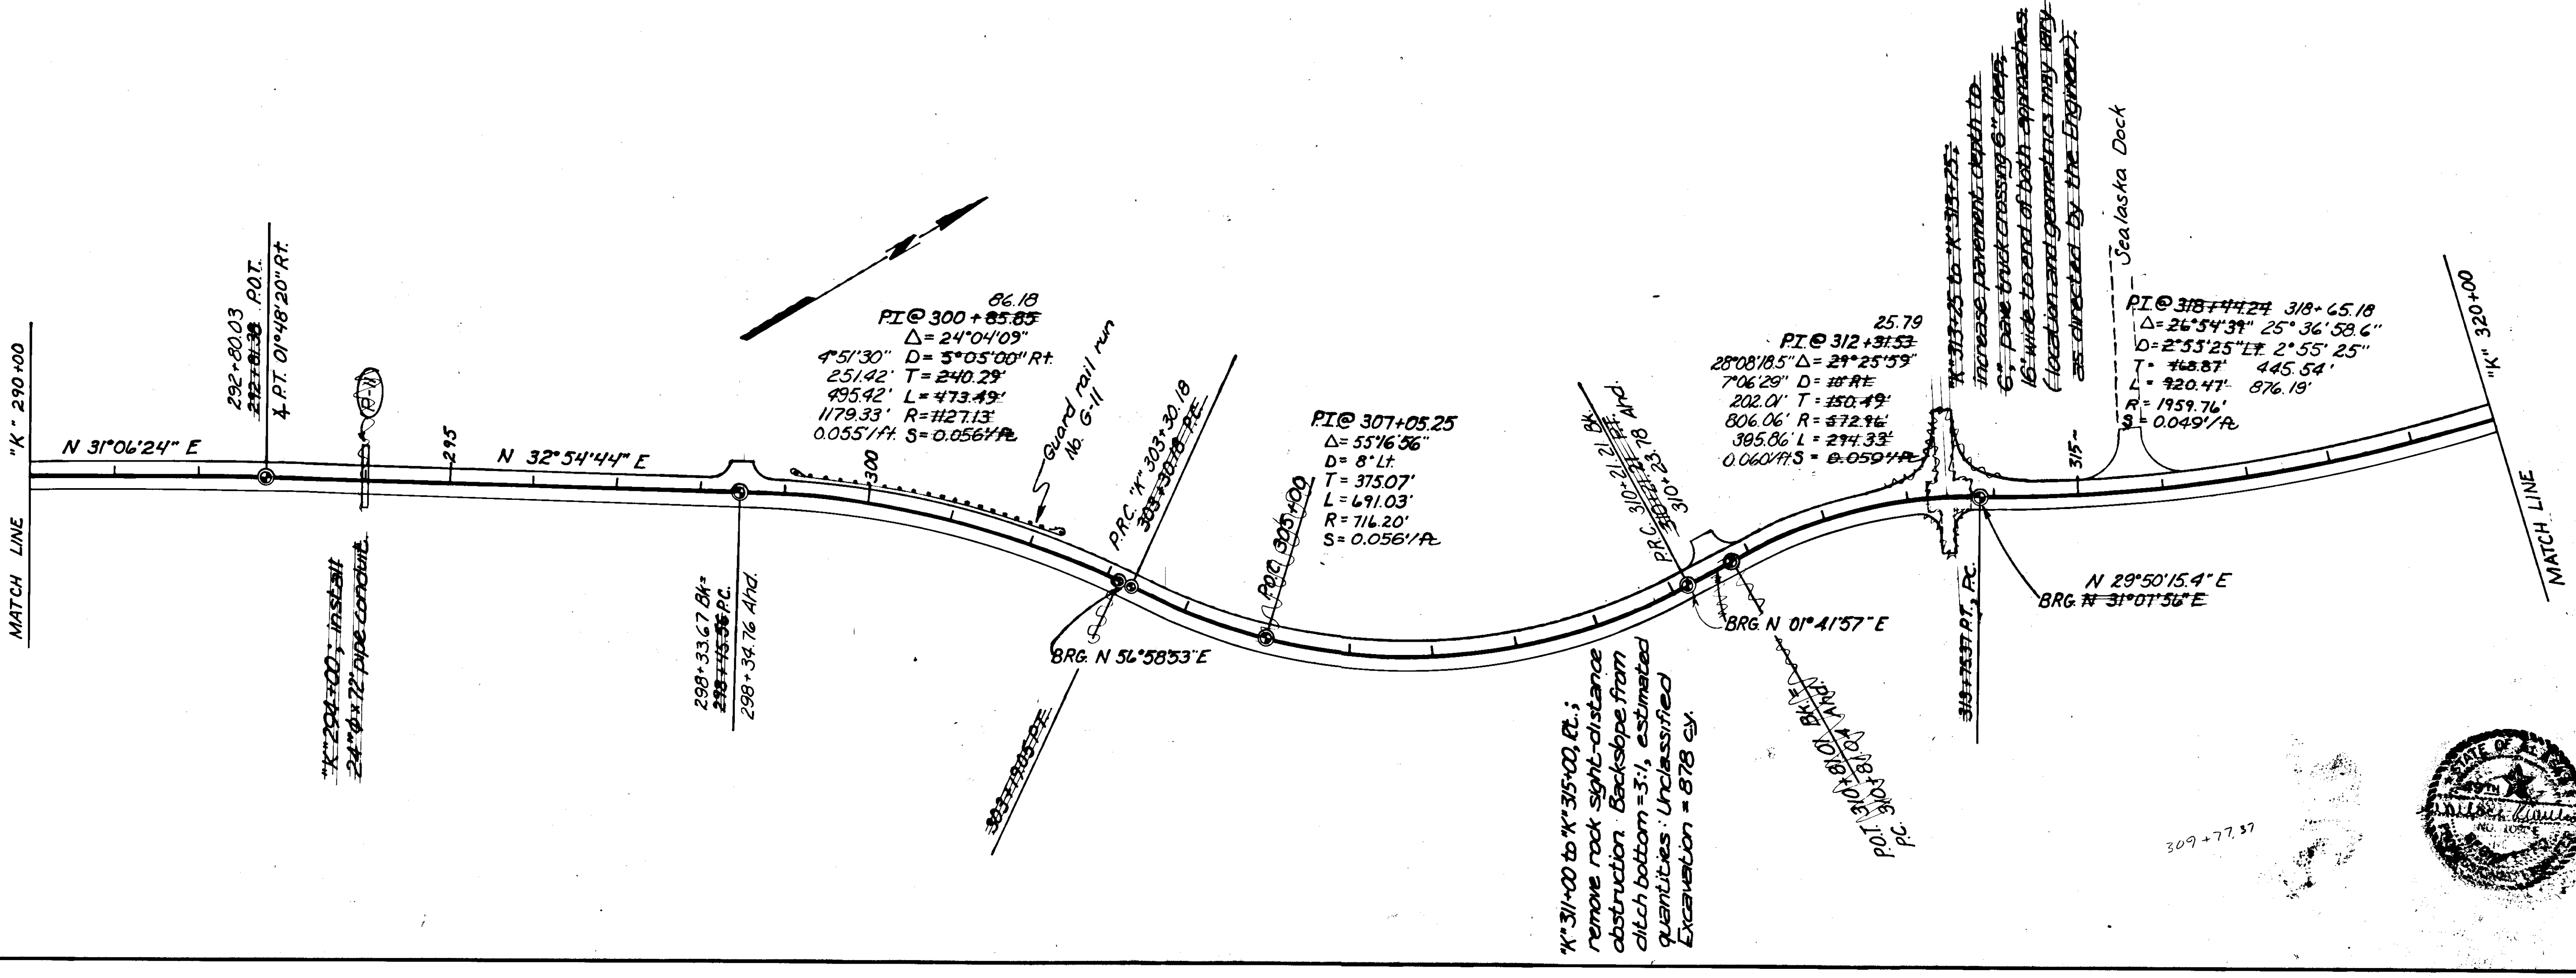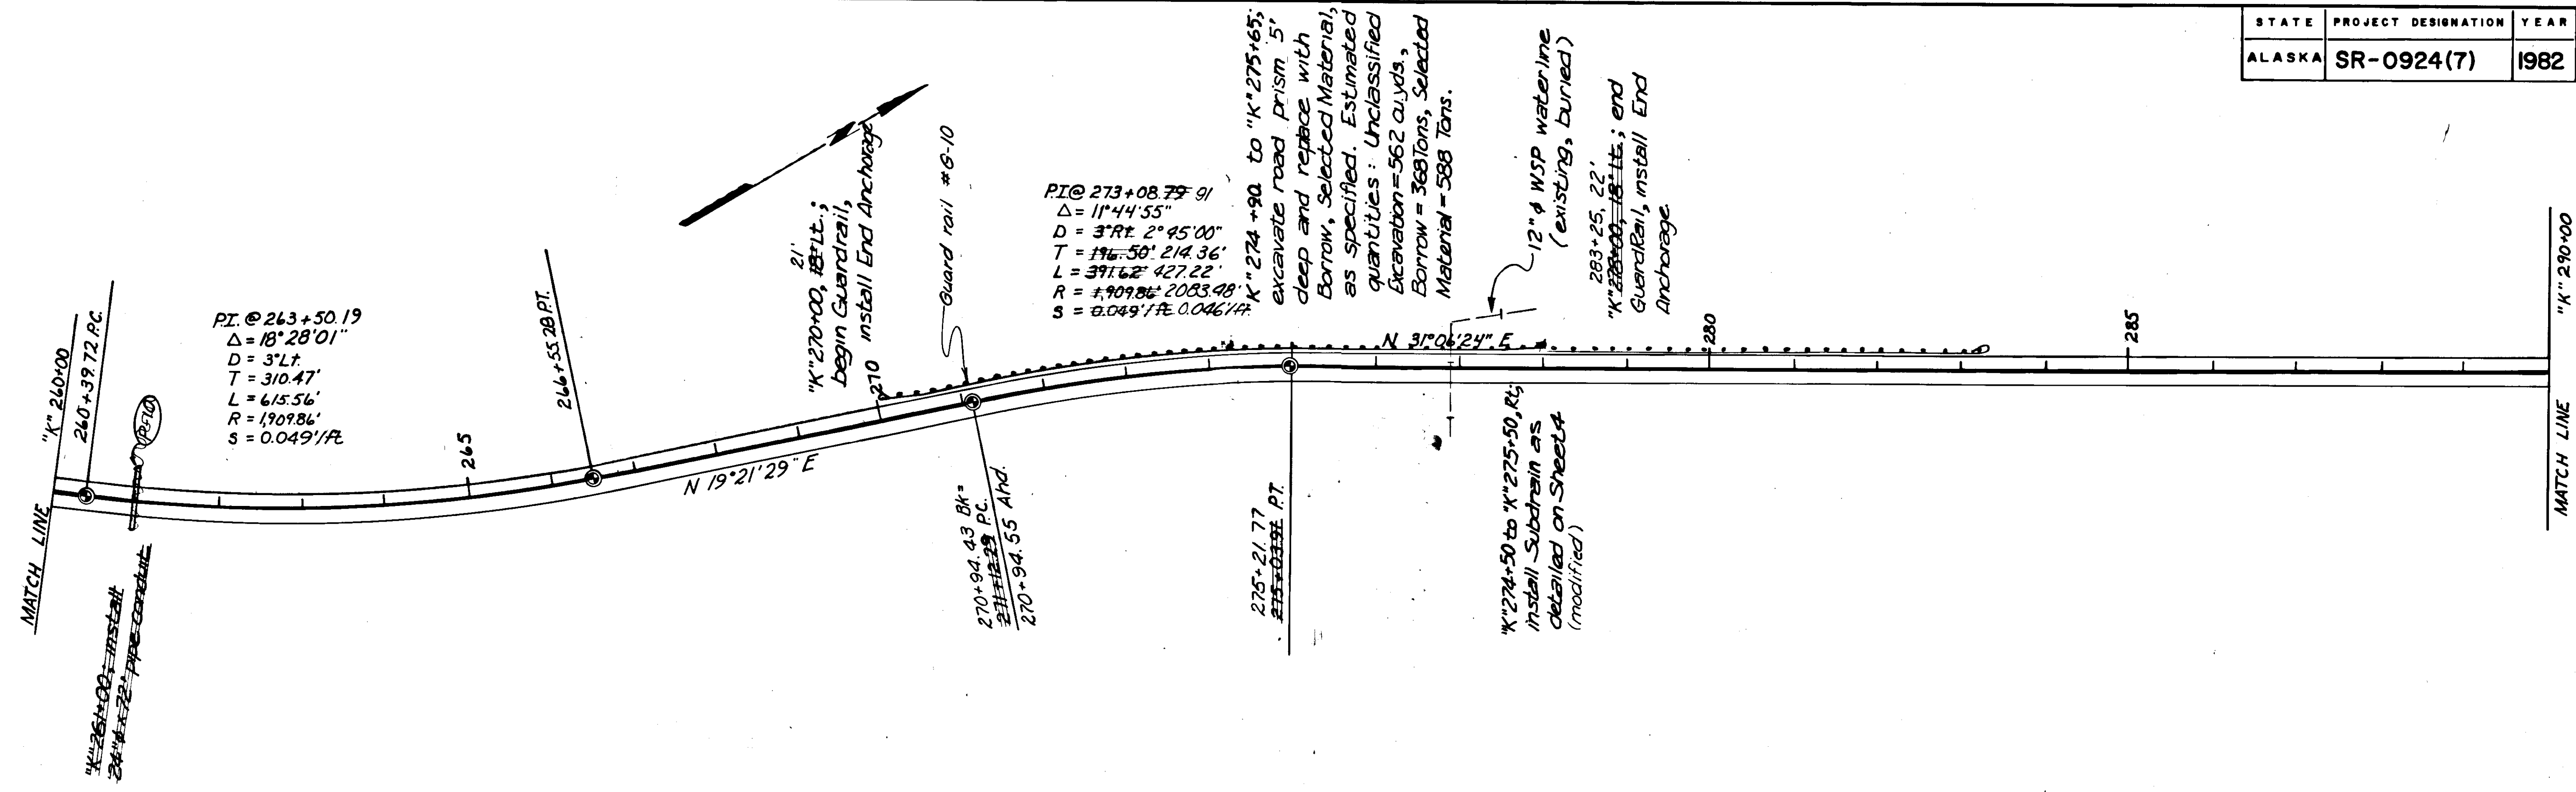

PI @ 273+08.79 91
 $\Delta = 11^{\circ}44'55''$
 $D = 3^{\circ}Rt. 2^{\circ}45'00''$
 $T = 176.50' 214.36'$
 $L = 391.62' 427.22'$
 $R = 1909.86' 2083.98'$
 $S = 0.0491/A 0.0461/A$

X "274+90 to "K"275+65;
 excavate road prism 5'
 deep and replace with
 Borrow, Selected Material,
 as specified. Estimated
 quantities: Unclassified
 Excavation = 562 cu yds,
 Borrow = 368 Tons, Selected
 Material = 588 Tons.

"K"274+50 to "K"275+50, R₁
 install Subdrain as
 detailed on Sheet A
 (modified)

12" 4 WSP waterline
 (existing, buried)
 283+25.22'
 "K"283+00 to 284+00;
 GuardRail, install End
 Anchorage

21'
 "K"270+00, 18 ft.;
 begin Guardrail,
 install End Anchorage

Guard rail #6-10


270+94.43 Bk =
~~270+94.43 PC~~
 270+94.55 Ahd.

275+21.77
~~275+21.77 PC~~
 275+21.77 PT.

PI @ 263+50.19
 $\Delta = 18^{\circ}28'01''$
 $D = 3^{\circ}Lt.$
 $T = 310.47'$
 $L = 615.56'$
 $R = 1909.86'$
 $S = 0.0491/A$

"K" 260+00
 260+39.72 P.C.

"K" 264+00, install
 24" 4 x 72" pipe concrete

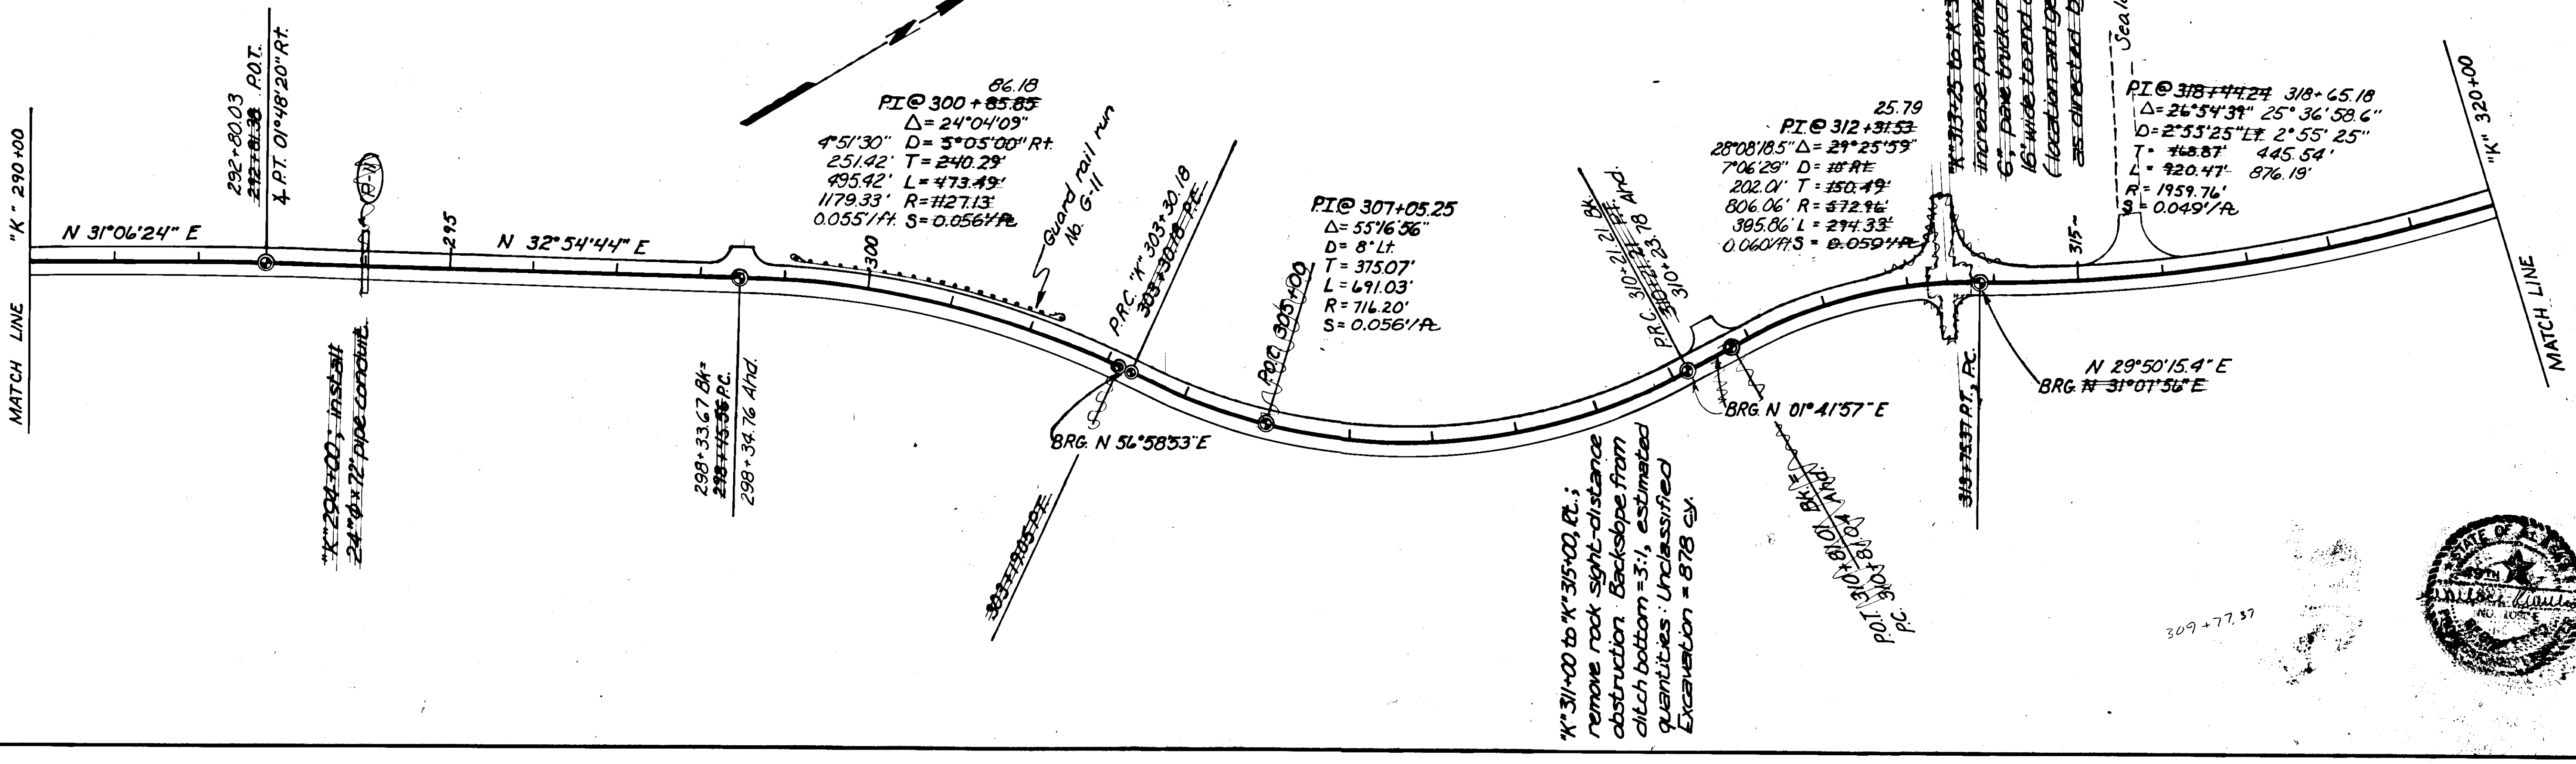

86.18
 PI @ 300+85.85
 $\Delta = 24^{\circ}04'09''$
 $D = 5^{\circ}05'00'' Rt.$
 $T = 251.92' 240.29'$
 $L = 495.92' 473.49'$
 $R = 1179.33' 1127.13'$
 $S = 0.0551/A 0.0561/A$

PI @ 307+05.25
 $\Delta = 55^{\circ}16'36''$
 $D = 8^{\circ}Lt.$
 $T = 375.07'$
 $L = 691.03'$
 $R = 716.20'$
 $S = 0.0561/A$

25.79
 PI @ 312+31.53
 $\Delta = 29^{\circ}25'59''$
 $D = 7^{\circ}06'29''$
 $T = 202.01' 150.49'$
 $L = 806.06' 572.96'$
 $R = 395.86' 274.33'$
 $S = 0.0601/A 0.0591/A$

PI @ 318+44.24 318+65.18
 $\Delta = 26^{\circ}54'39'' 25^{\circ}36'58.6''$
 $D = 2^{\circ}53'25'' Lt. 2^{\circ}55'25''$
 $T = 768.87' 445.54'$
 $L = 920.47' 876.19'$
 $R = 1959.76'$
 $S = 0.0491/A$

"K" 313+25 to "K" 313+25;
 increase pavement depth to
 6"; pave truck crossing 6" deep;
 16' wide to end of both approaches.
 (Location and geometrics may vary
 as directed by the Engineer).

Jealaska Dock

"K" 311+00 to "K" 315+00, Et.;
 remove rock sight-distance
 obstruction. Backslope from
 ditch bottom = 3:1, estimated
 quantities: Unclassified
 Excavation = 878 cu.

BRG N 01° 41' 57" E
 BRG N 56° 58' 53" E
 BRG N 29° 50' 15.4" E
 BRG N 31° 07' 56" E

"K" 294+00, install
 24" 4 x 72" pipe concrete

298+33.67 Bk =
~~298+33.67 PC~~
 298+34.76 Ahd.

292+80.03
~~292+80.03 P.O.T.~~
 292+80.03 P.O.T.

"K" 290+00
 N 31° 06' 24" E

MATCH LINE

MATCH LINE




309+77.37

STATE	PROJECT DESIGNATION	YEAR	SHEET NO.	TOTAL SHEETS
ALASKA	SR-0924(7)	1982	20	27

*Bridge Terminal Transition
Guard Rail Summary*


from	to	length
338+90.98 Lt	339+47.23 Lt	56.25'
339+90.98 Rt	339+47.23 Rt	56.25'
342+48.73 Lt	343+04.98 Lt	56.25' 18.75'
342+48.73 Rt	343+04.98 Rt	56.25'
		Total = 225.00'

Note: adjust as required

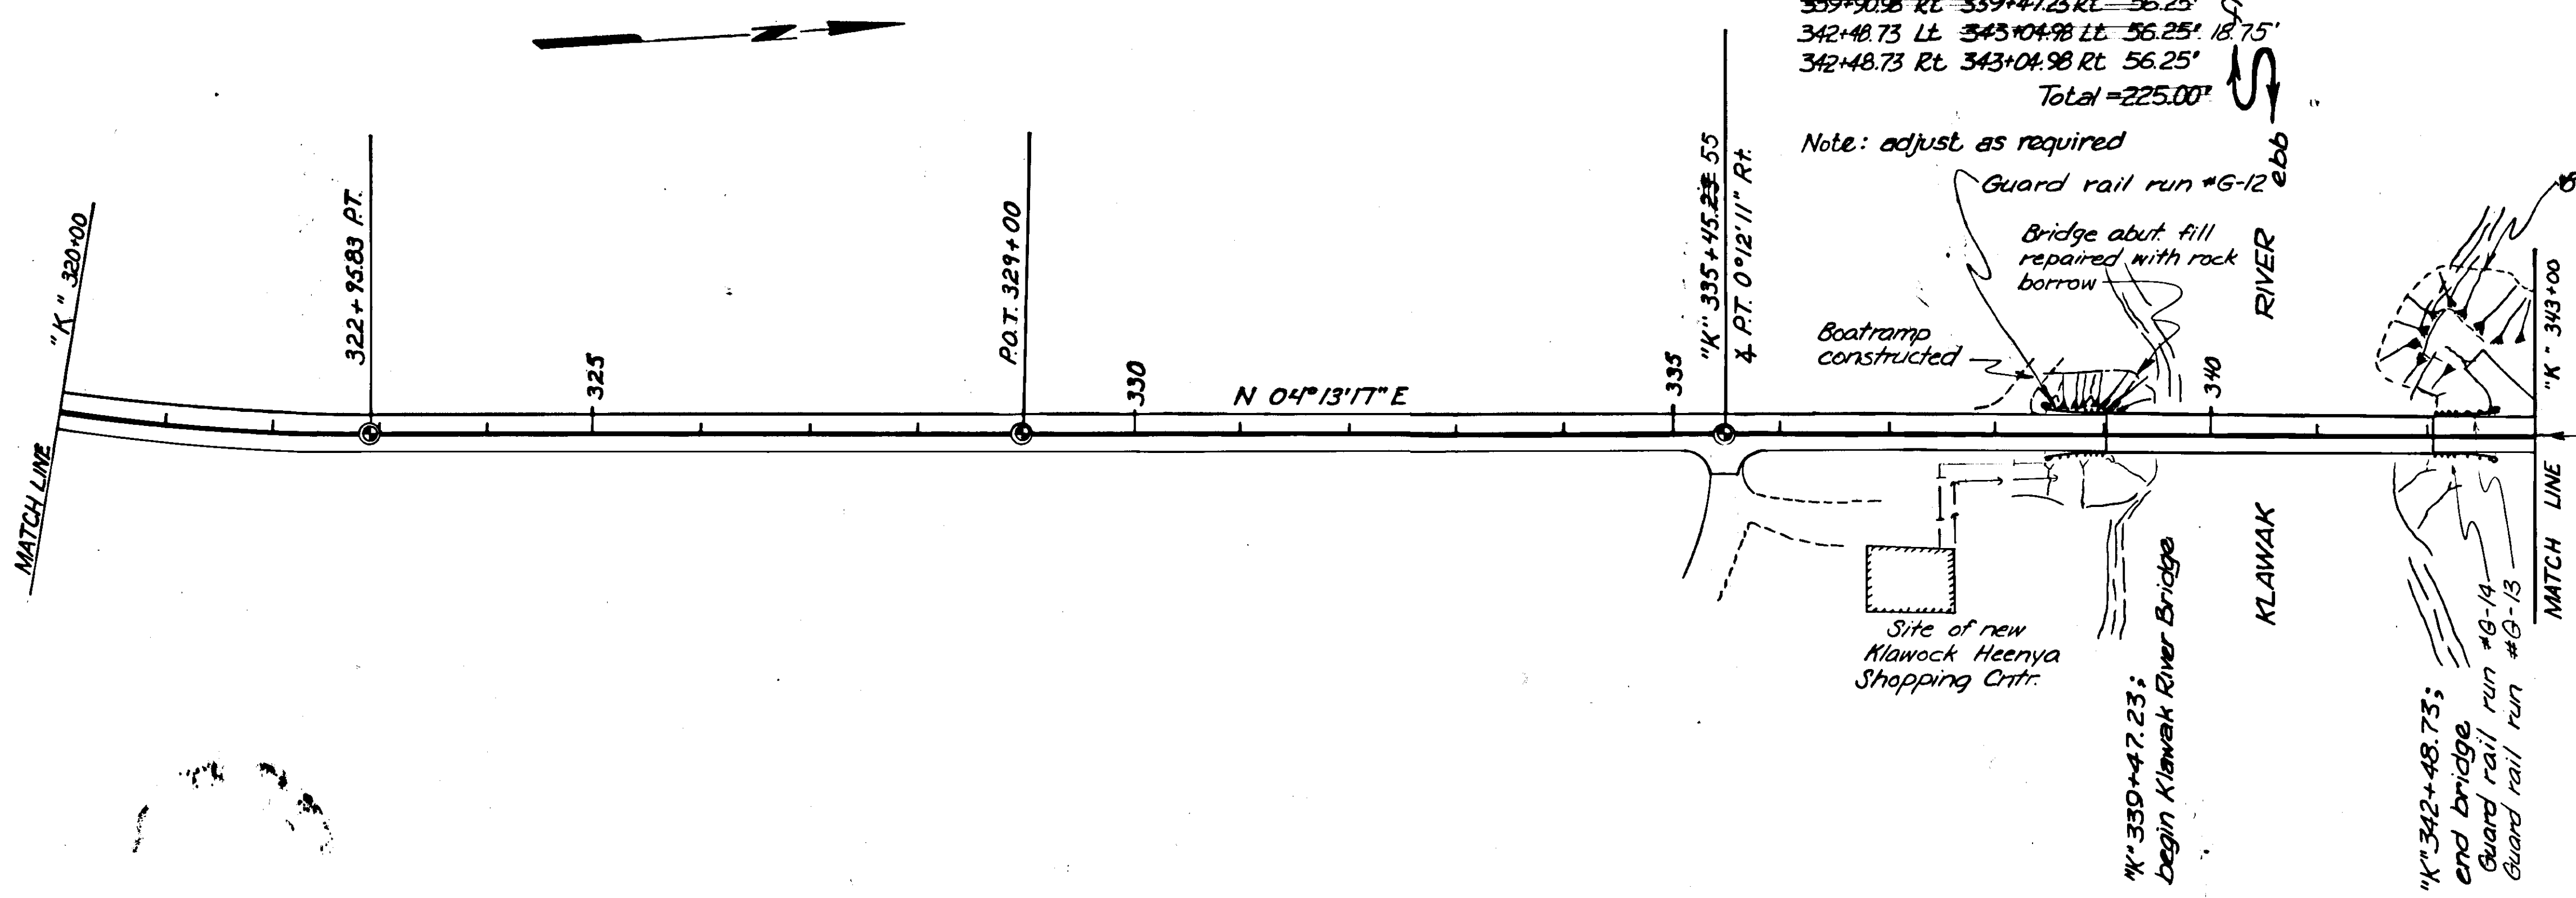


Note:
See Special Provisions for
description of Klawak River Bridge
repairs.

Continue to Sheet B-2

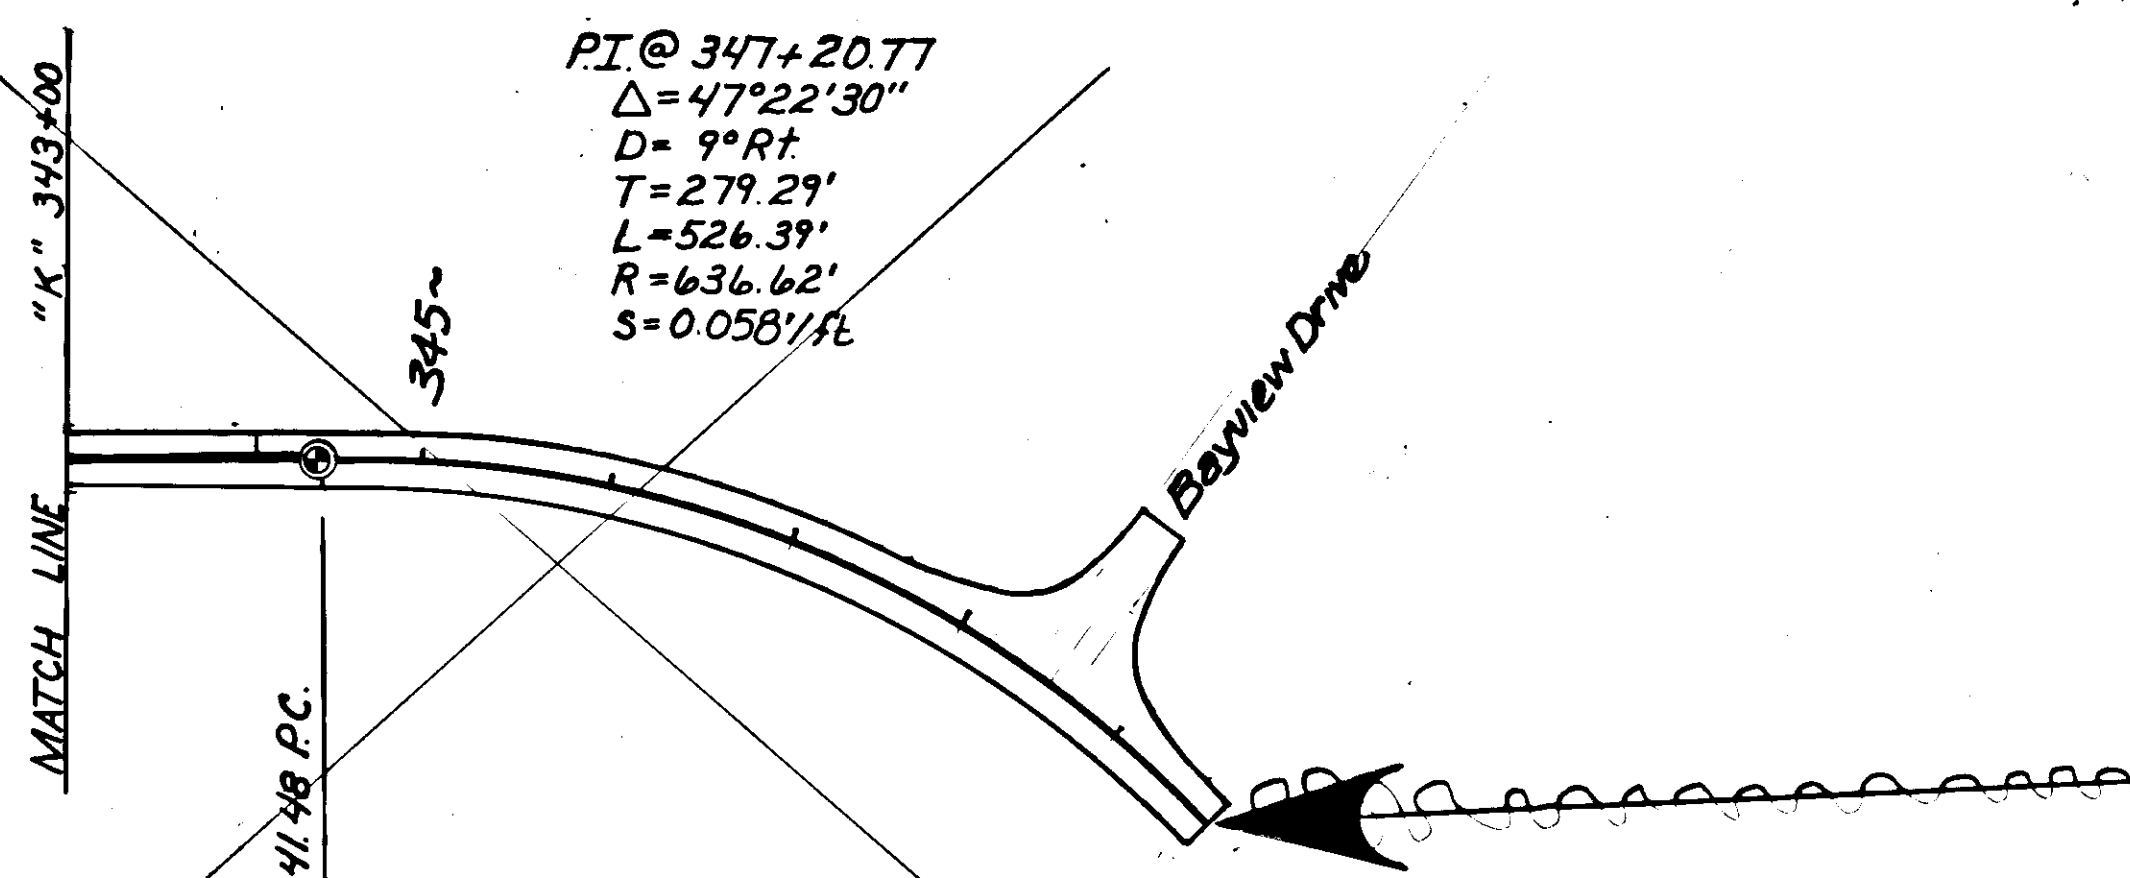


END PROJECT NO.
SR-0924(7)
Station "K" 349+67.87
= "AsBlt"(O) 349+22.64


~~See Sheet B-2 for continuation
of existing roadway~~
See Sheet B-2 for continuation
(Supplemental Agreement No. 1)

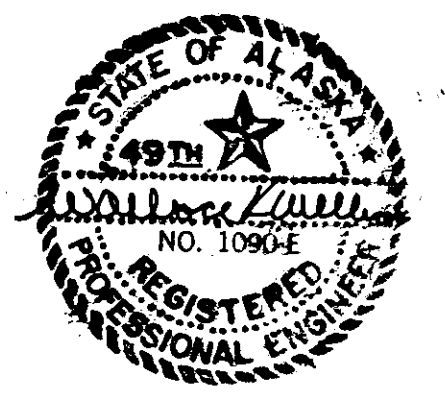



"A" - LINE

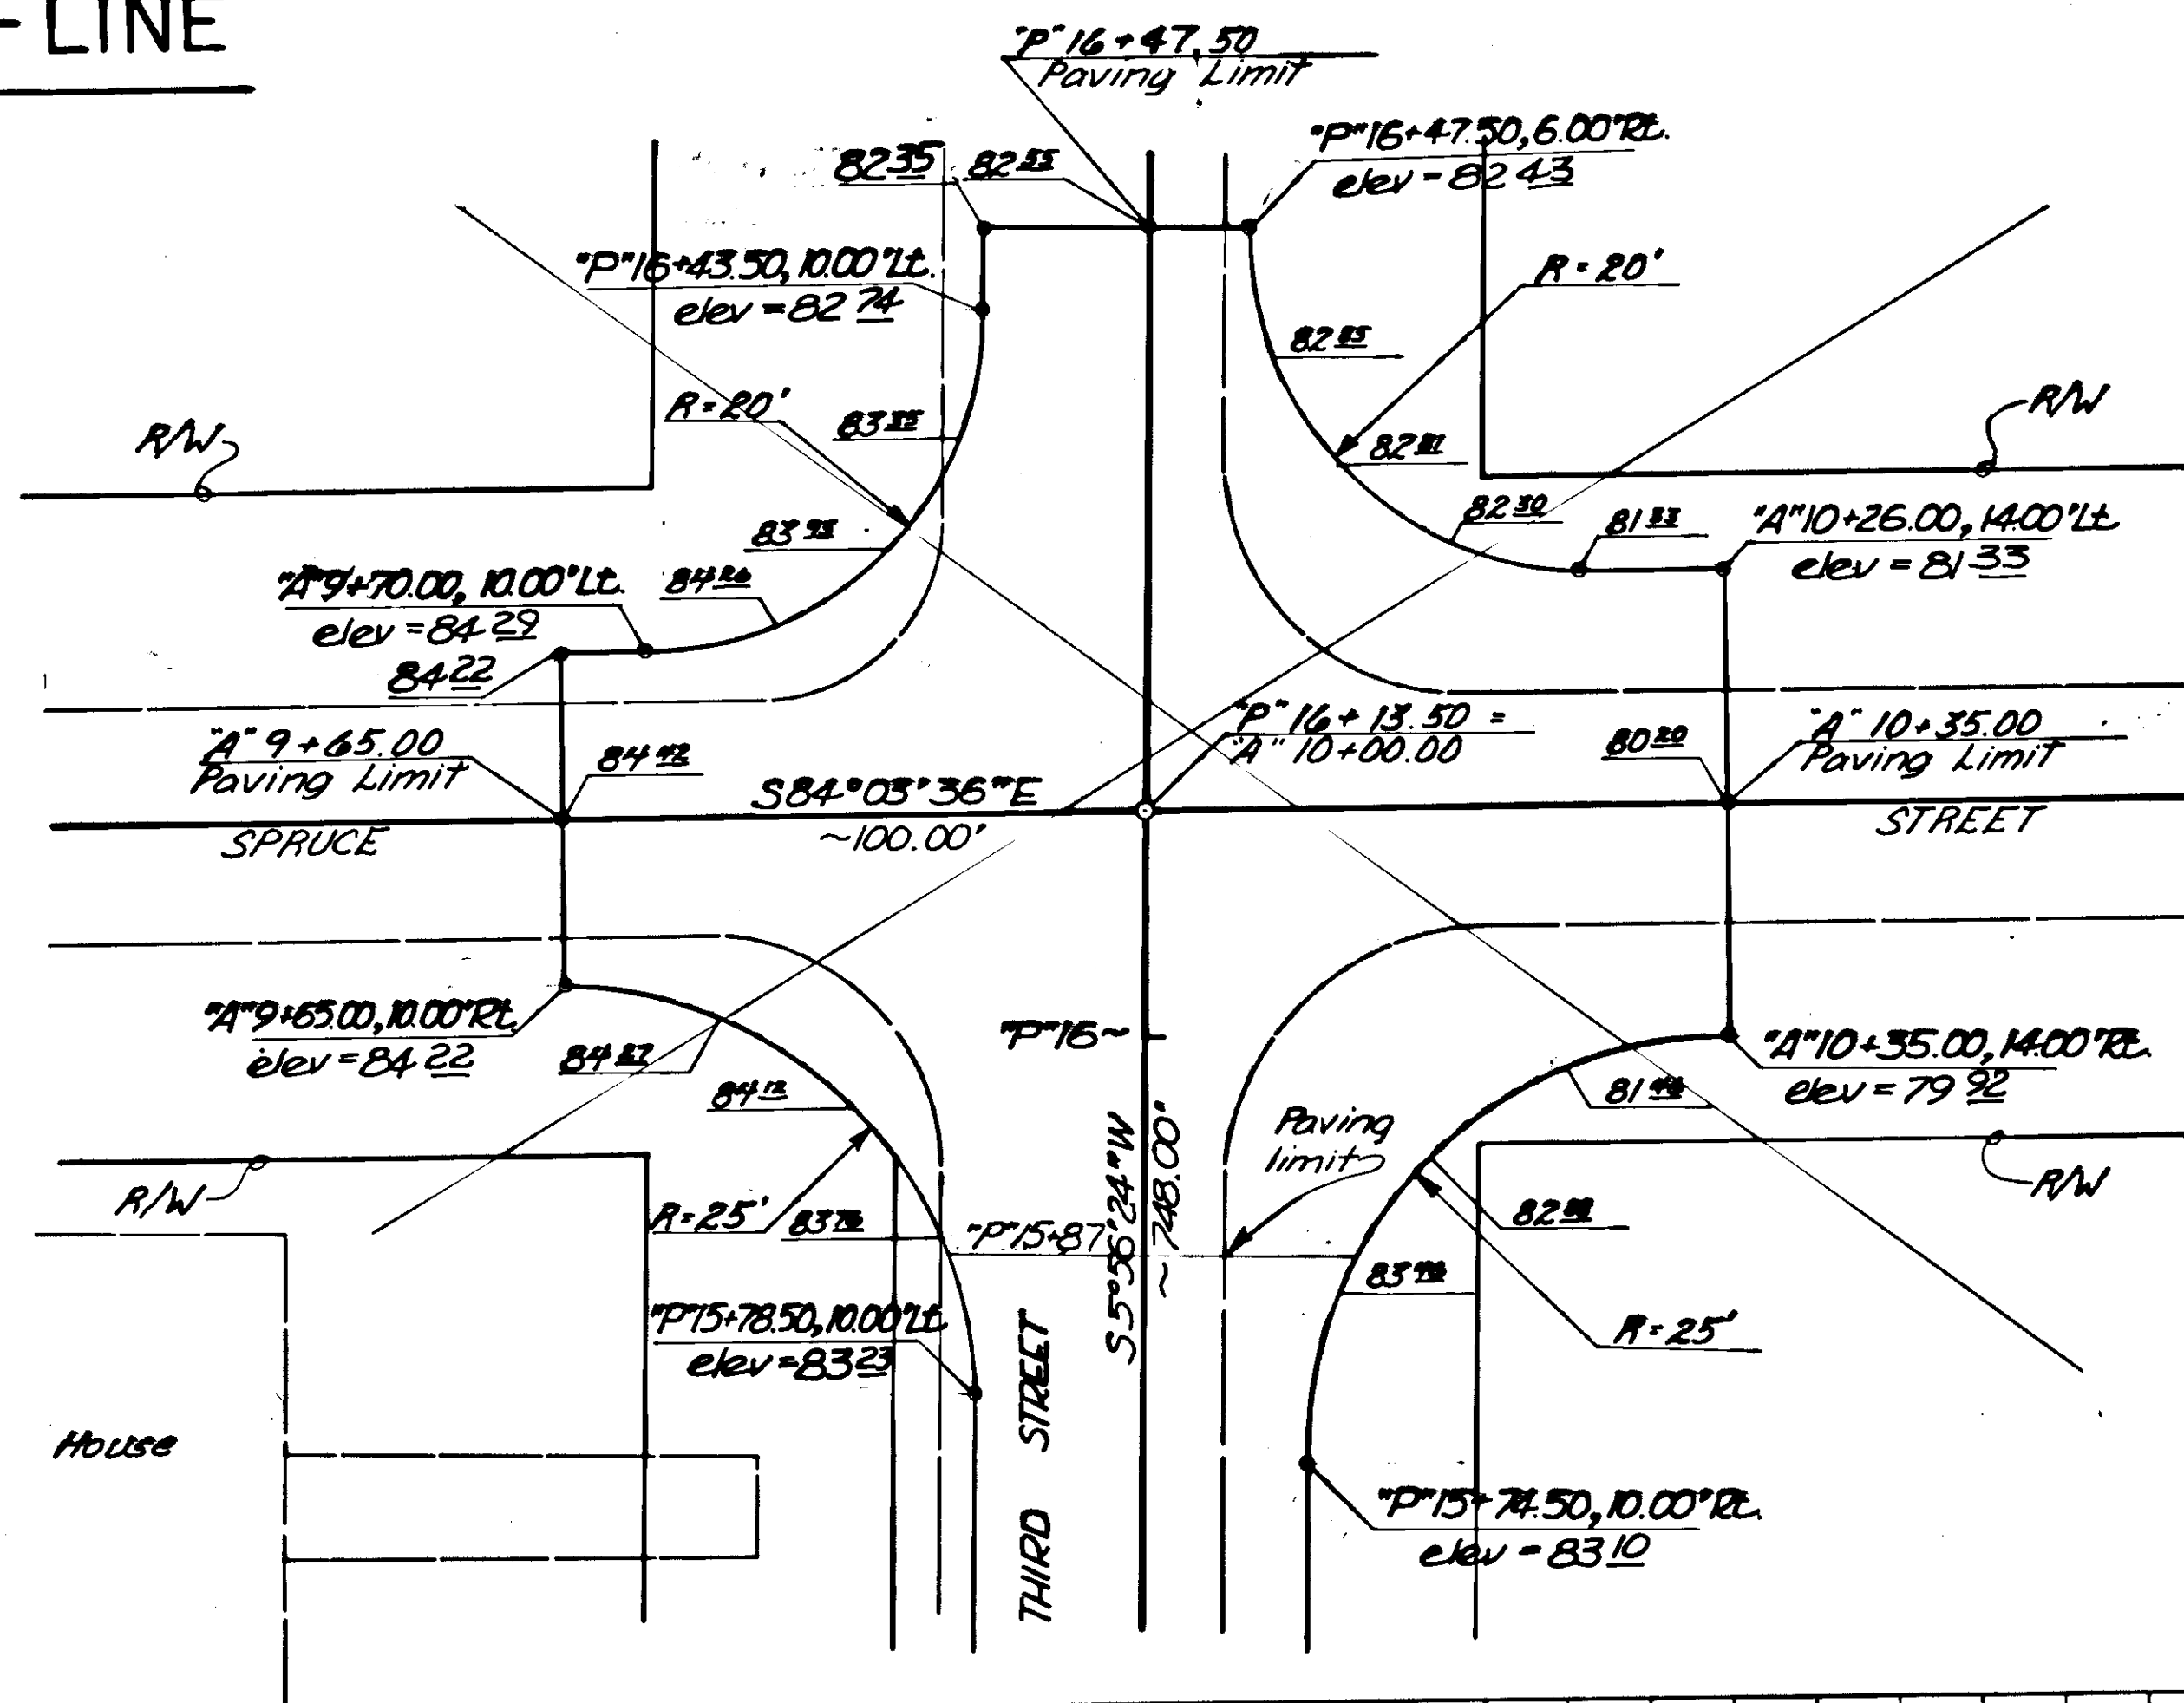

"B" - LINE

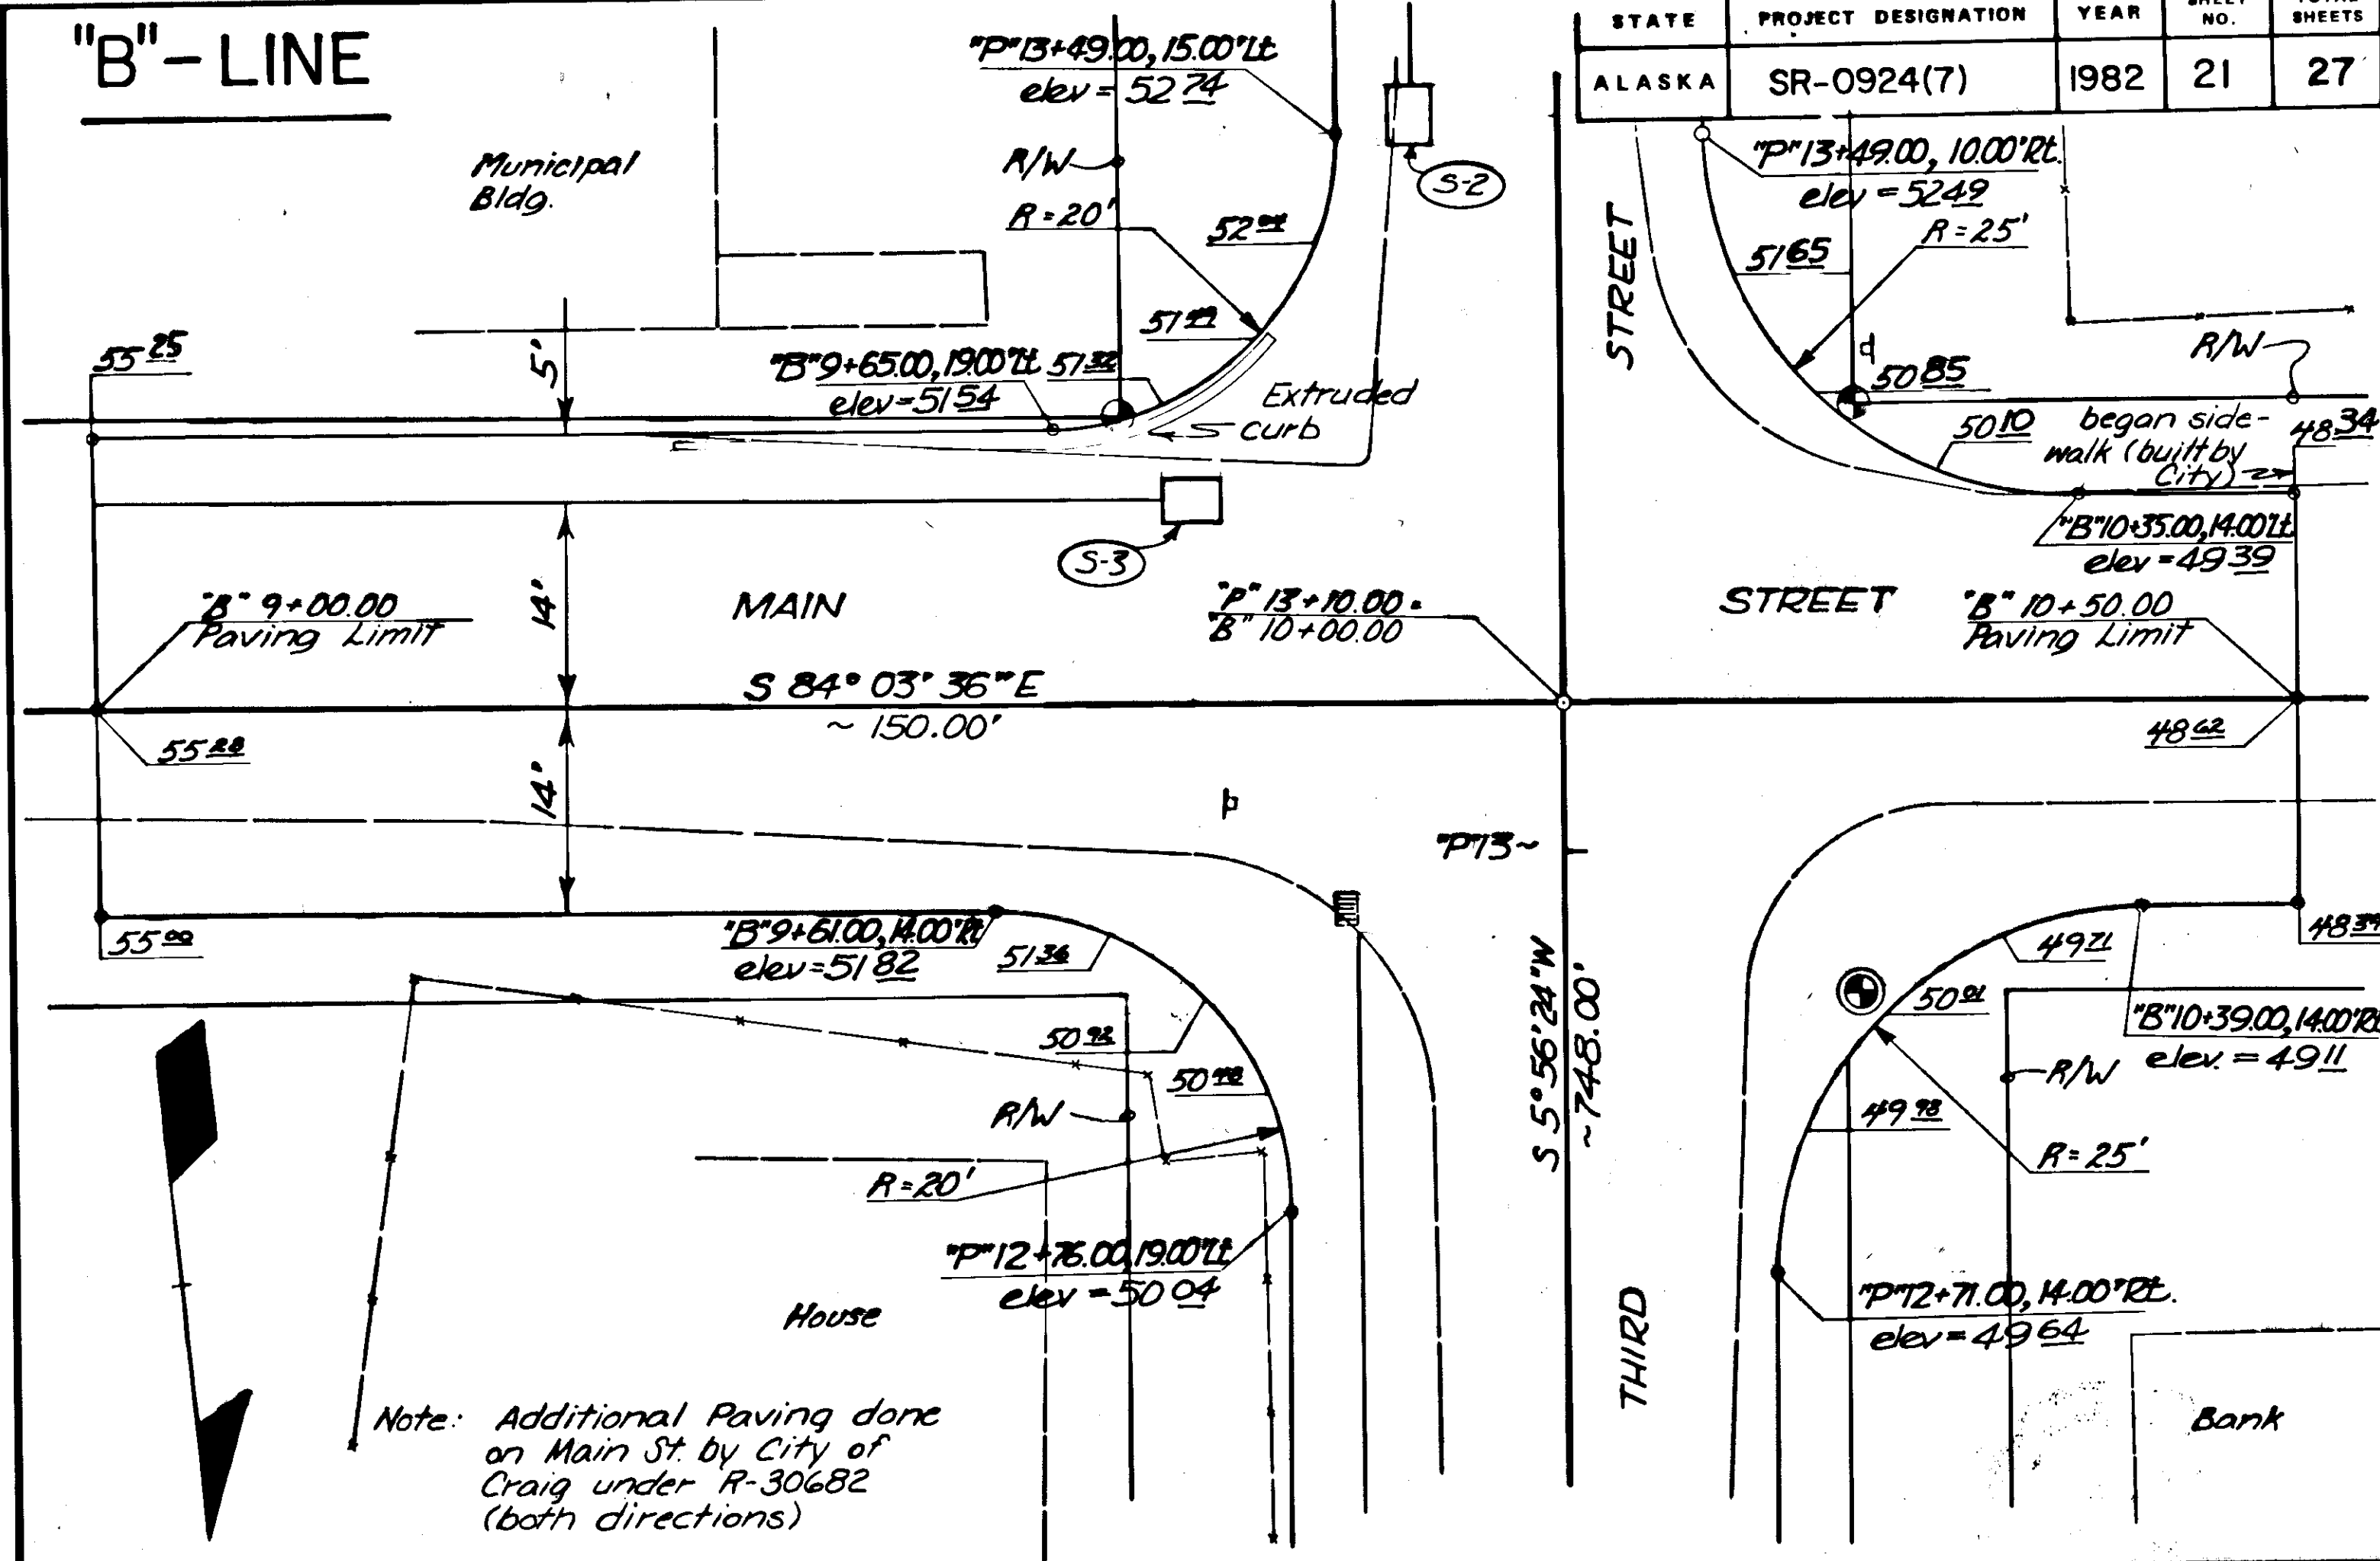

STATE	PROJECT DESIGNATION	YEAR	SHEET NO.	TOTAL SHEETS
ALASKA	SR-0924(7)	1982	21	27


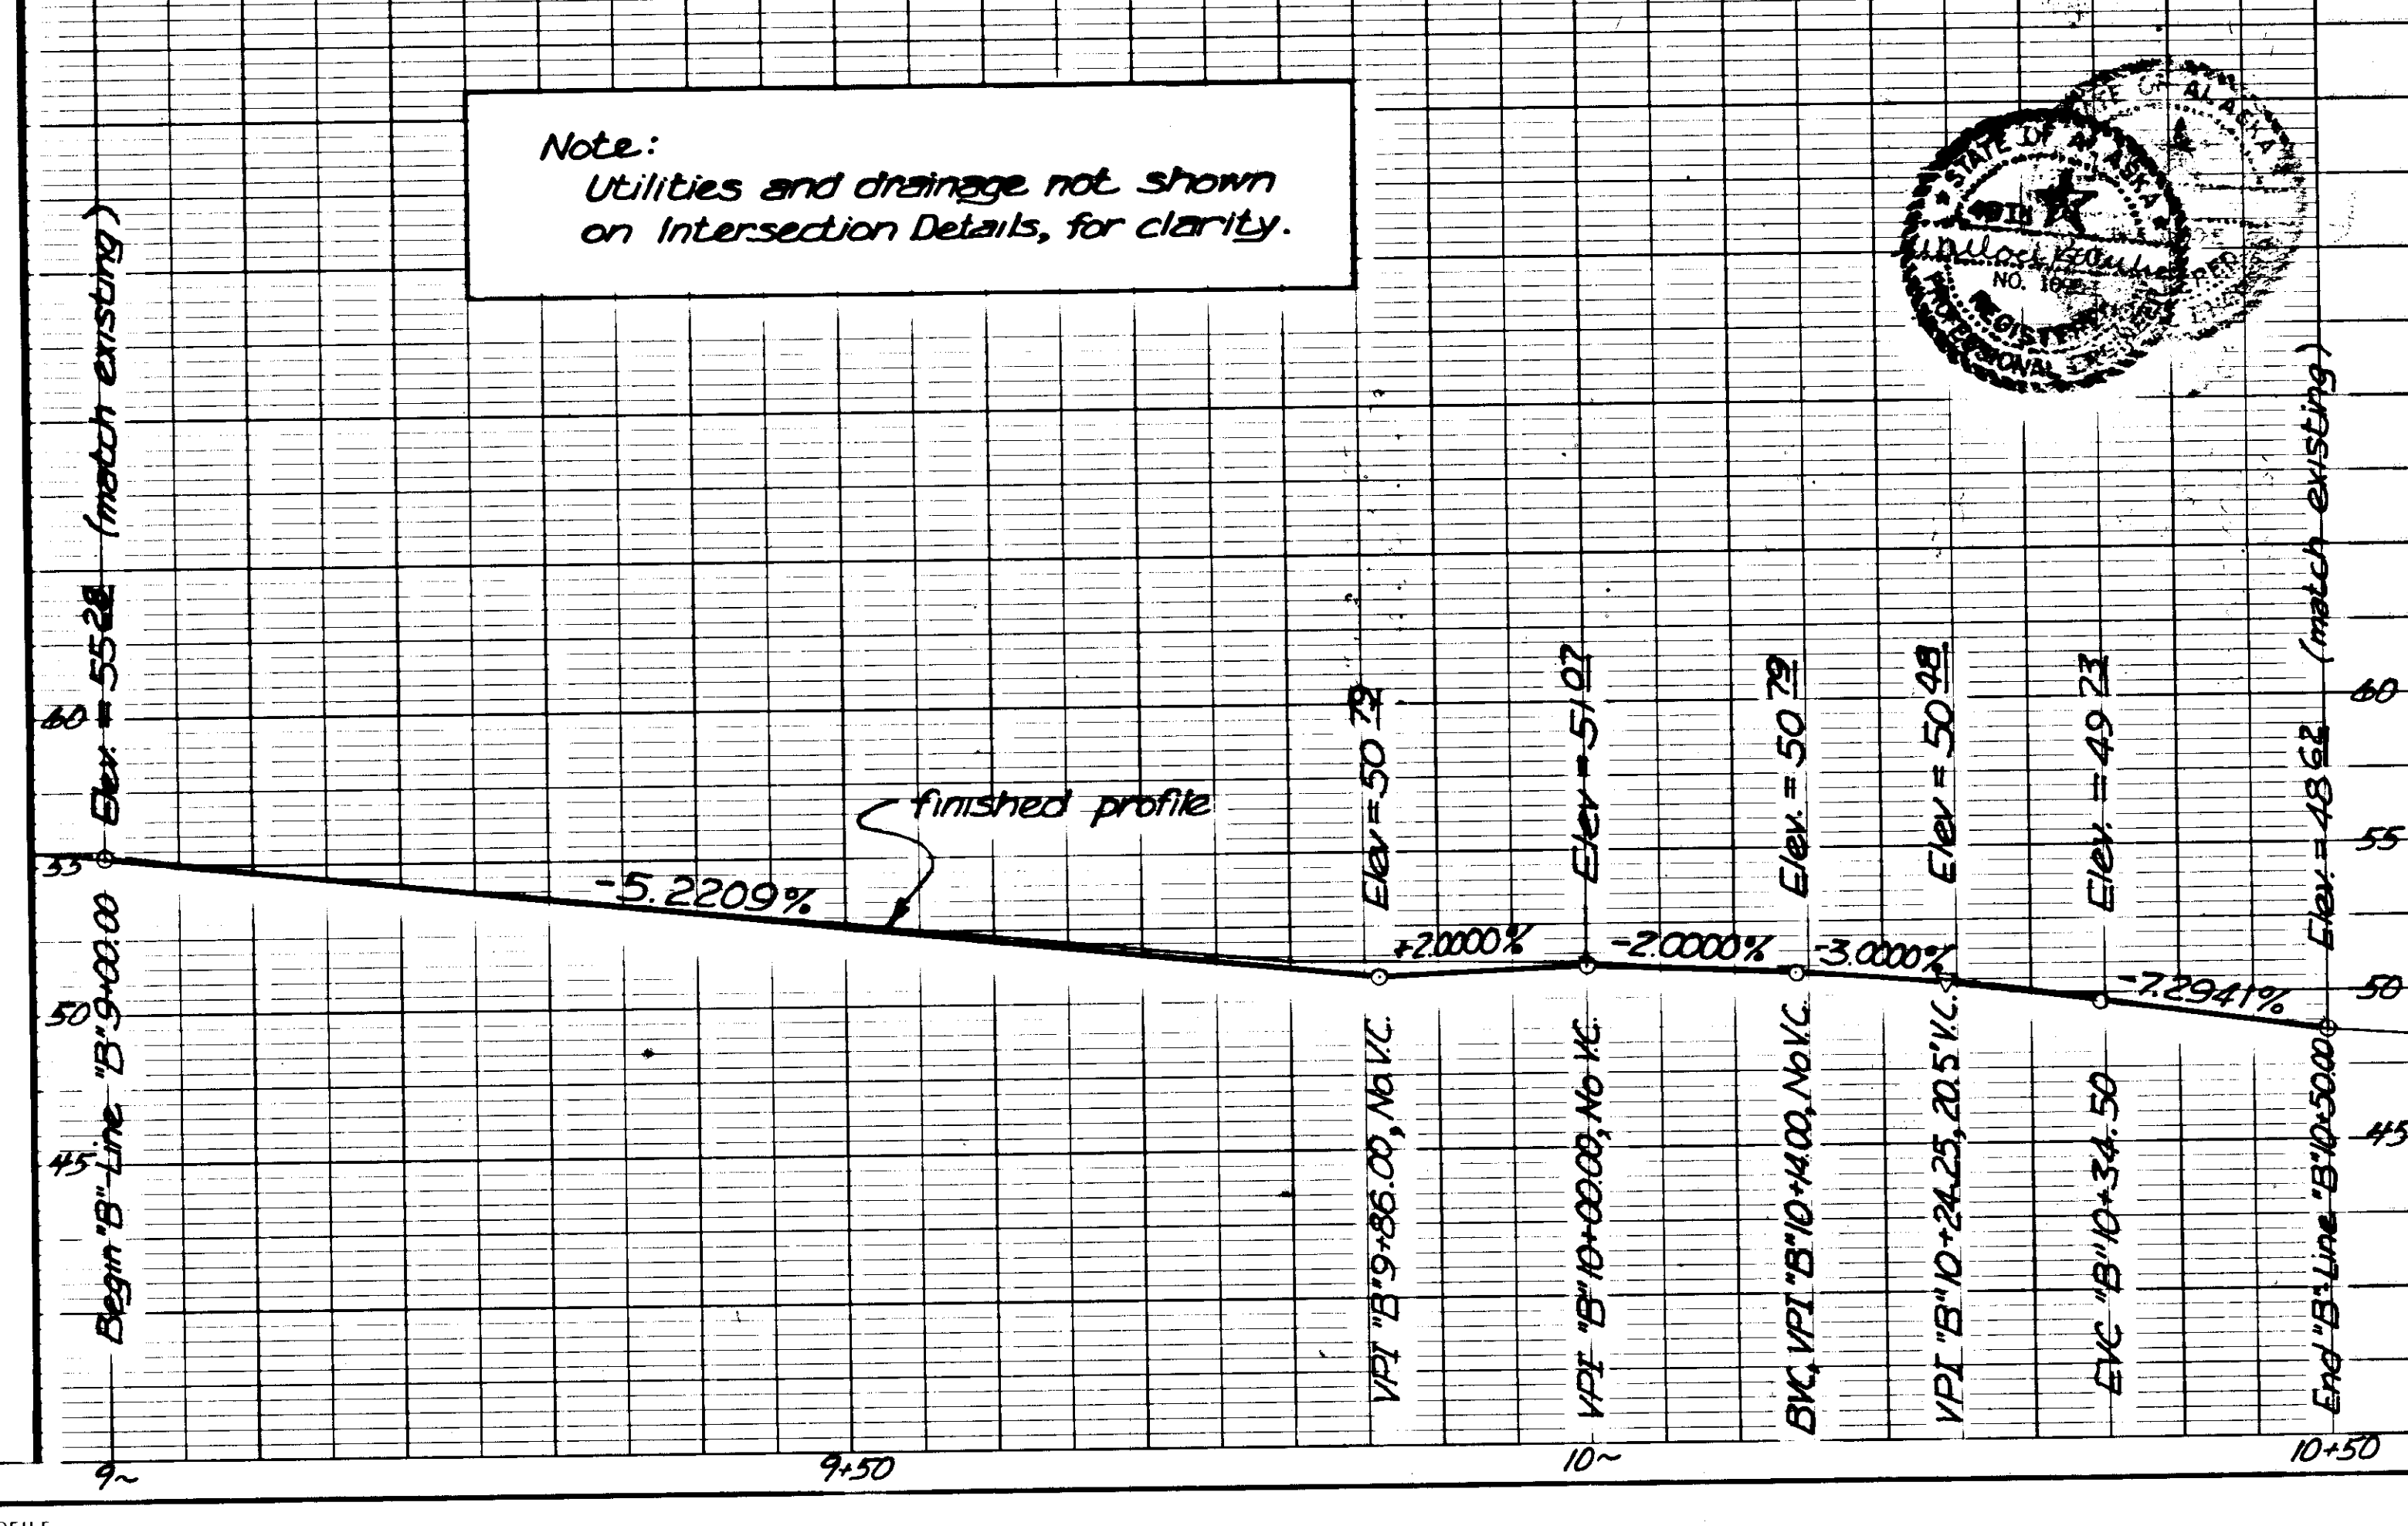
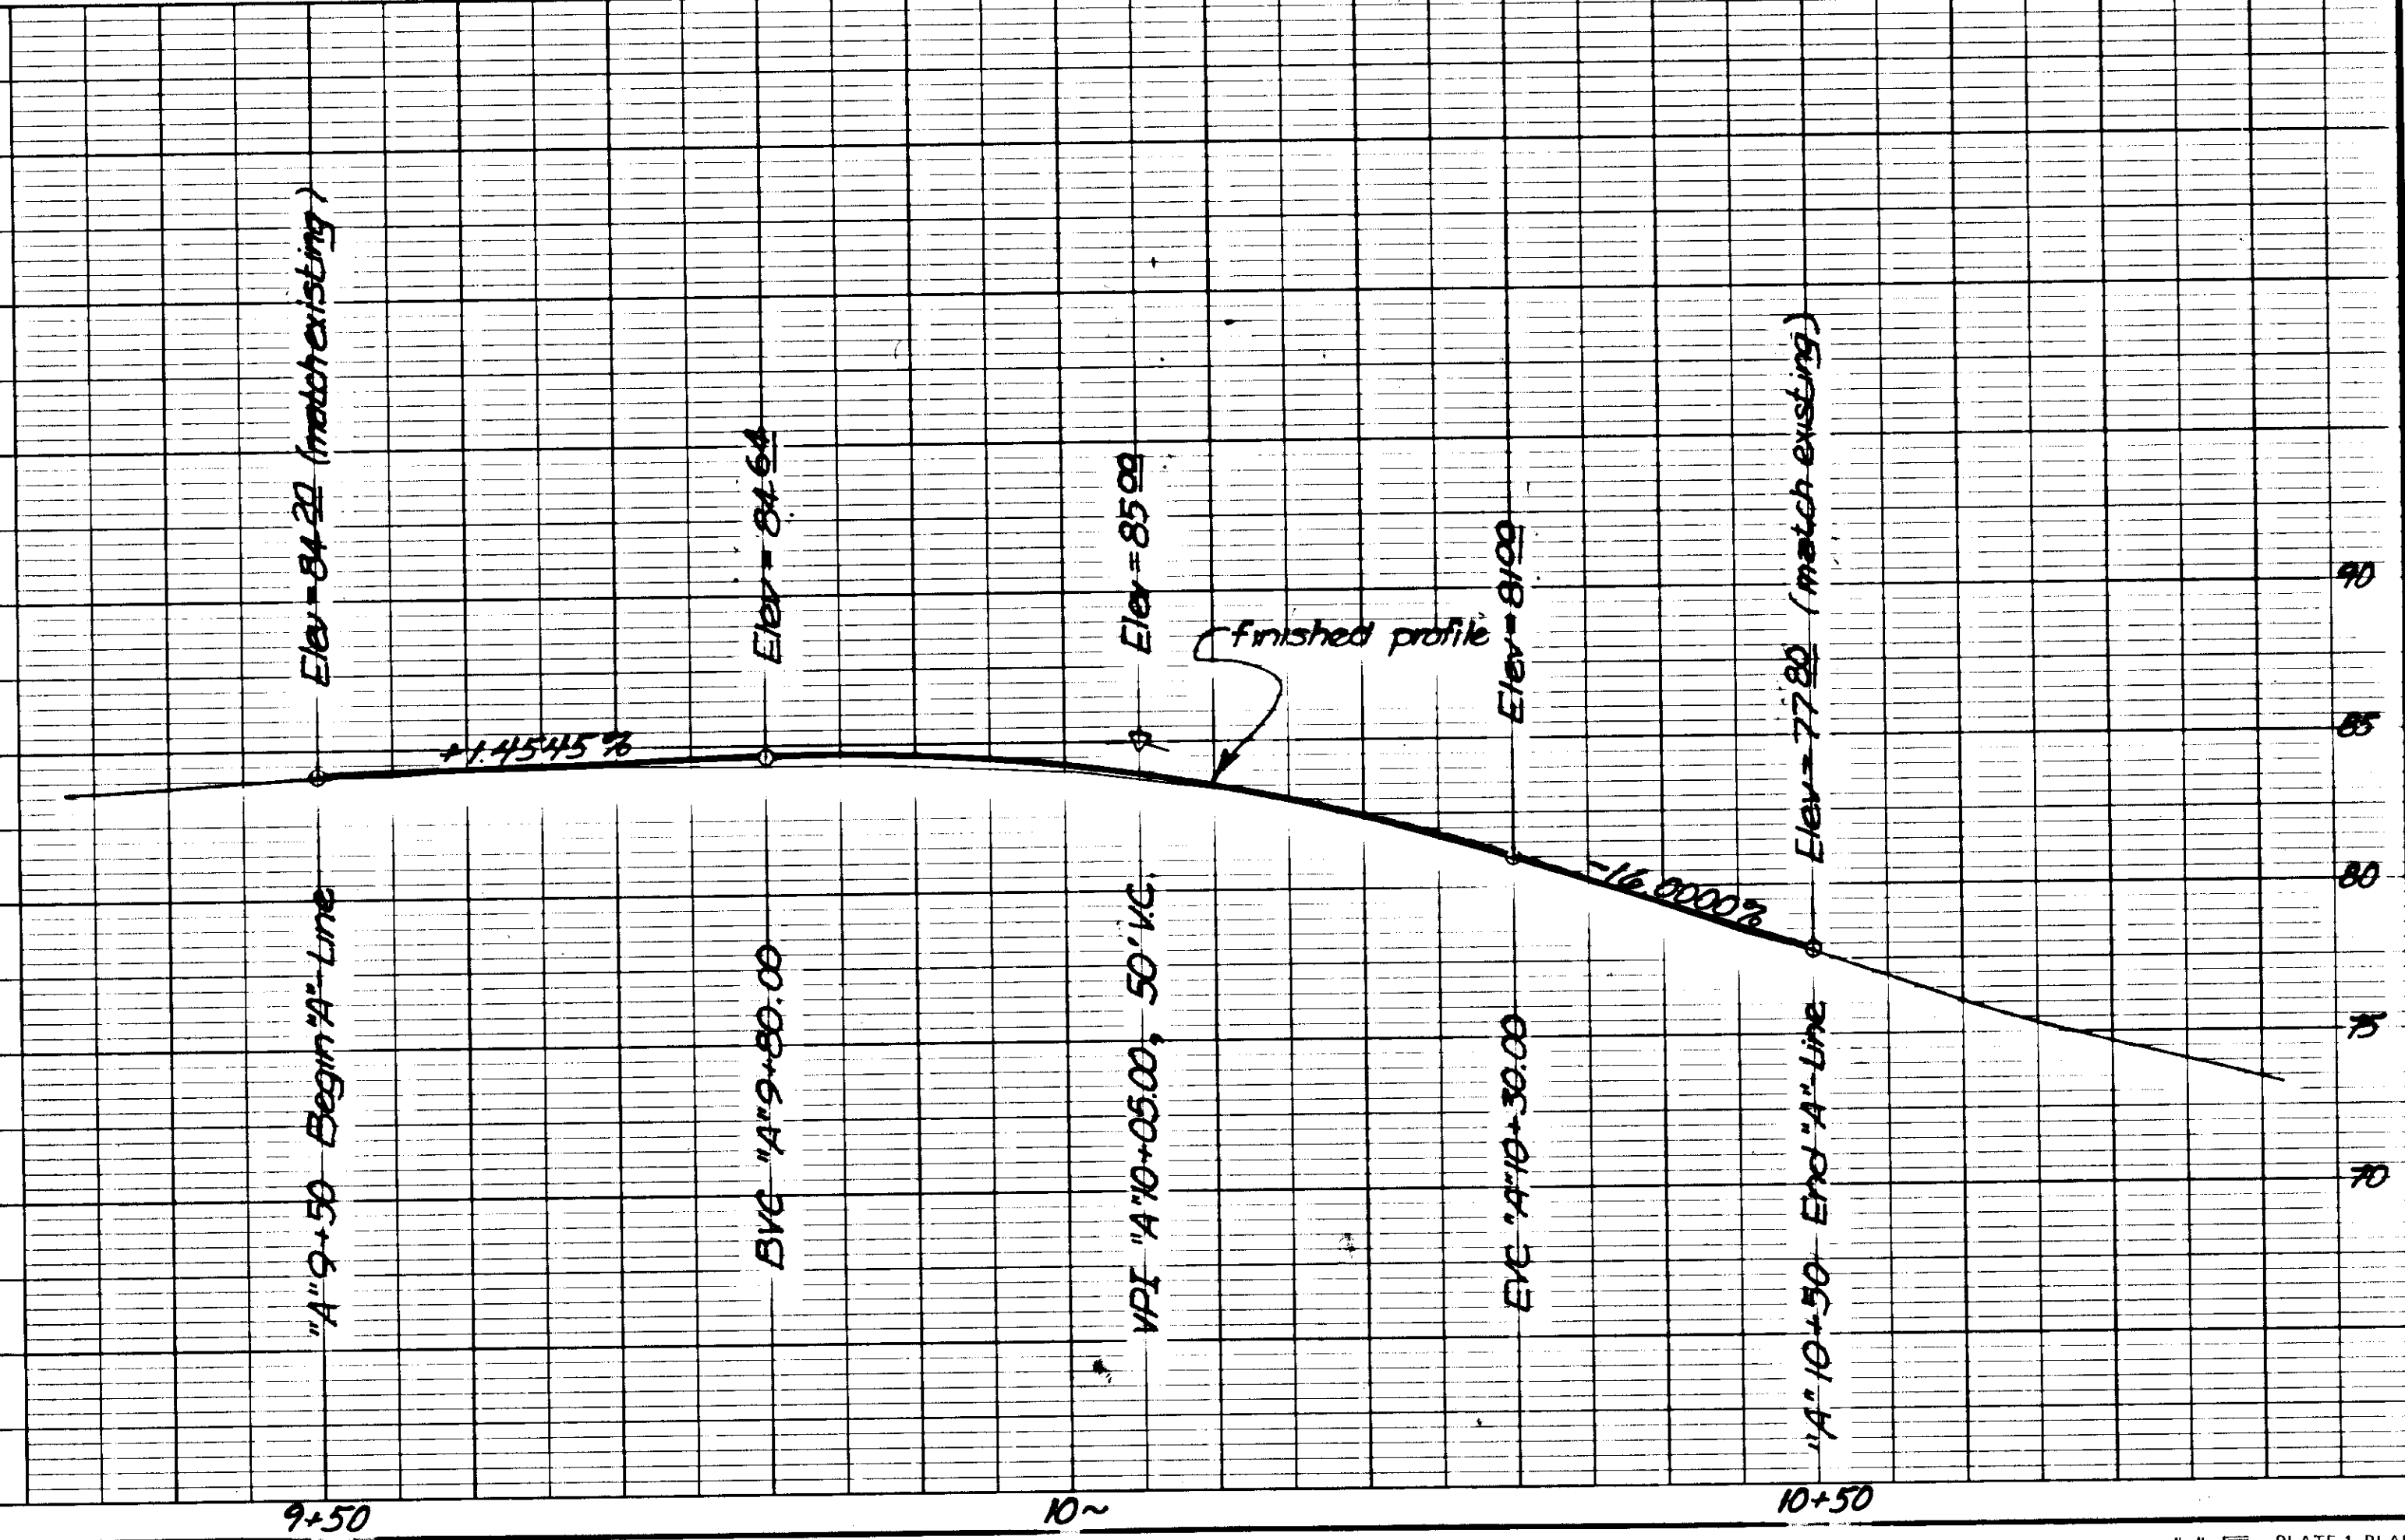


Note:
Utilities and drainage not shown
on Intersection Details, for clarity.



STATE	PROJECT DESIGNATION	YEAR	SHEET NO.	TOTAL SHEETS
ALASKA	SR-0924(7)	1982	22	27

"P"/"K" Intersection

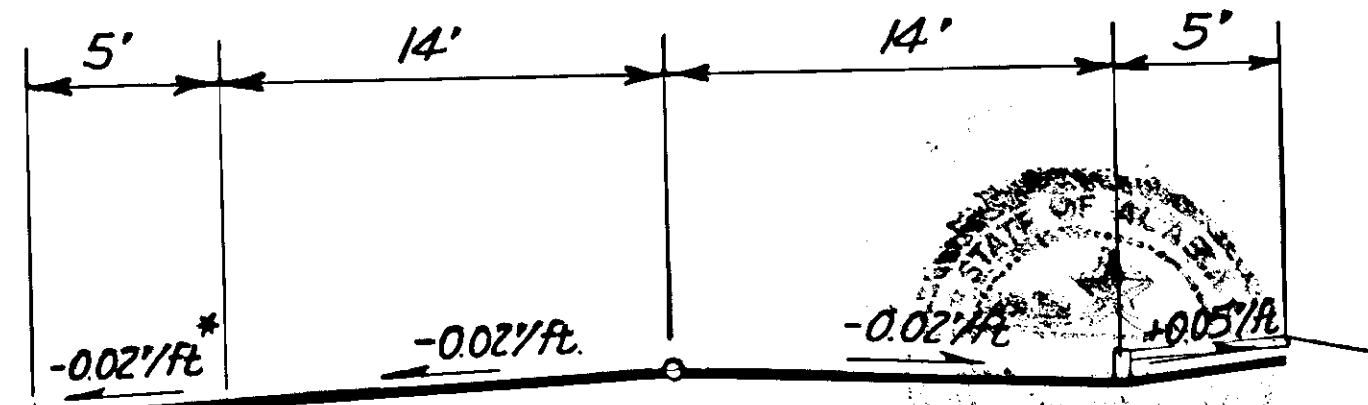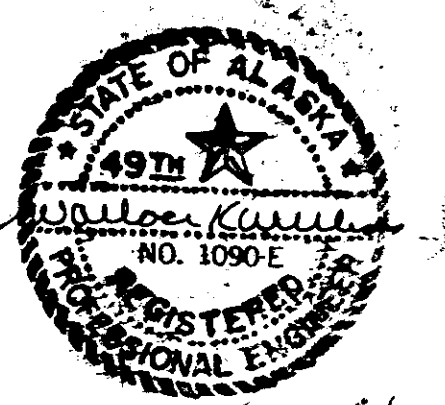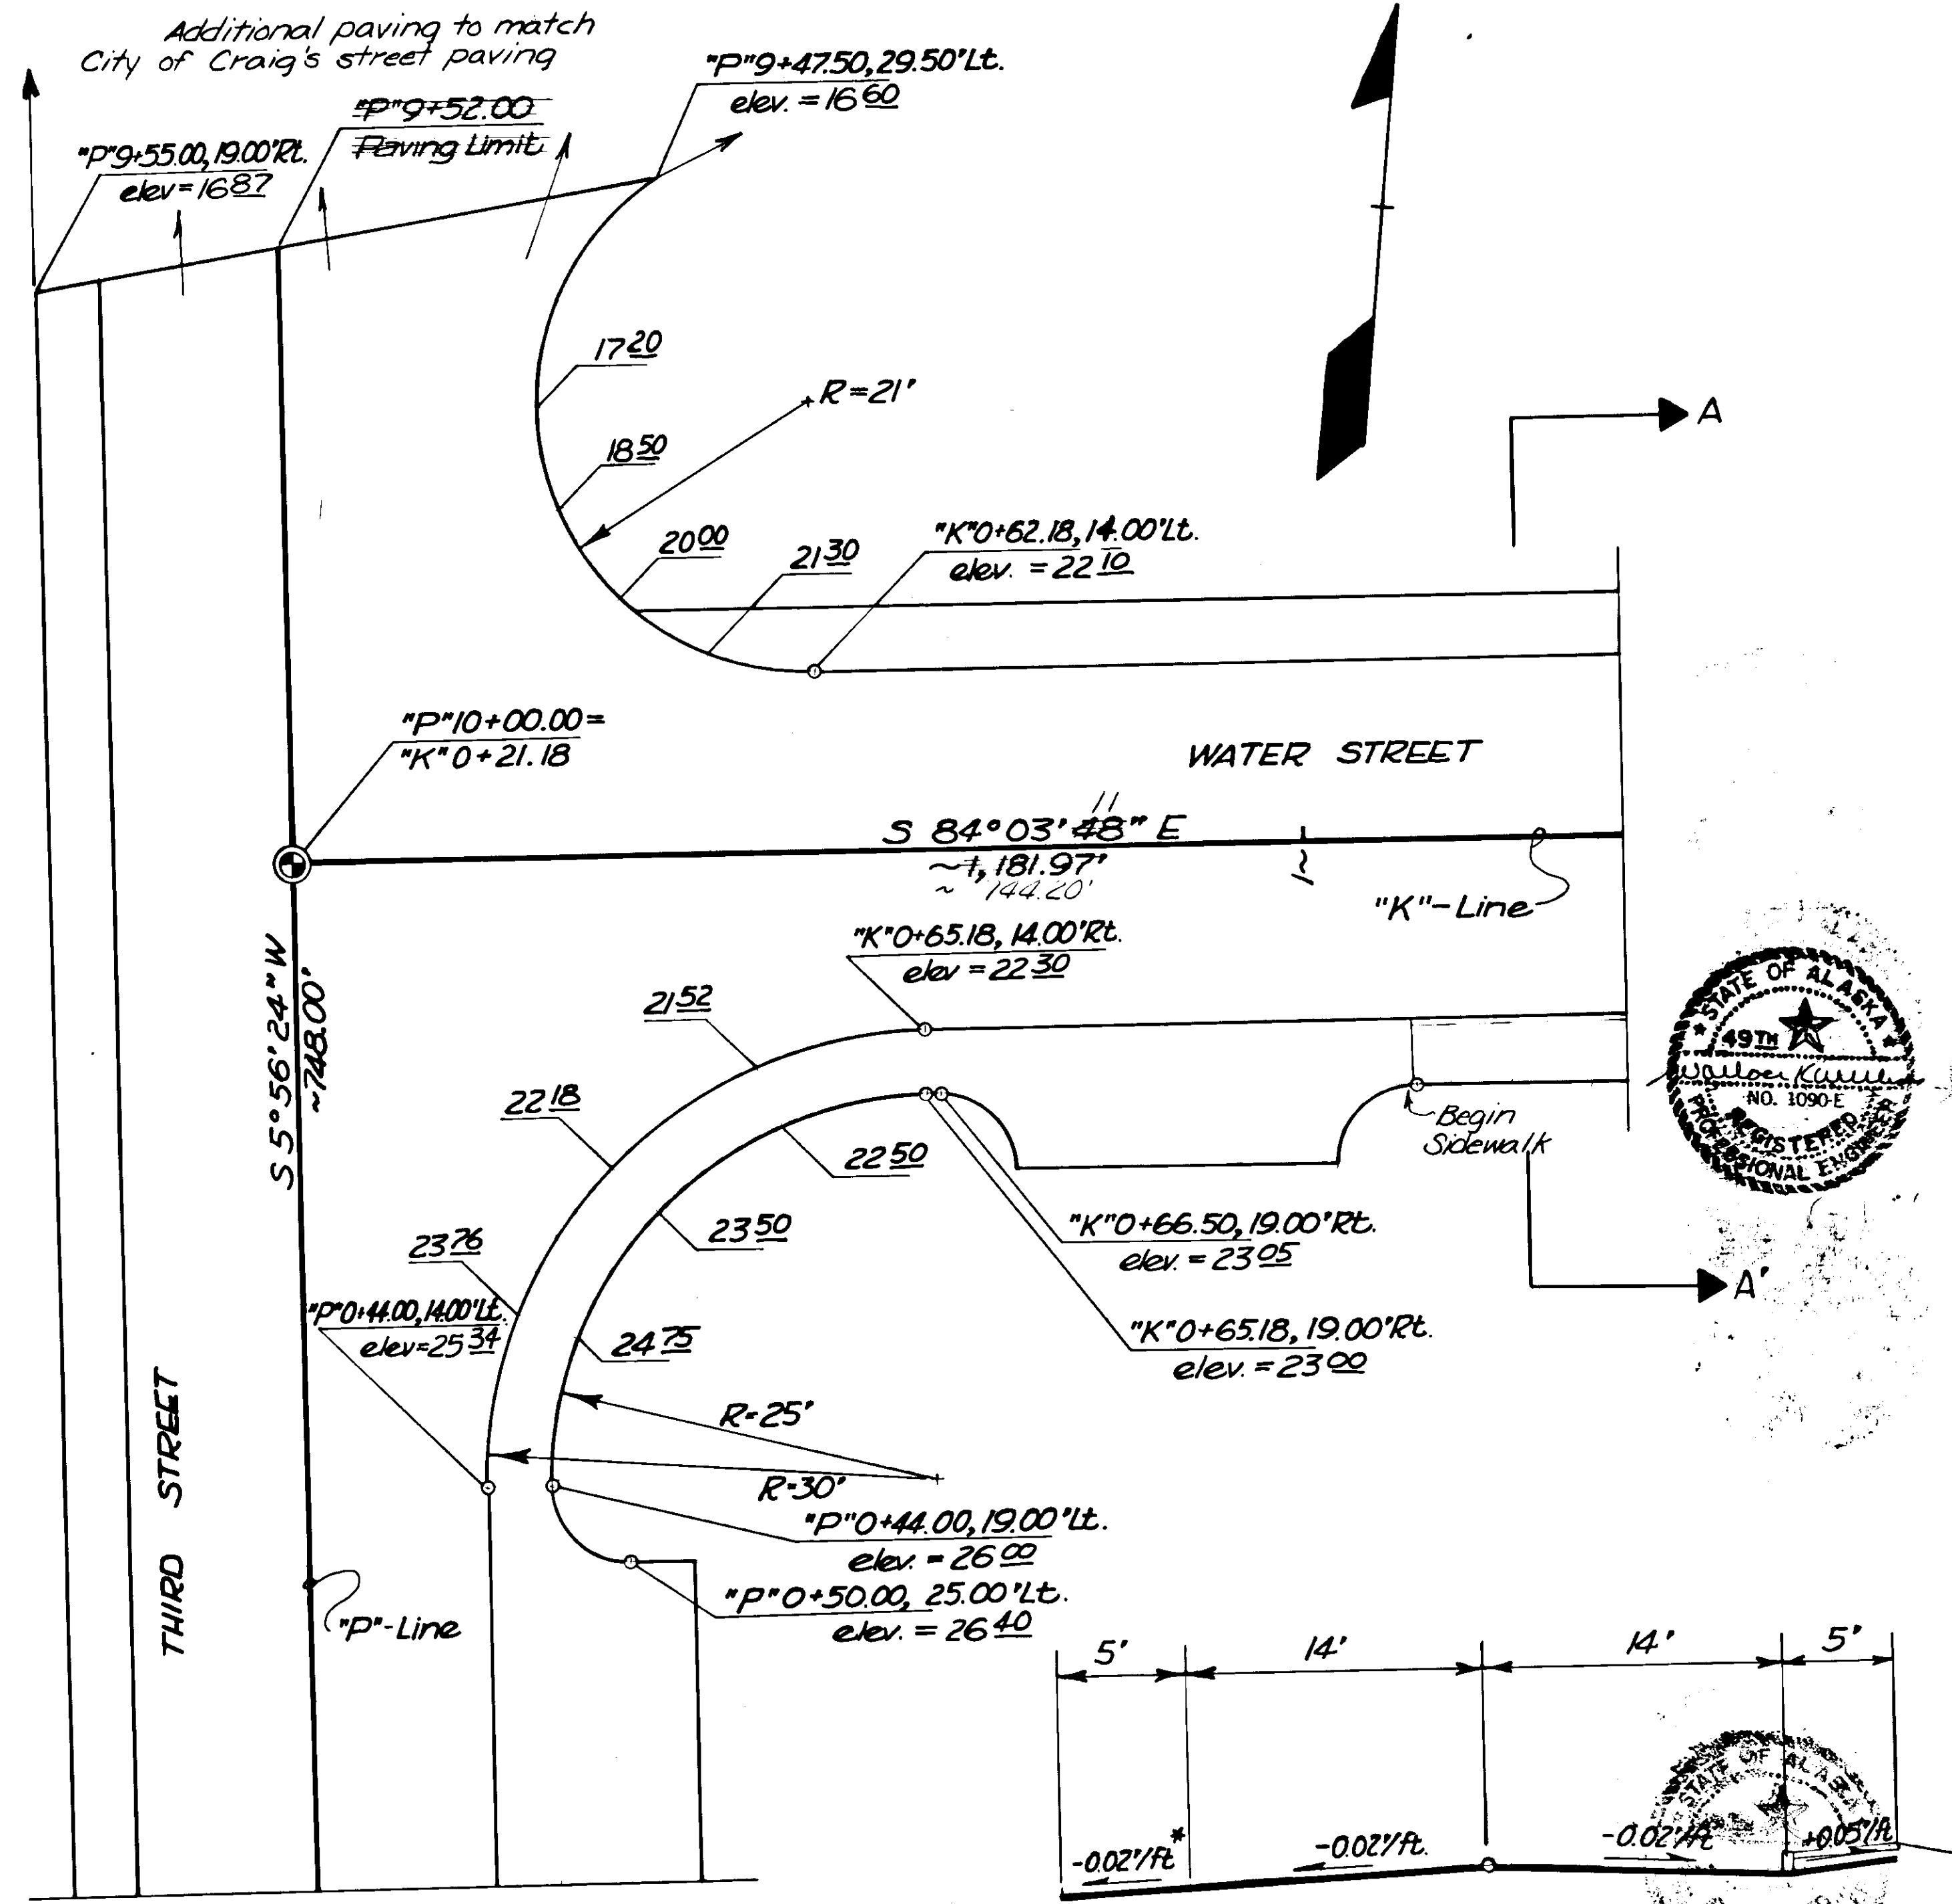


* from $"K"0+49, Lt.$ to $"K"3+50, Lt.$; then cross-slope reverts back to $+0.05'/ft.$




STATE	PROJECT DESIGNATION	YEAR	SHEET NO.	TOTAL SHEETS
ALASKA	SR-0924(7)	1982	23	27

"D"-LINE

NOTE
Cut top of existing steel retaining wall as required to fit paving of curve return.

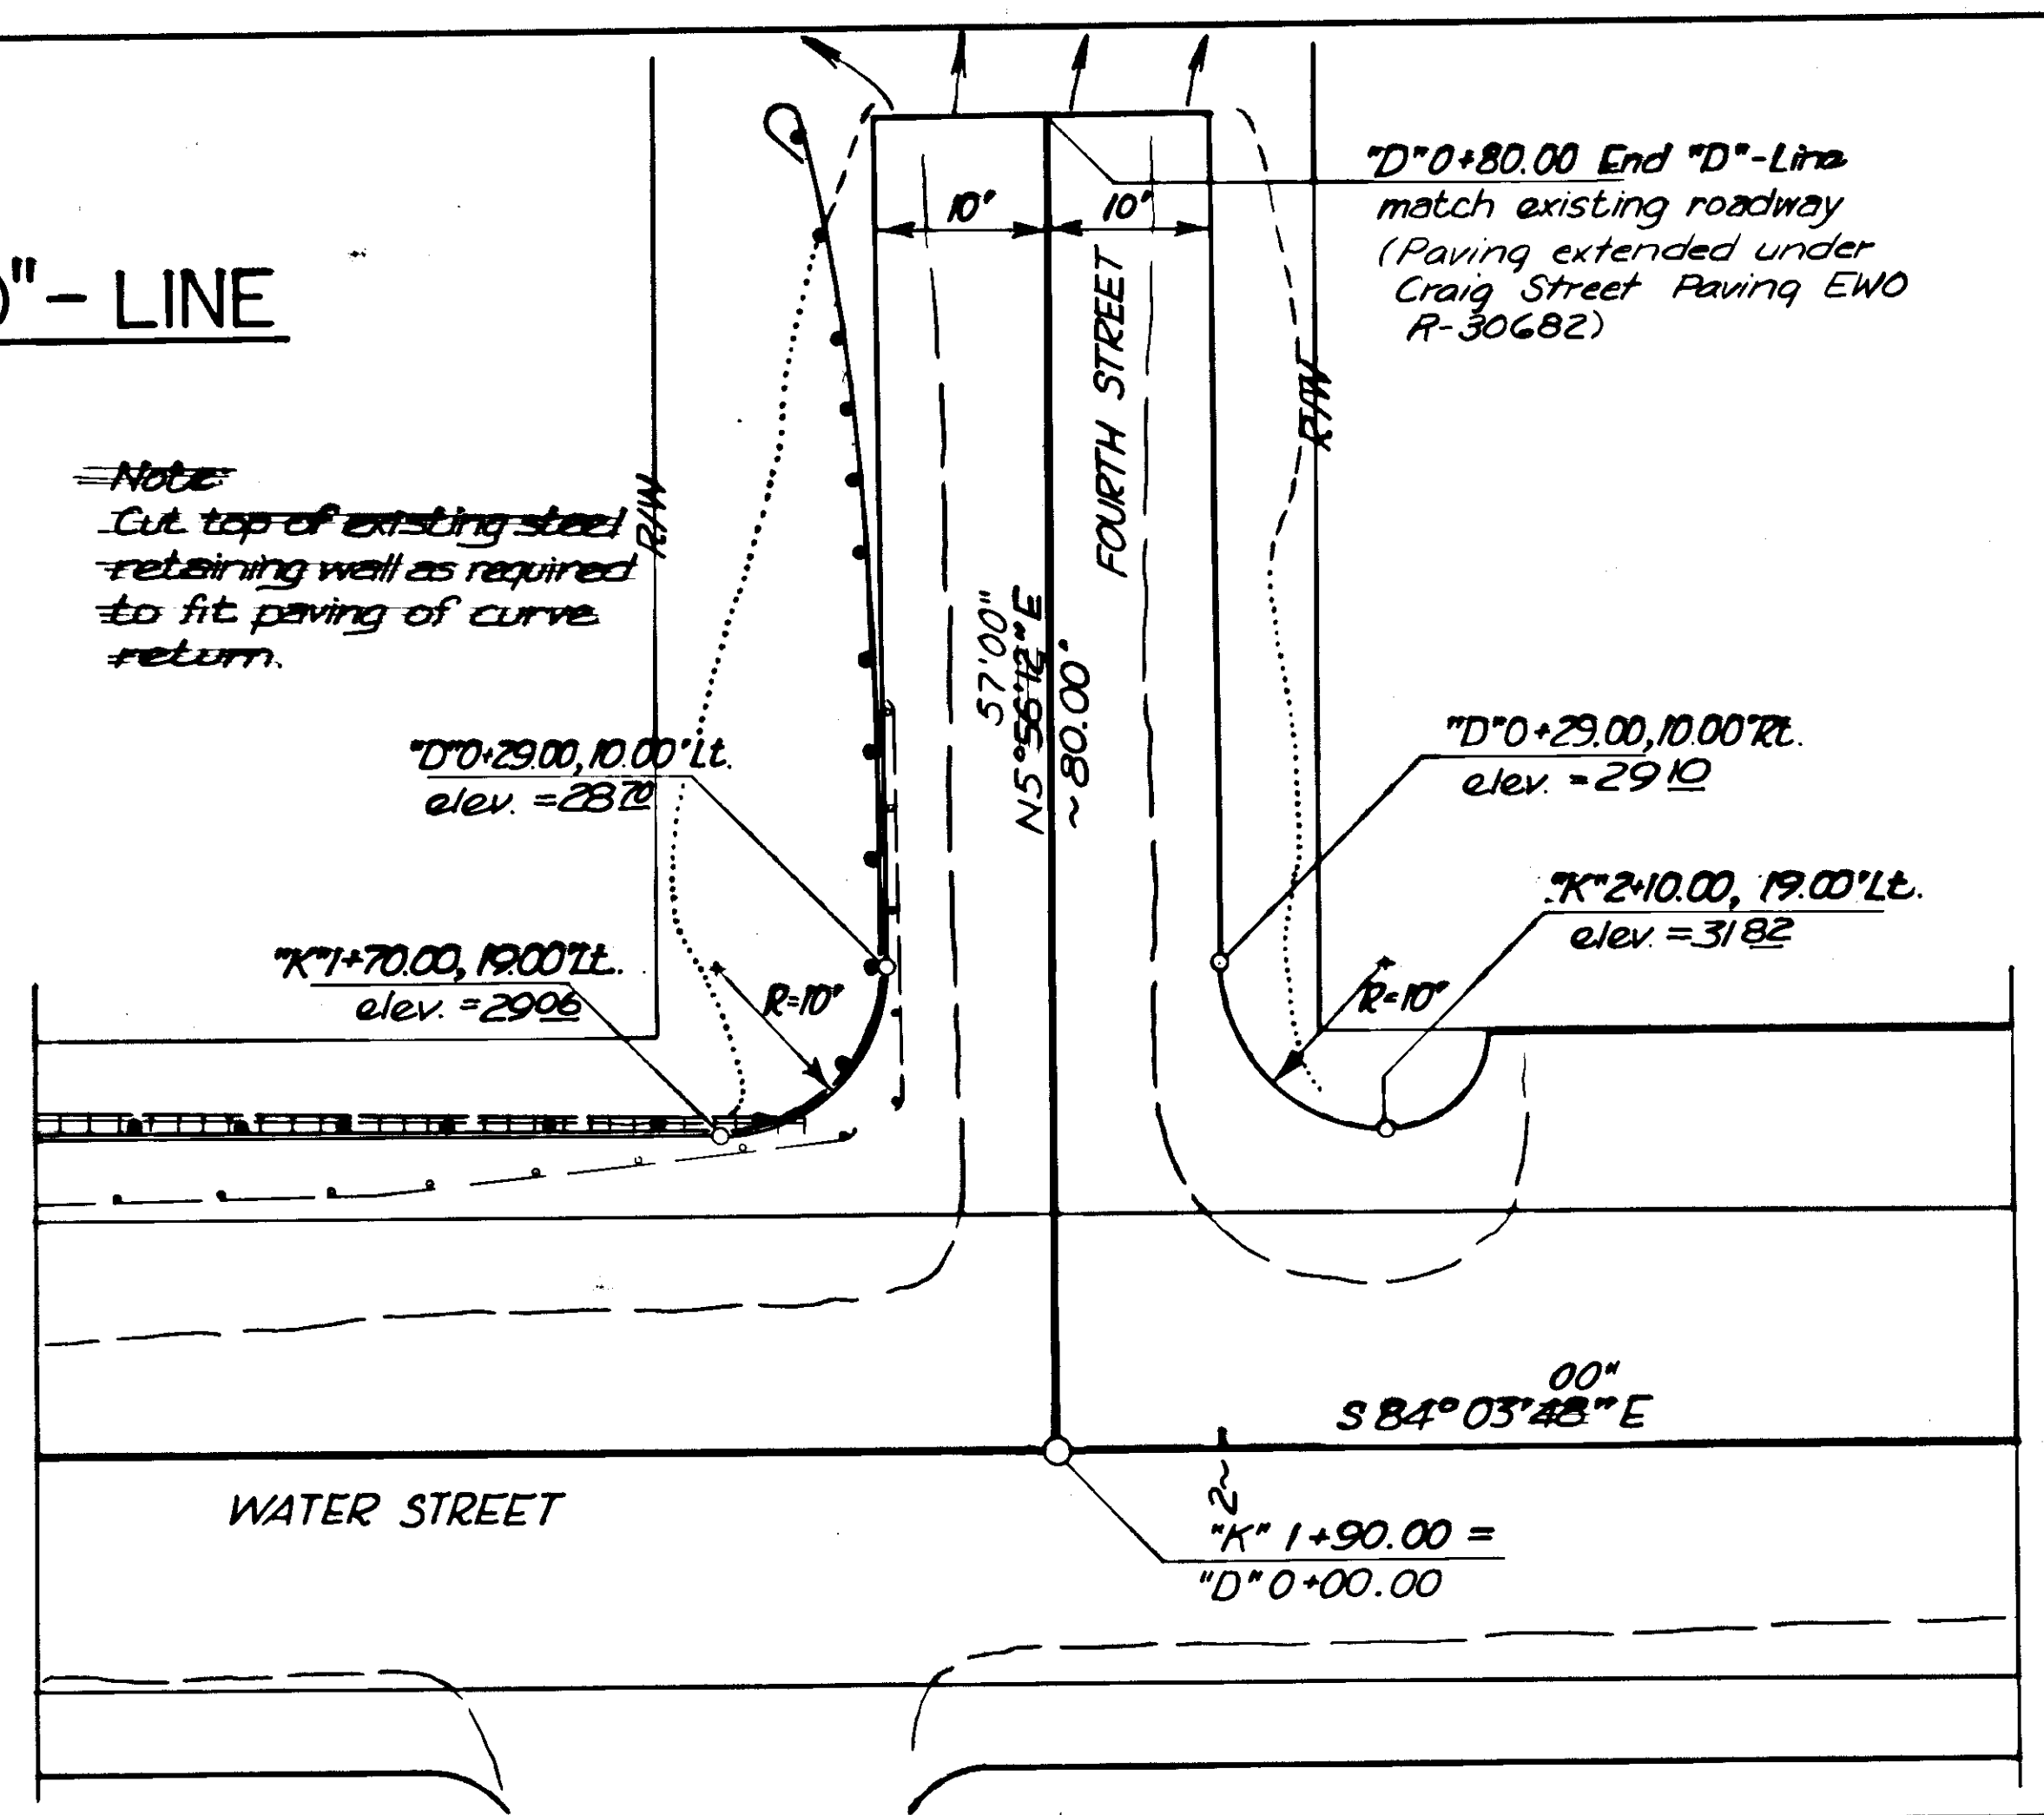


"E"-LINE


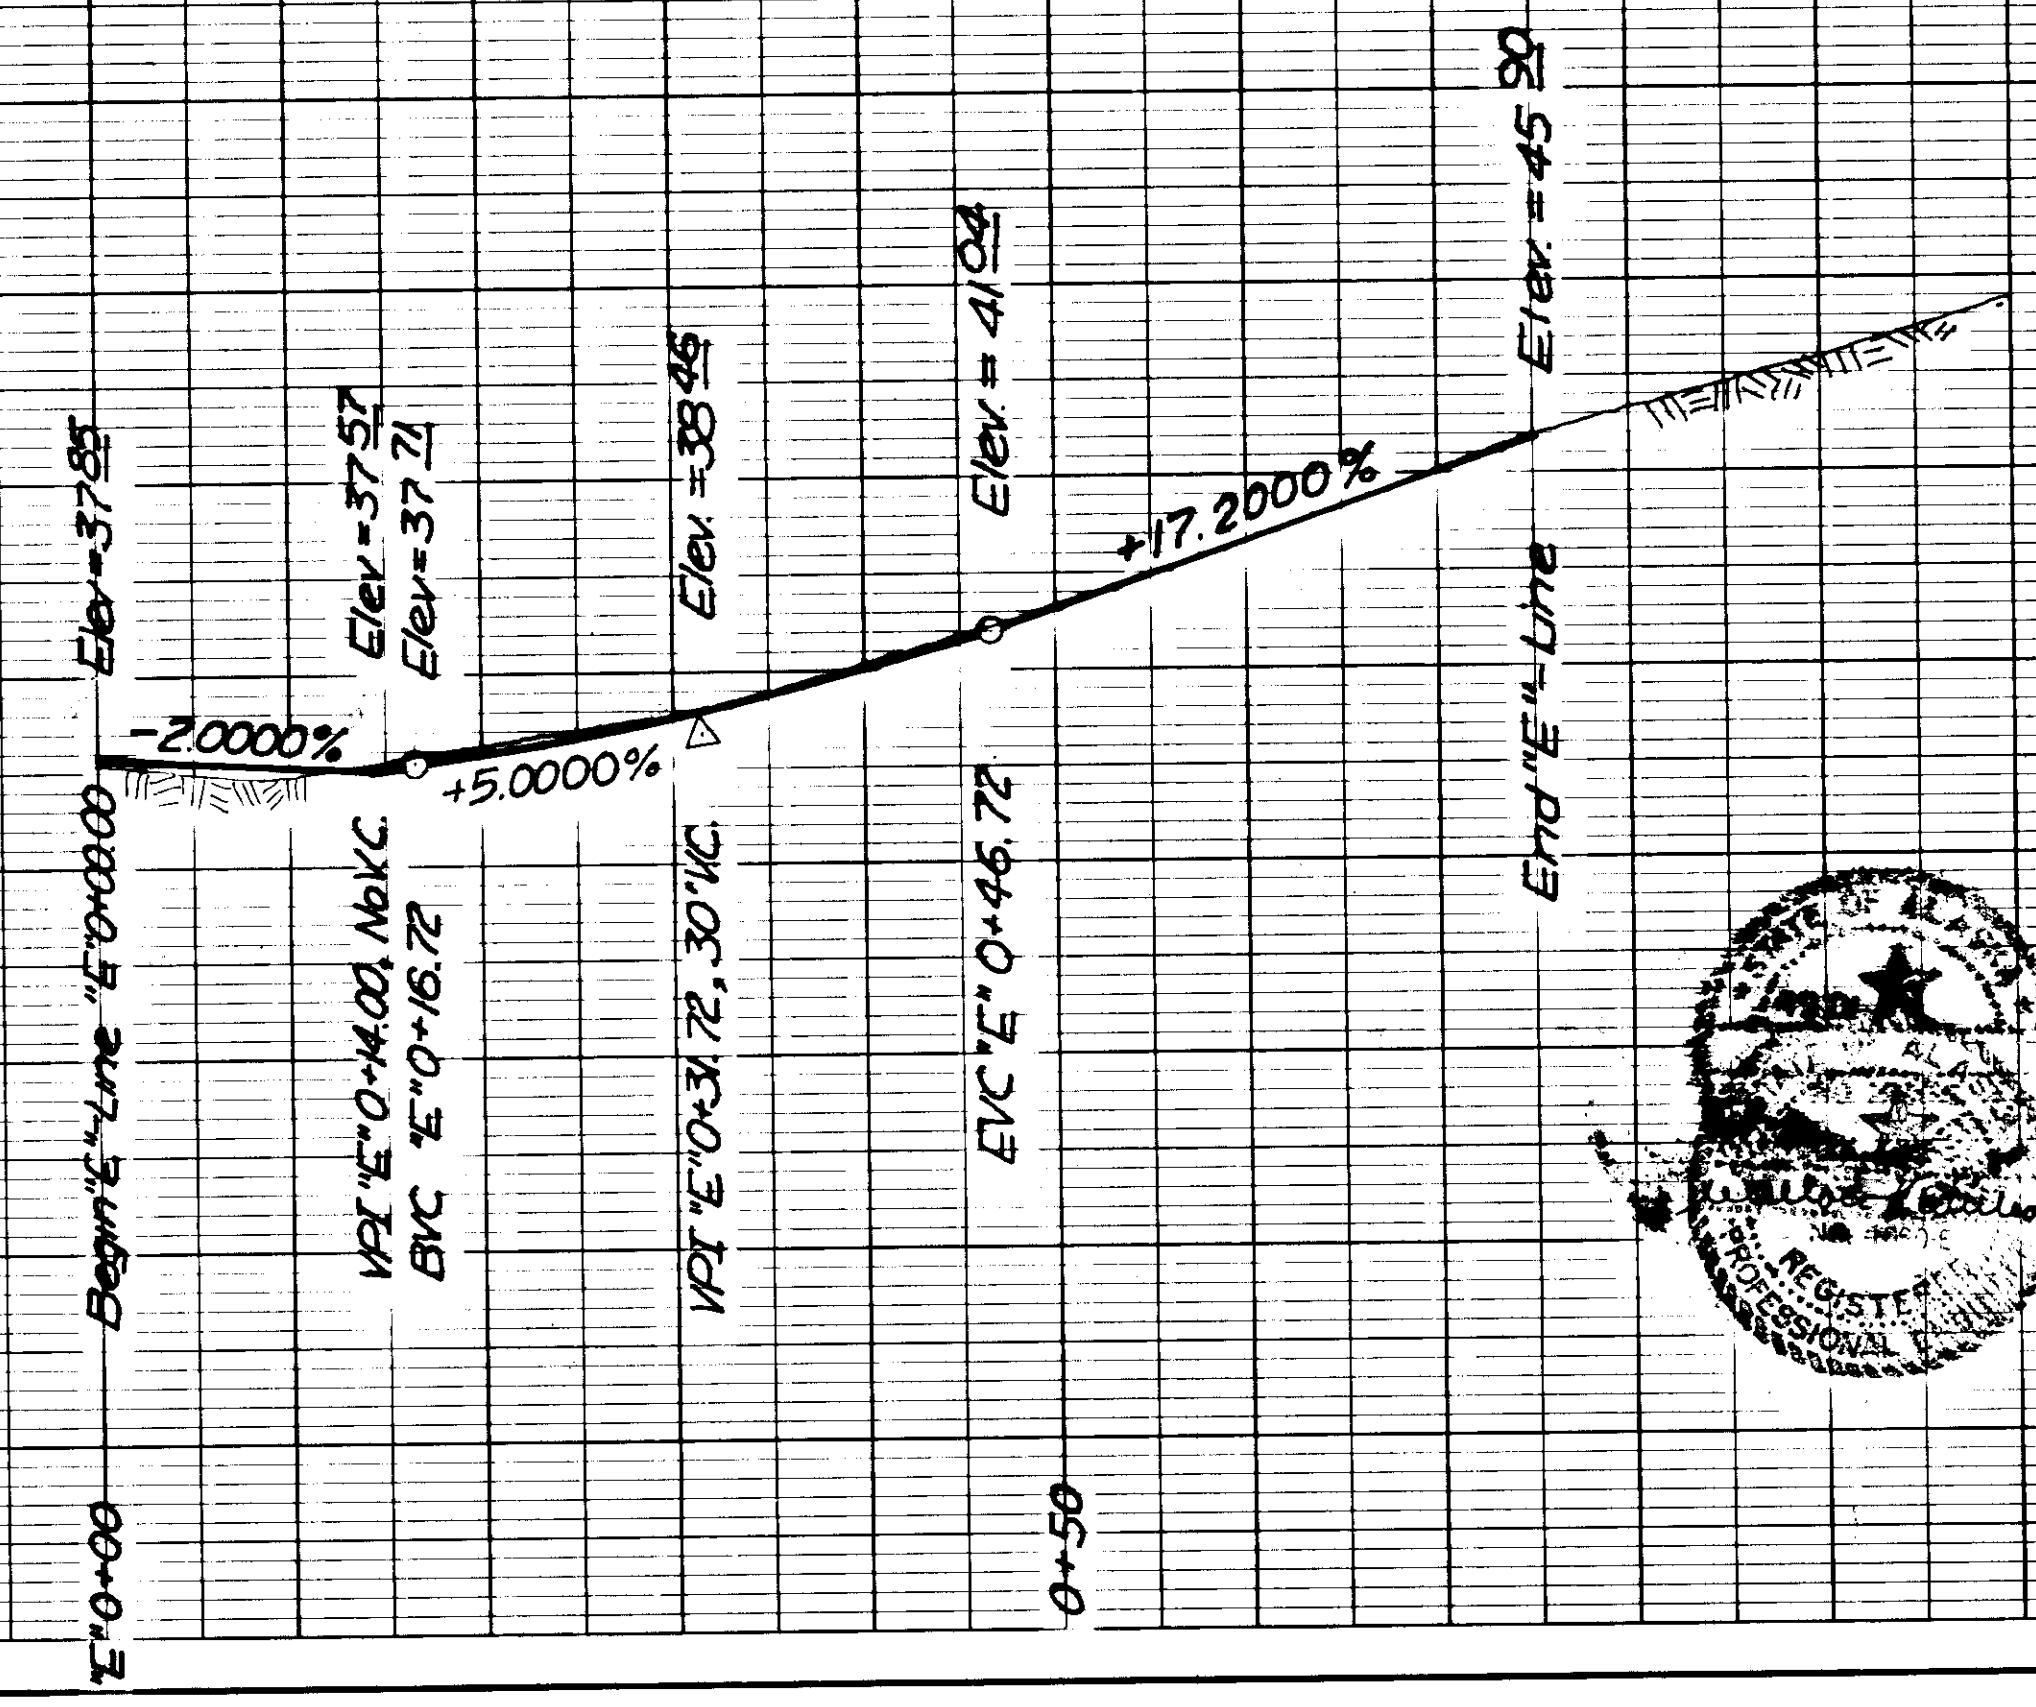
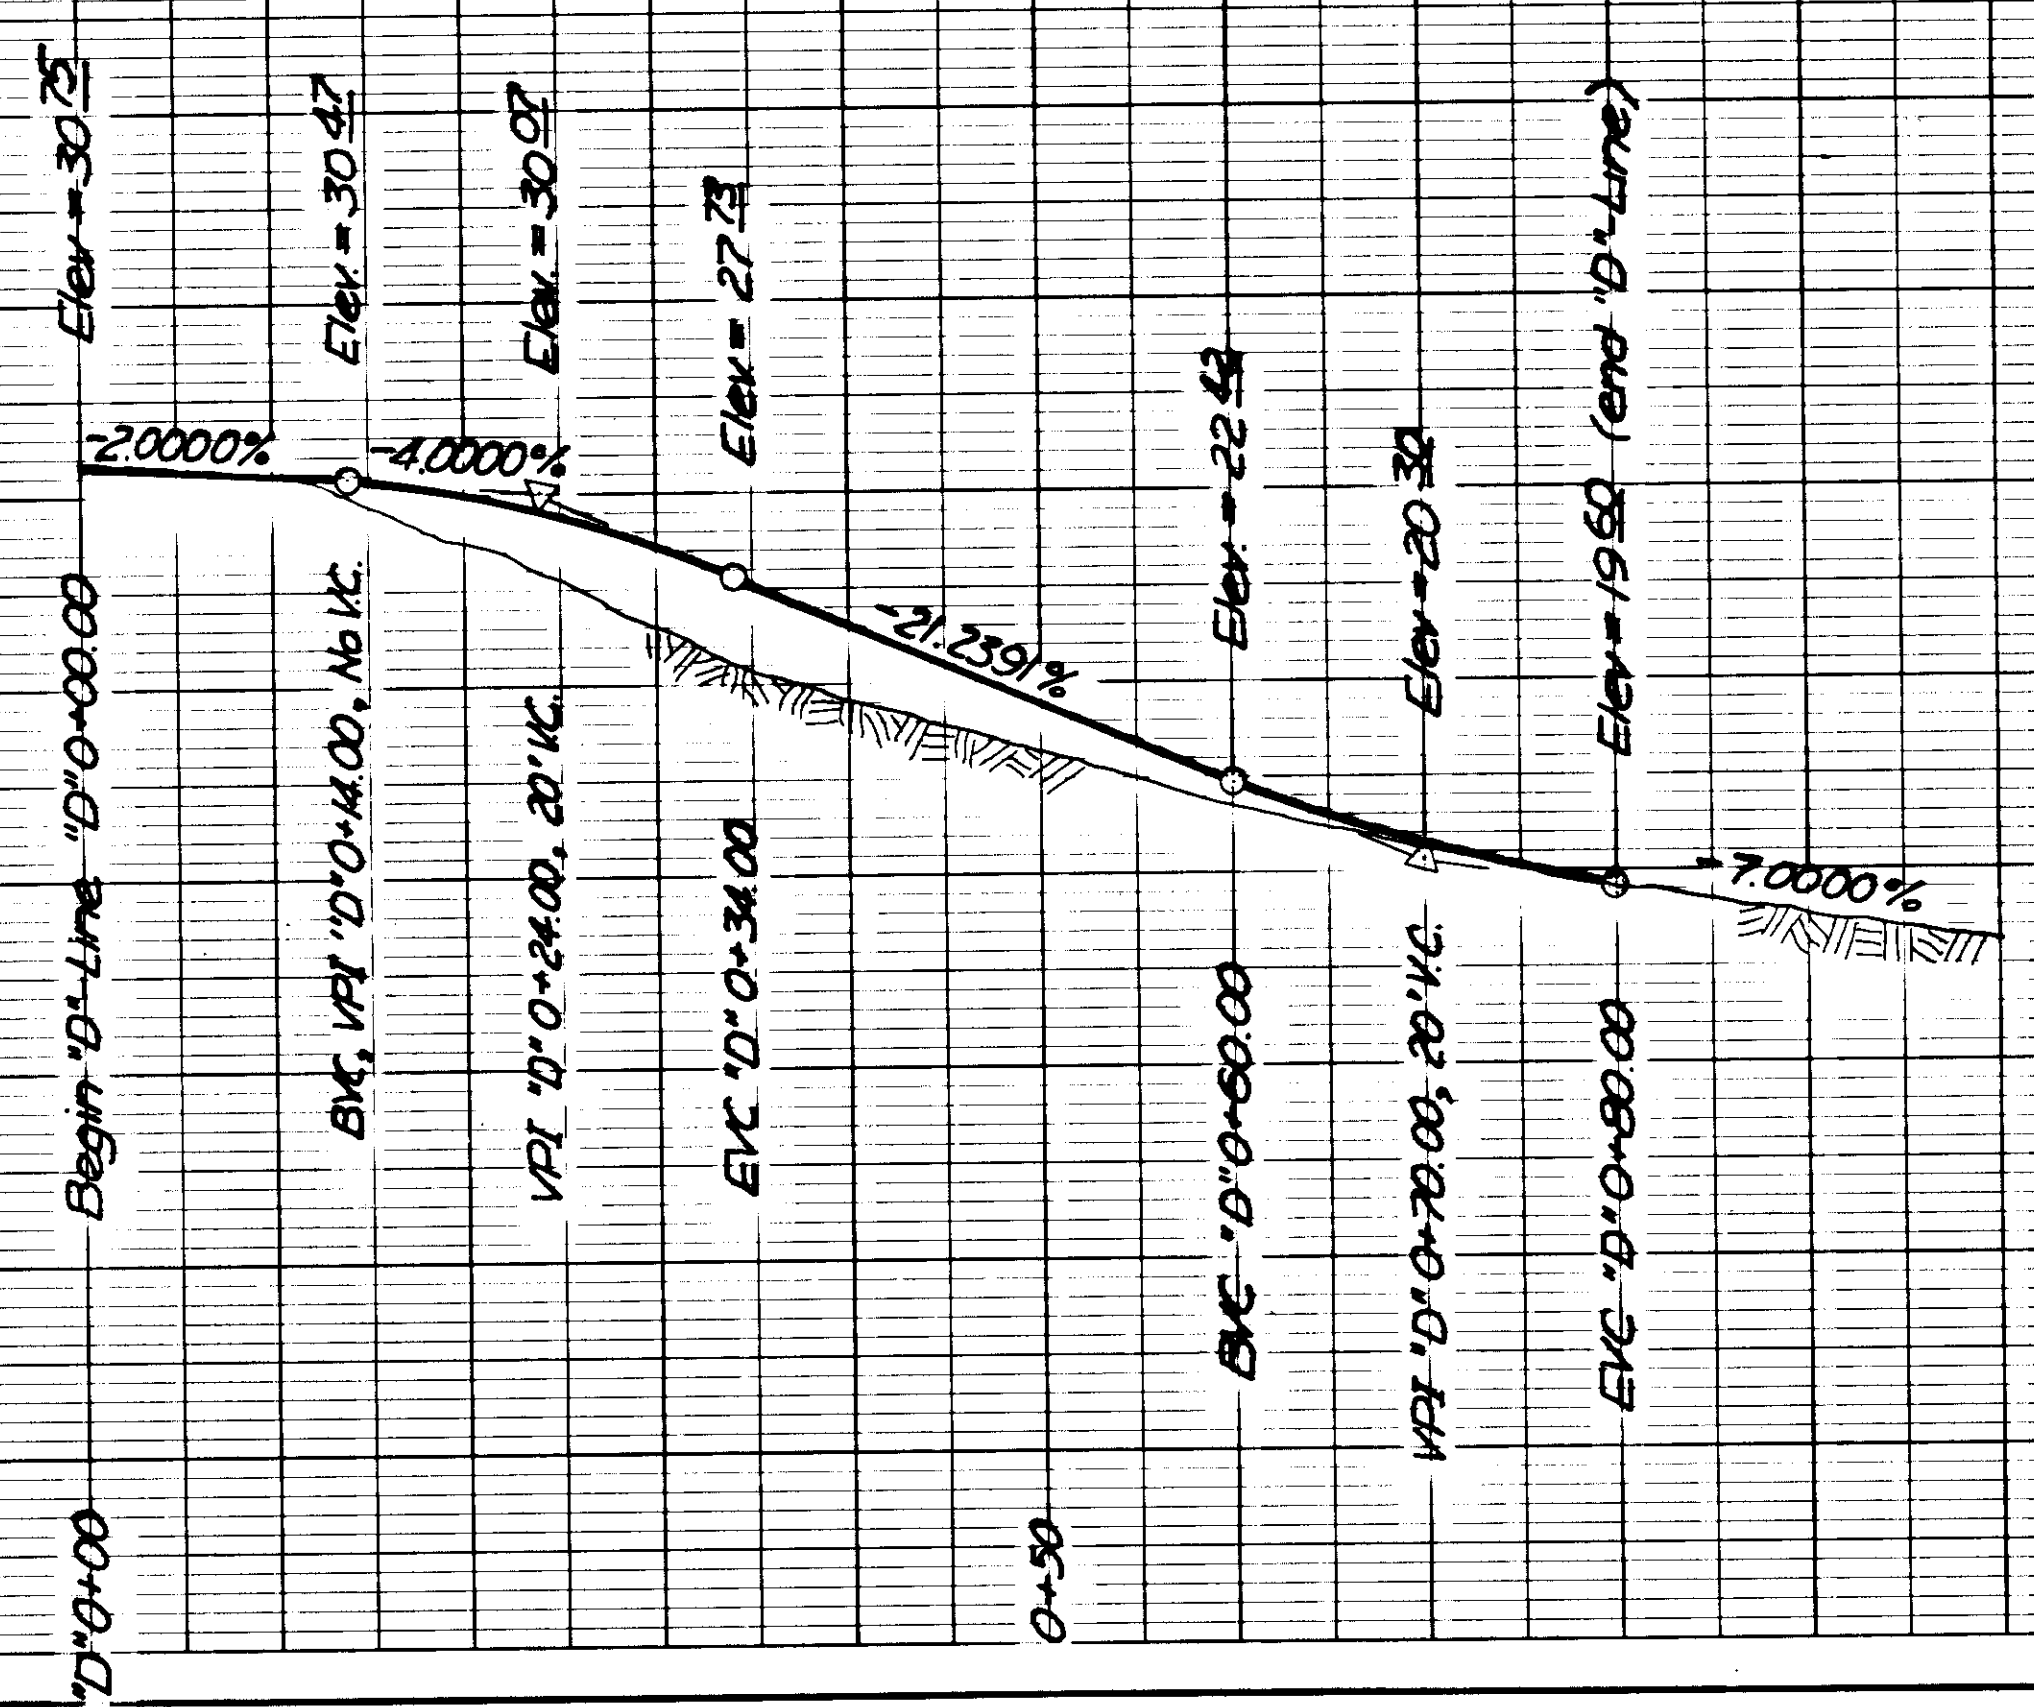
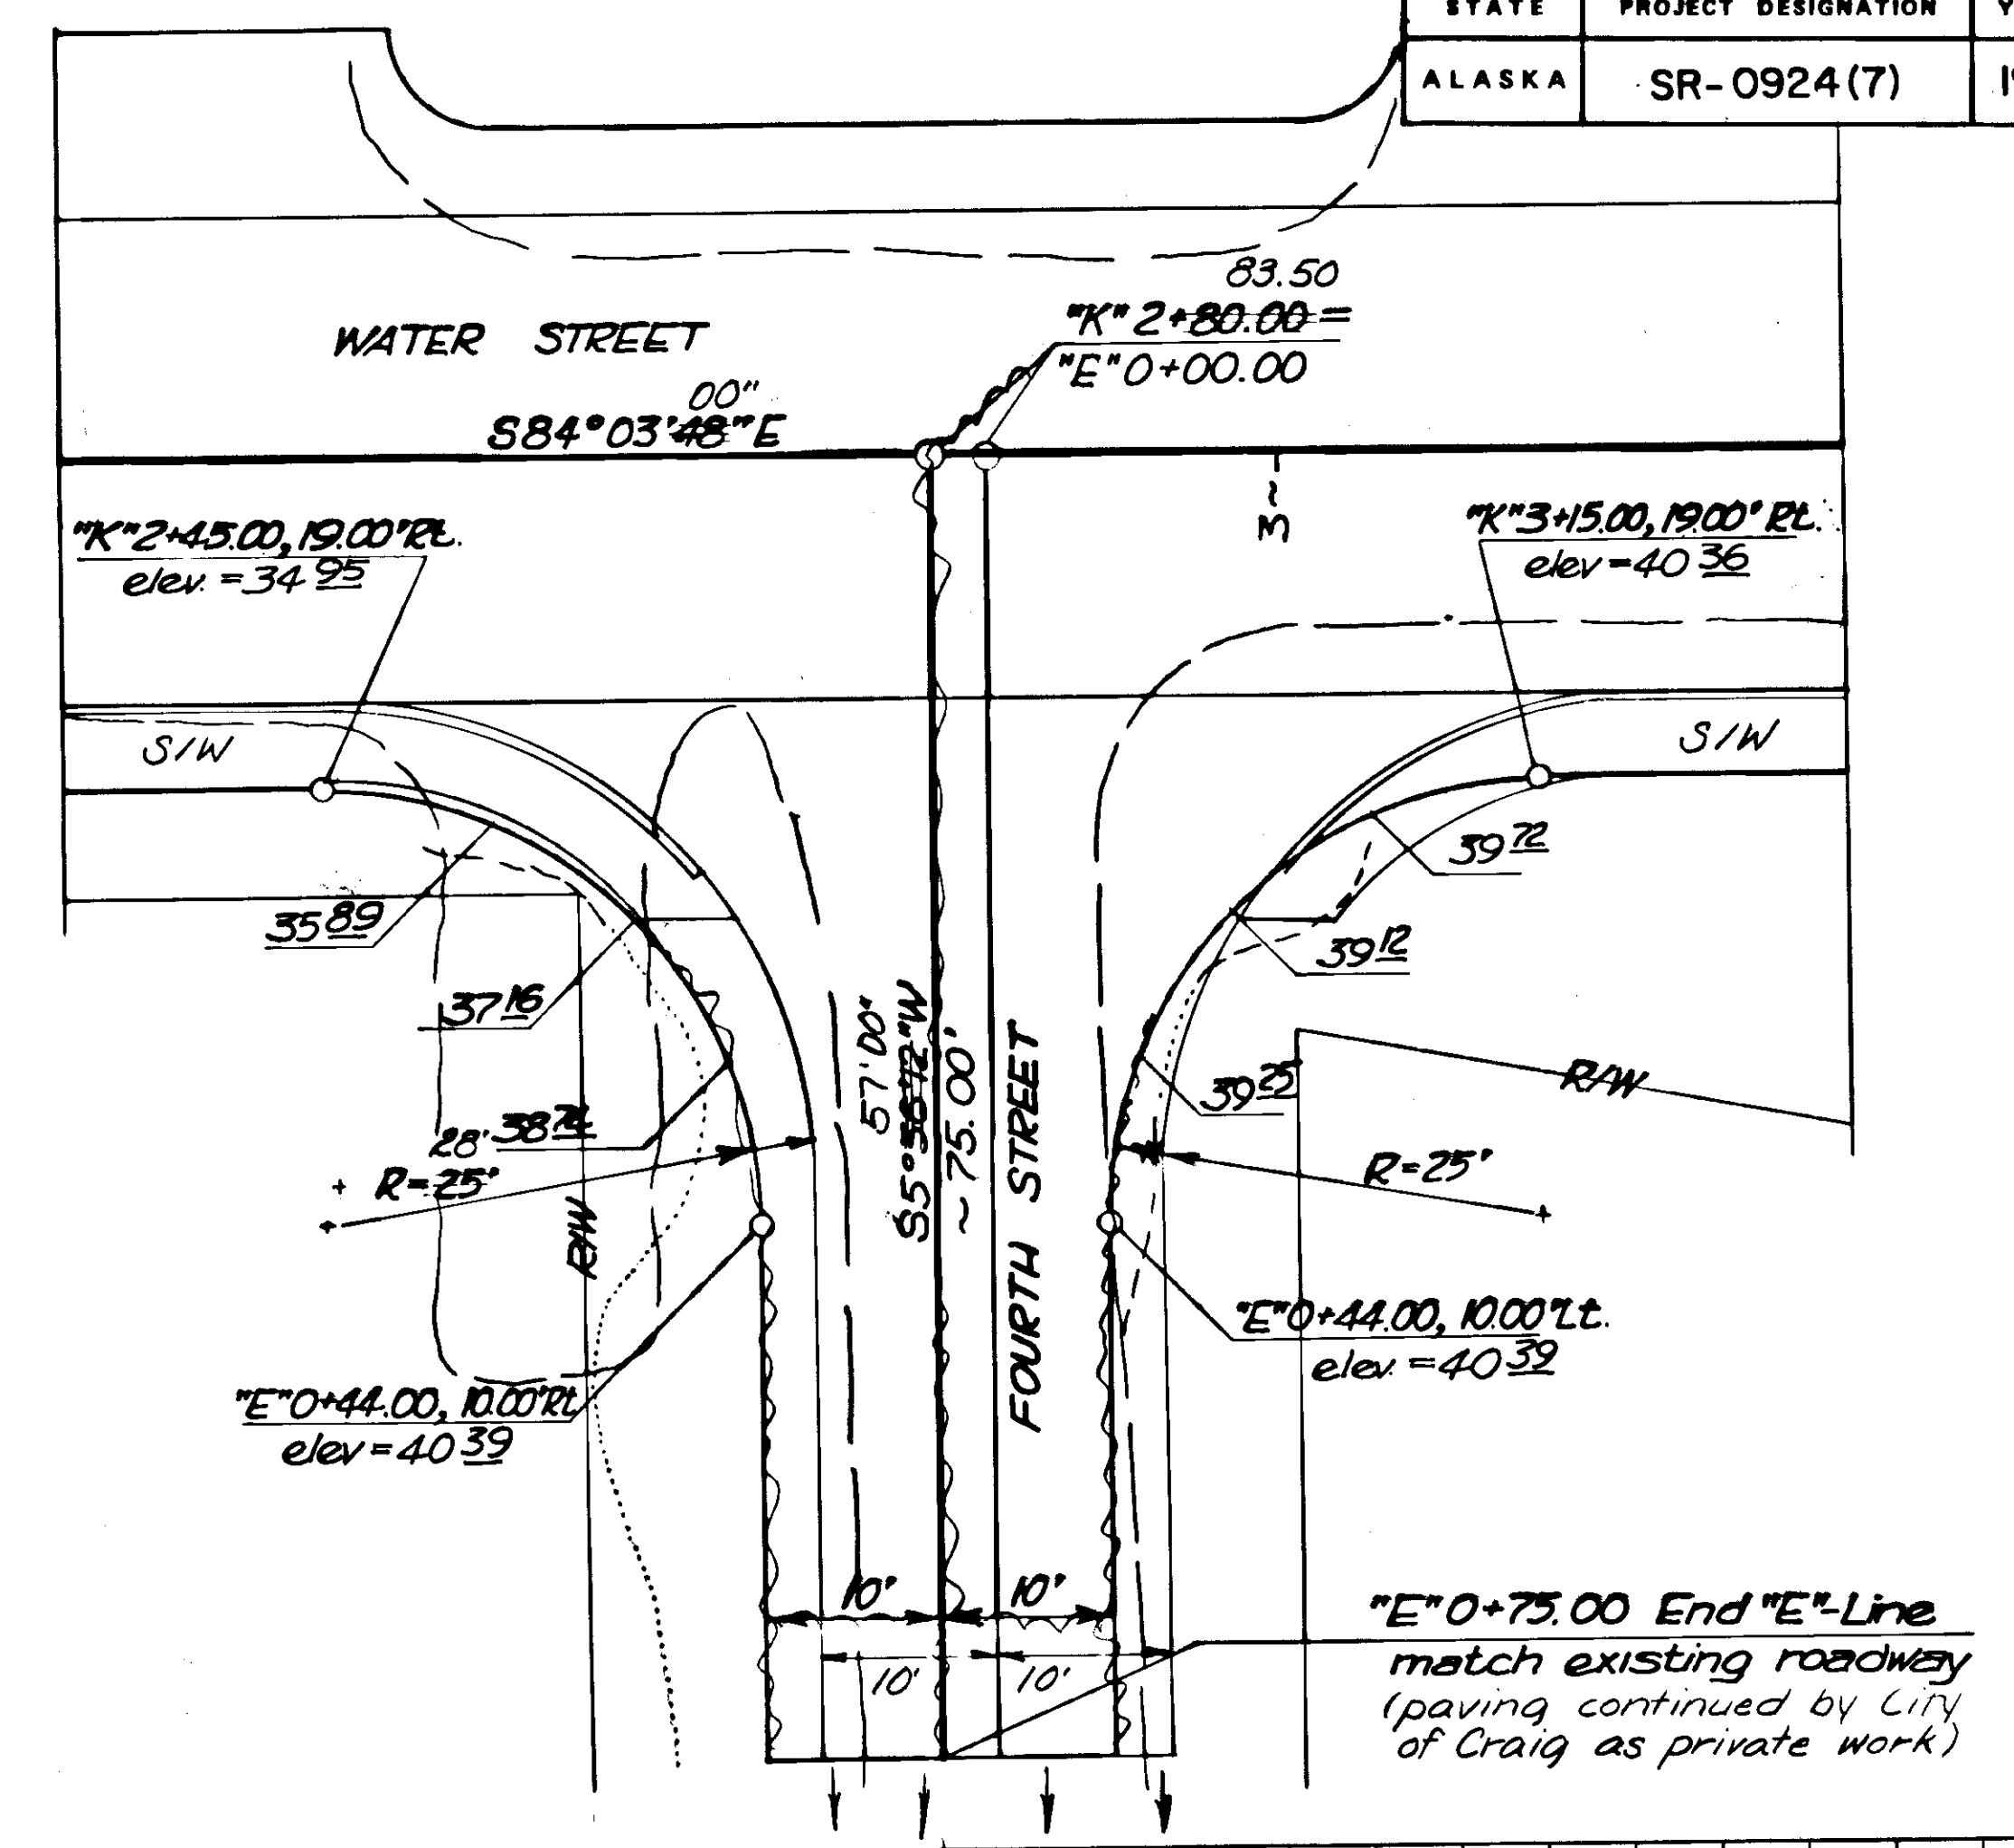


STATE	PROJECT DESIGNATION	YEAR	SHEET NO.
ALASKA	SR-0924(7)	1982	24

"F" - Line

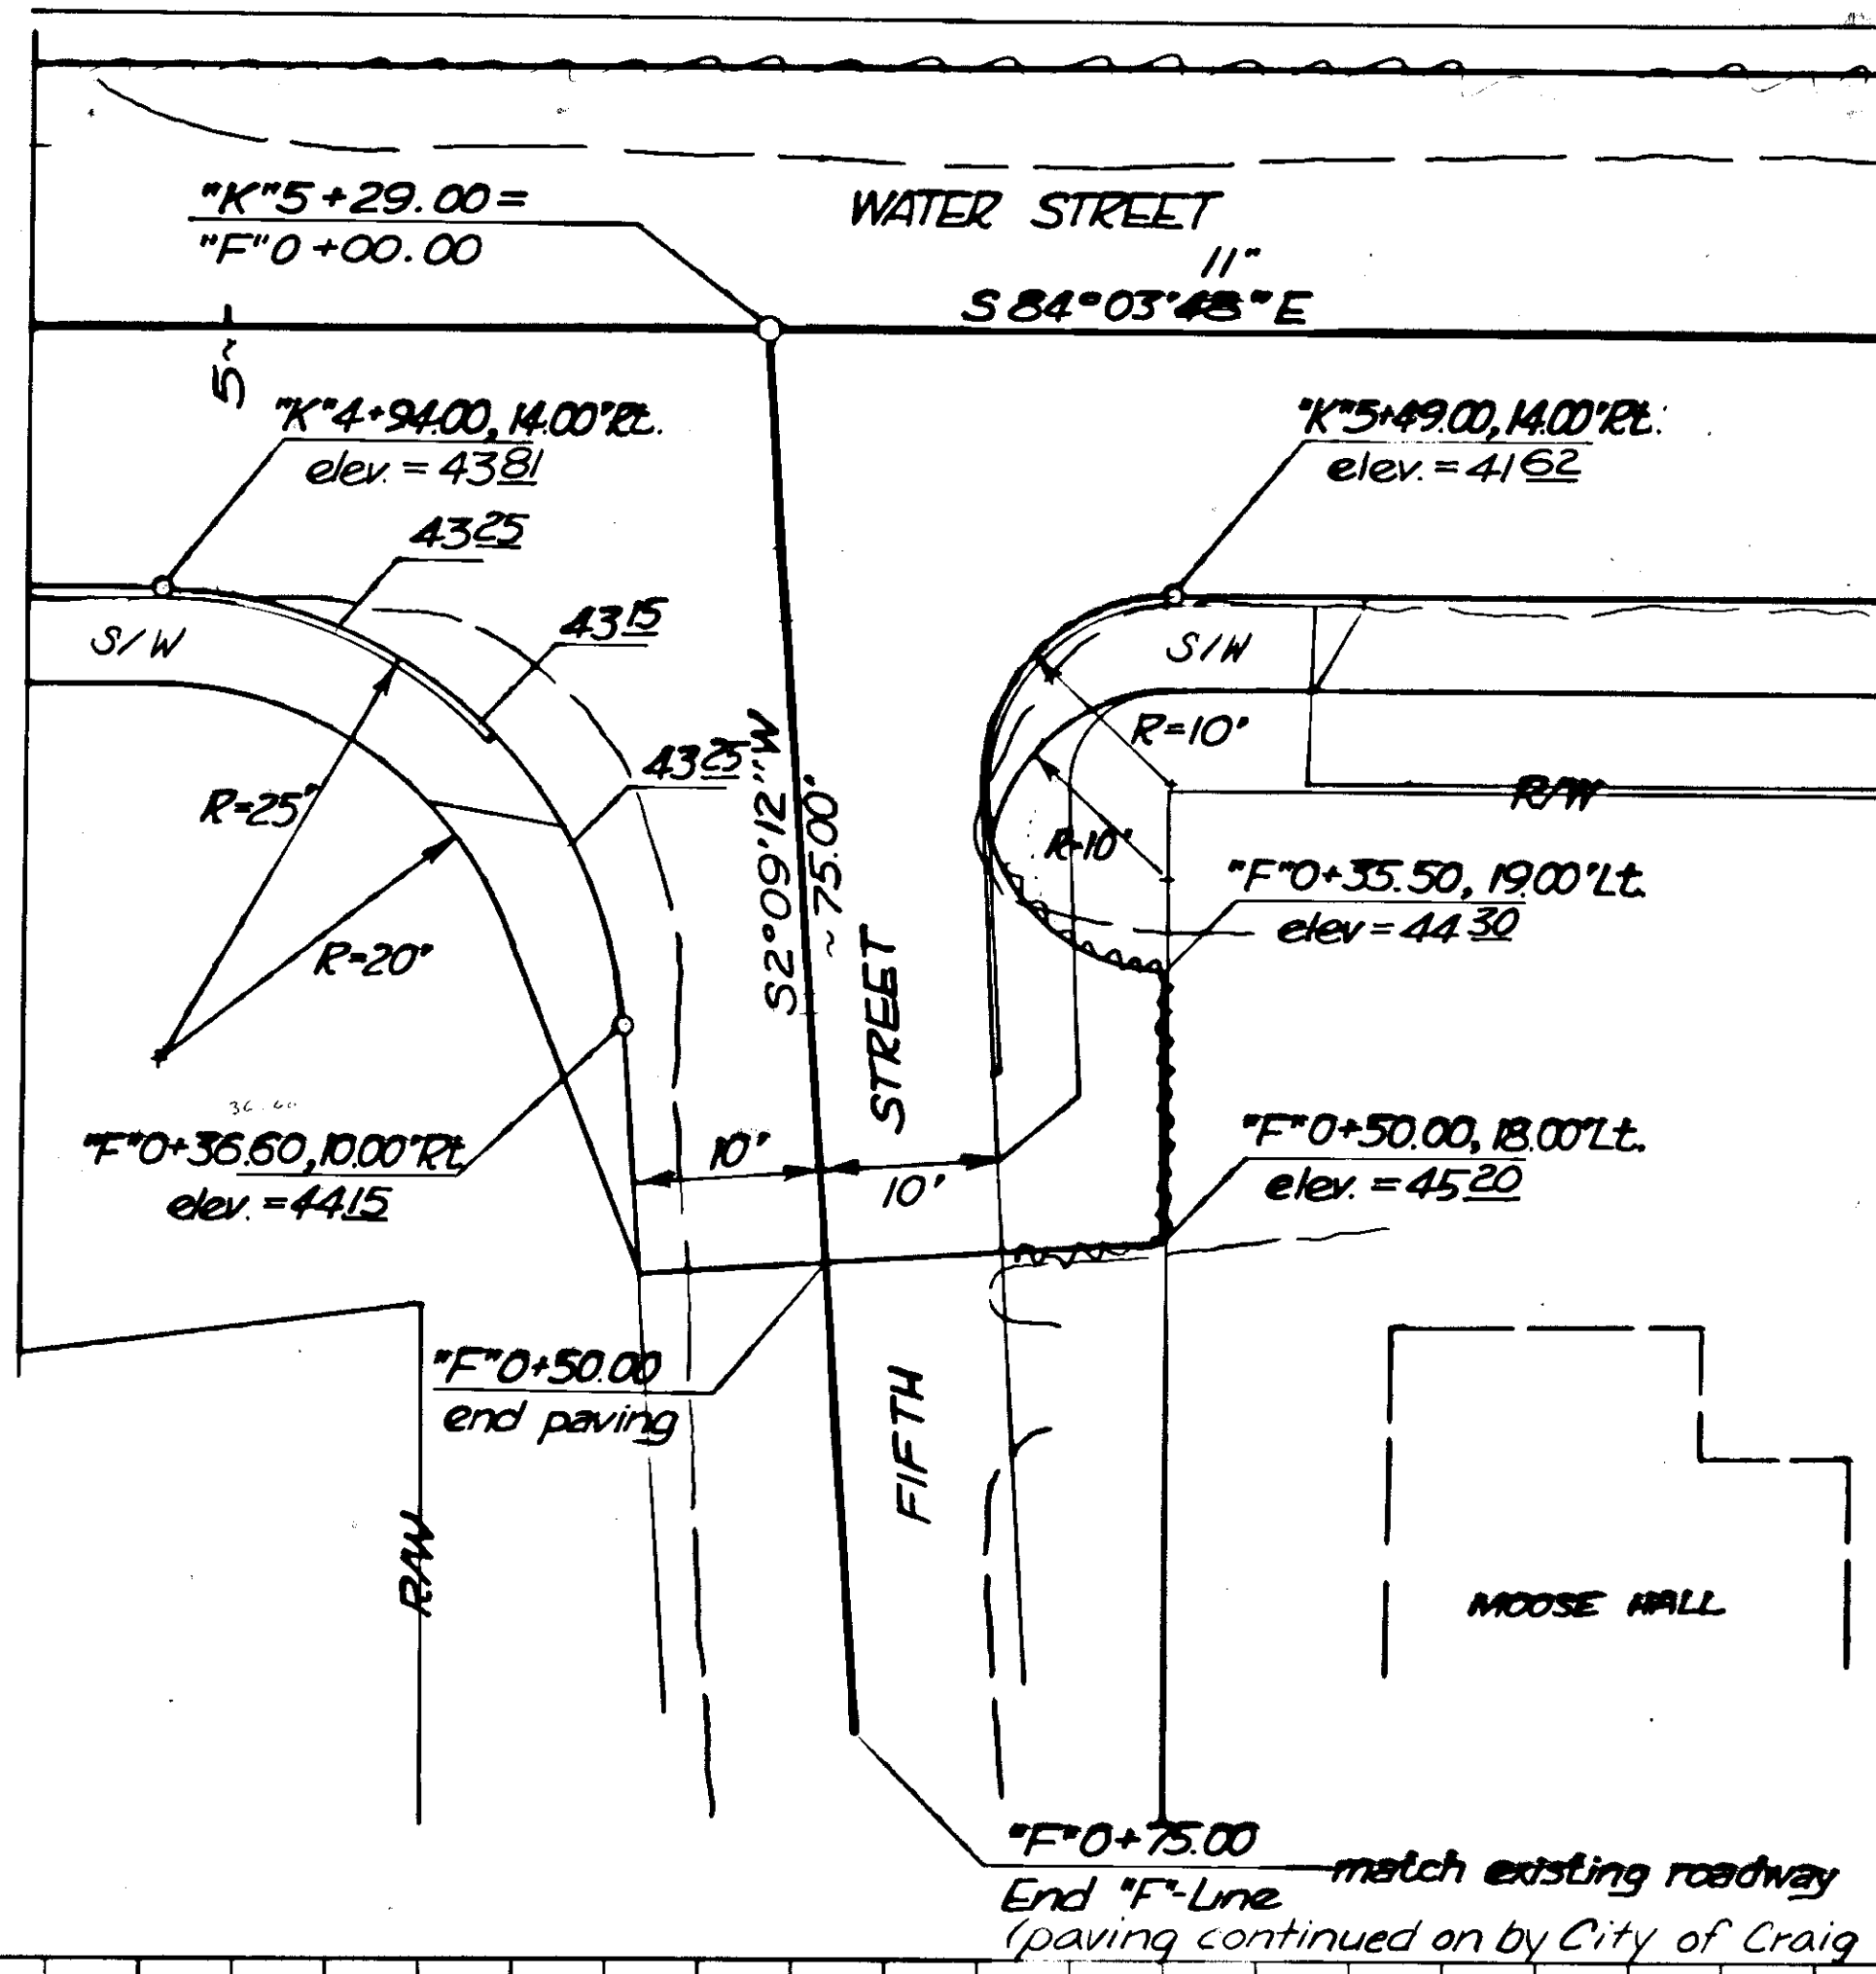


"G" - Line

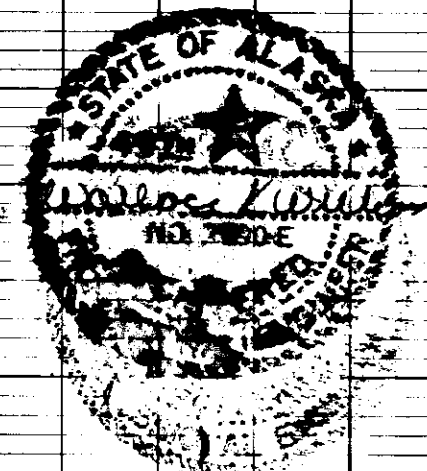
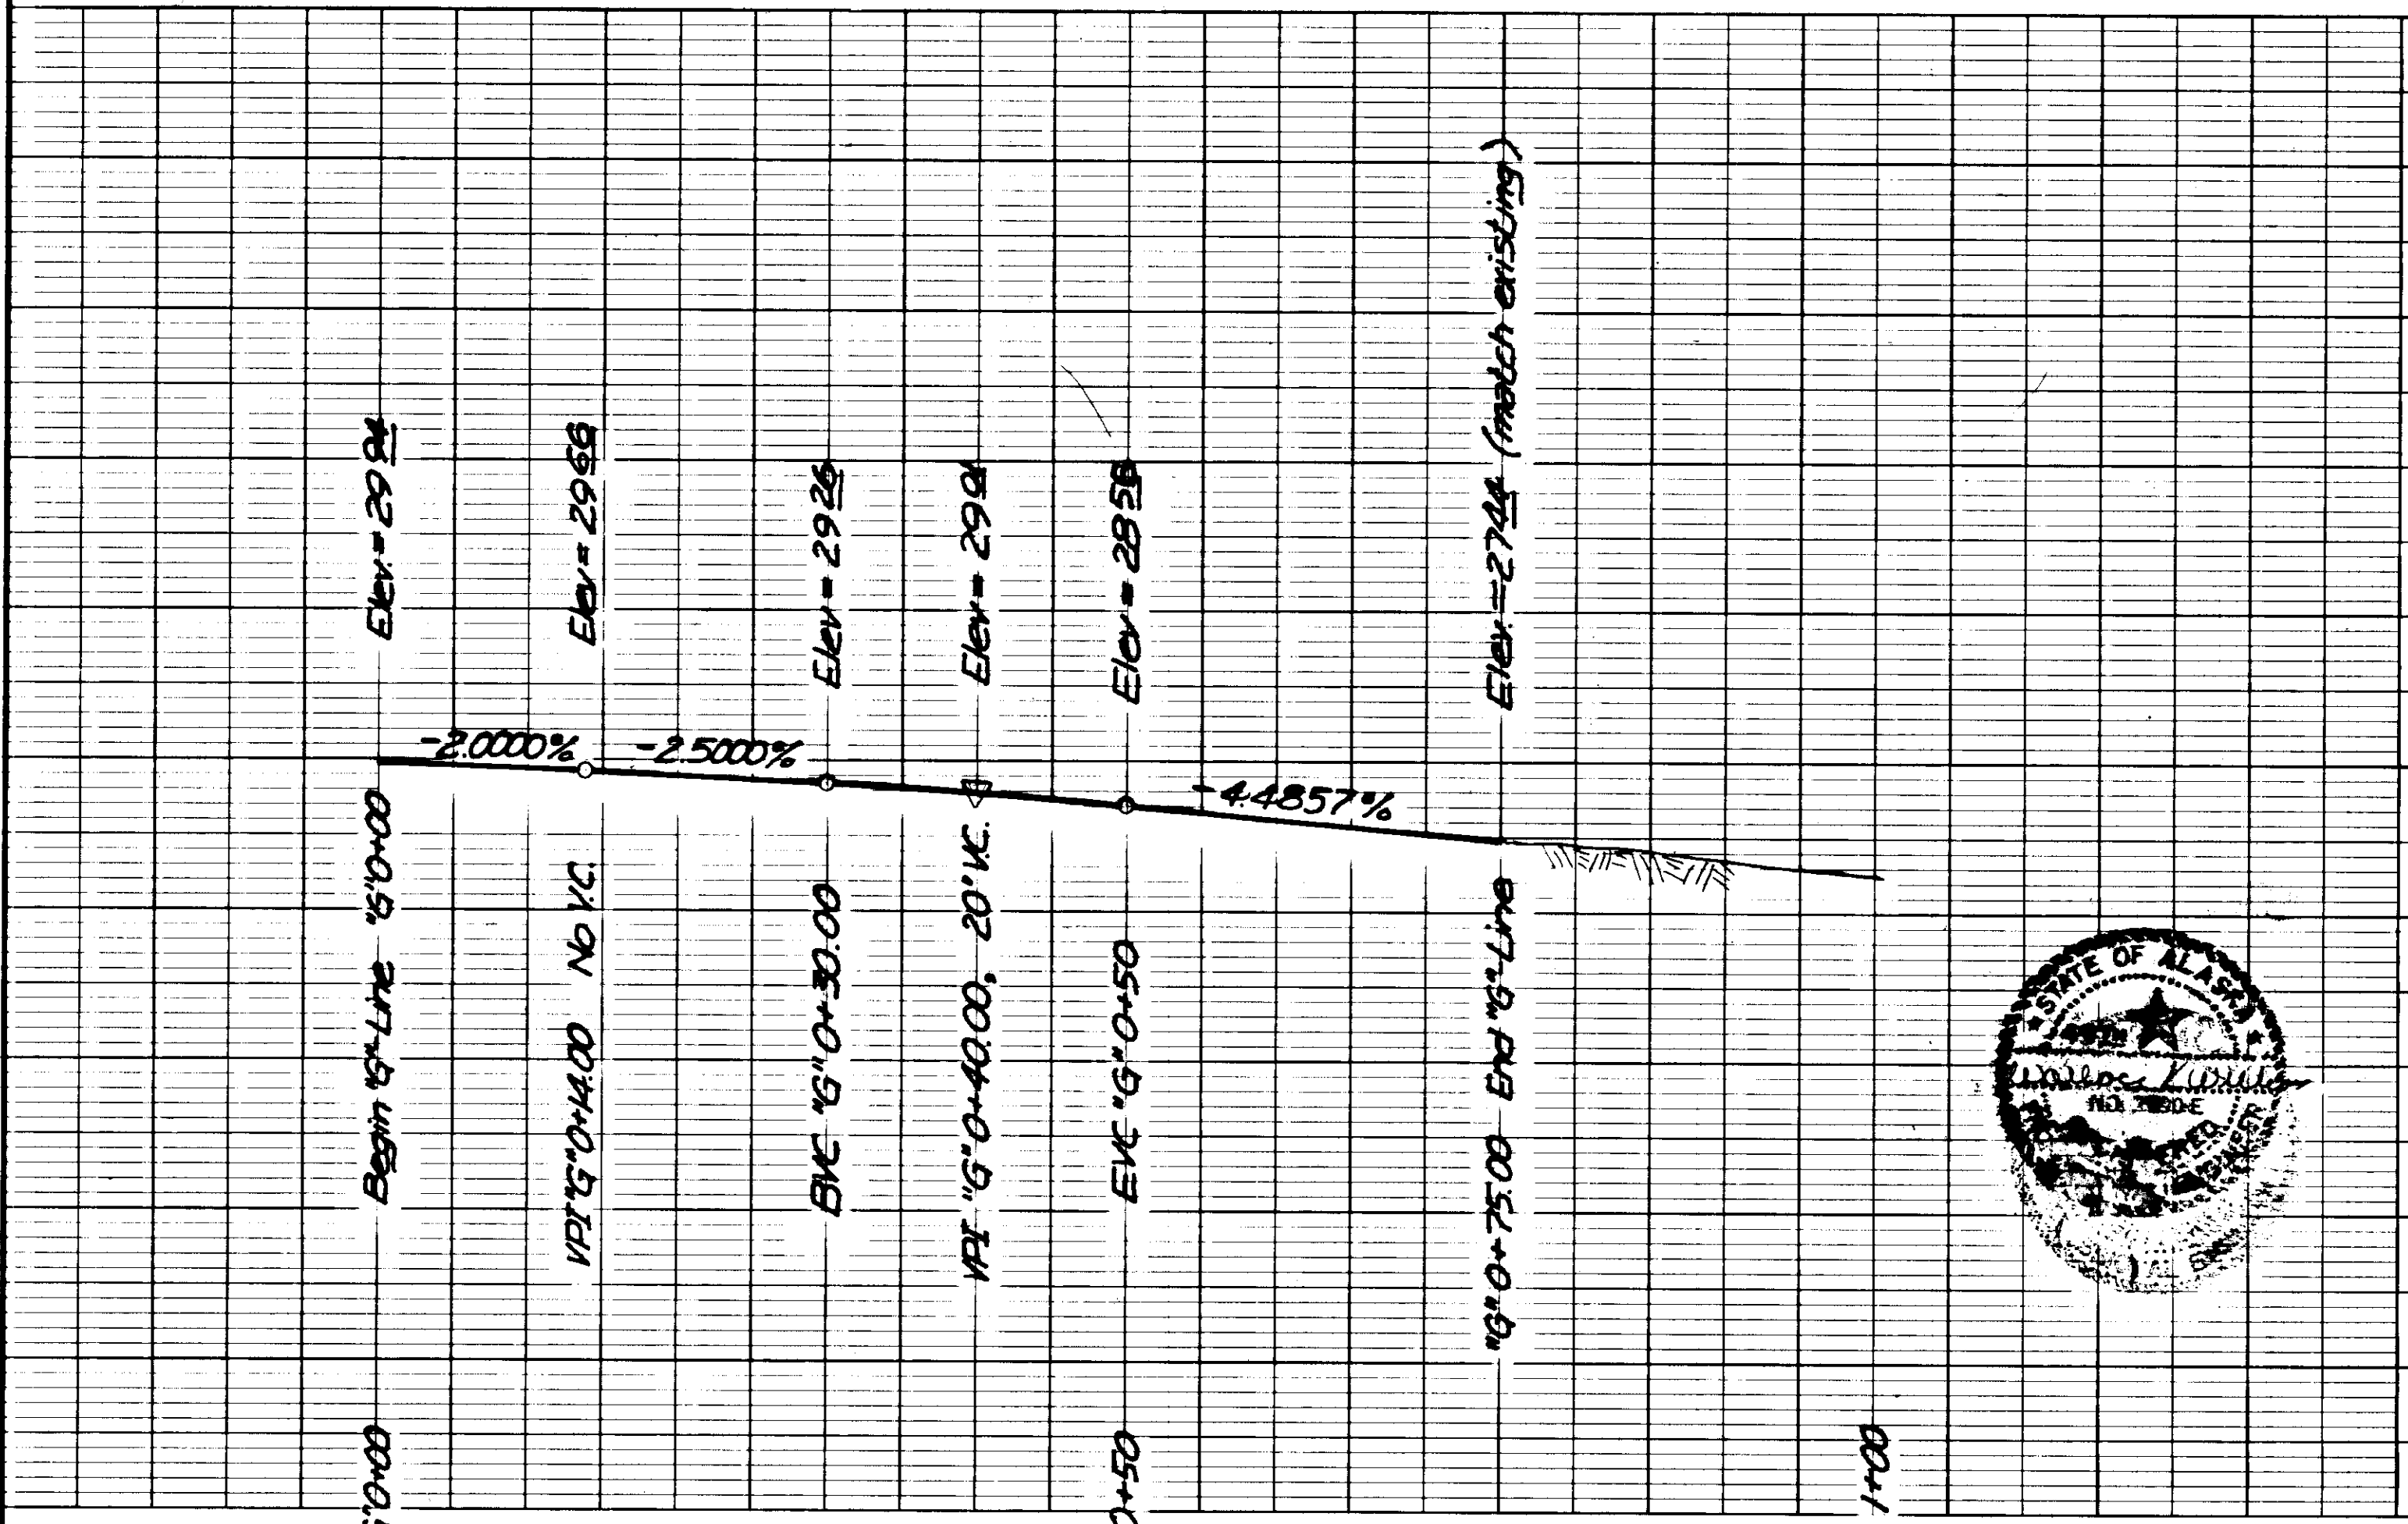
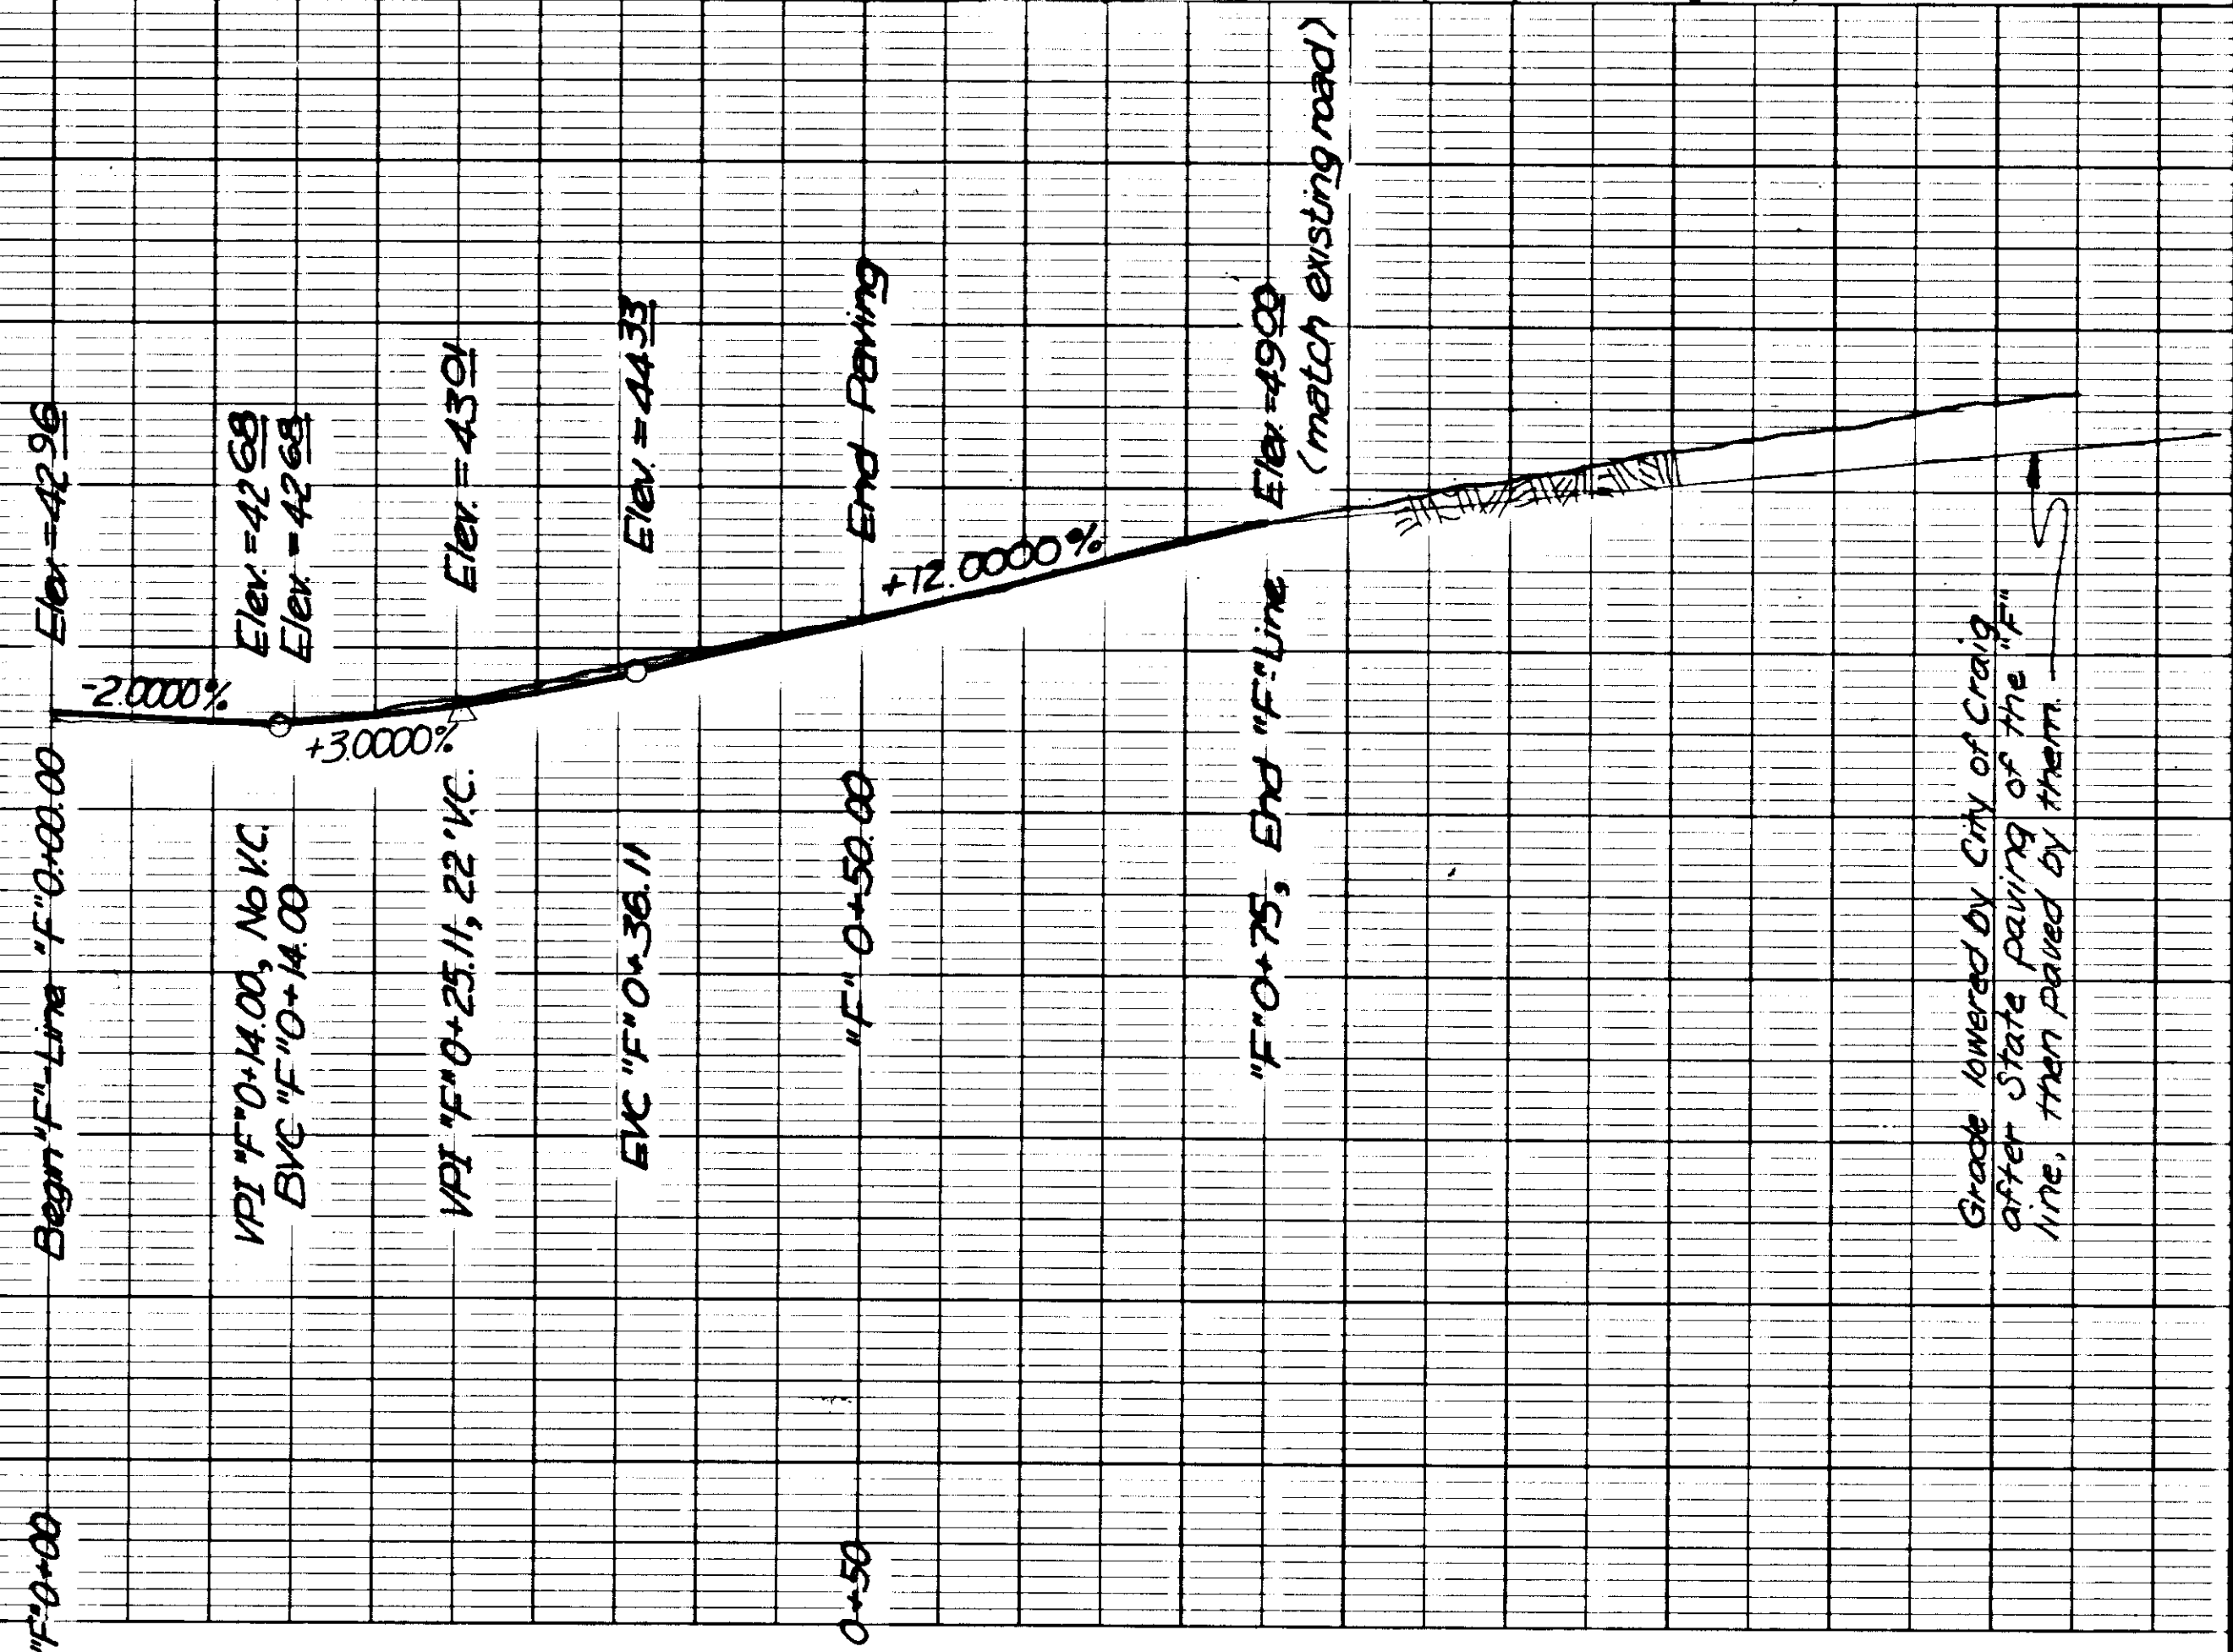
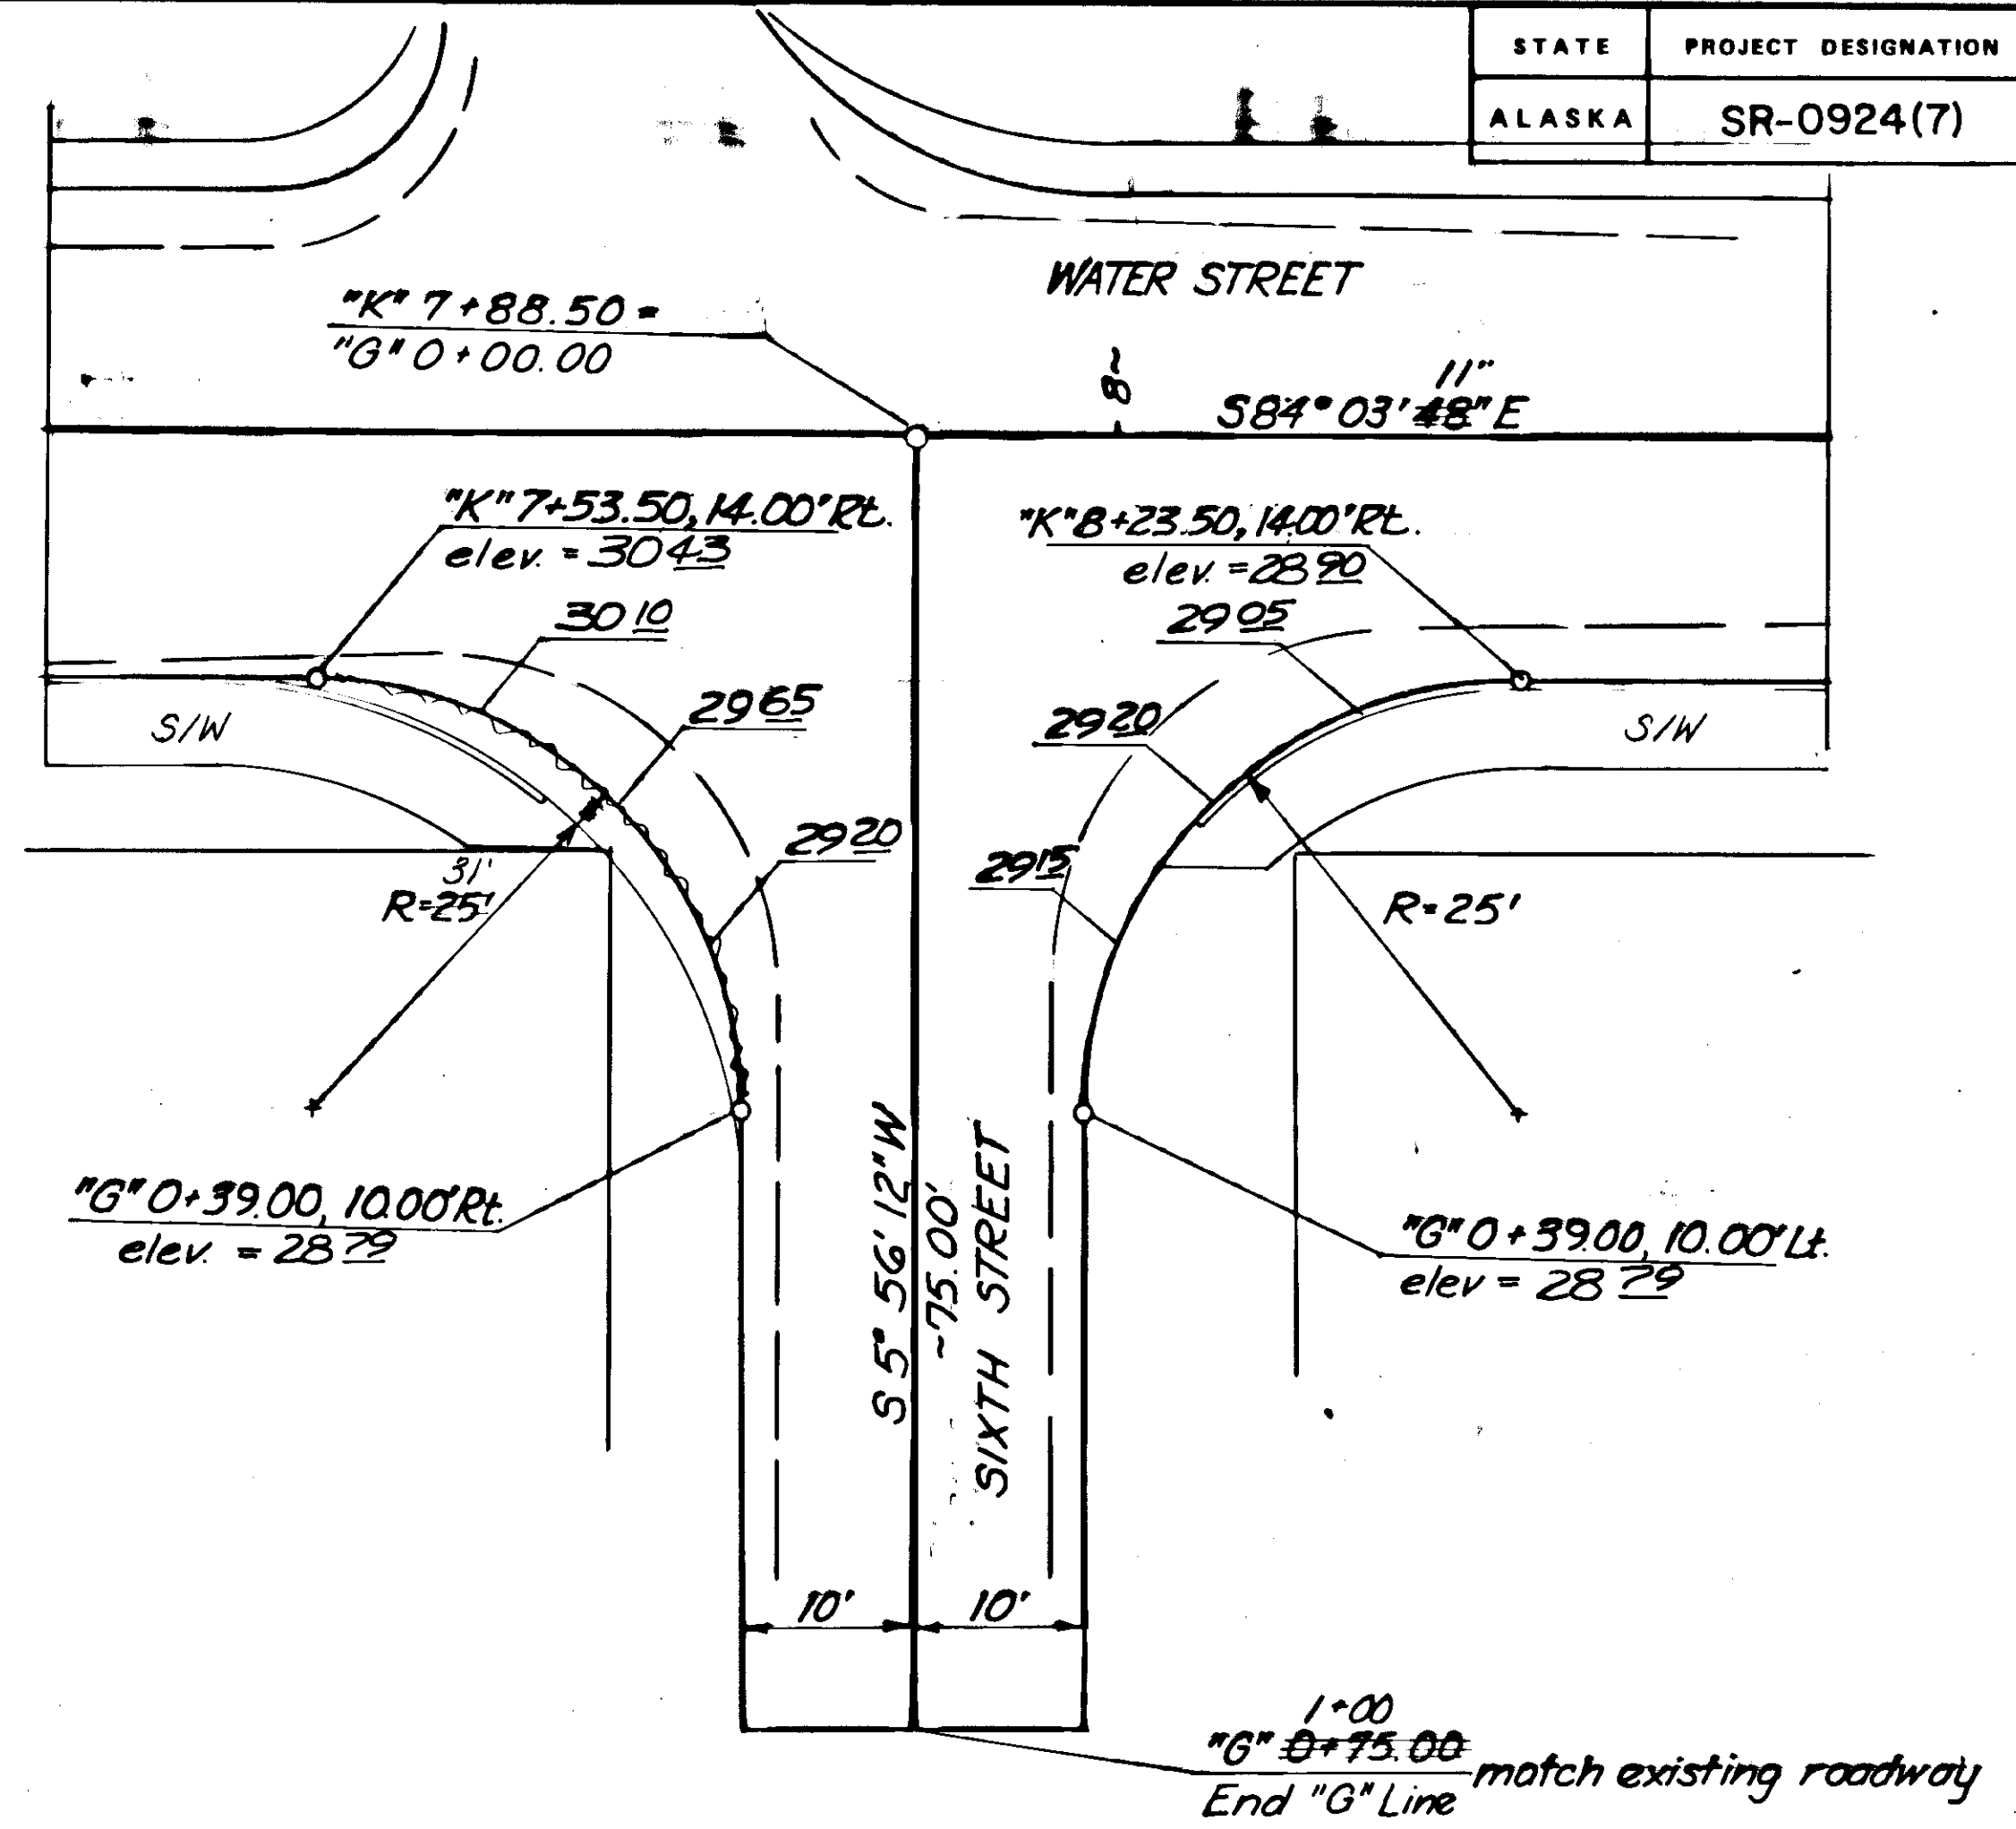


STATE	PROJECT DESIGNATION	YEAR	SHEET NO.	TOTAL SHEETS
ALASKA	SR-0924(7)	1982	25	27


"H"-LINE

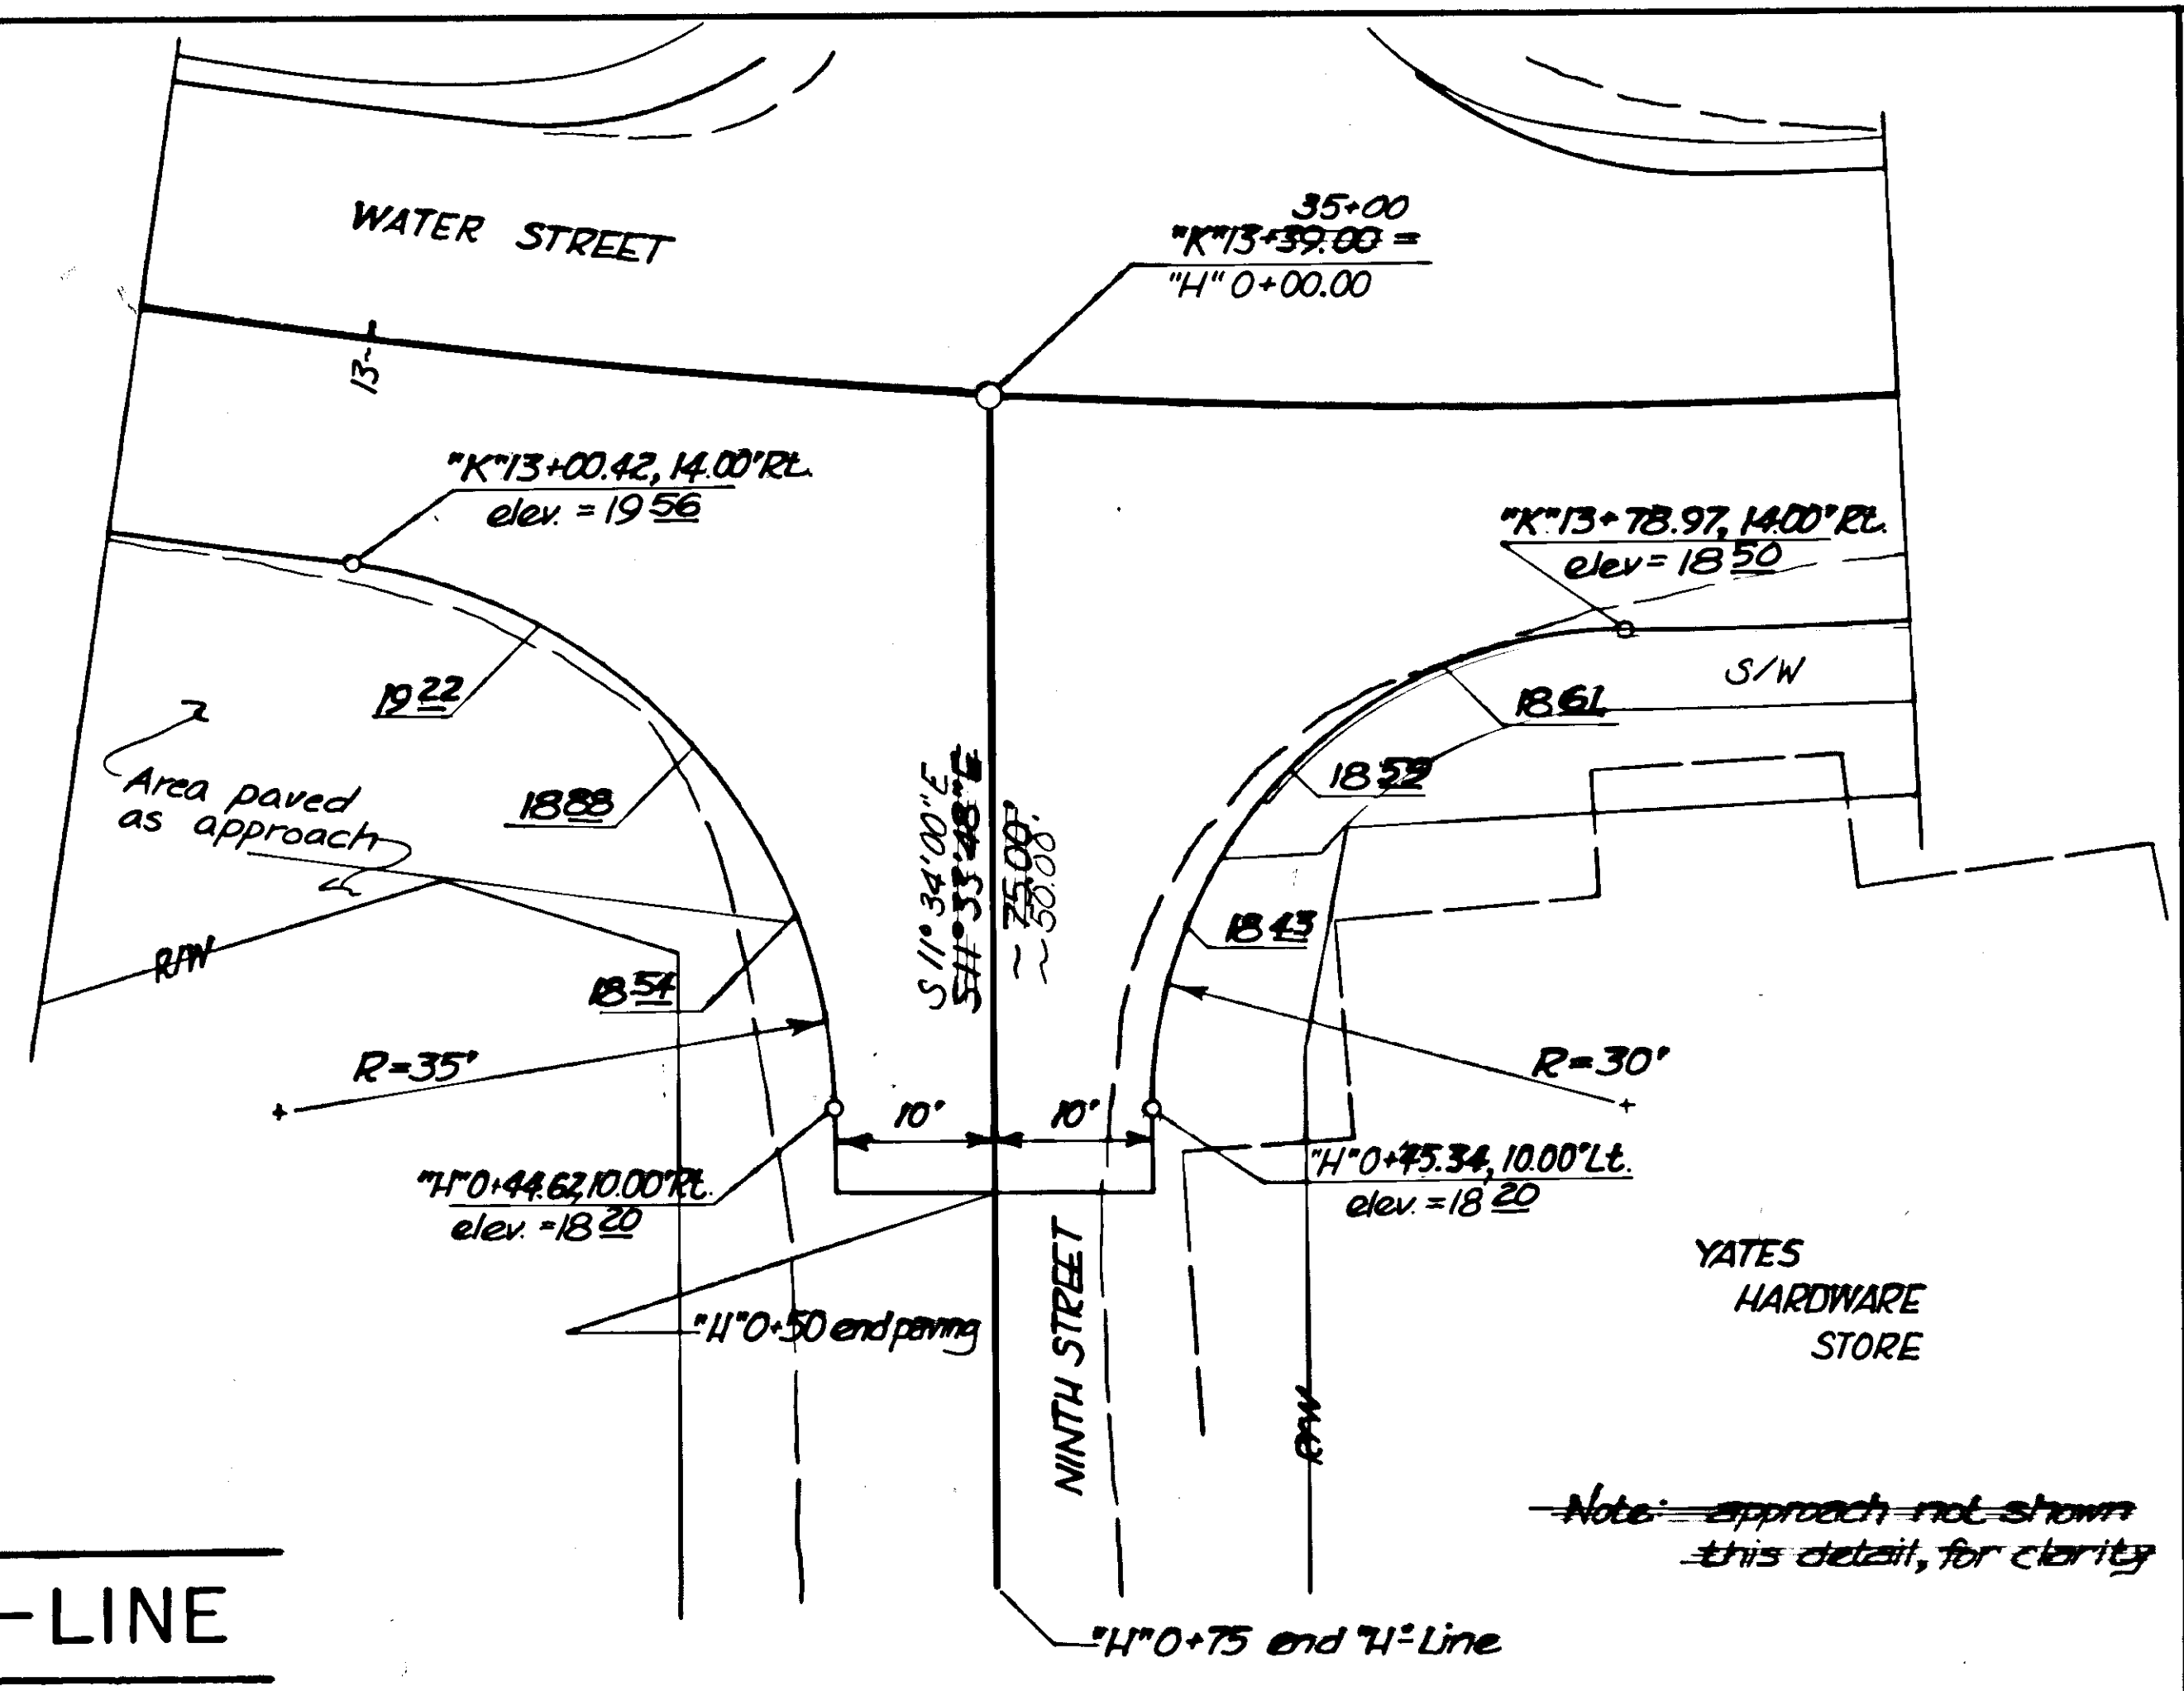

"J"-LINE

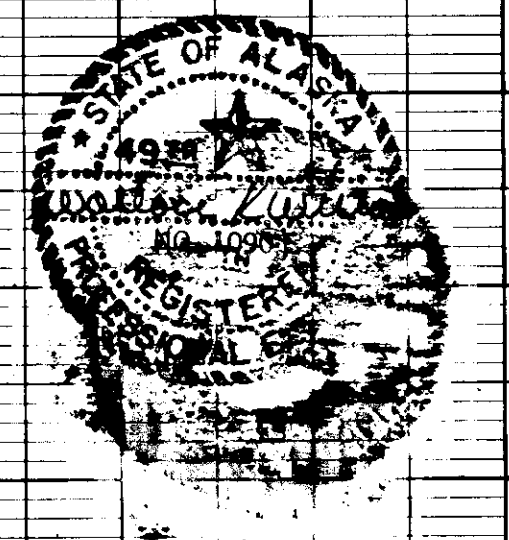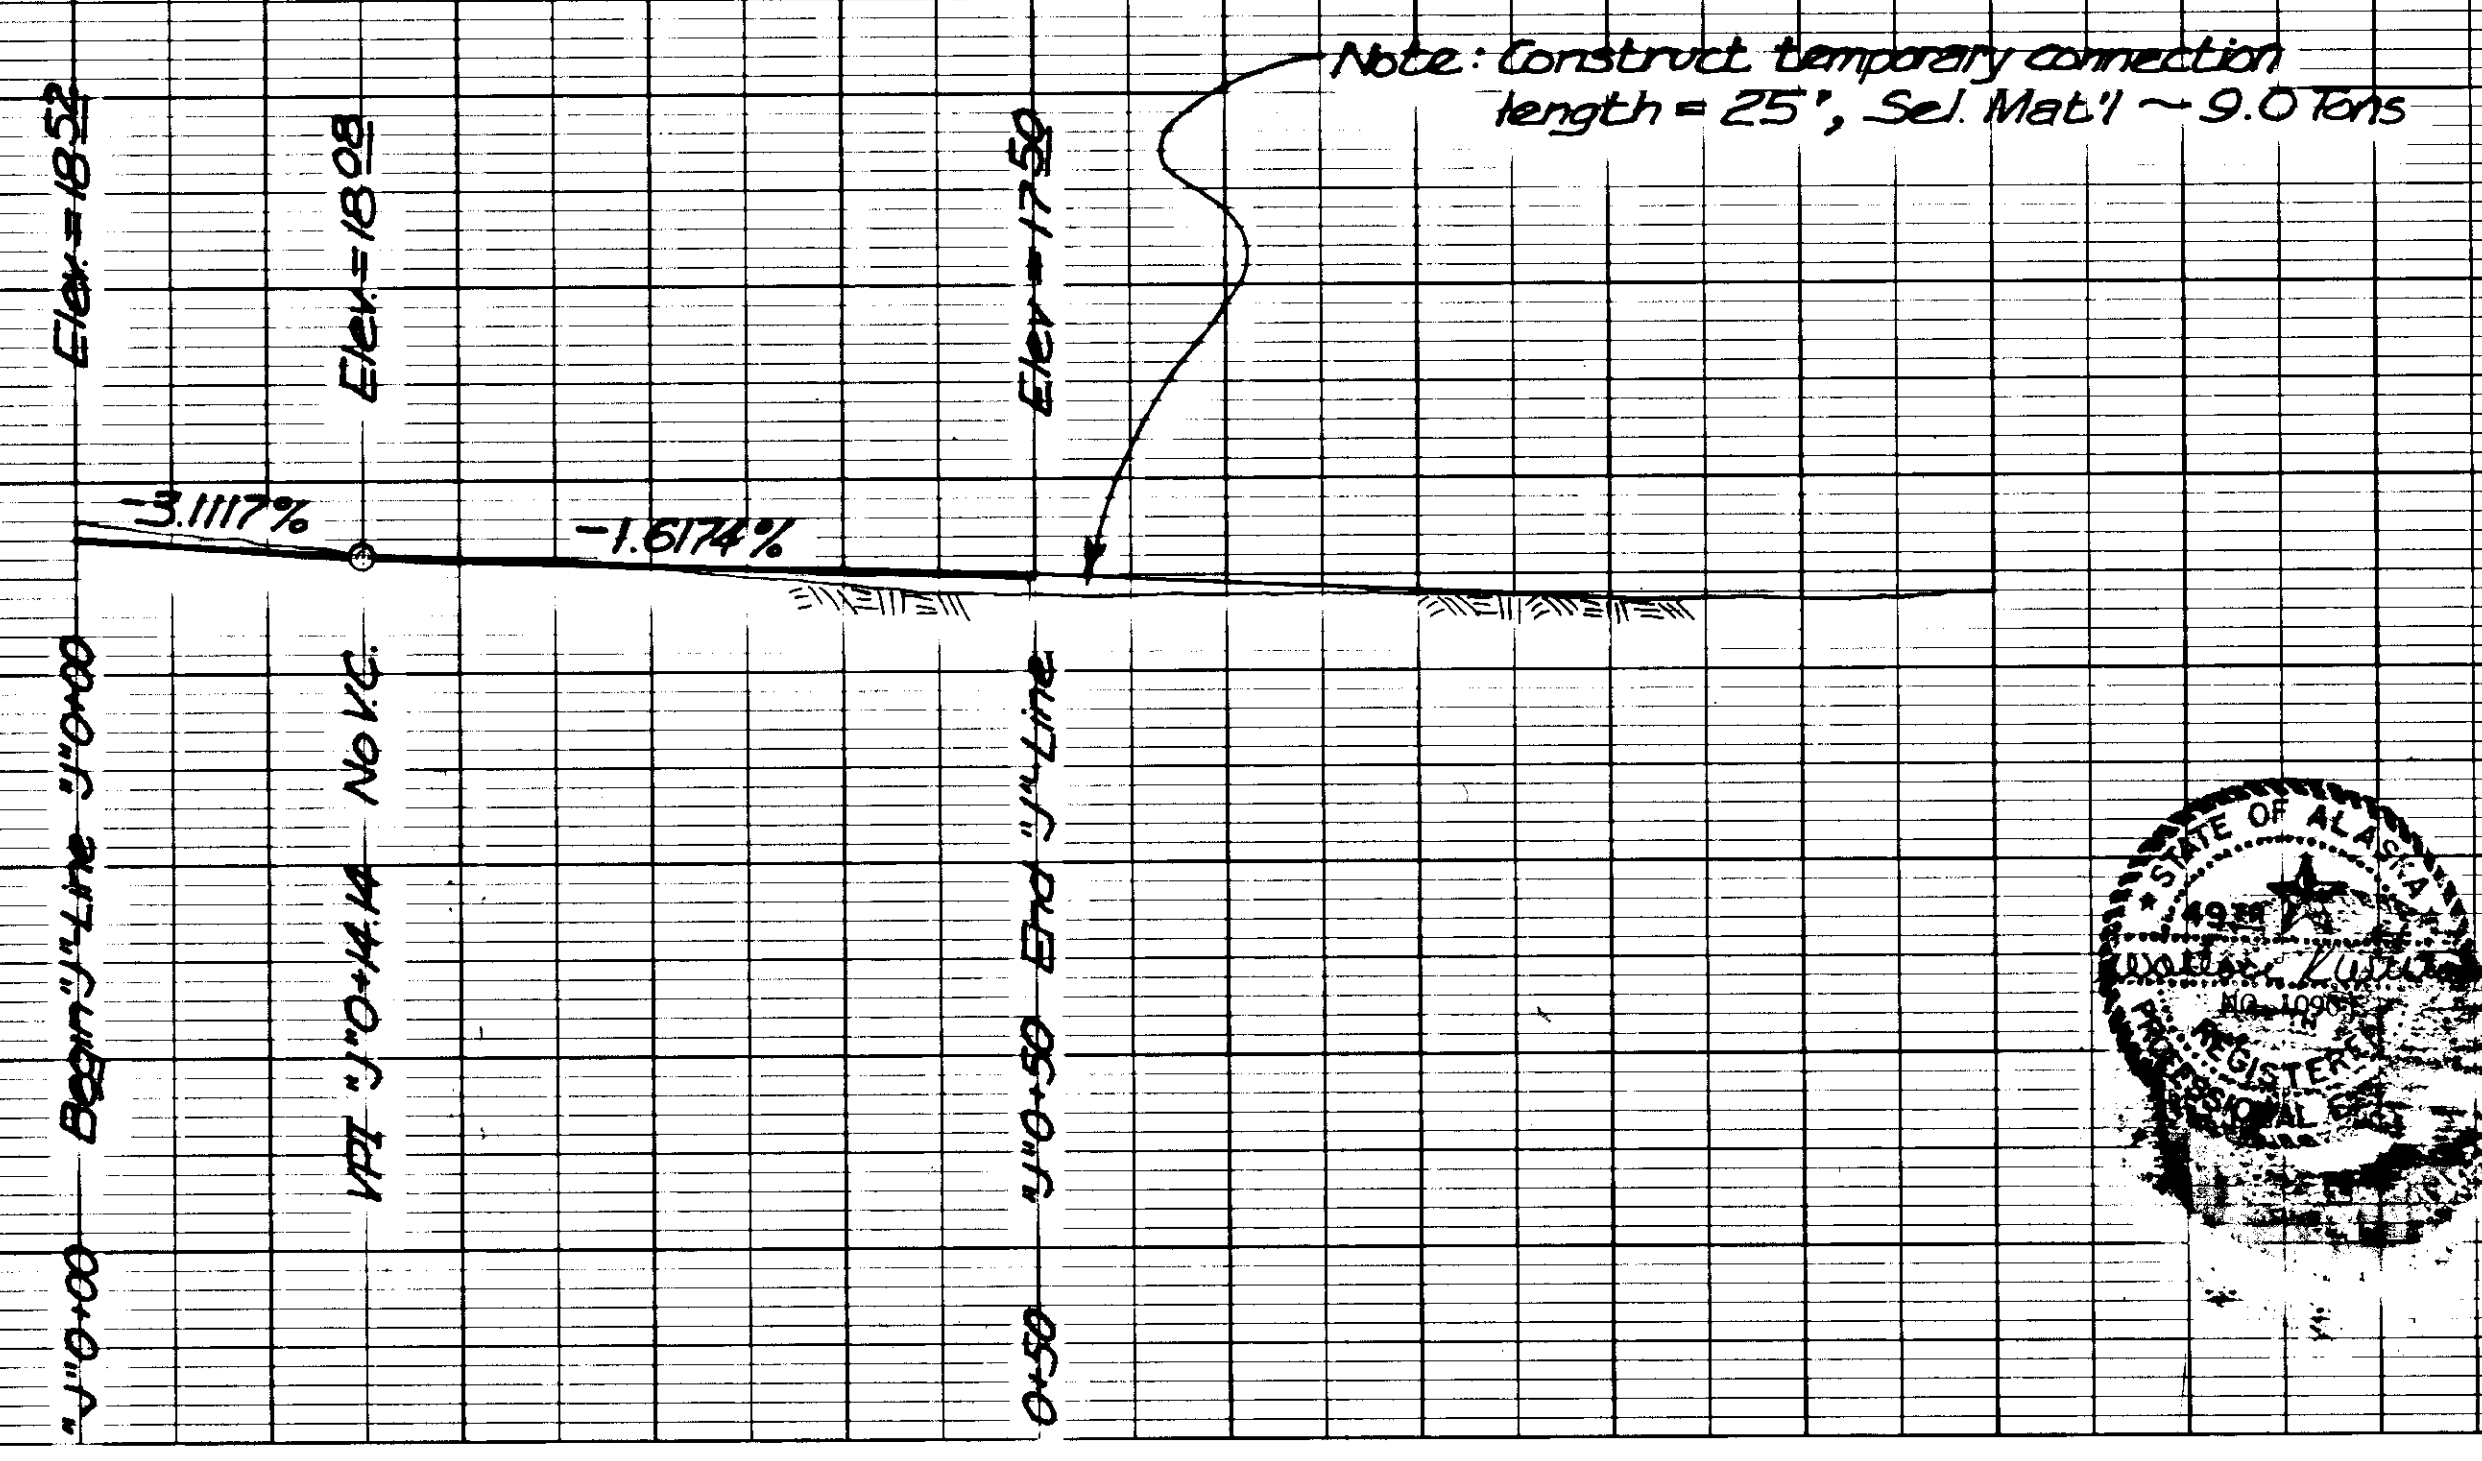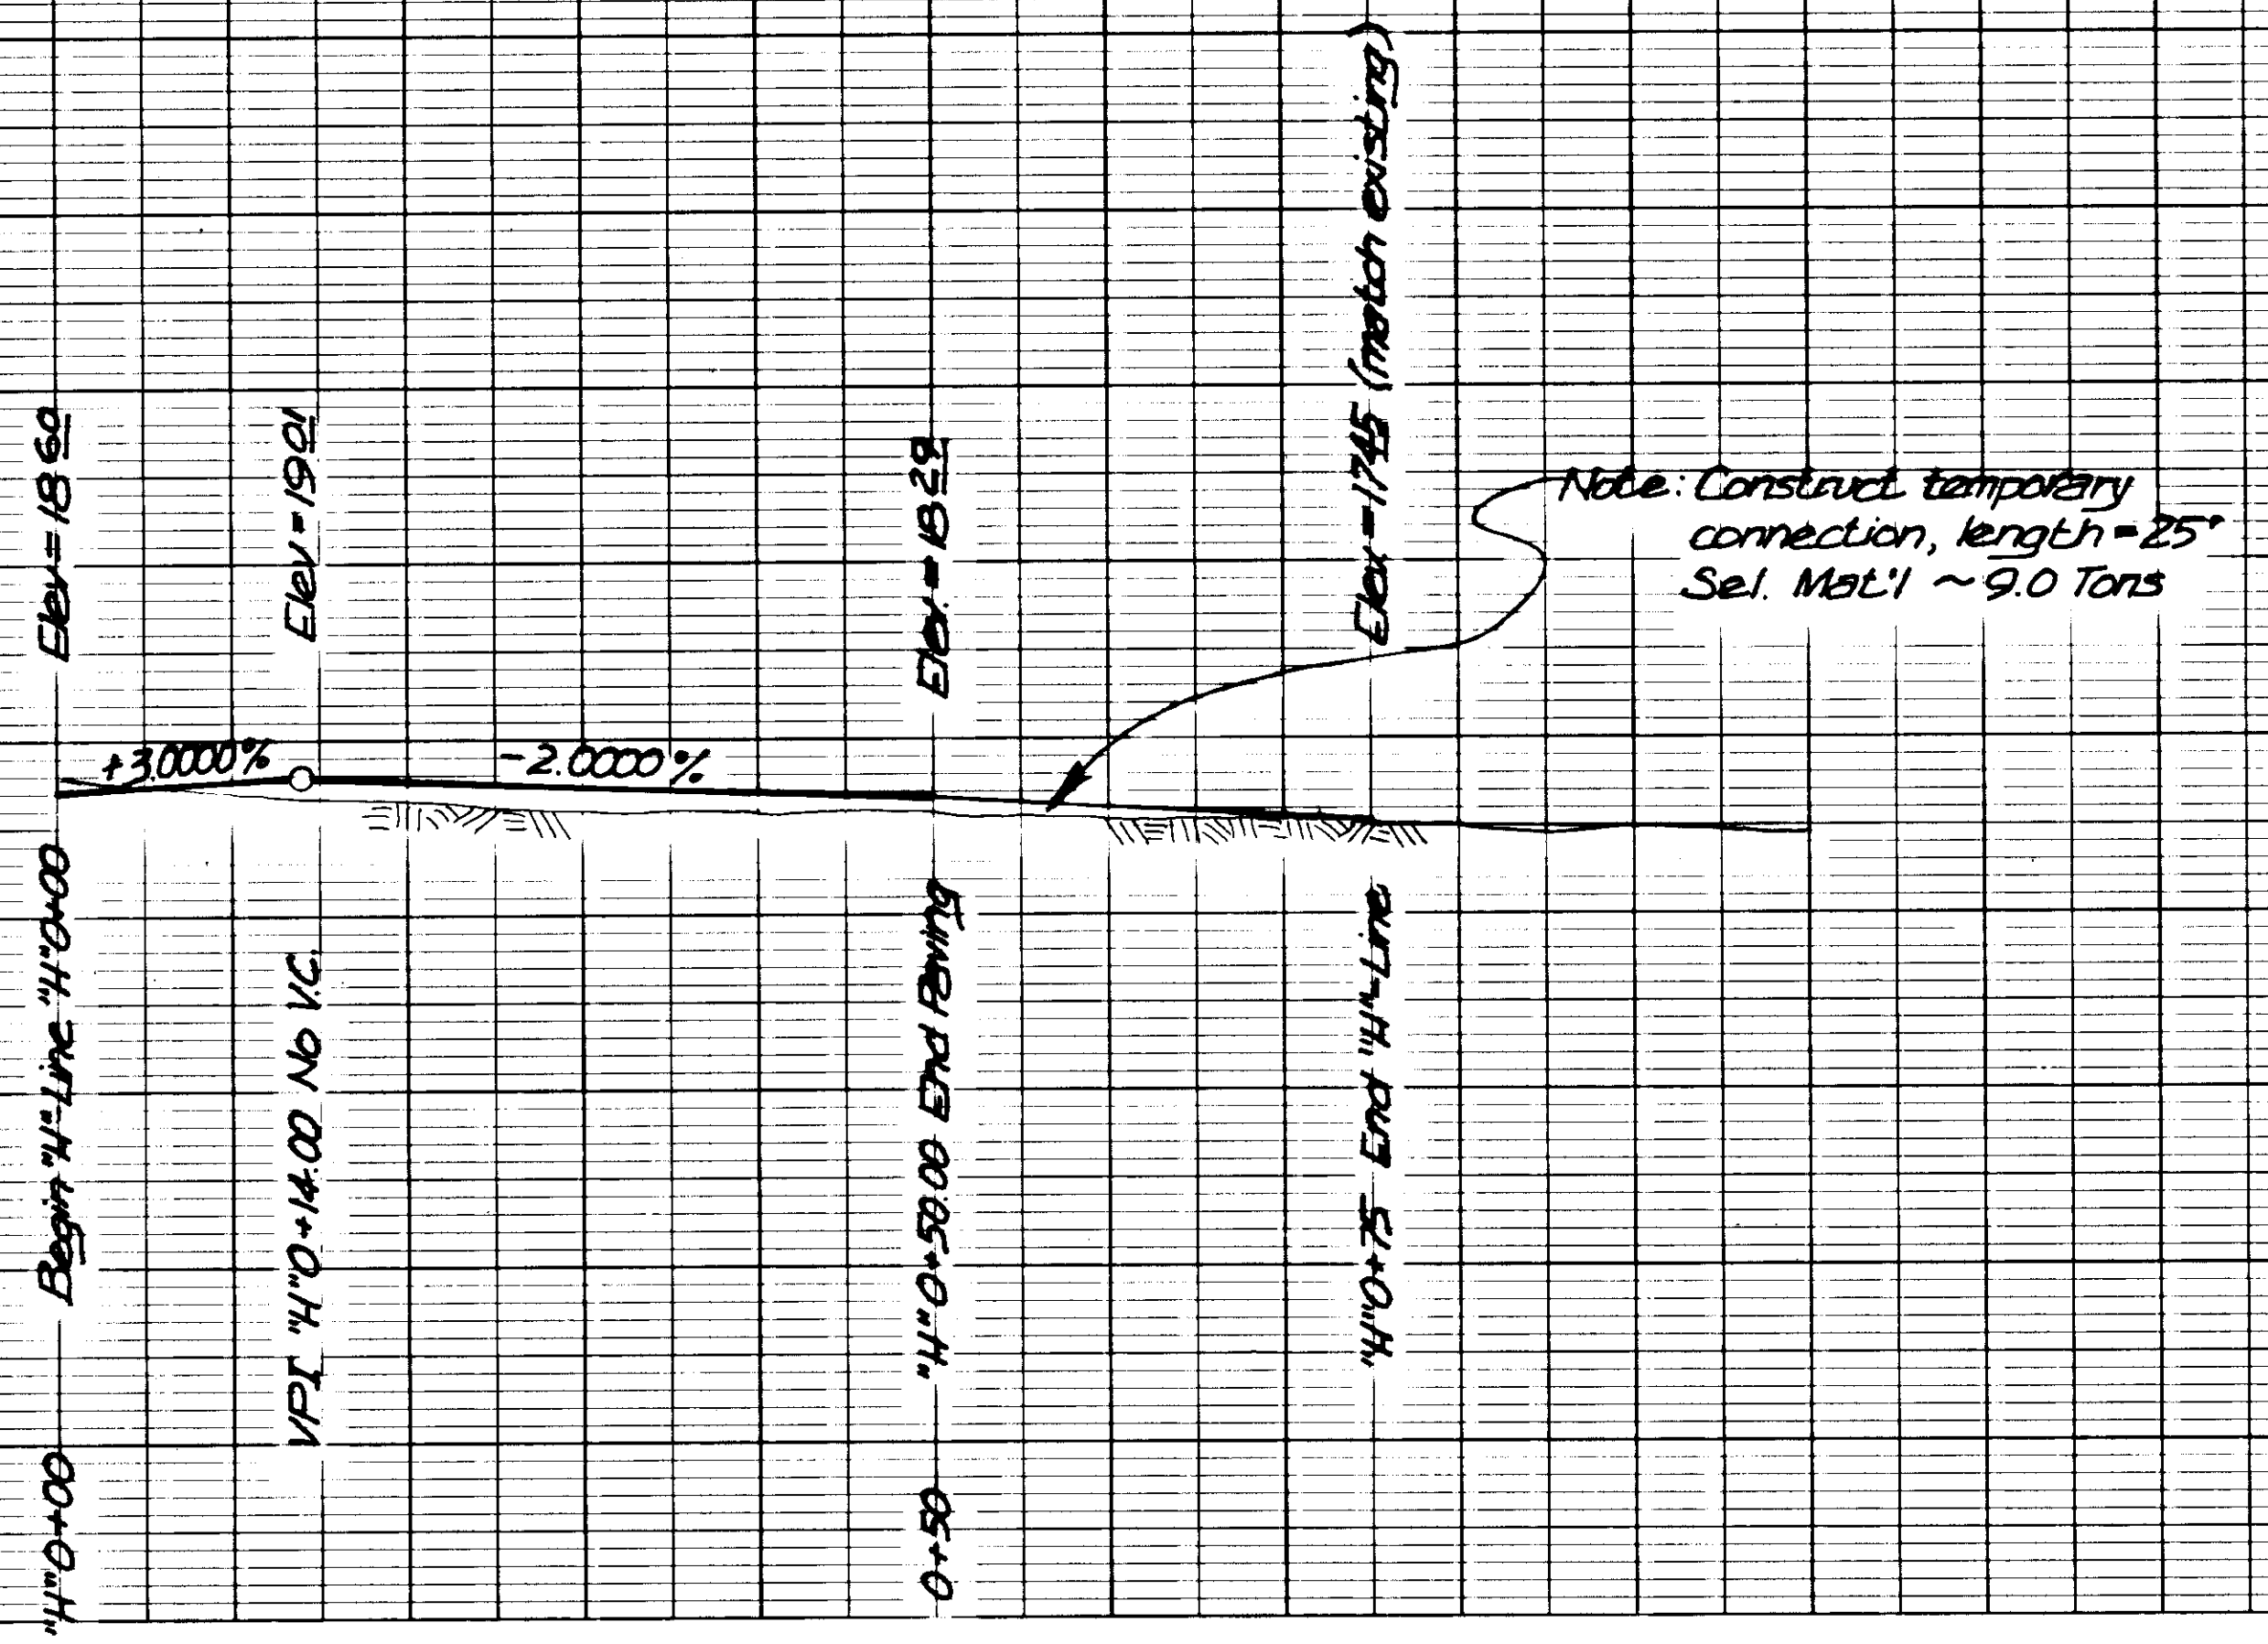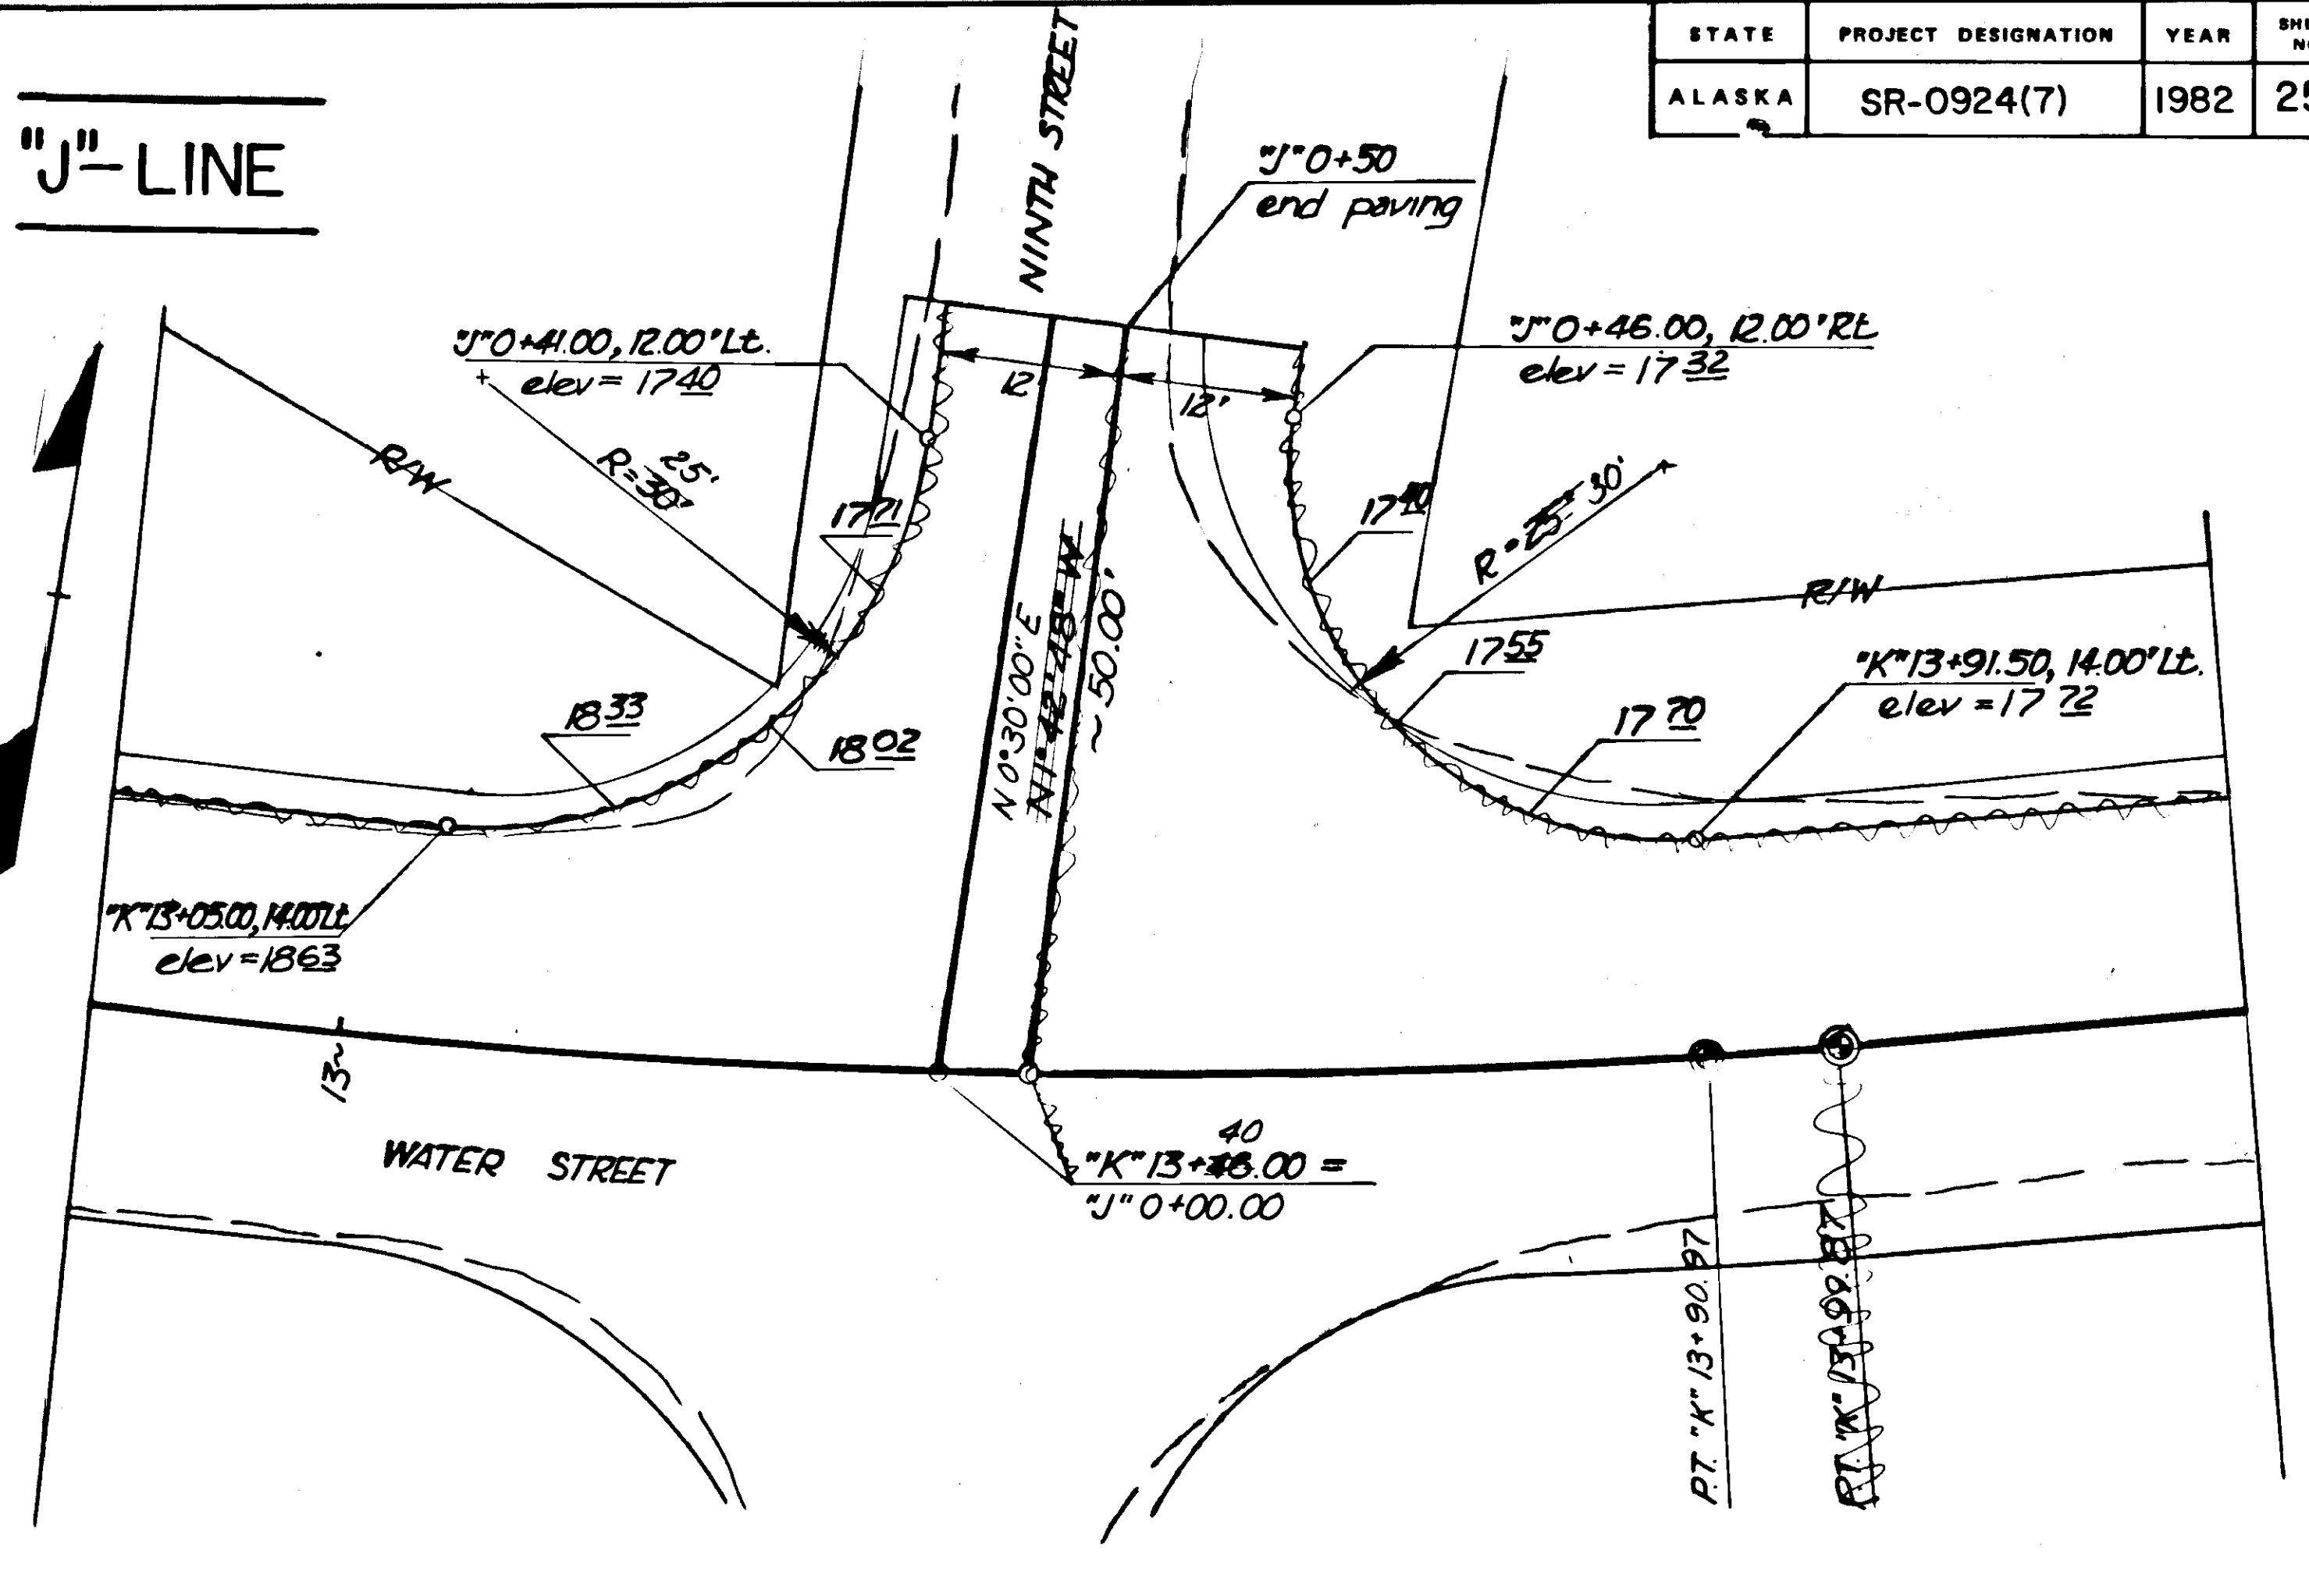


**TYPICAL SECTION OF
EXCAVATION FOR DRAINAGE**
NO SCALE

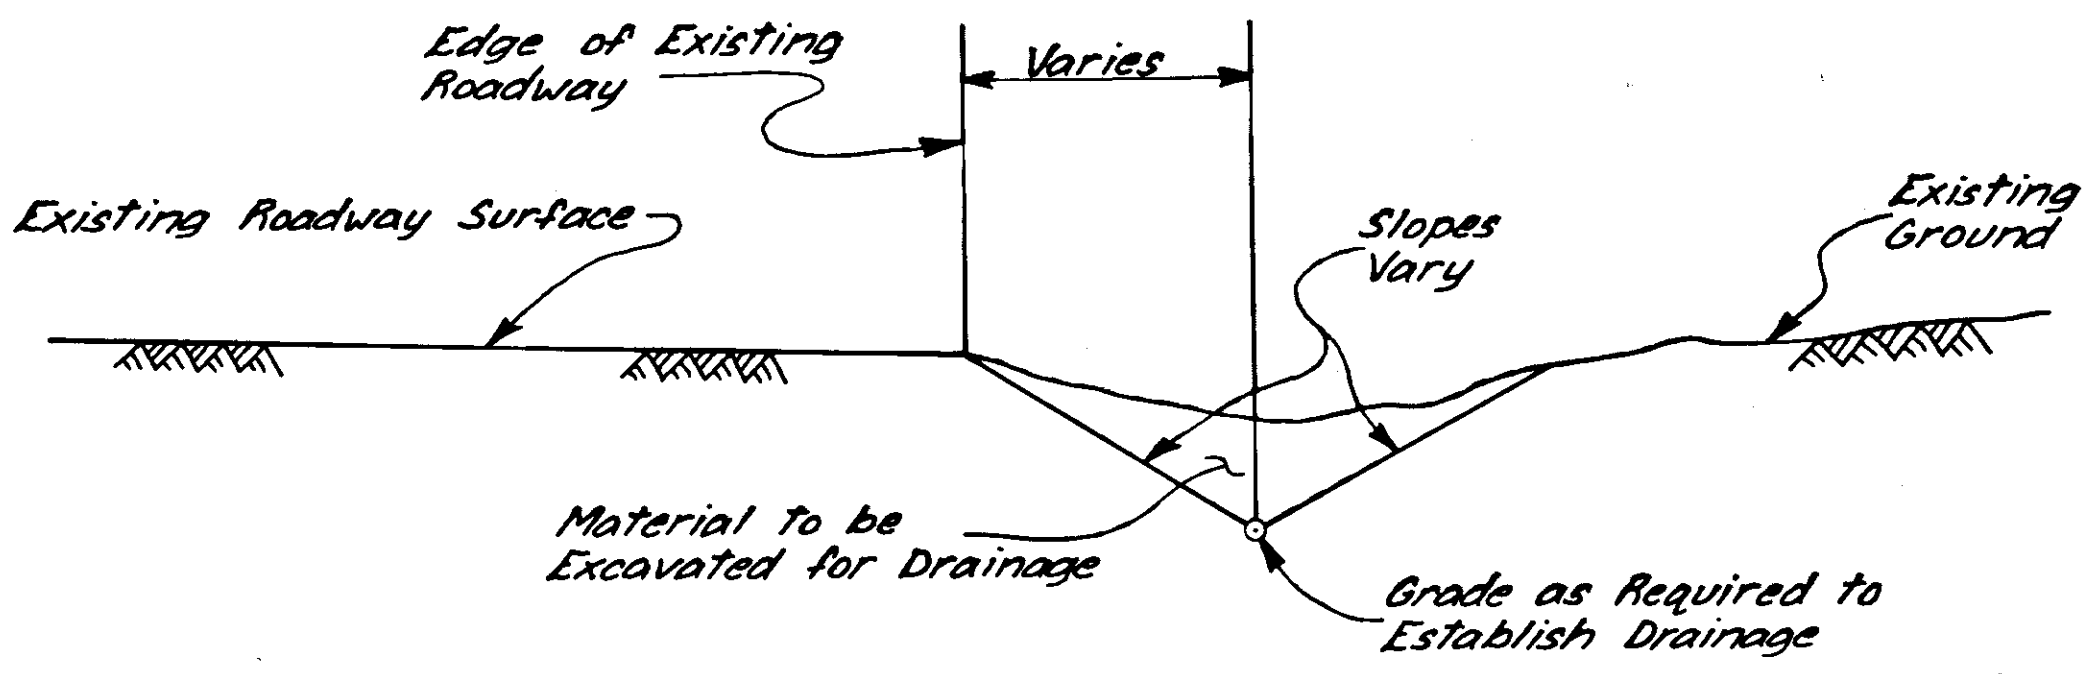


ESTIMATED QUANTITIES FOR PROJECT NO. G-37049			
ITEM NO.	ITEM	UNIT	QUANTITY
202(4)	Removal of Culvert Pipe	L.F.	92.69
203(10)	Selected Material	Ton	100.00
203(11)	Excavation for Drainage	L.F.	500-302
301(1)	Crushed Agg. Base Course	Ton	701.95
401(1)	Asphalt Concrete, Type I	Ton	554.37
603(13-18)	18" Corrugated Aluminum Pipe	L.F.	30
603(13-24)	24" Corrugated Aluminum Pipe	L.F.	126
401(2)	Asphalt Cement, AC-5	Ton	29.43
604(4)	Adjust Existing Manholes	Each	4.00
628(11)	Adjustment of Valve Box	Each	6.00
603(13-12)	12-inch Corrugate Aluminum Pipe	L.F.	72

NOTES

- Culverts to be installed shall be located so that the surface drainage is intercepted & routed to discharge. Installation locations shown on the Plan View at right are approximate only; actual locations are to be staked by the Contractor & approved by the Engineer.
- Minimum culvert grade shall be 1% and shall be staked by the Contractor.
- Upon completion of culvert backfilling, the Engineer may specify the placement of Selected Material over the area excavated for culvert installation; this material shall be paid for at Contract unit prices.

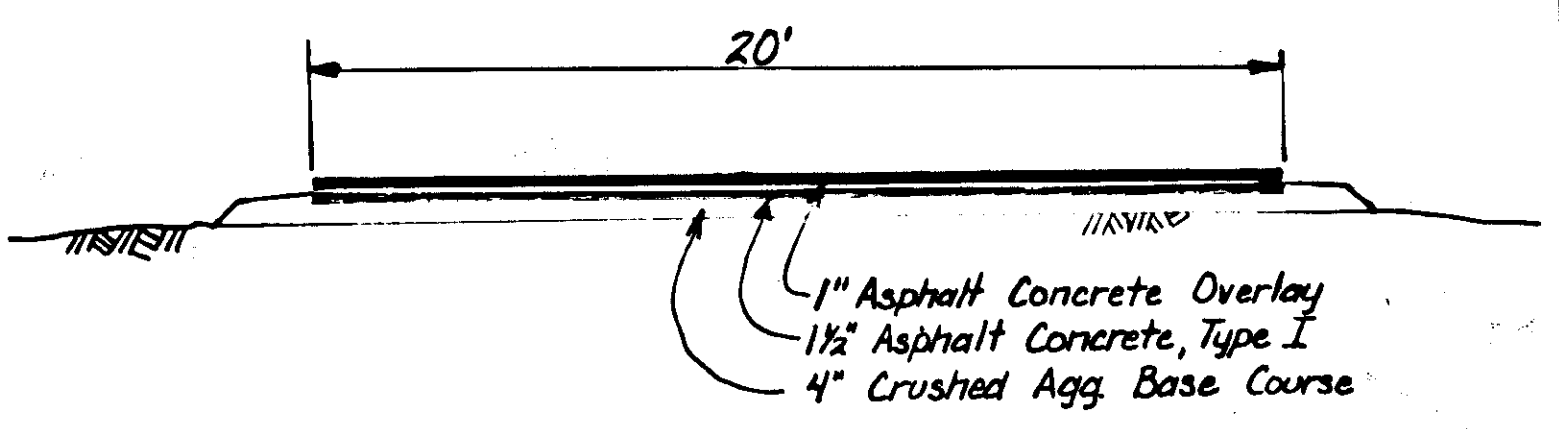


Klawock Paving Typical Section
per EWO #6

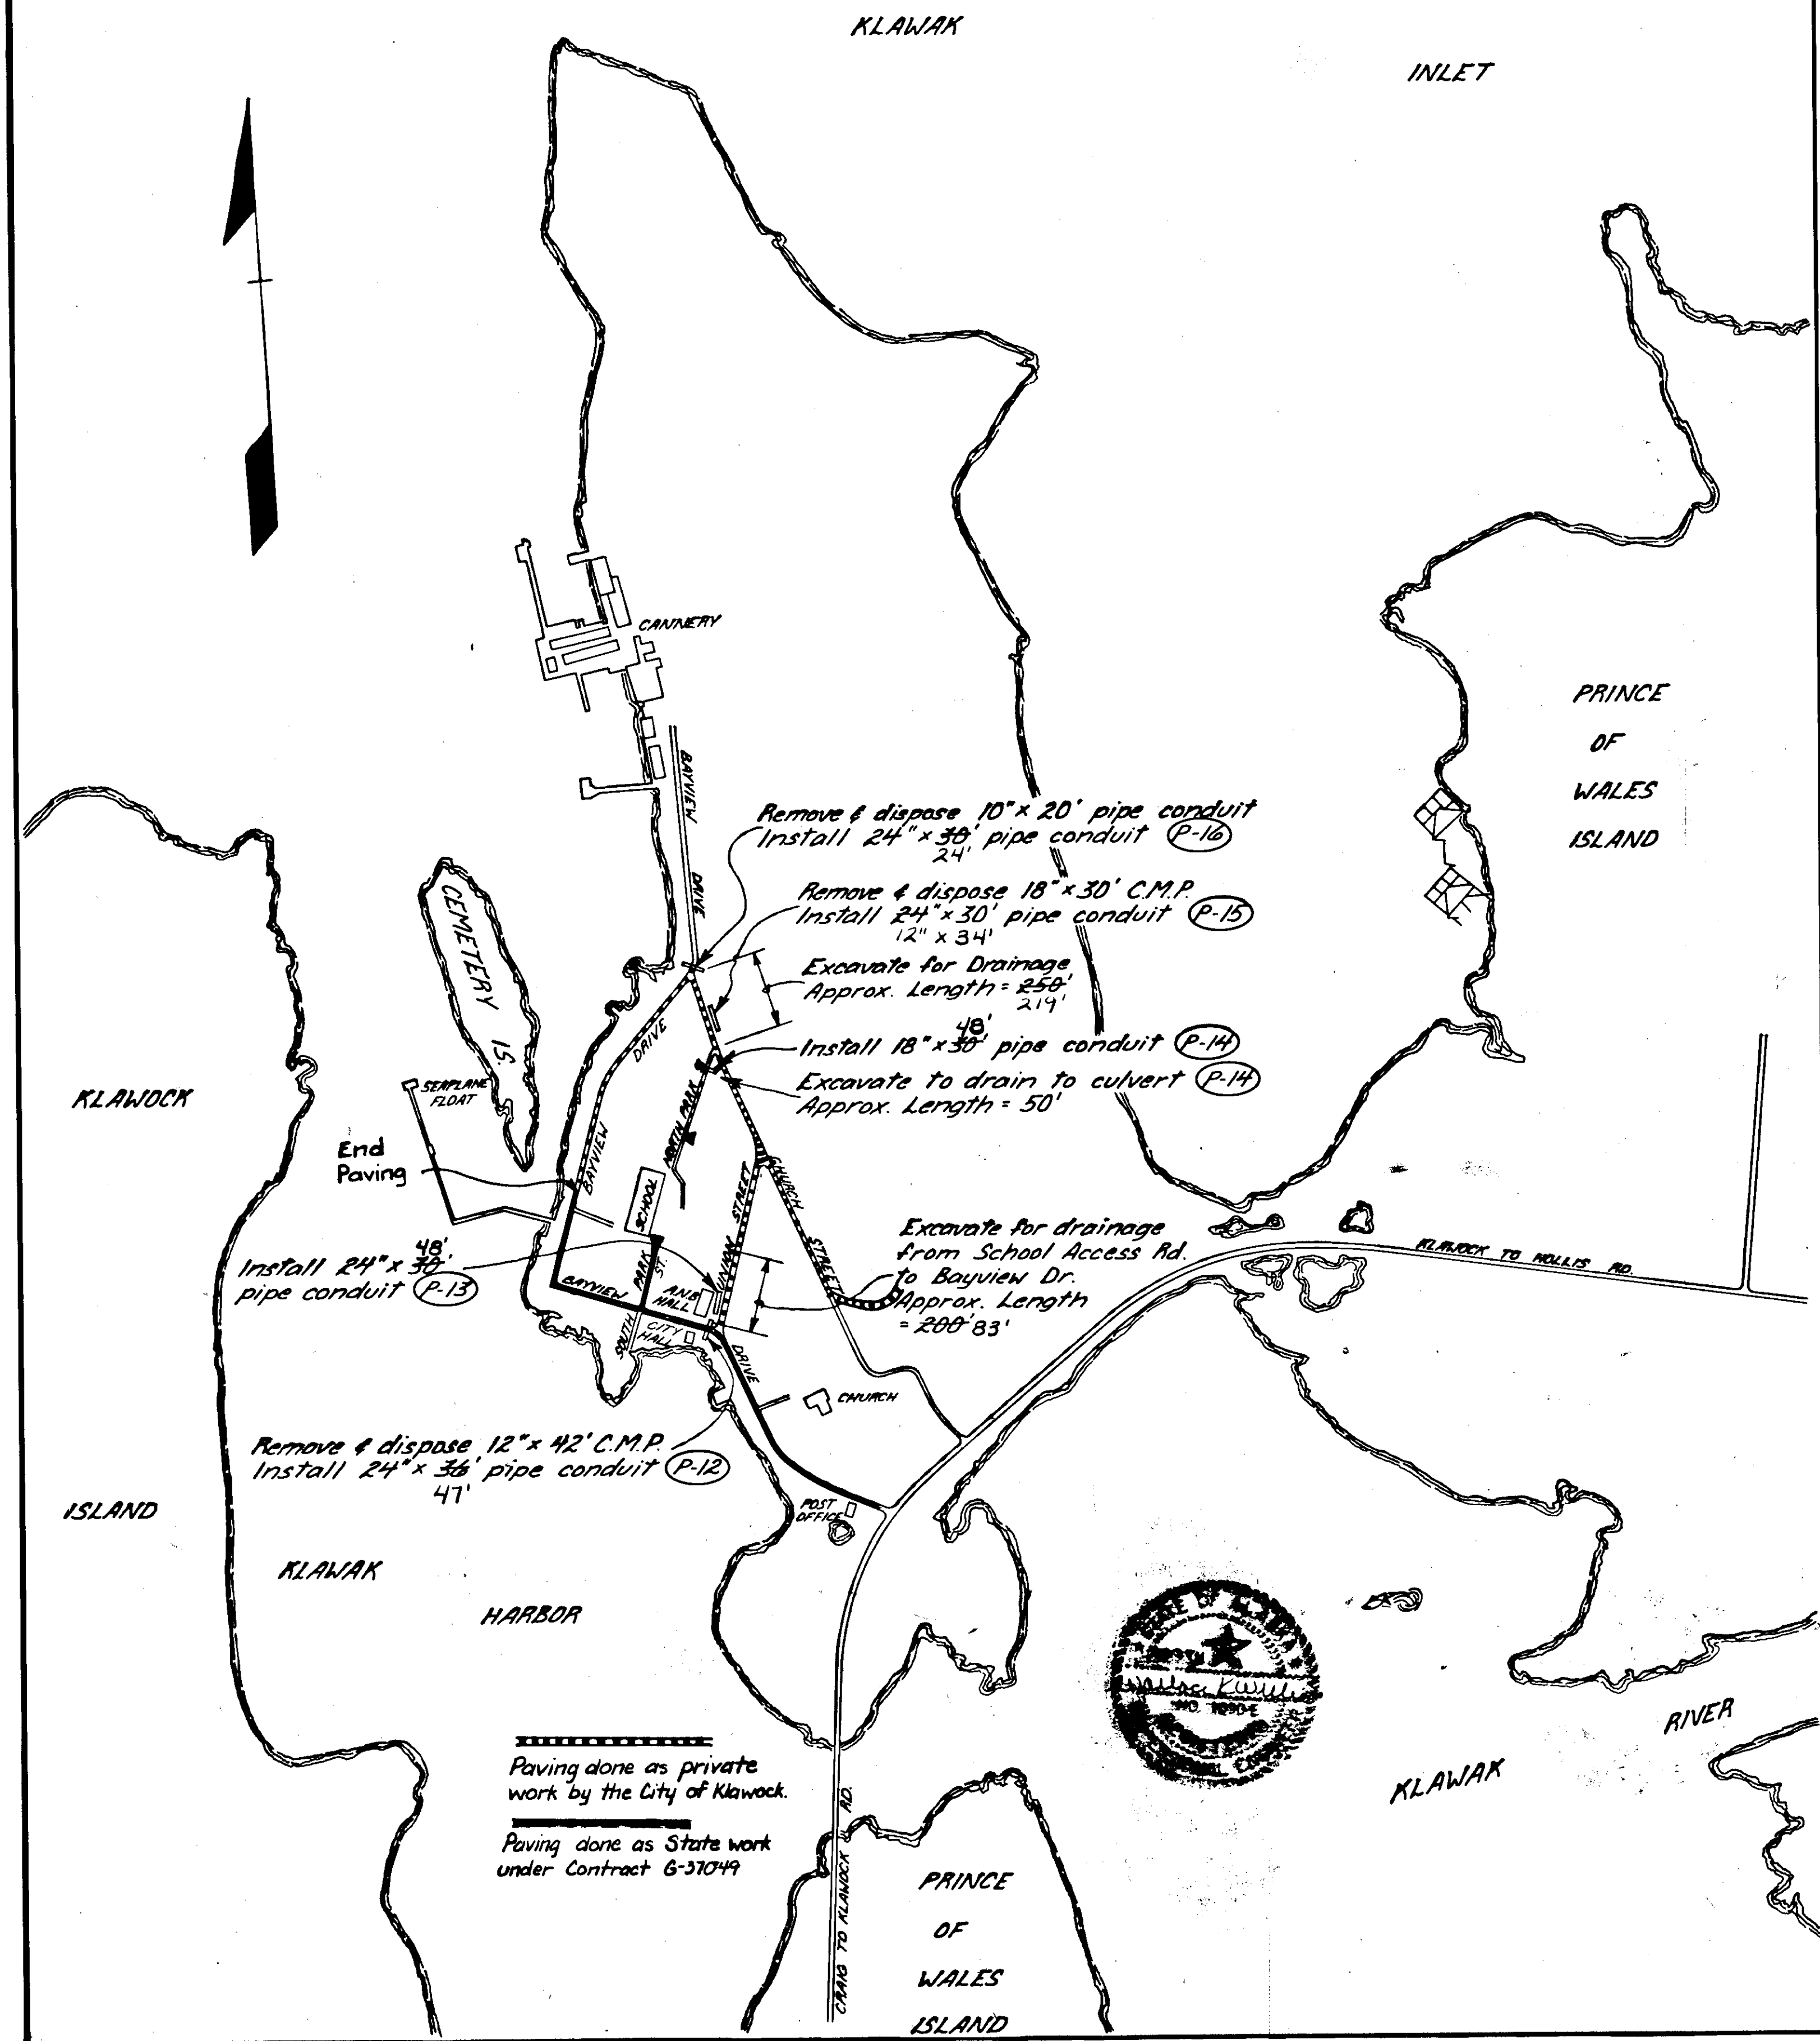


STATE	PROJECT DESIGNATION	YEAR	SHEET NO.	TOTAL SHEETS
ALASKA	SR-0924(7)	1982	B-2	

DRAWING B-2

NOTE: From "K" 350+00 to "K" 370+00, lower road grade approximately 11'-0" to accommodate wider paved surface. Work will be paid for as provide for in section 203. Estimated quantity = 2000 cy lnc. Exc.

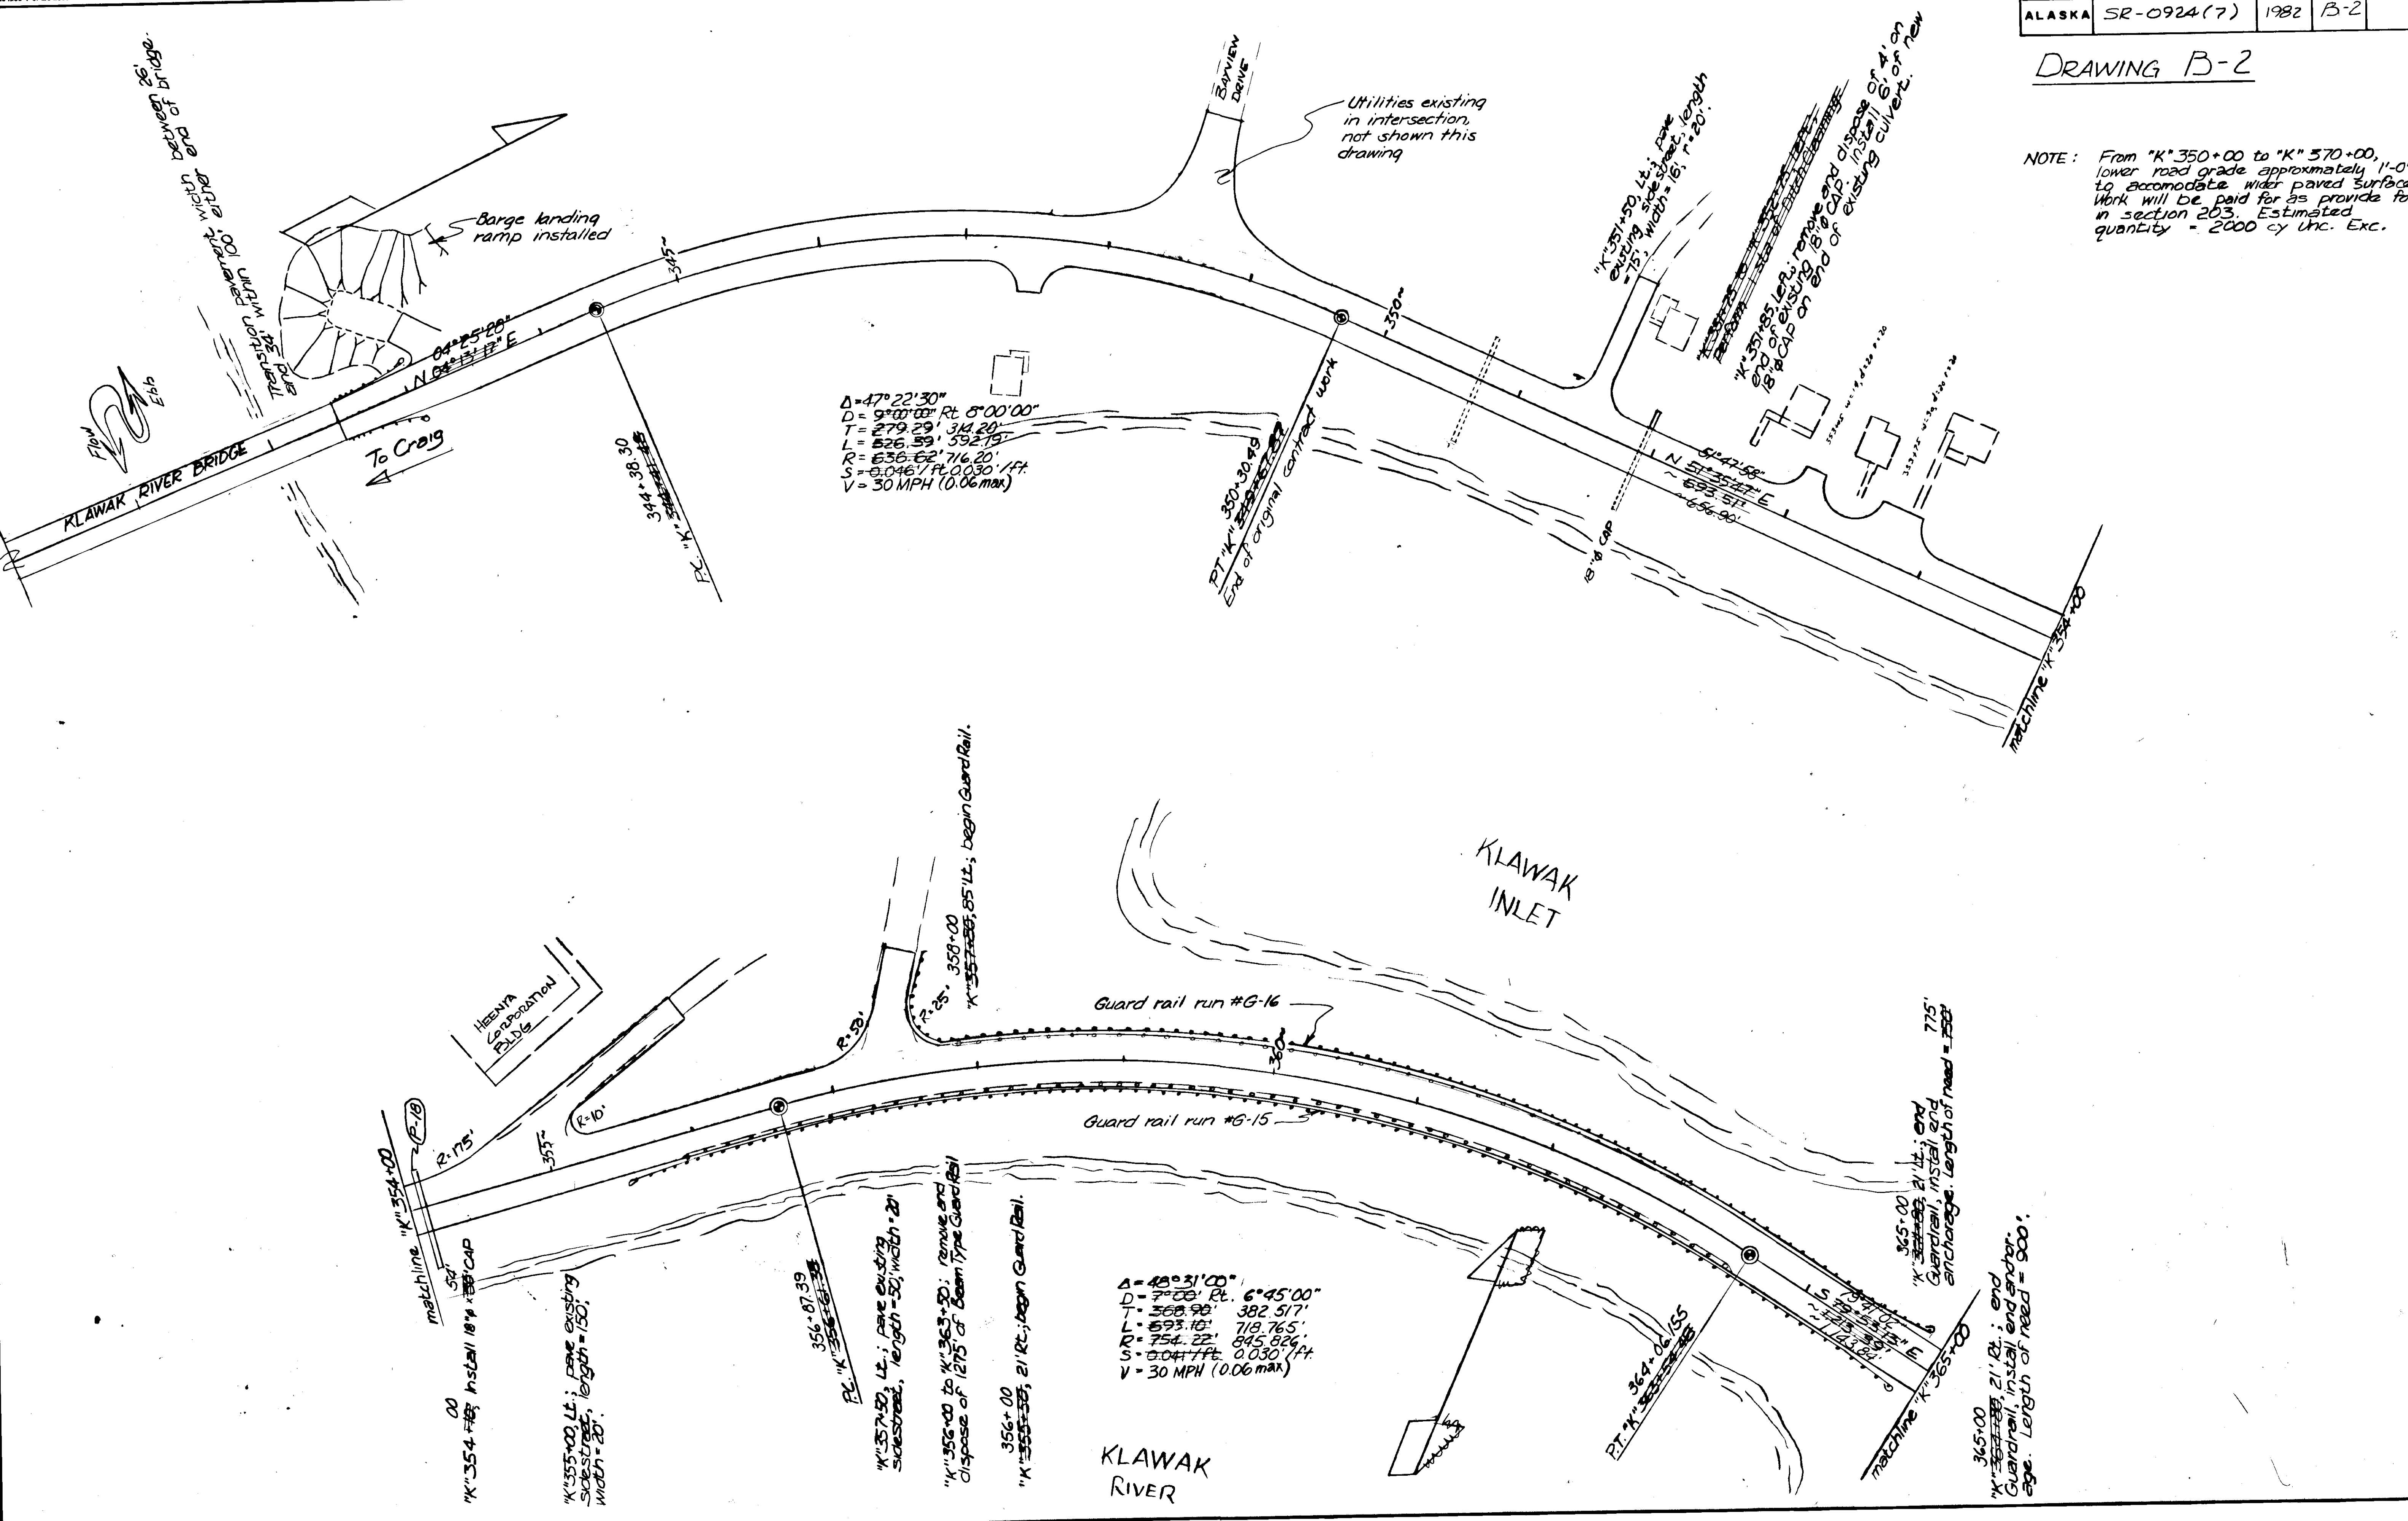

DRAWING B-3

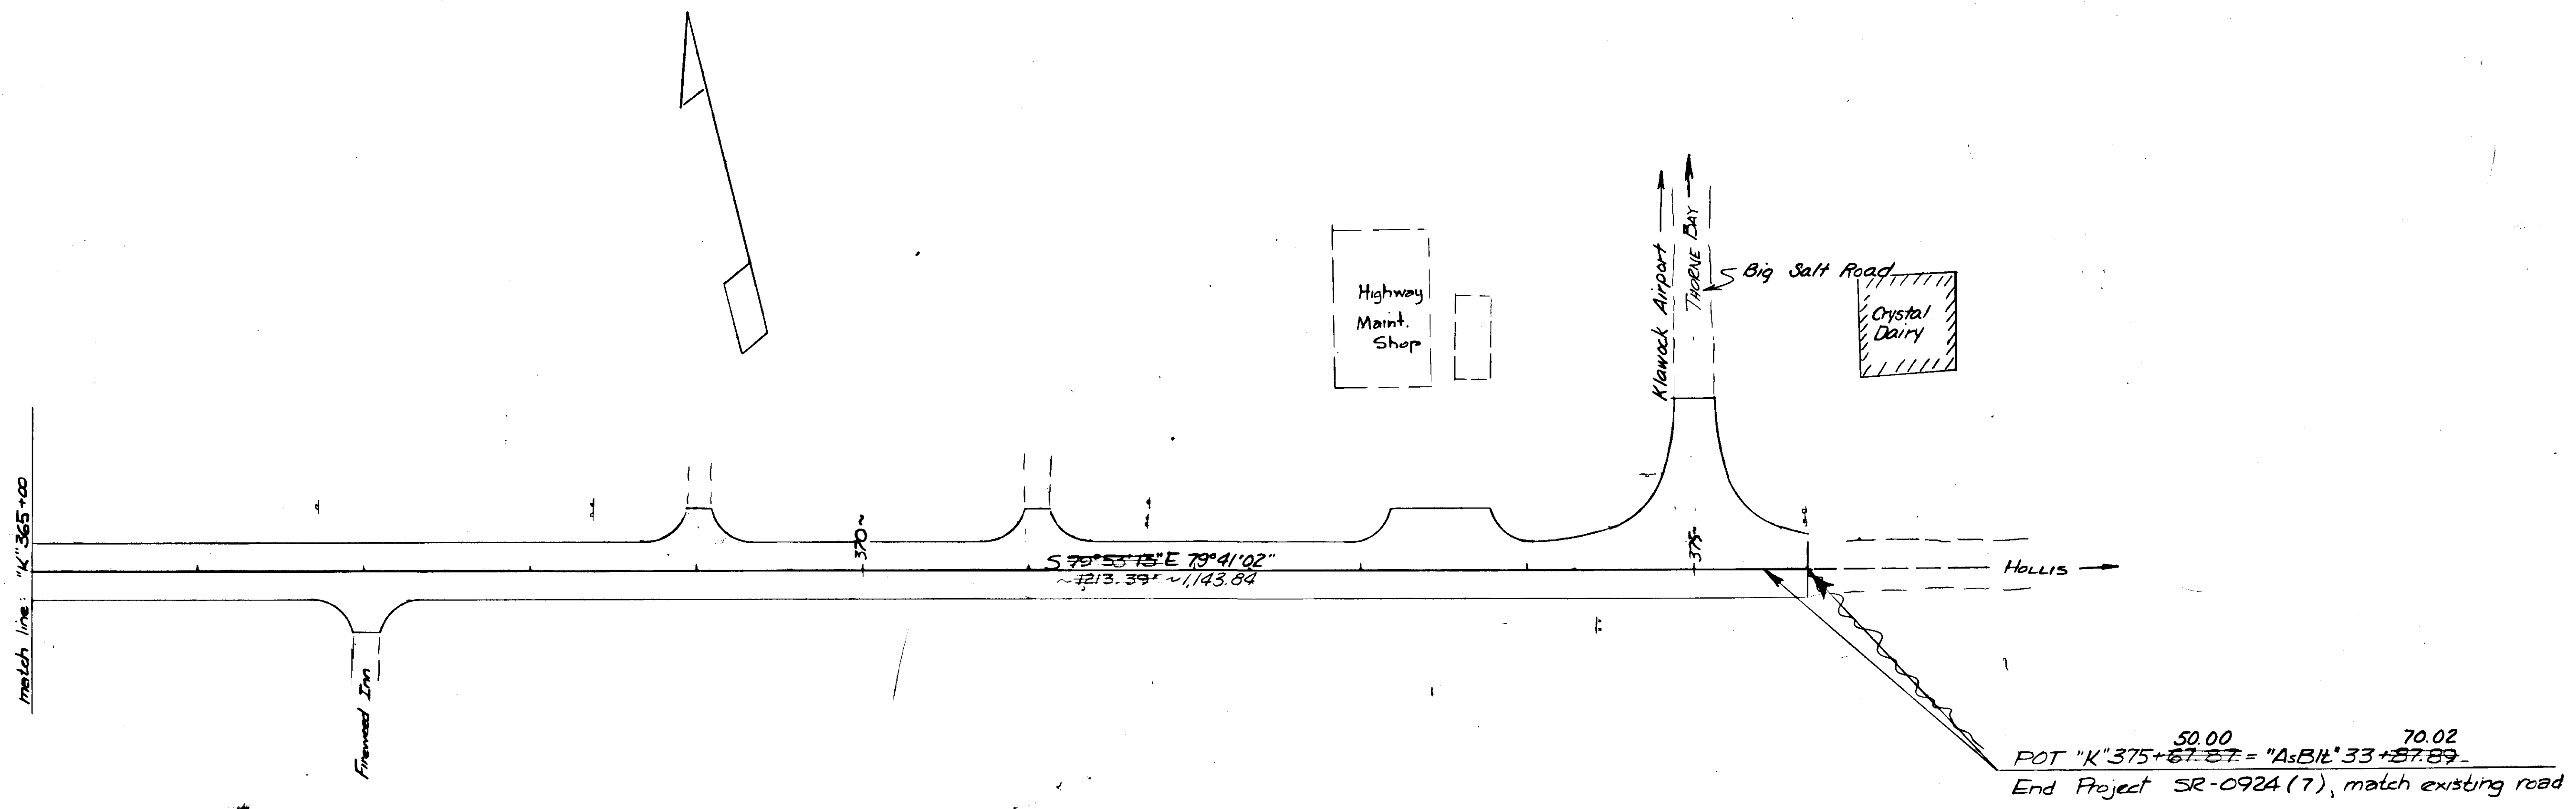

See Plan & Profile Sheets for Guard Rail Installations

From	To	Quant	Remarks	
P14+62.50	R13+50	112.5	Install	RT
K0+51.25	D0+80	150	Remove & Dispose	LT
K0+51.25	D0+80	150	Install	LT
K16+00	K17+00	100	Remove & Dispose	RT
K16+00	K17+00	100	Install	RT
K39+25	K43+25	400	Remove & Dispose	LT
K39+25	K43+25	400	Install	LT
K71+00	K74+50	350	Remove & Dispose	LT
K71+00	K74+50	350	Install	LT
K95+50	K100+50	500	Remove & Dispose	LT
K95+50	K100+50	500	Install	LT
K95+50	K100+50	500	Remove & Dispose	RT
K176+00	K212+46	3646	Install	LT
K212+39	K212+46	7	Remove & Dispose	LT
K214+65	K214+77.5	12.5	Remove & Dispose	LT
K214+77.5	K218+02.5	325	Install	LT

K270+00	K278+00	800	Install	LT
K		101.5	Remove & Dispose L&R	
K338+91	K339+47.25	56.25	Install	RT
K342+48.75	K343+05	56.25	Install	LT
K342+48.75	K343+05	56.25	Install	RT
K356+00	K363+30	750	Remove & Dispose	RT
K357+75	K363+00	525	Remove & Dispose	LT
K355+80	K364+80	900	Install	RT
K357+80	K364+80	750	Install	LT

Notes: 1. Summary contains work from both original contract and supplemental agreement.
2. Minor adjustments in stationing may be required for fit.

See Sheet 3

STATION	LEFT	RIGHT	WIDTH	RADIUS BACK	RADIUS AHEAD	DEPTH
351+50	x		16'	20'	20'	75'
353+05	x		14'	20'	20'	20'
353+75	x		30'	20'	20'	20'
355+00	x		20'	175'	10'	150'
357+50	x		20'	50'	25'	50'
367+00		x	16'	25'	25'	20'
369+00	x		14'	25'	25'	20'
371+00	x		14'	25'	25'	20'
373+45	x		60'	25'	25'	20'
375+00	x		24'	150-50-150	150-50-150	86'

Note: 1. Adjust stationing as required