


Float was moved out 6' at design's request to allow add'l. room inside for stall floats - wanted 10' but water depth wouldn't allow it - water actually deeper than shown - See pile records.

TIDAL INFORMATION

| | |
|------|------|
| EHW | 15.0 |
| MHHW | 10.8 |
| MHW | 10.0 |
| MTL | 5.7 |
| MLLW | 0.0 |
| ELW | -4.0 |

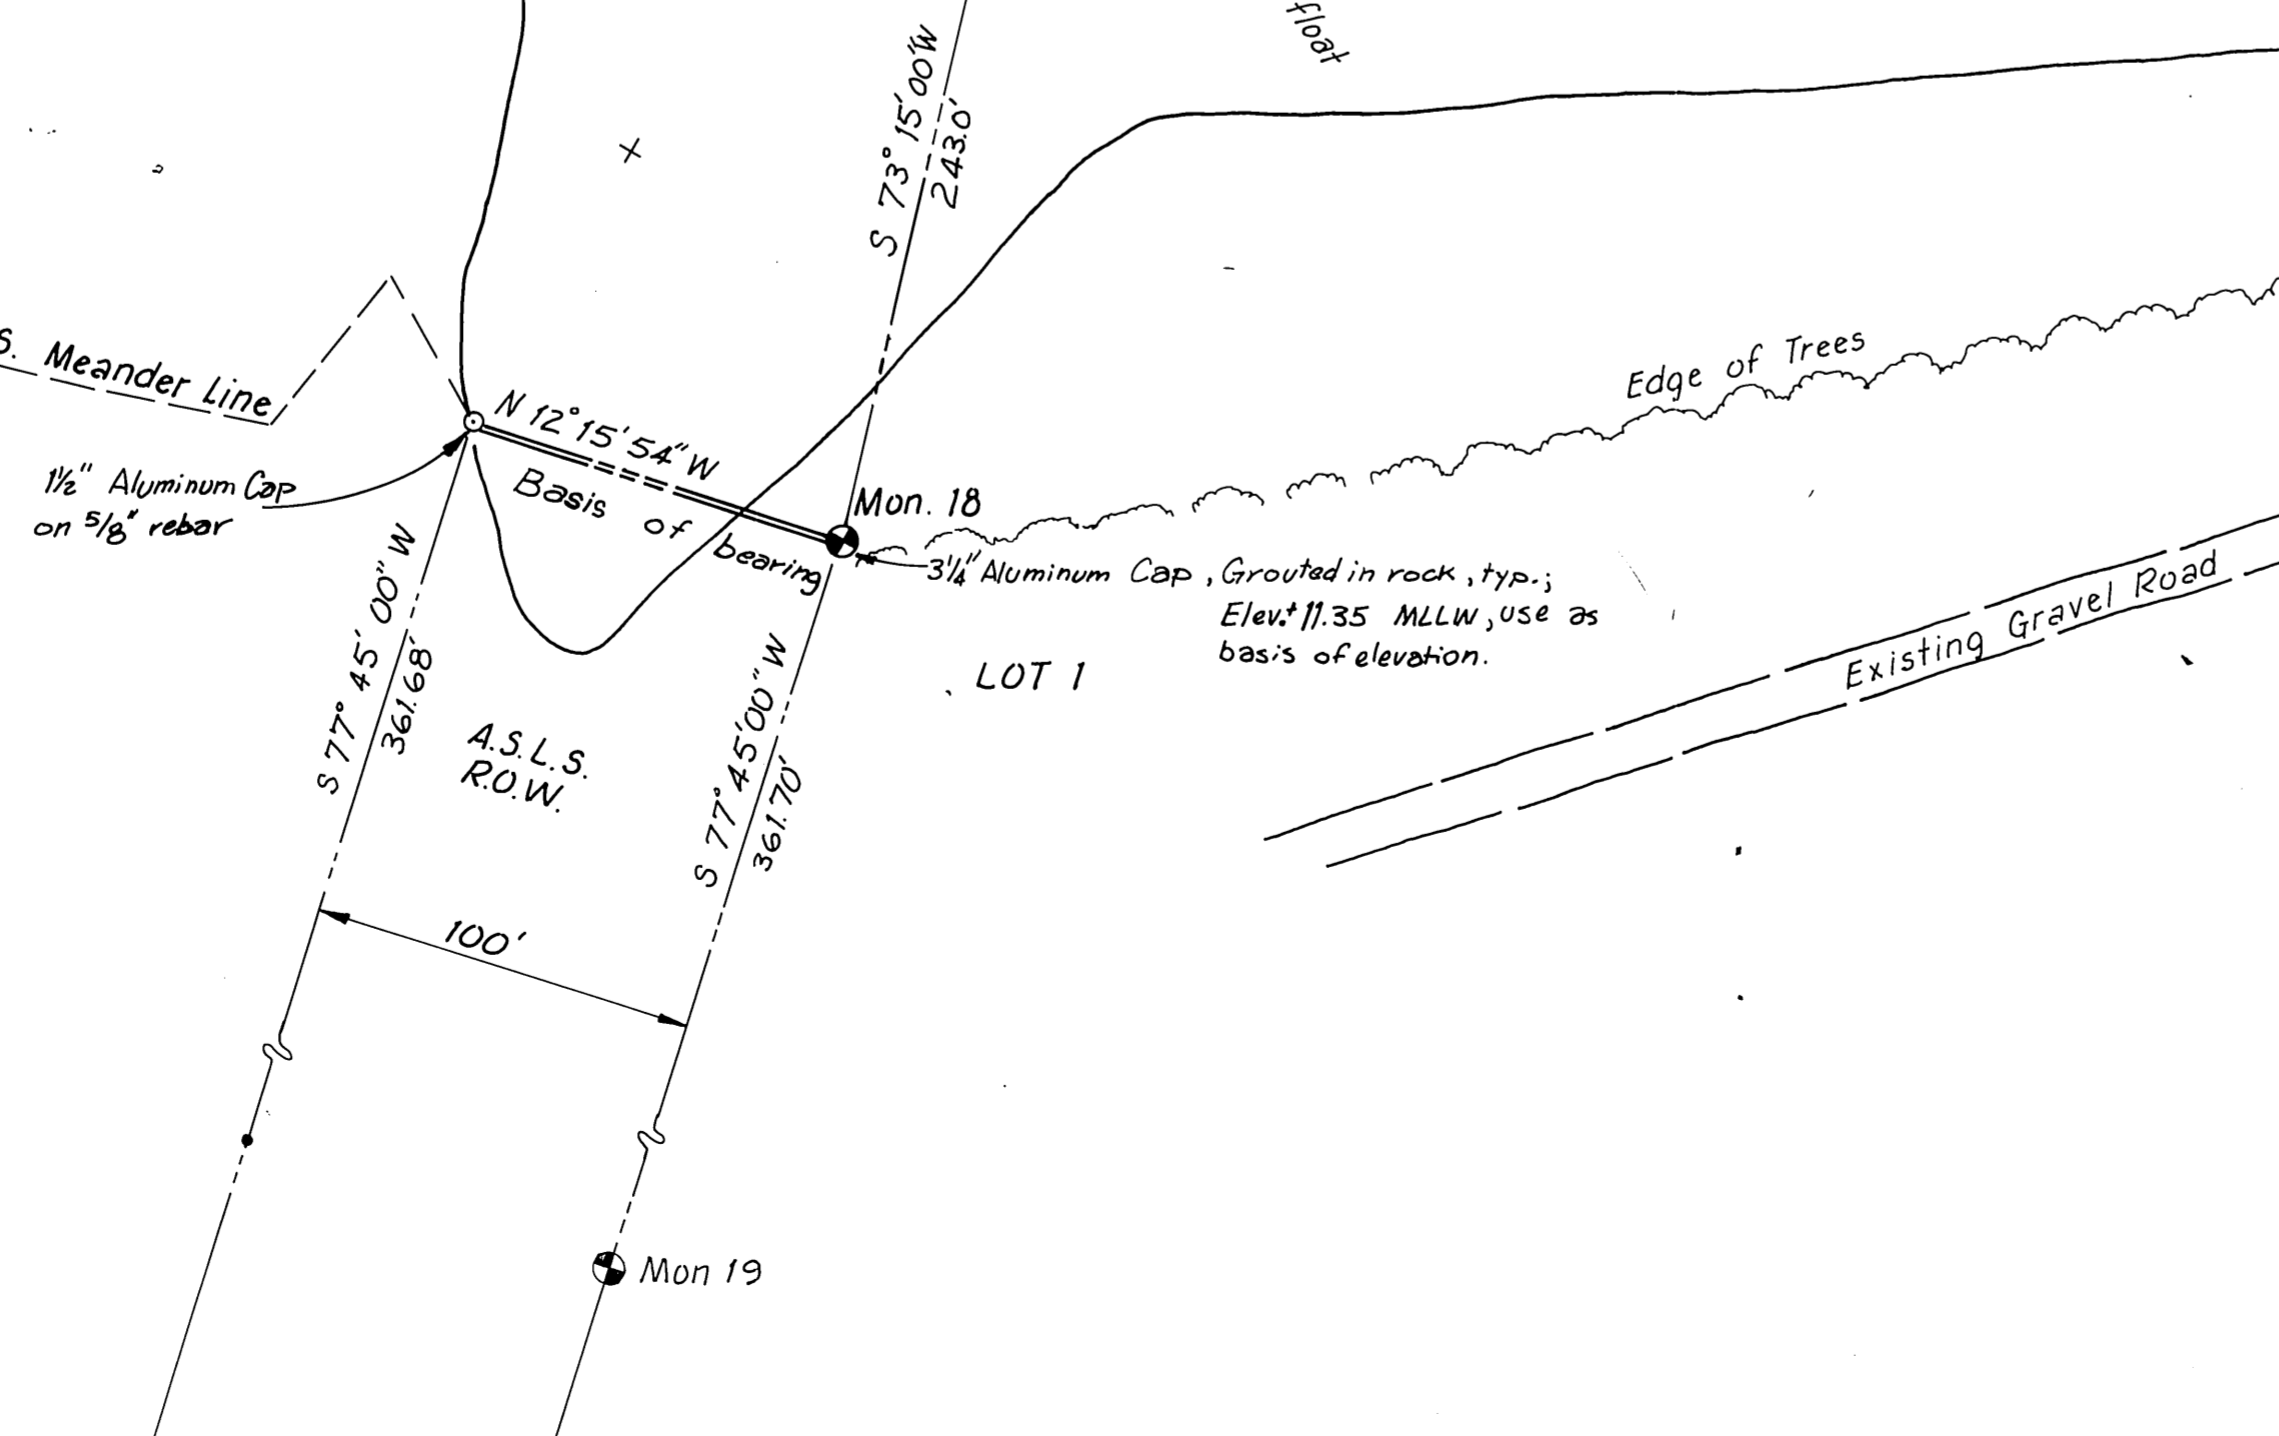

STAMP

DO NOT SCALE THIS DRAWING - USE DIMENSIONS

STATE OF ALASKA
DEPARTMENT OF TRANSPORTATION AND PUBLIC FACILITIES


EDNA BAY ALASKA

PROJECT LAYOUT

Scale: 1" = 50'


| | | | |
|-----------------------|--------------|----------|-----------|
| DESIGNED JDB | CHECKED | DRAWN TS | DATE 5/84 |
| PROJECT NUMBER K31041 | SHEET 2 OF 4 | | |

Jack Daniel Beedle
CE - 5309
REGISTERED PROFESSIONAL ENGINEER

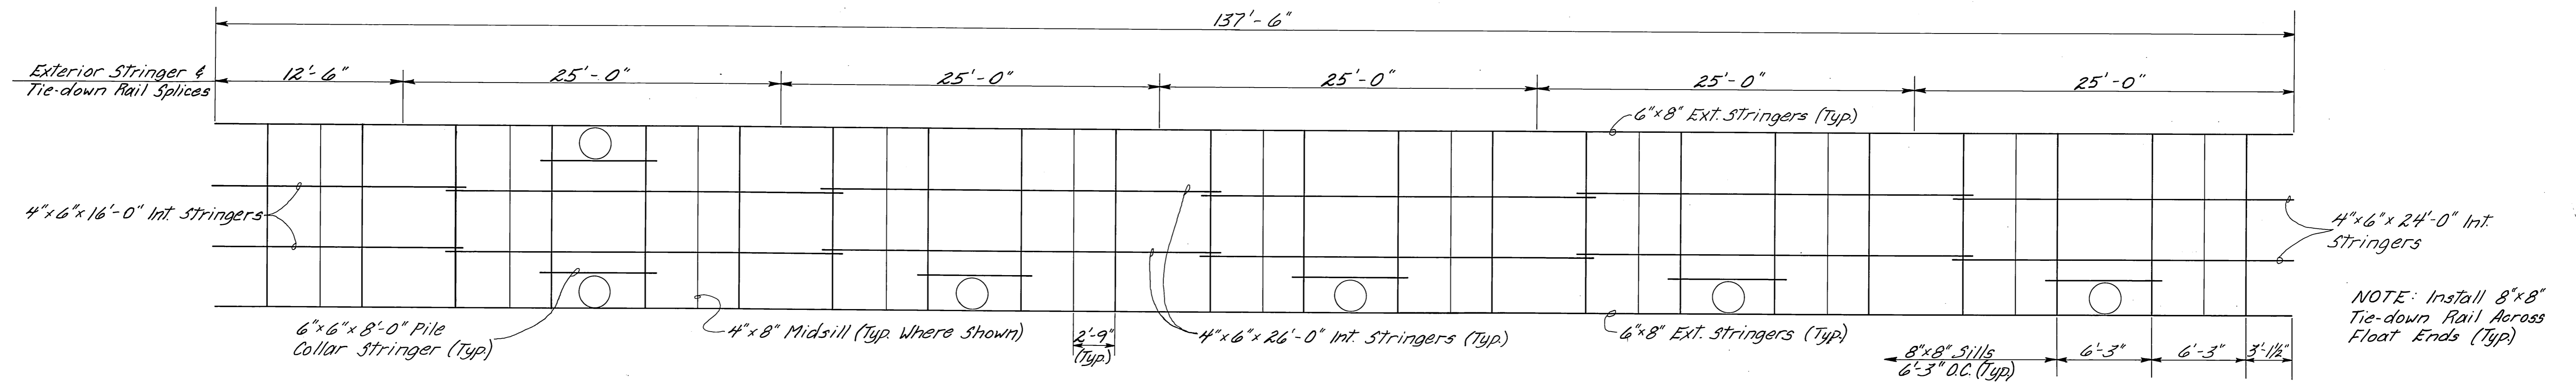

SILL & STRINGER LAYOUT
3/16" = 1'-0"

NOTE: Install 8"x8" Tie-down Rail Across Float Ends (Typ)

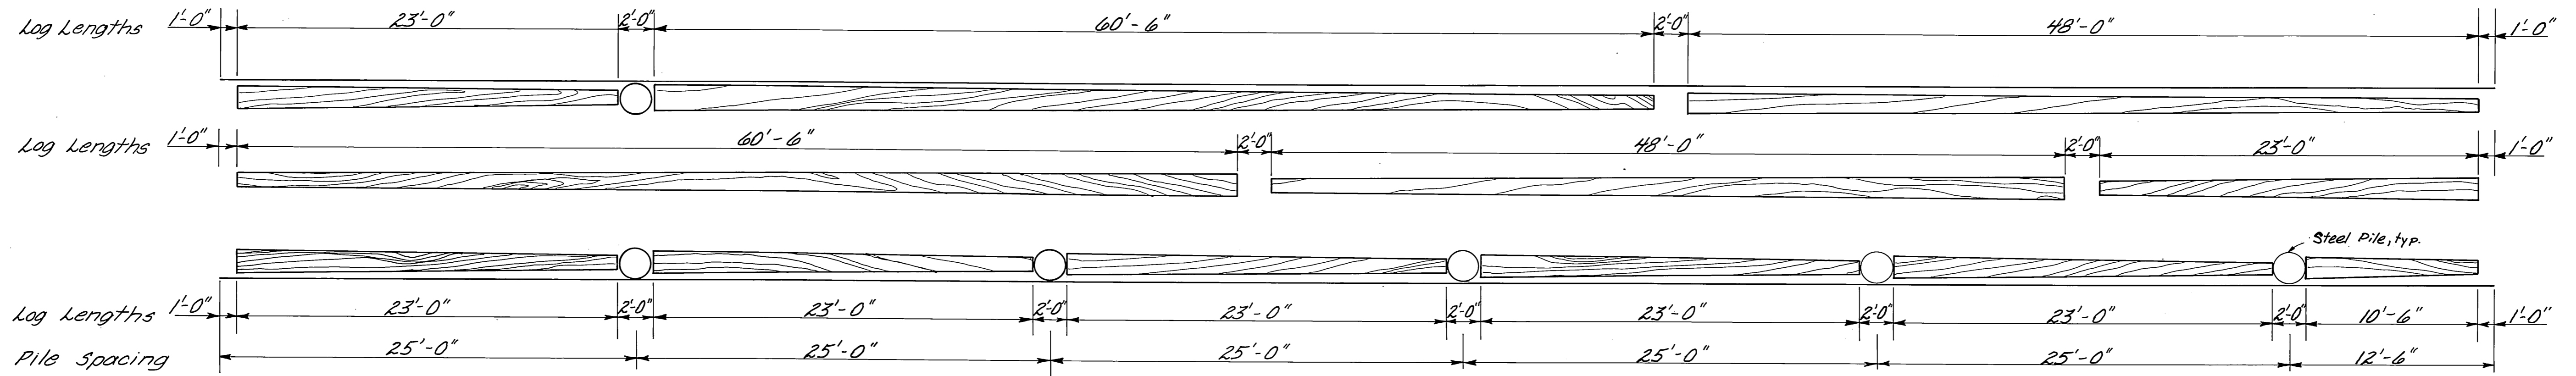

LOG LAYOUT
3/16" = 1'-0"

NOTE: Float Logs Shall Have a Min. Tip Circumference of 3 1/2" (10" Dia.) & a Max. Butt Circumference of 50" (16" Dia.)


PILE DRIVING REQUIREMENTS

A: GENERAL

1. Depth of overburden is unknown.
2. Adjacent uplands has been used as a log transfer site. Therefore upper 1'± may be wood waste or bark.
3. Adjacent uplands have many rock outcroppings, predominantly of limestone.


B: PILES

1. All piles to have cutting shoes (APFO-14000 or equal).
2. Piles to be of sufficient length to allow 15' of penetration. Estimated length is 58' (+27' to 30', +1' cutoff allowance).
3. Piles to be driven to 15' penetration or 8' of drilled rock socket.
4. If piling can be driven without socketing then no payment will be made for drilled pile socket. The desired penetration is 15', but Engineer may accept at a lesser penetration after evaluating lateral support. If after 15' of penetration lateral support is inadequate, pile shall be driven until cutoff elevation is +20' or if available more pile may be spliced on.
5. If socketing is required, due to inadequate penetration or lack of lateral support, the socket depth shall be 8'. Engineer may accept at a lesser depth after evaluating field conditions and lateral support.
6. Pile socket payment will be made in full for each socket drilled, when requested by the Engineer, regardless of accepted depth.

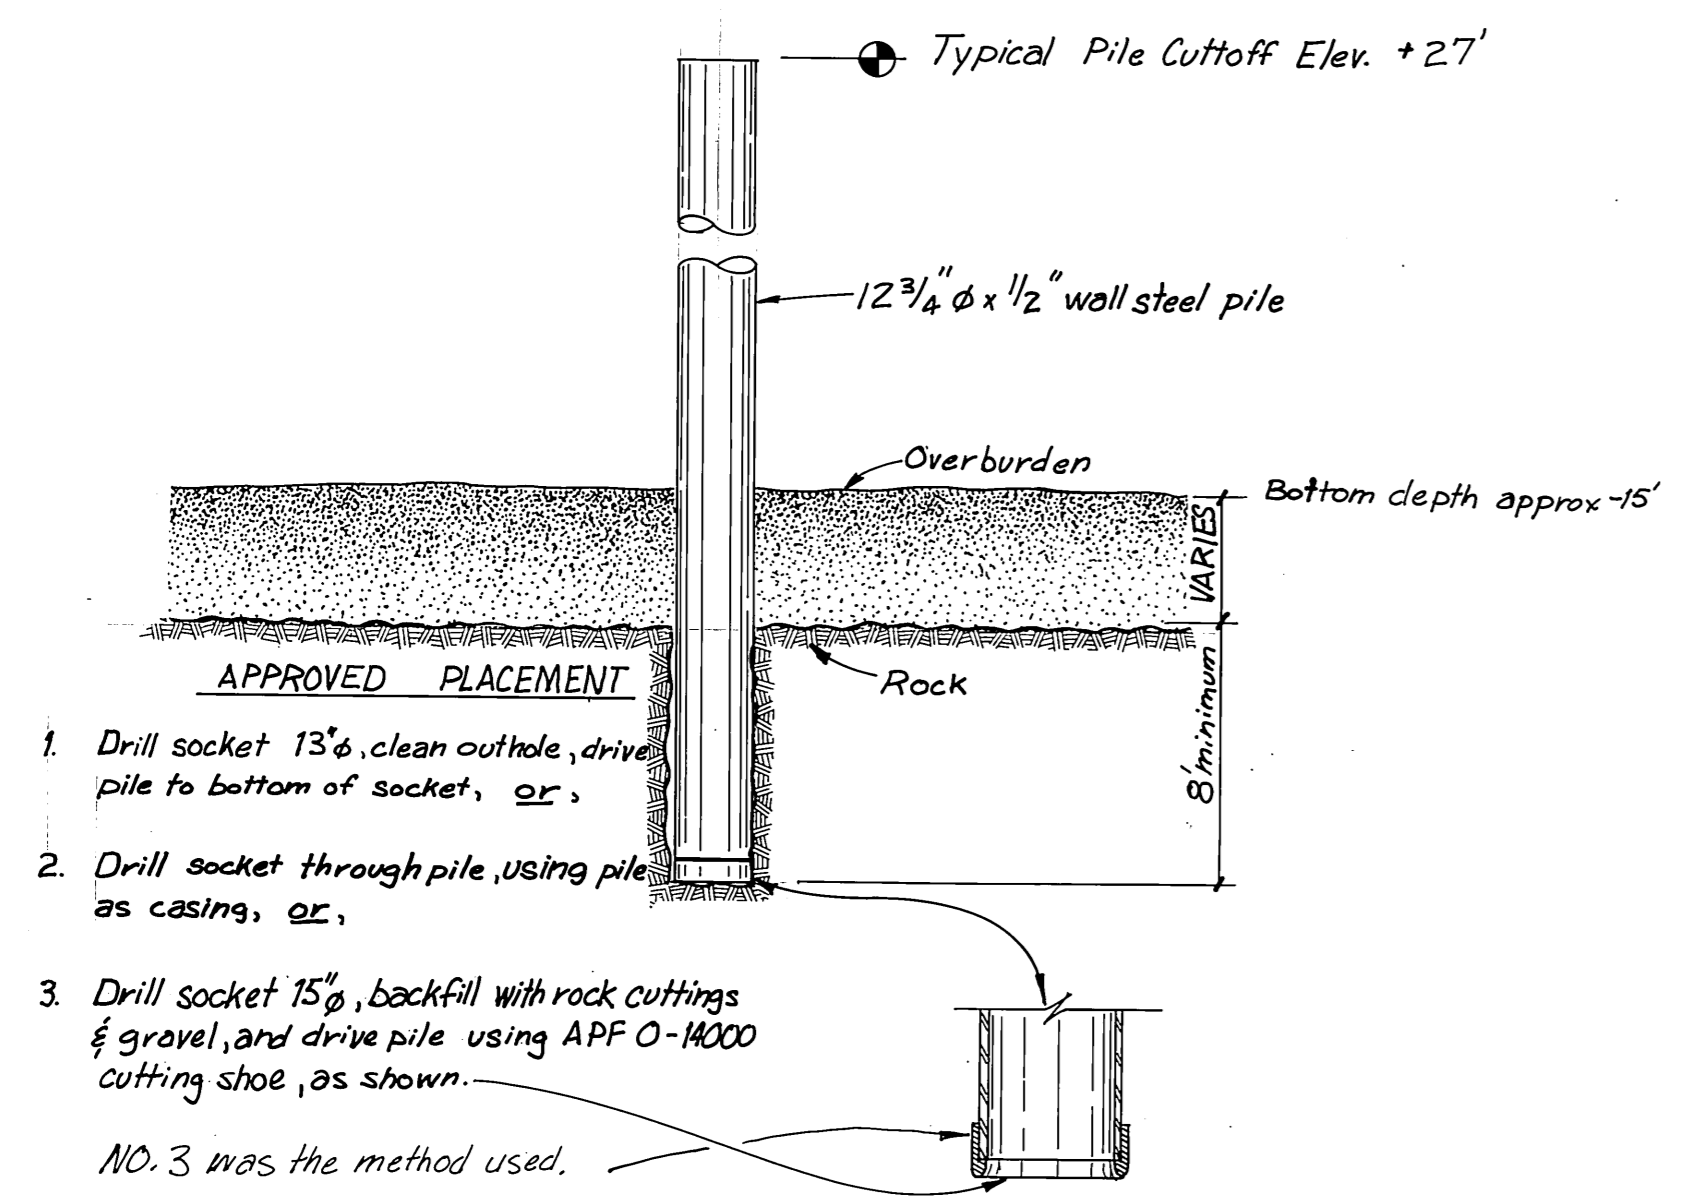

STEEL PILE SOCKET DETAIL
N. T. S.

| | | | | |
|--|---|-----------|-----------|--|
| | DO NOT SCALE THIS DRAWING - USE DIMENSIONS | | | |
| | STATE OF ALASKA DEPARTMENT OF TRANSPORTATION AND PUBLIC FACILITIES | | | |
| Edna Bay | | Alaska | | |
| SILL, STRINGER, LOG LAYOUT & PILE SOCKET DETAIL | | | | |
| DESIGNED JDB | CHECKED | DRAWN JEM | DATE 5/84 | |
| PROJECT NUMBER K 31041 | SHEET 3 | | OF 4 | |

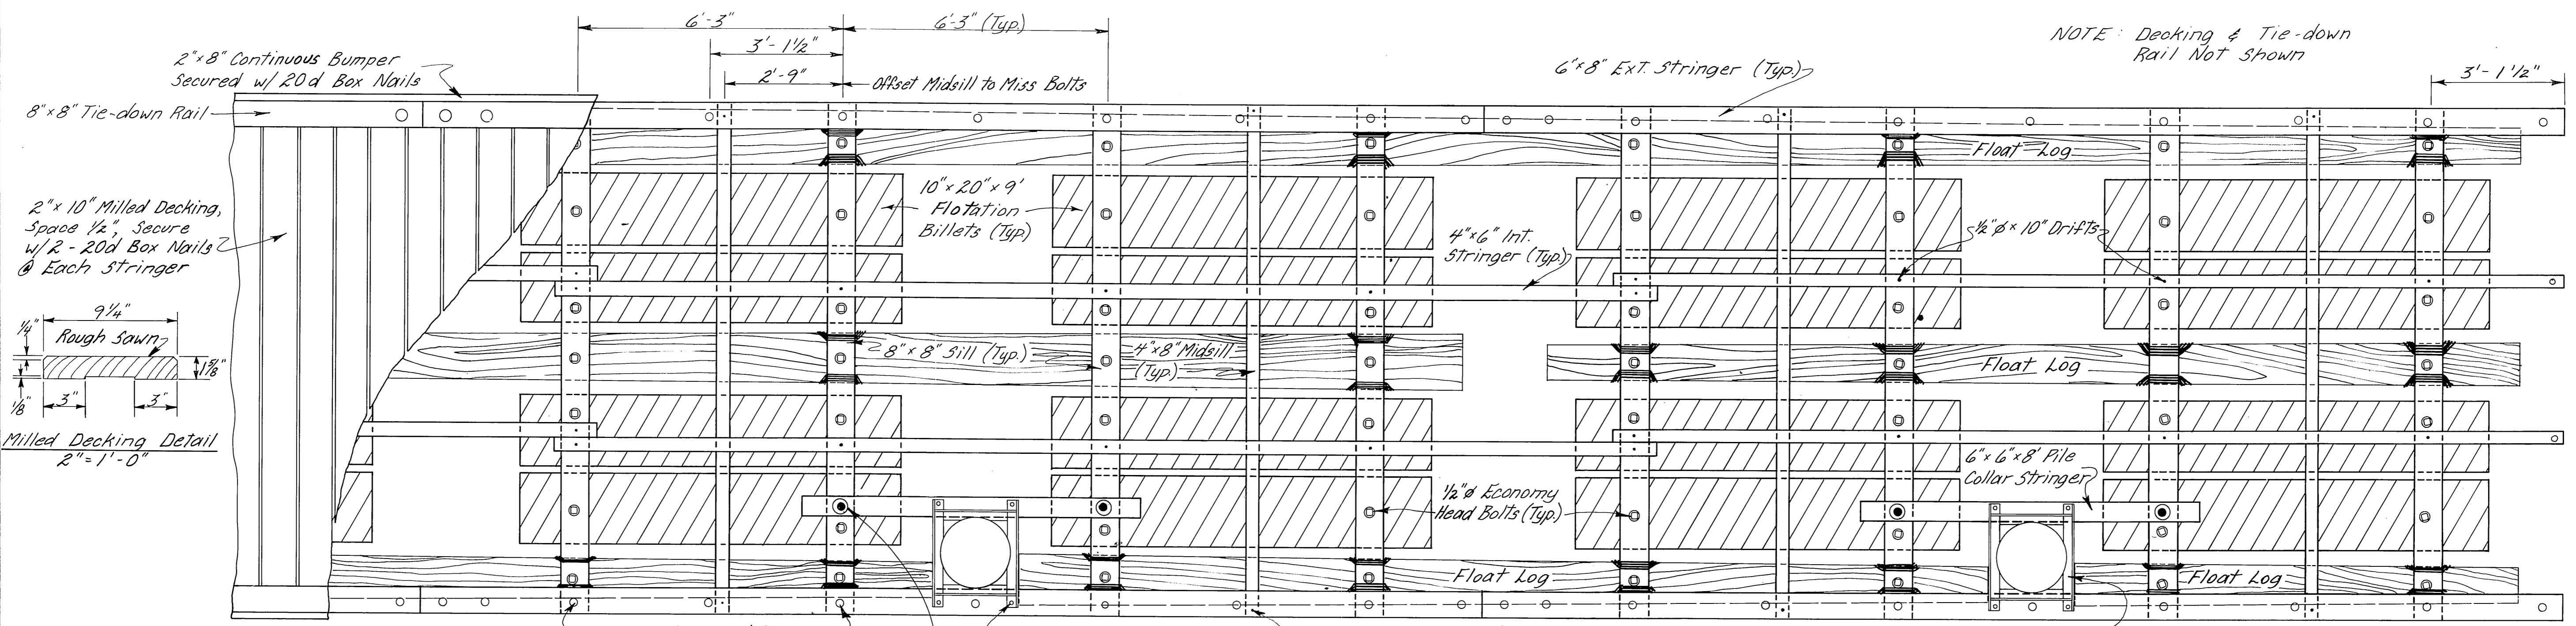

Install 8" x 8" Tie-down Rail Across Ends of Float, Secure To Int. & Ext. Stringers.

C-bore 3/8" for 3/4" Bolt


3/4" x 1 1/2" Economy head bolts (typ); install nuts up. Bore 3/8" hole through decking to clear nut & M.I. Washer. Bolt shall not extend above decking. Alternately bolt may be 27" long & bolt thru collar stringer, sill, billet, and lower sill.

5/8" A325 Bolts for Pile Collar Connections (Typ)

3/8" x 10" Drift, Pre-bore

Pile Collar, See Detail on this sheet.

PLAN
1/2" = 1'-0"

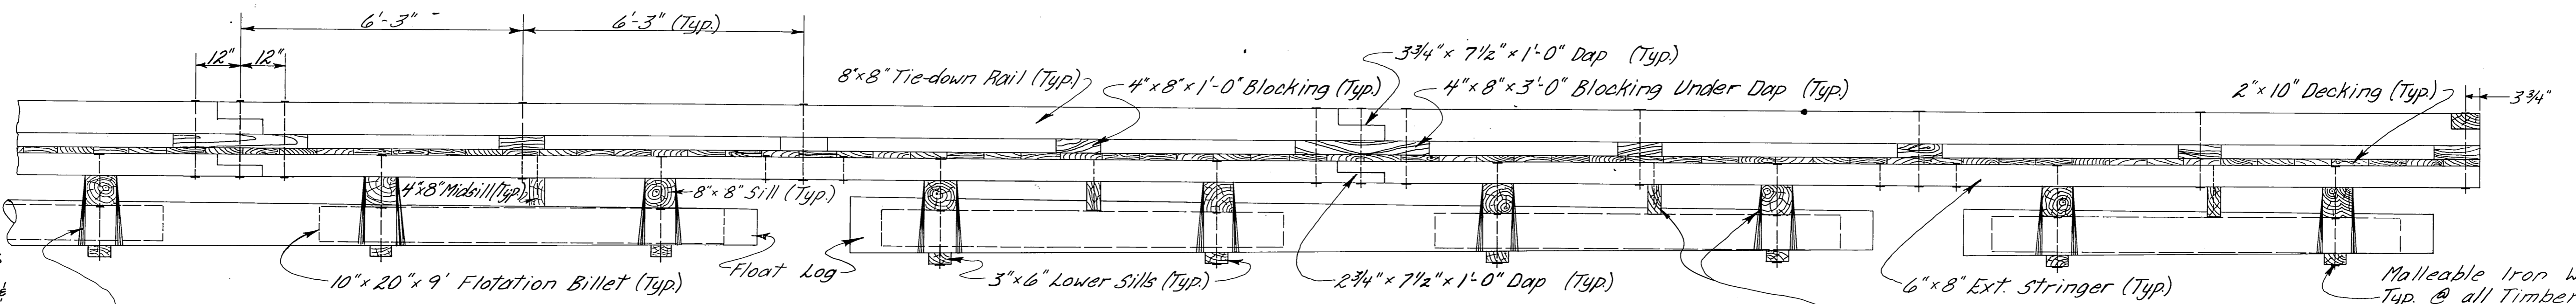


Saddle lash long logs to every other 8x8 sill & saddle lash short logs (23'-0" x 10'-6") to every 8x8 sill. 1/2" Cable lashing wrapped 4 times & secured w/ one staple per wrap, turn ends back & double staple, staple only into the logs.

3 wraps of 4 crosslashed to allow stapling into pile near top- flotation billets interfere with hammer swings lower down.


Dap Float Logs to 1/2 the Difference Between Tip Dia. & Log Dia. @ Each Sill. (Dap prior to pressure treatment.)

ELEVATION
1/2" = 1'-0"



| MATERIALS | | |
|----------------------------|--------------|----------------|
| ITEM | DRESSING | TREATMENT |
| 8" x 8" Tie-down Rails | S45 | 0.6Lb. Pentac |
| 4" x 8" Blocking | S45 | " " " |
| 2" x 10" Decking | Milled S1S2E | " " " |
| 2" x 8" Bumpers | S45 | " " " |
| 6" x 8" Exterior Stringers | S45 | 12Lb. Creosote |
| 4" x 6" Interior Stringers | S45 | " " " |
| 6" x 6" Collar Stringers | S45 | " " " |
| 8" x 8" & 4" x 8" Sills | S45 | " " " |
| 3" x 6" Lower Sills | S45 | " " " |
| Float Logs | A.S.T.M. D25 | 17Lb. Creosote |

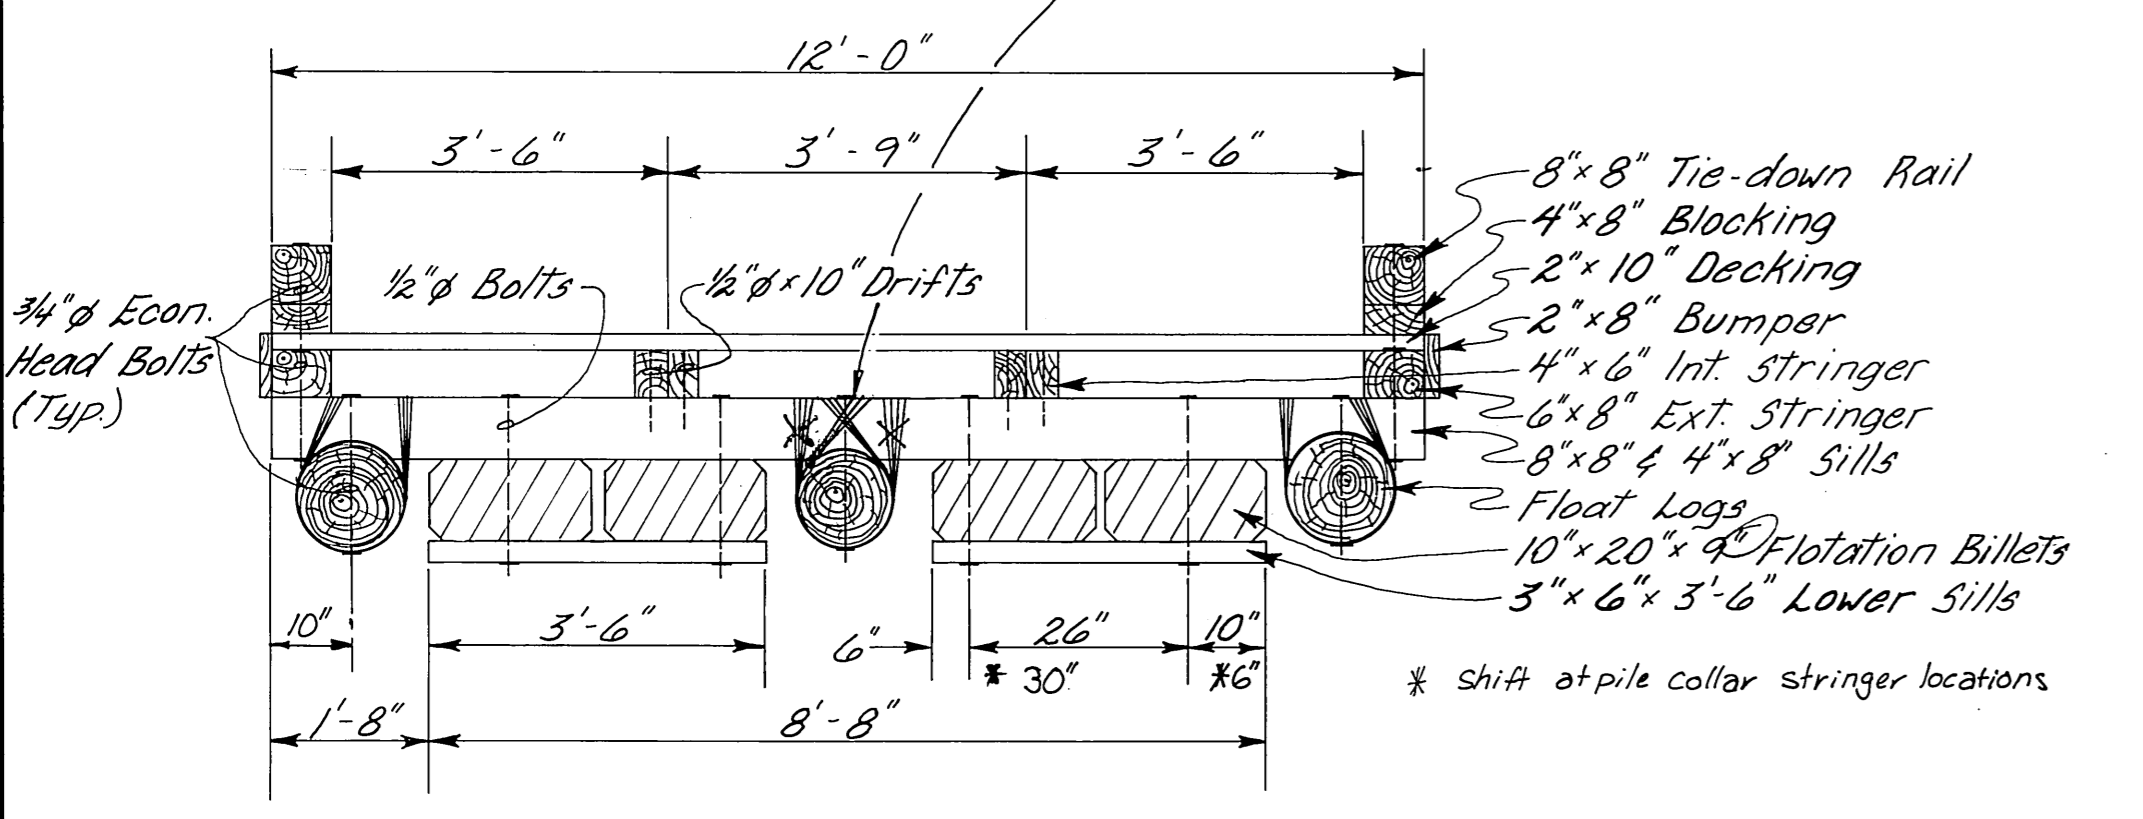

TYPICAL SECTION
1/2" = 1'-0"

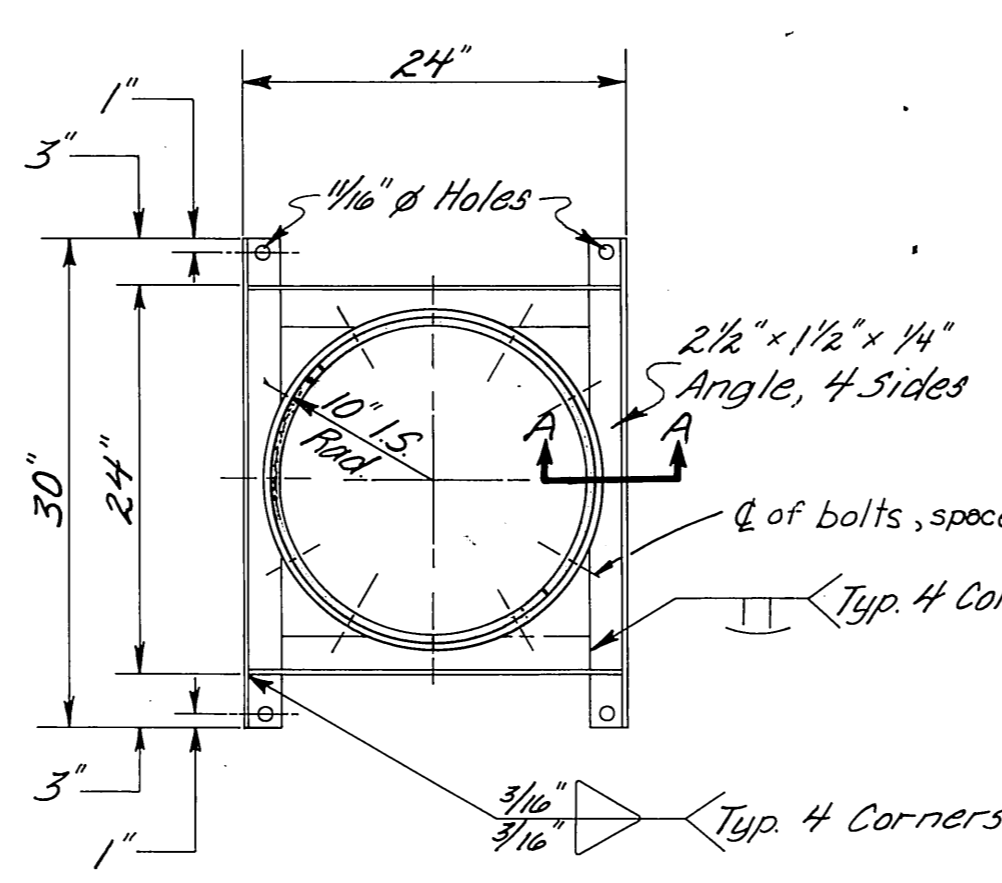

INTERNAL PILE COLLAR DETAIL

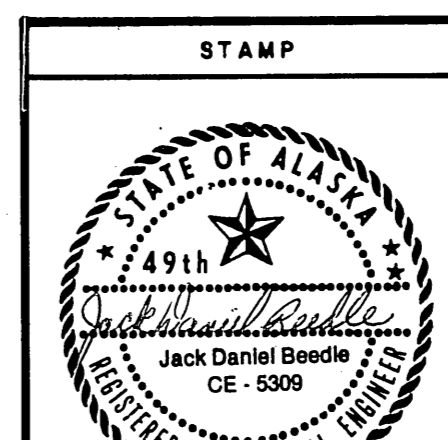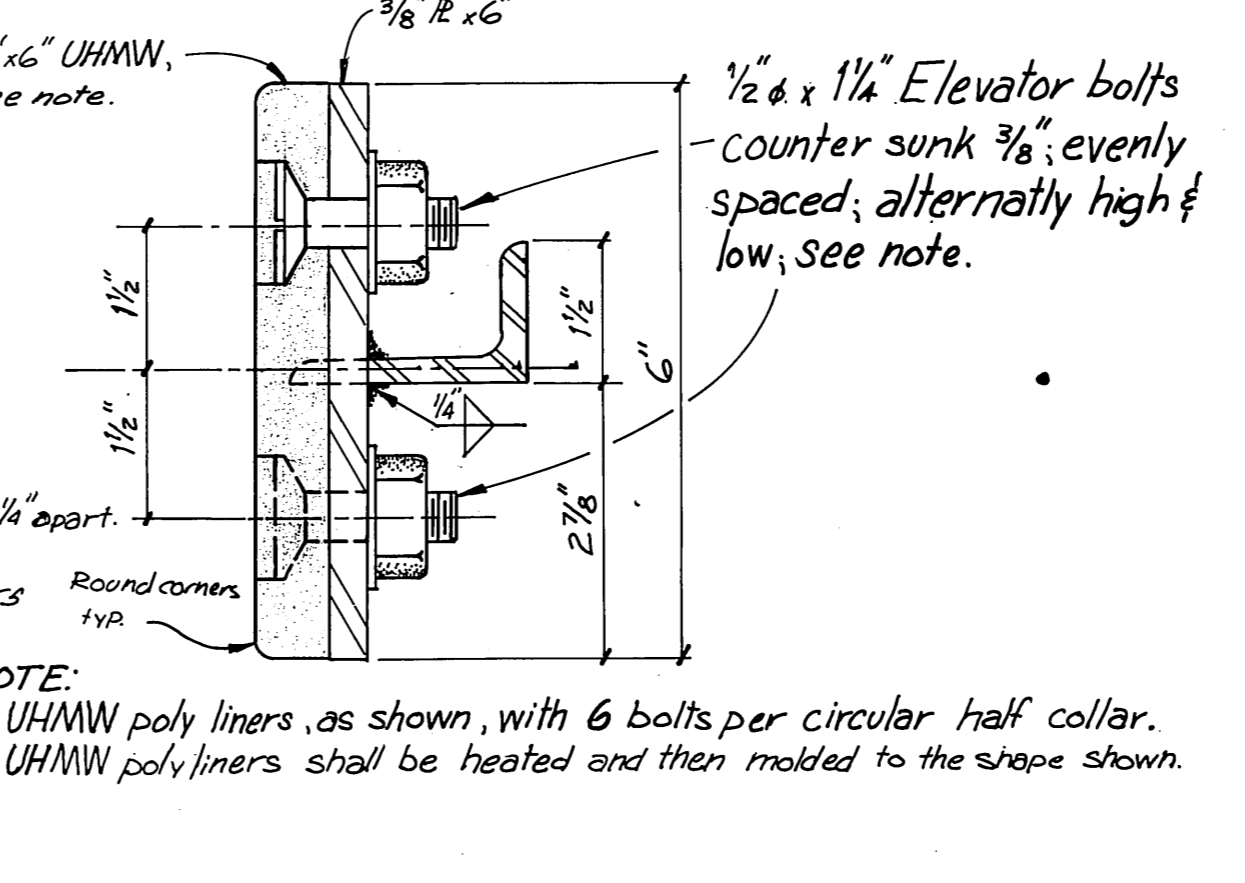

| | | | |
|--|--------|---------|--------|
| DO NOT SCALE THIS DRAWING - USE DIMENSIONS | | | |
| STATE OF ALASKA | | | |
| DEPARTMENT OF TRANSPORTATION AND PUBLIC FACILITIES | | | |
| EDNA BAY | | ALASKA | |
| 12' LOG REINFORCED FLOAT | | | |
| DESIGNED | J.D.B. | CHECKED | |
| DRAWN | J.M. | DATE | 5/84 |
| PROJECT NUMBER | K31041 | SHEET | 4 OF 4 |

As built 8-85