

SEE MONUMENT SUMMARY SHEET D1
TO LOCATE PROJECT STATIONING

E.O.P
END SPOT REPAIRS
STA "0". 841+96.52

End overlay

**END FULL WIDTH PAVEMENT
REHABILITATION STA. 508+00**
BEGIN SPOT REPAIRS
STA. "0" 509+40.05

B.O.P
**BEGIN FULL WIDTH
PAVEMENT REHABILITATION**
STA. "0" 172+50

Begin 2" pavement overlay

FREDERICK SOUND

MITKOF ISLAND

PETERSBURG

CRYSTAL LAKE
HATCHERY
ROAD

WRANGELL NARROWS

PAPKE'S LANDING
ROAD

HIGHWAY

TWIN CREEK

FUR FARM CREEK


FALLS
CREEK

TAAIN CR.

MITKOF

DO NOT SCALE FROM THESE DRAWINGS USE DIMENSIONS

CHECKED BY: C. HOWARD

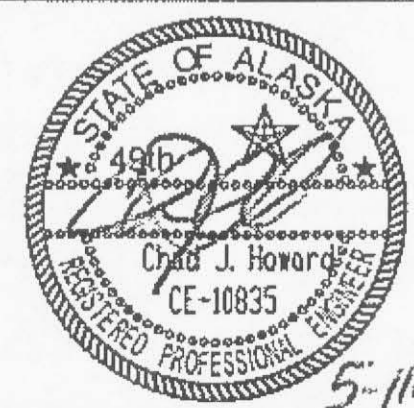

DESIGNED BY: C. IVANISZEK
DRAWN BY: B. WILSON

STATE OF ALASKA
DEPARTMENT OF TRANSPORTATION
& PUBLIC FACILITIES
DESIGN & ENGINEERING SERVICES DIVISION-SOUTHEAST REGION


**MITKOF HWY PAVEMENT
REHABILITATION AND DRAINAGE
IMPROVEMENTS
PROJECT #68819**

PROJECT LAYOUT PLAN

PATH: Q:\PSG\68819\PLANSET\DWG\3 PLAN LAYOUT.DWG
TAB: A2 Thursday, May 07, 2009 10:31:06 AM WILSON, BRIAN G (DOT)

REVISIONS			PROJECT DESIGNATION	YEAR	SHEET NO.	TOTAL SHEETS
NO.	DATE	DESCRIPTION				
			68819	2009	A2	17

JSK
2-1-2010

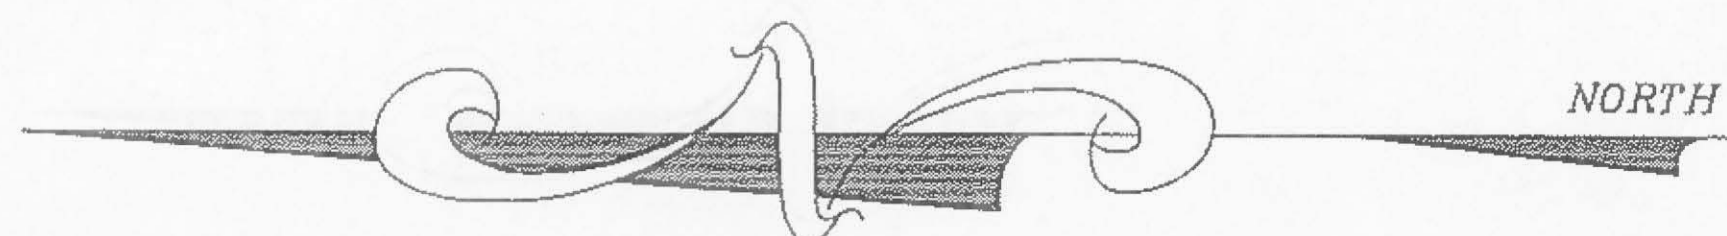


LEGEND

- ① EXISTING GROUND
- ② 2.5" ASPHALT CONCRETE PAVEMENT, TYPE II, CLASS B
- ③ STE-1 TACK COAT
- ④ 4" CRUSHED ASPHALT BASE COURSE (CABC)
- ⑤ EXISTING AGGREGATE BASE COURSE
- ⑥ LINEAR GRADING
- ⑦ 2" ASPHALT CONCRETE PAVEMENT, TYPE II, CLASS B


TYPICAL SECTION NOTES:

1. THE LIMITS OF PULVERIZING TO CONSTRUCT CABC SHALL BE THE WIDTH OF DRIVING LANES AND SHOULDERS.
2. PULVERIZE TO A DEPTH OF 4". INCREASE THE DEPTH OF PULVERIZING TO 6" FROM STA. 387+00 TO 391+00. SEE SHEET F3
3. CONTRACTOR SHALL MAKE INITIAL PASS THEN ADD AGGREGATE FOR CRUSHED ASPHALT BASE COURSE, IF REQUIRED TO MEET A SMOOTH AND UNIFORM GRADE.
4. LINEAR GRADING SHALL CONSIST OF GRADING, SHAPING, AND COMPACTING THE CRUSHED ASPHALT BASE MATERIALS AS SHOWN ON THE TYPICAL SECTION. SEE SECTION 308 OF THE SPECIAL PROVISIONS.
5. SEE PLANS FOR SPOT REPAIR LOCATIONS BETWEEN STA. 509+40.05 TO E.O.P. PLAN LOCATIONS ARE APPROXIMATE FOR ESTIMATING PURPOSES. FINAL LOCATIONS AND LIMITS WILL BE FIELD LOCATED BY THE ENGINEER PRIOR TO CONSTRUCTION.
6. WHERE PAVEMENT COLD PLANING IS REDUCED TO A SINGLE LANE, THE LIMITS SHALL EXTEND 12' FROM CENTERLINE TO THE SHOULDER, (THE FULL LANE WIDTH).
7. PULVERIZING TO CONSTRUCT CABC IS PAID UNDER ITEM 308. PAVEMENT COLD PLANING FOR SPOT REPAIRS IS PAID FOR UNDER ITEM 408.
8. EXISTING PAVEMENT THICKNESS IS APPROXIMATELY 2".



note: existing lane striping
town to BOP was 11'. matched
existing BOP to 492+00.

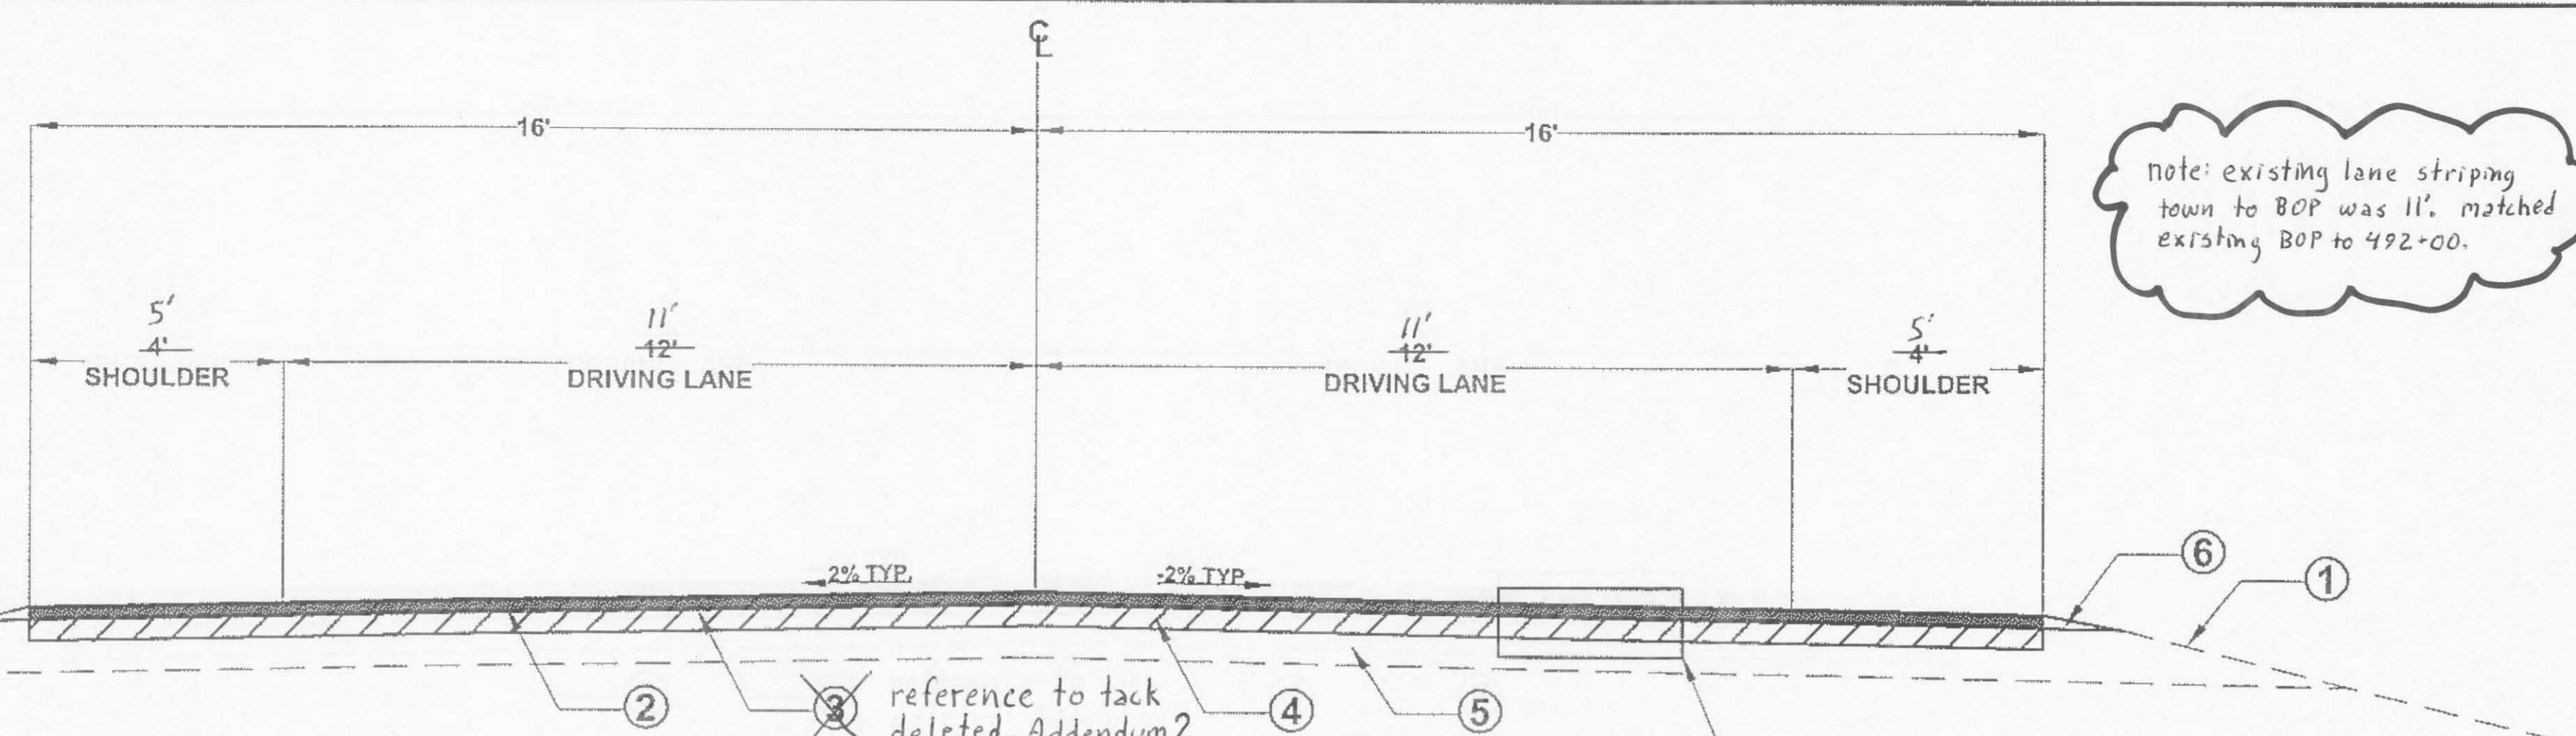

TYPICAL SECTION
B.O.P. TO STA. 492+00
STA. 491+00 TO 492+00 ROADWAY WIDTH NARROWS FROM 32' TO 24'.

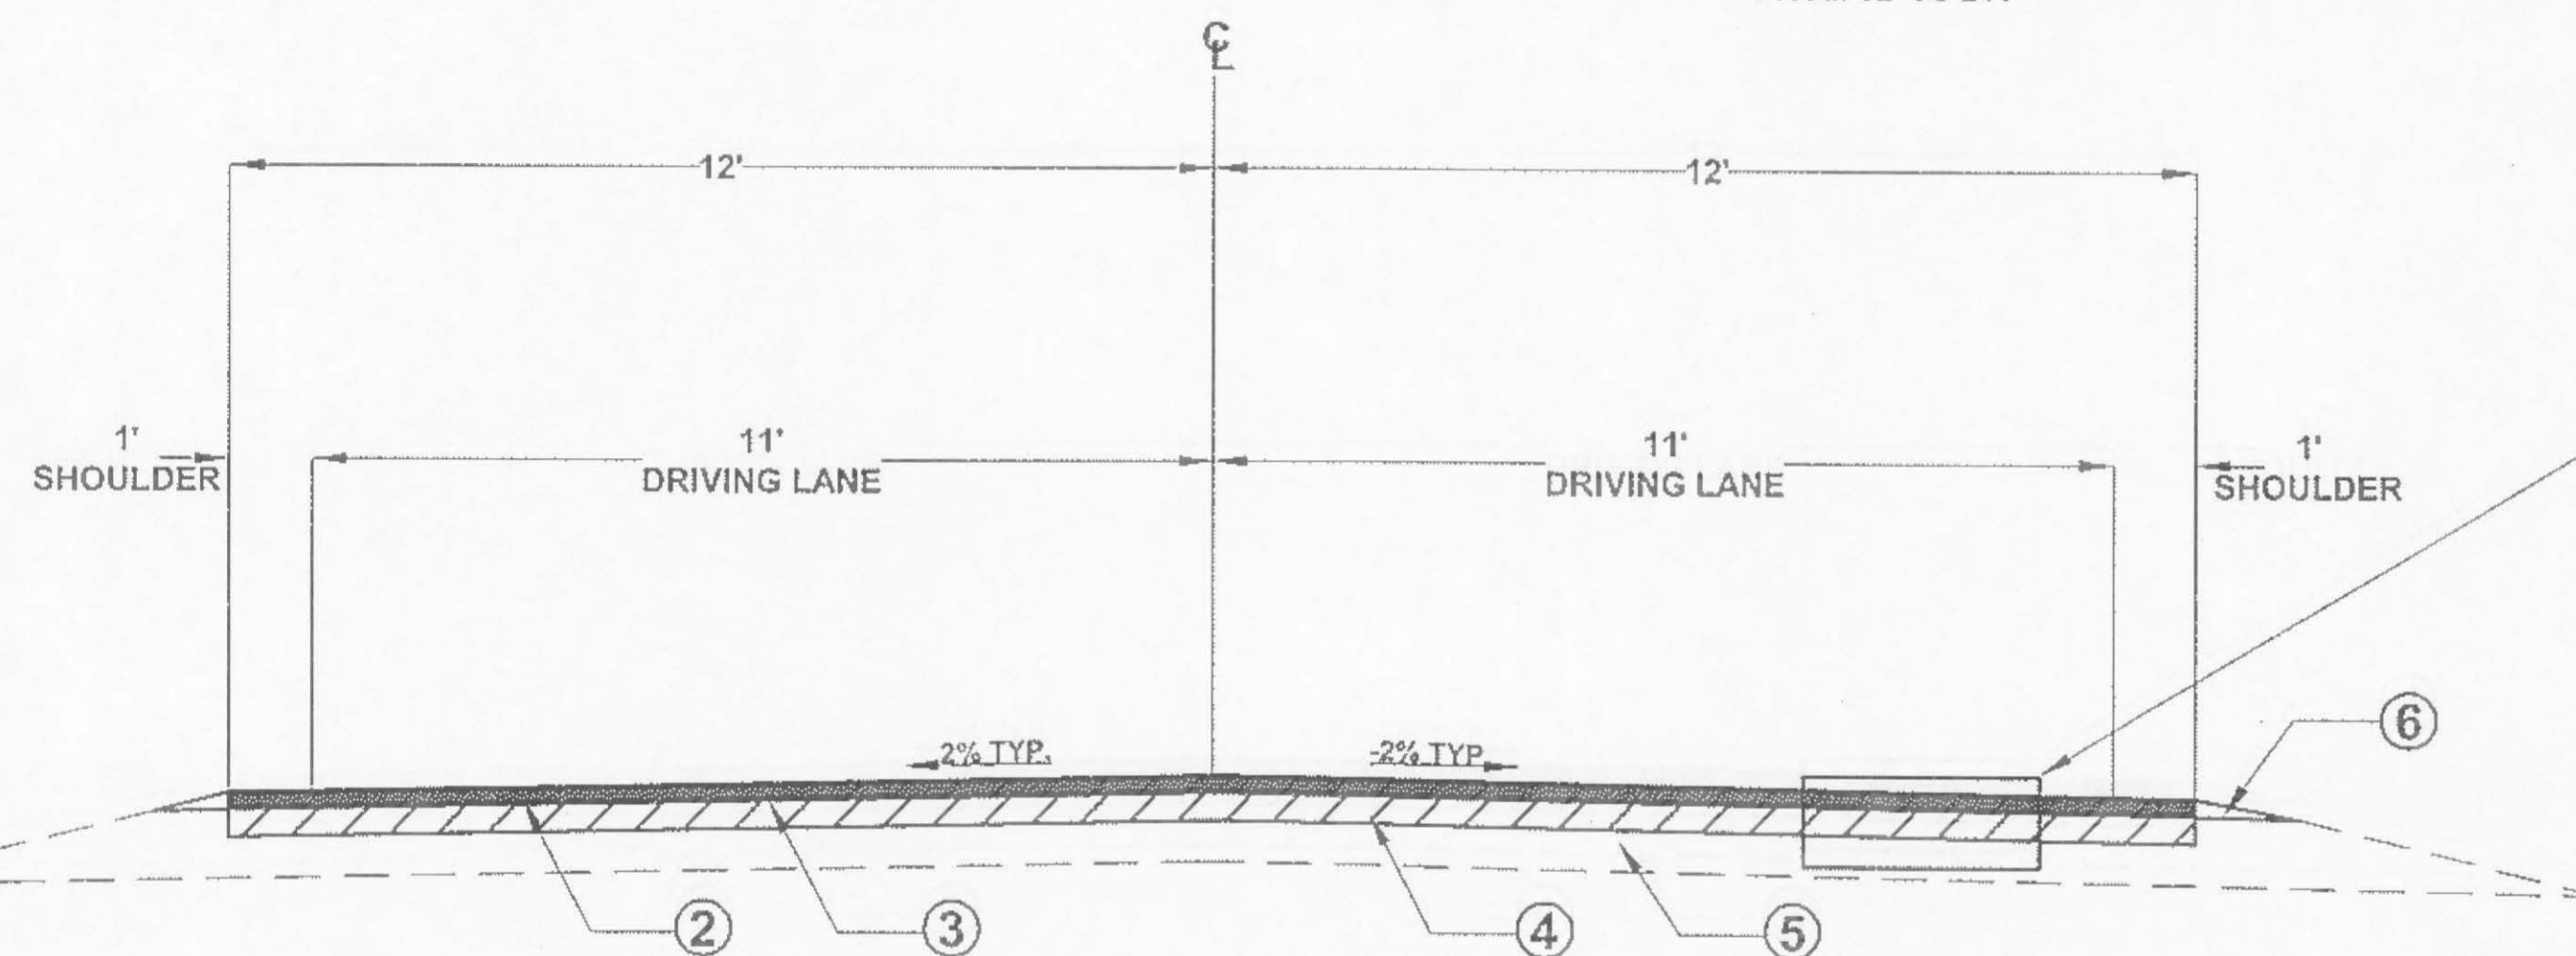


TYPICAL SECTION
STA. 492+00 TO STA. 508+00

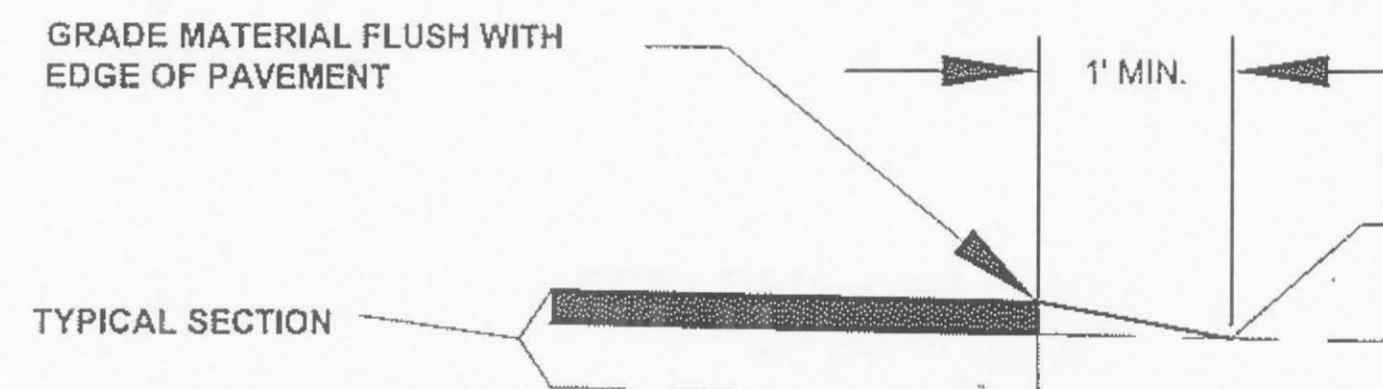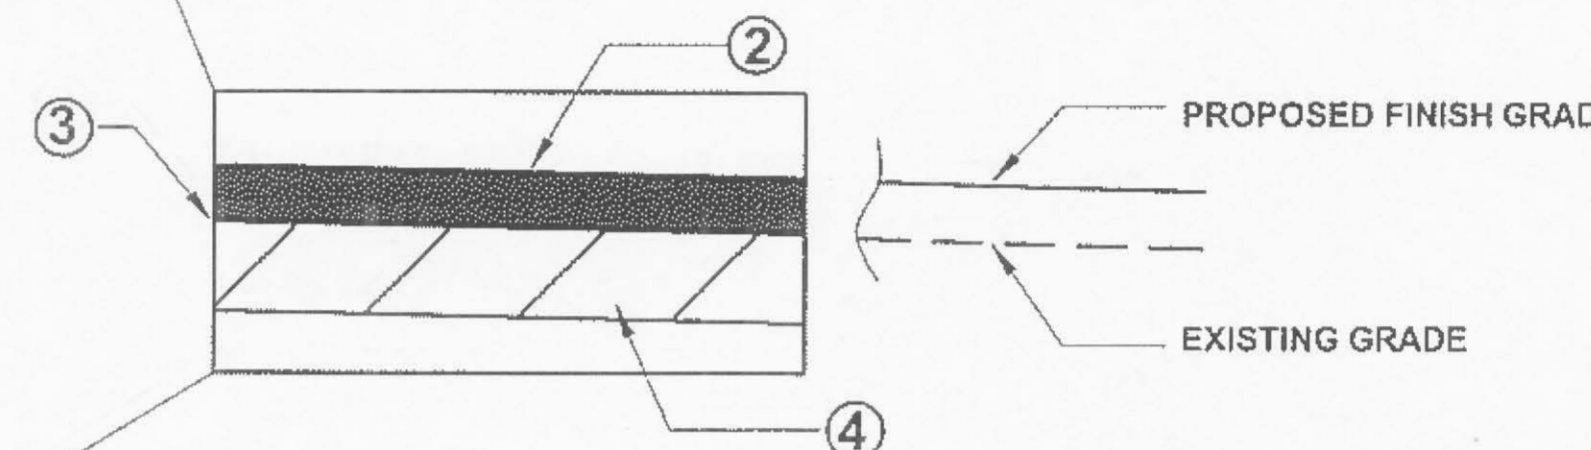

LINEAR GRADING


LEFT AND RIGHT EDGE OF PAVEMENT

1. MATERIAL FOR LINEAR GRADING SHALL MATCH THE REQUIREMENTS OF AGGREGATE BASE COURSE D-1 OR RAM.
2. LINEAR GRADING SHALL BE PAID FOR UNDER ITEM 303(3).

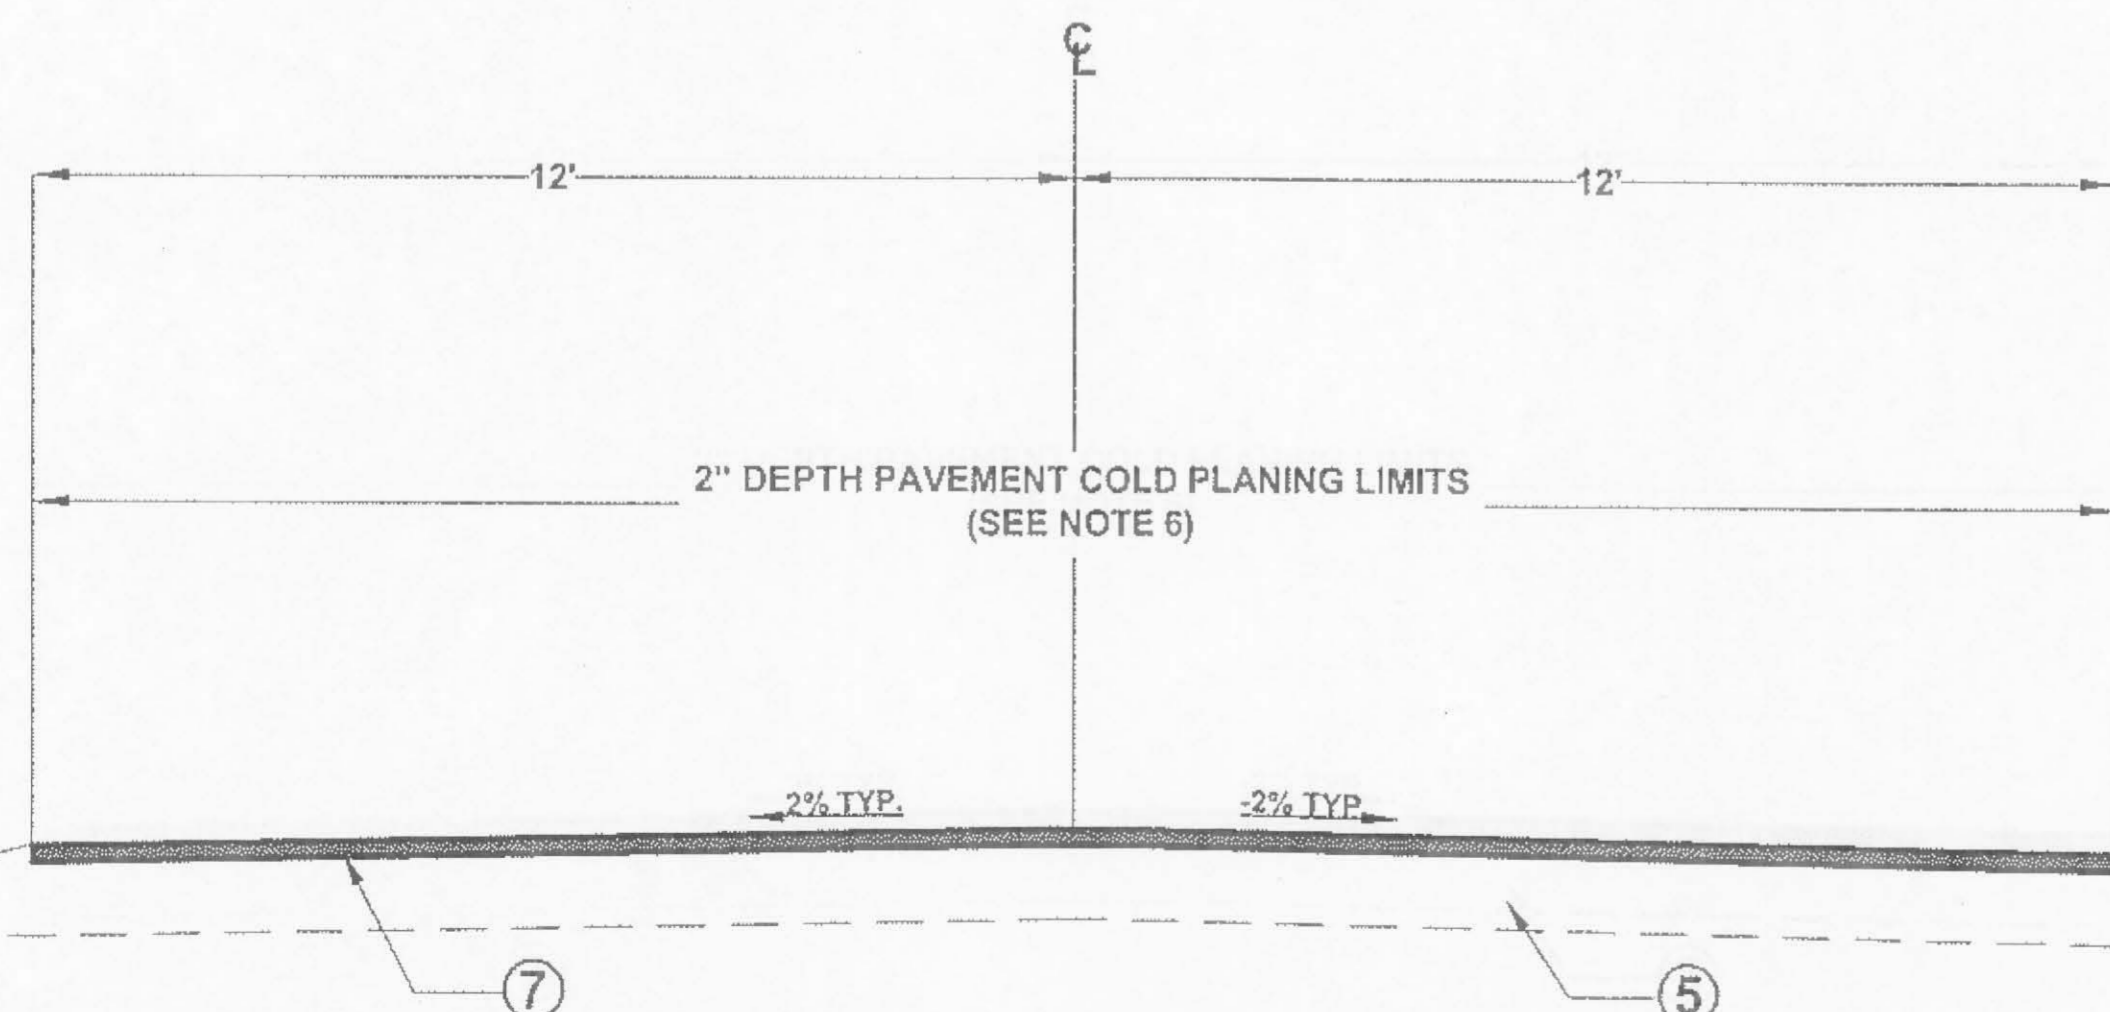

SPOT REPAIRS TYPICAL SECTION
STA. 509+40.05 TO E.O.P.
SEE PLANS FOR LOCATIONS

NOTE: COLD PLANE DEPTH SHALL BE 6" FROM STA. 550+60 TO 550+90. REPLACE WITH 6" ASPHALT CONCRETE (2 EACH-3" LIFTS).

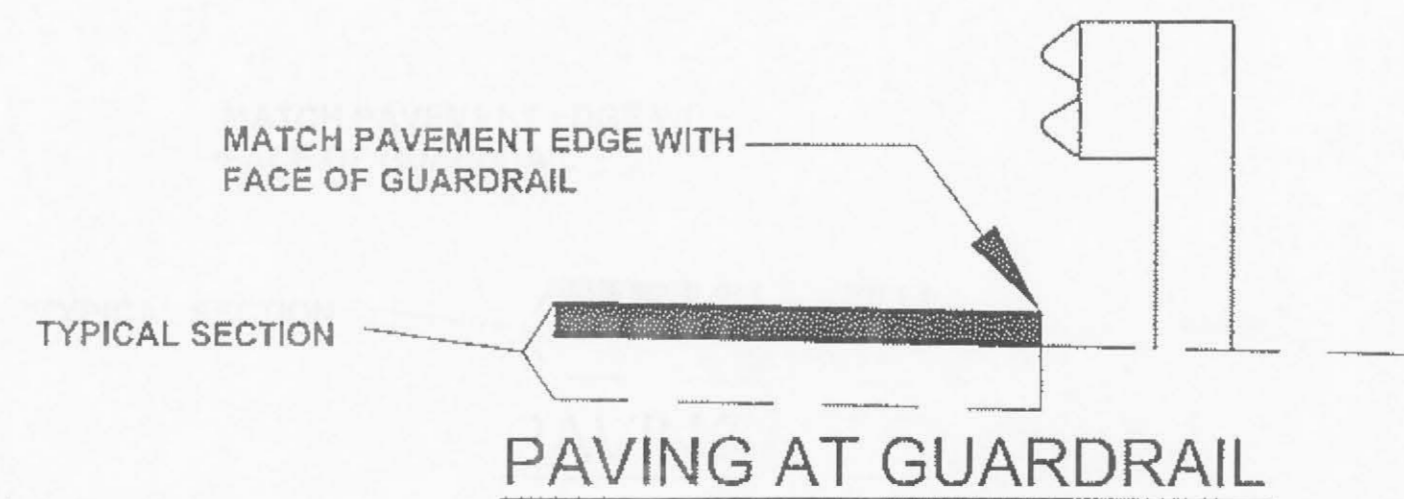


PAVING AT GUARDRAIL

1. DO NOT PAVE UNDER GUARDRAIL.
2. AT END OF GUARDRAIL SECTIONS, WHERE GUARDRAIL FLARES AWAY FROM CENTERLINE, MAINTAIN 12' OR 16' PAVEMENT WIDTH FROM CENTERLINE.


DO NOT SCALE FROM THESE DRAWINGS USE DIMENSIONS

CHECKED BY: C. HOWARD STATE OF ALASKA DEPARTMENT OF TRANSPORTATION & PUBLIC FACILITIES DESIGN & ENGINEERING SERVICES DIVISION-SOUTHEAST REGION MITKOF HWY PAVEMENT REHABILITATION AND DRAINAGE IMPROVEMENTS PROJECT #68819 5-11-09		TYPICAL SECTIONS	
DESIGNED BY: C. IVANISZEK DRAWN BY: B. WILSON	PROJECT DESIGNATION 68819	YEAR 2009	SHEET NO. B1
PATH: Q:\PSG\68819\PLANS\TOWG\B-TYPICAL SECTIONS.DWG TAB: B1 Monday, May 11, 2009 11:37:08 AM	WILSON, BRIAN G. (DOT)	TOTAL SHEETS 17	

JSK
2-1-2010

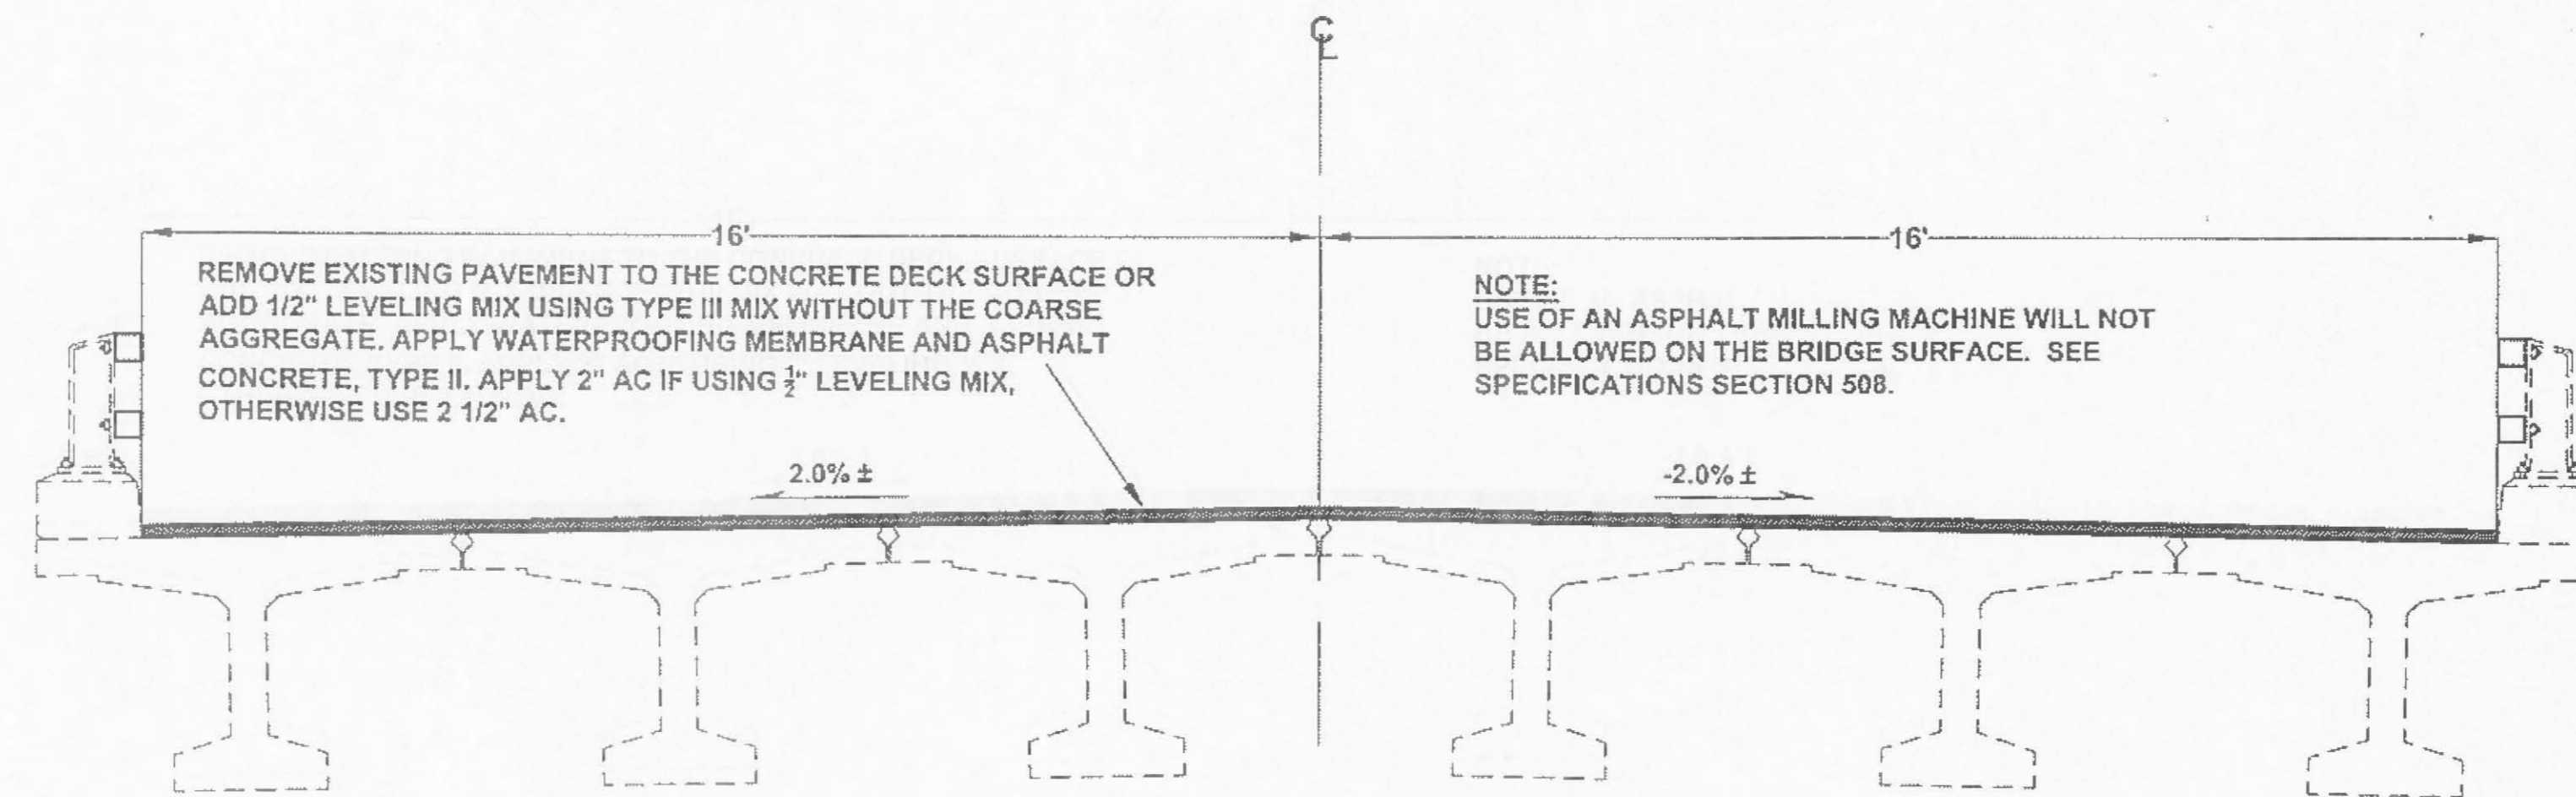


**PROPOSED TYPICAL SECTION
TWIN CREEK BRIDGE**

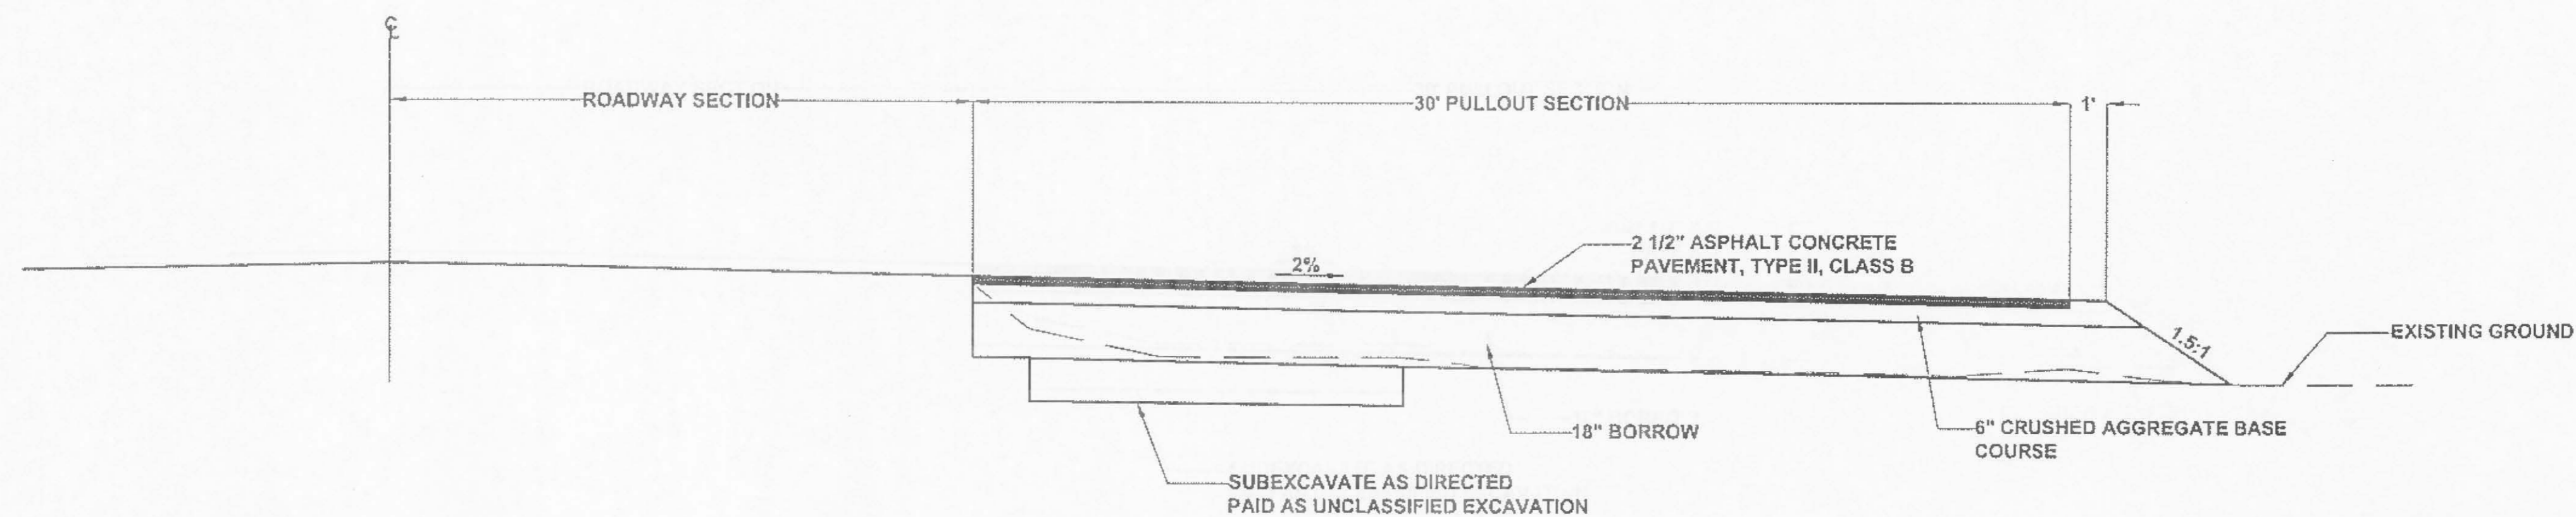

STA. 255+00 PULLOUT

JSK
2-1-2010

DO NOT SCALE FROM THESE DRAWINGS USE DIMENSIONS

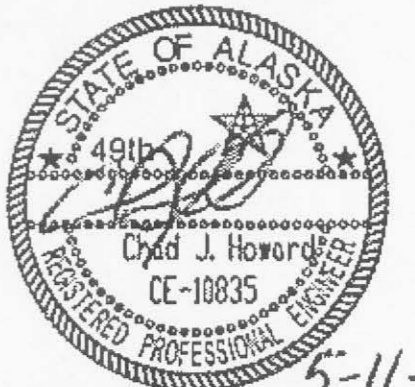CHECKED BY: C. HOWARD 		STATE OF ALASKA DEPARTMENT OF TRANSPORTATION & PUBLIC FACILITIES DESIGN & ENGINEERING SERVICES DIVISION-SOUTHEAST REGION	
DESIGNED BY: C. IVANISZEK DRAWN BY: B. WILSON		MITKOF HWY PAVEMENT REHABILITATION AND DRAINAGE IMPROVEMENTS PROJECT #68819	
PATH: Q:\PSG\68819\PLANS\TIDWGB-TYPICAL SECTIONS.DWG TAB: B2 Thursday, May 07, 2009 9:41:45 AM		WILSON, BRIAN G (DOT)	
REVISIONS NO. DATE DESCRIPTION		PROJECT DESIGNATION 68819	YEAR 2009
		SHEET NO. B2	TOTAL SHEETS 17

ESTIMATE OF QUANTITIES			
ITEM NO.	ITEM DESCRIPTION	PAY UNIT	QUANTITY
202 (4)	REMOVAL OF CULVERT PIPE	LINEAR FOOT	286 294.5
203 (6)	UNCLASSIFIED EXCAVATION	CUBIC YARD	180 0.0
203 (6)	BORROW	TON	1,500 366.22
303(3)	LINEAR GRADING	STATION	670 1382.29
* 308 (1)	CRUSHED ASPHALT BASE COURSE	SQUARE YARD	19,850 116,235.27
308 (2)	CSS-1 ASPHALT FOR BASE COURSE	TON	838 812.08
308 (3)	PORTLAND CEMENT	TON	270 235.66
308 (4)	AGGREGATE FOR CABC	TON	4,935 248.51
401 (1)	ASPHALT CONCRETE, TYPE II; CLASS B	TON	19,750 30,159.46
401 (2)	ASPHALT CEMENT, GRADE PG 58-28	TON	1,185 1,828.05
401 (6)	ASPHALT PRICE ADJUSTMENT + \$29,691.35	CONTINGENT SUM	ALL REQUIRED
401 (10)	ASPHALT MATERIALS PRICE ADJUSTMENT NOT USED	CONTINGENT SUM	ALL REQUIRED
402(1)	STE-1 ASPHALT FOR TACK COAT	TON	1 20.82
408(1)	PAVEMENT COLD PLANING	SQUARE YARD	16,100 6,446.89
508 (1)	WATERPROOFING MEMBRANE	LUMP SUM	ALL REQUIRED
603(1)-24	24 INCH CSP	LINEAR FOOT	28 10.0
603 (20)	END SECTION FOR 24 INCH PIPE	EACH	7 7
603(21)-36	36 INCH CORRUGATED POLYETHYLENE PIPE	LINEAR FOOT	258 264.00
606 (1)	W-BEAM GUARDRAIL	LINEAR FOOT	882 724.00
606 (6)	REMOVING AND DISPOSING OF GUARDRAIL	LINEAR FOOT	882 877.00
606 (11)	EXTRUDER TERMINAL (ET-PLUS)	EACH	8 8
606 (15)	RAIL REPLACEMENT	EACH	60 90
606 (16)	GUARDRAIL ADJUSTMENT	LINEAR FOOT	200 37.50
639 (3)	DRIVEWAY	EACH	96 68
640 (1)	MOBILIZATION AND DEMOBILIZATION \$310,000.00	LUMP SUM	ALL REQUIRED
640 (4)	WORKER MEALS AND LODGING, OR PER DIEM \$20,000.00	LUMP SUM	ALL REQUIRED
641 (1)	EROSION, SEDIMENT AND POLLUTION CONTROL ADMINISTRATION \$10K	LUMP SUM	ALL REQUIRED
641 (2)	TEMPORARY EROSION, SEDIMENT AND POLLUTION CONTROL \$14,555.36	CONTINGENT SUM	ALL REQUIRED
641 (5)	EROSION, SEDIMENT AND POLLUTION CONTROL PRICE ADJUSTMENT	CONTINGENT SUM	NOT USED 40
641 (11)	ROCK CHECK DAM	EACH	28 0
642 (1)	CONSTRUCTION SURVEYING	LUMP SUM	ALL REQUIRED
642(3)	THREE PERSON SURVEY PARTY	HOUR	50 0
642 (8)	ADJUST EXISTING MONUMENT	EACH	31 31
643 (2)	TRAFFIC MAINTENANCE	LUMP SUM	ALL REQUIRED
643 (3)	PERMANENT CONSTRUCTION SIGNS	LUMP SUM	ALL REQUIRED
643 (15)	FLAGGING \$60,699.00	CONTINGENT SUM	ALL REQUIRED
643 (25)	TRAFFIC CONTROL \$20,532.25	CONTINGENT SUM	ALL REQUIRED
644 (1)	FIELD OFFICE \$10,000.00	LUMP SUM	ALL REQUIRED
644 (6)	VEHICLES \$25,000.00	LUMP SUM	ALL REQUIRED
670 (1)	PAINTED TRAFFIC MARKINGS \$40,000.00	LUMP SUM	ALL REQUIRED
670 (8)	RECESSED PAVEMENT MARKER	EACH	858 914


* 19,850 was a typo. Plan quantity is 119,850.

BASIS OF ESTIMATE				
ITEM NO.	ITEM	ESTIMATING FACTORS		
203(6)	BORROW	MEET SELECTED MATERIAL TYPE A		
308(2)	CSS-1 ASPHALT FOR BASE COURSE	1.7 GAL./S.Y. FOR 4" CABC	2.5 GAL./S.Y. FOR 6" CABC	243 GAL./TON
308(3)	PORTLAND CEMENT	4.5 LBS./S.Y. FOR 4" CABC	2.5 GAL./S.Y. FOR 6" CABC	
308 (4)	AGGREGATE FOR CABC	5 TONS/100 S.Y. CABC	6.8 LBS./S.Y. FOR 6" CABC	
401 (1)	ASPHALT CONCRETE, TYPE II; CLASS B	117 LBS./S.Y./IN.		
401 (2)	ASPHALT CEMENT, GRADE PG-58-28	6.0% OF ITEM 401(1)		
402 (1)	STE-1 ASPHALT FOR TACK COAT	0.1 GAL./S.Y.	243 GAL./TON.	
408 (1)	RAM TO BE REUSED FOR LINEAR GRADING AND/OR AGG. FOR CABC	1300 C.Y.		
606 (15)	RAIL REPLACEMENT	EACH EXISTING RAIL SEGMENT IS 13'-6.5" LENGTH		
644 (6)	VEHICLES	3 EACH		
670 (8)	RECESSED PAVEMENT MARKER	BOP TO 508+00 LIMIT		

Items added by change order

- 603(21-36a) Additional 36" CPP (CO#3) LS - All Required
- 401(11) Long Distance Haul Surcharge (CO#1) Ton - 10,427.83
- 401(12) Additional Overhead for Overlay (CO#1) LS - All Required
- 670(1a) Added Traffic Markings (CO#1) LS - All Required
- 639(3a) 20' Paved Driveway (CO#4) ea. - 35
- 639(3b) Intersection at Papke's (CO#4) LS - All Required
- 639(3c) Additional 5' Paved Wedge (CO#4) LS - All Required
- 643(2a) Additional Traffic Maintenance (CO#4) LS - All Required

DO NOT SCALE FROM THESE DRAWINGS USE DIMENSIONS

CHECKED BY: C. HOWARD		STATE OF ALASKA DEPARTMENT OF TRANSPORTATION & PUBLIC FACILITIES DESIGN & ENGINEERING SERVICES DIVISION-SOUTHEAST REGION														
		MITKOF HWY PAVEMENT REHABILITATION AND DRAINAGE IMPROVEMENTS PROJECT #68819														
		ESTIMATE OF QUANTITIES														
DESIGNED BY: C. IVANISZEK		PROJECT DESIGNATION														
DRAWN BY: B. WILSON		YEAR														
PATH: Q:\PSG\68819\PLANSET\DWG\ESTIMATE OF QUANTITIES.DWG		SHEET NO.														
TAB: C1 Monday, May 11, 2009 11:32:14 AM WILSON, BRIAN G (DOT)		TOTAL SHEETS														
<table border="1"> <thead> <tr> <th>NO.</th> <th>DATE</th> <th>DESCRIPTION</th> </tr> </thead> <tbody> <tr><td> </td><td> </td><td> </td></tr> <tr><td> </td><td> </td><td> </td></tr> </tbody> </table>		NO.	DATE	DESCRIPTION							<table border="1"> <tr> <td>68819</td> <td>2009</td> <td>C1</td> <td>17</td> </tr> </table>		68819	2009	C1	17
NO.	DATE	DESCRIPTION														
68819	2009	C1	17													

JSK
2-1-2010

5-11-09

NOTE: 639(3) Driveway Summary does not include driveways shown on plans Sta. 335+ to 341+.

Driveways annotated 639(2) had no existing pavement, and were paved with a 20' approach, 2" thick. See Change Order #1 others given 5' asphalt wedge as specified in addendum 2.

639(3) DRIVEWAY					
STATION	OFFSET	WIDTH		RADIUS	
		(ft)	(ft)	RT	LT
173+43	LT	20	20	20	20
181+17.50	LT	Match Existing	Match Existing	Pulloff/Parking	
184+35	LT	Match Existing	Match Existing	Pulloff/Parking	
639(2) 191+50	LT	16	(20)	20	20
193+43	LT	20	20.5	20	20
207+73	LT	16	20.5	20	20
209+04	LT	18	20.5	20	20
216+52.50	LT	16	20.5	20	20
220+61	LT	16	20.5	20	20
225+50	LT	Driveway done by others			
233+15.19	LT	24	20.5	20	20
233+89	RT	16	20.5	20	20
235+72	RT	16	20.5	20	20
235+78	LT	14	20.5	20	20
236+62	RT	14	20.5	20	20
236+99.09	LT	16	20.5	20	20
238+91	RT	14	20.5	20	20
240+71	RT	18	20.5	20	20
243+90	LT	16	20.5	20	20
244+43	RT	14	20.5	20	20
245+73	LT	16	20.5	20	20
639(2) 247+26.46+47	LT	16	(20)	20	20
639(2) 252+20	LT	16	(20)	20	20
265+66	RT	Match Existing	Match Existing	Pulloff/Parking	
639(2) 271+00.40	RT	16	(20)	20	20
277+00	LT	Match Existing	Match Existing	Pulloff/Parking	
282+76.56	RT	24	20.5	20	20
284+20	LT	20	20.5	20	20
286+97.50	RT	14	20.5	20	20
287+97.32	LT	20	20	20	20
293+50	LT	Match Existing	Match Existing	Pulloff/Parking	
300+28	RT	Match Existing	Match Existing	Pulloff/Parking	
302+22	RT	16	20.5	20	20
307+08	RT	16	20	20	20
639(2) 315+00	LT	16	(20)	20	20
316+76	RT	14	20.5	20	20
317+40	RT	14	20.5	20	20
317+66	LT	18	20.5	20	20
318+88.05	LT	14	20.5	20	20
319+40	RT	14	20.5	20	20
320+06	RT	16	20.5	20	20
322+59	RT	18	20.5	20	20
639(2) 323+74.14	LT	18	20.5	20	20
326+82	LT	20	(20)	20	20
331+94	RT	18	20.5	20	20
331+99	LT	20	20.5	20	20

639(3) DRIVEWAY					
STATION	OFFSET	WIDTH		RADIUS	
		(ft)	(ft)	RT	LT
362+76	RT	18	20.5	20	20
639(2) 364+24.00	LT	16	(20)	20	20
364+61	RT	14	20.5	20	20
639(2) 366+50.367+00	LT	16	(20)	20	20
368+00	RT	16	20	20	20
371+61	RT	14	20.5	20	20
639(2) 372+25.75	LT	16	(20)	20	20
375+93	RT	14	20.5	20	20
639(2) 378+00.377+25	RT	16	(20)	20	20
383+96.03	RT	16	20.5	20	20
385+15	RT	14	(20)	20	20
386+68.50	RT	Match Existing	Match Existing	Pulloff/Parking	
391+58.16	RT	20	20.5	20	20
391+80.98	LT	16	20.5	20	20
396+78	LT	14	20.5	20	20
398+35	LT	14	20.5	20	20
404+22	RT	14	20.5	20	20
404+75	LT	14	20.5	20	20
419+12.50	RT	18	20.5	20	20
419+69	RT	16	20.5	20	20
639(2) 420+39.00	RT	16.22	(20)	20	20
639(2) 424+00.420+90	RT	16.2	(20)	20	20
432+17	RT	16	20.5	20	20
435+79	RT	16	20.5	20	20
440+32	LT	14	20.5	20	20
442+47	LT	16	20.5	20	20
444+09	RT	14	20.5	20	20
445+88	LT	18	20.5	20	20
447+24	RT	16	(20)	20	20
639(2) 447+60.15	LT	16	(20)	20	20
449+24.60	RT	16	(20)	20	20
457+24	RT	16	20	20	20
467+34.05	RT	14	20.5	20	20
472+66.59	RT	20	20.5	20	20
473+41.59	RT	20	20	20	20
479+00.478+45	RT	20	20	20	20
481+75	LT	16	20	20	20
486+50	LT	16	20	20	20
487+25	RT	16	20	20	20
489+25	RT	16	20	20	20
490+58.31	LT	30	20.5	20	20
490+66	RT	20	(20)	20	20
495+78.92	RT	20	20.5	20	20
504+49	RT	20	20	20	20
** 506+49.24	RT	24	20.48	50	50

** no driveway exists near this location ** extra work, not paid under 639(3)

606 (15) RAIL REPLACEMENT					
BEGIN		END		LENGTH	REMARKS
STATION	OFFSET	STATION	OFFSET		
173+25	RT	174+37.50	RT	113	REMOVE RAIL ONLY AND REPLACE WITH NEW RAIL
182+00	RT	186+00	RT	400	REMOVE RAIL ONLY AND REPLACE WITH NEW RAIL

606 (1) W-BEAM GUARDRAIL/ 606(6) REMOVE & DISPOSE G/R					
BEGIN		END		LENGTH	REMARKS
STATION	OFFSET	STATION	OFFSET		
691+98	RT	695+78	RT	380	REMOVE COMPLETE GUARDRAIL SYSTEM AND REPLACE USING 11' POSTS
706+87	RT	711+89	RT	502	REMOVE COMPLETE GUARDRAIL SYSTEM AND REPLACE USING 11' POSTS

SEE DETAIL SHEET J2 FOR 11' POSTS

606(11) EXTRUDER TERMINAL (ET-PLUS)				
STATION	OFFSET	STATION	OFFSET	REMARKS
173+25	RT	174+37.50	RT	
182+00	RT	186+00	RT	
691+98	RT	695+78	RT	
706+87	RT	711+89	RT	
TOTAL =			8	

603 PIPE SUMMARY										
PIPE NUMBER	603(1)-24		603(21)-36		INLET			OUTLET		
	24" CSP	36" CPP	STATION	OFFSET	INV.	STATION	OFFSET	INV.	SLOPE	REMARKS
P-1		-82-87	190+82	30 LT	MATCH EXISTING	190+82	36.84 RT		5.00%	REPLACE EXISTING PIPE
P-2	20.5		191+82	30 LT						REPLACE INLET END AND ADD END SECTION TO INLET ONLY
P-3		60-82-59.0	216+16.09	27.31 LT	MATCH EXISTING	216+17.04	31 RT		5.00%	REPLACE EXISTING PIPE
P-4	2.3		218+05	31 LT						REPLACE INLET END AND ADD END SECTION TO INLET ONLY
P-5	2.3		221+19	30 LT						REPLACE INLET END AND ADD END SECTION TO INLET ONLY
P-6	2.4		223+46	33 LT						REPLACE INLET END AND ADD END SECTION TO INLET ONLY
P-7		59.0-58-	225+88.8	29 LT	MATCH EXISTING	225+88.8	30.29 RT		5.00%	REPLACE EXISTING PIPE
P-8	0.0		230+10	29 LT						REPLACE INLET END AND ADD END SECTION TO INLET ONLY
P-9	0.0		267+07	28 LT						REPLACE INLET END AND ADD END SECTION TO INLET ONLY
P-10	0.0		298+34	38 LT						REPLACE INLET END AND ADD END SECTION TO INLET ONLY
P-11		56	316+10	28 LT	MATCH EXISTING	316+10	28 RT		5.00%	REPLACE EXISTING PIPE
TOTAL	28.335	286.910								

SEE STD. DWG. D-06.10 FOR END SECTIONS.
SET CULVERTS RECEIVING COMPLETE REPLACEMENT AT THE GIVEN SLOPE. (P-1, P-3, P-7, P-11)
Add P-12 10.0 57+0 311.754 26 LT 311+54 34 RT

202(4) CULVERT REMOVAL				
STATION	OFFSET	DIAMETER (IN)	LENGTH (FT)	REMARKS
190+50	0	24	82	
191+82	30 LT	24	52.7	REMOVE INLET SEGMENT ONLY
216+18	0	24	62	
218+05	31 LT	24	56.0	REMOVE INLET SEGMENT ONLY
221+19	30 LT	24	45.0	REMOVE INLET SEGMENT ONLY
223+46	33 LT	24	46.0	REMOVE INLET SEGMENT ONLY
225+88	0	24	58	
230+10	29 LT	24	43.0	REMOVE INLET SEGMENT ONLY
267+07	28 LT	24	45.0	REMOVE INLET SEGMENT ONLY
298+34	38 LT	24	45.8	REMOVE INLET SEGMENT ONLY
316+10	0	24	56	

642(8) ADJUST EXISTING MONUMENT			
MONUMENT	STATION	OFFSET	REMARKS
M-6	172+89	13.21 LT	
M-7	185+50	12.95 LT	
M-8	201+16	14.23 RT	
M-9	231+39	13.02 LT	
M-10	239+23	15.17 RT	
M-11	248+58	14.31 LT	
M-12	279+09	14.78 RT	
M-13	285+69	13.79 LT	
M-14	293+21	14.87 RT	
M-15	306+79	13.56 LT	
M-16	318+56	13.16 LT	
M-17	339+31	12.91 LT	
M-18	343+43	13.52 LT	
M-19	351+92	13.64 RT	
M-20	356+46	13.30 RT	
M-21	361+09	14.19 RT	
M-22	367+42	13.54 RT	
M-23	376+99	14.56 RT	
M-24	388+49	14.23 LT	
M-25	397+05	13.69 LT	
M-26	404+11	13.86 LT	
M-27	412+91	13.24 RT	
M-28	418+85	16.04 RT	
M-29	425+40	14.02 LT	
M-30	429+36	13.66 RT	
M-31	446+56	14.05 RT	
M-32	453+11	13.92 RT	
M-33	459+28	13.48 LT	
M-34	468+51	13.25 LT	
M-35	476+64	14.48 LT	
M-36	489+21	13.12 RT	

MONUMENT NO. IS STAMPED ON MONUMENT CAP FOR FIELD IDENTIFICATION.

186+50	LT	5' wedge	driveway not shown on plans or listed on driveway schedule
235+50	LT	5' wedge	driveway shown on plans but not listed on driveway schedule
241+90	LT	5' wedge	driveway shown on plans but not listed on driveway schedule
279+50	RT	20' approach	driveway not shown on plans or listed on driveway schedule
309+73	RT	20' approach	driveway not shown on plans or listed on driveway schedule
322+50	LT	5' wedge	driveway shown on plans but not listed on driveway schedule
334+70	LT	5' wedge	driveway shown on plans but not listed on driveway schedule
343+70	LT	5' wedge	driveway shown on plans but not listed on driveway schedule
345+00	RT	20' approach	driveway shown on plans but not listed on driveway schedule
350+50	LT	5' wedge	driveway shown on plans but not listed on driveway schedule
351+50	LT	20' approach	driveway not shown on plans or listed on driveway schedule
361+00	LT	20' approach	driveway shown on plans but not listed on driveway schedule
362+25	LT	20' approach	driveway shown on plans but not listed on driveway schedule
369+25	RT	20' approach	driveway not shown on plans or listed on driveway schedule
418+50	RT	20' approach	driveway not shown on plans or listed on driveway schedule
450+80	RT	20' approach	driveway not shown on plans or listed on driveway schedule
458+50	RT	20' approach	driveway not shown on plans or listed on driveway schedule
463+60	RT	20' approach	driveway not shown on plans or listed on driveway schedule
475+30	LT	20' approach	driveway not shown on plans or listed on driveway schedule
478+65	LT	20' approach	driveway not shown on plans or listed on driveway schedule
481+25	RT	20' approach	driveway not shown on plans or listed on driveway schedule
485+75	RT	20' approach	driveway not shown on plans or listed on driveway schedule

DO NOT SCALE FROM THESE DRAWINGS USE DIMENSIONS

CHECKED BY: C. HOWARD	STATE OF ALASKA DEPARTMENT OF TRANSPORTATION & PUBLIC FACILITIES DESIGN & ENGINEERING SERVICES DIVISION-SOUTHEAST REGION
DESIGNED BY: C. IVANISZEK	MITKOF HWY PAVEMENT REHABILITATION AND DRAINAGE IMPROVEMENTS PROJECT #68819
DRAWN BY: B. WILSON	SUMMARIES
PATH: Q:\PSG\68819\PLANSET\DWG\SUMMARIES.DWG	REVISIONS
TAB: D1 Monday, May 11, 2009 10:59:52 AM WILSON, BRIAN G (DOT)	PROJECT DESIGNATION
	YEAR
	SHEET NO.
	TOTAL SHEETS
	68819
	2009

WILSON, BRIAN G (DOT)		
TAB: F1	Monday, May 11, 2009 11:05:02 AM	
ADDENDUM NUMBER		
ATTACHMENT NUMBER		
RECORD OF REVISIONS		
No.	DATE	DESCRIPTION

LEGEND


- PROFILE DRAINAGE PATTERN
- SURFACE DRAINAGE PATTERN
- CULVERT FLOW DIRECTION
- ROCK CHECK DAM

**B.O.P.
STA. 172+50**

Start CAB/PAVE
174+70

- NOTES:**
- ALL AREAS SHOWN WITHOUT RADI ARE PULLOFF/PARKING AREAS, AND ARE NOT DRIVEWAYS.
 - 5' asphalt wedge only
MATCH EXISTING DIMENSIONS FOR PULLOFF/PARKING AREAS.
 - PULLOFF/PARKING AREAS WILL BE PAID UNDER ITEM 639(3).

overlay of existing paved
pulloff/parking eliminated.

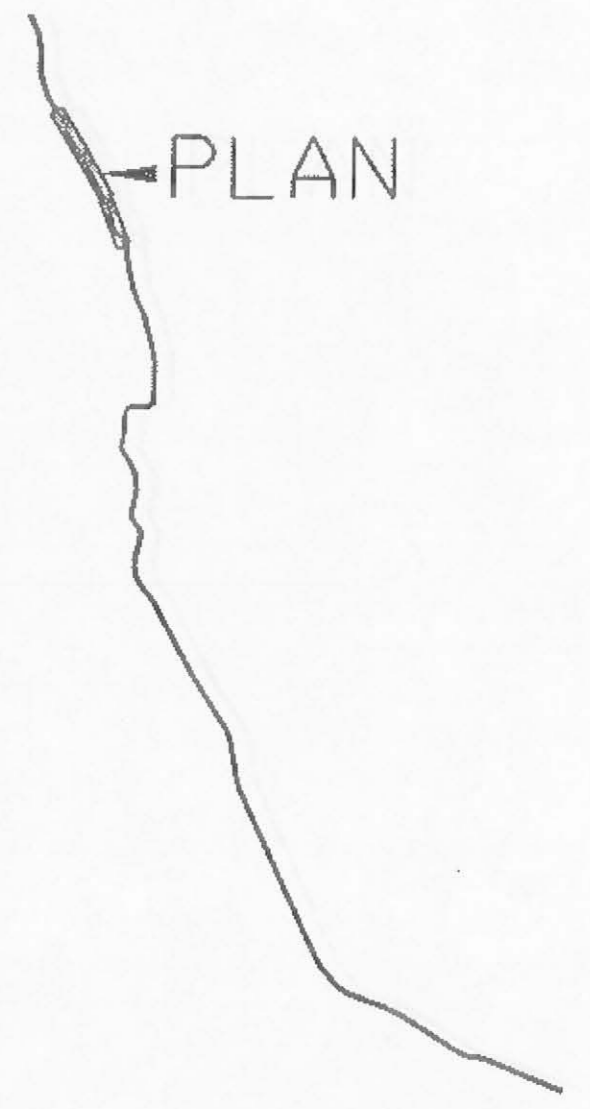

JSK
2-1-2010

PLAN LEGEND

CHECKED BY: C.HOWARD



DESIGNED BY: C. IVANISZEK

DRAWN BY: B. WILSON

STATE OF ALASKA
DEPARTMENT OF TRANSPORTATION
& PUBLIC FACILITIES
DESIGN & ENGINEERING SERVICES
DIVISION-SOUTHEAST REGION

MITKOF HWY PAVEMENT
REHABILITATION AND
DRAINAGE
PROJECT #68819

PLAN

PROJECT DESIGNATION
STP - 0920(20)

STATE	YEAR
ALASKA	2009
SHEET NUMBER	TOTAL SHEETS
F1	17


DO NOT SCALE FROM THESE DRAWINGS USE DIMENSIONS

WILSON, BRIAN G (DOT)
 TAB: F2 Monday, May 11, 2009 11:06:51 AM
 ADDENDUM NUMBER
 ATTACHMENT NUMBER
 RECORD OF REVISIONS

No.	DATE	DESCRIPTION




279+50
20' paved approach

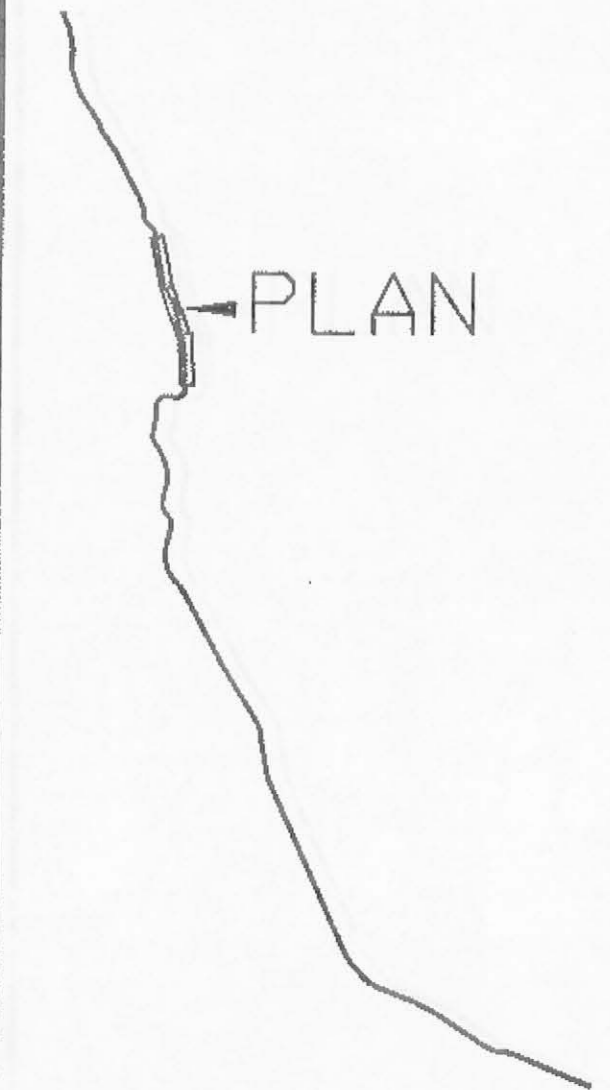

JSK
2-1-2010

PLAN LEGEND

CHECKED BY: C. HOWARD

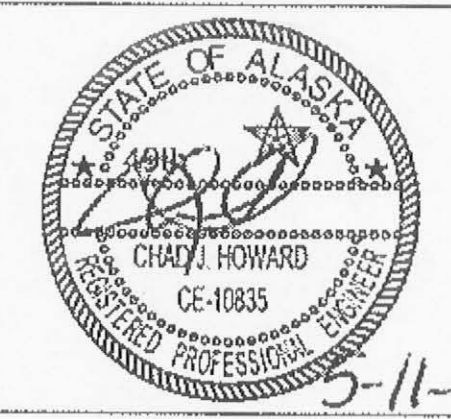

DESIGNED BY: C. IVANISZEK

DRAWN BY: B. WILSON

STATE OF ALASKA
 DEPARTMENT OF TRANSPORTATION
 & PUBLIC FACILITIES
 DESIGN & ENGINEERING SERVICES
 DIVISION-SOUTHEAST REGION

MITKOF HWY PAVEMENT
 REHABILITATION AND
 DRAINAGE
 PROJECT #68819

PLAN

PROJECT DESIGNATION
STP - 0920(20)

STATE	YEAR
ALASKA	2009
SHEET NUMBER	TOTAL SHEETS
F2	17

TWIN CREEK
 BRIDGE
 STA. 328+70 TO
 STA. 329+65
 SEE TYPICAL, SHEET B2
 SEE ESCP DETAIL, SHEET J2

DO NOT SCALE FROM THESE DRAWINGS USE DIMENSIONS

WILSON, BRIAN G (DOT)		
TAB: F3 Monday, May 11, 2009 11:06:56 AM		
ADDENDUM NUMBER		
ATTACHMENT NUMBER		
RECORD OF REVISIONS		
No.	DATE	DESCRIPTION



NOTE: Station 387~to 391~ observed seeps in the grade while ABC exposed, prior to paving. These seeps occurred when the ditch was running full. Water may be flowing through road bed in this location. Recommend investigating whether this is a problem and possibly make the ditch deeper or install an under drain.

NOTES:
 STA. 387+00
 TO
 STA. 391+00
 STABILIZE WITH 6"
 CRUSHED ASPHALT
 BASE COURSE

PLAN

JSK
 2-1-2010

PLAN LEGEND

CHECKED BY: C.HOWARD



DESIGNED BY: C. IVANISZEK
 DRAWN BY: B. WILSON

STATE OF ALASKA
 DEPARTMENT OF TRANSPORTATION
 & PUBLIC FACILITIES
 DESIGN & ENGINEERING SERVICES
 DIVISION-SOUTHEAST REGION

MITKOF HWY PAVEMENT
 REHABILITATION AND
 DRAINAGE
 PROJECT #68819

PLAN


PROJECT DESIGNATION
 STP - 0920(20)

STATE	YEAR
ALASKA	2009
SHEET NUMBER	TOTAL SHEETS
F3	17

DO NOT SCALE FROM THESE DRAWINGS USE DIMENSIONS

WILSON, BRIAN G (DOT)
 TAB: F4 Monday, May 11, 2009 11:07:02 AM


ADDENDUM NUMBER		
ATTACHMENT NUMBER		
RECORD OF REVISIONS		
No.	DATE	DESCRIPTION

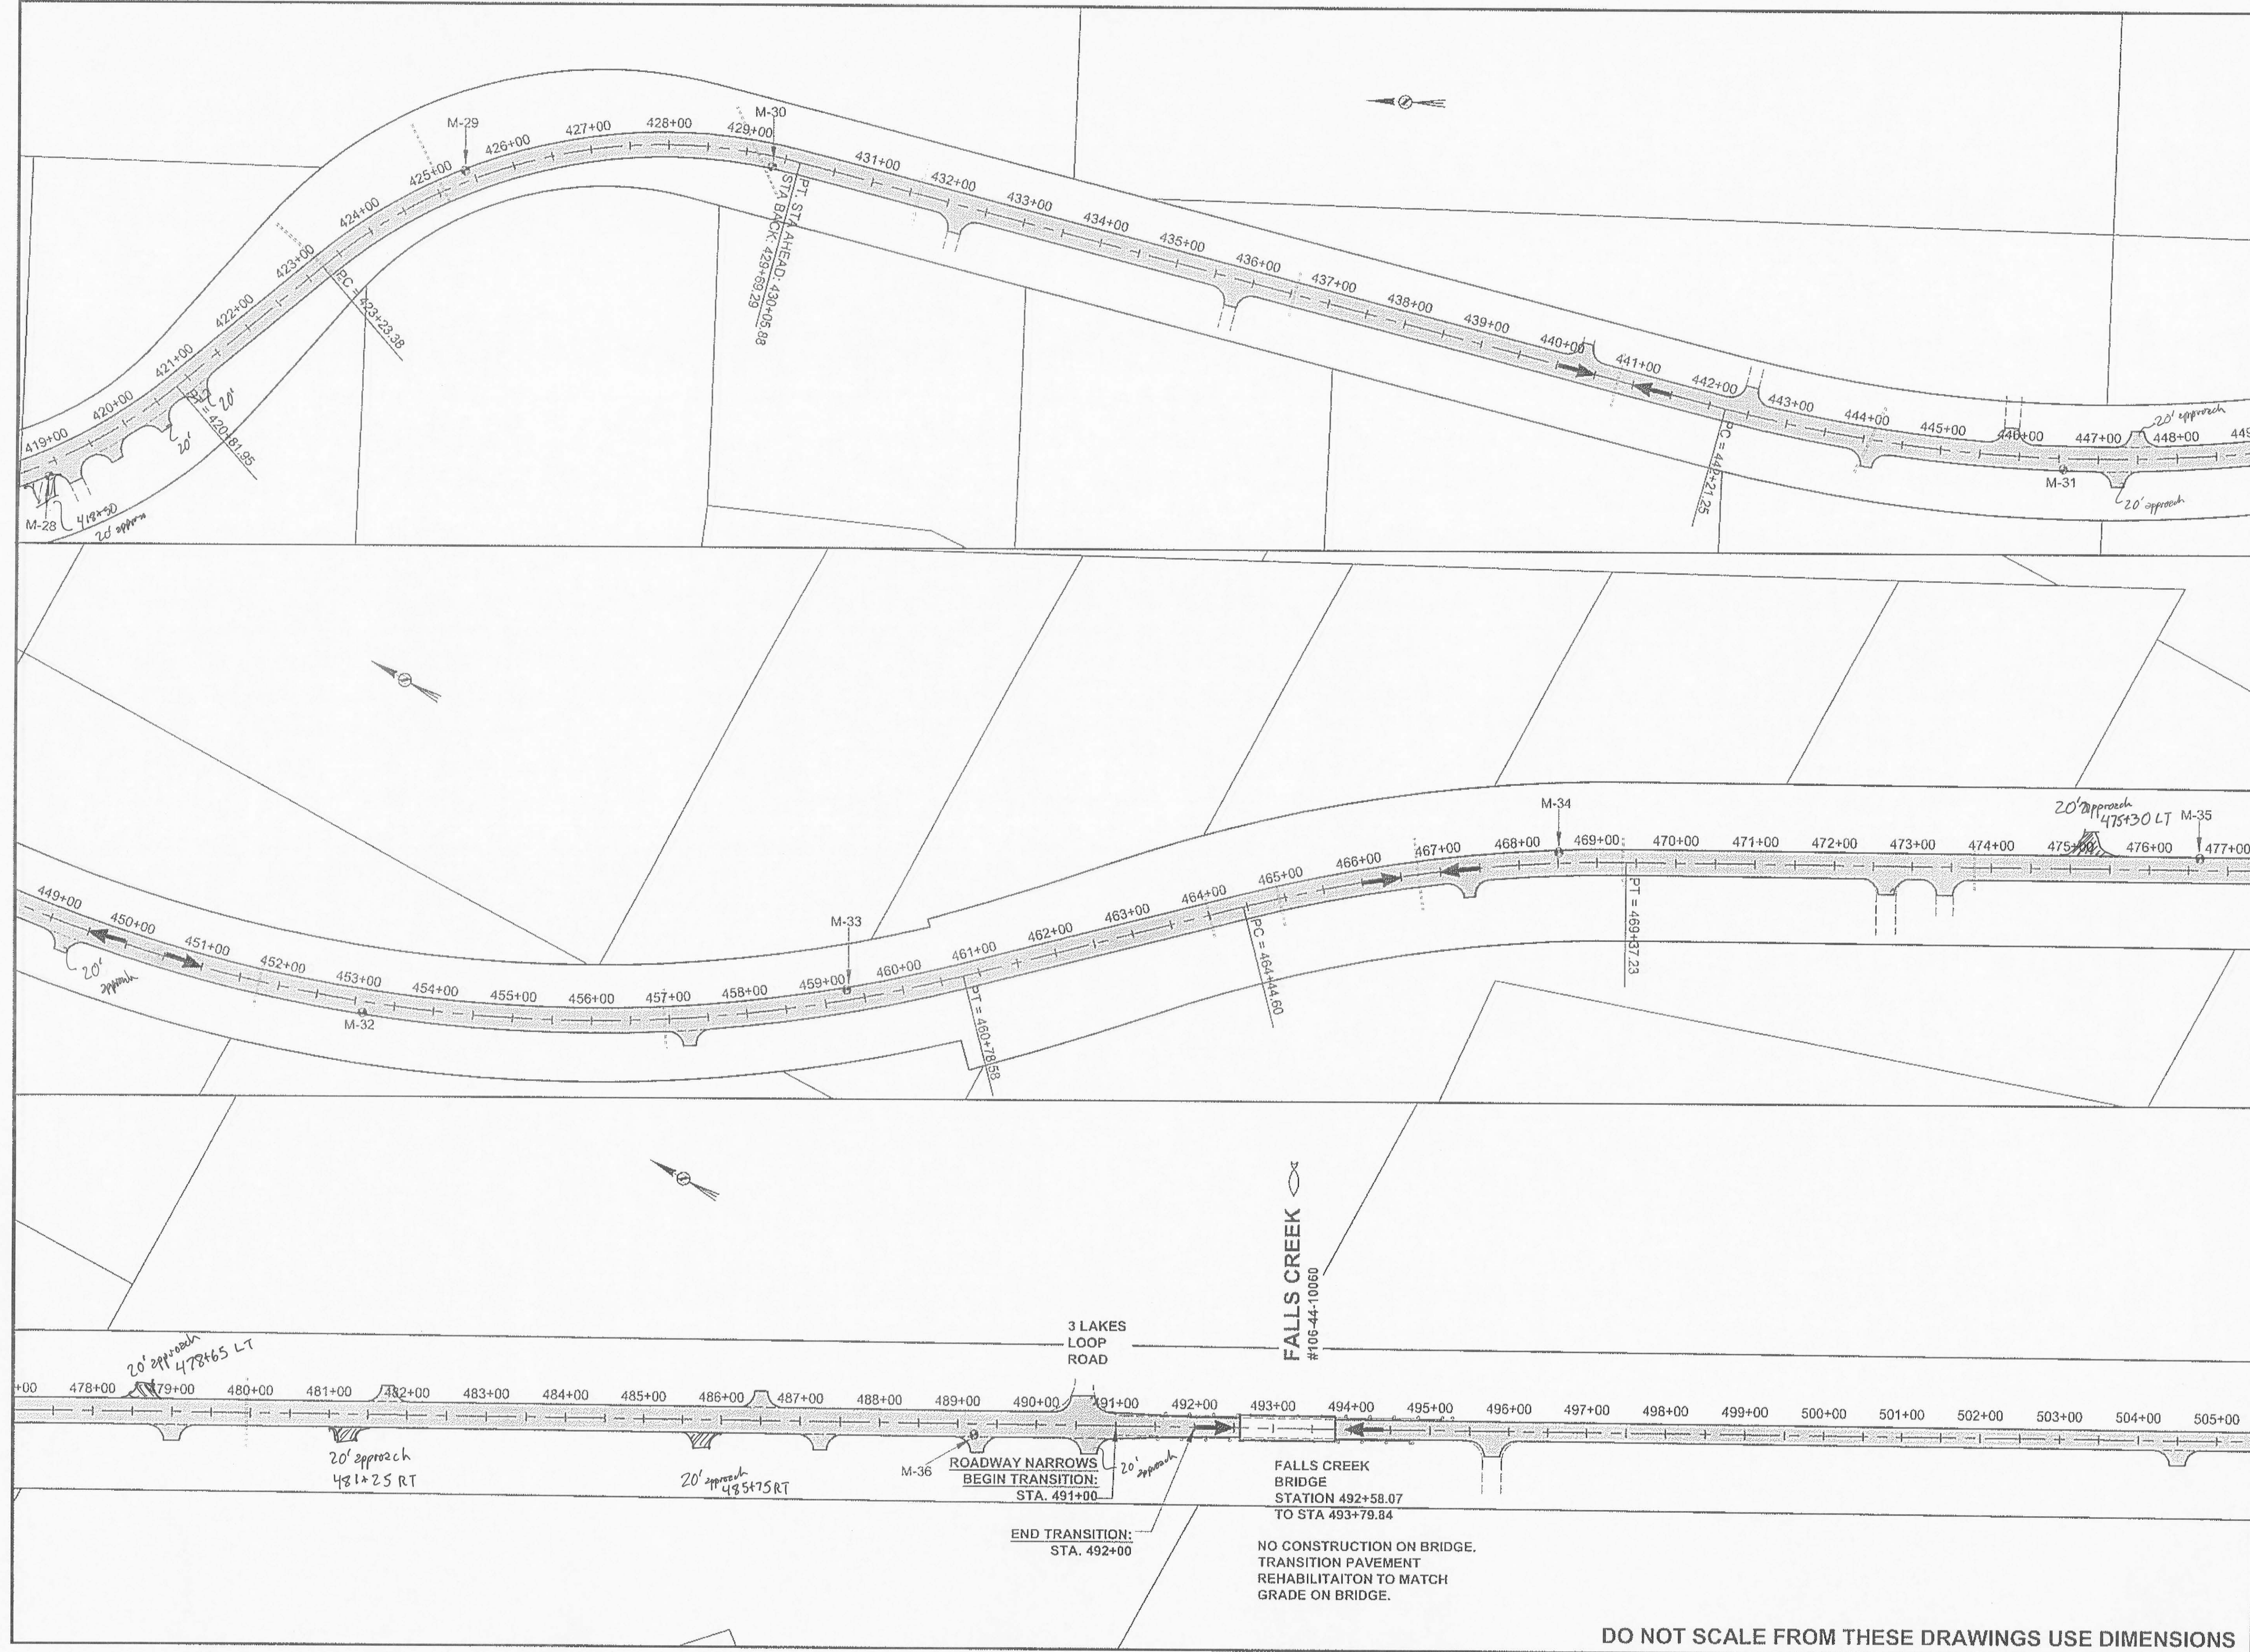

JSK
2-1-2010

PLAN LEGEND

CHECKED BY: C.HOWARD

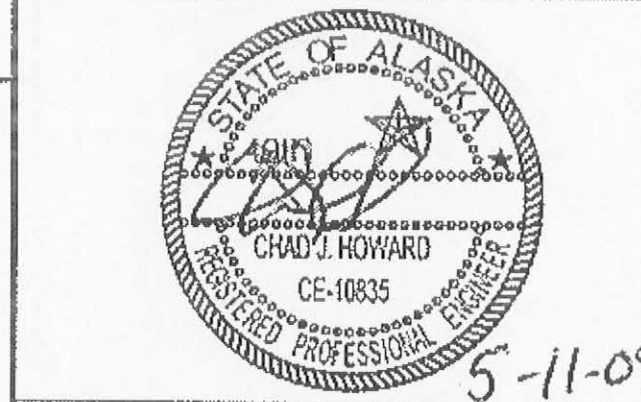

DESIGNED BY: C. IVANISZEK

DRAWN BY: B. WILSON

STATE OF ALASKA
 DEPARTMENT OF TRANSPORTATION
 & PUBLIC FACILITIES
 DESIGN & ENGINEERING SERVICES
 DIVISION-SOUTHEAST REGION

MITKOF HWY PAVEMENT
 REHABILITATION AND
 DRAINAGE
 PROJECT #68819

PLAN

PROJECT DESIGNATION
STP - 0920(20)




STATE	YEAR
ALASKA	2009
SHEET NUMBER	TOTAL SHEETS
F4	17

DO NOT SCALE FROM THESE DRAWINGS USE DIMENSIONS

WILSON, BRIAN G (DOT)
 TAB: F5 Monday, May 11, 2009 11:07:07 AM
 ADDENDUM NUMBER
 ATTACHMENT NUMBER

RECORD OF REVISIONS		
No.	DATE	DESCRIPTION


508+00 Back
 4" CABG +2.5" HMA
 509+40.05 Ahead
 2" overlay

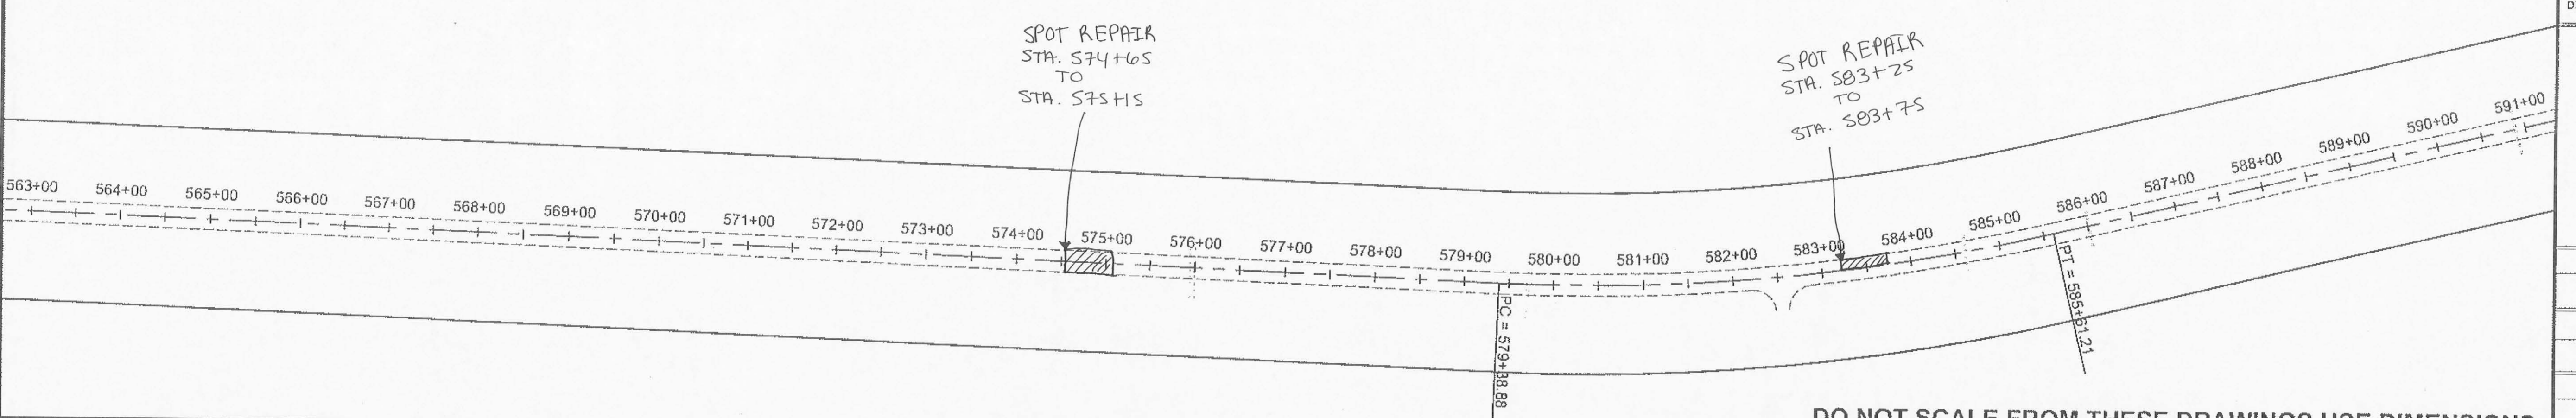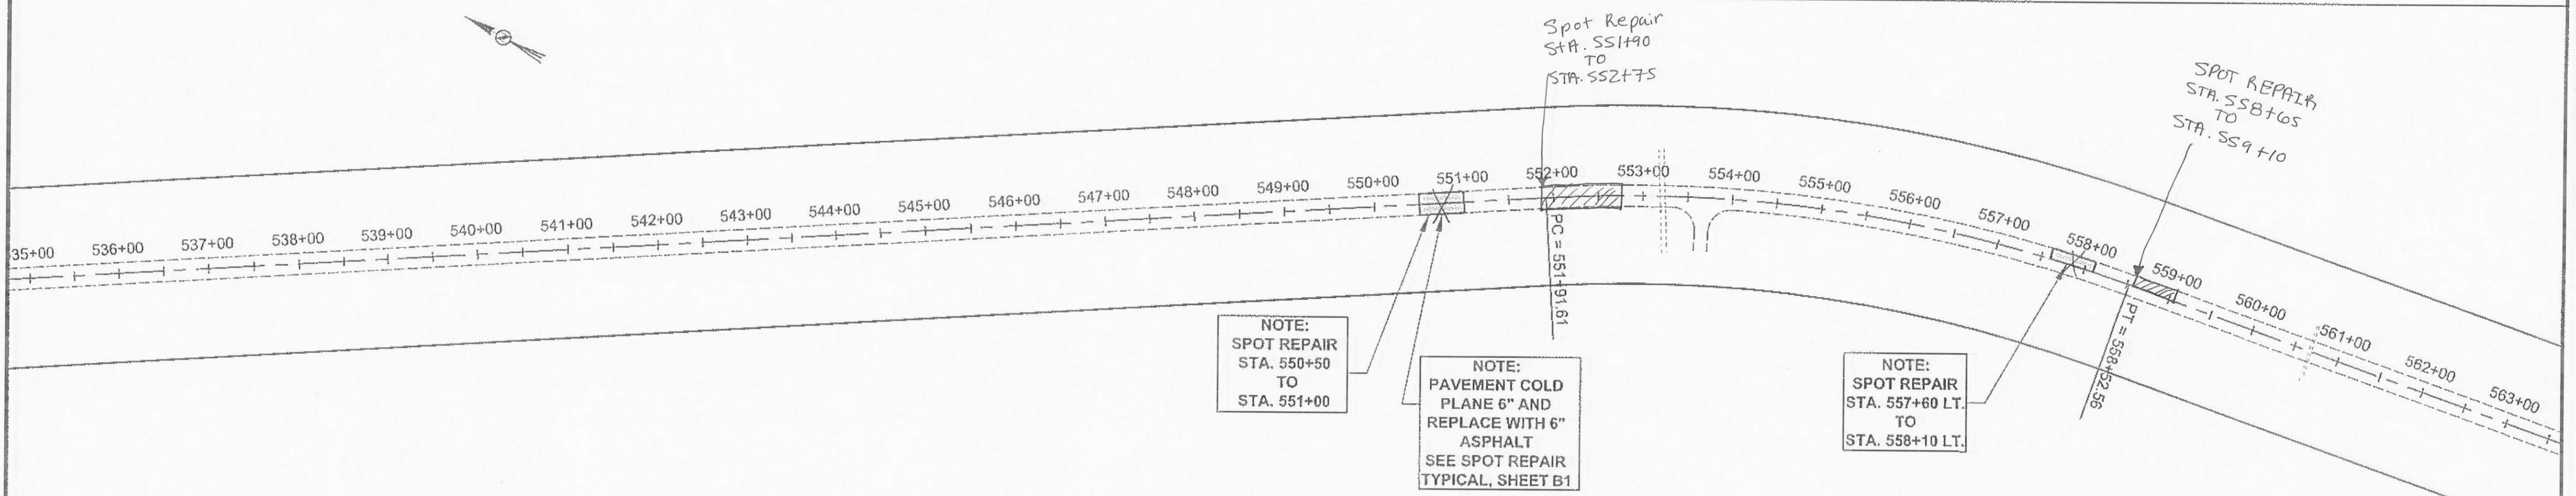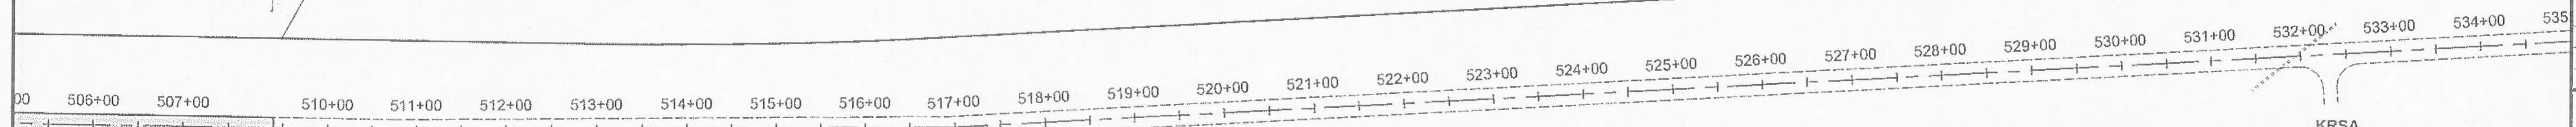

JSK
 2-1-2010

PLAN LEGEND

CHECKED BY: C.HOWARD

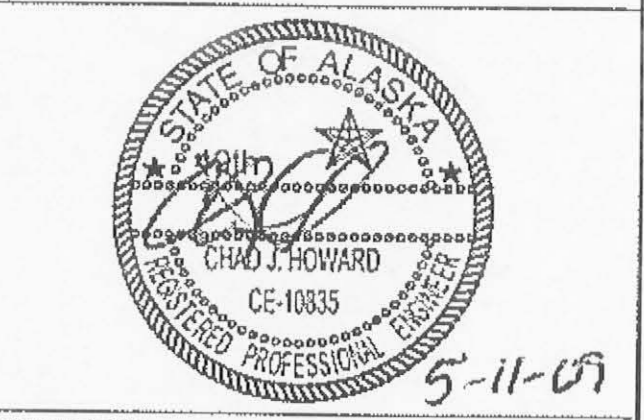

DESIGNED BY: C. IVANISZEK

DRAWN BY: B. WILSON

STATE OF ALASKA
 DEPARTMENT OF TRANSPORTATION
 & PUBLIC FACILITIES
 DESIGN & ENGINEERING SERVICES
 DIVISION-SOUTHEAST REGION

MITKOF HWY PAVEMENT
 REHABILITATION AND
 DRAINAGE
 PROJECT #68819

PLAN




PROJECT DESIGNATION
STP - 0920(20)

STATE	YEAR
ALASKA	2009
SHEET NUMBER	TOTAL SHEETS
F5	17

DO NOT SCALE FROM THESE DRAWINGS USE DIMENSIONS

WILSON, BRIAN G (DOT)
TAB: F6 Monday, May 11, 2009 11:07:13 AM
ADDENDUM NUMBER
ATTACHMENT NUMBER


RECORD OF REVISIONS		
No.	DATE	DESCRIPTION

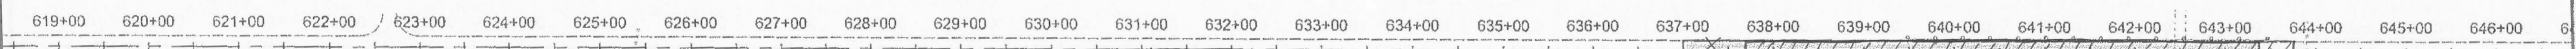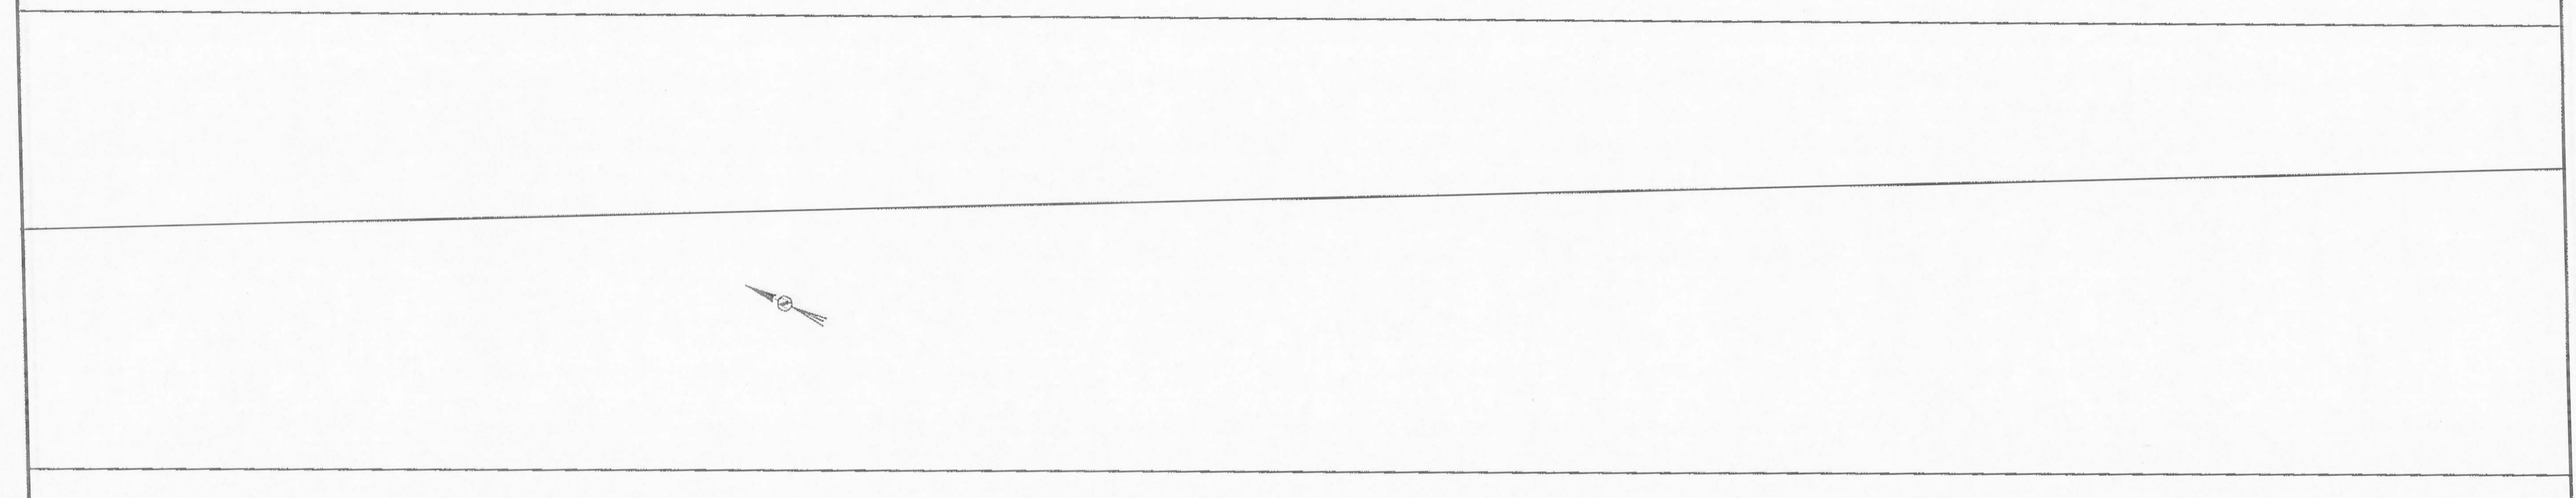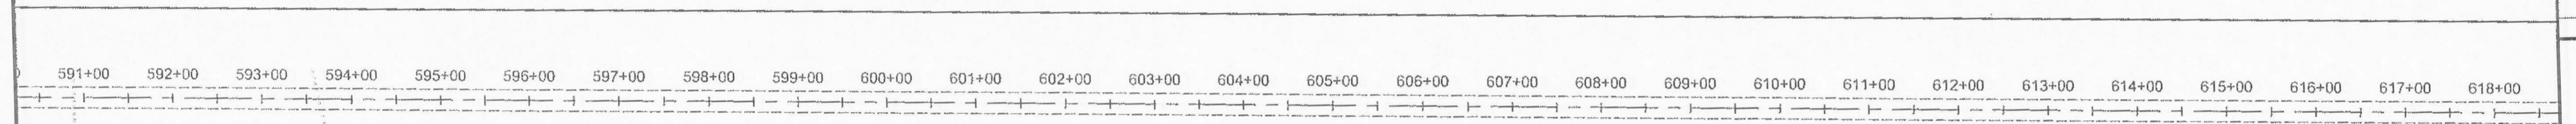

Spot Repair
STA. 631+00
TO
STA. 632+75

NOTE:
SPOT REPAIR
STA. 635+25 RT.
TO
STA. 635+75 RT.


NOTE:
SPOT REPAIR
STA. 637+00 Lt
TO
STA. 643+75 Lt

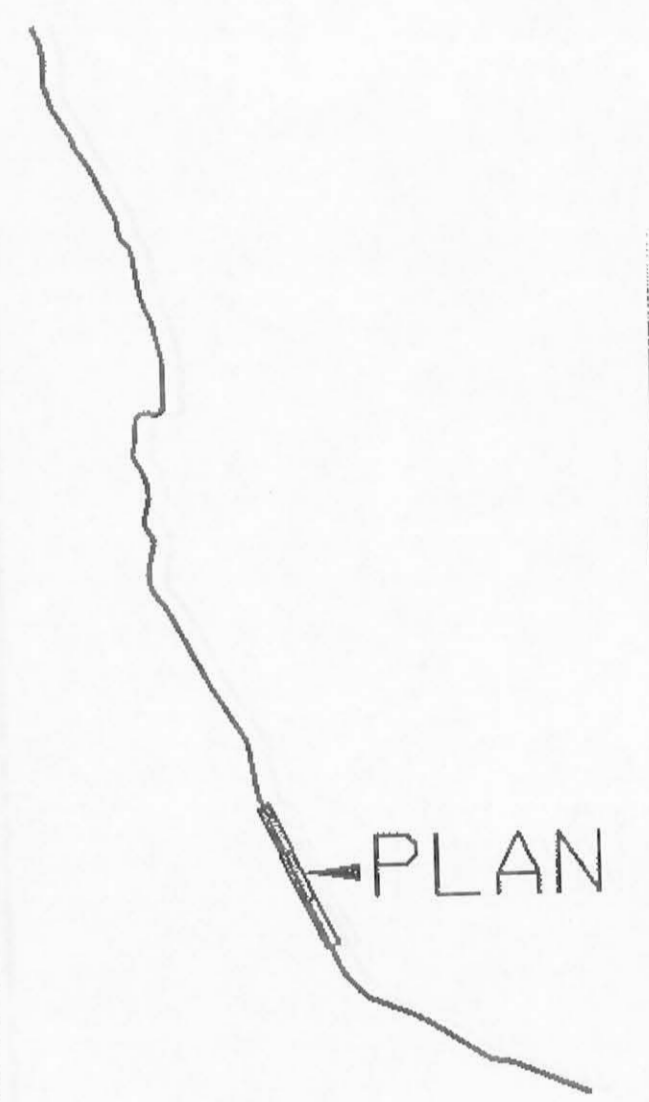

JSK
2-1-2010

PLAN LEGEND

CHECKED BY: C.HOWARD

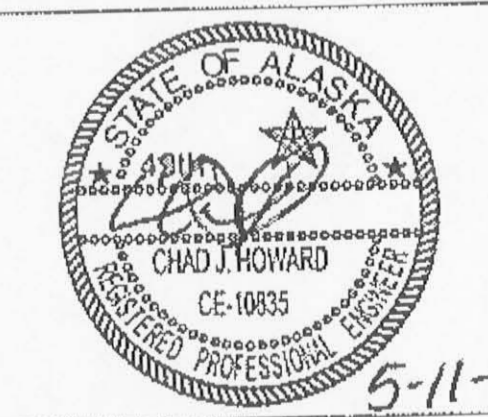

DESIGNED BY: C. IVANISZEK
DRAWN BY: B. WILSON


STATE OF ALASKA
DEPARTMENT OF TRANSPORTATION
& PUBLIC FACILITIES
DESIGN & ENGINEERING SERVICES
DIVISION-SOUTHEAST REGION

MITKOF HWY PAVEMENT
REHABILITATION AND
DRAINAGE
PROJECT #68819

PLAN

PROJECT DESIGNATION
STP - 0920(20)

STATE	YEAR
ALASKA	2009
SHEET NUMBER	TOTAL SHEETS
F6	17

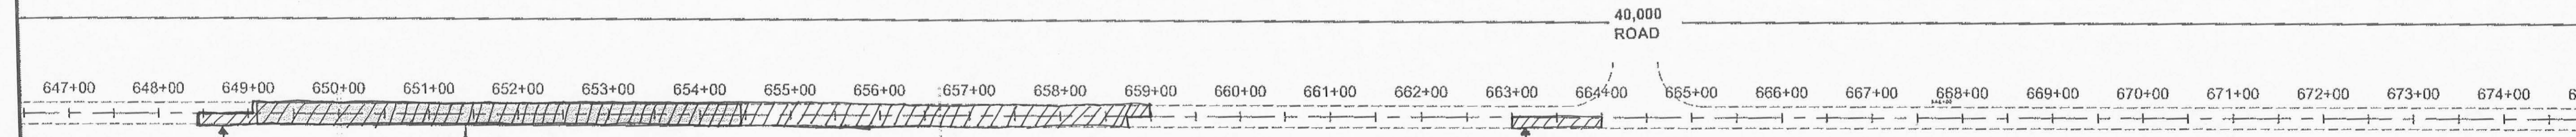

Spot Repair
STA. 648+45 RT
TO
STA. 658+75 RT





NOTE:
SPOT REPAIR
STA. 649+10
TO
STA. 654+45

Spot Repair
STA. 663+00 RT
TO
STA. 664+00 RT

DO NOT SCALE FROM THESE DRAWINGS USE DIMENSIONS


WILSON, BRIAN G (DOT)
 TAB: F7 Monday, May 11, 2009 11:07:20 AM

ADDENDUM NUMBER		
ATTACHMENT NUMBER		
RECORD OF REVISIONS		
No.	DATE	DESCRIPTION

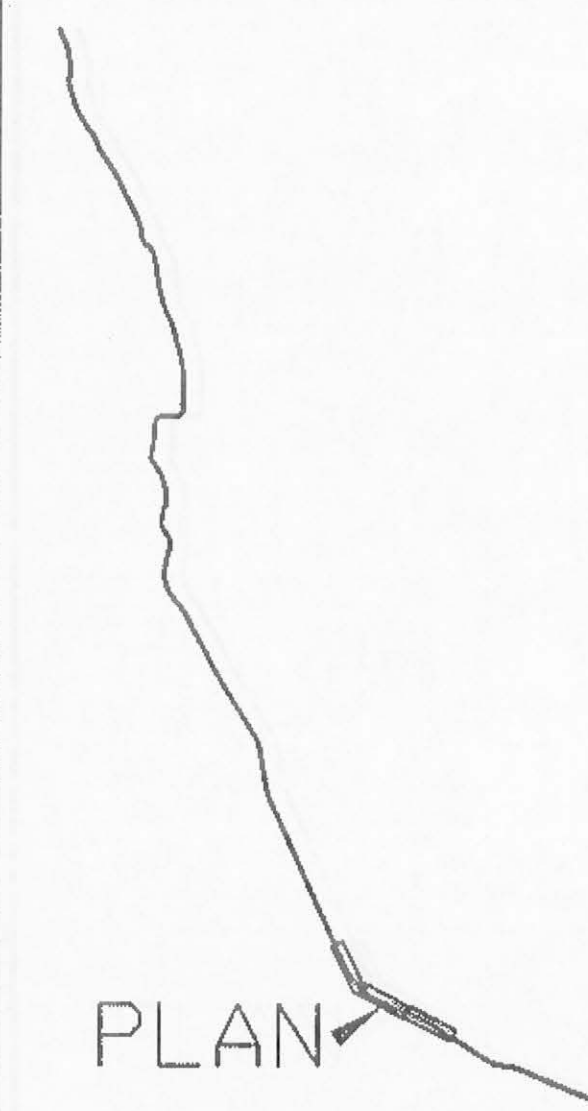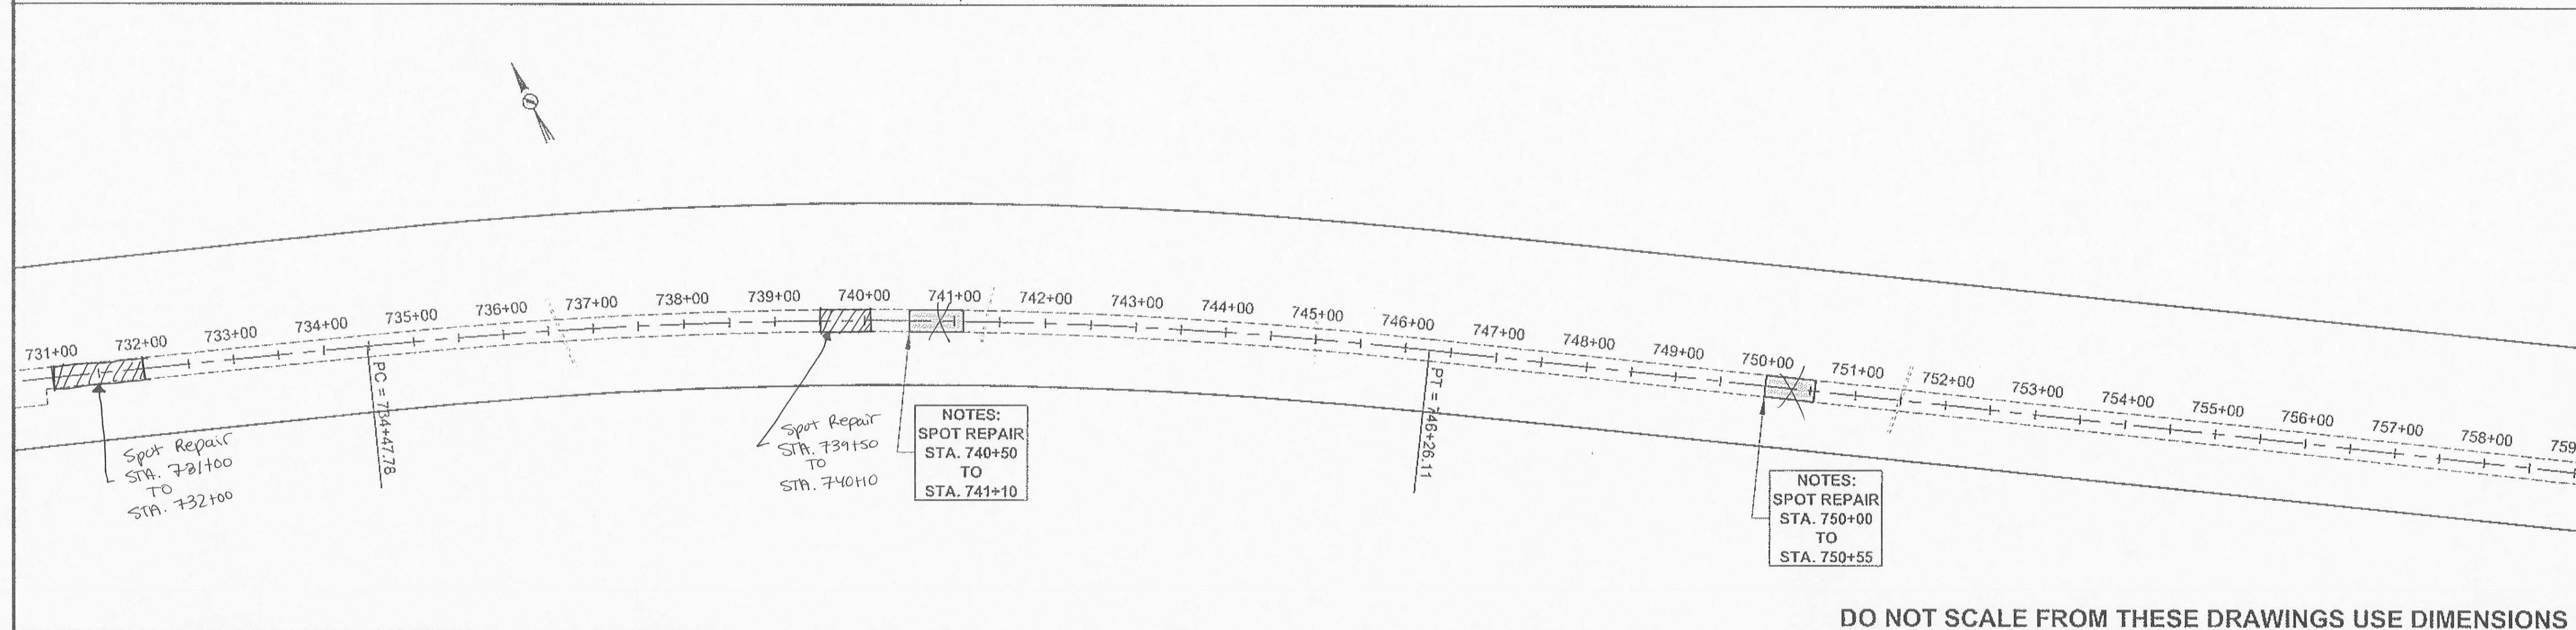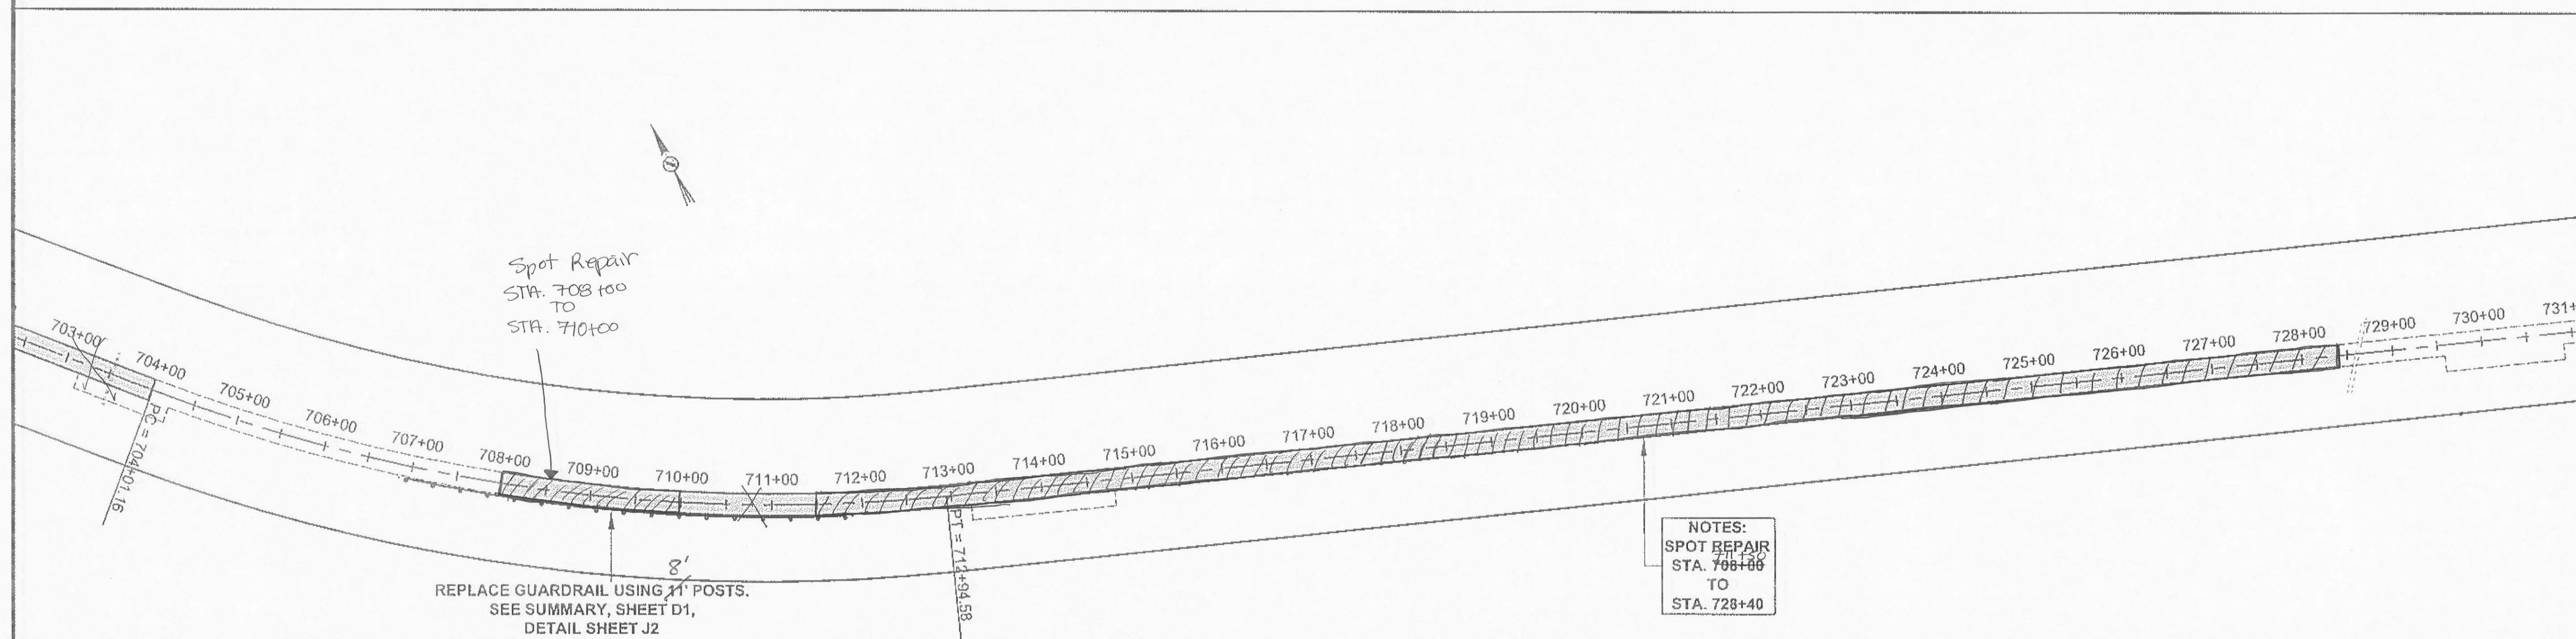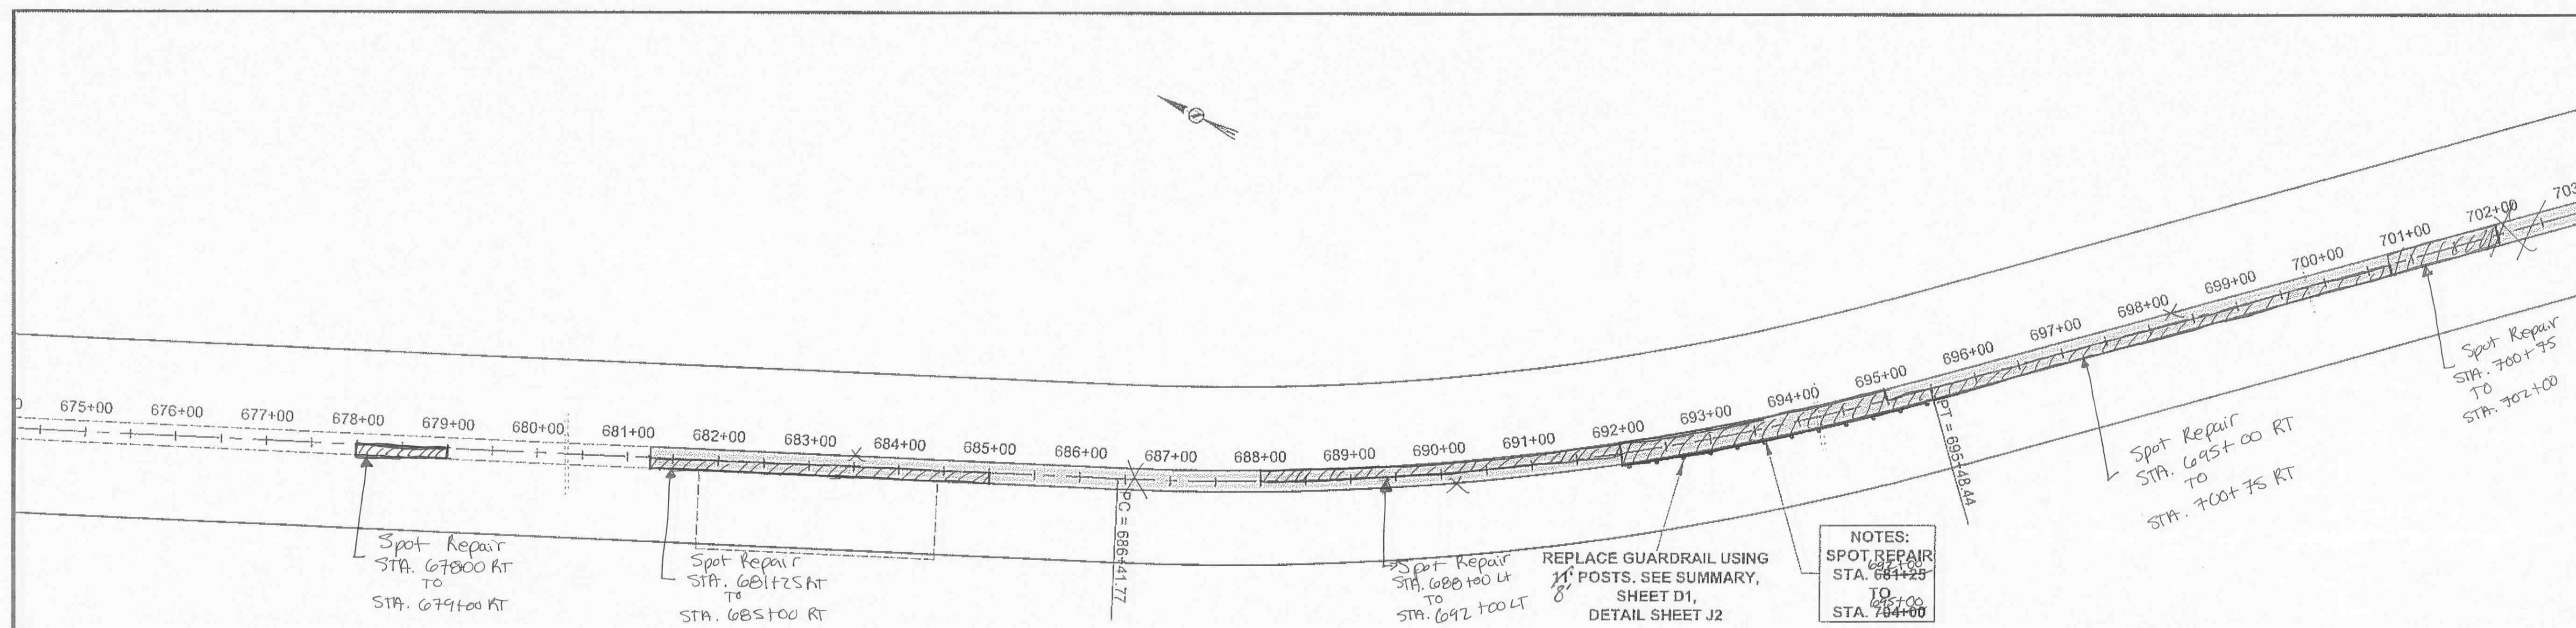

JSK
2-1-2010

PLAN LEGEND
 CHECKED BY: C. HOWARD

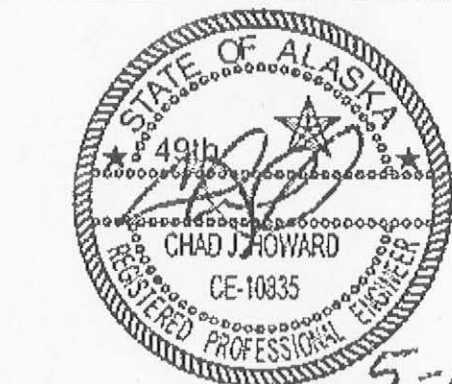

DESIGNED BY: C. IVANISZEK
 DRAWN BY: B. WILSON

STATE OF ALASKA
 DEPARTMENT OF TRANSPORTATION
 & PUBLIC FACILITIES
 DESIGN & ENGINEERING SERVICES
 DIVISION-SOUTHEAST REGION

MITKOF HWY PAVEMENT
 REHABILITATION AND
 DRAINAGE
 PROJECT #68819


PLAN

PROJECT DESIGNATION
STP - 0920(20)


STATE	YEAR
ALASKA	2009
SHEET NUMBER	TOTAL SHEETS
F7	17

DO NOT SCALE FROM THESE DRAWINGS USE DIMENSIONS

ADDENDUM NUMBER		
ATTACHMENT NUMBER		
RECORD OF REVISIONS		
No.	DATE	DESCRIPTION

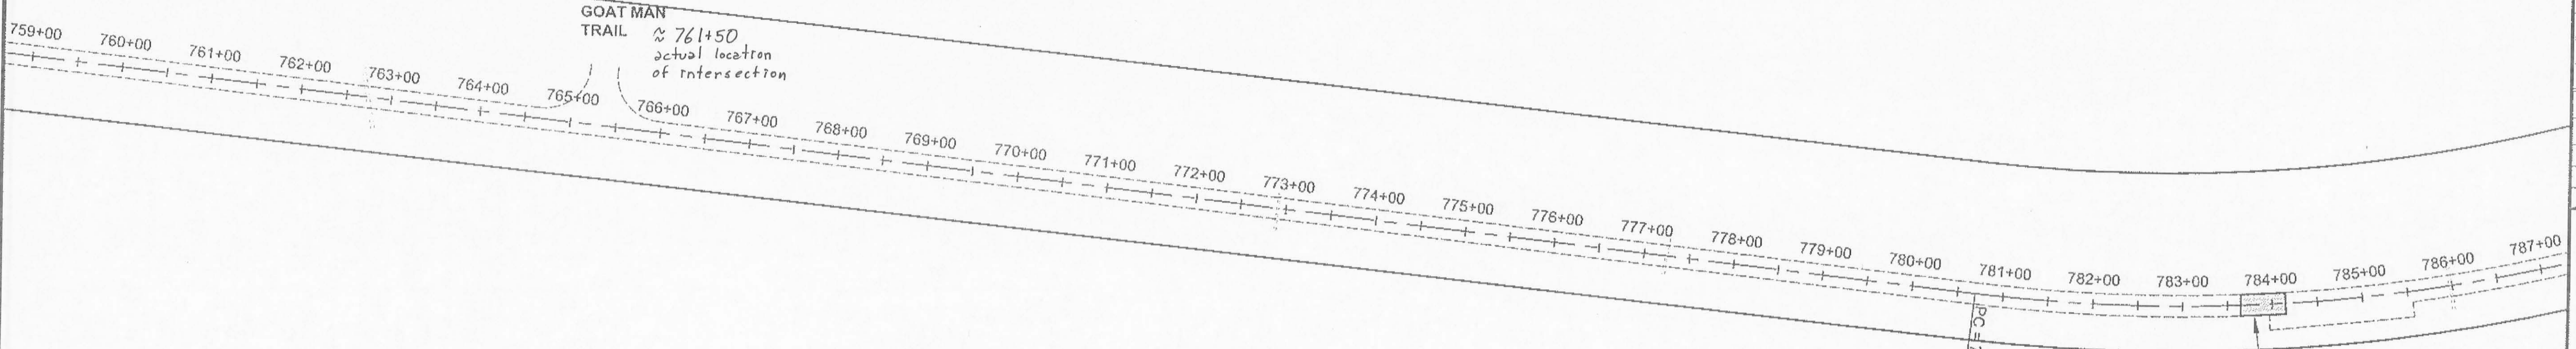

NOTES:
 SPOT REPAIR
 STA. 783+65
 TO
 STA. 784+15

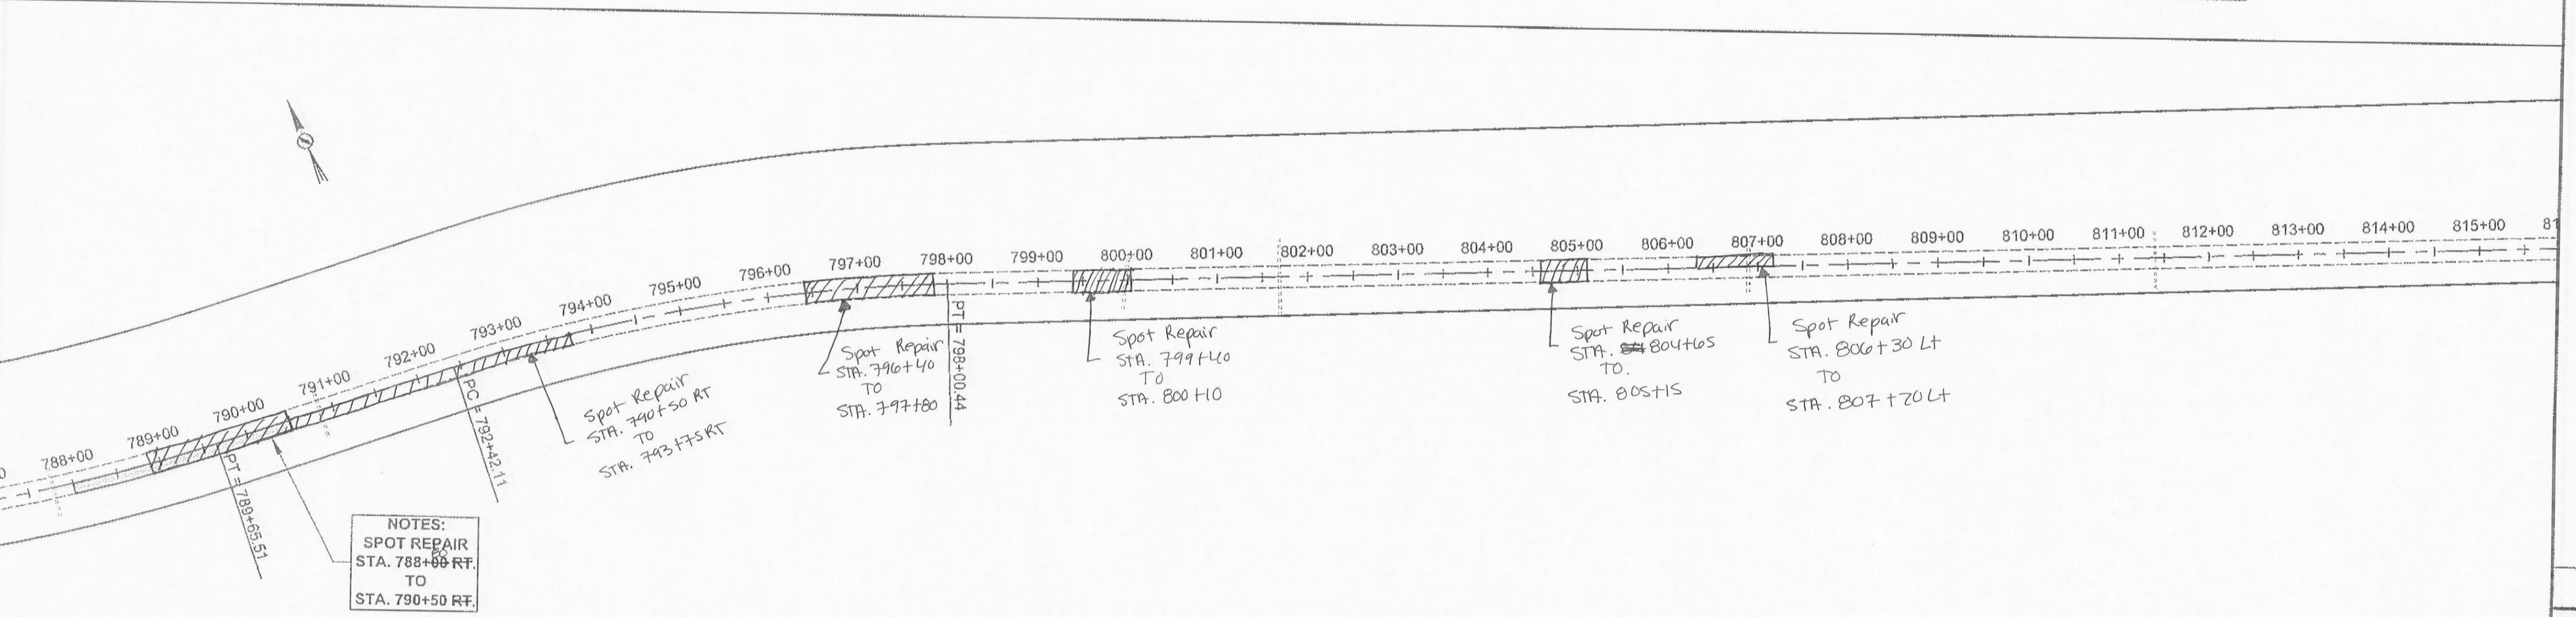

NOTES:
 SPOT REPAIR
 STA. 788+00 RT.
 TO
 STA. 790+50 RT.


Spot Repair
 STA. 790+50 RT.
 TO
 STA. 793+75 RT.

Spot Repair
 STA. 796+40
 TO
 STA. 797+80

Spot Repair
 STA. 799+40
 TO
 STA. 800+10

Spot Repair
 STA. 804+65
 TO
 STA. 805+15

Spot Repair
 STA. 806+30 Lt
 TO
 STA. 807+20 Lt

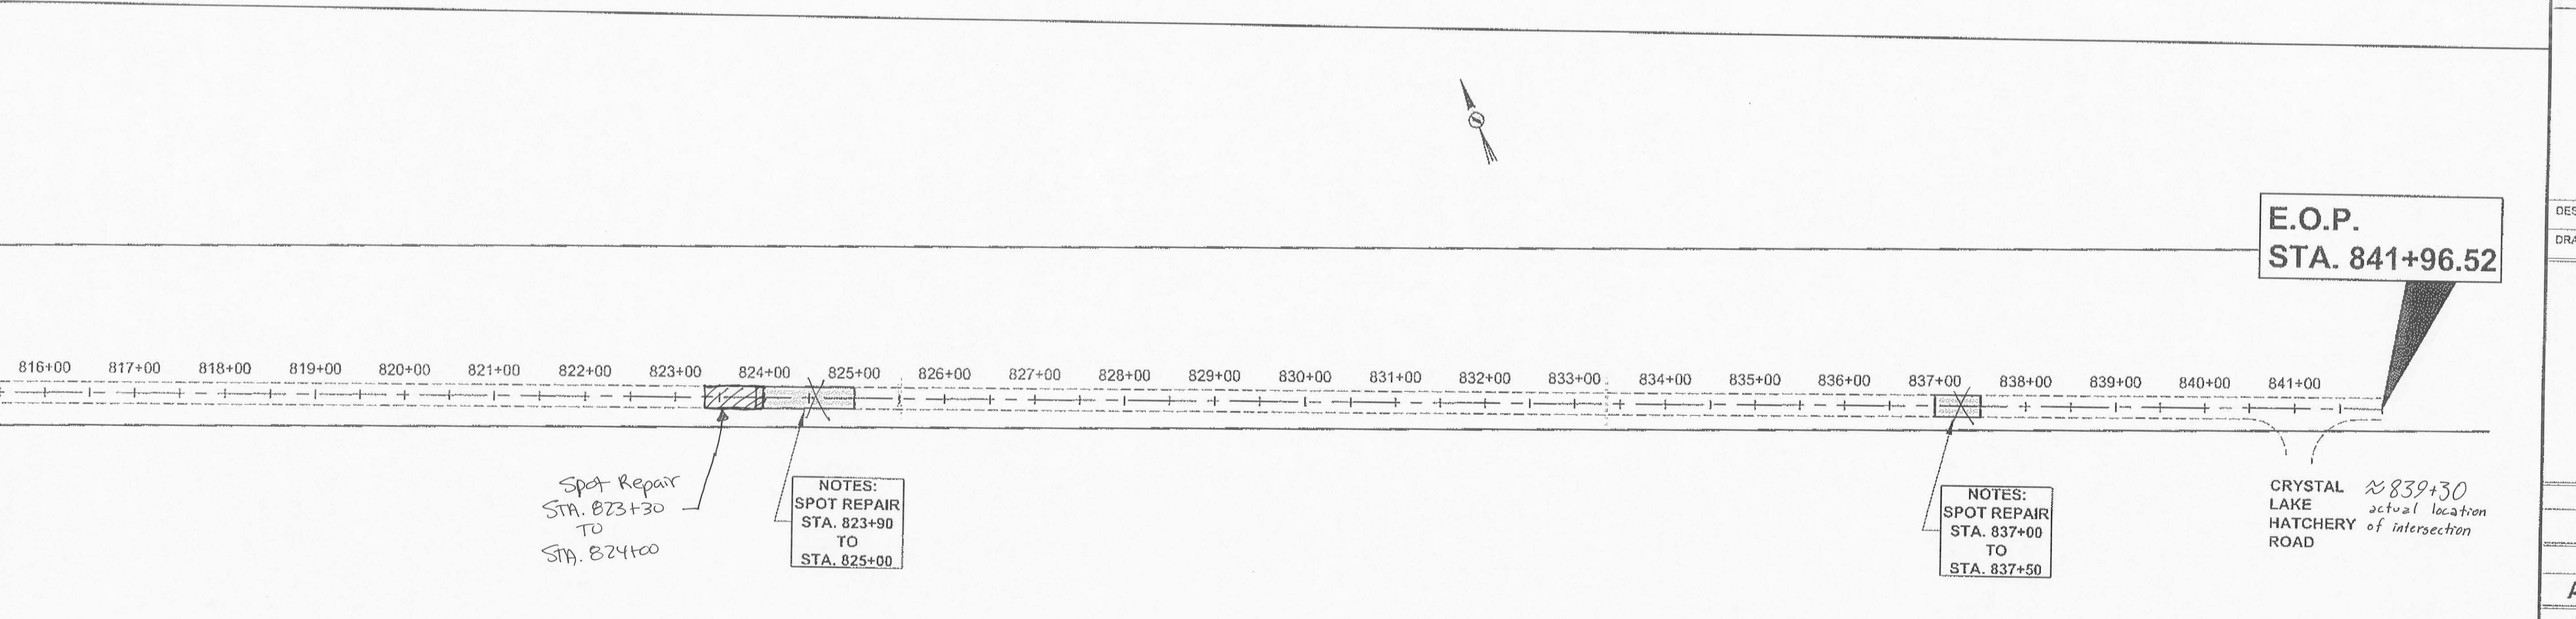

Spot Repair
 STA. 823+30
 TO
 STA. 824+00

NOTES:
 SPOT REPAIR
 STA. 823+90
 TO
 STA. 825+00.

NOTES:
 SPOT REPAIR
 STA. 837+00
 TO
 STA. 837+50

E.O.P.
 STA. 841+96.52


CRISTAL LAKE
 HATCHERY
 ROAD
 ≈ 839+30
 actual location
 of intersection

PLAN

JSK
 2-1-2010

PLAN LEGEND

CHECKED BY: C. HOWARD

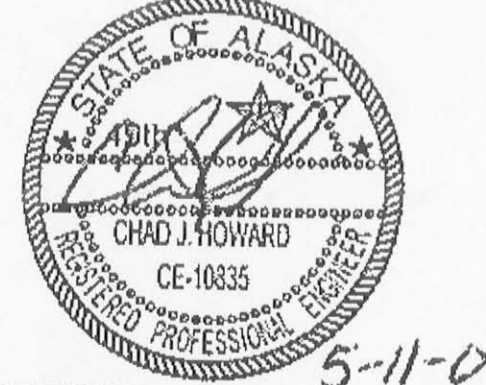

DESIGNED BY: C. IVANISZEK

DRAWN BY: B. WILSON

STATE OF ALASKA
 DEPARTMENT OF TRANSPORTATION
 & PUBLIC FACILITIES
 DESIGN & ENGINEERING SERVICES
 DIVISION-SOUTHEAST REGION


MITKOF HWY PAVEMENT
 REHABILITATION AND
 DRAINAGE
 PROJECT #68819

PLAN



PROJECT DESIGNATION
STP - 0920(20)

STATE	YEAR
ALASKA	2009
SHEET NUMBER	TOTAL SHEETS
F8	17

DO NOT SCALE FROM THESE DRAWINGS USE DIMENSIONS

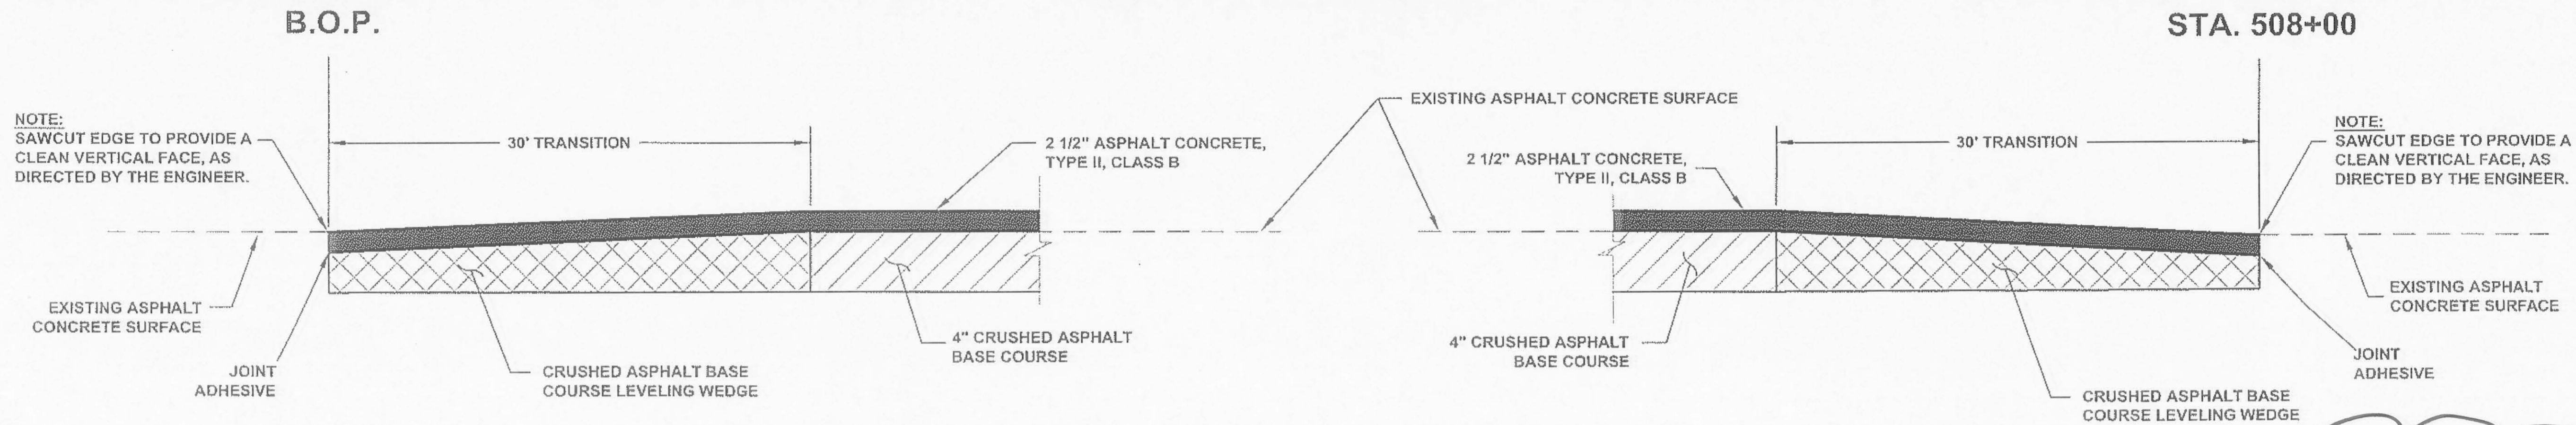


PAVEMENT TRANSITION DETAIL
B.O.P. AND STA. 508+00

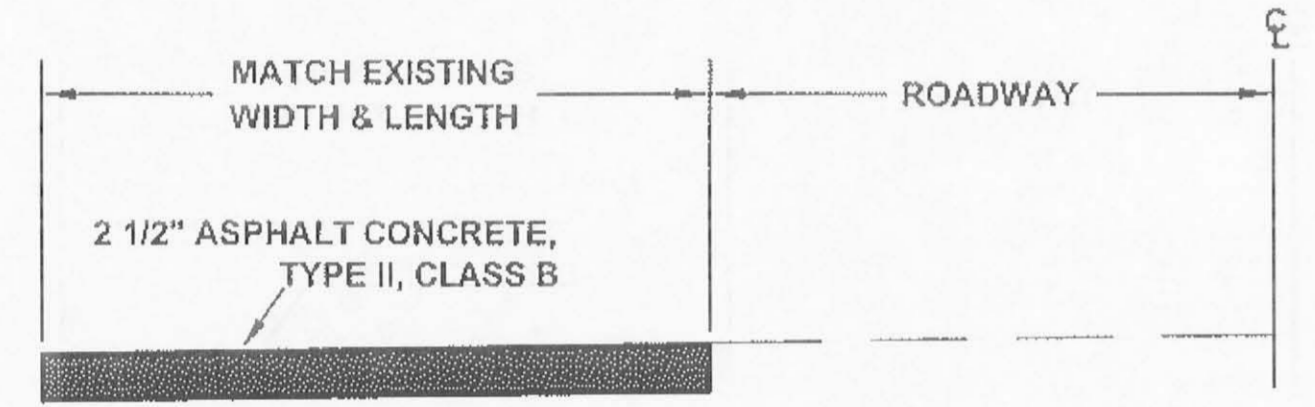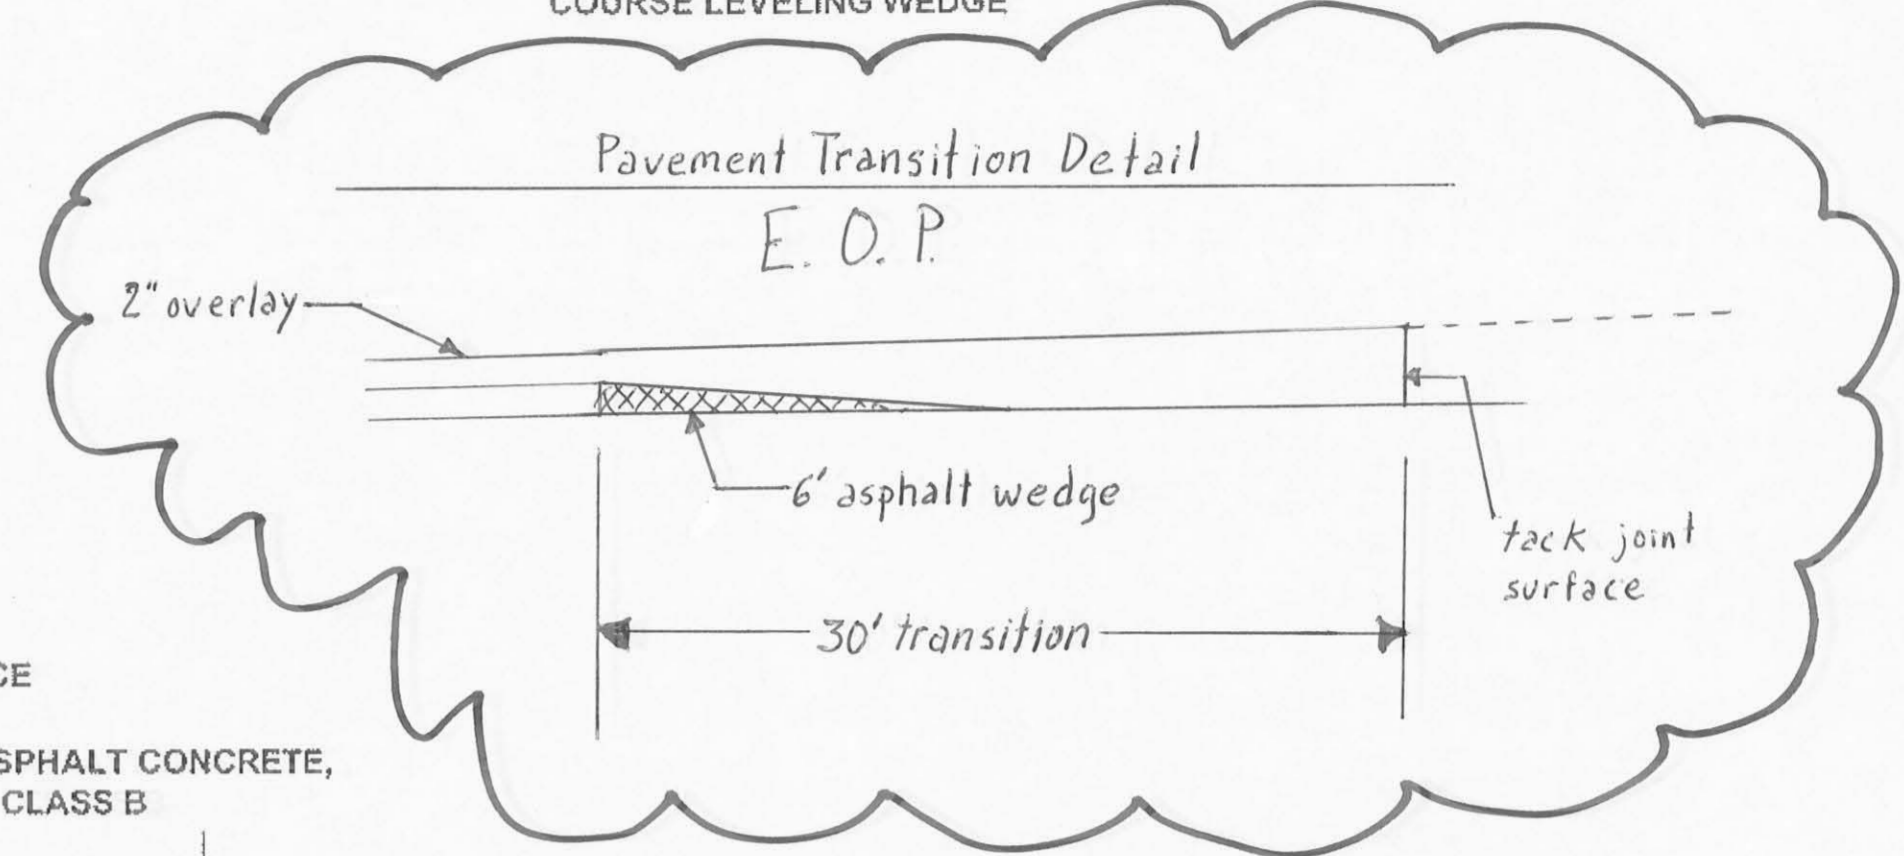


PULLOFF/PARKING DETAIL

SEE PLANS & 639(3) SUMMARY TABLE FOR LOCATIONS.

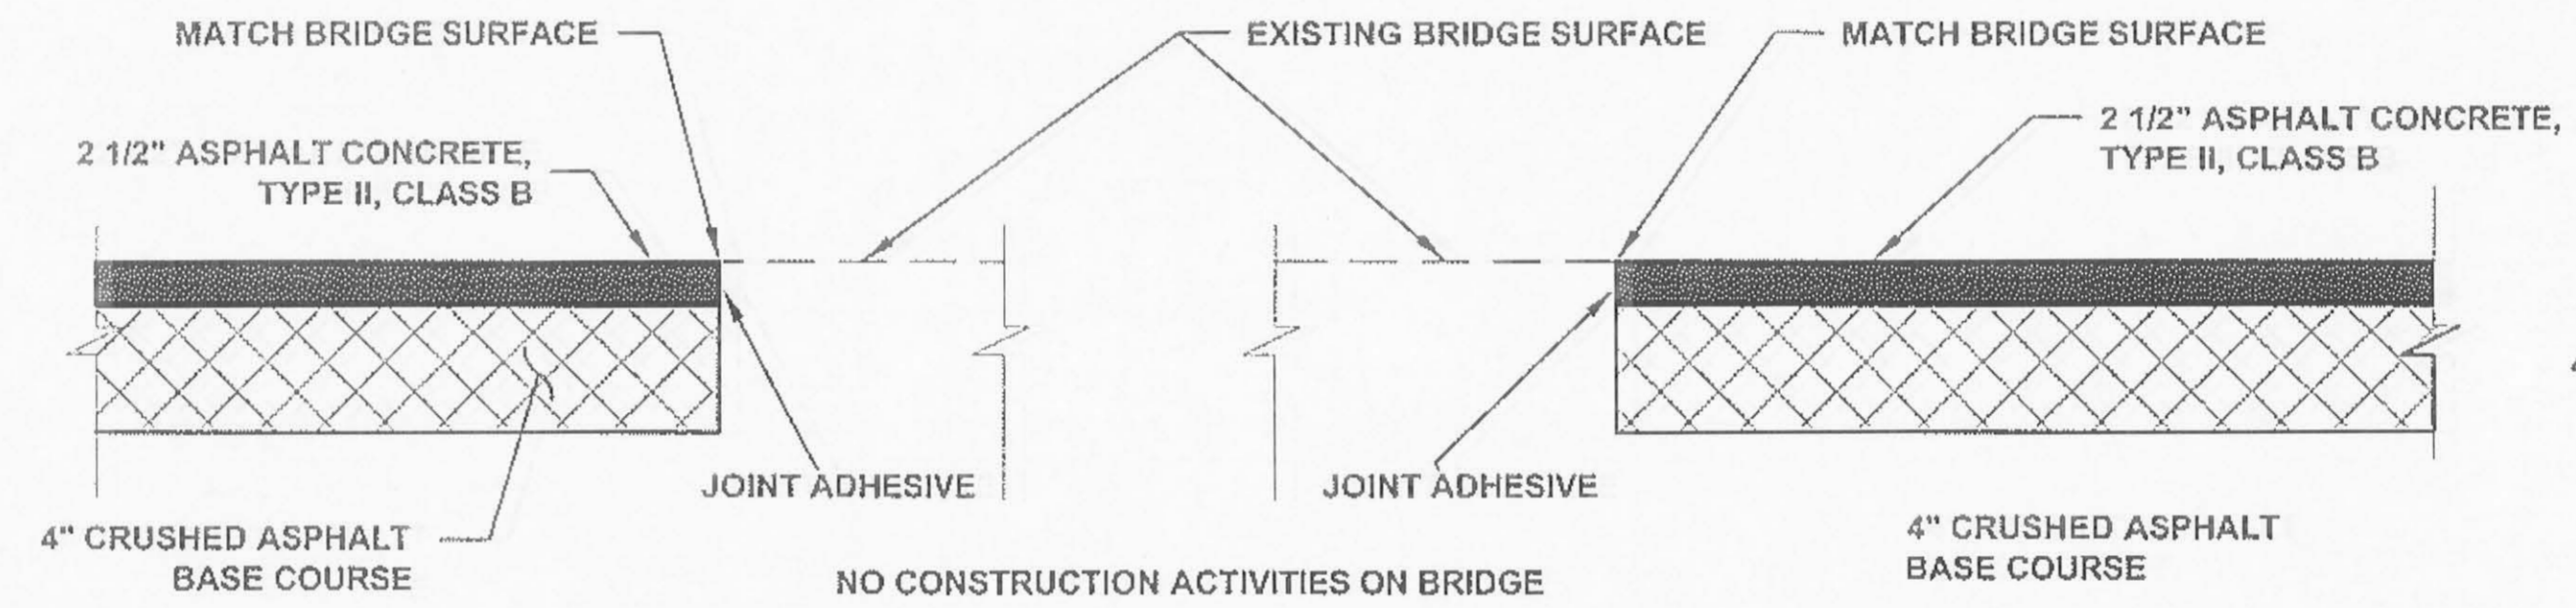

FALLS CREEK BRIDGE DETAIL


STA. 492+58.07 TO 493+79.84

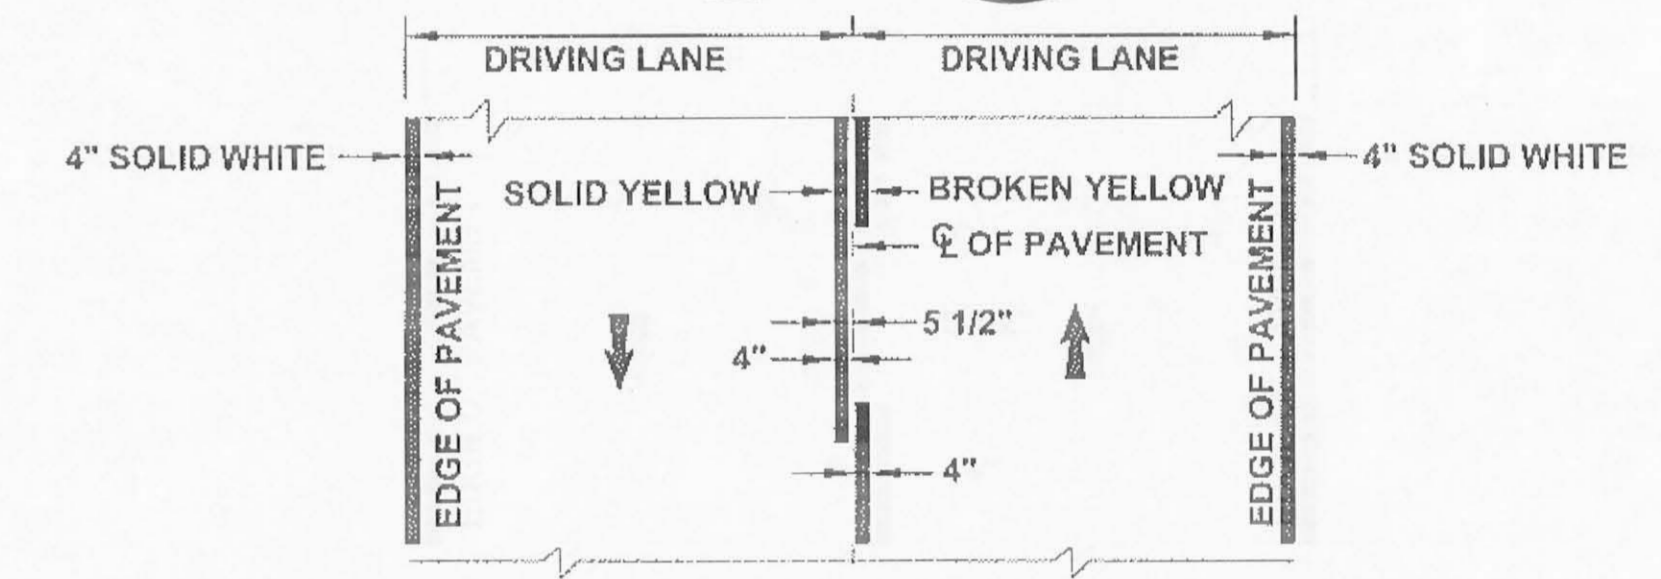

STRIPING DETAIL


STRIPING NOTES:

1. PASSING ZONES SHALL BE LOCATED IN FIELD. THE CONTRACTOR SHALL REFERENCE AND STAKE THE LOCATIONS OF PASSING ZONES PER SPECIAL PROVISION 670.
2. CONTRACT STRIPING SHALL BE LIMITED TO AREAS RECEIVING PAVEMENT REHABILITATION AND PAVEMENT COLD PLANING. THE CONTRACTOR IS RESPONSIBLE TO RESTRIPE ANY STRIPING THAT IS OBLITERATED DUE TO CONSTRUCTION ACTIVITIES.

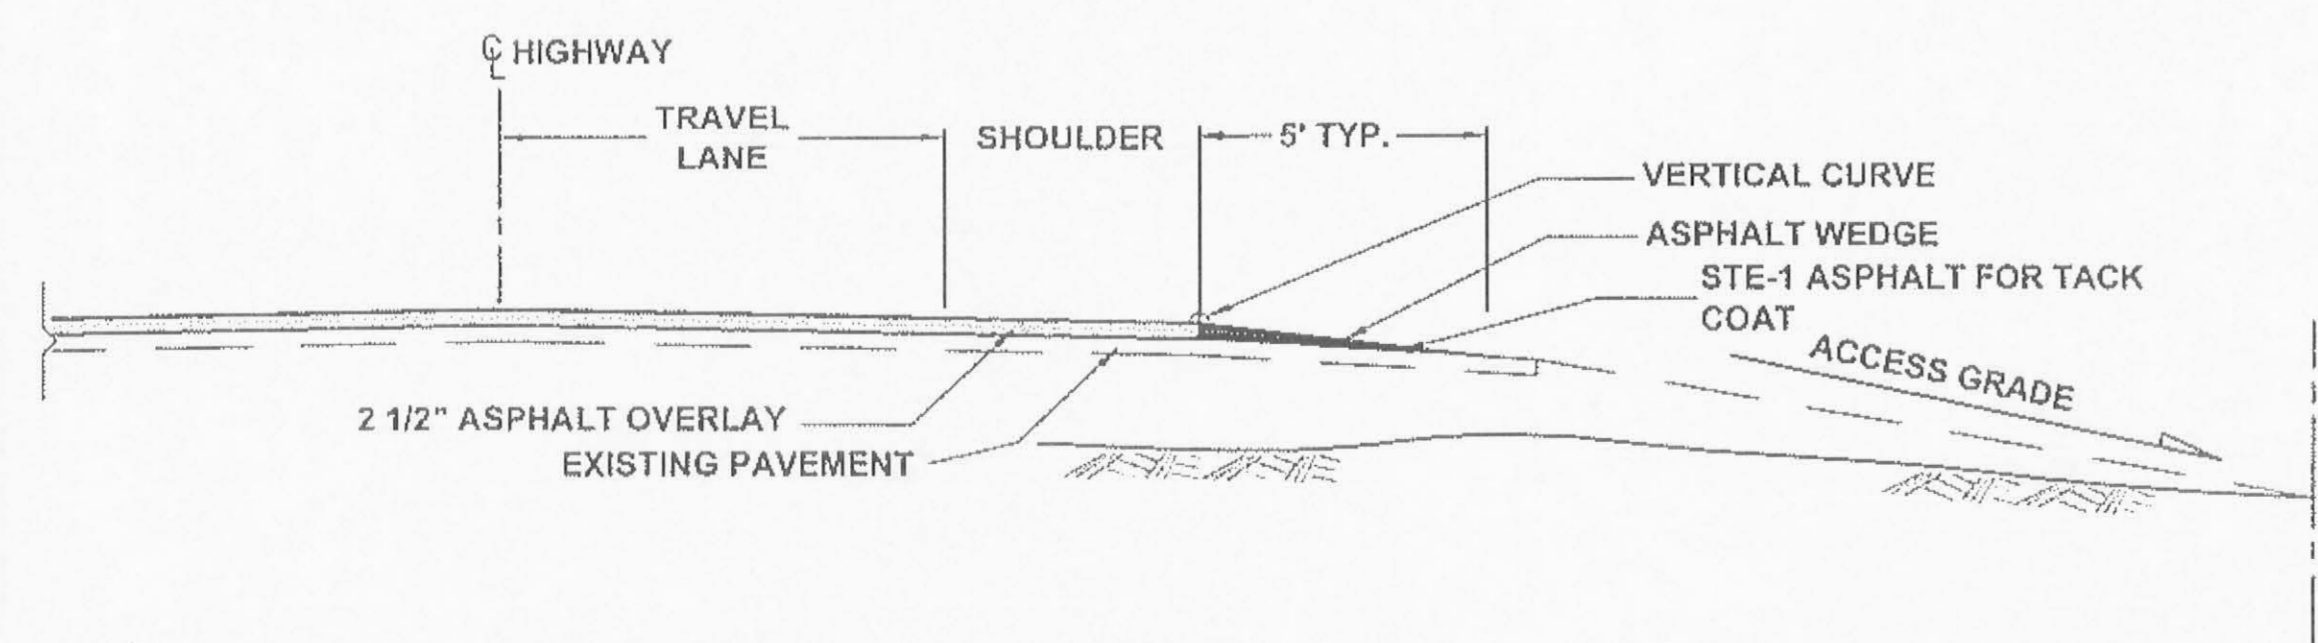

TYPICAL DRIVEWAY PROFILE

DRIVEWAY VERTICAL CURVE REQUIREMENTS:
CREST: 3/4" MAXIMUM HUMP IN 10' CHORD
SAG: 2" MAXIMUM DEPRESSION IN 10' CHORD

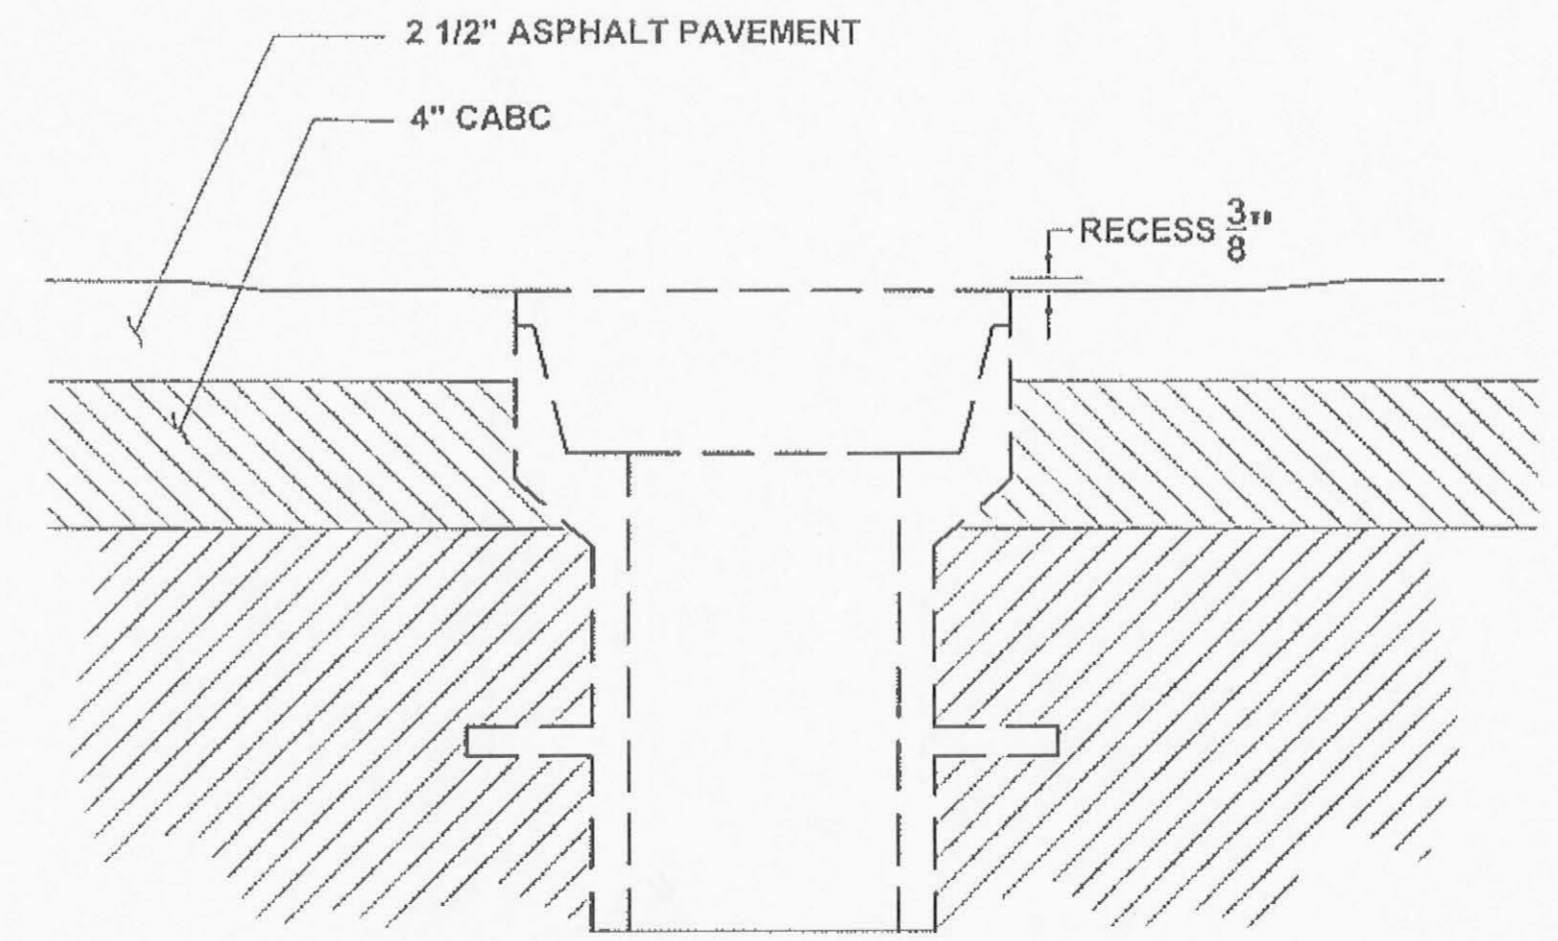


MONUMENT ADJUSTMENT DETAIL

DO NOT SCALE FROM THESE DRAWINGS USE DIMENSIONS

CHECKED BY: C. HOWARD	STATE OF ALASKA DEPARTMENT OF TRANSPORTATION & PUBLIC FACILITIES DESIGN & ENGINEERING SERVICES DIVISION-SOUTHEAST REGION
DESIGNED BY: C. IVANISZEK	MITKOF HWY PAVEMENT REHABILITATION AND DRAINAGE IMPROVEMENTS PROJECT #68819
DRAWN BY: B. WILSON	MISCELLANEOUS DETAILS
PATH: Q:\PSG\68819\PLANSET\DWGJ- MISC DETAILS.DWG	PROJECT DESIGNATION
TAB: J1 Monday, May 11, 2009 11:37:44 AM WILSON, BRIAN G (DOT)	YEAR
REVISIONS	YEAR
NO. DATE DESCRIPTION	SHEET NO.
	TOTAL SHEETS
	68819
	2009
	J1
	17


5-11-09

JSK
2-1-2010

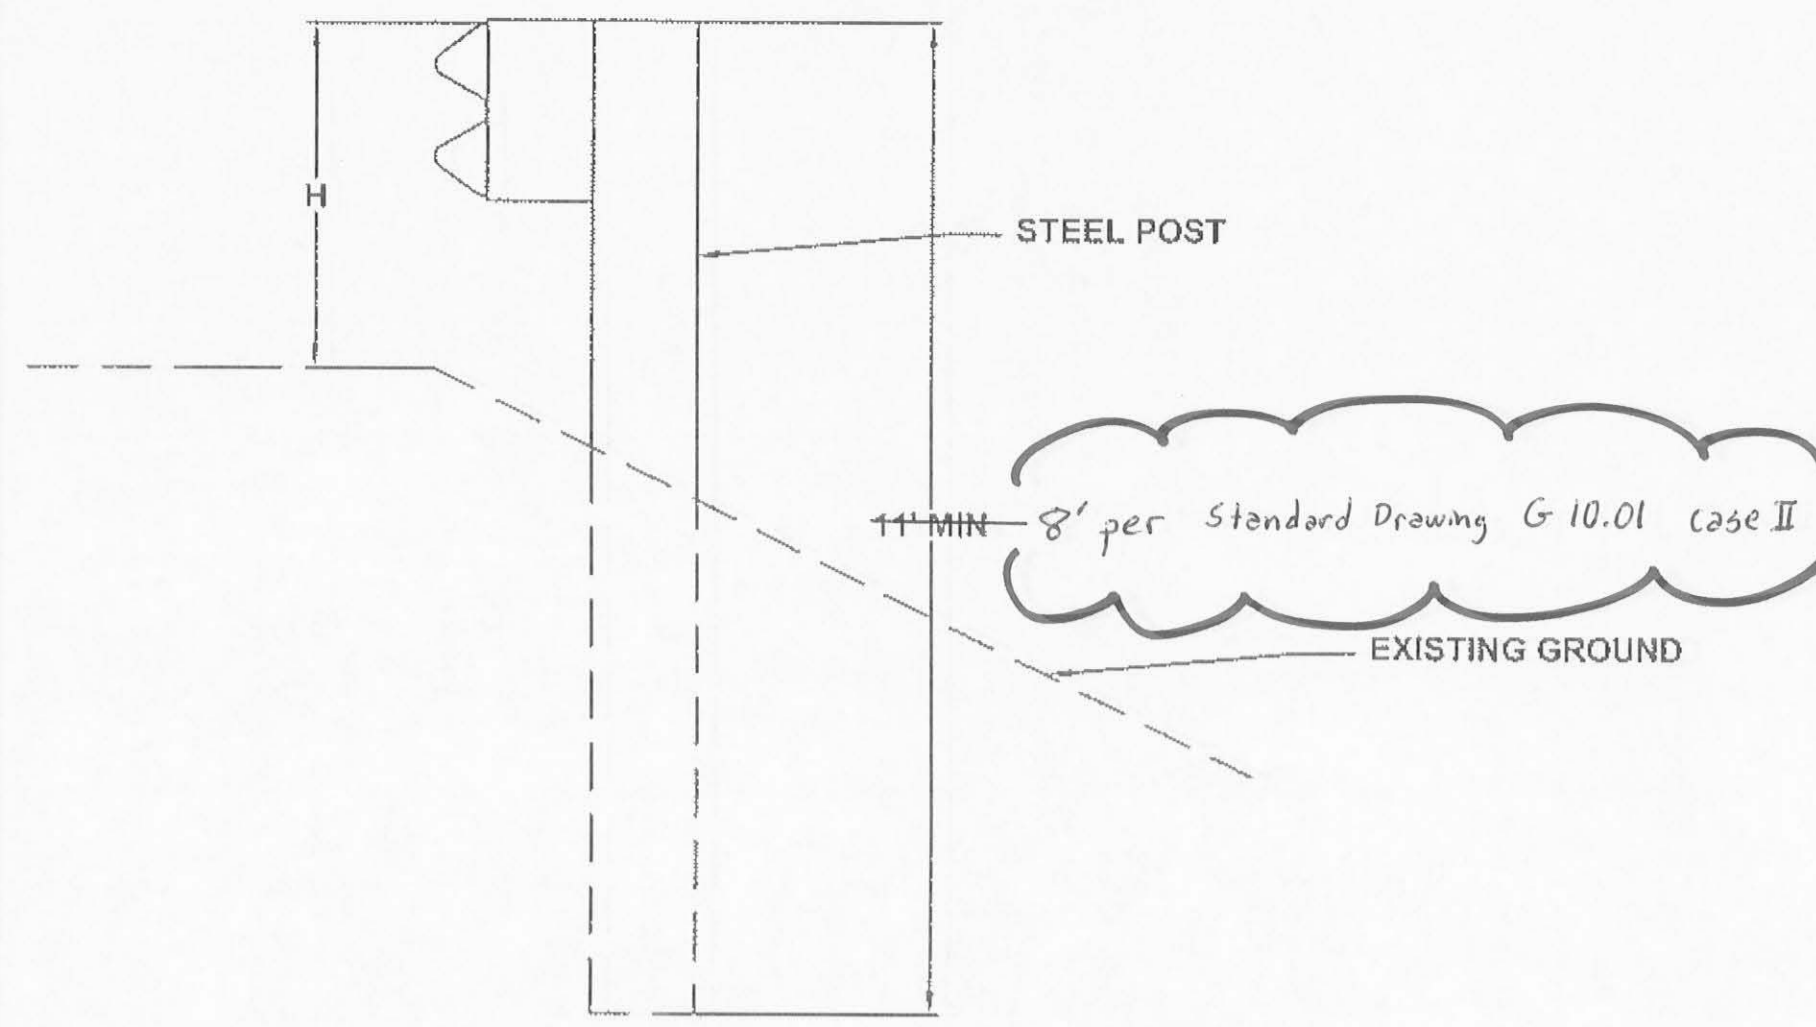

GUARDRAIL POST DETAIL


REFER TO SUMMARY TABLE, SHEET D1, FOR LOCATIONS TO INSTALL POSTS.
IT IS ANTICIPATED THAT BASE OF POSTS MAY ENCOUNTER LARGER ROCK FILL.

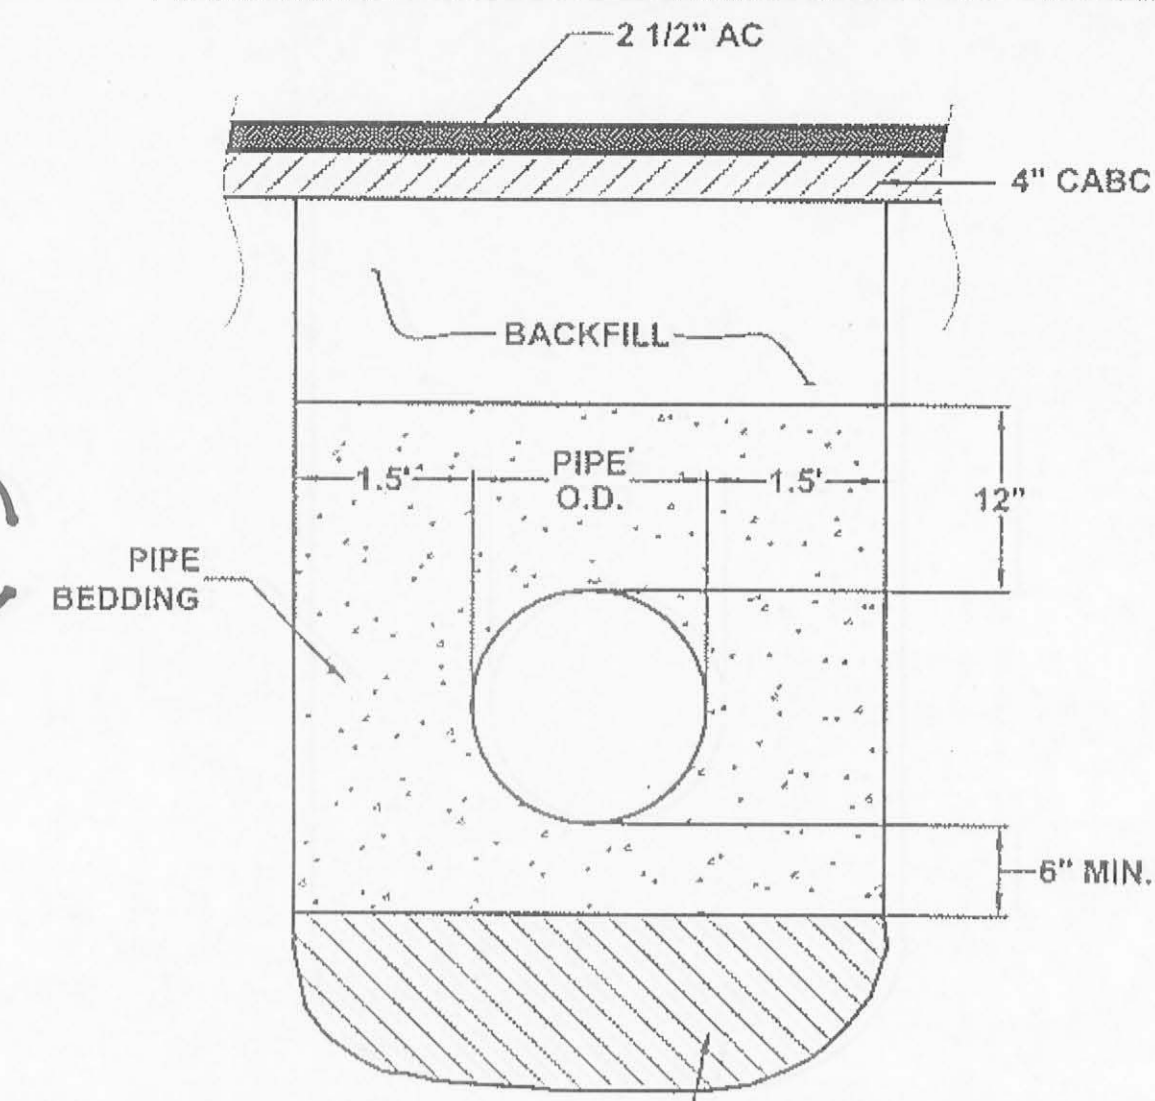

CULVERT BEDDING/BACKFILL DETAIL

N.T.S.


REMOVE UNSUITABLE MATERIAL WHEN AUTHORIZED. PAID FOR AS UNCLASSIFIED EXCAVATION. REPLACE WITH BORROW.

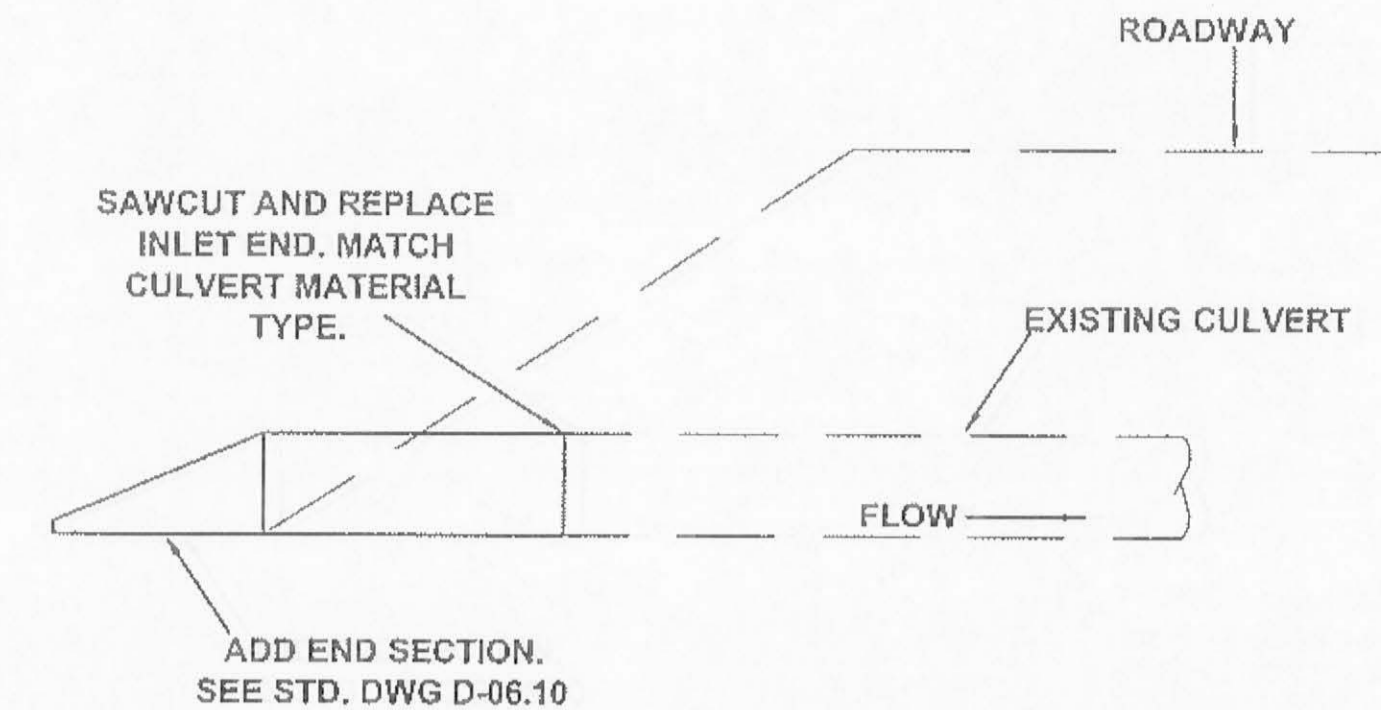

CULVERT INLET REPLACEMENT DETAIL


SAWCUT AND REPLACE INLET END. MATCH CULVERT MATERIAL TYPE.

ADD END SECTION. SEE STD. DWG D-06.10

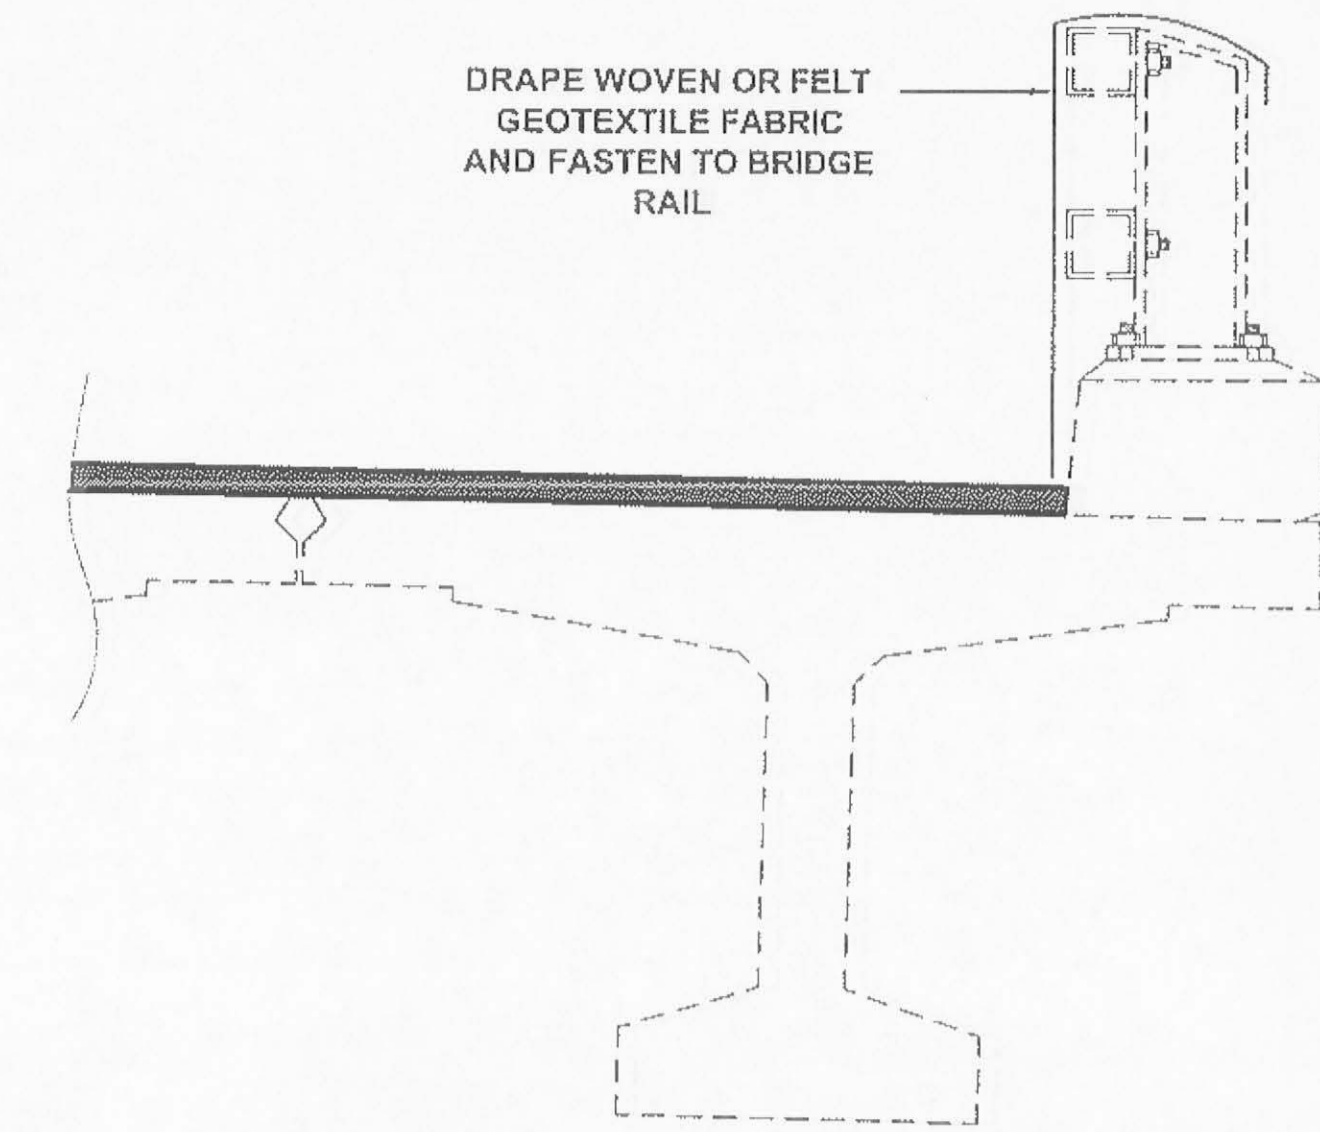


TWIN CREEK BRIDGE ESCP

PLUG ANY SCUPPERS TO PREVENT DEBRIS OR TACK COAT FROM ENTERING FISH STREAM.

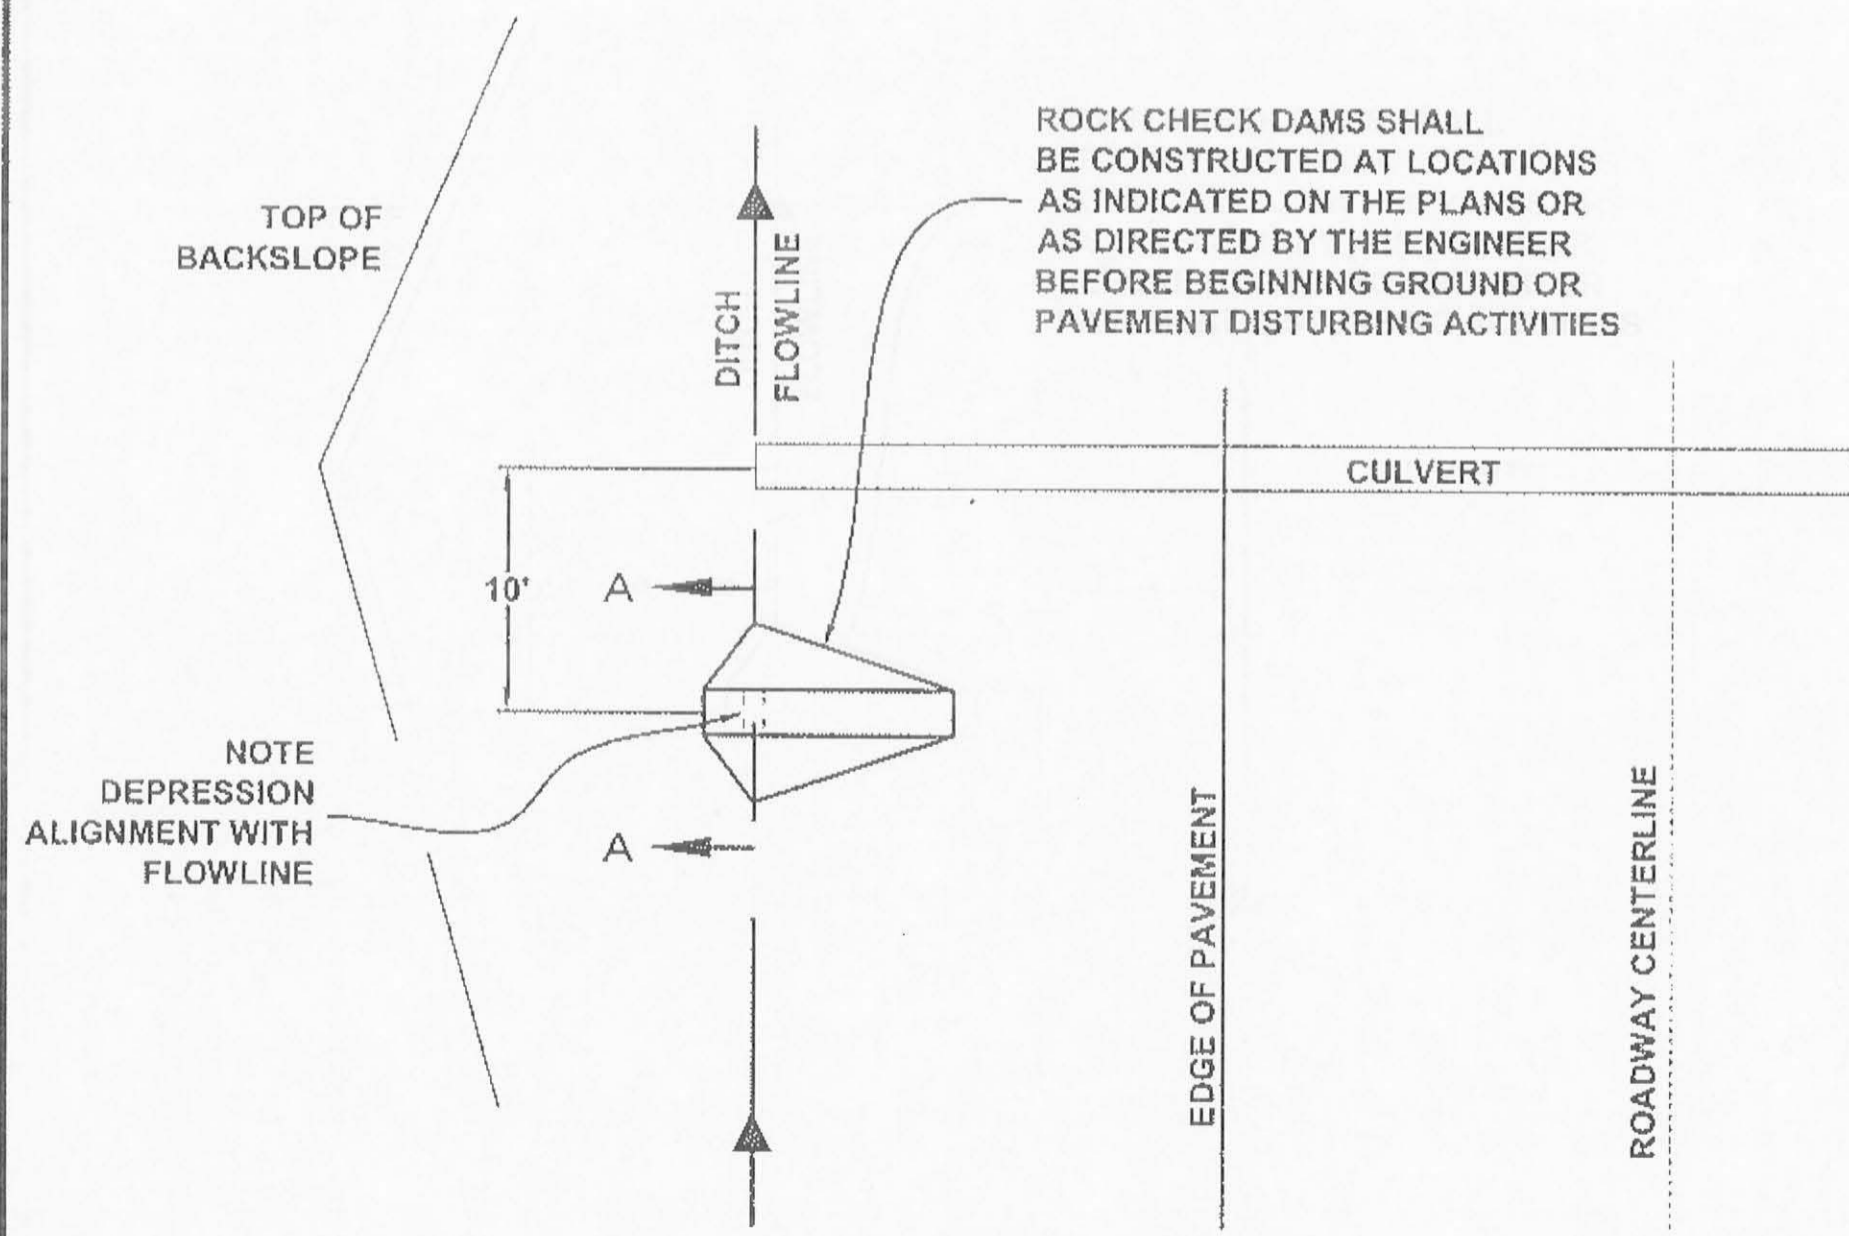


Plan

ROCK CHECK DAMS SHALL BE CONSTRUCTED AT LOCATIONS AS INDICATED ON THE PLANS OR AS DIRECTED BY THE ENGINEER BEFORE BEGINNING GROUND OR PAVEMENT DISTURBING ACTIVITIES

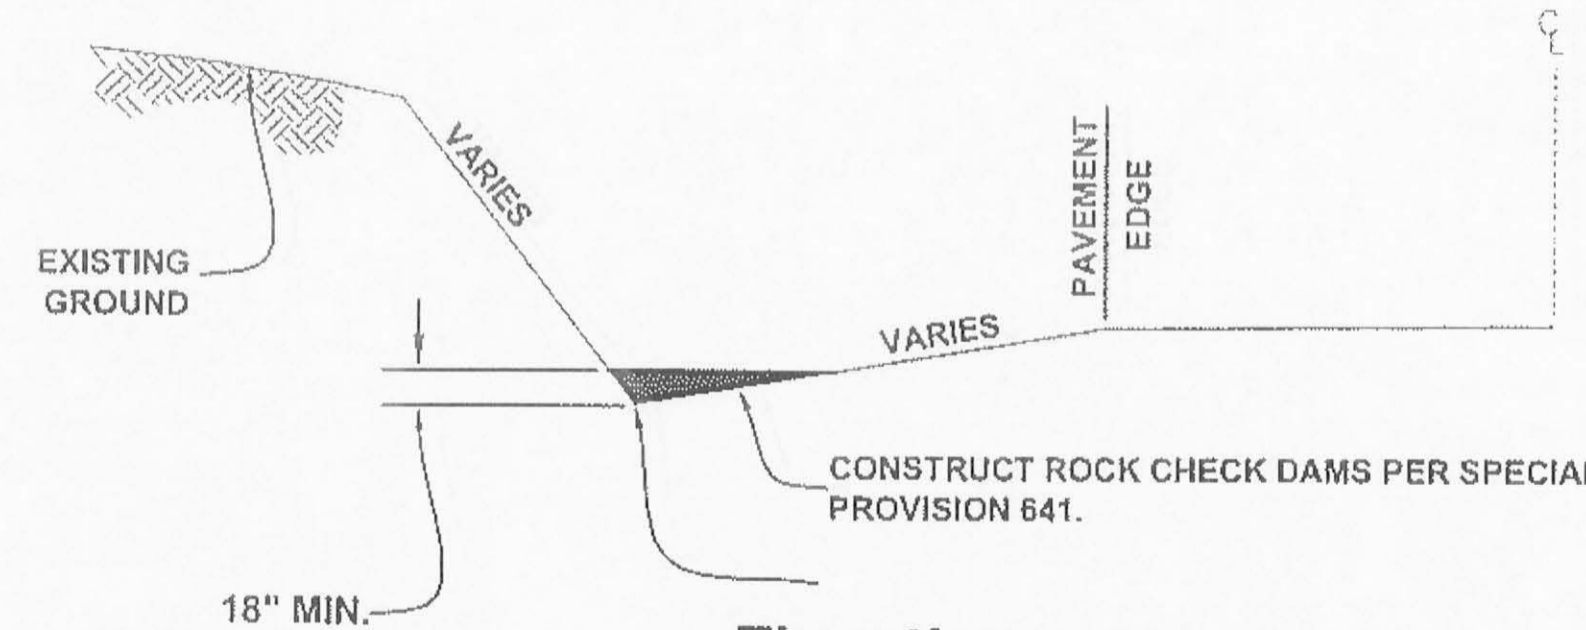

Elevation

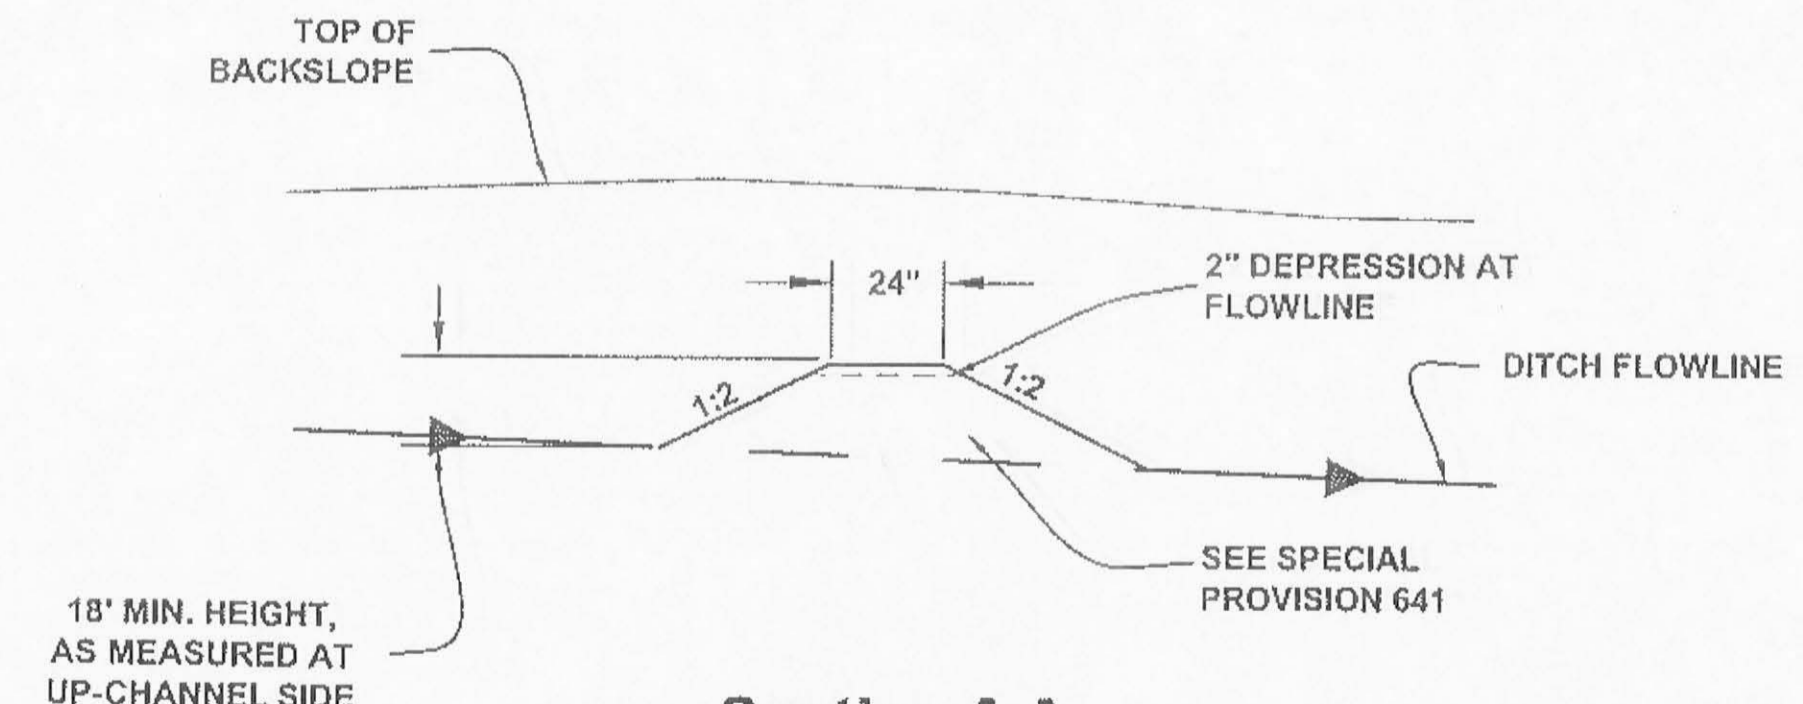

Section A-A

ROCK CHECK DAM DETAILS

ROCK CHECK DAM NOTES:

1. INSTALL EROSION AND SEDIMENT CONTROL DEVICES BEFORE BEGINNING GROUND OR PAVEMENT DISTURBING ACTIVITIES.
2. MAINTAIN DEVICES. MONITOR DAILY. EXCAVATE SEDIMENT BEHIND CHECK DAMS WHEN 4" OR MORE SEDIMENT IS PRESENT.
3. IF INSPECTION REVEALS SEDIMENT IS DISCHARGING BEYOND THE PROJECT WORK LIMITS, IMMEDIATELY IMPLEMENT CORRECTIVE ACTION. ADDITIONAL CHECK DAMS MAY BE REQUIRED.

EROSION & SEDIMENT CONTROL NOTES:

1. REFER TO APPENDIX B OF THE CONTRACT DOCUMENTS FOR THE ENVIRONMENTAL COMMITMENTS.
2. THE LOCATIONS OF TEMPORARY EROSION & SEDIMENT POLLUTION CONTROLS ARE RECOMMENDATIONS. IT IS THE RESPONSIBILITY OF THE CONTRACTOR TO PREPARE AND IMPLEMENT A SWPPP ACCORDING TO SECTION 641 OF THE SPECS.
3. DIVERT WATER FLOW BY NATURAL FLOW OR PUMPING BEFORE WORK ON CULVERT PIPES.
4. DO NOT WORK OR PLACE MATERIAL OUTSIDE THE ROAD PRISM WHILE WORKING ON CULVERT PIPES.

DO NOT SCALE FROM THESE DRAWINGS USE DIMENSIONS


CHECKED BY: C. HOWARD		STATE OF ALASKA DEPARTMENT OF TRANSPORTATION & PUBLIC FACILITIES DESIGN & ENGINEERING SERVICES DIVISION-SOUTHEAST REGION												
		MITKOF HWY PAVEMENT REHABILITATION AND DRAINAGE IMPROVEMENTS PROJECT #68819												
		MISCELLANEOUS DETAILS												
DESIGNED BY: C. IVANISZEK		PROJECT DESIGNATION	YEAR	SHEET NO.	TOTAL SHEETS									
DRAWN BY: B. WILSON		68819	2009	J2	17									
PATH: Q:\PSG\68819\PLANS\ETD\WGU-MISC.DETAILS.DWG TAB: J2 Monday, May 11, 2009 11:21:24 AM WILSON, BRIAN G (DOT)														
<table border="1"> <thead> <tr> <th colspan="3">REVISIONS</th> </tr> <tr> <th>NO.</th> <th>DATE</th> <th>DESCRIPTION</th> </tr> </thead> <tbody> <tr> <td> </td> <td> </td> <td> </td> </tr> </tbody> </table>						REVISIONS			NO.	DATE	DESCRIPTION			
REVISIONS														
NO.	DATE	DESCRIPTION												

JSK
2-1-2010

5-11-09

TRAFFIC CONTROL NOTES

1. MINIMUM OF ONE LANE SHALL REMAIN OPEN AT ALL TIMES IN WORK AREAS.
2. TEMPORARY DRIVING LANES SHALL HAVE A MINIMUM WIDTH OF 10'-0".
3. CONSTRUCTION SIGNING SHALL BE IN PLACE ONLY WHEN THE CONDITIONS EXIST FOR WHICH THE SIGNS ARE INTENDED.
4. CHANNELIZATION DEVICES IF USED AT NIGHT SHALL BE LIT IN ACCORDANCE WITH THE ALASKA TRAFFIC MANUAL.
5. DRIVEWAYS MAY BE CLOSED DURING ACTUAL WORK ON A GIVEN DRIVEWAY, PROVIDED THAT THE CLOSURE DOES NOT EXCEED 8 HOURS AND THE AFFECTED RESIDENTS HAVE BEEN GIVEN 24 HOURS NOTICE OF THE CLOSURE.
6. IT IS THE INTENT OF THIS TRAFFIC CONTROL PLAN (TCP) TO ILLUSTRATE SOME, NOT ALL, OF THE TRAFFIC CONTROL SETUPS WHICH WILL BE REQUIRED ON THIS PROJECT. PLANS FOR CONFIGURATIONS NOT COVERED BY THE TCP SHALL BE CREATED BY THE CONTRACTOR AND SUBMITTED TO THE ENGINEER FOR APPROVAL. WHERE APPROPRIATE, THEY SHALL INCORPORATE APPLICABLE DETAILS FROM THESE SHEETS.
7. ALL TRAFFIC CONTROL PLANS SUBMITTED BY THE CONTRACTOR SHALL BE NUMBERED. ALL TRAFFIC CONTROL PLANS THAT USE A TYPICAL APPLICATION AS DESCRIBED IN THE MUTCD SHALL REFERENCE THE TYPICAL APPLICATION. EXAMPLE: TCP 3, MUTCD TA-10.
8. THE CONTRACTOR SHALL KEEP THE PUBLIC INFORMED OF HIS CONSTRUCTION ACTIVITIES THROUGH THE USE OF THE LOCAL NEWS MEDIA. NEWS RELEASES SHALL BE APPROVED BY THE PROJECT ENGINEER PRIOR TO THEIR RELEASE. NEWS RELEASES WILL BE REQUIRED BUT NOT LIMITED TO, THE ONSET OF WORK, GRINDING, PAVING, AND CHANGES IN THE LANE CONFIGURATIONS.

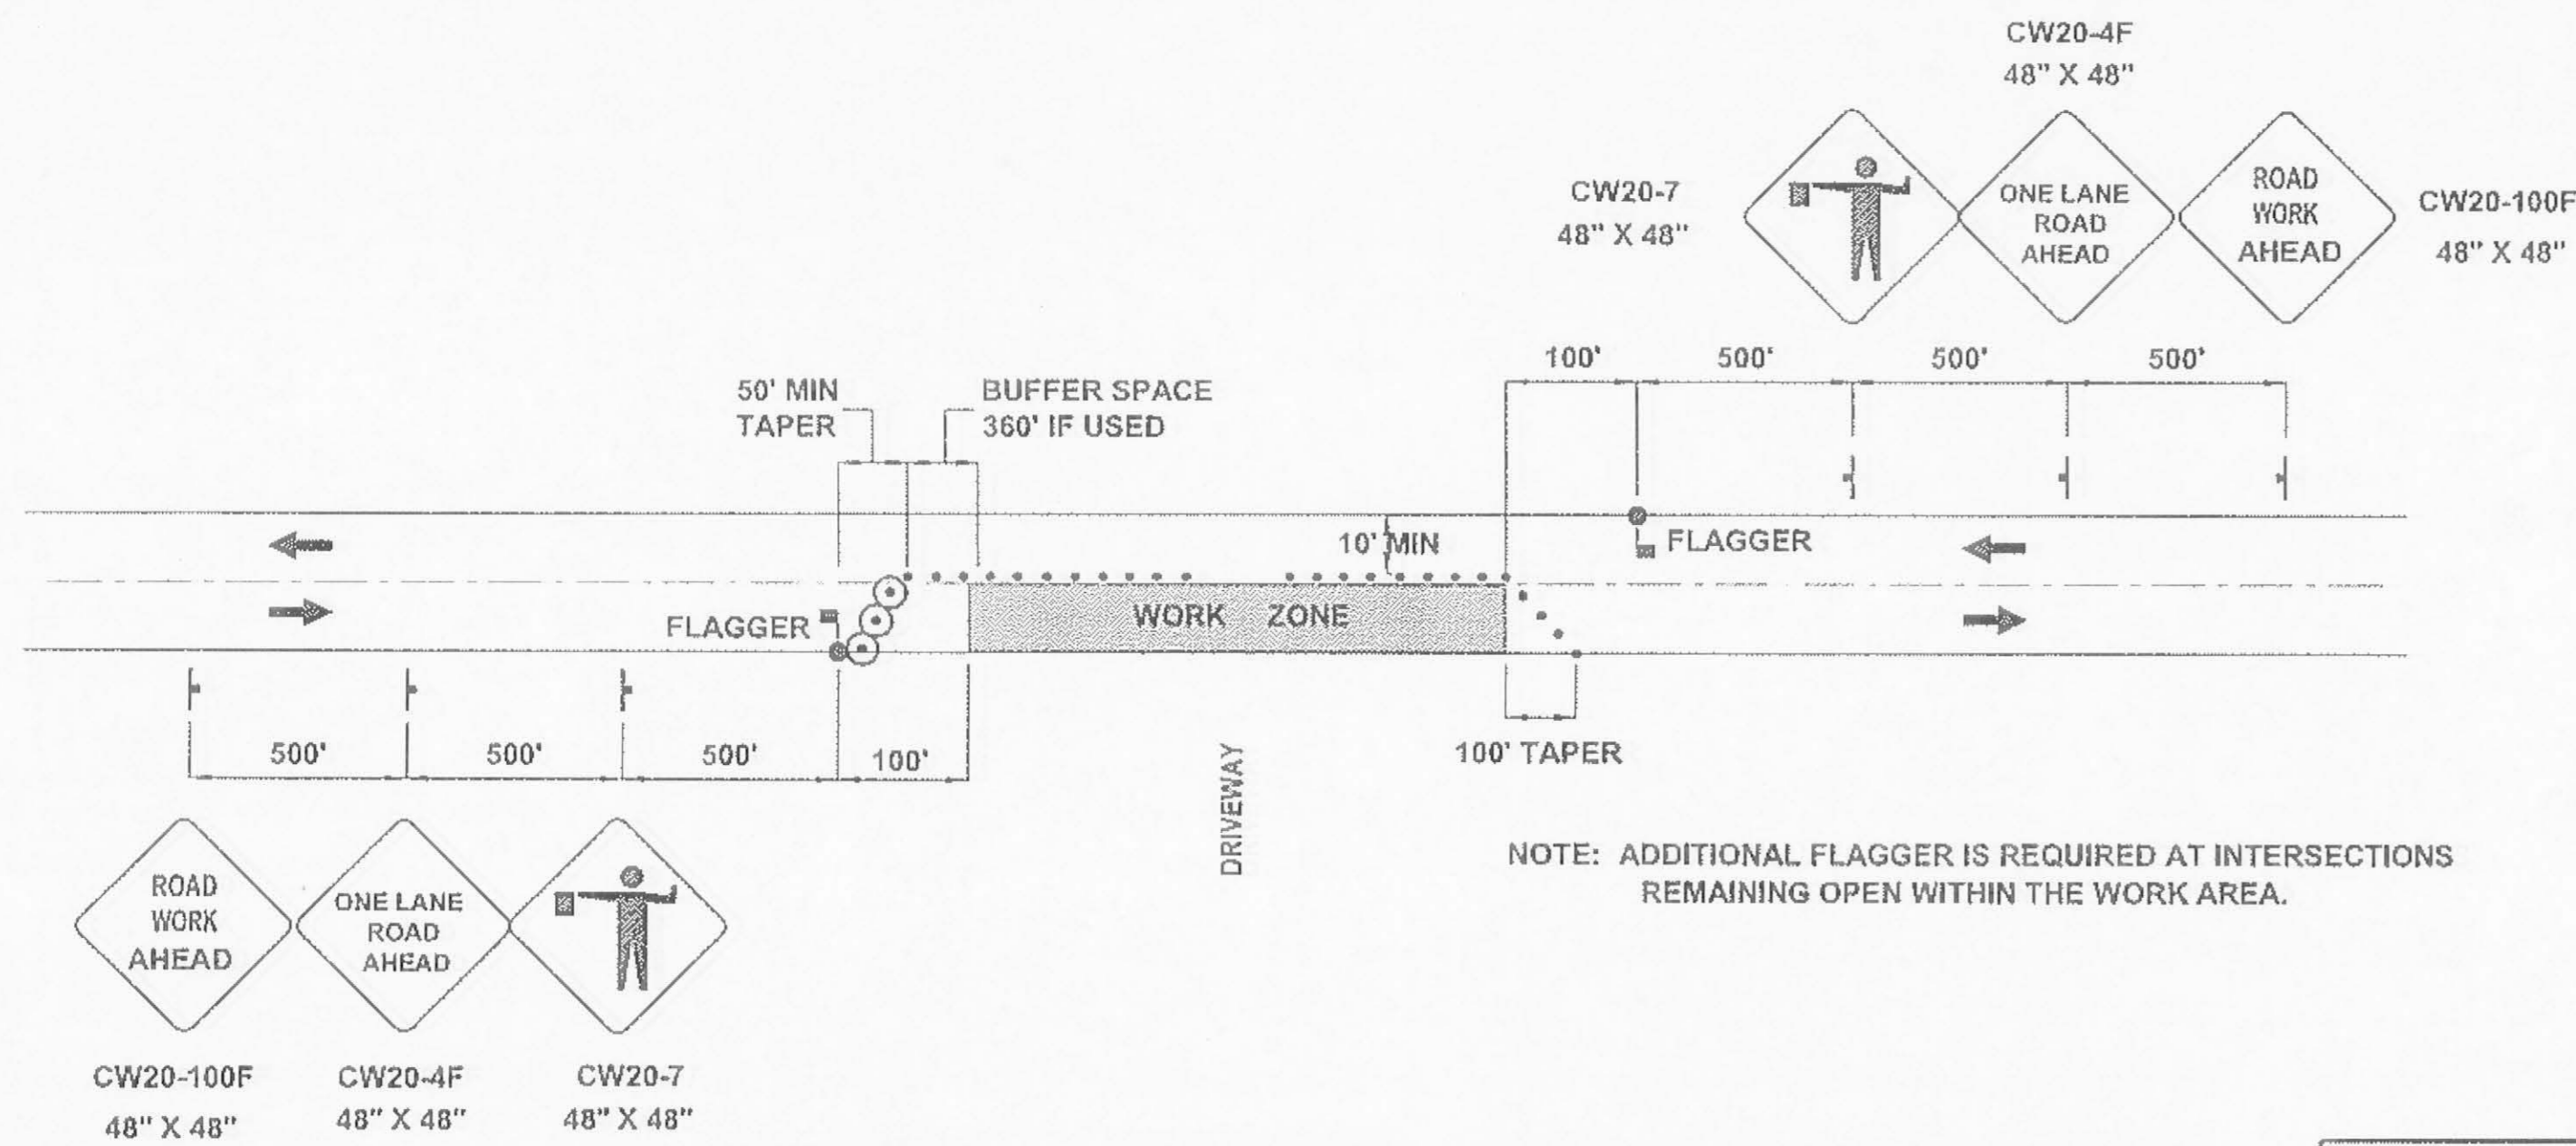

TWO LANE ROADWAY-SINGLE LANE CLOSURE

LEGEND

- SIGN
- CONE
- DRUM
- TYPE III BARRICADE
- FLAGGING STATION

FORMULAS FOR L (TAPER LENGTH)

40 MPH OR LESS $L = \frac{W \times S^2}{60}$


45 MPH OR GREATER $L = W \times S$

WHERE W= WIDTH OF OFFSET
S= POSTED SPEED LIMIT

DRUM OR CONE SPACING = S (IN FEET)


S	MIN. BUFFER LENGTH
20	35
25	55
30	85
35	120
40	170
45	220
50	280
55	335
60	415
65	485

* NO PARKING WITHIN 200' OF CONES

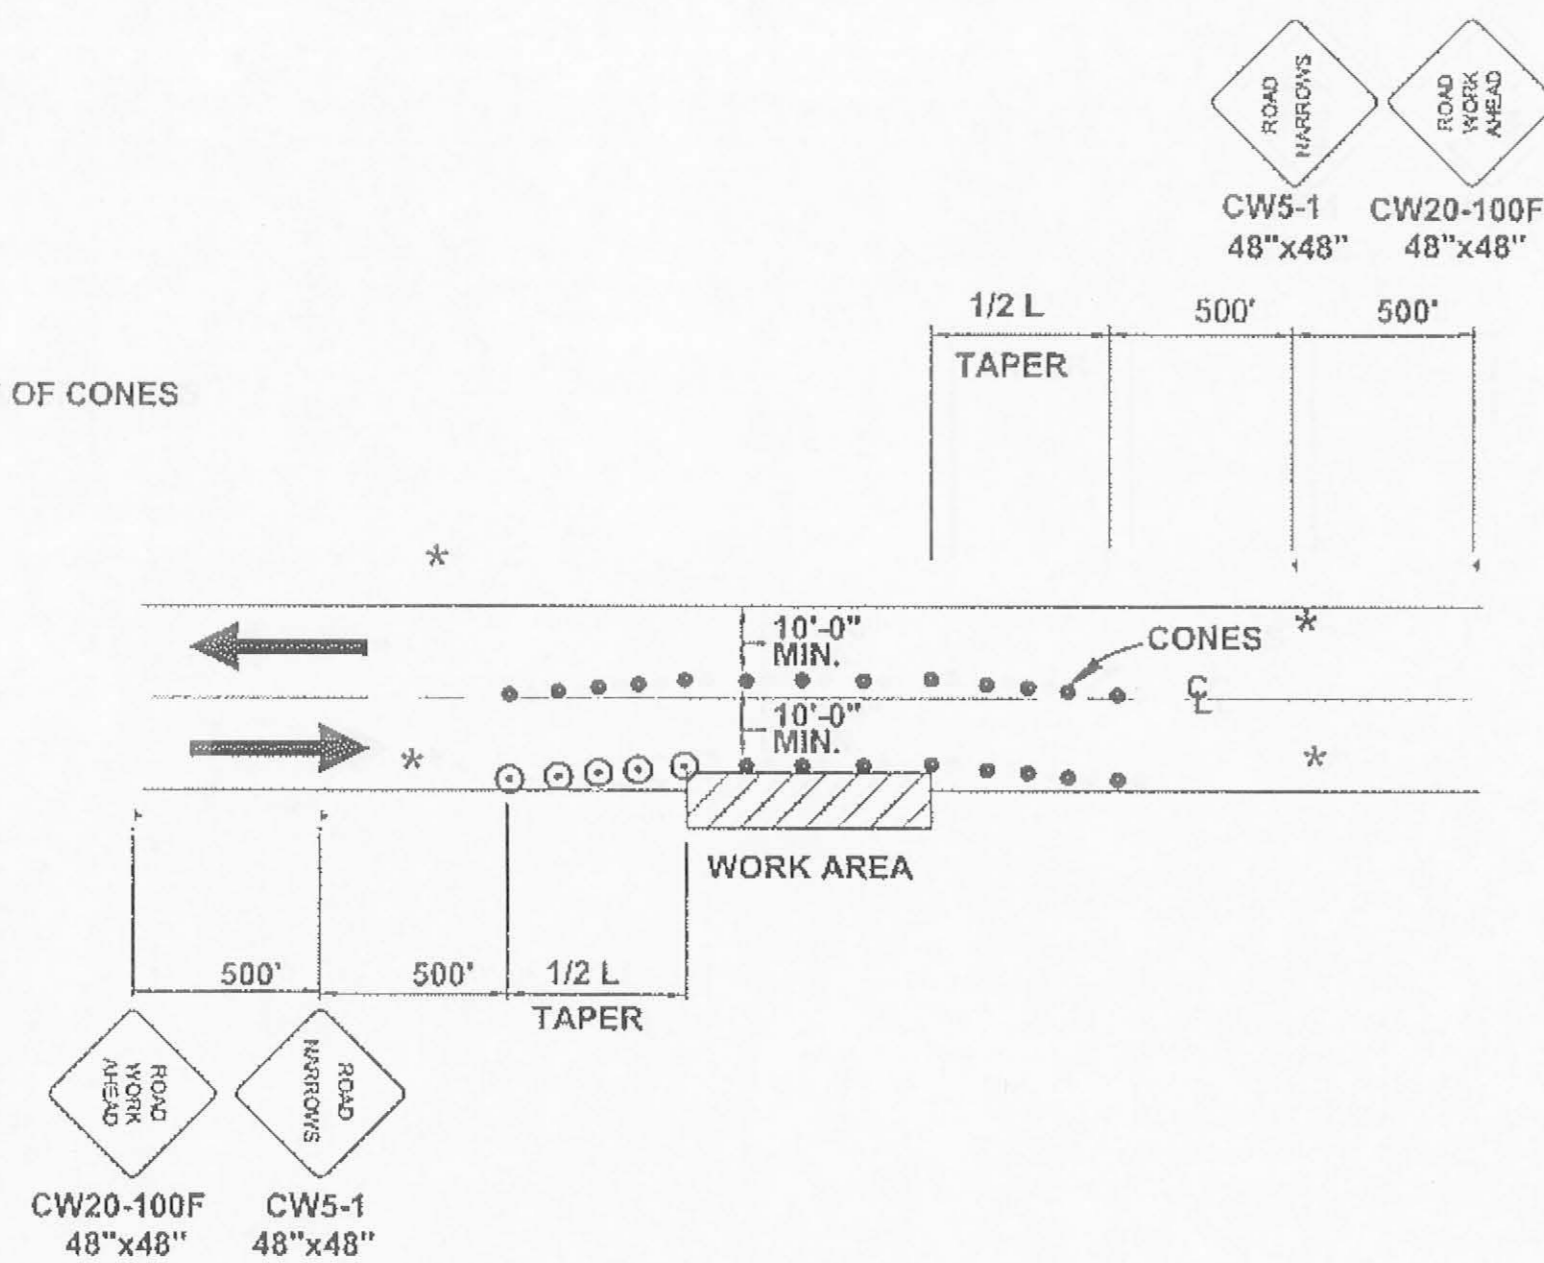

ROADWAY ENCROACHMENT

NOTE: IF ONLY ONE LANE IS EFFECTED BY ROAD WORK (THAT IS, THE CONES ALONG THE WORK AREA ARE NO CLOSER THAN 10' TO CENTERLINE) THE CENTERLINE CONES FOR THE OPPOSING LANE MAY BE DELETED.

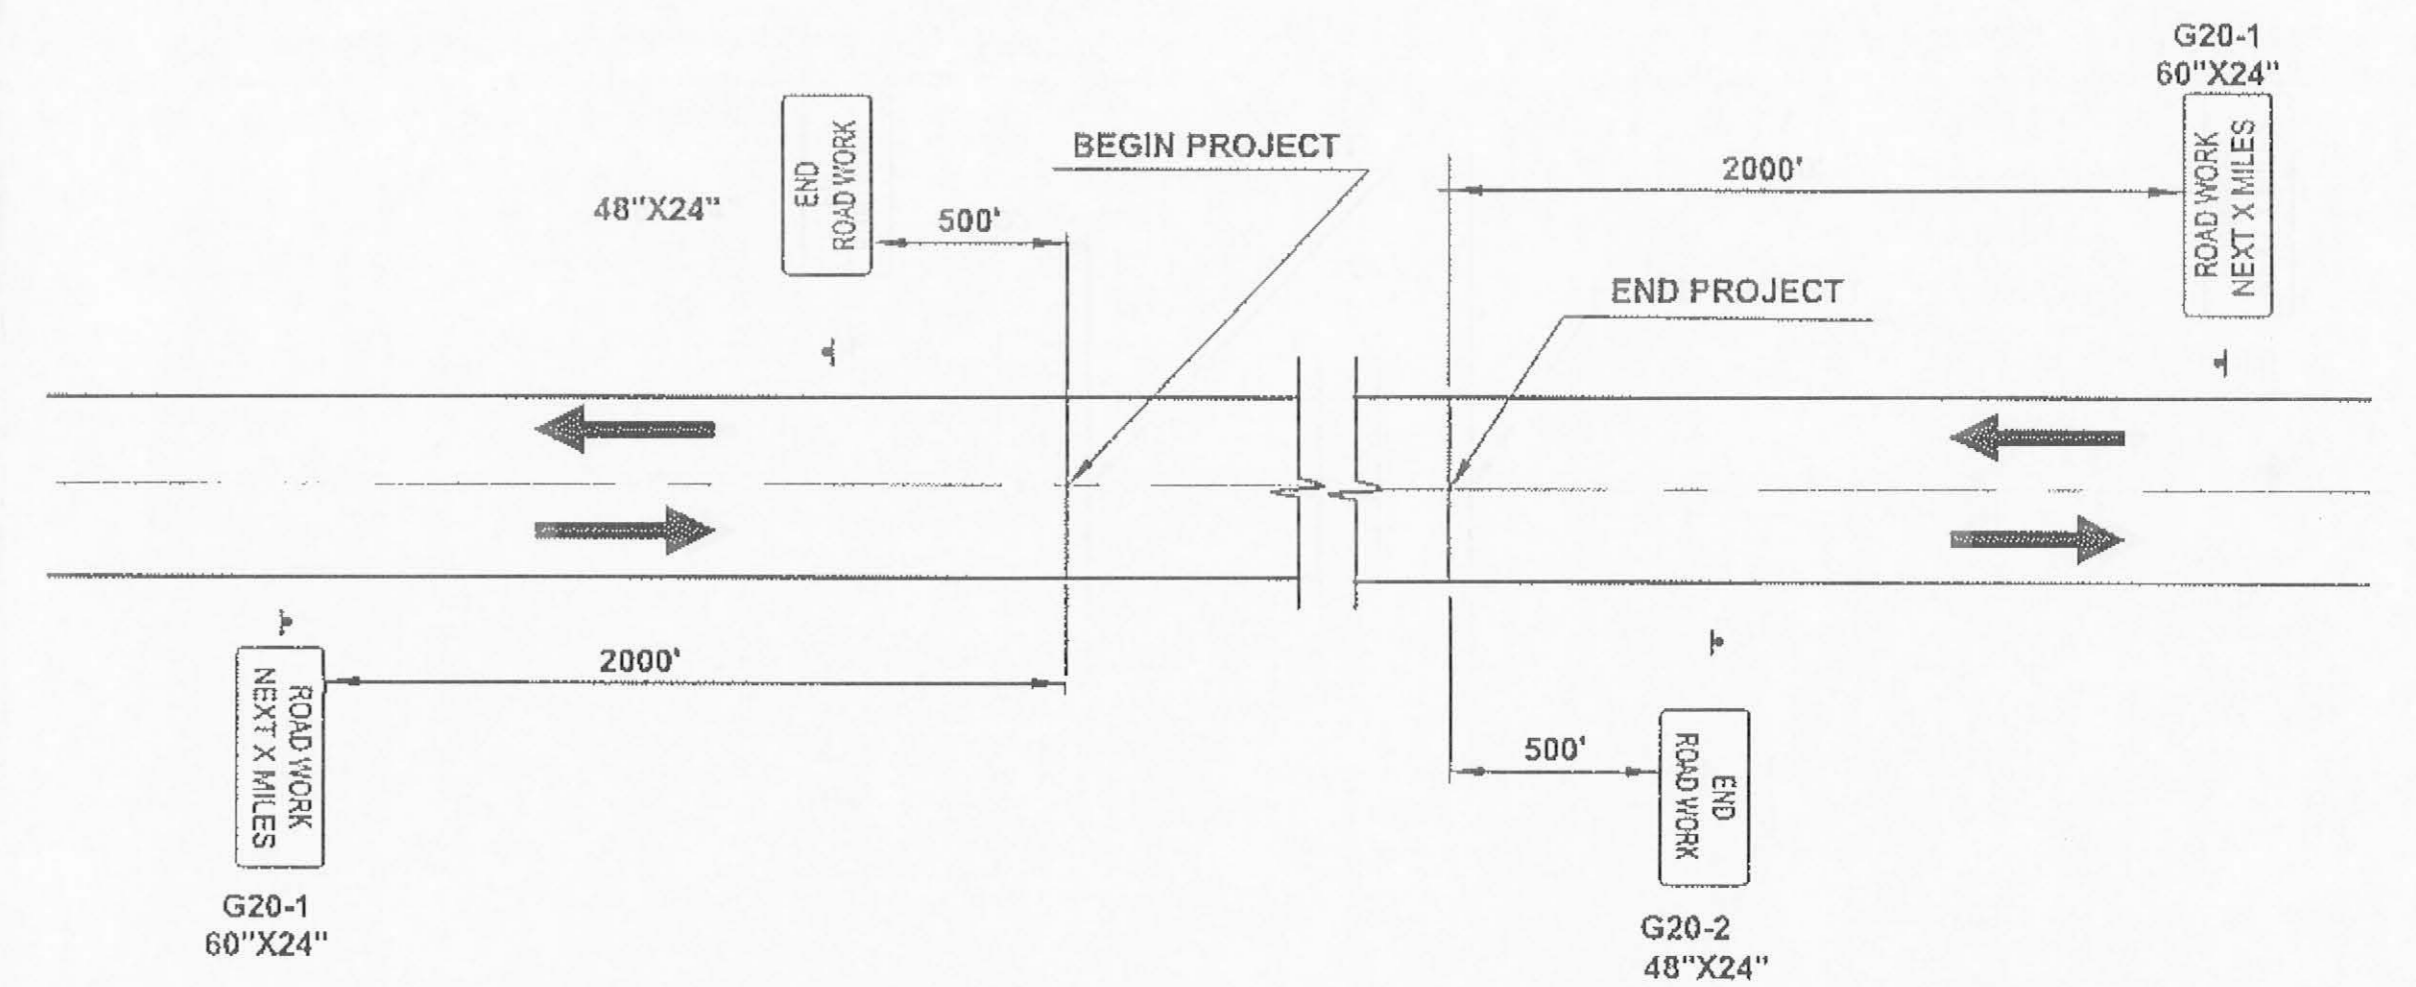

PERMANENT CONSTRUCTION SIGNING

DO NOT SCALE FROM THESE DRAWINGS USE DIMENSIONS

CHECKED BY: C. HOWARD 		STATE OF ALASKA DEPARTMENT OF TRANSPORTATION & PUBLIC FACILITIES DESIGN & ENGINEERING SERVICES DIVISION-SOUTHEAST REGION	
DESIGNED BY: C. IVANISZEK DRAWN BY: B. WILSON		MITKOF HWY PAVEMENT REHABILITATION AND DRAINAGE IMPROVEMENTS PROJECT #68819	
PATH: Q:\PSG\68819\PLANSET\DWGS-TRAFFIC CONTROL.DWG TAB: S1 Monday, May 11, 2009 11:22:30 AM WILSON, BRIAN G.(DOT)		TRAFFIC CONTROL PLAN	
REVISIONS NO. DATE DESCRIPTION		PROJECT DESIGNATION 68819	YEAR 2009
		SHEET NO. S1	TOTAL SHEETS 17

JSK
2-1-2010