

STATE OF ALASKA
DEPARTMENT OF TRANSPORTATION
AND
PUBLIC FACILITIES
SOUTHEAST REGION
DESIGN AND CONSTRUCTION DIVISION

PETERSBURG, ALASKA

**TWIN CREEK
CULVERT REPLACEMENT
PROJECT NO. STP-0937(26)/71646**

**BRIDGE, EXCAVATION,
PAVING & GUARDRAIL CONNECTIONS**

INDEX OF SHEETS	
SHEET NO.	DESCRIPTION
1	TITLE SHEET
2	TYPICAL SECTIONS OF IMPROVEMENT
3	ESTIMATE OF QUANTITIES
4	BRIDGE RAILING & GUARDRAIL PLAN
5	EROSION AND SEDIMENT CONTROL
6	TRAFFIC CONTROL PLAN - BRIDGE DETOUR PLAN
7	TRAFFIC CONTROL PLAN
8-14	TWIN CREEK BRIDGE PLANS <small>ZEROX COPIES OF THESE 7 SHEETS ARE INCLUDED, ORIGINALS ARE AT HEADQUARTERS (BRIDGE DESIGN).</small>
15-16	TEST HOLE LOGS


THE FOLLOWING STANDARD DRAWINGS APPLY TO THIS PROJECT:
A-1, C-01.03, C-02.01, G-04.04S, G-04.05W, G-09.01S, G-09.02W, G-14.04S,
G-14.04W, G-18.00S, G-18.00W, G-29.01S, G-29.01W, S-05.00, S-20.00,
T-20.00

DESIGN DESIGNATION

A.D.T. 1995.....580
A.D.T. 2015.....640
D.H.V. 13.6%.....90
% T.....3.3%
V.....50 M.P.H.
E.A.L.100,000

DESIGN DESIGNATION

LENGTH OF PROJECT = 135'
LENGTH OF PAVING = 135'
WIDTH OF PAVING = 36' TO 32'

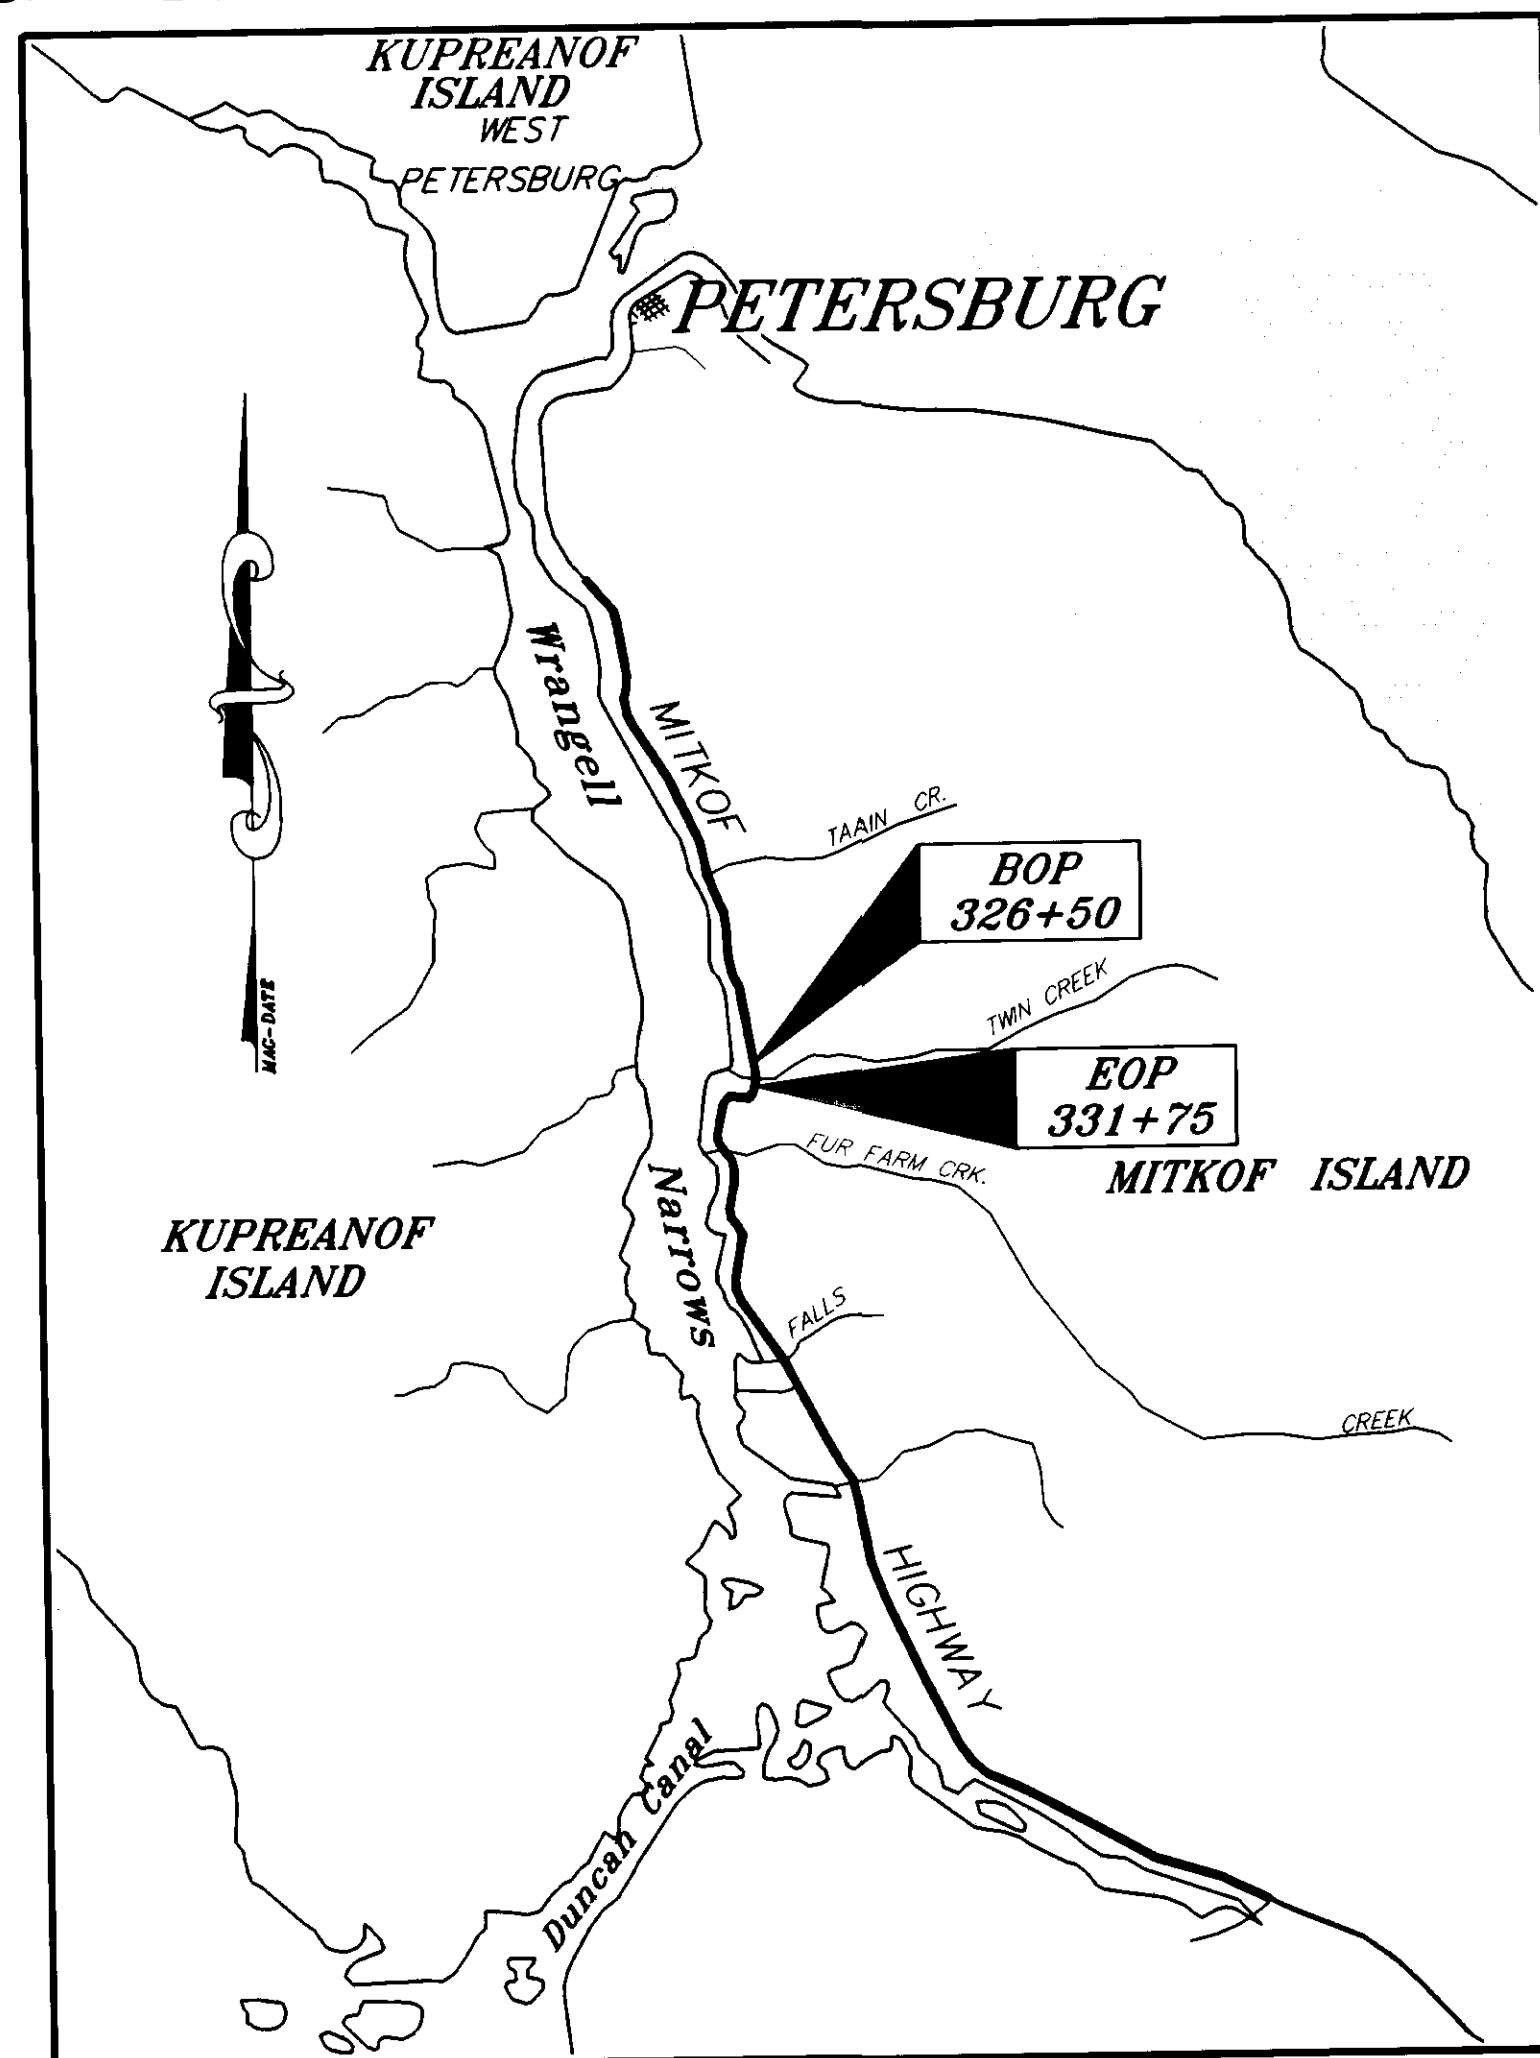

VICINITY MAP

ASBUILT PLANS

CONTRACTOR: ROCK-η-ROAD CONST.
ORIGINAL CONTRACT AMOUNT: \$655,980.00
PROJECT ENGR.: THAD HOPPER
START DATE: 6-11-96
END DATE: 9-16-96

AS-BUILT
BY: KK DATE: 7/27/99

STATE OF ALASKA
DEPARTMENT OF TRANSPORTATION
AND
PUBLIC FACILITIES
SOUTHEAST REGION DESIGN SECTION

APPROVED Date 7/17/95
Regional Preconstruction Engineer


APPROVED Date 7/17/95
Director, S.E. Region Design & Construction

PROJECT NUMBER: 71646	ENGINEER'S SEAL
DATE: 1995	
SHEET 1 OF 16	

6895 PLANS SET #1541
REVISED 7/27/99
LT K.K. 7/27/99

GENERAL NOTES

1. VERTICAL AND HORIZONTAL ALIGNMENTS SHOWN ON THESE PLANS ARE SUBJECT TO MINOR REVISIONS.
2. THE LOCATION OF ALL UTILITIES SHOWN ON THESE PLANS ARE APPROXIMATE ONLY, AND SHOULD BE VERIFIED BY CONTRACTOR.
3. ALL WASTE MATERIAL SHALL BE PLACED OUTSIDE THE PROJECT LIMITS AT A LOCATION PROVIDED BY THE CONTRACTOR AND APPROVED BY THE ENGINEER.

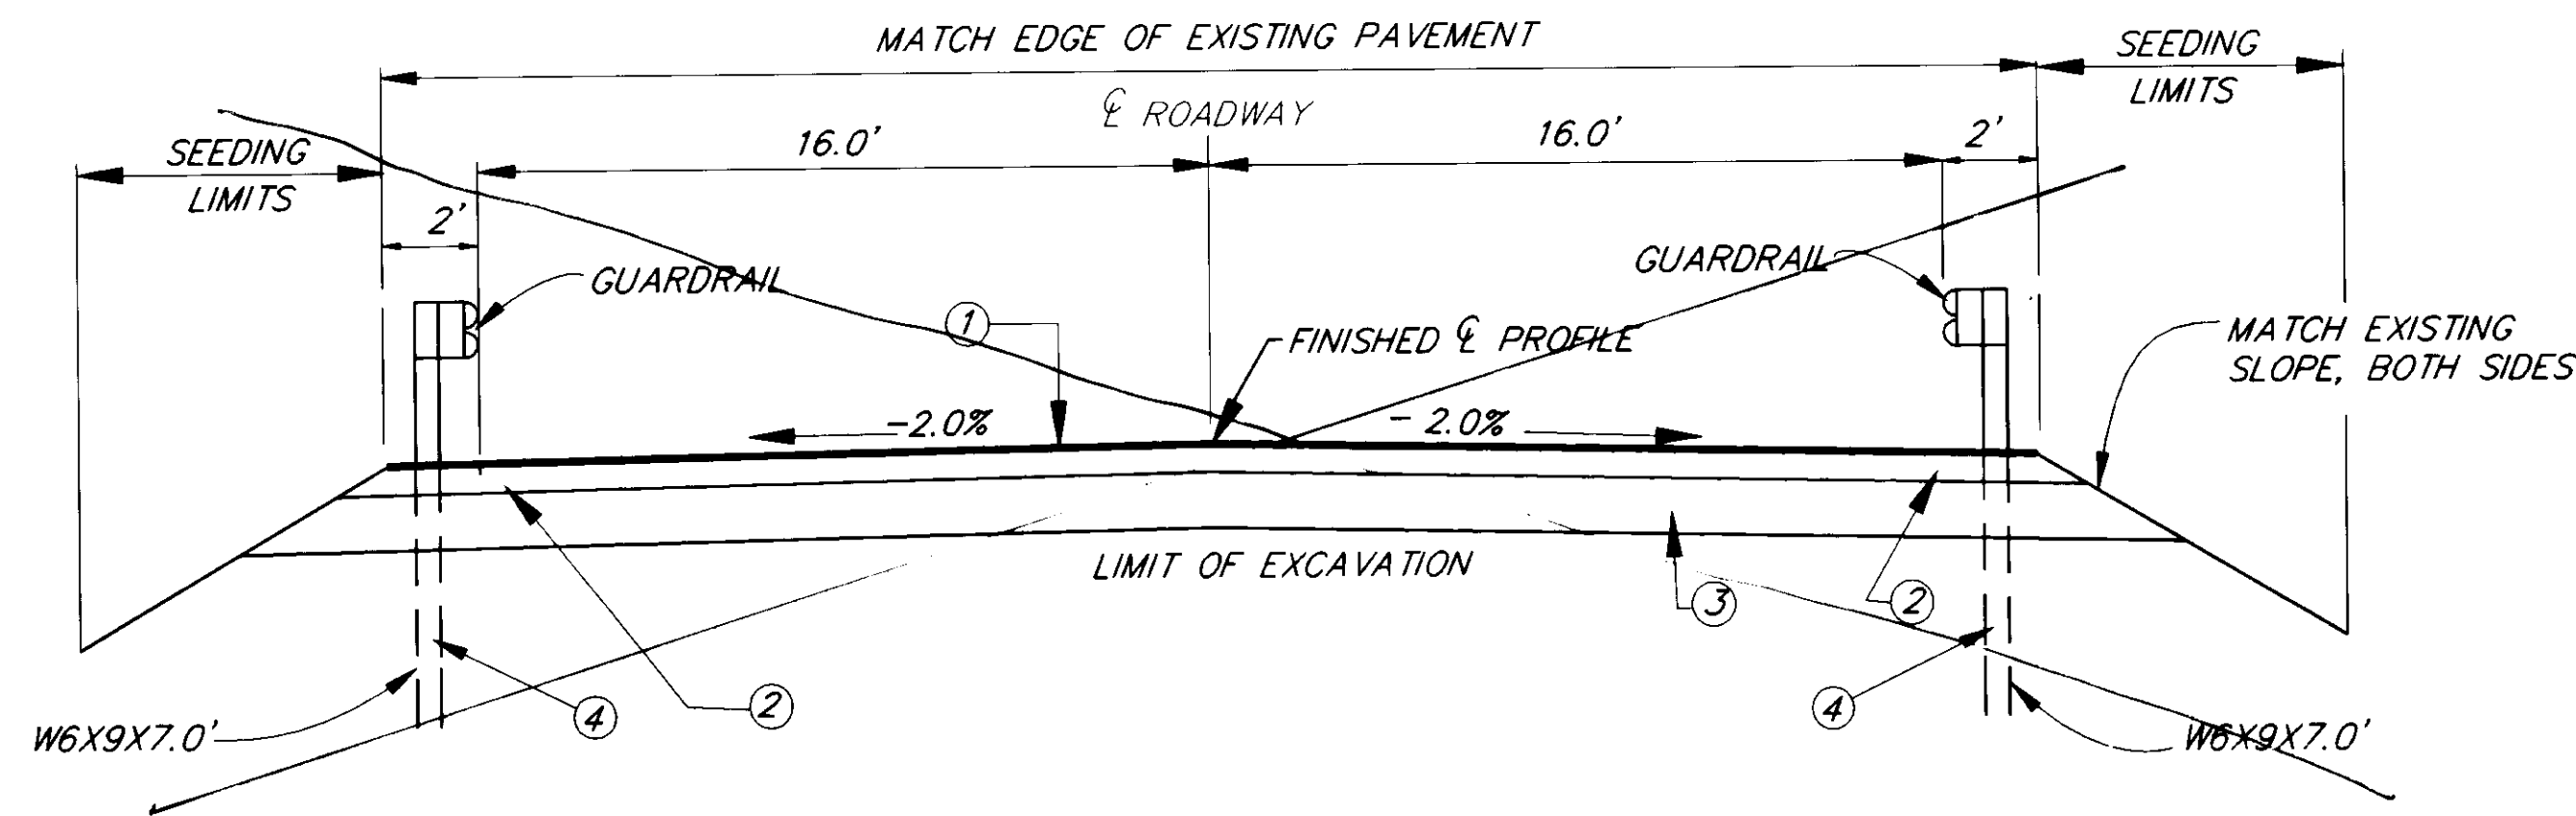

TYPICAL RECONSTRUCTION AREA SECTION

STA. "0" 328+50 TO 328+70 & STA. "0" 329+65 TO 329+85

BASIS OF SURVEY CONTROL

HORIZONTAL CONTROL


THE BASIS OF CONTROL IS THE BEARING BETWEEN DOT/PF HIGHWAY MONUMENTS MH-16 (PROJECT COORDINATES OF N 84117.956, E 210985.685) AND MH-17 (PROJECT COORDINATES OF N 82042.523, E 210940.498) OF S 1° 14' 50" W

MH-16 IS A DOT/PF MONUMENT IN A ALUMINUM CASE SET IN THE LEFT SHOULDER OF MITKOF HIGHWAY AT STATION 318+55, 13.10' LT.

MH-17 IS A DOT/PF MONUMENT IN A ALUMINUM CASE SET IN THE LEFT SHOULDER OF MITKOF HIGHWAY AT STATION 339+30, 13.0' LT.

VERTICAL CONTROL

THE BASIS OF VERTICAL CONTROL IS THE TOP OF THE BRASS CAP IN AN ALUMINUM CASE, DESIGNATED AS MH-16 HAVING AN ELEVATION OF 62.74' M.L.L.W. AS DETERMINED DURING PROJECT 70265 MITKOF HIGHWAY SCOW BAY TO PAPKE'S LANDING.

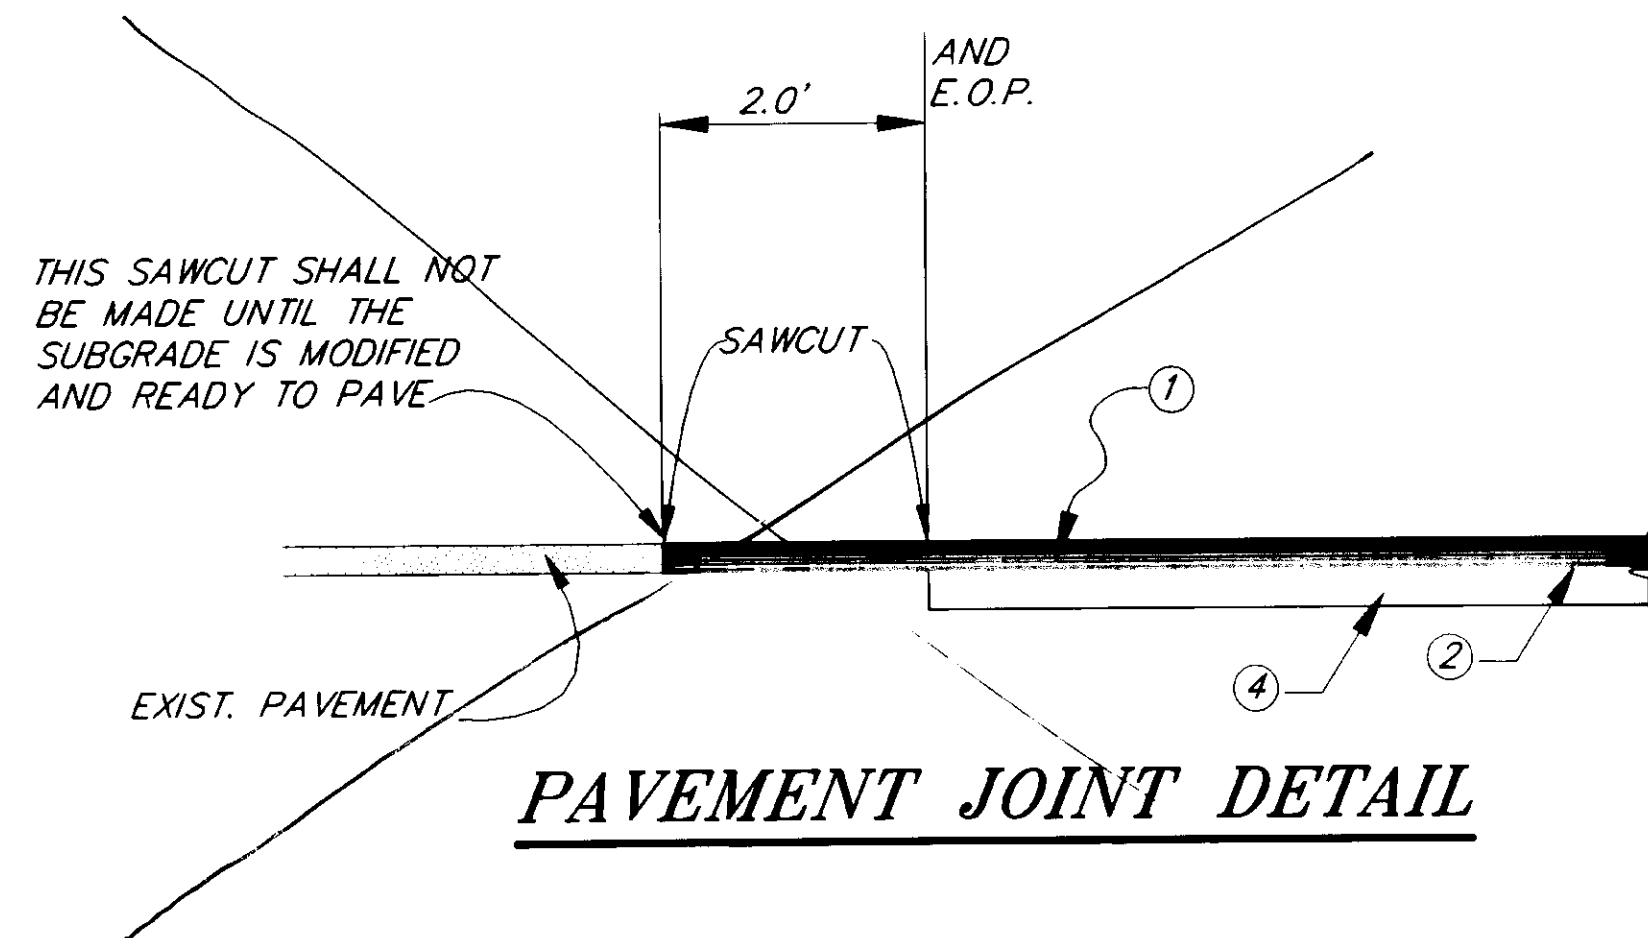

PAVEMENT JOINT DETAIL

THIS SAWCUT SHALL NOT BE MADE UNTIL THE SUBGRADE IS MODIFIED AND READY TO PAVE

THIS SHEET REPLACED BY ATTACHMENT #3, ADDENDUM # 2.

LABELING INDEX

①	2" ASPHALT PAVEMENT
②	4" CRUSHED AGGREGATE BASE COURSE
③	14" BORROW, TYPE "A"
④	STEEL POST GUARDRAIL

BASIS OF ESTIMATE

ITEM NO.	ESTIMATING FACTOR
203(1)	1.85 TONS/CY.
301(1)	1.96 TONS/CY.
401(1)	116 LBS/YD ² IN DEPTH
401(2)	6.0% OF 401(1)
403(1)	0.25 GAL/YD. ² 256 GAL/TON

AS-BUILT

BY: JK DATE: 7/27/94

NOTE: DO NOT SCALE FROM THESE PLANS-USE DIMENSIONS

BY:	DATE:	DESCRIPTION OF CHANGE:

RECORD OF REVISIONS

STATE OF ALASKA
DEPARTMENT OF TRANSPORTATION
AND PUBLIC FACILITIES
SOUTHEAST REGION DESIGN & CONSTRUCTION


Petersburg

PSG-Twin Creek
Culvert Replacement
STP-0937 (26) 71646

Alaska


DESIGNED BY:	M. SHEELER	PROJECT NO.	71646
DRAWN BY:	M. SHEELER	DATE:	1995
CHECKED BY:	A.J. STEININGER	SHEET	2 OF 16

TYPICAL SECTIONS OF IMPROVEMENT

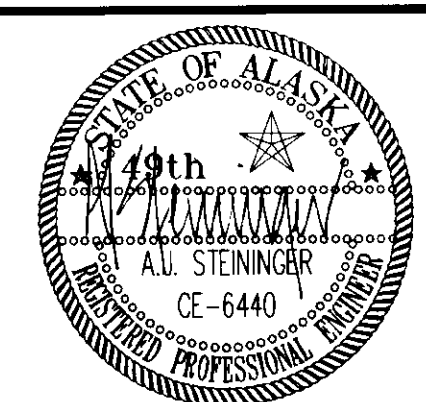


ESTIMATE OF QUANTITIES

ITEM NO.	ITEM	UNIT	QUANTITY
120(1)	DBE ADJUSTMENT	CONTINGENT SUM	ALL REQUIRED
202(12)	REMOVAL OF PAVEMENT (APPROX. 510 S.Y.)	LUMP SUM	ALL REQUIRED
202(13)	REMOVAL OF CULVERT PIPE (APPROX. 234 L.F.)	LUMP SUM	ALL REQUIRED
203(11)	UNCLASSIFIED EXCAVATION (5,000 C.Y.)	LUMP SUM	ALL REQUIRED
301(3)	CRUSHED AGGREGATE BASE COURSE (APPROX. 17 TONS)	LUMP SUM	ALL REQUIRED
401(1)	ASPHALT CONCRETE PAVEMENT (APPROX. 64.2 TONS)	LUMP SUM	ALL REQUIRED
401(2)	ASPHALT CEMENT (APPROX. 3.8 TONS)	LUMP SUM	ALL REQUIRED
501(1)	CLASS A CONCRETE	LUMP SUM	ALL REQUIRED
502(1)	PRESTRESSED CONCRETE STRUCTURAL MEMBERS (93'-2" BULB TEES)	EACH	6
503(1)	REINFORCING STEEL	LUMP SUM	ALL REQUIRED
505(5)	STRUCTURAL STEEL PILES, FURNISHED	LINEAR FOOT	432 373.5
505(6)	STRUCTURAL STEEL PILES, DRIVEN	EACH	12
507(1)	METAL BRIDGE RAILING	LINEAR FOOT	190
508(1)	MEMBRANE WATERPROOFING	LUMP SUM	ALL REQUIRED
606(1)	W-BEAM GUARDRAIL	LINEAR FOOT	550 521.85
606(2)	THREE BEAM GUARDRAIL	LINEAR FOOT	75
606(5)	REMOVAL AND DISPOSAL OF GUARDRAIL	LINEAR FOOT	811 690.6
606(6)	END ANCHORAGES	EACH	4
611(1)	RIPRAP, CLASS II	CUBIC YARD	990 862.9
631(2)	GEOTEXTILE EROSION CONTROL, CLASS A	SQUARE YARD	1330 1074.8
633(1)	GEOTEXTILE SEDIMENT CONTROL	LINEAR FOOT	300 299
640(1)	MOBILIZATION AND DEMOBILIZATION	LUMP SUM	ALL REQUIRED
641(1)	EROSION & POLLUTION CONTROL ADMINISTRATION	LUMP SUM	ALL REQUIRED
641(2)	EROSION & POLLUTION CONTROL	LUMP SUM	ALL REQUIRED
642(1)	CONSTRUCTION SURVEYING	LUMP SUM	ALL REQUIRED
643(2)	TRAFFIC MAINTENANCE	LUMP SUM	ALL REQUIRED
643(4)	CONSTRUCTION SIGN	EACH PER DAY	500 1340
643(6)	TYPE III BARRICADE	EACH PER DAY	500 326
643(7)	TRAFFIC CONE	EACH PER DAY	3,000 2319
643(8)	DRUM	EACH PER DAY	1,000 909
643(15)	FLAGGING	LUMP SUM	ALL REQUIRED
643(30)	BRIDGE DETOUR CROSSING	LUMP SUM	ALL REQUIRED

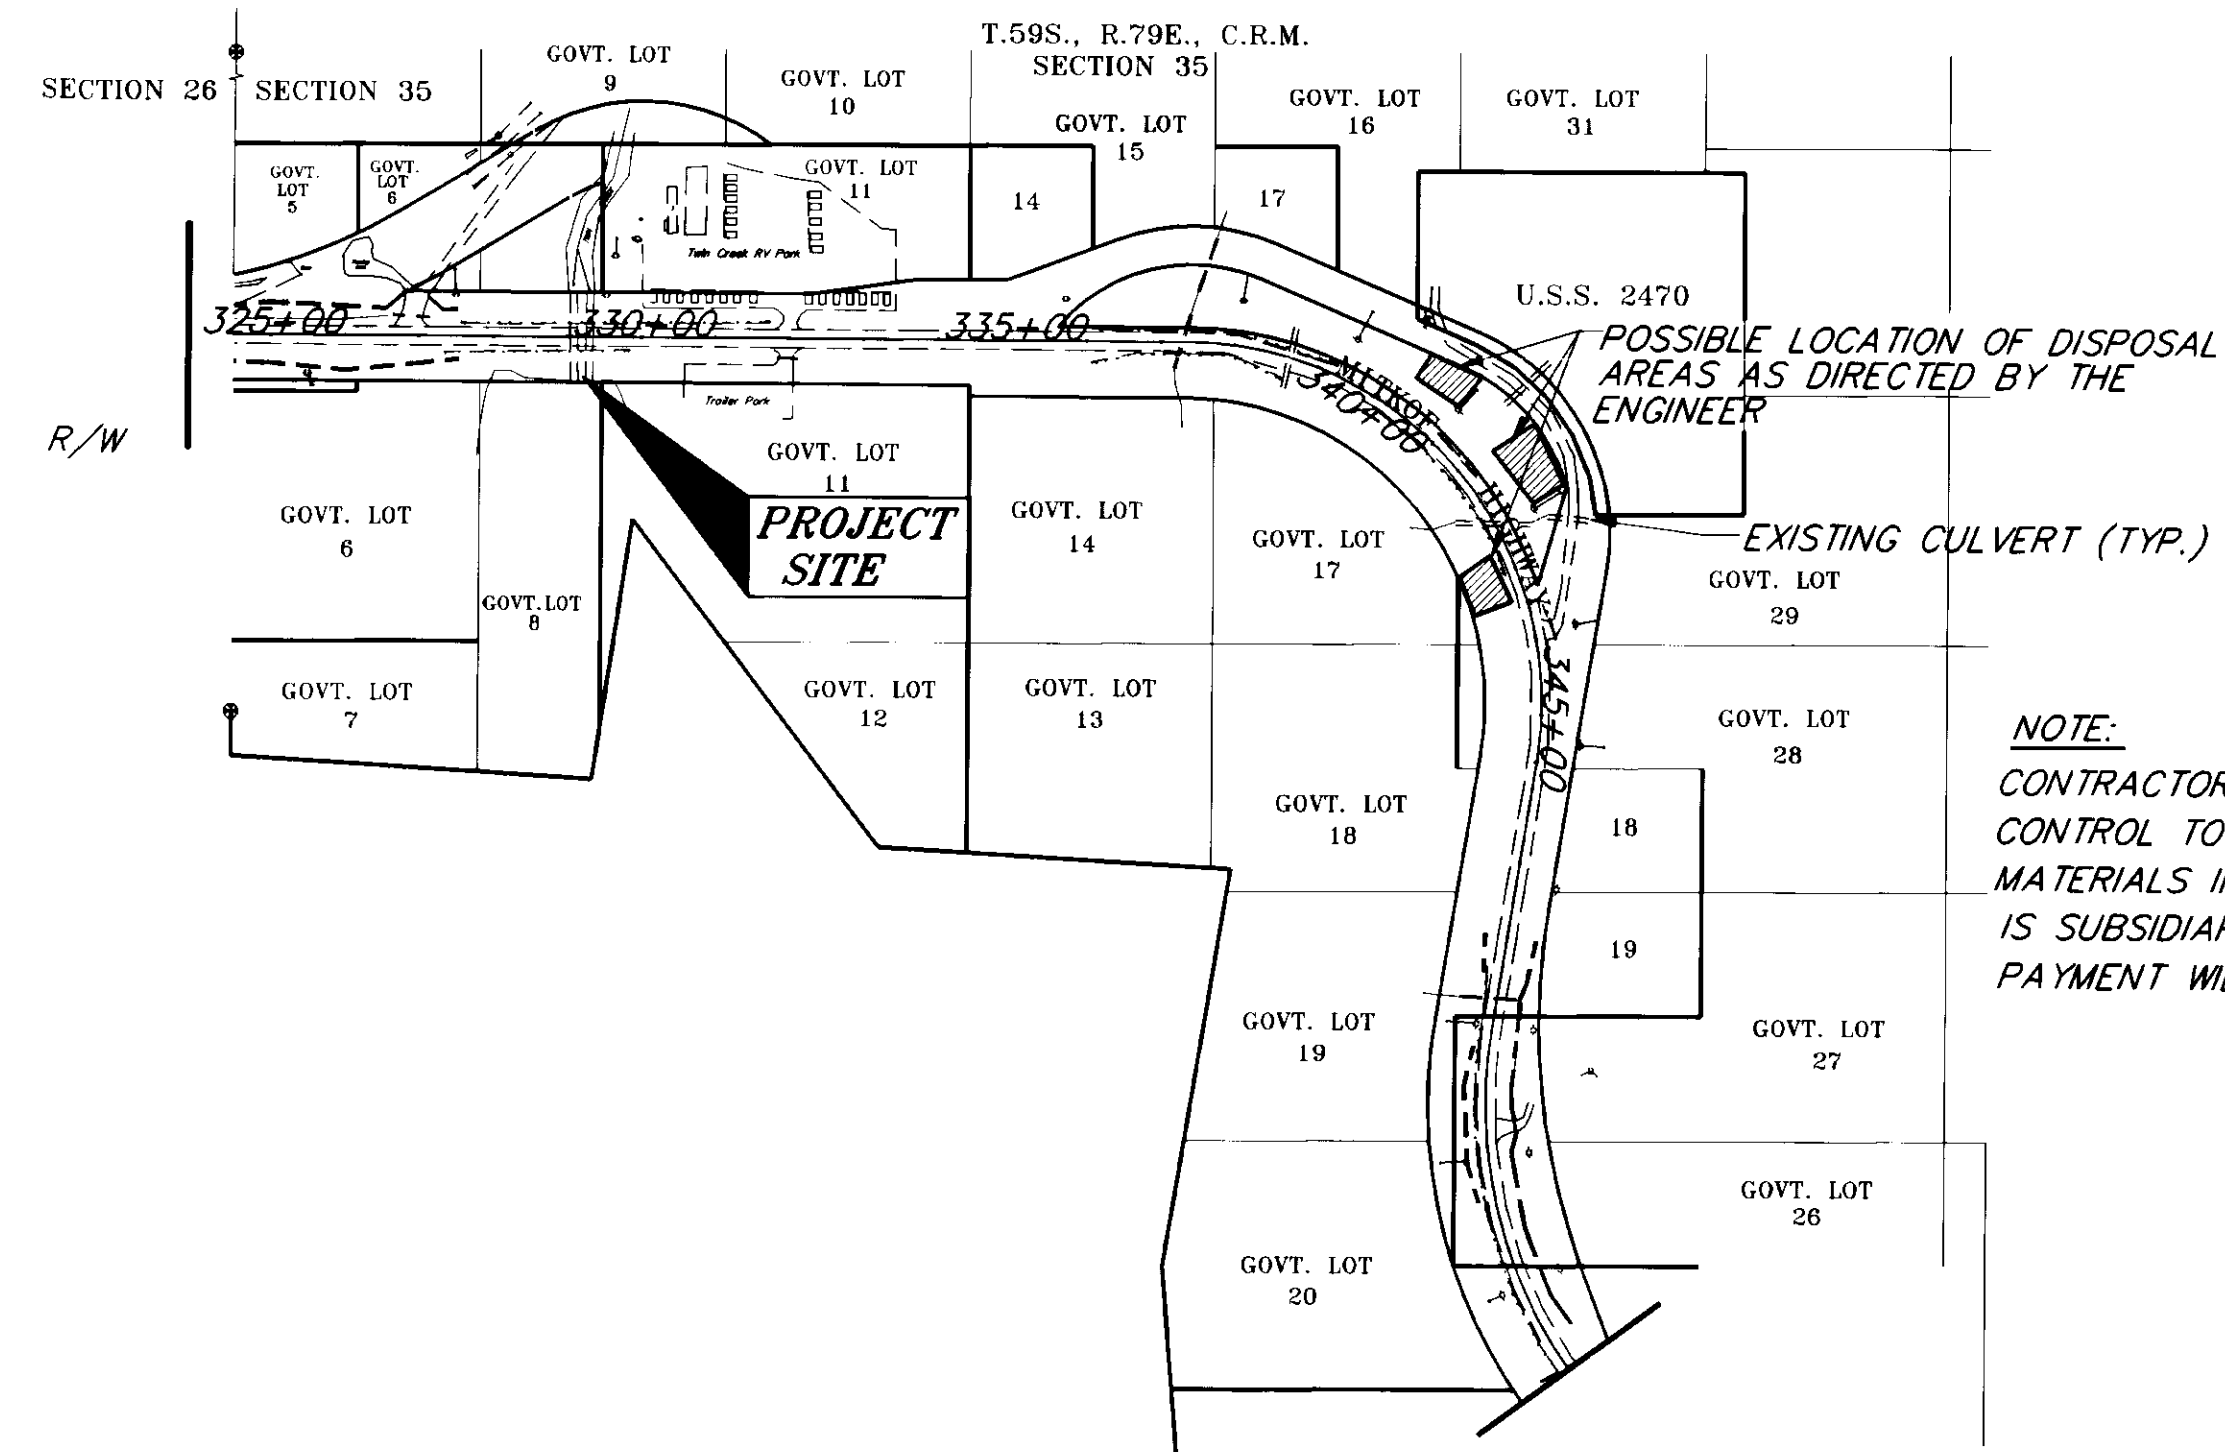

NOTE:
CONTRACTOR SHALL PROVIDE EROSION AND SEDIMENT CONTROL TO PREVENT POLLUTION AND DEPOSITION OF MATERIALS INTO ADJACENT WATER COURSES. THIS WORK IS SUBSIDIARY TO WASTE DISPOSAL AND NO ADDITIONAL PAYMENT WILL BE MADE.

POSSIBLE WASTE DISPOSAL AREA

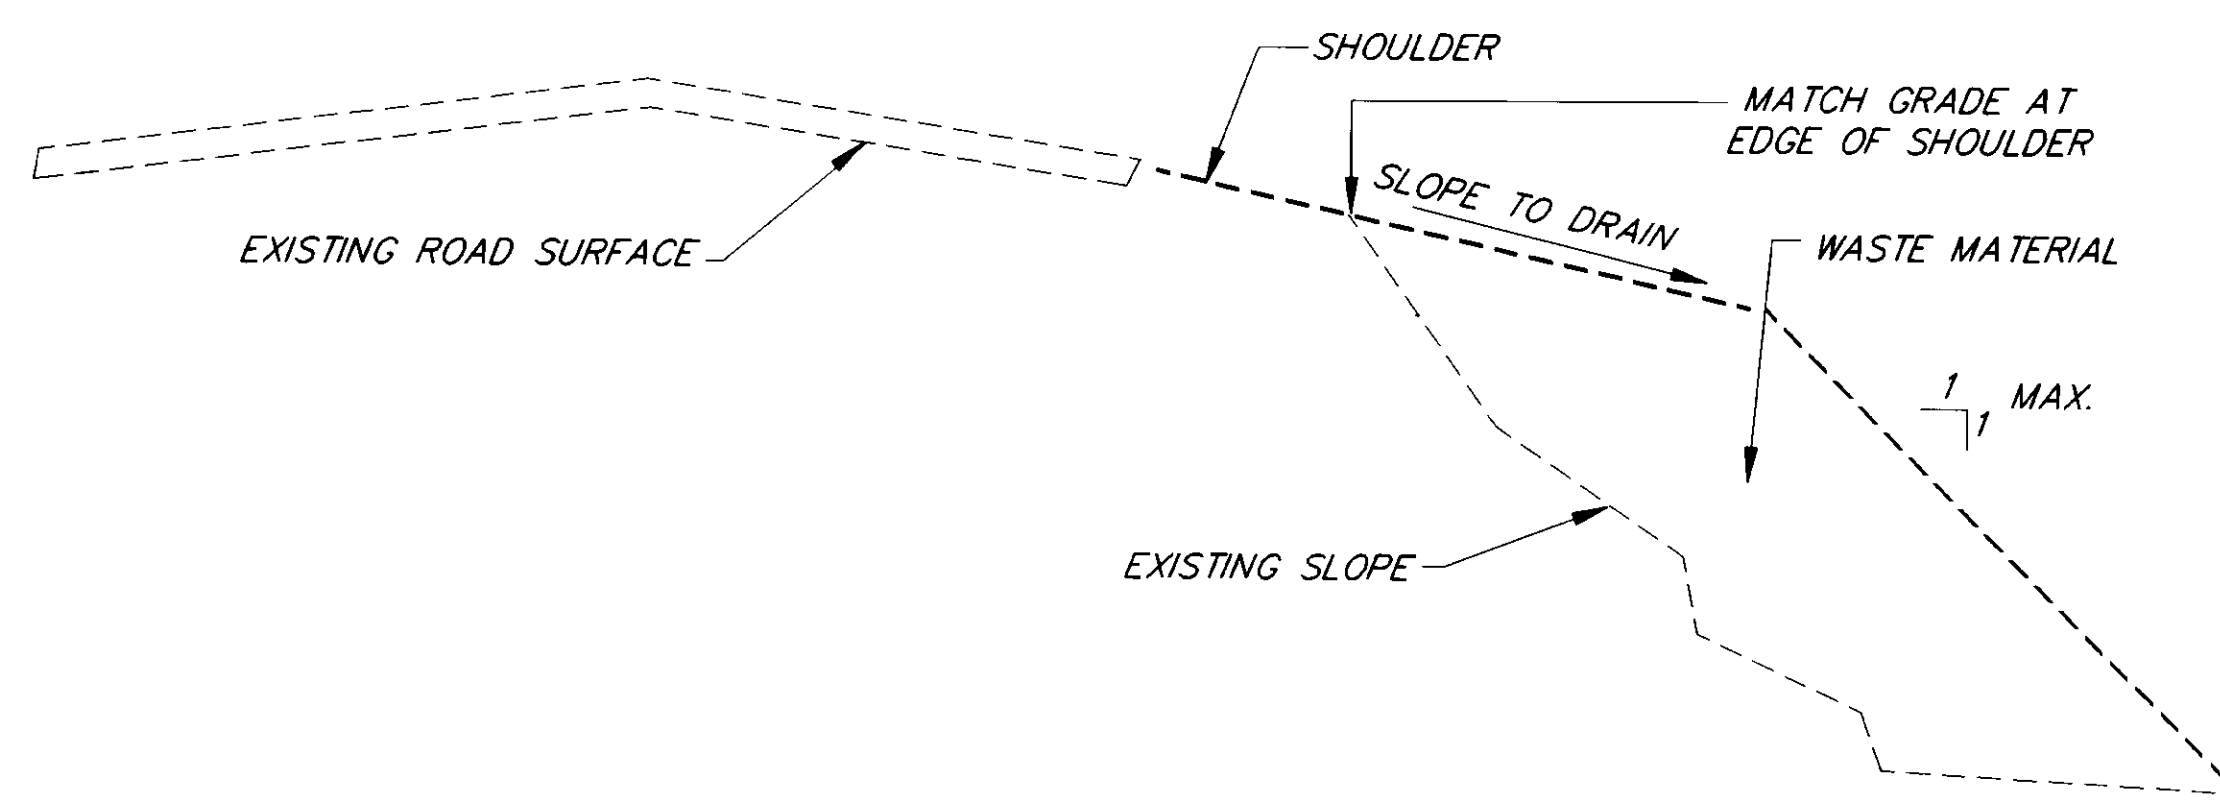

TYPICAL SECTION WASTE DISPOSAL AREA

AS-BUILT
BY: KK DATE: 7/27/99

P:\PSG\71646\951\PLANSET\#EST

BY:	DATE:	DESCRIPTION OF CHANGE:
KK	7/27/99	AS-BUILT WITH CORRECTIONS

RECORD OF REVISIONS


STATE OF ALASKA
DEPARTMENT OF TRANSPORTATION
AND PUBLIC FACILITIES
SOUTHEAST REGION DESIGN & CONSTRUCTION



PETERSBURG

PSG- Twin Creek
Culvert Replacement
STP-0937 (26) ~ 71646
ESTIMATE OF QUANTITIES

NOTE: DO NOT SCALE FROM THESE PLANS-USE DIMENSIONS

DESIGNED BY: M. SHEELER	PROJECT NO. 71646
DRAWN BY: K. KLEMMETSON	DATE: 1995
CHECKED BY: A.J. STEININGER	SHEET 3 OF 16

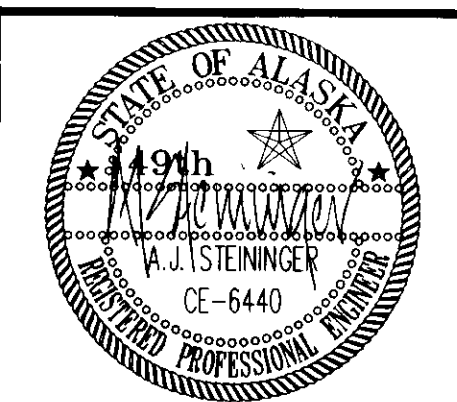

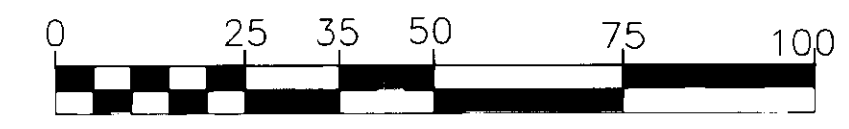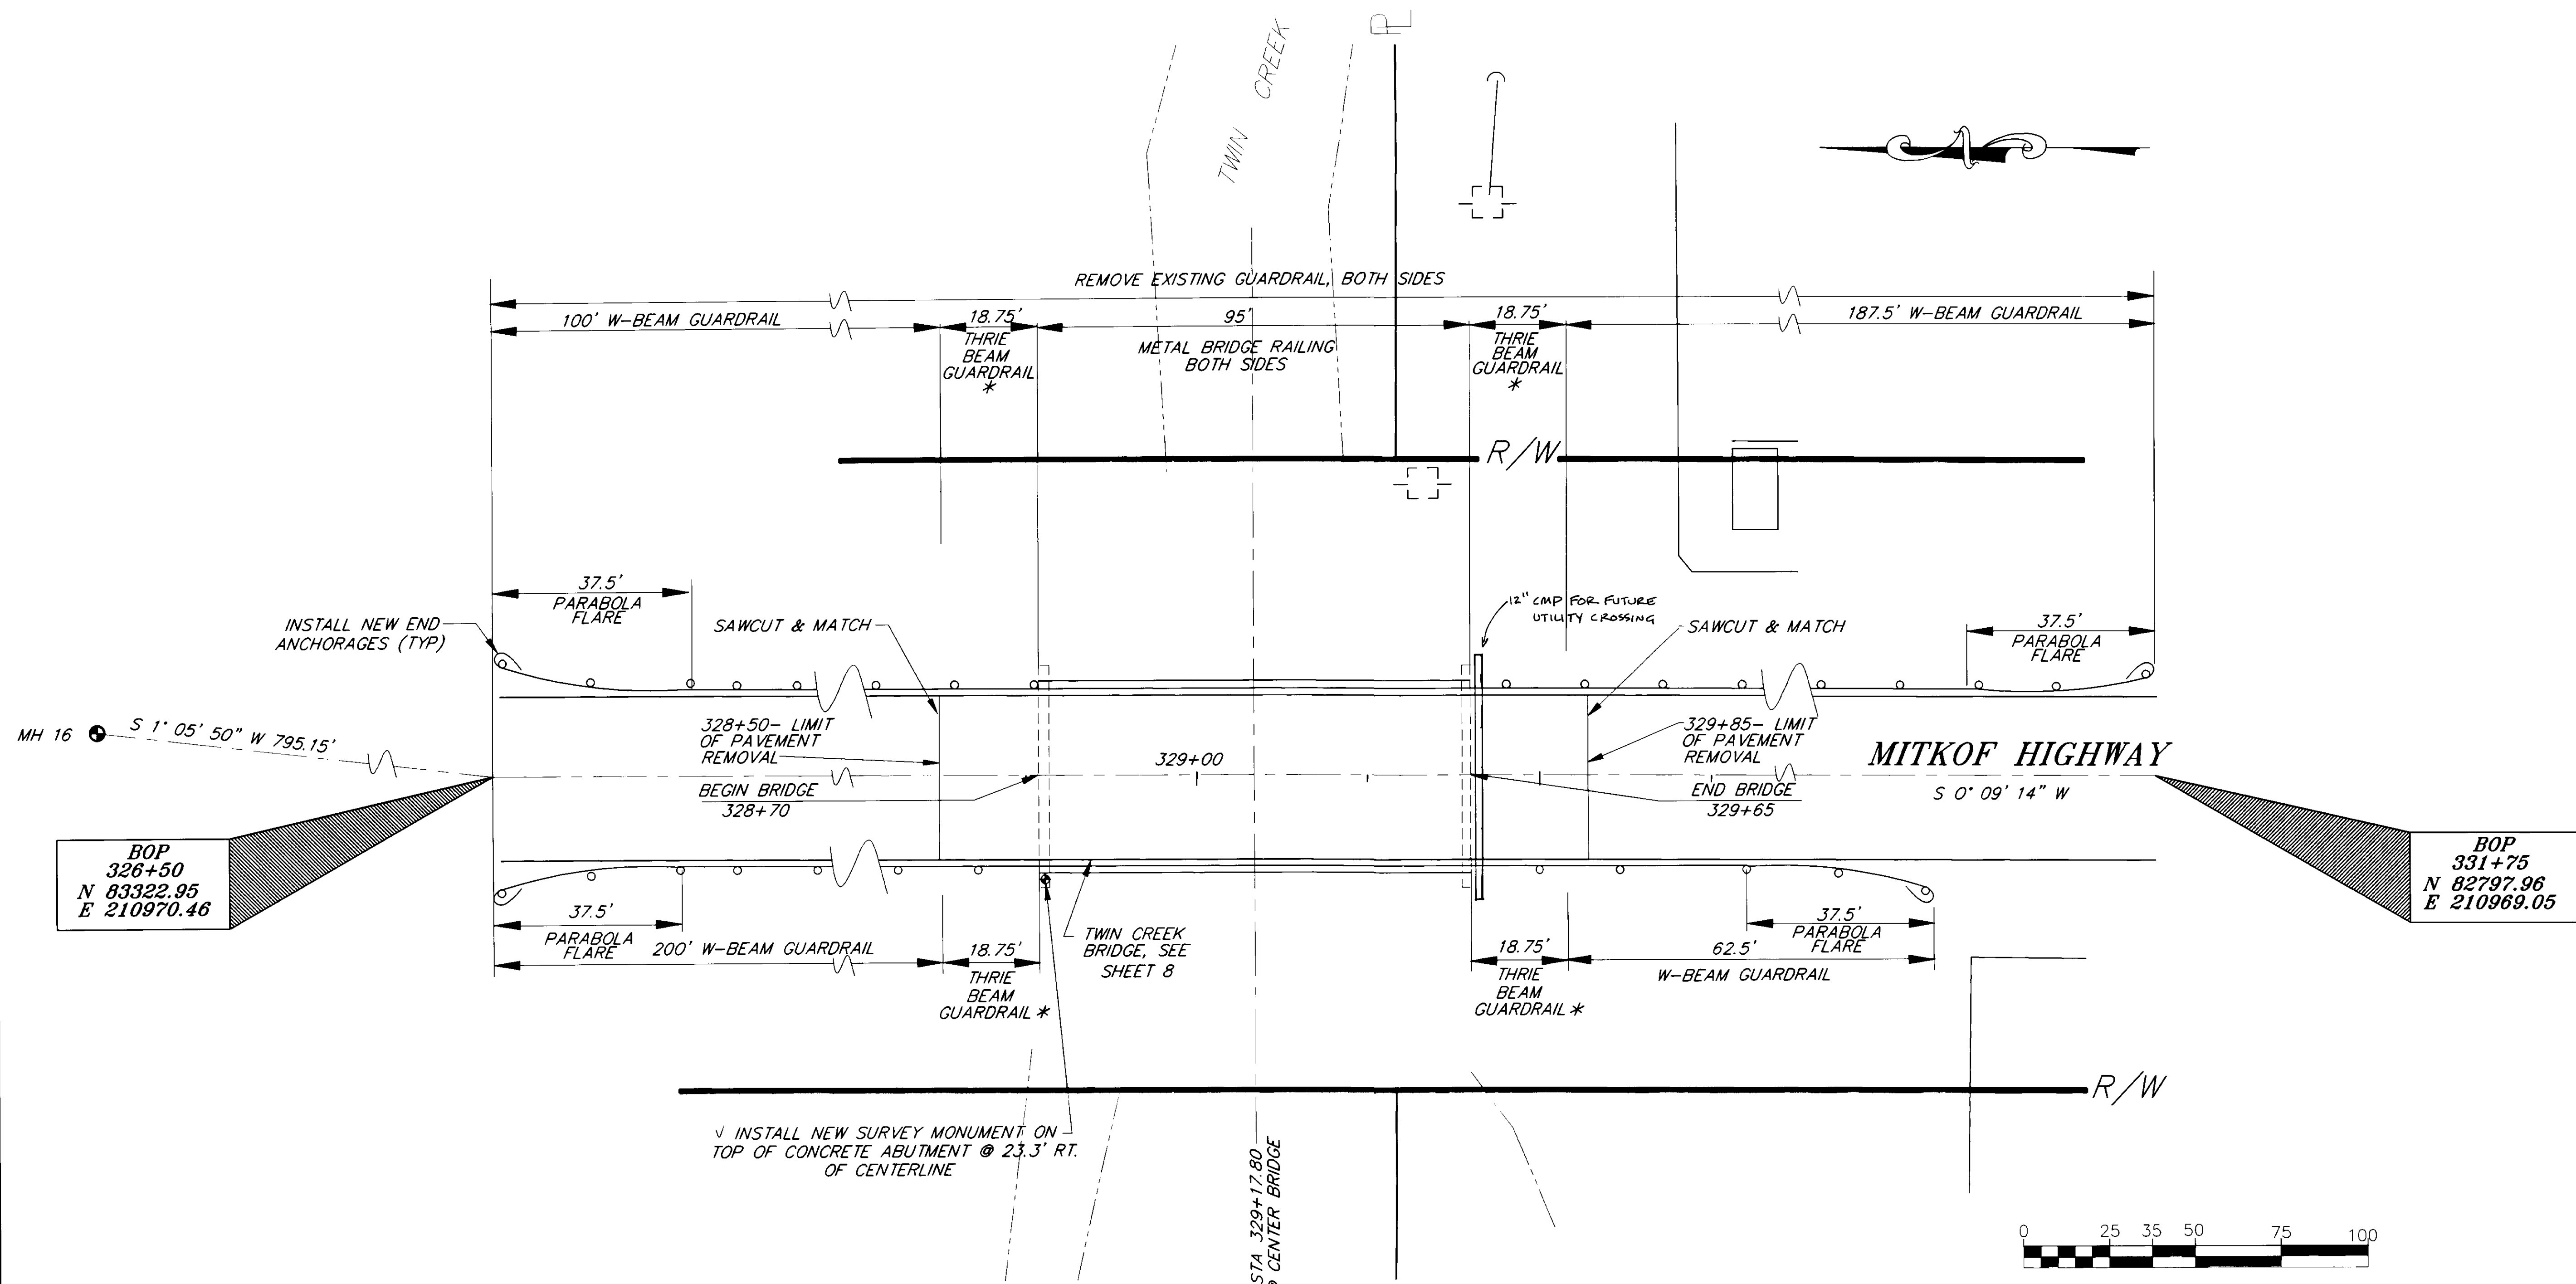

* SEE STANDARD DRAWING G-29.01S FOR POST SPACING

BRIDGE RAILING & GUARDRAIL PLAN

AS-BUILT
BY: KK DATE: 7/27/99

P:\pca\71646\95\PLANSET\#GUARD

BY:	DATE:	DESCRIPTION OF CHANGE:
KK	7/27/99	AS-BUILT WITH CORRECTIONS

RECORD OF REVISIONS

STATE OF ALASKA
DEPARTMENT OF TRANSPORTATION
AND PUBLIC FACILITIES
SOUTHEAST REGION DESIGN & CONSTRUCTION

PETERSBURG


PSG- Twin Creek
Culvert Replacement
STP-0937 (26) ~ 71646


BRIDGE RAILING & GUARDRAIL PLAN

NOTE: DO NOT SCALE FROM THESE PLANS-USE DIMENSIONS

DESIGNED BY: M. SHEELER
DRAWN BY: K. KLEMMETSON
CHECKED BY: A.J. STEININGER

PROJECT NO. 71646
DATE: 1995
SHEET 4 OF 16

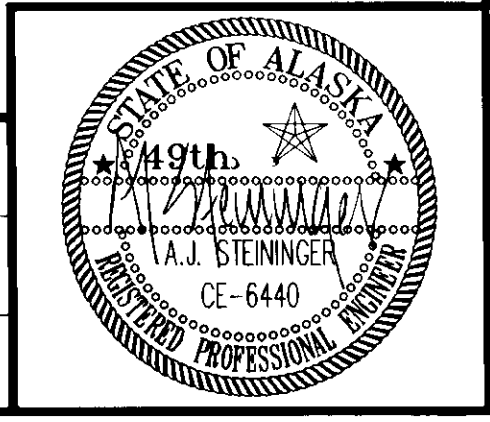

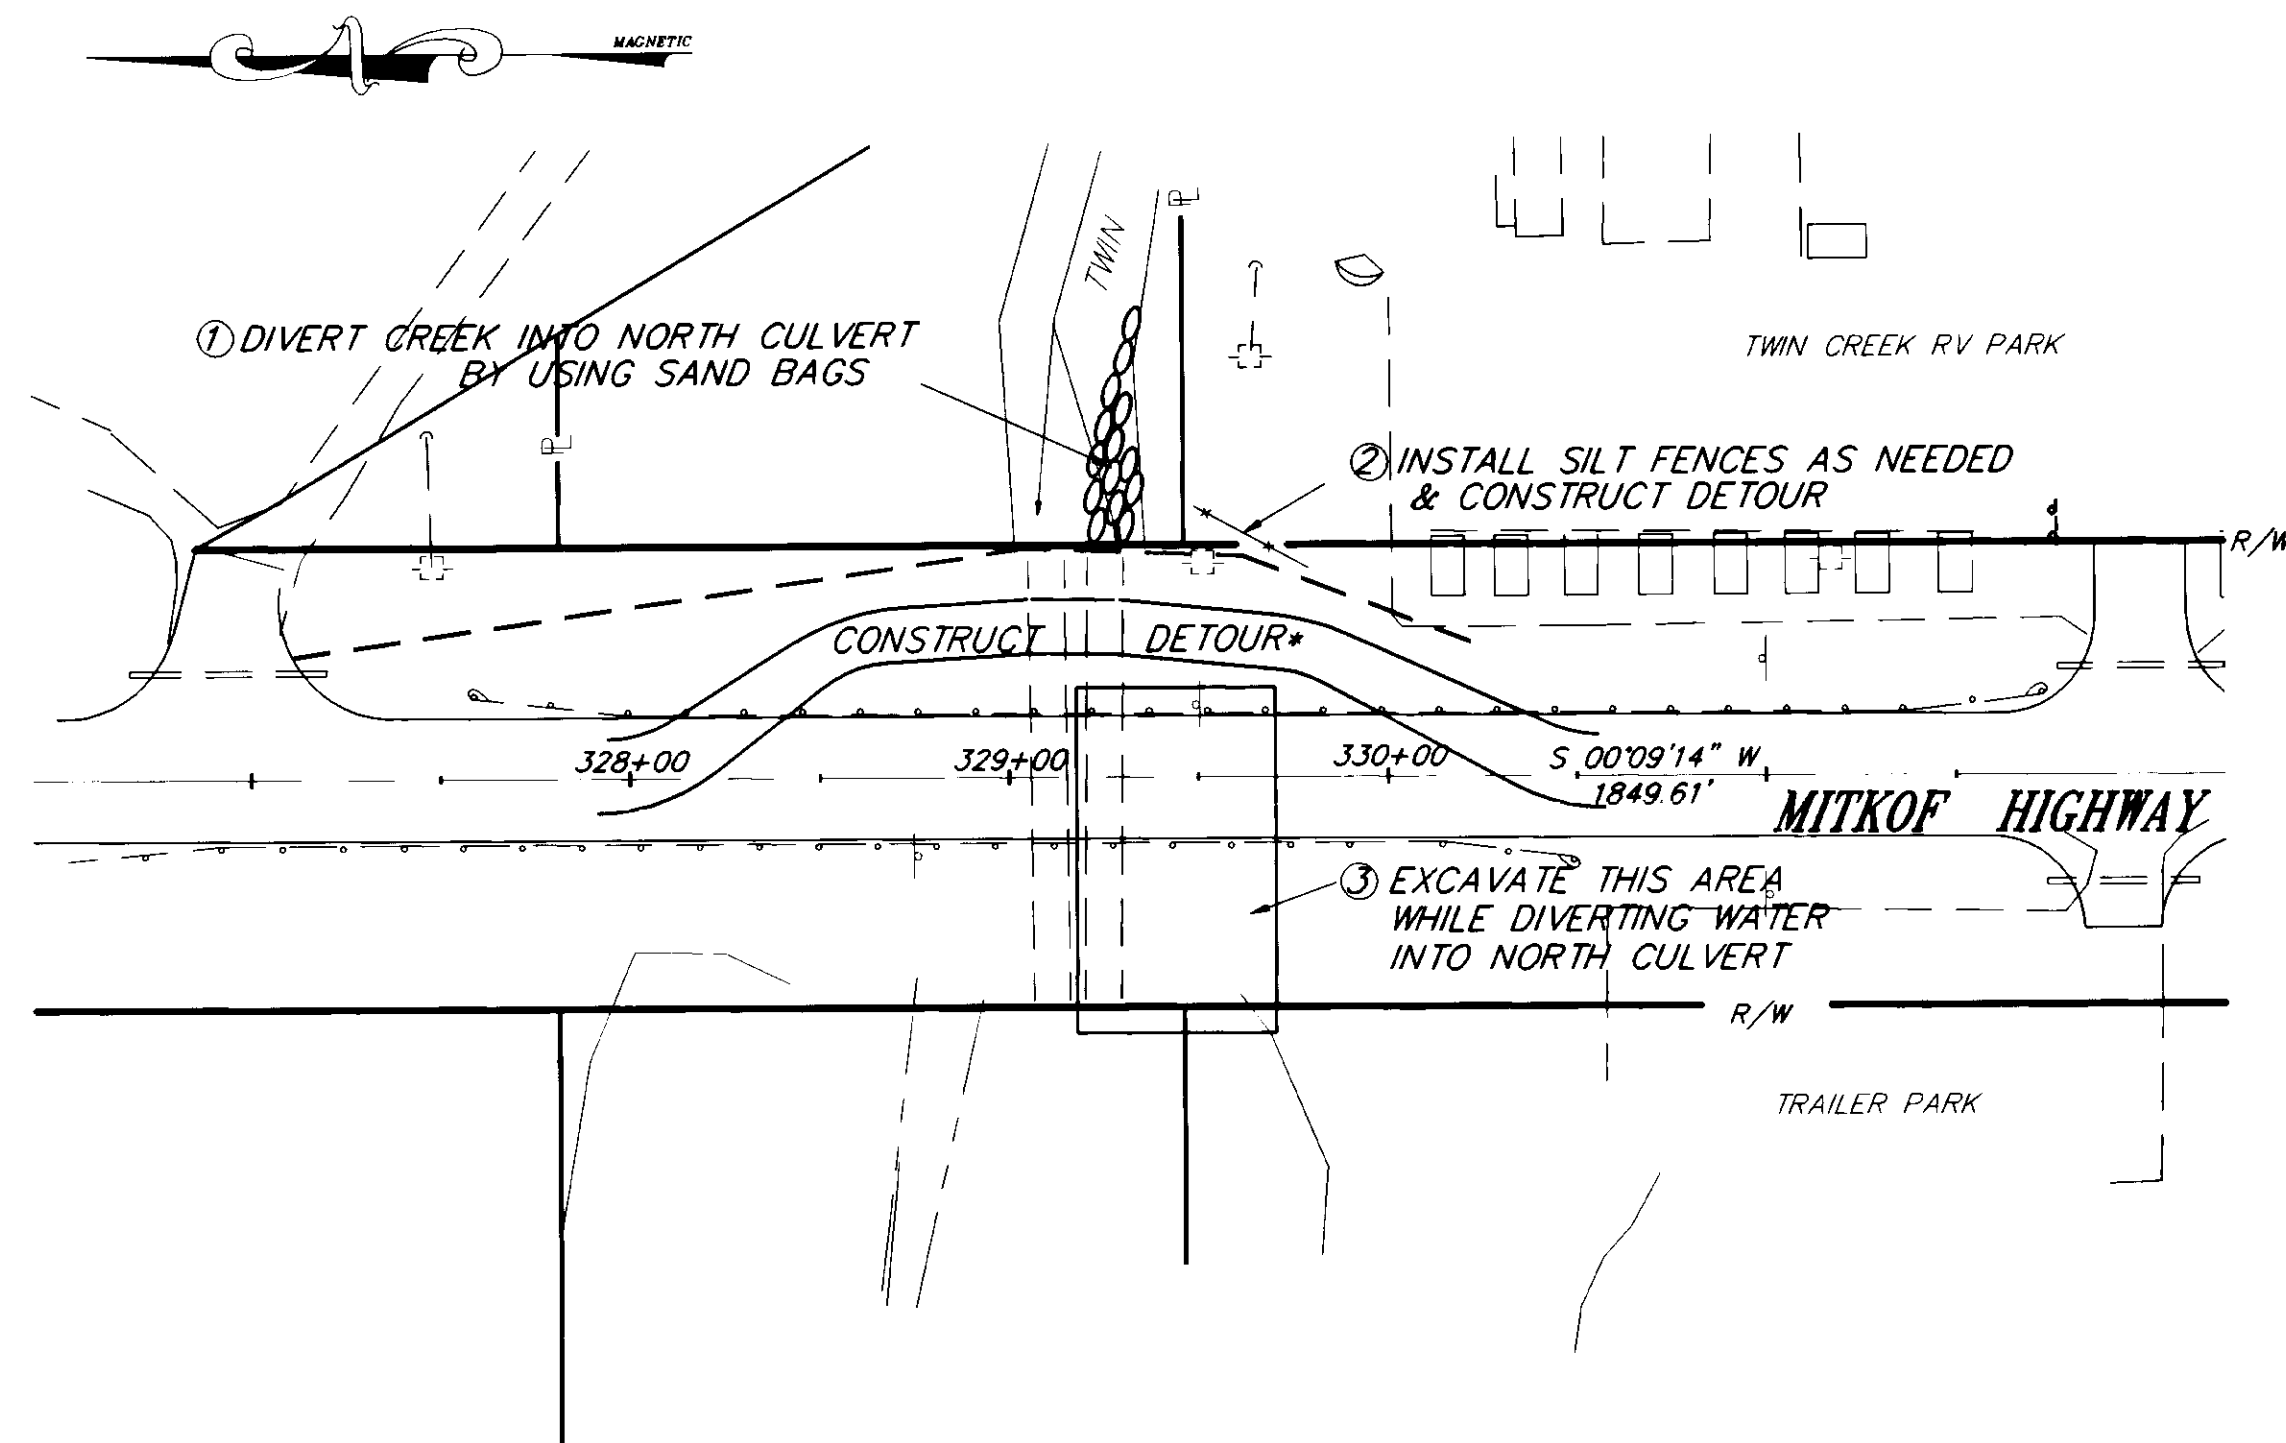


PHASE I EROSION AND SEDIMENT CONTROL PLAN


* SEE SHEET 6 FOR BRIDGE DETOUR

NOTE:


1. IN WATER WORK SHALL BE LIMITED TO THE PERIOD FROM JUNE 15 THRU SEPTEMBER 1.
2. IF IT BECOMES NECESSARY TO REMOVE WATER FROM AN EXCAVATION AREA, OR BEHIND A DAM, WATER SHALL BE PUMPED TO A VEGETATED AREA SITUATED A MINIMUM OF 50' FROM ANY STREAM.
3. REFER TO SECTION 641 OF THE SPECIAL PROVISIONS FOR CONSTRUCTION SEQUENCE.
4. SAND BAGS & SAND BAG MATERIAL SHALL BE INCIDENTAL TO ITEM 641(2)

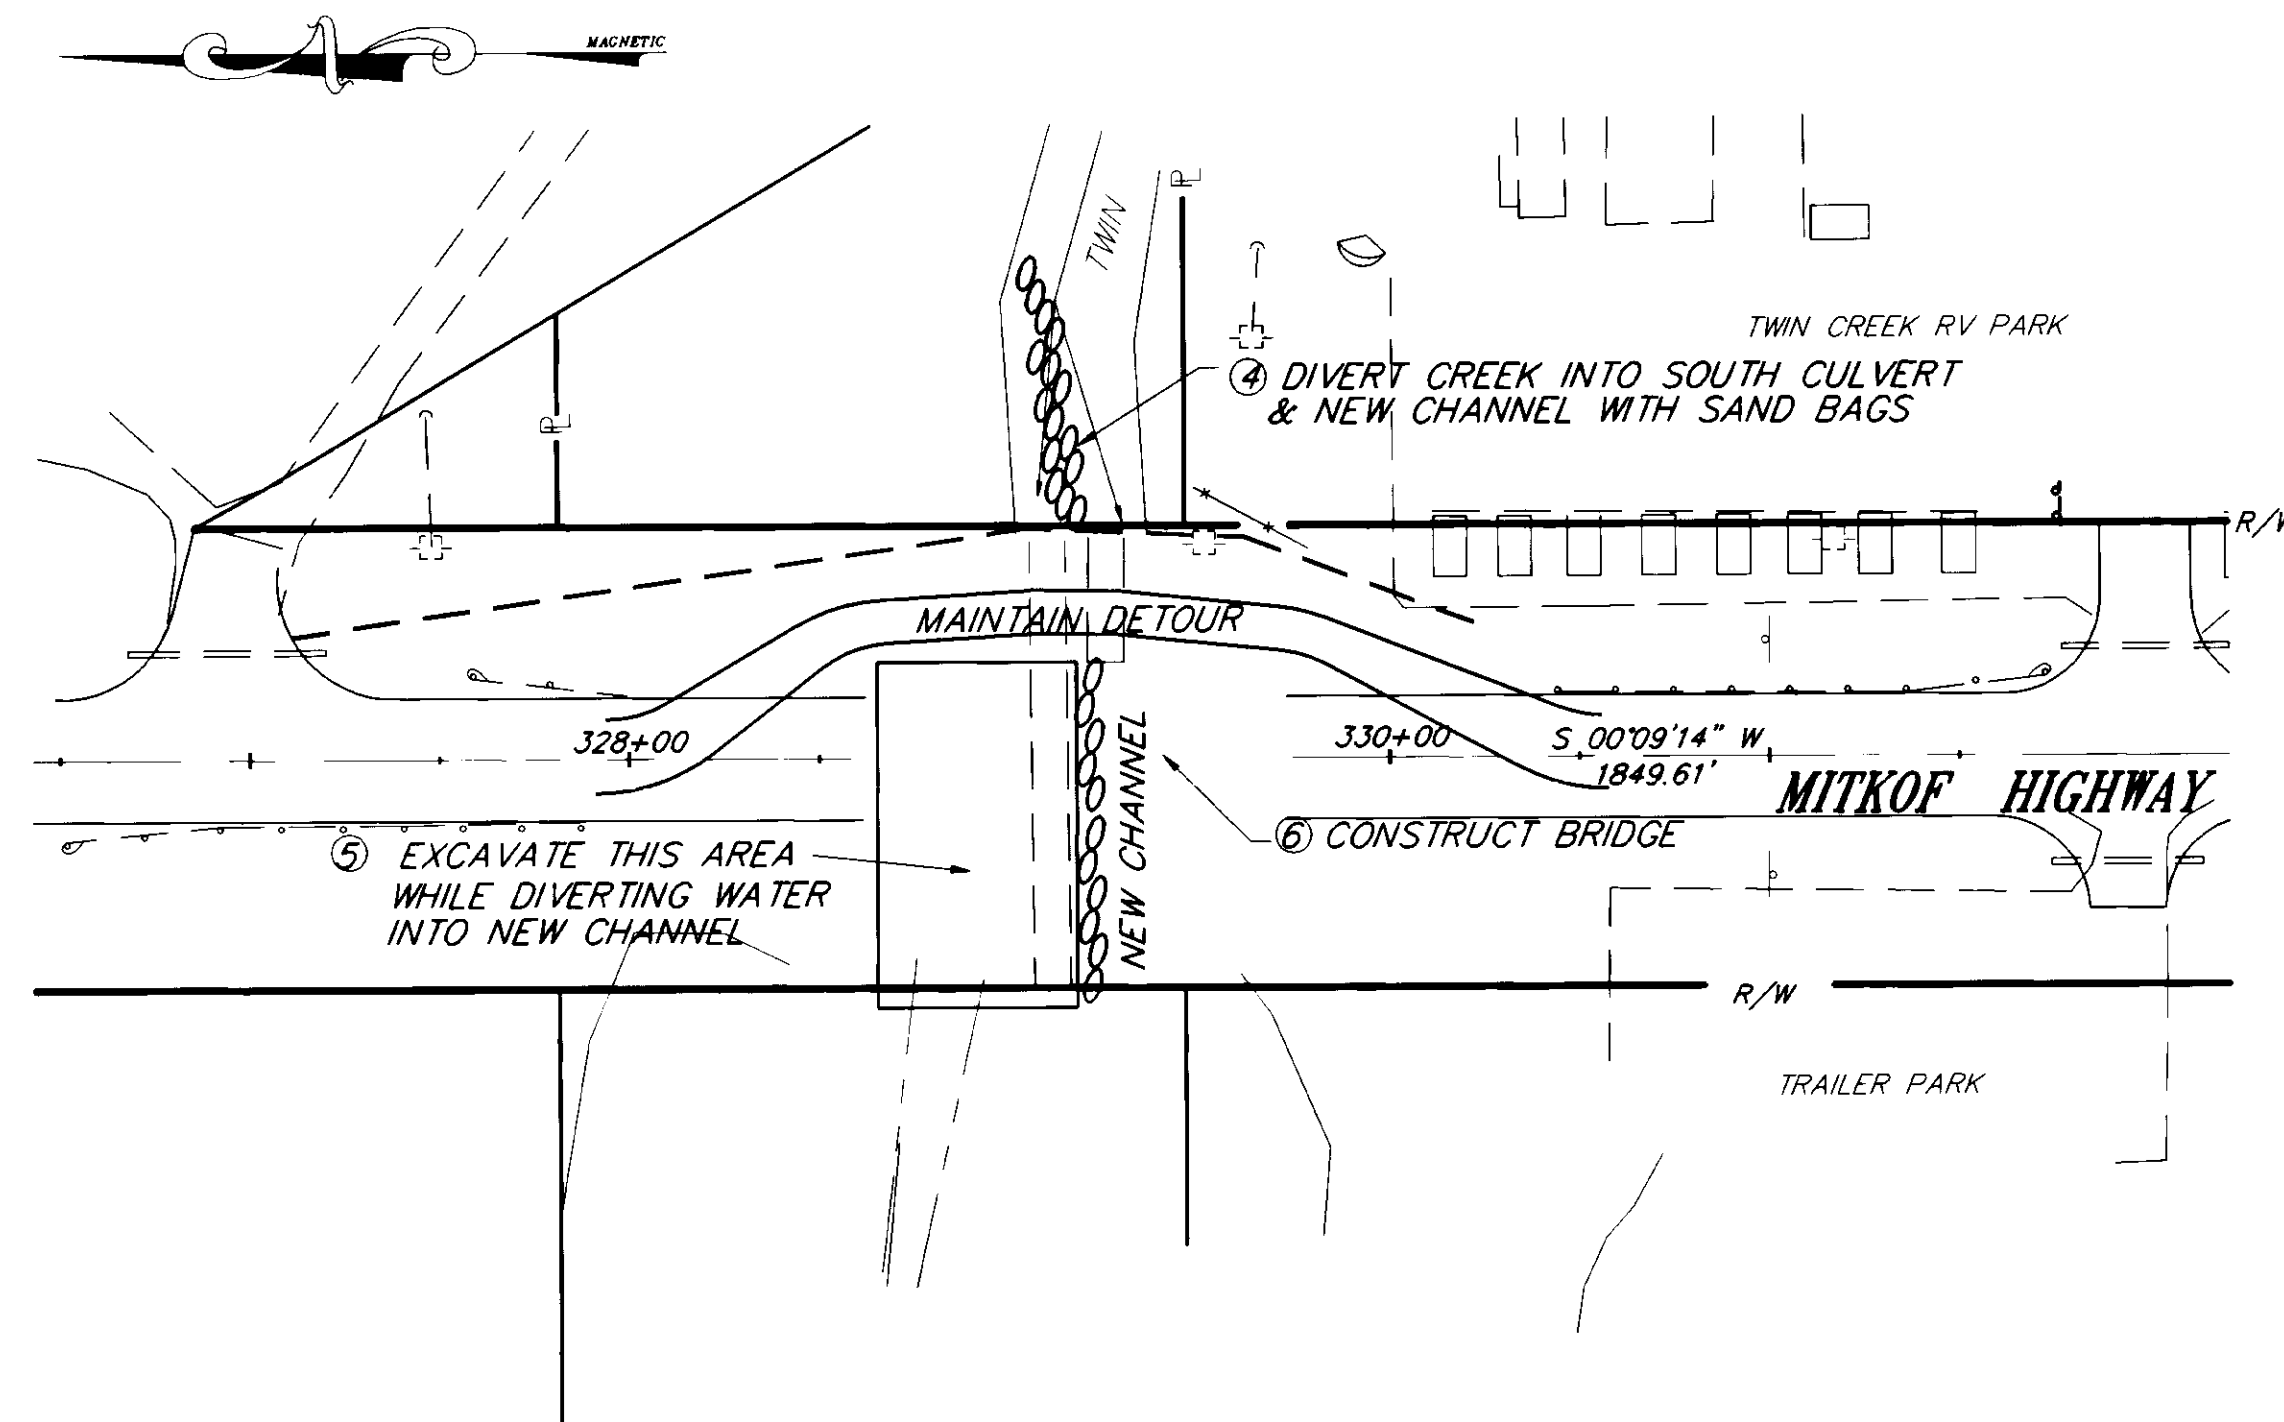


PHASE II EROSION AND SEDIMENT CONTROL PLAN

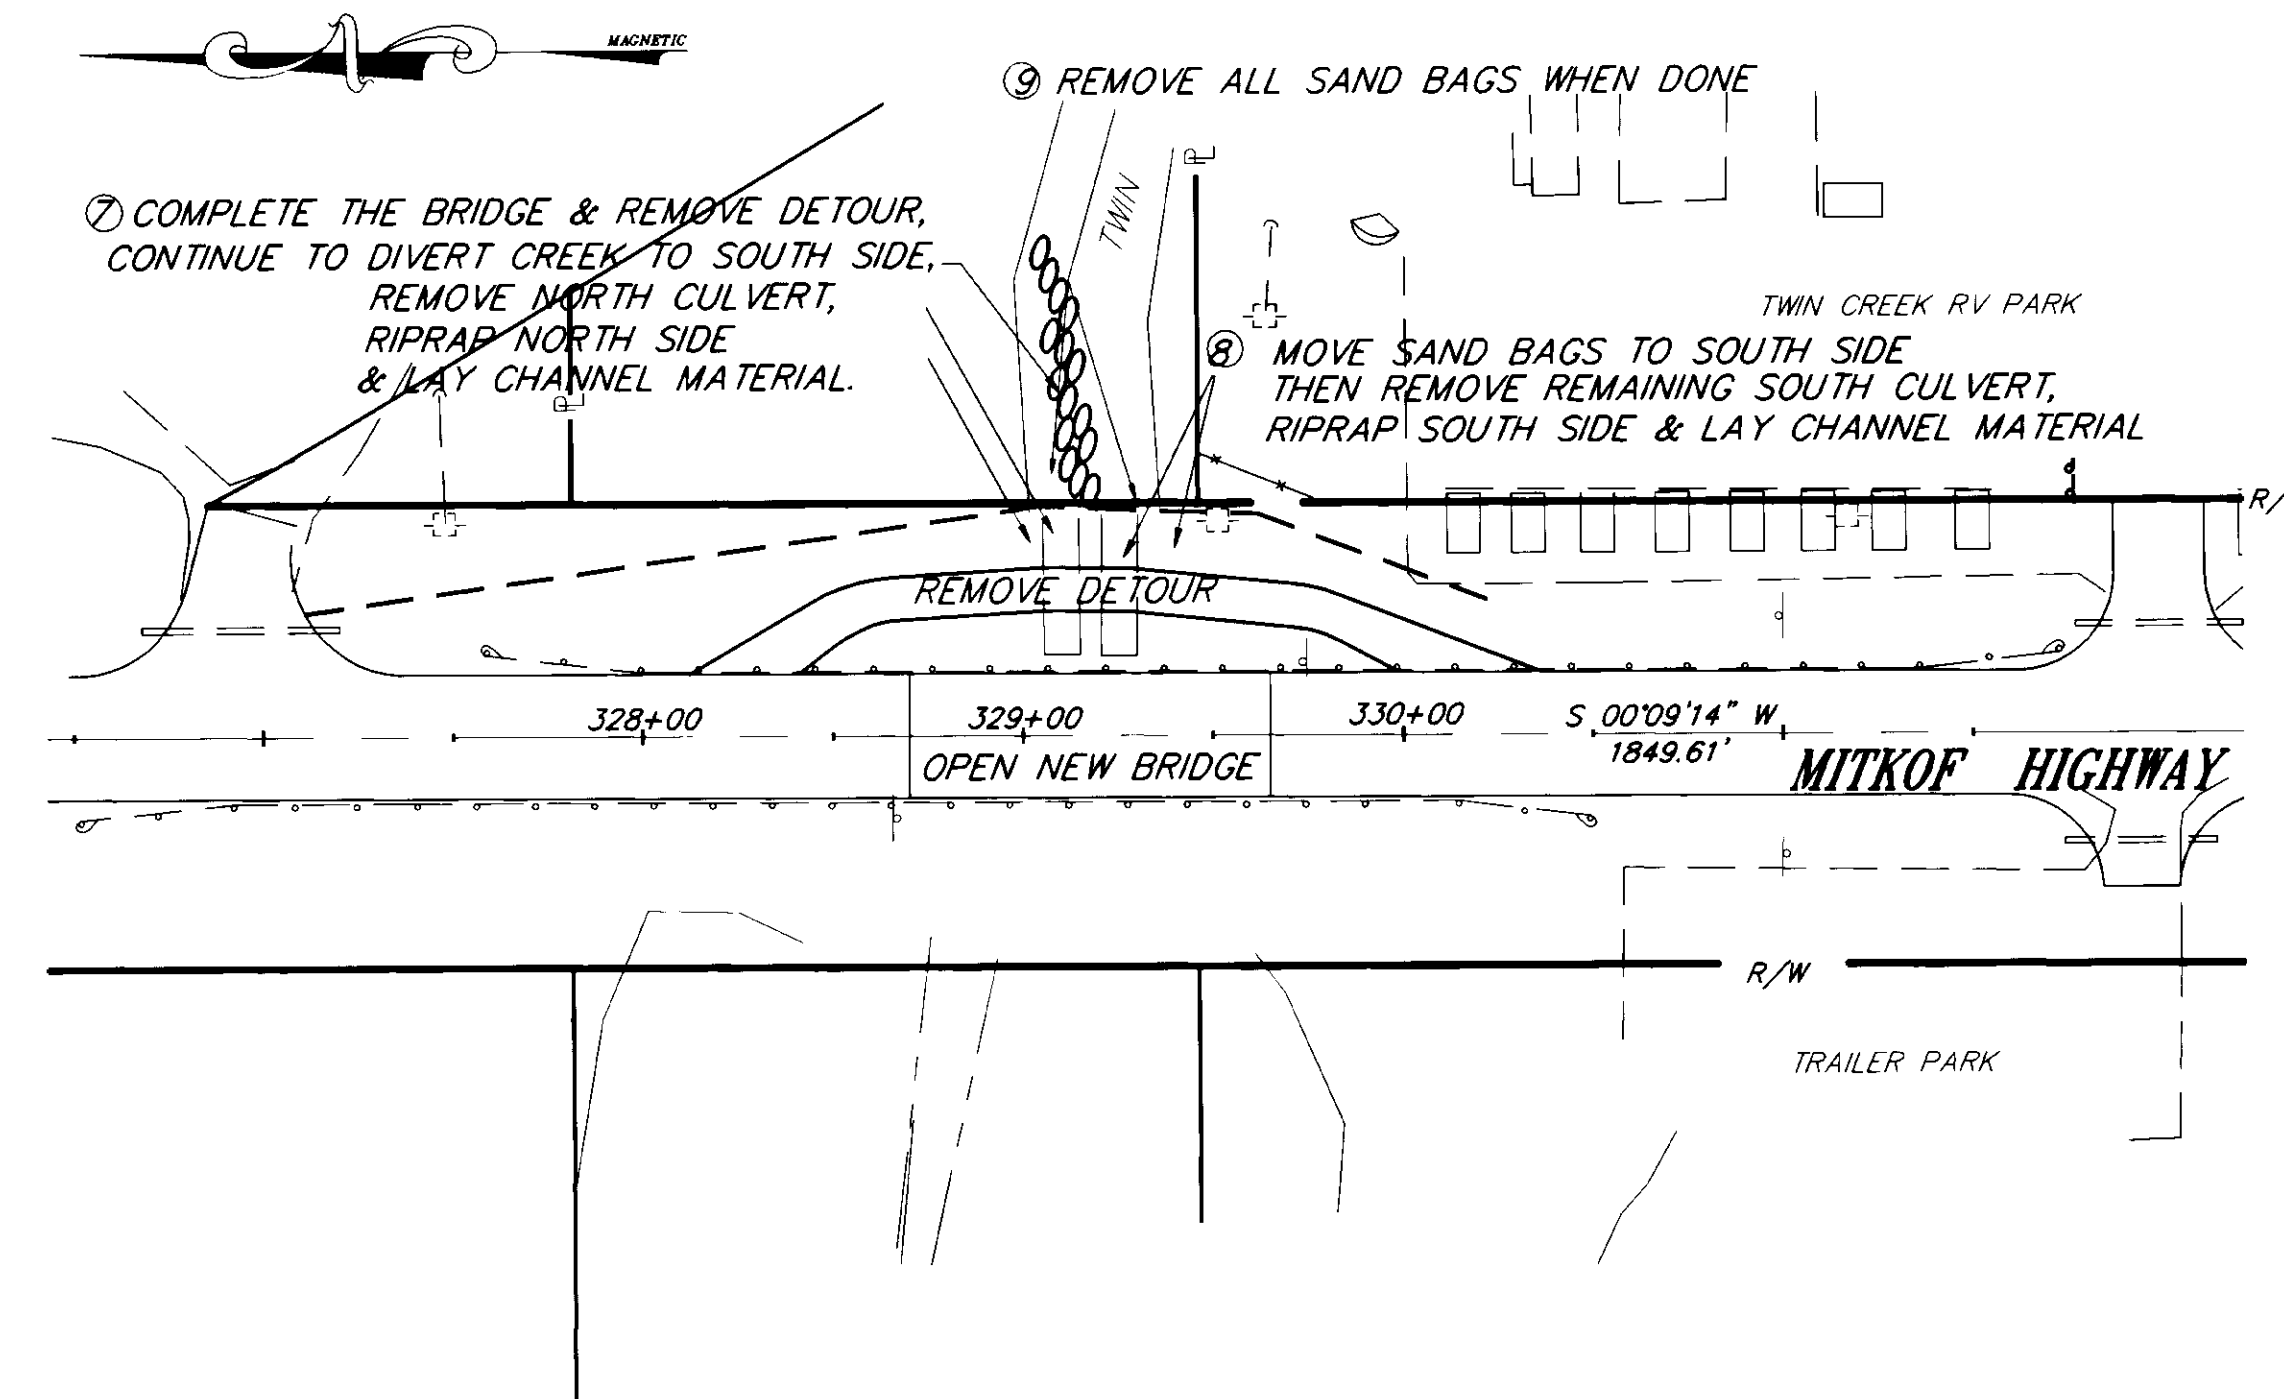

PHASE III EROSION AND SEDIMENT CONTROL PLAN

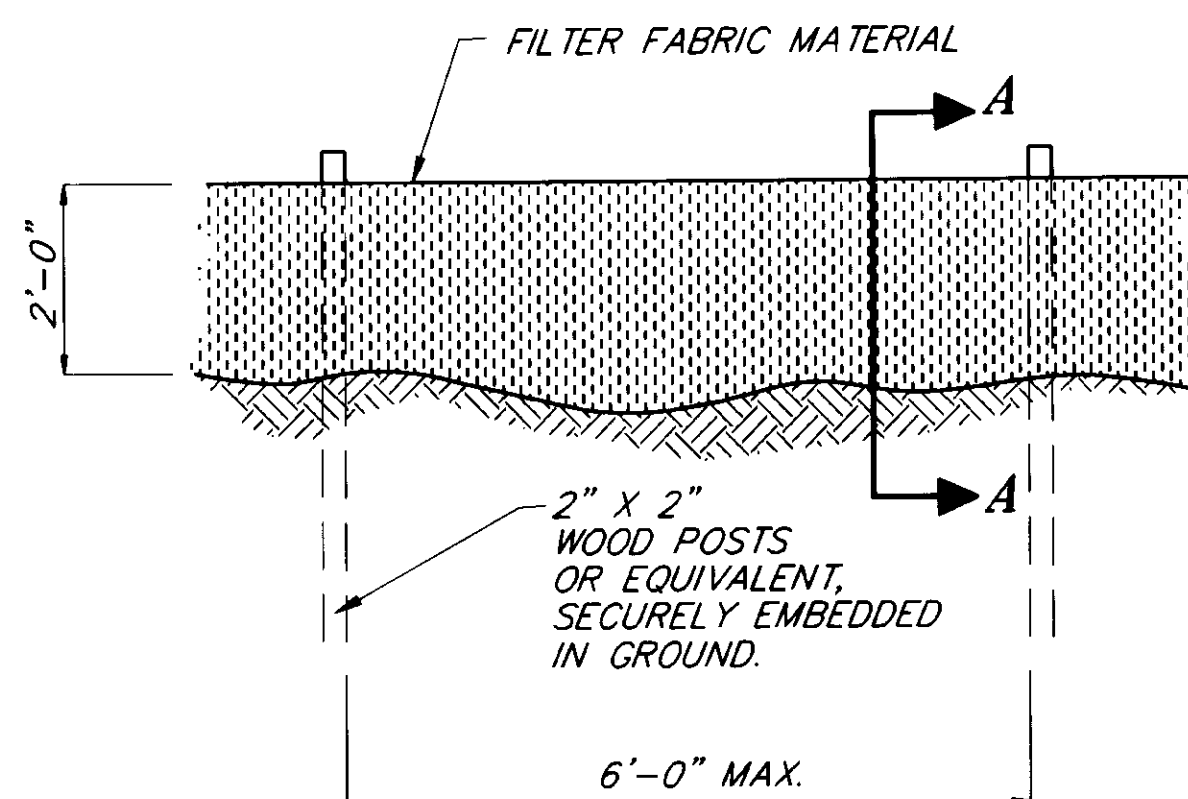

ELEVATION

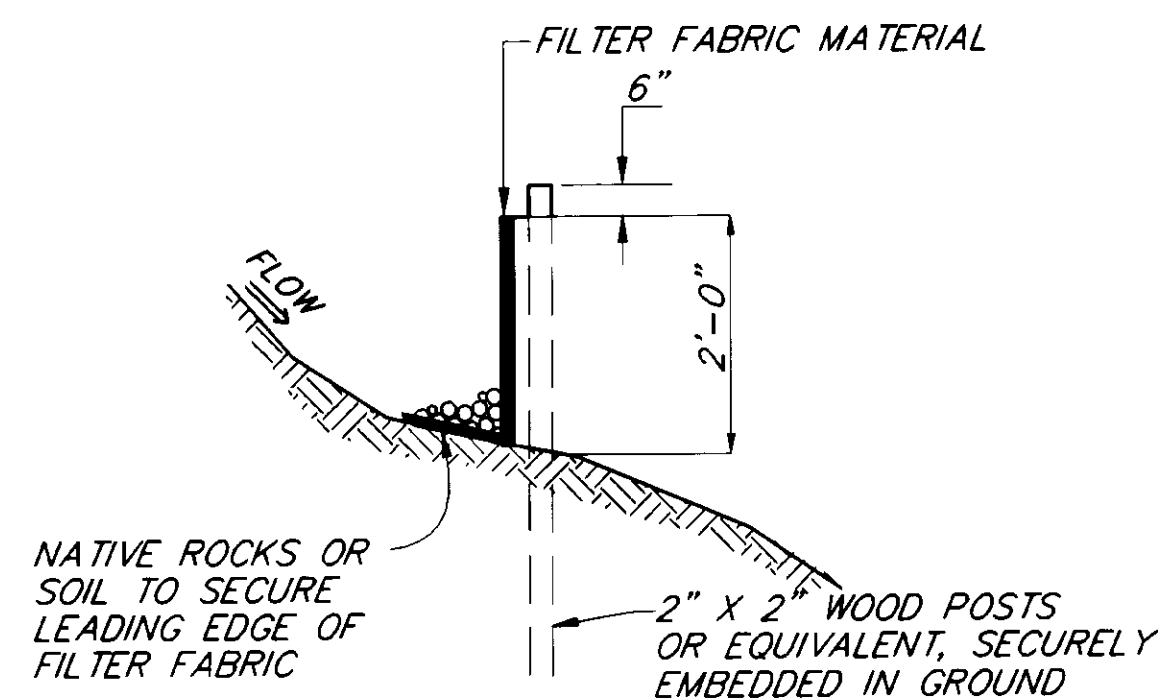

SECTION A-A

SILT FENCE DETAILS

AS-BUILT

BY: KK DATE: 7/27/99

NOTE: DO NOT SCALE FROM THESE PLANS--USE DIMENSIONS

P:\PSG\71646\95\PLANSET\# EROSED		
PATH:	P:\PSG\71646\95\OR\EROSION PLOT\PCP(50) OR PLOT\PCP(100)	
BY:	DATE:	DESCRIPTION OF CHANGE:
K.K.	7/27/99	AS BUILT

STATE OF ALASKA
 DEPARTMENT OF TRANSPORTATION
 AND PUBLIC FACILITIES
 SOUTHEAST REGION DESIGN & CONSTRUCTION

Petersburg


PSG-Twin Creek
 Culvert Replacement
 STP-0937 (26) 71646





Alaska

DESIGNED BY:
M. SHEELER
 DRAWN BY:
K. KLEMMETSON
 CHECKED BY:
A.J. STEININGER

PROJECT NO.
71646
 DATE:
1995
 SHEET 5 OF 16


EROSION AND SEDIMENT CONTROL

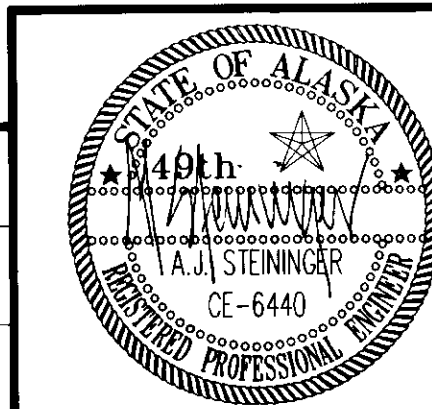

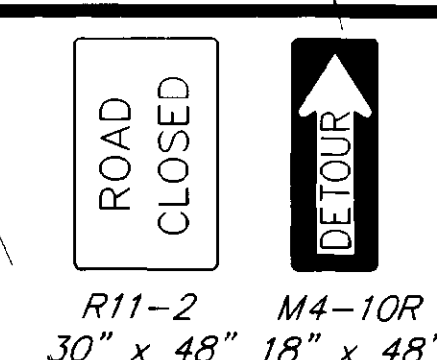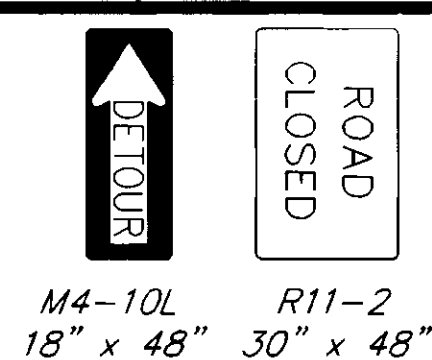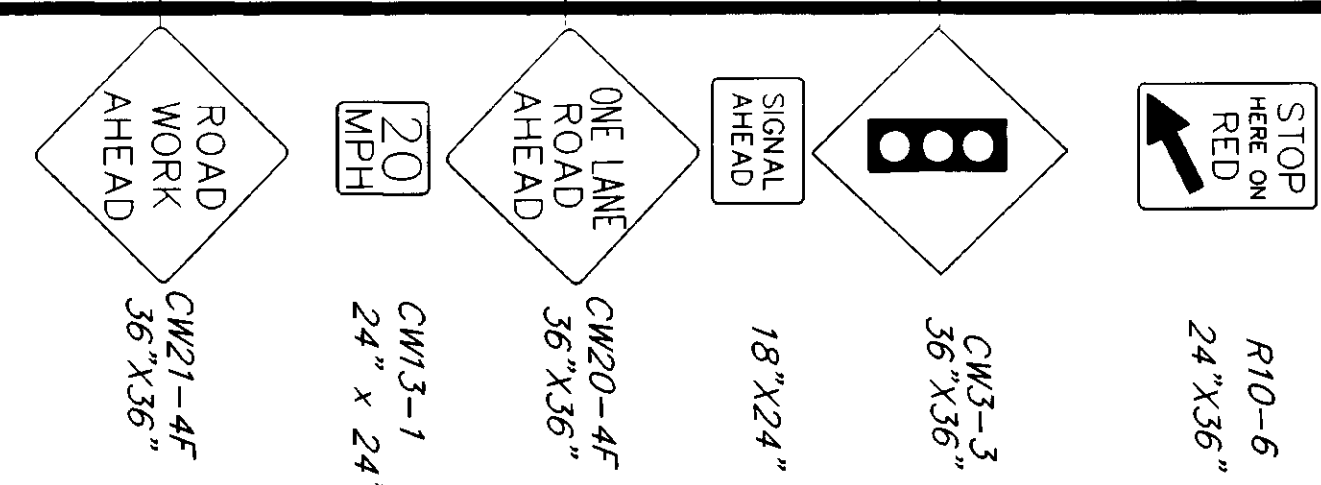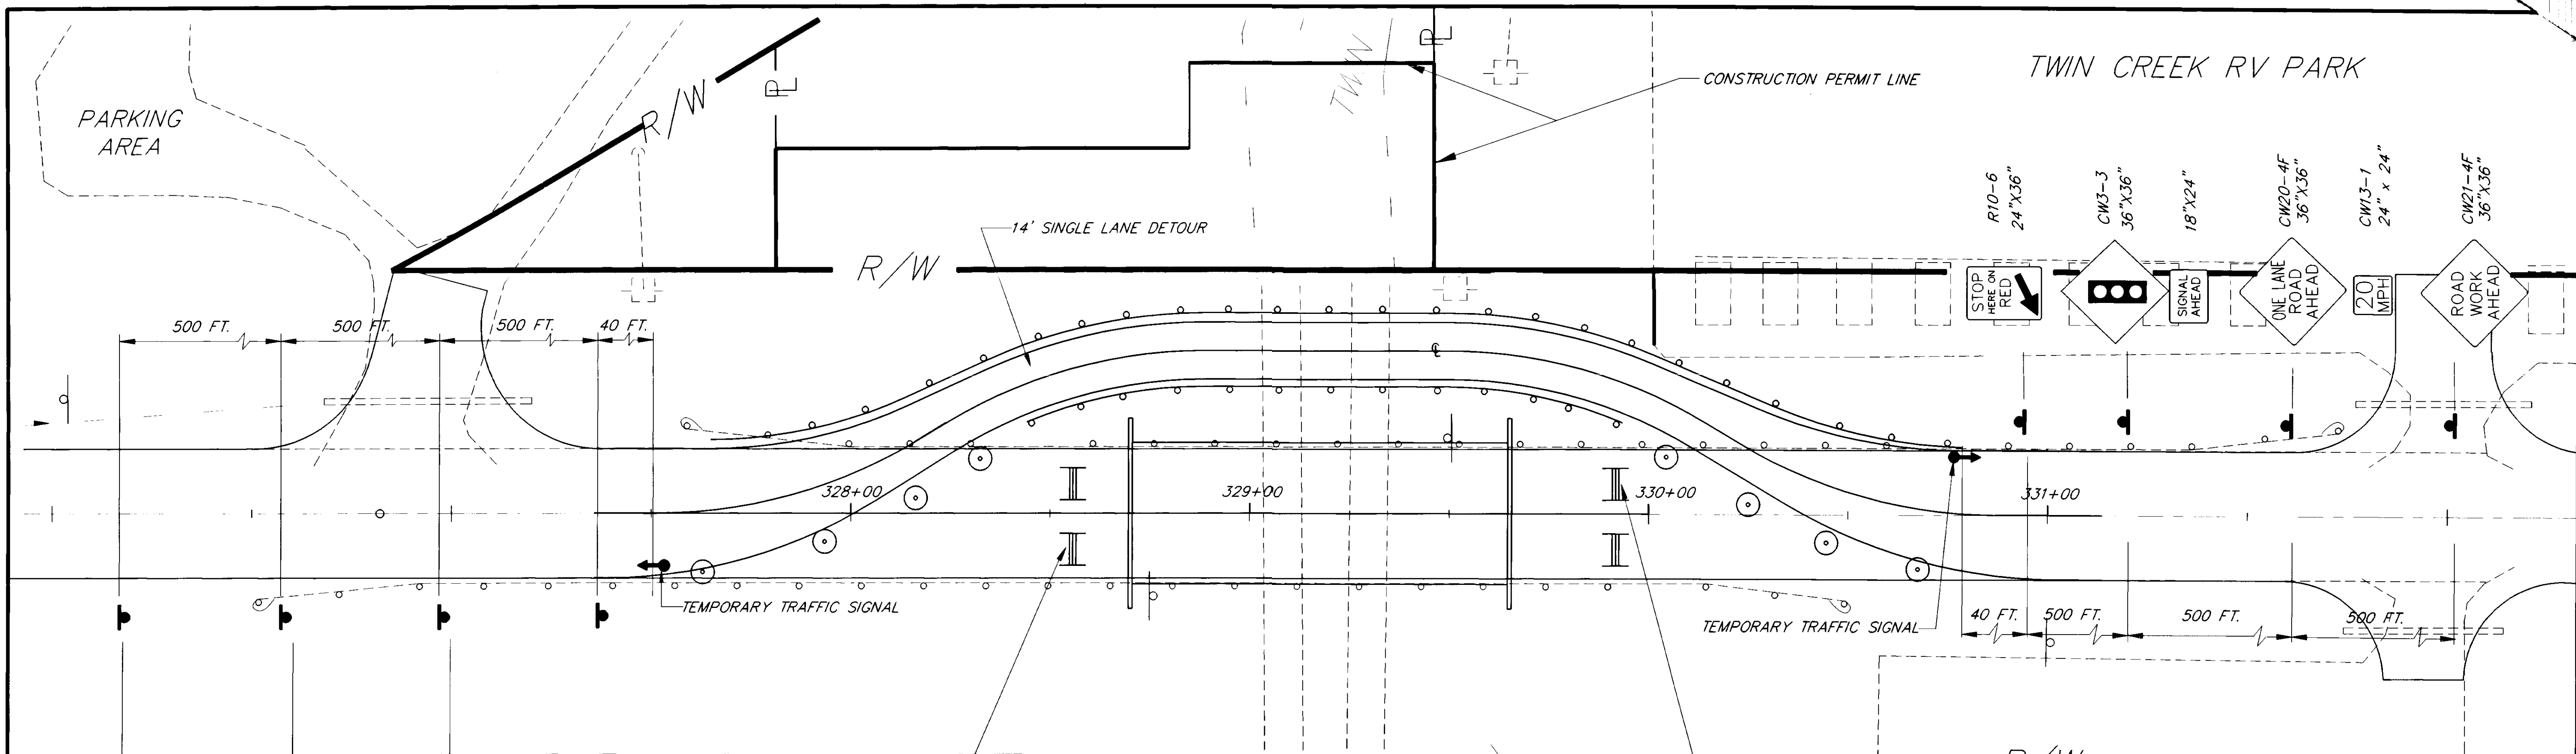


NOTES

1. SEE SECTION 643-3.02 OF THE SPECIAL PROVISIONS FOR DETOUR DESIGN CRITERIA.
2. A MINIMUM OF ONE LANE OF TRAFFIC SHALL BE MAINTAINED THROUGH THE WORK AREA AT ALL TIMES.
3. FLOOD LIGHTS SHALL BE PROVIDED FOR FLAGGER STATIONS DURING NIGHT OPERATIONS.
4. CHANNELIZATION DEVICES IF USED AT NIGHT SHALL BE LIT IN ACCORDANCE WITH THE ALASKA TRAFFIC MANUAL.
5. CONSTRUCTION SIGNS SHALL BE DIAMOND GRADE (SCOTCHLITE ORANGE 3924F OR APPROVED EQUAL).
6. GUARDRAIL FOR THE TEMPORARY DETOUR SHALL TIE BACK INTO EXISTING GUARDRAIL. SALVAGED GUARDRAIL IF UNDAMAGED, MAY BE USED.
7. DRIVEWAYS MAY BE CLOSED DURING ACTUAL WORK ON A GIVEN DRIVEWAY, PROVIDED THAT THE CLOSURE DOES NOT EXCEED 8 HOURS AND THE AFFECTED RESIDENTS HAVE BEEN GIVEN 24 HOURS NOTICE OF THE CLOSURE.
8. IT IS THE INTENT OF THIS TRAFFIC CONTROL PLAN (TCP) TO ILLUSTRATE SOME, NOT ALL, OF THE TRAFFIC CONTROL SETUPS WHICH WILL BE REQUIRED ON THIS PROJECT. PLANS FOR CONFIGURATIONS NOT COVERED BY THE TCP SHALL BE CREATED BY THE CONTRACTOR AND SUBMITTED TO THE ENGINEER FOR APPROVAL. WHERE APPROPRIATE, THEY SHALL INCORPORATE APPLICABLE PORTIONS OF DETAILS ON THESE SHEETS.

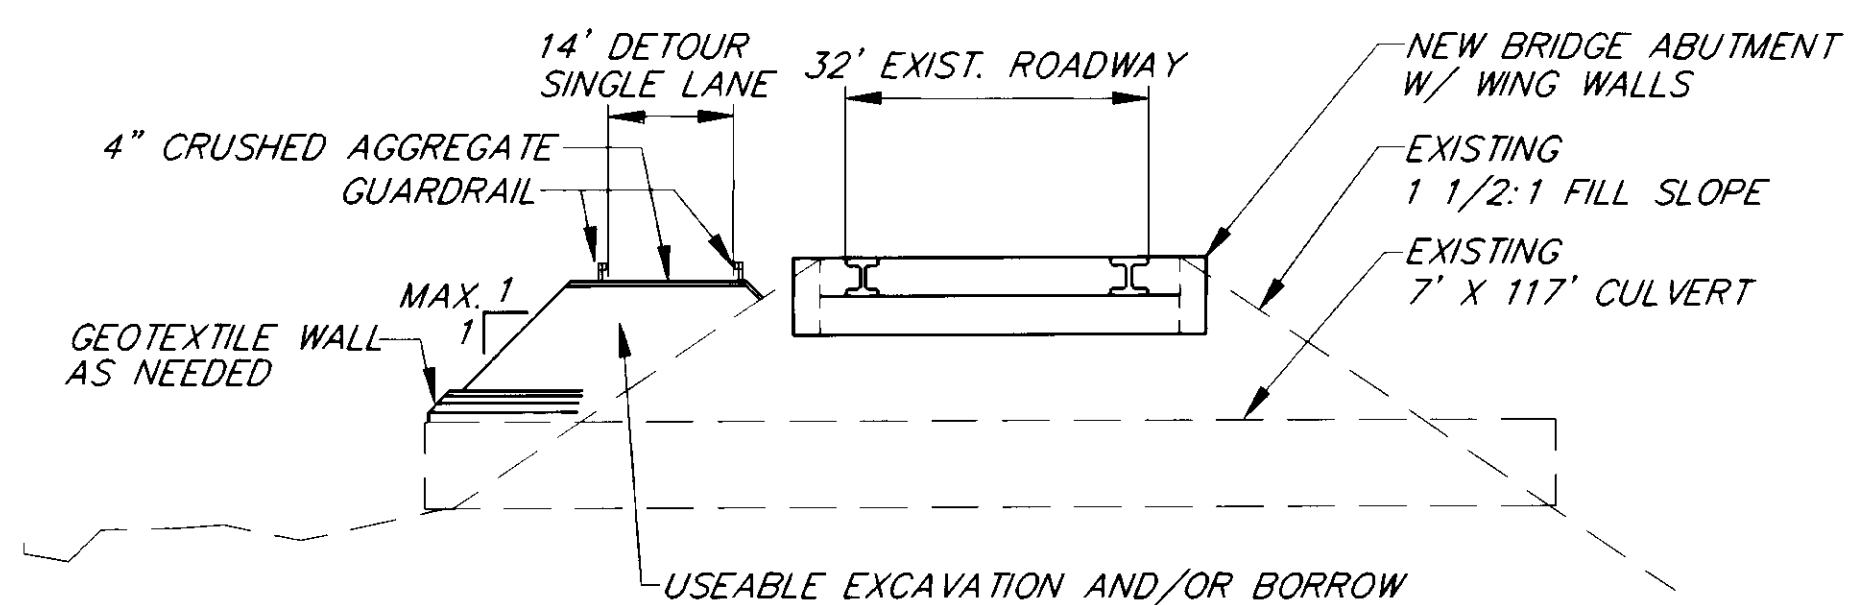

TYPICAL DETOUR SECTION

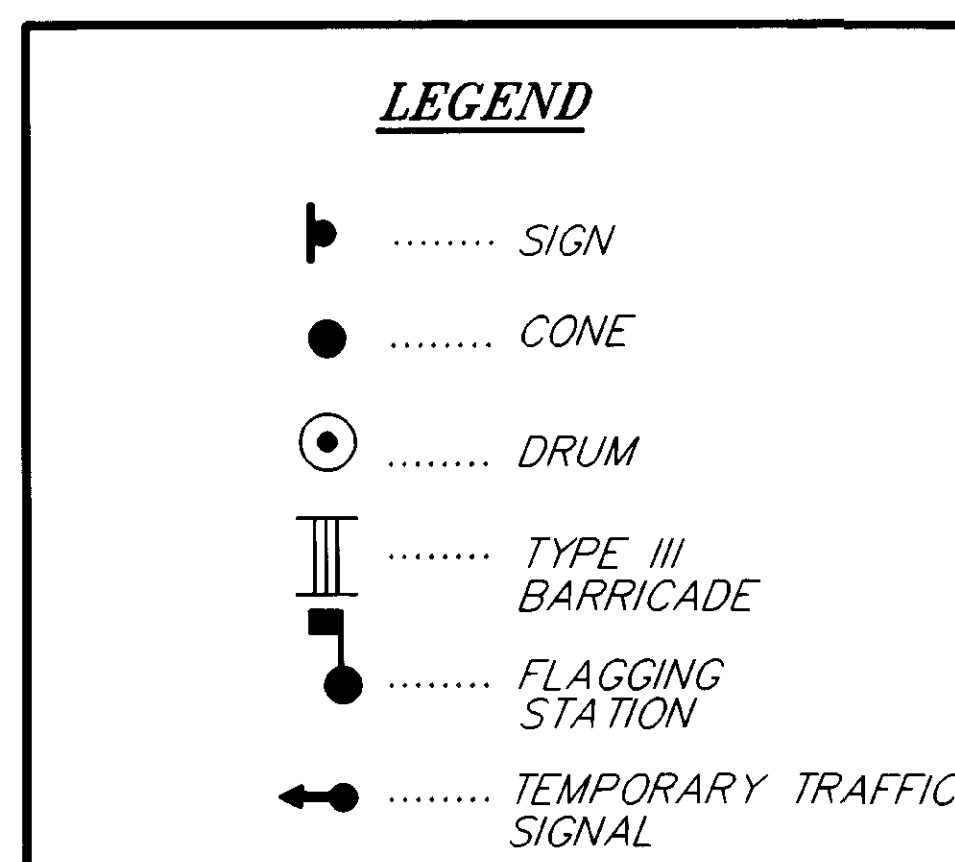

AS-BUILT
BY: KK DATE: 7/27/99

NOTE: DO NOT SCALE FROM THESE PLANS-USE DIMENSIONS

P:\PSG\71646\95\PLANSET\#TCP

PATH:	DATE:	DESCRIPTION OF CHANGE:
P:\PSG\71646\95\DR\TCP	7/27/99	AS BUILT


RECORD OF REVISIONS


STATE OF ALASKA
DEPARTMENT OF TRANSPORTATION
AND PUBLIC FACILITIES
SOUTHEAST REGION DESIGN & CONSTRUCTION

JUNEAU

PSG- Twin Creek
Culvert Replacement
STP-0937 (26) ~ 71646
TRAFFIC CONTROL PLAN
BRIDGE DETOUR

DESIGNED BY:	K. MATTSON	PROJECT NO.	71646
DRAWN BY:	K. MATTSON	DATE:	1995
CHECKED BY:	K. SMITH	SHEET	6 OF 16

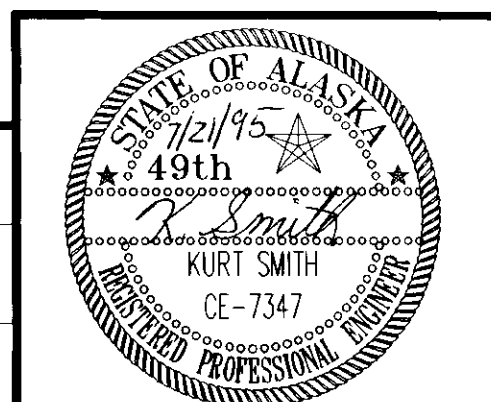


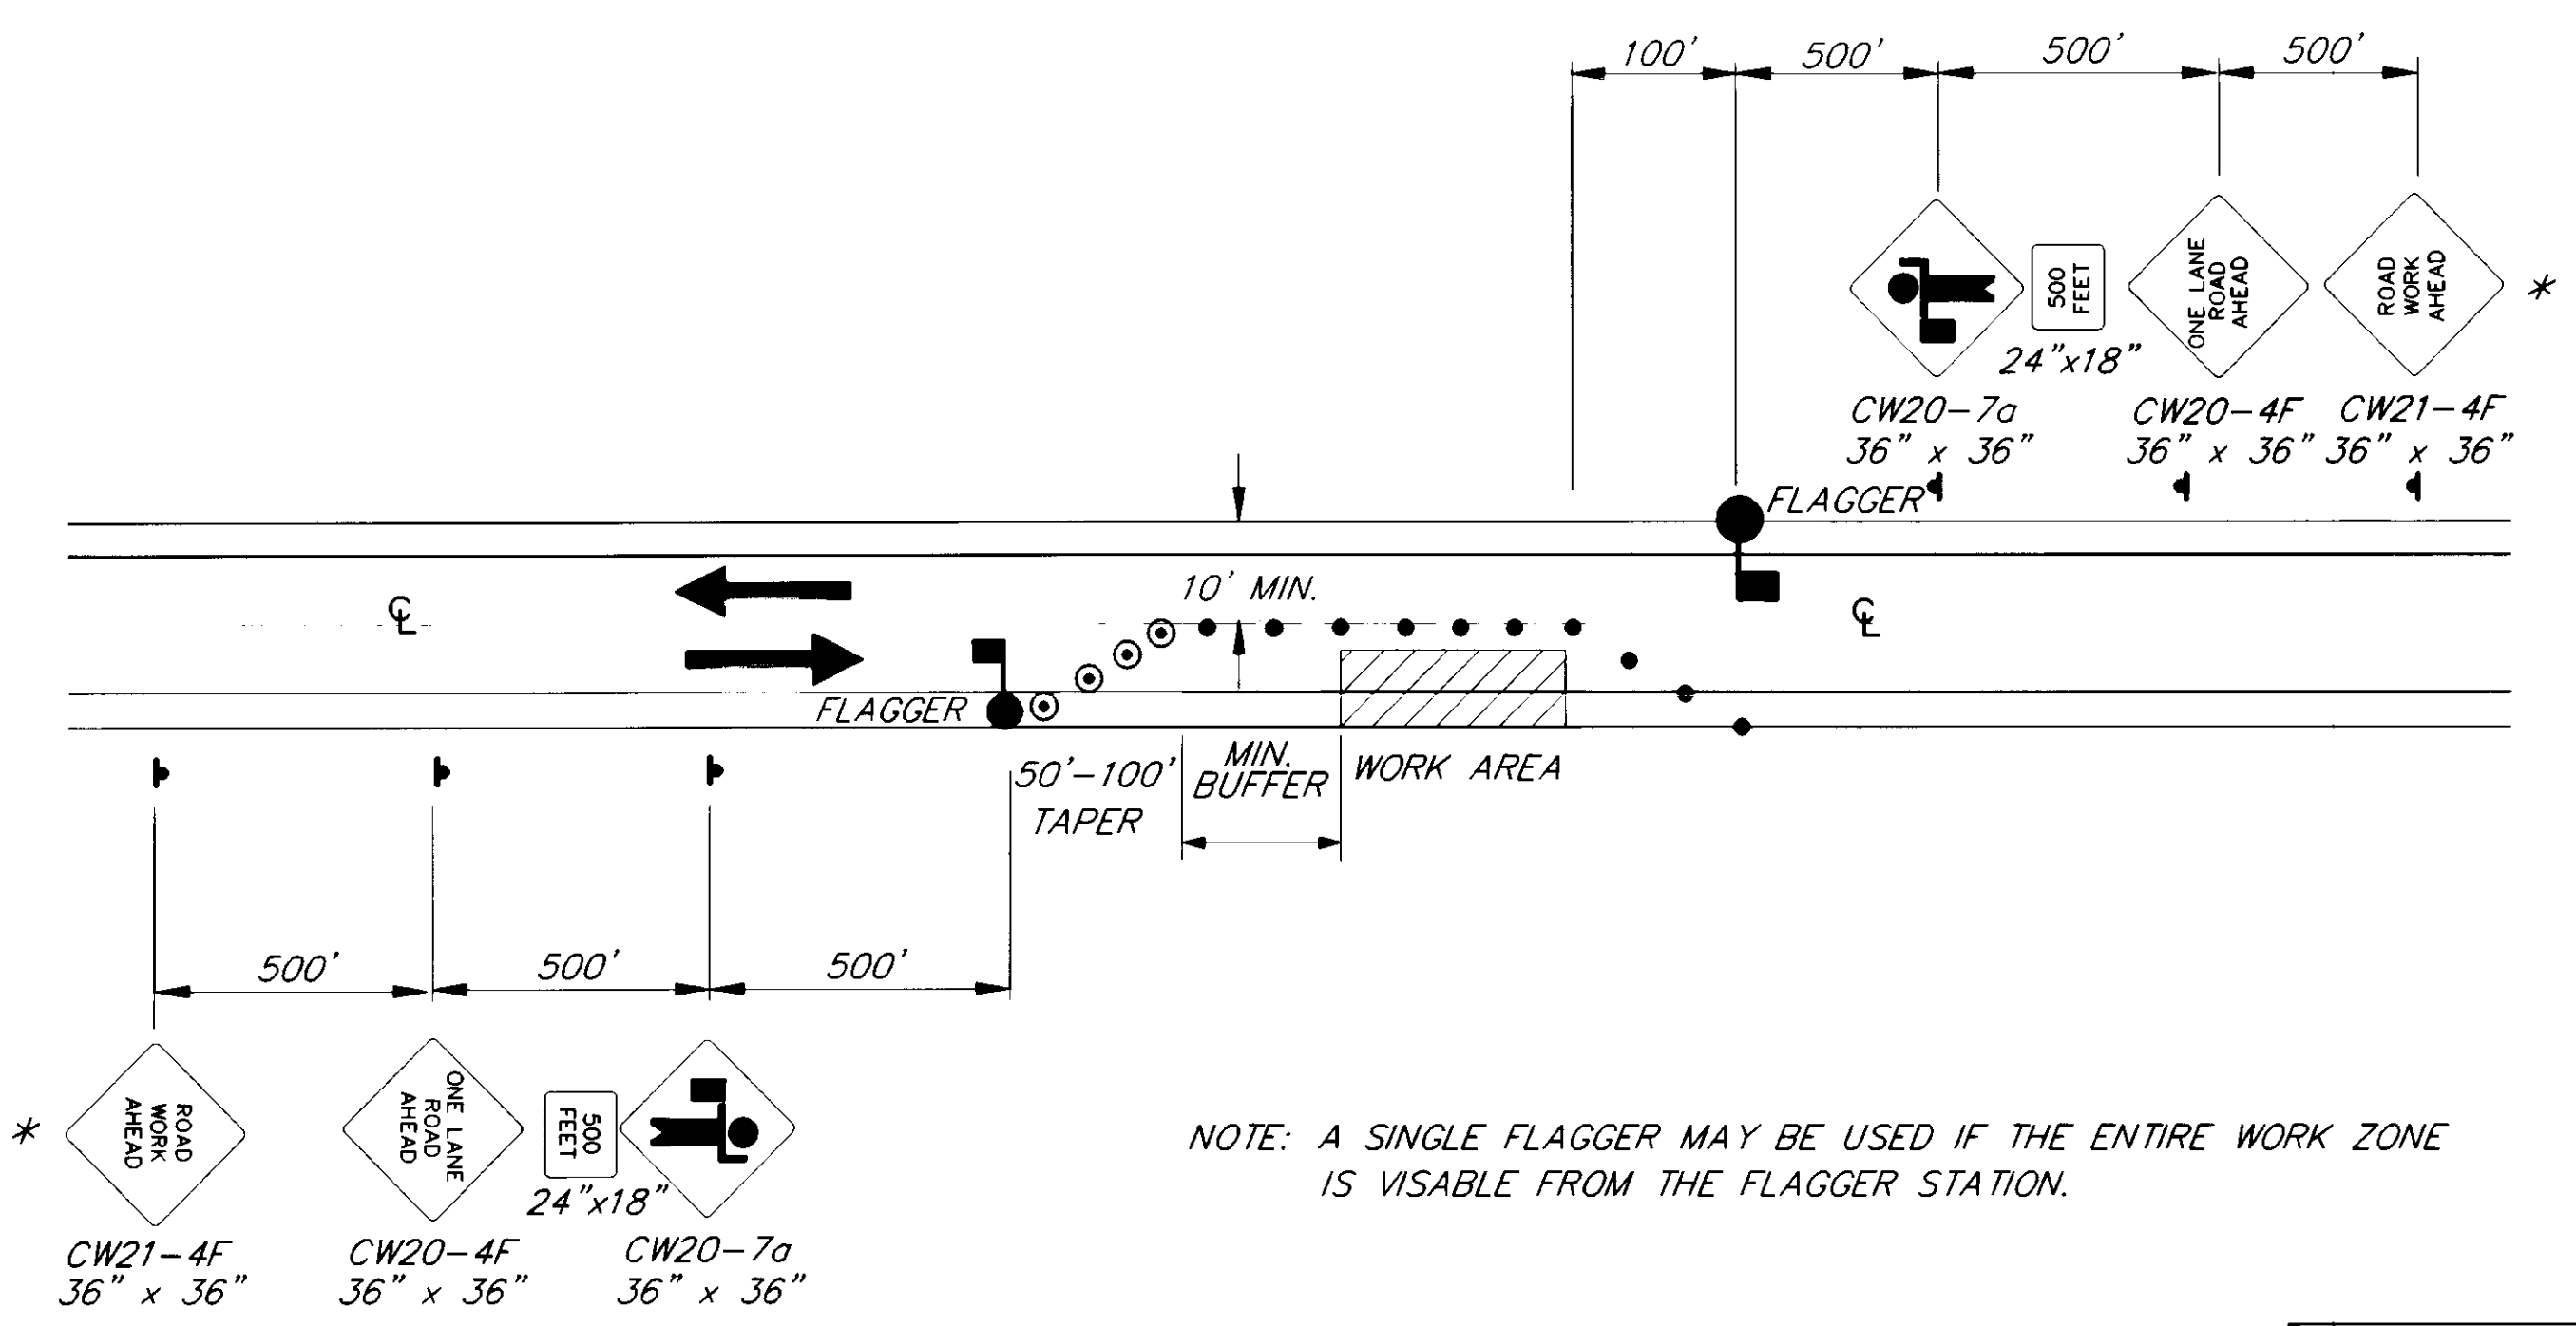

NOTE: A SINGLE FLAGGER MAY BE USED IF THE ENTIRE WORK ZONE IS VISABLE FROM THE FLAGGER STATION.

**SINGLE LANE CLOSURE
TWO LANE ROAD**

* DENOTES PERMANENT CONSTRUCTION SIGNING ALREADY INSTALLED.

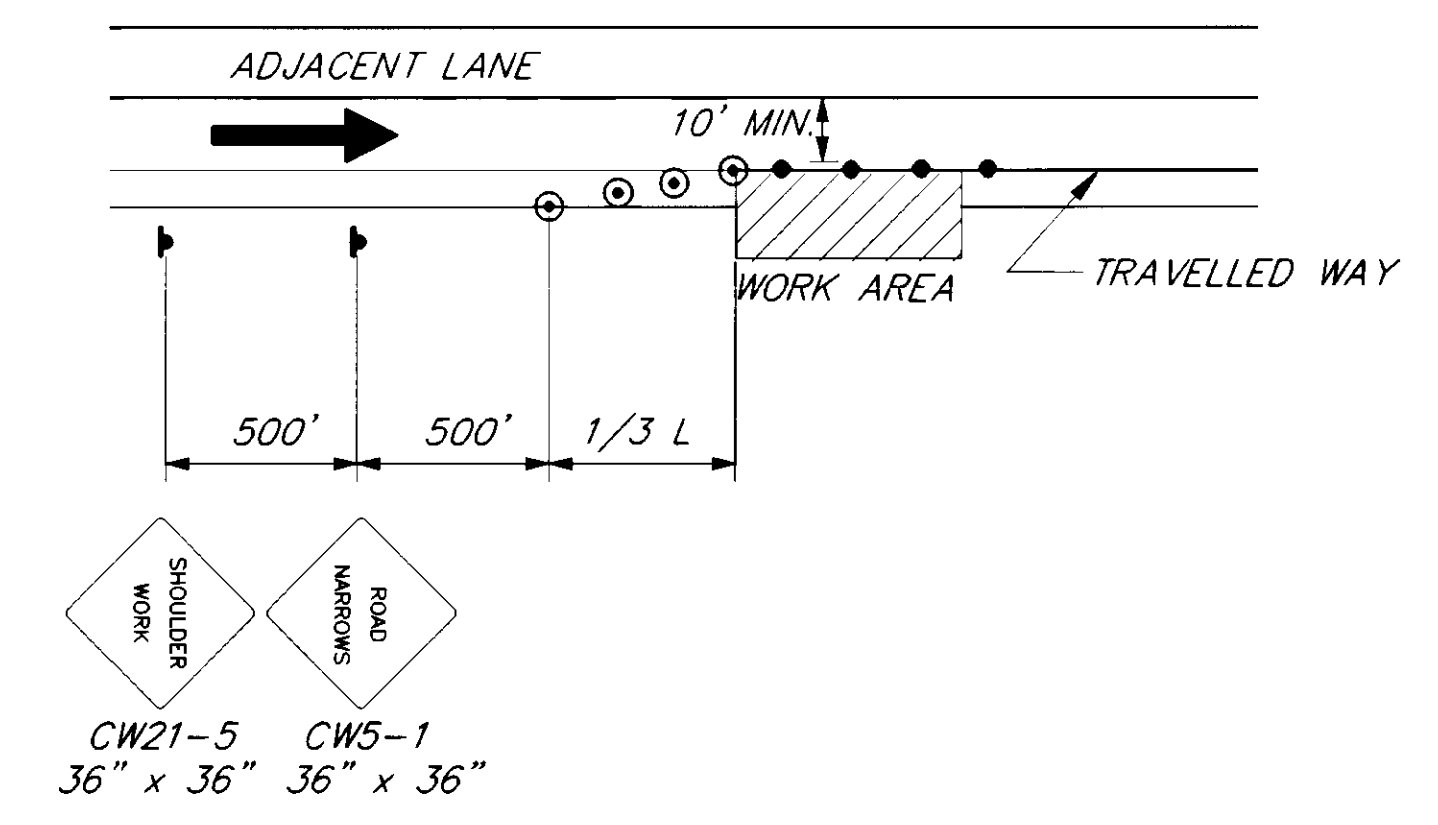

SHOULDER WORK

LEGEND

- SIGN
- CONE
- ⊙ DRUM
- TYPE III BARRICADE
- FLAGGING STATION

FORMULAS FOR L (TAPER LENGTH)


40 MPH OR LESS $L = \frac{W \times S^2}{60}$

45 MPH OR GREATER $L = W \times S$

WHERE W = WIDTH OF OFFSET
S = POSTED SPEED LIMIT OR ANTICIPATED OPERATING SPEED


DRUM OR CONE SPACING = S (IN FEET)

S	MIN. BUFFER LENGTH
20	35
25	55
30	85
35	120
40	170
45	220
50	280
55	335
60	415
65	485

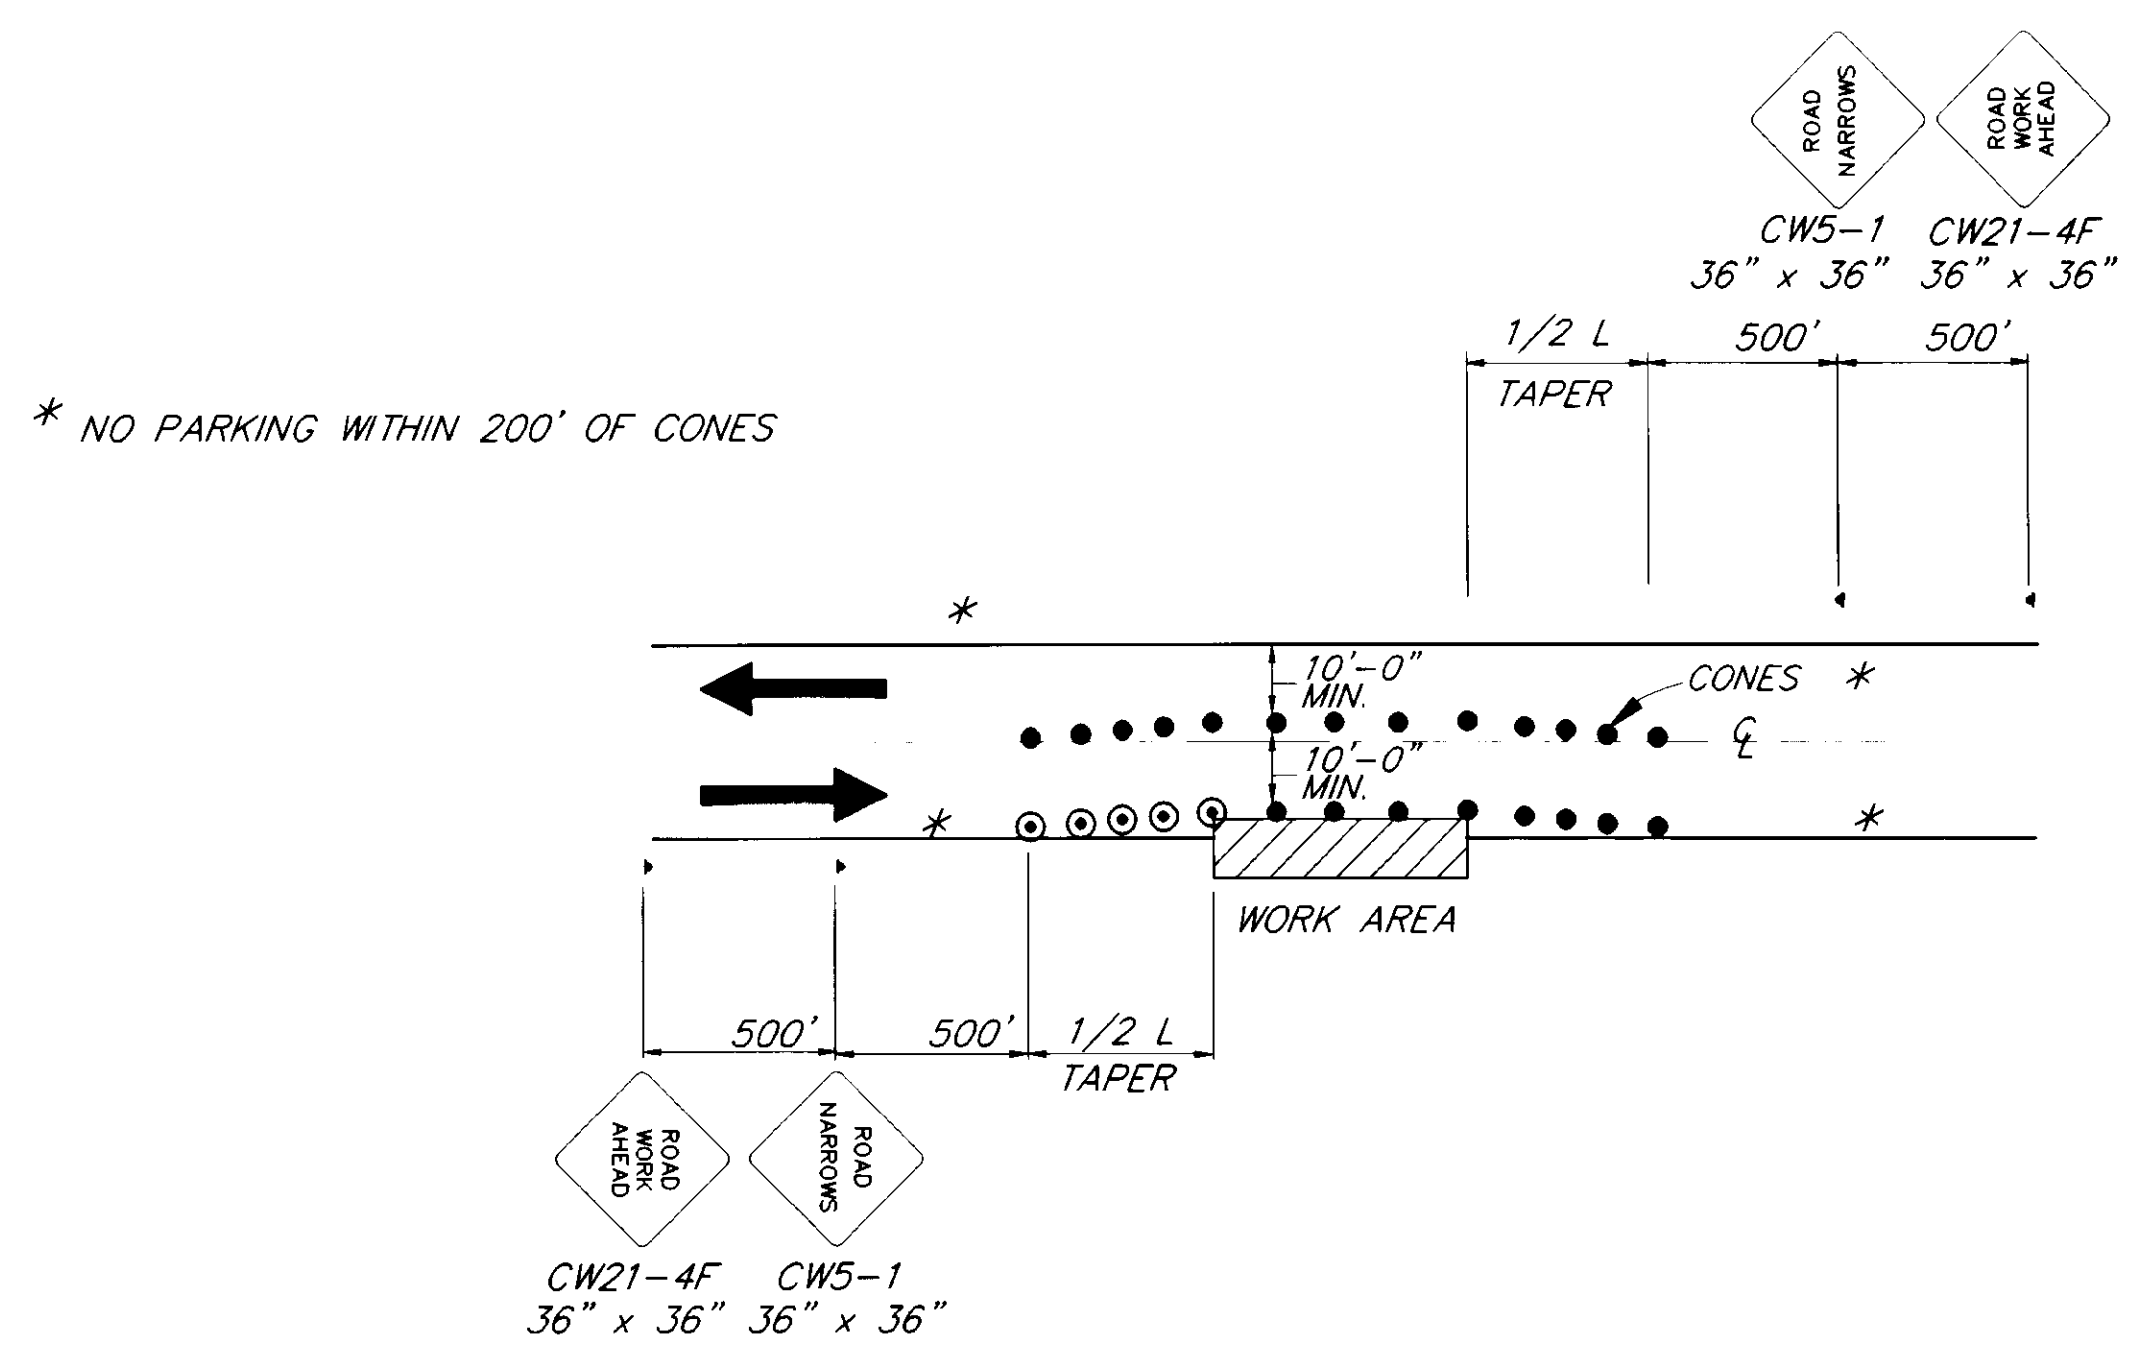

ROADWAY ENCROACHMENT

NOTE: IF ONLY ONE LANE IS EFFECTED BY ROAD WORK (THAT IS, THE CONES ALONG THE WORK AREA ARE NO CLOSER THAN 10' TO CENTERLINE) THE CENTERLINE CONES FOR THE OPPOSING LANE MAY BE DELETED.

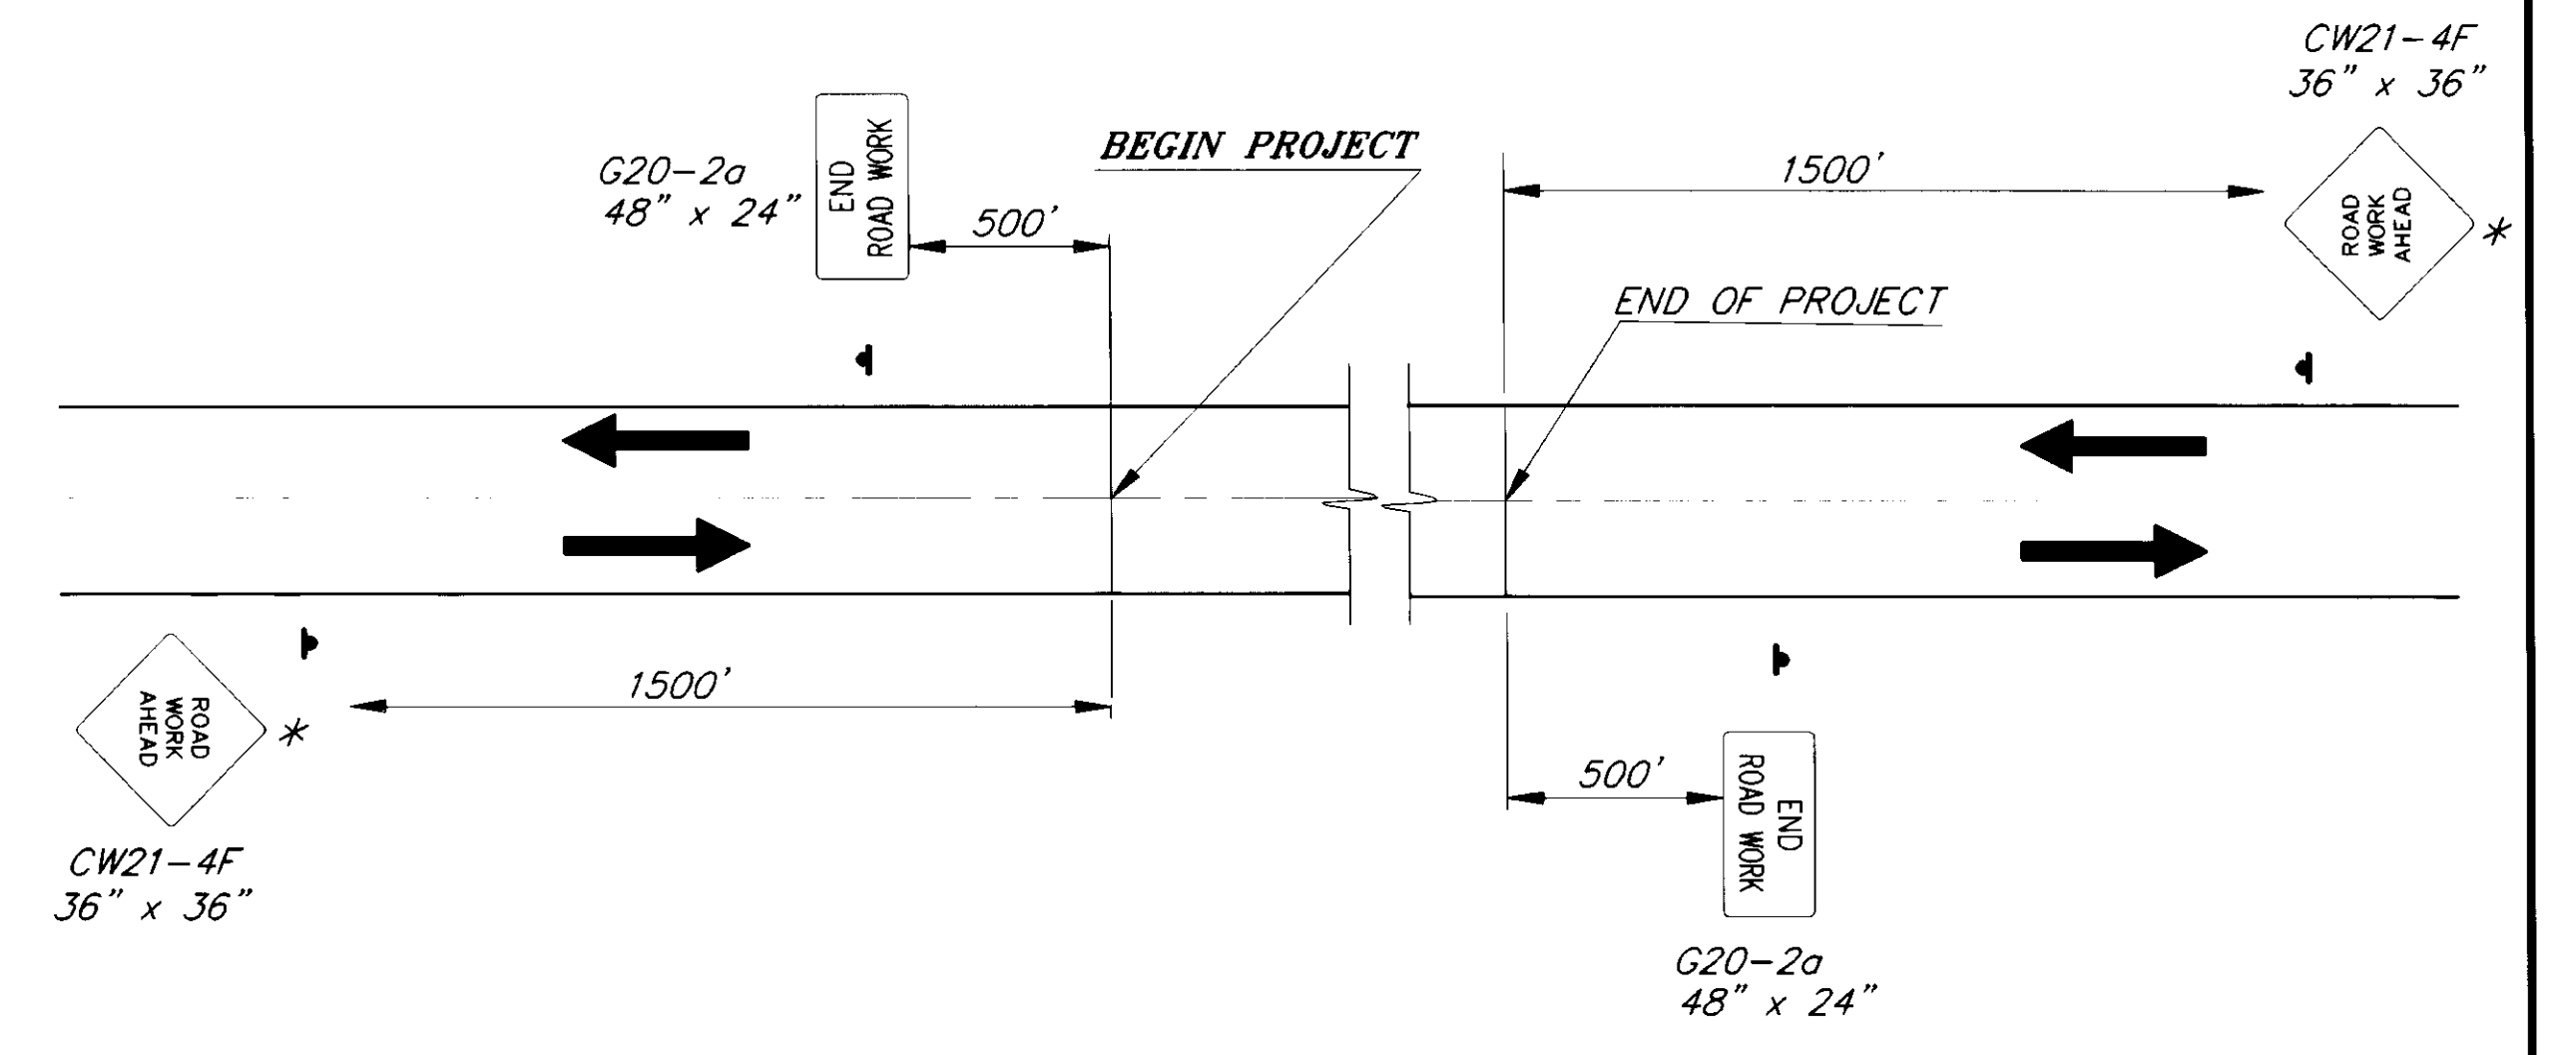

PERMANENT CONSTRUCTION SIGNING

AS-BUILT
BY: K.K. DATE: 7/27/99

NOTE: DO NOT SCALE FROM THESE PLANS-USE DIMENSIONS

P:\PSG\71646\AS-BUILT\#TCP2

BY:	DATE:	DESCRIPTION OF CHANGE:
K.K.	7/27/99	AS-BUILT


RECORD OF REVISIONS






STATE OF ALASKA
DEPARTMENT OF TRANSPORTATION
AND PUBLIC FACILITIES
SOUTHEAST REGION DESIGN & CONSTRUCTION

PETERSBURG


PSG-Twin Creek
Culvert Replacement
STP-0937 (26) ~ 71646
ALASKA
TRAFFIC CONTROL PLAN

DESIGNED BY: K. MATTSON	PROJECT NO. 71646
DRAWN BY: K. MATTSON	DATE: 1995
CHECKED BY: K. SMITH	SHEET 7 OF 16

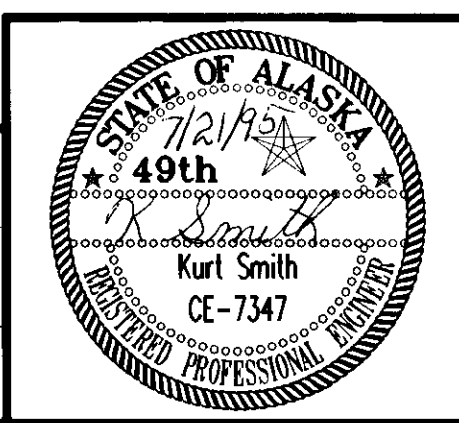

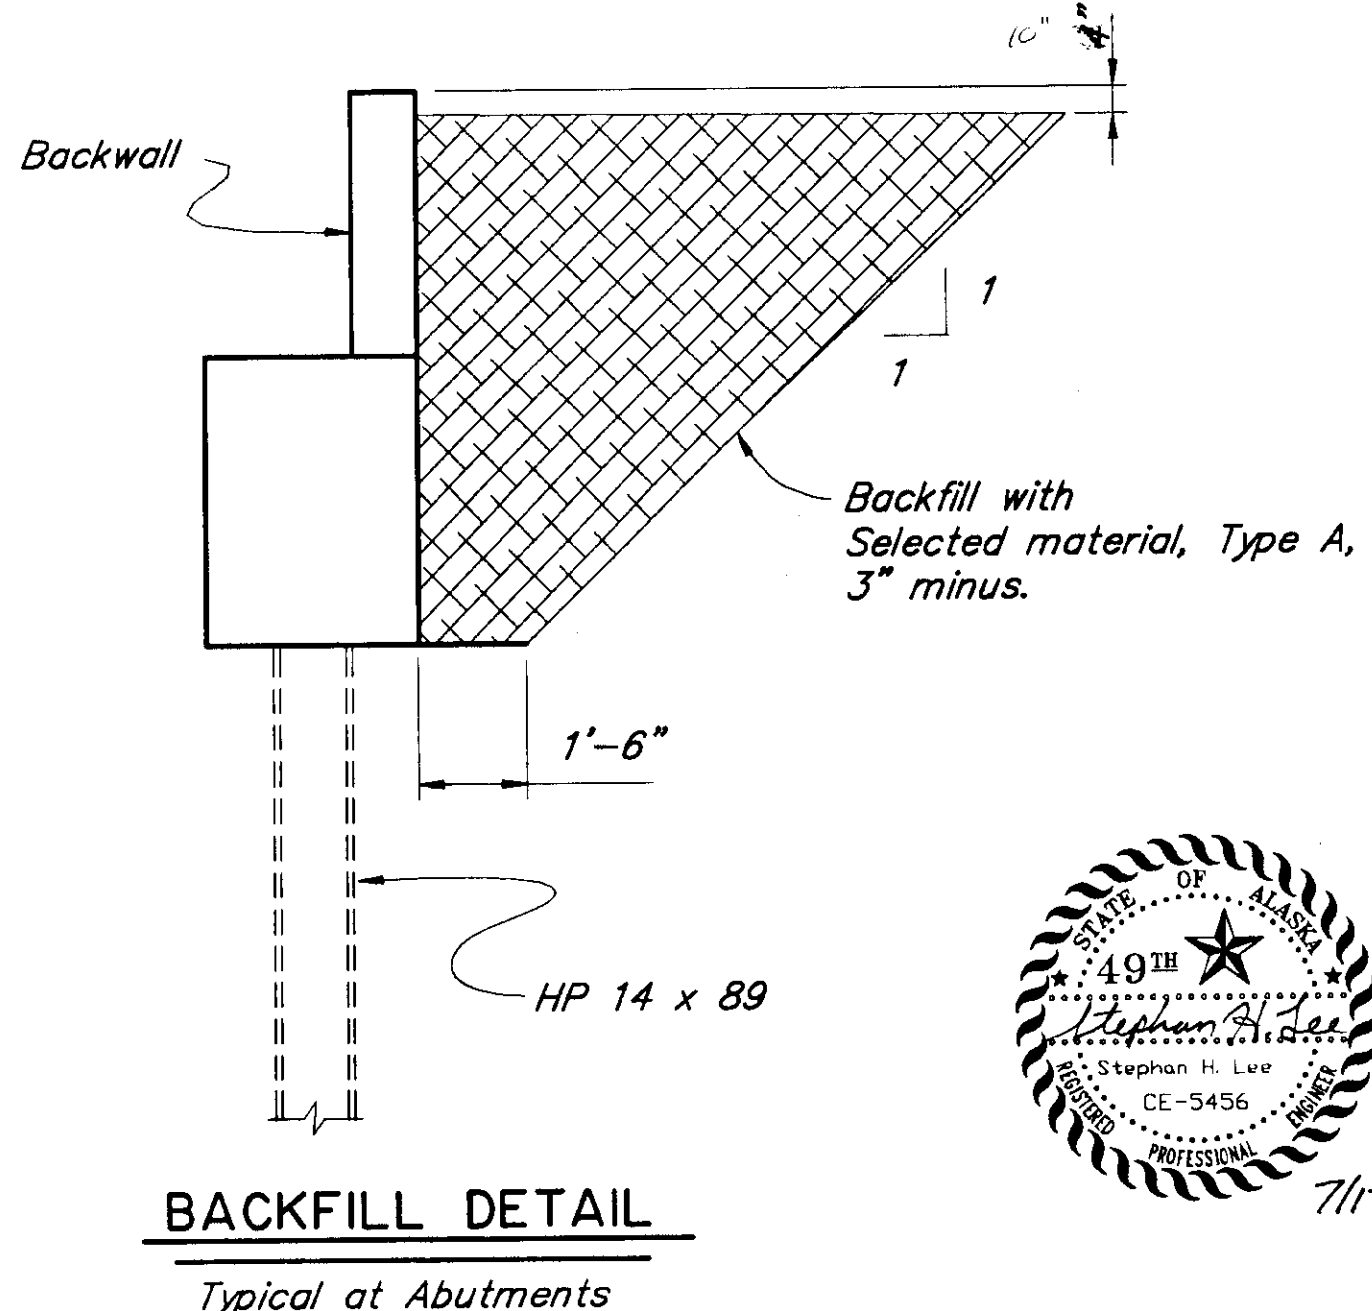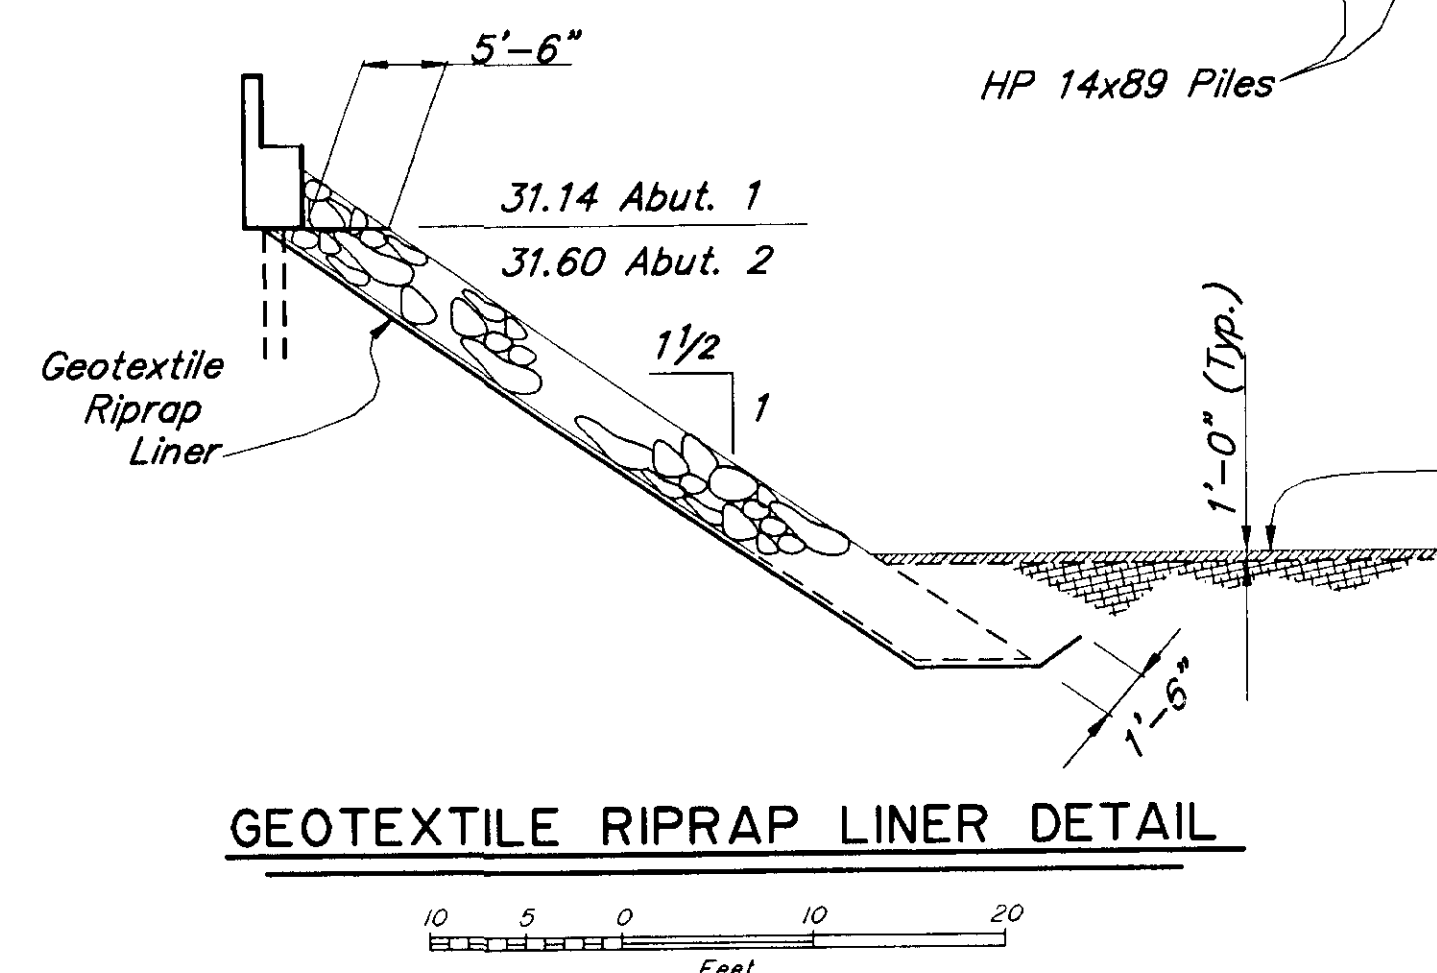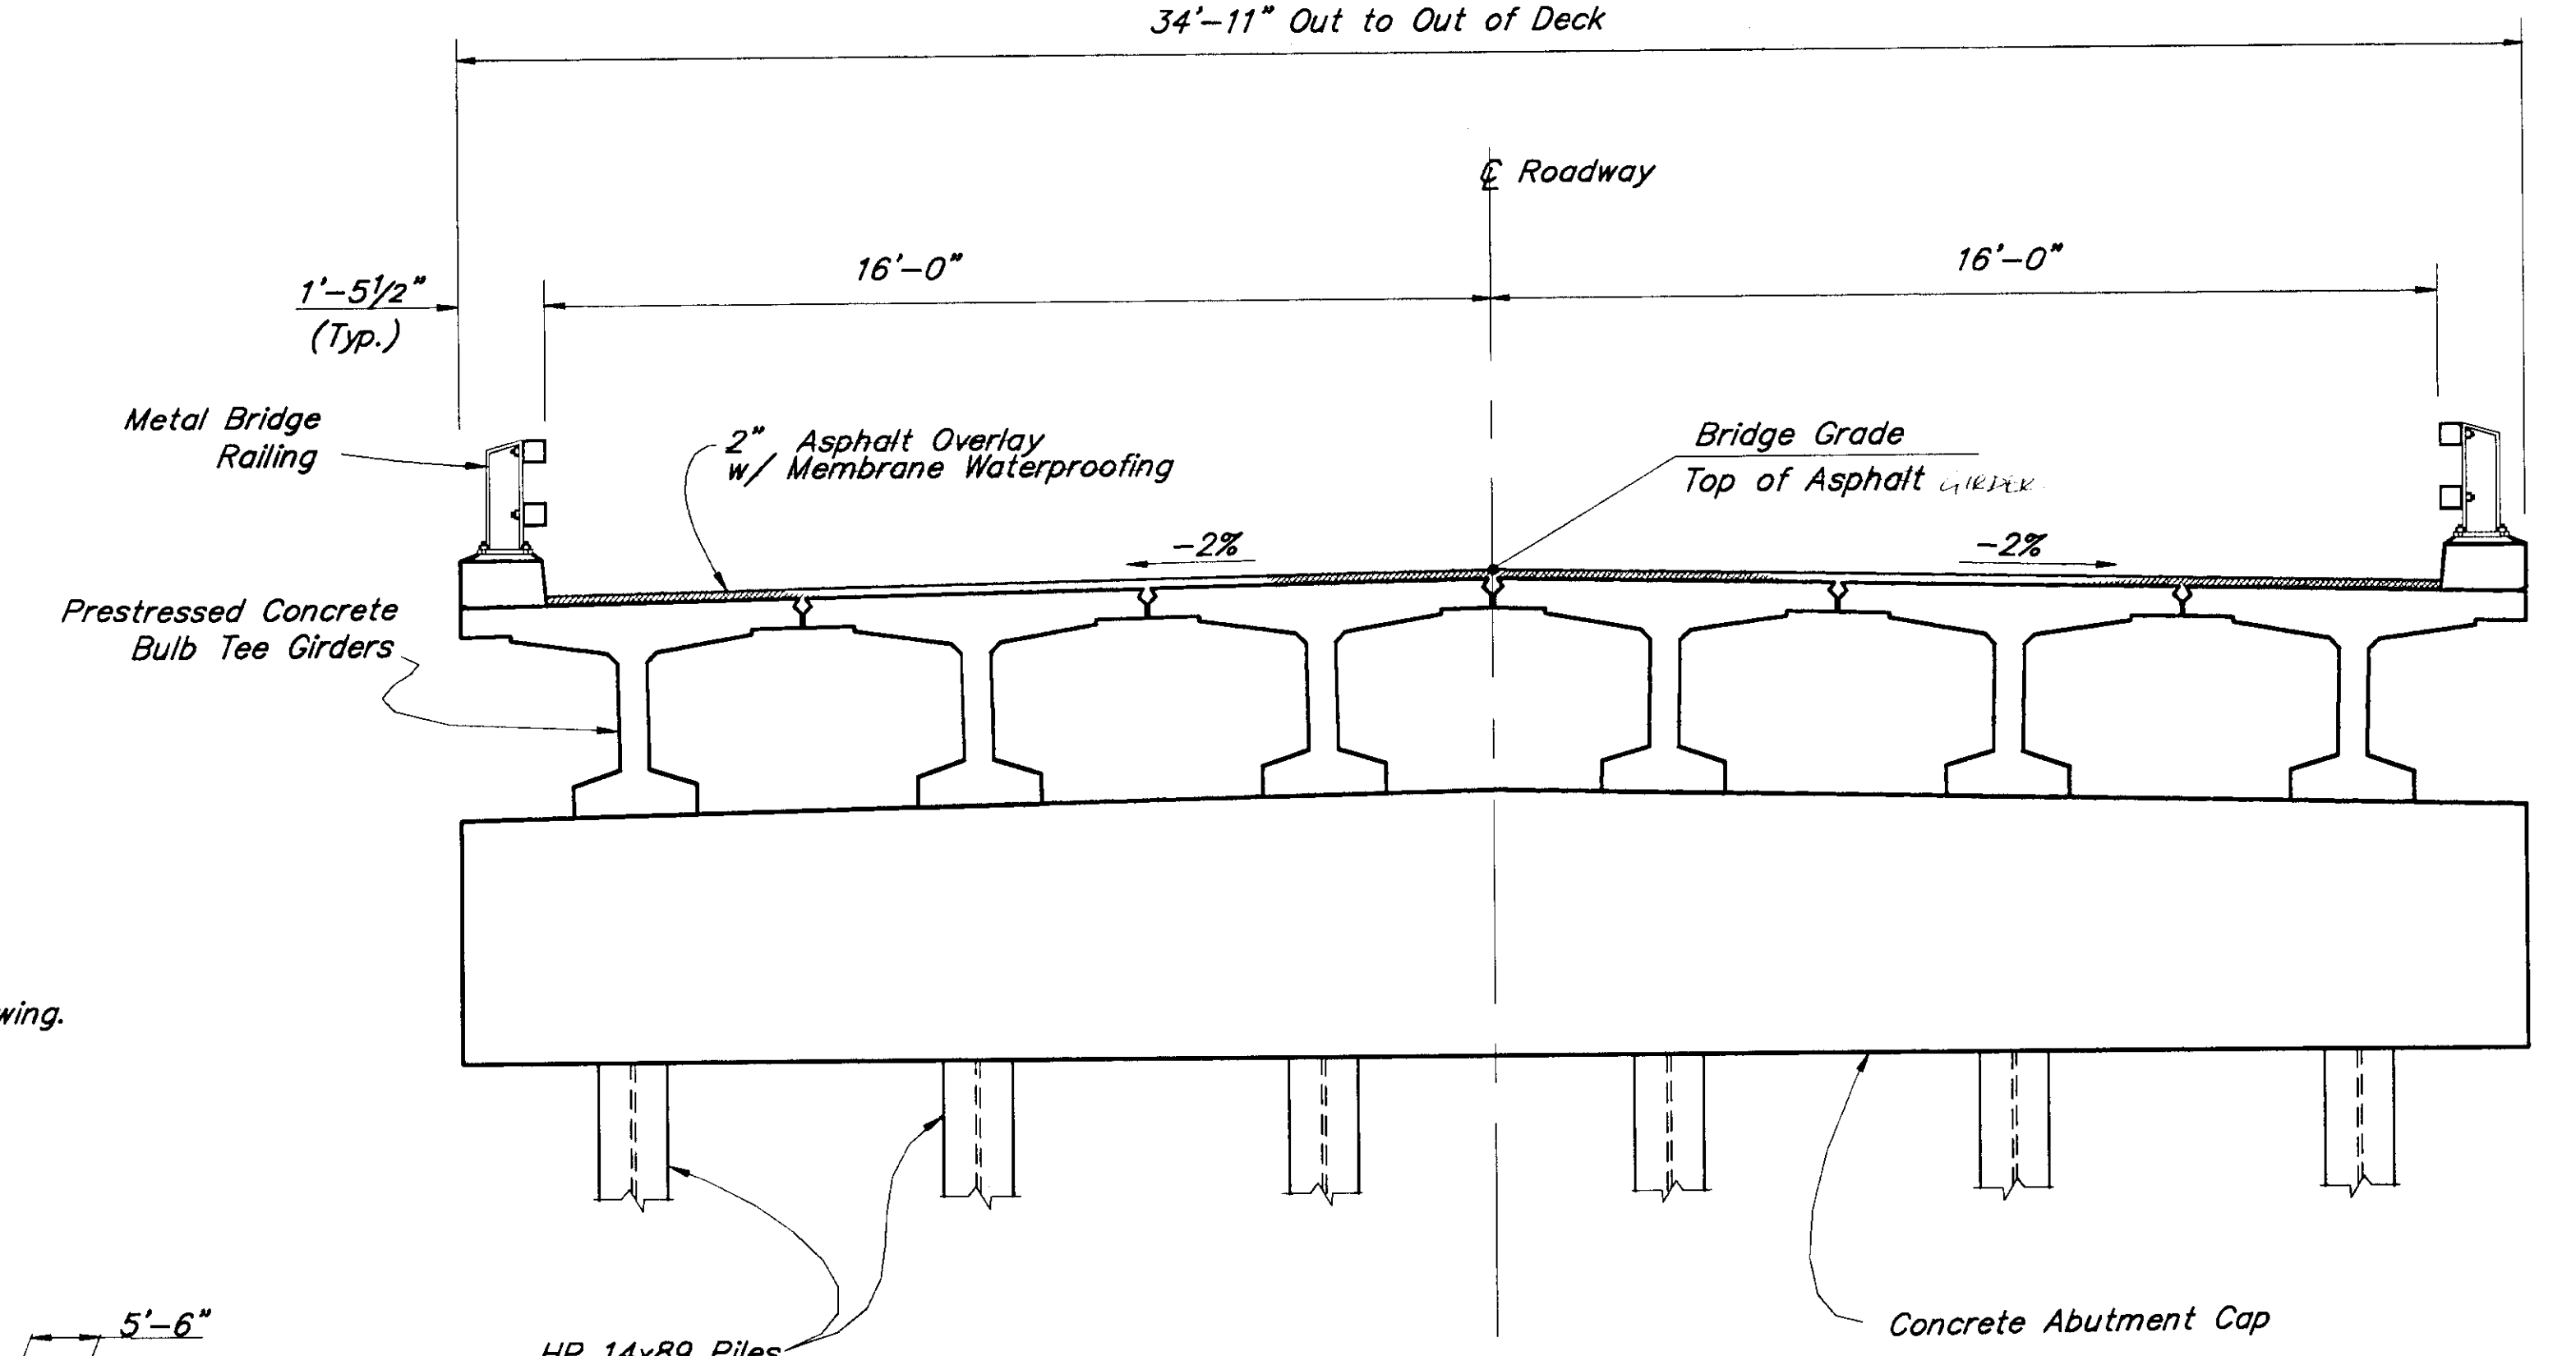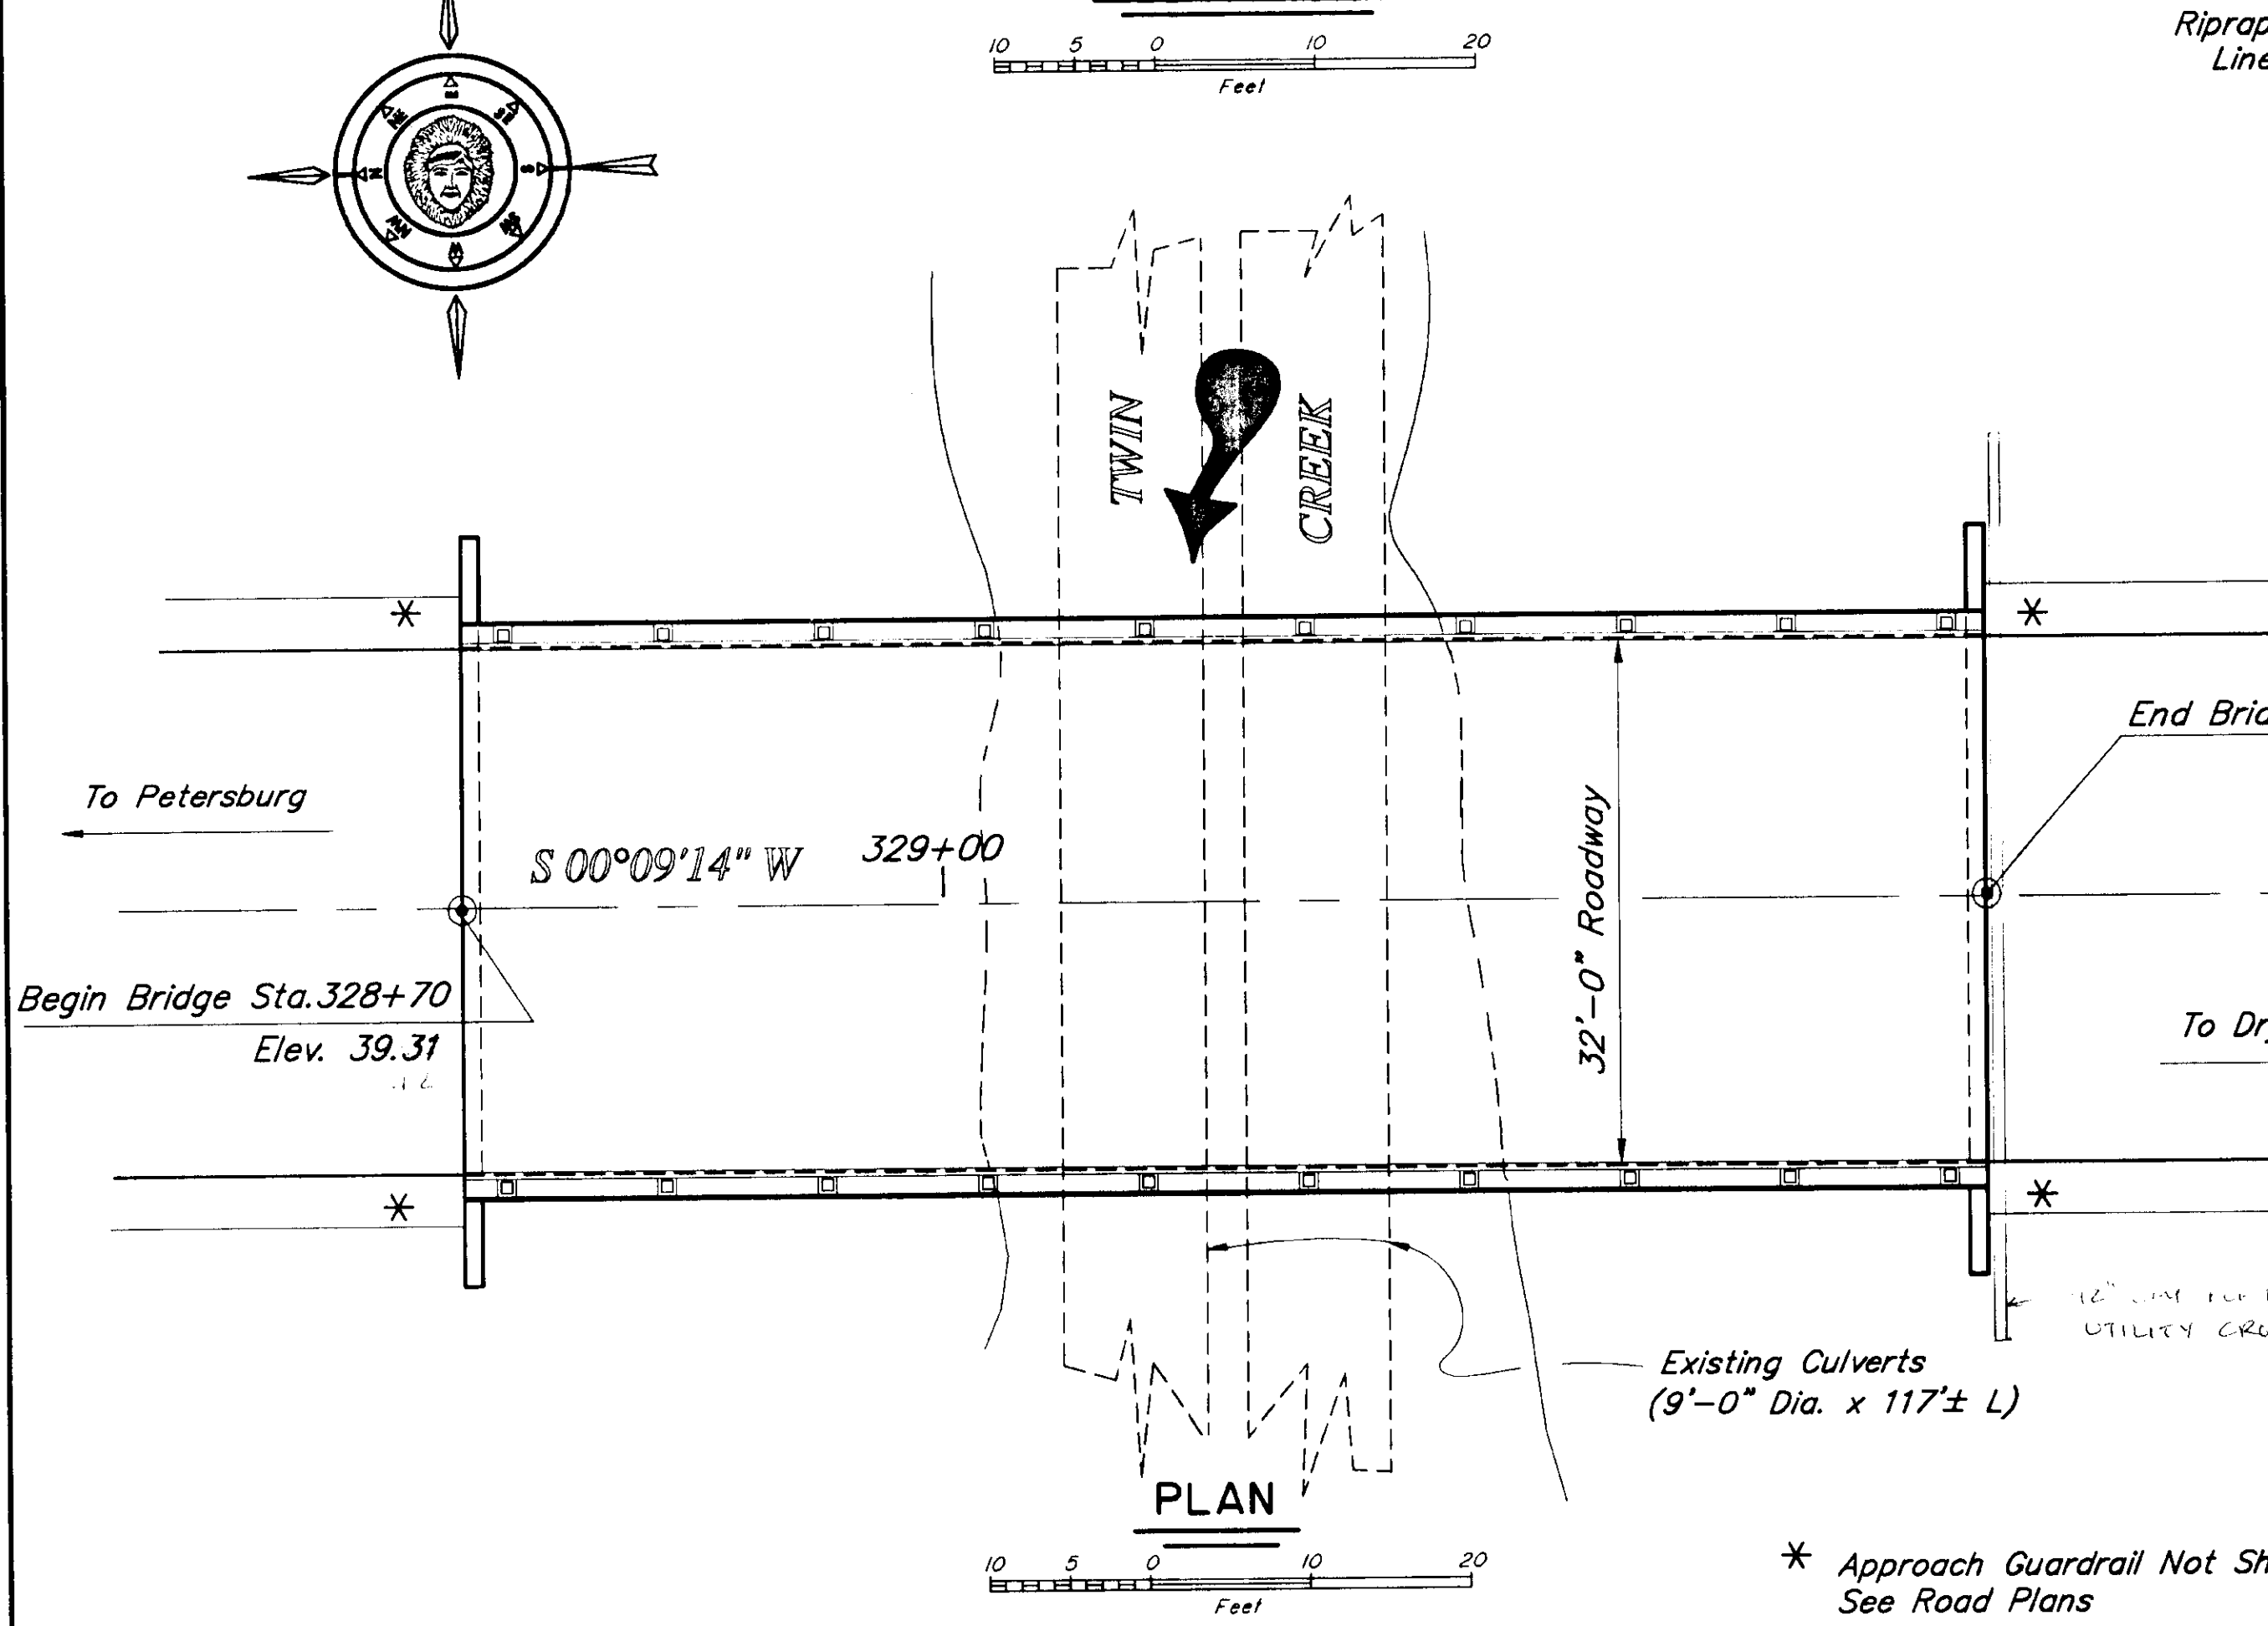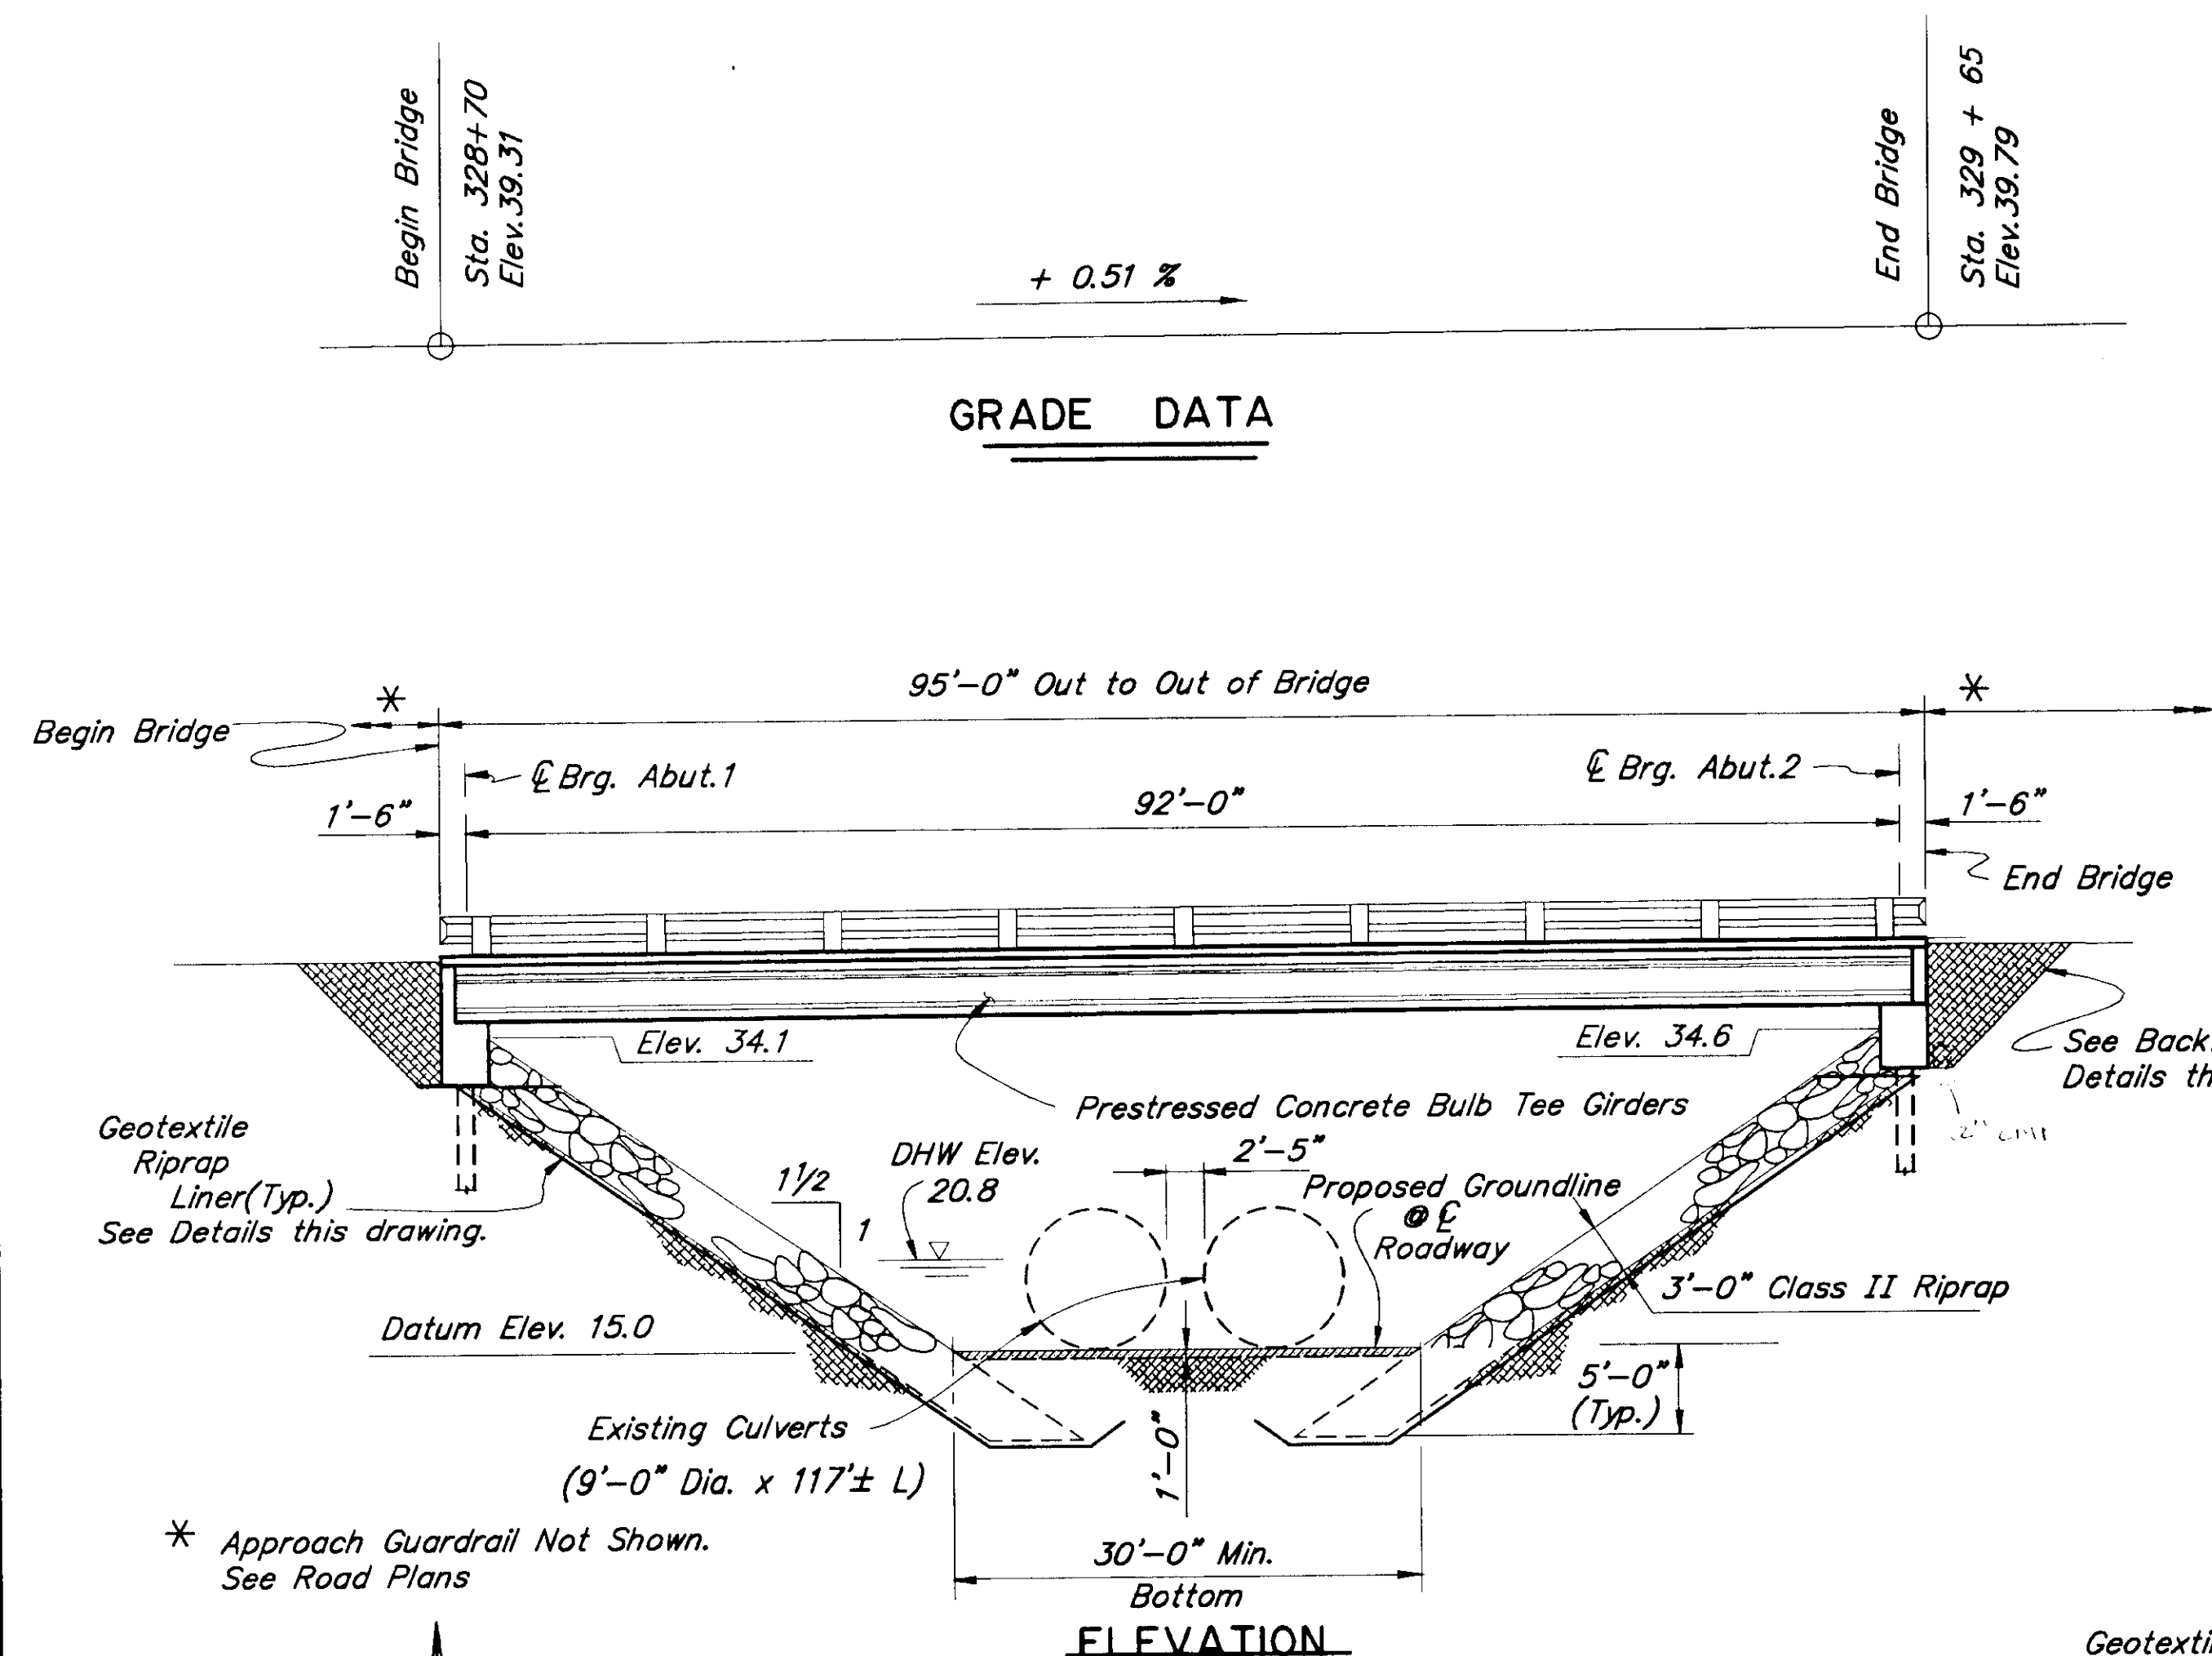

DRAWING INDEX	
TITLE	DWG. NO.
GENERAL LAYOUT	1
SITE PLAN	2
ABUTMENTS	3
TYPICAL SECTION	4
GIRDERS	5
GIRDER DETAILS	6
METAL BRIDGE RAILING	7
TEST HOLE LOGS & LOCATIONS	8 - 9

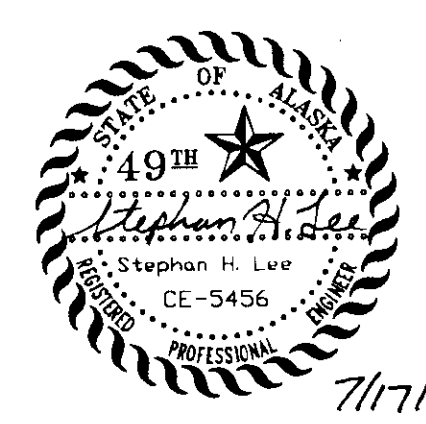

TWIN CREEK BRIDGE
Route No. FAS 937
GENERAL LAYOUT

STATE OF ALASKA
DEPARTMENT OF TRANSPORTATION
and PUBLIC FACILITIES
JUNEAU, ALASKA



BRIDGE No. 960
DWG. NO. 1

Designed By: SHL
Detail Check By: EEM
Design Check By: EEM

P-1960/P-1960/1960-1
7/17/95 8:58
Plot Scale = 20:00
Drawn/Revised By: GJM

* Approach Guardrail Not Shown.
See Road Plans

GENERAL NOTES

SPECIFICATIONS:

Design: AASHTO Standard Specifications for Highway Bridges, 1992 edition with latest Interim Specifications.
Construction: State of Alaska Standard Specifications for Highway Construction 1988, with Standard Modifications and Special Provisions.

Live Load: HS-25
Dead Load: Includes 25 psf for future paving.

DESIGN UNIT STRESSES:


Cast-in-Place Concrete: $f'_c = 3,000$ psi
 $F_y = 60,000$ psi
Prestressed Concrete: See Girder Details.
Structural Steel: A36: $F_y = 36,000$ psi
 $F_s = 20,000$ psi

STRUCTURAL MATERIALS:

Concrete: All cast-in-place concrete shall be Class A.
Reinforcing Steel: All reinforcing steel shall be ASTM A615, Grade 60.
Structural Steel: All structural steel shall be galvanized A36, unless otherwise noted.
 Girder steel shear connectors shall be furnished in black iron finish.
 All other structural steel embedded in or attached to concrete girders shall be galvanized.
Piling: All abutment piles shall be HP14x89, ASTM A572, Grade 50. Provide pile tip reinforcing as shown - See Dwg. No. 3.

STANDARD DRAWINGS:

The following standard drawings apply to the bridge: G-04.04S, G-09.01S, G-14.04S, G-18.00S and G-29.01S.

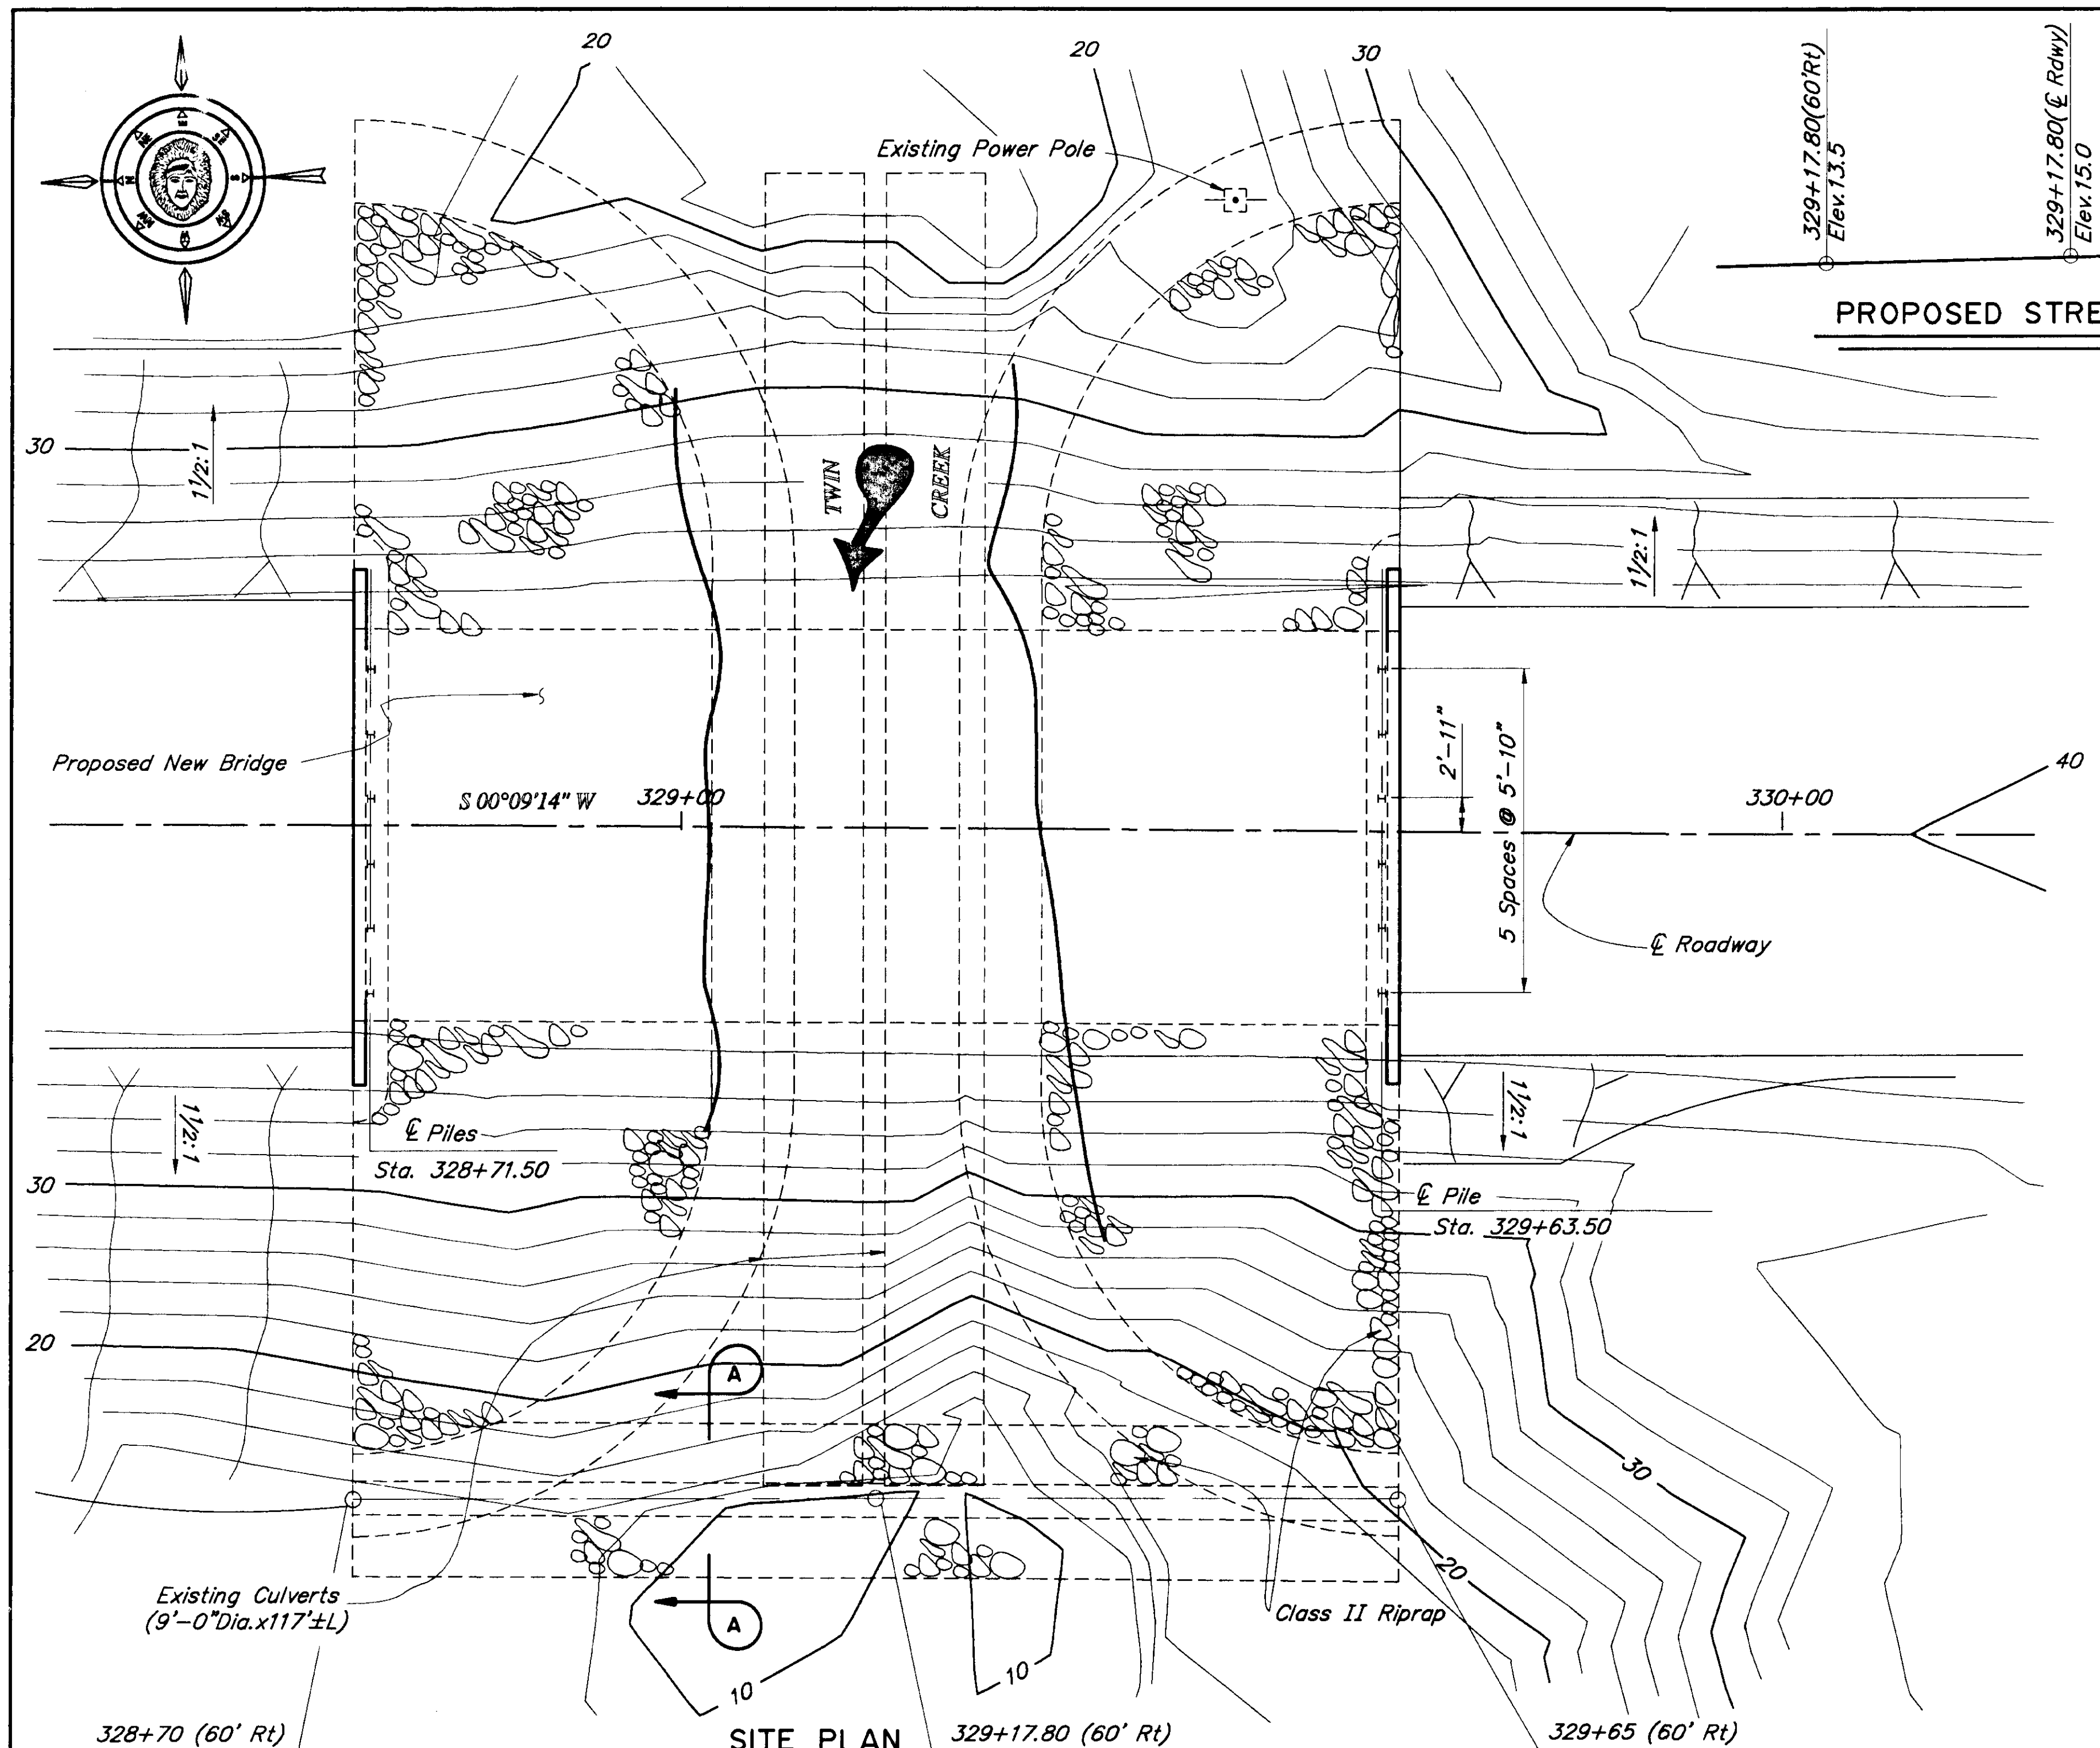

ESTIMATE OF QUANTITIES


ITEM NO.	ITEM	UNIT	SUBST.	SUPERST.	TOTAL
202(4)	Removal of Culvert Pipe	LS/LF	234		234
203(3)	Unclassified Excavation	LS/CY	5100		5100
203(6)	Borrow	Ton	670		670
401(1)	Asphalt Concrete Pavement	LS/Ton		39.2	39.2
401(2)	Asphalt Cement	LS/Ton		2.4	2.4
501(1)	Class A Concrete	LS/CY	41.8	9.9	51.7
502(1)	Prestressed Concrete Structural Members (93'-2" Bulb Tees)	EA		6	6
503(1)	Reinforcing Steel	LS/LBS	3570	3200	6770
505(5)	Structural Steel Piles, Furnished (HP14x89)	LF	432		432
505(6)	Structural Steel Piles, Driven (HP14x89)	EA	12		12
507(1)	Metal Bridge Railing	LF		190	190
508(1)	Membrane Waterproofing	LS			All Req'd
606(2)	Thrie Beam Guardrail	LF		75	75
611(1)	Riprap, Class II	CY	990		990
631(2)	Geotextile, Erosion Control, Class A	SY	1330		1330
643(30)	Bridge Detour Crossing	LS			All Req'd

Item numbers are for reference only. Quantities shown are not necessarily the pay quantities nor the total quantity of the particular item. Reinforcing steel lap lengths are not included in the quantity shown.

HYDRAULIC & HYDROLOGIC SUMMARY

	50	100	500
Flood Frequency (yr)	50	100	500
Exceedance Probability (%)	2	1	0.2
Design Discharge (cfs)	923	1030	1260
Design High Water (ft)	20.8	21.0	21.5
Anticipated Additional Backwater (ft)	0.0	0.0	
Contraction Scour (ft.)		0	0
Abutment Scour (ft.)		5	5

Drainage Area for this crossing: 3.0 Square Miles.
 Additional backwater estimated immediately upstream of existing structure.
 Hydraulic Capacity: 11,200 cfs at Low Superstructure Elevation which has an exceedance probability less than .2% (Q500).
 Datum: Mean Lower Low Water = 0.0 ft.
 Mean High Water = 14.8 ft.

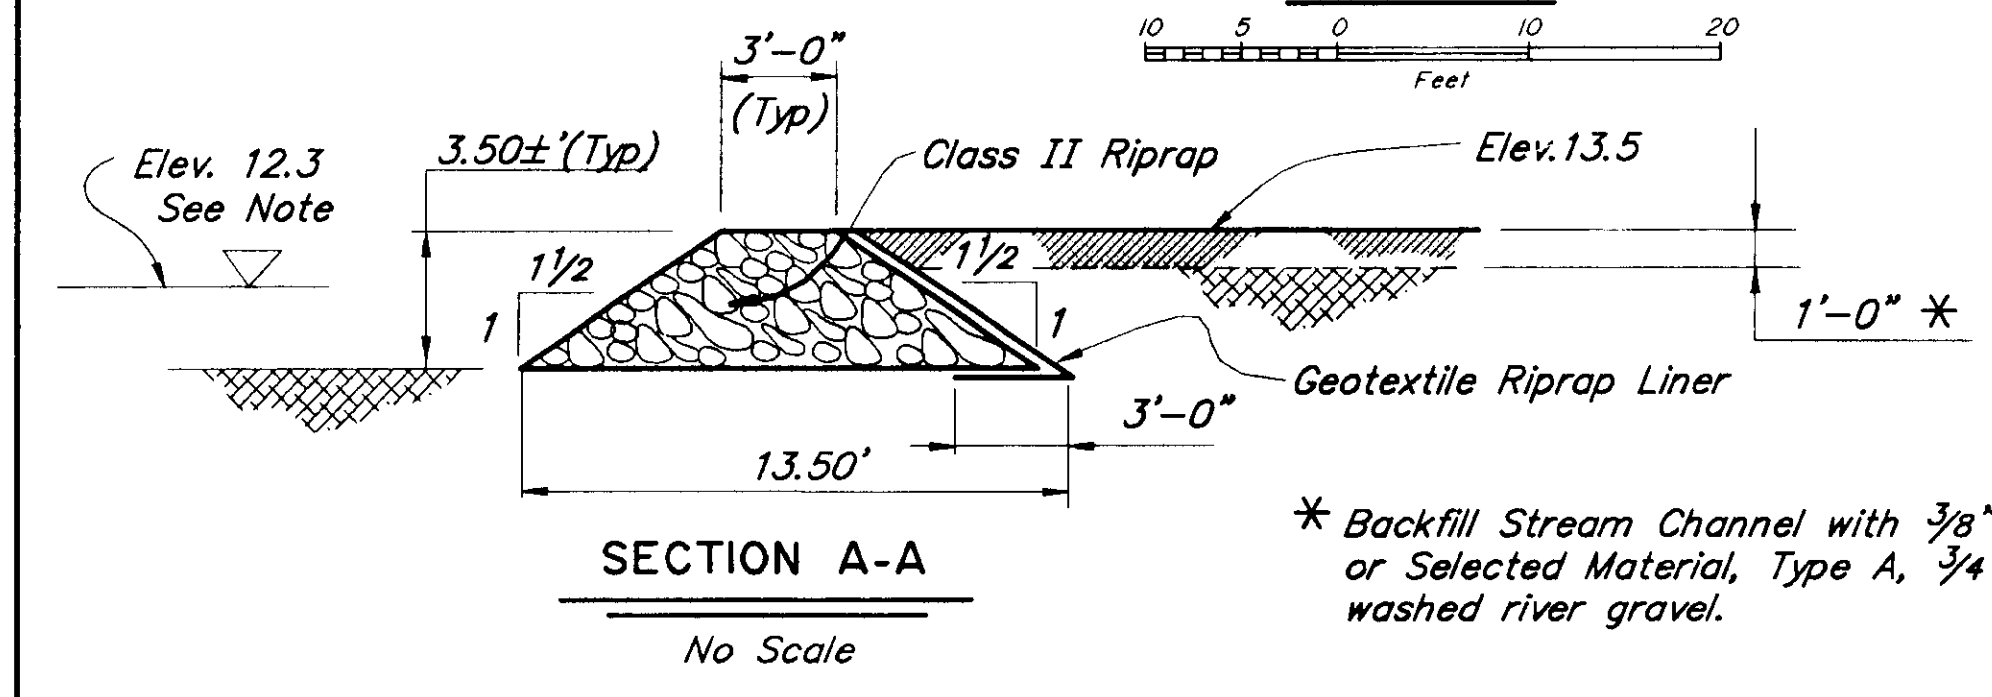

* Backfill Stream Channel with 3/8" Pea Gravel or Selected Material, Type A, 3/4" minus washed river gravel.


Note: The water surface elevation of the intertidal pool immediately downstream of the existing culverts was measured on 6/6/95 at approximately 11:00 am. (Low Tide = 2.2 @ 1:26 pm.)





TWIN CREEK BRIDGE

Route No. FAS 937
 SITE PLAN

STATE of ALASKA
 DEPARTMENT of TRANSPORTATION
 and PUBLIC FACILITIES
 JUNEAU, ALASKA

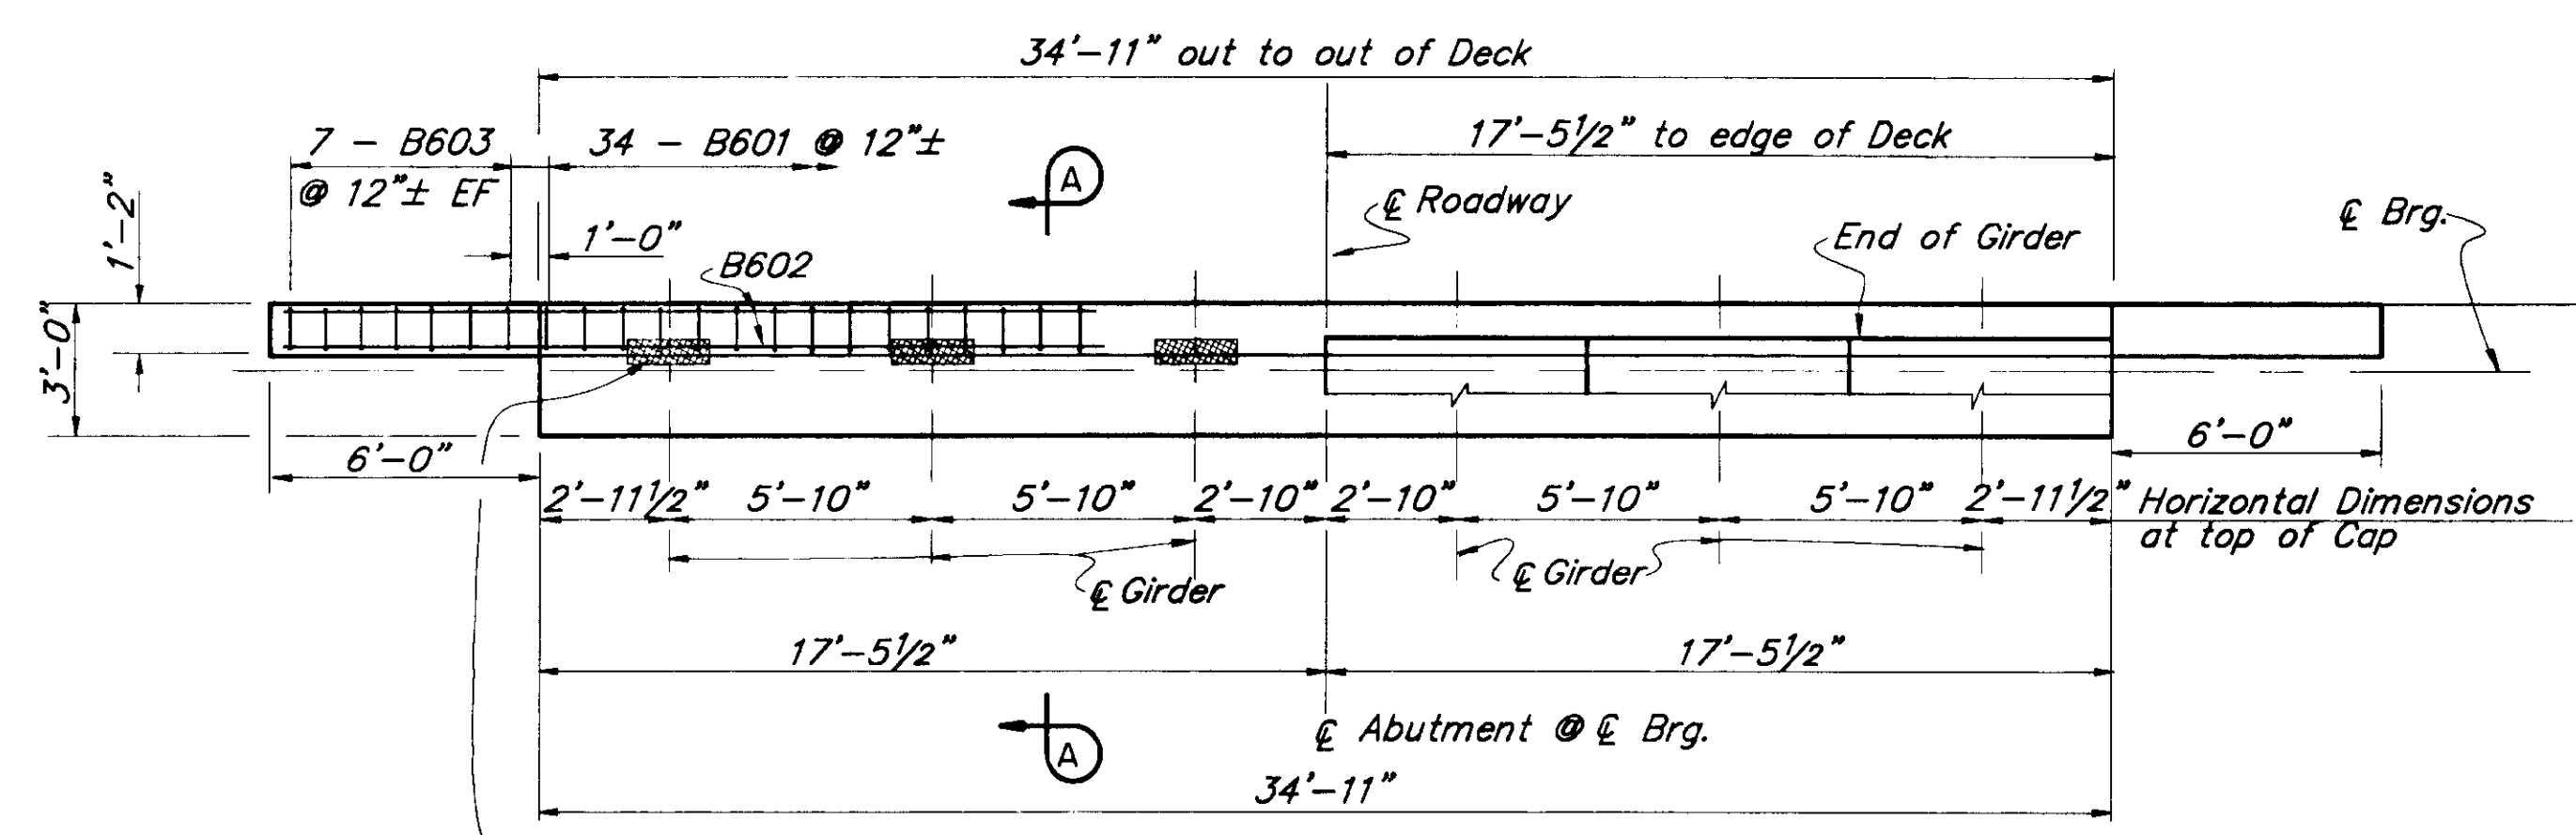


PLAN

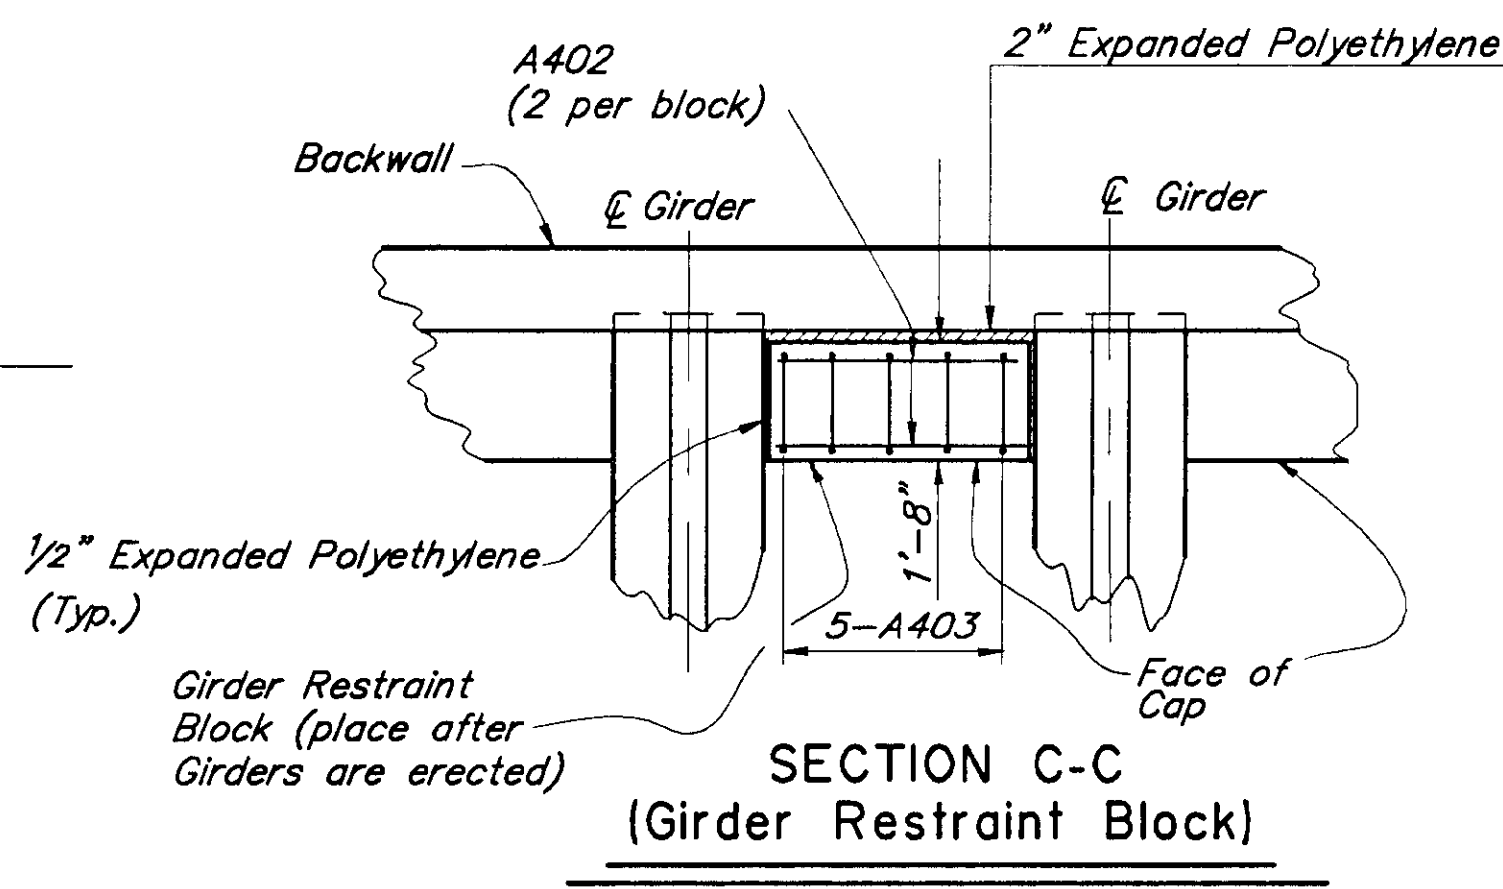
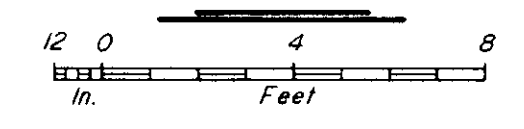


MARK	SIZE	NO.	LENGTH	TYPE	BENDING DIAGRAMS
A401	4	36	Varies	Bent	
A402	4	10	3'-5"		
A403	4	25	4'-1"	Bent	
a B601	6	34	9'-0"	Bent	
b B602	6	10	46'-7"		
B603	6	28	7'-3"		
B604	6	16	5'-8"		
A701	7	18	34'-7"		
A801	8	12	2'-9"	Bent	



a - Epoxy coated
 b - Epoxy coat two top bars.
 Bar length excludes lap splice length
 Lap splice length: B602 = 2'-6", A701 = 3'-0"

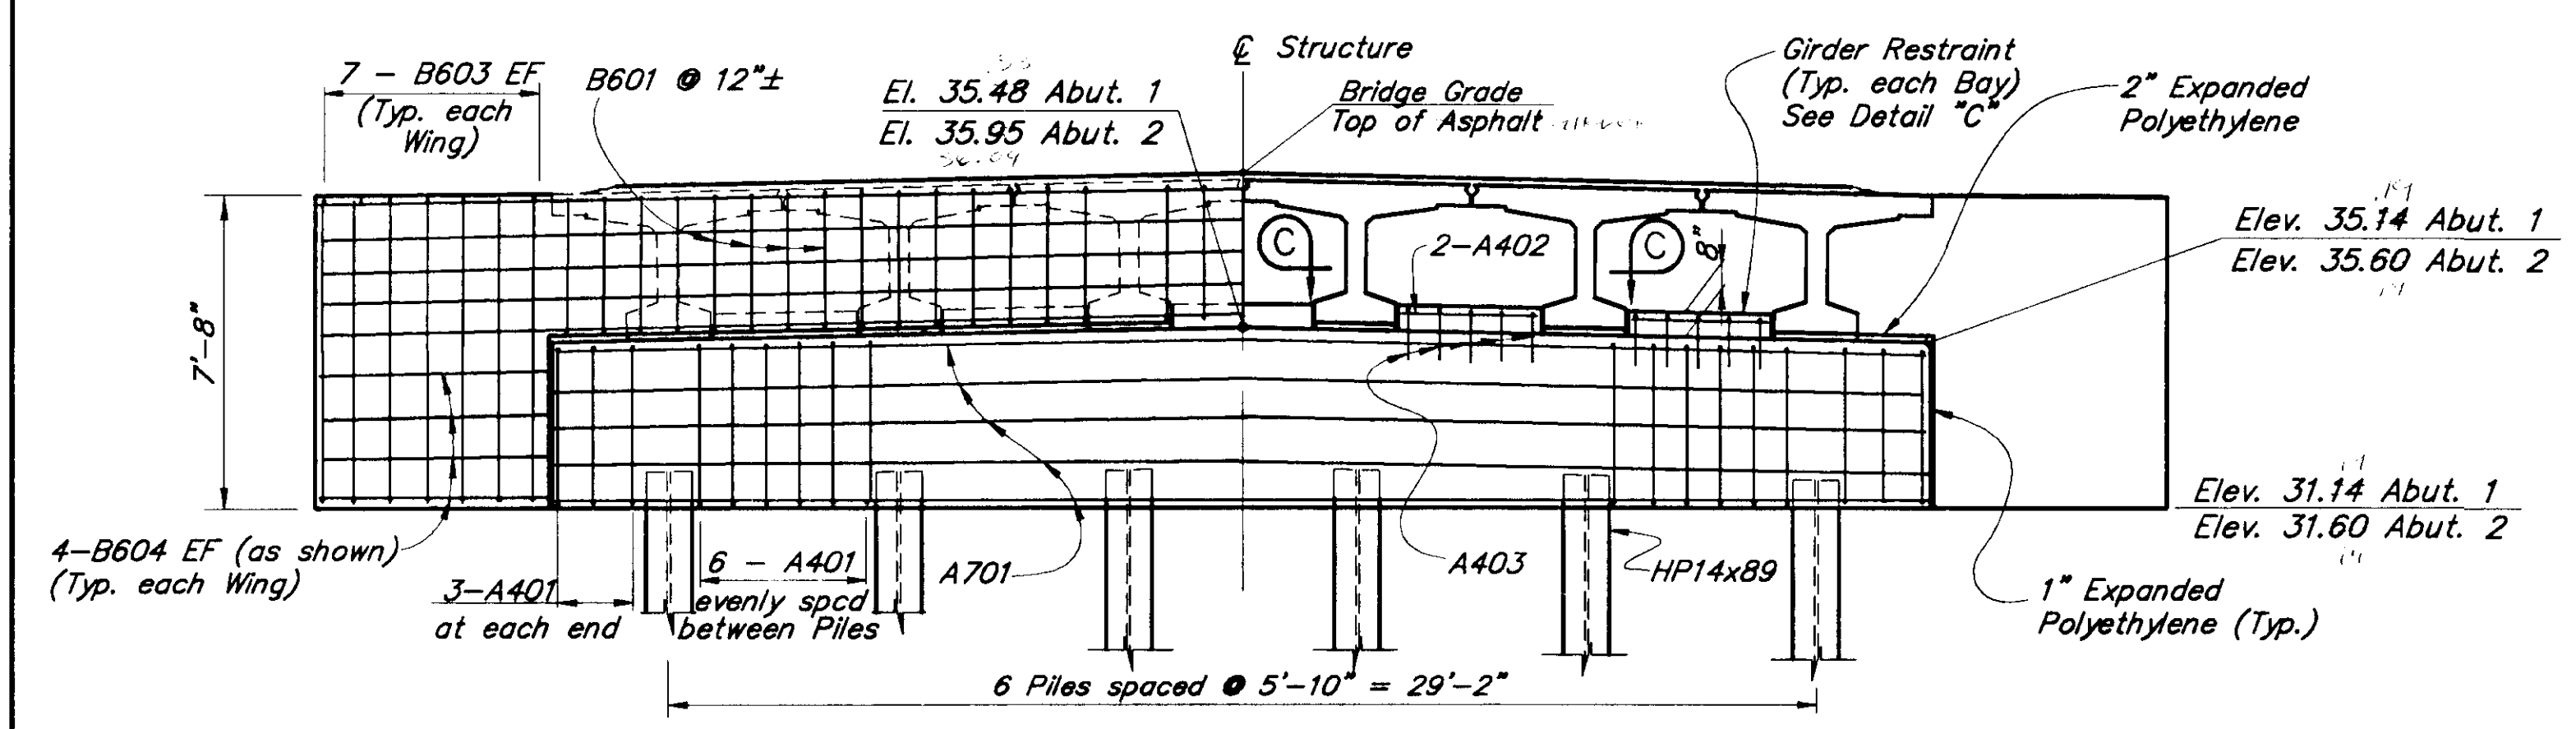



ELEVATION

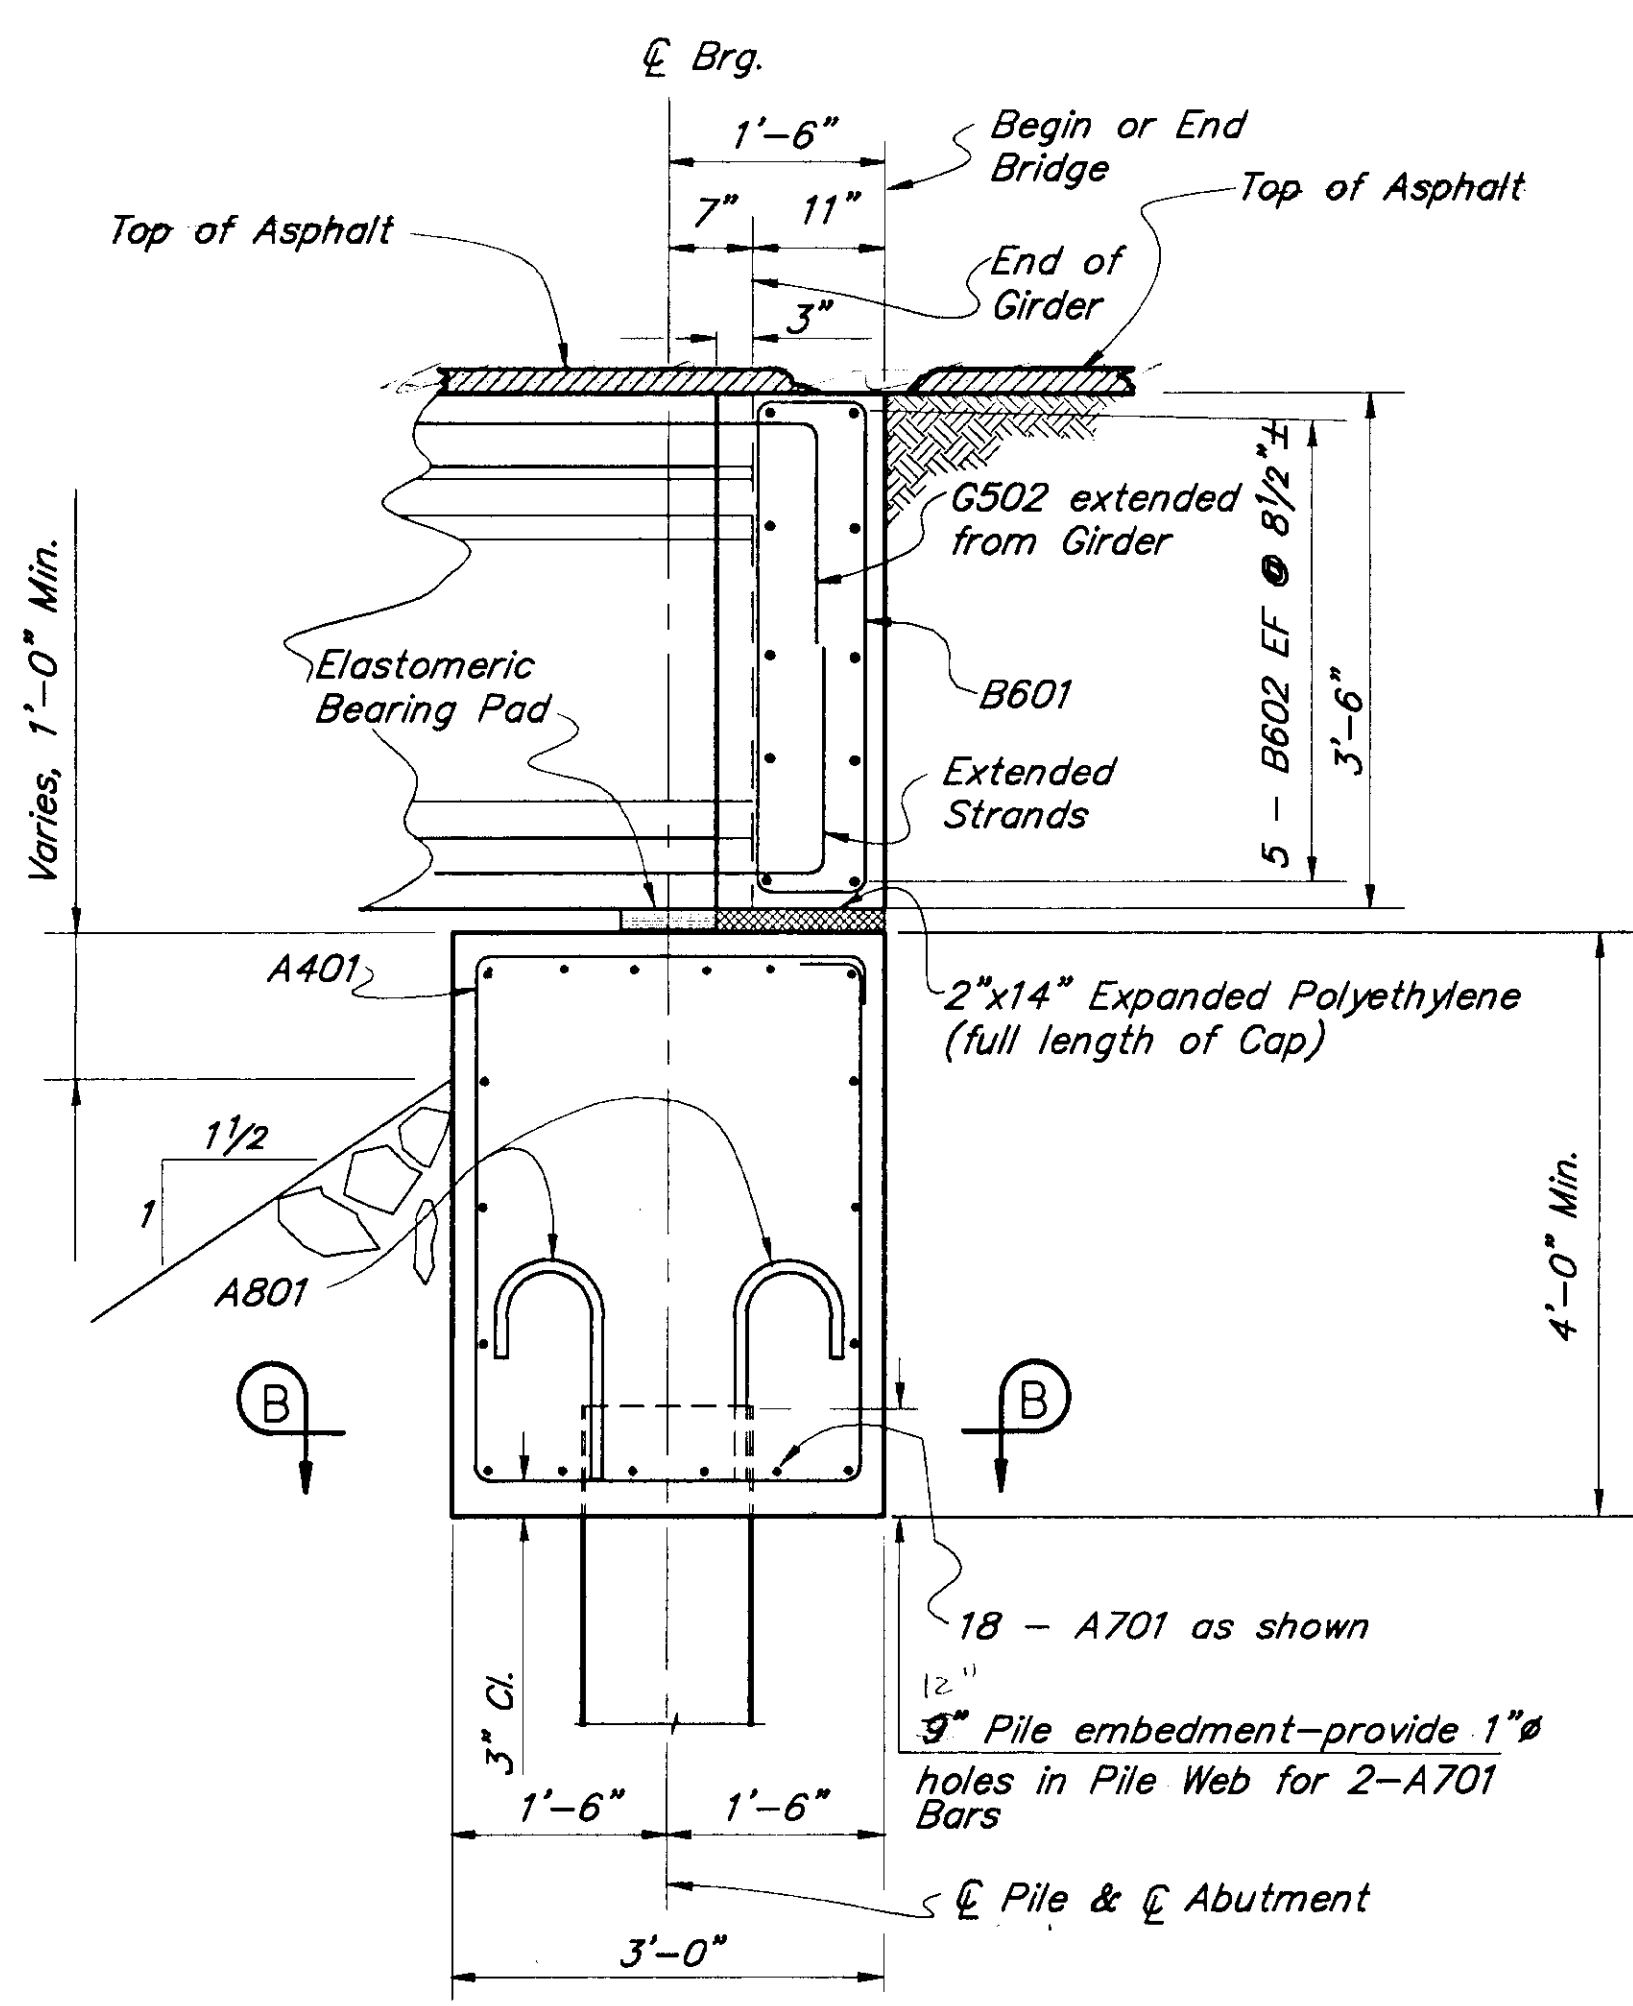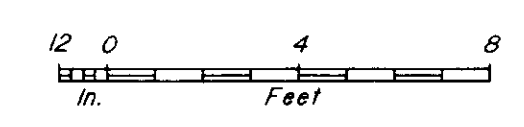

SECTION A-A

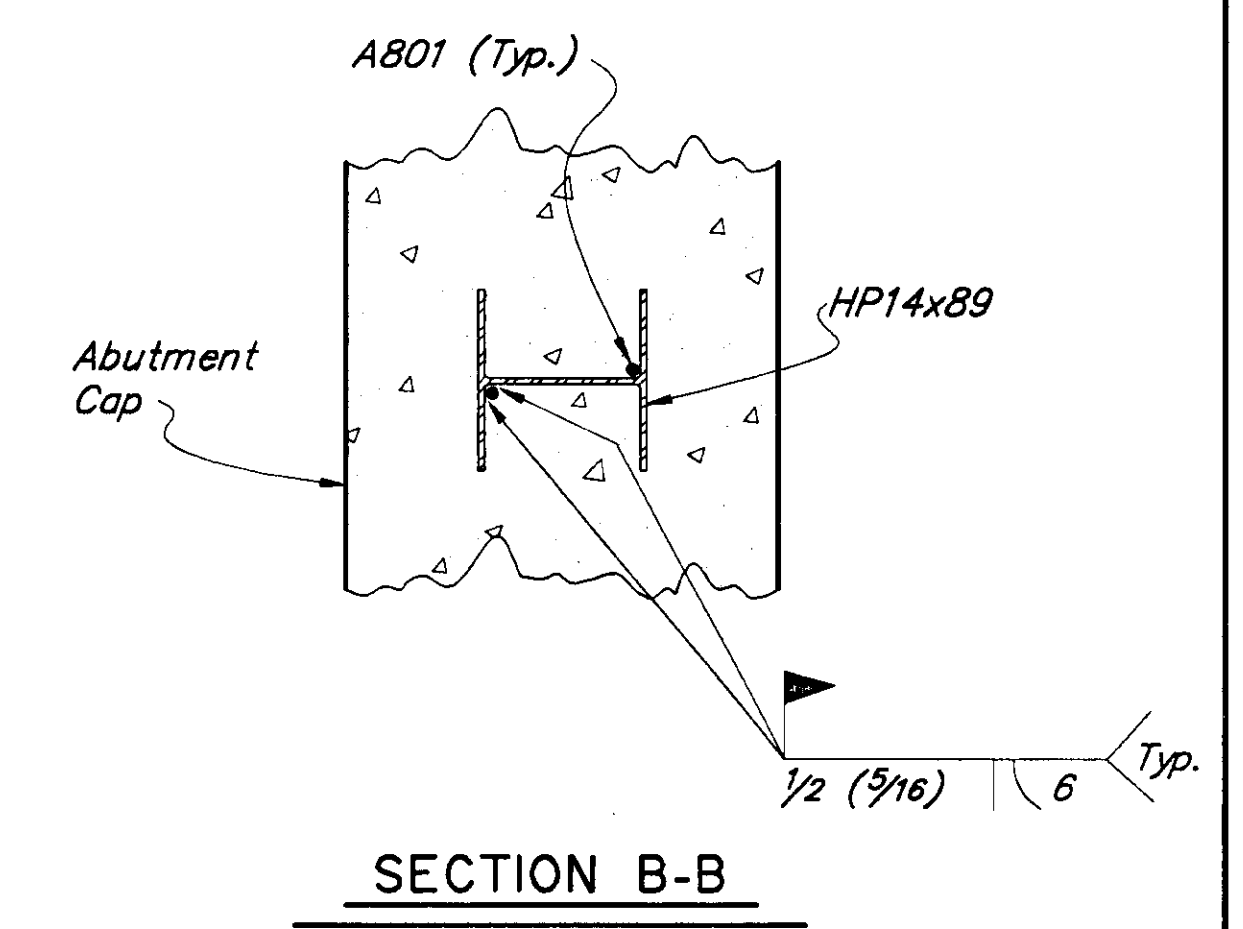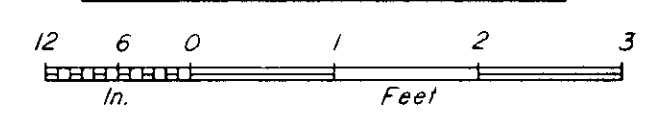


SECTION B-B

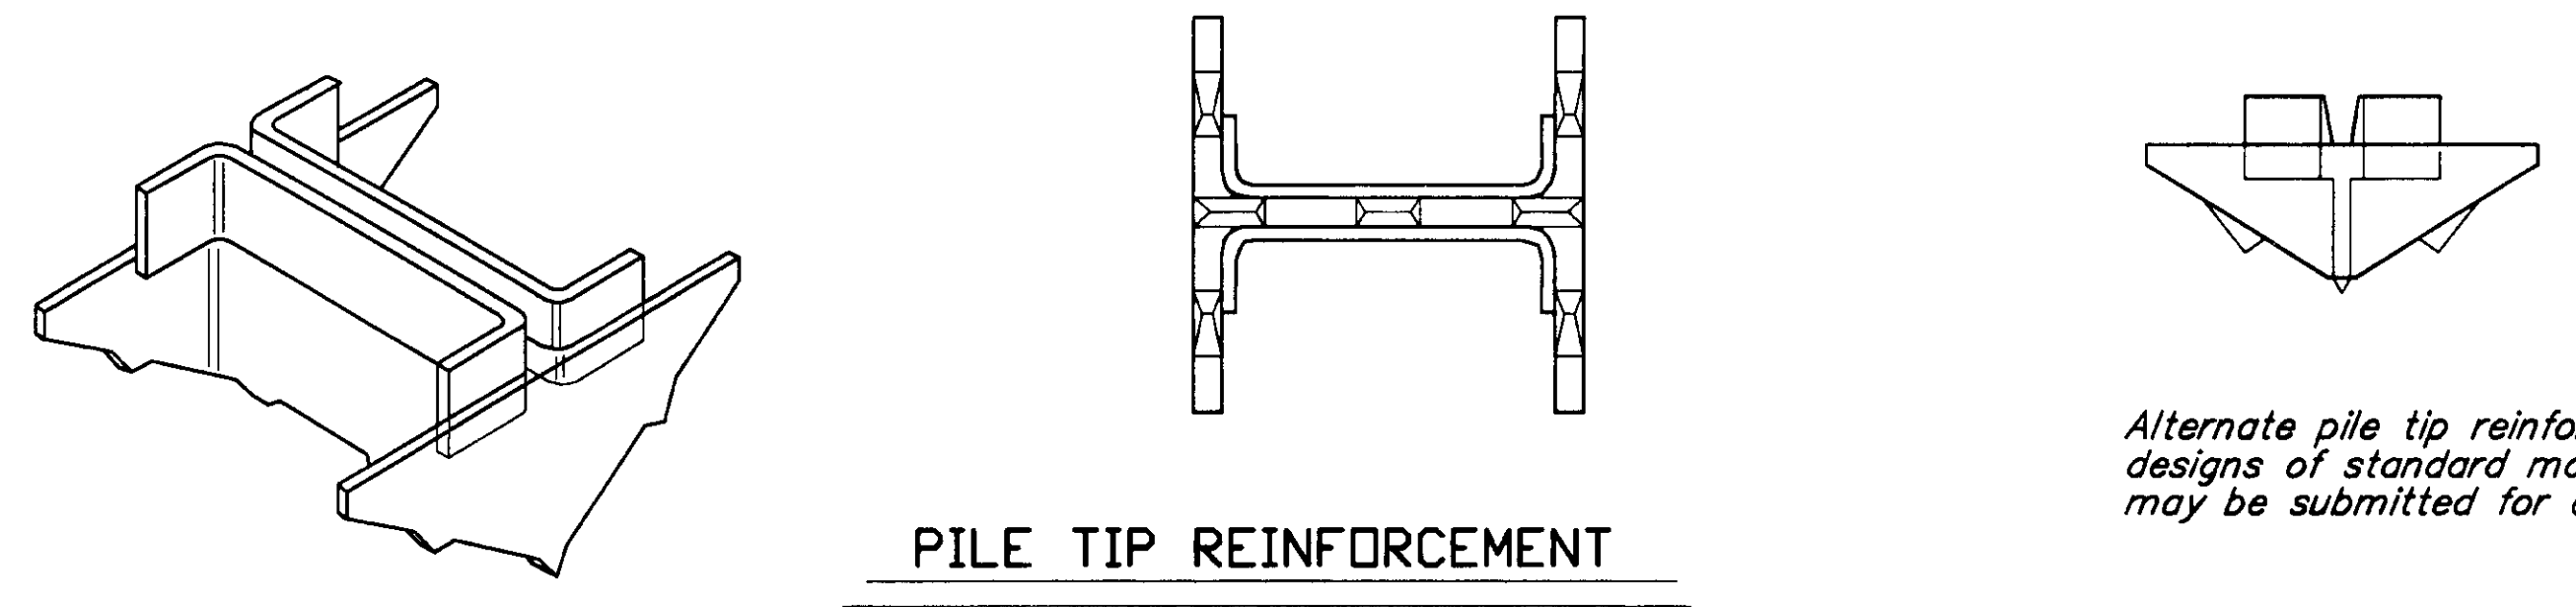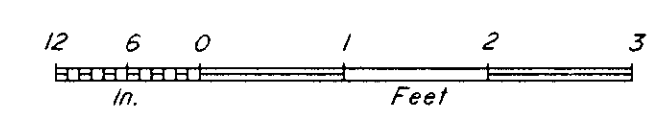

	Abut. 1	Abut. 2
Girder A	35.19	35.66
Girder B	35.31	35.78
Girder C	35.43	35.89
Girder D	35.43	35.89
Girder E	35.31	35.78
Girder F	35.19	35.66

	Desirable	Estimated	Design Load	Ult. Brg. Cap
Abut. 1	1.0	-4.0	80 Tons	200 Tons
Abut. 2	1.0	-4.0	80 Tons	200 Tons

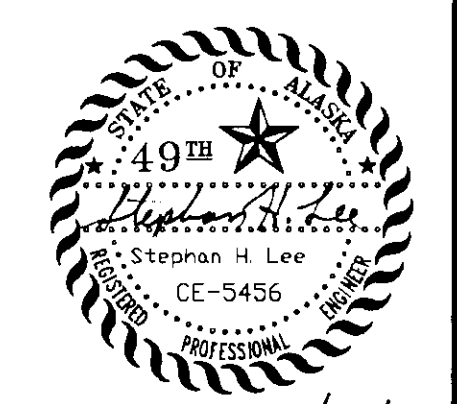


TWIN CREEK BRIDGE
 ROUTE NO. FAS 937
 ABUTMENTS

STATE OF ALASKA
 DEPARTMENT of TRANSPORTATION
 and PUBLIC FACILITIES
 JUNEAU, ALASKA



Designed By: SHL
 Detail Check By: EEM
 Design Check By: EEM
 P: 1960/P: 1960/1960-3
 6/8/1995 13:8
 Plot Scale = 4:00
 Drawn or Revised By: GJM

BRIDGE NO. 960
 DWG. NO. 3

STATE	PROJECT DESIGNATION	YEAR	SHEET NO.	TOTAL SHEETS
ALASKA	STP-0937(26)/71646	1995	11	16

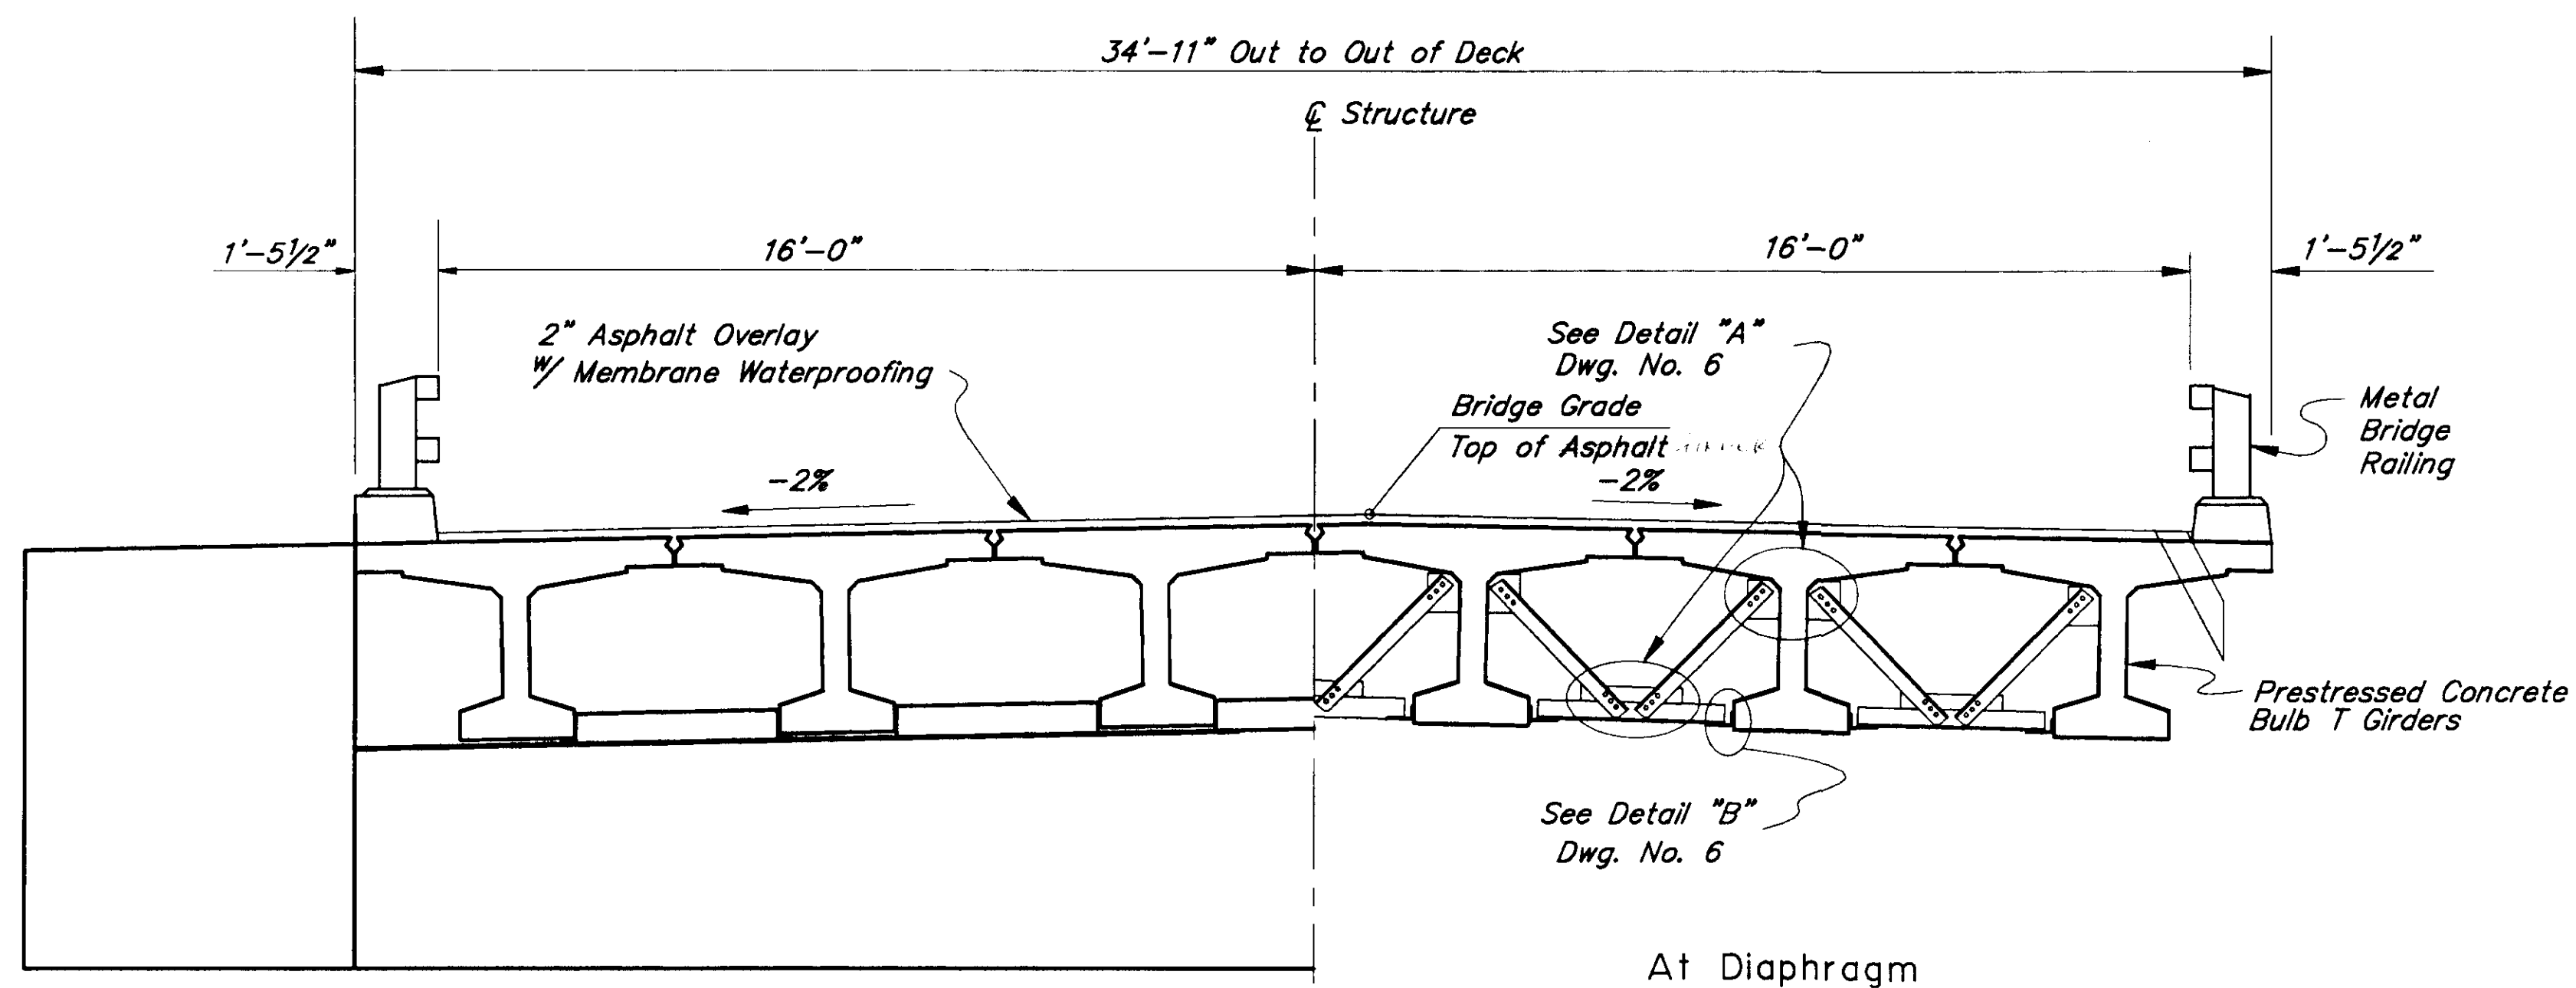

TYPICAL SECTION
At Abutment At Diaphragm

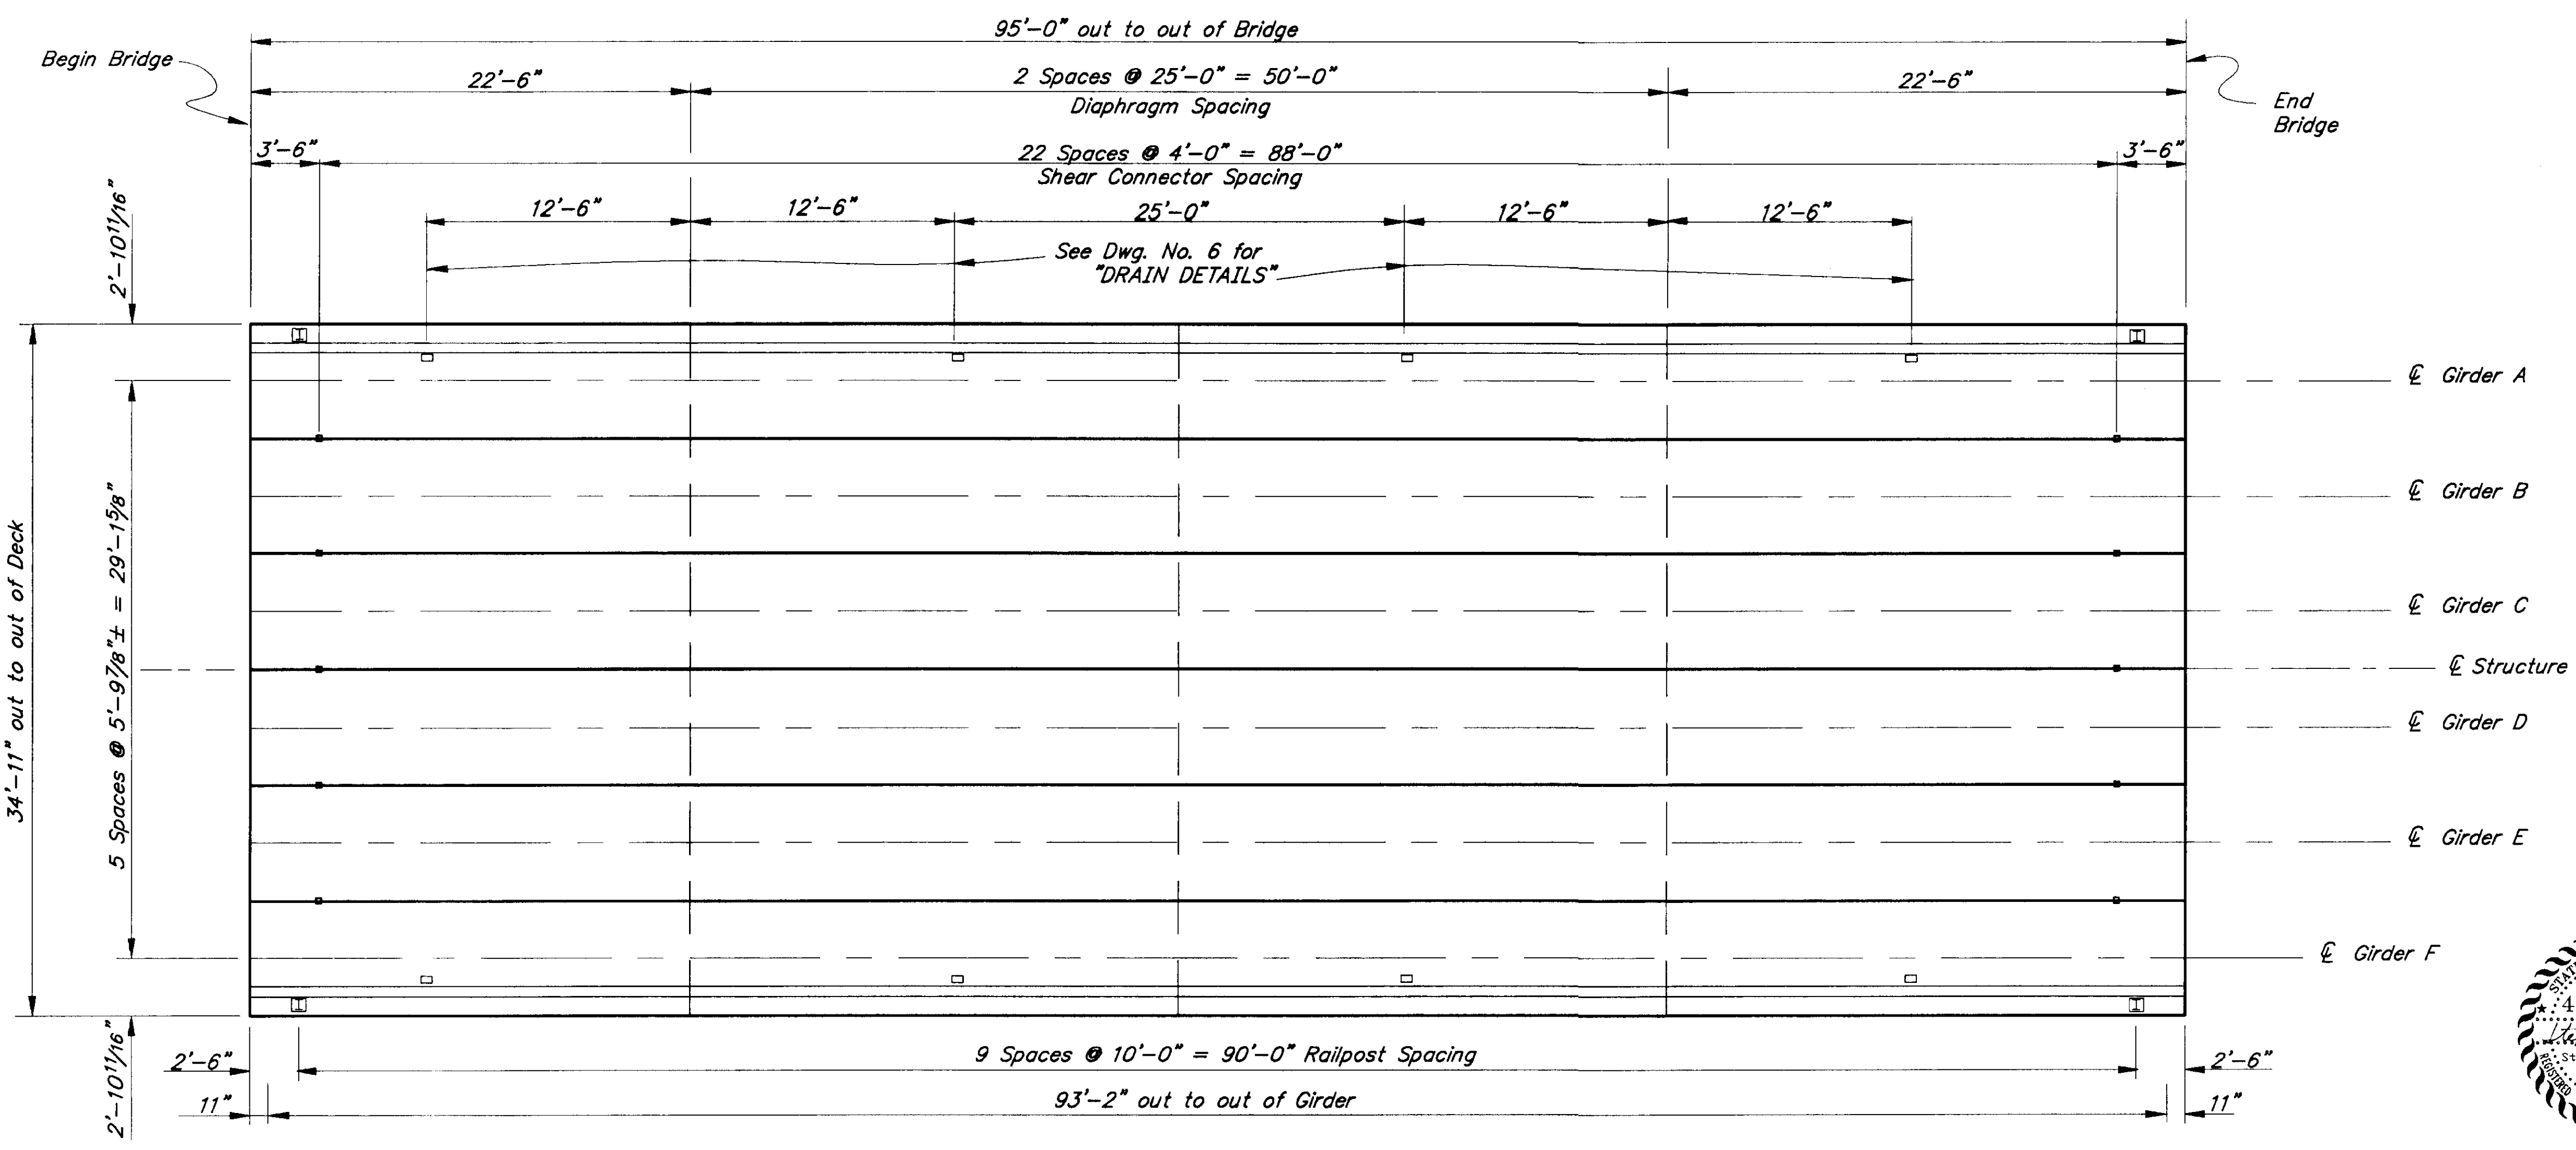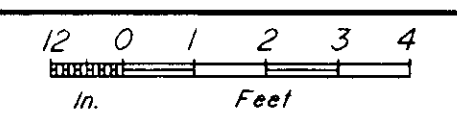

FRAMING PLAN
No Scale





TWIN CREEK BRIDGE
ROUTE NO. FAS 937
TYPICAL SECTION

STATE OF ALASKA
DEPARTMENT of TRANSPORTATION
and PUBLIC FACILITIES
JUNEAU, ALASKA


Designed By: S.H.L.
Detail Check By: EEM
Design Check By: EEM
7/17/95
P. 1960/P. 1960-4
3/25/1995 8:29
Plot Scale = 2.67
Drawn or Revised By: G.M.

BRIDGE NO. 960
DWG. NO. 4

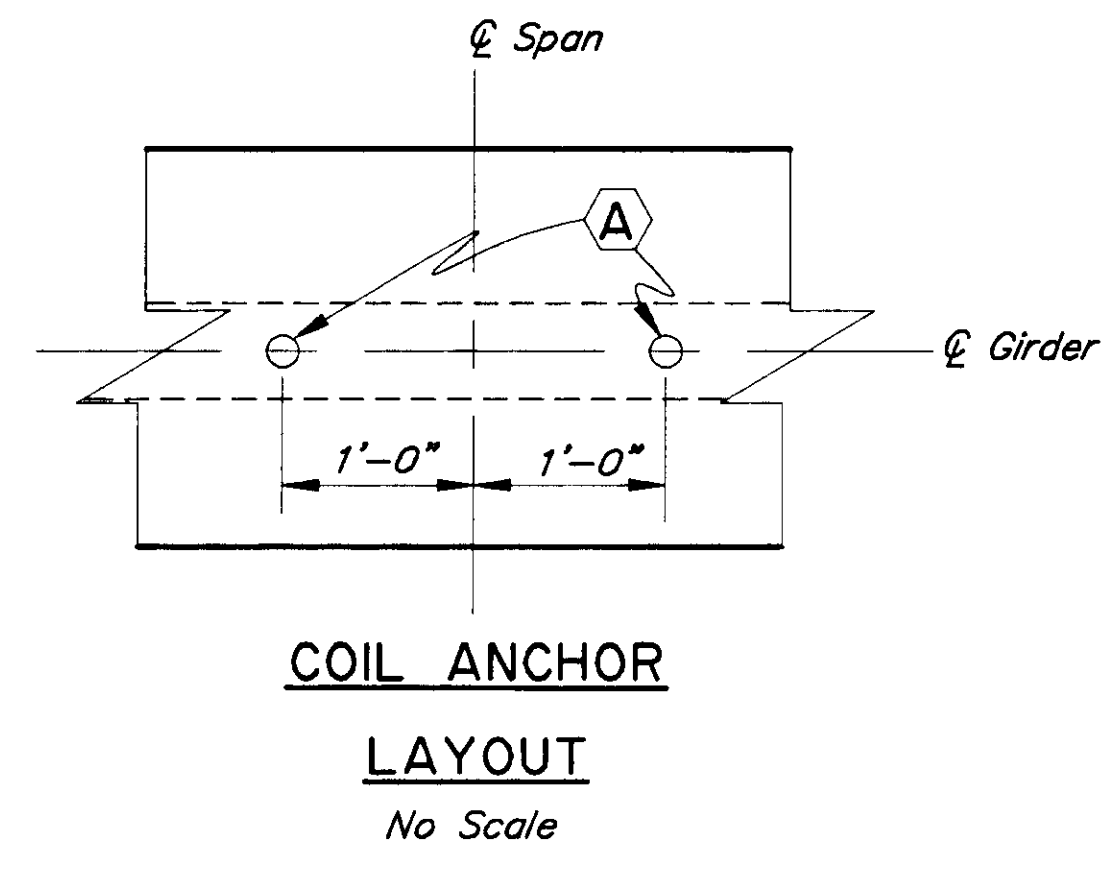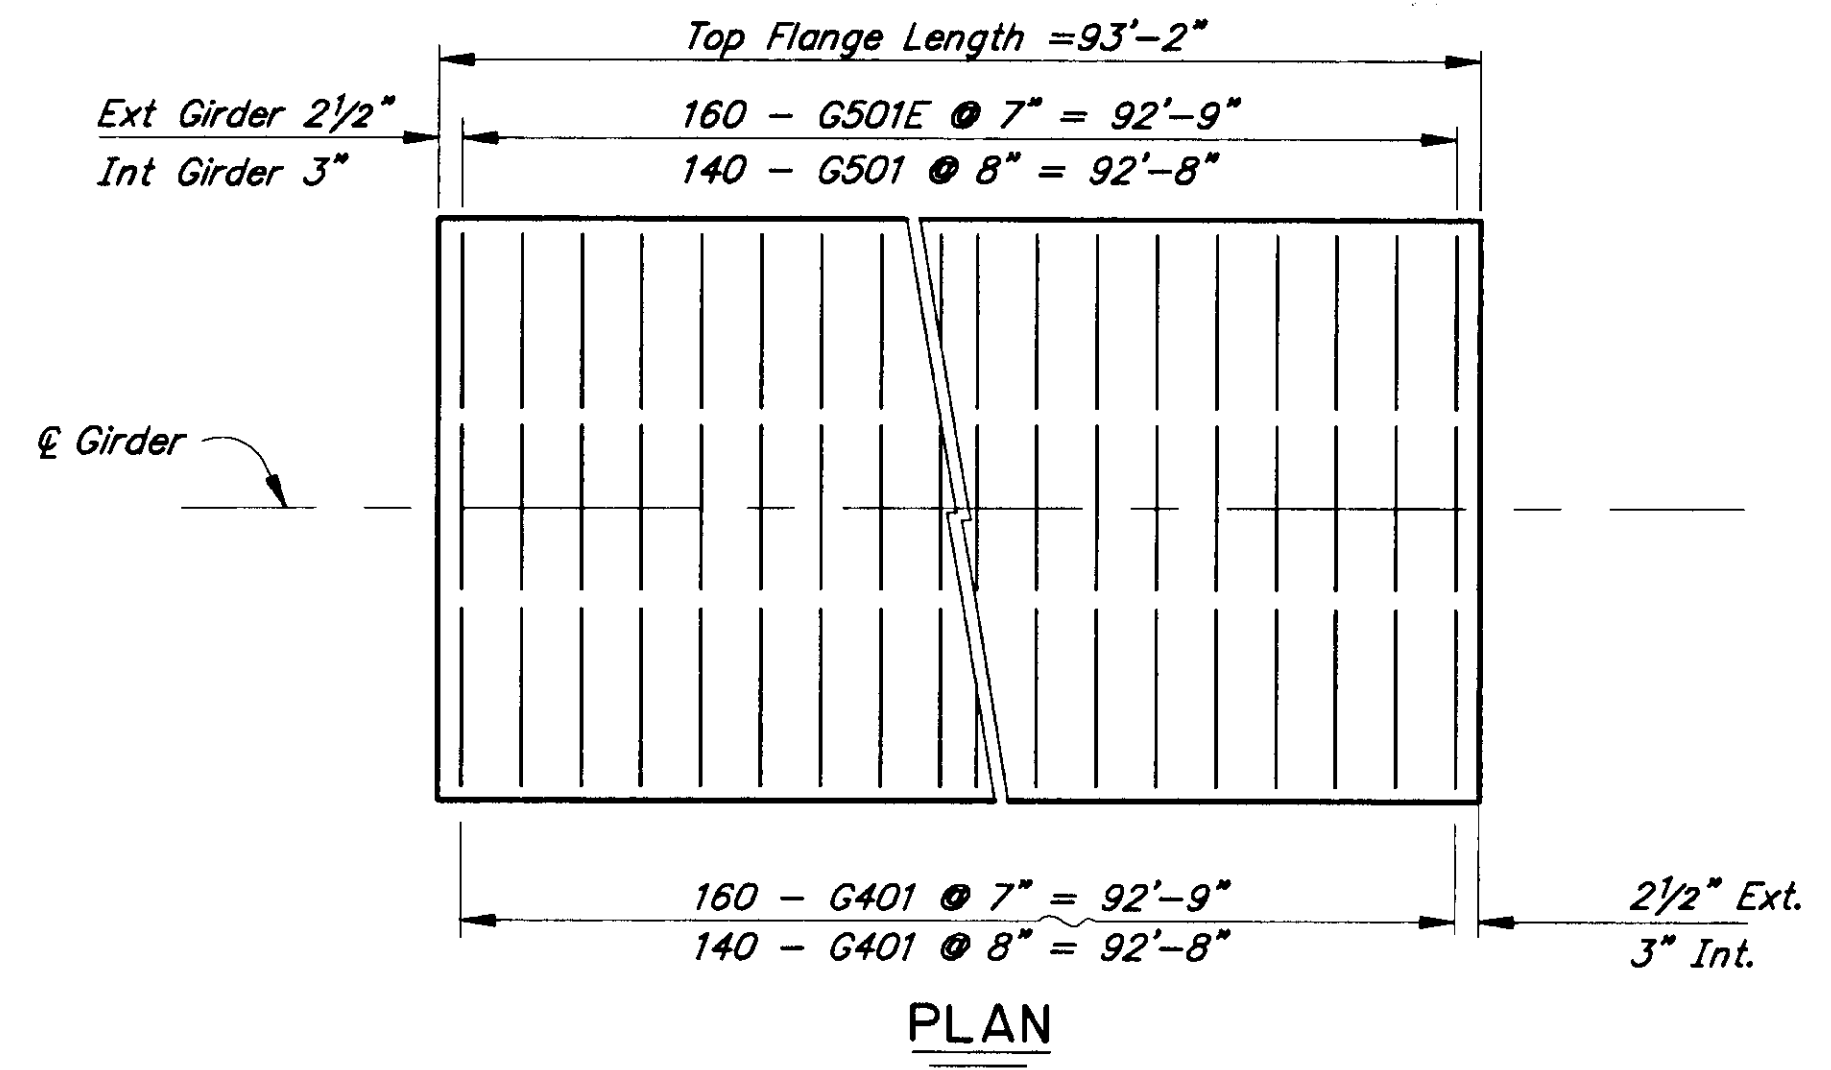

^a REINFORCING STEEL (One Girder)

MARK	SIZE	NO.	LENGTH	TYPE
G401	4	140	5'-5"	Bent
G401	4	160	5'-5"	Bent
G402	4	8	92'-10"	
G402	4	8	92'-10"	
G403	4	208	5'-0"	Bent
G501	5	140	5'-4"	
G501E	5	160	5'-11"	Bent
G502	5	8	98'-2"	Bent
G502	5	8	98'-2"	Bent
C501	5	2	94'-8"	
C502	5	20	3'-6"	
C503	5	134	4'-11"	Bent
G301	3	44	3'-3"	Bent

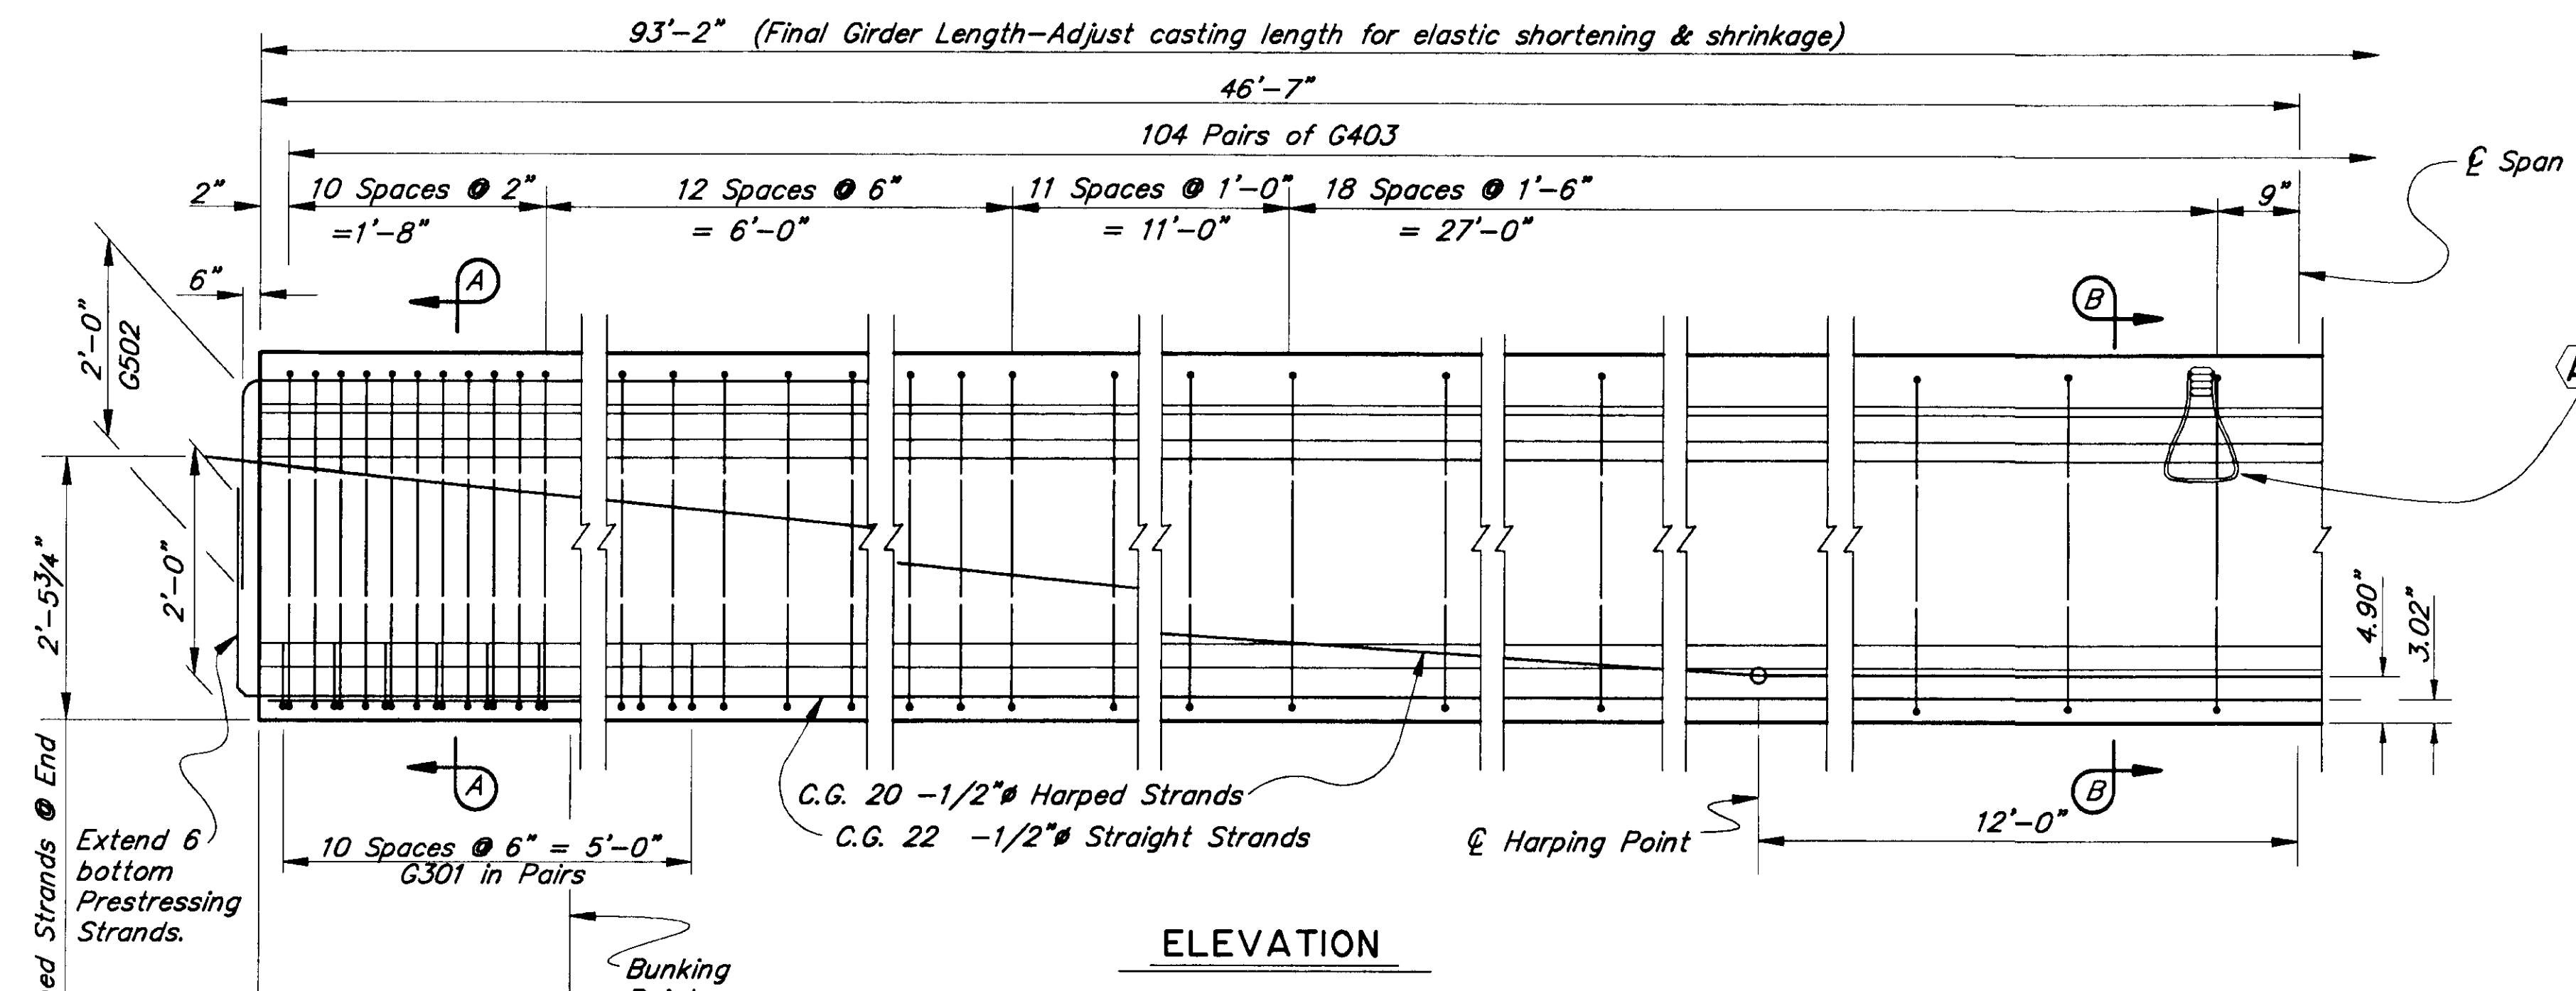

DECK REINFORCING REQUIRED (Including Contractor Proposed Alternate)

BAR	GIRDER WIDTH					
	≤ 6.0'	6.0-6.5	6.5-7.0	7.0-7.5	7.5-8.0	8.0-8.5
Interior						
G401 Spaced at	8"	7"	6 1/2"	6"	5 3/4"	5 1/2"
G402 No. of bars	8	10	10	10	12	14
G501 Spaced at	8"	7"	6 1/2"	6"	5 3/4"	5 1/2"
G502 No. of bars	8	10	10	10	12	14
Exterior						
G401 Spaced at	7"	6"	5 1/2"	5"	4 1/2"	4"
G402 No. of bars	8	10	12	14	16	16
G501 Spaced at	7"	6"	5 1/2"	5"	4 1/2"	4"
G502 No. of bars	8	10	12	14	16	16

- a - Epoxy coat all girder reinforcing.
- b - Length does not include splices. Minimum lap length for splices shall be 1'-3" for No. 4 bars and 1'-5" for No. 5 bars.
- c - Exterior Girder Only
- d - Ship loose.
- e - One curb

GIRDER NOTES:

Alternative designs are allowed per Section 502 of the Specifications.

Concrete for girders shall be normal weight having the following strengths: At Stress Transfer $f'_{ci} = 6000$ psi
At 28 Days $f'_c = 7000$ psi

All prestressing shall be 1/2" round low relaxation strands having an ultimate strength of 270 ksi, and an area of 0.153 sq. in.

Design is based on the following Steel Stresses:
Pretensioning - Jacking Stress 189 ksi
After Losses 149 ksi

One inch clear on all reinforcing except as noted.


All structural steel embedded in girders shall be A36, unless otherwise noted. All structural steel except shear connectors shall be galvanized after fabrication.

Approximate girder weight = 92.4 kips.

Deflect forms to match grade & compensate for camber - see Specifications. The roadway surface of precast members shall have a wood or magnesium float finish. Surface under railing curbs shall be roughened.

Girder pay items shall include the cost of epoxy coated reinforcing steel and all structural steel required.

All girders shall have recessed coil anchor inserts as shown for field leveling girders during installation.

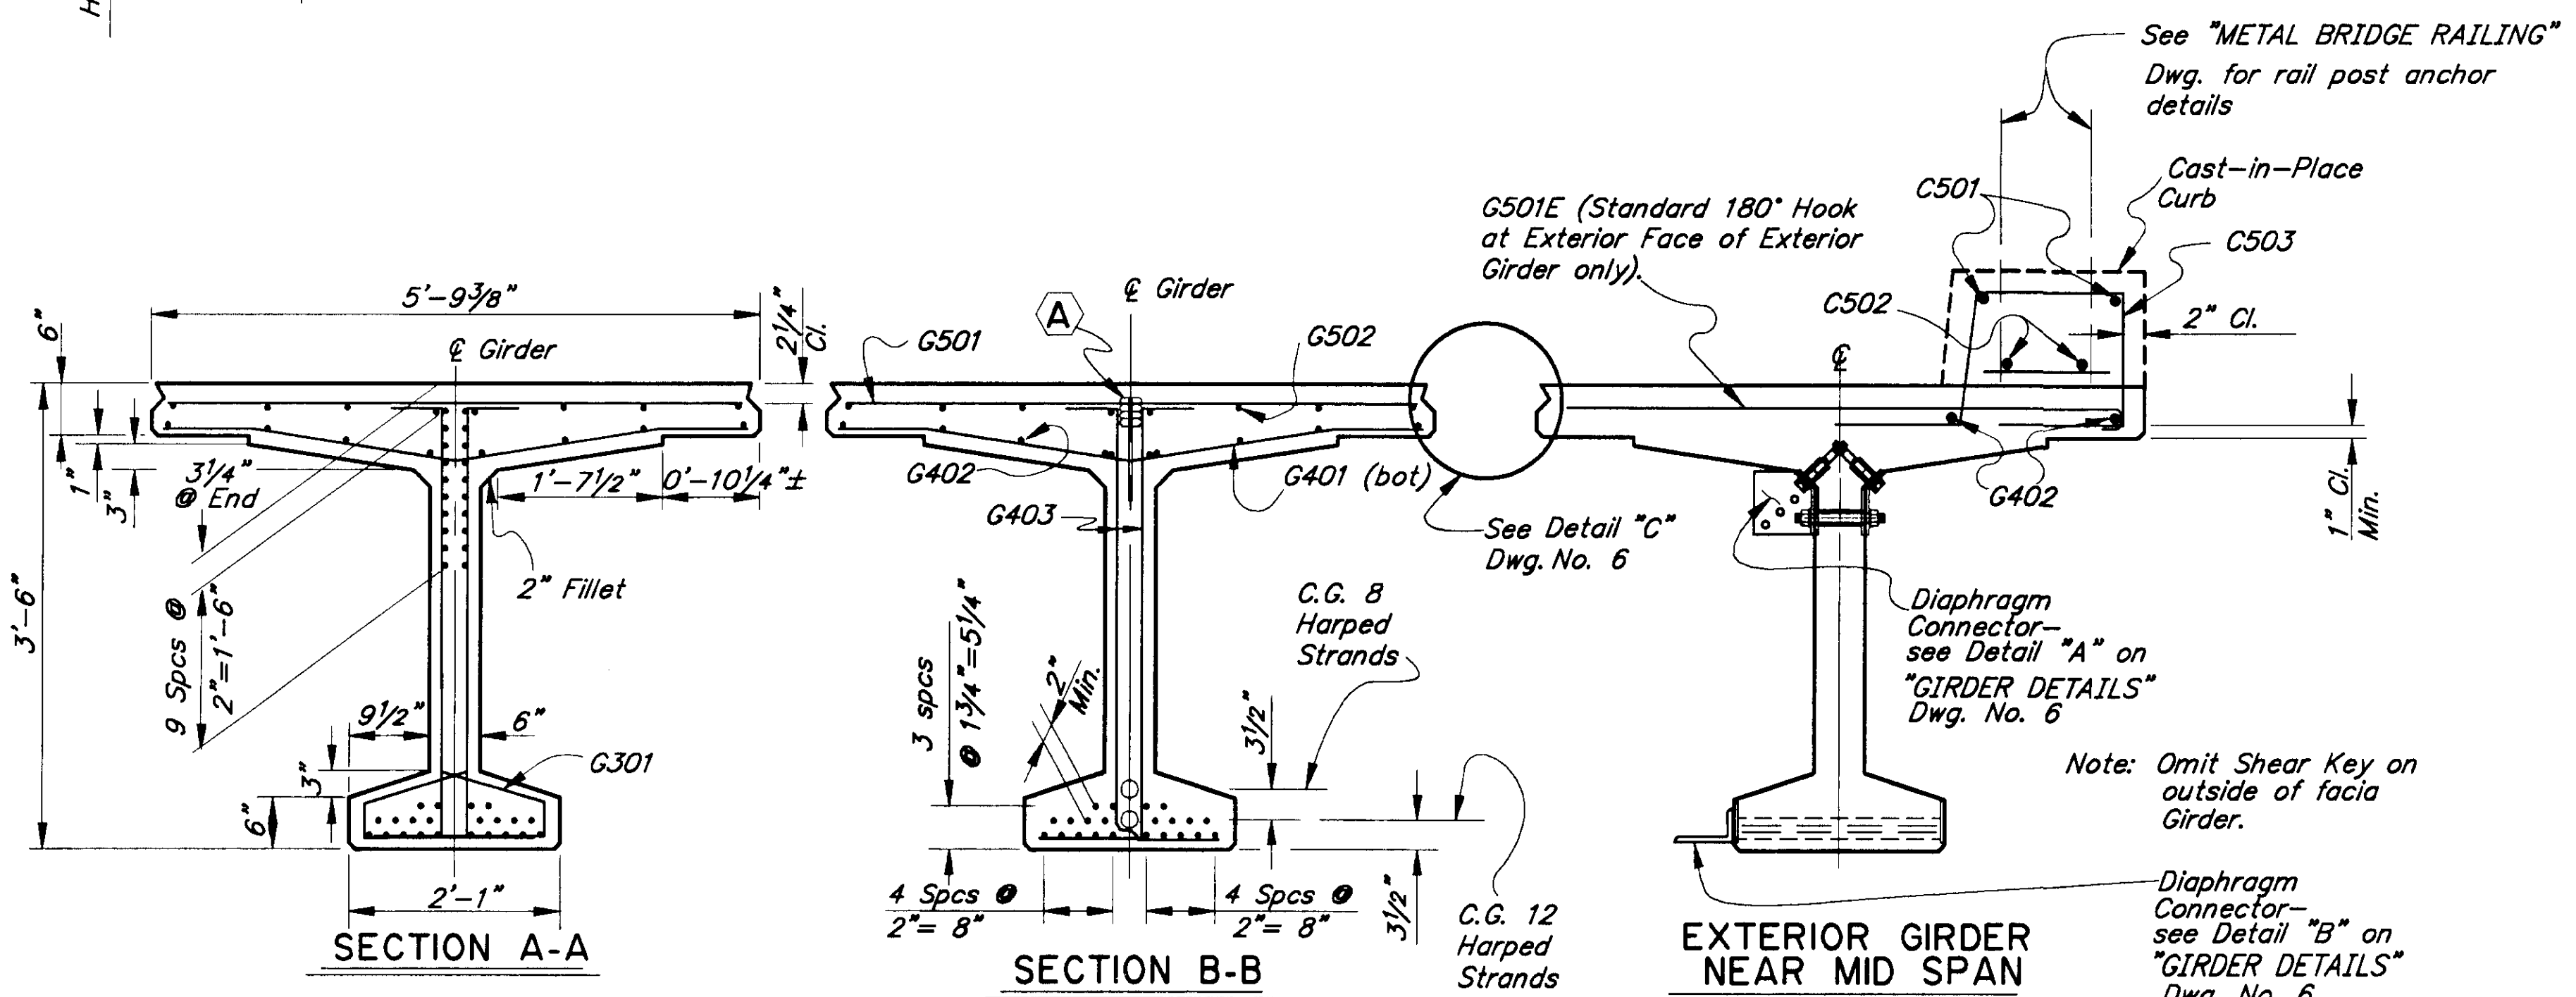













Note: Girder manufacturer to furnish & install all diaphragm connector brackets for detail 'A' before shipping girder.



TWIN CREEK BRIDGE
ROUTE NO. FAS 937
GIRDERS

STATE OF ALASKA
DEPARTMENT OF TRANSPORTATION
and PUBLIC FACILITIES
JUNEAU, ALASKA

STATE	PROJECT DESIGNATION	YEAR	SHEET NO.	TOTAL SHEETS
ALASKA	STP-0937(26)/71646	1995	13	16

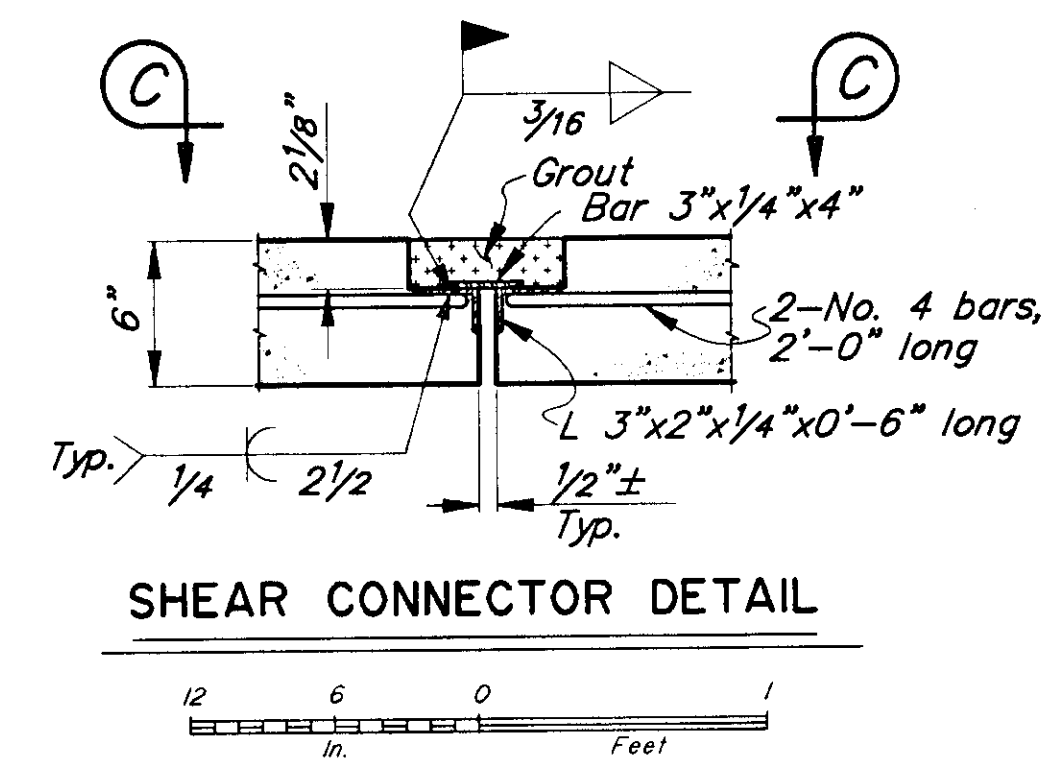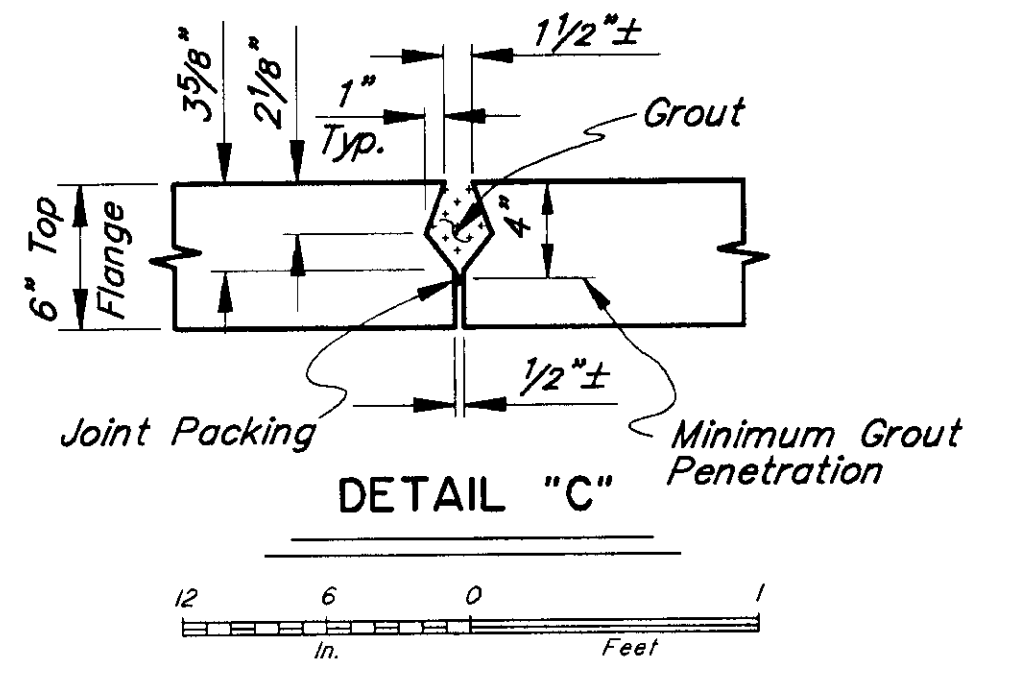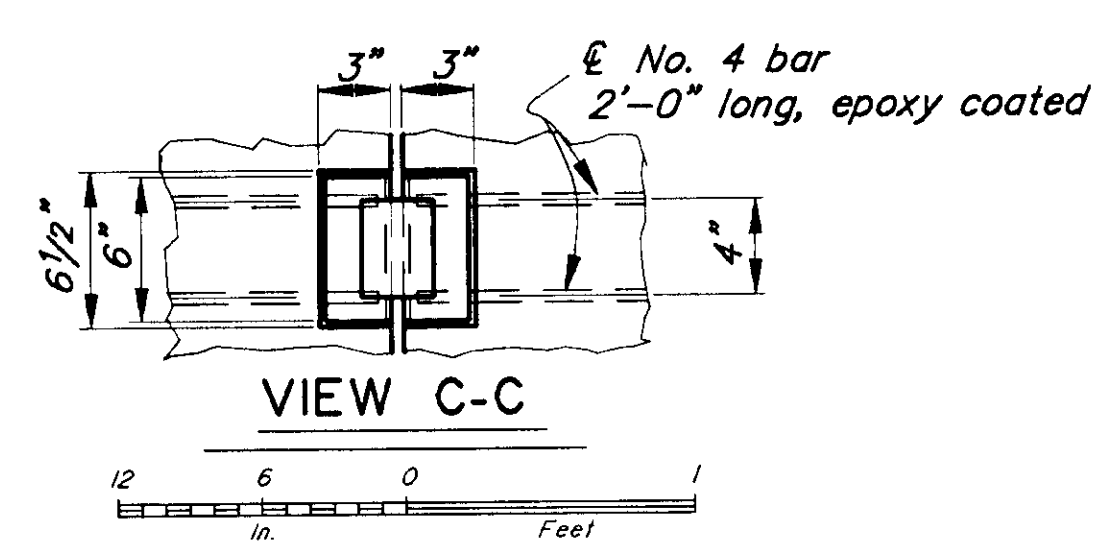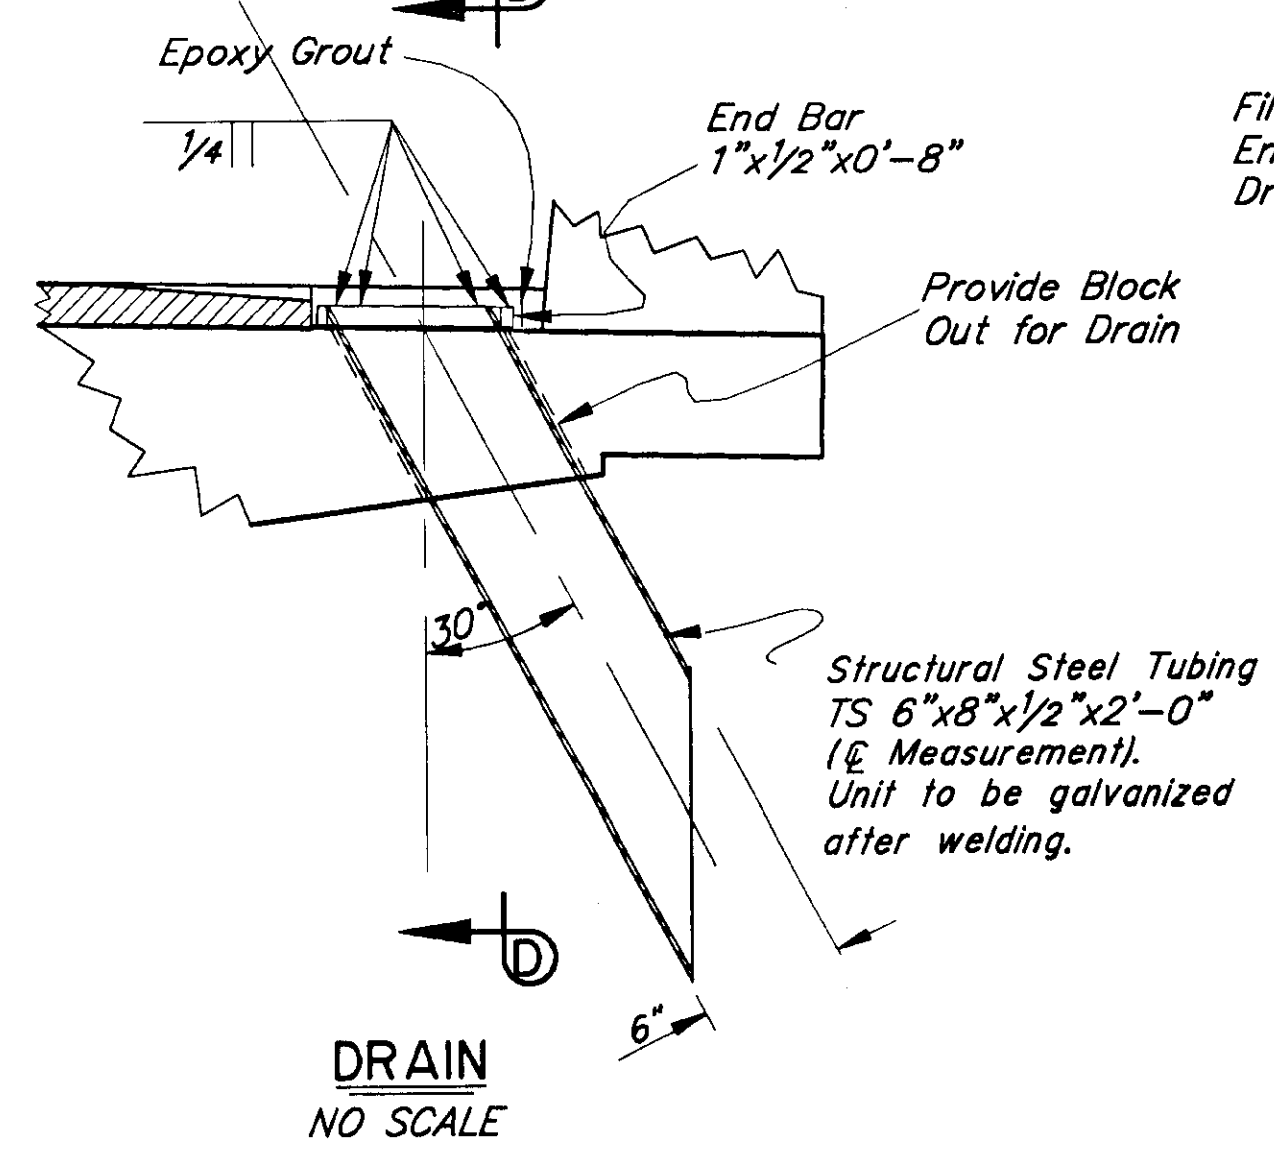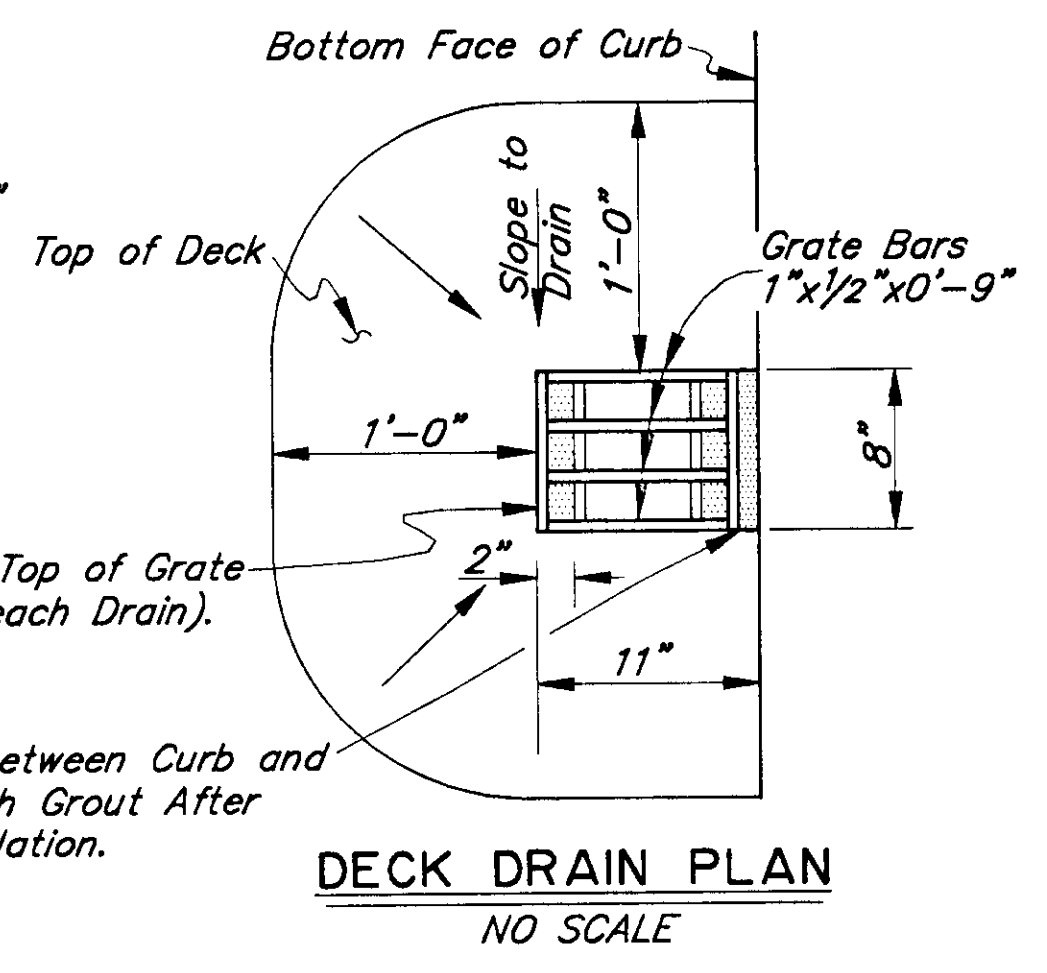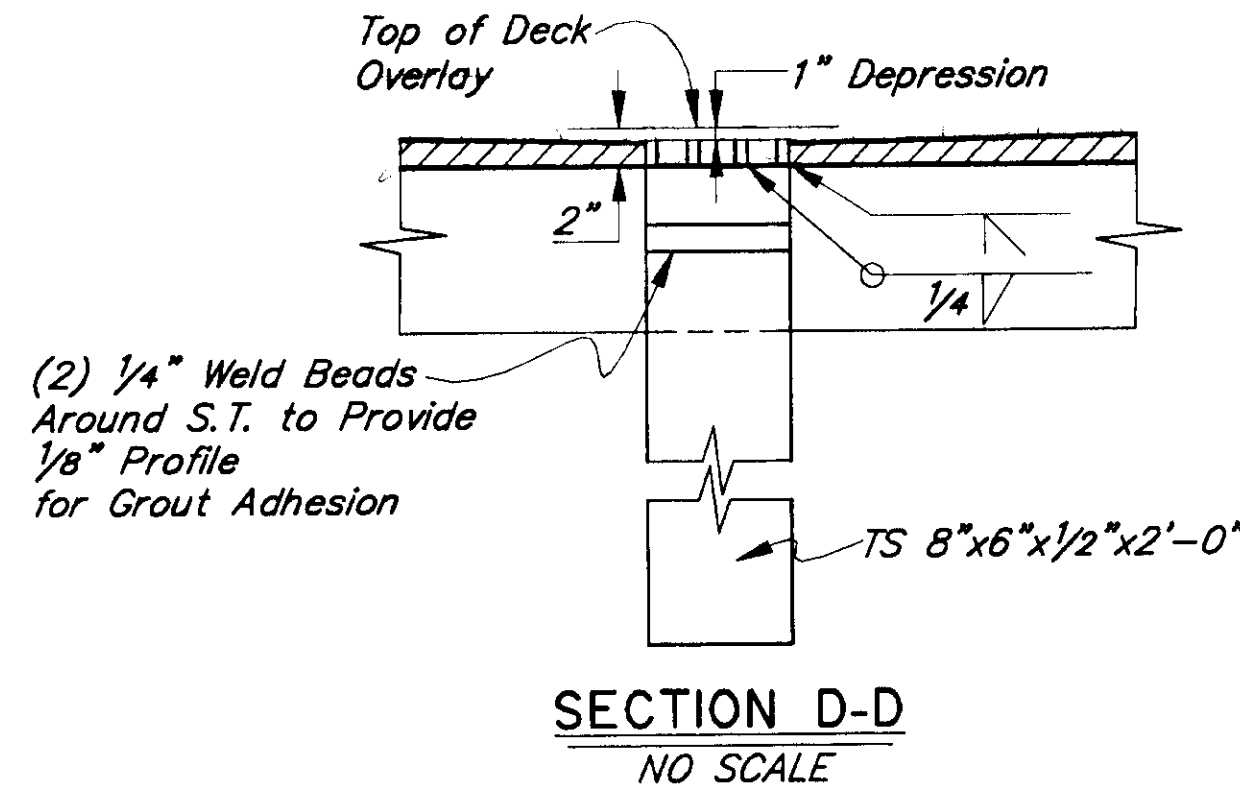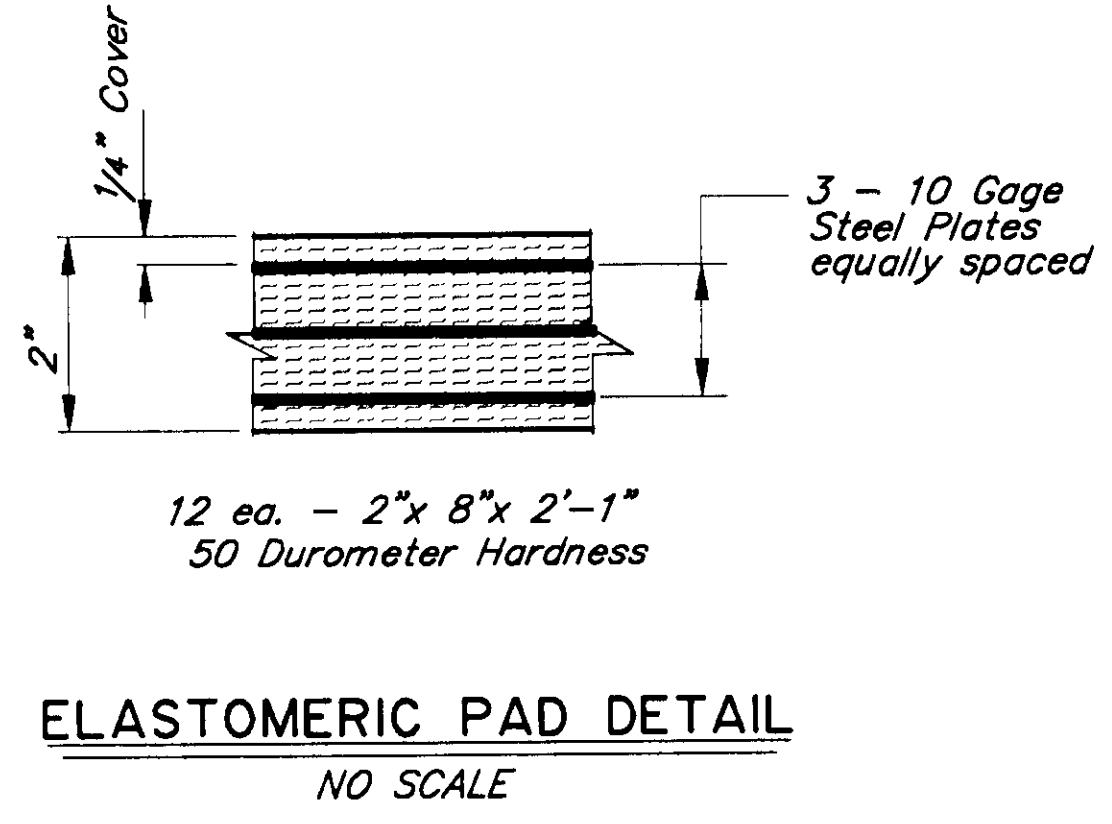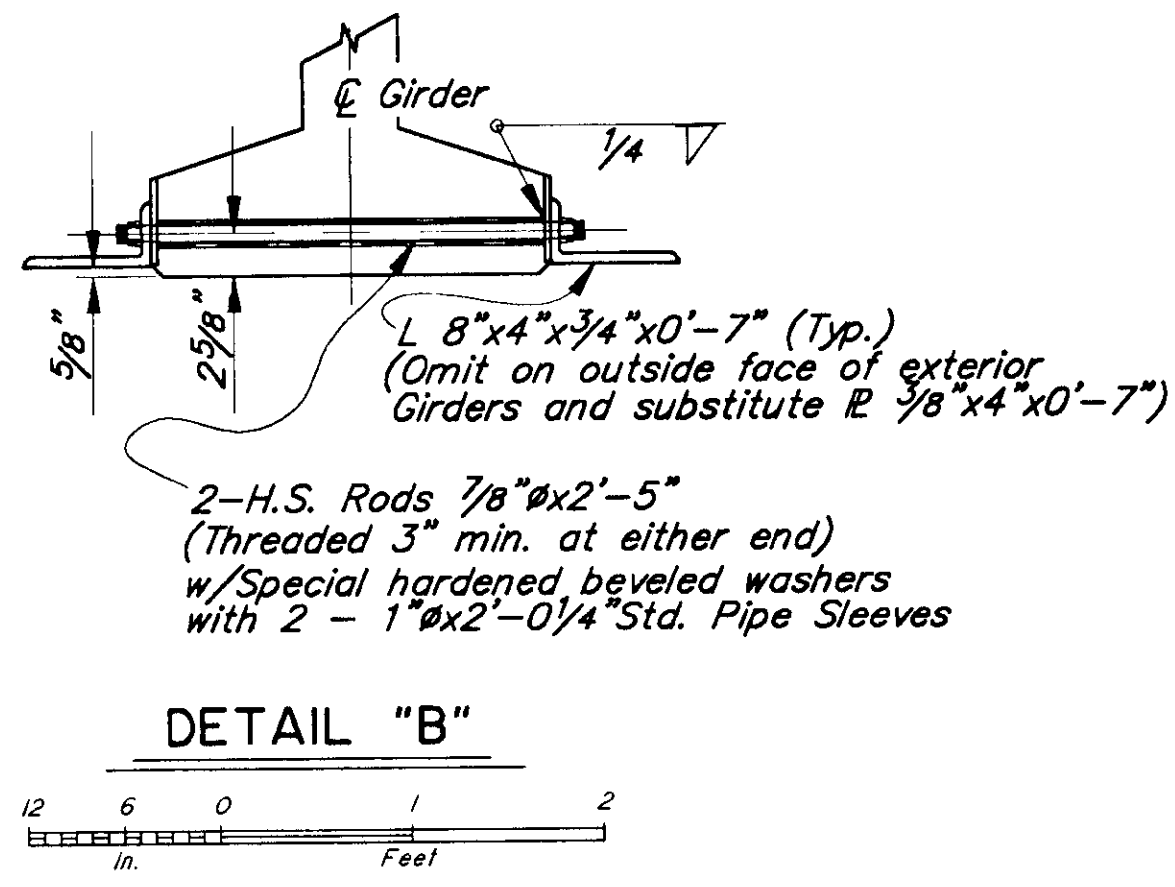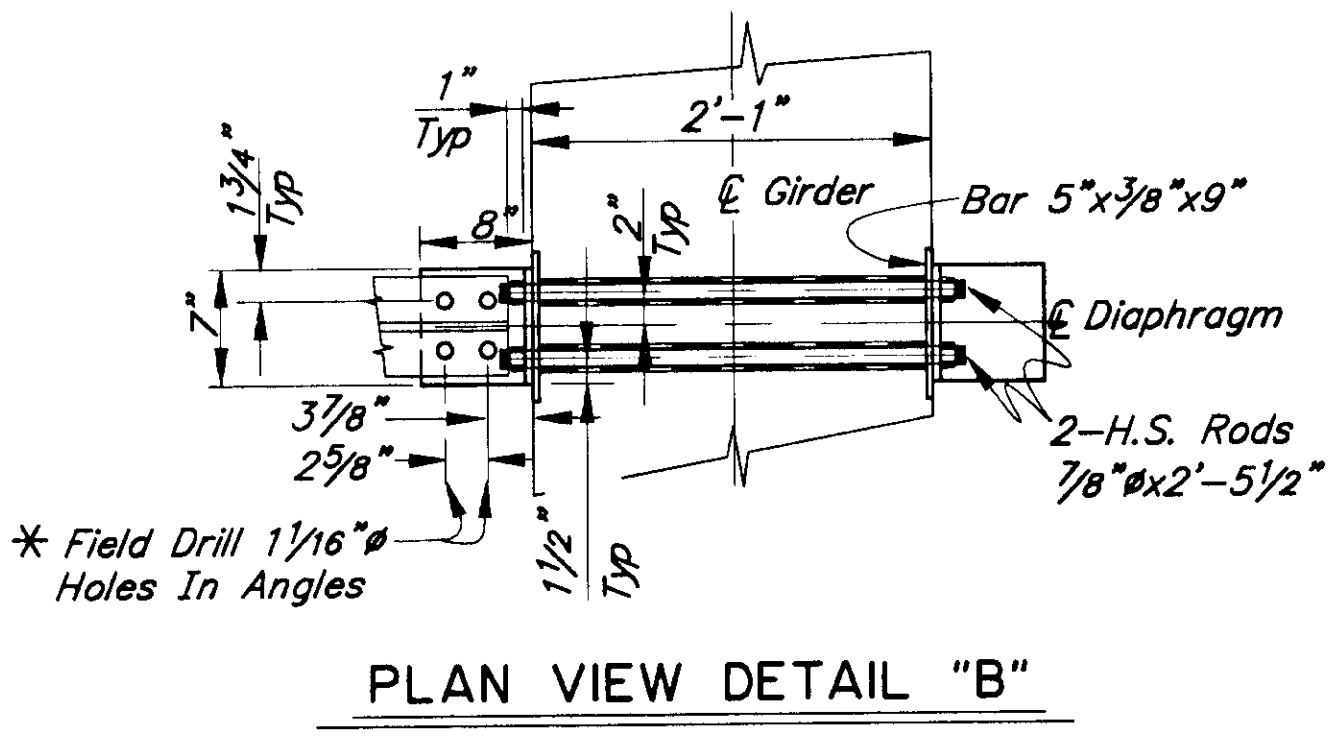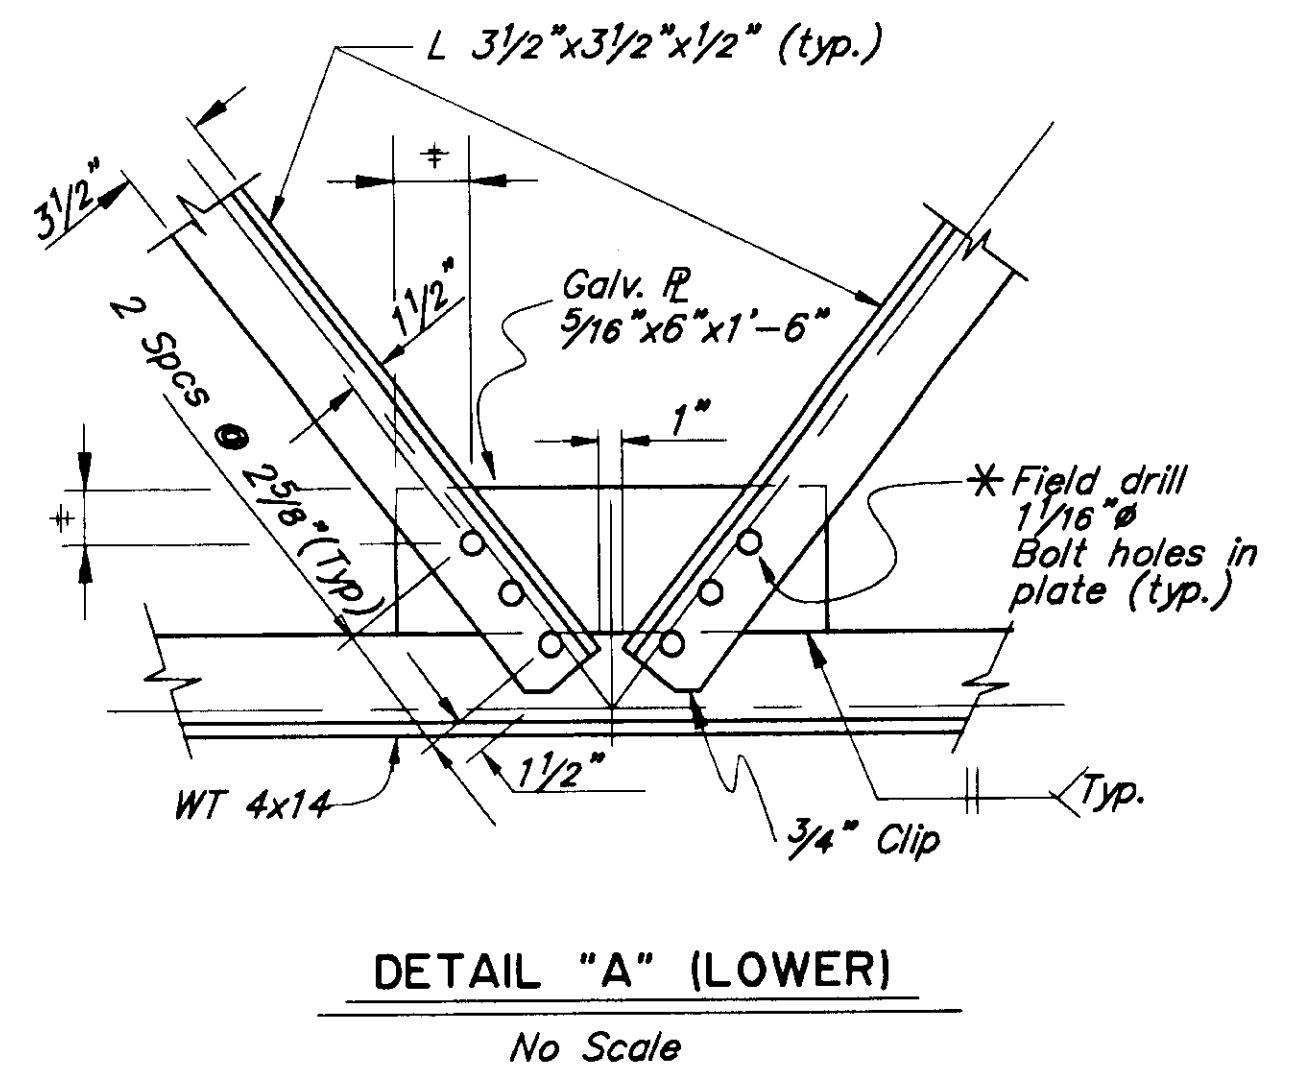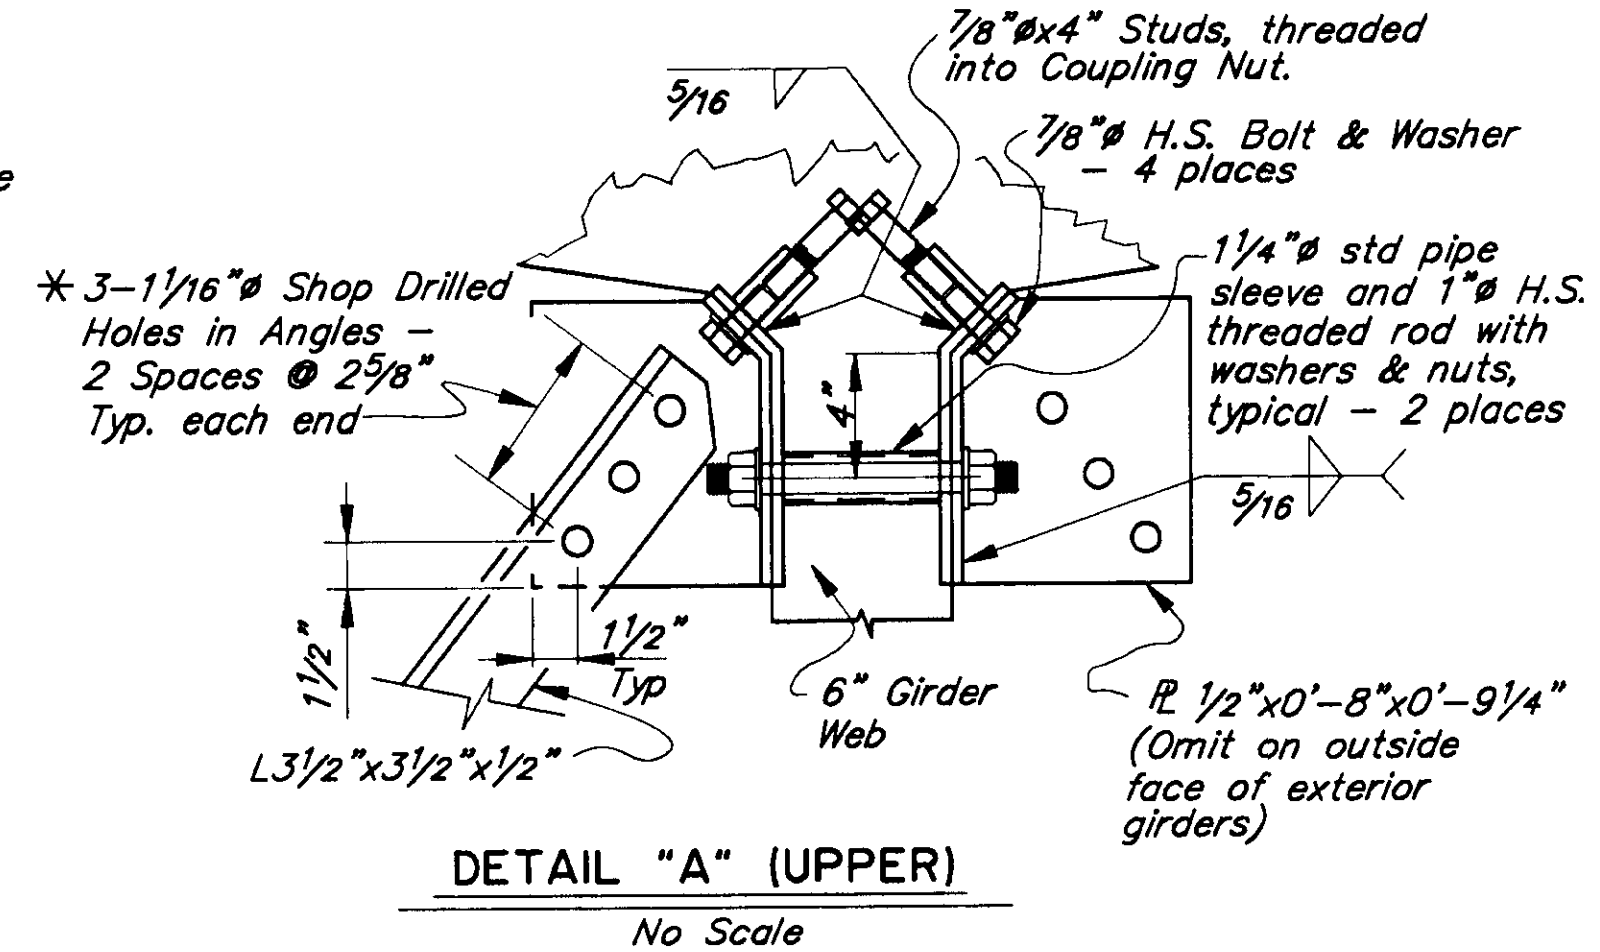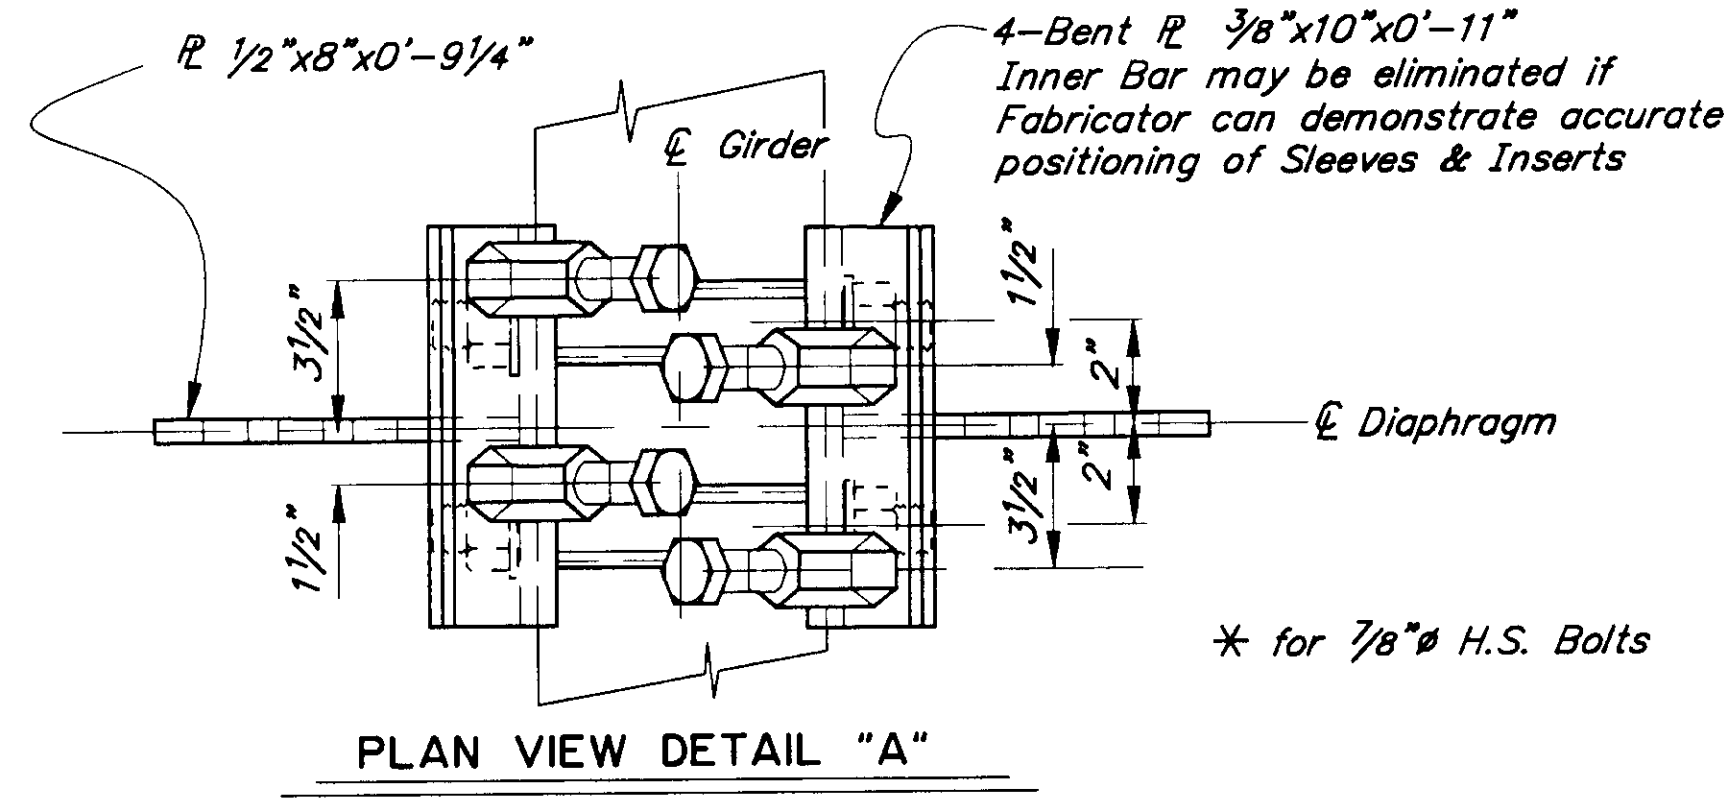



TWIN CREEK BRIDGE
ROUTE NO. FAS 937
GIRDER DETAILS

STATE OF ALASKA
DEPARTMENT of TRANSPORTATION
and PUBLIC FACILITIES
JUNEAU, ALASKA

Designed By: SHL
Detail Check By: EEM
Design Check By: EEM
P: 1960/P: 1960/960-8
6/6/1995 13:24
Plot Scale = 1.00
Drawn or Revised By: GJM

BRIDGE No. 960
DWG. No. 6

STATE	PROJECT DESIGNATION	YEAR	SHEET NO.	TOTAL SHEETS
ALASKA	71646	1995	15	16

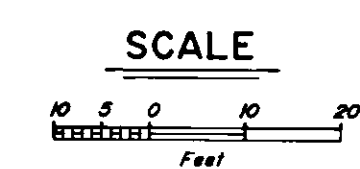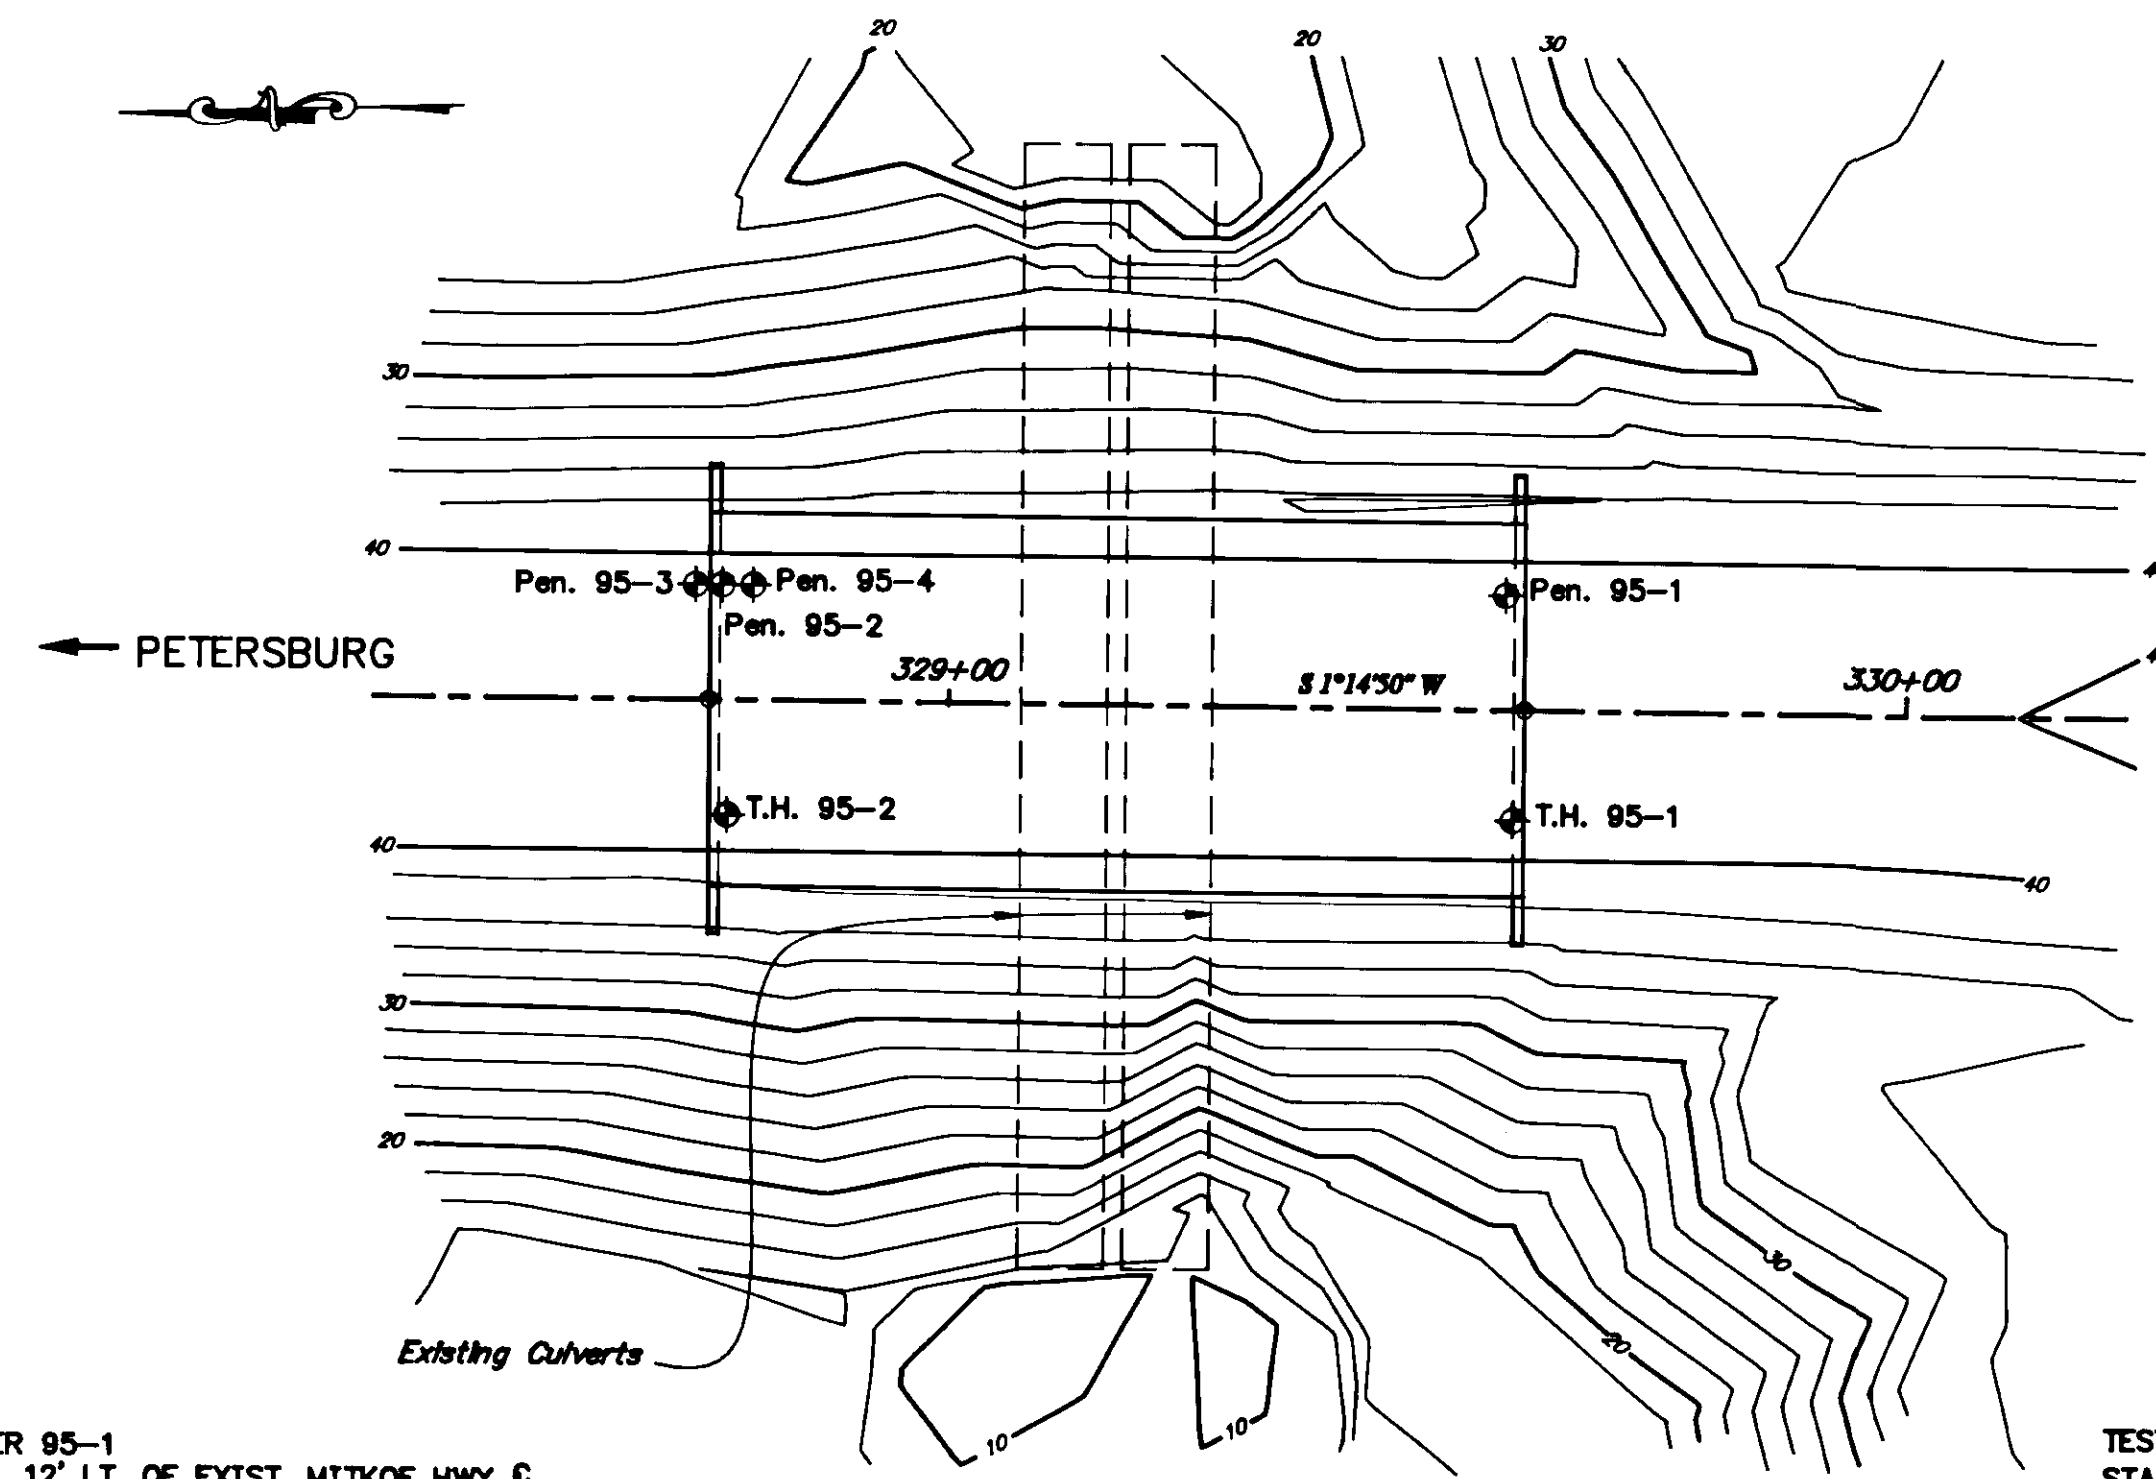

BASIC MATERIALS SYMBOLS

	Organic		Silt
	Cobbles/Boulders		Clay
	Gravel		Bedrock
	Sand		

NOTE: SIGNIFICANT SOIL MIXTURES ARE SHOWN BY COMBINING SOIL SYMBOLS.

TYPICAL TEST HOLE SYMBOLS





Plan View

-
-
RELATIVE DENSITY AND CONSISTENCY CLASSIFICATION

Based on Standard Penetration Test

GRANULAR		COHESIVE	
Blows/ft.	Rel. Density	Blows/ft.	Consistency
0-5	Very Loose	2	Very Soft
6-10	Loose	2-4	Soft
11-20	Firm	5-8	Medium
21-35	Compact	9-15	Stiff
36-50	Dense	16-30	Very Stiff
51-70	Very Dense	31-60	Hard
71+	V. Very Dense	61+	Very Hard

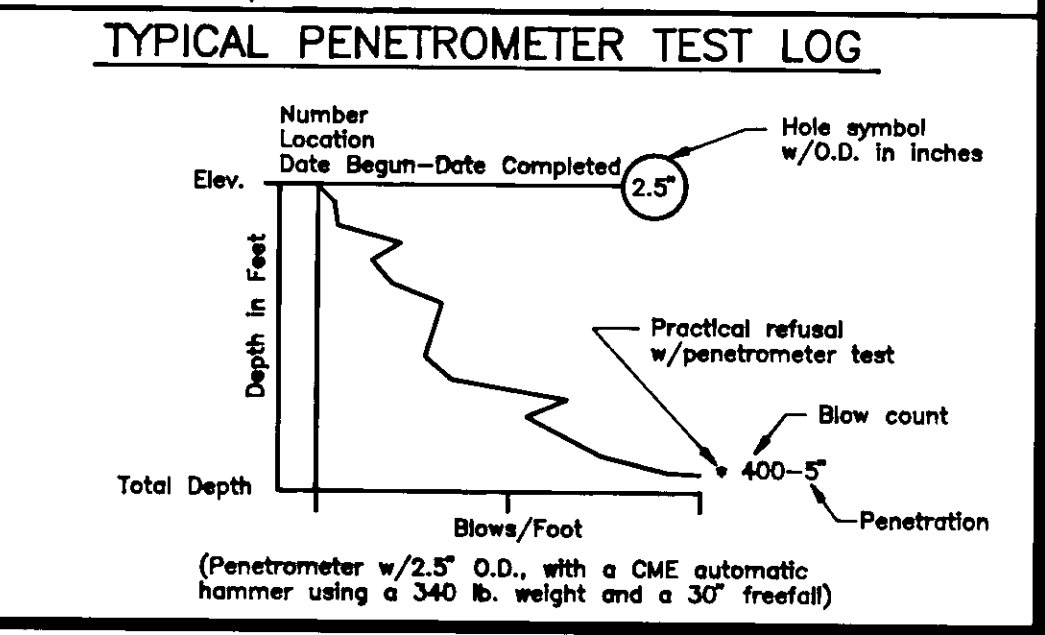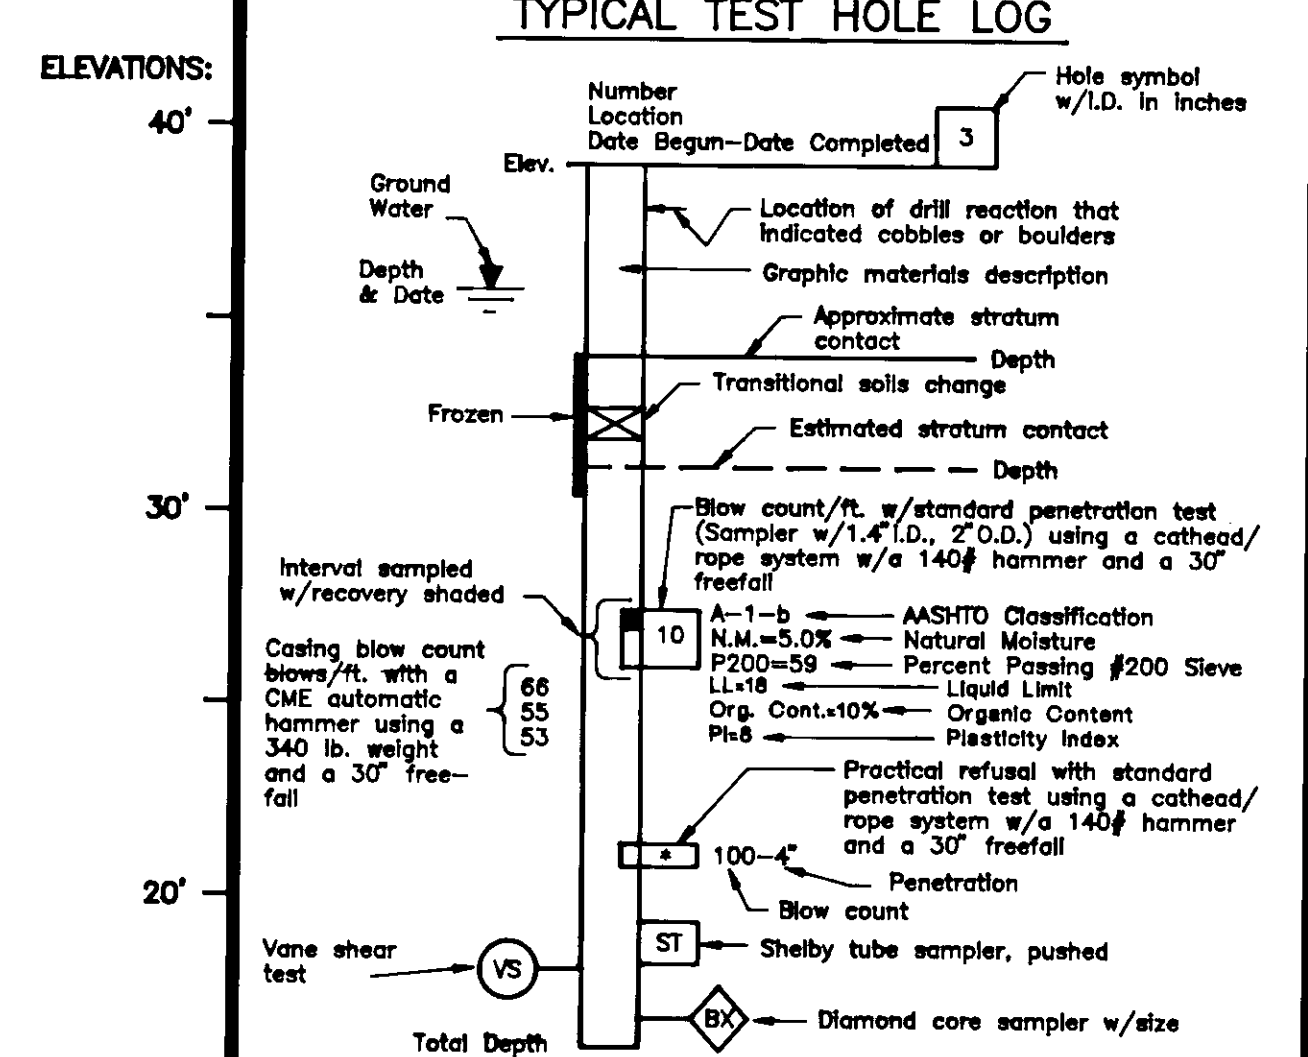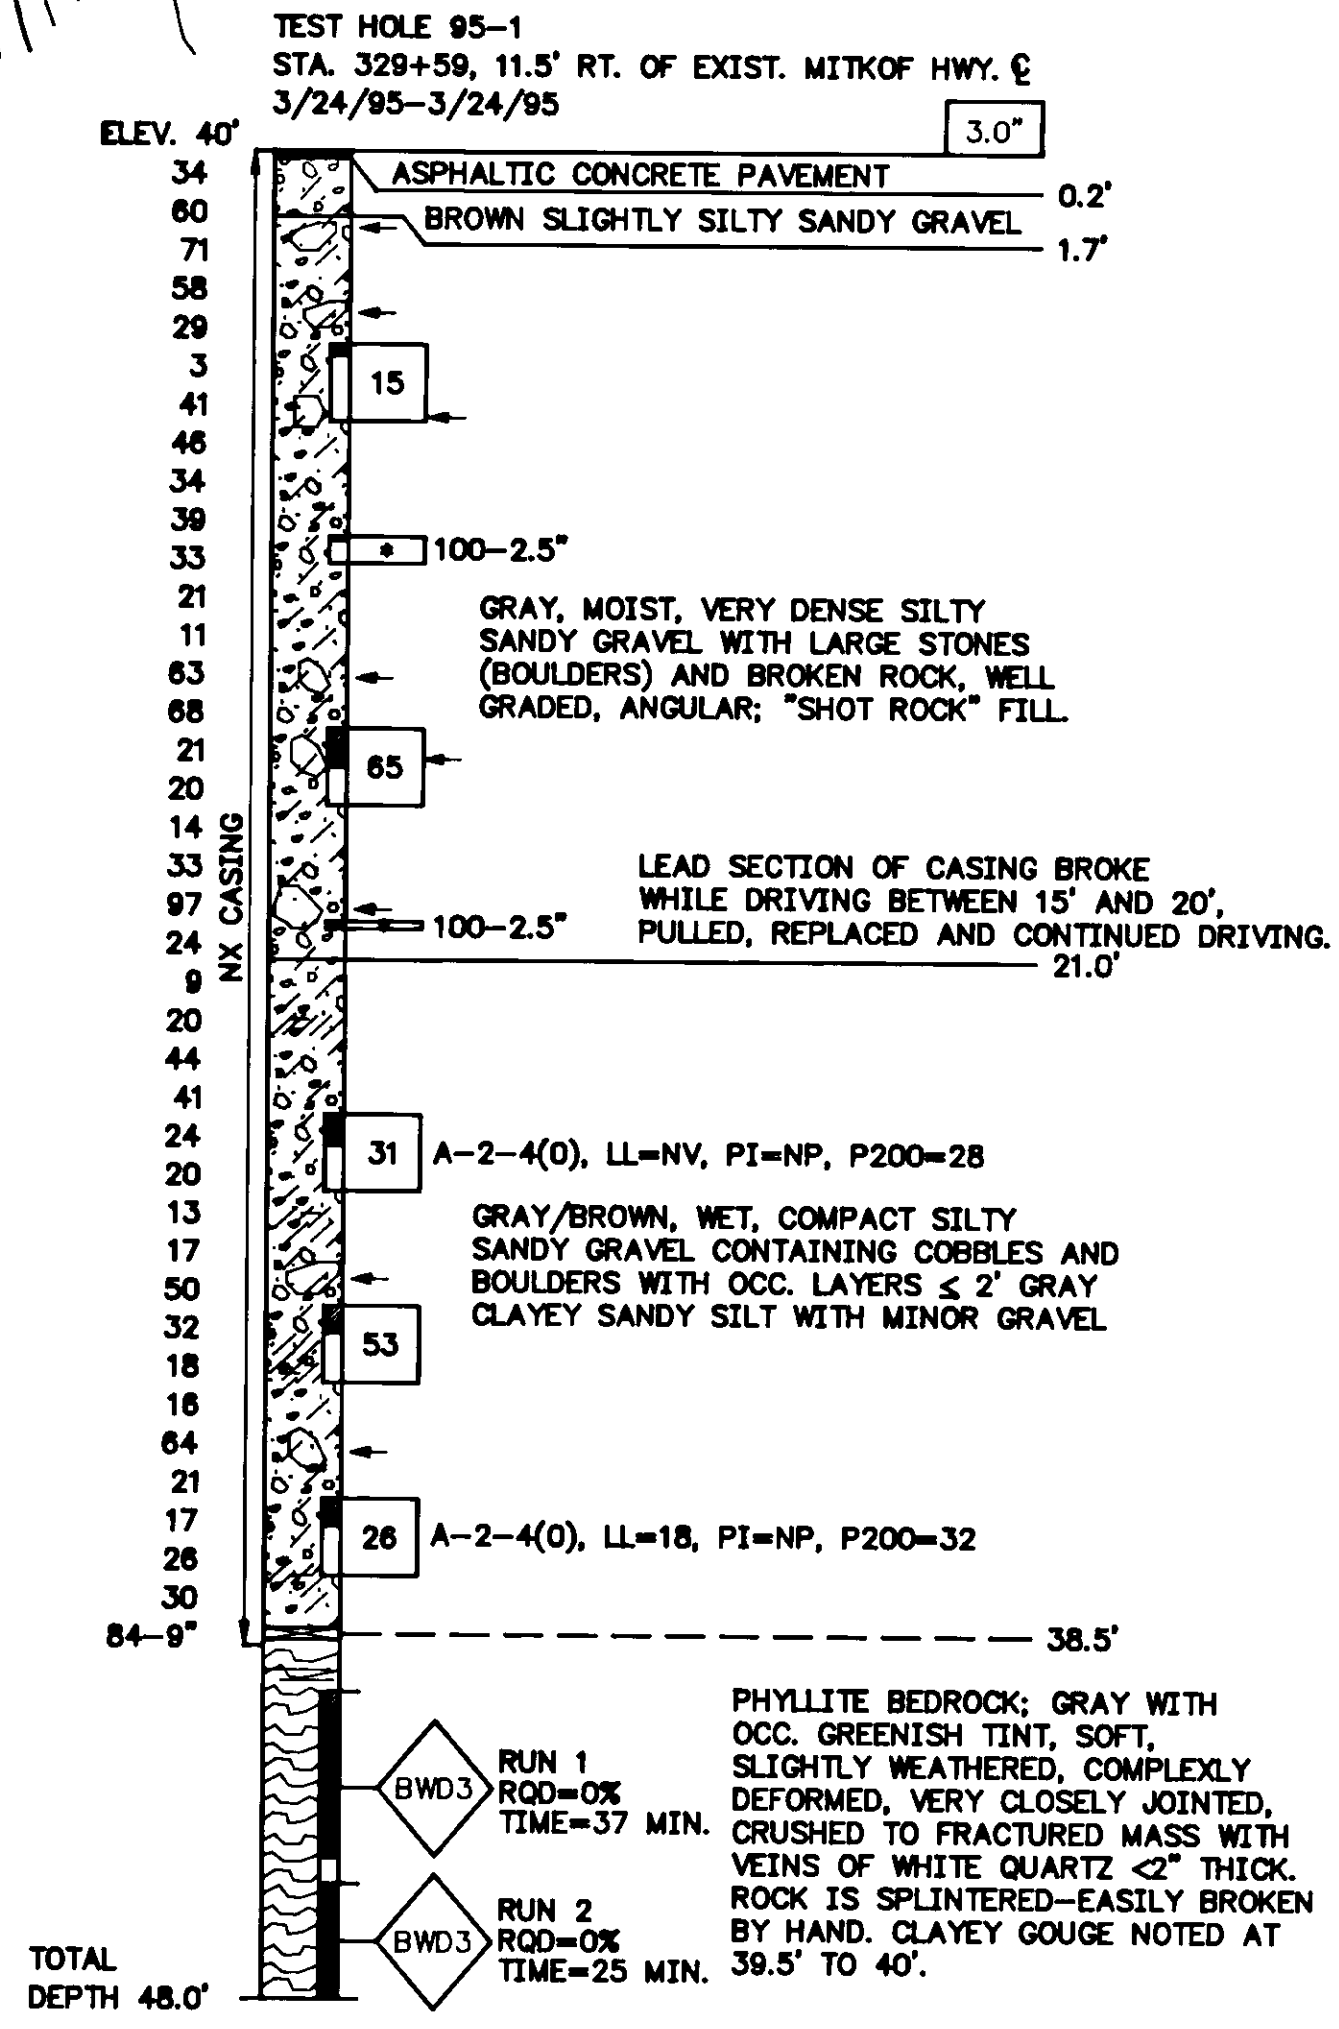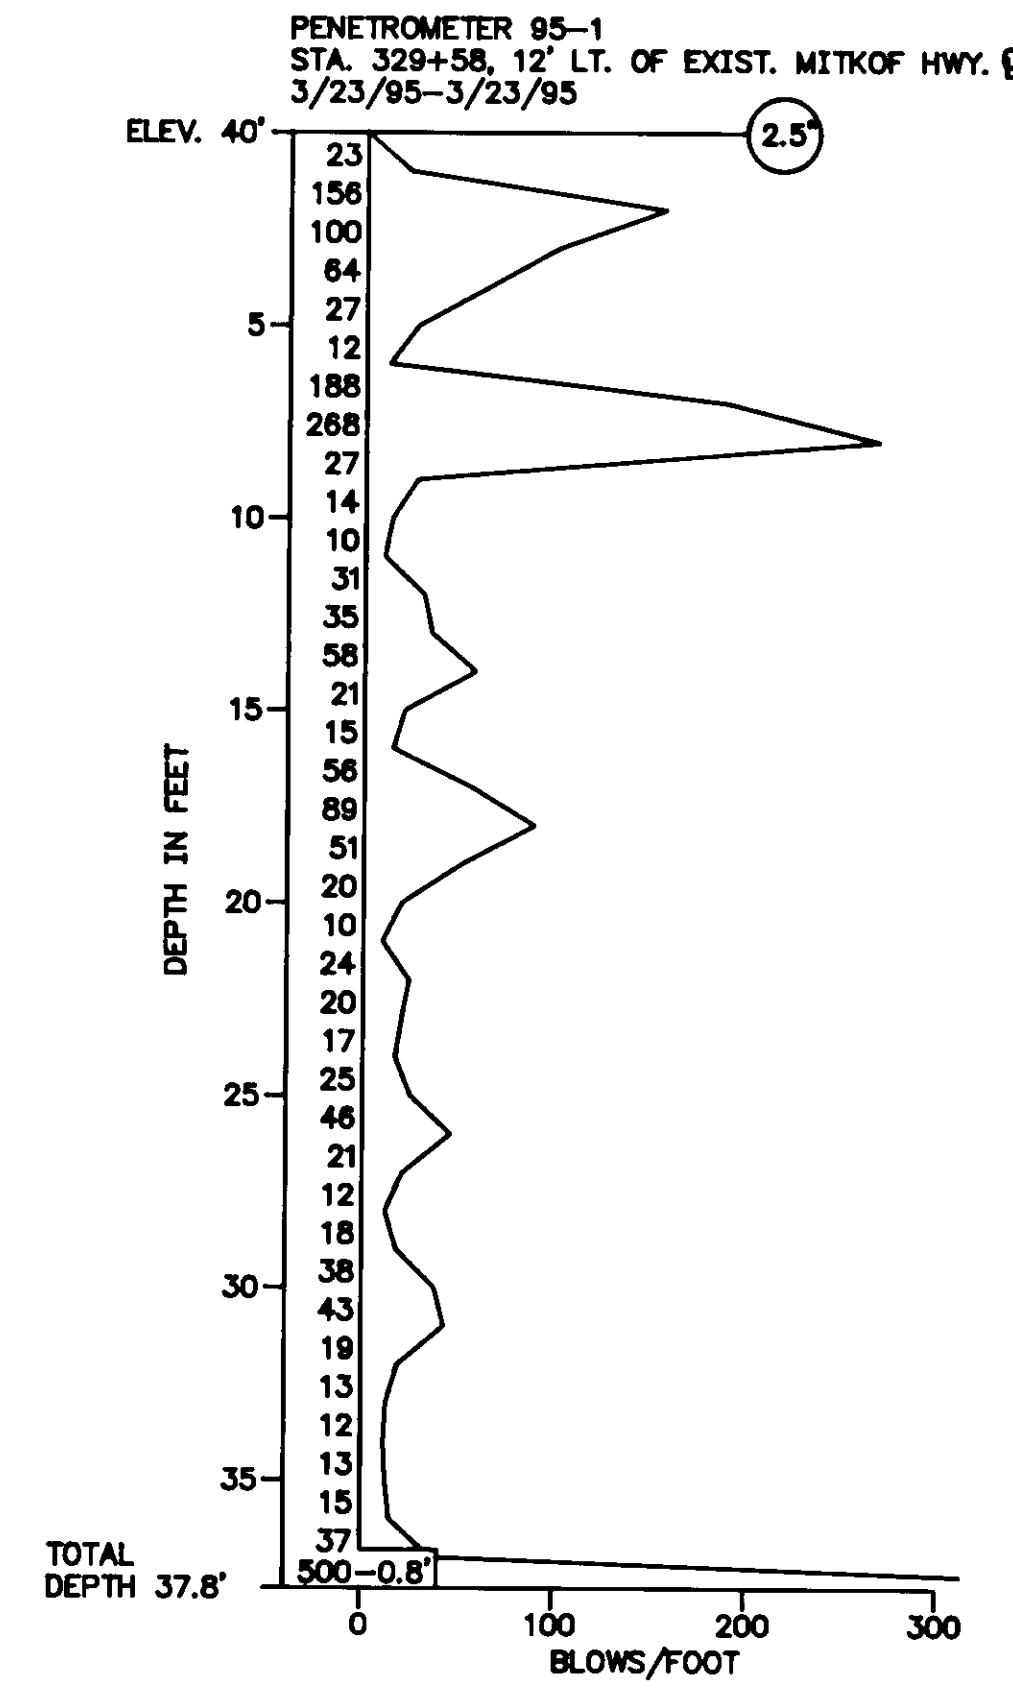

GENERAL NOTES:
1. THE TEST HOLE(S) DEPICTED ARE A COMBINATION OF THE ORIGINAL FIELD



4. FIELD MOISTURE DESCRIPTIONS (DRY, MOIST, AND WET) ARE BASED ON THE FOLLOWING FIELD OBSERVATIONS:

5. SOIL SAMPLES WERE TAKEN WITH A 1.4" I.D. THEREFORE PARTICLE SIZES LARGER THAN 1.4" ARE NOT REFLECTED IN

SOIL GRAIN SIZE DEFINITIONS

State of Alaska DEPARTMENT OF TRANSPORTATION

STATE	PROJECT DESIGNATION	YEAR	SHEET NO.	TOTAL SHEETS
ALASKA	71646	1995	16	16

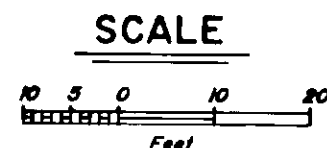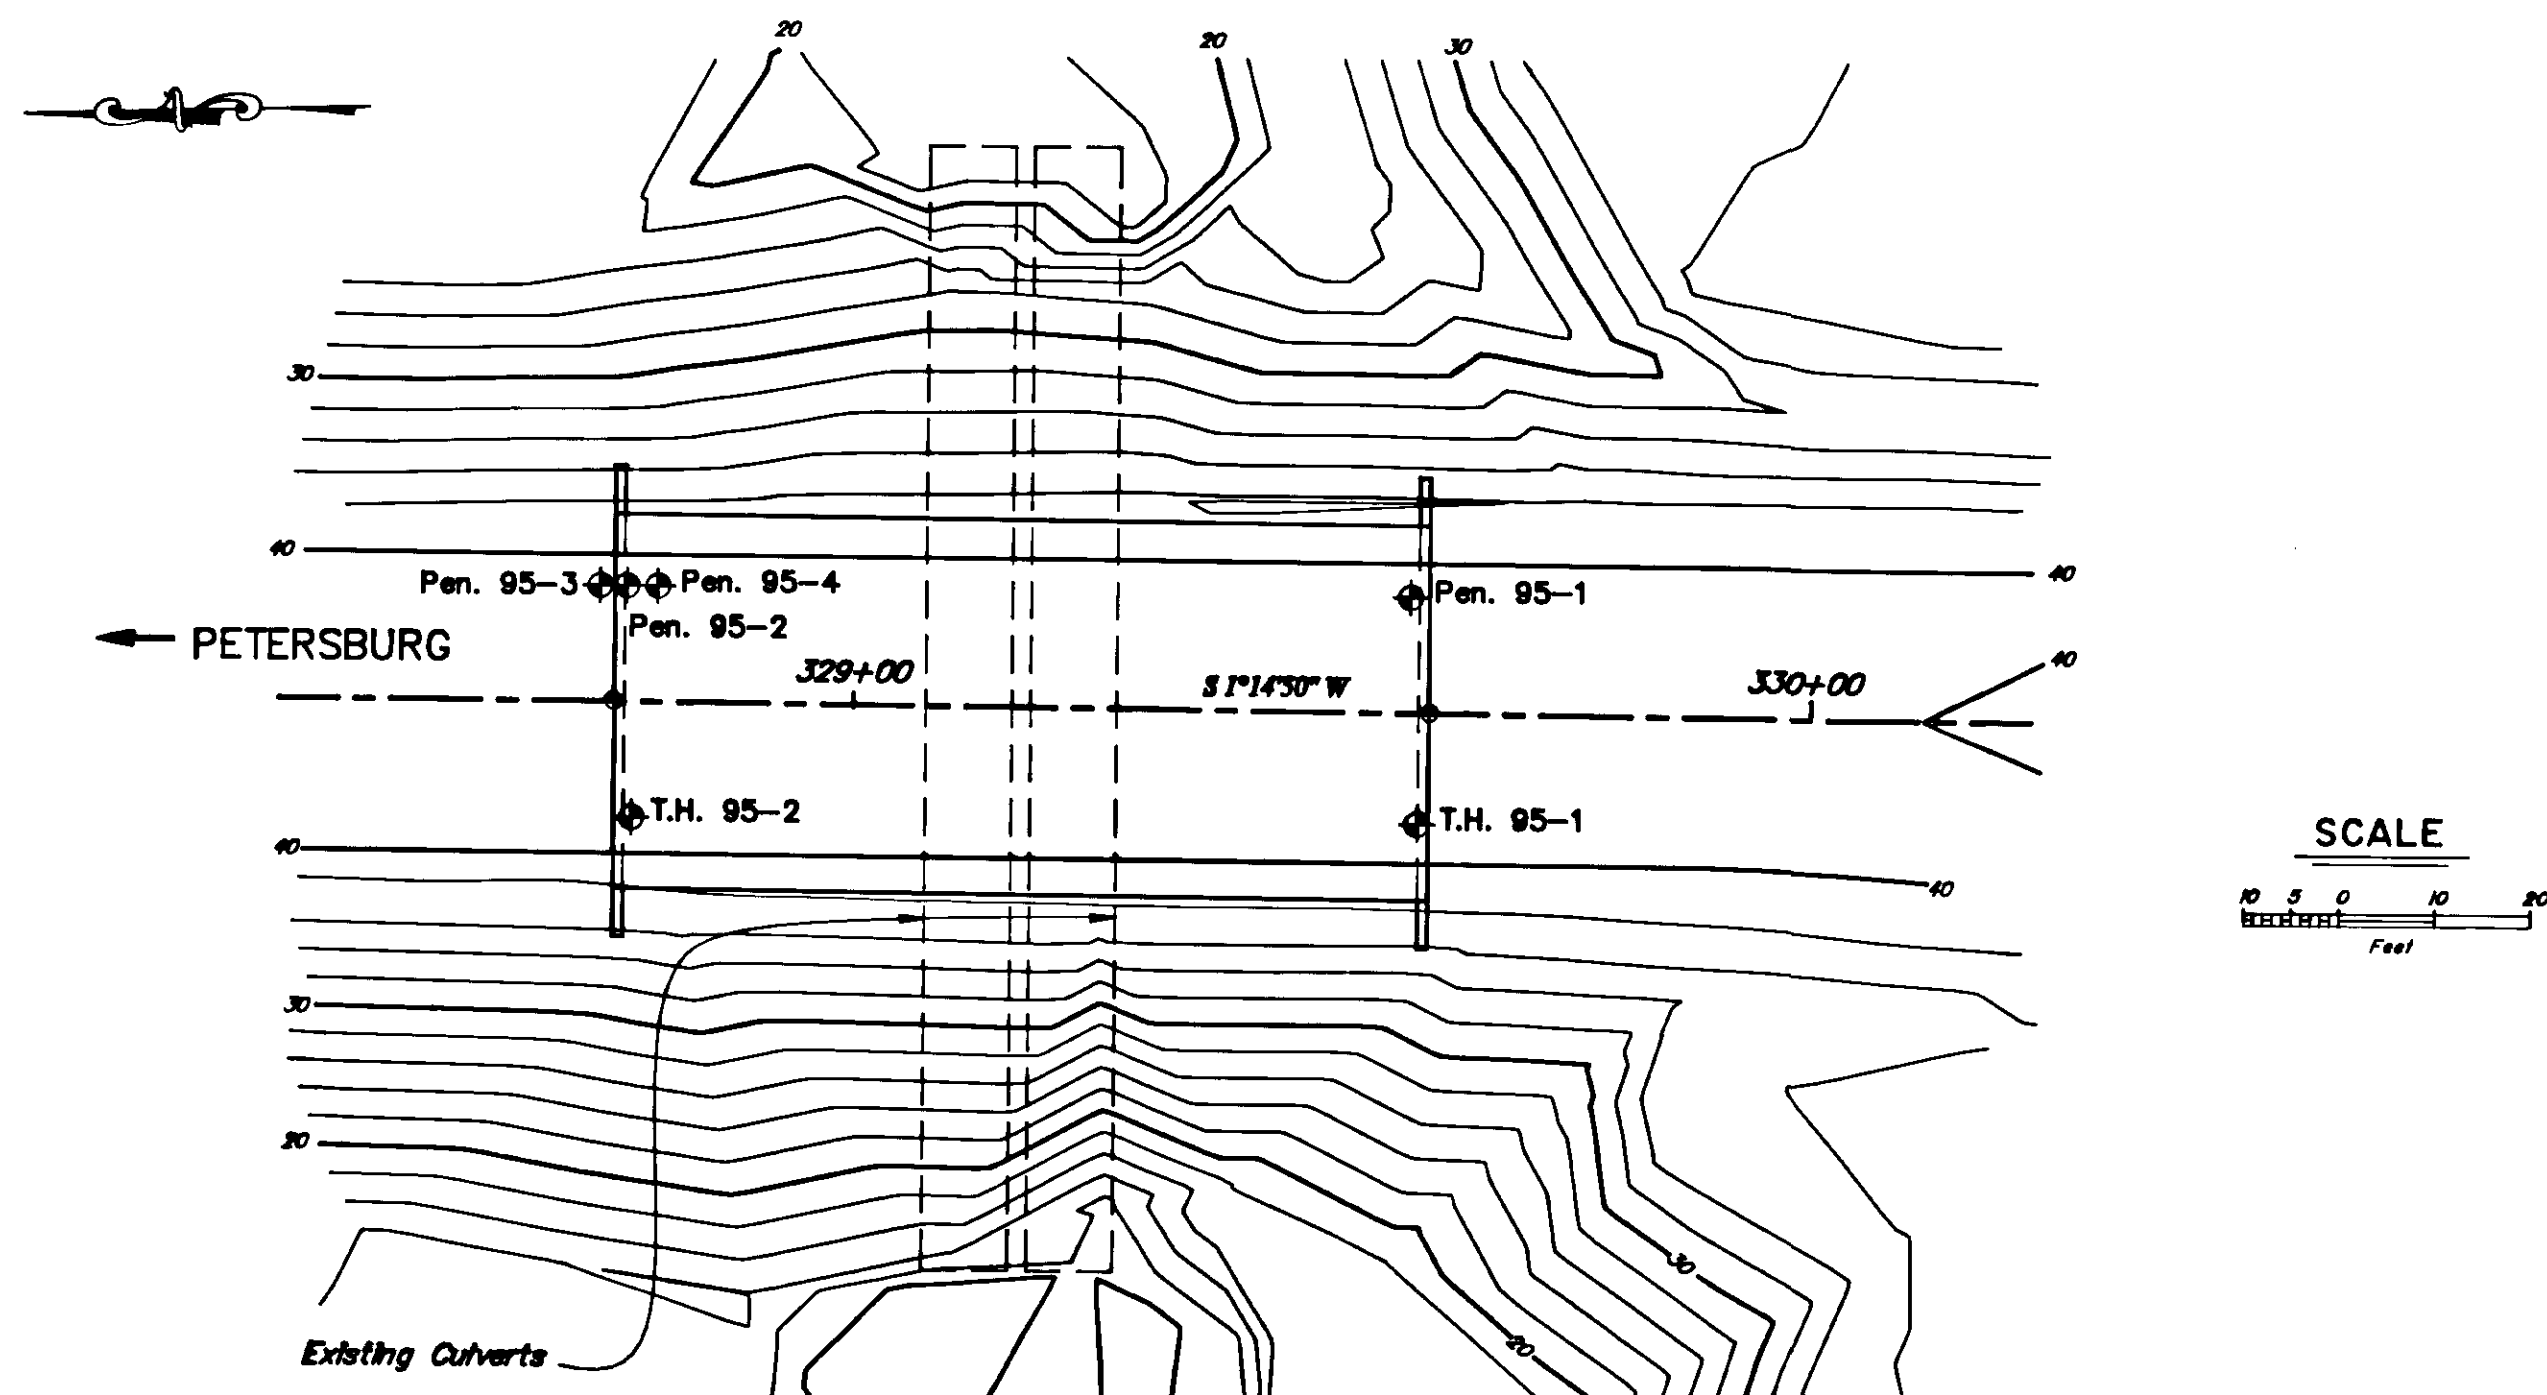

BASIC MATERIALS SYMBOLS

	Organic		Silt
	Cobbles/Boulders		Clay
	Gravel		Bedrock
	Sand		

NOTE: SIGNIFICANT SOIL MIXTURES ARE SHOWN BY COMBINING SOIL SYMBOLS.

TYPICAL TEST HOLE SYMBOLS







Plan View: Location of any hole

Section View: Rotary, Auger, Diamond Core, Penetrometer

RELATIVE DENSITY AND CONSISTENCY CLASSIFICATION

Based on Standard Penetration Test

GRANULAR		COHESIVE	
Blows/ft.	Rel. Density	Blows/ft.	Consistency
0-5	Very Loose	2	Very Soft
6-10	Loose	2-4	Soft
11-20	Firm	5-8	Medium
21-35	Compact	9-15	Stiff
36-50	Dense	16-30	Very Stiff
51-70	Very Dense	31-60	Hard
71+	V. Very Dense	61+	Very Hard

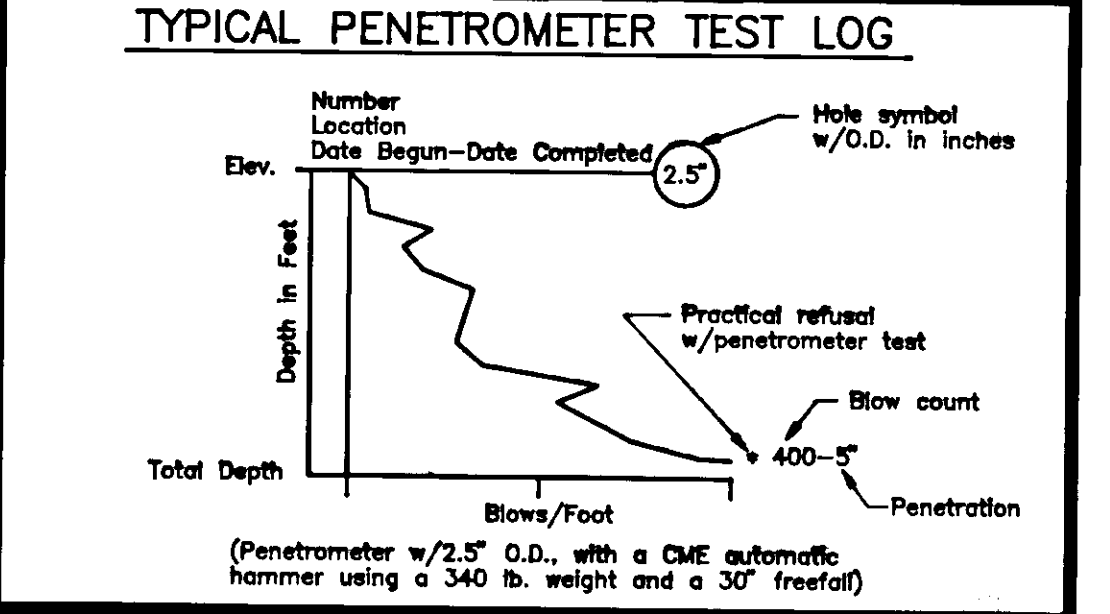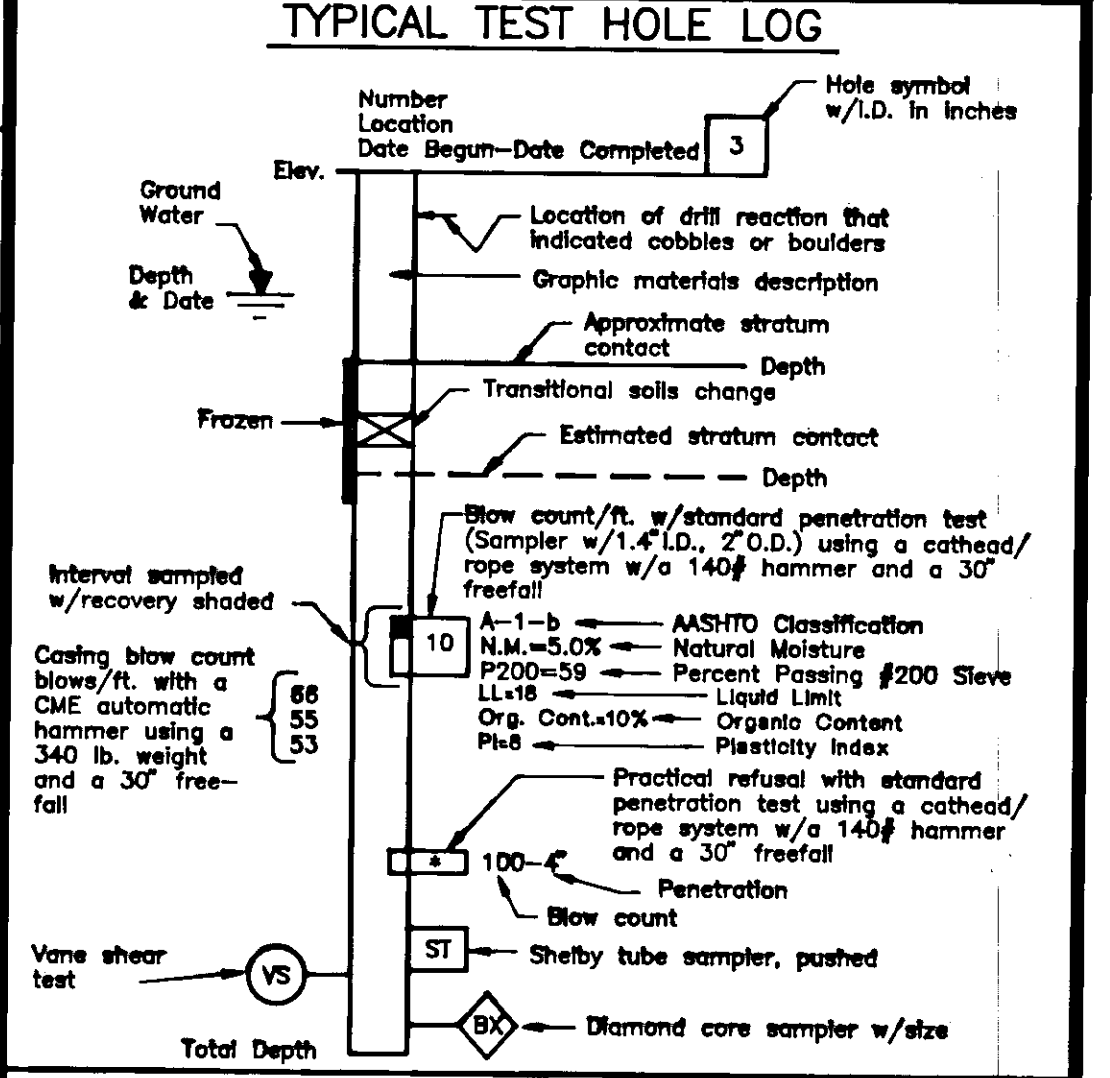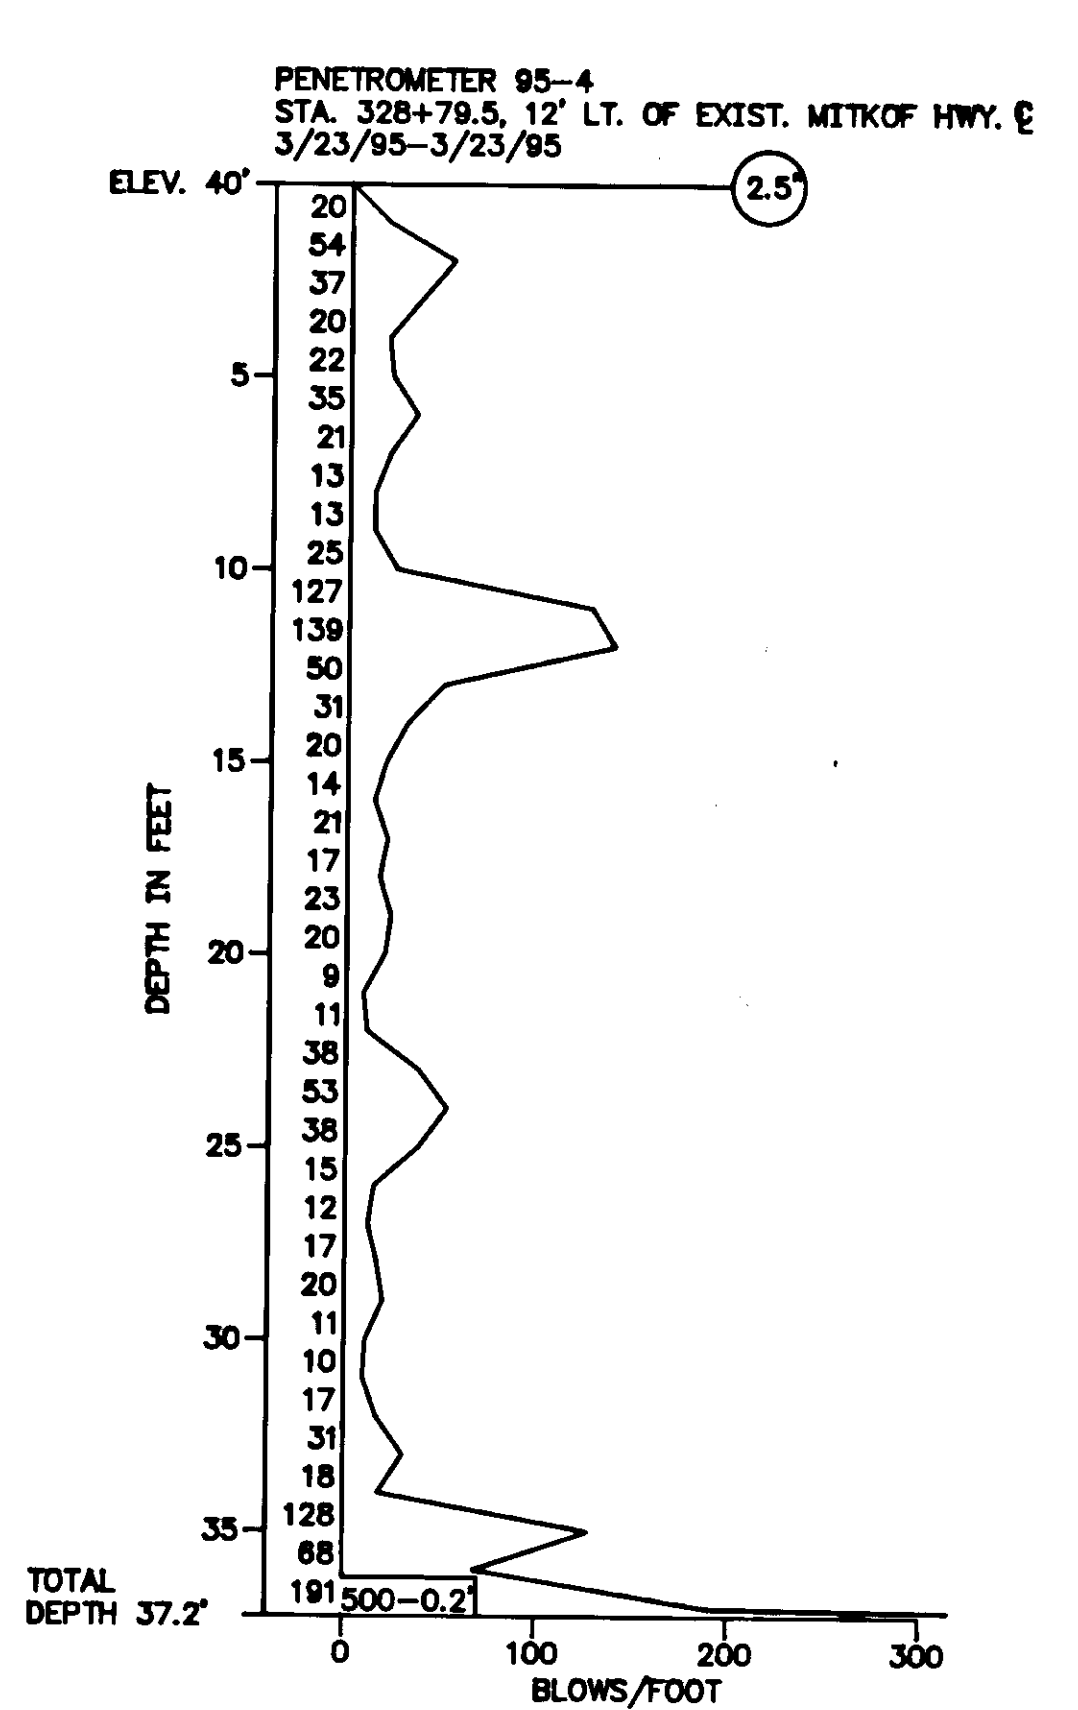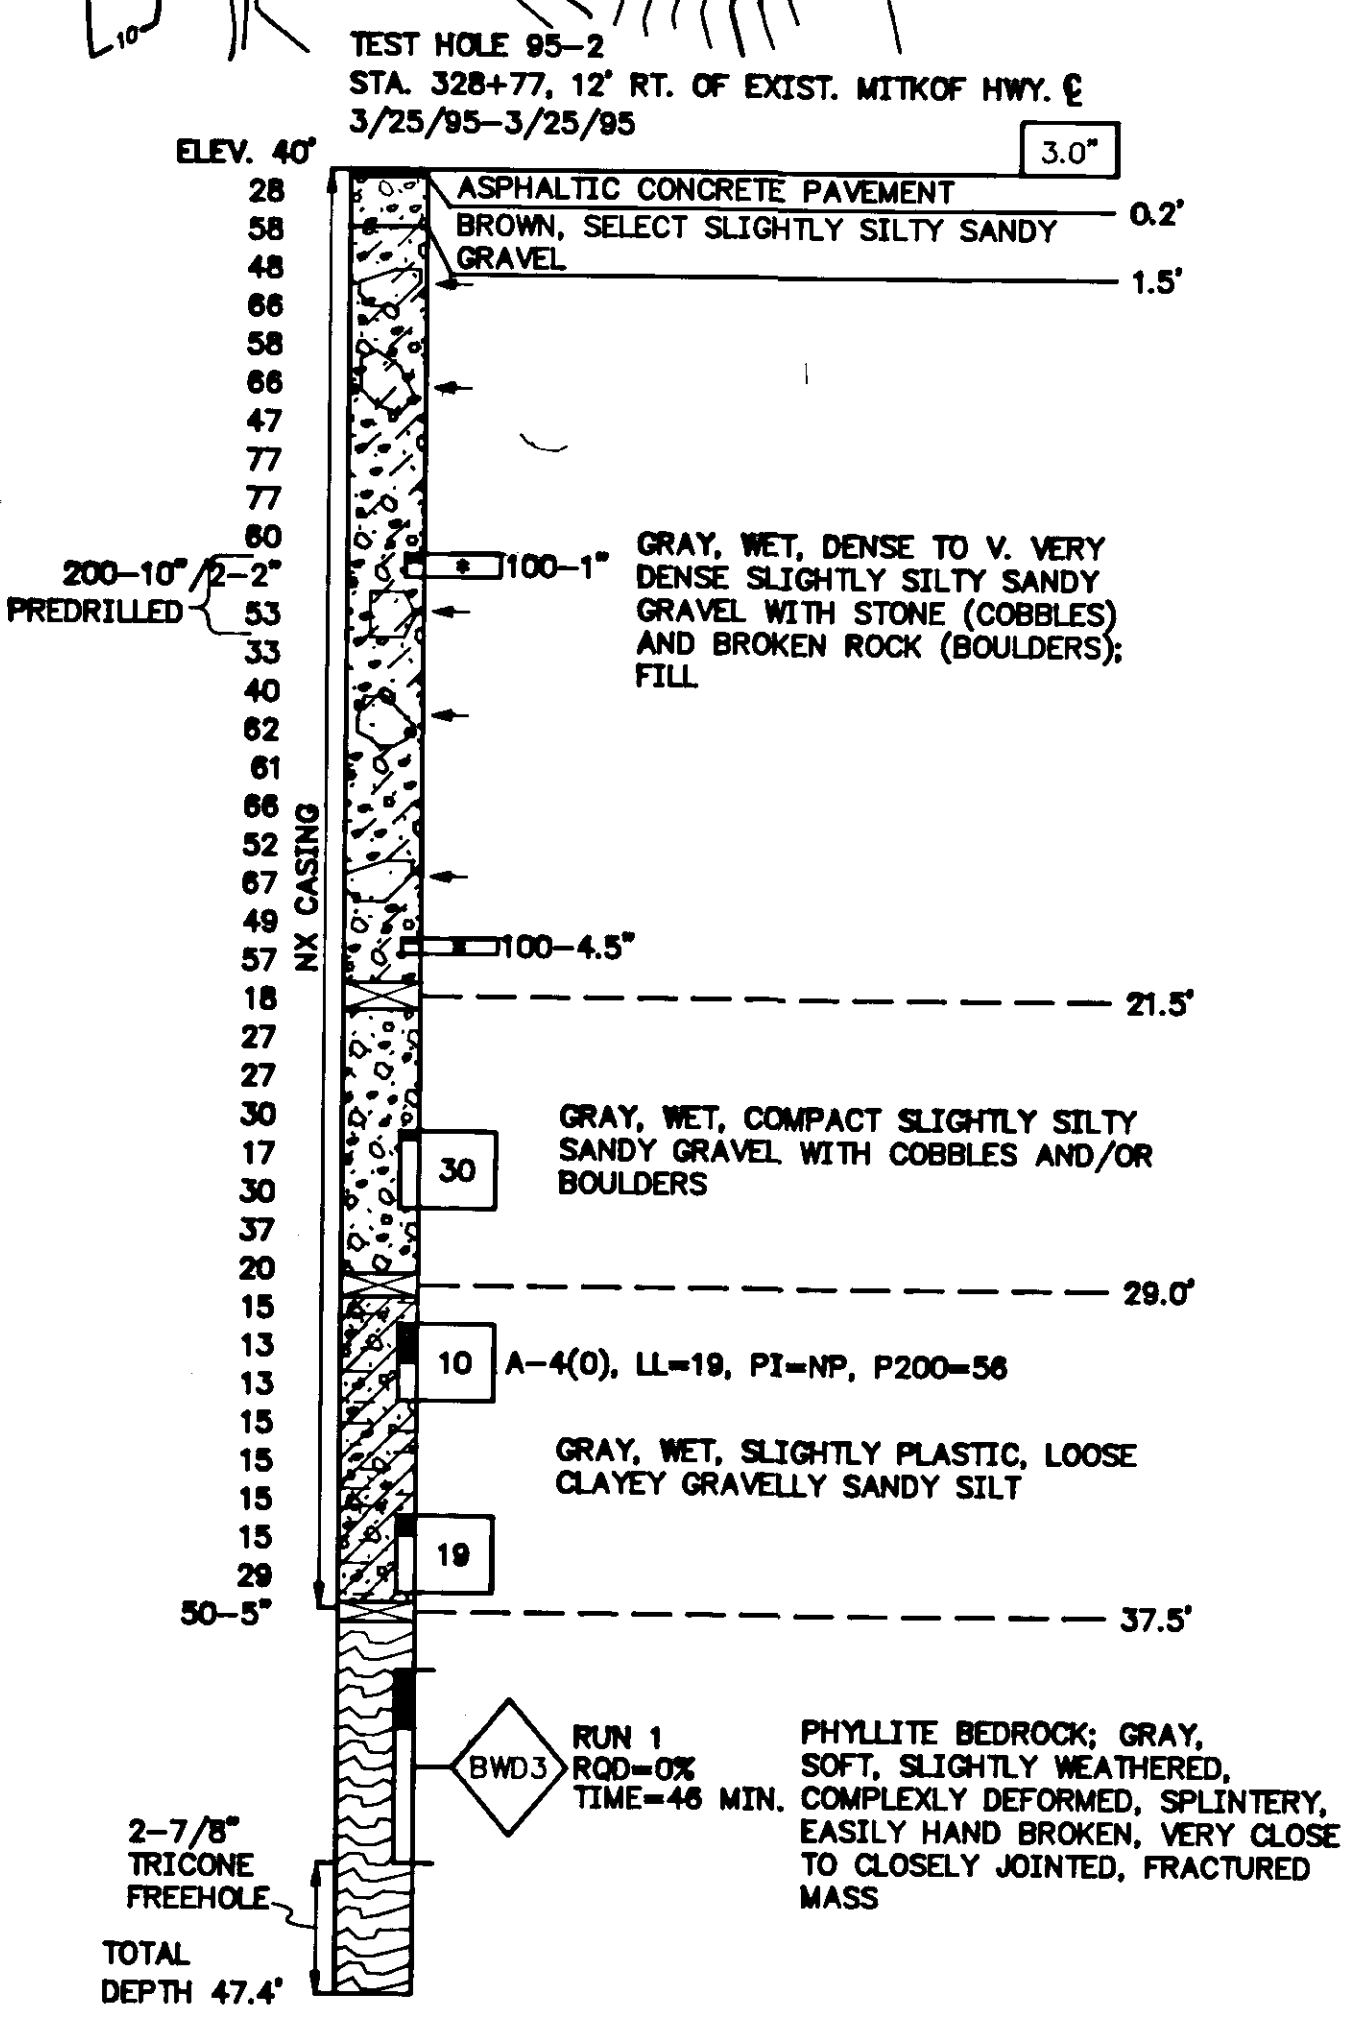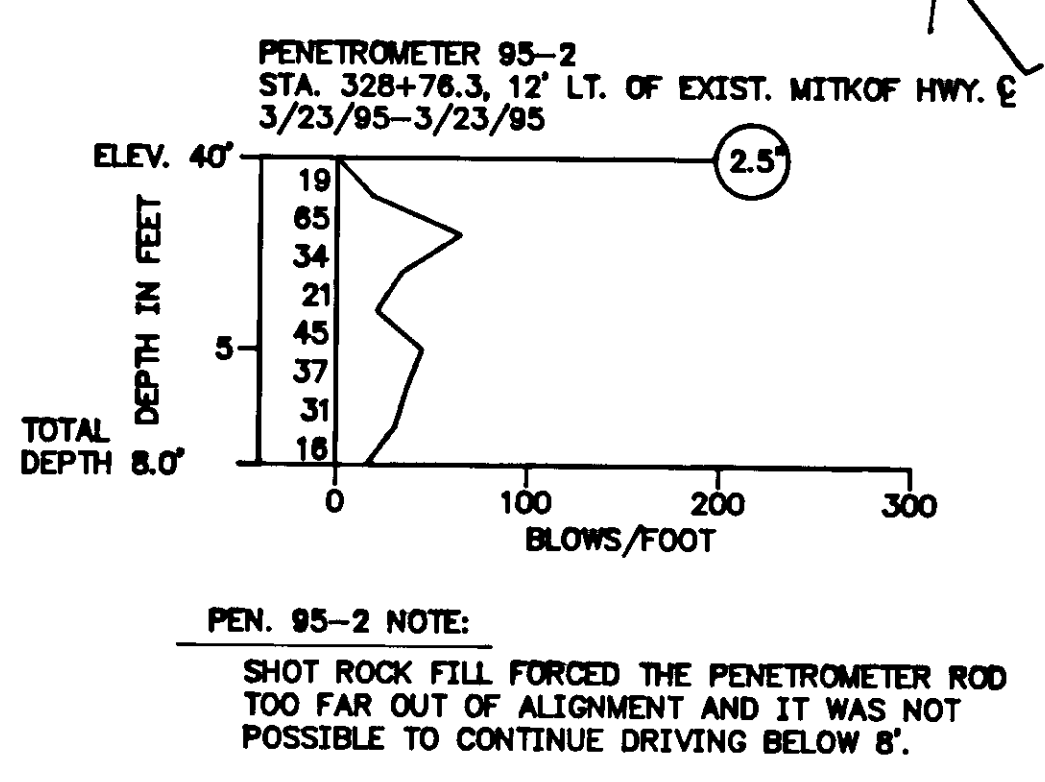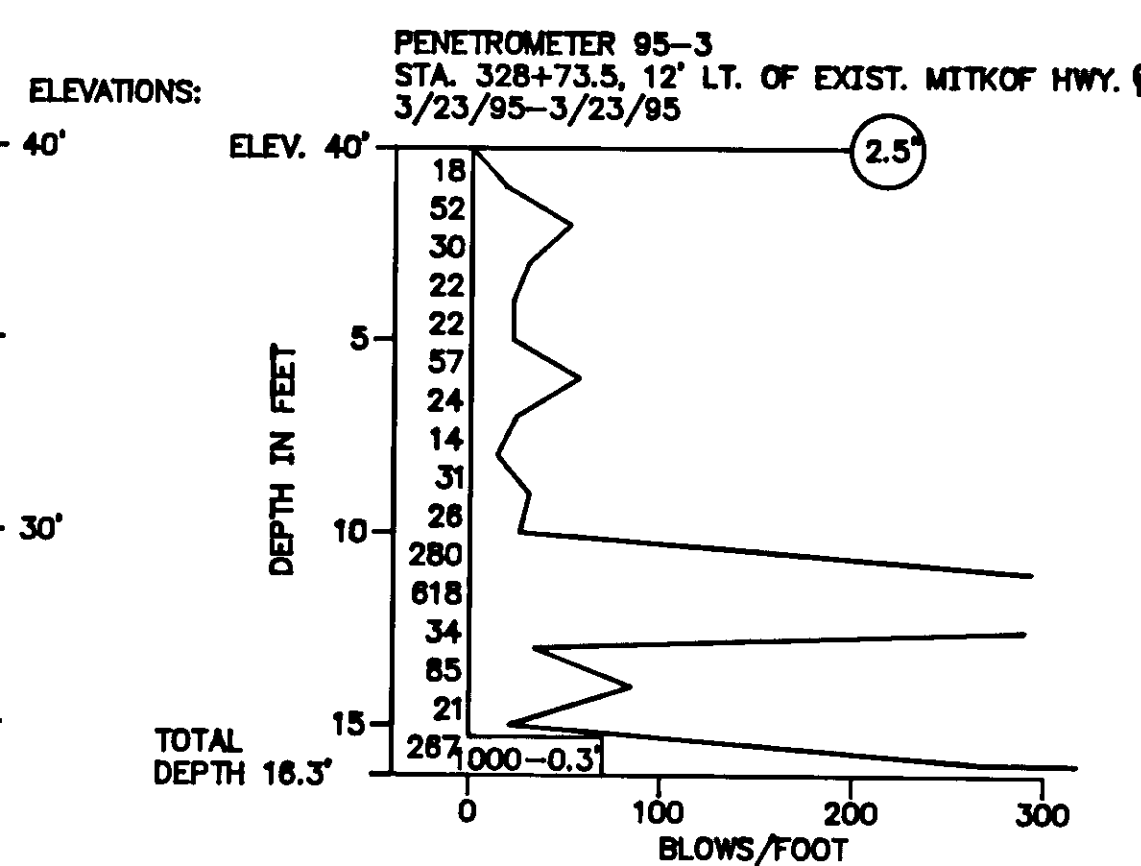

NOTE:
DURING THE FIELD INVESTIGATION IT WAS REPORTED BY LOCAL PERSONS THAT BOULDERS AS LARGE AS THE DRILL WERE OBSERVED BEING PLACED IN THE FILL "ONE ROCK IN A EUC."

GENERAL NOTES:
THE TEST HOLE(S) DEPICTED ARE A COMBINATION OF THE ORIGINAL FIELD

4. FIELD MOISTURE DESCRIPTIONS (DRY, MOIST, AND WET) ARE BASED ON THE FOLLOWING FIELD OBSERVATIONS:

5. SOIL SAMPLES WERE TAKEN WITH A 1.4" I.D. THEREFORE PARTICLE SIZES LARGER THAN 1.4" ARE NOT REFLECTED IN

SOIL GRAIN SIZE DEFINITIONS

TEST HOLE LOGS & LOCATIONS

PETERSBURG-TWIN CREEK BRIDGE (CULVERT REPLACEMENT)

State of Alaska