



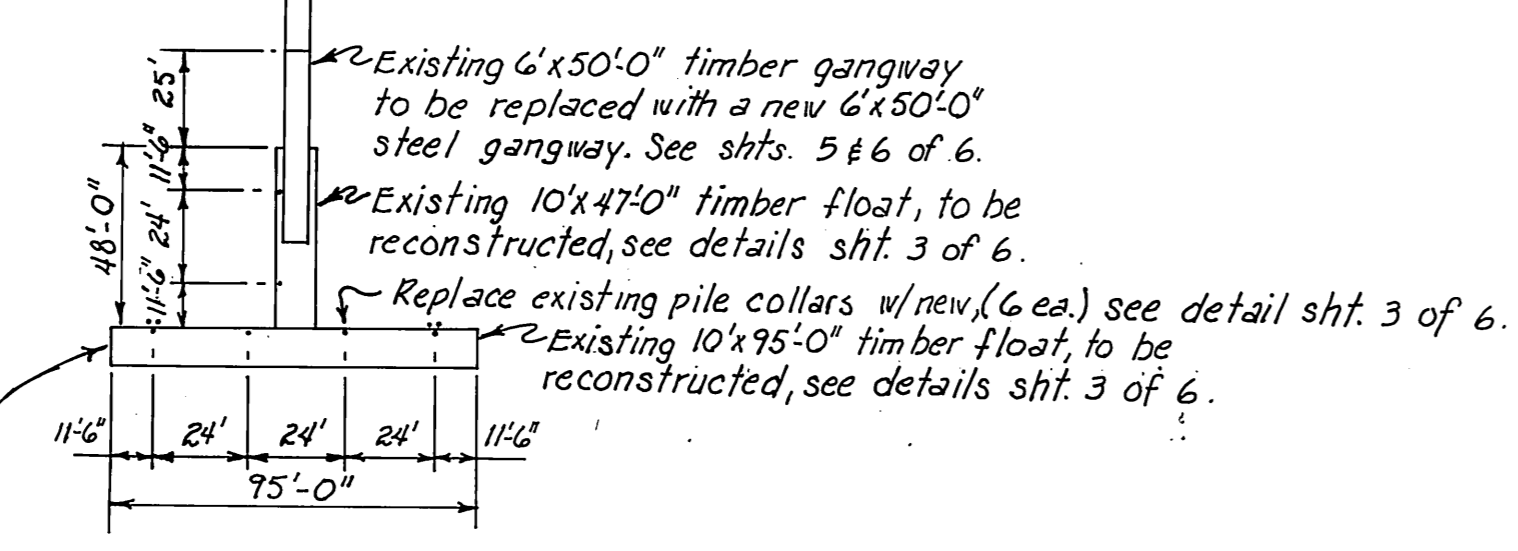



WEST  
PETERSBURG

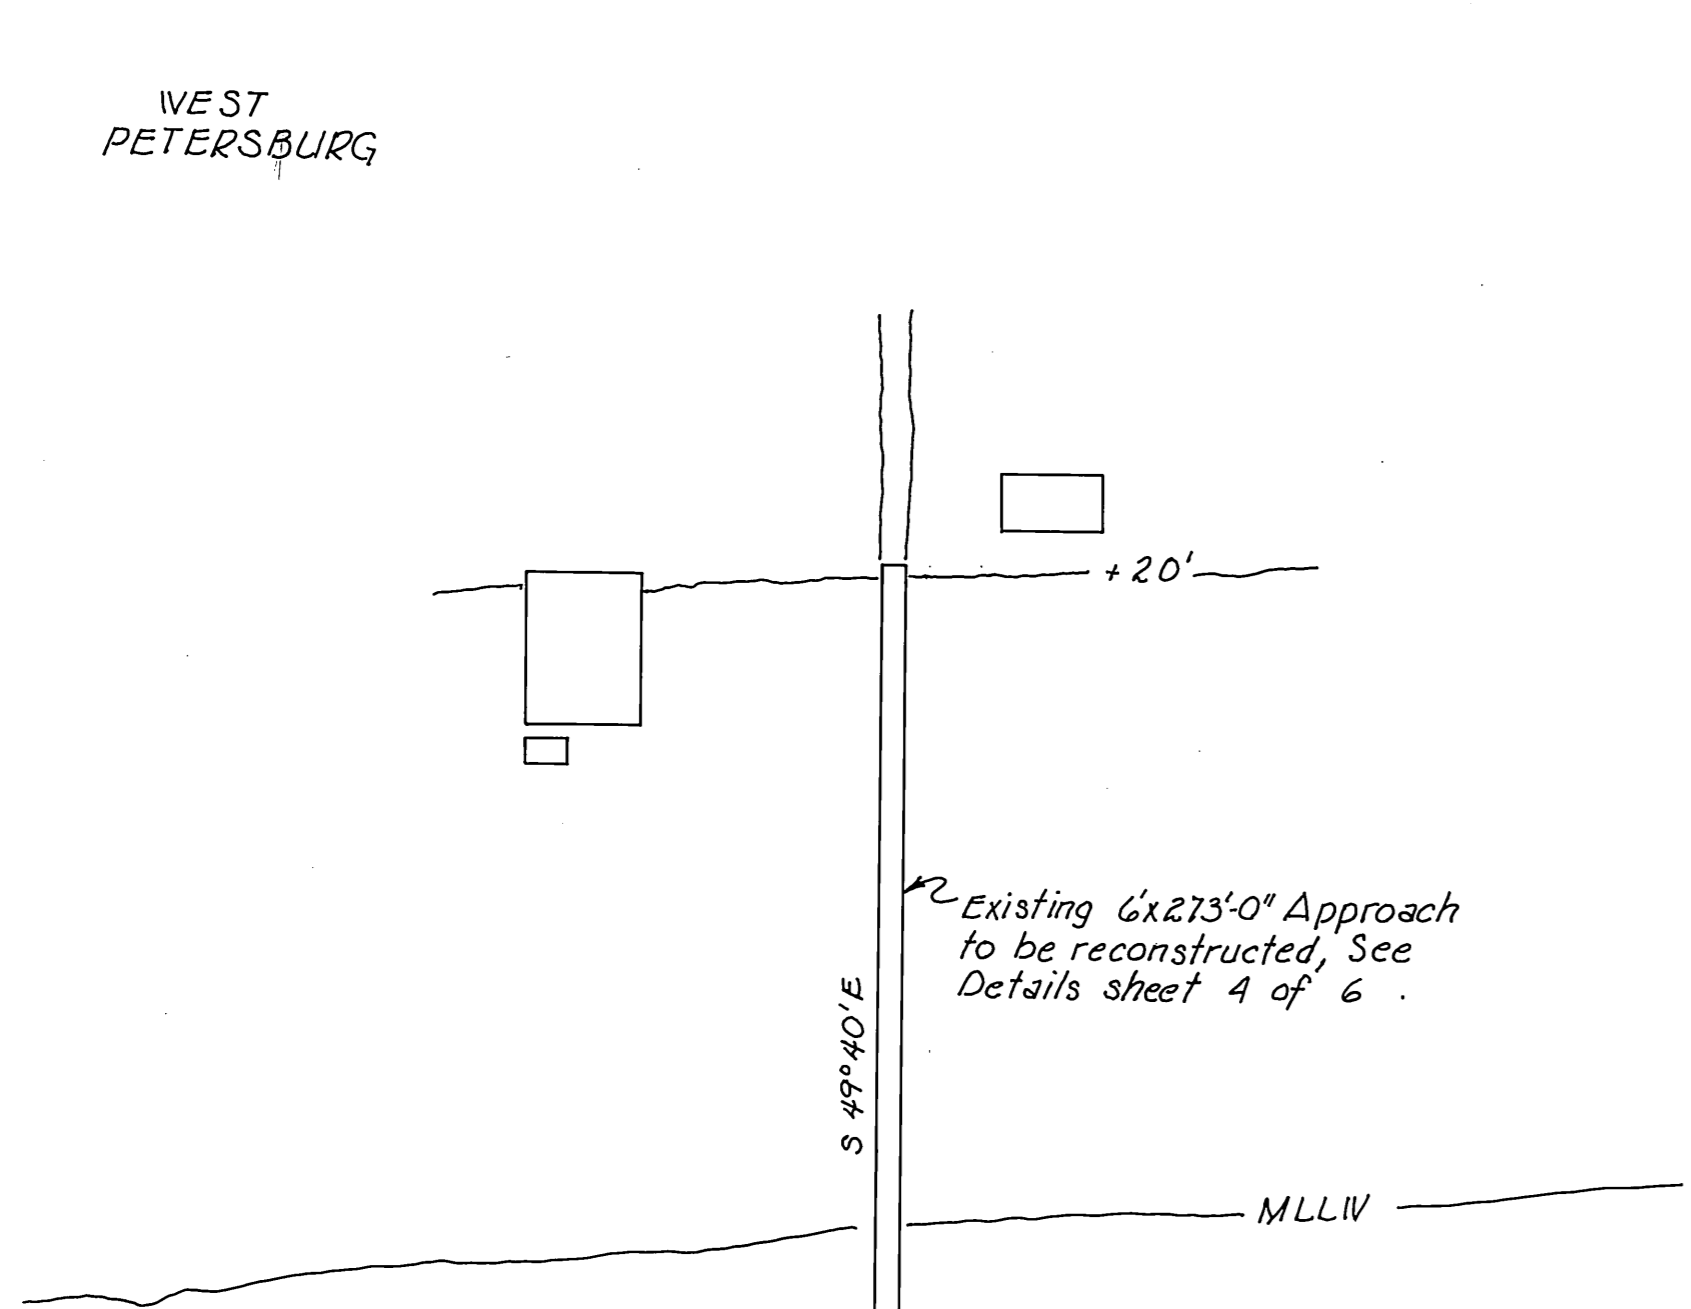

**PROJECT LAYOUT**  
1" = 50'-0"

WRANGELL

NARROWS

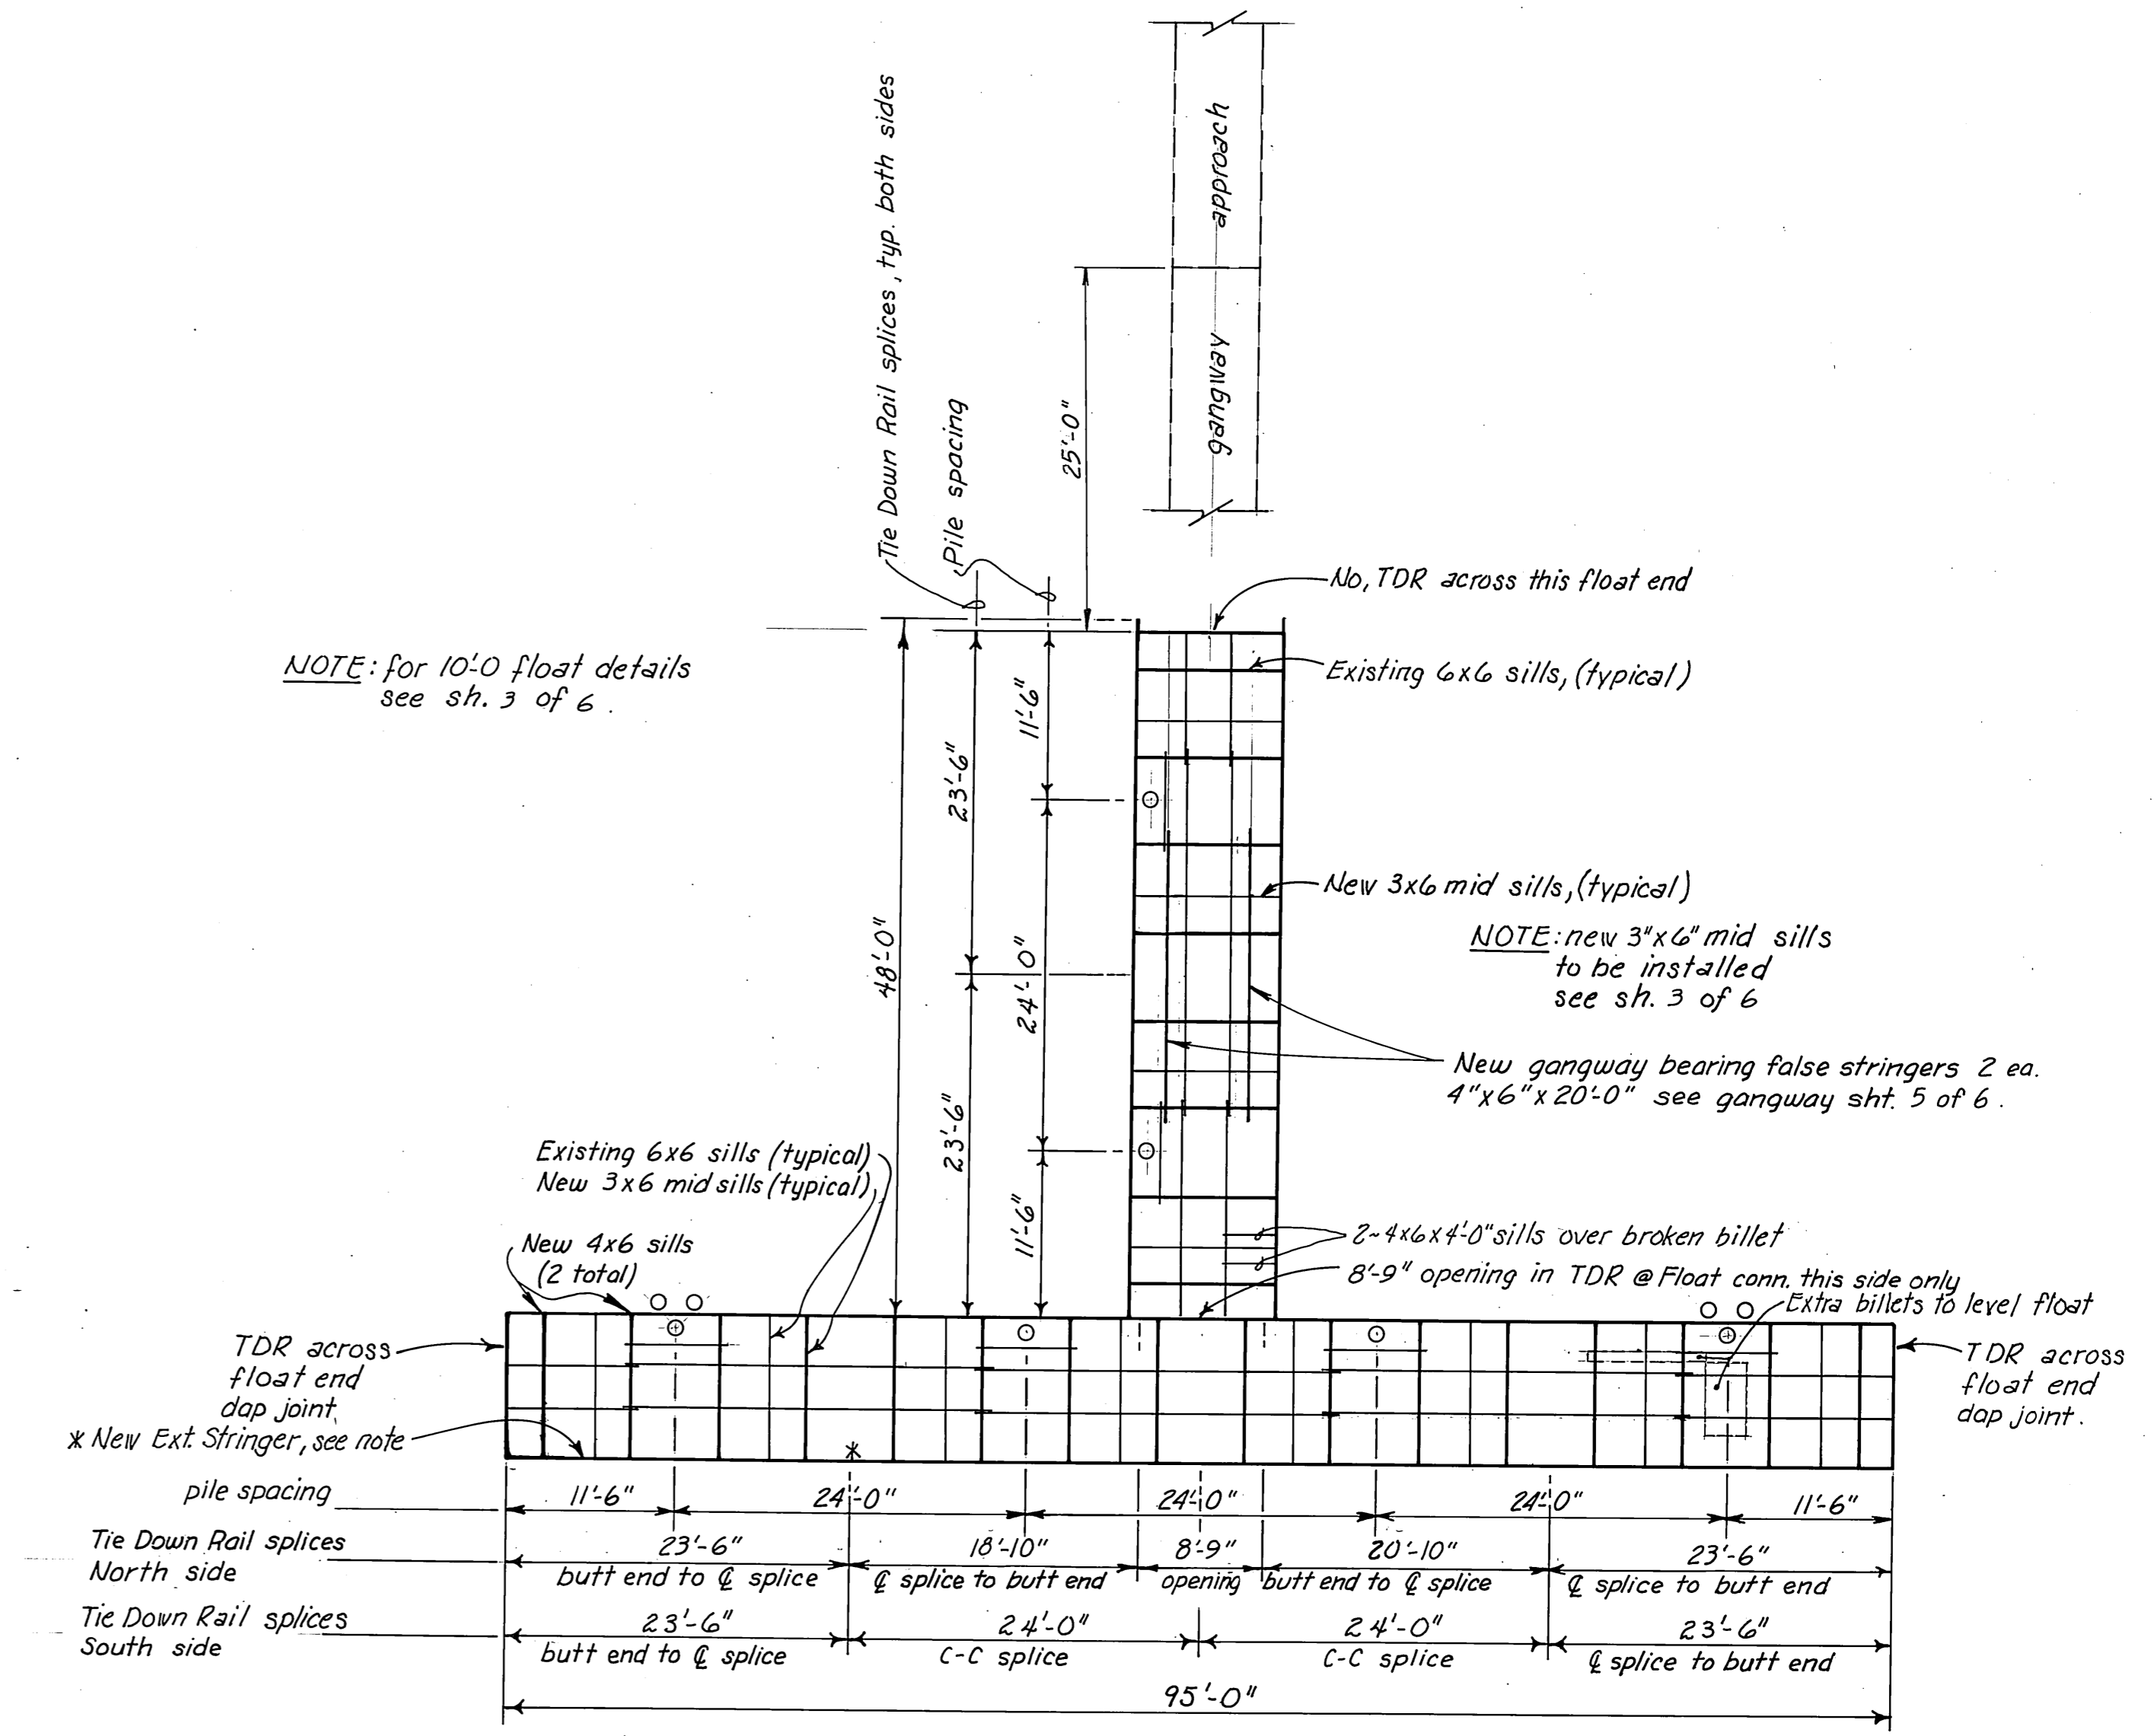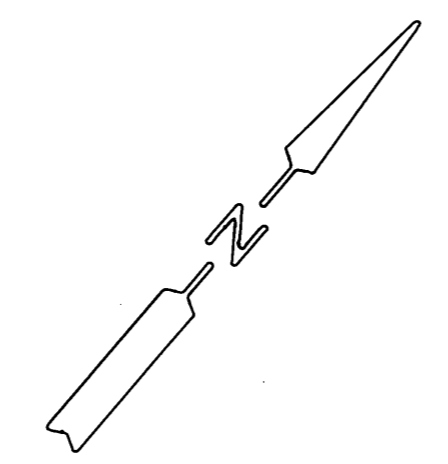

**STRINGER DIAGRAM**  
1" = 10'-0"




**PROJECT SCOPE - WEST PETERSBURG**

1. Reconstruct Existing Timber Floats - 1420 SF.  
 New 2"x10" decking  
 New 8"x8" tie down rail  
 New tie down rail scupper blocking  
 New 10"x20"x9'-0" polystyrene planks (4 total)  
 \* New 6"x8"x26'-0" Exterior Stringer to replace existing broken stringer, field splice w/ new splice block (4x6x6'-0")  
 New steel internal pile collars  
 Replace existing 3/4" tie down rail, exterior stringer, to sill bolts with new 3/4" bolts as detailed on typical 10'-0" float sh. 3 of 6.  
 New 3x6 mid sills @ each pontoon (12 each).
2. Reconstruct Existing Timber Approach - 1638 SF  
 New 2"x10" decking  
 New handrail, handrail posts, and girts  
 New X-bracing between bents #3 & 4, 4 ea. @ 20'±
3. Replace Existing 6'x50' Timber Gangway with new 6'x50' Steel Gangway

		DO NOT SCALE THIS DRAWING - USE DIMENSIONS	
		STATE OF ALASKA DEPARTMENT OF TRANSPORTATION AND PUBLIC FACILITIES DIVISION OF HARBOR DESIGN AND CONSTRUCTION	
WEST PETERSBURG		ALASKA	
<b>PROJECT LAYOUT</b>			
SCALE <i>As Noted</i>	SURVEYED	APPROVED	
DESIGNED	DRAWN <i>G.R.F.</i>	 <b>ROBERT P. BECK</b> CHIEF OF DESIGN	
CHECKED	DATE <i>Dec. 1979</i>		
PROJECT NUMBER <i>K30154</i>	SHEET <i>2</i> OF <i>6</i>		


MATERIALS		
ITEM	DRESSING	TREATMENT
3"x6" & 6"x6" Upper Sill	S-4-S	Creosote
2"x10" Siding	1 1/2" x 10 1/2" S4S	"
3"x6" & 2"x6" Lower Sill	S-4-S	"
4"x6" Interior Stringers	S-4-S	"
6"x8" Exterior Stringers	S-4-S	"
2"x8" Bumpers	S-4-S	Penta
6"x6" Collar Stringers	S-4-S	Creosote
2"x10" Decking	Milled	Penta
4"x8" Blocking	S-4-S	"
8"x8" Tie Down Rail	S-4-S	"
		(See Specs)

\* Exact width to conform to width of floatation material  
All material to be, no. 1 grade Hem./Fir, 10% max. no. 2 grade.

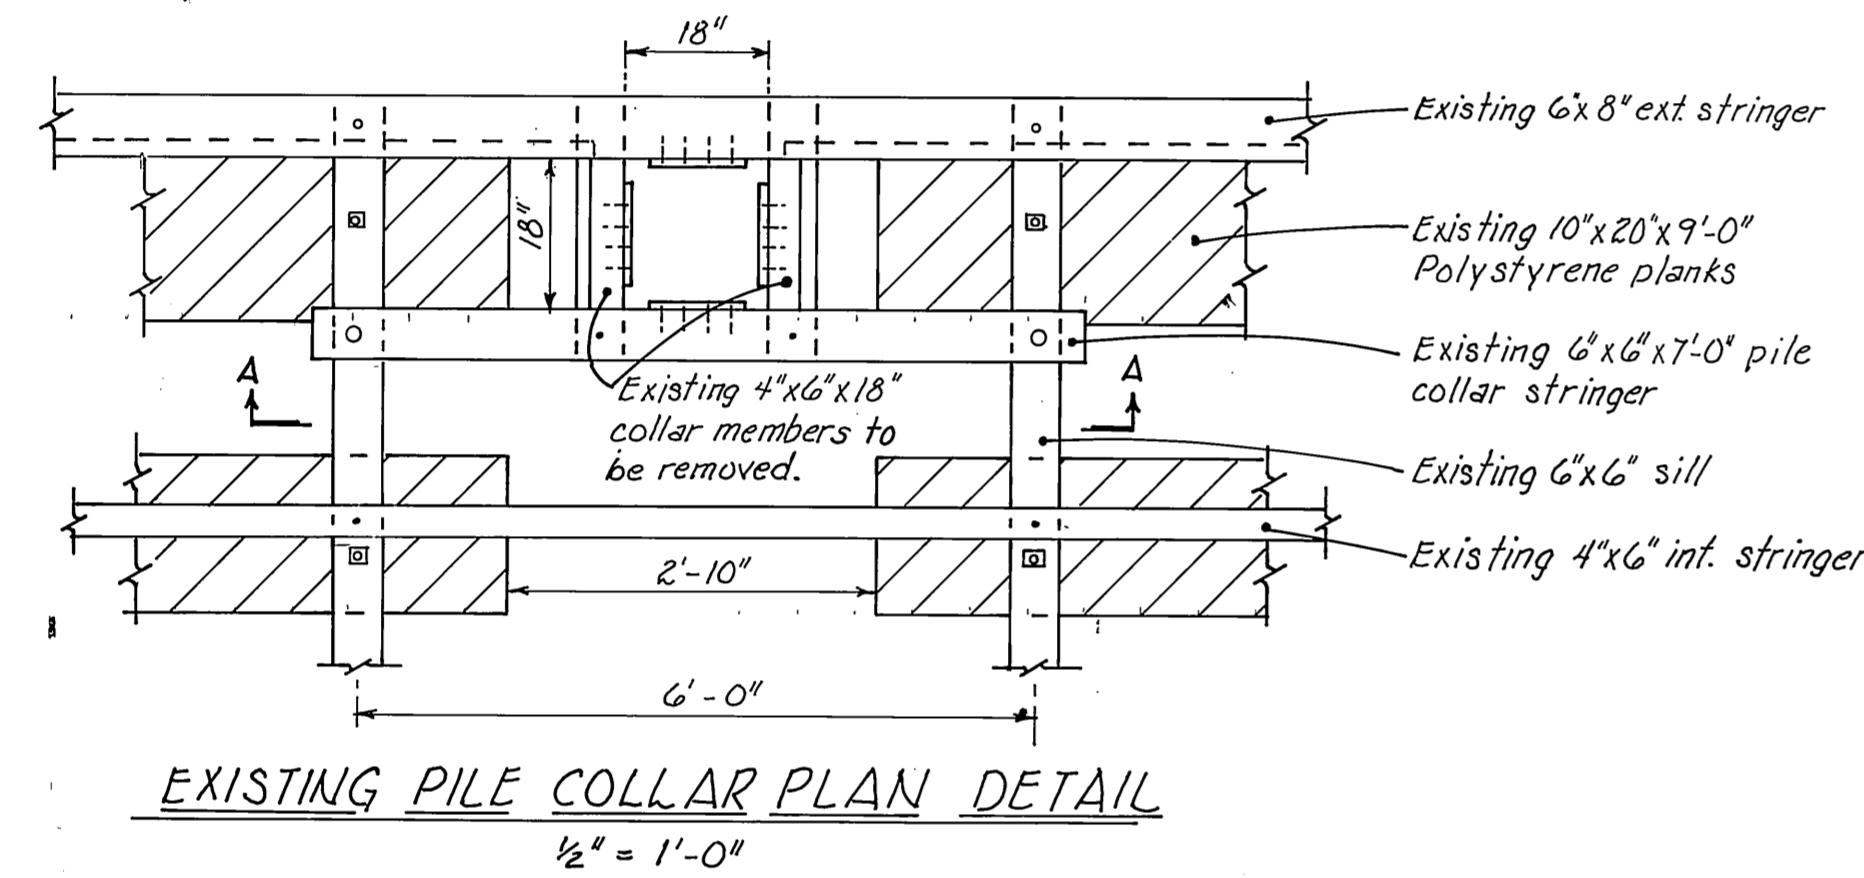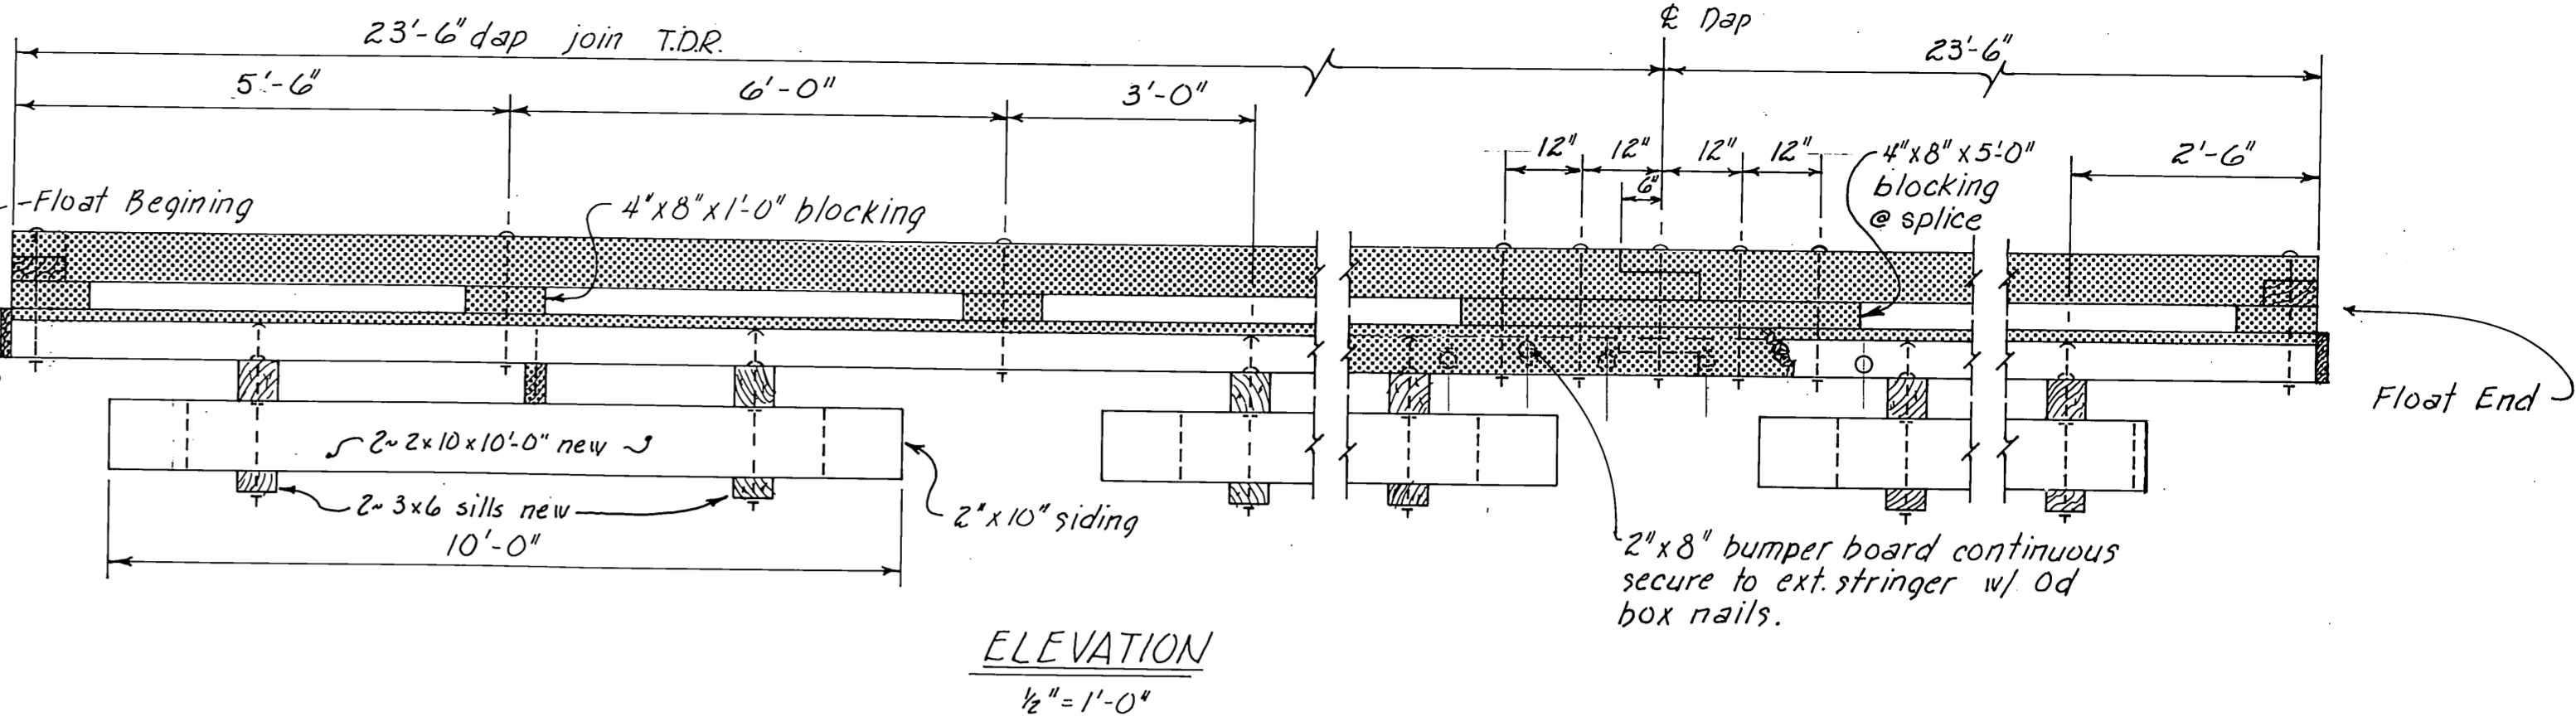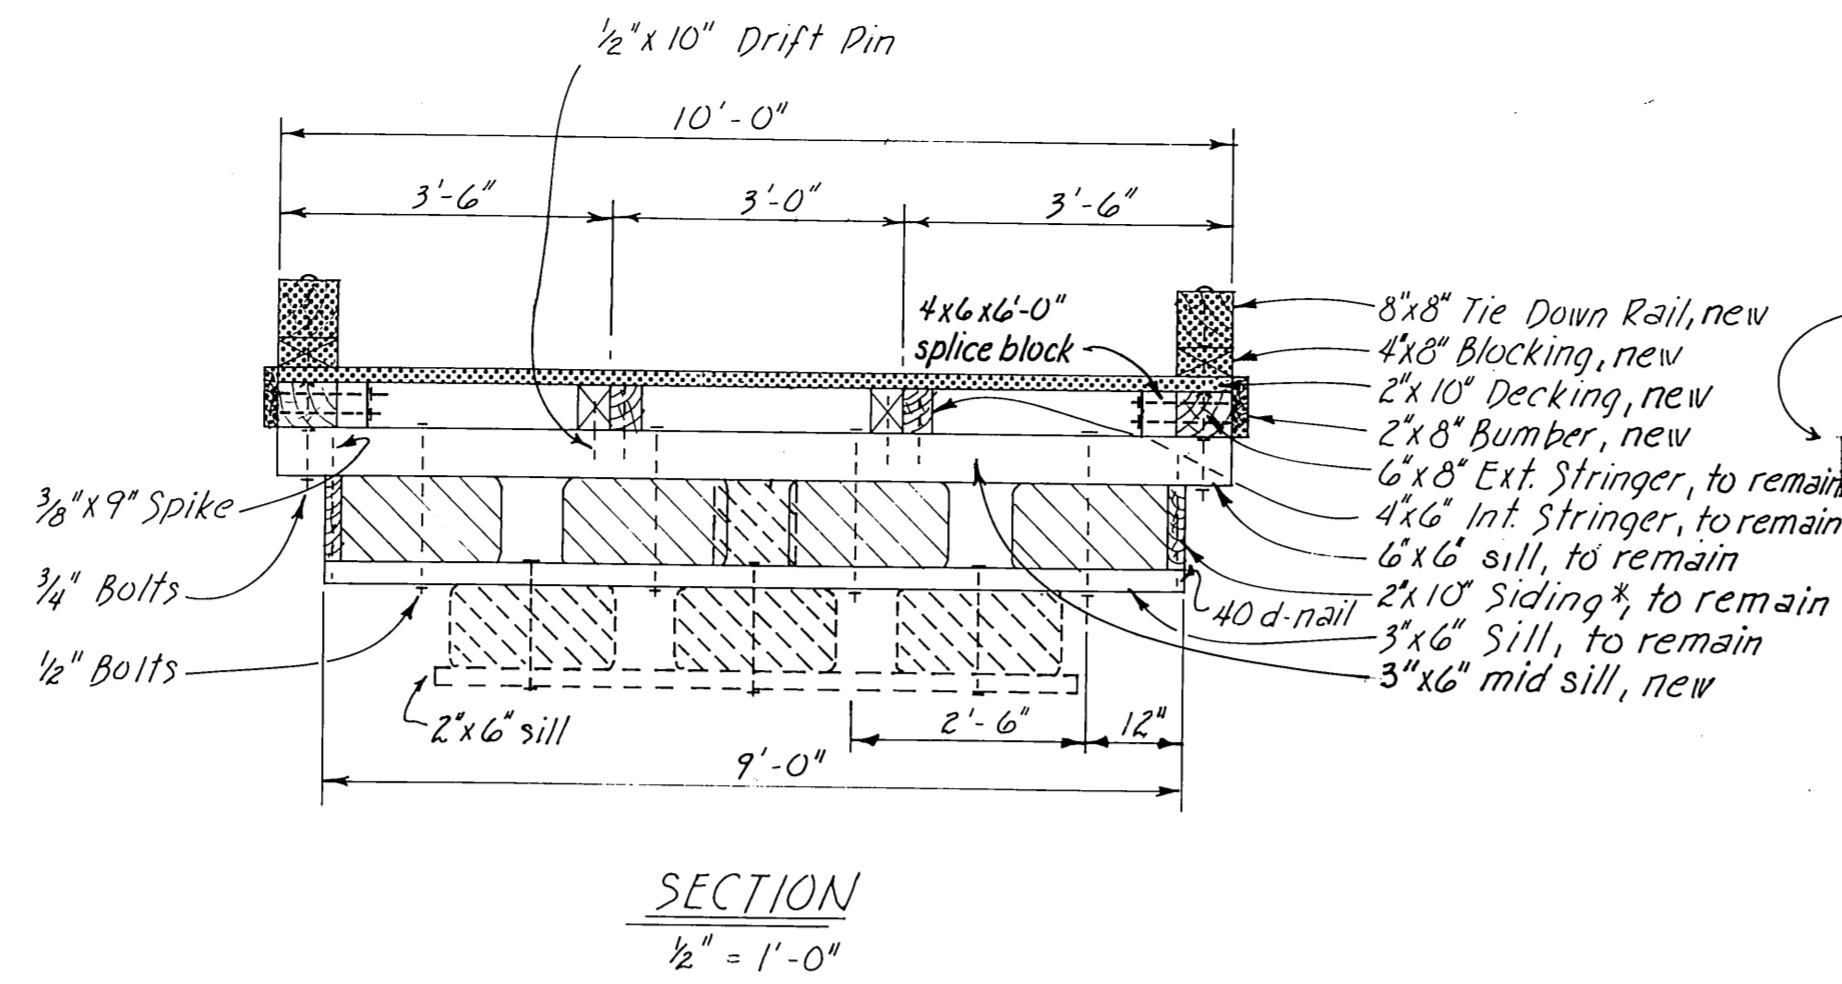


SECTION A-A  
EXISTING PILE COLLAR SECTION DETAIL  
1/2" = 1'-0"



Note:  
4- new 10" x 20" x 9'-0"  
Polystyrene planks  
on S.W. end of 95'-0"  
float. Install 2x10 siding  
@ each end, 95'-0" float

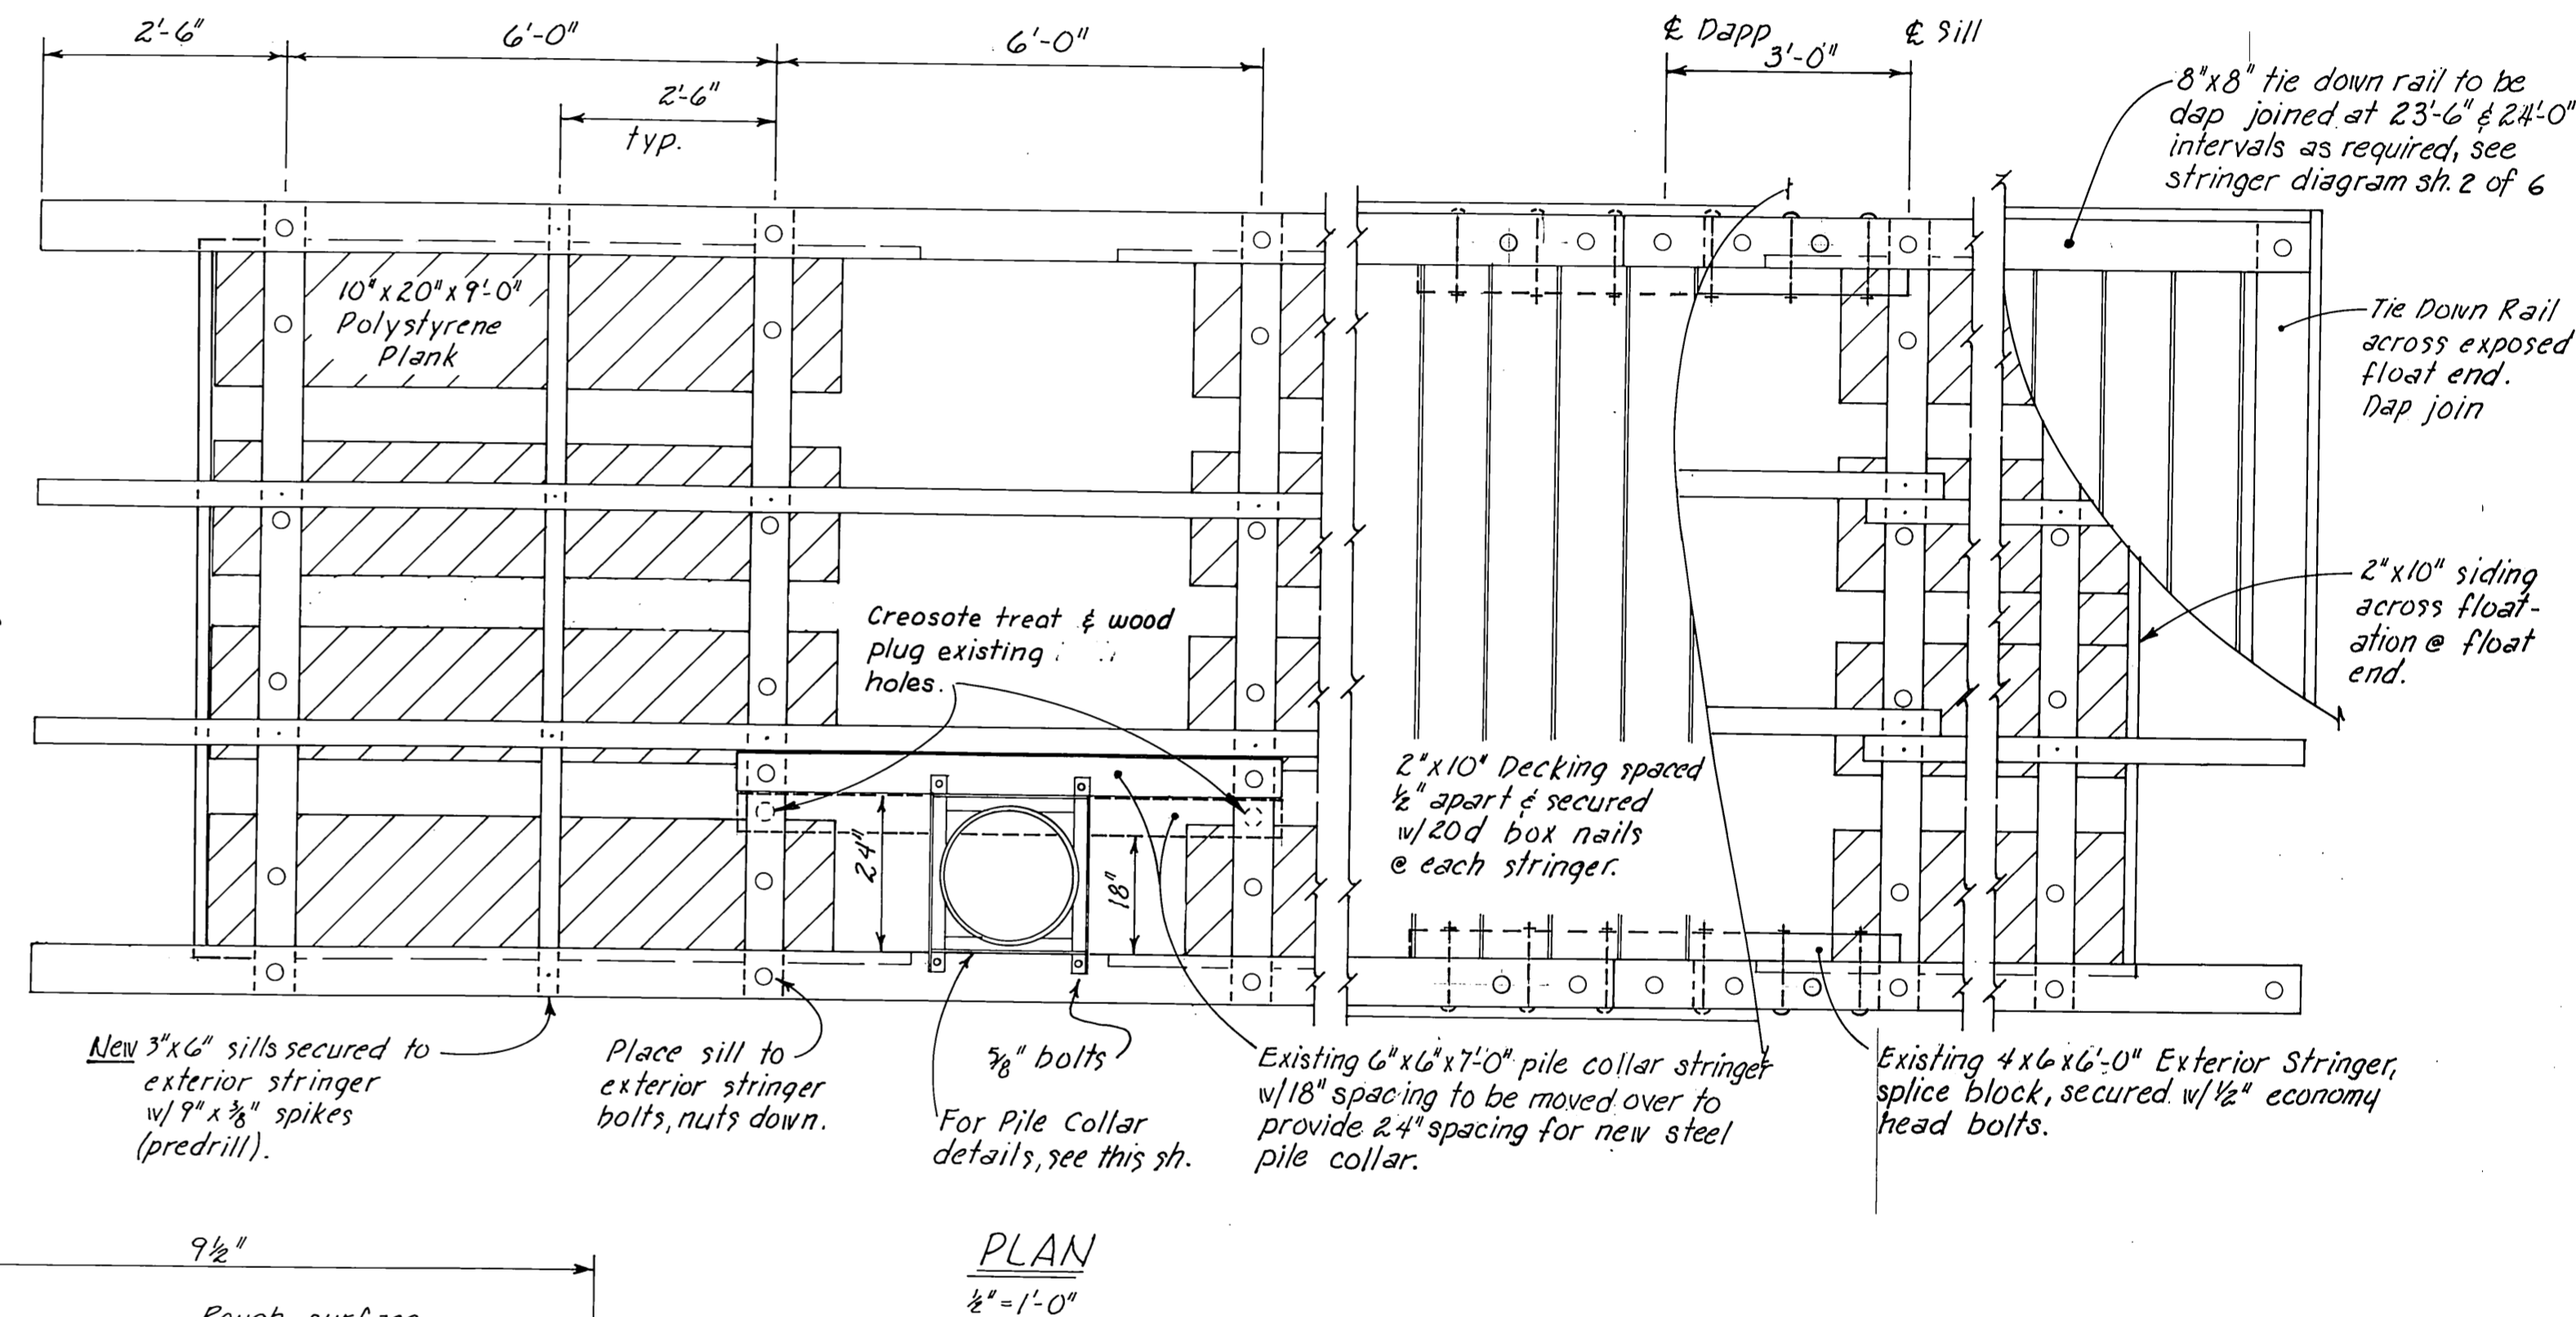

NOTES:  
All hardware to be hot-dipped galvanized. A malleable iron washer shall be placed between all nut and wood surfaces. All bolts to be of the economy head type. Bolt holes to be drilled 1/16" oversize except sill bolt holes for floatation planks, 1/8" oversize. Drift holes to be drilled, 1/16" undersize. All field drilled holes shall be treated with hot creosote oil. All pressure treated material shall be cut to size prior to treatment. Tie Down rails shall extend across all float ends except under gangway's. All bolt heads facing decking shall be countersunk 1/4" previous to treatment. Field drill all drift bolt holes. A barrier of 6 mil black polyethylene shall be placed between the contact surfaces of all creosote timber and floatation material (except float siding members). Nail holes in existing stringers to be given a flood coat of hot creosote oil prior to installation of new decking.

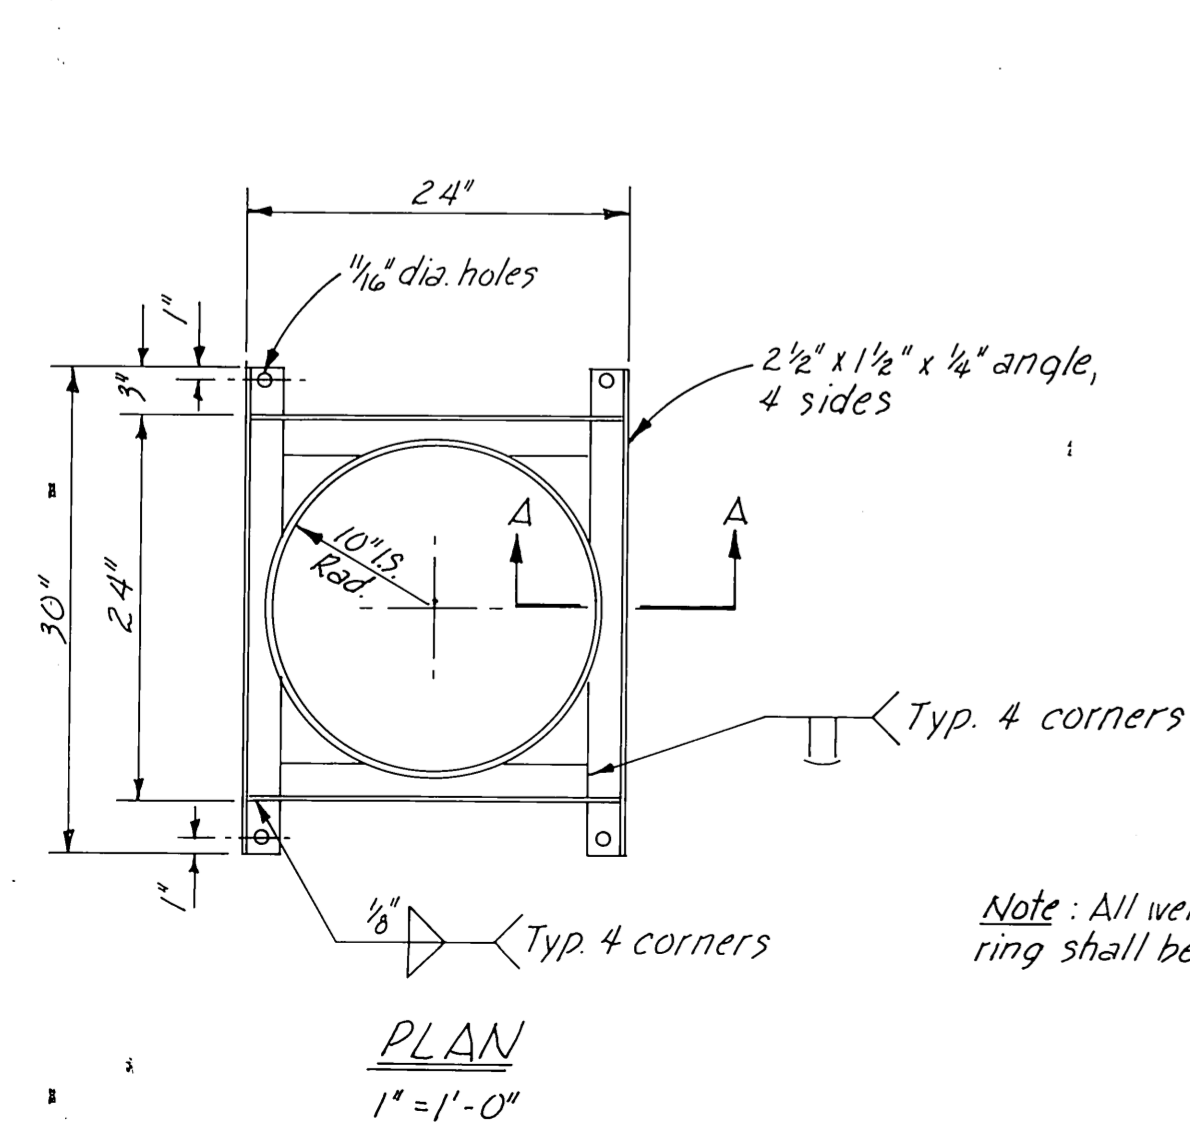

NEW INTERNAL PILE COLLAR DETAIL

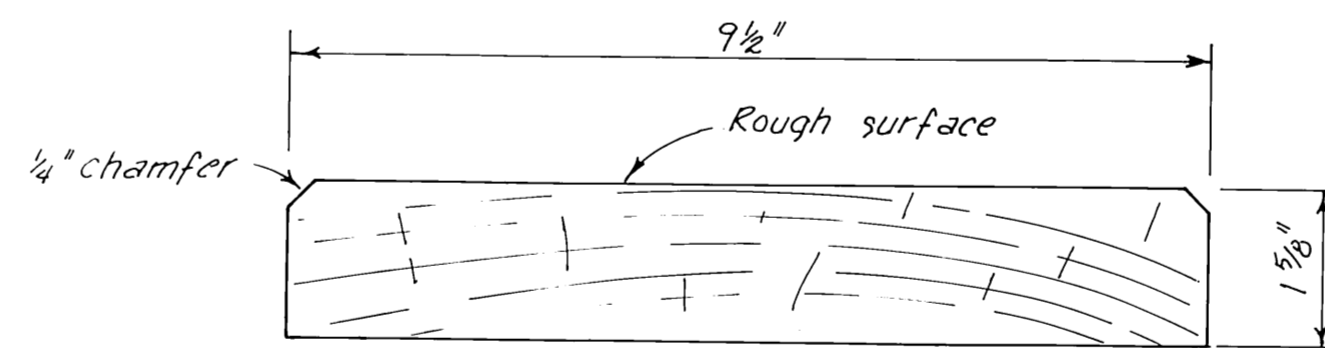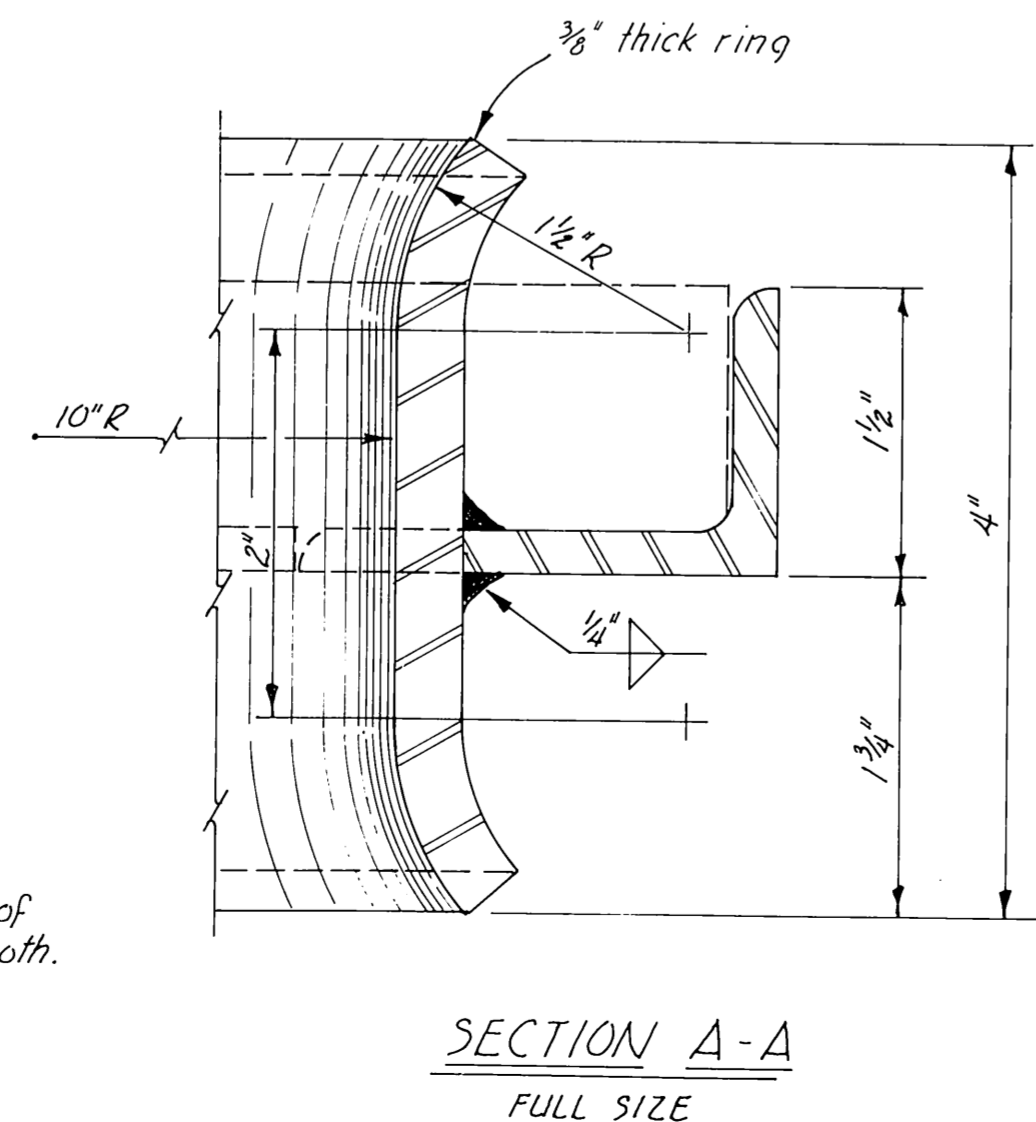


MILLED DECKING DETAIL  
1/2 SIZE

PREDRILLED BOLT HOLES


Collar Members - all holes  
Sills - Holes for floatation plank bolts  
Stringers - holes for stringer to sill bolts  
Tie Down Rail - all holes

FIELD DRILLED BOLT HOLES

Pile Collar Int. Stringers - all holes  
Rail Blocking - all holes  
Exterior Stringer - 1. holes for tie down rail bolts  
2. holes for pile collar plate bolts

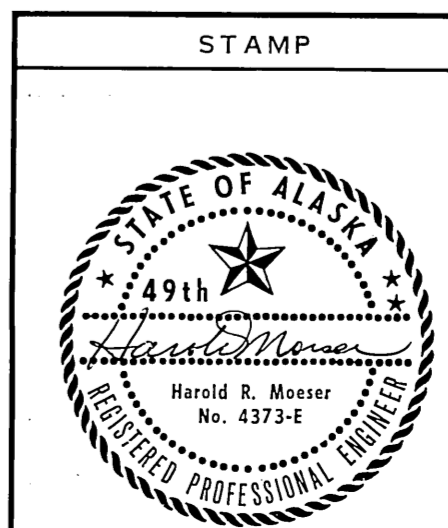

DO NOT SCALE THIS DRAWING - USE DIMENSIONS	
STATE OF ALASKA DEPARTMENT OF TRANSPORTATION AND PUBLIC FACILITIES DIVISION OF HARBOR DESIGN AND CONSTRUCTION	
TYPICAL 10'-0" FLOAT (SHOWING EXISTING & NEW WORK)	
SCALE As Noted	SURVEYED
DESIGNED	DRAWN G.R.F.
CHECKED	DATE Jan. 1979
PROJECT NUMBER K30154	APPROVED ROBERT P. BECK CHIEF OF DESIGN
	SHEET 3 OF 6

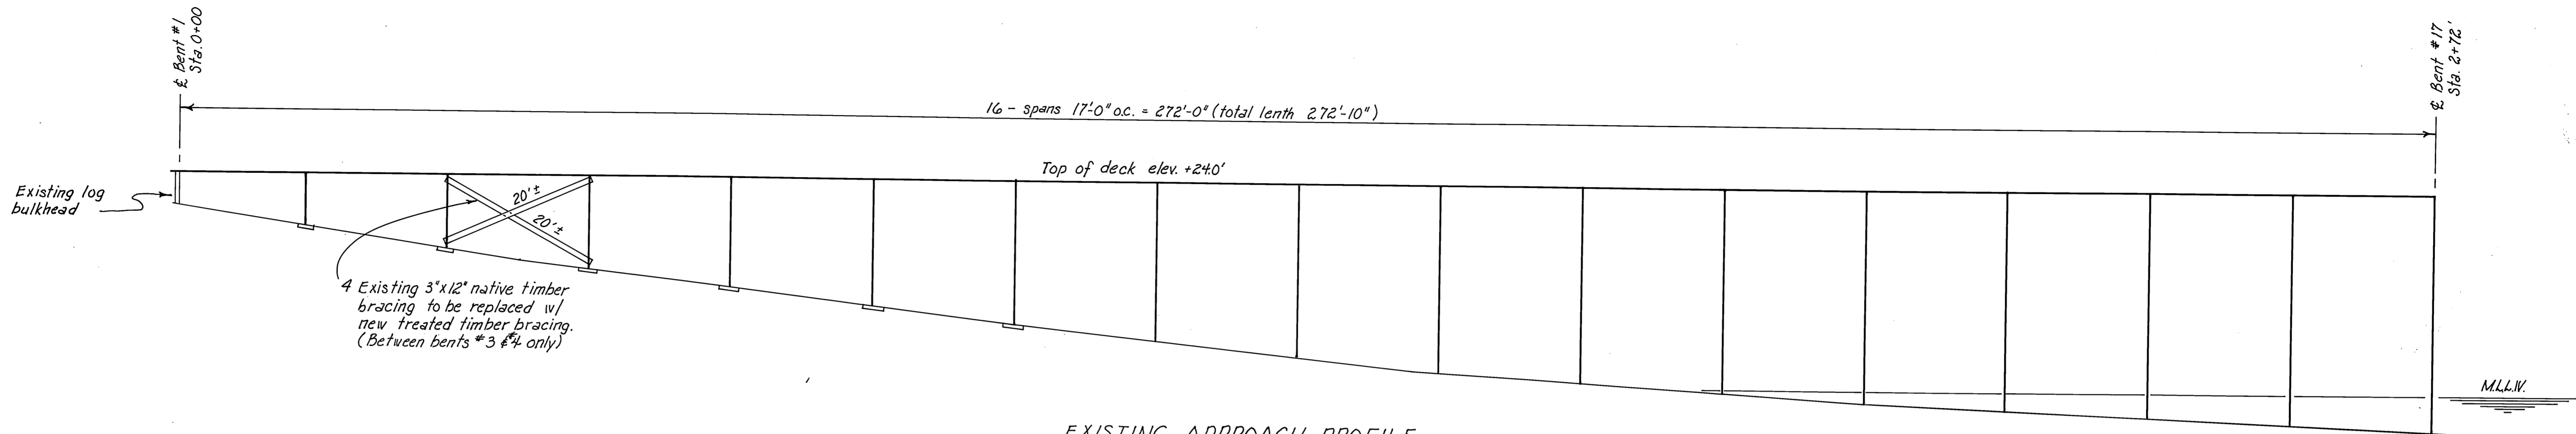


EXISTING APPROACH PROFILE  
1" = 10'-0"


**Notes**

1. All hardware to be hot dip galvanized. A malleable iron washer shall be placed between all nut and wood surfaces.
2. All bolts to be of the economy head type. Bolt holes to be 1/16" oversize.
3. Drift holes to be 1/16" undersize.
4. All pressure treated materials to be cut to size prior to treatment.
5. All field cuts or field drilled holes shall be treated with hot creosote oil or pentachlorophenol, as applicable.
6. All nail holes in creosote material shall be given a flood coat of hot creosote oil prior to installation of new decking.


MATERIALS		
ITEM	DRESSING	TREATMENT
Decking	Milled	Penta.
Handrail	S-4-S	"
Handrail Post	"	"
Girts	"	"
Bracing	"	Creosote
		See Specs

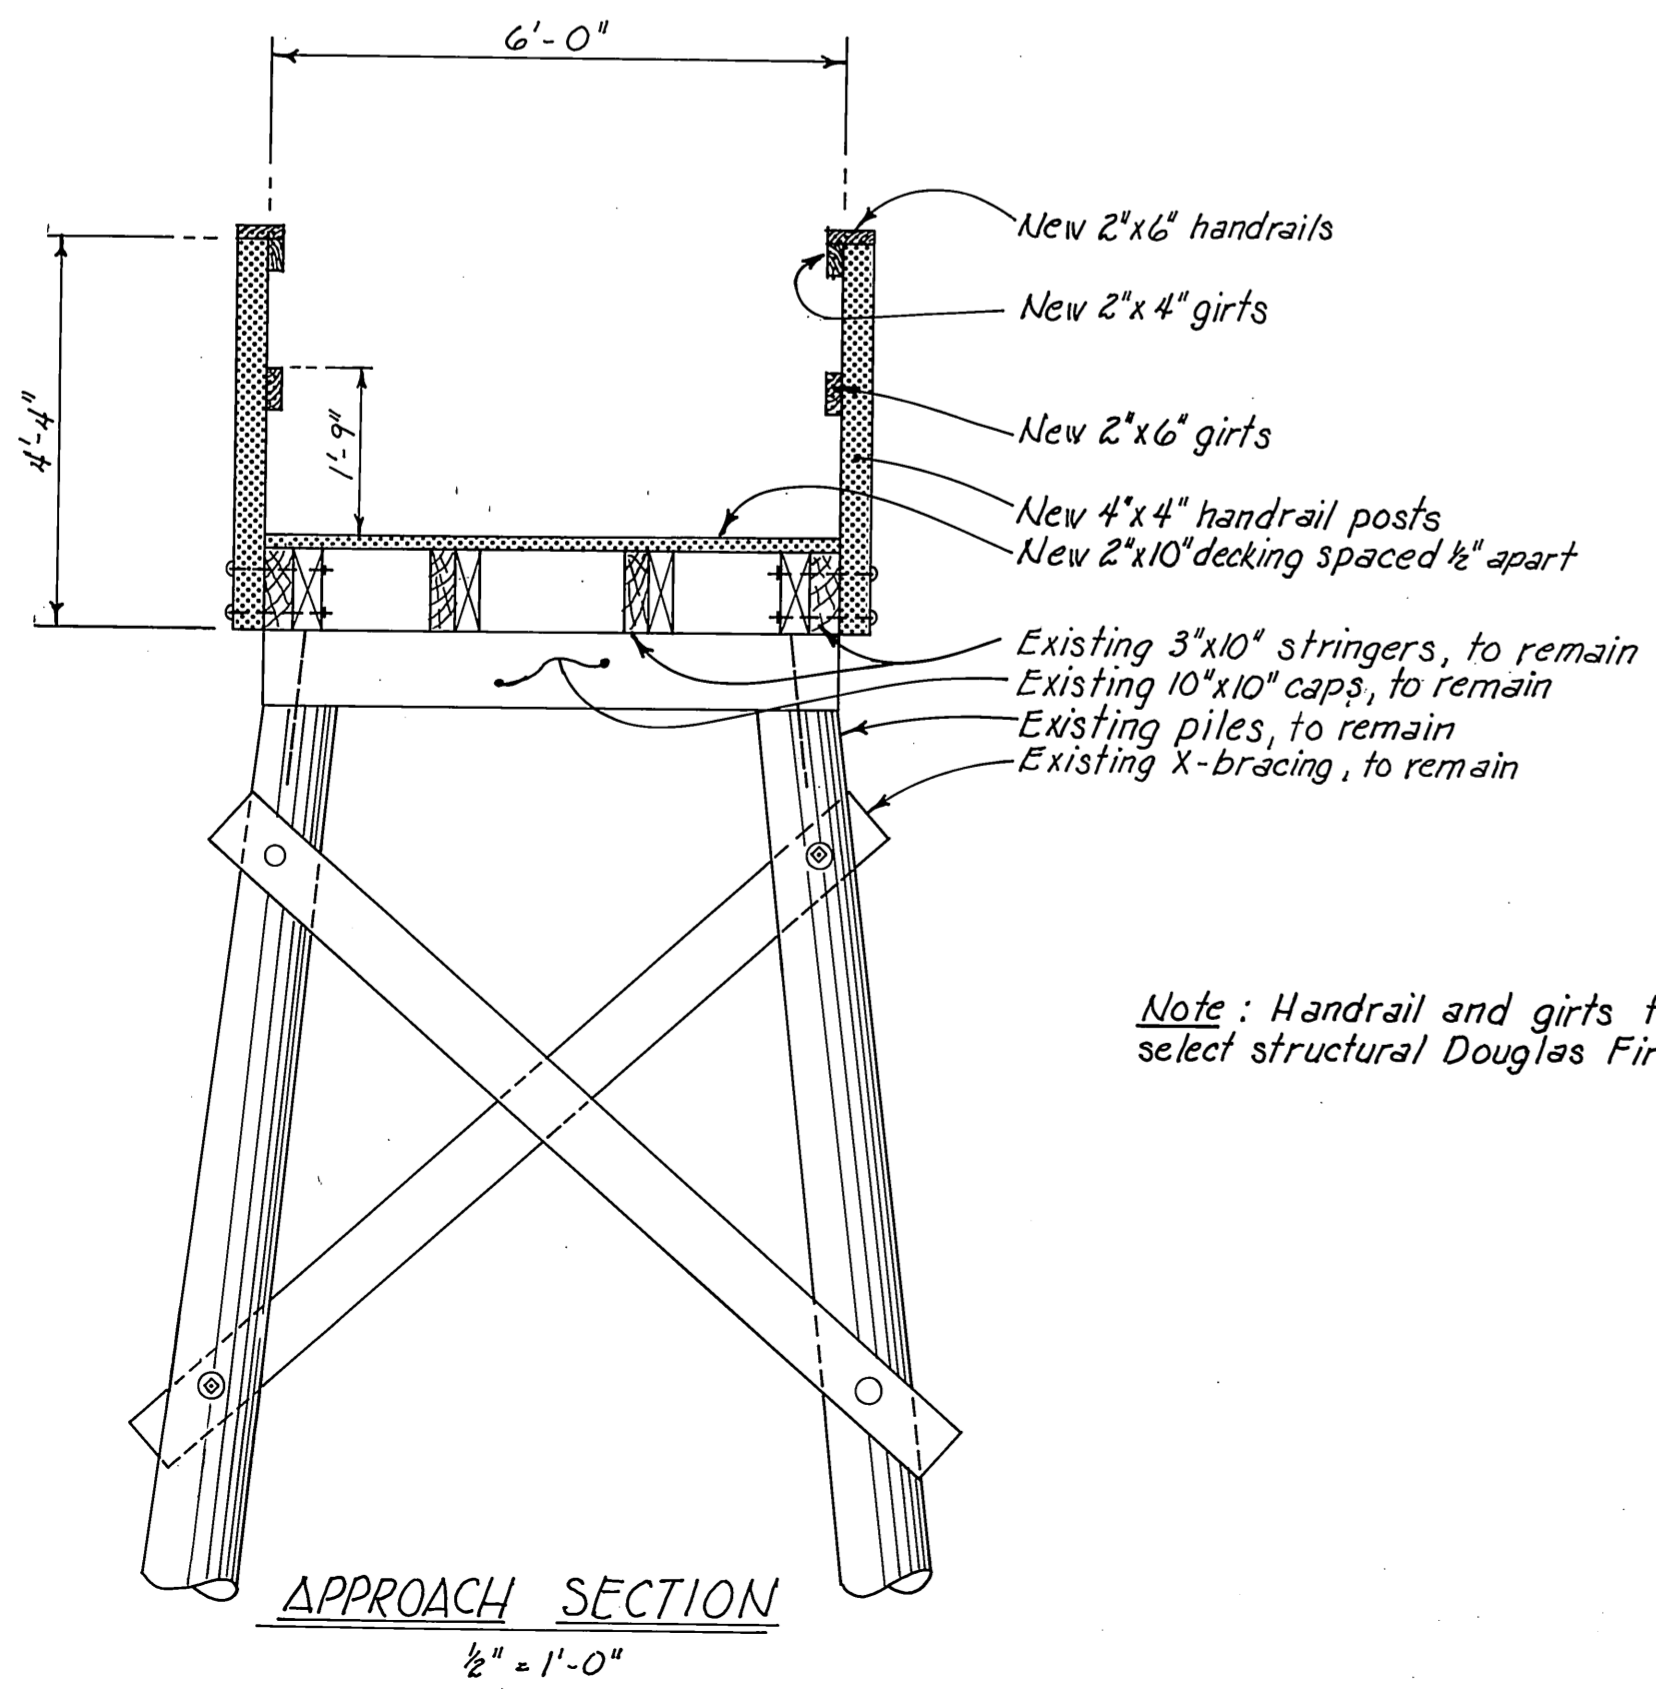


Note: Handrail and girts to be select structural Douglas Fir.

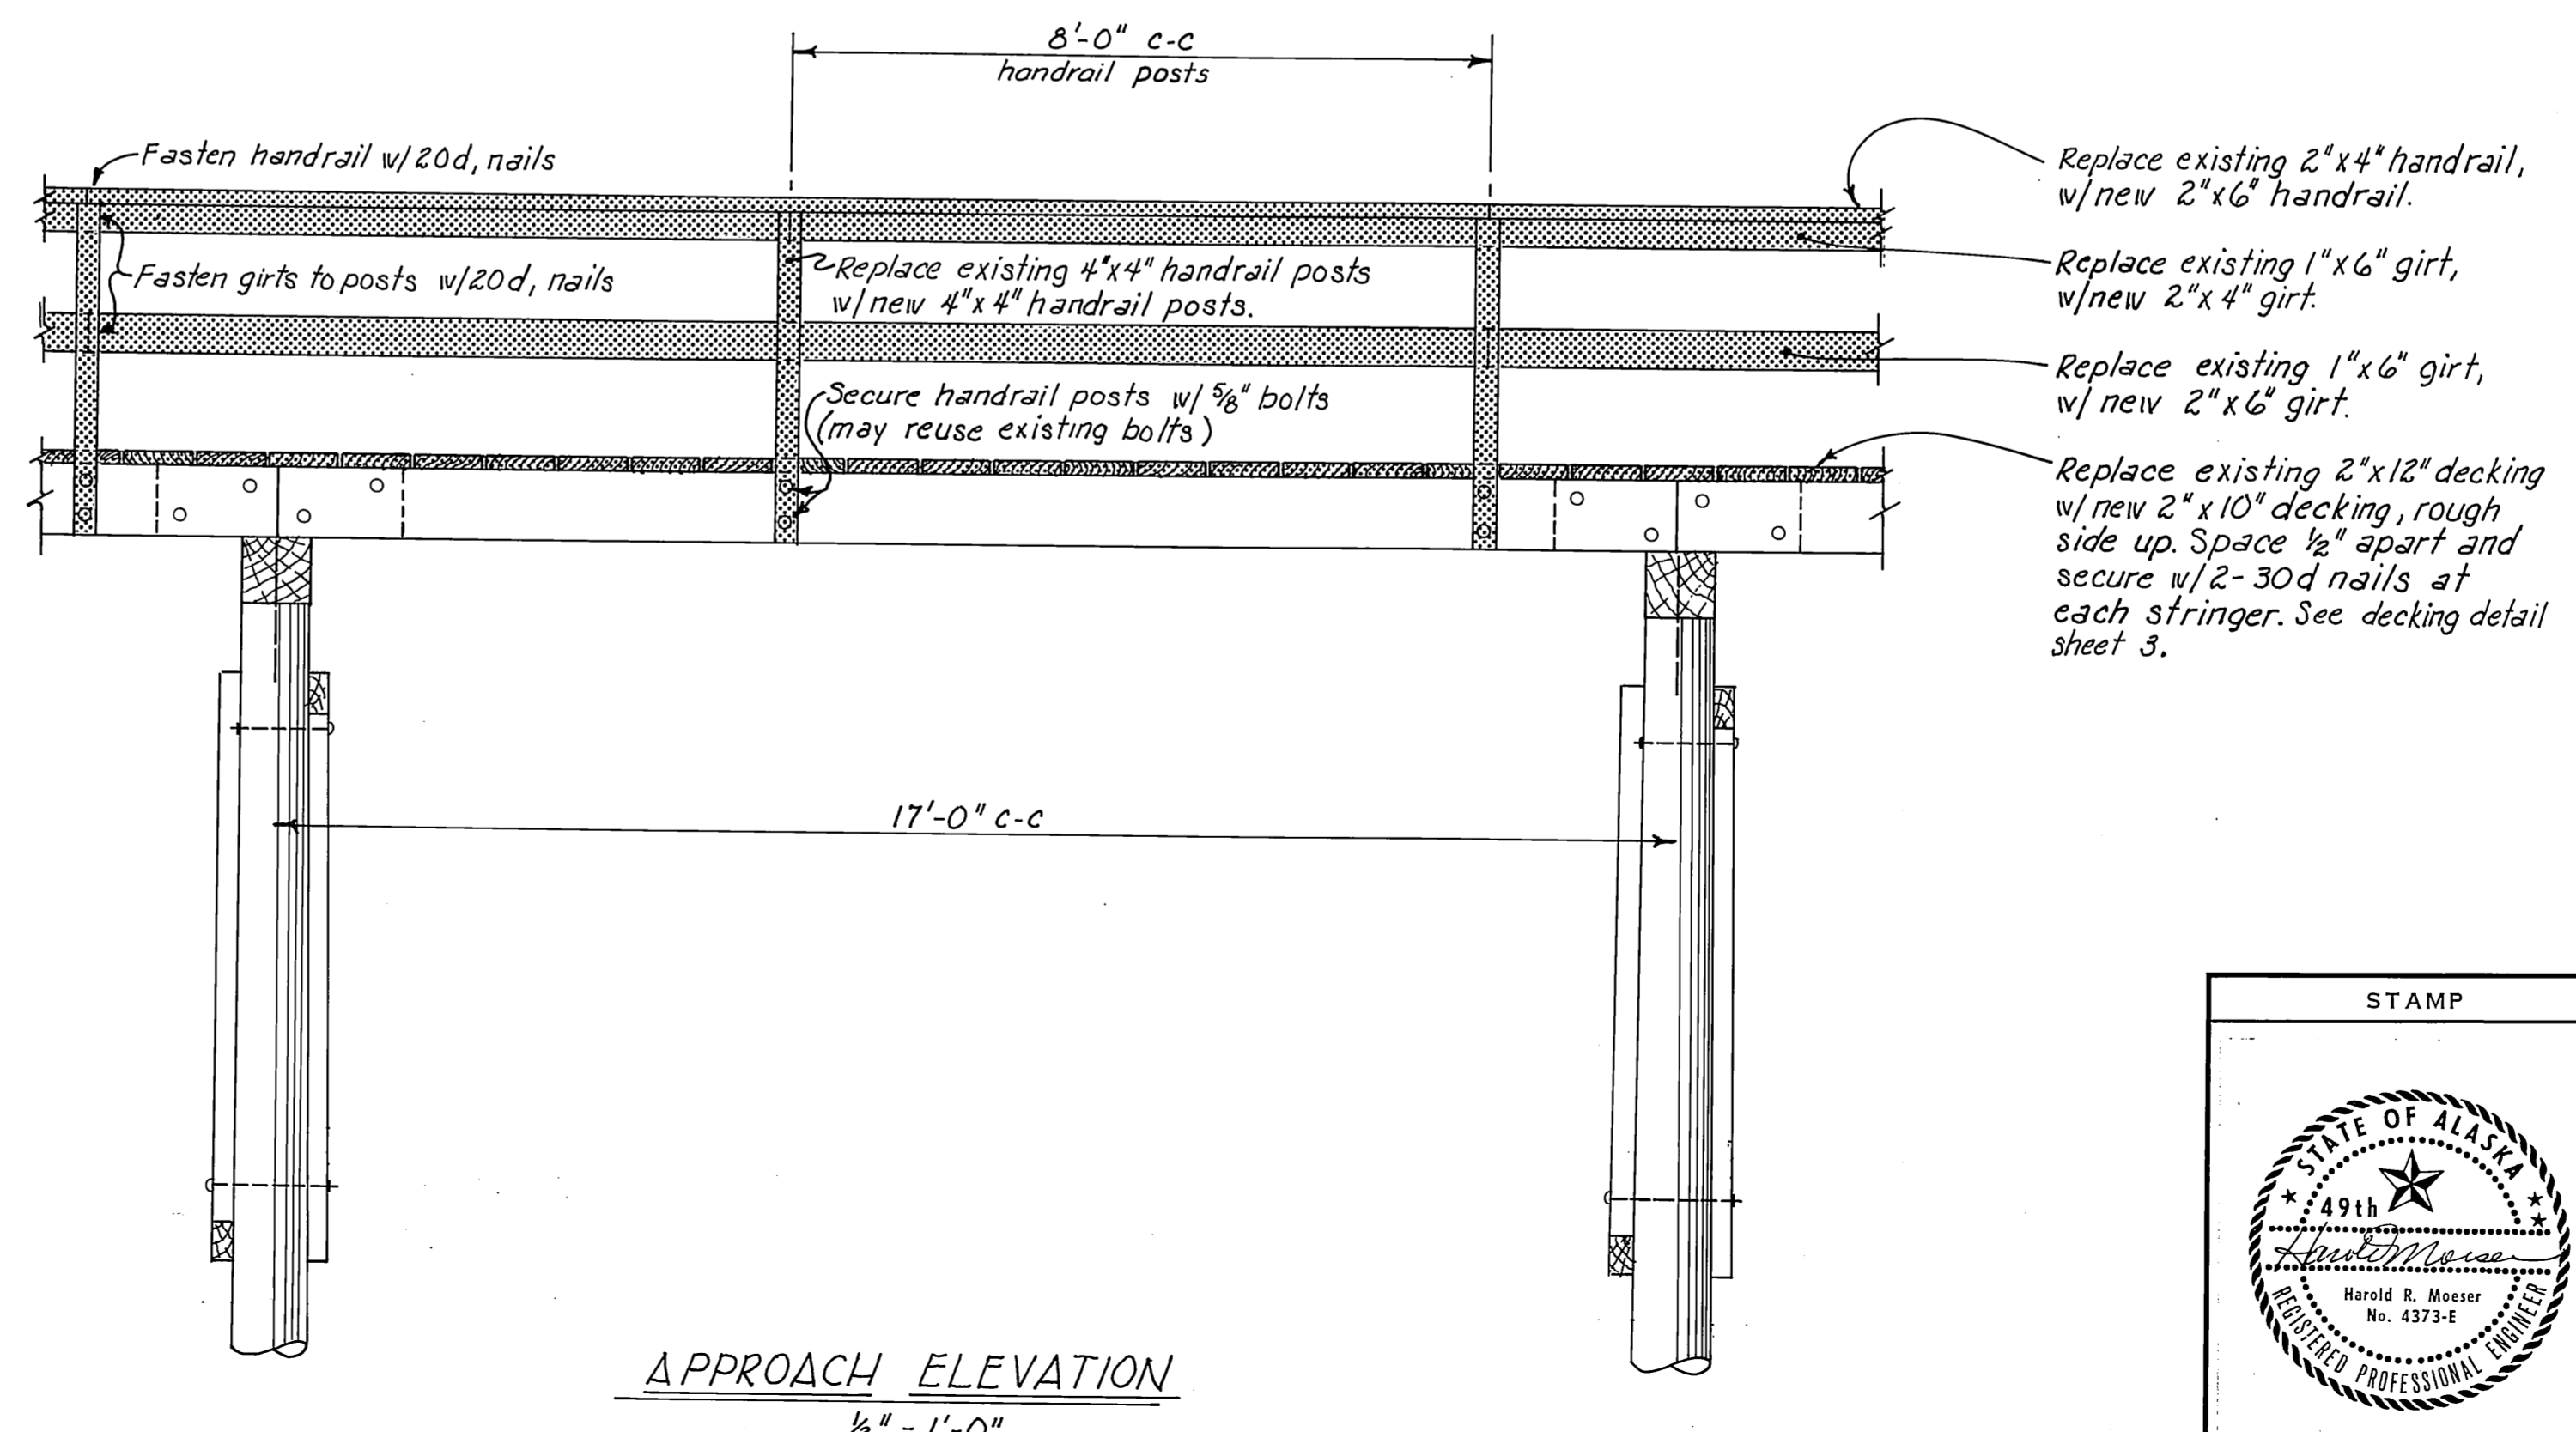


<p>STAMP</p>	DO NOT SCALE THIS DRAWING - USE DIMENSIONS	
	STATE OF ALASKA DEPARTMENT OF TRANSPORTATION AND PUBLIC FACILITIES DIVISION OF HARBOR DESIGN AND CONSTRUCTION	
WEST PETERSBURG		ALASKA
6'-0" APPROACH DETAILS		
SCALE <i>As noted</i>	SURVEYED	APPROVED
DESIGNED	DRAWN <i>GRF</i>	<i>ROBERT P. BECK</i>
CHECKED	DATE <i>Dec. 1979</i>	CHIEF OF DESIGN
PROJECT NUMBER <i>K30154</i>	SHEET <i>4</i> OF <i>6</i>	

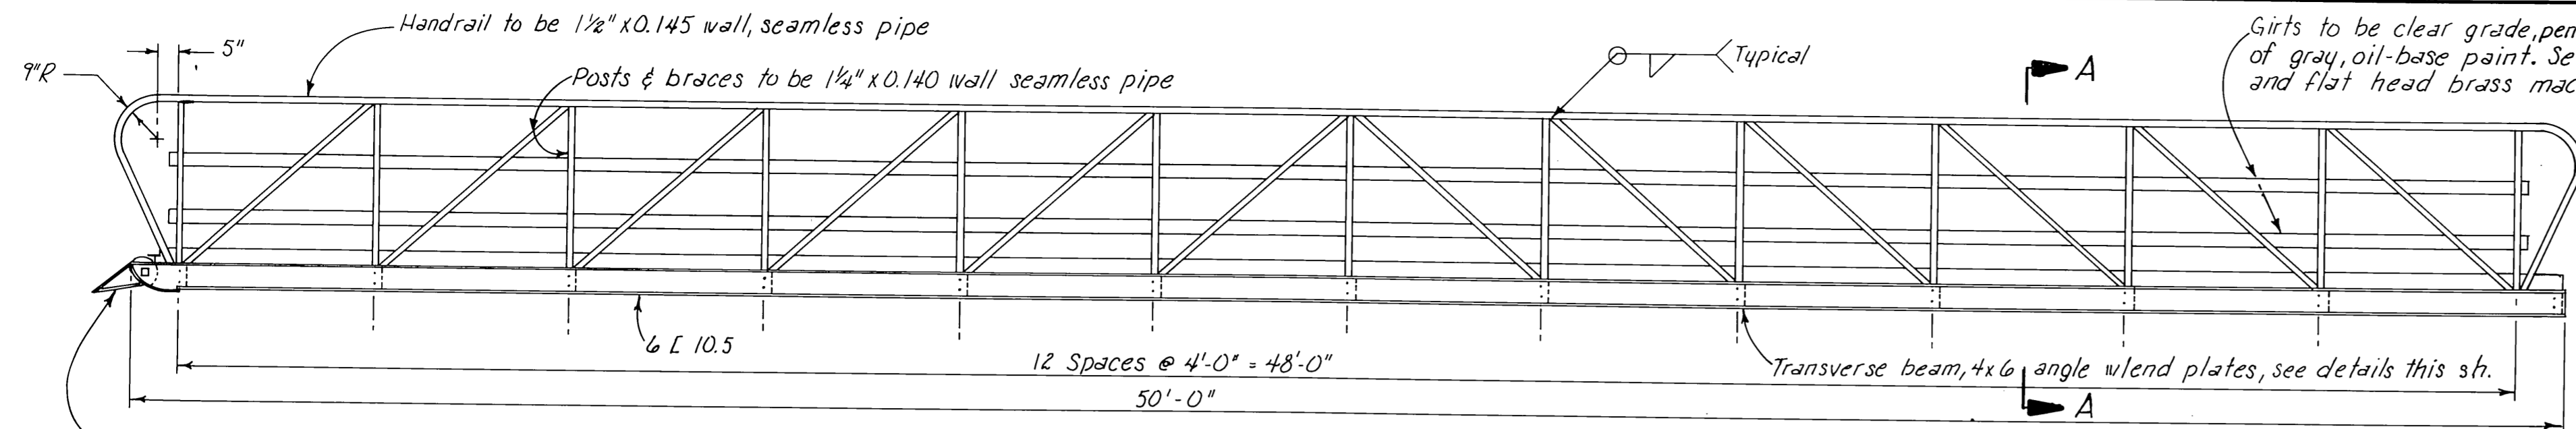


ELEVATION  
3/8" = 1'-0"

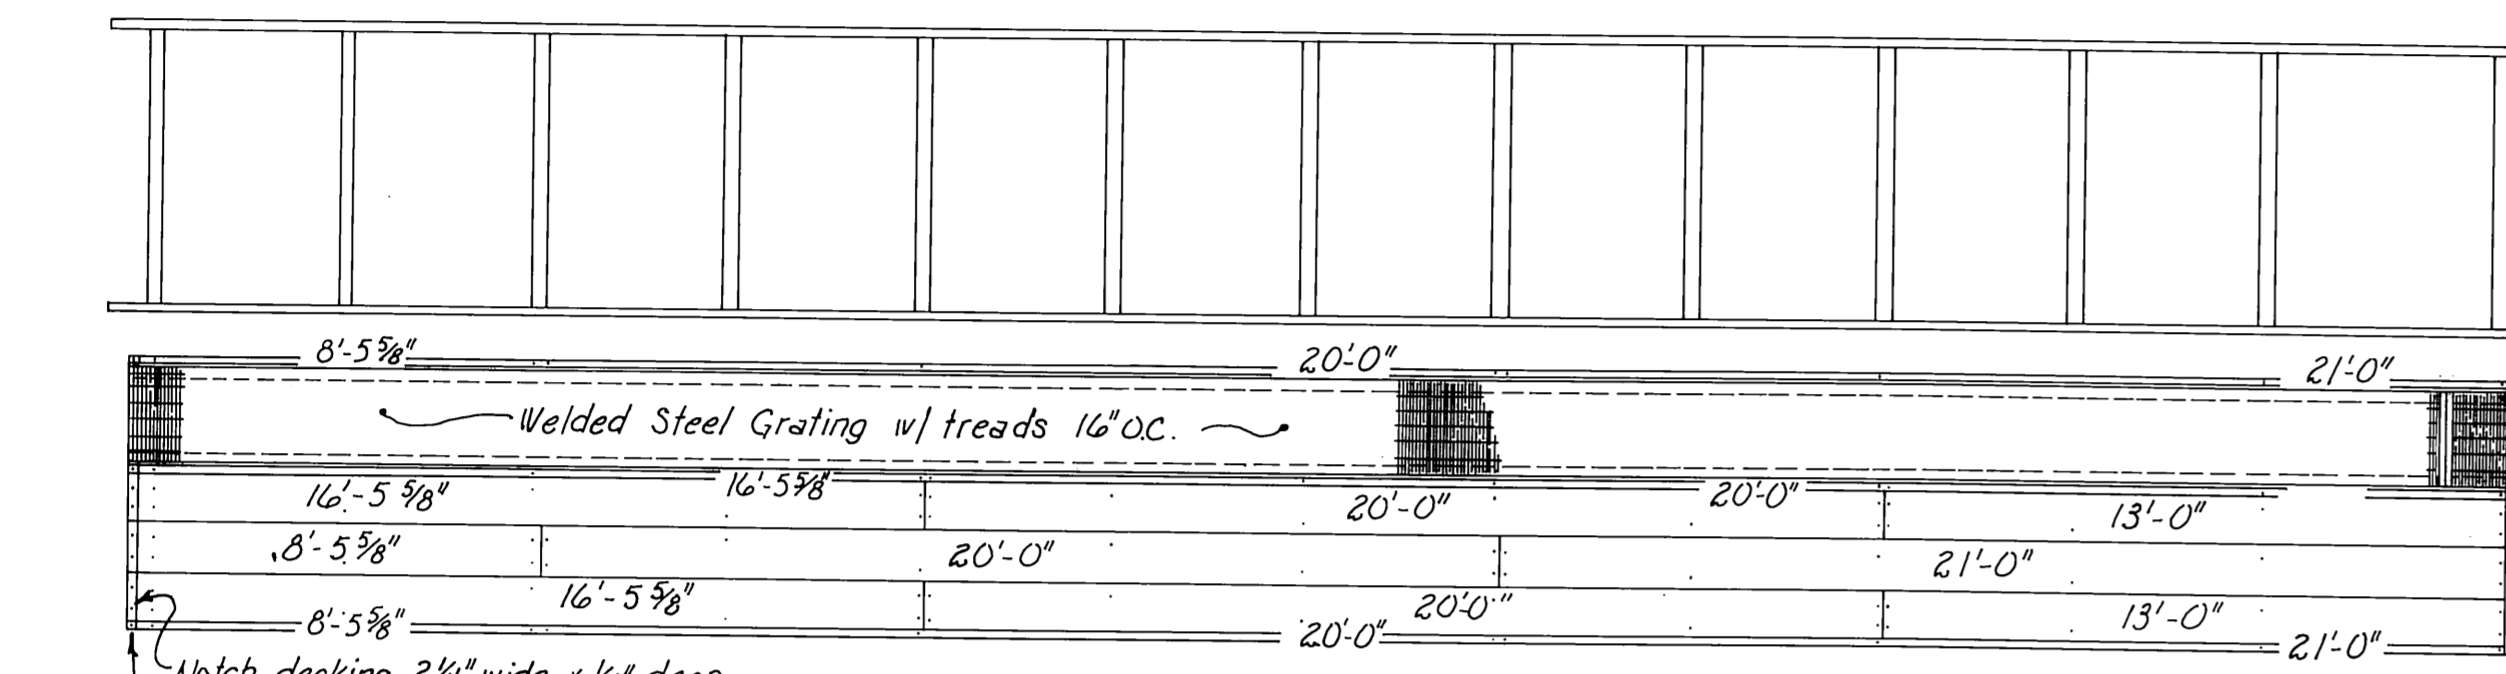


STRINGER & DECKING LAYOUT  
1/4" = 1'-0"

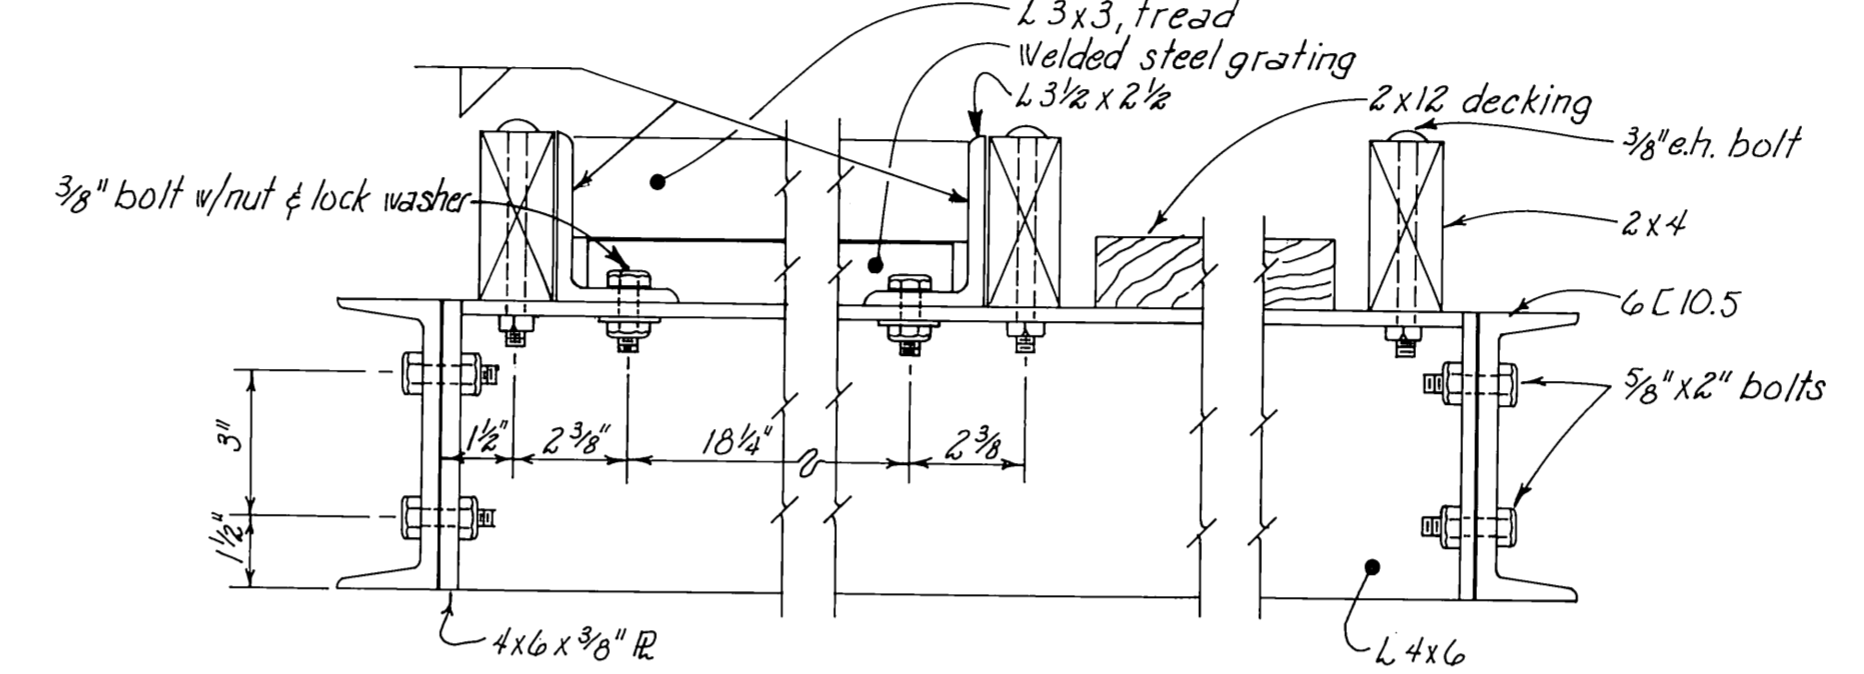


SECTION DETAIL ~ L 3/2 x 2 1/2 Bolted to, L 4x6  
3" = 1'-0"

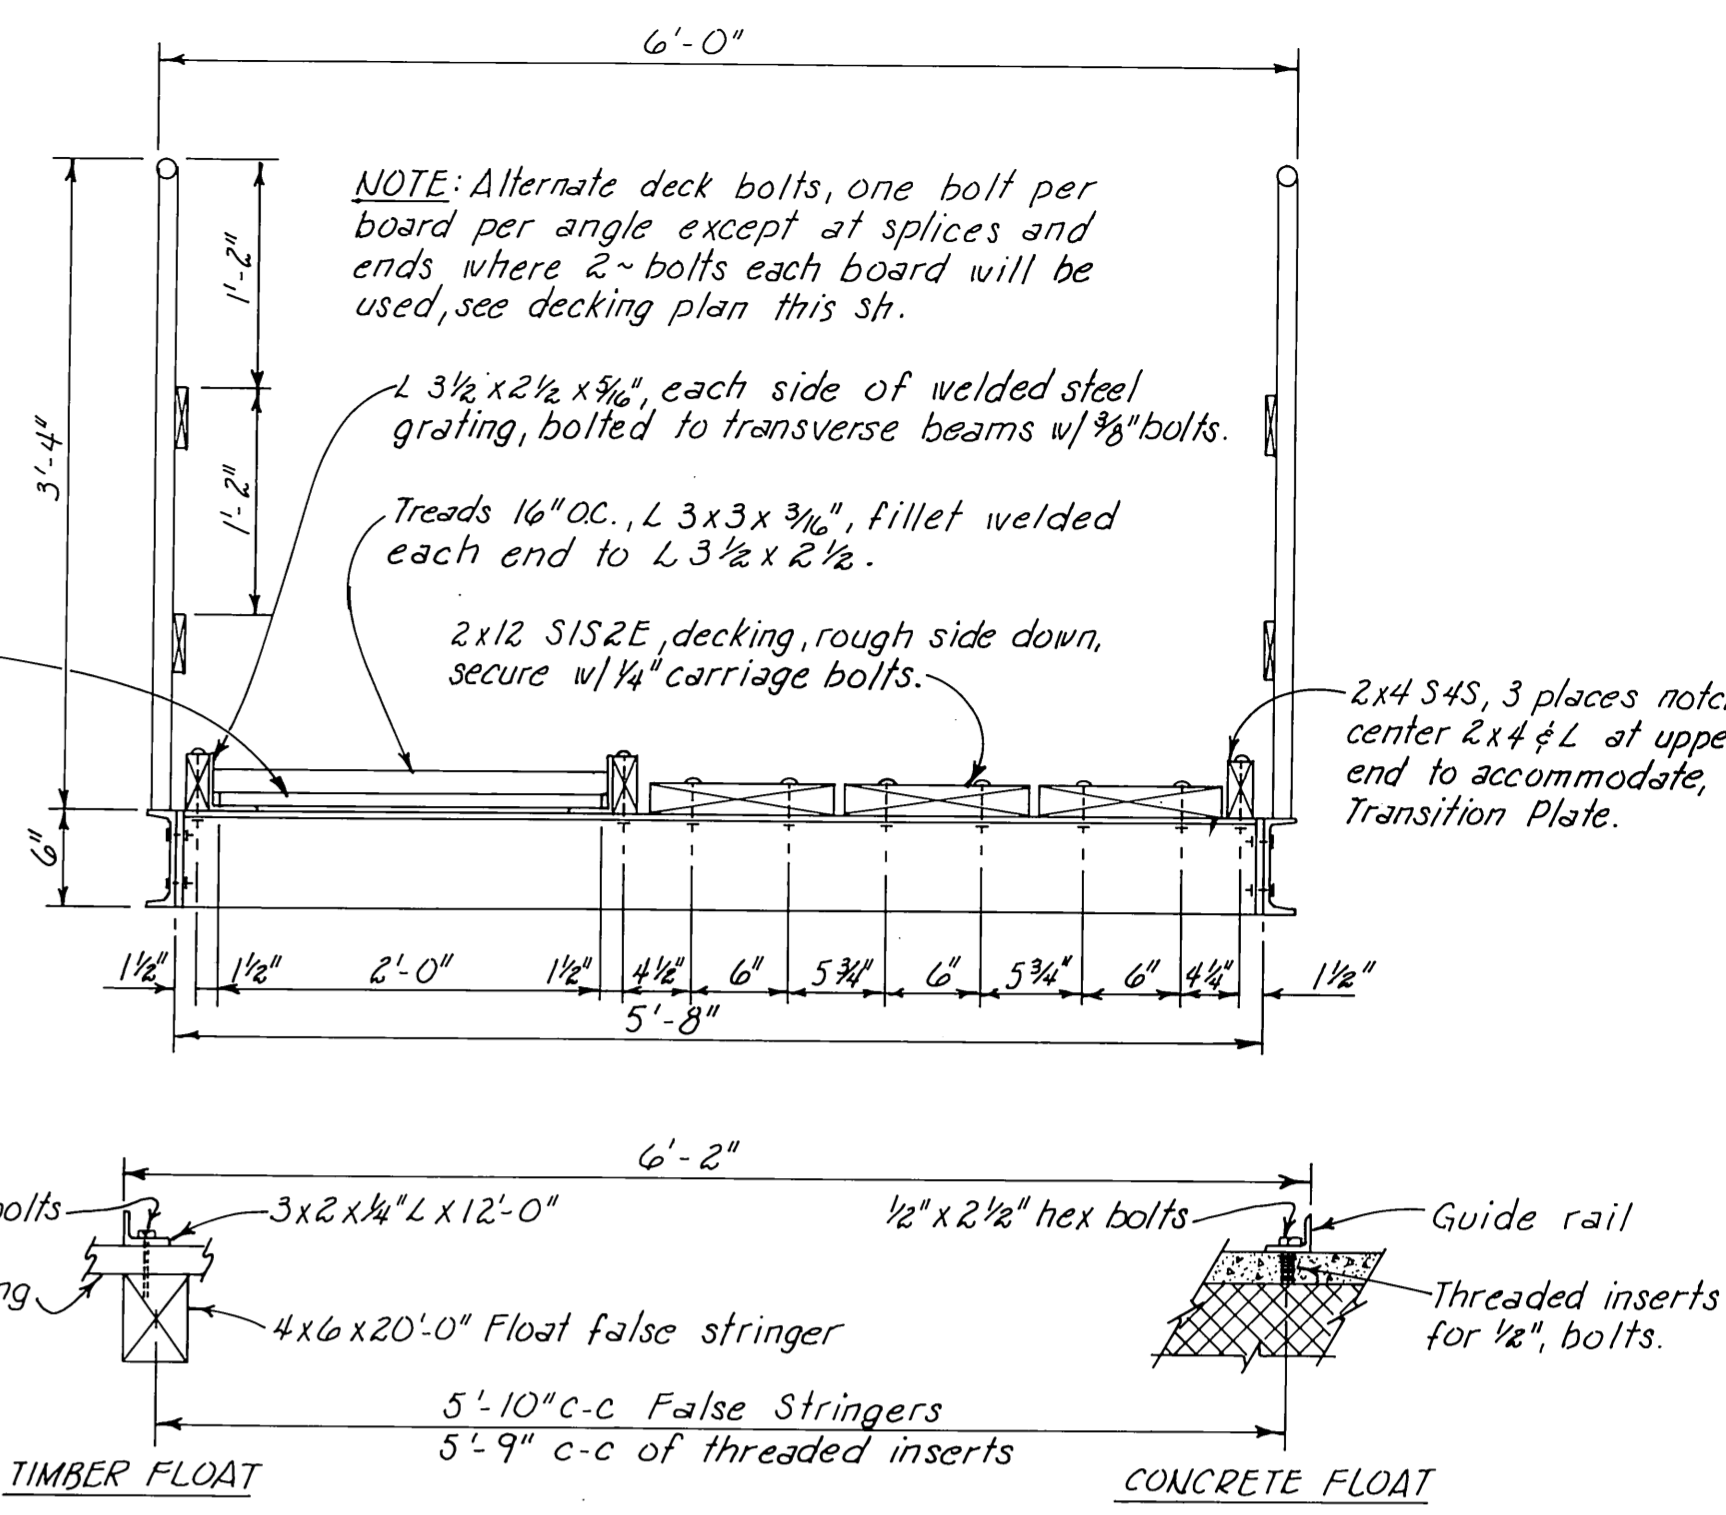


SECTION A-A  
1" = 1'-0"

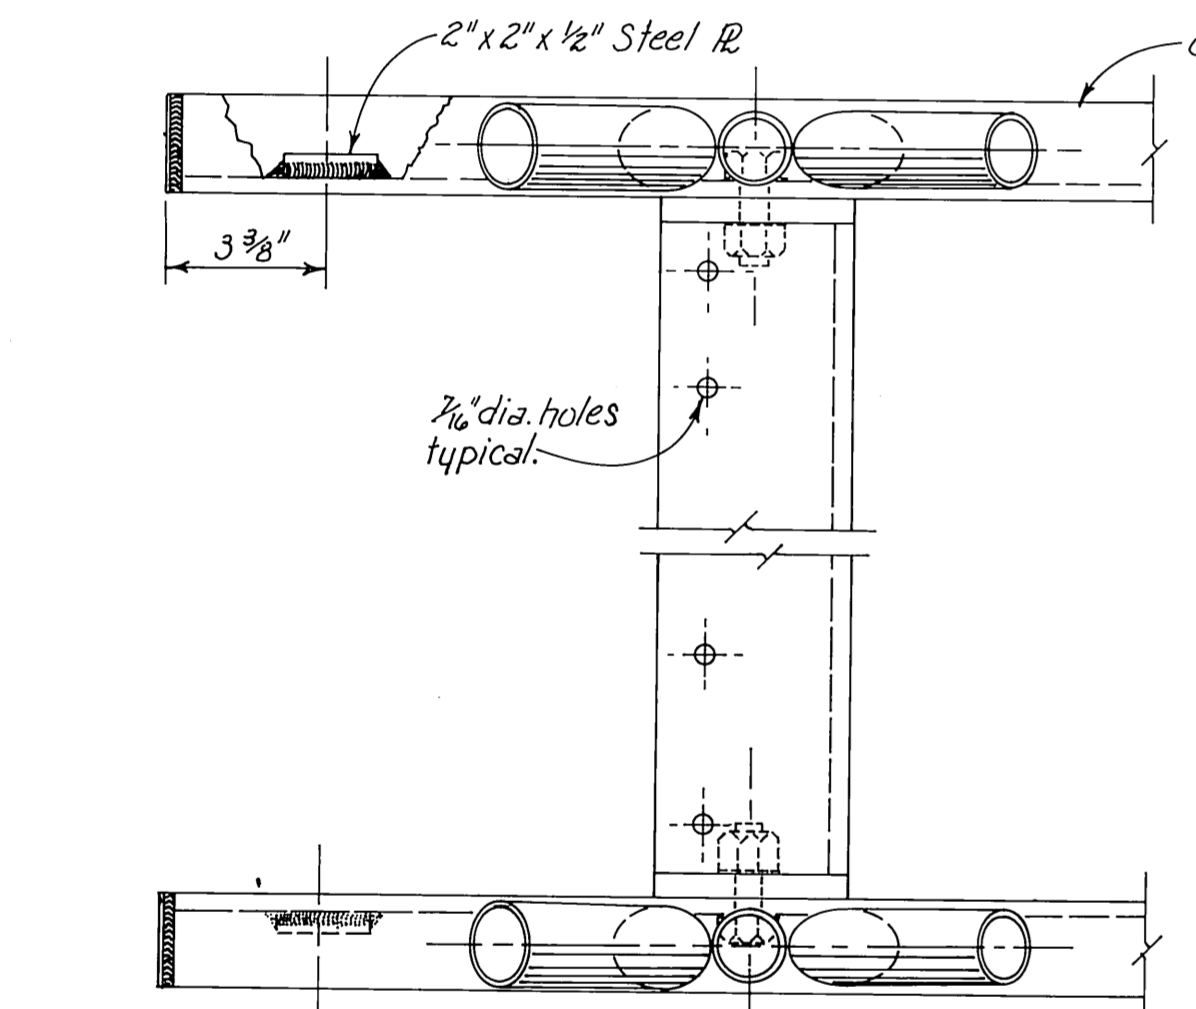


GANGWAY DETAILS  
3" = 1'-0"

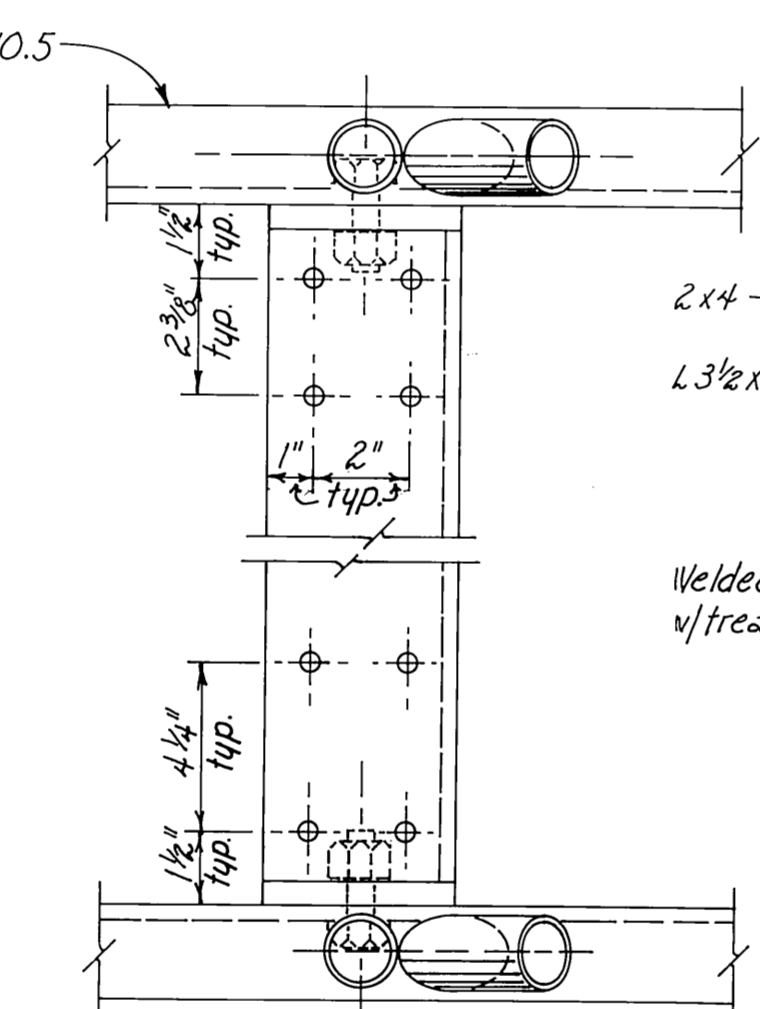

TYPICAL @ DECKING SPLICE  
3" = 1'-0"

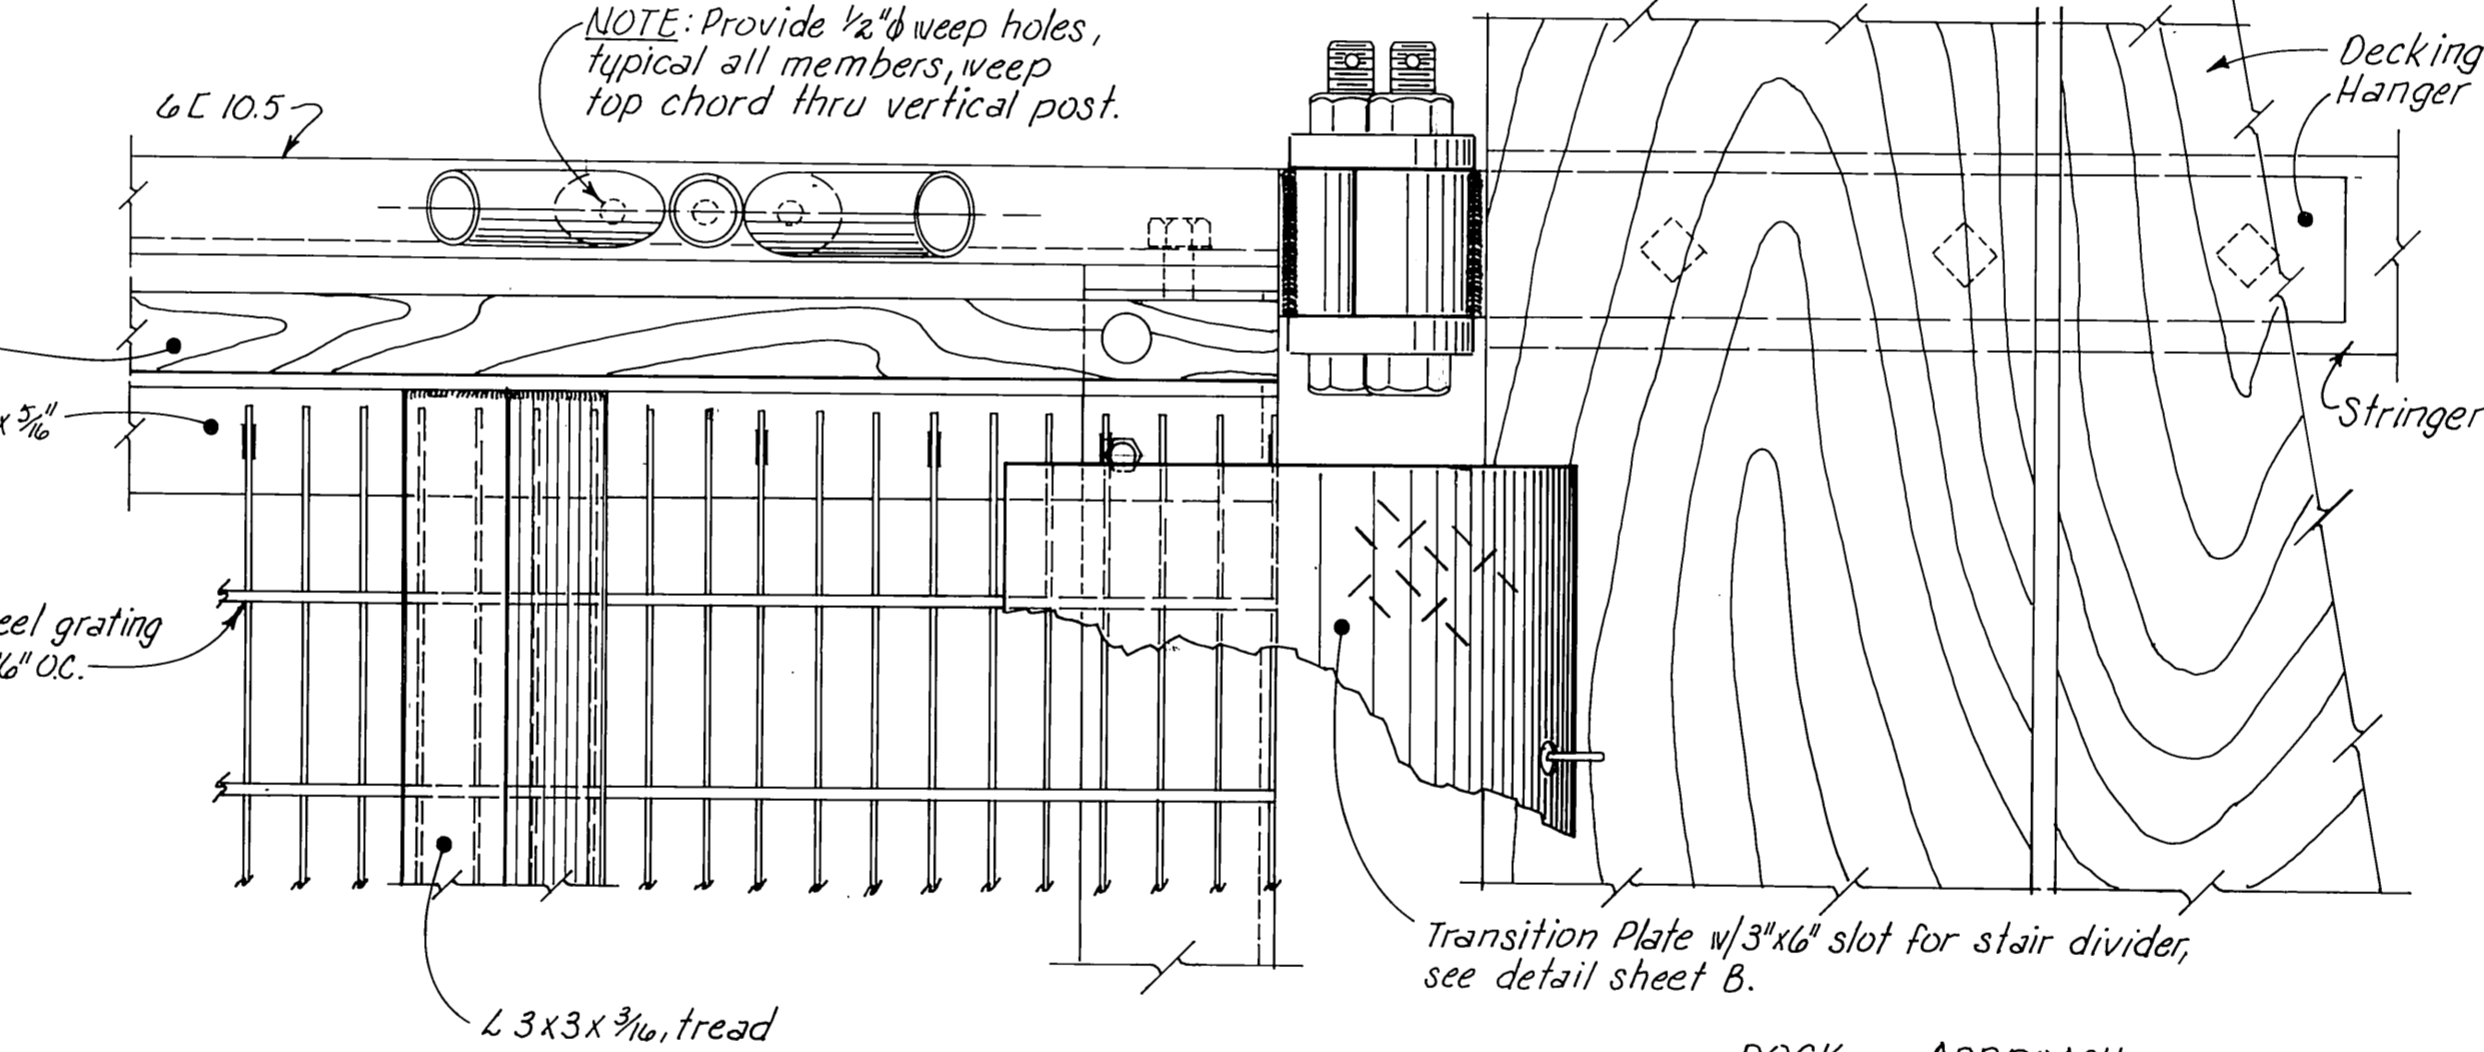


GANGWAY HEAD DETAILS  
3" = 1'-0"

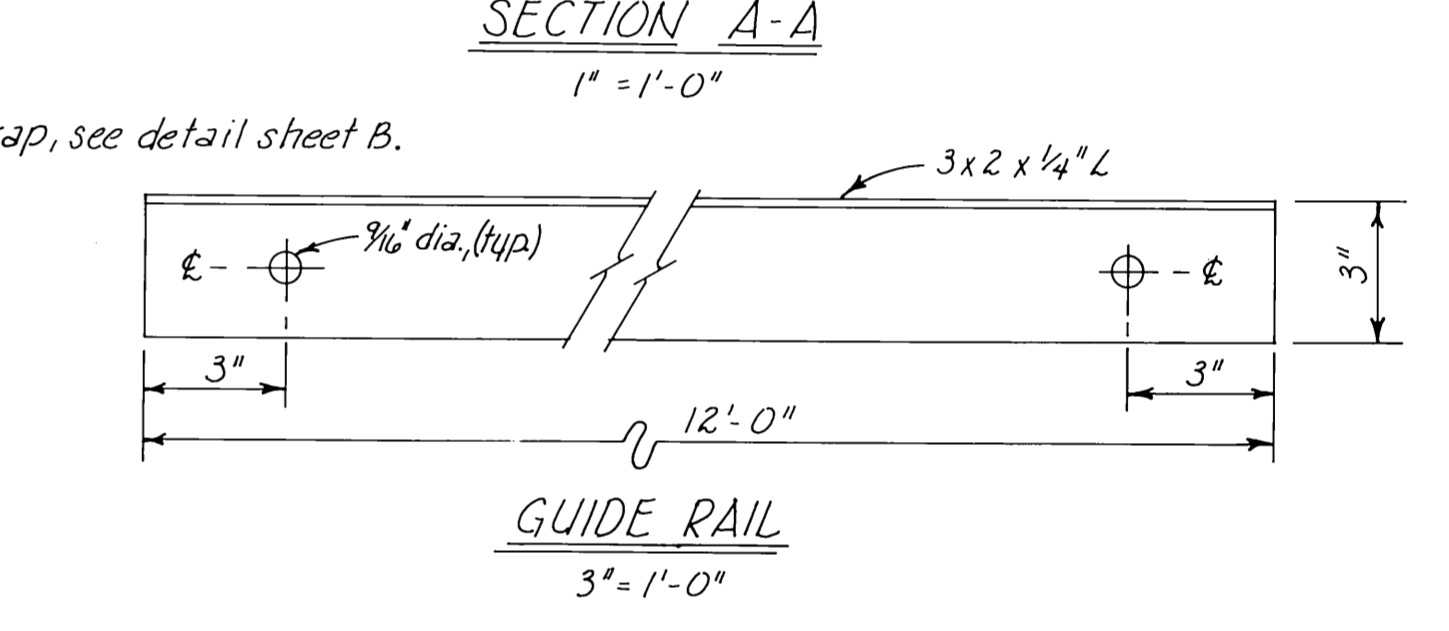


GUIDE RAIL  
3" = 1'-0"


- NOTES
1. Design load, 35 psf on gangway or 85 psf on treaded walkway only.
  2. All seamless pipe shall conform to ASTM A-53, Grade B or ASTM A-500.
  3. All shapes & plates shall conform to ASTM A-36.
  4. Trusses shall be shop fabricated & assembled including hangers.
  5. Splices shall be held to a minimum and where necessary shall be made in a manner that will not reduce the strength of the truss structure.
  6. No tubing or channel splices will be permitted within 10' of the center of the truss structure.
  7. Trusses & transverse beams shall be hot dipped galvanized after fabrication and in accordance with ASTM A-23, A-384, A-385 & A-386.
  8. All steel hardware & fasteners shall be hot dipped galvanized in accordance with ASTM A-153.
  9. Decking & deck spacers shall be No. 1 grade HEM-FIR penfa pressure treated to 0.4 lb. cu. ft. retention and shall be field drilled to match shop drilled holes in transverse members.
  10. Assembly shop drawing shall be submitted for approval.

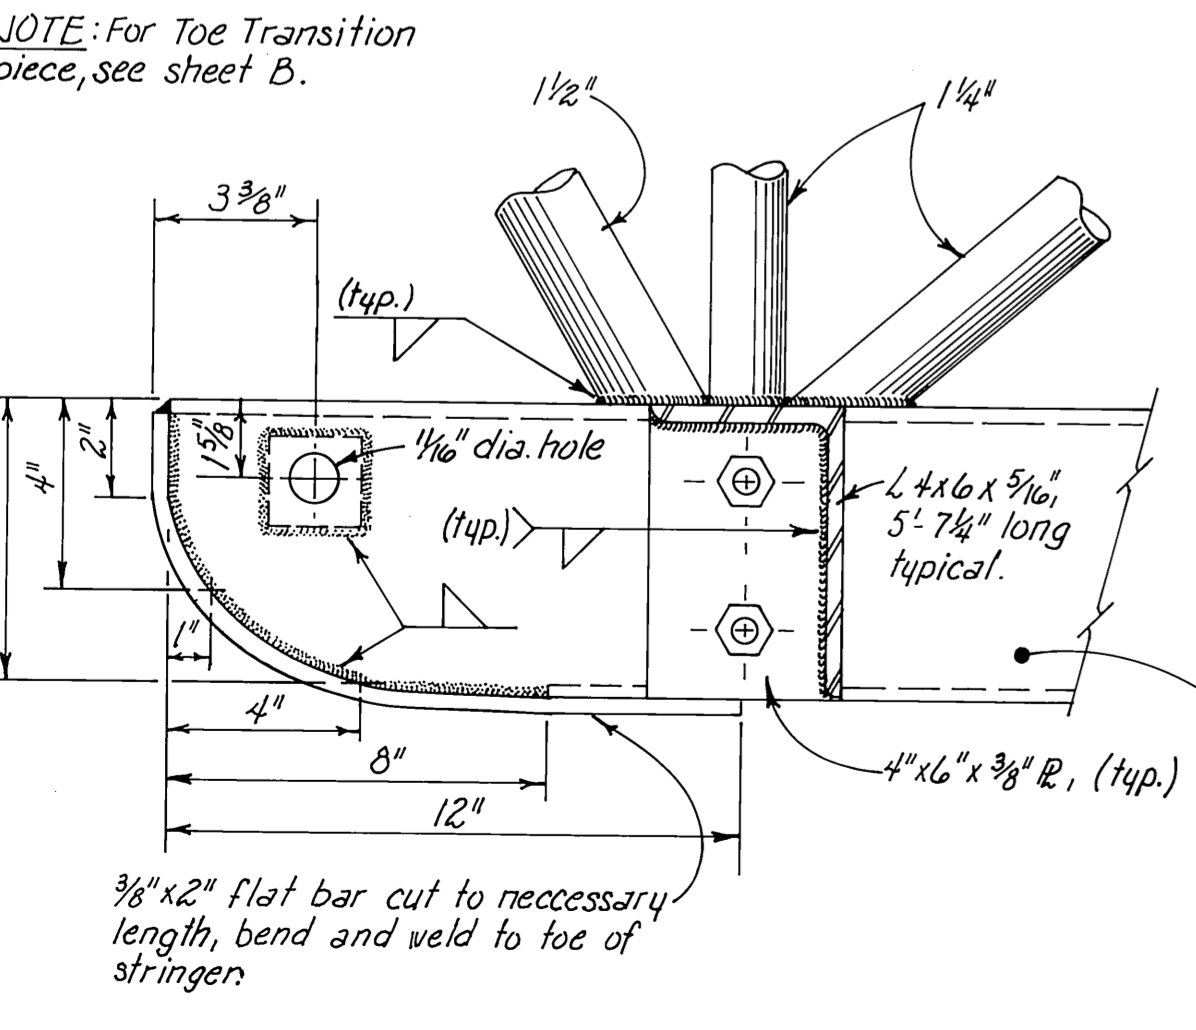


SECTIONAL ELEVATIONS  
3" = 1'-0"

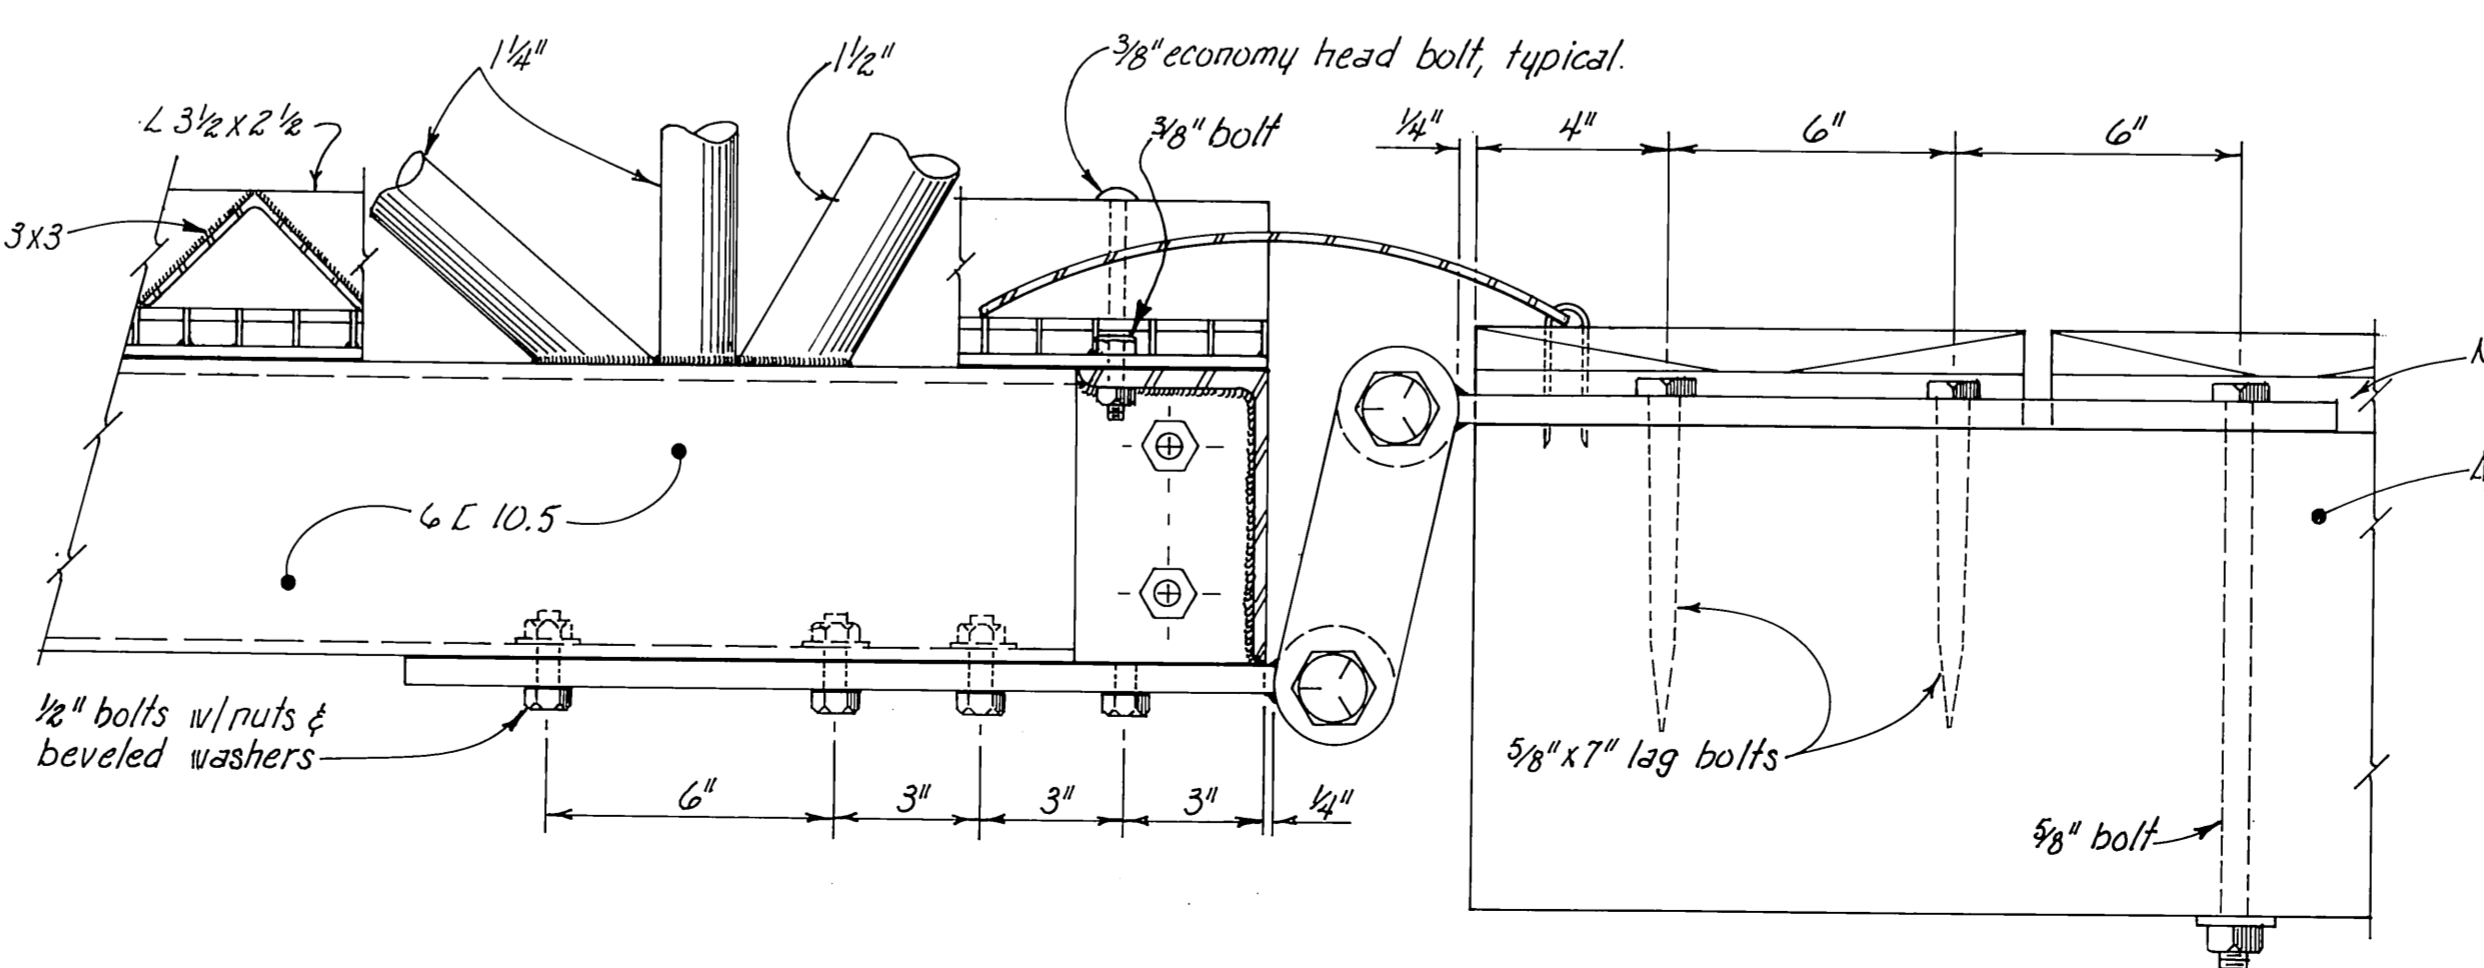


DOCK or APPROACH  
3" = 1'-0"

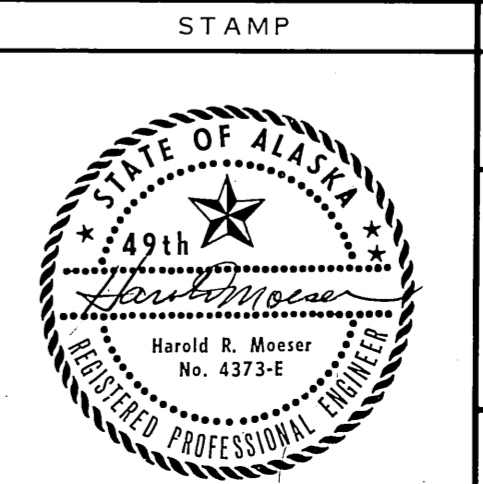


STAMP			DO NOT SCALE THIS DRAWING - USE DIMENSIONS		
STATE OF ALASKA DEPARTMENT OF TRANSPORTATION AND PUBLIC FACILITIES DIVISION OF HARBOR DESIGN AND CONSTRUCTION					
TYPICAL 6'x50'-0" STEEL GANGWAY (SHEET A)					
SCALE: As noted	SURVEYED: ~	APPROVED:			
DESIGNED: ~	DRAWN: GRF	Robert P. Beck CHIEF OF DESIGN			
CHECKED: ~	DATE: Dec. 1979				
PROJECT NUMBER: K30154	SHEET: 5	OF: 6			

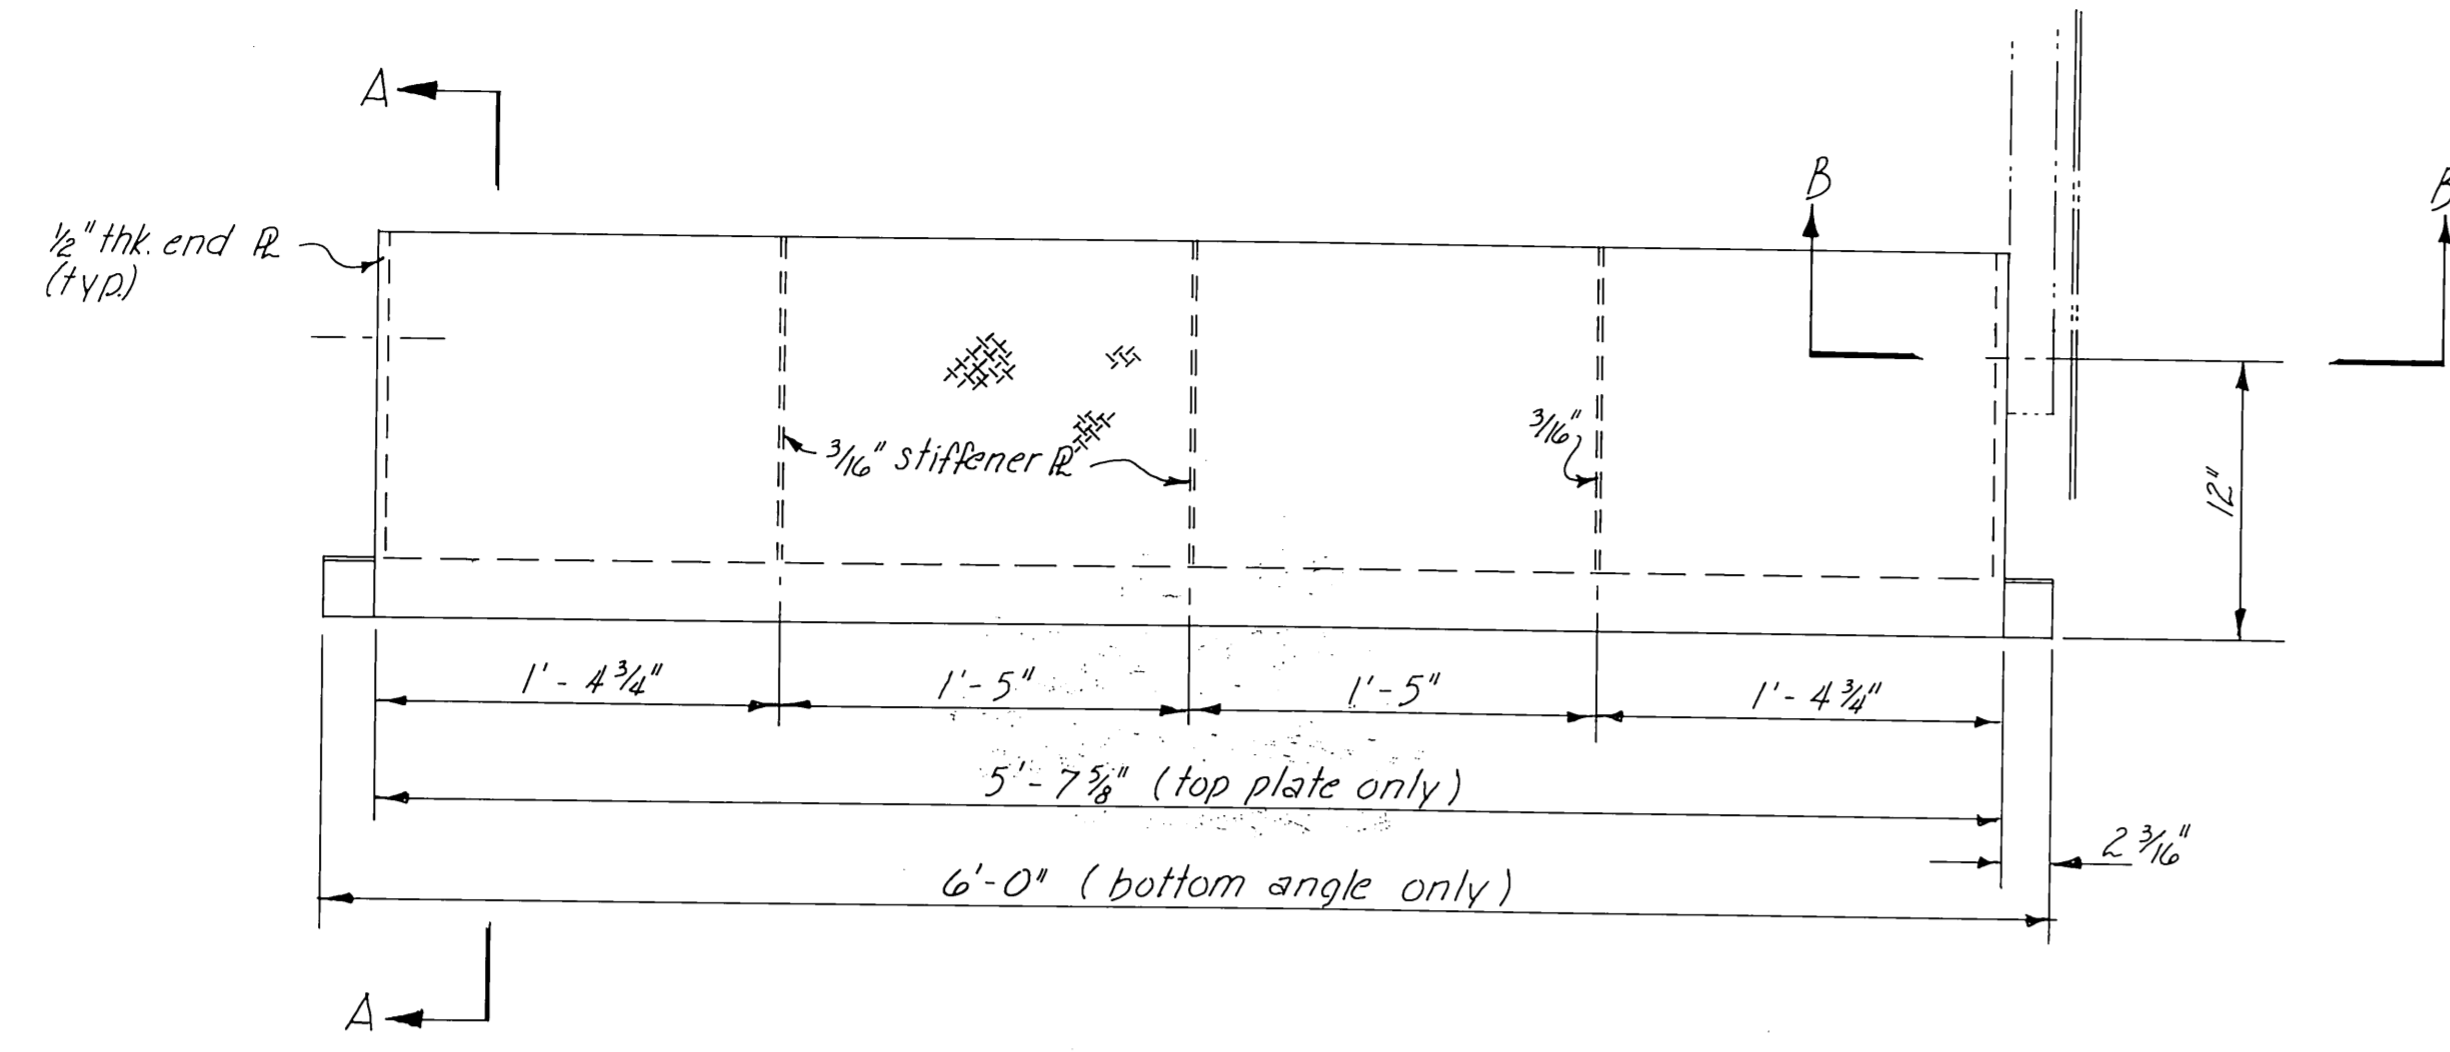


PLAN VIEW  
1/2" = 1'-0"

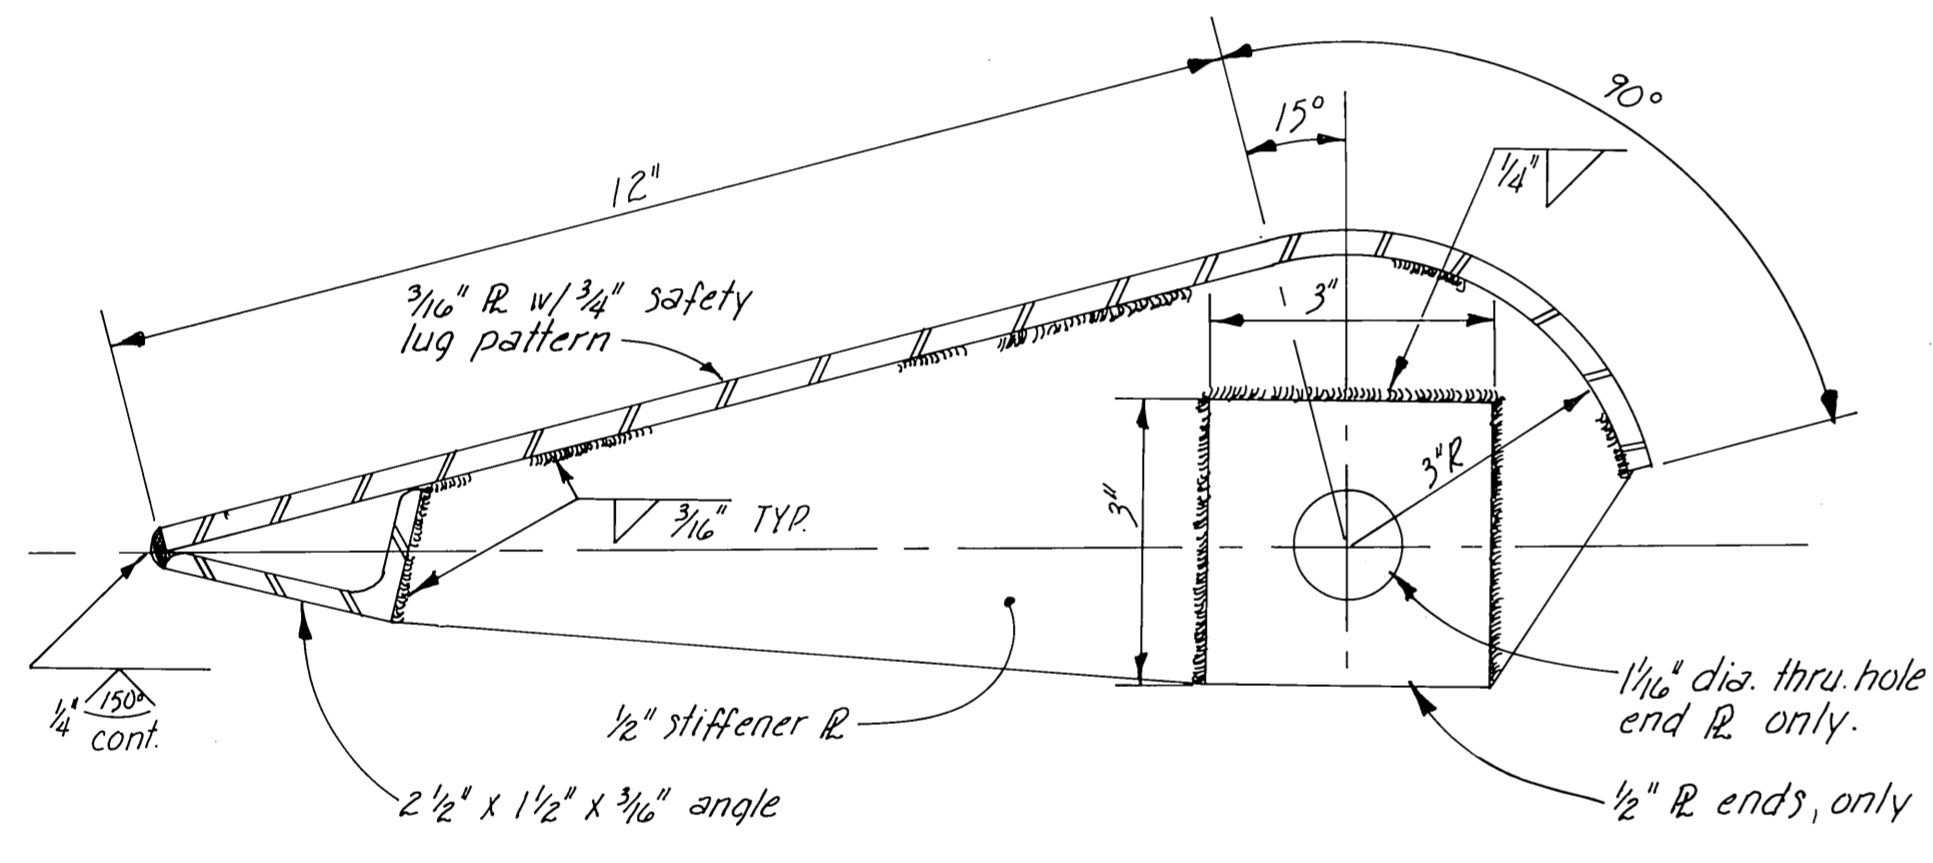


SECTION A-A  
HALF SIZE

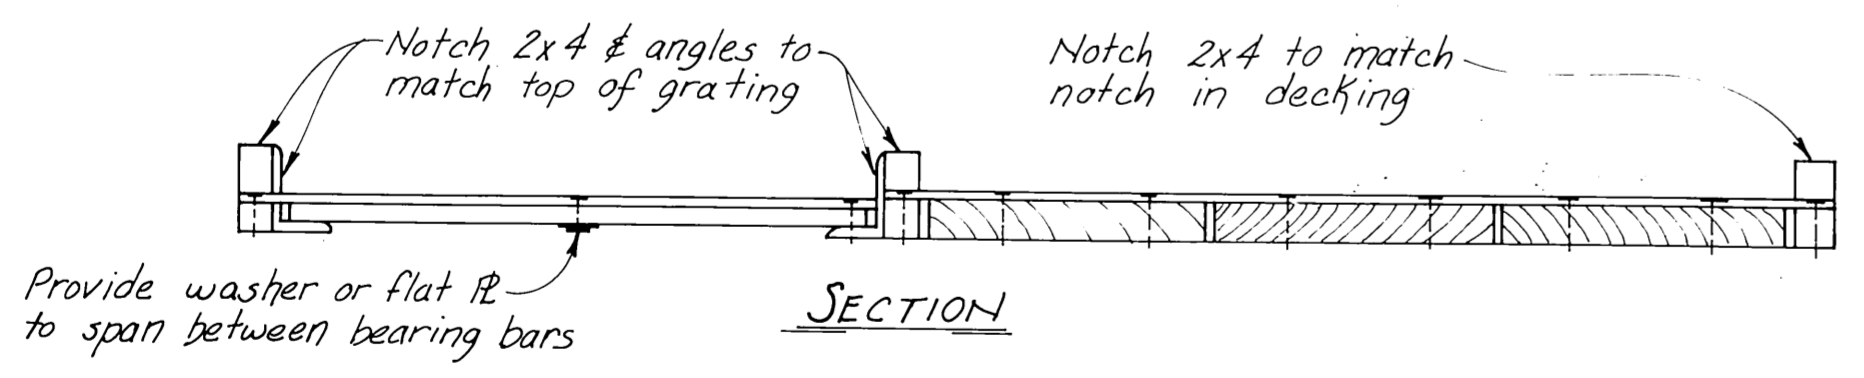


SECTION

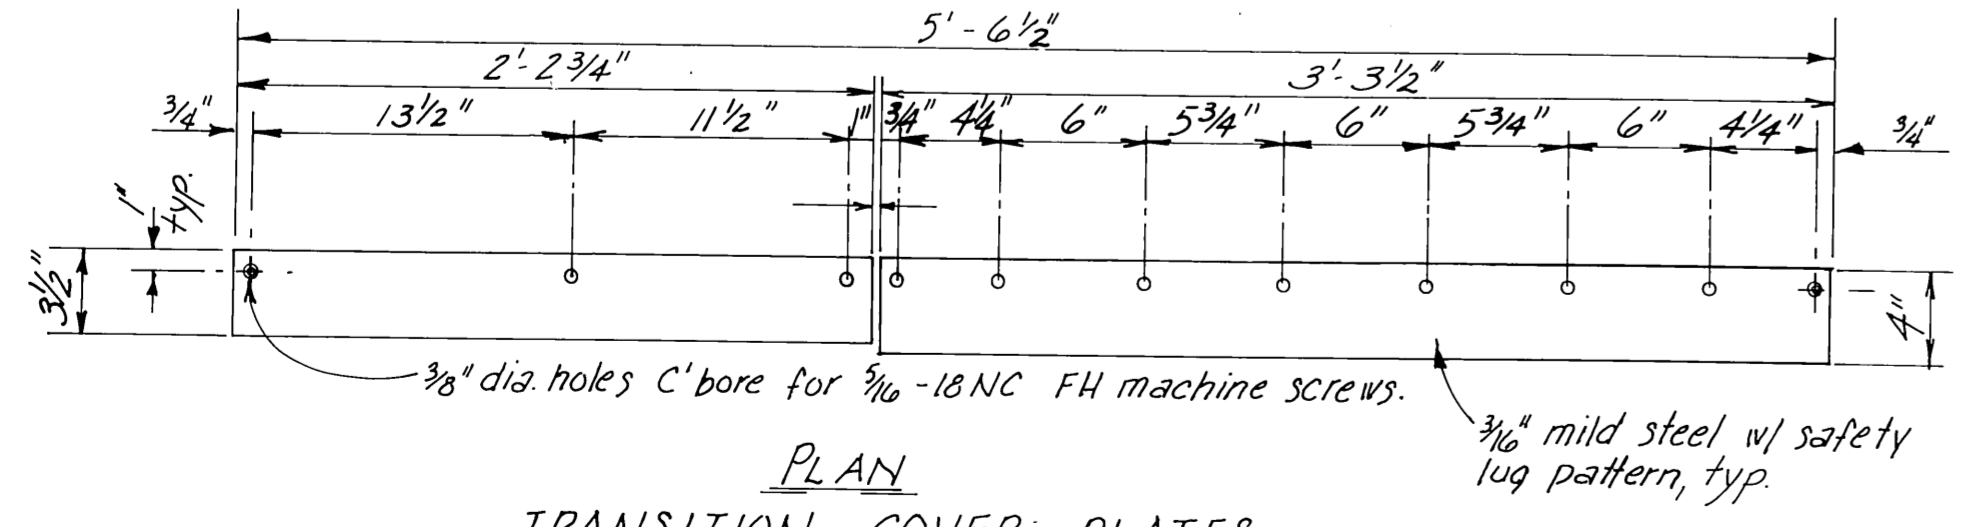


PLAN  
TRANSITION COVER PLATES  
1/2" = 1'-0"

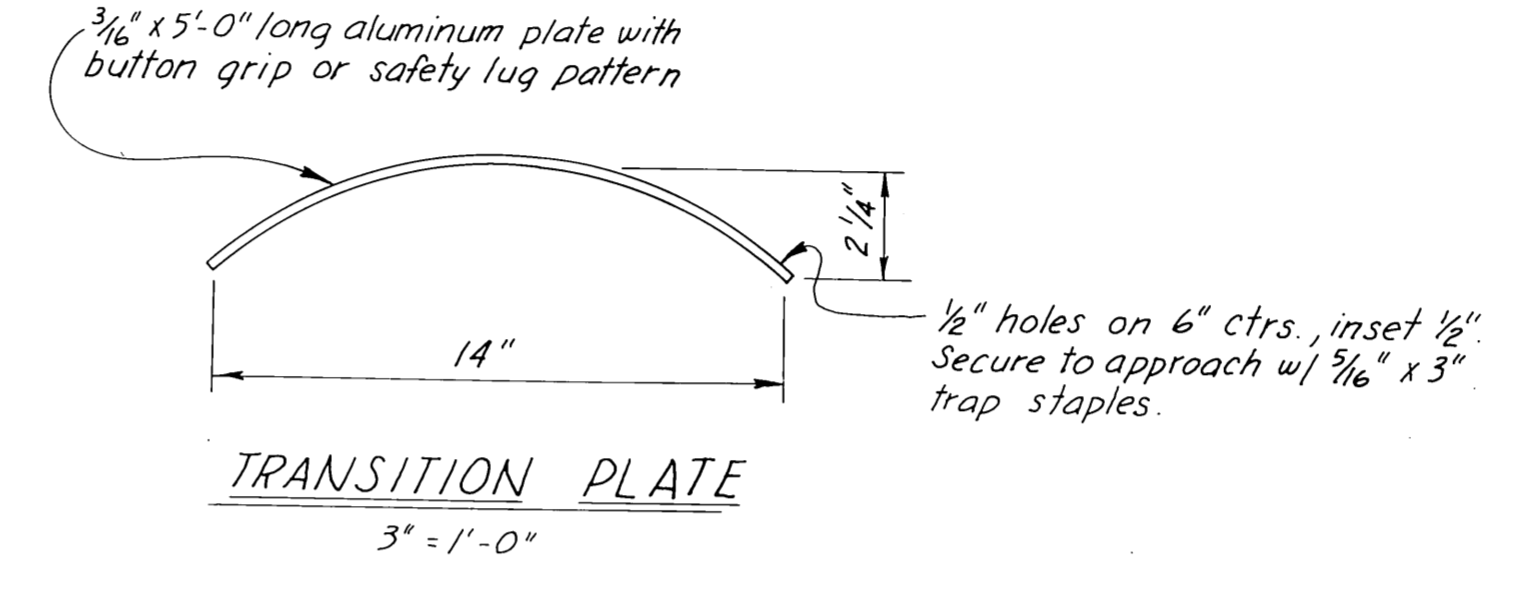


TRANSITION PLATE  
3" = 1'-0"

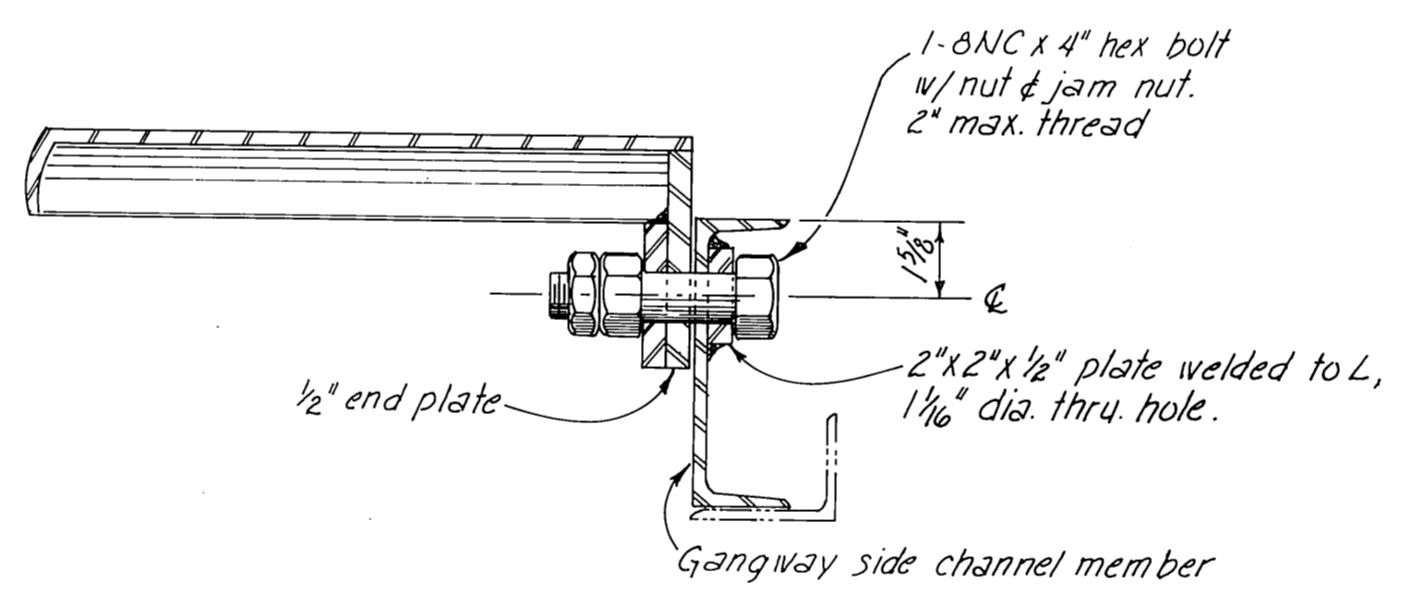


SECTION B-B  
3" = 1'-0"  
(Typ. ea. end)

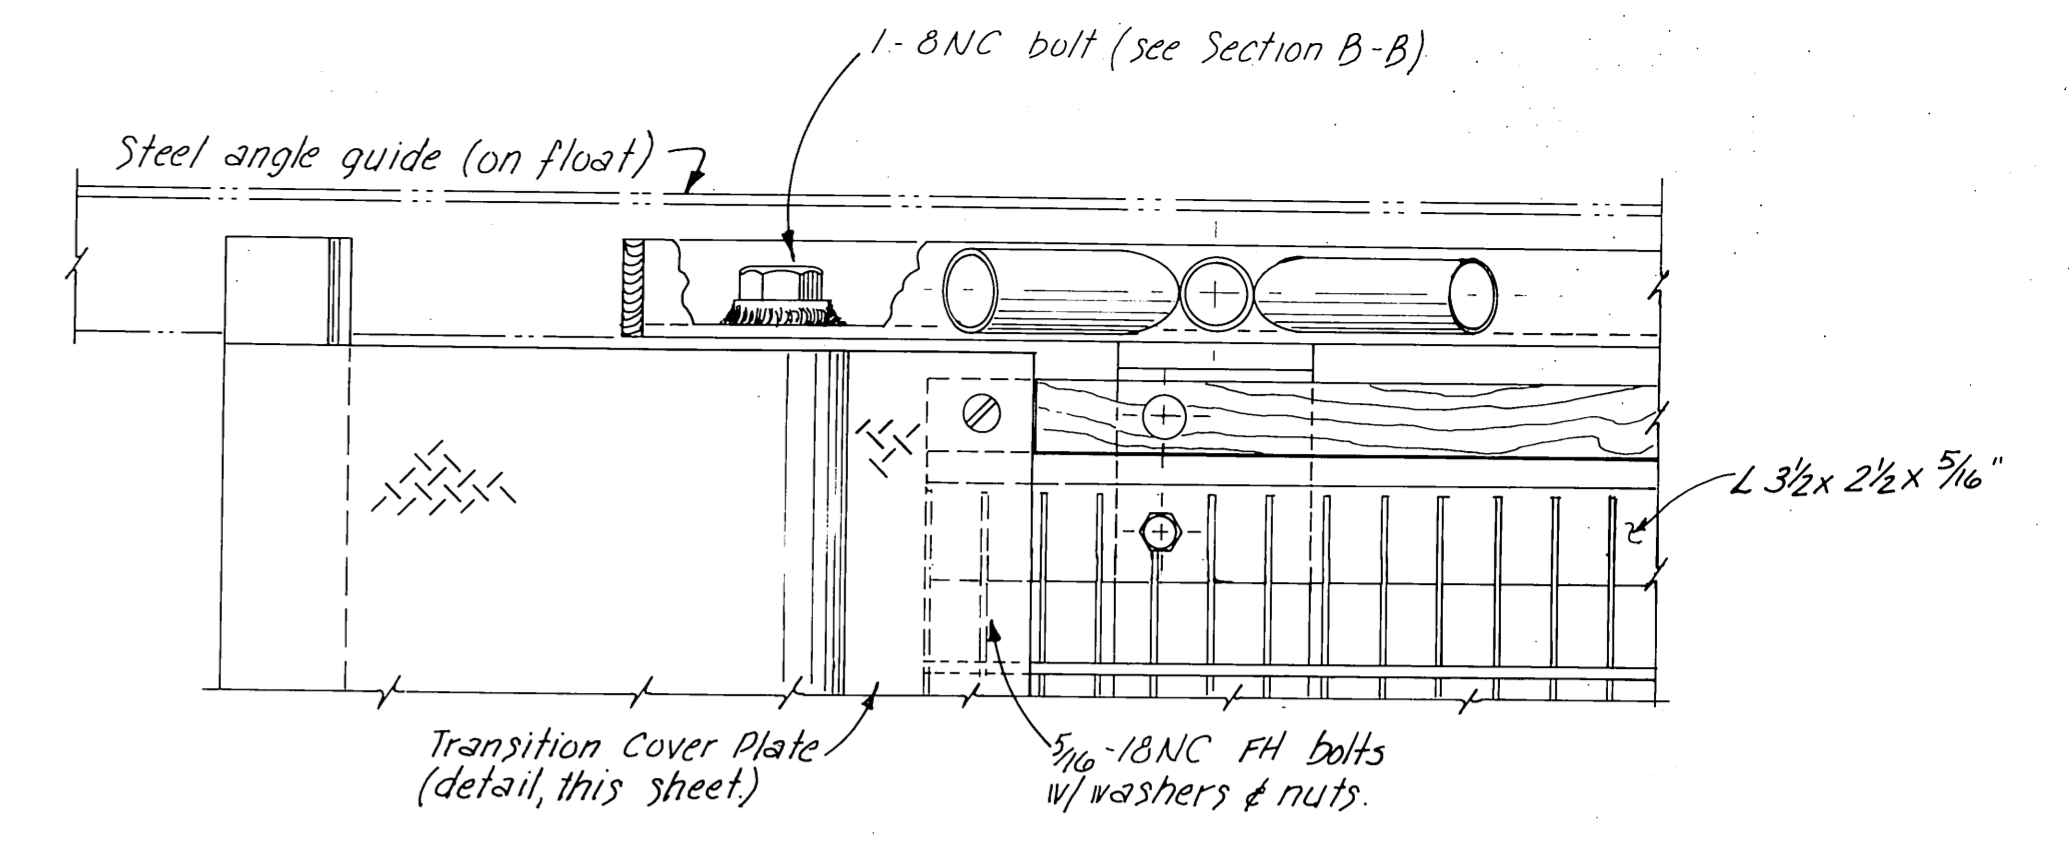

PLAN  
3" = 1'-0"

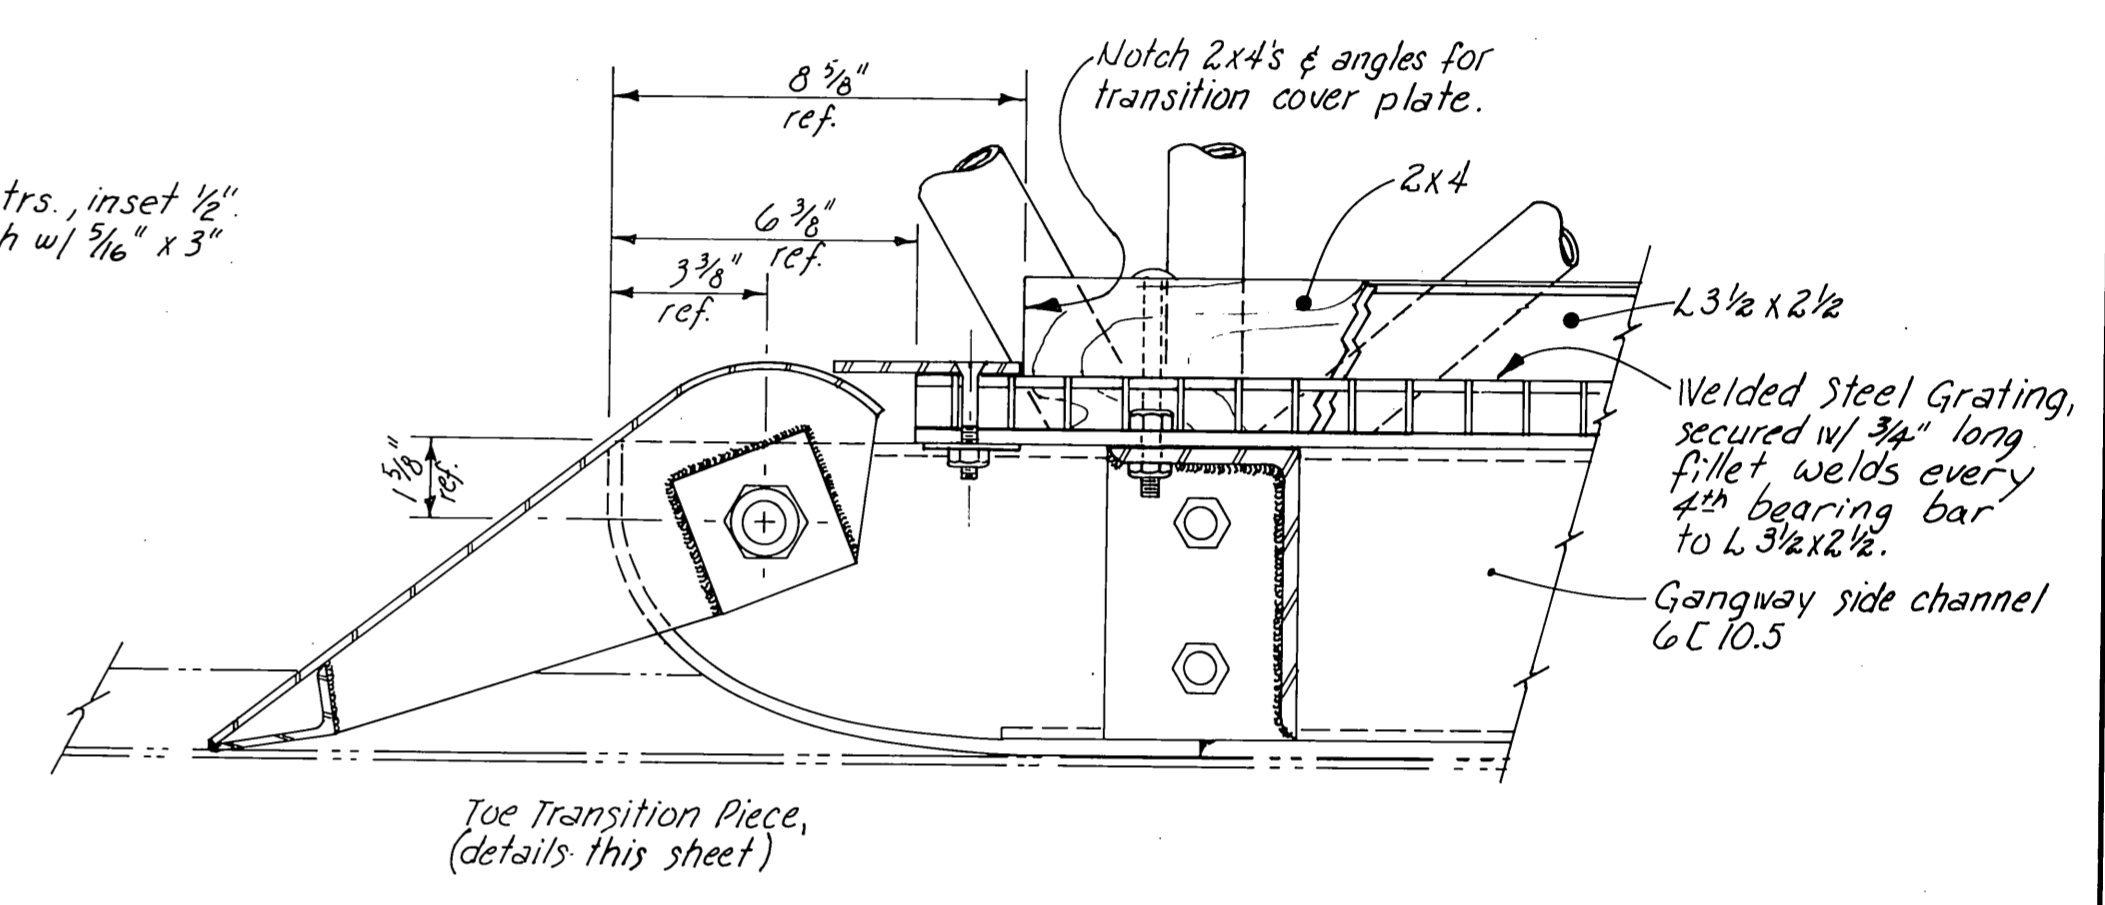

SECTIONAL ELEVATION  
3" = 1'-0"  
Assembly Detail

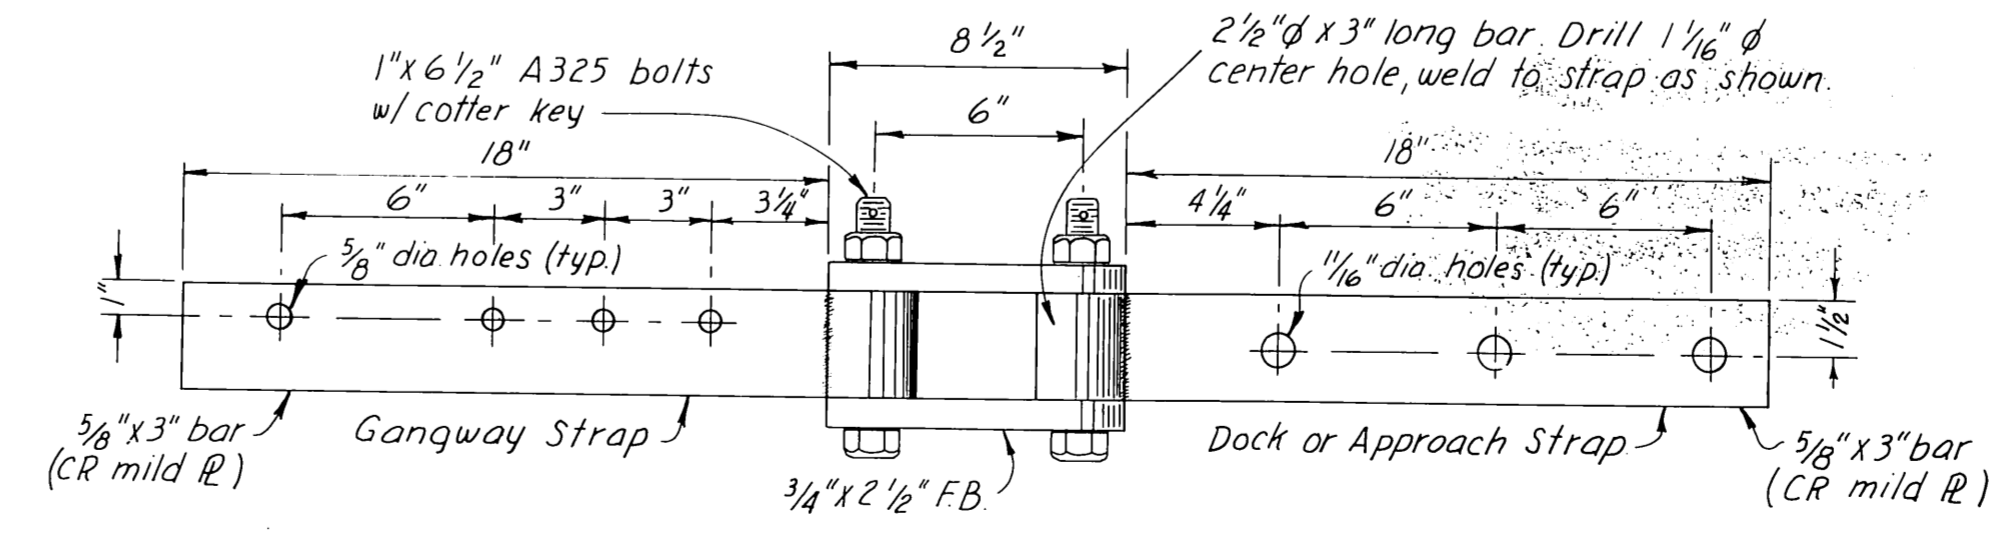

HANGER STRAP ASSEMBLY  
NOT TO SCALE

Note:  
For notes pertaining to fabrication and galvanizing, see Sheet A.

STAMP		DO NOT SCALE THIS DRAWING USE DIMENSIONS	
		STATE OF ALASKA DEPARTMENT OF TRANSPORTATION AND PUBLIC FACILITIES DIVISION OF HARBOR DESIGN AND CONSTRUCTION	
		TYPICAL STEEL GANGWAY (SHEET B)	
SCALE As Noted	SURVEYED	APPROVED	
DESIGNED	DRAWN GRF	CHIEF OF DESIGN	
CHECKED	DATE JAN. 1979		
PROJECT NUMBER K30154		SHEET 6 OF 6	