


ALASKA DEPARTMENT OF PUBLIC WORKS

WATER AND HARBOR DIVISION

PETERSBURG - CITY FLOATS
PROJECT NO. W5901

No Scale for As-Built
Use Distances Shown

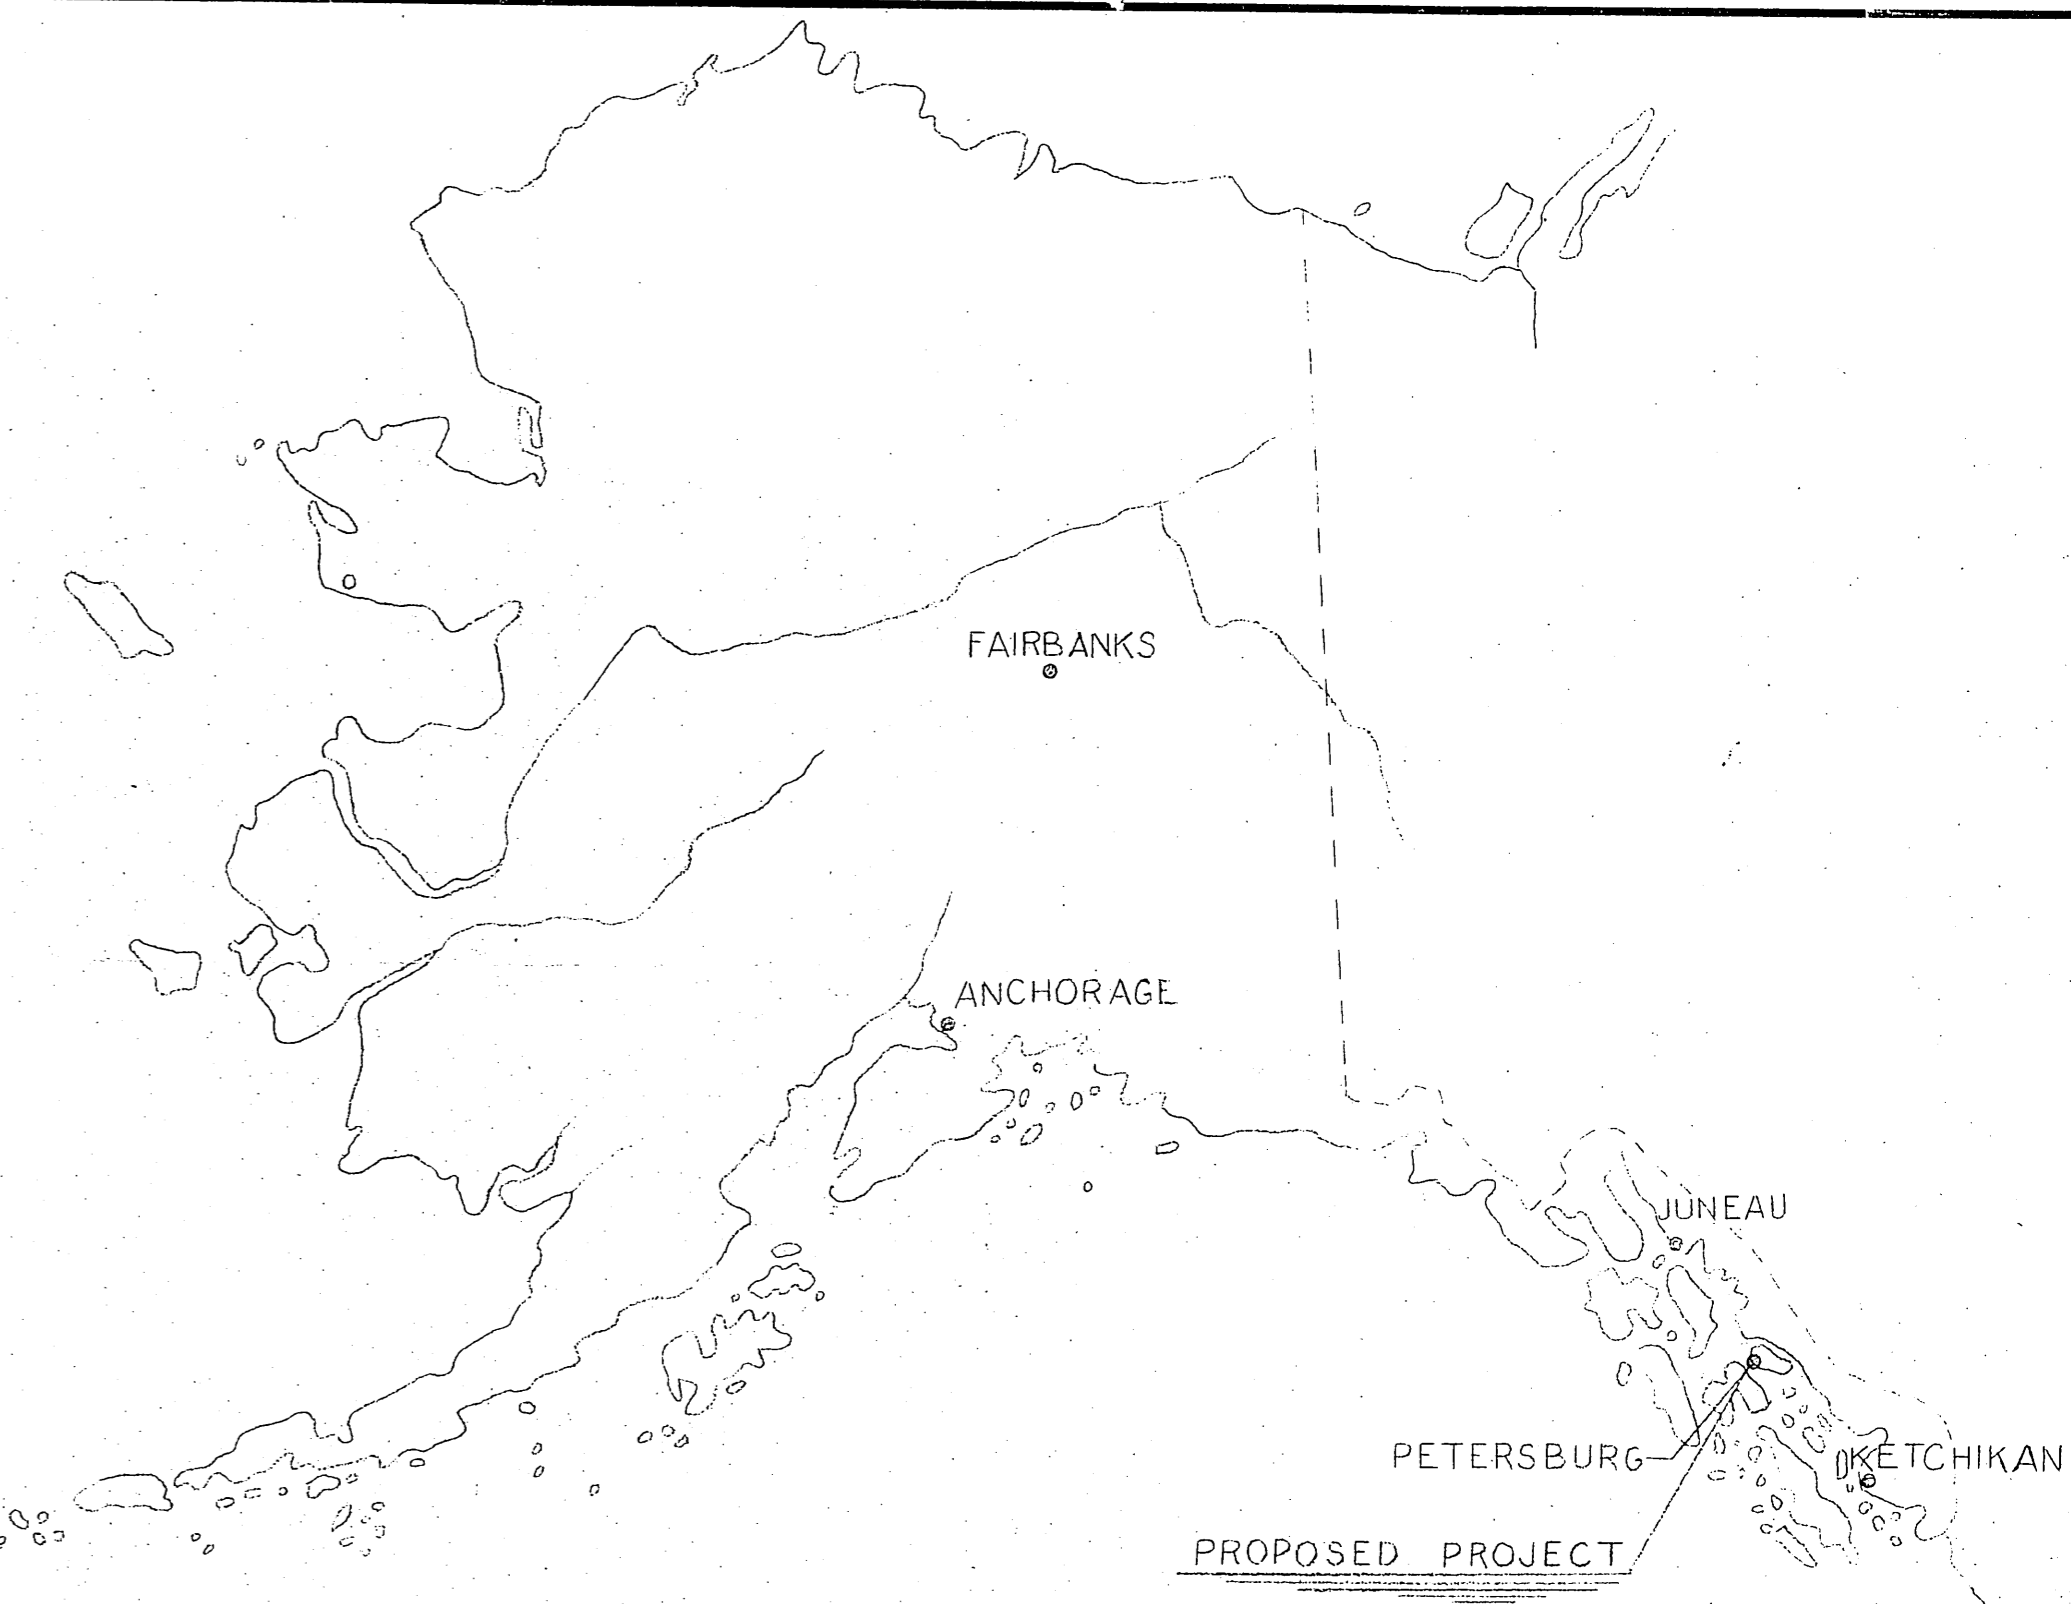

PETERSBURG HARBOR



WORK SUMMARY

Major units of this project shall include construction & installation of 674 L.F. of 10' wide styrofoam float, driving of 950 L.F. of float piling & 1850 L.F. of stall piling & pulling of 13 piling.

INDEX TO SHEETS


TITLE SHEET - - - - 1
PLAN & DETAILS - - - - 2

Revised
3-29-60
OK by Fort Howard - Phone
(Signature)

LEG FLOATS
250
430
320
50
1050

File # 39
File # 22
File # 7 will be used as the sheet for the original City floats.

AS-BUILT

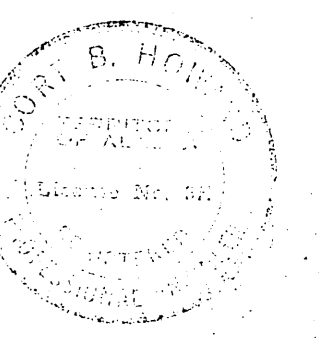

As Built April 1960