



STATE OF ALASKA

DEPARTMENT OF PUBLIC WORKS

DIVISION OF WATER & HARBORS

PETERSBURG SEAPLANE APPROACH

PROJECT NO. WA6120

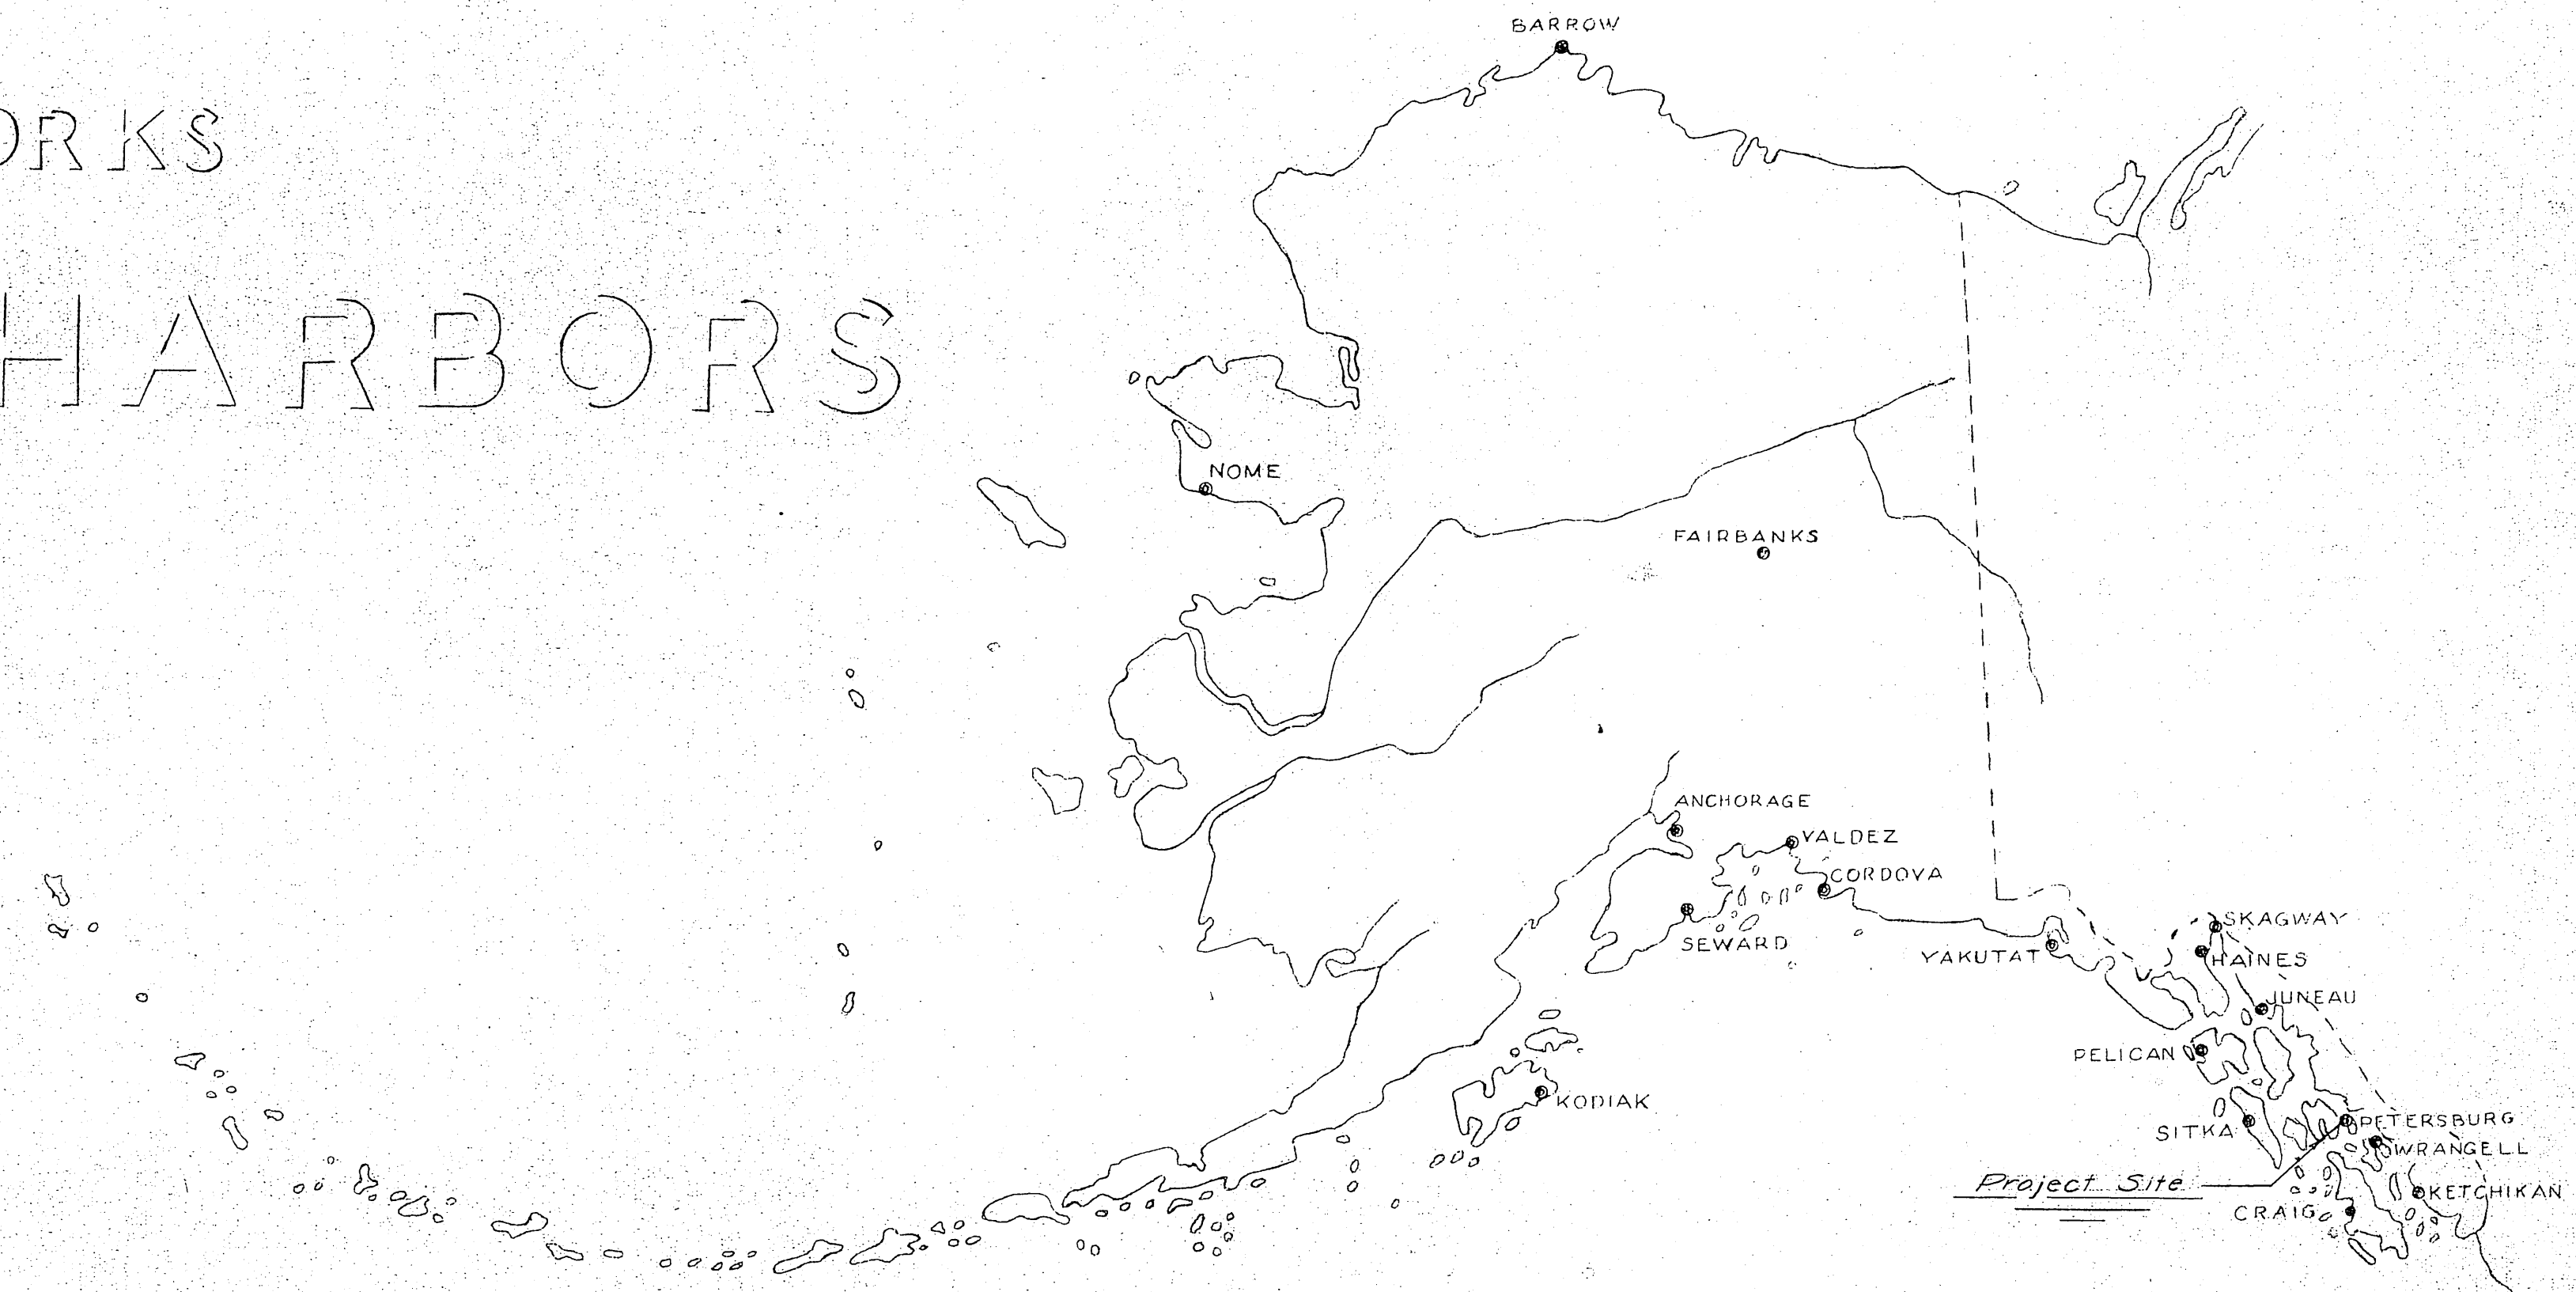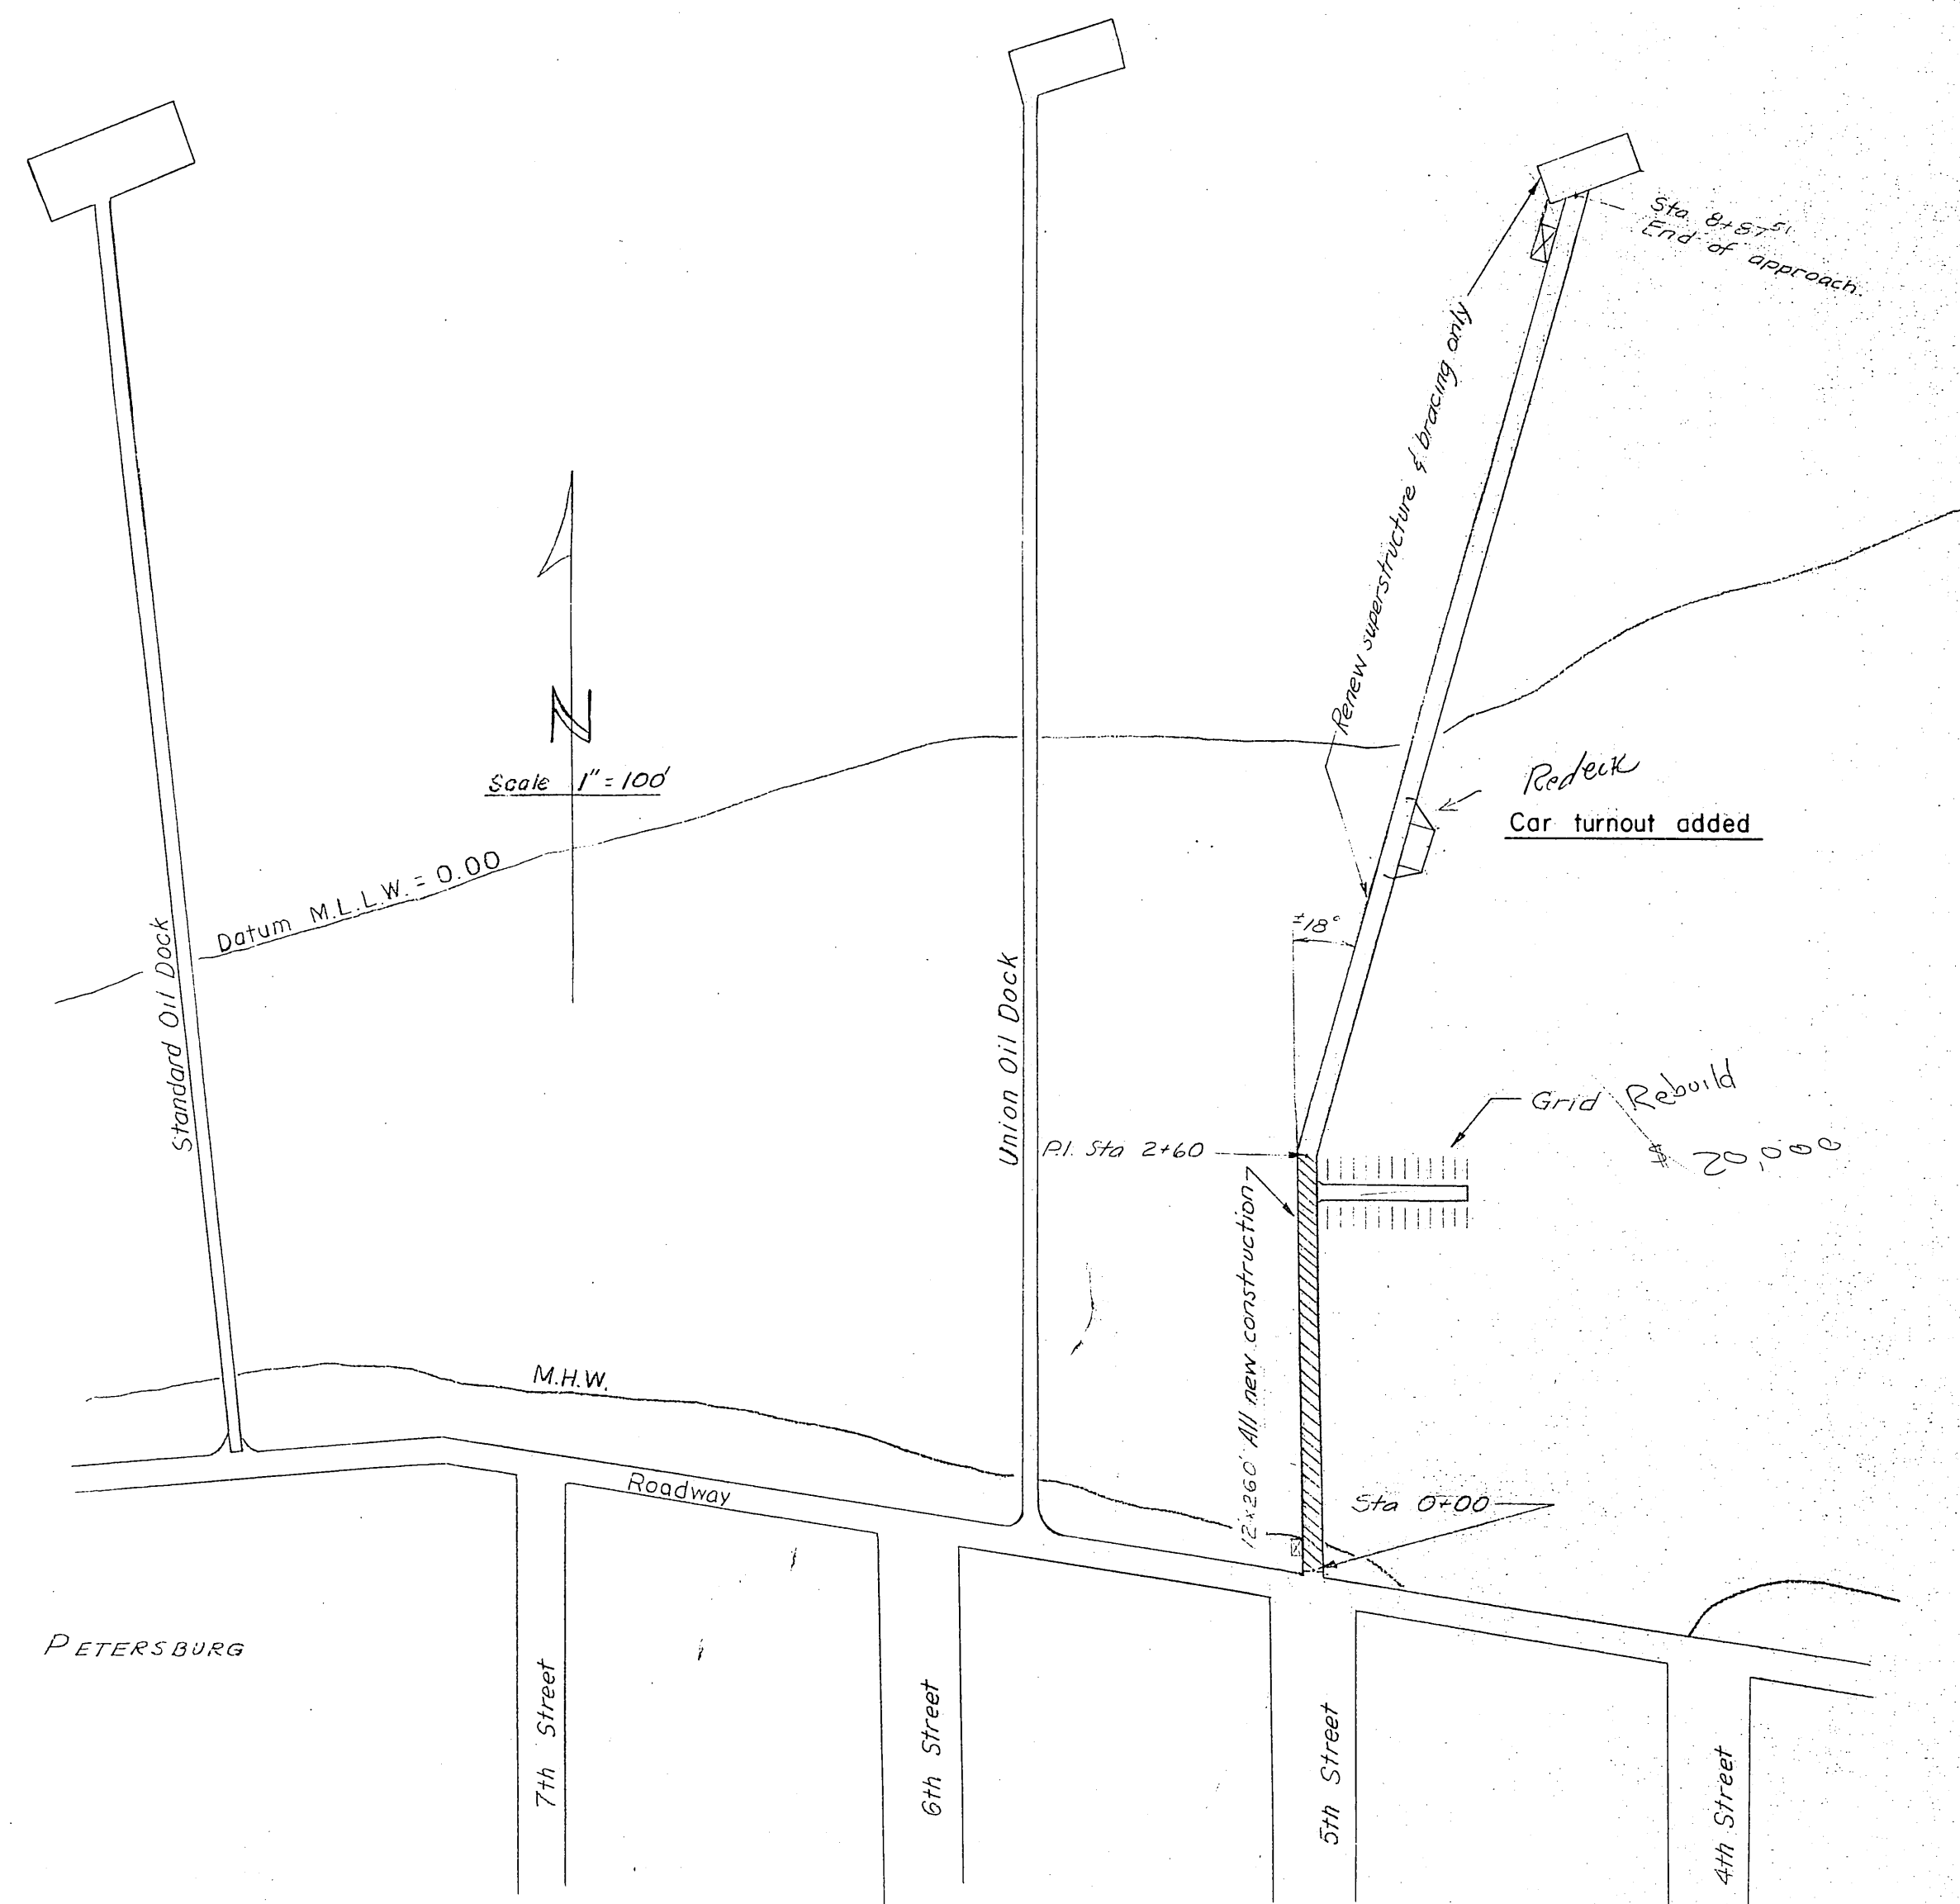

WORK SUMMARY


Major units of this project shall include the dismantling & complete replacement of 12'x260' of dock approach, the dismantling & replacement of 12'x624' of approach superstructure, & 1440 sq. ft. of dock superstructure.

INDEX TO SHEETS

TITLE & LAYOUT SHEET	1
PROFILE & TYPICAL SECTION	2
DOCK CONSTRUCTION DETAILS	3

This is an As-Built set of plans. This project consists of replacing the untreated timber decking, wheelgunds & Hand rail 13,200 sq. ft.

Need \$120,000.

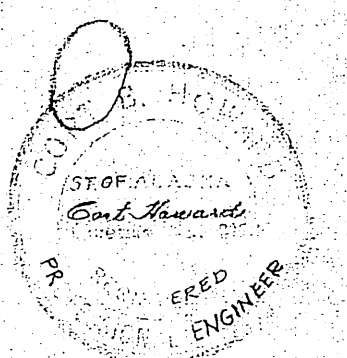

AS BUILT

DATE 4/25/61 APPROVED *E. J. Howard* COMMISSIONER

