

STATE OF ALASKA DEPARTMENT OF HIGHWAYS

PLAN AND PROFILE PROPOSED HIGHWAY PROJECT PETERSBURG "H" STREET FROM MAIN STREET TO EIGHTH STREET GRADING, PAVING, & DRAINAGE & PEDESTRIAN ACCESS EIGHTH ST. TO THE AIRPORT RS-0938 (I) X-30130

INDEX OF SHEETS	
1	TITLE SHEET
2	TYPICAL SECTIONS
3-6	EST. OF QUANTITIES & SUM. TABLES
7-15	PLAN & PROFILE SHEETS
16-18	INTERSECTION DETAILS
19-25	DRAINAGE DETAILS & PROFILE
26-30	UTILITIES PLAN & PROFILE SHEETS
31	MISC. DETAILS
32	UTILITIES DETAILS
33	TRAFFIC CONTROL PLAN
34	TRAFFIC MARKINGS

THESE STANDARD DRAWINGS SHALL APPLY TO THIS PROJECT
A-1, C-00.04, C-10.03, C-11.03, D-04.00, D-20.10, D-23.01, D-24.13,
D-26.02, D-27.10, I-20.01, I-80.00, M-05.01, M-16.03, S-00.11, S-05.00
S-30.12, T-20.03, T-21.02, U-03.00

PROJECT SUMMARY

- WIDTH OF SUBGRADE = 32.5'
- WIDTH OF PAVEMENT = 28.5'
- LENGTH OF PAVEMENT = 1997.55' = 0.378 MI.
- LENGTH OF GRADING = 1997.55' = 0.378 MI.
- LENGTH OF PROJECT = 5005' = 0.948 MI.

BEGINNING OF PROJECT
X-30130
"O" 66+33.43


DESIGN DESIGNATION

- ADT 1979 = 500
- ADT 1999 = 1095
- DHV 12% = 130
- D = 60-40
- T = 5%
- V = 30
- TI = 6.5

BEGIN PROJECT
RS-0938 (I)
STA. "L" 50+50

END OF PROJECT
X-30130
"O" 109+00.00

END PROJECT
RS-0938 (I)
STA. "L" 100+55

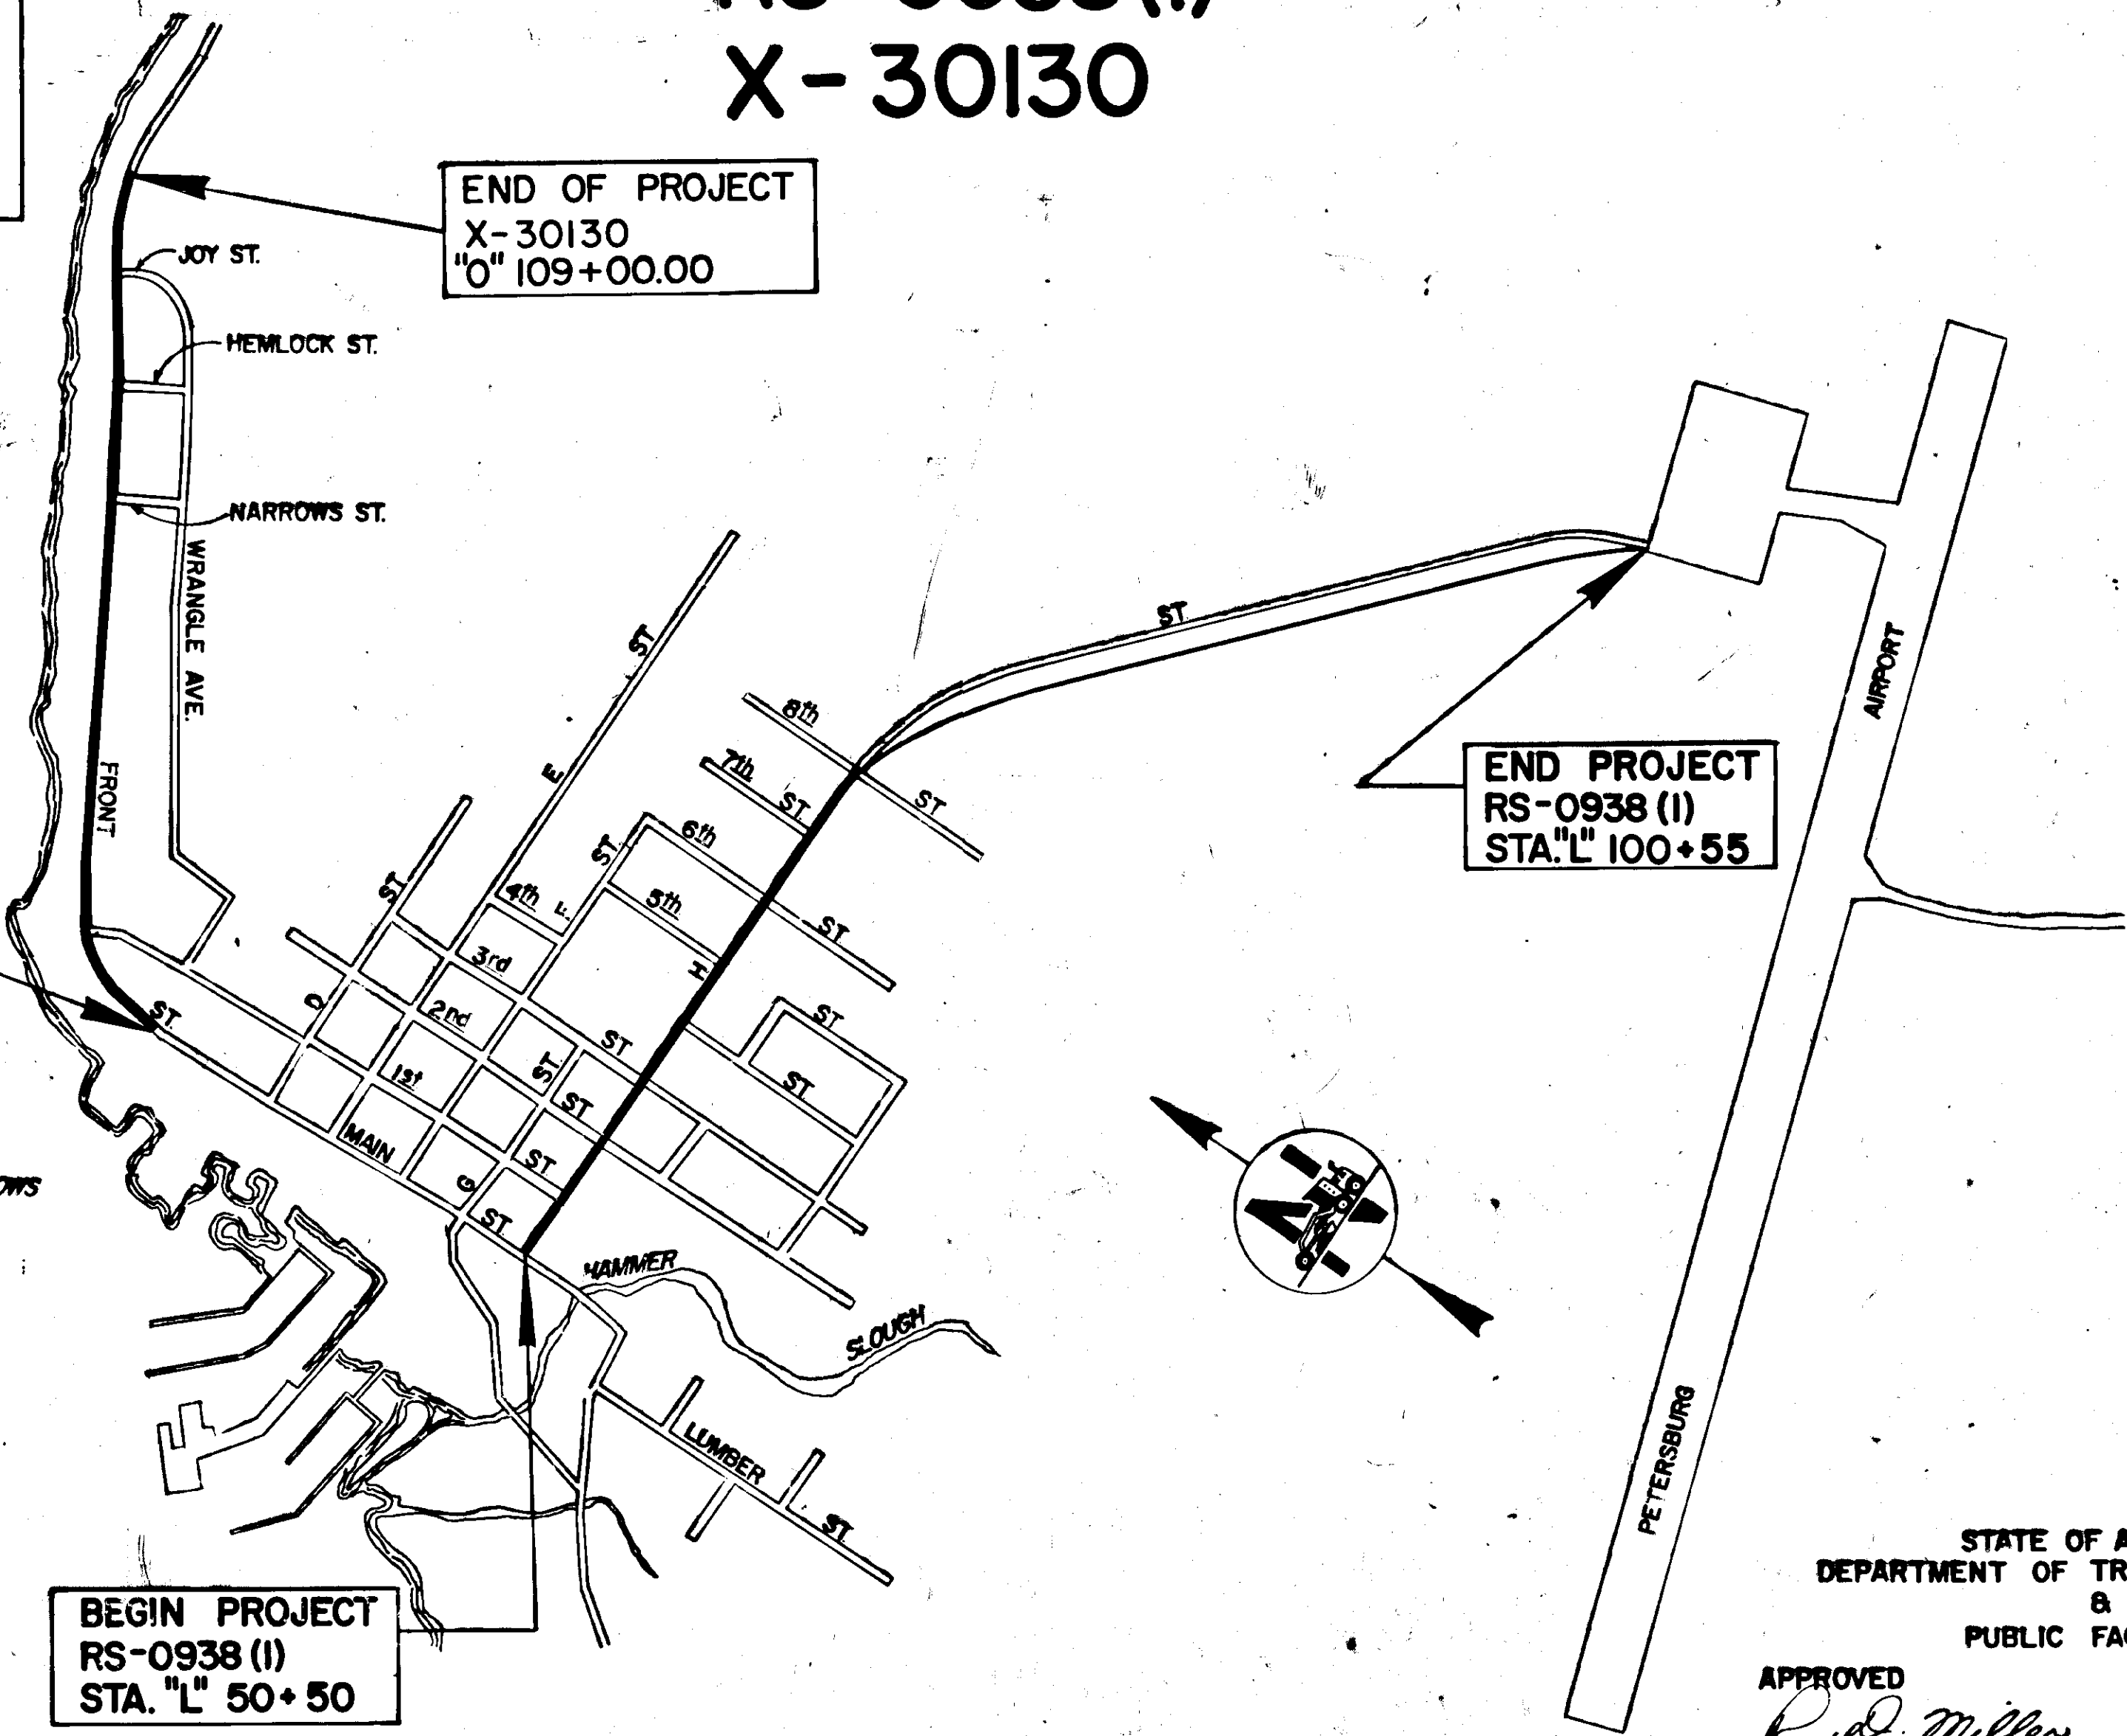

AS-BUILT PLANS

CONTRACTOR: BUND CONST. CO.
PROJECT ENGINEERS: VINCE RHEA 5/30/80 to 12/5/80
BILL BOYD 12/5/80 to 6/20/81
BEGINNING DATE: 5-28-80
COMPLETION DATE: 6-4-81


STATE OF ALASKA
DEPARTMENT OF TRANSPORTATION
&
PUBLIC FACILITIES

APPROVED
R. D. Miller Date 7-13-79
SOUTHEASTERN REGION
DESIGN/CONSTRUCTION ENGINEER


STATE OF ALASKA
DEPARTMENT OF TRANSPORTATION
&
PUBLIC FACILITIES

APPROVED
Charles M. ... Date 12-7-77
DIRECTOR-HIGHWAY DESIGN & CONSTRUCTION

TYPICAL SECTIONS

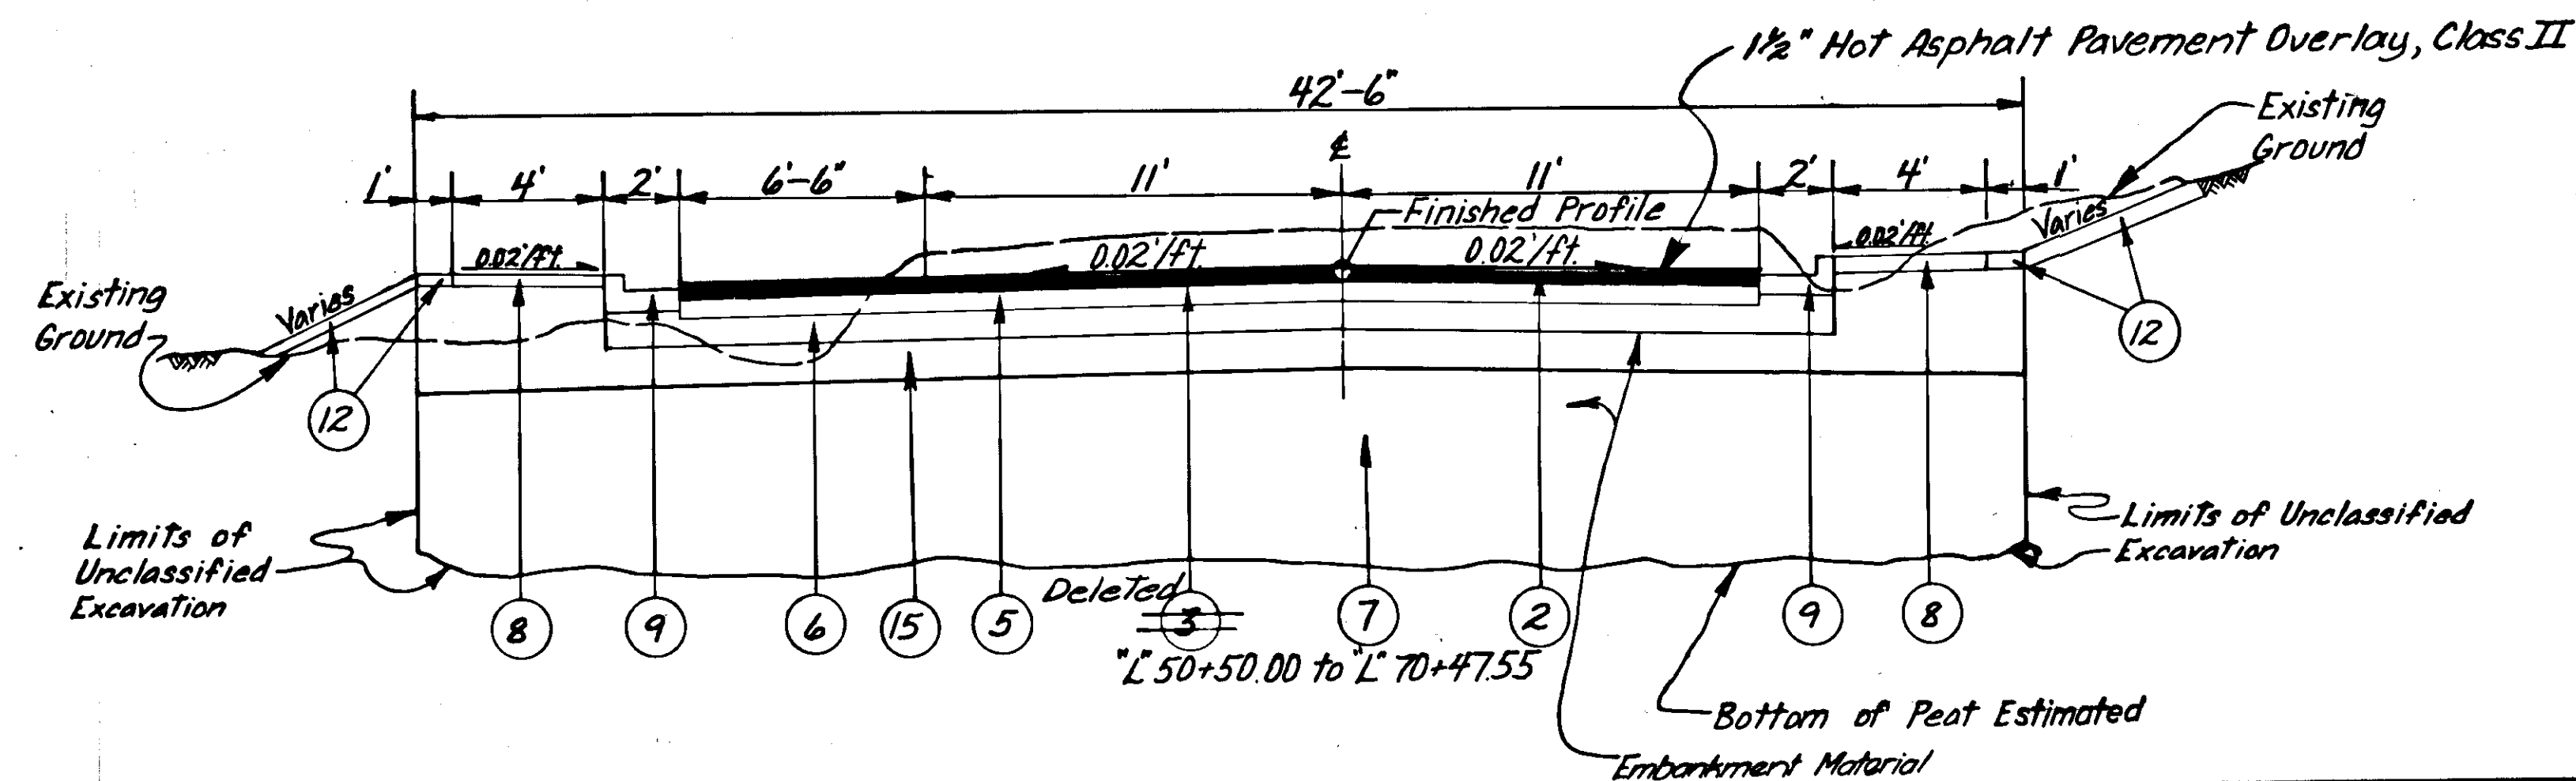


TYPICAL SECTION ROADWAY

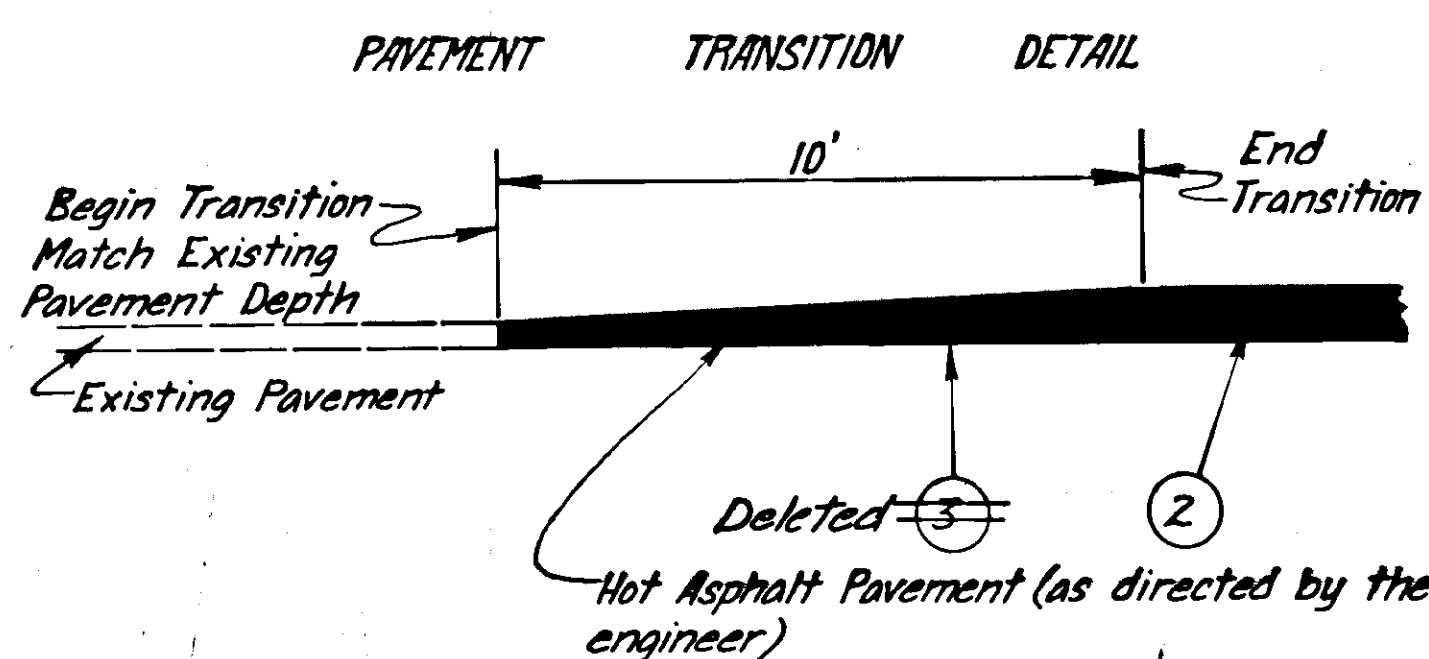

BASIS OF ESTIMATE	
Item No.	Estimating Factor
30A(1)	1.95 Tons per cu. yd.
30I(1)	1.95 Tons per cu. yd.
40I(1)	116 lbs. per sq.yd. Inch depth
40I(2)	6% Item 40I(1)
403(1)	0.25 Gal. per sq.yd. 2.56 Gal. per ton

LABELING INDEX	
1	2 1/2" Hot Asphalt Pavement (Class I)
2	2 1/2" Hot Asphalt Pavement (Class I)
3	MC-80 Liquid Asphalt for Prime Coat Deleted
4	4" Crushed Agg. Base Course
5	6" Crushed Agg. Base Course
6	9" Subbase (Grading A)
7	Embankment Material
8	4" Concrete Sidewalk
9	Standard Curb & Gutter
10	Embankment Material (for method of Payment see, 555-401 of the special provisions)
11	Corduroy Over Muskeg Deleted
12	4" Topsoil
13	8" Ductile Iron Water Main
14	8" Ductile Iron Sewer Main
15	12" Material conforming to the requirements of Section 703-2.07

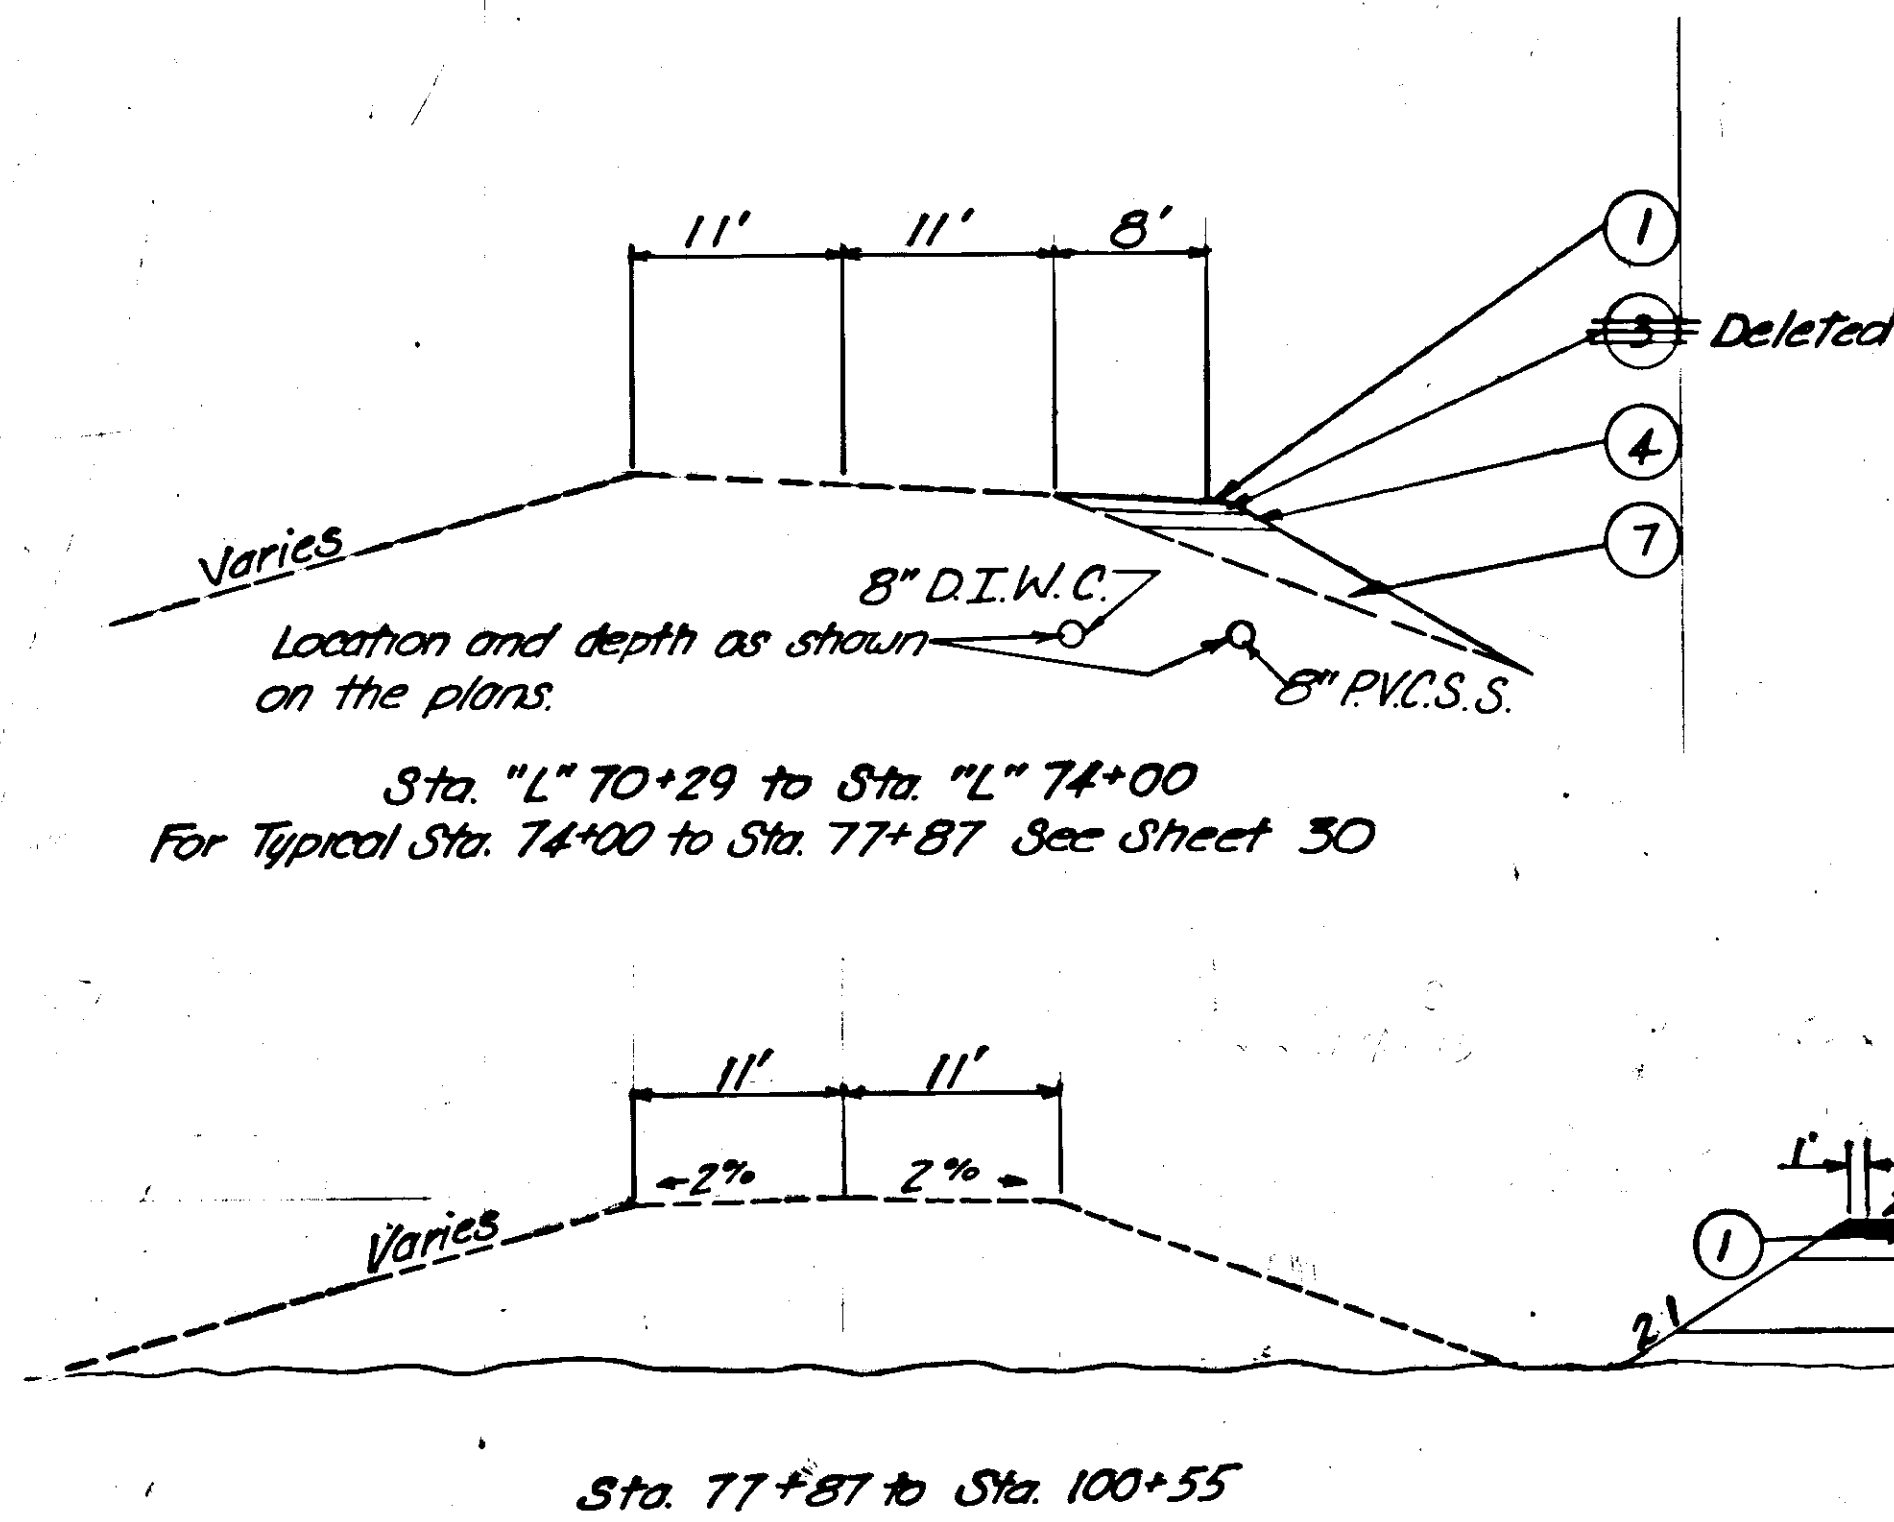

TYPICAL SECTIONS PEDESTRIAN ACCESS

PROJECT X-30130
Shall consist of Topsoil and Seeding on a previously constructed project as shown on the Title sheet and as directed by the engineer.

GENERAL NOTES

- Grades shown on these plans are subject to minor revisions.
- Superelevations shall revolve around the \pm , see Standard Drawing 1-80.00.
- Corduroy may be encountered in various areas under the exist. roadway up to sta. 'L' 67+00. Corduroy will be encountered ahd. of 'L' 67+00.
- The locations of all utilities shown on the plans are approx. only & should be field verified with the utility.
- The installation, adjustment, or removal of utility poles & appurtenances shall be performed by others & are not considered items of work under this contract.
- Removal of existing concrete or wood walkways & concrete driveways shall be considered incidental to item 202(1).
- Regrade all existing approaches at curb cuts with Crushed Aggregate base course as directed by the engineer.
- All stairs & walkways shall be field fit to give a suitable approach to the property owner & shall conform to standard drawing M-05.01.
- The existing manholes & sewer were excavated to & bedded on hard pan. Peat excav. below them will not be required. It shall be the contractor's responsibility to protect them as per Gen. Note 14.
- Clearing & grubbing limits shall be 5' beyond slope limits in a fill section or to the R/W whichever is less.
- All existing signs shall be removed by the contractor and returned to the State of Alaska Dept. of Trans. as directed by the engineer. This work shall be considered incidental to other items of work and no separate payment shall be made therefore.
- The area to be seeded shall be from the back of sidewalk to the clearing limits. The paved pedestrian access path shall be excluded from this area.
- Regrading of side street ditches to drain will not be measured or paid for but shall be incidental to item 203(3) Unclassified Excavation.

GENERAL NOTES (Cont)

- Protection of existing underground utilities shall be considered incidental to item 203(3) 'Unclassified Excavation'. No measurement or payment shall be made for this required protective work.
- Removal of existing pavement shall be paid for under item 203(3) 'Unclassified Excavation'; & no separate payment shall be made therefore.
- Existing asphalt pavement to be removed shall be broken into pieces not to exceed 75 lbs. & mixed in with the borrow in a manner that will eliminate large voids and meet with the engineers approval.
- Disposal of project unclassified excavation waste & other items to be wasted during construction shall be in a disposal area to be provided by the contractor.
- Curb inlets, storm inlets, & culvert lengths & locations are subject to minor revisions.
- Pay for wood stairs & walkways to match exist. woodwalks shall be incidental to item 608(1A). Repairs at stations 'L' 58+89, 'L' 60+43, 'L' 61+58, & 'L' 63+02 shall be necessary totaling approx. 100 board feet of lumber. See detail on sht. 31.
- The exist. elec. poles & houses adjacent to the construction activities shall be protected by bracing or other approved means. Such protection shall be incidental to other items of work.
- Any connections between the existing concrete walkways & the new sidewalks shall be paid for as 4" sidewalk. If steps are required the height of the risers & the width of the tread will be included in the measurement. Any connections between existing concrete driveways & the new curb cuts for driveways shall be paid for as 6" driveway.
- Water & sewer service shall be maintained to existing residences until the new services are operational.

ESTIMATE OF QUANTITIES

STATE	PROJECT DESIGNATION	YEAR	SHEET NO.	TOTAL SHEETS
ALASKA	RS-0938(1) X-30/30	1979	3	34

SHEET NUMBERS

ITEM No	ITEM	UNIT	SHEET NUMBERS													RS-0938(1) Subtotal	X-30/30 Subtotal	TOTAL		
			7	8	9	10	11	12	13	14	15	26	27	28	29				30	
1	Furnishing and Maintaining Engineering Facilities	L.S.																All Req'd.		All Req'd.
110(1)	Mobilization	L.S.																All Req'd.		All Req'd.
111(1)	Temporary Erosion and Pollution Control	C.S.																All Req'd.		All Req'd.
401(1A)	Hot Asphalt Pavement (Class II)	L.S.																All Req'd.		All Req'd.
114(1)	Construction Engineering	L.S.																All Req'd.		All Req'd.
115(1)	Traffic Maintenance	L.S.																All Req'd.		All Req'd.
401(2A)	AC-5 Asphalt Cement	L.S.																All Req'd.		All Req'd.
401(1B)	Hot Asphalt Pavement (Class II), 1/2" Overlay	L.S.																All Req'd.		All Req'd.
401(2B)	AC-5 Asphalt Cement, 1/2" Overlay	L.S.																All Req'd.		All Req'd.
202(1)	Removal of Structures and Obstructions	L.S.																All Req'd.		All Req'd.
202(4)	Removal and Disposal of Culvert Pipe	L.F.	167	492	309	20											988		988	
202(5)	Removal and Disposal of Manholes - Deleted (C.O. #2)	Ea.																±		±
203(3)	Unclassified Excavation	Cu. Yd.	7,834	8,666	8,666	4,634	2,000											31,800		31,800
301(1A)	Crushed Agg. Base Course, Rejected Asphalt	L.S.																All Req'd.		All Req'd.
203(5D)	Embankment	Cu. Yd.	6875	7472	7472	2,959	2,000											26,778		26,778
301(1)	Crushed Aggregate Base Course	Ton	647	727	738	446	131	132	132	62	131							3,146		3,146
304(1)	Subbase Grading A	Ton	1,152	1,282	1,292	632												4,358		4,358
401(1)	Hot Asphalt Pavement Class I - Deleted (E.W.O. #18)	Ton	282	317	317	203	46	46	46	23	38							1,318		1,318
401(2)	AC-5 Asphalt Cement - " " "	Ton	16.3	18.4	19.1	11.2	3	3	3	1.5	3.5							79		79
403(1)	MC-90 Liquid Asphalt for Prime Coat - Deleted	Ton																10.0		10.0
555(1)	Contractor Designed & Constructed Access Path	L.S.																All Req'd.		All Req'd.
603(21A)	Pipe Conduit Connection	Ea.			1													1		1
603(22C)	12" Pipe Conduit	L.F.		42	160													202		202
603(22E)	18" Pipe Conduit	L.F.	64	310	1002													1,376		1,376
603(22G)	24" Pipe Conduit	L.F.		529	87													616		616
603(22H)	30" Pipe Conduit	L.F.	661	123														784		784
604(1)	Storm Sewer Manhole	Ea.	1															1		1
604(2)	Sanitary Sewer Manhole	Ea.										1	1	1	5			7		7
604(3)	Reconstruct Existing Manhole	Ea.										1						1		1
604(4)	Adjust Existing Manholes	Ea.										1	3	2				6		6
604(5A)	Type A Curb Inlets	Ea.	1	2	7													10		10
604(5B)	Type B Curb Inlets	Ea.	3	3	1													7		7
628(12)	Connect New 8" D.I.W.C. to existing 6" Transite Water Main - L.S. - E.W.O. #17	L.S.																		All Req'd.
604(7A)	24" Pipe Conduit Inlets	Ea.		6	13													19		19
604(7B)	36" Pipe Conduit Inlets	Ea.		3														3		3
605(6)	Subsurface Underdrain	L.S.																All Req'd.		All Req'd.
607(4)	Fence Reconstruction - Deleted (C.O. #1)	L.F.			67													67		67
608(1A)	4" Sidewalk	Sq. Yd.									428	454	416	131				1,429		1,429
608(1B)	6" Sidewalk	Sq. Yd.									49	62	80	49				240		240
609(2)	Standard Curb and Gutter	L.F.	1,080	1,190	1,182	419											3,871		3,871	
614(1)	Survey Monuments	Ea.	1			1											2		2	
614(2)	Survey Monument Cases	Ea.	1			1											2		2	
615(1)	Standard Signs	Sq. Ft.	51.31	44.14	42.64	31.32					4						173.41		173.41	
618(1)	Seeding	MSF	6.8	6.6	5.2	2.3								5.9	3.2		30.0	70	100	
618(2)	Water for Maintenance	M. Gal.															30	70	100	
626(2A)	Repair 4" Sanitary Sewer Service (E.W.O. #1)	L.S.																		All Req'd.
621(2)	Replanting Fir Trees (E.W.O. #2)	L.S.																		All Req'd.
605(6A)	Subsurface Underdrain Special (E.W.O. #3)	Ea.																4		4
626(1B)	6" PVC Sewer Main	L.F.										86						86		86
626(1C)	8" Ductile Iron Sewer Main	L.F.										20	40	20	119			199		199
626(1D)	8" PVC Sewer Main	L.F.										45		295	486	436		1,262		1,262
626(1E)	6" PVC Sewer Services	L.F.										205	375	250	229			1,059		1,059
627(1)	Watering	M. Gal.																30		30
628(2B)	Relaying of Existing Water Main (E.W.O. #6)	L.F.																		443
628(2A)	8" Ductile Iron Water Conduit	L.F.										437	770	396	370	430		2,403		2,403
628(4)	Install Valve Box	Ea.										4	6	2	1			13		13
628(6)	Fire Hydrant Installation	Ea.											1	1				2		2
628(8)	Fire Hydrant Removal	Ea.											1	1				2		2
628(9A)	3/4" Water Service Connection	Ea.										12	14	10	4			40		40
628(9B)	1" Water Service Connection	Ea.												1				1		1
660(9)	Repair Electrical Conduits (E.W.O. #7)	L.S.																		All Req'd.
628(10A)	Install 8" Gate Valve	Ea.										4	6	2	1			13		13
628(11)	Adjustment of Valve Box	Ea.										1		1				2		2
635(1)	Insulation Board	M. B. M.										4.27	1.35	0.96	0.38			7		7
670(1)	Painted Traffic Markings	L.S.																All Req'd.		All Req'd.
670(6)	Thermoplastic Pavement Markings	L.S.																All Req'd.		All Req'd.
605(6B)	Subsurface French Drain (E.W.O. #8)	L.S.																		All Req'd.
628(2)	Relocate Existing Water Meters (E.W.O. #9)	Ea.																4		4
608(3)	Retaining Wall for 4" Sidewalk (E.W.O. #10)	L.S.																		All Req'd.
608(5)	8" Retaining Wall (E.W.O. #11)	L.S.																		"
203(10)	Regrading of Existing Driveways (E.W.O. #12)	L.S.																		"
603(22I)	Special Outlet for Storm Drain (E.W.O. #13)	L.S.																		"
603(35)	Extend Parking Lot Storm Drain (E.W.O. #15)	L.S.																		"
501(1A)	Concrete Price Adjustment (E.W.O. #4)	L.S.																		All Req'd.

MISCELLANEOUS SUMMARY TABLES

SUBSURFACE UNDERDRAIN, SPECIAL E.W.O. #3

STATION	PIPE LENGTH	SLOPE	REMARKS
54+00	8" x 30'	1.0%	Perforated Pipe
56+80	8" x 22'	1.0%	"
59+45	8" x 25'	1.5%	"
62+10	8" x 30'	1.0%	"

P.V.C. SEWER SERVICES

STATION	LENGTH	SIZE	OFFSET	REMARKS
L' 52+00		6"	Rt.	Abandon
L' 53+03 03	22' 15'	6"	Rt.	
L' 53+23 11	27' 25'	6"	Lt.	Capped
L' 53+33 31	26' 33'	6"	Lt.	
L' 53+69	23'	6"	Rt.	Capped
L' 53+92	23'	6"	Rt.	Deleted
L' 53+98	25'	6"	Lt.	
L' 54+53	24' 23'	6"	Rt.	
L' 55+07	10' 22'	6"	Lt.	Hook in at 2 nd St. 9+55
L' 55+51 52	25' 27'	6"	Lt.	Cap
L' 56+07	25'	6"	Lt.	Cap
L' 56+35 50	25' 23'	6"	Rt.	
L' 56+51 52	25'	6"	Lt.	Cap
L' 57+06 08	25'	6"	Rt.	Cap
L' 57+22 25	25'	6"	Lt.	Cap
L' 58+28 32	25' 29'	6"	Rt.	
L' 58+29	25'	6"	Lt.	
L' 58+86	25'	6"	Lt.	
L' 58+90	25' 22'	6"	Rt.	Capped
L' 59+41	25'	6"	Rt.	
L' 59+55 68	25'	6"	Lt.	
L' 60+44	25'	6"	Lt.	
L' 61+00 50	25' 20'	6"	Rt.	
L' 61+45 44	25'	6"	Lt.	
L' 61+85 99	25' 20'	6"	Rt.	
L' 62+33	25'	6"	Lt.	
L' 62+33 63+01	25' 21'	6"	Rt.	
L' 63+05 00	25' 23'	6"	Lt.	
L' 63+45 50	25' 24'	6"	Lt.	Cap
L' 64+00 63+75	25' 22'	6"	Rt.	
L' 64+25 27	25' 23'	6"	Lt.	
L' 64+33 37	25' 19'	6"	Rt.	
L' 65+44 25	25' 30'	6"	Lt.	
L' 65+47 27	25'	6"	Rt.	
L' 66+80 82	25'	6"	Lt.	
L' 66+81 88	25'	6"	Rt.	
L' 67+38	22'	6"	Rt.	
L' 68+25 21	25'	6"	Rt.	
L' 68+72 56	10' 18'	6"	Lt.	
L' 68+52	32' 16'	6"	Lt.	
L' 70+27 36	17' 20'	6"	Lt.	Cap
L' 70+49	50'	6"	Rt.	Cap
L' 71+24	35' 26'	6"	Lt.	Cap
L' 71+36	30' 32'	6"	Rt.	Cap

CURB CUT SUMMARY

STATION	WIDTH	LEFT	RIGHT	REMARKS
L' 51+24.00-23	14'		X	
L' 52+10.00-09	24'		X	
L' 53+44.00-13	14'		X	
L' 56+88.00-07	14'		X	
L' 58+63.00-62	14'		X	
L' 53+89.00	14'		X	Deleted
L' 59+25.00-29	14'		X	
L' 59+48.00-50	14'	X		
L' 60+43.00	14'		X	Deleted
L' 60+75.00	14'		X	
L' 61+80.00-79	14'		X	
L' 53+50	14'	X		
L' 61+92.00-89	14'	X		
L' 62+86.00	14'		X	Deleted
L' 63+57.00-38	14'		X	
L' 63+67.00-66	14'		X	
L' 64+05.00-03	14'	X		
L' 58+51	20'	X		
L' 64+26.00-65+25	14'	X	X	
L' 65+84.00-88'	14'		X	
L' 66+20.00	14'	X		
L' 66+66.00-67	14'	X		
L' 66+70.00-76	14'		X	
L' 61+15	14'	X		
L' 68+28.00-30	14'	X		
L' 68+63.00-59	14'	X		
L' 69+04.00-05	24'	X		
L' 69+25.00-18	34'		X	

PIPE CONDUIT SUMMARY

STATION	PIPE LENGTH				SLOPE	REMARKS
	12"	18"	24"	30"		
1st St. 13+37 03			61'	92'	2.00%	P-1A 2.36%
1st St. 10+35			36'	Subsurface Drain	+5.6%	Part. #1 1.11%
1st St. 10+35			225'	227'	15.64%	P-1 2.48%
L' 52+87			41'	33'	1.72%	P-2 2.80%
L' 52+88.5			252'	250'	1.85%	P-3
L' 55+36 40			34'	145'	1.00%	P-4A 0.20%
L' 55+43 46			30'	32'	1.90%	P-4 2.40%
L' 55+40.5			186'	184'	3.26%	P-5
L' 57+28.26			68'	70'	1.00%	P-6
3rd St. 10+50			38'	42'	2.37%	P-7 3.52%
L' 57+26.5				64'	2.72%	P-8
3rd St. 9+44 65 437			58'	57'	0.74%	P-9 1.00%
3rd St. 9+30 32			64'		0.67%	P-10 1.30%
L' 57+93.3			30'	32'	2.00%	P-11 2.10%
L' 57+90.5			248'	250'	2.02%	P-12 2.04%
L' 58+82			42'	43'	13.68%	P-13 12.10%
4th St. 10+50 51			38'	41'	1.00%	P-14 1.10%
L' 60+46			42'	43'	1.00%	P-15 4.80%
L' 60+43.3			30'	32'	1.00%	P-16 1.40%
L' 60+39				184'	2.95%	P-17 2.86%
L' 62+28.08			58'	52'	1.76%	P-18 3.10%
L' 62+25			32'	34'	1.00%	P-19 2.30%
5th St. 9+50			38'	40'	1.32%	P-20
5th St. 10+40			42'	45'	3.10%	P-21 3.60%
L' 60+39			36'		2.00%	P-29 2.70%
L' 62+26 23			62'	67'	2.26%	P-22 1.97%
L' 62+93.30			30'	32'	2.00%	P-23 2.80%
L' 62+90.5			184'	187'	5.03%	P-24 4.94%
L' 62+97.5					2.61%	P-25 8.10%
L' 63+51			66'	68'	7.73%	P-26 5.40%
L' 63+87			6" x 77'	PVC	10.00%	P-38 PVC 2.00%
L' 64+78.14			68'	-10'	2.54%	P-27 4.30%
L' 64+76.5			64'		3.42%	P-28 5.20%
6th St. 10+50			38'	36'	2.00%	P-29 4.10%
L' 65+39			34'	36'	1.76%	P-30 1.50%
L' 65+43.30			30'	32'	2.00%	P-31 4.80%
L' 65+40.5			248'	251'	2.19%	P-32 2.70%
L' 66+05			16'	10'	12.44%	P-33 16.9%
L' 66+31			24'	10'	3.33%	P-34 17.2%
7th St. 9+50			38'	40'	1.95%	P-35 1.10%
L' 67+89			32'		2.00%	P-36 1.10%
L' 67+89			30'	32'	1.00%	P-37
L' 57+25			21'		1.12%	P-9A

PIPE CONDUIT REMOVAL

STATION	LINEAR FEET	OFFSET	
		LEFT	RIGHT
L' 51+23.00	20'		16.5'
L' 52+85.00 51	5' 15'		17.5' 15'
L' 53+02.00	5' 20'	18'	17'
L' 53+15.00 52+50	16' 20'	18'	17.5'
L' 53+38.00 = 52+67.5	5' 15'		17.5' 15'
L' 53+89.00	42' 48'	15'	
L' 53+65.00 Not Removed	8'	18.7'	
L' 53+92.00 Not Removed	6'	18.2'	
L' 54+22.00 Not Removed	4'		17.5'
L' 56+07.00 10	20'		15.4' 16'
L' 56+24.00 28	7'		14.2' 15'
L' 57+07.00 Not Removed	56'	27.5'	
L' 57+34.00	56' 57'	40'	16.3'
L' 57+57.00 Not Removed	720'	35'	
L' 57+58.00	38'		18.2'
L' 58+10.00	9'	16'	
L' 58+30.00	9' 8'		16.3'
L' 53+13	16'	18'	
L' 58+64.00	17'		16.1'
L' 58+88.00	9'	16'	
L' 59+24.00	32' 29'		16.6'
L' 59+48.00	22'	15.8'	
L' 60+07.00	48'		18.3'
L' 60+44.00	26' 25'	16'	
L' 60+76.00	24' 25'		18.8'
L' 61+58.00	8' 5'	15.8'	
L' 61+79.00	20'		17'
L' 61+95.00 90	27' 26'	16.2'	
L' 62+75.00	12' 15'	17' to 32'	
L' 62+69.00 67	32' 53'	15.4' 16'	
L' 63+02.00 03	6' 5'		18'
L' 63+02.00 03	5'	16.5'	
L' 63+40.00	26'		18'
L' 63+67.00	16'		18'
L' 64+08.00 05	29'	17'	
L' 64+26.00 54	17'		17.8'
L' 65+06.00	32' 33'		21.8' 21'
L' 65+08.00	27' 25'	15.4' 16'	
L' 65+62.00	5'		17.2'
L' 65+87.00	20'		16.6'
L' 66+22.00	20'	15.6'	
L' 66+66.00	22' 20'	14.5'	
L' 66+70.00 Not Removed	-20'		-18.8'
L' 68+28.00 25	20' 23'	17.5' 18'	

MANHOLE SUMMARY

STATION	OFFSET	REMARKS
L' 52+57	1' 2.5' Rt.	Reconstruct
L' 55+07	£	Adjust
L' 57+39	10' Rt.	
L' 57+57	£	
L' 60+07	£	
L' 62+57	£	
L' 65+07	£	Reconstruct
L' 67+04	£	Remove - Deleted (C.O.#2)
L' 67+57	£	Install
L' 70+07	22' Lt.	
L' 74+09	25.5' Rt.	
L' 75+10	45.5' Rt.	
L' 76+61	45.5' Rt.	
L' 77+81 78+05	45.5' Rt. 70' Rt.	
L' 78+07	16' Lt. 11'	
L' 59+94	£	Adjusted

MONUMENT SUMMARY

STATION	INSTALL		REMARKS
	MONUMENT	CASE	
L' 54+00.00	X	X	P.O.T.
L' 69+49.15	X	X	P.C.

SLOPE LIMITS

STATION	LEFT	RIGHT
L' 50+50	24'	24'
L' 51~	24'	21'
L' 51+50	25'	23'
L' 52~	25'	23'
L' 52+57.13		23'
L' 53~	25'	22'
L' 53+50	25'	23'
L' 54~	25'	23'
L' 54+50	25'	25'
L' 55+50	32'	25'
L' 56~	32'	25'
L' 56+50	33'	25'
L' 57~	31'	25'
L' 58~	25'	24'
L' 58+50	25'	23'
L' 59~	25'	21'
L' 59+50	29'	25'
L' 60+50	25'	25'
L' 61~	25'	24'
L' 61+50	25'	24'
L' 62~	25'	23'
L' 62+57.13		22'
L' 63~	25'	23'
L' 63+50	25'	23'
L' 64~	25'	21'
L' 64+50	25'	20'
L' 65+50	25'	22'
L' 66~	25'	20'
L' 66+50	25'	22'
L' 67~	25'	23'
L' 67+07.13		24'
L' 68~	27'	32'
L' 68+50	28'	20'
L' 69~	29'	21'
L' 69+50	35'	22'

SEWER MAIN SUMMARY

SIZE	L.F.	TYPE	STATION	OFFSET	REMARKS
8"	54'	PVC.</			

MISC. SUMMARY TABLES

NOTE: See plan sheets 26-32 for utilities installation details.

WATER MAIN APPURTENANCES		
STATION	OFFSET	REMARKS
L 50+55	20 Lt	Adjust Valve Box
L 50+98-51+12	Rt	Install 3/4" W.S.
L 51+98 43	Rt 5'	8" x 6" Reducer
L 52+44 50	Rt 10'	8" GV/V.B.
L 52+51-52	Rt 10'	8" x 8" x 8" T.
L 52+51-52	Rt 15'	8" GV/V.B.
L 52+95	Lt.	3/4" W.S. & Cap for future use
L 53+04 03	Rt.	3/4" W.S.
L 53+66 66	Lt.	3/4" W.S.
L 53+71	Rt Lt.	3/4" W.S.
L 53+95	Rt.	3/4" W.S. & Cap for future use
L 53+95	Lt.	3/4" W.S.
L 54+40	Rt.	3/4" W.S.
L 54+95 82	Lt.	3/4" W.S.
L 55+14	15 Rt.	8" GV/V.B.
L 55+17	15 Rt.	8" x 8" x 8" T.
L 55+17	Rt 17.5'	8" GV/V.B.
L 55+81	Rt.	3/4" W.S. & Cap for future use
L 55+81	Lt.	3/4" W.S. & Cap for future use
L 56+46 51	Rt.	3/4" W.S.
L 56+82	Lt.	3/4" W.S. & Cap for future use
L 57+12	Rt.	3/4" W.S. & Cap for future use
L 57+70 69	15 Rt.	8" GV/V.B.
L 57+72 70.5	15 Rt.	8" x 8" Cross
L 57+72 70.5	Rt 12'	8" GV/V.B.
L 57+72 70.5	Rt 18'	8" GV/V.B.
L 57+72 58+18	27 Lt.	3/4" W.S.
L 57+86 85	Rt.	3/4" W.S.
L 58+12 11	Rt.	3/4" W.S.
L 58+99	Lt.	3/4" W.S.
L 60+75	16 Rt.	8" GV/V.B.
L 59+06 09	Rt.	3/4" W.S.
L 59+41 42	Rt.	3/4" W.S.
L 60+77	15 Rt.	8" GV/V.B.
L 59+67 63	Rt Lt.	3/4" W.S.
L 60+75 17.5	15 Rt.	8" GV/V.B.
L 60+77 19.8	15 Rt.	8" x 8" Cross
L 60+77 19.8	Rt 17.5'	8" GV/V.B.
L 60+77 19.8	38 Rt.	8" x 8" 45° Elbow
L 60+36	Lt.	1" W.S.
L 60+26	47 Rt.	8" x 8" 45° Elbow
L 60+77 19.8	Rt 12.5'	8" GV/V.B.
L 60+17	38 Lt.	1" W.S. Deleted
L 60+49 53	Lt.	3/4" W.S.
L 61+23 24	Rt.	3/4" W.S.
L 61+68	Lt.	3/4" W.S.
L 61+95	Rt.	3/4" W.S.
L 62+16	Rt.	3/4" W.S.
L 60+20	Lt.	3/4" W.S.
L 62+74.8	15 Rt.	8" x 8" x 8" T.
L 62+74.8	Rt 12.5'	8" GV/V.B.
L 62+95 63+08	Lt.	3/4" W.S.
L 63+07 08	Rt.	3/4" W.S.
L 63+81	Rt.	3/4" W.S. ERROR IN PLANS, DELETED
L 63+55 61	Lt.	3/4" W.S. & Cap for future use
L 63+91 90	Rt.	3/4" W.S.
L 64+24 31	Lt.	3/4" W.S.
L 67+75	20 Rt.	Adjust Valve Box - Removed Under W.C. #16
L 64+51 53	Rt.	3/4" W.S. Capped
L 65+28	Rt 15'	8" GV/V.B.
L 65+39 58	Lt.	3/4" W.S.
L 65+44 38	Rt.	3/4" W.S.
L 66+44 86	Lt.	3/4" W.S.
L 66+94	Rt.	3/4" W.S.
L 68+50 45	Lt.	3/4" W.S.
L 68+73 83	Lt.	3/4" W.S.
L 70+25 28	11 Rt.	8" GV/V.B.
L 70+44 48	Rt.	3/4" W.S.
L 71+37 35	Rt.	3/4" W.S.
L 77+73 93	35 Rt 28'	65° Elbow 8" x 8" x 8" TEE

D.I. WATER MAIN INSTALLATION SUMMARY				
SIZE	L.F.	STATION	OFFSET	REMARKS
8"	77/152'	From L 51+98	10' Rt.	Connect to 8" x 6" Reducer
		To L 52+75	11' Rt.	Install at 15' Rt. And.
8"	10'	From L 52+51	12.5' Rt.	Connect to T
		To L 52+51	25' Rt.	Connect to Exist 6" Transite w/ 8" x 6" Reducer (See E.W.O.#17)
8"	12.6/16'	From L 52+75	77' Rt.	End Taper to 15' Rt. @ 54+89
		To L 65+36	23' Rt.	Connect to Existing 8" D.I.W.C. See E.W.O.#6
8"	25'	From L 55+16	17' Rt.	" to T
		To L 55+16	17' Rt.	" to Existing w/ 8" x 6" Reducer
8"	61'	From L 57+72	70.5' Rt.	" to Cross
		To L 57+72	70.5' Rt.	" to Existing 6" A.C. w/ 8" x 6" Reducer
8"	34'	From L 57+72	70.5' Rt.	" to Cross
		To L 57+72	70.5' Rt.	" to Existing 6" w/ 8" x 6" Reducer
8"	56'	From L 60+17	20' Rt.	" to Cross
		To L 60+17	20' Rt.	Cap for future use
8"	32'	From L 60+17	20' Rt.	Connect to Cross
		To L 60+26	47' Rt.	" to Existing 6" w/ 8" x 6" Reducer
8"	63.5'	From L 62+74	75' Rt.	" to T
		To L 62+74	75' Rt.	" to Existing 6" Transite w/ 8" x 6" Reducer
8"	76'	From L 70+24	11' Rt.	" to Existing T
		To L 77+73	93' Rt.	" to 65° Elbow 8" x 8" x 8" TEE
8"	53'	From L 77+73	93' Rt.	"
		To L 78+00	11' Rt.	Cap for future use
8"	13'	From L 69+25	16' Rt.	"

FIRE HYDRANT SUMMARY			
INSTALL		REMOVE	
STATION	OFFSET	STATION	OFFSET
L 57+28	21' Rt.	L 57+28	19' Rt.
L 62+28	27' Rt.	L 62+79	27' Rt.

CONCRETE ENCASED SEWER			
STATION TO STATION	LENGTH	REMARKS	TYPE
54+82	55+02	20'	THIS INSTALLATION NOT REQUIRED
57+39	58+00	20'	E TO 20' RT. - ENCL. D.T. LEFT TO PLACE - 10' P.V.C. -

- NOTE:
- Concrete encasement shall be 10' each side of intersecting water and sewer mains.
 - Contractor has the option of using Ductil Iron Conduit Pipe or Concrete Encasement.
 - Encasement shall be incidental to waterline const.

SIGNING SCHEDULE

NO.	STATION	OFFSET		CODE	LEGEND	SIZE	SIGN THICKNESS		AREA SQ. FT.	NO. OF POSTS	TYPE	SIZE	TOTAL LENGTH	EMBED.	FACING TRAFFIC	REMARKS
		LEFT	RIGHT				Framed	Unframed								
1	L 50+53	23.5'		D3-1	MAIN ST.	36"x8"		.063	2.0						EB	
2	L 50+53	23.5'		D3-1	H ST.	24"x8"		.063	1.33						N# SB	Install below # 1
3	L 50+53	23.5'		R1-1	STOP	30"x30"		.063	6.25	1	TUBE	2"	14.5'	3.5'	WB	Install below # 2
4	L 51+40 45		17.5'	R7-1B	NO PARKING ANYTIME ←	12"x18"		.063	1.5	1	TUBE	2"	12'	3.5'	EB	
5	L 51+60	24'		14-4	FERRY	24"x30"		.063	5.0	1	TUBE	2"	14'	3.5'	WB	
6	L 51+60	24'		D7-L	←	24"x6"		.063	1.0						WB	Install below # 5
7	L 51+90		17.5'	R2-1	SPEED LIMIT 25	18"x24"		.063	3.0	1	TUBE	2"	13.5'	3.5'	EB	
8	L 52+38	33'		D3-1	H ST.	24"x8"		.063	1.33						SB	
9	L 52+38	33'		D3-1	N. 1ST. ST.	42"x8"		.063	2.33						E#WB	Install below # 8
10	L 52+38	33'		R1-1	STOP	30"x30"		.063	6.25	1	TUBE	2"	14.5'	3.5'	SB	Install below # 9
11	L 53+80		17.5'	R7-1B	NO PARKING ANYTIME ←	12"x18"		.063	1.5	1	TUBE	2"	12'	3.5'	EB	
12	L 54+88	33'		D3-1	H ST.	24"x8"		.063	1.33						SB	
13	L 54+88	33'		D3-1	N. 2ND ST.	42"x8"		.063	2.33						E#WB	Install below # 12
14	L 54+88	33'		R1-1	STOP	30"x30"		.063	6.25	1	TUBE	2"	14.5'	3.5'	SB	Install below # 13
15	L 55+26		25'	D3-1	H ST.	24"x8"		.063	1.33						NB	
16	L 55+26		25'	D3-1	S. 2ND ST.	42"x8"		.063	2.33						E#WB	Install below # 15
17	L 55+26		25'	R1-1	STOP	30"x30"		.063	6.25	1	TUBE	2"	14.5'	3.5'	NB	Install below # 16
18	L 56+32		17.5'	R7-1B	NO PARKING ANYTIME ←	12"x18"		.063	1.5	1	TUBE	2"	12'	3.5'	EB	
19	L 57+38	33'		D3-1	H ST.	24"x8"		.063	1.33						SB	
20	L 57+38	33'		D3-1	N. 3RD ST.	42"x8"		.063	2.33						E#WB	Install below # 19
21	L 57+38	33'		R1-1	STOP	30"x30"		.063	6.25	1	TUBE	2"	14.5'	3.5'	SB	Install below # 20
22	L 57+78		30'	D3-1	H ST.	24"x8"		.063	1.33						NB	
23	L 57+78		30'	D3-1	S. 3RD ST.	42"x8"		.063	2.33						E#WB	Install below # 22
24	L 57+78		30'	R1-1	STOP	30"x30"		.063	6.25	1	TUBE	2"	14.5'	3.5'	NB	Install below # 23
25	L 58+80 86		17.5'	R7-1B	NO PARKING ANYTIME ←	12"x18"		.063	1.5	1	TUBE	2"	12'	3.5'	EB	
26	L 59+88	33'		D3-1	H ST.	24"x8"		.063	1.33						SB	
27	L 59+88	33'		D3-1	N. 4TH ST.	42"x8"		.063	2.33						E#WB	Install below # 26
28	L 59+88	33'		R1-1	STOP	30"x30"		.063	6.25	1	TUBE	2"	14.5'	3.5'	SB	Install below # 27
29	L 60+26		30'	D3-1	H ST.	24"x8"		.063	1.33						NB	
30	L 60+26		30'	D3-1	S. 4TH ST.	42"x8"		.063	2.33						E#WB	Install below # 29
31	L 60+26		30'	D3-1	STOP	30"x30"		.063	6.25	1	TUBE	2"	14.5'	3.5'	NB	Install below # 30
32	L 61+32		17.5'	R7-1B	NO PARKING ANYTIME ←	12"x18"		.063	1.5	1	TUBE	2"	12'	3.5'	EB	
33	L 62+38	33'		D3-1	H ST.	24"x8"		.063	1.33						SB	
34	L 62+38	33'		D3-1	N. 5TH ST.	42"x8"		.063	2.33						E#WB	Install below # 33
35	L 62+38	33'		R1-1	STOP	30"x30"		.063	6.25	1	TUBE	2"	14.5'	3.5'	SB	Install below # 34
36	L 63+82 85		17.5'	R7-1B	NO PARKING ANYTIME ←	12"x18"		.063	1.5	1	TUBE	2"	12'	3.5'	EB	
37	L 64+88	33'		D3-1	H ST.	24"x8"		.063	1.33						SB	
38	L 64+88	33'		D3-1	N. 6TH ST.	42"x8"		.063	2.33						E#WB	Install below # 37
39	L 64+88	33'		R1-1	STOP	30"x30"		.063	6.25	1	TUBE	2"	14.5'	3.5'	SB	Install below # 38
40	L 65+26		30'	D3-1	H ST.	24"x8"		.063	1.33						NB	
41	L 65+26		30'	D3-1	S. 6TH ST.	42"x8"		.063	2.33						E#WB	Install below # 40
42	L 65+26		30'	R1-1	STOP	30"x30"		.063	6.25	1	TUBE	2"	14.5'	3.5'	NB	Install below # 41
43	L 66+32		17.5'	R7-1B	NO PARKING ANYTIME ←	12"x18"		.063	1.5	1	TUBE	2"	12'	3.5'	EB	
44	L 67+38	33'		D3-1	H ST.	24"x8"		.063	1.33						SB	
45	L 67+38	33'		D3-1	N. 7TH ST.	42"x8"		.063	2.33						E#WB	Install below # 44
46	L 67+38	33'		R1-1	STOP	30"x30"		.063	6.25	1	TUBE	2"	14.5'	3.5'	SB	Install below # 45
47	L 68+82		17.5'	R7-1B	NO PARKING ANYTIME ←	12"x18"		.063	1.5	1	TUBE	2"	12'	3.5'	EB	
48	L 69+85	38'		D3-1	H ST.	24"x8"		.063	1.33						SB	
49	L 69+85	38'		D3-1	N. 8TH ST.	42"x8"		.063	2.33						E#WB	Install below # 48
50	L 69+85	38'		R1-1	STOP	30"x30"		.063	6.25	1	TUBE	2"	14.5'	3.5'	SB	Install below # 49
51	L 70+29		30'	D3-1	H ST.	24"x8"		.063	1.33						NB	
52	L 70+29		30'	D3-1	S. 8TH ST.	42"x8"		.063	2.33						E#WB	Install below # 51
53	L 70+29		30'	R1-1	STOP	30"x30"		.063	6.25	1	TUBE	2"	14.5'	3.5'	NB	Install below # 52
54	L 70+50	18'		R2-1	SPEED LIMIT 25	18"x24"		.063	3.00	1	TUBE	2"	13.5'	3.5'	WB	
55	L 71+00		28'	R2-1	SPEED LIMIT 35	18"x24"		.063	3.00	1	TUBE	2"	13.5'	3.5'	EB	
56	L 73+10		27'	R5-3	NO MOTOR VEHICLES	24"x24"		.063	4.00	1	TUBE	2"	12.5'	3.5'	EB	
57	L 100+47		20'	R5-3	NO MOTOR VEHICLES	24"x24"		.063	4.00	1	TUBE	2"	12.5'	3.5'	WB	



MISC. SUMMARY TABLES

SIGNING NOTES
 1. Sleeve type w/ concrete foundation embankment as shown in Standard Drawing S-30.11 shall be used for all signs.
 2. Sign post lengths are approx. only & for estimating purposes only.


STATE	PROJECT DESIGNATION	YEAR	SHEET NO.	TOTAL SHEETS
ALASKA	RS-0938 (I)	1979	7	34

HORIZONTAL CONTROL: Bearings for this project are based on U.S.C. & G.S. triangulation stations "USE" #8 & "USE" #4 (Scale Factor = 99990608)

VERTICAL CONTROL: Vertical control was derived from U.S.C. & G.S. benchmark #10, a standard disc stamped No. 10 (1958) set in S.E. curb of Main St. approx. one half foot above street level, at the intersection of Main St. & "D" St. U.S.C. & G.S. Elev. = 24.12.

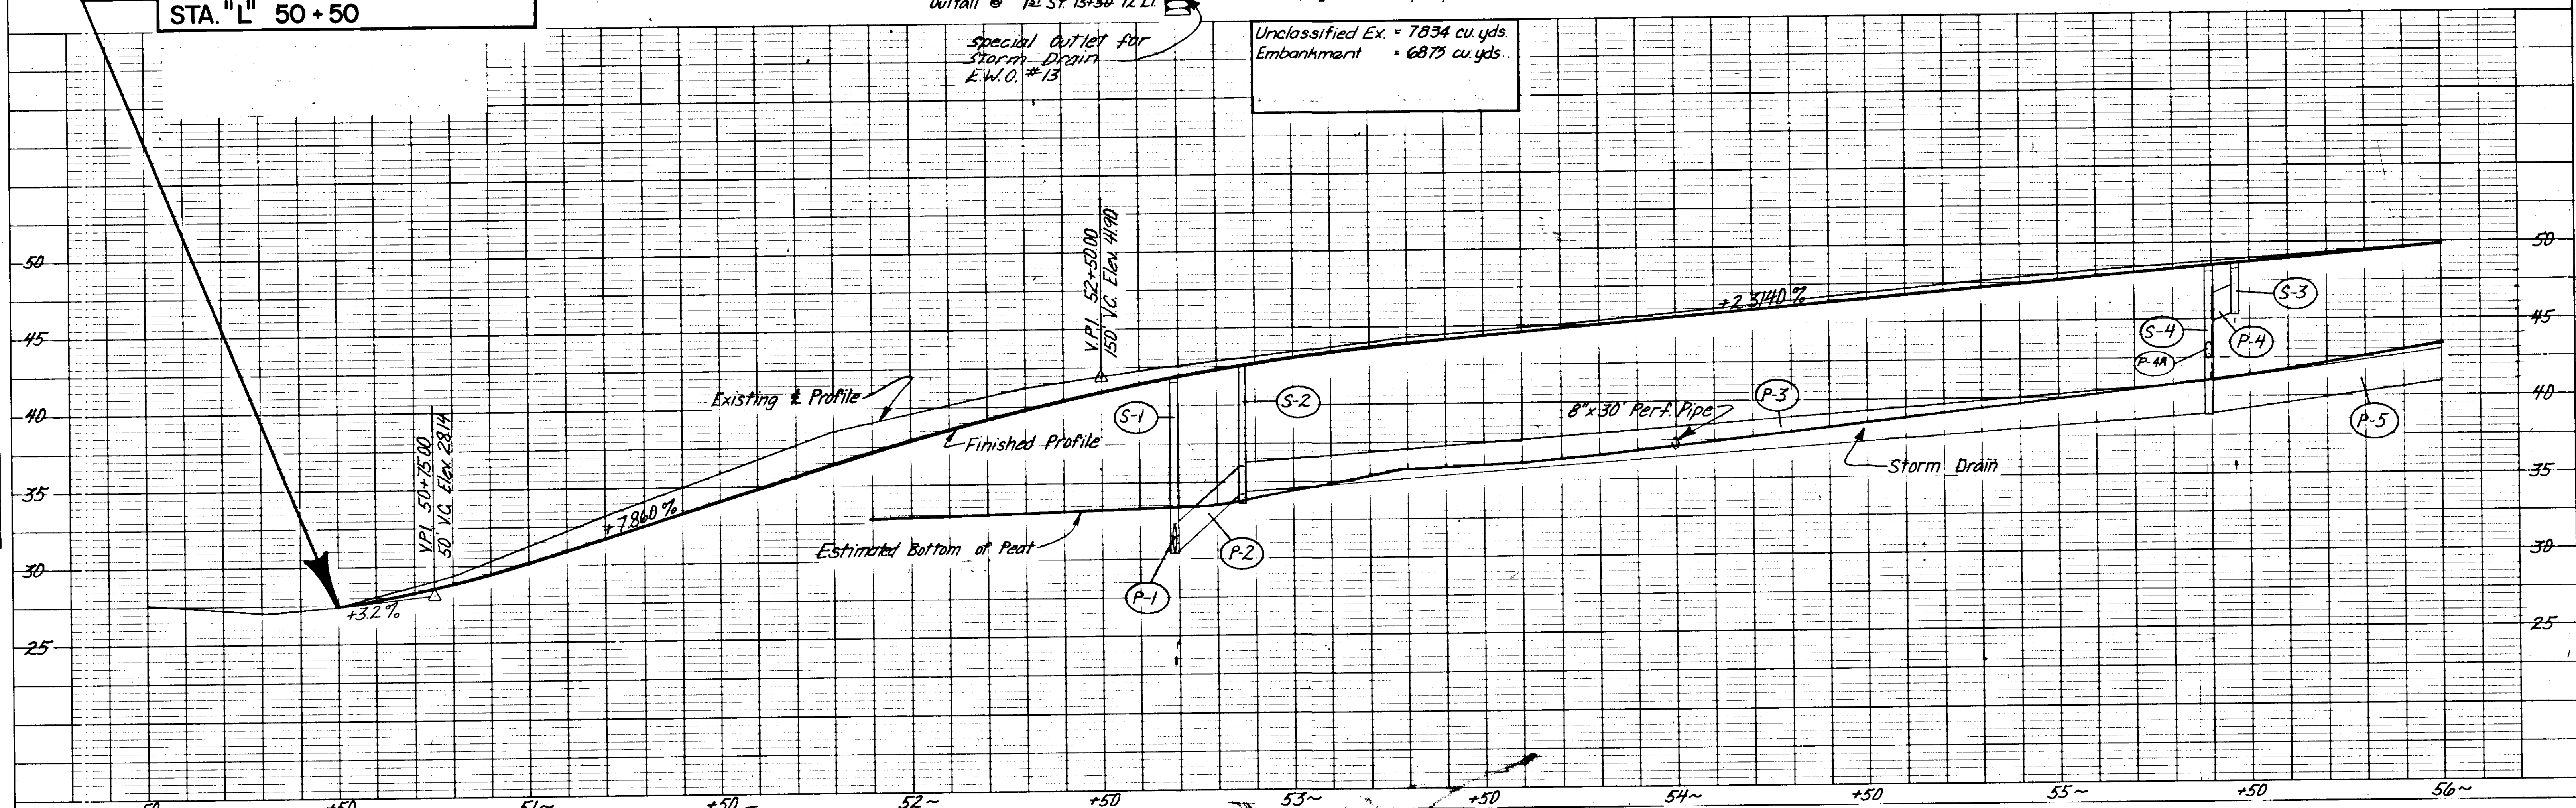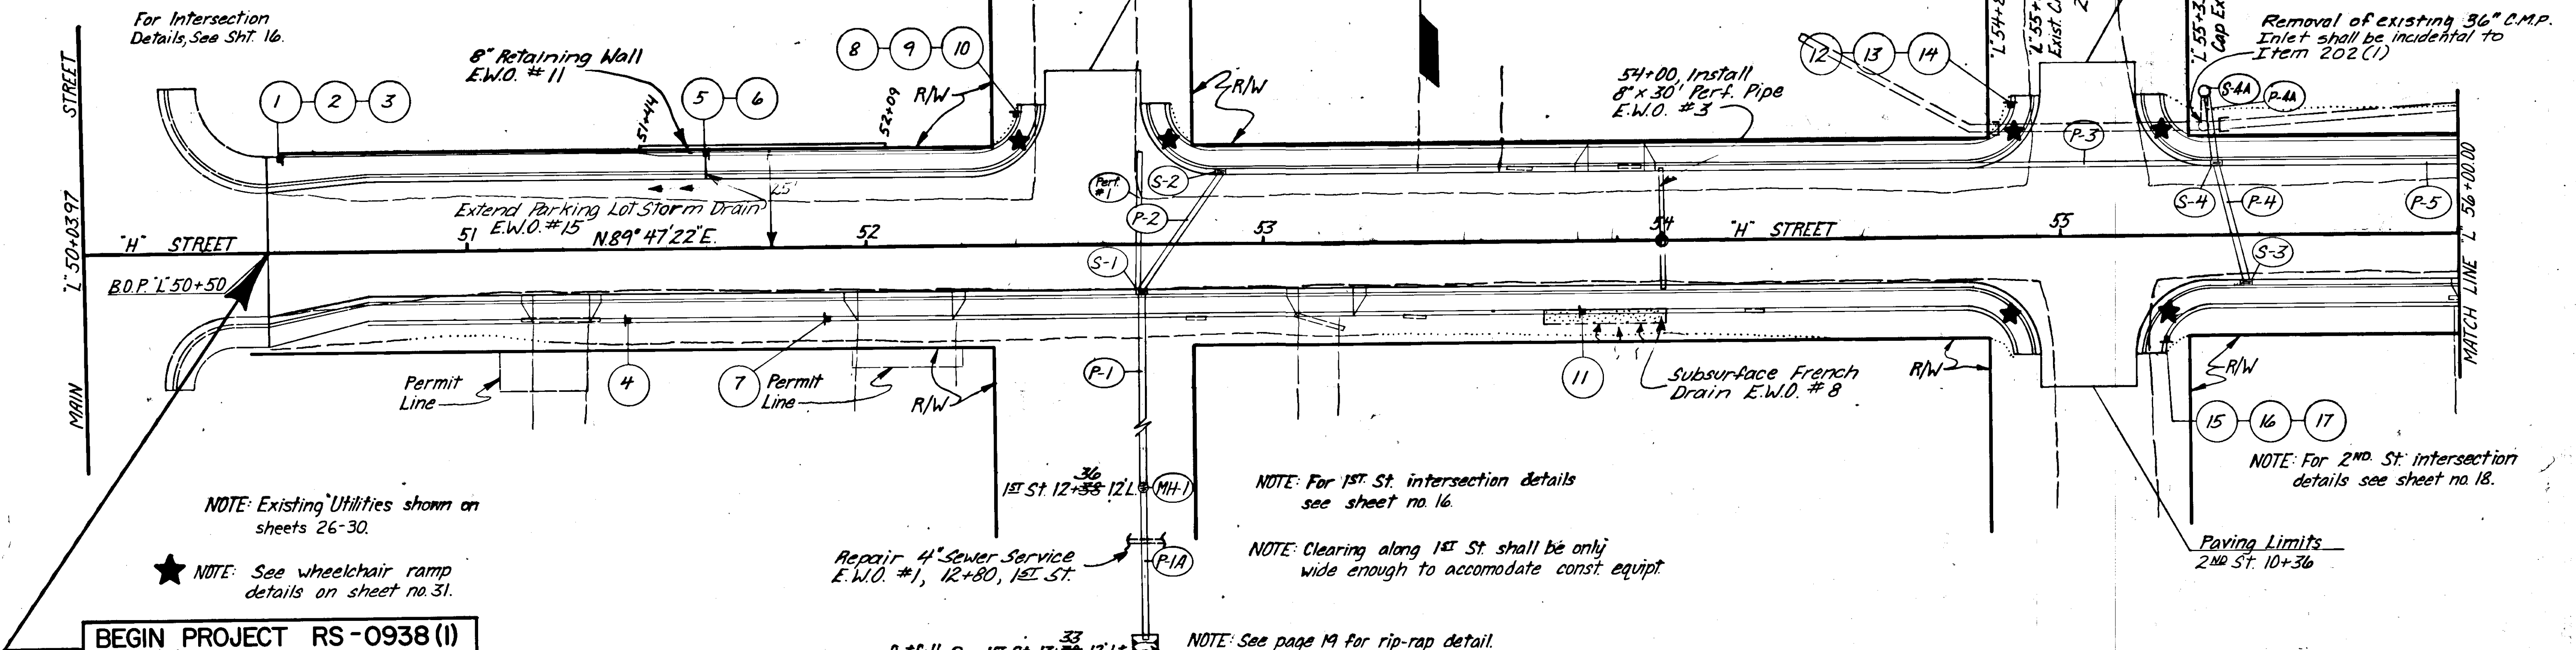

STATE	PROJECT DESIGNATION	YEAR	SHEET NO.	TOTAL SHEETS
ALASKA	RS-0938(I)	1979	8	34

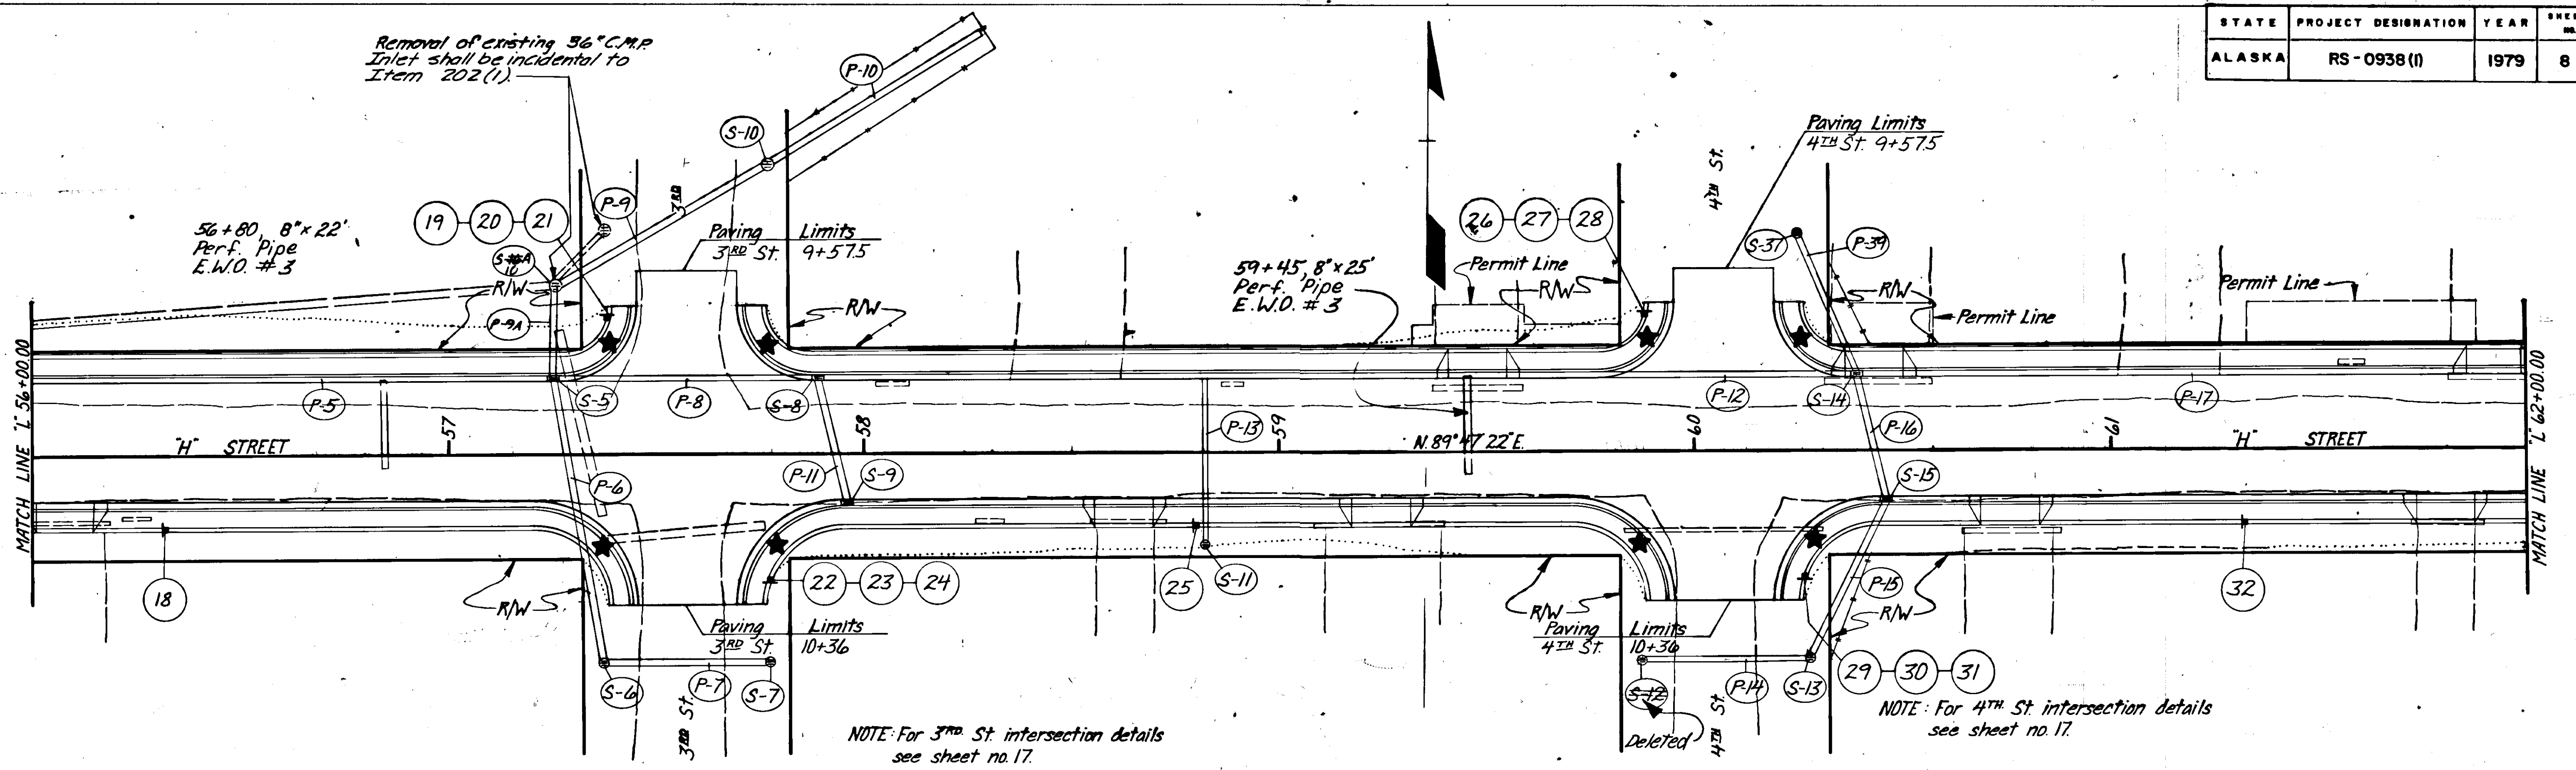


★ NOTE: See wheelchair ramp details on sheet no. 31.


NOTE: For 3rd St intersection details see sheet no. 17.

NOTE: For 4th St intersection details see sheet no. 17.

Unclassified Exc. = 8666 cu. yds.
Embankment = 7472 cu. yds.

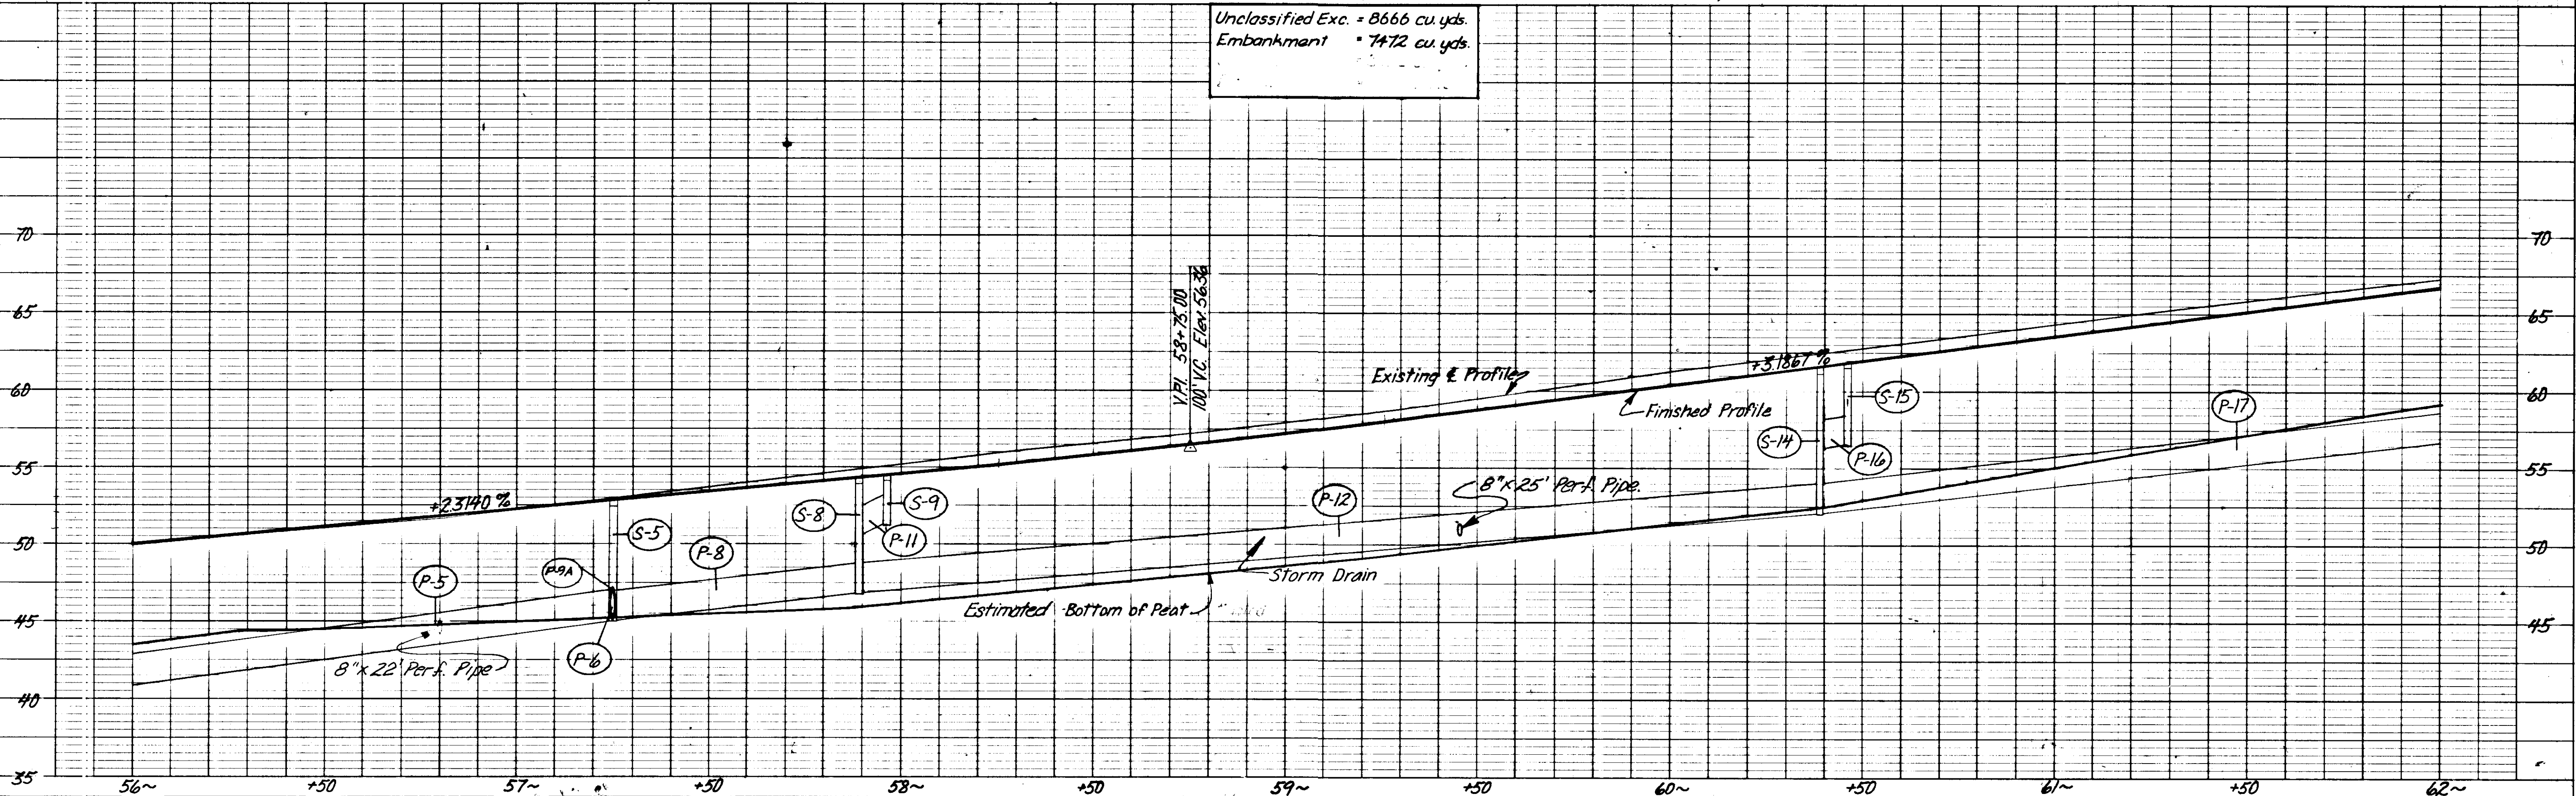

STATE	PROJECT DESIGNATION	YEAR	SHEET NO.	TOTAL SHEETS
ALASKA	RS-0938 (I)	1979	9	34

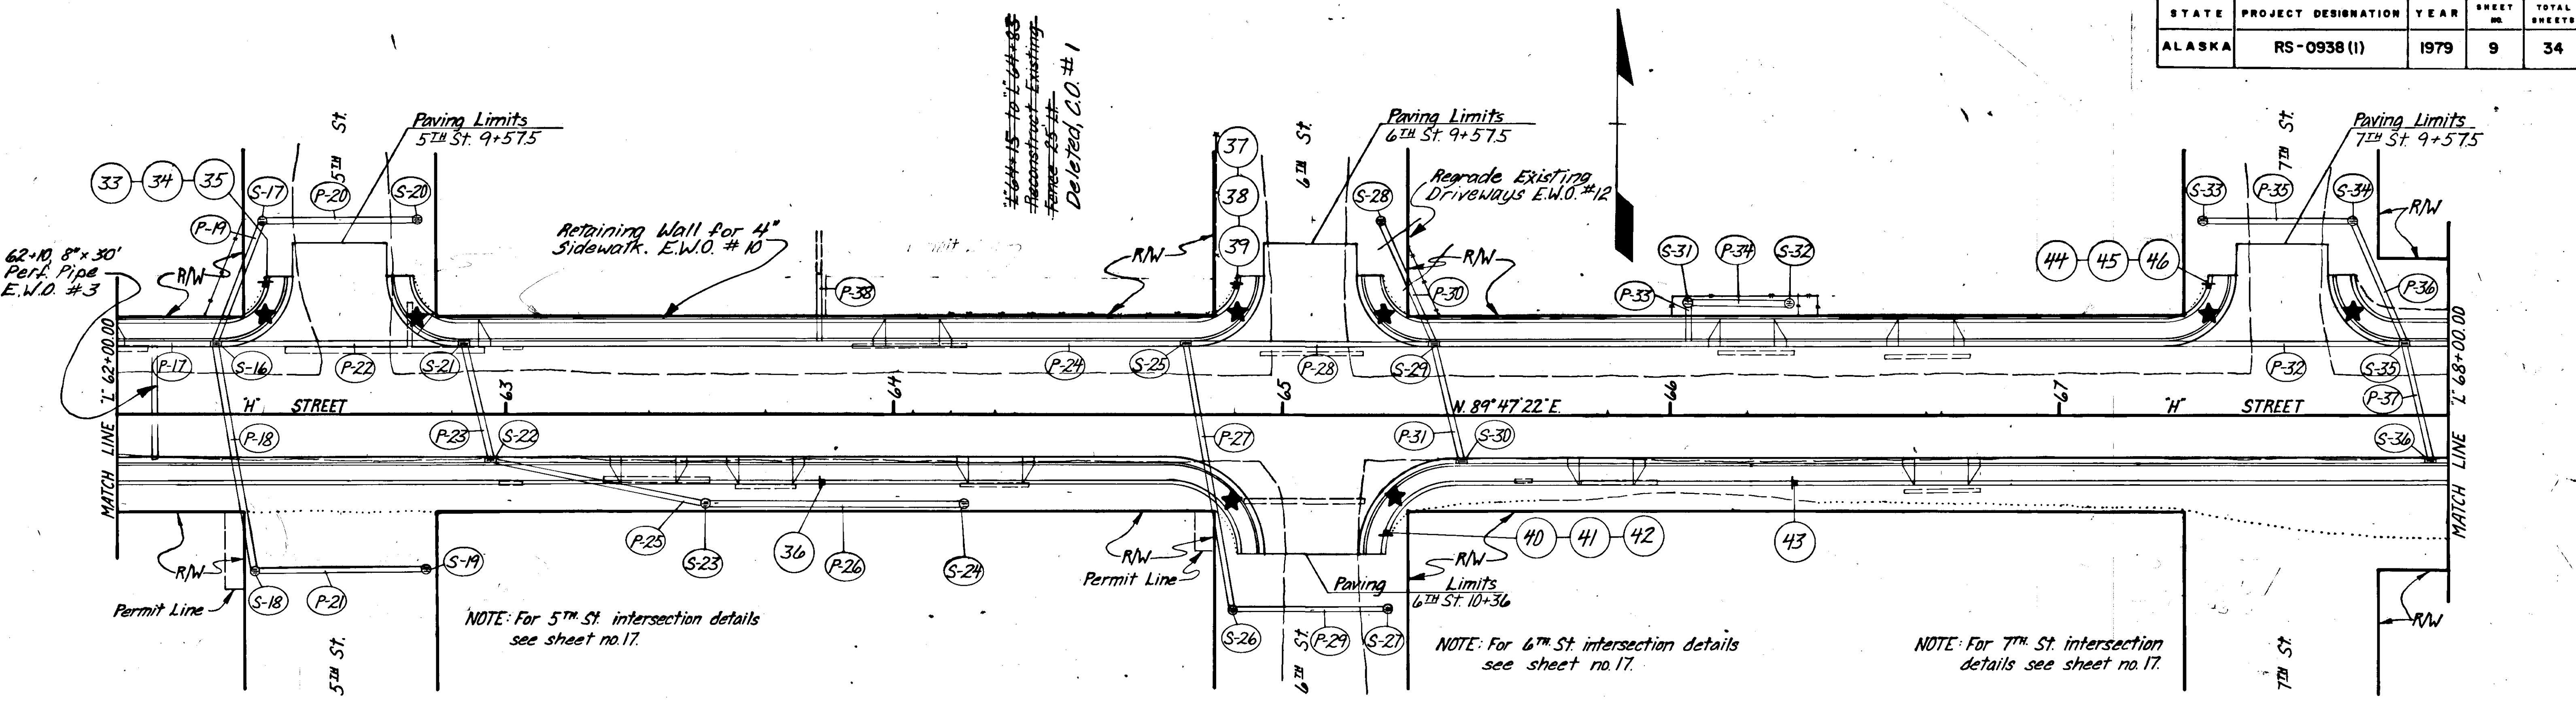


NOTE: For 5th St. intersection details see sheet no.17.

NOTE: For 6th St. intersection details see sheet no.17.

NOTE: For 7th St. intersection details see sheet no.17.


★ NOTE: See wheelchair ramp details on sheet no.31.

Unclassified Exc. = 8666 cu.yds.
Embankment = 7472 cu.yds.

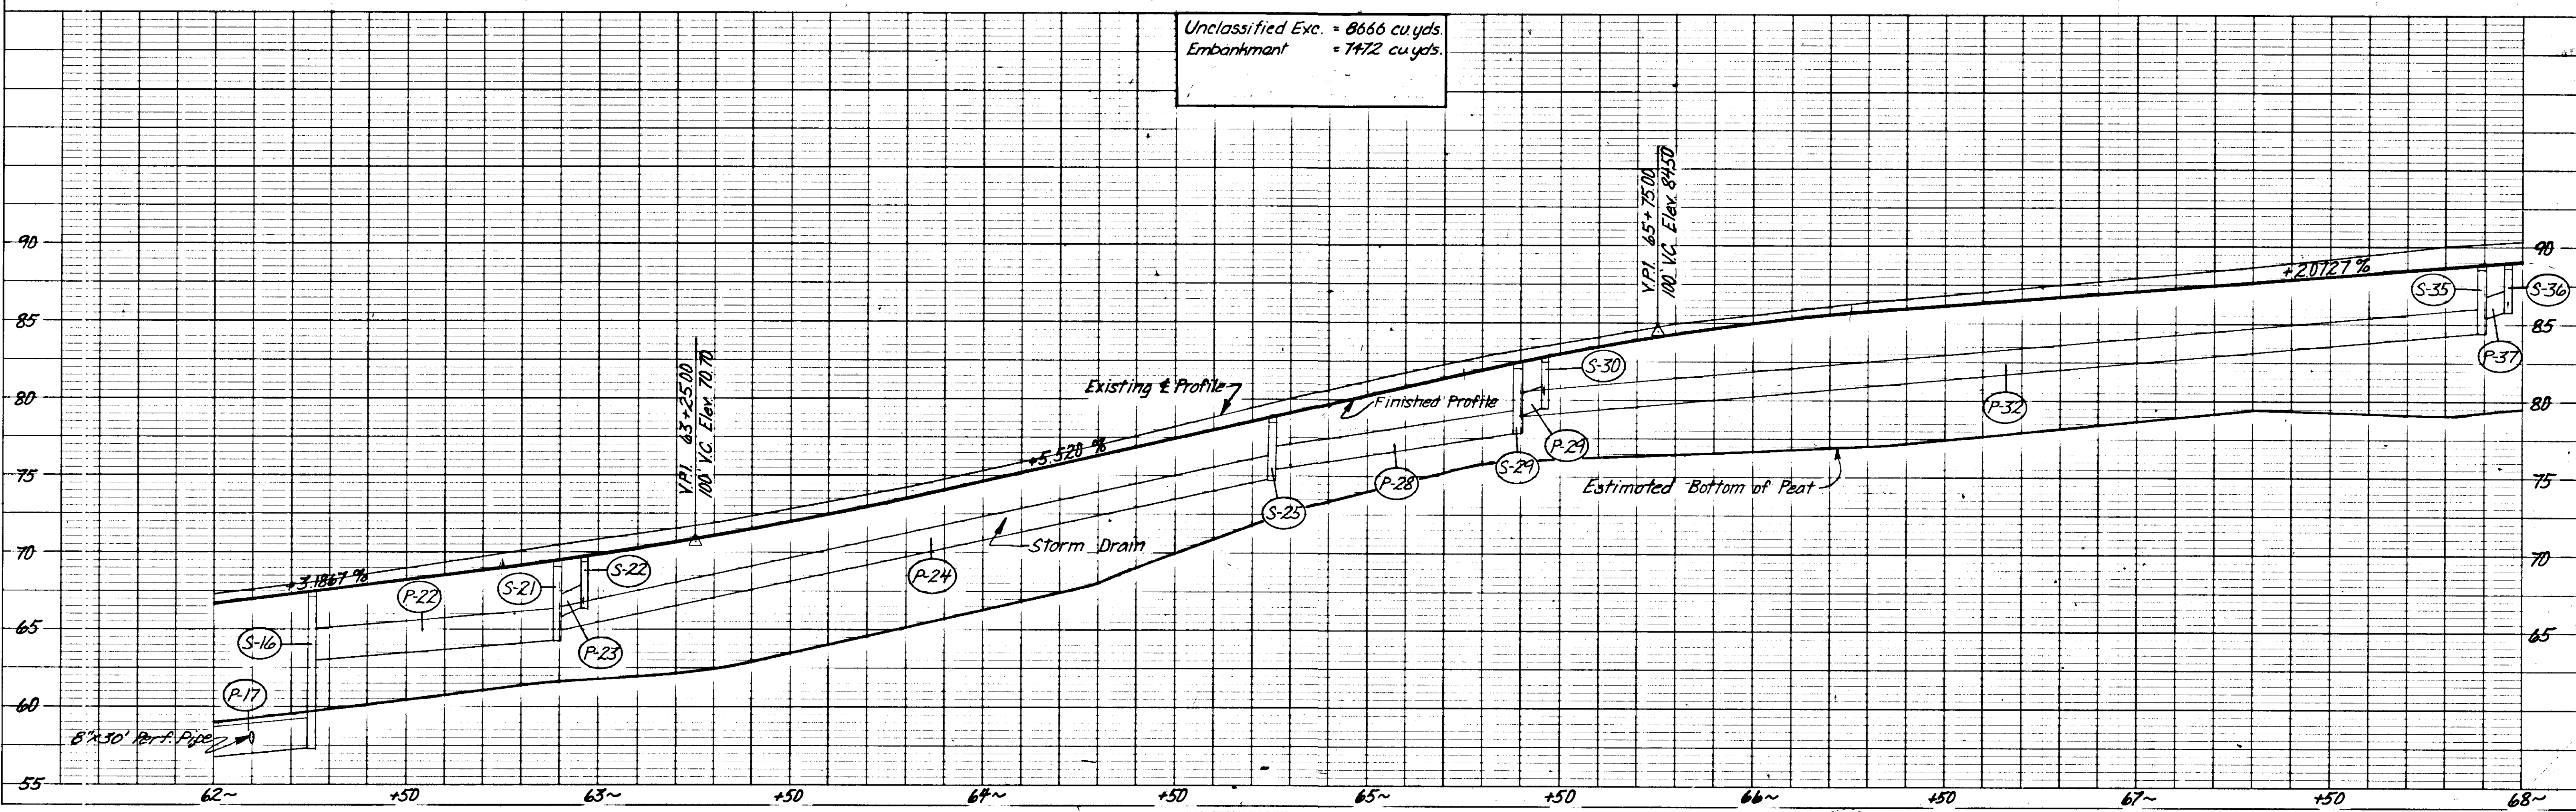

STATE	PROJECT DESIGNATION	YEAR	SHEET NO.	TOTAL SHEETS
ALASKA	RS-0938 (I)	1979	10	34

NOTE: Pedestrian Access, See Special Provision Section 555 & Plan Sheets 29 & 30.

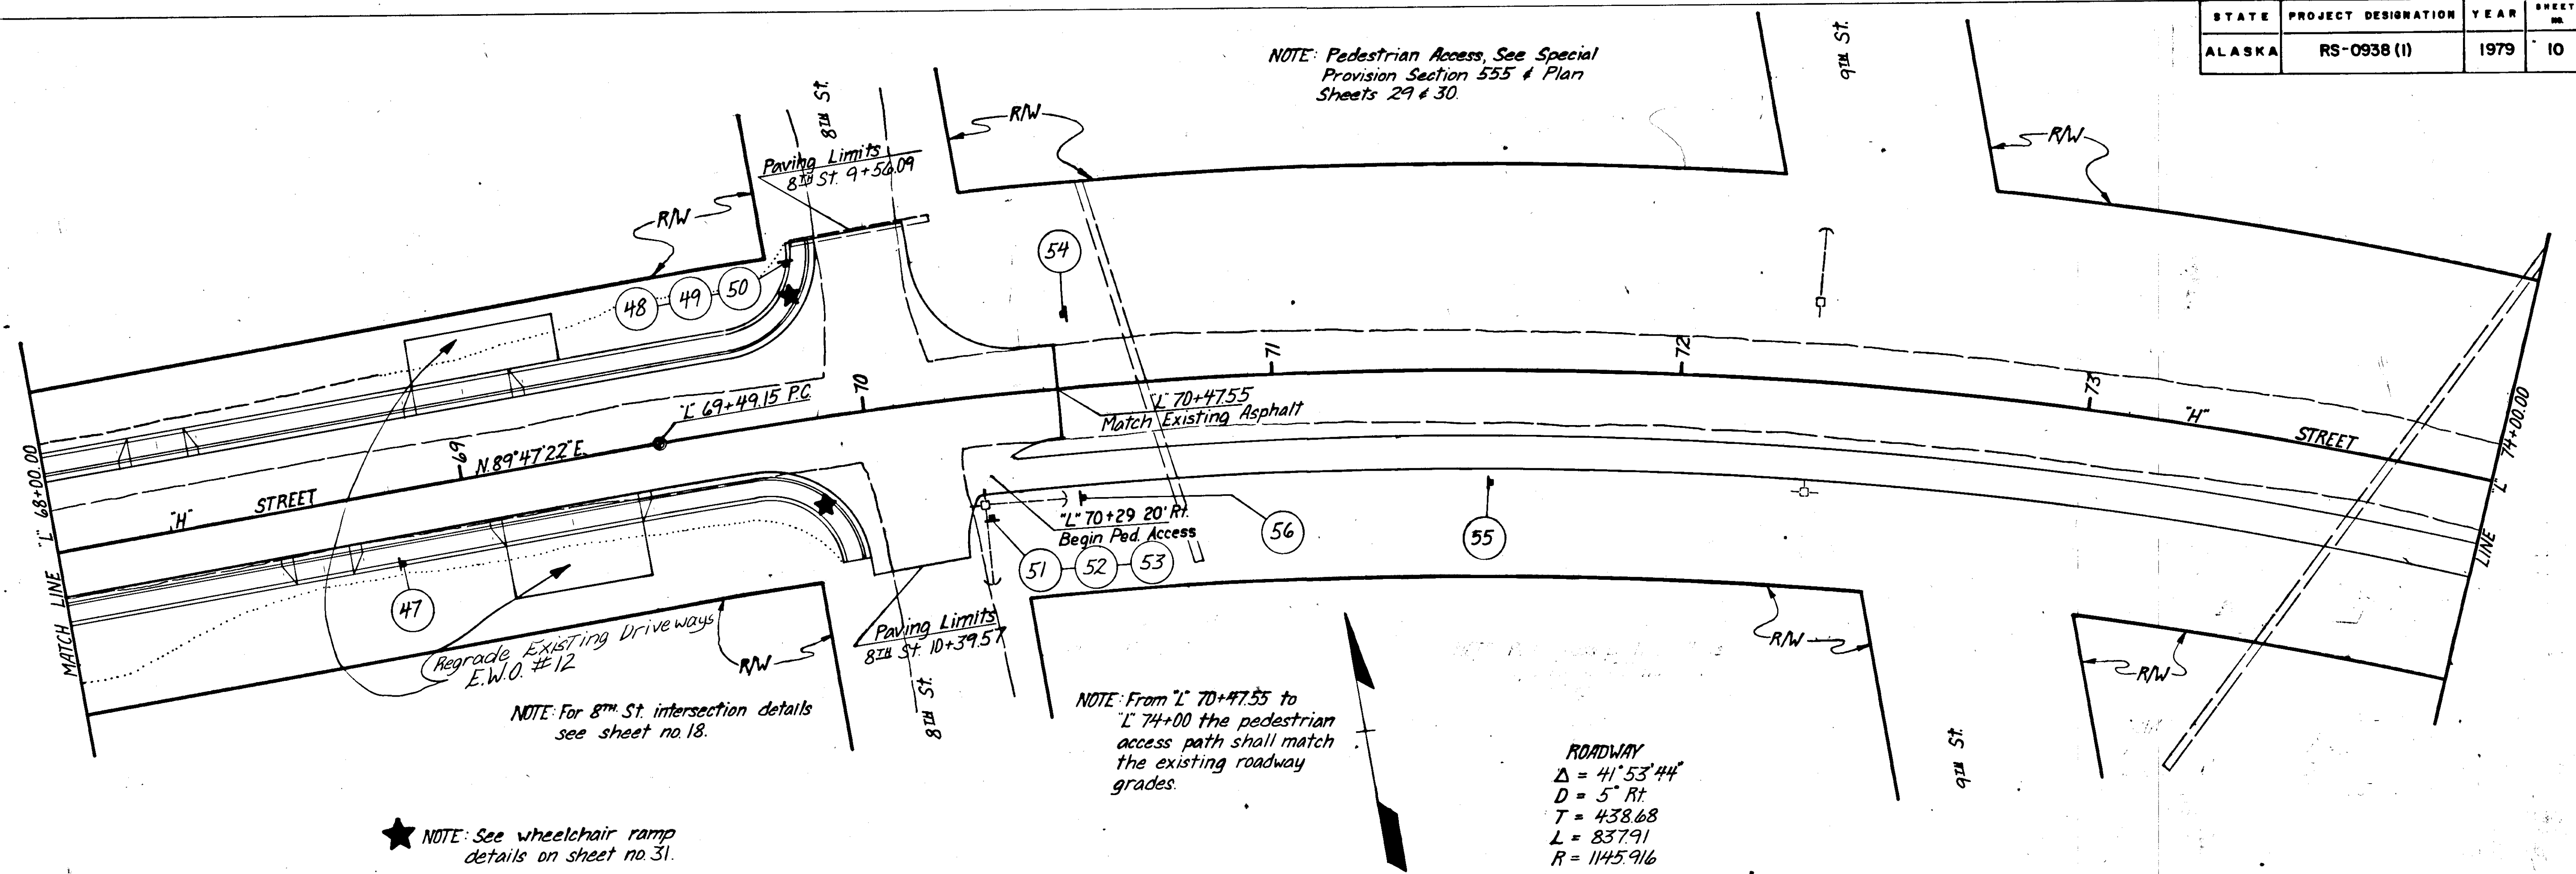


NOTE: For 8th St. intersection details see sheet no. 18.


NOTE: From 'L' 70+47.55 to 'L' 74+00 the pedestrian access path shall match the existing roadway grades.

★ NOTE: See wheelchair ramp details on sheet no. 31.

Unclassified Exc. = 4634 cu.yds.
Embankment = 2959 cu.yds.

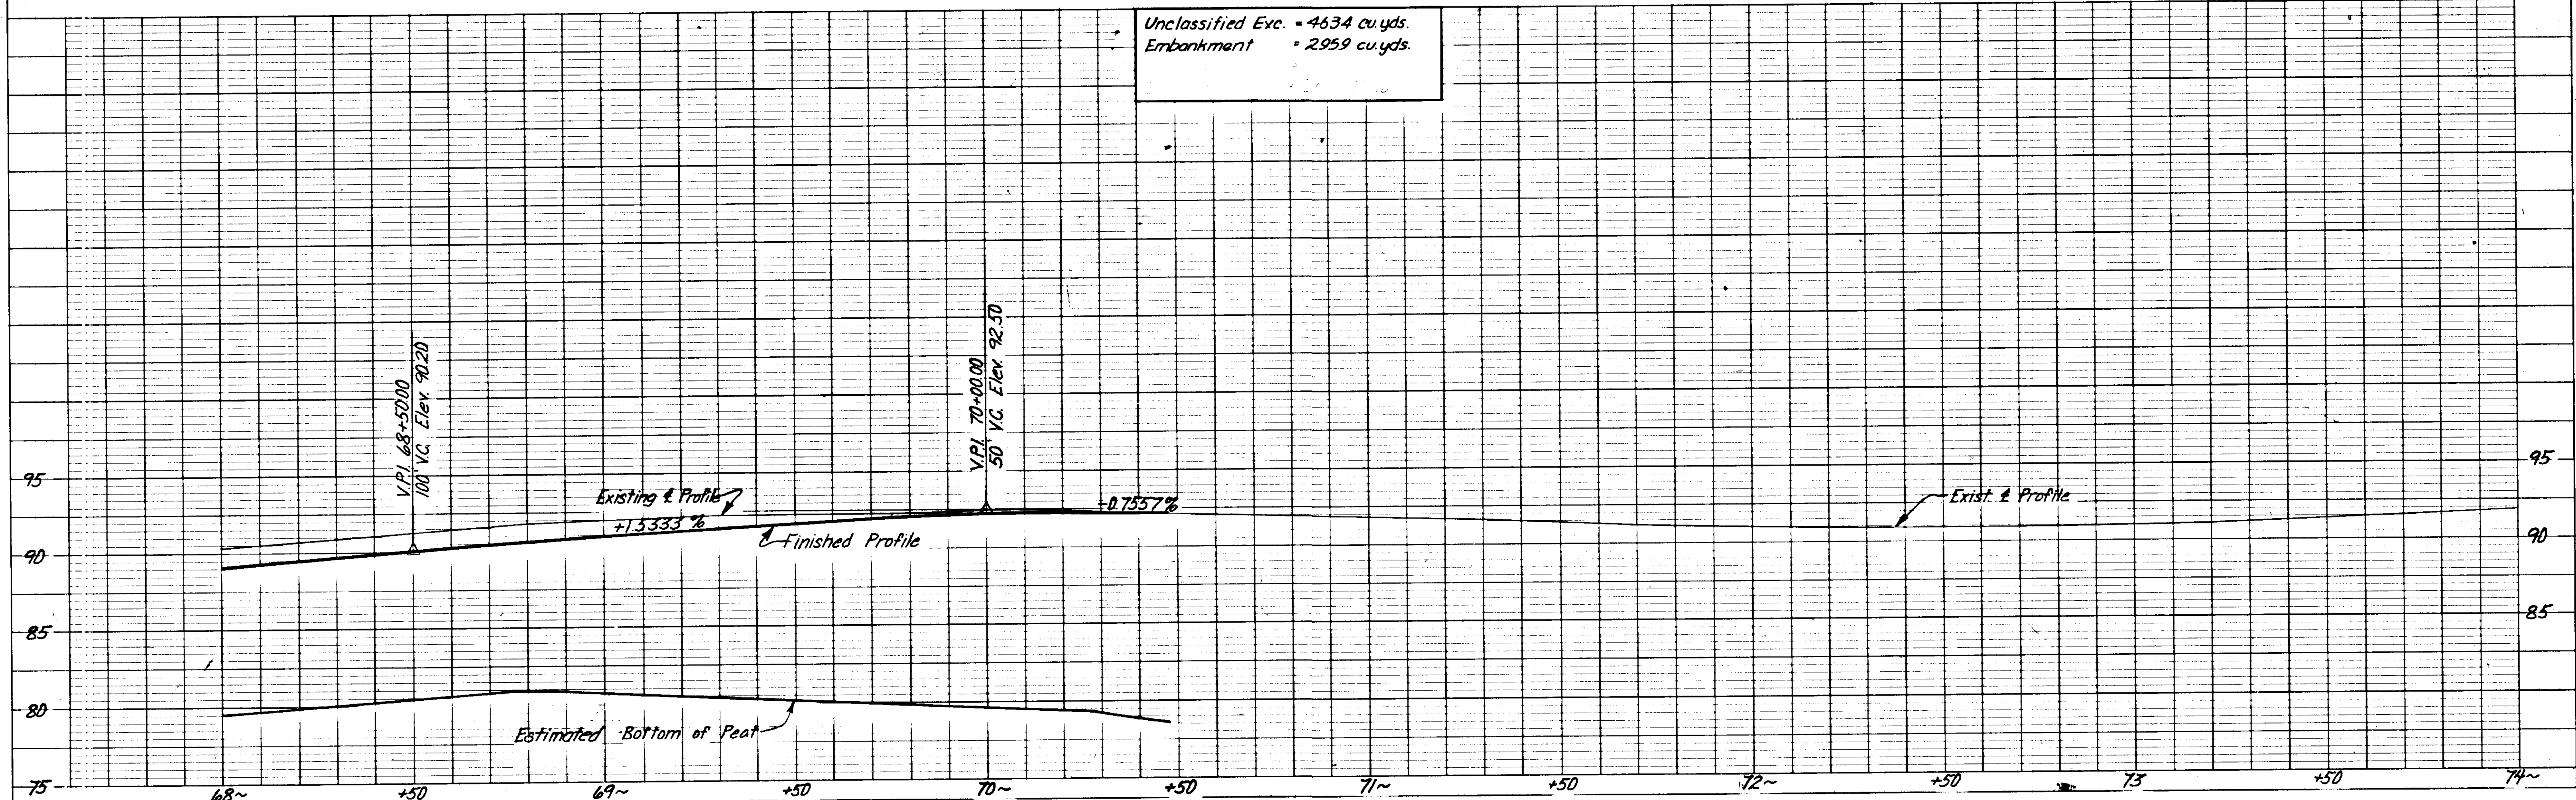


STATE	PROJECT DESIGNATION	YEAR	SHEET NO.	TOTAL SHEETS
ALASKA	RS-0938 (I)	1979	11	34

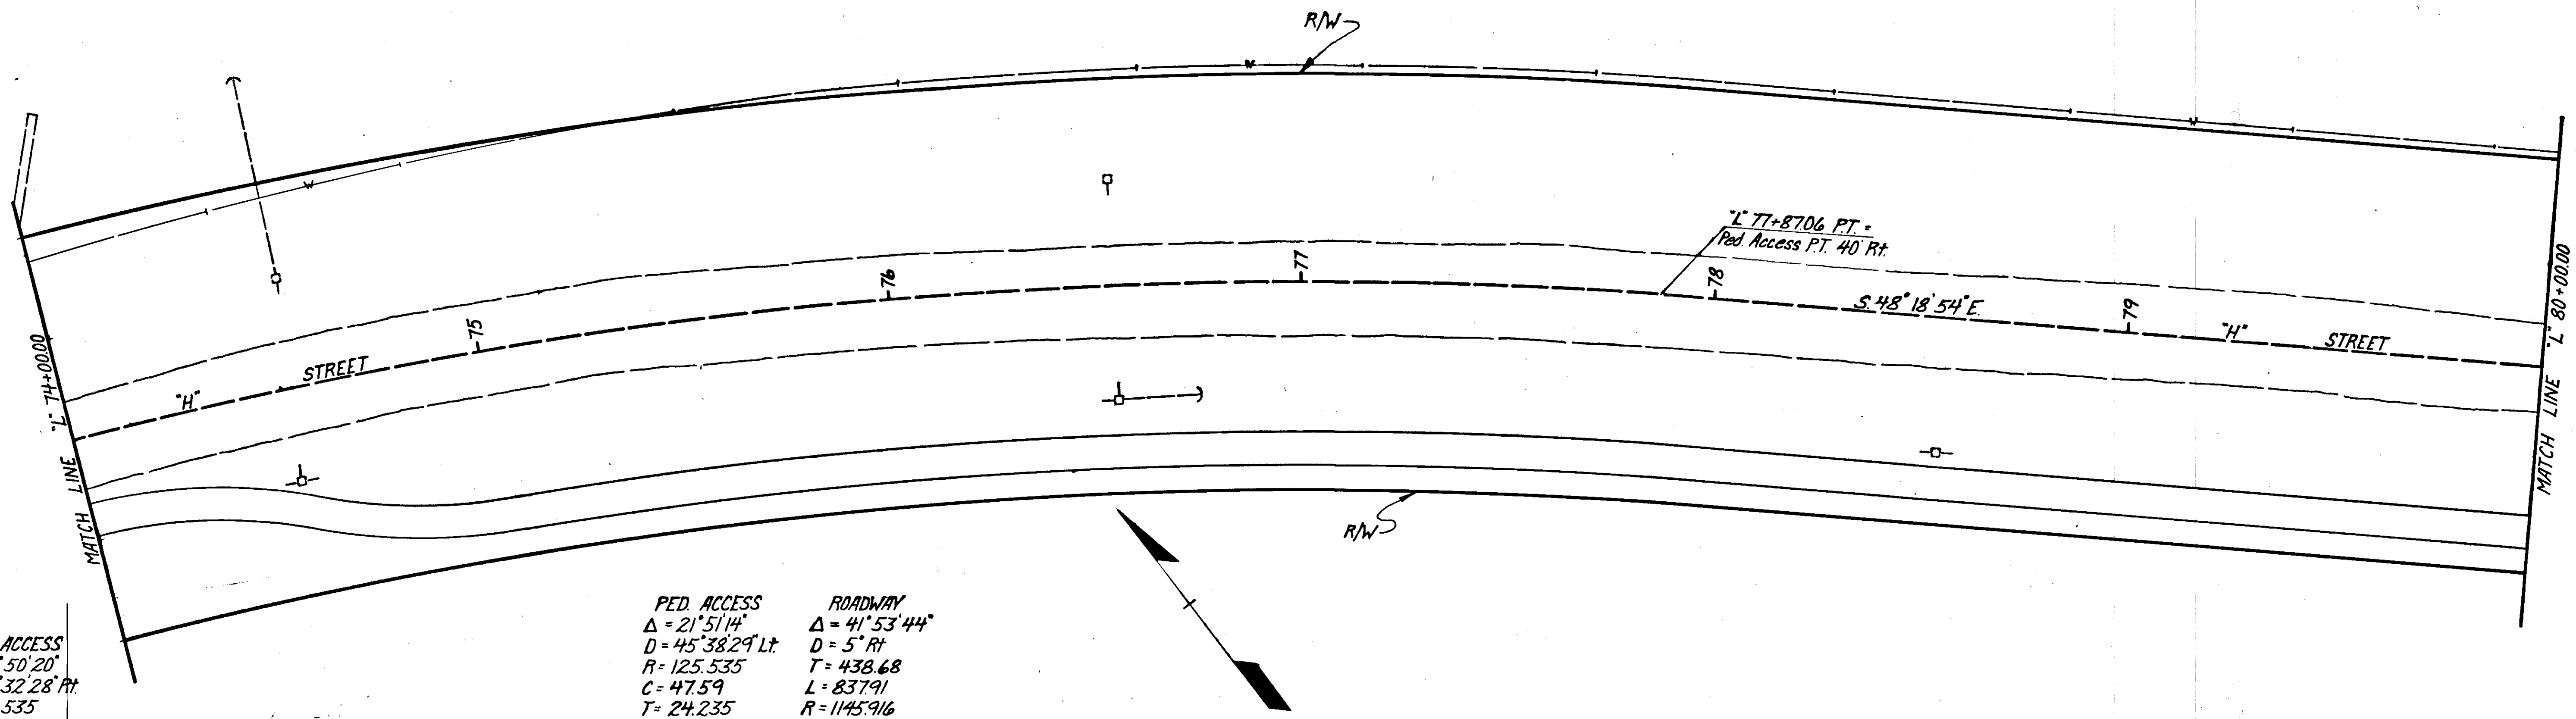




PED. ACCESS
 $\Delta = 24^\circ 50' 20''$
 $D = 47^\circ 32' 28''$ Rt.
 $R = 125.535$
 $C = 51.839$
 $T = 26.54$

PED. ACCESS	ROADWAY
$\Delta = 21^\circ 51' 14''$	$\Delta = 41^\circ 53' 44''$
$D = 45^\circ 38' 29''$ Lt.	$D = 5^\circ$ Rt.
$R = 125.535$	$T = 438.68$
$C = 47.59$	$L = 837.91$
$T = 24.235$	$R = 1145.916$




Unclassified Exc. = 2000 cu. yds.
 Embankment = 2000 cu. yds.

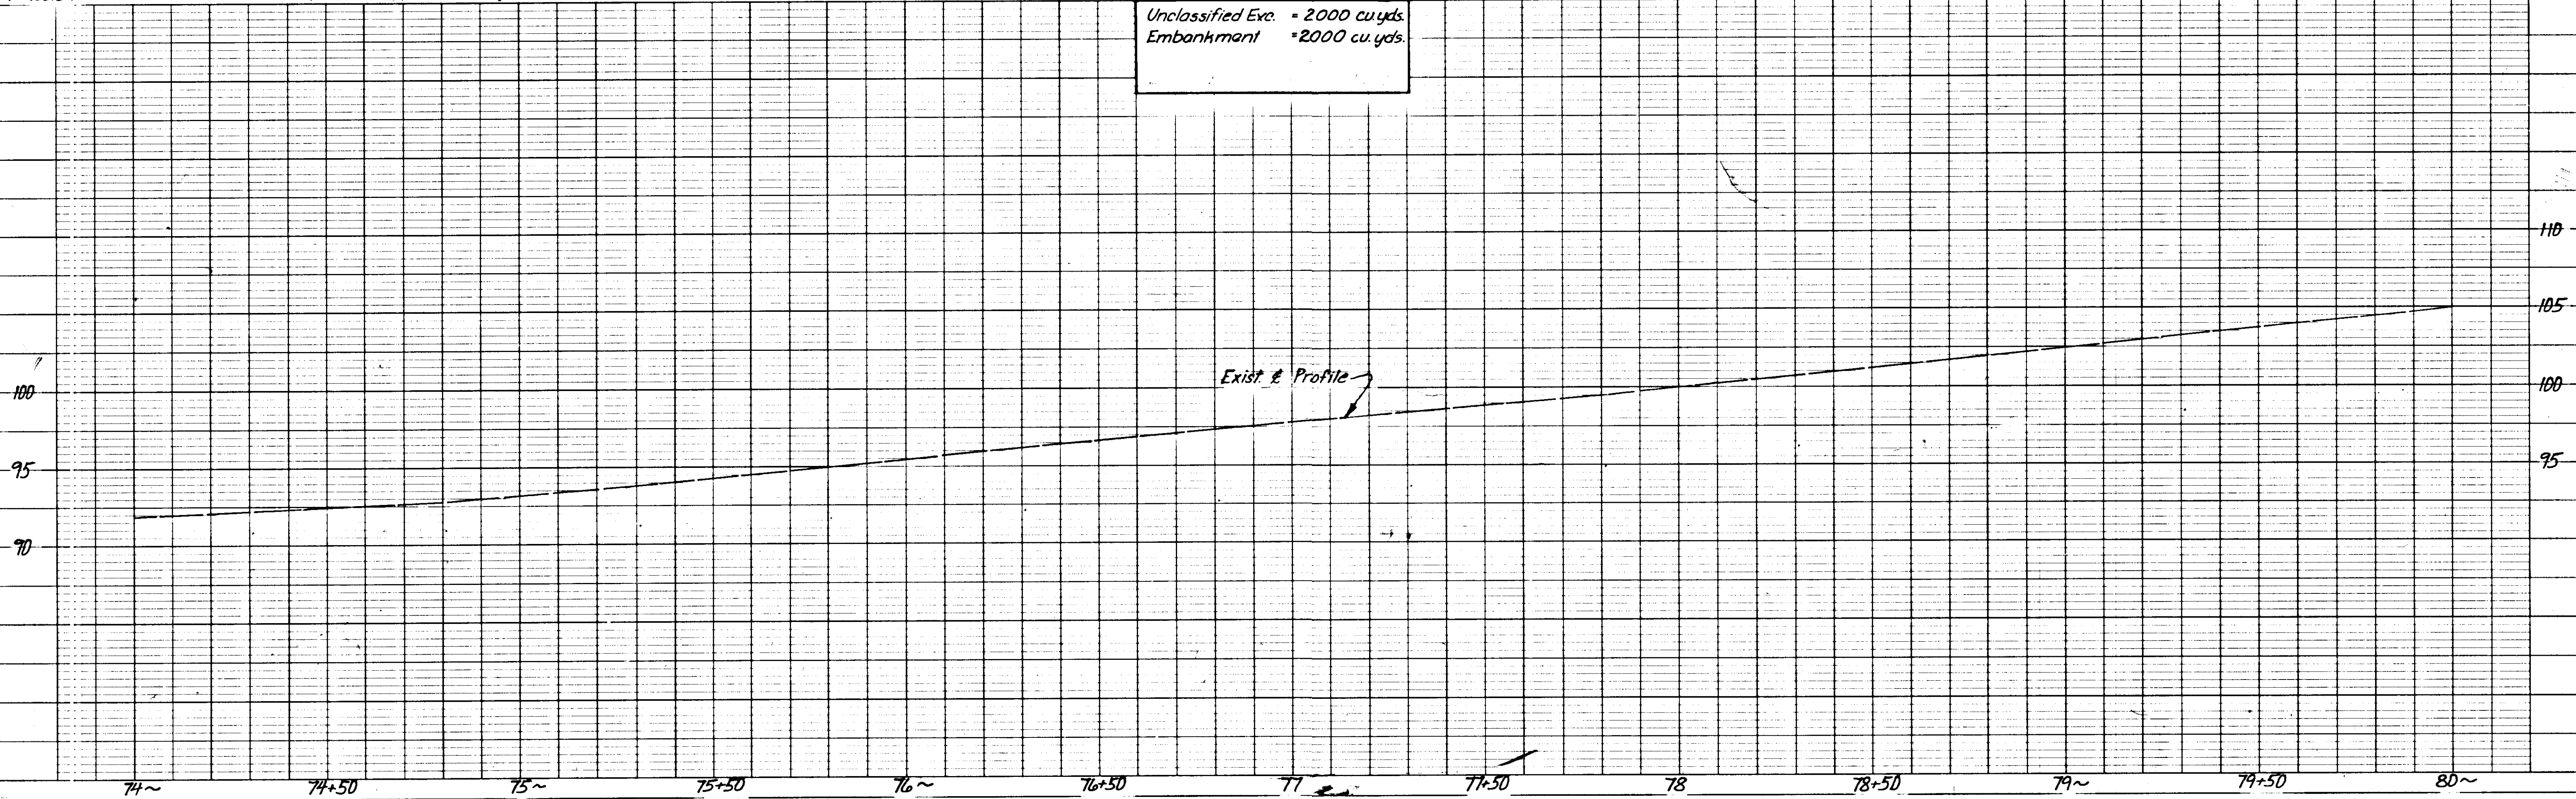



STATE	PROJECT DESIGNATION	YEAR	SHEET NO.	TOTAL SHEETS
ALASKA	RS-0938 (I)	1979	12	34

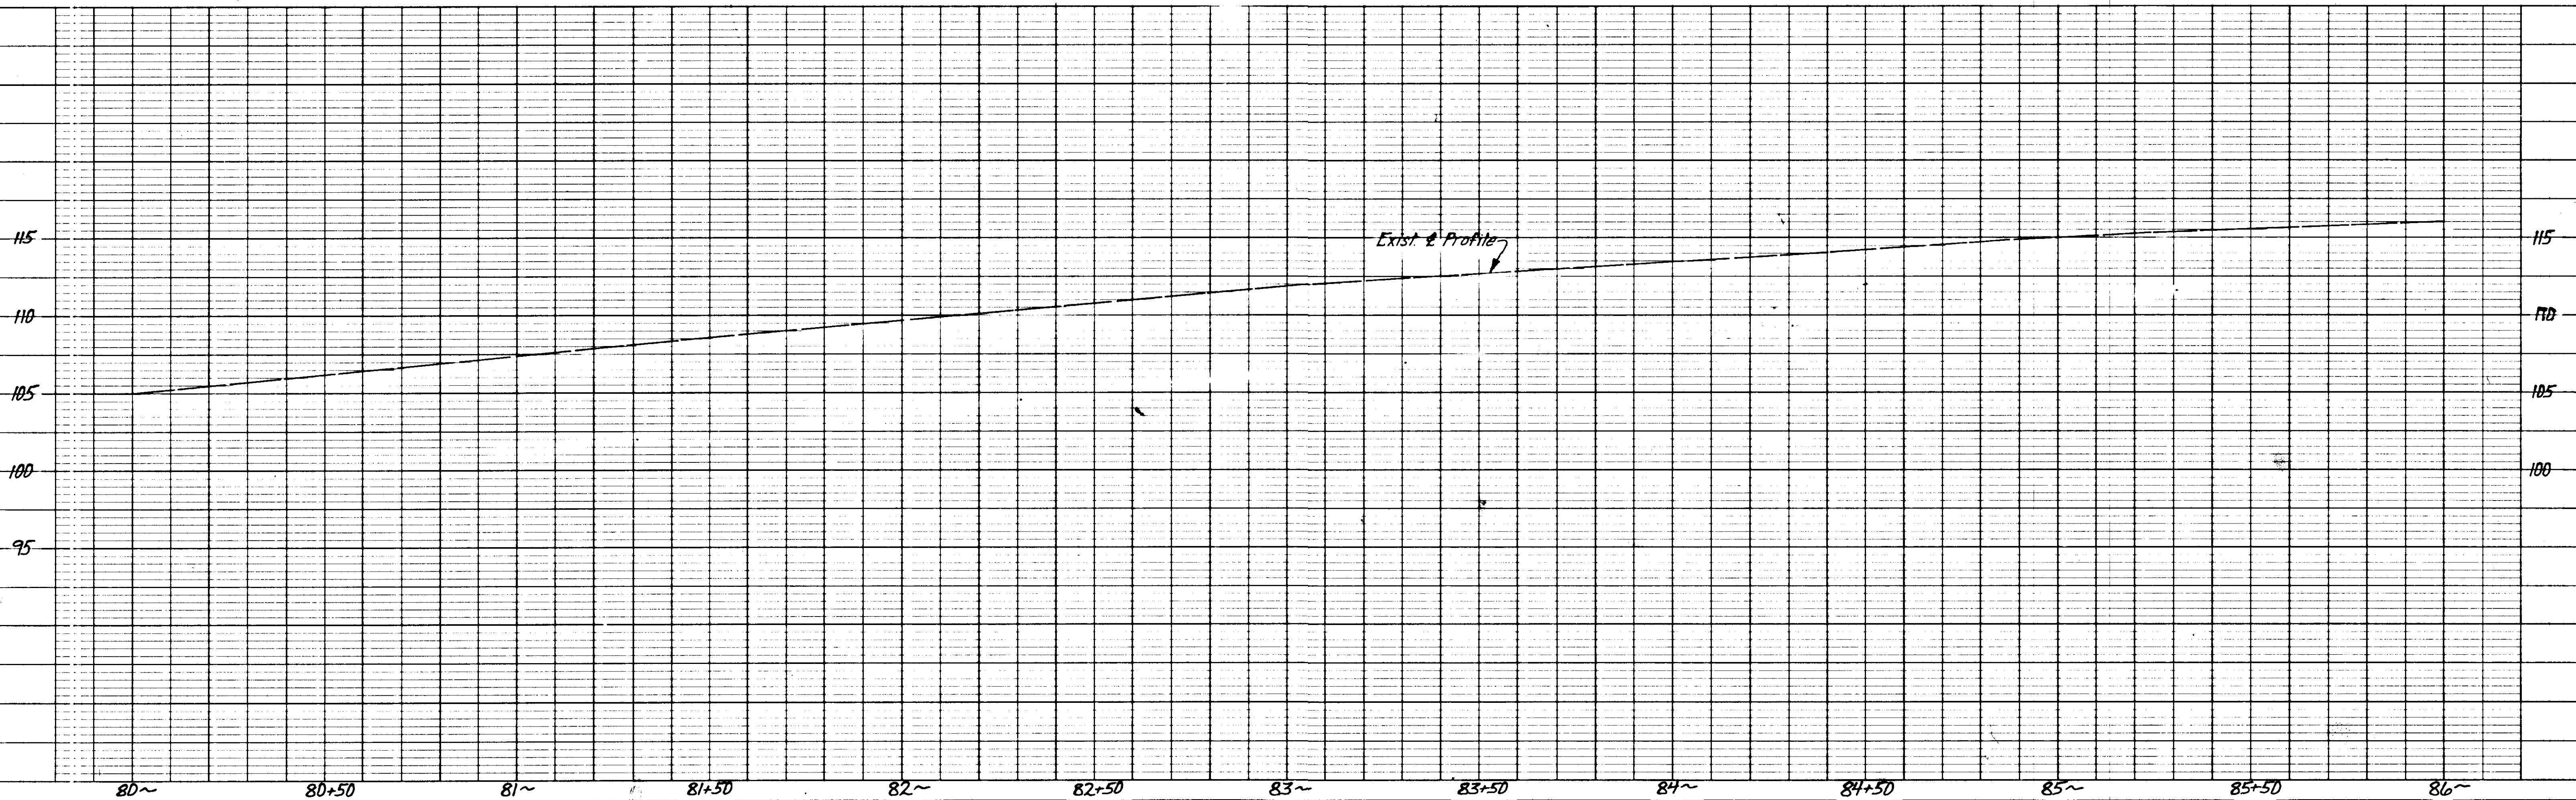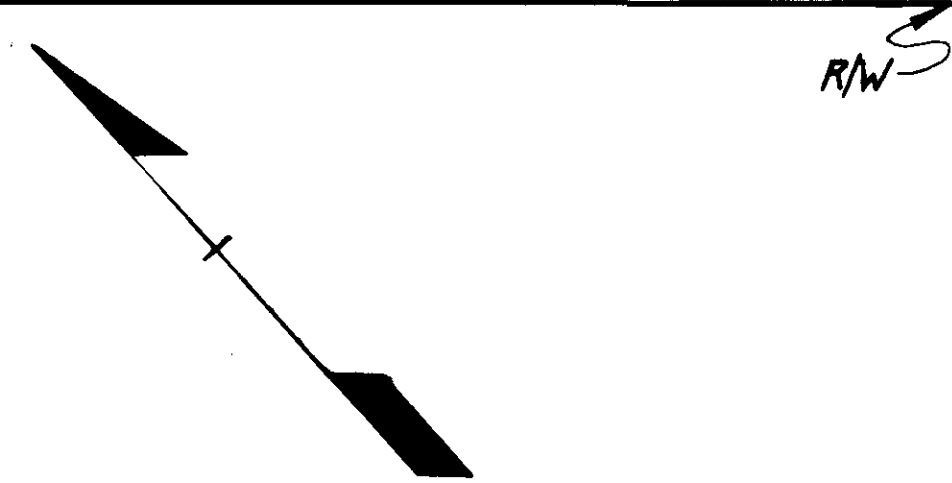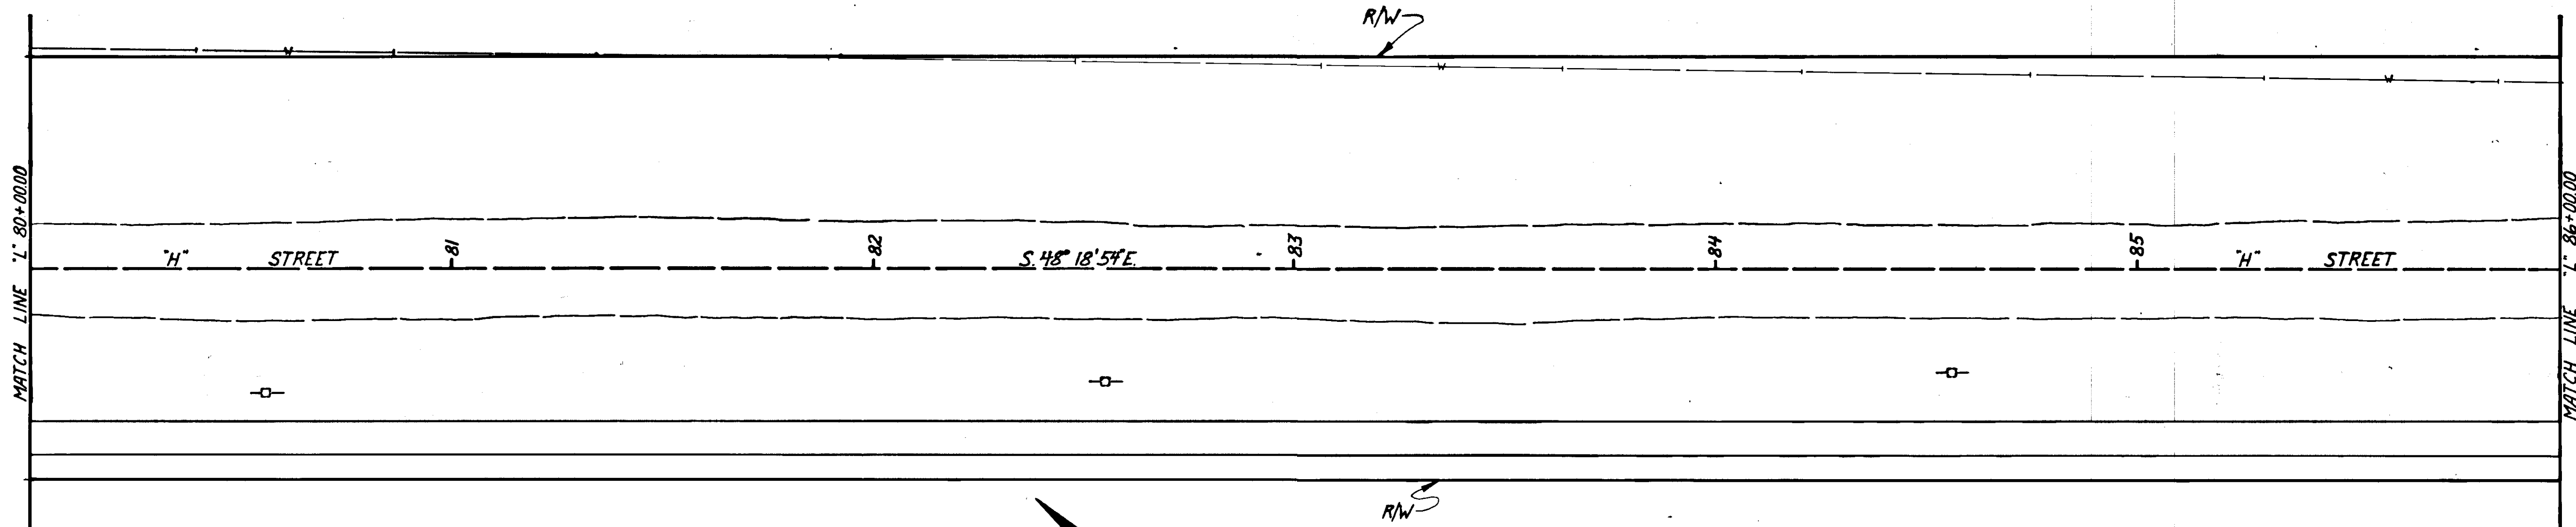



STATE	PROJECT DESIGNATION	YEAR	SHEET NO.	TOTAL SHEETS
ALASKA	RS-0938(1)	1979	13	34

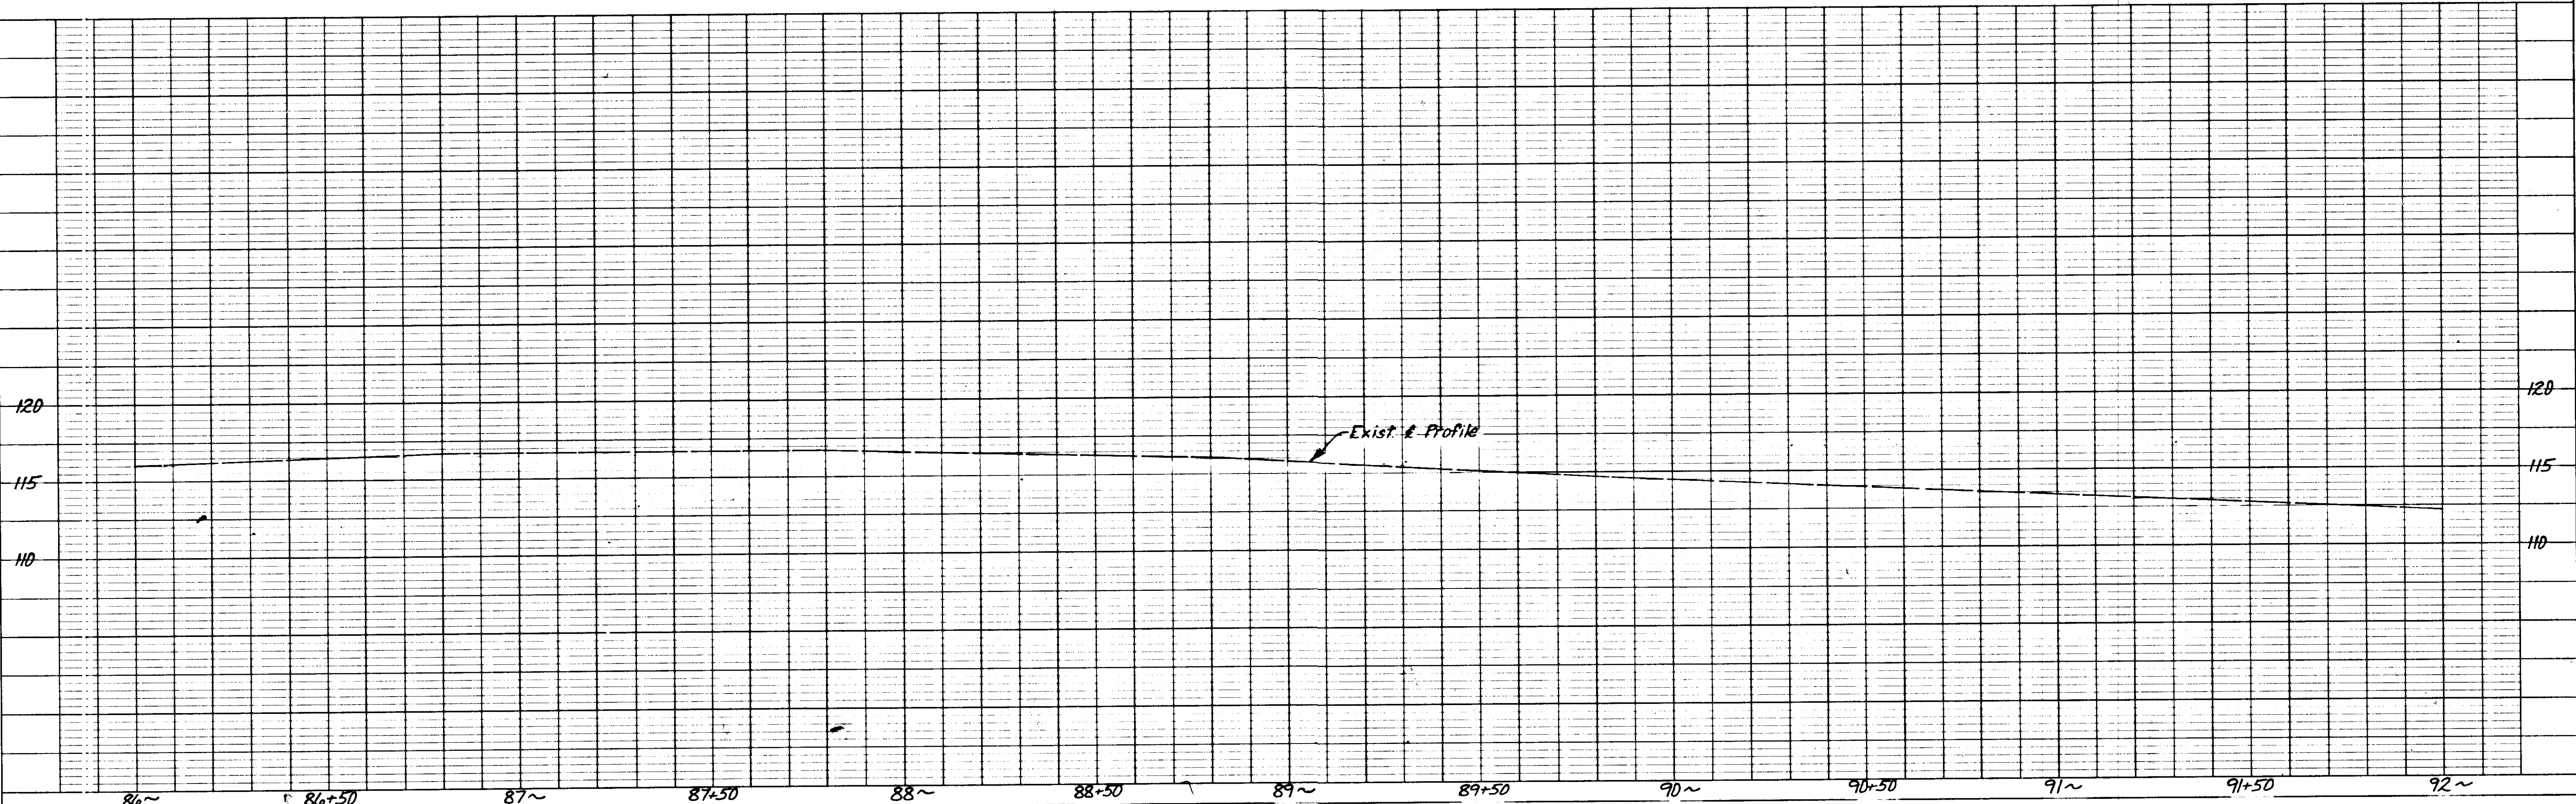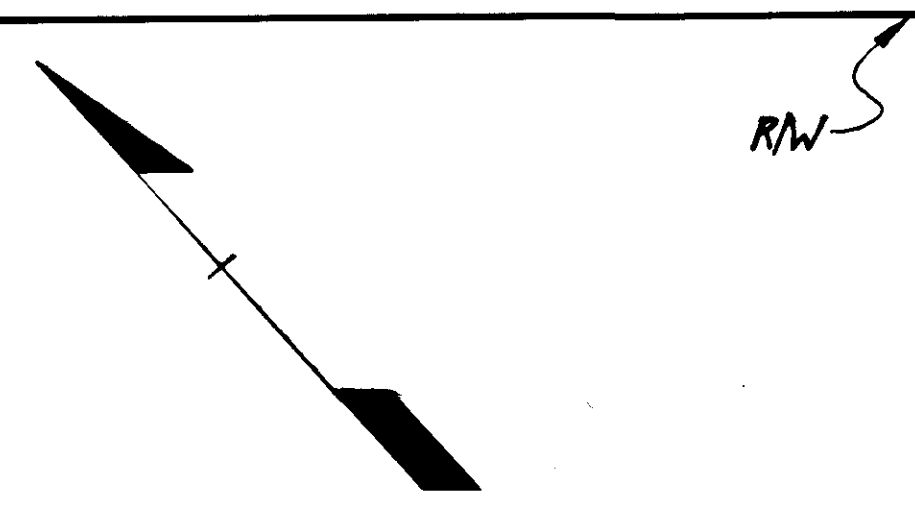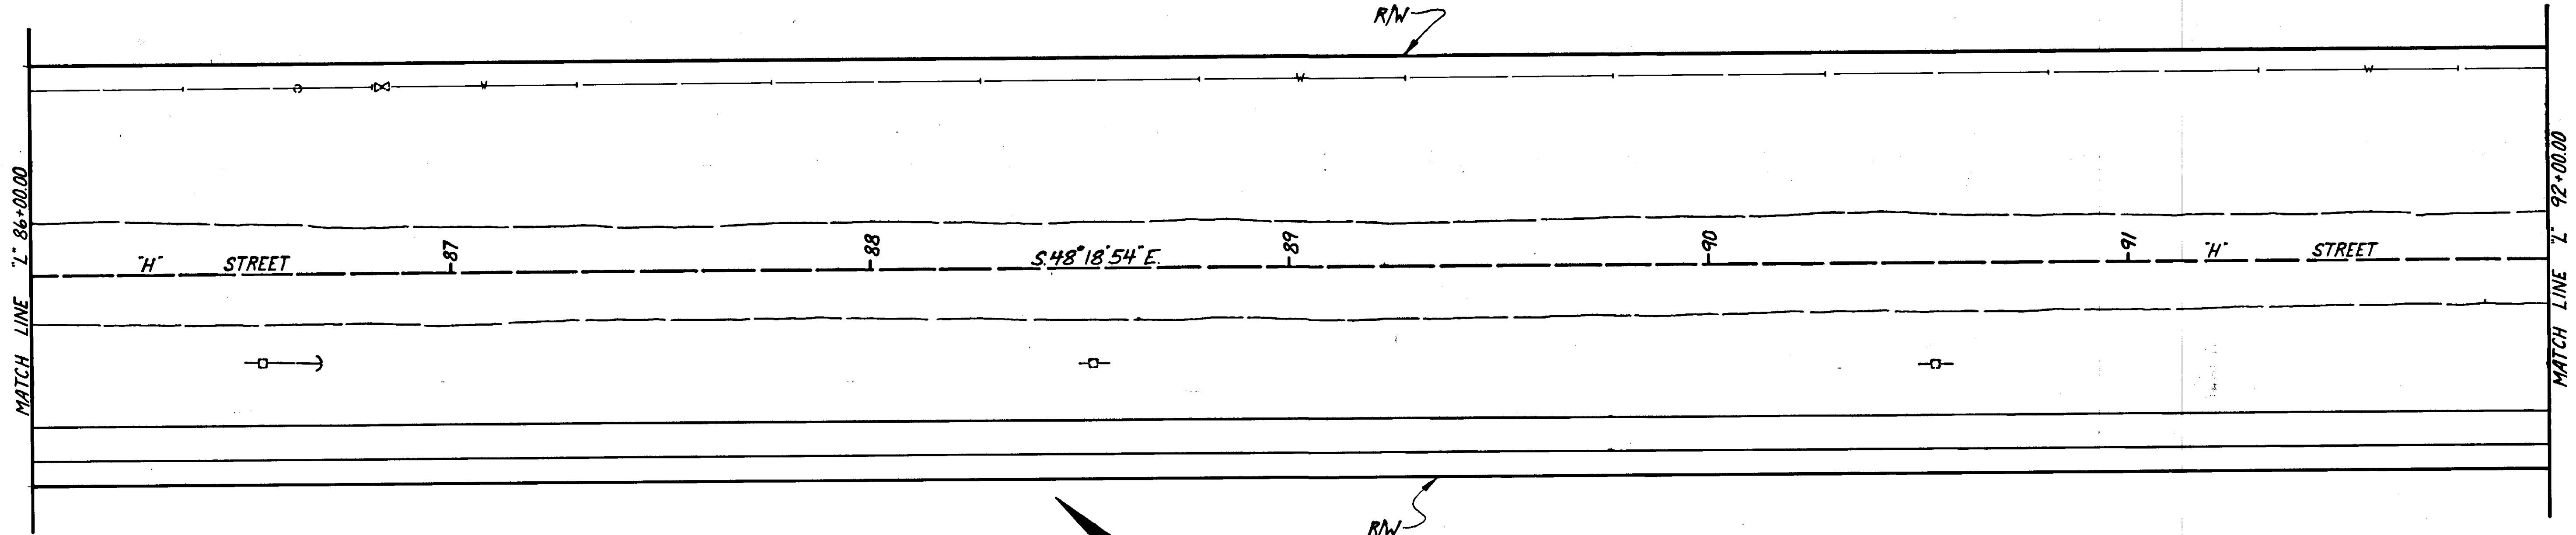

STATE	PROJECT DESIGNATION	YEAR	SHEET NO.	TOTAL SHEETS
ALASKA	RS-0938 (I)	1979	14	34

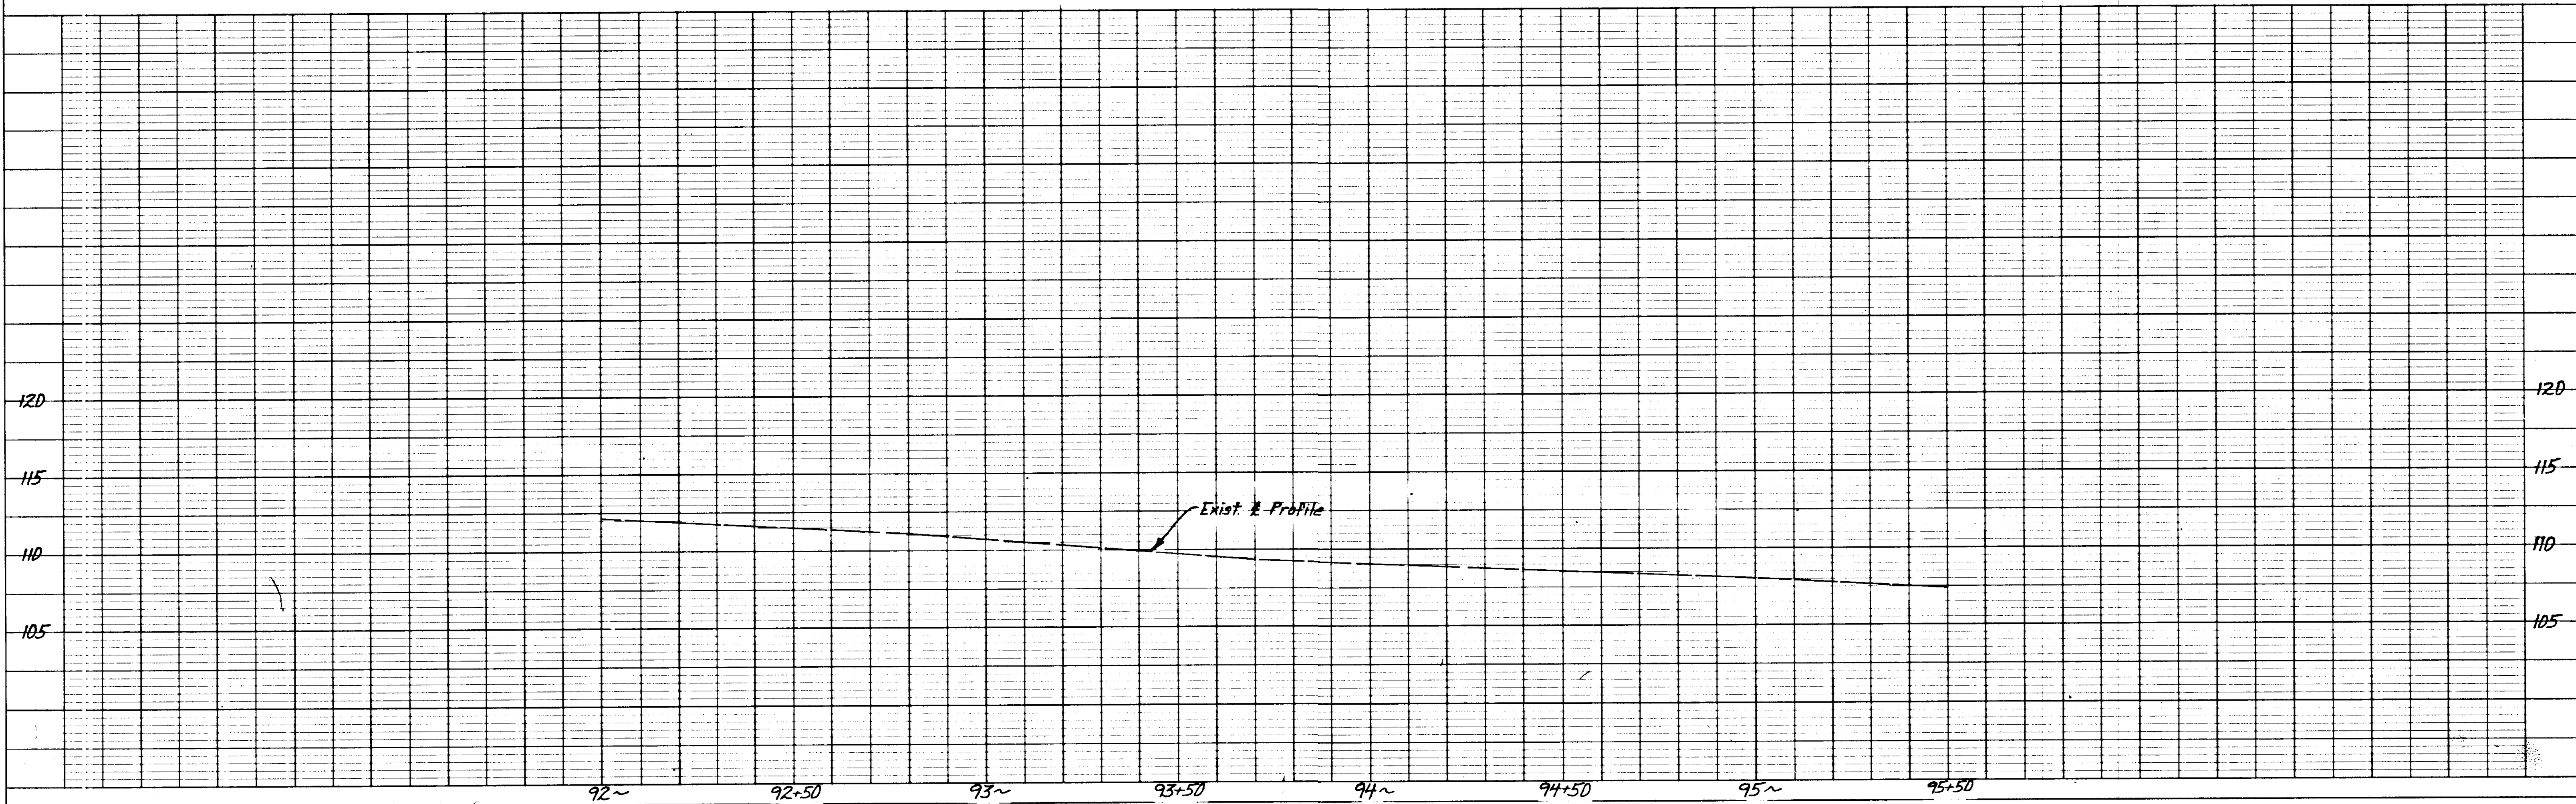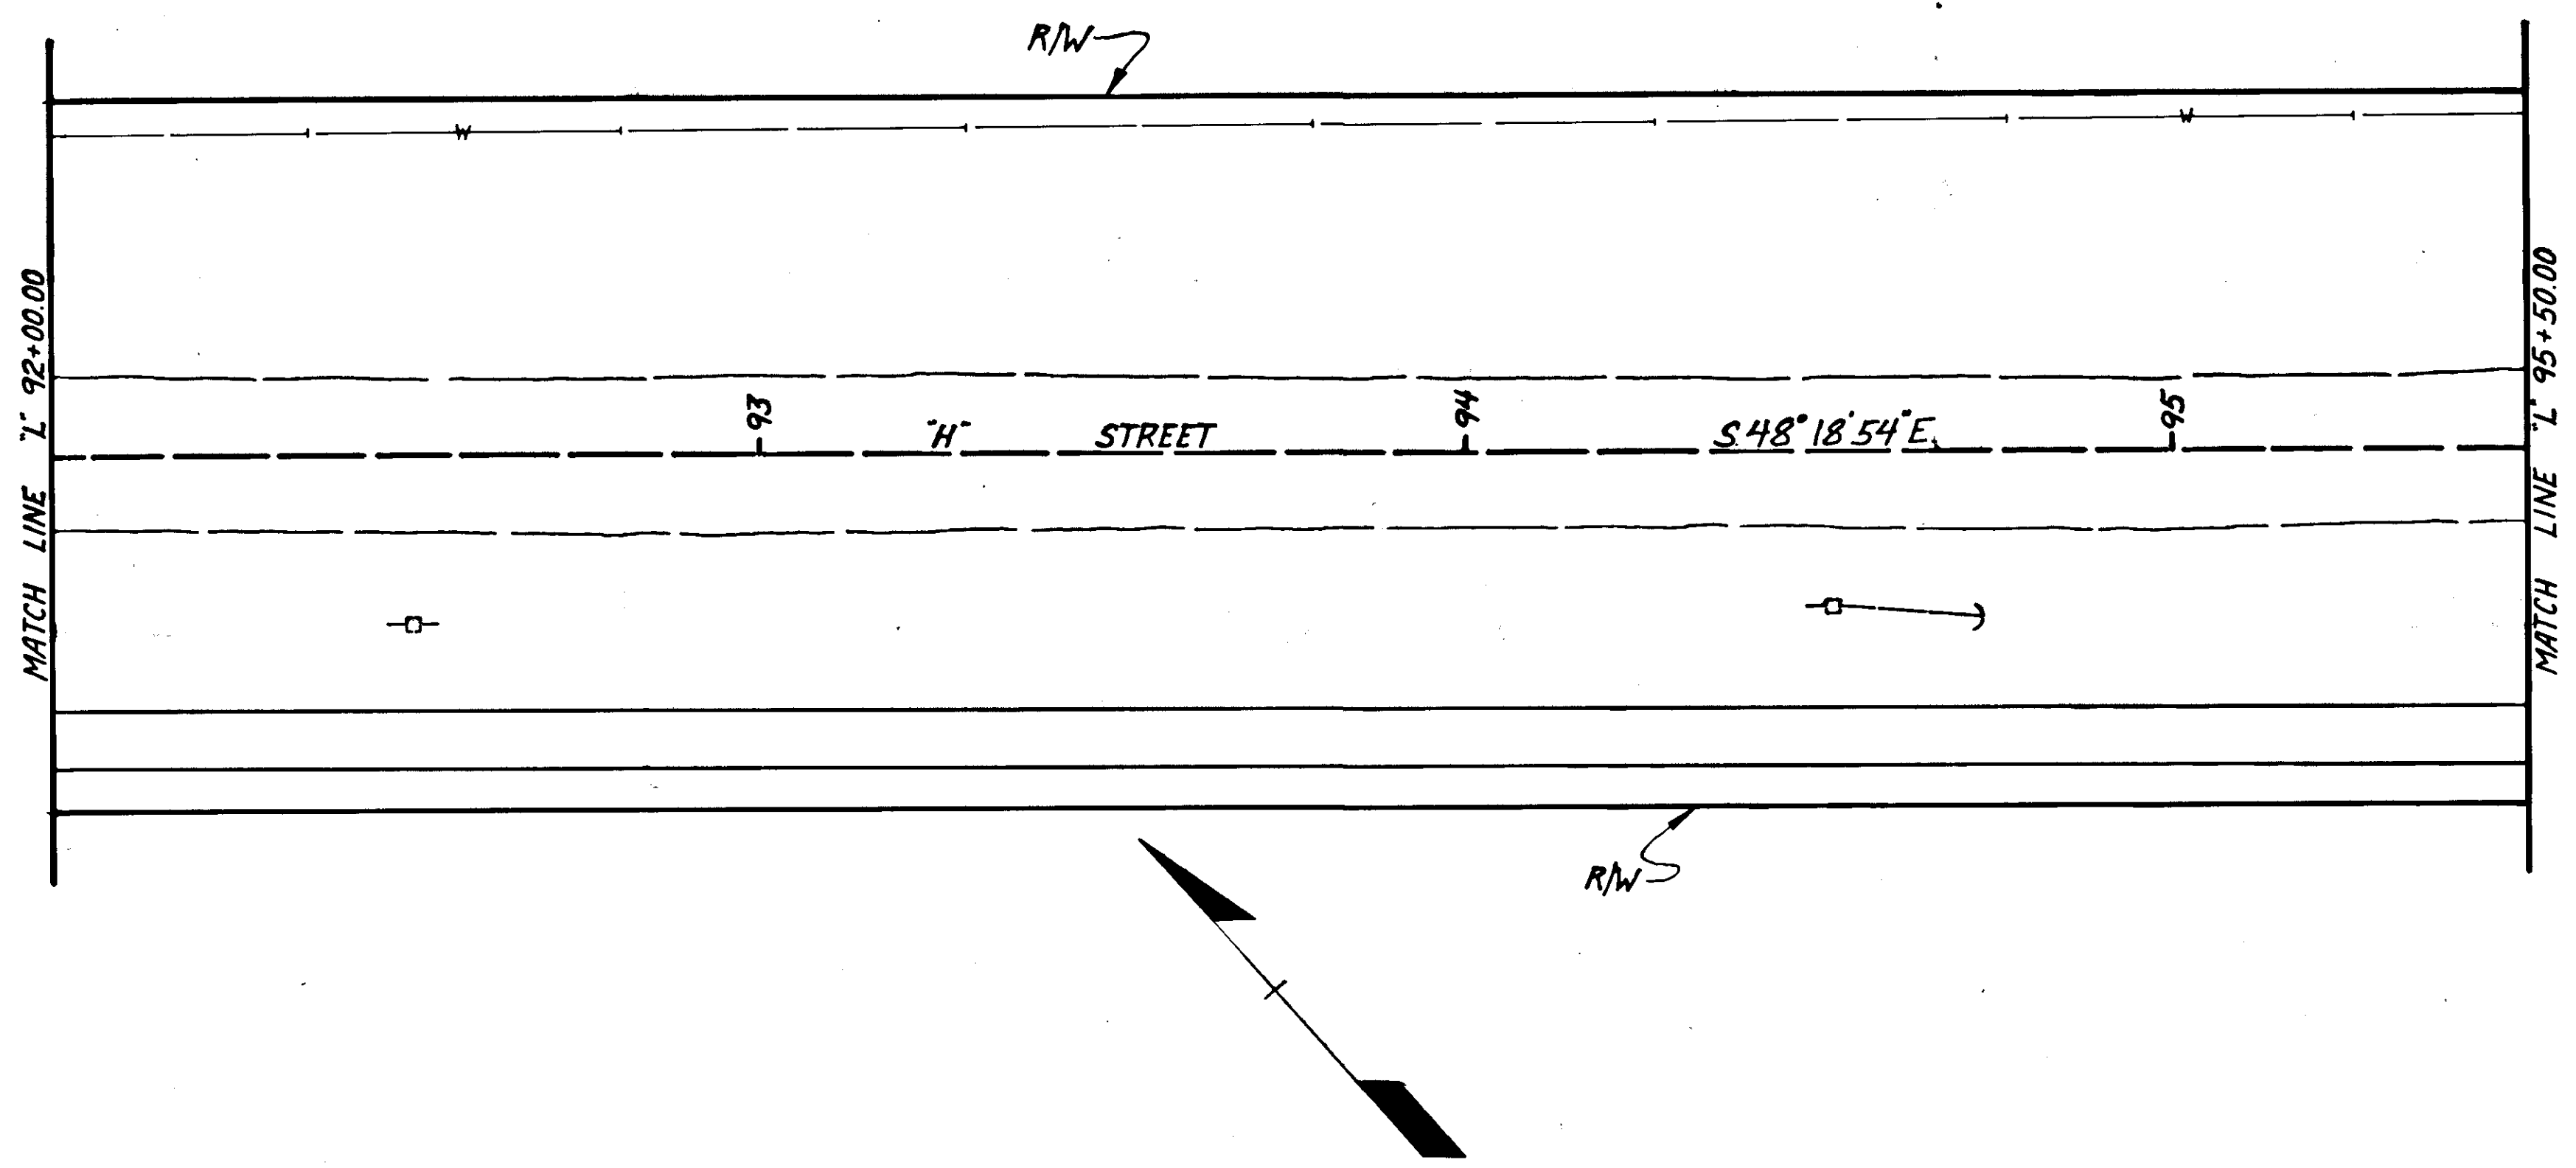


STATE	PROJECT DESIGNATION	YEAR	SHEET NO.	TOTAL SHEETS
ALASKA	RS-0938(1)	1979	15	34

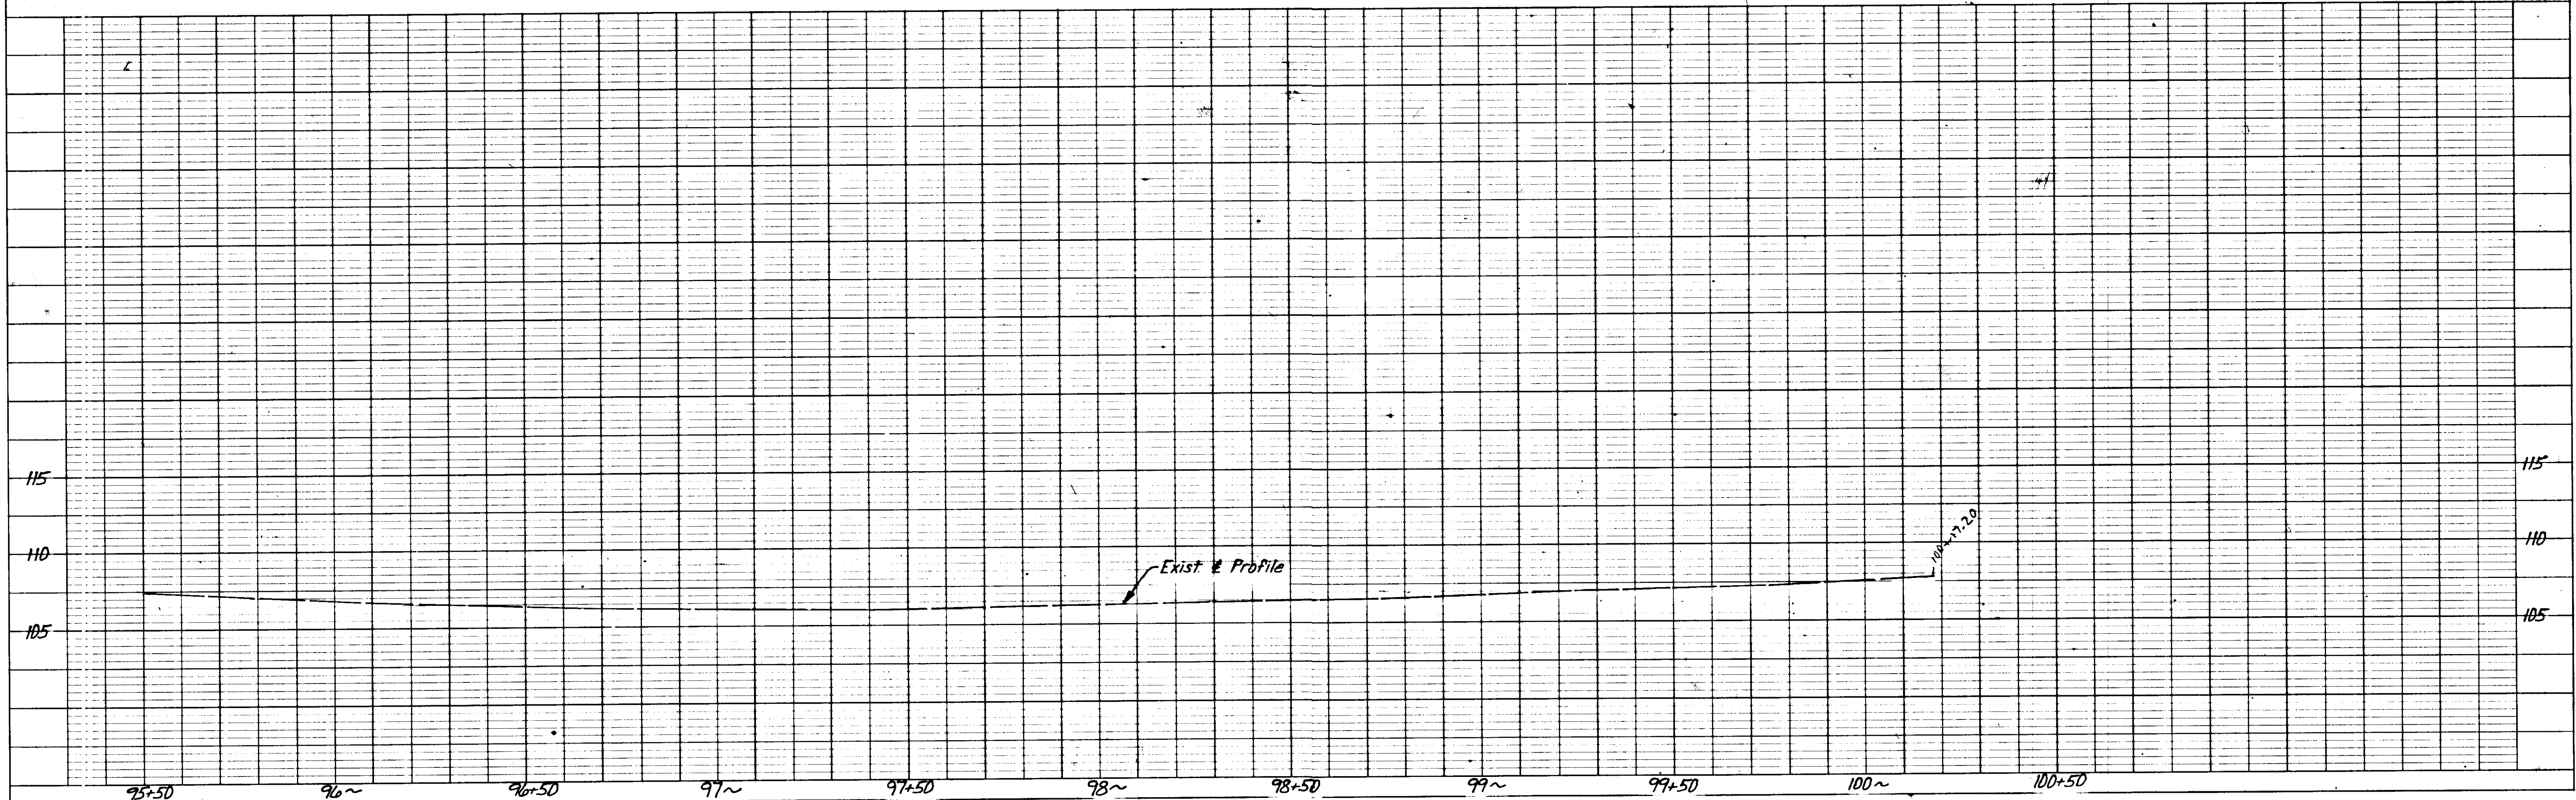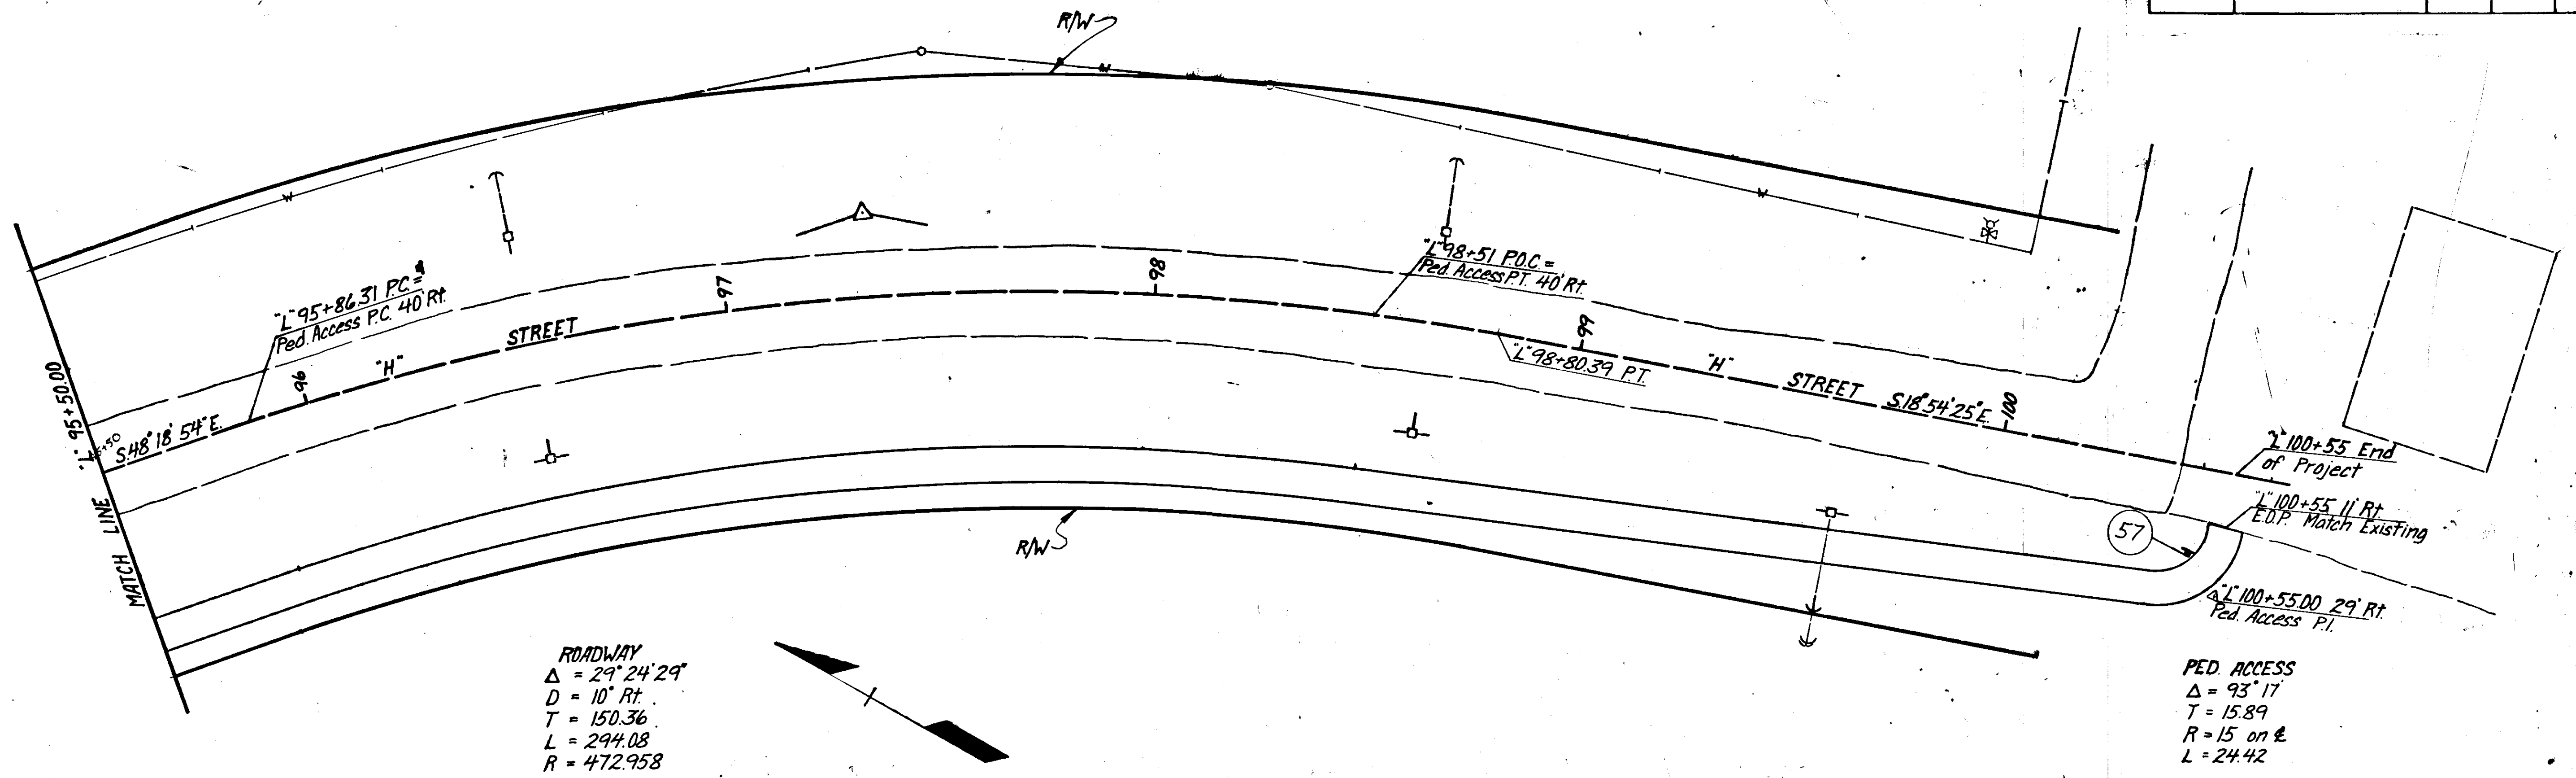


STATE	PROJECT DESIGNATION	YEAR	SHEET NO.	TOTAL SHEETS
ALASKA	RS-0938(1)	1979	16	34

INTERSECTION DETAILS

NOTE: "L" 50+50 to "L" 51+44 Lt. back of S.W. shall meet exist. retaining wall.

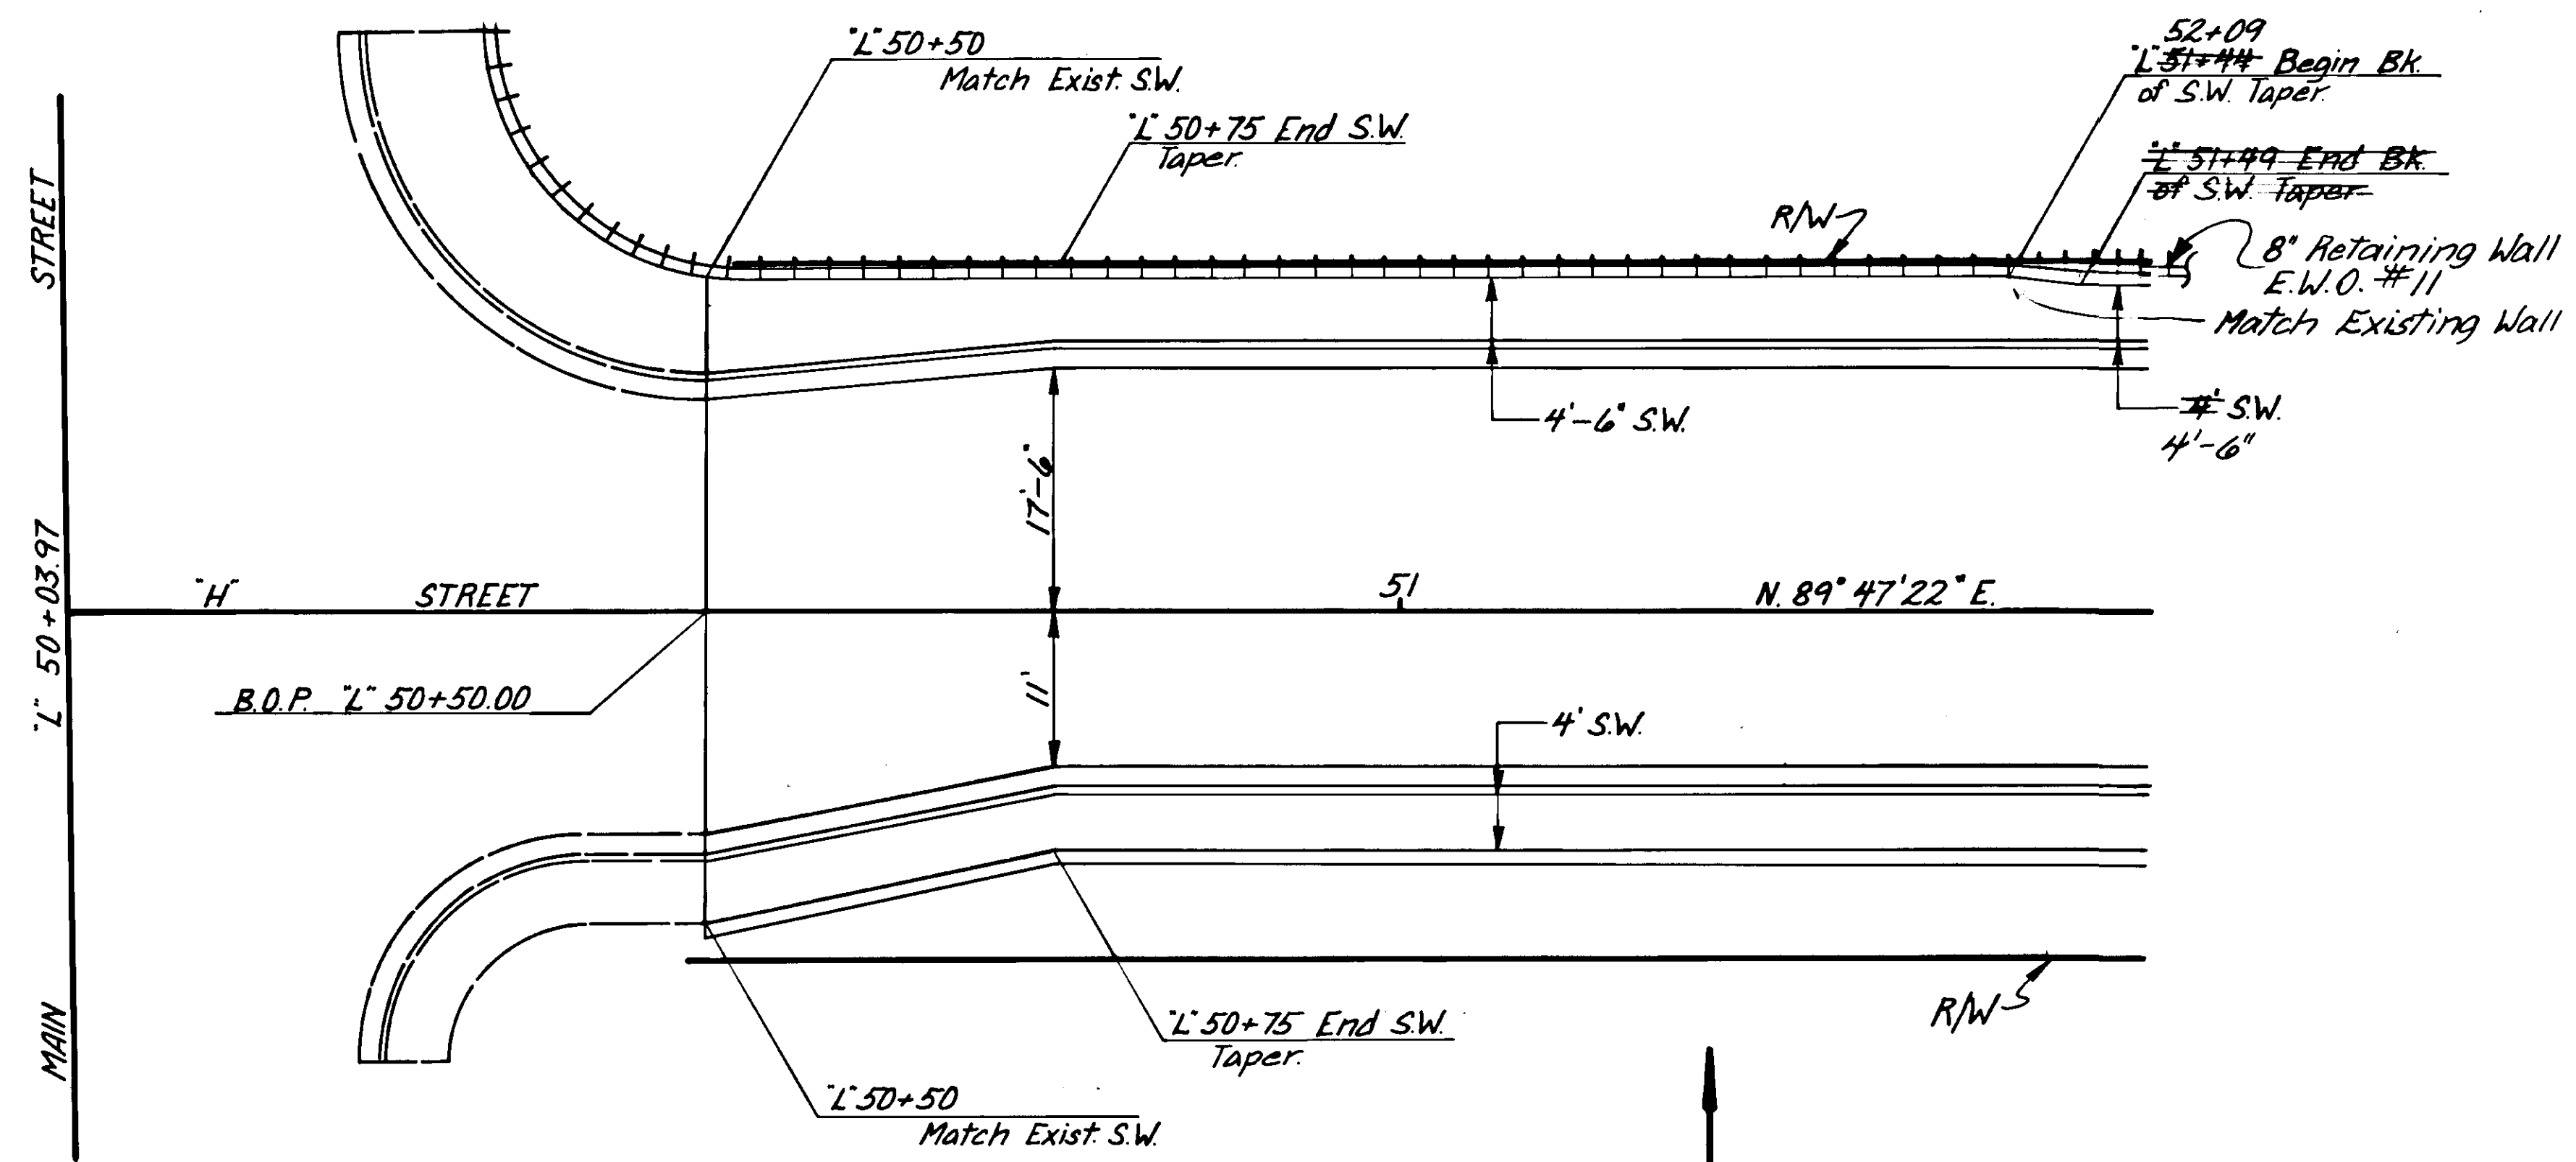


INTERSECTION MAIN & "H"

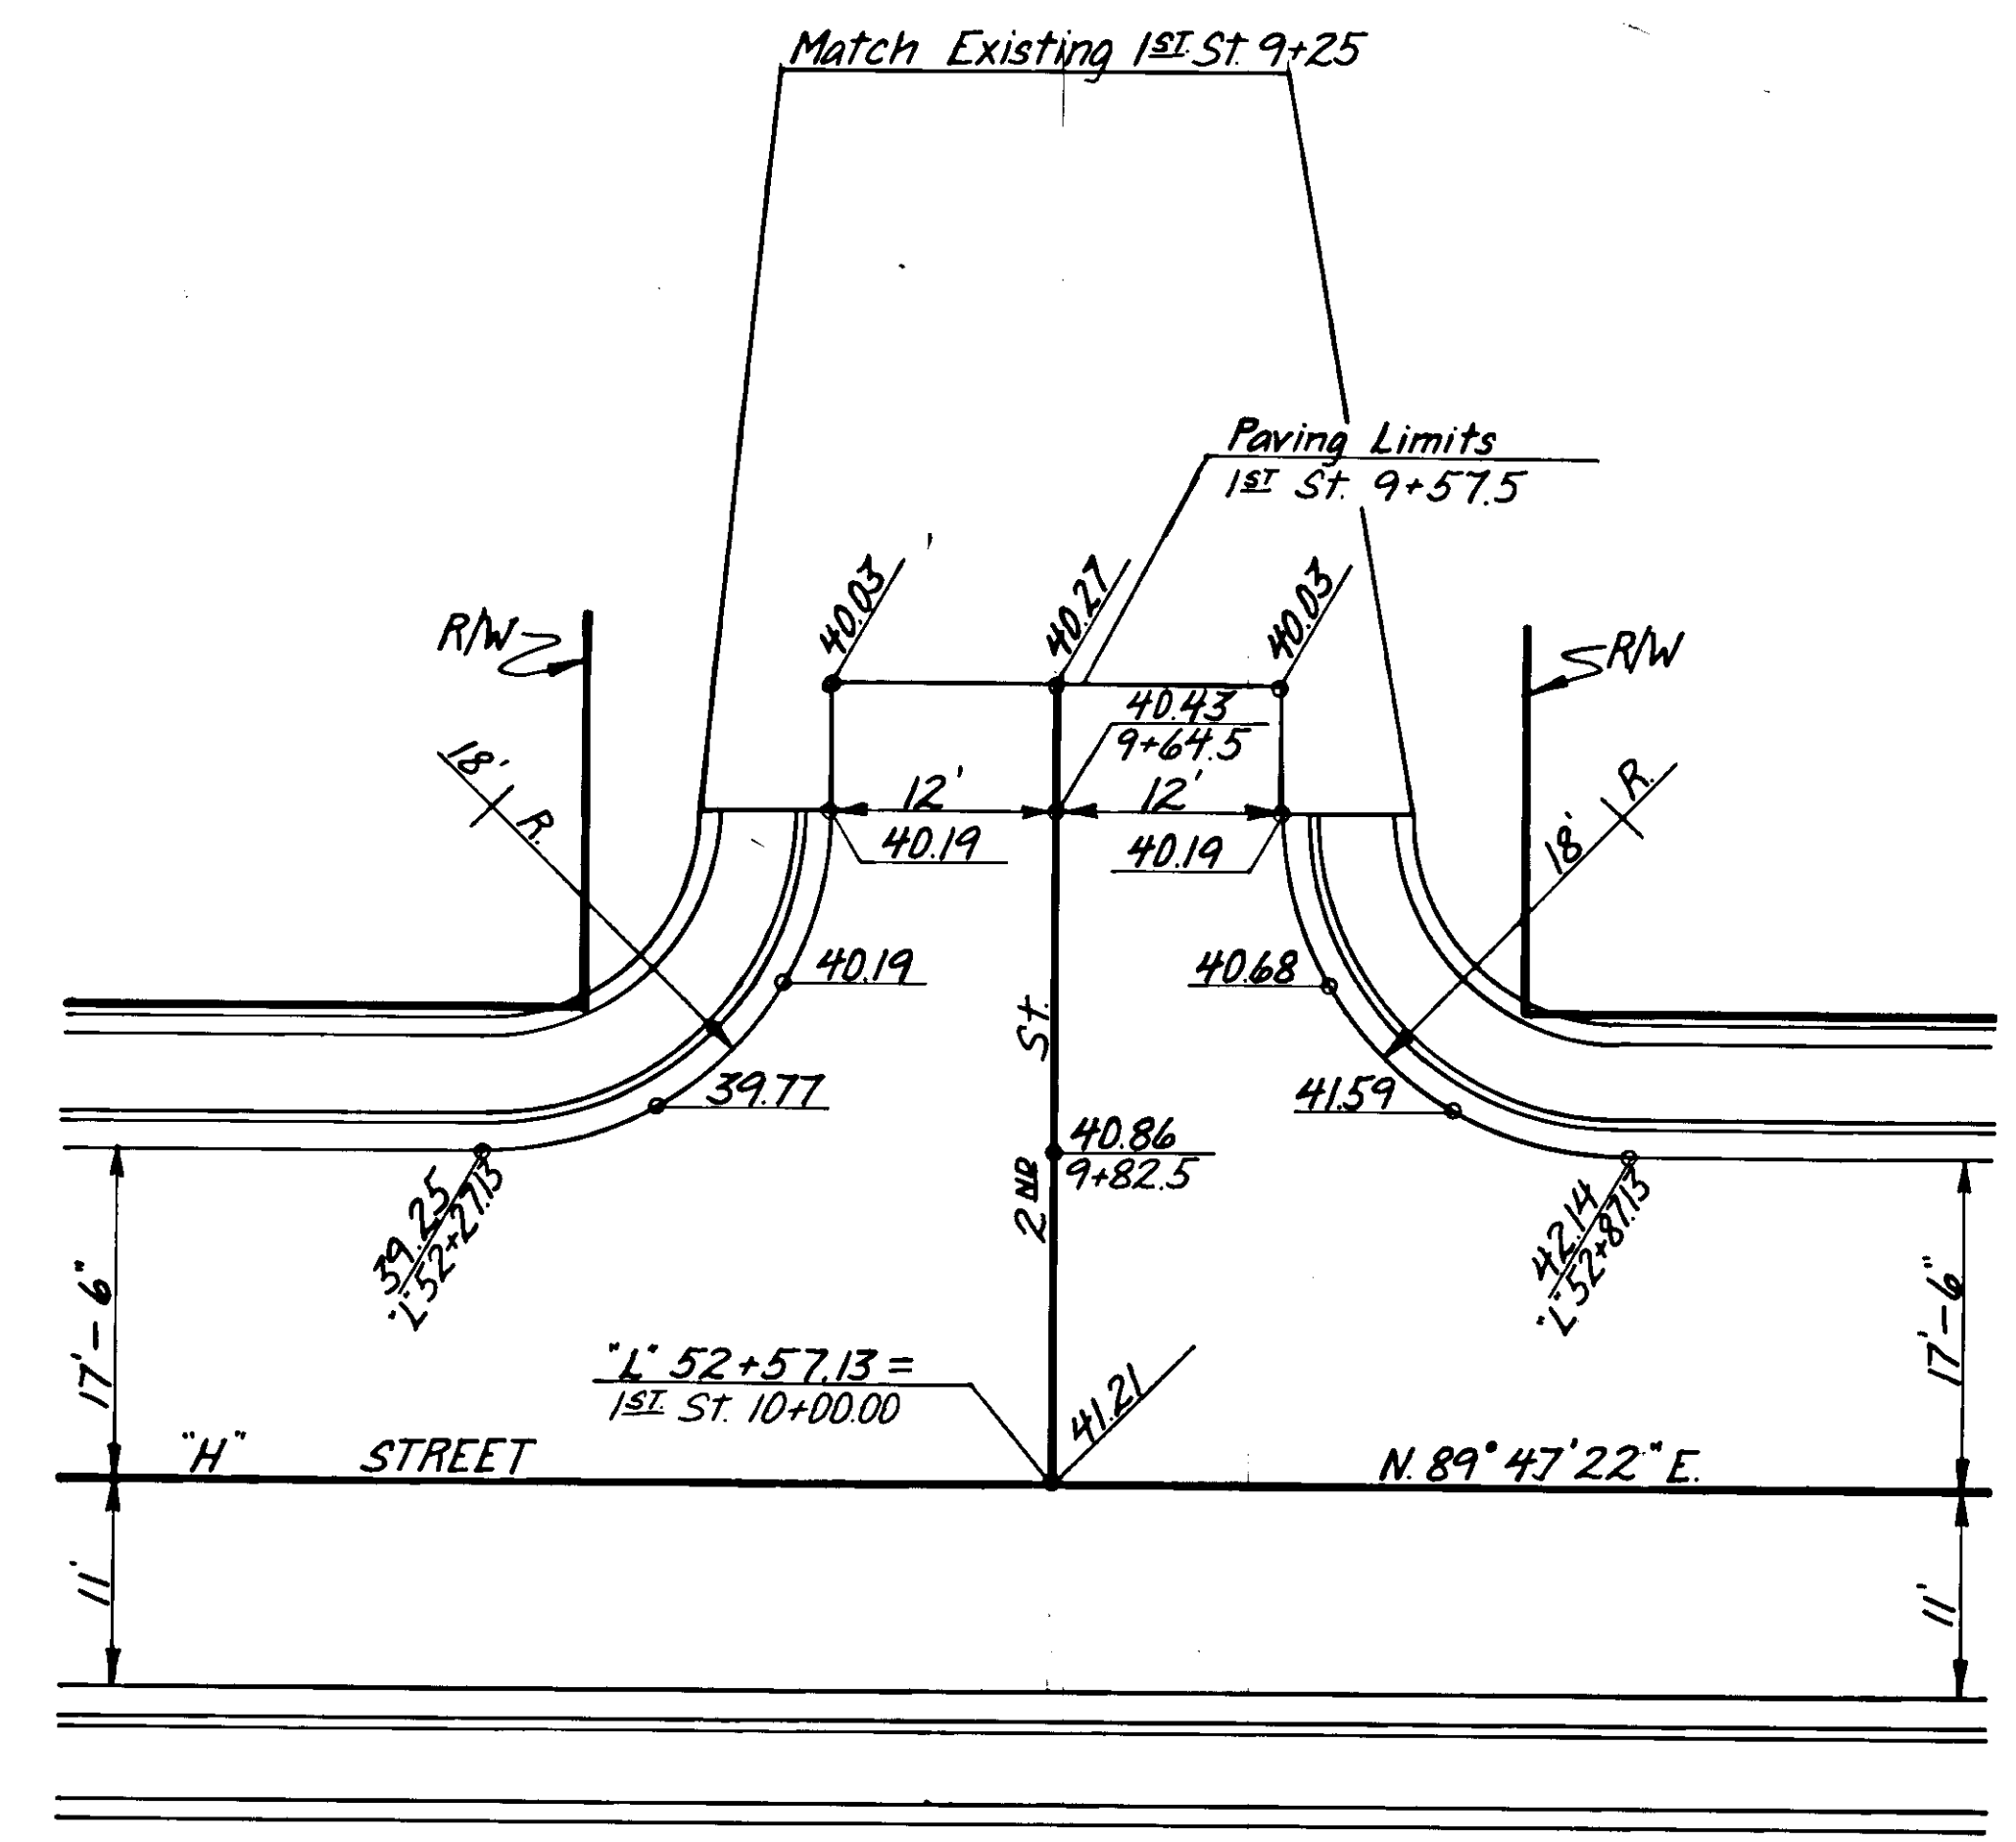

INTERSECTION "H" & 1st

NOTE: End peat excavation at end of sidewalks, continue excavation for base course & subbase to paving limits. Any excavation below bottom of subbase or past paving limits shall be as directed by the engineer.

INTERSECTION DETAILS

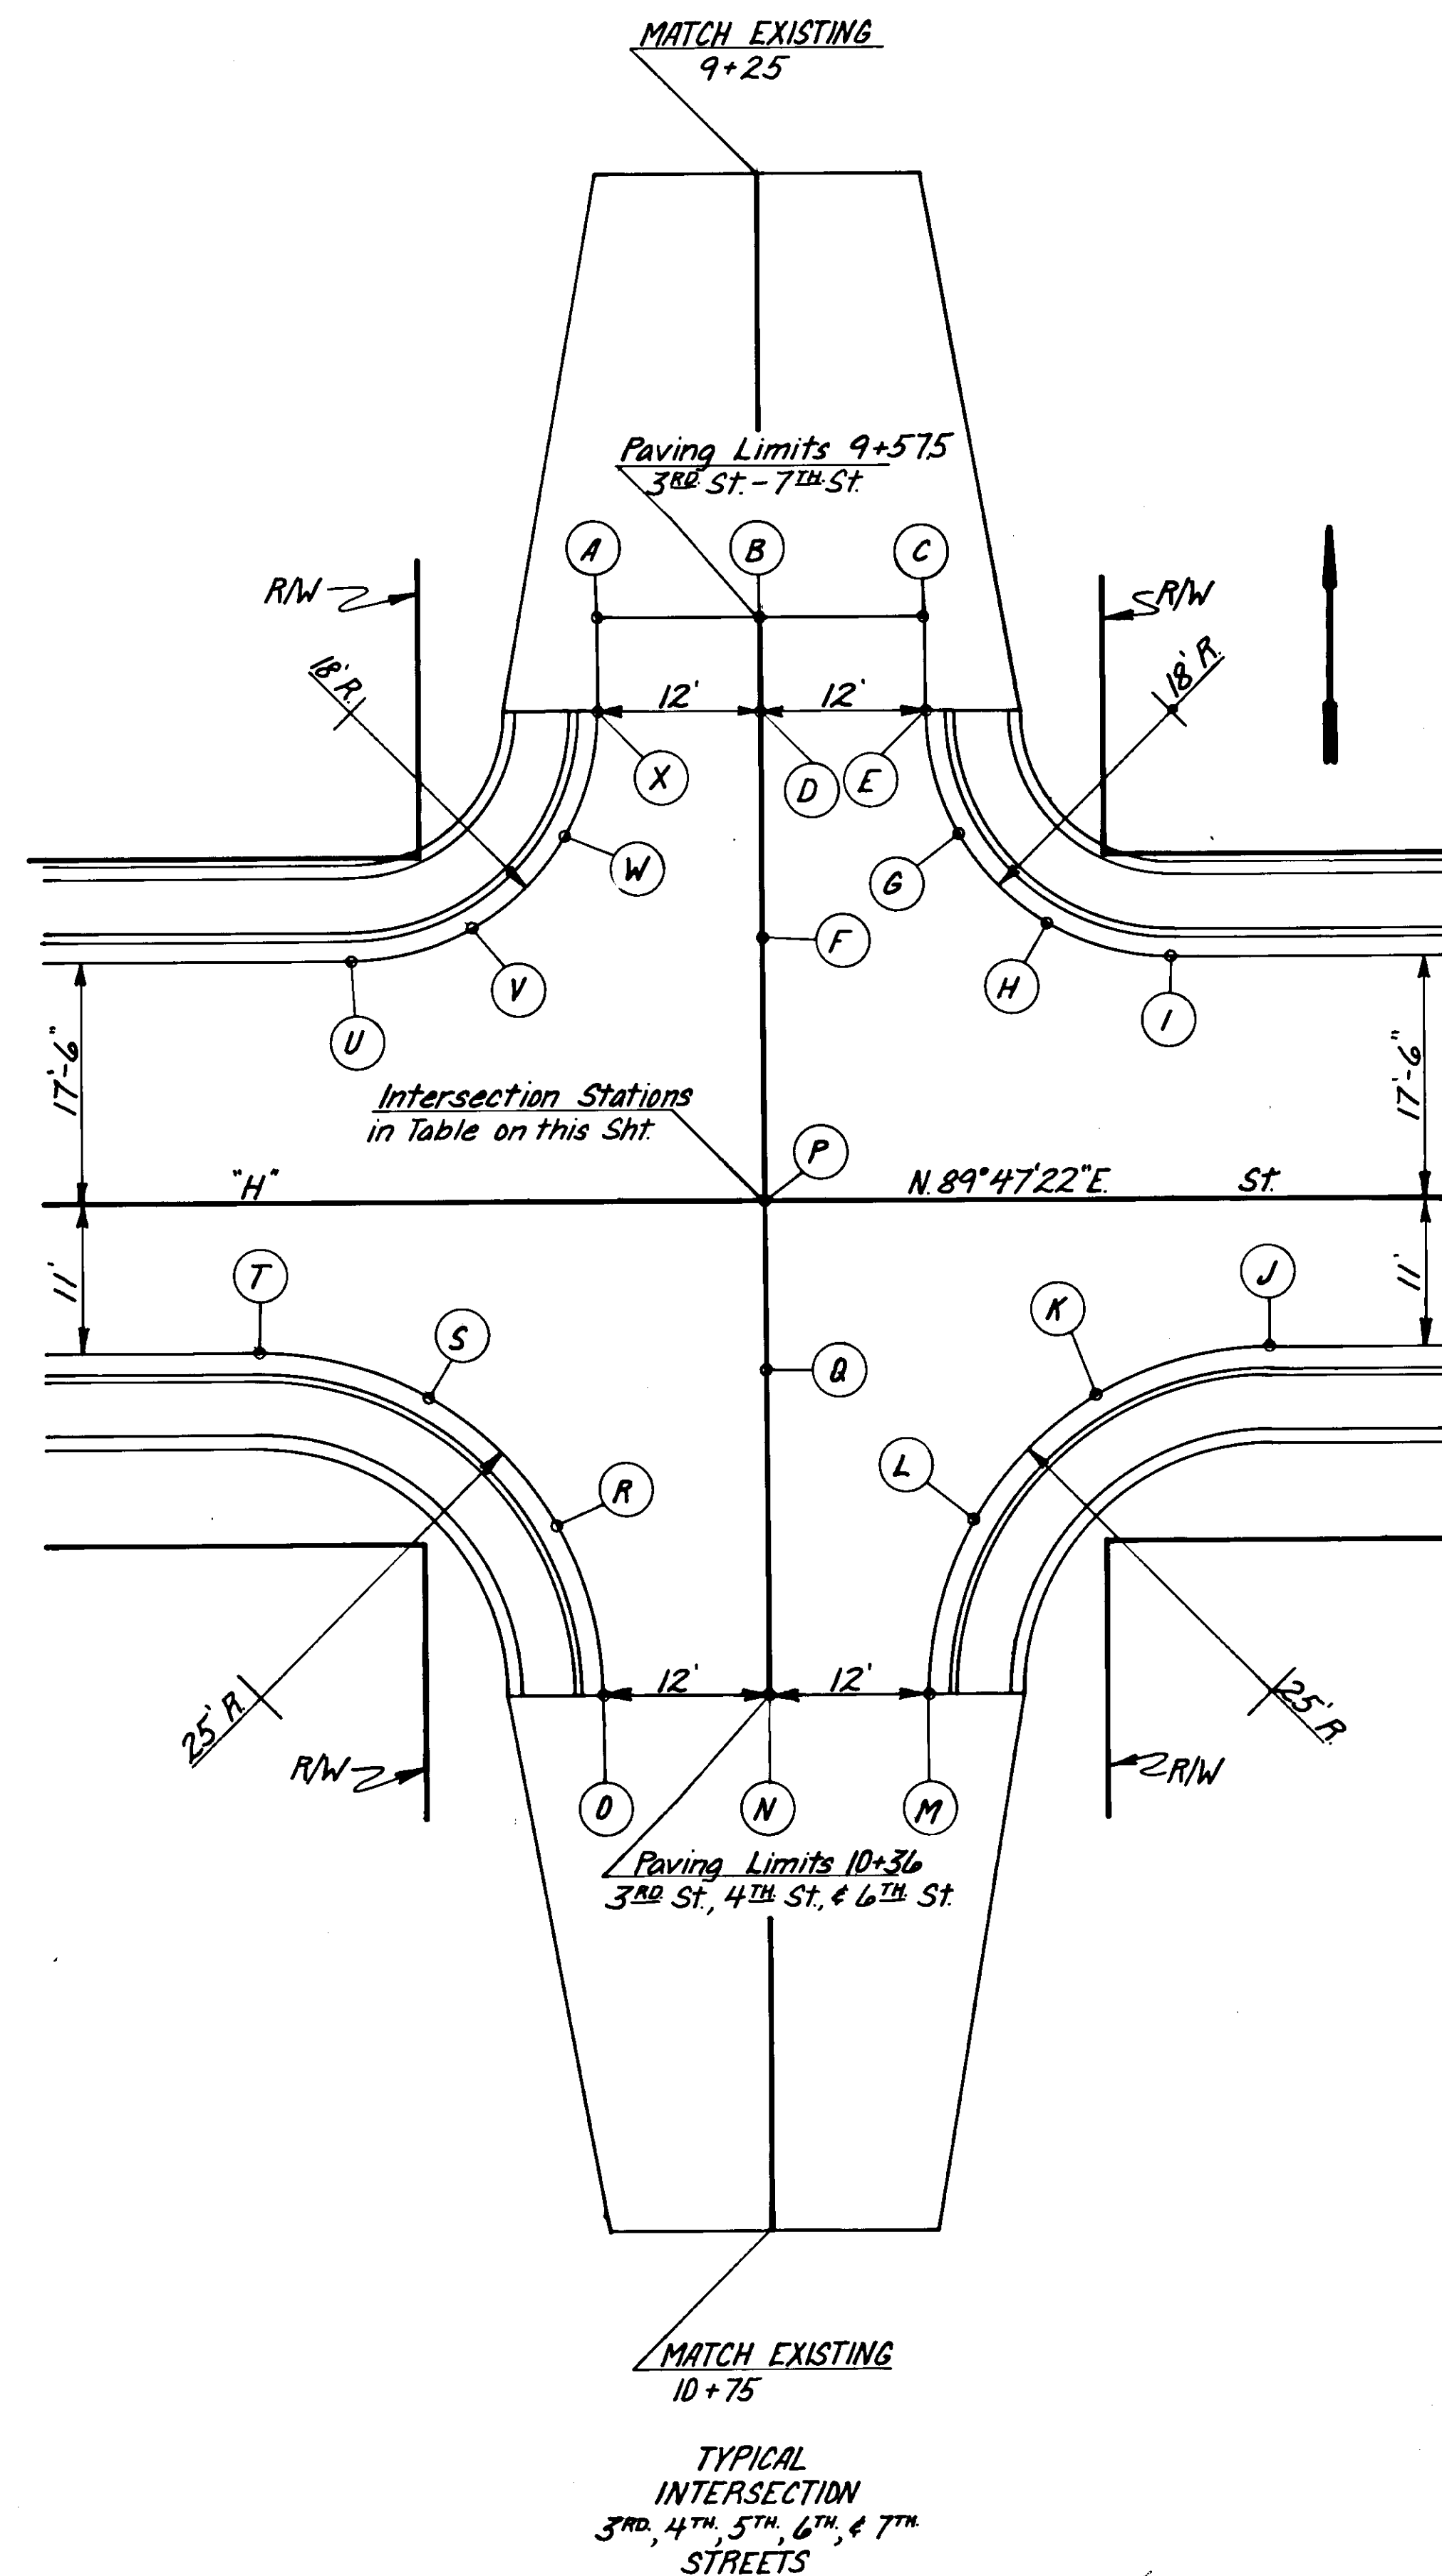



POINT LETTER	3RD ST. H 57+5713	4TH ST. H 60+0713	5TH ST. H 62+5713	6TH ST. H 65+0713	7TH ST. H 67+5713
A	53.16	59.80	67.73	80.90	88.55
B	53.40	60.04	67.97	81.14	88.79
C	53.16	59.80	67.73	80.90	88.55
D	53.27	60.04	67.99	80.74	88.33
E	53.03	59.80	67.75	80.49	88.08
F	53.28	60.22	68.19	80.40	87.93
G	53.11	60.06	68.02	80.47	87.85
H	53.63	60.72	68.69	81.34	88.25
I	53.97	61.18	69.16	82.03	88.55
J	54.27	61.53		82.51	
K	53.83	60.98		81.64	
L	53.21	60.29		80.60	
M	53.05	60.30		80.51	
N	53.29	60.54		80.75	
O	53.05	60.30		80.51	
P	53.63	60.57	68.54	80.75	88.28
Q	53.41	60.35		80.53	
R	52.92	59.86		79.93	
S	52.79	59.54		79.22	
T	52.55	59.17		78.49	
U	52.59	59.27	67.23	78.74	87.31
V	52.77	59.53	67.49	79.30	87.47
W	52.88	59.73	67.70	79.92	87.64
X	53.03	59.80	67.75	80.49	88.08

NOTE: End peat excavation at end of sidewalks, continue excavation for base course & subbase to paving limits. Any excavation below bottom of subbase or past paving limits shall be as directed by the engineer.

NOTE: No intersection rt. on 5TH or 7TH Streets

STATE	PROJECT DESIGNATION	YEAR	SHEET NO.	TOTAL SHEETS
ALASKA	RS-0938(I)	1979	18	34

INTERSECTION DETAILS

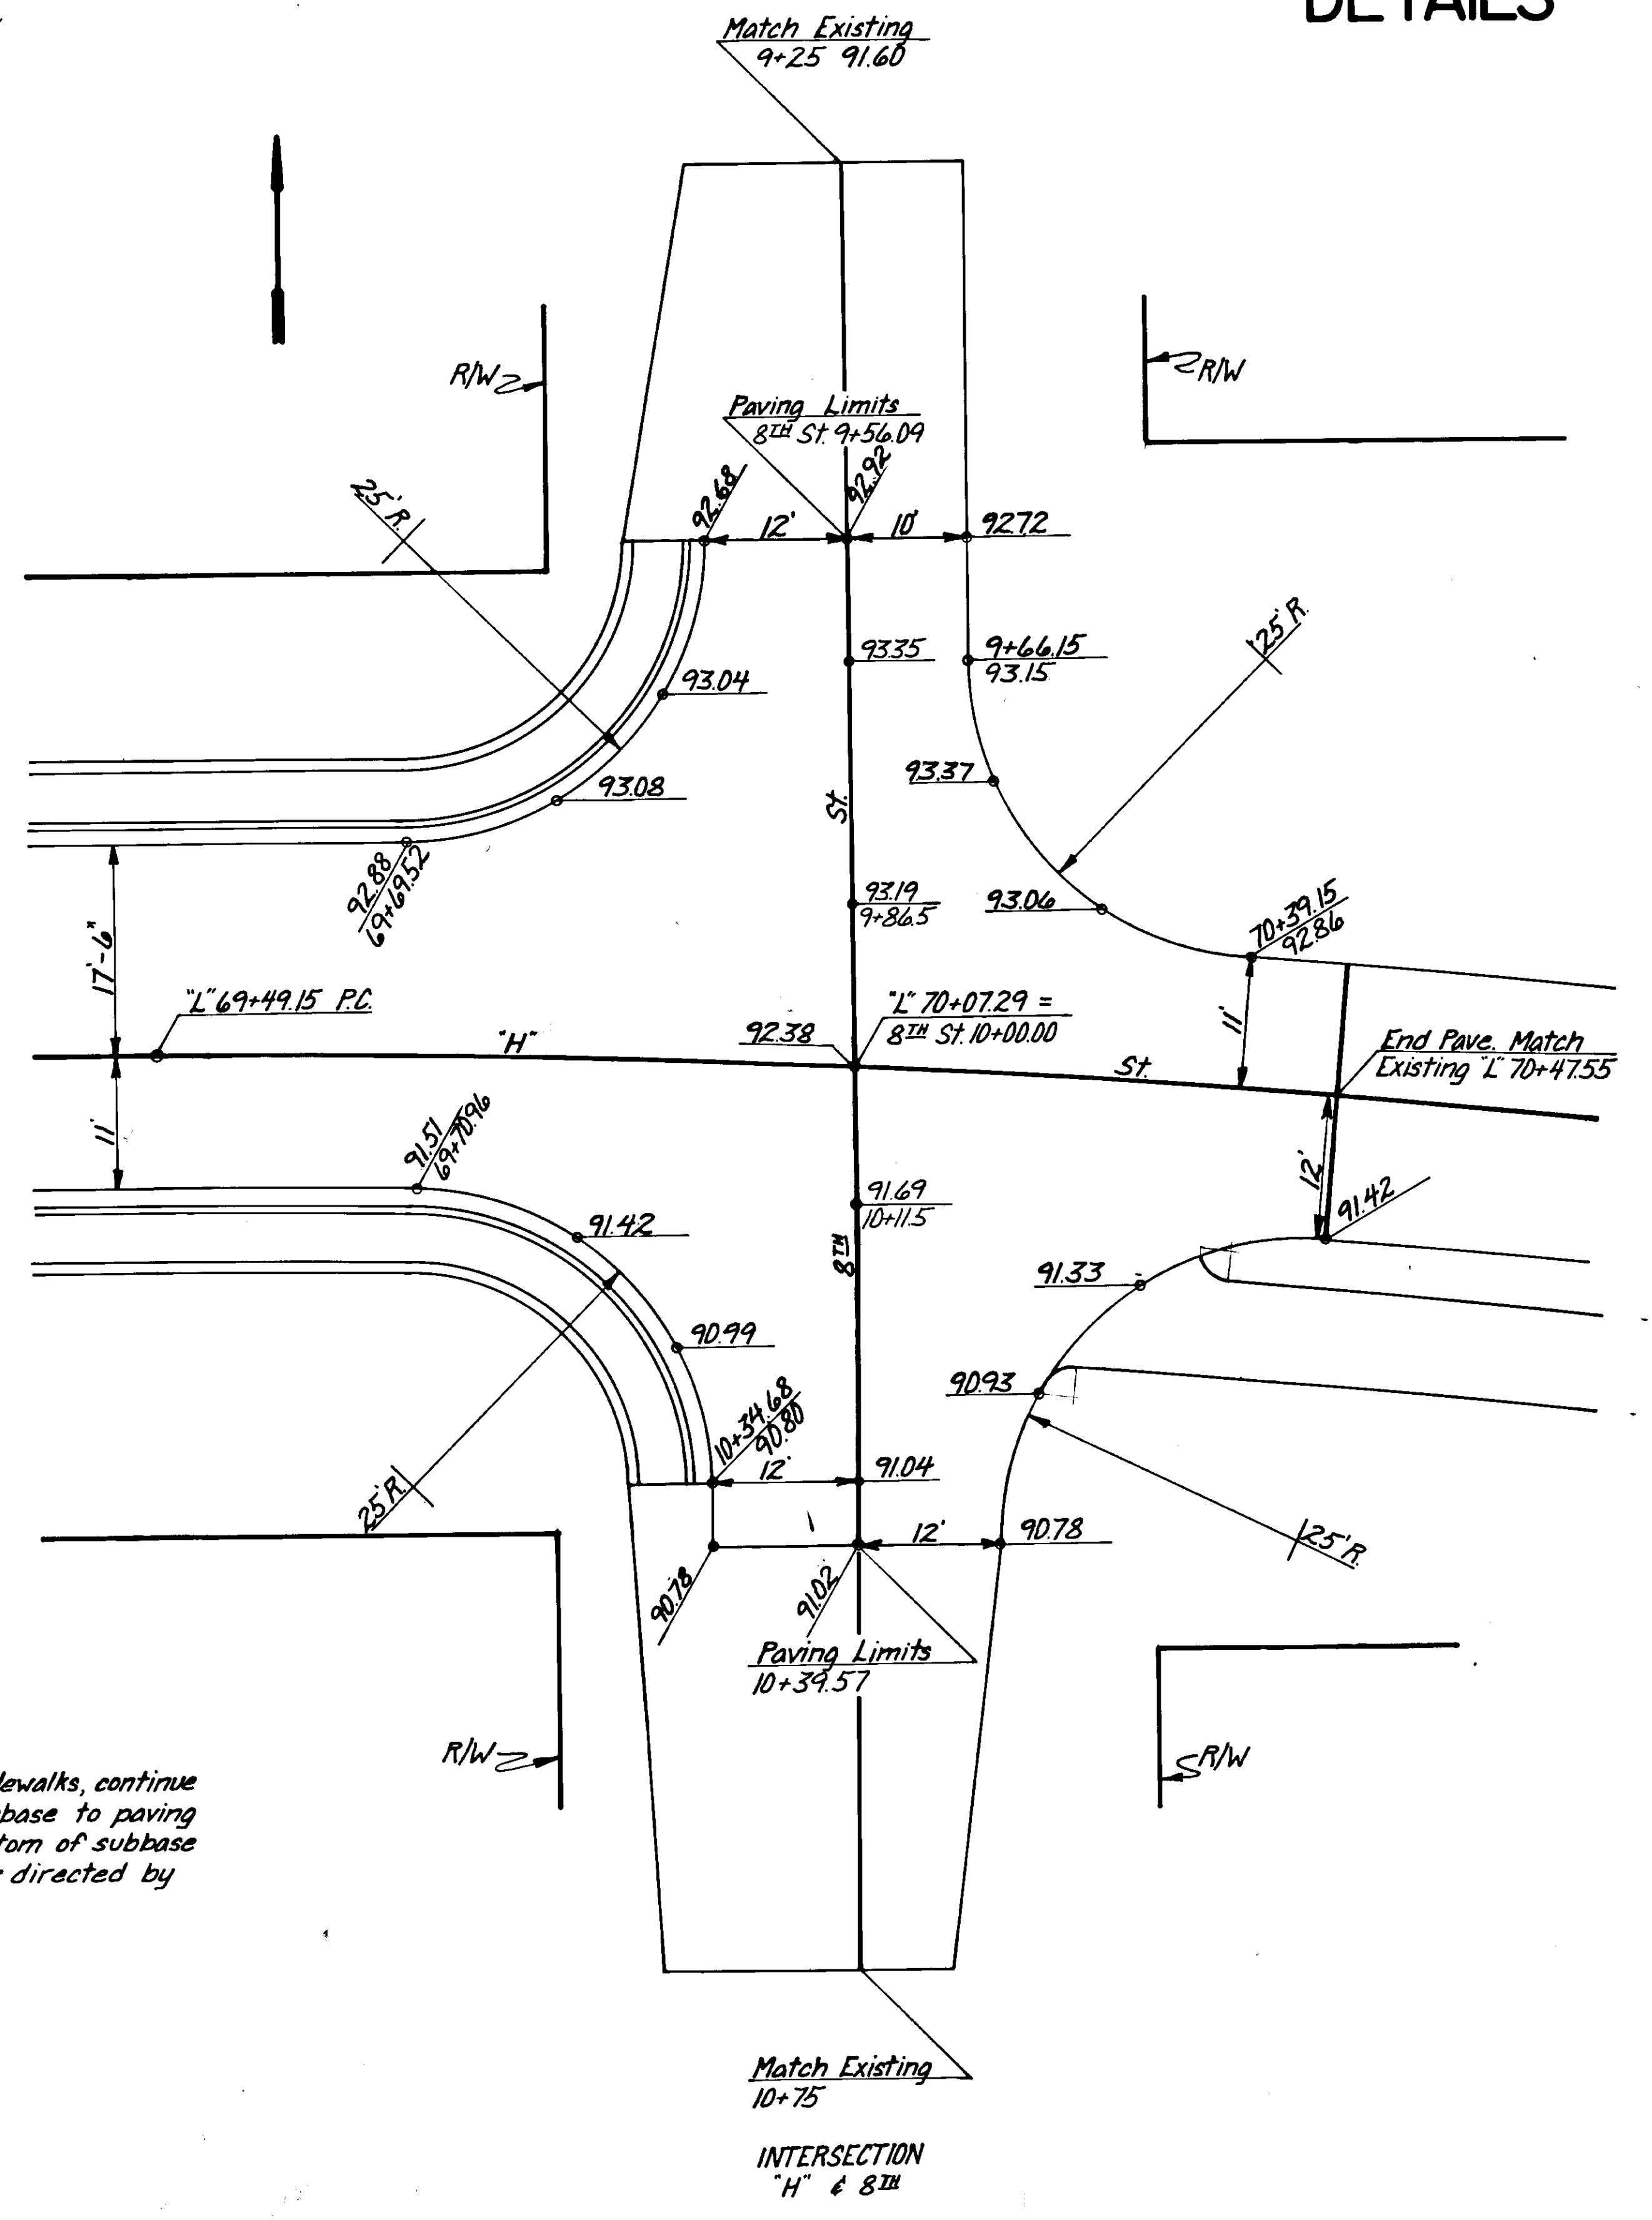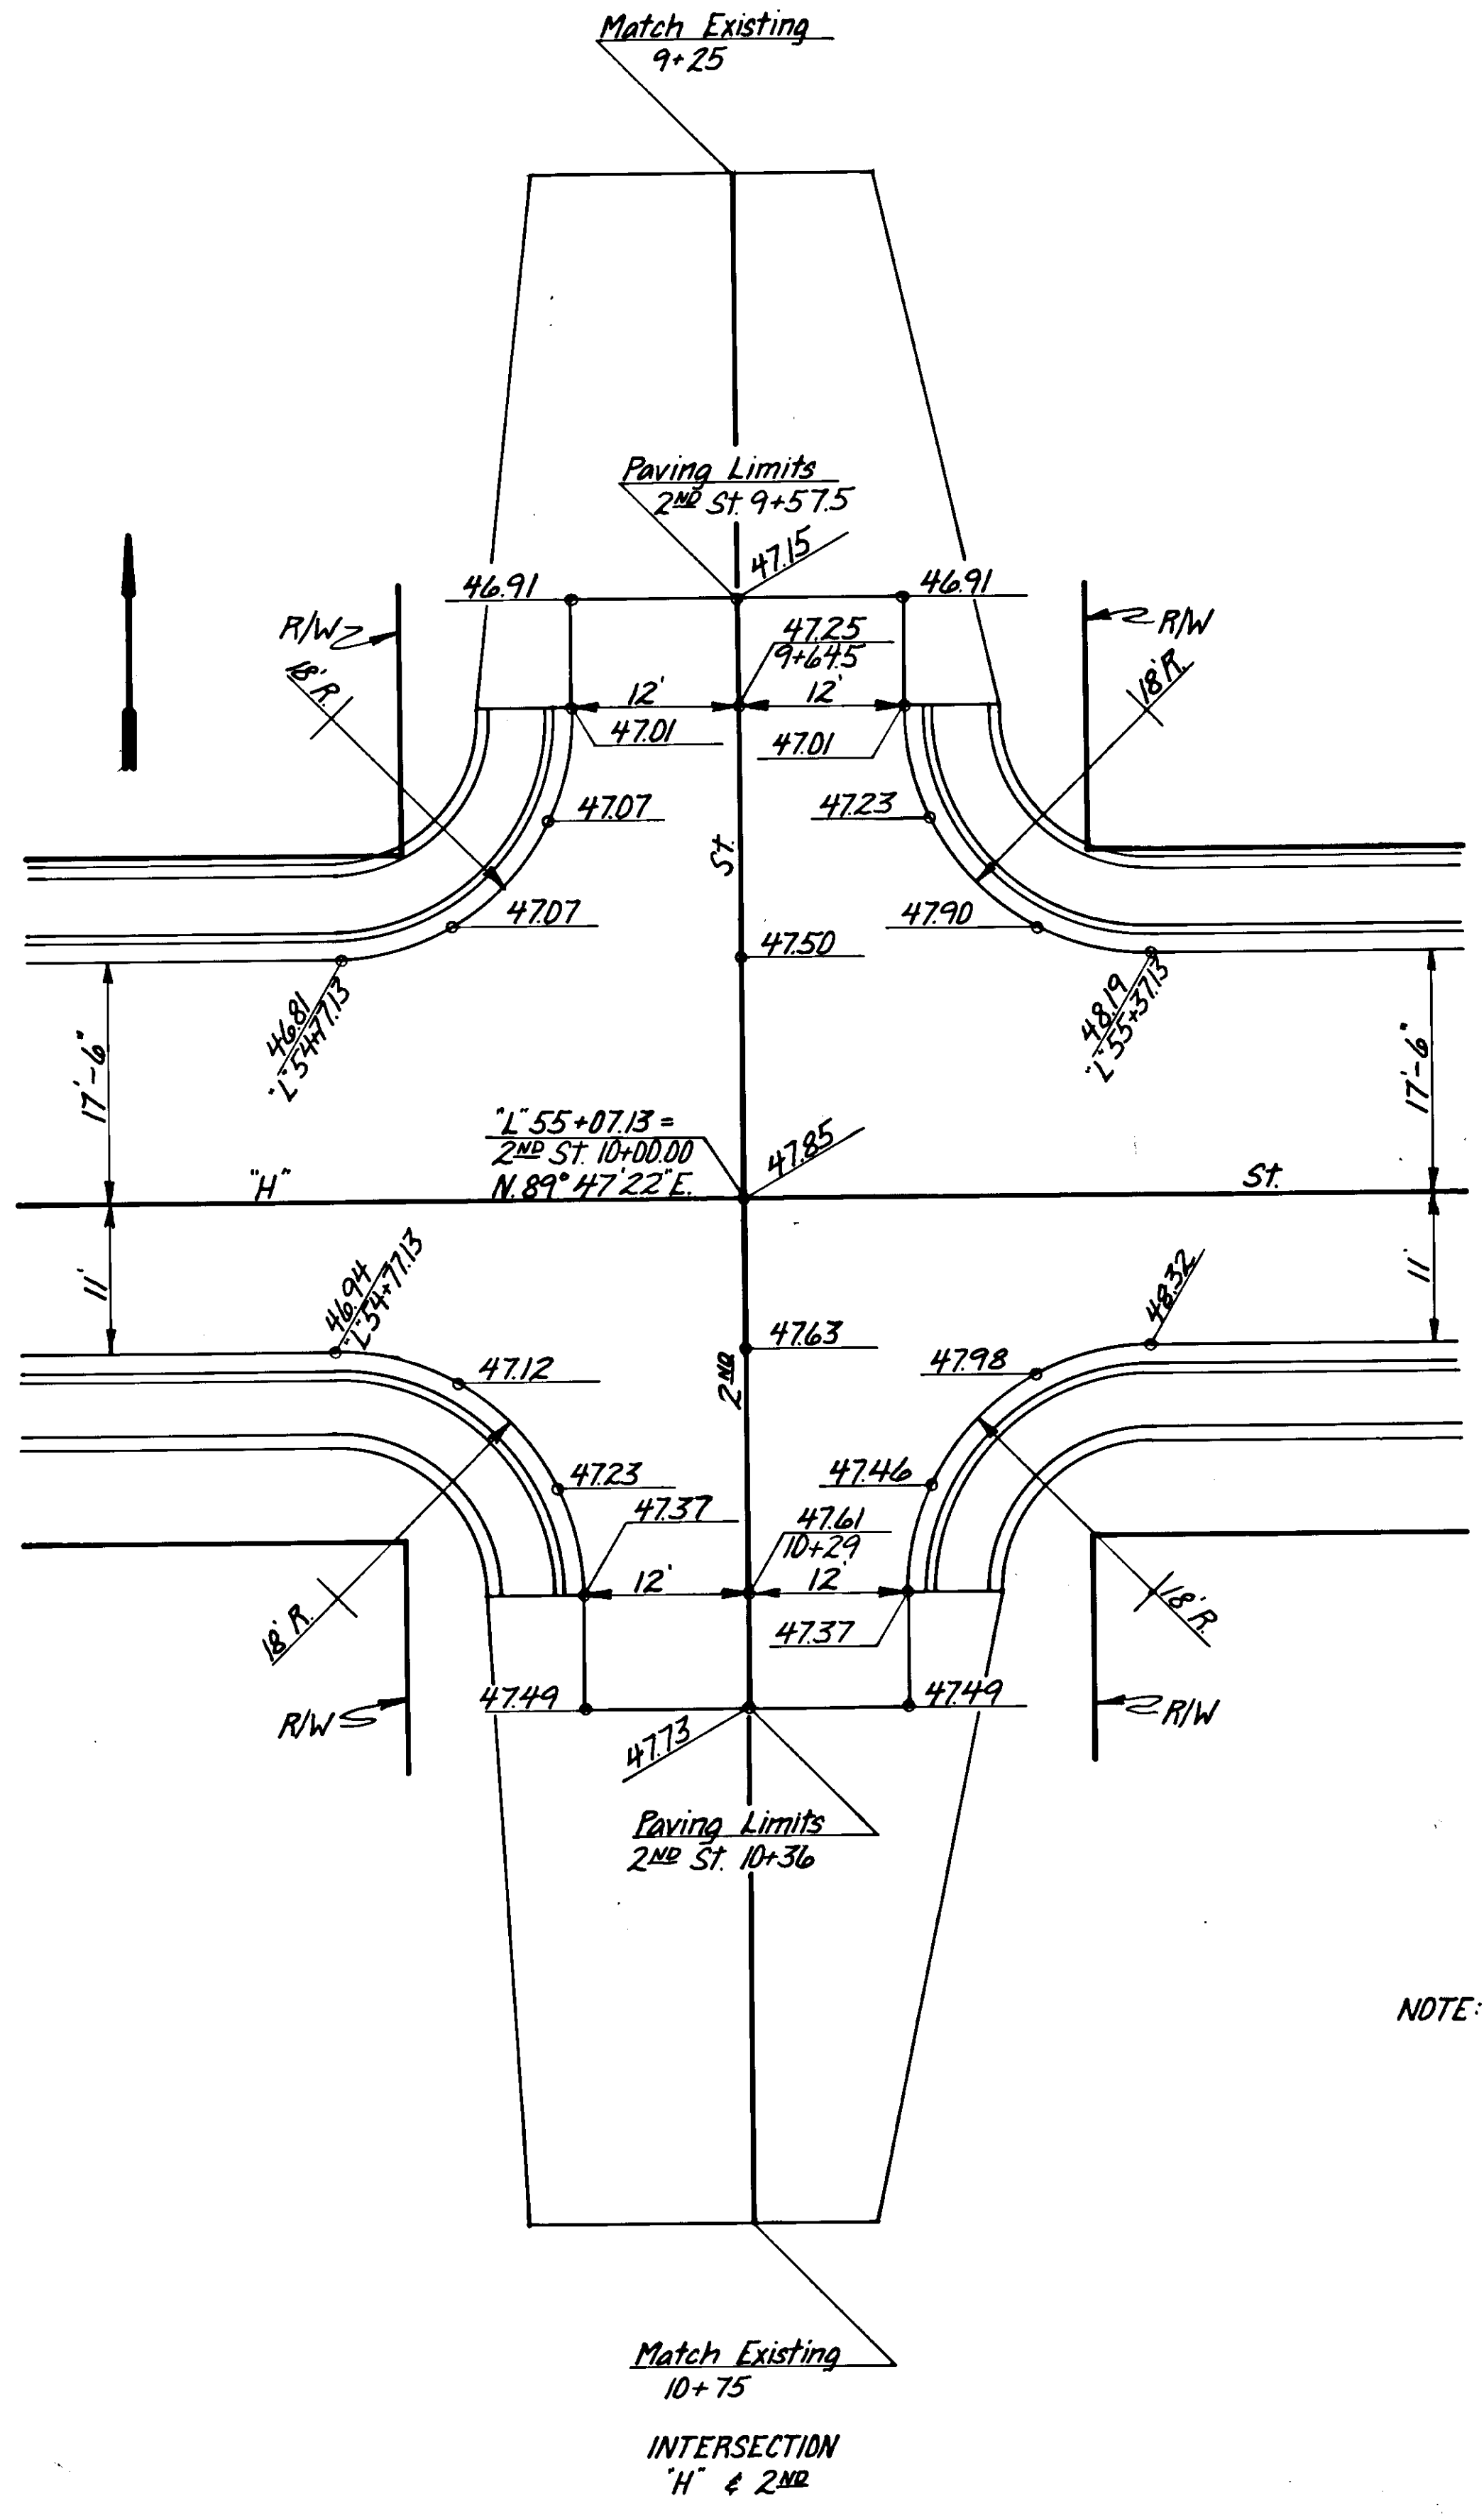



NOTE: End peat excavation at end of sidewalks, continue excavation for base course & subbase to paving limits. Any excavation below bottom of subbase or past paving limits shall be as directed by the engineer.

INTERSECTION
"H" & 2ND ST

INTERSECTION
"H" & 8TH ST

DRAINAGE DETAILS

STATE	PROJECT DESIGNATION	YEAR	SHEET NO.	TOTAL SHEETS
ALASKA	RS-0938 (I)	1979	21	34

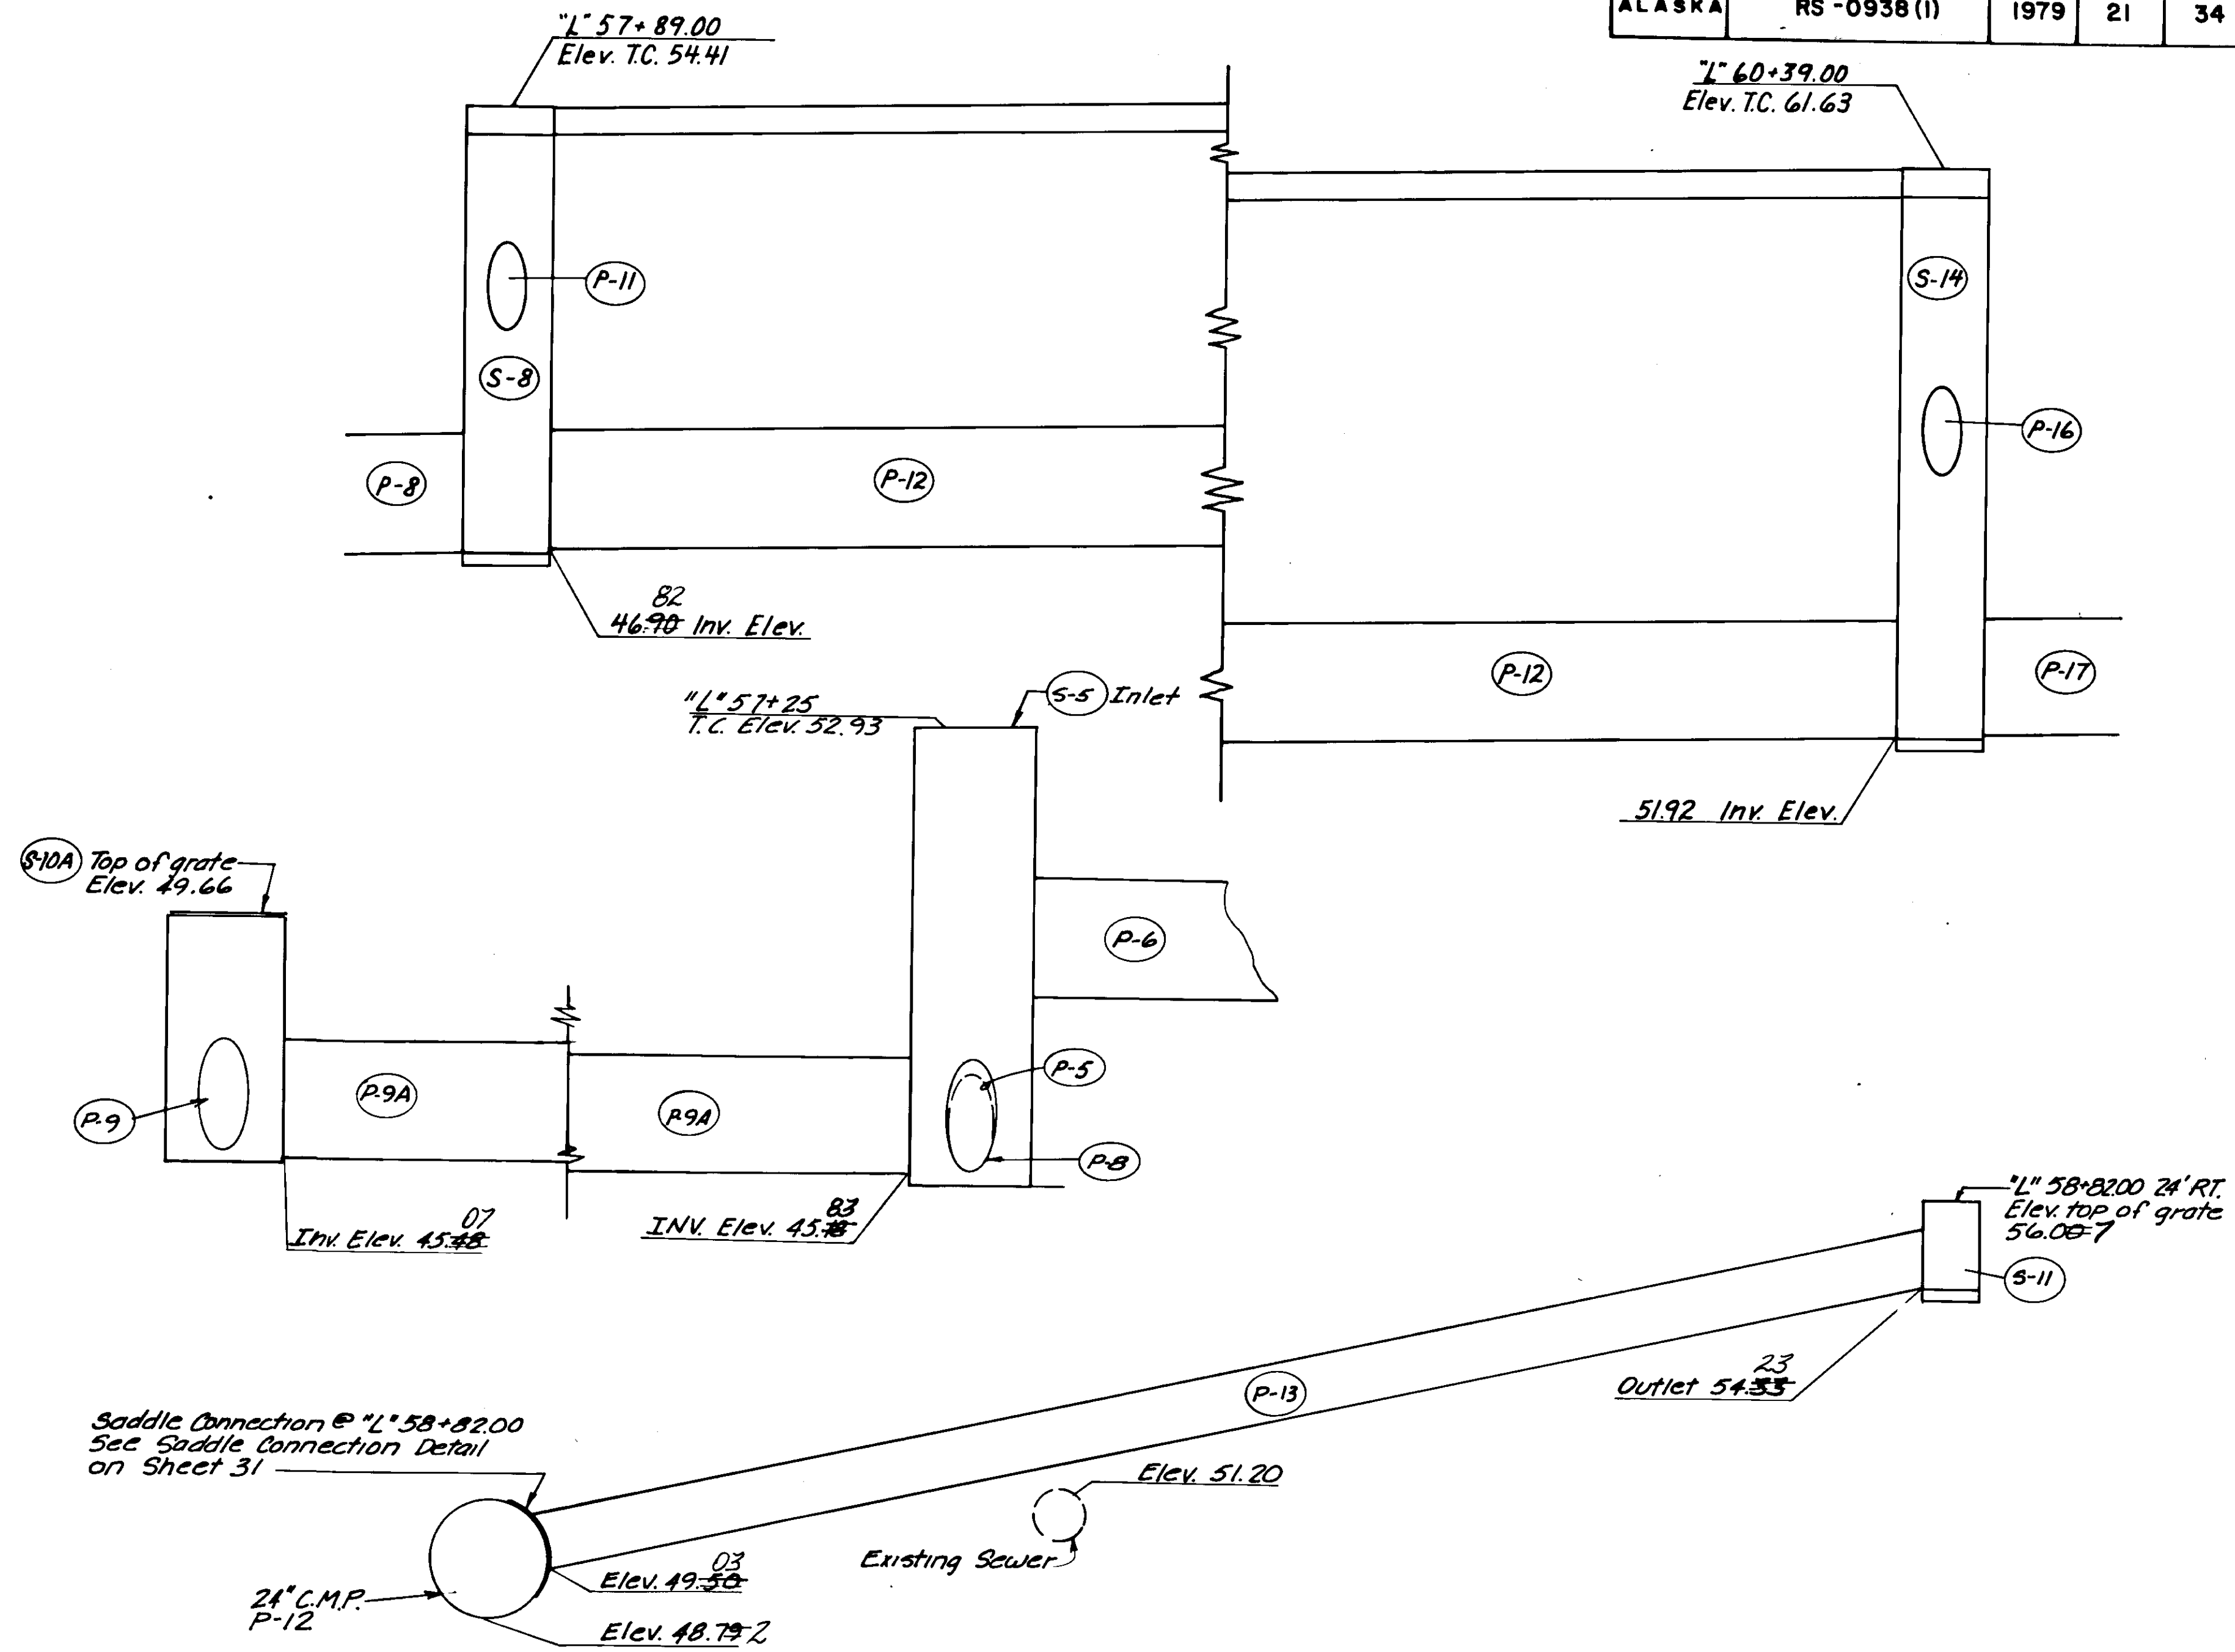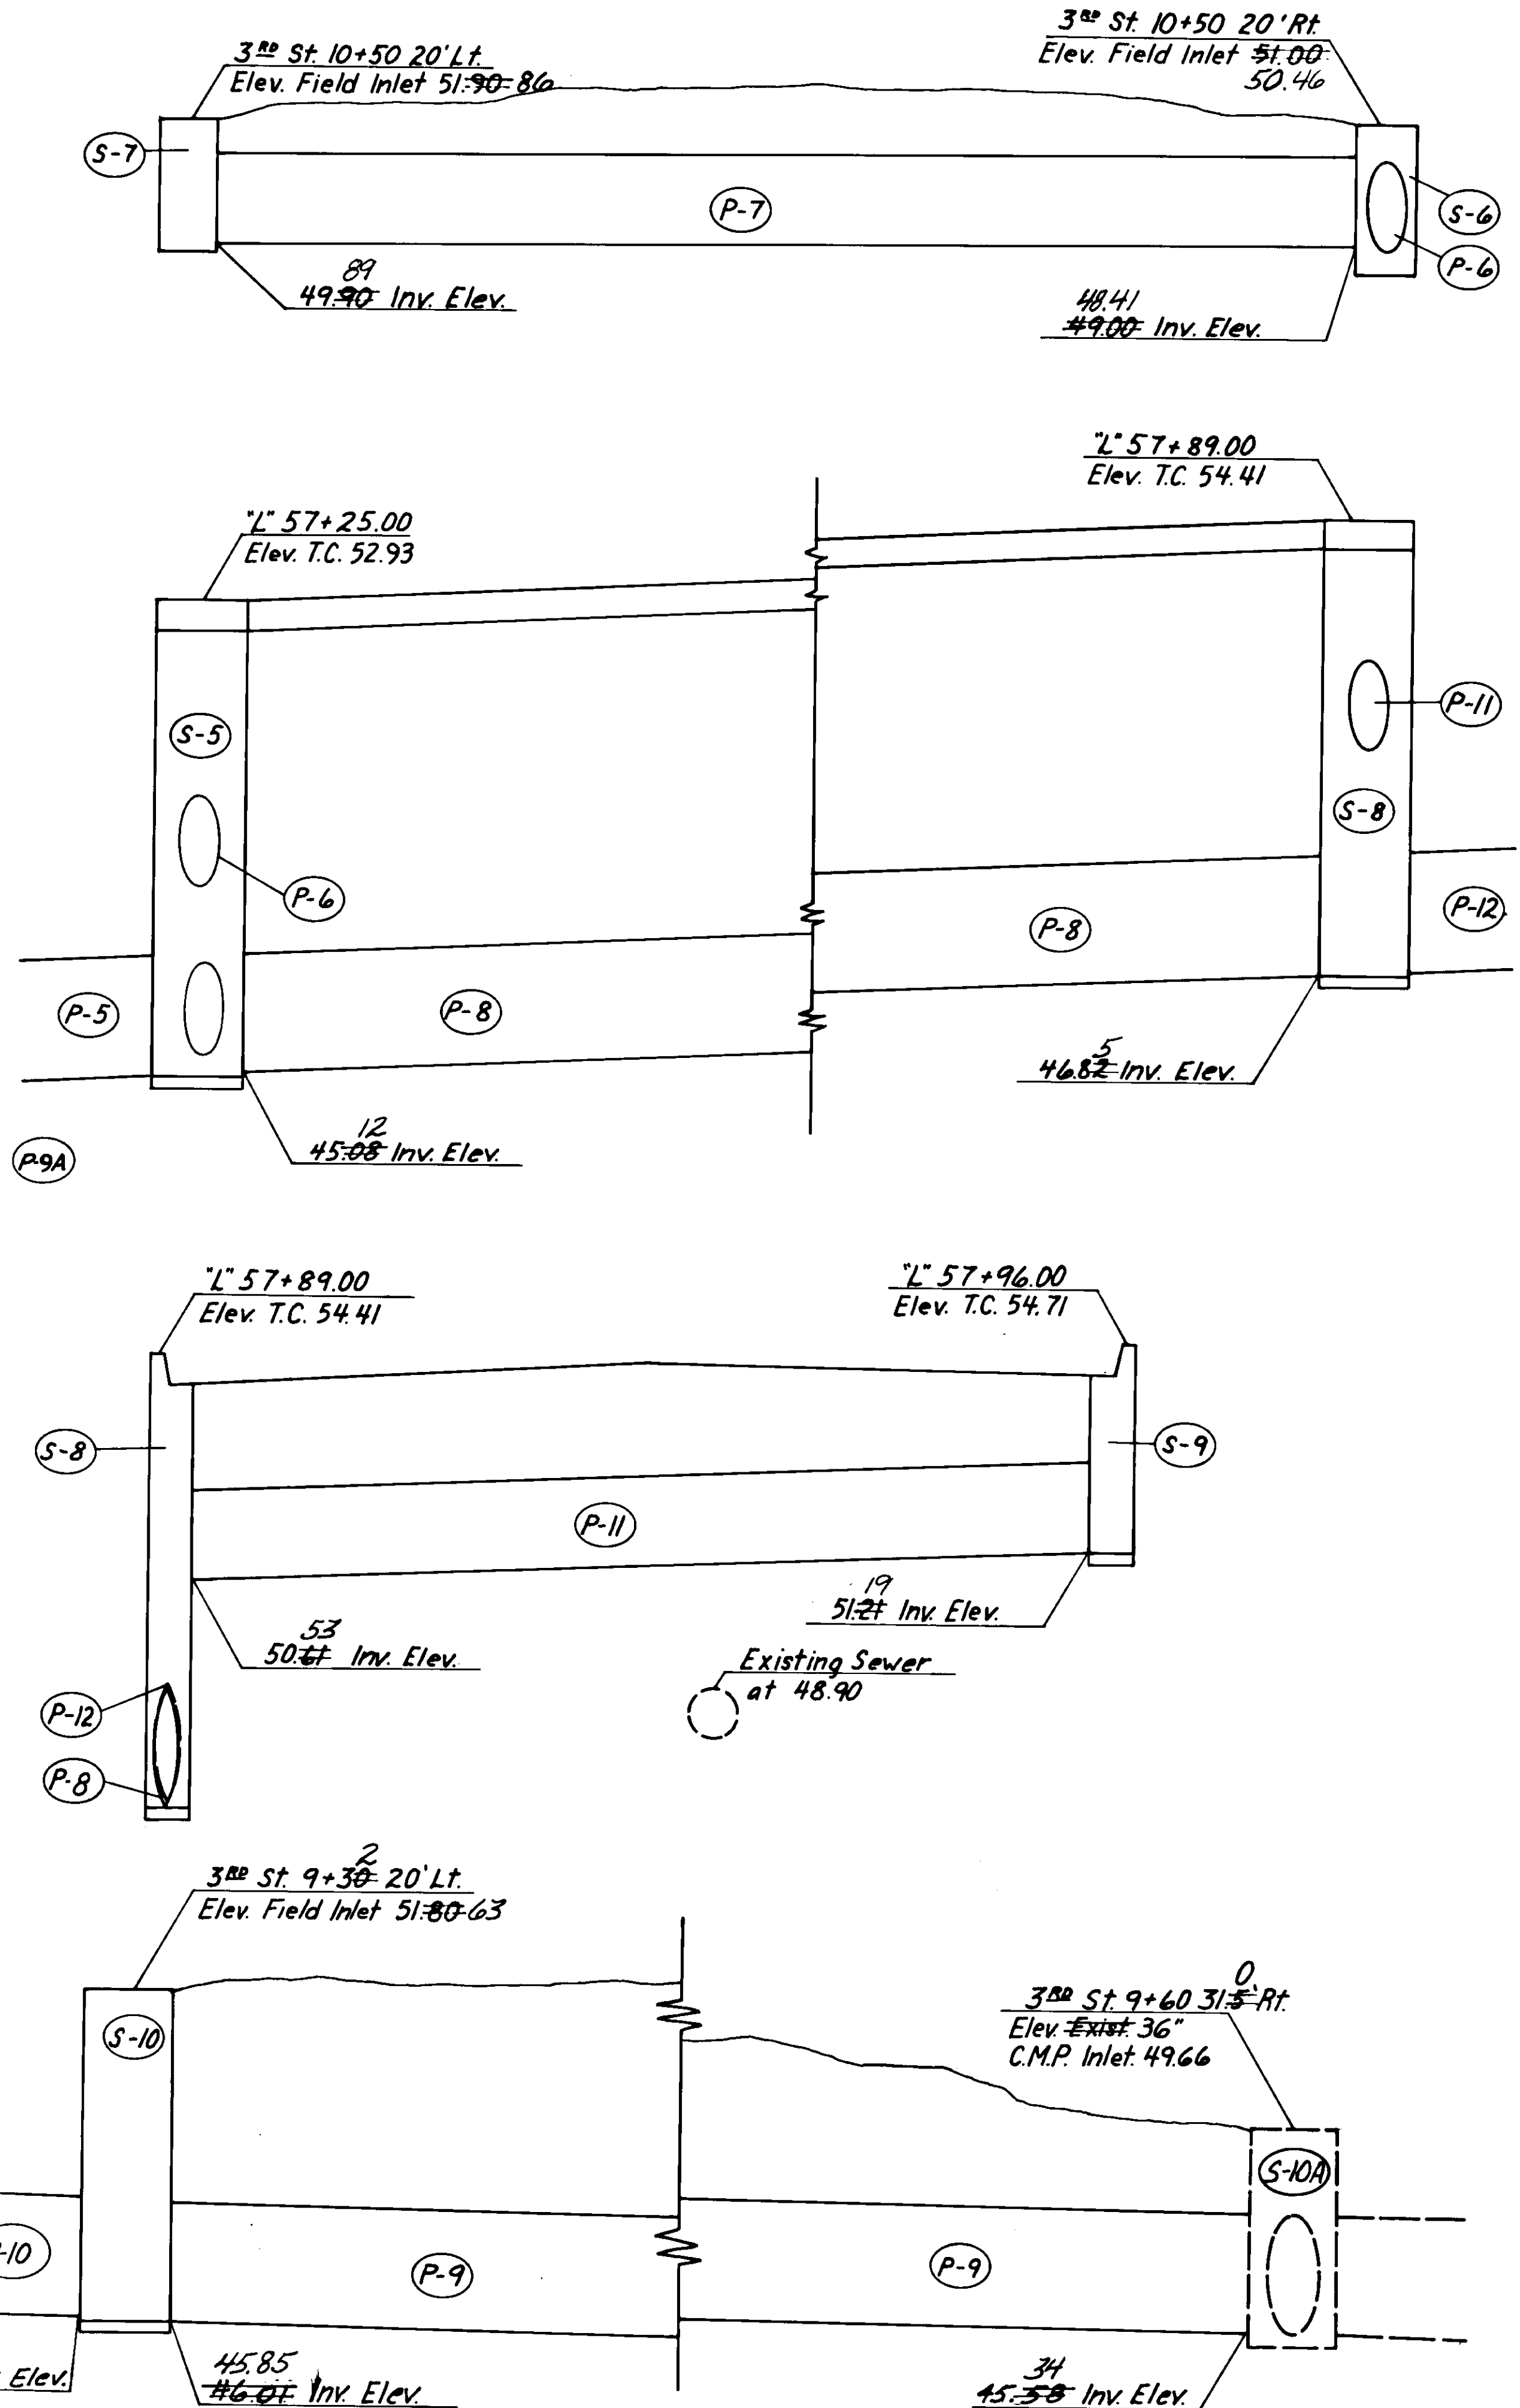






STRUCTURE SUMMARY						PIPE SUMMARY							
STRUCTURE	TYPE	LOCATION	OFFSET		TOP CURB ELEV.	INVERT ELEV.	PIPE	DIA.	LENGTH	FROM		TO	
			LEFT	RIGHT						STRUCTURE	ELEV.	STRUCTURE	ELEV.
S-5	B	L 57+25.00	19.5'		52.93	45.00	P-7	18"	38' 42"	S-7	49.90	S-6	49.00
S-6	X	3rd St 10+50		20' **	51.00	48.92	P-8	24"	64'	S-8	46.82	S-5	45.88
S-7	X	3rd St 10+50	20' **	50.46	51.90	49.90	P-9	24"	58' 7"	S-10	46.01	S-10A	45.85
S-8	B	L 57+89.00	19.5'		54.41	46.82	P-9A	24"	23' 1"	S-10A	45.88	S-5	45.88
S-9	A	L 57+96.00		13'	54.71	51.21	P-10	18"	64'	S-9	51.21	S-8	50.61
S-10A	Z	3rd St 9+60		31' **	49.66	45.85	P-11	18"	30' 2"	S-9	51.21	S-8	50.61
S-10	Z	3rd St 9+30	20' **		51.80	46.01	P-12	24"	24' 5"	S-14	51.92	S-8	46.90
S-11	X	L 58+82.00		21' 30' **	56.00	54.33	P-13	12"	42' 3"	S-11	54.33	24" C.M.P. @ L 58+82	49.50
S-14	B	L 60+39.00	19.5'		61.63	51.92							

NOTES: 1. * = Top of grate elev.
 2. ** = Offsets are to center of grate.
 3. A = See standard drawing D-26.02.
 4. B = " " " " D-27.10
 5. X = 24" Pipe conduit inlet. (See sht. 31 for details).
 6. Z = 36"
 7. On type A or B inlets the offsets are to back of curb.

NOTES: (cont.) 8. Back of curb elevations are approx. only.
 9. Curb inlet grates shall be type G-3R, see standard drawing D-23.01.

DRAINAGE DETAILS

STATE	PROJECT DESIGNATION	YEAR	SHEET NO.	TOTAL SHEETS
ALASKA	RS-0938(I)	1979	22	34

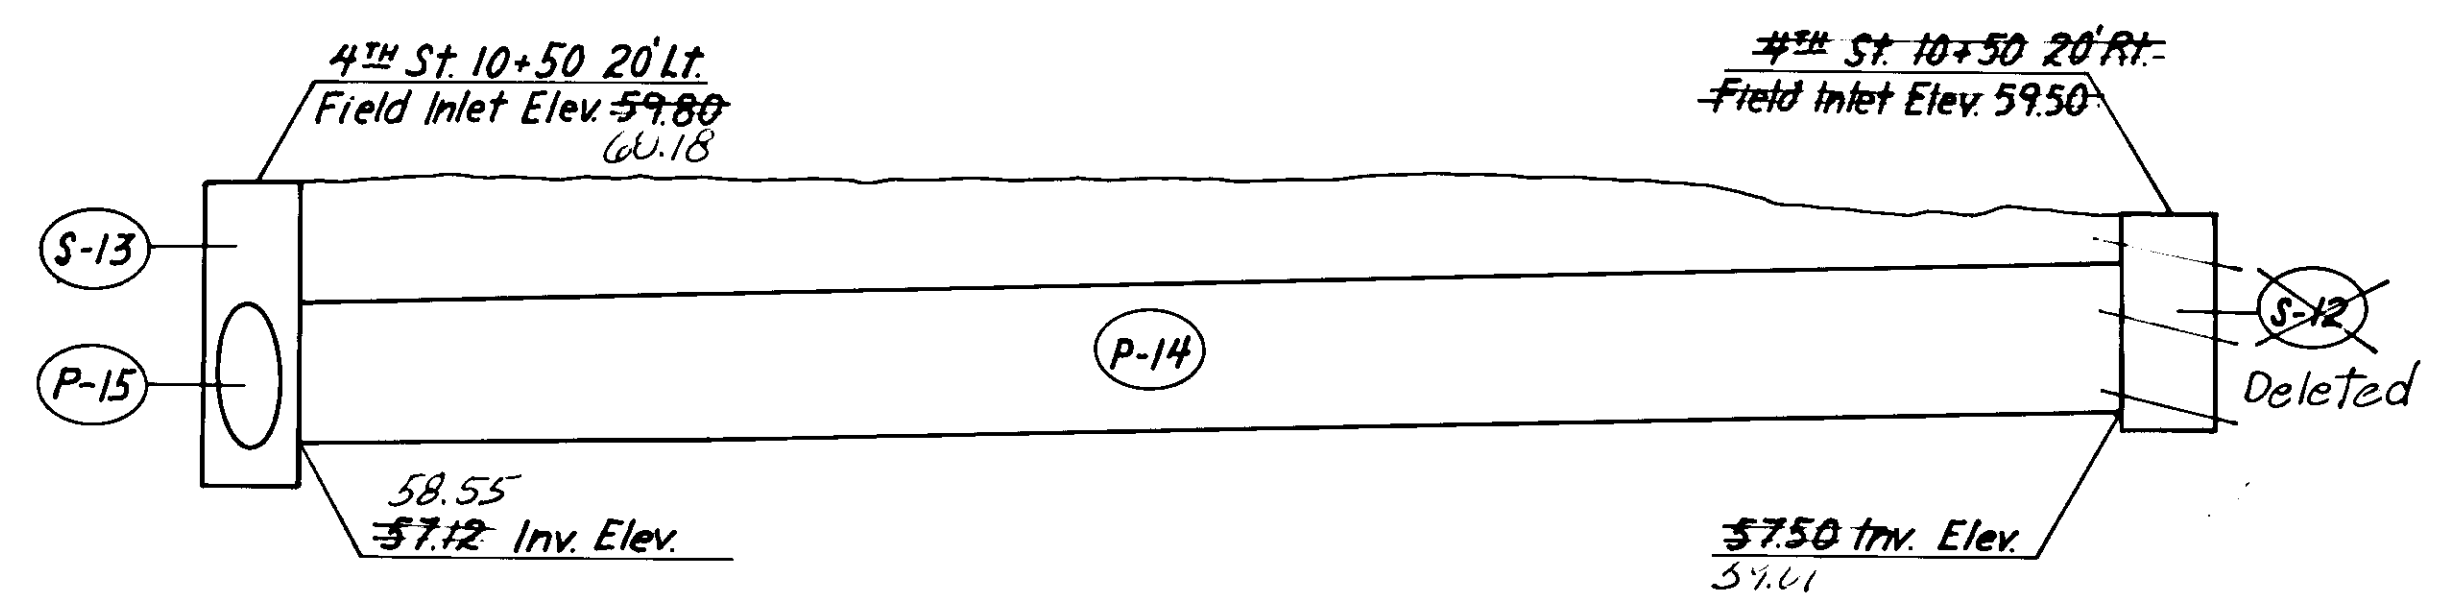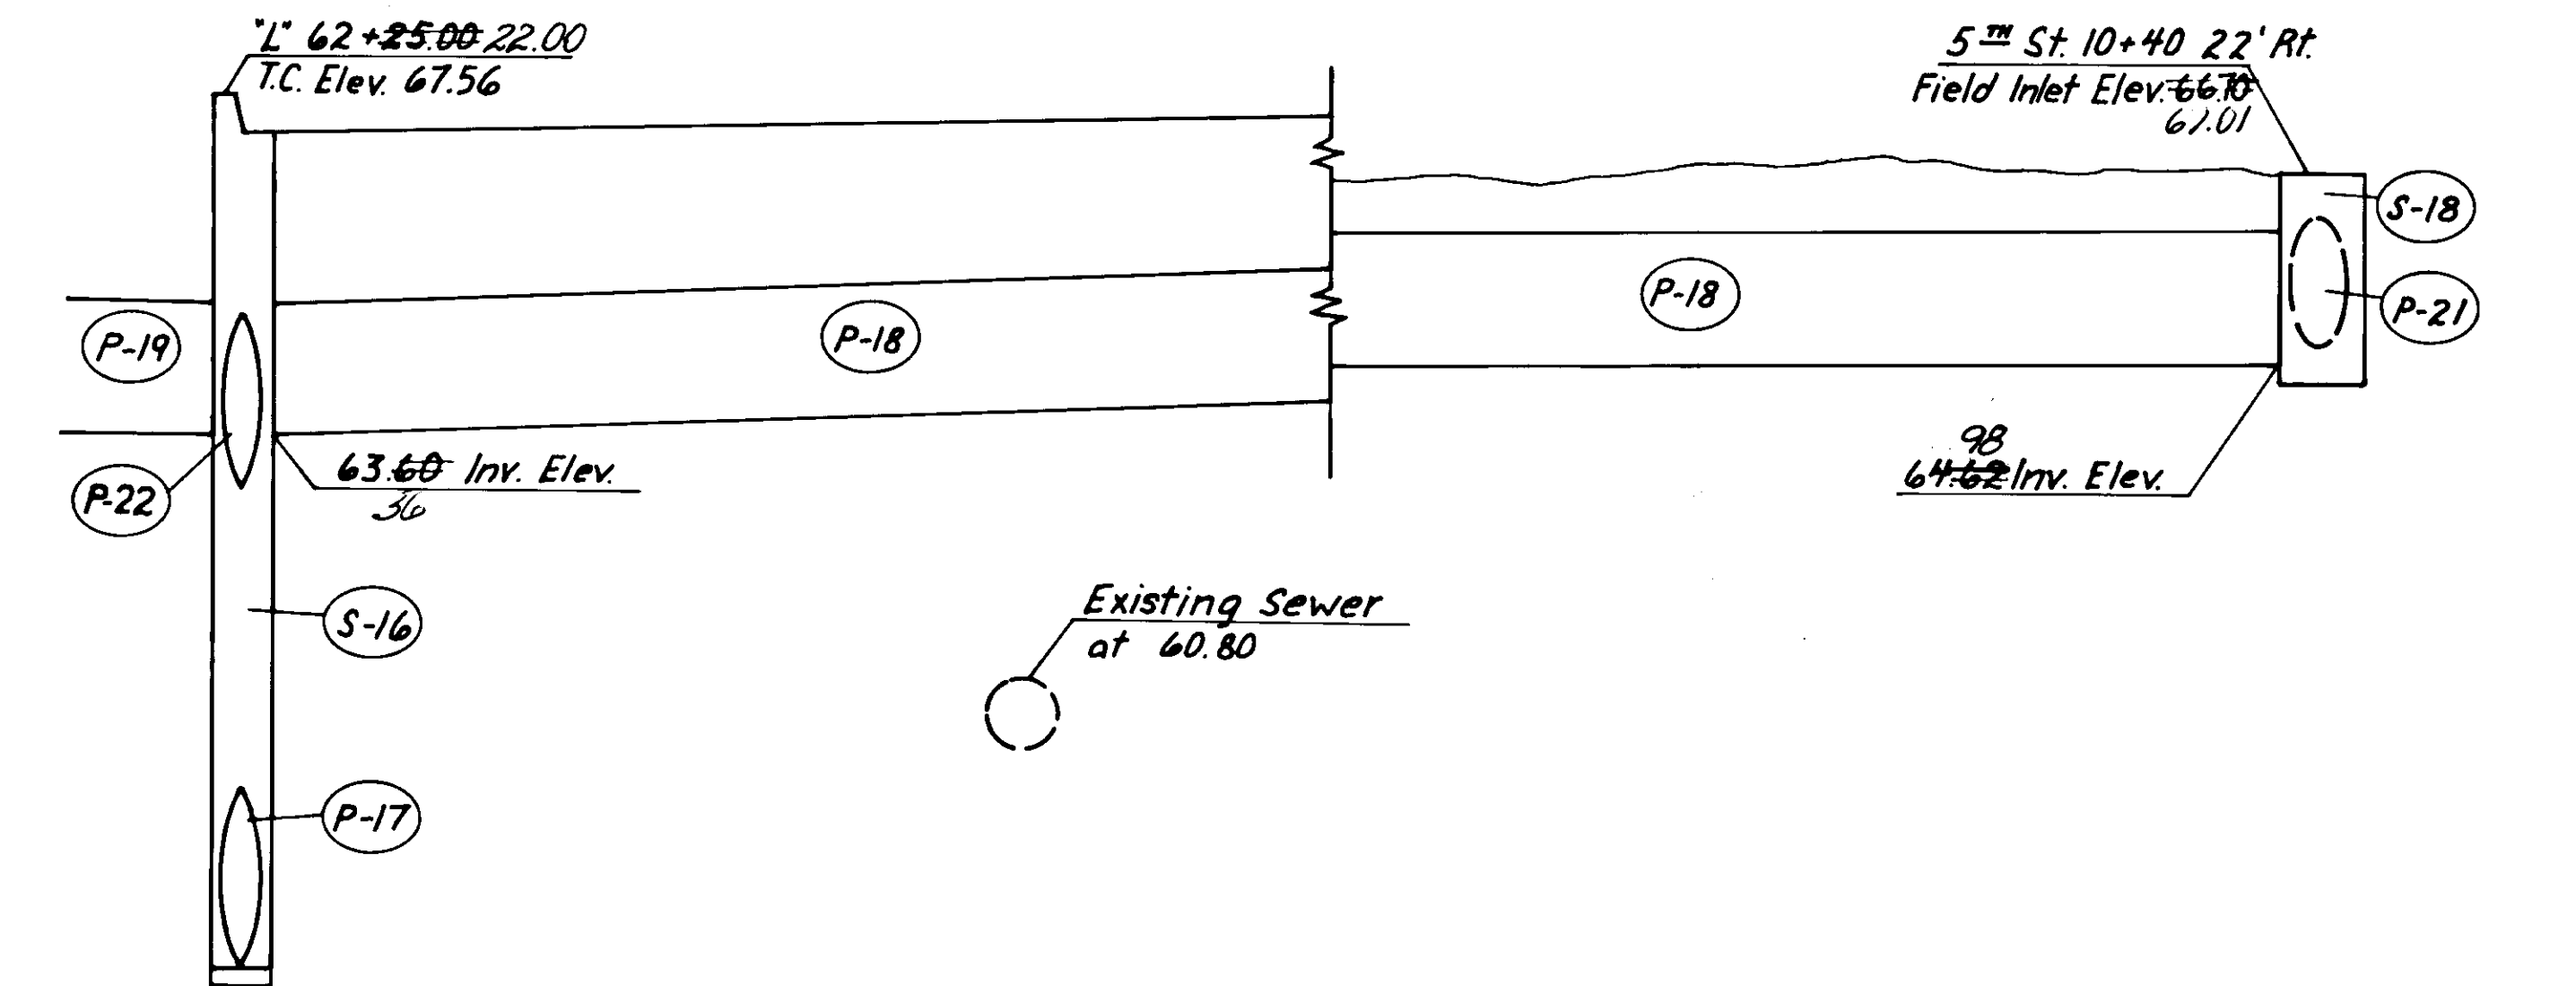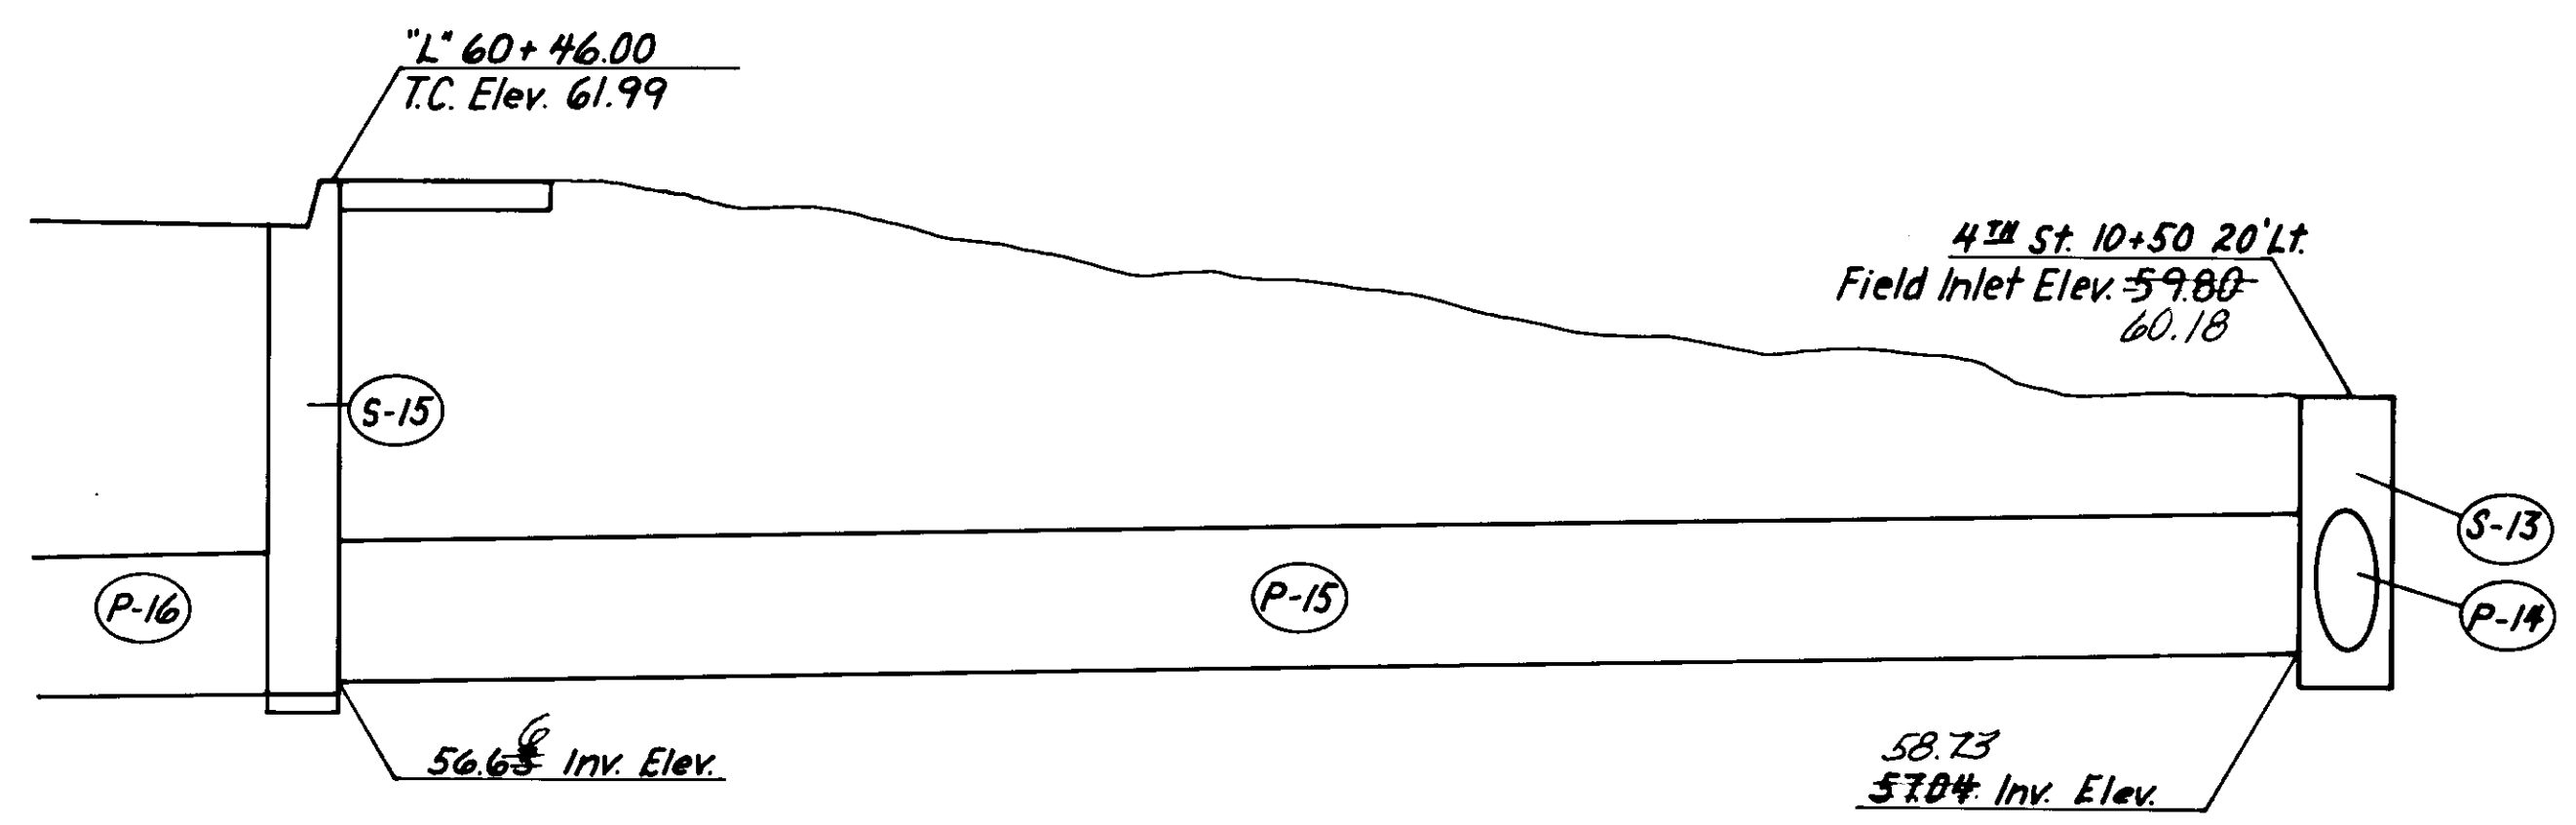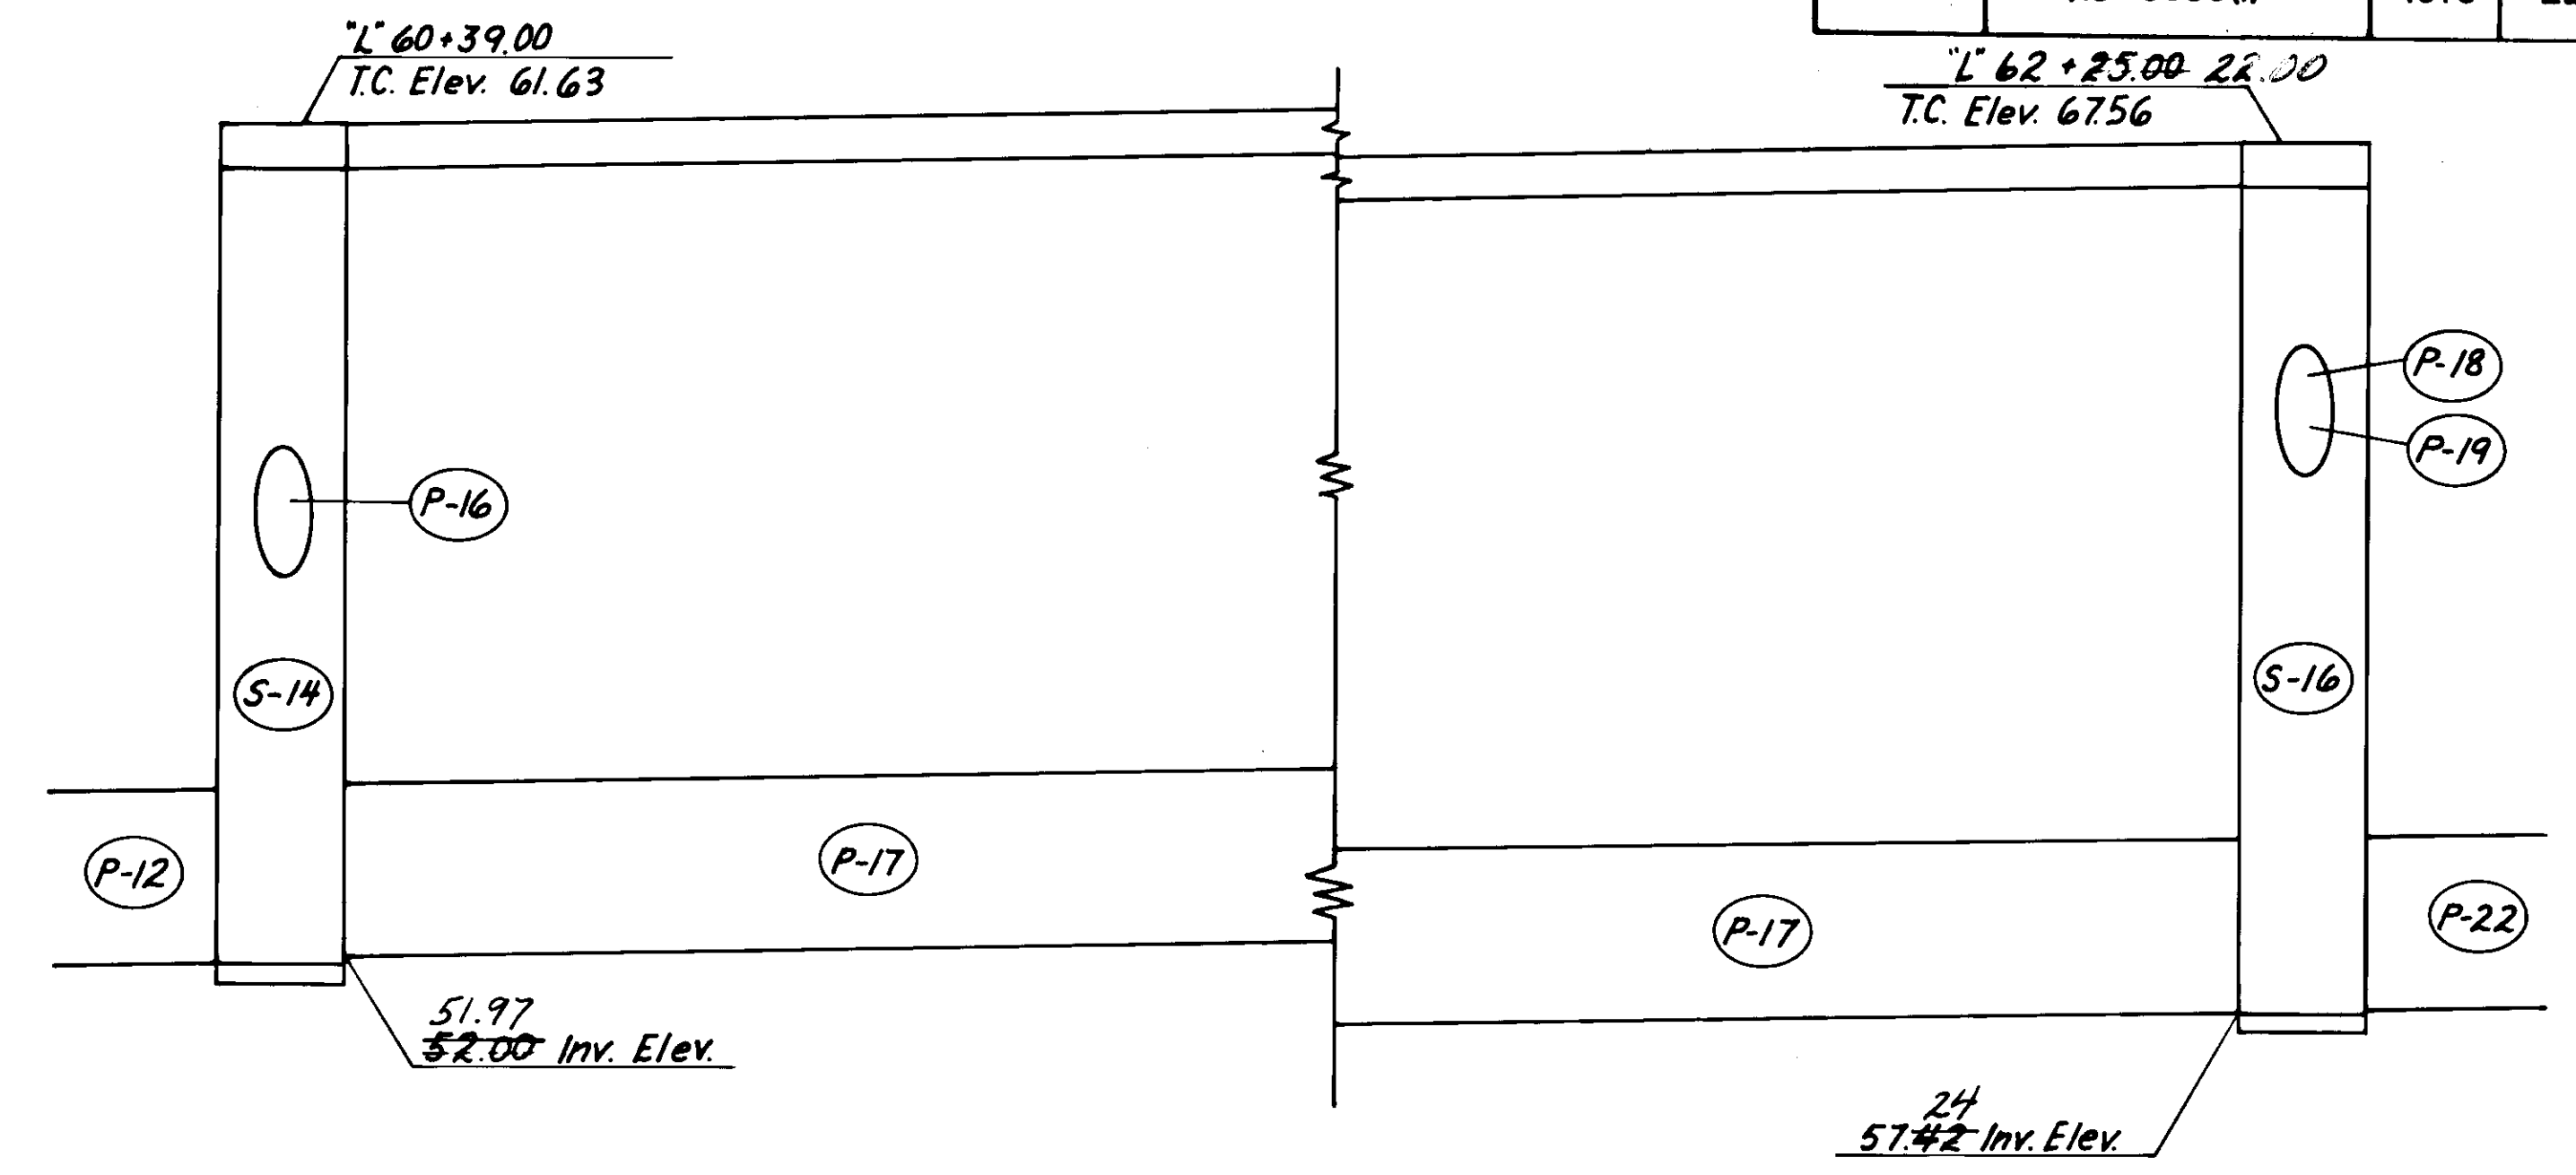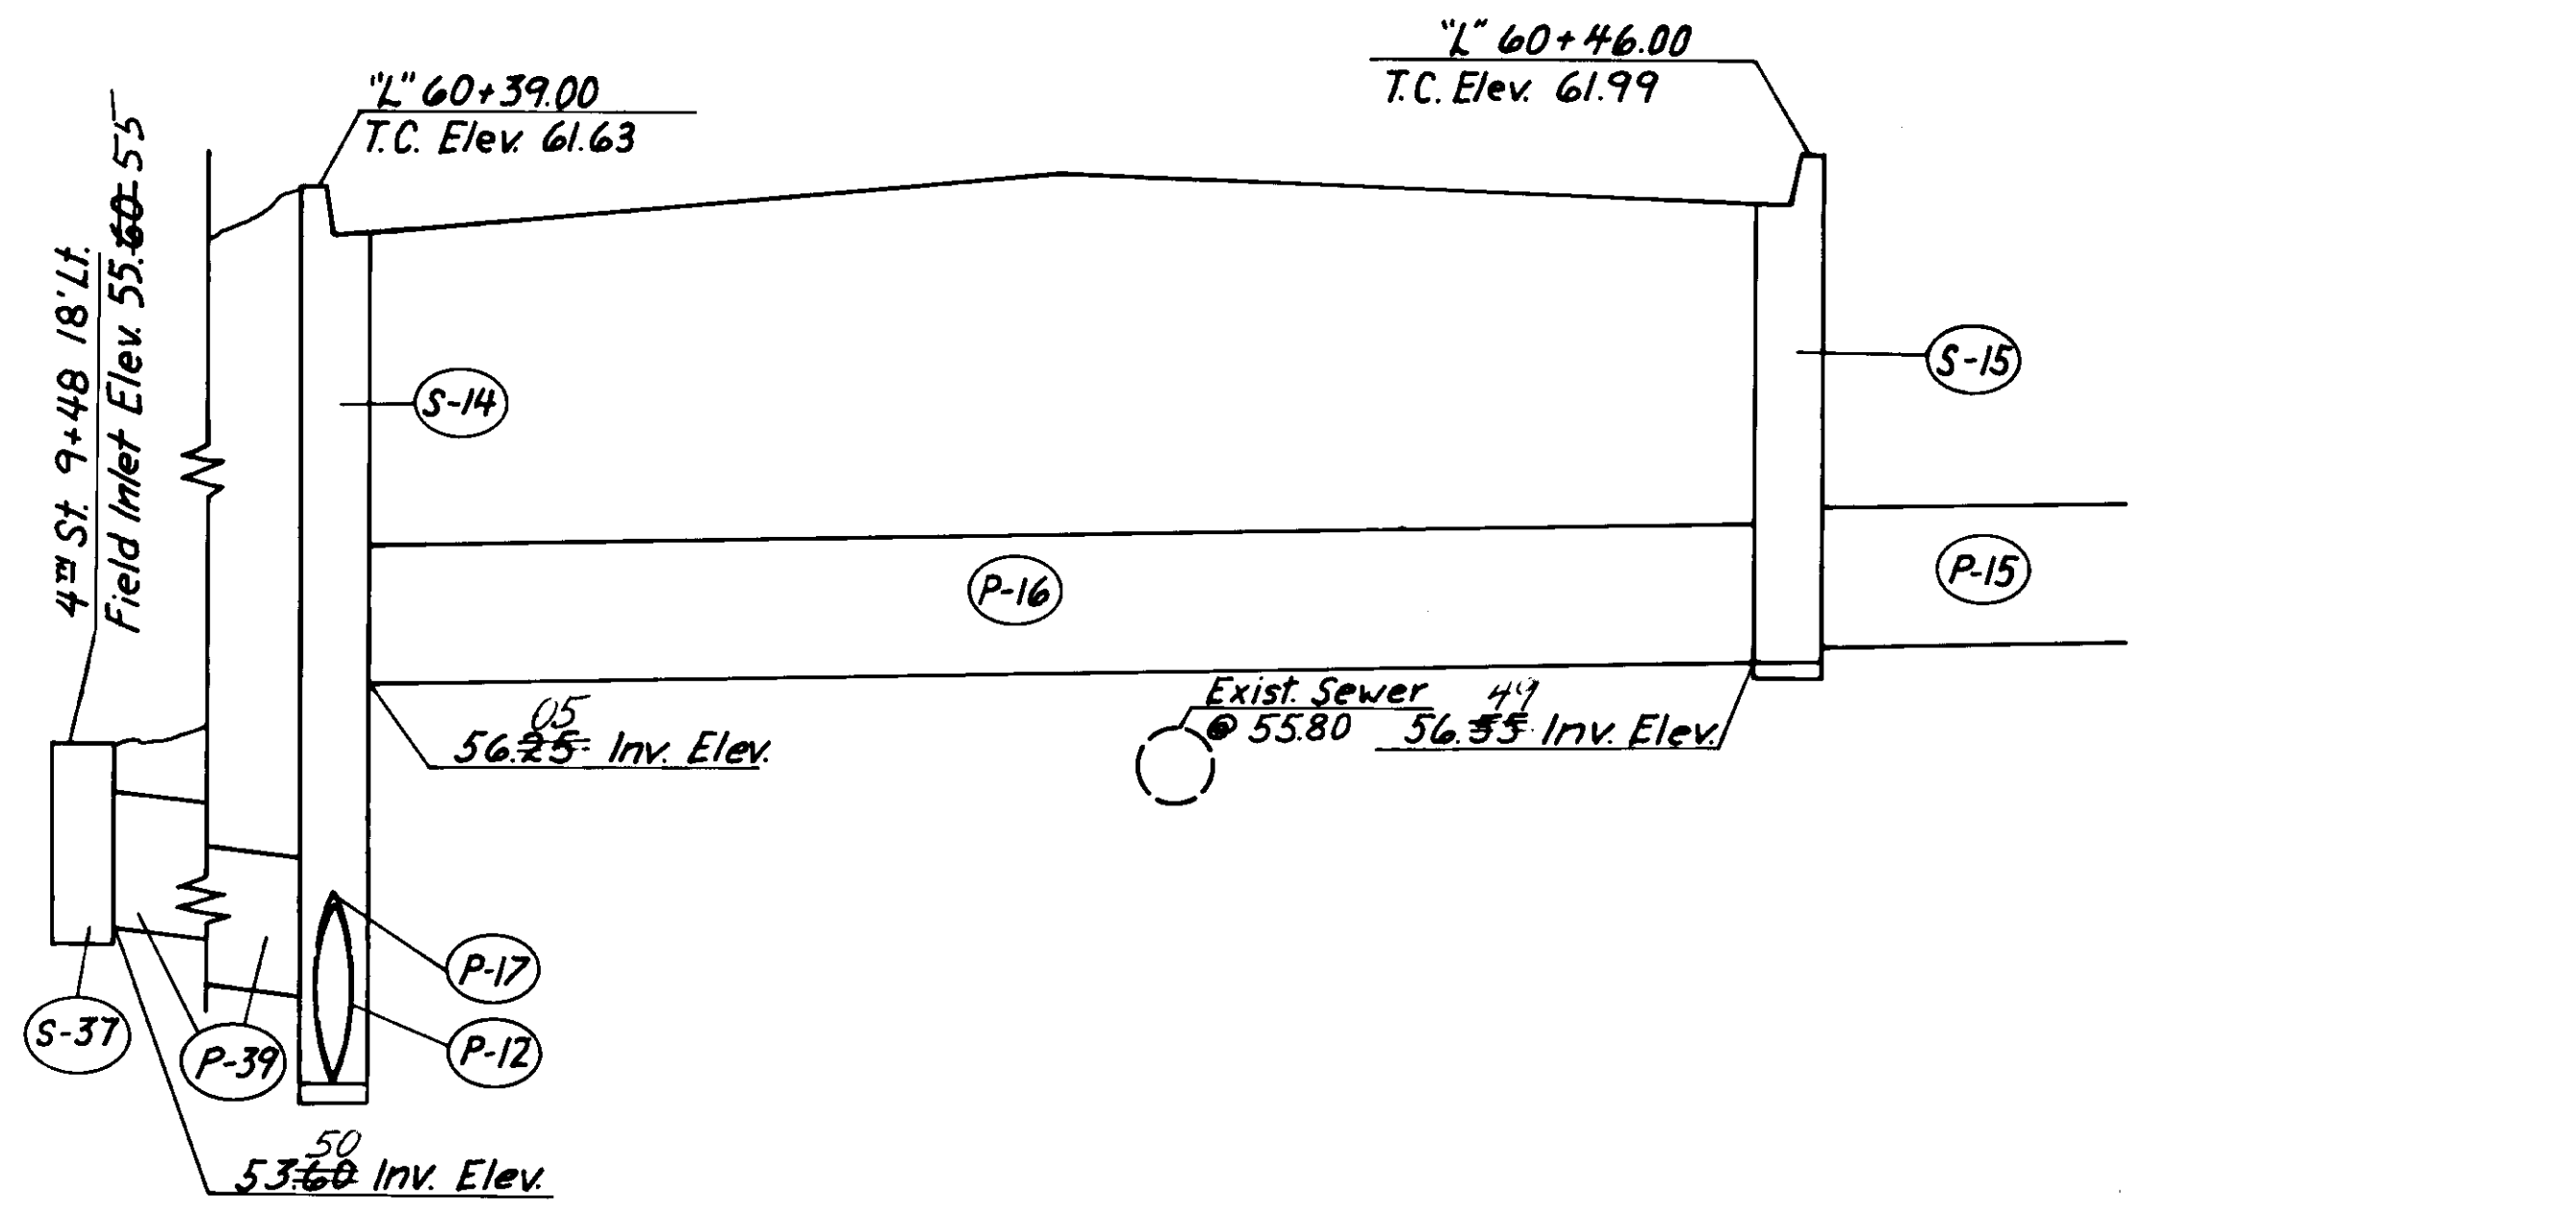







STRUCTURE SUMMARY							PIPE SUMMARY						
STRUCTURE	TYPE	LOCATION	OFFSET		TOP CURB ELEV.	INVERT ELEV.	PIPE	DIA	LENGTH	FROM		TO	
			LEFT	RIGHT						STRUCTURE	ELEV.	STRUCTURE	ELEV.
S-12	X	4th St 10+50		20' **	59.50 *	57.34	P-14	18"	38' 4"	S-12 Deleted	57.50	S-13	57.12
S-13	X	4th St 10+50	20' **	60.18	59.80 *	56.88	P-15	18"	42' 3"	S-13 Deleted	57.04	S-15	56.25
S-14	B	L 60+39.00	19.5'	61.63	51.92	P-16	18"	30' 2"	S-15	56.55	S-14	56.25	
S-15	A	L 60+46.00		13'	61.99	56.55	P-17	24"	184'	S-16	57.42	S-14	52.00
S-16	B	L 62+25.00-22.00	19.5'	67.01	67.56	P-18	18"	58' 2"	S-18	64.62	S-16	63.60	
S-18	X	5th St 10+40		22' **	66.70 *	64.45	P-39	18"	36'	S-37	53.60	S-14	52.88
S-37	X	4th St 9+48	18' **		55.60 *	53.43							

NOTES: 1. * = Top of grate elev.
 2. ** = Offsets are to center of grate.
 3. A = See standard drawing D-26.02.
 4. B = " " " " D-27.10
 5. X = 24" Pipe conduit inlet. (See sht. 31 for details)
 6. On type A or B inlets the offsets are to back of curb.
 7. Back of curb elevations are approx. only.

NOTES: (cont) 8. Curb inlet grates shall be type G-3R, see standard drawing D-23.01.

DRAINAGE DETAILS

STATE	PROJECT DESIGNATION	YEAR	SHEET NO.	TOTAL SHEETS
ALASKA	RS-0958 (I)	1979	24	34


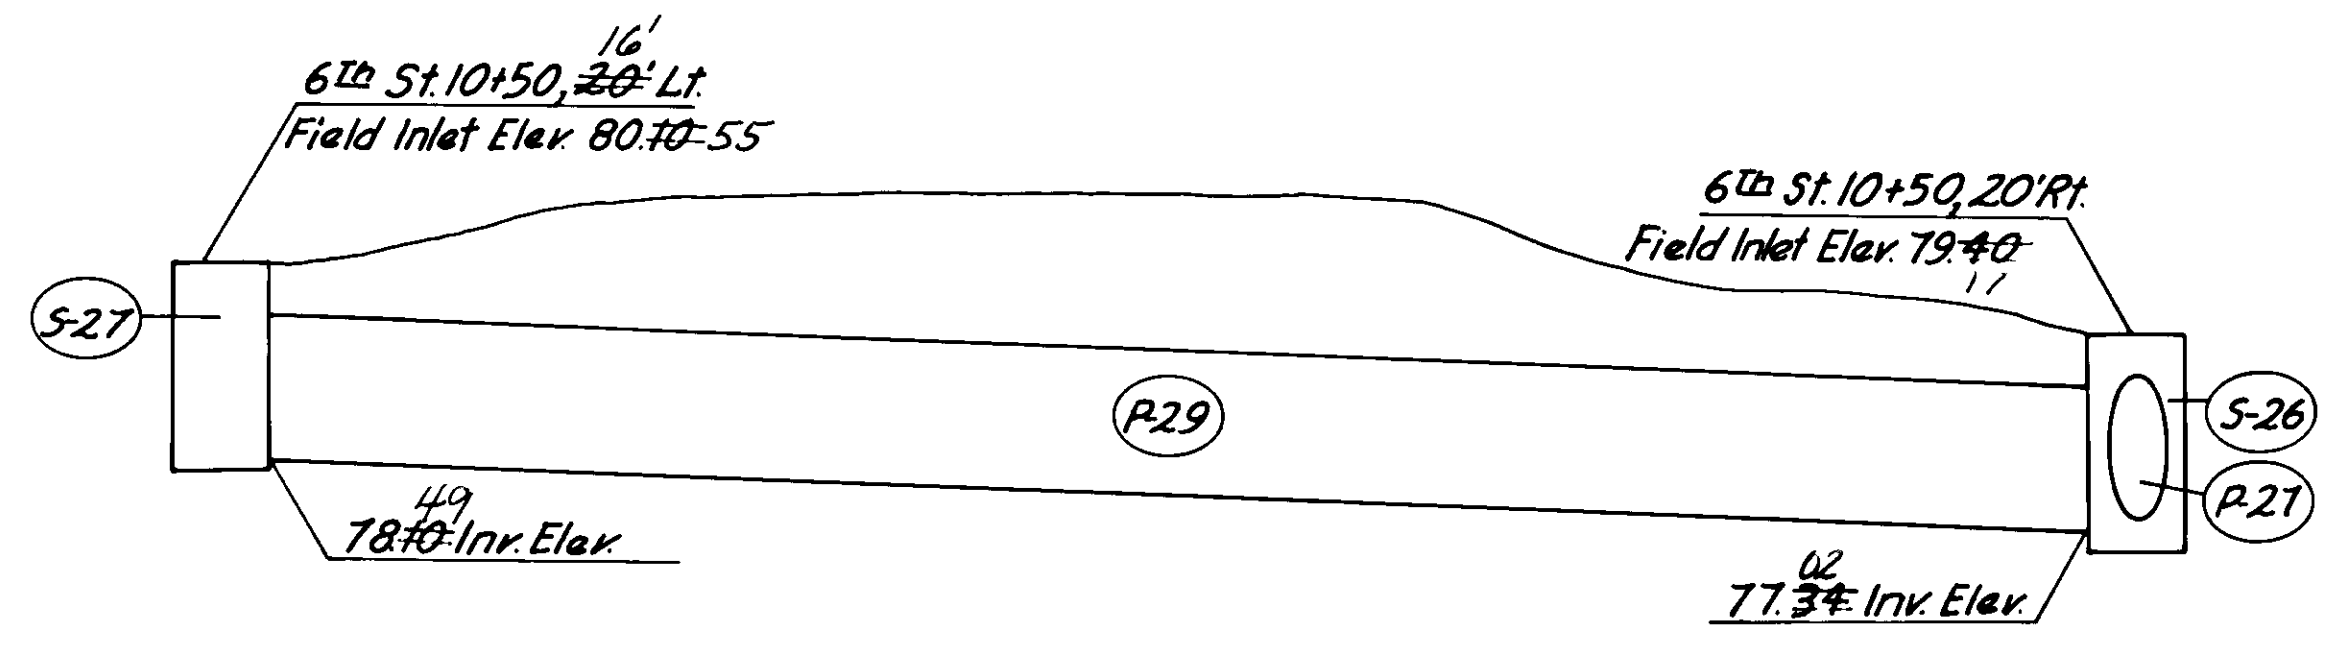
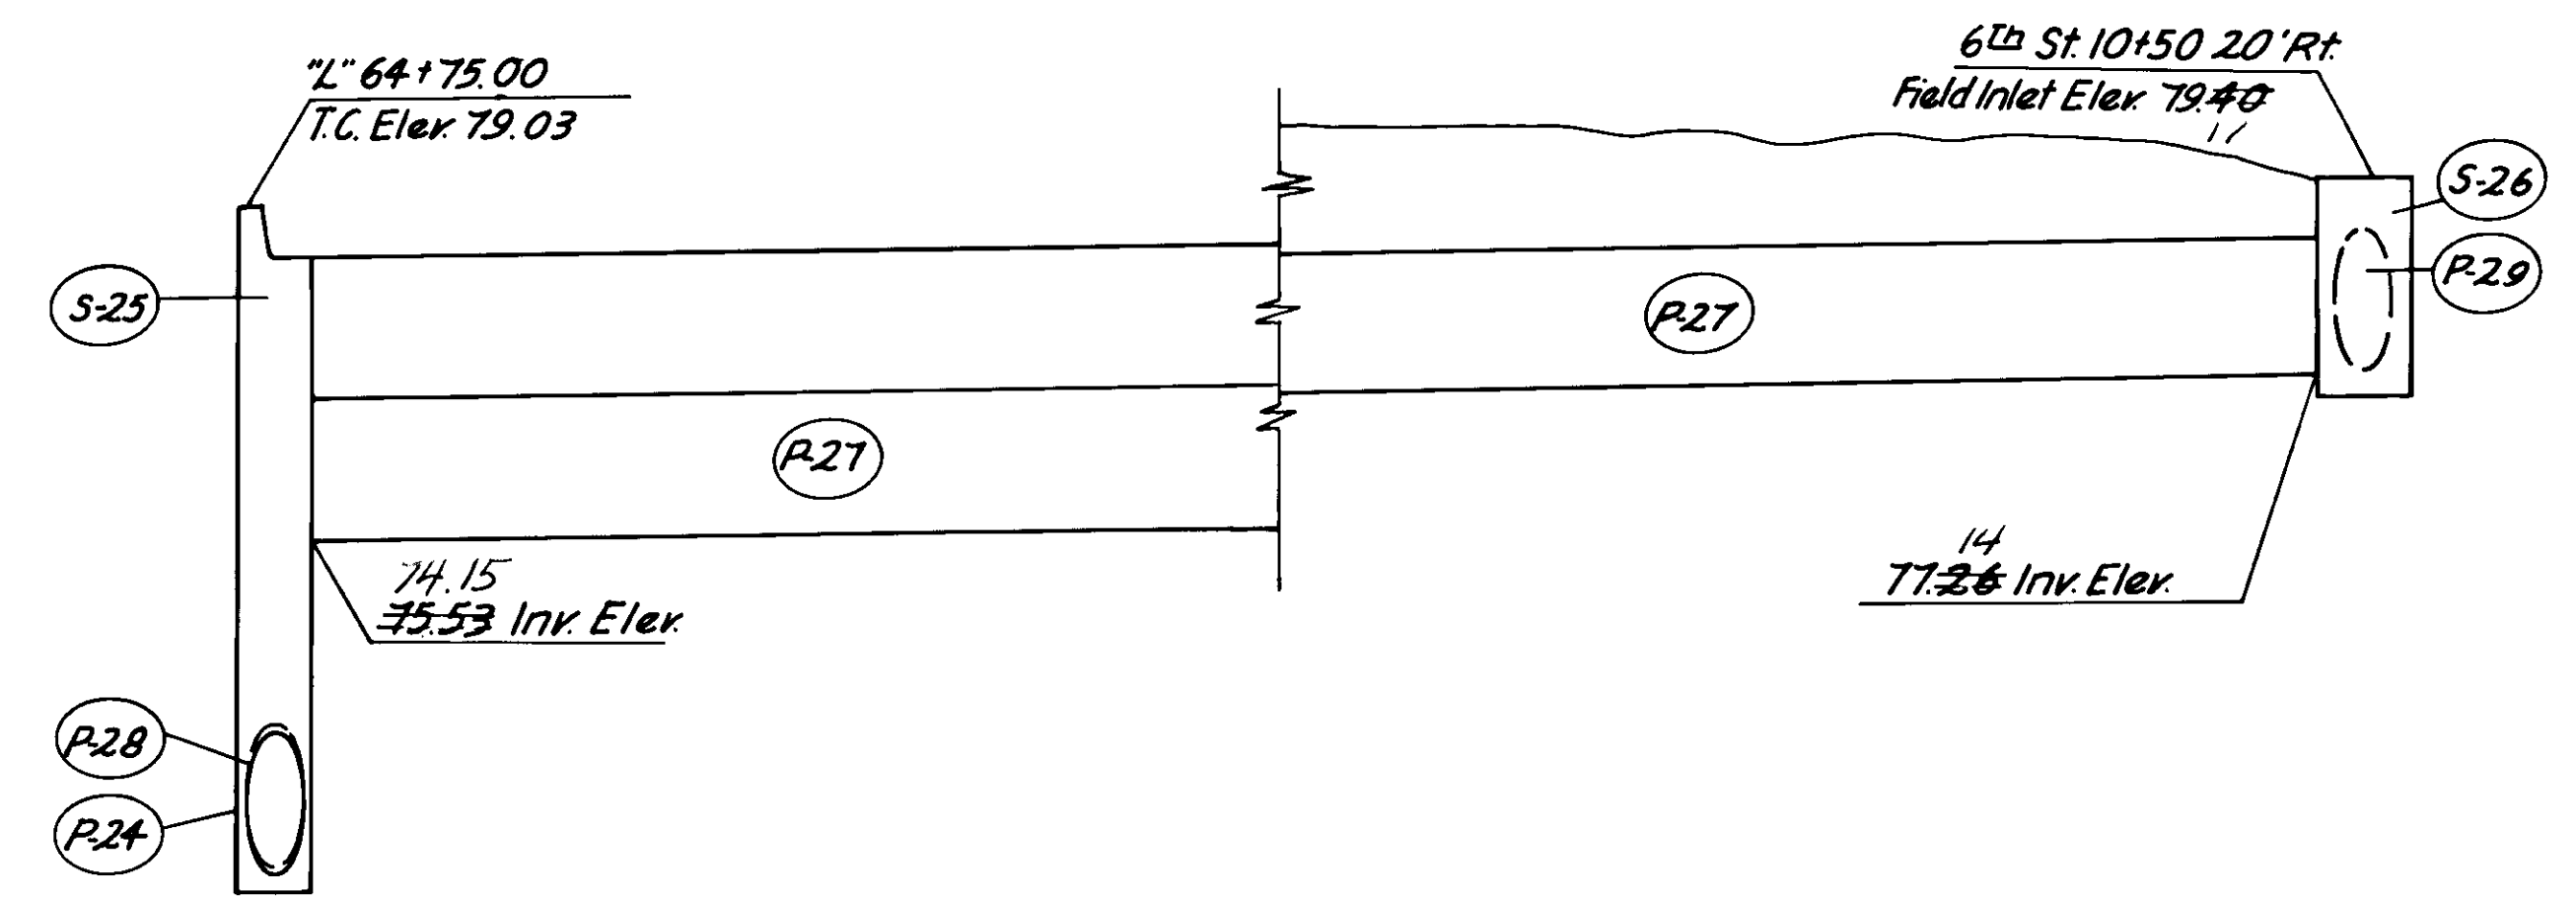
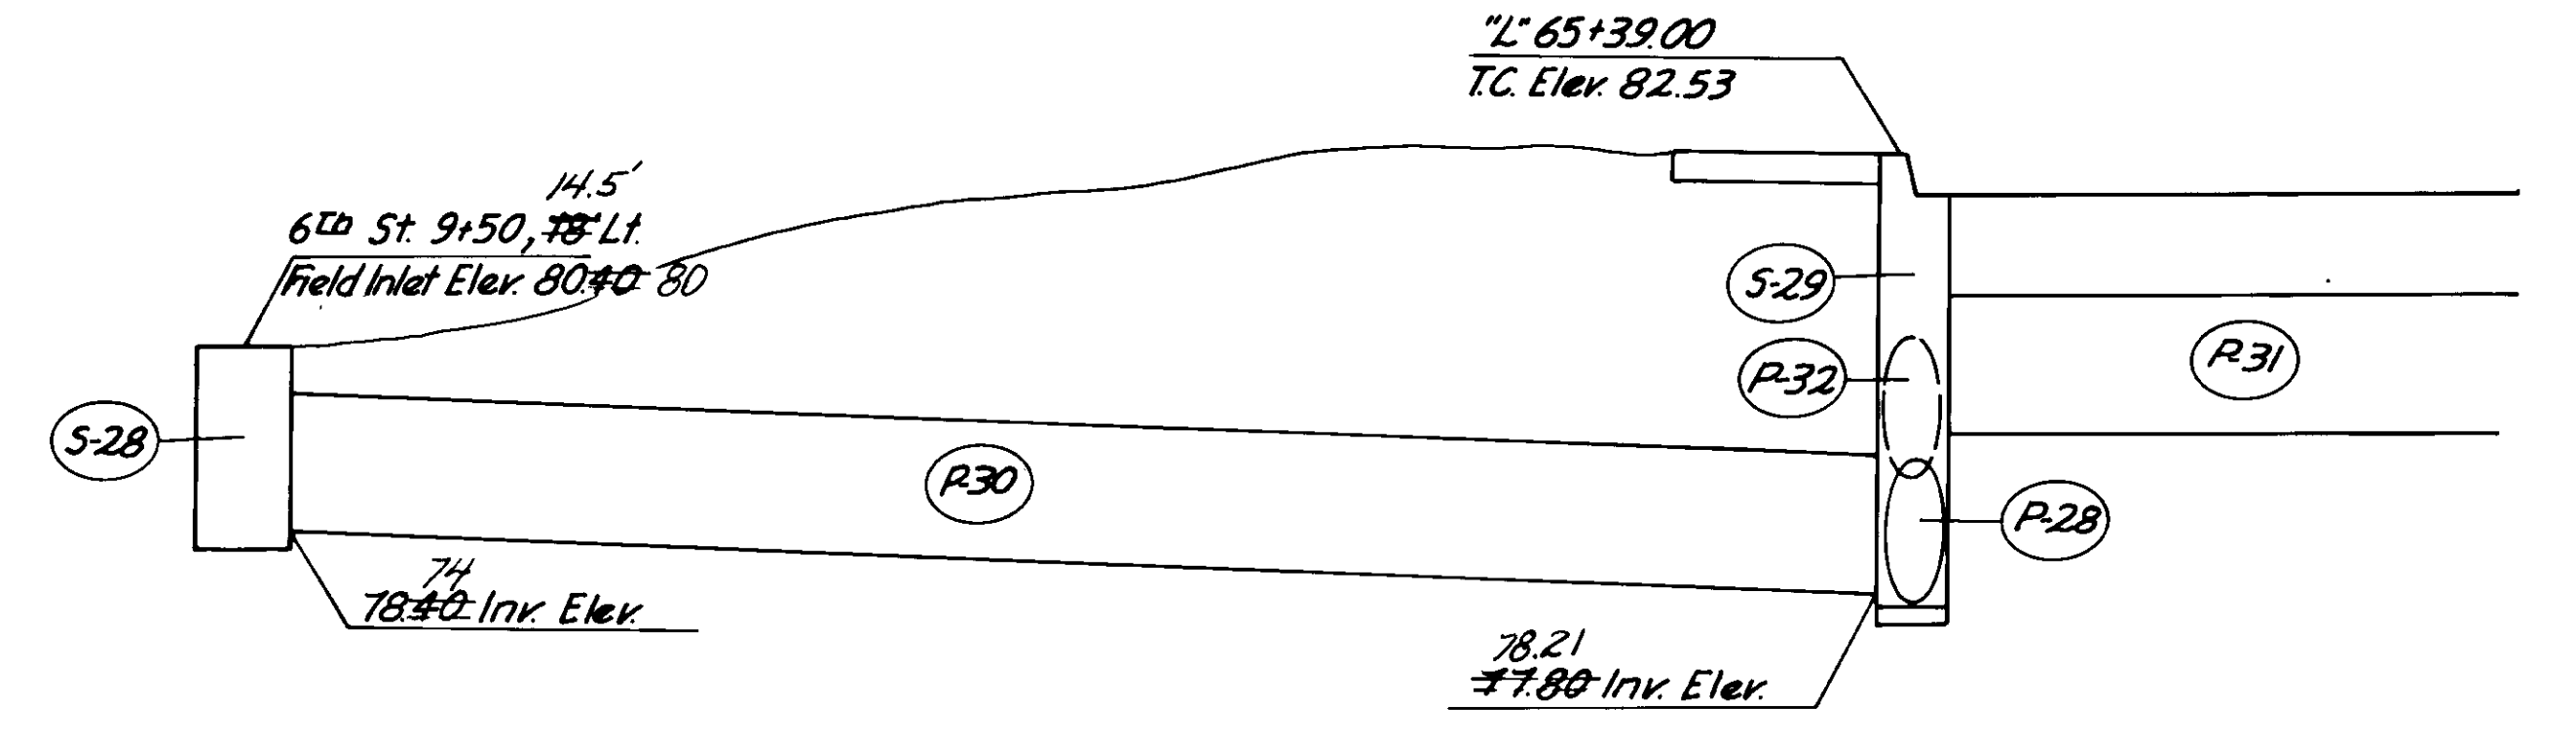
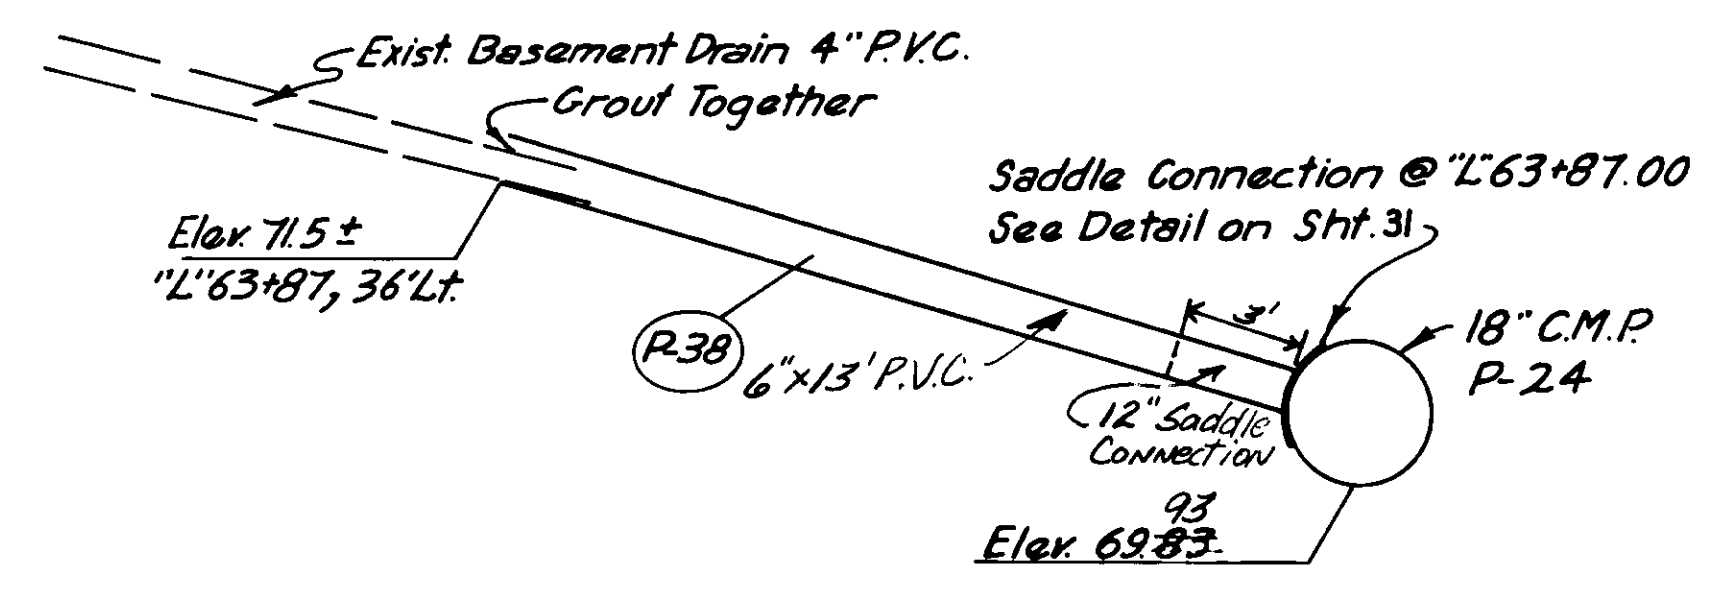
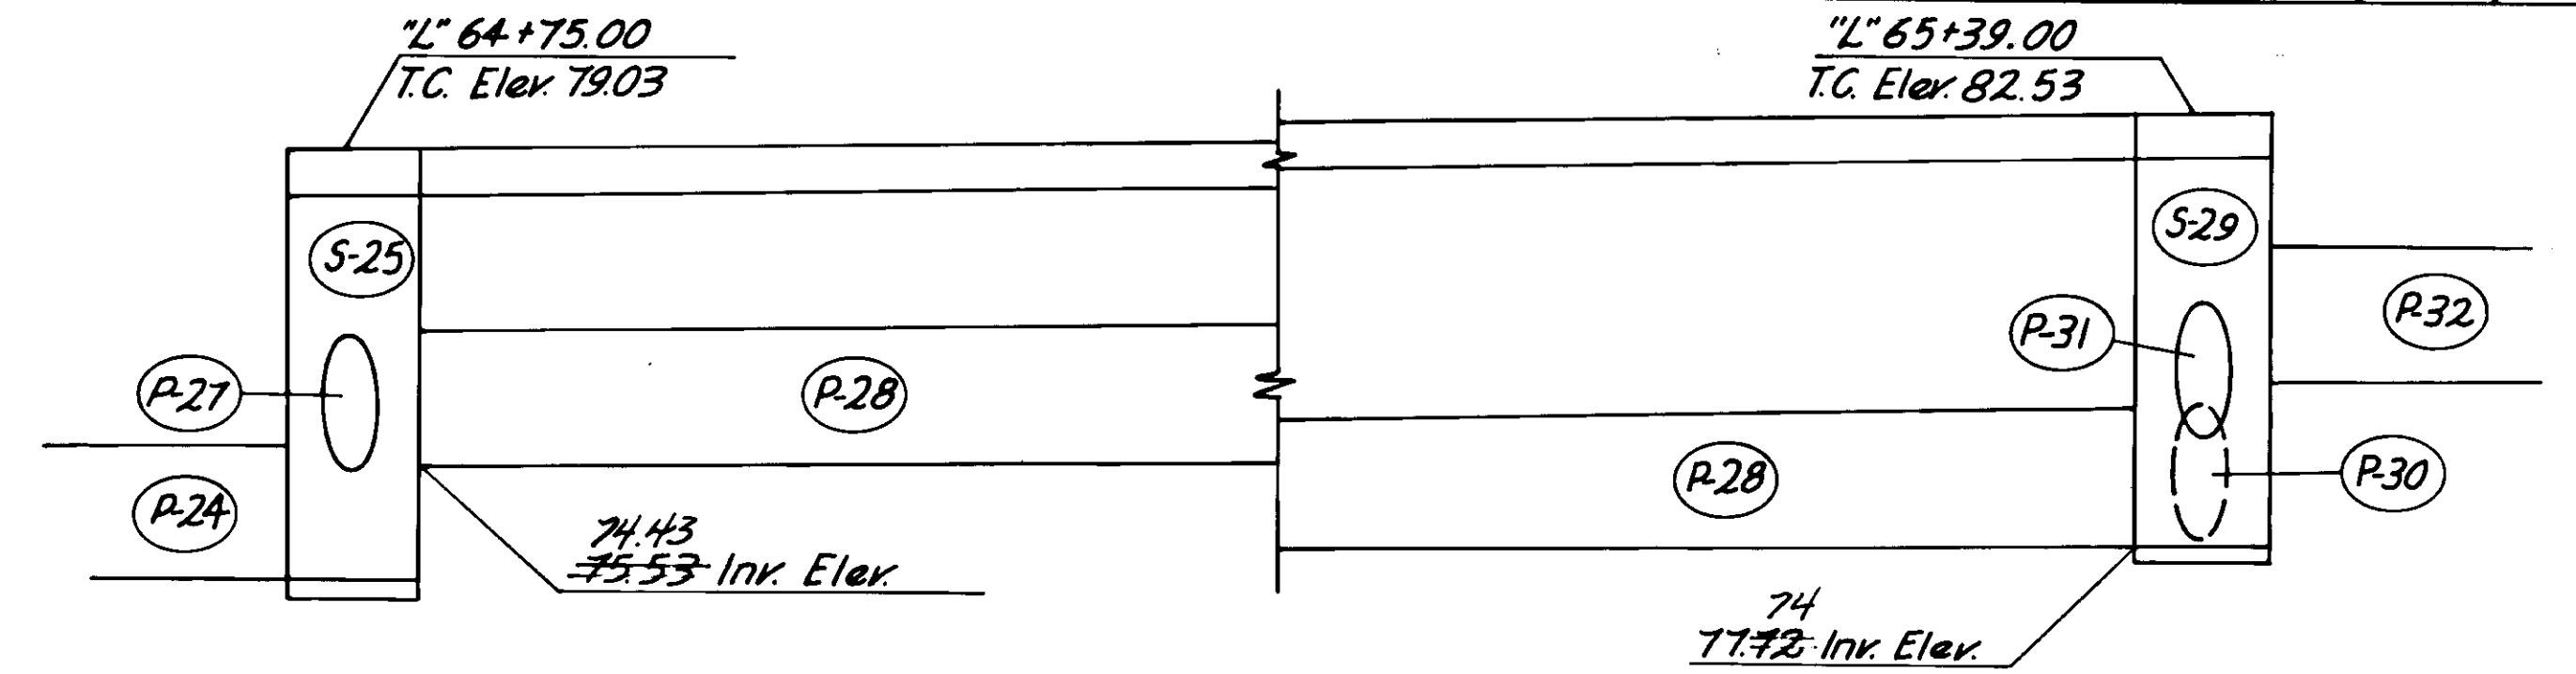
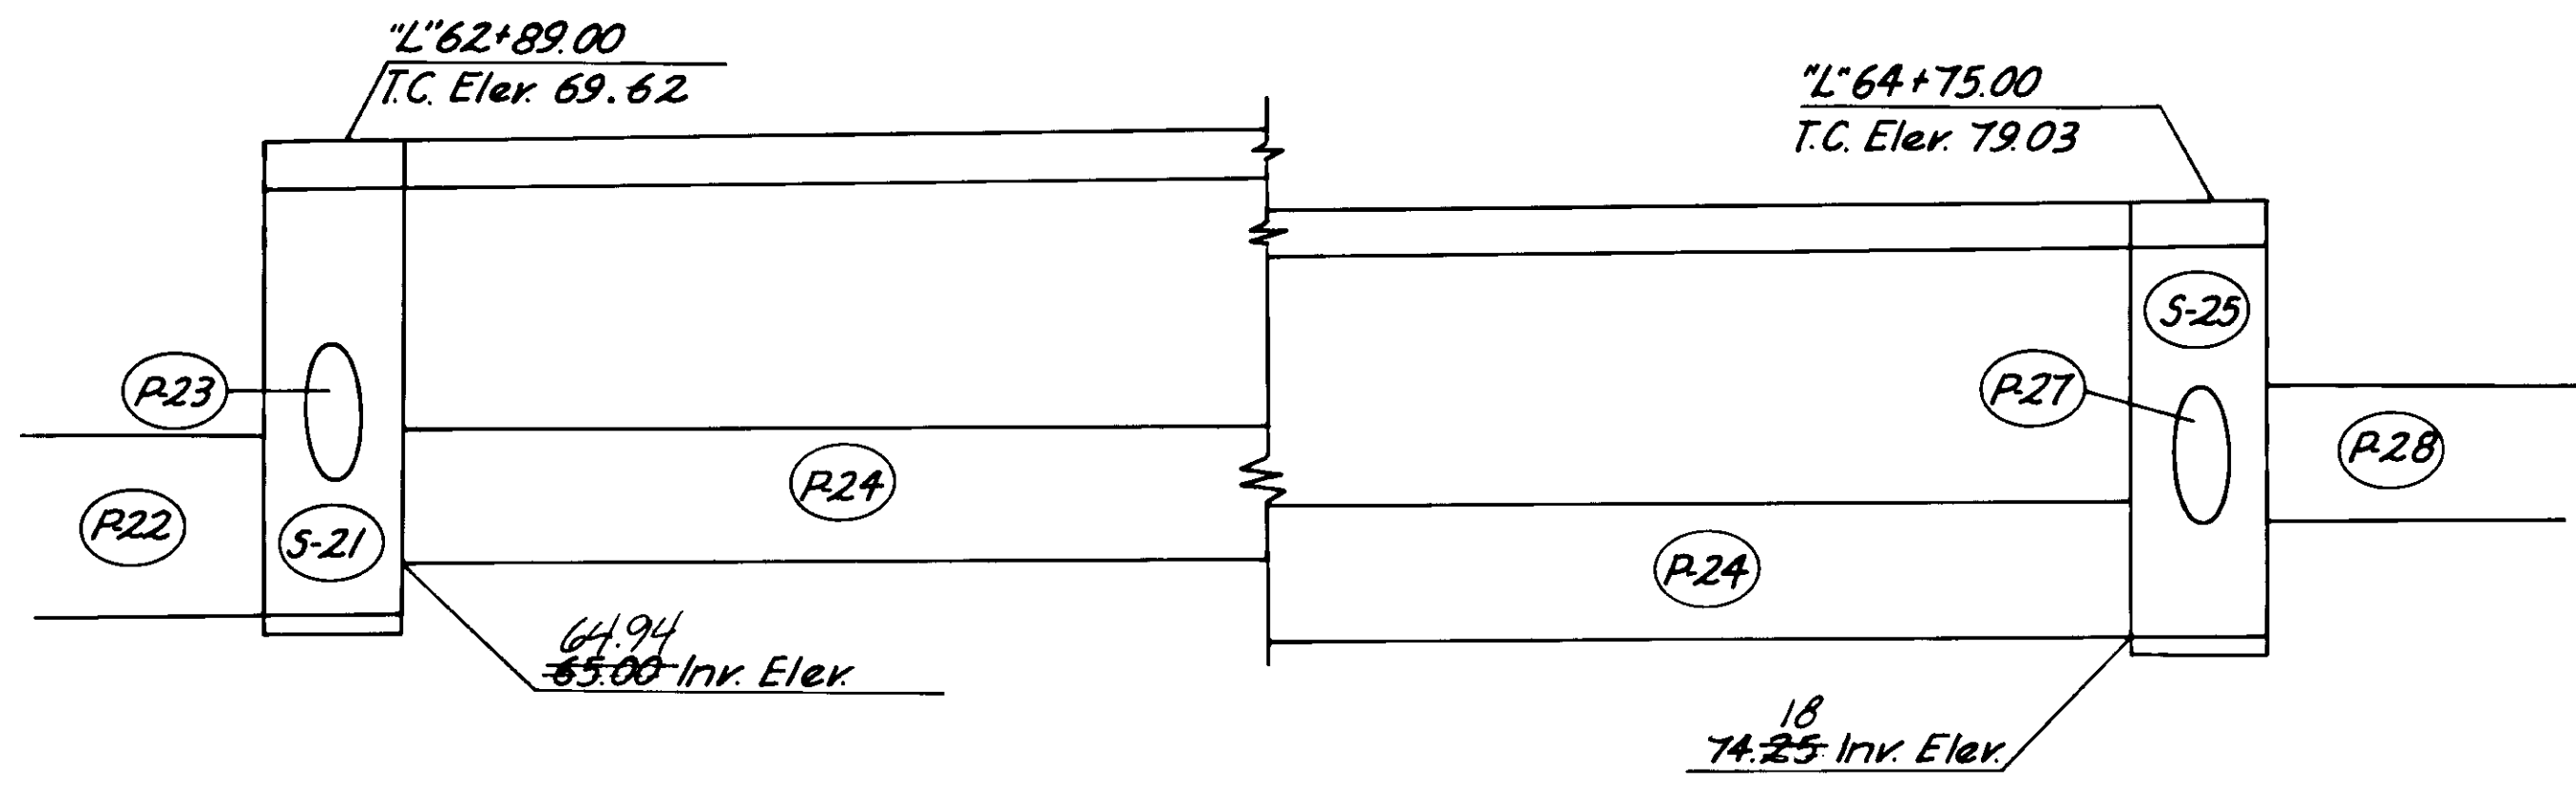


STRUCTURE SUMMARY							PIPE SUMMARY							
STRUCTURE	TYPE	LOCATION	OFFSET		TOP CURB ELEV.	INVERT ELEV.	PIPE	DIA.	LENGTH	FROM		TO		
			LEFT	RIGHT						STRUCTURE	ELEV.	STRUCTURE	ELEV.	
S-21	A	"L'62+89.00	19.5'		69.62	64.94	P-24	18"	10'	S-25	74.25	S-21	65.00	64.94
S-25	A	"L'64+75.00	19.5'		79.03	74.15	P-27	18"	68' 10"	S-26	77.26	S-25	75.53	74.15
S-26	X	6th St. 10+50		20**	79.40*	77.80	P-28	18"	64'	S-29	77.72	S-26	75.53	74.43
S-27	X	6th St. 10+50	20**		80.70*	77.93	P-29	18"	38' 6"	S-27	78.21	S-26	77.34	78.21
S-28	X	6th St. 9+50	18**		80.40*	78.21	P-30	18"	34' 6"	S-28	78.21	S-29	77.80	78.21
S-29	A	"L'65+39.00	19.5'		82.53	77.80	P-31	18"	77' 13"	4" PVC	71.50±	18" CMP @ L'63+87	69.83	77.80

NOTES: 1. * = Top of grate elev.
 2. ** = Offsets are to center of grate.
 3. A = See standard drawing D-26.02.
 4. X = 24" Pipe Conduit Inlet, (See sht. 31 for details).
 5. On type A or B inlets the offsets are to the back of curb.
 6. Back of curb elevations are approx. only.
 7. Curb inlet grates shall be type G-3R, (See standard drawing D-23.01).

DRAINAGE DETAILS

STATE	PROJECT DESIGNATION	YEAR	SHEET NO.	TOTAL SHEETS
ALASKA	RS-0938(I)	1979	25	34

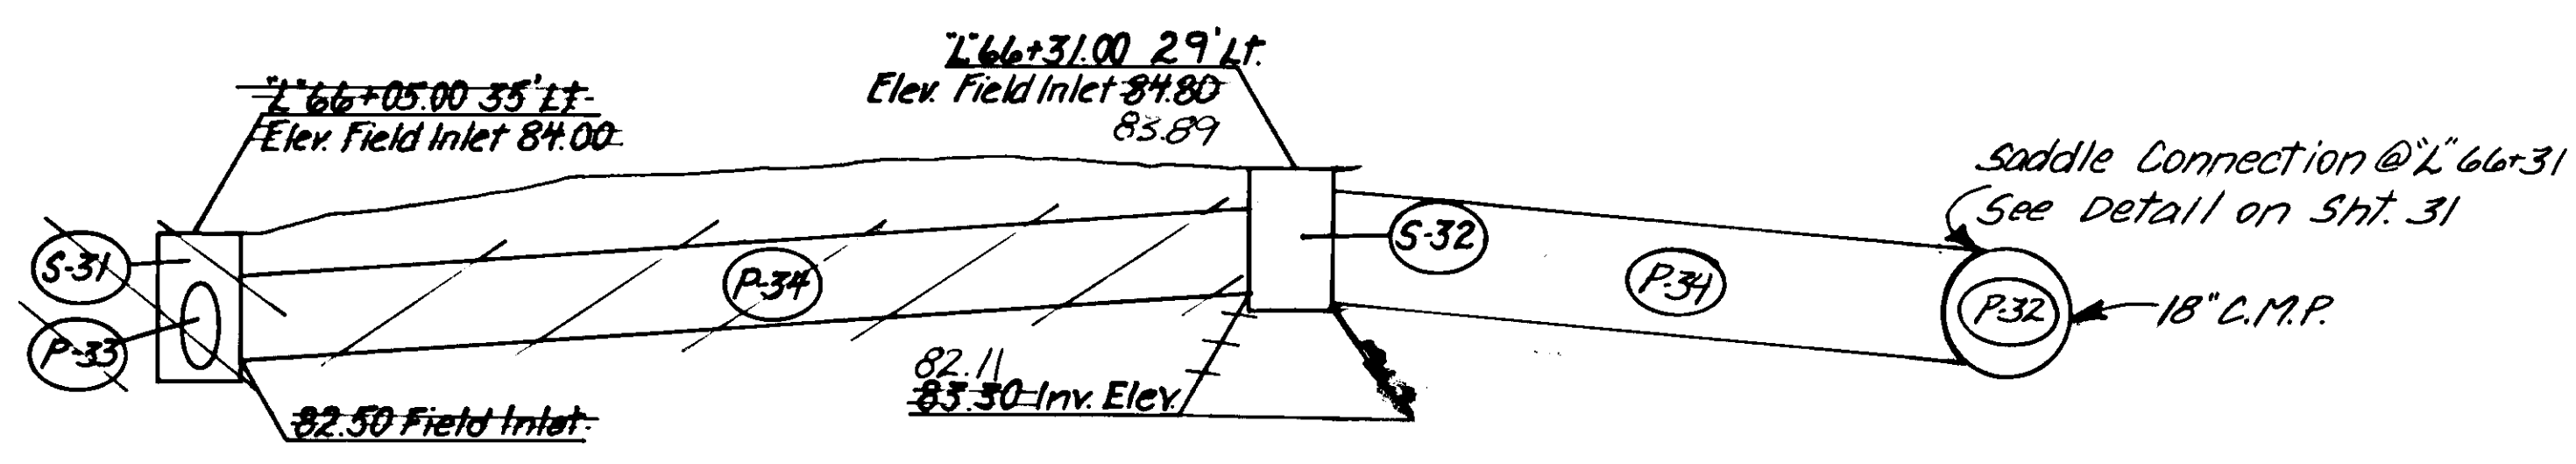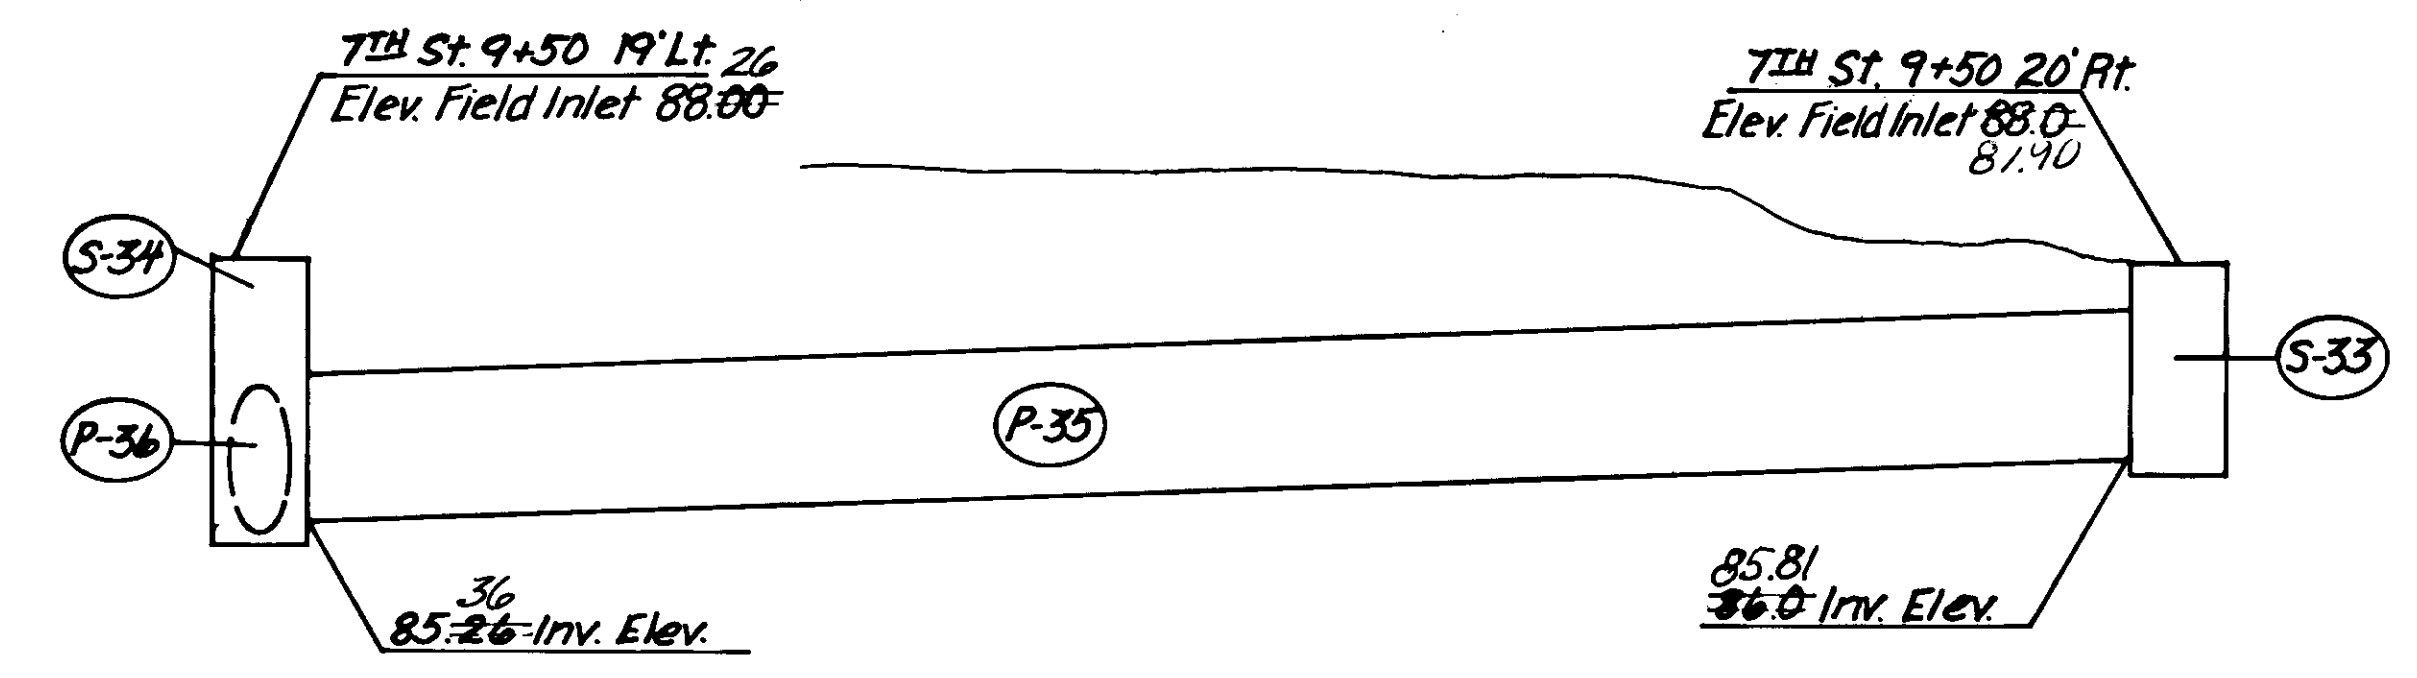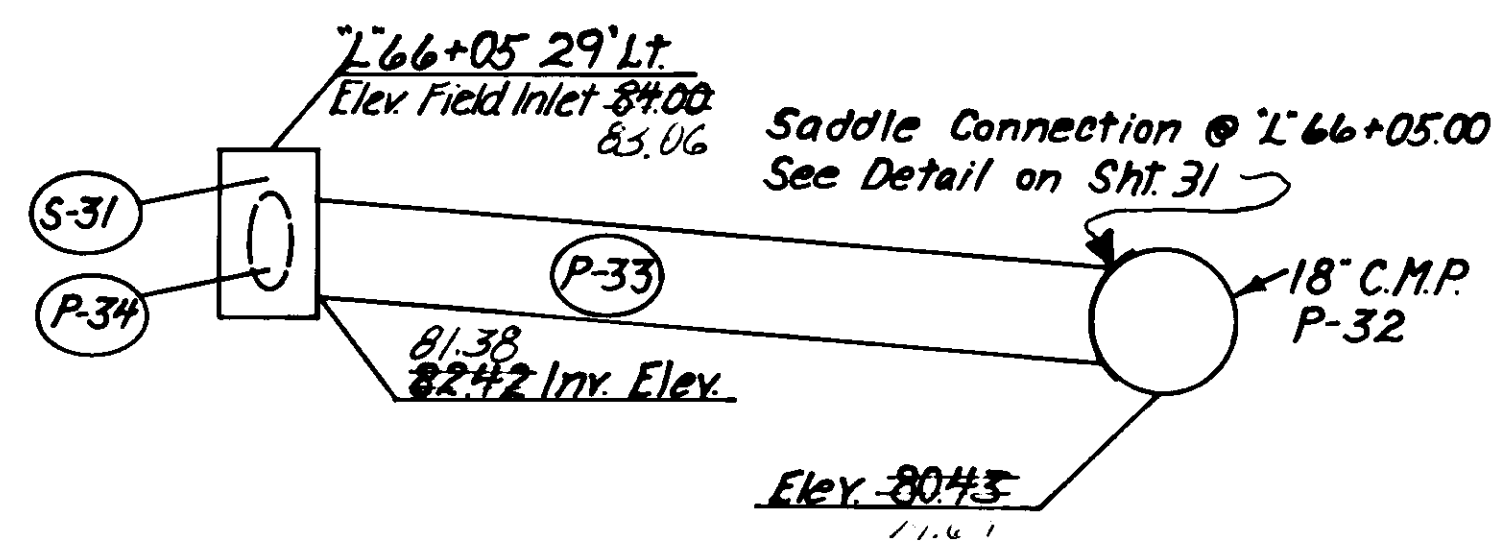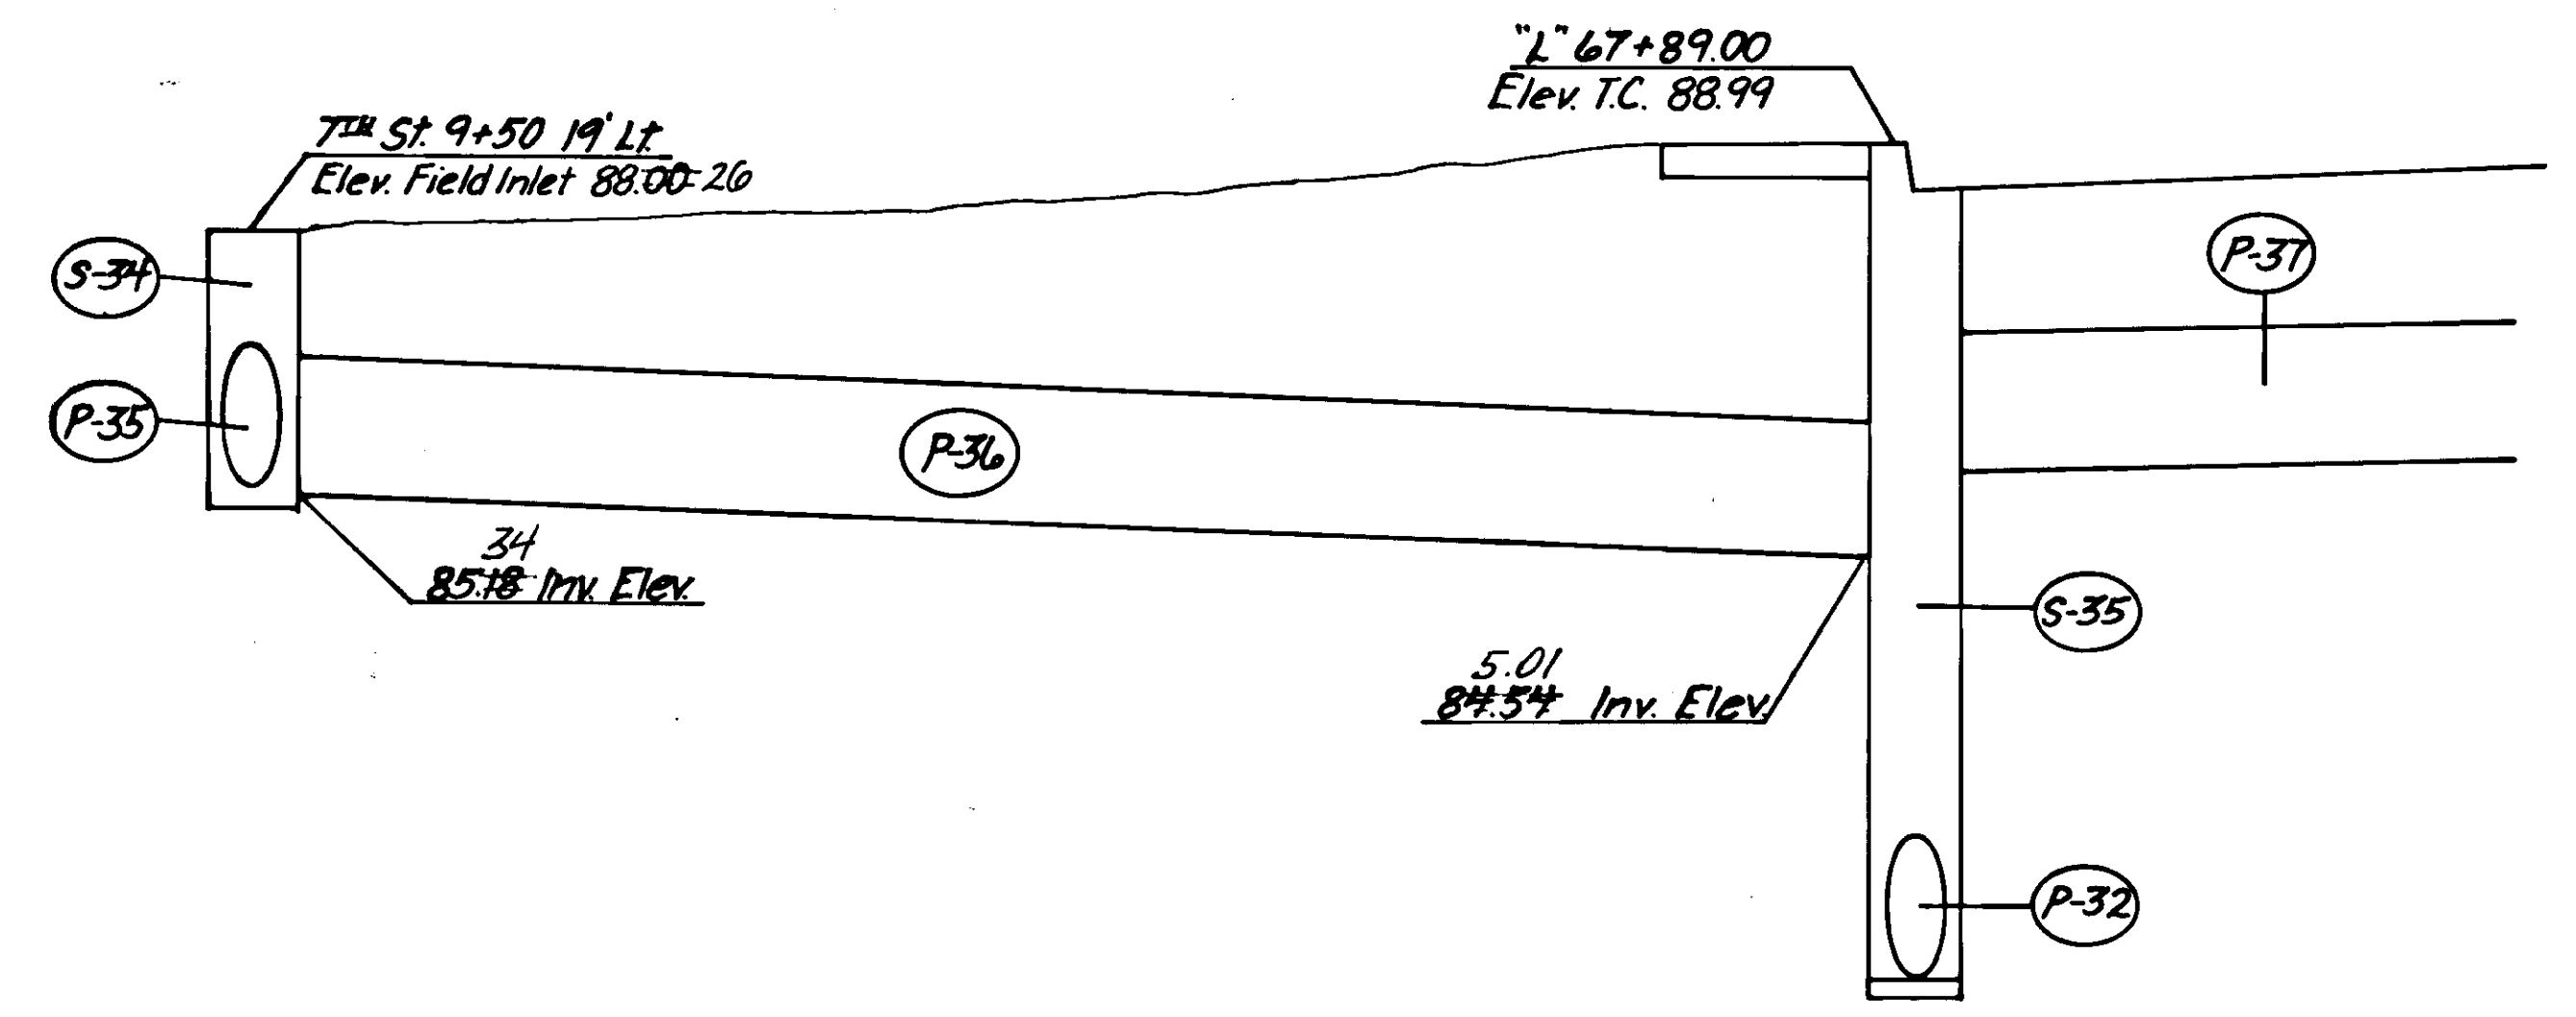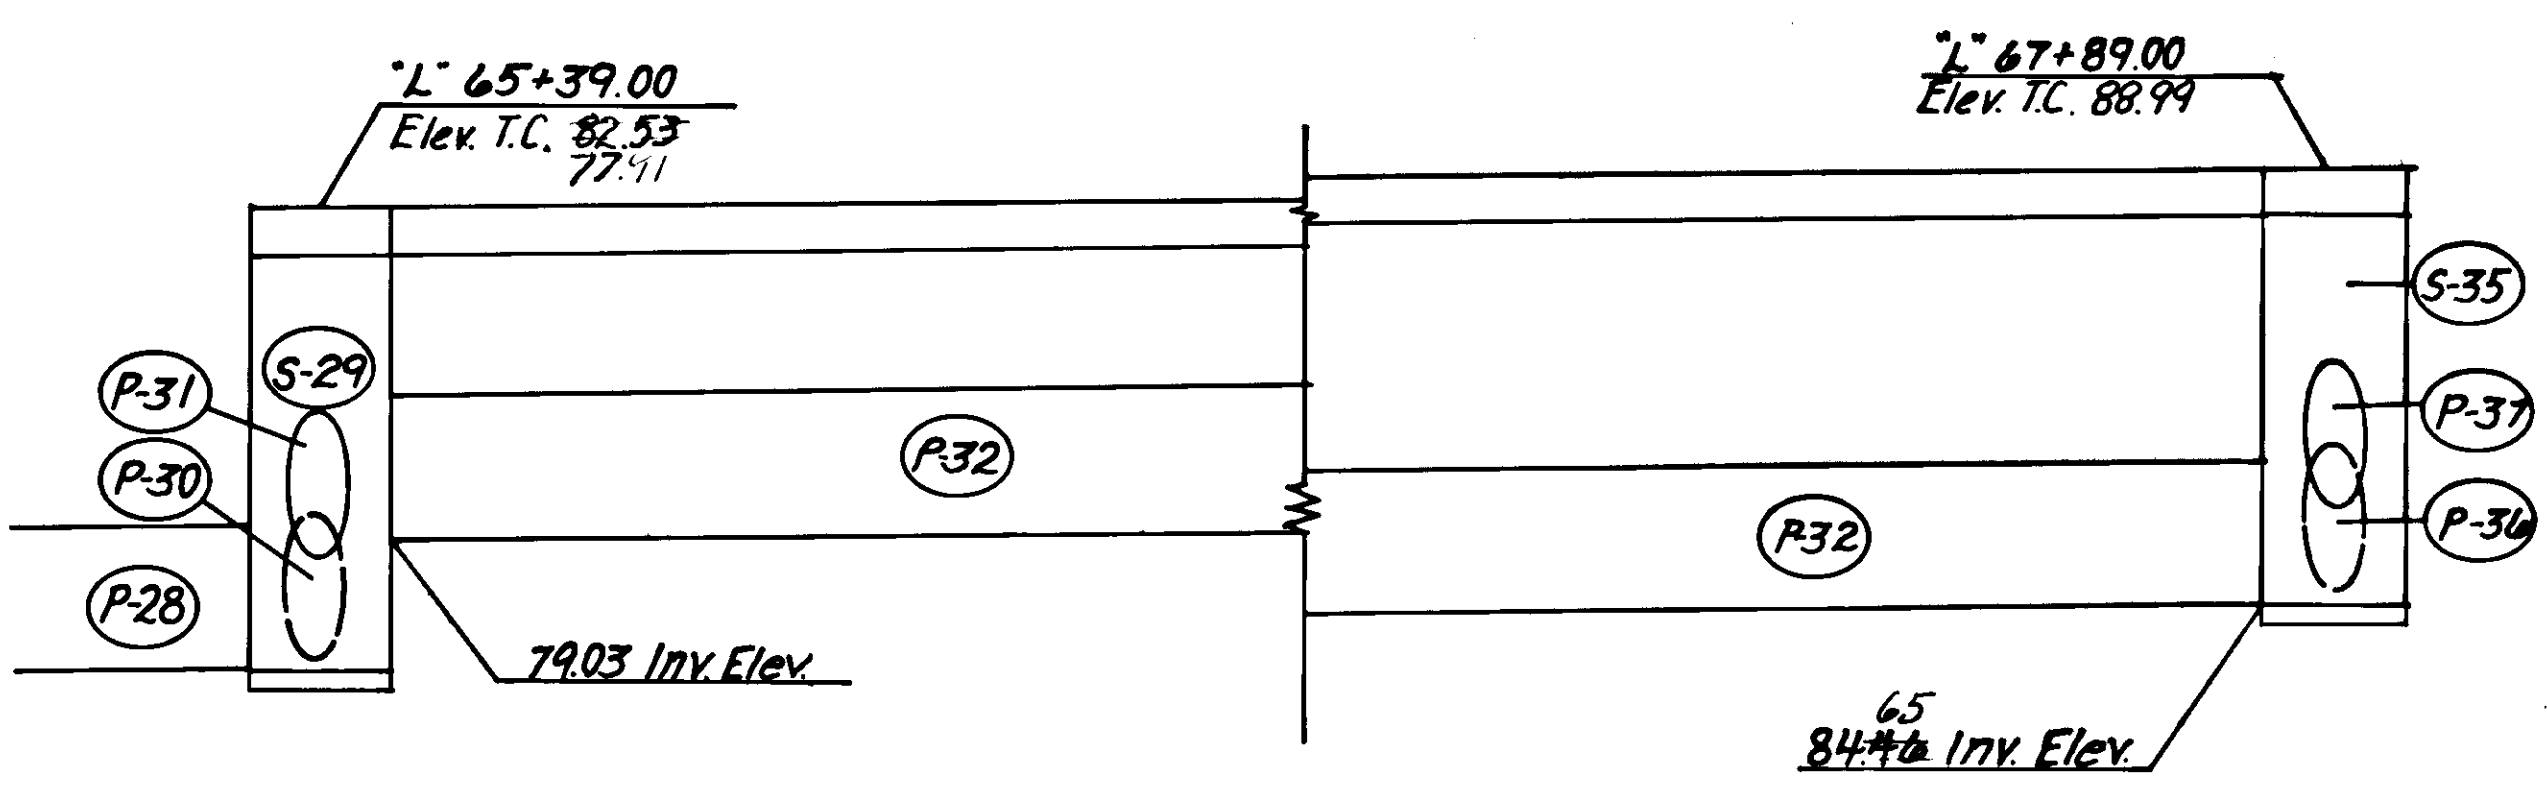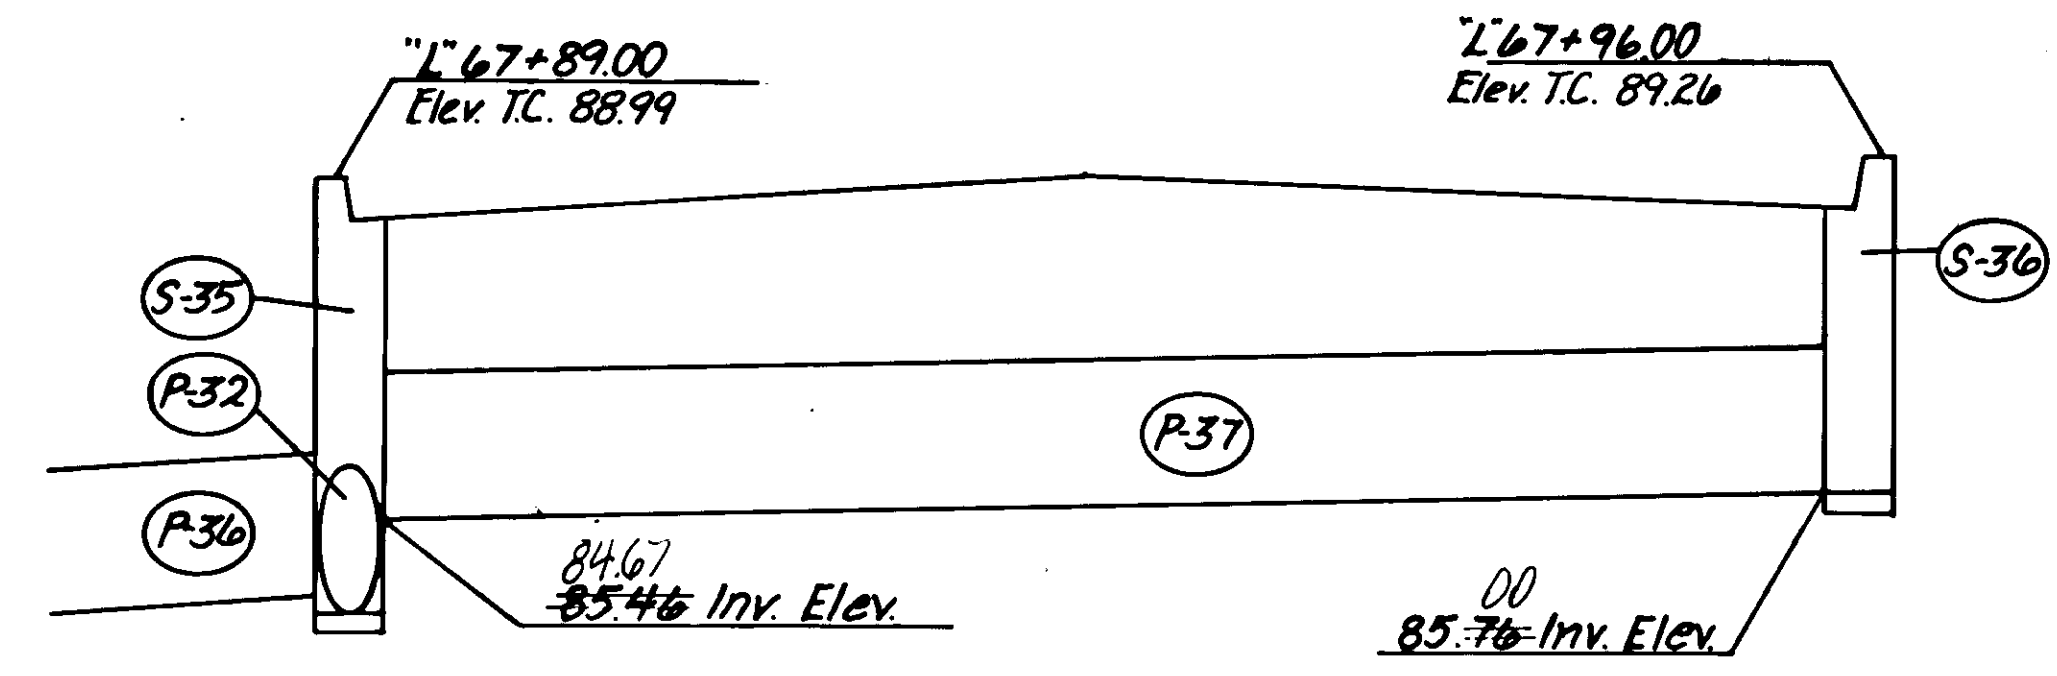
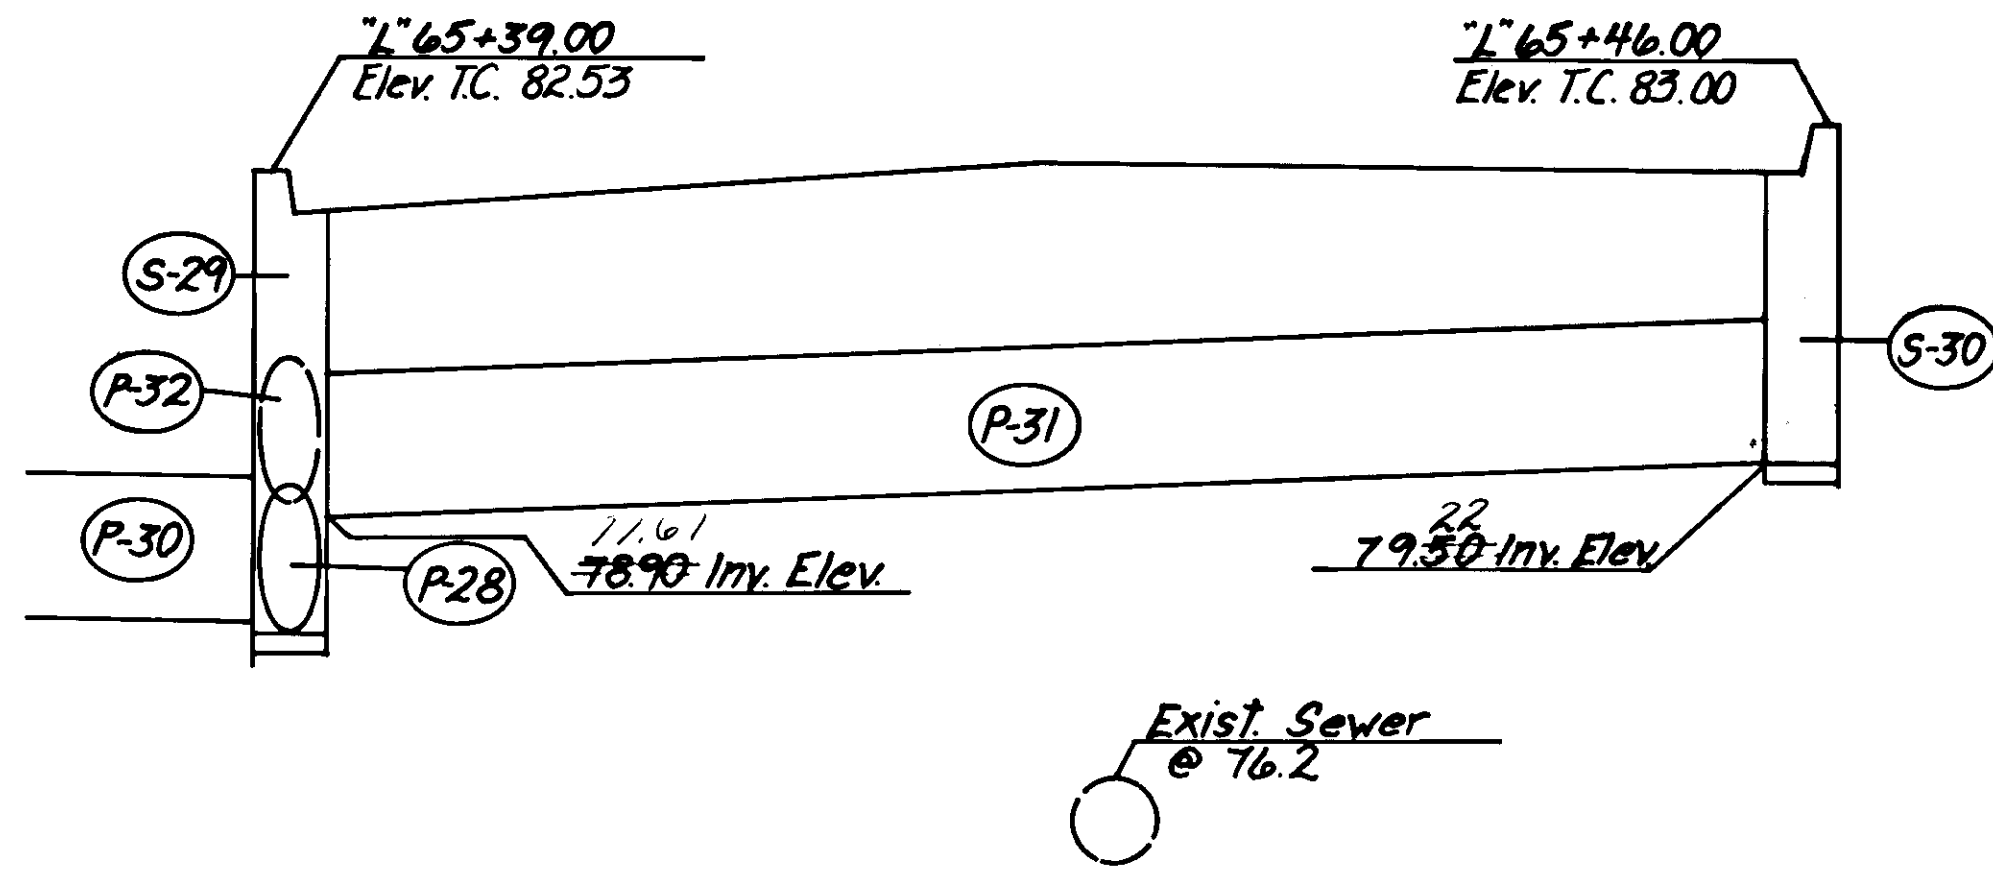


STRUCTURE SUMMARY						PIPE SUMMARY							
STRUCTURE	TYPE	LOCATION	OFFSET		TOP CURB ELEV.	INVERT ELEV.	PIPE	DIA.	LENGTH	FROM		TO	
			LEFT	RIGHT						STRUCTURE	ELEV.	STRUCTURE	ELEV.
S-29	A	L'65+39.00	19.5'		82.53	77.72	P-31	18"	30'-2"	S-30	79.50	S-29	78.90
S-30	A	L'65+46.00		13'	83.00	79.50	P-32	18"	24'-8.5'	S-35	84.46	S-29	79.03
S-31	X	L'66+05.00	29' **		84.00	82.25	P-33	12"	16'-10"	S-31	81.38	18" C.M.P. @ L'66+05	80.43
S-32	X	L'66+31.00	29' **		84.80	83.13	P-34	12"	24'-10"	S-32	83.30	S-31	82.50
S-33	X	7th St. 9+50		20' **	88.00	85.83	P-35	18"	38'-40"	S-33	86.00	S-34	85.26
S-34	X	7th St. 9+50	19' **		88.00	85.01	P-36	18"	32'	S-34	85.18	S-35	84.54
S-35	A	L'67+89.00	19.5'		88.99	84.46	P-37	18"	30'-2"	S-36	85.76	S-35	85.46
S-36	A	L'67+96.00		13'	89.26	84.81							

NOTES: 1. * = Top of grate elev.
 2. ** = Offsets are to center of grate.
 3. A = See standard drawing D-26.02.
 4. X = 24" Pipe Conduit Inlet. (See sht. 31 for details)
 5. On type A or B inlets the offsets are to back of curb.
 6. Back of curb elevations are approx. only.
 7. Curb inlet grates shall be type G-3R, see standard drawing D-23.01.



STATE	PROJECT DESIGNATION	YEAR	SHEET NO.	TOTAL SHEETS
ALASKA	RS-0938(I)	1979	26	34

UTILITIES

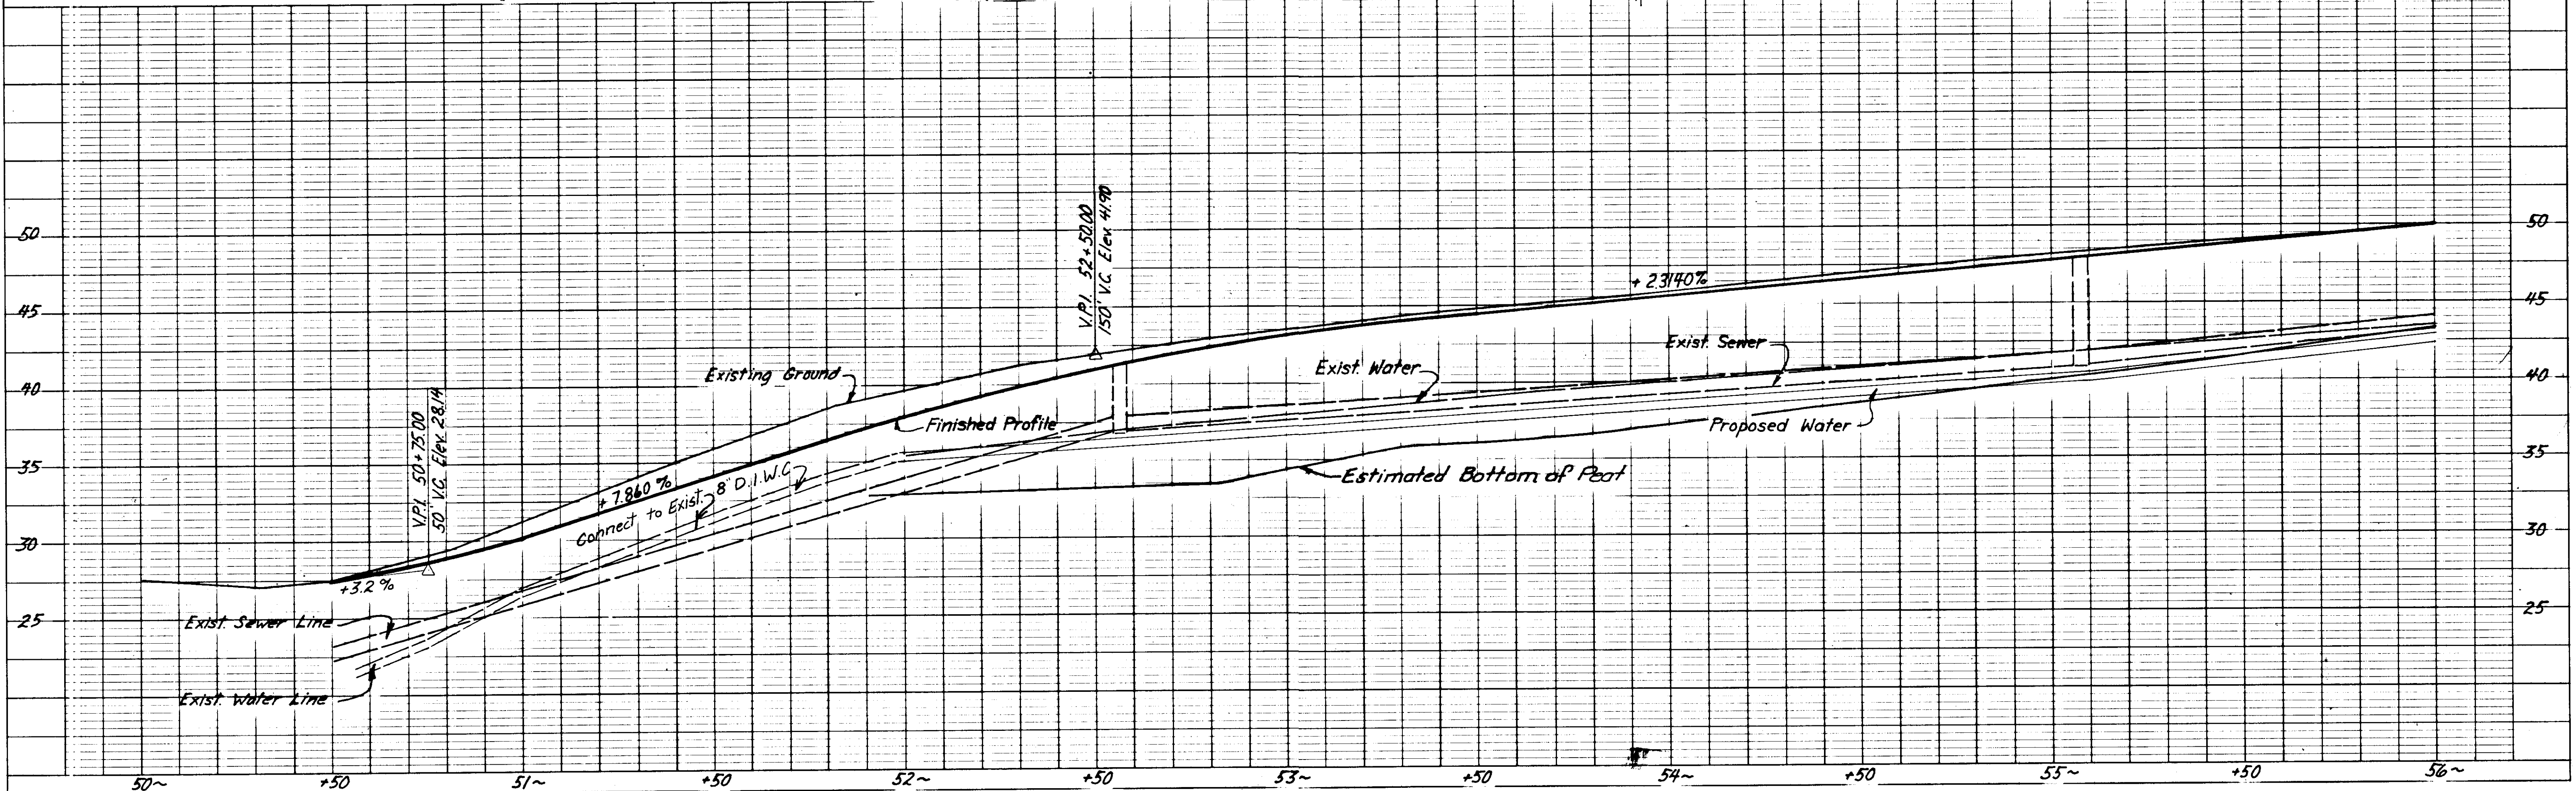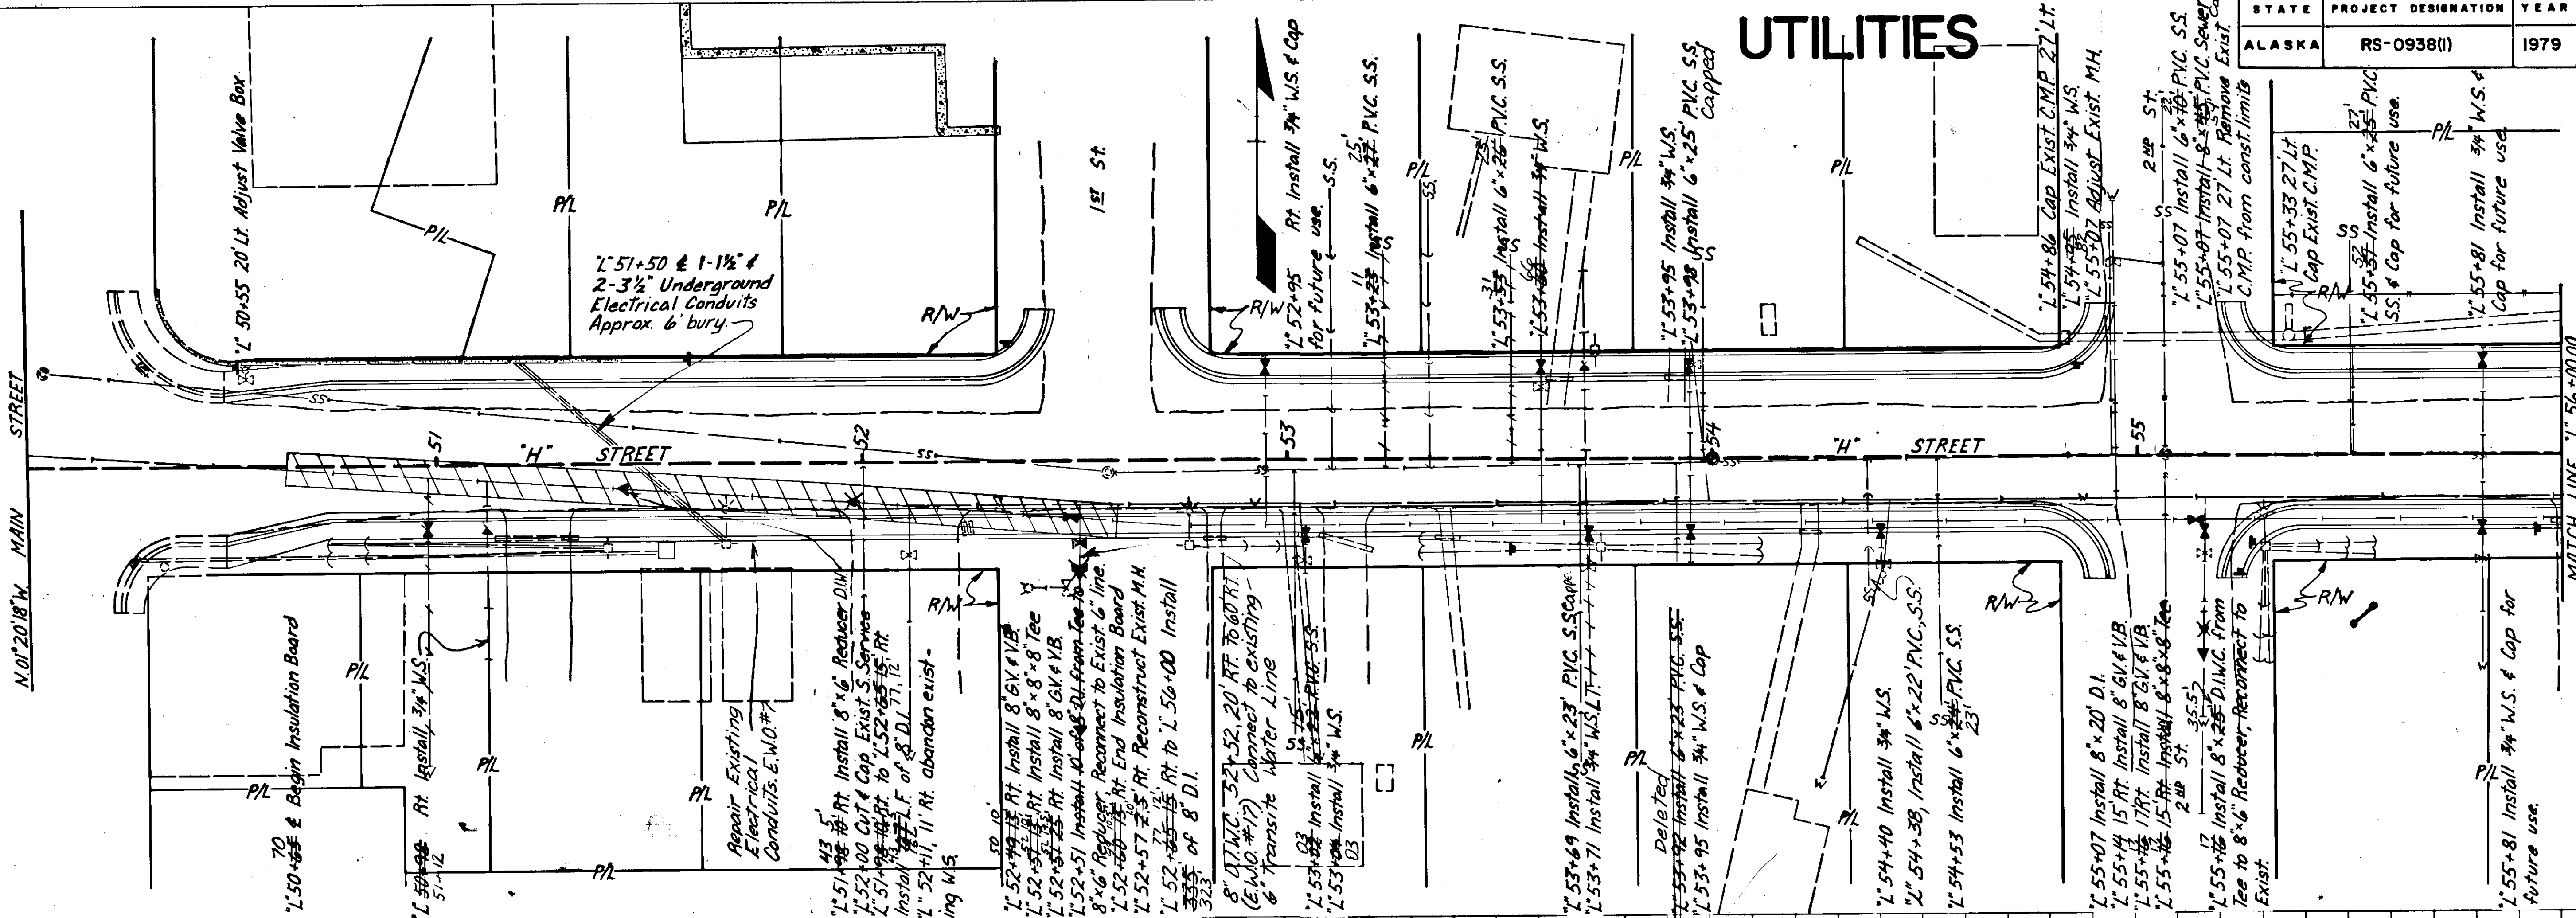




UTILITIES

STATE	PROJECT DESIGNATION	YEAR	SHEET NO.	TOTAL SHEETS
ALASKA	RS-0938(I)	1979	27	34

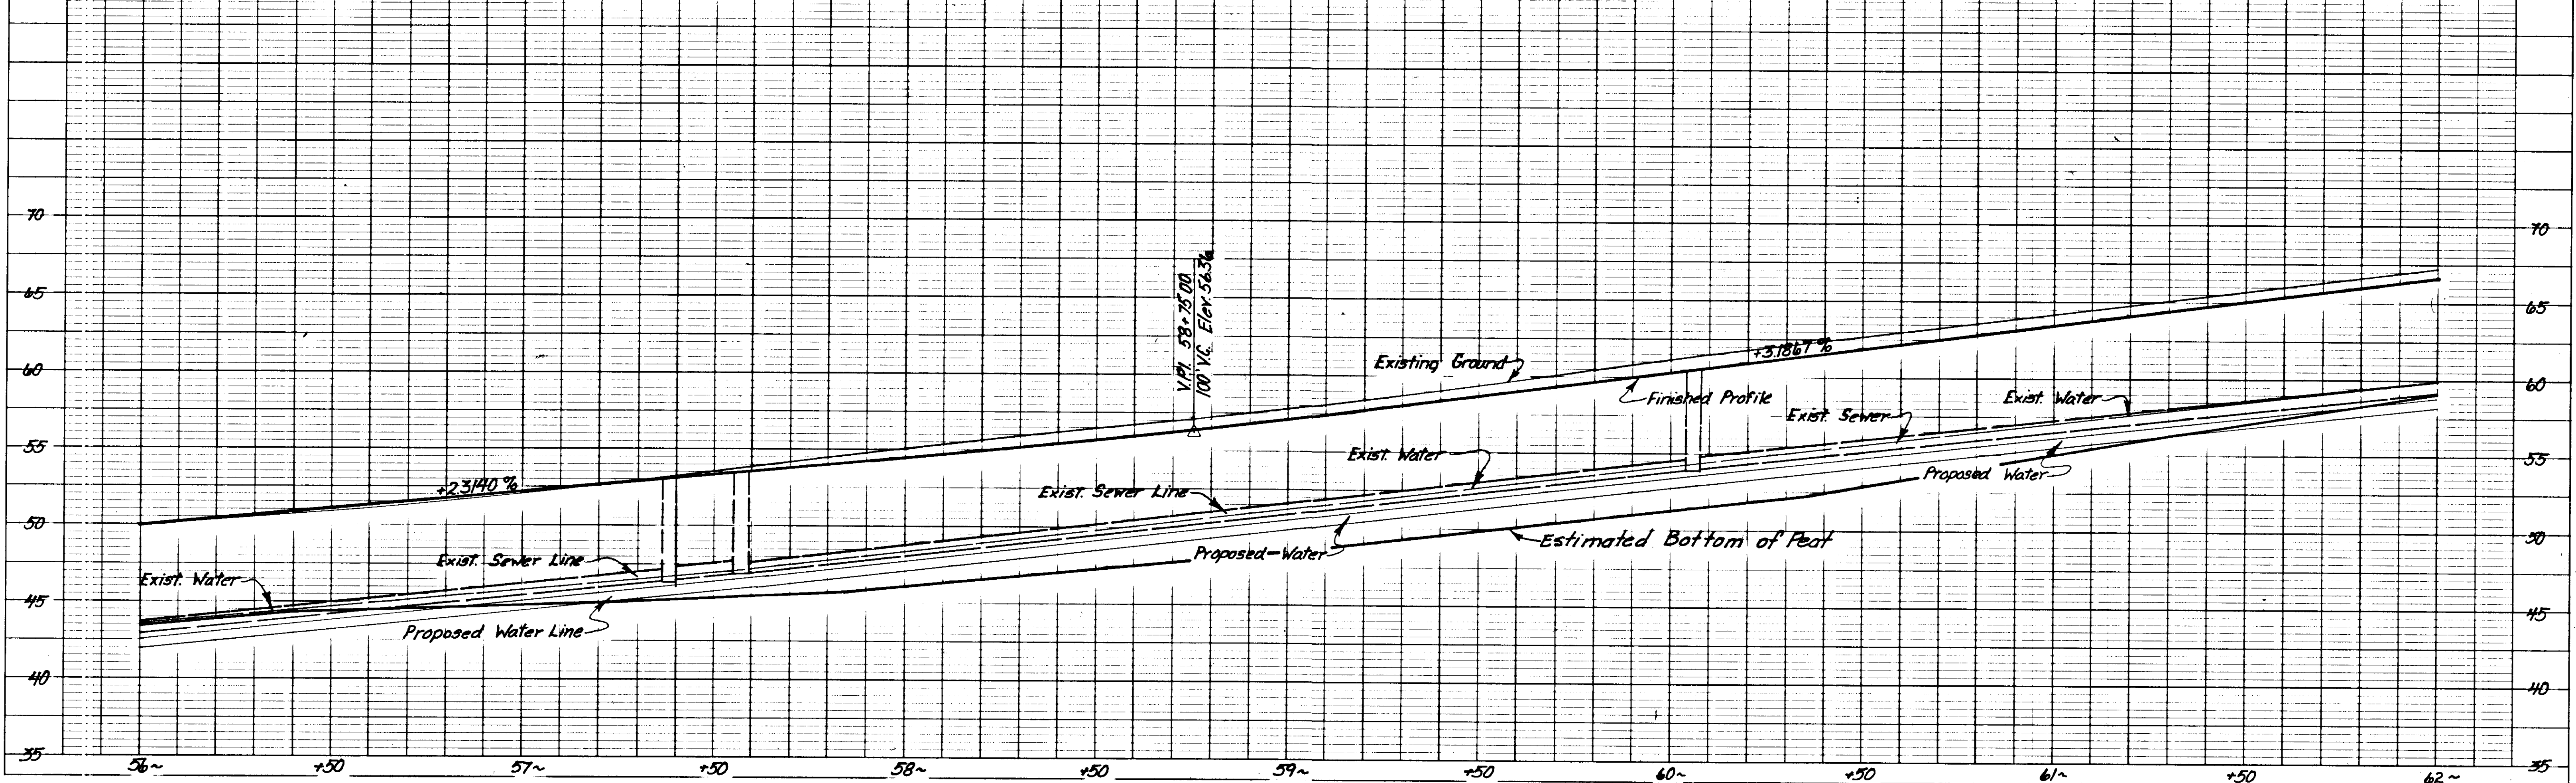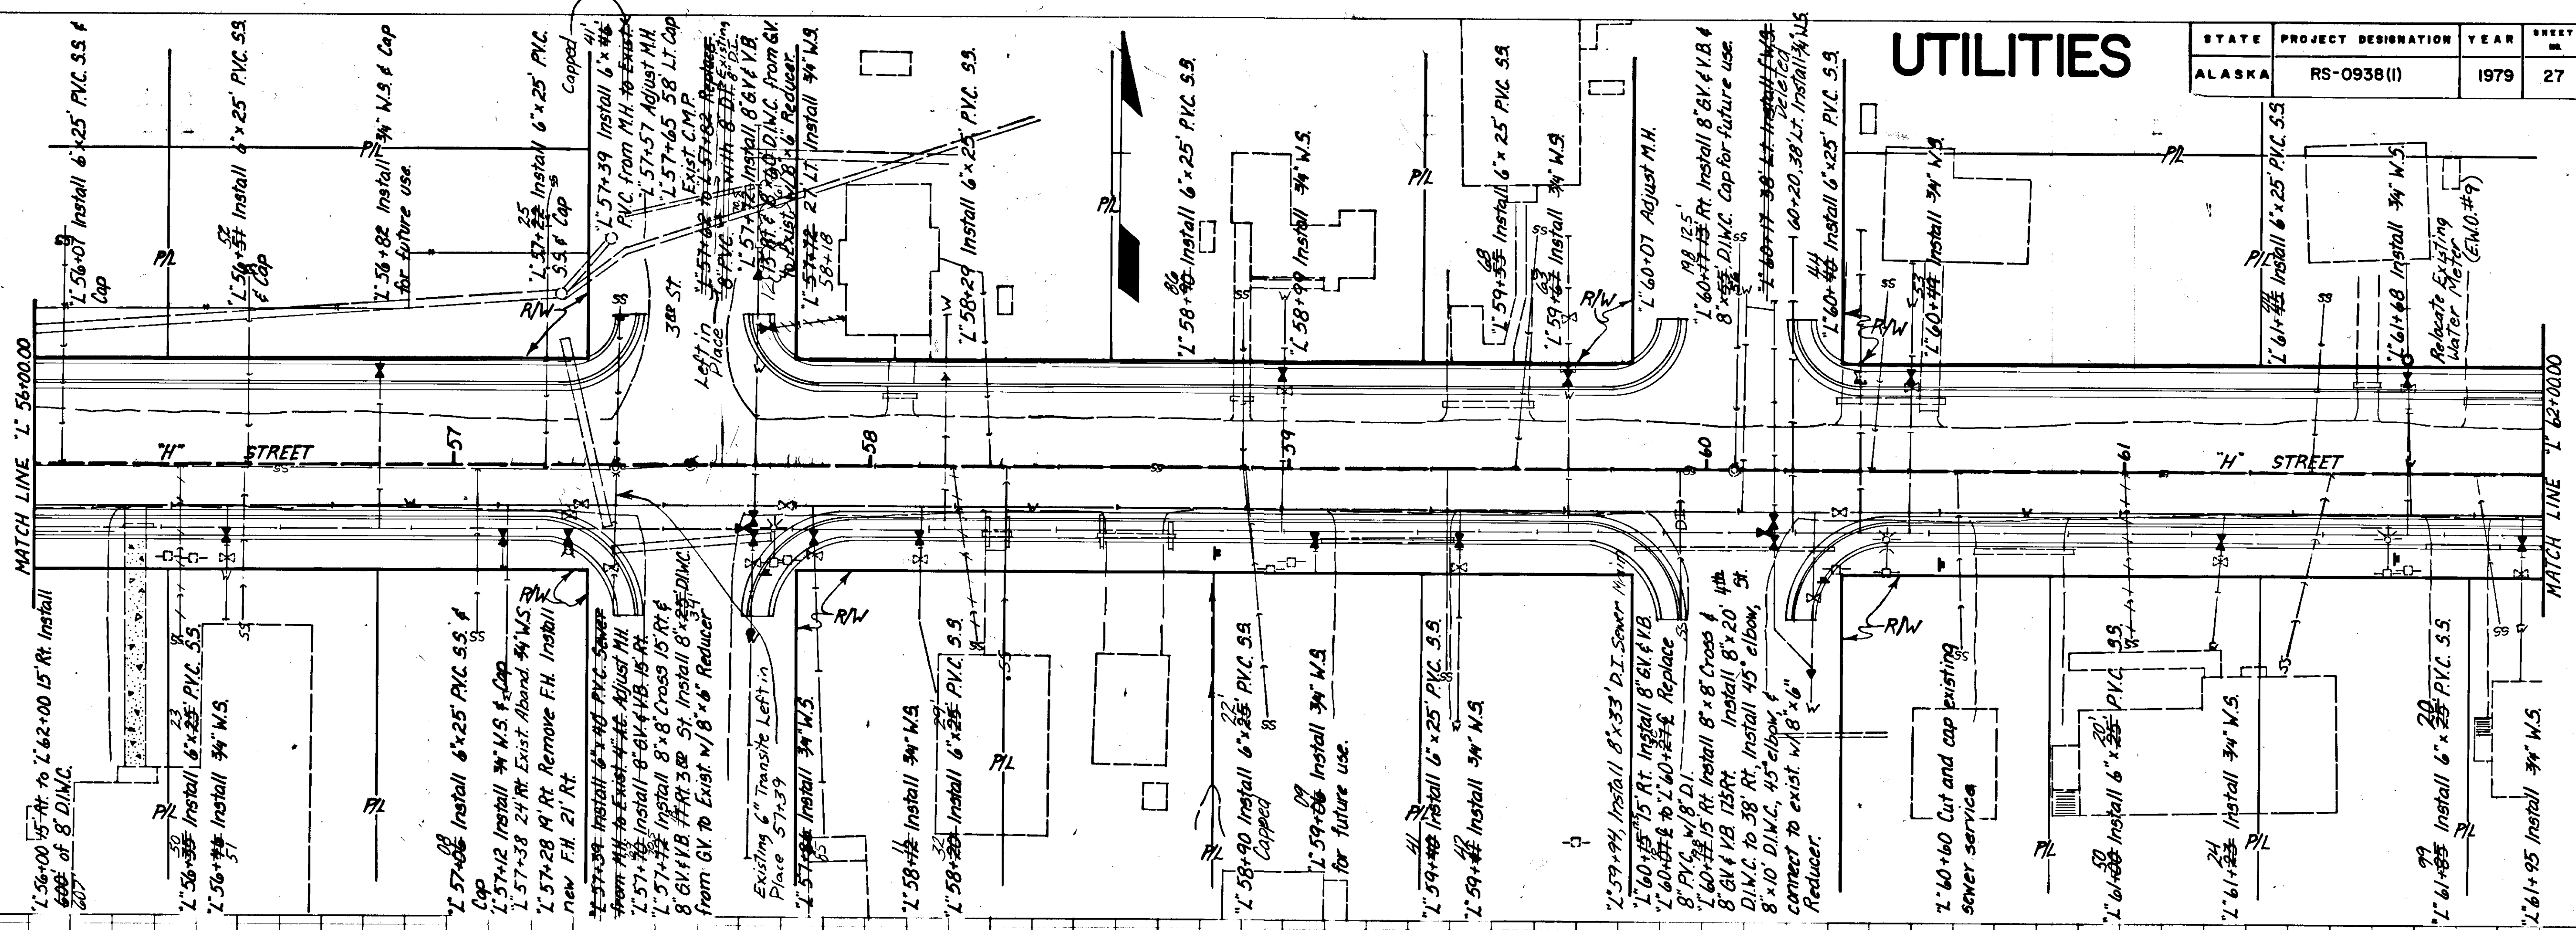


STATE	PROJECT DESIGNATION	YEAR	SHEET NO.	TOTAL SHEETS
ALASKA	RS-0938(I)	1979	29	34

UTILITIES

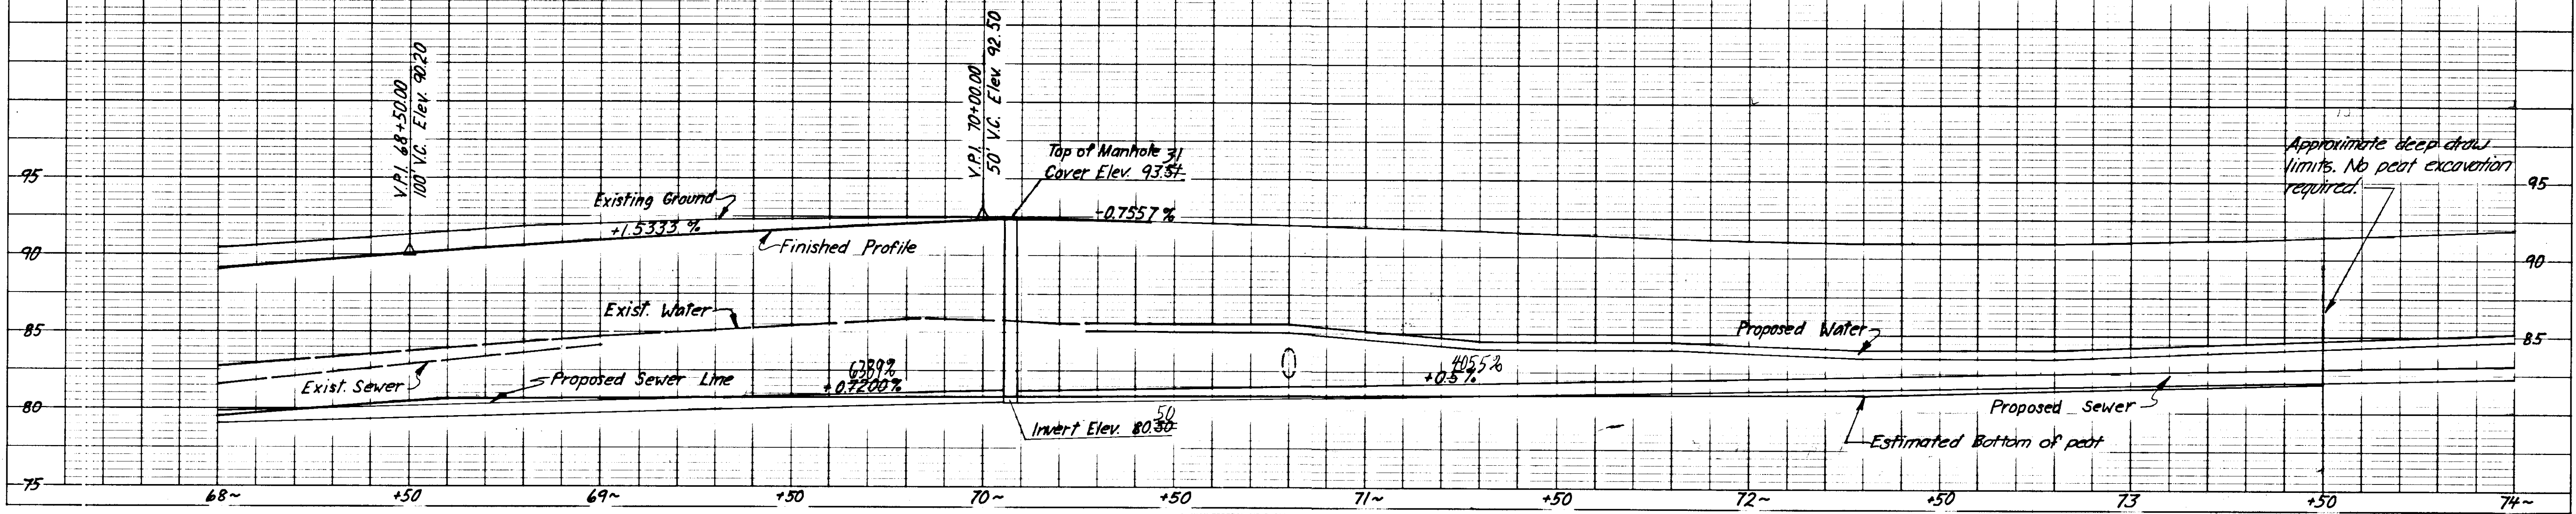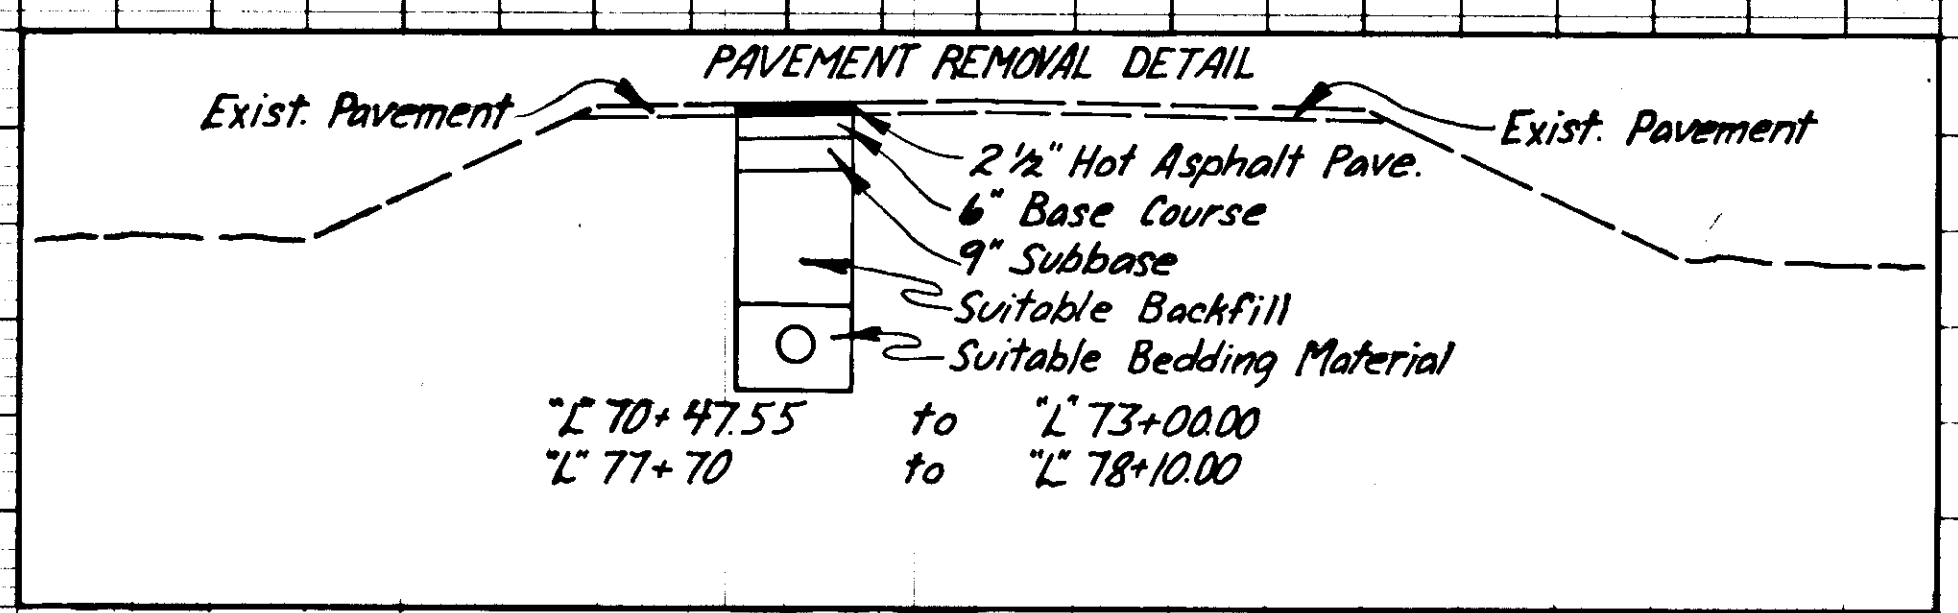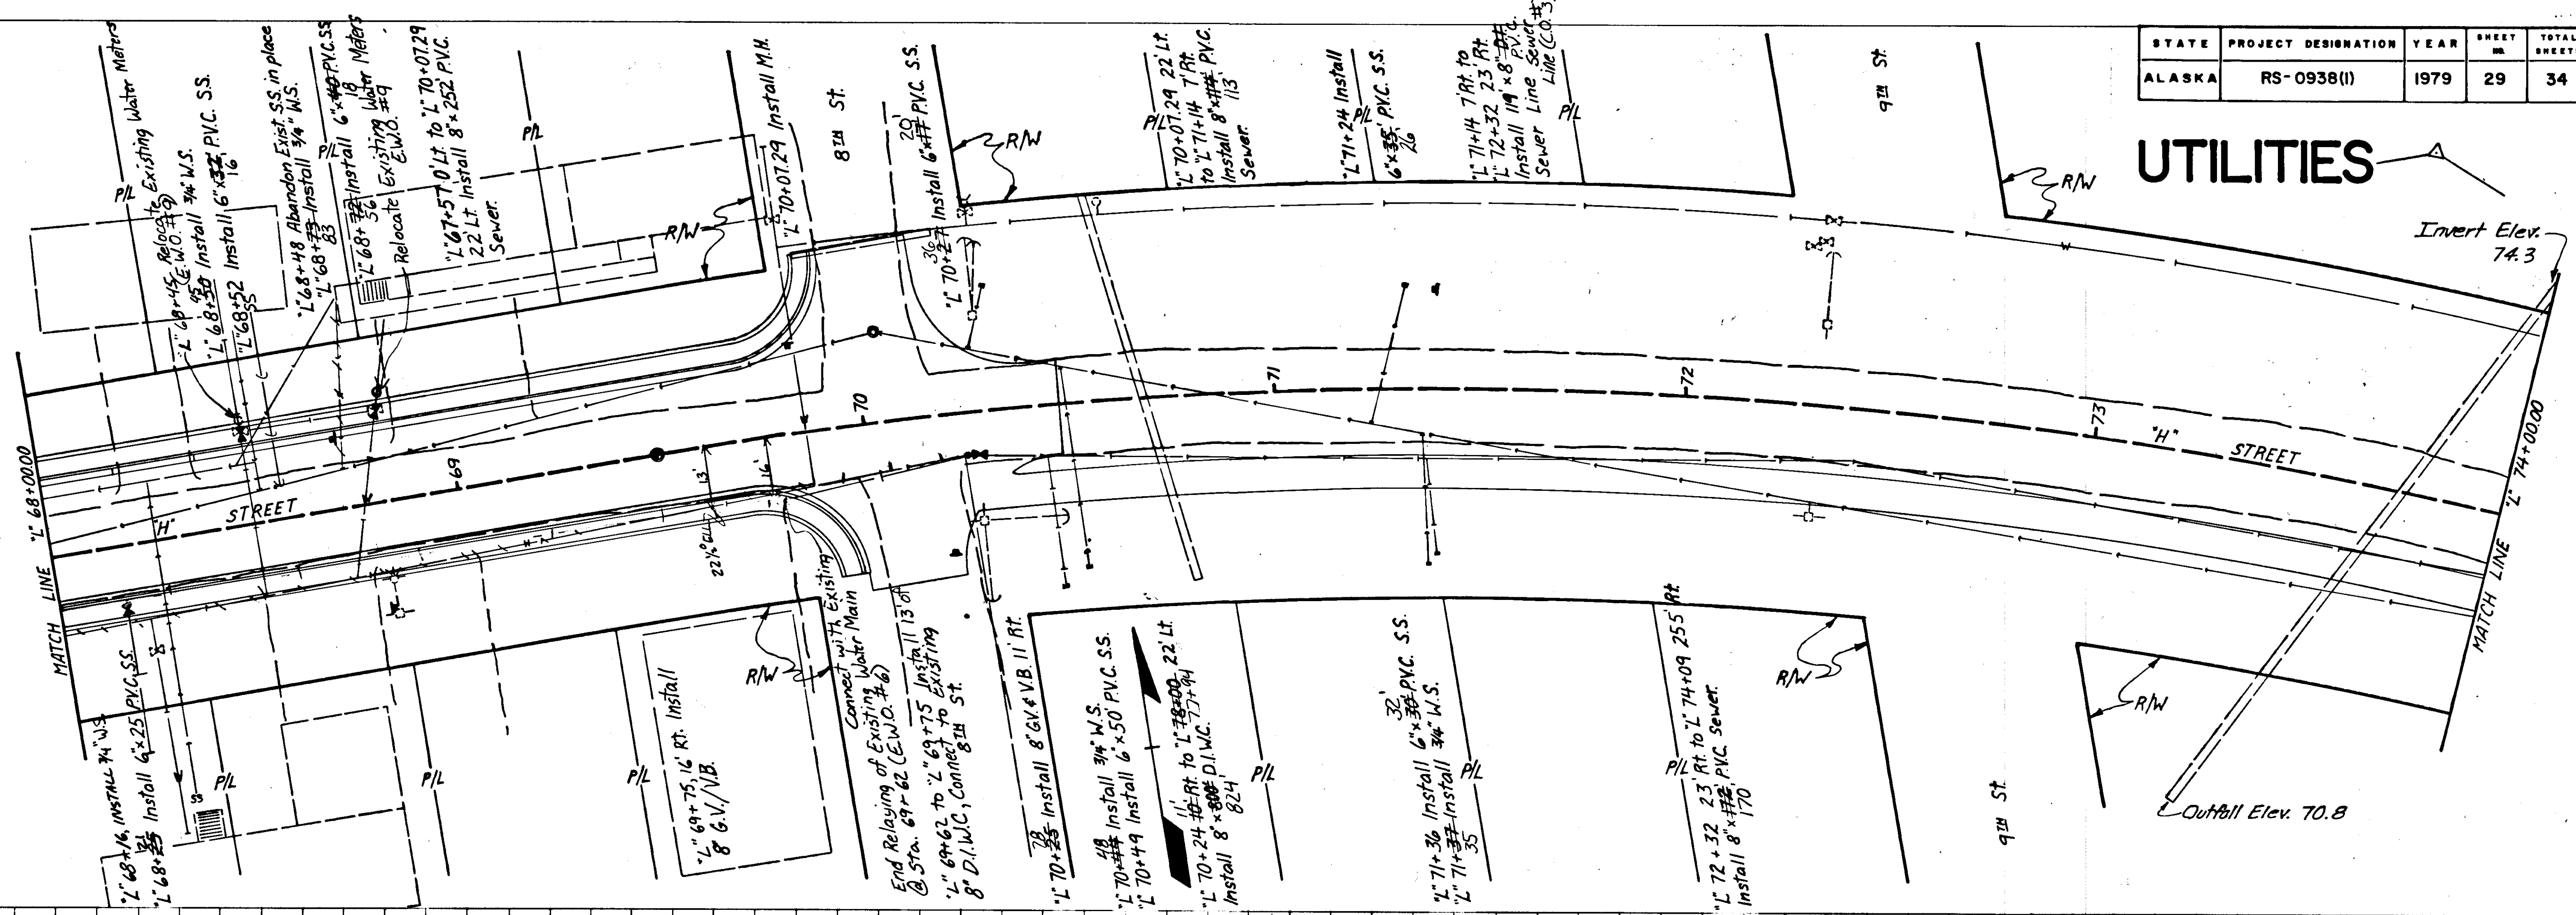



STATE	PROJECT DESIGNATION	YEAR	SHEET NO.	TOTAL SHEETS
ALASKA	RS-0938(I)	1979	30	34

UTILITIES

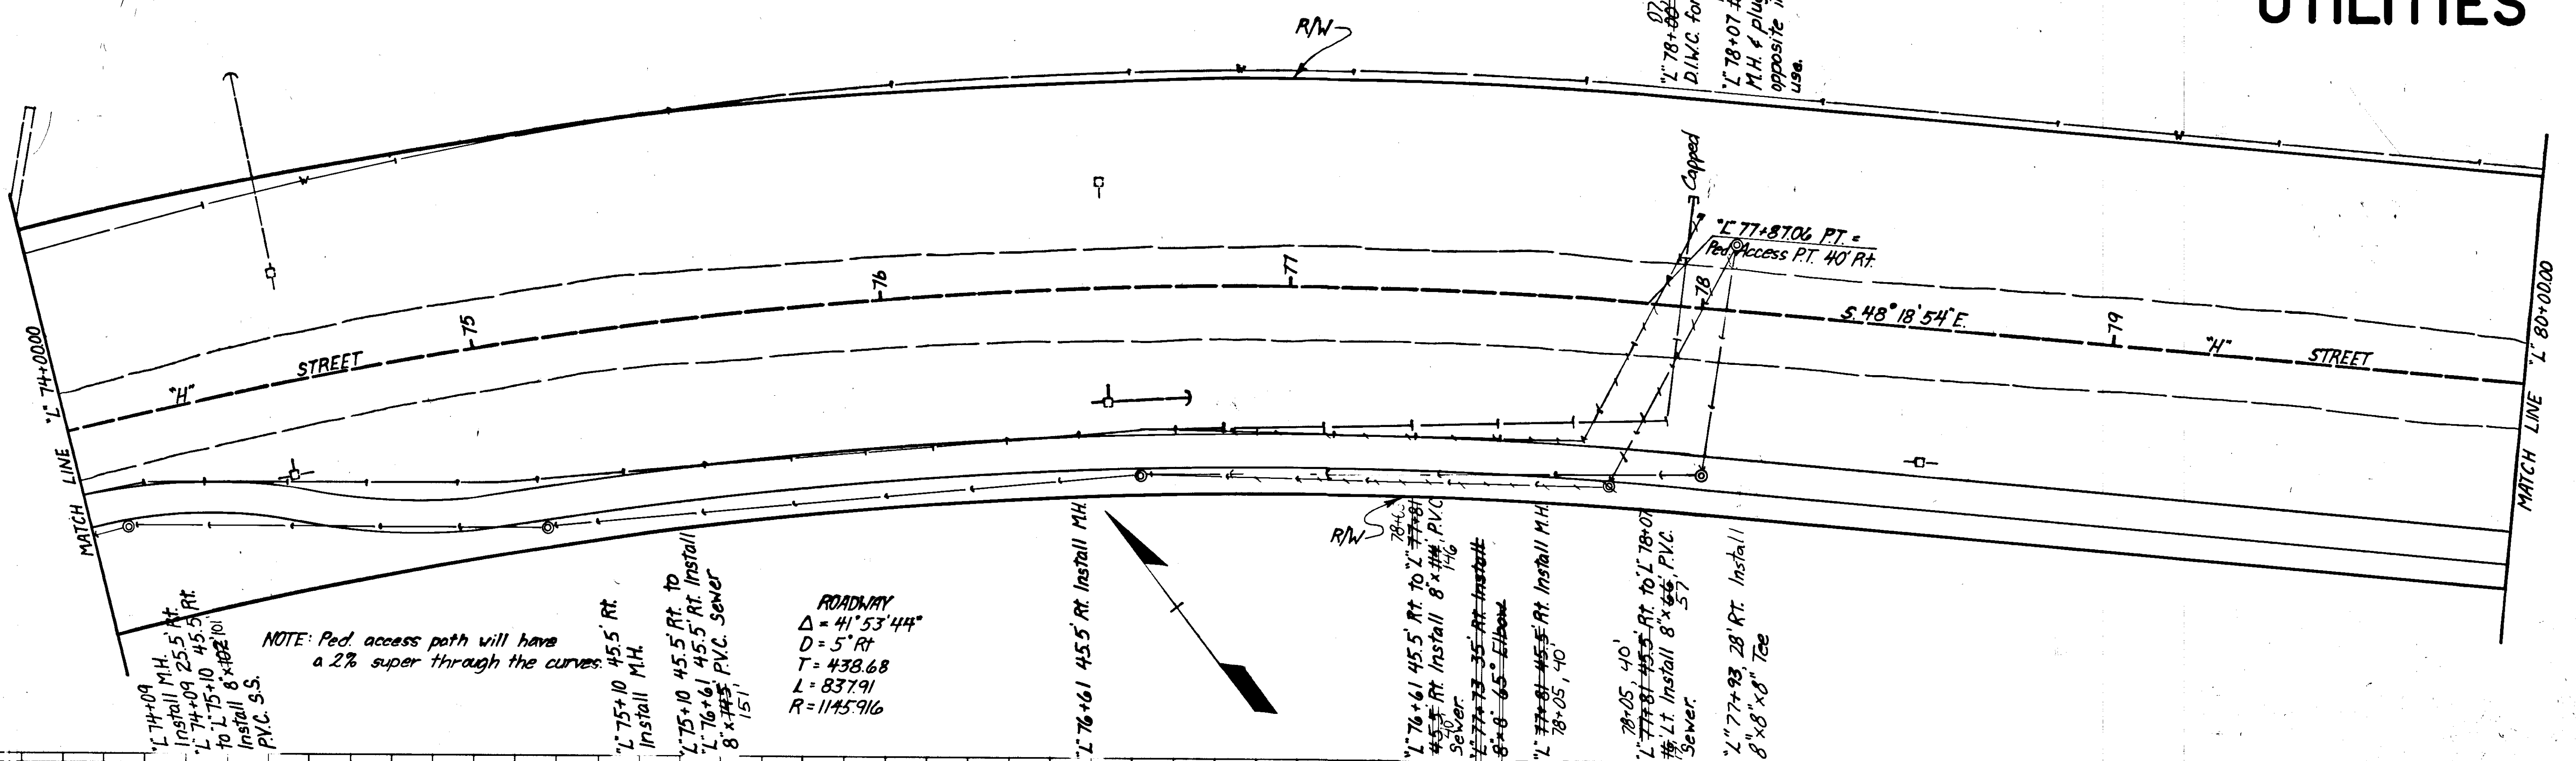


NOTE: Ped. access path will have a 2% super through the curves.

ROADWAY
 $\Delta = 41^{\circ} 53' 44''$
 $D = 5^{\circ} \text{ Rt}$
 $T = 438.68$
 $L = 837.91$
 $R = 1145.916$

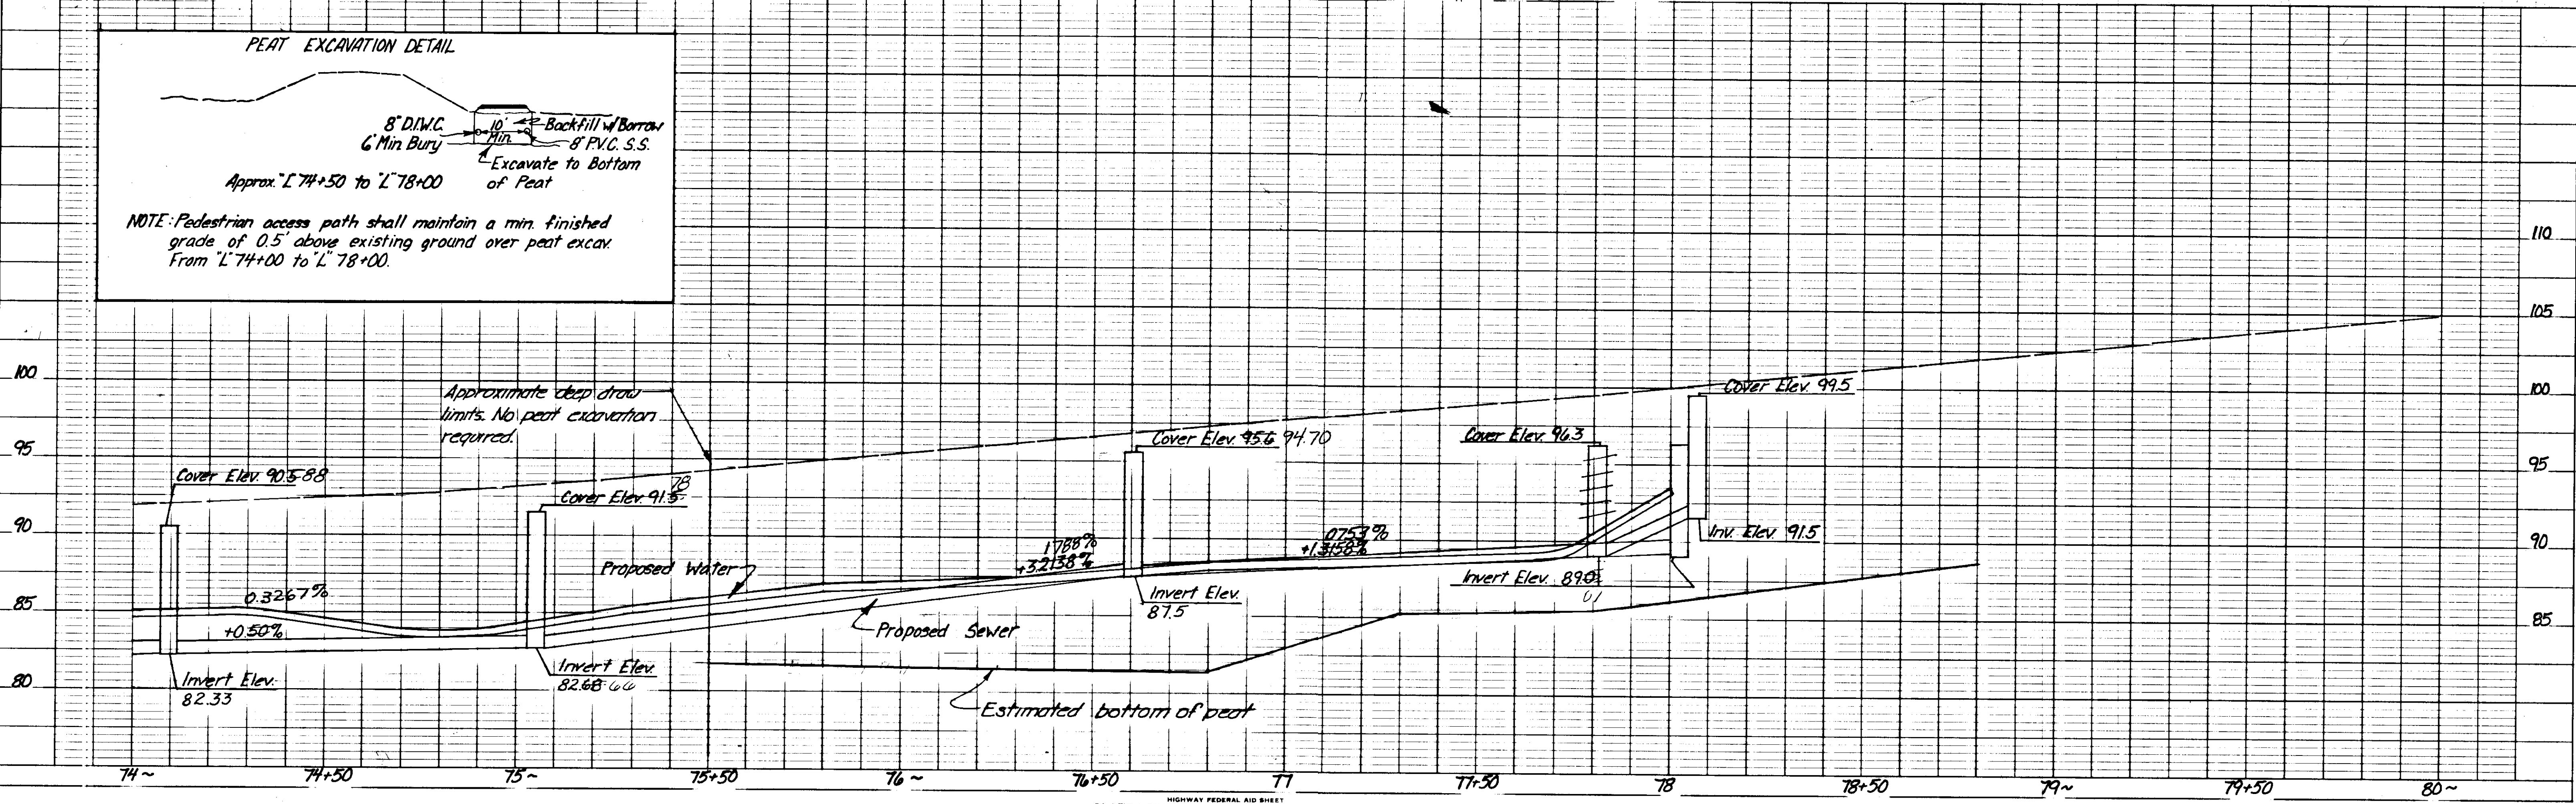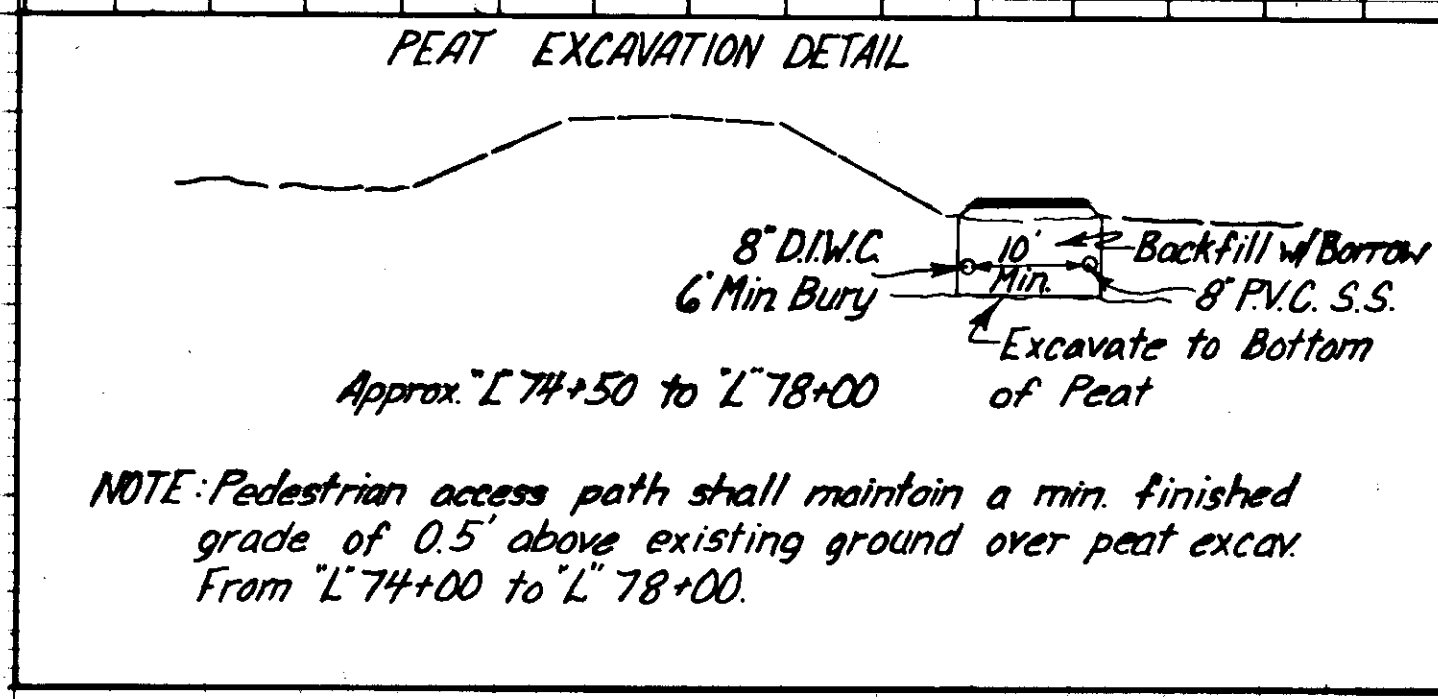

STATE	PROJECT DESIGNATION	YEAR	SHEET	TOTAL SHEETS
ALASKA	RS-0938(I)	1979	31	34

TYPICAL CURB & SIDEWALK JOINT DETAIL

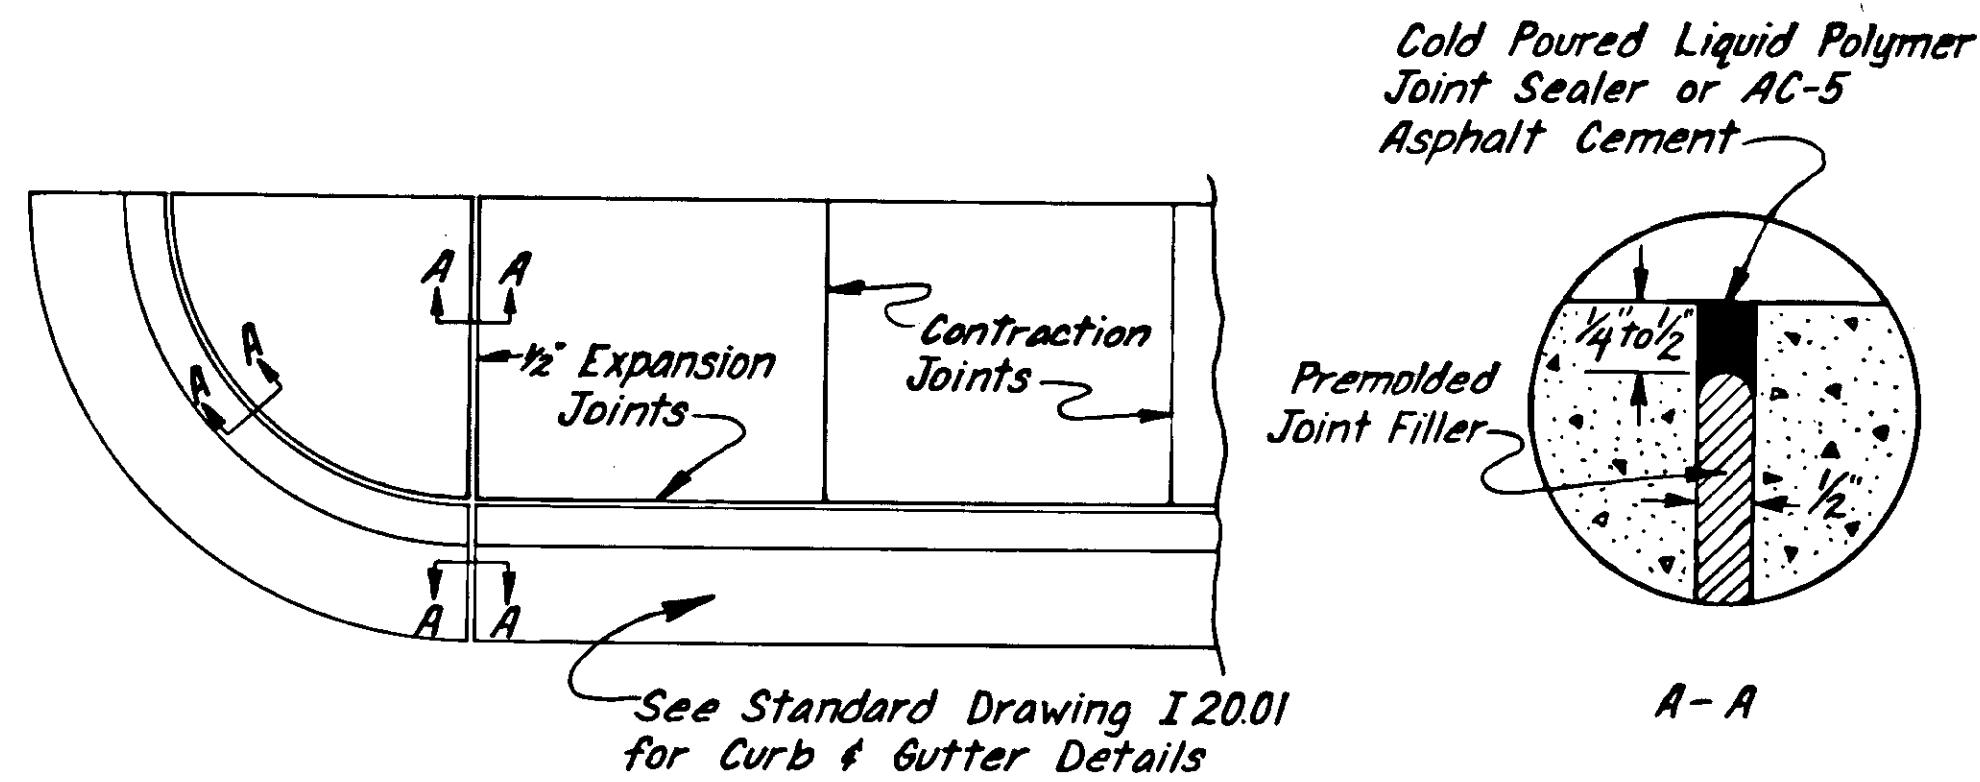


See Standard Drawing I 20.01 for Curb & Gutter Details


NOTES

1. Premolded expansion joint filler & liquid polymer joint sealer (see specs.) or AC-5 asphalt cement shall be considered incidental to Pay Item 608(1) "Concrete Sidewalk" and no separate payment shall be made therefore.
2. Curb & gutter expansion joints shall be at each end of the curb returns, & immediately preceding & following all curb cuts. Thereafter they shall be placed at intervals of 30' except where shorter sections are needed for closure.
3. Sidewalk expansion joints shall be opposite expansion joints in adjoining curb & gutter. Contraction joints shall be equally spaced between expansion joints & spacing shall not exceed 5'.
4. Wheelchair ramps shall be constructed as detailed on this sheet & shall be constructed at locations designated by a ★ on the plan sheets.


24" PIPE CONDUIT INLET

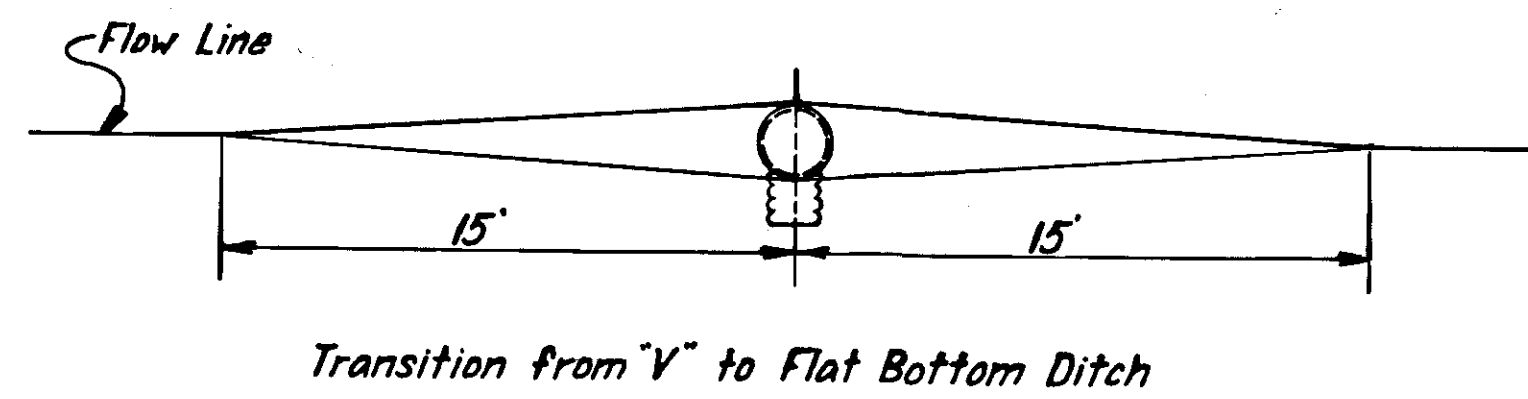


24" FIELD INLET DETAIL

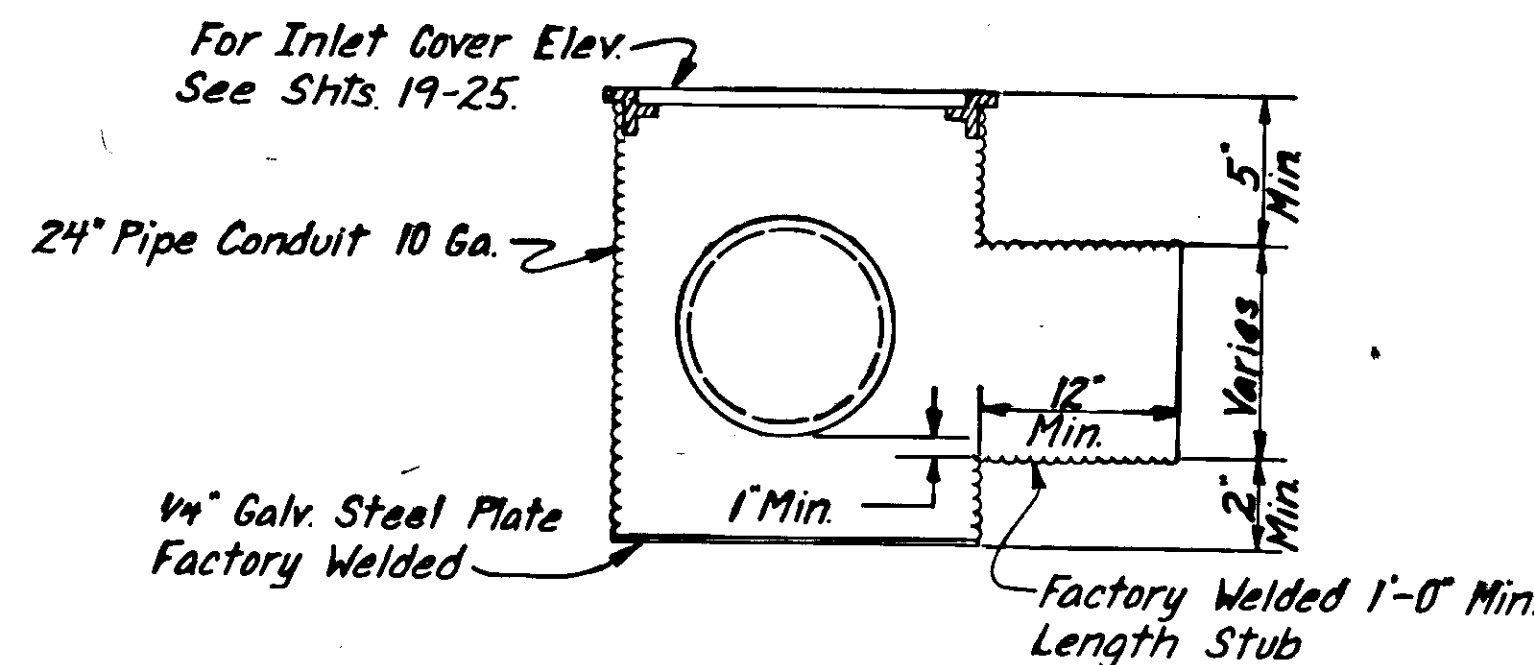


GRATE DETAIL

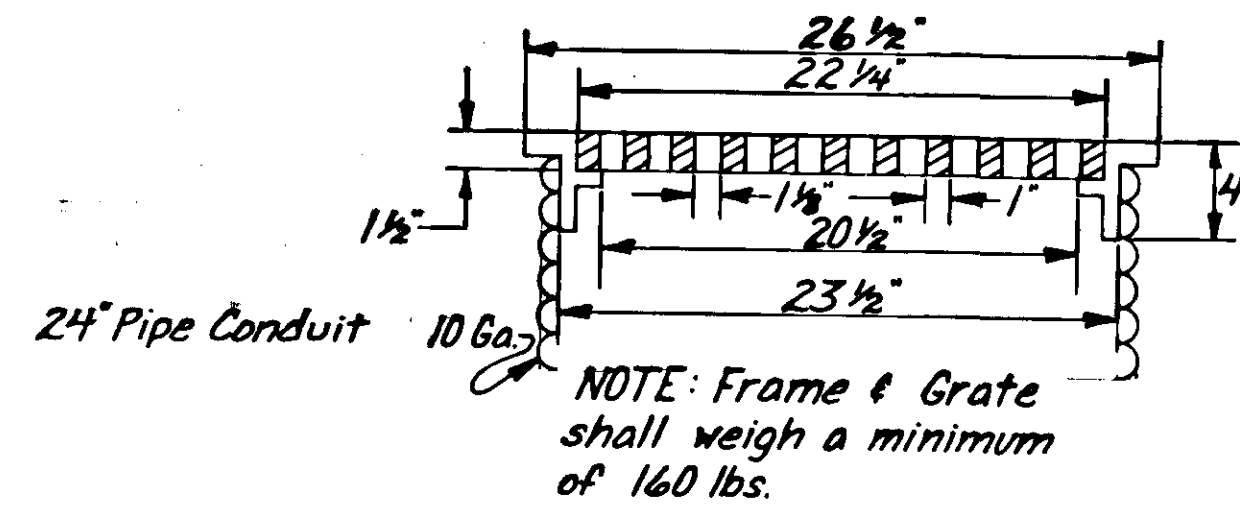

36" FIELD INLET DETAIL

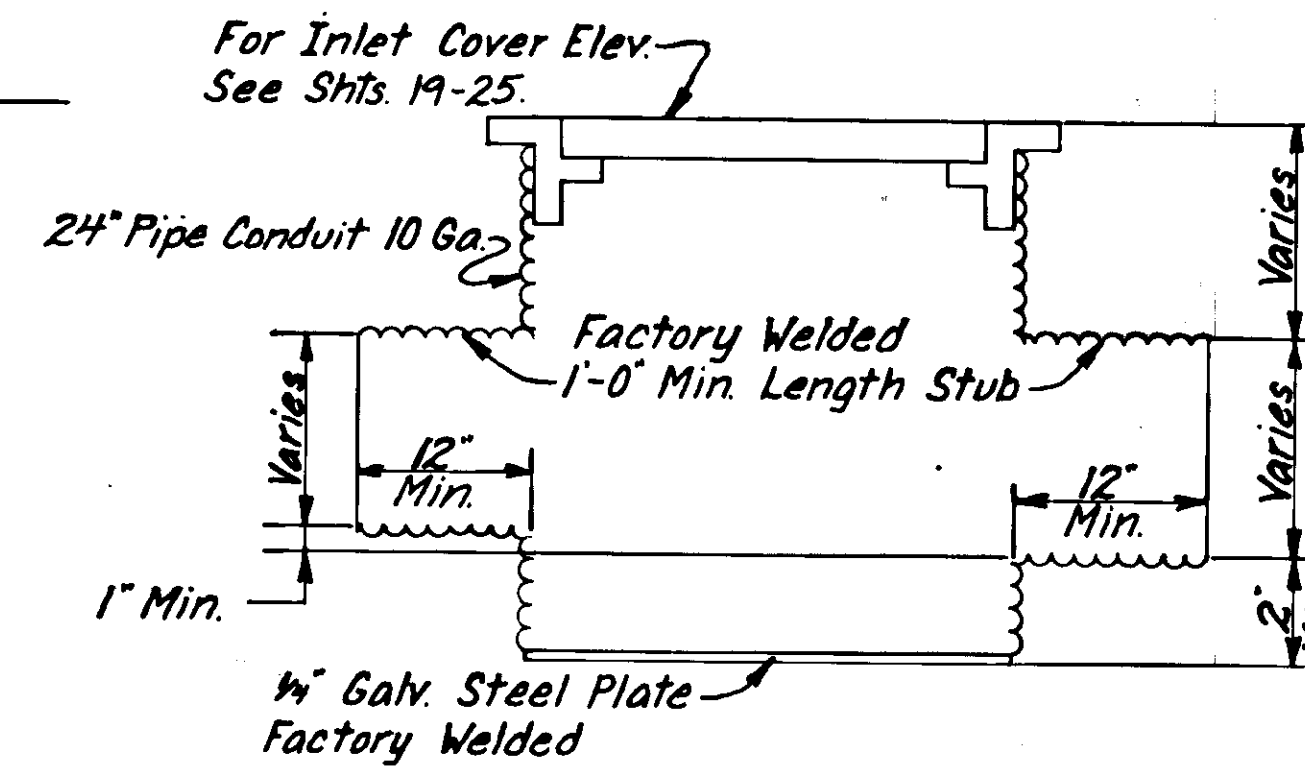


GRATE DETAIL

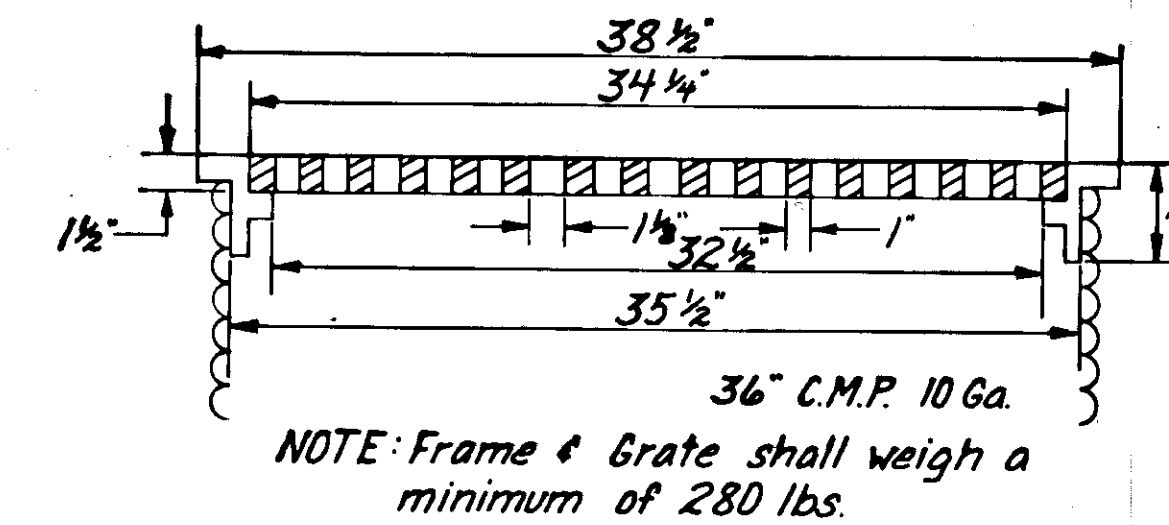

MISC. DETAILS


WOODEN STAIR AND SIDEWALK DETAIL

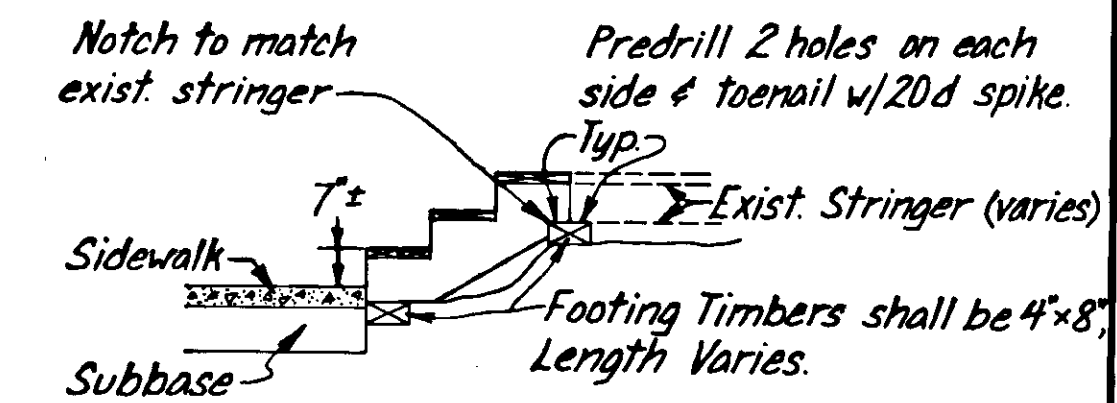

NOTES

1. Wooden stairs & sidewalks shall be field fit to match exist. walks to new concrete sidewalks as directed by the engineer.
2. Exist. structures not being removed shall be protected during construction.
3. Footing timbers shall extend 2" outside the outer stringer.
4. All stairs with 3 risers or less & sidewalks wider than 3' shall have 3 stringers.
5. All lumber dimensions & nail sizes shall conform to Standard Drawing M-05.01 except 2"x8" stringers may be used on the wood sidewalks or as directed by the engineer.
6. Where applicable & the walk is in an embankment area Standard Drawing M-05.01 shall be utilized with the landing to match back of sidewalk grade.
7. Footings, posts, & field cuts in contact w/ the ground shall be treated w/ preservative creosote oils. Water born preservatives shall be used above ground as per the latest standards of the A.W.P.A.
8. All ferrous metals shall be galvanized.
9. Furnish & install wood bracing as req'd. by the eng.


WHEELCHAIR RAMP DETAIL

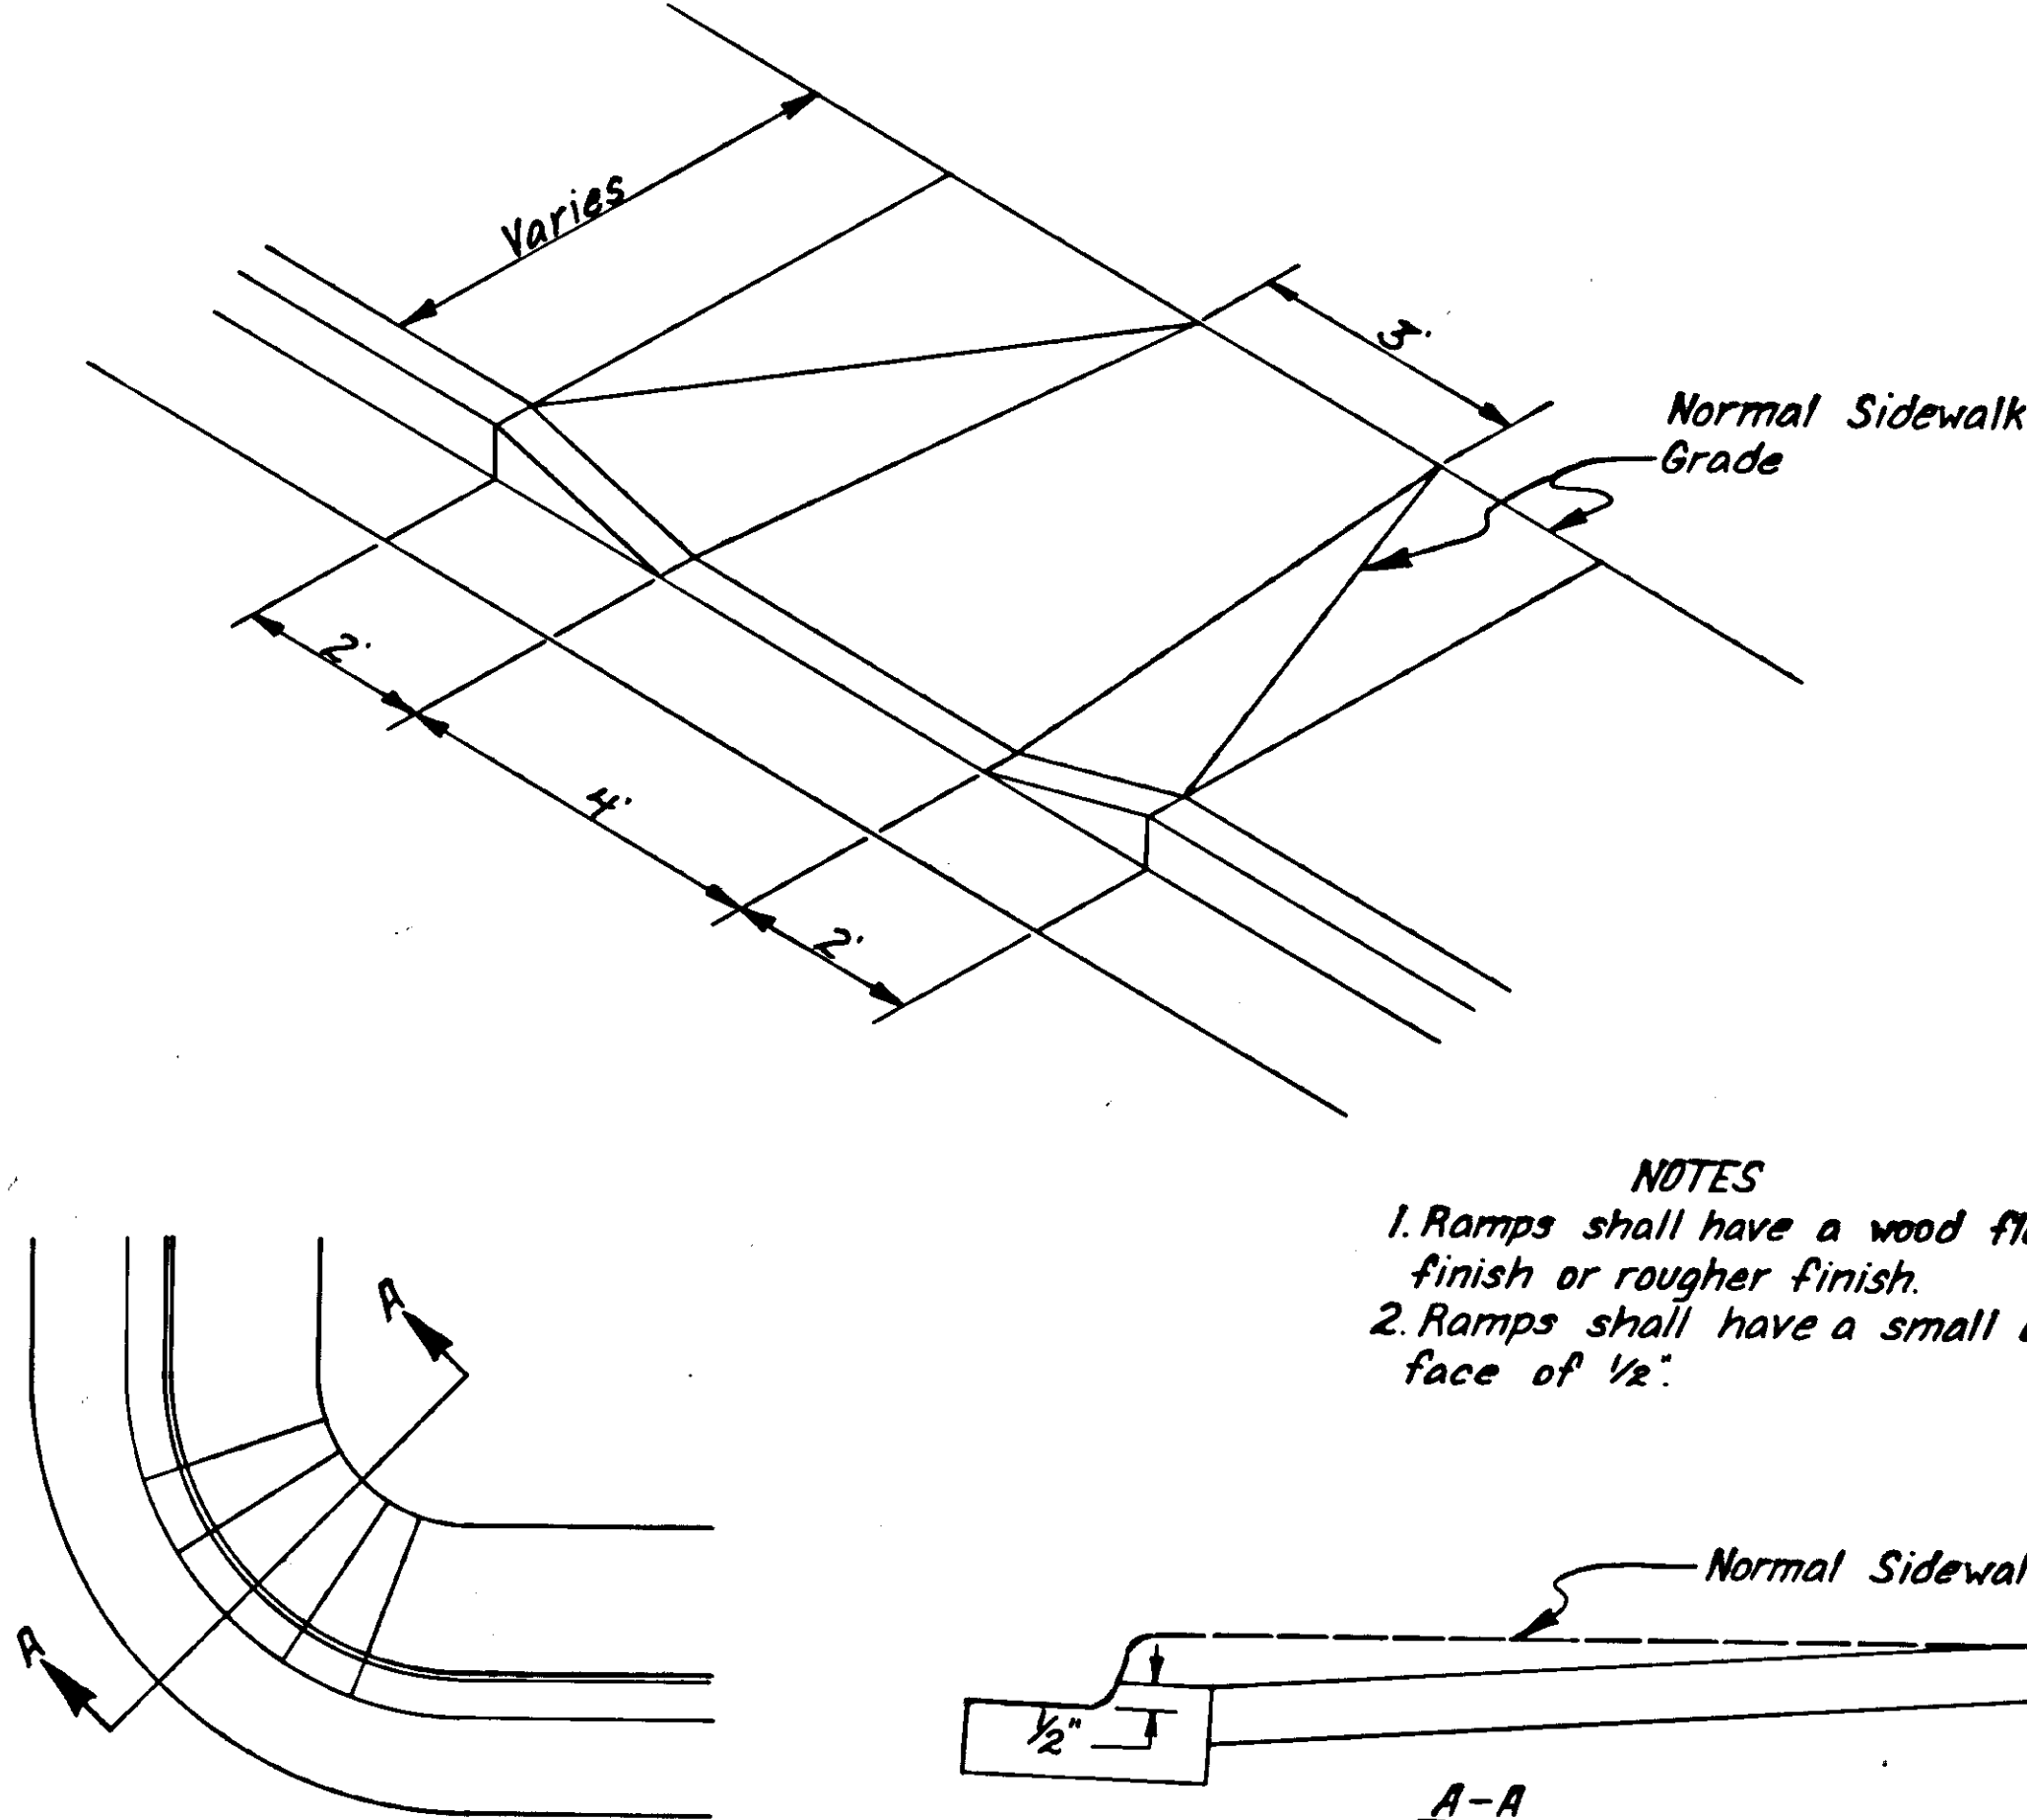


NOTES

1. Ramps shall have a wood float finish or rougher finish.
2. Ramps shall have a small curb face of 1/2".

SADDLE CONNECTION DETAIL

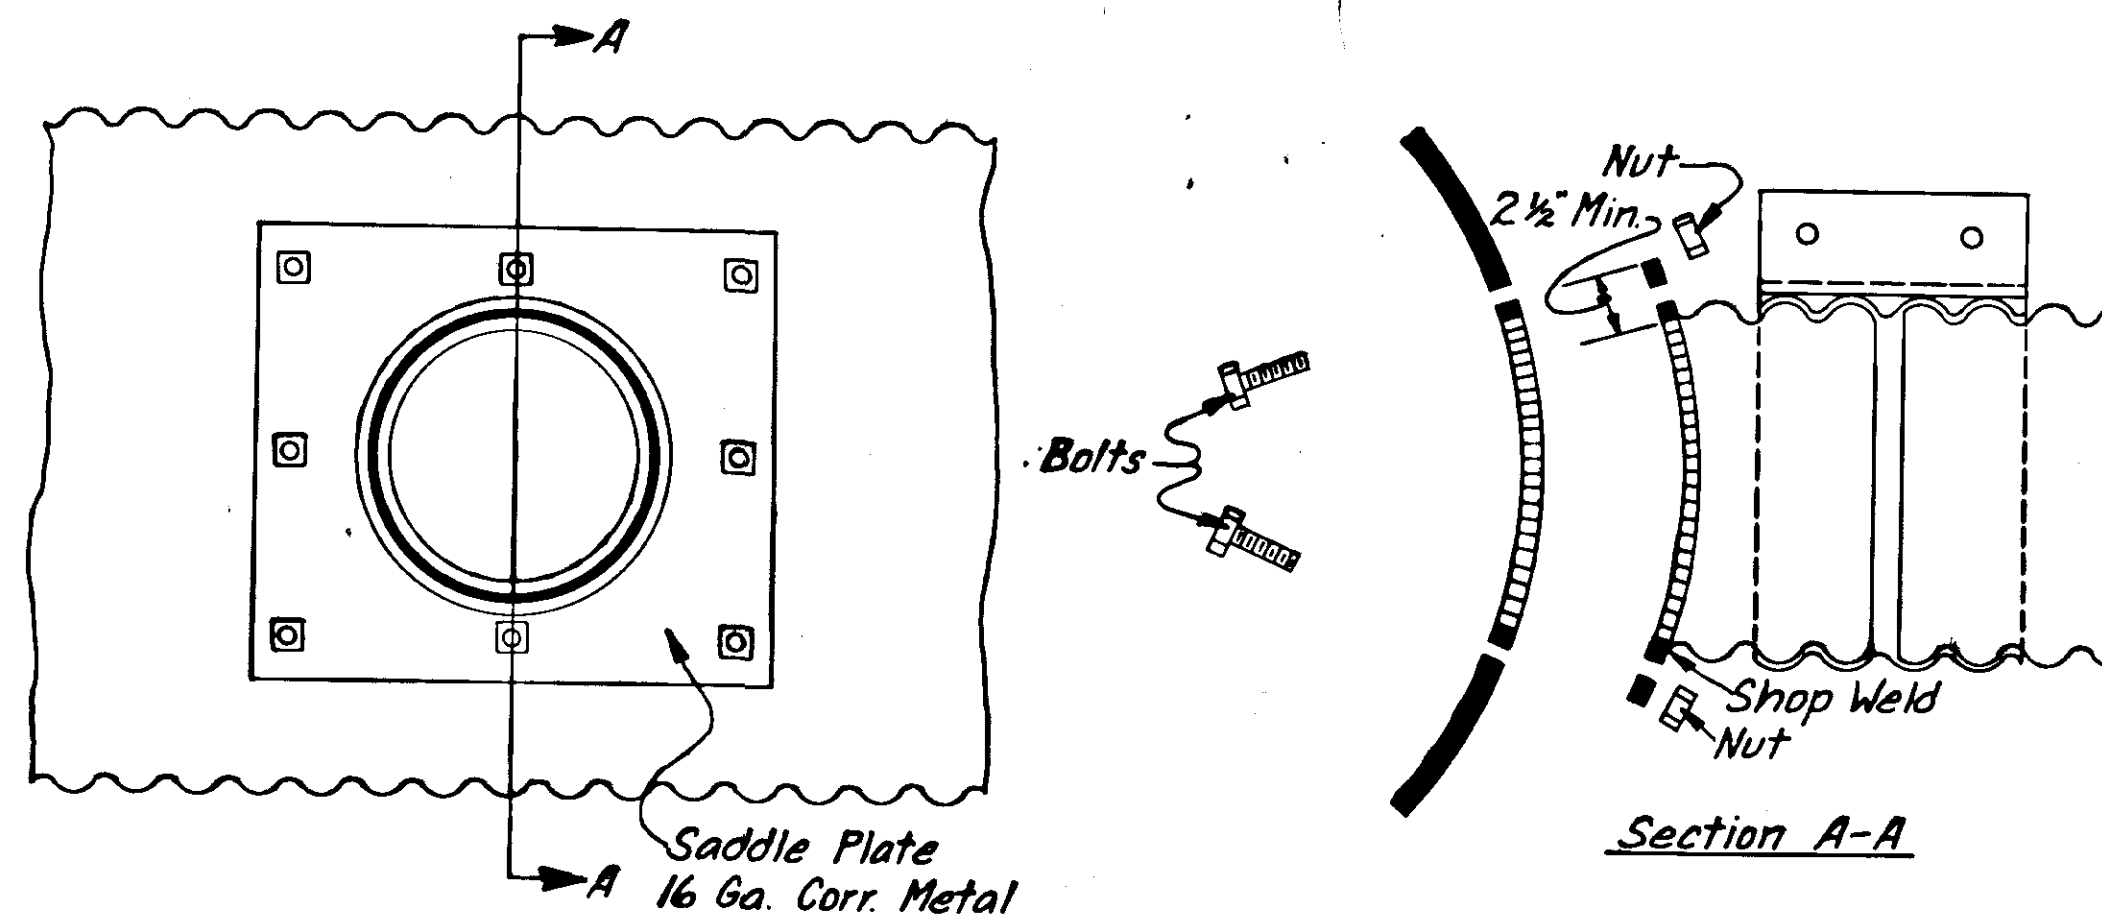


PERF. PIPE DETAIL

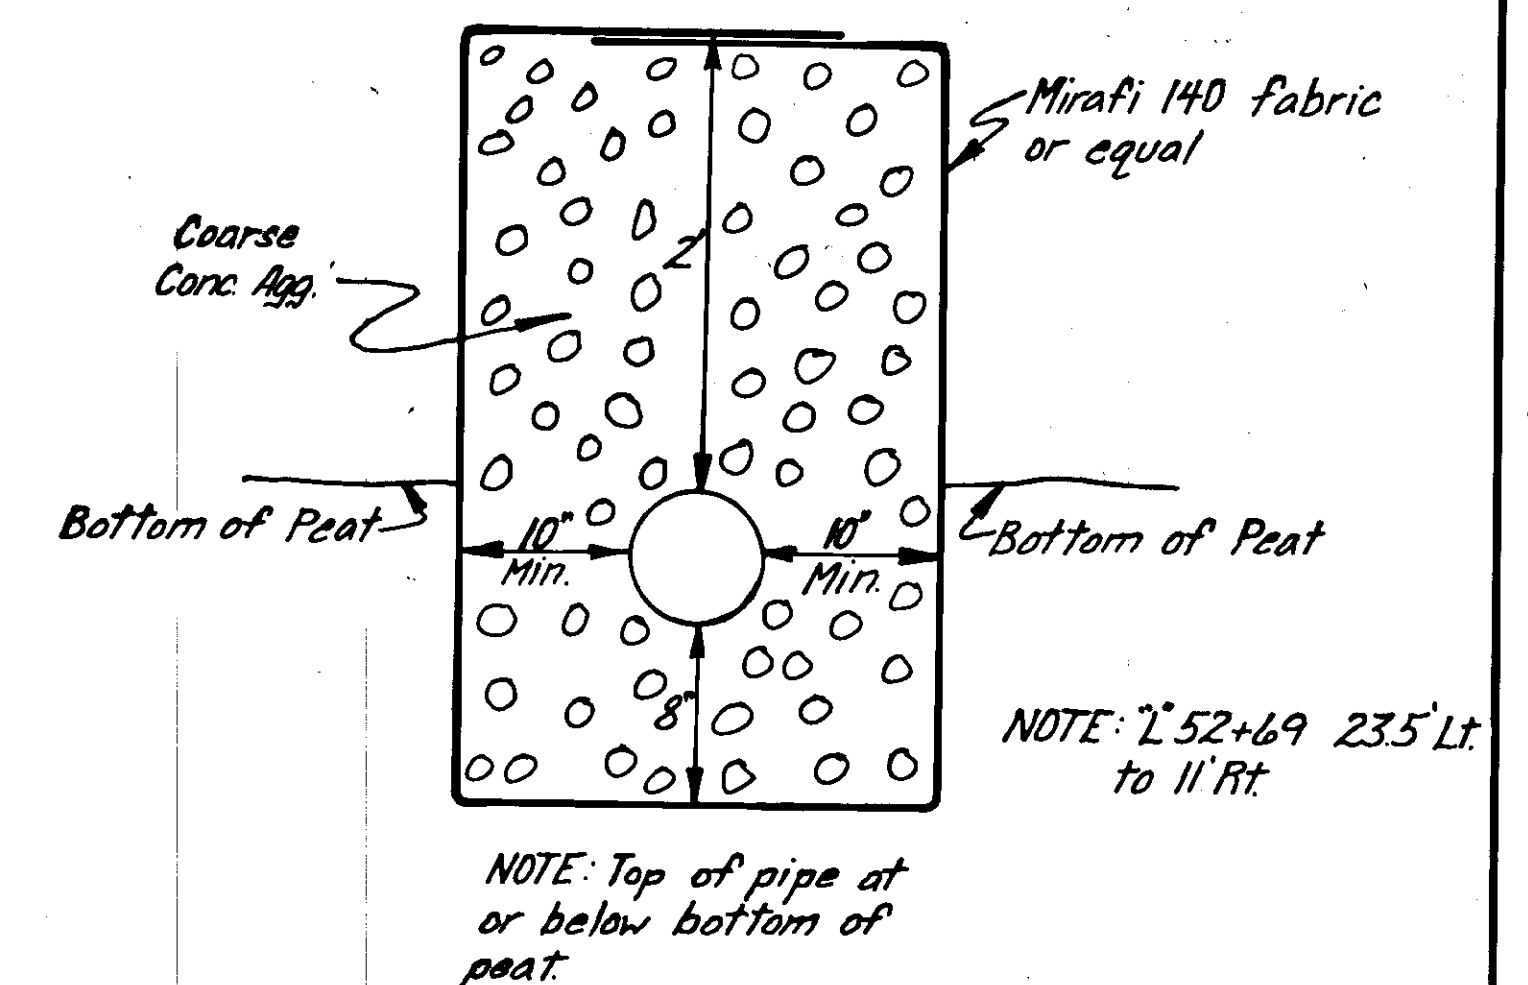


UTILITIES DETAILS

TYPICAL WATER AND SEWER PIPE BEDDING

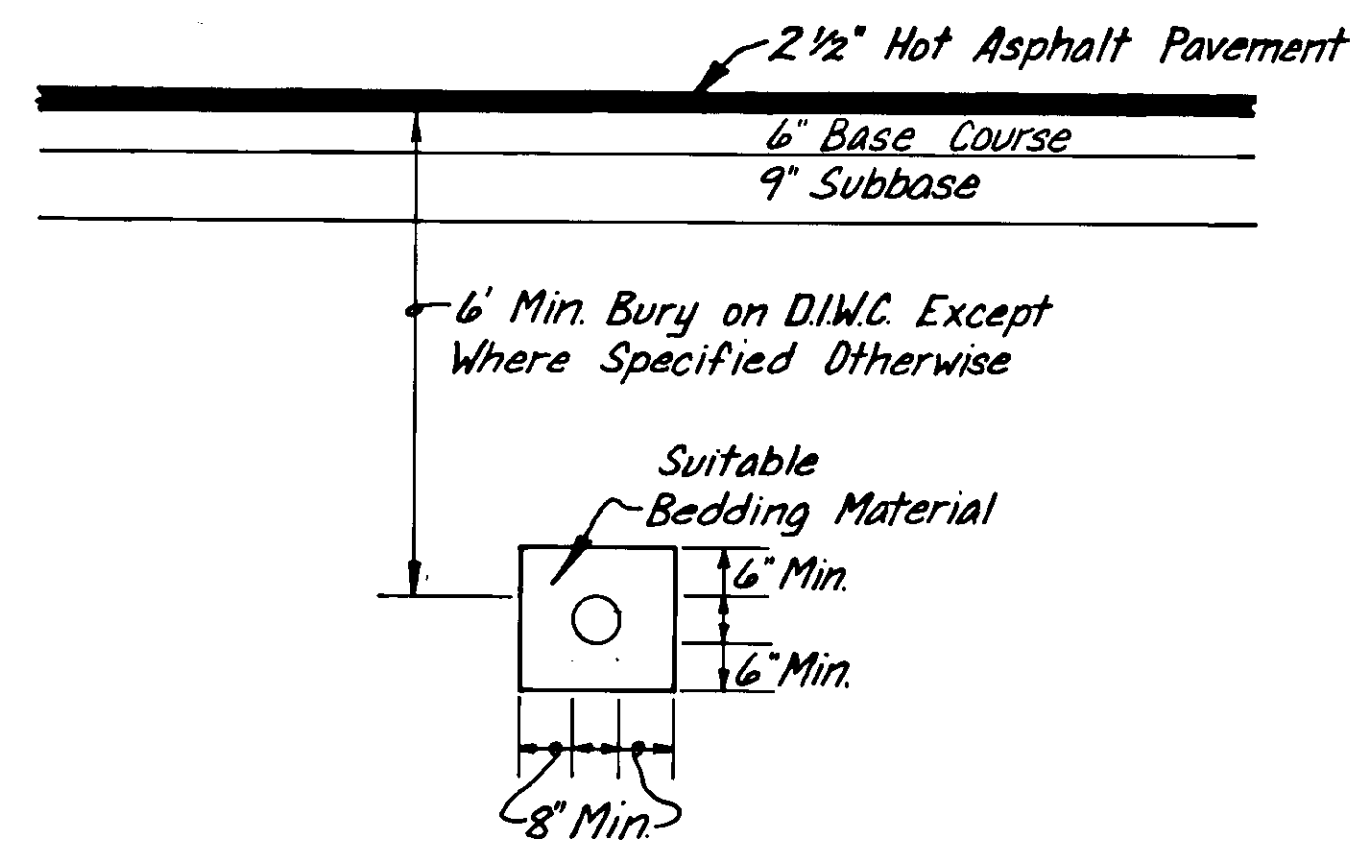


INSULATION BOARD DETAIL

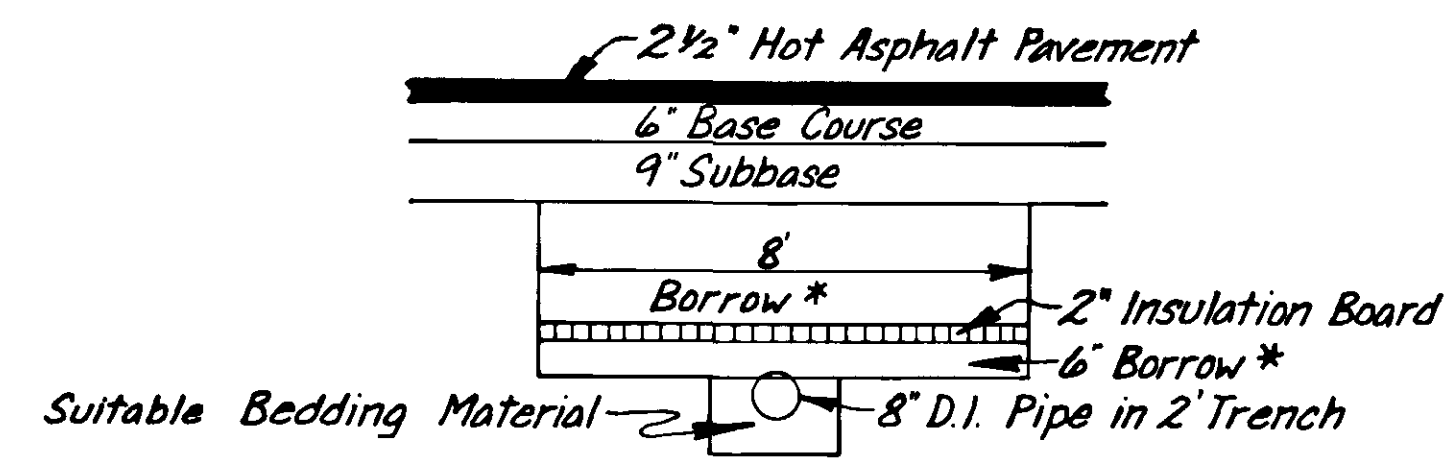


* Borrow shall be 2" minus # suitable to the project engineer.

WATER SERVICE CONNECTION DETAIL

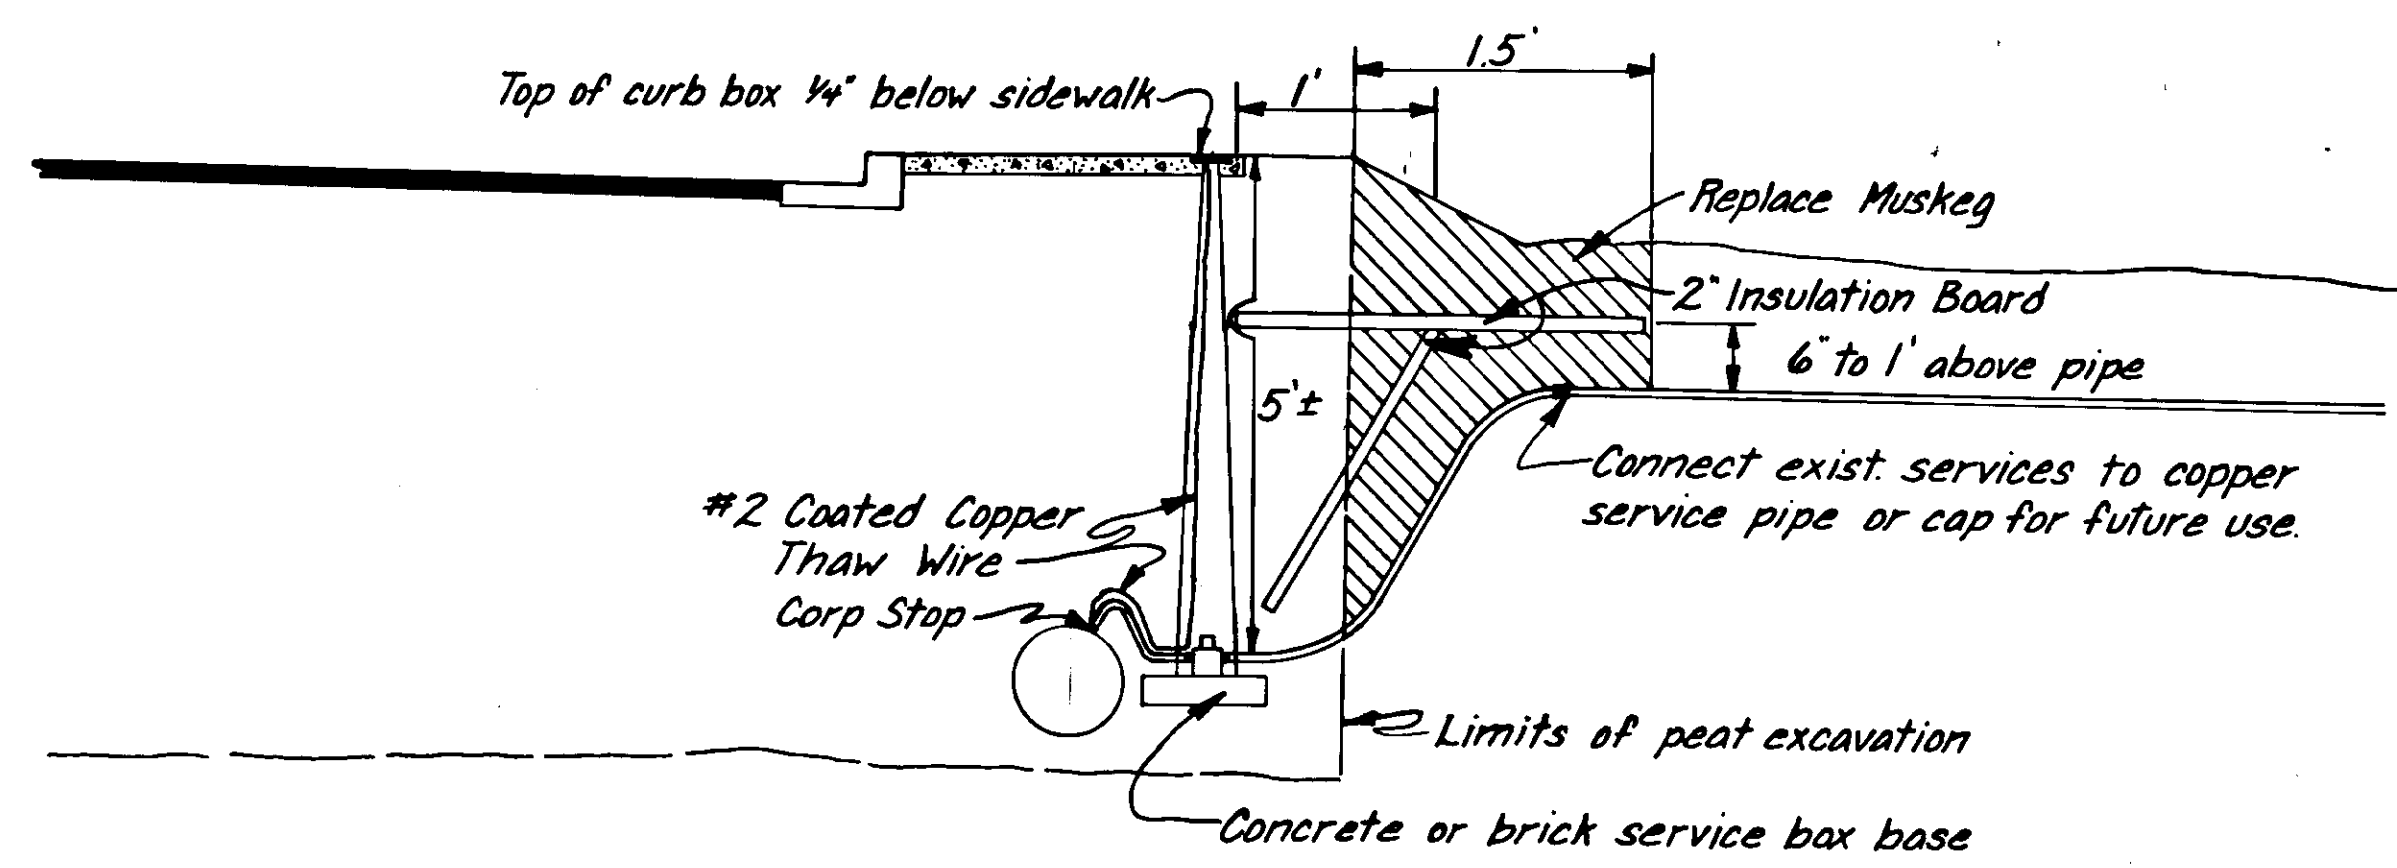


- WATER SERVICE NOTES**
1. See water service connection table on sheet 5 for Corp. & Service sizes.
 2. Thaw wire shall be long enough to extend 1' above top of service box.
 3. Insulation board is 8' wide.

SEWER SERVICE CONNECTION DETAIL

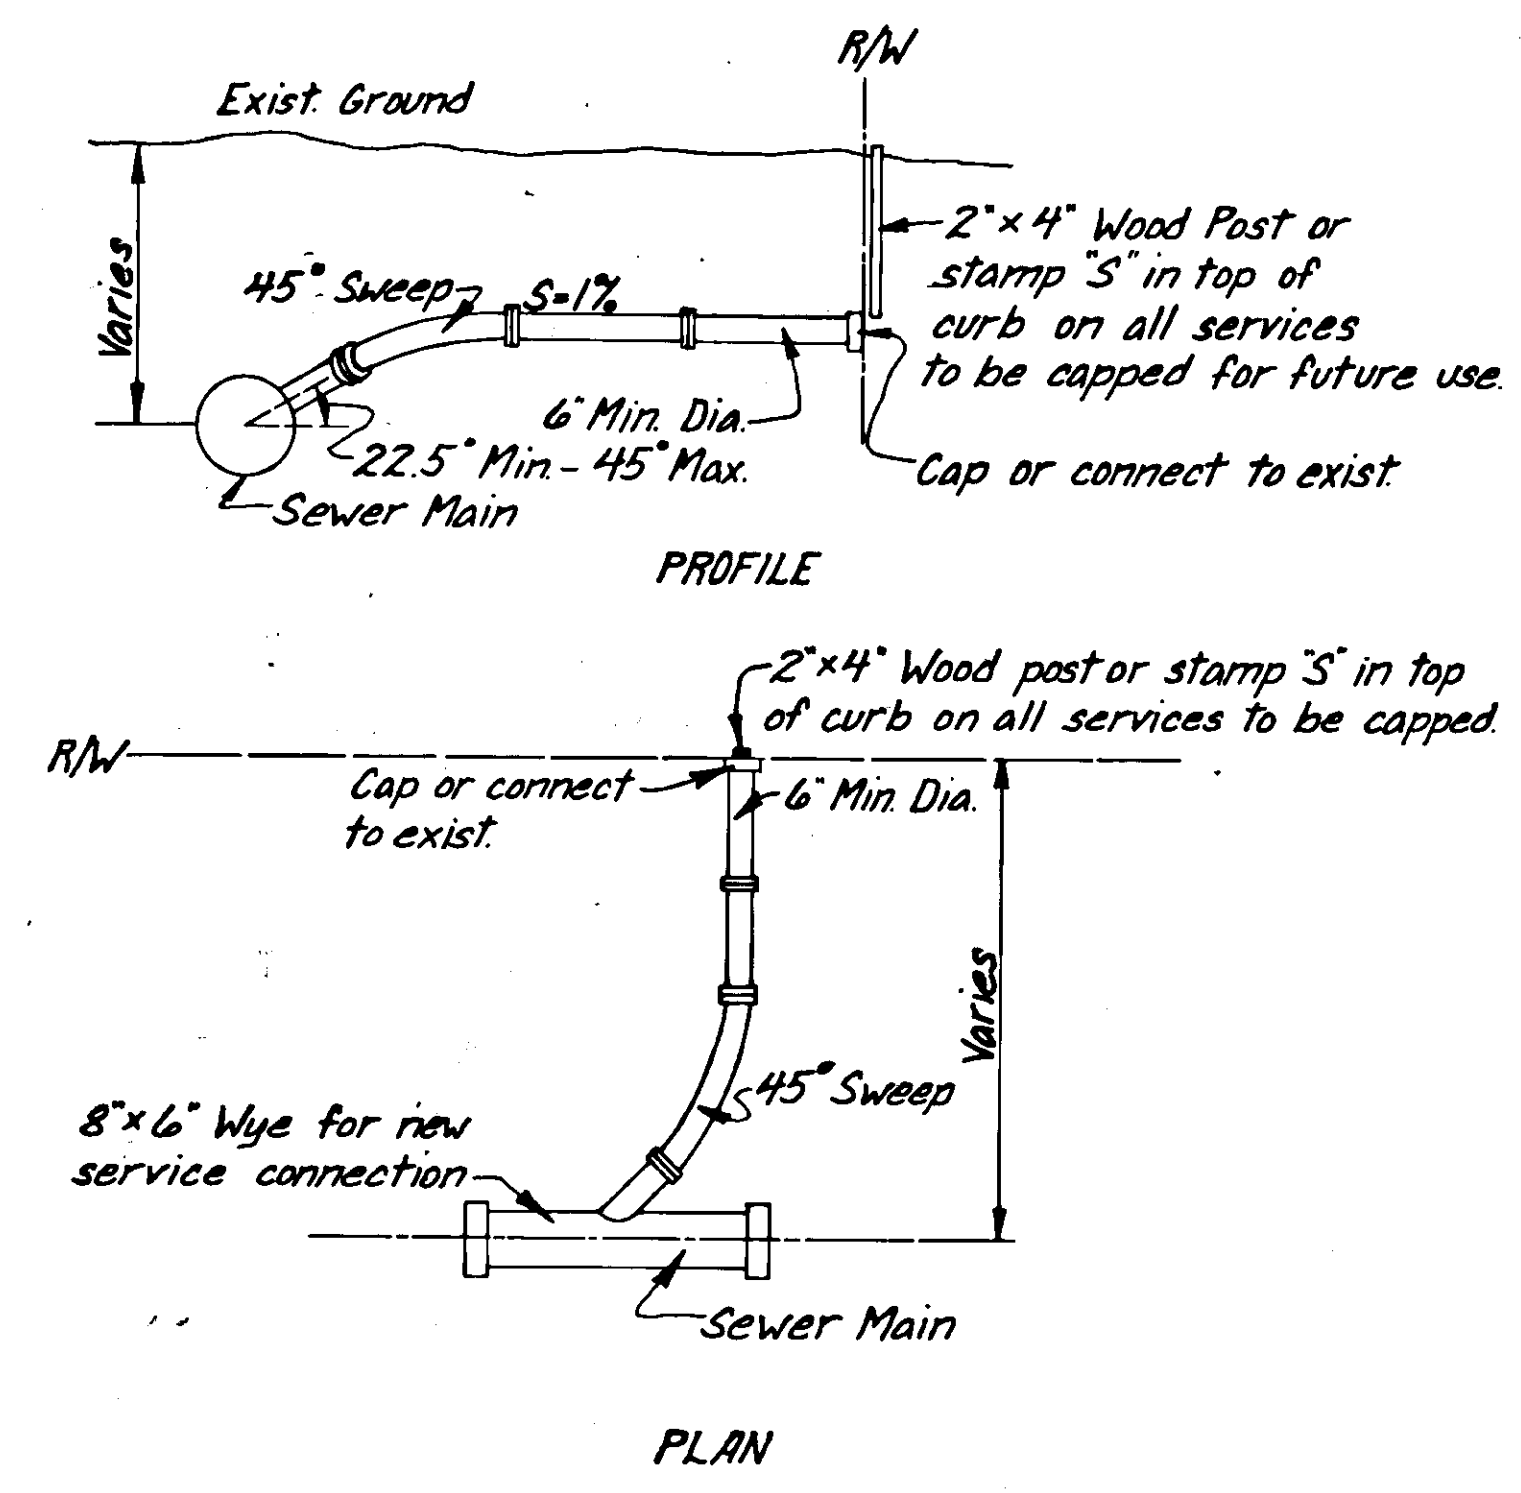


EXAMPLE SIGNING FOR DETOUR

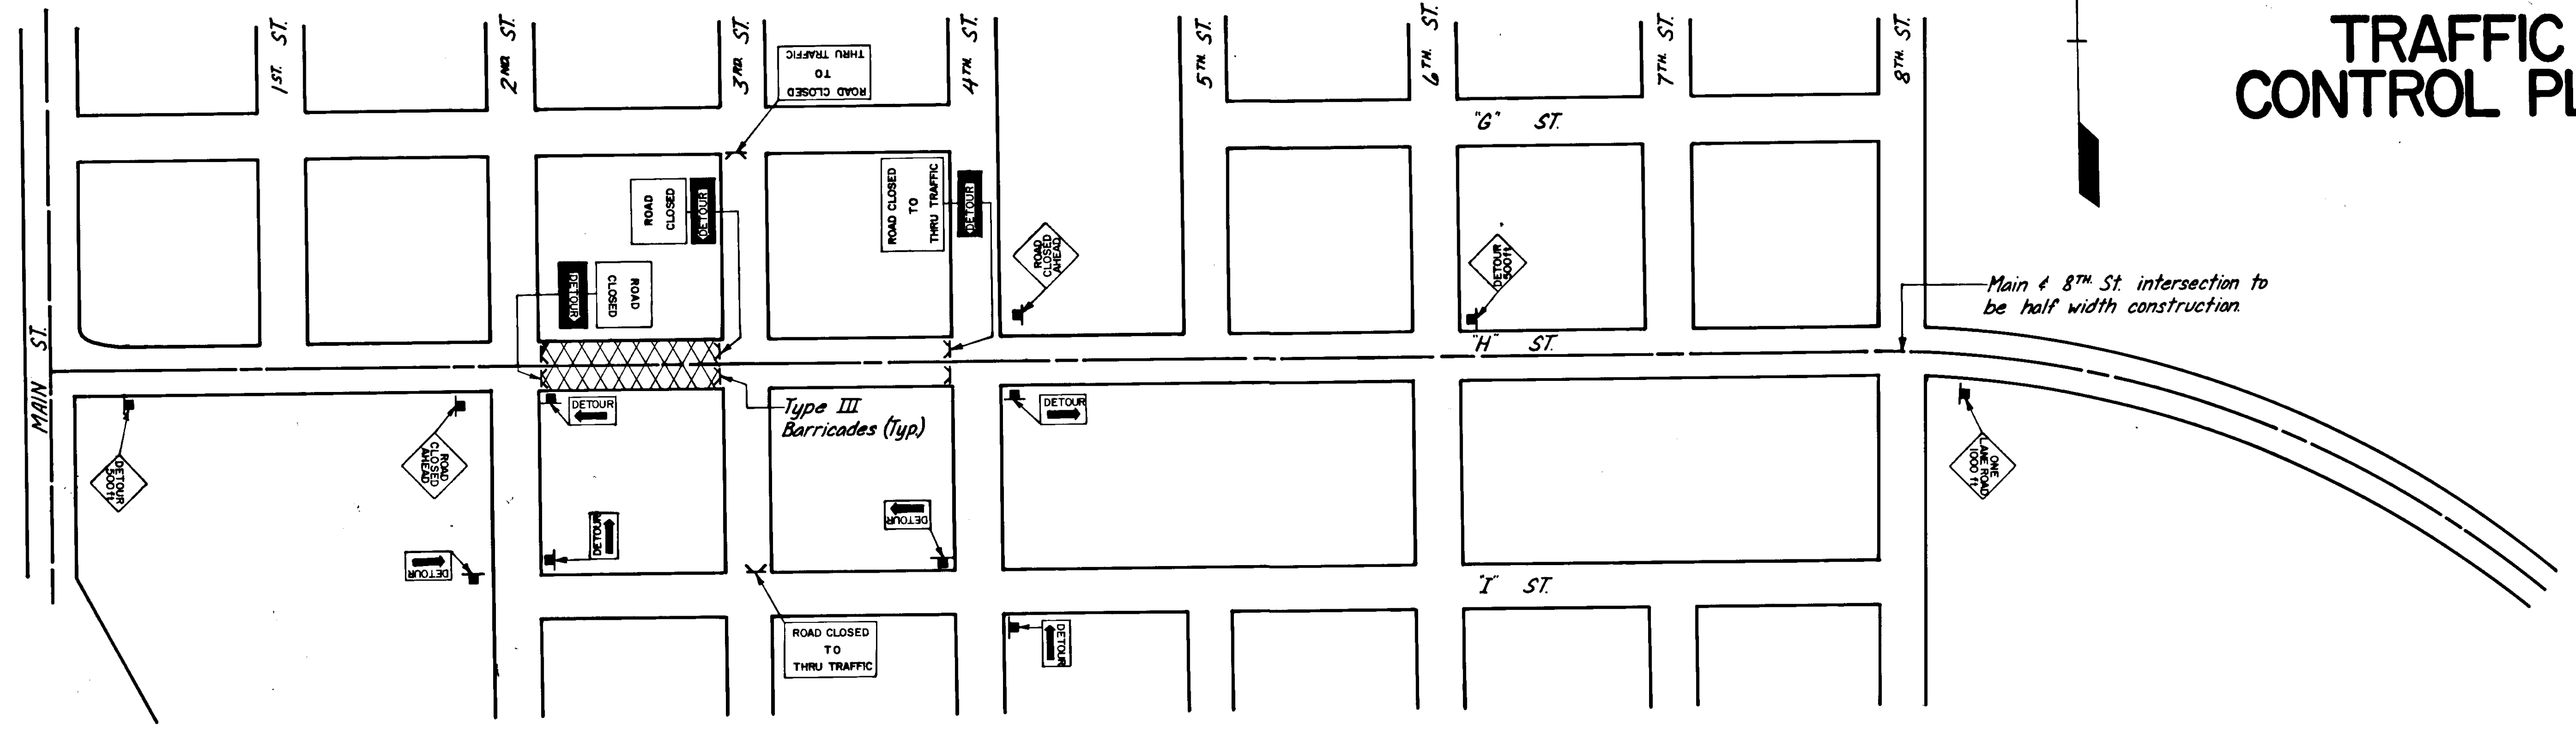

TRAFFIC CONTROL PLAN

EXAMPLE SIGNING FOR ONE LANE ROAD

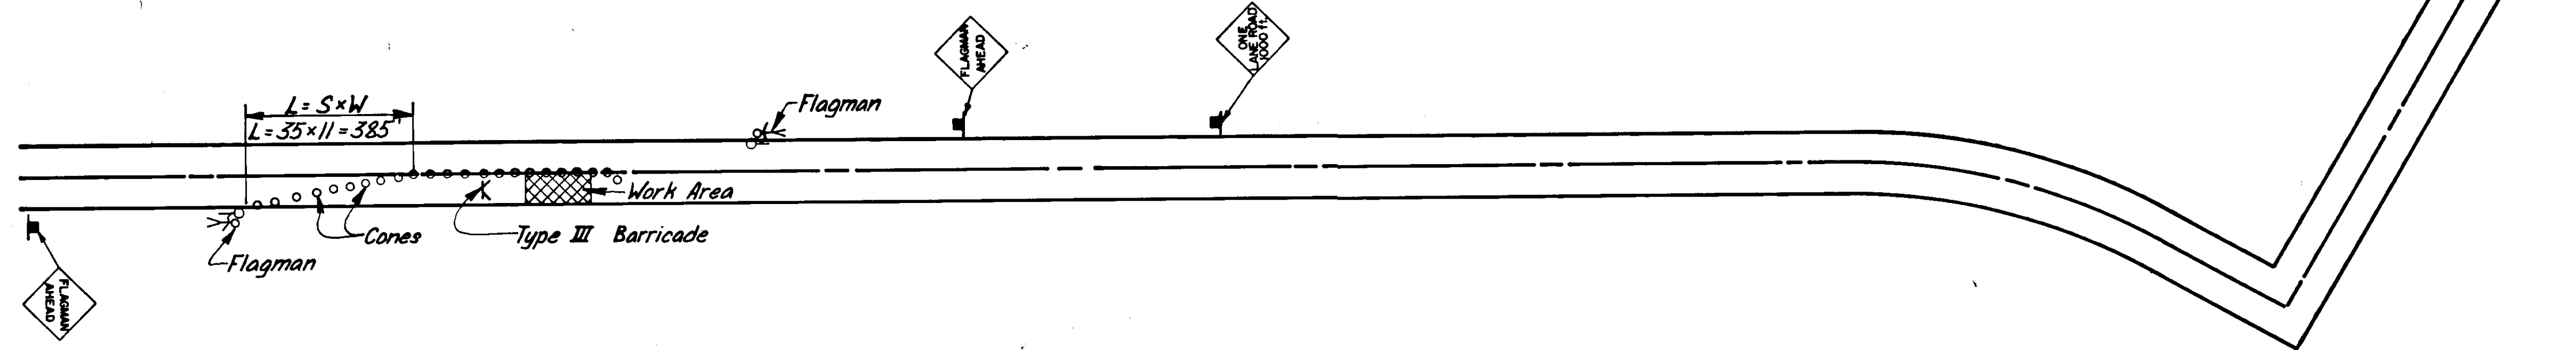


RECOMMENDED DETOURS	
H ST. CLOSED BETWEEN	DETOUR ON
Main & 1st. Streets	Main, G, & 2nd. Streets
1st. & 2nd.	Main, G, & 2nd.
H & 2nd. St. Inters.	1st, G, & 3rd.
2nd. & 3rd. Streets	2nd, I, & 4th.
3rd. & 4th.	2nd, I, & 4th.
H & 4th. St. Inters.	3rd, I, & 6th.
4th. & 5th. Streets	4th, I, & 6th.
5th. & 6th.	4th, G, & 6th.
6th. & 7th.	6th, G, & 8th.
7th. & 8th.	6th, G, & 8th.

- NOTES
- Where part width construction is deemed impractical by the contractor, along with the engineer, detours may be used.
 - Additional traffic control information & construction signing will be required as shown on Std. Drawings C-00.04, C-10.03, & C-11.03.
 - Const. equipt. shall be routed within the project limits whenever possible.
 - The contractor shall be responsible to see that any resident is given 24 hrs. notice before access to his property is cut off. The engineer shall be given the same notice 24 hrs. in advance.
 - No more than one block at a time shall be closed to vehicle access and continuous pedestrian access to residences shall be provided.
 - Permission to close city streets or to use city streets for detours shall be coordinated with the project engineer & local officials, including fire & police depts., ambulance service, & other emergency vehicles.

STATE	PROJECT DESIGNATION	YEAR	SHEET NO.	TOTAL SHEETS
ALASKA	RS-0938(1)	1979	34	34

STRIPING PLAN

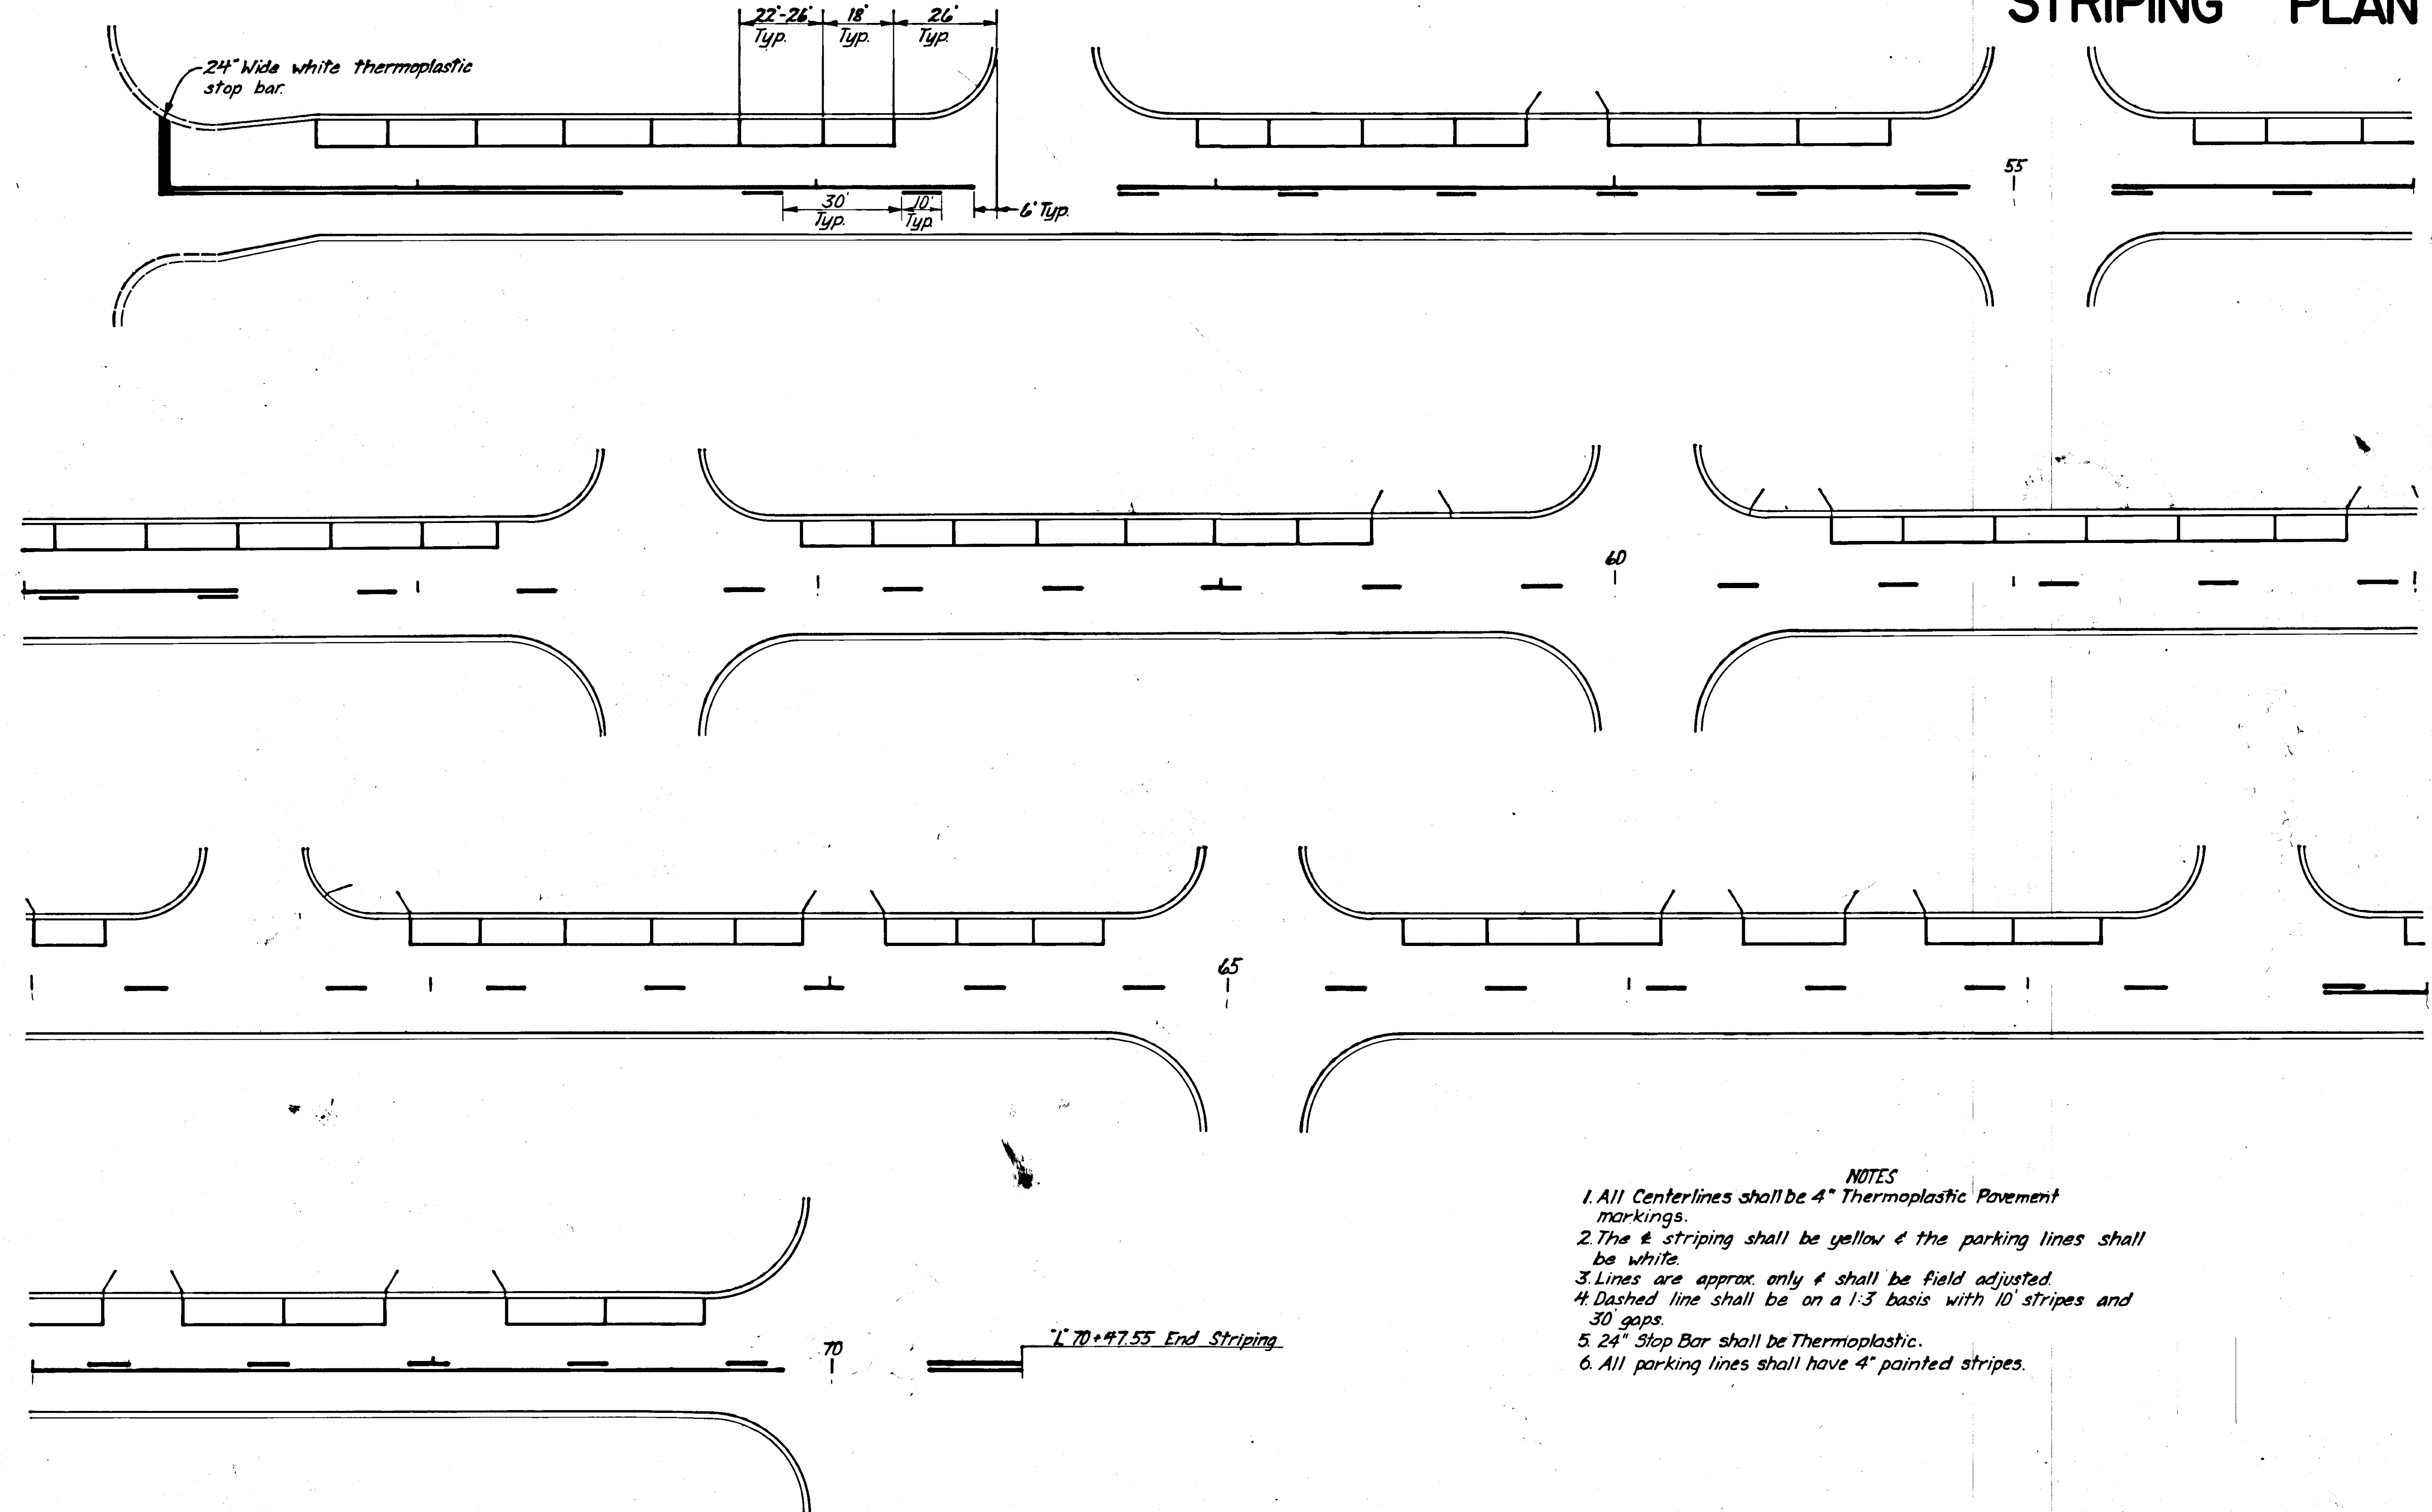

- NOTES**
1. All Centerlines shall be 4" Thermoplastic Pavement markings.
 2. The ϵ striping shall be yellow & the parking lines shall be white.
 3. Lines are approx. only & shall be field adjusted.
 4. Dashed line shall be on a 1:3 basis with 10' stripes and 30' gaps.
 5. 24" Stop Bar shall be Thermoplastic.
 6. All parking lines shall have 4" painted stripes.

70+47.55 End Striping