



# ESTIMATE OF QUANTITIES

ITEM NO.	ITEM	PAY UNIT	ESTIMATED QUANTITIES
110	Mobilization/Demobilization	L.S.	All Req'd
111(1)	Erosion & Pollution Control, Administration	L.S.	All Req'd
111(2)	Erosion & Pollution Control	C.S.	All Req'd
<b>Craig City Harbor</b>			
201(1)	Removal or Relocation of Structures and Obstructions	L.S.	All Req'd
301(1)	12 3/4" x 3/8" wall Pipe Piles, Furnished	L.F.	560 503
301(2)	12 3/4" x 3/8" wall Pipe Piles, Driven	EA.	9
301(3)	Creosote Treated Timber Piles, Furnished	L.F.	468 515
301(4)	Creosote Treated Timber Piles, Driven	EA.	9.12
301(5)	Rehabilitate Existing Fender Piles	L.S.	All Req'd
302(1)	Pile Caps, Furnished and Installed	L.S.	All Req'd
302(2)	Steel Safety Ladders, Furnished and Installed	L.S.	All Req'd
306(1)	Timber Handrail Repair	L.S.	All Req'd
311(1)	Furnish & Install 12'x50' Float	L.S.	All Req'd
311(2)	Furnish & Install 10'x150' Float	L.S.	All Req'd
403	Float Water System	L.S.	All Req'd
501	Electrical Lighting System	L.S.	All Req'd
<b>Hydaburg City Harbor</b>			
201(2)	Removal or Relocation of Structures and Obstructions	L.S.	All Req'd
301(6)	Creosote Treated Timber Piles, Furnished	L.F.	208 183
301(7)	Creosote Treated Timber Piles, Driven	EA.	6.8
302(3)	Gangway Transition Plate, Non-Skid Surface & Handrail Extensions	L.S.	All Req'd
302(4)	Galvanized Steel Pile Collars For Existing Floats	L.S.	All Req'd
302(5)	Replace Hinges & Hardware on Existing Timber Floats	L.S.	All Req'd
304	Precast Concrete Abutment	L.S.	All Req'd
306(2)	Timber Approach Handrails, Luminaire Poles & Braces	L.S.	All Req'd
306(3)	Miscellaneous Repairs	L.S.	All Req'd
311(3)	Furnish & Install 2'-5 1/2" x 21'-0" Stall Floats	L.S.	All Req'd
311(4)	Furnish & Install 6' x 50' Stall Floats	L.S.	All Req'd
311(5)	Furnish & Install Foam Repair & Leveling Billets	L.S.	All Req'd
<b>Mellakatto Main Harbor</b>			
201(3)	Removal or Relocation of Structures and Obstructions	L.S.	All Req'd
302(6)	Gangway Expanded Metal Non-Skid Surface & Steel Treads	L.S.	All Req'd
302(7)	Steel Pile Collars For New & Existing Stall Floats & Marginal Float	L.S.	All Req'd
302(8)	Replace Hinges & Hardware on New & Existing Concrete Floats	L.S.	All Req'd
302(9)	Tighten All Thru-Rods & Replace Damaged Hardware on Existing Floats	L.S.	All Req'd
306(4)	Miscellaneous Repairs	L.S.	All Req'd
309	Furnish & Install 4'x48' Concrete Float	L.S.	All Req'd

# GENERAL NOTES

**Specifications:**

**Construction:** Per Contract Documents for Project No. 67746

**Design:** Float and Restraint Piles:  
5 foot wave load, 20 degrees to longitudinal axis of gangway  
20 psf Live Load on float deck

**Protective Coatings:**  
Timber bumper, deck, planks & timbers above deck shall be pressure treated with pentachlorophenol in light oil except as noted.  
Timber stringers, sills & timbers below deck shall be pressure treated w/ creosote.  
Timber piles shall be pressure treated with creosote.  
Steel Pipe Piles and Caps, Hinge Assemblies, and Hardware: Galvanized after fabrication.  
Bolts, washers, nuts and hardware 1/2" diameter and larger shall be hot dip galvanized; bolts, nuts, washers, and hardware 3/8" diameter and smaller shall be A316 stainless steel.  
Water line shall be U.V. stabilized P.E. plastic per specifications.  
Pipe risers, fittings, hose bibs, and backflow preventers shall be brass suitable for marine environment or A316 stainless steel.

**Glue-laminated Members:**  
Glu-Lam members shall be Douglas Fir. Glu-Lam stringers and sills used in vessel floats & gangway support float shall be AITC Combination 22F-V7. Glu-Lams shall be produced to U.S. Commercial Standard PS 56-73 (latest edition), with adhesives for wet conditions of use & appearance of members shall be industrial grade or better.

**Steel Piling:**  
Size: 12 3/4" x 3/8" wall steel piles  
Tips: Reinforced tips w/ APF 0-14000 or APF 0-14001 Drive Shoes or Approved equal. Drive Shoes are required for all steel piling.

**Timber Piling:** Timber Bearing Piles & Timber Fender Piles shall be driven tip down, and Timber Float Restraint Piles shall be driven butt end down.  
Size: 25" min. tip circumference (turn to 45" max. butt circum. if req'd.) length on pile table = length in place, add length for trimming & cut-off.  
Tips: Reinforce timber with 1 1/4" steel banding per spec. Allow additional length to square ends prior to driving and to trim damaged pile top (as required) during & after driving.

Priority Of Vessel Traffic

- Once the Contractor begins improvements the following will remain in force until the project is completed.
  - The Contractor shall conduct his operations so as not to interfere with normal scheduled boat or barge access or vehicular traffic to and from the existing City Dock at Craig.
  - Scheduled vessel traffic shall have priority over construction activities and it shall be the Contractor's responsibility to coordinate his activities with the City Harbor Master for vessel arrivals and departures.
  - The Contractor shall coordinate with each city harbor master to have vessels and property moved during repairs. Move vessels and property from the repair site and adjacent areas such as those "downwind" from deck cleaning or pile driving operations.
  - The Contractor shall maintain pedestrian & scheduled vehicular access to harbor approach, floats and/or dock at all times except during hazardous operations such as pile driving. Contractor shall provide and use cones, folding barricades, rope barriers and signs to maintain work area and control vehicular & pedestrian traffic.
- The Contractor shall not stockpile any materials at any site or in the adjacent parking areas without approval of the Engineer and/or appropriate City Authority.

# PILING DATA

PILE LOCATION (Layout Sht. 3) STRUCTURE ORIENTATION & (pile tip)	P L E S	DIA Inches	CAPACITY (TONS)		ELEVATIONS		TIP ELEVATIONS		TOTAL ESTIMATED LENGTH
			BEARING	UPLIFT	APPROX MUDLINE	CUT-OFF	MIN.	EST.	
<b>CRAIG CITY HARBOR</b>									
1 - 50' Gangway Float - Vert. (o)	1	12 3/4"	penet.	---	-6	+28.0	-21	-27	55
2 - 50' Gangway Float - Vert. (o)	1	12 3/4"	penet.	---	-6	+28.0	-21	-27	55
3 - 150' Main Float - Vert. (o)	1	12 3/4"	penet.	---	-7	+28.0	-22	-27	55
4 - 150' Main Float - Vert. (o)	1	12 3/4"	penet.	---	-8	+28.0	-23	-30	58
5 - 150' Main Float - Vert. (o)	1	12 3/4"	penet.	---	-9	+28.0	-24	-30	58
6 - 150' Main Float - Vert. (o)	1	12 3/4"	penet.	---	-10	+28.0	-25	-32	60
7 - 150' Main Float - Vert. (o)	1	12 3/4"	penet.	---	-12	+28.0	-27	-32	60
8 - 150' Main Float - Vert. (o)	1	12 3/4"	penet.	---	-14	+28.0	-29	-34	62
9 - 150' Main Float - Vert. (o)	1	12 3/4"	penet.	---	-14	+28.0	-29	-34	62
10-18 Timber Fender Piles -1:10btr	9	8" tip	penet.	---	-16	+17.8	-31	-34	52
<b>HYDABURG CITY HARBOR</b>									
19 - South End Float-D - Vert.	1	8" tip	penet.	---	-31	+24.0	-46	-46	70
20 - Stall 5-West, Float-A - Vert.	1	8" tip	penet.	---	-31	+24.0	-46	-46	70
21 - Stall 5-West, Float-A - Vert.	1	8" tip	penet.	---	-28	+24.0	-43	-44	68
* 22 - Stall 3-East, Float-A - Vert.	1	8" tip	penet.	---	-27	+24.0	-42	-42	66
* 23 - Stall 3-East, Float-A - Vert.	1	8" tip	penet.	---	-26	+24.0	-41	-41	65
* 24 - Stall 9-West, Float-B - Vert.	1	8" tip	penet.	---	-18	+24.0	-33	-34	58

\* Reuse existing salvaged timber piles

STRUCTURE NAME Craig Float									
DATE	ABUT OR PIER NO.	PILE NO.	TYPE OF PILE (specify tip & butt diameter of timber & concrete pile in inches)	LENGTH PLACED IN LEADS INCLUDING EXTENSIONS (FT)	CUTOFF LENGTH (FT)	NET LENGTH CUTOFF TO TIP (FT)	PENETRATION IN GROUND (FT)	PILE CUTOFF ELEV.	
7/10/00		1	12 3/4" Steel Pile	60	14	46	10	+28.0	
7/10/00		2	12 3/4" Steel Pile	60	10	60	12	+28.0	
7/10/00		3	12 3/4" Steel Pile	60	15.3	44.7	15	+28.0	
7/10/00		4	12 3/4" Steel Pile	60	14.4	45.6	15	+28.0	
7/10/00		5	12 3/4" Steel Pile	60	10.2	49.8	15	+28.0	
7/11/00		6	12 3/4" Steel Pile	65	12.8	52.4	9	+28.0	
7/11/00		7	12 3/4" Steel Pile	65	17.0	48	7	+28.0	
7/11/00		8	12 3/4" Steel Pile	65	9.8	55.4	12	+28.0	
7/11/00		9	12 3/4" Steel Pile	65	9.0	55.8	12	+28.0	
7/20/00		10	Timber Fender Pile	55	14.5	40.5	7	17.5	
7/20/00		11	Timber Fender Pile	55	15.5	39.5	6.5	17.5	
7/20/00		12	Timber Fender Pile	55	12.3	42.7	8	17.5	
7/21/00		13	Timber Fender Pile	55	12.5	42.5	6	17.5	
7/21/00		14	Timber Fender Pile	55	10.8	44.2	7	17.5	
7/21/00		15	Timber Fender Pile	55	11.5	43.5	7.5	17.5	
7/21/00		16	Timber Fender Pile	55	12.2	42.8	7	17.5	
7/21/00		17	Timber Fender Pile	55	11.2	43.8	8	17.5	
7/21/00		18	Timber Fender Pile	55	12.0	43.0	8	17.5	
7/21/00		25	Timber Fender Pile	55	12.0	43.0	8	17.5	
7/21/00		28	Timber Fender Pile	55	9.0	46.0	8	17.5	
7/21/00		27	Timber Fender Pile	55	11.3	43.7	7	17.5	

STRUCTURE NAME Hydaburg Harbor									
DATE	ABUT OR PIER NO.	PILE NO.	TYPE OF PILE (specify tip & butt diameter of timber & concrete pile in inches)	LENGTH PLACED IN LEADS INCLUDING EXTENSIONS (FT)	CUTOFF LENGTH (FT)	NET LENGTH CUTOFF TO TIP (FT)	PENETRATION IN GROUND (FT)	PILE CUTOFF ELEV.	
8/8	Float D	1	New Timber	70	0	70	15	17.5	
8/8	Float D	2	Used Timber	66.5	1.5	66	13	17.5	
8/8	Float D	3	Used Timber	67	1	66	14	17.5	
8/8	Float A	4	New Timber	70	13.5	56.5	7	17.5	
8/8	Float A	5	New Timber	70	13.0	57	7	17.5	
8/12	Gangway	6	Used Timber	56	11.0	45	8	17.5	
8/12	Gangway	7	Used Timber	46	3.0	45	8	17.5	
8/14	Float C (endpile)	8	12 3/4" Steel Pile	49	3.0	46	10	17.5	

Pile driving records from construction

NOTE: DO NOT SCALE FROM THESE PLANS-USE DIMENSIONS


PATH: Q:\SEA\67746\Mf\Sheet2.dwg Plot Scale=1.00 10/6/1999 13:32			
BY:	DATE:	DESCRIPTION OF CHANGE:	
RECORD OF REVISIONS			


STATE OF ALASKA  
**DEPARTMENT OF TRANSPORTATION AND PUBLIC FACILITIES**  
SOUTHEAST REGION DESIGN & CONSTRUCTION

SOUTHEAST  
**HARBOR REHAB PROJECTS**  
Proj. No. 67746  
**ESTIMATE OF QUANTITIES & GENERAL NOTES**

ALASKA  
DESIGNED BY: *RWM*  
DRAWN BY: *BN*  
CHECKED BY: *BAS*

PROJECT NO. 67746  
DATE: DECEMBER 1999  
SHEET 2 OF 41

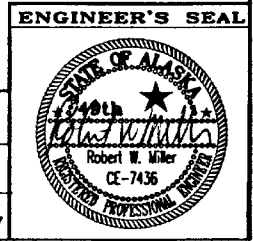

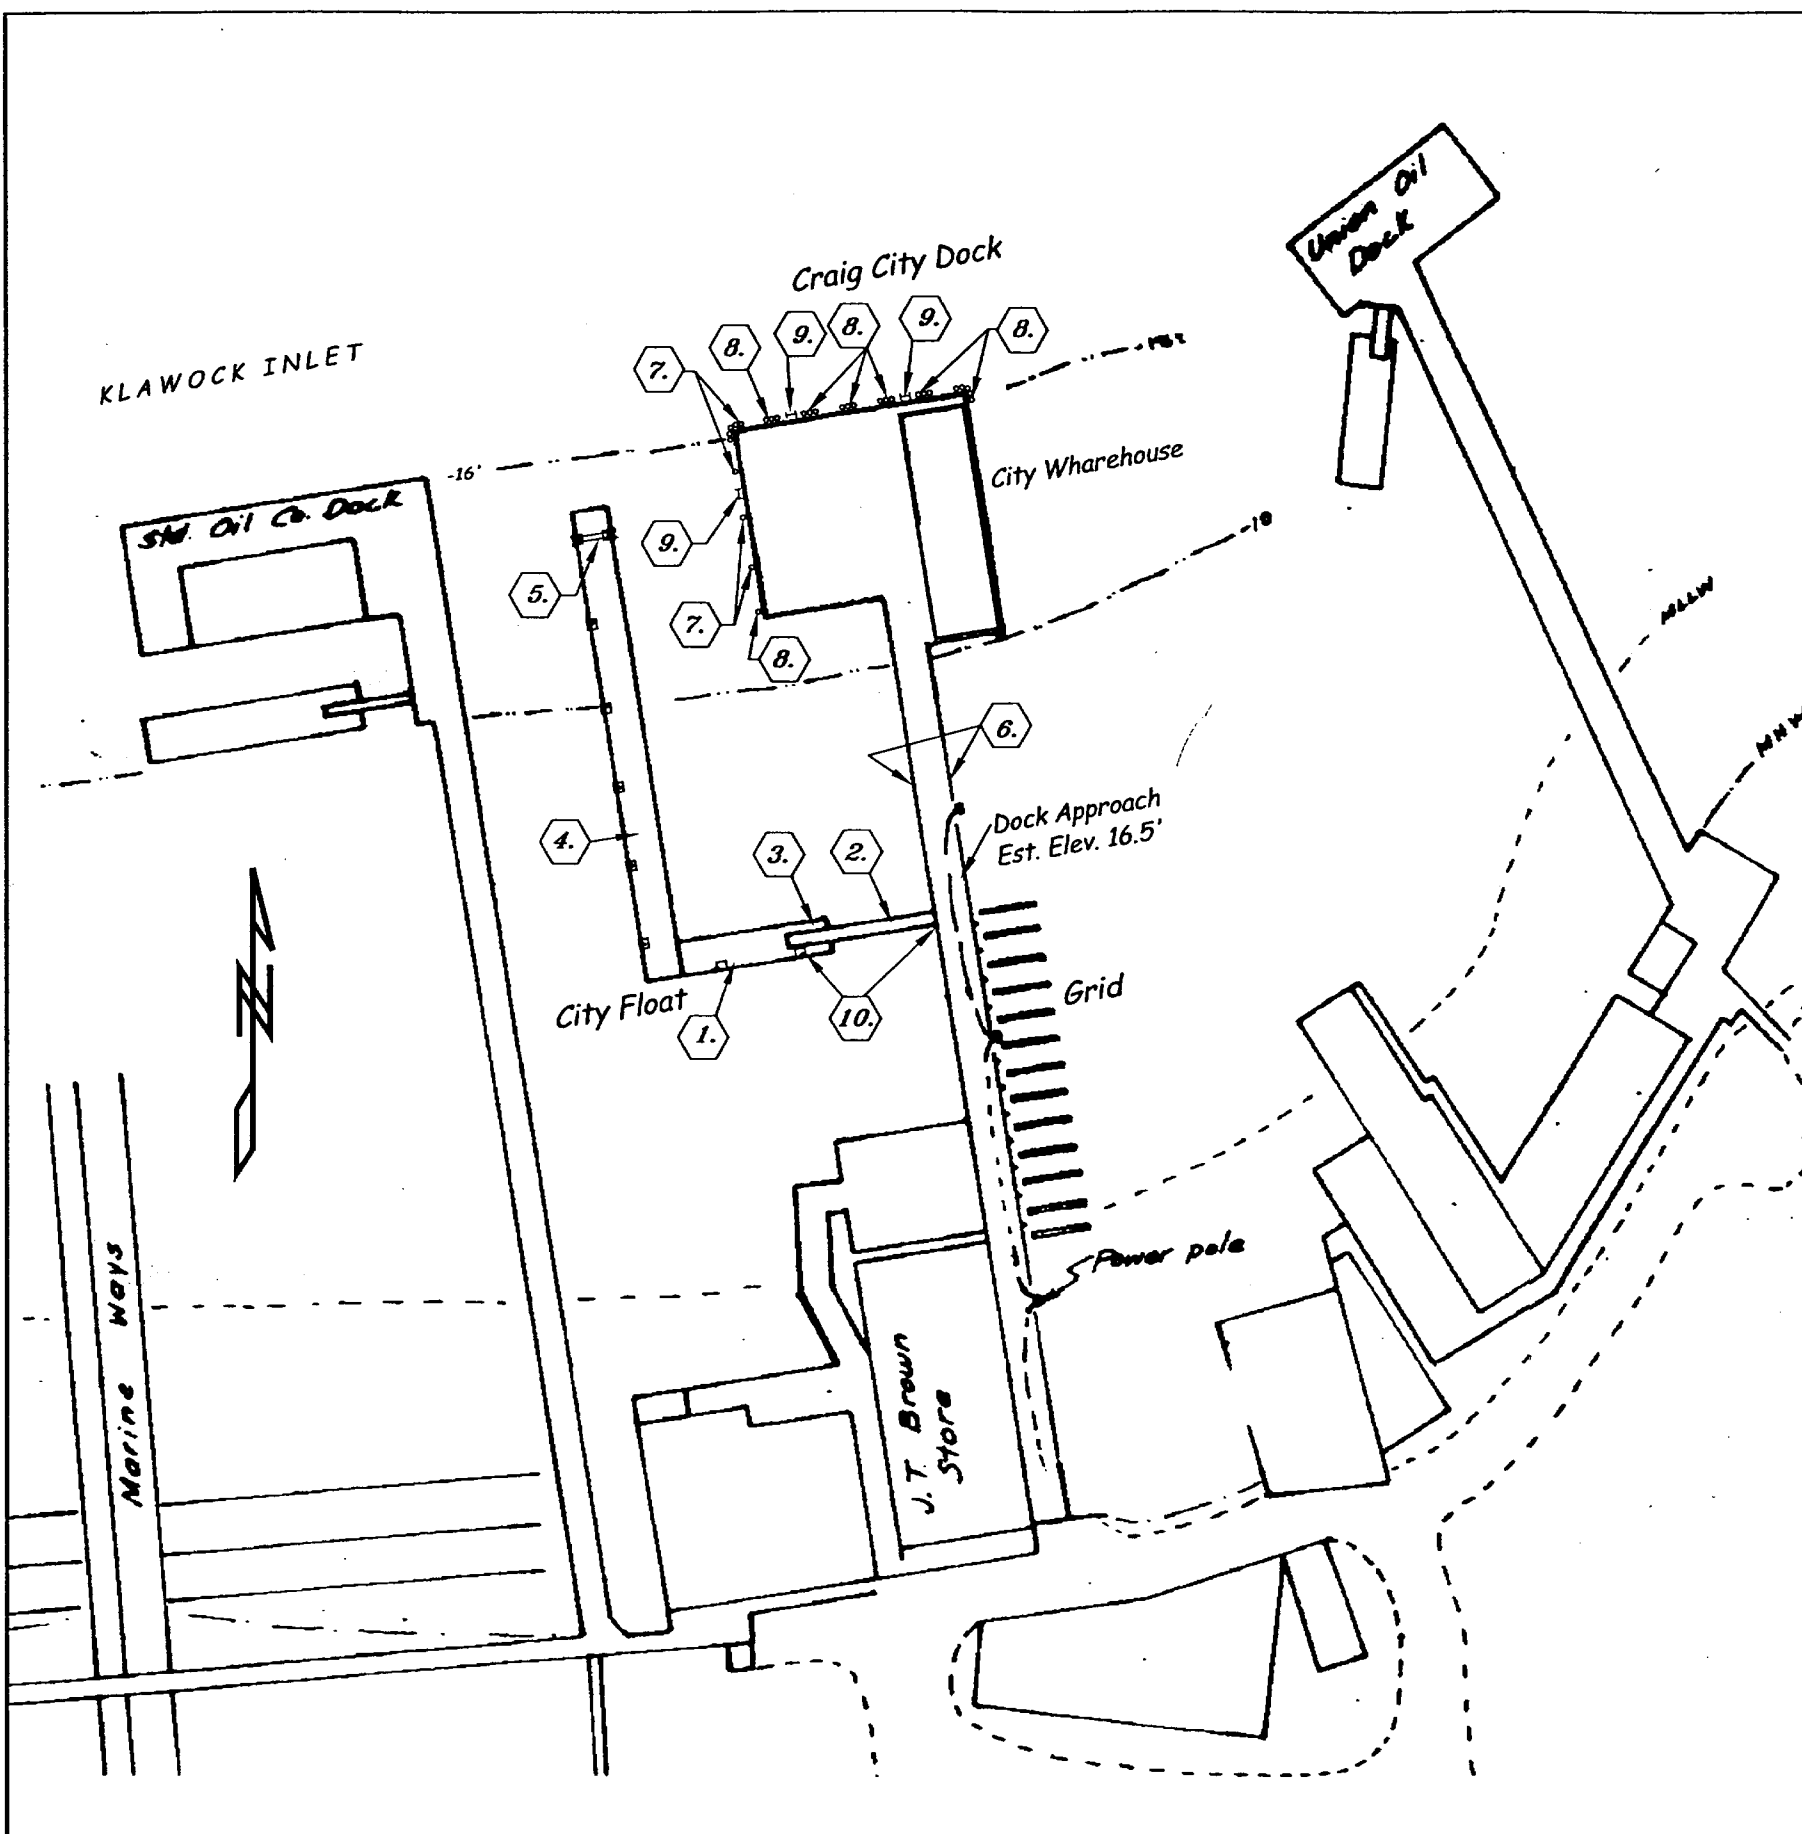

- HARBOR REHAB PROJECT NOTES :**
1. Fabricate & Install new 12'x 50' timber Gangway Float. Supply personnel, equipment & supplies to place survey control, locate existing dock, gangway & floats, and to facilitate field placement of all new floats & piling. Supply & Install 2 new 12 3/4" steel piling. Supply & install new P.E. plastic conical pile tops with SS. hardware. Remove & salvage existing timber piling for City of Craig. Salvage existing 12'x 50' Gangway Float for City of Craig. Transport to City property for storage. Carefully salvage exist. conical pile tops for city.
  2. Rehab existing gangway deck w/ 2'x50' open grating & 3'x50' treated timber w/ non-skid surface. Supply & Install new transition plate to approach. Supply & Install new 1 1/2" pipe rail extensions. Locate new skid plates on New Gangway Float as req'd for tidal movement. See Sht 10 of 41.
  3. Contractor shall coordinate connection of new float waterline to new underwater service supply line with City of Craig, Harbor Office. See note 11 this sheet.
  4. Fabricate & Install new 10'x150' timber float. Supply & Install new 12 3/4" steel piling (7 req'd). Supply & install new P.E. plastic conical pile tops with SS. hardware. Remove & salvage existing timber piling for City of Craig. Carefully salvage exist. 10'x150' float (disassemble to 10'x50' modules) & salvage old conical pile tops for City of Craig. Transport to City property for storage.
  5. Supply & Install a steel tube (TS8x12) cross-tie brace between the two piling at the north end of the new 10'x 150' timber float. See float details.
  6. Clean exist. approach handrail by applying 5% hypochlorate solution (chlorine bleach) and rinsing with 1500 psi. hot water. Clean no more than 50' along one rail at a time to minimize inconvenience and use caution to protect people and adjacent boats or properties. Supply & install as required, 6ea.4x6 treated posts & 580 LF. of 2x6 treated planks (CCA, ACA, ACZA or ACO) as middle girt along exist. wood handrail. Coat new posts, girts & exist. rail prior to installing girt. Coating shall be a penetrating semi-transparent stain light grey or white color. Secure with 2 - 20d nails each post, predrill nail holes near ends.
  7. Supply & Install 9 creosote treated fender piling, 5 at the northwest corner & 3 along the west face of the existing timber City Dock. Supply & Install one additional pile (9 total) to replace other hidden damage or the most worn of the remaining fender piles. Supply new 7/8" economy head bolts & nuts (long threads are recommended). Reuse existing bolt holes through the bull rail, existing backing plates at corners & M.I. washers where possible. Salvage old piles for City of Craig. See As-built drawings for details.
  8. Rehab those fender piling not replaced as required. Where existing fender pile top has some core rot the pile shall be pulled up 1' to 2' cut-off & trimmed to fit 8x12 fender chocks & adjacent piling.
  9. Supply & Install 3 steel safety ladders. Each safety ladder requires two new 4x8 x 16'-0" horizontal braces at approx. -0.5' and +9.5' elevations. Remove and salvage existing ladders & braces for City of Craig. Where existing piles are to remain, immediately plug & repair (or reuse) existing brace bolt holes.
  10. Supply & Install Two luminaires Adjacent To Existing Gangway. Supply One 6x6x16'-0" Luminaire Pole, One 4x6x2'-6" & One 4x14x3'-0" Blocking (field cut to fit), And One 4x8x7'-0" Diagonal Brace (all Penta Treated). Secure w/ 3/4" Econ. Hd. Bolts. Supply and Install Luminaires, Brackets, Insulators, Junction Boxes, Conduit & Wire Cable as shown on sheet 7 of 41. Coordinate with City of Craig Harbormaster & Electrical Utility to connect with existing conduit. Remove & Salvage existing luminaire, pole, & upper conduit for City of Craig.
  11. Supply to the City of Craig one Back Flow Preventer Assembly, 1" Febc 805 Y double check with optional ball shut-off valves as required by Craig Utilities. Service supply line w/ back flow preventer to be installed by City of Craig. See note 3 this sheet.
  12. Repair all drill holes & cuts (new & old timbers) with three separate brush coats of creosote oil. Plug all abandoned holes 1/4" & larger with pressure treated wood dowels (creosote), cover dowel ends and holes less than 1/4" with asphaltic roof pitch. To repair pile cut-off tops drill 3 to 5 equally spaced holes 1" x 3" deep in Pile Cut-off Ends (after brush crea. treat) and fill holes with Copper Naphthenate crystals or rods. Seal Pile Cut-off Ends with 1/4" thick layer of asphaltic roof pitch, add a layer of burlap fabric (size 1/2" less than pile dia.), then add a second 1/4" layer of roof pitch.
  13. The contractor shall supply the following new materials. Any remaining new material shall be stockpiled as directed, at Juneau, Alaska.
    1. One 12' x 50' timber gangway float, complete & in place.
    2. One 10' x 150' timber walkway float, complete & in place.
    3. Nine (9) Steel 12 3/4" x 3/8" wall galv. pipe float restraint piles, Approx. 468 LF. from 55' to 62' long as required. Driven to 15' minimum penetration and cut-off at +28.0' elevation. Supply & install UV. stabilized plastic pile tops & SS. fasteners.
    4. Nine (9) creosote treated fender piles approx. 52' long. Driven to 15' minimum penetration and cut-off at top of bull rail (est.+17.75' elev).
    5. Three (3) steel safety ladders w/ 4x8 timber bracing & hardware.
    6. 6 each 4x6 treated posts for approach handrail
    7. 580 LF. of 2x6 treated planks for approach handrail
    8. Supply 2'x50' Serrated Grating Deck w/ Angle Stringers & Treads for one side of the exist. gangway & 3'x50' of 2x12 Treated Timber Deck w/ Expanded Steel Mesh Grating Surface for the other side. Supply transition plate w/ non-skid surface to approach. Supply 1 1/2" pipe rail extensions.
    9. Supply Two Luminaires w/ brackets, Insulators, Junction Boxes, Conduit & Wire Cable for lighting modifications. Supply 6x6x16'-0" Luminaire Pole, 4x8x7'-0" Diagonal Brace, 4x6x2'-6" & 4x14 x3'-0" Blocking. Supply SS. Screws and galvanized bolts, M.I.washers & nuts.
    10. Supply one Back Flow Preventer Assembly, 1" Febc 805 Y double check with optional ball shut-off valves.
    11. Supply all consumables, cleaners, fasteners, coatings & wood treatments required to complete installation.


NOTE: DO NOT SCALE FROM THESE PLANS-USE DIMENSIONS

PATH: Q:\SEA\67746\MF\Sheet2.dwg 10/14/1999 13:32		
BY:	DATE:	DESCRIPTION OF CHANGE:
RECORD OF REVISIONS		


STATE OF ALASKA  
 DEPARTMENT OF TRANSPORTATION  
 AND PUBLIC FACILITIES  
 SOUTHEAST REGION DESIGN & CONSTRUCTION

CRAIG  
**HARBOR REHAB PROJECTS**  
 Proj. No. 67746  
**CRAIG CITY HARBOR REPAIRS**


DESIGNED BY: <b>RWM</b>	PROJECT NO. <b>67746</b>
DRAWN BY: <b>BN</b>	DATE: <b>DECEMBER 1999</b>
CHECKED BY: <b>BAS</b>	SHEET <b>3 OF 41</b>

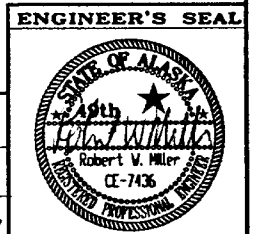




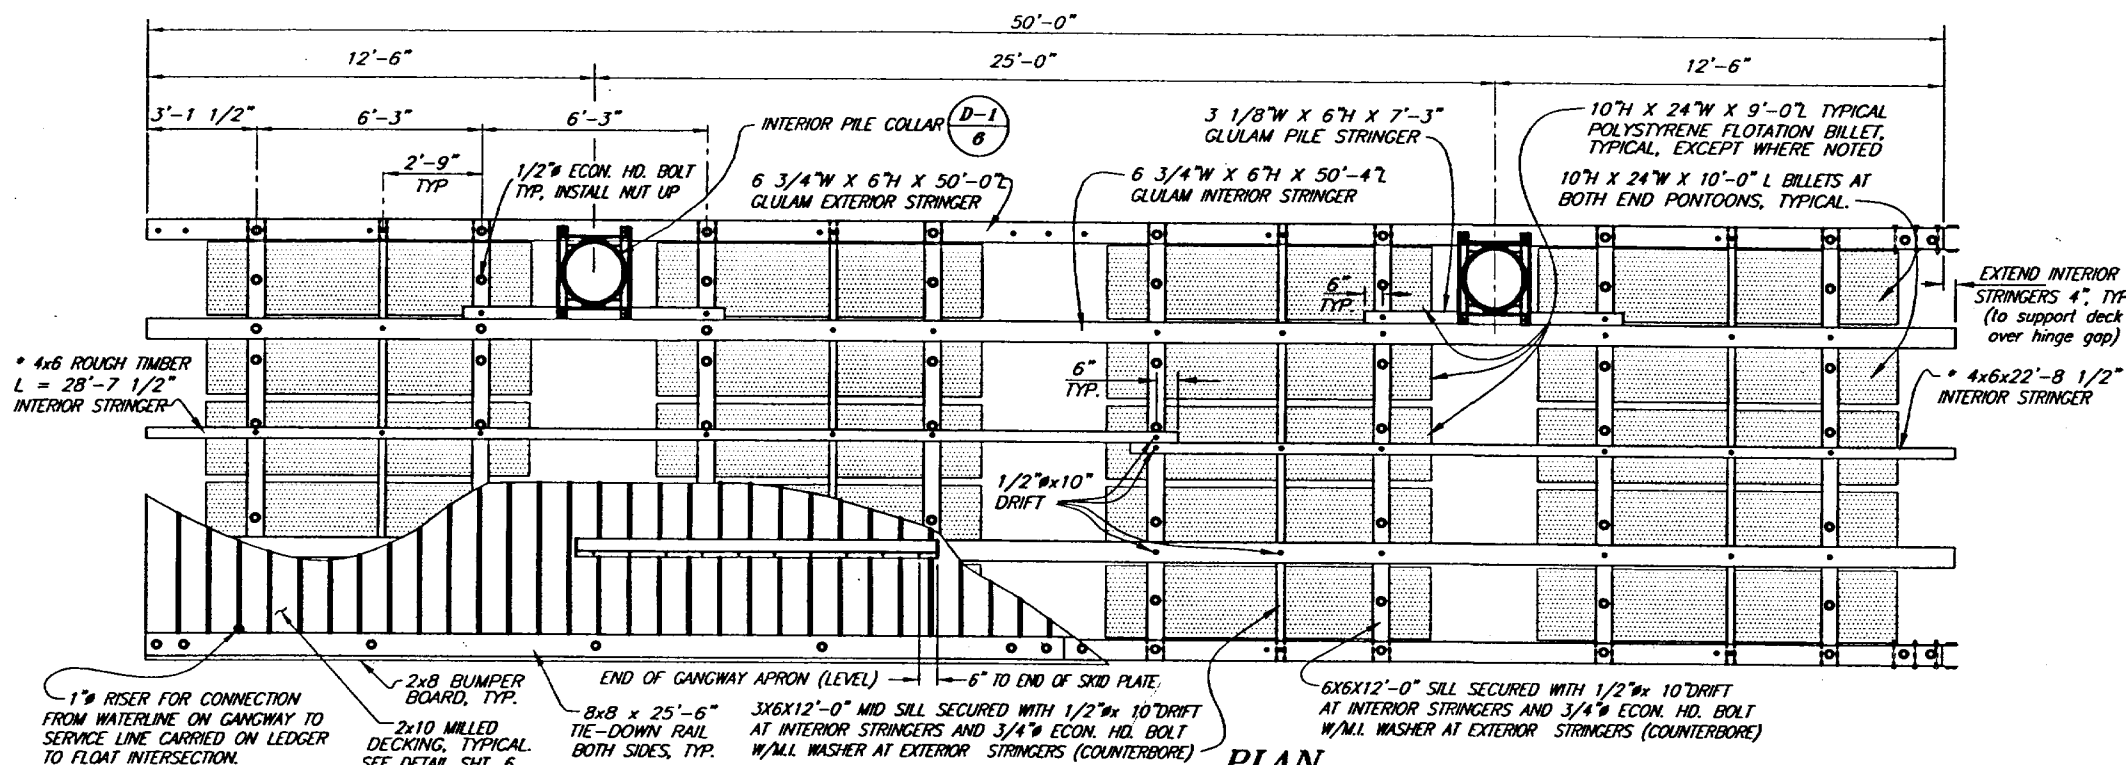


**PLAN**  
 \* SEE NOTE No.3  
 \*\* SEE NOTES No.2 & 4.

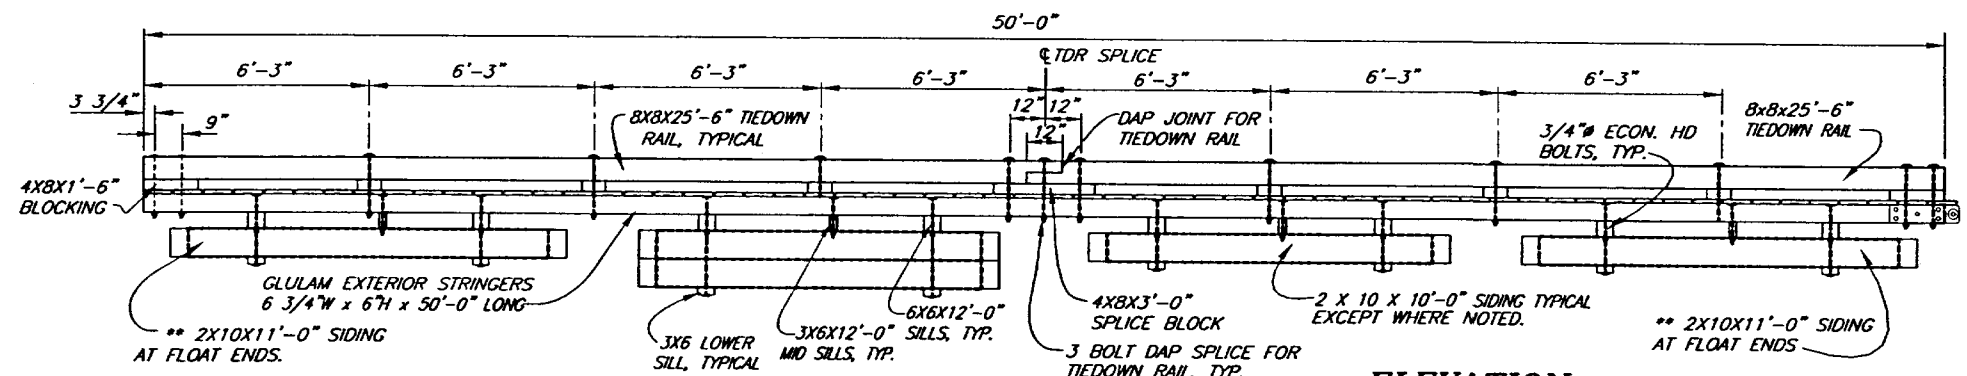


**ELEVATION**

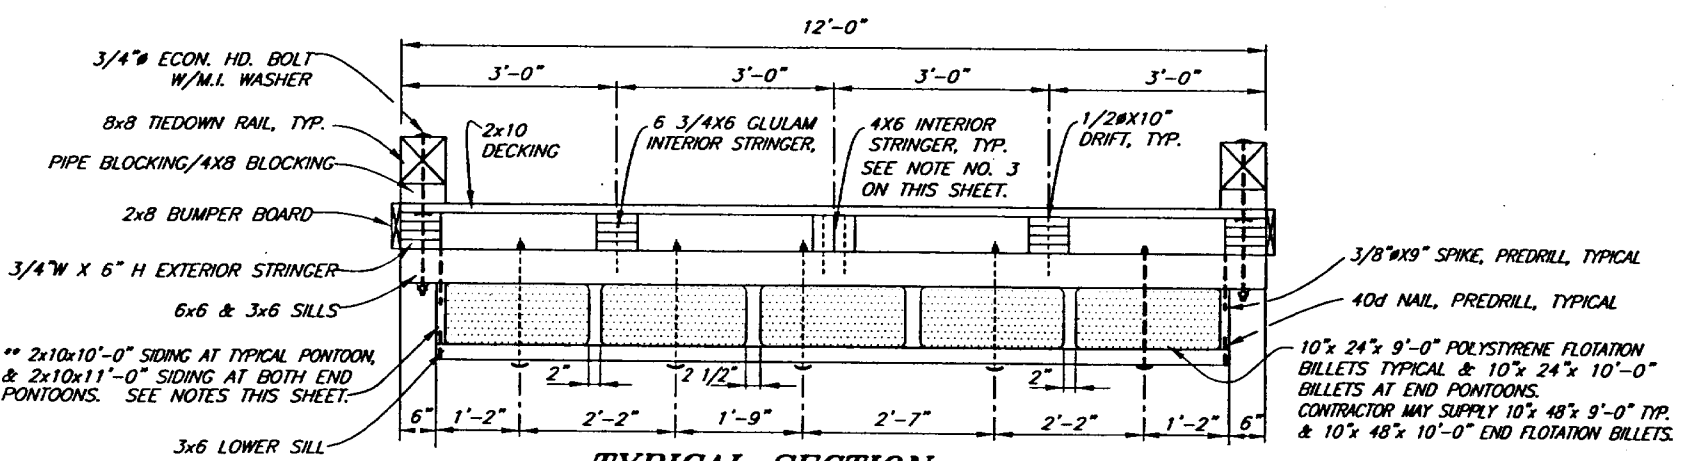

**TYPICAL SECTION**

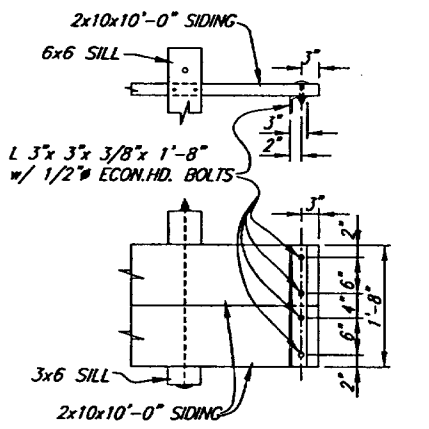

**SIDING ANGLE DETAILS**

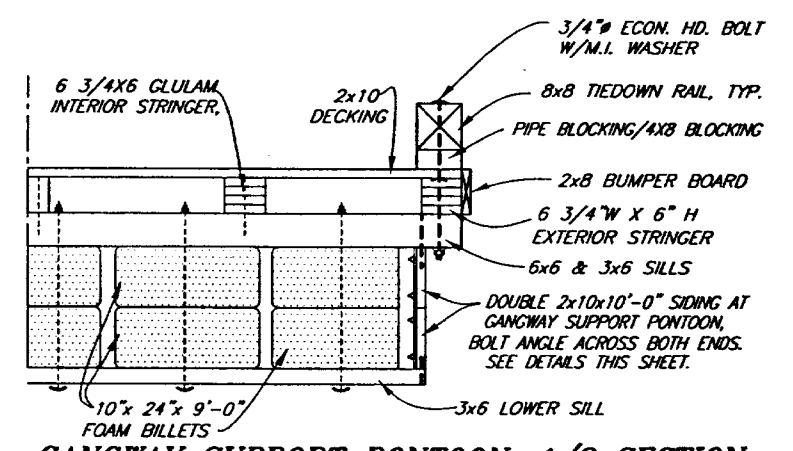

**GANGWAY SUPPORT PONTOON, 1/2 SECTION**

**NOTES:**

1. ALL PRESSURE TREATED MATERIAL SHALL BE CUT TO SIZE AND DRILLED PRIOR TO TREATMENT AND SHALL BE SELECT STRUCTURAL NO.1 DOUGLAS FIR.
2. ALL TIMBER SHALL BE S4S EXCEPT DECKING (MILLED S1S2E), 4x6 INTERIOR STRINGERS (NOTE BELOW), & 2x10 SIDING (NOTE BELOW).
3. THE 4x6 INTERIOR STRINGERS SHALL BE ROUGH CUT TO MATCH HEIGHT OF 6 3/4"x6" GLULAM STRINGERS. CONTRACTOR MAY ELECT TO USE 3 1/8"x6" GLULAM INTERIOR STRINGERS.
4. 2x10 SIDING MAY BE FULL DIMENSION ROUGH OR 2x12 (S4S) CUT TO MATCH THICKNESS OF FLOTATION BILLETS.
5. TREAT ALL MILLED DECKING, RUB BOARDS, TIE-DOWN RAILS, UTILITY LEDGER, & BLOCKING ABOVE DECK WITH PENTACHLOROPHENOL IN LIGHT OIL.
6. CREOSOTE TREAT ALL STRINGERS, SILLS, PONTOON SIDING, & BLOCKING BELOW DECK TO 25 PCF RETENTION.
7. 2x8 BUMPER BOARD CONTINUOUS BOTH SIDES OF FLOAT. MINIMUM BUMPER BOARD LENGTH = 10'-0". SECURE WITH 30d DOUBLE HOT-DIP GALV. NAILS, STAGGER ALTERNATELY HIGH & LOW AT 12" o.c. & 2 NAILS AT ENDS (PREDRILL ENDS).
8. DECKING SHALL BE SPACED 1/4" APART AND SECURED TO EACH STRINGER WITH 2 - 20d GALVANIZED NAILS.
9. ALL HARDWARE SHALL BE HOT-DIP GALVANIZED. ALL BOLTS ARE 3/4" ECONOMY HEAD TYPE WITH LUGS, EXCEPT AS NOTED. A MALLEABLE IRON WASHER SHALL BE PLACED BETWEEN ANY NUT AND WOOD SURFACES.
10. BOLT HOLES TO BE DRILLED 1/16" OVERSIZE EXCEPT SILL HOLES FOR FLOTATION BILLETS 1/8" OVERSIZE. COUNTERBORE FOR ALL BOLT HEADS FACING DECKING 3/8" DEEP. DRIFT PIN HOLES TO BE DRILLED 1/16" UNDERSIZE.
11. REPAIR FIELD DRILLED HOLES & CUTS PER SPEC. WITH TWO BRUSH COATS 60% CREOSOTE & 40% ROOF PITCH, OR WITH 3 SEPARATE COATS HOT CREOSOTE OIL, OR ON PENTACHLOROPHENOL TREATED TIMBER WITH COPPER NAPHTHENATE SOLUTION AS REQUIRED.
12. ALL PILING SHALL BE CREOSOTE TREATED PER SPEC. TO 20 PCF RETENTION.
13. CONTRACTOR MAY SUBMIT LARGER BILLET SIZES SO AS TO REDUCE SURFACE AREA TO BE COATED WITH URETHANE. NOTE THAT 10"x24"x9'-0" AND 10"x24"x10'-0" ARE NOT STANDARD BILLETS.


NOTE: DO NOT SCALE FROM THESE PLANS-USE DIMENSIONS


PATH: Q:\SEA\67746\Mf\Sheet5.dwg 10/14/1999 13:32		
BY:	DATE:	DESCRIPTION OF CHANGE:
<b>RECORD OF REVISIONS</b>		

STATE OF ALASKA  
 DEPARTMENT OF TRANSPORTATION  
 AND PUBLIC FACILITIES  
 SOUTHEAST REGION DESIGN & CONSTRUCTION

CRAIG  
 HARBOR REHAB PROJECTS  
 Alaska  
 Proj. No. 67746  
 12' WIDE TIMBER GANGWAY FLOAT

DESIGNED BY: RWM	PROJECT NO. 67746
DRAWN BY: BN	DATE: DECEMBER 1999
CHECKED BY: BAS	SHEET 5 OF 41

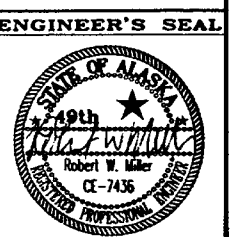

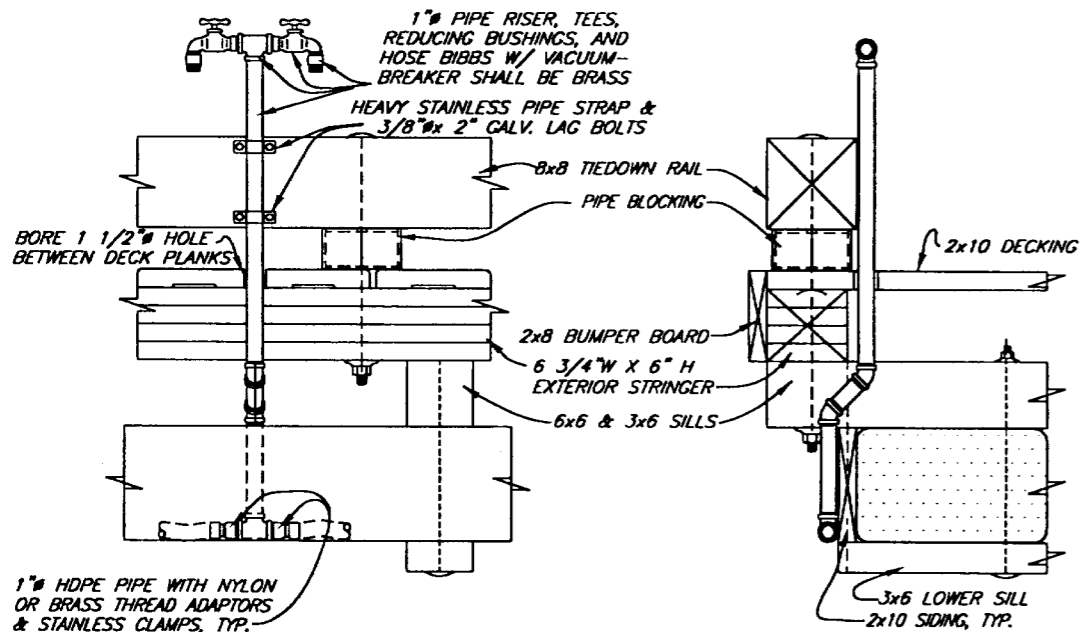

**HOSE BIBB RISER DETAILS**

6 REQ'D. ON 150' FLOAT AT APPROX. 25' o.c. (opposite pile collars)

1" HDPE PIPE WITH NYLON OR BRASS THREAD ADAPTORS & STAINLESS CLAMPS, TYP.

1" PIPE RISER, TEES, REDUCING BUSHINGS, AND HOSE BIBBS W/ VACUUM-BREAKER SHALL BE BRASS

HEAVY STAINLESS PIPE STRAP & 3/8" x 2" GALV. LAG BOLTS

8x8 TIEDOWN RAIL

PIPE BLOCKING

BORE 1 1/2" HOLE BETWEEN DECK PLANKS

2x8 BUMPER BOARD


6 3/4" W X 6" H EXTERIOR STRINGER

6x6 & 3x6 SILLS



2x10 DECKING

3x6 LOWER SILL


2x10 SIDING, TYP.

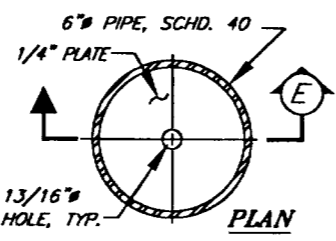


**PIPE BLOCKING DETAILS**

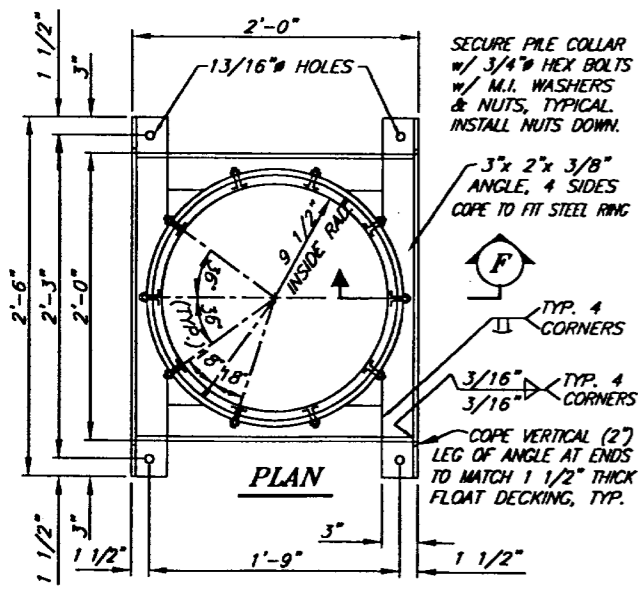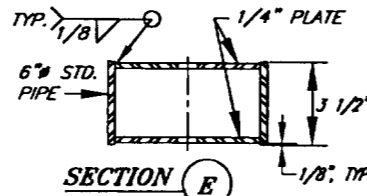


**INTERIOR PILE COLLAR DETAIL D-1**  
4,5

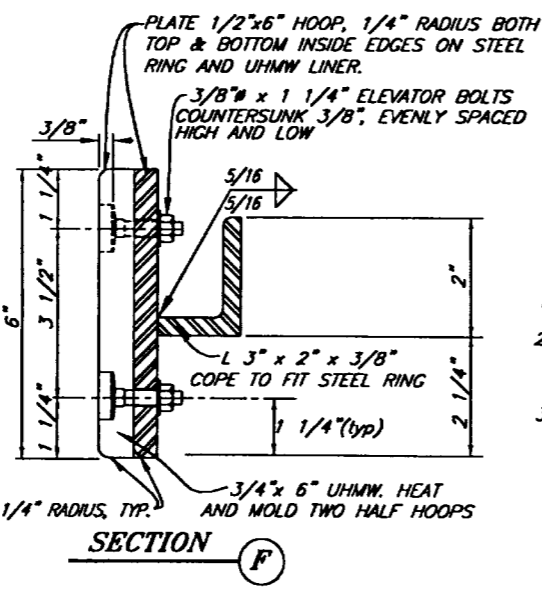


**SECTION F**

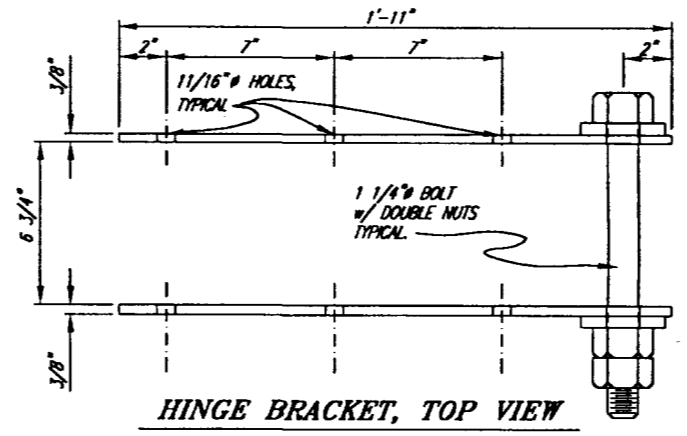


**HINGE BRACKET, TOP VIEW**

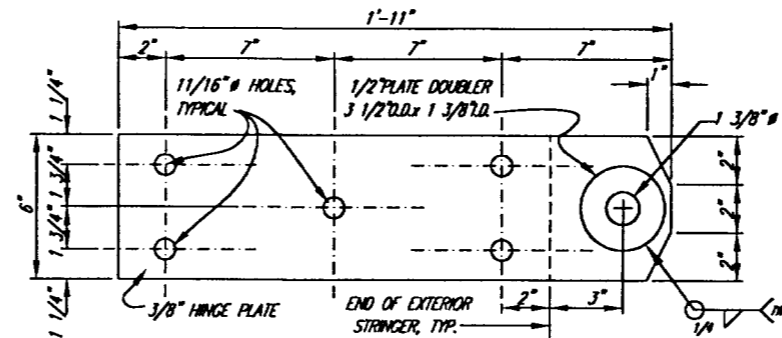


**HINGE BRACKET, SIDE VIEW**

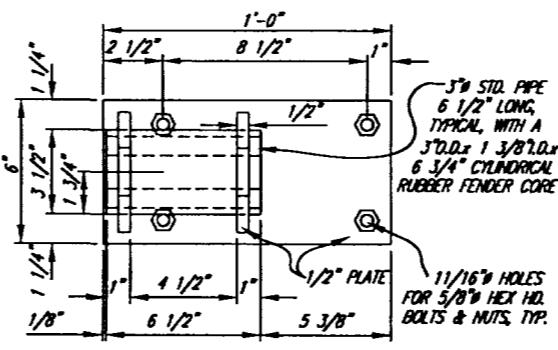


**END-HINGE CORE, FRONT VIEW**

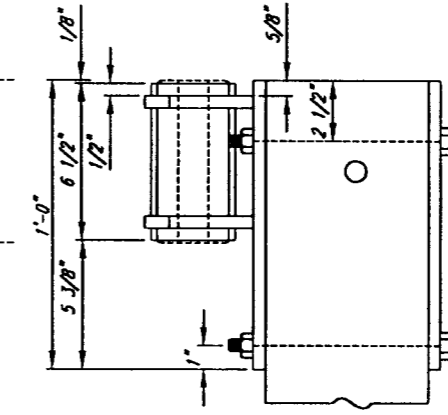


**END-HINGE CORE, TOP VIEW**

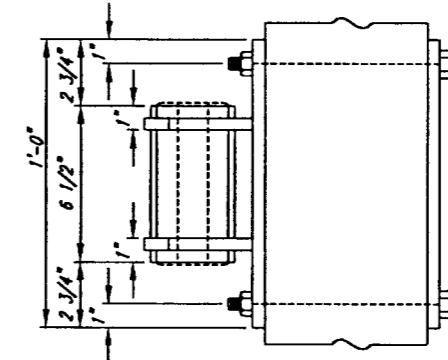


**MID-HINGE CORE, TOP VIEW**

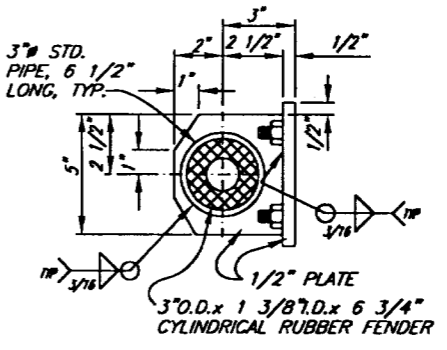


**HINGE CORE, TYPICAL SIDE VIEW**

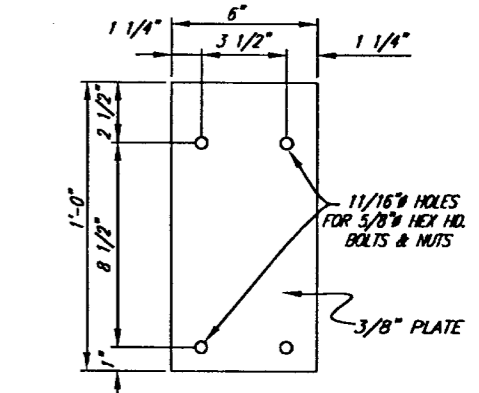

**END-HINGE, BACKING PLATE DETAIL**

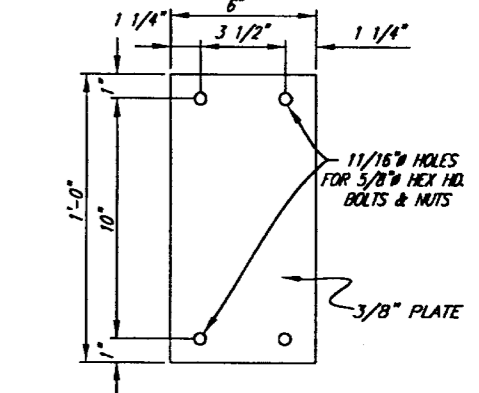


**MID-HINGE, BACKING PLATE DETAIL**

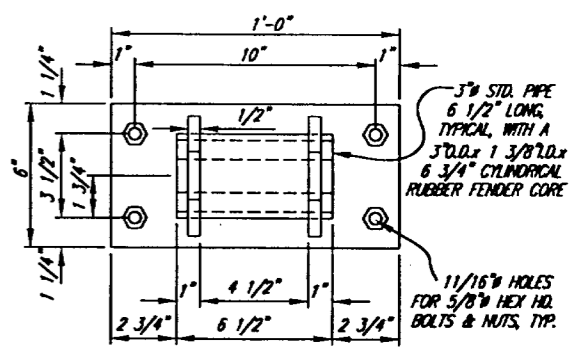

**MID-HINGE CORE, FRONT VIEW**


**INTERIOR COLLAR NOTES**

1. ALL WELDS ON INSIDE OF STEEL RING SHALL BE GROUND SMOOTH.
2. UHMW POLY LINERS, AS SHOWN, WITH 5 BOLTS PER CIRCULAR HALF COLLAR. UHMW POLY LINERS SHALL BE HEATED AND THEN MOLDED TO THE SHAPE SHOWN ON THE DETAILS.
3. THE SECURING BOLTS SHALL BE COUNTERSUNK AS SHOWN AND EVENLY SPACED HIGH AND LOW.

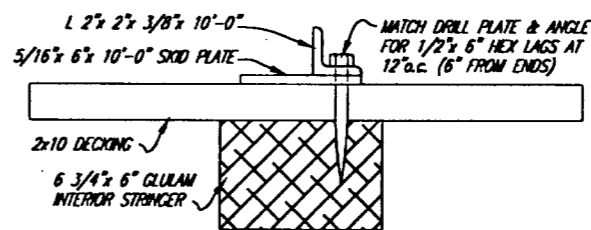

**GANGWAY SKID PLATE DETAILS**

2 REQ'D. AT 12' FLOAT FOR EXISTING GANGWAY

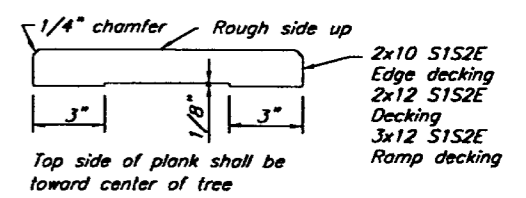

**MILLED DECKING DETAIL**

Top side of plank shall be toward center of tree


NOTE: DO NOT SCALE FROM THESE PLANS-USE DIMENSIONS


PATH: Q:\SEA\67746\Mf\Sheet6.dwg 10/14/1999 13:32		
BY:	DATE:	DESCRIPTION OF CHANGE:
<b>RECORD OF REVISIONS</b>		

STATE OF ALASKA  
DEPARTMENT OF TRANSPORTATION  
AND PUBLIC FACILITIES  
SOUTHEAST REGION DESIGN & CONSTRUCTION

CRAIG  
HARBOR REHAB PROJECTS  
Proj. No. 67746  
ALASKA  
**TIMBER GANGWAY FLOAT DETAILS**


DESIGNED BY: RWM	PROJECT NO. 67746
DRAWN BY: BN	DATE: DECEMBER 1999
CHECKED BY: BAS	SHEET 6 OF 41

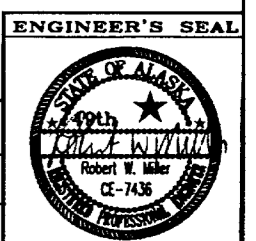

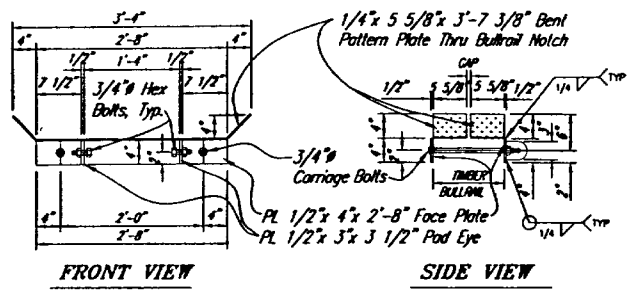


**LADDER MOUNT, NOTCH BULLRAIL**

NOTE: Two Halves Similar, Pad Eyes on Front Only, Punch Square Holes Back Only

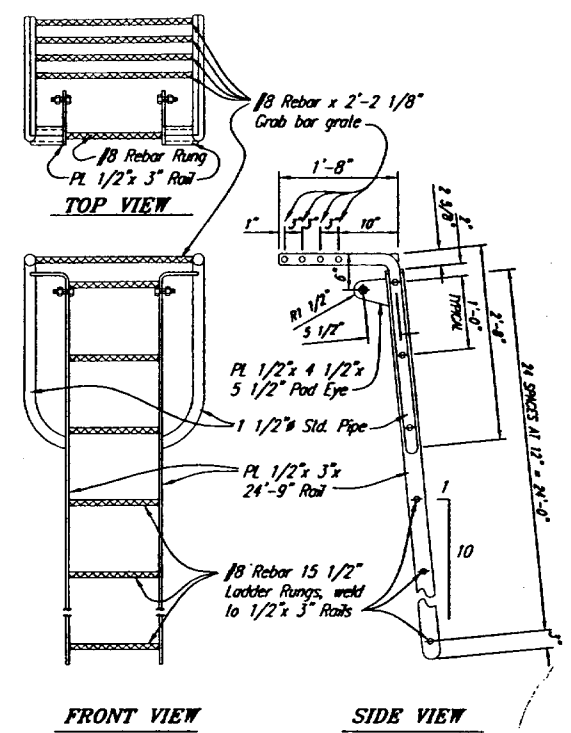


**TYPE 'B' LADDER DETAILS**

Two Required Adjacent To Dock Crane

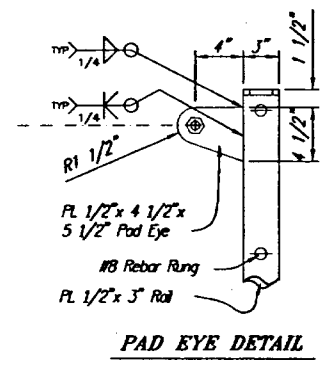


**PAD EYE DETAIL**

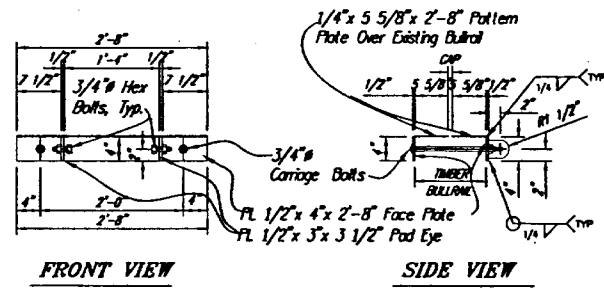


**LADDER MOUNT, TOP BULLRAIL**

NOTE: Two Halves Similar, Pad Eyes on Front Only, Punch Square Holes Back Only

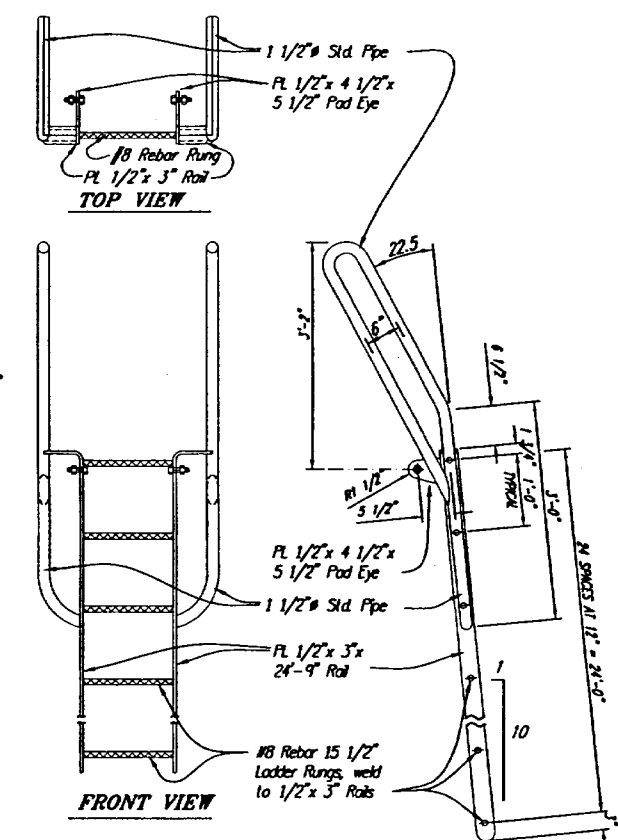


**TYPE 'A' LADDER DETAILS**

One Required Adjacent To Warehouse

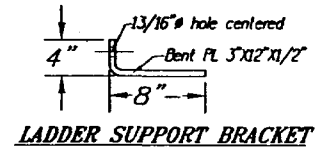


**LADDER SUPPORT BRACKET**

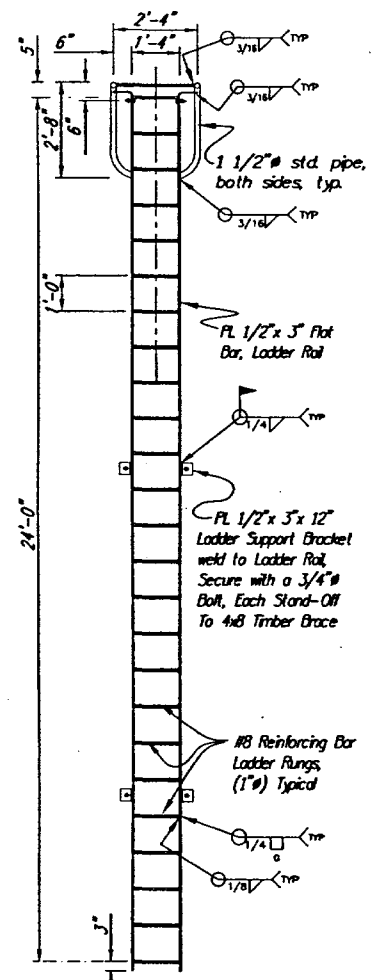

**LADDER DETAILS Type B shown,**


Type A similar except top has handrail loop

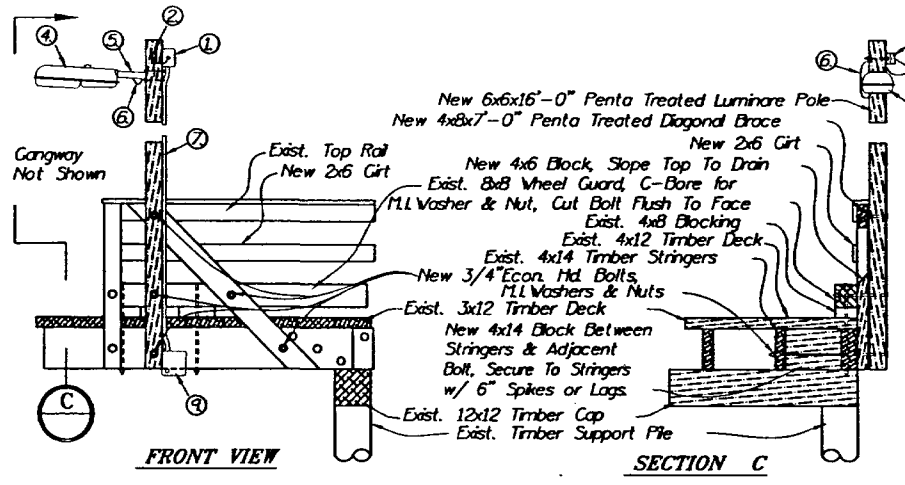


**GANGWAY LIGHTING MODIFICATION**

Two Luminaires Required One On Approach & One On First Float Pile


- LIGHTING NOTES :**
- 1 6x6x16 NE1A 4 Junction Box, Secure w/ SS. Screws or Bolts
  - 2 Clevis & Insulator : Joslin J43 & J151, Secure w/ 5/8" Galv. Bolt, M.L. Washer & Nut.
  - 3 AERIAL CABLE : #8 Triplex w/ ACSR Messenger
  - 4 LUMINAIRE : Thom Beta 79, 70 watt High Pressure Sodium, IES Type I, (QB79S70). Equip One With Photoelectric Cell To Control Circuit.
  - 5 Luminaire Pole Bracket, Galvanized, Secure w/ 3/8" Galv. Bolts, Nuts & M.L. Washers as req'd
  - 6 Feed each luminaire with #10/3 SO Cord (black UV stabilized) from Junction Box
  - 7 1" Galvanized Rigid Conduit Between Junction Boxes
  - 8 All bolts and fabrication hardware shall be hot-dipped galvanized or stainless steel
  - 9 8x8x4 NE1A 4 Junction Box, Secure w/ SS. Screws. Coordinate w/ City of Craig Harbormaster and Electric Utility to route the existing conduit to the new junction box.

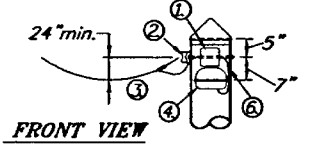

**FRONT VIEW**

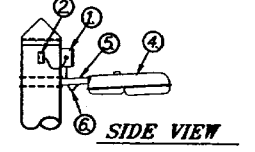


**SIDE VIEW**

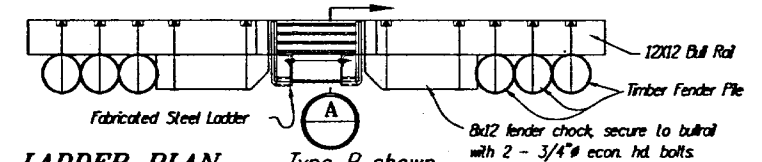


**LADDER PLAN Type B shown,**

Type A similar except top has handrail loop

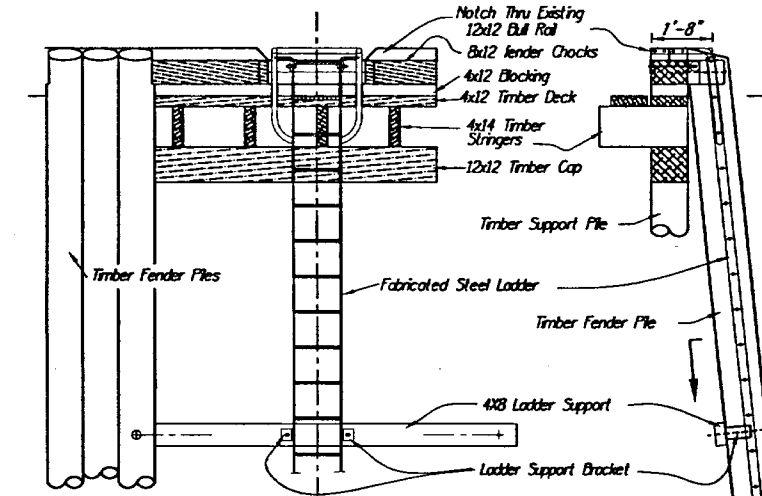

**LADDER ELEVATION Type B shown,**

Type A similar except top has handrail loop

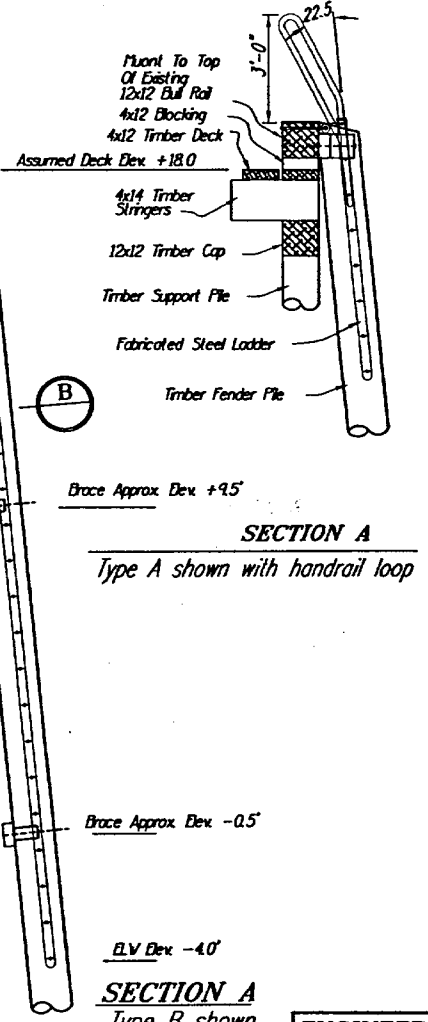

**SECTION A**

Type A shown with handrail loop

**SECTION B**

Note: All Steel Fabrications Shall Be Hot Dip Galvanized

NOTE: DO NOT SCALE FROM THESE PLANS-USE DIMENSIONS

PATH: Q:\SEA\67746\Mf\Sheet7.dwg 10/14/1999 13:32	
BY:	DATE:
DESCRIPTION OF CHANGE:	
RECORD OF REVISIONS	


STATE OF ALASKA  
DEPARTMENT OF TRANSPORTATION  
AND PUBLIC FACILITIES  
SOUTHEAST REGION DESIGN & CONSTRUCTION

CRAIG

HARBOR REHAB PROJECTS  
Proj. No. 67746  
ALASKA  
**STEEL SAFETY LADDER DETAILS**


ALASKA

DESIGNED BY: BN	PROJECT NO. 67746
DRAWN BY: BN	DATE: DECEMBER 1999
CHECKED BY: RWM	SHEET 7 OF 41

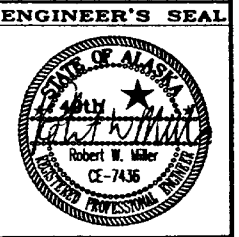

**HARBOR REHAB PROJECT NOTES :**

1. Replace Timber Approach Handrails, Posts & Luminaire Poles. Supply & install new 4x4 x 4'-6" posts approx. 8'-0" o.c. (reuse exist. bolt holes thru stringers if practical) and new 2x6 rails & girts. Refer also to 1962 project as-built drawing for approach length & pile bent spacing. Replace treated double 2x12 mounts for electrical j-boxes on railing both sides of last seaward end span. Supply & install Sea. 8x8x 16'-0" timber luminaire poles with 2ea. 4x8 diagonal braces each pole. All rails, girts, posts, poles & braces shall be pressure treated with pentachlorophenol in light oil solution. All cut ends and holes (include temporary nail holes) shall get three brush applied coats of copper naphthenate in light oil solution. Plug abandoned holes 1/4" & larger w/ same size treated dowels & seal all holes w/ roof pitch. Supply all new bolts, nuts, M.L. washers to secure posts, poles & braces.
2. Furnish & install transition plate between existing steel & wood gangway and existing timber approach. See Craig/Hydaburg Harbor Miscellaneous Detail sheet 10 of 41 for more information.
3. Rehab Exist. Gangway Surface. Supply & install 3'x 49'-5 5/8" treated timber deck with 3'-0" wide galv. steel 3/4" #9 standard expanded carbon steel grate (1.80 psf before galv.) non-skid surface. Supply & install 2'-4" x 49'-9 5/8" serrated open steel bar grating with angle stringers & treads. See sheet 10 of 41 for details.
4. Remove existing wood crib abutment except 10x10 sill & construct a new concrete abutment. See shoreward end of approach detail sheet for precast abutment or submit similar cast-in-place abutment plans for approval.
5. Supply & install new flotation billets to level gangway float. Remove marine growth from bottom of existing flotation billets prior to installing new foam. Supply standard billets (10'x 20'x 9'-0") to replace missing or broken billets, supply quarter billets (5'x 20'x 4'-6") for leveling and supply 3/8" #4 x 18" galv. steel L-pins, w/ chisel point on long end. Billets shall be urethane coated, see spec. Where leveling is req'd, place leveling billet between lower sills and drive L-pins through existing flotation into new leveling billet. Use 3 L-pins per leveling billet evenly spaced.
6. Remove 22 existing timber pile guide collars & Replace with new steel collars, 2 req'd. on gangway float, 20 req'd. on marginal float. See Misc. Detail Sheet for details. Treat all bolt holes, nail holes, cuts & abrasions prior to replacing deck planks.
7. Remove & replace all existing gangway float & main float to marginal float hinges, hinge bolts and fastener bolts with new hinges & hardware. See as-built plans for hinge details (1974 gangway to marginal), (1977 main A & D to marginal), (1979 main B & C to marginal).
8. Replace Two 6'x50' stall floats on main float A. Add billets to level the other 8 existing 6'x50' stall floats at main float A. See details 1979 project as-built drawings. Refer also to note 5 above.
9. Pull 6 existing piling, 2 at each of 2 damaged 6'x50' stall floats on main float A, one loose piling on main float D and one leaning pile at stall float 9-west, float-B. Replace 2 piling at stall 5-west, float-A with new 70' & 68' long timber piles and one pile at float D with a new 70' long timber pile, all piles treated with creosote to 20 lb/cf per spec. Reuse remaining used piling at stall 3-east, float-A and at stall 9-west, float B where shorter piles should be sufficient. Repair any small holes, cuts or surface scuffing with 50-50 mix of creosote & roof pitch. Treat pile tops: drill 3 to 5 holes 1" #4 x 3" deep, 3" o.c.; fill with copper naphthenate crystals or rod & seal top w/ 1/4" roof pitch.
10. Replace segment of failed 8x8 timber bullrail along breakwater float D & along marginal float. Supply Sea. new 26'-0" long sections of pentachlorophenol treated 8x8 timber and new economy head bolts, nuts & M.L. washers as required.
11. Replace 2 damaged stall floats near the west end of the marginal float with new 2'-5 1/2" x 21'-0" stall floats. See 1975 project as-built drawings for details.
12. Add billets to raise & level a 25' segment of the 6'x250' main float C near the north end between stalls 9-east & 9-west. See details 1979 project as-built drawings. Refer also to note 5 above.
13. Some deck planking & bullrails must be removed & reinstalled to make repairs such as replacing hinges & pile collars or securing foam leveling billets. Carefully remove & store existing planks & timbers and Treat & Fill ALL Nail Holes in stringers prior to reinstalling planks. Replace broken, split or damaged planks with new 2x10 milled decking, and repair minor damage (holes, cuts or abrasions) similar to note 1 above.
14. Fabricate 1 1/2" galv. std. pipe rail extensions, 2 required, weld to shoreward end of exist. gangway rail. Refer to details in Section A on Sheet 10.
15. Supply the following materials for Hydaburg repairs. Any remaining new materials shall be stockpiled as directed by the engineer at Juneau, Alaska.
  1. Approx. 1400 lf. 2x6x16'-0" min. (verify post spacing to minimize waste) penta treated rails & girts.
  2. 46 ea. 4x4x 4'-6" pentachlorophenol treated handrail posts
  3. 4 ea. 2x12x 4'-0" penta treated planks to mount J-boxes
  4. Fab. precast concrete abutment (see detail for options)
  5. 148.4 lf. Treated Timber Decking (verify exact plank sizes), 150 sf. Galv. 3/4" #9S Standard Expanded Steel Mesh non-skid gangway surface.
  6. 2'-4" x 49'-5 5/8" galv. serrated steel deck w/ L3'x5"x1/4" stringers, L2 1/2"x3/16" treads at 16 5/8" o.c. Fab. galv. steel transition plate for approach to gangway.
  7. Fab. 1 1/2" galv. std. pipe gangway rail extensions
  6. Flotation billets with urethane coating :
    - 2 ea. 10'x 20'x 9'-0" std. replacement billets
    - 40 ea. 5'x 20'x 4'-6" leveling billets
    - 120 ea. 3/8" #4 x 18" galv. steel L-pins to secure leveling billets
  7. Fab. 22 ea. galv. steel pile collars (req'd. at gangway & marginal floats)
  8. Fab. New Hinges for Gangway float & 4 main floats to marginal floats
  9. Fab. 2 ea. 6'x50' stall floats (with new pile collars, hinges & hardware)
  10. 2 ea. 70' & One 68' crea. treated timber pilings (tip 8" dia. min. & butt 15" dia. max.)
  11. 3 ea. 8x8x 26'-0" penta. treated timber bullrails
  12. Fab. 2 ea. 2'-5 1/2" x 21'-0" stall floats for marginal float
  13. 240 lf. 2x10 milled decking (6 pc. 12'-0", 12 pc. 10'-0", 6 pc. 8'-0")
  14. 5 ea. 8x8x 16'-0" penta treated timber luminaire poles
  15. 10 ea. 4x8x 6'-0" pent. treated timber diagonal braces
  16. Supply all consumables, cleaners, fasteners, coatings & wood treatments required to complete installation.

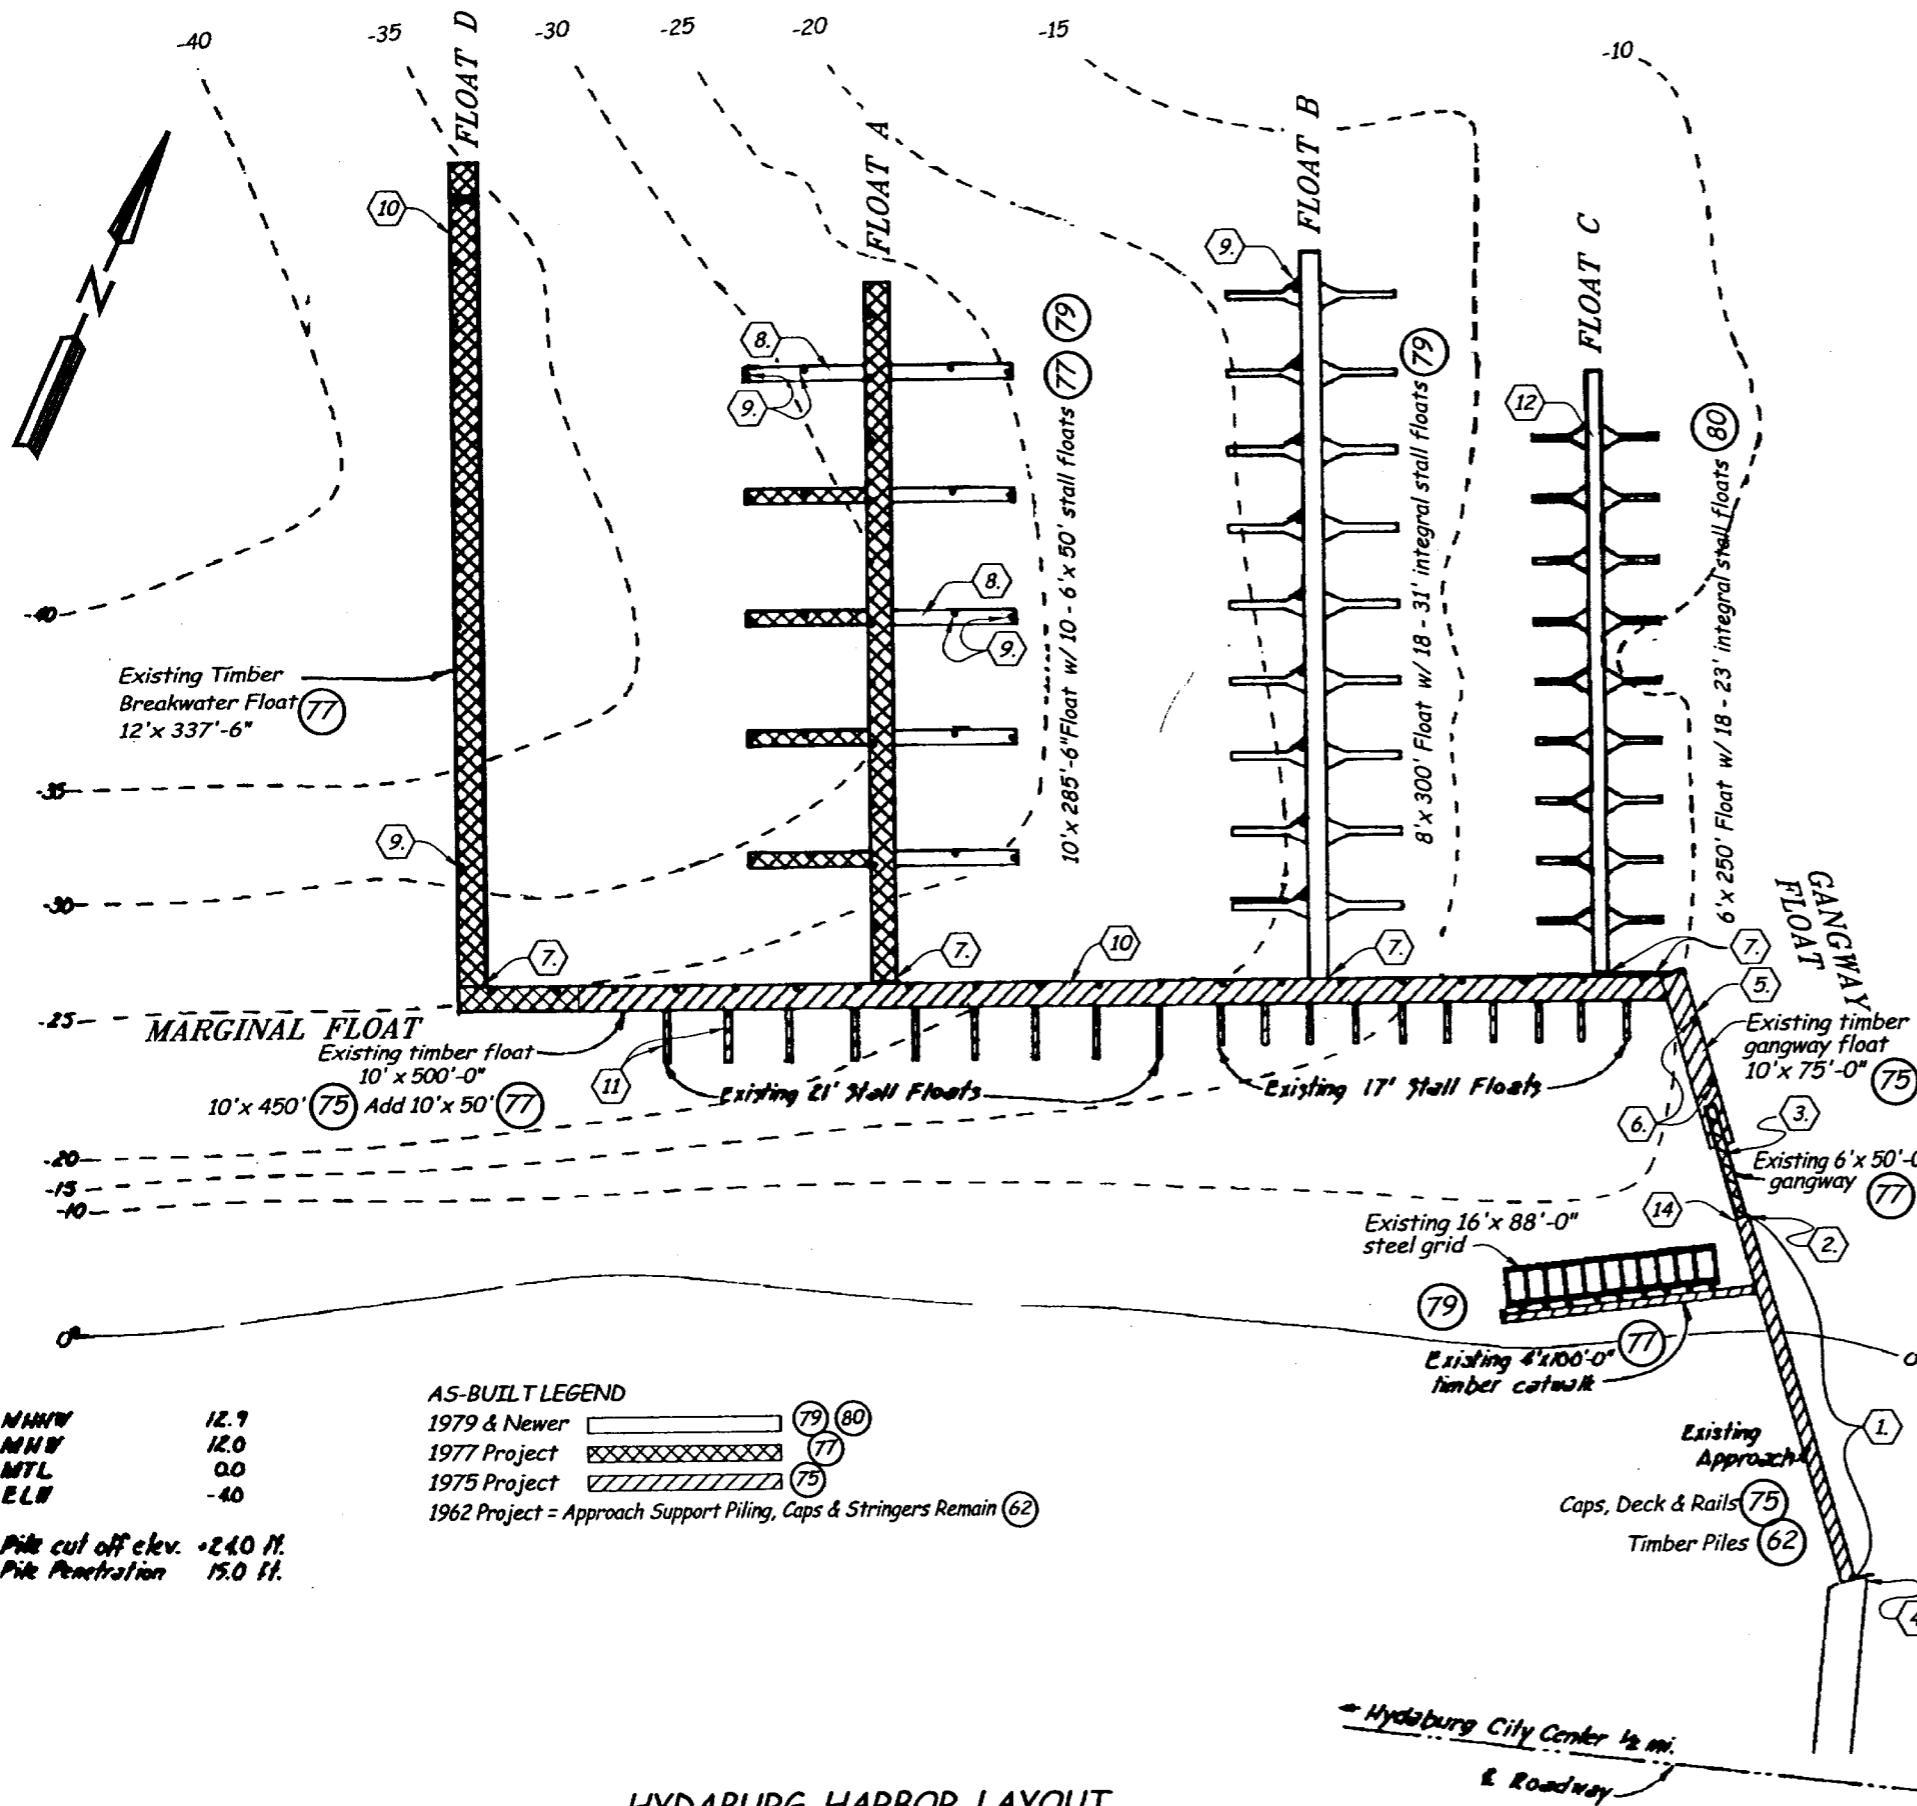

MHW 12.9  
 MHW 12.0  
 MTL 0.0  
 ELW -4.0

Pile cut off elev. +24.0 ft.  
 Pile Penetration 15.0 ft.

**AS-BUILT LEGEND**

- 1979 & Newer (79) (80)
- 1977 Project (77)
- 1975 Project (75)
- 1962 Project = Approach Support Piling, Caps & Stringers Remain (62)

**HYDABURG HARBOR LAYOUT**

Hydaburg City Center 1/2 mi.  
 E Roadway

NOTE: DO NOT SCALE FROM THESE PLANS-USE DIMENSIONS

PATH: Q:\SEA\67746\N\Sheet8.dwg 10/14/1999 15:49	
BY:	DESCRIPTION OF CHANGE:
DATE:	
RECORD OF REVISIONS	

STATE OF ALASKA  
 DEPARTMENT OF TRANSPORTATION  
 AND PUBLIC FACILITIES  
 SOUTHEAST REGION DESIGN & CONSTRUCTION

HYDABURG

HARBOR REHAB PROJECTS  
 Proj. No. 67746

**HYDABURG HARBOR REPAIRS, LAYOUT**

ALASKA

DESIGNED BY: RWM

DRAWN BY: BN


CHECKED BY: BAS


PROJECT NO.  
67746

DATE:  
DECEMBER 1999


SHEET 8 OF 41

ENGINEER'S SEAL

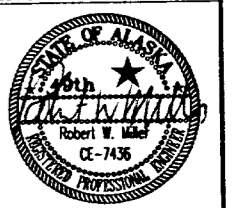

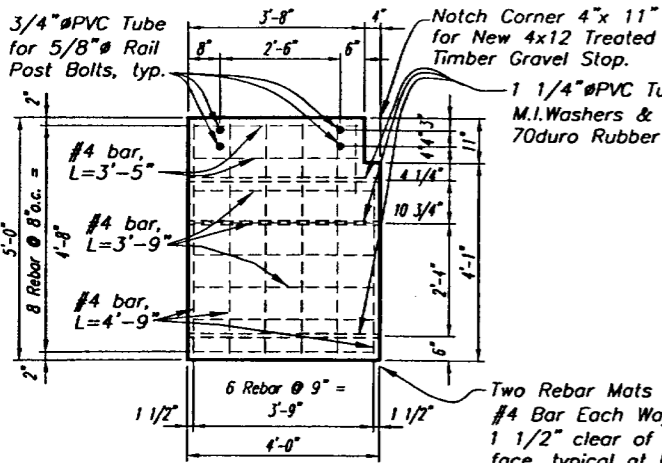


PRECAST ABUTMENT, WING WALLS

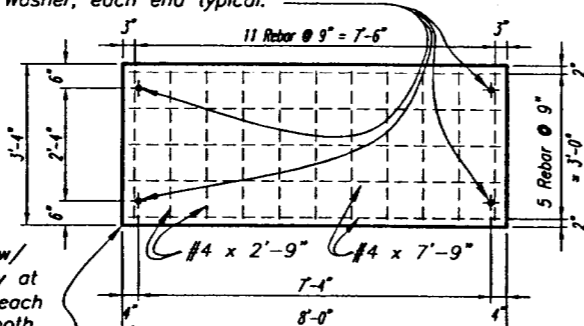

PRECAST ABUTMENT, GRADE BEAM


GENERAL NOTES :

1. Pressure treat ALL rails, girts, posts, luminair poles & braces w/ Pentachlorophenol in light oil solution to 0.6 lb/cf after cutting.
2. Treat cut ends, drilled holes, nail holes & minor abrasions with three(3) brush coats of Copper Naphthenate in light oil for members at deck level & above. Treat cuts, abrasions, drill holes & nail holes (new & existing) below deck level with two brush coats creosote oil & one brush coat of approx. 50-50 creosote oil & asphaltic roof pitch. Plug unused and/or abandoned holes 1/4" & larger (after brush treatment as above) with snug fit pressure treated dowels, cut flush & treat cut end as above.
3. All hardware to be hot-dip galvanized with malleable iron washers between nut and wood surfaces. All bolts to be economy head (mushroom head), except as noted. Bolt holes to be drilled true size in wood for snug fit, holes in steel to be 1/16" oversize.
4. Traffic Note : Contactor shall maintain pedestrian traffic at all times except for short periods, up to one hour. A sign notifying CLOSURE PERIOD, DATE, 1 HOUR STARTING AM/PM shall be posted at the head of the approach & toe of the gangway at least 24 hours prior to closure. Remove & rehab handrail along one side of approach at a time to minimize inconvenience and use caution to protect people and adjacent boats or properties. A short pedestrian bridge w/ handrails may be required to access approach while replacing abutment. Contactor may submit a traffic control plan with an on-request skiff shuttle to & from shore that is manned and ready during a longer closure period. Contactor must have an emergency plan to get sick or injured persons ashore during worst case situation.

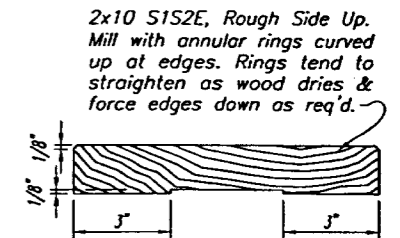


2x10 MILLED DECKING DETAIL


(req'd where float or approach decking is damaged)

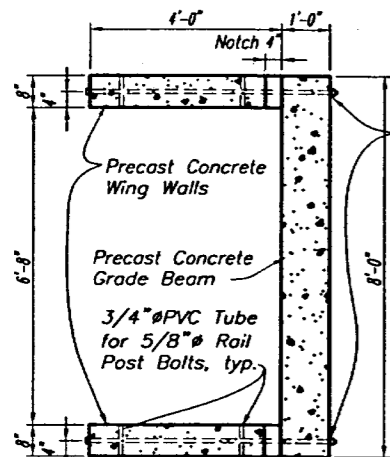


PRECAST ABUTMENT, PLAN VIEW

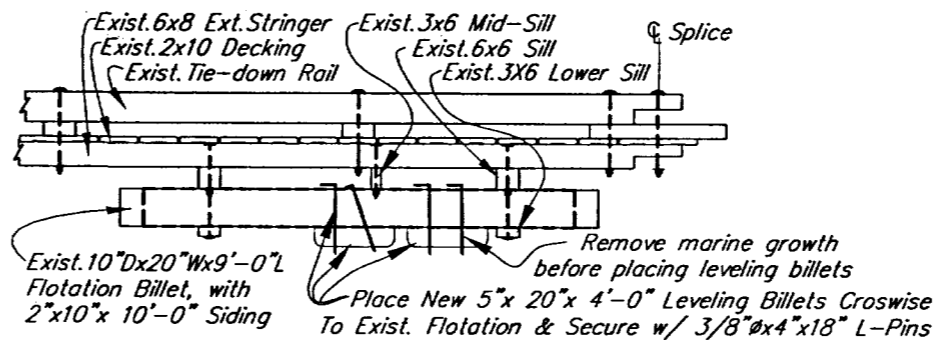


LEVELING FLOTATION PLACEMENT DETAILS

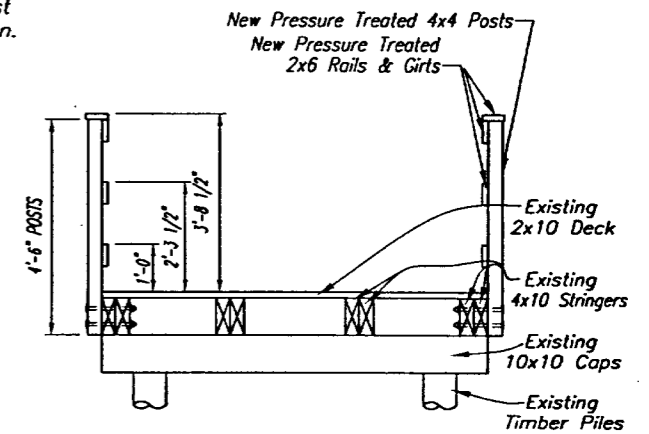


TYPICAL APPROACH SECTION

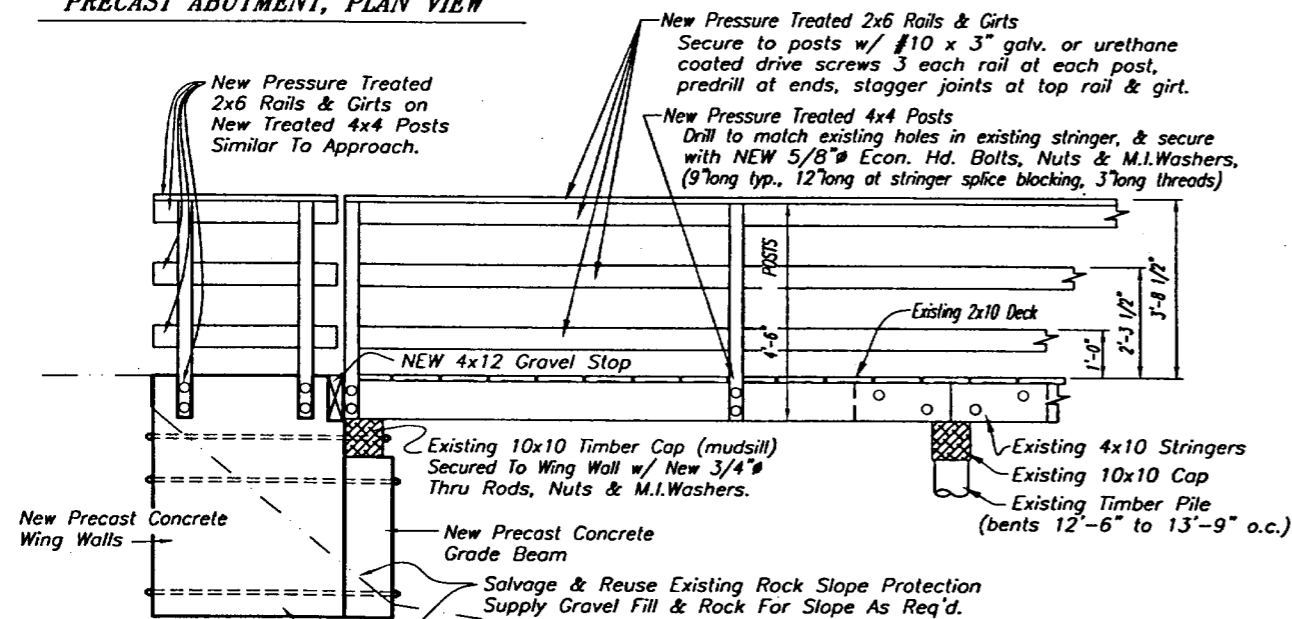

APPROACH DETAILS, SHOREWARD END

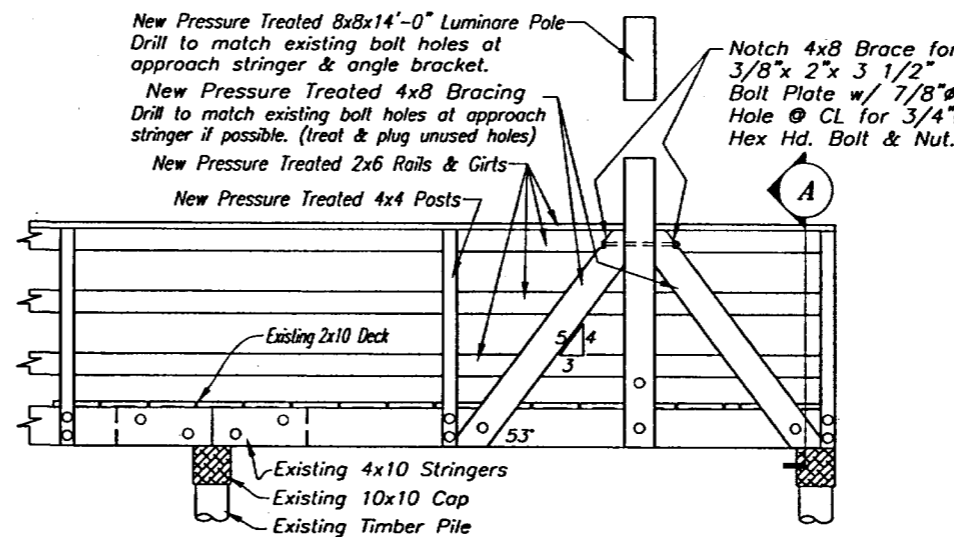

SEAWARD END ELEVATION

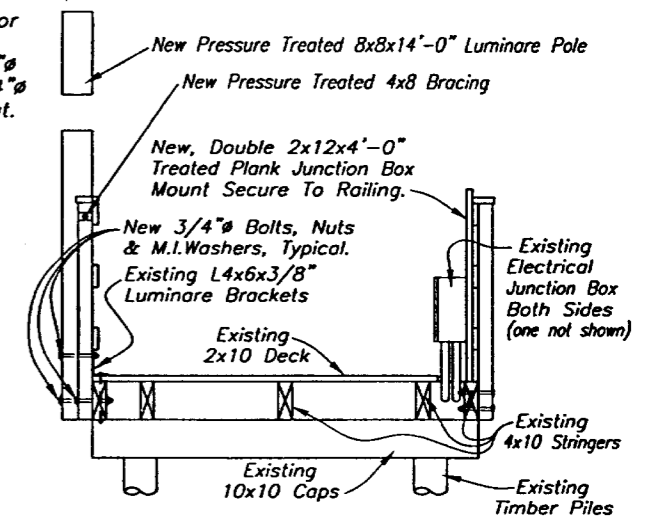

APPROACH SECTION A

APPROACH DETAILS, SEAWARD END

PATH: Q:\SEA\67746\NF\Sheet9.dwg Plot Scale=24.00 10/6/1999 13:32

BY:	DATE:	DESCRIPTION OF CHANGE:

RECORD OF REVISIONS

STATE OF ALASKA  
DEPARTMENT OF TRANSPORTATION  
AND PUBLIC FACILITIES  
SOUTHEAST REGION DESIGN & CONSTRUCTION


HYDABURG


HARBOR REHAB PROJECTS  
Proj. No. 67746  
ALASKA  
HYDABURG HARBOR APPROACH DETAILS

NOTE: DO NOT SCALE FROM THESE PLANS-USE DIMENSIONS


DESIGNED BY: RWM	PROJECT NO. 67746
DRAWN BY: BN	DATE: DECEMBER 1999
CHECKED BY: BAS	SHEET 9 OF 41

ENGINEER'S SEAL

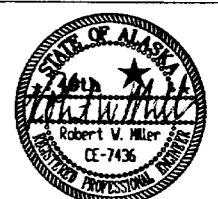


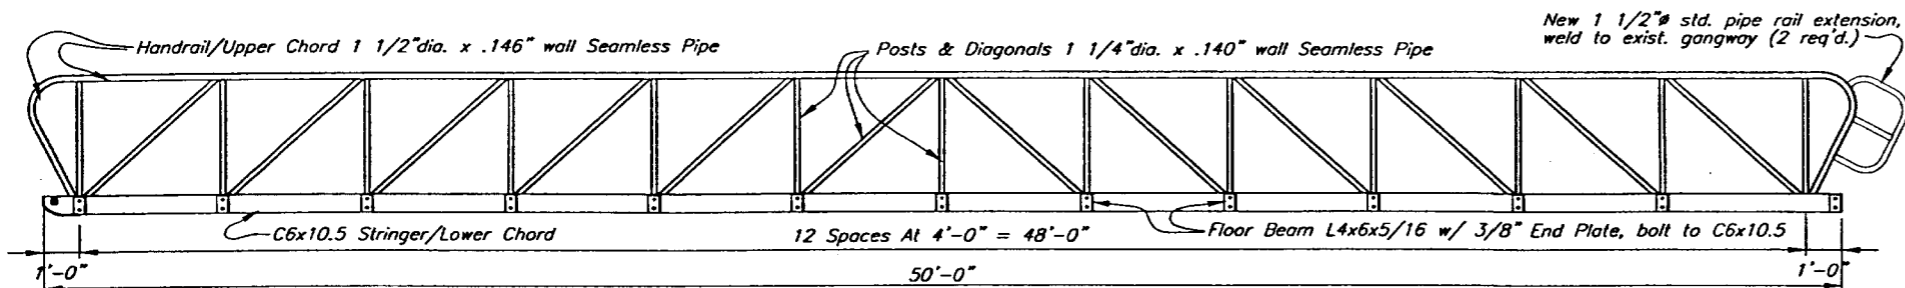

EXISTING GANGWAY SIDE ELEVATION

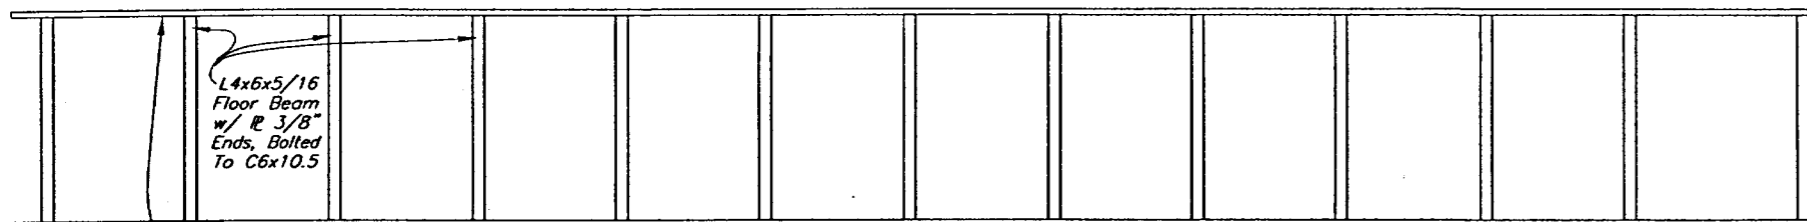


EXISTING GANGWAY FLOOR BEAM LAYOUT

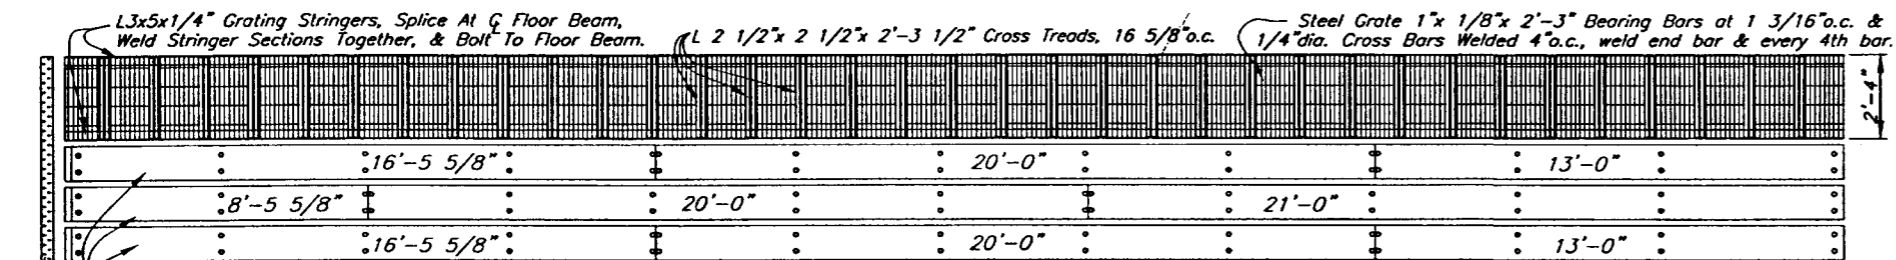


GANGWAY DECKING LAYOUT

New Decking Required At Both Craig & Hydaburg

Supply New 2x12 Penta Treated Timber Planks, lengths as shown or field cut, field drill for new 3/8 inch dia. econ. hd. bolts. Notch Decking 2 1/4 inch wide x 1/4 inch deep for cover plate. Reuse Exist. Transition Cover Plate (supply new screws, bolts, nuts & washers).

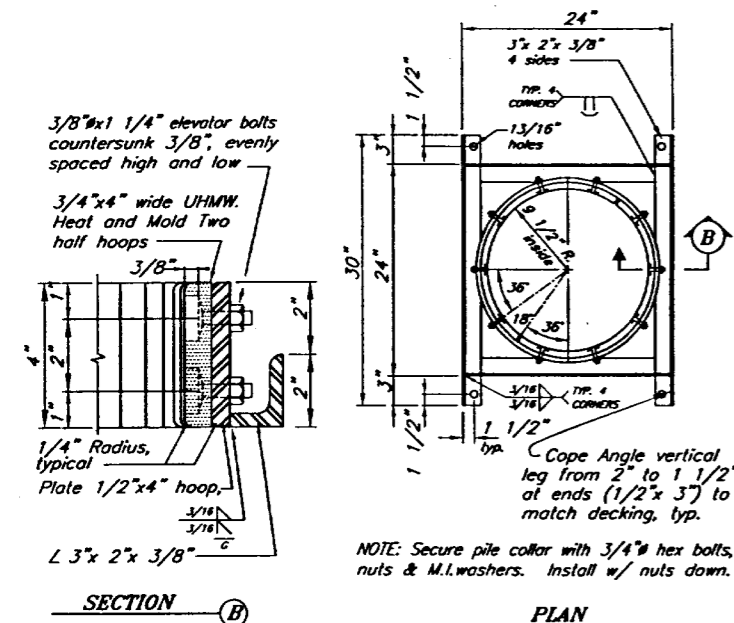


PILE COLLAR DETAIL  
(HYDABURG MARGINAL & GANGWAY FLOATS)

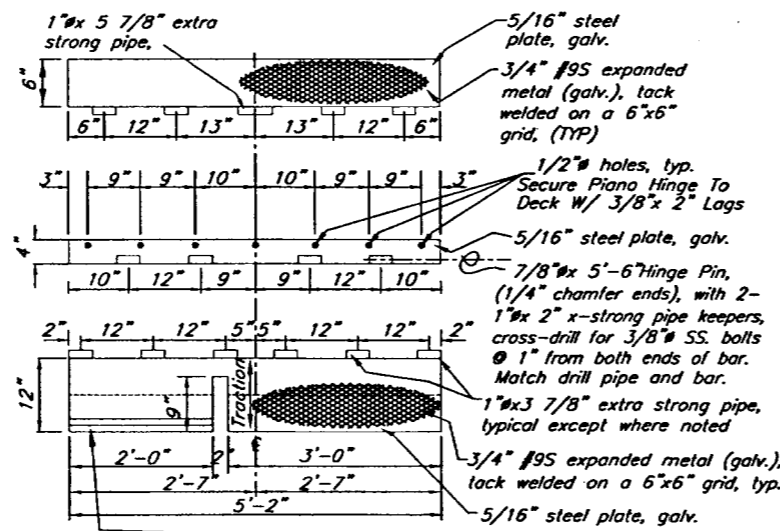


TRANSITION PLATE PLAN


New Transition Plate Required At Both Craig & Hydaburg

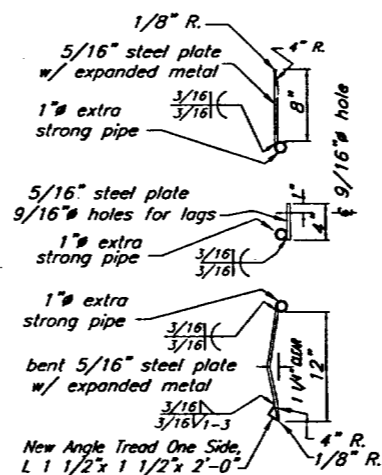


TRANSITION PLATE, END VIEW

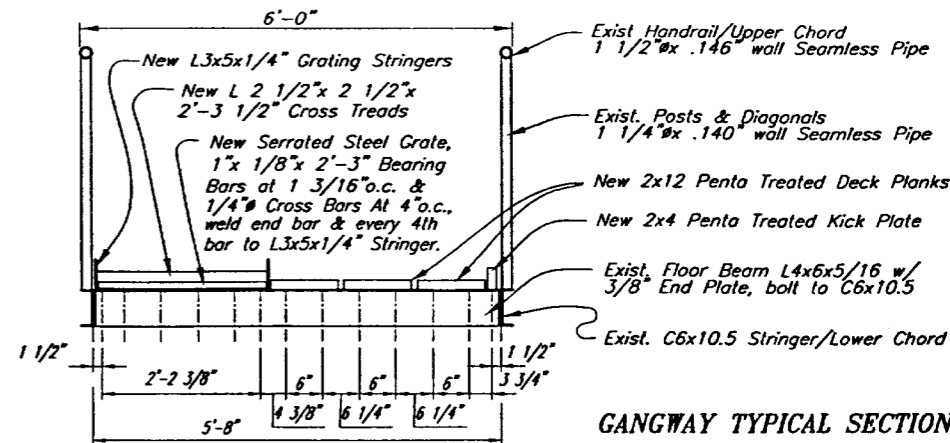


GANGWAY TYPICAL SECTION

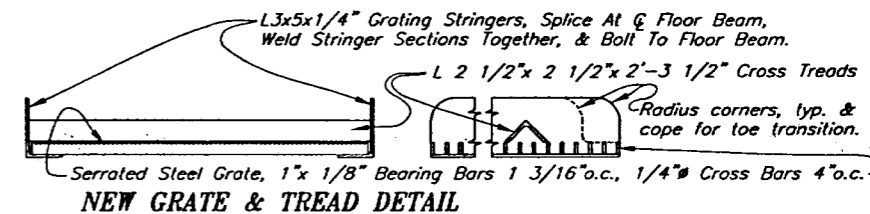

NEW GRATE & TREAD DETAIL

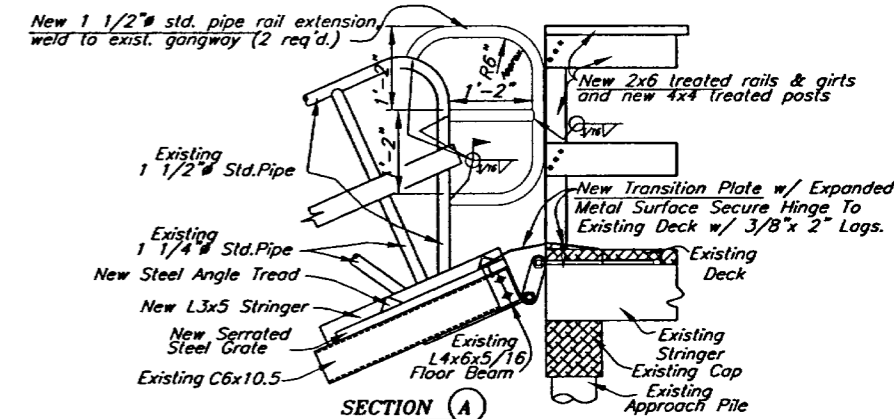

SECTION A

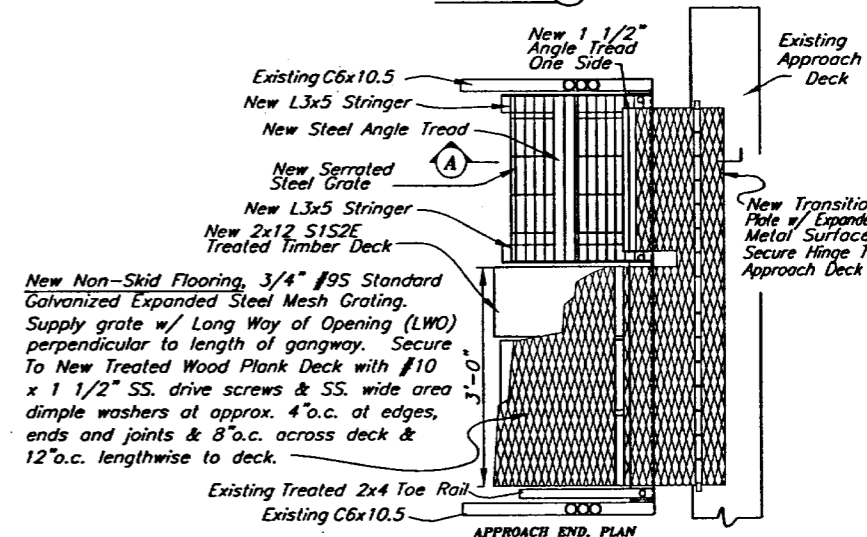

APPROACH END PLAN

GANGWAY MODIFICATIONS

New Transition Plate, Decking & Handrail Loops Required At Both Craig & Hydaburg Gangways


NOTE: DO NOT SCALE FROM THESE PLANS-USE DIMENSIONS


PATH: Q:\SEA\67746\M\Sheet10.dwg	10/14/1999	13:32
BY:	DATE:	DESCRIPTION OF CHANGE:
RECORD OF REVISIONS		

STATE OF ALASKA  
DEPARTMENT OF TRANSPORTATION  
AND PUBLIC FACILITIES  
SOUTHEAST REGION DESIGN & CONSTRUCTION

CRAIG & HYDABURG  
HARBOR REHAB PROJECTS  
Proj. No. 67746  
ALASKA  
CRAIG & HYDABURG HARBOR MISC. DETAILS

DESIGNED BY: RWM	PROJECT NO. 67746
DRAWN BY: BN	DATE: DECEMBER 1999
CHECKED BY: BAS	SHEET 10 OF 41

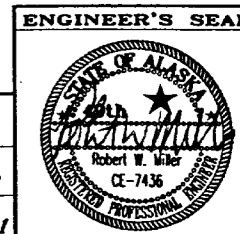

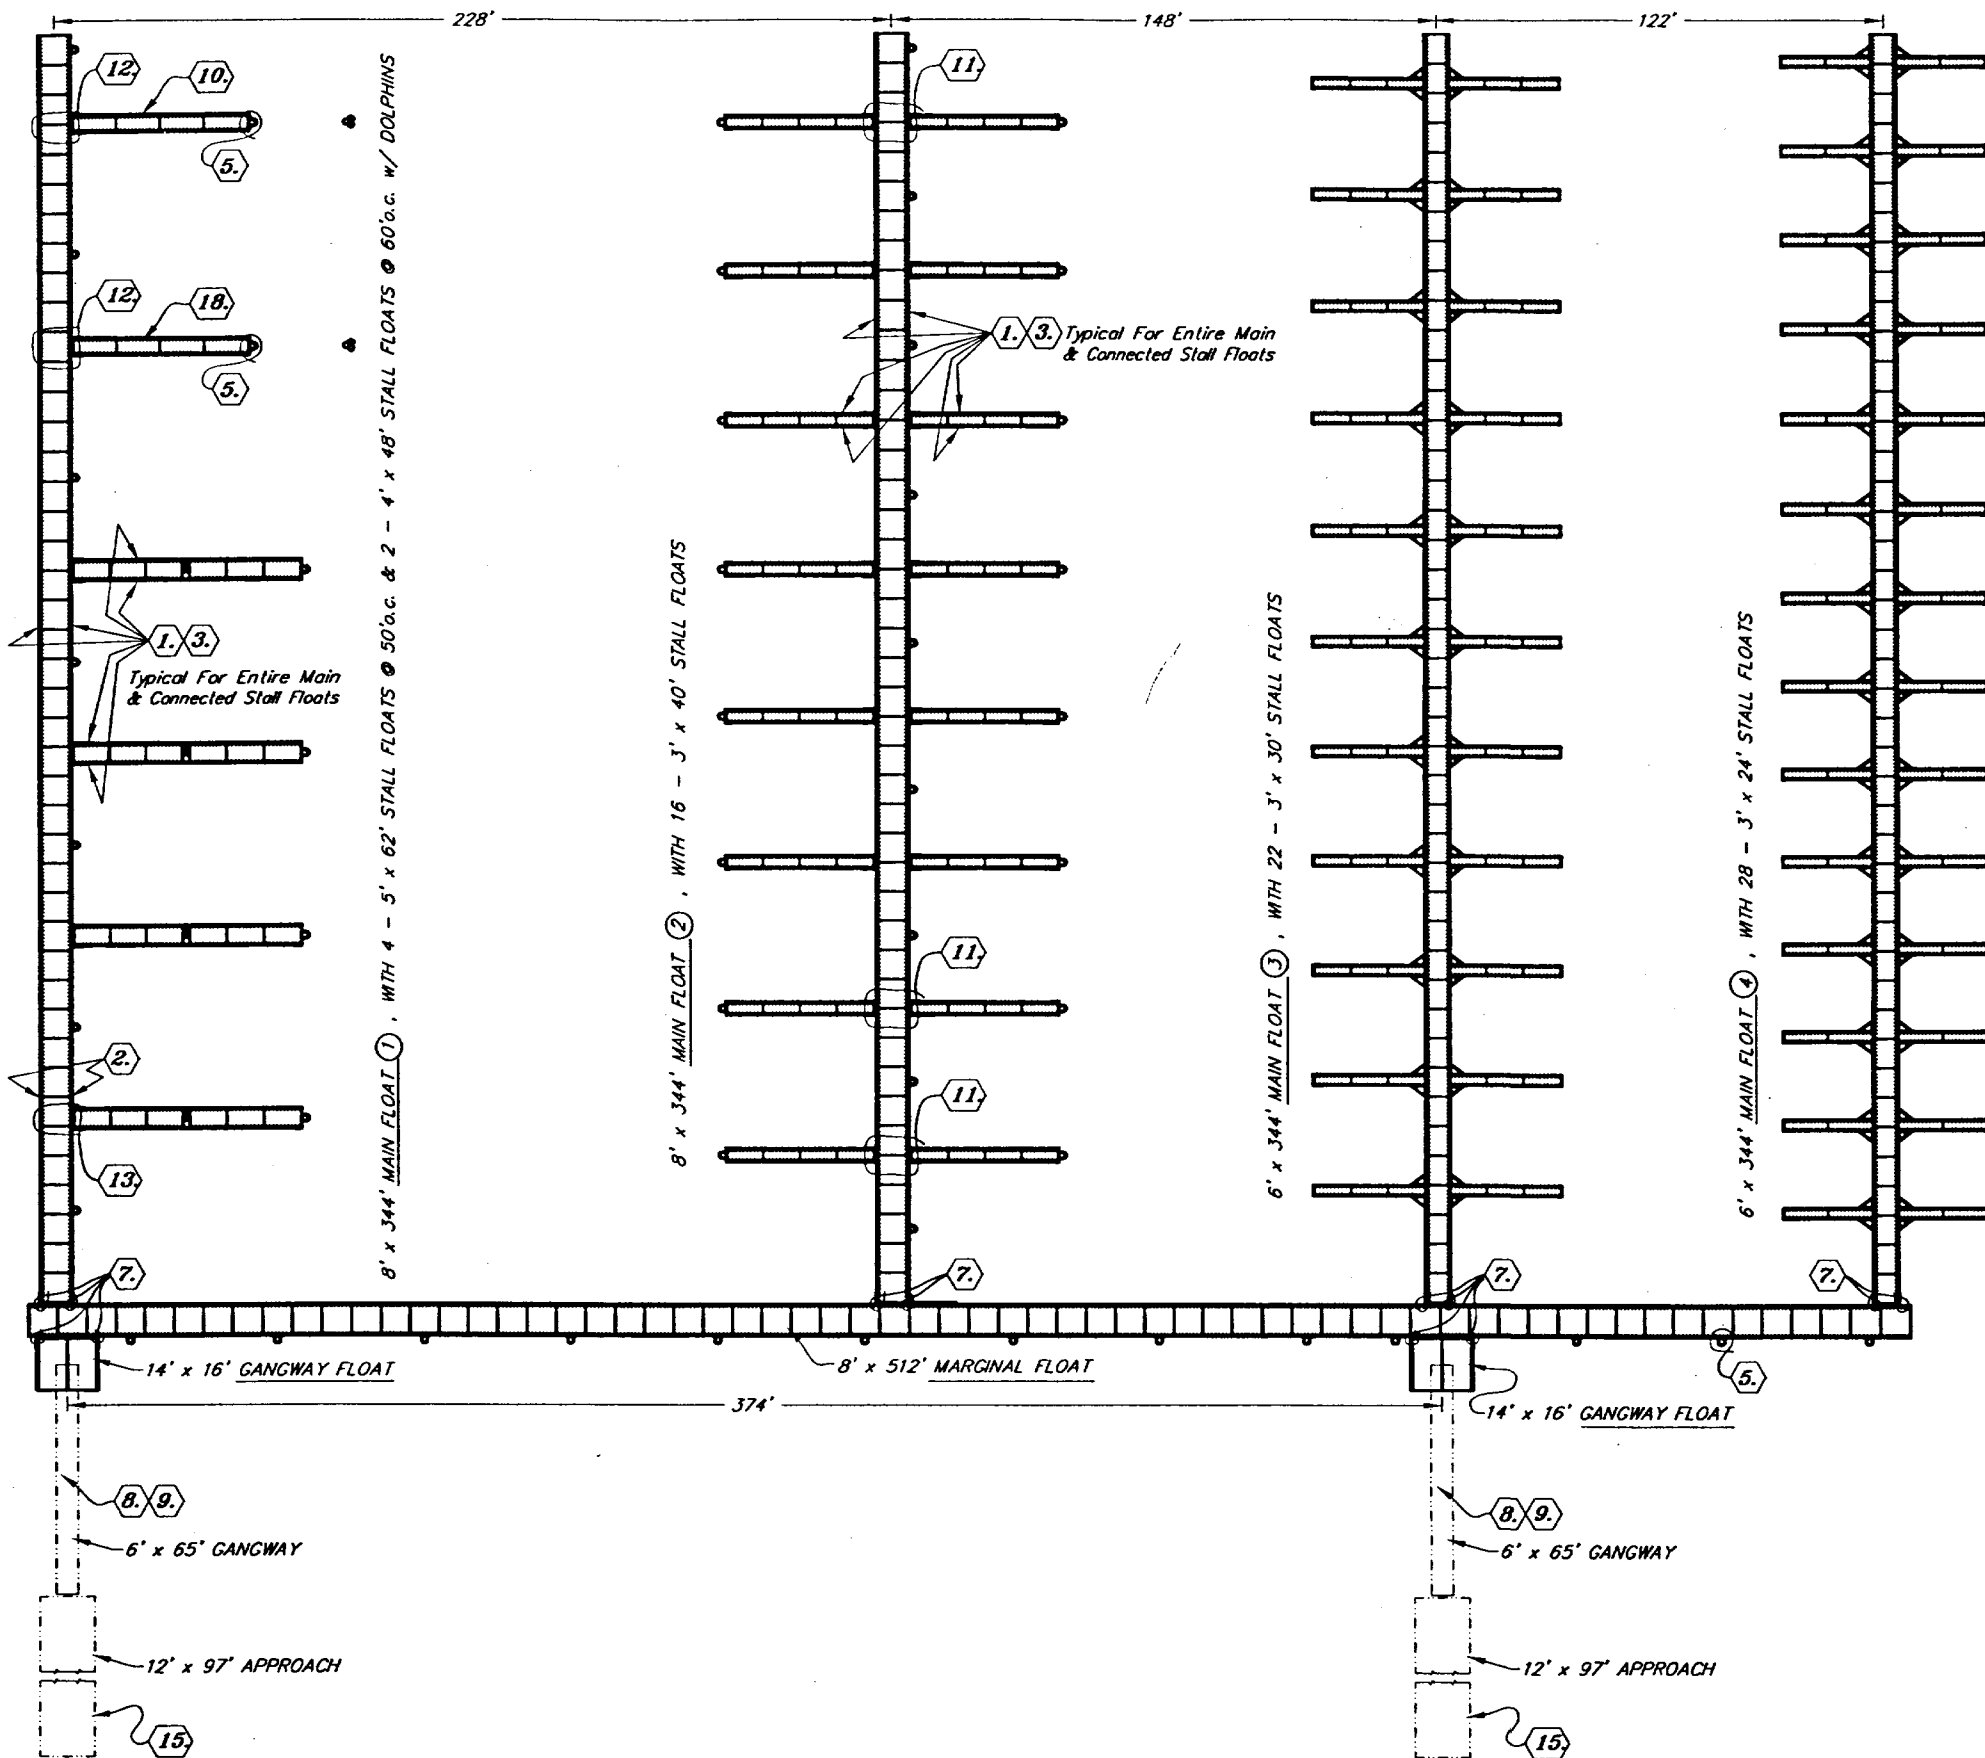

**HARBOR REHAB PROJECT NOTES :**

- ①. Remove & replace all 2x8 bumper boards on Main Floats 1 & 2 & all Stall Floats connected to Main Floats 1 & 2. Bumper boards have 3 1/2" x 1/2" deep C-bore & 2" hole thru at center, spaced 12" o.c. Begin holes at 6" from ends. Pressure treat wood with pentachlorophenol in light oil after drilling holes. See Detail Sheet for Bumper Board
- ②. Remove & Replace all Broken 3x8 wales (estimated 2 locations). Wales have 3/4" holes through timber spaced 12" o.c. along centerline of face, beginning 6" from ends. Pressure treat wood w/ pentachlorophenol in light oil solution after drilling holes. Floats have 2 wales each side with staggered splices. Removal of thru rods from at least 24 LF. of float (min. 12 rods) is required for repair.
- ③. Check & Tighten all thru Rods on Main Floats 1 & 2 and all connected Stall Floats. Replace all broken or missing thru rods where required. Each float unit is tied to wales with 4 req'd thru rods, plus rods req'd for hinges & pile collars (8'-0" long float has 8 conduits, 12" oc.)
- ④. Pressure Wash bottoms and sides of all Main, Marginal, and Stall floats to remove marine growth.
- ⑤. Replace 3 Pile Collars, Two end collars at the 4' x 48' Stall floats with Three 5/8" x 5'-0" Thru Rods each collar, and One exterior collar at the Marginal float with Four 5/8" x 5'-0" Thru Rods. See Collar Details Sht.12. See also note 3 above.
- ⑥. Tighten all Stall Float attachment brackets and Replace Broken or Damaged Brackets. Small cracks in attachment brackets or pile collars shall be ground out and repaired with field welds.
- ⑦. Replace 12ea. 1" Hinge Bolts at Main Float & Gangway Float connections to the Marginal Float. Replace all worn stall hinge bolts. Hinge bolts are tack welded to the C4x7.25 channel connector, new bolt welds will require galvanize coating repair per spec.
- ⑧. Supply & Install 3'-0" wide galvanized 1 1/2" #65 Standard Steel Expanded Grating along one side of both 6' x 65' Gangways. Grating Long Way of Opening shall be Perpendicular to the gangway length. Secure over surface of existing open bar steel grate deck with tack welds approx. 3" o.c. along edges & ends and 12" o.c. each way over surface.
- ⑨. Install angle iron tread at bottom of both gangways adjacent to piano hinge at the toe transition. The angles are 1 1/2" x 1 1/2" x 3/16" x 2'-0" long, placed touching top edge of hinge, weld to fixed side of hinge & tack to bearing bars. Placement shall not interfere with hinge movement.
- ⑩. Replace the 6x6 Tie Down Rail on the seaward edge of the end 4' x 48' stall on main float 1. Carefully measure existing 6x6 & fabricate new members to reuse existing bolt holes. Pressure treat wood with pentachlorophenol in light oil solution after cutting dapp joints & drilling holes.
- ⑪. Remove & Reinstall Stall Float Hinges (3 locations w/ 2 adjacent stalls). Supply at each location 3ea. 5/8" x 9'-0" Main Float Thru Rods & Four 1" Hinge Bolts with all Nuts, Washers & Pins, As Required.
- ⑫. Supply & Install Entire Stall Float Hinge Assembly at Two Locations. Supply at each location 4ea. 5/8" x 9'-0" Main Float Thru Rods, 3ea. 5/8" x 5'-0" Stall Float Thru Rods & Two 1" Hinge Bolts with all Nuts, Washers & Pins, As Required.
- ⑬. Remove & Reinstall Stall Float Hinges. Supply 4ea. 5/8" x 6'-0" Stall Float Thru Rods & Two 1" Hinge Bolts with all Nuts, Washers & Pins, As Required.
- ⑭. Hot-dip Galvanize all steel weldments and hardware after fabrication. Hardware 1/2" & larger are galvanized, hardware 3/8" & smaller are stainless steel.
- ⑮. Replace missing & damaged handrail & girts on approach to gangway. Pressure treat wood w/ pentachlorophenol in light oil solution.
- ⑯. All tie-down rails, wales & bumper shall be pressure treated with pentachlorophenol in light oil solution. All cut ends and holes (include temporary nail holes) shall get three brush applied coats of copper naphthenate in light oil solution. Plug abandoned holes 1/4" & larger w/ same size treated dowels & seal all holes w/ roof pitch.
- ⑰. The adjacent layout has notes for only the most obvious damage, the contractor shall adjust & lighten all connections, & repair other minor damage as required.
- ⑱. Supply & Install one new 4' x 48' stall float assembled with 3x8 wales, 5/8" thru-rods, 6x6 tie-down rail, 4x6 blocking, and 2x8 bumper board (see as-built Sht.35 of 41) to replace missing float, secure with new pile collar (note 5 above) & new hinges (note 12 above).
- ⑲. The Contractor Shall Provide the following new materials. Any remaining new materials shall be stockpiled, as directed, at Juneau, Alaska.

1. 3500 LF. 2x8 treated Bumper Boards
2. 12ea. 3x8x16'-0" float Wale
3. 30ea. 5/8" x 9'-0" main float thru rods w/60 nuts & 60 M.I. washers.
4. 12ea. 5/8" x 6'-0" stall float thru rods w/24 nuts & 24 M.I. washers.(5'x62"stall)
5. 12ea. 5/8" x 5'-0"stall float thru rods w/24 nuts & 24 M.I. washers.(4'x48"stall)
6. 12ea. 5/8" x 4'-8 1/2"stall float t-rods w/24 nuts & 24 M.I. washers.(3'x40"stall)
7. 6ea. 5/8" x 3'-4"stall float thru rods w/12 nuts & 12 M.I. washers.(2'-9"x21"stall)
8. 2ea. 4'x48"stall attachment brackets, main float 1
9. 2ea. 3'x40"stall attachment brackets, main float 2
10. 2ea Pile Collars for end 4'x48' stall float
11. One ea. Exterior Pile Collars, marginal & main floats
12. 48ea. 1" Hinge Bolts, Nuts & 1/4 Cotter Pins
13. 48lf 6x6 tie down rail, 5ea 4x6x8" scupper blocks & 4ea 4x6x2'-0" splice blocks @ end 4'x48"stall float
14. 17ea 3/4" x 18" econ. hd. tie-down rail bolts
15. 400sf., Galv. 1 1/2" #65 Standard Steel Expanded Grate, at gwys
16. 2ea galv. 1 1/2" x 1 1/2" x 3/16" angle, at gangways
17. Pressure treated approach handrail & girts, 4ea 2x6x16'-0" & 6ea 2x4x16'-0"
18. One ea. 4' x 48' concrete stall float, complete & in place.
19. Supply all consumables, cleaners, fasteners, coatings & wood treatments required to complete installation.


NOTE: DO NOT SCALE FROM THESE PLANS-USE DIMENSIONS


PATH: Q:\SEA\67746\MA\Sbcel11.dwg 10/14/1999 15:49	
BY:	DESCRIPTION OF CHANGE:
DATE:	
RECORD OF REVISIONS	

STATE OF ALASKA  
 DEPARTMENT OF TRANSPORTATION  
 AND PUBLIC FACILITIES  
 SOUTHEAST REGION DESIGN & CONSTRUCTION


METLAKATLA  
 HARBOR REHAB PROJECTS  
 Proj. No. 67746  
 ALASKA  
 METLAKATLA MAIN HARBOR LAYOUT

DESIGNED BY: RWM	PROJECT NO. 67746
DRAWN BY: BN	DATE: DECEMBER 1999
CHECKED BY: BAS	SHEET 11 OF 41

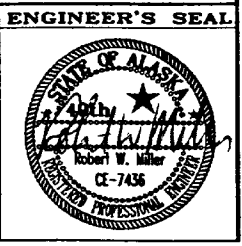


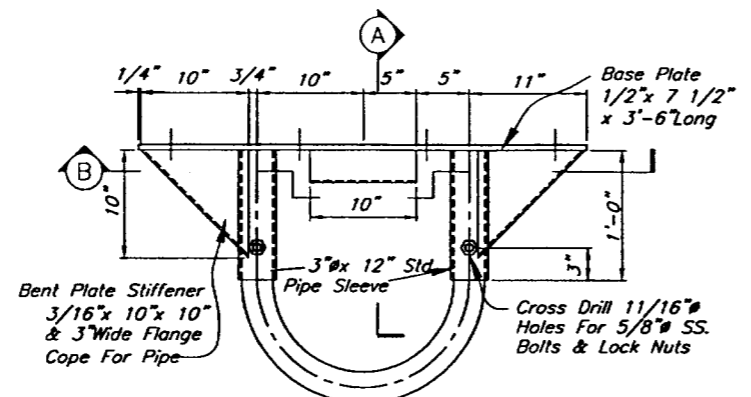


TOP VIEW

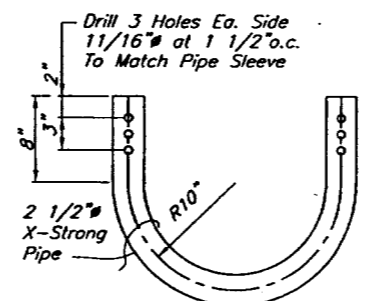


REMOVABLE PIPE LOOP

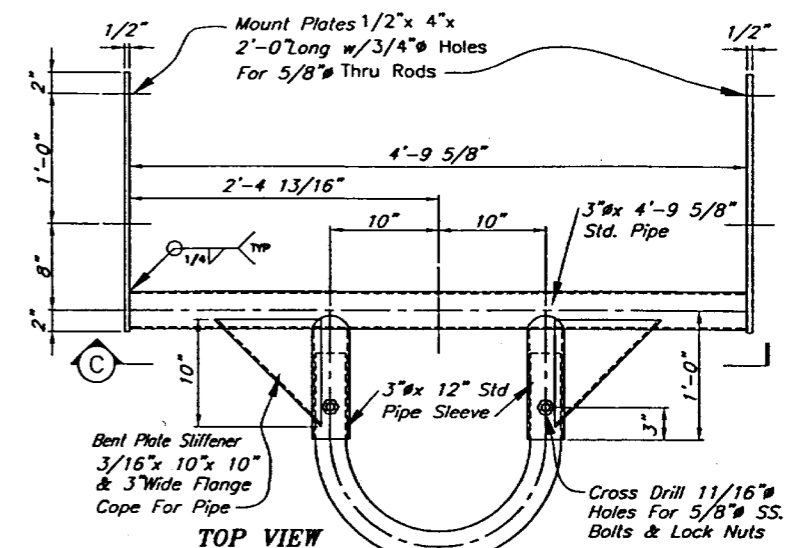


TOP VIEW

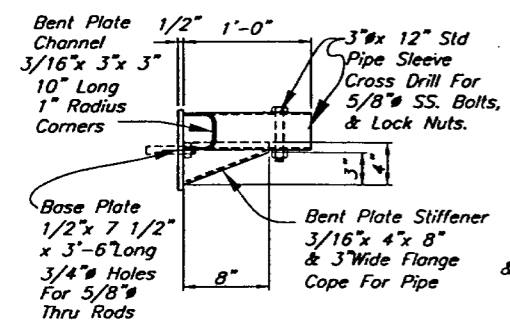


SECTION A

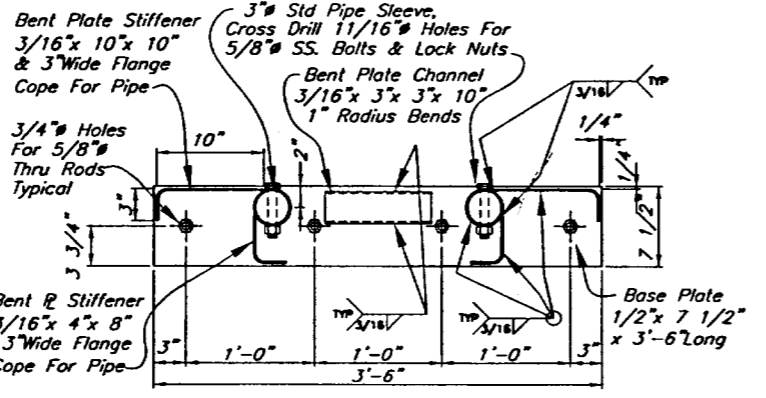

SECTION B

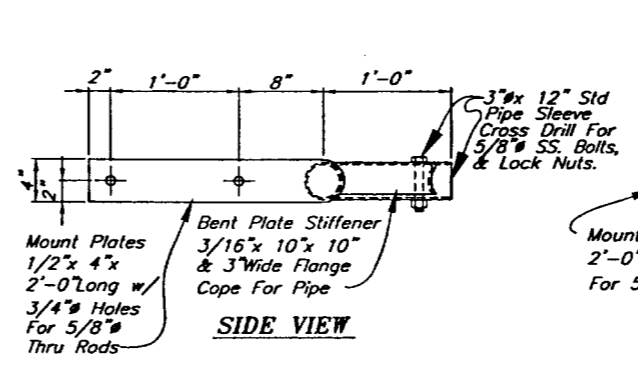


SIDE VIEW

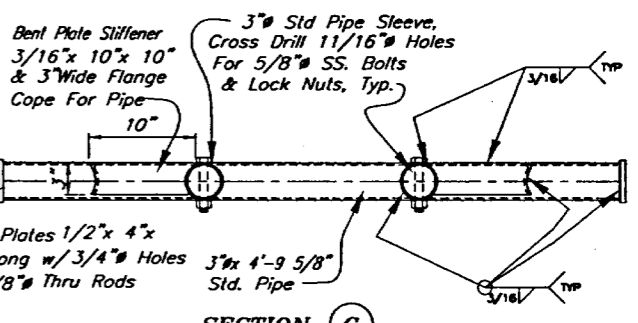

SECTION C


**NEW EXTERIOR PILE COLLAR**  
(MARGINAL FLOAT, ONE REQ'D.)

**NEW END PILE COLLAR @ 4' x 48' STALL FLOAT**

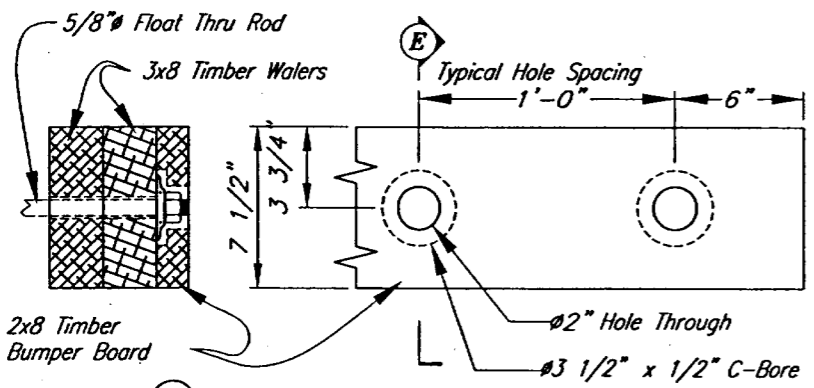

SECTION E

**BUMPER BOARD DETAIL**

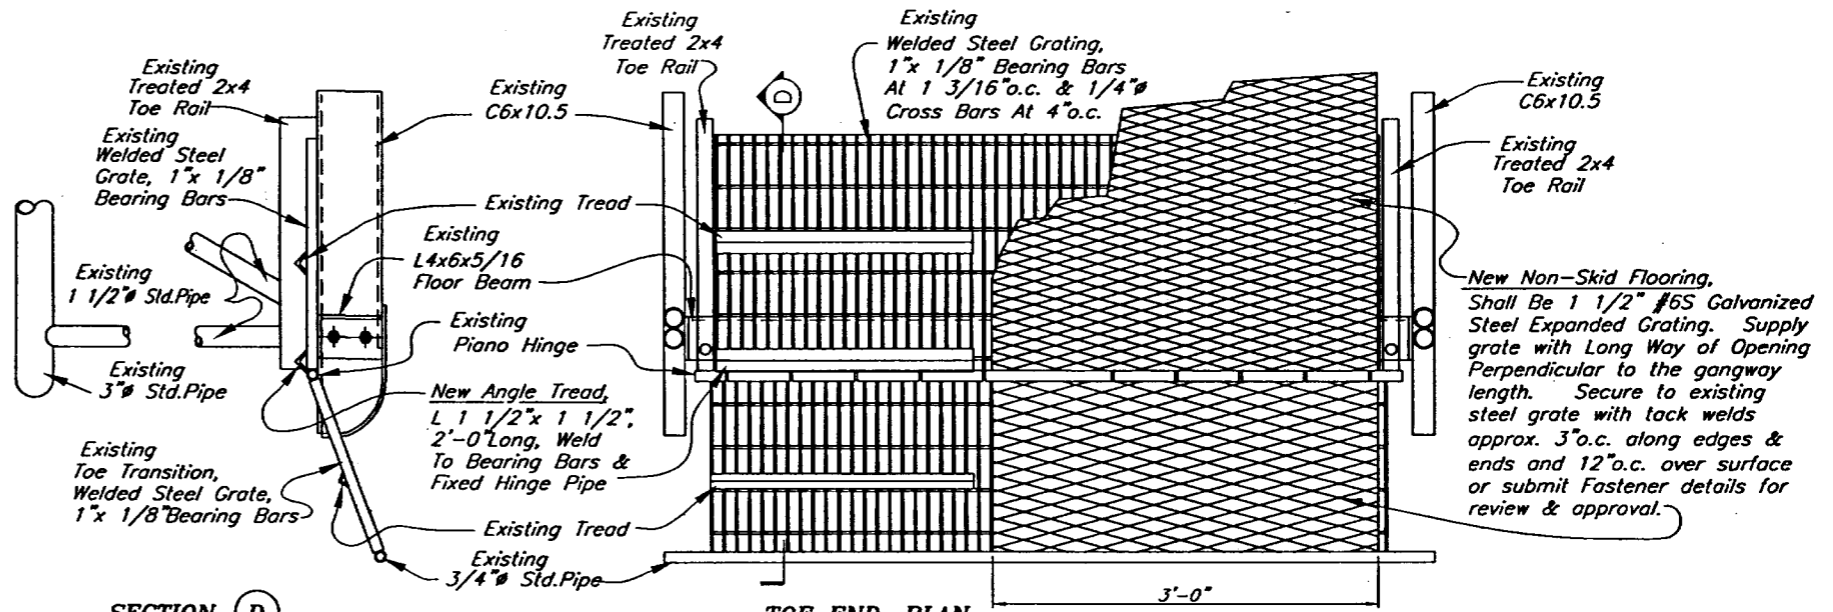

SECTION D

**EXISTING GANGWAY MODIFICATIONS**


NOTE: DO NOT SCALE FROM THESE PLANS--USE DIMENSIONS


PATH: Q:\SEA\67746\Sheet12.dwg Plot Scale=12.00 10/15/1999 16:33		
BY:	DATE:	DESCRIPTION OF CHANGE:
RECORD OF REVISIONS		

STATE OF ALASKA  
DEPARTMENT OF TRANSPORTATION  
AND PUBLIC FACILITIES  
SOUTHEAST REGION DESIGN & CONSTRUCTION


METLAKATLA  
HARBOR REHAB PROJECTS  
Proj. No. 67746  
ALASKA  
METLAKATLA HARBOR MISC. DETAILS

DESIGNED BY: RWM	PROJECT NO. 67746
DRAWN BY: BN	DATE: DECEMBER, 1999
CHECKED BY: BAS	SHEET 12 OF 41

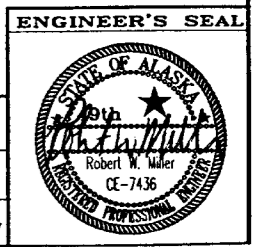

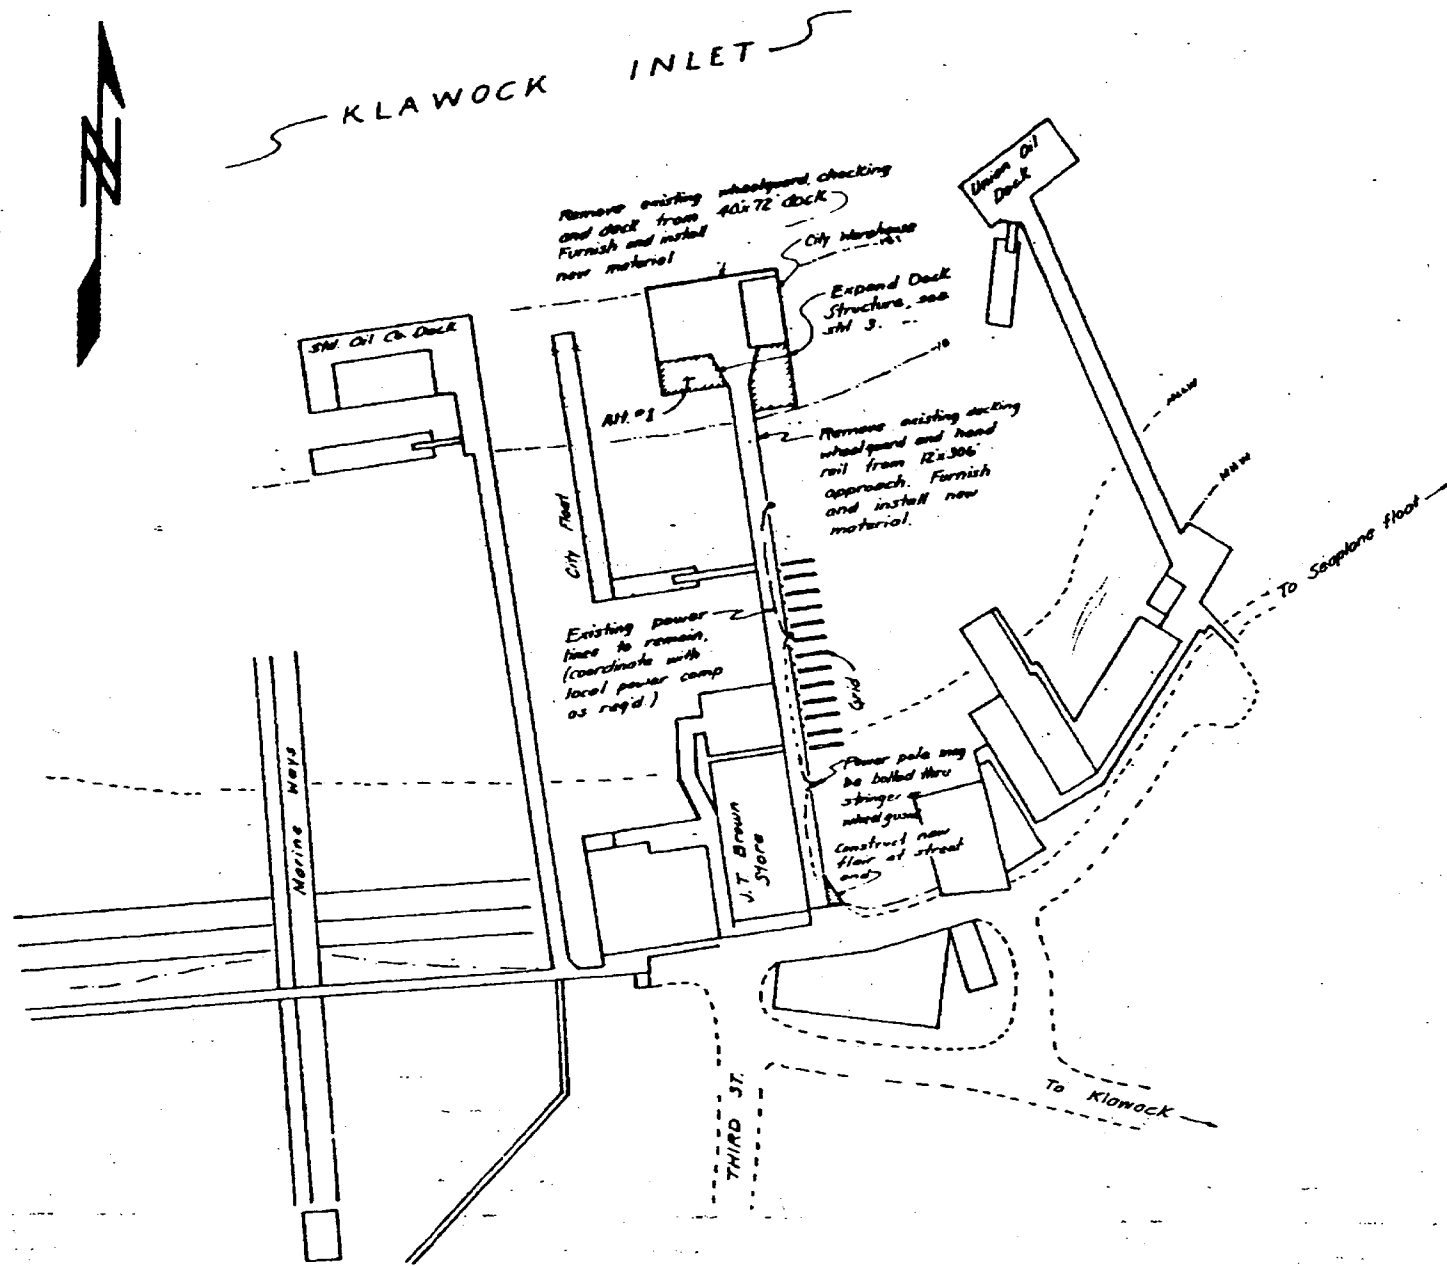

**PROJECT LAYOUT**  
1/2" = 1'-0"

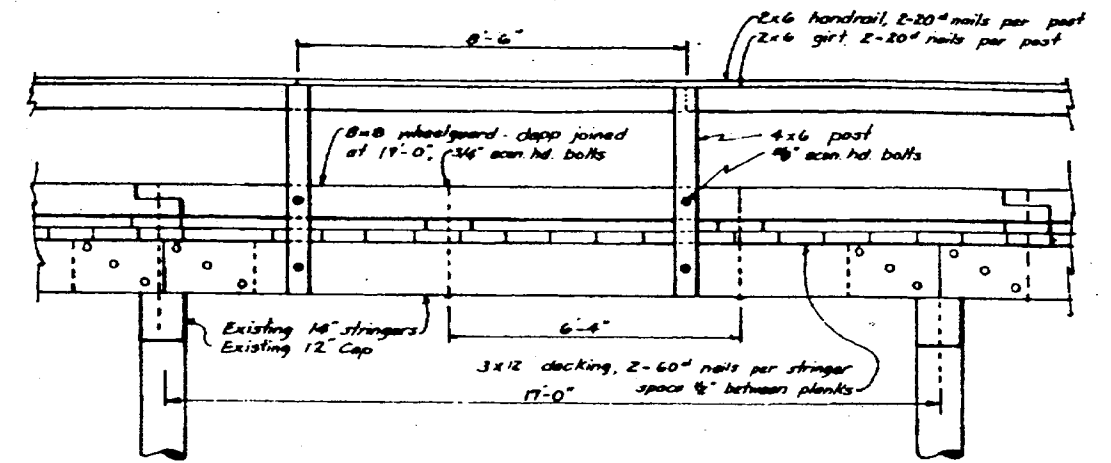


**APPROACH ELEVATION**  
1/2" = 1'-0"


Remove existing native materials and install new penta treated:

- 2x6, S4S handrail -
- 2x6, S4S girt -
- 4x6, S4S post
- 8x8, S4S wheelguard,
- 4x8x1'-0", S4S scupper block
- Creosote 3x12, S1S2E decking

Cross hatched members to remain.

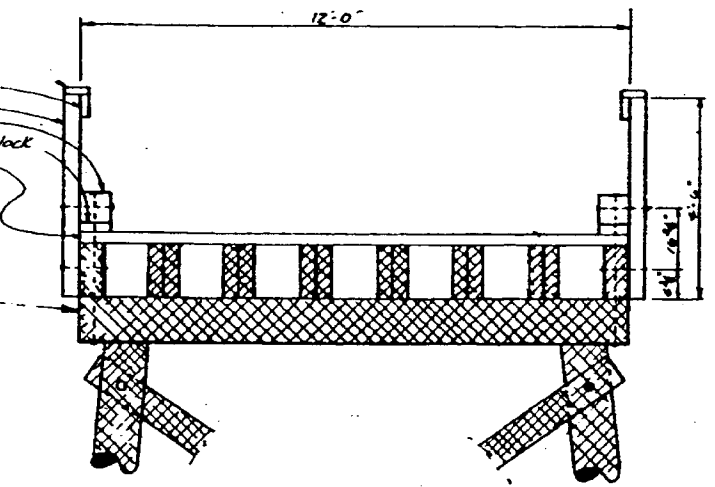

**APPROACH SECTION**  
1/2" = 1'-0"

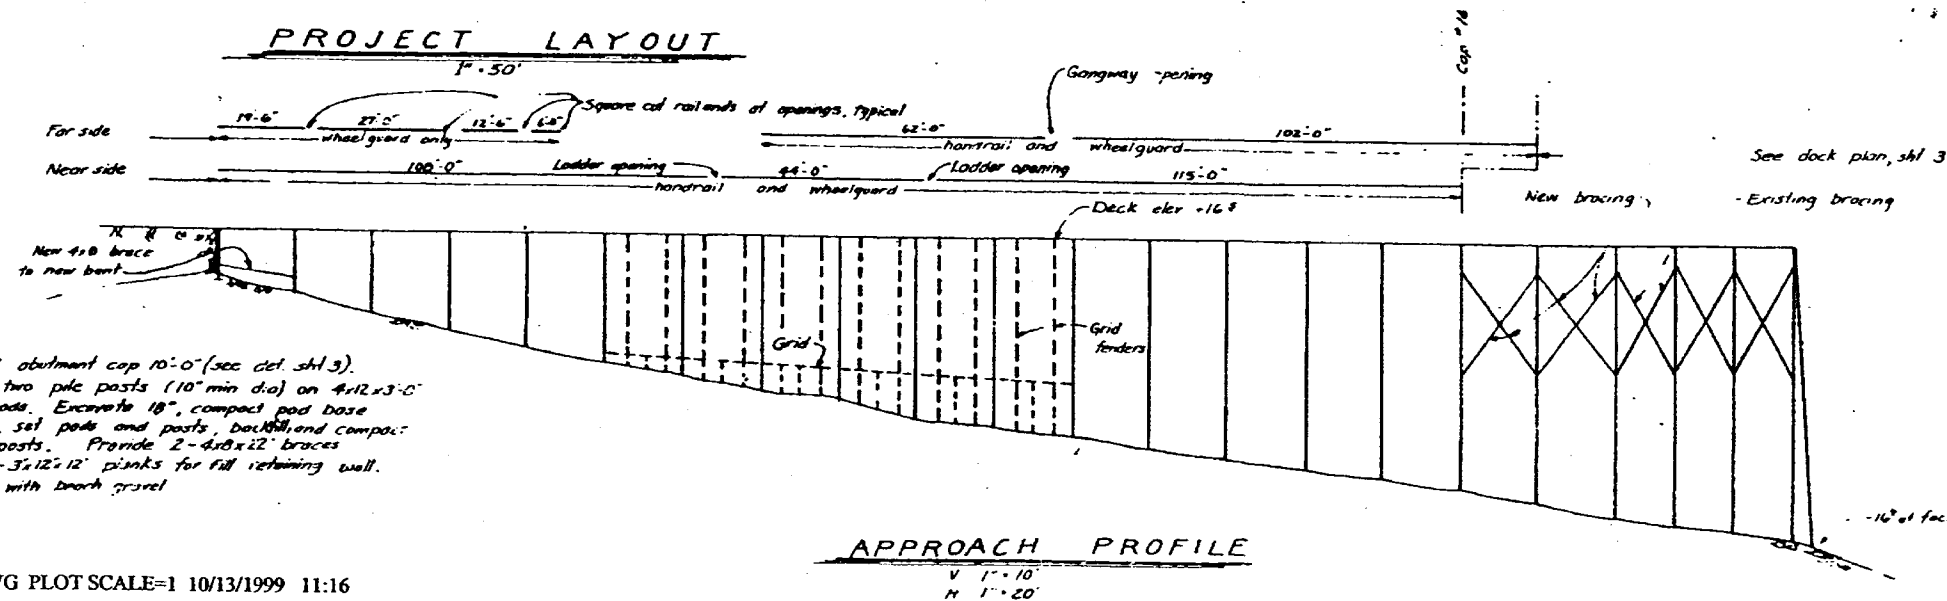



**APPROACH PROFILE**  
V 1" = 10'  
H 1" = 20'

**AS BUILT**  
Sheet 13 of 41




*Robert J. Baker*

DO NOT SCALE THIS DRAWING. USE DIMENSIONS.		
STATE OF ALASKA DEPARTMENT OF PUBLIC WORKS DIVISION OF WATER AND HARBORS		
Craig	Alaska	
Project Layout and Approach Reconstruction Details		
SCALE AS NOTED	DESIGNED BY MAY 1998	CHECKED BY DATE July 6
PROJECT NUMBER 874029	APPROVED Don Stoffer SUPERVISOR	
SHEET 2 OF 10		





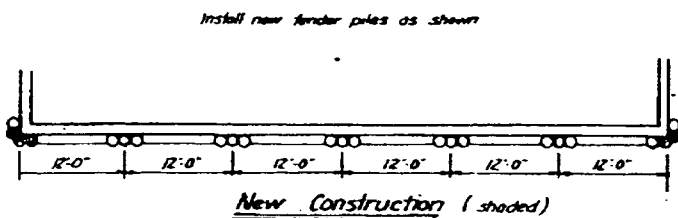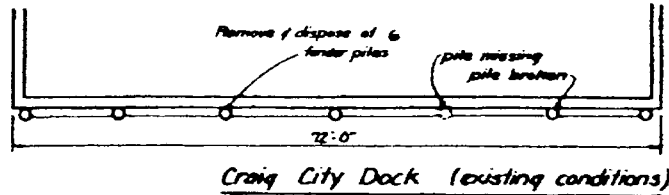

Note: Provide and install 3-3/8"x16" bracing as directed by engineer

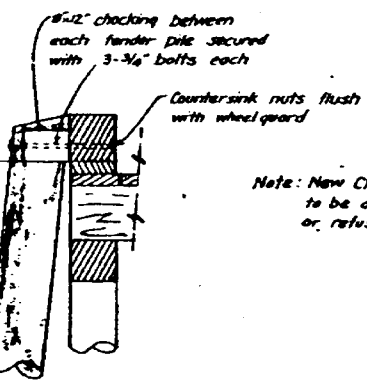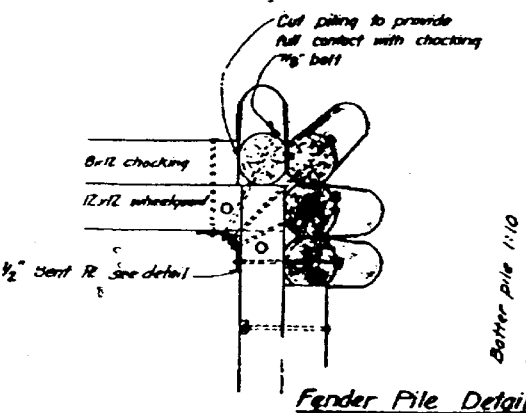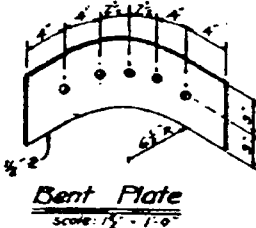

Craig City Dock Reconstruction

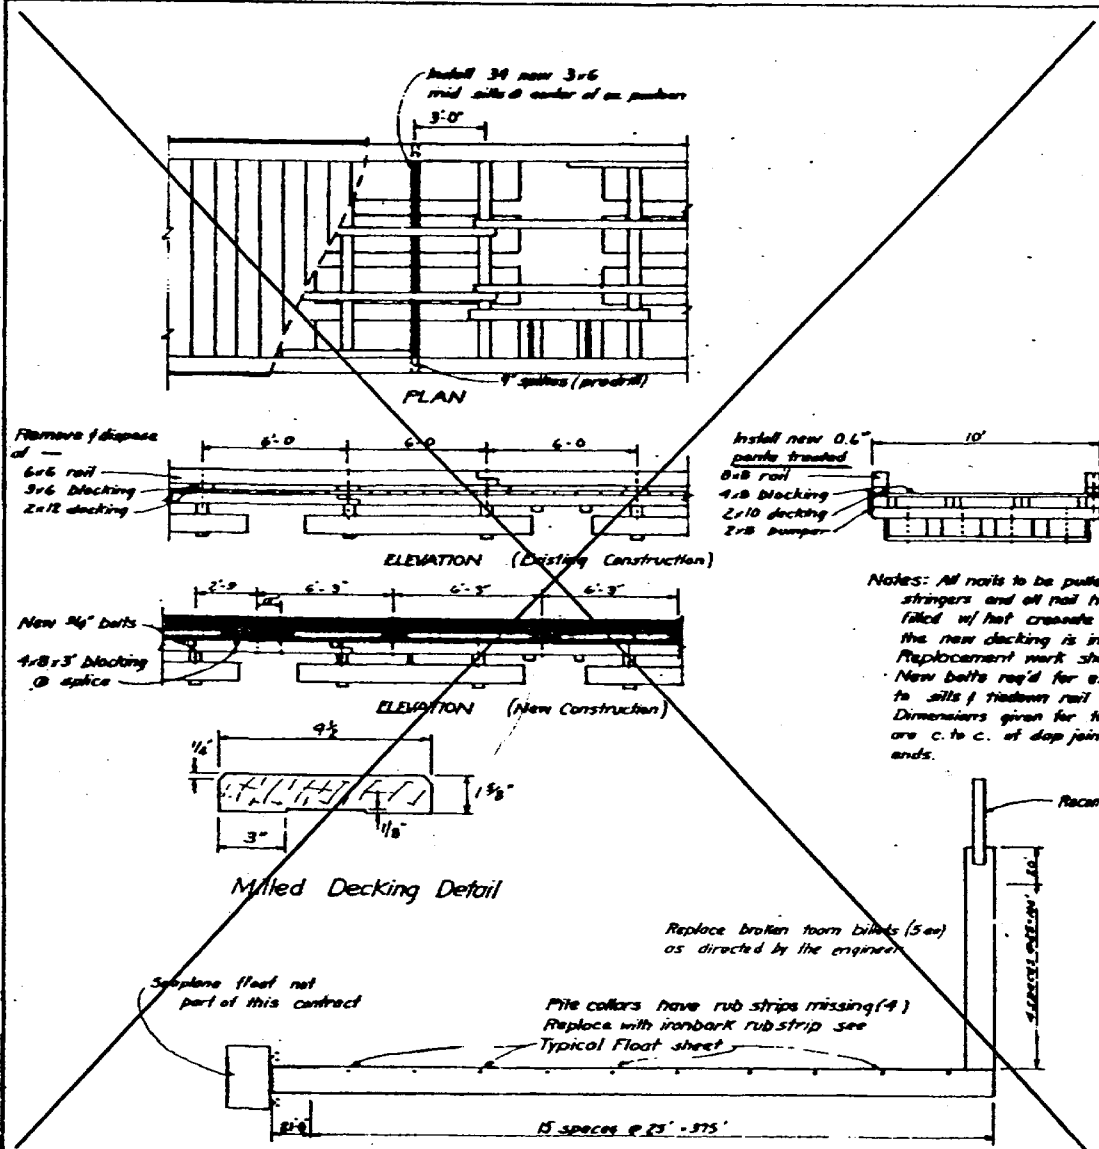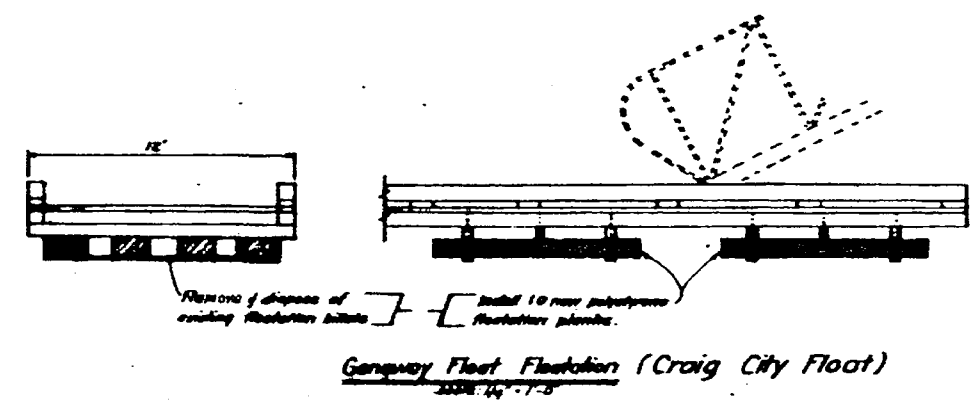


TDR LAYOUT  
Klawock ALASKA

AS BUILT  
Sheet 15 of 41


DO NOT SCALE THIS DRAWING - USE DIMENSIONS		
STATE OF ALASKA DEPARTMENT OF PUBLIC WORKS DIVISION OF WATER AND HARBORS		
Craig	Alaska	
City Float and Dock		
Klawock	Alaska	
SCALE AS NOTED	DRAWN BY HRM	APPROVED
DESIGNED BY	DATE Mar 74	Don Stotter DIRECTOR
PROJECT NUMBER 5 73:06	SHEET 12 OF 24	



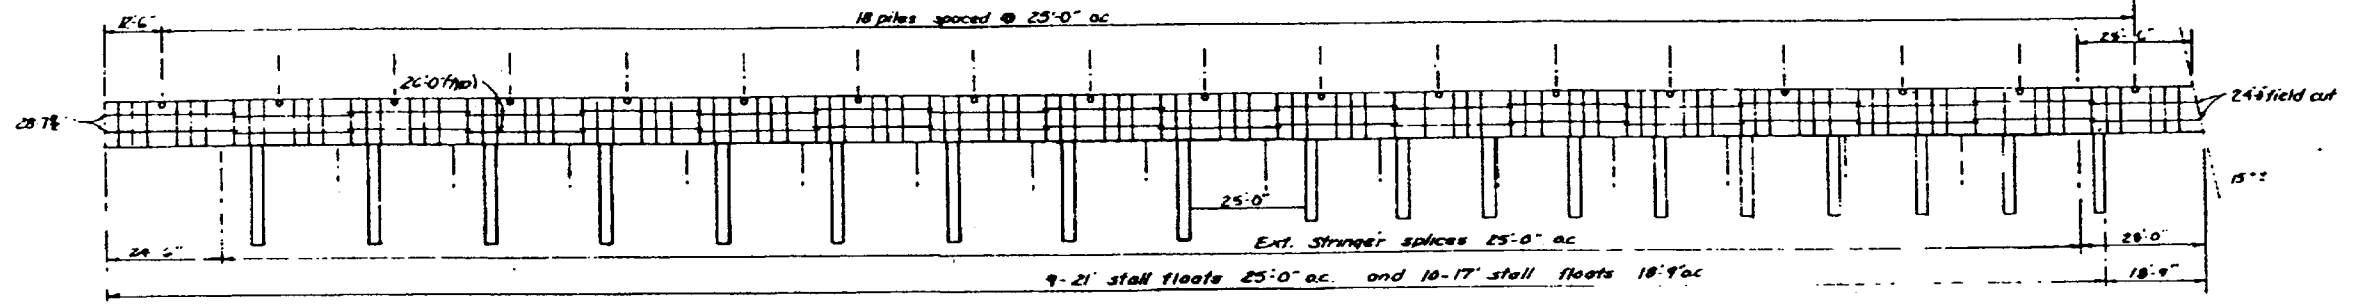


**10'x450' Timber Float Stringer Diagrams**

scale 1"=20'

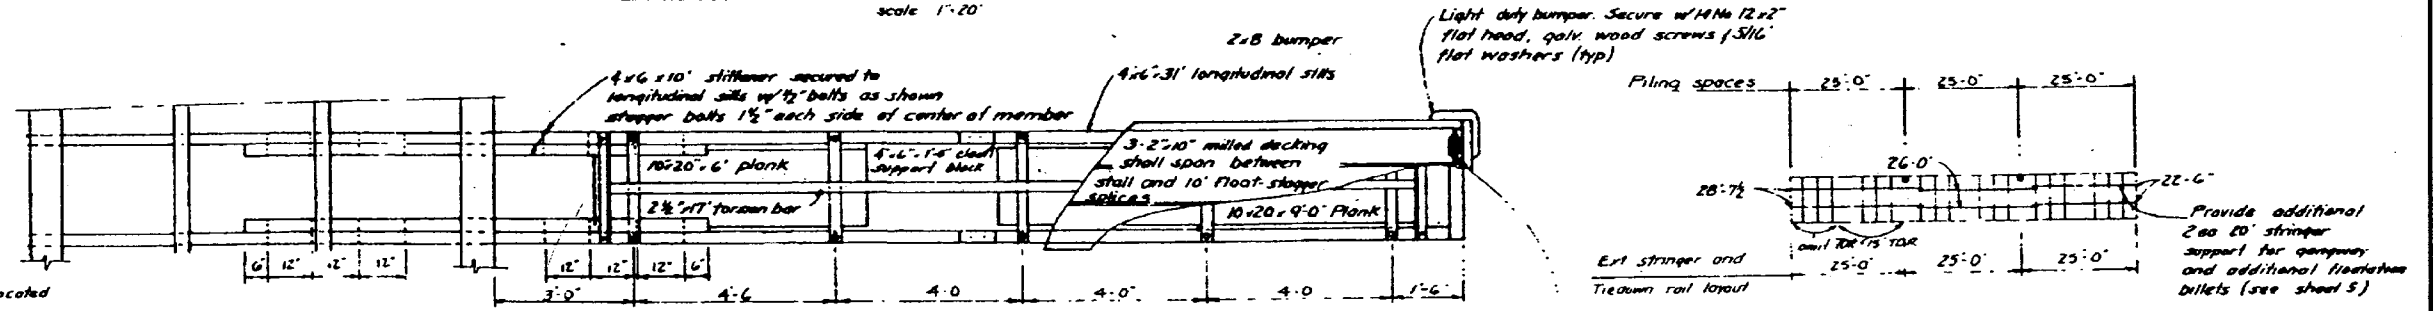

**10'x75' Gangway Float Stringer Diagrams**

scale 1"=20'

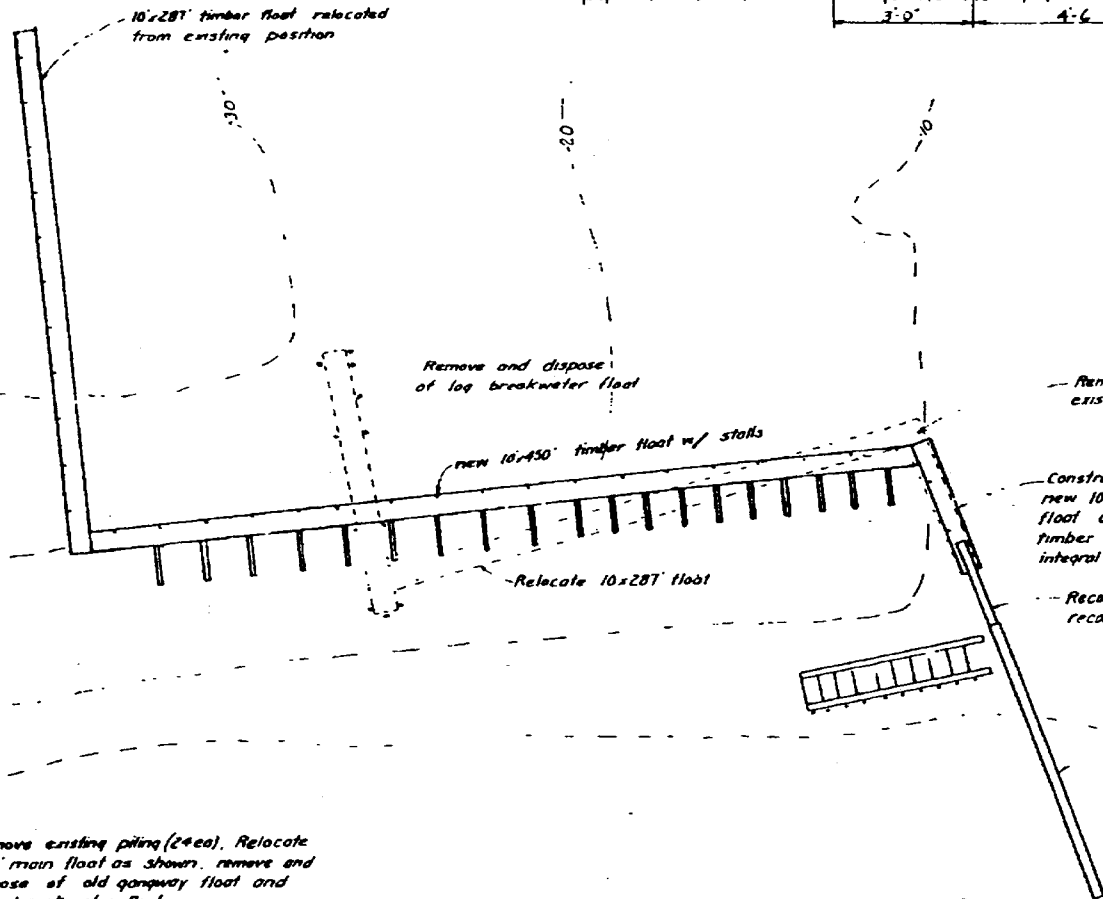

**Project Layout**  
scale 1"=30'

**2'-5 1/2" x 21' Stall Float**  
scale 1/2"=1'-0"

- Notes
- 10' Floats to be constructed as detailed on Typical Float Sheet (Sht #5). Str (TDR) dimensions given from center of dapp to center of dapp or butt ends. Provide TDR at end of 75' float.
  - Final float position to be determined by the engineer
  - Float piling to be driven butt down to 15' penetration or refusal as determined by the engineer. File cut off elevation = -22 =
  - 17' stall floats to be constructed as detailed on sheet 6
  - 21' stall float to be constructed as detailed on this sheet. 21' stall float section and stabilizer details are same as 17' stalls see sheet 6 for details.

- Note
1. Remove existing piling (24ea). Relocate 287' main float as shown. remove and dispose of old gangway float and log breakwater float.
  2. Approximately 12 piles are considered to be reusable but pile soundness will be determined in the field by the engineer

Remove and dispose of existing gangway float


Construct and install new 10'x75' gangway float and 10'x450' timber float with 17' integral stalls

Reconstruct as shown on gangway reconstruction sheet (Sht #3)

Reconstruct superstructure of 6'x156'x9' timber approach (see sht #17)

**AS BUILT**  
**Sheet 17 of 41**

DO NOT SCALE THIS DRAWING USE DIMENSIONS		
STATE OF ALASKA DEPARTMENT OF PUBLIC WORKS DIVISION OF WATER AND HARBORS		
Hydaburg		Alaska
Project Layout and Stringer Diagram		
75		
SCALE AS NOTED	SURVEYED	APPROVED
DESIGNED FM	DRAWN FM	Don Staller
CHECKED DW	DATE Apr 74	DIRETOR
PROJECT NUMBER 3-7506	SHEET 17 OF 24	


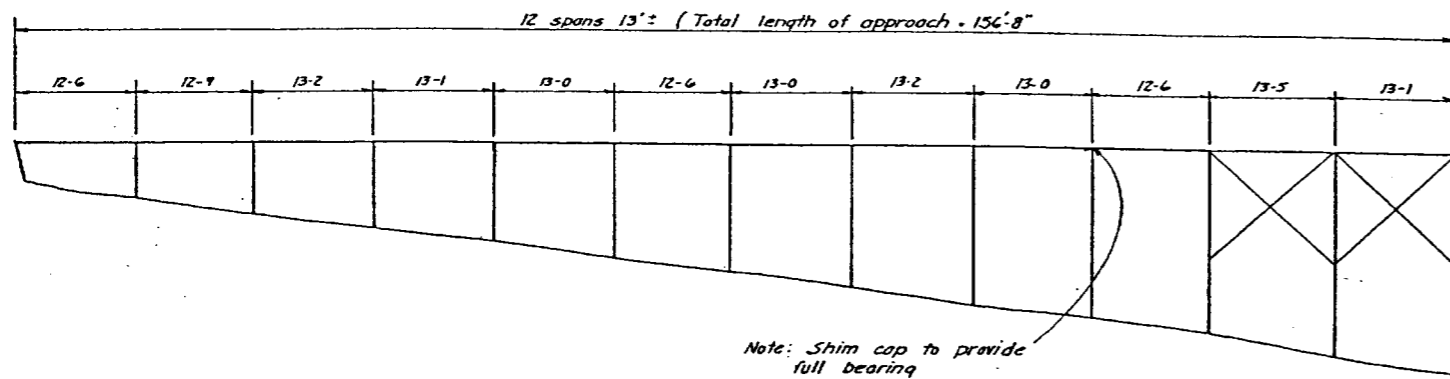


2 replaced  
 Provide for new bracing (3'40-3x8x20' & 2x0-3x8x10') to be installed as directed by the engineer

Note: New Construction Shaded

All nails to be pulled from stringers and all nail holes filled w/hot creosote oil before the new decking is installed

All handrails & girts come cut to 8' lengths.

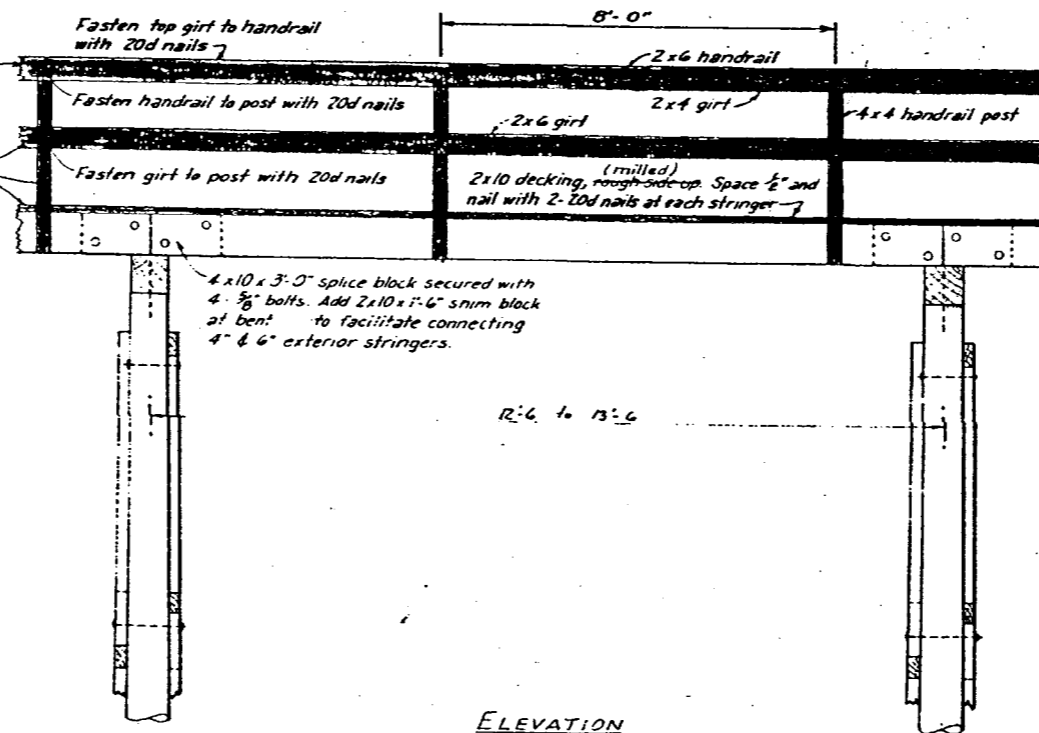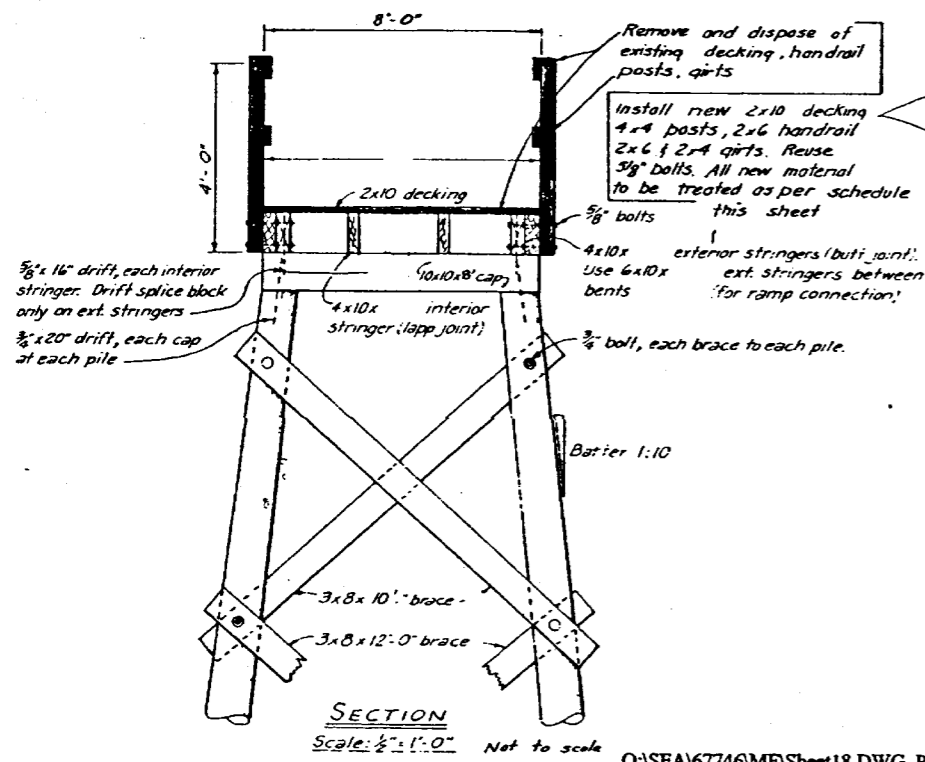

NOTES:

1. All hardware to be hot dip galvanized. A malleable iron washer shall be placed between all nut and wood surfaces.
2. All bolts to be of the economy headed type. Bolt holes to be drilled 1/16" oversize.
3. Drift holes to be 1/16" undersize.
4. All pressure treated creosote materials shall be cut to size prior to treatment.
5. Drift holes in stringers & splice blocks, and bolt holes in exterior stringers for splice blocks shall be drilled prior to treatment. All other holes may be field drilled.
6. All field drilled holes shall be treated with hot creosote oil.

ITEM	MATERIALS	
	DRESSING	TREATMENT
Piling		12" Creo. Ret.
Bracing	Rough	" " "
Caps	S4S	8" Creo. Ret.
Stringers	S2E	" " "
Splice Block	"	" " "
Decking	S1S	.06" Penta
Handrail Post	S4S	0.6" Penta
Handrail	"	WR Penta
Girts	"	" " "

All 12-1b creo. treatment to be Full Cell.  
 All 8-1b creo. treatment to be Empty Cell.  
 All material to be const. grade Douglas fir.


AS BUILT  
 Sheet 18 of 41

As Constructed 6-12-78

STATE OF ALASKA  
 DEPARTMENT OF PUBLIC WORKS  
 DIVISION OF WATER AND MARINE  
 Hyaburg Alaska  
 TYPICAL 8'-0" APPROACH  
 CONSTRUCTION DETAILS

SCALE: As noted  
 DATE: APPROVED: Don Statter, DIRECTOR  
 PROJ. NO. 3-75116  
 SURVEYED BY: DRAWN BY: JET CHECKED BY: DM




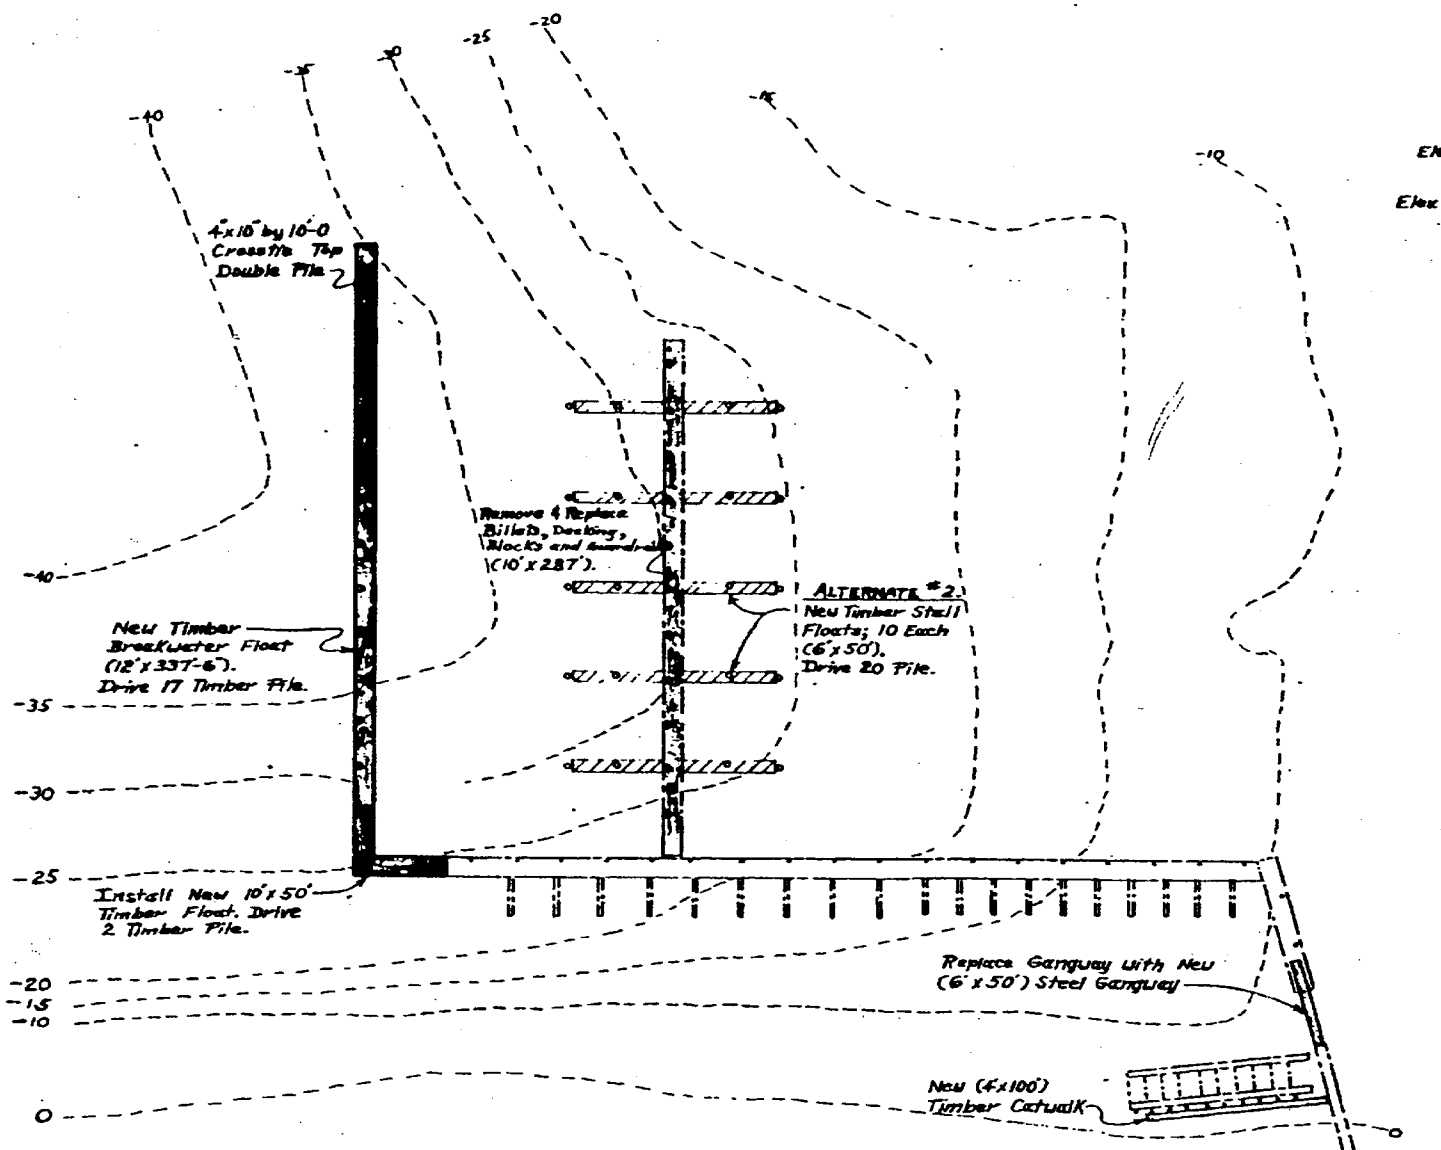


**LEGEND:**  
 [Solid Line] BASIC PROJECT WORK  
 [Dashed Line] ALTERNATE WORK  
 [Dotted Line] NEW PILE  
 [Circle with Dot] EXISTING PILE  
 [Dashed Circle] CONTOURS REPEAT U.S. CORPS ENGINEER'S SOUNDING  
 [Dotted Line] EXISTING FACILITIES (RECONSTRUCTED 1975)

**PROJECT LAYOUT**  
 Scale 1"=50'-0"


**AS BUILT**  
 Sheet 20 of 41

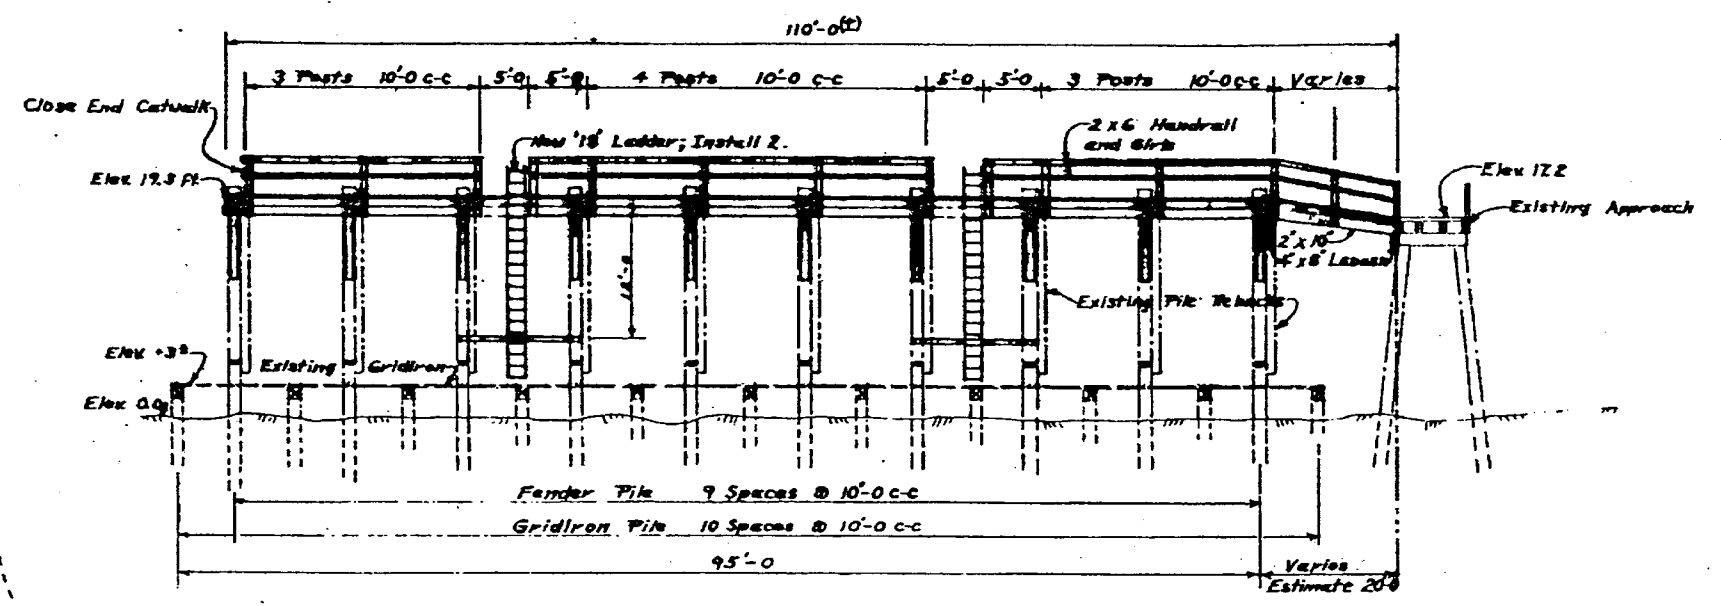

**ELEVATION**  
 Scale 1/8"=1'-0"

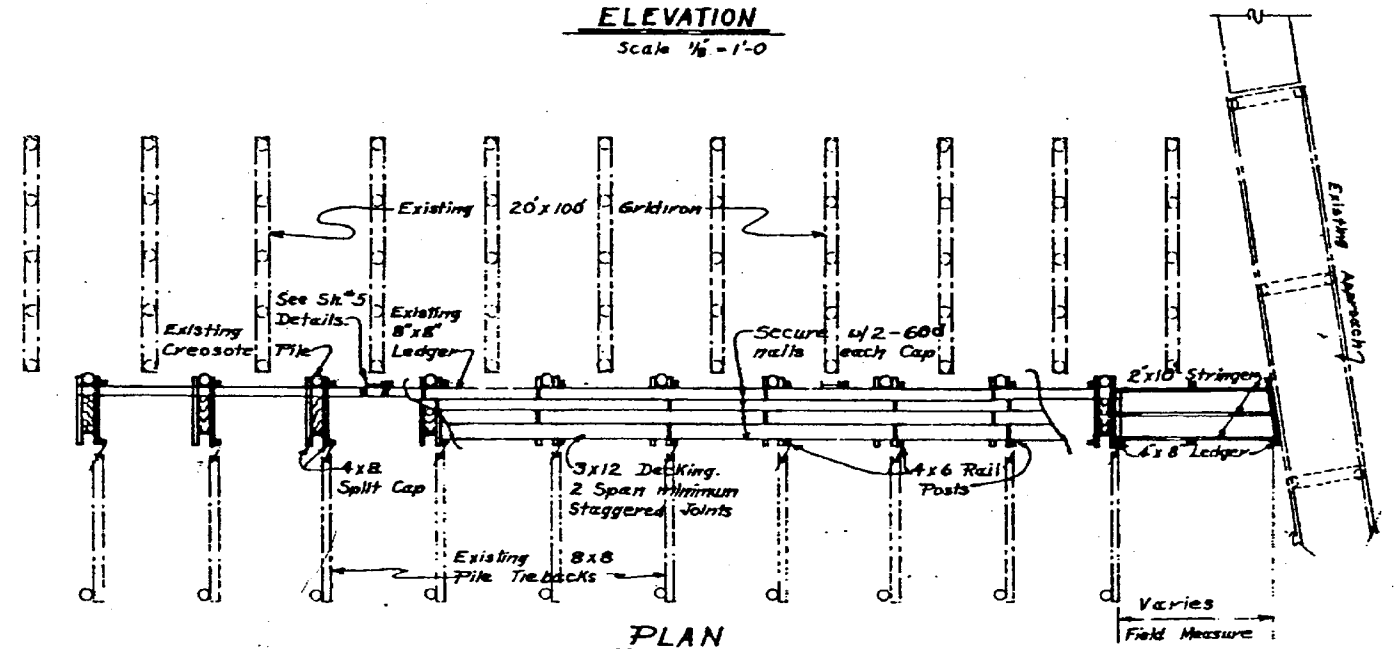

**PLAN**  
 Scale 1/8"=1'-0"

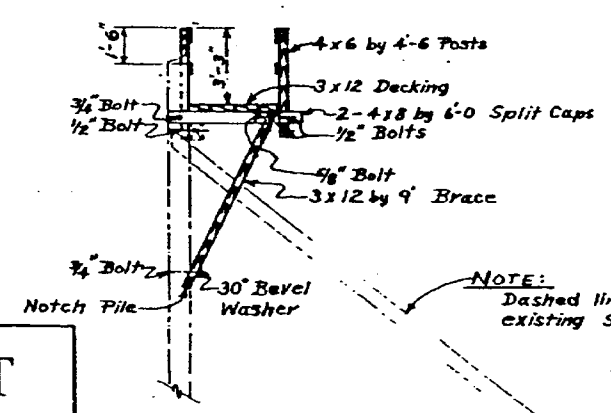



**SECTION**  
 Scale 1/8"=1'-0"

- GENERAL:**
1. Reconstruct 10x287 Float Superstructure per Sheet # 4.
  2. Provide Steel Gangway As Detailed Sheets # 9 & 10.
  3. New Catwalk Details Are As Shown On Sheet # 4 & 5.
  4. Breakwater Float Details Are On Sheet # 5.
  5. 50'-0" Shell Float Details Are On Sheet # 7.
  6. Float Connections Are Shown On Sheet # 8.
  7. Piling Shall be Driven BUT DOWN TO 15 Ft. or Refusal As Determined By The Engineer.


DO NOT SCALE THIS DRAWING USE DIMENSIONS		
STATE OF ALASKA DEPARTMENT OF PUBLIC WORKS DIVISION OF WATER AND HARBORS		
HYDABURG	ALASKA	
<b>PROJECT</b>		
<b>CATWALK DETAILS</b>		
SCALE AS SHOWN	SURVEYED	APPROVED
DESIGNED BMM	DRAWN BMM	
CHECKED	DATE AUG. 1976	DIRECTOR
PROJECT NUMBER 377116	SHEET 4 OF 10	




LAST SILL 3'-1 1/2" FROM END.

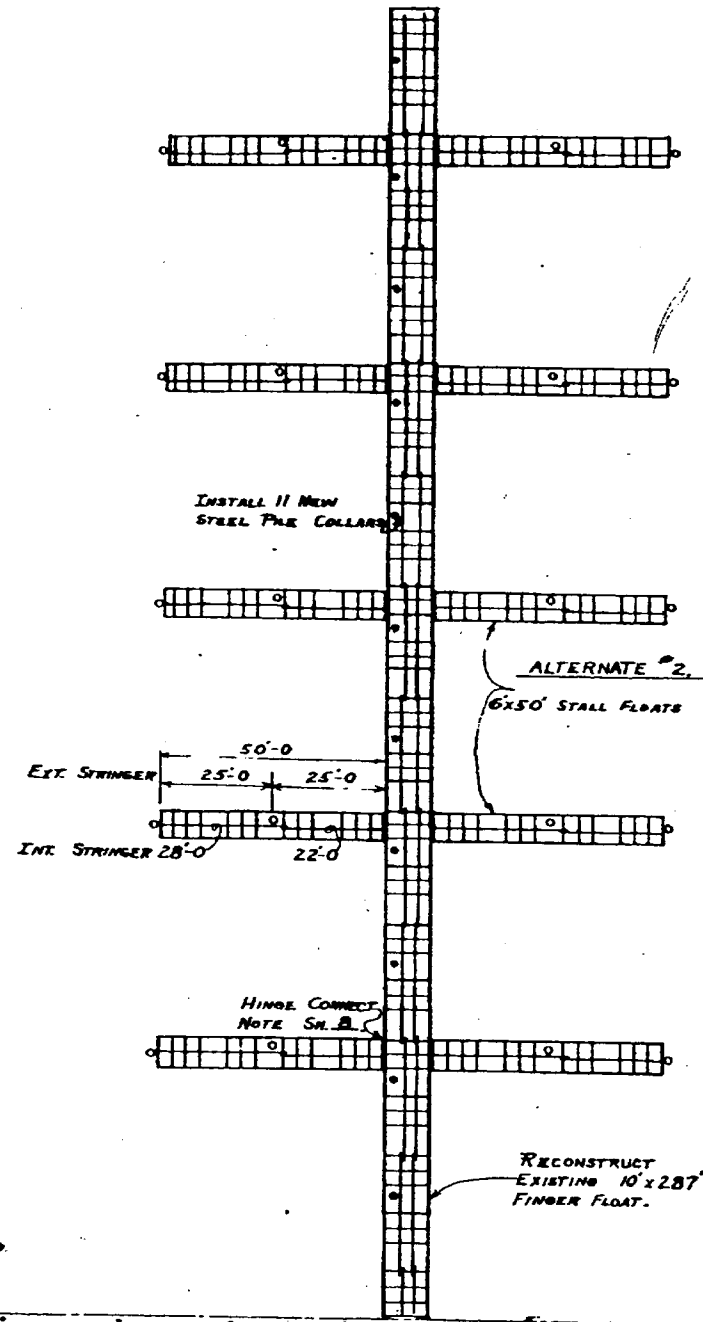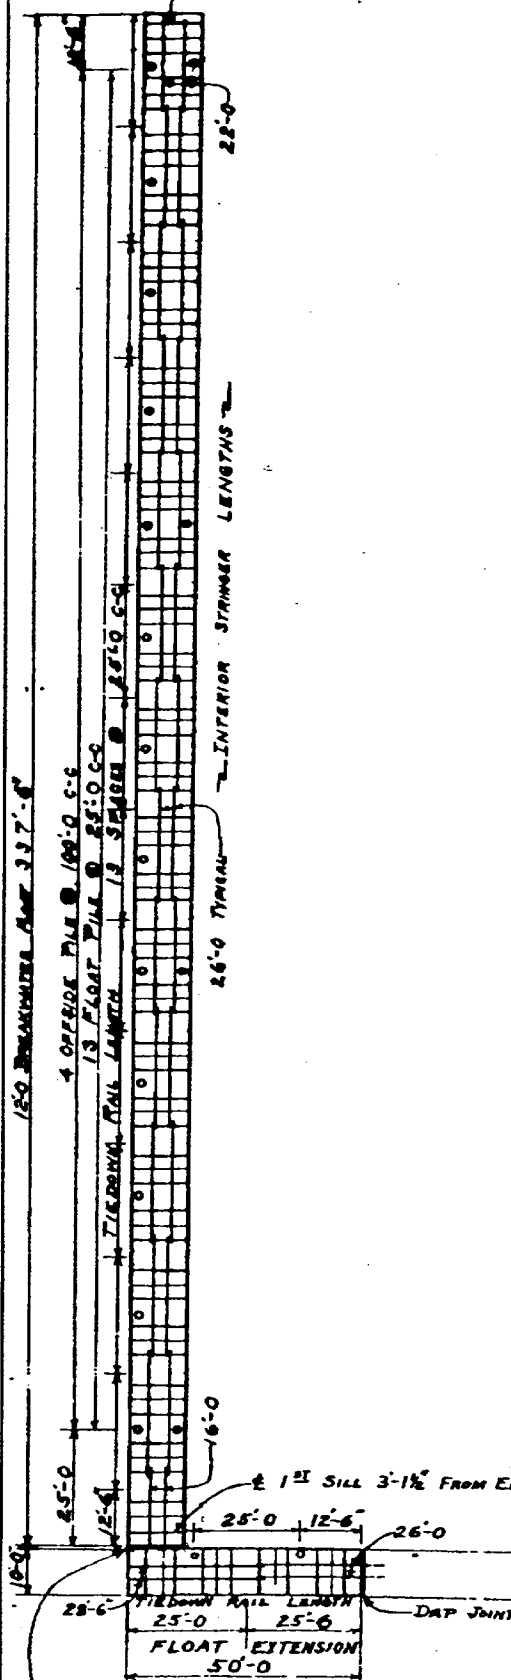


**FLOAT LAYOUT**  
SCALE 1"=20'-0"

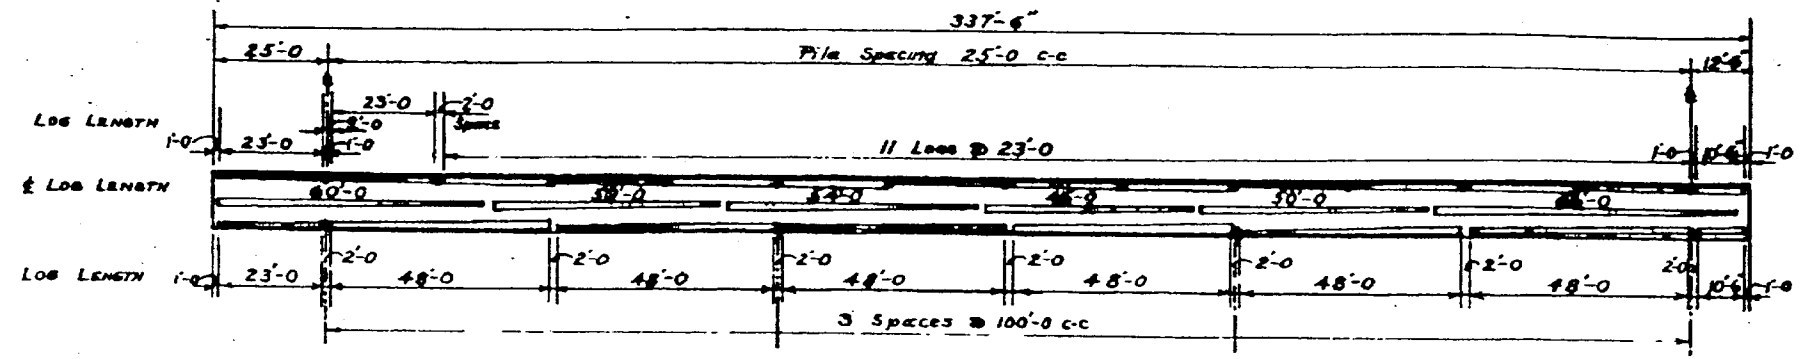

**BREAKWATER FLOAT**  
**LOG PLAN**  
SCALE 1"=20'-0"

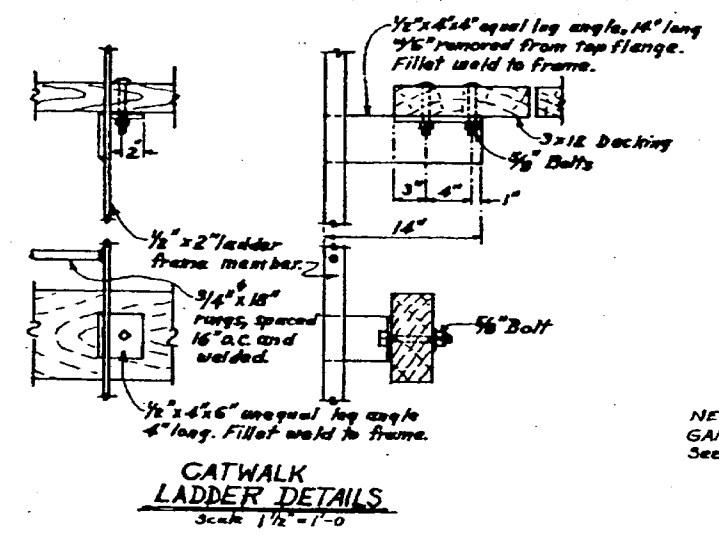

**CATWALK LADDER DETAILS**  
SCALE 1/2"=1'-0"

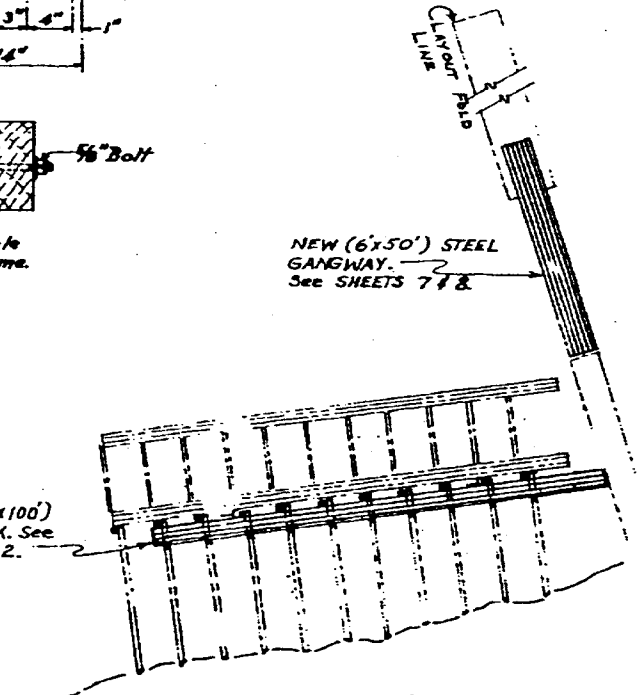

**FLOAT LAYOUT CONTINUED**  
SCALE 1"=20'-0"

NO WORK ON 6' x 15'-9" TIMBER APPROACH (NEW 1975).

NO WORK ON THIS FLOAT (NEW 1975)

- GENERAL NOTES:**
1. Dimensions given for Tierdown Rails are the same for Exterior Stringers. Measurements are from c. to c. of dwp joints or to butt ends.
  2. Install Hinge Connection between Breakwater and 10'x50' Float.
  3. Breakwater Float Log Plan Shows This sheet.
  4. New 6'x50' Stall Floats shall be Hinge Connected to existing 10'x28' float.

LAYOUT FOLD LINE (See above)


STEEL GANGWAY

**AS BUILT**  
**Sheet 21 of 41**




DO NOT SCALE THIS DRAWING USE DIMENSIONS	
STATE OF ALASKA DEPARTMENT OF PUBLIC WORKS DIVISION OF WATER AND HARBORS	
HYDABURG, ALASKA	12'-0"
<b>BREAKWATER FLOAT - LOG &amp; STRINGER PLAN</b>	
SCALE AS SHOWN DESIGNED BY JMM CHECKED BY	DRAWN BY JMM DATE
PROJECT NUMBER 377116	SHEET 5 OF 10






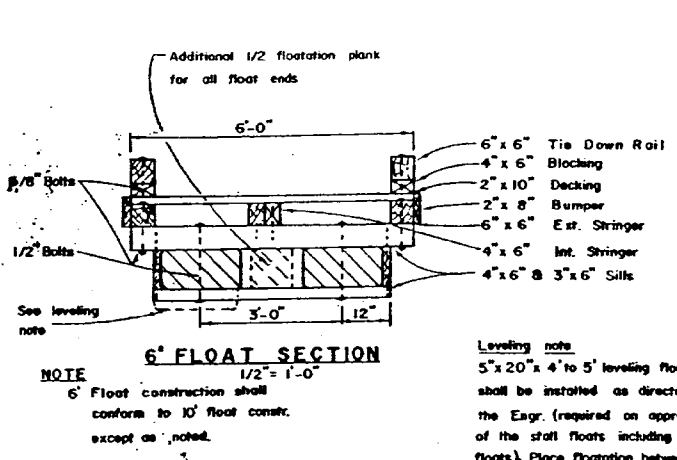


**NOTE**  
6' float construction shall conform to 10' float const. except as noted.




**Leveling note**  
5'x20' x 4' to 5' leveling floatation shall be installed as directed by the Engr. (required on approx. 20% of the stall floats including 6' stall floats). Place floatation between lower sill members with the outer edge bearing on siding members (cut side up). Pin floatation together with 3/8\" x 20\" \"all\" pin (see detail, this sheet), 3 places, approx. equally spaced.

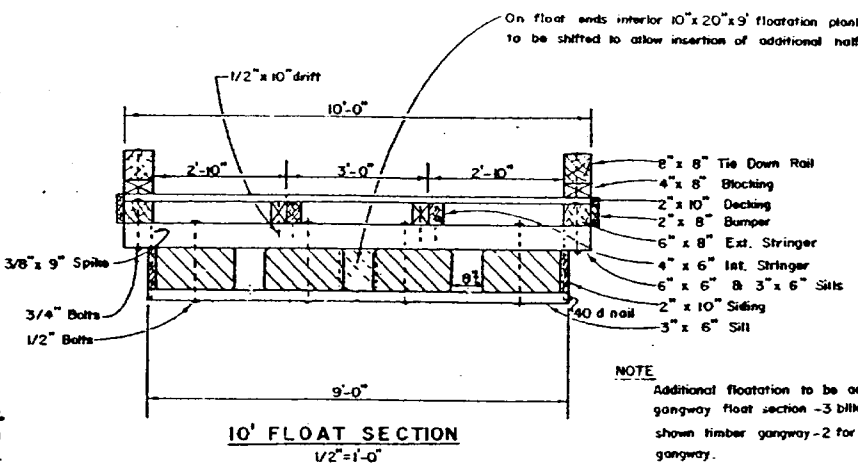

**NOTE**  
Additional floatation to be added on gangway float section - 3 billets as shown timber gangway - 2 for steel gangway.

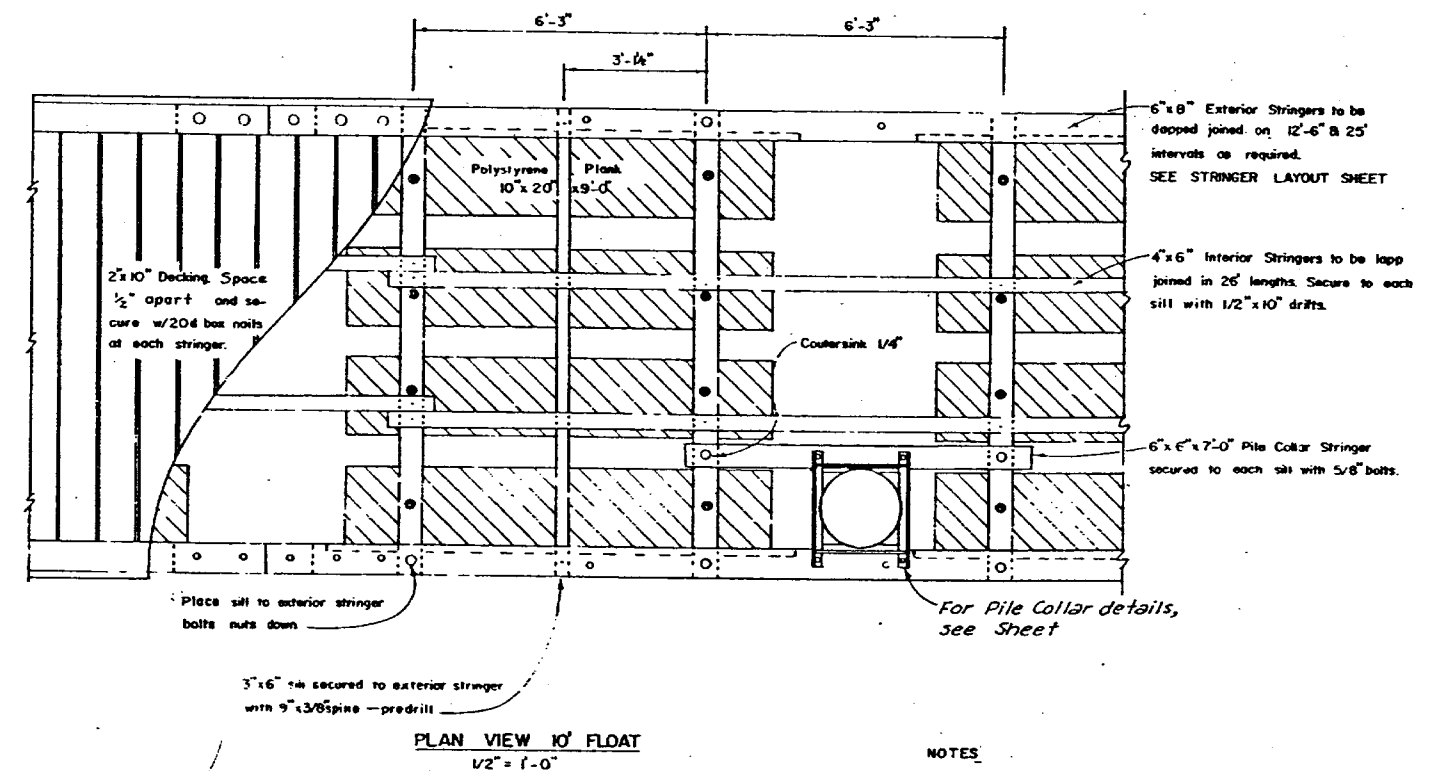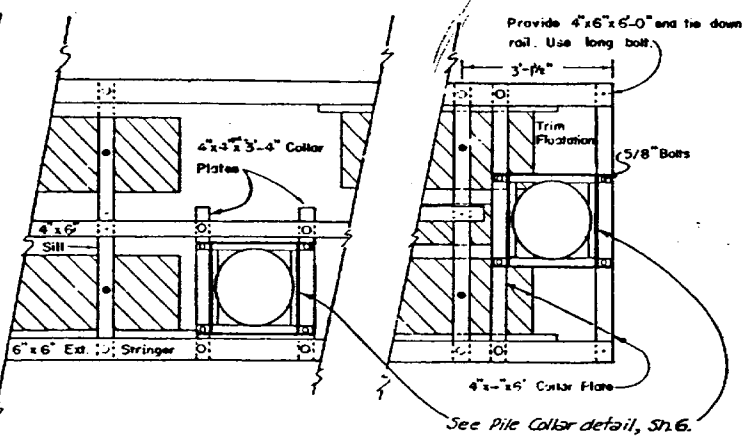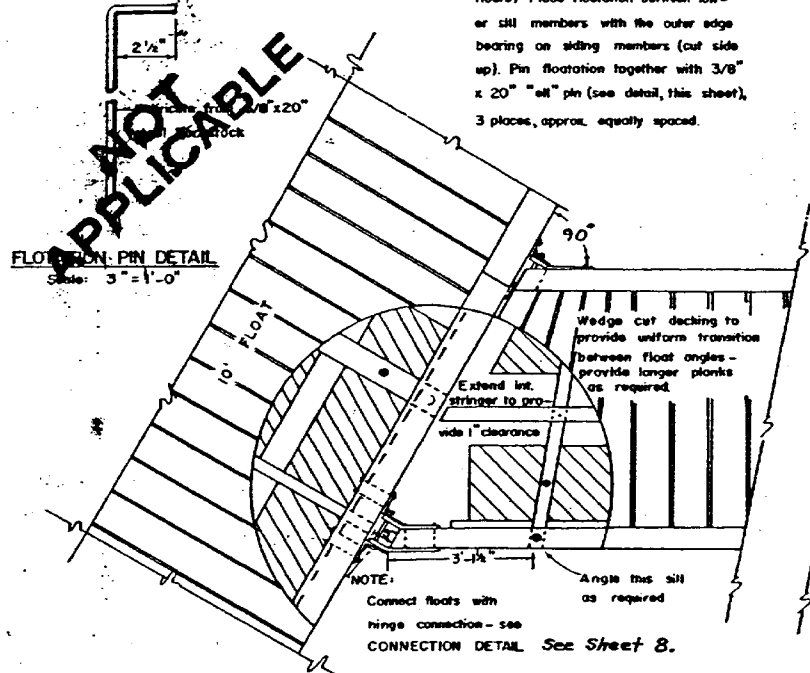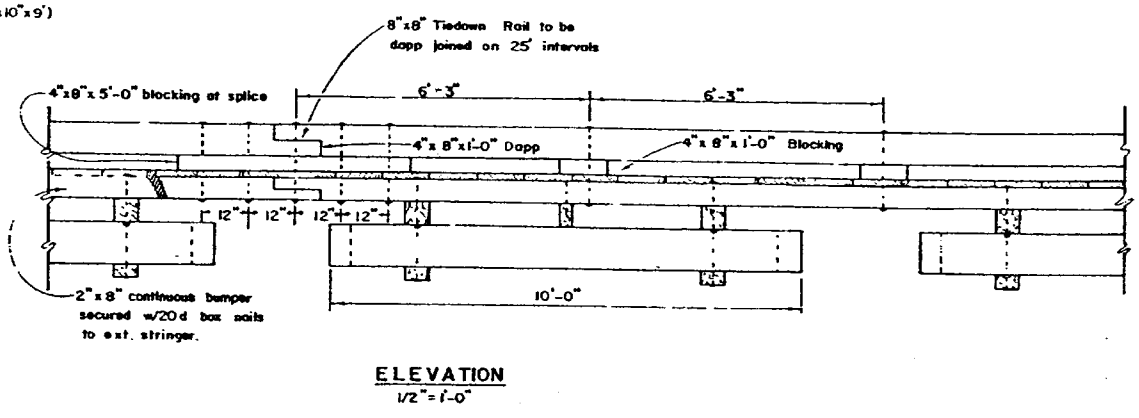

**NOTES**  
All hardware to be hot-dipped galvanized. A malleable iron washer shall be placed between all nut and wood surfaces. All bolts to be of the economy headed type. Bolt holes to be drilled 1/16\" over size except sill bolt holes for floatation planks 1/8\" over size. Drift holes to be drilled 1/16\" under size. All field drill holes shall be treated with hot creosote oil. All pressure treated creosote material shall be cut to size prior to treatment. Tie down rails shall extend across all float ends except under gangway. All bolt heads facing deckings shall be countersunk 1/4\" previous to treatment. Field drill all drift bolt holes. A barrier of 6 mil black polyethylene shall be placed between the contact surfaces of all creosote timber and floatation material (except float siding members).

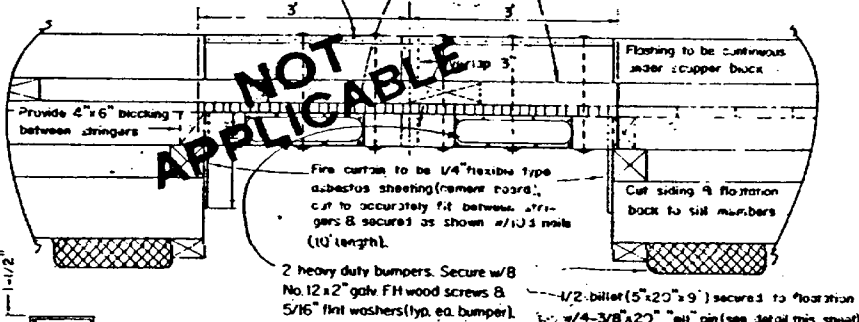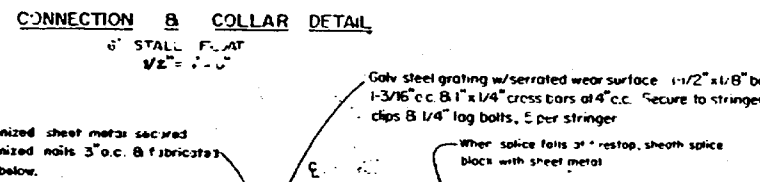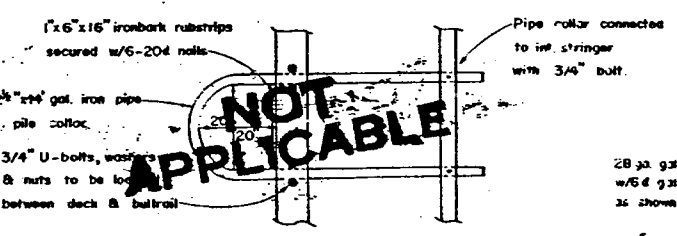


MATERIALS		
ITEM	DRESSING	TREATMENT
3"x6"-4"x6" 8'x6" upper sill	S-1-E 1/8" dia	10 lbs. ret (LP-5)
2"x10" Sill	2"x10"	
3"x6" Lower Sill	Rough	
4"x4" 3"x6" Collar Plates	Rough	
4"x6" Collar Members	S-2-E	
4"x6" Interior Stringers		8 lbs ret (LP-5)
6"x6" 6"x8" Ext. Stringers	S-4-S	
2"x8" Bumpers		0.5lb. Penta
1"x6" Collar Stringers		8lb. ret. (LP-5)
2"x10" Decking	Milled	0.5lb. Penta.
4"x6" 4"x8" Blocking	S-4-S	
6"x6" 8"x8" Rail		

**AS BUILT**  
Sheet 23 of 41



DO NOT SCALE THIS DRAWING USE DIMENSIONS		
STATE OF ALASKA DEPARTMENT OF PUBLIC WORKS DIVISION OF WATER AND HARBORS		
<b>TYPICAL FLOATS</b>		
SCALE AS SHOWN	SUNVEYED	APPROVED
DESIGNED DN/BS	DRAWN MH/JRT	Don Statter
CHECKED DS	DATE 4-60	DIRECTOR
PROJECT NUMBER 377116	SHEET 7 OF 10	


1	Changed treatment for bumpers, decking, blocking & tie-down rails to 0.5lb. Penta. Spaced deck planks 1/2"	7-23-71	JCT
No.	Revision	Date	By

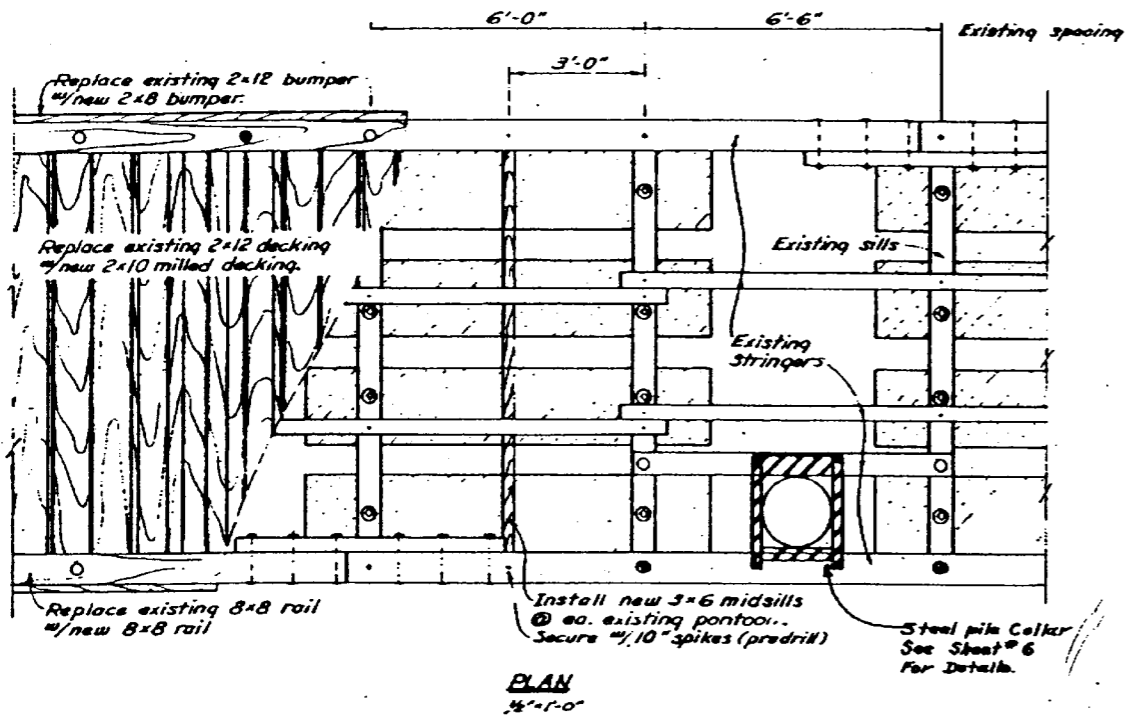


PLAN  
1/2" = 1'-0"

**NOTES**


- 1 Existing tie-down rails, scupper blocks, decking and bumpers to be removed and replaced with new pentec treated material.
- 2 New creos. treated midsills shall be installed at each existing pontoon.
- 3 All existing flotation billets shall be replaced.
- 4 Flotation replacement requires the removal and reinstallation of the existing siding, and lower sills. Replace 1/2 bolts w/new 1/2 col. bolts.
- 5 All pile collars shall be replaced; details are shown on this sheet. Collars are called out on float layout sheet 6.
- 6 Field c'bers all existing bolt heads facing decking.

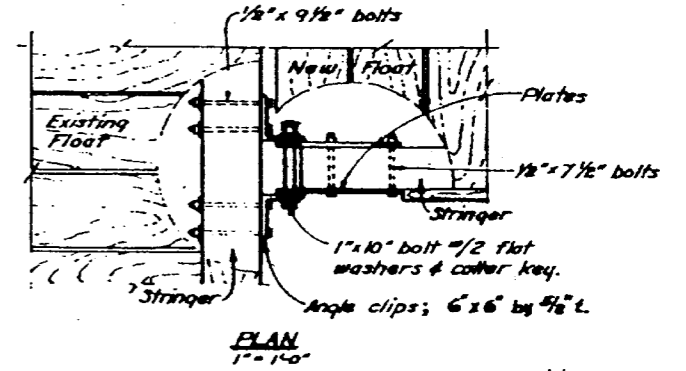


PLAN  
1" = 1'-0"

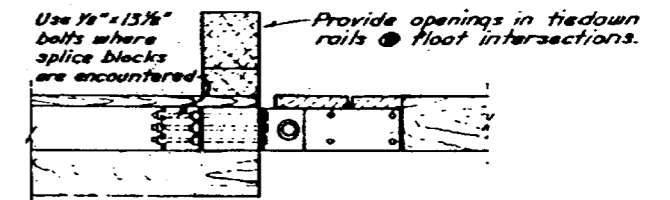

ELEVATION  
1" = 1'-0"

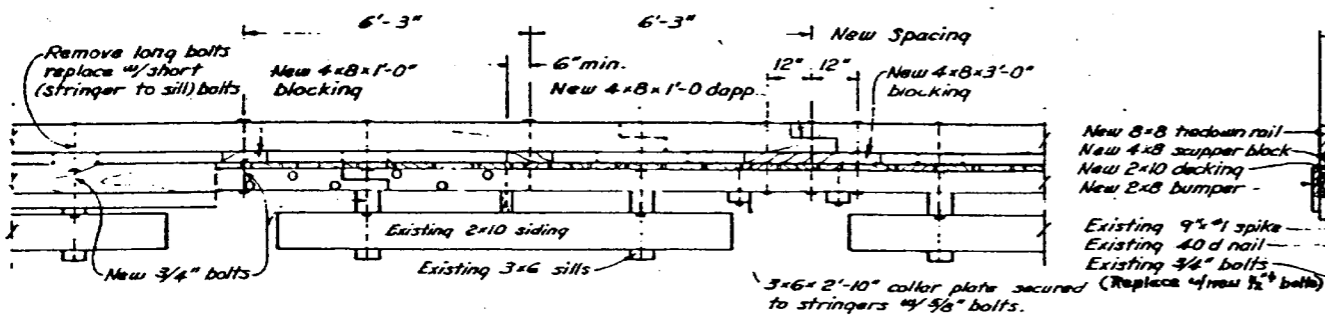

ELEVATION  
1/2" = 1'-0"

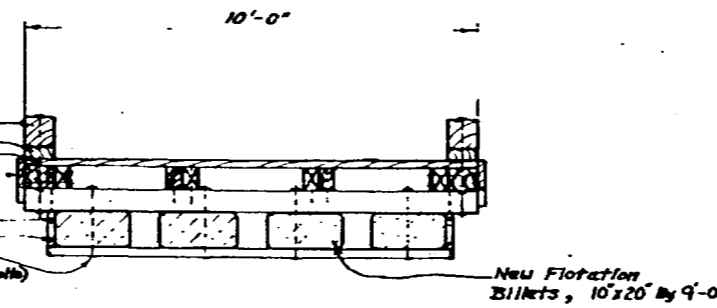

SECTION  
1/2" = 1'-0"


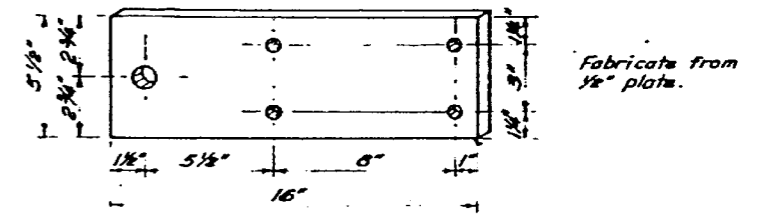


PLATE DETAIL  
5" = 1'-0"


MATERIALS		
ITEM	DRESSING	TREATMENT
8x8 tie-down rail	S4S	12 lb. creos.
4x8 blocking	"	"
2x10 decking	Milled	"
2x8 bumper	S4S	"
3x6 midsill	S2E	12 lb. creos.
4x6 collar member	S2E	"
3x6 collar plate	S2E	"

DRILLING SCHEDULE	
SHOP DRILL	FIELD DRILL
Tie-down rail - all holes.	Blocking - all holes.
	Collar plate - all holes for stringer to midsill spikes.

Drill holes for bolts 1/8" undersize.  
Drill holes for spikes 1/16" undersize.

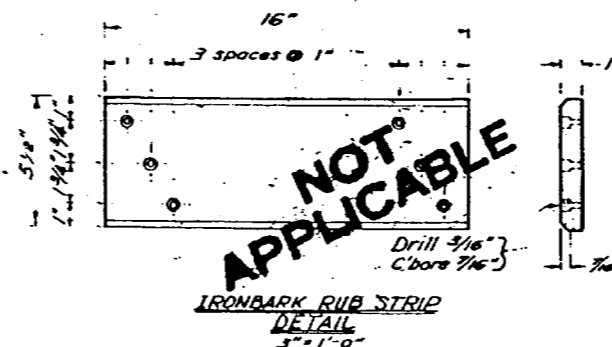

IRONBARK RIB STRIP  
DETAIL  
5" = 1'-0"

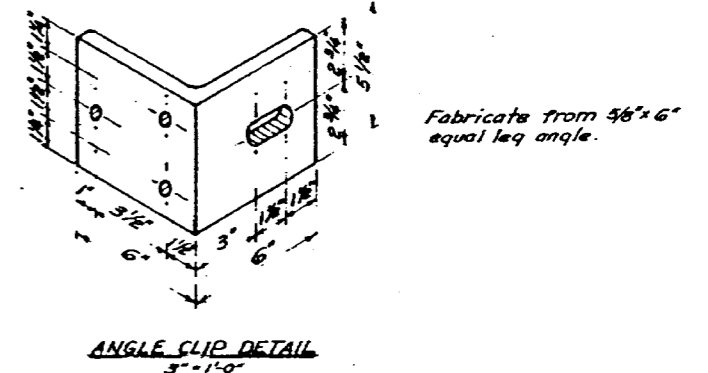

ANGLE CLIP DETAIL  
5" = 1'-0"

**HINGE CONNECTION DETAILS**








AS BUILT  
Sheet 24 of 41

DO NOT SCALE THIS DRAWING - USE DIMENSIONS



STATE OF ALASKA  
DEPARTMENT OF PUBLIC WORKS  
DIVISION OF WATER AND HARBORS

10' x 28'  
FLOAT RECONSTRUCTION  
HINGE CONNECTION (77)

SCALE: As Noted	SURVEYED	APPROVED
DESIGNED: D.C.W.	DRAWN: [Signature]	Don. Statter
CHECKED: [Signature]	DATE: Nov. 1974	DIRECTOR
PROJECT NUMBER: 377116	SHEET 8 OF 10	

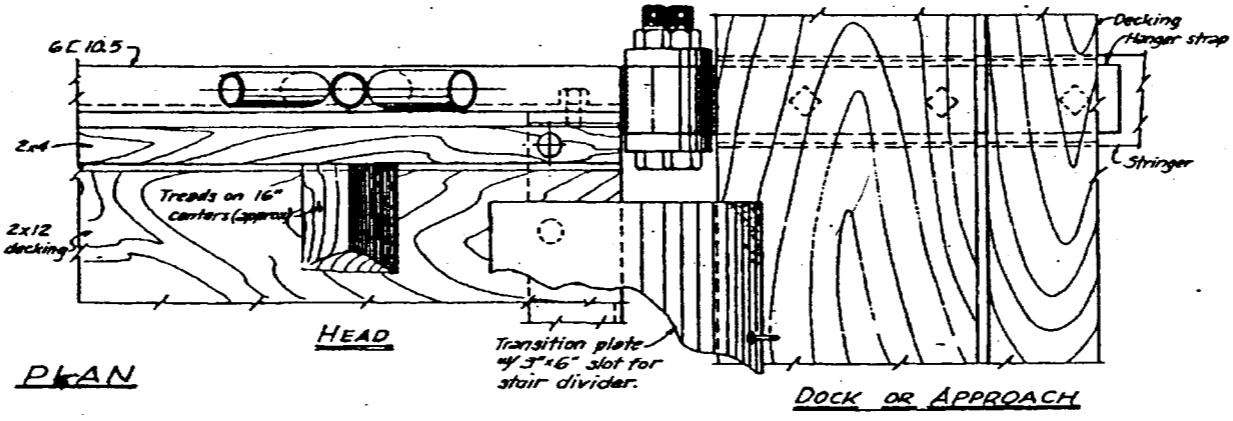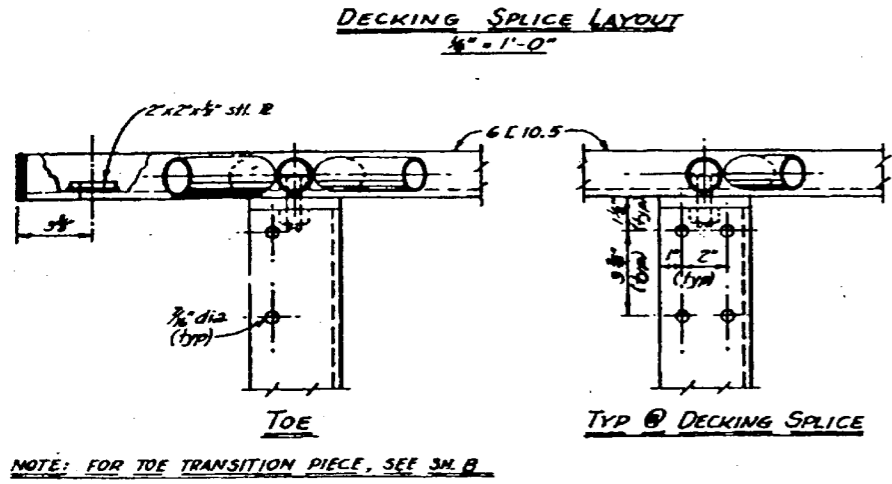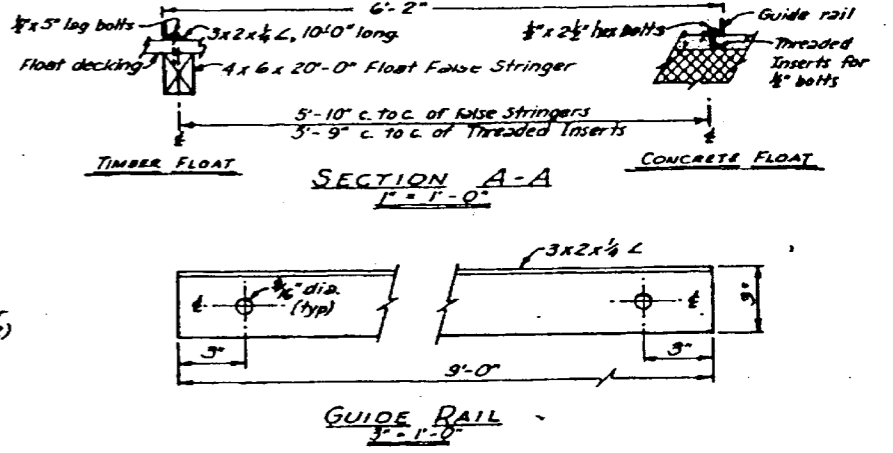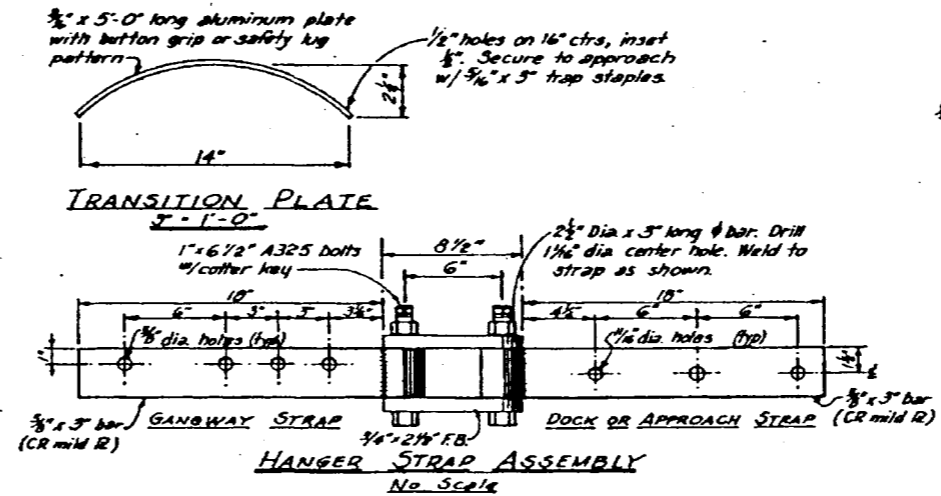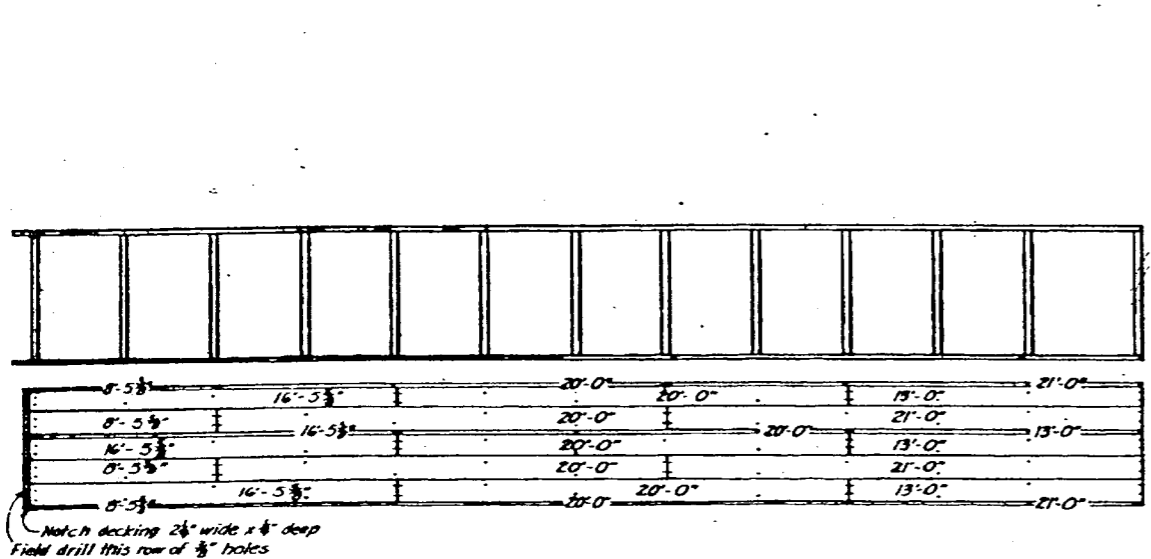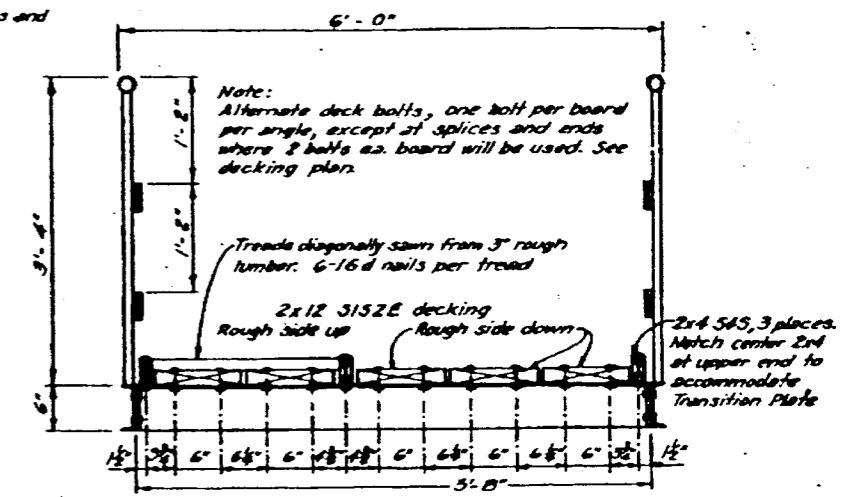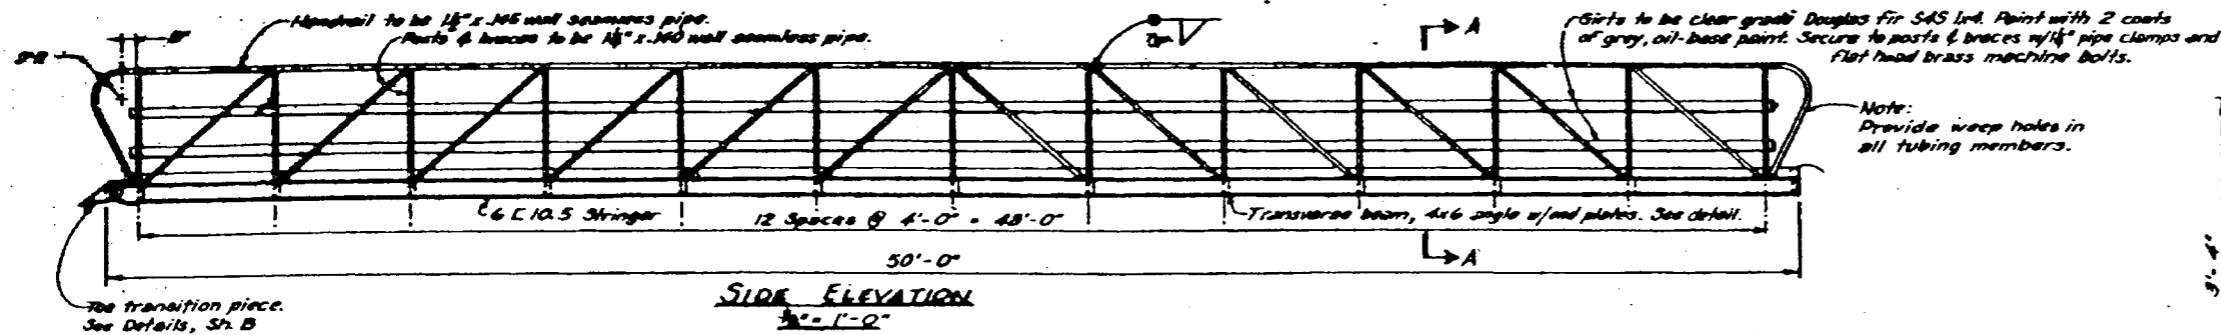

- NOTES:
1. All seamless pipe shall conform to ASTM A-53.
  2. All channels, angles & plates shall conform to ASTM A-36.
  3. Trusses shall be shop fabricated & assembled including hangers.
  4. Splices shall be held to a minimum and, where necessary, shall be made in a manner that will not reduce the strength of the truss.
  5. No tubing or channel splices will be permitted within the middle half of the truss structure.
  6. Trusses & transverse beams shall be hot dipped galvanized after fabrication and in accordance with ASTM A-123, A-584, A-385 & A-306.
  7. All steel hardware & fasteners shall be hot dipped galvanized in accordance with ASTM A-153.
  8. Decking & deck spacers shall be Dense No 1 grade Douglas fir, W.D. Penta or equivalent pressure treated to 0.5 lb. cu ft retention, and shall be field drilled to match shop drilled holes in transverse members.

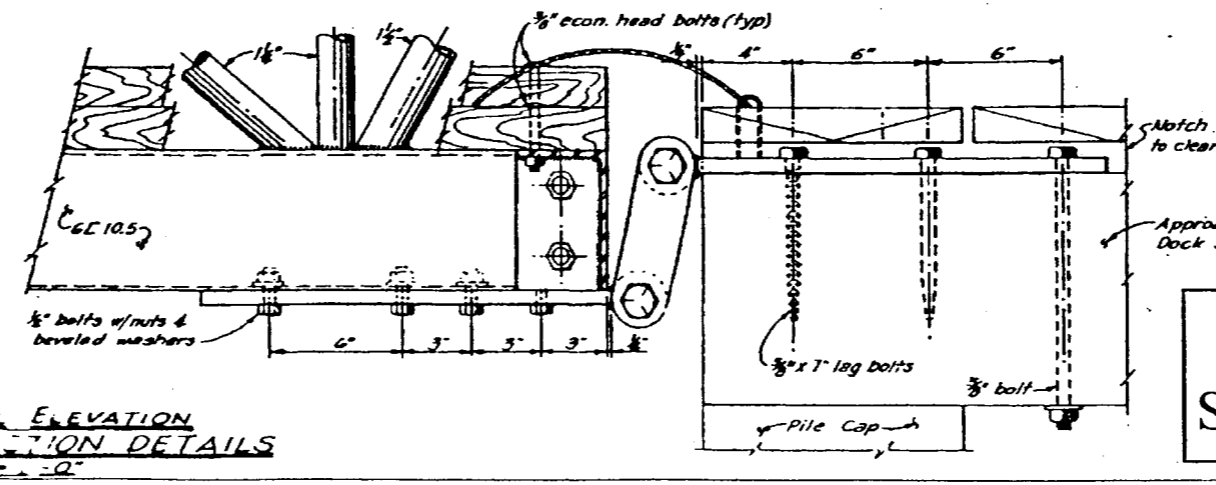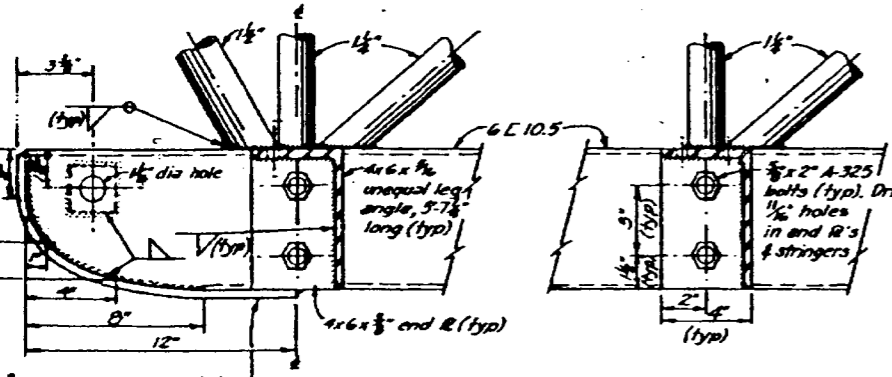

AS BUILT  
Sheet 25 of 41

Revised 3-12-73 Hanger linkage  
Lumber grade  
Penta. retard  
Misc. holes, no. & size  
Revised 4-7-71. Removed Tension Wires.

ELJ  
JET

DO NOT SCALE THIS DRAWING - USE DIMENSIONS


STATE OF ALABAMA  
DEPARTMENT OF PUBLIC WORKS  
DIVISION OF WATER AND HARBORS

TYPICAL STEEL GANGWAY  
CONSTRUCTION DETAILS  
(SHEET A)


SCALE AS SHOWN  
DESIGNED JT/RB  
CHECKED DSM

APPROVED  
DATE Dec. 1970  
Don Statter,  
DIRECTOR


PROJECT NUMBER T-116  
SHEET 25 OF 41

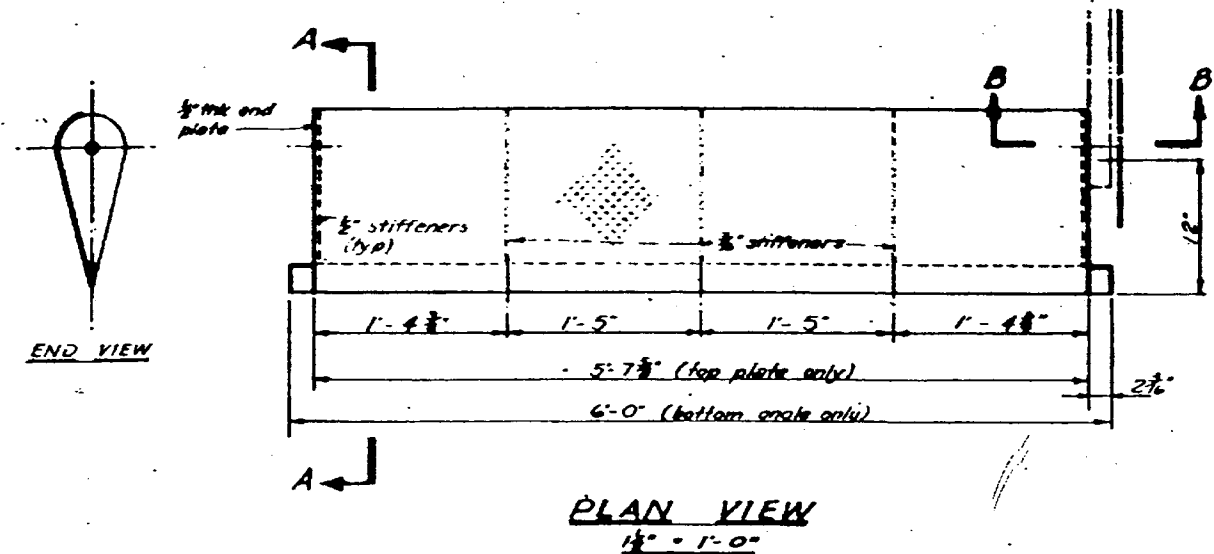


**PLAN VIEW**  
1 1/2" = 1'-0"

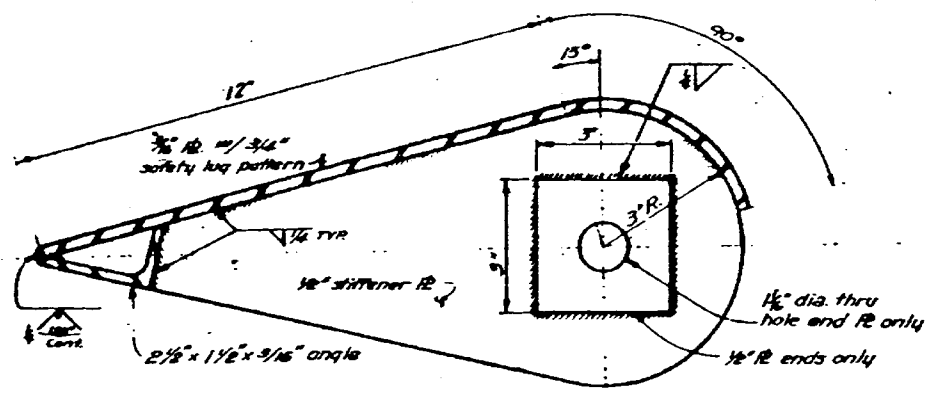


**SECTION A-A**  
SYMMETRICAL ABT. HORIZ. &  
HALF SIZE

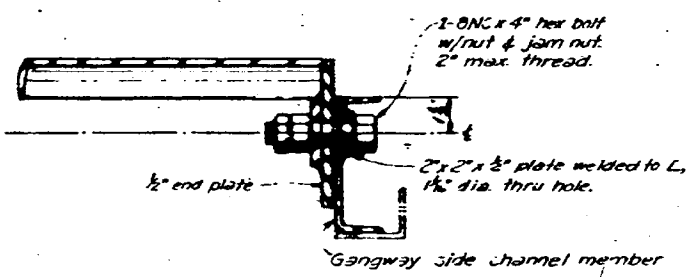


**SECTION B-B**  
3" = 1'-0"  
(TYP. EA. END)

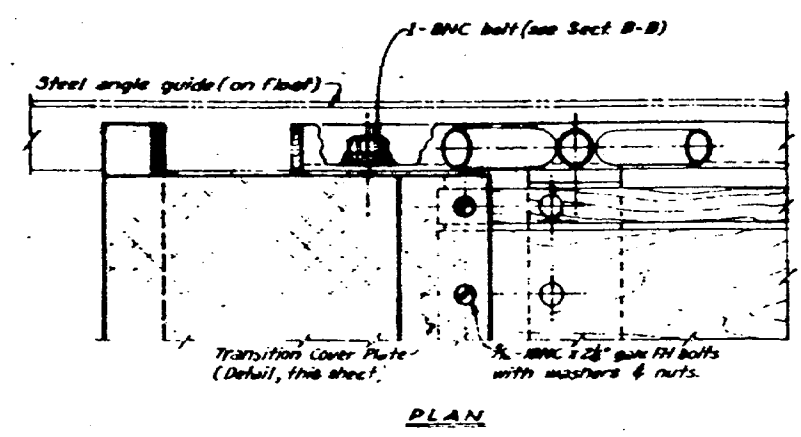

**PLAN**

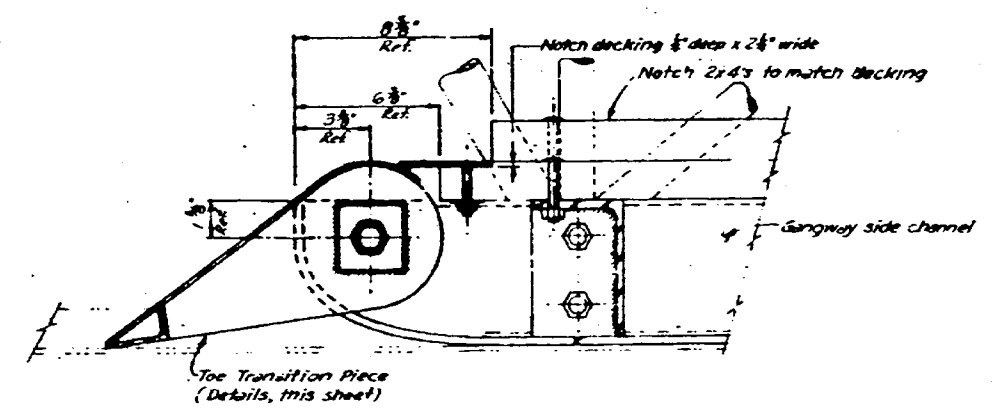

**SECTIONAL ELEVATION**  
**ASSEMBLY DETAIL**  
3" = 1'-0"

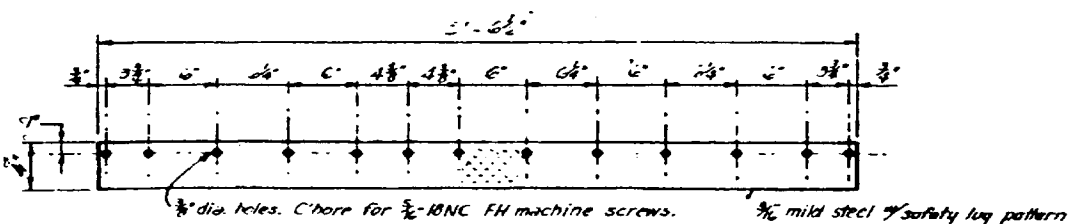





**TRANSITION COVER PLATE**  
1 1/2" = 1'-0"

NOTES:  
For notes pertaining to fabrication and galvanizing, see Sheet A.

**AS BUILT**  
Sheet 26 of 41

Revised 1-28-75 Removed 6" pipe ELS

DO NOT SCALE THIS DRAWING - USE DIMENSIONS		
STATE OF ALASKA DEPARTMENT OF PUBLIC WORKS DIVISION OF WATER AND HARBORS		
TYPICAL STEEL GANGWAY TRANSITION PIECE DETAILS (SHEET B) 77		
DESIGNED BY CHECKED BY PROJECT NUMBER	DRAWN BY DATE 2-11-74	APPROVED Dan Stetter DIRECTOR
SHEET 10 OF 10		

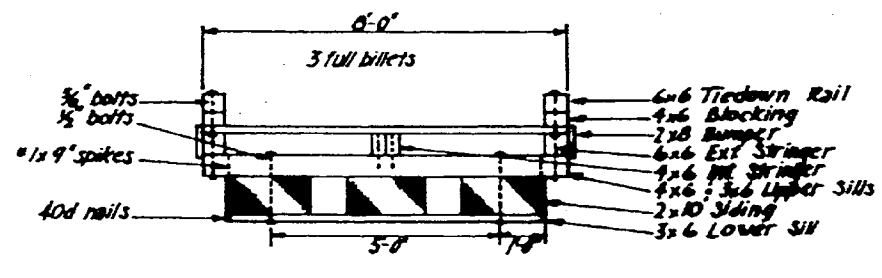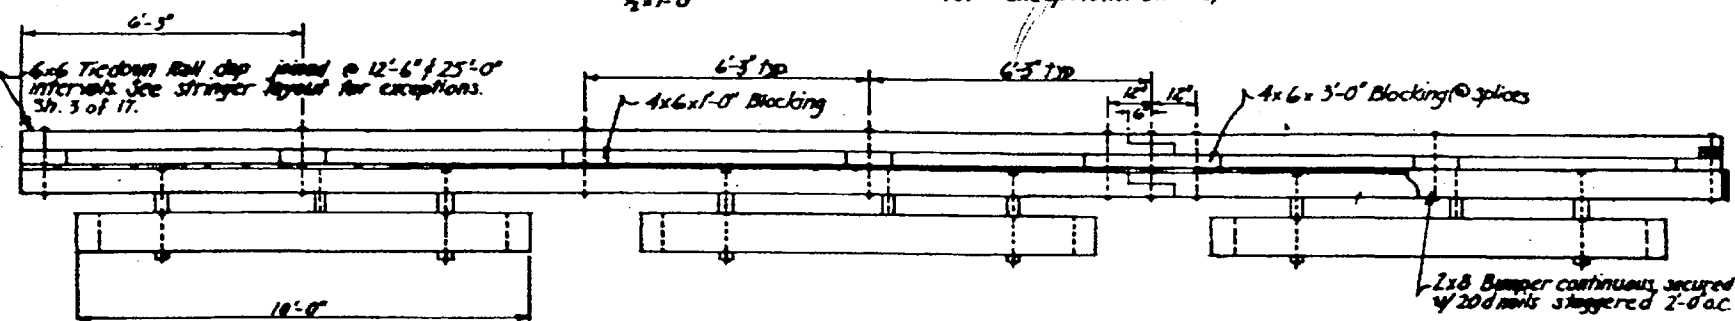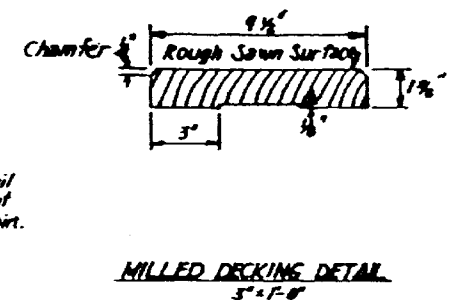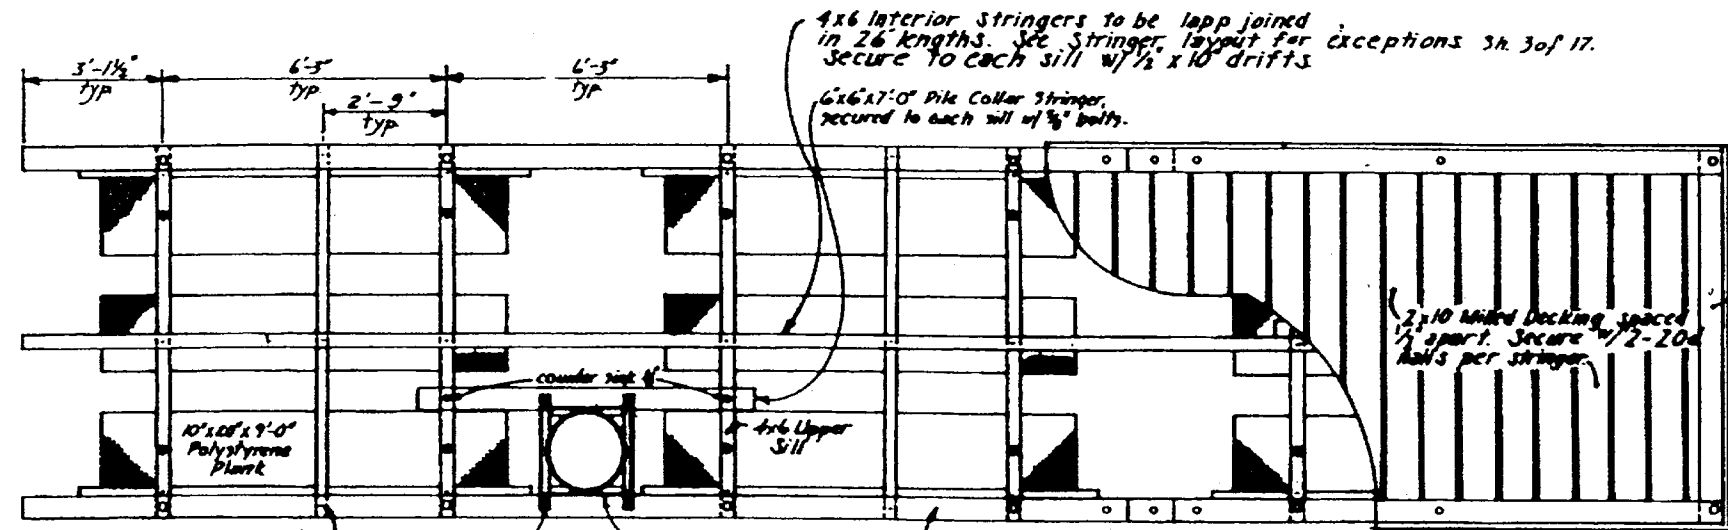

Note: See Specifications for Treatment.

MATERIALS		
ITEM	DRESSING	TREATMENT
6x6-4x6 upper sills	3-4-3	Cresote
2x10 siding	2'x10' S&S	"
5x6 lower sill	3-4-3	"
6x6x17'-0" Pile Collar Stringer	"	"
4x6 interior stringers	"	"
6x6 exterior stringers	S&S	"
2x8 bumpers	"	Penta
4x6 blocking	"	"
6x6 rail	"	"
2x10 decking	Milled	"

- Shop Drilled Holes:
- Tie down rails - all holes.
  - Stringers - holes for stringer to sill bolts.
  - Sills - holes for floatation billet bolts.
  - Collar members - all holes.
- Field Drilled Holes:
- Rail blocking - all holes.
  - Exterior stringer - holes for tie down rail bolts.
  - Interior stringer - all holes.
  - Sills - holes for stringer to sill bolts.
  - Collar plates - all holes.
- Tie down rails shall extend across all float ends. A barrier of 6 mil black polyethylene shall be placed between the contact surfaces of treated timber & floatation material except the siding. Nails shall be galv. box.

NOTES: All pressure treated material shall be cut to size prior to treatment, and shall be per specifications.

\* Exact width of siding to conform to thickness of floatation billets. All piles shall be per specifications.

All hardware shall be hot-dipped galvanized. A malleable iron washer shall be placed between all nut and wood surfaces. All bolts shall be of the economy headed type. Bolt holes to be drilled 1/16" oversize except sill bolt holes for floatation billets 1/8" oversize. Drift holes to be drilled 1/8" under size in the field. All bolt heads facing decking shall be countersunk 3/8" prior to treatment. All field drilled holes shall be treated with hot cresote oil.

Revised 3-17-77 - Pile Collar.

AS BUILT  
Sheet 27 of 41



DO NOT SCALE THIS DRAWING - USE DIMENSIONS

STATE OF ALASKA  
DEPARTMENT OF PUBLIC WORKS  
DIVISION OF WATER AND HARBORS

8' FLOAT

79

SCALE: AS SHOWN

DESIGNED: [Signature]

CHECKED: [Signature]

PROJECT NUMBER: K391/B


DRAWN: TM

DATE: JAN 1977

APPROVED: [Signature]

CHECKED: [Signature]

SHEET 12 OF 17

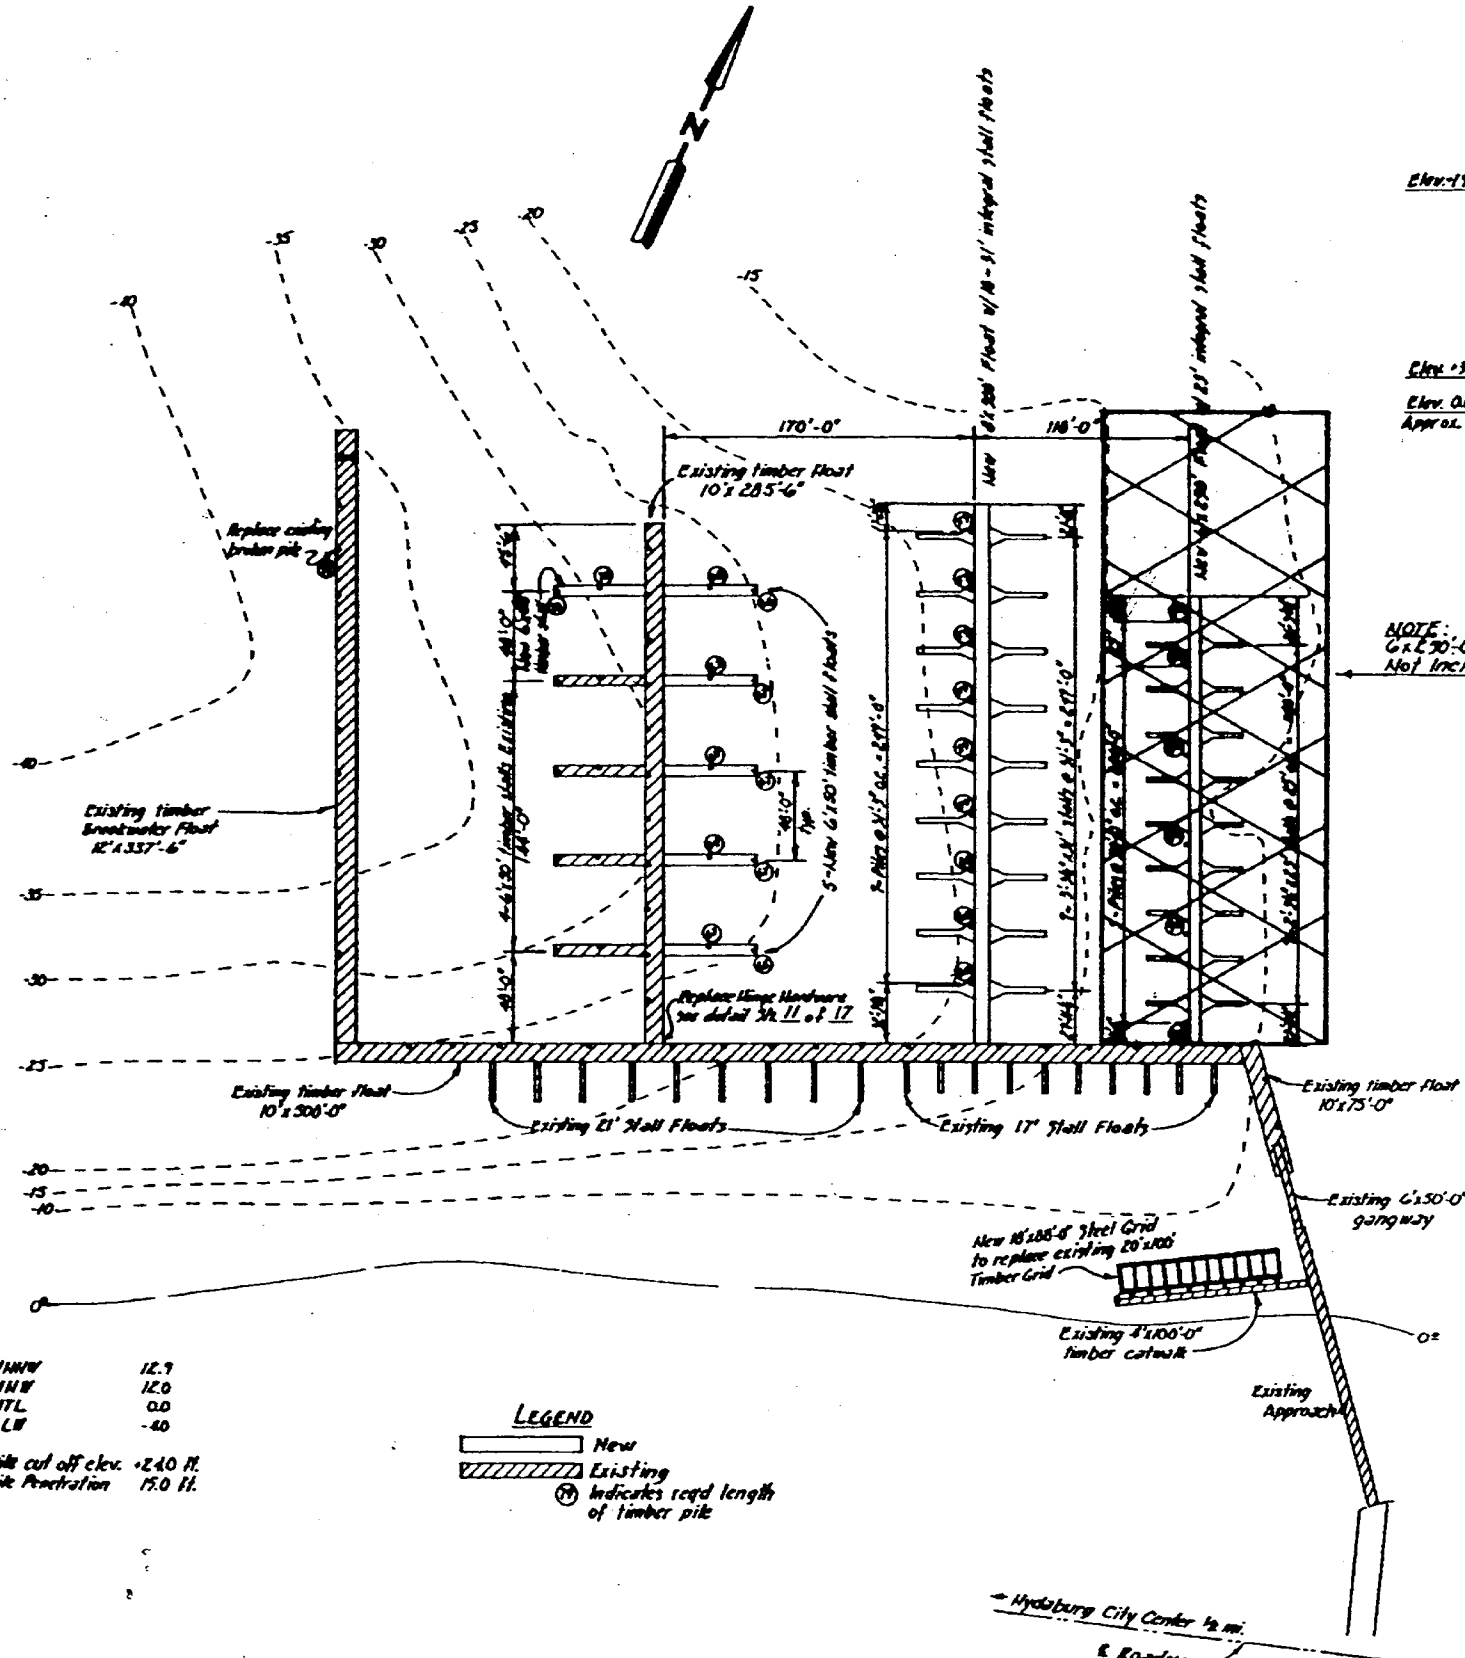


MHW 12.7  
 MNL 12.0  
 MTL 0.0  
 ELB -4.0

Pile cut off elev. +2.40 ft.  
 Pile Penetration 17.0 ft.


**LEGEND**  
 [Solid Line] New  
 [Hatched Line] Existing  
 (Symbol) Indicates req'd length of timber pile

**PROJECT LAYOUT**  
 1" = 50'-0"

NOTE:  
 Gr. 230'-0" Timber Float  
 Not Included This Project.

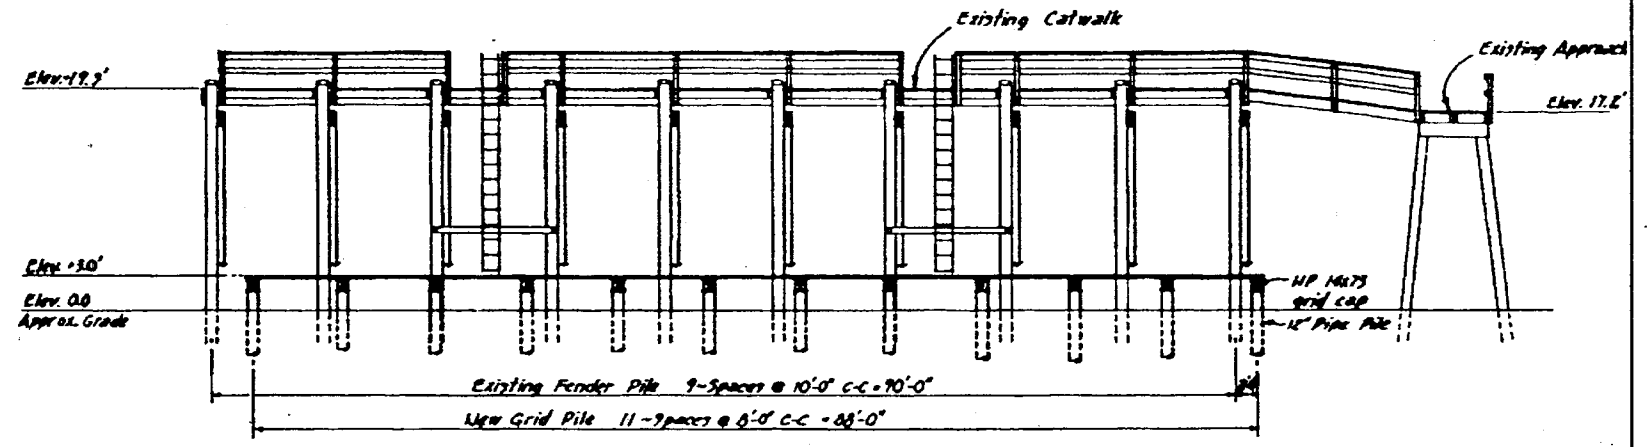


**ELEVATION**  
 1/4" = 1'-0"

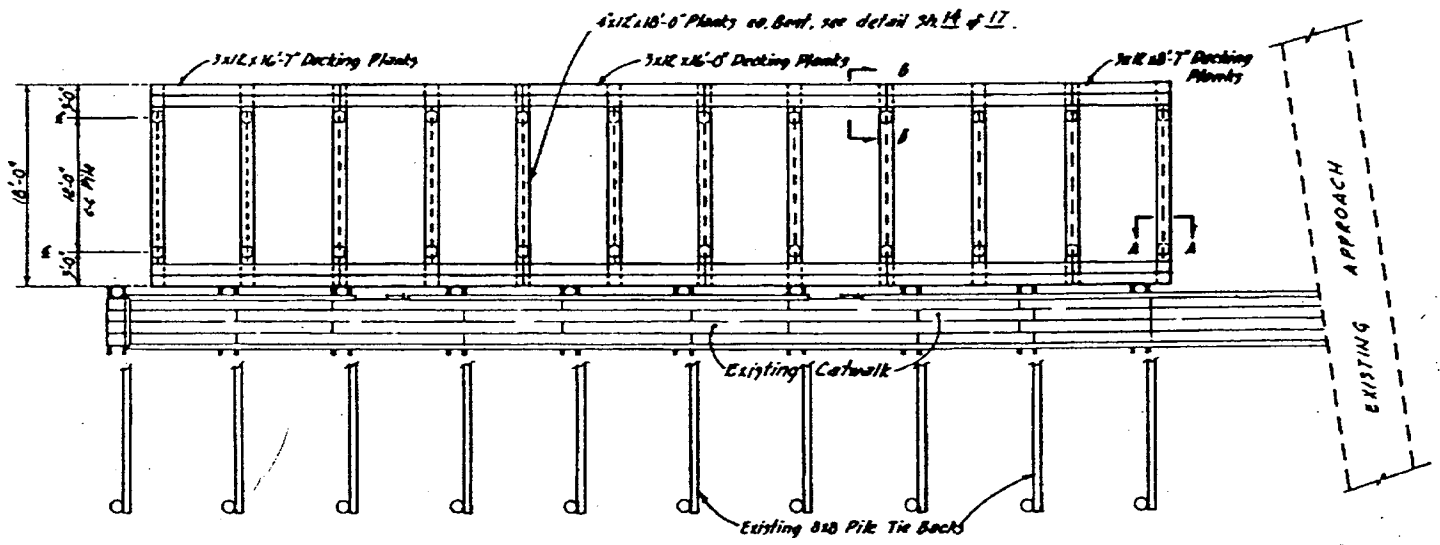


**PLAN**  
 1/4" = 1'-0"

Note: See Grid Details sh. 14 of 17.

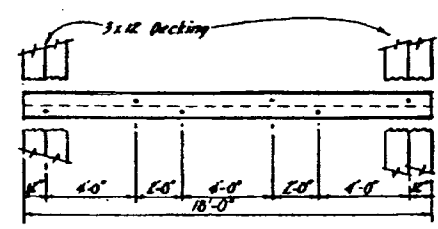

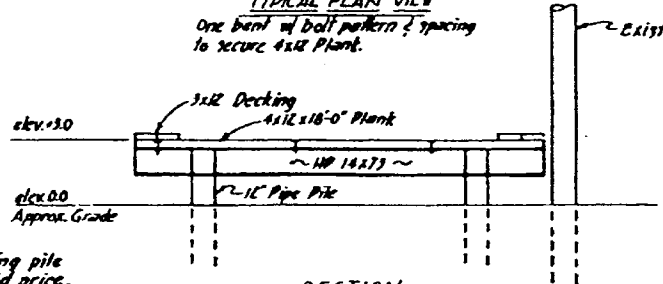

**TYPICAL PLAN VIEW**  
 One bent of bolt pattern & spacing to secure 4x12 Plank.



**SECTION**  
 1/4" = 1'-0"





Note: 20' of Grid bearing pile included in lump sum bid price.

**AS BUILT**  
**Sheet 28 of 41**


STAMP		DO NOT SCALE THIS DRAWING - USE DIMENSIONS	
		STATE OF ALASKA	
		DEPARTMENT OF TRANSPORTATION AND PUBLIC FACILITIES DIVISION OF HARBOR DESIGN AND CONSTRUCTION	
HYDABURG		ALASKA	
		PROJECT LAYOUT & STEEL GRID PLAN	
		(79)	
SCALE: As Noted	SURVEYED: GRF	APPROVED: [Signature]	
DRAWN: RPB	DATE: Nov 1978	Checked: [Signature]	
CHECKED: RPB		PROJECT NUMBER: K59116	
		SHEET 13 OF 17	

Note: For 6x30 stall float details, see sh. 5 of 17.

Note: For 8' float w/ 51' stall float details, see sh. 15 of 17.

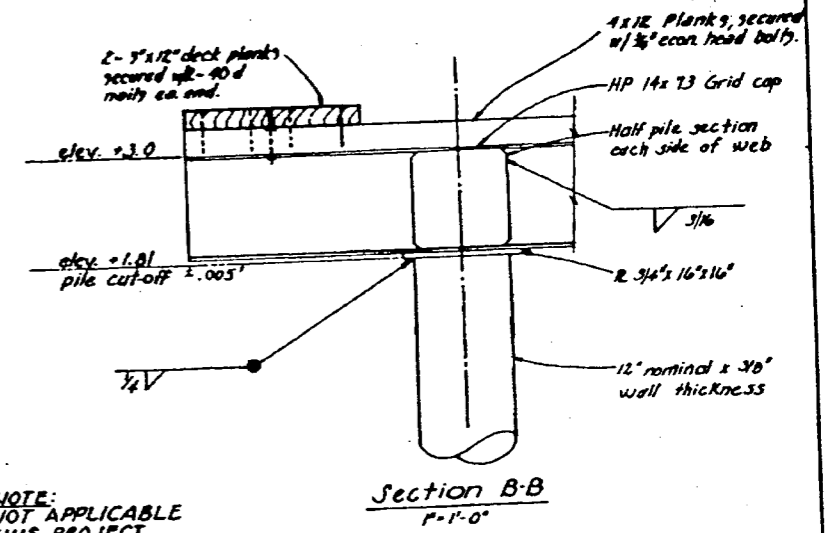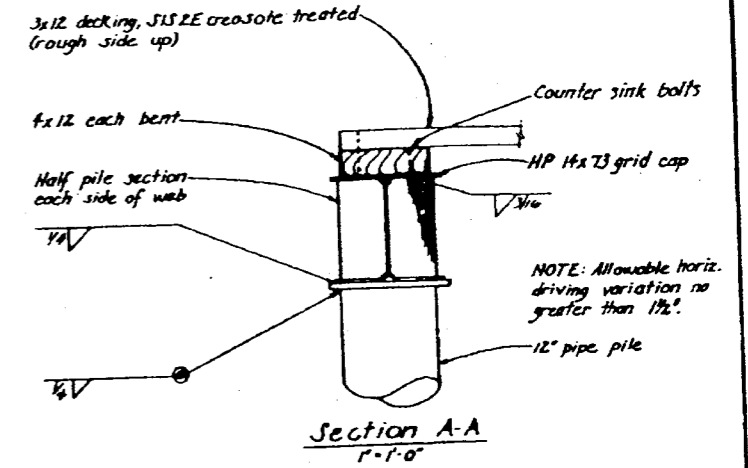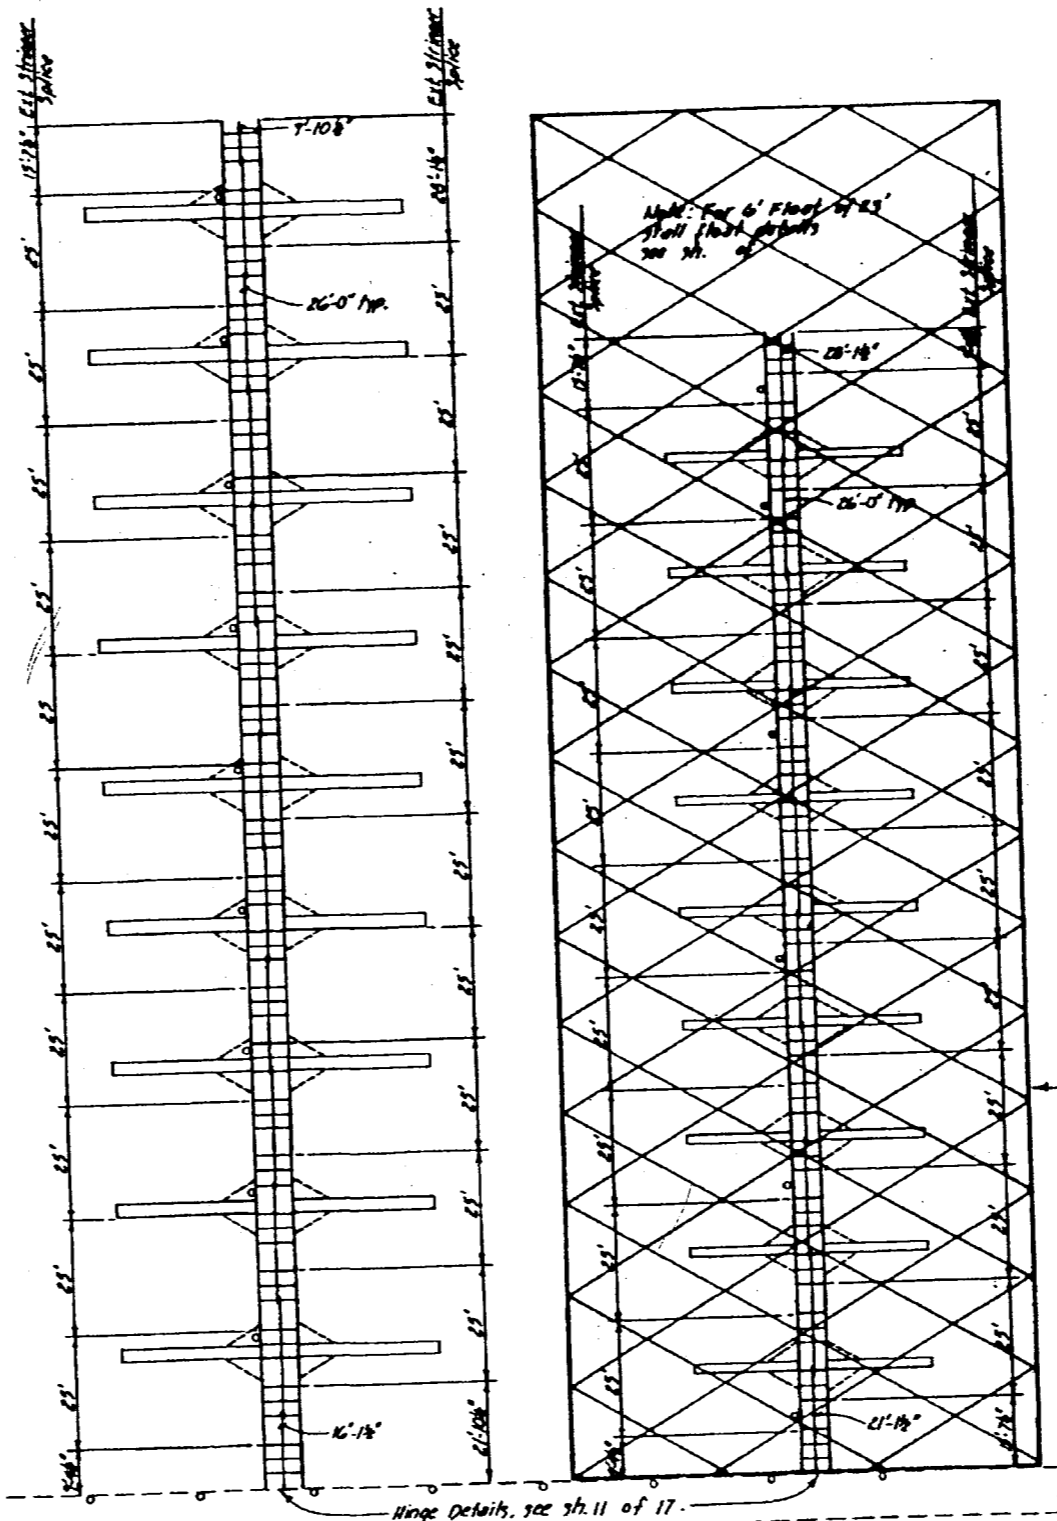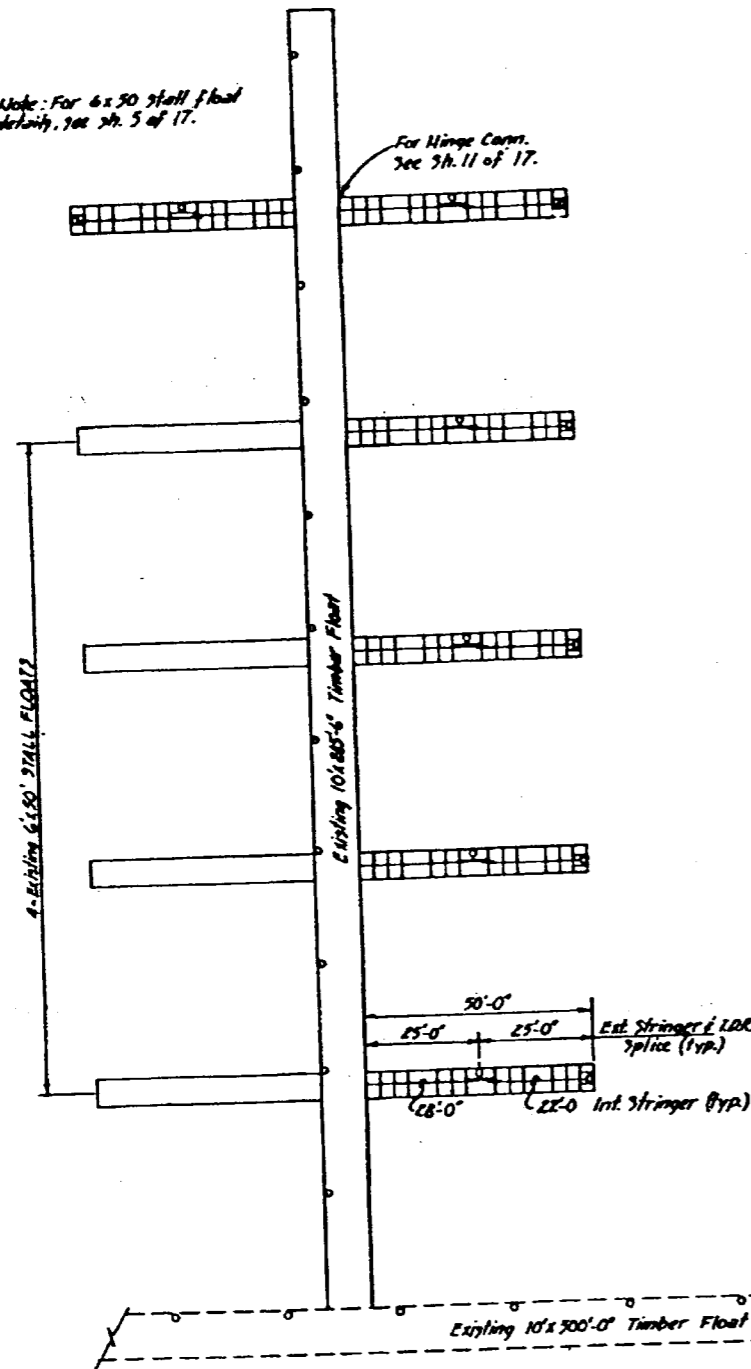

NOTE: NOT APPLICABLE THIS PROJECT

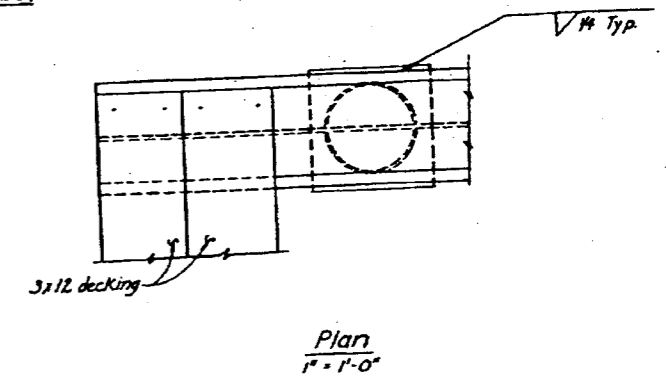


GRID CONSTRUCTION DETAILS

HYDABURG  
STRINGER LAYOUT DIAGRAM  
1" = 20'-0"





AS BUILT  
Sheet 29 of 41

	DO NOT SCALE THIS DRAWING - USE DIMENSIONS	
	STATE OF ALASKA DEPARTMENT OF TRANSPORTATION AND PUBLIC FACILITIES DIVISION OF HARBOR DESIGN AND CONSTRUCTION	
	HYDABURG ALASKA	
	STRINGER LAYOUT DIAGRAM & GRID DETAILS (79)	
SCALE: AS NOTED	DRAWN: G.R.F.	APPROVED: [Signature]
CHECKED: R.P.B.	DATE: FEB 1979	CHECKED BY: [Signature]
PROJECT NUMBER: K39116	SHEET 14 OF 17	



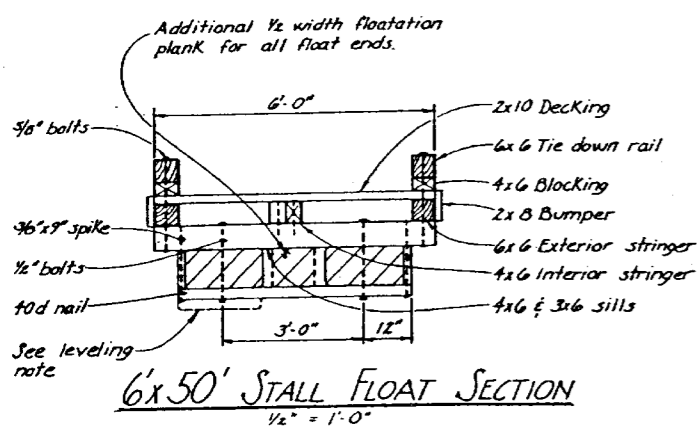

**LEVELING NOTE:**  
 5"x20"x4'-0" to 5'-0" leveling floatation shall be installed as directed by the engineer (may be required on approx. 20% of stall floats). Place floatation between lower sill members with the outer edge bearing on siding members (cut side up). Pin floatation together with 3/8"x20" ell pin, (see detail this sheet), required 3 places approx. equally spaced.

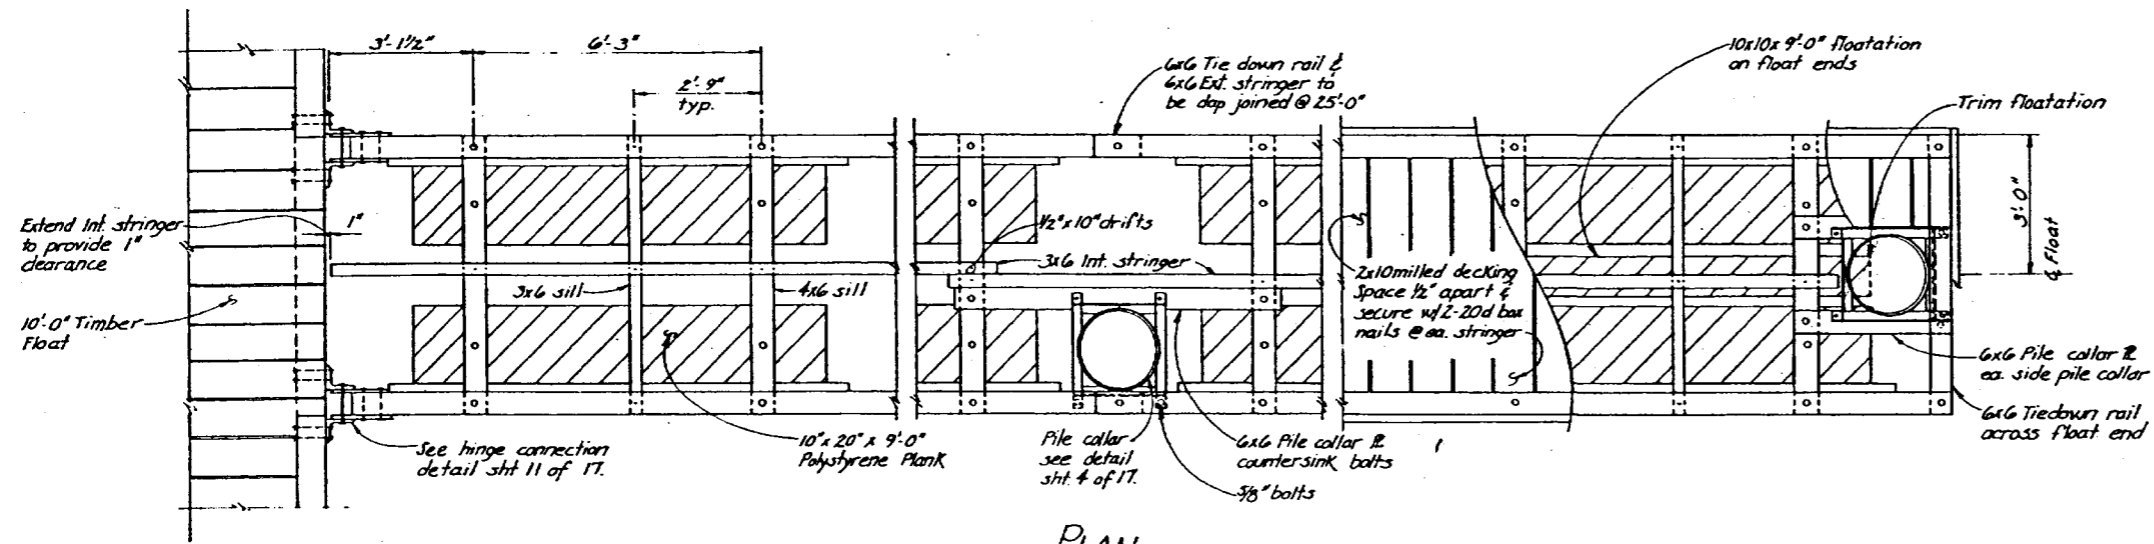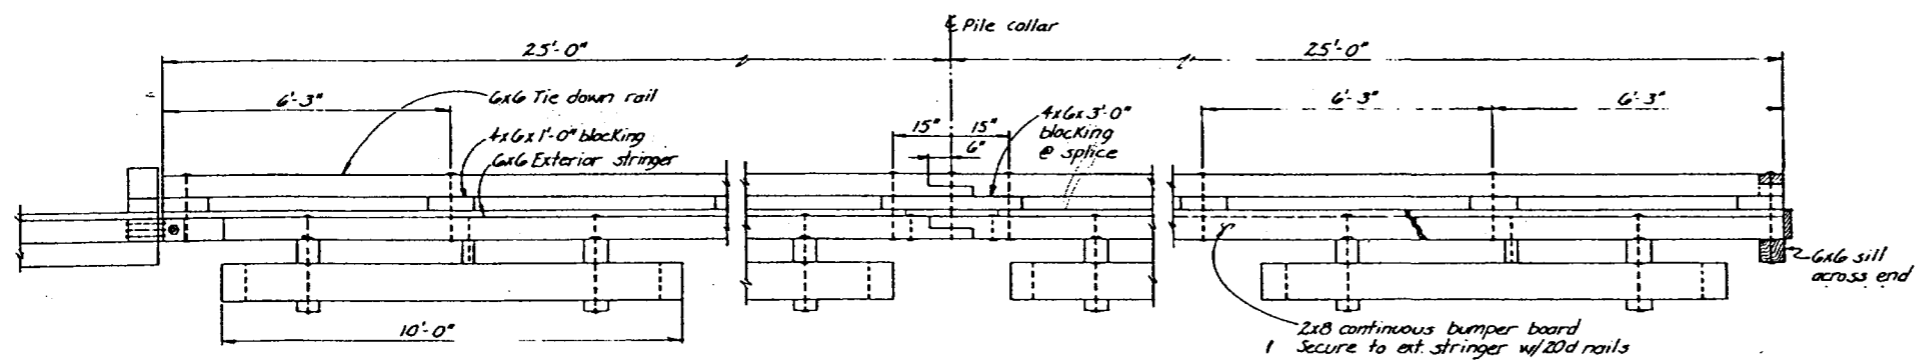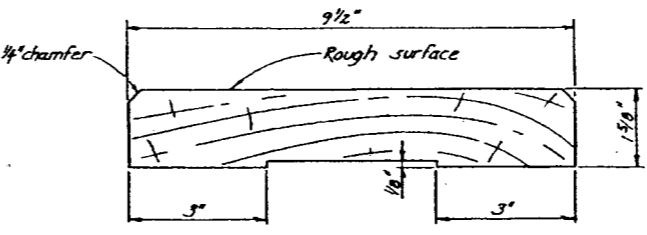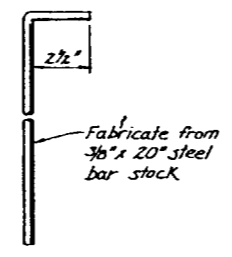

MATERIALS		
ITEM	DRESSING	TREATMENT
3"x6"-4"x6"x6'6" Upper Sill	S-4-S	Creasote
2"x10" Siding	2"x10 1/2"	"
3"x6" Lower Sill	S-4-S	"
6"x6" Collar Plates	S-4-S	Creasote
4"x6" Interior Stringers	S-4-S	"
6"x6" Exterior Stringers	S-4-S	"
2"x8" Bumpers	S-4-S	Penta
2"x10" Decking	Milled	"
4"x6" Blocking	S-4-S	"
6"x6" Rail	S-4-S	"
		See Specs

\* Exact width to conform to thickness of floatation material.


**PRE-DRILLED BOLT HOLES**  
 COLLAR MEMBERS - all holes  
 SILLS - holes for floatation plank bolts  
 STRINGERS - holes for stringer to sill bolts  
 TIE DOWN RAIL - all holes

**FIELD DRILLED BOLT HOLES**  
 SILLS - 1. holes for stringer to sill bolts  
 2. pile collar stringer to sill  
 PILE COLLAR INT. STRINGER - G-FLOAT - all holes  
 RAIL BLOCKING - all holes  
 COLLAR PLATES - all holes  
 EXTERIOR STRINGER - 1. holes for tie down rail bolts  
 2. holes for pile collar plate bolts


**NOTES**  
 All hardware to be hot-dipped galvanized. A malleable iron washer shall be placed between all nut and wood surfaces. All bolts to be of the economy head type. Bolt holes to be drilled 1/16" oversize except sill bolt holes for floatation planks 1/8" oversize. Drift holes to be drilled 1/16" undersize. All field drill holes shall be treated with hot creasote oil. All pressure treated creasote material shall be cut to size prior to treatment. Tie down rails shall extend across all float ends, except under gangway. All bolt heads facing decking shall be countersunk 1/4" previous to treatment. Field drill all drift bolt holes. A barrier of 6mil black polyethylene shall be placed between the contact surfaces of all creasote timber and floatation material (except float siding members).

**AS BUILT**  
 Sheet 31 of 41


STAMP		DO NOT SCALE THIS DRAWING - USE DIMENSIONS	
STATE OF ALASKA DEPARTMENT OF TRANSPORTATION AND PUBLIC FACILITIES DIVISION OF HARBOR DESIGN AND CONSTRUCTION			
6'x50' TIMBER STALL FLOAT			
SCALE AS NOTED		SURVEYED	APPROVED
DESIGNED	DATE	DATE	DATE
CHECKED			
PROJECT NUMBER	R-39106 & K-39115	SHEET	5 OF 17

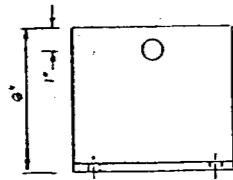


ELEVATION  
3'-11 1/2"

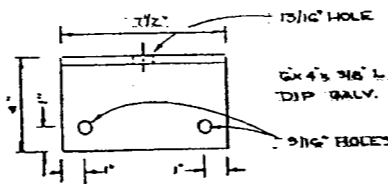


ANGLE CLIP PLAN  
3'-11 1/2"

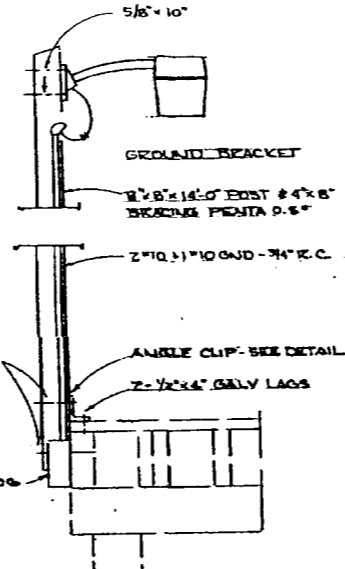


TYPE A FIXTURE  
1/2\"/>

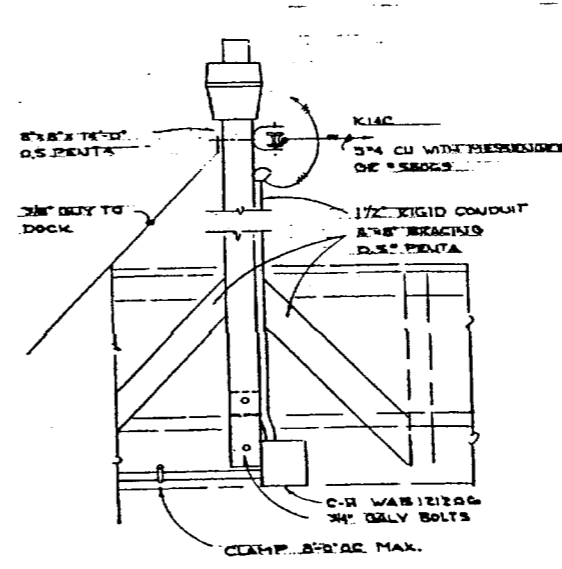

TYPE B FIXTURE  
1/2\"/>

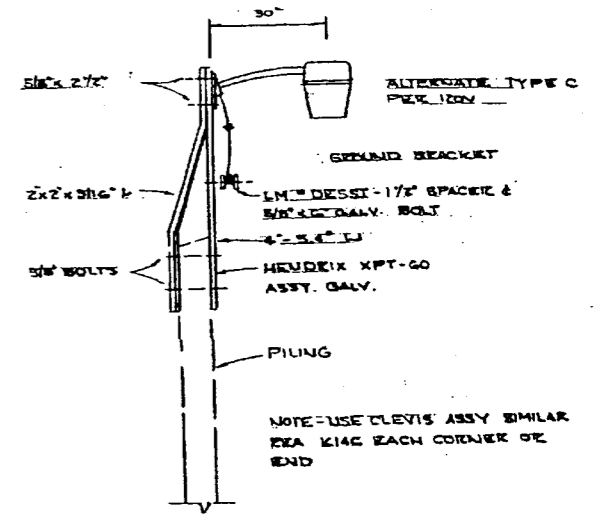

TYPE C FIXTURE  
1/2\"/>

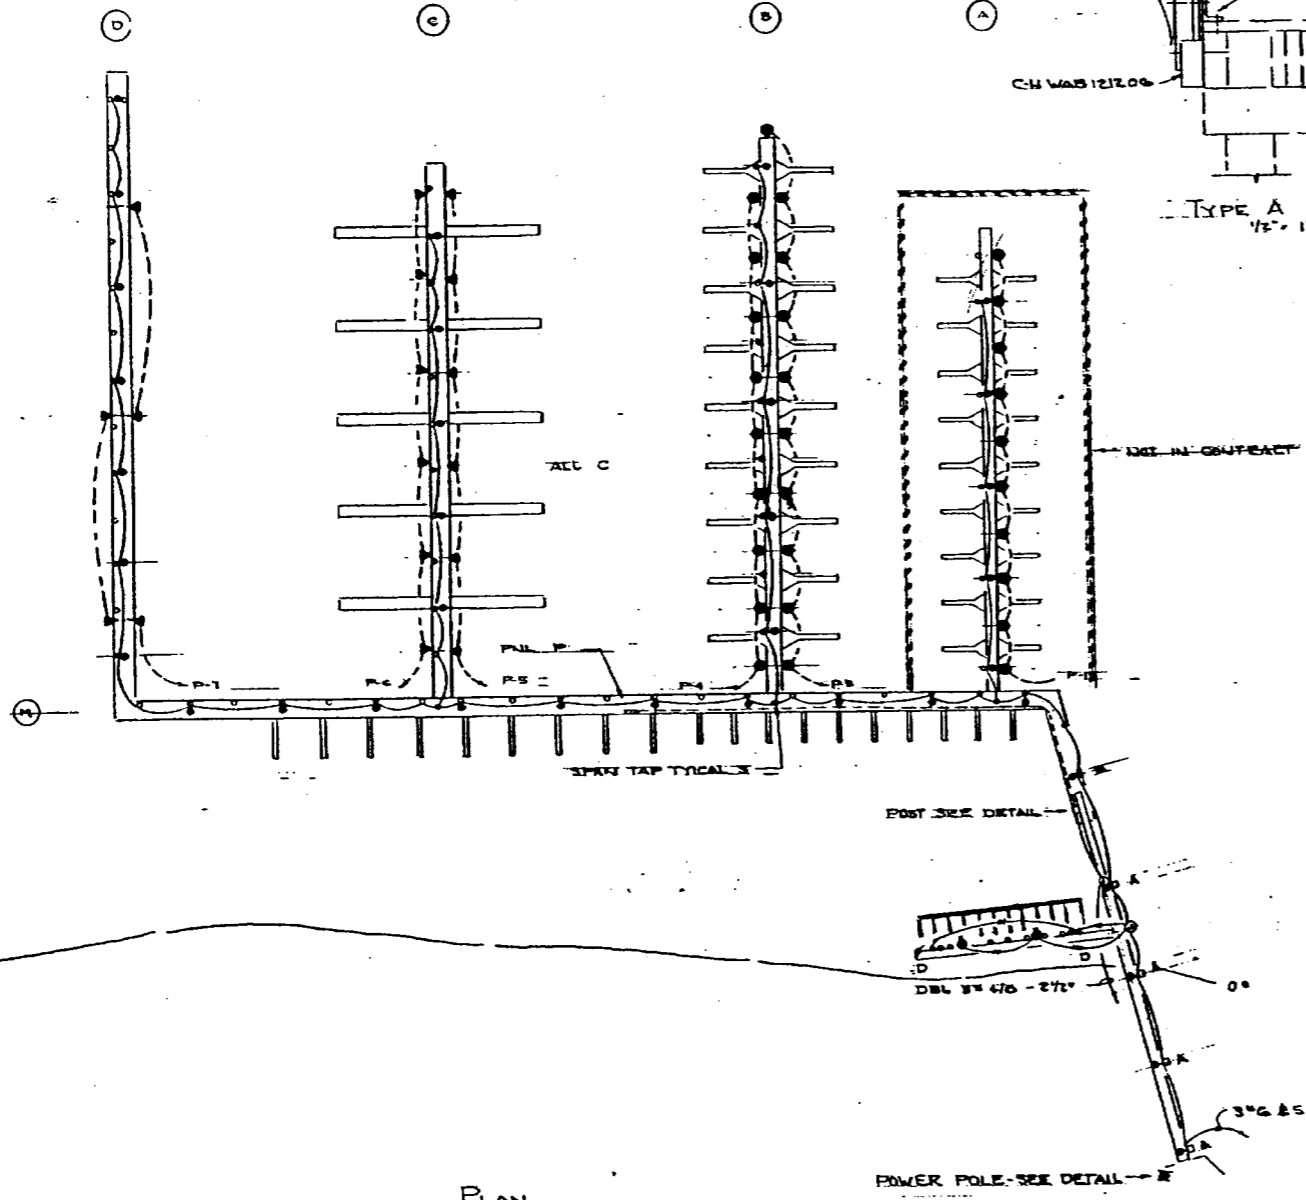

PLAN  
1:50'

FIXTURE SCHEDULE			
TYPE	MEG	W	REMARKS
A	WESTINGHOUSE VSP-SDMK-11A	15 HPS	120V ON POST TYPE III
B			120V PILING - 12"
C	VSP-SDMK-11A		POST - III
D	VSP-SDMK-11A		

ARM SIMILAR. MCGRAW HILL PHOTO CELL - ALL BALLASTS FOR 20% & REGULATED OUTPUT WITH POWER FACTOR 90% OR BETTER  
TYPE D SAME DETAIL AS A EXCEPT BOLL VERTICAL POST TO SIDE OF EXISTING PILING

- Legend:
- NEW WIRING OVERHEAD OR IN CONDUIT
  - BELOW FLOORS
  - TRIM POWER OUTLET USE WOOD FLOORS BULL RAIL
  - POWER OUTLET GRID FLS 3000 AT ELEV 15.0' NEAR LADDER
  - PHOTO-ELECTRIC
  - JUNCTION
  - LIGHT FIXTURE SEE SCHEDULE

PILE CUT OFF ± 23.0  
EHW ± 14.0  
ELW ± 4.0  
FLOATS A+B NO BULL RAIL  
C.D.M.

AS BUILT  
Sheet 32 of 41

STAMP

DO NOT SCALE THIS DRAWING - USE DIMENSIONS

STATE OF ALASKA  
DEPARTMENT OF TRANSPORTATION AND PUBLIC FACILITIES  
DIVISION OF HARBOR DESIGN AND CONSTRUCTION


ELECTRICAL  
HYDABURG BOAT HARBOR  
ALASKA 79

Hydaburg

SCALE NOTED SURVEYED DRAWN LPL  
DESIGNED DATE APRIL 73  
CHECKED  
APPROVED  
Chief of Design

PROJECT NUMBER R 39116 SHEET 16 OF 17

NOTE: DO NOT SCALE FROM THESE PLANS—USE DIMENSIONS

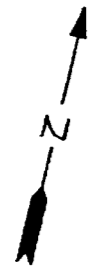

**TIDE DATA**


Highest tide (estimated)	11.5'
Mean Higher High Water	10.7'
Mean High Water	9.9'
Mean Tide Level	7.7'
Mean Low Water	1.5'
Mean Lower Low Water	0.0'
Lowest Tide (estimated)	-4.5'

**NOTES**

Electric Pole cutoff at 40'  
 Float pile cutoff at 30'  
 Dolphin pile cutoff at 30'  
 Socket all timber piles - 10' penetration minimum - A.B.: Used 7' min primarily  
 A.B. - Changed to 6' minimum w/ State approval - sufficient support  
 Horizontal control (basis of bearing) shall be established between MET T (N 120, 222.84, E 3,121,386.77) and MET B (N 120, 130.84, E 3,122,051.10)  
 Vertical control shall be "MET B" Elev. 27.70 (USACE, brass cap at sidewalk curb).

- Timber Float Pile
- 3-Pile Timber Dolphin
- Approximate Drill Hole Location (Corps of Engrs.)


**As Built:**  
 † Original socket drilled crooked, discarded, moved & redrilled  
 \* Stall float pairs moved distance & direction indicated to fit drilled pile sockets

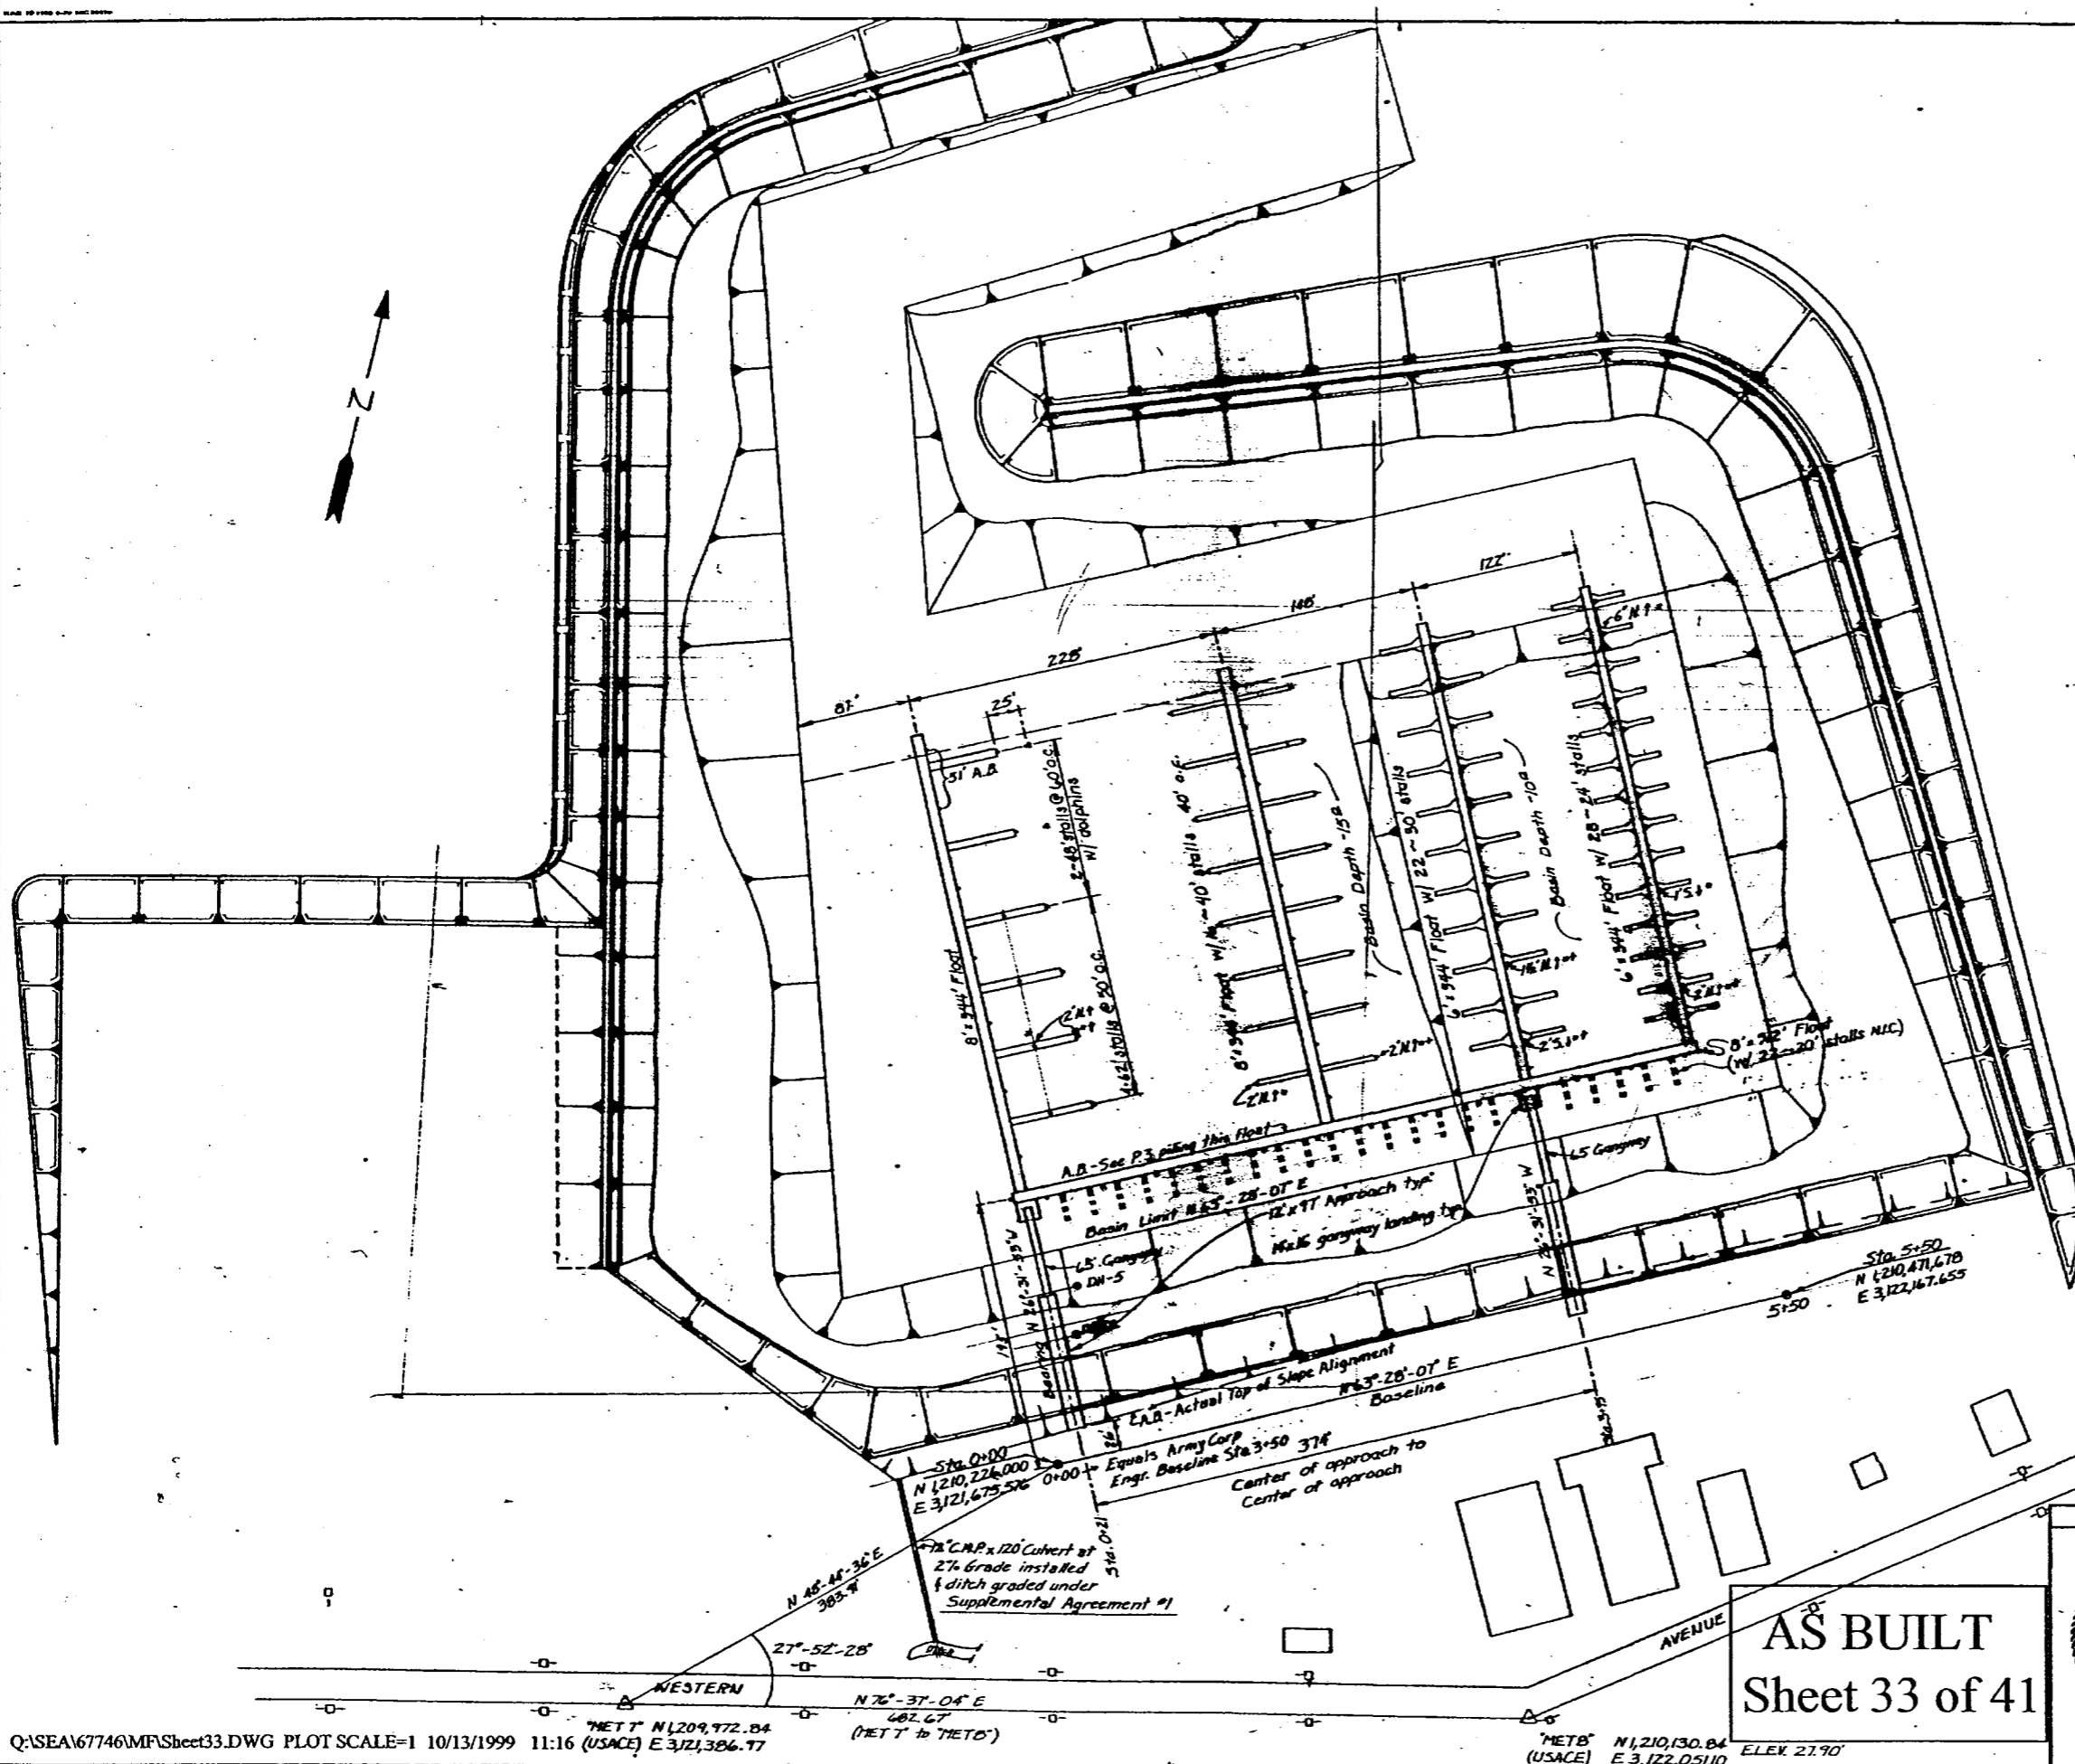

AS BUILT


AS BUILT  
 Sheet 33 of 41

STAMP		DO NOT SCALE THIS DRAWING - USE DIMENSIONS	
		STATE OF ALASKA DEPARTMENT OF TRANSPORTATION AND PUBLIC FACILITIES DIVISION OF HARBOR DESIGN AND CONSTRUCTION	
		METLARATLA ALASKA	
<b>PROJECT LAYOUT</b>			
SCALE 1" = 60'	SURVEYED	APPROVED	
DESIGNED	DATE 12/80	Robert P. Beck CHIEF OF DESIGN	
CHECKED			
PROJECT NUMBER K93124		SHEET 2 OF 21	

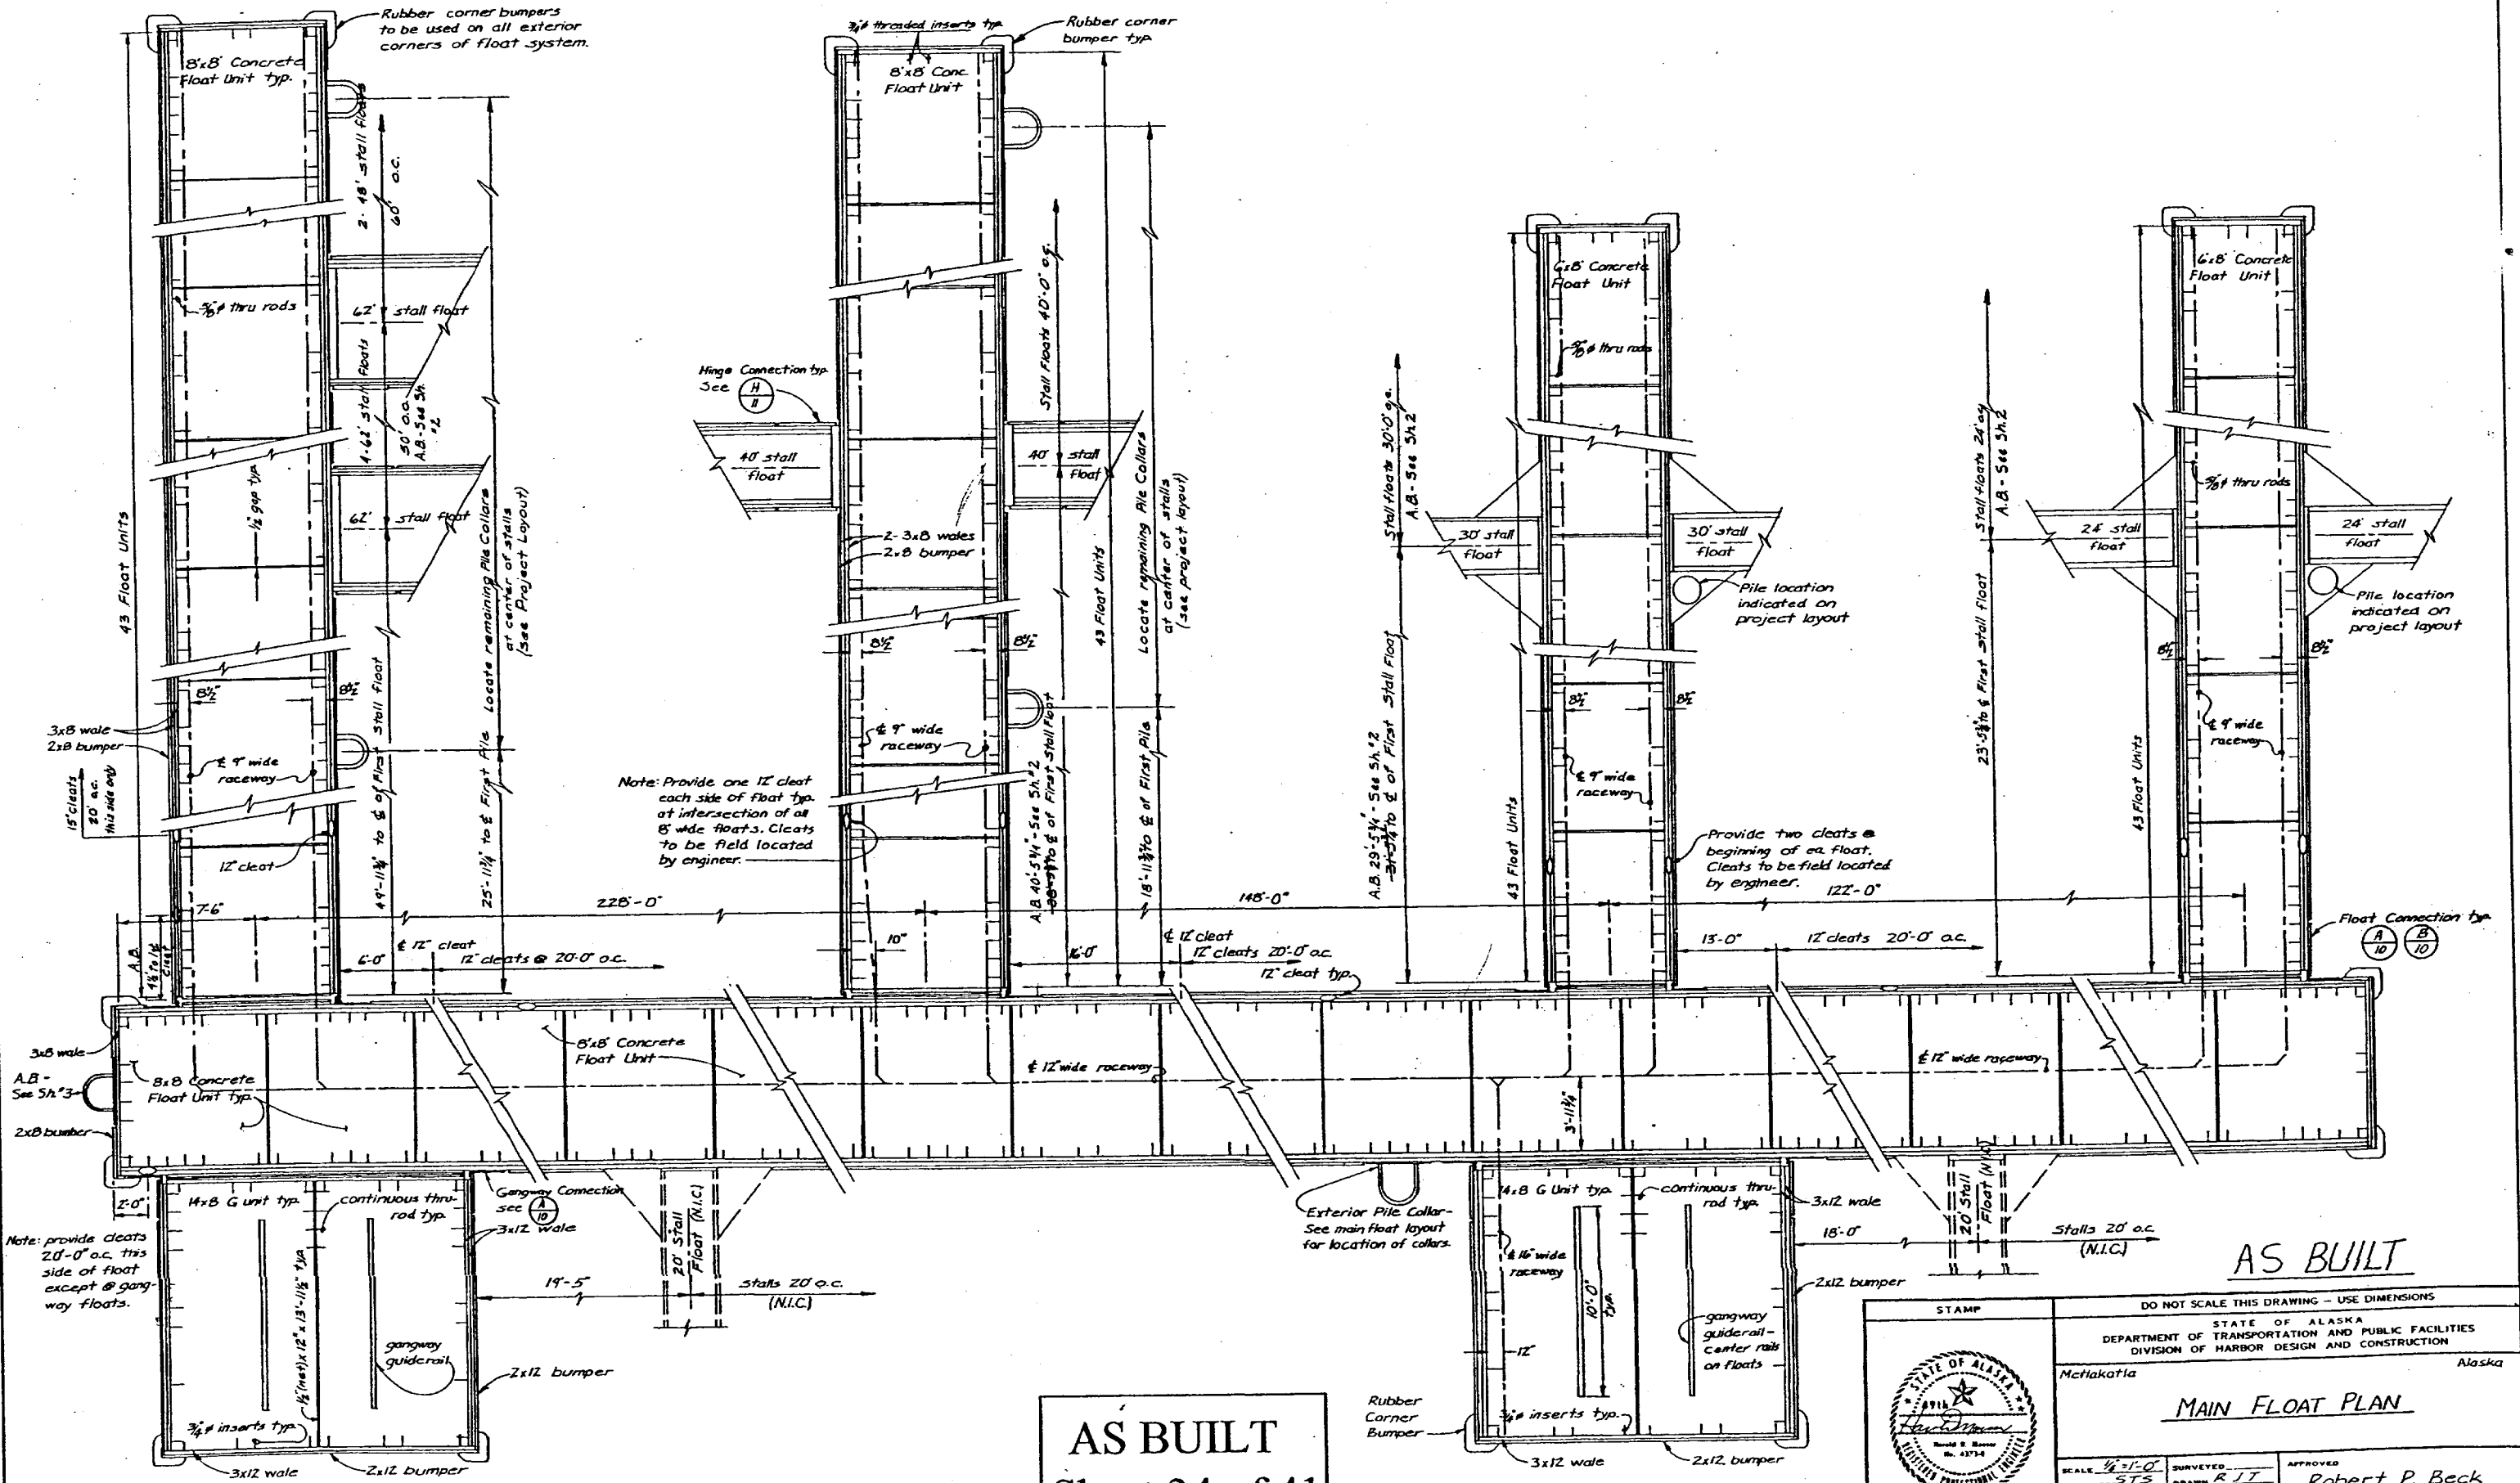


**AS BUILT**  
Sheet 34 of 41

STAMP		DO NOT SCALE THIS DRAWING - USE DIMENSIONS	
		STATE OF ALASKA DEPARTMENT OF TRANSPORTATION AND PUBLIC FACILITIES DIVISION OF HARBOR DESIGN AND CONSTRUCTION	
		Metlakatla Alaska	
<b>MAIN FLOAT PLAN</b>			
SCALE 1/8"=1'-0"	SURVEYED	APPROVED	
DESIGNED STS	DRAWN RIT	Robert P. Beck	
CHECKED	DATE	CHIEF OF DESIGN	
PROJECT NUMBER K 93124	SHEET 4 OF 21		

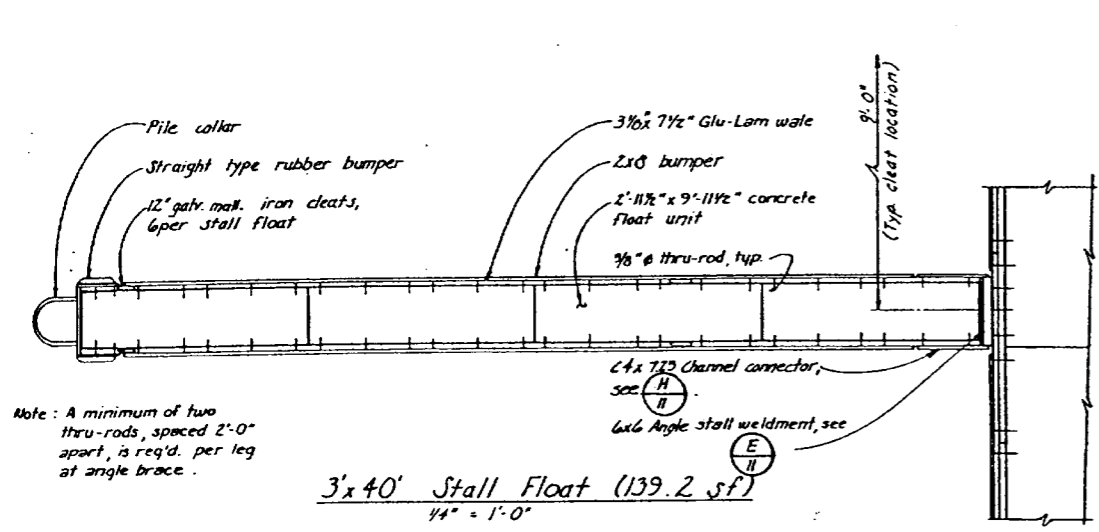


**3' x 40' Stall Float (139.2 sf)**  
1/4" = 1'-0"


Note: A minimum of two thru-rods, spaced 2'-0" apart, is req'd. per leg at angle brace.

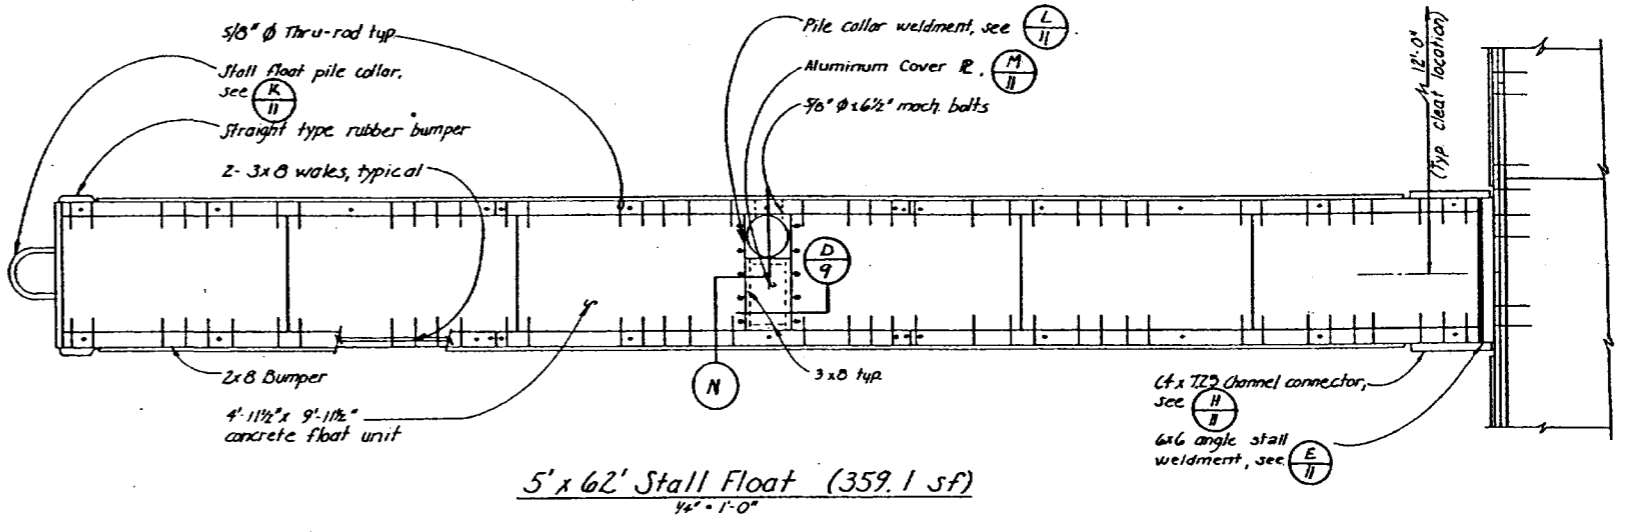


**5' x 62' Stall Float (359.1 sf)**  
1/4" = 1'-0"

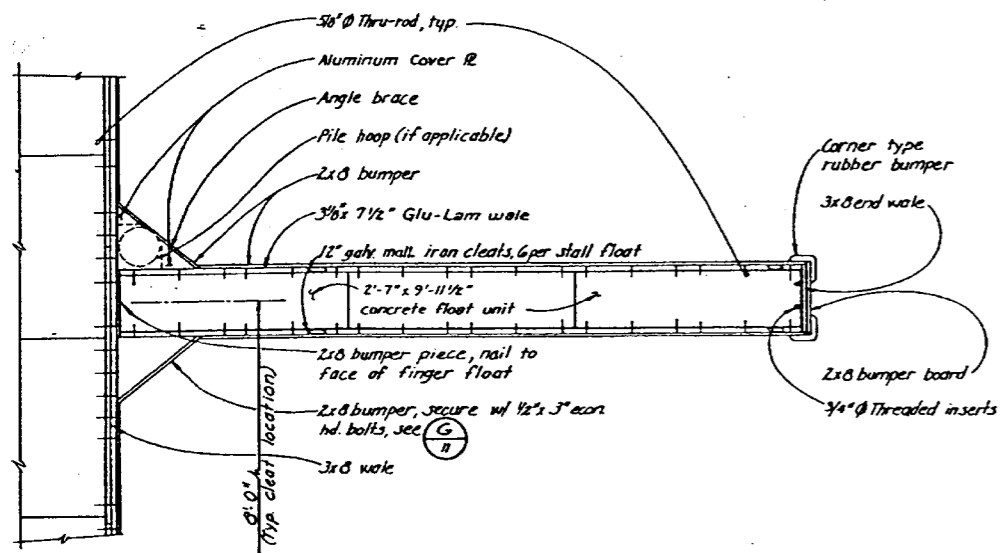


**3' x 30' Stall Float (105.1 sf)**  
1/4" = 1'-0"

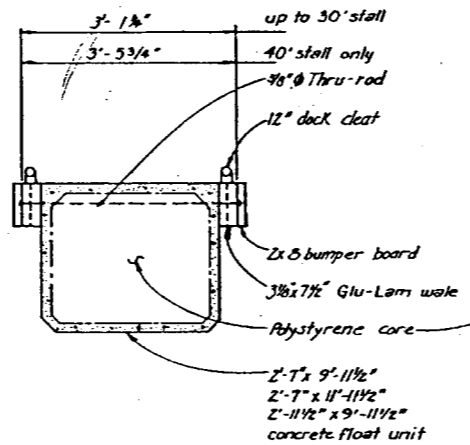


**3' Stall Section**  
3/4" = 1'-0"

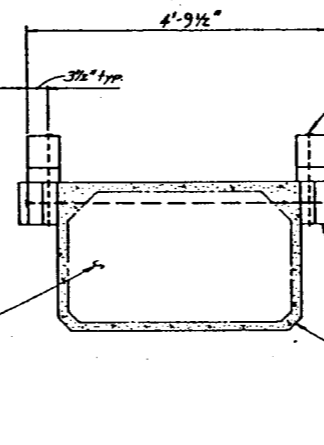


**4' Stall Section**  
3/4" = 1'-0"

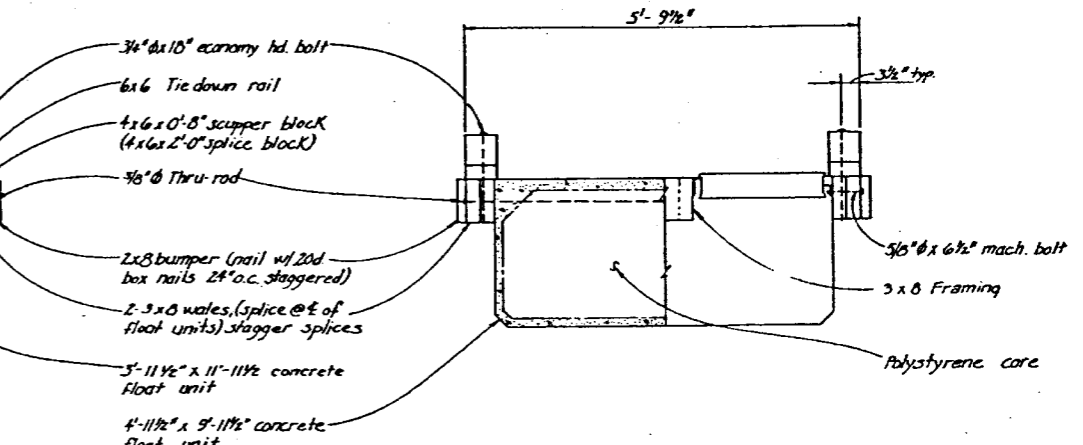

**5' Stall Section**  
3/4" = 1'-0"

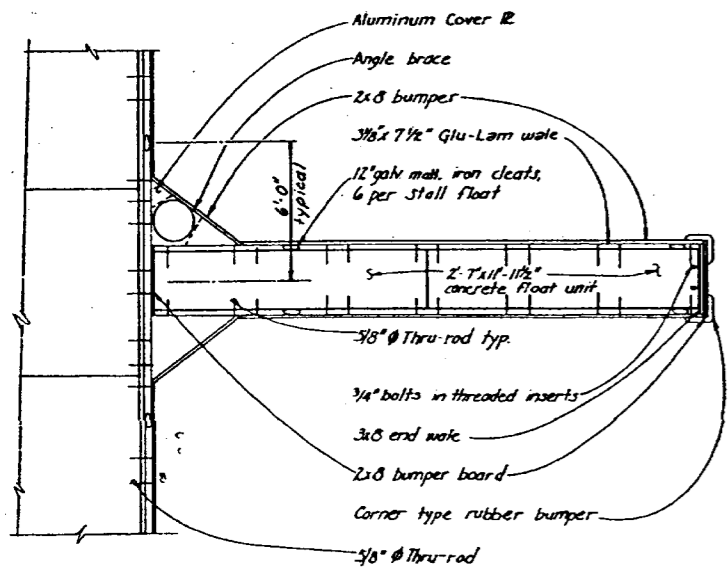


**3' x 24' Stall Floats (86.5 sf)**  
1/4" = 1'-0"

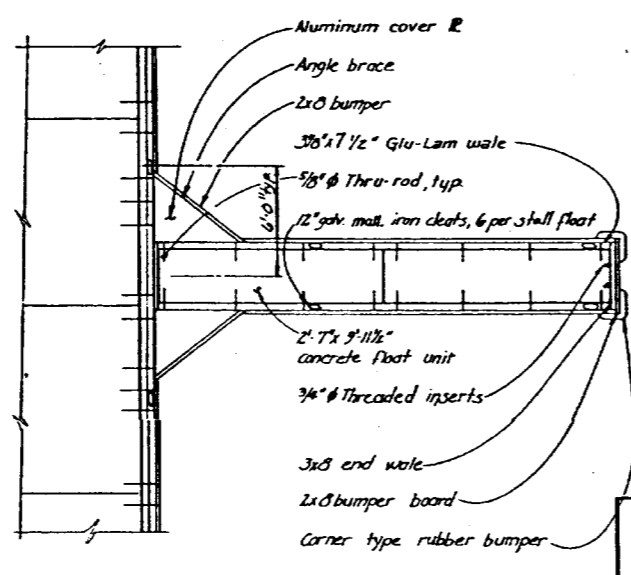





**3' x 20' Stall Floats (74.1 sf)**  
1/4" = 1'-0"

**AS BUILT**  
Sheet 35 of 41

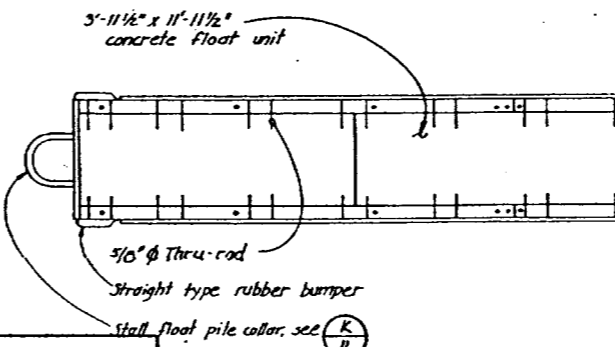

**4' x 48' Stall Floats (230.0 sf)**  
1/4" = 1'-0"

STAMP		DO NOT SCALE THIS DRAWING - USE DIMENSIONS	
		STATE OF ALASKA DEPARTMENT OF TRANSPORTATION AND PUBLIC FACILITIES DIVISION OF HARBOR DESIGN AND CONSTRUCTION	
		Metlakatla, Alaska	
<b>TYPICAL STALL FLOATS</b>		SCALE: As Noted	SURVEYED: _____
		DESIGNED: _____	DRAWN: SJS
PROJECT NUMBER: K 93124		APPROVED: Robert P. Beck CHIEF OF DESIGN	
SHEET 5 OF 21			

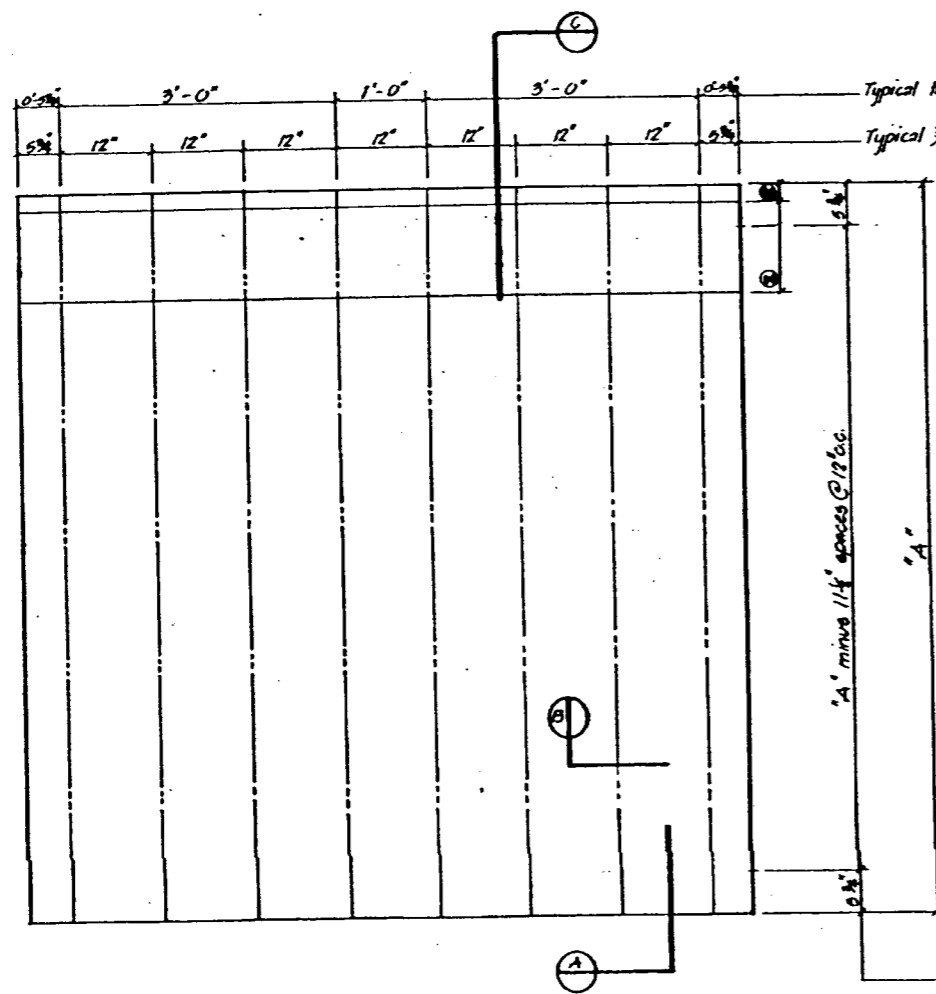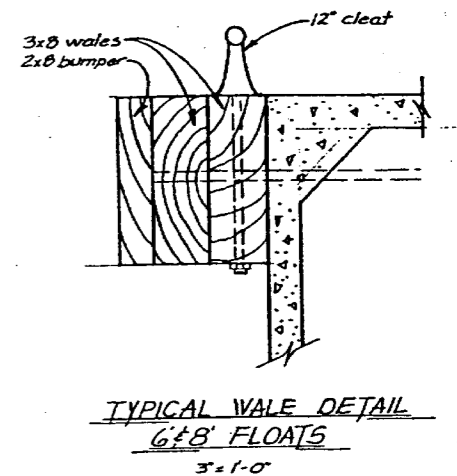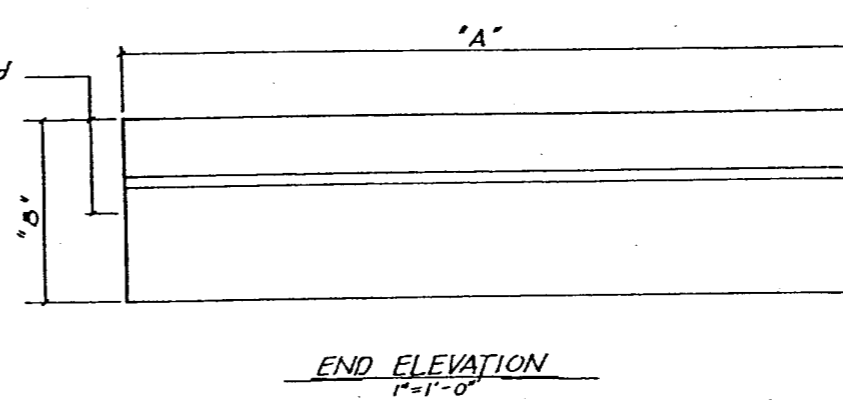
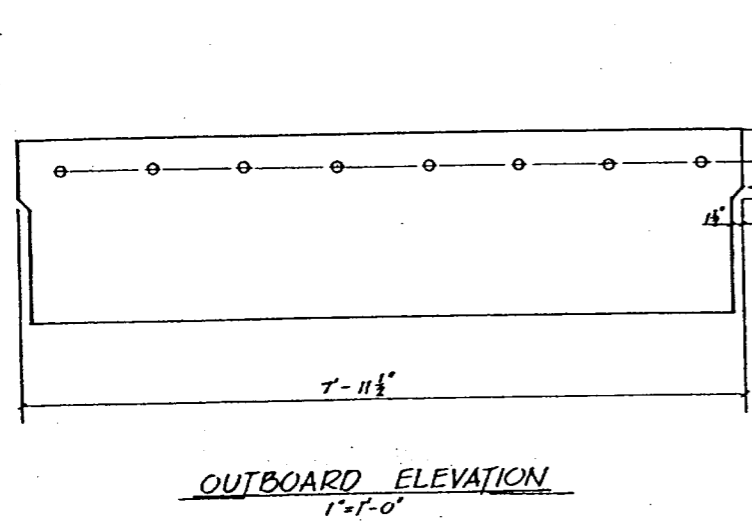


Design Freeboard 12" ①  
 Maximum Freeboard 14"  
 Minimum Freeboard 11"

DIMENSIONS			IMMERSION CAPACITY
Nominal Float	"A"	"B"	Pounds per linear ft.
6x8	3'-11 1/2"	Note ①	30.6
8x8	7'-11 1/2"	"	40.8
10x8	9'-11 1/2"	"	51.0
12x8	11'-11 1/2"	"	61.2

- General Notes:
- ① Pontoon supplier to provide float unit w/ required freeboard. Allow 35 lbs. per linear foot for wales, bumper & utilities.
  - ② Utility raceway location shown on layout drawings.

12' cont. 3x6 - W3xV3, shape as shown side trough only. Haunch typical all troughs. Cut cross wires to go around thru rods. See note ②

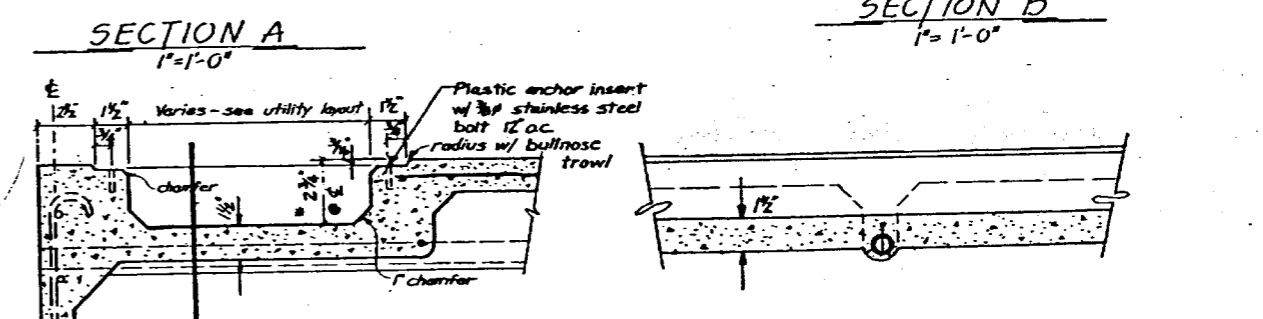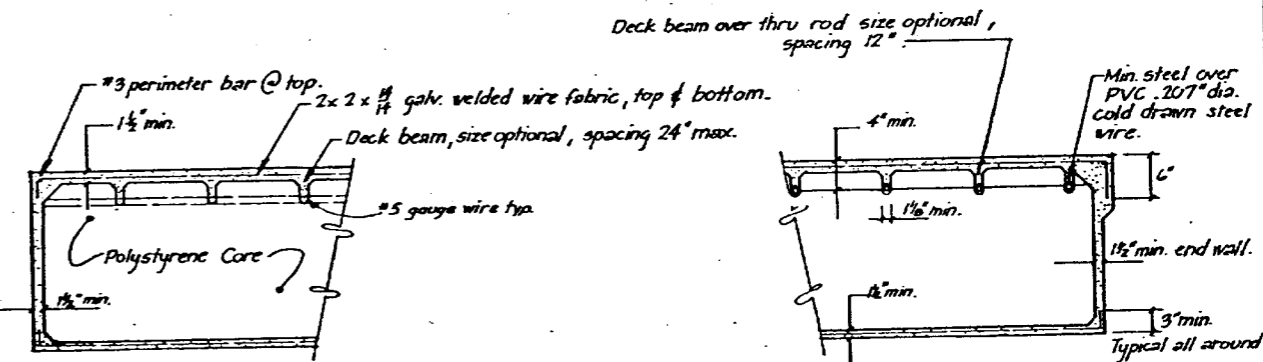

**AS BUILT**  
 Sheet 36 of 41

STAMP


DO NOT SCALE THIS DRAWING - USE DIMENSIONS

STATE OF ALASKA  
 DEPARTMENT OF TRANSPORTATION AND PUBLIC FACILITIES  
 DIVISION OF HARBOR DESIGN AND CONSTRUCTION

Matlakalla Alaska


**TYPICAL FLOAT UNITS**

SCALE: As Shown SURVEYED: \_\_\_\_\_ APPROVED: Robert P. Beck  
 DESIGNED: \_\_\_\_\_ DRAWN: DATE 11-80 CHIEF OF DESIGN  
 CHECKED: \_\_\_\_\_ PROJECT NUMBER: K 93/24 SHEET: 6 OF 21

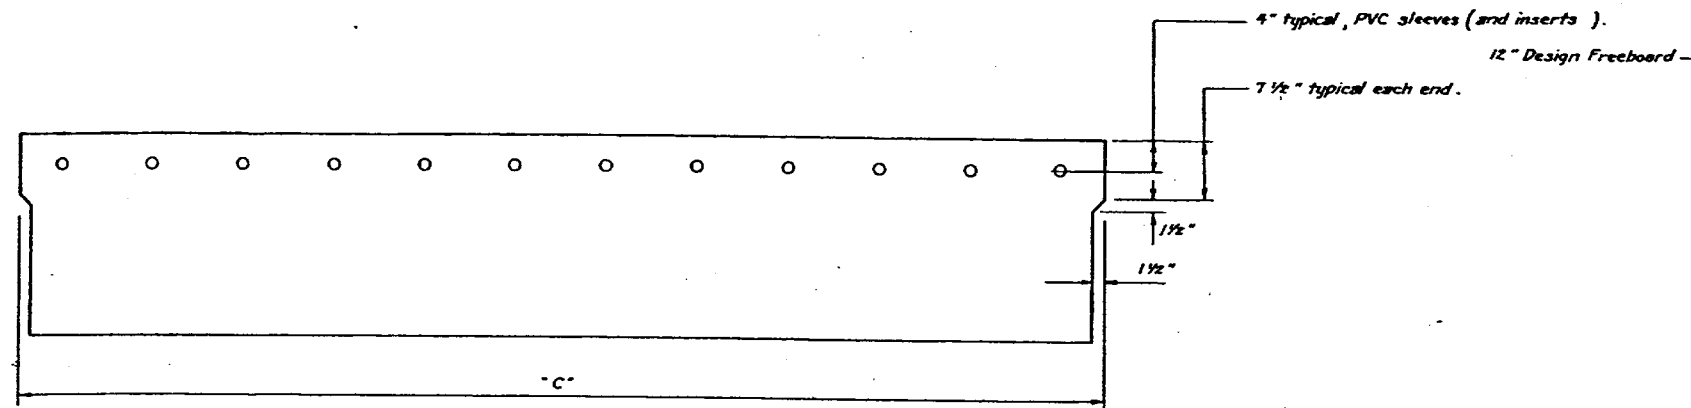


**OUTBOARD ELEVATION**

1" = 1'-0"

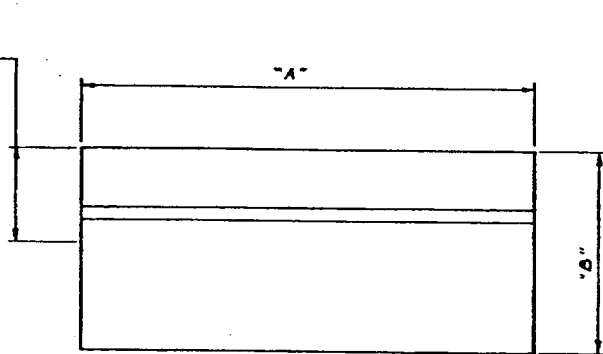


**END ELEVATION**

1" = 1'-0"

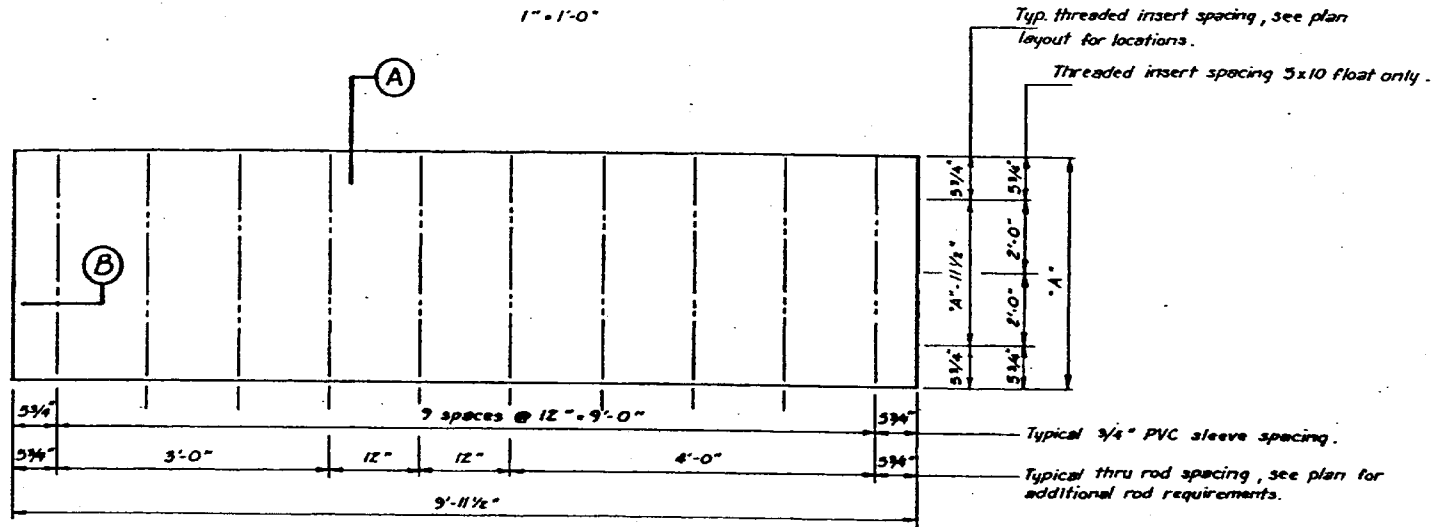

**PLAN**

1" = 1'-0"

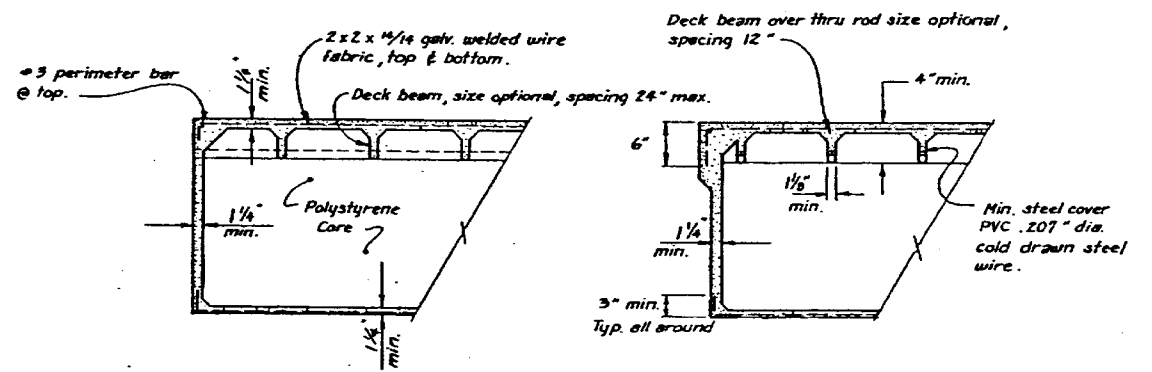


**SECTION A**

1" = 1'-0"

**SECTION B**

1" = 1'-0"

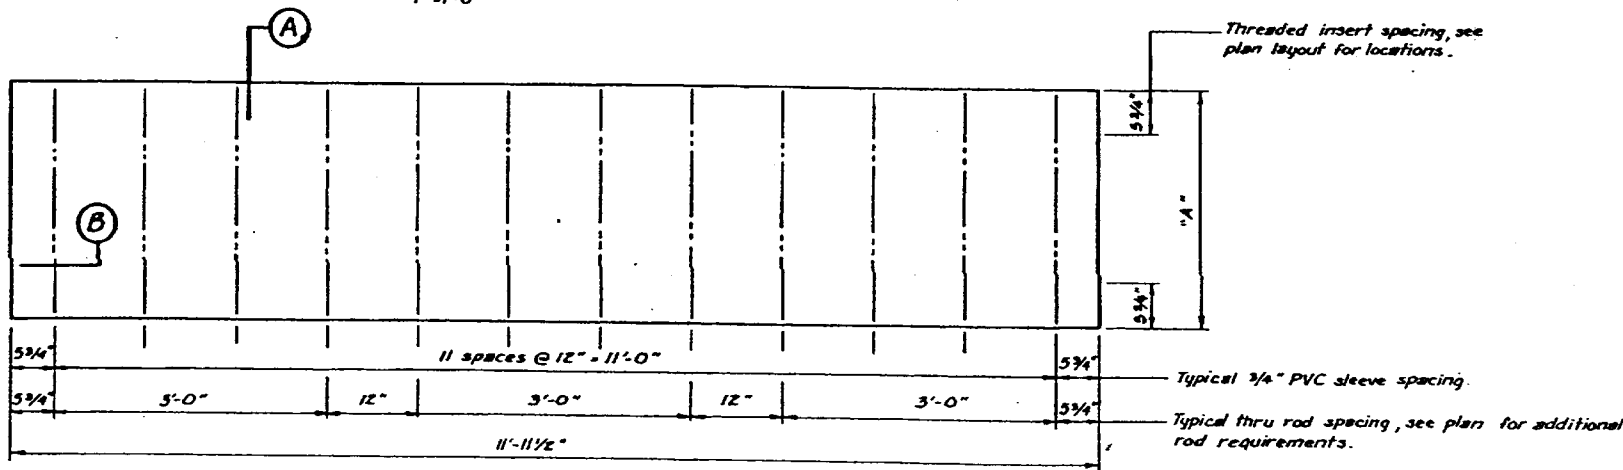

**PLAN**

1" = 1'-0"

**General Notes:**  
 1. Float supplier to provide float unit w/ required freeboard.  
 Allow 16.4 lbs. per lin. ft. for 3' wide float and 26.0 lbs. per lin. ft. for 4' & 5' wide floats for wakes & bumpers.


Nom. Float	DIMENSIONS			IMMERSION CONSTANT Pounds per linear ft.
	"A"	"B"	"C"	
3 x 10	2'-7"	Note 1	9'-11 1/2"	13.4
3 x 12	2'-7"	-	11'-11 1/2"	13.4
4 x 12	3'-11 1/2"	-	11'-11 1/2"	20.6
5 x 10	4'-11 1/2"	-	9'-11 1/2"	21.4
3 x 10	2'-11 1/2"	-	9'-11 1/2"	15.8

Design Freeboard 12" ①  
 Maximum Freeboard 14"  
 Minimum Freeboard 11"


**AS BUILT**

**AS BUILT**  
 Sheet 37 of 41

		DO NOT SCALE THIS DRAWING - USE DIMENSIONS	
		STATE OF ALASKA DEPARTMENT OF TRANSPORTATION AND PUBLIC FACILITIES DIVISION OF HARBOR DESIGN AND CONSTRUCTION Metlakatla Alaska	
<b>TYPICAL STALL FLOAT UNITS</b>			
SCALE: As Noted	SURVEYED: _____	APPROVED: _____	
DESIGNED: _____	DRAWN: TS	Robert P. Beck	
CHECKED: _____	DATE: 10/80	CHIEF OF DESIGN	
PROJECT NUMBER: K 93124	SHEET 7		OF 21

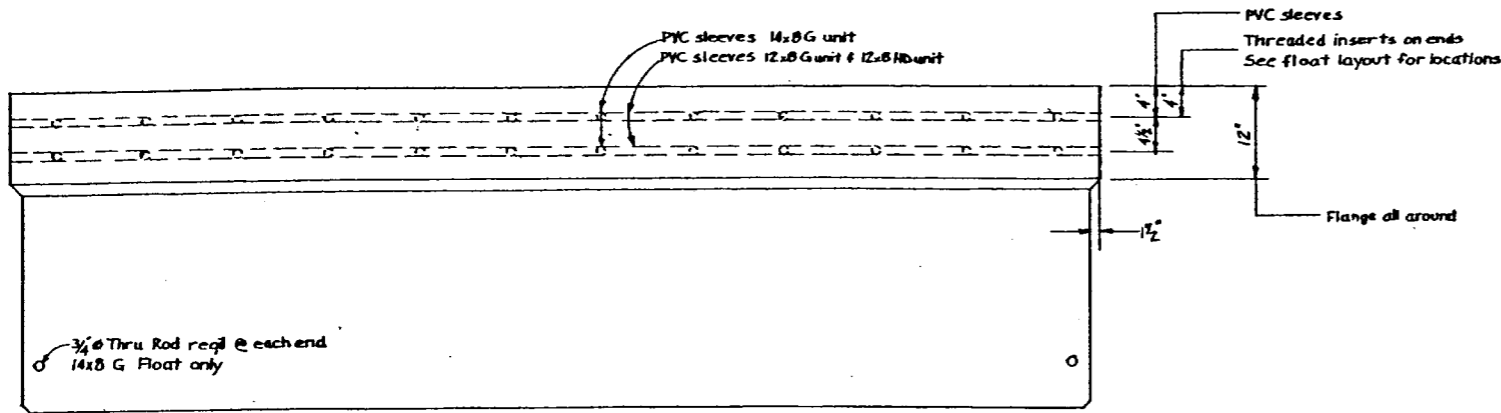

**OUTBOARD ELEVATION**  
1" = 1'-0"

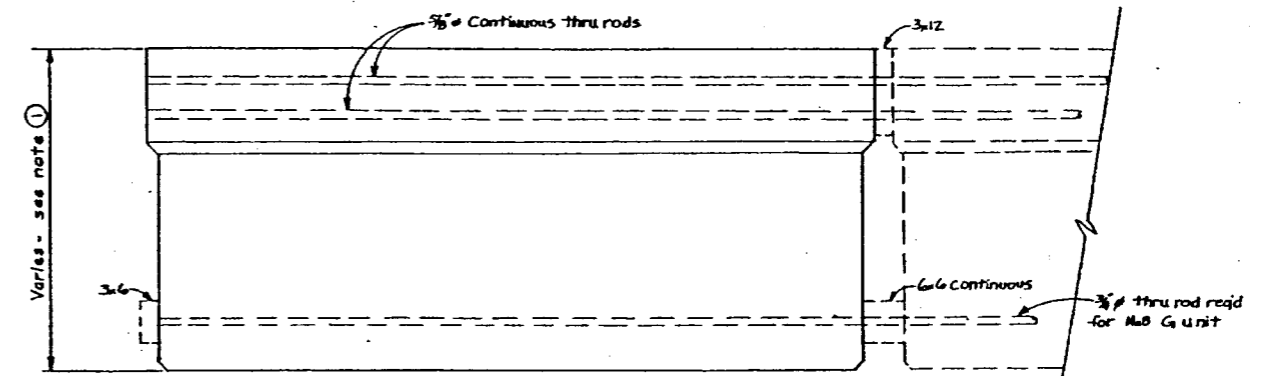


**END ELEVATION**  
1" = 1'-0"

Design Freeboard 16'  
Maximum Freeboard 18'  
Minimum Freeboard 12'


Dimensions			Immersion Constant
Nominal Float	Width	Length	Lbs. Per linear ft.
12x8 HD	11'-11 1/2"	7'-10 1/2"	61.2
12x8 G	11'-10 1/2"	7'-10 1/2"	61.2
14x8 G	7'-10 1/2"	13'-10 1/2"	40.8

**General Notes:**


- ① Pontoon supplier to provide float unit w/ req'd freeboard. Allow 35 lbs. per linear foot for wales, bumper utilities on HD units. Allow 2000 lbs. per float unit for gangway on all G units.
- ② Utility raceway location shown on layout drawings.

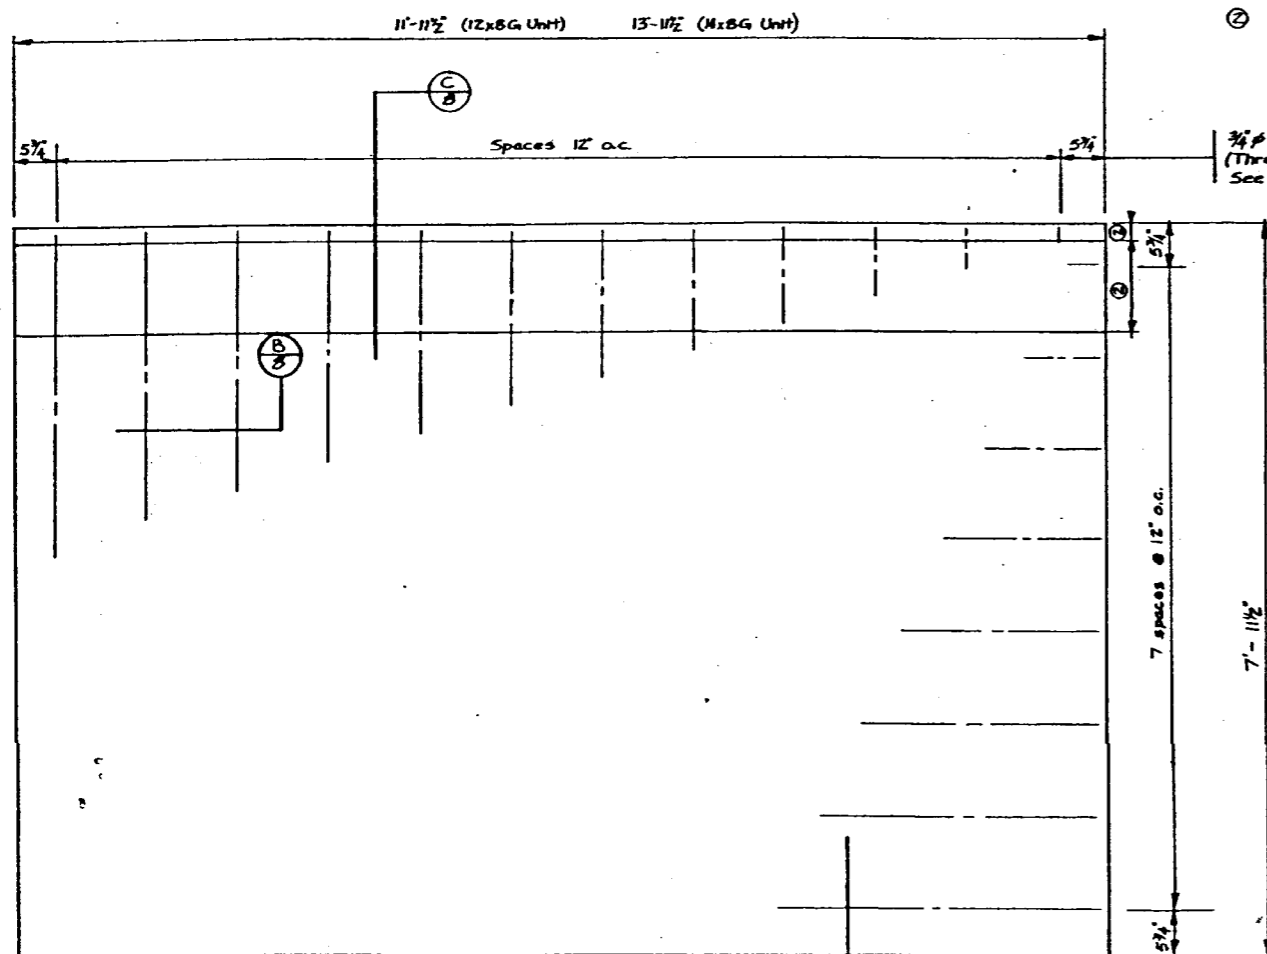


**PLAN**  
1" = 1'-0"

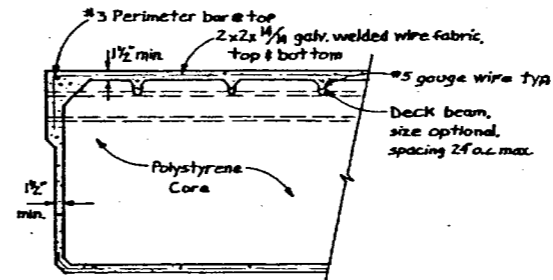


**SECTION A**  
3/4" = 1'-0"

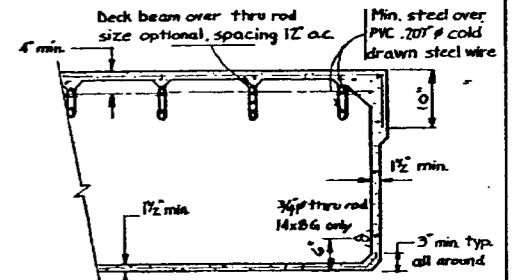

**SECTION B**  
3/4" = 1'-0"

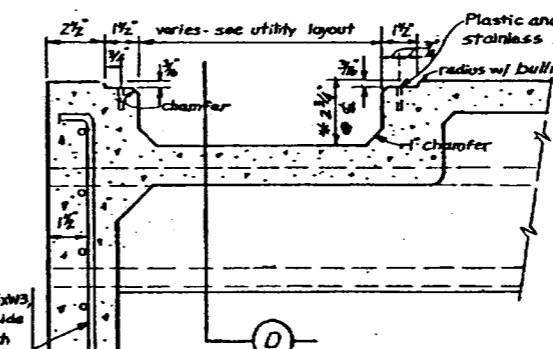

**SECTION C**  
3" = 1'-0"

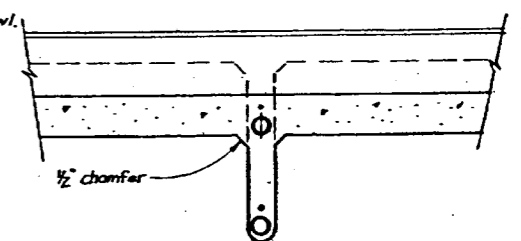

**SECTION D**  
3" = 1'-0"

**AS BUILT**  
Sheet 38 of 41

**AS BUILT**

STAMP

DO NOT SCALE THIS DRAWING - USE DIMENSIONS

STATE OF ALASKA  
DEPARTMENT OF TRANSPORTATION AND PUBLIC FACILITIES  
DIVISION OF HARBOR DESIGN AND CONSTRUCTION


Metlakatla Alaska

**GANGWAY AND HEAVY DUTY FLOAT UNITS**


SCALE: As noted  
DESIGNED: RJT/CV  
CHECKED: DATE:  
PROJECT NUMBER: K93124

APPROVED: Robert P. Beck  
CHIEF OF DESIGN


SHEET 8 OF 21

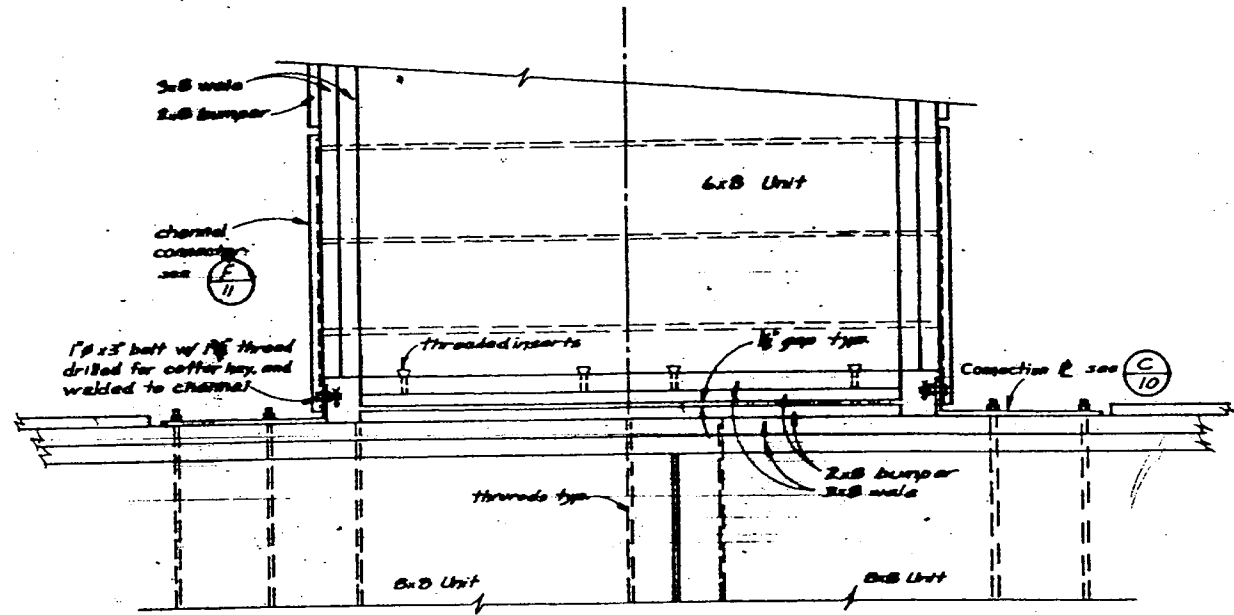

6x8 FINGER FLOAT CONNECTION DETAIL (A)  
1" = 1'-0"

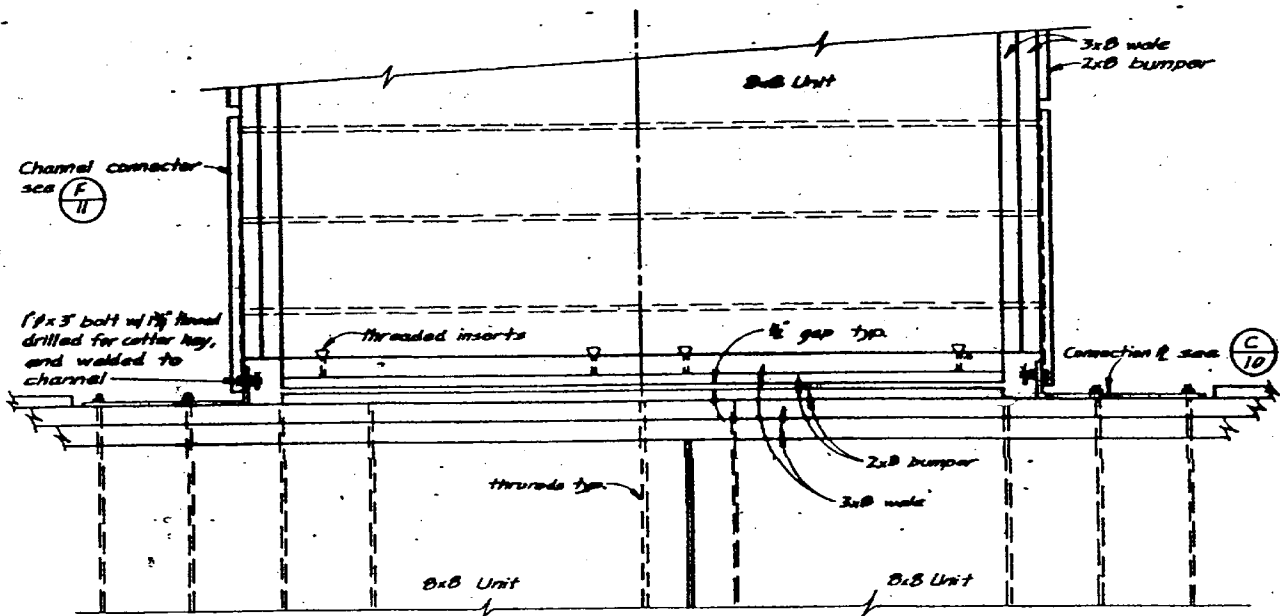

8x8 FINGER FLOAT CONNECTION DETAIL (B)  
1" = 1'-0"










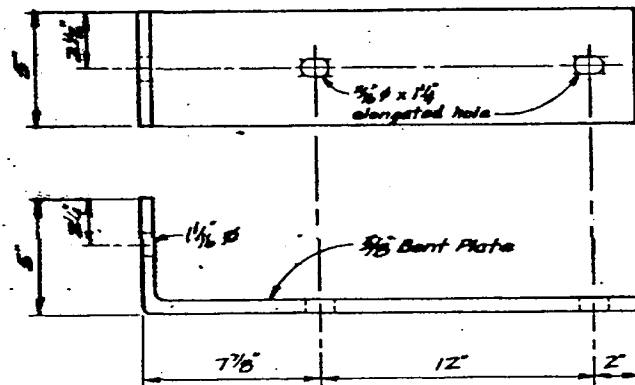


CONNECTION # (C)  
3" = 1'-0"

AS BUILT  
Sheet 39 of 41

AS BUILT

STAMP		DO NOT SCALE THIS DRAWING - USE DIMENSIONS	
		STATE OF ALASKA DEPARTMENT OF TRANSPORTATION AND PUBLIC FACILITIES DIVISION OF HARBOR DESIGN AND CONSTRUCTION	
		Metlakatla Alaska	
		FLOAT CONNECTION DETAILS	
SCALE AS NOTED	SURVEYED	APPROVED	
DESIGNED	DRAWN R.P.T.	Robert P. Beck	
CHECKED	DATE APR. 81	CHIEF OF DESIGN	
PROJECT NUMBER K93124	SHEET 10		OF 21

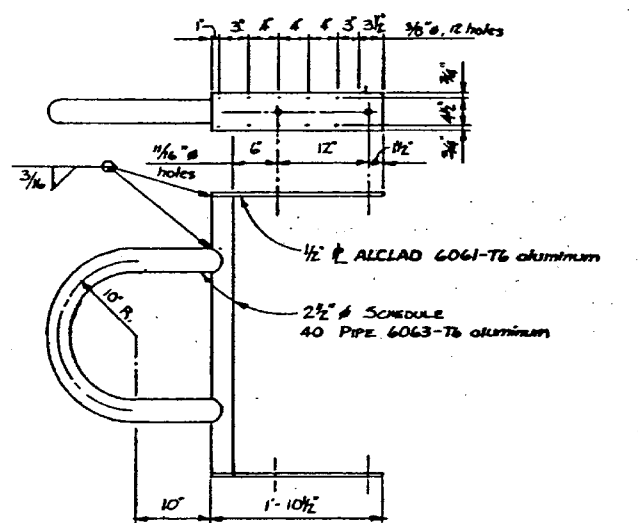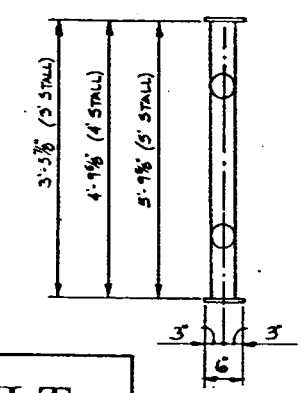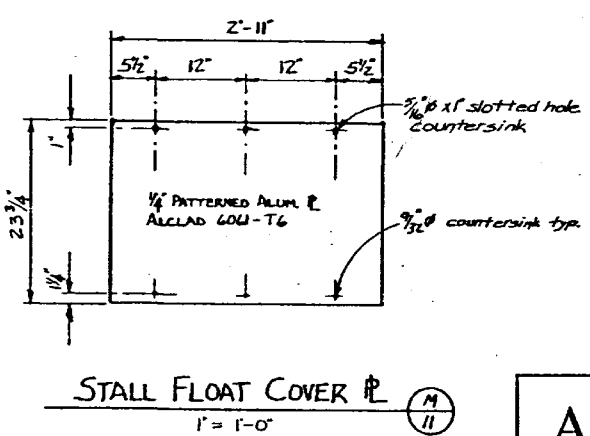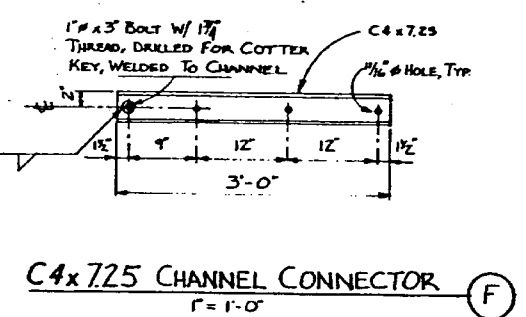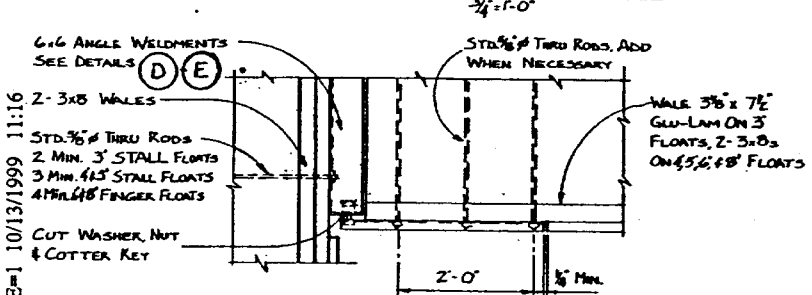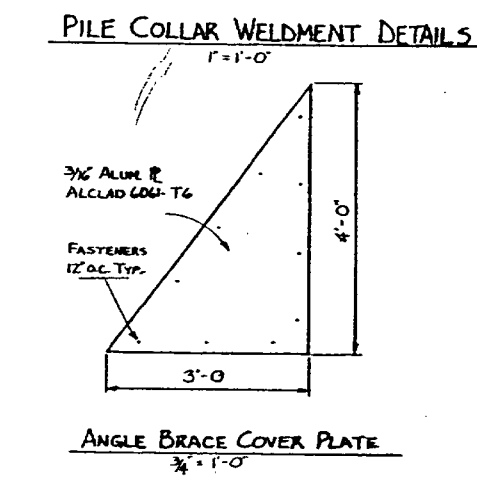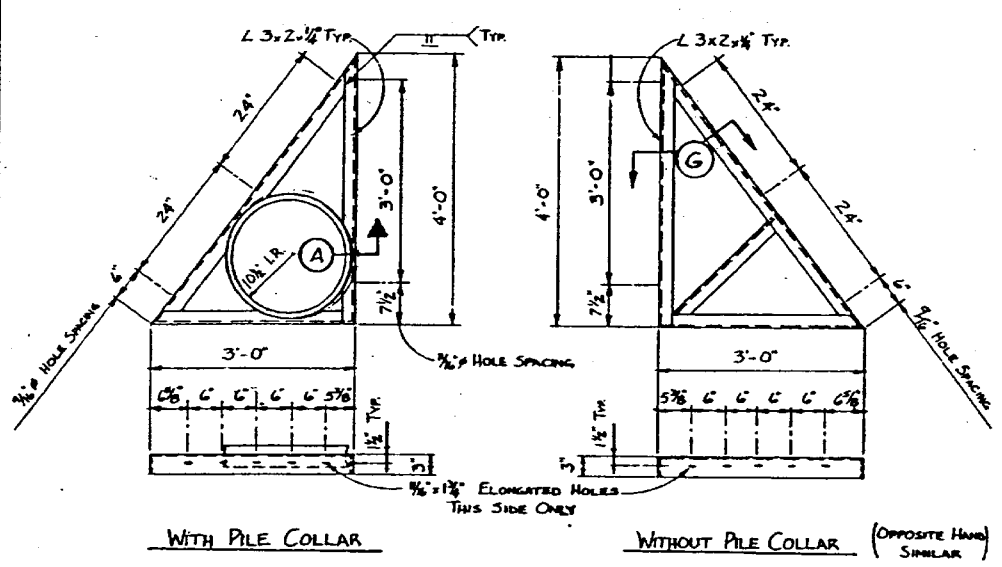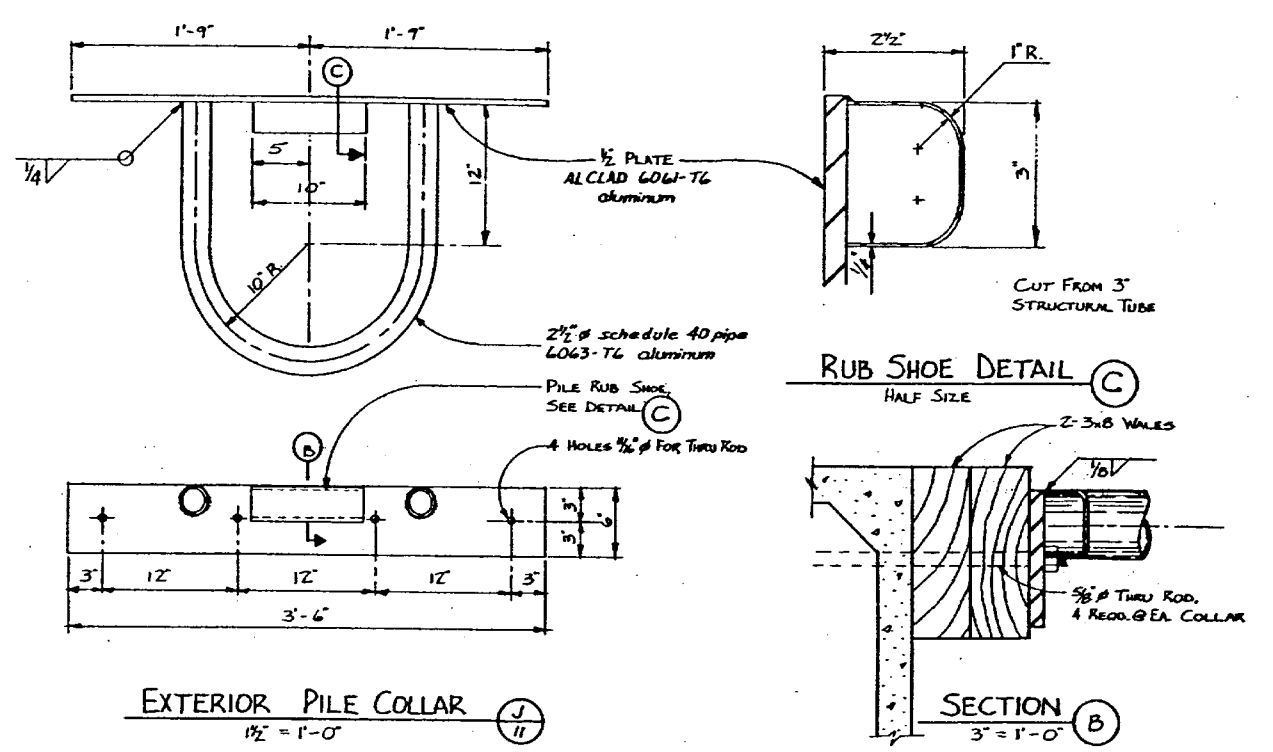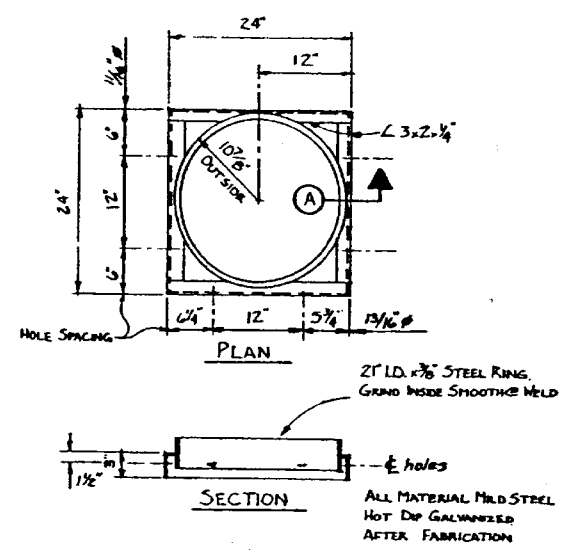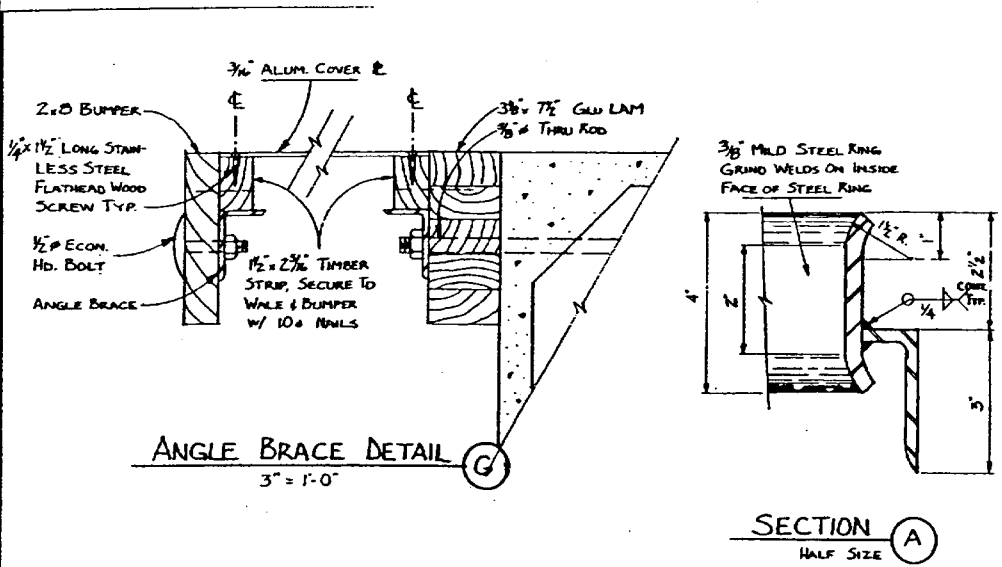

**AS BUILT**  
Sheet 40 of 41

**AS BUILT**

STAMP


DO NOT SCALE THIS DRAWING - USE DIMENSIONS

STATE OF ALASKA  
DEPARTMENT OF TRANSPORTATION AND PUBLIC FACILITIES  
DIVISION OF HARBOR DESIGN AND CONSTRUCTION


METLAKATLA ALASKA

MISCELLANEOUS DETAILS

SCALE AS NOTED SURVEYED APPROVED  
DESIGNED DRAWN BY **ROBERT P. BECK**  
CHECKED DATE  
PROJECT NUMBER K 93124 SHEET 11 OF 21

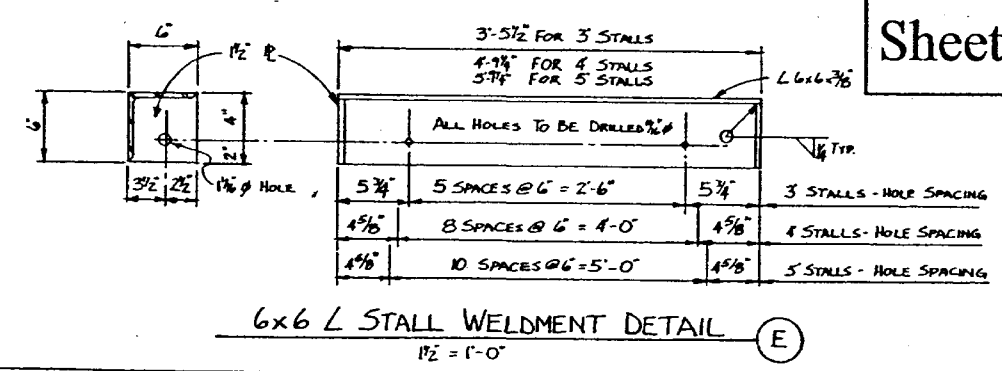


Q:\SEA\67746\IF\Sheet40.DWG PLOT SCALE=1 10/13/1999 11:16

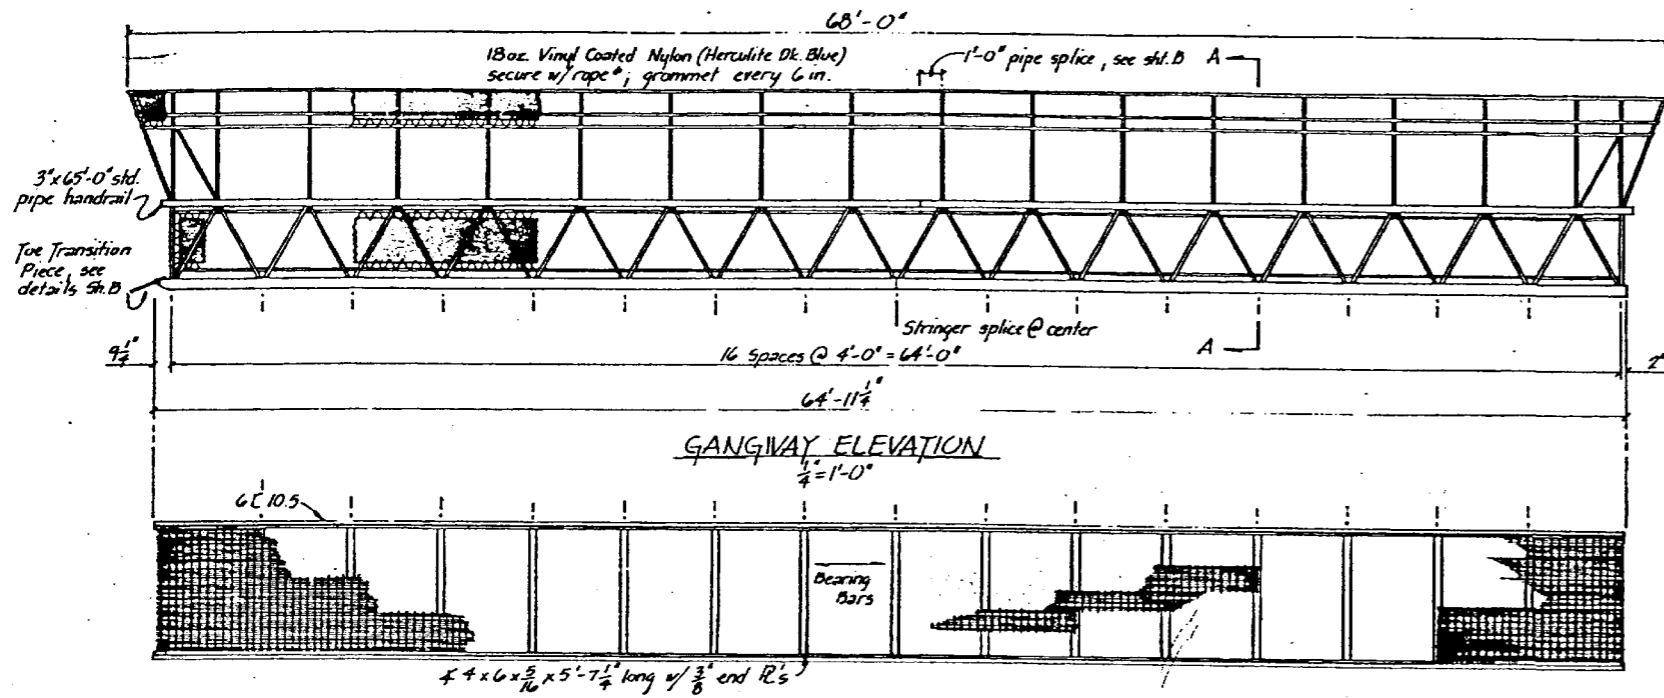


STRINGER & BEAM LAYOUT  
1/4" = 1'-0"

AS BUILT  
Sheet 41 of 41

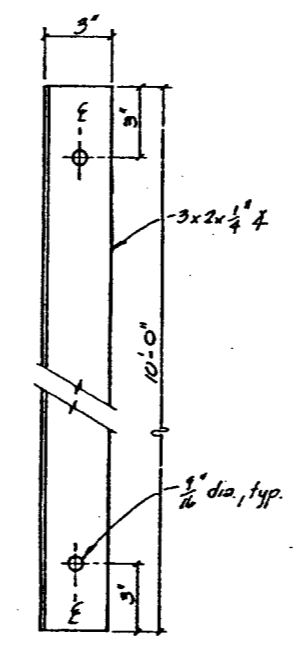


GUIDE RAIL  
3" = 1'-0"

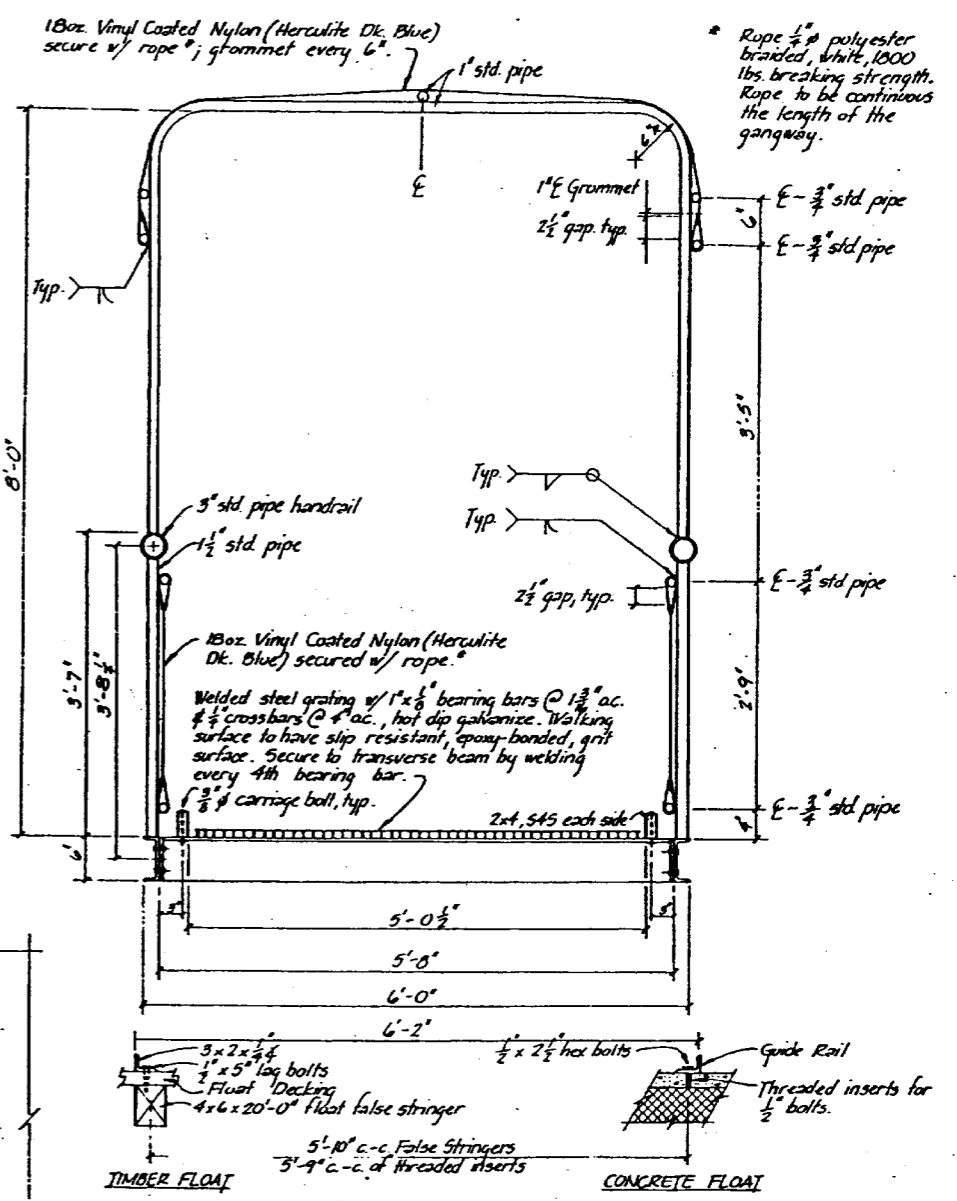

SECTION A-A  
1" = 1'-0"


- NOTES
1. Design live load 85 psf.
  2. All seamless pipe shall conform to ASTM A-53, Grade B or ASTM A-500.
  3. All shapes & plates shall conform to ASTM A-36.
  4. Trusses shall be shop fabricated & assembled after galvanizing, including hangers.
  5. Shop splices shall be held to a minimum, optional field splice as shown.
  6. Trusses & transverse beams shall be hot dipped galvanized after fabrication and in accordance w/ ASTM, A-73, A-364, A-365, A-366.
  7. All steel hardware & fasteners shall be hot dipped galvanized in accordance with ASTM, A-153.
  8. Toe rails shall be No. 1 Grade Hem-Fir, pentapressure treated to 0.4 lb. cuff retention and shall be field drilled holes to match shop drilled holes in transverse members.
  9. Assembly shop drawing shall be submitted for approval. Shop assembled except cover may be shipped separately.

AS BUILT

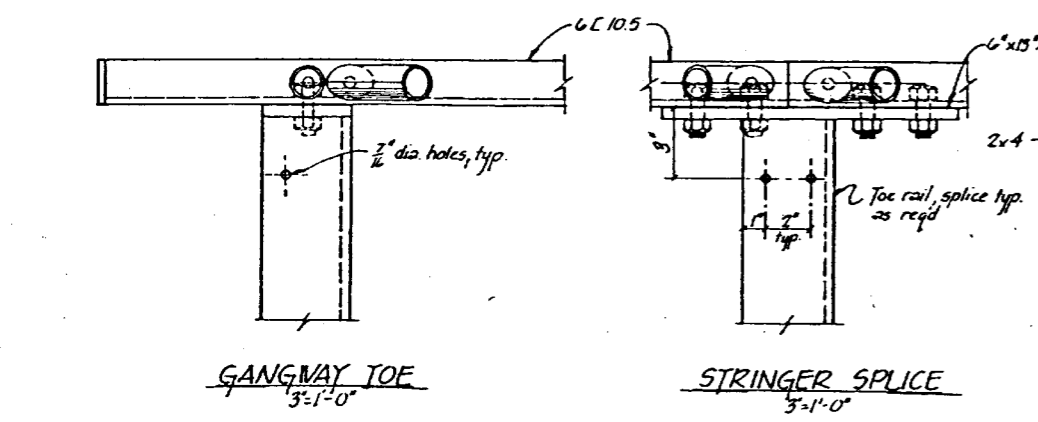


GANGWAY TOE  
3" = 1'-0"


STRINGER SPLICE  
3" = 1'-0"

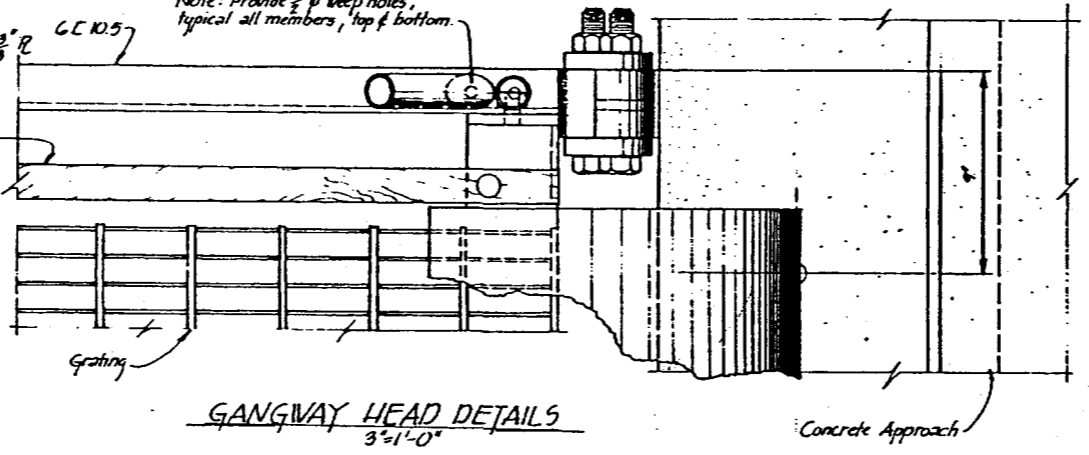

GANGWAY HEAD DETAILS  
3" = 1'-0"

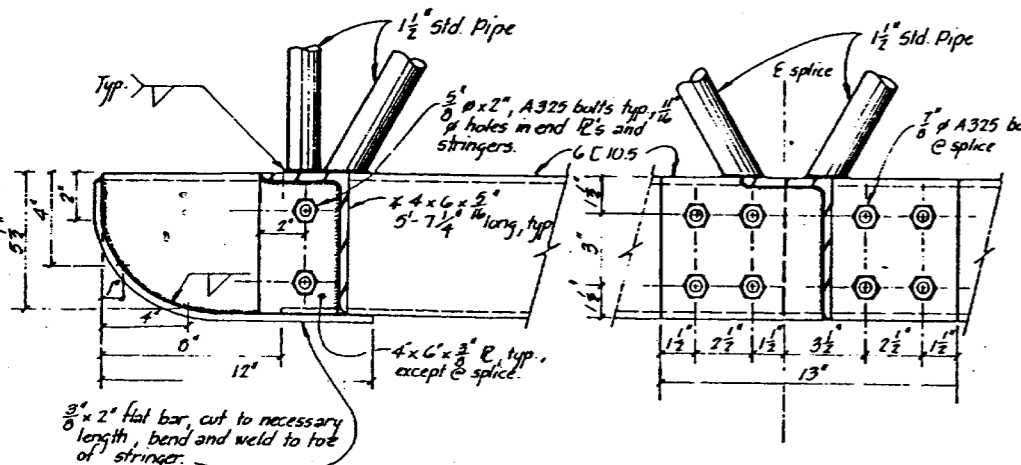

SECTIONAL ELEVATIONS  
3" = 1'-0"

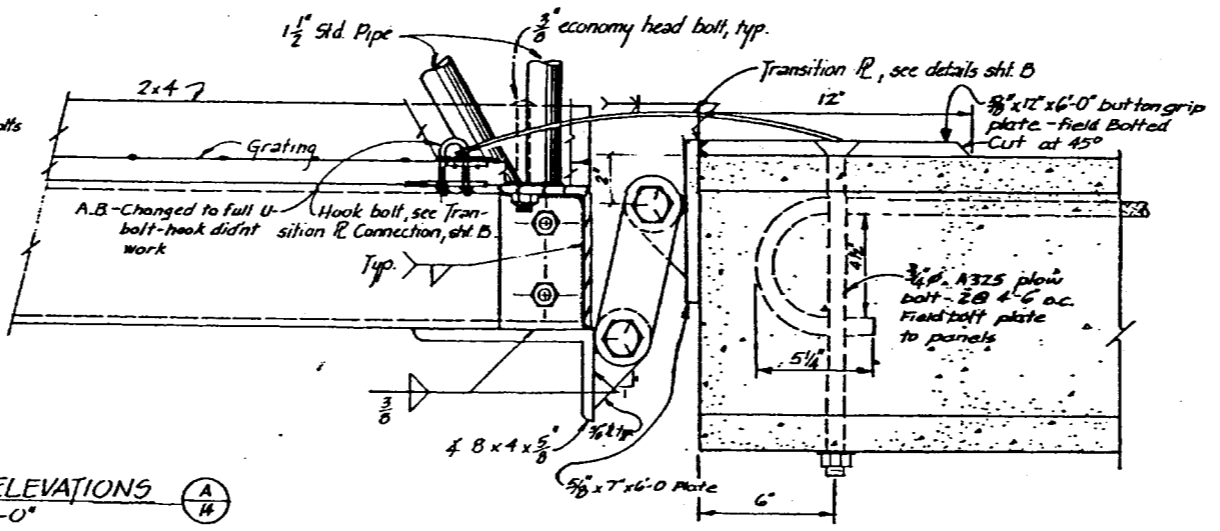

STAMP		DO NOT SCALE THIS DRAWING - USE DIMENSIONS	
		STATE OF ALASKA DEPARTMENT OF TRANSPORTATION AND PUBLIC FACILITIES DIVISION OF HARBOR DESIGN AND CONSTRUCTION	
		Metlakatla Alaska 6'x65'-0" COVERED STEEL GANGWAY SHEET A	
SCALE As Noted	SURVEYED	APPROVED	
DESIGNED HRM	DRAWN JTM	Robert P. Beck	
CHECKED	DATE 11-80	CHIEF OF DESIGN	
PROJECT NUMBER K93124	SHEET 14	OF 21	