

RED LINE


# State of Alaska

Department of Transportation  
and Public Facilities  
Southcoast Region


Project As-Built Drawings have been reviewed  
by the Project Engineer and represent to the  
best of my knowledge the project as  
constructed.

PE *M. Edwards* Date 11/12/2017

## PORT ALEXANDER OUTER HARBOR IMPROVEMENTS PORT ALEXANDER, ALASKA PROJECT No. Z835040000

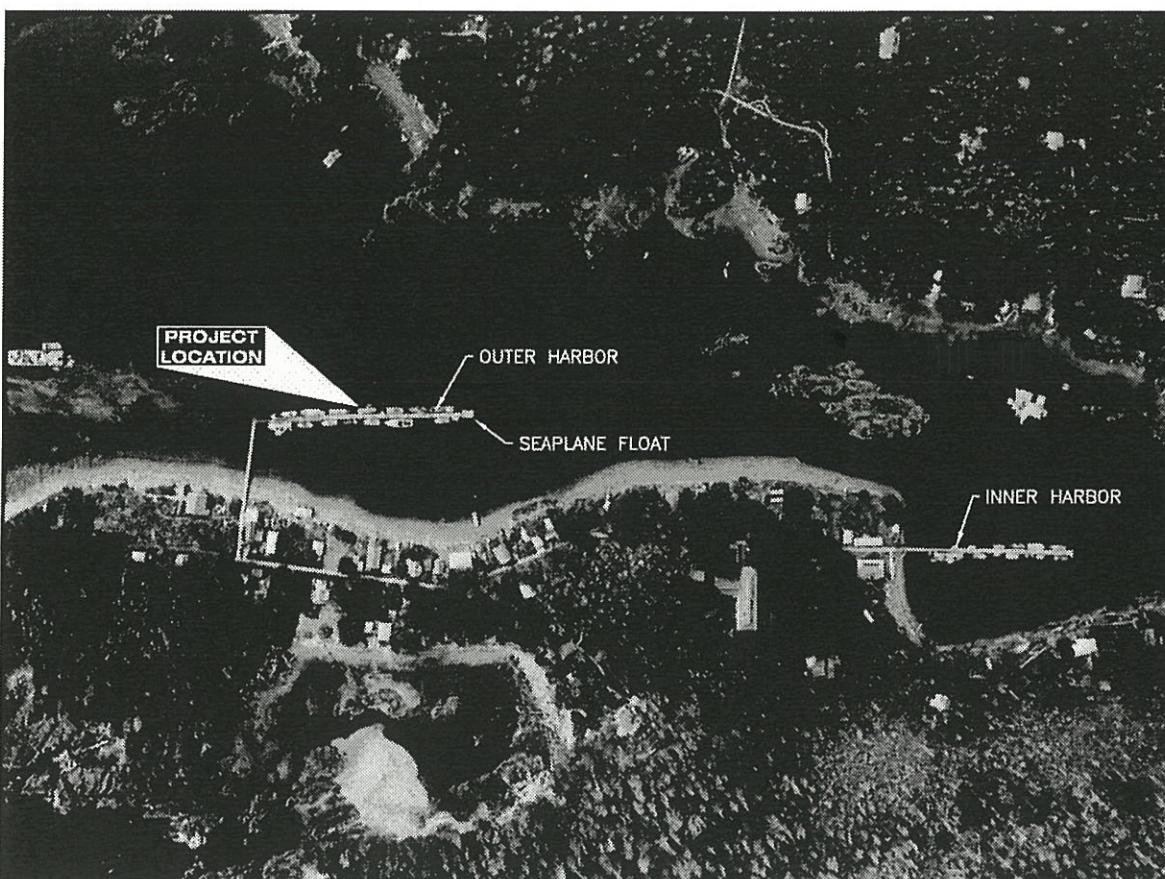

SITE MAP

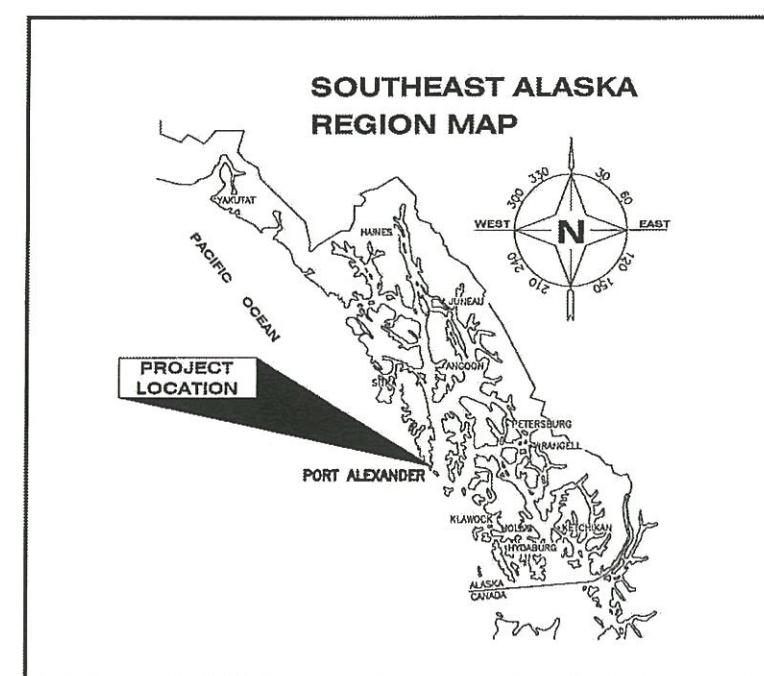

REGIONAL MAP

The undersigned hereby  
certifies that this duplicated  
document is an exact and  
true copy of the original.

*Cody Salsbury*

April 28, 2017

9A - GANGWAY  
ASSEMBLY

TIDAL DATA	
HTL	+15.0'
MHW	+10.1'
MLLW	0.0'
ELW	-4.3'

SHEET INDEX	
SHEET NO.	DESCRIPTION
01	TITLE SHEET
02	ESTIMATE OF QUANTITIES & GENERAL NOTES
03	DEMOLITION PLAN
04	NEW SITE PLAN
05	APPROACH DOCK PLAN
06-07	APPROACH DOCK DETAILS
08	TRESTLE CROSS BRACING REPAIR
09	EXISTING GANGWAY DETAILS
10-11	10' x 400' FLOAT LAYOUT
12	50' FLOAT MODULE
13-14	FLOAT DETAILS
15	20' x 25' SEAPLANE FLOAT
16	TYPICAL SEAPLANE FLOAT MODULE
17	SEAPLANE FLOAT HINGE
18	SEAPLANE FLOAT CROSS SILL CONNECTORS
19	MISCELLANEOUS DETAILS
20	3-PILE DOLPHIN
21	TRANSITION PLATE DETAILS
22	WATERLINE DETAILS
23	INNER HARBOR WORK

PATH: Q:\SEA\83504\MF\PLANSET PORT ALEXANDER\FINAL\01 - TITLE SHEET.DWG TAB 01

STATE OF ALASKA  
DEPARTMENT OF TRANSPORTATION  
& PUBLIC FACILITIES  
SOUTHCOST REGION



APPROVED:  
REGIONAL PRE-CONSTRUCTION ENGINEER  
L. PAT CARROLL, P.E.  
DATE 3/16/17

APPROVED:  
DIRECTOR, SOUTHCOST REGION  
MICHAEL J. COFFEY  
DATE 3/17/17

CERTIFIED TRUE & CORRECT AS-BUILT OF ACTUAL FIELD  
CONDITION:

CONSTRUCTION PROJECT MANAGER DATE

STATE	PROJECT DESIGNATION	YEAR	sheet no.	total sheets
ALASKA	Z835040000	2017	01	23

3/16/17

3/17/17

DATE

## GENERAL NOTES

DESIGN SPECIFICATIONS  
 1. PER CONTRACT DOCUMENTS FOR Z835040000  
 2. AISC STEEL CONSTRUCTION MANUAL 14TH ED. ASD.  
 3. ASCE 7-10 MINIMUM DESIGN LOADS FOR BUILDINGS  
 4. AWS STRUCTURAL WELDING CODE D1.1, 2010  
 5. NDS FOR WOOD CONSTRUCTION, ASD/LRFD, 2012.

### OTHER INFORMATION

1. REFERENCE AS-BUILT DRAWINGS FOR EXISTING TIMBER FLOAT SYSTEM AND APPROACH TRESTLE DETAILS NOT SHOWN

### MATERIALS

STEEL:	HSS-	ASTM A500 GRADE B
	PILING-	ASTM A252 GRADE 3 OR EQUAL, STRAIGHT SEAM
	PIPE-	ASTM A53, GRADE B, TYPE E OR S
	SHAPES-	ASTM A572 GRADE 50
	PLATES-	ASTM A36, UNLESS OTHERWISE NOTED
	STAINLESS-	ASTM A276 TYPE 316
	PILE TIPS-	APF-0-14000 OR APF 0-14001 DRIVE SHOES OR APPROVED EQUAL. DRIVE SHOES ARE REQUIRED ON ALL PILING.
	COATINGS-	ALL STEEL FABRICATION & HARDWARE SHALL BE HOT DIP GALVANIZED AFTER FABRICATION IN CONFORMANCE WITH ASTM A123 AND A153.
ALUMINUM:	SHAPES-	ASTM 6061-T6
	PLATES-	ASTM 5068 H12
	COATINGS-	TRANSITION PLATES TO BE COATED WITH NON-SKID COATING PER SECTION 504 OF SPECIFICATIONS.
BOLTS AND FASTENERS:	STEEL-TO-STEEL:	ASTM A325, PRETENSIONED, U.O.N.
	TIMBER-TO-STEEL:	ASTM A307, SNUG-TIGHTENED, U.O.N.
	TIMBER-TO-TIMBER:	ASTM A307, SNUG-TIGHTENED, U.O.N.
TIMBER:	SAWN TIMBER SHALL BE DOUGLAS FIR NO. 1 OR BETTER PER WCLIB/WWPA GRADING RULES. SAWN TIMBER DECKING SHALL BE DOUGLAS FIR, SELECTED GRADE PER WWPA GRADING RULES. ALL SAWN TIMBER SHALL BE S4S EXCEPT DECKING (MILLED S123)	

## PILE DATA

PILE ID	LOCATION	PILE SIZE	APPROX MUDLINE ELEV	EST PENE-TRATION	EST TIP ELEV	CUTOFF ELEV	EST PILE LENGTH	
1	APPROACH DOCK	16"Øx1/2"	-11'	20'	-31.0'	+13'	44'	
2			-12'	20'	-32.0'	+13'	45'	
3			-13'	20'	-33.0'	+13'	46'	
4			-12'	20'	-32.0'	+13'	45'	
5	10'x350' MOORING FLOAT		-17'	20'	-37.0'	+24'	61'	
6			-19'	20'	-39.0'	+24'	63'	
7			-21'	20'	-41.0'	+24'	65'	
8			-23'	20'	-43.0'	+24'	67'	
9			-25'	20'	-45.0'	+24'	69'	
10			-26'	20'	-46.0'	+24'	70'	
11			-26'	20'	-46.0'	+24'	70'	
12			-26'	20'	-46.0'	+24'	70'	
13			-27'	20'	-47.0'	+24'	71'	
14			-27'	20'	-47.0'	+24'	71'	
15			-26'	20'	-46.0'	+24'	70'	
16			-24'	20'	-44.0'	+24'	68'	
17			-23'	20'	-41.0'	+24'	65'	
18			-22'	20'	-42.0'	+24'	66'	
			-21'	20'	-41.0'	+24'	65'	
			BASIC BID - 16Ø TOTAL				1121'	
19	10'x50' MOORING FLOAT (ALT. A)	16"Øx1/2"	-19'	20'	-39.0'	+24'	63'	
20			-16'	20'	-36.0'	+24'	60'	
	ADDITIVE ALTERNATE A - 16Ø TOTAL							
	123'							
21	3-PILE DOLPHIN	12-3/4"Øx1/2" (SALVAGED)	-4'	15'	-19.0'	+15.0'	34'	
22			-2'	15'	-17.0'	+19.0'	36'	
23			-6'	15'	-21.0'	+19.0'	40'	
	BASIC BID - SALVAGED 12 3/4Ø TOTAL							
	110'							

NOTE: DRIVE ALL PILES TO ESTIMATED TIP ELEVATION OR INTO DRILLED ROCK SOCKET.

GLULAM MEMBERS SHALL BE DF/DF, COMBINATION 24F-V8

### UHMW:

ULTRA HIGH MOLECULAR WEIGHT PLASTIC (UHMW) TO BE MADE FROM MATERIALS CONFORMING TO ASTM D4020, COLOR TO BE BLACK UNLESS OTHERWISE NOTED.

### WELDING:

ALL WELDING TO BE DONE BY QUALIFIED WELDERS IN ACCORDANCE WITH AWS D1.1 OR AWS D1.2.

### TIMBER TREATMENT:

SAWN TIMBER BELOW DECK LEVEL TO BE TREATED WITH CREOSOTE, 20 PCF RETENTION. GLULAM TIMBER BELOW DECK LEVEL TO BE TREATED WITH CREOSOTE, 12 PCF RETENTION. DECKING, BULLRAILS, AND BUMPER BOARDS TO BE TREATED WITH ACZA, 0.6 PCF RETENTION.

CUT ALL MEMBERS TO LENGTH AND DRILL ALL HOLES/COUNTERBORING PRIOR TO PRESSURE TREATMENT. TREAT ALL FIELD DRILLED HOLES AND CUTS PER AWPA M4.

### TIMBER FLOAT SYSTEM:

ALL FABRICATION AND CONNECTION DETAILS MAY NOT BE SHOWN. PROVIDE DETAILED SHOP DRAWINGS SHOWING ALL MEMBERS AND FABRICATION SEQUENCE.

ALL FASTENERS SHALL BE HOT-DIP GALVANIZED OR STAINLESS STEEL, TYPE 316 AS NOTED ON THE PLANS. DECK SCREWS SHALL BE SQUARE DRIVE HEAD, TYPE 316. WHERE NAILING IS SPECIFIED, USE HOT-DIP GALVANIZED HAND DRIVEN NAILS. MACHINE OR POWER DRIVEN NAILS WILL NOT BE PERMITTED.

ALL TIMBER BOLTS ARE ECONOMY HEAD TYPE WITH LUGS AND M.I. WASHERS, UNLESS OTHERWISE NOTED. PROVIDE DOUBLE NUTS OR JAM NUTS WHERE NOTED ON THE PLANS.

MINIMUM BUMPER BOARD LENGTH IS 10'-0" UON. BUTT SPLICING OVER ENDS OF SILLS ONLY. SECURE BUMPER BOARDS WITH #12 X 4" L SS DECK SCREWS SPACED AT 12" OC, STAGGERED ROW (12" APART TOP & BOTTOM) AND 2 SCREWS AT EACH END. PREDRILL PILOT HOLE TO PREVENT SPLITTING.

DECKING SHALL BE SPACED 1/8" APART AND SECURED TO EACH STRINGER WITH 2 EA #12 X 4" L SS DECK SCREWS. PREDRILL ALL LOCATIONS AND ENDS WHERE SPLITTING MAY OCCUR. CTSK FLUSH OR JUST BELOW DECK SURFACE.

COUNTERBORE FOR ALL BOLT HEADS FACING DECKING OR OTHERWISE NOTED TO BE FLUSH.

RUBBER TIRE BUMPERS: TIRE BUMPERS SHALL BE OF 13-14 INCH NOMINAL RIM SIZE HAVING AN OUTSIDE DIAMETER OF 23-25 INCHES AND A TREAD WIDTH OF APPROXIMATELY 6-INCHES. TIRES SHALL GENERALLY BE OF UNIFORM APPEARANCE AND SIZE. ALL TIRES SHALL HAVE A MINIMUM OF 1/8-INCH OF TREAD. TIRES WITH STUDS, EXPOSED BELTING OR OTHER VISIBLE SIGNS OF DAMAGE WILL NOT BE ACCEPTED. PRE-DRILL HOLES FOR HARDWARE INSTALLATION.

## LIMITATIONS OF OPERATIONS:

1. PROVIDE ADVANCE NOTICE AND COORDINATE ALL WORK WITH THE CITY OF PORT ALEXANDER. SEE SECTION 202 OF SPECIFICATIONS.
2. REFERENCE SECTION 108 OF THE SPECIFICATIONS FOR ADDITIONAL WORK LIMITATIONS NOT NOTED.


## ABBREVIATIONS:

ALUM-	ALUMINUM
CTSK-	COUNTER SINK
DF-	DOUGLAS FIR
ECON HD-	ECONOMY HEAD
ELEV-	ELEVATION
EXT-	EXTERIOR
GALV-	GALVANIZED
GL-	GLUE LAMINATED
GR-	GRADE
HSS-	HOLLOW STRUCTURAL SECTION
MI-	MALLEABLE IRON
MISC-	MISCELLANEOUS
OC-	ON CENTER
PL-	PLATE
SS-	STAINLESS STEEL
TYP-	TYPICAL
UHMW-	ULTRA HIGH MOLECULAR WEIGHT
UON-	UNLESS OTHERWISE NOTED


Project As-Built Drawings have been reviewed by the Project Engineer and represent to the best of my knowledge the project as constructed.

PE *McDonald* Date *11/12/2017*

ESTIMATE OF QUANTITIES			
ITEM NO.	PAY ITEM	UNIT	QUANTITY
202 (1)	DEMOLITION AND REMOVAL	LS	ALL REQ'D
504 (1)	APPROACH DOCK PILE CAP	EA	2
504 (2)	3-PILE DOLPHIN CAP	LS	ALL REQ'D
504 (3)	6'x65' GANGWAY, SALVAGED	LS	ALL REQ'D
504 (4)	TRANSITION PLATES	LS	ALL REQ'D
505 (1)	16" x 0.500" PIPE PILE, FURNISHED	LF	1121
505 (2)	16" x 0.500" PIPE PILE, DRIVEN	EA	18
505 (3)	12 3/4" PIPE PILE, SALVAGED AND RE-DRIVEN	EA	3
505 (4)	DRILLED ROCK SOCKET, FURNISHED	LS	ALL REQ'D
505 (5)	DRILLED ROCK SOCKET, INSTALLED	EA	<del>10</del> <sup>6</sup>
505 (6)	100 LB PILE ANODE	EA	31
505 (7)	WIND SOCK	EA	1
506 (1)	APPROACH DOCK SUPERSTRUCTURE	LS	ALL REQ'D
506 (2)	APPROACH DOCK FENDER PILES	LS	ALL REQ'D
506 (3)	TIMBER TRESTLE MODIFICATIONS	LS	ALL REQ'D
506 (4)	10'x350' TIMBER MOORING FLOAT	LS	ALL REQ'D
506 (5)	20'x25' TIMBER SEAPLANE FLOAT	LS	ALL REQ'D
506 (6)	LEVELING FLOTATION FURNISHED 5"x20"x4"-6"	EA	6
506 (7)	LEVELING FLOTATION, INSTALLED	EA	<del>6</del> <sup>0</sup>
506 (8)	FIRE EXTINGUISHER STATION	EA	2
506 (9)	LIFE RING STATION	EA	2
506 (10)	RESCUE LADDER	EA	3
615 (7)	SIGNS	LS	ALL REQ'D
627 (1)	WATER SYSTEM	LS	ALL REQ'D
640 (1)	MOBILIZATION & DEMOBILIZATION	LS	ALL REQ'D
640 (4)	WORKER MEALS & LODGING, OR PER DIEM	LS	ALL REQ'D
642 (1)	CONSTRUCTION SURVEYING	LS	ALL REQ'D
644 (1)	FIELD OFFICE	LS	ALL REQ'D
644 (6)	VEHICLES (SKIFF)	LS	ALL REQ'D
647 (1)	PROTECTED SPECIES OBSERVER	LS	ALL REQ'D
ADDITIVE ALTERNATE A			
505 (1A)	16" x 0.500" PIPE PILE, FURNISHED	LF	123
505 (2A)	16" x 0.500" PIPE PILE, DRIVEN	EA	2
505 (4A)	100 LB. PILE ANODE	EA	2
506 (4A)	10'x50' TIMBER MOORING FLOAT	LS	ALL REQ'D
640 (1A)	MOBILIZATION & DEMOBILIZATION		

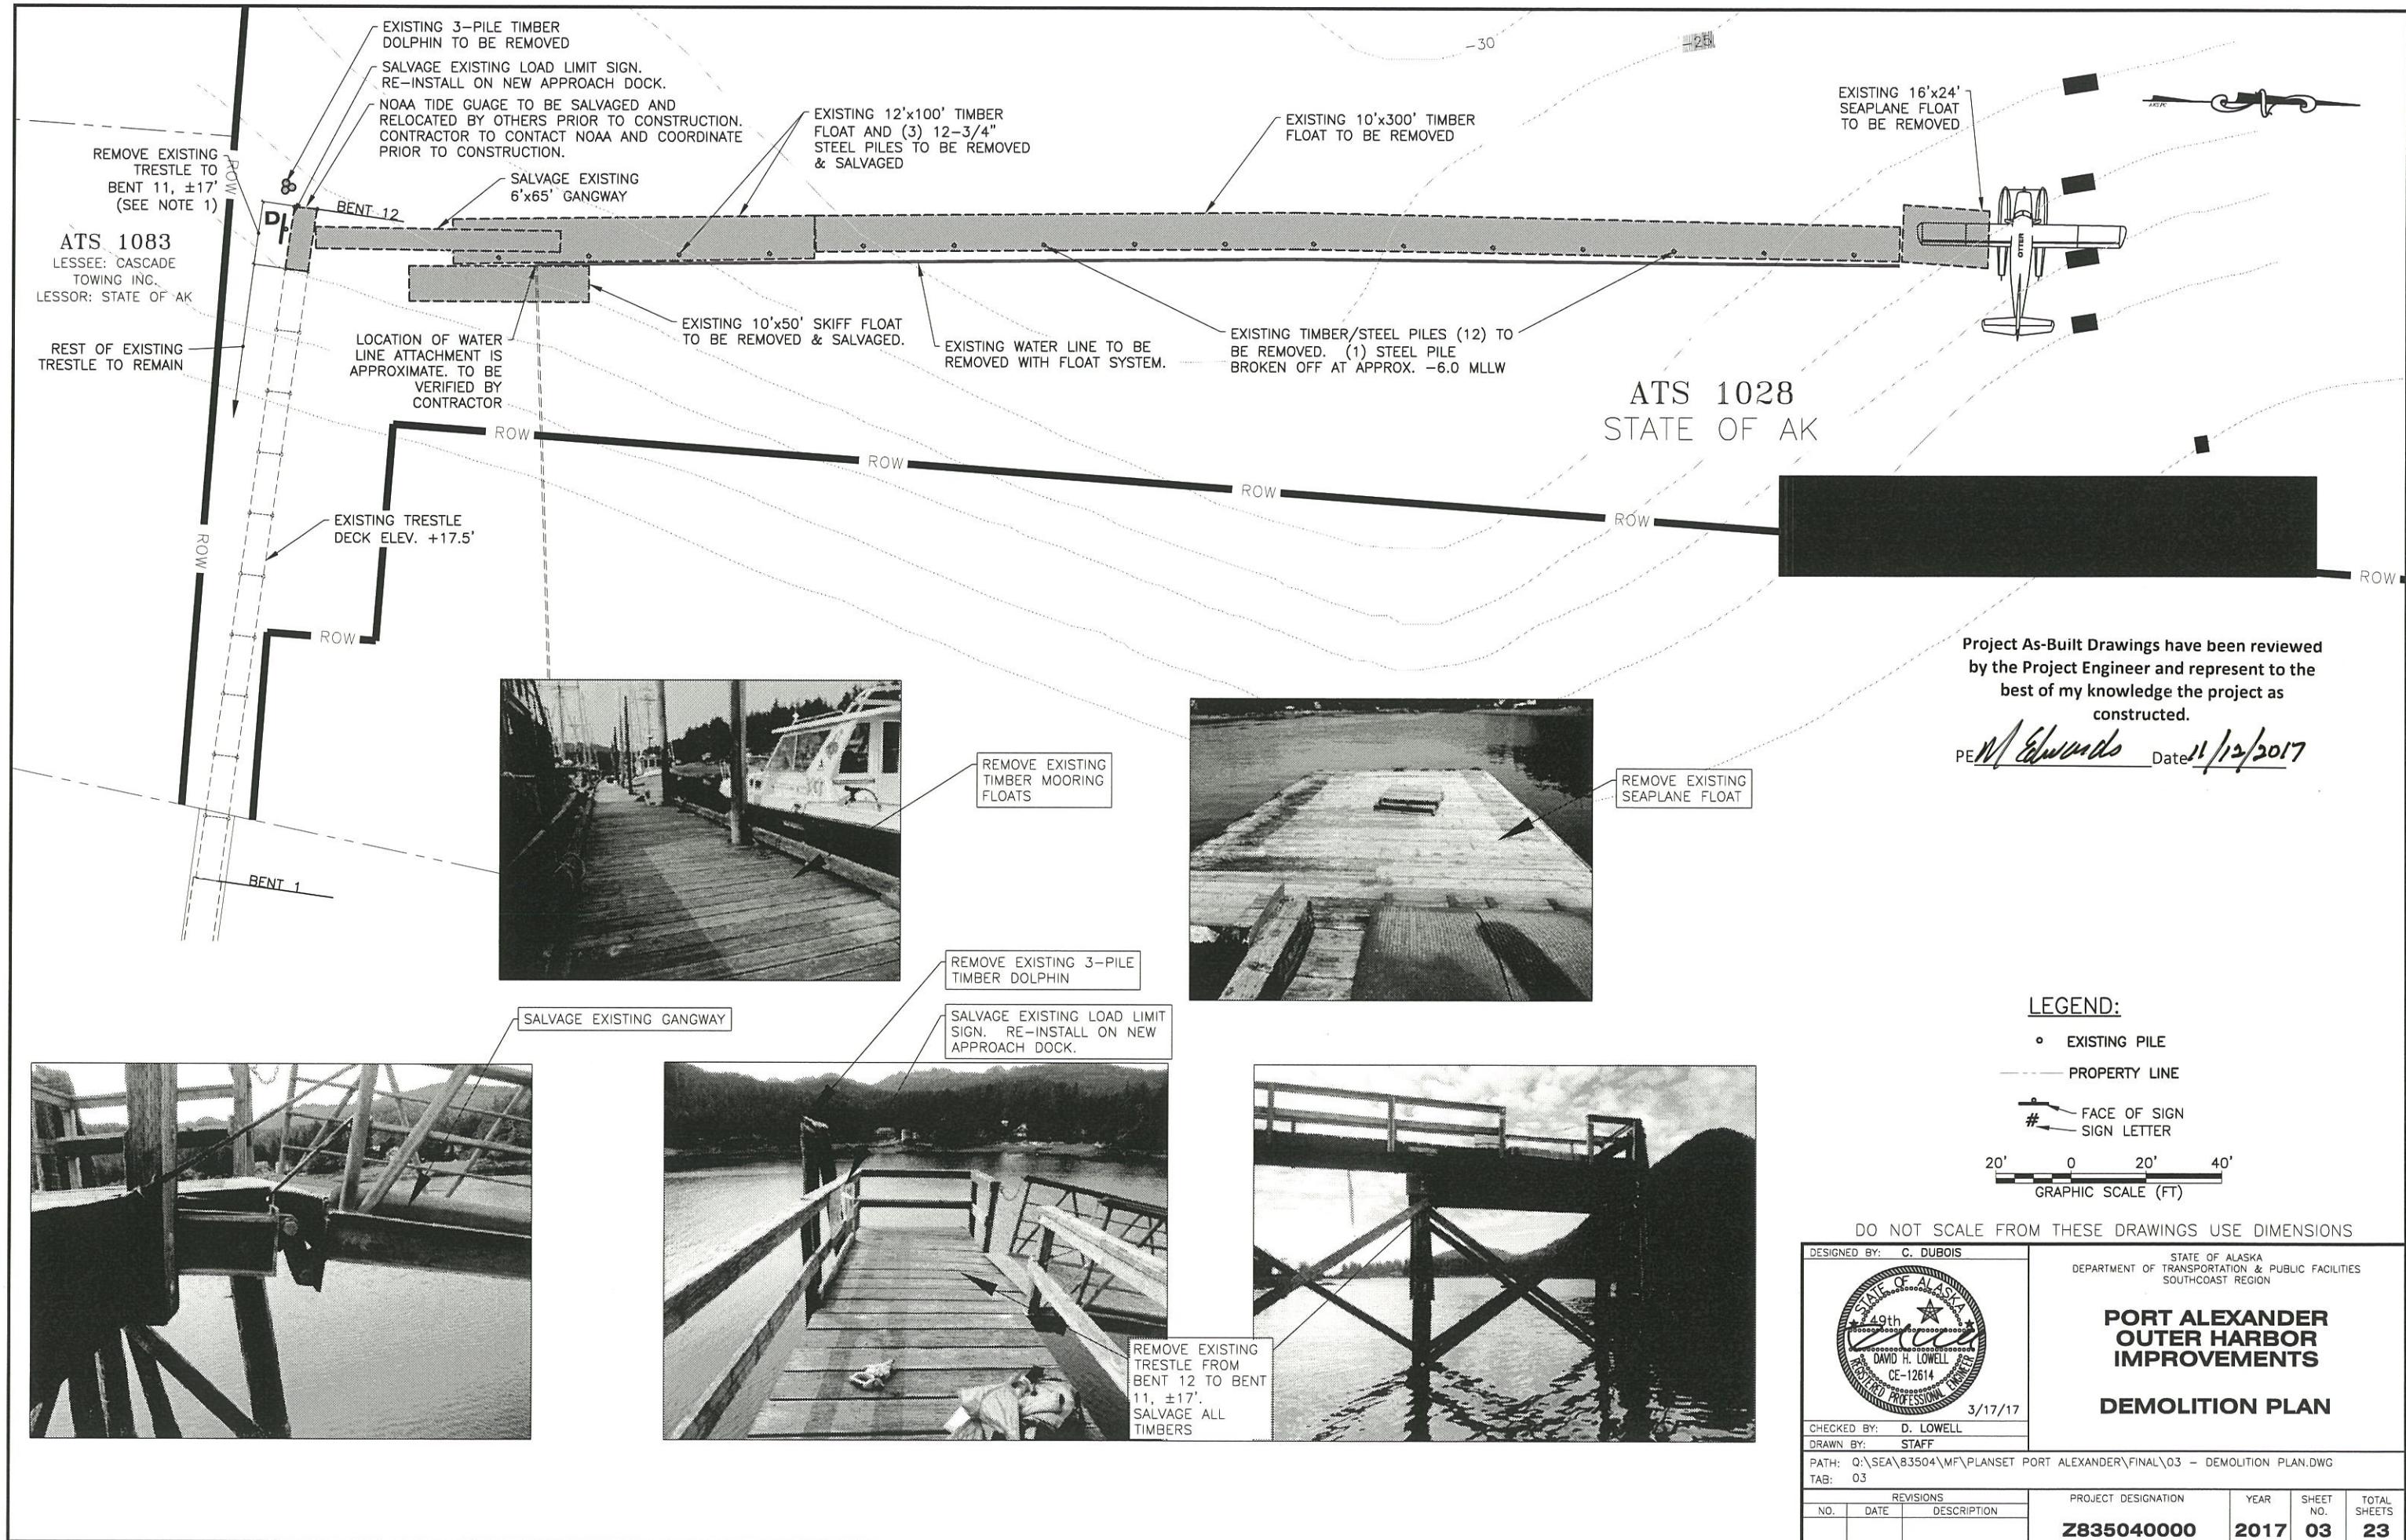




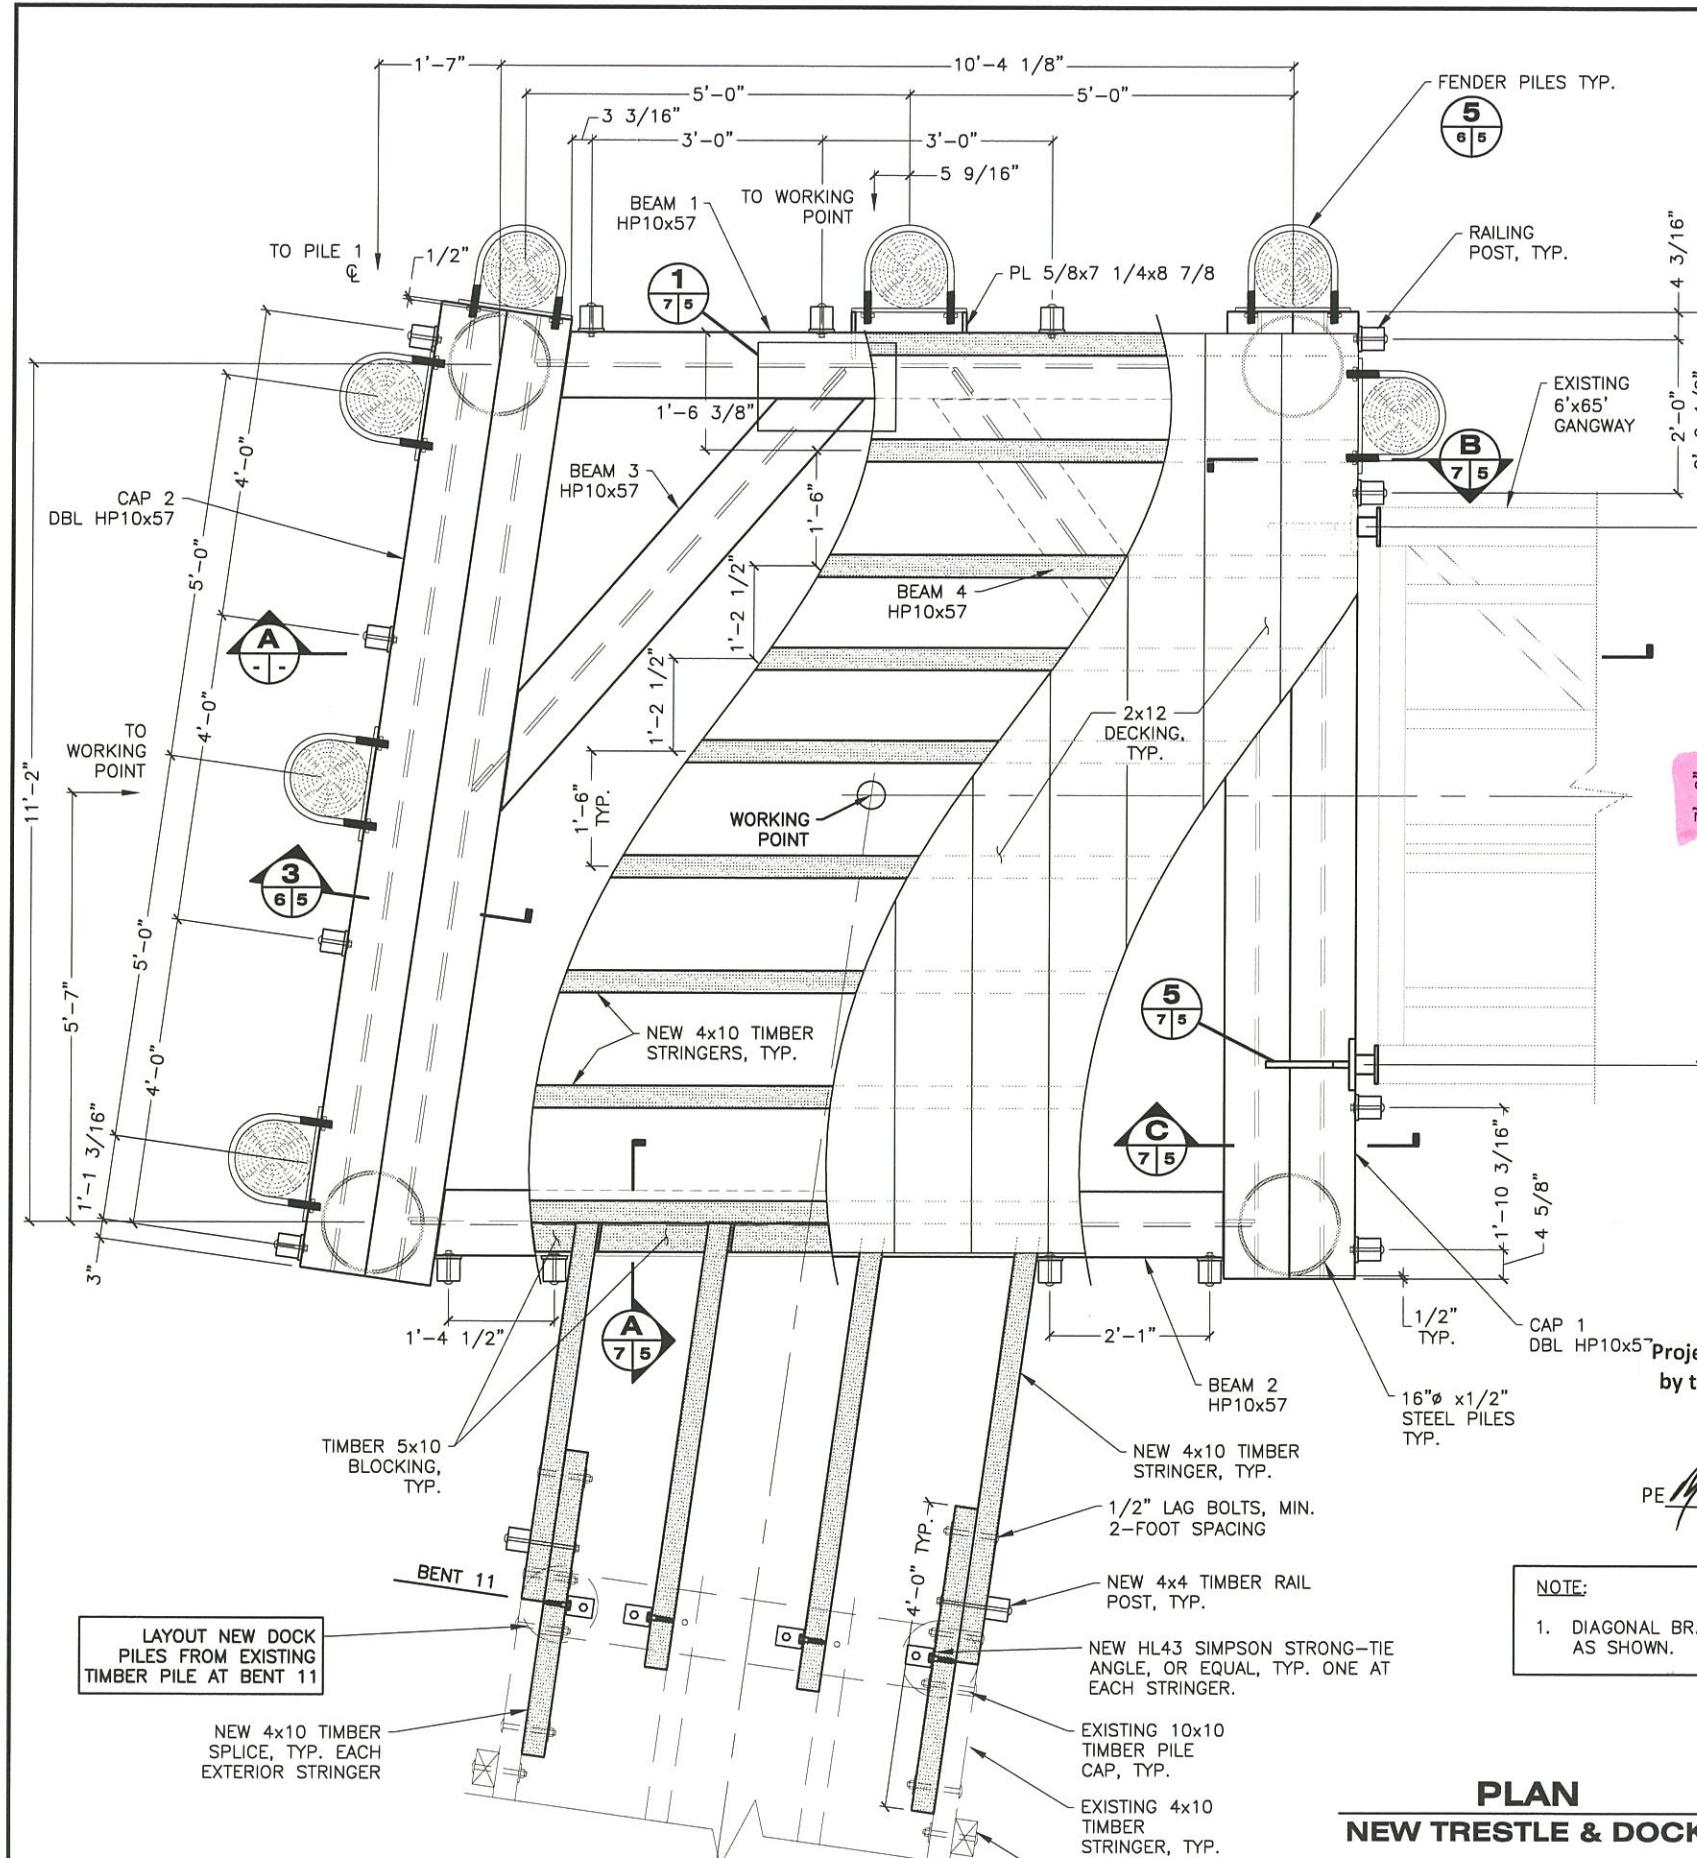

PLAN  
NEW TRESTLE & DOCK

15' 0 15' 30'  
GRAPHIC SCALE (FT)

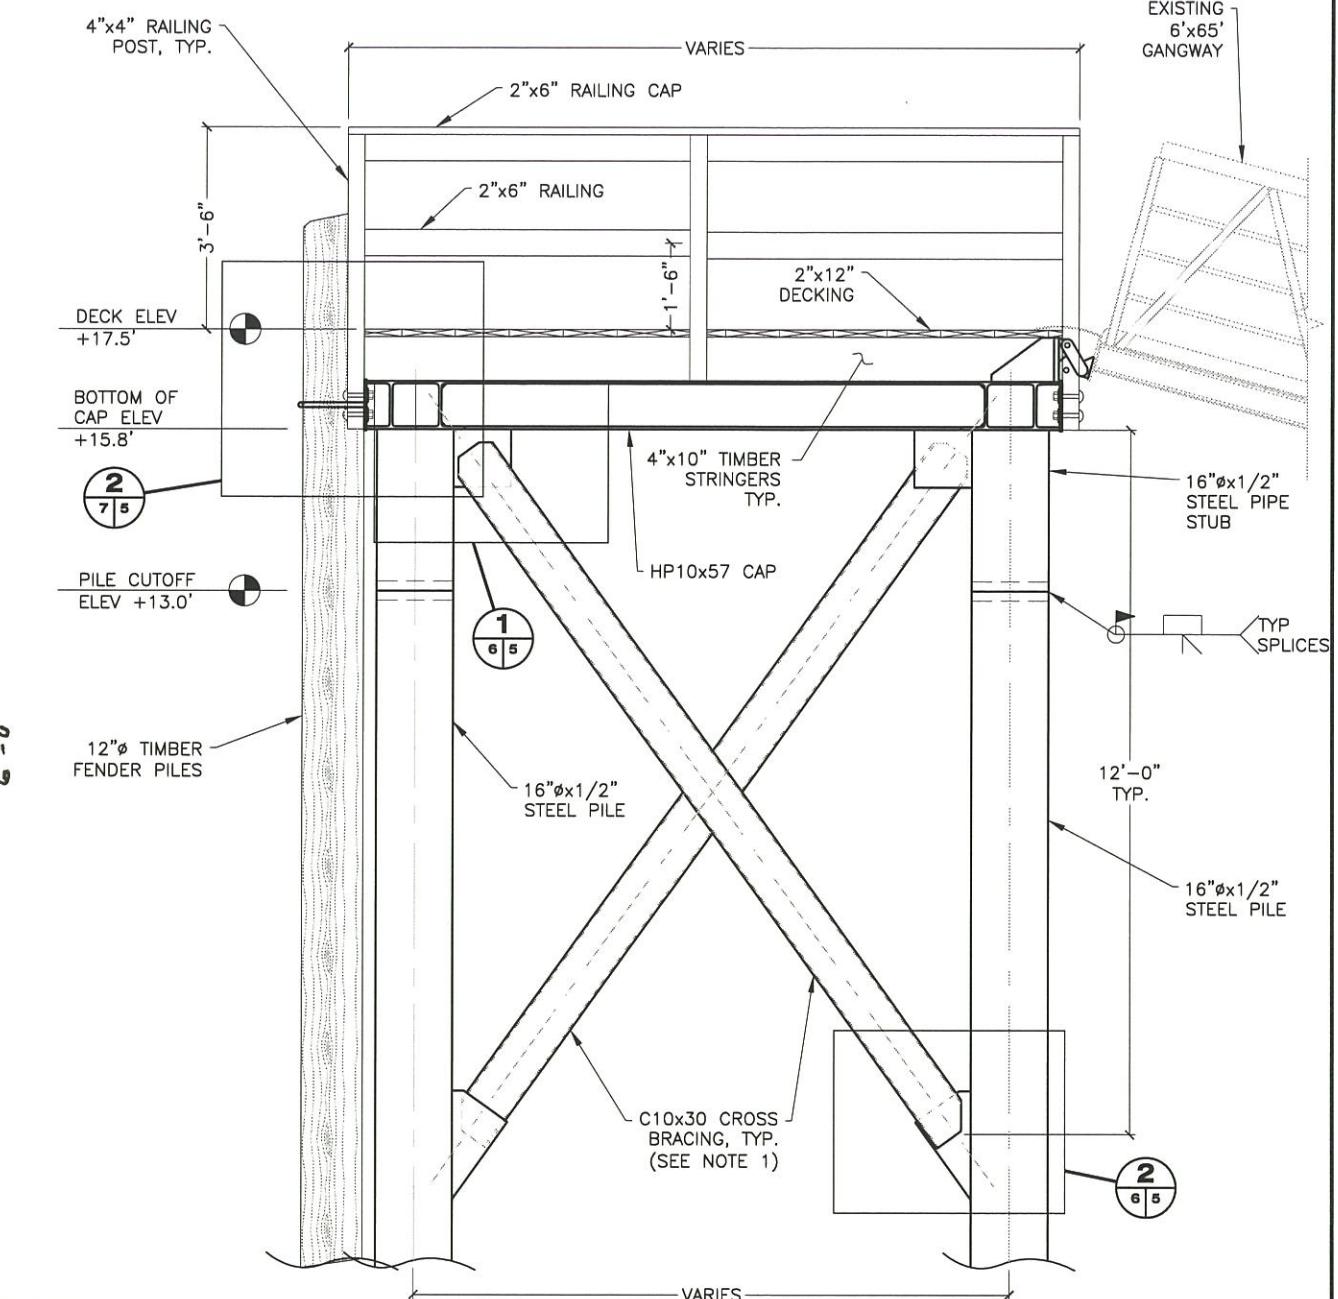




ELEVATION  
DOCK

NOTE:


1. DIAGONAL BRACING BETWEEN ALL PILES. TYPICAL INSTALLATION AS SHOWN.

DO NOT SCALE FROM THESE DRAWINGS USE DIMENSIONS		
DESIGNED BY: C. DUBOIS		
STATE OF ALASKA DEPARTMENT OF TRANSPORTATION & PUBLIC FACILITIES SOUTHCOAST REGION		
 49th CE-12614 DAVID H. LOWELL REGISTERED PROFESSIONAL ENGINEER 3/17/17		
PORT ALEXANDER OUTER HARBOR IMPROVEMENTS		
APPROACH DOCK PLAN		
CHECKED BY: D. LOWELL DRAWN BY: STAFF PATH: Q:\SEA\83504\MF\PLANSET PORT ALEXANDER\FINAL\05 - TRESTLE IMPROVEMENT PLAN.DWG TAB: 05		
REVISIONS NO. DATE DESCRIPTION		
PROJECT DESIGNATION Z835040000		
YEAR 2017		
SHEET NO. 05		
TOTAL SHEETS 23		



PE M. Schumacher Date 11/12/2017

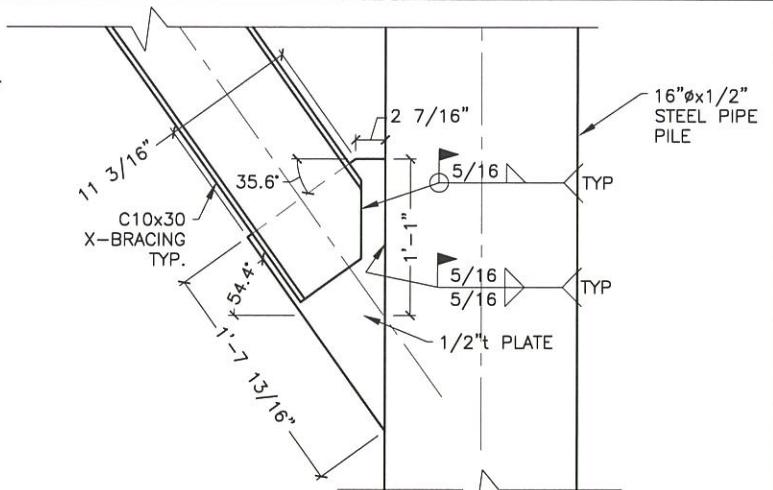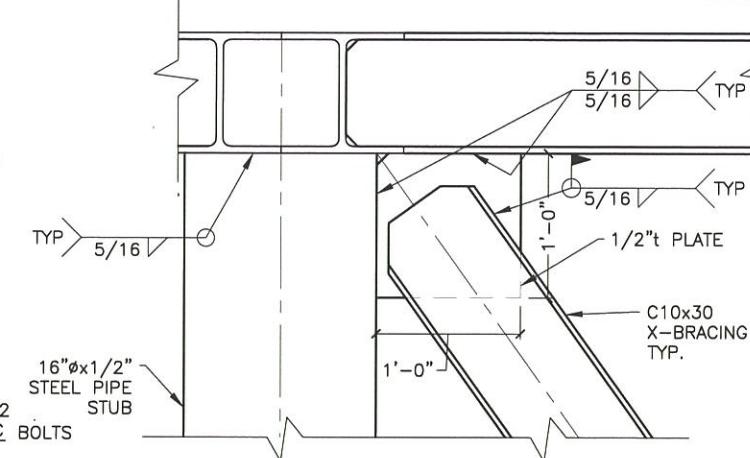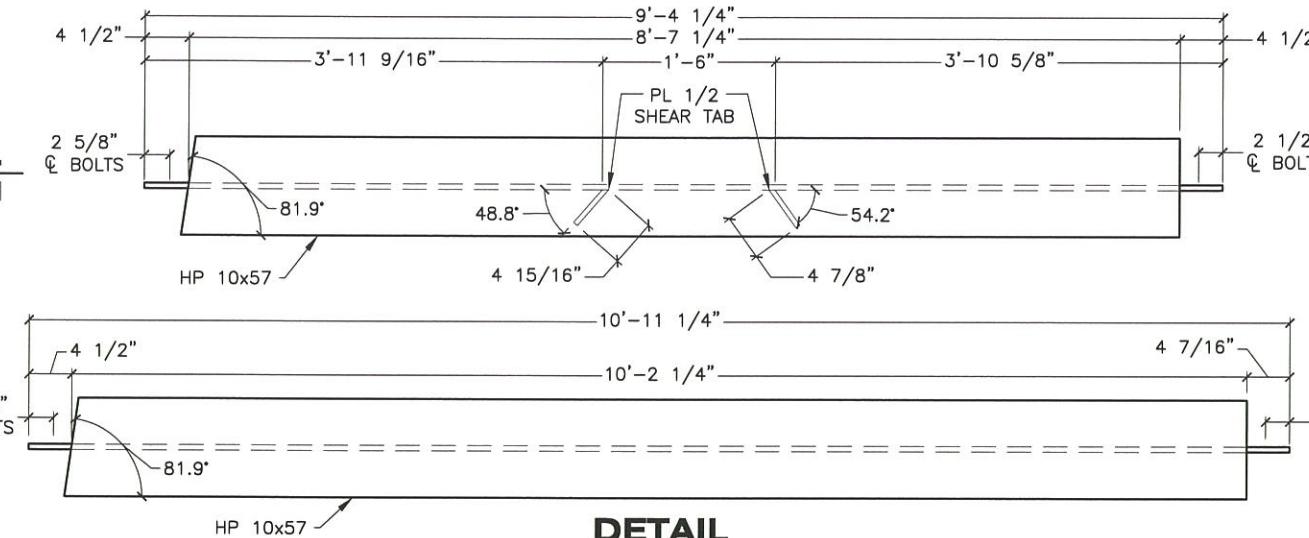


**DETAIL  
BEAM #3**

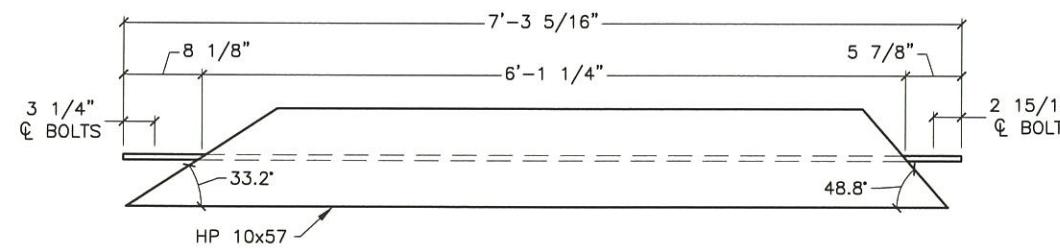


**DETAIL  
BEAM #4**

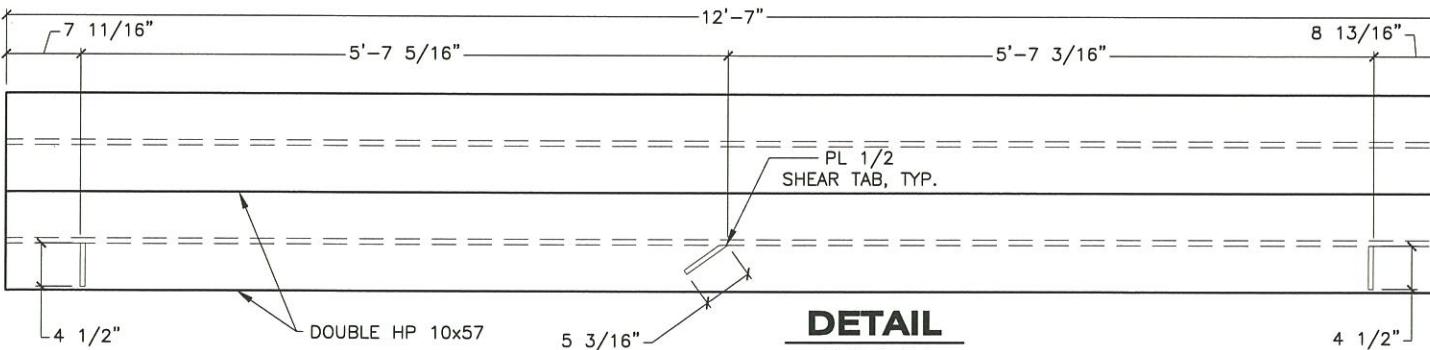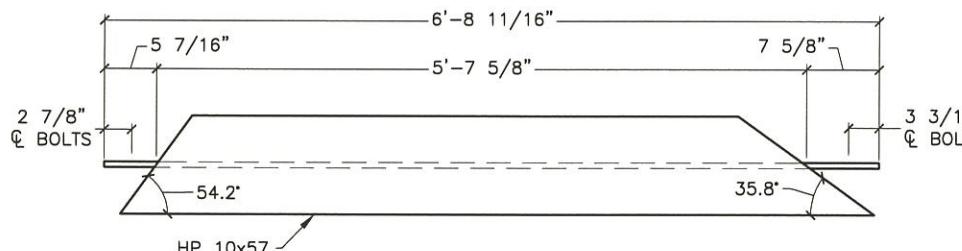


**DETAIL  
CAP #1**

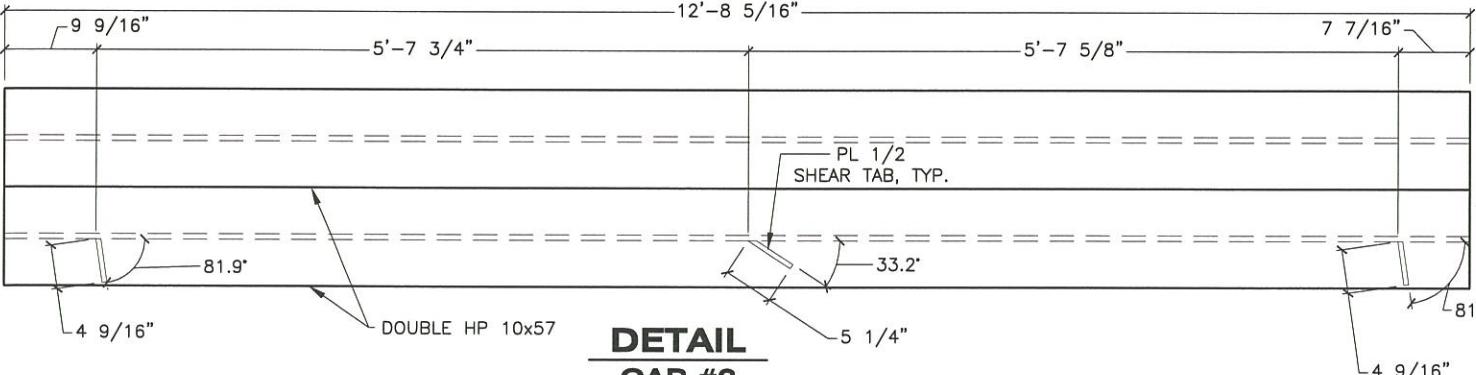

**DETAIL  
CAP #2**

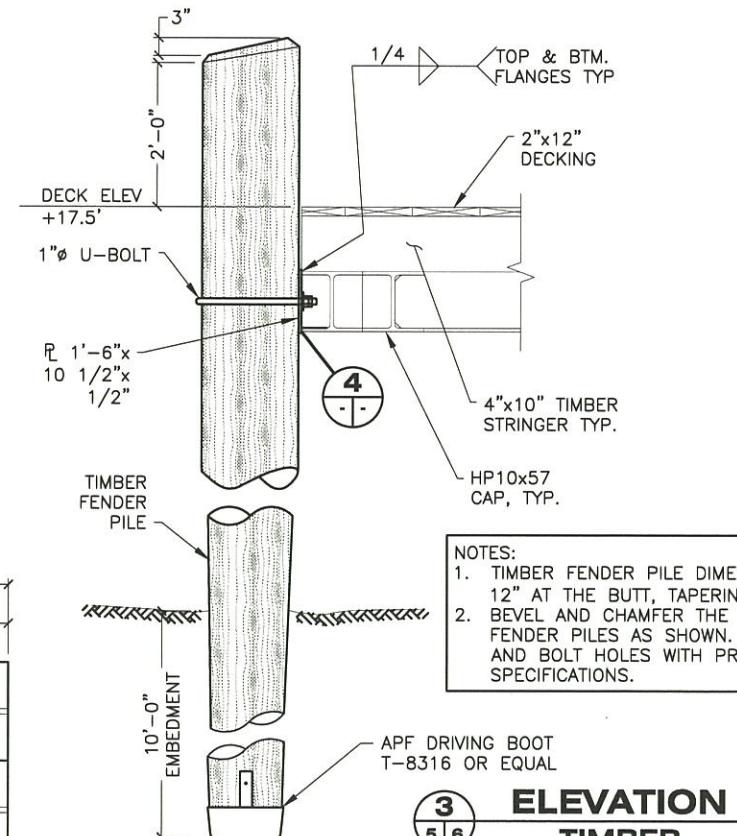

**DETAIL  
UPPER BRACING  
CONNECTION**

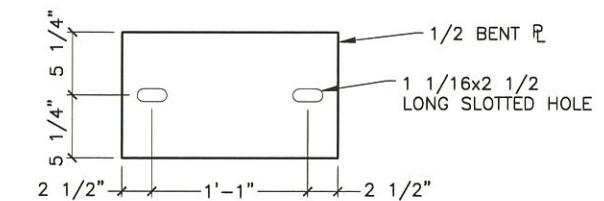


**DETAIL  
LOWER BRACING  
CONNECTION**

**NOTES:**  
1. TIMBER FENDER PILE DIMENSIONS ARE NOMINALLY 12" AT THE BUTT, TAPERING TO 8" AT THE TIP.  
2. BEVEL AND CHAMFER THE TOPS OF TIMBER FENDER PILES AS SHOWN. FIELD TREAT CUTS AND BOLT HOLES WITH PRESERVATIVE PER THE SPECIFICATIONS.

**ELEVATION  
TIMBER  
FENDER PILE**


**DETAIL  
FENDER PILE CONNECTION**

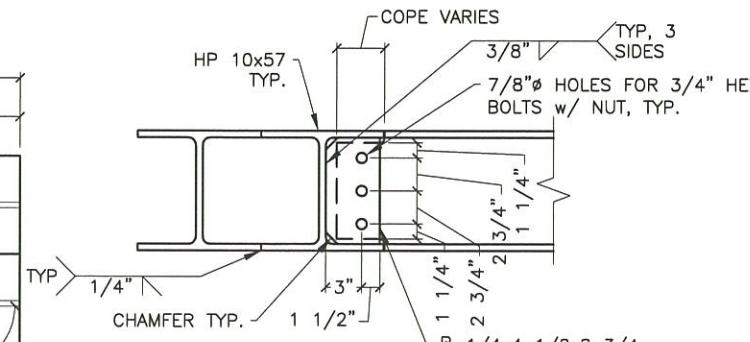

**DETAIL  
COPED BEAM CONNECTION**


DO NOT SCALE FROM THESE DRAWINGS USE DIMENSIONS		
DESIGNED BY: C. DUBOIS		
STATE OF ALASKA DEPARTMENT OF TRANSPORTATION & PUBLIC FACILITIES SOUTHCOAST REGION		
 49th DAVID H. LOWELL CE-12614 3/17/17		
PORT ALEXANDER OUTER HARBOR IMPROVEMENTS		
APPROACH DOCK DETAILS		
NO.	DATE	DESCRIPTION
1	2017	PROJECT DESIGNATION
2	2017	YEAR
3	2017	SHEET NO.
4	2017	TOTAL SHEETS

Z835040000 2017 06 23

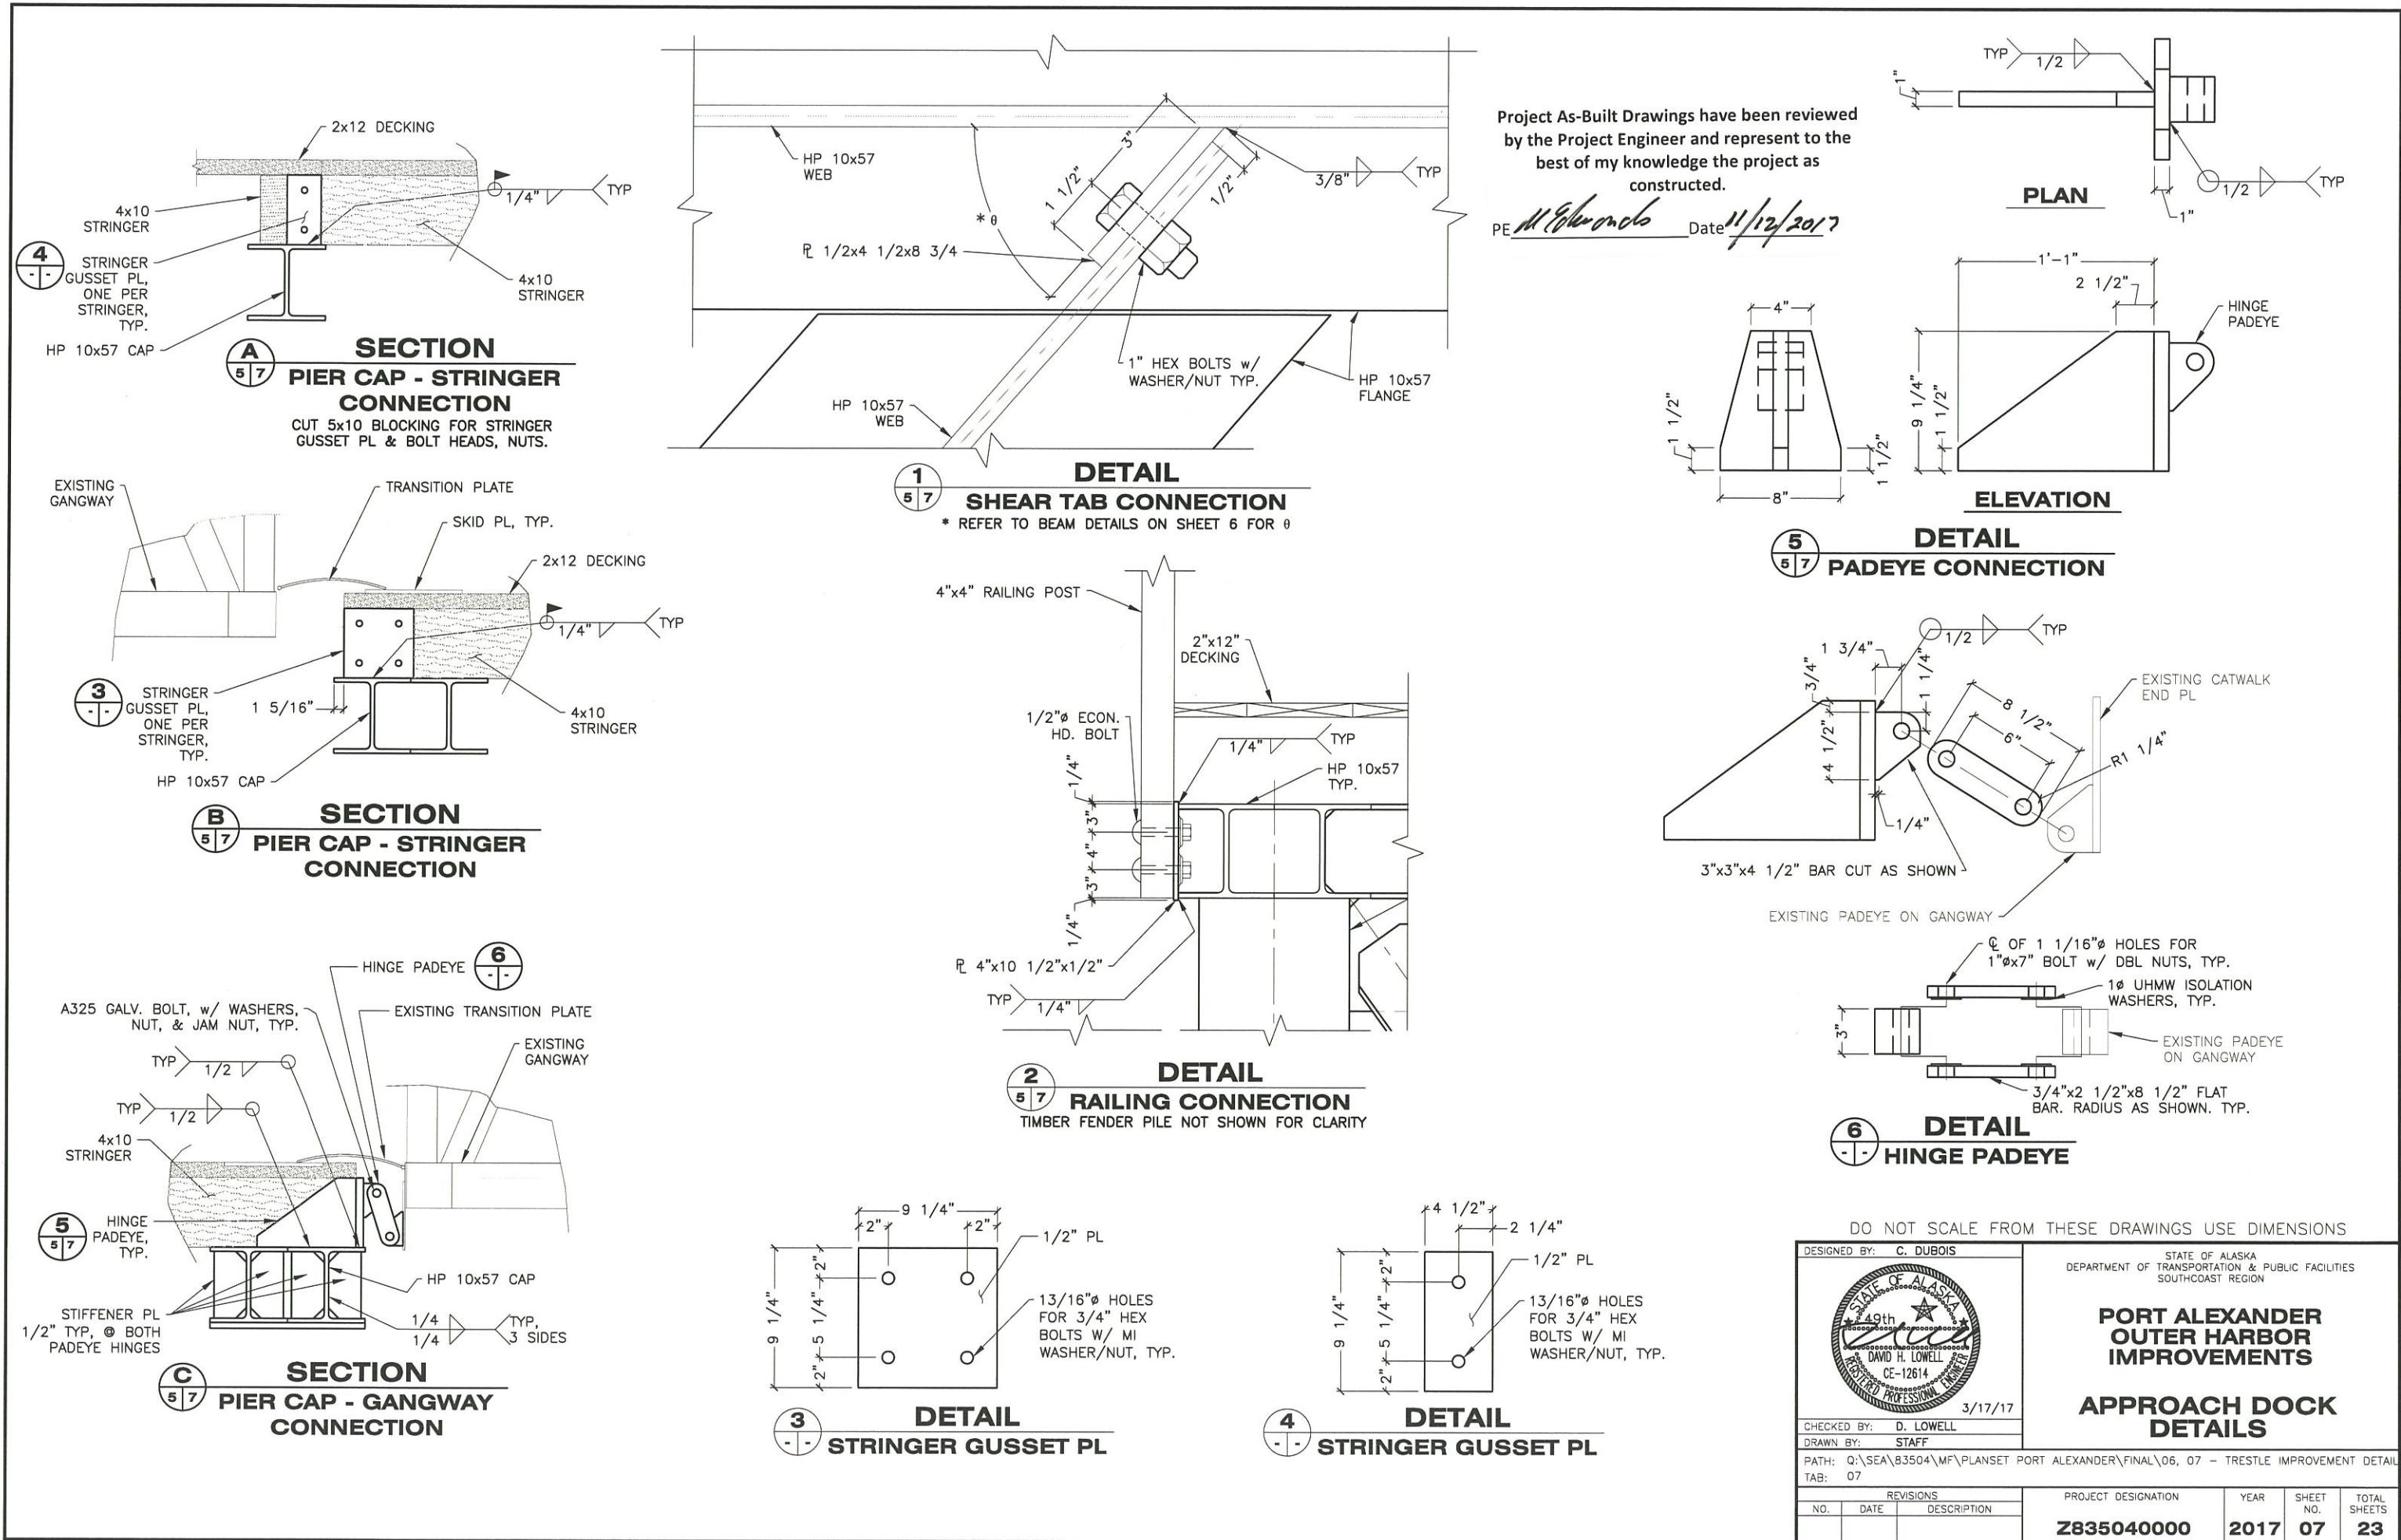


Project As-Built Drawings have been reviewed by the Project Engineer and represent to the best of my knowledge the project as constructed.

PE McElwain do Date 1/12/2017

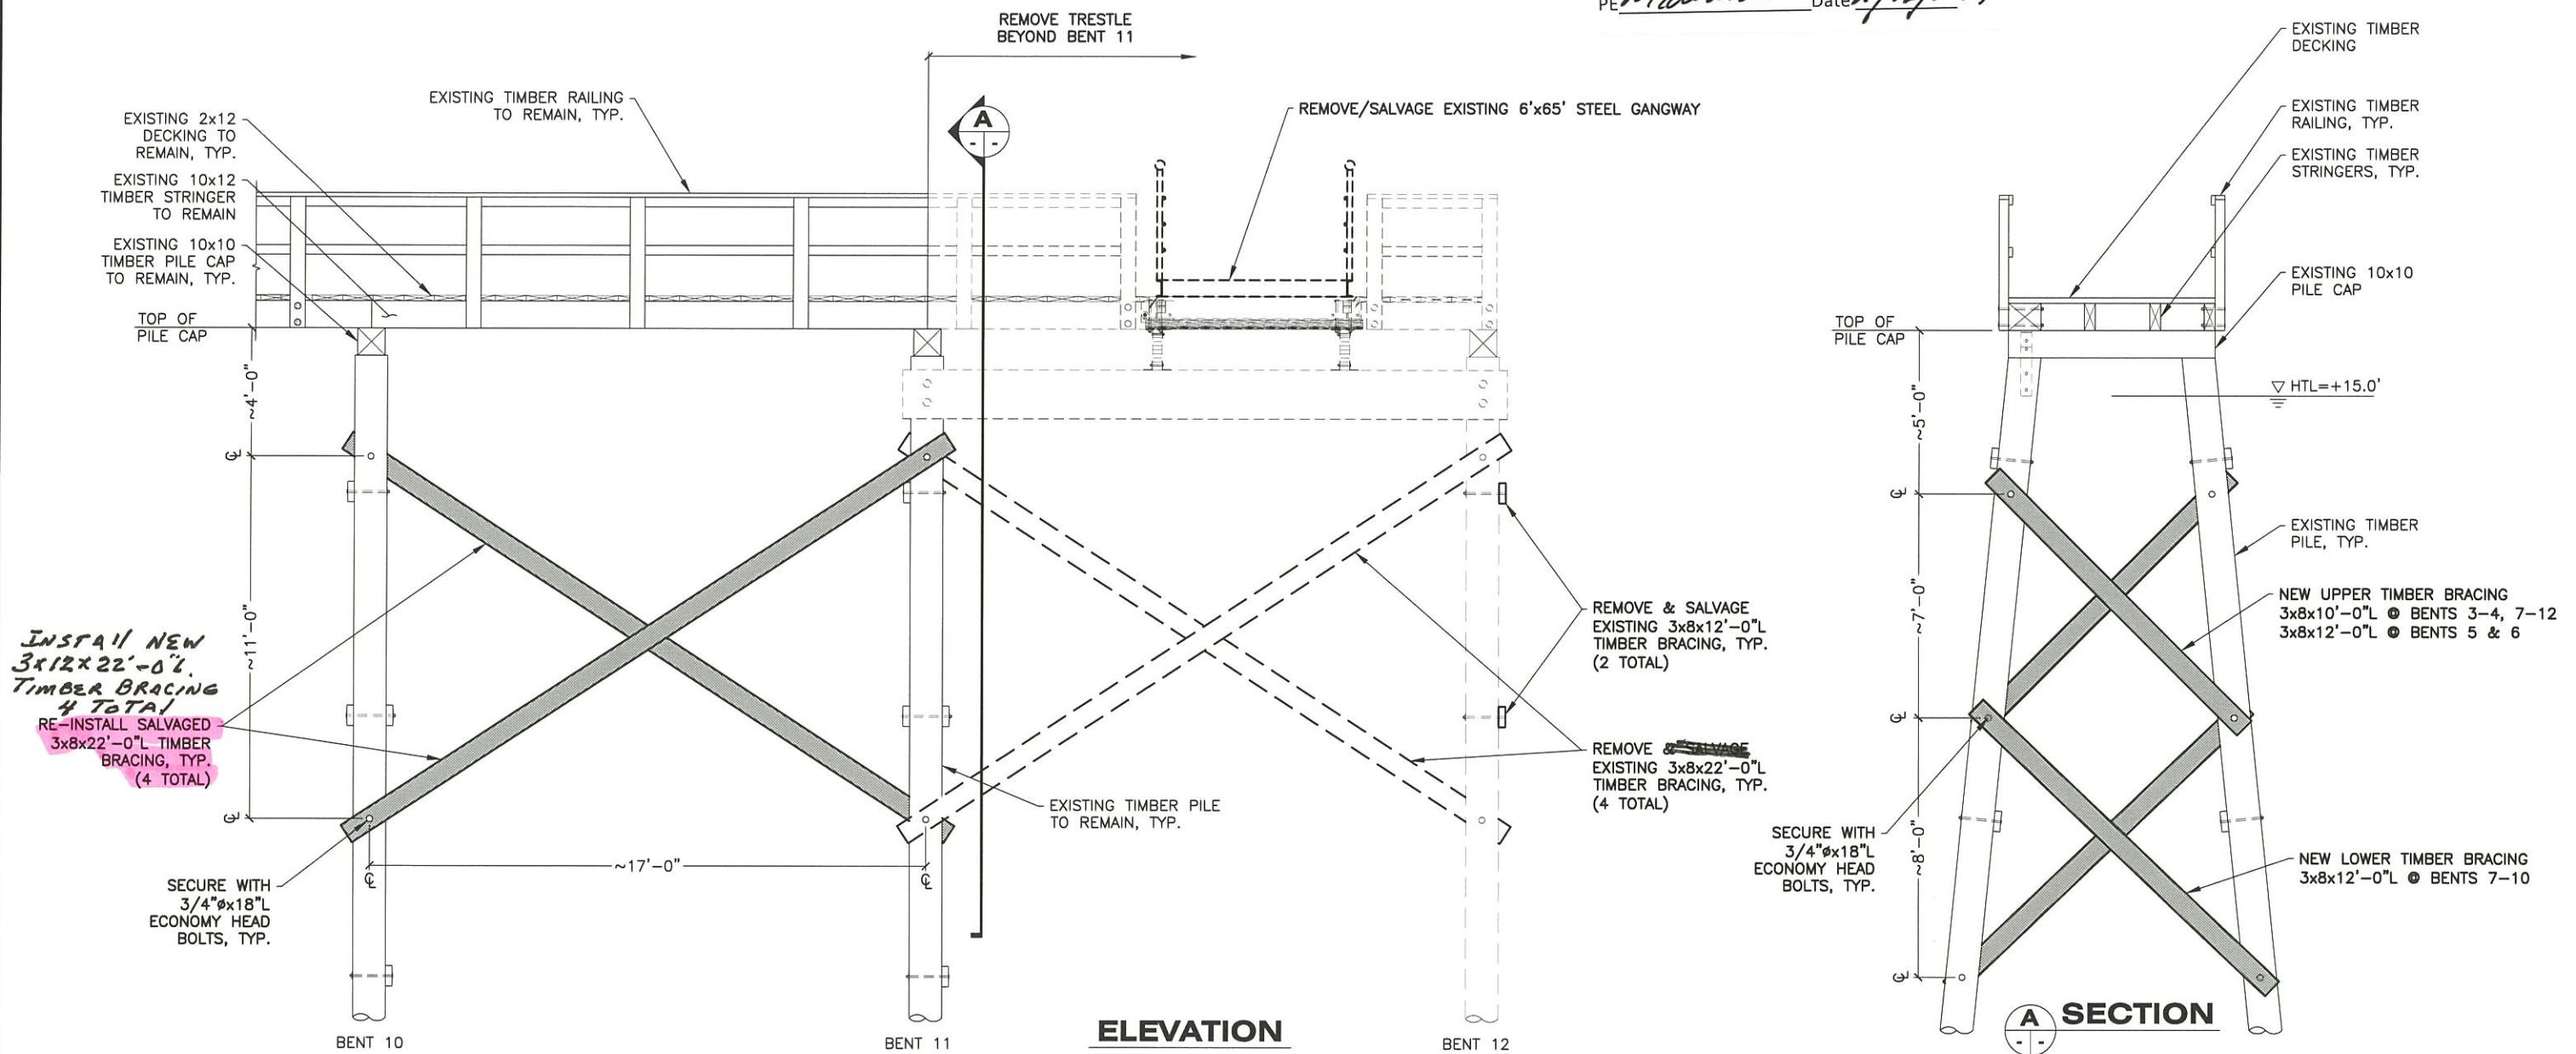

DO NOT SCALE FROM THESE DRAWINGS USE DIMENSIONS


DESIGNED BY: C. DUBOIS		STATE OF ALASKA DEPARTMENT OF TRANSPORTATION & PUBLIC FACILITIES SOUTHCOAST REGION			
 <b>DAVID H. LOWELL</b> <small>REGISTERED PROFESSIONAL ENGINEER</small> CE-12614		<b>PORT ALEXANDER OUTER HARBOR IMPROVEMENTS</b>			
CHECKED BY: D. LOWELL DRAWN BY: STAFF		<b>TRESTLE CROSS BRACING REPAIR</b>			
PATH: Q:\SEA\83504\MF\PLANSET PORT ALEXANDER\FINAL\08, 09 - GANGWAY & CROSS BRACING.DWG TAB: 08					
REVISIONS		PROJECT DESIGNATION	YEAR	SHEET NO.	TOTAL SHEETS
NO.	DATE	DESCRIPTION	Z835040000	2017	08
					23

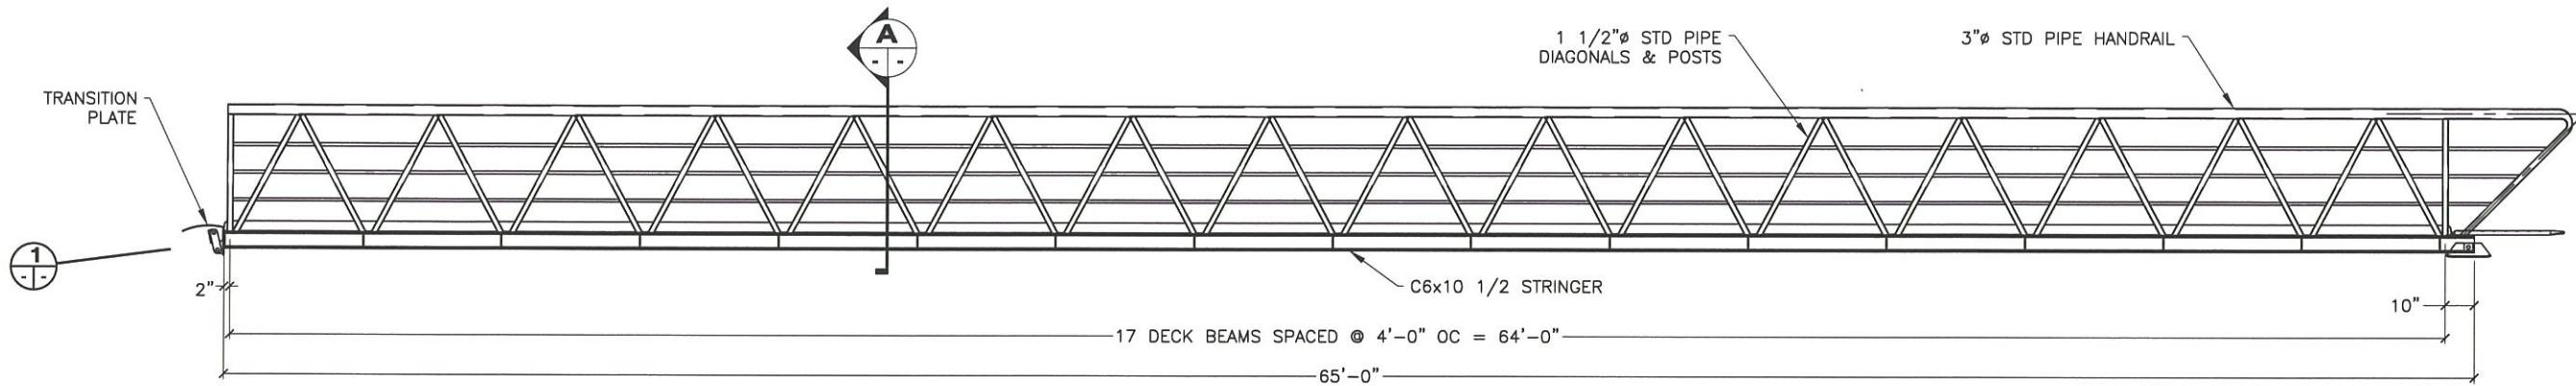

Project As-Built Drawings have been reviewed  
by the Project Engineer and represent to the  
best of my knowledge the project as  
constructed.

PE *M. Charno* Date 11/12/2017


### ELEVATION EXISTING GANGWAY

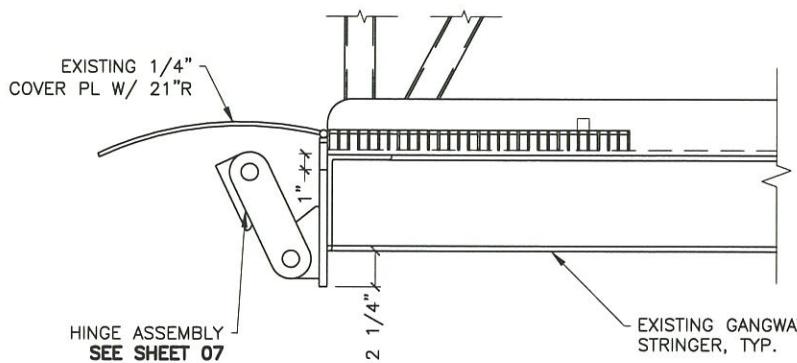


### 1 GANGWAY HEAD

REFER TO SHEET 07  
FOR HINGE DETAILS

REFER TO SHEET 23A  
FOR PADEYE & HINGE  
PLACEMENT

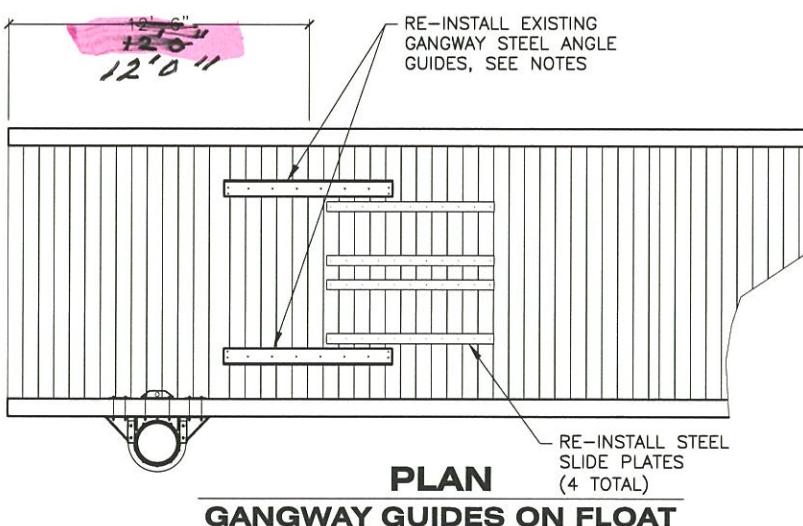

### PLAN GANGWAY GUIDES ON FLOAT

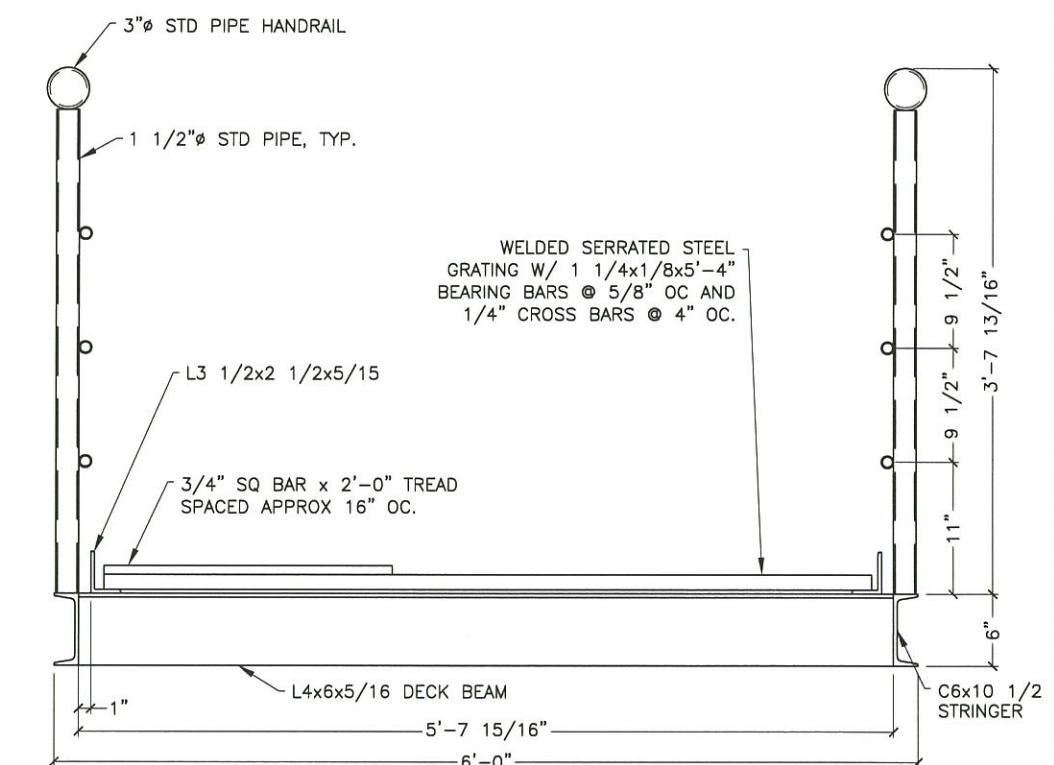

### SECTION EXISTING GANGWAY

#### GANGWAY GUIDE & SLIDE PLATE NOTES:

1. TACK GANGWAY ANGLE GUIDES & SLIDE PLATES IN PLACE.
2. MONITOR GANGWAY TRAVEL AREA DURING AT LEAST ONE FULL TIDE CYCLE BEFORE PERMANENTLY INSTALLING AS SHOWN.
3. REUSE EXISTING  $\frac{1}{4}$ "t STEEL SLIDE PLATES (4 TOTAL). COUNTERSINK PLATE  $\frac{1}{8}$ " INTO DECK. SPACE PLATES EVENLY UNDER WIDTH OF EXISTING TRANSITION RAMP. ATTACH TO DECKING w/  $\frac{1}{4}$ " STD. FLATHEAD DECK SCREWS AS SHOWN. SCREWS SHALL SIT FLUSH WITH TOP OF PLATE.
4. ADJUST ANGLES AND SLIDE PLATES ACCORDINGLY w/ CONSIDERATION TO TIDAL RANGE.
5. REUSE EXISTING STEEL GANGWAY ANGLE GUIDES. PRE-DRILL  $\frac{1}{8}$ " AND COUNTERSINK HOLES. ATTACH TO DECKING w/  $\frac{1}{4}$ "  $\times$   $\frac{1}{8}$ " SS OR GALV. FLATHEAD DECK SCREWS.
6. FINAL LOCATION MUST BE APPROVED BY THE ENGINEER.


DO NOT SCALE FROM THESE DRAWINGS USE DIMENSIONS

DESIGNED BY: C. DUBOIS	STATE OF ALASKA DEPARTMENT OF TRANSPORTATION & PUBLIC FACILITIES SOUTHCOAST REGION									
CHECKED BY: D. LOWELL	PORT ALEXANDER OUTER HARBOR IMPROVEMENTS									
DRAWN BY: STAFF	EXISTING GANGWAY DETAILS									
PATH: Q:\SEA\83504\MF\PLANSET PORT ALEXANDER\FINAL\08, 09 - GANGWAY & CROSS BRACING.DWG										
TAB: 09										
<table border="1"> <tr> <th colspan="3">REVISIONS</th> </tr> <tr> <th>NO.</th> <th>DATE</th> <th>DESCRIPTION</th> </tr> <tr> <td></td> <td></td> <td></td> </tr> </table>		REVISIONS			NO.	DATE	DESCRIPTION			
REVISIONS										
NO.	DATE	DESCRIPTION								
PROJECT DESIGNATION	YEAR	HEET NO.	TOTAL SHEETS							
Z835040000	2017	09	23							


# PLAN Sheet 9A


Project As-Built Drawings have been reviewed  
by the Project Engineer and represent to the  
best of my knowledge the project as  
constructed.

PE M. Edwards Date 11/13/2017

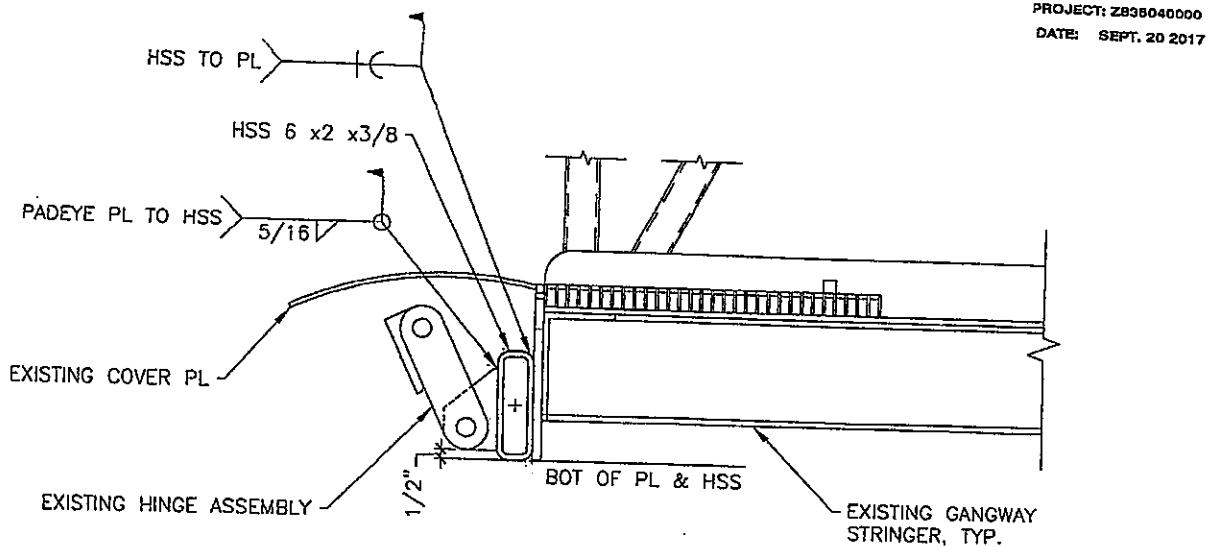



ATTCH b  
pg 2 of 3

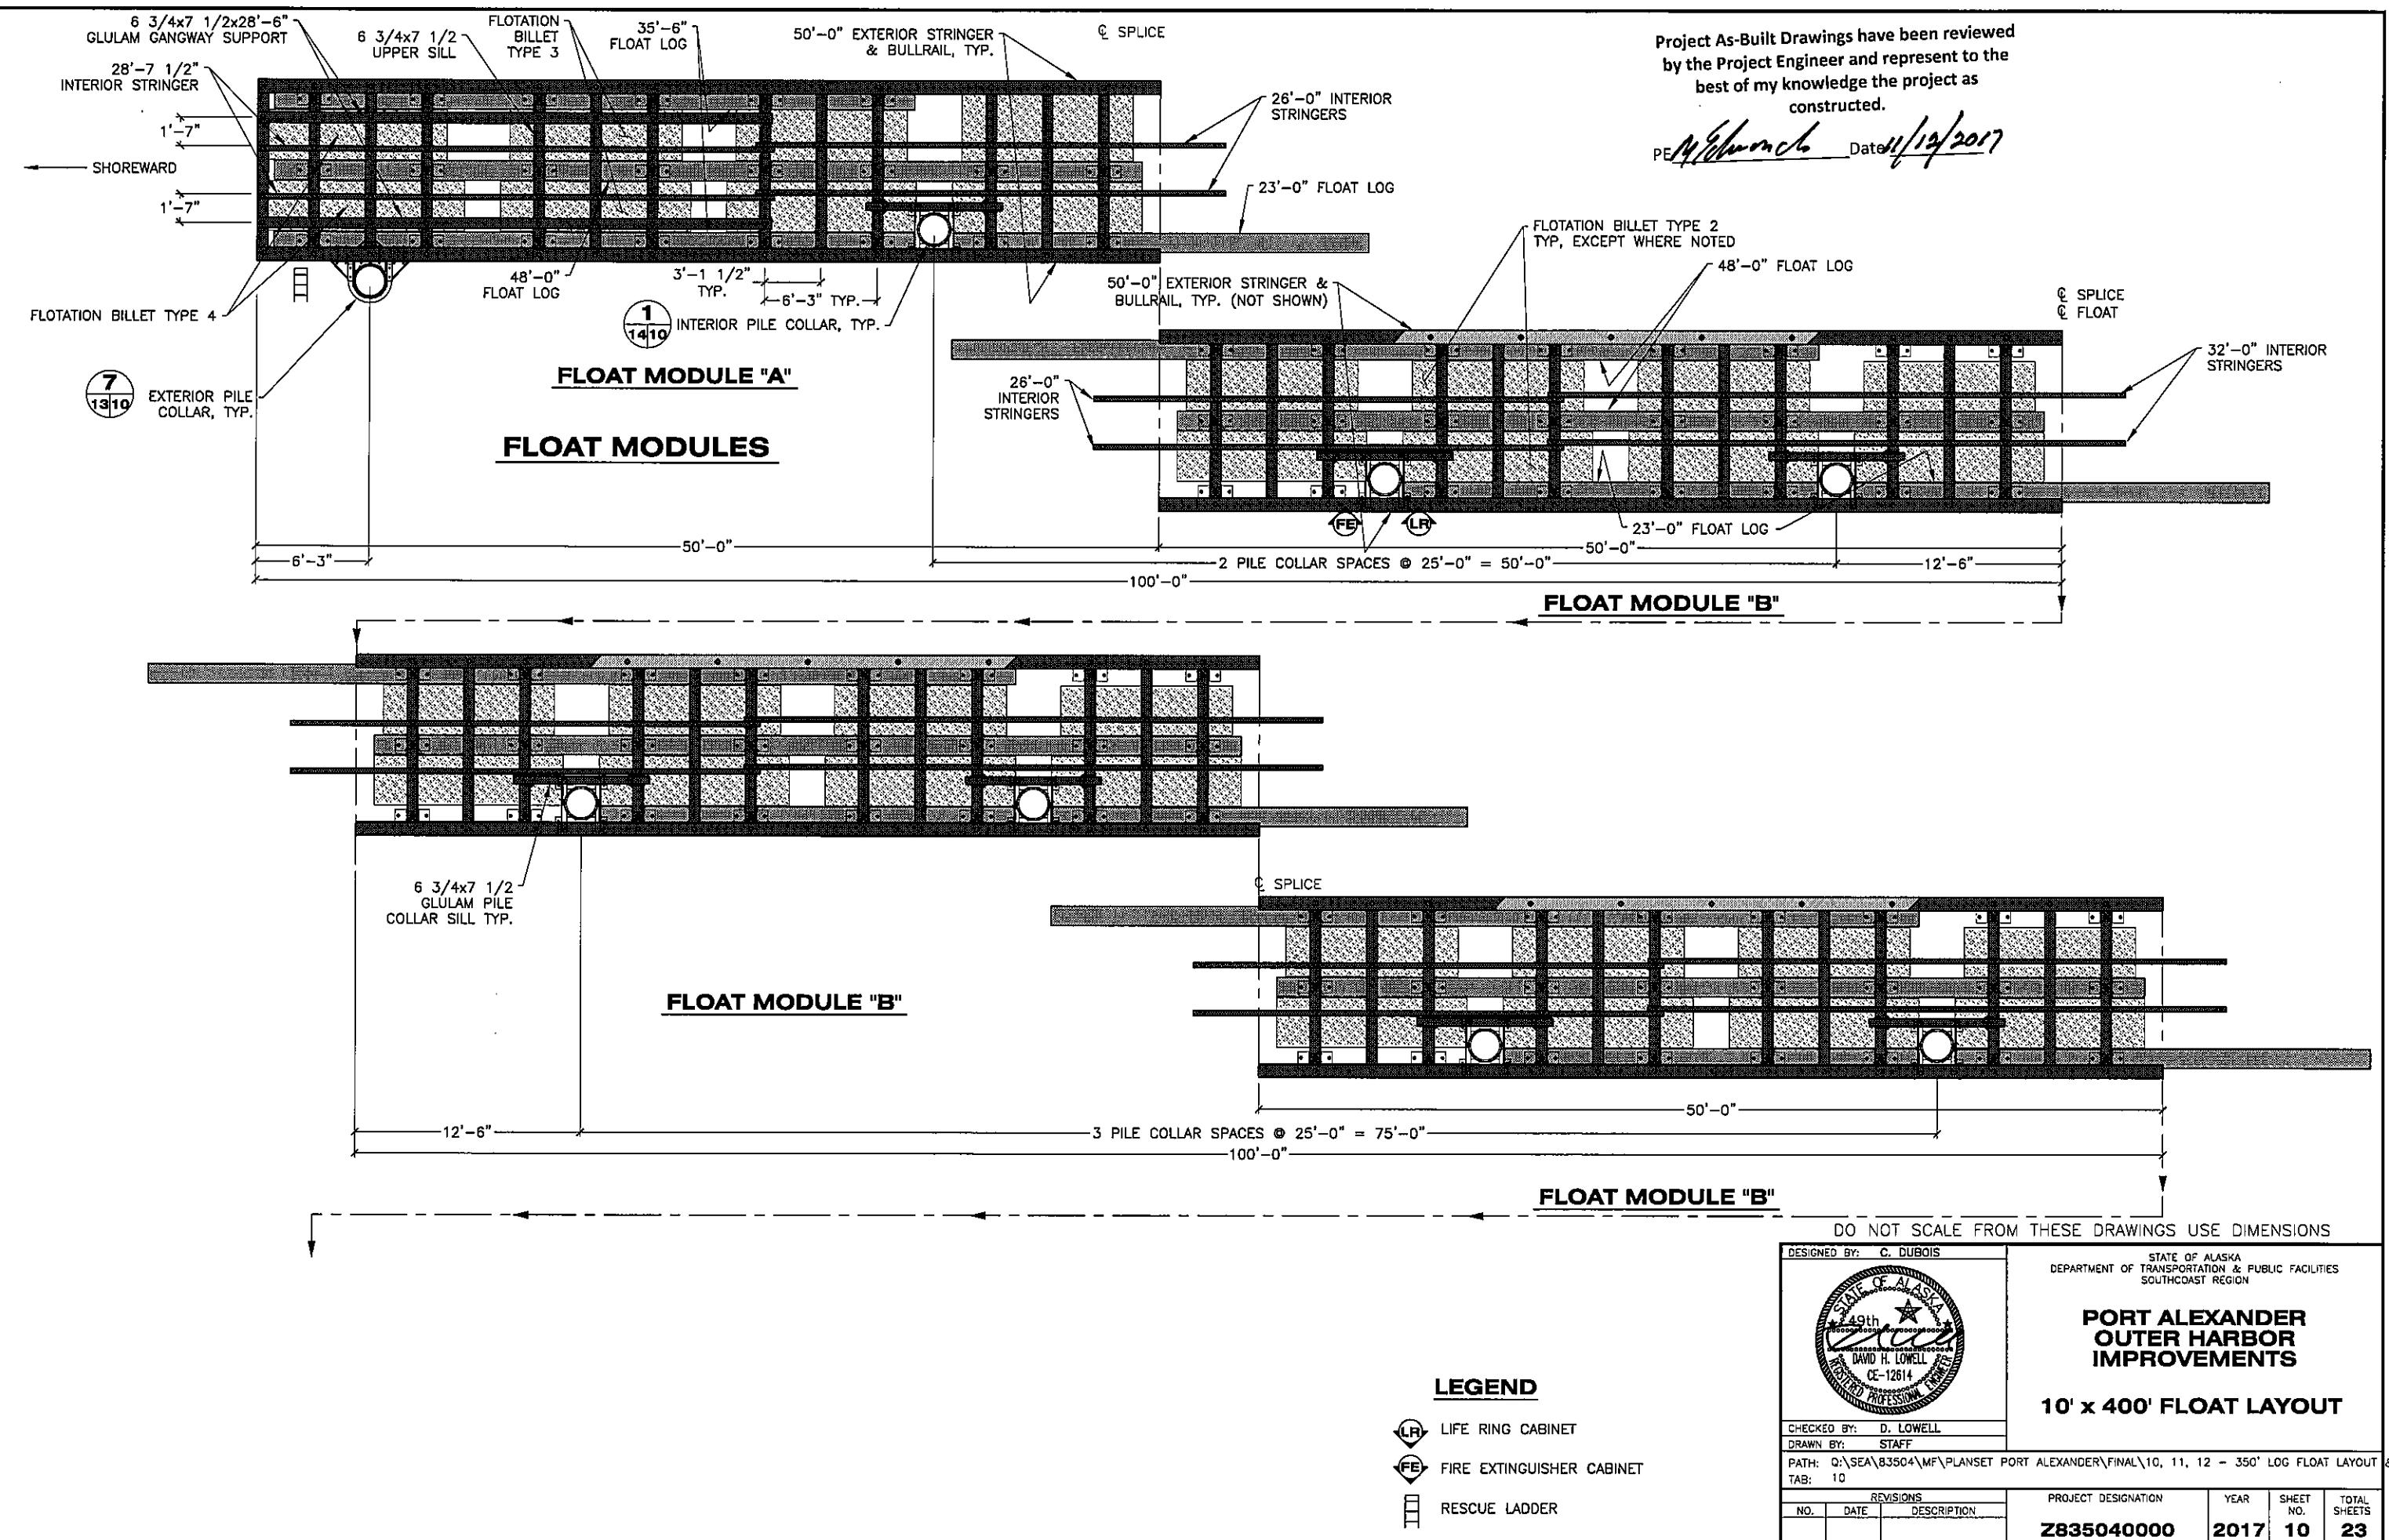

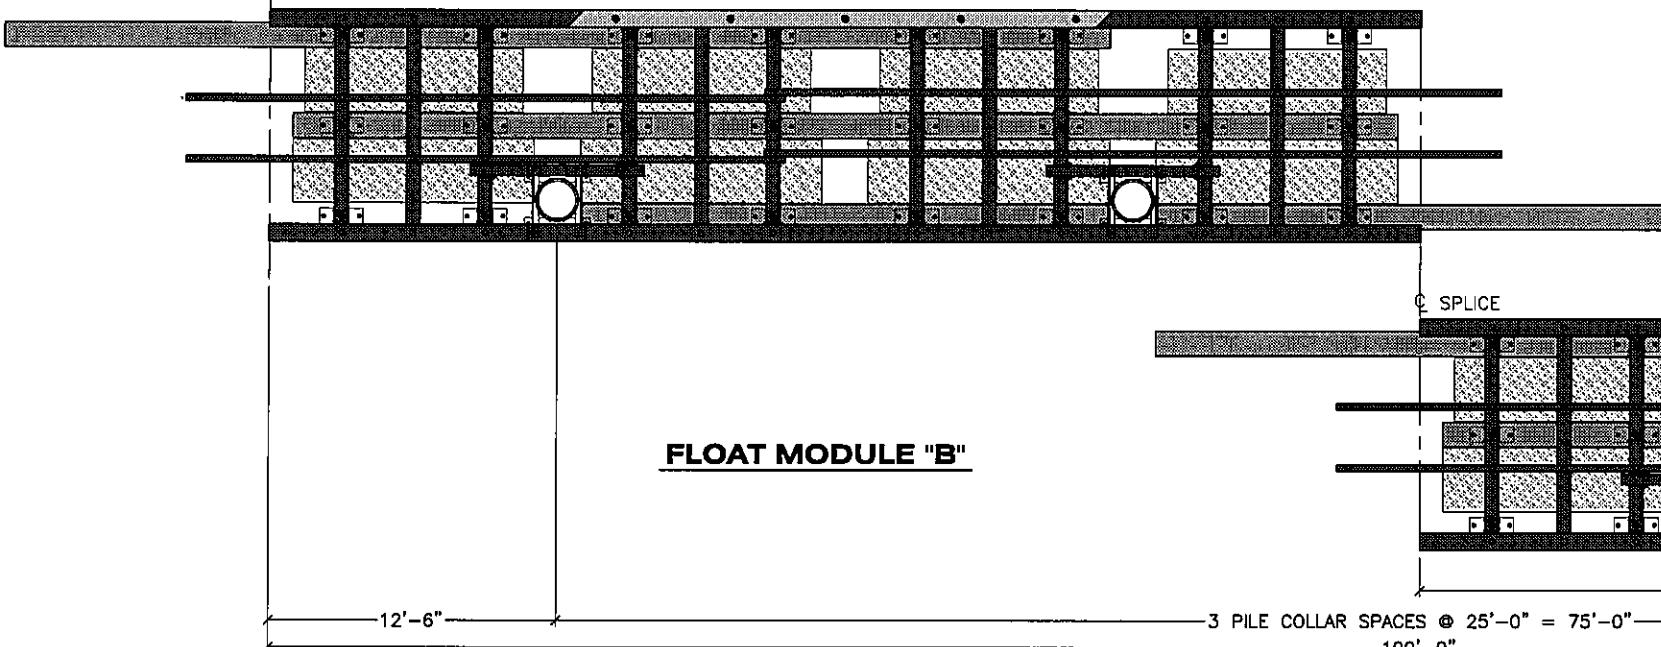

Project As-Built Drawings have been reviewed  
by the Project Engineer and represent to the  
best of my knowledge the project as  
constructed.

PE McEdward Date 11/22/2017

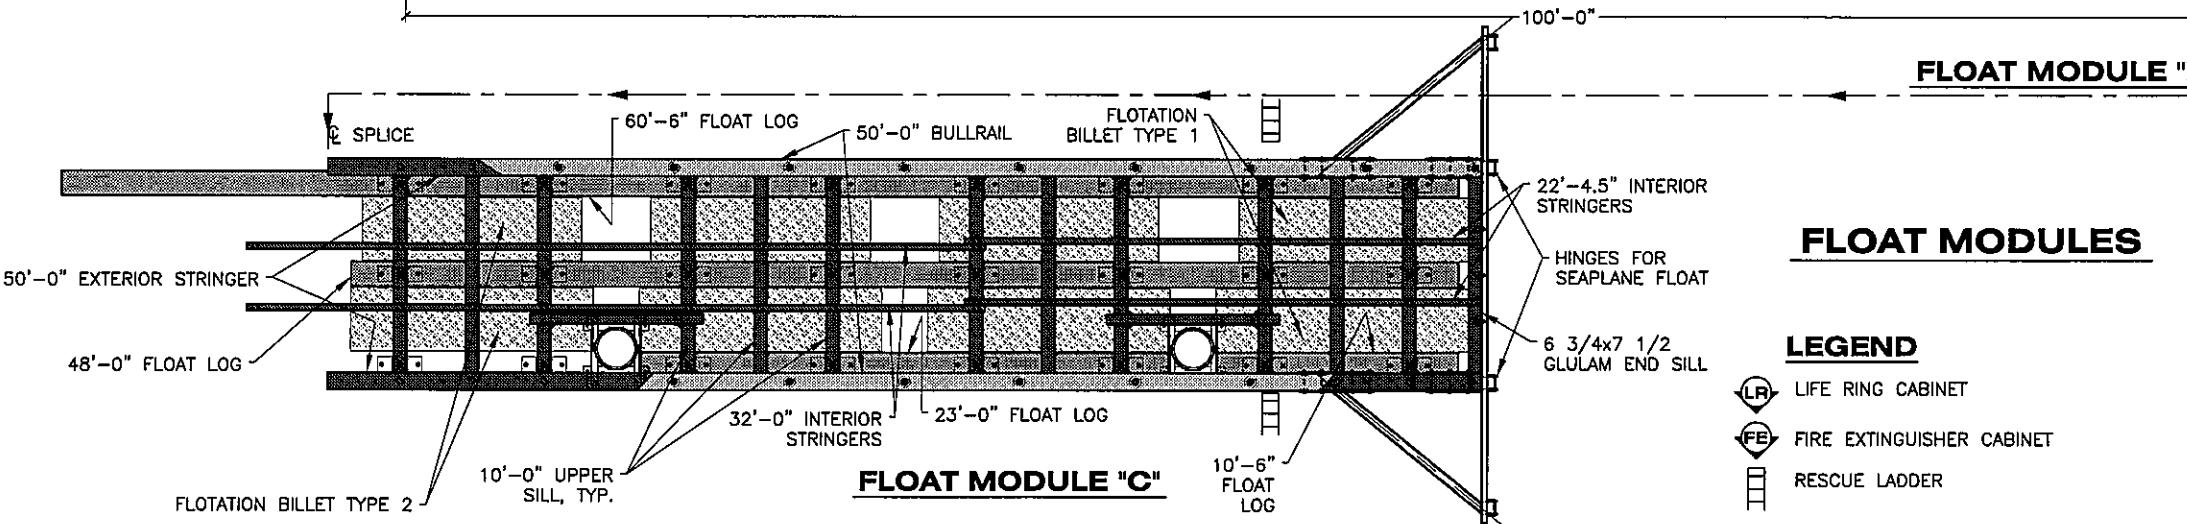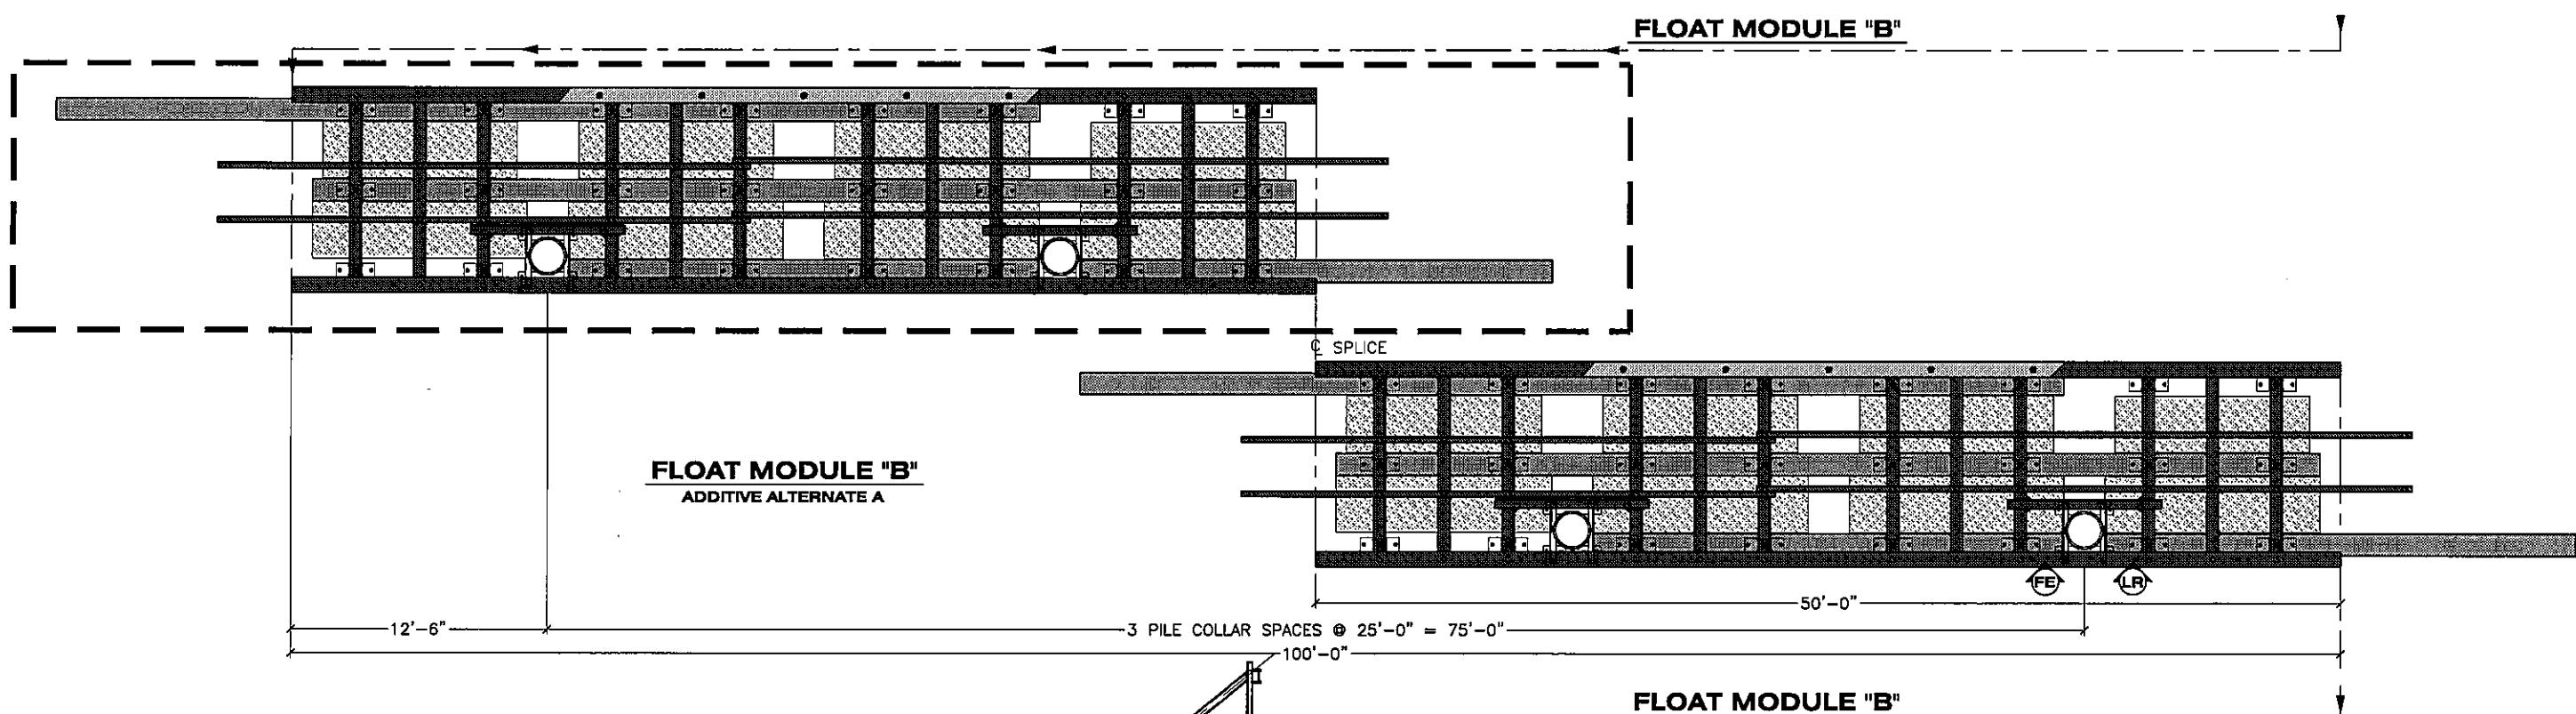


### FLOAT MODULES

#### LEGEND

- LIFE RING CABINET
- FIRE EXTINGUISHER CABINET
- RESCUE LADDER

DO NOT SCALE FROM THESE DRAWINGS USE DIMENSIONS

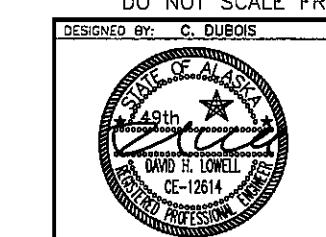


STATE OF ALASKA  
DEPARTMENT OF TRANSPORTATION & PUBLIC FACILITIES  
SOUTHCOAST REGION


### PORT ALEXANDER OUTER HARBOR IMPROVEMENTS

#### 10' x 400' FLOAT LAYOUT


REVISIONS			PROJECT DESIGNATION	YEAR	SHEET NO.	TOTAL SHEETS
NO.	DATE	DESCRIPTION	Z835040000	2017	11	23

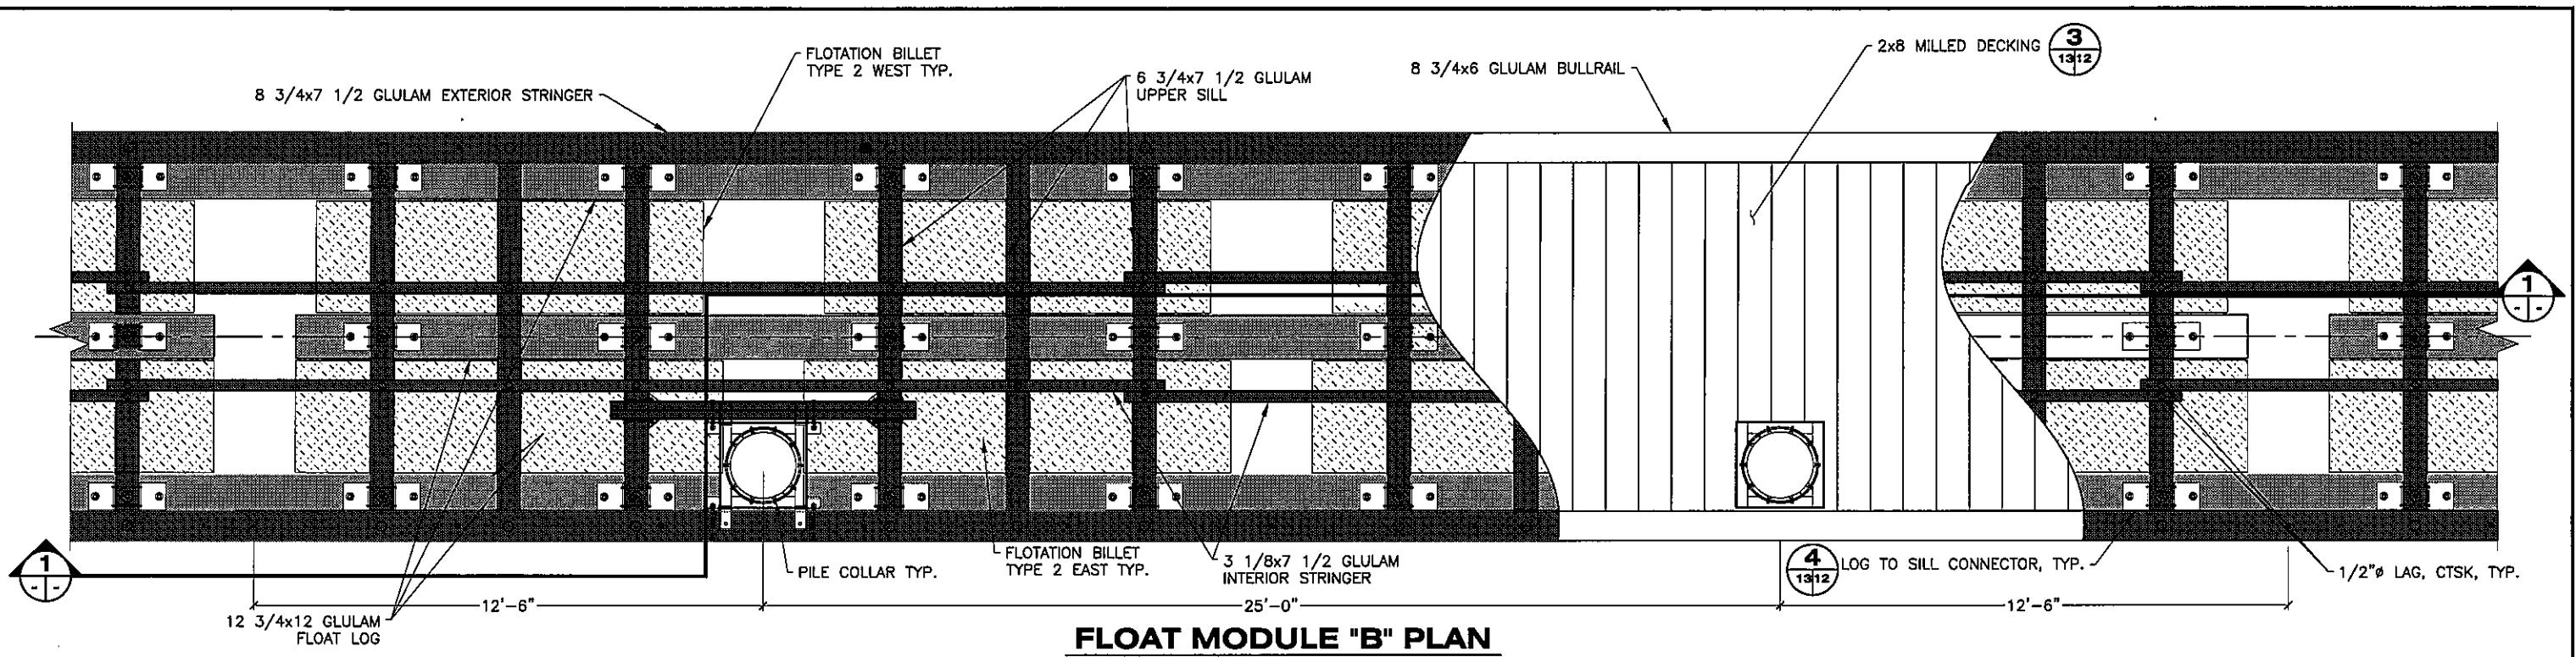

**FLOAT MODULE 'B' PLAN**

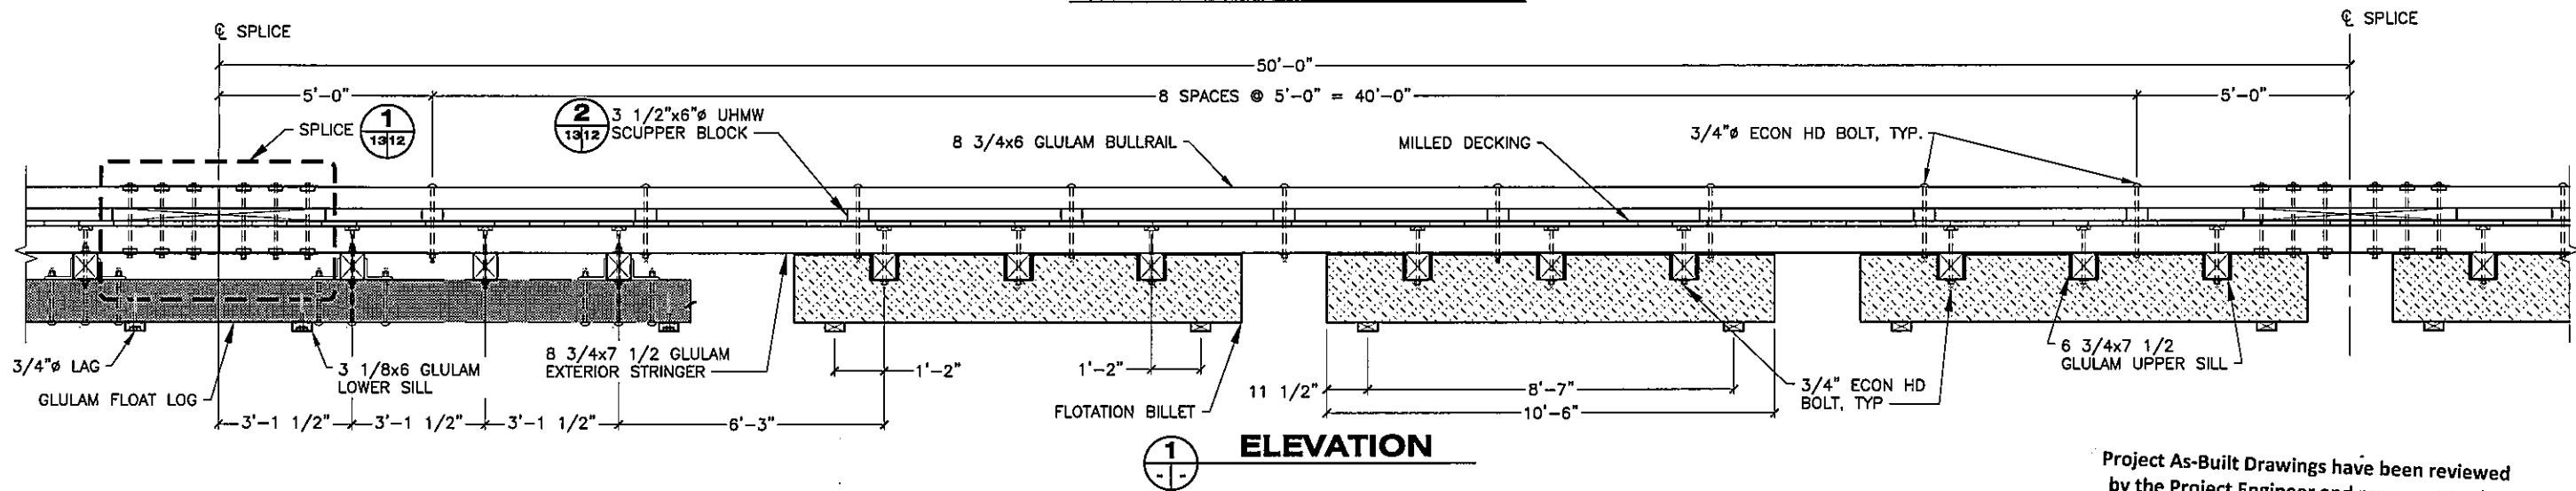

**ELEVATION**

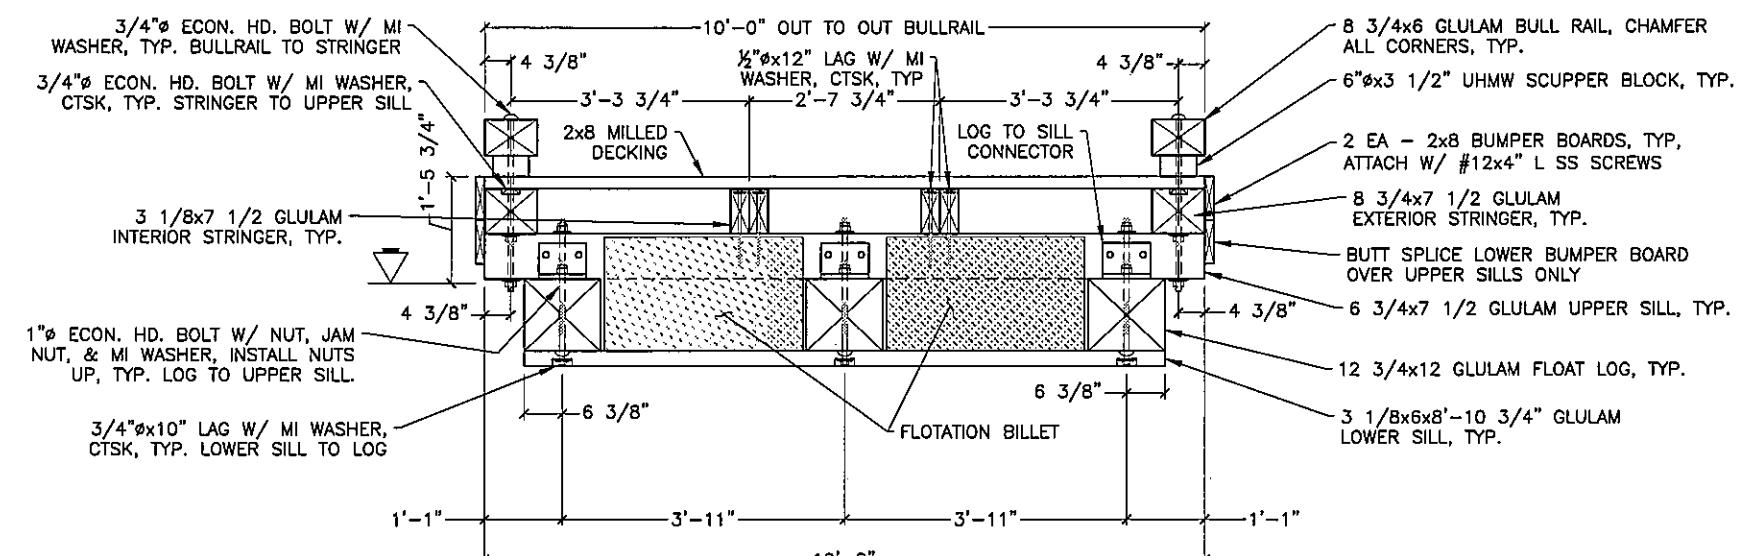

**TYPICAL SECTION**


Project As-Built Drawings have been reviewed  
by the Project Engineer and represent to the  
best of my knowledge the project as  
constructed.


PE *M. Johnstone* Date 11/12/2017


DO NOT SCALE FROM THESE DRAWINGS USE DIMENSIONS

DESIGNED BY: C. DUBOIS	STATE OF ALASKA 49th DAVID H. LOWELL CE-12614 REGISTERED PROFESSIONAL ENGINEER	DEPARTMENT OF TRANSPORTATION & PUBLIC FACILITIES SOUTHCOAST REGION
PORT ALEXANDER OUTER HARBOR IMPROVEMENTS		50' FLOAT MODULE
CHECKED BY: D. LOWELL	PROJECT DESIGNATION	
DRAWN BY: STAFF	YEAR	SHEET NO.
PATH: Q:\SEA\83504\MF\PLANSET PORT ALEXANDER\FINAL\10, 11, 12 - 350' LOG FLOAT LAYOUT & MC		TOTAL SHEETS
TAB: 12		23
REVISIONS		
NO.	DATE	DESCRIPTION

Z835040000 2017 12 23

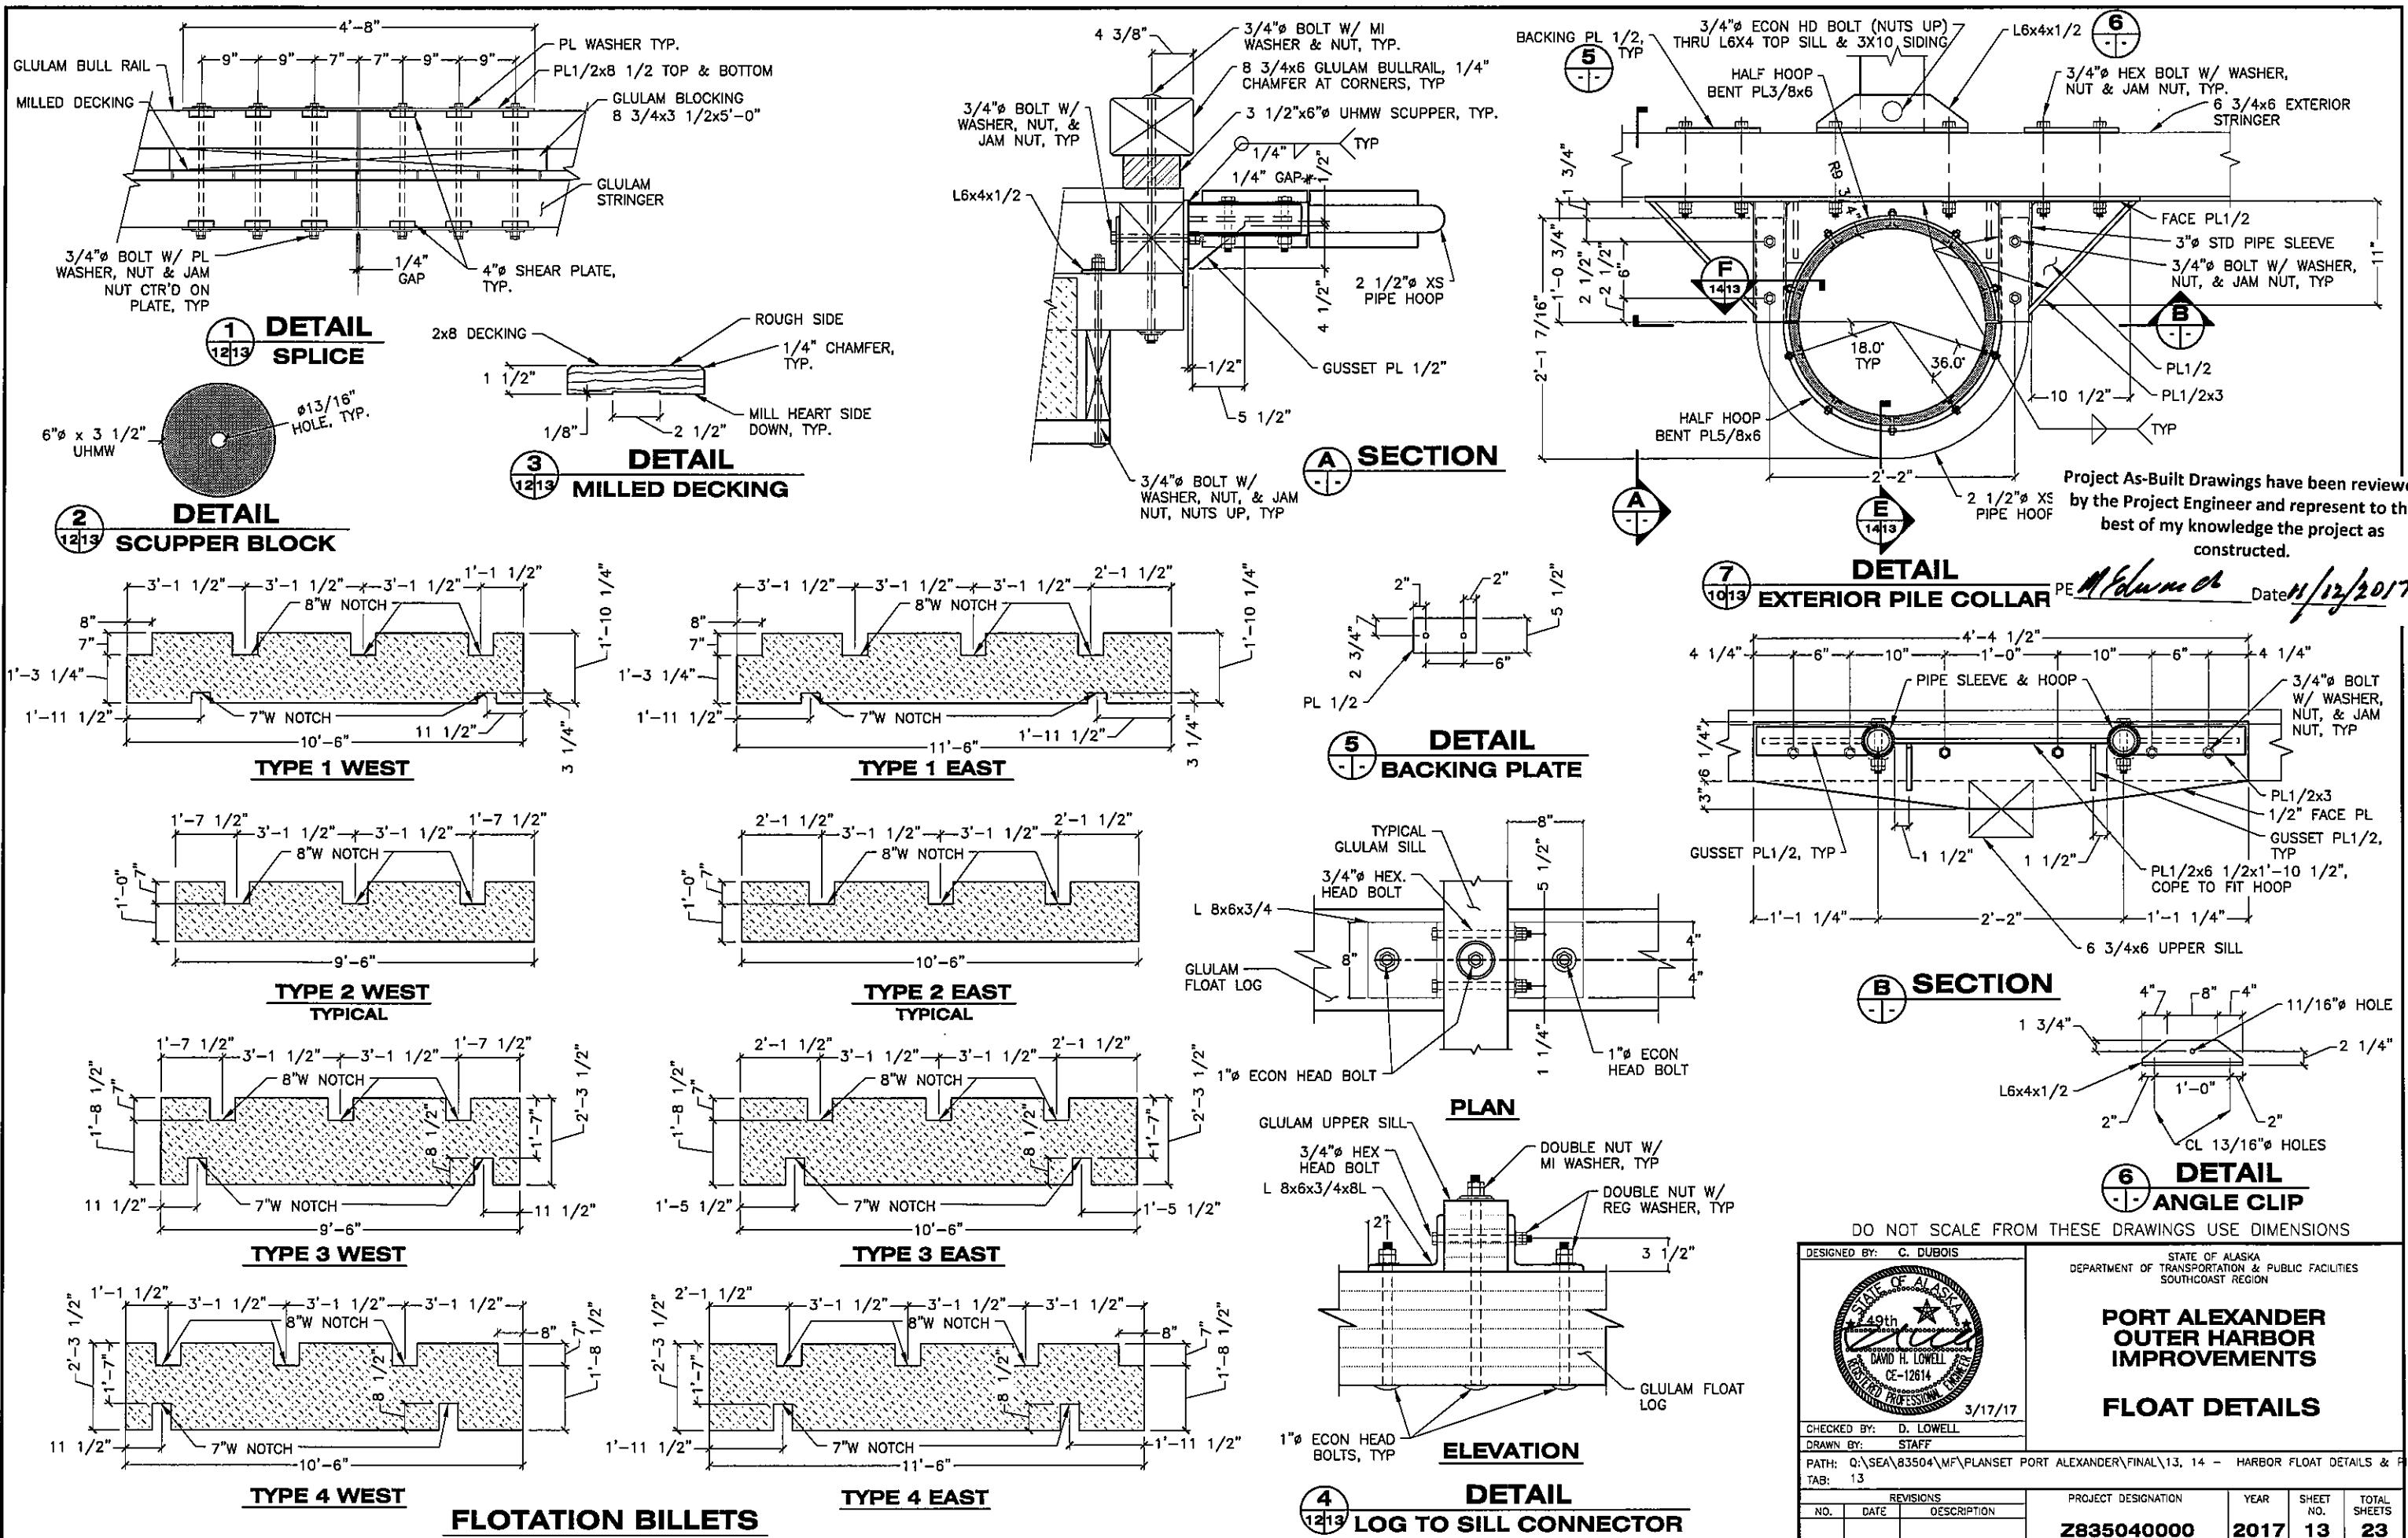

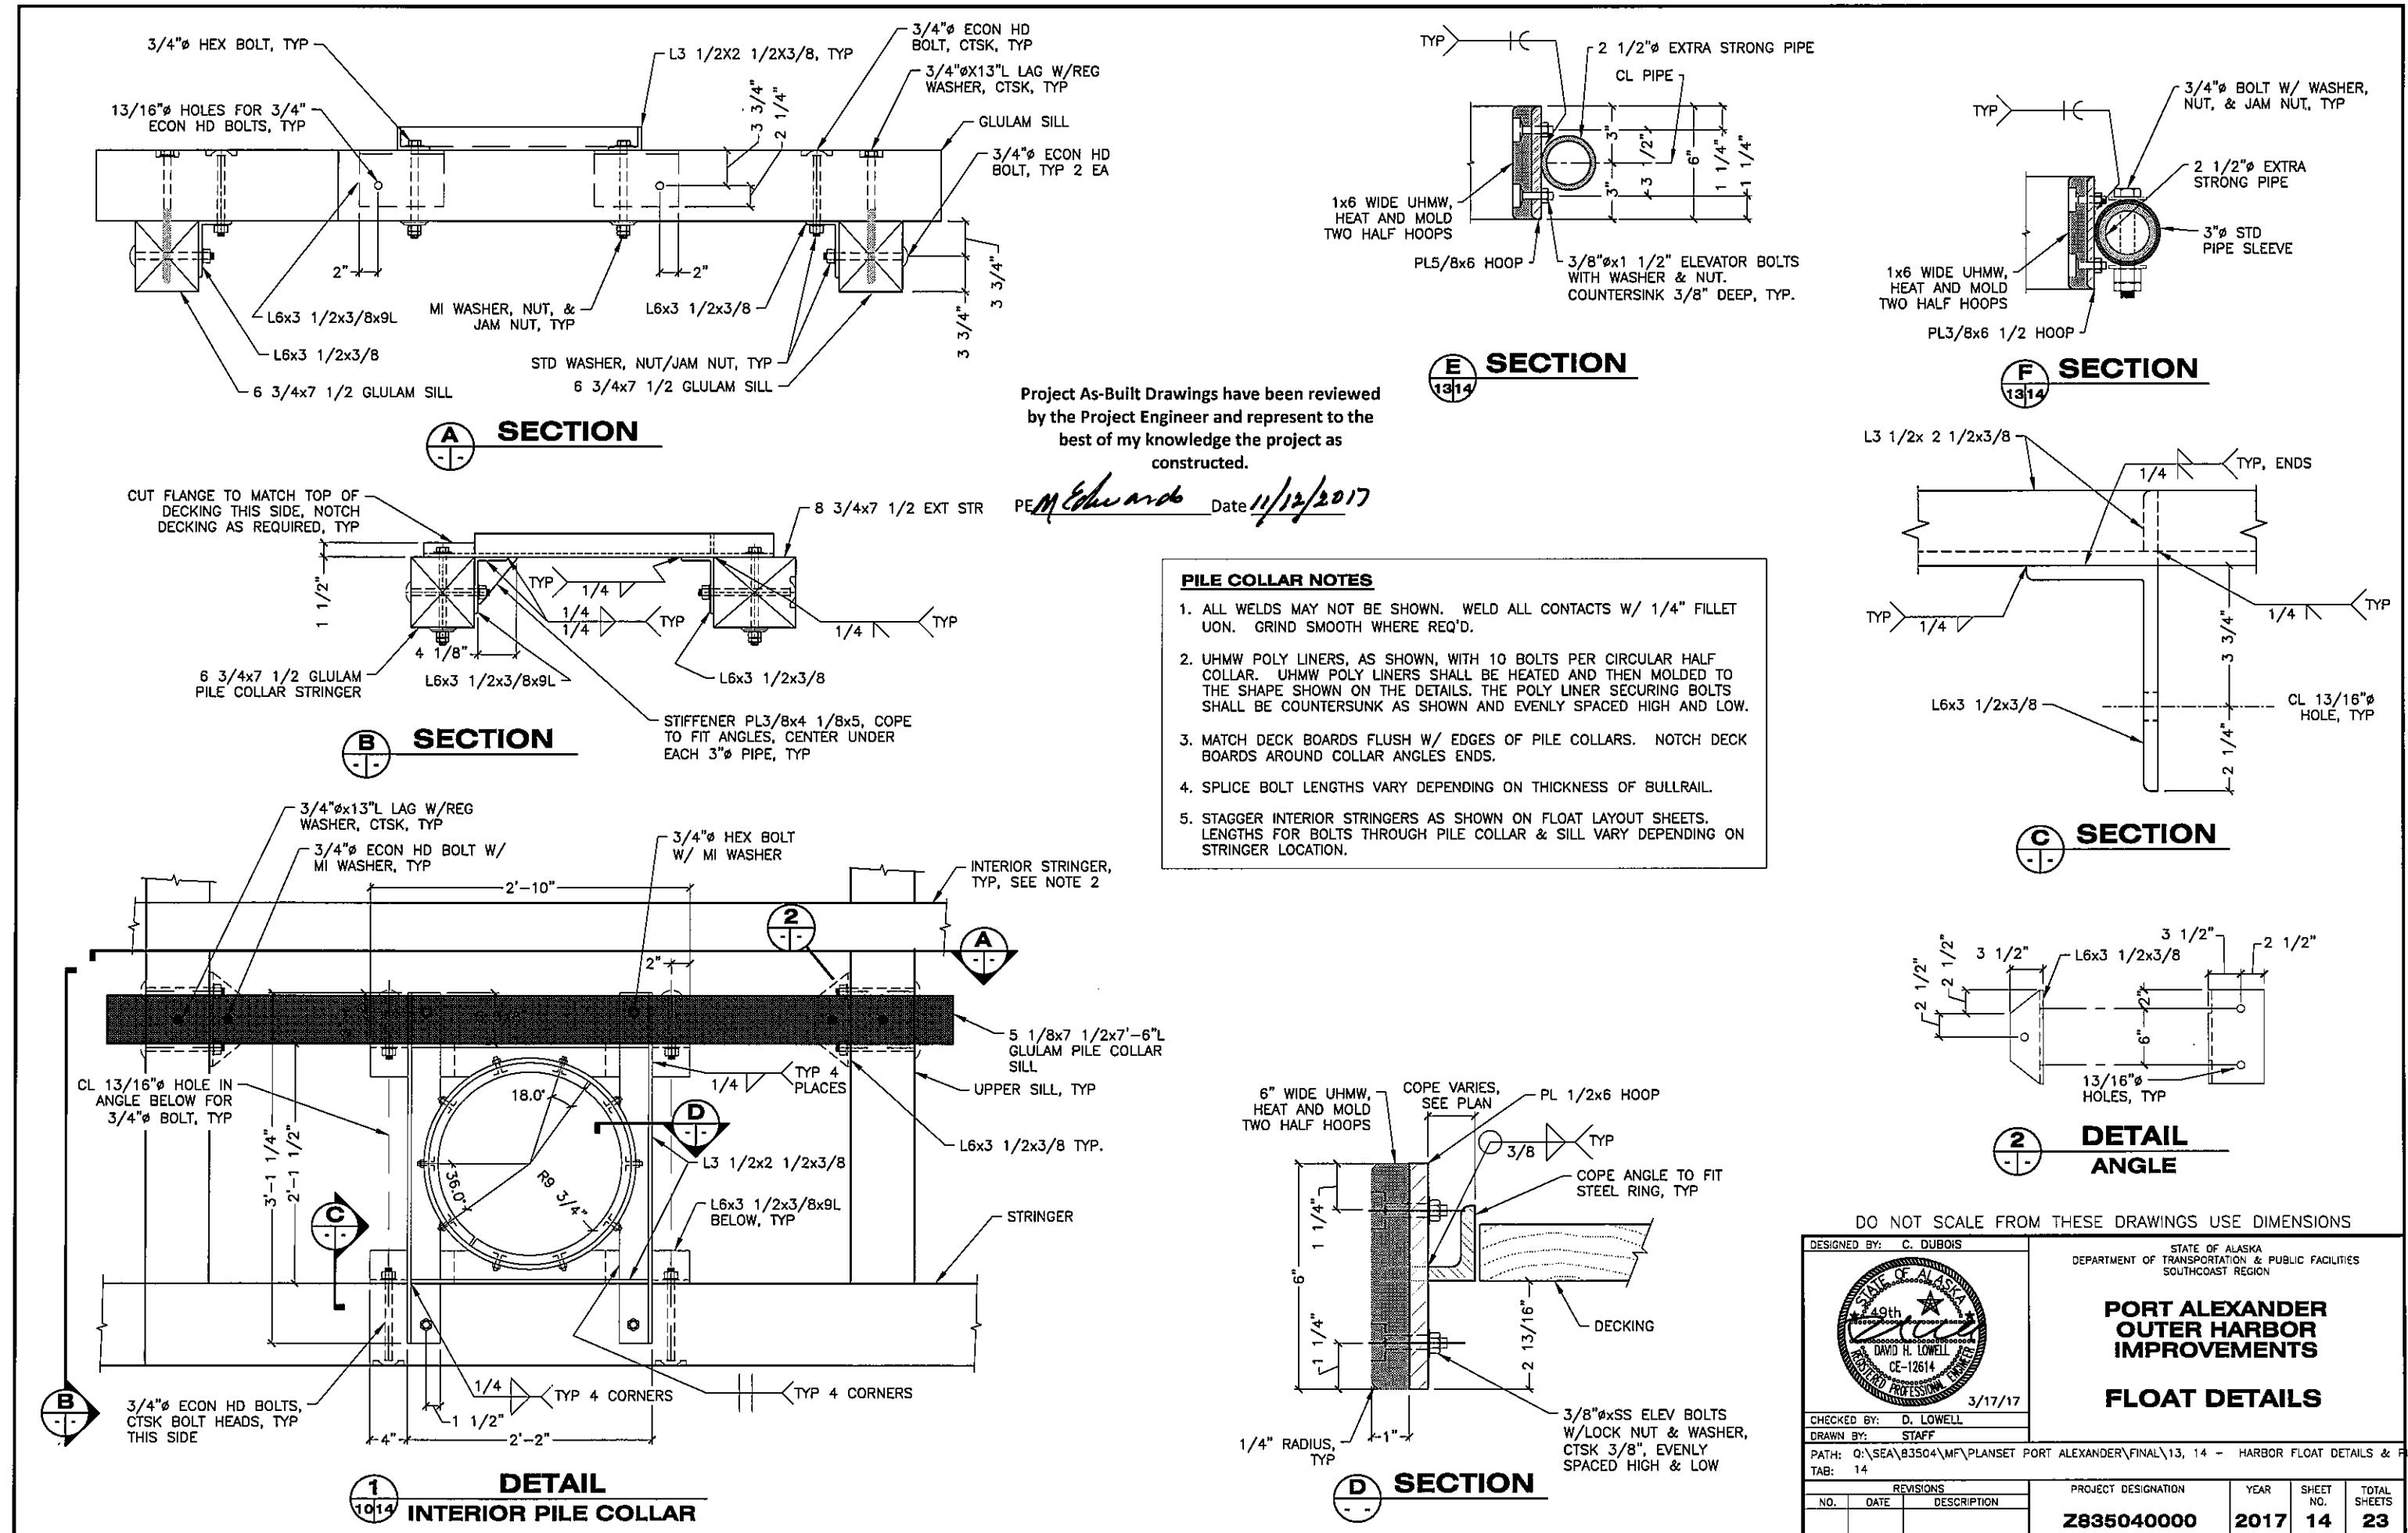


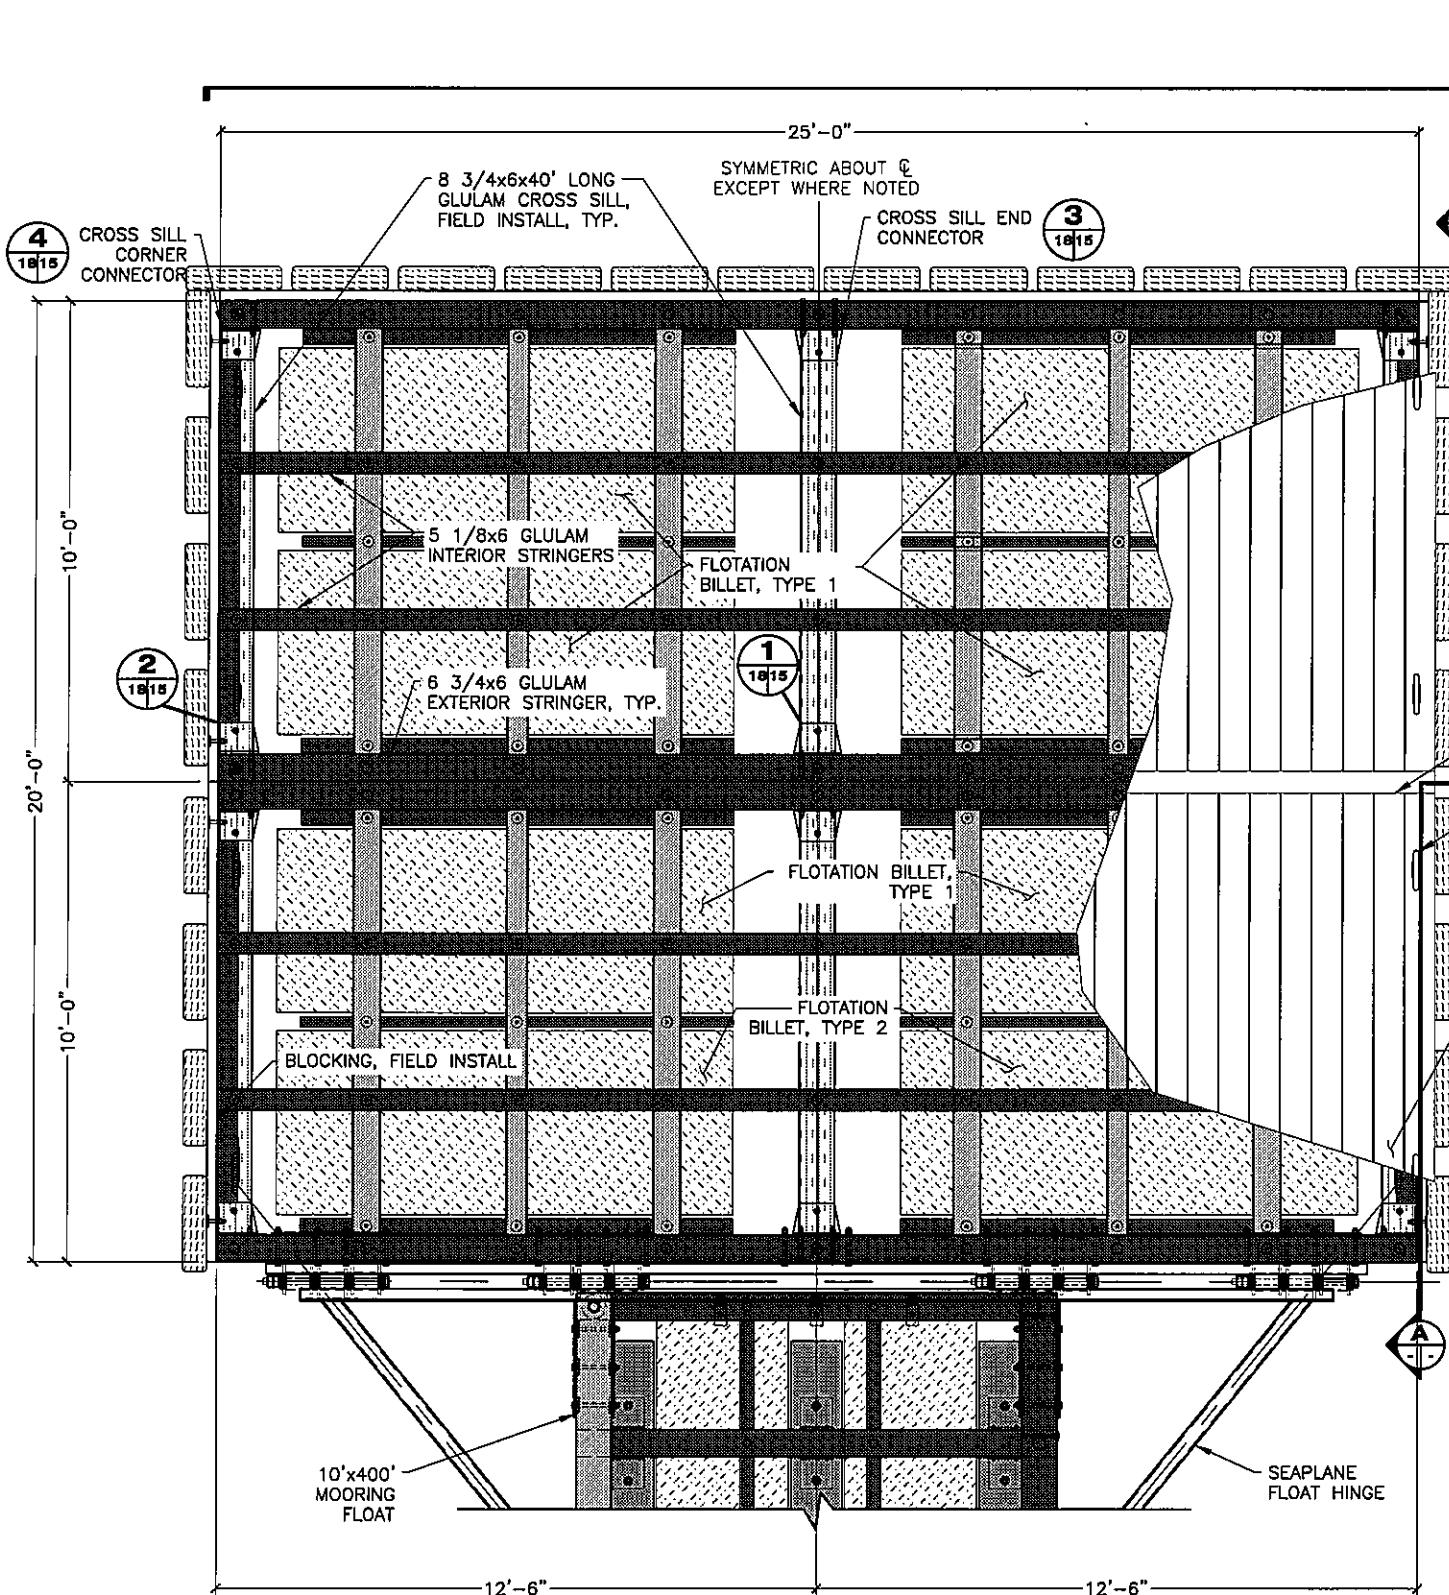

## **SEAPLANE FLOAT PLAN**


**Project As-Built Drawings have been reviewed by the Project Engineer and represent to the best of my knowledge the project as constructed.**

PE of Edinburgh Date 11/12/2017

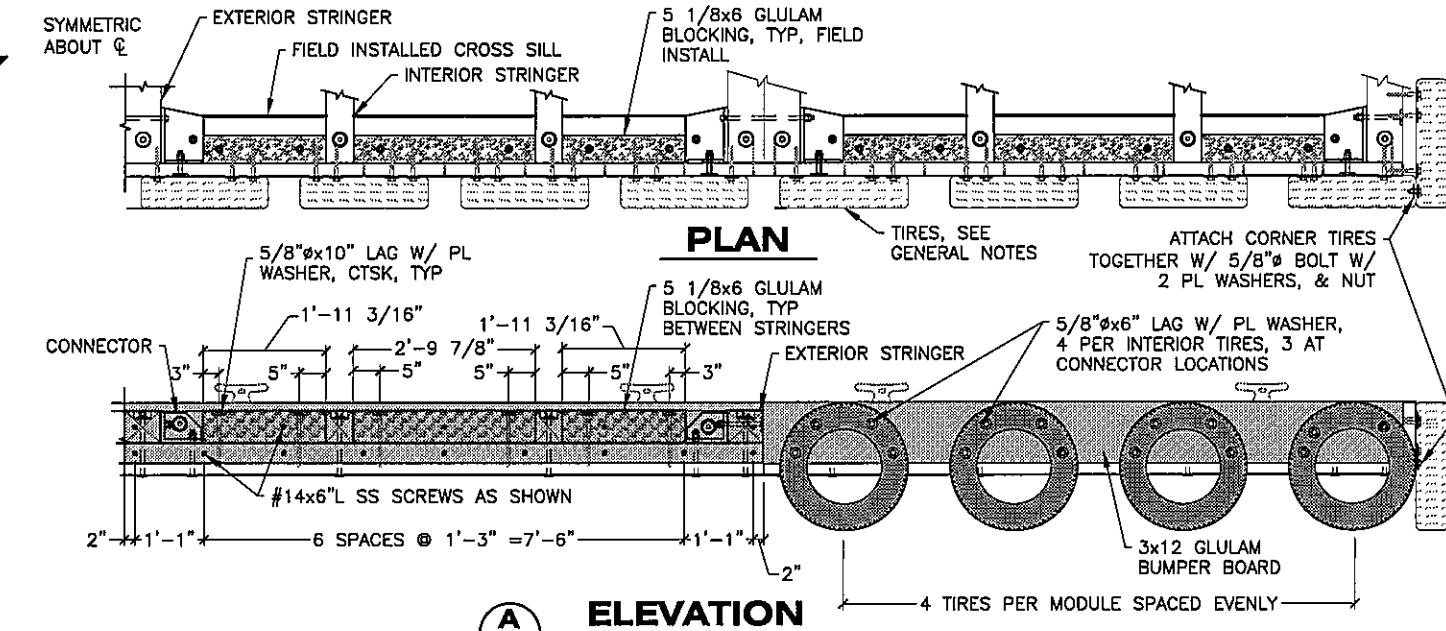


TIRE BUMPER NOTES:

1. REFERENCE GENERAL NOTES ON SHEET 2 FOR NOMINAL SIZE AND TYPE OF TIRES.
2. PRE-DRILL ALL HOLES FOR TIRE INSTALLATION. PROVIDE 2" DIAMETER HOLE IN OUTSIDE FACE OF TIRE TO FACILITATE EXTERIOR LAG BOLT INSTALLATION. ALL LAG BOLTS SHALL BE EQUIPPED WITH GALVANIZED PLATE WASHERS IN CONTACT WITH RUBBER SURFACES.
3. COORDINATE AND/OR ADJUST LOCATIONS SO THAT ATTACHMENT HARDWARE DOES NOT CONFLICT WITH OTHER FLOAT FEATURES AS MAY BE REQUIRED.

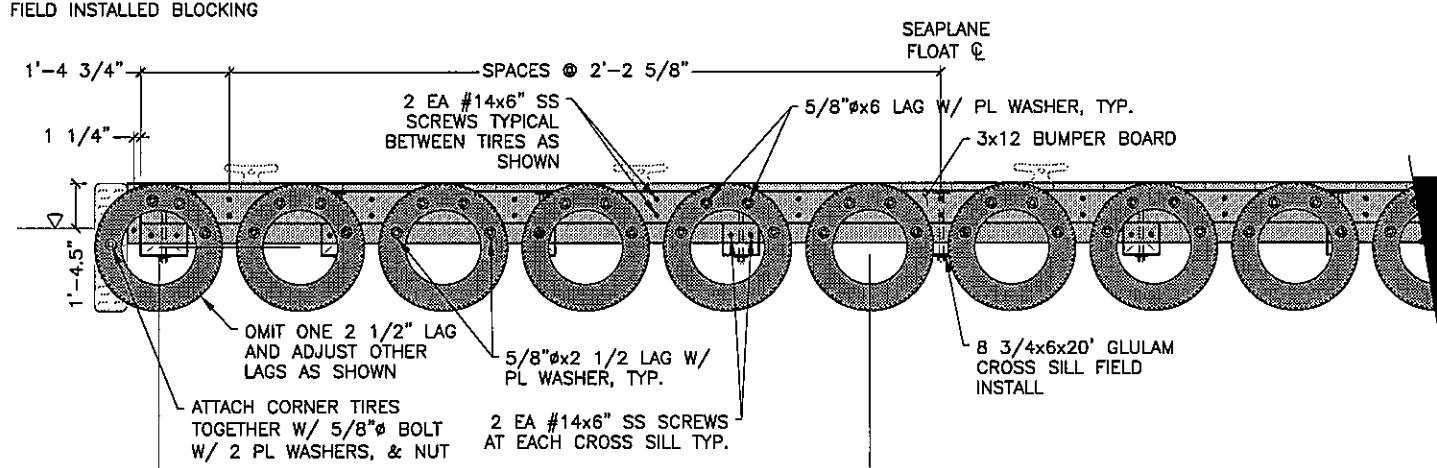

DO NOT SCALE FROM THESE DRAWINGS. USE DIMENSIONS

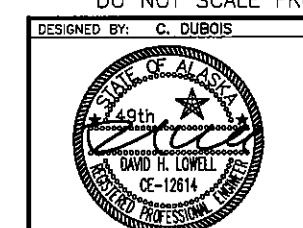



STATE OF ALASKA  
DEPARTMENT OF TRANSPORTATION & PUBLIC FACILITIES

## **PORT ALEXANDER OUTER HARBOR IMPROVEMENTS**

## **20' x 25' SEAPLANE FLOAT**


DESIGNED BY: C. DUBOIS		STATE OF ALASKA DEPARTMENT OF TRANSPORTATION & PUBLIC FACILITIES SOUTHCOAST REGION			
 <b>DAVID H. LOWELL</b> CE-12614 REGISTERED PROFESSIONAL ENGINEER		<b>PORT ALEXANDER OUTER HARBOR IMPROVEMENTS</b>			
CHECKED BY: D. LOWELL		<b>20' x 25' SEAPLANE FLOAT</b>			
DRAWN BY: STAFF		PATH: Q:\SEA\83504\MF\PLANSET PORT ALEXANDER\FINAL\15 - SEAPLANE FLOAT LAYOUT.DWG			
TAB: 15					
REVISIONS		PROJECT DESIGNATION	YEAR	SHEET NO.	TOTAL SHEETS
NO.	DATE	DESCRIPTION	Z835040000	2017	15
					23

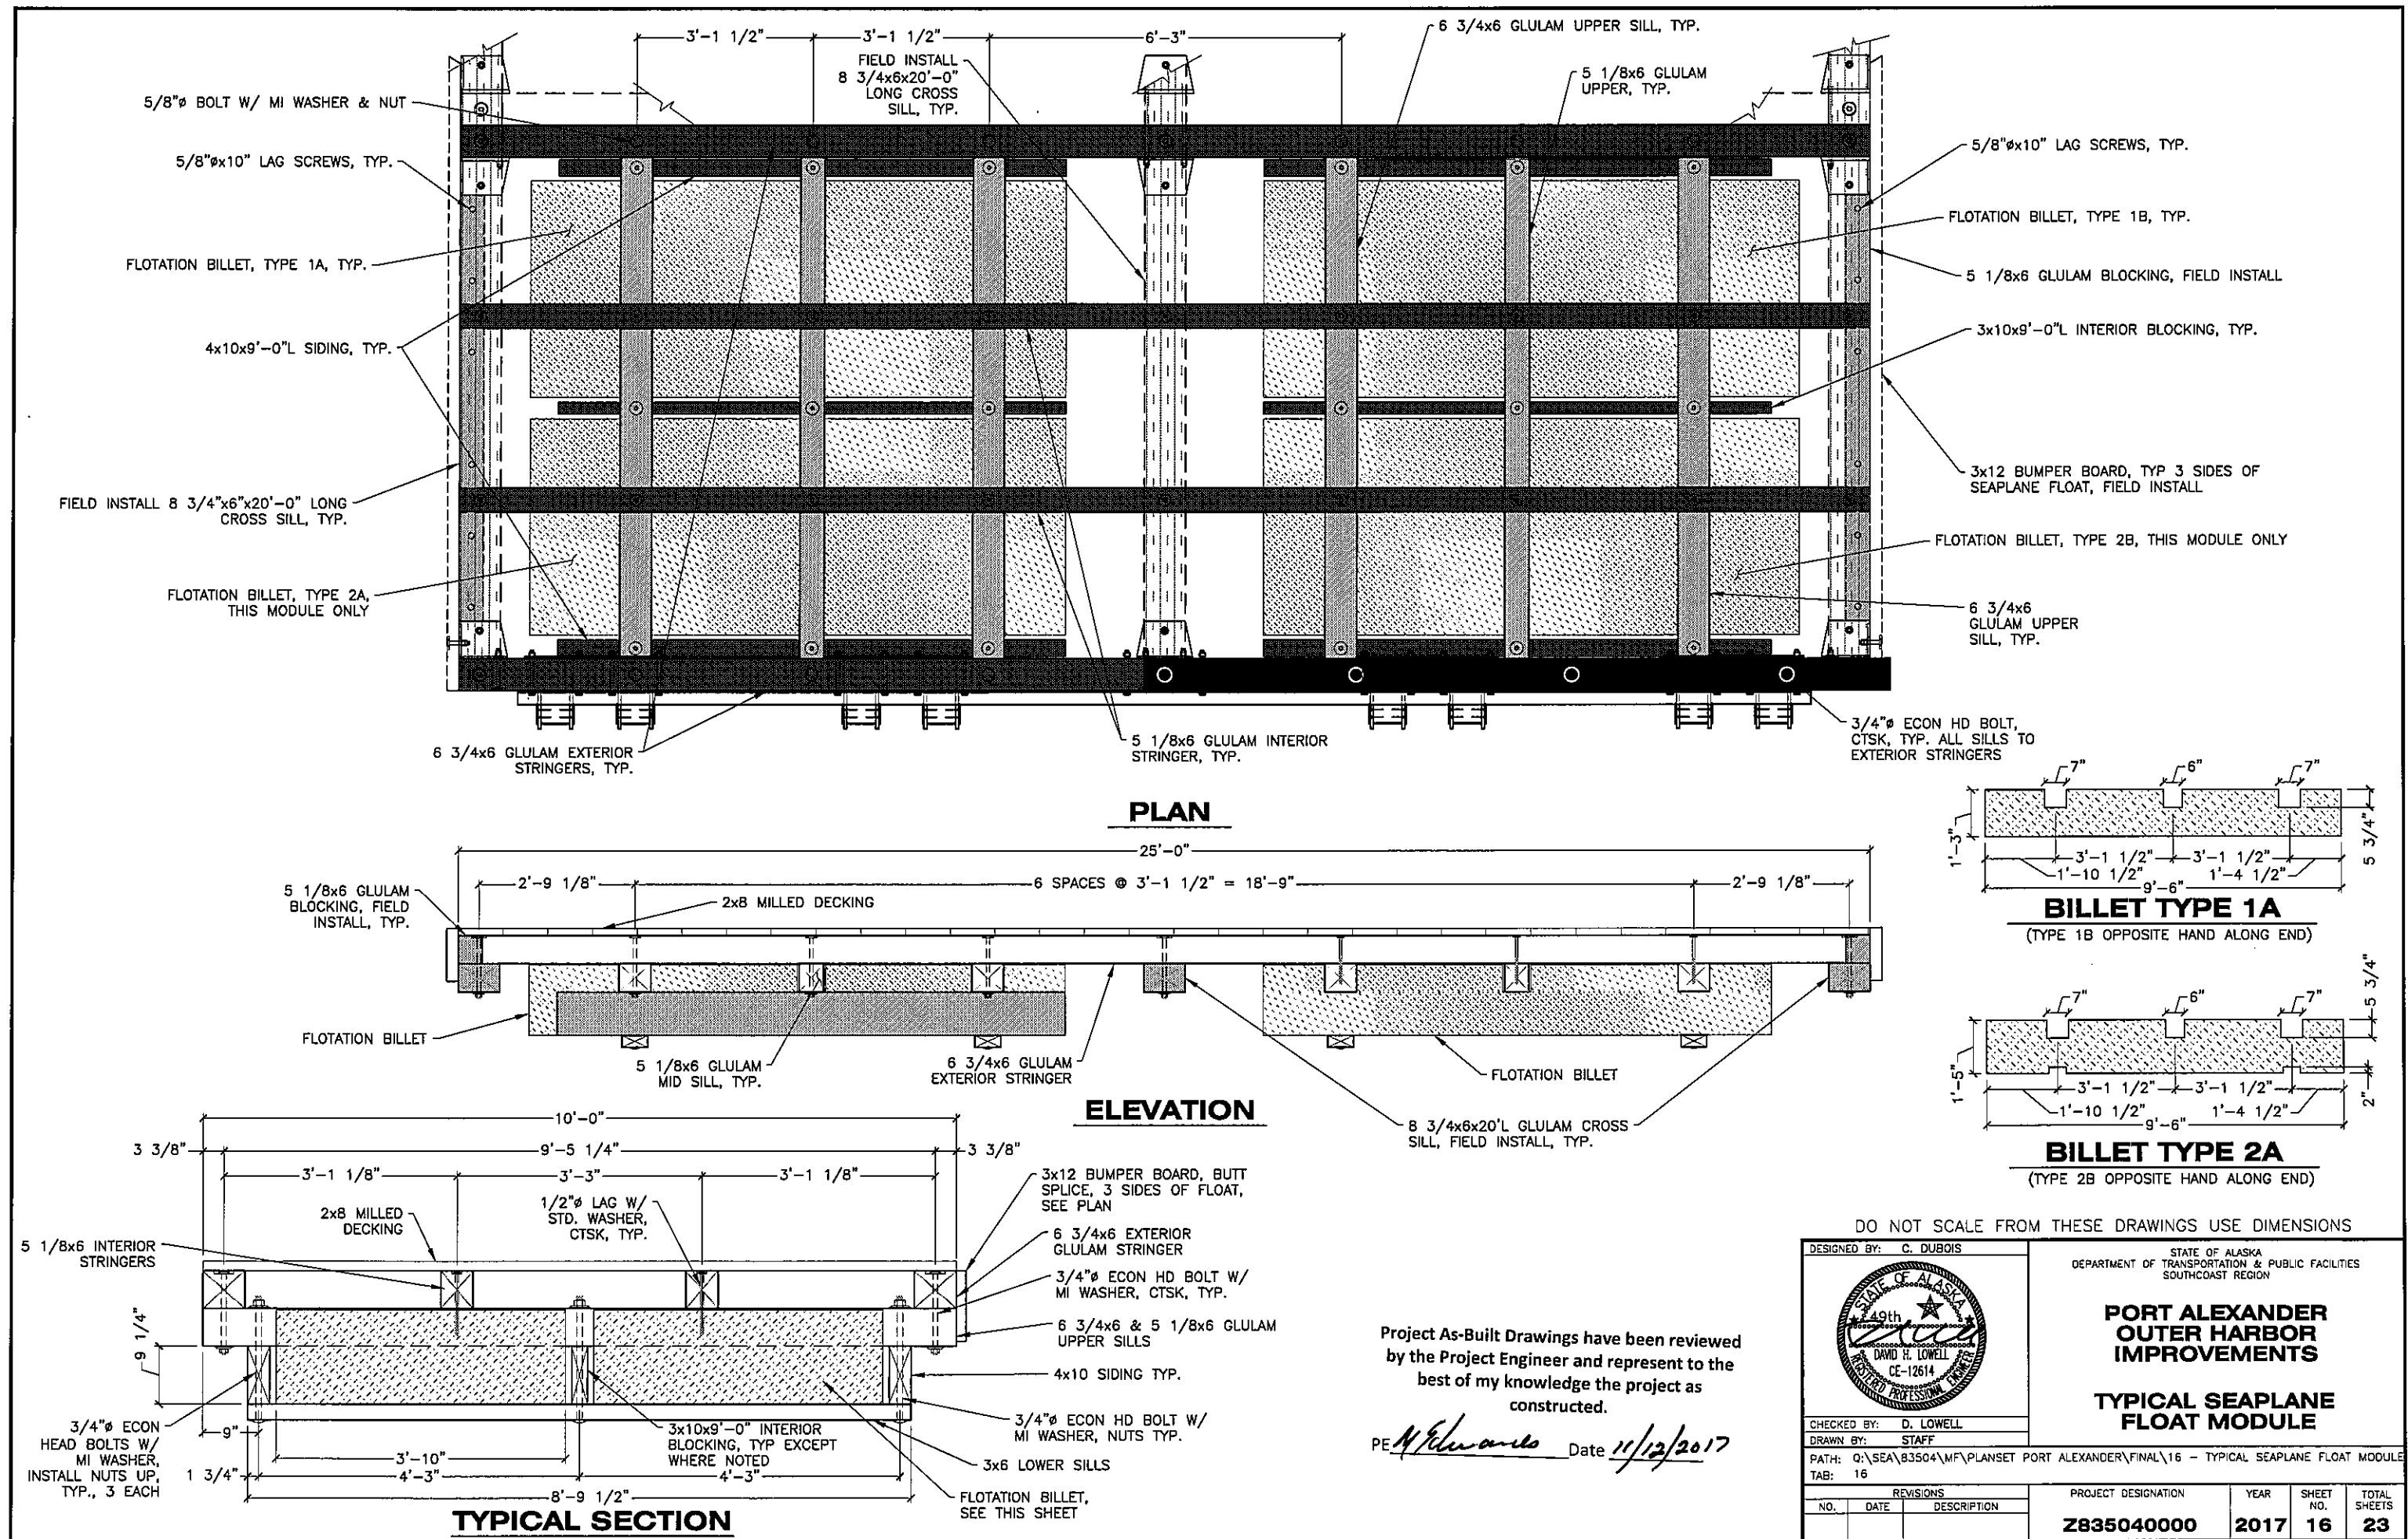

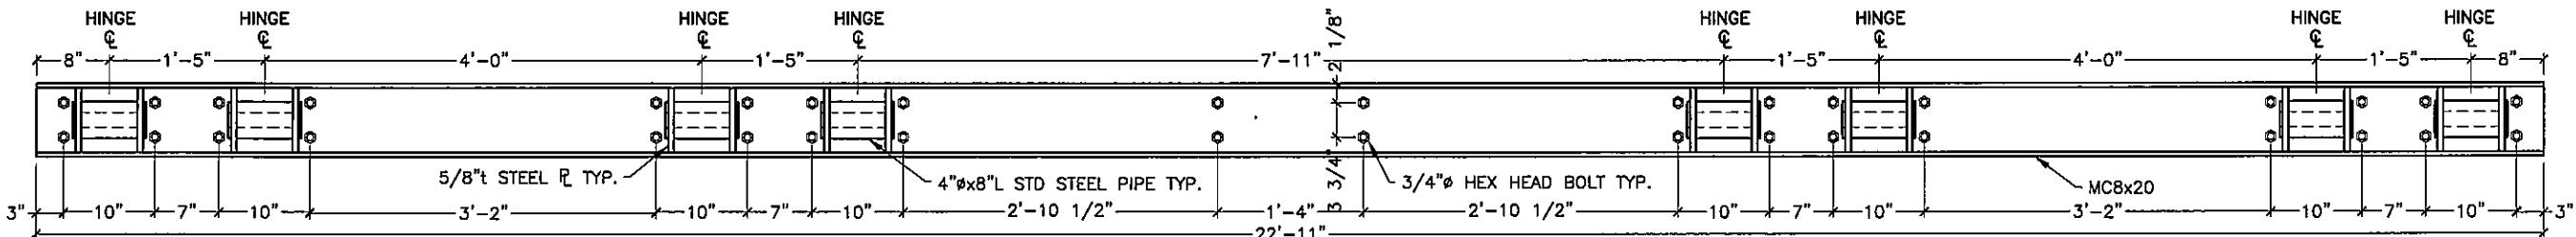


## **CONNECTION HINGE A**

## SEAPLANE FLOAT PROFILE

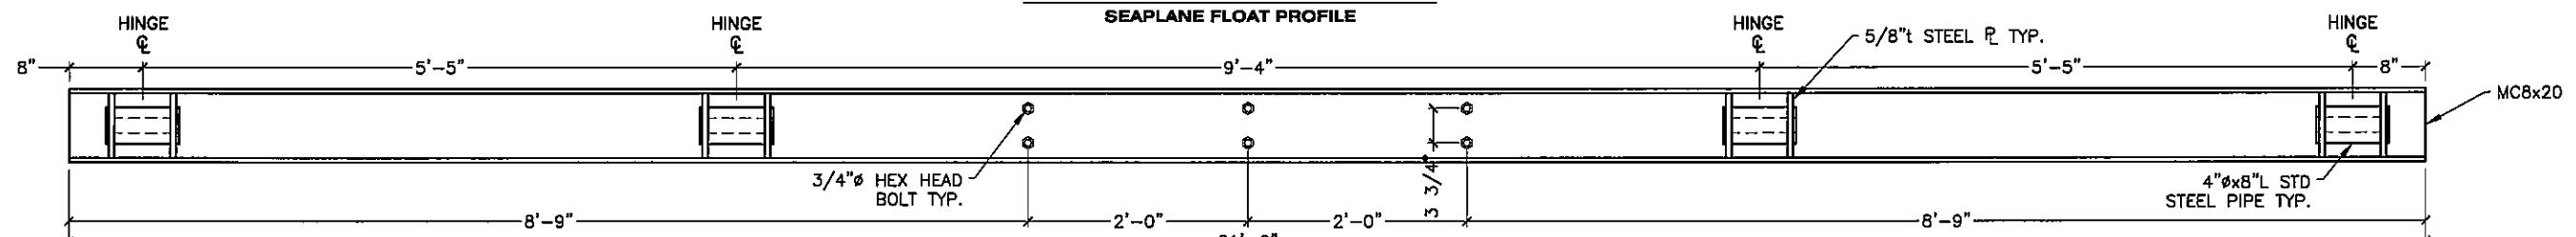

## **CONNECTION HINGE B**


## MAIN FLOAT PROFILE

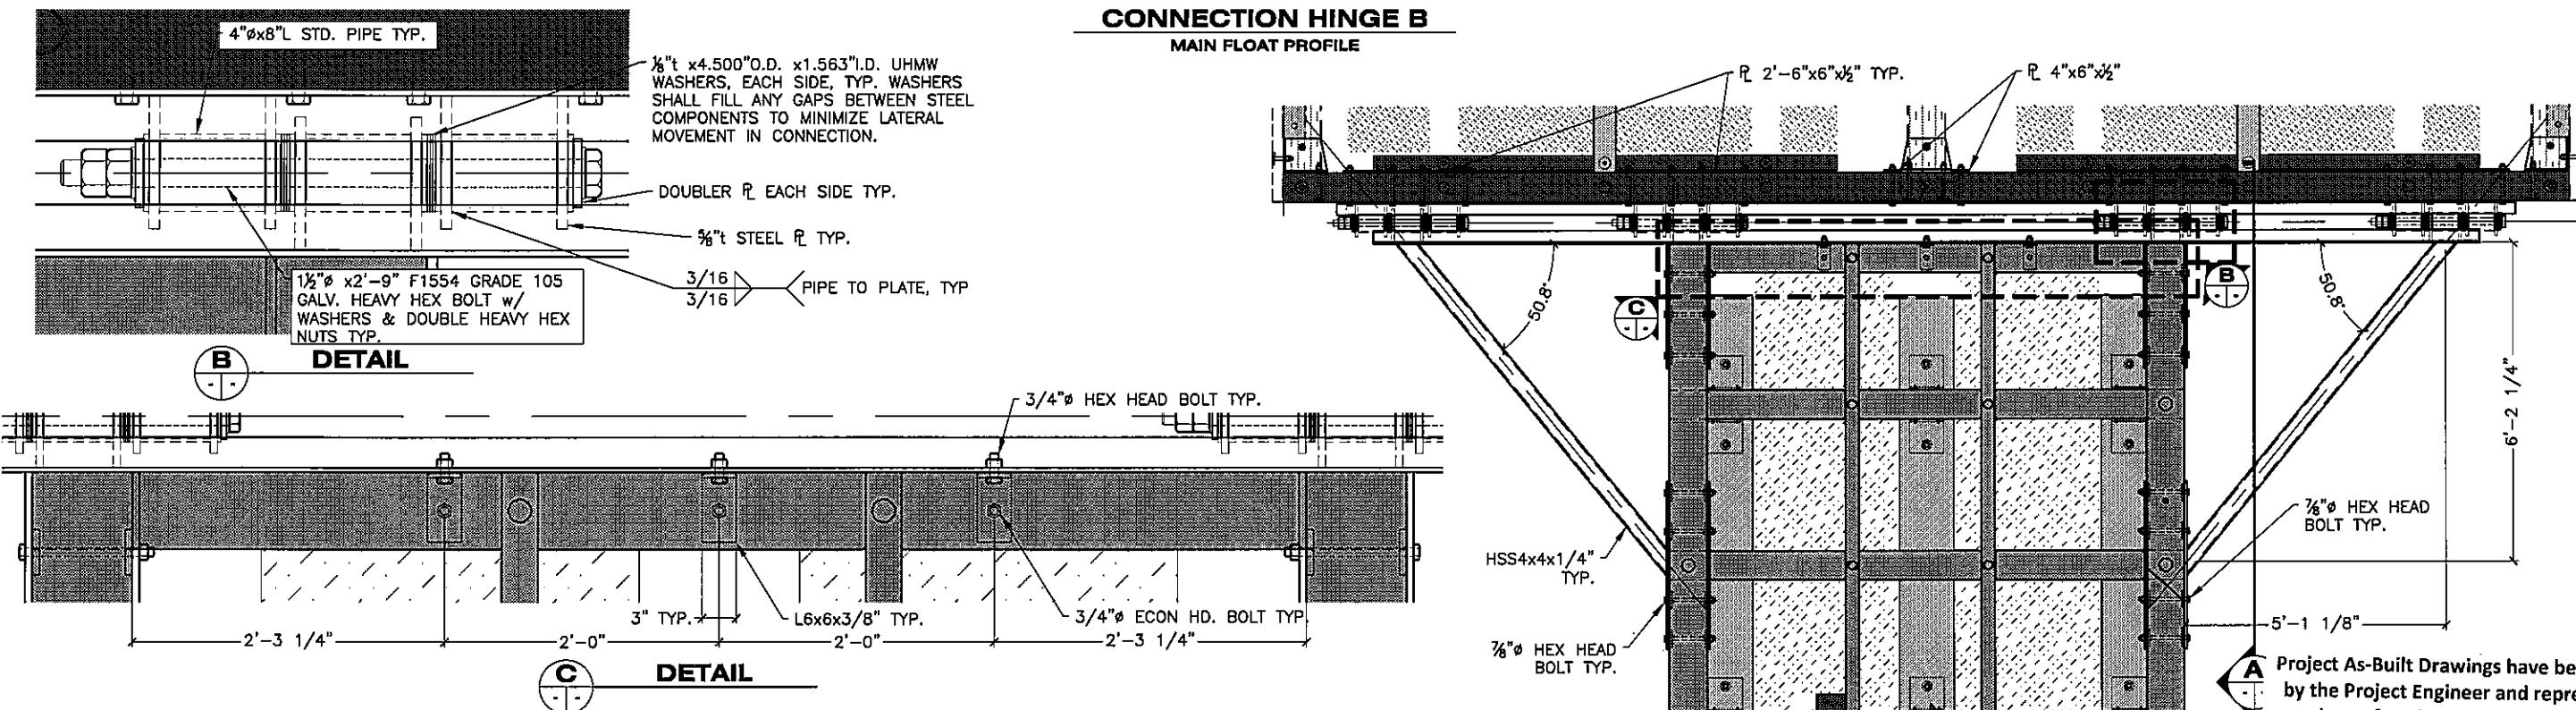

 Project As-Built Drawings have been reviewed by the Project Engineer and represent to the best of my knowledge the project as constructed.

## SEAPLANE FLOAT HINGE CONNECTION

**VIEW DESCRIPTION**

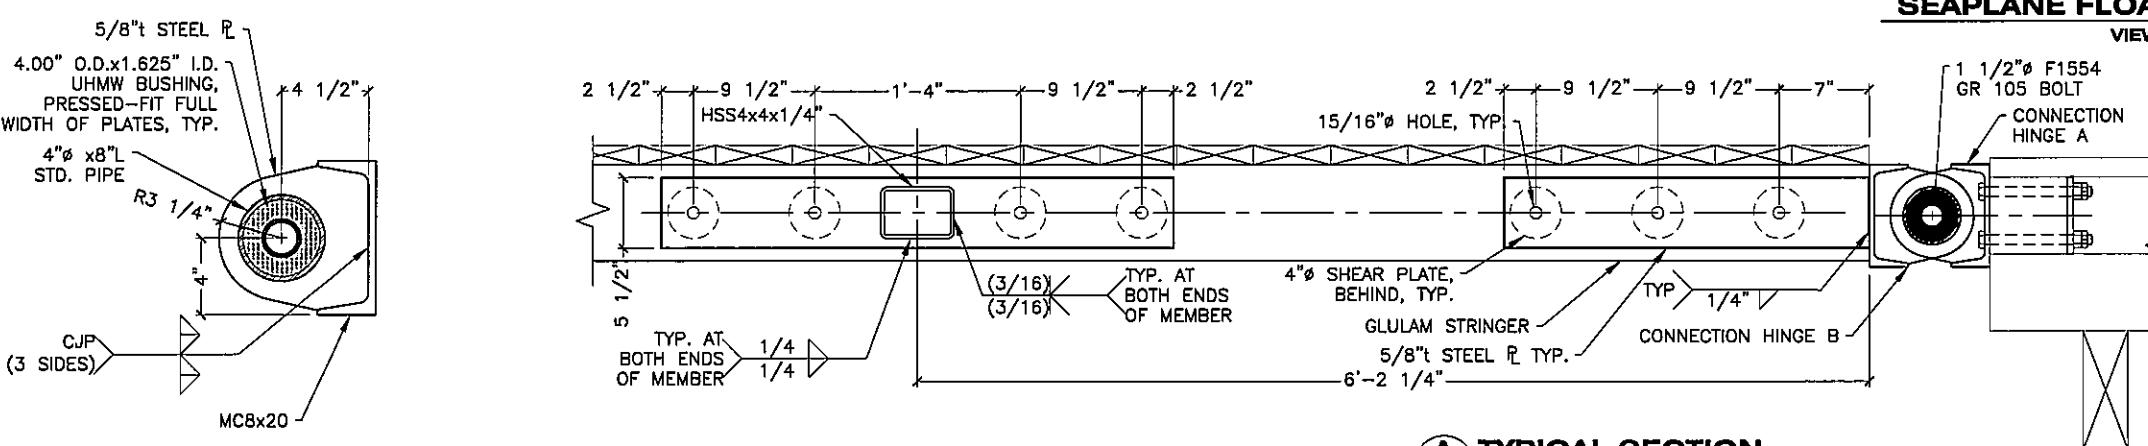



## **TYPICAL HINGE**

DO NOT SCALE FROM THESE DRAWINGS USE DIMENSIONS  
SIGNED BY: C. DUBOIS STATE OF ALASKA

STATE OF ALASKA  
DEPARTMENT OF TRANSPORTATION & PUBLIC FACILITIES

# PORT ALEXANDER OUTER HARBOR IMPROVEMENTS

## **SEAPLANE FLOAT HINGE**

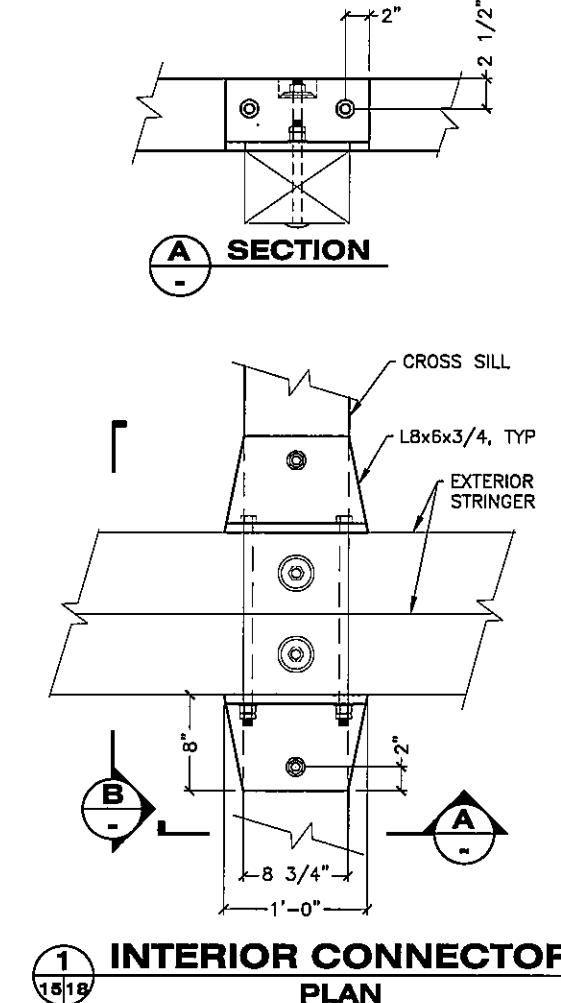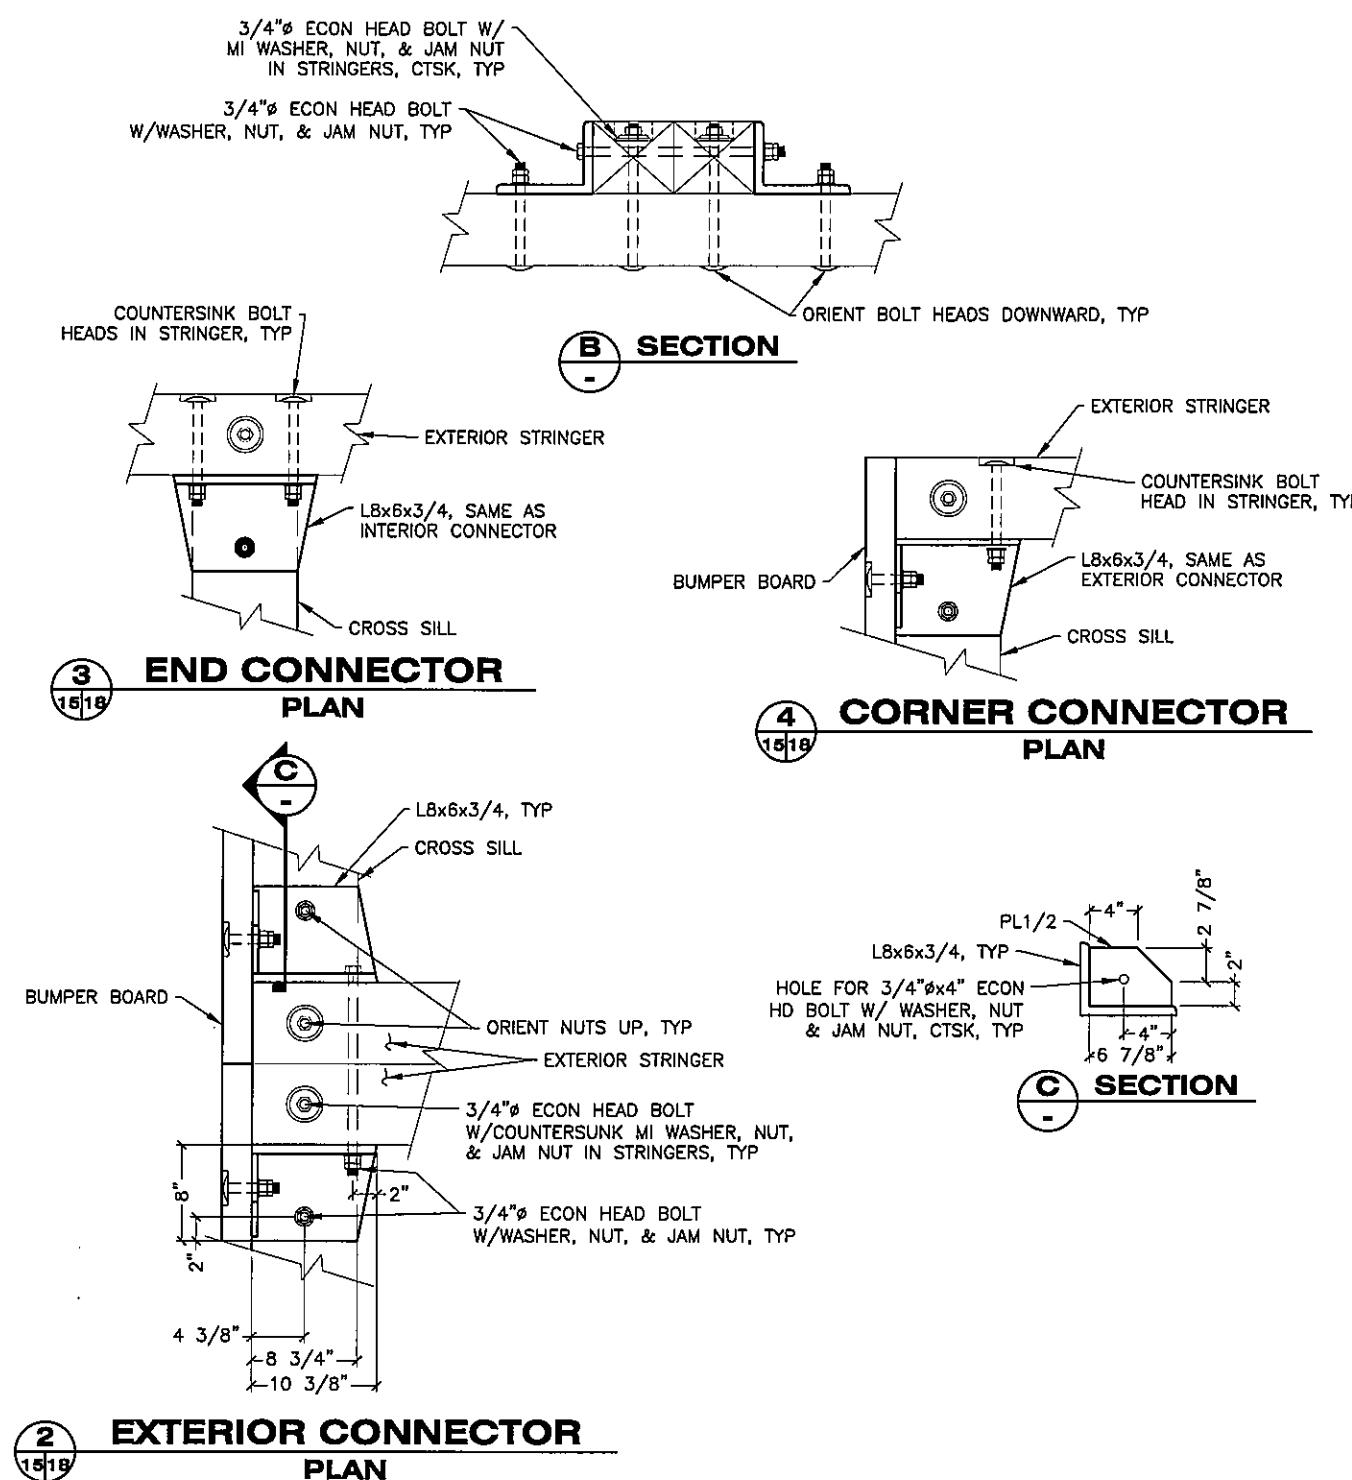


DO NOT SCALE FROM THESE DRAWINGS USE DIMENSIONS

DESIGNED BY: C. DUBOIS	STATE OF ALASKA 49th					
DAVID H. LOWELL CE-12614 REGISTERED PROFESSIONAL ENGINEER						
3/17/17						
CHECKED BY: D. LOWELL	STATE OF ALASKA 49th					
DRAWN BY: STAFF	DAVID H. LOWELL CE-12614 REGISTERED PROFESSIONAL ENGINEER					
PATH: Q:\SEA\83504\MF\PLANSET PORT ALEXANDER\FINAL\17, 18 - SEAPLANE FLOAT HINGE & CROSS						
TAB: 18						
REVISIONS						
NO.	DATE	DESCRIPTION	PROJECT DESIGNATION	YEAR	SHEET NO.	TOTAL SHEETS
		Z835040000		2017	18	23


Project As-Built Drawings have been reviewed  
by the Project Engineer and represent to the  
best of my knowledge the project as  
constructed.

PE *M. Edwards* Date *11/12/2017*

**PORT ALEXANDER  
OUTER HARBOR  
IMPROVEMENTS  
SEAPLANE FLOAT  
CROSS SILL  
CONNECTORS**

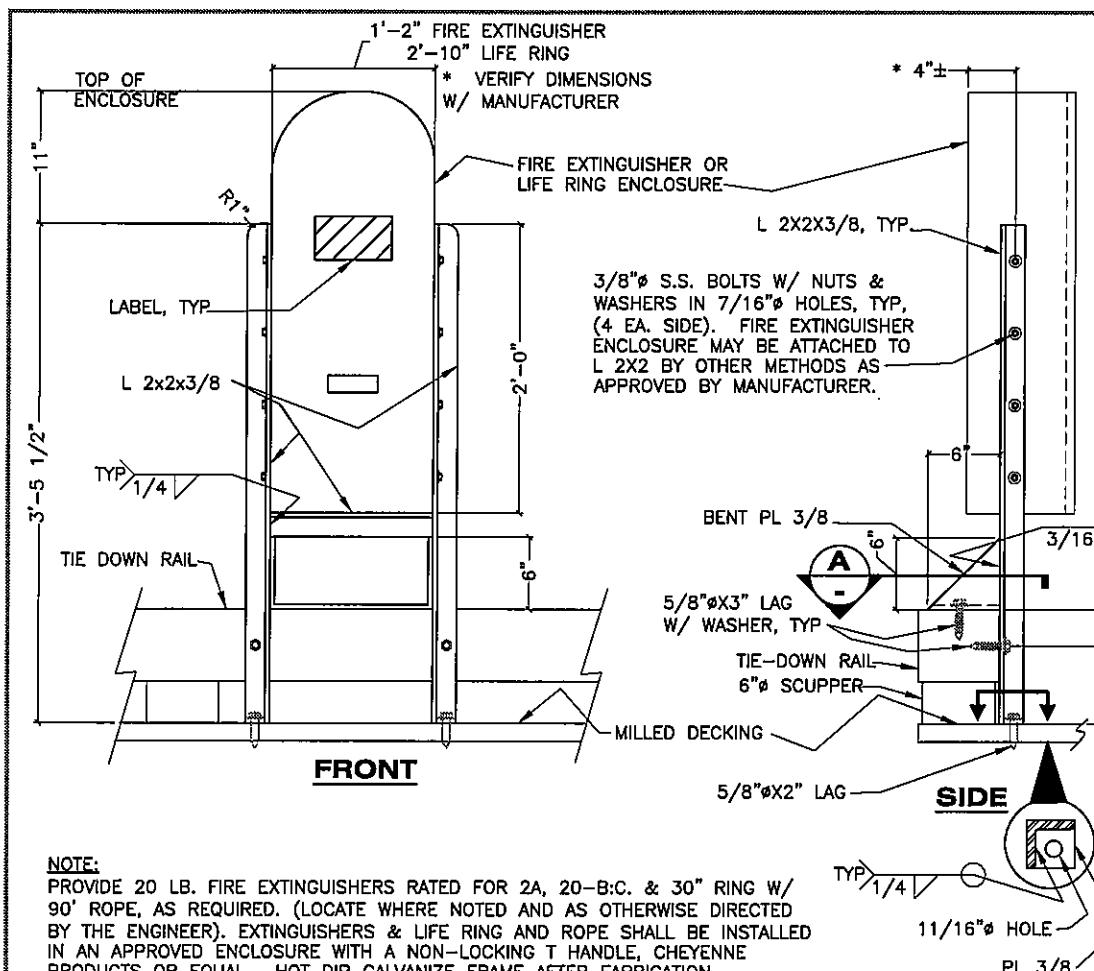


## **FIRE EXTINGUISHER/LIFE RING ENCLOSURE**

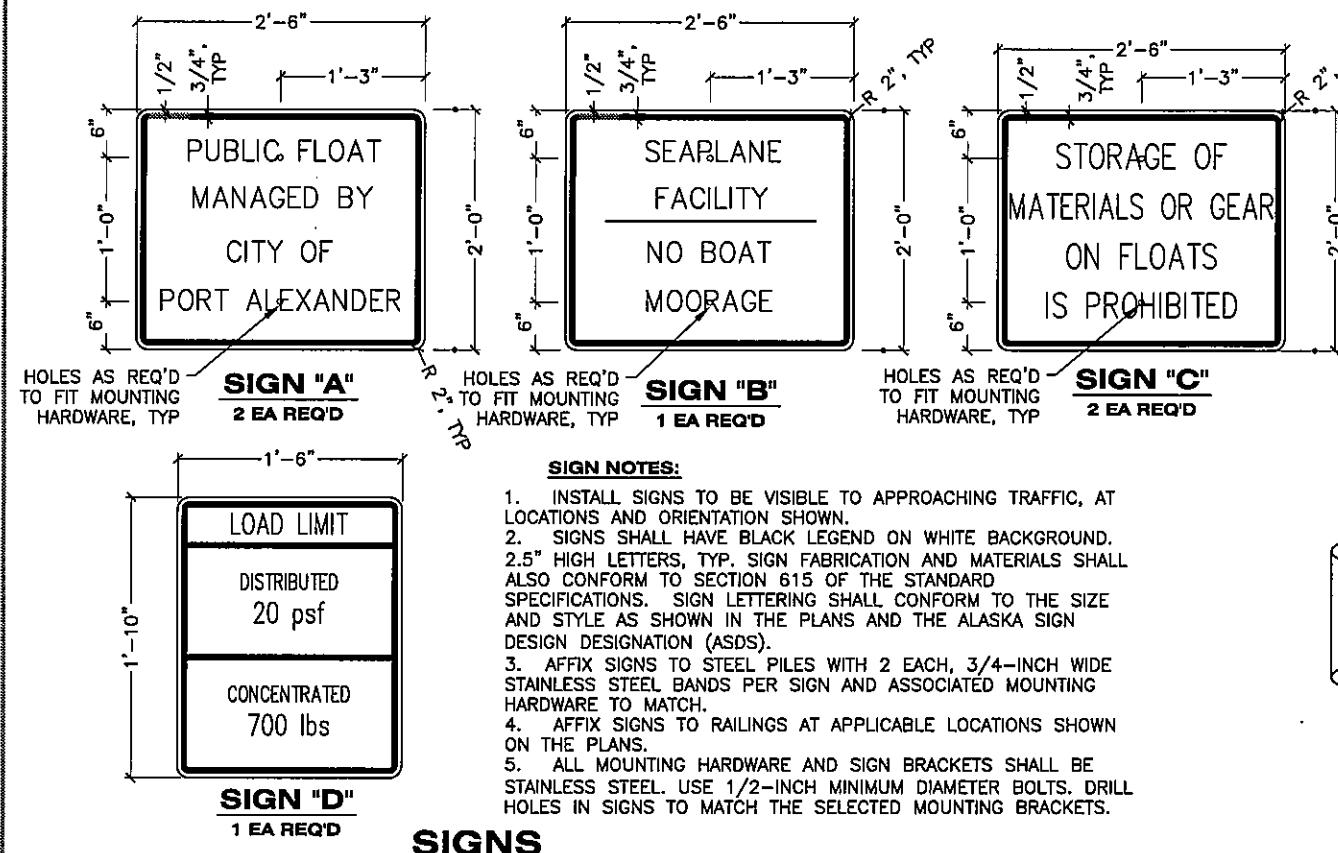


Project As-Built Drawings have been reviewed by the Project Engineer and represent to the best of my knowledge the project as constructed.


Date 11/12/2011

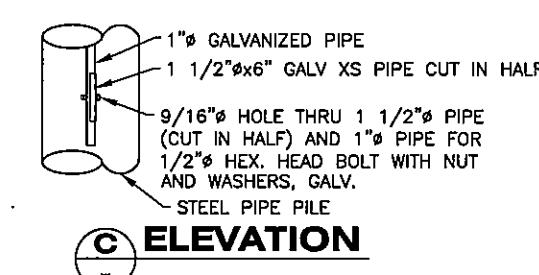

## STEEL PIPE TUBE

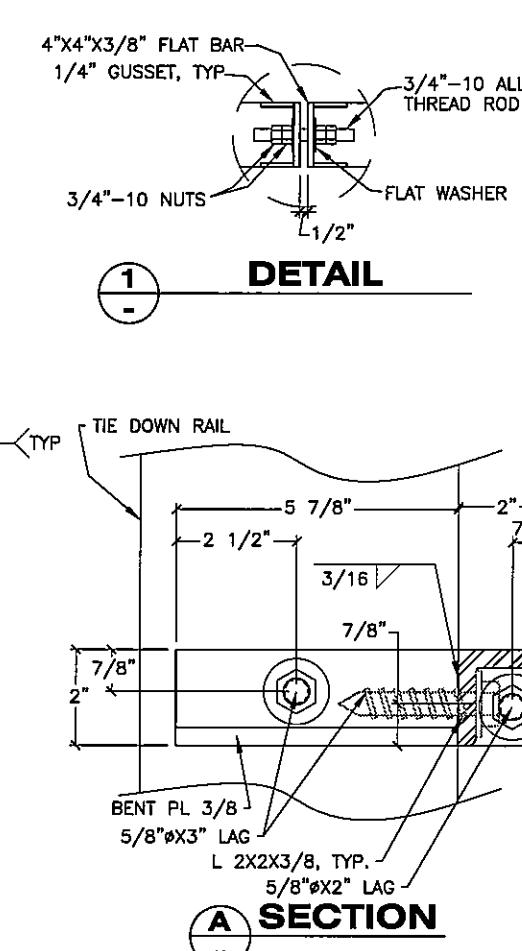


**A SECTION**

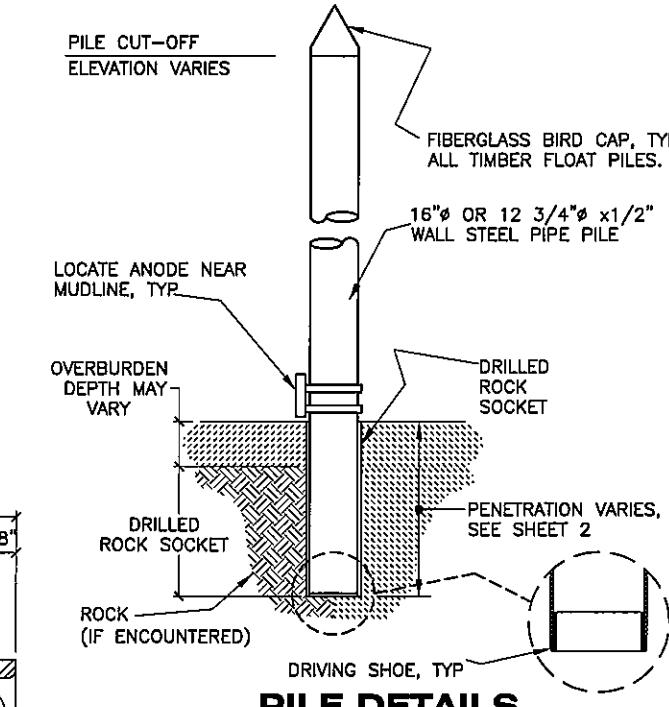

## PILE DETAILS


## PILE NOTES

1. DRIVE ALL PILES TO ESTIMATED TIP ELEVATION UNLESS OTHERWISE APPROVED BY THE ENGINEER. SEE SHEET 2 FOR ESTIMATED TIP, PILE CUTOFF ELEVATIONS AND PILE LENGTHS.
2. AT PILE LOCATIONS WHERE THE ESTIMATED TIP ELEVATION CANNOT BE ACHIEVED DUE TO REFUSAL ON ROCK, DRILL A ROCK SOCKET TO THE DEPTH OF THE ESTIMATED TIP ELEVATION. THE DRILLED ROCK SOCKET NEED NOT EXCEED A DEPTH OF GREATER THAN 10 FEET BELOW THE SURFACE OF THE ENCOUNTERED ROCK.

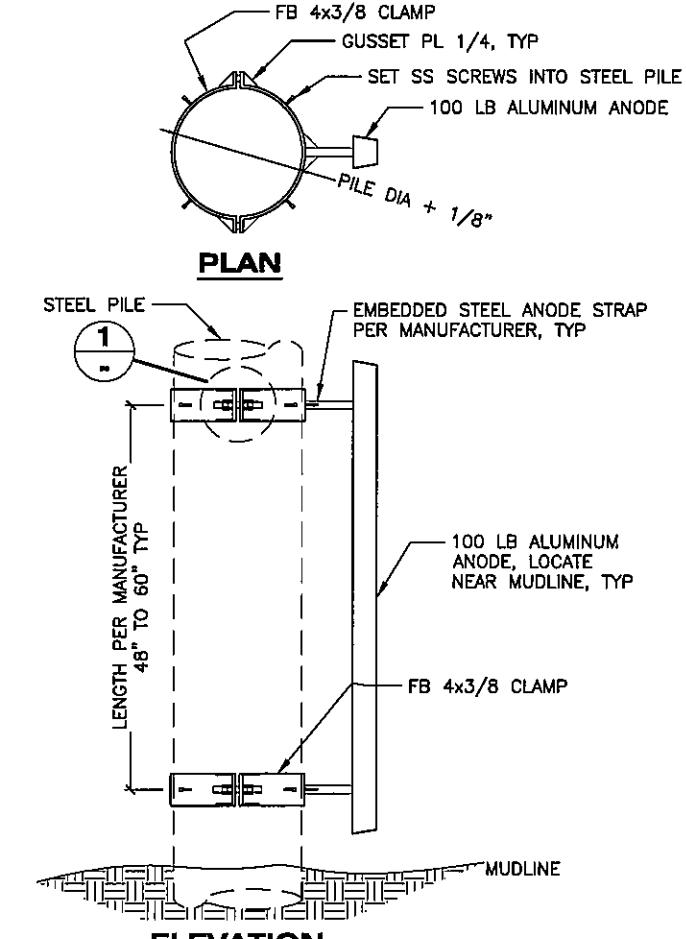


NOTE:  
ANODES MAY BE WELDED UNDERWATER TO PILE IN  
LIEU OF USING ANODE CLAMP.

## PILE ANODE

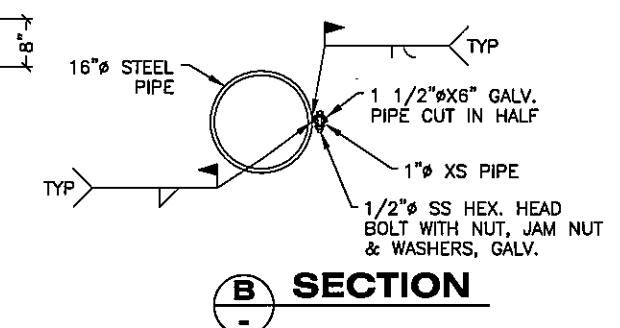

**B SECTION**

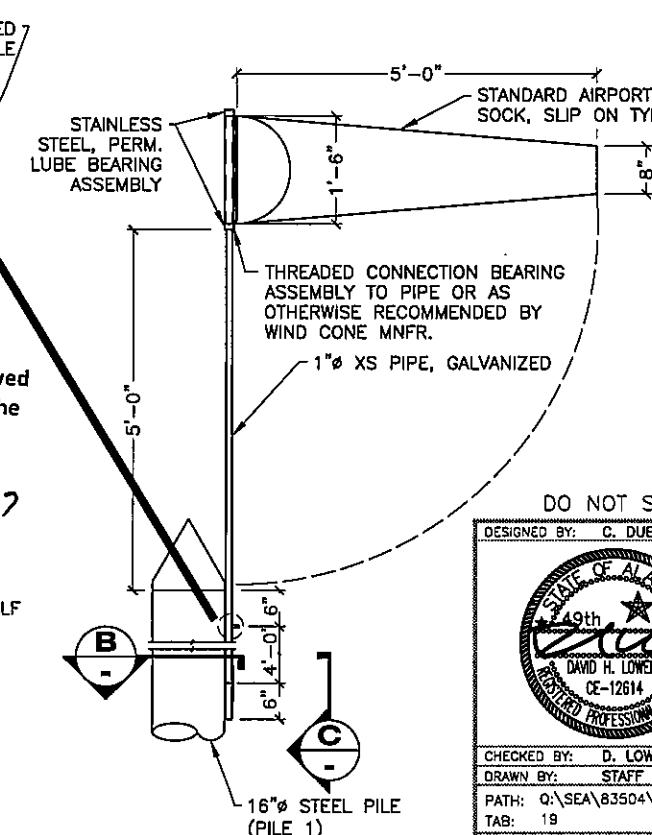

(FILE 1)


DO NOT SCALE FROM THESE DRAWINGS USE DIMENSIONS

STATE OF ALASKA  
DEPARTMENT OF TRANSPORTATION & PUBLIC FACILITIES  
SOUTHCOAST REGION

## PORT ALEXANDER OUTER HARBOR IMPROVEMENTS

## MISCELLANEOUS DETAILS


STATE OF ALASKA  
49th  
DAVID H. LOWELL, PE  
PE-12614  
REGISTERED PROFESSIONAL ENGINEER  
3/17

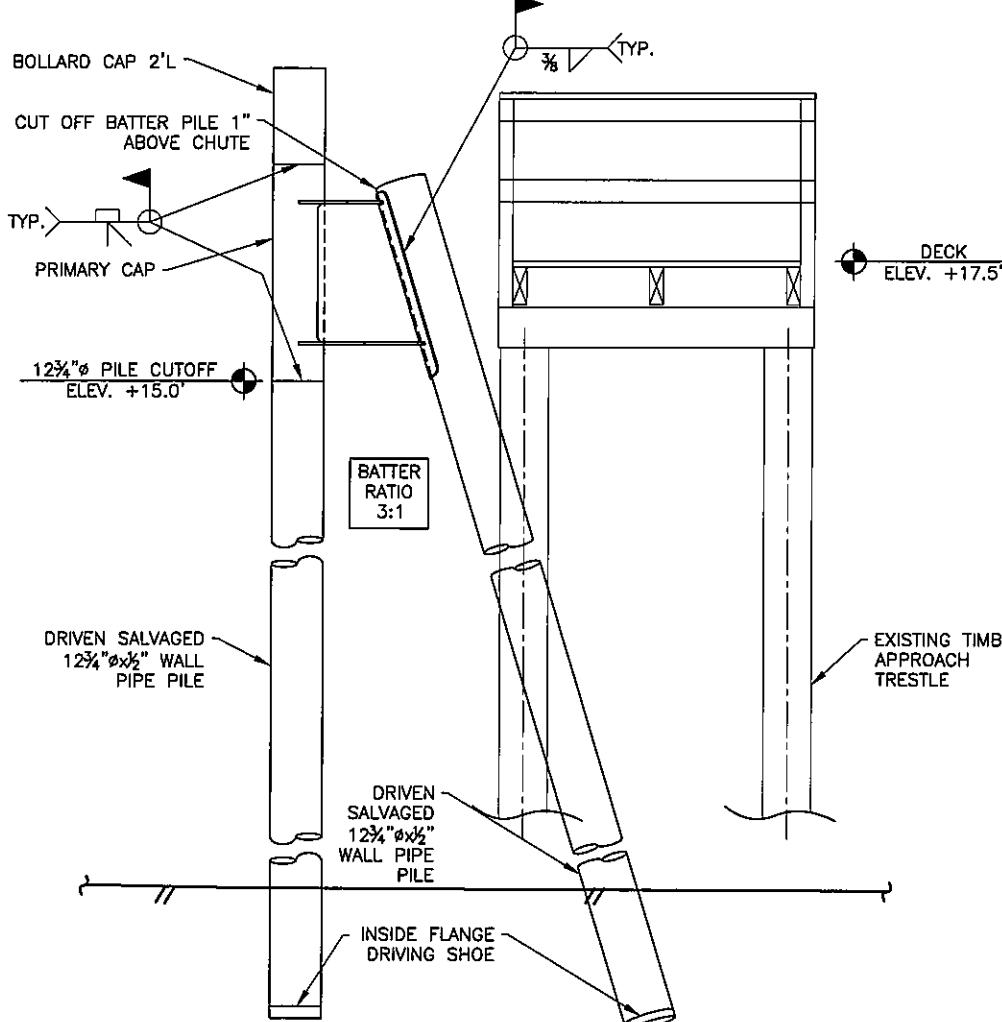


### SIDE ELEVATION

---

**DETAILS**

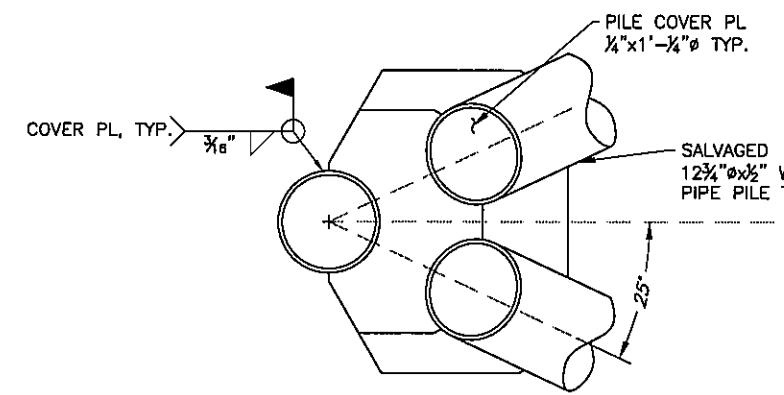


PLAN

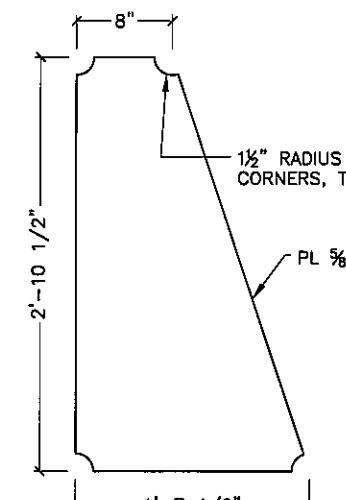


#### CHUTE WEI

**DETAILS**

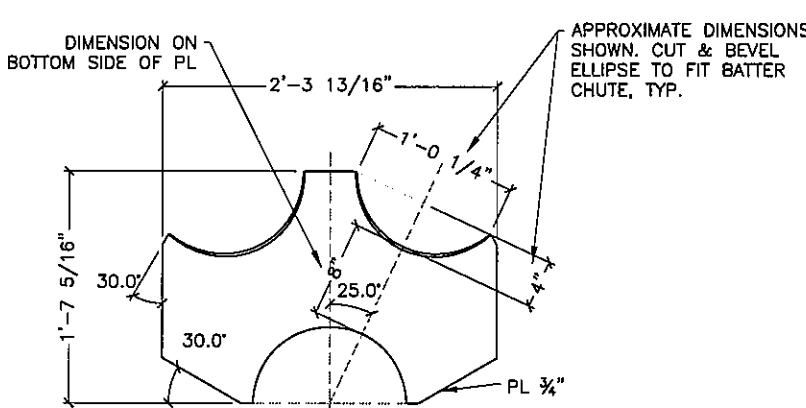

#### UPPER CHUTE FLANGE

**DETAILS**

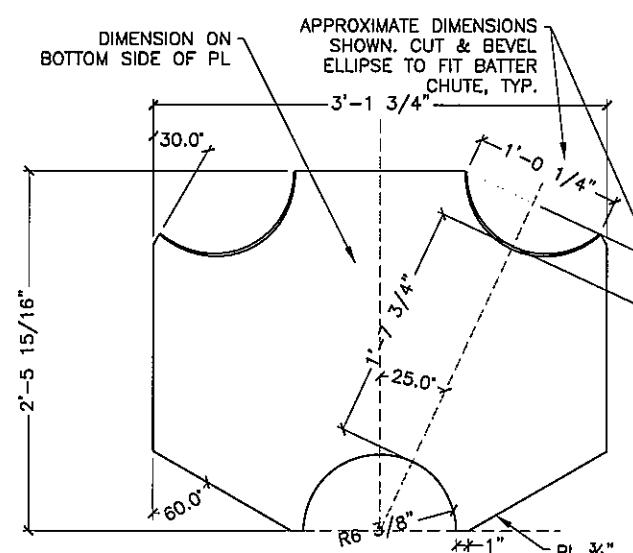



## LOWER CHUTE FLANGE

**OFFICE  
REPAIRS**



**Project As-Built Drawings have been reviewed  
by the Project Engineer and represent to the  
best of my knowledge the project as**

PE M. Edwards Date 15/02/2017

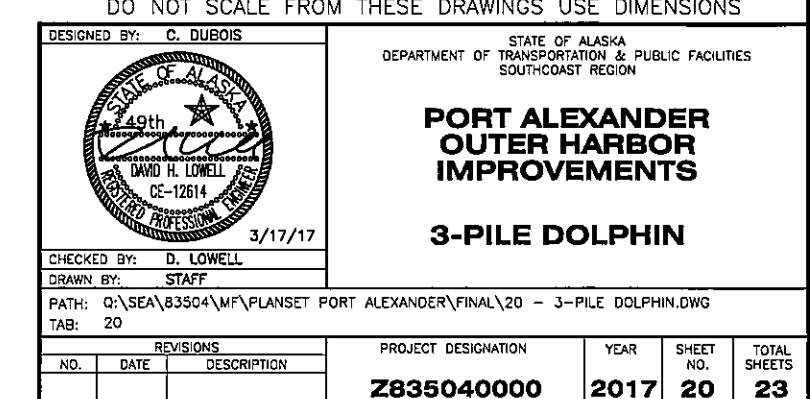

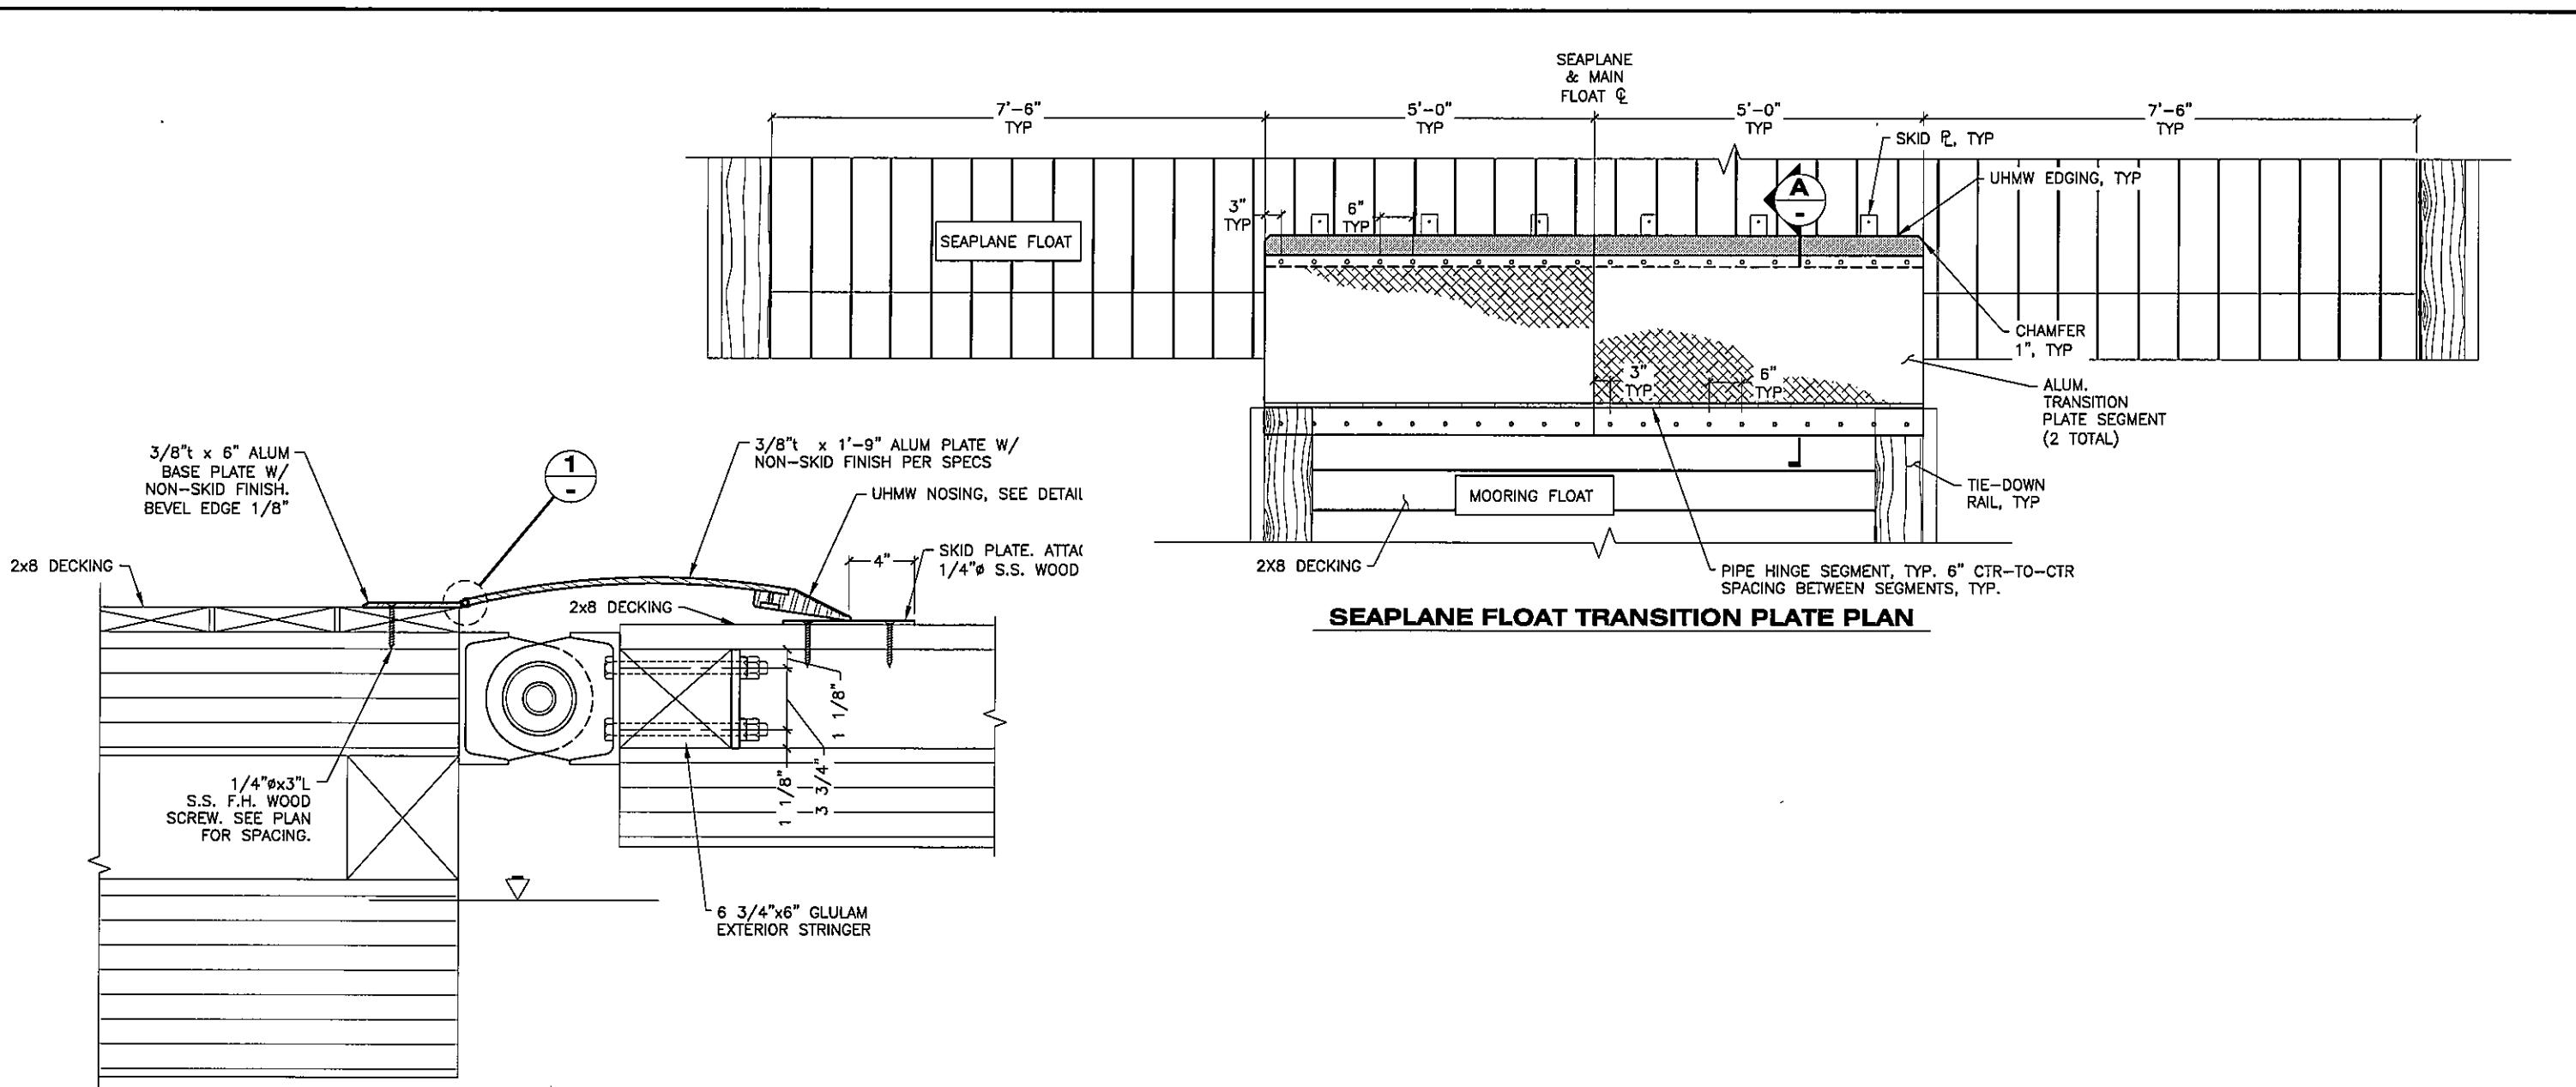

**A TRANSITION PLATE INSTALLED**  
ELEVATION

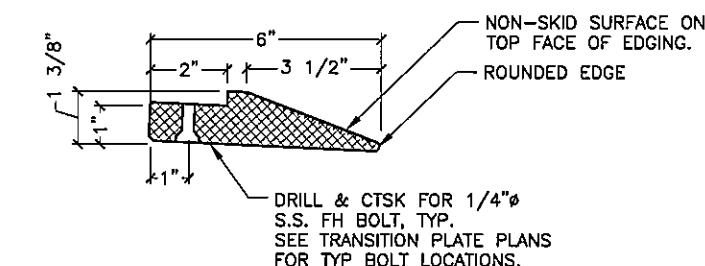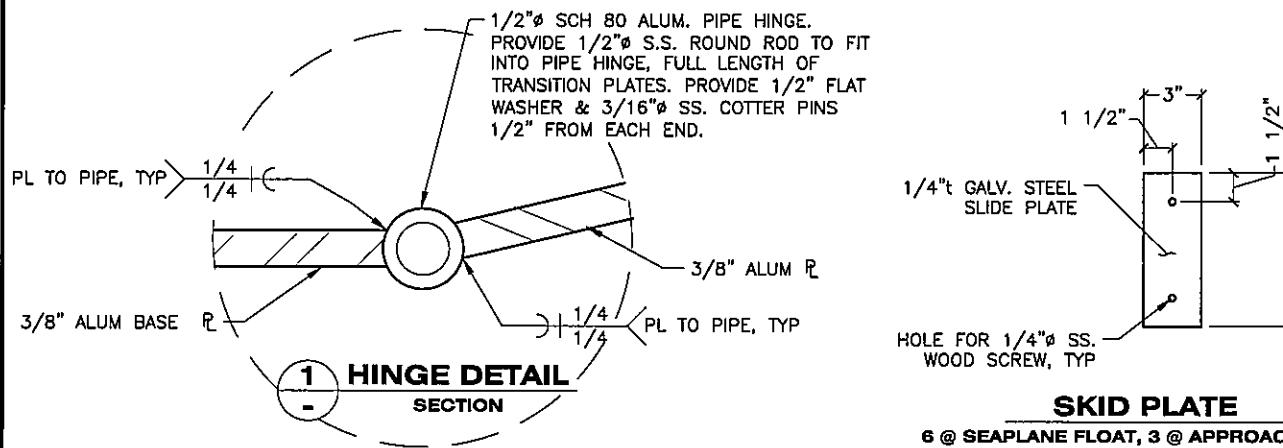


Project As-Built Drawings have been reviewed  
by the Project Engineer and represent to the  
best of my knowledge the project as  
constructed.


PE McDonald Date 11/13/2017

DO NOT SCALE FROM THESE DRAWINGS USE DIMENSIONS


DESIGNED BY: C. DUBOIS	STATE OF ALASKA DEPARTMENT OF TRANSPORTATION & PUBLIC FACILITIES SOUTHCOAST REGION														
 49th CE-12614 DAVID H. LOWELL REGISTERED PROFESSIONAL ENGINEER 3/17/17															
CHECKED BY: D. LOWELL	PORT ALEXANDER OUTER HARBOR IMPROVEMENTS														
DRAWN BY: STAFF	TRANSITION PLATE DETAILS														
PATH: Q:\SEA\83504\MF\PLANSET PORT ALEXANDER\FINAL\21 - TRANSITION PLATE DETAILS.DWG															
TAB: 21															
<table border="1"> <thead> <tr> <th colspan="3">REVISIONS</th> <th>PROJECT DESIGNATION</th> <th>YEAR</th> <th>SHEET NO.</th> <th>TOTAL SHEETS</th> </tr> </thead> <tbody> <tr> <td>NO.</td> <td>DATE</td> <td>DESCRIPTION</td> <td>Z835040000</td> <td>2017</td> <td>21</td> <td>23</td> </tr> </tbody> </table>		REVISIONS			PROJECT DESIGNATION	YEAR	SHEET NO.	TOTAL SHEETS	NO.	DATE	DESCRIPTION	Z835040000	2017	21	23
REVISIONS			PROJECT DESIGNATION	YEAR	SHEET NO.	TOTAL SHEETS									
NO.	DATE	DESCRIPTION	Z835040000	2017	21	23									

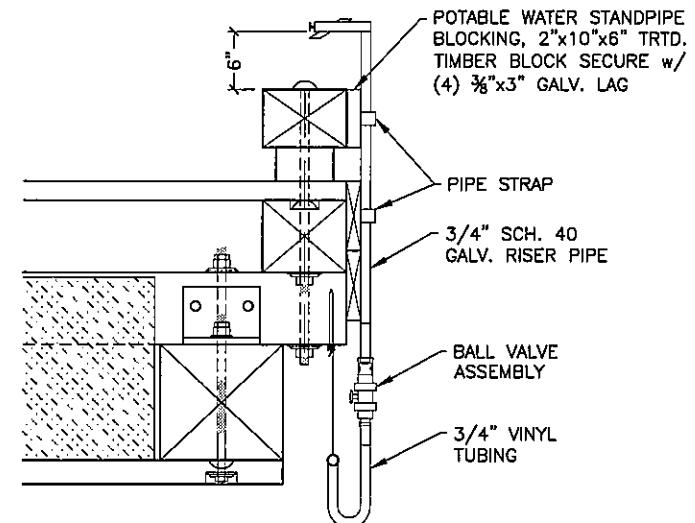


**TYPICAL SECTION**

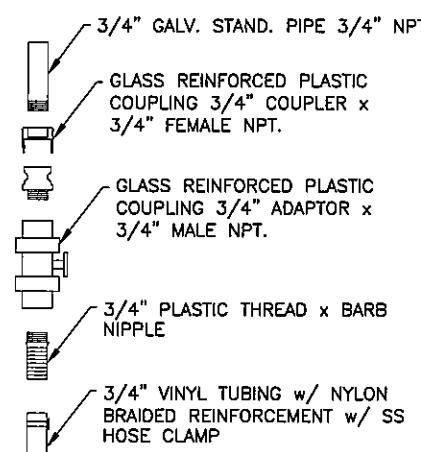


**BALL VALVE ASSEMBLY**

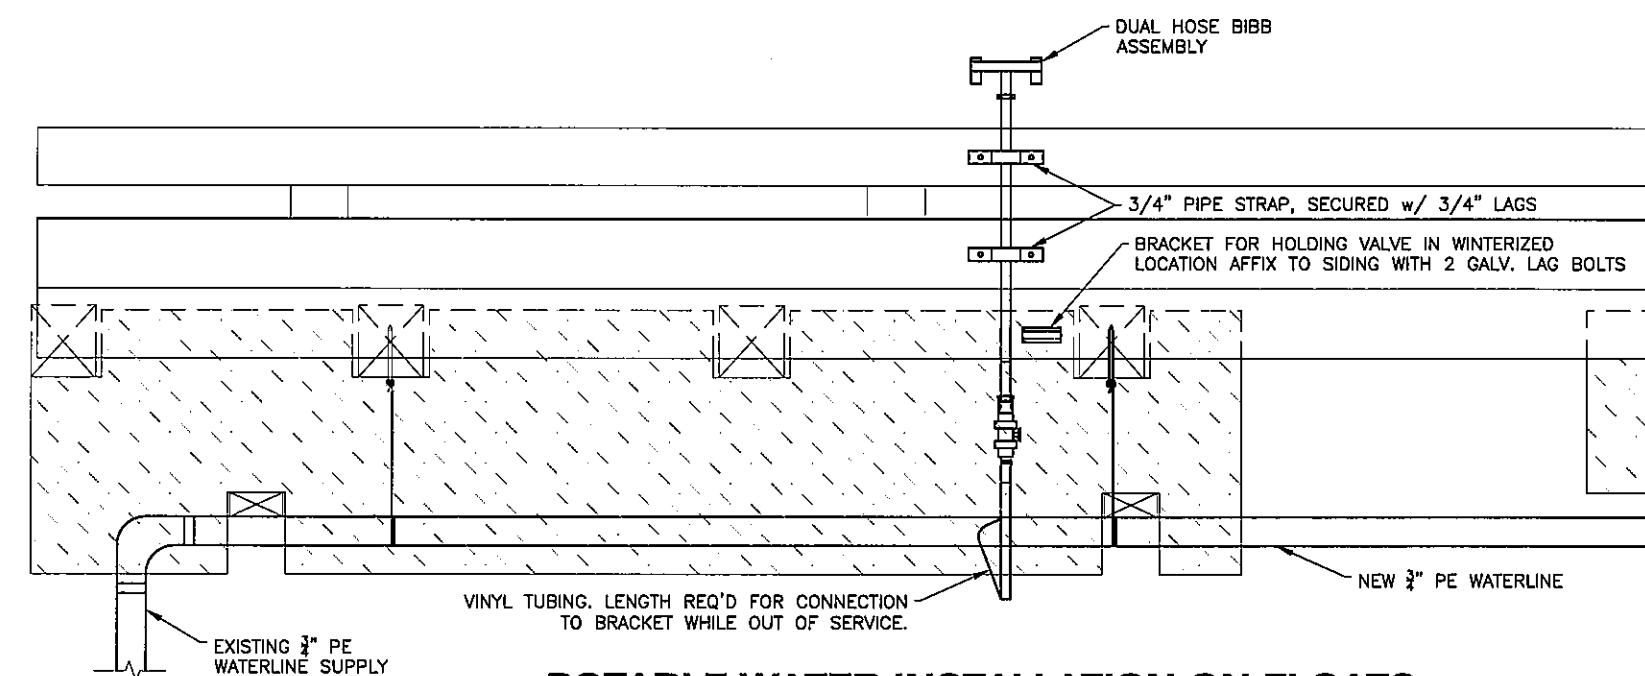

**POTABLE WATER INSTALLATION ON FLOATS**

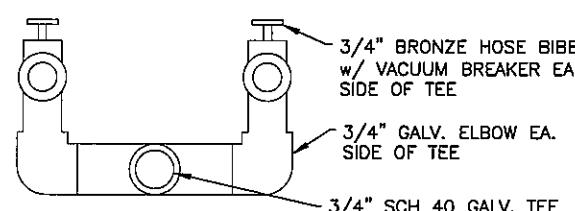


**DUAL HOSE BIB ASSEMBLY**

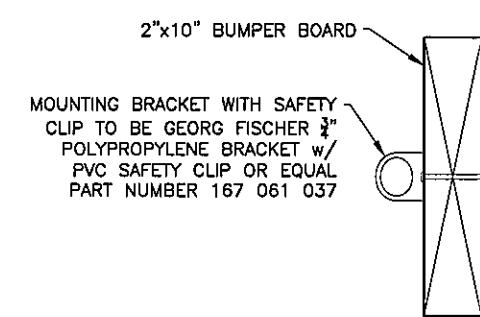



**TYP. HOLDING BRACKET CONNECTION**

Project As-Built Drawings have been reviewed by the Project Engineer and represent to the best of my knowledge the project as constructed.

PE *M. Edwards* Date *1/13/2017*

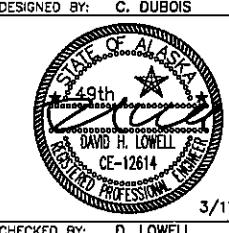DO NOT SCALE FROM THESE DRAWINGS USE DIMENSIONS		
DESIGNED BY: C. DUBOIS  STATE OF ALASKA DEPARTMENT OF TRANSPORTATION & PUBLIC FACILITIES SOUTHCOAST REGION		
<b>PORT ALEXANDER OUTER HARBOR IMPROVEMENTS</b>		
<b>WATERLINE DETAILS</b>		
PATH: Q:\SEA\83504\MF\PLANSET PORT ALEXANDER\FINAL\22 -WATERLINE DETAILS.DWG TAB: 22		
REVISIONS NO. DATE DESCRIPTION		
PROJECT DESIGNATION YEAR SHEET NO. TOTAL SHEETS Z835040000 2017 22 23		

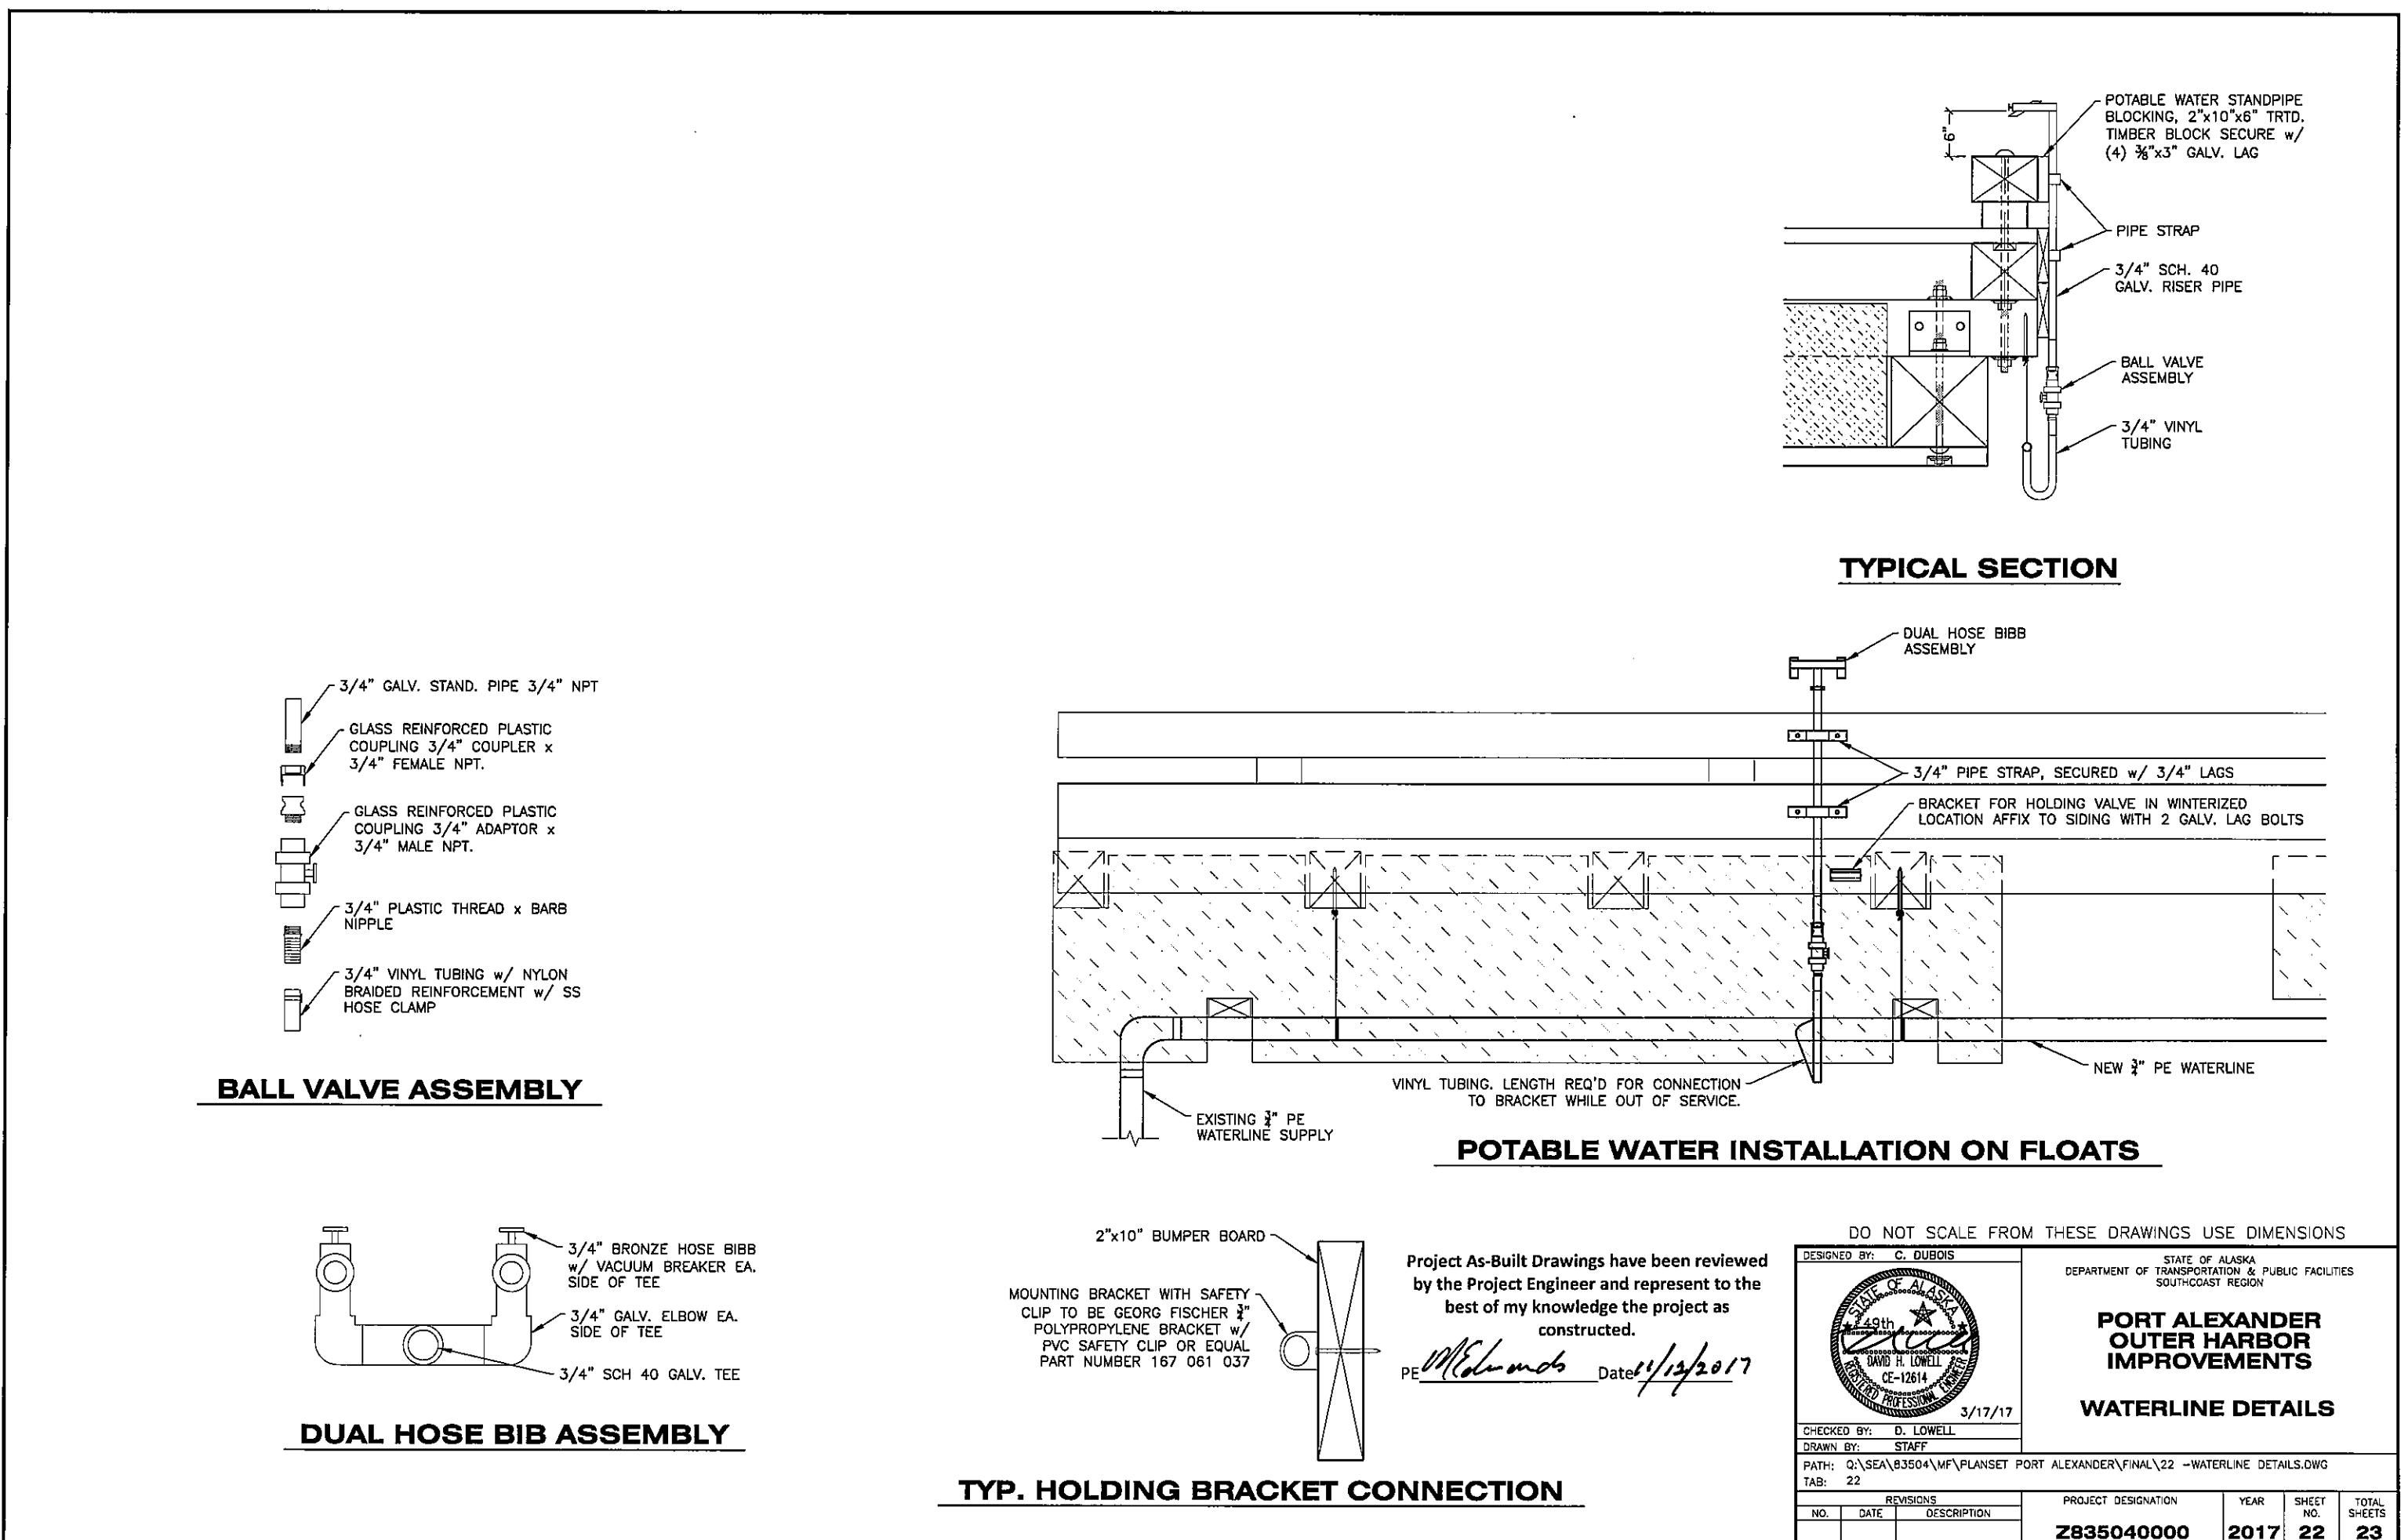

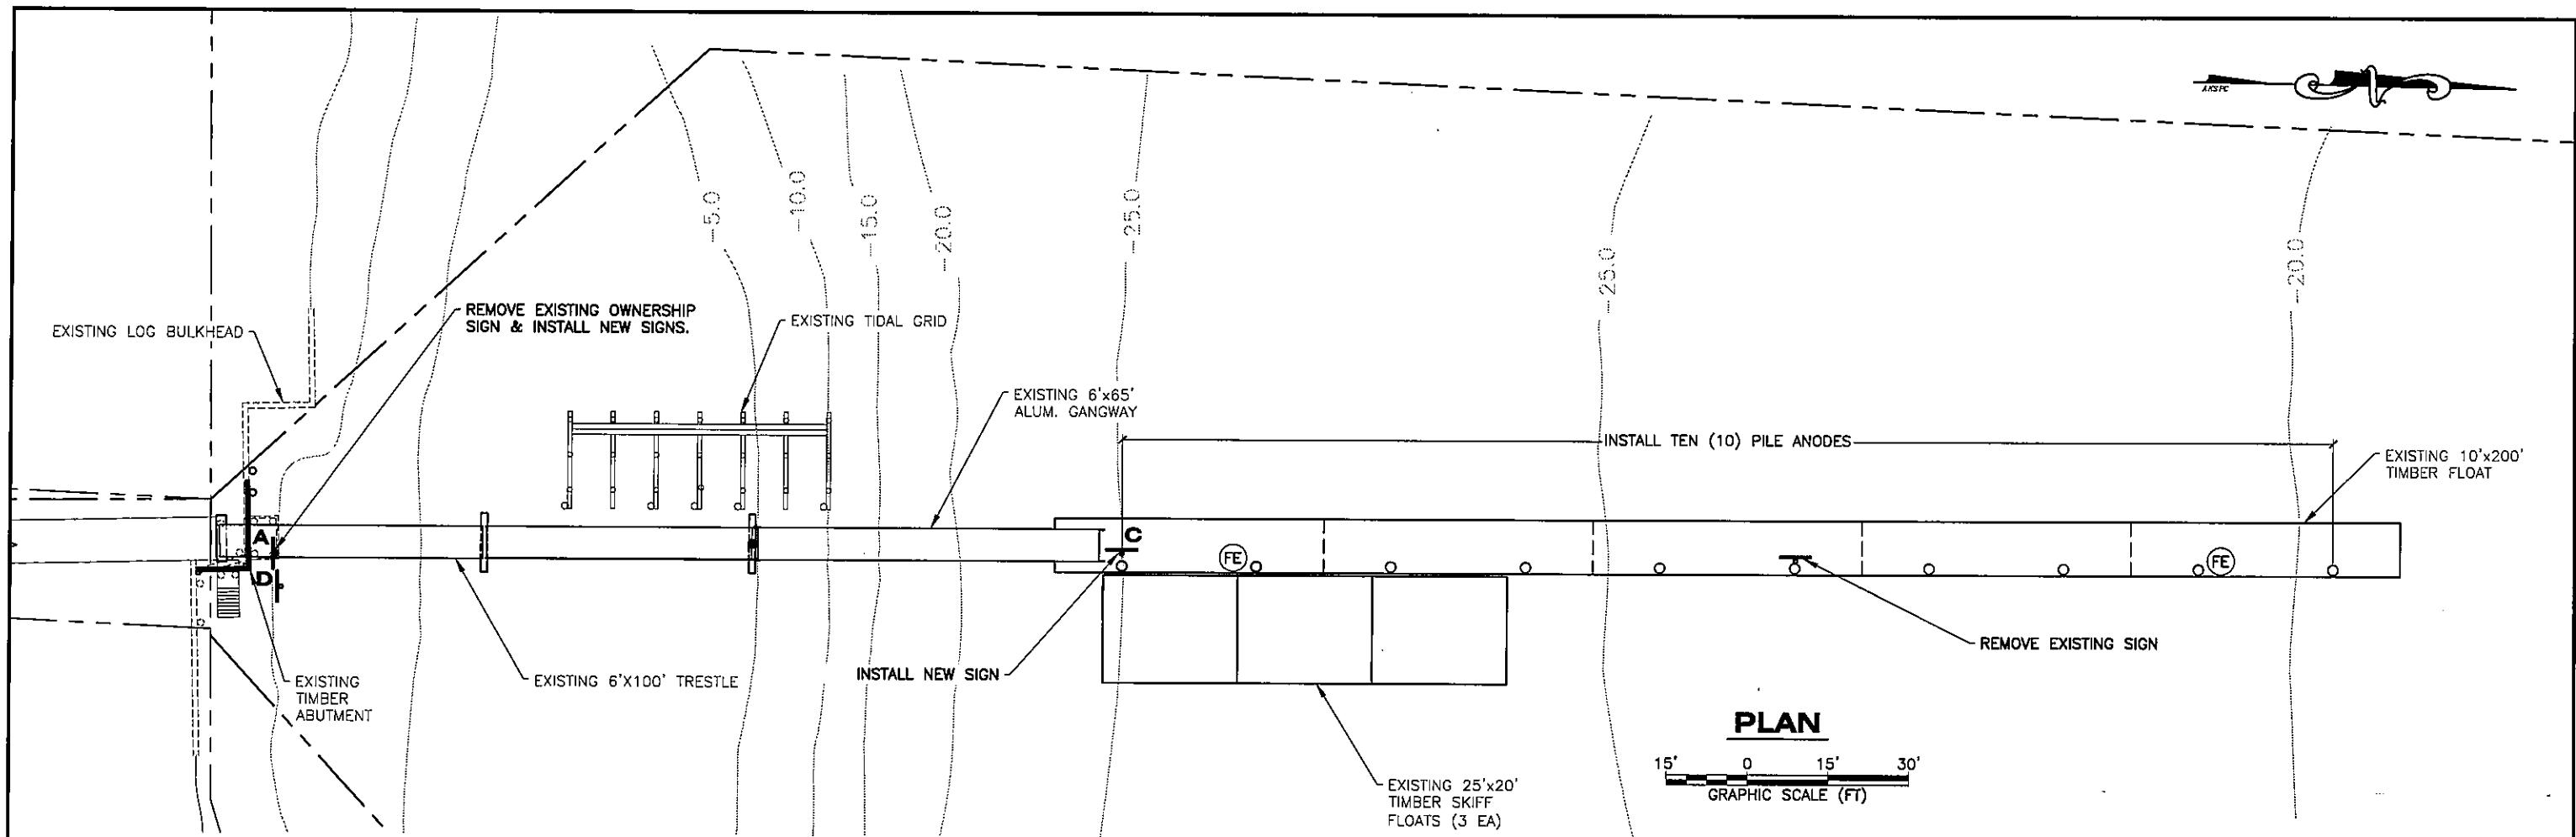

LEGEND:

- EXISTING PILE
- (LR) LIFE RING CABINET
- (FE) FIRE EXTINGUISHER CABINET
- PROPERTY LINE
- # SIGN LETTER
- # FACE OF SIGN

**NOTES:**

1. REMOVE EXISTING SIGNS, PROVIDE TO CITY OF PORT ALEXANDER.
2. INSTALL NEW SIGNS AT LOCATION SHOWN.
3. SALVAGE EXISTING ANODES OFF THE BOTTOM. EXISTING ANODES NO LONGER SECURE TO PILING.

DO NOT SCALE FROM THESE DRAWINGS USE DIMENSIONS

DESIGNED BY: C. DUBOIS	STATE OF ALASKA DEPARTMENT OF TRANSPORTATION & PUBLIC FACILITIES SOUTHCOST REGION									
 49th DAVID H. LOWELL CE-12614 REGISTERED PROFESSIONAL ENGINEER										
3/17/17										
CHECKED BY: D. LOWELL										
DRAWN BY: STAFF										
PATH: Q:\SEA\83504\MF\PLANSET PORT ALEXANDER\FINAL\23 - INNER HARBOR WORK.DWG										
TAB: 23										
<table border="1"> <thead> <tr> <th colspan="3">REVISIONS</th> </tr> <tr> <th>NO.</th> <th>DATE</th> <th>DESCRIPTION</th> </tr> </thead> <tbody> <tr> <td></td> <td></td> <td></td> </tr> </tbody> </table>		REVISIONS			NO.	DATE	DESCRIPTION			
REVISIONS										
NO.	DATE	DESCRIPTION								
PROJECT DESIGNATION										
YEAR										
SHEET NO.										
TOTAL SHEETS										

**PORT ALEXANDER  
OUTER HARBOR  
IMPROVEMENTS**

**INNER HARBOR WORK**

PE *M. Edwards* Date *11/12/2017*