




PATH: C:\USERS\MRS.JOROOS\ONEEDRIVE - STATE OF ALASKA\DESKTOP\BACKUP FOLDER\MIKE\WORK\DAVID EPSTEIN\SFAP\T0270\MET\_SITE\_PLAN\_CSD\_ASBUILT 4.4.23\_MS\_ALP\_02.01.2024.DWG

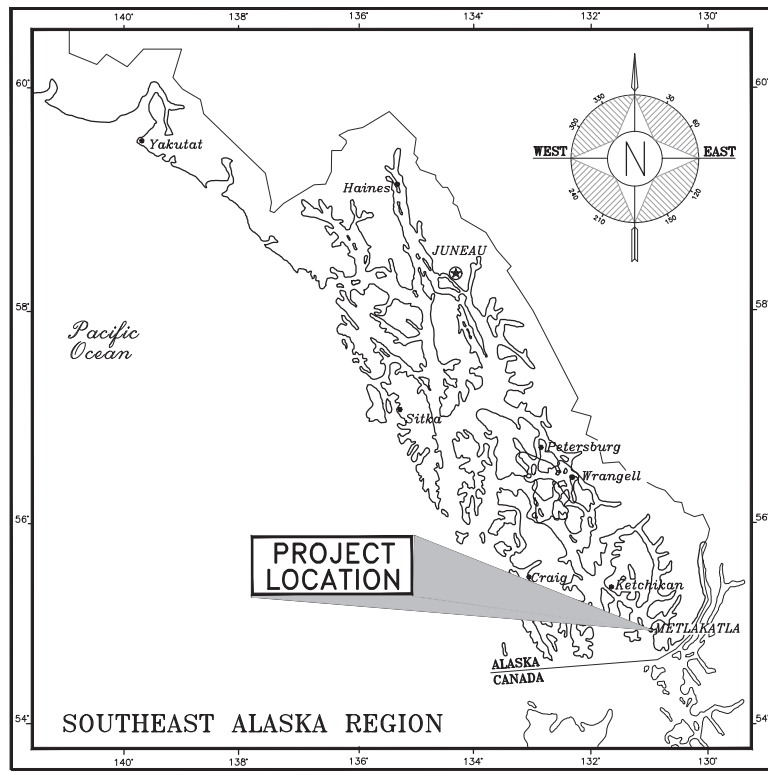

LOCATION MAP

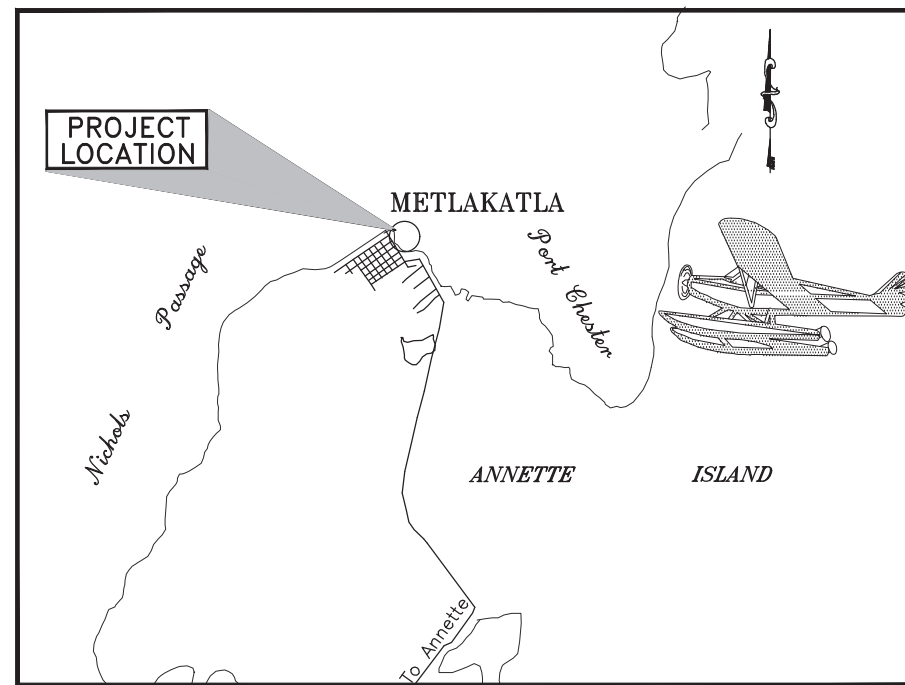

VICINITY MAP

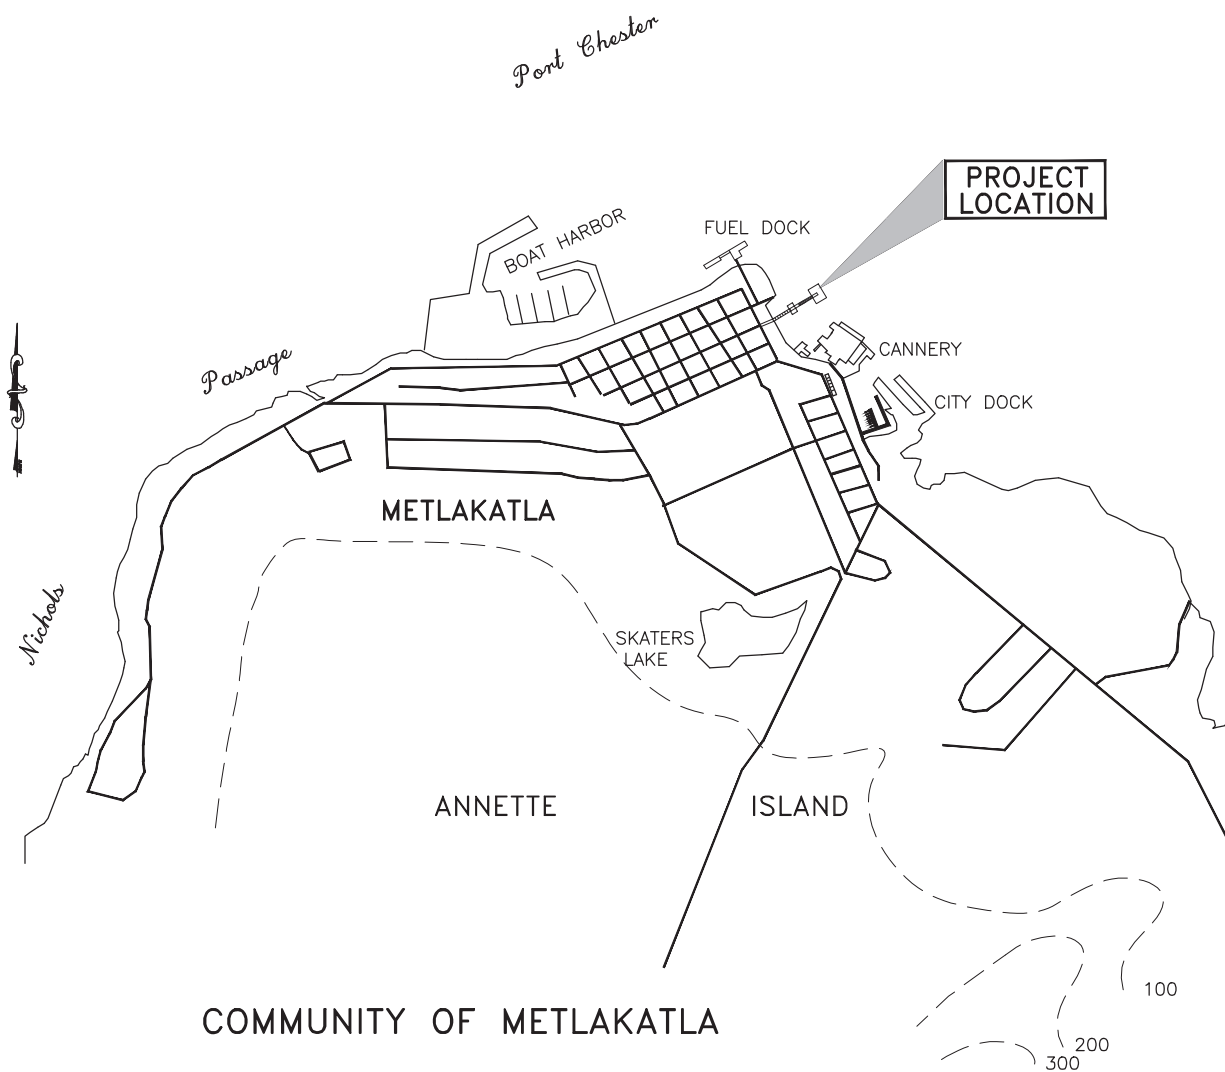

COMMUNITY OF METLAKATLA

**AIRPORT DATA**

2. NO DATA AVAILABLE FOR COMPILATION OF A WIND ROSE,
3. PREVAILING WINDS ARE FROM THE SOUTHEAST.
4. TEMPERATURE: MEAN DAILY MAX. TEMP. FOR HOTTEST MONTH= 64° F
5. TIDAL DATUM:

EXTREME HIGH WATER	=	19.5
HIGHEST TIDE (EST.)	=	18.7
MEAN HIGHER HIGH WATER	=	14.6
MEAN HIGH WATER	=	13.7
MEAN LOW WATER	=	7.6
MEAN LOWER LOW WATER	=	0.0
LOWEST TIDE (EST.)	=	-4.5

6. SEAPLANE FACILITY LOCATION – 55° 07' 50.788880" N. LAT.  
131° 34' 27.49755" W. LONG.

**NOTES:**

1. THIS DRAWING HAS BEEN COMPILED FROM U.S. SURVEY NO. 1807 (CRM T 78S-R 92 E)
2. LATITUDE AND LONGITUDE ARE IN ACCORDANCE WITH NORTH AMERICAN DATUM 1983 (NAD 83).
3. CONTOUR LINES HAVE BEEN COMPILED FROM PREVIOUS PROJECT RECORDS AND ARE APPROXIMATE.

AIRPORT LAYOUT PLAN APPROVED  
 By: *Laurie June H.*  
 FAA AIRPORTS DIVISION  
 ALASKA REGION, AAL-600  
 DATE: 2/22/25

**As-Built ALP Accepted**

JENELLE RENE  
 BRINKMAN  
 Digitally signed by JENELLE RENE BRINKMAN  
 Date: 2025.06.05 16:54:39 -08'00'

NO.	DATE	REVISION
1	2/1/24	ADDED SECOND PAGE
2	2/20/25	UPDATED AIRPORT DATA #6

STATE OF ALASKA  
 DEPARTMENT OF TRANSPORTATION  
 AND PUBLIC FACILITIES  
 S.E. REGION, DESIGN & CONSTRUCTION


METLAKATLA SEAPLANE FACILITY  
 PROJECT NO. 70641

**AIRPORT LAYOUT PLAN**

APPROVED BY: *Andy Hughes* 10-20-25  
 MIKE LAKOVIC CHIEF OF PLANNING


SCALE: AS SHOWN  
 DESIGNED: [ ]  
 CHECKED: [ ]  
 DRAWN: [ ]  
 DATE: [ ]  
 SHEET 1 of 2

PATH: C:\USERS\MRSJOROOS\ONEEDRIVE - STATE OF ALASKA\DESKTOP\BACKUP FOLDER\MIKE\WORK\DAVID EPSTEIN\SFAPT00270\MET\_SITE PLAN\_CSD ASBUILT 4.4.23\_MS\_ALP\_02.01.2024.DWG

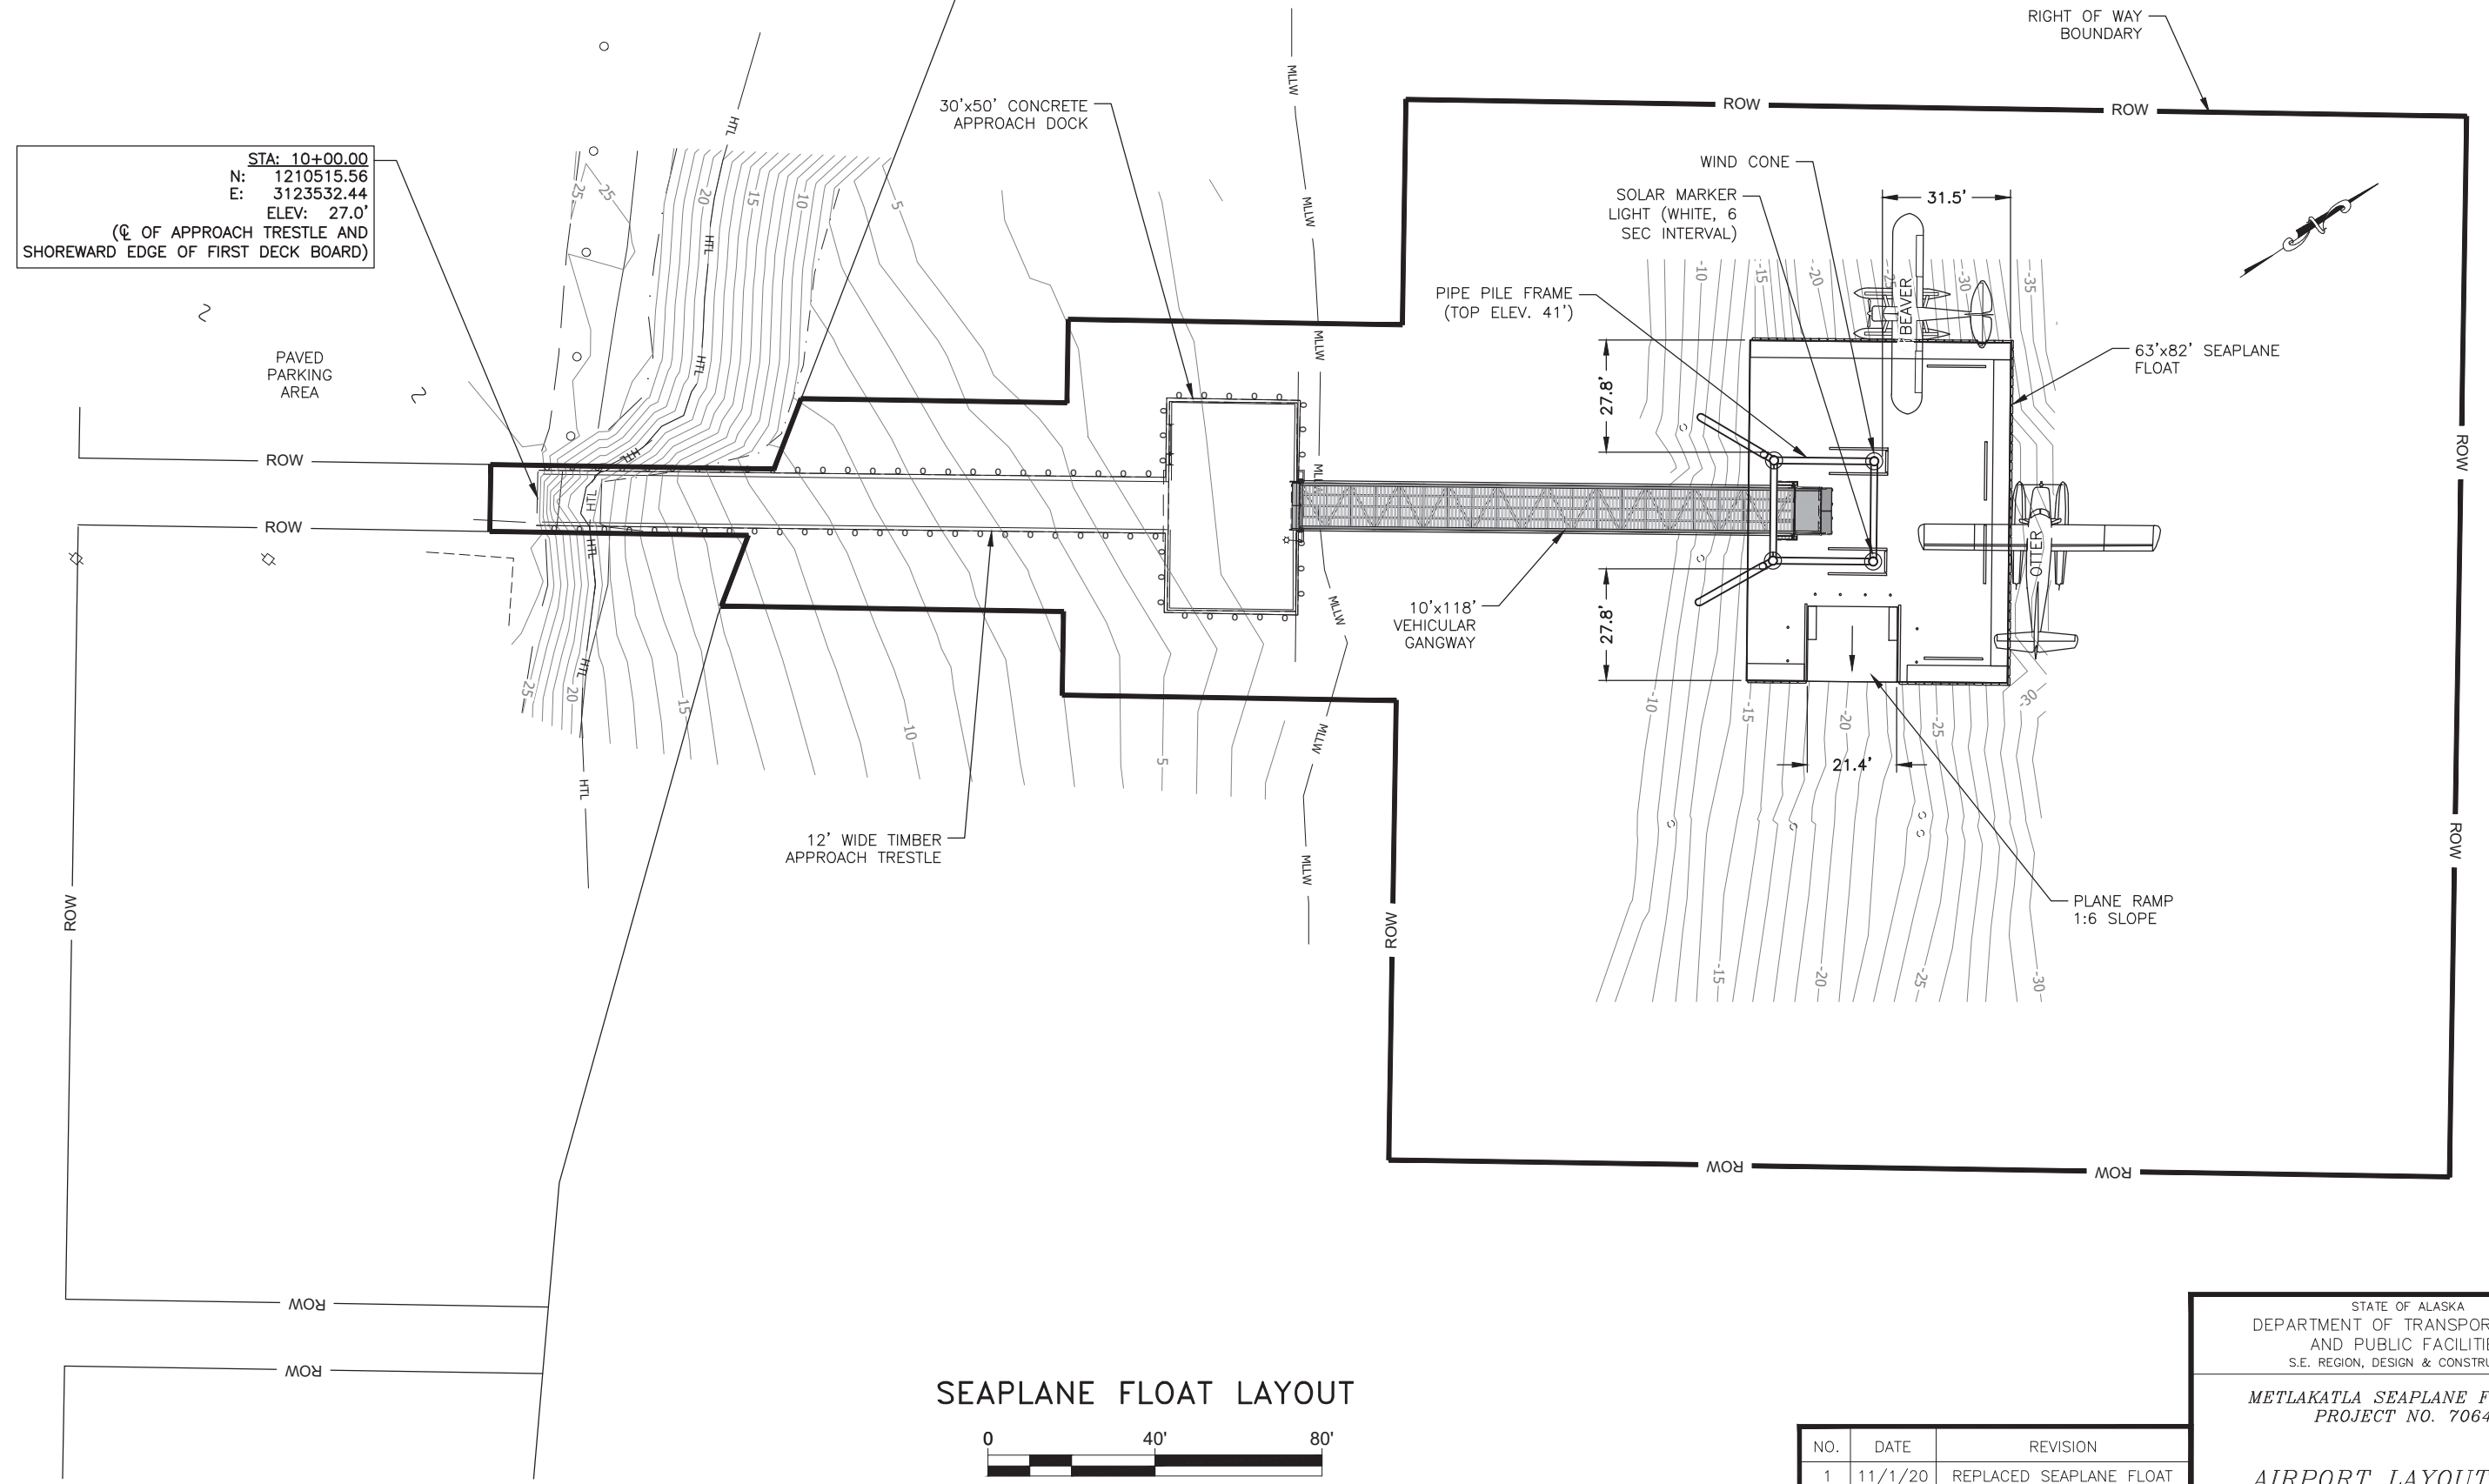

STA: 10+00.00  
 N: 1210515.56  
 E: 3123532.44  
 ELEV: 27.0'  
 (☉ OF APPROACH TRESTLE AND SHOREWARD EDGE OF FIRST DECK BOARD)

### SEAPLANE FLOAT LAYOUT

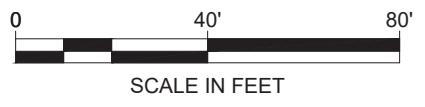

NO.	DATE	REVISION
1	11/1/20	REPLACED SEAPLANE FLOAT
2	2/1/24	REVISED FLOAT & GANGWAY
		DIMENSIONS

STATE OF ALASKA  
 DEPARTMENT OF TRANSPORTATION  
 AND PUBLIC FACILITIES  
 S.E. REGION, DESIGN & CONSTRUCTION

**METLAKATLA SEAPLANE FACILITY**  
 PROJECT NO. 70641

**AIRPORT LAYOUT PLAN**

APPROVED BY: *MIKE MCKINNON* CHIEF OF PLANNING  
DESIGNED DRAWN  
CHECKED DATE

SCALE AS SHOWN SHEET 2 OF 2



U.S. Department  
of Transportation  
**Federal Aviation  
Administration**

Alaskan Region Airports Division

222 W. 7<sup>th</sup> Avenue, #14  
Anchorage, Alaska 99513-7587  
Tel. (907) 271-5438 / Fax (907) 271-2851

June 5, 2025

David Epstein  
State of Alaska DOT&PF - Southcoast Region  
P.O. Box 112506  
Juneau, AK 99811-2506

Dear Mr. Epstein:

**Metlakatla Airport, Metlakatla, Alaska  
As-Built Airport Layout Plan  
(Original ALP Airspace No. 95-AAL-015NRA)**

We have completed our review of the Metlakatla Airport As-Built Airport Layout Plan (ALP) dated February 20, 2025, and find it acceptable for documenting the existing conditions of the airport.

Please attach this letter to the enclosed As-Built ALP and retain it in your files for future reference.

Sincerely,

Jenelle Brinkman, P.E.  
Lead Civil Engineer  
Airports Division