


# SKAGWAY BOAT HARBOR FACILITIES

PROJECT NO. 3-70165

AS BUILT

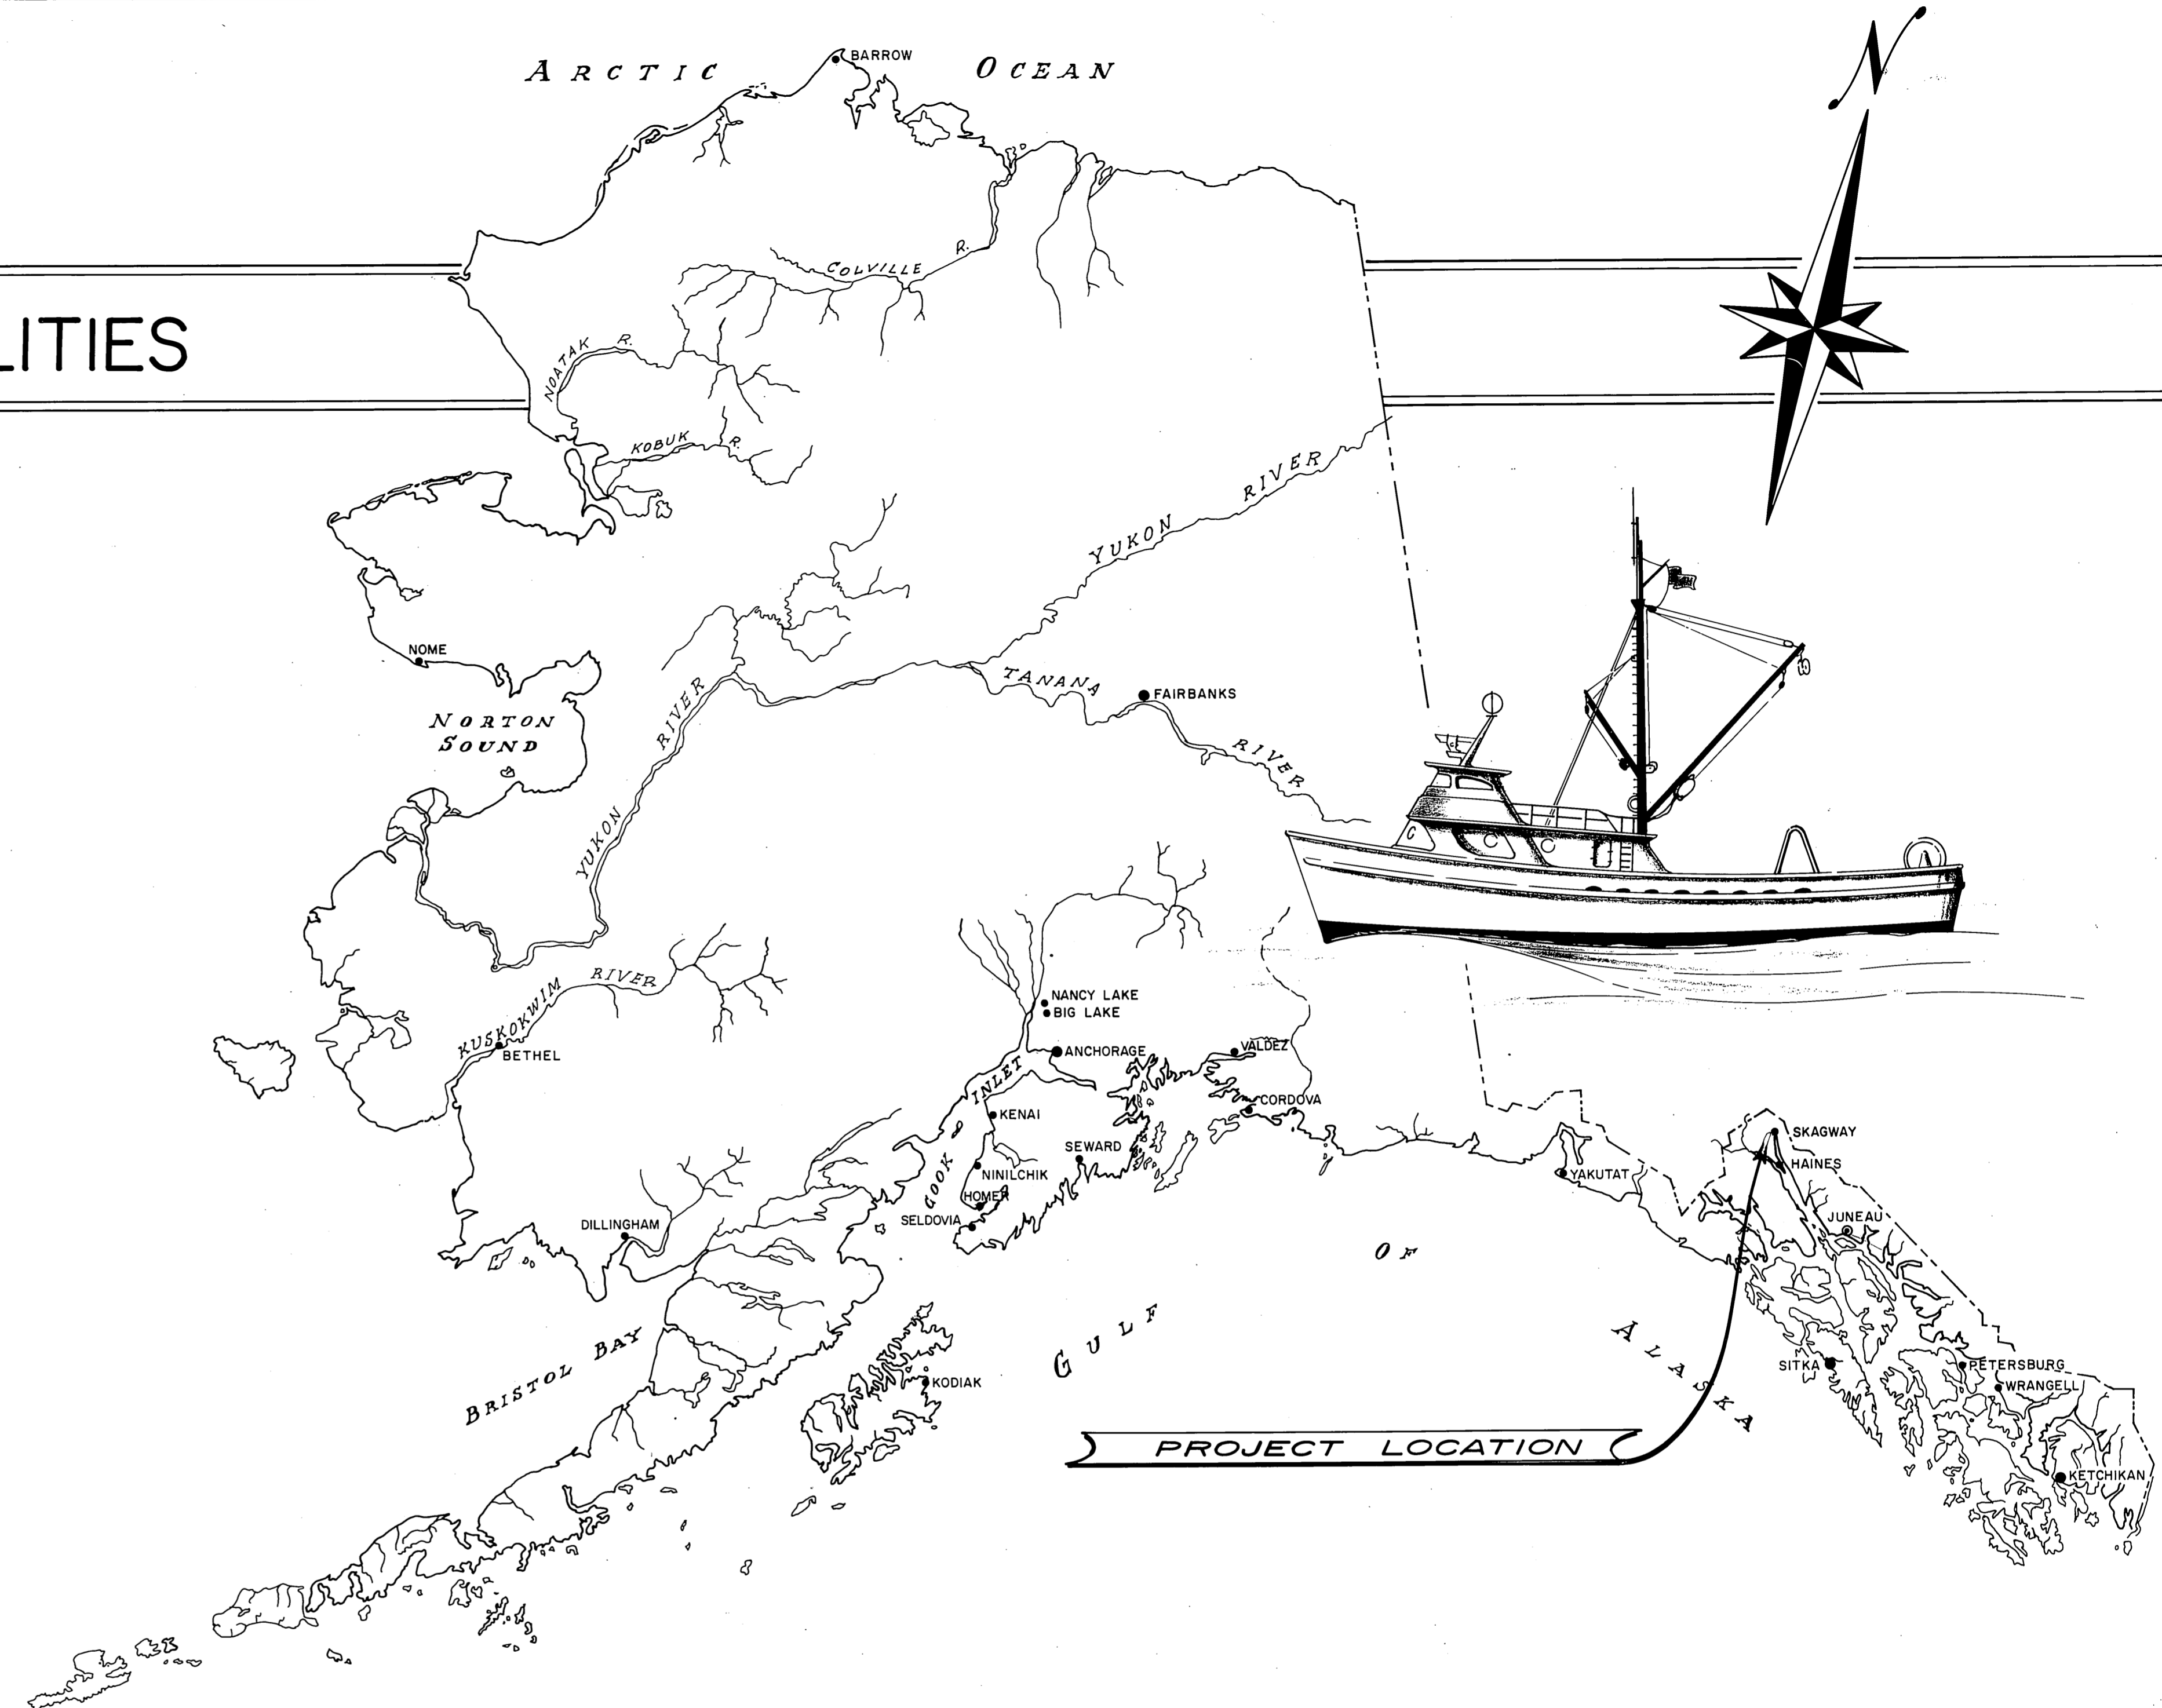

### WORK SUMMARY

Major units of this project consist of the construction & installation of 4827 S.F. of new float, the extraction of 19 existing piling, redriving 11 selected used piling, furnishing & driving of 18 new piling (1062 L.F.); modification & relocation of existing floats, and construction & installation of a Fire Protection & Domestic Water System; performing misc. float repairs at Skagway and Haines.

STATE OF ALASKA DEPARTMENT OF PUBLIC WORKS  
**DIVISION OF WATER & HARBORS**

### INDEX TO SHEETS

1	TITLE & LOCATION	6	TYPICAL FIRE PROTECTION & DOMESTIC WATER SYSTEM
2	FLOAT LAYOUT-STRINGER DIAGRAMS- MISC. DETAILS		
3	TYPICAL STALL FLOATS		
4	TYP. 6' FLOAT WITH INTEGRAL STALLS		
5	TYPICAL 10-FT. FLOATS		

APPROVED

*Harold A. ...*  
 COMMISSIONER

DATE

SHEET 1 OF 6

