
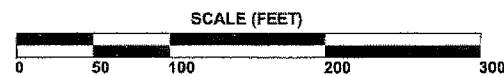


[illegible]

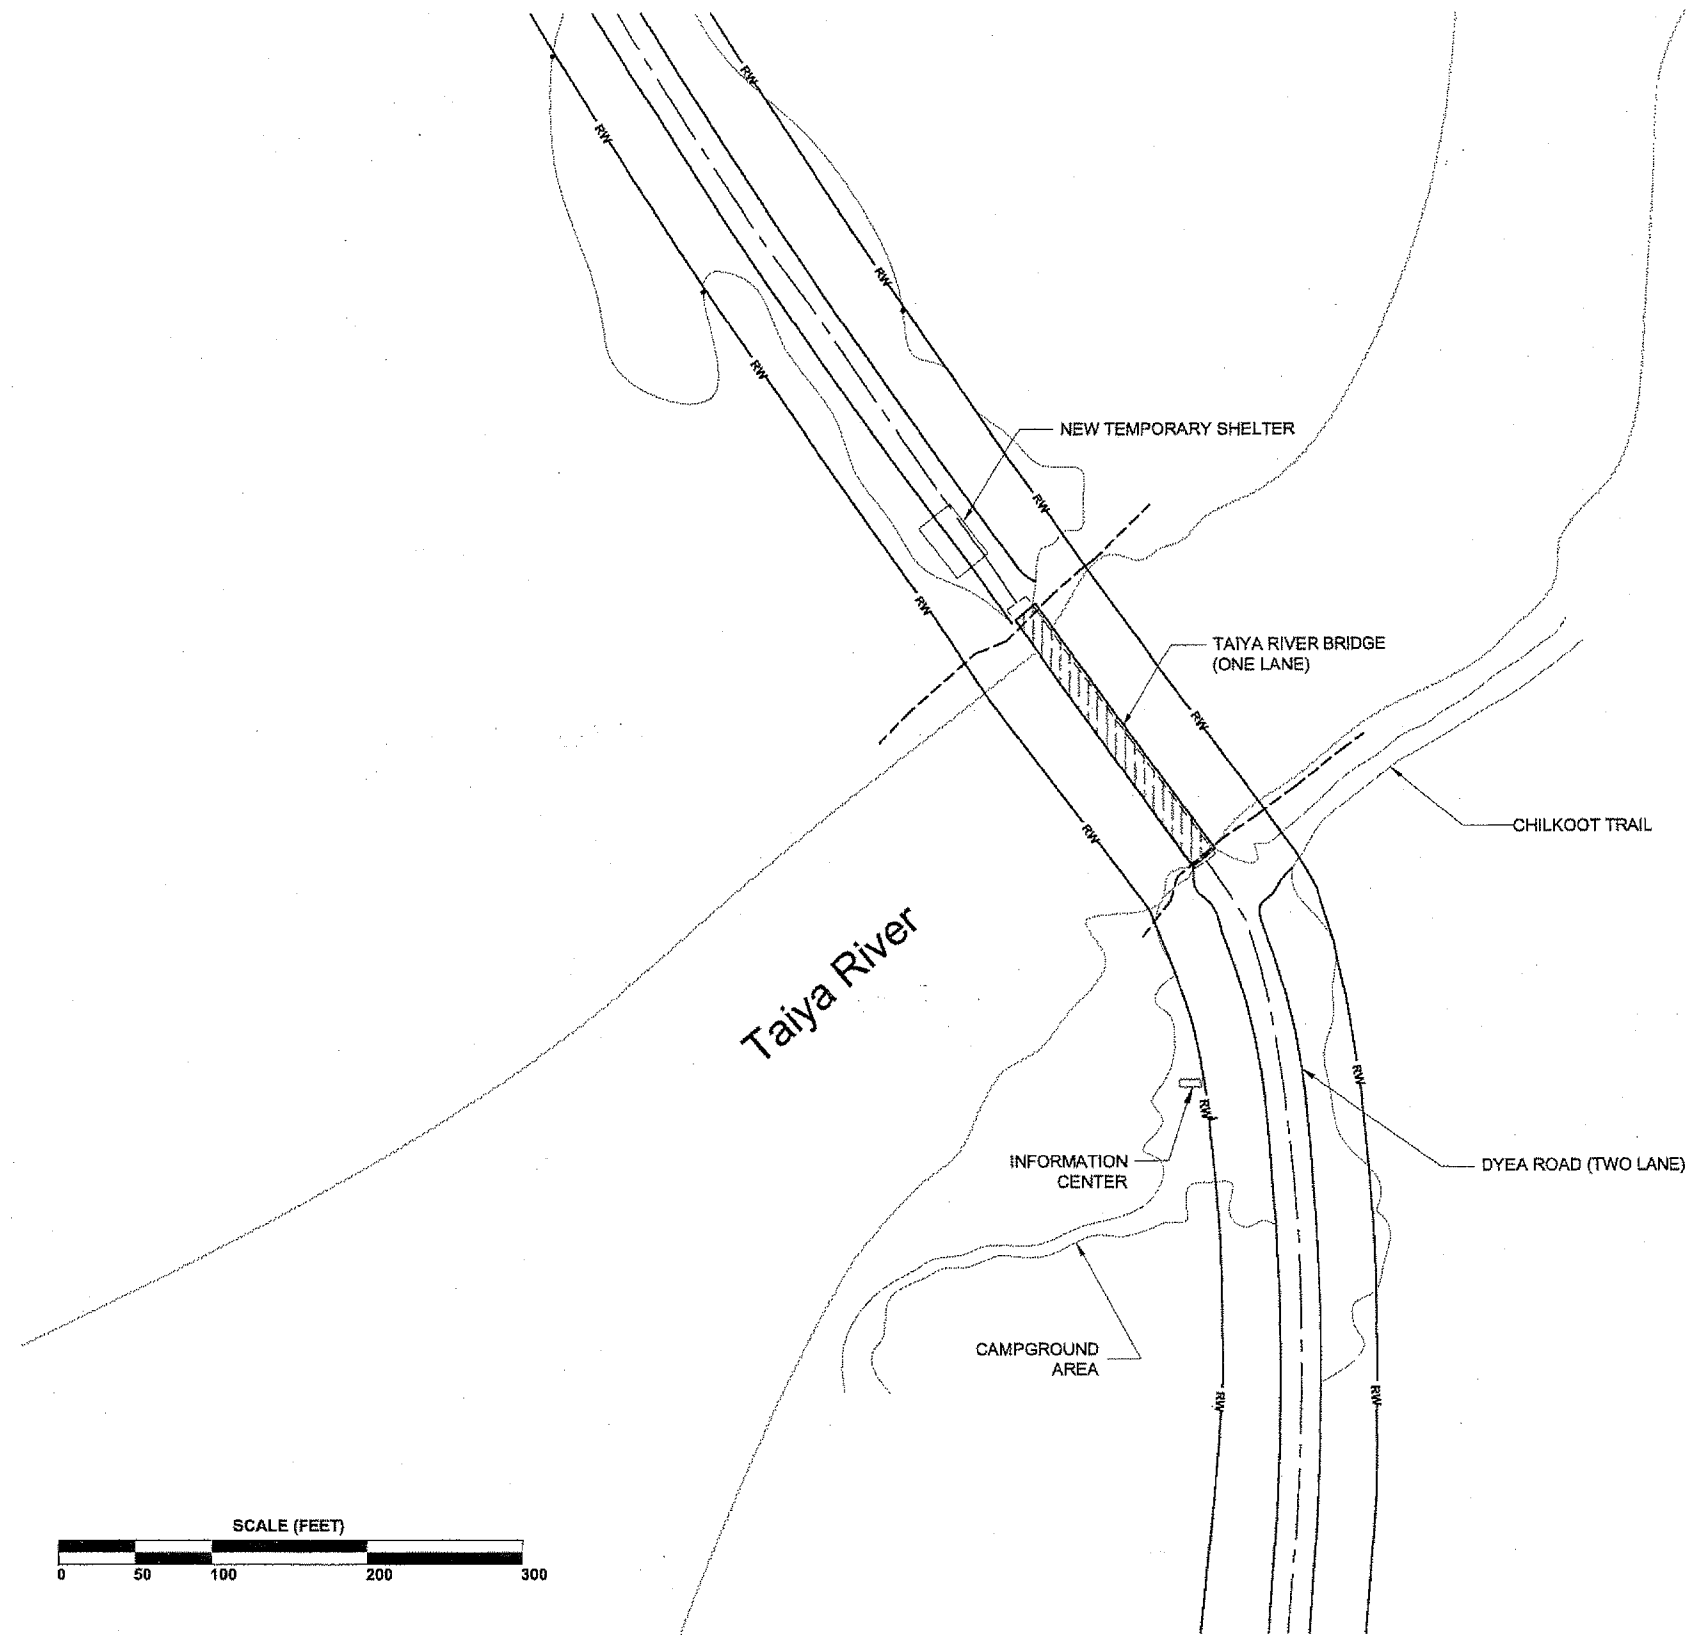

LEGEND

— RW —	RIGHT OF WAY BOUNDARIES
----	CENTERLINE LOCATION
----	APPROXIMATE ROAD LOCATION
----	CLEAR GROUND
----	ORDINARY HIGH WATER

Project As-Built Drawings have been reviewed by the Project Engineer and represent to the best of my knowledge, the project as constructed.
 PE Charles M. Tripp Date 3/26/13

ADDENDUM NUMBER		
ATTACHMENT NUMBER		
RECORD OF REVISIONS		
No.	DATE	DESCRIPTION
LAYOUT PLAN		
CHECKED BY: C. TRIPP		
DESIGNED BY: K. NOVIKOVA / T. FAGNANT		
DRAWN BY: K. NOVIKOVA / T. FAGNANT		
STATE OF ALASKA DEPARTMENT OF TRANSPORTATION & PUBLIC FACILITIES SOUTHEAST REGION		
SGY DYE A ROAD BRIDGE # 309 REPLACEMENT (TAYIA RIVER BRIDGE)		
LAYOUT PLAN		
PROJECT DESIGNATION NUMBER		
69275		
STATE	YEAR	
ALASKA	2011	
SHEET NUMBER	TOTAL SHEETS	
A2	13	

ESTIMATE OF QUANTITIES			
ITEM NO.	PAY ITEM	PAY UNIT	PLAN QUANTITY
202(13)	REMOVAL OF BRIDGE COMPONENTS	LUMP SUM	ALL REQ'D
202(14)	CONTAINMENT	LUMP SUM	ALL REQ'D
504(1)	STRUCTURAL STEEL	LUMP SUM	ALL REQ'D
504(3)	MISCELLANEOUS REPAIRS	CONTINGENT SUM	ALL REQ'D
506(1)	TREATED TIMBER	LUMP SUM	ALL REQ'D
506(2)	UNTREATED TIMBER	LUMP SUM	ALL REQ'D
507(5)	TIMBER BRIDGE RAILING	LINEAR FOOT	410 - 5
640(1)	MOBILIZATION AND DEMOBILIZATION	LUMP SUM	ALL REQ'D
640(4)	WORKER MEALS AND LODGING, OR PER DIEM	LUMP SUM	ALL REQ'D
641(1)	EROSION AND POLLUTION CONTROL ADMINISTRATION	LUMP SUM	ALL REQ'D
641(2)	TEMPORARY EROSION AND POLLUTION CONTROL	CONTINGENT SUM	ALL REQ'D
641(5)	EROSION, SEDIMENT AND POLLUTION CONTROL PRICE ADJUSTMENT	CONTINGENT SUM	ALL REQ'D
643(2)	TRAFFIC MAINTENANCE	LUMP SUM	ALL REQ'D
643(3)	PERMANENT CONSTRUCTION SIGNS	LUMP SUM	ALL REQ'D
643(23)	TRAFFIC PRICE ADJUSTMENT	CONTINGENT SUM	ALL REQ'D
643(30)	PEDESTRIAN CROSSING	LUMP SUM	ALL REQ'D
644(1)	FIELD OFFICE	LUMP SUM	ALL REQ'D
644(6)	VEHICLES	LUMP SUM	ALL REQ'D
645(1)	TEMPORARY SHELTER	LUMP SUM	ALL REQ'D
645(2)	SNOW REMOVAL	LUMP SUM	ALL REQ'D
645(3)	SHUTTLE SERVICE	LUMP SUM	ALL REQ'D

BASIS OF ESTIMATE			
ITEM NO.	PAY ITEM	ESTIMATING UNIT	TOTAL
504(1)	STRUCTURAL STEEL	LB	51,223
506(1)	TREATED TIMBER	MBM	20.7
506(2)	UNTREATED TIMBER	MBM	5.9
645(2)	SNOW REMOVAL	SY	15,000

640(2)	Additional Mobilization Costs, C.O. #1	Lump Sum	All Reg'd
501(10)	Temporary Concrete Pavement, C.O. #2	Lump Sum	All Reg'd
515(7)	Low Clearance Sign, C.O. #3	Lump Sum	All Reg'd

No.	DATE	DESCRIPTION

5-17-01

49th

Charles M. Tripp

CE-6613




REGISTERED PROFESSIONAL ENGINEER

STATE OF ALASKA

C1	13
----	----

PE Steve Miller Date 3/26/13

STATE	PROJECT DESIGNATION	YEAR	SHEET NO.	TOTAL SHEETS
ALASKA	89275	2011	N1	13

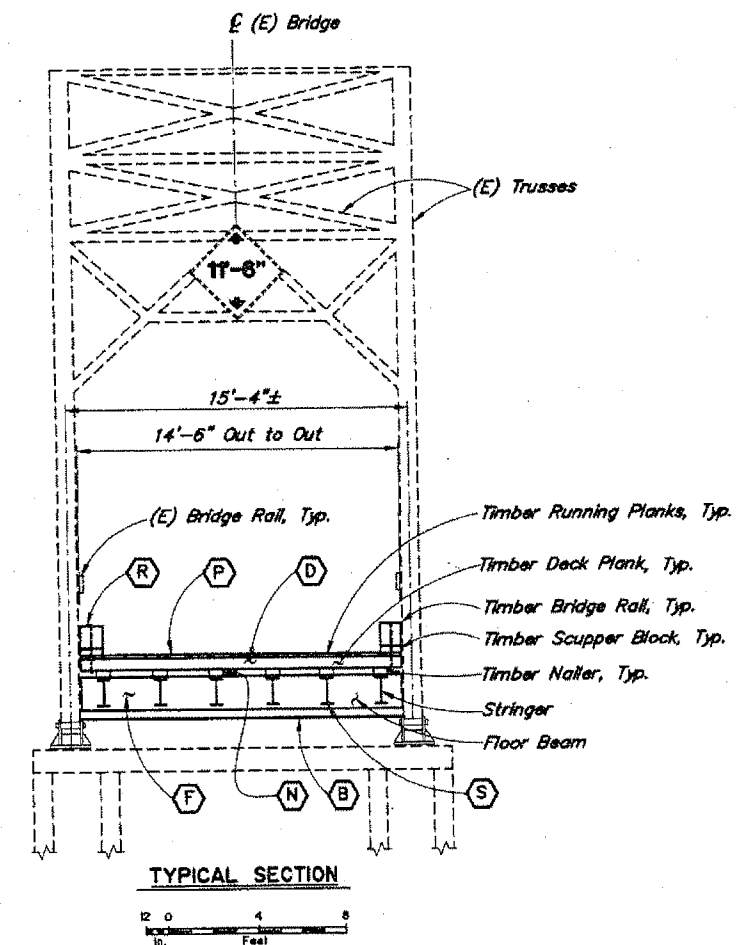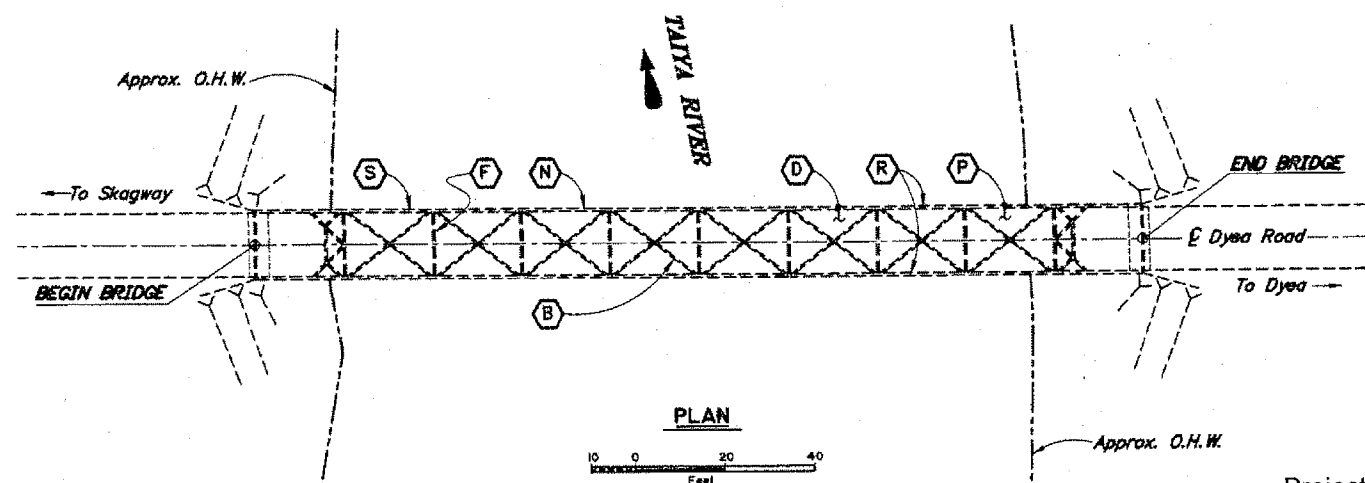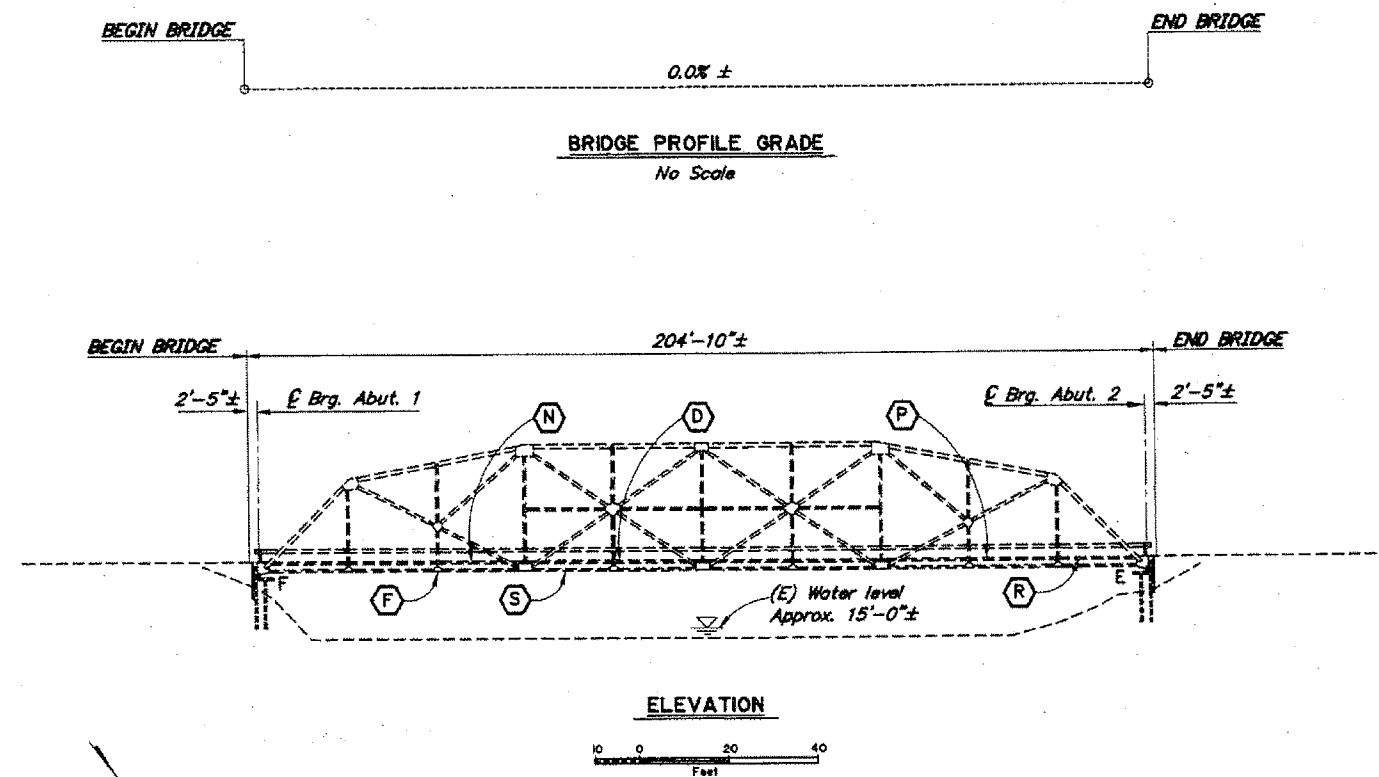

REPLACEMENT WORK LEGEND	
(B) - Lateral Bracing	
(D) - Timber Deck	
(F) - Floor Beam	
(N) - Timber Nailers	
(P) - Timber Running Planks	
(R) - Bull Rail	
(S) - Stringers	


BRIDGE DRAWING INDEX	
TITLE	DWG. NO.
GENERAL LAYOUT	1
ESTIMATE OF QUANTITIES	2
FRAMING PLAN AND TYPICAL SECTION	3
FLOOR BEAM AND STRINGER DETAILS	4
LATERAL BRACING	5
DECK	6
DECK DETAILS	7
TIMBER BRIDGE RAILING	8
PEDESTRIAN GANGWAY	9

LEGEND
 --- Existing
 --- Work in this Contract

Project As-Built Drawings have been reviewed by the Project Engineer and represent to the best of my knowledge, the project as constructed.
 PE *[Signature]* Date 3/26/13

DESIGNED BY: <i>[Signature]</i> Todd Barke	CHECKED BY: <i>[Signature]</i> Jared Landings	LAYOUT BY: <i>[Signature]</i> Todd Barke	CHECKED BY: <i>[Signature]</i> Jared Landings
DRAWN BY: <i>[Signature]</i> Cathy Anderson	CHECKED BY: <i>[Signature]</i> Todd Barke	SPECIFICATIONS BY: <i>[Signature]</i> Todd Barke	P S & E COMPARED: <i>[Signature]</i> Todd Barke
QUANTITIES BY: <i>[Signature]</i> Todd Barke	CHECKED BY: <i>[Signature]</i> Jared Landings	APPROVAL RECOMMENDED BY: <i>[Signature]</i> Richard Pratt	

STATE OF ALASKA
 DEPARTMENT OF TRANSPORTATION
 AND PUBLIC FACILITIES
 BRIDGE SECTION

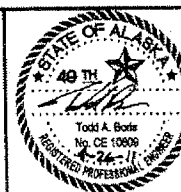

TAIYA RIVER BRIDGE
 DYEA ROAD
 GENERAL LAYOUT



BRIDGE NO. 309
 DWG. NO. 1

STATE	PROJECT DESIGNATION	YEAR	SHEET NO.	TOTAL SHEETS
ALASKA	69275	2011	N2	13

BRIDGE BASIS OF ESTIMATE						
ITEM NO.	ITEM	PAY UNIT	ESTIMATING UNIT	SUBST.	SUPERST.	TOTAL
202(13)	Removal of Bridge Components	LS	LS		All Req'd	All Req'd
202(14)	Containment	LS	LS		All Req'd	All Req'd
504(1)	Structural Steel	LS	LB		51,223	51,223
504(3)	Miscellaneous Repairs	CS	CS		All Req'd	All Req'd
506(1)	Treated Timber	LS	MBM		20.7	20.7
506(2)	Untreated Timber	LS	MBM		5.9	5.9
507(5)	Timber Bridge Railing	LF	LF		410	410
643(30)	Pedestrian Crossing	LS	LS		All Req'd	All Req'd

Item numbers are for reference only. Quantities shown are not necessarily the pay quantities nor the total quantity of the particular item.

GENERAL NOTES

DESIGN:.....AASHTO Standard Specifications for Highway Bridges with latest interim specifications.

LIVE LOAD:.....H-15

DEAD LOAD:.....Includes 17 psf for all wearing surfaces.


STRUCTURAL STEEL:.....ASTM A709, Grade 36T3, Fy = 36,000 psi
Galvanize structural steel.

STRUCTURAL TIMBER:.....Treated Douglas Fir-Larch, No. 1 (WCLIB & WMPA)
for deck planks and nail laminated approach planks.
Treated Douglas Fir-Larch, No. 2 (WCLIB & WMPA)
for nailers.
Untreated Douglas Fir-Larch, Alaska Hemlock, or
Alaska Spruce, No. 2 for timber running planks.

"As-Built" drawings, fabrication shop drawings or other documentation for the existing bridges note significant changes from the original contract plans but do not necessarily show normal construction tolerances and variances. These documents are for informational use only and the Department neither warrants nor represents that these documents accurately depict the configuration of the existing bridges. Where dimensions of the proposed work in this Contract are dependent on the dimensions of the existing bridge, adjust dimensions of the work to fit existing conditions.

SYMBOLS & ABBREVIATIONS

- ± = Approximate dimension, verify controlling field dimensions.
- E = Centerline
- (E) = Existing
- & = and
- @ = at
- Ø = diameter
- Approx. = Approximate
- Abut. = Abutment
- Brg. = Bearing(s)
- H.S. = High Strength
- max. = maximum
- min. = minimum
- o.c. = on center
- O.H.W. = Ordinary High Water
- Symm. = Symmetric
- Typ. = Typical

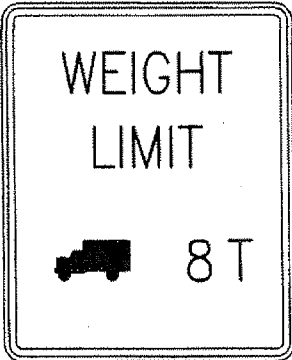

CURRENT BRIDGE POSTING
No Scale

Project As-Built Drawings have been reviewed by the Project Engineer and represent to the best of my knowledge, the project as constructed.
PE [Signature] Date 3/26/13

DESIGNED BY: <u>Todd Borie</u>	CHECKED: <u>Jared Leverage</u>
DRAWN BY: <u>Cathy Anderson</u>	CHECKED: <u>Todd Borie</u>
QUANTITIES BY: <u>Todd Borie</u>	CHECKED: <u>Jared Leverage</u>



STATE OF ALASKA
DEPARTMENT OF TRANSPORTATION
AND PUBLIC FACILITIES
BRIDGE SECTION



TAIYA RIVER BRIDGE
DYEA ROAD
ESTIMATE OF QUANTITIES


BRIDGE NO. 309
DWG. NO. 2

STATE	PROJECT DESIGNATION	YEAR	SHEET NO.	TOTAL SHEETS
ALASKA	69275	2011	N3	13

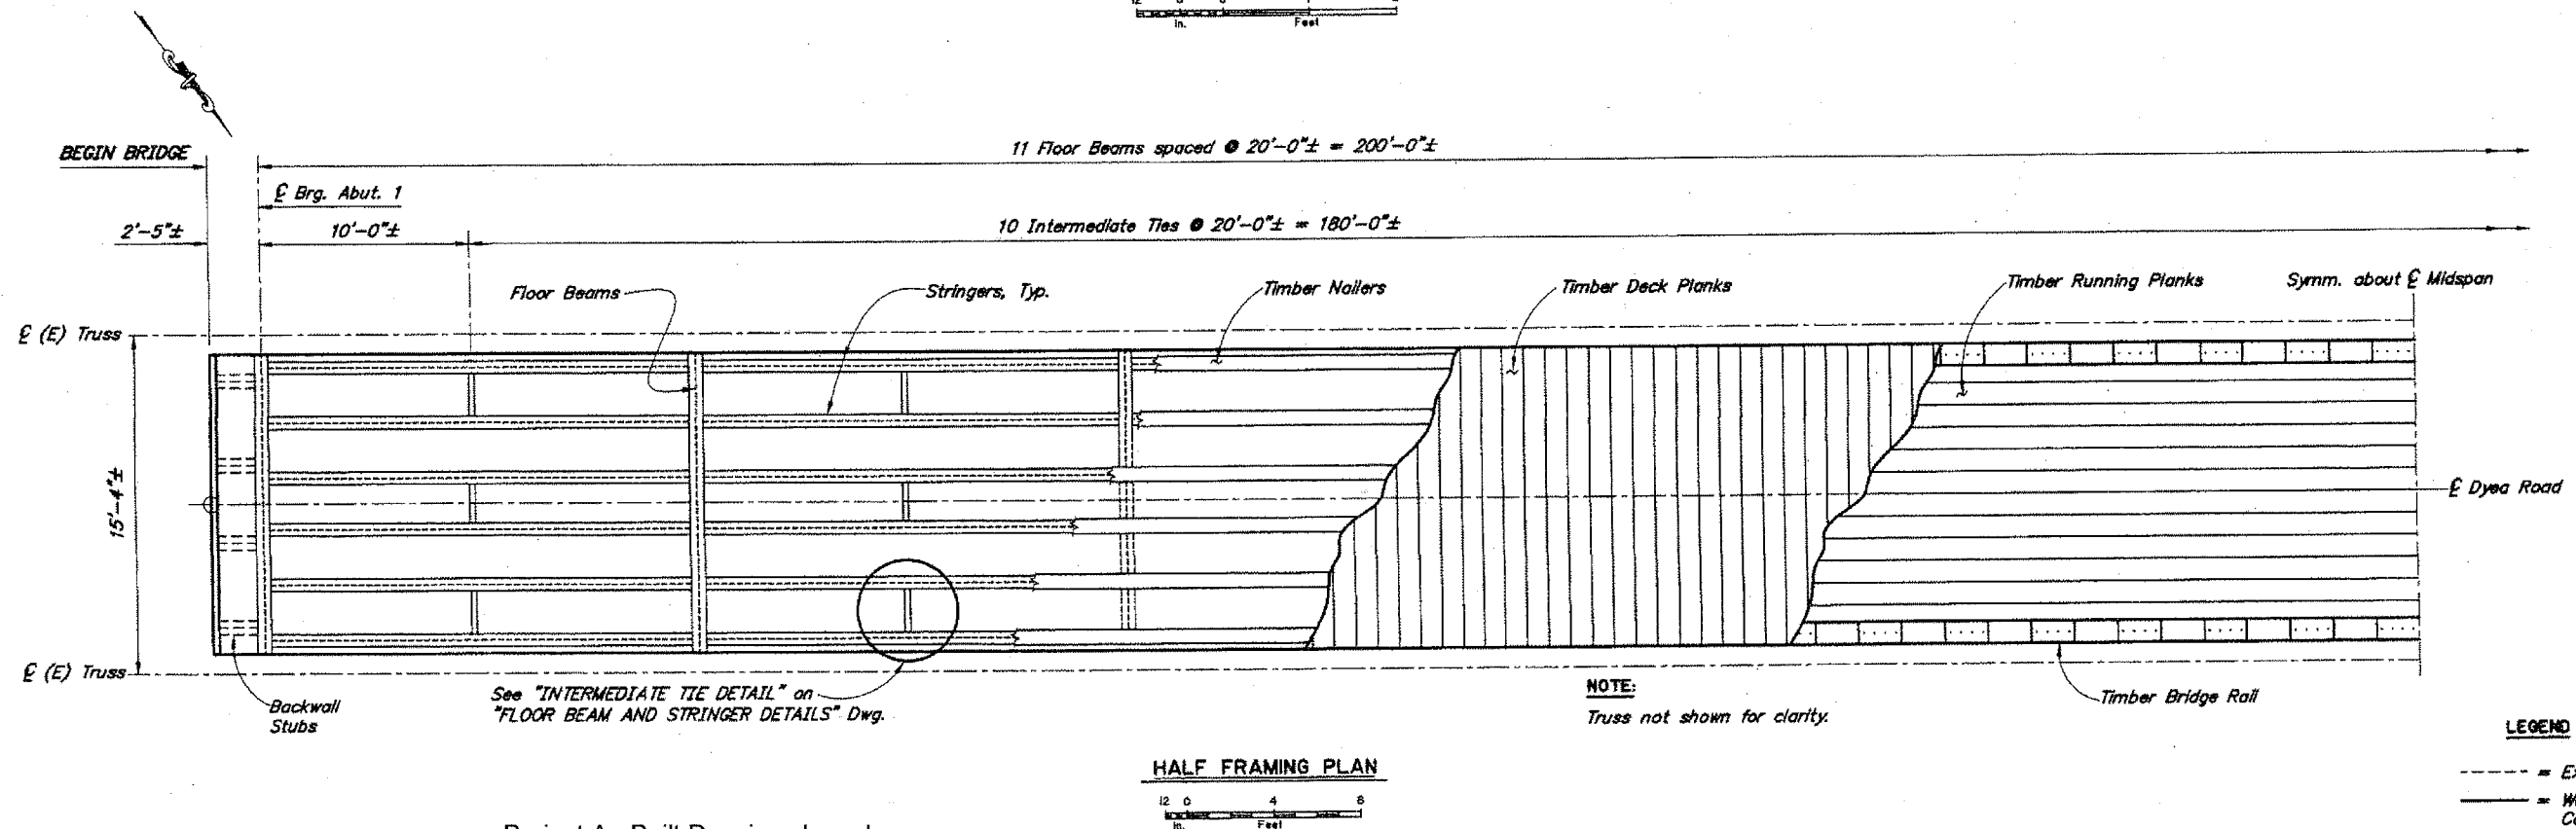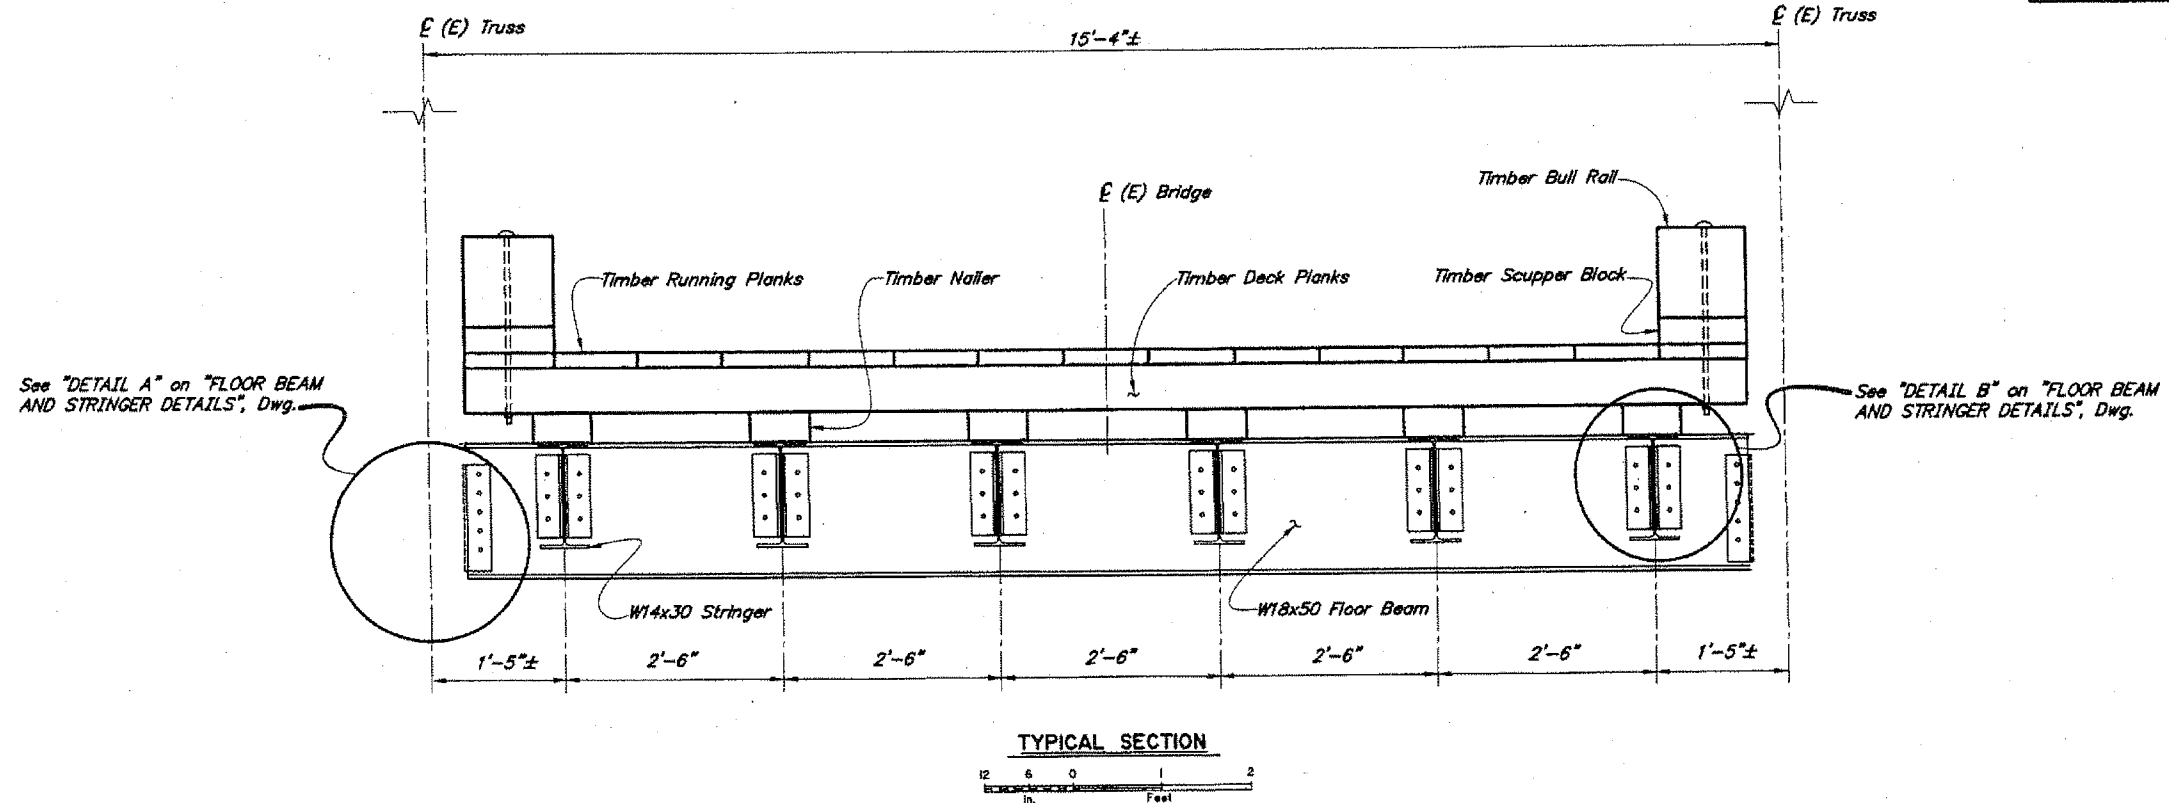

LEGEND

--- = Existing


— = Work in this Contract

DESIGNED BY: Todd Barke	CHECKED: Jared Lovings
DRAWN BY: C. Anderson	CHECKED: Todd Barke
QUANTITIES BY: Todd Barke	CHECKED: Jared Lovings

Project As-Built Drawings have been reviewed by the Project Engineer and represent to the best of my knowledge, the project as constructed.

PE Steve Miller Date 3/26/13


STATE OF ALASKA
DEPARTMENT OF TRANSPORTATION
AND PUBLIC FACILITIES
BRIDGE SECTION

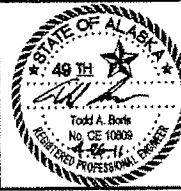

TAIYA RIVER BRIDGE
DYEA ROAD
FRAMING PLAN AND TYPICAL SECTION




BRIDGE NO. 309
DWG. NO. 3

STATE	PROJECT DESIGNATION	YEAR	SHEET NO.	TOTAL SHEETS
ALASKA	69275	2011	N4	13

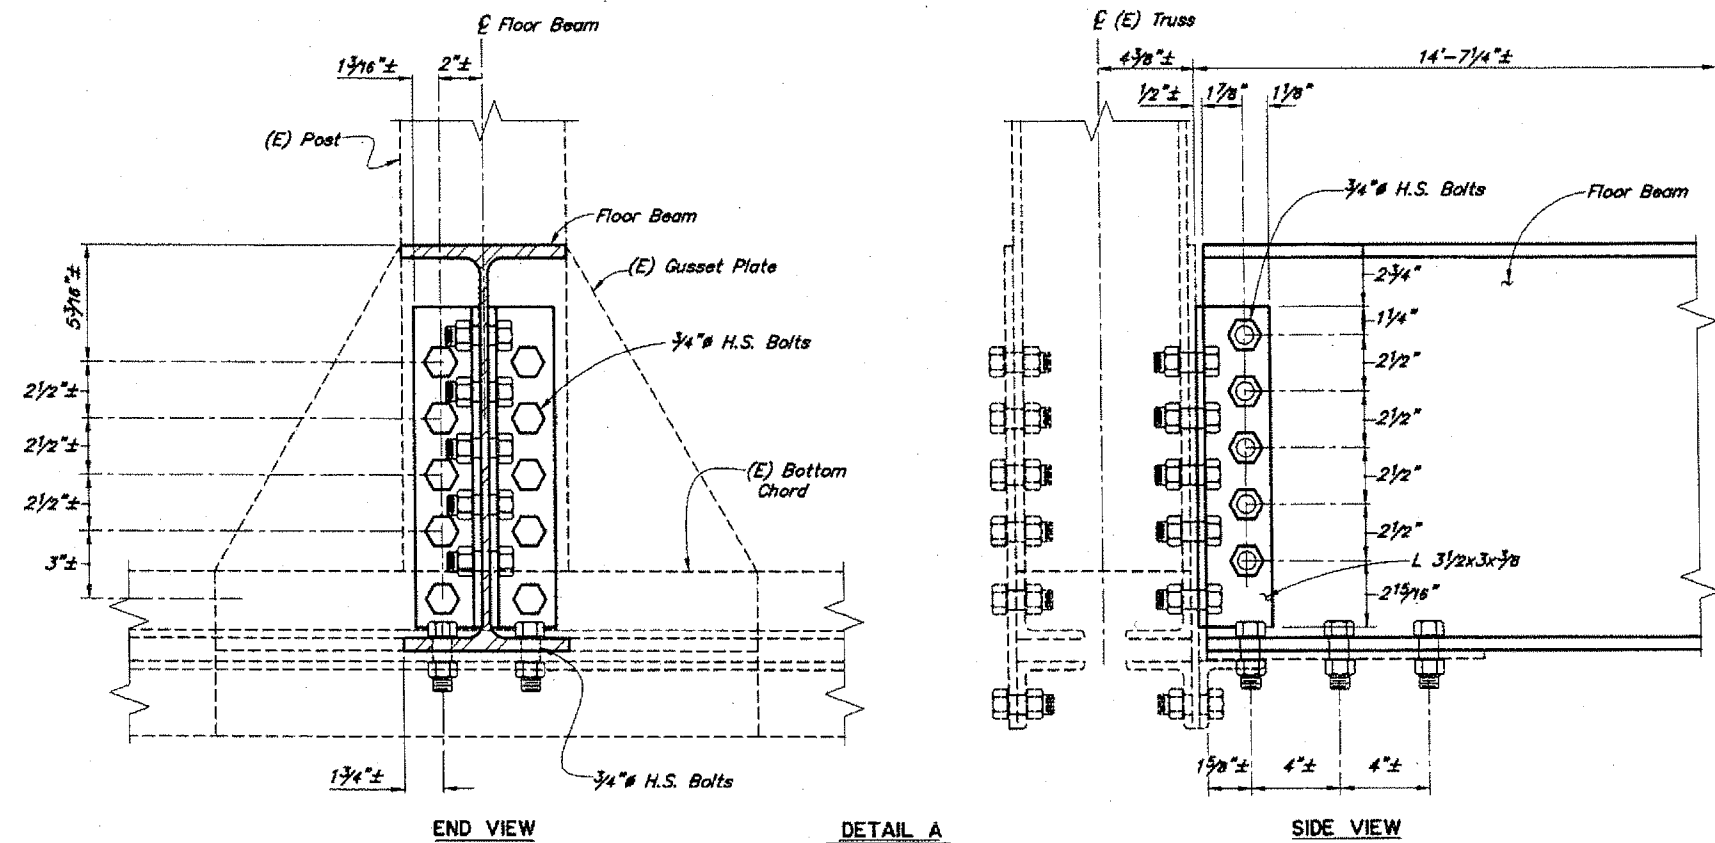

Project As-Built Drawings have been reviewed by the Project Engineer and represent to the best of my knowledge, the project as constructed.

PE SK mba Date 3/26/13

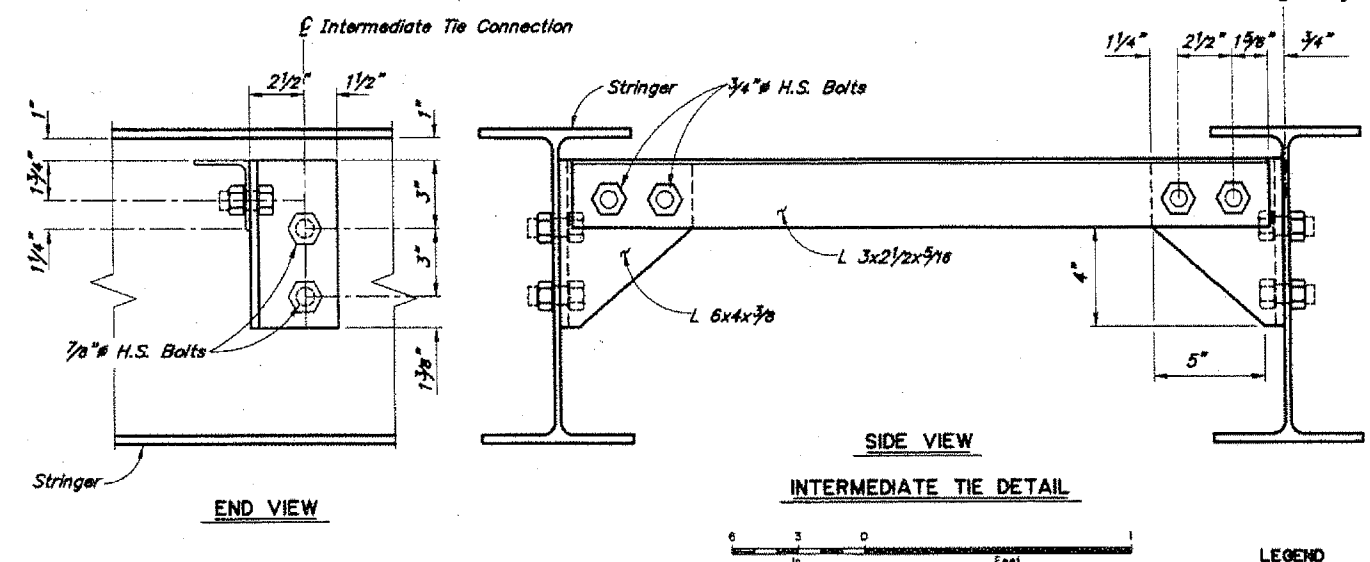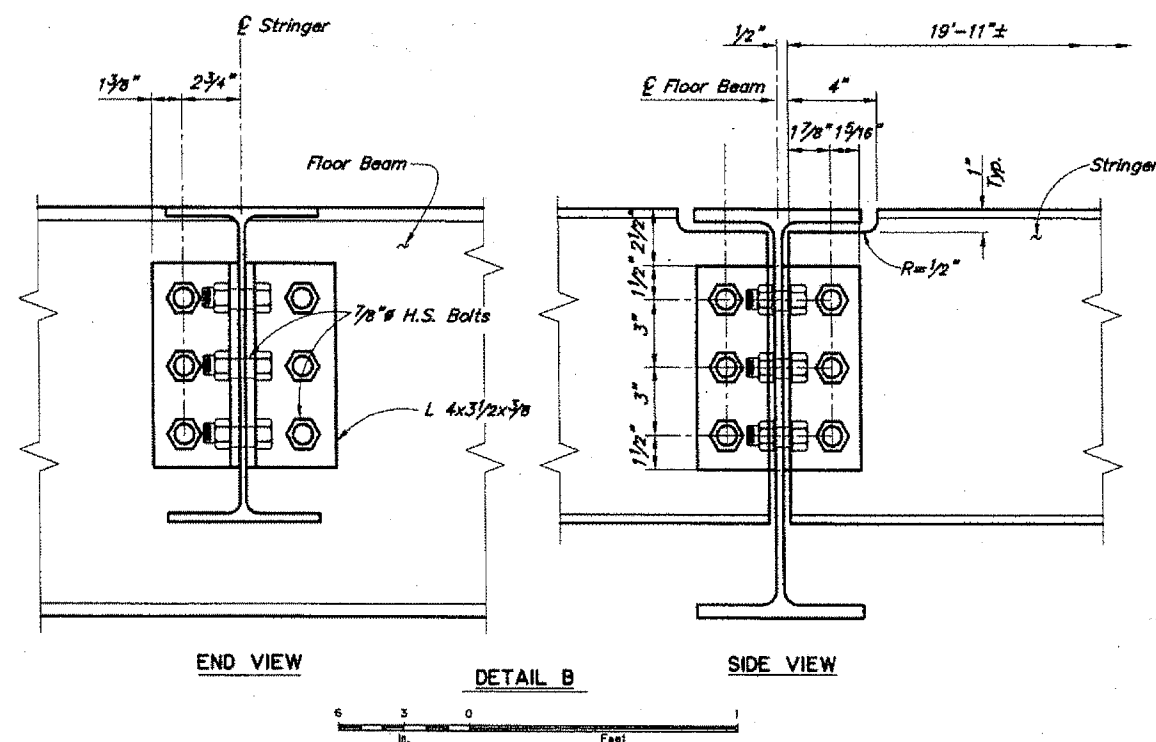


LEGEND

----- = Existing
 _____ = Work in this Contract

DESIGNED BY: Todd Borte	CHECKED: Jared Lavigne
DRAWN BY: C. Anderson	CHECKED: Todd Borte
QUANTITIES BY: Todd Borte	CHECKED: Jared Lavigne


STATE OF ALASKA
DEPARTMENT OF TRANSPORTATION
AND PUBLIC FACILITIES
BRIDGE SECTION

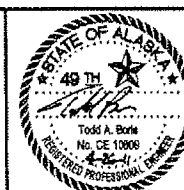


TAIYA RIVER BRIDGE
DYEA ROAD
FLOOR BEAM AND STRINGER DETAILS





STATE	PROJECT DESIGNATION	YEAR	SHEET NO.	TOTAL SHEETS
ALASKA	69275	2011	N5	13

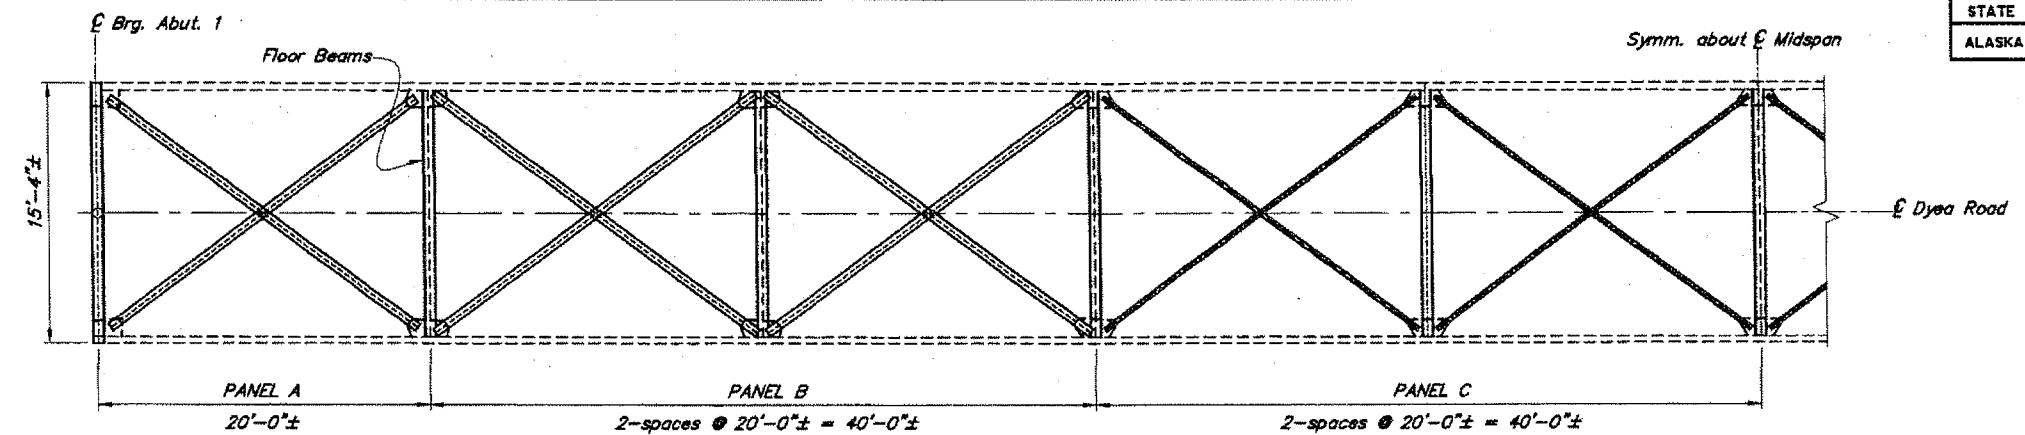


HALF LATERAL BRACING PLAN

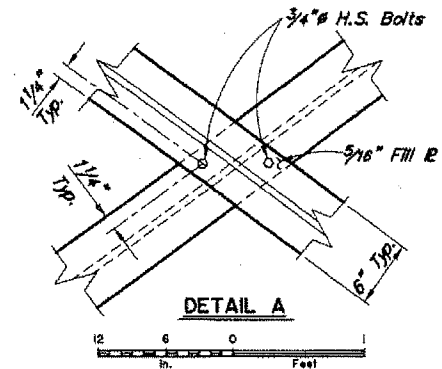


DETAIL A

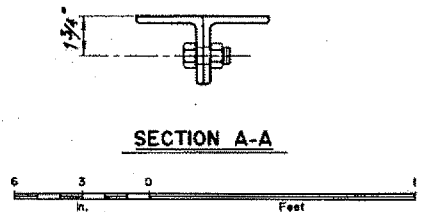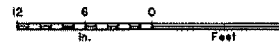


SECTION A-A

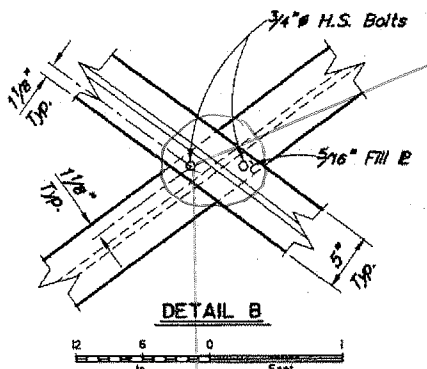


DETAIL B

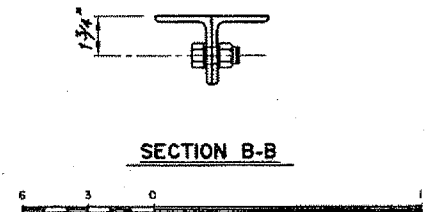

SECTION B-B

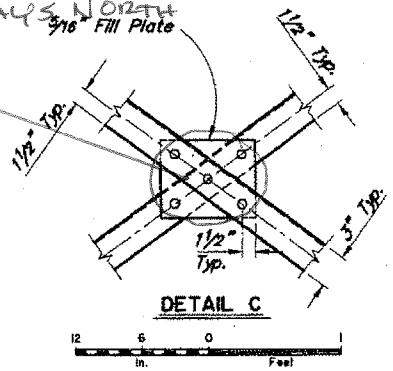


DETAIL C

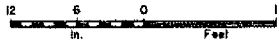


CHANGED HOLE LAYOUT TO FIT CONNECTION POINT. LAST 3 BAYS NORTH


DRILLED NEW HOLES CONNECTION POINT & CLIPS DID NOT ALIGN... LAST 2 BAY NORTH

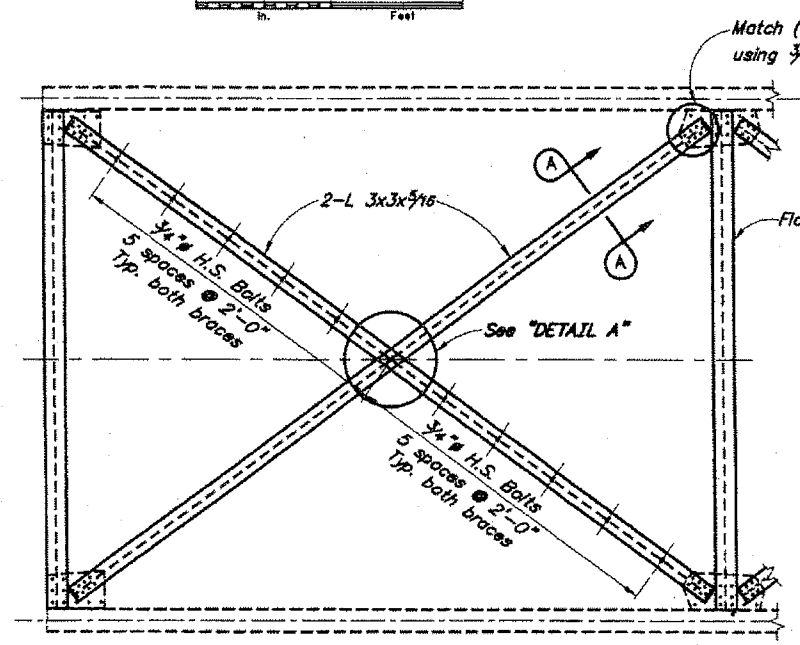

PANEL A DETAILS

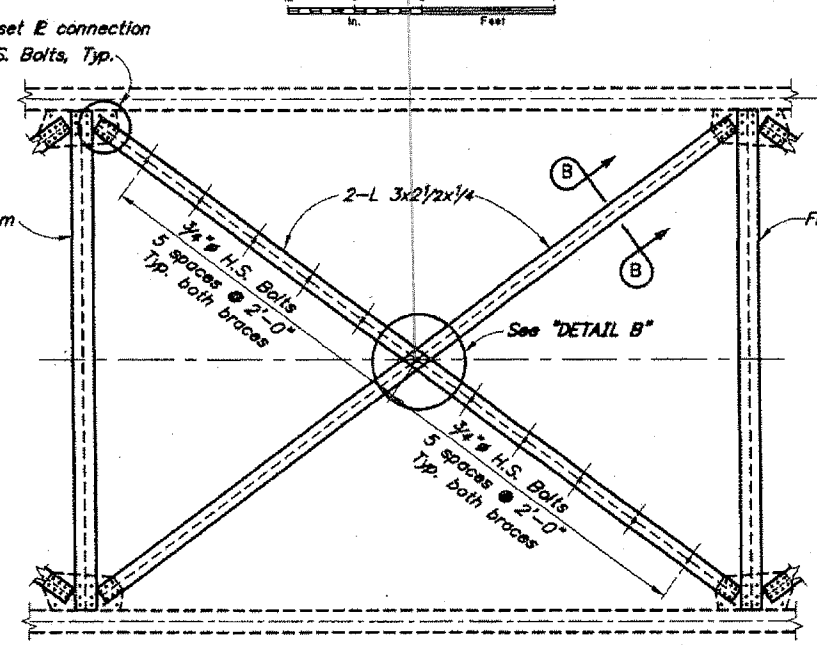

PANEL B DETAILS

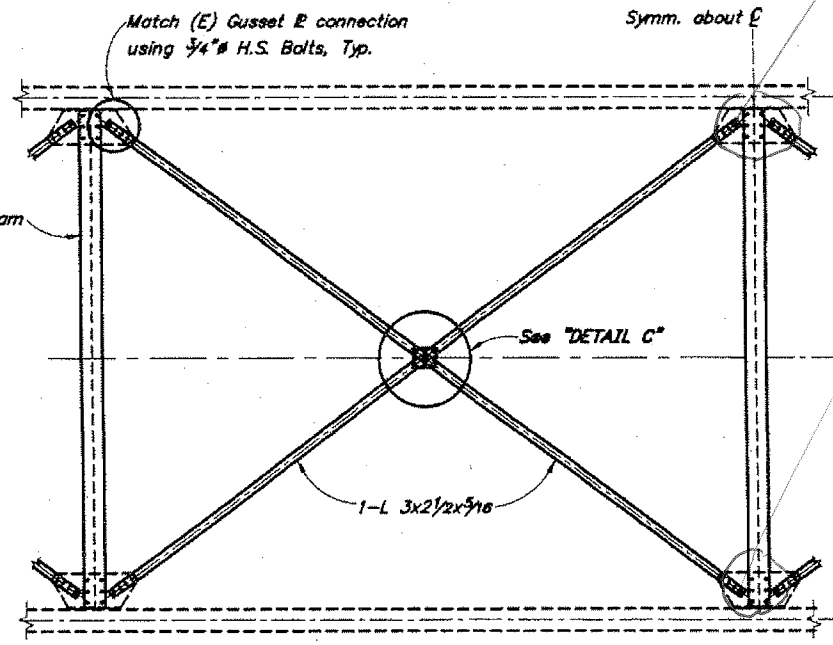

PANEL C DETAILS

LATERAL BRACING CONNECTION DETAILS




NOTES:
 - Existing
 - Work in this Contract
 Stringers and Truss not shown for clarity.

DESIGNED BY: Todd Barte	CHECKED: Jared Levinge
DRAWN BY: C. Anderson	CHECKED: Todd Barte
QUANTITIES BY: Todd Barte	CHECKED: Jared Levinge

Project As-Built Drawings have been reviewed by the Project Engineer and represent to the best of my knowledge, the project as constructed.
 PE Shane Miller Date 3/26/13


STATE OF ALASKA
 DEPARTMENT OF TRANSPORTATION
 AND PUBLIC FACILITIES
 BRIDGE SECTION

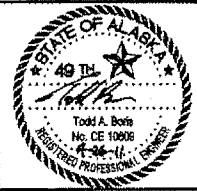

TAIYA RIVER BRIDGE
 DYEA ROAD
 LATERAL BRACING


BRIDGE NO. 309
 DWG. NO. 5

STATE	PROJECT DESIGNATION	YEAR	SHEET NO.	TOTAL SHEETS
ALASKA	69275	2011	N6	13

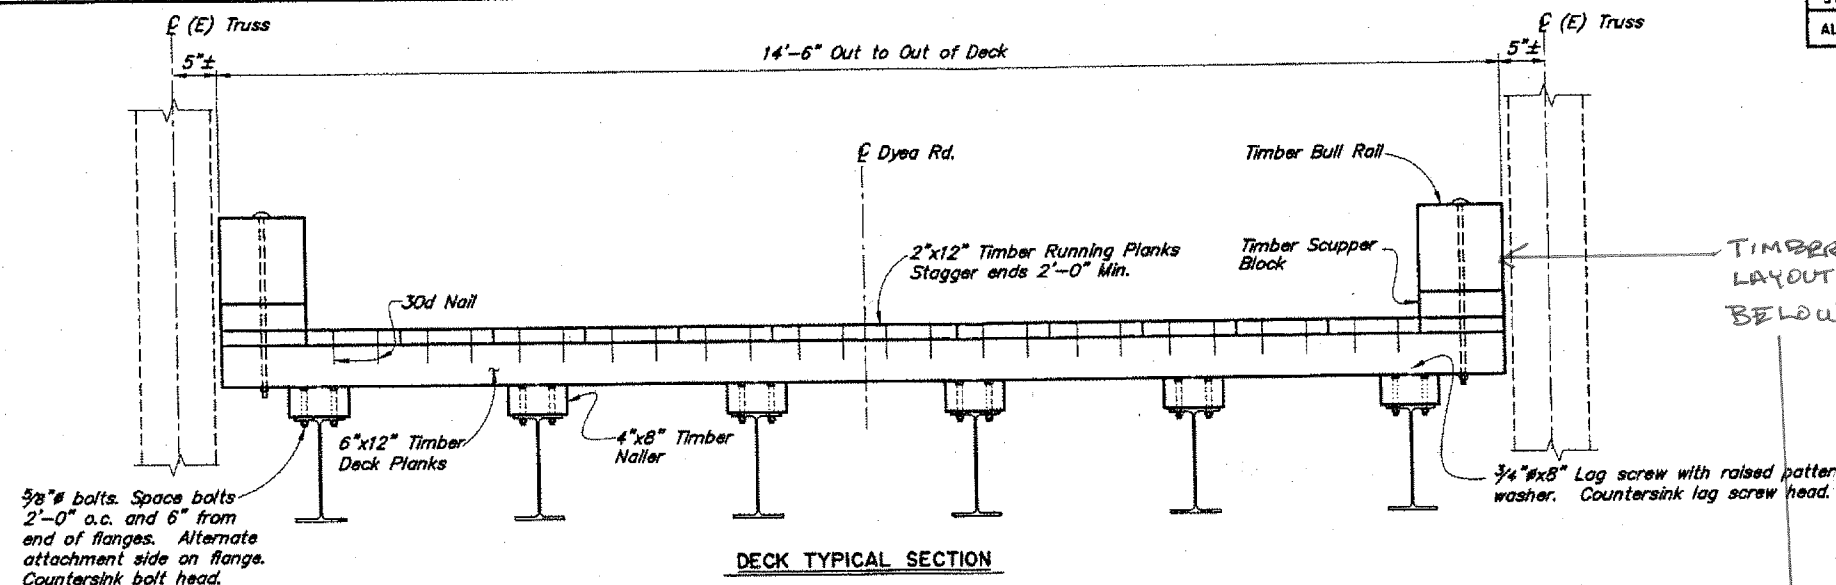

TIMBER BULL RAILS CHANGE TO 18' WITH CHANGED LAYOUT & TIMBER SCUPPER BLOCKS TO 4' SEE DETAIL BELOW

Project As-Built Drawings have been reviewed by the Project Engineer and represent to the best of my knowledge, the project as constructed.
PE *Sts. 2/1/11* Date *3/26/13*

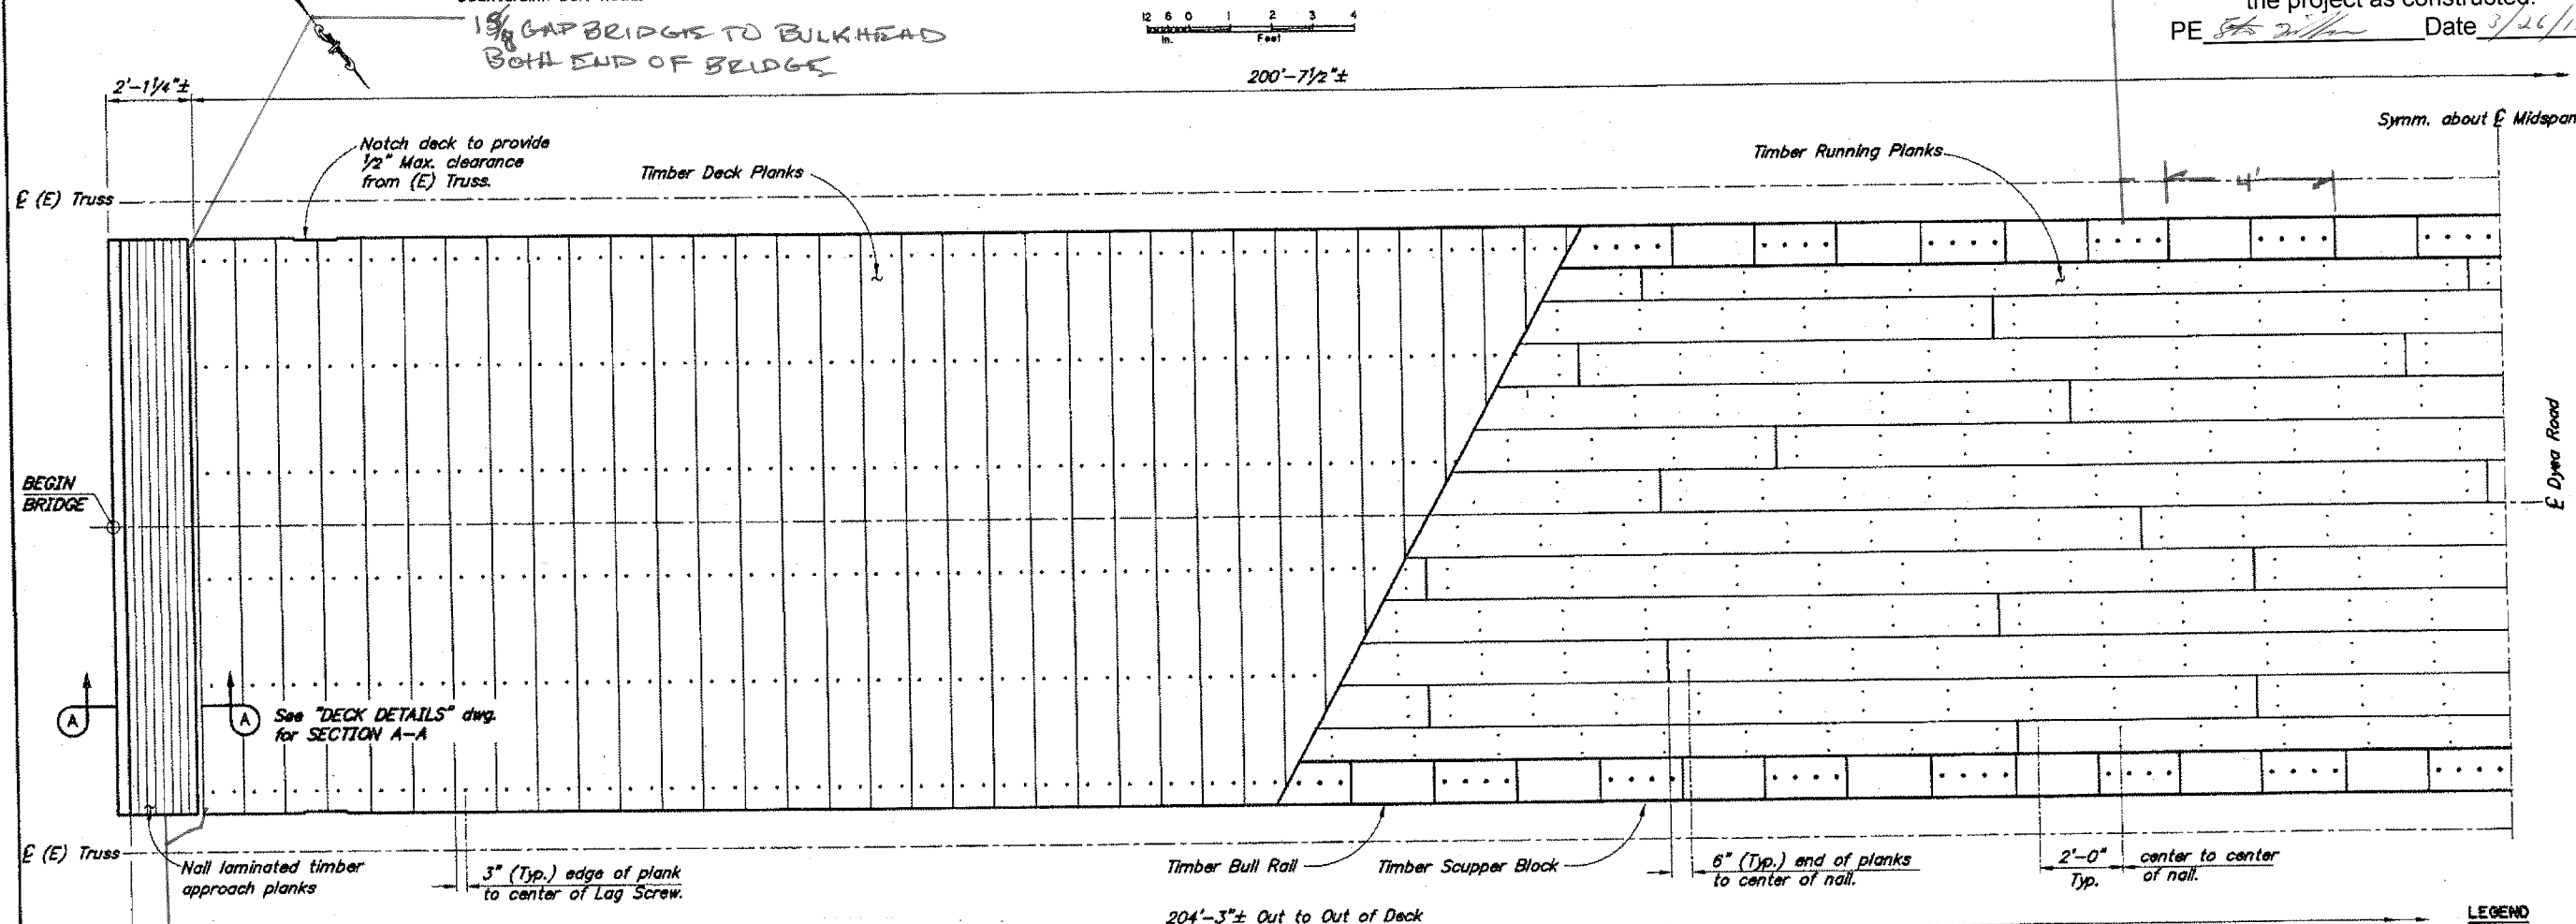

DECK PLANKS
NORTH END CHANGED TO 22"
ALSO ADDED BOARD TO BRIDGE SIDE TO FIX BROKEN ATTACHING
BOARDS RIP DOWN TO PORE CONCRETE.


NOTE:
Truss not shown for clarity.

RUNNING PLANKS

LEGEND
--- Existing
— Work in this Contract

DESIGNED BY: <i>Todd Boris</i>	CHECKED: <i>Jared Levings</i>
DRAWN BY: <i>Cathy Anderson</i>	CHECKED: <i>Todd Boris</i>
QUANTITIES BY: <i>Todd Boris</i>	CHECKED: <i>Jared Levings</i>


STATE OF ALASKA
DEPARTMENT OF TRANSPORTATION
AND PUBLIC FACILITIES
BRIDGE SECTION

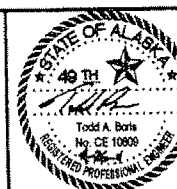



TAIYA RIVER BRIDGE
DYEA ROAD
DECK

BRIDGE NO. 309
DWG. NO. 6


STATE	PROJECT DESIGNATION	YEAR	SHEET NO.	TOTAL SHEETS
ALASKA	69275	2011	N7	13

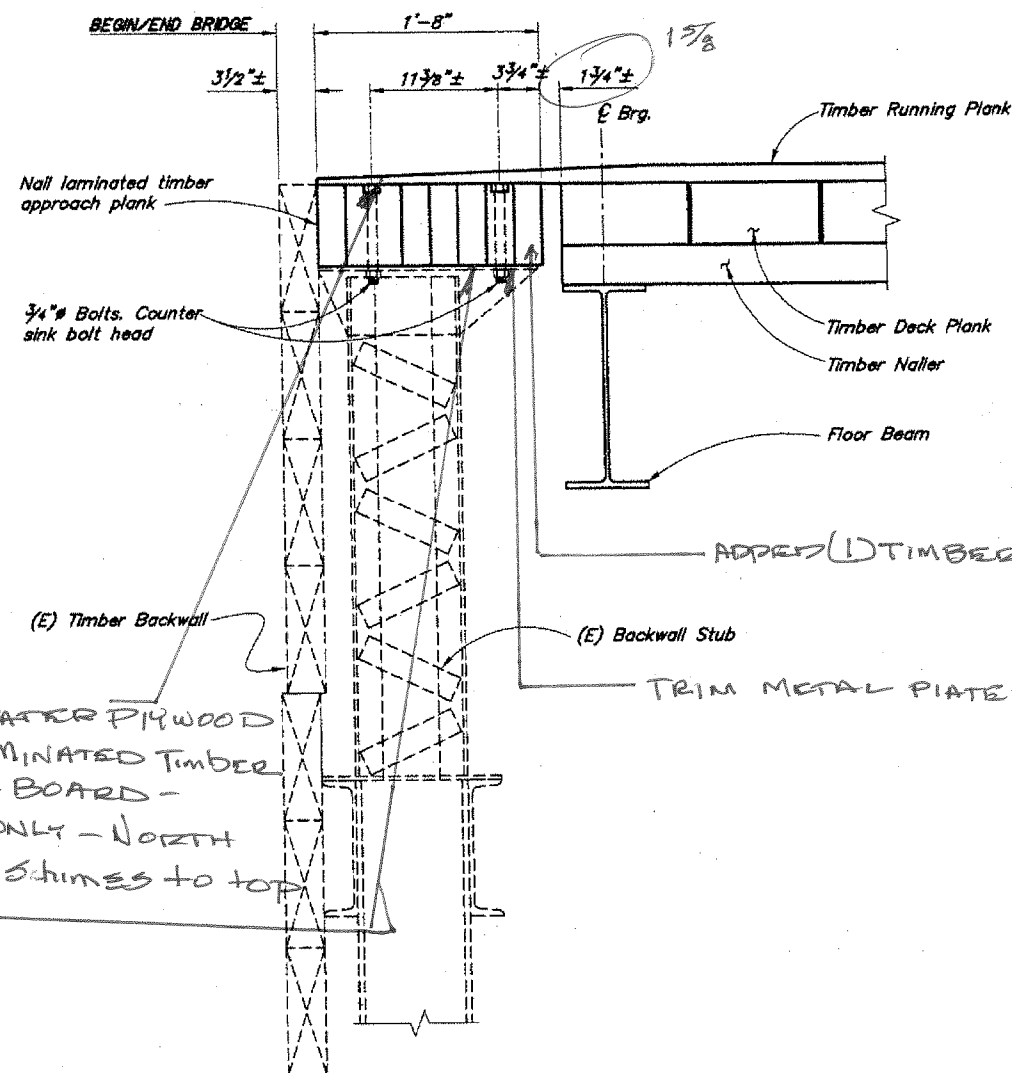

SECTION A-A

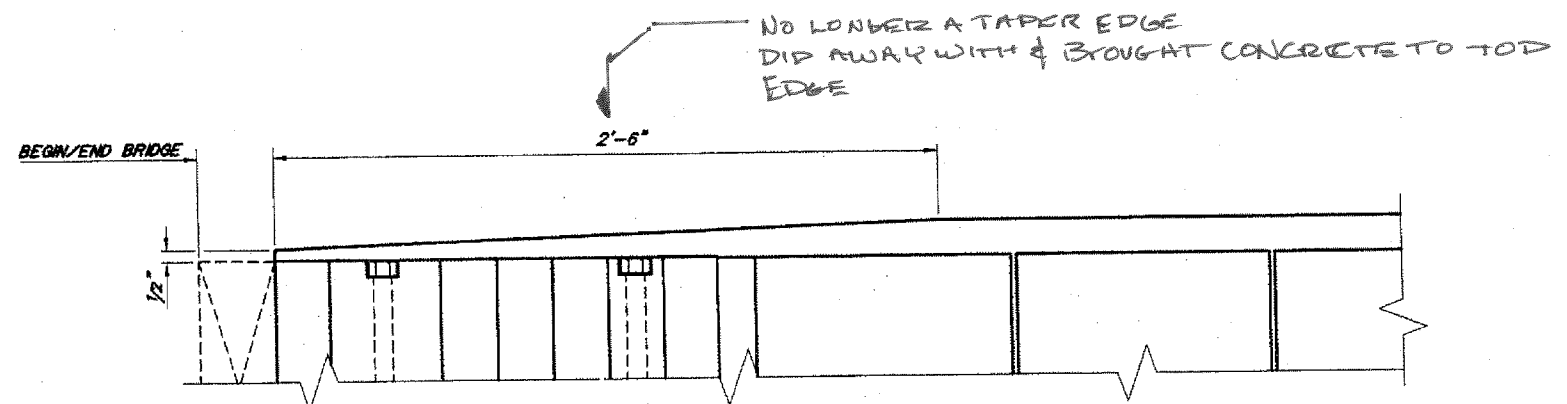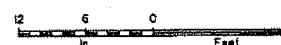

RUNNING PLANK TRANSITION DETAIL

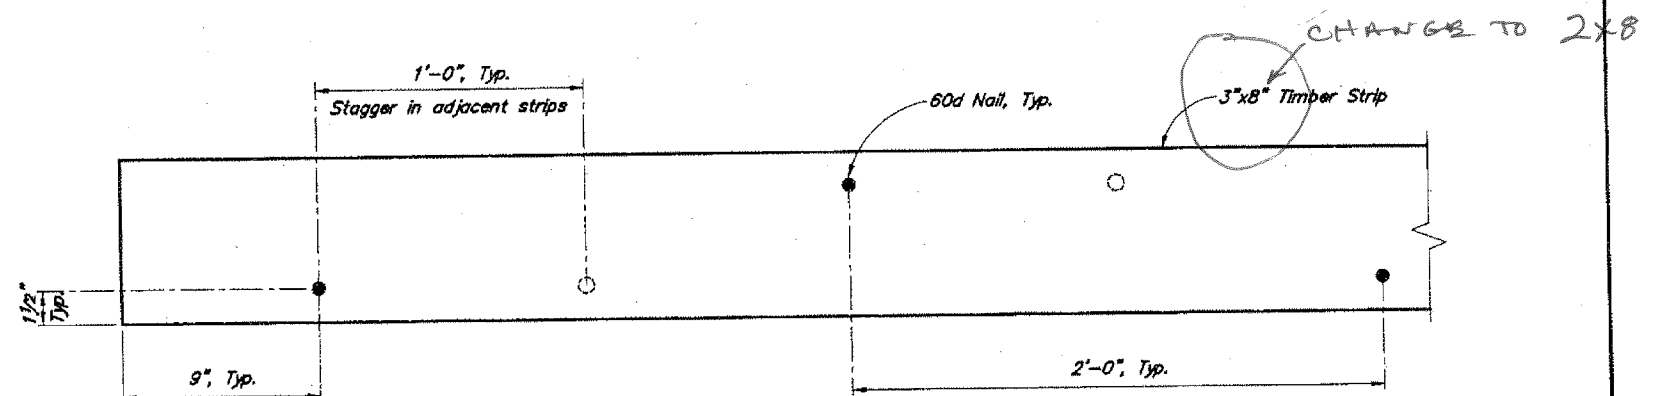

NAIL LAMINATED TIMBER APPROACH PLANK DETAIL



Project As-Built Drawings have been reviewed by the Project Engineer and represent to the best of my knowledge, the project as constructed.


PE Todd A. Bore Date 3/26/13

LEGEND

- Existing
- Work in this Contract

DESIGNED BY: <u>Todd Bore</u>	CHECKED: <u>Jared Levinge</u>
DRAWN BY: <u>Cathy Anderson</u>	CHECKED: <u>Todd Bore</u>
QUANTITIES BY: <u>Todd Bore</u>	CHECKED: <u>Jared Levinge</u>

STATE OF ALASKA
DEPARTMENT OF TRANSPORTATION
AND PUBLIC FACILITIES
BRIDGE SECTION

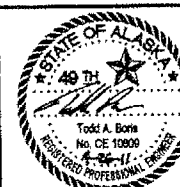


TAIYA RIVER BRIDGE
DYEA ROAD
DECK DETAILS




BRIDGE NO. 309
DWG. NO. 7

STATE	PROJECT DESIGNATION	YEAR	SHEET NO.	TOTAL SHEETS
ALASKA	69275	2011	N8	13

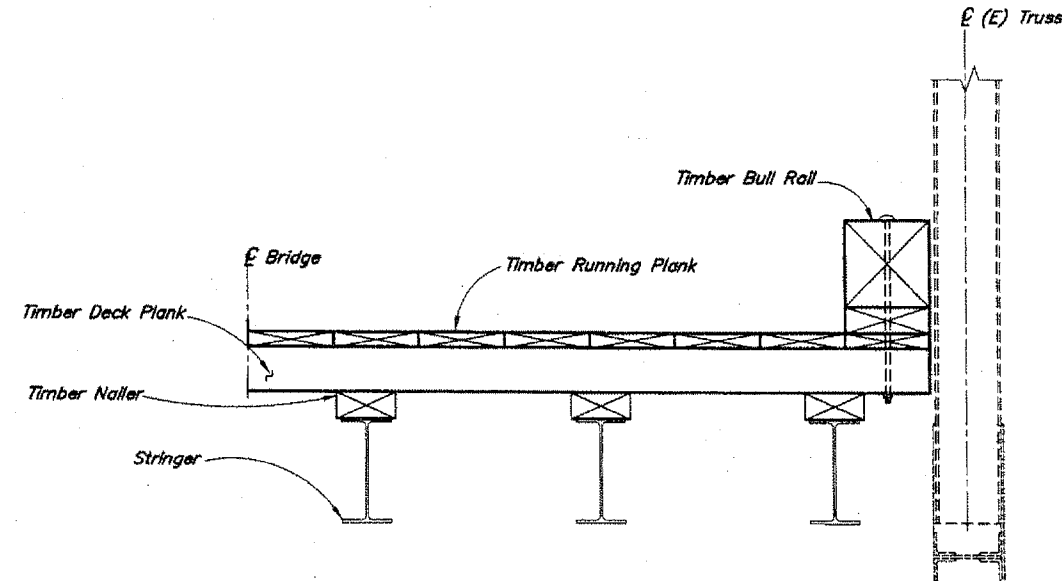

HALF TYPICAL SECTION AT BRIDGE RAIL

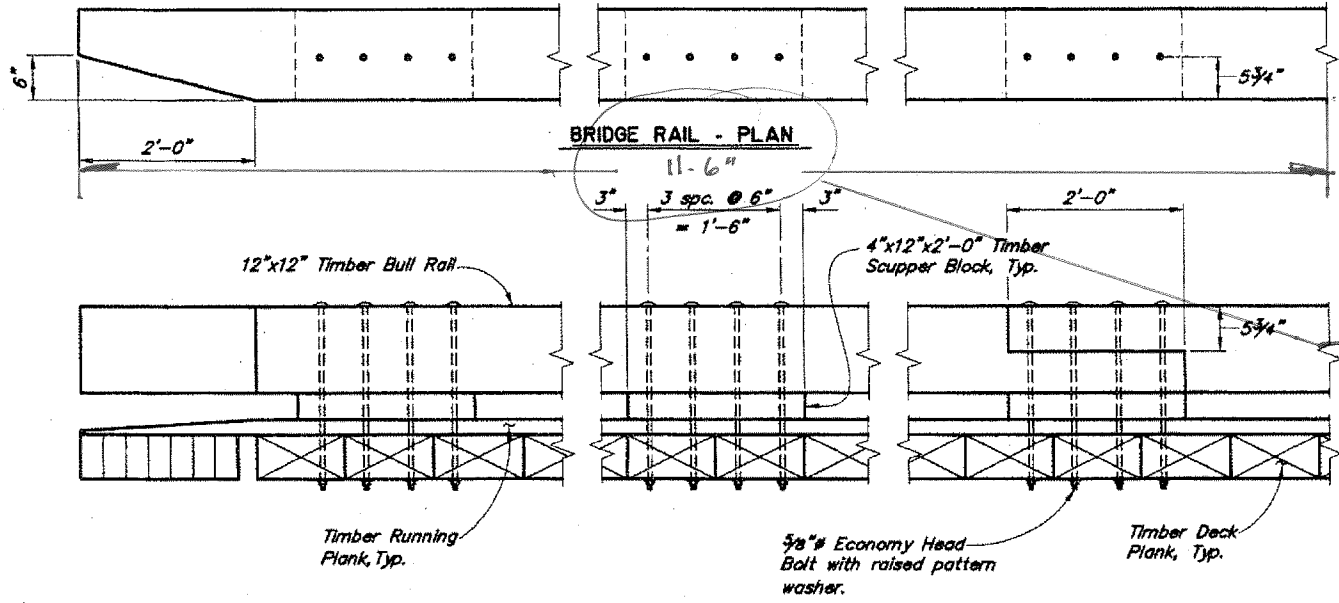

TYPICAL END


TYPICAL SCUPPER BLOCK

TYPICAL SPLICE


BRIDGE RAIL - ELEVATION



NOTE: LAST BULL RAIL CUT 11'-6" TO FINISH LAYOUT
 RATHER TO ARRIVE 12-27-11 TO FINISH 10 BOLTS 2 END RAILS 4 SCUPPER BLOCKS CLEAN UP.

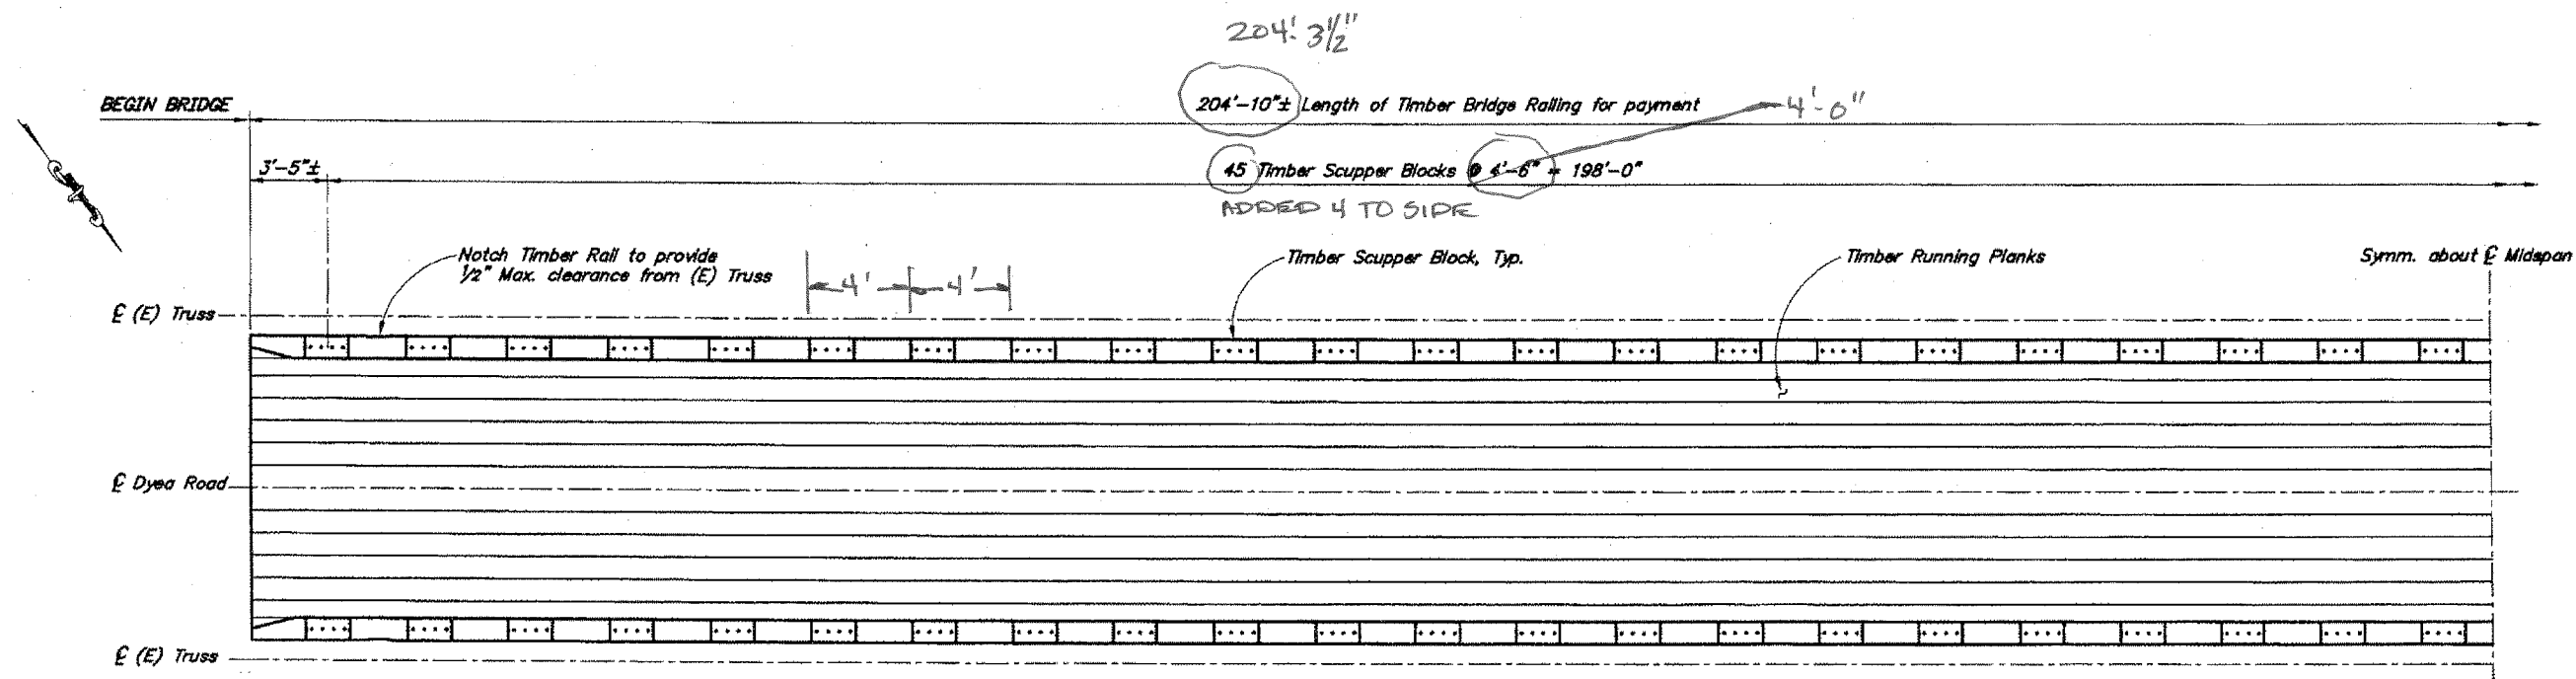

HALF DECK PLAN

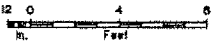


NOTE: Truss not shown for clarity.

LEGEND
 --- = Existing
 — = Work in this Contract

DESIGNED BY: Todd Barte	CHECKED: Jared Leverage
DRAWN BY: C. Anderson	CHECKED: Todd Barte
QUANTITIES BY: Todd Barte	CHECKED: Jared Leverage

Project As-Built Drawings have been reviewed by the Project Engineer and represent to the best of my knowledge, the project as constructed.
 PE Steve Ziller Date 3/26/13

STATE OF ALASKA
 DEPARTMENT OF TRANSPORTATION
 AND PUBLIC FACILITIES
 BRIDGE SECTION

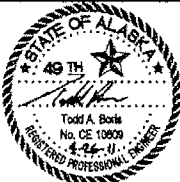

TAIYA RIVER BRIDGE
 DYEA ROAD
 TIMBER BRIDGE RAILING

BRIDGE NO. 309
 DWG. NO. 8


STATE	PROJECT DESIGNATION	YEAR	SHEET NO.	TOTAL SHEETS
ALASKA	68275	2011	N9	13

NOTES:


Limit the total weight of dead load and live load applied to the existing structure from each end of the gangway to the following:

Maximum Dead Load = 9,600 lb.


Maximum Live Load = 6,800 lb.

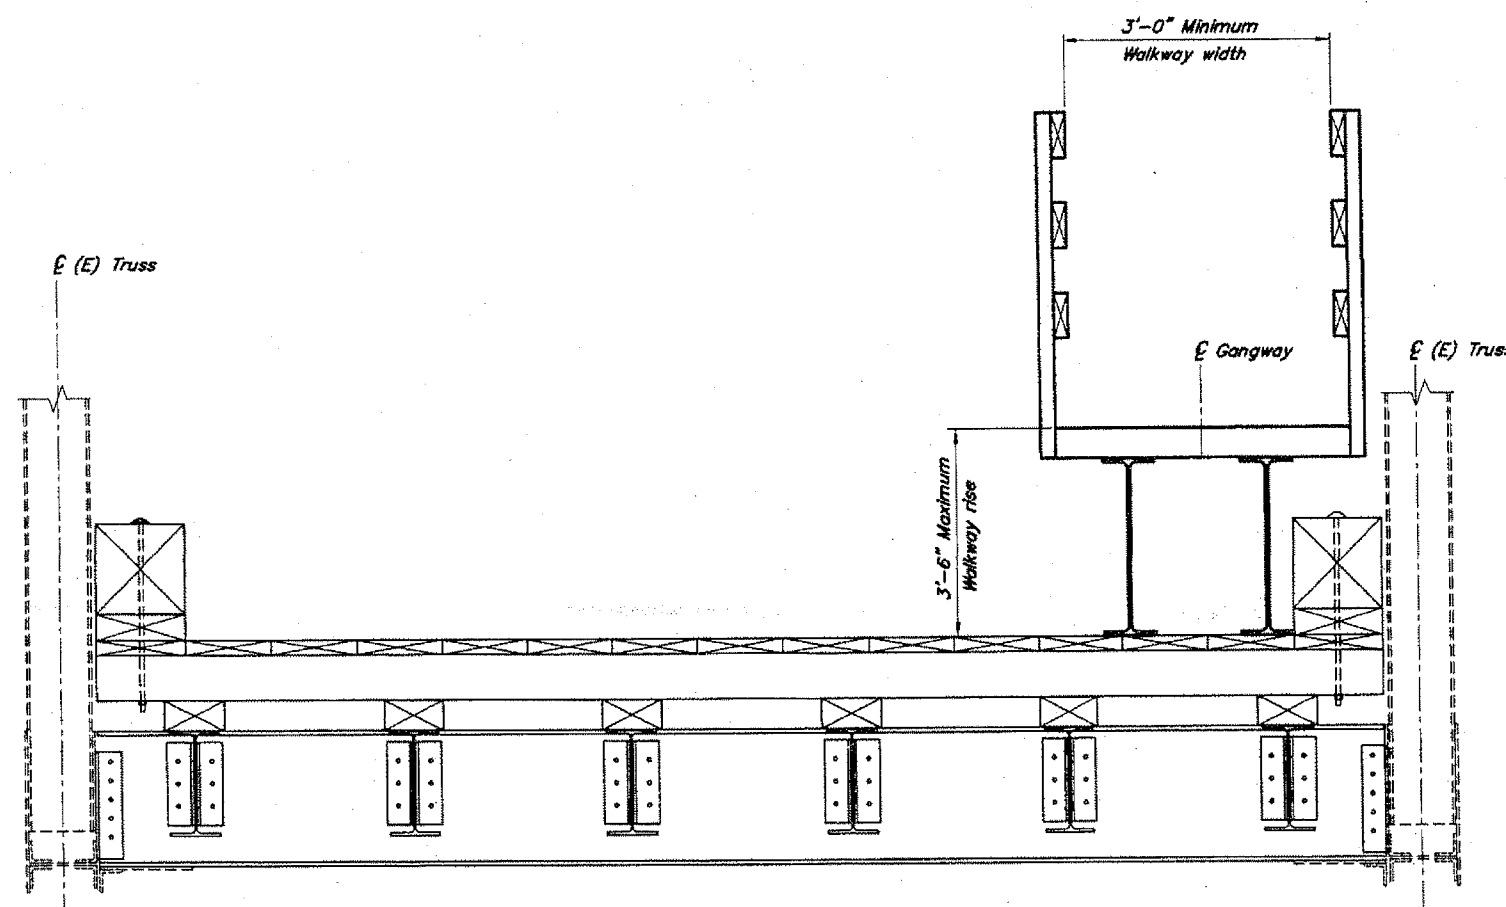

TYPICAL SECTION

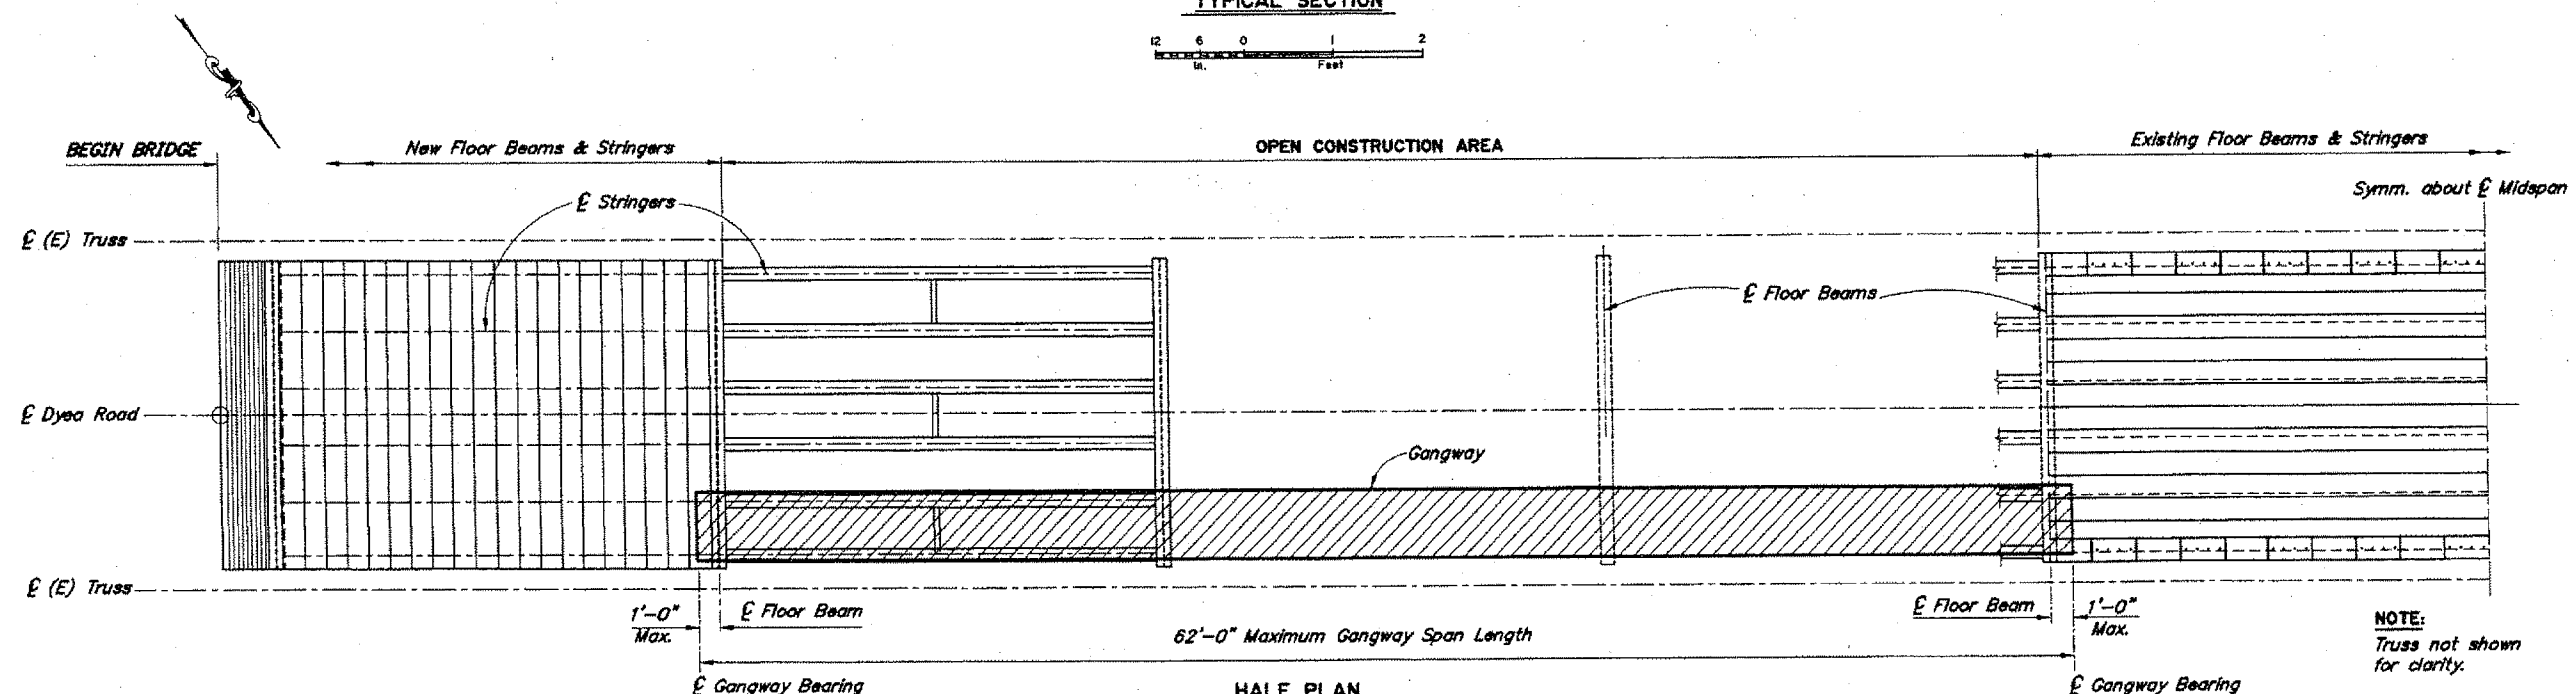

HALF PLAN
(Showing replacement work on Panels 2, 3 & 4)

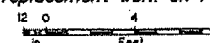

NOTE:
Truss not shown
for clarity.

LEGEND


- Existing
- Work in this Contract

DESIGNED BY: Todd Bork	CHECKED: Jared Lovings
DRAWN BY: C. Anderson	CHECKED: Todd Bork
QUANTITIES BY: Todd Bork	CHECKED: Jared Lovings

Project As-Built Drawings have been reviewed by the Project Engineer and represent to the best of my knowledge, the project as constructed.

PE 5th 2/26/13 Date 3/26/13

STATE OF ALASKA
DEPARTMENT OF TRANSPORTATION
AND PUBLIC FACILITIES
BRIDGE SECTION

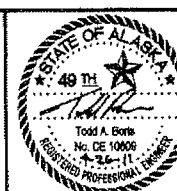

TAIYA RIVER BRIDGE
DYEA ROAD
PEDESTRIAN GANGWAY



BRIDGE NO. 309

DWG. NO. 9

NOTES:

- KEEP TRAIL ENTRANCE AND ACCESS TO CAMPGROUND ROAD OPEN AT ALL TIMES. DO NOT BLOCK, OBSTRUCT OR DAMAGE ANY PART OF THE TRAIL, CAMPGROUND ROAD OR ANY OTHER PROPERTY OF PARK SERVICES.
- A MINIMUM OF ONE ROAD LANE SHALL BE MAINTAINED TO THE SOUTH END OF THE BRIDGE, RESUMING AT THE NORTH END. TEMPORARY DRIVING LANE WILL HAVE A MINIMUM WIDTH OF 10'.
- NO CONTRACTOR VEHICLES WILL BE PARKED OR CONSTRUCTION ACTIVITY SHALL BE PERFORMED OUTSIDE RIGHT OF WAY BOUNDARIES (50' FROM CENTERLINE OF ROAD). IT'S CONTRACTOR'S RESPONSIBILITY TO DELINEATE THE BOUNDARIES WITH A TEMPORARY FENCE OR APPROPRIATE NUMBER OF CONES, AS SPECIFIED ON PLANS.
- USE APPROPRIATE NUMBER OF CONES OR TEMPORARY CONSTRUCTION FENCE TO DELINEATE ZONES 1 AND 2 AS SHOWN ON PLANS.
- INSTALL APPROPRIATE NUMBER OF BARRICADES TO RESTRICT VEHICULAR ACCESS TO THE BRIDGE.
- DESIGNATE MORE PARKING FOR RESIDENTS BELOW ZONE 2B IF EXTRA SPACE IS REQUIRED.
- USE AT LEAST 6 CONES IN THE TAPER ZONE.
- INSTALL SIGNS AS INDICATED ON PLANS. SIGNS 1 AND 2 ARE FOR GUIDANCE ONLY AND DON'T HAVE TO CONFORM TO STANDARD SPECIFICATIONS.
- ALL LOCATIONS AND DIMENSIONS ARE APPROXIMATE AND ARE BASED ON AERIAL VIEW PHOTOS.

ZONES				
CATEGORY	ZONE 1	ZONE 2a	ZONE 2b	ZONE 3
DESIGNATION	AMBULANCE, VISITORS, RESIDENTS' VEHICLES, SHUTTLE PARKING	CONTRACTOR'S EQUIPMENT STAGING AREA, STORAGE	CONTRACTOR'S EMPLOYEE PARKING, EXTRA PARKING FOR RESIDENTS' AND VISITORS' VEHICLES	TEMPORARY SHELTER, RESIDENTS' PARKING <i>Shuttle Parking</i>
APPROXIMATE OCCUPANCY (VEHICLES)	14-16	N/A	12-14	10-12


PERMANENT CONSTRUCTION SIGNS		
SIGN NO.	DESCRIPTION	ASDS SIGN NUMBER
1	PARKING FOR AMBULANCE, SHUTTLE, RESIDENTS AND VISITORS	N/A
2	PARKING FOR CONTRACTOR'S EMPLOYEES, RESIDENTS AND VISITORS	N/A
3	ONE LANE ROAD AHEAD	CW-20-4
4	BRIDGE CLOSED AHEAD	W14-104
5	BRIDGE CLOSED	R11-2
6	BRIDGE CLOSED 7 MILES AHEAD. LIMITED PEDESTRIAN ACCESS. CALL [CONTRACTOR], [TIMES AVAILABLE]	N/A

LEGEND

	RIGHT OF WAY BOUNDARIES
	CENTERLINE LOCATION
	APPROXIMATE ROAD LOCATION
	CLEAR GROUND
	ORDINARY HIGH WATER

Project As-Built Drawings have been reviewed by the Project Engineer and represent to the best of my knowledge, the project as constructed.
 PE Stu M... Date 3/26/13

NOTE: DO NOT SCALE FROM DRAWING. USE DIMENSIONS

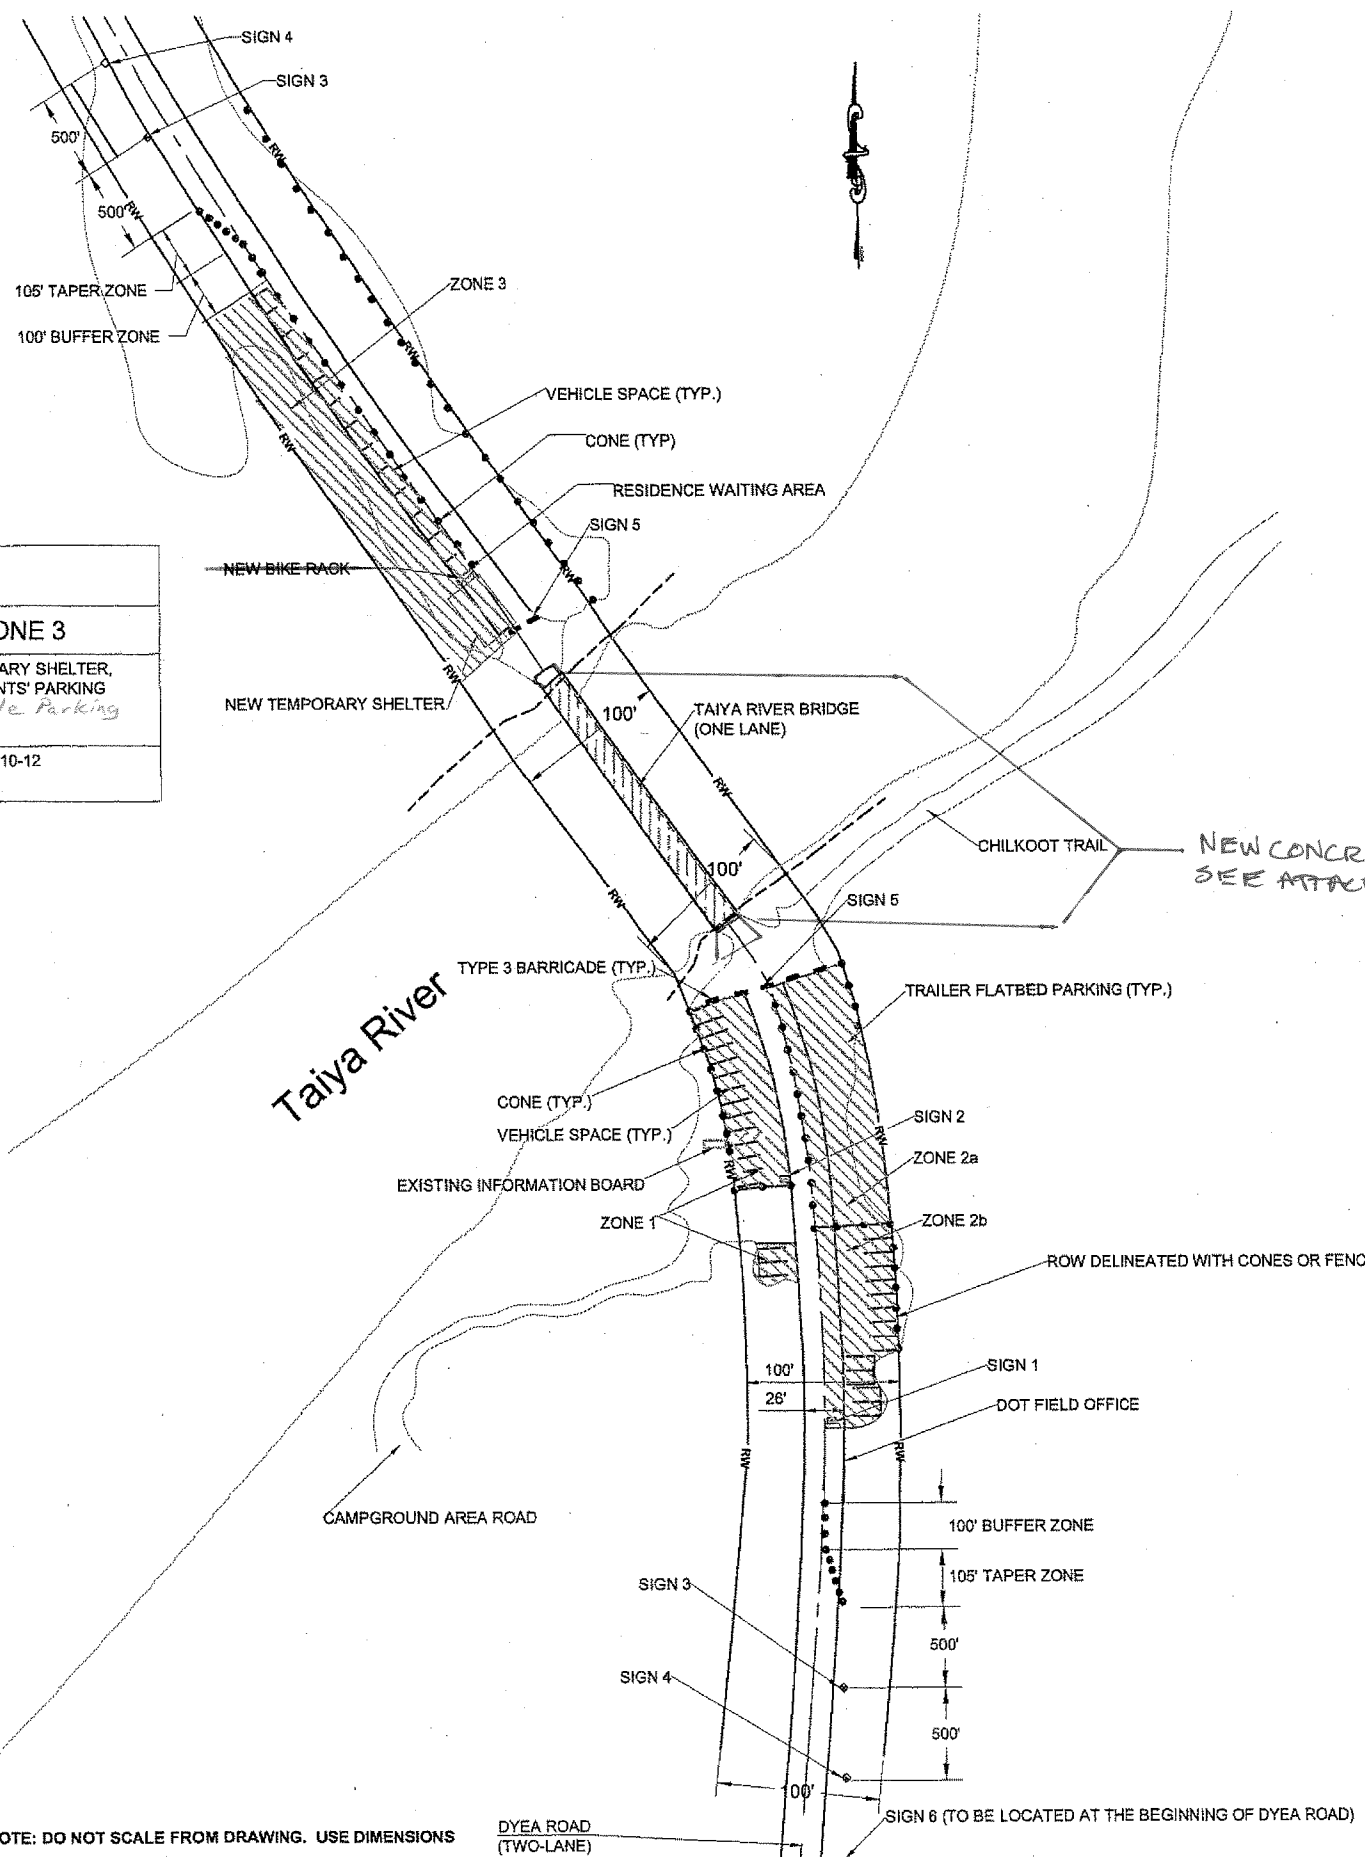

ADDENDUM NUMBER


ATTACHMENT NUMBER

RECORD OF REVISIONS

No.	DATE	DESCRIPTION

TRAFFIC MAINTENANCE

CHECKED BY: C. TRIPP

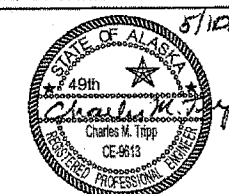

DESIGNED BY: K. NOVIKOVA / T. FAGNANT

DRAWN BY: K. NOVIKOVA / T. FAGNANT

STATE OF ALASKA
 DEPARTMENT OF TRANSPORTATION
 & PUBLIC FACILITIES
 SOUTHEAST REGION

SGY
 DYE ROAD BRIDGE # 309
 REPLACEMENT
 (TAIYA RIVER BRIDGE)

TRAFFIC MAINTENANCE

PROJECT DESIGNATION NUMBER

69275


STATE YEAR

ALASKA 2011

SHEET NUMBER TOTAL SHEETS

S1 13

501(10)

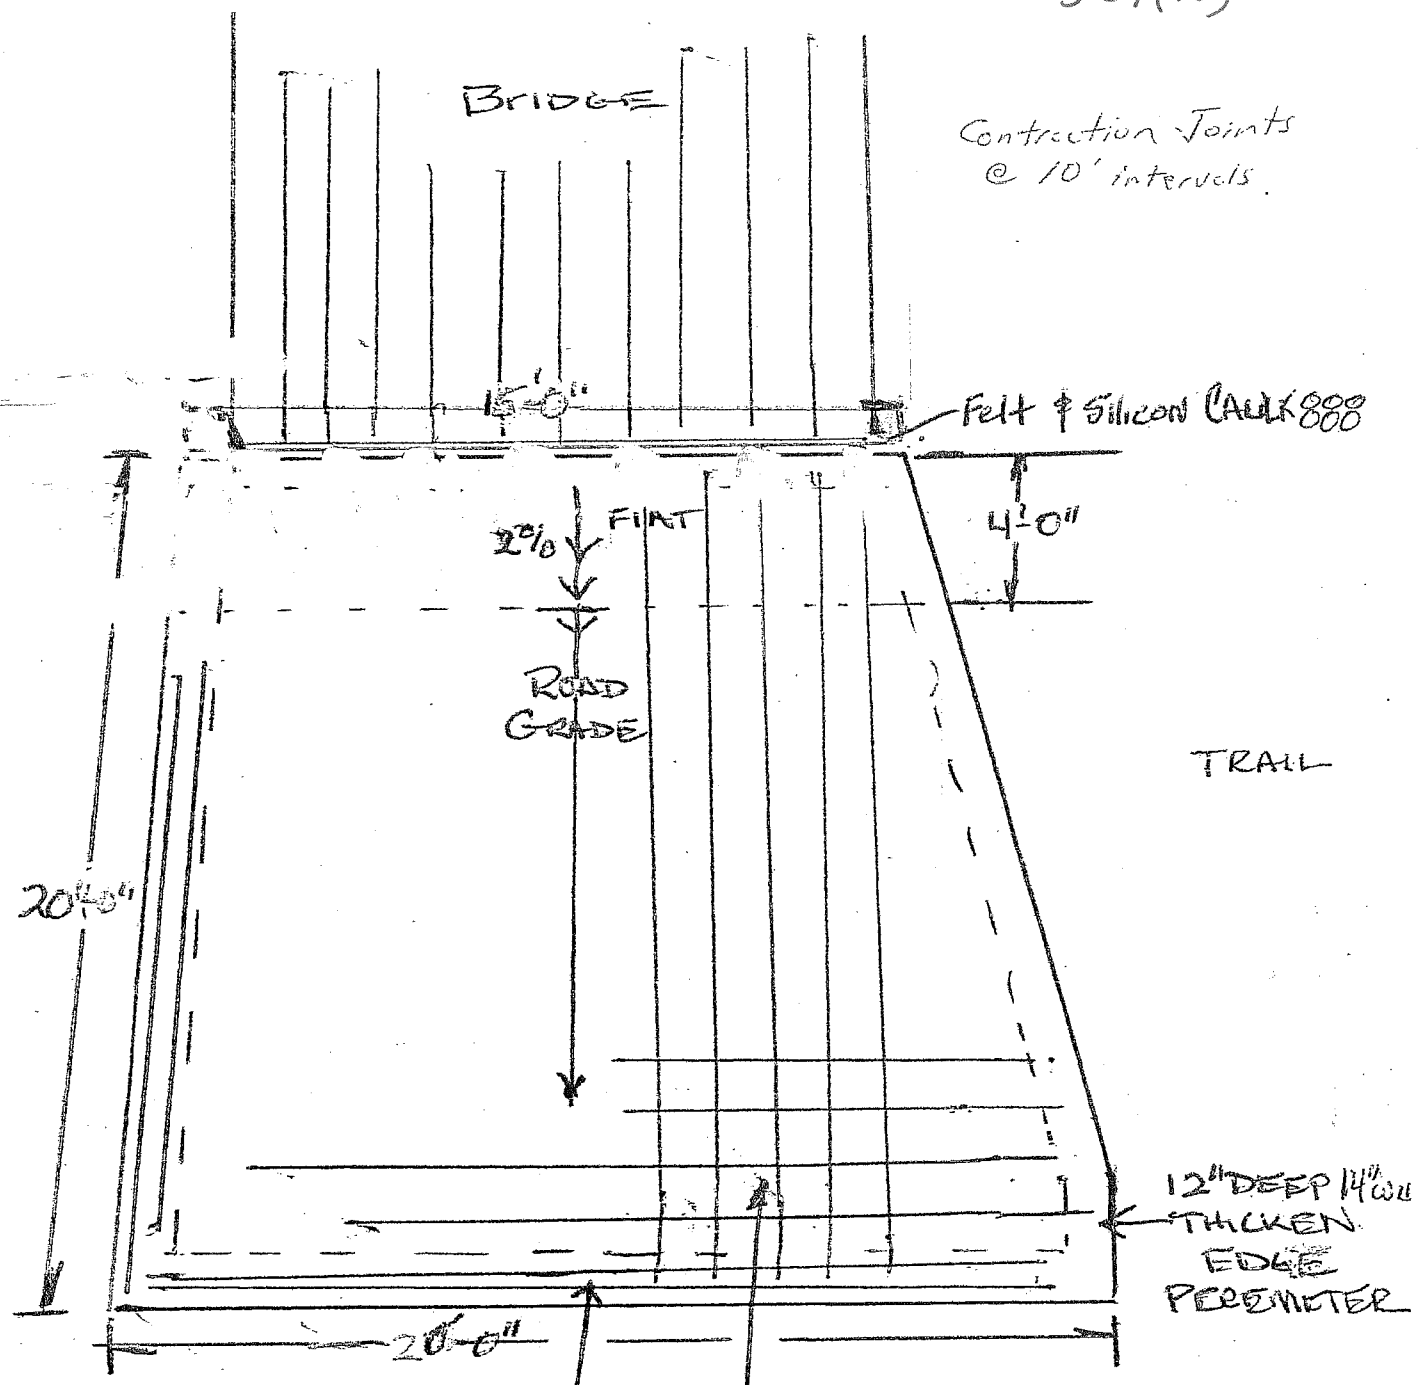

BRIDGE

Contraction Joints
@ 10' intervals

Felt & Silicon Caulk

2% FINISH

ROAD
GRADE

TRAIL

12" DEEP 14" THICKEN
EDGE
PERIMETER

#4 REBAR 12" @ EACH WAY

2#4 REBAR BOTTOM OF THICKEN
EDGE

6" SLAB 7 SACK
HOT WATER MIX
2% EXPANSION

HEAVY BROOM FINISH
AWAY FROM BRIDGE WATER
Run off


SOUTH SIDE

Project As-Built Drawings have been
reviewed by the Project Engineer and
represent to the best of my knowledge,
the project as constructed.
PE [Signature] Date 3/26/13

BRIDGE

501(10)

Temporary Concrete
Pavement

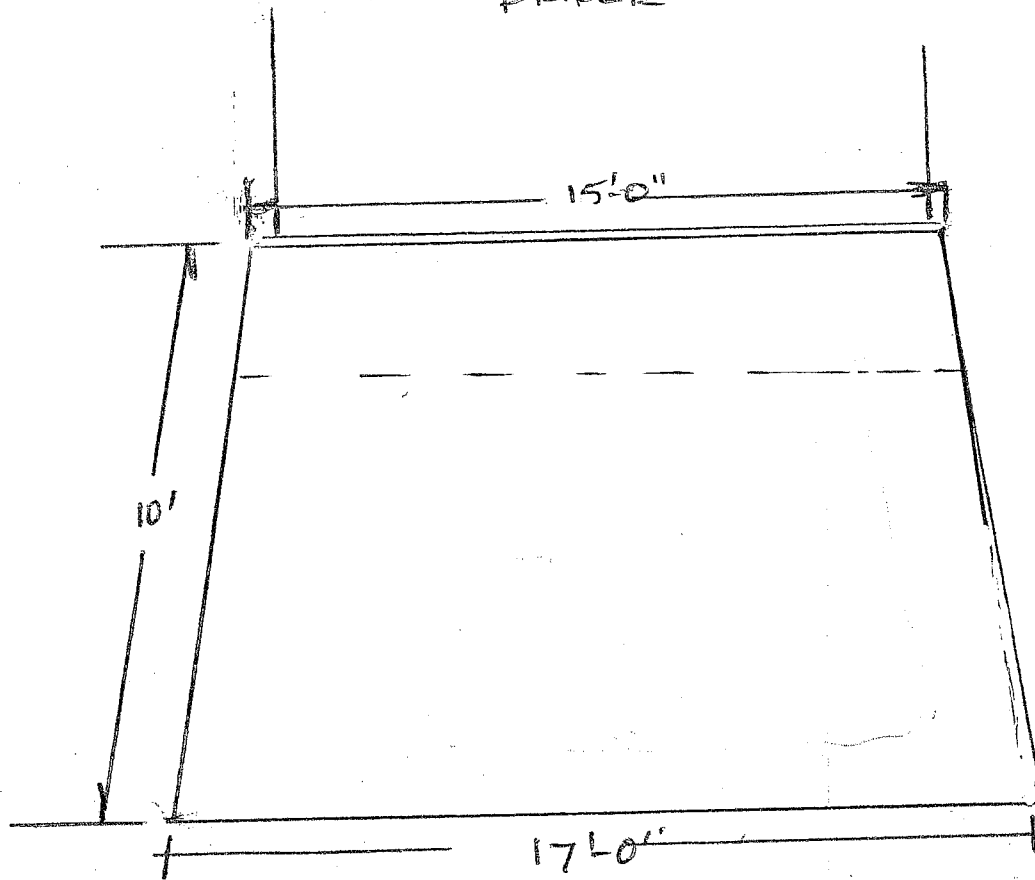

SAME DETAILS AS South Side

Project As-Built Drawings have been
reviewed by the Project Engineer and
represent to the best of my knowledge,
the project as constructed.

PE SK [signature] Date 3/26/13

NORTH SIDE