

# STATE OF ALASKA DEPARTMENT OF TRANSPORTATION & PUBLIC FACILITIES

## PLAN AND PROFILE PROPOSED HIGHWAY PROJECT F-097-2 (4) - (A - 38402) \$ F-097-2(8) KLONDIKE HIGHWAY - SANITORIUM ROAD TO CANADIAN BORDER GRADING AND SURFACING,

STATE	PROJECT DESIGNATION	YEAR	SHEET NO.
ALASKA	F-097-2(4)	1985	1

### INDEX OF SHEETS

SHEET NO.	DESCRIPTION
1	TITLE SHEET
2	TYPICAL SECTION SHEET
3	ESTIMATE OF QUANTITIES
4	SUMMARY TABLES
5	TRAFFIC CONTROL PLAN
6	DETAILS AT U.S. CUSTOMS STATION
7 - 9	STATE FURNISHED MATERIALS SITE
10 - 33	PLAN AND PROFILE SHEETS
	STANDARD DRAWINGS
2A	Revised Typical Section Sheet 1-097-2(8)
4A	Quantities - 1986 - F-097-2(8)
5A	Guardrail Summary - 1986 - F-097-2(8)
5B-5C	Guardrail Details - 1986 - F-097-2(8)
5D-5F	Concrete Barrier (Sta. 109) - F-097-2(8)

THE FOLLOWING STANDARD DRAWINGS ARE INCLUDED IN THIS PROJECT

A-1, C-00.00 C-10.01, C-11.01 D-01.00, D-04.01, D-05.01, G-04.01W, G-14.01W, G-15.00, G-18.00, M-16.00, S-00.00 S-05.00, S-30.00, T-21.00

#### PROJECT SUMMARY

WIDTH OF SUBGRADE: MAXIMUM VARIES 28' TO 32'±  
 LENGTH OF SURFACING: 61,925.80 = 11,729 MI.  
 LENGTH OF PROJECT = 11,925.80 = 11,729

DESIGN SPEED: 40 M.P.H. VS. 50 M.P.H. FOR RURAL ARTERIAL

HORIZONTAL ALIGNMENT: P.I. STA. 200+03, 1107+84-1112+28, 1126+2, 1383+63-1396+79, 1415+18-1430+00, 1497+85-1503+61

INADEQUATE S.S. DIST.

ON HORIZONTAL CURVES: P.I. STA. 183+89, 203+03, 224+61, 231+16, 260.00-280+00, 1092+95, 1030+00, 1133+00, 1294+63, 1383+63, 1392+75, 1425+84, 1457+18, 1490+00-1486+00, 1534+00, 1539+00 & 1150+00

INADEQUATE S.S. DIST.

ON VERTICAL CURVES: V.P.I. 1583+00

INADEQUATE CLEAR ZONE

BETWEEN EXISTING BACKSLOPE & EDGE T.W. 8.6 MILES ±


#### EXCEPTIONS APPROVED

DIRECTOR OF DESIGN & CONSTRUCTION 12/14/84 & FHWA 12/21/84

#### DESIGN DESIGNATION

- ADT 1983 = 187
- ADT 2004 = 289
- DIV 12% = 35
- D = 60-40
- %T = 6%
- V = 40 MPH

*11/12/85 to 12/14/84... This is a continuation of the 1984 plan of the 1984 paving, base course project and the 1986 overlay project. It was compiled to include all relevant, physical roadway characteristics on one set of plans. Horizontal and vertical measurements 1 to 3" order accuracy. In case of conflict 1986 details govern over 1985.*

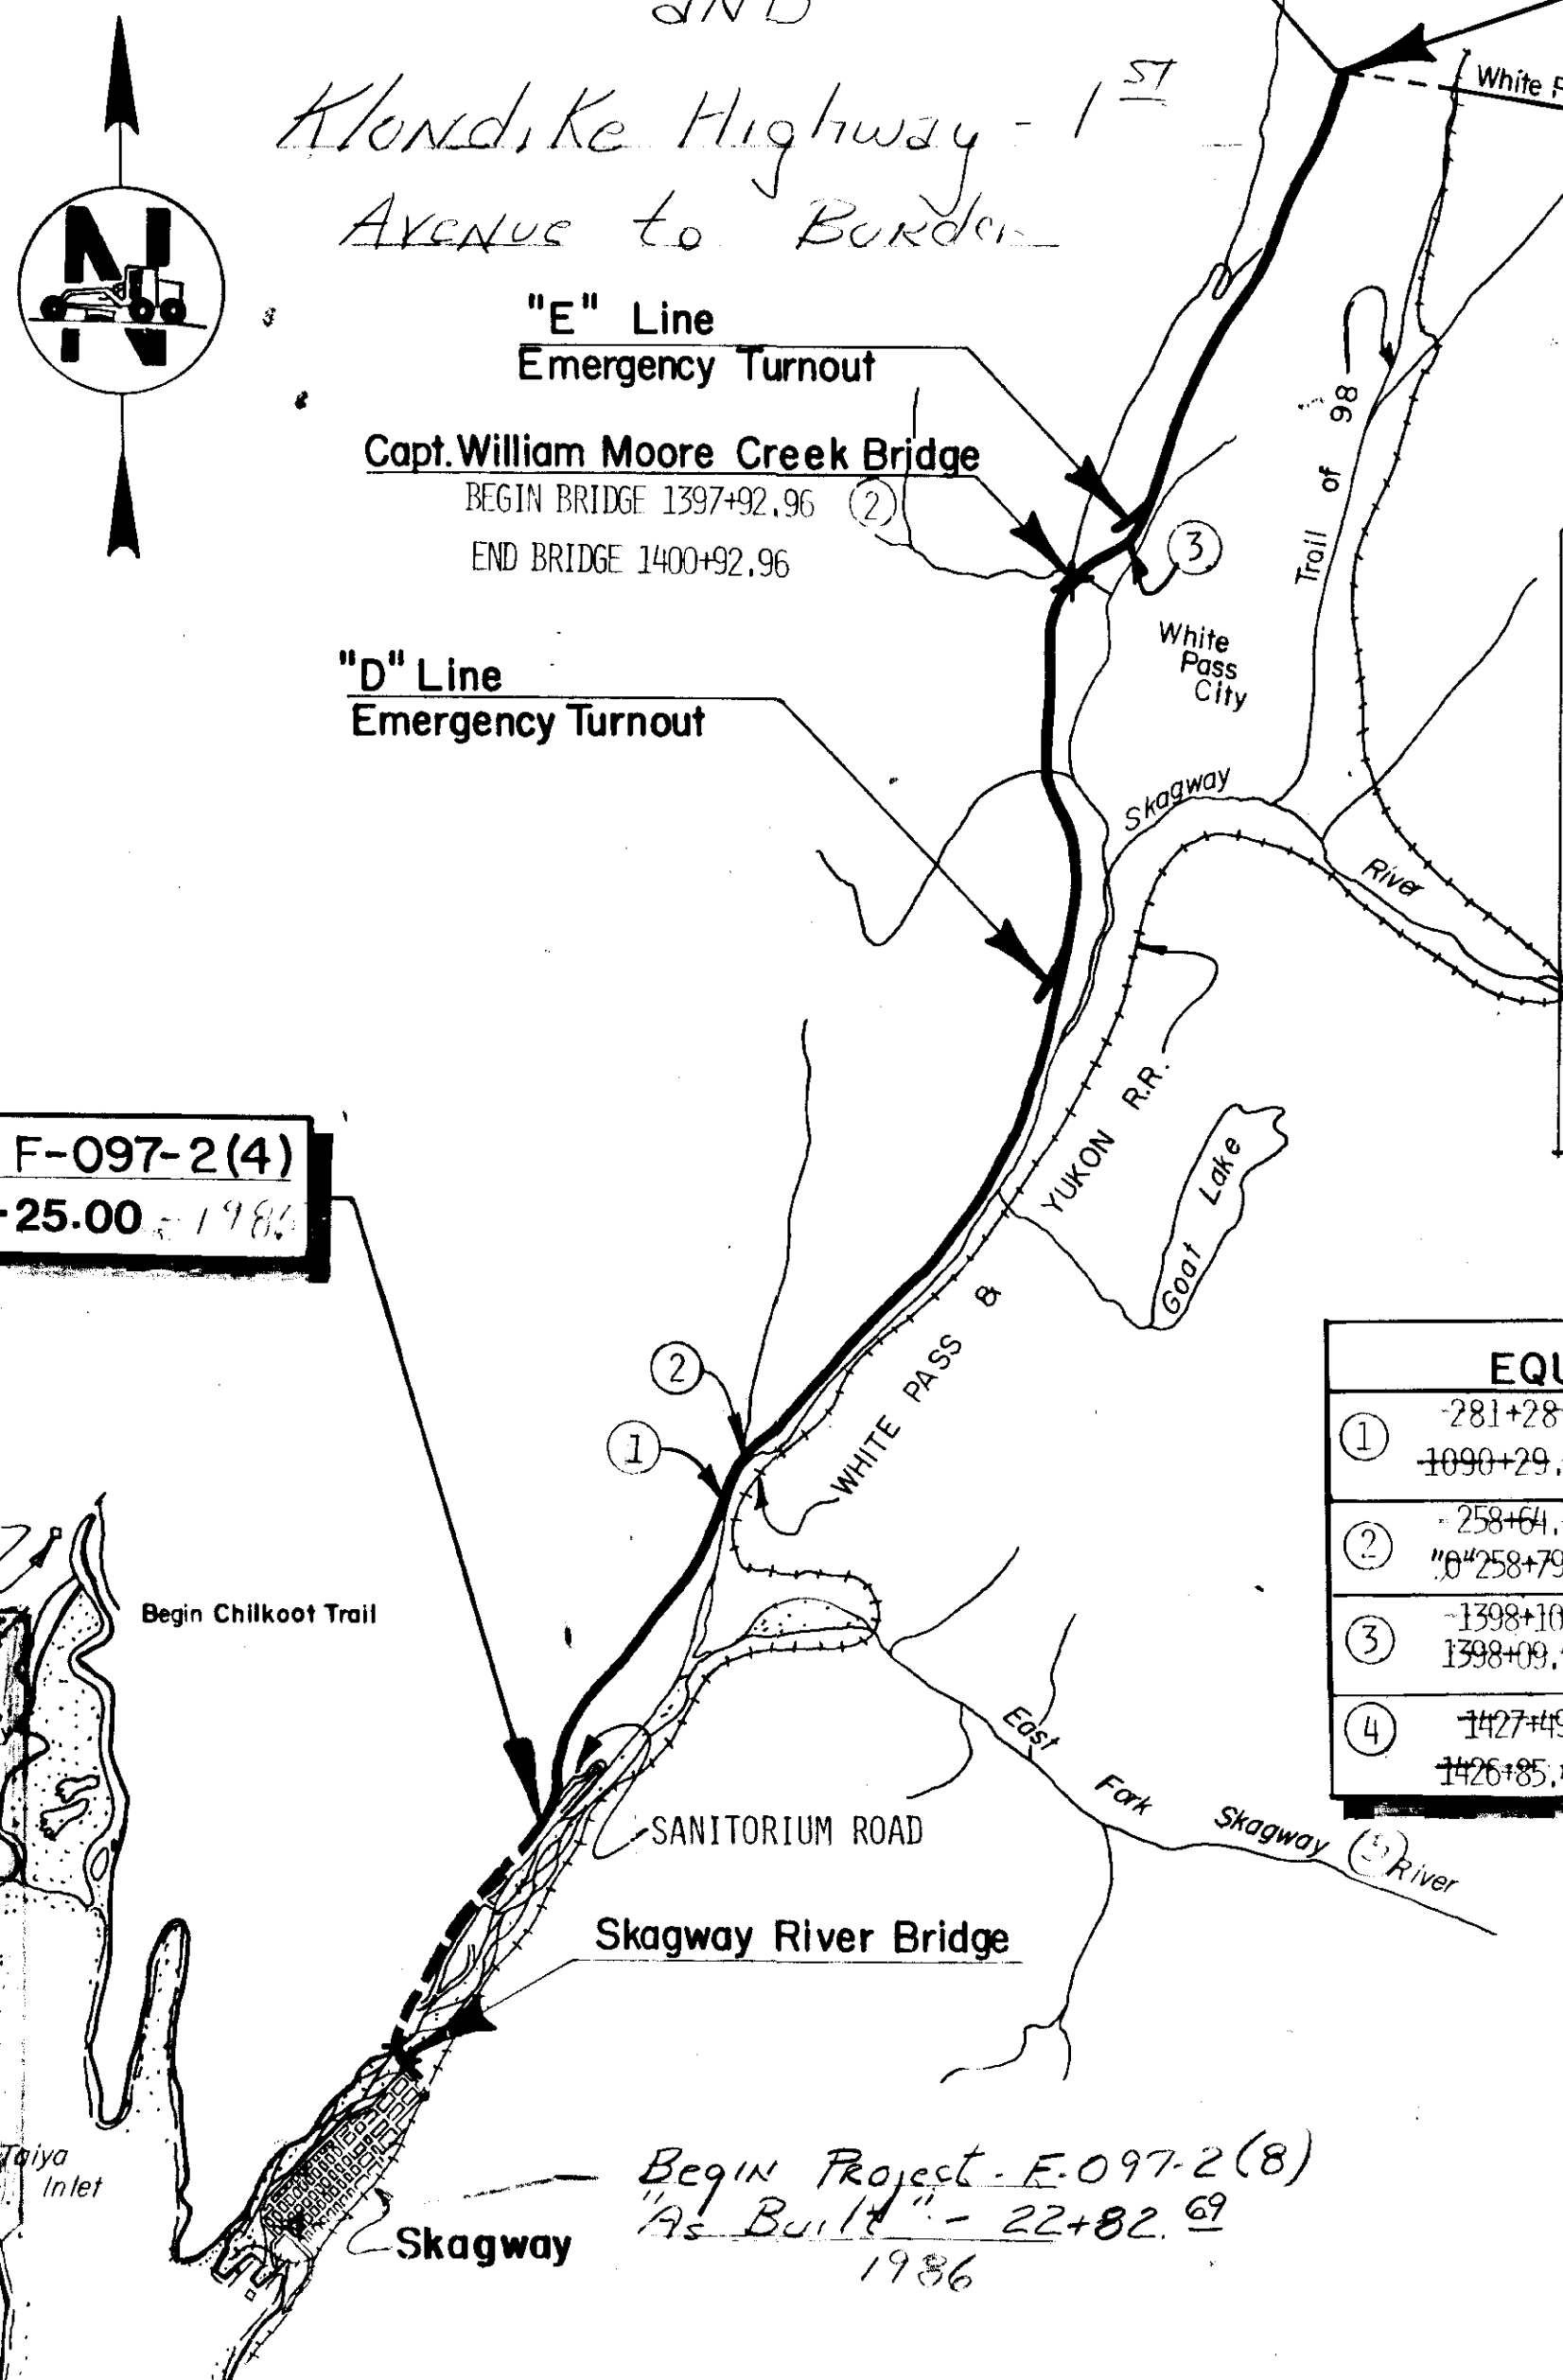

END PROJECT NO. F-097-2(4) "AS BUILT" 1590+86.50 ± 159 +00 \$ F-097-2(8)

BEGIN PROJECT NO. F-097-2(4) "AS BUILT" 163+25.00 ± 163 ± 1986

F-097-2(8)  
AS-BUILT  
July 1986 - July 1987  
ASSOCIATED SAND & GRAVEL  
PROJ. Warm Falls Valley Lorry Gene

F-097-2(4)  
AS-BUILT  
June 1985 - May 1986  
SELEY INC  
Lorry Gene


EQUATIONS	
① 281+28.86 P.T. BK. = 1090+29.37 P.O.T. AHD.	205+58.66 BK 205+58.43 AHD.
② 258+64.66 P.T. BK. = 1090+79.64 P.O.T. AHD.	281+13.92 BK 1090+07.15 AHD.
③ 1398+10.22 P.T. BK. = 1398+09.96 P.O.T. AHD.	1090+75.02 BK 1090+74.82 AHD.
④ 1427+49.30 P.T. BK. = 1426+85.45 P.O.T. AHD.	1168+93.66 BK 1168+93.77 AHD.

STATE OF ALASKA  
DEPARTMENT OF TRANSPORTATION  
AND  
PUBLIC FACILITIES

APPROVED BY: *Wallace Kullback* DATE: 2/21/85  
 CHIEF  
 Southeast Design




STATE OF ALASKA  
DEPARTMENT OF TRANSPORTATION  
AND  
PUBLIC FACILITIES

APPROVED BY: \_\_\_\_\_ DATE: \_\_\_\_\_  
 DIRECTOR  
 Southeast Region  
 Design and Construction

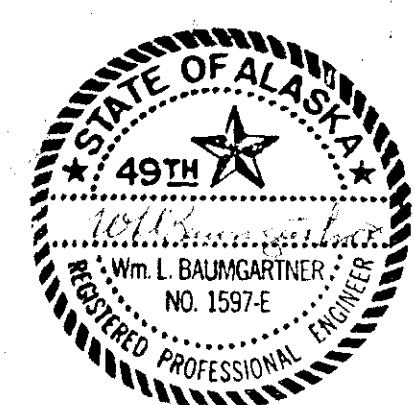

# TYPICAL SECTION OF IMPROVEMENTS

STATE	PROJECT DESIGNATION	YEAR	SHEET NO.	TOTAL SHEETS
ALASKA	F-097-2(4)	1984	2	33

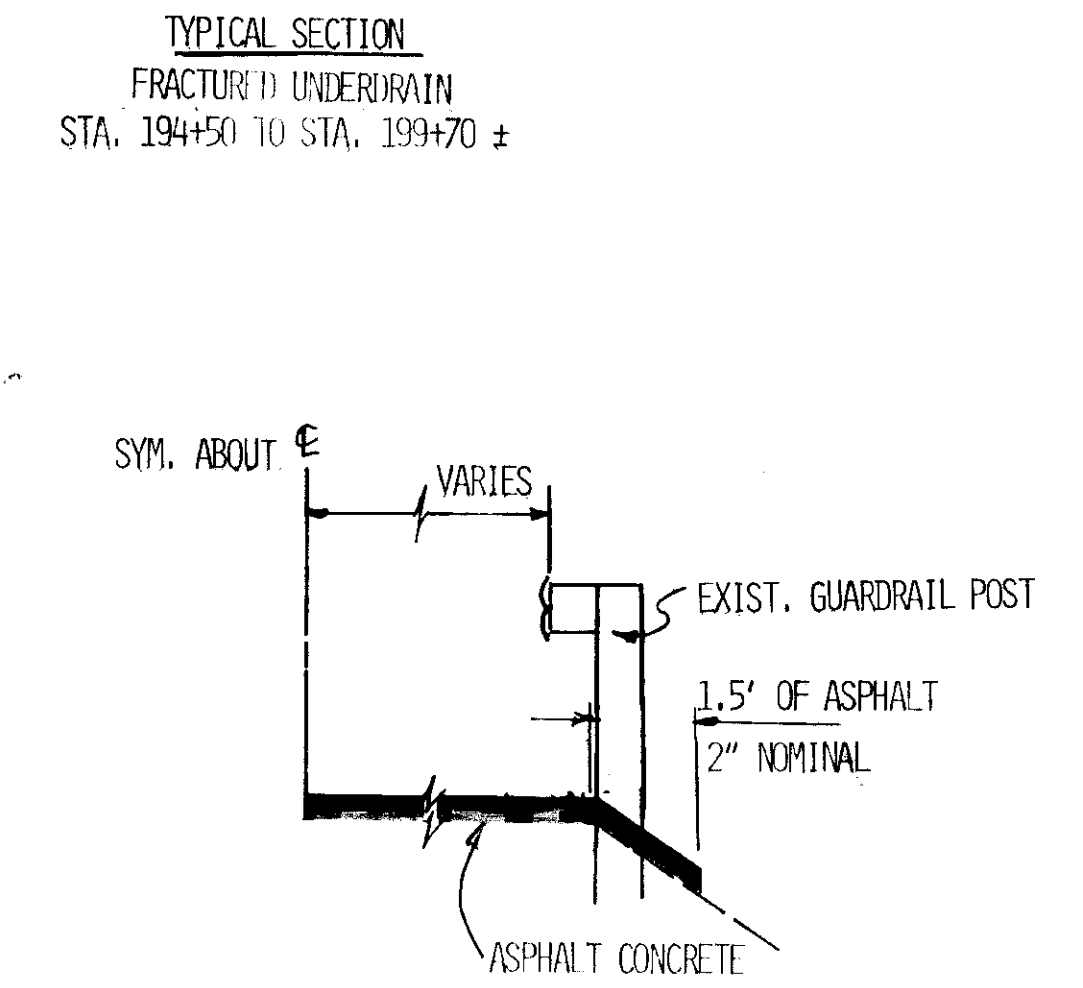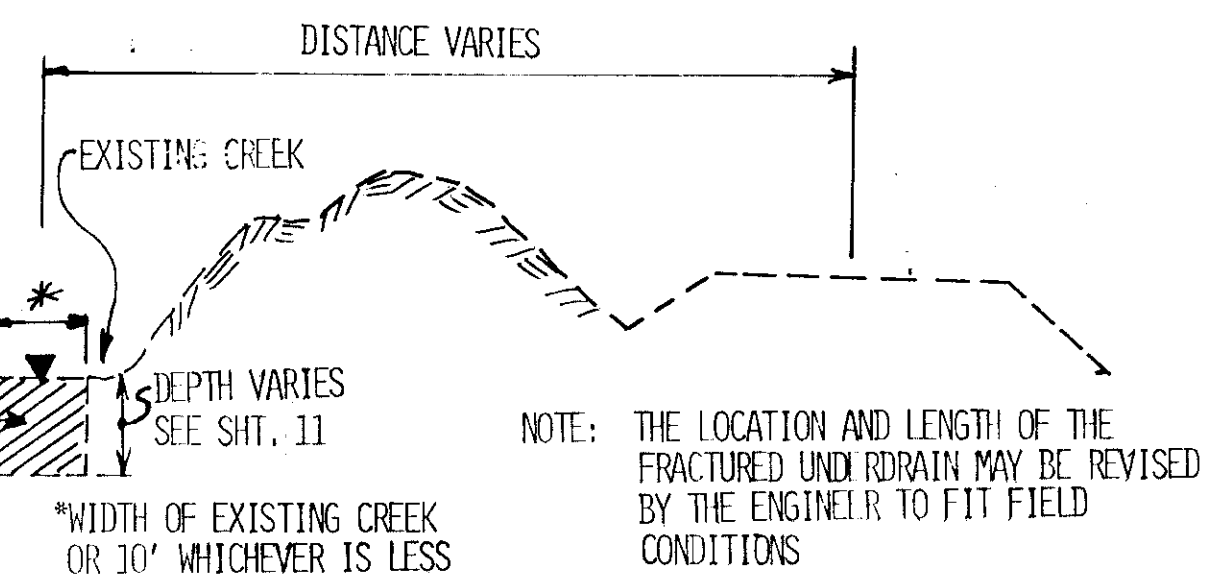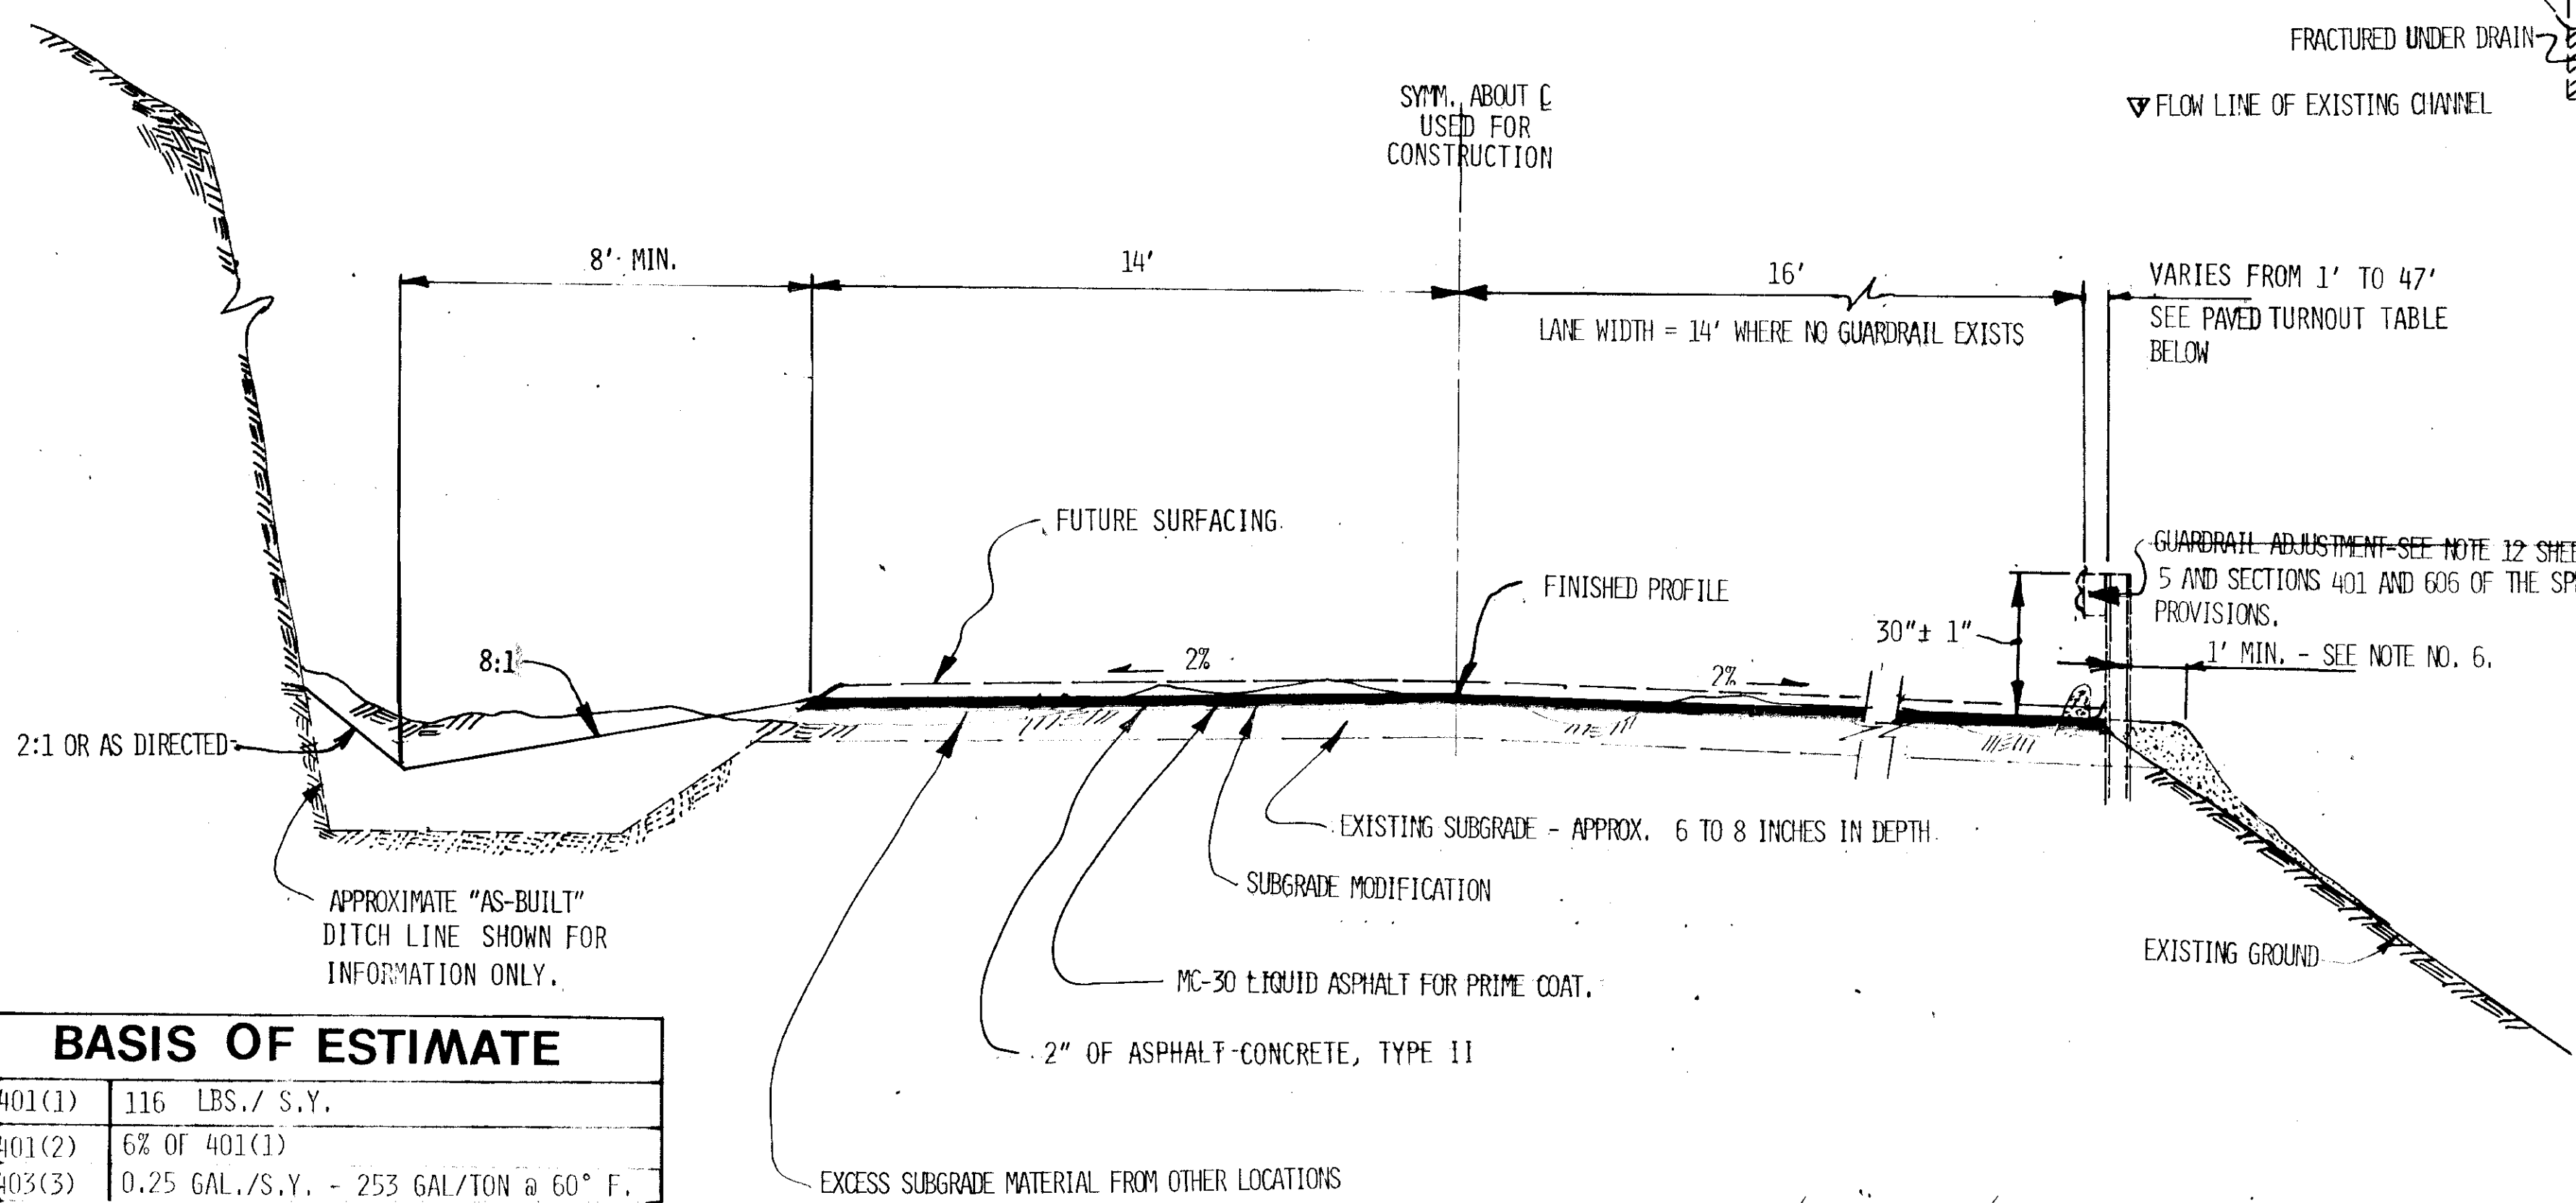


### BASIS OF ESTIMATE


401(1)	116 LBS./ S.Y.
401(2)	6% OF 401(1)
403(3)	0.25 GAL./S.Y. - 253 GAL/TON @ 60° F.

See sheet 2A for typical sections

## B.O.P. STA. 163+25.00 to E.O.P. STA. 1590+86.5

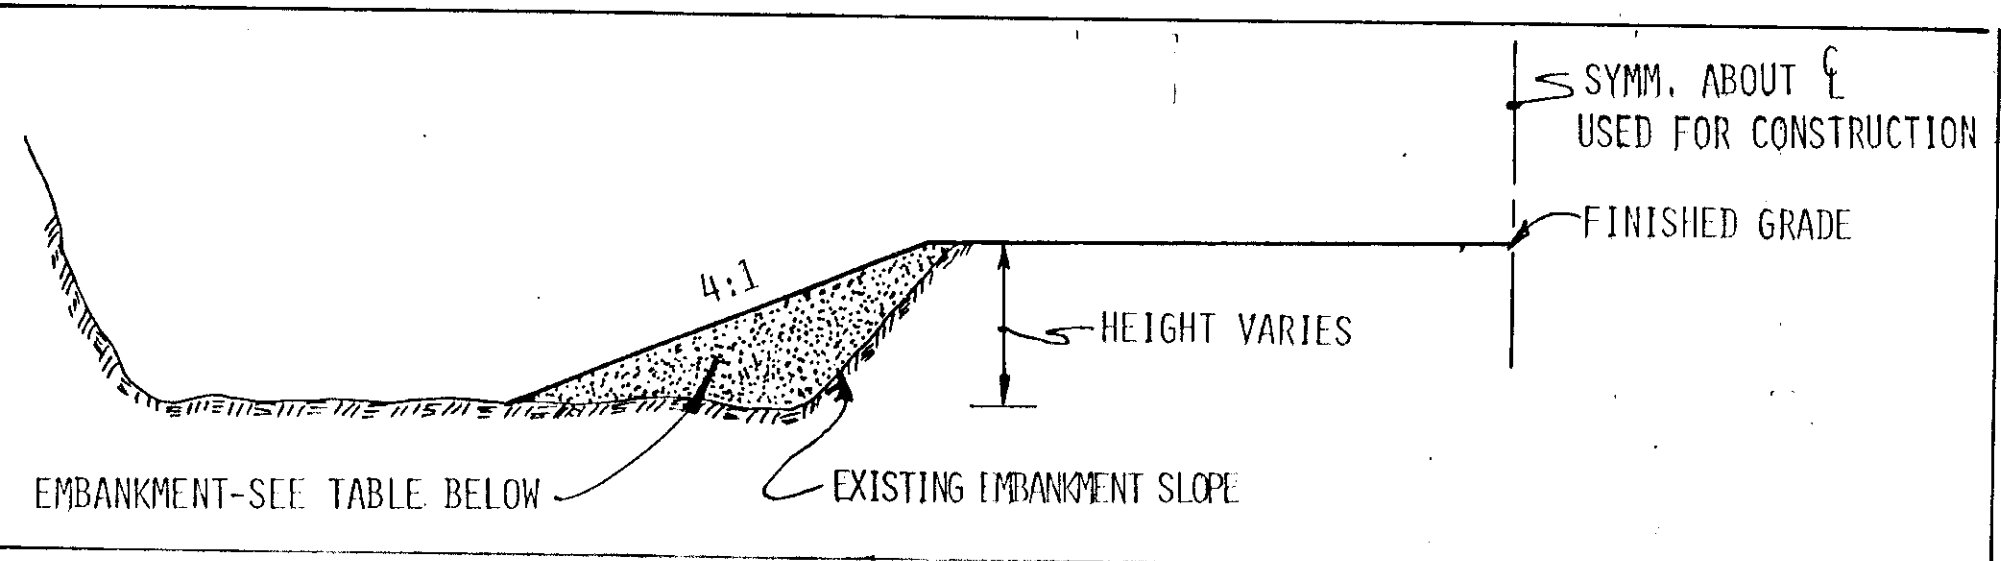

PAVED TURNOUT TABLE				
STA. TO STA.	LT.	RT.	APPROX. WIDTH	REMARKS
245+00 to 245+75	✓		25'	BLACK LAKE TURNOUT
250+50 to 255+00	✓		15'	BLACK LAKE TURNOUT
264+50 to 271+00		✓	VARIES	TURNOUT WIDTH VARIES FROM 0 TO 22 FEET
1098+00 to 1100+00		✓	VARIES	0 TO 10 FEET
1101+50 to 1100+00		✓	VARIES	0 TO 42 FEET
1124+50 to 1128+10		✓	VARIES	0 TO 47 FEET
1136+75 to 1139+50	✓		VARIES	0 TO 36 FEET
1202+00 to 1209+00		✓	VARIES	0 TO 19 FEET
1209+50 to 1215+00	✓		VARIES	0 TO 20 FEET
1242+50 to 1246+60	✓		VARIES	0 TO 45 FEET
1263+50 to 1268+00	✓		VARIES	0 TO 20 FEET
1272+00 to 1281+50	✓		VARIES	0 TO 16 FEET
1291+35 to 1298+00	✓		VARIES	0 TO 42 FEET
LOWER ESCAPE RAMP	✓		VARIES	SEE SHT. 20
1418+50 to 1426+50		✓	VARIES	0 TO 82 FEET & 0 TO 46 FEET
UPPER ESCAPE RAMP	✓		VARIES	SEE SHT. 25
1497+50 to 1500+00	✓		VARIES	0 TO 20 FEET
1564+50 to 1568+90	✓		VARIES	0 TO 40 FEET
1576+40 to 1581+50	✓		VARIES	0 TO 30 FEET

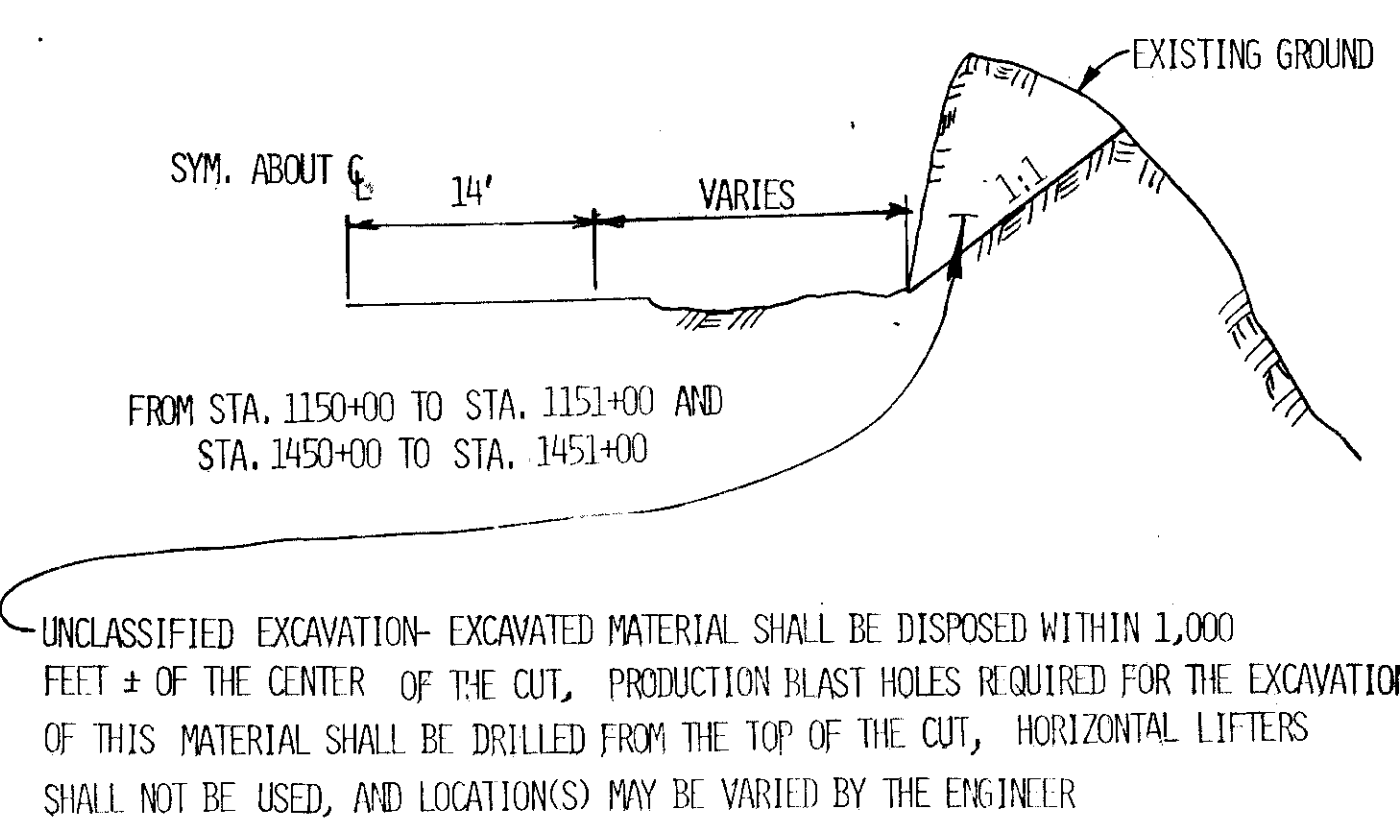

EMBANKMENT AREAS			
STA. TO STA.	LT.	RT.	APPROXIMATE C.Y OF EMBANKMENT
1225+00 to 1238+00	✓		3,500
1250+00 to 1255+00	✓		225
1335+00 to 1344+00	✓		400
1381+00 to 1387+00	✓		300
1488+10 to 1489+60	✓		600
LOCATIONS VARIES-SEE SHT. FOR DETAILS AND PLAN AND PROFILE SHEETS FOR LOCATIONS	8	6	280
GUARDRAIL FLAIR 200- TO 201+25	✓		200
GUARDRAIL FLAIR 241- TO 241+50		✓	200
GUARDRAIL FLAIR 243- TO 243+50	✓		100

## GENERAL NOTES

- THE STATIONING CURVE DATA, AND EXISTING MONUMENTS SHOWN IN THIS PLAN ASSEMBLY ARE "AS-BUILT" AND ORIGINATED FROM "AS-BUILT" PROJECT NUMBERS RF-097-2(5), 22 ND. AVENUE TO SANATORIUM ROAD, DATUM 1983, S 0999(6) SKAGWAY TO CARCROSS HIGHWAY, DATED 1966, AND ALS-0999(12), SKAGWAY TO THE CANADIAN BORDER, DATED 1974. THE STATE OFFERS NO GUARANTEE AS TO THE ACCURACY OF THE ELEVATIONS, STATIONS, BEARINGS, DISTANCES, CURVE DATA, OR LOCATIONS OF EXISTING MONUMENTS. THESE ITEMS ARE PROVIDED TO THE CONTRACTOR FOR HIS GENERAL INFORMATION AND USE IN DEVELOPING THE CONTROL ALIGNMENTS. *Red line changes have been done to the plan showing the proposed roadway grades shown in the plan only. Actual grades will vary.*
- THE HORIZONTAL AND VERTICAL ALIGNMENTS ARE TO BE AS-BUILT AND DEVELOPED BY THE CONTRACTOR. SEE SECTION 114 OF THE SPECIAL PROVISIONS. THESE ALIGNMENTS ARE TO BE DEVELOPED BY BEST FITTING THE "AS-BUILT" DATA AND THE OTHER DETAILS SHOWN IN THE ACCOMPANYING PLANS TO THE EXISTING ROADWAY PRISM.
- Method of rotation varies to meet field conditions.* ALL SUPERELEVATION IS TO BE INSTALLED BY ROTATING THE SUPERELEVATION ABOUT THE INSIDE SHOULDER. RATES OF SUPERELEVATION AND BEGINNING STATIONS FOR SUPERELEVATION TRANSITIONS ARE SHOWN ON THE PLAN AND PROFILE SHEETS.
- PLACEMENT OF PRIME COAT OR ASPHALT MATERIAL SHALL NOT BEGIN UNTIL THE ENGINEER HAS APPROVED THE RESHAPED/MODIFIED SUBGRADE. APPROVAL OF THE RESHAPED SUBGRADE SHALL NOT BE GRANTED UNTIL THE CONTRACTOR HAS BLUE TOPPED THE EXISTING SUBGRADE AND RESHAPED THE EXISTING SUBGRADE (SUBGRADE MODIFICATION).
- THE CONTRACTOR SHALL CLEAN ALL DITCHES AS DETAILED ON THE TYPICAL SECTION. THIS WORK ALSO INCLUDES THE REMOVAL OF ANY BOULDERS FROM THE EXISTING DITCH LINE(S) AS DIRECTED. THE CONSTRUCTION OF ANY SPECIAL DITCH REQUIRED, AND ALL ENGINEERING AND STAKING REQUIRED FOR INSTALLATION OF SPECIAL DITCH(S) SHALL BE PAID FOR AS EXTRA WORK UNDER ITEMS 114(7) & 203(3)
- DISPOSAL AREA FOR SPOIL FROM DITCH CLEANING OR EXCESS SUBGRADE MODIFICATION. LOCATIONS, PERCENT OF COMPACTION, AND SLOPES SHALL BE AS DIRECTED IN LOCATING DISPOSAL AREA(S). THE PROPOSED GUARDRAIL LOCATIONS SHALL HAVE FIRST PRIORITY. PROPOSED GUARDRAIL LOCATIONS HAVE PRIORITY SO THAT THE EXISTING ROADWAY IS SHIFTED INTO TO 2 FEET LEFT, OR THE EXISTING EMBANKMENT IS WIDENED AND THE GUARDRAIL INSTALLED AS DETAILED ON THIS SHEET. PAYMENT FOR THIS WORK IS SUBSIDIARY OBLIGATION UNDER ITEM 302.
- PAINTED PAVEMENT MARKINGS ARE REQUIRED ON THIS PROJECT FROM THE B.O.P. TO THE E.O.P. A DOUBLE YELLOW CENTERLINE AND WHITE EDGE LINES SHALL BE INSTALLED IN ACCORDANCE WITH THE PAVED SHOULDER DETAIL SHOWN ON STANDARD DRAWING T-21.00, SECTION 670 OF THE STANDARD SPECIFICATIONS AND SECTION 670 AND 708 OF THE SPECIAL PROVISIONS. TEMPORARY PAVEMENT MARKINGS MAY BE REQUIRED. SEE SHEET 5 FOR DETAILS.
- THE CONTRACTOR'S ATTENTION IS CALLED TO THE LAST TWO PARAGRAPHS IN SUBSECTION 108-1.05 OF THE STANDARD SPECIFICATIONS.





# GUARDRAIL SUMMARY

# MONUMENT SUMMARY

STATE	PROJECT DESIGNATION	YEAR	SHEET NO.	TOTAL SHEETS
ALASKA	1-097-2(A)	1985	4	33

Approximate Only

FROM STATION	TO STATION	OFFSET LEFT	OFFSET RIGHT	REMOVE DISPOSE	INSTALL	END S/LCT	REMARKS ② & ③
166+50	172+50						INSTALL 49 NEW INTERMEDIATE POSTS/BLOCKS @ 12'-6" C.C. ①
172+75	173+50			25.0	75.0	1	REMOVE EXISTING END SECTION
183+25	183+75			50.0	50.0	1	REMOVE EXISTING END SECTION 2-12.5' PANELS
183+75	195+25						INSTALL 90 NEW INTERMEDIATE POST/BLOCKS @ 12'-6" C.C. ①
193+50	194+50				100.00	2	ANCHOR BOTH ENDS TO ROCK USING TERMINAL END & CONCRETE ANCHORS SHOWN ON STANDARD DRAWING G-15.00. ④
194+50	195+50			25.0	62.5	1	REMOVE EXISTING END SECTION
200+00	201+25			125.0	125.0	2	REMOVE EXISTING RAIL AND END SECTIONS ④
236+00					550.	2	
243+00	244+50				150.0	2	
245+75	251+00			37.5	625.0	2	REMOVE 3 PANELS AT 251+00 LT. INSTALL NEW GUARDRAIL AND END SECTIONS, MATCH END OF EXISTING GUARDRAIL
254+50	255+00			25.0	25.0		
261+00	270+00			25.0	1000.0	1	TIE TO EXISTING RAIL AT 270+00
270+00	1100+74±						INSTALL 115 NEW INTERMEDIATE POST/BLOCKS @ 12'-6" C.C. ①
1107+00							
1124+00	1125+25				125'	2	INSTALL NEW TERMINAL END ASSEMBLY ONLY ANCHOR 1125 END TO ROCK, -SEE STANDARD DRAWING G-15.00
1129+62.5	1130+87.5			37.5	125	1	④
1158+10						1	INSTALL NEW TERMINAL END ASSEMBLY
1235+00						1	INSTALL NEW TERMINAL END ASSEMBLY
1373+50						1	INSTALL NEW TERMINAL END ASSEMBLY
1387+00	1388+00				87.5	2	ANCHOR BOTH ENDS TO ROCK. SEE STANDARD DRAWING G-15.00 ④
1395+00						1	INSTALL TERMINAL END ASSEMBLY ONLY
1402+42	1403+42			12.5	100	1	INSTALL NEW GUARDRAIL AND END SECTION
1402+92	1404+00			75.0	175	0	INSTALL NEW GUARD RAIL MATCH TO EXISTING
1408+25	1412+50			37.5	462.5	1	
1416+90						1	INSTALL NEW TERMINAL END ASSEMBLY ONLY
1431+15	1433+90			50.0	275.0	0	NO END SECTION REQUIRED
1447+50						1	INSTALL NEW TERMINAL END ASSEMBLY ONLY
1460+00						1	INSTALL NEW TERMINAL END ASSEMBLY ONLY
1461+12	1462+62			62.5	150.0	1	MATCH TO EXISTING GUARDRAIL ④
1463+00	1463+50			12.5	50	1	④
1465+10	1465+18				37.5	1	④
1484+00	1492+75				875	1	MATCH TO EXISTING GUARDRAIL ④
1490+00						1	INSTALL NEW TERMINAL END ASSEMBLY ONLY
1531+13	1531+75			62.5	62.5	1	④
1534+35						1	INSTALL TERMINAL END ASSEMBLY ONLY
1536+00	1537+00				125.0	2	INSTALL NEW GUARDRAIL AND END SECTION ④
1581+10						1	INSTALL NEW END SECTION
1588+75						1	INSTALL NEW END SECTION (DIAPHRAGM, CABLES, ETC.)

STATION	POINT	MONUMENT & CASE
163+88.78	P.C.	✓ ①
167+88.79	P.T.	✓
174+45.48	P.C.	✓
177+07.98	P.T.	✓
181+78.85	P.C.	✓
185+97.60	P.T.	✓
192+50.96	P.C.	✓
241+64.57	P.T.	✓
247+76.10	P.C.	✓
272+97.38	P.T.	✓
278+74.88	P.T.	✓
281+28.86	P.T. Bk=	✓
1090+29.37	P.O.T. AND	✓
1138+52.97	P.T.	✓
1150+89.76	P.C.	✓
1194+10	P.I.	✓
1194+10	P.I.	✓
1126+50	P.C.	✓
1126+50	P.C.	✓
1379+80	P.I.	✓
1379+80	P.I.	✓
1391+60	P.C.	✓
1391+60	P.C.	✓
1413+10	P.I.	✓
1413+10	P.I.	✓
1429+00	P.I.	✓
1429+00	P.I.	✓
1454+00	P.I. RT.	✓
1454+00	P.I. RT.	✓
1465+50	P.O.T.	✓
1465+50	P.O.T.	✓
1365+00.00	P.I.	✓
1375+75.93	P.O.T.	✓
1470+50	P.I.	✓
1470+50	P.I.	✓
1503+60	P.I.	✓
1503+60	P.I.	✓
1401+13.61	P.C.	✓
1427+49.30	P.T. Bk=	✓
1426+85.45	P.O.T. AND	✓
1449+07.19	P.O.T. =	✓
1449+07.19	P.O.T. =	✓
1464+50.13	P.C. 13.70 LT.	✓
1464+50.13	P.C. 13.70 LT.	✓
1511+53.82	P.I.	✓
1525+36.83	P.C.	✓
1577+83.74	P.T.	✓
1585+53.57	P.C.	✓
1590+86.50	E.O.P.	✓

# STANDARD SIGNING SCHEDULE


NO.	STATION	DIST. FROM		CODE NO.	LEGEND	SIGN PANEL THICKNESS			NO. OF POSTS	* POST			FACING	REMARKS	
		LT.	RT.			UNFRAMED	FRAMED	AVG S.F.		TYPE	SIZ	LENGTH			EMBEDMENT
11	192+15			MI-2	Mile 3	28	6" x 12"		1.0		Tube	2"	13'	3'	
12	246+65				" 4										
14	1107+05				" 5										
16	1164+25				" 6										
17	1244+65				" 7										
21	1267+45				" 8										
23	1320+25				" 9										
24	1393+05				" 10										
27	1426+58				" 11										
29	1498+78				" 12										
31	1531+54				" 13										
33	1584+34				" 14										
	195+15	20	WI-2R	30 mph	36x36			9.0							
	195+15	20	WI-1	30 mph	24x24			4.0							
	204+50	21	WI-2L	30 mph	36x36			9.0							
	204+50	21	WI-1	30 mph	24x24			4.0							
	1111+00	18	WI-5R	30 mph	36x36			9.0							
	1111+00	18	WI-1	30 mph	24x24			4.0							
	1117+00	18	WI-5R	30 mph	36x36			9.0							
	1117+00	18	WI-1	30 mph	24x24			4.0							
	1194+10	18	WI-1R	30 mph	36x36			9.0							
	1194+10	18	WI-1	30 mph	24x24			4.0							
	1126+50	14	WI-1R	30 mph	36x36			9.0							
	1126+50	14	WI-1	30 mph	24x24			4.0							
	1379+80	18	WI-4L	30 mph	36x36			9.0							
	1379+80	18	WI-1	30 mph	24x24			4.0							
	1391+60	18	WI-4L	30 mph	36x36			9.0							
	1391+60	18	WI-1	30 mph	24x24			4.0							
	1413+10	18	WI-4L	30 mph	36x36			9.0							
	1413+10	18	WI-1	30 mph	24x24			4.0							
	1429+00	18	WI-4L	30 mph	36x36			9.0							
	1429+00	18	WI-1	30 mph	24x24			4.0							
	1454+00	16	WI-4L	35 mph	36x36			9.0							
	1454+00	16	WI-1	35 mph	24x24			4.0							
	1465+50	16	WI-4L	35 mph	36x36			9.0							
	1465+50	16	WI-1	35 mph	24x24			4.0							
	1470+50	17	WI-5R	35 mph	36x36			9.0							
	1470+50	17	WI-1	35 mph	24x24			4.0							
	1503+60	18	WI-4L	35 mph	36x36			9.0							
	1503+60	18	WI-1	35 mph	24x24			4.0							

- INSTALL INTERMEDIATE POSTS AND BLOCK-SEE SECTION 606 OF THE SPECIAL PROVISIONS.
- ALL POST AND BLOCKS REQUIRED SHALL BE TYPE 1 WOOD POSTS.
- THE CONTRACTOR SHOULD ANTICIPATE THE POSSIBLE PRESENCE OF A COARSE ROCK EMBANKMENT AND BEDROCK WITHIN THE DRIVING LIMITS OF POSTS.
- INSTALL EMBANKMENT FOR GUARDRAIL FLAIRS AS DETAILED ON SHT. NO. 12.
- OFFSET TO FACE OF RAIL SHALL BE 16 FEET UNLESS OTHERWISE DIRECTED.

- MONUMENT NOTES:
- EACH MONUMENT CASE SHALL BE SET IN A 9"x9"x9" BLOCK OF CONCRETE. THE LID OF THE CASE SHALL BE SET 1/2 INCH BELOW THE FINISHED SURFACE.

### GENERAL SIGNING NOTES


- SIGN LOCATIONS & POST LENGTHS ARE APPROXIMATE ONLY & ARE SUBJECT TO MINOR REVISIONS.
- ALL SIGN POSTS SHALL BE SQUARE TELESCOPING PERFORATED GALVANIZED STEEL POSTS THE 2" SIZE SHALL BE USED ABOVE GROUND & THE 1 1/4" SIZE SHALL BE USED BELOW GROUND FOR THE SLEEVE.
- ALL SIGN POSTS SHALL BE INSTALLED WITH THE SLEEVE TYPE EMBEDMENT AS PER STANDARD DRAWING S-30.12 EXCEPT THAT THE 2 1/4" SIZE SHALL BE USED FOR THE ENTIRE EMBEDMENT DEPTH.
- POST LENGTHS ARE FROM THE CUT-OFF IN THE SLEEVE TO THE TOP OF THE POST. SEE STANDARD DRAWINGS S-05.00 & S-30.00.
- THIS WORK SHALL ALSO CONSIST OF THE REMOVAL AND INSTALLATION OF NEW SIGN PANELS, THE REMOVAL AND REINSTALLATION OF EXISTING SIGNS THAT ARE OBSTRUCTING CONSTRUCTION, AND THE REMOVAL OF EXISTING SIGNS TO BE REPLACED, TO THE SKAGWAY MAINTENANCE STATION. ALL OF THE ABOVE WORK SHALL BE CONSIDERED INCIDENTAL TO ITEM 615(1) "STANDARD SIGNS".

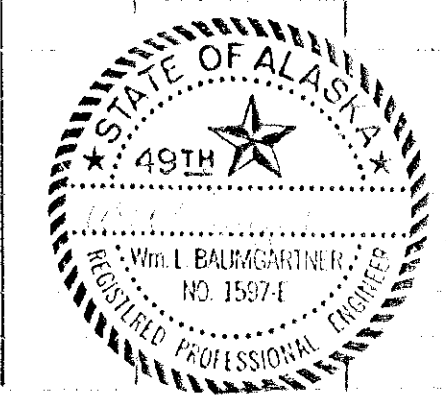


# U.S. CUSTOMS STATION -DETAILS-

STATE	PROJECT DESIGNATION	YEAR	SHEET NO.
ALASKA	F-097-2(4)	1985	6


"As-Built" Curve Data  
 $\Delta = 54^{\circ} 18' 29''$   
 $D = 5^{\circ} \text{ Lt.}$   
 $T = 587.76'$   
 $L = 1086.16'$   
 $R = 1145.916'$   
 $S = 0.056' \text{ / ft.}$

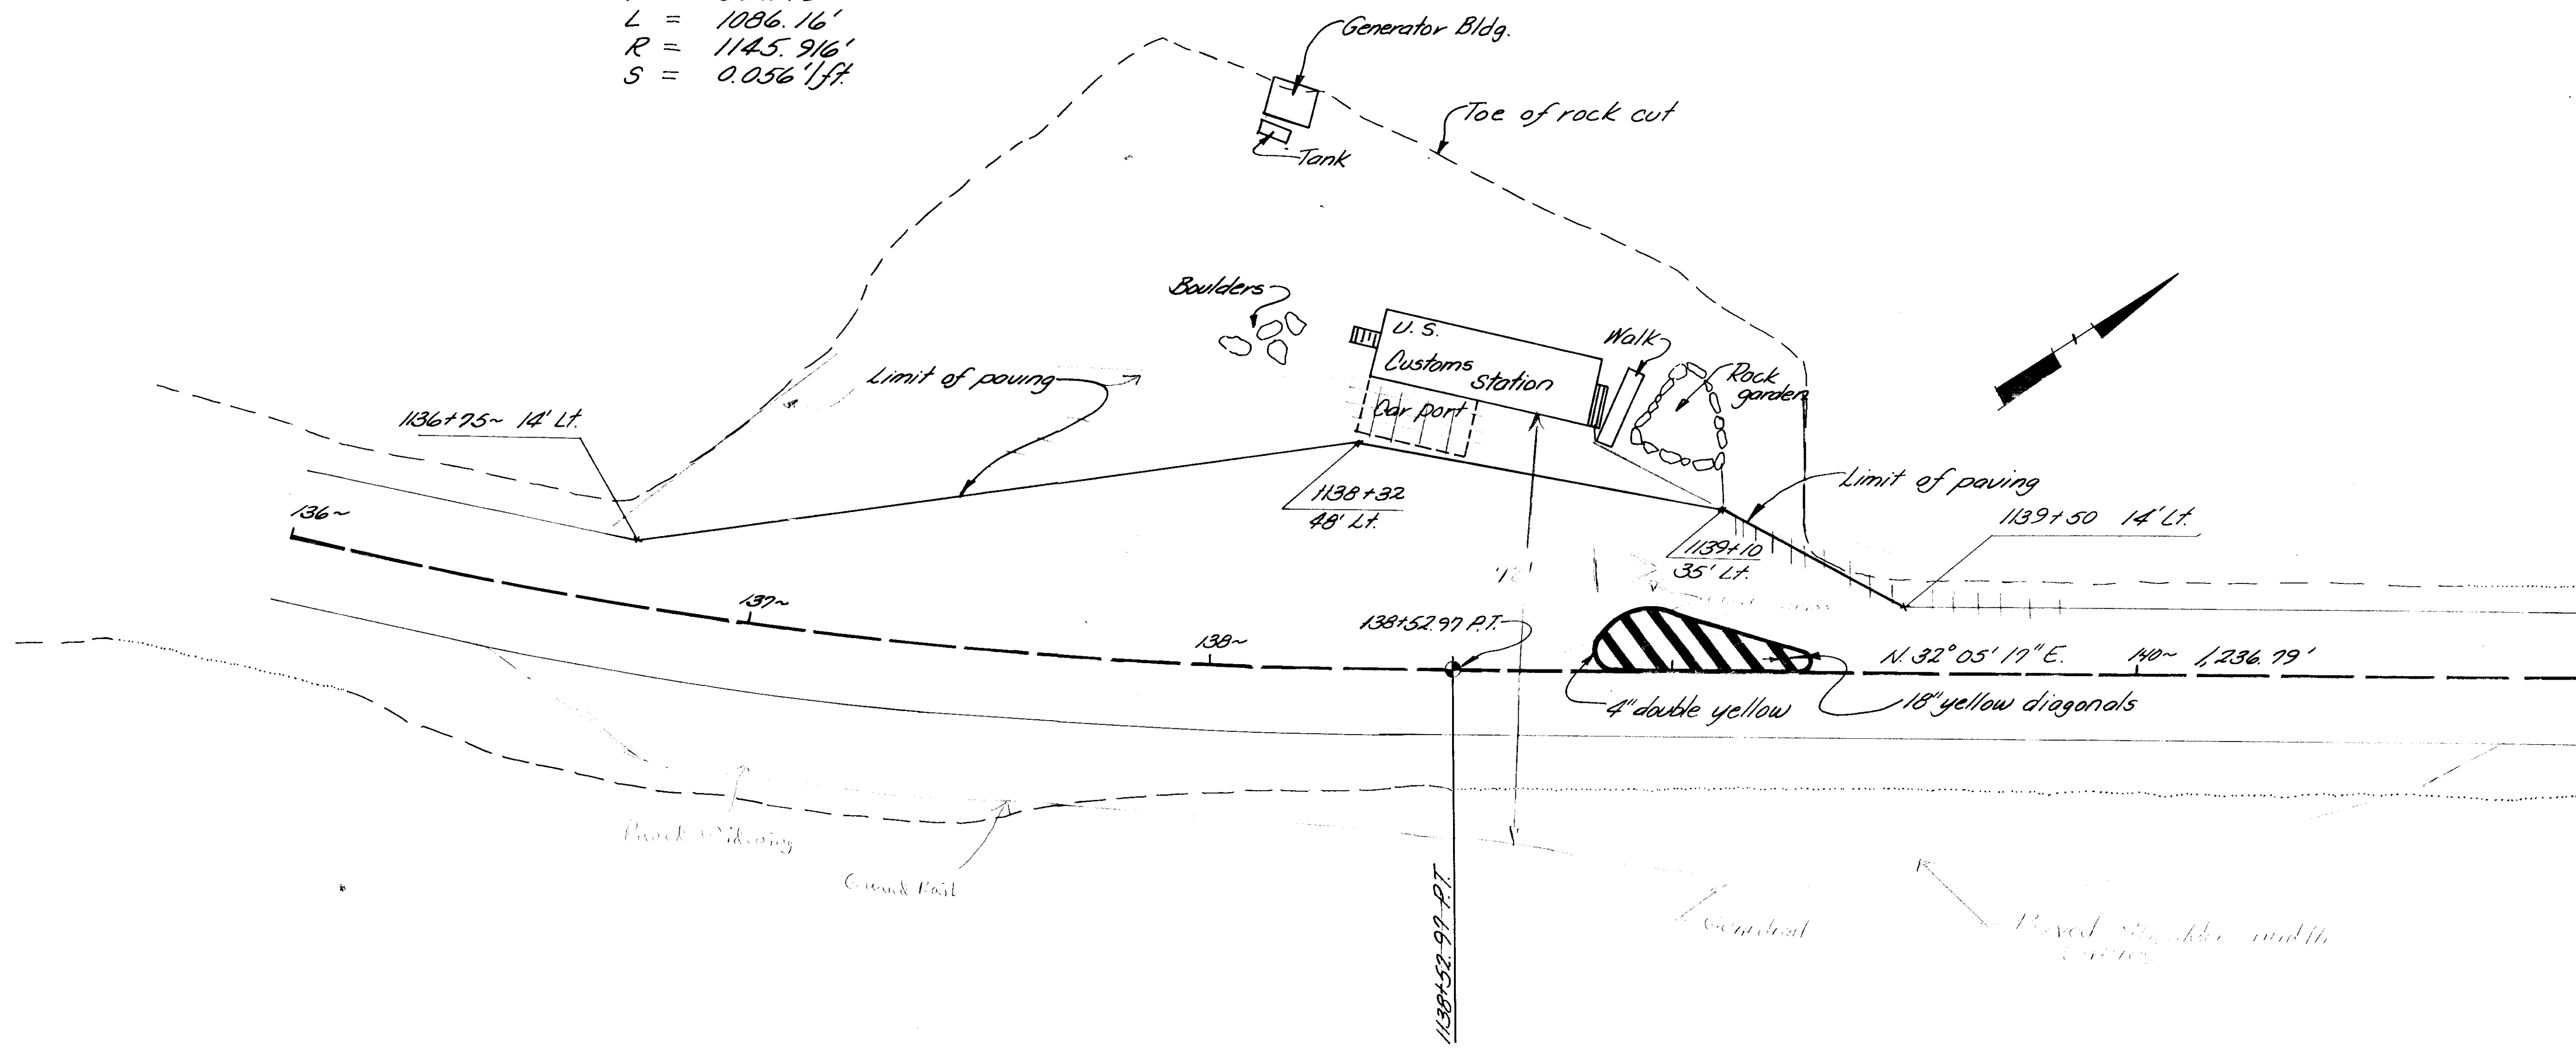

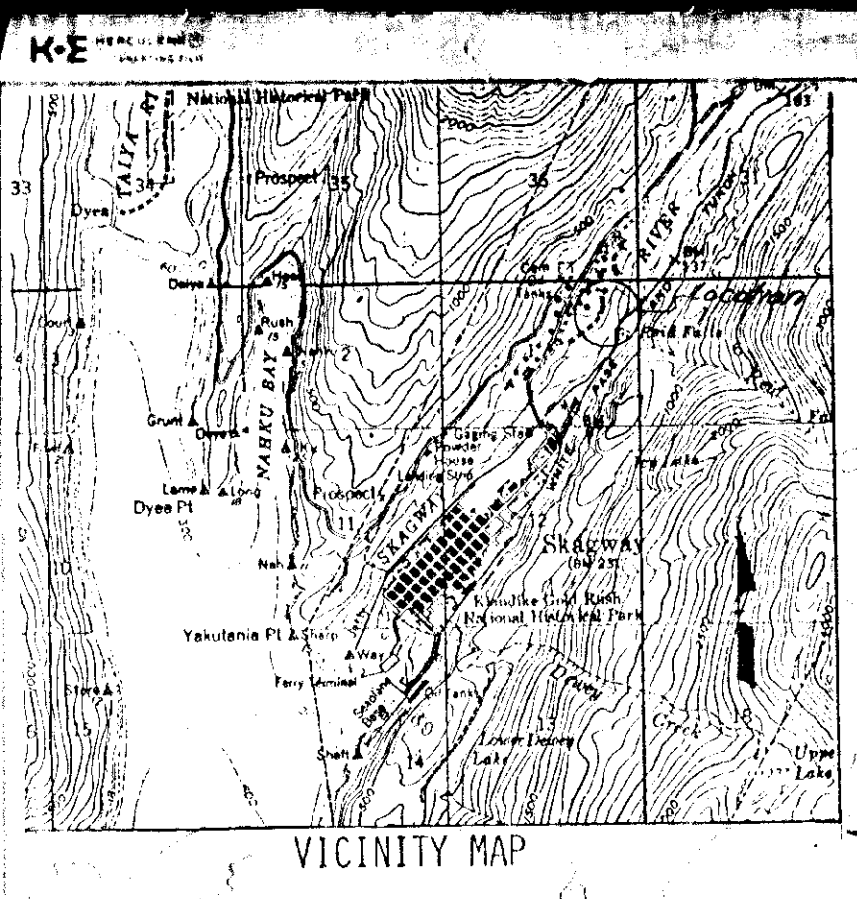

# SKAGWAY MATERIAL SITE ADL NO. 103936 MINING PLAN

STATE OF ALASKA PROJECT DESIGNATION YEAR 1985 7 8  
F-097-2(4)

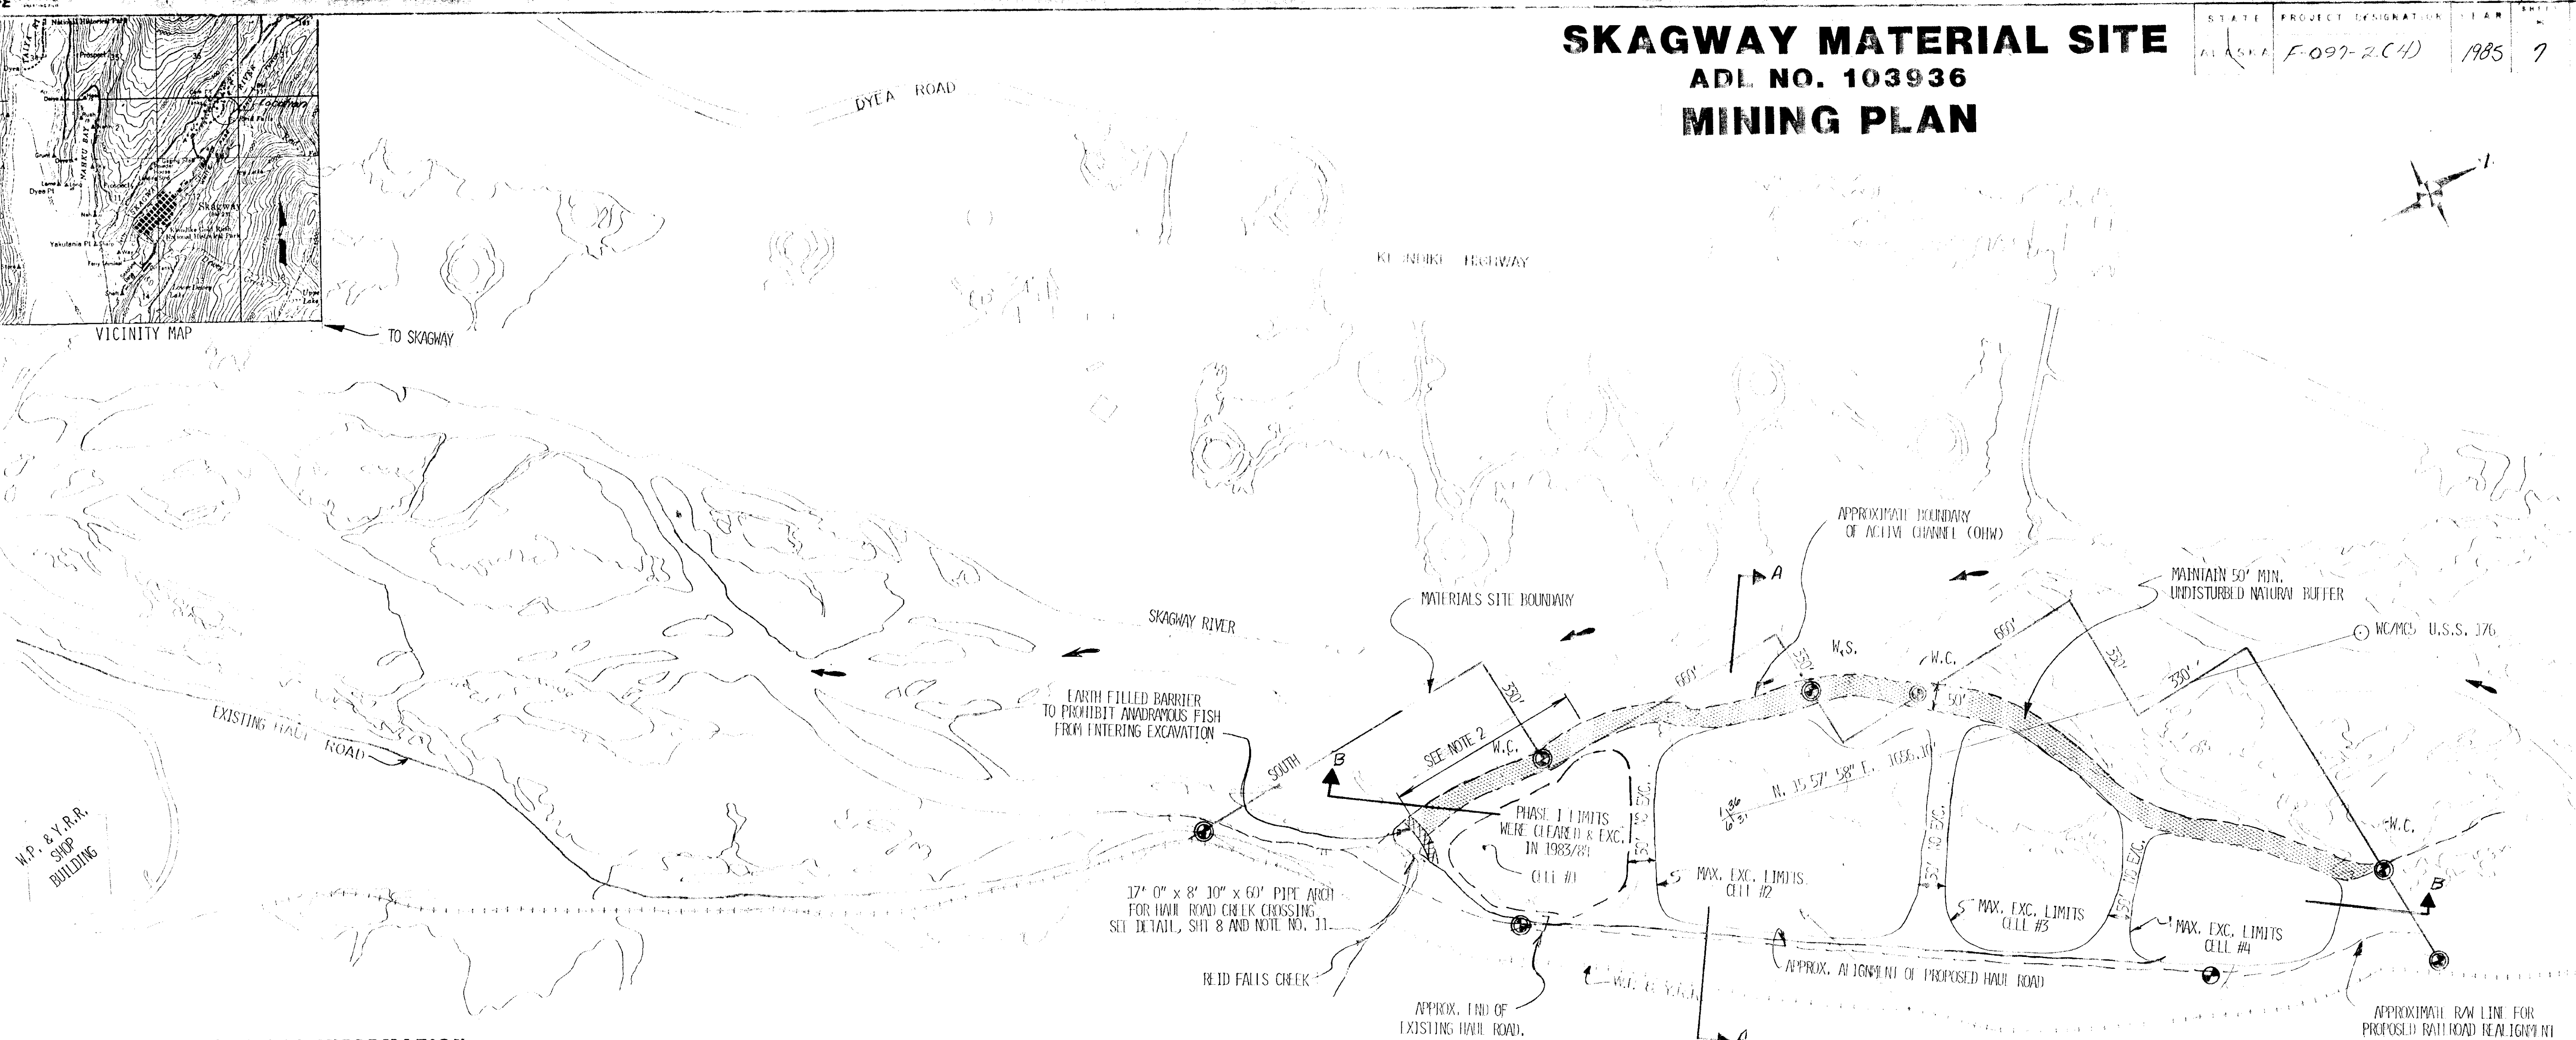

## GENERAL INFORMATION

**DOMINANT MATERIAL:** GREY, SANDY GRAVEL - A-1-A, N.F.S., WITH BOULDERS (MAX. SIZE SEEN 26")

**SITE LOCATION:** WITHIN T-27S., R.60E., C.R.M., UNSURVEYED SECTION 31, T-28S., R-59E., C.R.M., UNSURVEYED SECTION 1 AND T-28S., R-60E., C.R.M. UNSURVEYED SECTION 6.

**OWNER:** STATE OF ALASKA, DIVISION OF LAND AND WATER MANAGEMENT (ADL 103936)

**LEASEE:** ALASKA DEPARTMENT OF TRANSPORTATION MAINTAINS VALID SALE CONTRACT FOR 3 YEAR PERIOD ENDING JUNE 1987.

**TOTAL ACREAGE:** APPROXIMATELY 80.0 TOTAL ACRES ALTHOUGH MATERIAL EXTRACTION IS LIMITED TO 53.8 (ACCORDING TO D.H.R. CONTRACT)

**LOCATION AND GEOLOGY:** THE SKAGWAY MATERIAL SITE IS LOCATED ON AN ABANDONED SIDE CHANNEL OF THE SKAGWAY RIVER APPROXIMATELY ONE MILE NORTH OF THE CITY OF SKAGWAY. THE LIMITS OF EXTRACTION ARE GENERALLY BOUNDED BY THE ORDINARY HIGH WATER LEVEL (ACTIVE CHANNEL) OF THE SKAGWAY RIVER ON THE WEST AND THE W.P. & Y.R.R. (PACIFIC AND ARCTIC RAILROAD) RIGHT OF WAY ON THE EAST.

THE DEPOSIT CONSISTS OF RIVER DEPOSITED SAND AND GRAVELS WITH BOULDERS. BOULDERS FROM 16" TO 26" ARE PRESENT THROUGHOUT THE SITE. MATERIAL PASSING THE #200 SCREEN ON SAMPLES TESTED RANGED FROM 1 TO 4 PERCENT.

**OVERBURDEN:** AVERAGE DEPTH OF ORGANIC SOIL IS APPROXIMATELY 8", BUT VARIES IN DEPTH FROM 0-12".

**VEGETATION:** UNDISTURBED AREAS OF THE PIT GENERALLY CONTAIN COTTONWOOD AND ALDER TREES TO A MAXIMUM DIAMETER OF 24". SCATTERED WILLOW BRUSH IS ALSO PRESENT.


**WATER TABLE:** DURING TIME OF INVESTIGATION (10/84) DEPTH OF WATER TABLE VARIED BETWEEN 3.0 AND 8.5'. SEASONAL FLUCTUATION OF WATER TABLE DEPTH SHOULD BE EXPECTED.


## GENERAL NOTES

1. PRIOR TO BEGINNING ANY WORK WITHIN THE PIT: THE CONTRACTOR UNDER THE DIRECTION OF THE ENGINEER SHALL SURVEY, MONUMENT, AND FLAG THE PROPOSED RAILROAD RIGHT-OF-WAY, THE PIT BOUNDARY, THE HAUL ROAD, AND BUFFER ZONE.
2. THIS EXISTING EARTH FILLED BUFFER BERM SHALL BE RECONSTRUCTED TO MATCH THE BUFFER ZONE BEING LEFT BETWEEN THE ACTIVE CHANNEL AND CELL #2.
3. ORGANIC MATERIAL STRIPPED AS OVERBURDEN SHALL BE PLACED ON UNVEGETATED AREAS AS OF THE BUFFER ZONE (RECONSTRUCTED PER FIRST) ADJACENT TO AND ON TOP OF THE BUFFER ZONE TO RE-ESTABLISH VEGETATION AND PREVENT EROSION.
4. AN EARTH FILLED BARRIER OR BERM SHALL BE ESTABLISHED ADJACENT TO THE MOUTH OF RED FALLS CREEK ON THE NORTH BANK TO PROHIBIT ANADROMOUS FISH FROM ENTERING THE PIT.

5. USABLE FIREWOOD CLEARED FROM THE PIT AS A SHALL BE MADE AVAILABLE TO THE PUBLIC. OTHER CLEARED MATERIAL SHALL BE DISPOSED OF (BURNED) WITHIN EXCAVATION BOUNDARIES.
6. A 50' MINIMUM BUFFER ZONE OF UNDISTURBED MATERIAL PARALLELING THE ACTIVE CHANNEL SHALL BE LEFT IN PLACE TO SEGREGATE THE RIVER FROM THE WORKING AREA AND PROHIBIT THE ENTRANCE OF ANADROMOUS FISH INTO THE PIT DURING PERIODS OF HIGH WATER. IN AREAS WHERE THE NATURAL BUFFER HAS BEEN ALTERED OR ELIMINATED (DUE TO PIONEER OPERATIONS) A BERM EQUAL TO THE ELEVATION OF THE UPSTREAM BUFFER ZONE SHALL BE CONSTRUCTED PARALLELING AND ADJACENT TO THE ACTIVE CHANNEL.
7. ADDITIONAL SOILS INFORMATION MAY BE OBTAINED FROM THE SOUTHEAST REGIONAL MATERIALS ENGINEER.
8. THE SEQUENCE OF OPERATIONS SHALL GENERALLY CONSIST OF:
  - PHASE I - MATERIAL IS EXCAVATED WITHIN LIMITS OF THE CELLS TO A MAXIMUM DEPTH OF 15 FEET.
  - PHASE II - MATERIAL WILL BE REMOVED BY DREDGING OPERATION TO MAXIMUM DEPTH OF 15 FEET.
  - RECLAMATION - PONDS CREATED FROM DREDGING OPERATION MAY BE USED AS FISH REARING PONDS.
9. FINAL (ALL) PIT SLOPES SHALL BE NO GREATER THAN 2:1.
10. OPERATIONAL PERMITS SHALL BE THE RESPONSIBILITY OF THE CONTRACTOR (SUCH AS, BUT NOT LIMITED TO CRUSHER PLANT OR SCREENING PLANT). ASPHALT PLANT SHALL NOT BE LOCATED WITHIN MATERIAL SITE.


11. ALL LABOR AND MATERIALS REQUIRED TO GAIN INGRESS & EGRESS FROM THIS MATERIAL SITE SHALL BECOME THE PROPERTY OF THE STATE UPON COMPLETION OF THE PROJECT. PAYMENT FOR THESE ITEMS ARE INCIDENTAL TO OTHER ITEMS OF WORK APPEARING IN THE BID SCHEDULE.

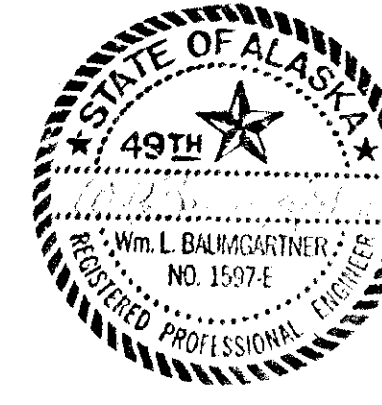

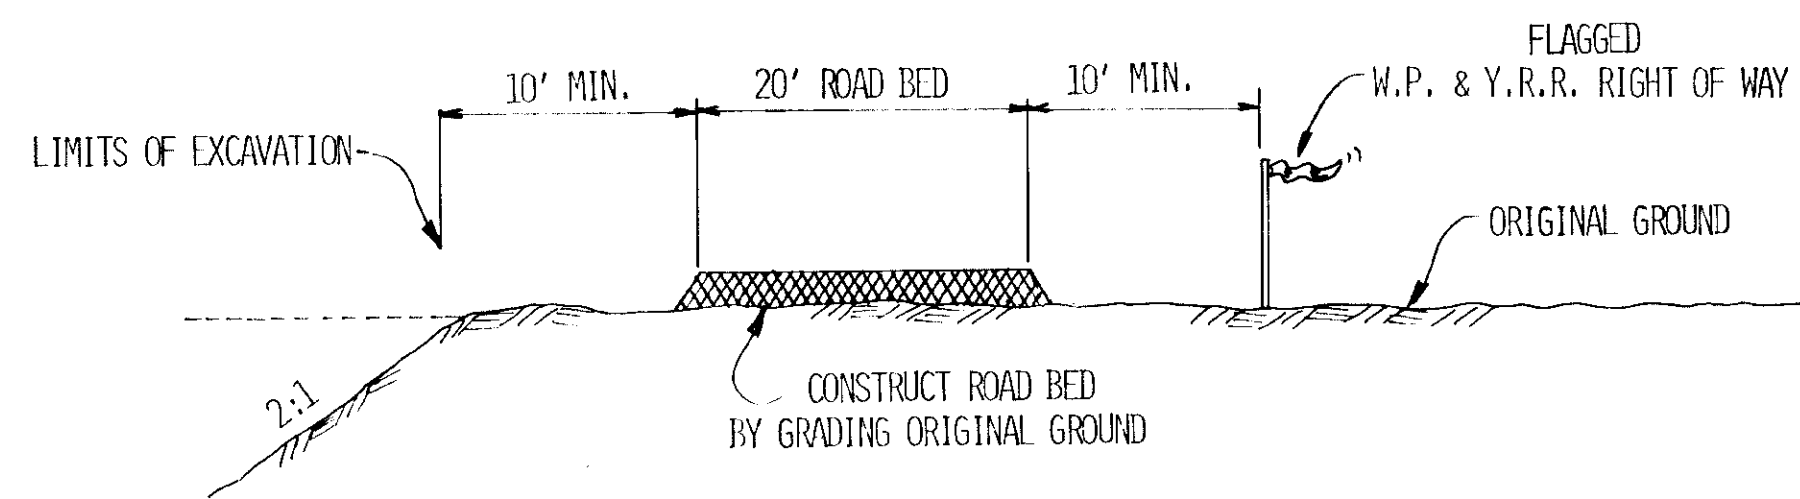

### TYPICAL HAUL ROAD SECTION WITHIN MATERIAL SITE


SCALE: HORIZ: 1" = 200'  
VERT.: NOT TO SCALE

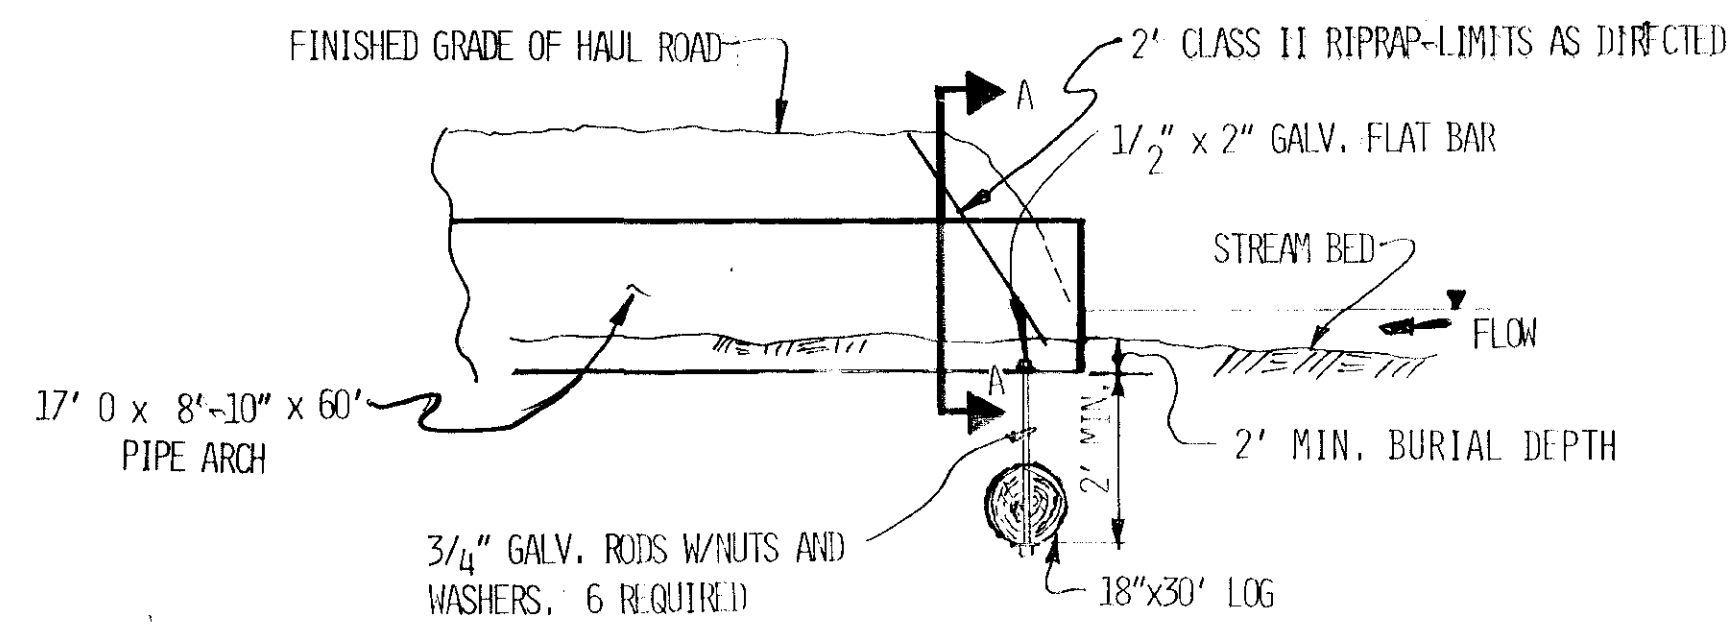


### PIPE ARCH ANCHORING DETAIL

SIDE VIEW

NOT TO SCALE

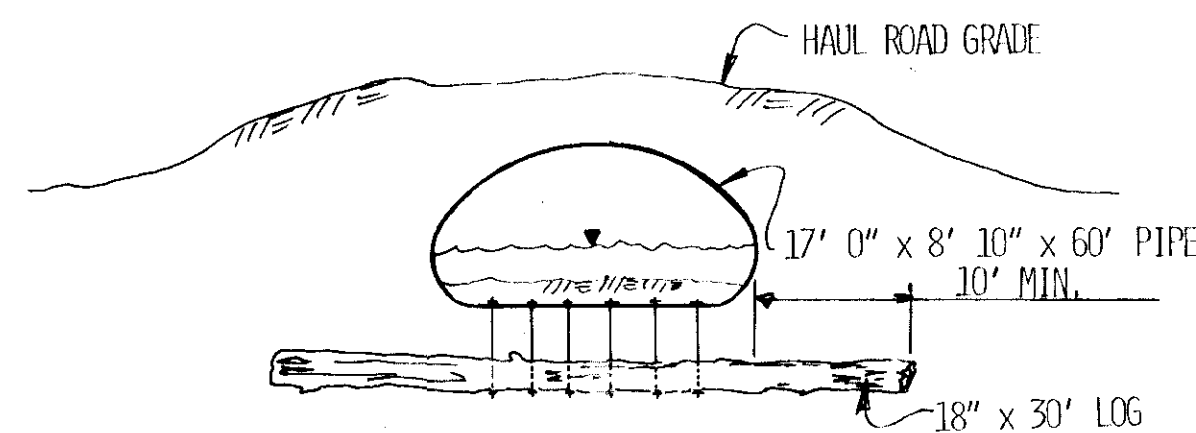


### SECTION A-A

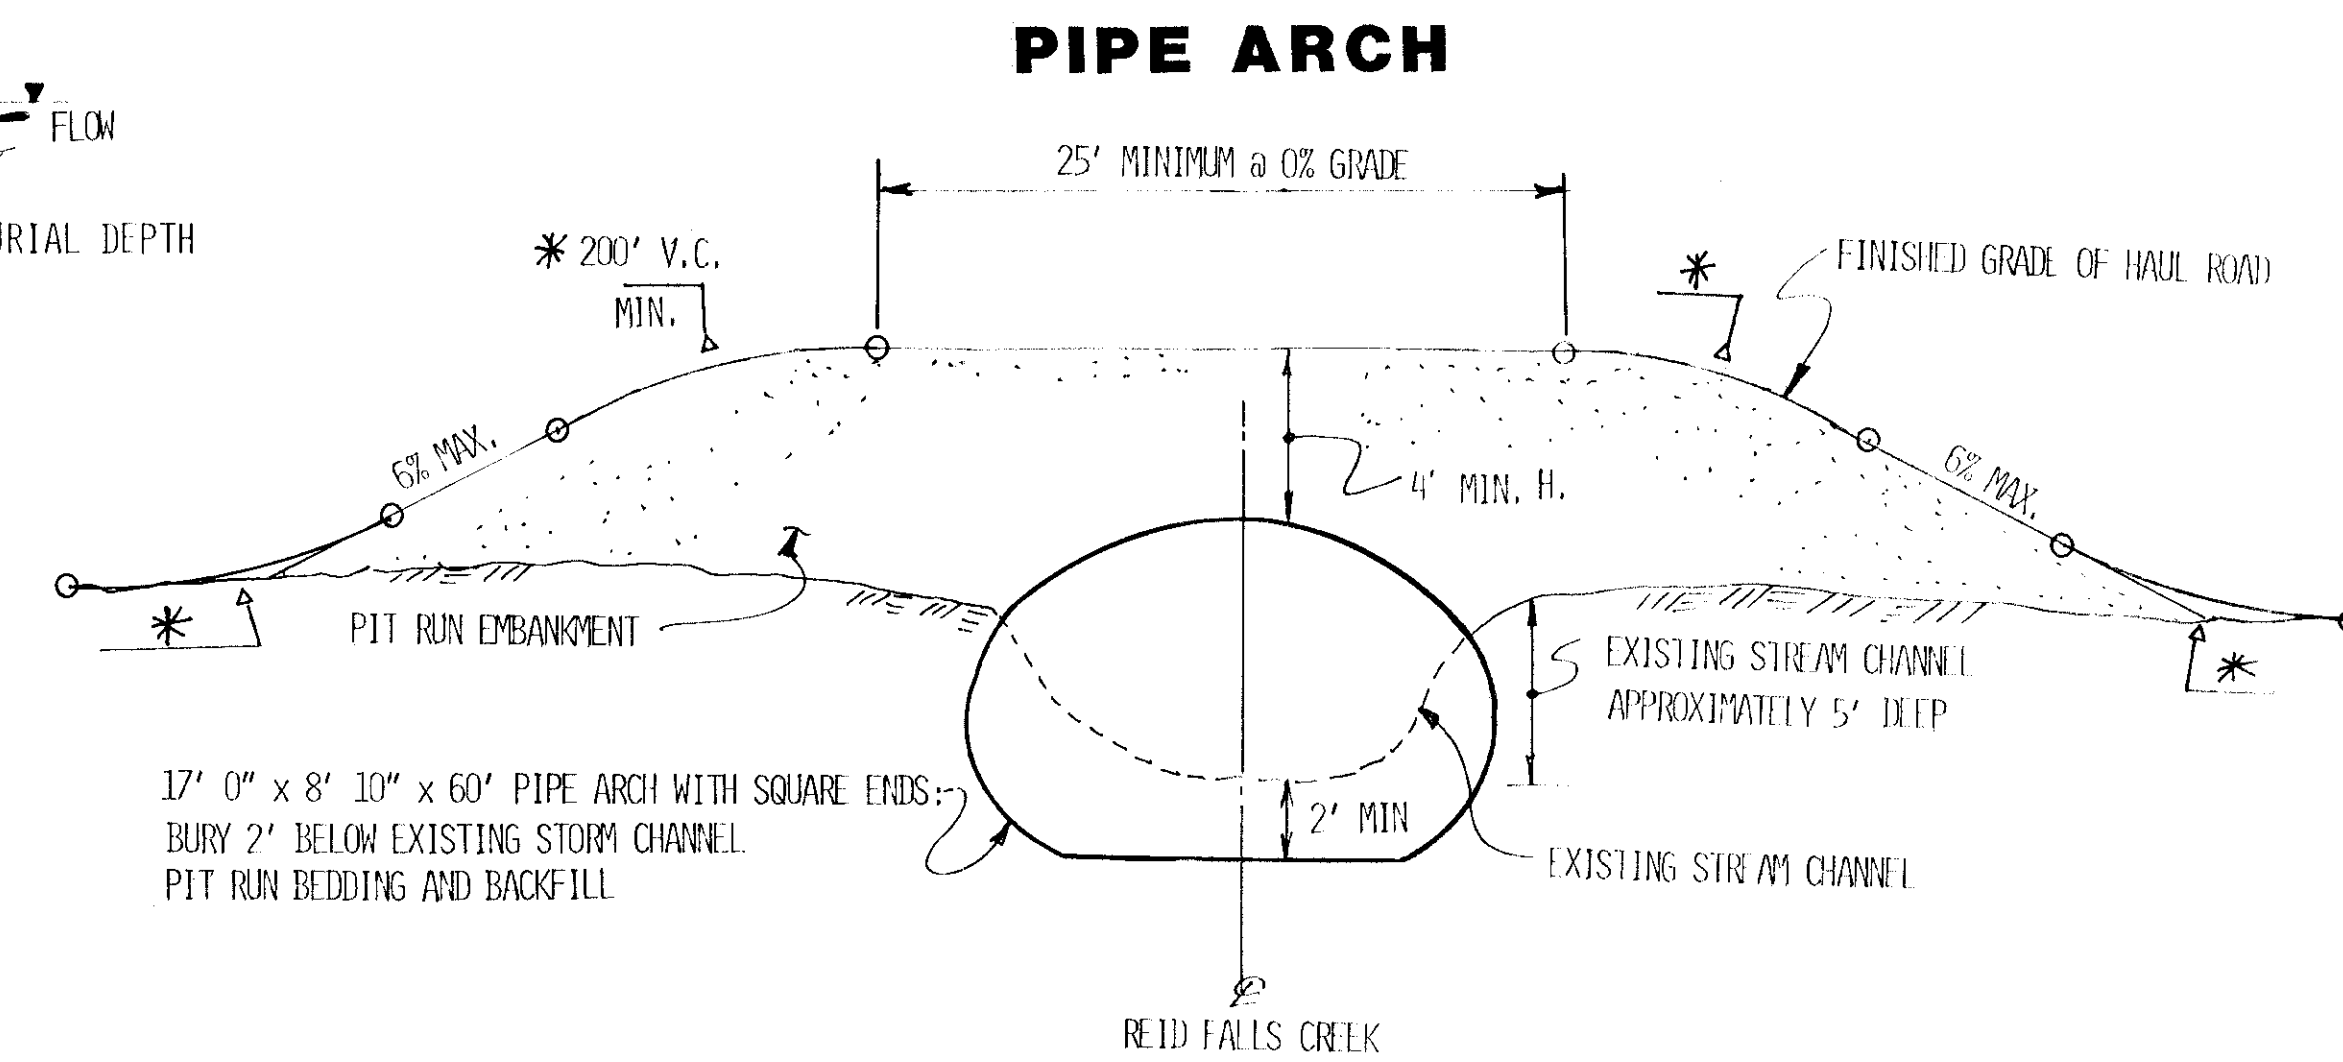

### REID FALLS CREEK HAUL ROAD CROSSING DETAIL

NOT TO SCALE


HYDRAULIC DATA		
DESIGN FREQUENCY YRS.	50	100
DESIGN AREA SQ. MI.	3.3	
DESIGN DISCHARGE CFS	600	660

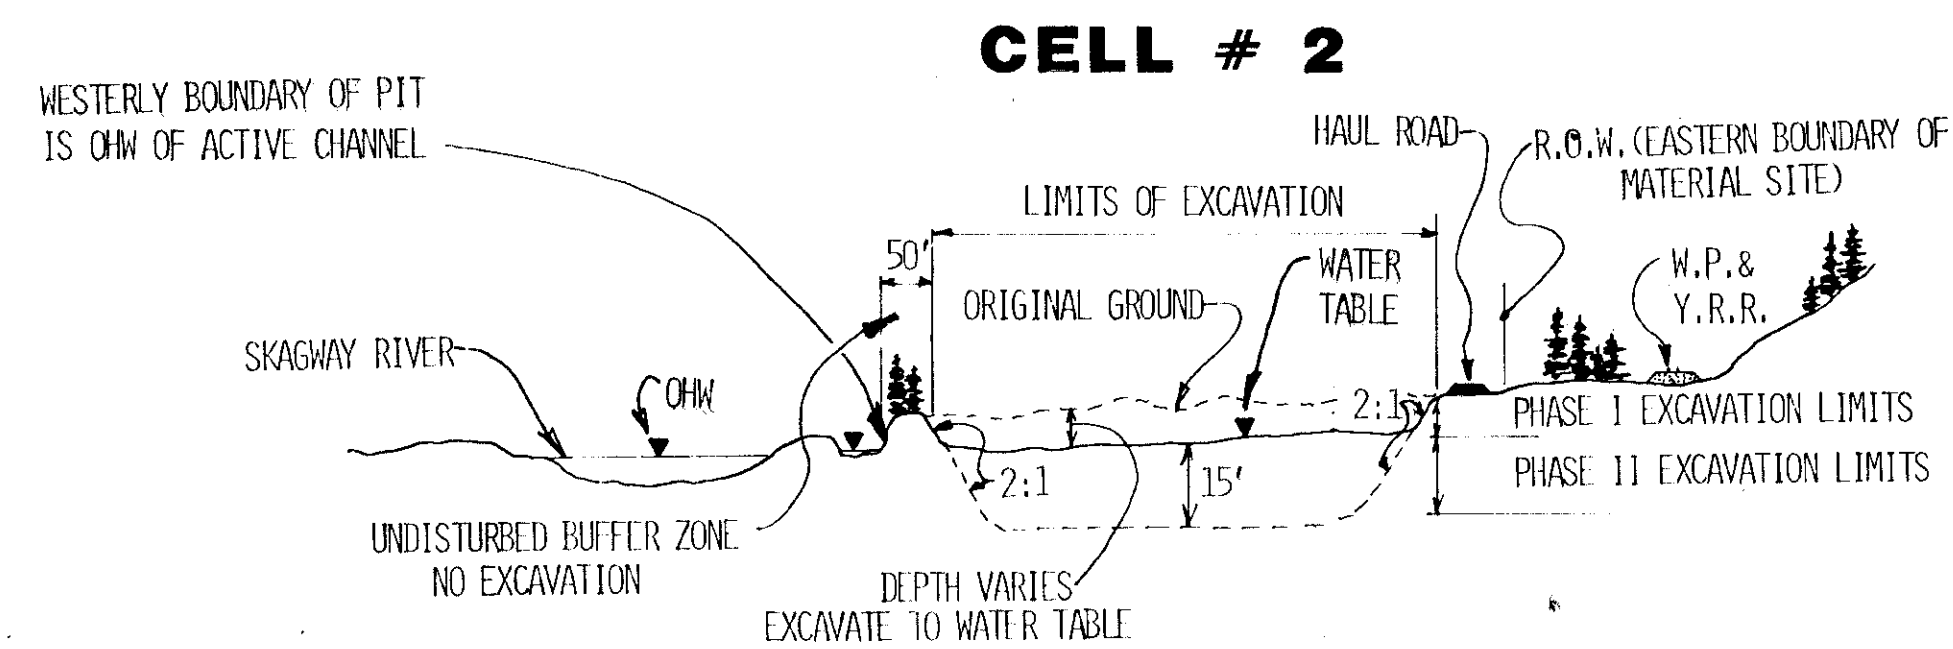

### SKAGWAY MATERIAL SITE

SECTION A-A

SCALE: HORIZ: 1" = 10'  
VERT.: NOT TO SCALE

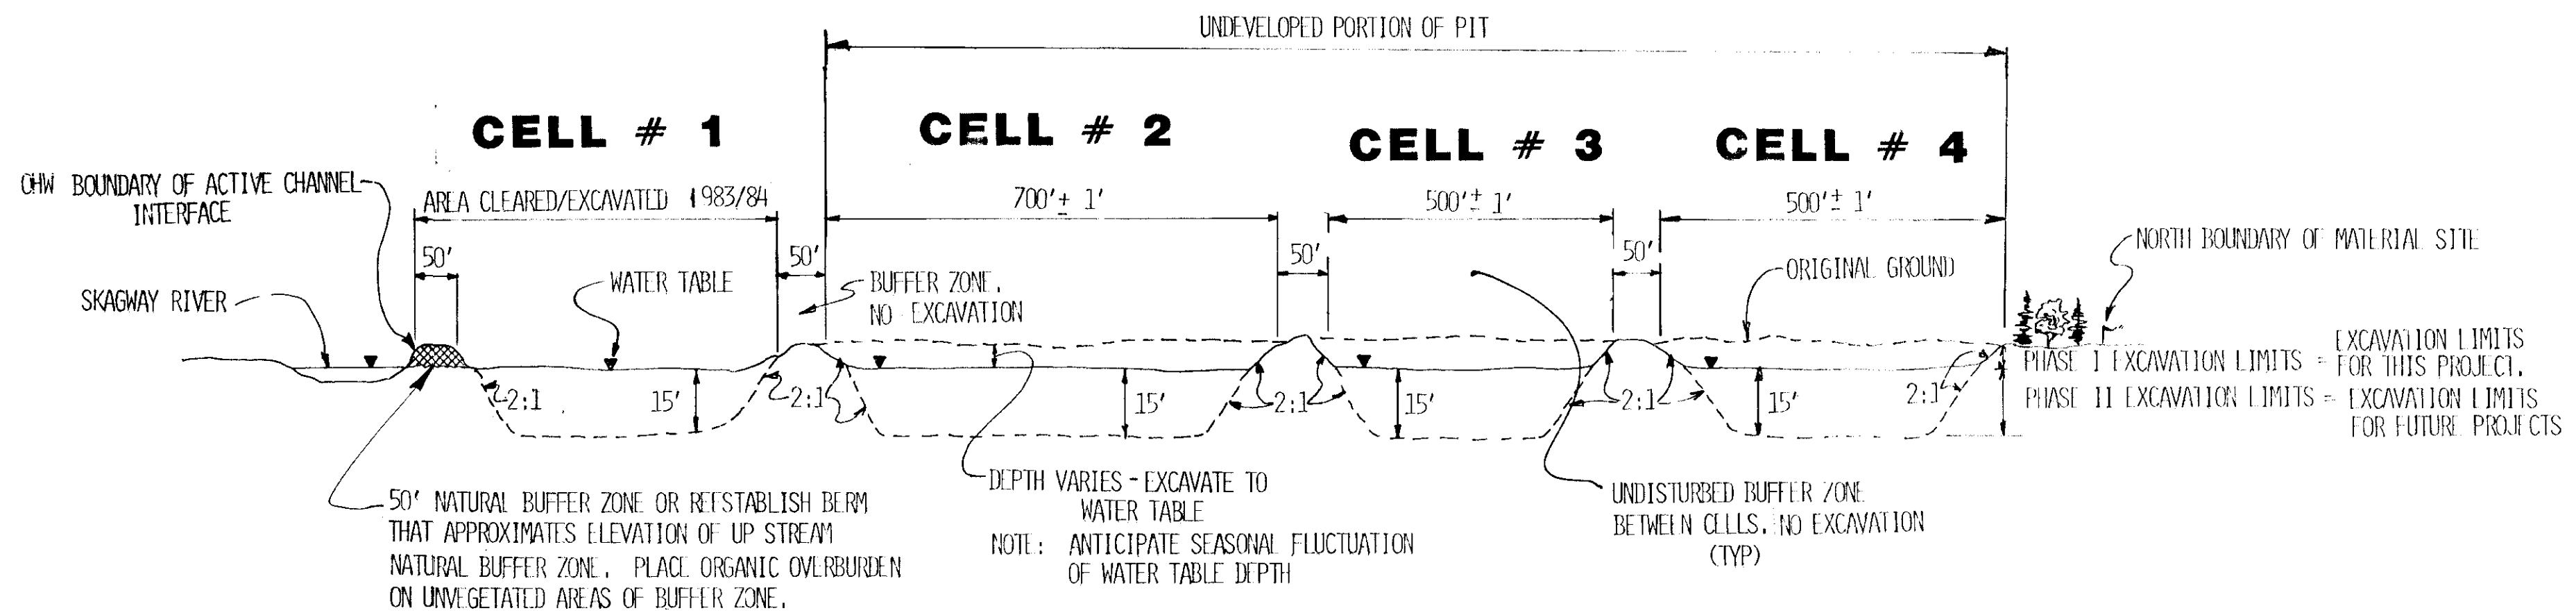

### SKAGWAY MATERIAL SITE

SECTION B-B

SCALE: HORIZ: 1" = 200'  
VERT.: NOT TO SCALE




# SKAGWAY MATERIAL SITE

## LOG OF TEST BORINGS

STATE PROJECT NO. 097-2(4) 905



Boring ID	Soil Description	Soil Analysis Data
TH-1 10/18/84	0-9 Gray sandy gravel with boulders	Est. 10% + 10" 25% + 2" 30% + 1 1/2" Max seen 16" FS 1, A-1-a
TH-2 10/18/84	0-0.5 Organic soil 0.5-11.0" Gray sandy gravel with boulders	Est. 10% + 10" 25% + 2" 30% + 2" Max seen 16" FS 2, A-1-a
TH-3 10/18/84	0-0.8" Organic soil 0.8-11.0" Gray sandy gravel with boulders	Est. 15% + 10" 40% + 3" Max seen 16" FS 1, A-1-a
TH-4 10/18/84	0-1" Organic soil 1-11.0" Gray sandy gravel with boulders	Est. 15% + 10" 40% + 3" Max seen 20" FS 1, A-1-a
TH-5 10/18/84	0-0.4" Organic soil 0.4-11.0" Gray sandy gravel with boulders	Est. 15% + 10" 40% + 3" Max seen 16" FS 1, A-1-a
TH-6 10/18/84	0-1" Organic soil 1-11.0" Gray sandy gravel with boulders	Est. 15% + 10" 40% + 3" Max seen 16" FS 1, A-1-a
TH-7 10/18/84	0-1" Organic soil 1-11.0" Gray sandy gravel with boulders	Est. 15% + 10" 40% + 3" Max seen 16" FS 1, A-1-a
TH-8 10/18/84	0-10" Organic soil 10-11.0" Gray sandy gravel with sand lenses	Est. 15% + 10" 40% + 3" Max seen 16" FS 1, A-1-a
TH-9 10/18/84	0-5.0" Organic soil 5.0-11.0" Gray sandy gravel with boulders	Est. 15% + 10" 40% + 3" Max seen 16" FS 1, A-1-a
TH-10 10/18/84	0-11.0" Organic soil 11.0-11.0" Gray sandy gravel with boulders	Est. 15% + 10" 40% + 3" Max seen 16" FS 1, A-1-a

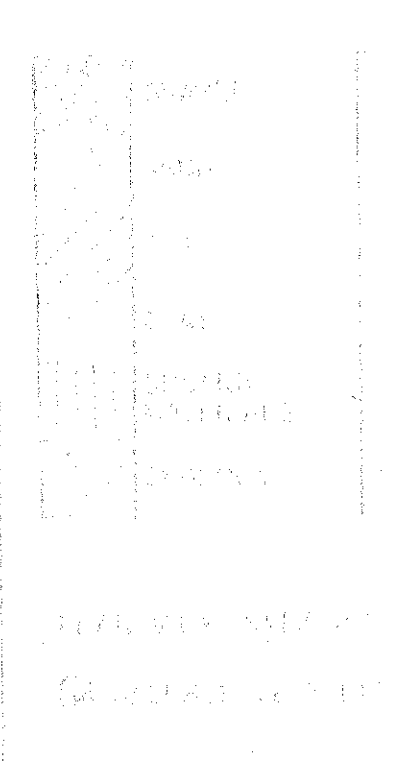

EGIN PROJECT NO. F-097-2(4)  
 "AS-BUILT" 163+25.00

STATE	PROJECT DESIGNATION	YEAR	SHEET NO.	TOTAL SHEETS
ALASKA	F-097-2(4)	1985	10	33

$\Delta = 15^{\circ}57'13''$   
 $D = 3^{\circ}59'18''$   
 $T = 201.31'$   
 $L = 400.01'$   
 $R = 1436.61'$   
 $S = 4.0\%$

BST ~ Begin Supertransition  
 BFS ~ Begin Full Super  
 EFS ~ End Full Super  
 EST ~ End Supertransition

BST As directed\*  
 BFS 164+25  
 EFS 167+26  
 EST 169+16

$\Delta = 16^{\circ}45'$   
 $D = 4^{\circ}11'$   
 $T = 216.88'$   
 $L = 418.16'$   
 $R = 1432.40'$   
 $S = 4.0\%$   
 $TL = 150'$

$\Delta = 16^{\circ}45'$   
 $D = 4^{\circ}$   
 $T = 210.88'$   
 $L = 418.75'$   
 $R = 1432.40'$   
 $S = 4.0\%$

BST 180+50  
 BFS 182+42  
 EFS 185+34  
 EST 187+24

$\Delta = 10^{\circ}30'$   
 $D = 4^{\circ}11'$   
 $T = 131.62'$   
 $L = 262.50'$   
 $R = 1432.41'$   
 $S = 4.0\%$

BST 173+18  
 BFS 175+28  
 EFS 176+44  
 EST 178+34

- EXISTING SIGN LEGENDS
- ① No maint 10/15 to 5/1
  - ② Speed limit 40
  - ③ Speed limit 40
  - ④ Rocks next 12 miles

$N 39^{\circ}58'39'' E$   
 $63.98'$

$N 24^{\circ}01'26'' E$   
 $\sim 656.69$

$N 34^{\circ}57'35'' E$   
 $470.80$   
 $N 34^{\circ}31'26'' E$   
 $\sim 470.87$

$N 17^{\circ}41'35'' E$   
 $654.07$   
 $N 17^{\circ}46'26'' E$   
 $\sim 653.36$

$\Delta = 16^{\circ}30'41''$   
 $D = 4^{\circ}15'15''$   
 $T = 195.67'$   
 $L = 388.50'$   
 $R = 1348.14'$

\* AS-BUILT 161+40.1 PI BK =  
 \* AS-BUILT 161+52.74 P.O.T. Ahd.



159+48.12 PI BK =  
 159+59.12 PI Ahd.

**\* HORIZONTAL CONTROL**  
 Horizontal alignment for this project is based on "As built" bearings for Project No. (s) RF-097-2(3) see detail this sht.


TBM # 55-17 Spike in 18' Cottonwood 40' Rt. of Sta. 163+30 & 41' N. of the Liarsville campground sign Elev. 128.64.

**VERTICAL CONTROL**  
 Vertical control is based upon U.S.C. & G.S. brass monument A (1910) with an elev. of 23.491'. Mean sea level (1950) located on the S.E. corner of the District Courthouse and Boundary Point 117, a cross on the west side of the monument, located at the summit of White Pass. Elevation is 2916.58 feet Mean Sea Level. (U.S.C. & G.S., 1950 value)



**GUARDRAIL CRITERIA**  
 The guardrail design on this project was completed in accordance with State of Alaska Road Design Memo #22 and AASHTO Guide for selecting, Locating & Designing Traffic Barriers, (1977)

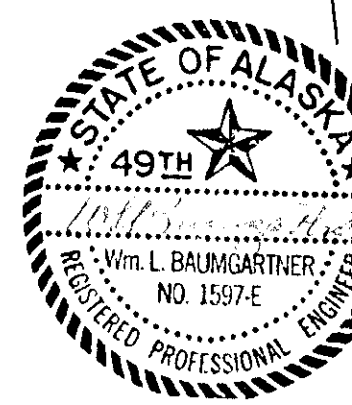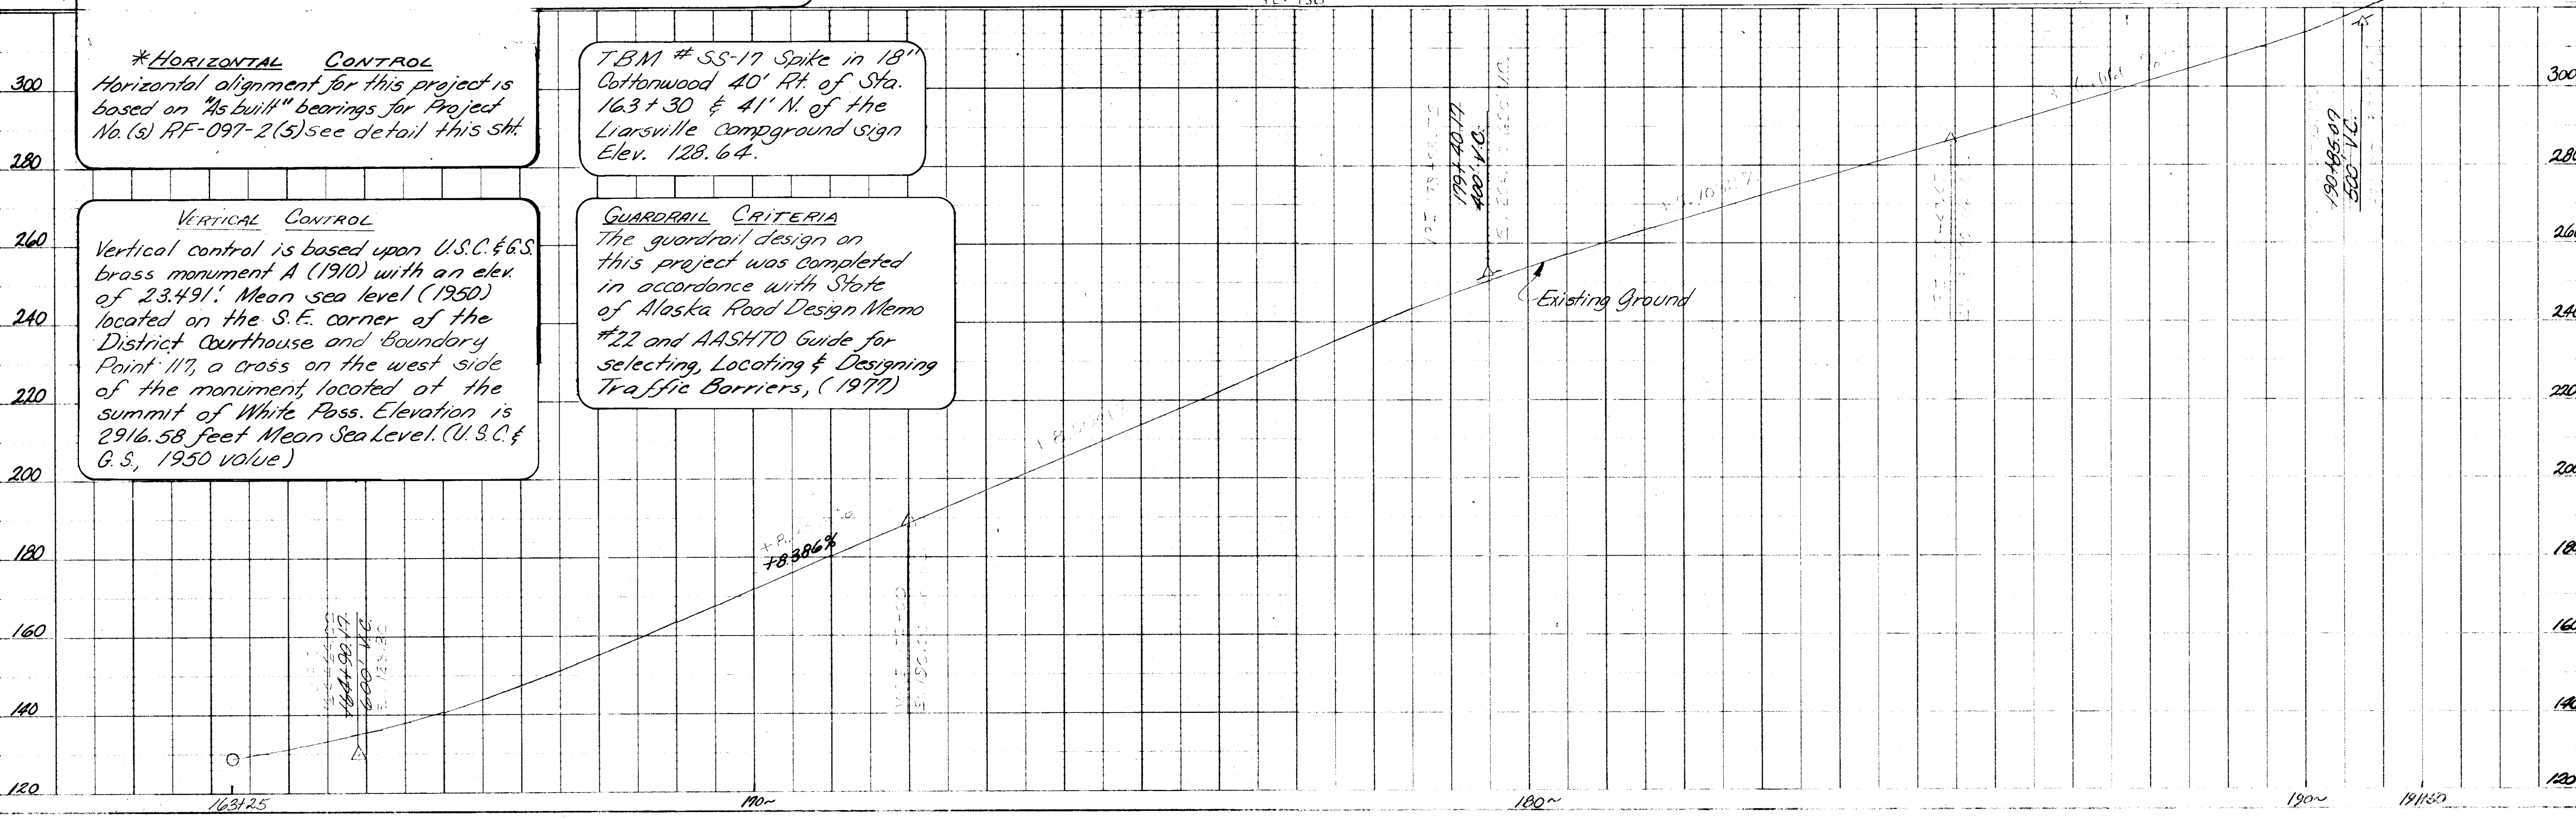


STATE	PROJECT DESIGNATION	YEAR	SHEET NO.
ALASKA	F-097-2(4)	1985	11

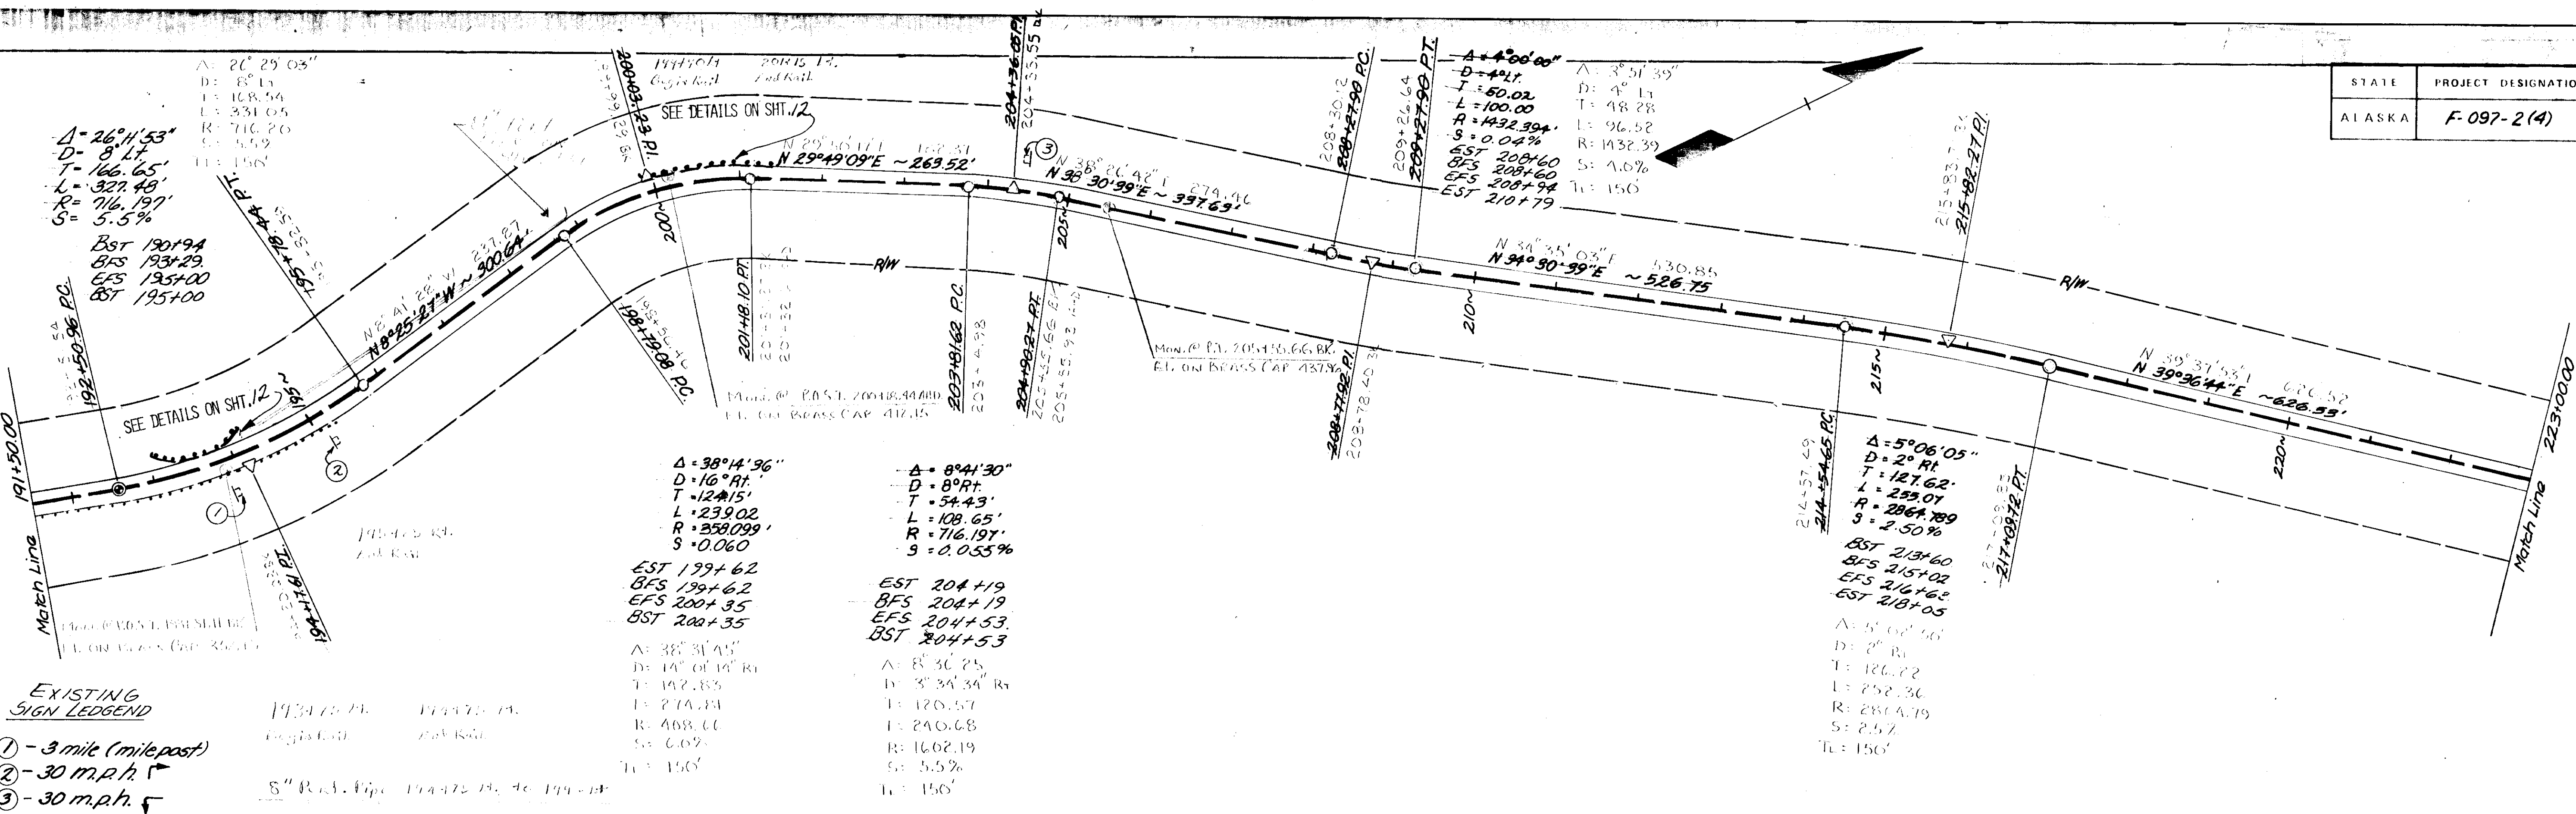


- EXISTING SIGN LEGEND
- ① - 3 mile (milepost)
  - ② - 30 m.p.h.
  - ③ - 30 m.p.h.

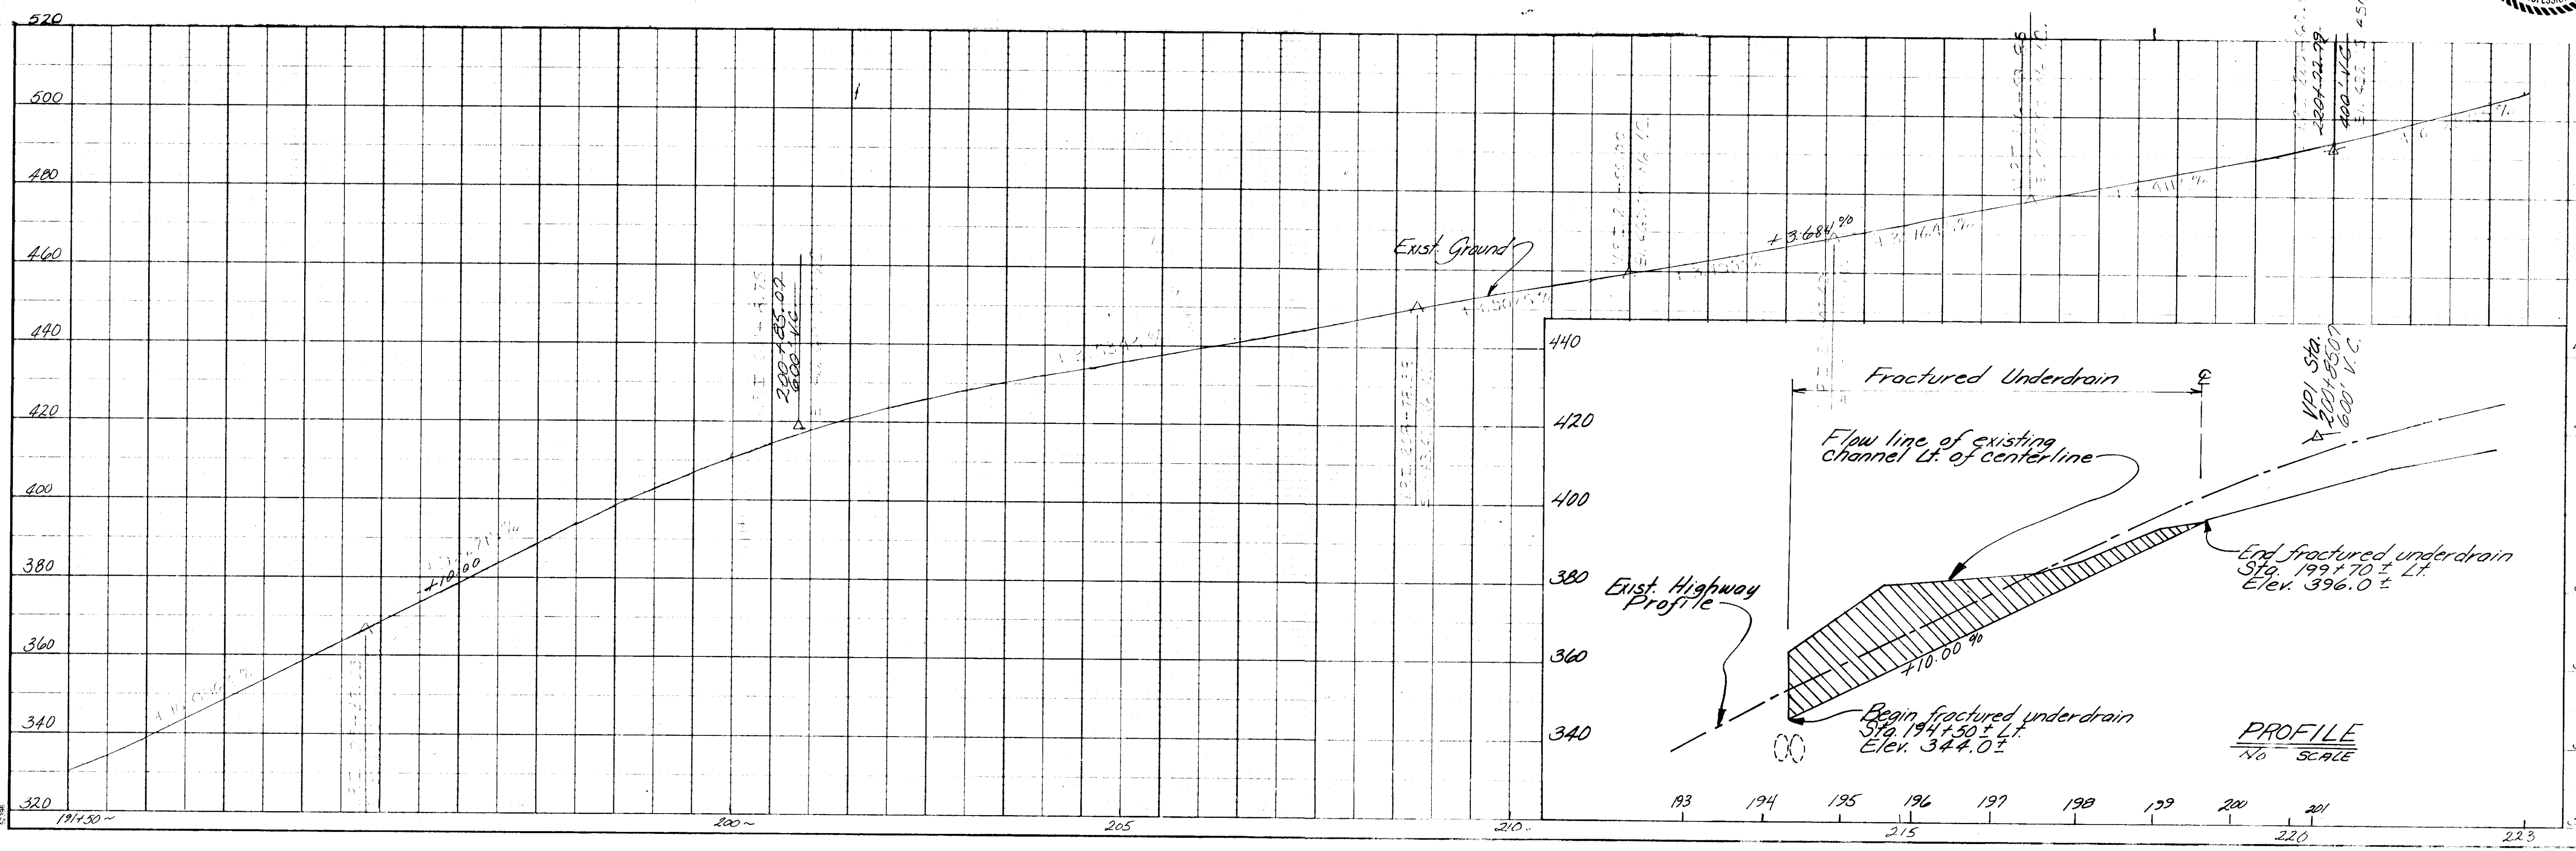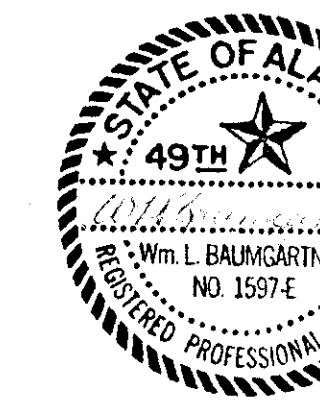



STATE	PROJECT DESIGNATION	YEAR	SHEET NO	TOTAL SHEETS
ALASKA	F-097-2(4)	1985	12	3


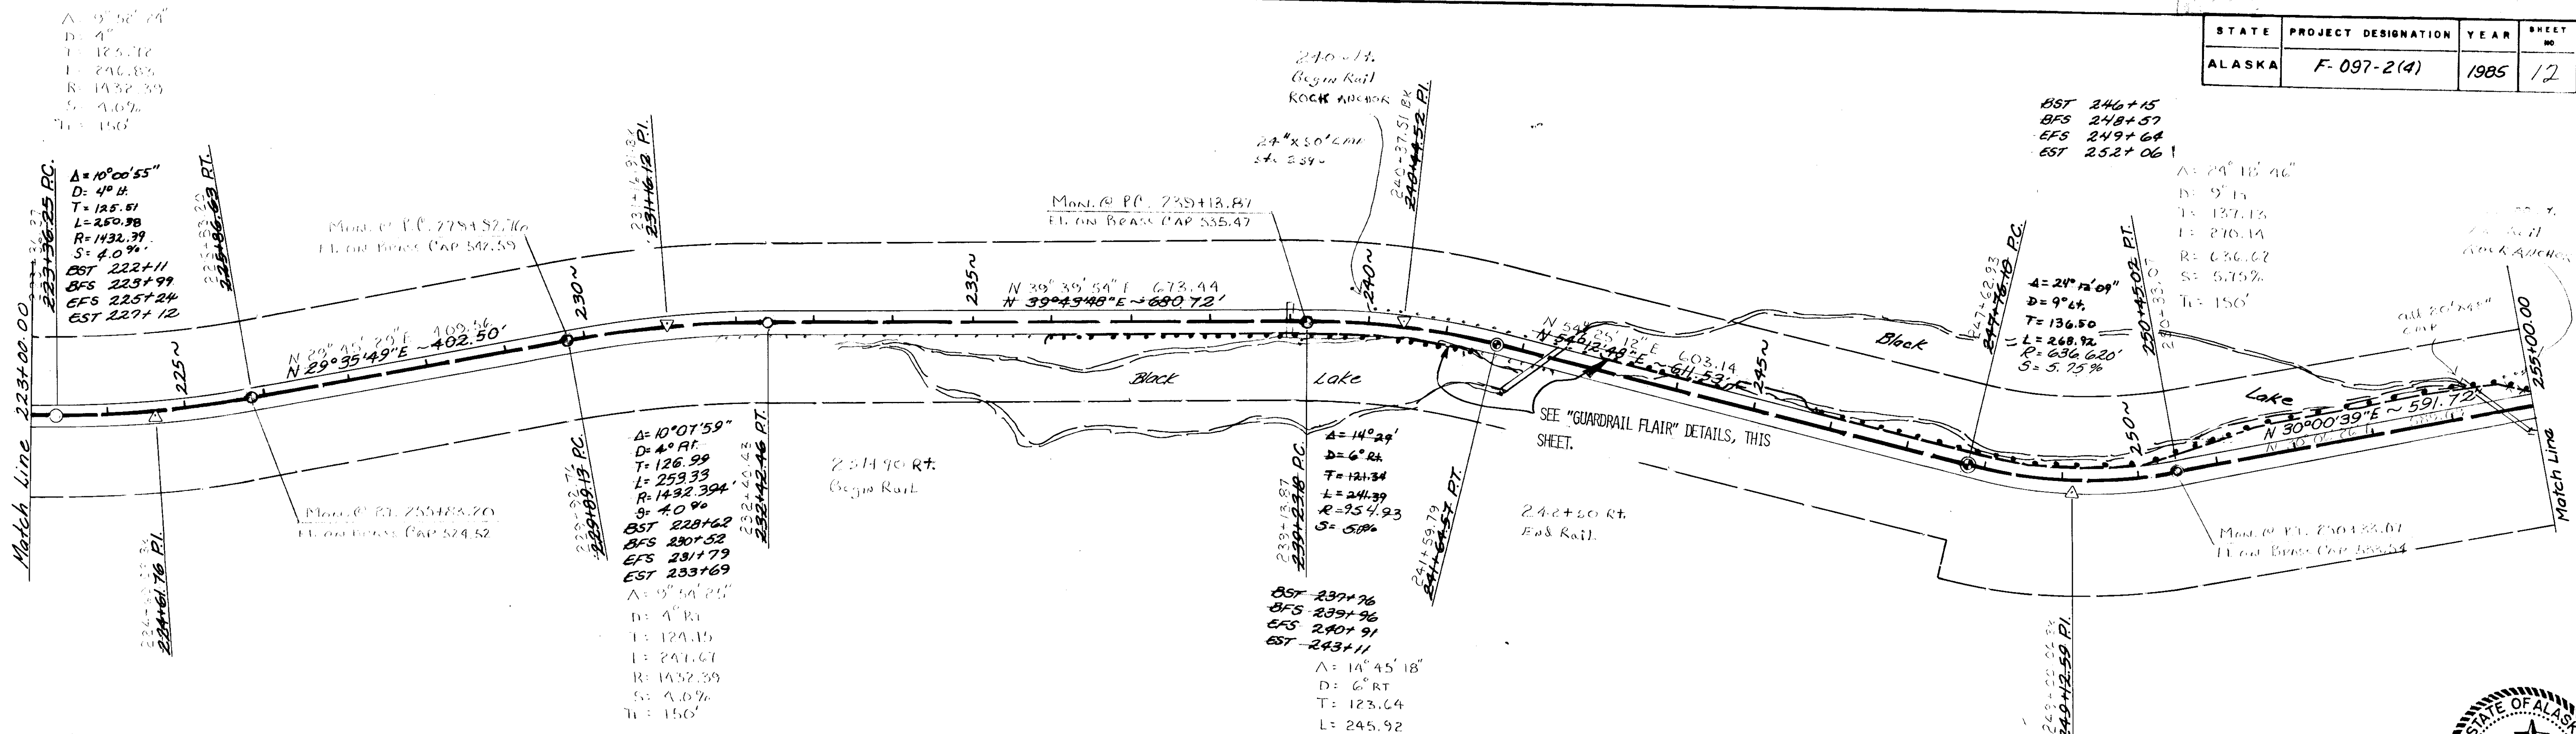


**GUARDRAIL FLAIR DETAILS**

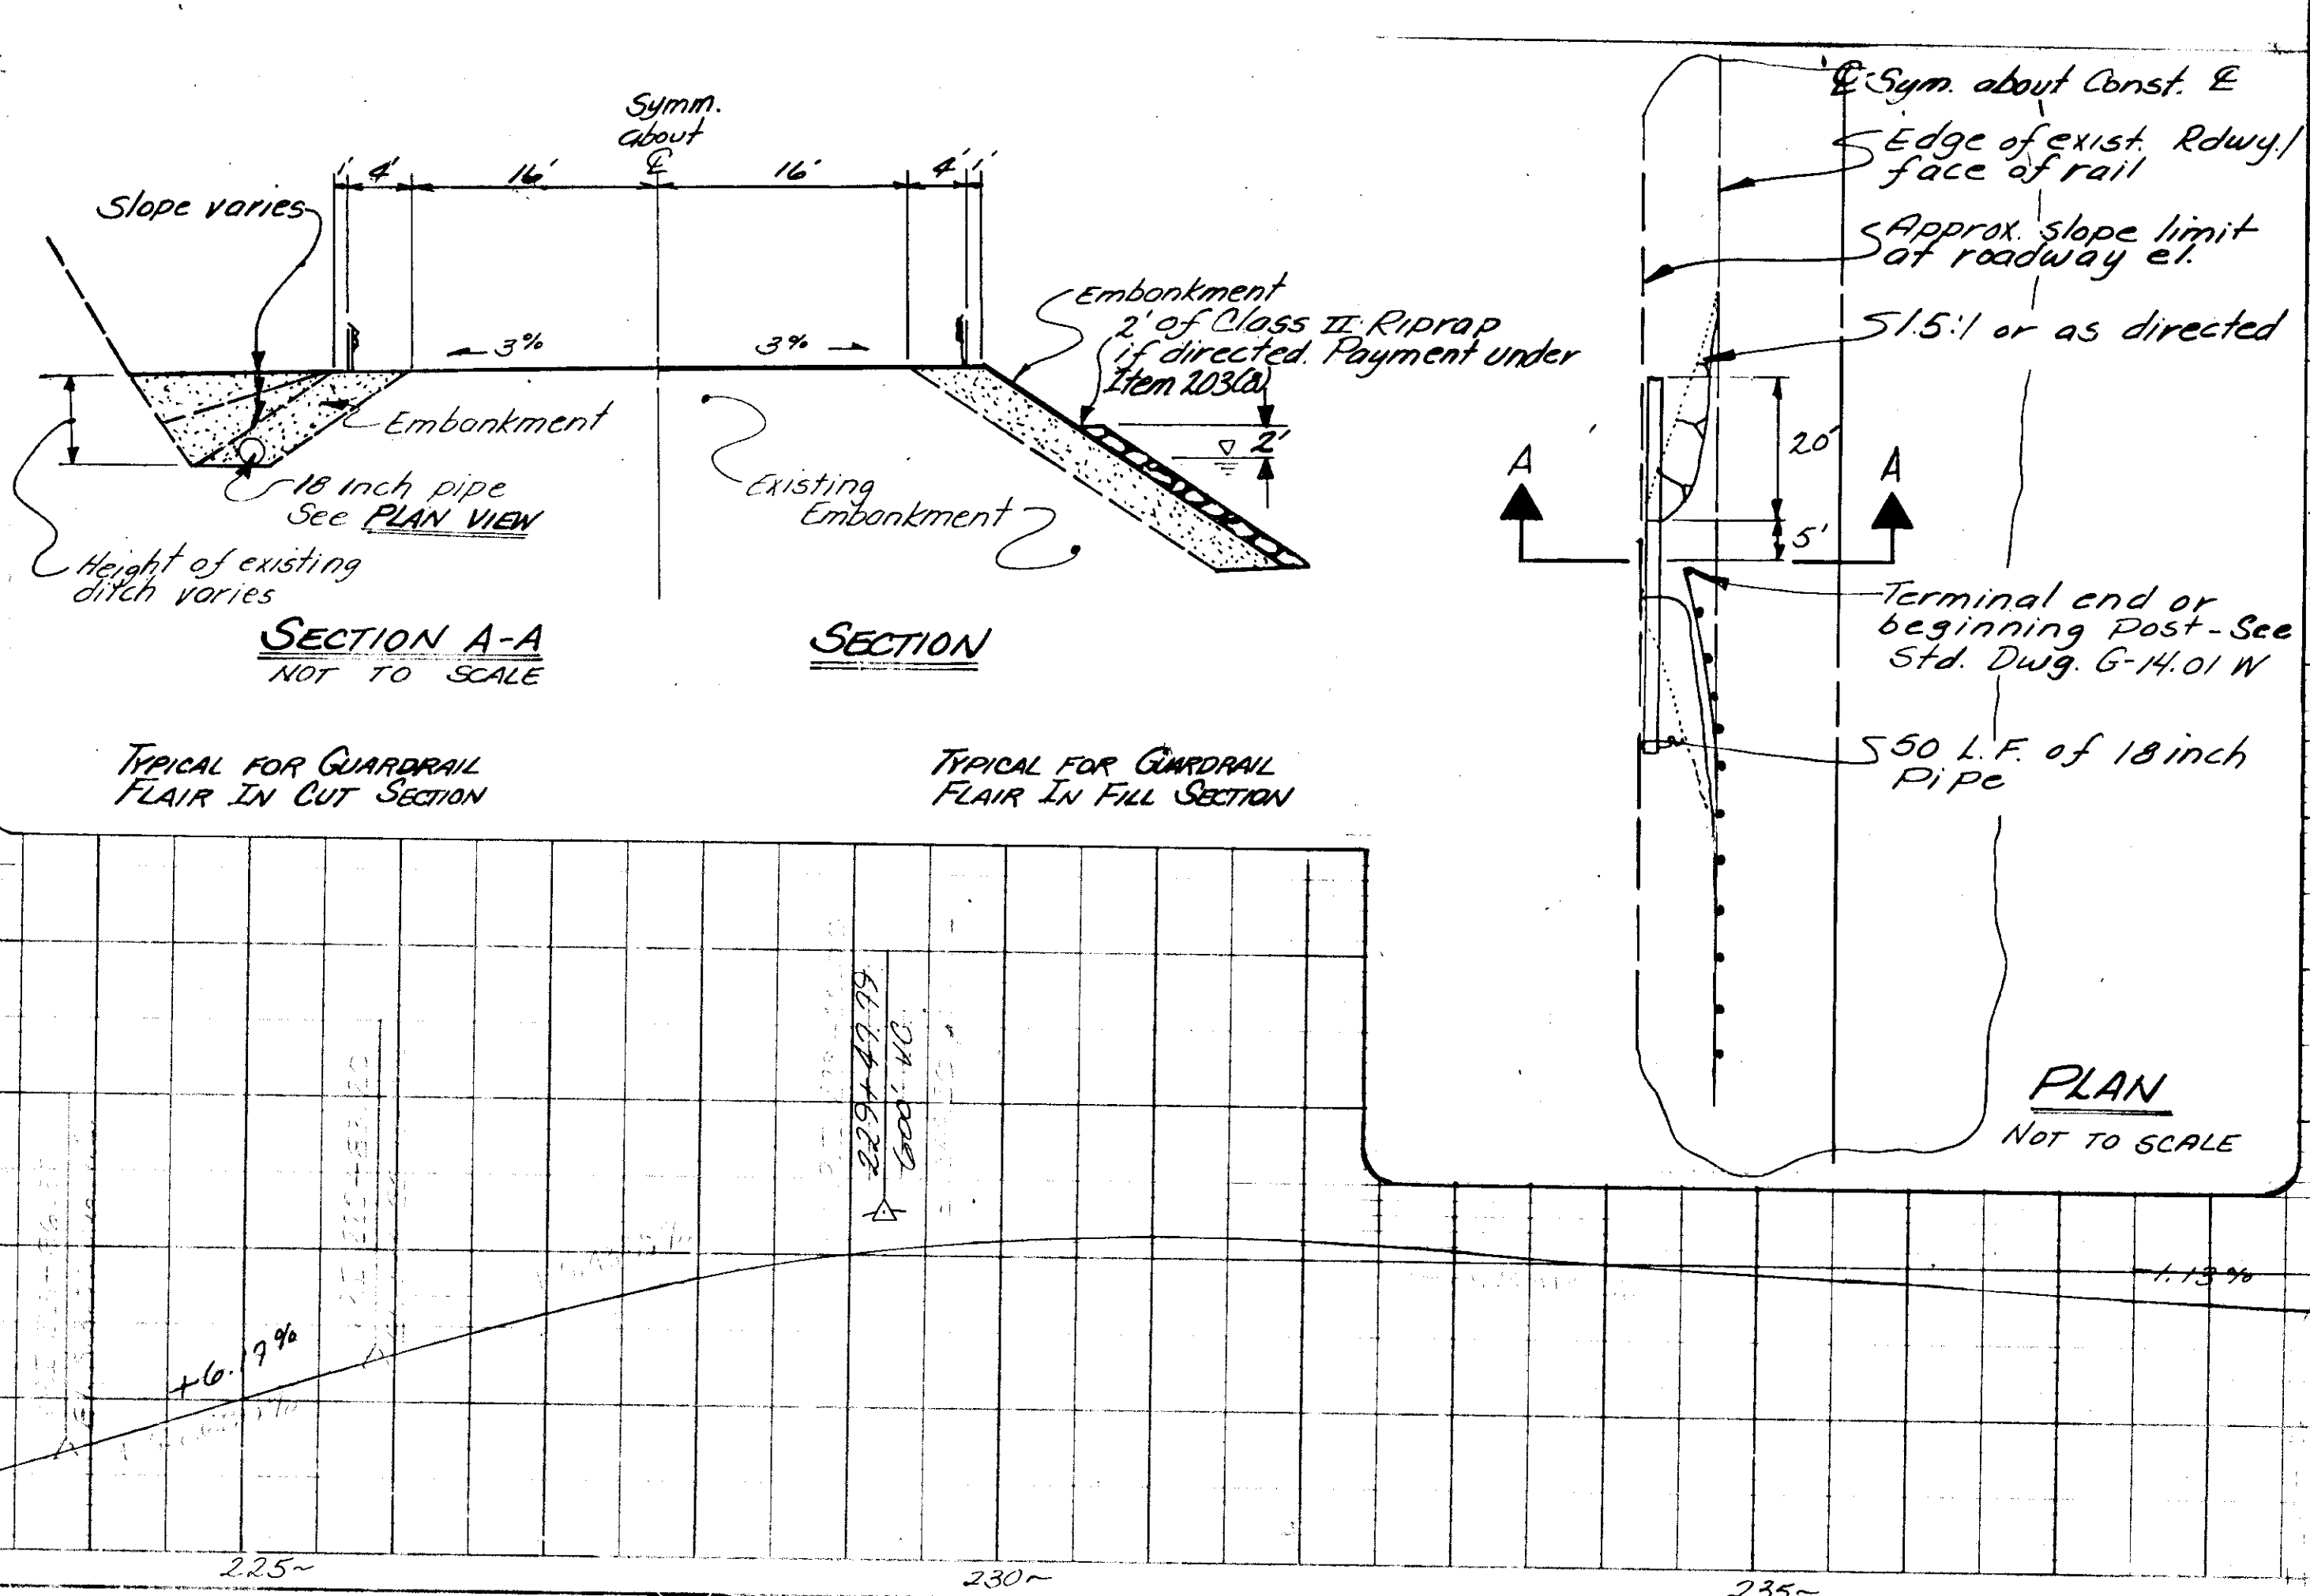

STATE	PROJECT DESIGNATION	YEAR	SHEET NO.	TOTAL SHEETS
ALASKA	F-097-2(4)	1985	13	3

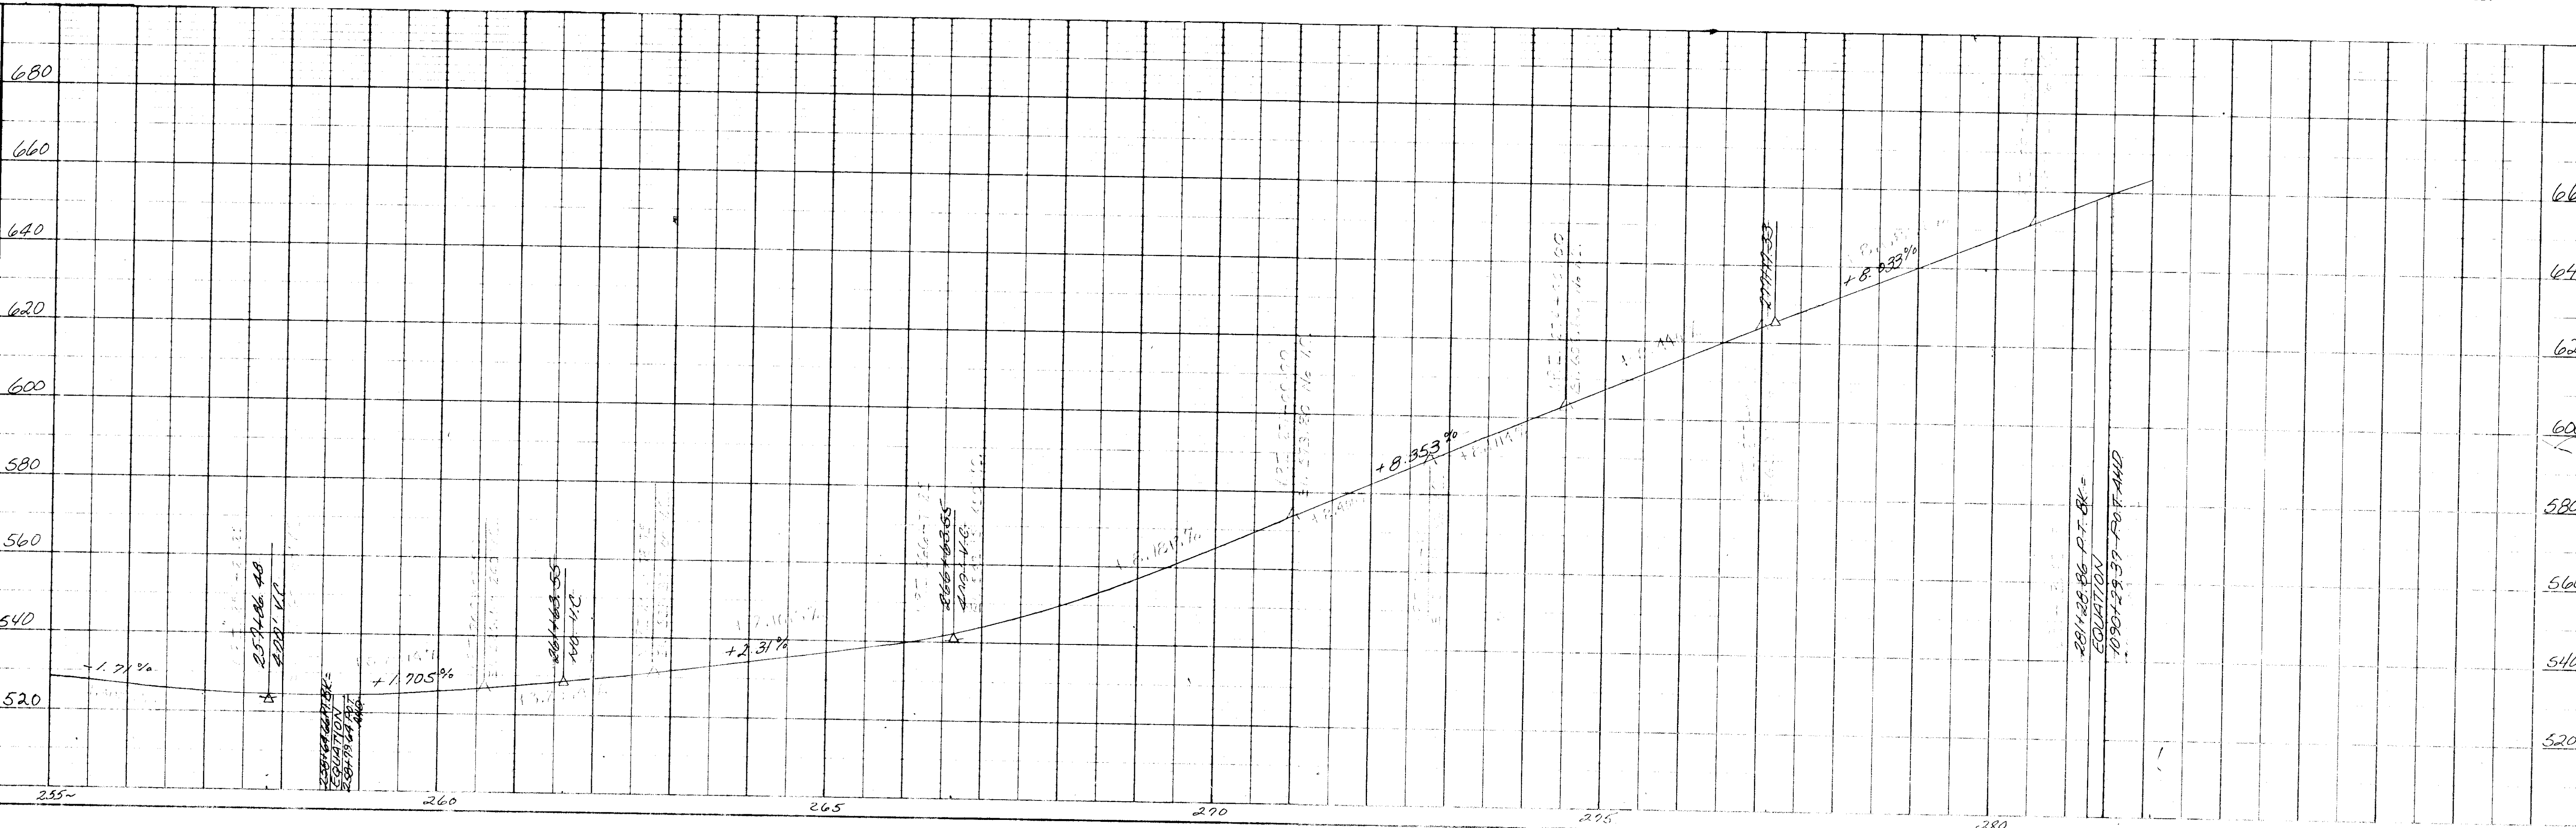
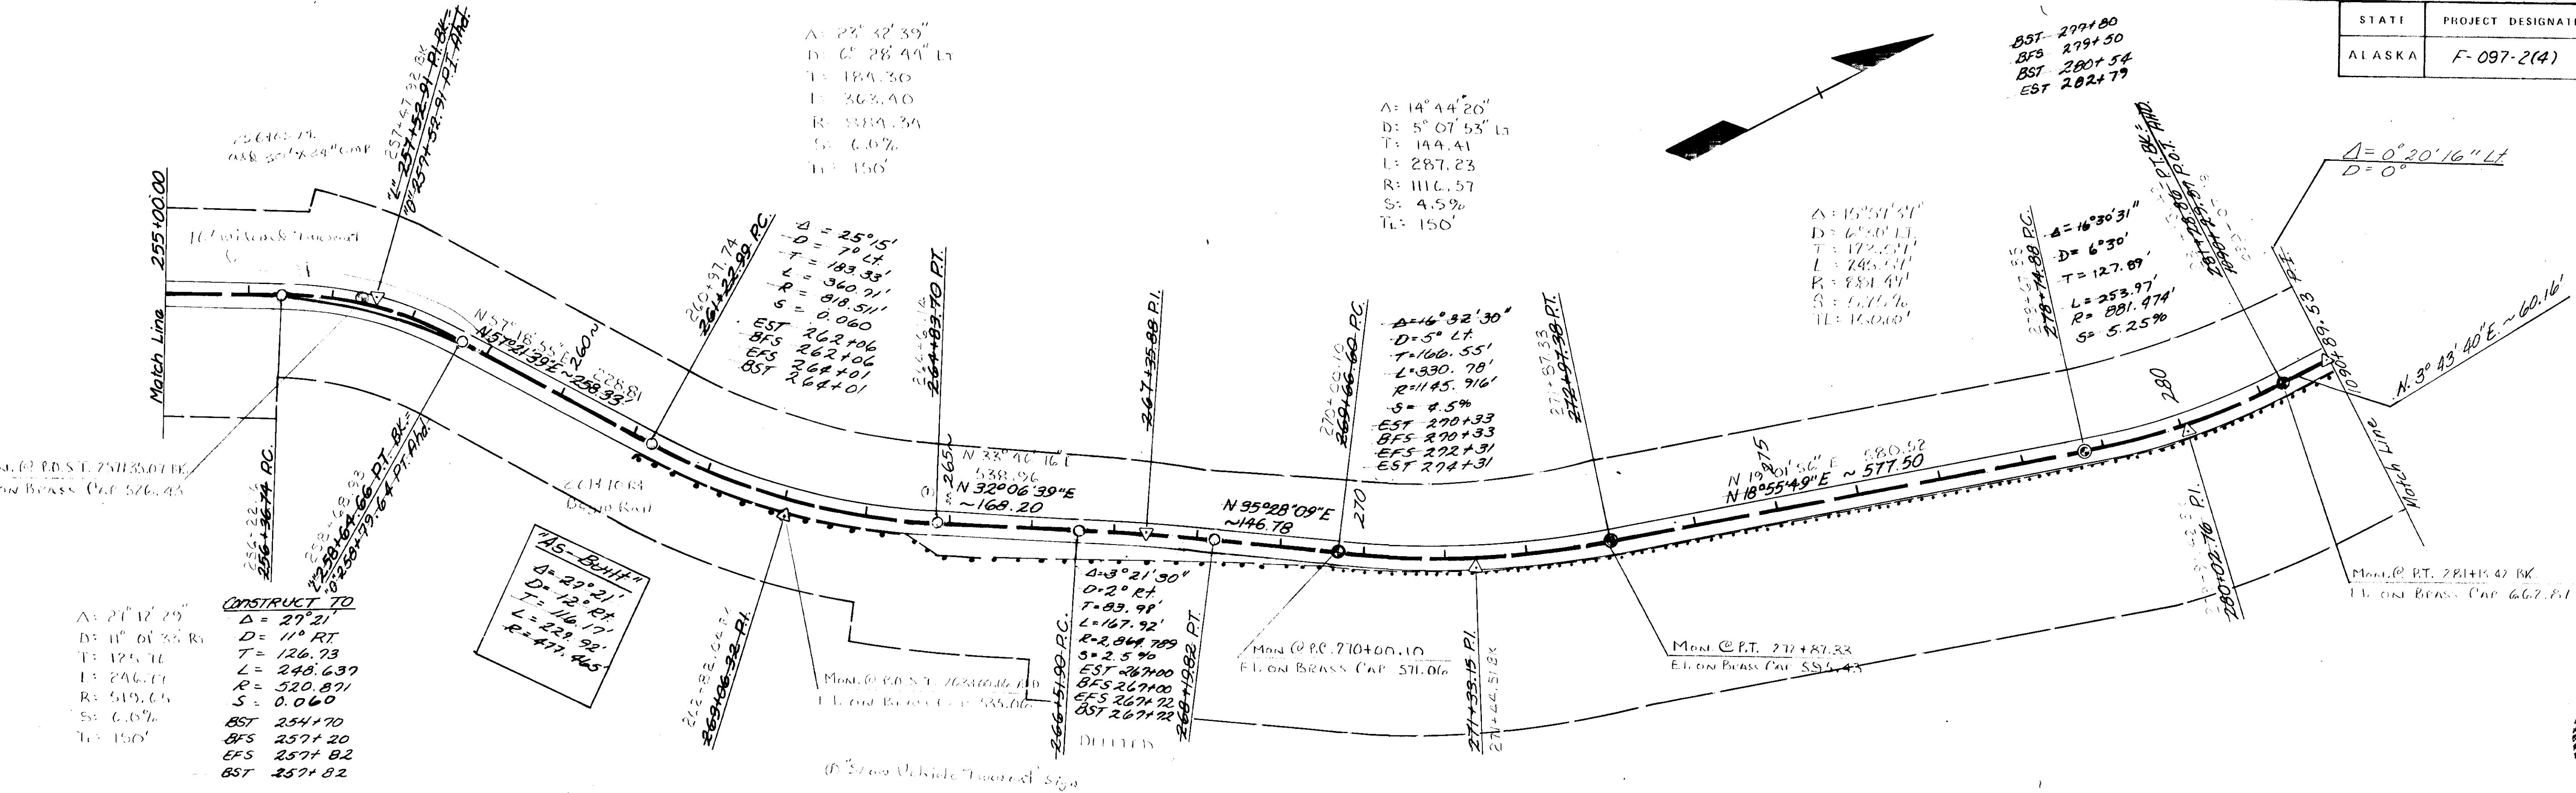


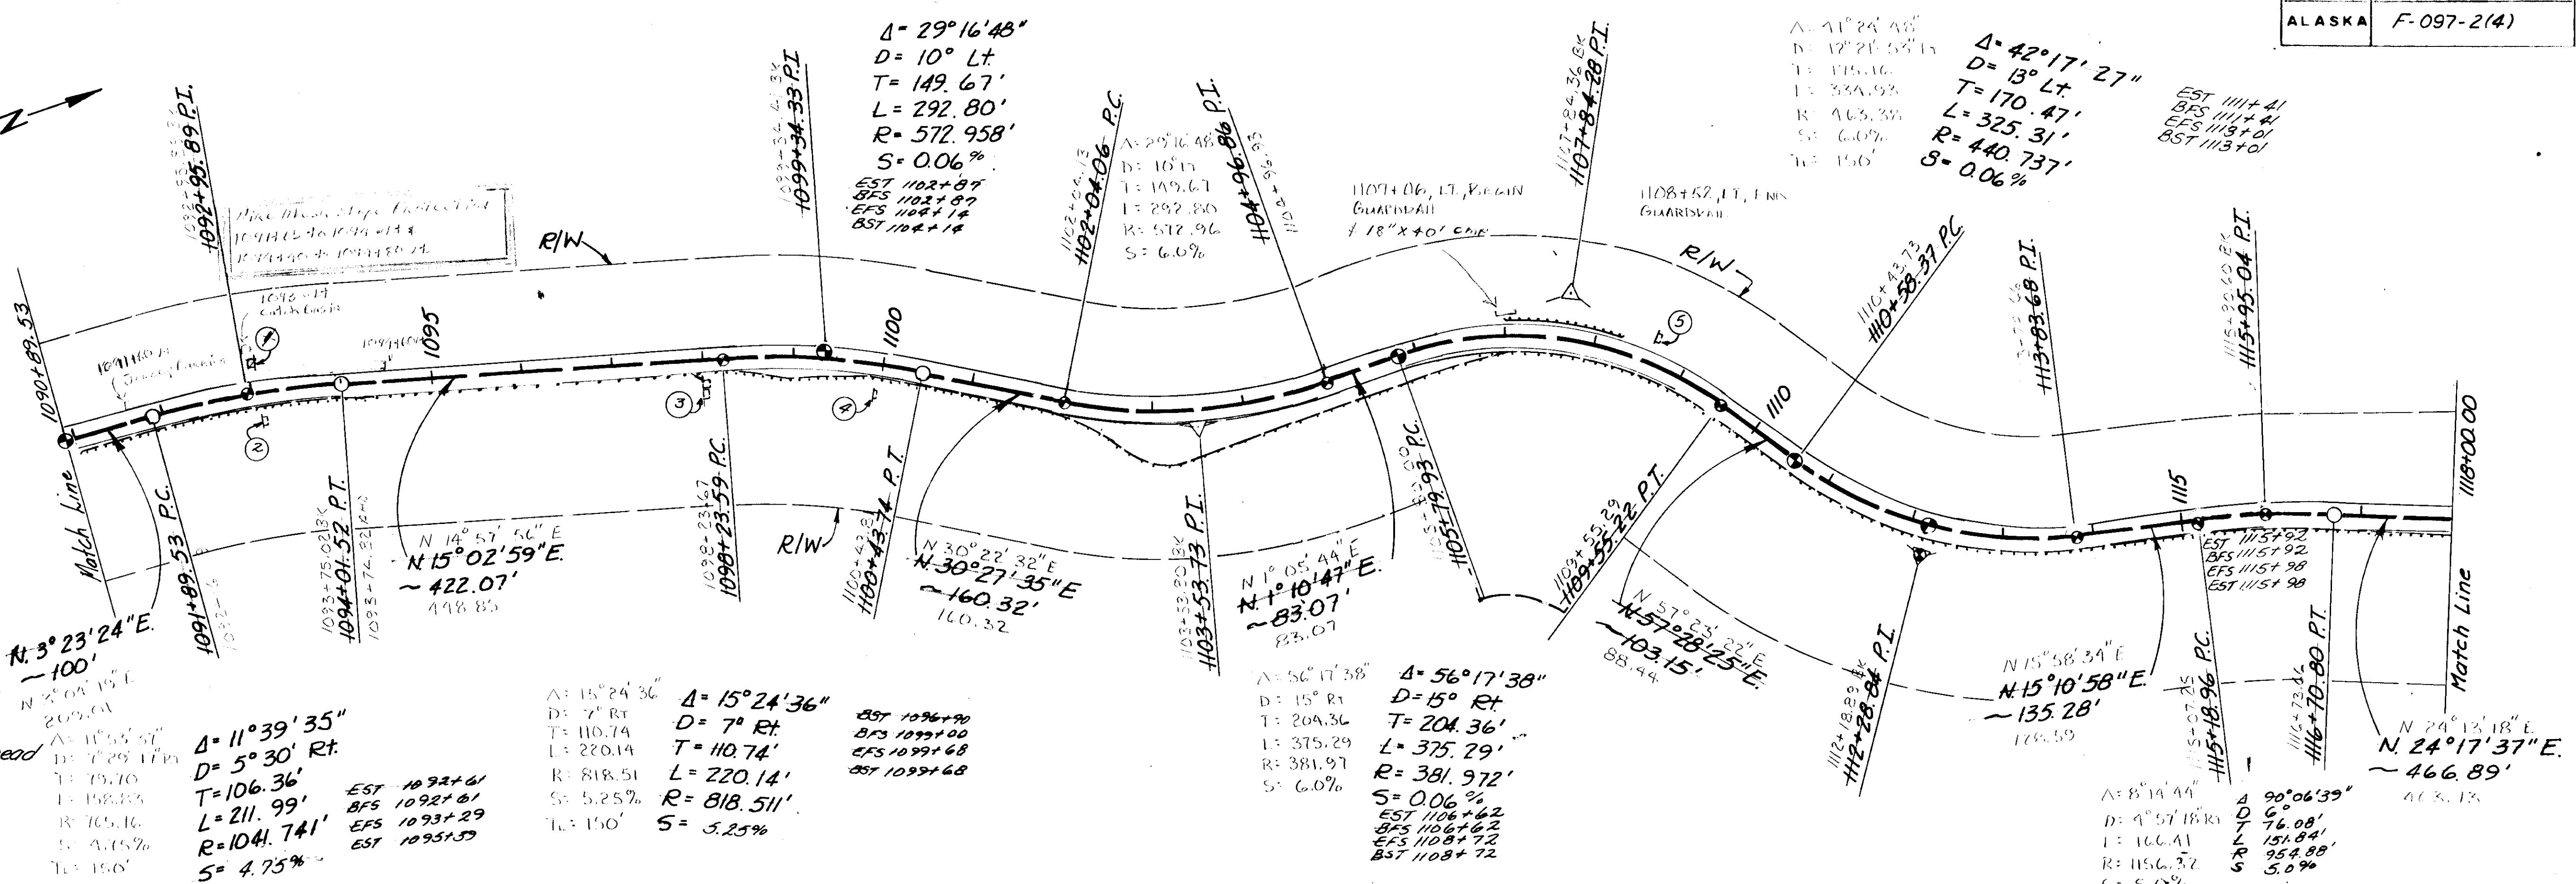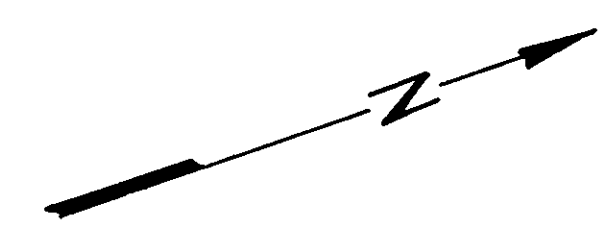


- EXISTING SIGN LEGENDS**
- Speed Limit 40
  - Speed Limit 40
  - Historical Exhibit Ahead
  - 30 m.p.h.
  - Historical Sign





STATE	PROJECT DESIGNATION	YEAR	SHEET NO.	TOTAL SHEETS
ALASKA	F-097-2(4)	1985	15	33

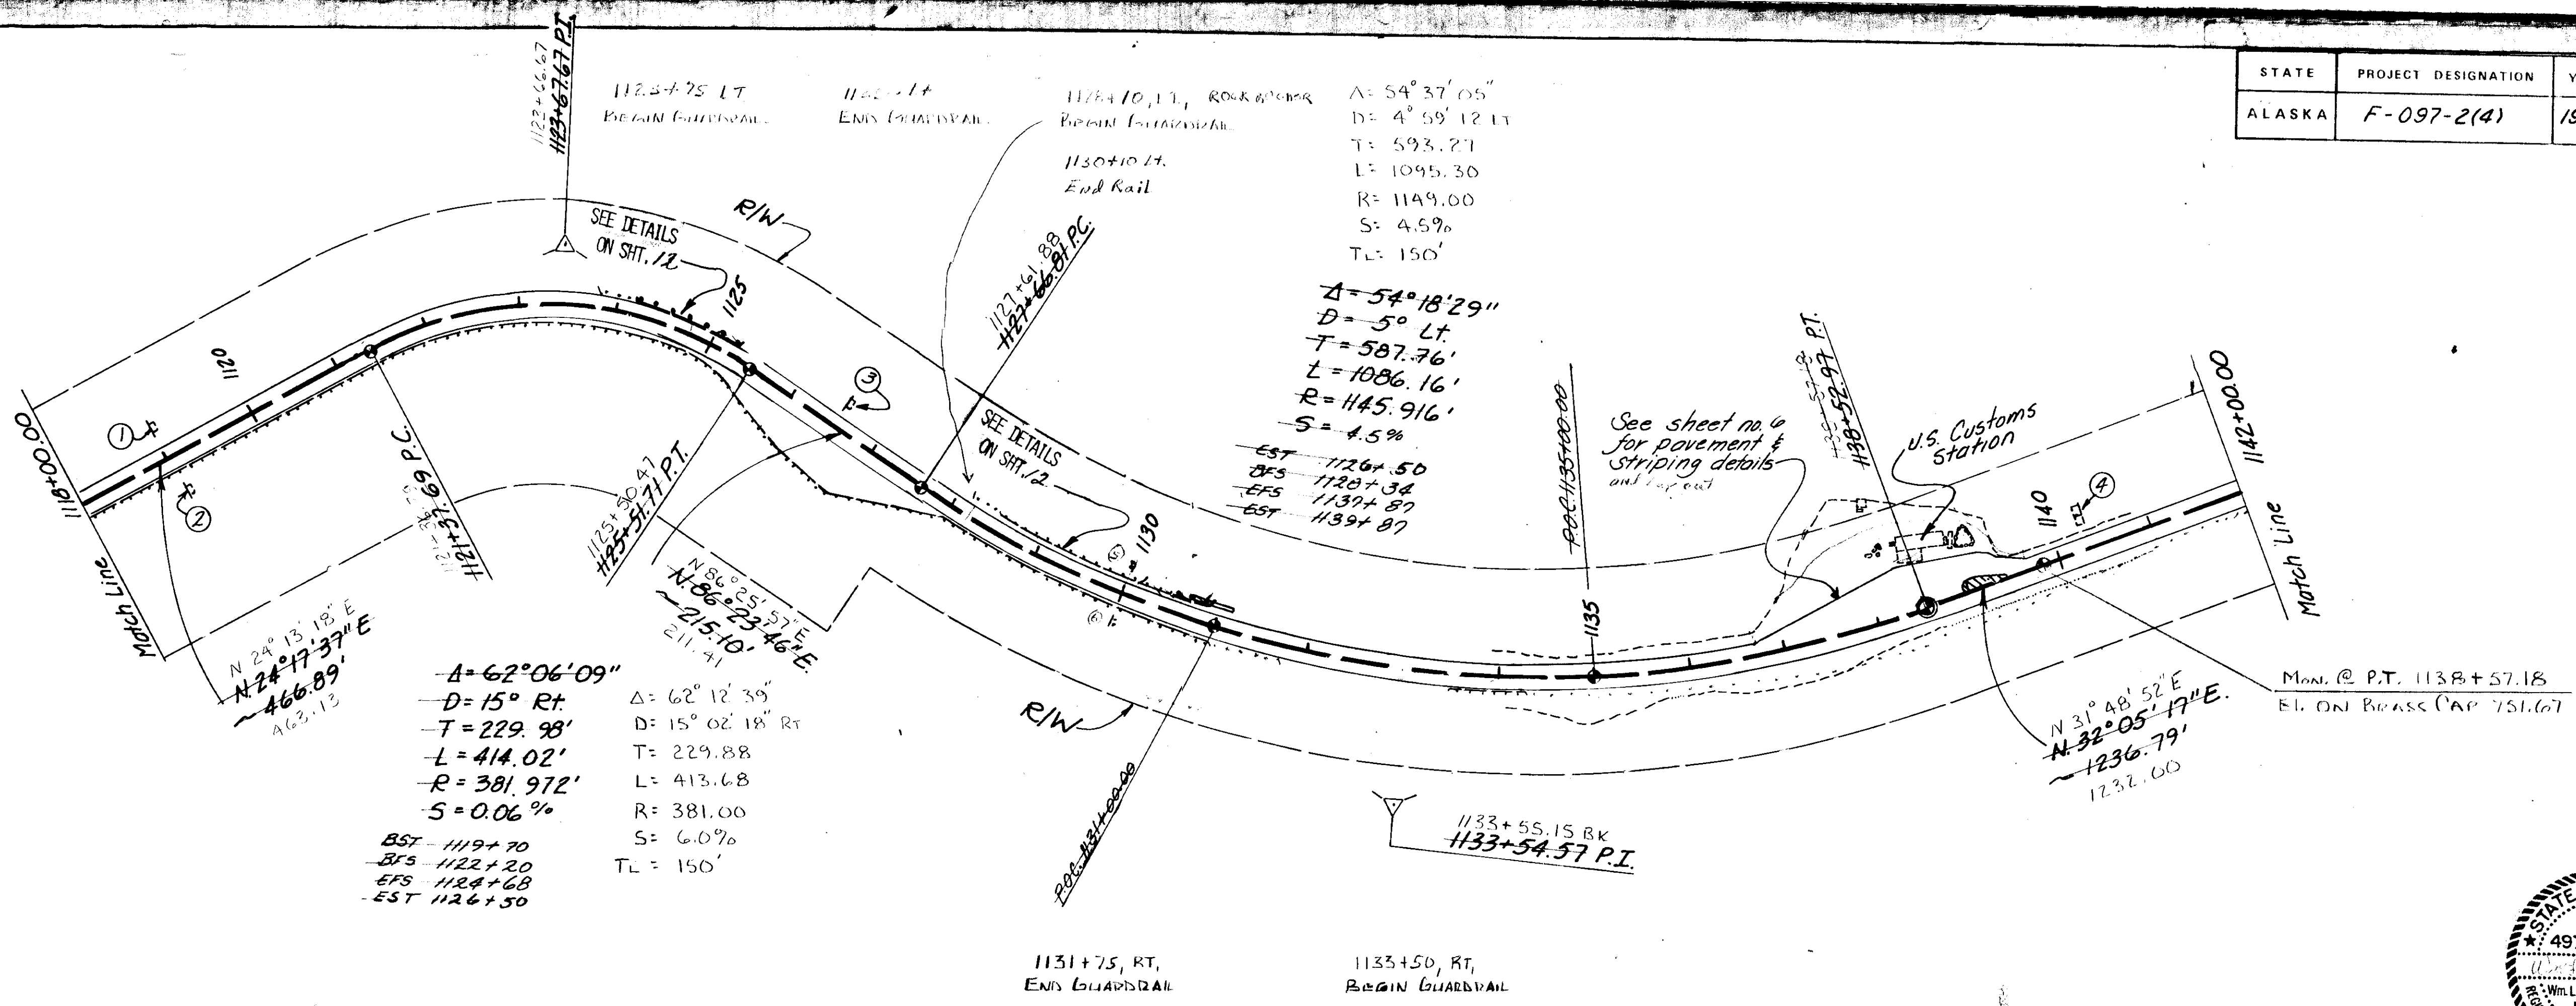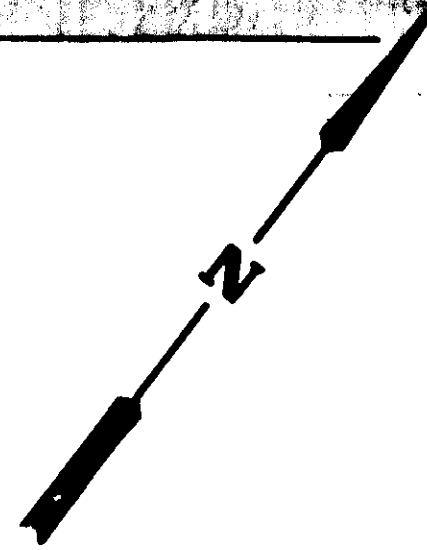

- EXISTING SIGN LEGEND**
- ① - 30 m.p.h.
  - ② - 30 m.p.h.
  - ③ - 30 m.p.h.
  - ④ - Customs
  - ⑤ - 40 m.p.h.
  - ⑥ - 25 m.p.h.

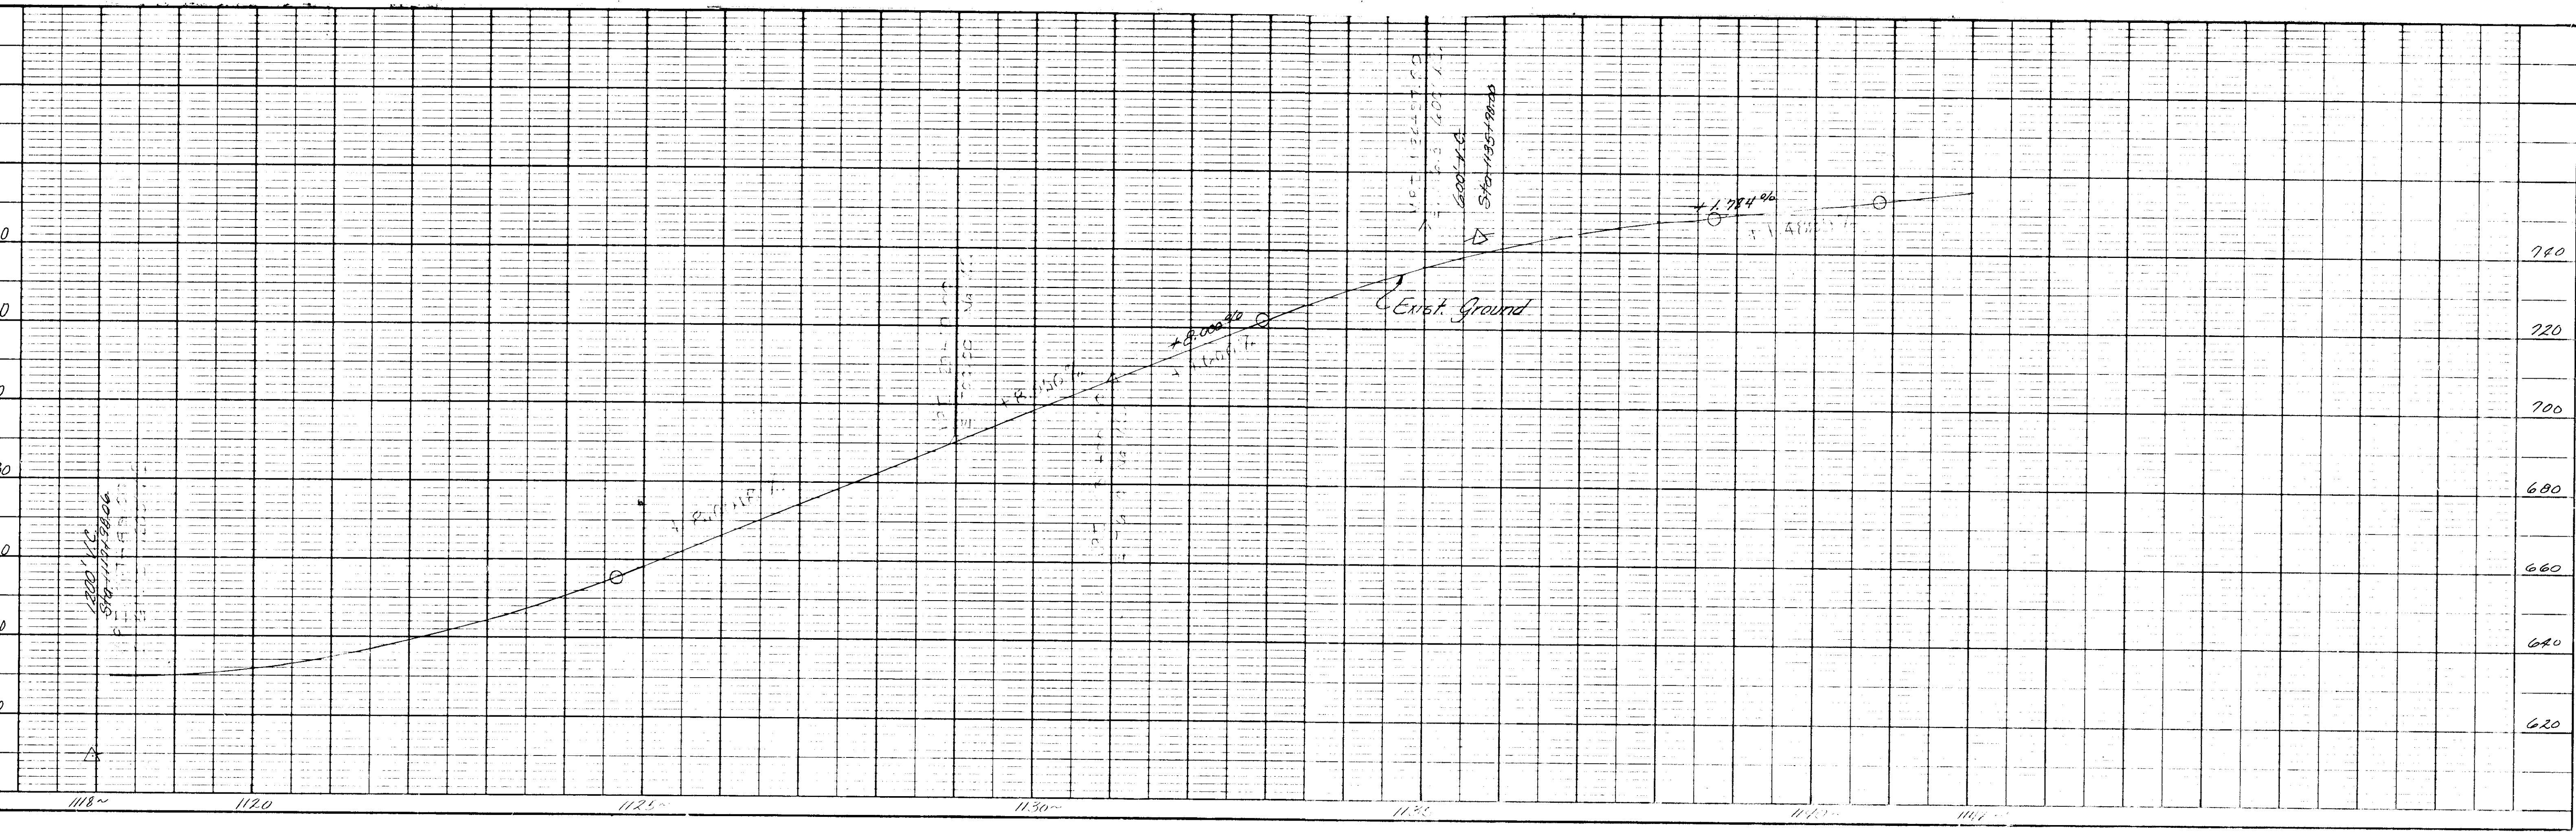

STATE	PROJECT DESIGNATION	YEAR	SHEET NO	TOTAL SHEETS
ALASKA	F-097-2(4)	1985	16	33

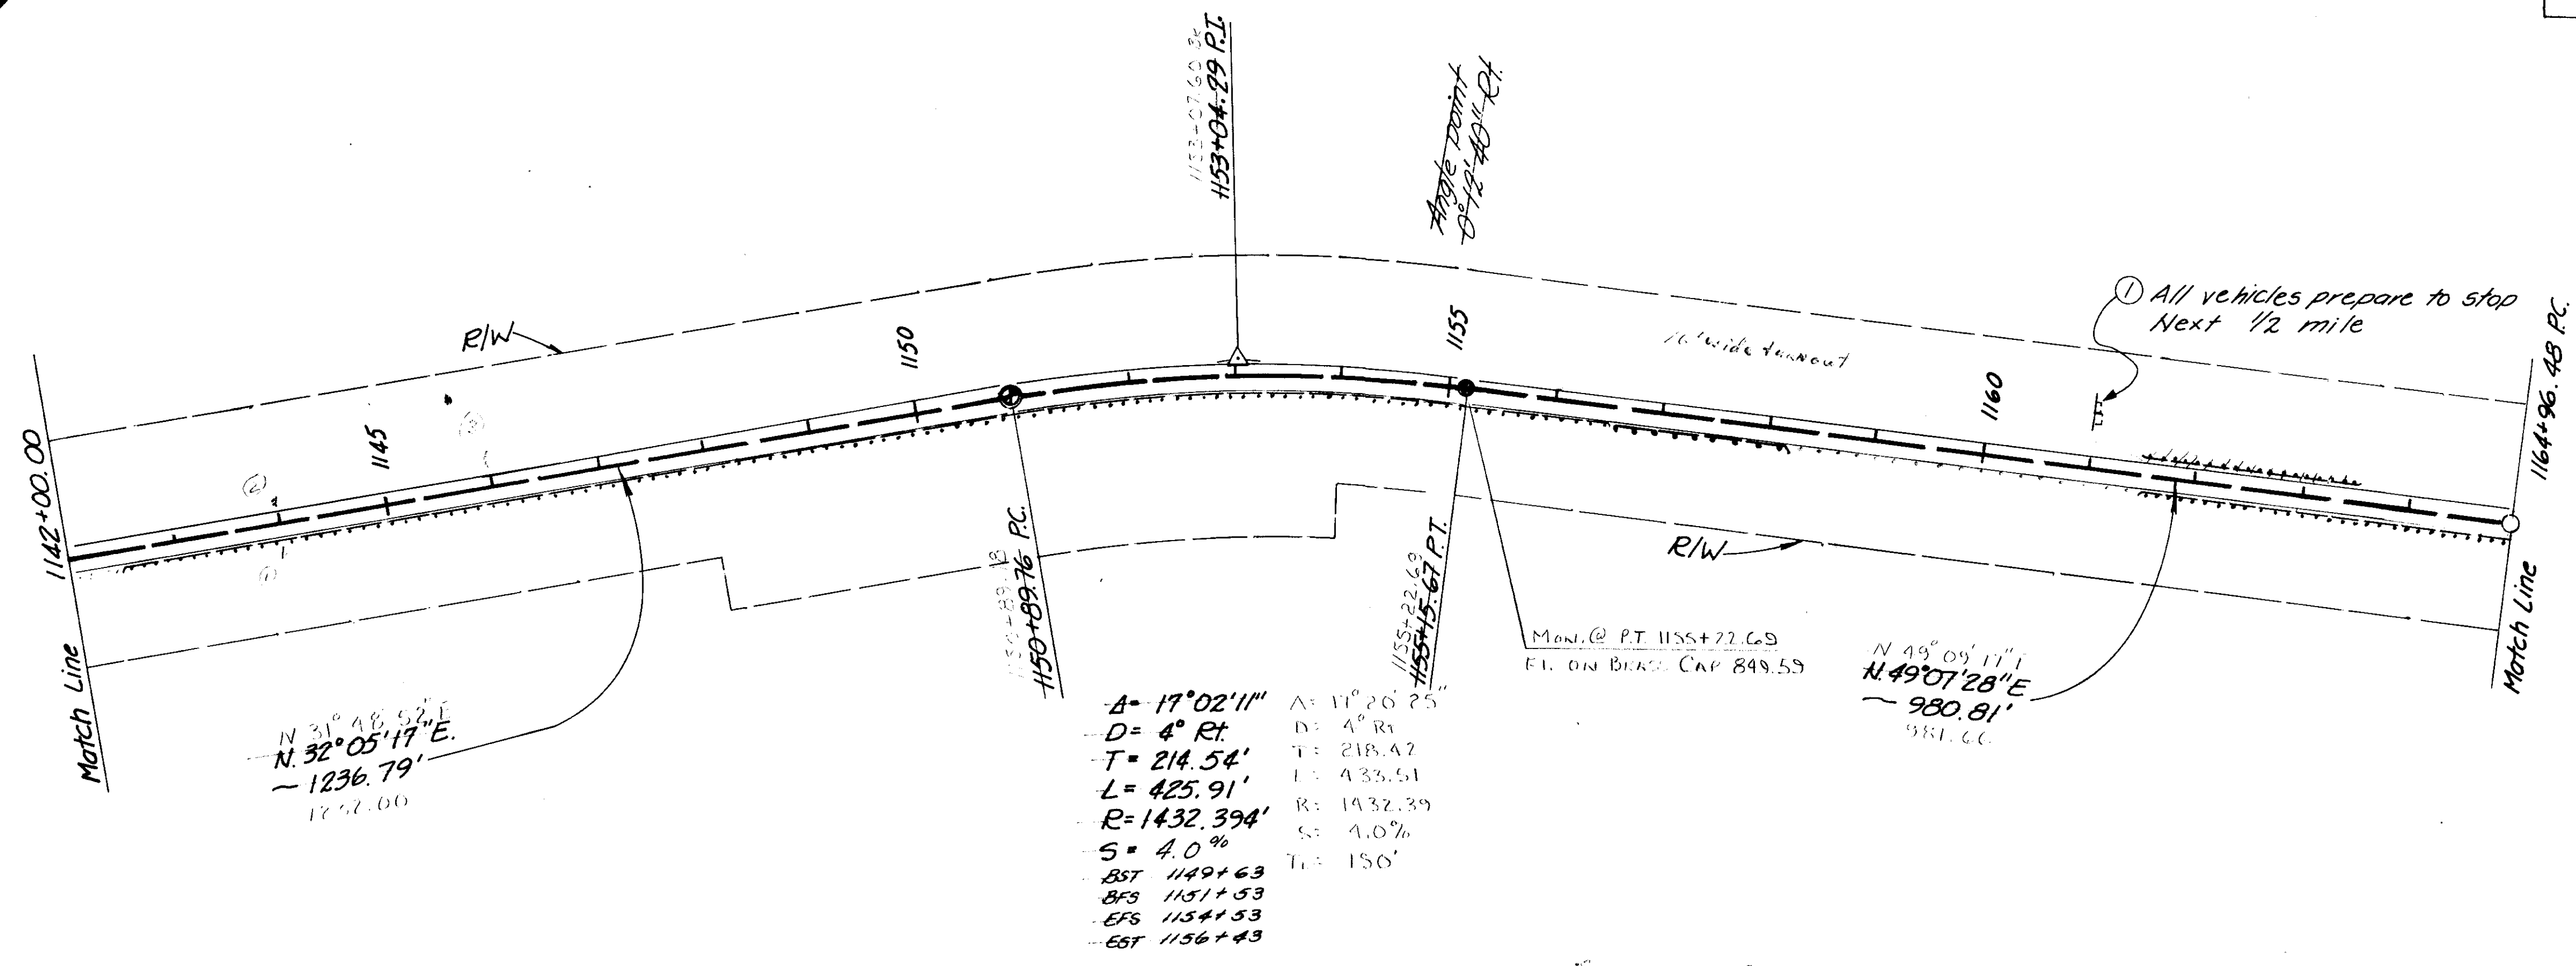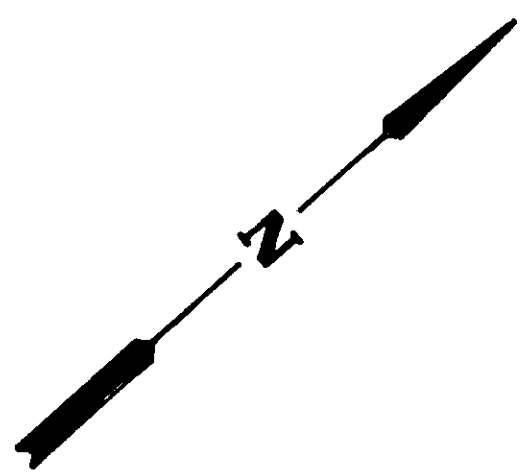



- Sign Legend
- (1) 40 mph
  - (2) 25 mph
  - (3) Construction



N 31° 48' 52" E  
 N 32° 05' 17" E  
 - 1236.79'  
 17.52.00

A = 17° 02' 11"    A = 17° 20' 25"  
 D = 4° Rt        D = 4° Rt  
 T = 214.54'      T = 218.42'  
 L = 425.91'      L = 433.51'  
 R = 1432.394'    R = 1432.39'  
 S = 4.0%         S = 4.0%  
 BST 1149+63      T = 150'  
 BFS 1151+53  
 EFS 1154+53  
 EST 1156+43



N 49° 09' 11" E  
 N 49° 07' 28" E  
 - 980.81'  
 981.66'

Mon. @ PT 1155+22.69  
 EL. ON BEAR CAP 848.55


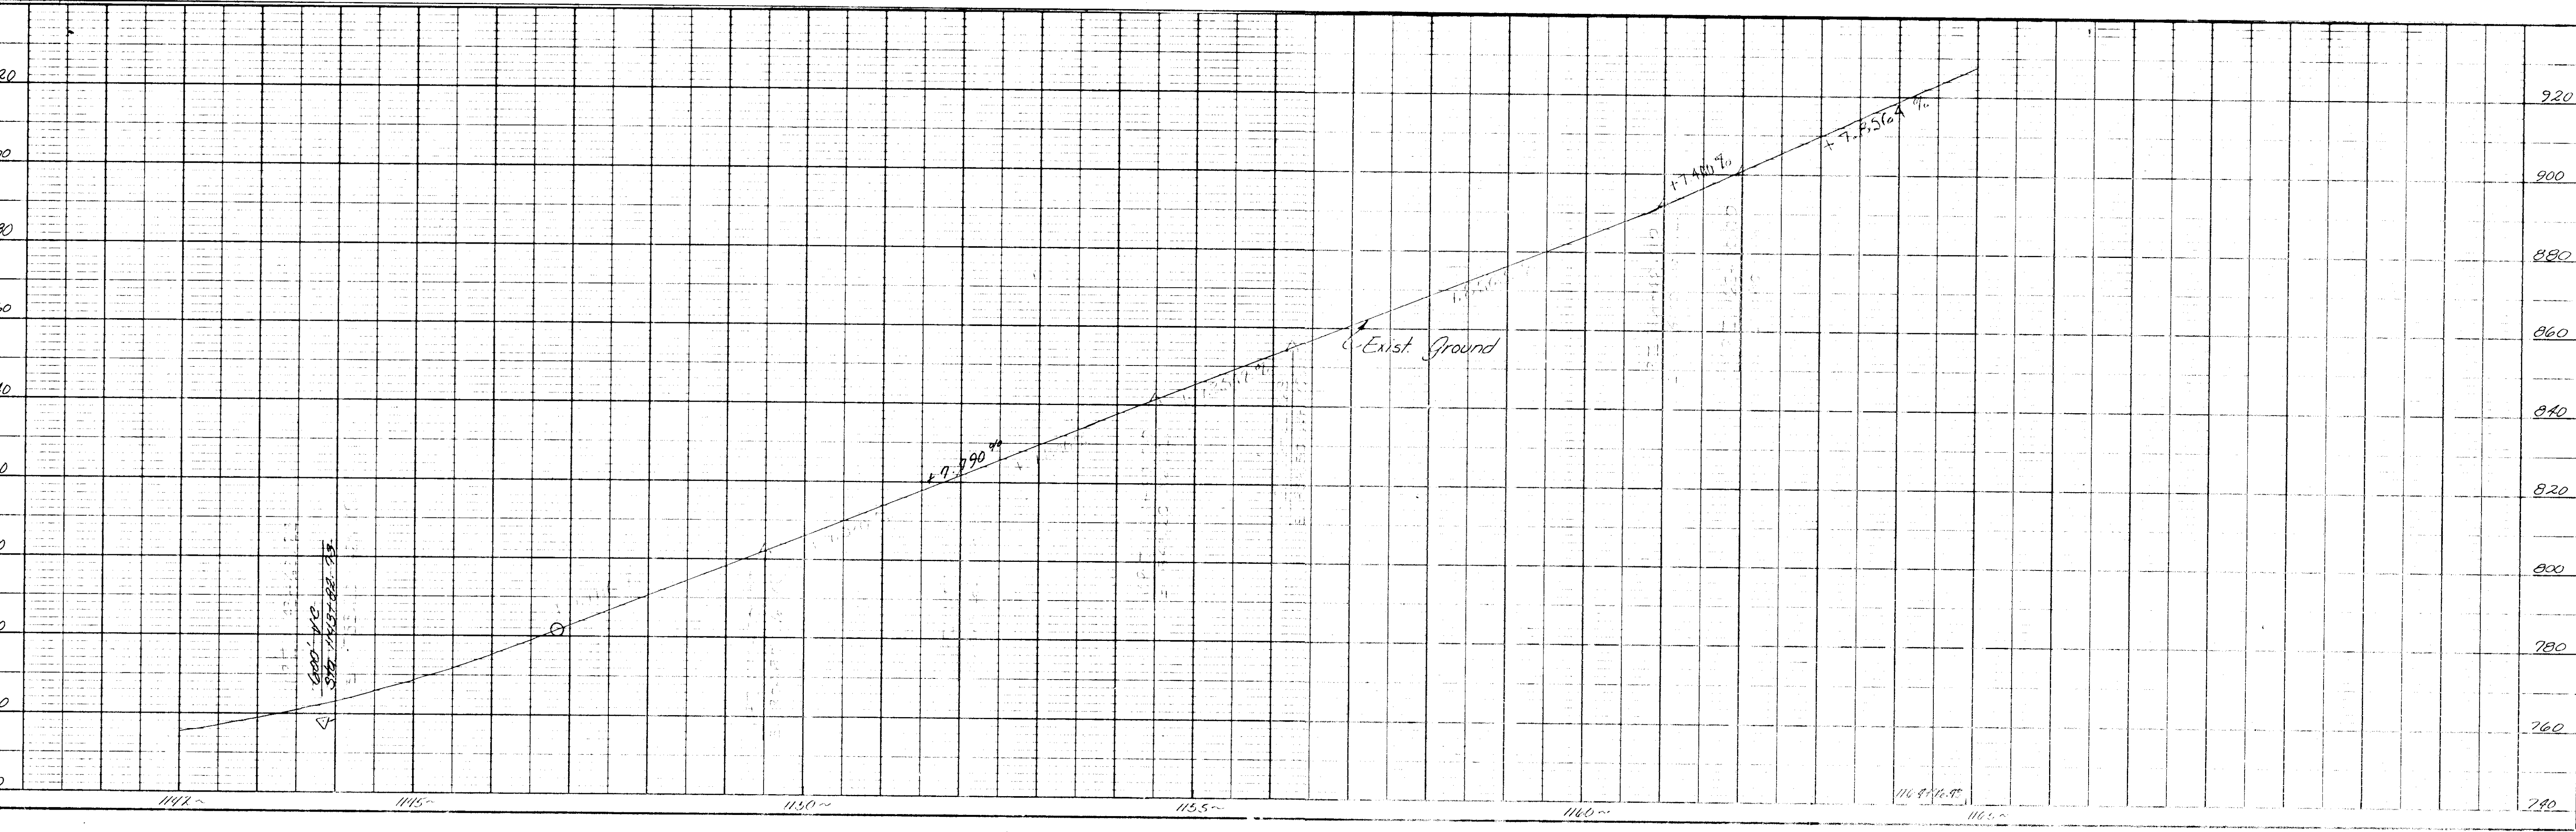
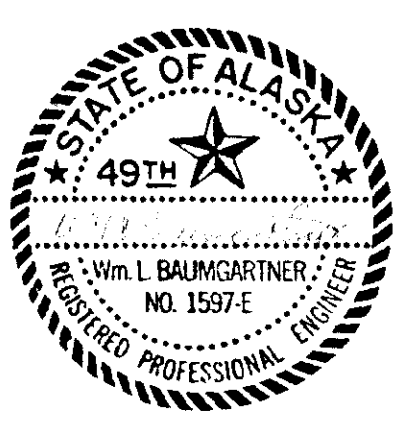


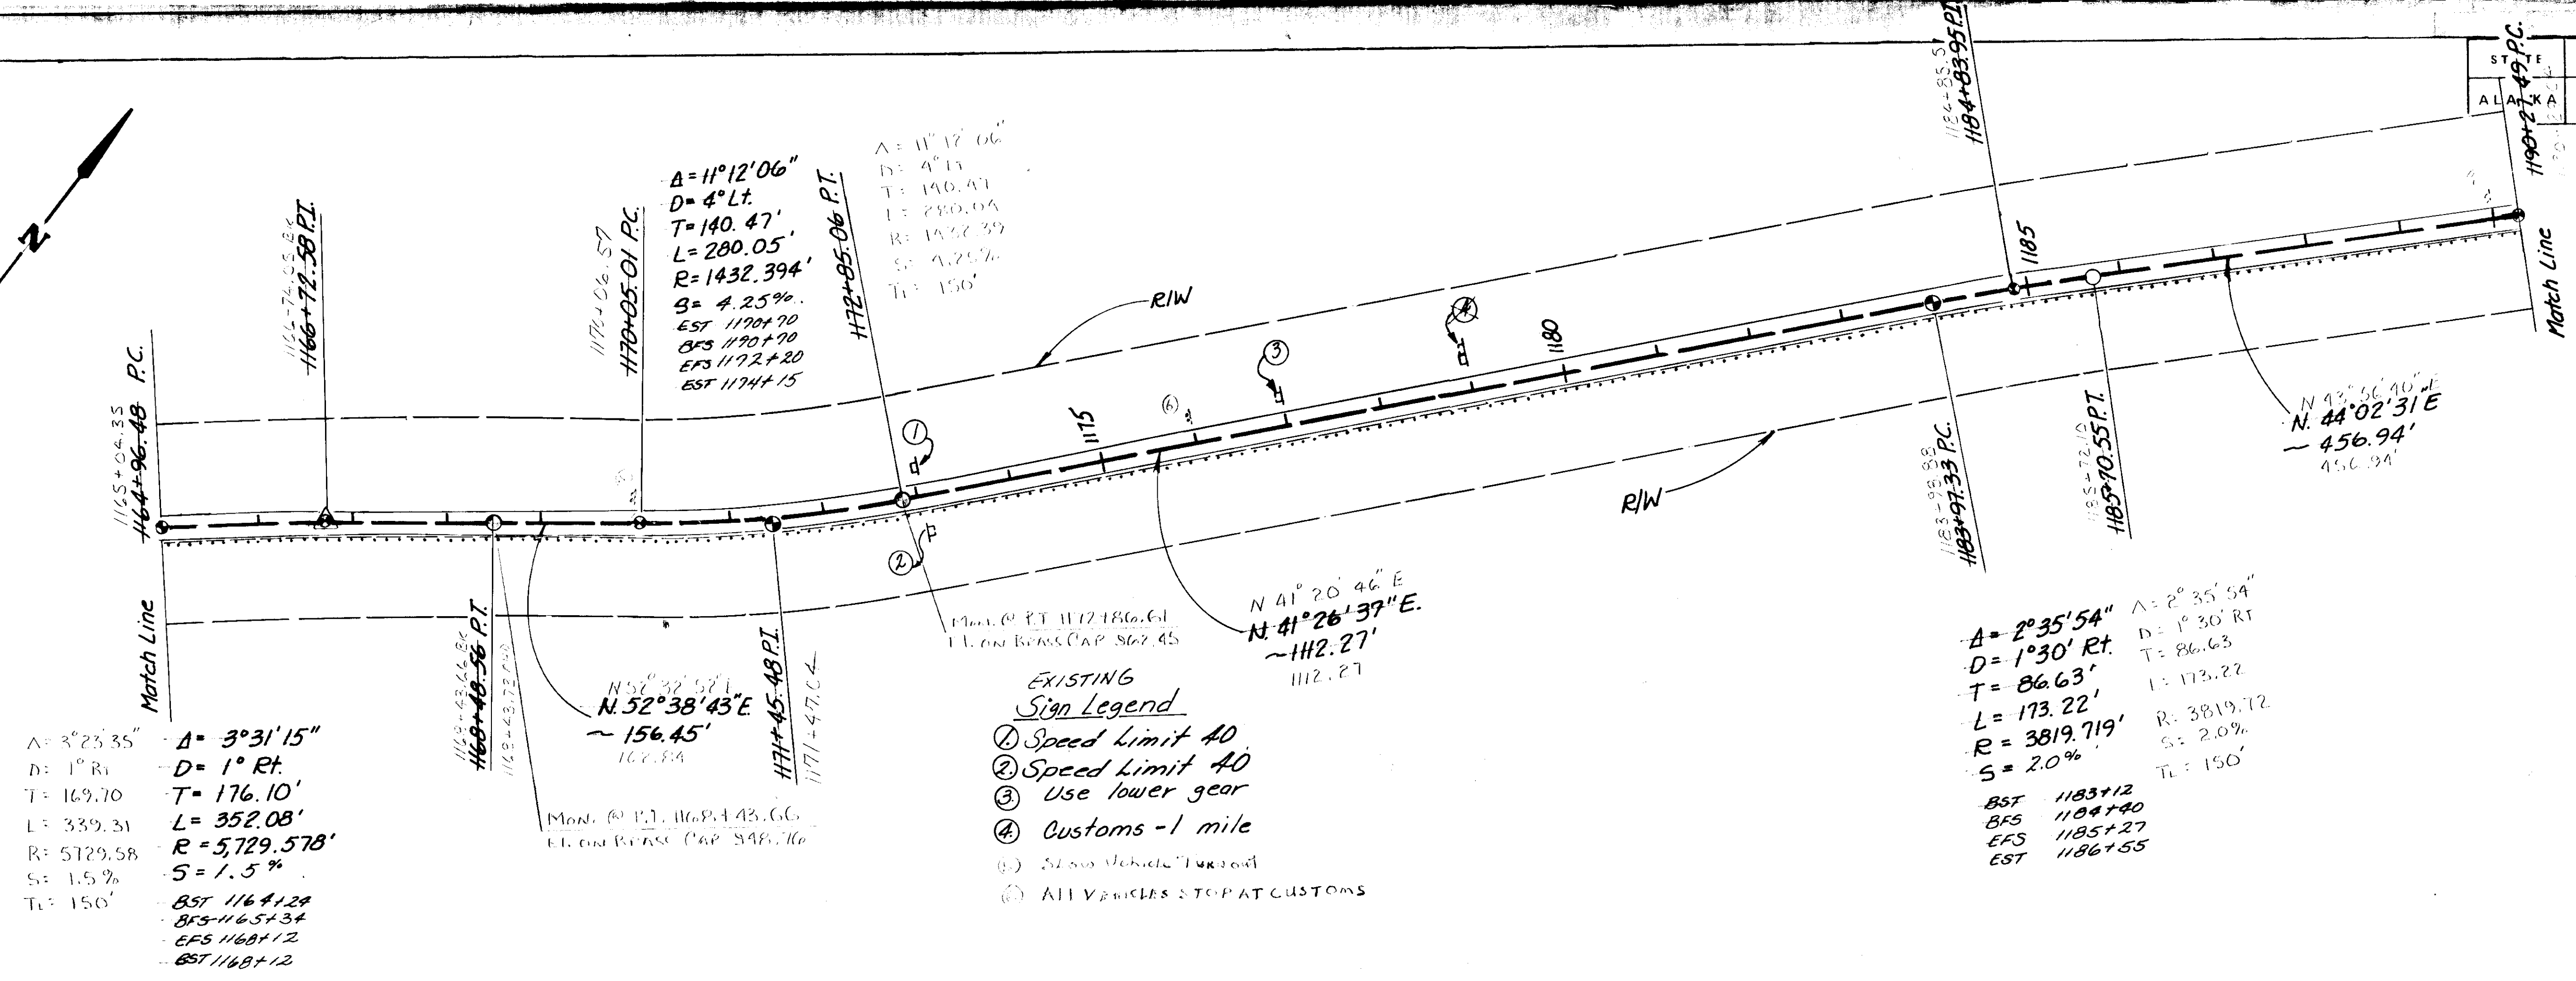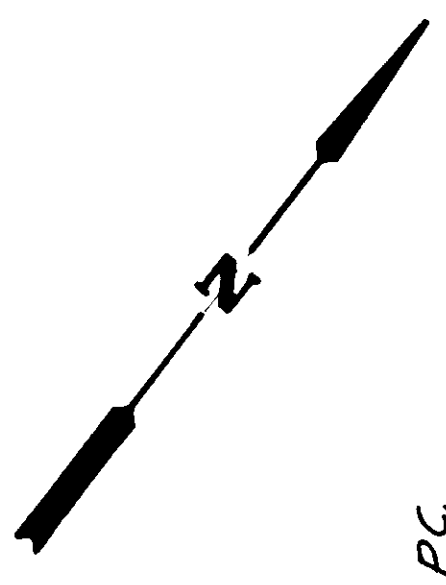





- EXISTING Sign Legend**
- ① Speed Limit 40
  - ② Speed Limit 40
  - ③ Use lower gear
  - ④ Customs - 1 mile
  - ⑤ Slow Vehicle Forward
  - ⑥ All Vehicles STOP AT CUSTOMS

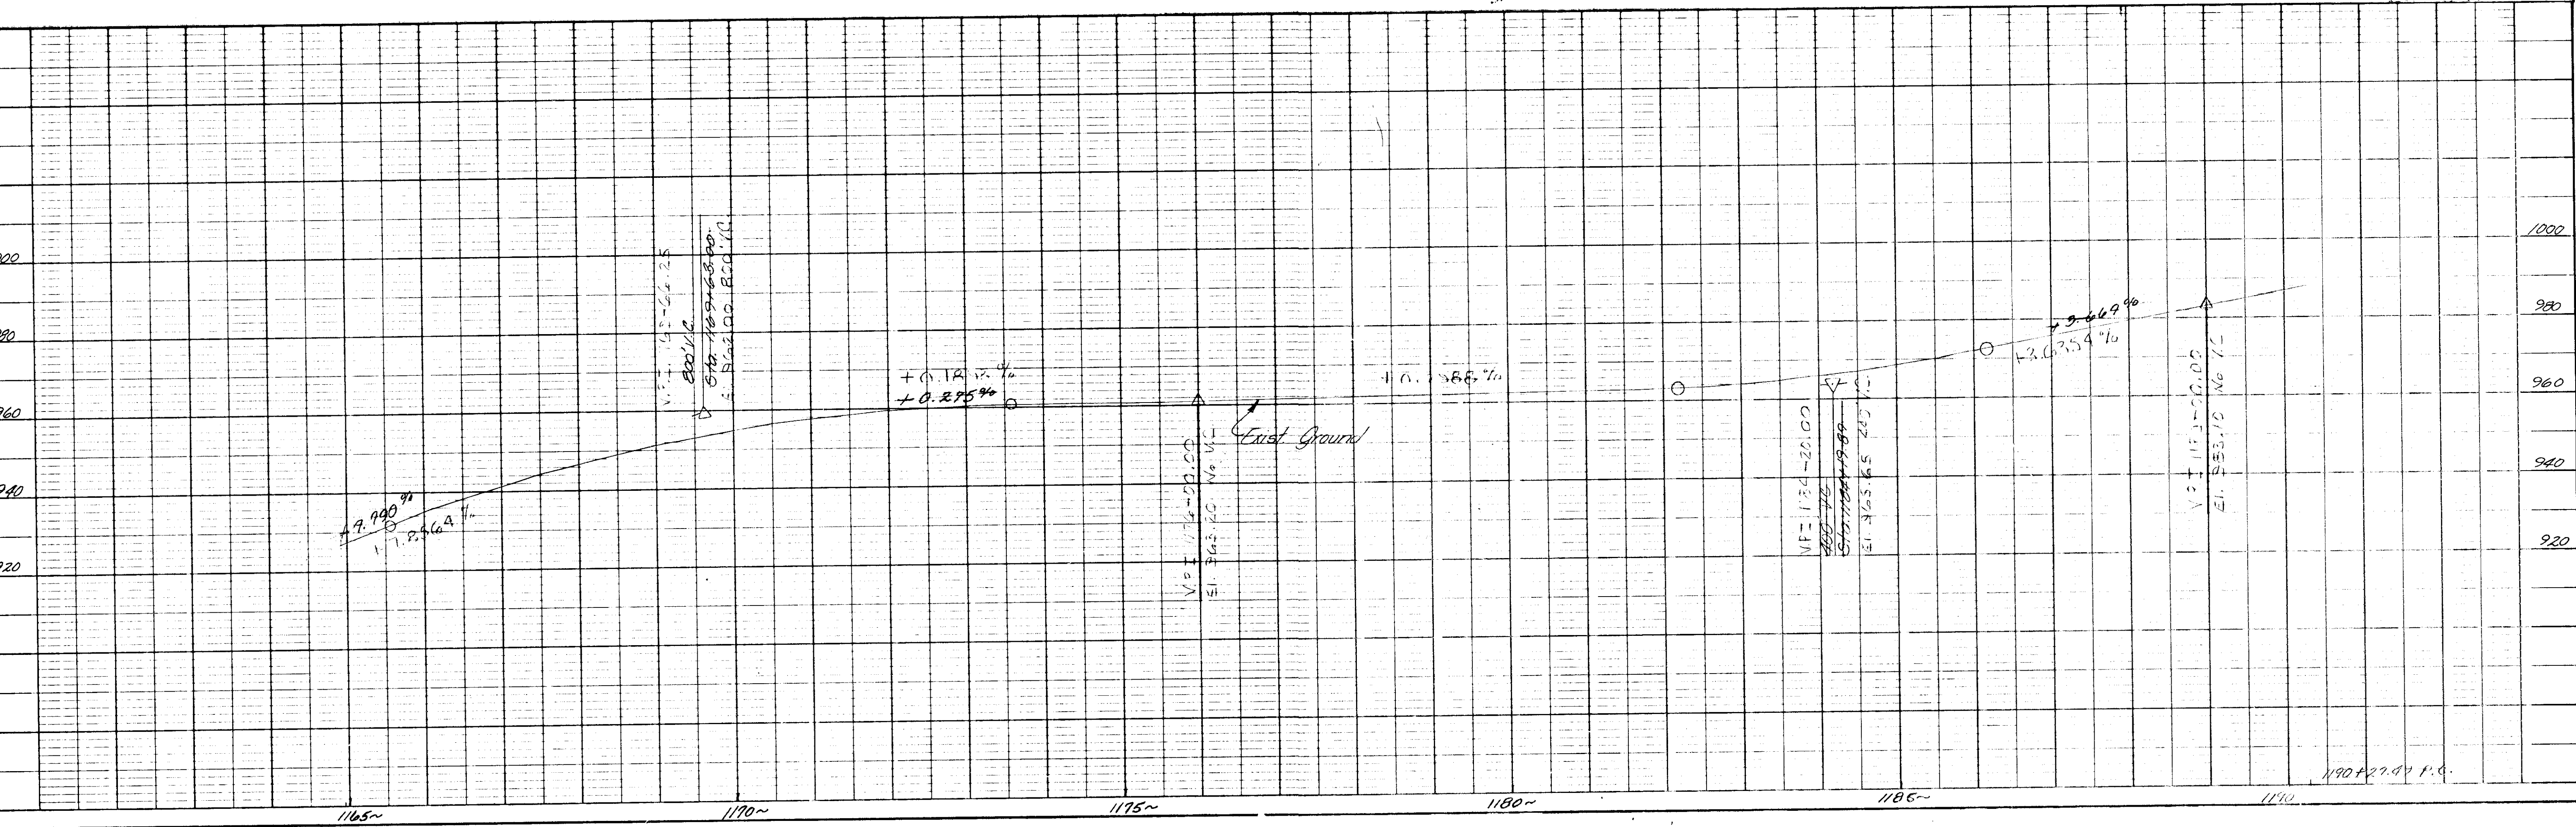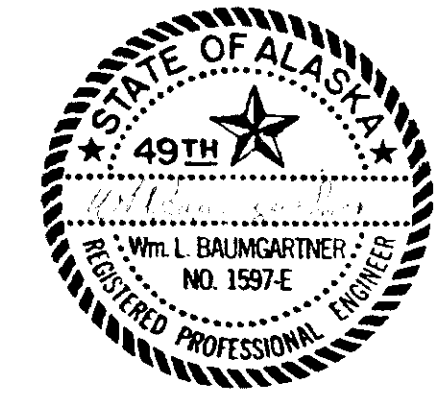


STATE	PROJECT DESIGNATION	YEAR	SHEET NO.
ALASKA	F-097-2(4)	1985	18

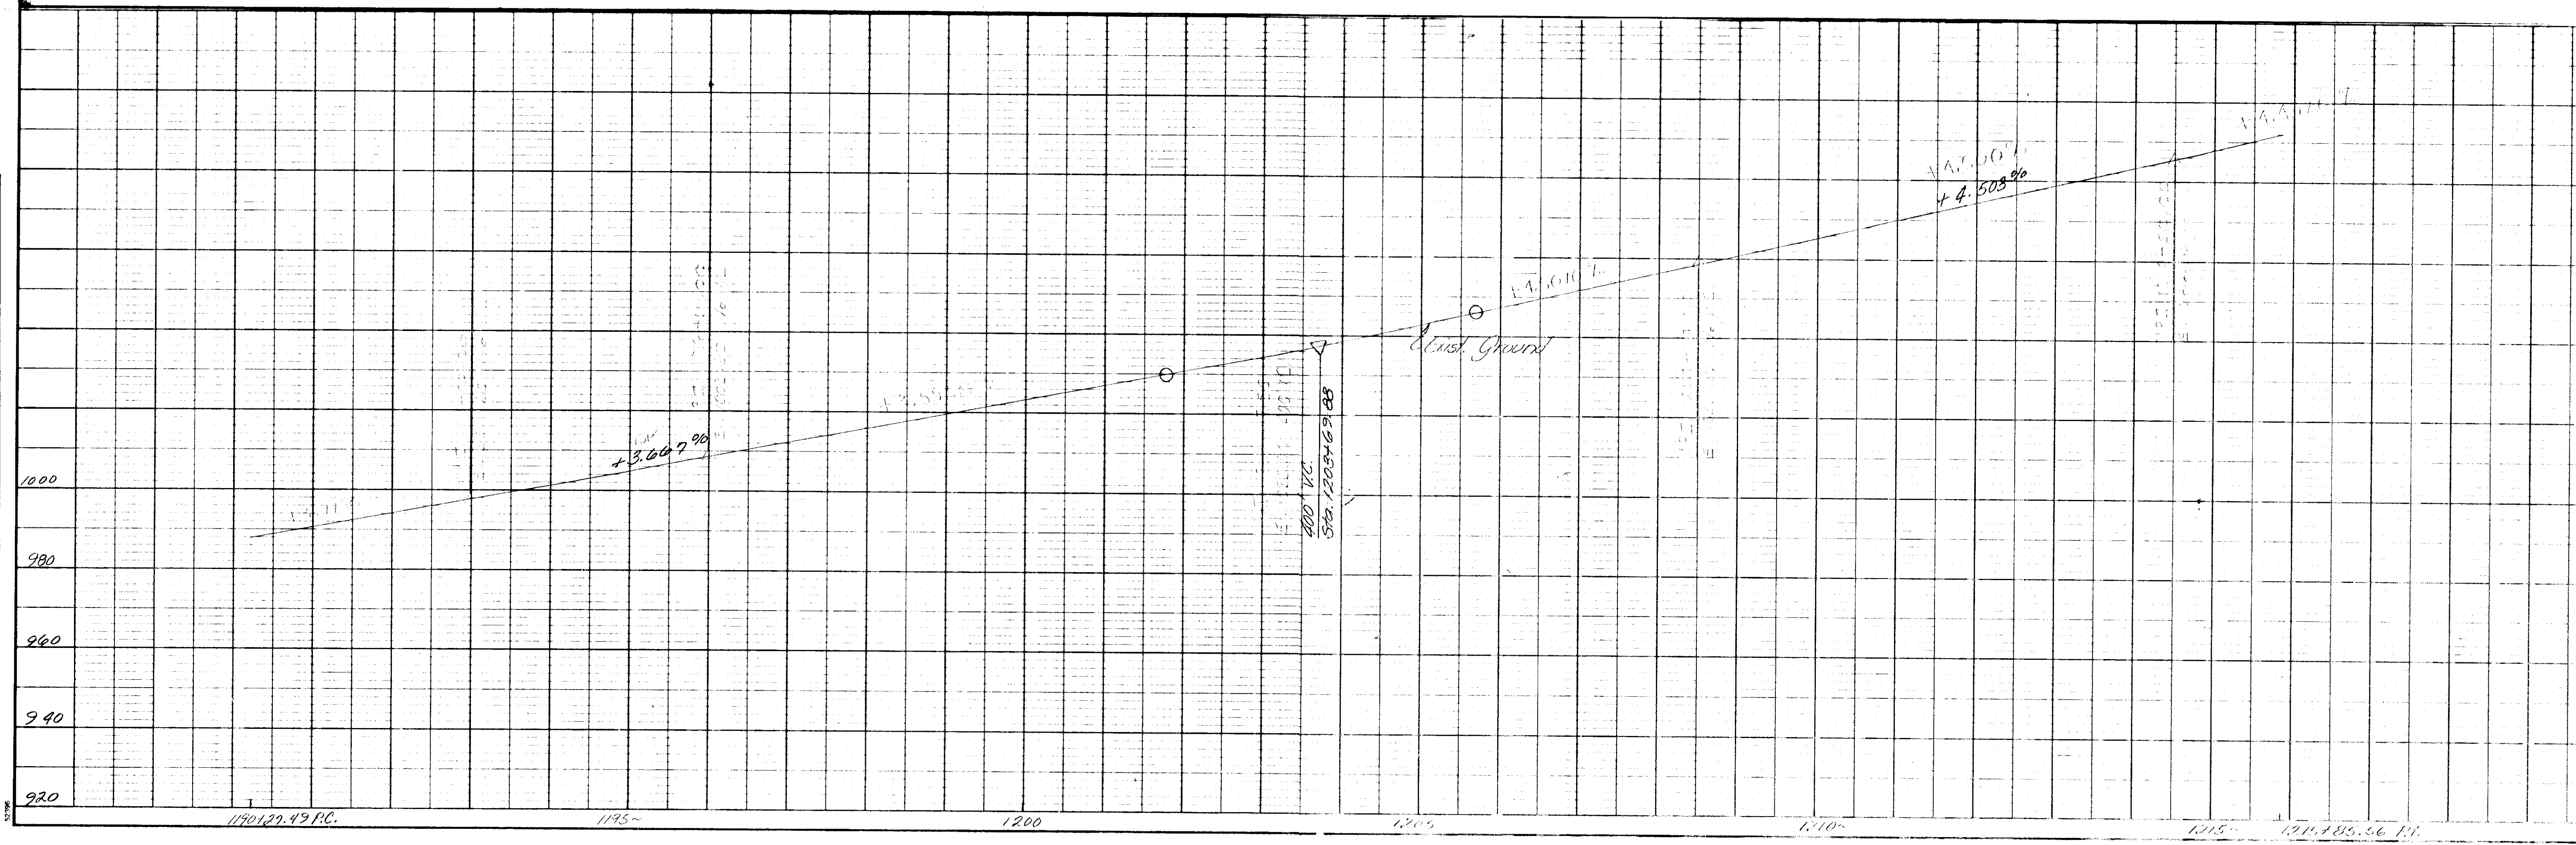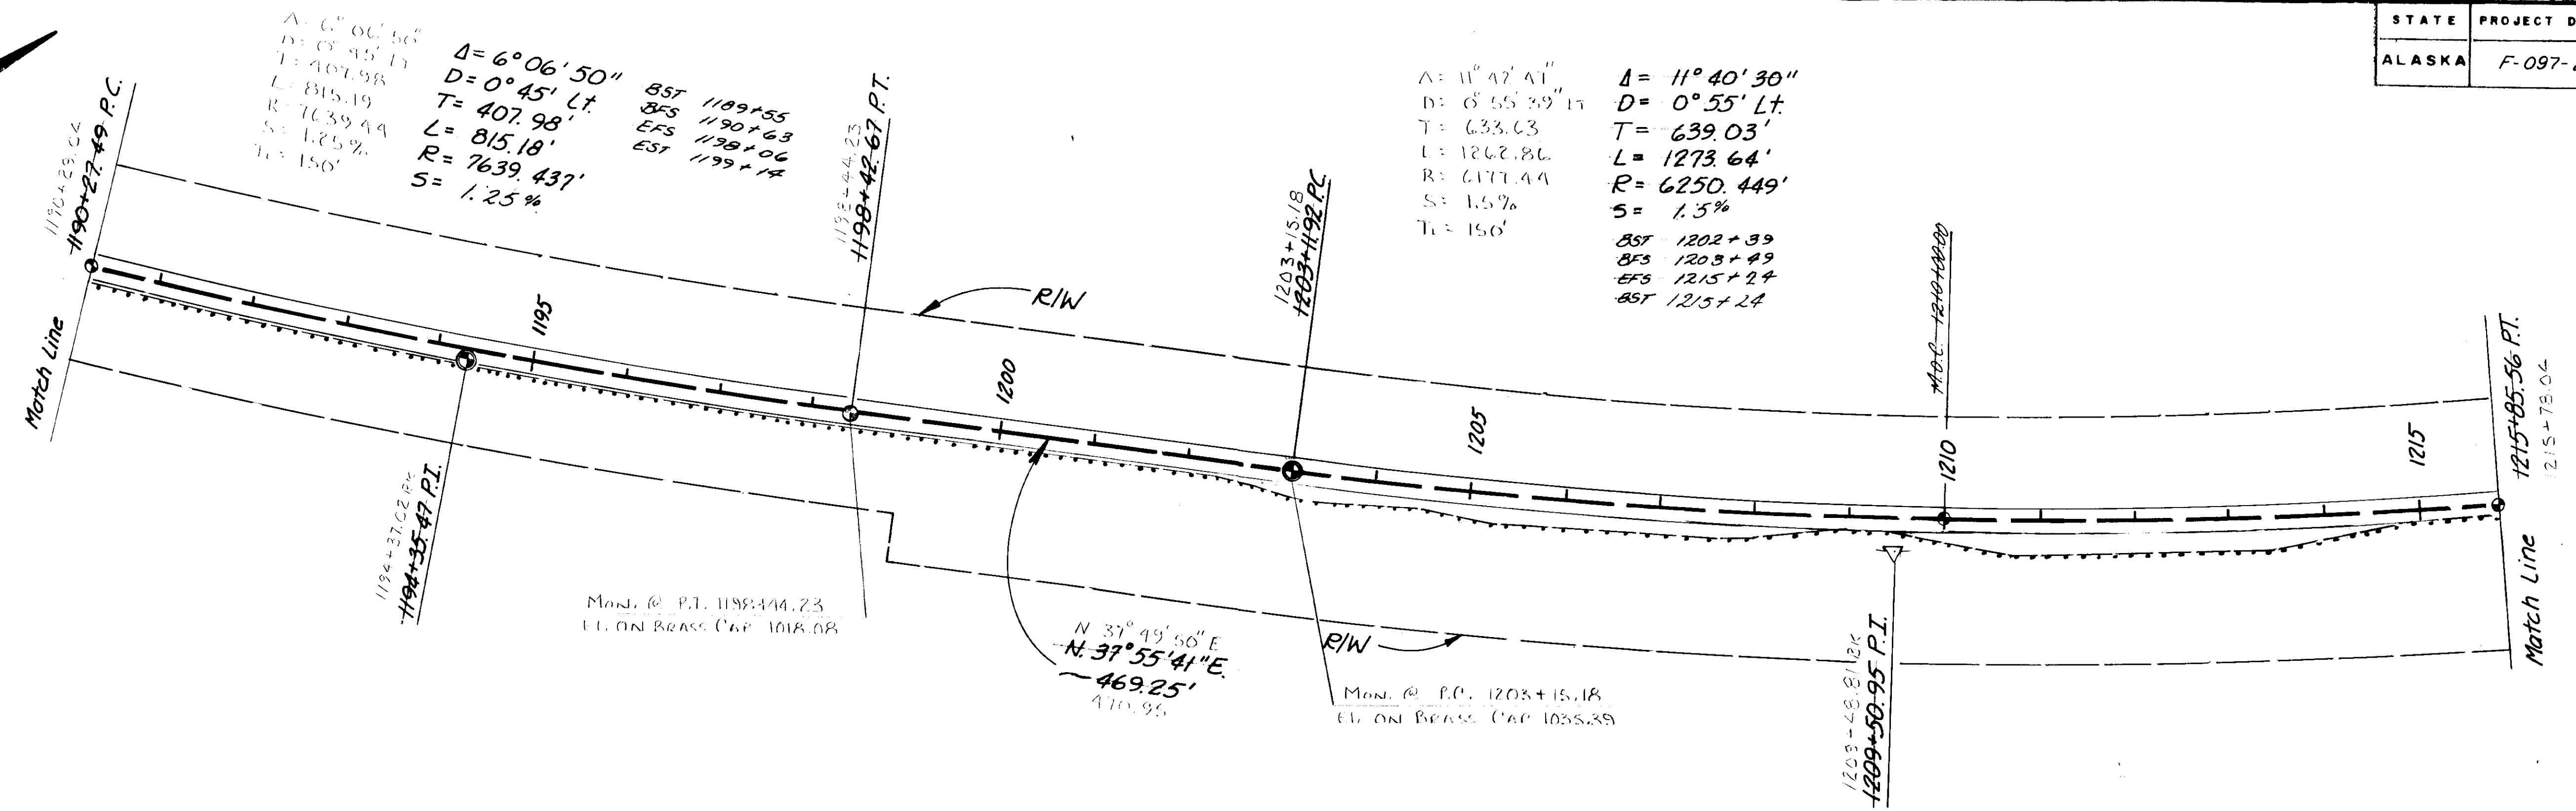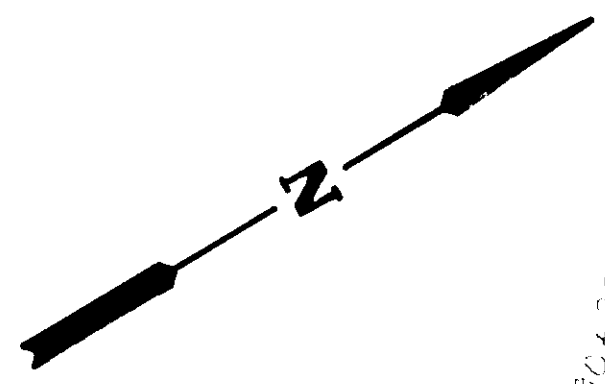


STATE	PROJECT DESIGNATION	YEAR	SHEET NO.	TOTAL SHEETS
ALASKA	F-097-2(4)	1985	19	33

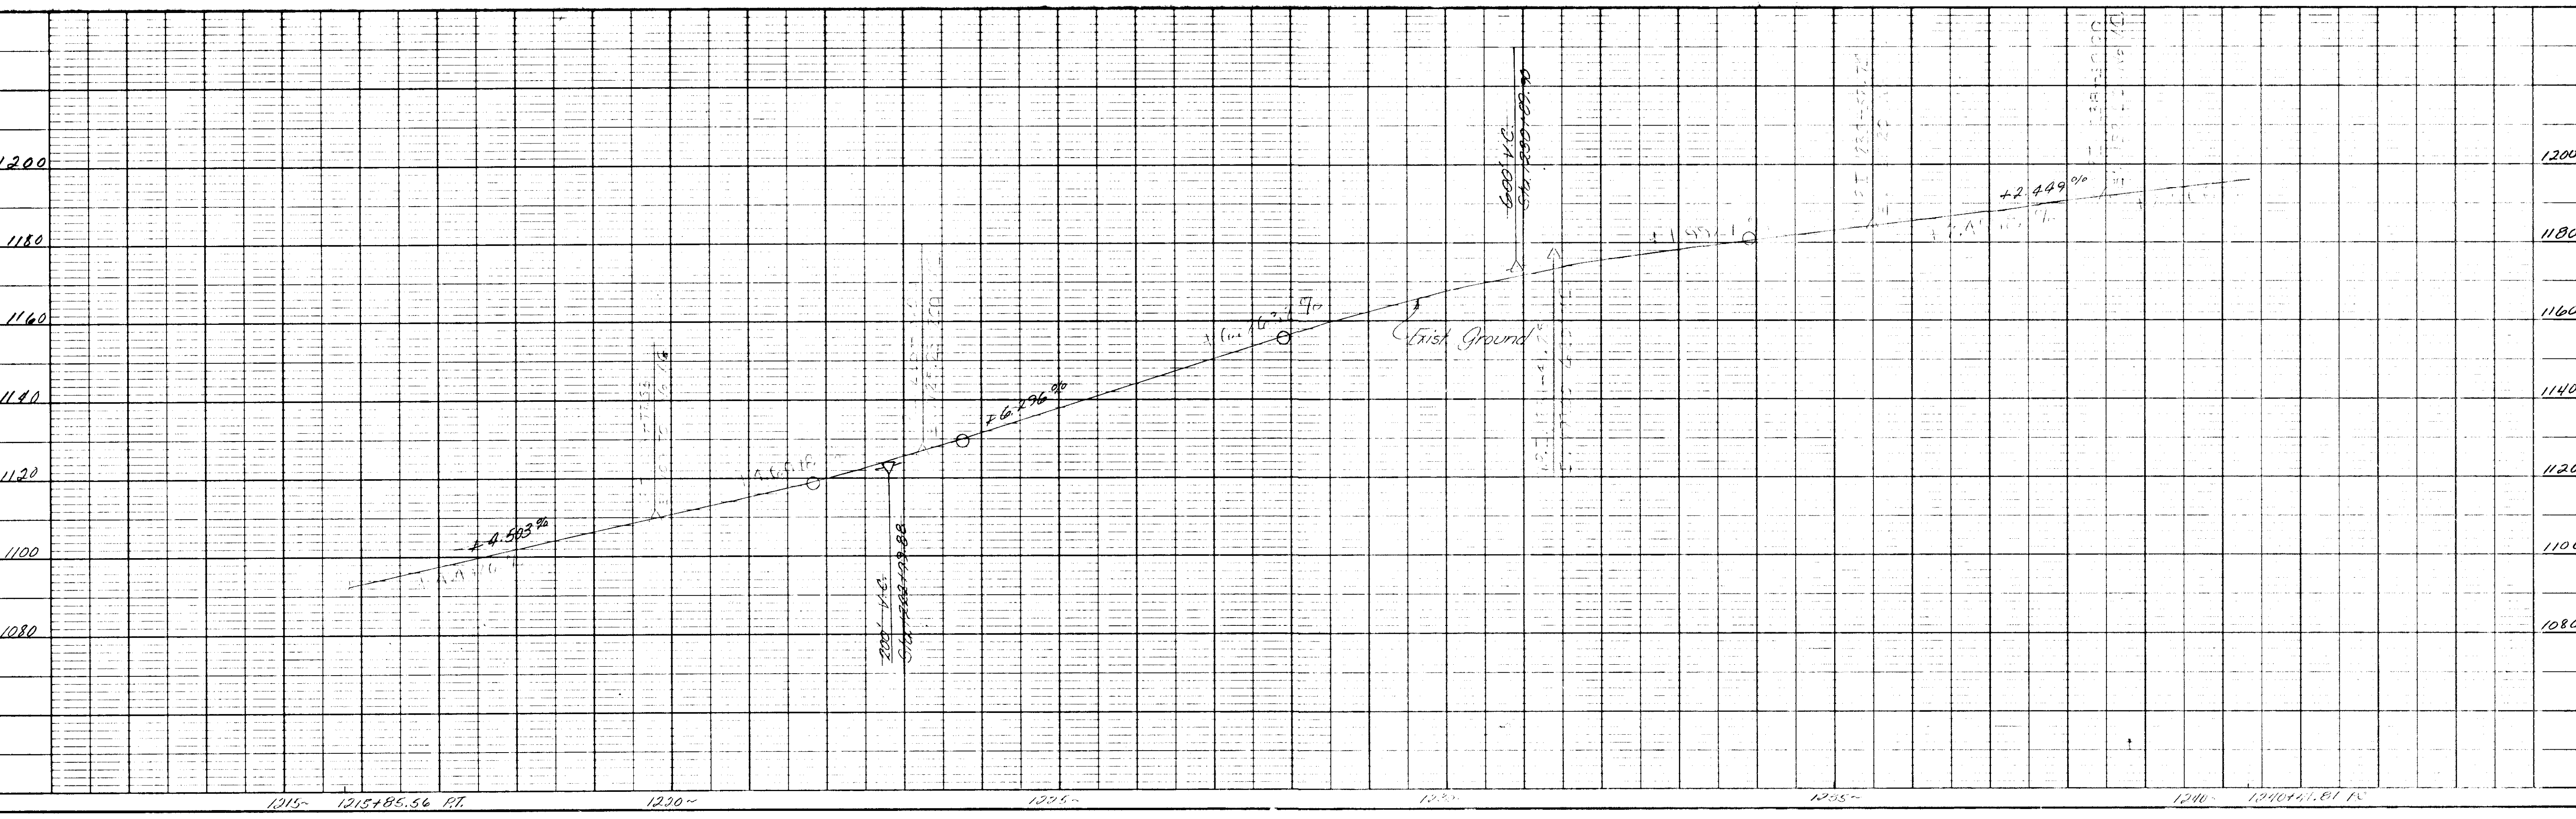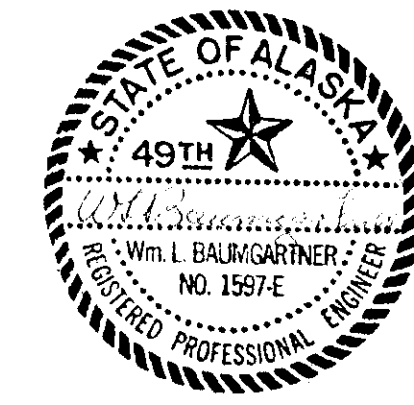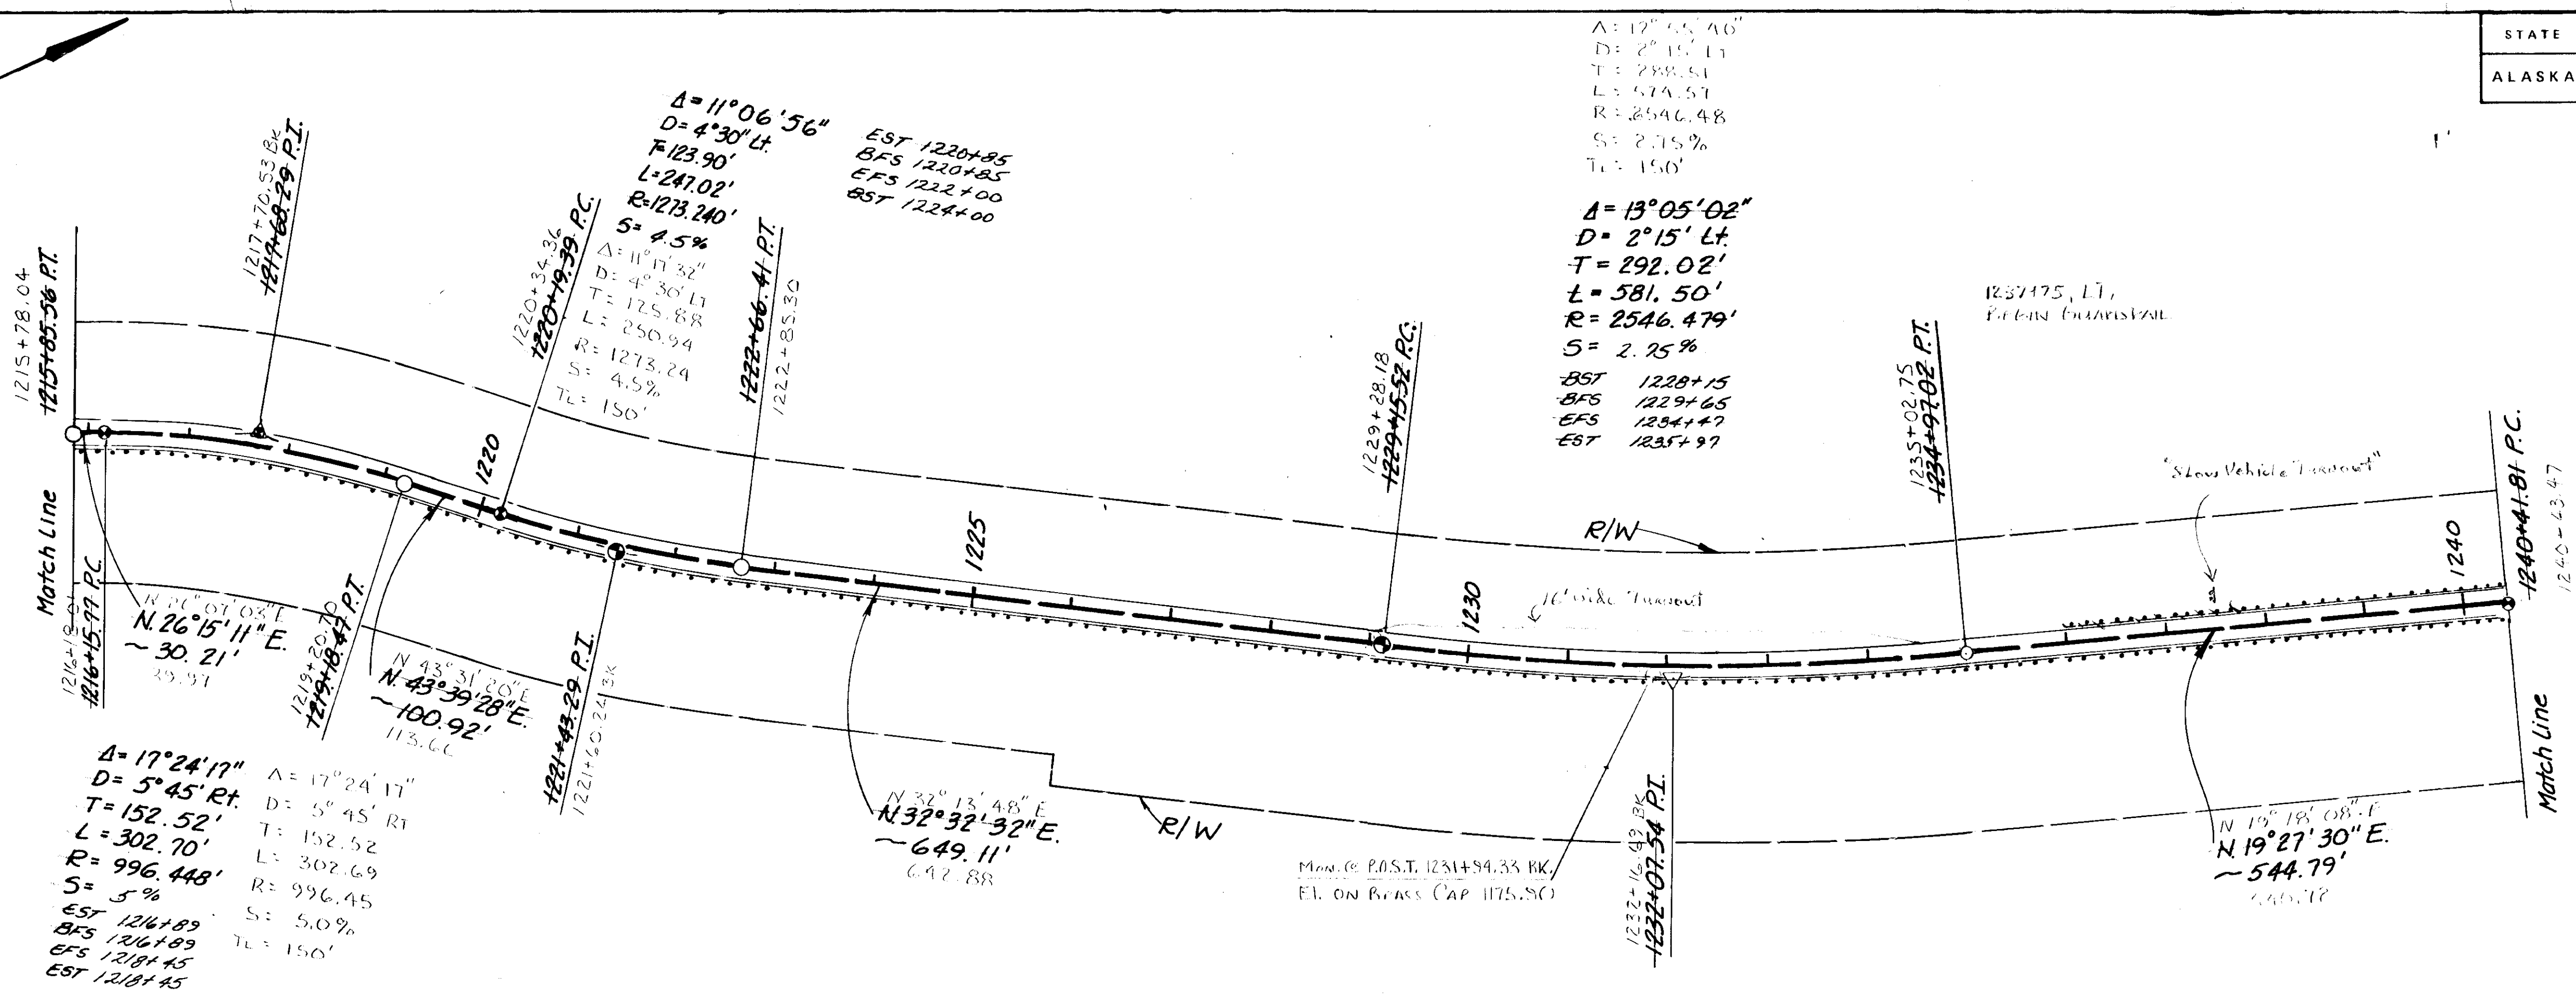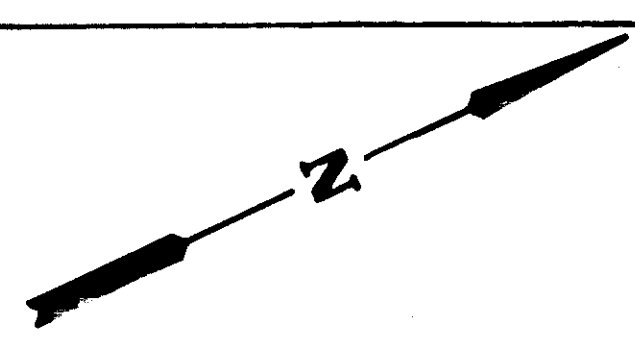



STATE	PROJECT DESIGNATION	YEAR	SHEET NO	TOT SHEETS
ALASKA	F-097-2(4)	1985	20	3

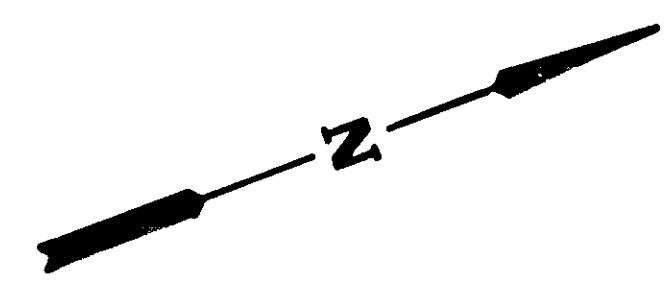

$\Delta = 11^{\circ}33'10''$       $-A = 11^{\circ}33'09''$   
 $D = 0^{\circ}45'47''$       $-D = 0^{\circ}45'47''$   
 $T = 772.83$           $T = 772.79'$   
 $L = 1540.41$          $L = 1540.34'$   
 $R = 7639.64$         $R = 7639.437'$   
 $S = 3.0\%$            $S = 1.25\%$   
 $TL = 100'$           $BST = 1256+42$   
                           $BFS = 1257+42$   
                           $EFS = 1272+16$   
                           $EST = 1273+16$

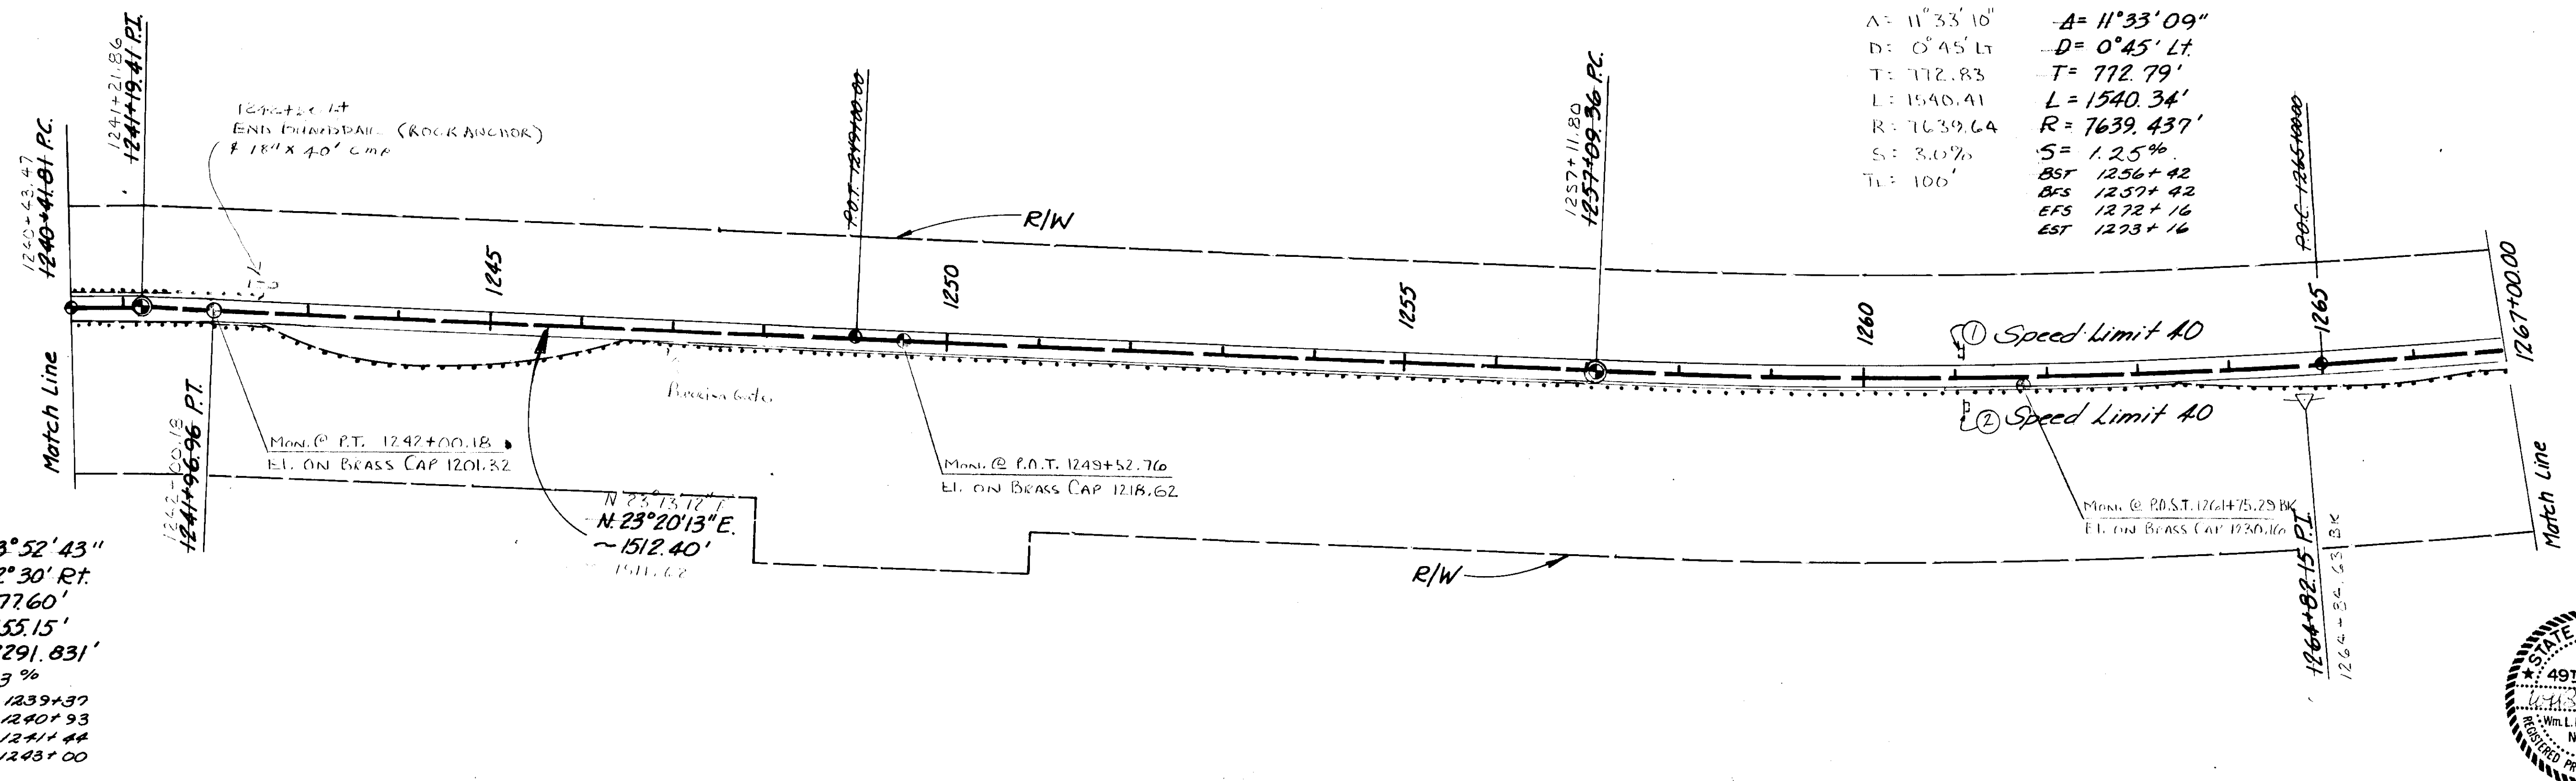


$\Delta = 3^{\circ}55'04''$       $-A = 3^{\circ}52'43''$   
 $D = 2^{\circ}30'00''$       $-D = 2^{\circ}30'00''$   
 $T = 78.39$           $T = 77.60'$   
 $L = 156.71$          $L = 155.15'$   
 $R = 2291.83$        $R = 2291.831'$   
 $S = 3.0\%$           $S = 3\%$   
 $TL = 150'$          $BST = 1239+37$   
                           $BFS = 1240+93$   
                           $EFS = 1241+44$   
                           $EST = 1243+00$

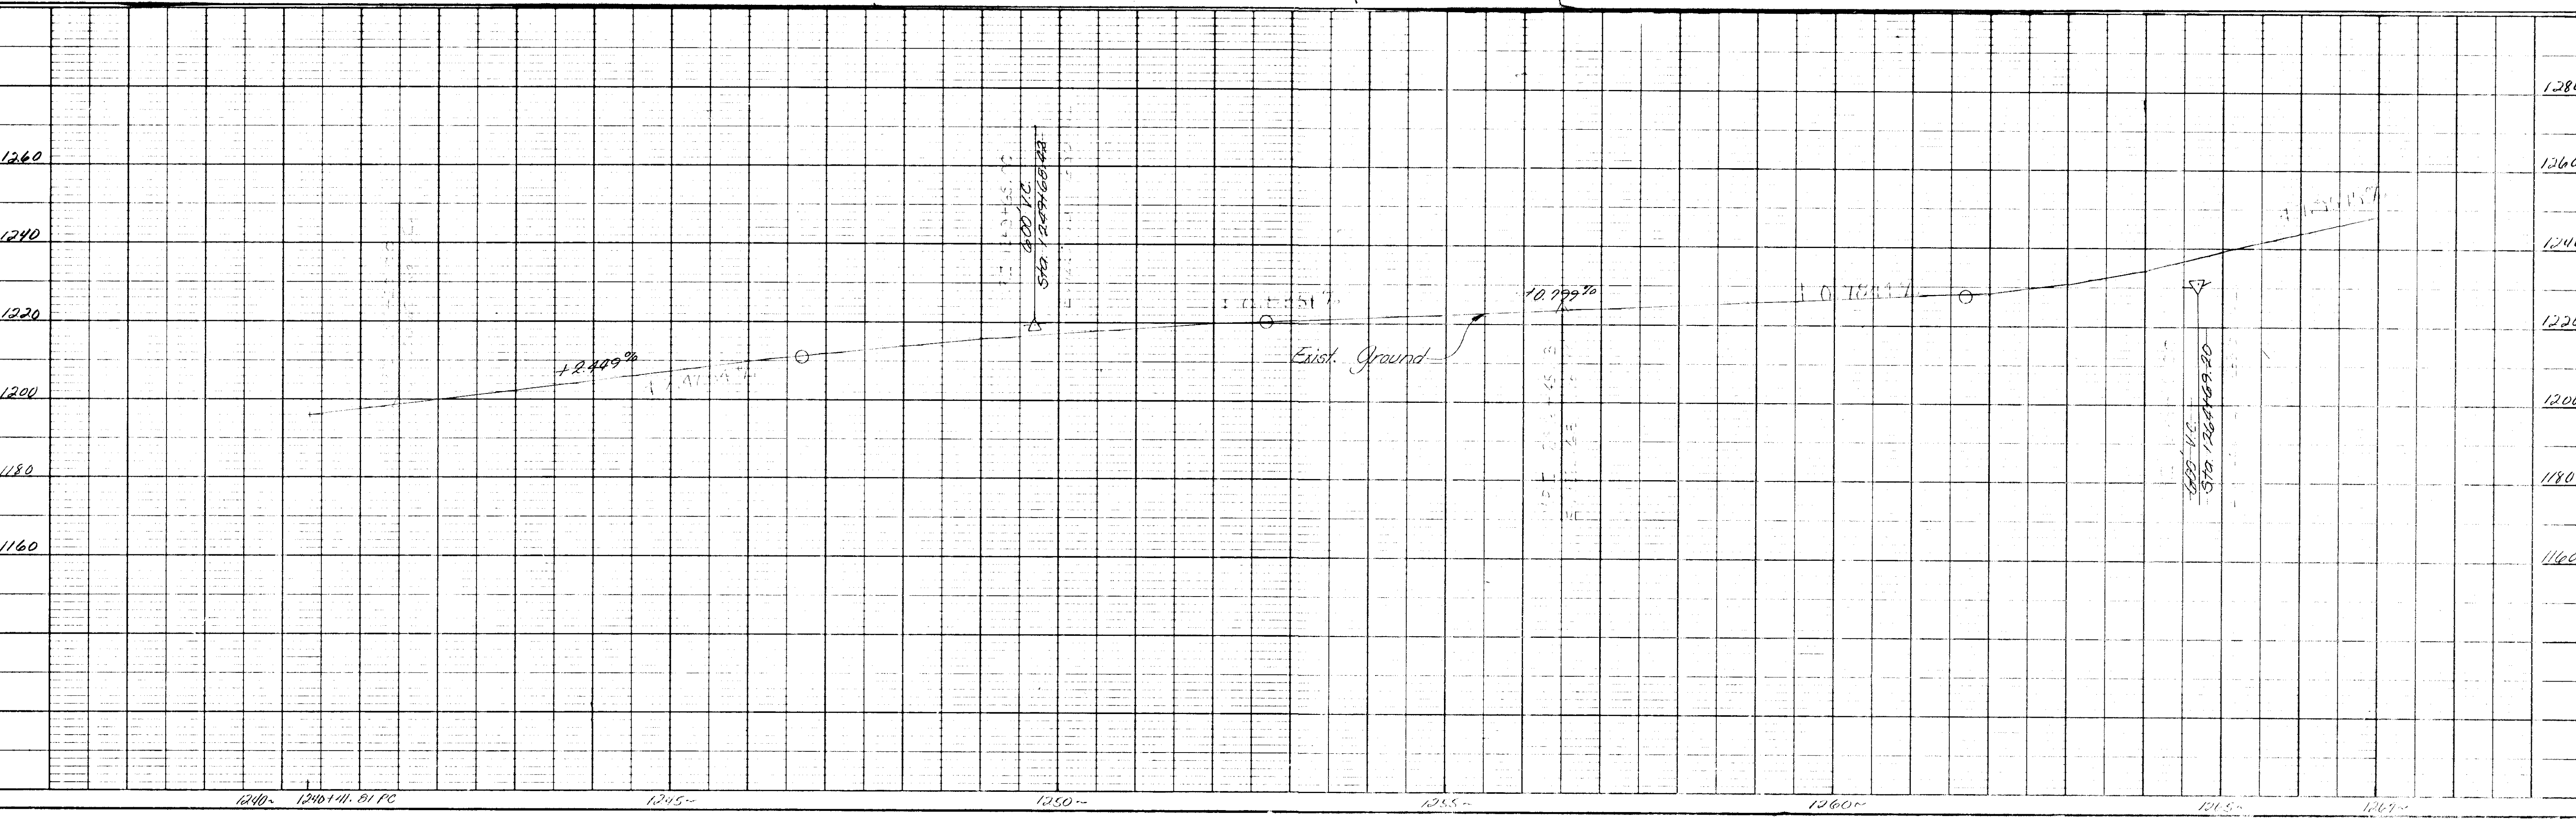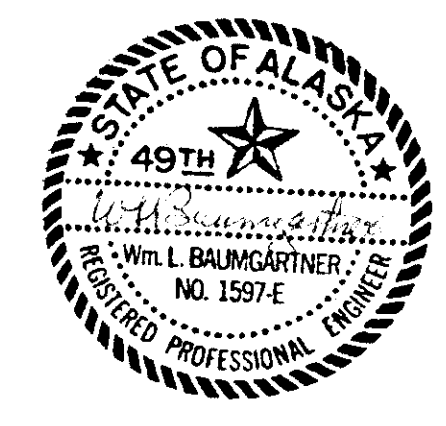



STATE	PROJECT DESIGNATION	YEAR	SHEET NO	TOTAL SHEET
ALASKA	F-097-2(4)	1985	22	33

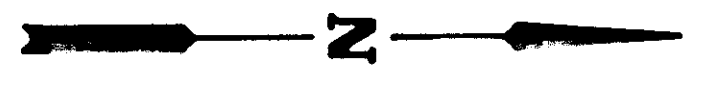

$\Delta = 23^\circ 34' 23''$   
 $D = 5^\circ \text{ Lt.}$   
 $T = 239.11'$   
 $L = 471.46'$   
 $R = 1145.916'$   
 $S = 4.5\%$

BST 1290+89  
 BFS 1292+92  
 EFS 1296+27  
 EST 1298+90

$\Delta = 7^\circ 23' 30''$   
 $D = 4^\circ \text{ Lt.}$   
 $T = 92.52'$   
 $L = 184.79'$   
 $R = 1432.394'$   
 $S = 4.0\%$

BST 1302+34  
 BFS 1304+24  
 EFS 1304+82  
 EST 1306+72


$\Delta = 1^\circ 26' 37''$   
 $D = 4^\circ \text{ Lt.}$   
 $T = 91.90'$   
 $L = 182.56'$   
 $R = 1432.39'$   
 $S = 4.0\%$   
 $T = 190'$

$\Delta = 1^\circ 26' 37''$   
 $D = 4^\circ \text{ Lt.}$   
 $T = 91.90'$   
 $L = 182.56'$   
 $R = 1432.39'$   
 $S = 4.0\%$   
 $T = 190'$


$\Delta = 8^\circ 14' 38''$   
 $D = 6^\circ \text{ Rt.}$   
 $T = 68.82'$   
 $L = 137.40'$   
 $R = 954.93'$   
 $S = 5.0\%$   
 $T = 215.37'$

$\Delta = 8^\circ 14' 20''$   
 $D = 6^\circ \text{ Rt.}$   
 $T = 68.78'$   
 $L = 137.32'$   
 $R = 954.930'$   
 $S = 5.0\%$


BST 1309+12  
 BFS 1311+32  
 EFS 1311+32  
 EST 1313+52

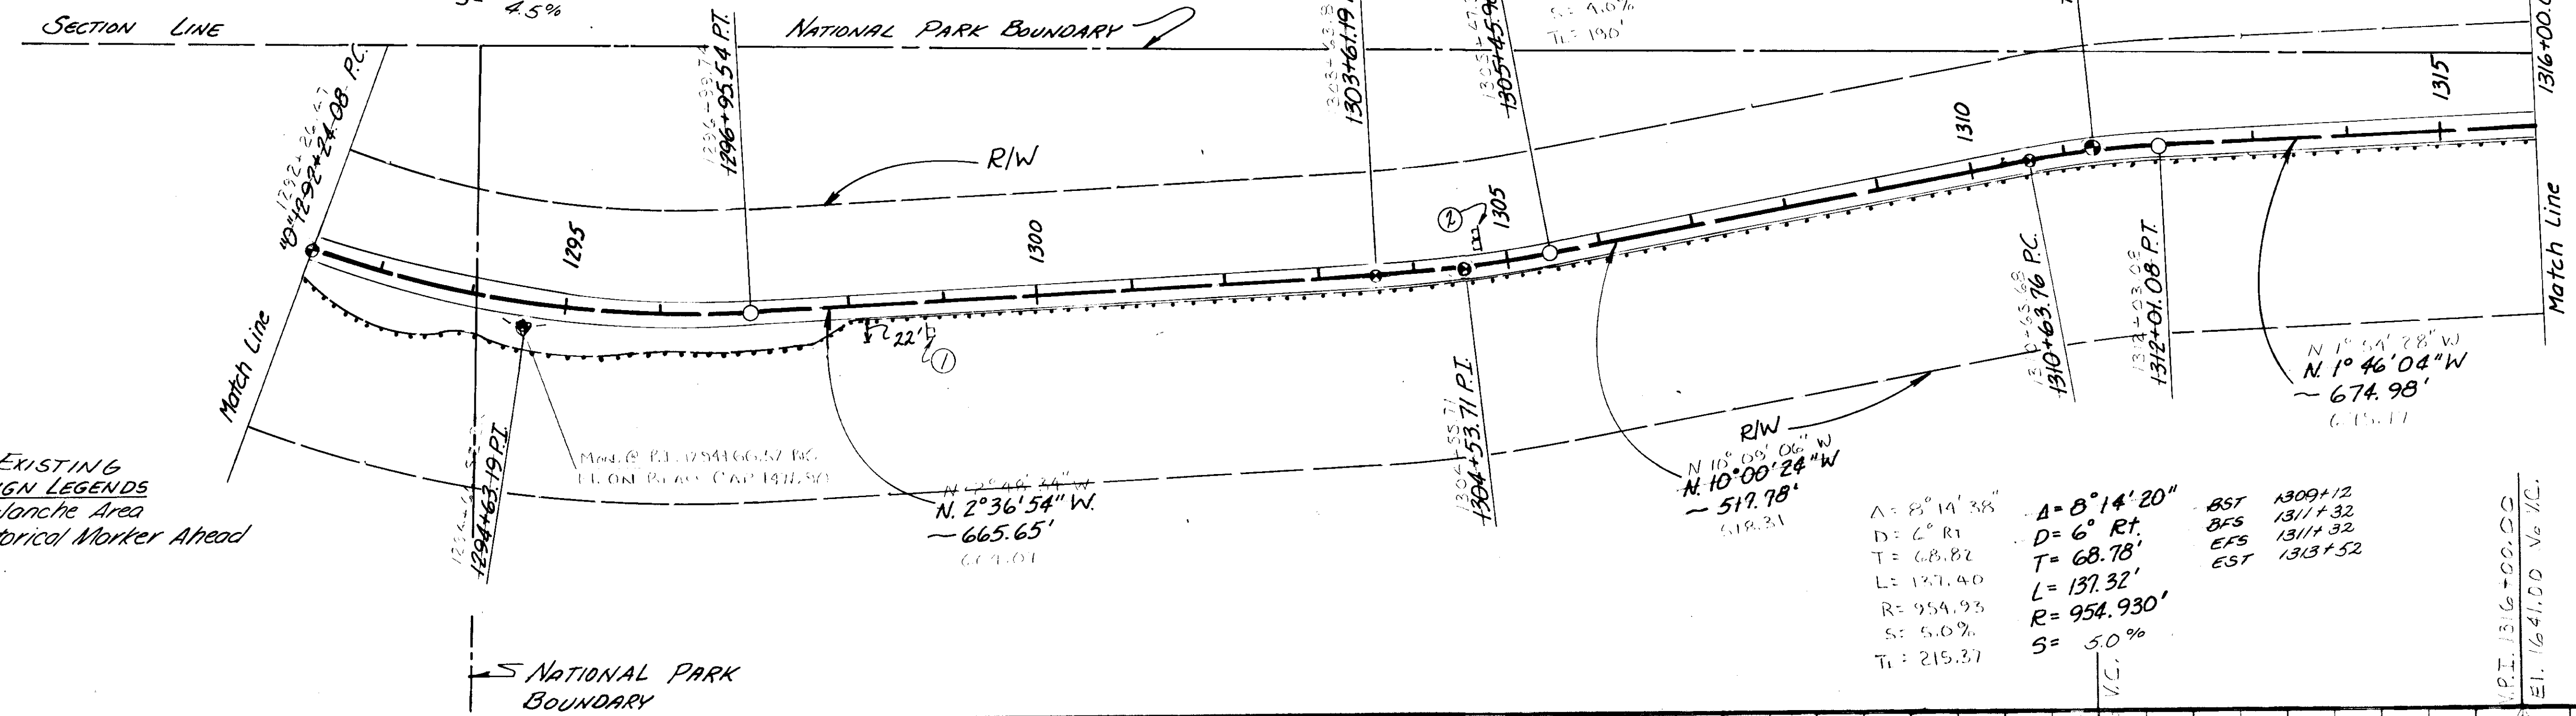

EXISTING SIGN LEGENDS  
 ① Avalanche Area  
 ② Historical Marker Ahead

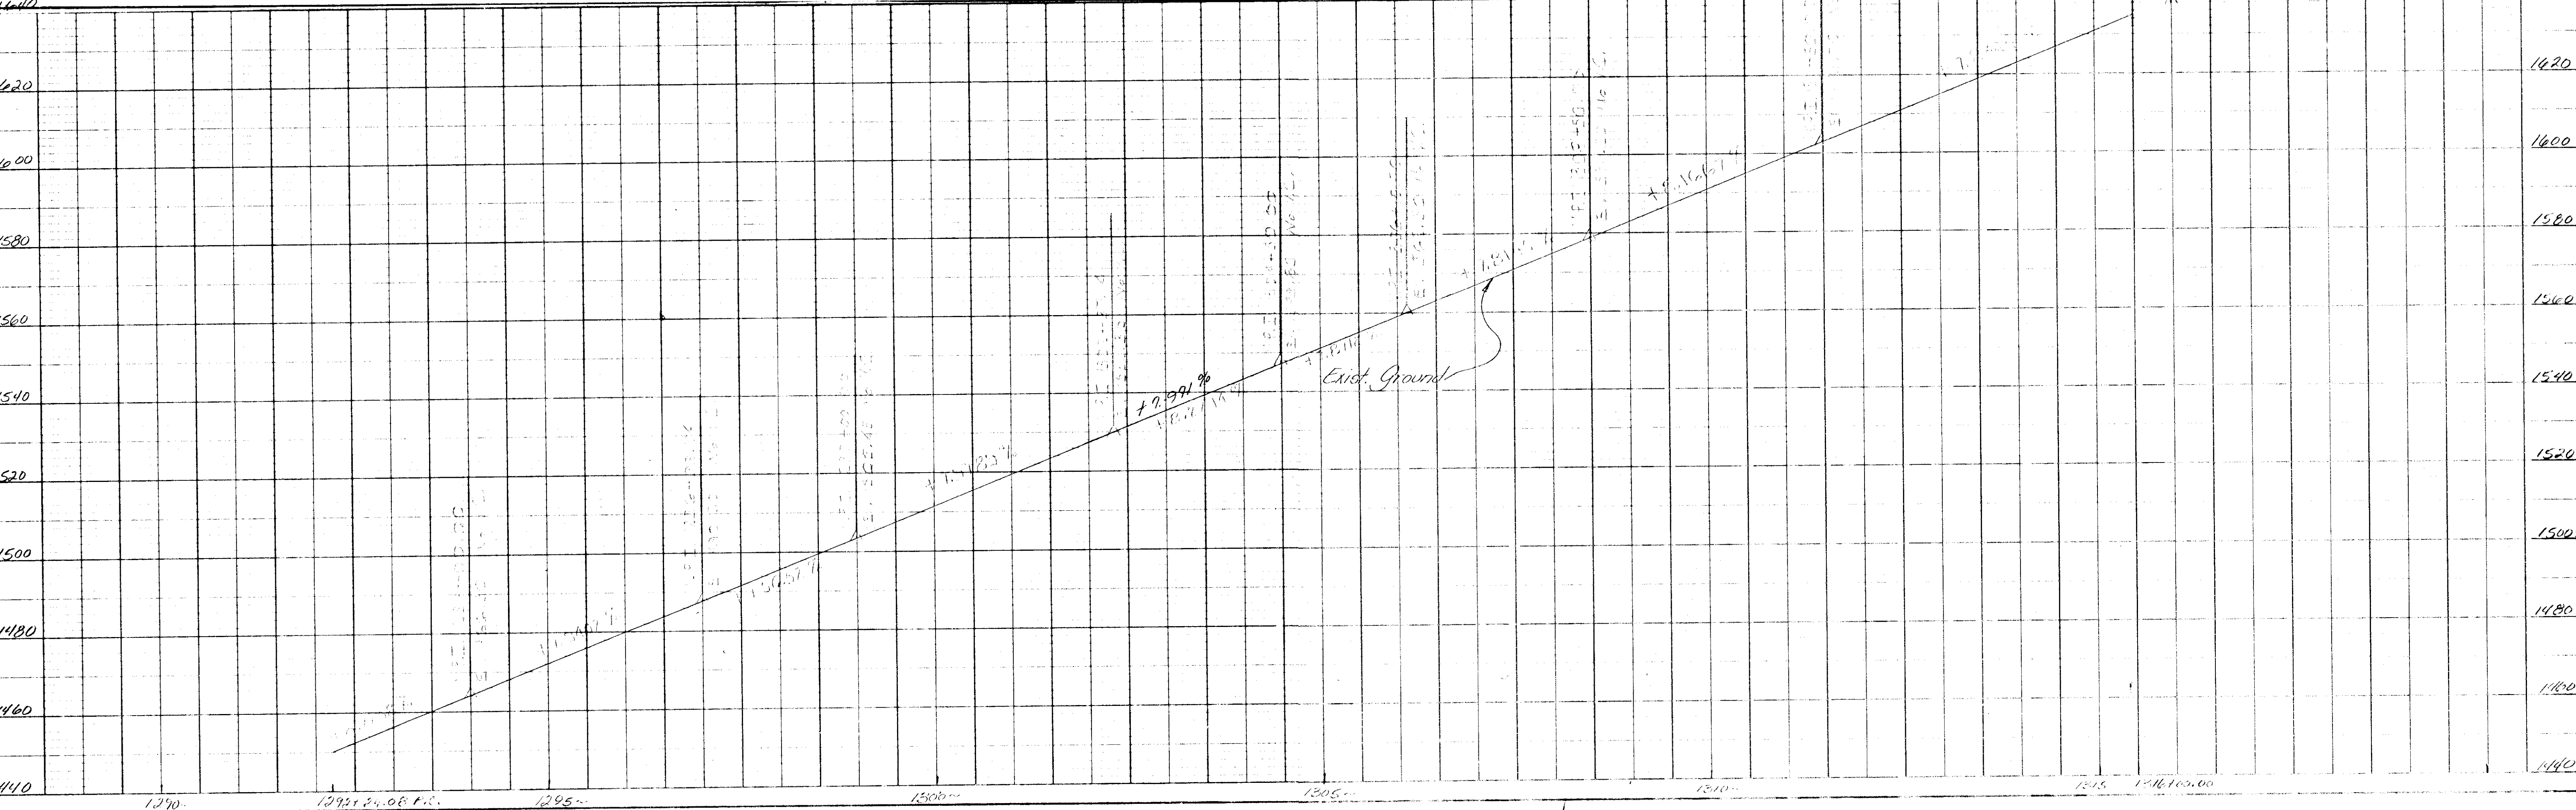

STATE	PROJECT DESIGNATION	YEAR	SHEET NO.	TOTAL SHEETS
ALASKA	F-097-2(4)	1985	23	33

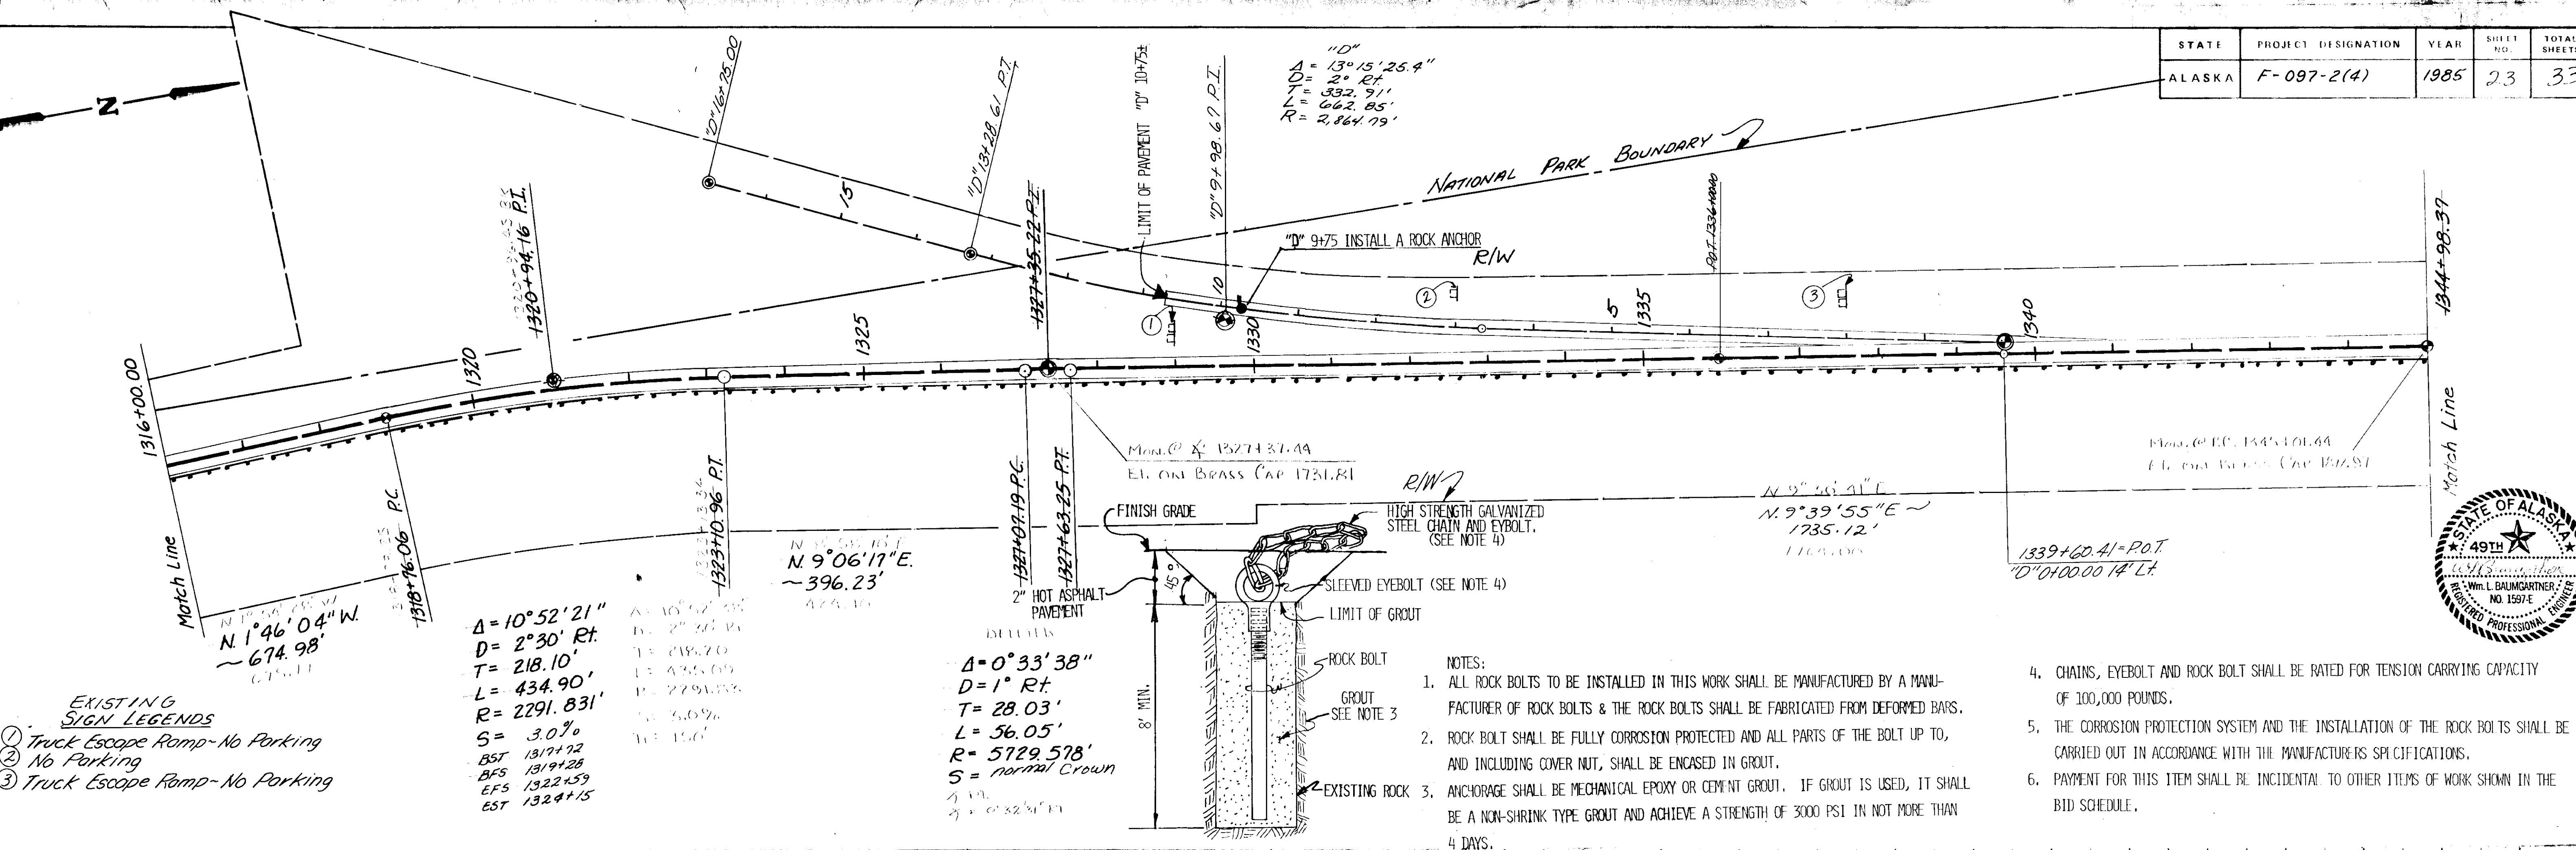



- EXISTING SIGN LEGENDS**
- ① Truck Escape Ramp-No Parking
  - ② No Parking
  - ③ Truck Escape Ramp-No Parking

$\Delta = 10^{\circ}52'21''$   
 $D = 2^{\circ}30' \text{ Rt.}$   
 $T = 218.10'$   
 $L = 434.90'$   
 $R = 2291.831'$   
 $S = 3.0\%$   
 BST 1317+72  
 BFS 1319+28  
 EFS 1322+59  
 EST 1324+15

$\Delta = 0^{\circ}33'38''$   
 $D = 1^{\circ} \text{ Rt.}$   
 $T = 28.03'$   
 $L = 36.05'$   
 $R = 5729.578'$   
 $S = \text{normal Crown}$


- NOTES:**
- ALL ROCK BOLTS TO BE INSTALLED IN THIS WORK SHALL BE MANUFACTURED BY A MANUFACTURER OF ROCK BOLTS & THE ROCK BOLTS SHALL BE FABRICATED FROM DEFORMED BARS.
  - ROCK BOLT SHALL BE FULLY CORROSION PROTECTED AND ALL PARTS OF THE BOLT UP TO, AND INCLUDING COVER NUT, SHALL BE ENCASED IN GROUT.
  - ANCHORAGE SHALL BE MECHANICAL EPOXY OR CEMENT GROUT. IF GROUT IS USED, IT SHALL BE A NON-SHRINK TYPE GROUT AND ACHIEVE A STRENGTH OF 3000 PSI IN NOT MORE THAN 4 DAYS.
  - CHAINS, EYEBOLT AND ROCK BOLT SHALL BE RATED FOR TENSION CARRYING CAPACITY OF 100,000 POUNDS.
  - THE CORROSION PROTECTION SYSTEM AND THE INSTALLATION OF THE ROCK BOLTS SHALL BE CARRIED OUT IN ACCORDANCE WITH THE MANUFACTURER'S SPECIFICATIONS.
  - PAYMENT FOR THIS ITEM SHALL BE INCIDENTAL TO OTHER ITEMS OF WORK SHOWN IN THE BID SCHEDULE.

**ROCK ANCHOR DETAIL**

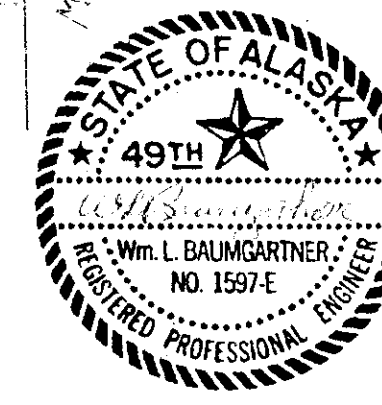
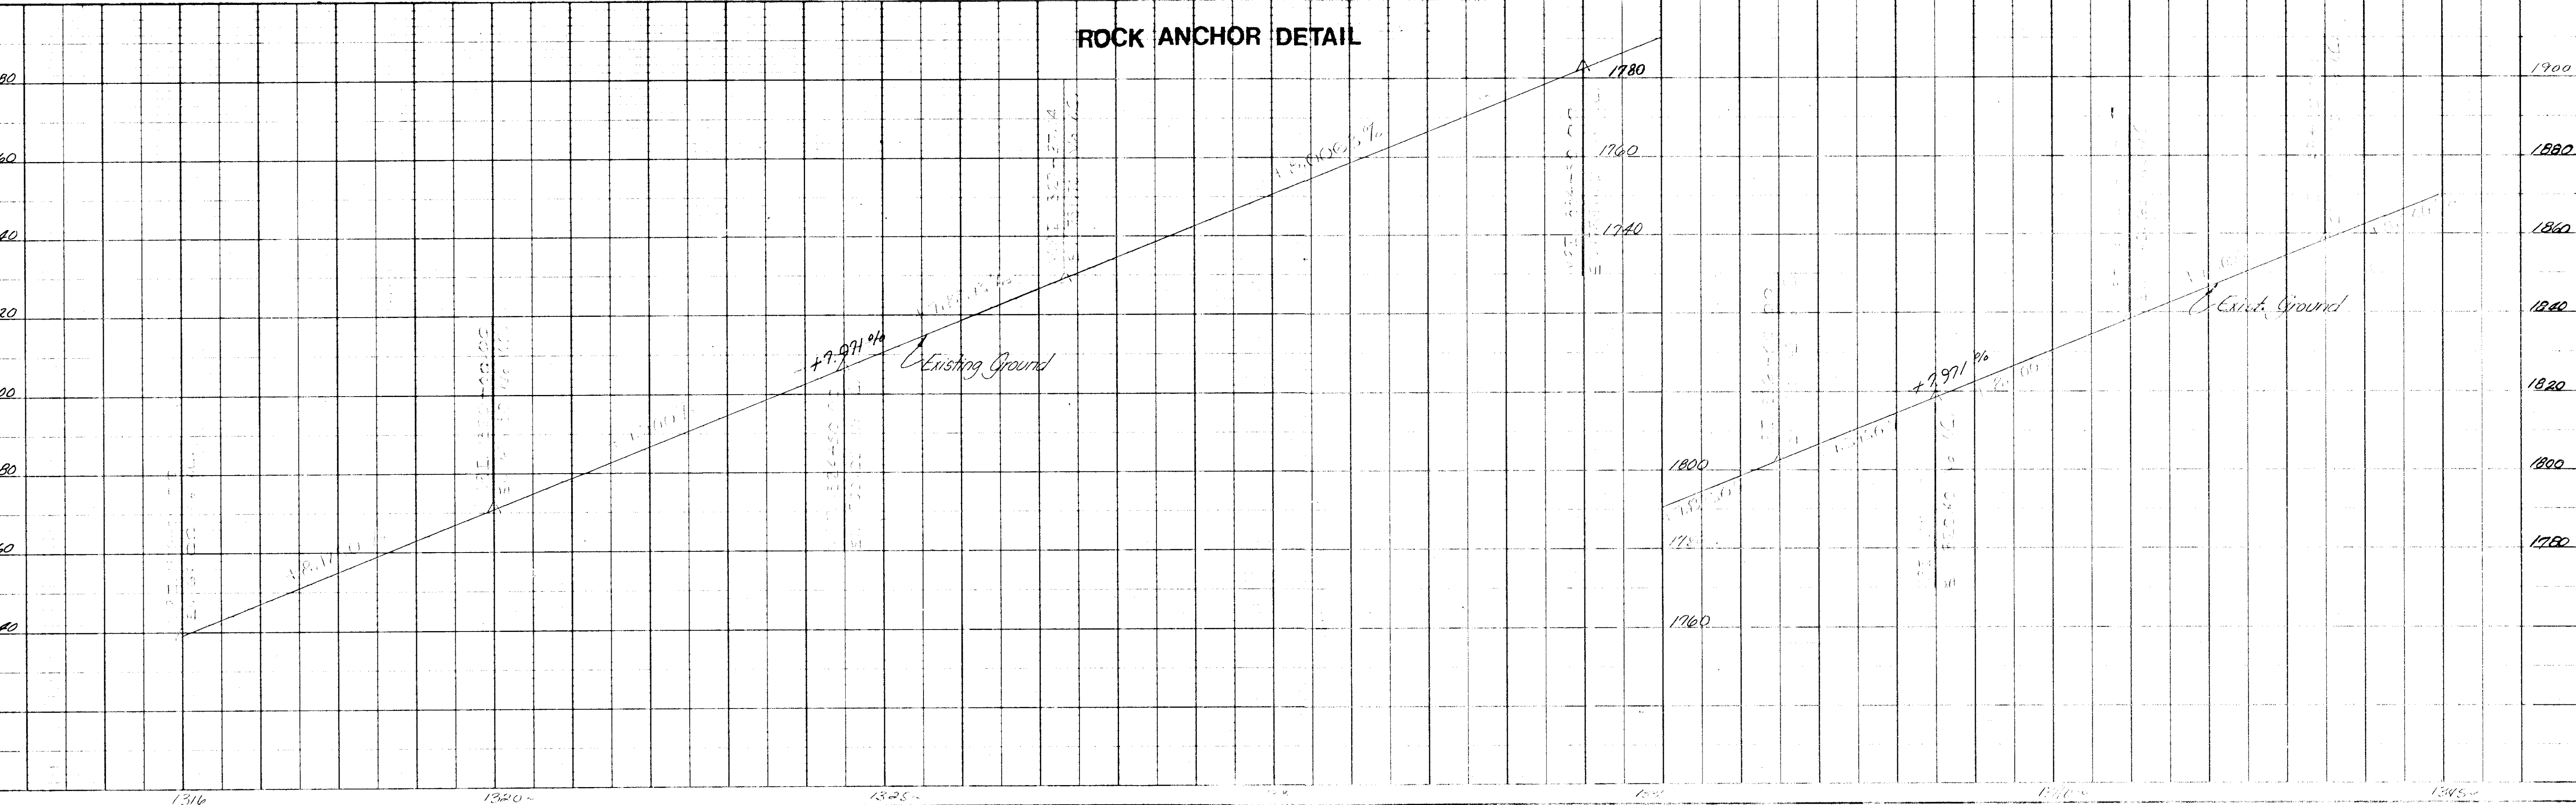




STATE	PROJECT DESIGNATION	YEAR	SHEET NO.	TOTAL SHEETS
ALASKA	F-097-2(4)	1985	25	33

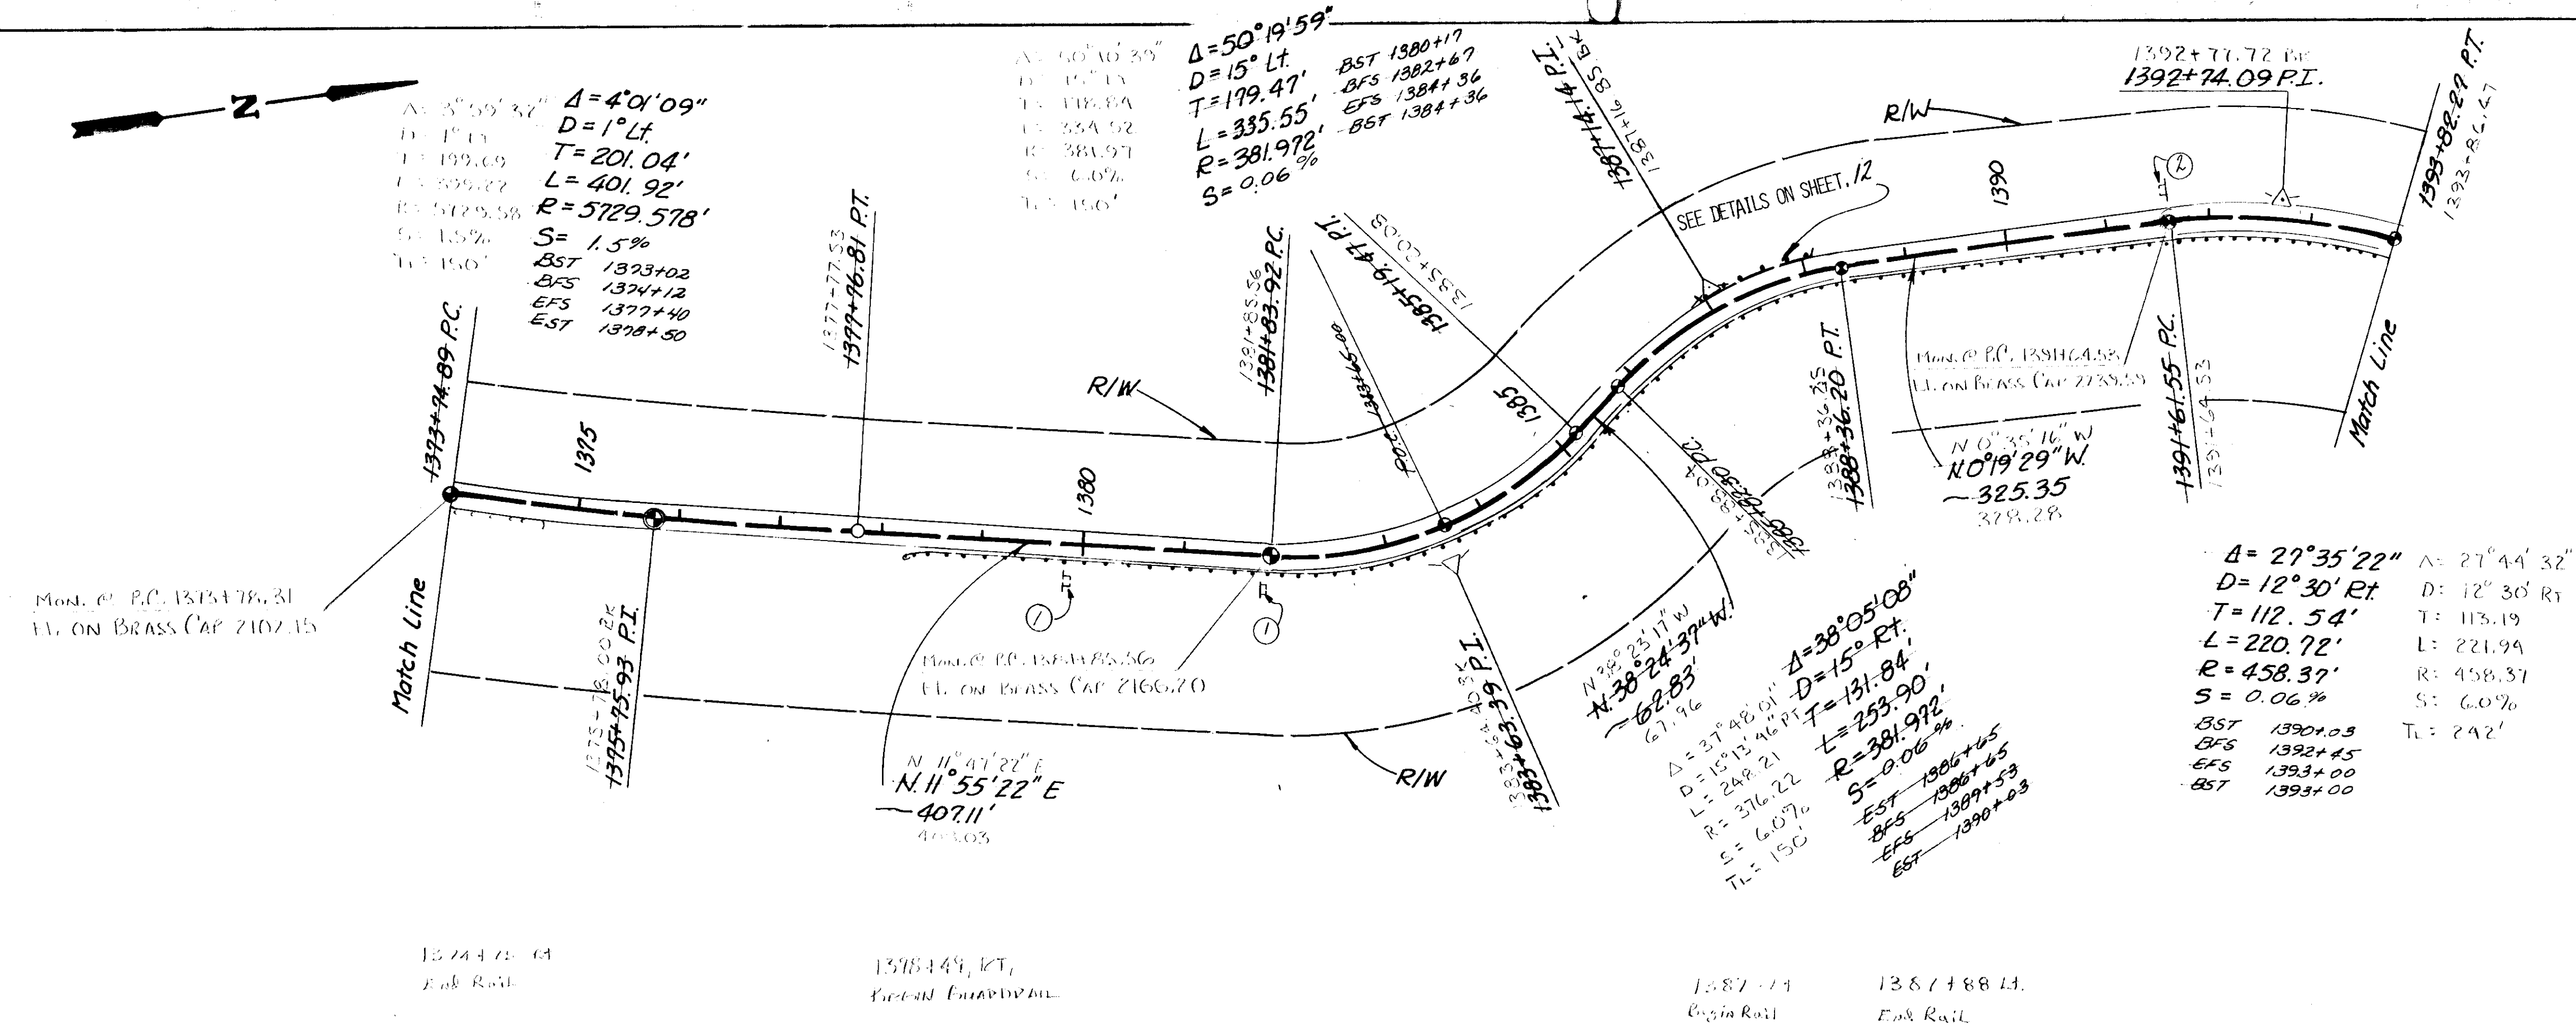


EXISTING SIGN LEGENDS:  
 ① 35 m.p.h.  
 ② 30 m.p.h.

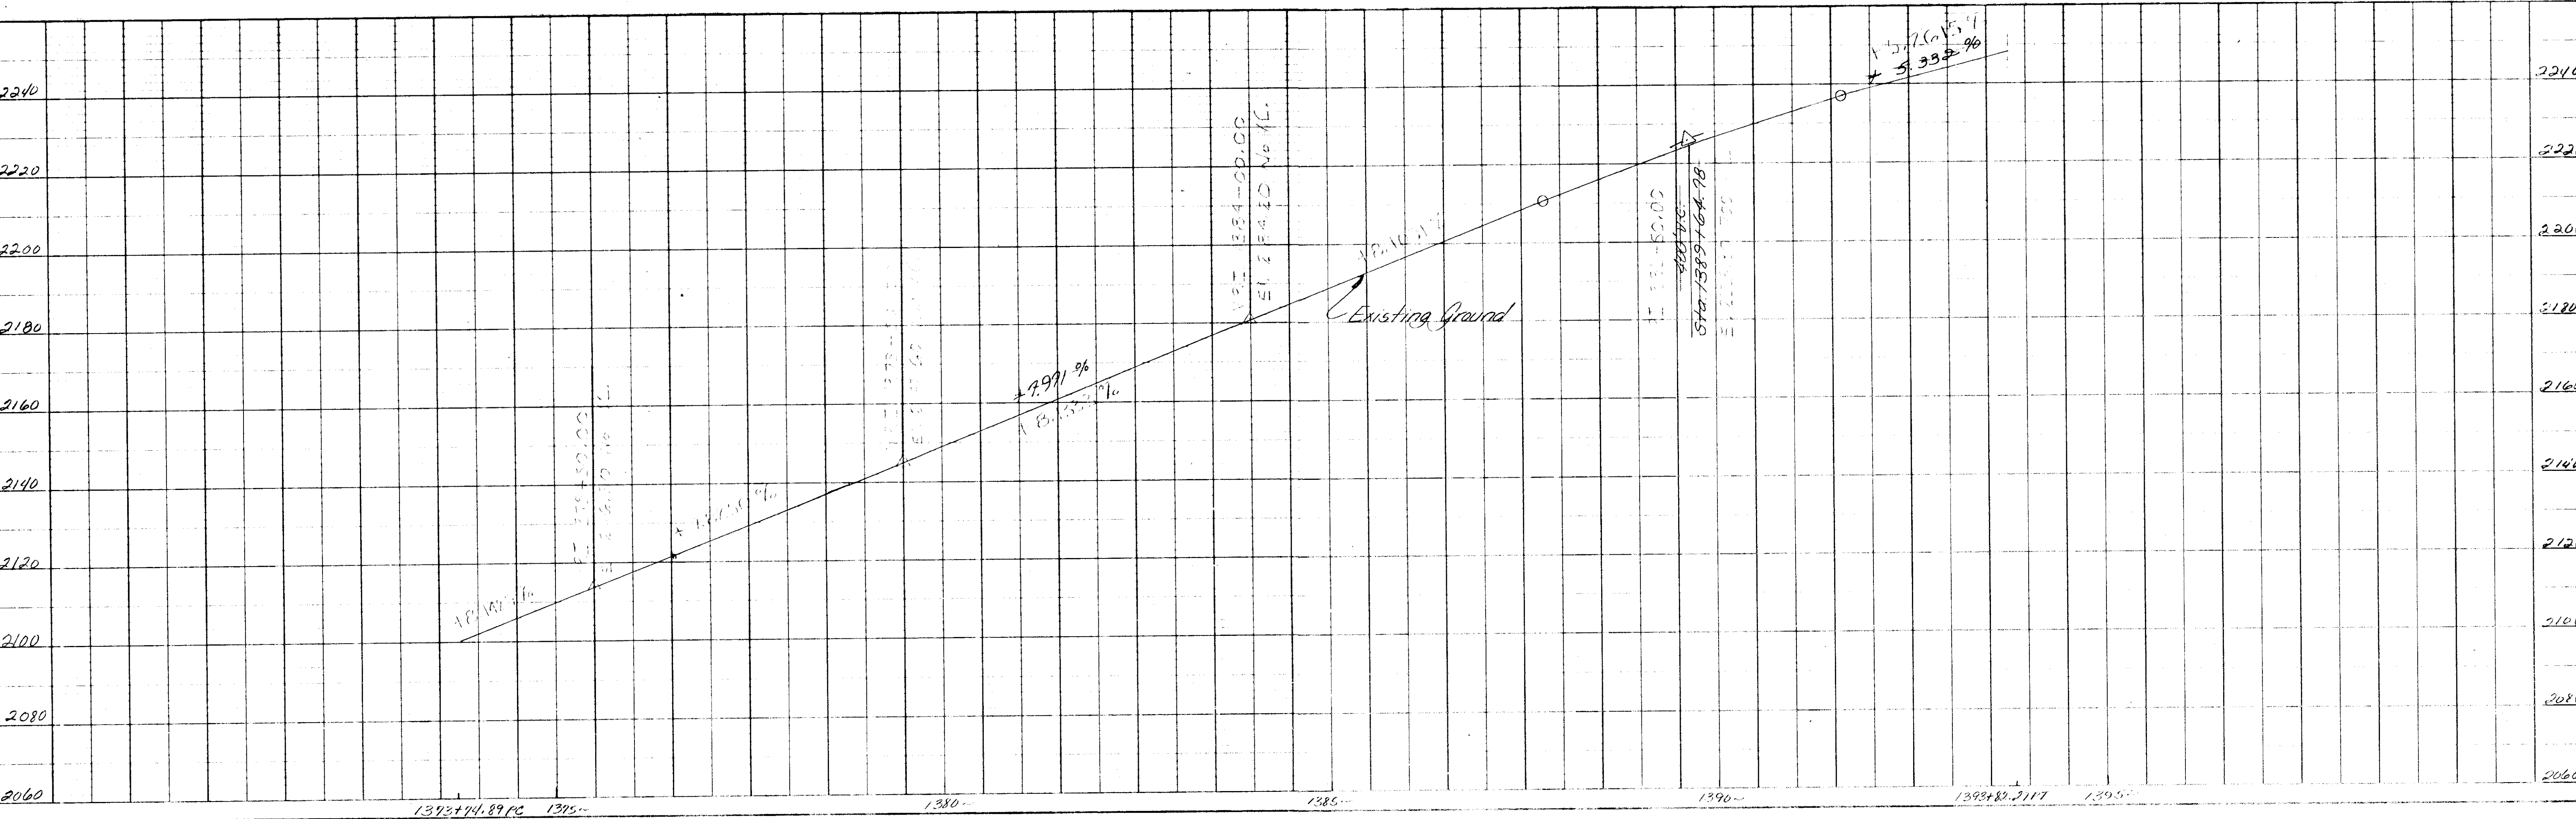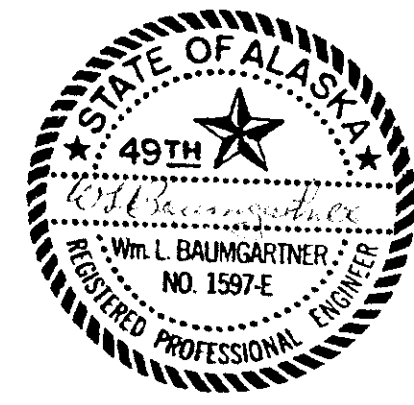


$\Delta = 41^{\circ}12'45''$   
 $D = 13^{\circ}$   
 $T = 165.57'$   
 $L = 316.76'$   
 $R = 440.74'$   
 $S = 0.06\%$   
 $S = 0.06\%$   
 $T = 150'$

\* TRANSITION FROM 6% SUPERELEVATION LEFT AT EFS TO 3% SUPER LEFT AT BEGIN BRIDGE  
 \*\* TRANSITION FROM 3% SUPER RIGHT AT END BRIDGE TO 6% SUPERELEVATION RIGHT AT B.F.S.

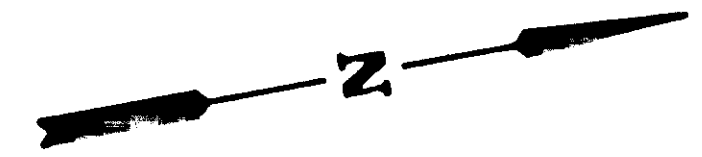

1394+162.17, END BRIDGE


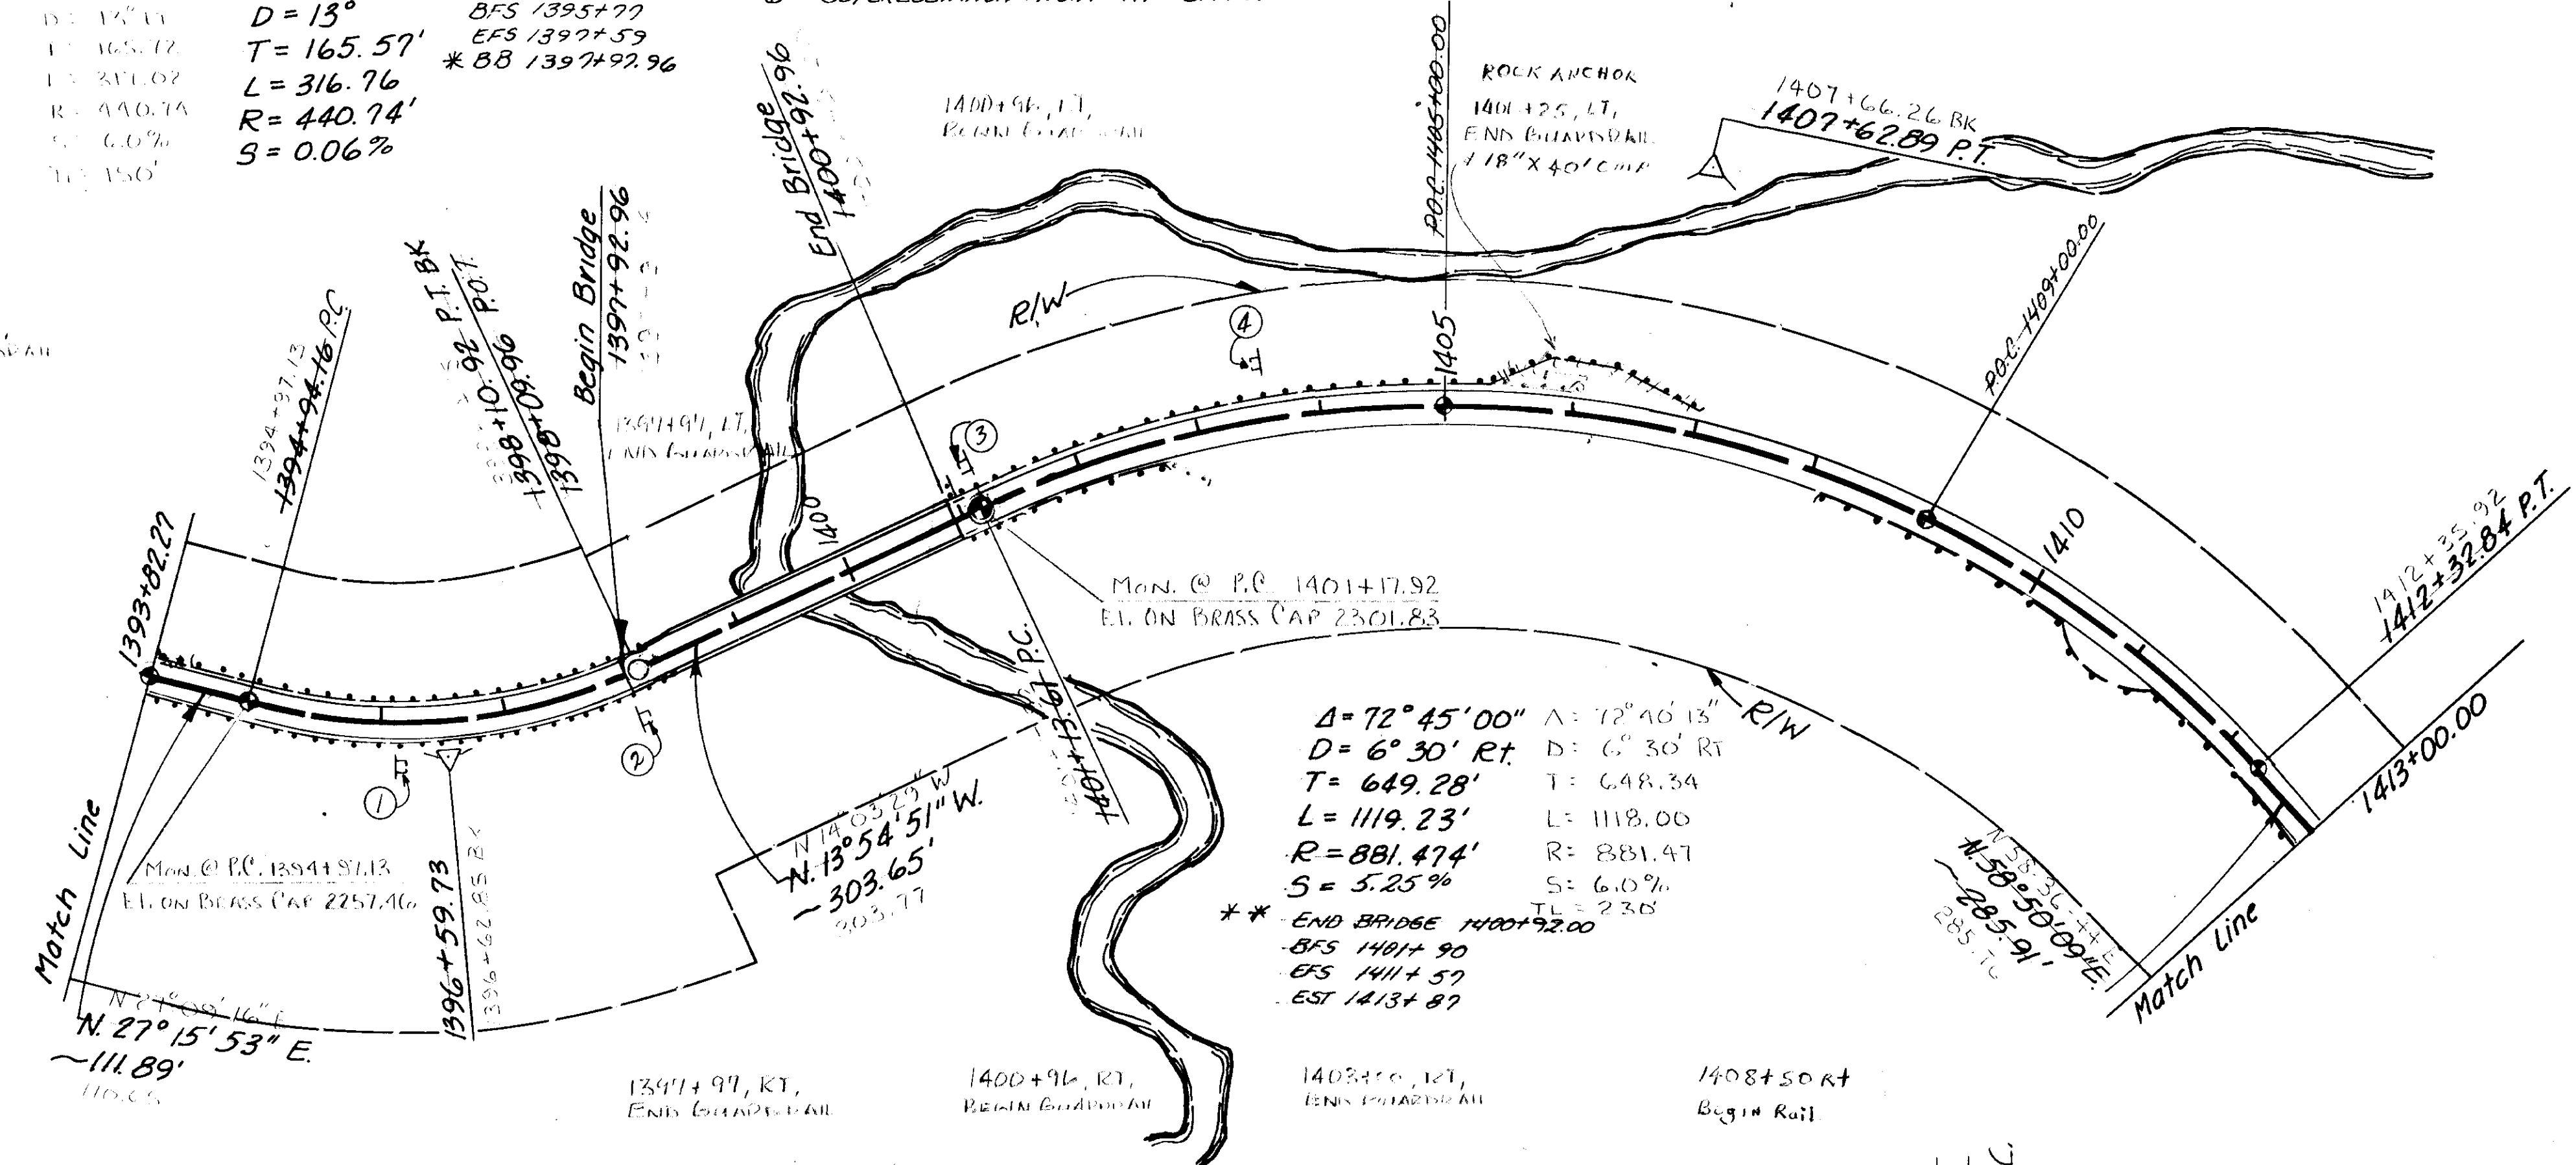


- EXISTING SIGN LEGENDS**
- ① Slippery when wet
  - ② William Moore Creek
  - ③ William Moore Creek
  - ④ Slippery when wet



$\Delta = 72^{\circ}45'00''$   
 $D = 6^{\circ}30' R$   
 $T = 649.28'$   
 $L = 1119.23'$   
 $R = 881.474'$   
 $S = 5.25\%$

$\Delta = 72^{\circ}40'13''$   
 $D = 6^{\circ}30' R$   
 $T = 648.34'$   
 $L = 1118.00'$   
 $R = 881.47'$   
 $S = 6.0\%$



\*\* END BRIDGE 1400+92.00  
 B.F.S. 1401+90  
 E.F.S. 1411+57  
 EST 1413+87

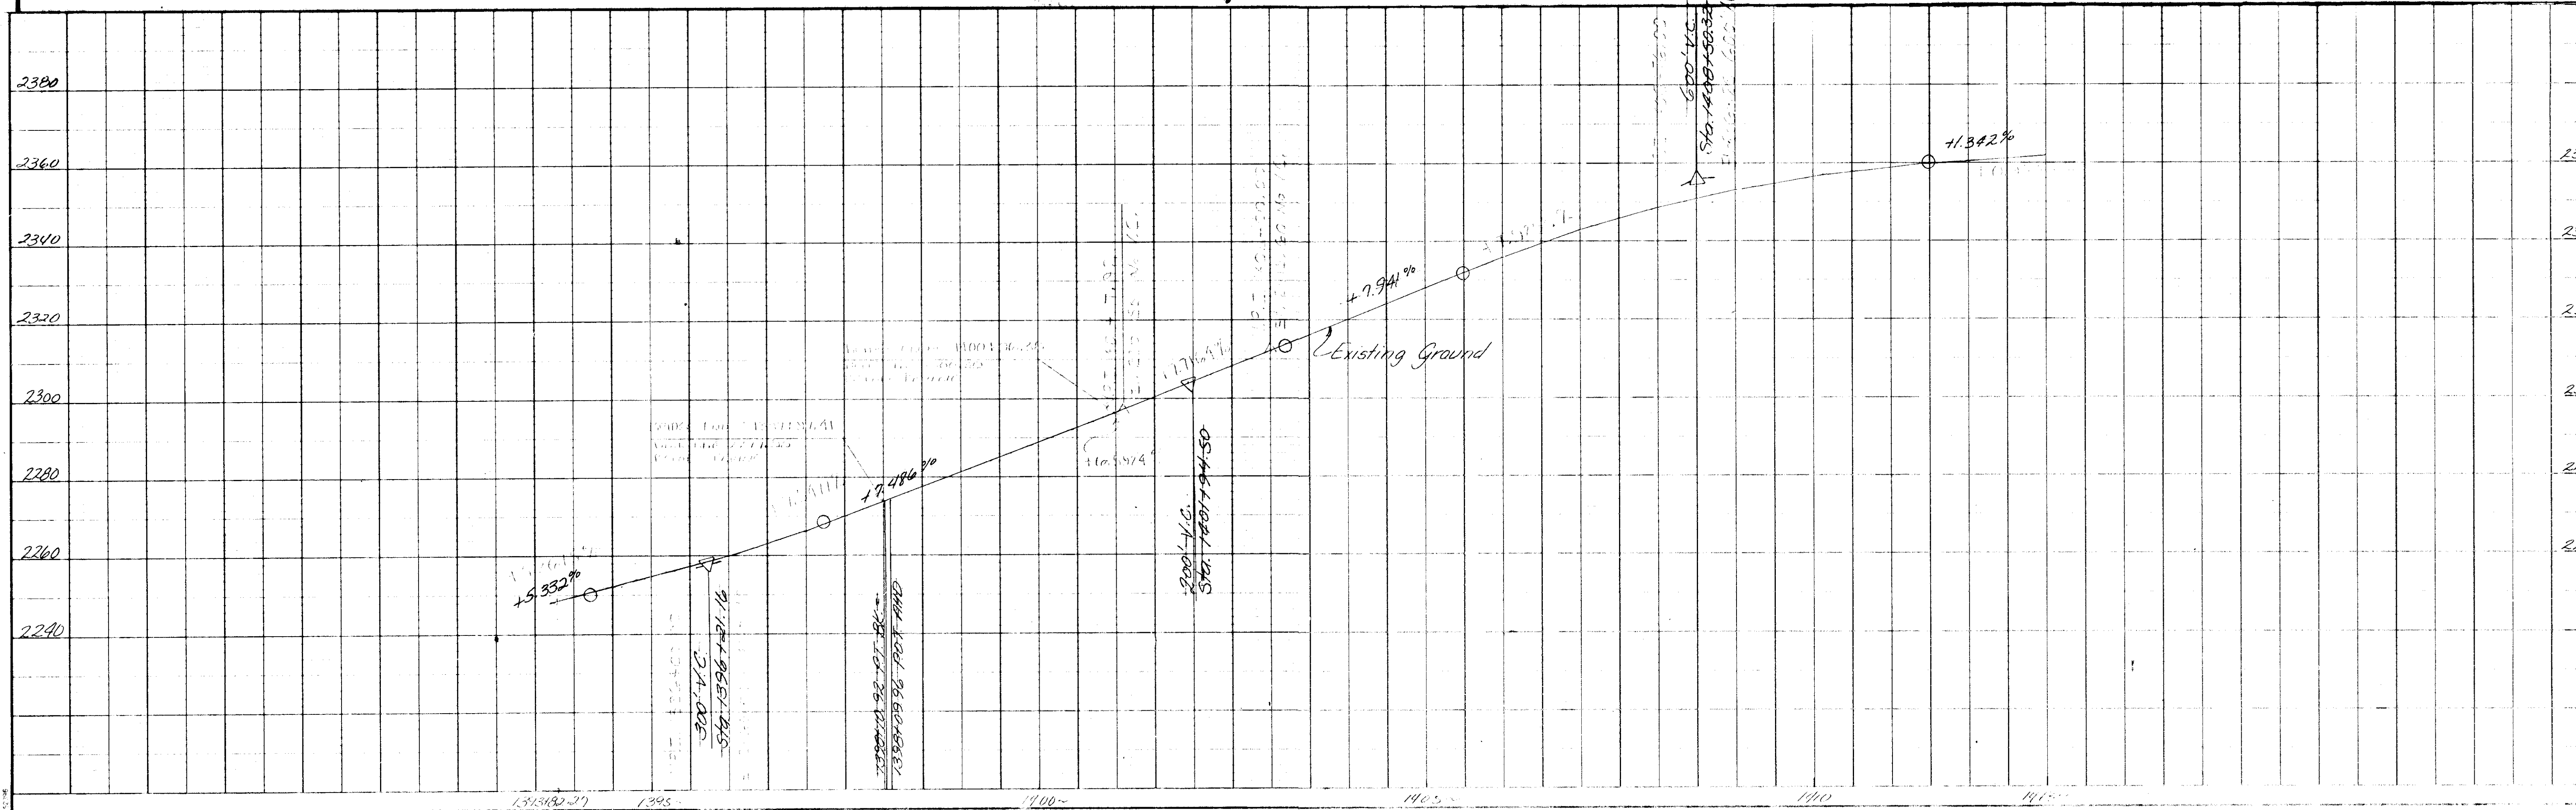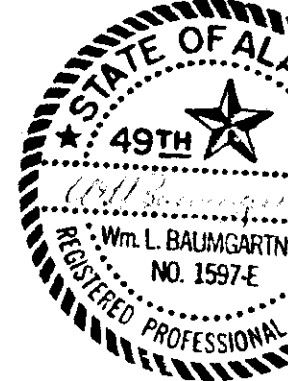


STATE	PROJECT DESIGNATION	YEAR
ALASKA	F-097-2(4)	1985

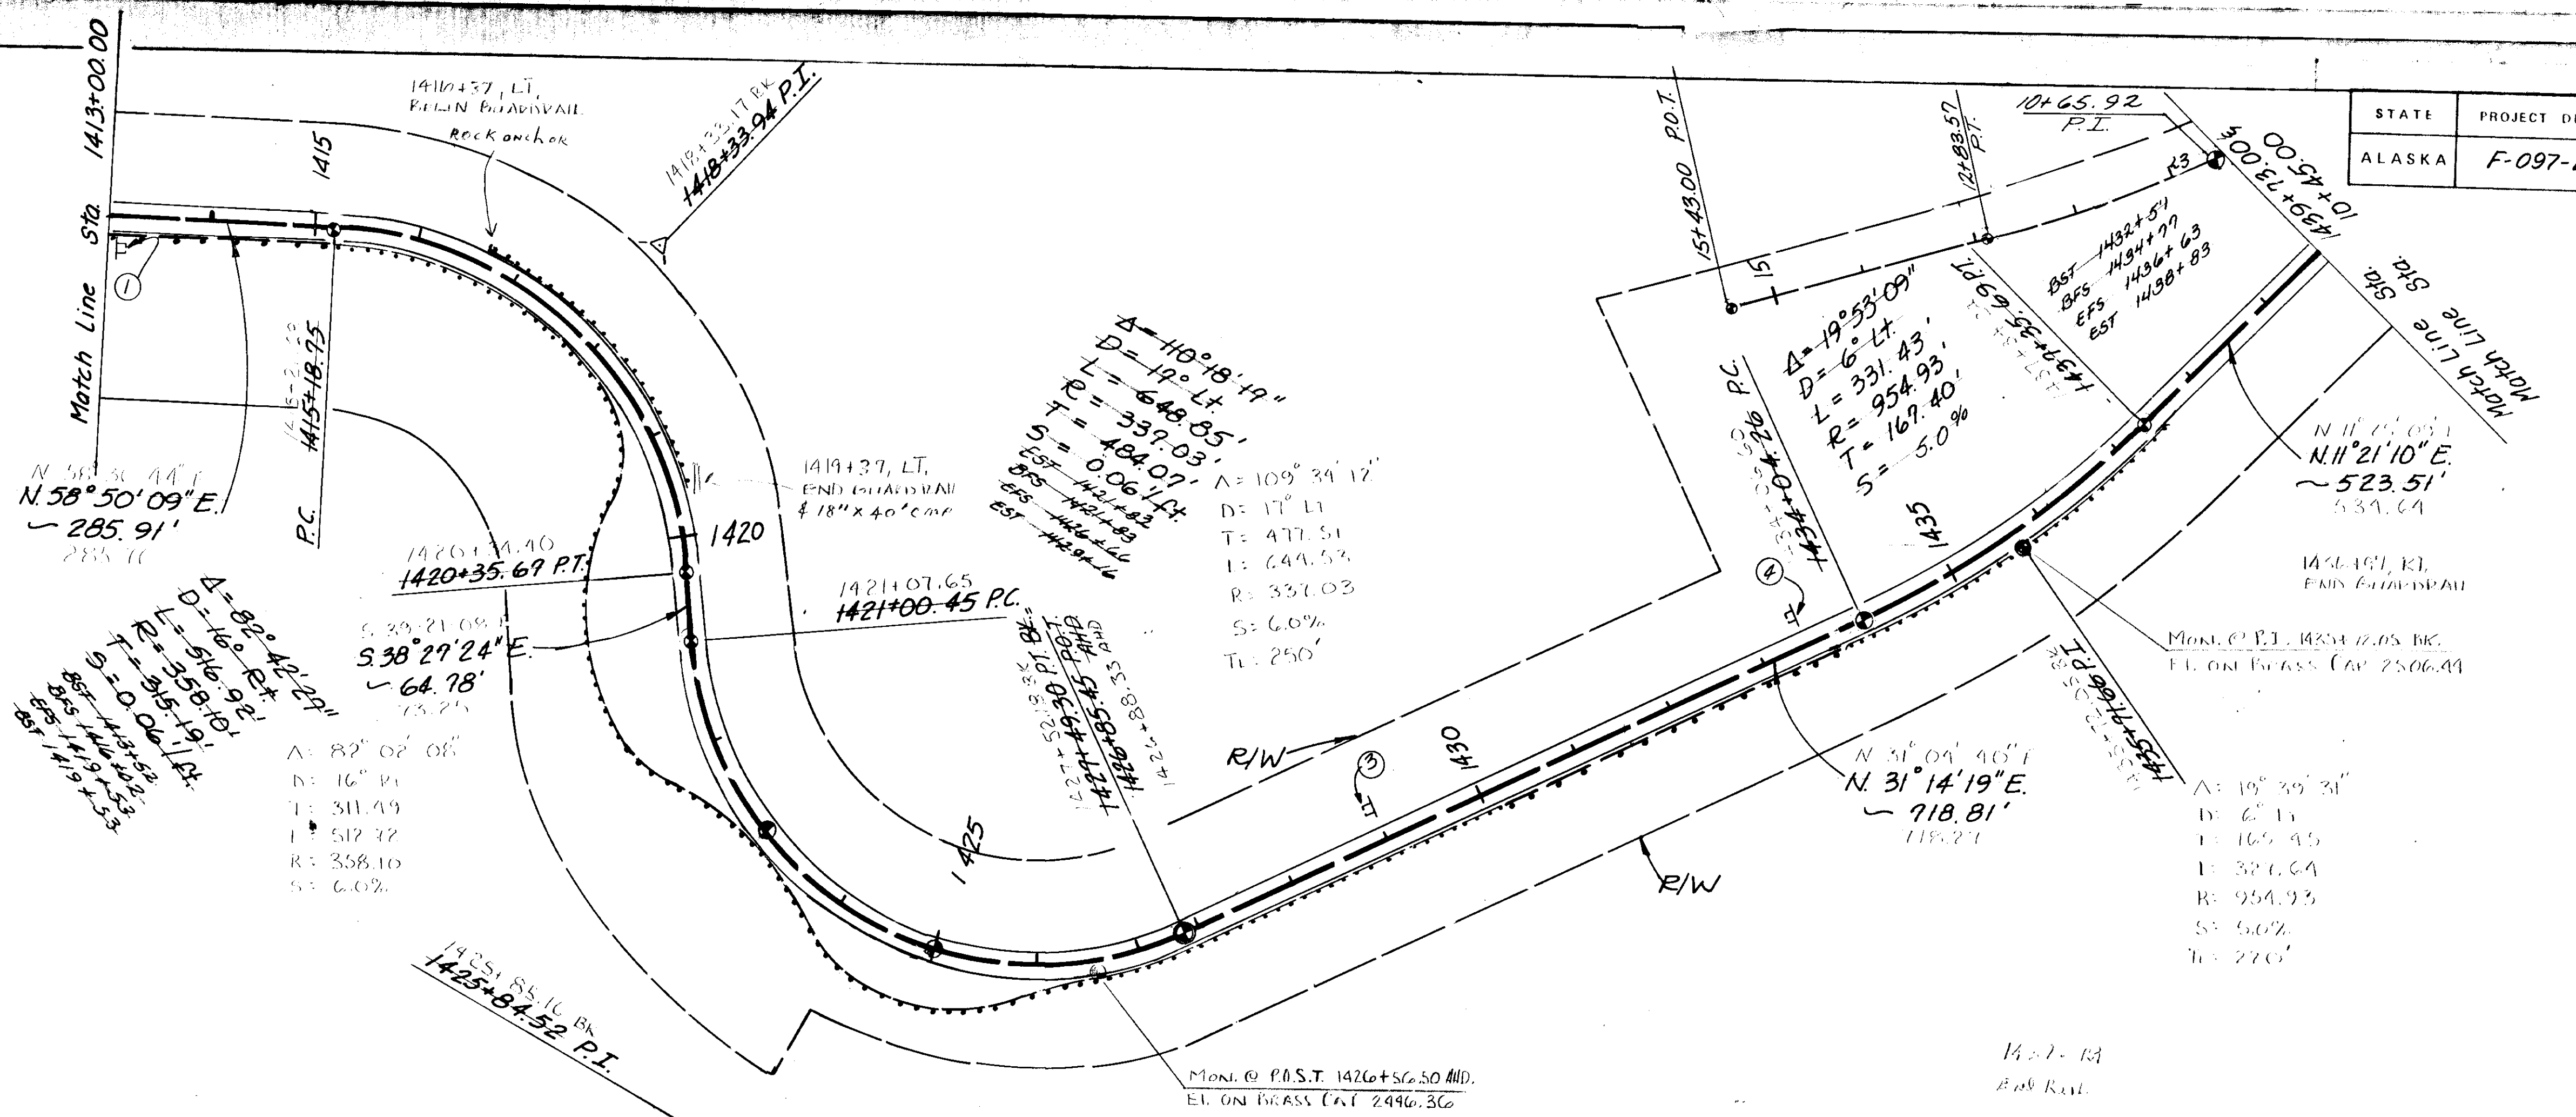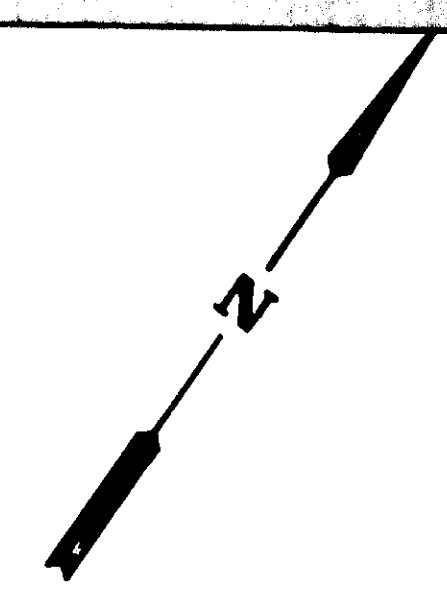

- EXISTING SIGN LEGENDS**
- ① - 30 mph
  - ② - 30 mph
  - ③ - Trucks use low gear

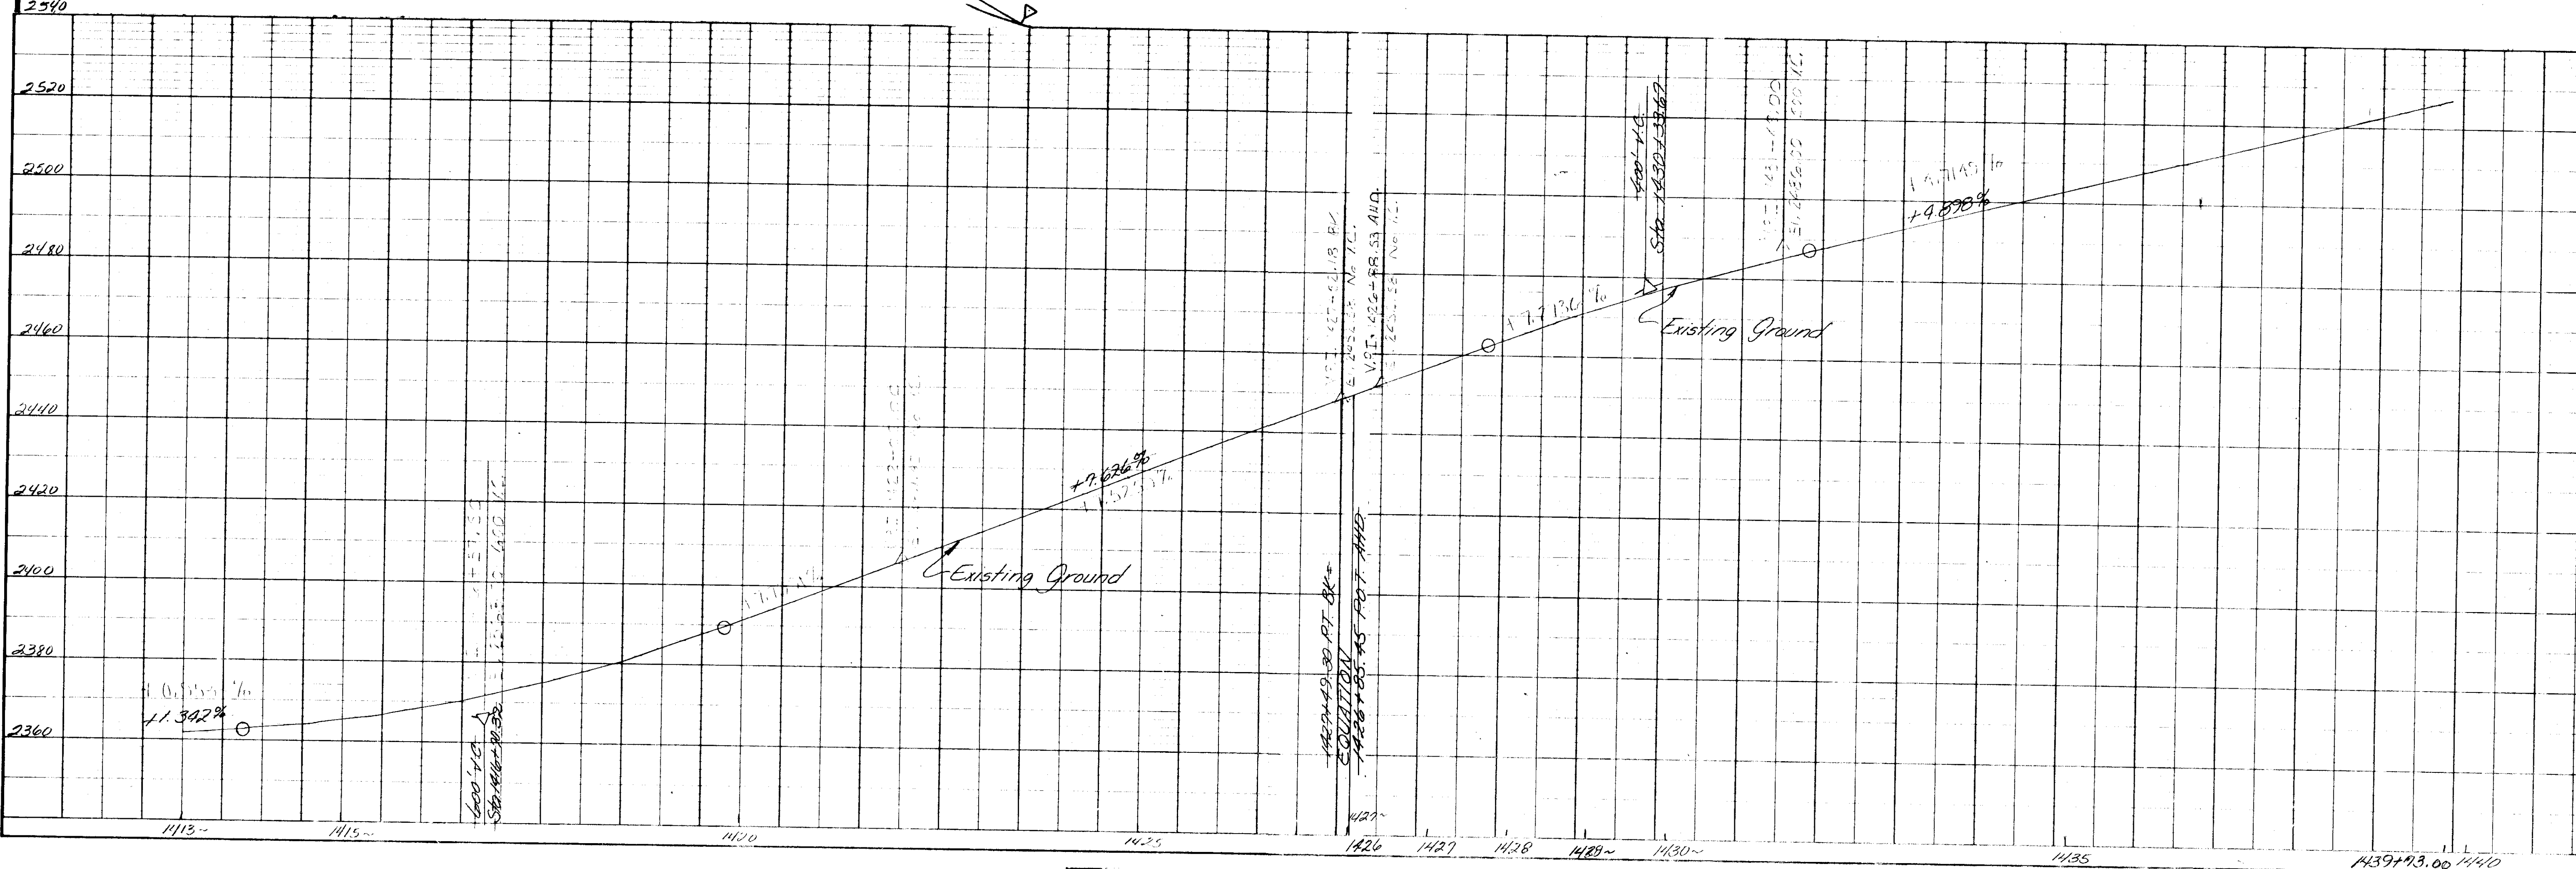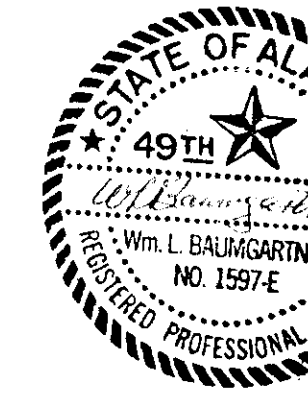

NO.	STRUCTURE NOTES

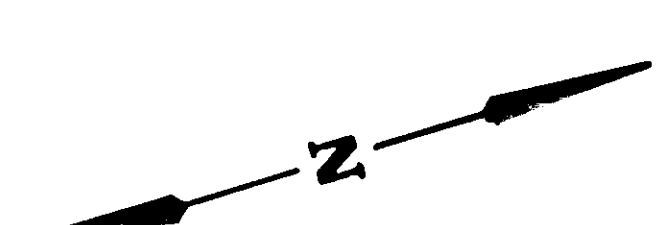


$\Delta = 9^{\circ} 49' 40''$   
 $D = 6^{\circ} 11'$   
 $L = 836.52'$   
 $R = 166.61'$   
 $T = 954.93'$   
 $S = 5.0\%$

$\Delta = 10^{\circ} 21' 54''$   
 $D = 6^{\circ} 11'$   
 $L = 172.75'$   
 $R = 954.93'$   
 $T = 86.61'$   
 $S = 5.0\%$



$\Delta = 51^{\circ} 51' 12''$   
 $D = 10^{\circ} 15' 12''$   
 $L = 505.88'$   
 $R = 558.98'$   
 $T = 271.75'$   
 $S = 0.06\%$

$\Delta = 33^{\circ} 03' 53''$   
 $D = 11^{\circ} 21' 10''$   
 $L = 300.59'$   
 $R = 520.87'$   
 $T = 154.61'$   
 $S = 0.06\%$



"E" 8" 50 INSTALL A ROCK ANCHOR SEE SHT. 23 FOR DETAILS

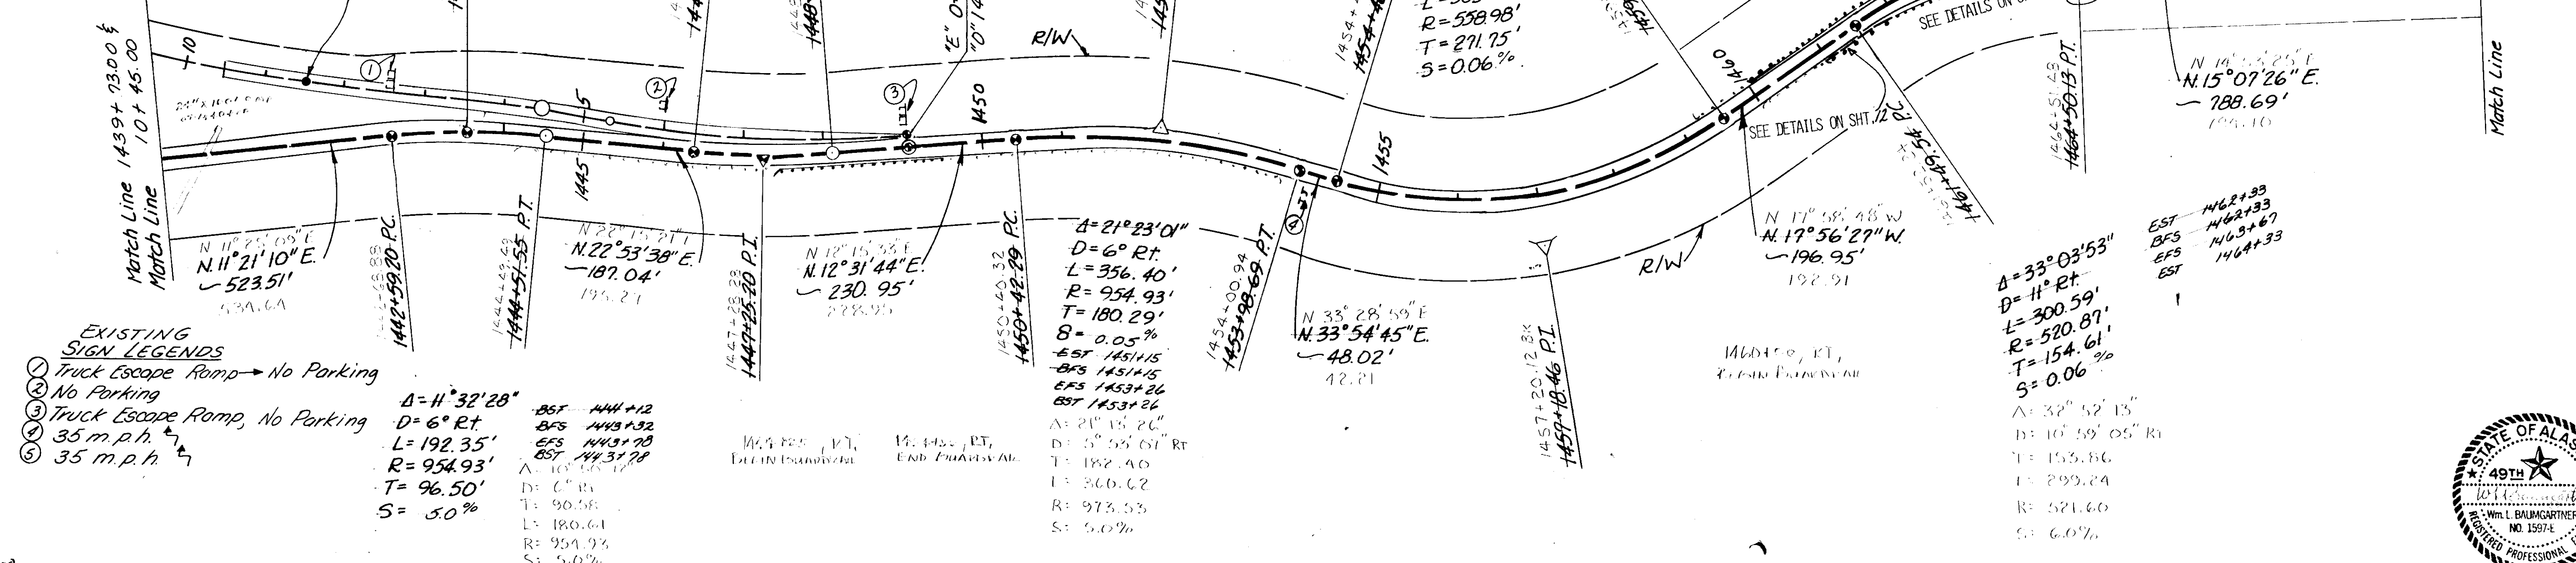


- EXISTING SIGN LEGENDS**
- ① Truck Escape Ramp → No Parking
  - ② No Parking
  - ③ Truck Escape Ramp, No Parking
  - ④ 35 m.p.h.
  - ⑤ 35 m.p.h.

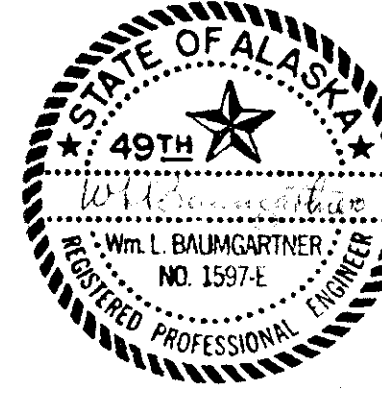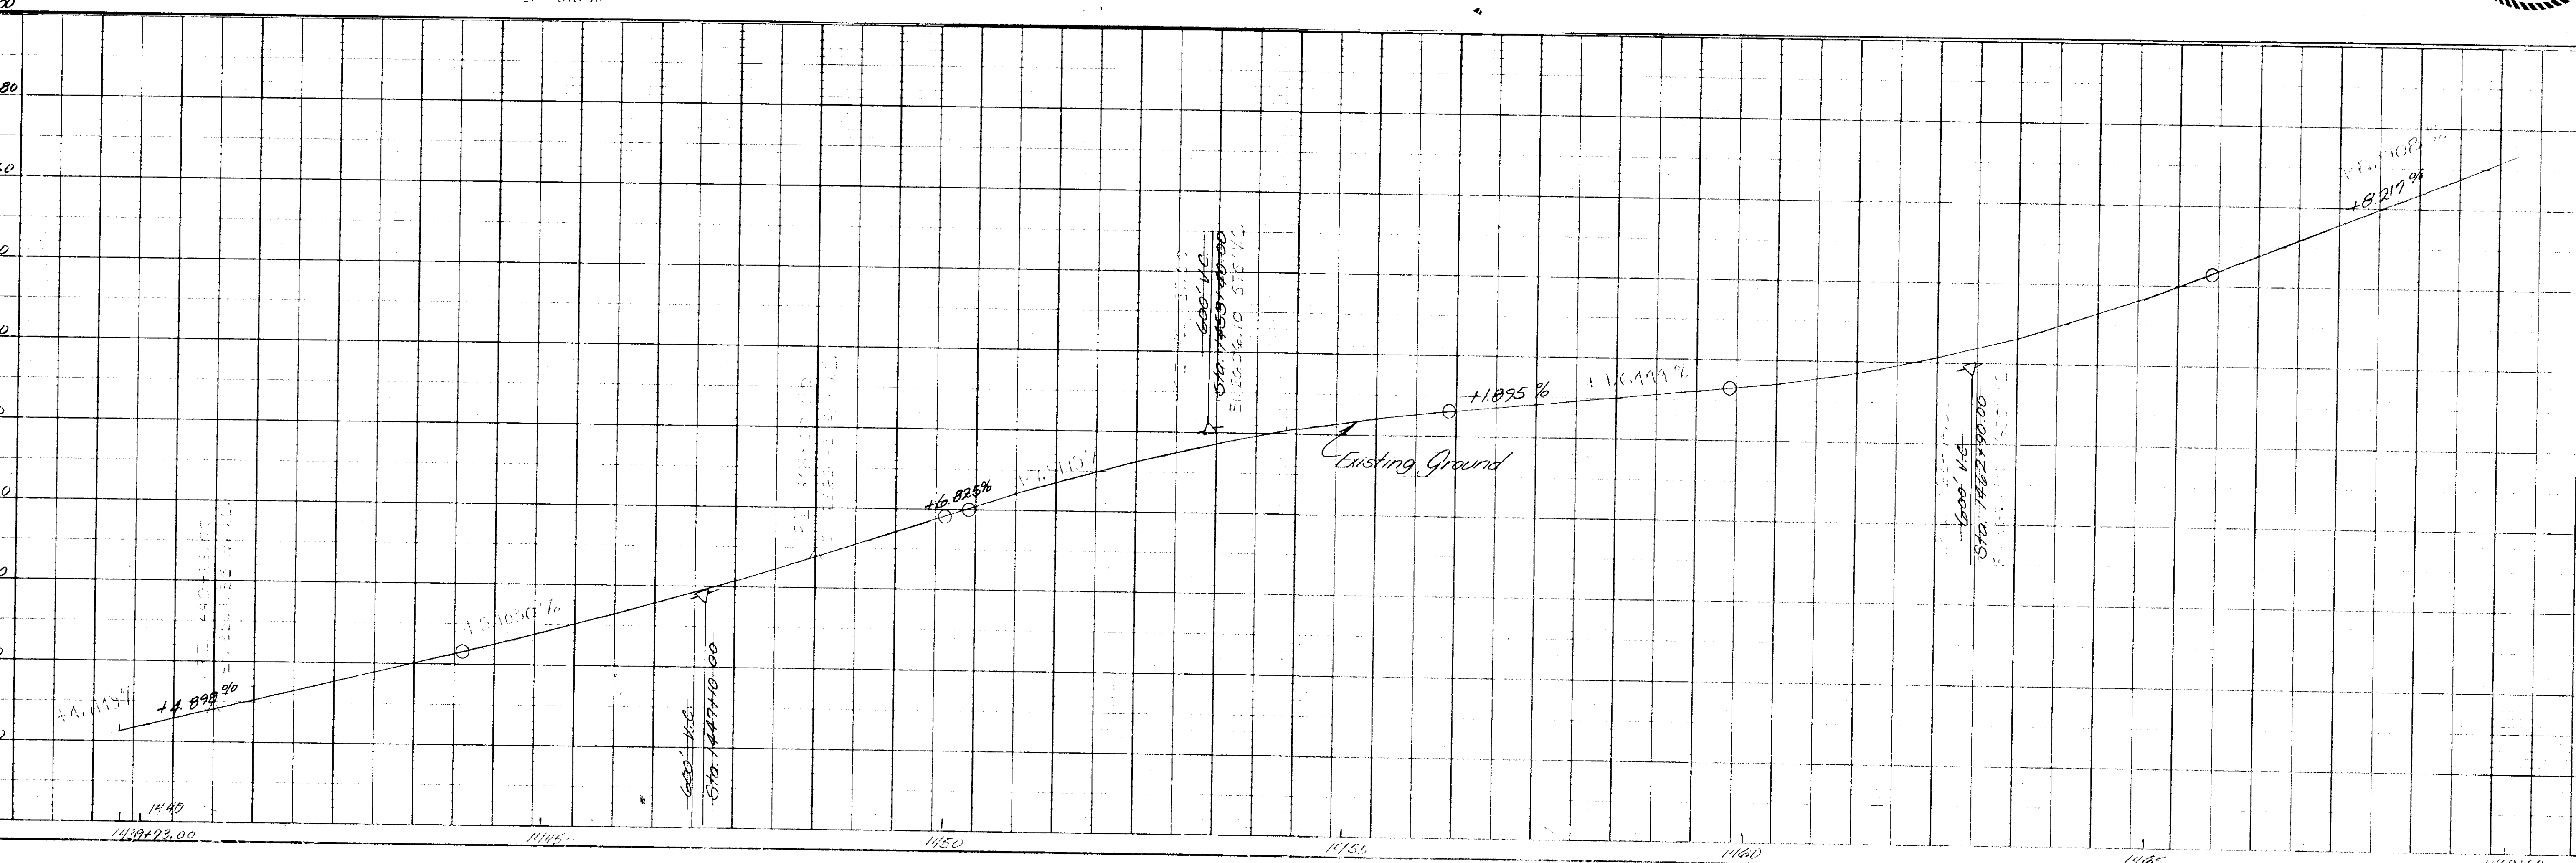




STATE	PROJECT DESIGNATION	YEAR	SHEET NO.	TOTAL SHEETS
ALASKA	F-097-2(4)	1985	29	33

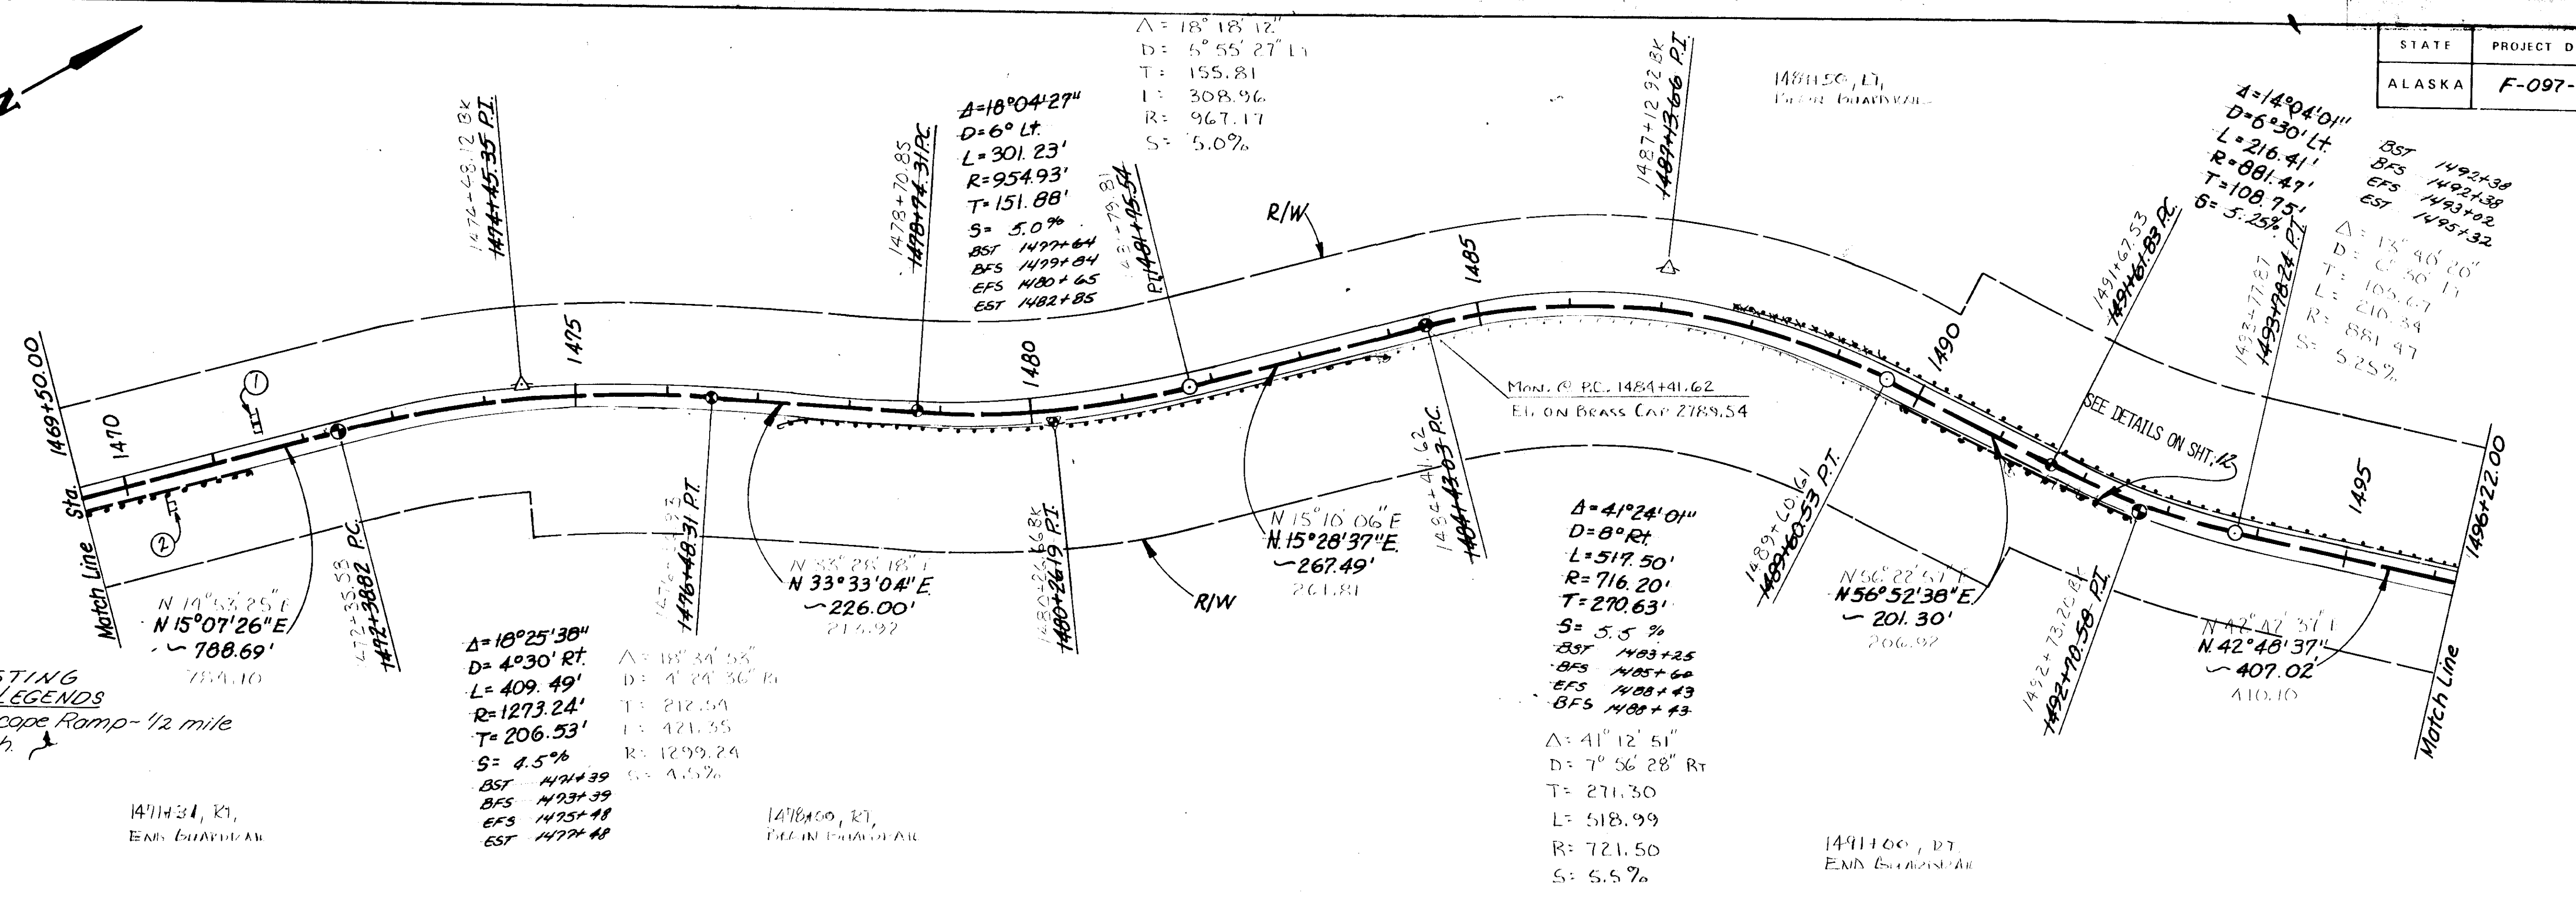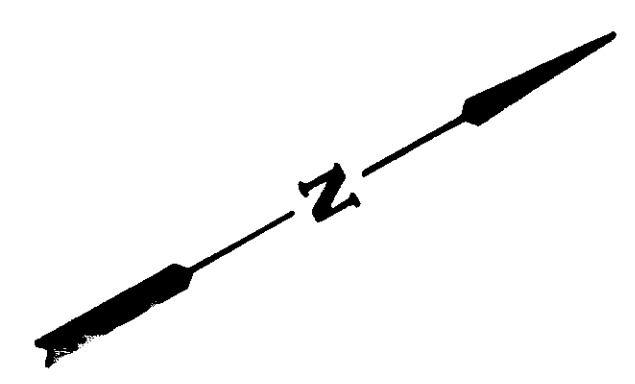


**EXISTING SIGN LEGENDS**  
 ① Truck Escape Ramp - 1/2 mile  
 ② 35 m.p.h.

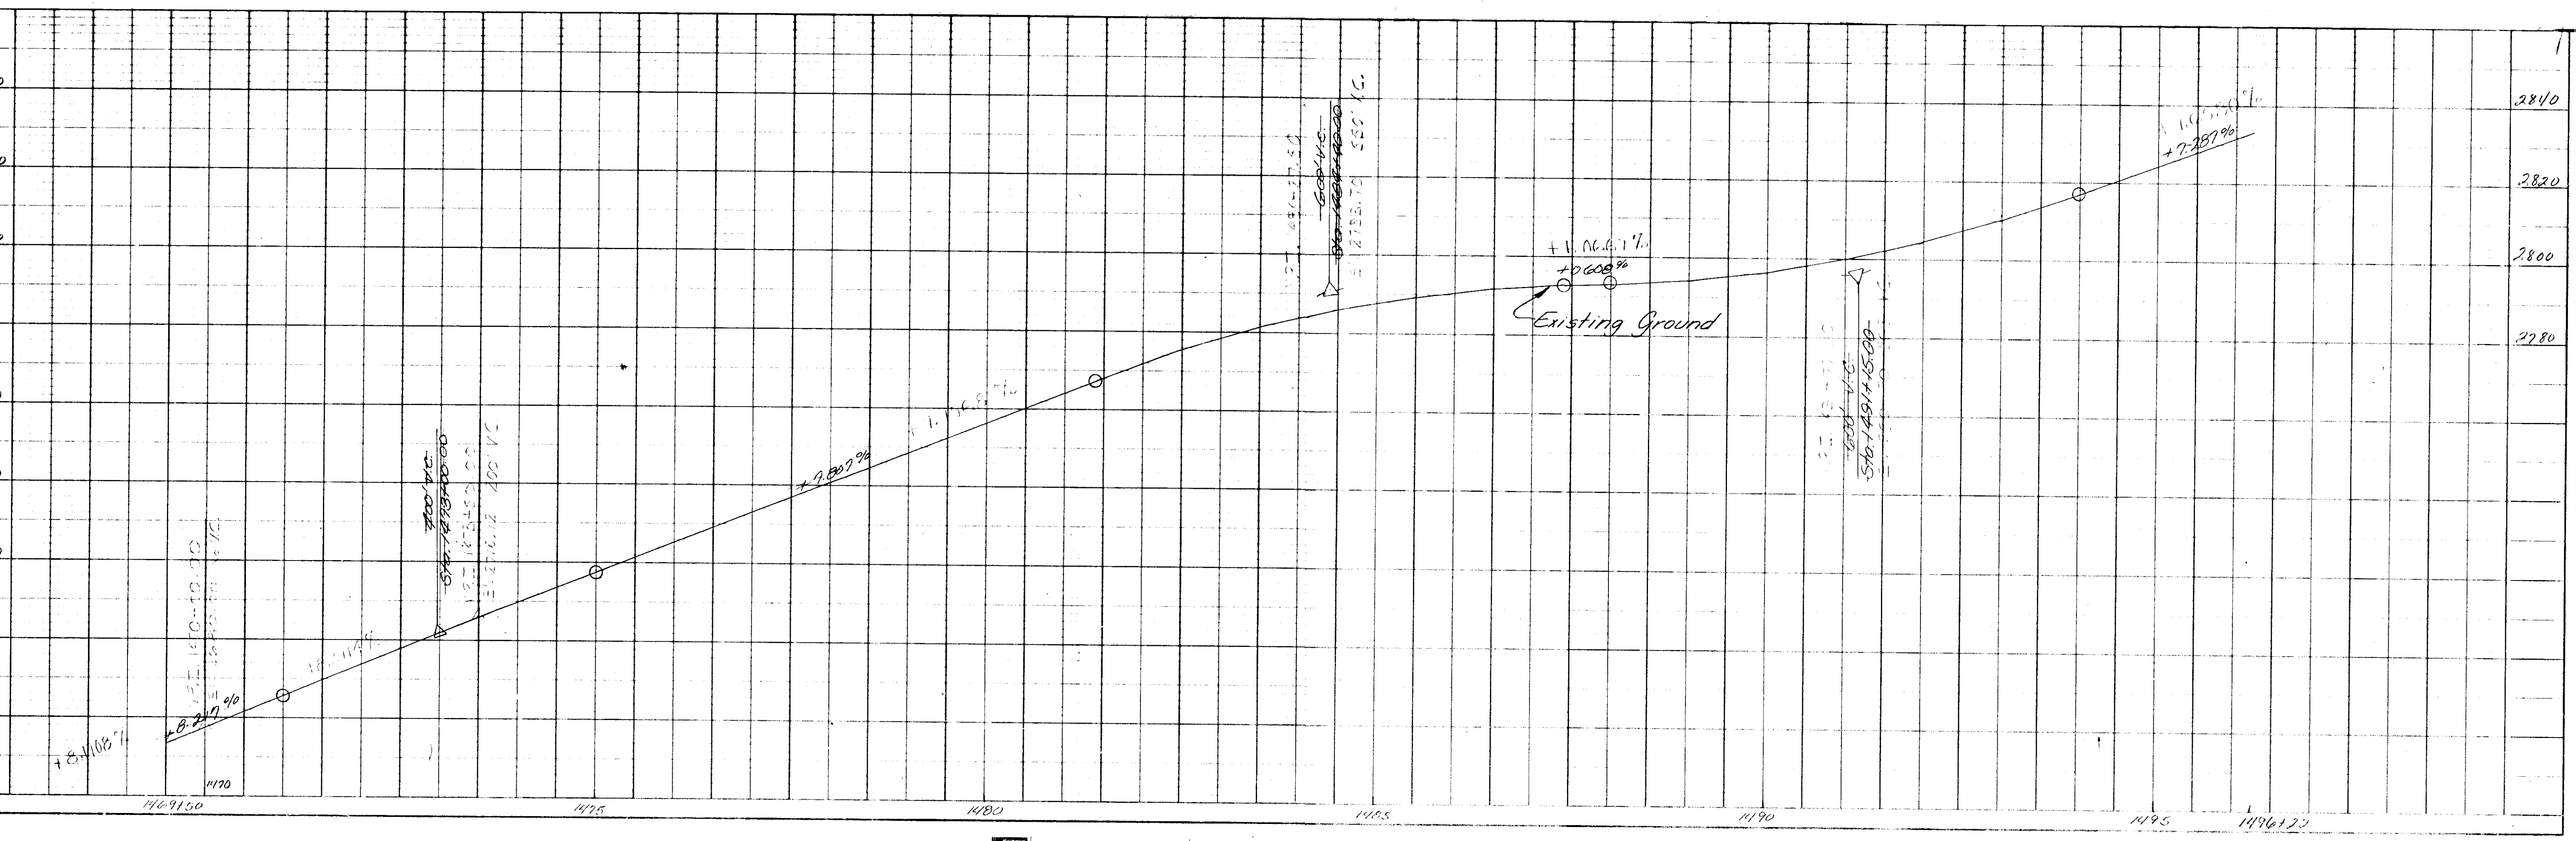

STATE	PROJECT DESIGNATION	YEAR	SHEET NO.
ALASKA	F-097-2(4)	1985	30

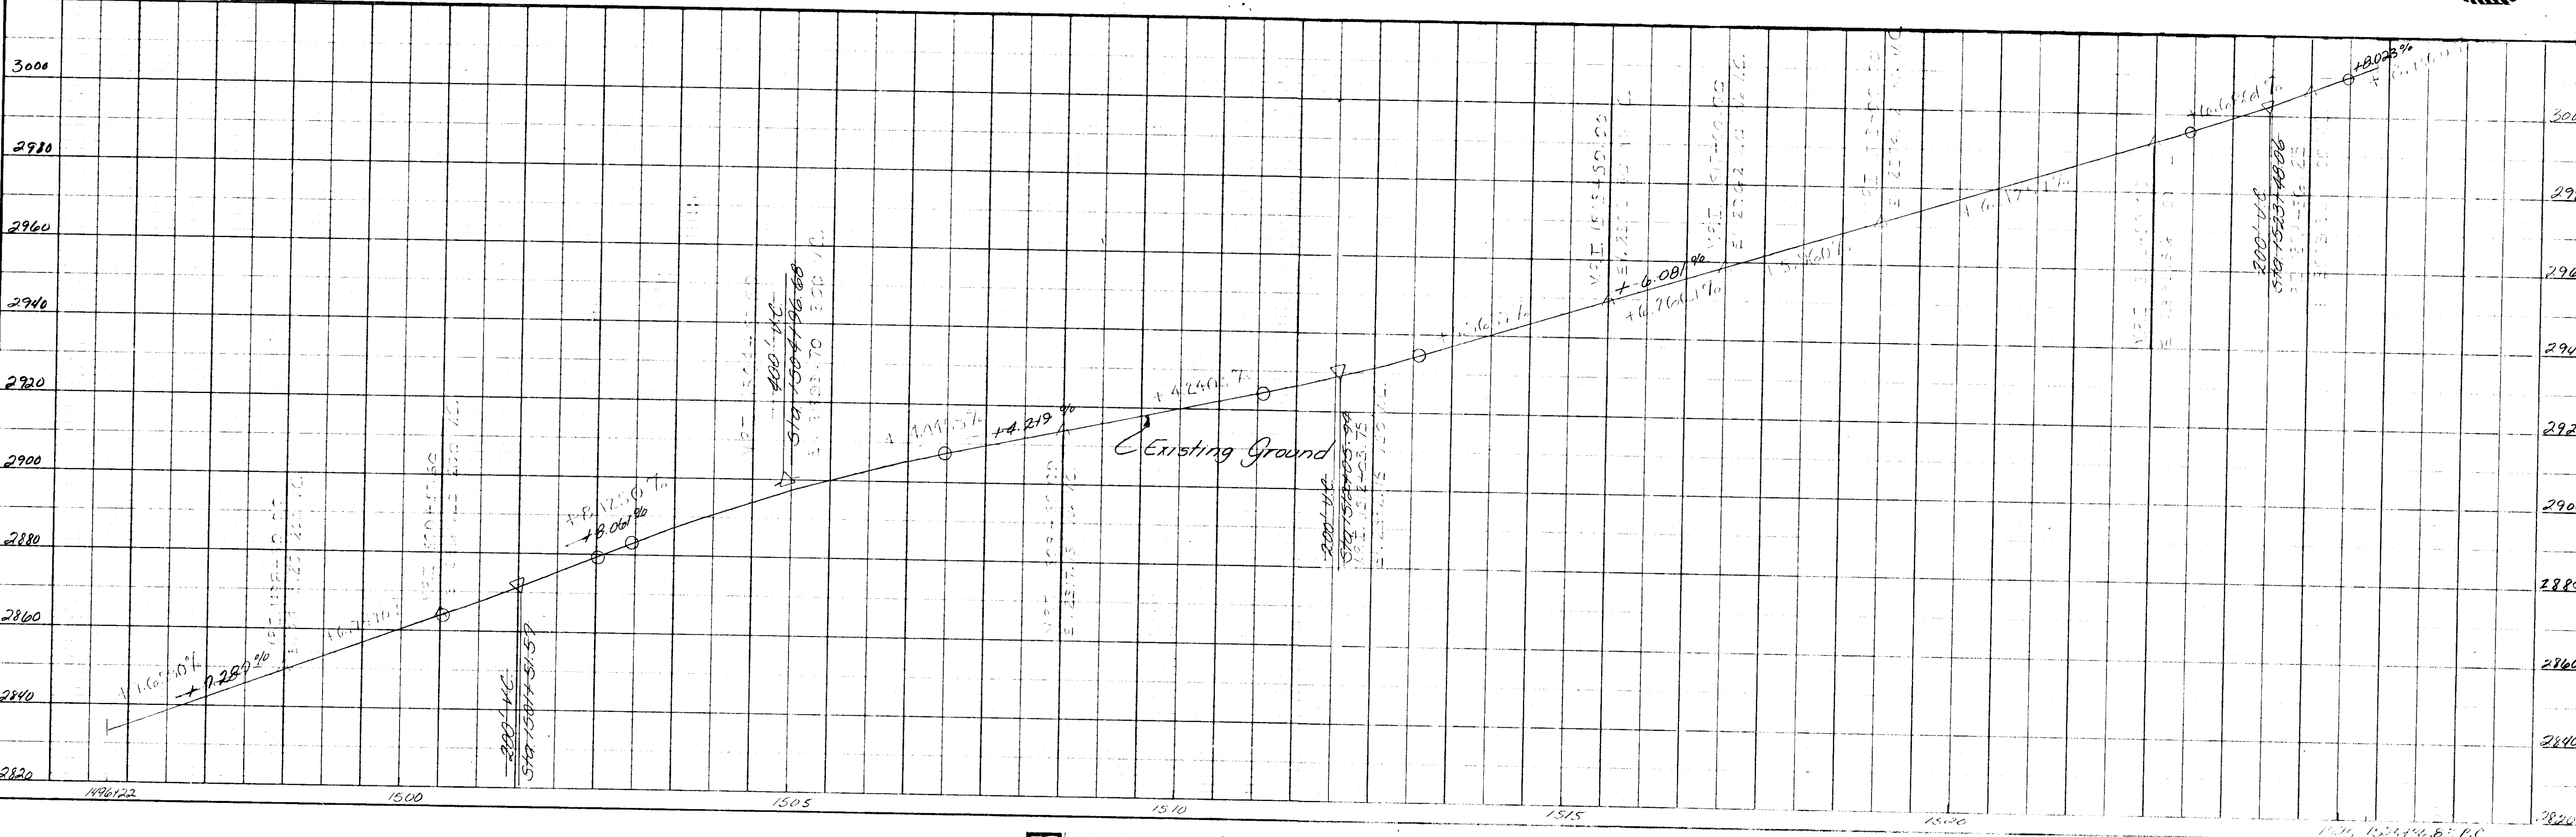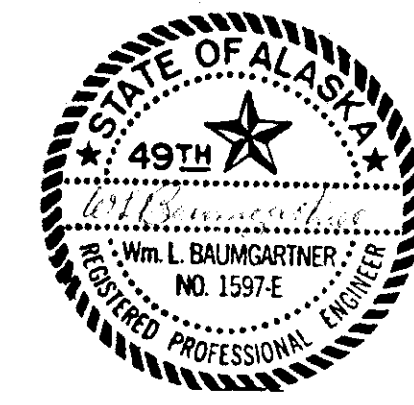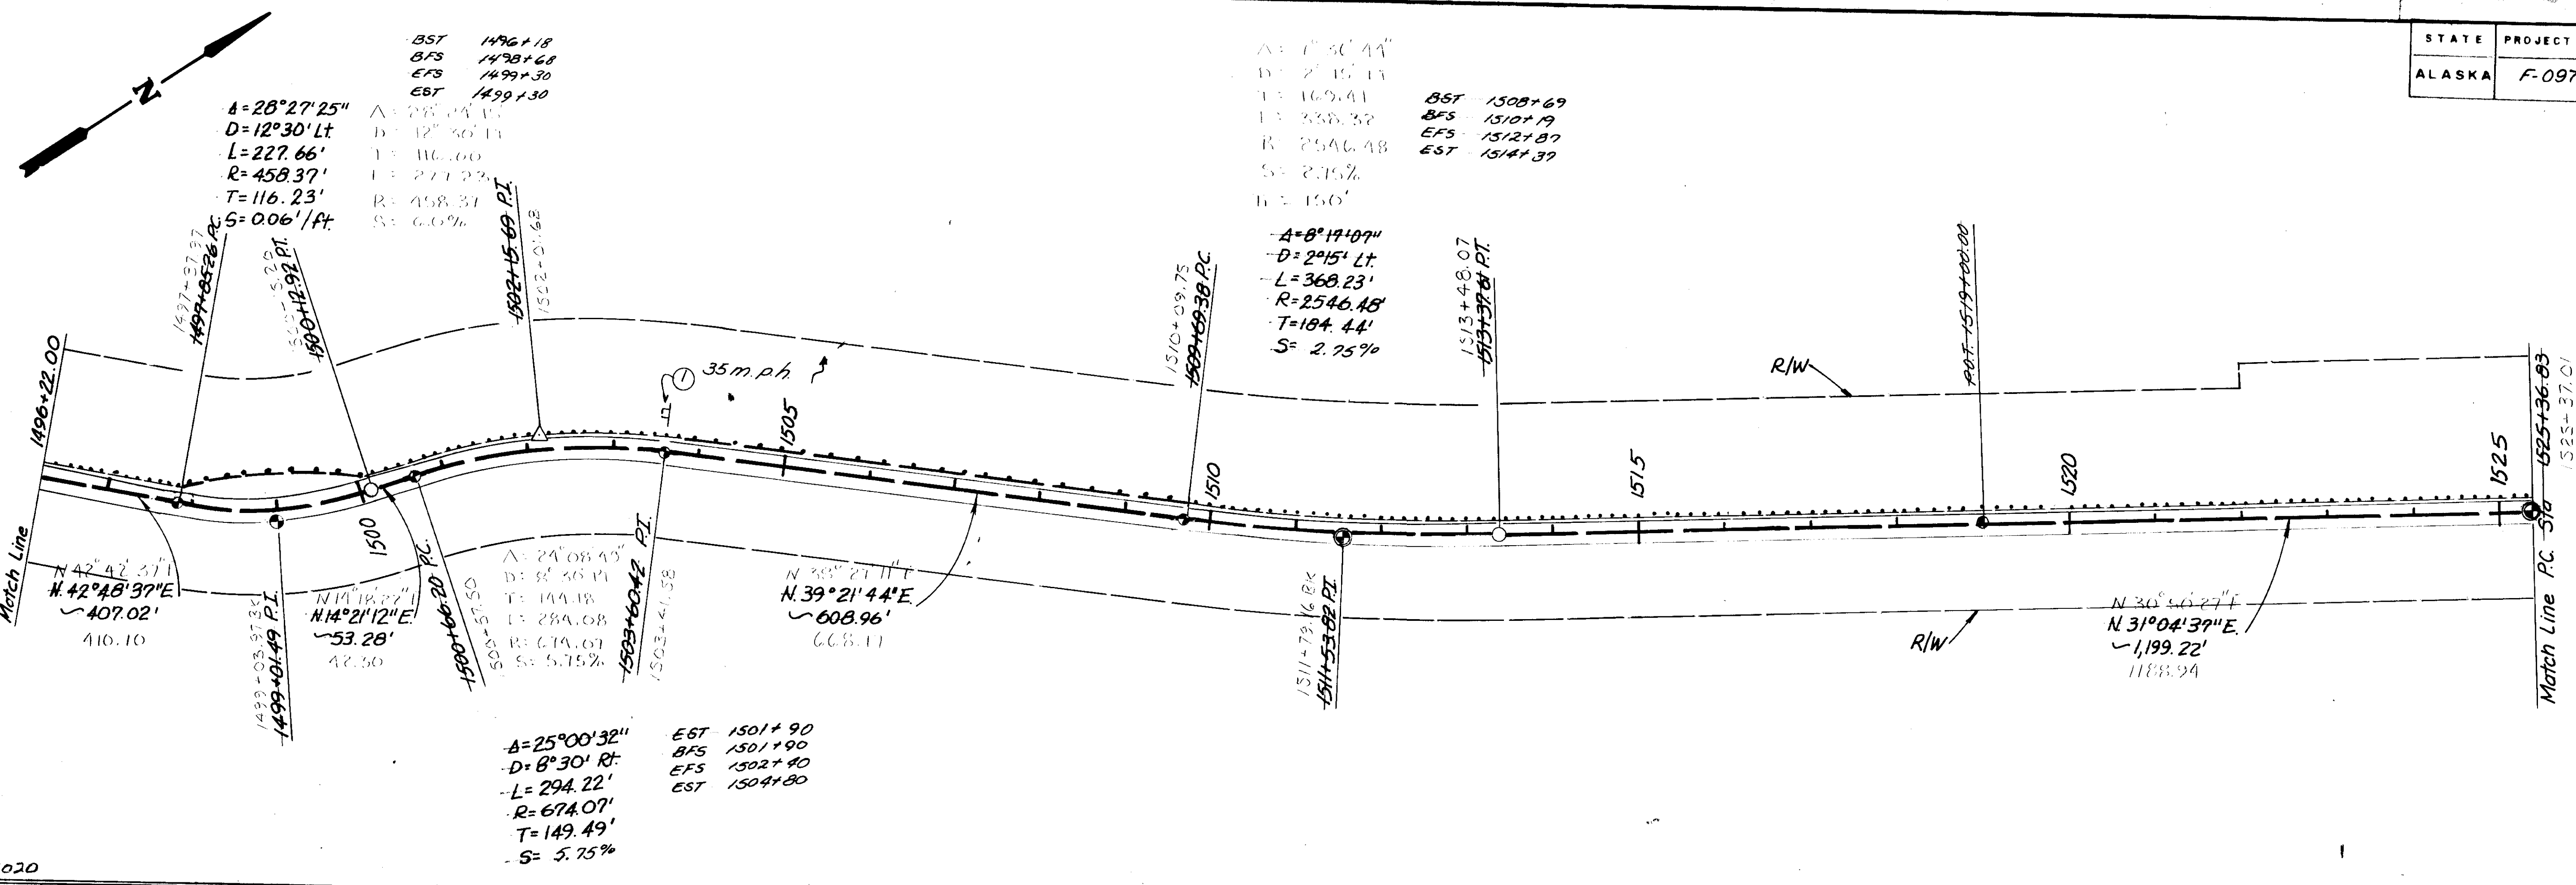

STATE	PROJECT DESIGNATION	YEAR	SHEET NO.
ALASKA	F-097-2(4)	1985	31

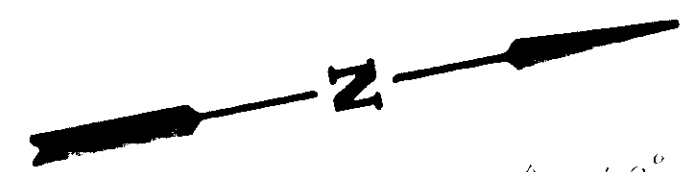

$\Delta = 52^\circ 28' 15''$   
 $D = 8^\circ \text{ Lt.}$   
 $L = 352.32'$   
 $R = 654.84'$   
 $T = 116.20'$   
 $S = 5.5\%$   
 $T = 2.35'$

$\Delta = 52^\circ 06' 51''$   
 $D = 8^\circ \text{ Lt.}$   
 $L = 651.43'$   
 $R = 716.20'$   
 $T = 350.20'$   
 $S = 5.5\%$   
 BST 1524+20  
 BFS 1526+55  
 EFS 1530+70  
 EST 1530+78

$\Delta = 26^\circ 44' 36''$   
 $D = 8^\circ \text{ Rt.}$   
 $L = 334.29'$   
 $R = 716.20'$   
 $T = 2.35'$   
 $S = 5.5\%$

$\Delta = 26^\circ 25' 17''$   
 $D = 8^\circ \text{ Rt.}$   
 $L = 330.27'$   
 $R = 716.20'$   
 $T = 168.12'$   
 $S = 5.5\%$   
 ST 1533+87  
 BFS 1533+87  
 EFS 1534+82  
 EST 1534+82

$\Delta = 15^\circ 30' 01''$   
 $D = 3^\circ 45' \text{ Rt.}$   
 $L = 413.34'$   
 $R = 1527.89'$   
 $T = 207.94'$   
 $S = 4\%$

BST 1538+40  
 BFS 1538+40  
 EFS 1540+64  
 EST 1540+64  
 $\Delta = 15^\circ 21' 05''$   
 $D = 3^\circ 45' \text{ Rt.}$   
 $L = 412.19'$   
 $R = 1527.89'$   
 $T = 190'$   
 $S = 4.0\%$

$\Delta = 5^\circ 15' 00''$   
 $D = 1^\circ 30' \text{ Rt.}$   
 $L = 350.00'$   
 $R = 3819.72'$   
 $T = 175.12'$   
 $S = 2.25\%$




BST 1543+02  
 BFS 1543+02  
 EFS 1545+16  
 EST 1545+16  
 $\Delta = 5^\circ 16' 19''$   
 $D = 1^\circ 30' \text{ Rt.}$   
 $L = 351.46'$   
 $R = 3819.72'$   
 $T = 130'$   
 $S = 2.25\%$

$\Delta = 6^\circ 15' 00''$   
 $D = 2^\circ 45' \text{ Lt.}$   
 $L = 227.27'$   
 $R = 2083.48'$   
 $T = 113.75'$   
 $S = 3.25\%$

EST 1547+53  
 BFS 1547+53  
 EFS 1548+15  
 EST 1548+15


$\Delta = 6^\circ 15' 24''$   
 $D = 2^\circ 45' \text{ Lt.}$   
 $L = 229.33'$   
 $R = 2083.48'$   
 $T = 114.78'$   
 $S = 3.25\%$   
 $T = 165'$

EST 1548+99.29  
 BFS 1548+99.29

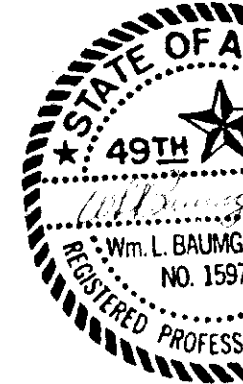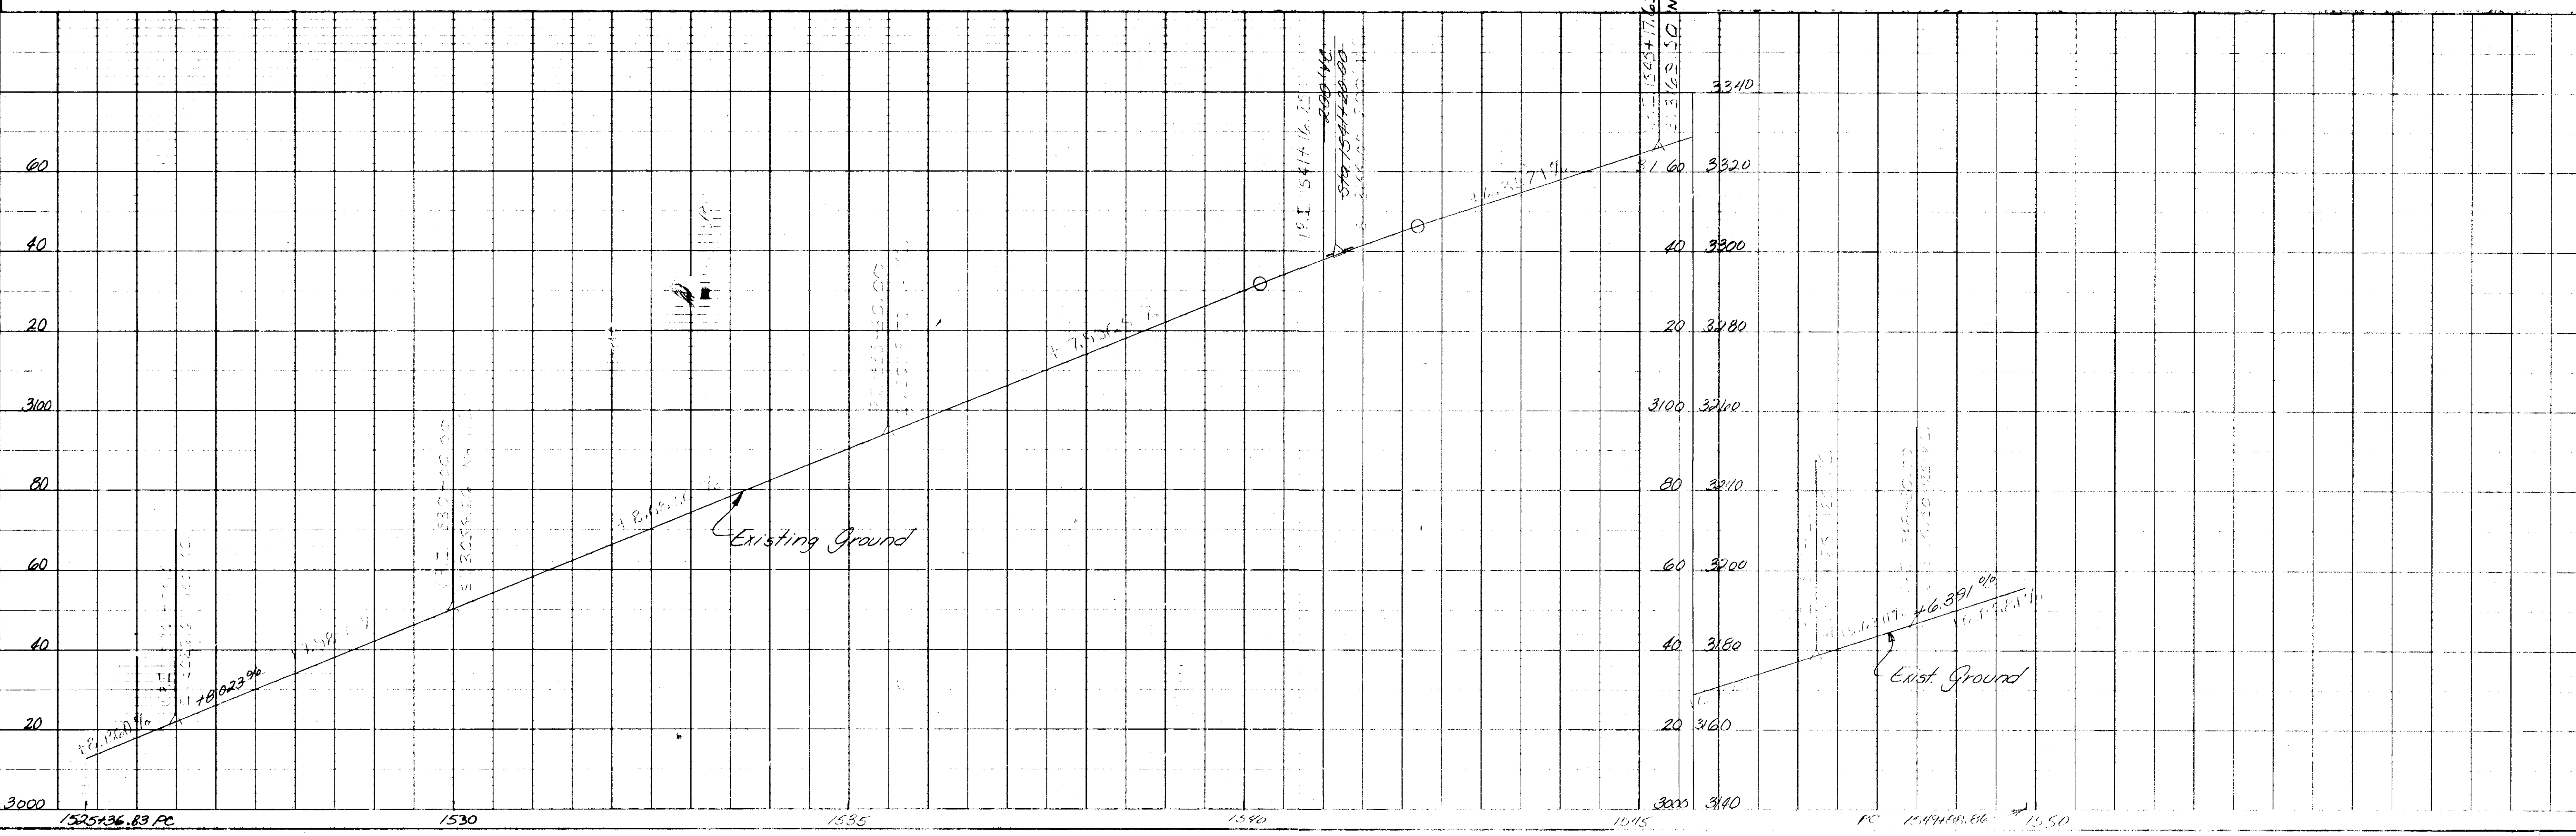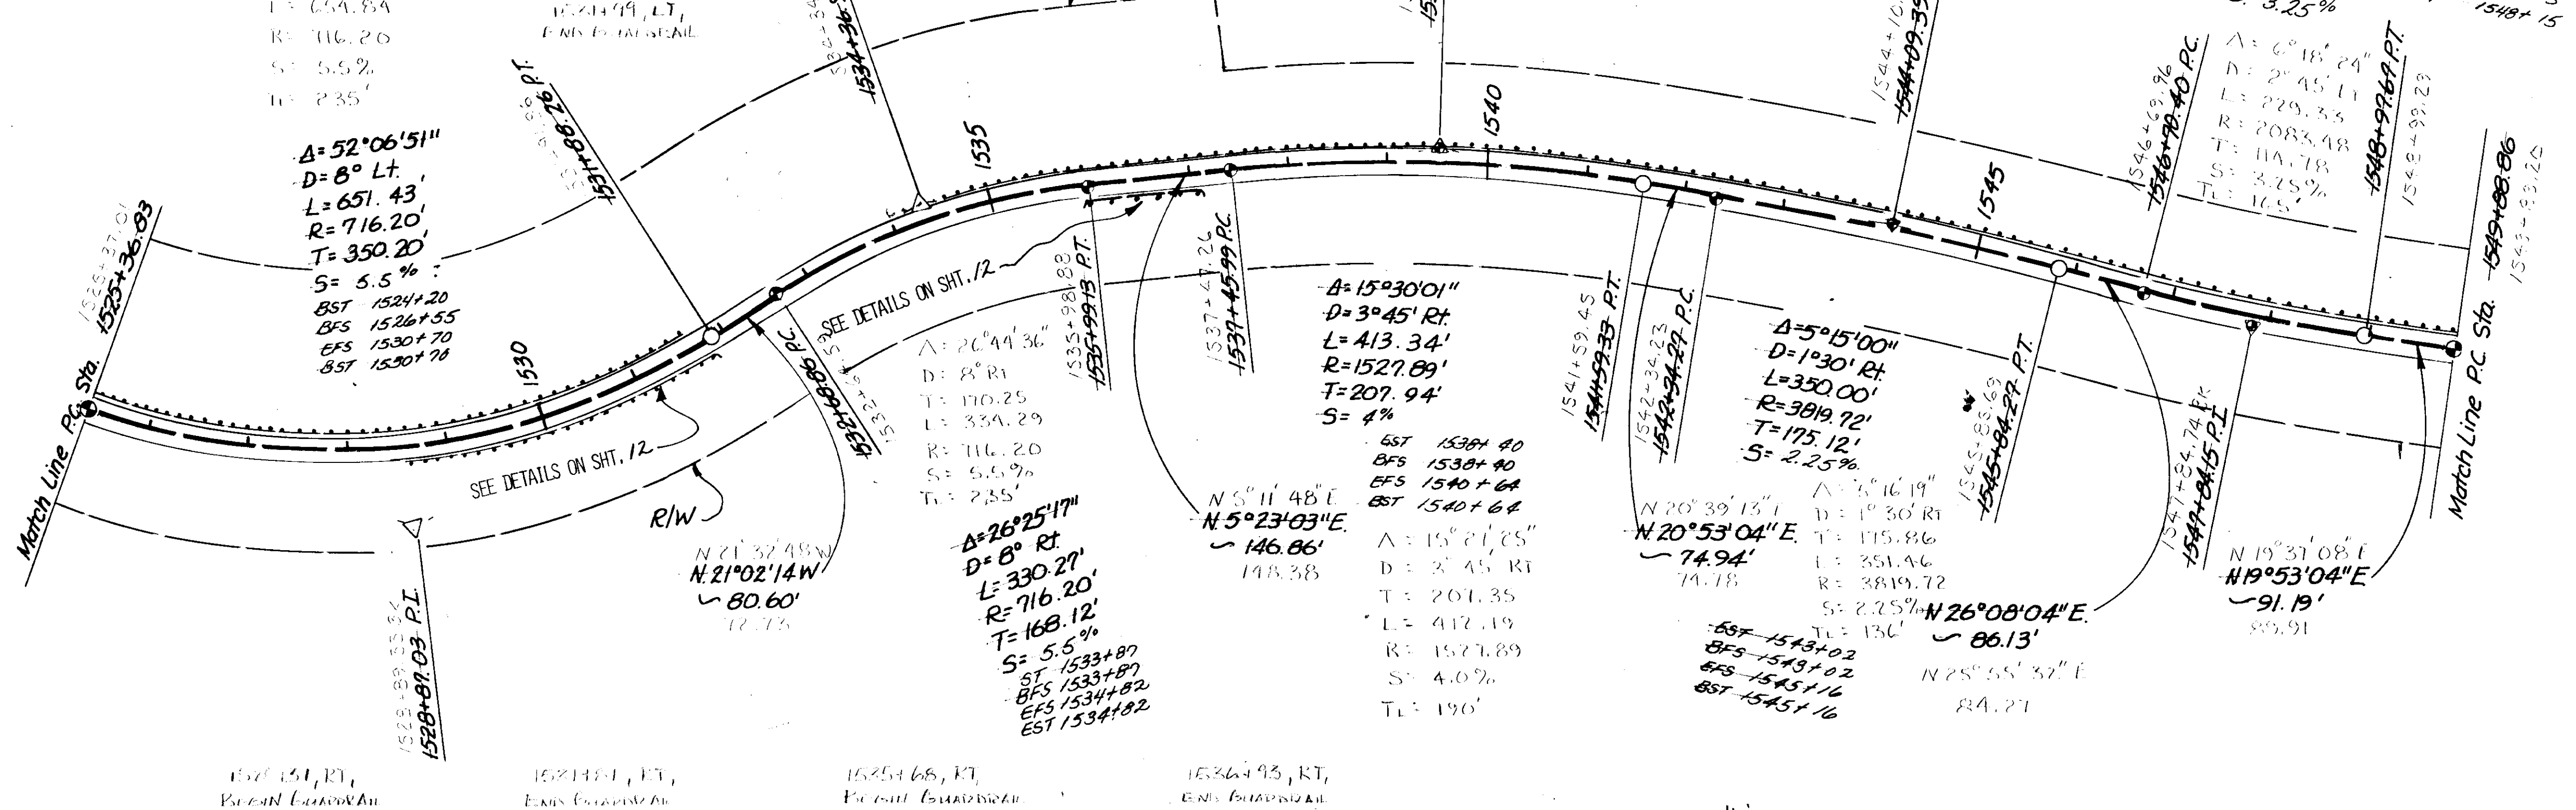



STATE	PROJECT DESIGNATION	YEAR	SHEET NO.	TOTAL SHEETS
ALASKA	F-097-2(4)	1985	33	33

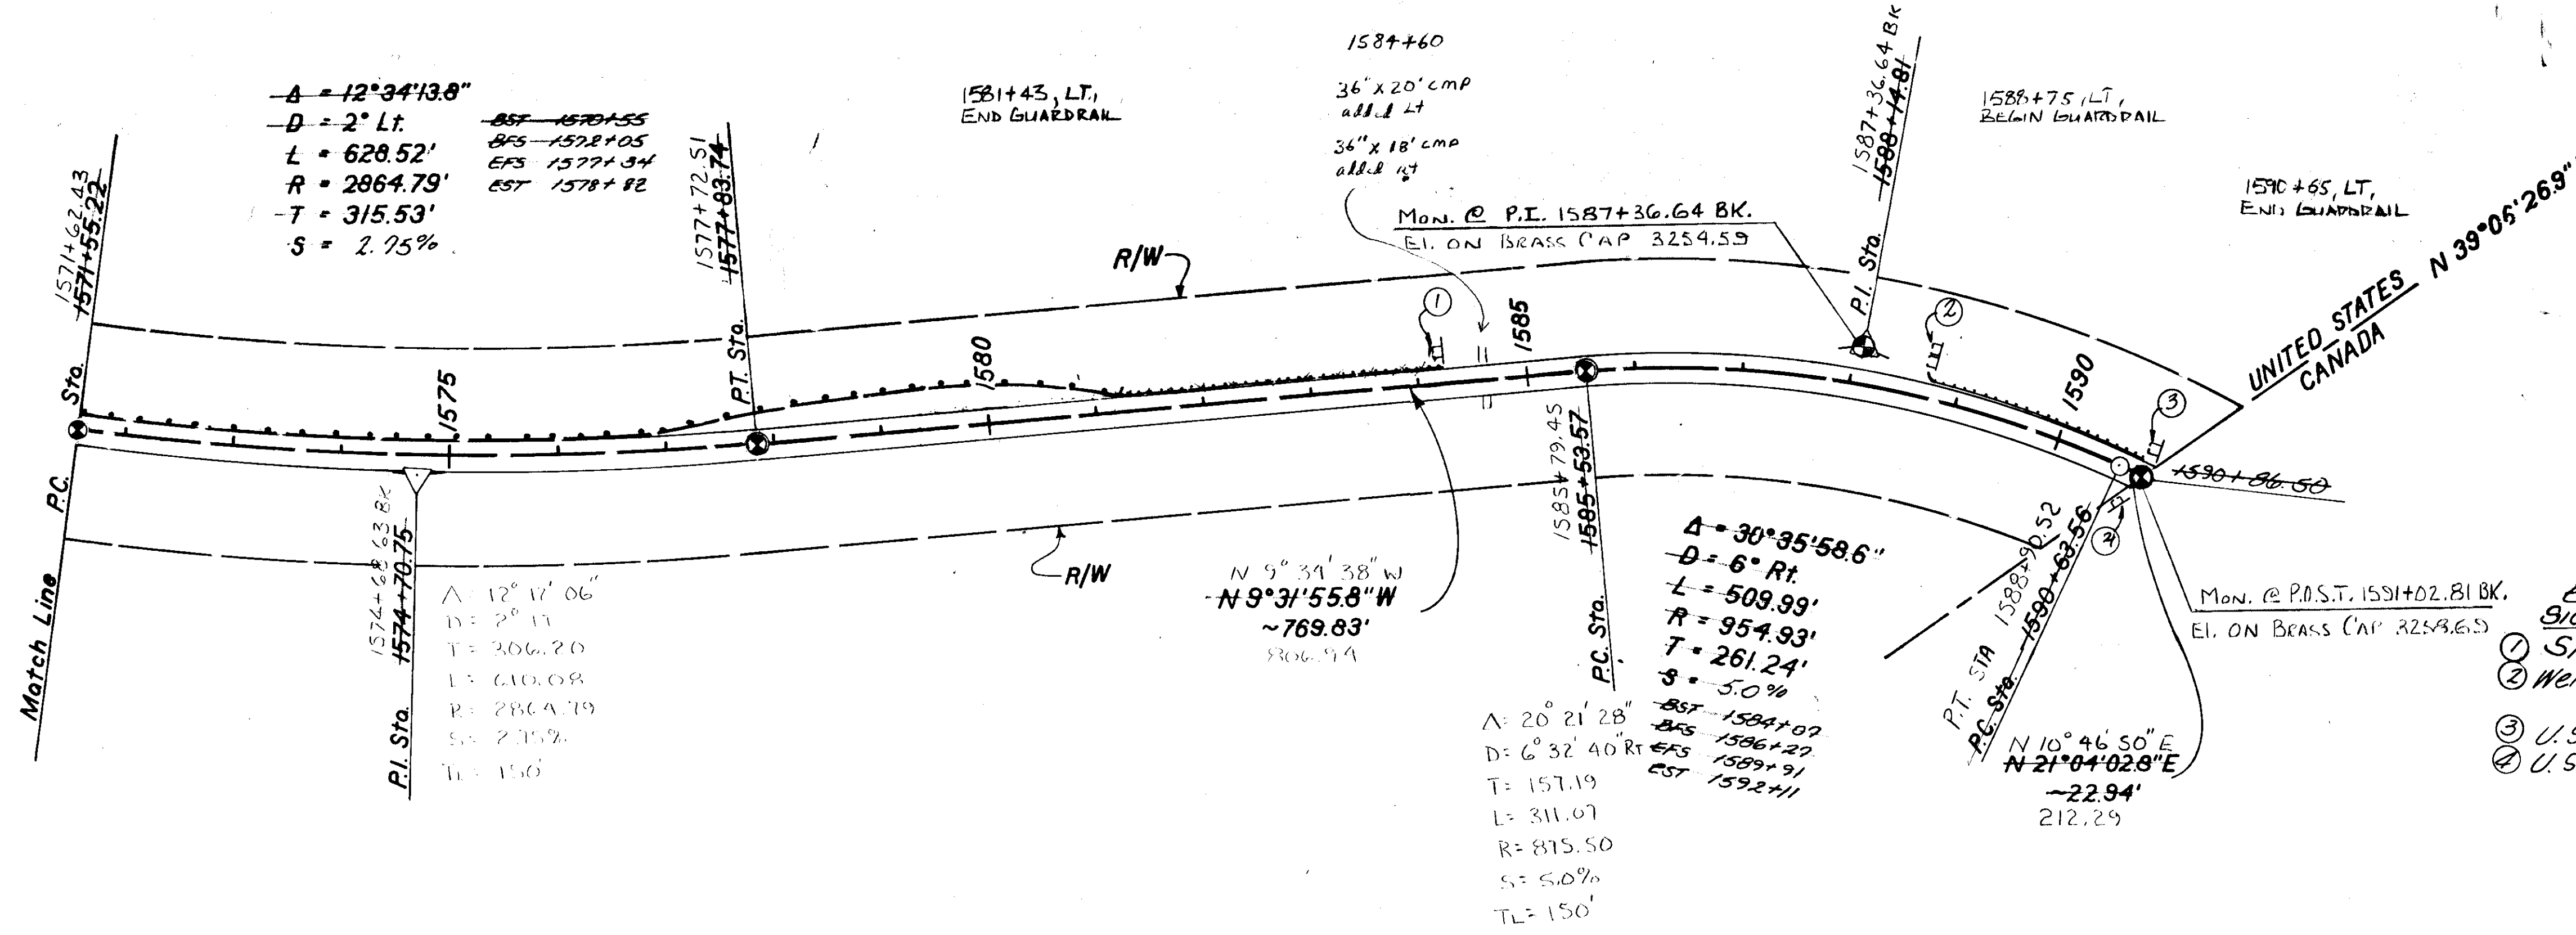

- EXISTING SIGN LEGENDS**
- ① Speed Limit 40
  - ② Welcome to the U.S. Customs & Info. 9 miles ahead Stop & Report
  - ③ U.S. Canada Border
  - ④ U.S. Canada Border

