

**STATE OF ALASKA  
DEPARTMENT OF TRANSPORTATION  
&  
PUBLIC FACILITIES**

**PLAN AND PROFILE  
PROPOSED HIGHWAY PROJECT  
F-097-2(2)  
SKAGWAY FERRY TERMINAL FACILITY  
AT SKAGWAY ALASKA**

STATE	PROJECT DESIGNATION	YEAR	SHEET NO.	TOTAL SHEETS
ALASKA	F-097-2(2)	1978	1	41


INDEX OF SHEETS

SHEET NO.	DESCRIPTION
1	TITLE SHEET
2	ESTIMATE OF QUANTITIES
3-5	SITE PREPARATION PLANS
6	SITE MAP OF DISPOSAL & STORAGE AREA
7	SUGGESTED TEMPORARY FERRY TERMINAL DETAILS
8-10	GENERAL LAYOUT
11	MARINE LAYOUT
12&13	MISCELLANEOUS DETAILS
14&15	DOCK POWER DETAILS
16	ILLUMINATION DETAILS
17-20	TRANSFER BRIDGE DETAILS # 805
21-31	FLOATING DOCK DETAILS
32	FENDER SYSTEM DETAILS
33-35	TRANSFER RAMP DETAILS
36-41	DOLPHIN DETAILS

The following standard drawings apply to this project: A-1, C-00.04, C-10.02, C-11.02, F-01.21, G-04.13, G-04.31, I-20.01, L-03.11, L-23.03, L-30.01 & U-03.00.

**DESIGN DESIGNATION**

- ADT 1978 = 25
- ADT 1999 = 53
- DHV 44% = 23
- D = 90-10
- T = 13%

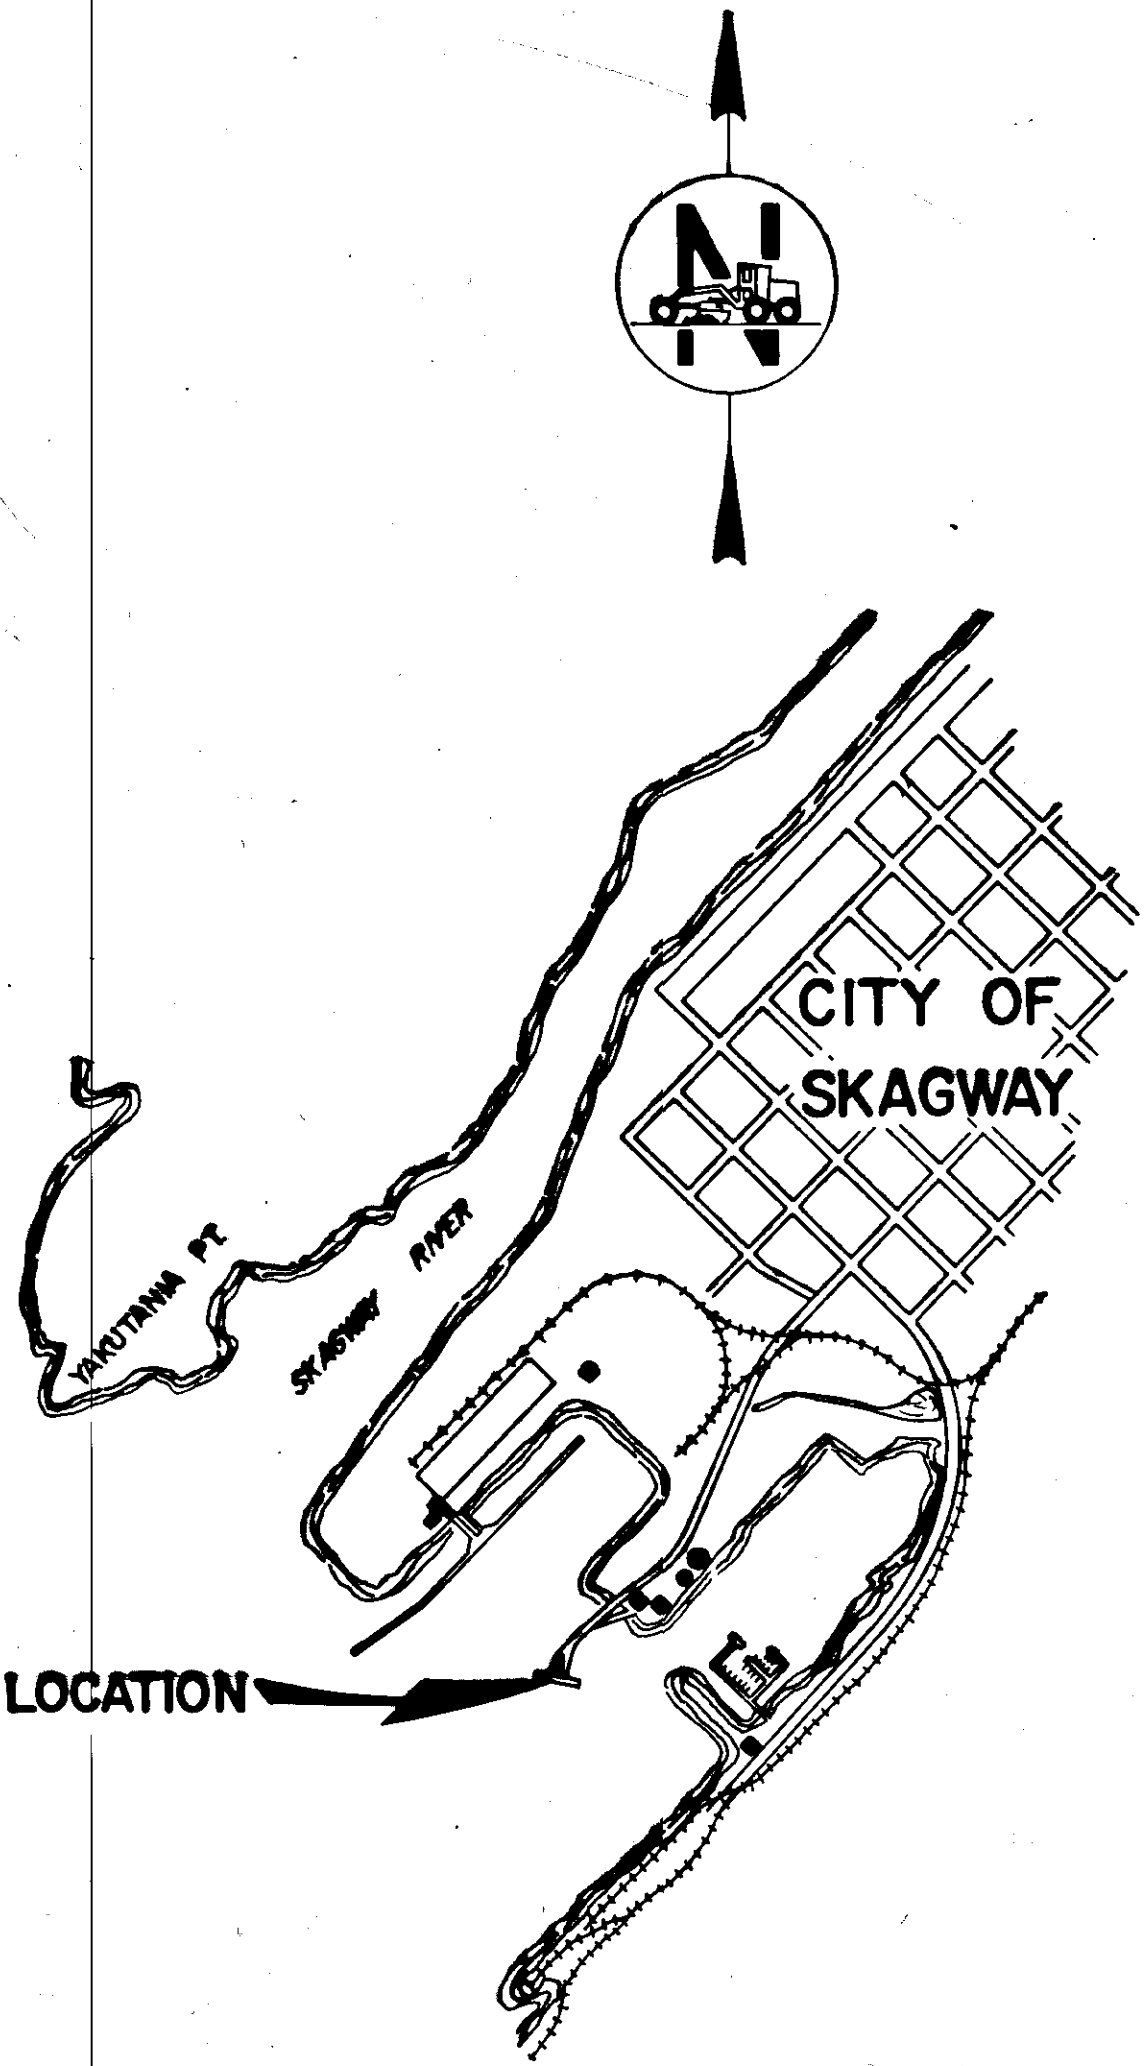

*AS-BUILTS*

Contractor - Western Marine Construction, Inc., Seattle  
Subcontractors - Berg Construction Co. Inc., Juneau  
W.R. Gracie, Inc. Portland  
Earthmovers of Fairbanks

Project Engineer - John R. Edwards  
Work Began - April 1, 1979  
Work Completed - February 11, 1980

STATE OF ALASKA  
DEPARTMENT OF TRANSPORTATION  
&  
PUBLIC FACILITIES

APPROVED  
*Wallace K. Williams* Date *8/4/78*  
SOUTHEASTERN REGION  
DESIGN/CONSTRUCTION ENGINEER

STATE OF ALASKA  
DEPARTMENT OF TRANSPORTATION  
&  
PUBLIC FACILITIES

APPROVED  
*R. D. Shumway* Date *8/13/78*  
DIRECTOR-HIGHWAY DESIGN & CONSTRUCTION

# ESTIMATE OF QUANTITIES

STATE	PROJECT DESIGNATION	YEAR	SHEET NO.	TOTAL SHEETS
ALASKA	F-097-2(2)	1978	2	41

ITEM NO.	ITEM	PAY UNIT	Estimated Quantity	UNIT	TOTAL
	Furnishing and Maintaining Engineering Facilities	L. S.			All Req'd
110(1)	Mobilization	L. S.			All Req'd
111(1)	Temporary Erosion and Pollution Control	C. S.			All Req'd
114(1)	Construction Engineering by the Contractor	L. S.			All Req'd
115(1)	Traffic Maintenance	L. S.			All Req'd
115(2)	Vessel Traffic Maintenance <i>EW No. 3</i>	L. S.			All Req'd
202(1)	Removal of Structures and Obstructions	L. S.			All Req'd
203(3A)	Unclassified Excavation <i>C.O. No. 2</i>	L. S.	67,050	C.Y.	All Req'd
301(A)	Crushed Aggregate Base Course, Grading	L.S.	540	C.Y.	All Req'd
401(5)	Hot Asphalt Pavement, Class I * <i>EW No. 13</i>	L.S.	4,848	5.Y. @ 2" Depth	All Req'd
403(2)	MC-30 Liquid Asphalt for Prime Coat <i>EW No. 13</i>	L.S.	4,848	5.Y. @ 0.25 gal./S.Y.	All Req'd
01(1)	Class "A" Concrete	L. S.			All Req'd
02(1)	Furnish and Install Prestressed Concrete Floating Dock	L. S.			All Req'd
02(2)	Furnish and Install Anchor System, Complete	L. S.			All Req'd
03(1)	Reinforcing Steel	L. S.			All Req'd
04(1)	Structural Steel, Furnished, Fabricated and Erected	L. S.			All Req'd
04(3)	Transfer Ramp and Operating Equipment	L. S.			All Req'd
05(2)	Treated Timber Piles, Furnished and Driven <i>C.O. No. 3</i>	L.F.			3,688 2240
05(3)	Structural Steel Piles, Furnished and Driven (HP 12x74)	L.F.			436 443
05(11A)	Furnished 24" x 0.375" Pipe Piles	L.F.			655
05(11B)	Furnished 24" x 0.500" Pipe Piles	L.F.			240
05(11C)	Furnished 10' Dia. Cylinder Pipe Pile	L.F.			62
05(12)	Dolphin Pipe Piles Driven (24" Dia.) <i>C.O. No. 1 &amp; EW No. 7</i>	Each			17 14
05(13)	10' Dia. Cylinder Pipe Pile Placed	L. S.			All Req'd
08(1)	Dolphin "C"	L. S.			All Req'd
08(2)	Dolphin "R"	L. S.			All Req'd
08(3)	Dolphin "A"	L. S.			All Req'd
08(4)	Barge Hanging Rubber Fender System	L. S.			All Req'd
08(5)	Barge Timber & Wale Fender System	L. S.			All Req'd
06(1)	Beam Type Guardrail, Type I Post	L.F.			342 350
07(4)	Reconstructed Fence	L.F.			4041
08(1)	Concrete Sidewalk, 4" Depth <i>EW No. 11</i>	S.Y.			131.8 73
09(2)	Curb and Gutter, Standard Type <i>EW No. 11</i>	L.F.			218 165
611(3)	Riprap, Class IIA	L.S.	3,450	C.Y.	All Req'd
611(4)	Filter Course	L.S.	2,630	C.Y.	All Req'd
03(3A)	Quarry Run Borrow <i>EW No. 2</i>	L.S.			All Req'd
26(1)	12" Ductile Iron Sewer Conduit	L.F.			141 126
28(13)	Water System, Complete	L. S.			All Req'd
30(1)	Oil Line Facilities <i>EW No. 4</i>	L. S.			All Req'd
40(3)	Illumination System, Complete	L. S.			All Req'd
81(1)	Dock Power System, Complete <i>EW No. 10</i>	L. S.			All Req'd
28(13A)	Water System Modifications <i>EW No. 6</i>	L. S.			All Req'd
01(1A)	Concrete Abutment City of Skagway <i>EW No. 8</i>	L. S.			All Req'd
02(2A)	Anchor Pile Extensions <i>EW No. 9</i>	L. S.			All Req'd
* Item 401(5) will require approximately 35 tons of AC-5 Asphalt Cement.					
03(1A)	Culvert Repairs <i>EW No. 12</i>	L.S.			All Req'd
02(1A)	Asphalt Pavement Removal <i>EW No. 13</i>	S.Y.			2 37
02(2B)	Anchor System Modifications <i>EW No. 14</i>	Day			4.75
04(1A)	Bridge Bearing Modifications <i>EW No. 14</i>	Day			0.25
09(1B)	Modification Materials <i>EW No. 14</i>	L. S.			All Req'd
09(1C)	Temporary Barge, Bridge & Ramp Modifications <i>EW No. 15</i>	L. S.			All Req'd
09(1D)	Barge, Bridge & Ramp Modifications <i>EW No. 15</i>	L. S.			All Req'd
08(13B)	Install 6" Water Meter <i>EW No. 16</i>	L. S.			All Req'd
00(3A)	Electrical Conduit Modifications <i>EW No. 17</i>	L. S.			All Req'd
04(1B)	Trunion Wheel Repairs <i>EW No. 18</i>	L. S.			All Req'd

### GENERAL NOTES


1. Alignment and elevation shown on these plans are subject to minor revision.
2. All salvaged material shall be stockpiled in the area indicated on sheet No. 6 as directed by the Engineer.

STATE	PROJECT DESIGNATION	YEAR	SHEET NO.	TOTAL SHEETS
ALASKA	F-097-2(2)	1978	3	41

**SITE PREPARATION PLANS**

 Indicates Removal & Disposal of Structures and Obstructions

N 2,786,250  
E 2,378,000

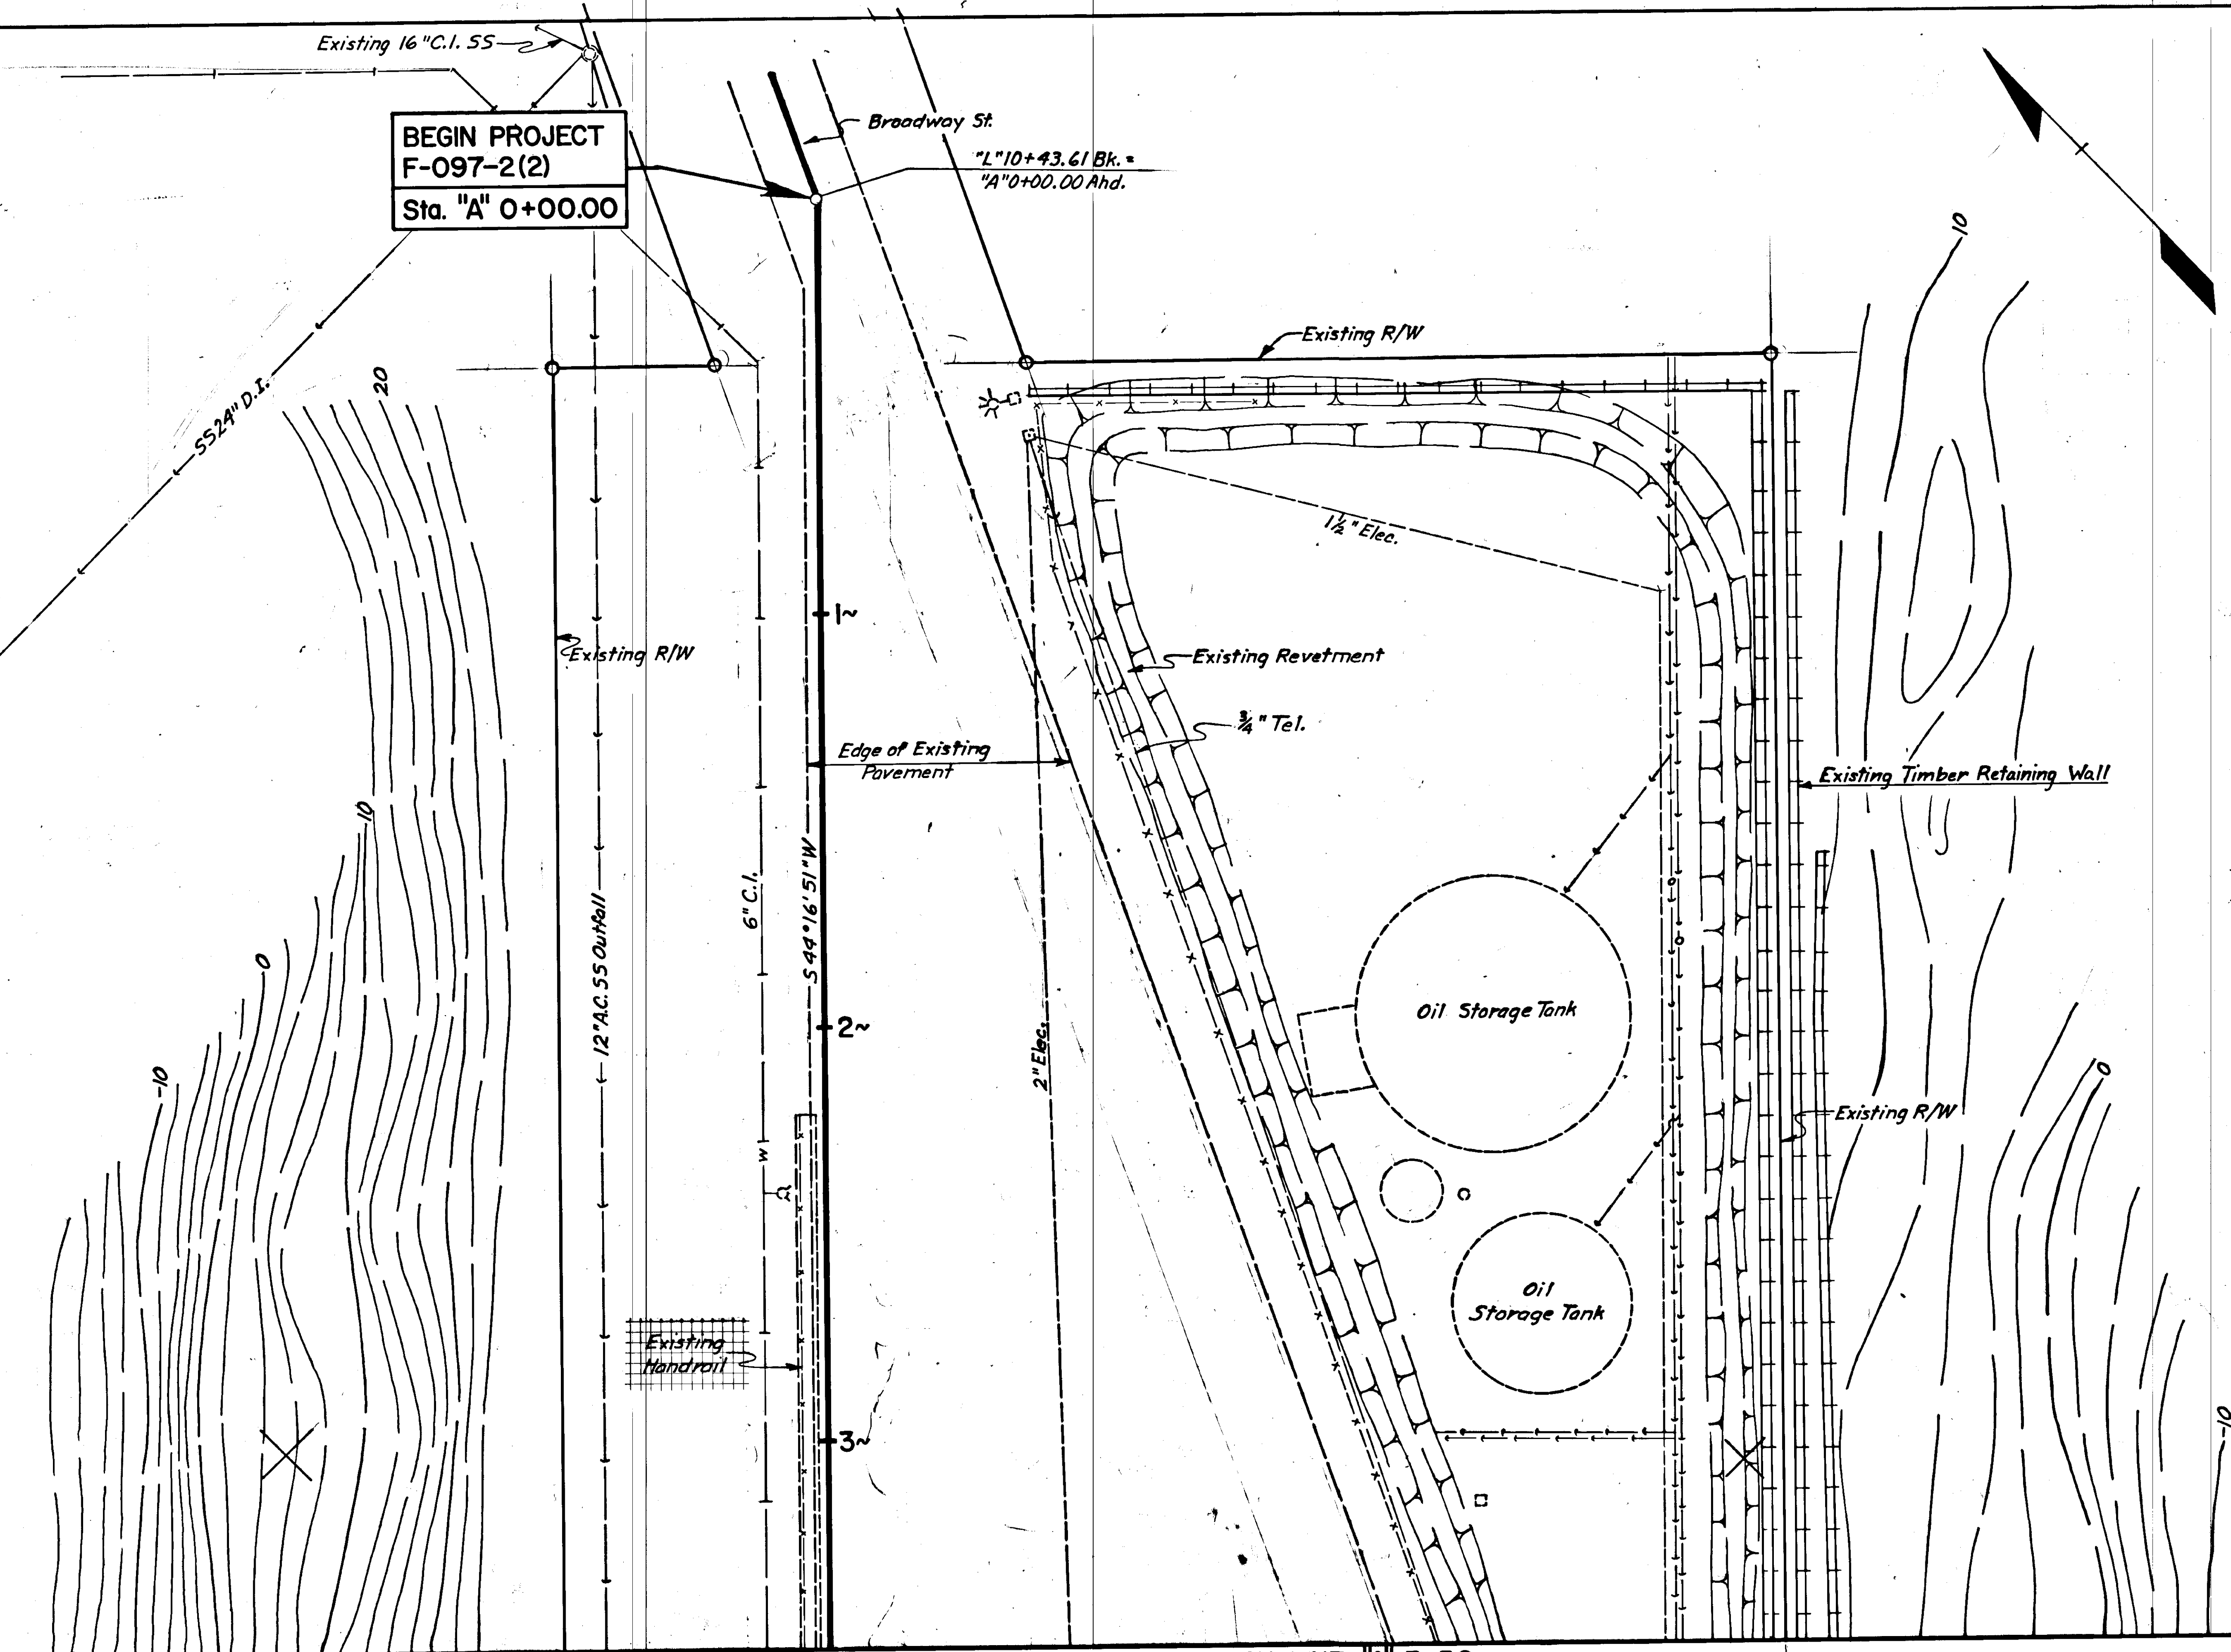



**BEGIN PROJECT  
F-097-2(2)  
Sta. "A" 0+00.00**

MATCH LINE "A" 3+50


STATE	PROJECT DESIGNATION	YEAR	NO.
ALASKA	F-097-2(2)	1978	4

**SITE PREPARATION PLAN**

**LEGEND**


 Indicates Removal & Disposal of Structures and Obstructions  
 Indicates Removal & Salvage of Existing Structures

"A" 5'x65'-85' Rt. to "A" 4'x50'; 220' Lt.  
Remove the existing retaining wall.  
4' below finished grade

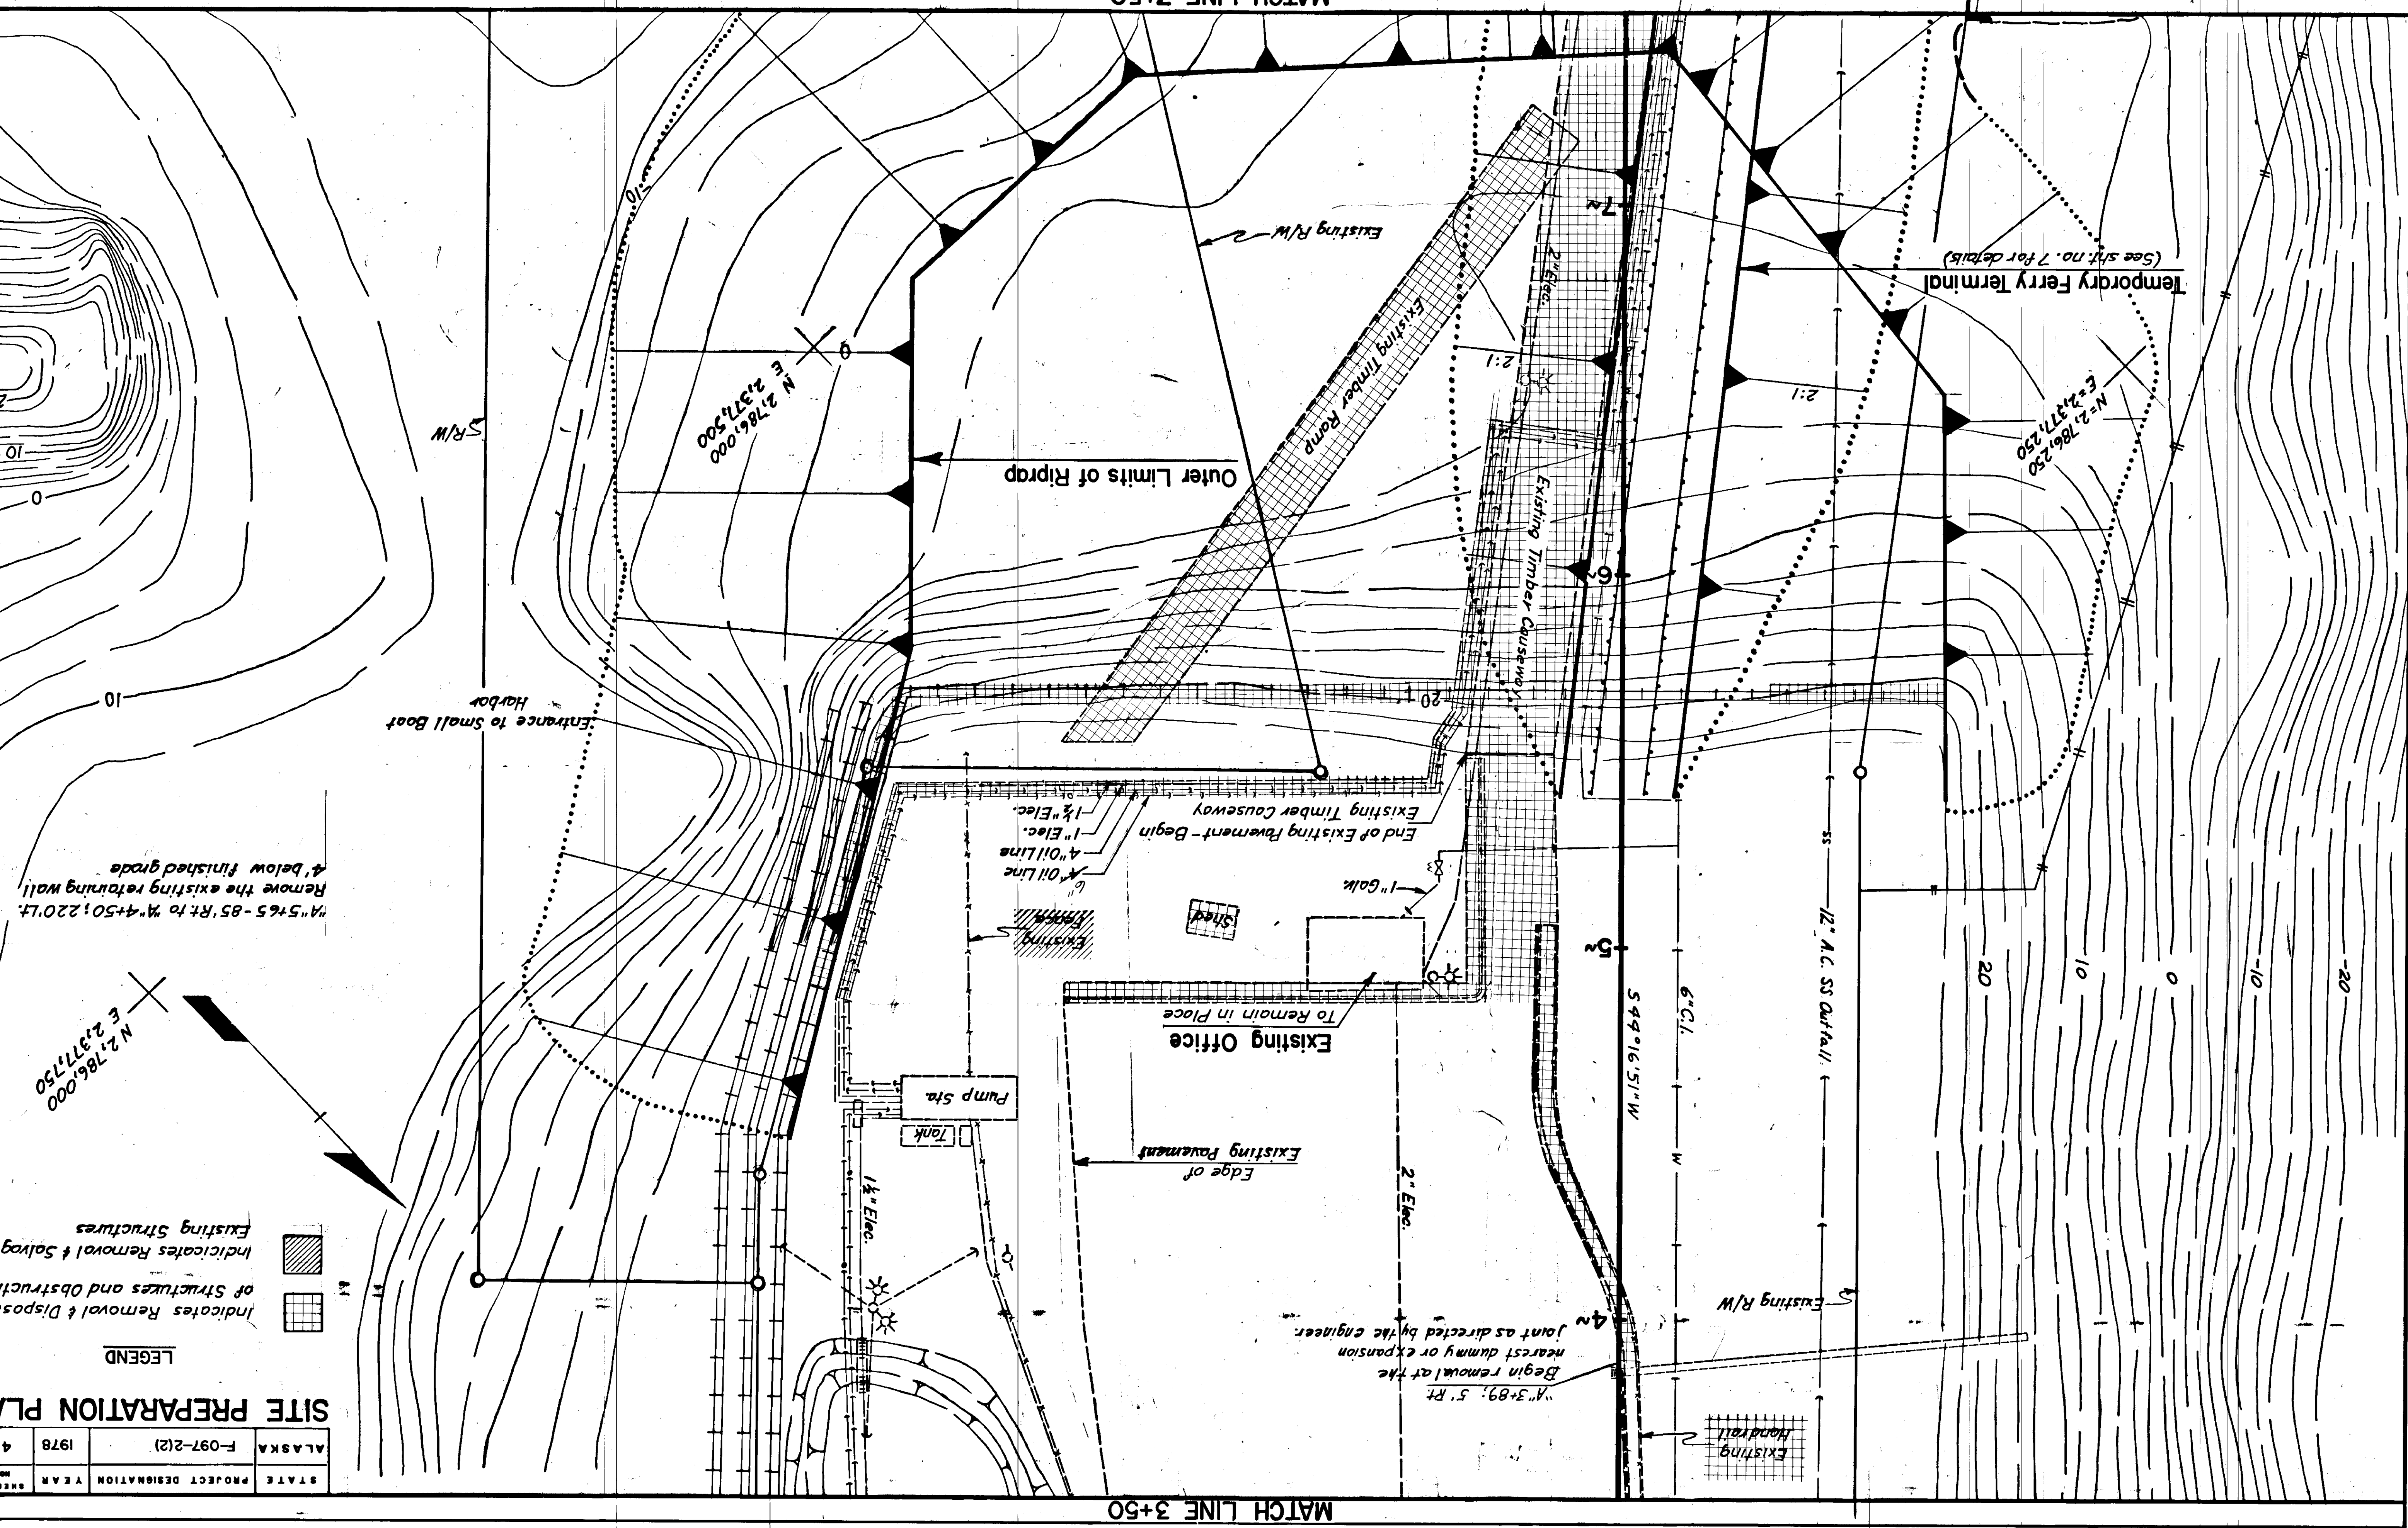

MATCH LINE 3+50

MATCH LINE 7+50


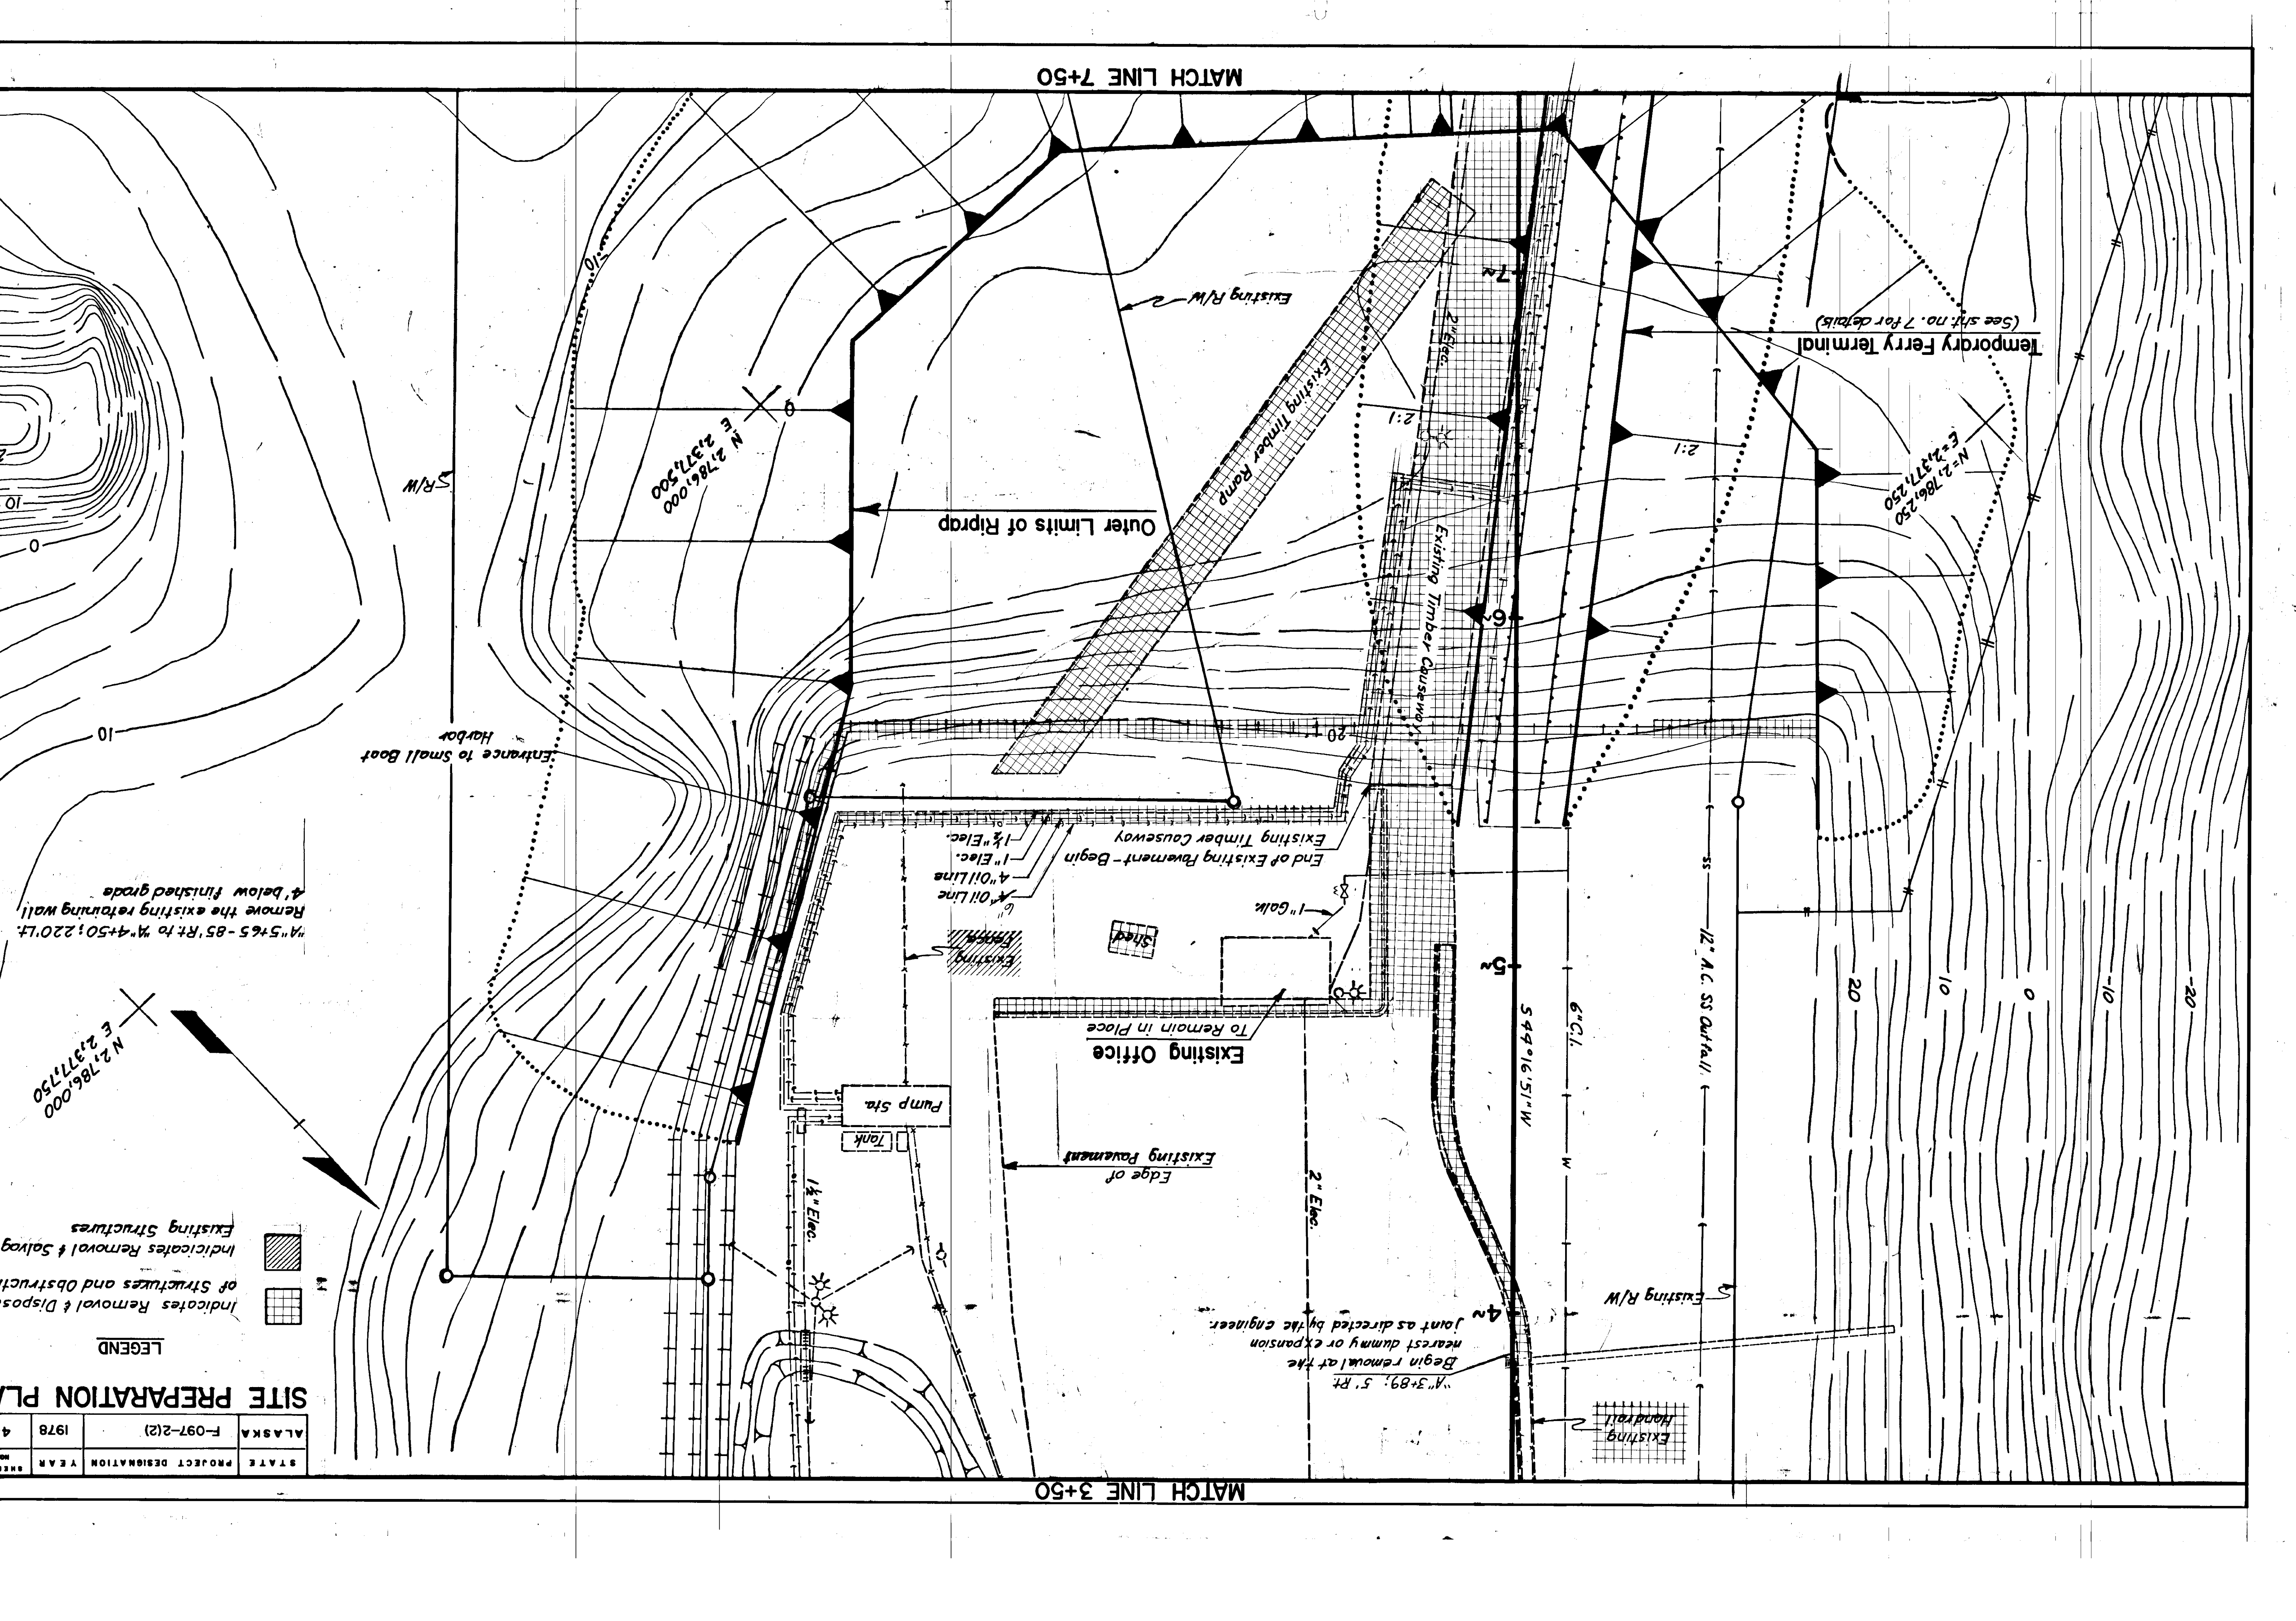





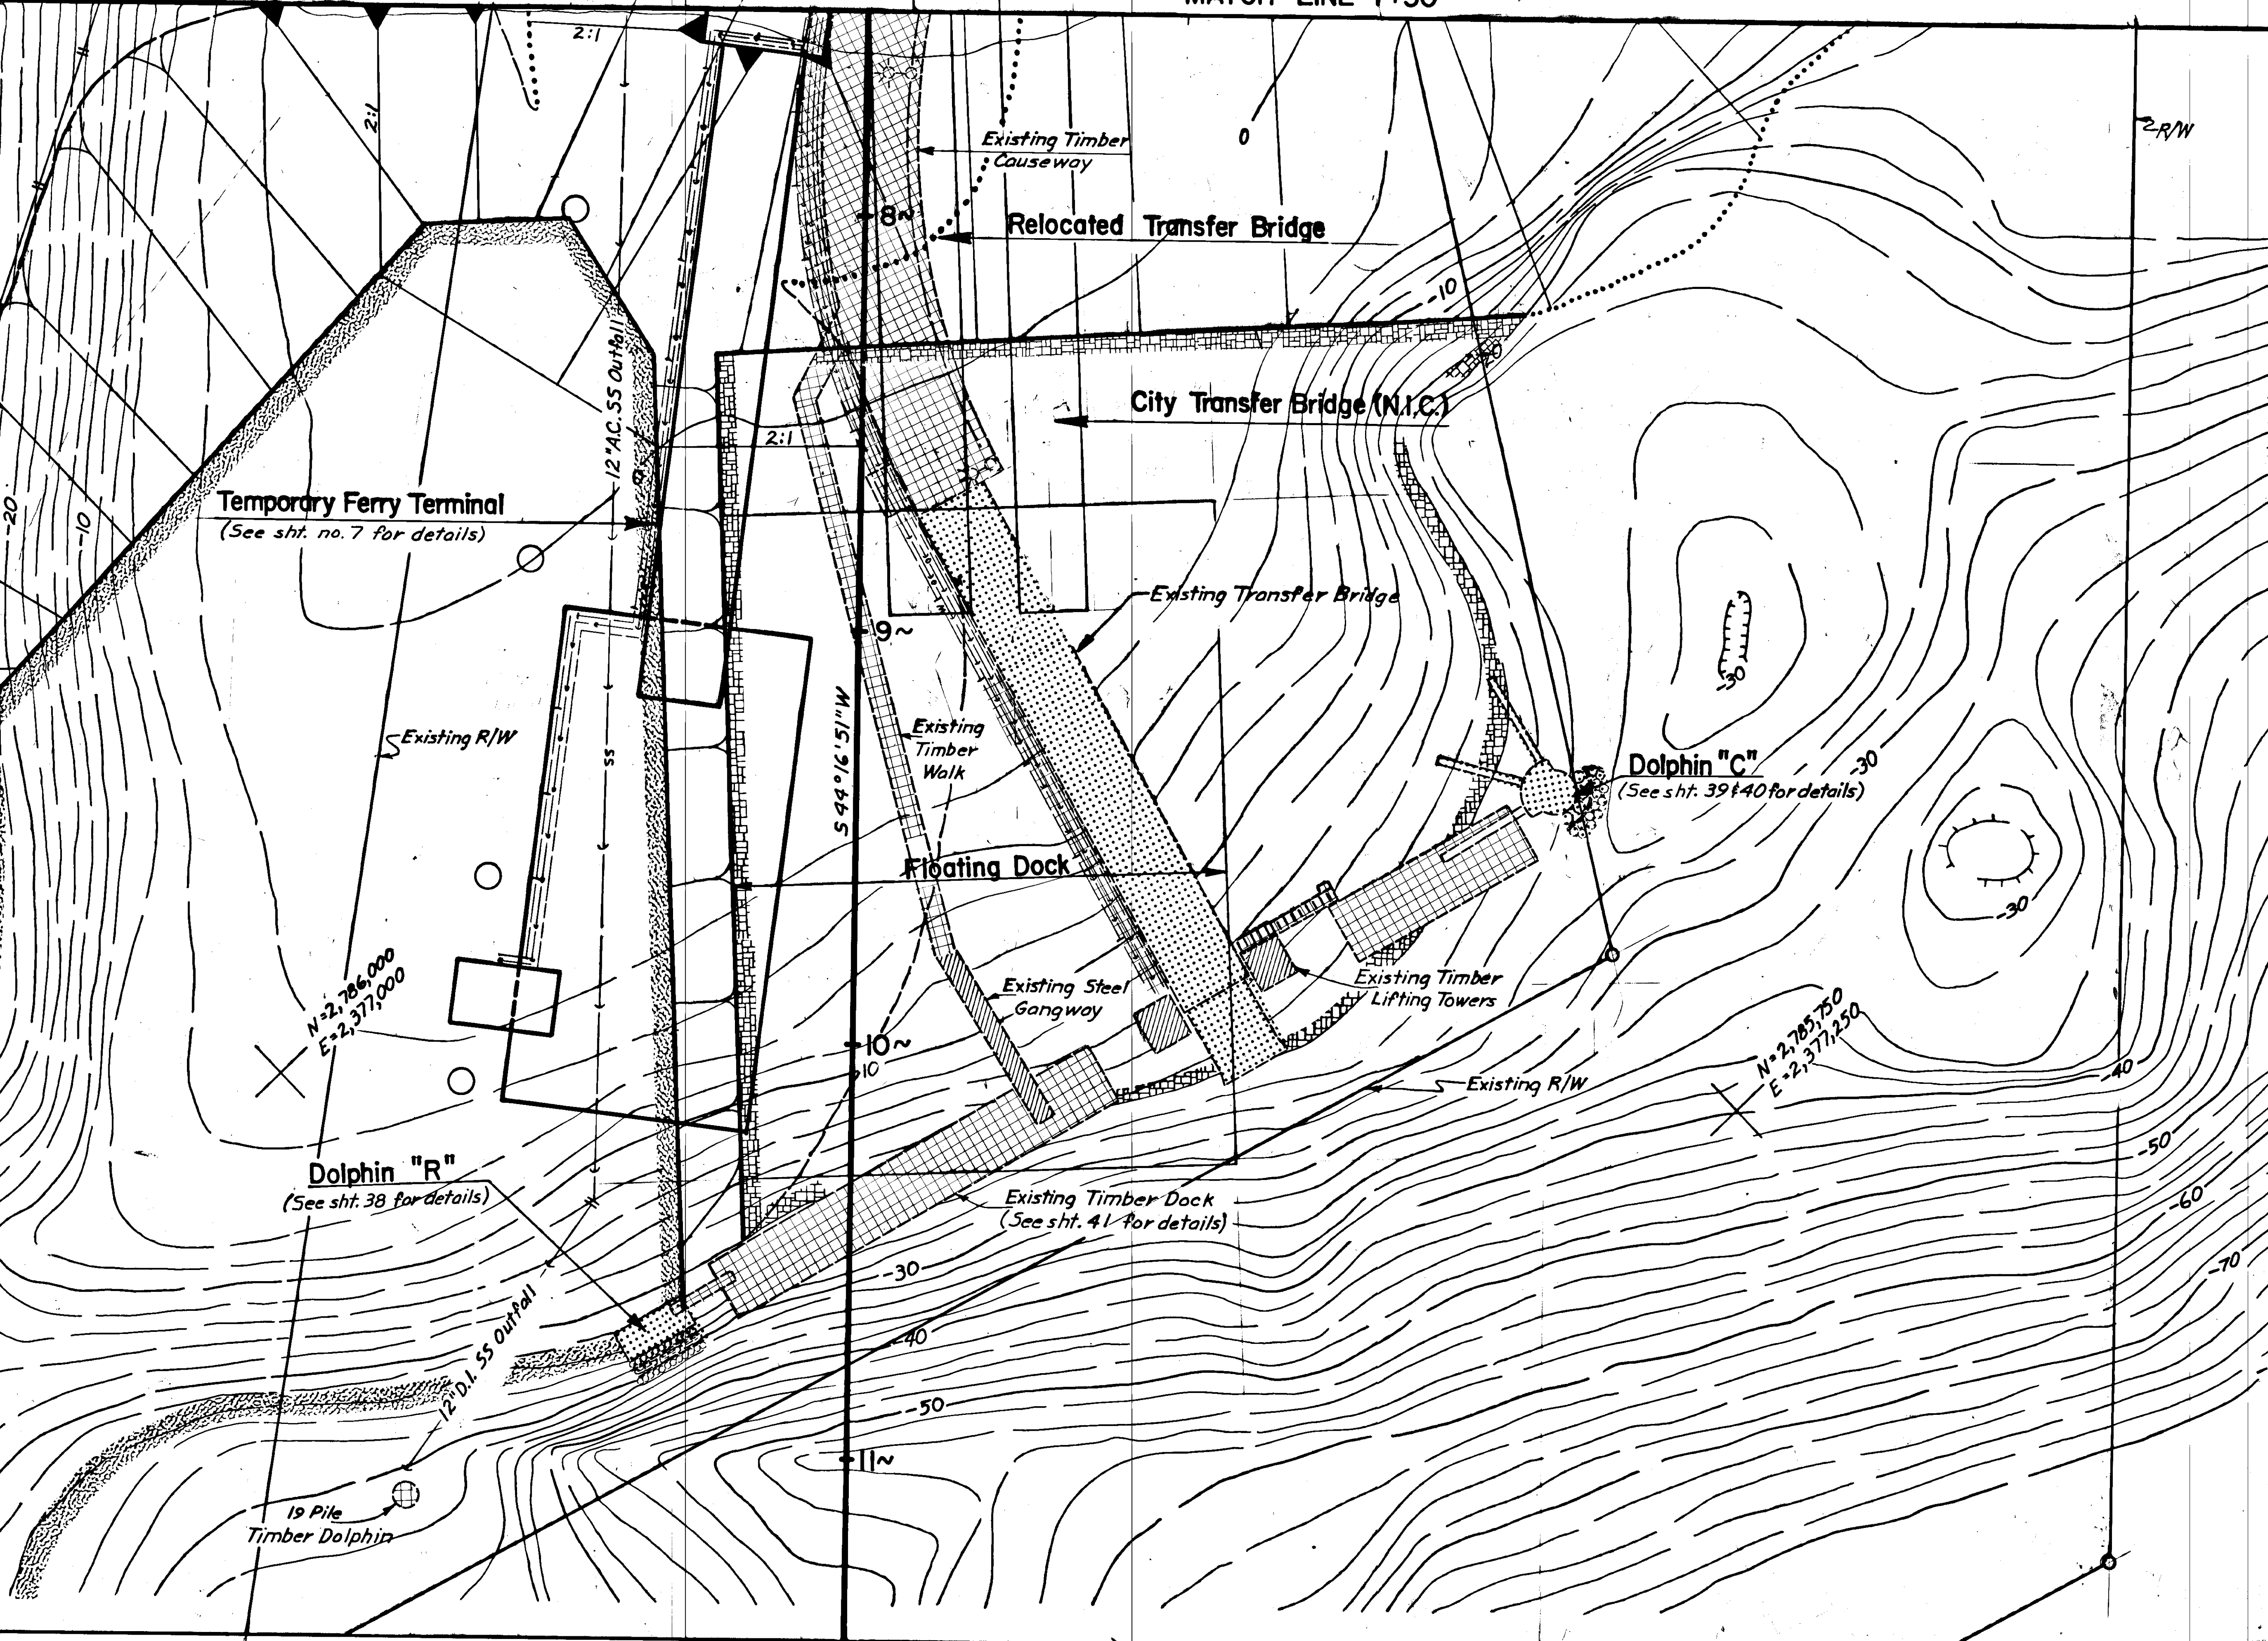
STATE	PROJECT DESIGNATION	YEAR	SHEET NO.	TOTAL SHEETS
ALASKA	F-097-2(2)	1978	5	41

MATCH LINE 7+50


**SITE PREPARATION PLANS**

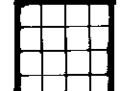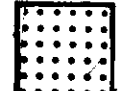**LEGEND**


-  Indicates Removal & Disposal of Structures & Obstruction
-  Indicates Relocation of Existing Structures
-  Indicates Removal & Salvage of Existing Structures
-  Indicates -20.0' Dredge Limits
-  Indicates -25.0' Dredge Limits





"A" 8+65; 7' Lt. Salvage Valves & Meters, store in area shown on sht.

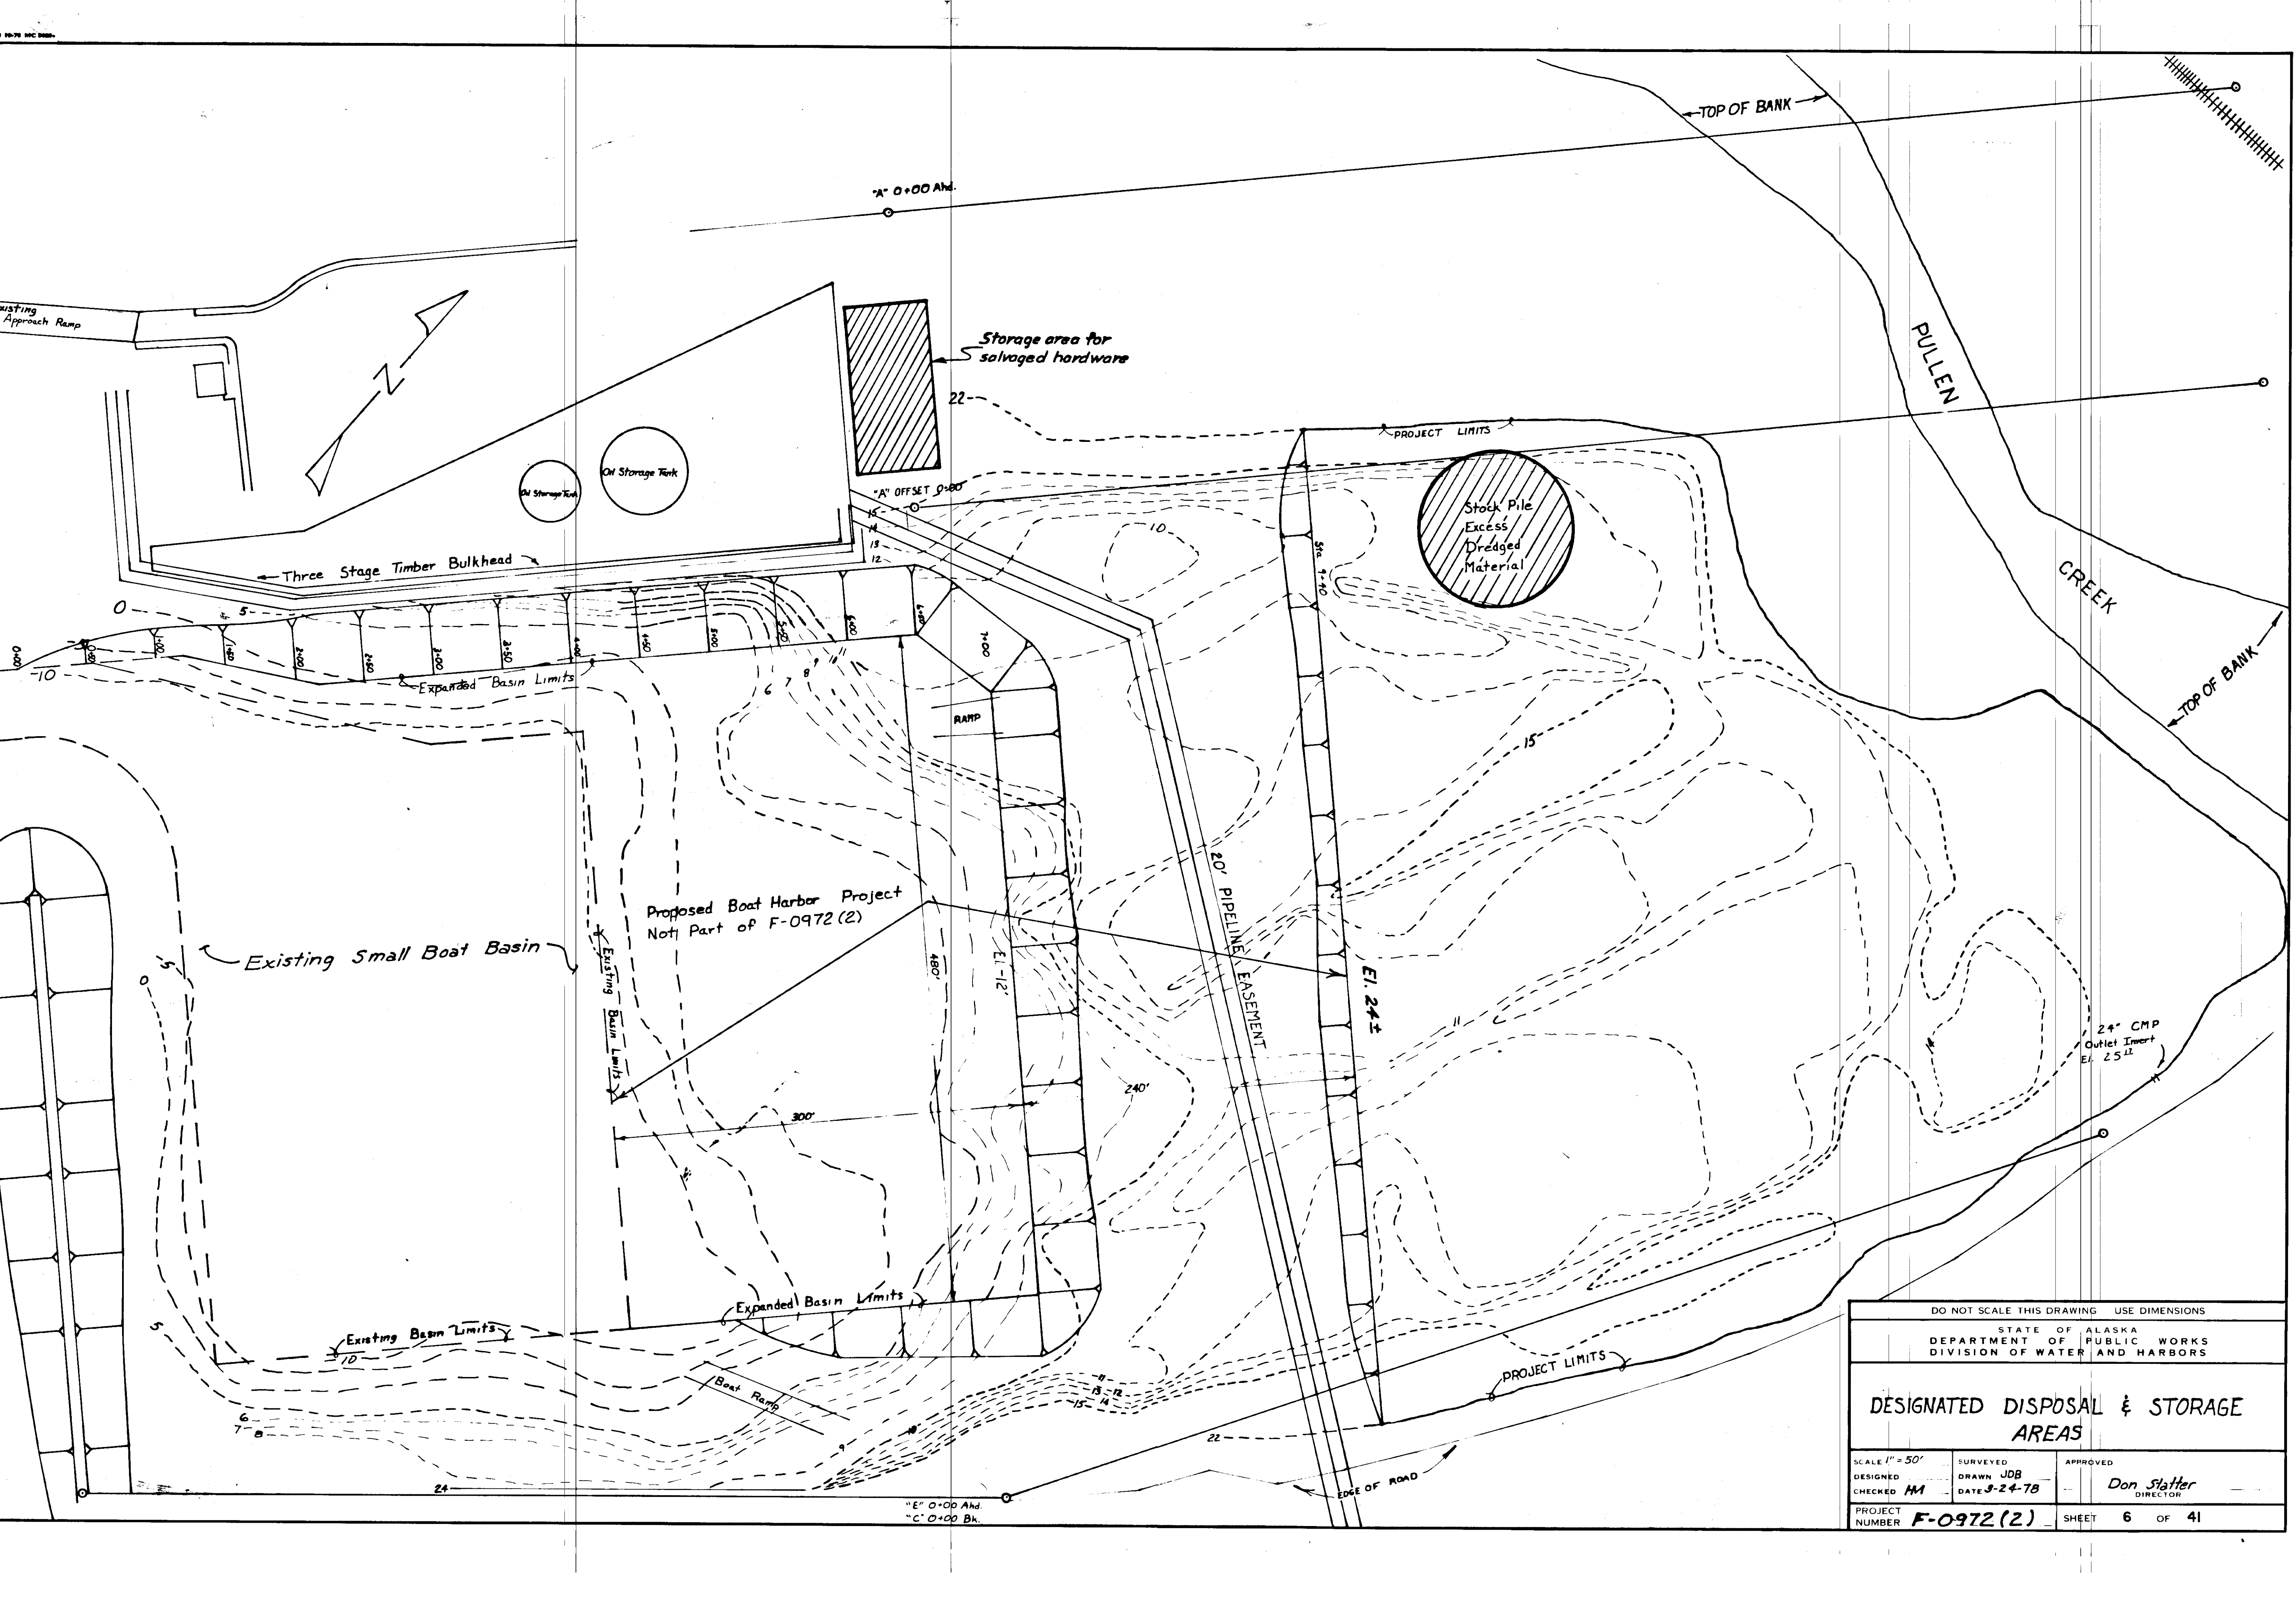

DO NOT SCALE THIS DRAWING USE DIMENSIONS		
STATE OF ALASKA DEPARTMENT OF PUBLIC WORKS DIVISION OF WATER AND HARBORS		
<b>DESIGNATED DISPOSAL &amp; STORAGE AREAS</b>		
SCALE 1" = 50'	SURVEYED DRAWN JDB	APPROVED
CHECKED HM	DATE 9-24-78	Don Statter DIRECTOR
PROJECT NUMBER F-0972 (2)	SHEET 6 OF 41	

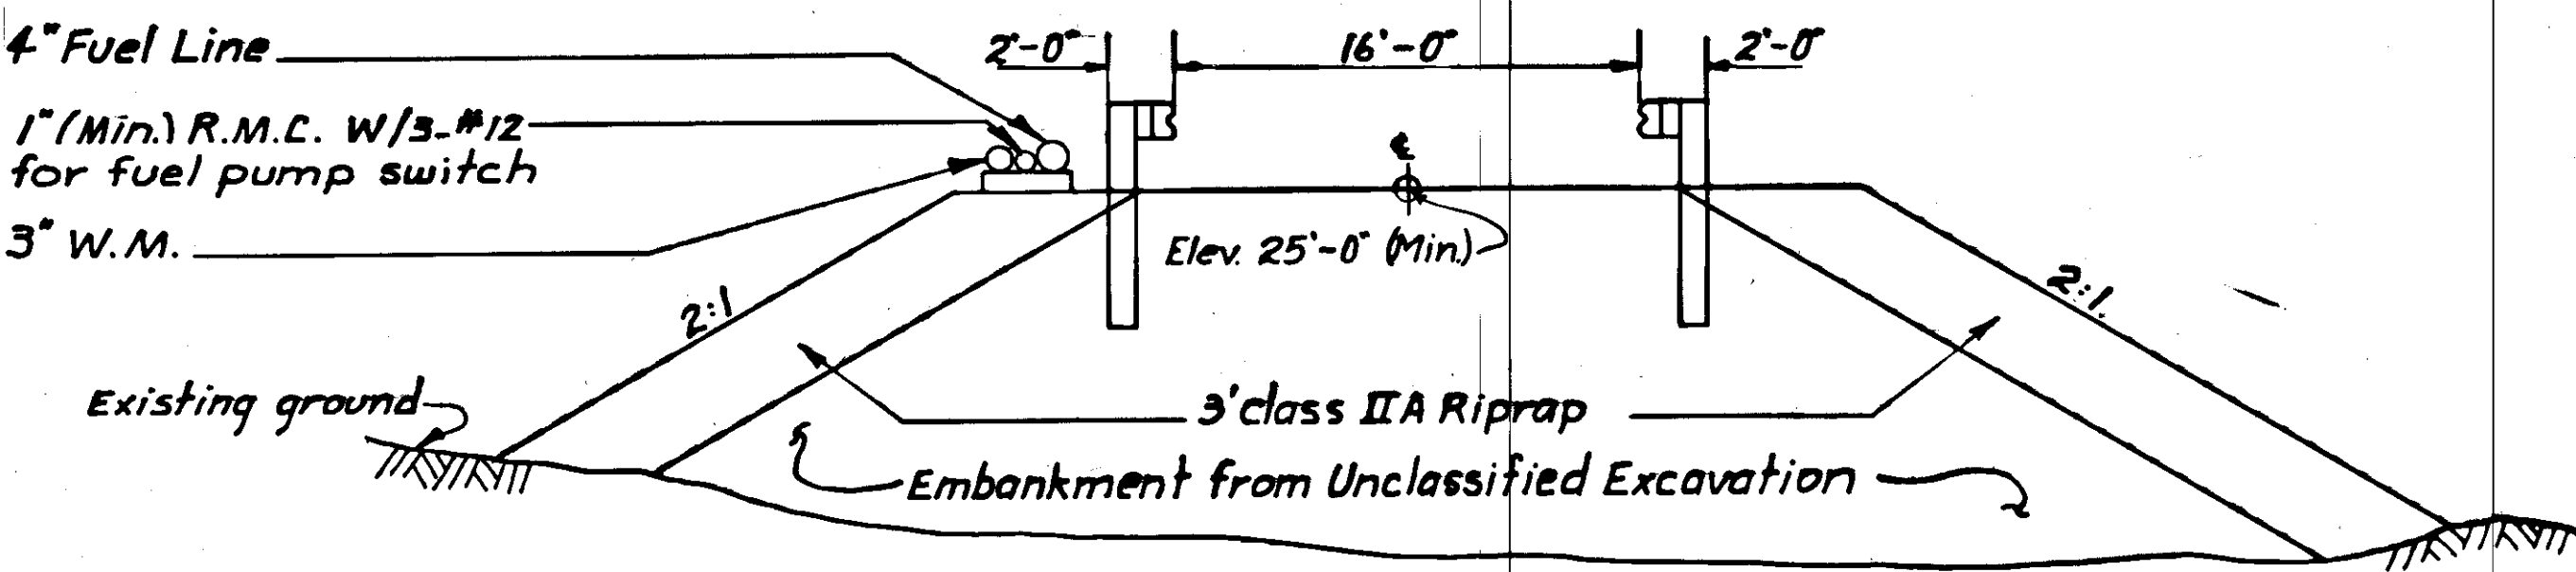

SECTION G-G

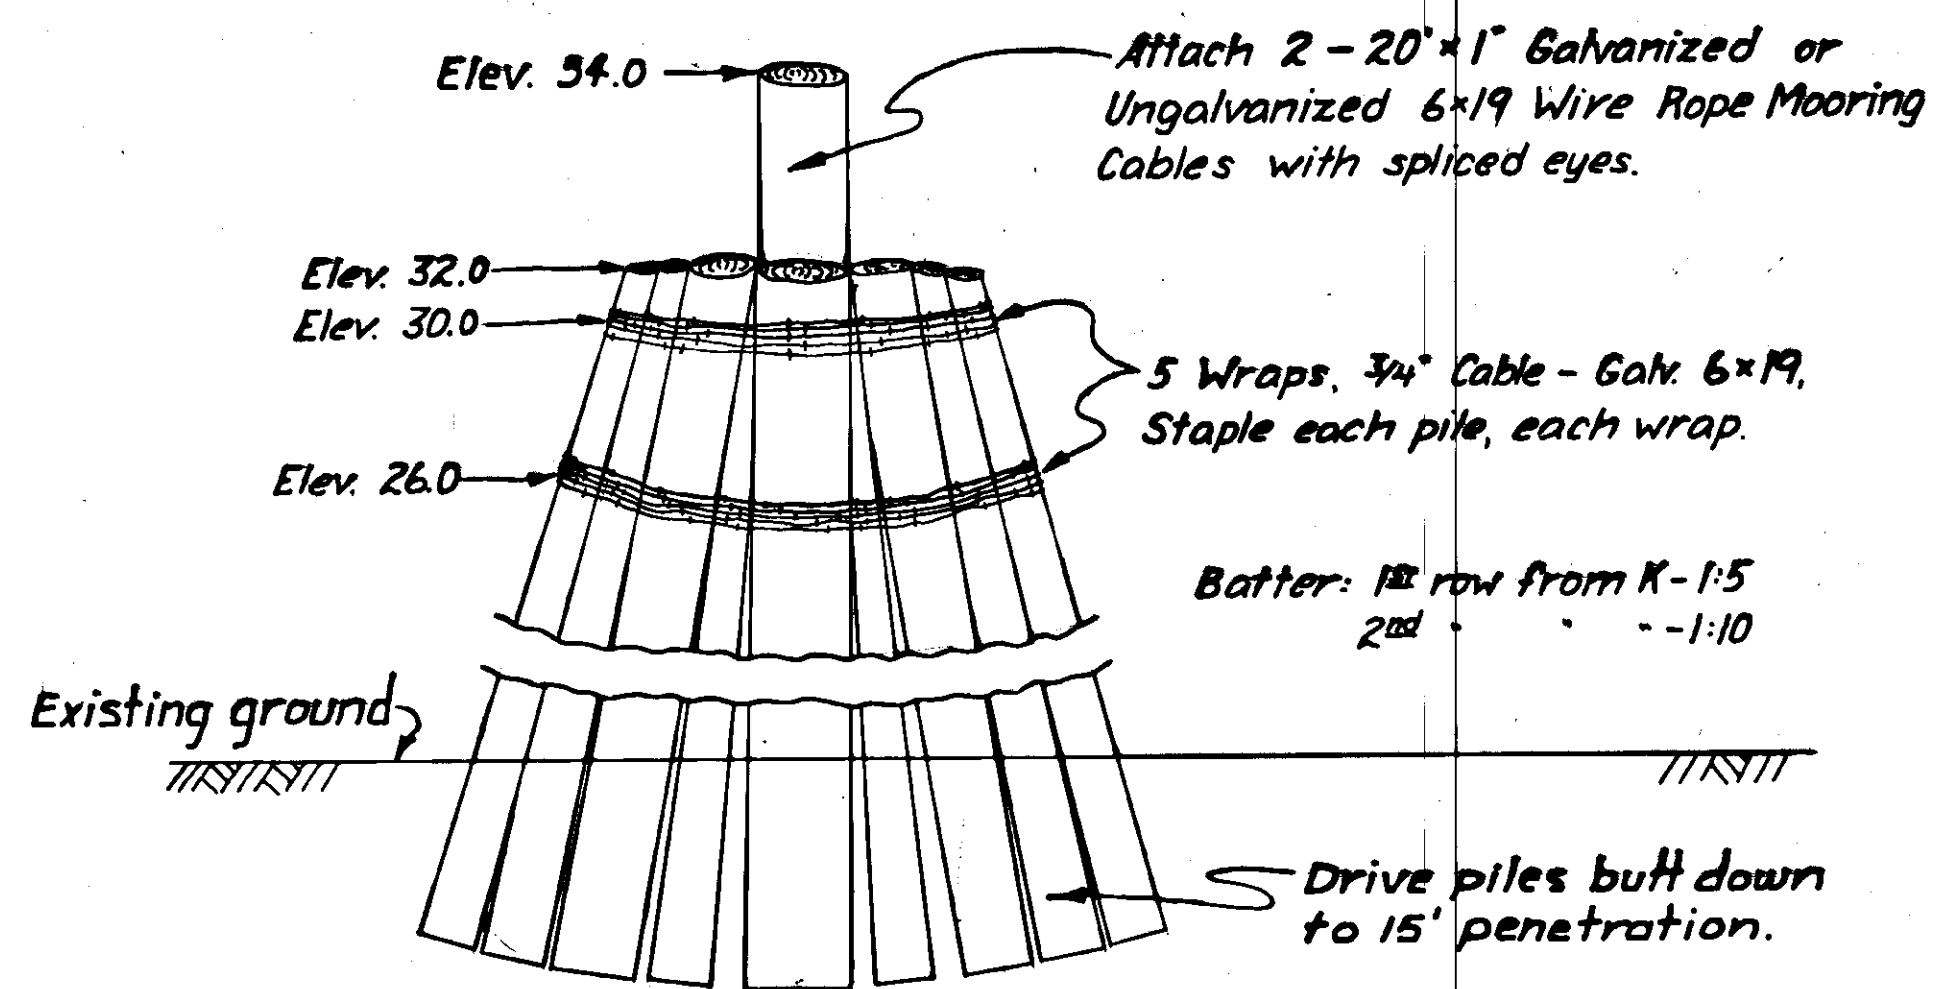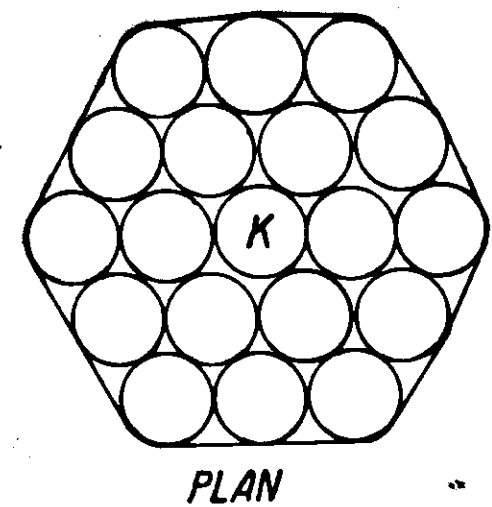


Note: New piles, if furnished, shall be a min. of 16" butt dia. Used piles shall be approved by the engineer.

Elevation

TYPICAL 19 PILE DOLPHIN

NOTE:  
The temporary ferry terminal shown on the plans is a suggested location and design. If the contractor elects to use some other location and/or design, see section 115 "Traffic Maintenance" for more details.

SUGGESTED TEMPORARY FERRY TERMINAL DETAILS

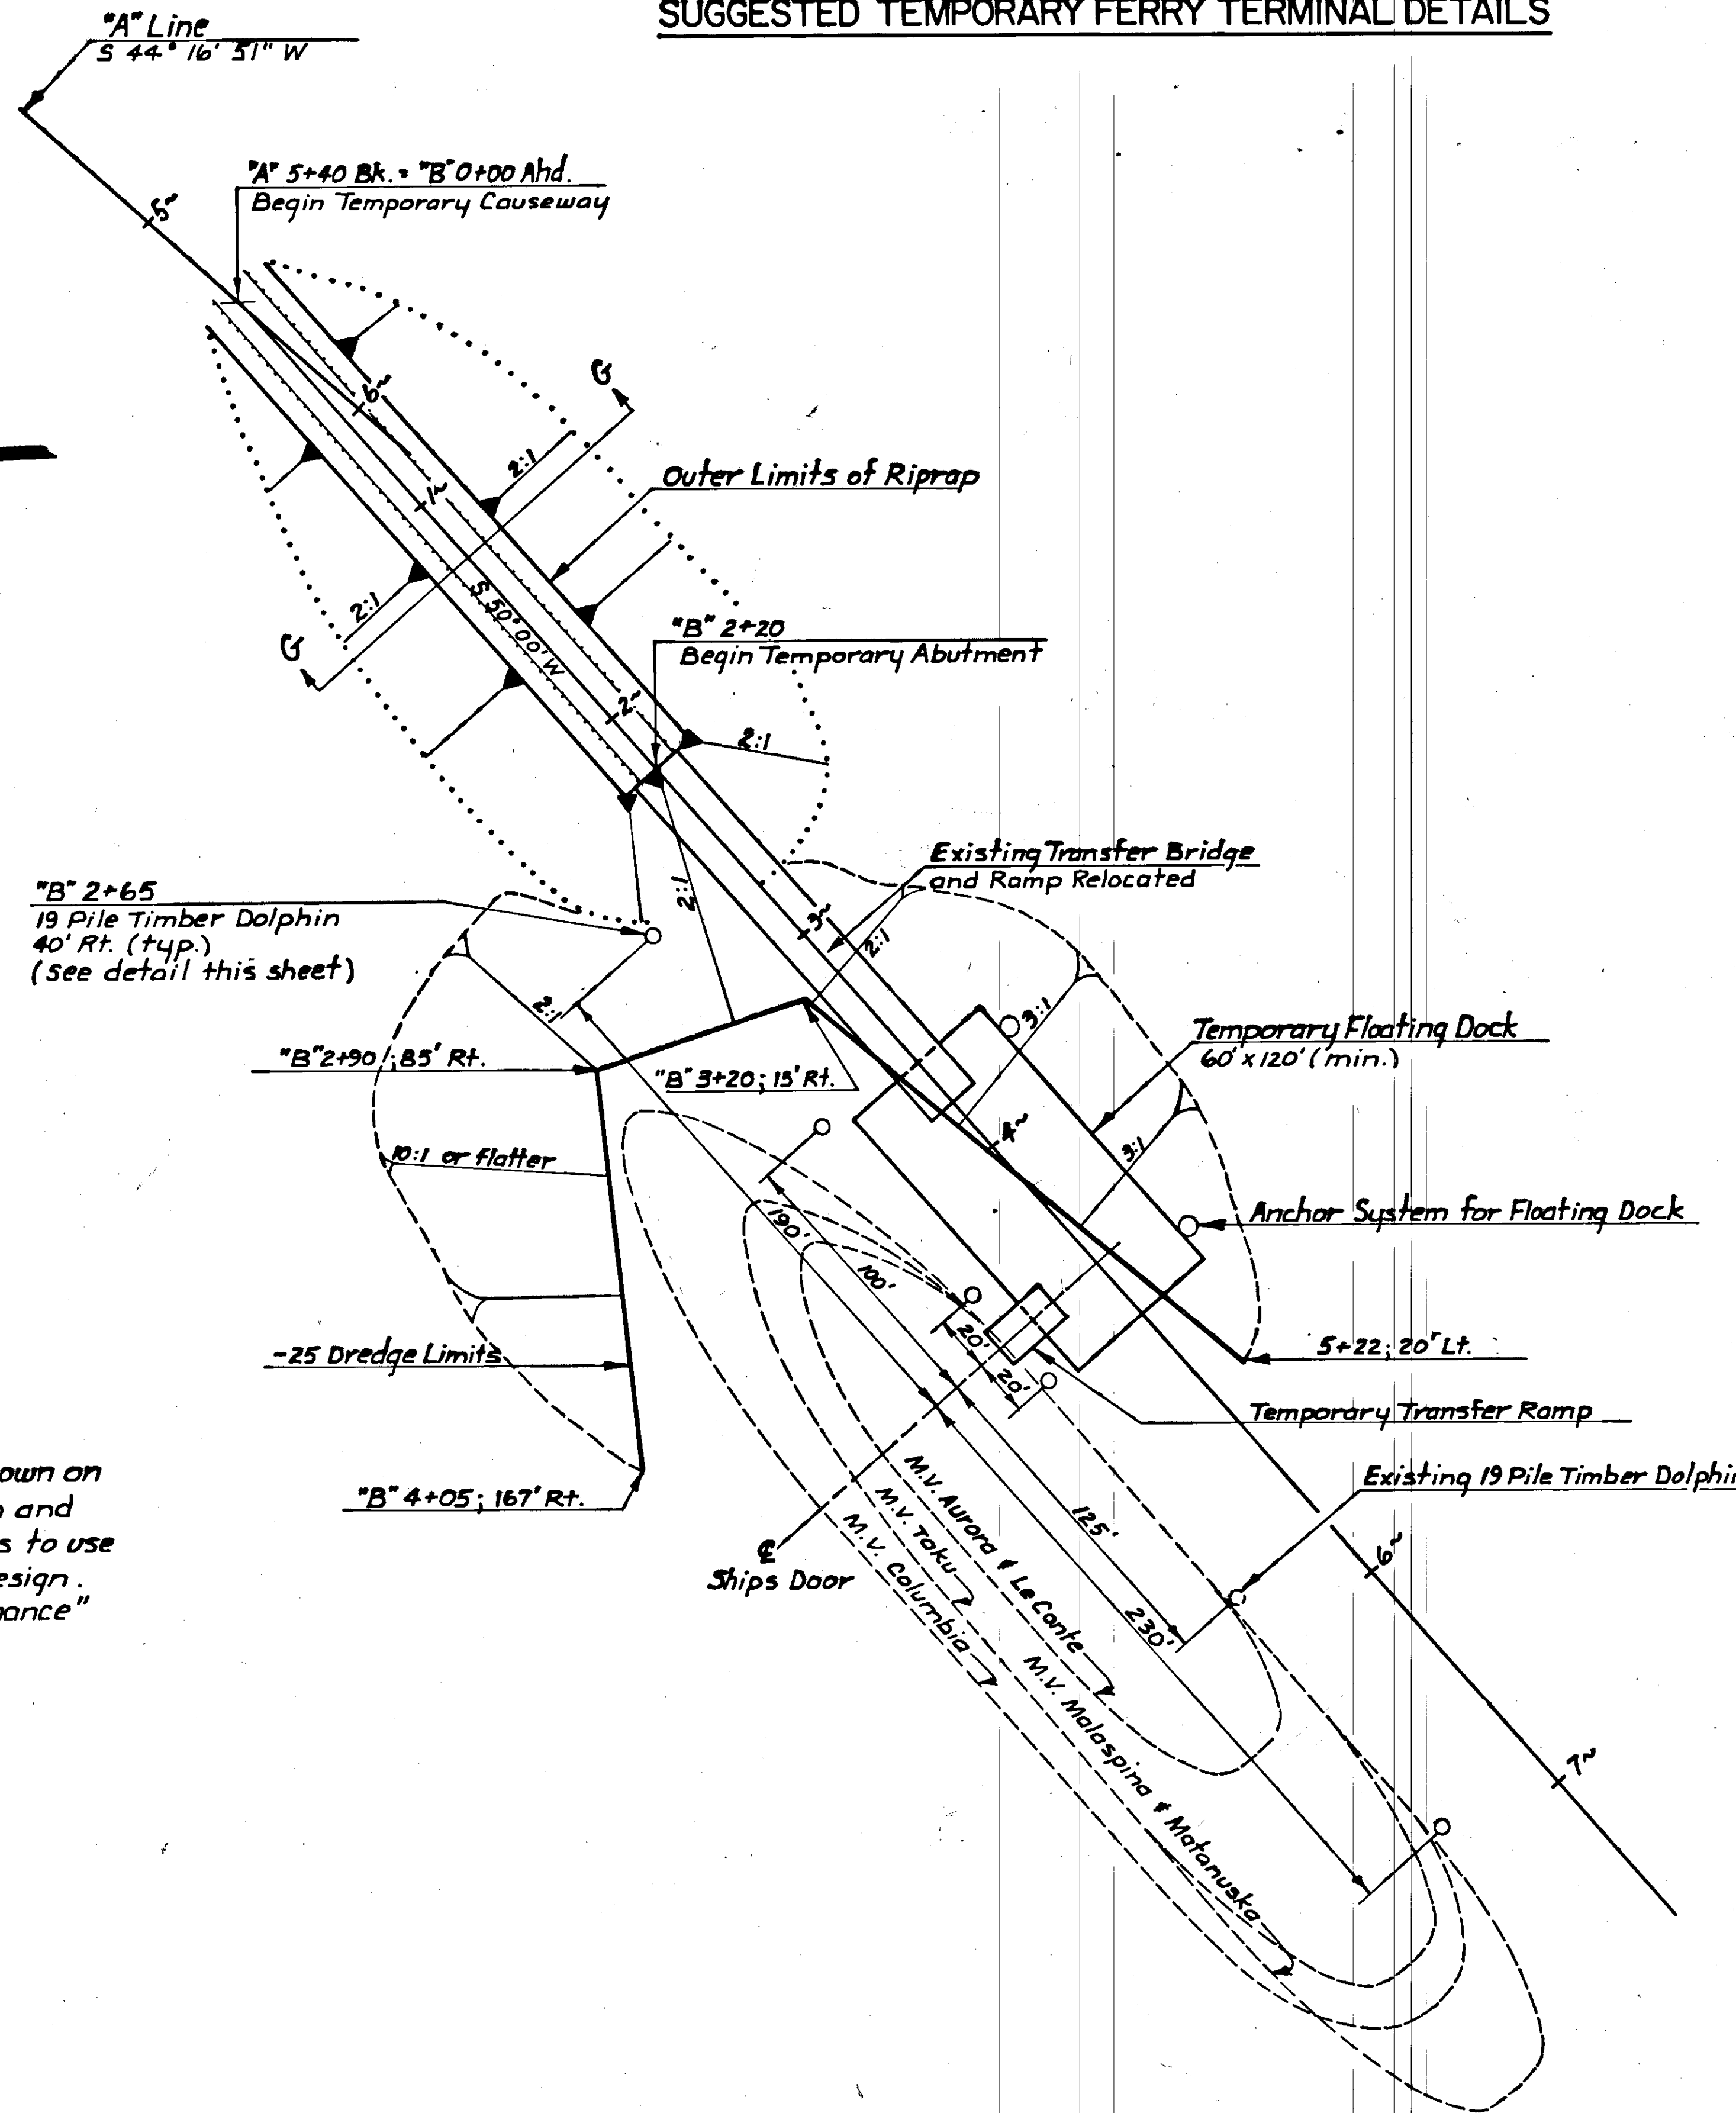

SUGGESTED TEMPORARY FERRY TERMINAL LAYOUT

**HORIZONTAL CONTROL:**  
 Bearings for the project are based  
 U.S.C. & G.S. Triangulation  
 stations "Long" & "Sharp".

**VERTICAL CONTROL:**  
 Vertical Control was derived from  
 U.S.C. & G.S. Benchmark #12. A  
 standard disk stamped "No. 12 1970"  
 is located on the southeast corner of  
 the Soapy Smith monument  
 U.S.C. & G.S. El. 26.07 M.L.L.W.




**BEGIN PROJECT**  
**F-097-2(2)**  
**Sta. "A" 0+00.00**

**Earthwork Equation:**  
 $Embarkment = (Excavation - Waste) \times$   
 $Grading Factor + Borrow$

Embarkment = 39,600 C.Y. All from  
 Unclassified Excavation (Includes 1620  
 C.Y. of Selected Material)  
 Excavation = 67,050 C.Y. (Includes no  
 Waste).  
 All excess excavation material shall be  
 stockpiled in the area shown on sheet  
 no. 6. The exact quantity to be stockpiled  
 will depend on factors such as shrinkage  
 and method of handling.

STATE	PROJECT DESIGNATION	YEAR	SHEET NO.	TOTAL SHEETS
ALASKA	F-097-2(2)	1978	8	41

**GENERAL LAYOUT**

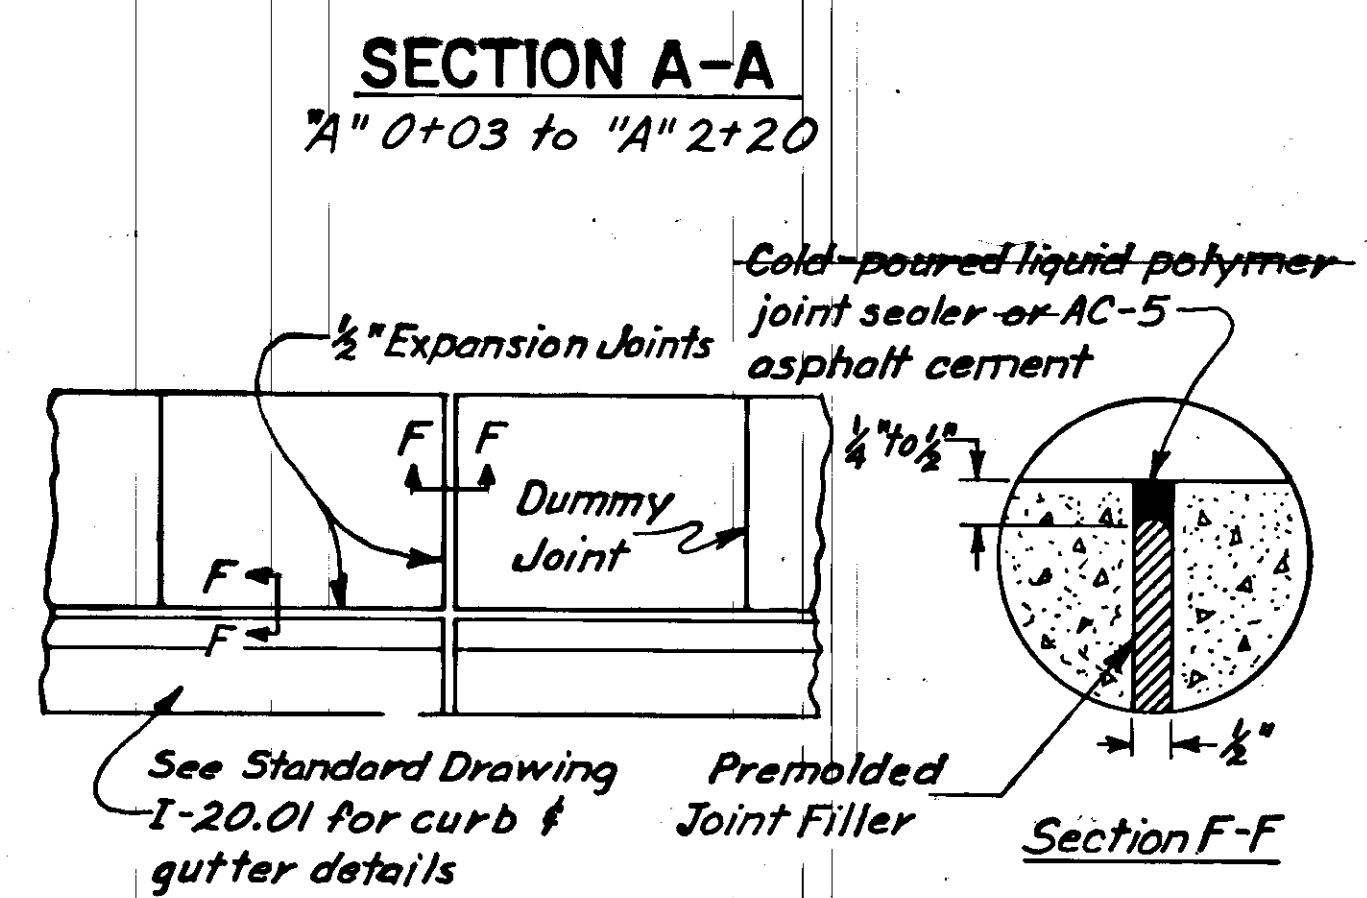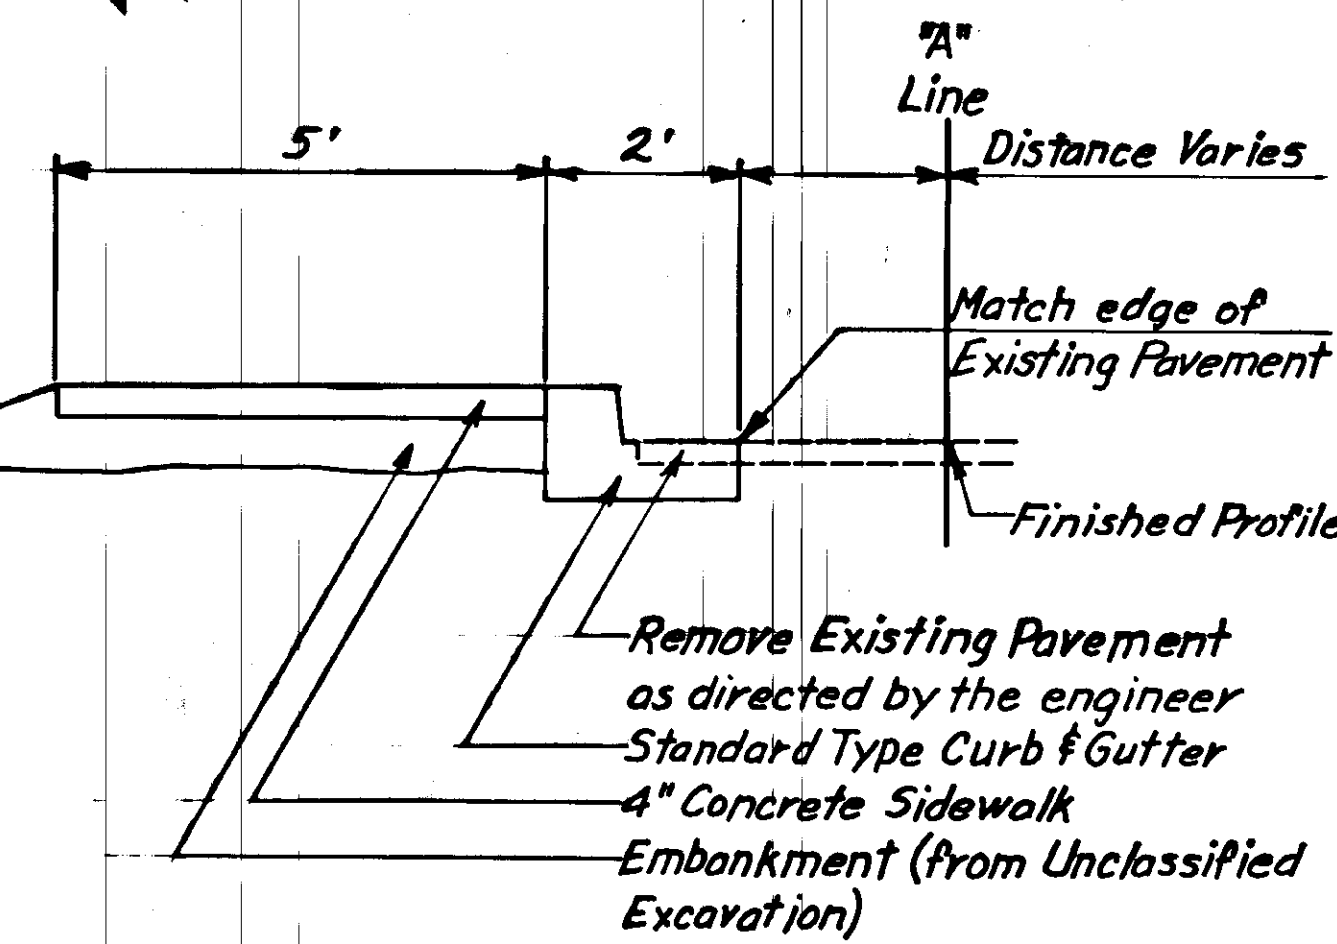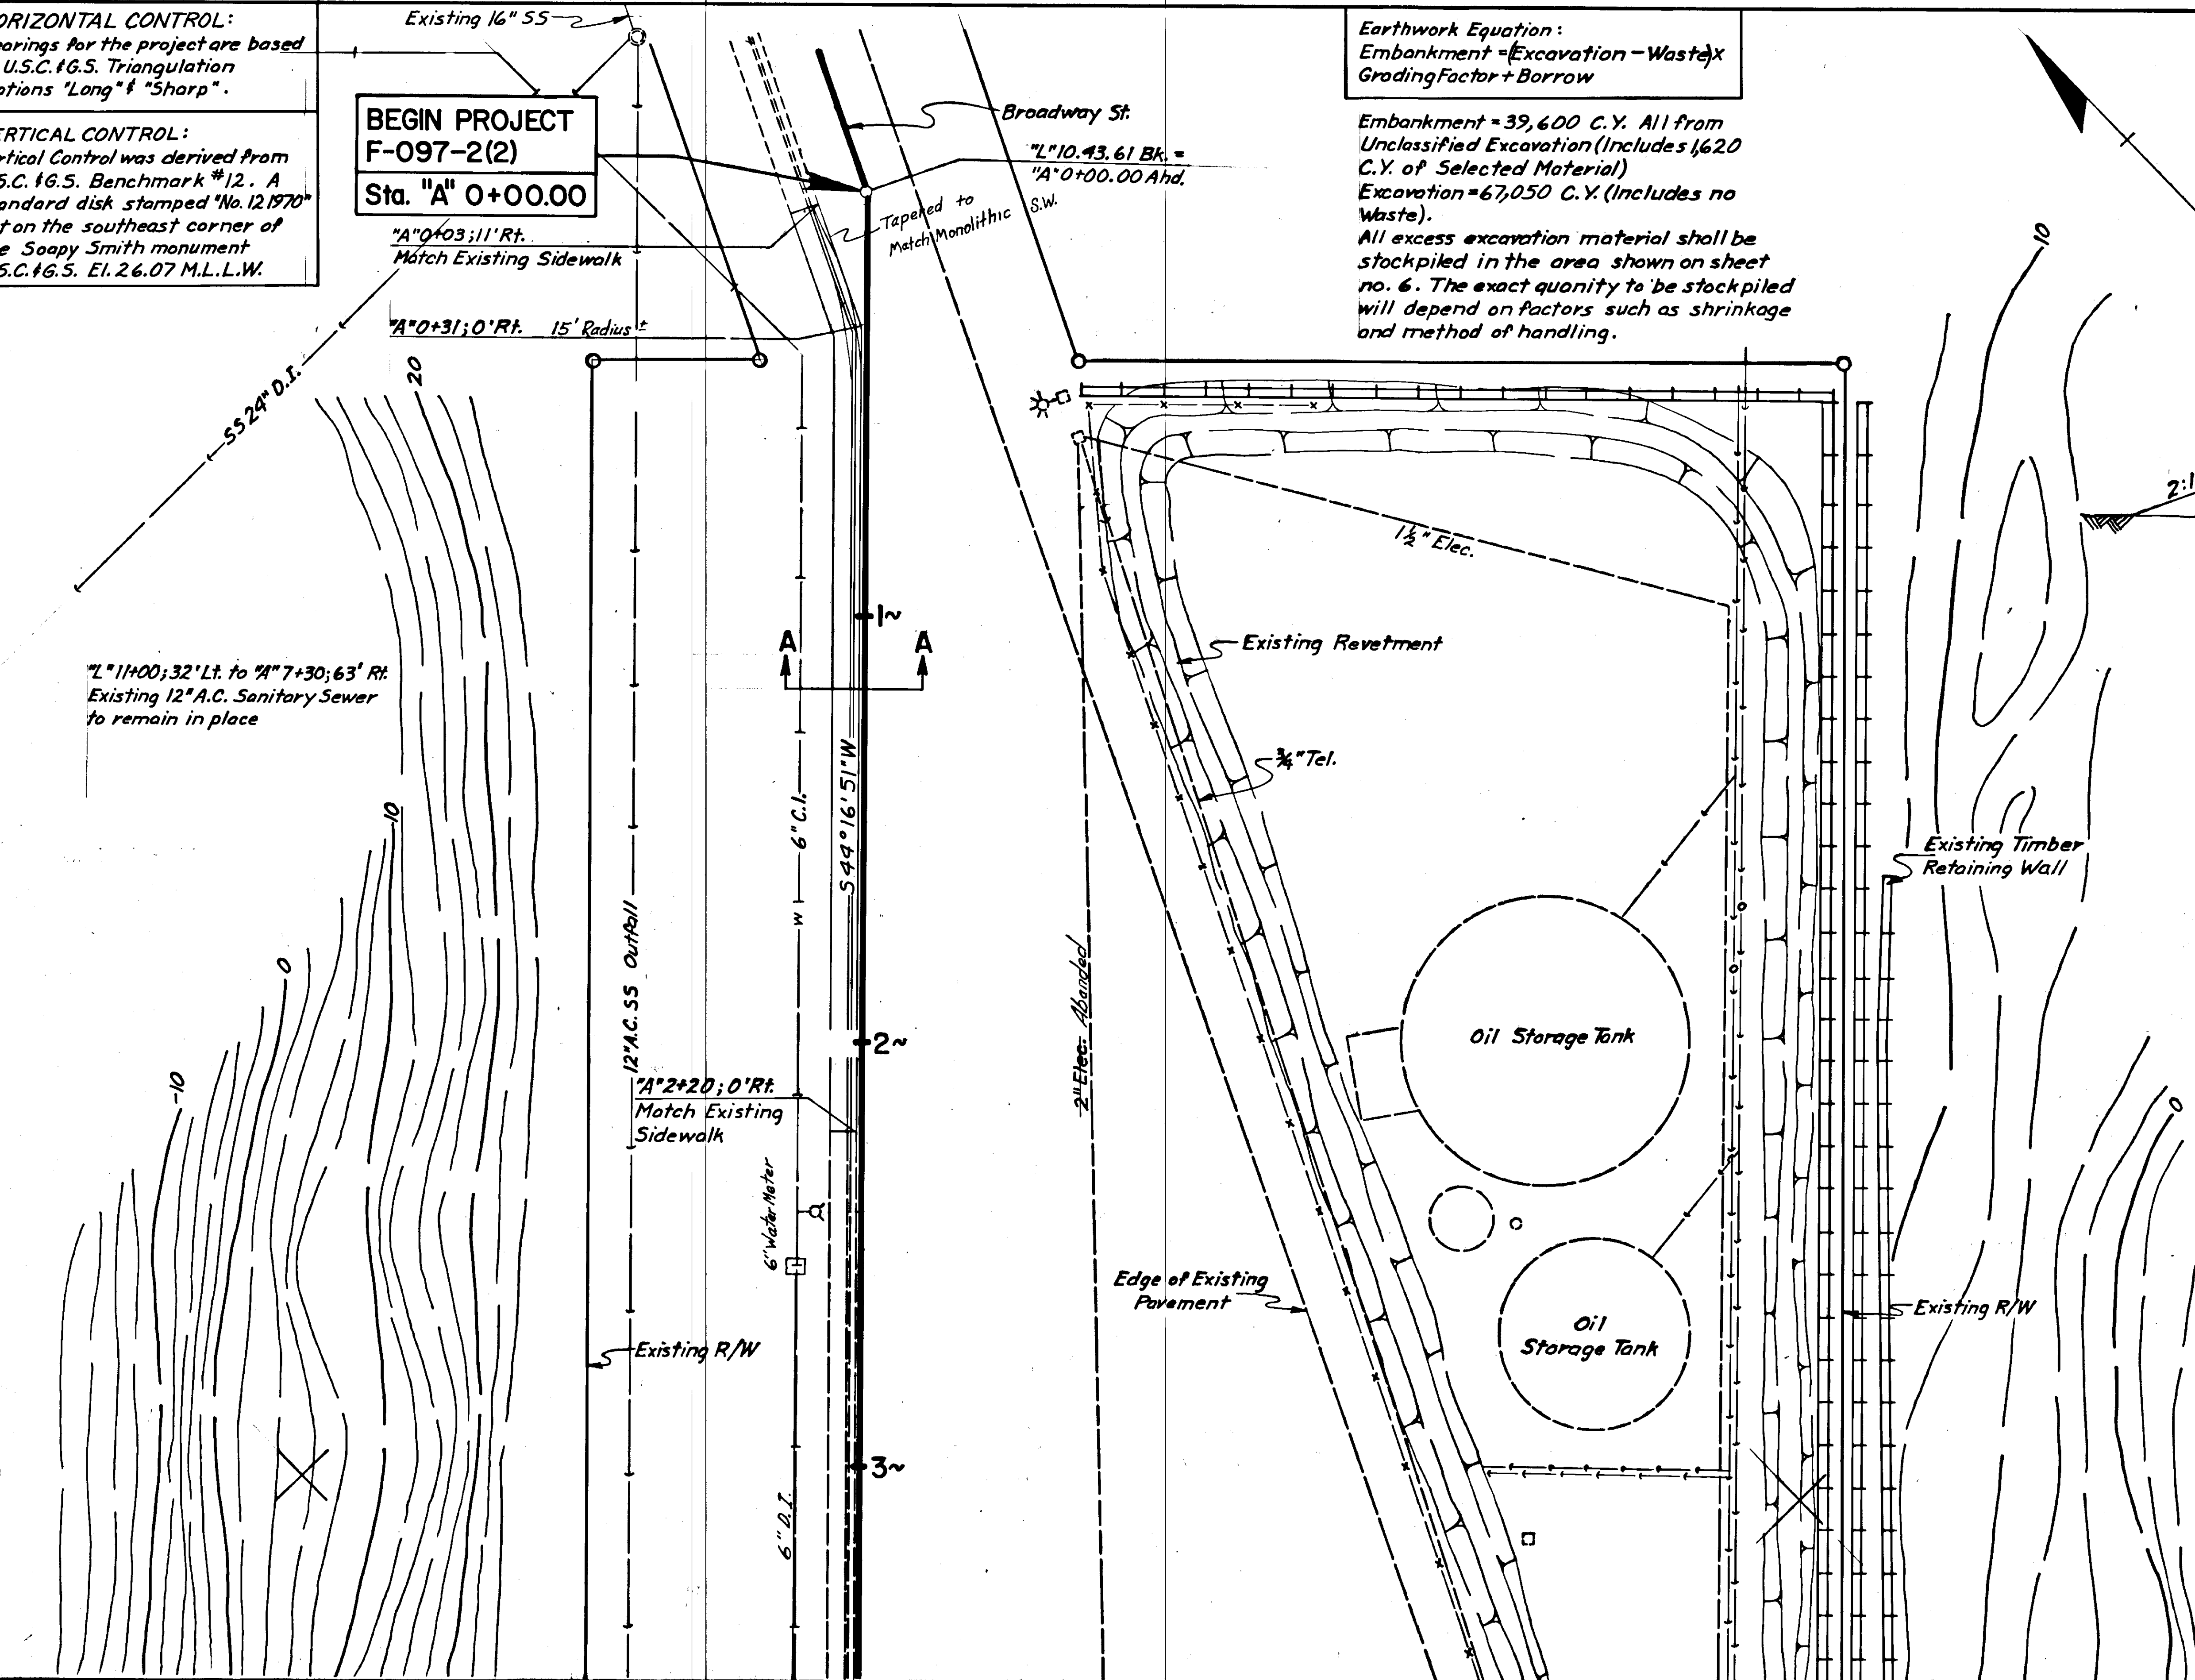

- NOTES**
1. Premolded expansion joint filler & liquid polymer joint sealer (see specs.) or AC-5 asphalt cement shall be considered incidental to pay item 608(1) "Concrete Sidewalk" and no separate payment shall be made therefore.
  2. Curb & Gutter expansion joints shall be placed at the beginning and end of the sidewalk and at the angle point. Thereafter they shall be placed at intervals of 30' except where shorter sections are needed for closure.
  3. Sidewalk expansion joints shall be opposite expansion joints in adjoining curb & gutter. Dummy joints shall be equally spaced between expansion joints and the spacing shall not exceed 5'.

**MATCH LINE "A" 3+50**

MATCH LINE "A" 3+50

STATE	PROJECT DESIGNATION	YEAR	SHEET NO.	TOTAL SHEETS
ALASKA	F-097-2(2)	1978	9	41

# GENERAL LAYOUT

"A" 1+00; 32' Lt. to "A" 7+30; 63' Rt.  
Existing 12" A.C. Sanitary Sewer to remain in place

"A" 7+30; 63' Rt. to "A" 11+00; 105' Rt.  
Abandon existing 12" A.C. in place

Begin Riprap Toe and Filter Course "A" 6+00 Rt.


Rock not keyed on right side. See detail "A" on sheet 12.

Begin Riprap and filter course "A" 4+50 Lt.

Rock keyed on Left side. See detail "B" on sheet 12.

"A" 4+75; 175' Lt. to 216' Lt. Relocate 40 L.F. of existing fence


"A" 4+86; 200' Lt. to "A" 7+39; 50' Lt. Install 342 L.F. of Beam Type Guardrail, Type I Post.

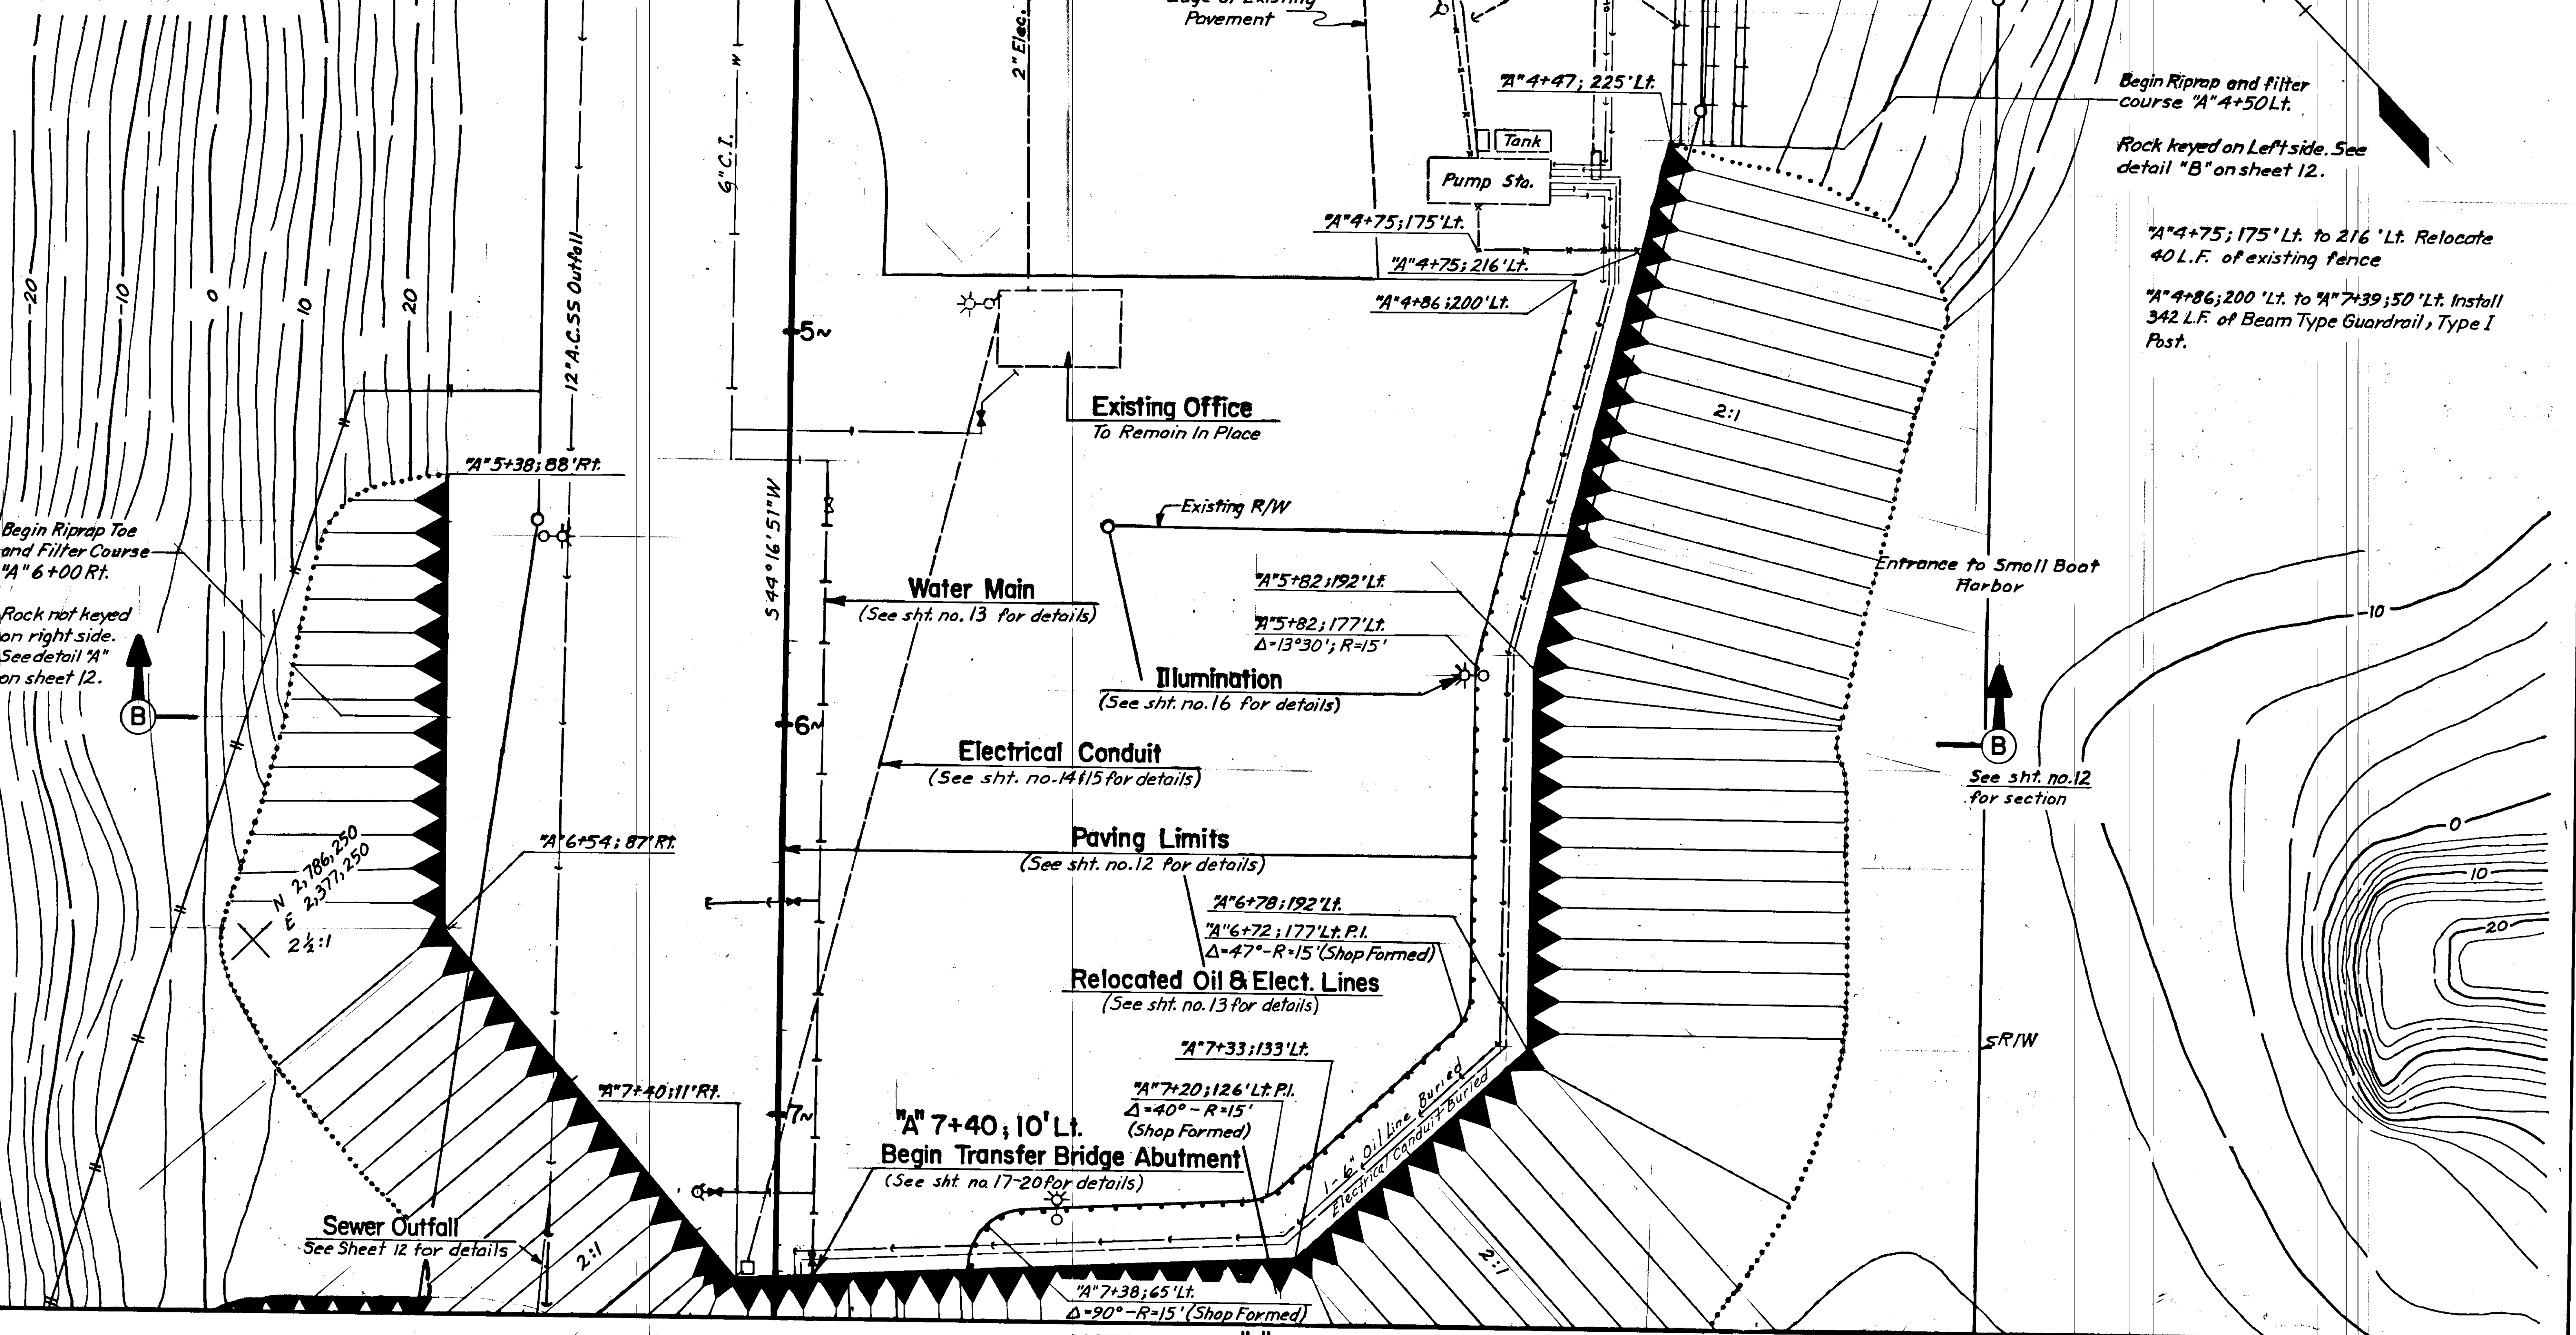

MATCH LINE "A" 7+50

MATCH LINE "A" 7+50

GENERAL LAYOUT

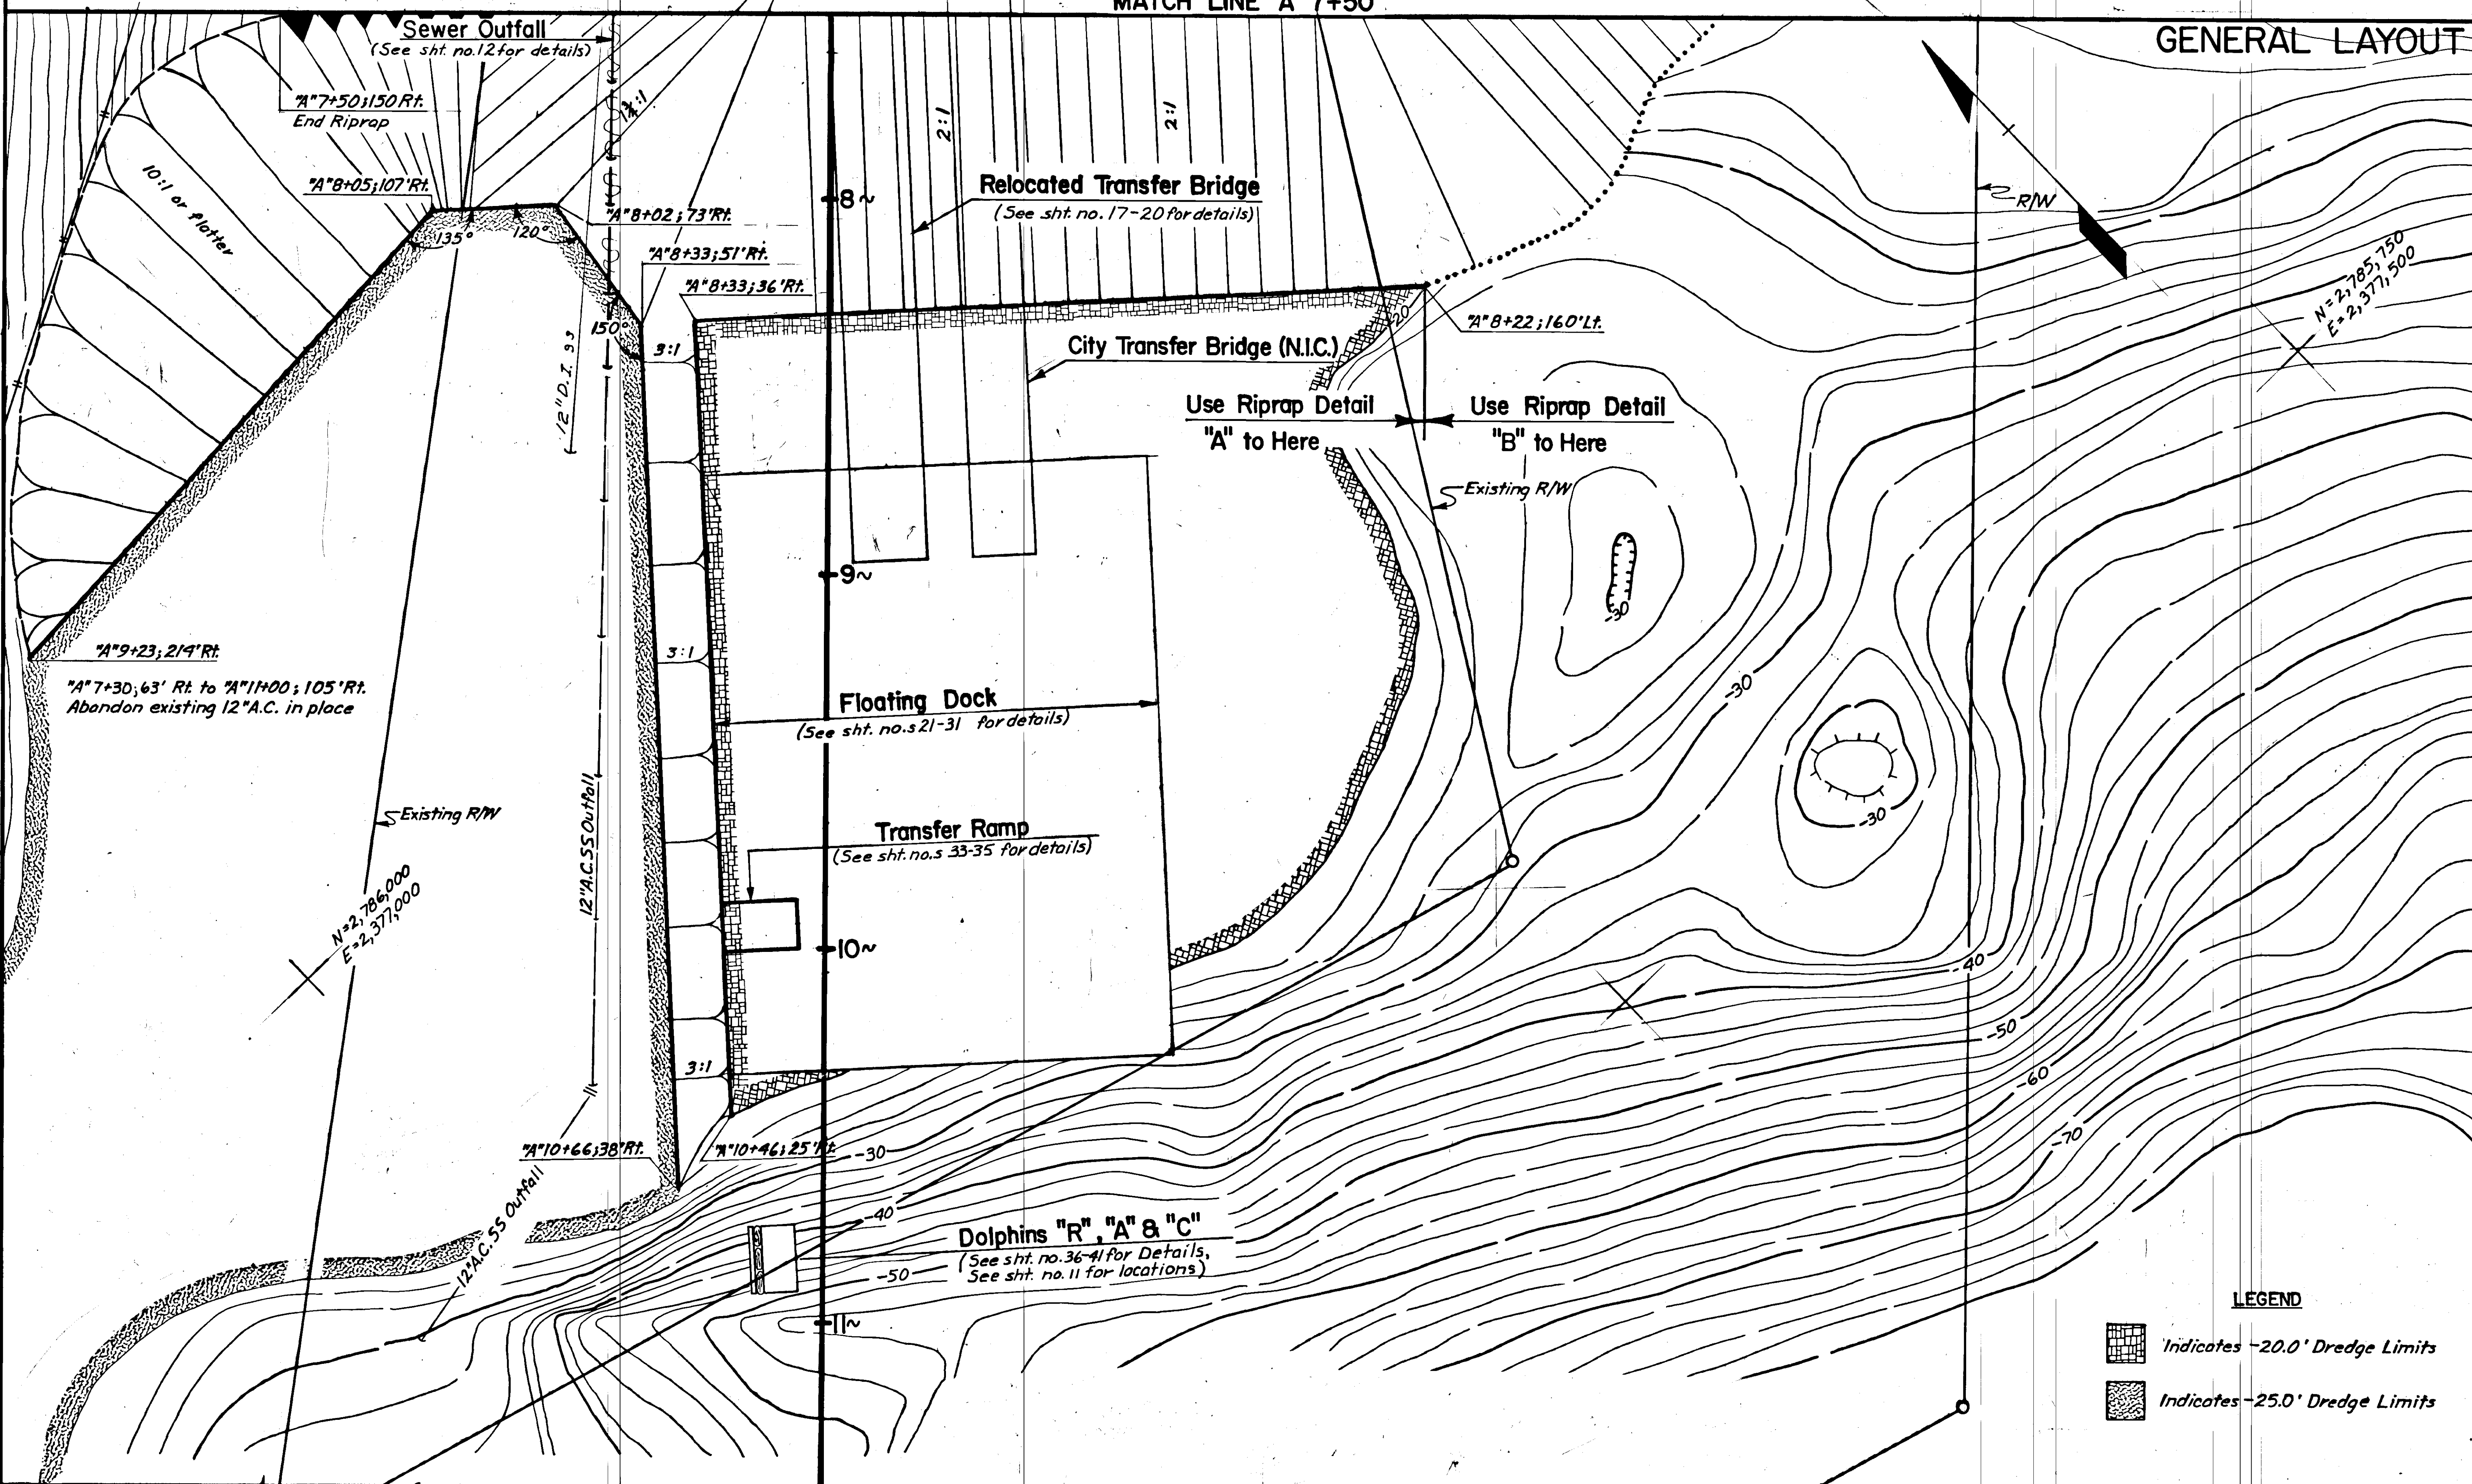

Sewer Outfall  
(See sht. no. 12 for details)

"A"7+50; 150' Rt.  
End Riprap

"A"8+05; 107' Rt.

"A"8+02; 73' Rt.

"A"8+33; 51' Rt.

"A"8+33; 36' Rt.

Relocated Transfer Bridge  
(See sht. no. 17-20 for details)

City Transfer Bridge (N.I.C.)

Use Riprap Detail  
"A" to Here

Use Riprap Detail  
"B" to Here



Existing R/W

Floating Dock  
(See sht. no.s 21-31 for details)

Transfer Ramp  
(See sht. no.s 33-35 for details)

Dolphins "R", "A" & "C"  
(See sht. no. 36-41 for Details,  
See sht. no. 11 for locations)



LEGEND

-  Indicates -20.0' Dredge Limits
-  Indicates -25.0' Dredge Limits




STATE	PROJECT DESIGNATION	YEAR	SHEET NO.	TOTAL SHEETS
ALASKA	F-097-2(2)	1978	12	41


MISCELLANEOUS DETAILS

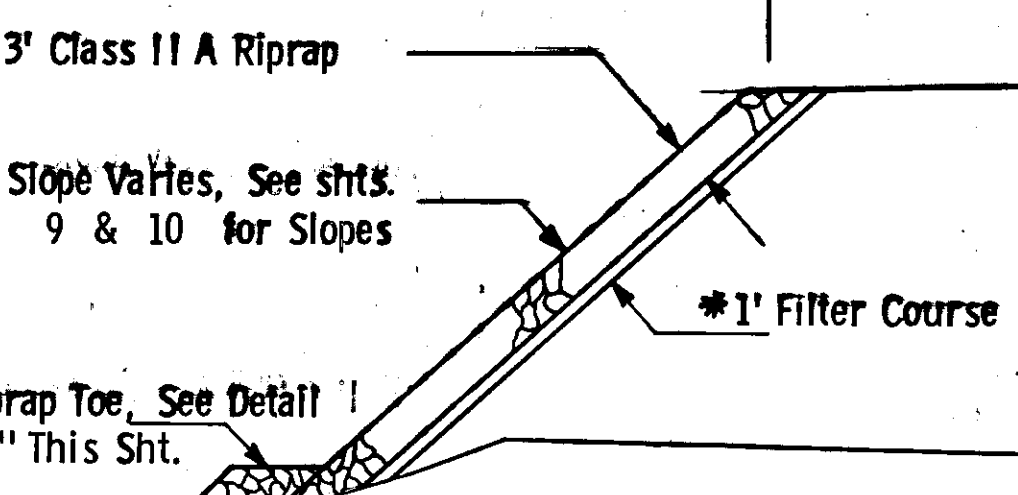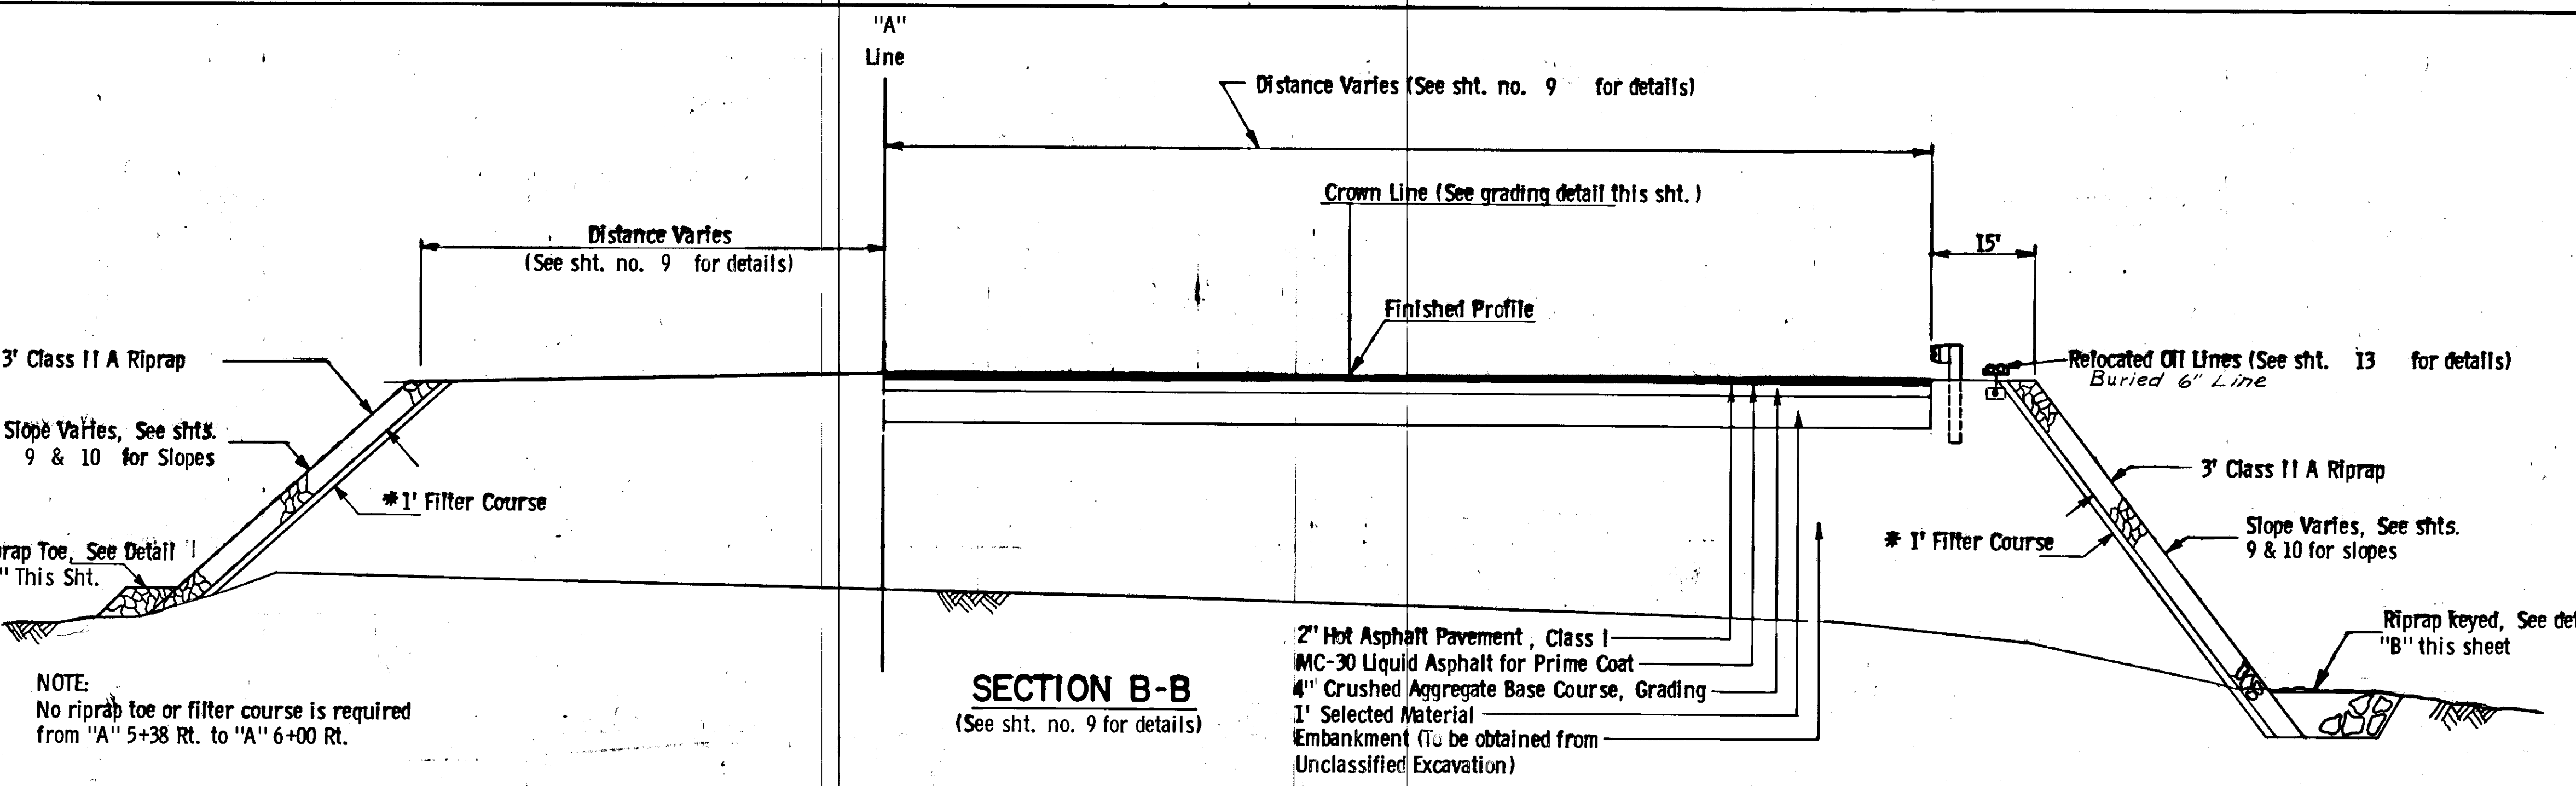

NOTE:  
No riprap toe or filter course is required from "A" 5+38 Rt. to "A" 6+00 Rt.

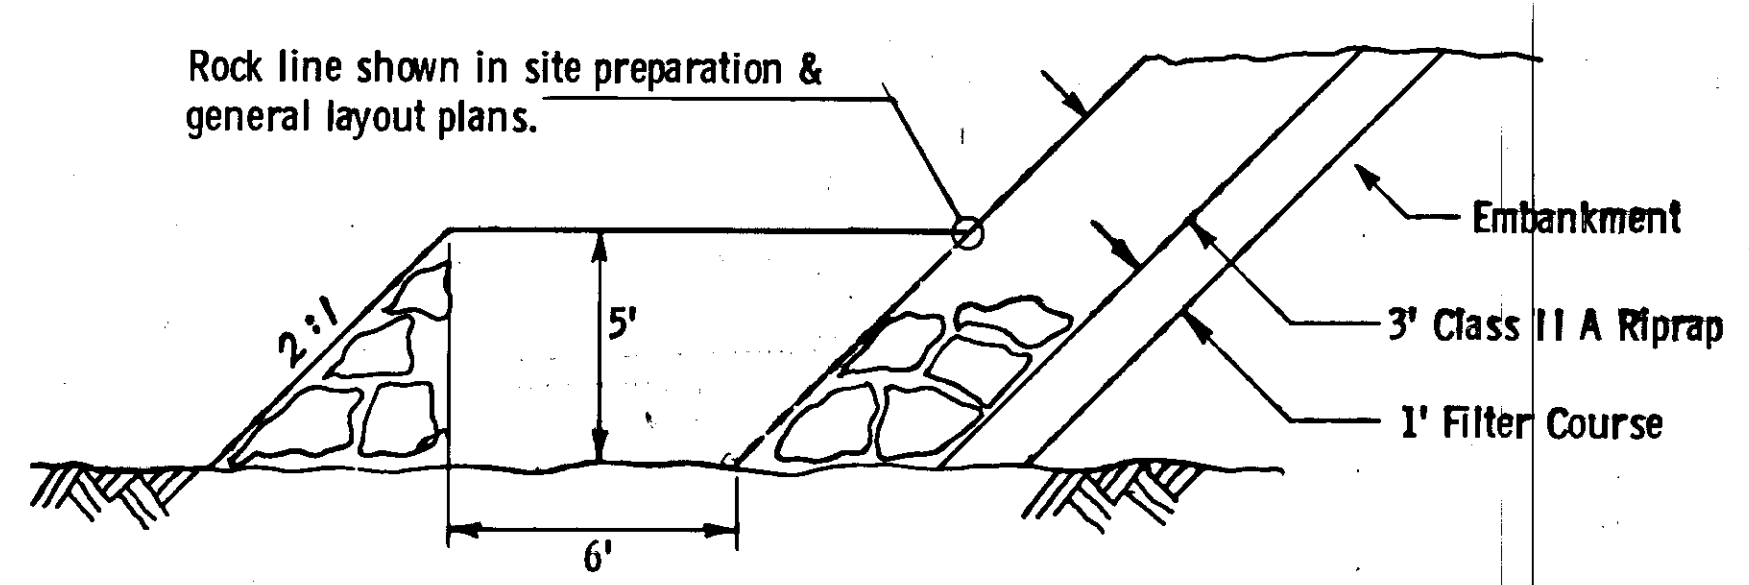


RIPRAP TOE DETAIL "A"

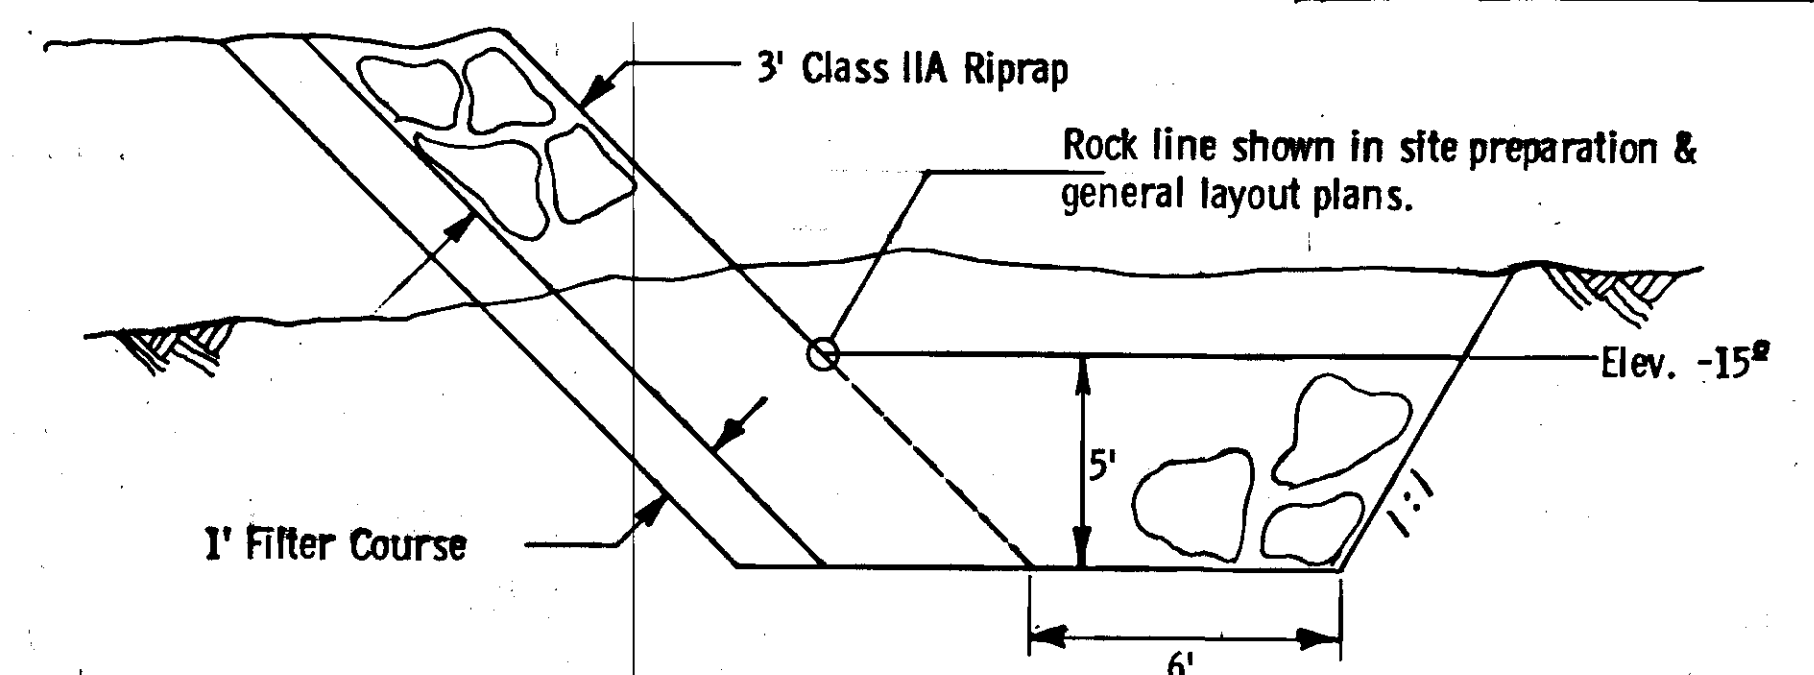


RIPRAP DETAIL "B" (KEYED)

NOTES

1. Any complete closure of the 24" or 12" outfall lines shall be a maximum of four hours; two hours each side of the recorded low tide.
2. Before beginning any work on the 12" D.I. outfall the contractor shall plug the existing 12" A.C. outfall at the existing manhole ("L" 10+92-40' Lt.) and use the existing 24" outfall for a temporary outfall.
3. Before putting the existing 12" outfall back in operation the contractor shall rework the floor of the existing manhole so that the majority of the sewage will flow out of the 12" outfall as directed by the engineer. This work shall be considered incidental to pay item 626(1) 12" Sewer Conduit and no separate payment shall be made.

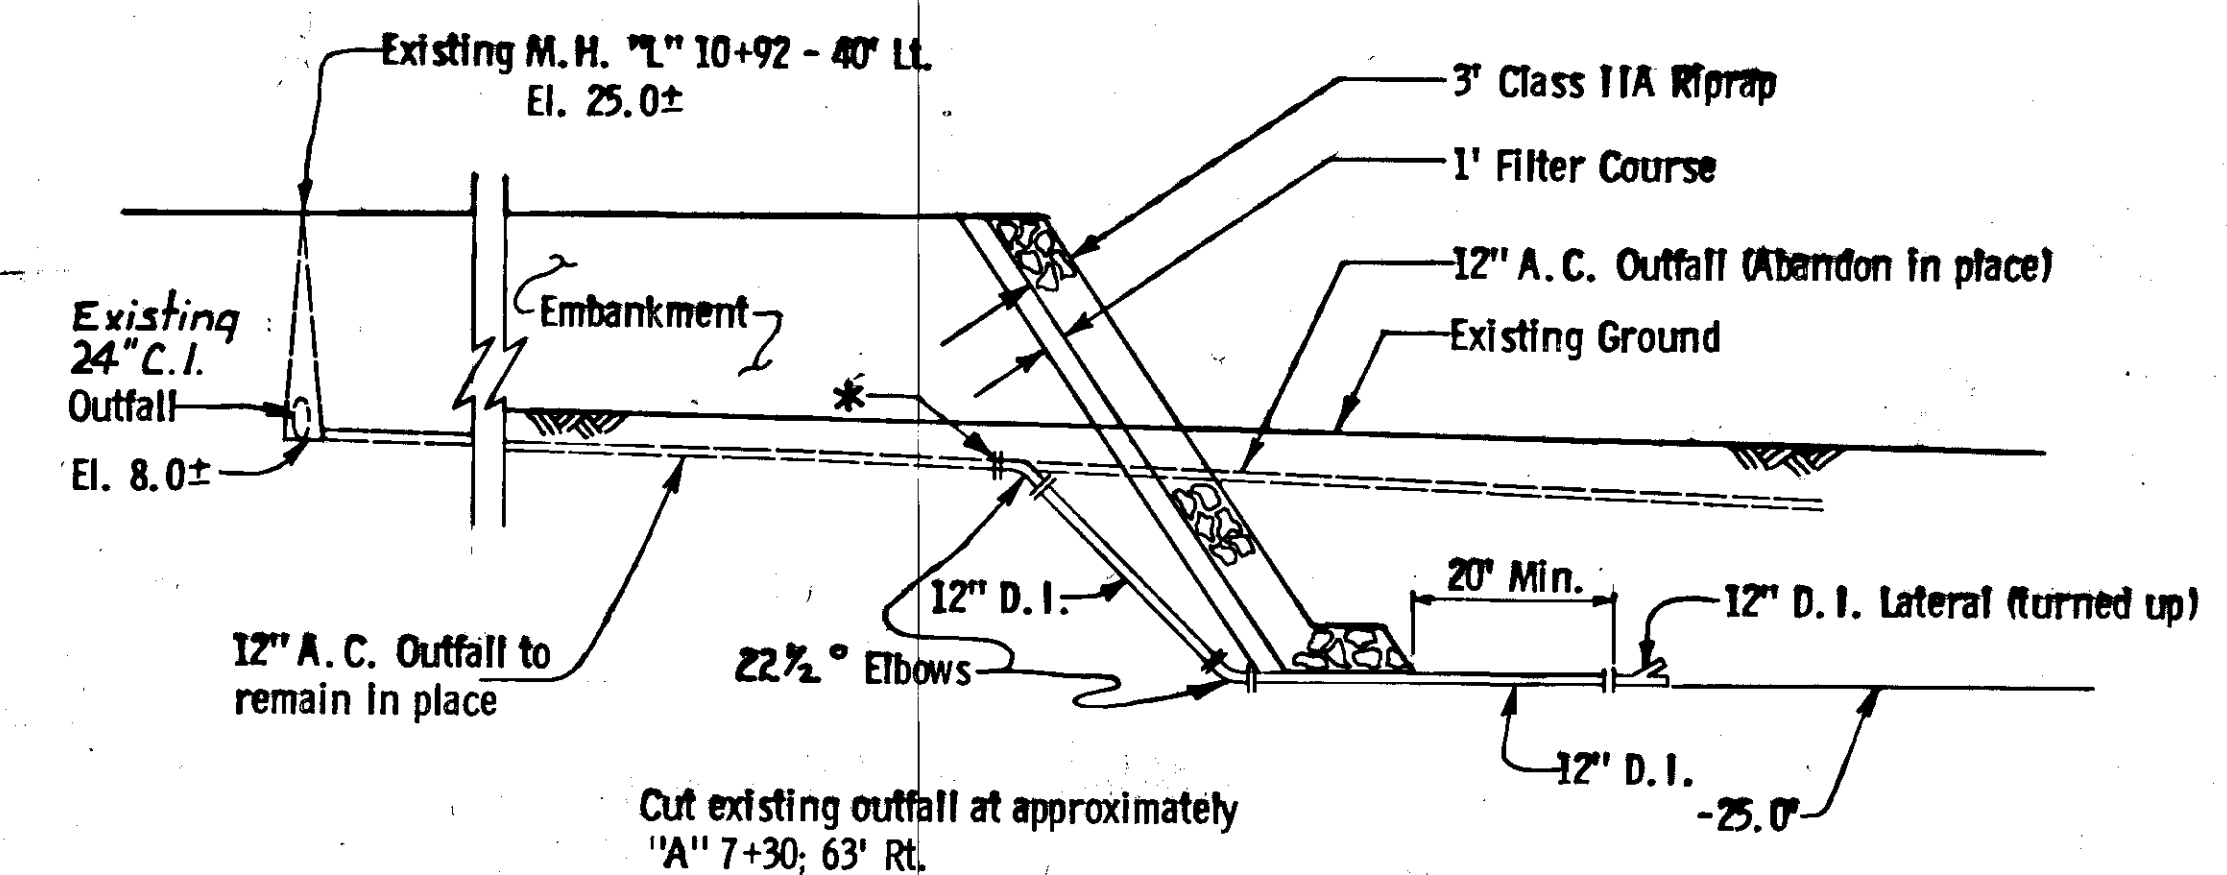

SEWER OUTFALL DETAIL  
(See General Layout sht. no. 9&10 for Plan View)

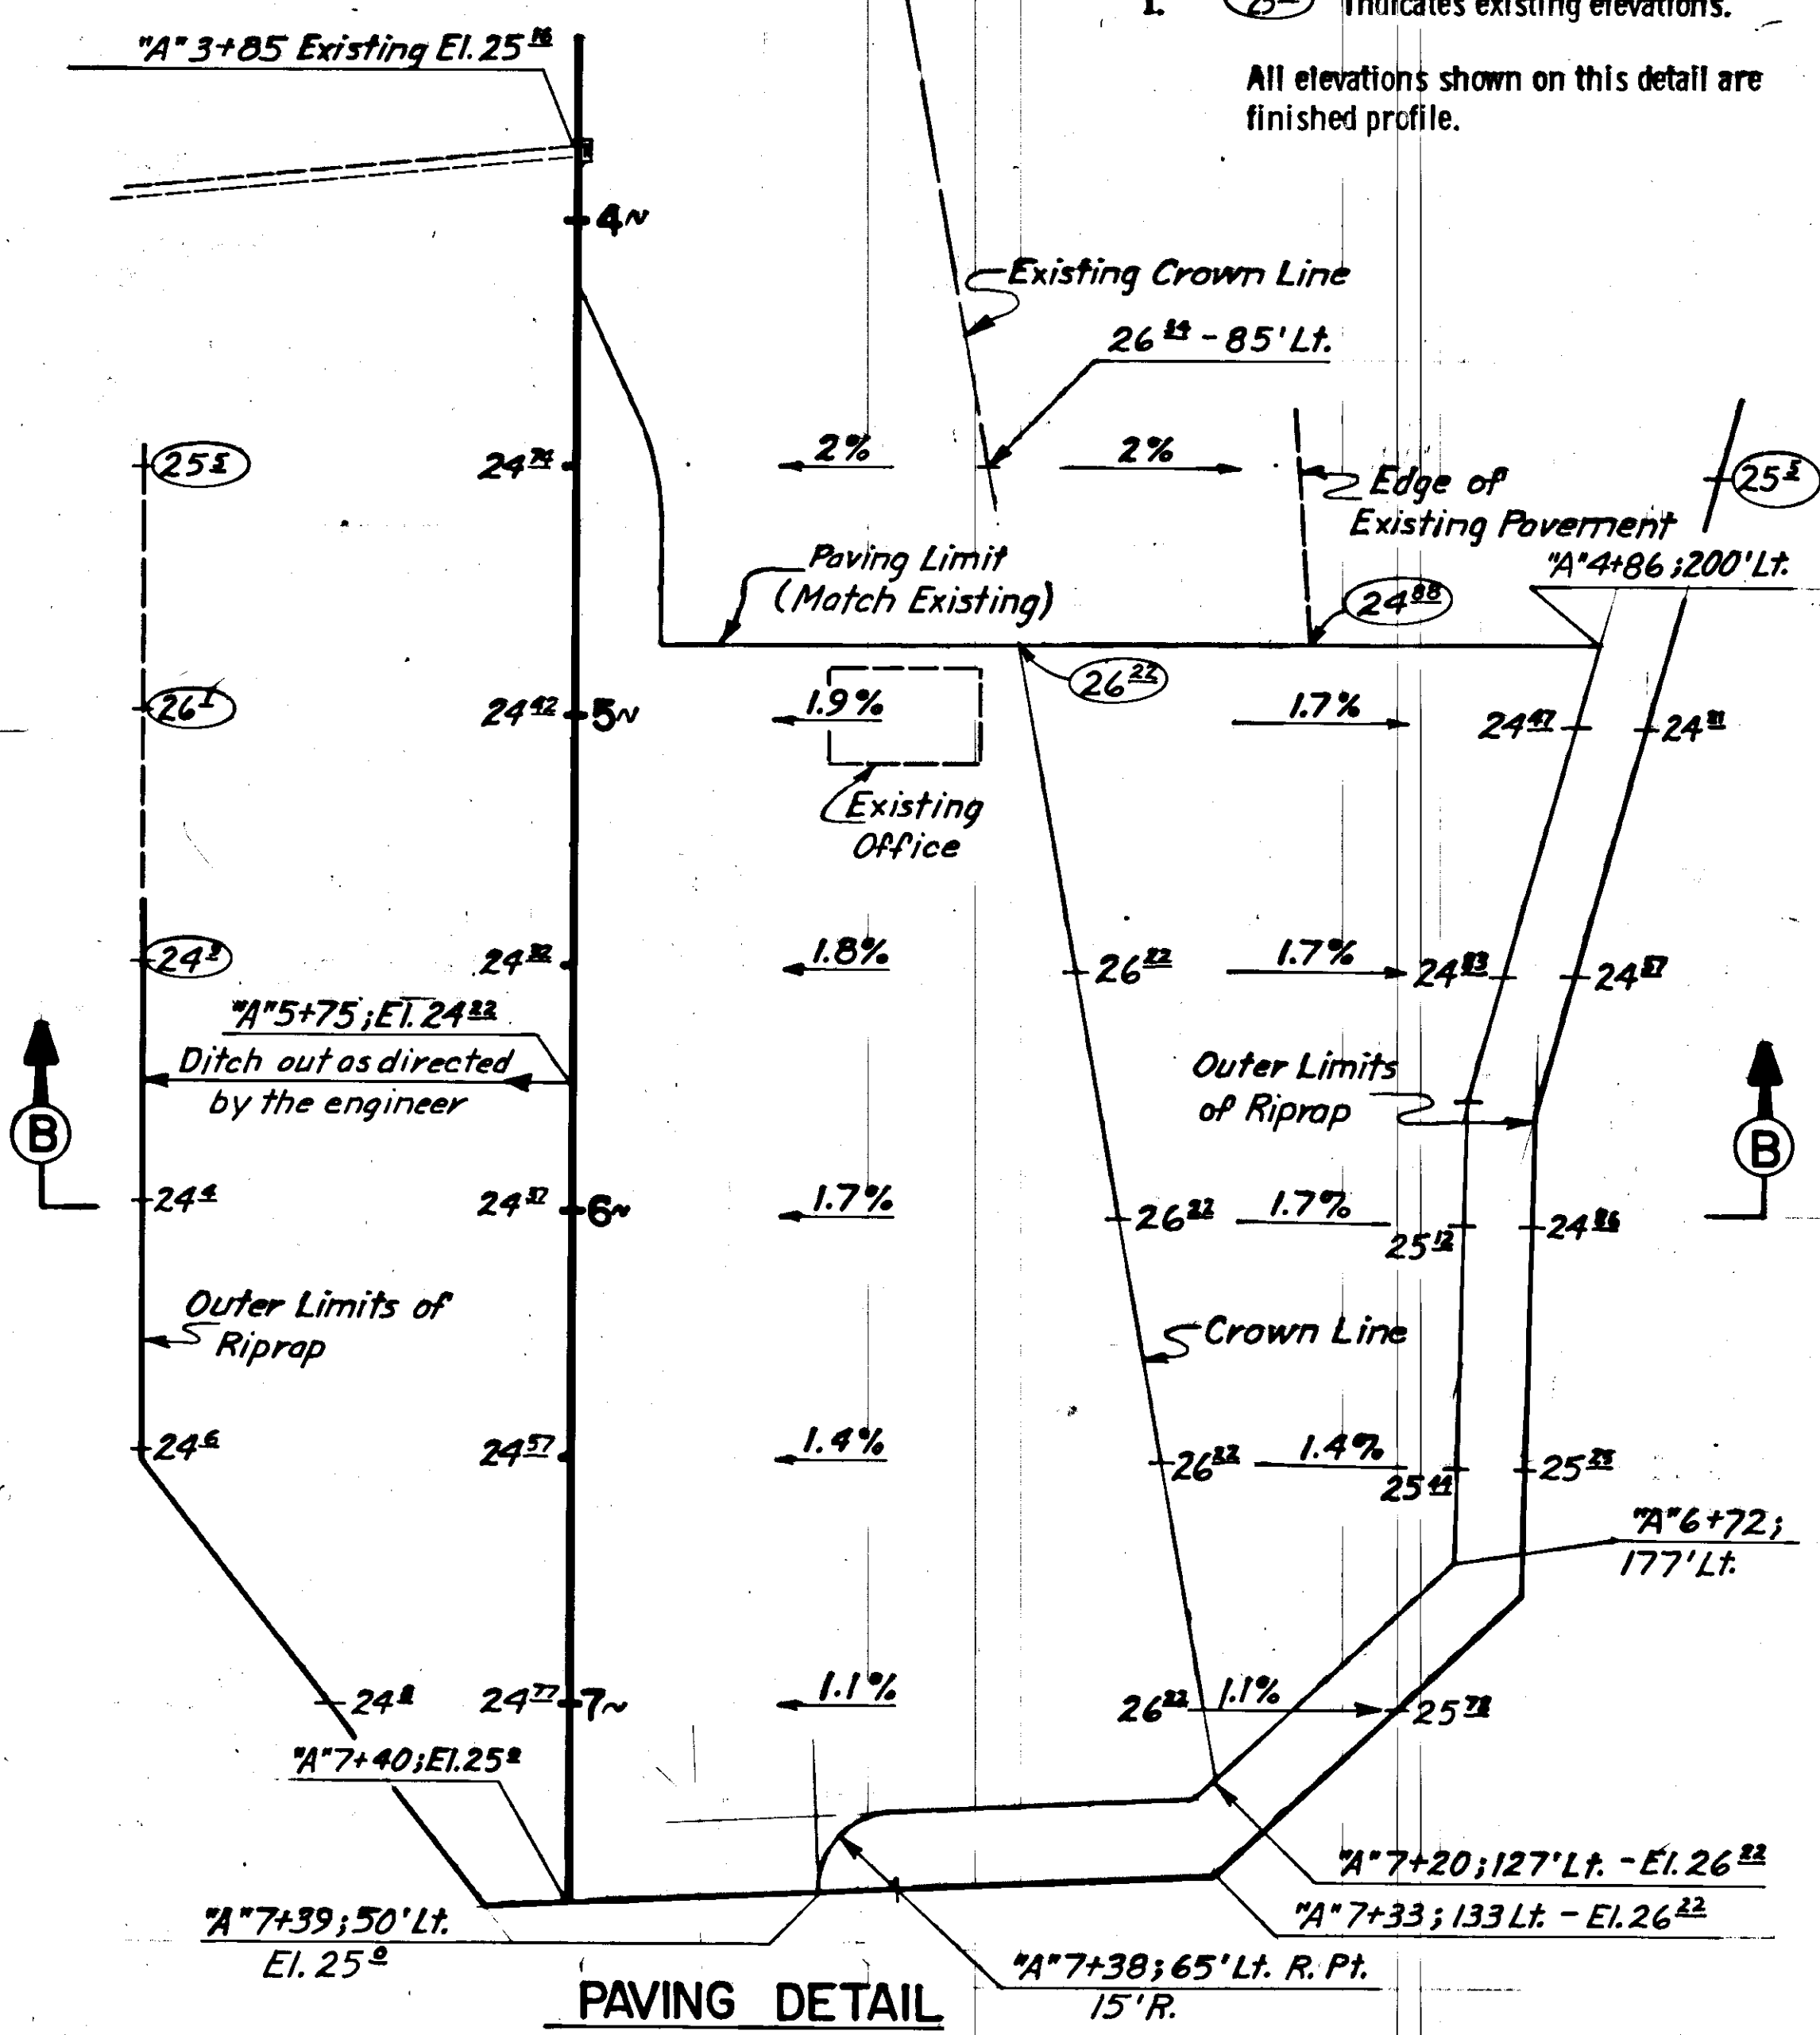

PAVING DETAIL





NOTES

1. (25)<sup>±</sup> Indicates existing elevations.  
All elevations shown on this detail are finished profile.

**MISCELLANEOUS DETAILS**

**NOTES**

1. The location of utilities shown on these plans are approximate and shall be verified by the contractor prior to starting construction.
2. All valve boxes shall be Mueller catalogue no. H-10360 or equal.
3. Depth of conduit bedding shall be 6" below the bottom of and 6" above the top of the conduit.
4. Flexible connections for the 3" water main and the 4" fuel lines will each require approximately 16 L.F. of rubber hose with bronze male hose nipples - I.P.T. to N.S.T. - and bronze pin lug female hose couplings at each end. The rubber hoses used in the above installations shall have the following minimum P.S.I. ratings: 3" - 75 P.S.I., 4" - 200 P.S.I.
5. Flexible connection for the 1" R.M.C. shall be watertight in accordance with the N.E.C.

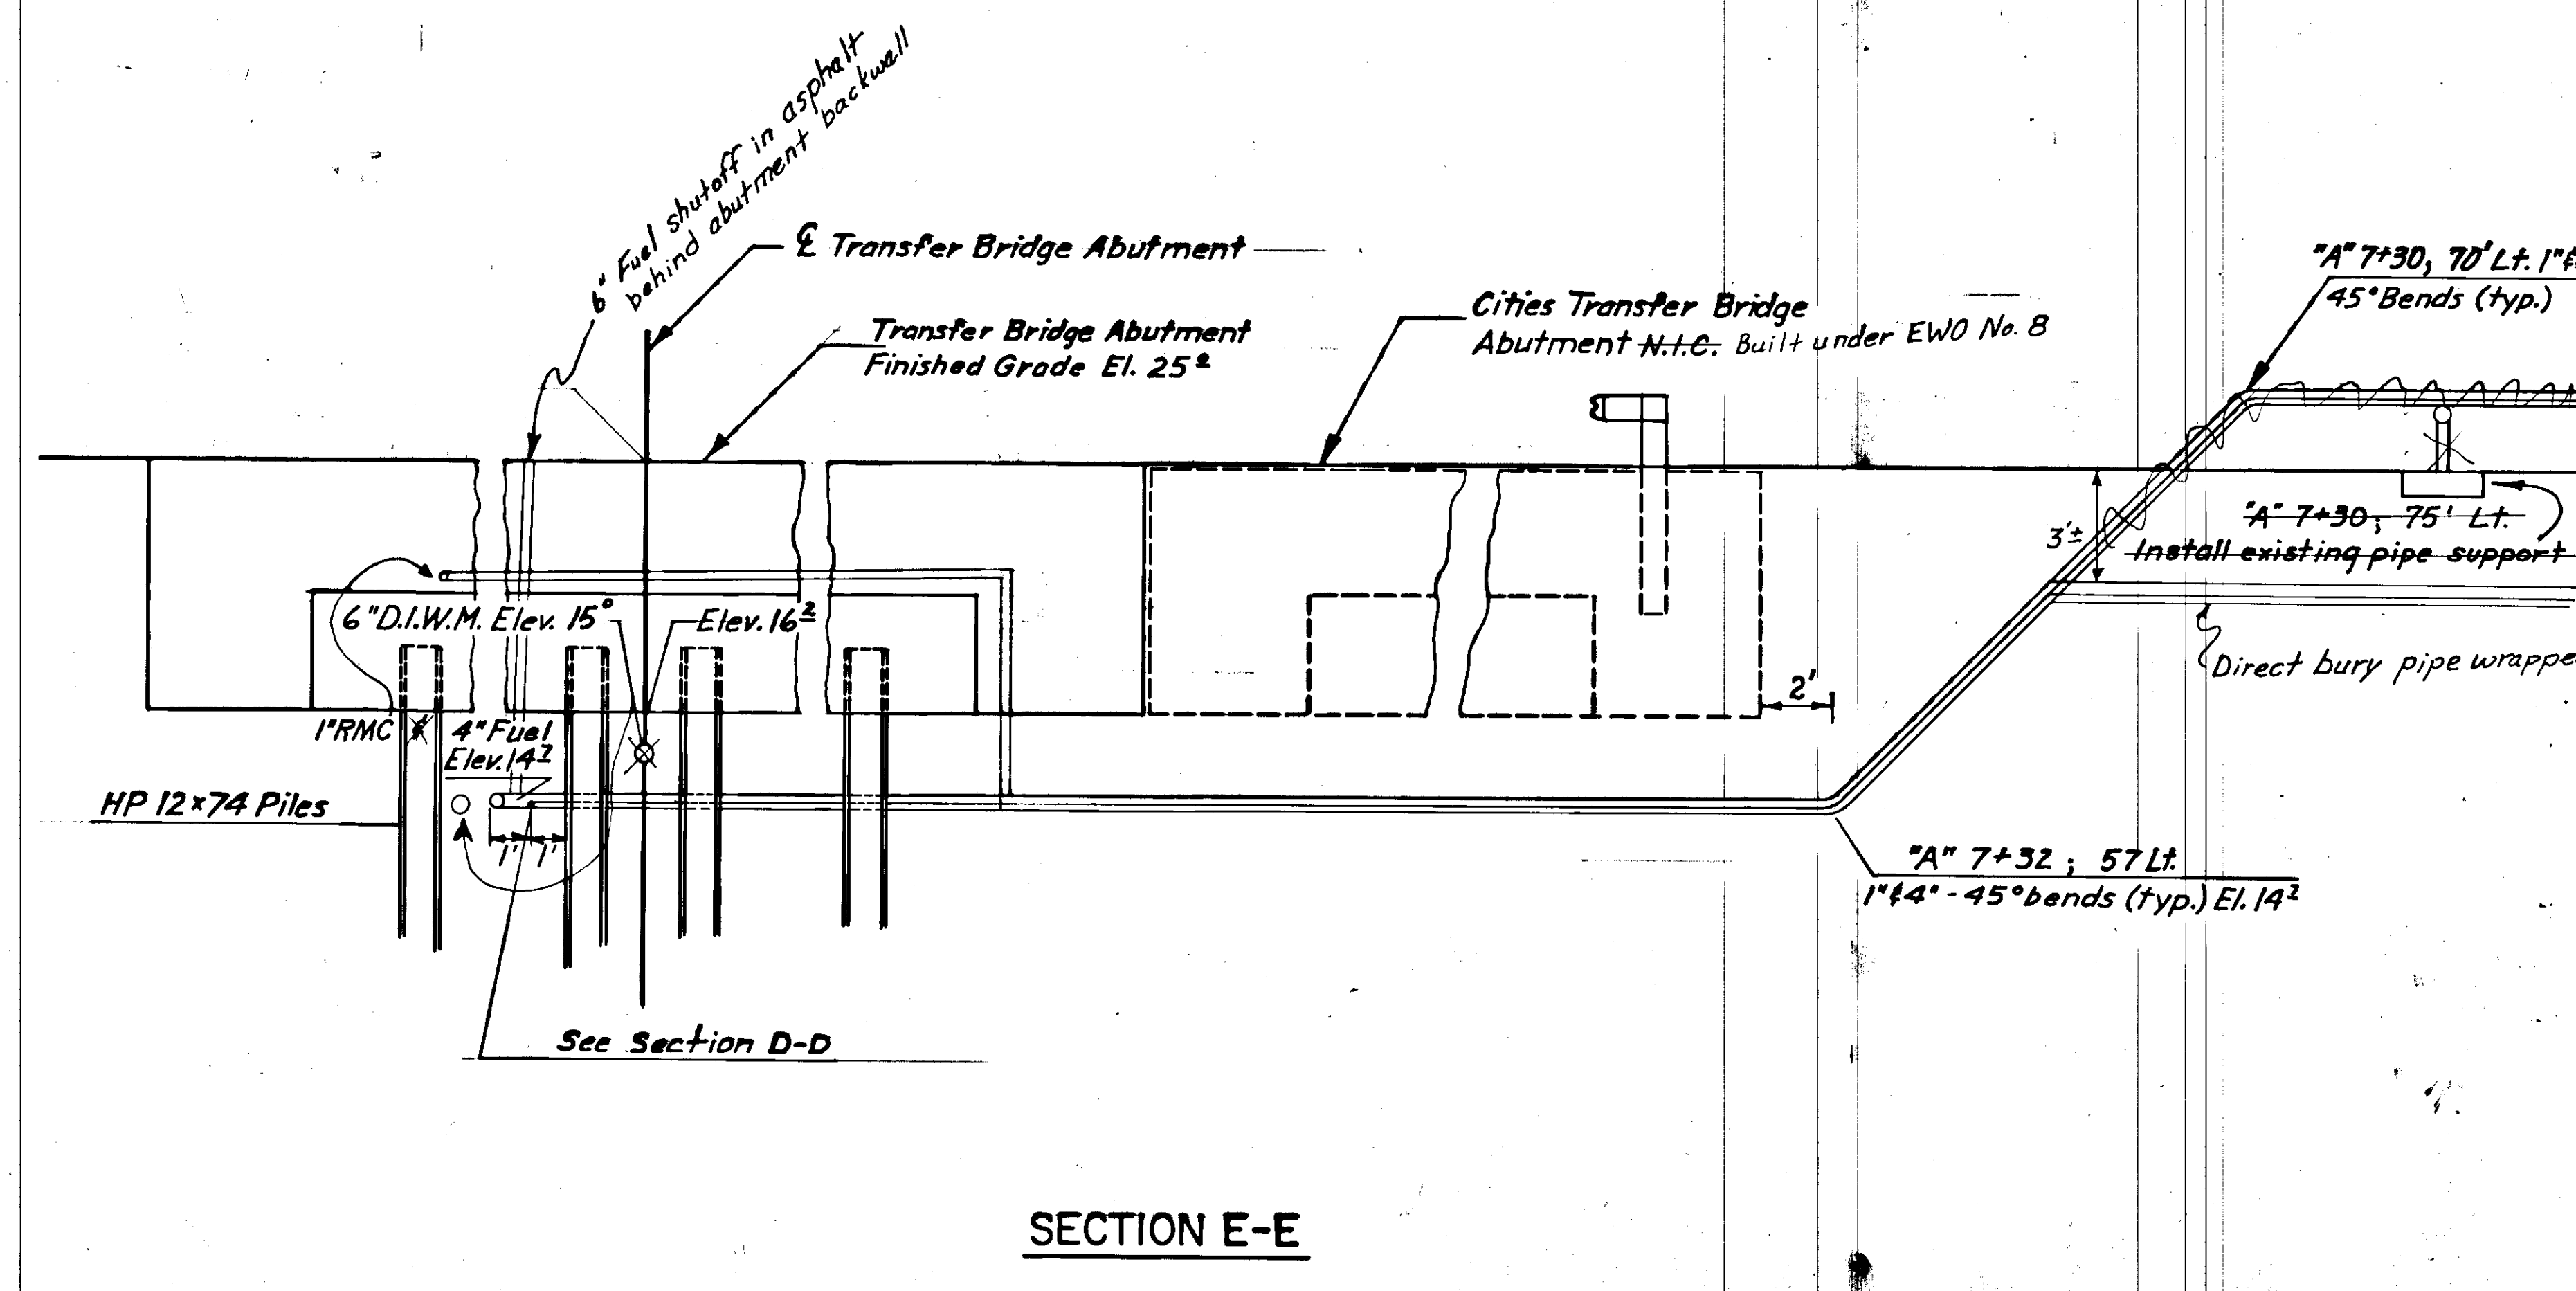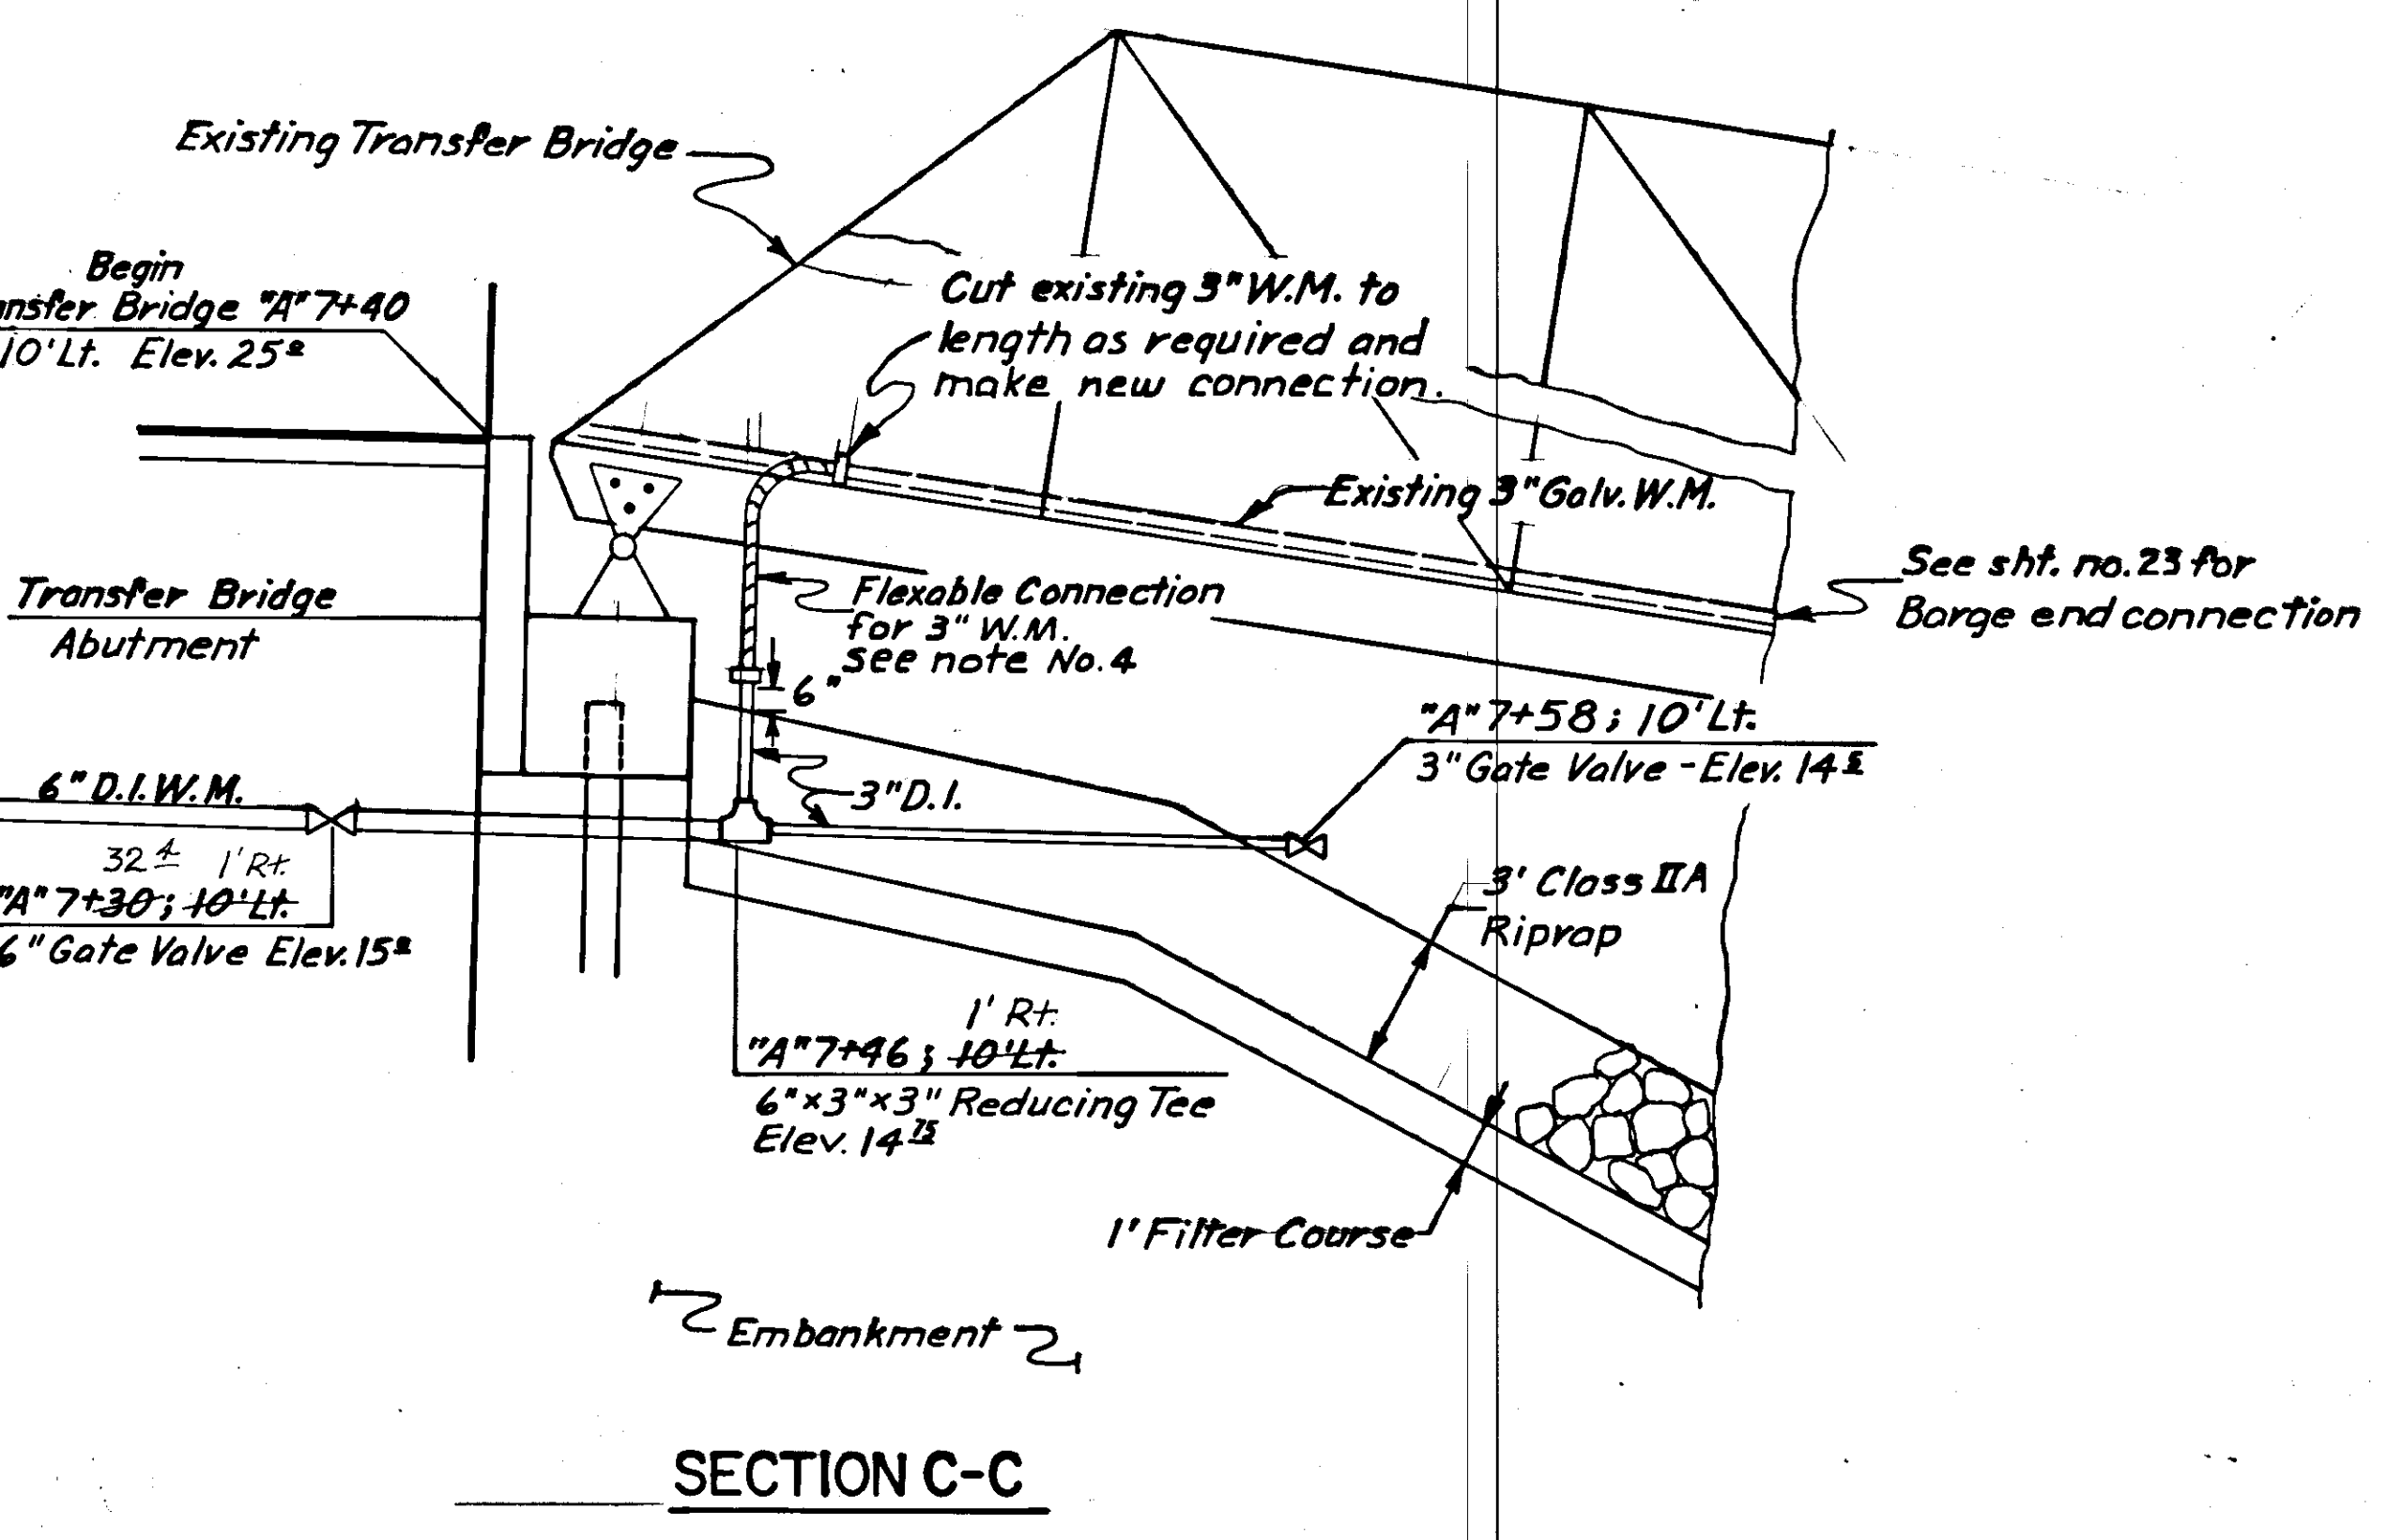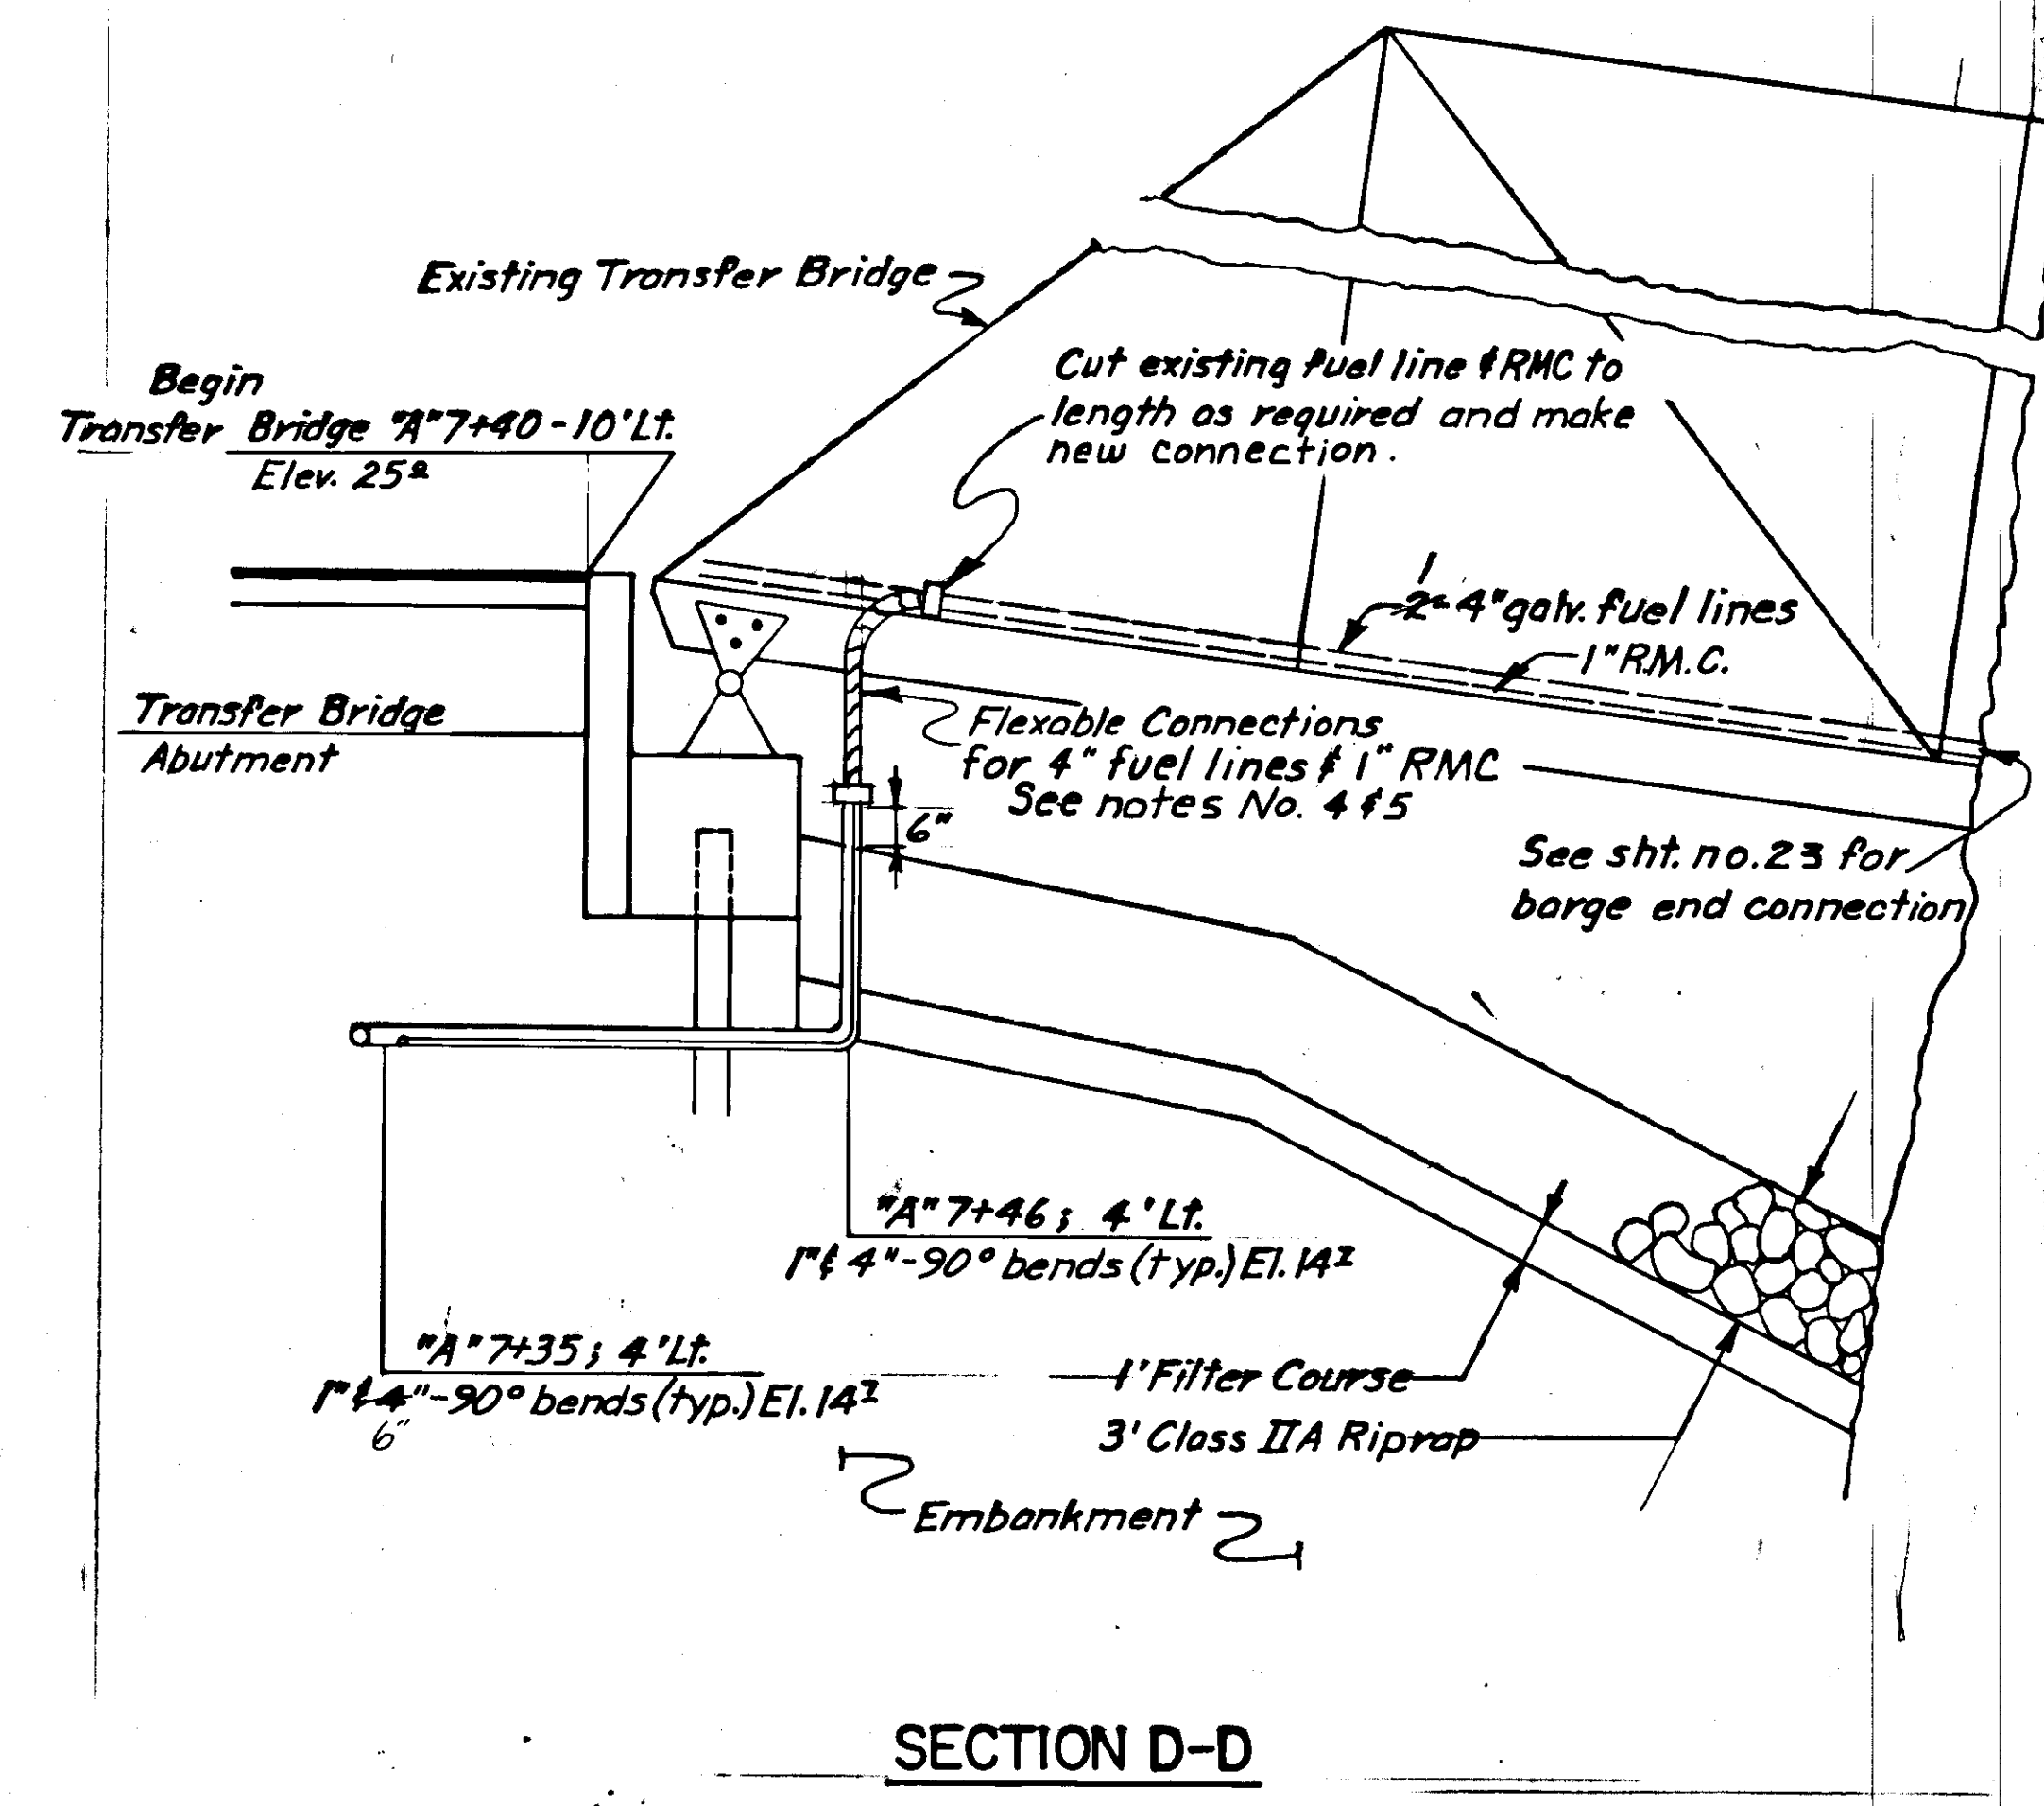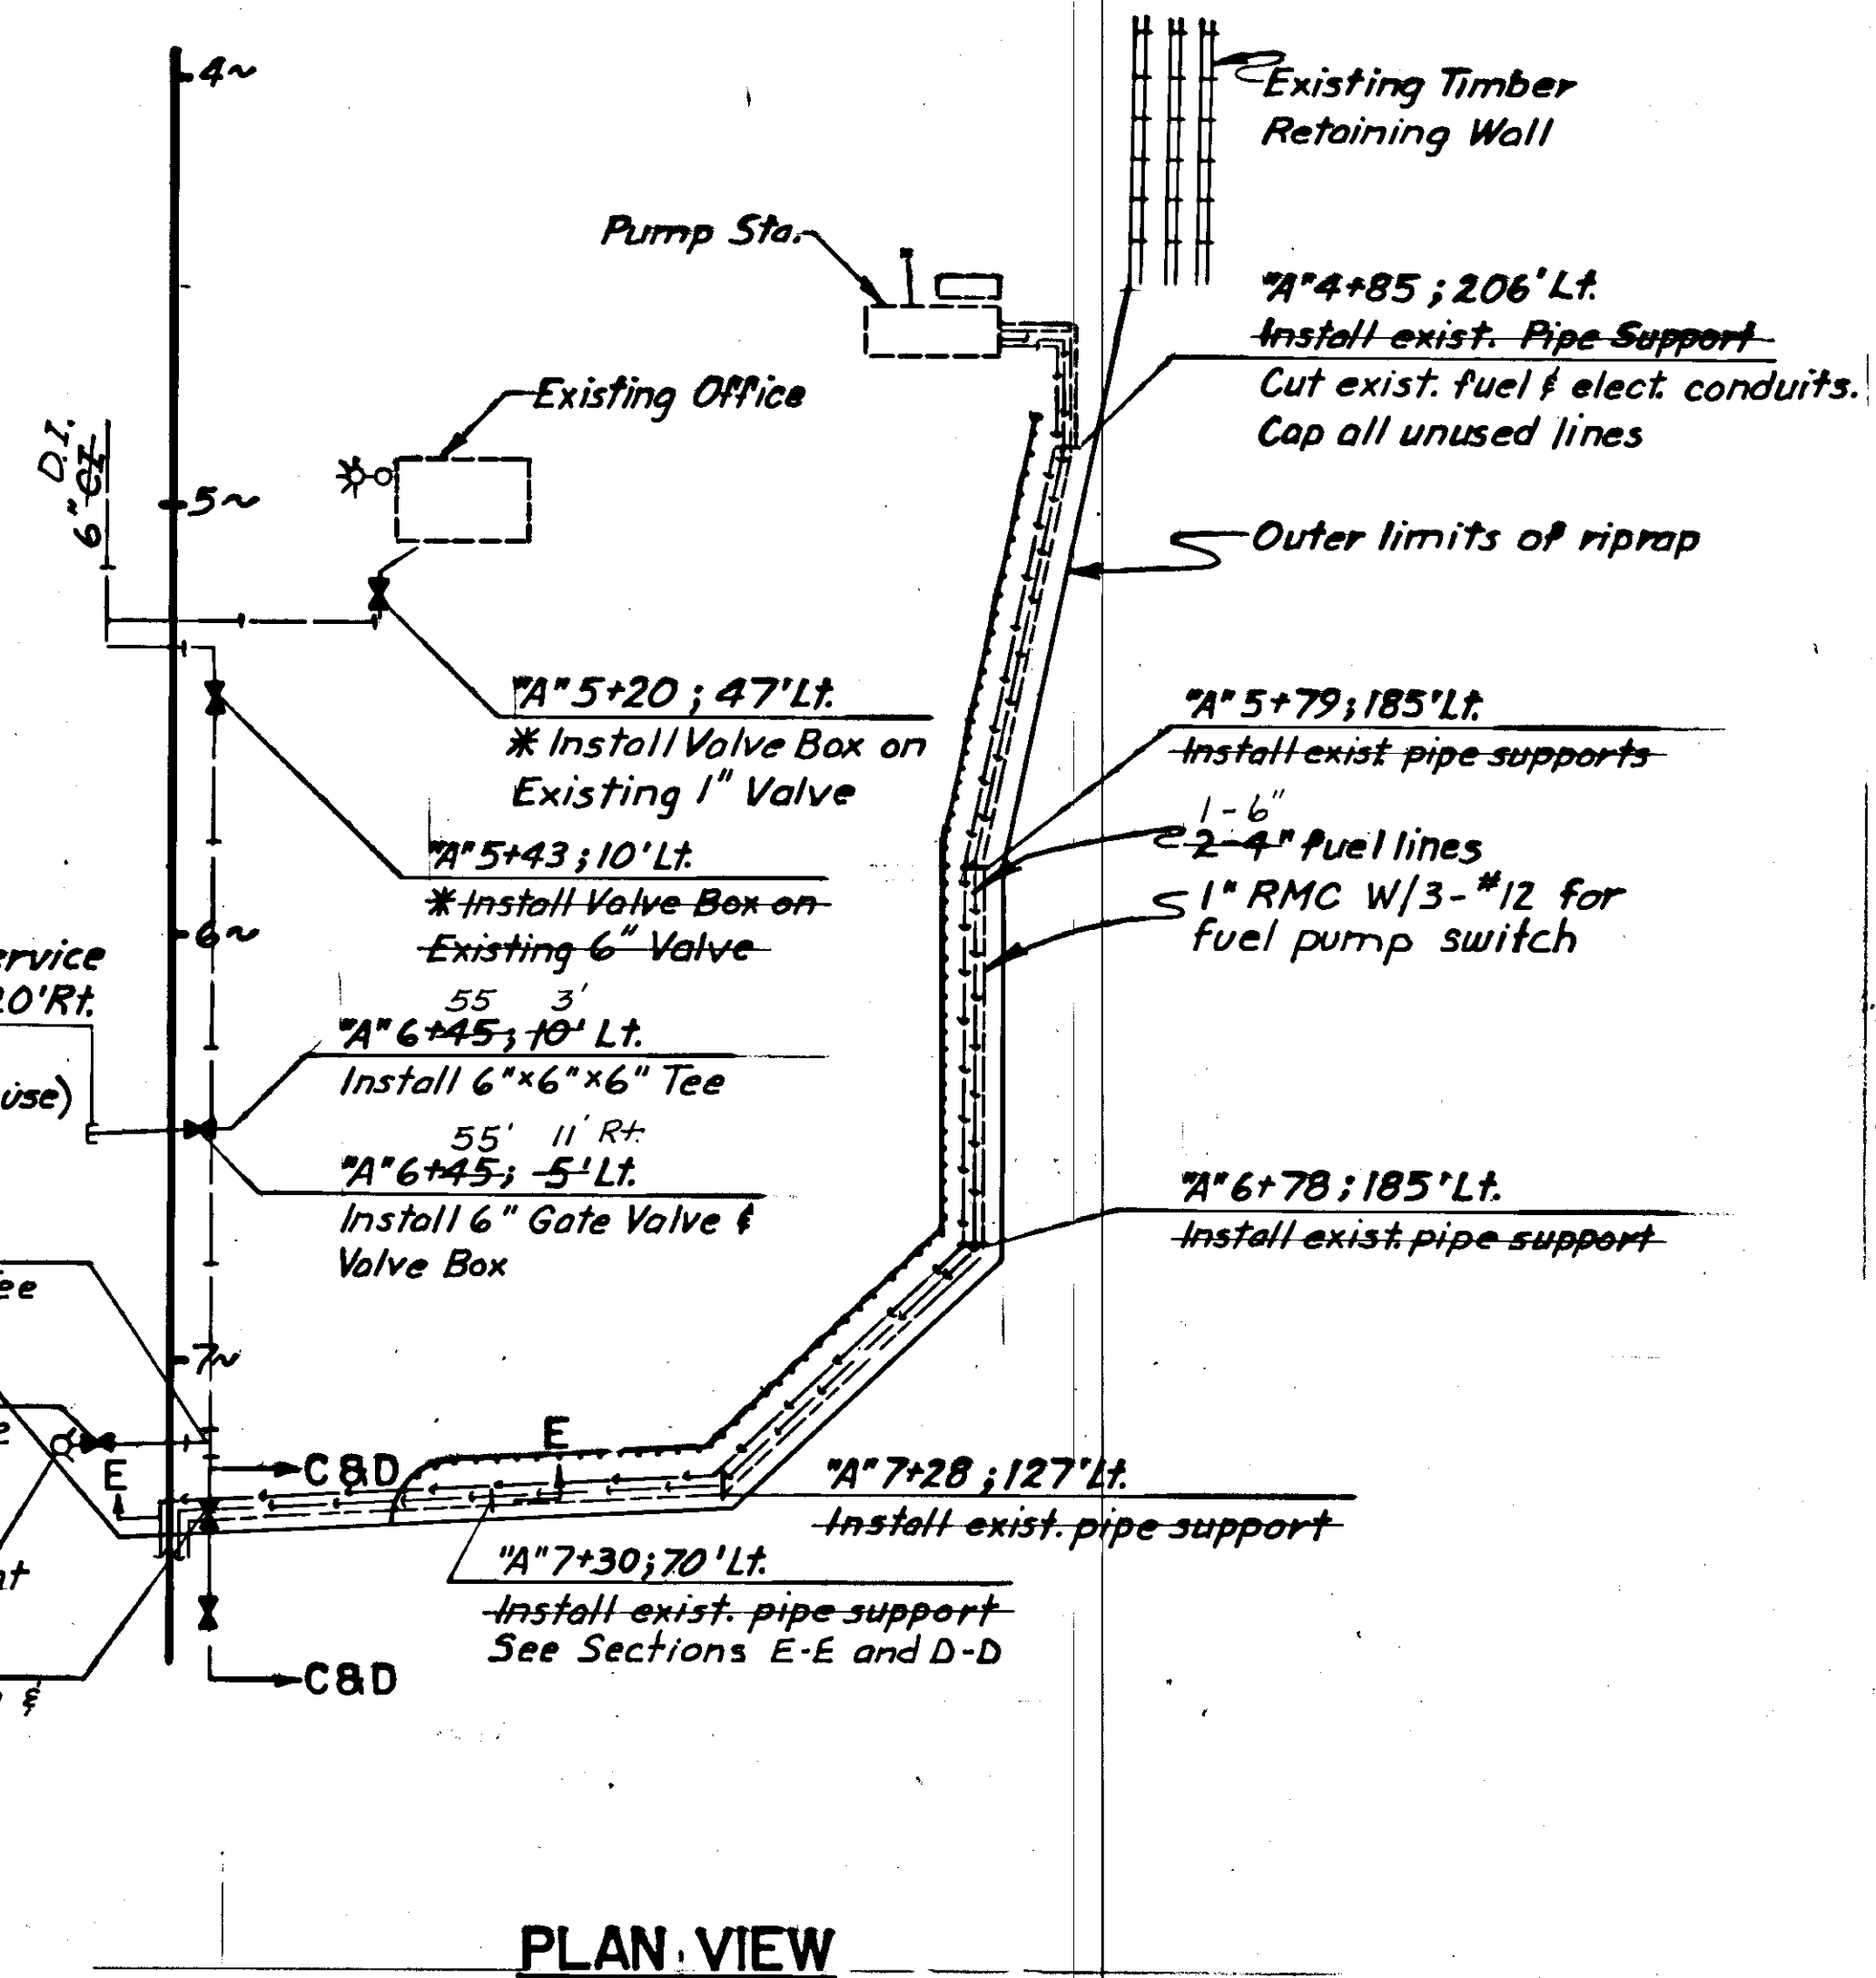







# ILLUMINATION DETAILS

## GENERAL ILLUMINATION NOTES


1. Locations given are approximate only and are subject to minor field revisions by the engineer.
2. All luminaires will be mounted 35' above staging area surface.
3. All mast arms shall be 6' long.
4. All luminaires shall be 240V-250W, medium distribution, semi-cut off type II High Pressure Sodium.
5. Footings for luminaire poles shall be cast-in-drilled holes, type II, See Standard Drawing L-30.01 for more details.
6. All luminaire poles shall be furnished with flange bases.
7. All junction boxes will be type II, see Standard Drawing L-23.03 for more details.

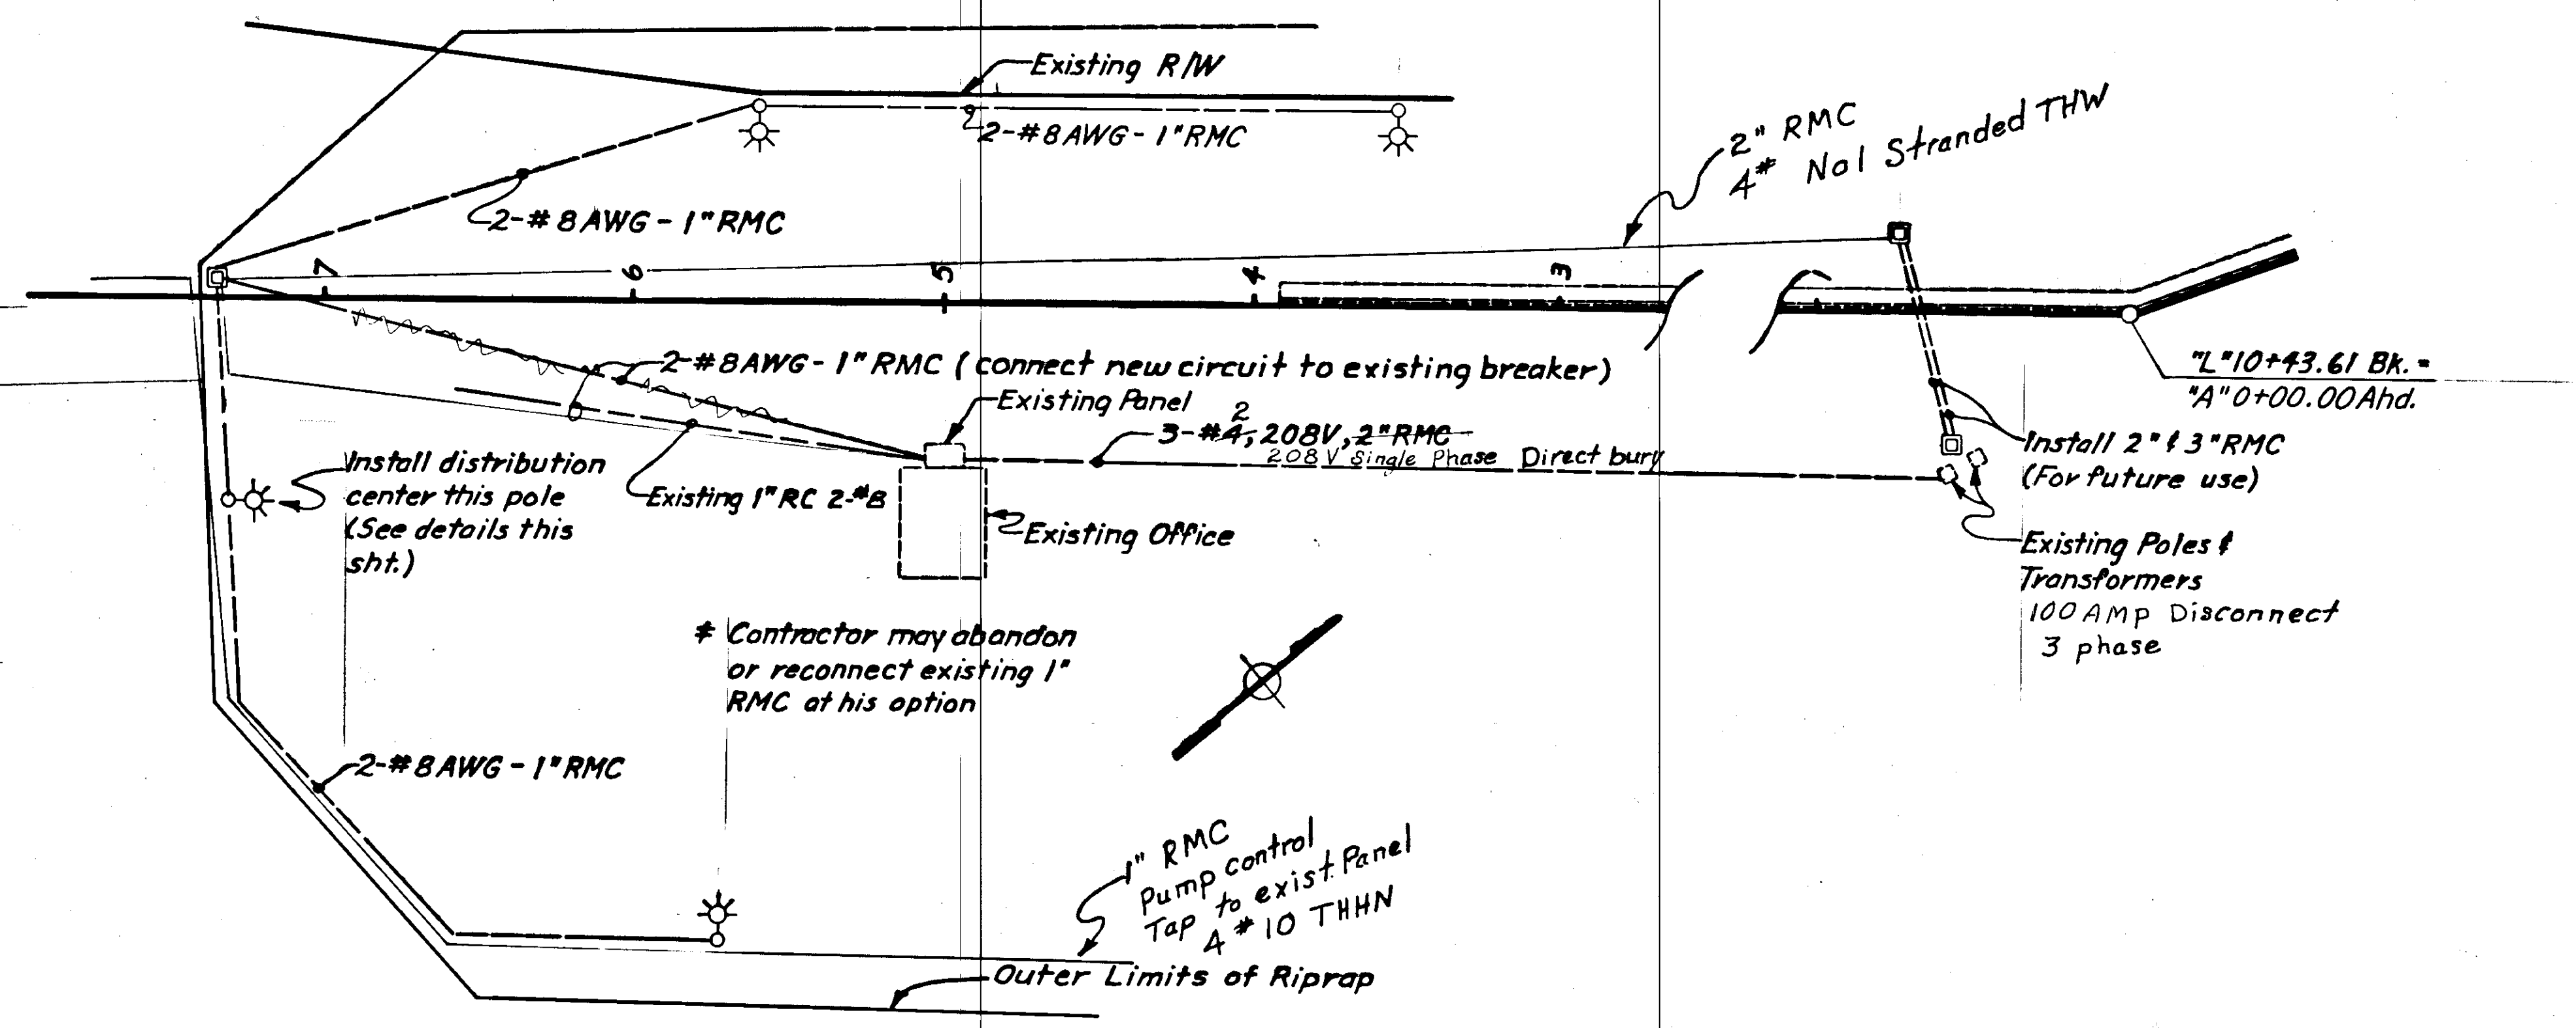

PLAN VIEW

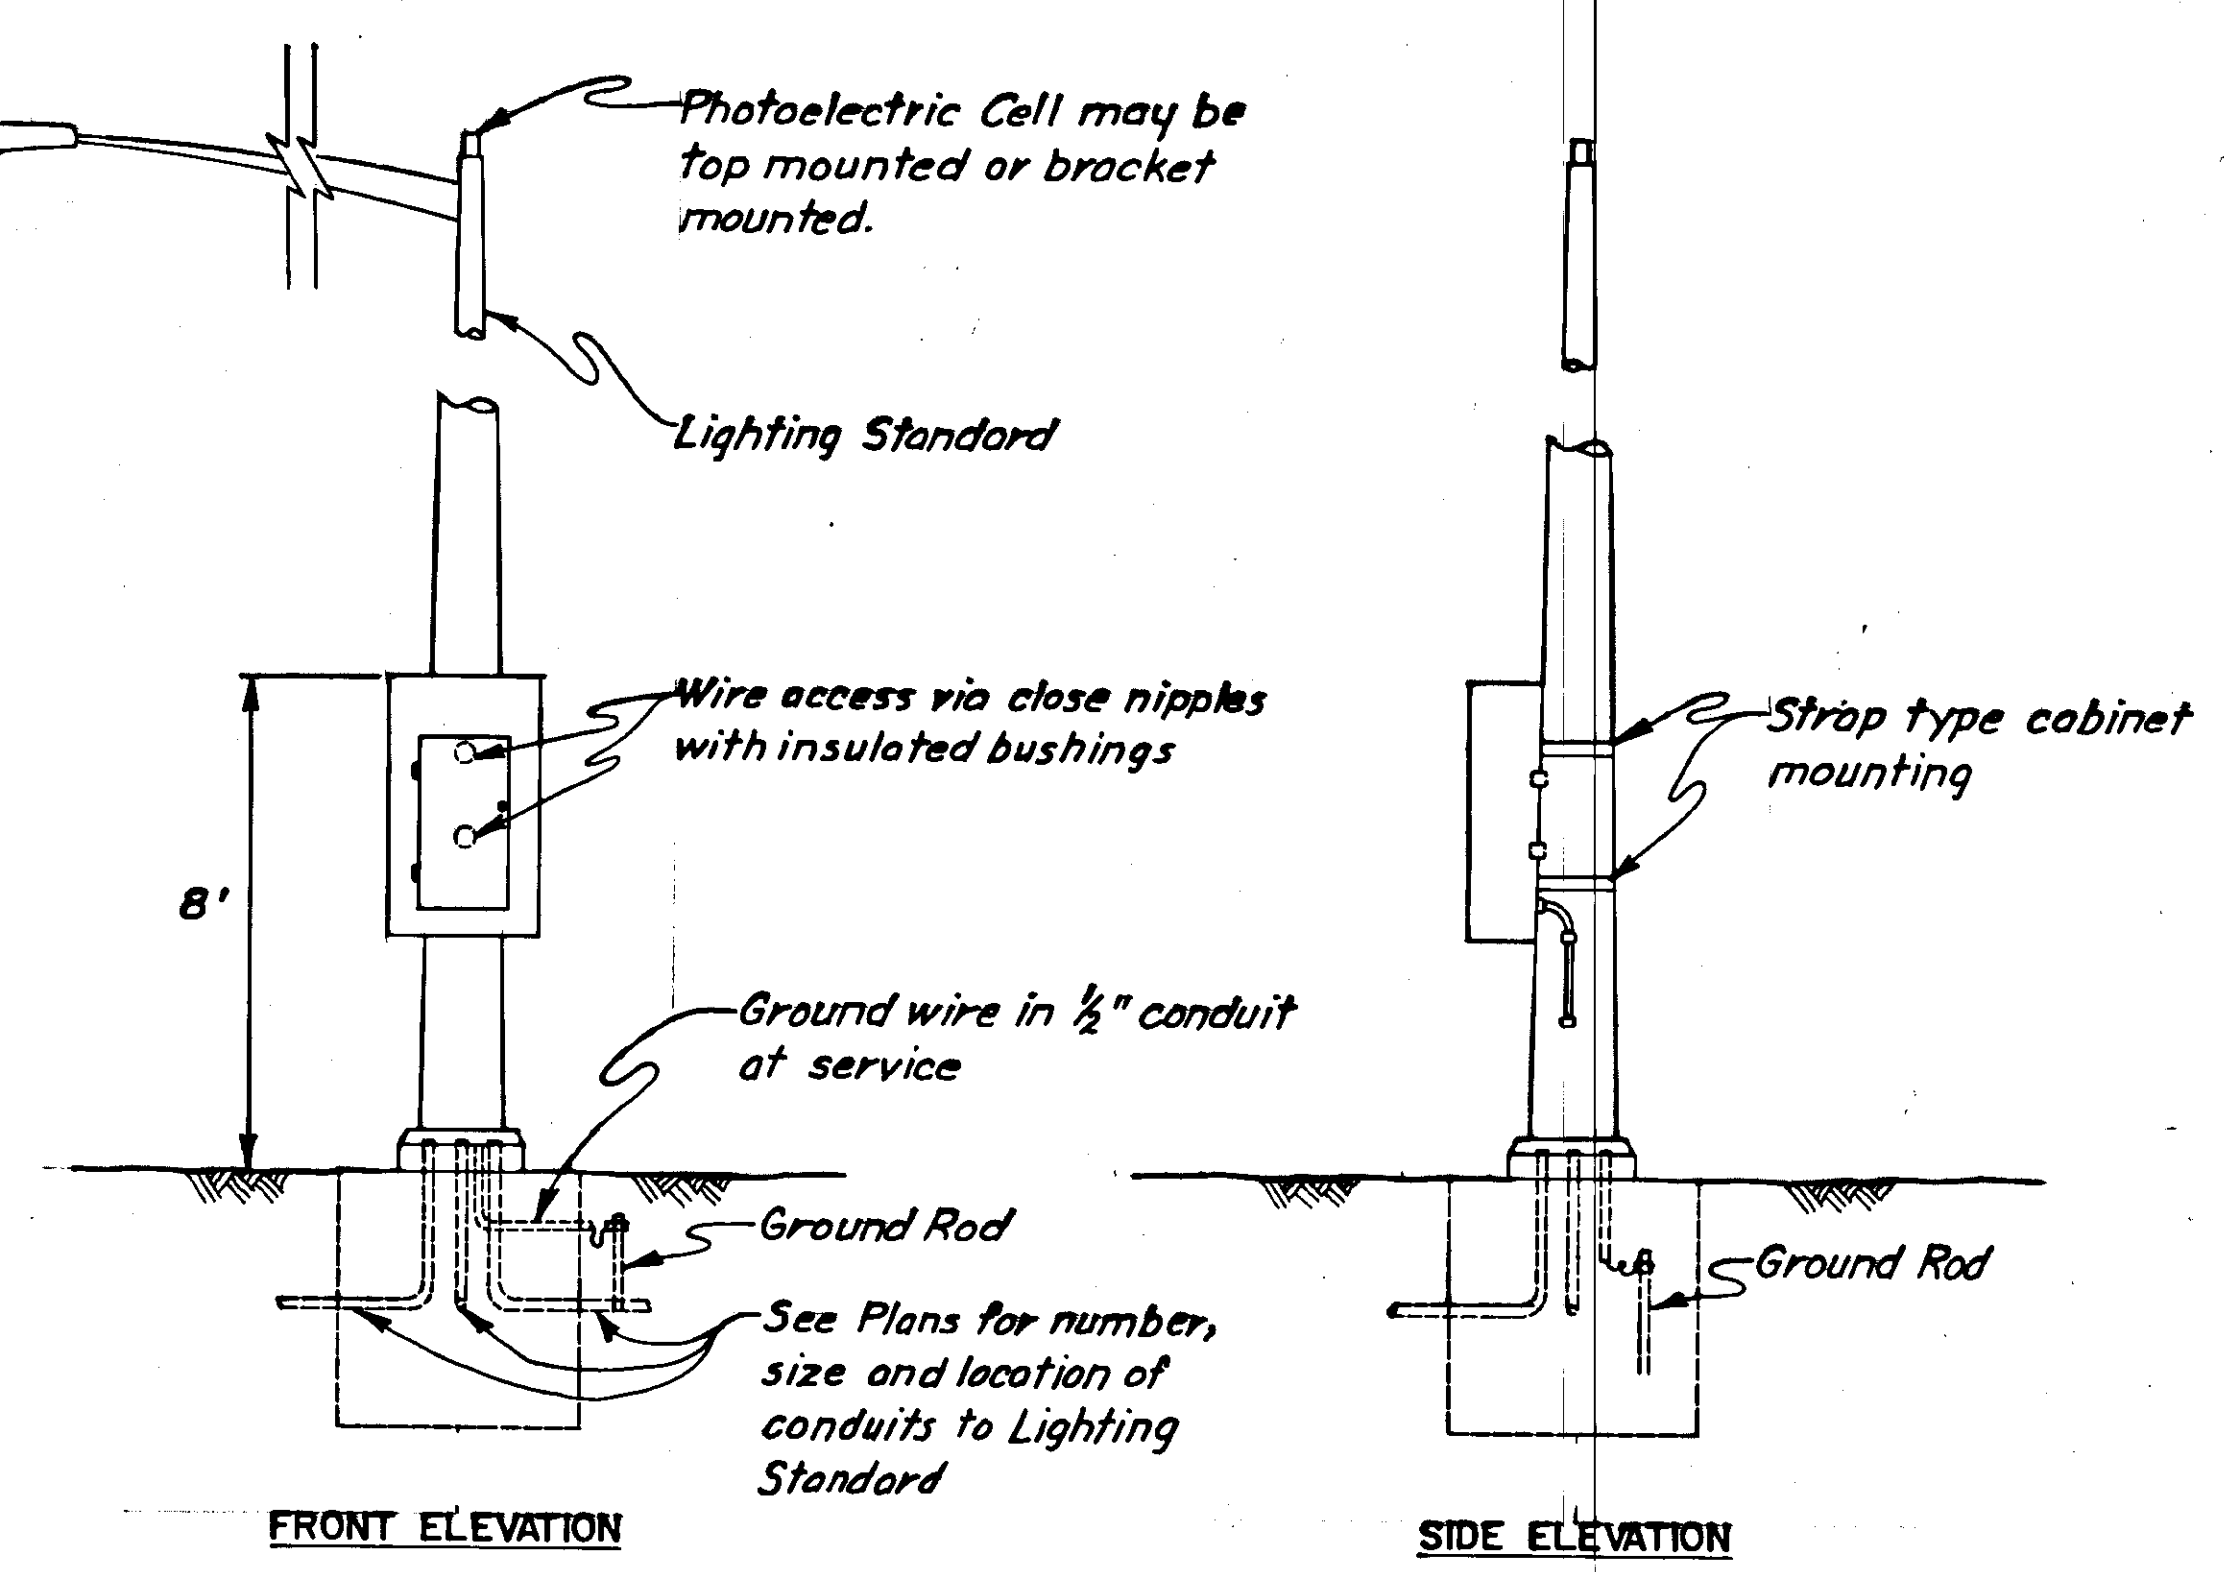







DISTRIBUTION CENTER ON METAL POLE

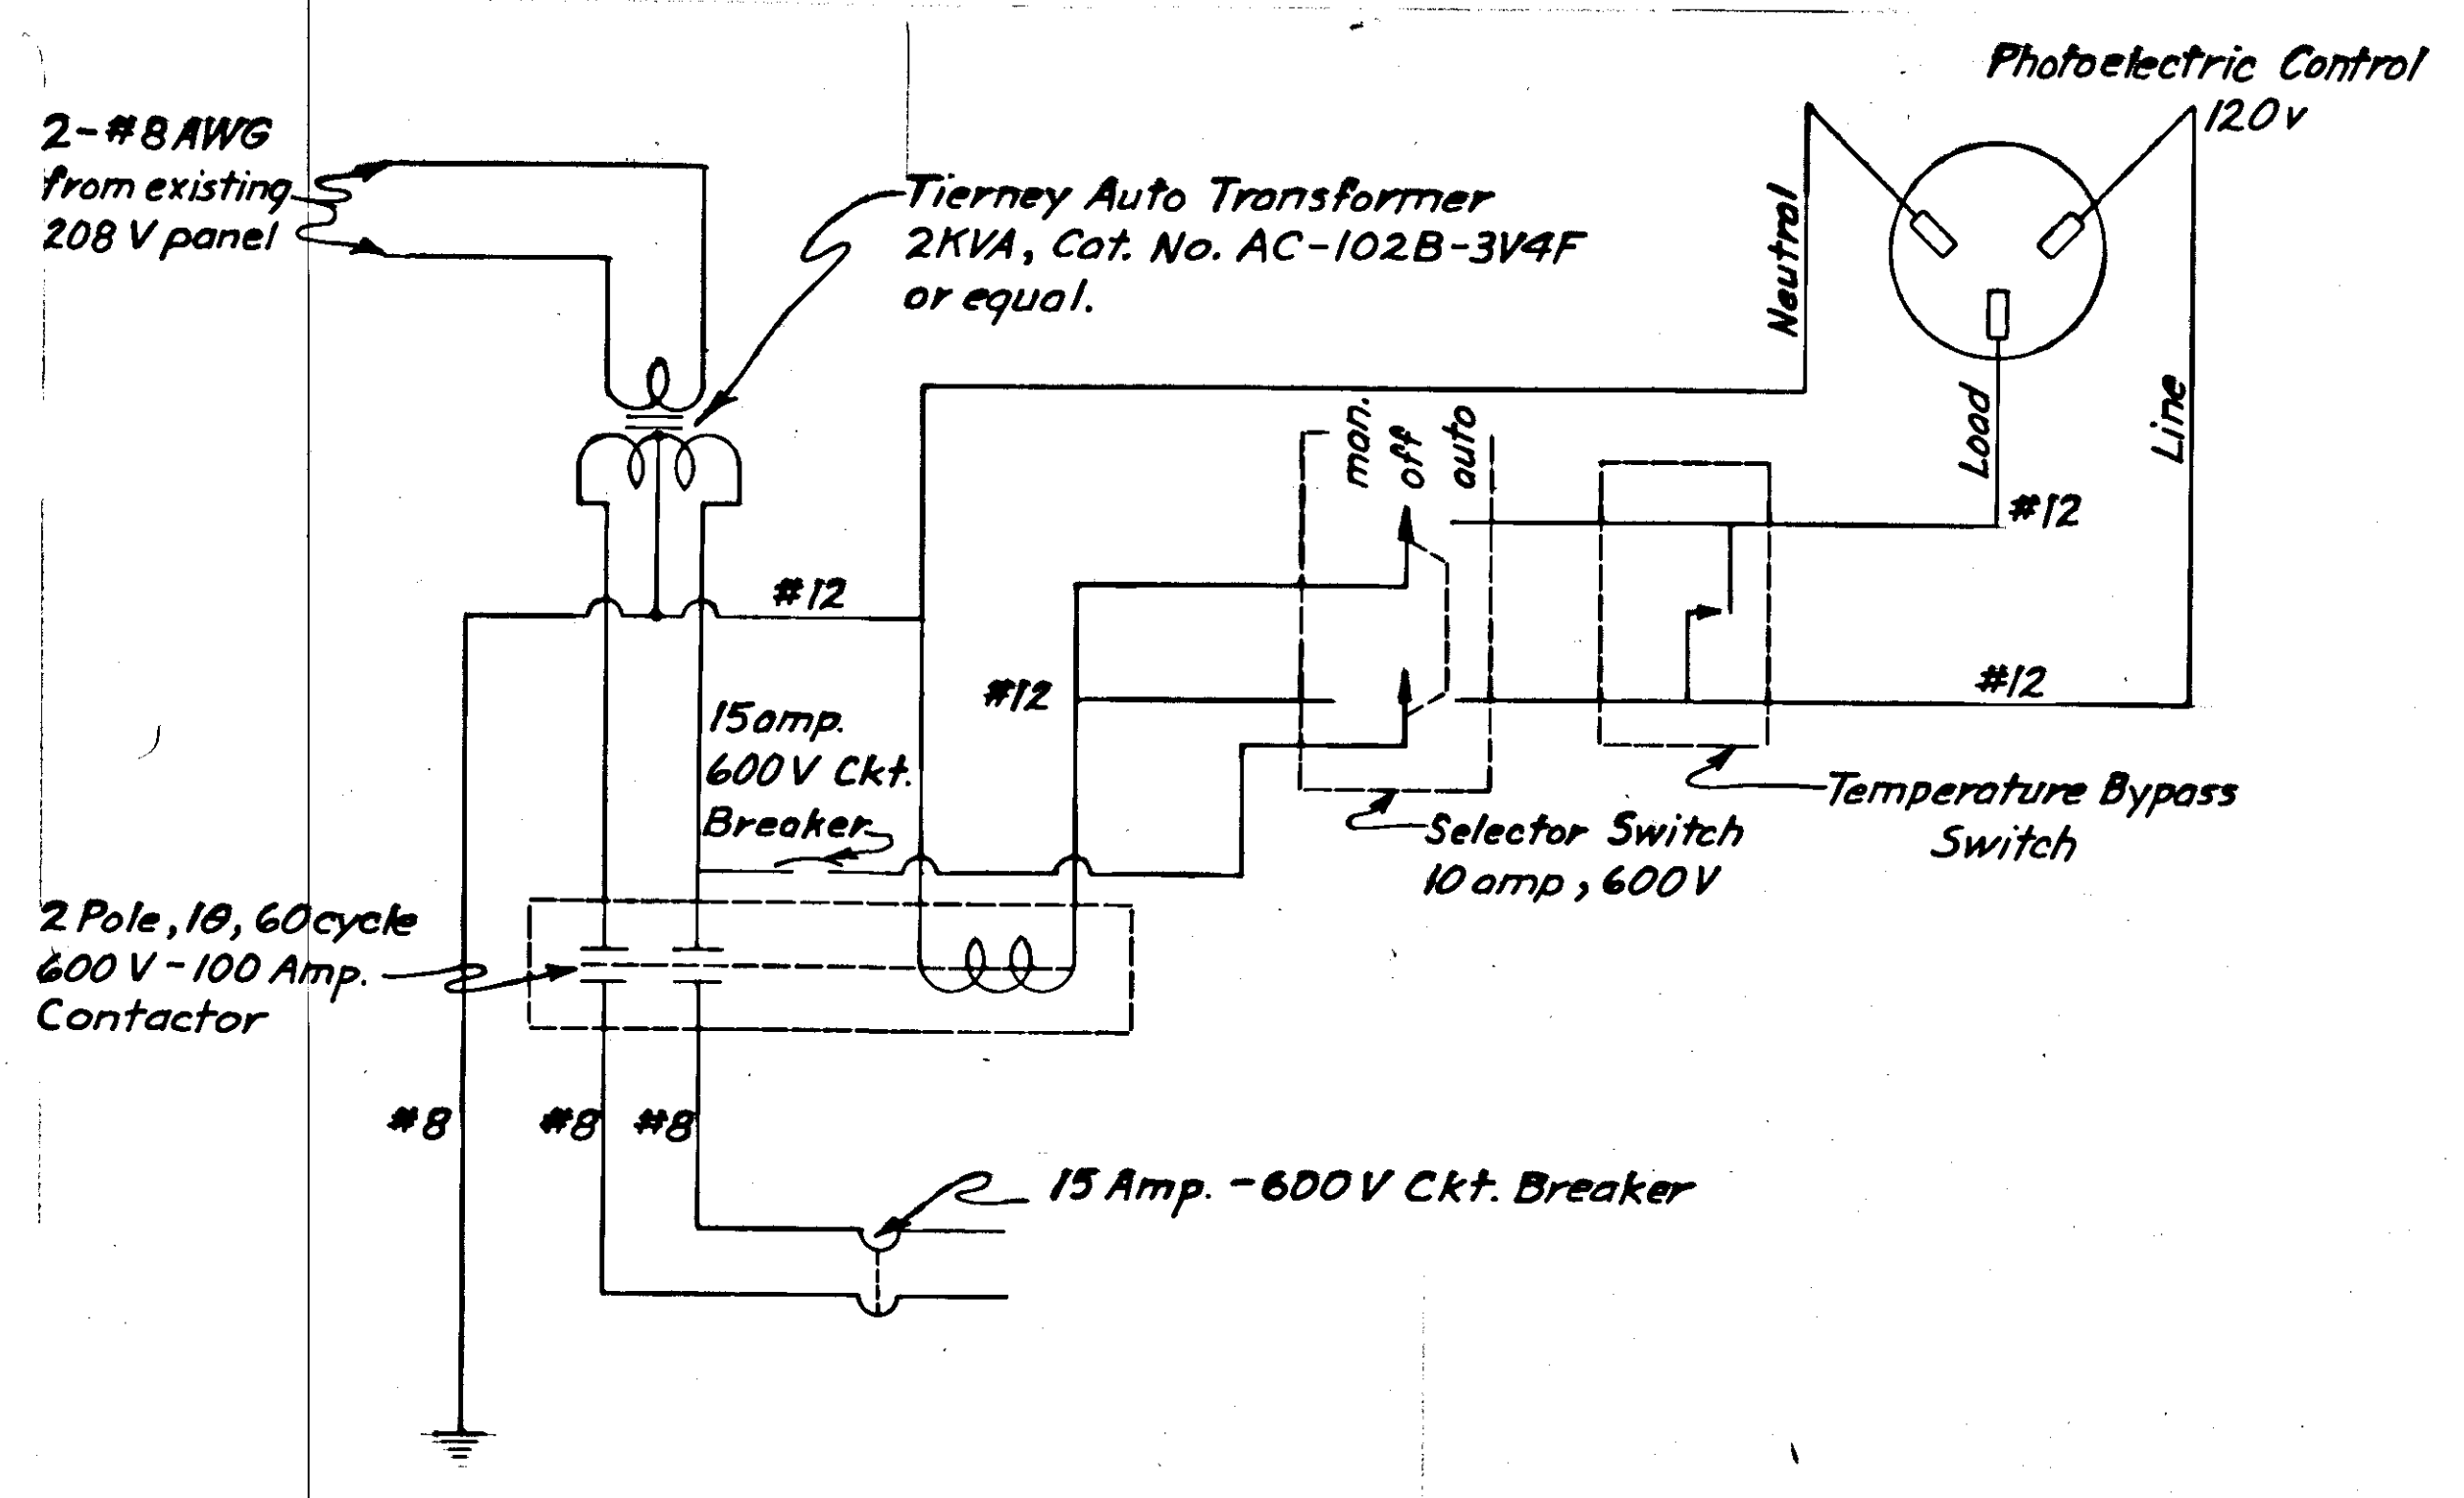

120V-240V SCHEMATIC DIAGRAM

## ILLUMINATION TABLE

STATION	OFFSET		ITEM	REMARKS
	Lt.	Rt.		
"A"0+58	58'		J-Box	For Future Use
"A"0+75		25'	J-Box	For Future Use
"A"3+50		63'	Pole	
"A"5+60	185'		Pole	
"A"5+70		63'	Pole	
"A"7+27	65'		Pole	
"A"7+35		7'	J-Box	

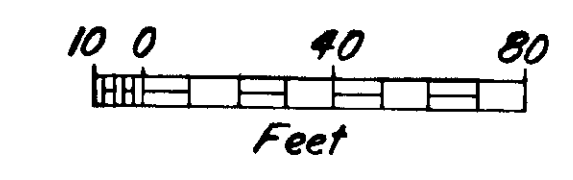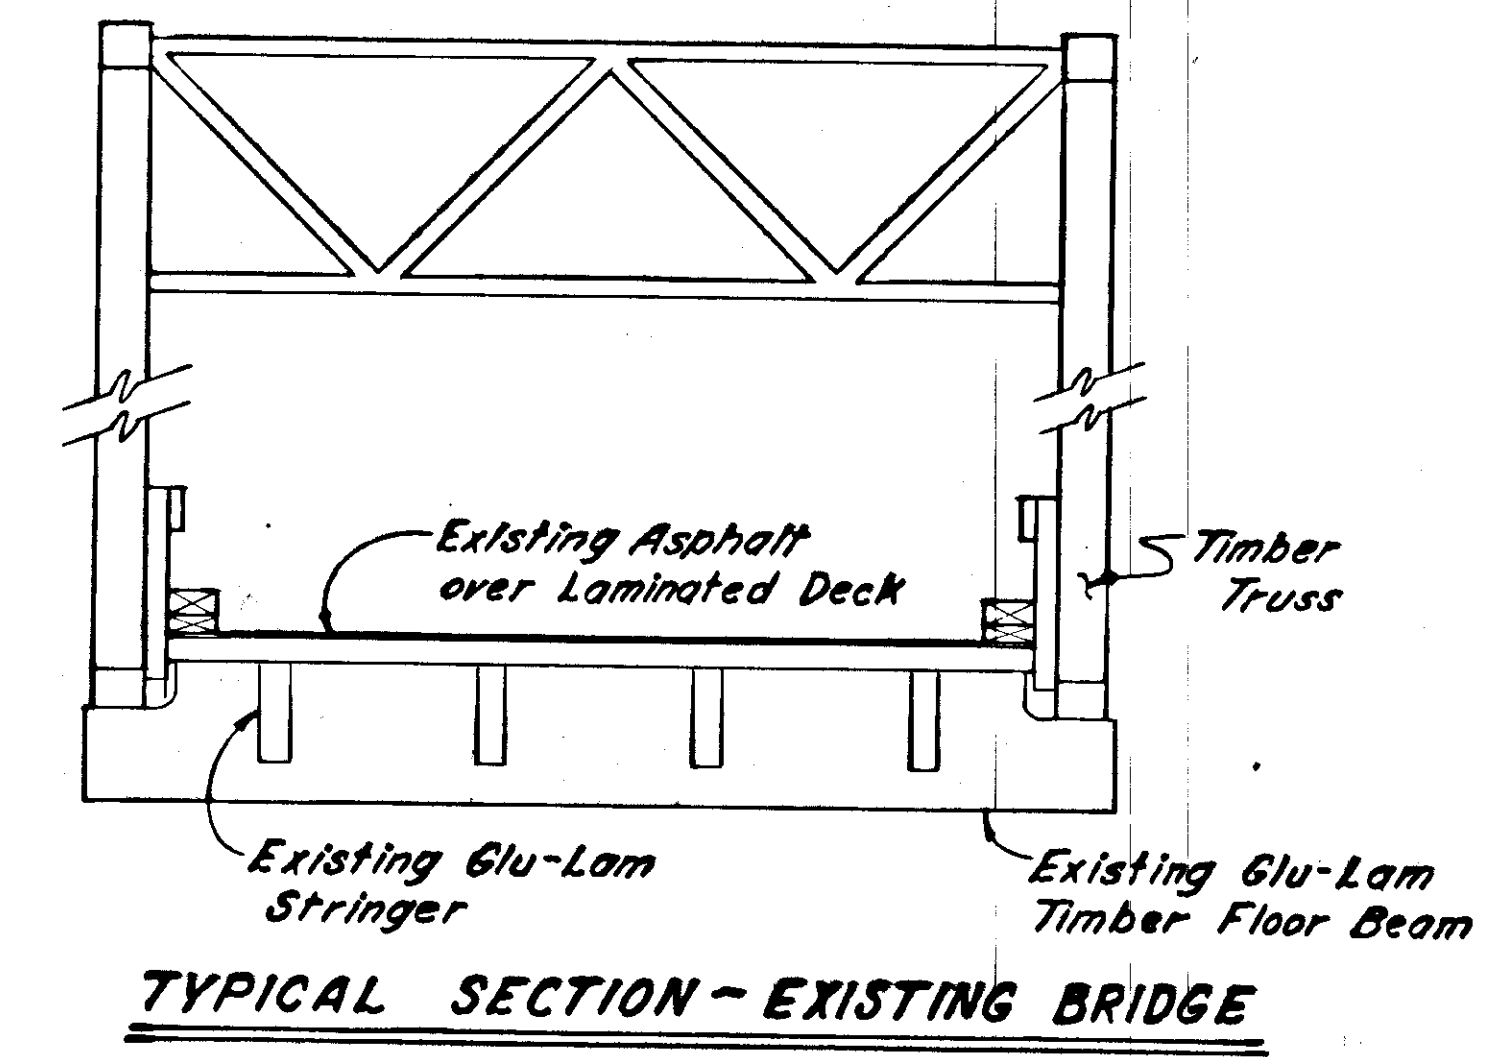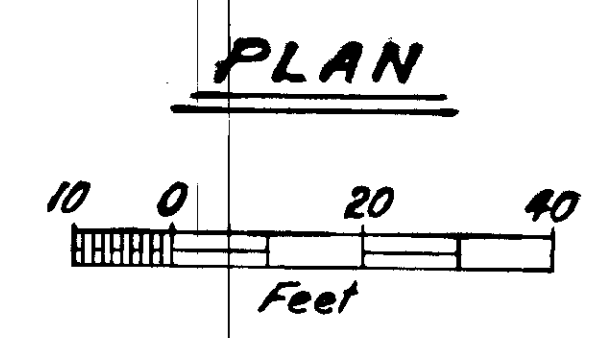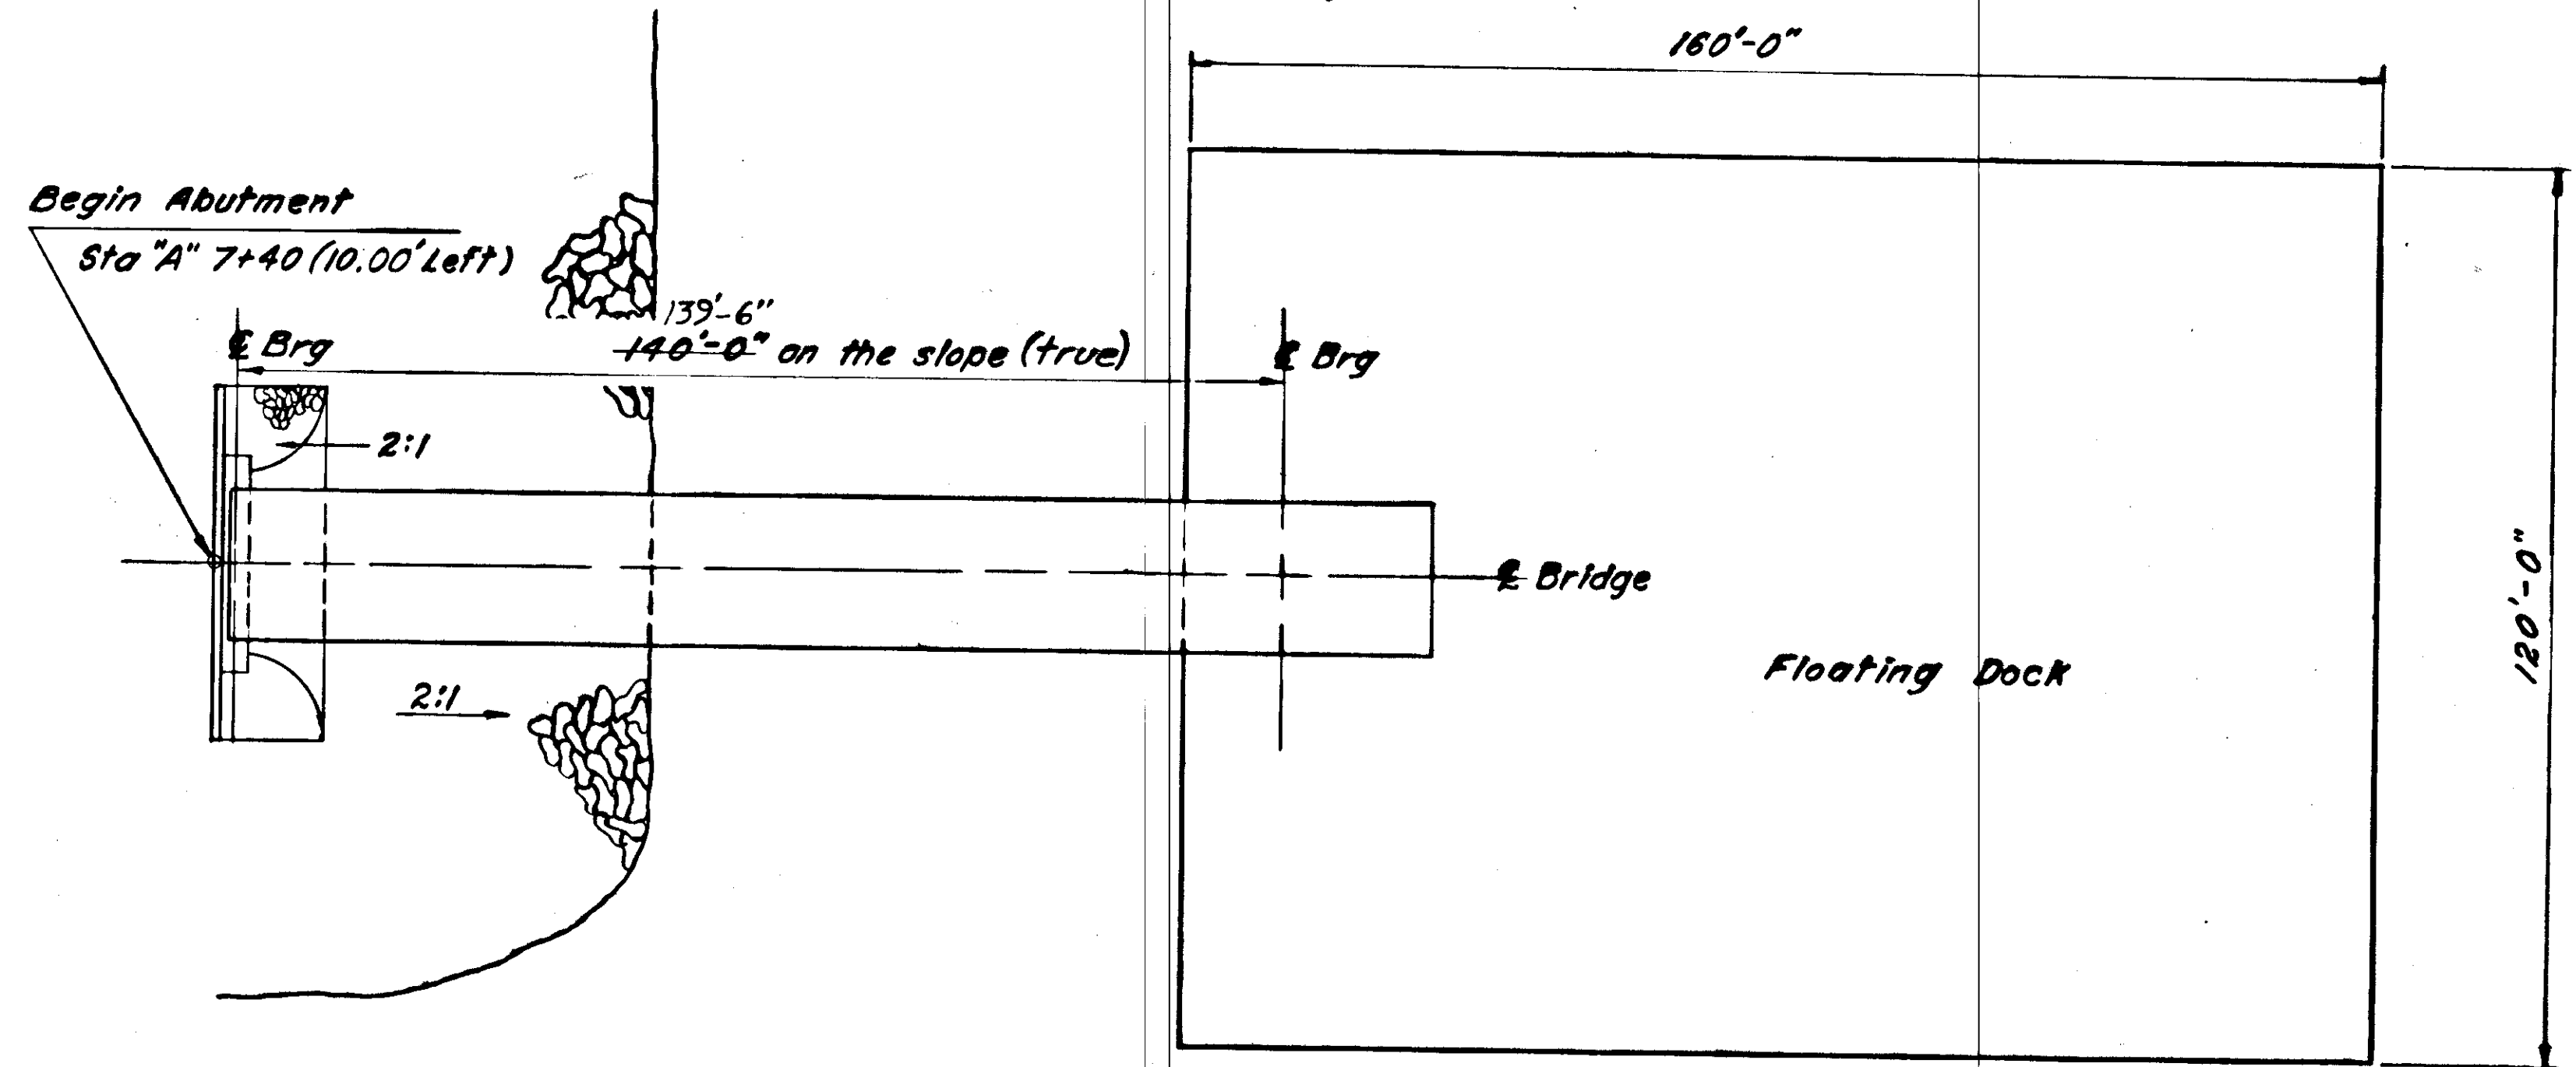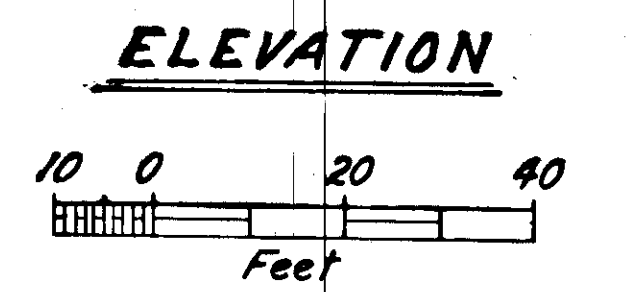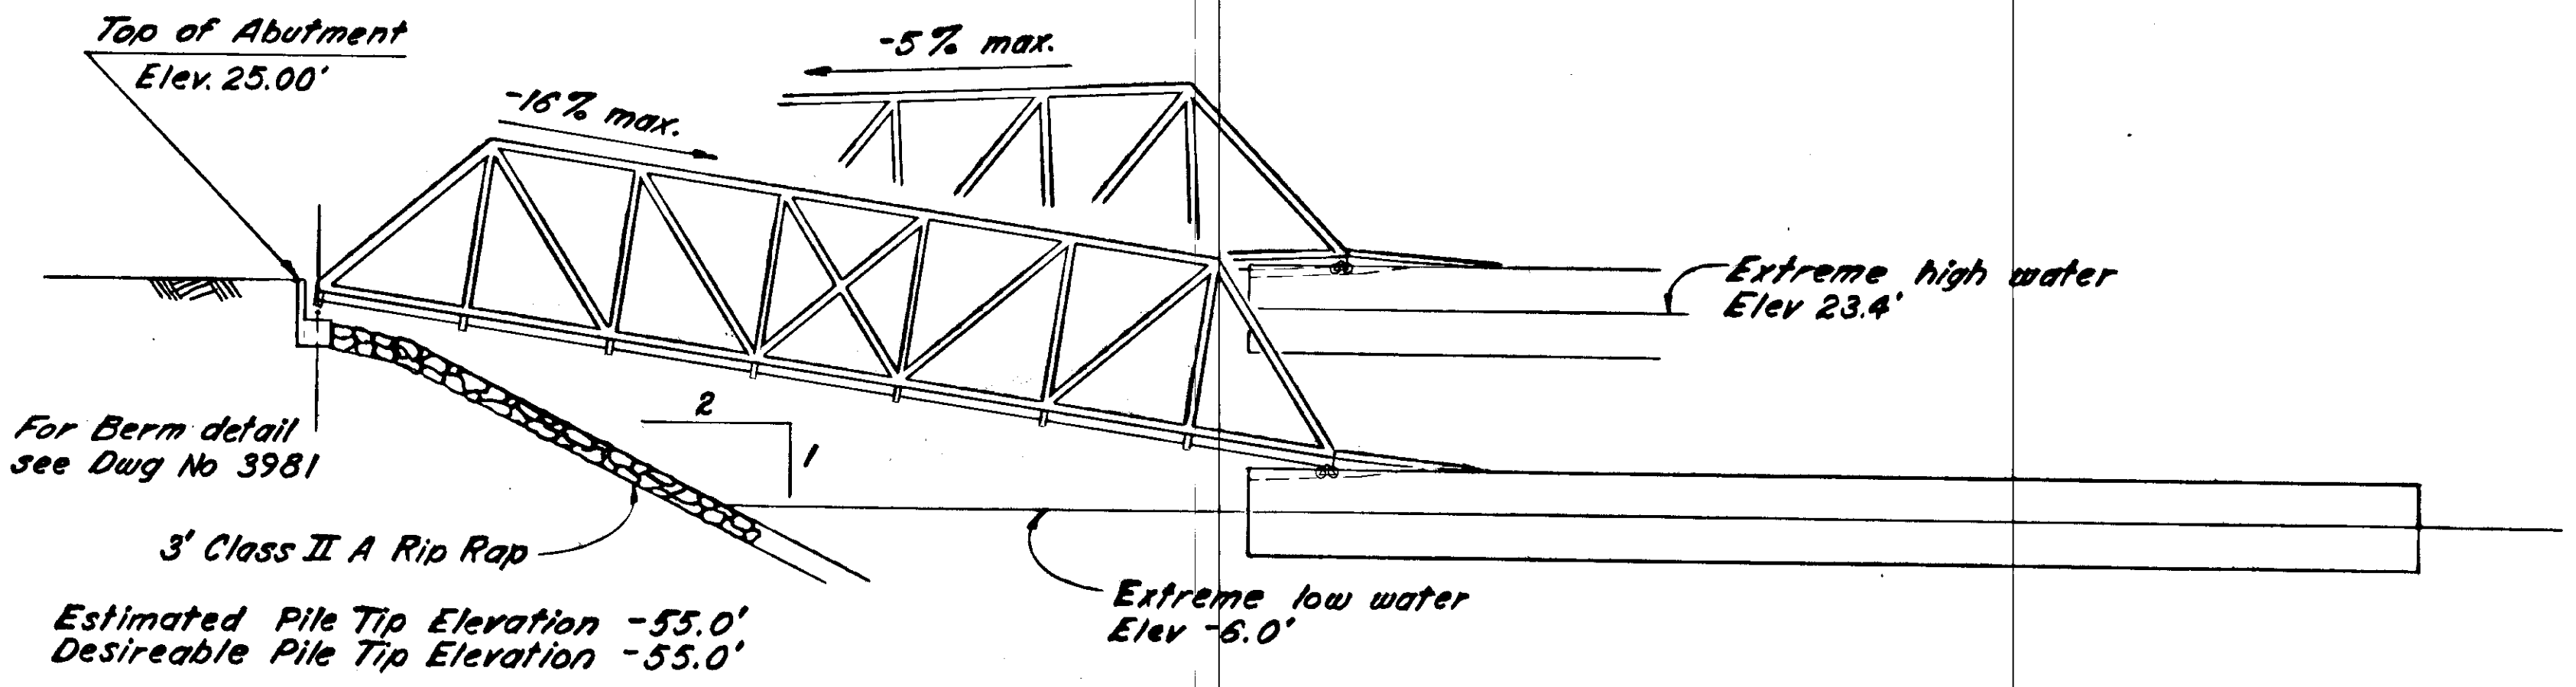

TOTAL ESTIMATED QUANTITIES				
ITEM	PAY UNIT	SUBSTR.	SUPERSTR.	TOTAL
Removal of Structures & Obstructions	Lump Sum	—	—	All Req'd
Class "A" Concrete	C. Y.	29.1	—	29.1
Reinforced Steel	Lbs.	2420	—	2420
* Structural Steel furnished, fabricated & erected	Lbs.	3090	3180	6270
Structural Steel Piles furnished & driven	L.F.	436	—	436
Relocation of Structures	Lump Sum	—	—	All Req'd

\* Does not include the weight of wheels and axles

**GENERAL NOTES:**

- Specifications:**  
 Design: AASHTO Standard Specifications for Highway Bridges, 1977 Edition  
 Construction: State of Alaska Standard Specifications for Highway Construction, 1972, with Supplemental Specifications, 1975 and Special Provisions.  
 Design Live Load: HS 20-44  
 Design Unit Stresses:  
 Structural Steel: Tension and extreme fiber bending stress 20,000psi(A36) and 27,000psi(A572)  
 Reinforced Concrete:  $f_c' = 3000$  psi,  $f_y = 60,000$  psi,  $n=10$   
**Structural Materials:**  
 Structural Steel: All structural steel shall be A36 unless noted otherwise.  
 Concrete: All cast-in-place concrete shall be Class "A."  
 Reinforcing Steel: All reinforcing steel shall conform to ASTM 615 Grade 60  
**Steel Piles:**  
 Design Load: 40 Tons  
 Type: MP 12 X 74
- When the dock is in its neutral position the face of the dock will be 127' horizontal from the centerline of abutment bearings.

**INDEX**

TITLE	DWG NO
GENERAL LAYOUT	3980
ABUTMENT	3981
ABUTMENT BEARING	3982
DOCK BEARING	3983











The following Standard Drawing applies to this Bridge: F-01.20

**SKAGWAY TRANSFER BRIDGE**  
 ROUTE NO. F-97  
 GENERAL LAYOUT

State of Alaska  
 DEPARTMENT OF TRANSPORTATION  
 and PUBLIC FACILITIES  
 Juneau, Alaska


Date 8-17-78  
 Approved *[Signature]*  
 BRIDGE NO. 805  
 DWG. NO. 3980

STATE	PROJECT DESIGNATION	YEAR	SHEET NO.	TOTAL SHEETS
ALASKA	F-097-2(2)	1978	18	41

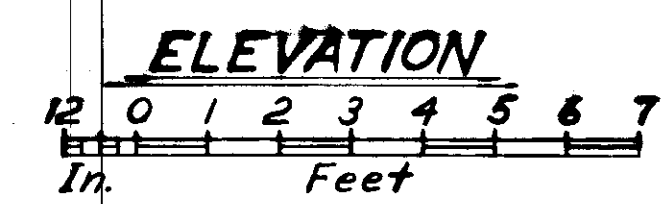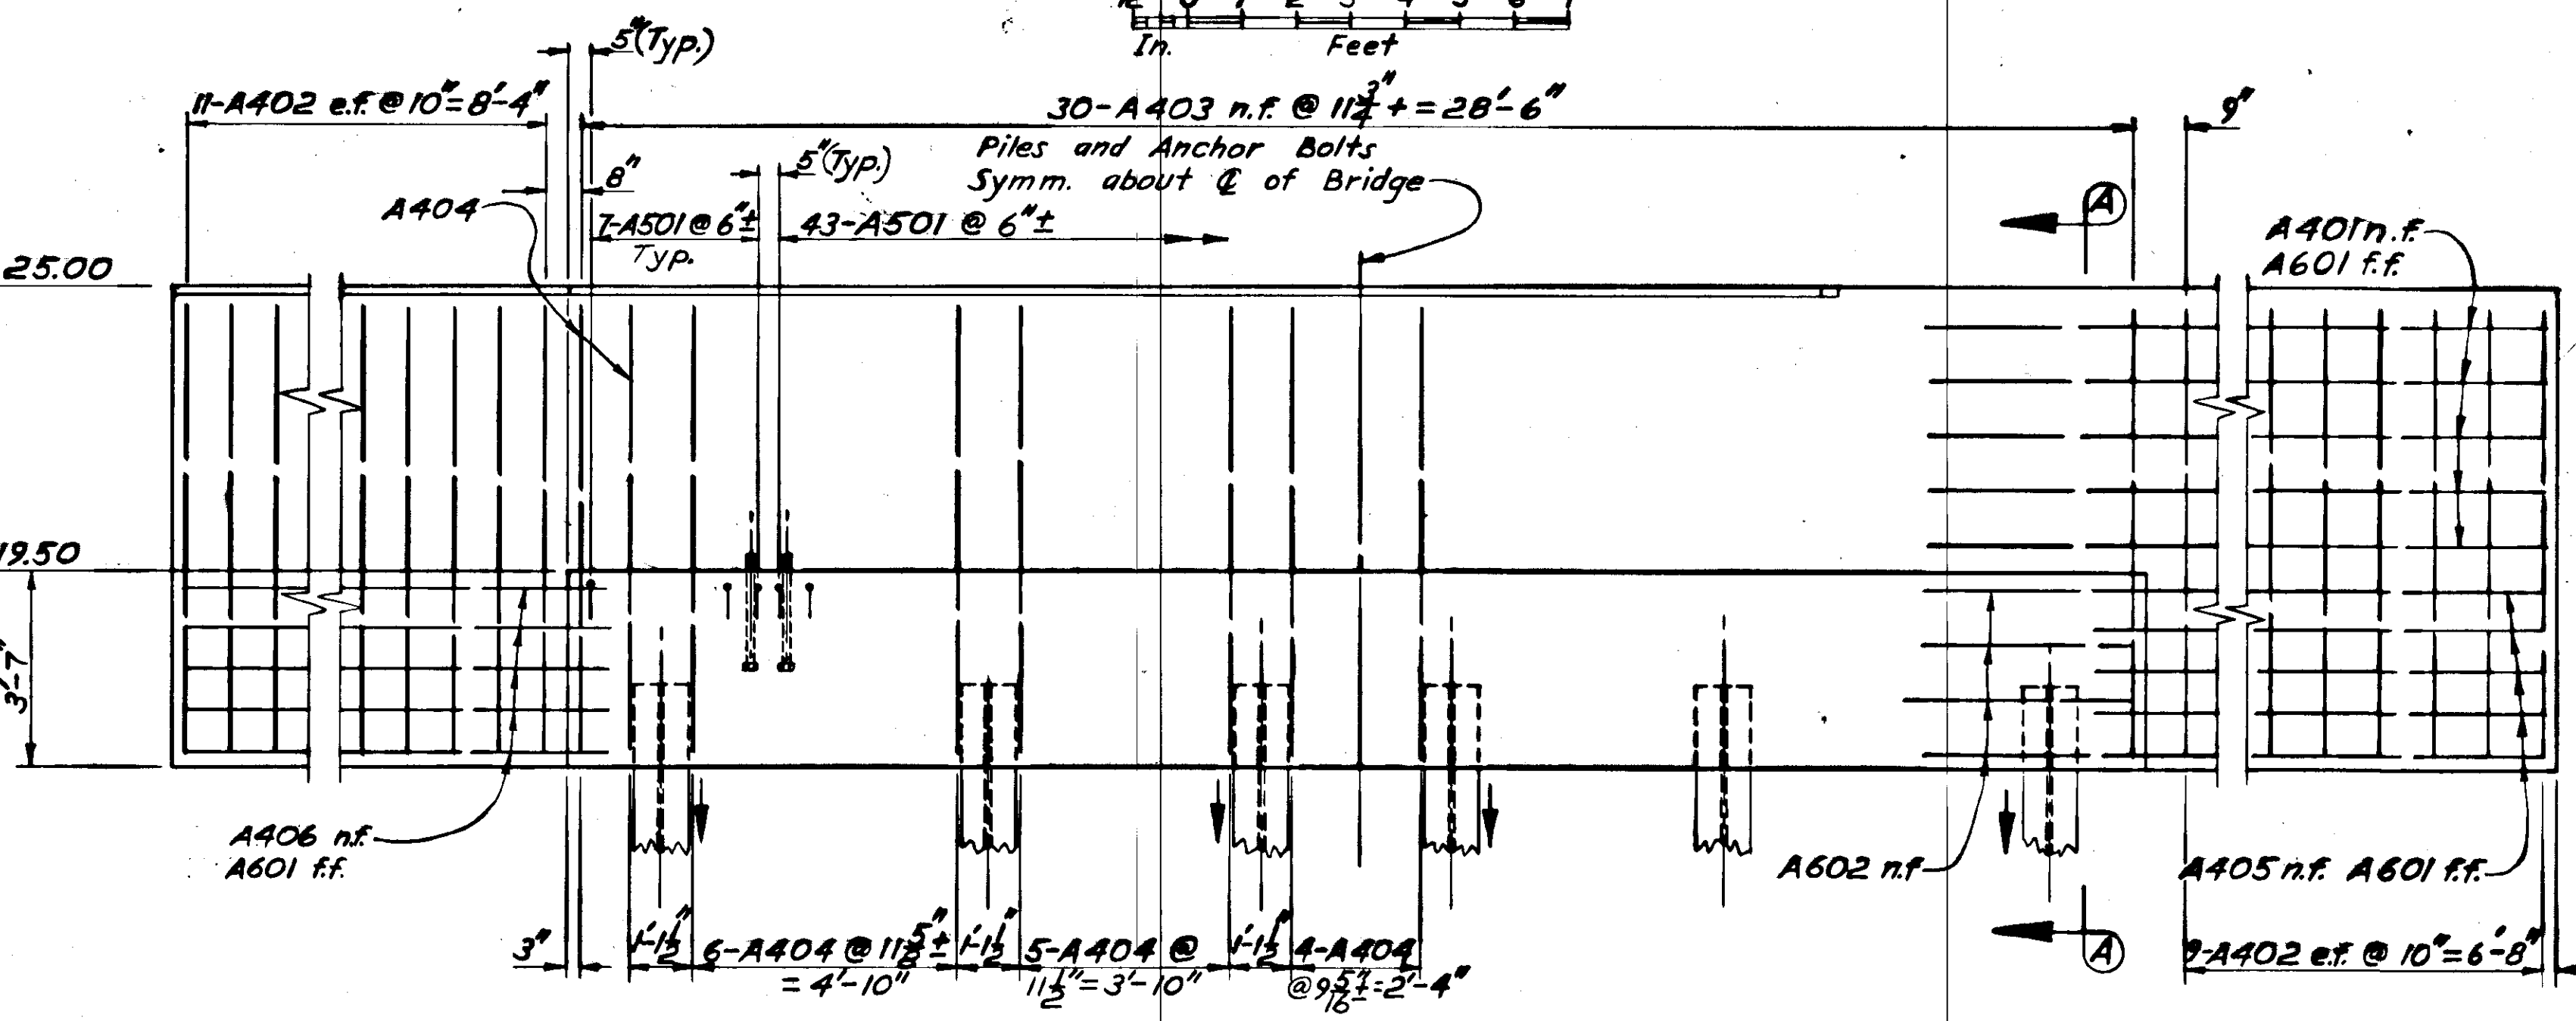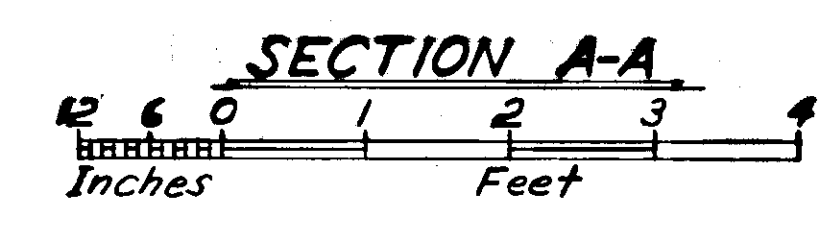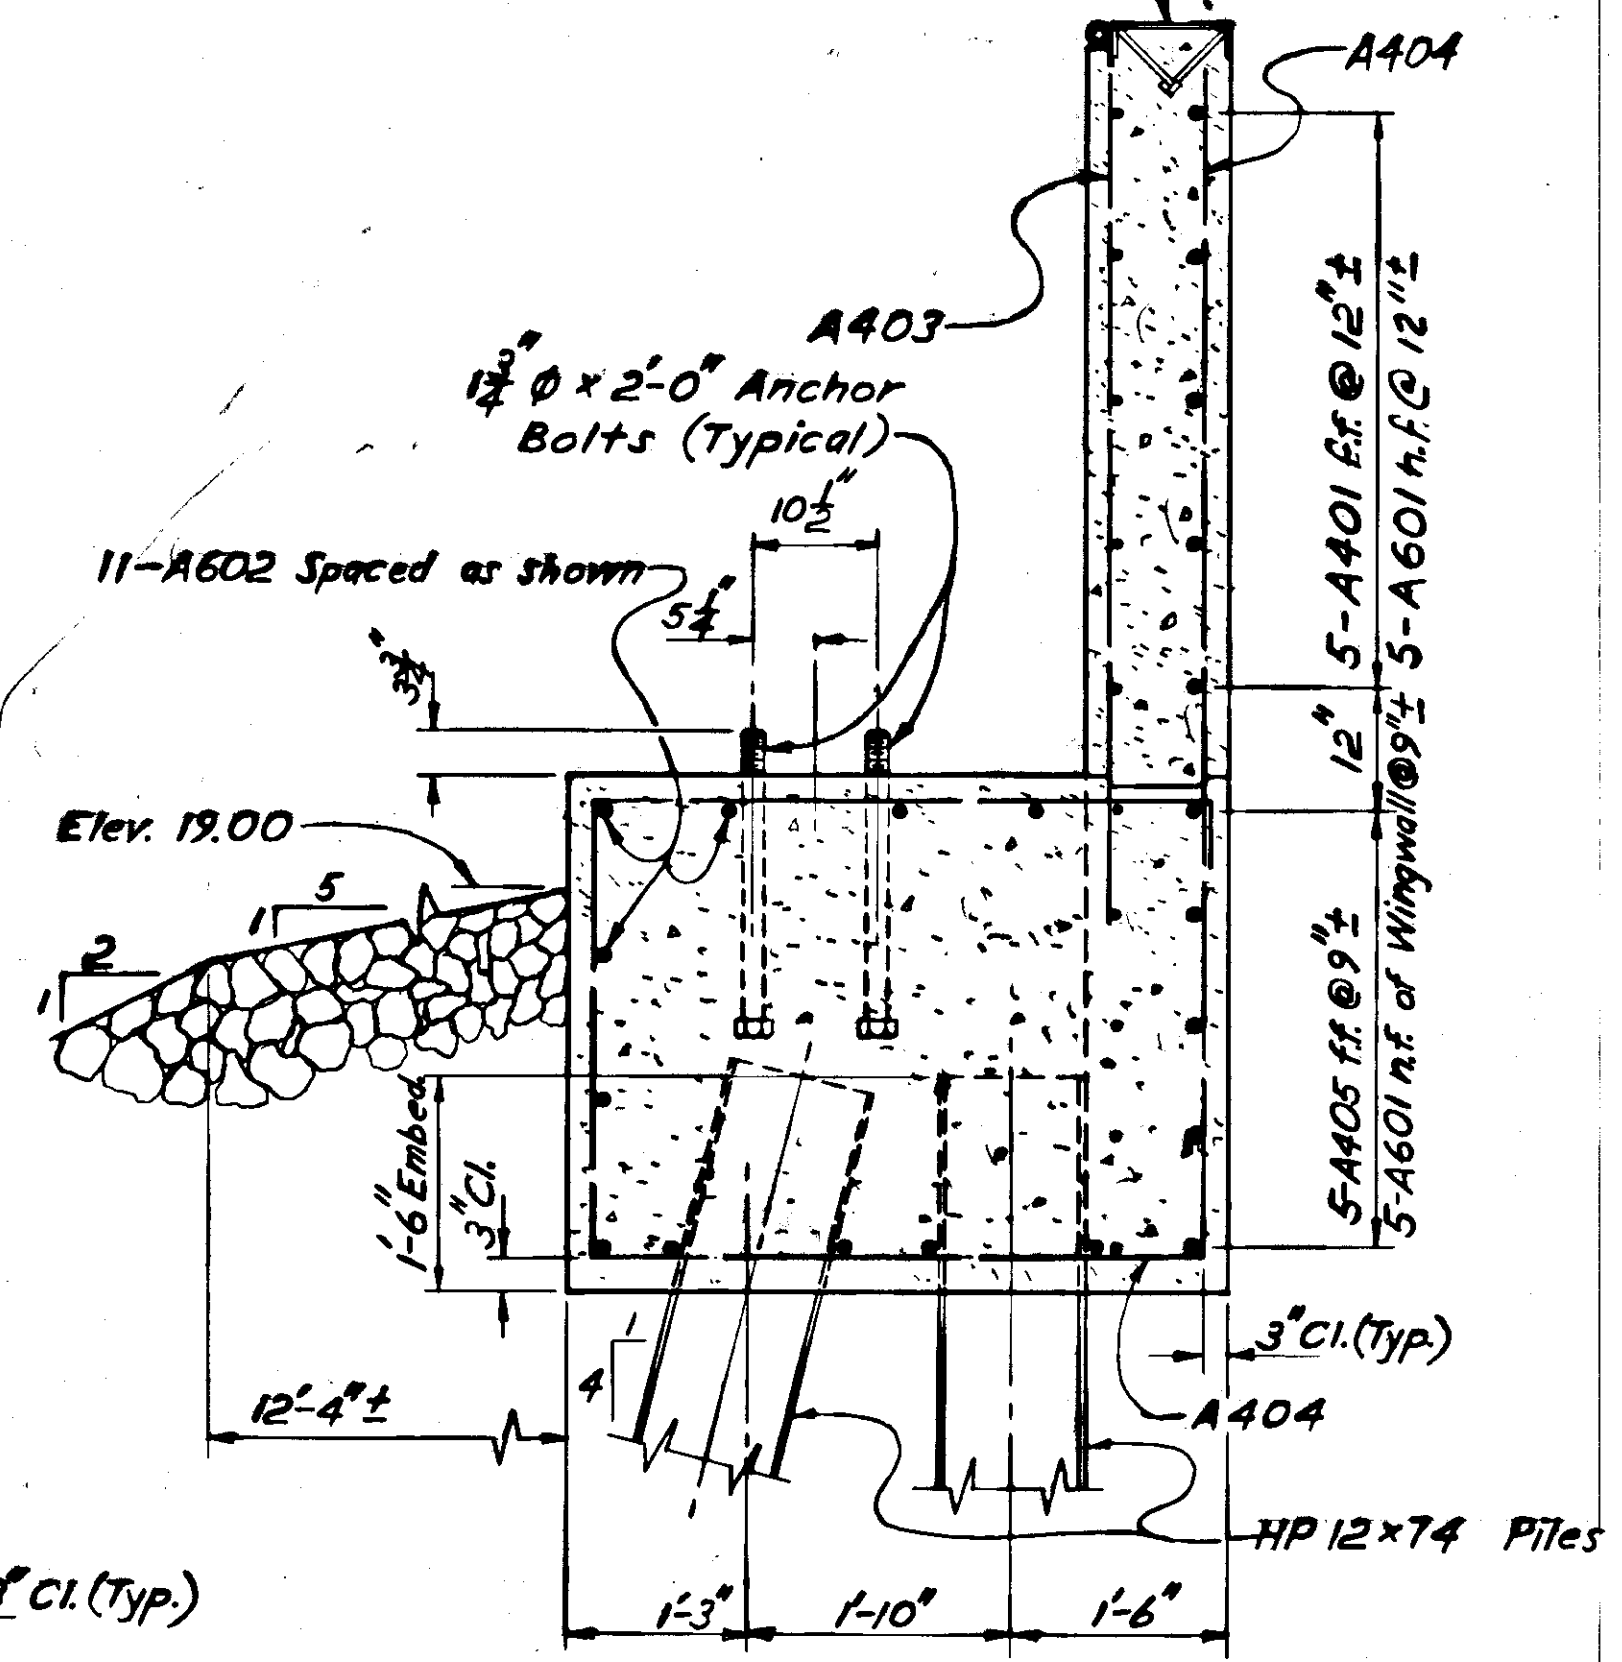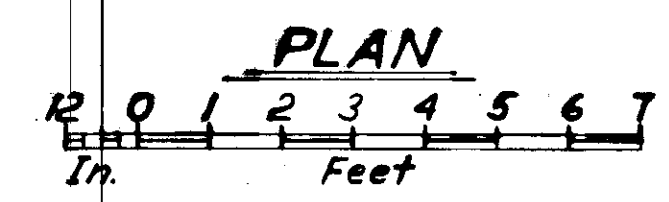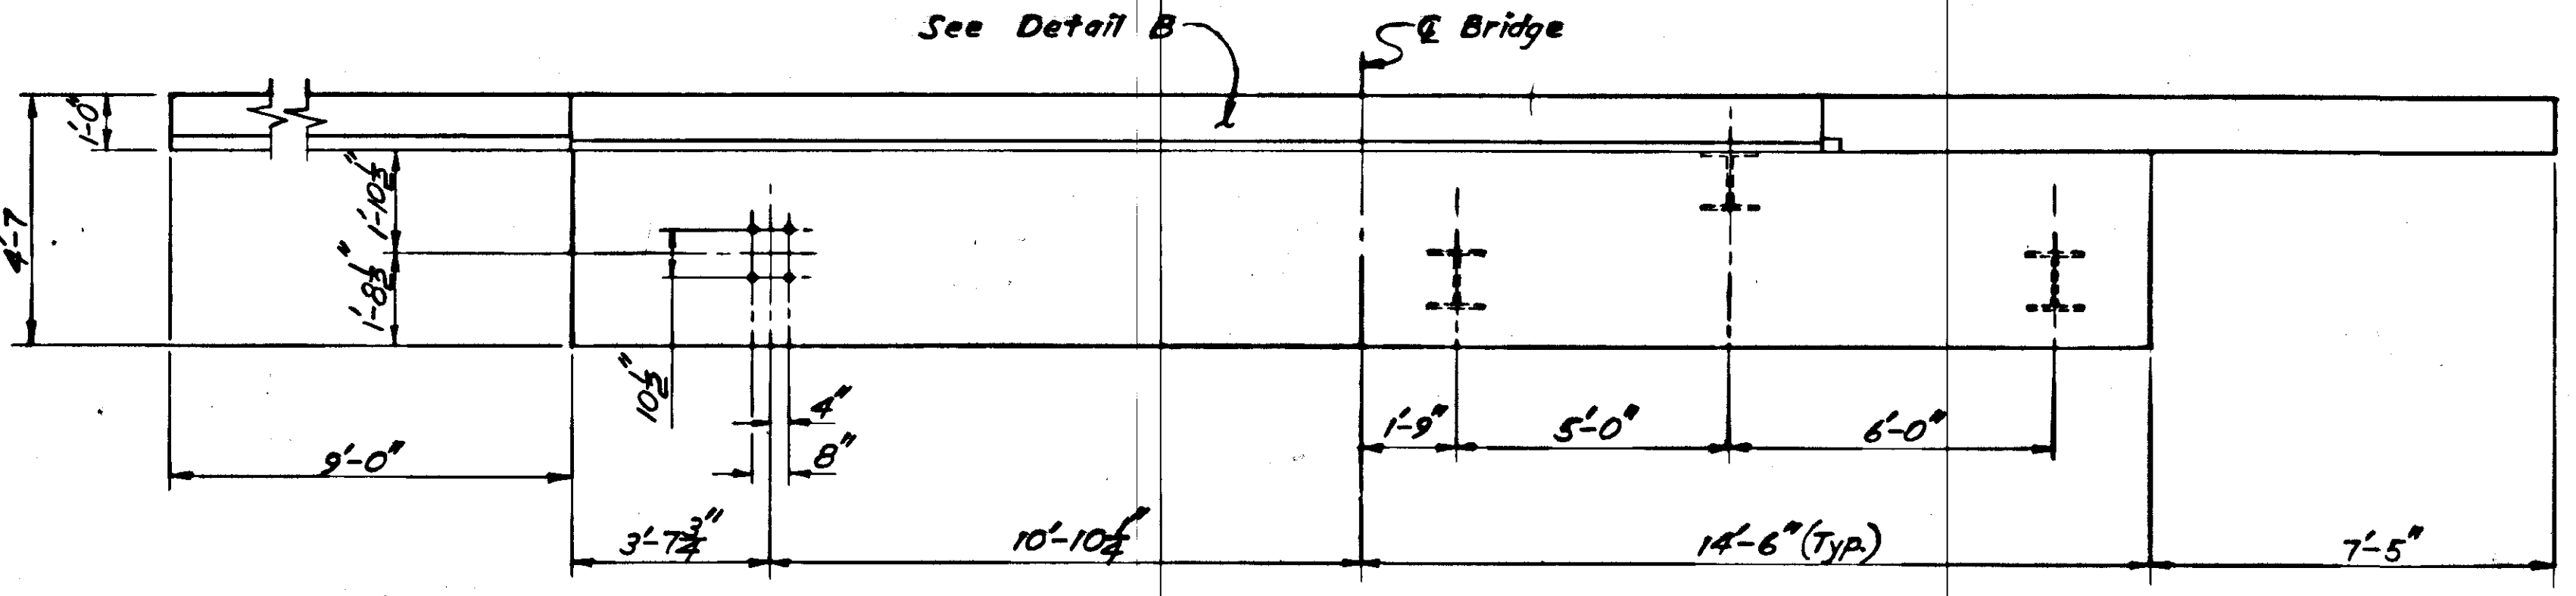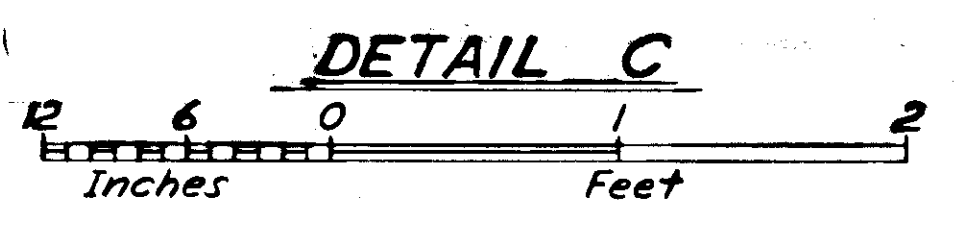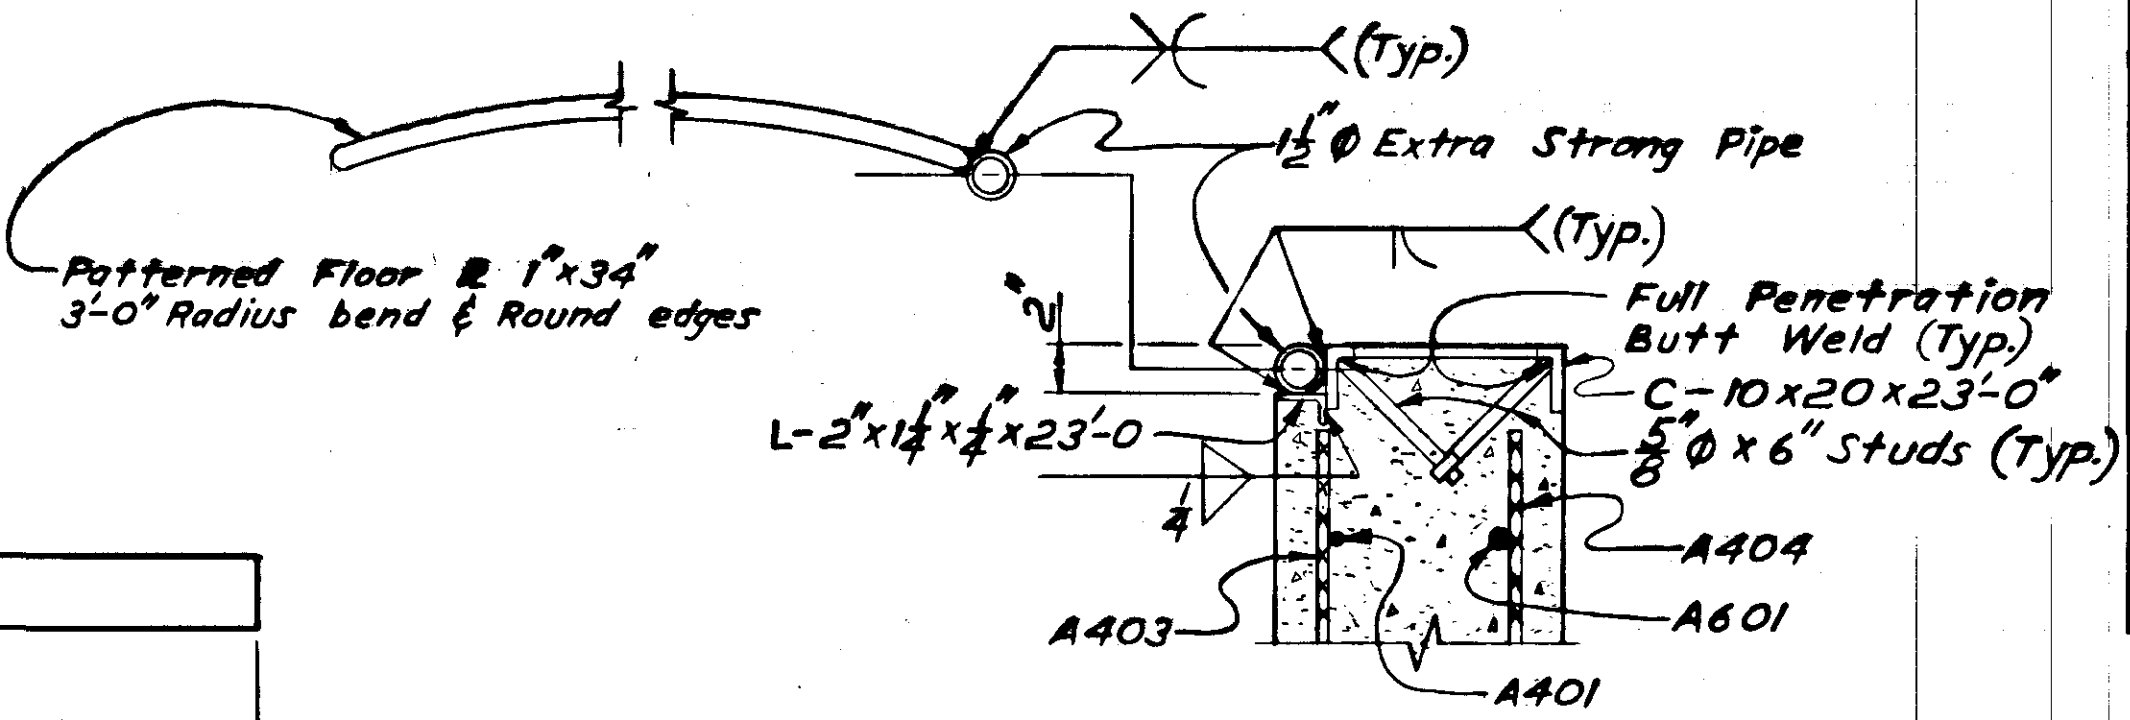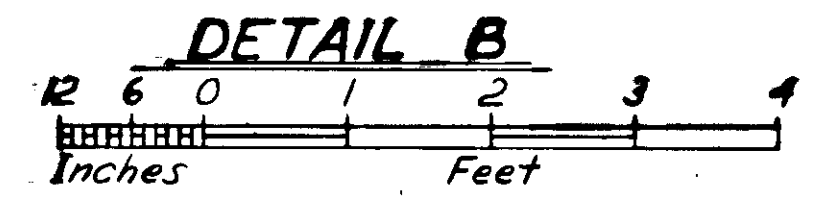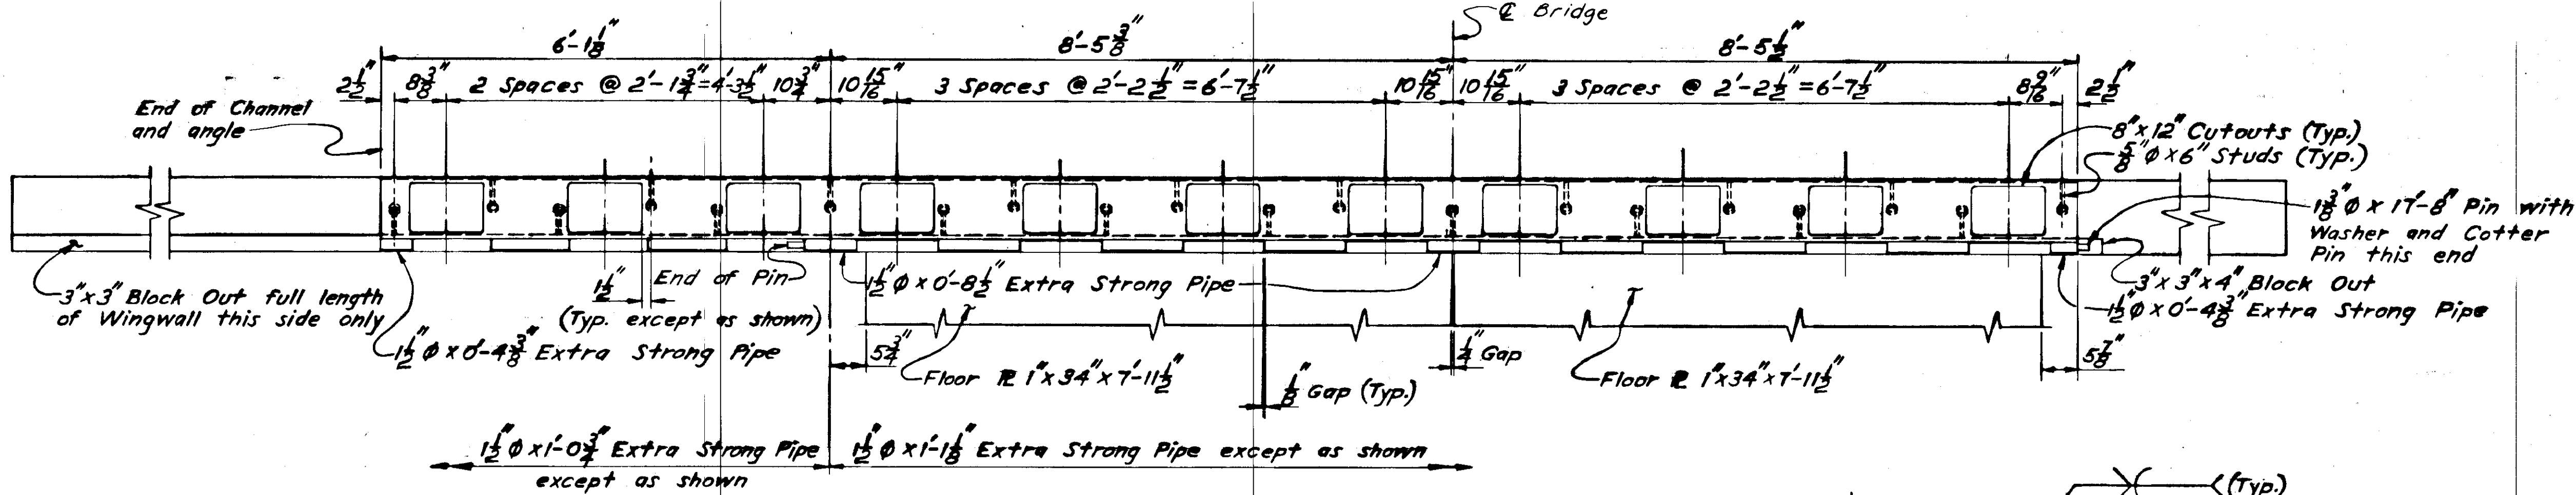

Arrow denotes battered Piles 1:4

ABUTMENT REINFORCING STEEL				
MARK	SIZE	NO.	LENGTH	TYPE
A401	4	5	45'-0"	
A402	4	40	8'-6"	
A403	4	30	6'-3"	
A404	4	30	20'-4"	Bent
A405	4	5	8'-6"	
A406	4	5	10'-0"	
A501	5	57	5'-1"	Bent
A601	6	10	45'-0"	
A602	6	11	28'-6"	

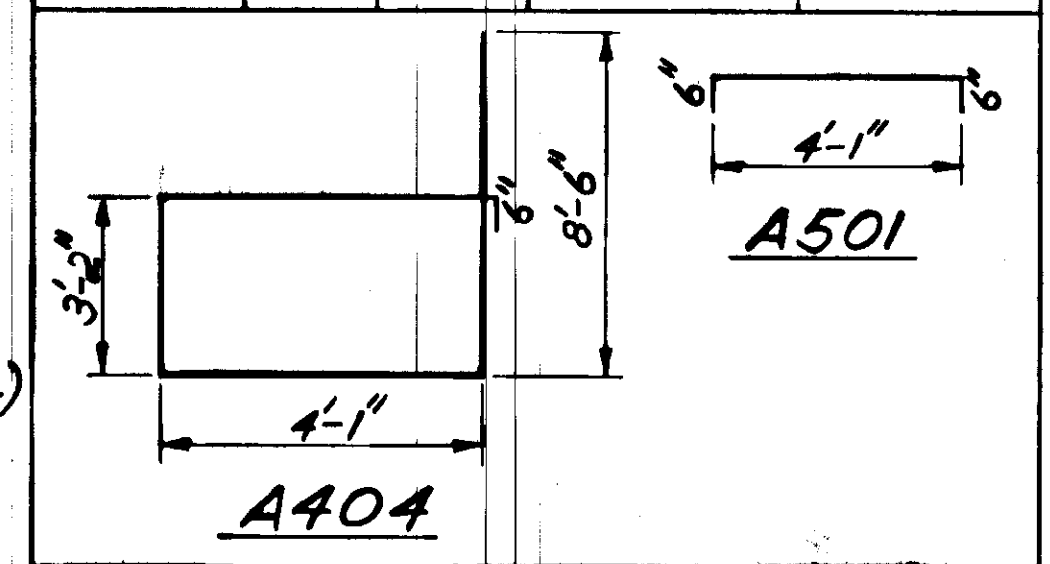






**SKAGWAY TRANSFER BRIDGE**  
 ROUTE NO. F-97  
**ABUTMENT**

State of Alaska  
 DEPARTMENT OF TRANSPORTATION  
 and PUBLIC FACILITIES  
 Juneau, Alaska

Date 8-17-78  
 Approved [Signature]

BRIDGE NO. 805  
 DWNG. NO. 3981

STATE	PROJECT DESIGNATION	YEAR	SHEET NO.	TOTAL SHEETS
ALASKA	F-097-2 (2)	1978	19	41

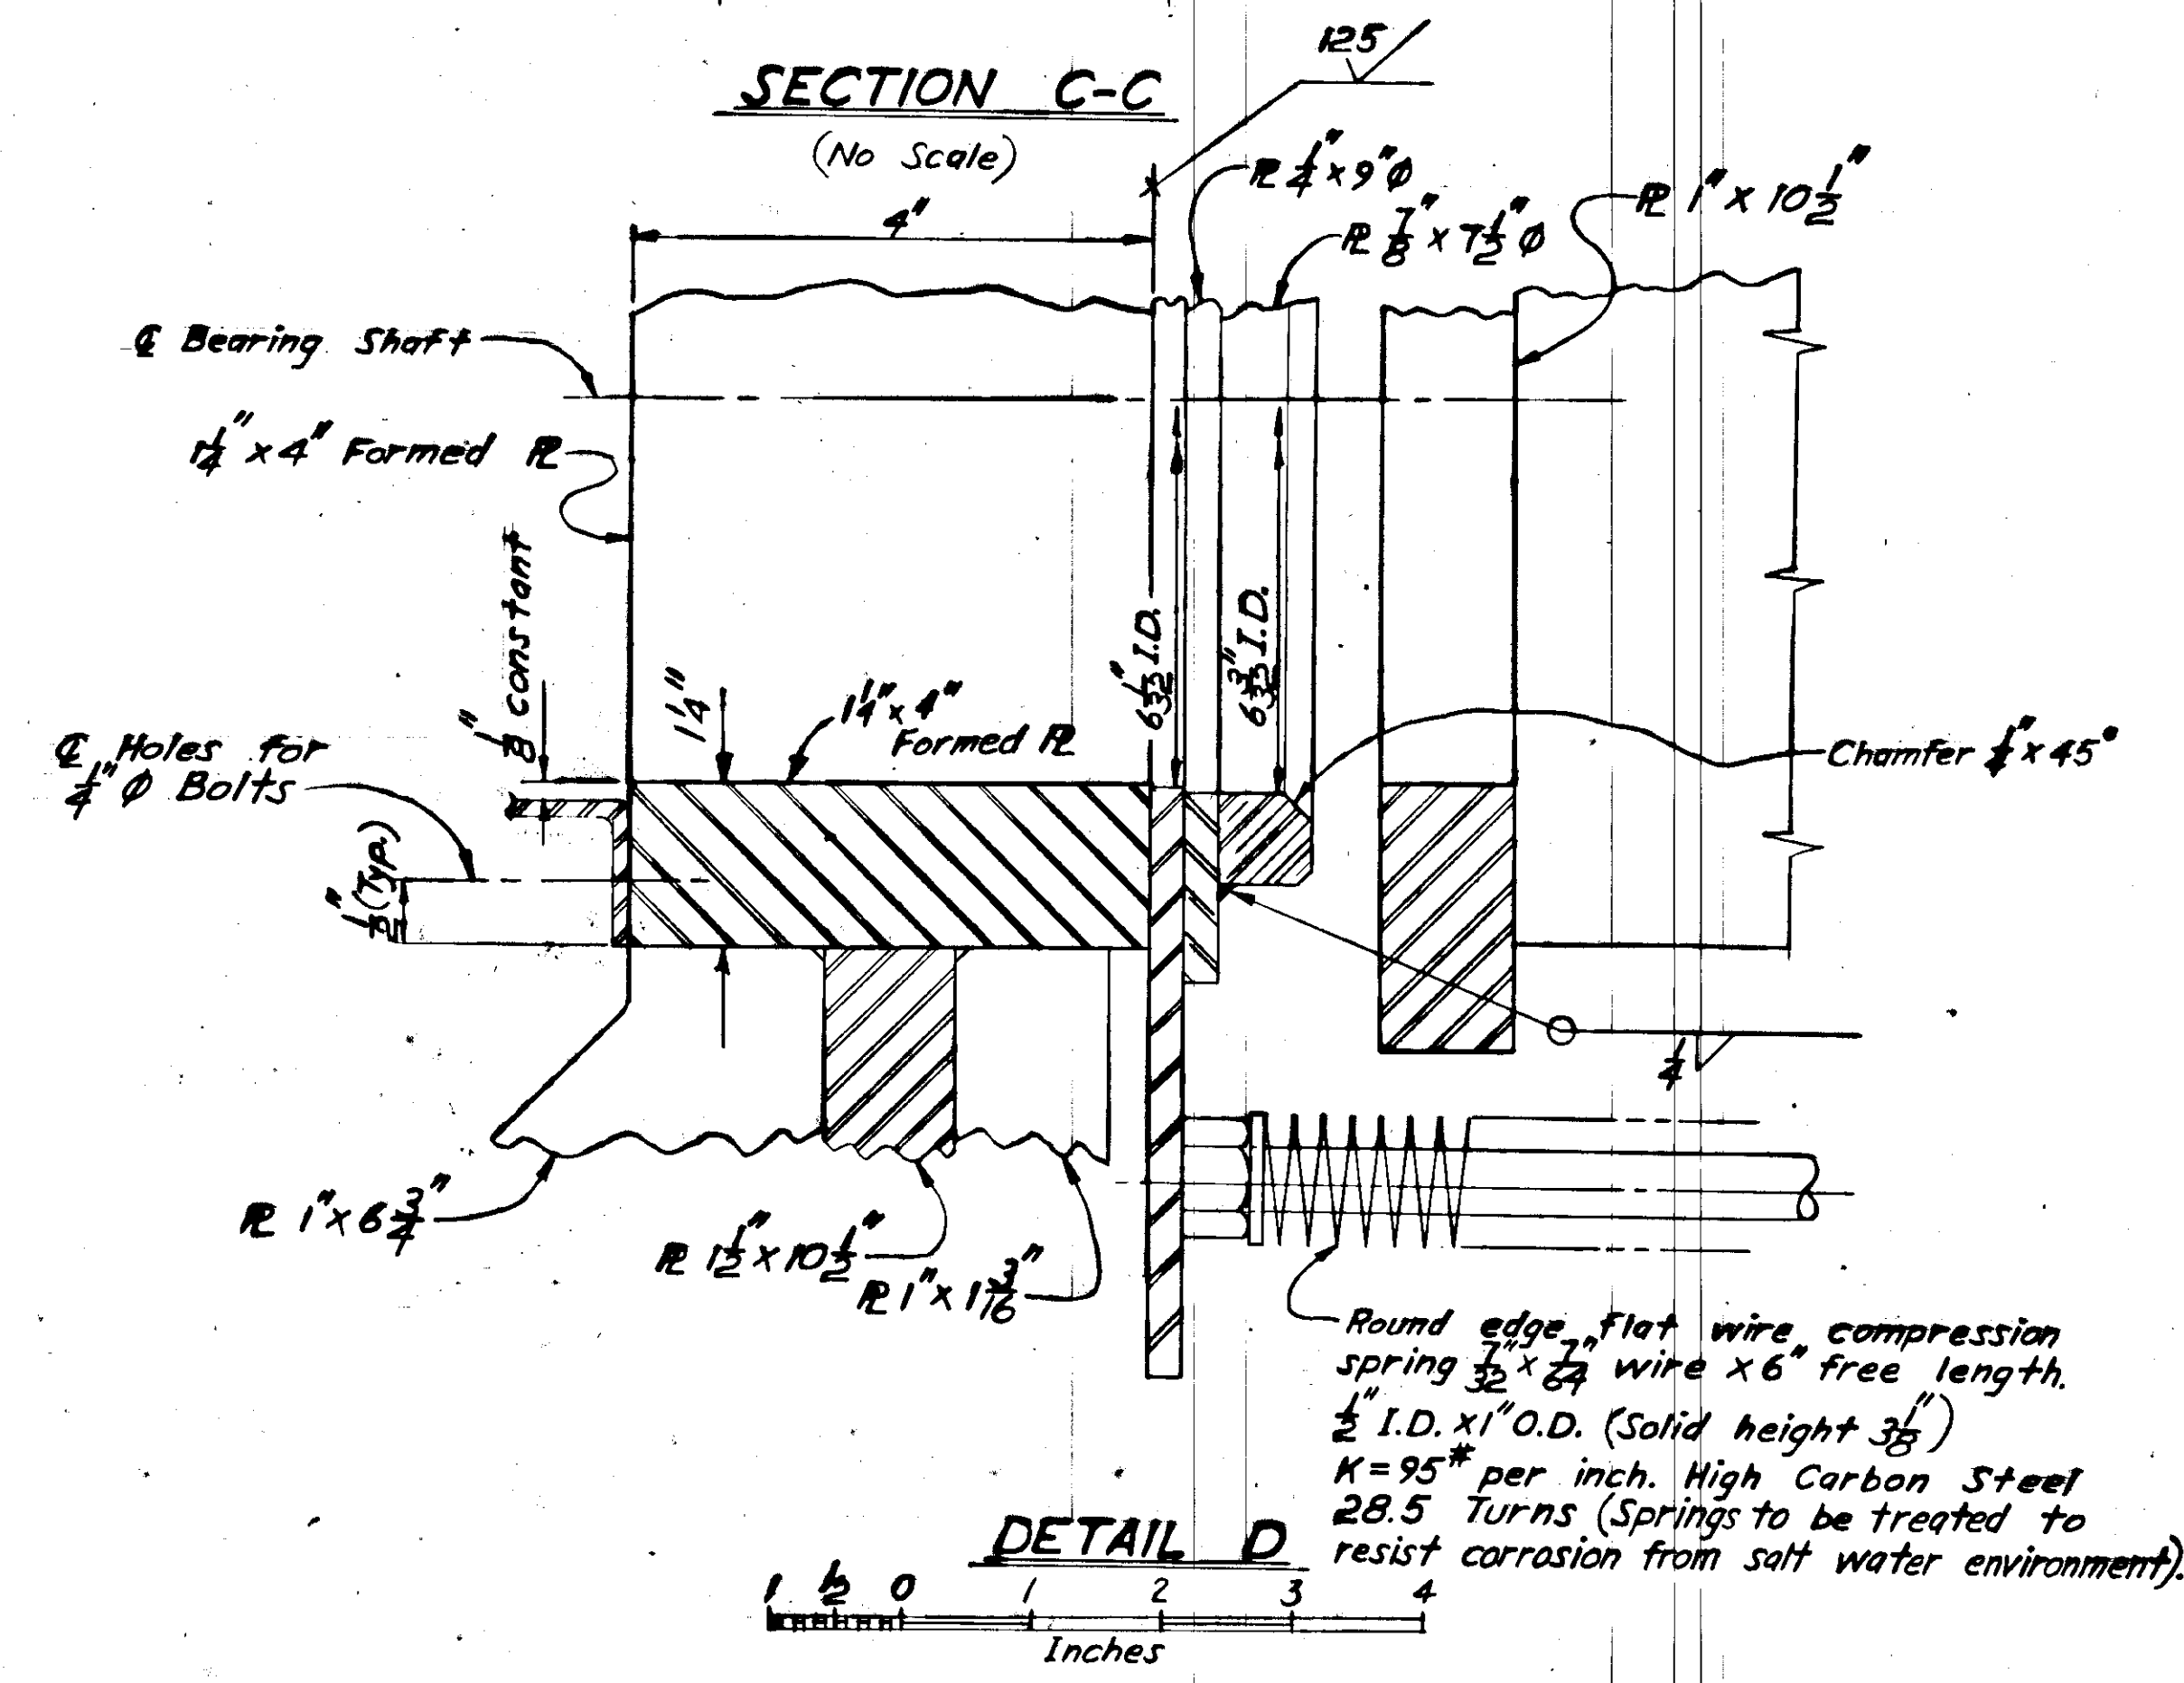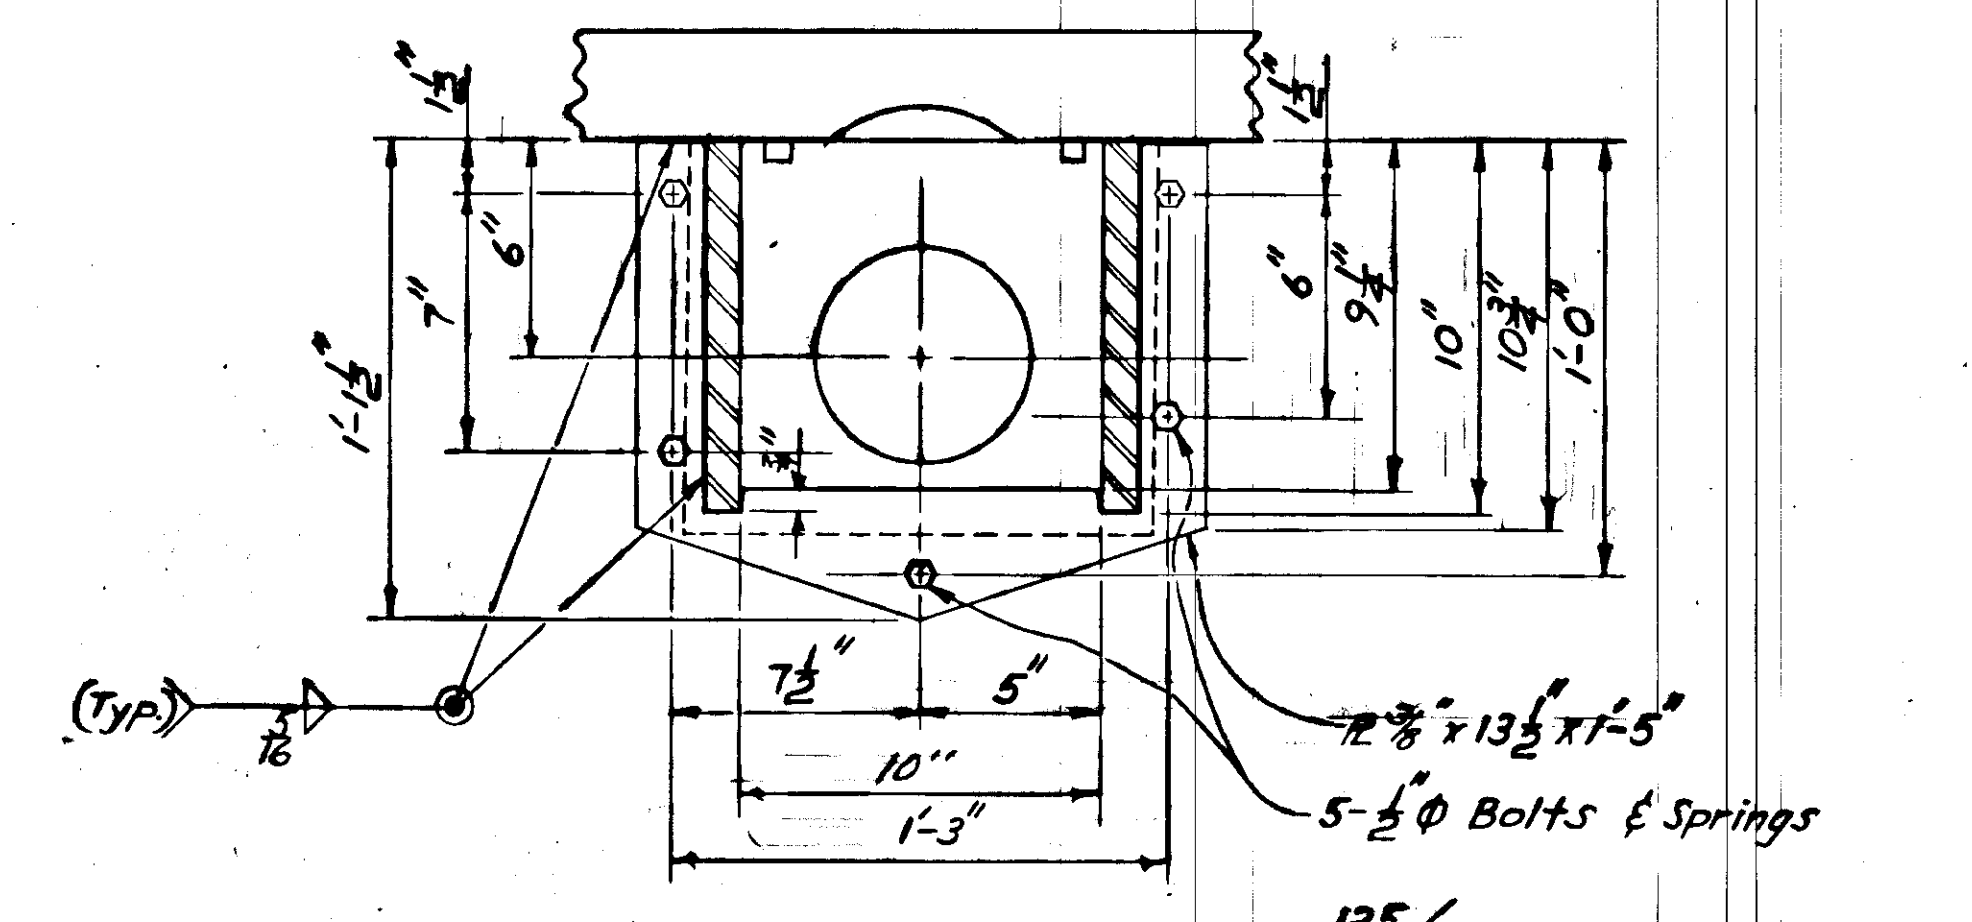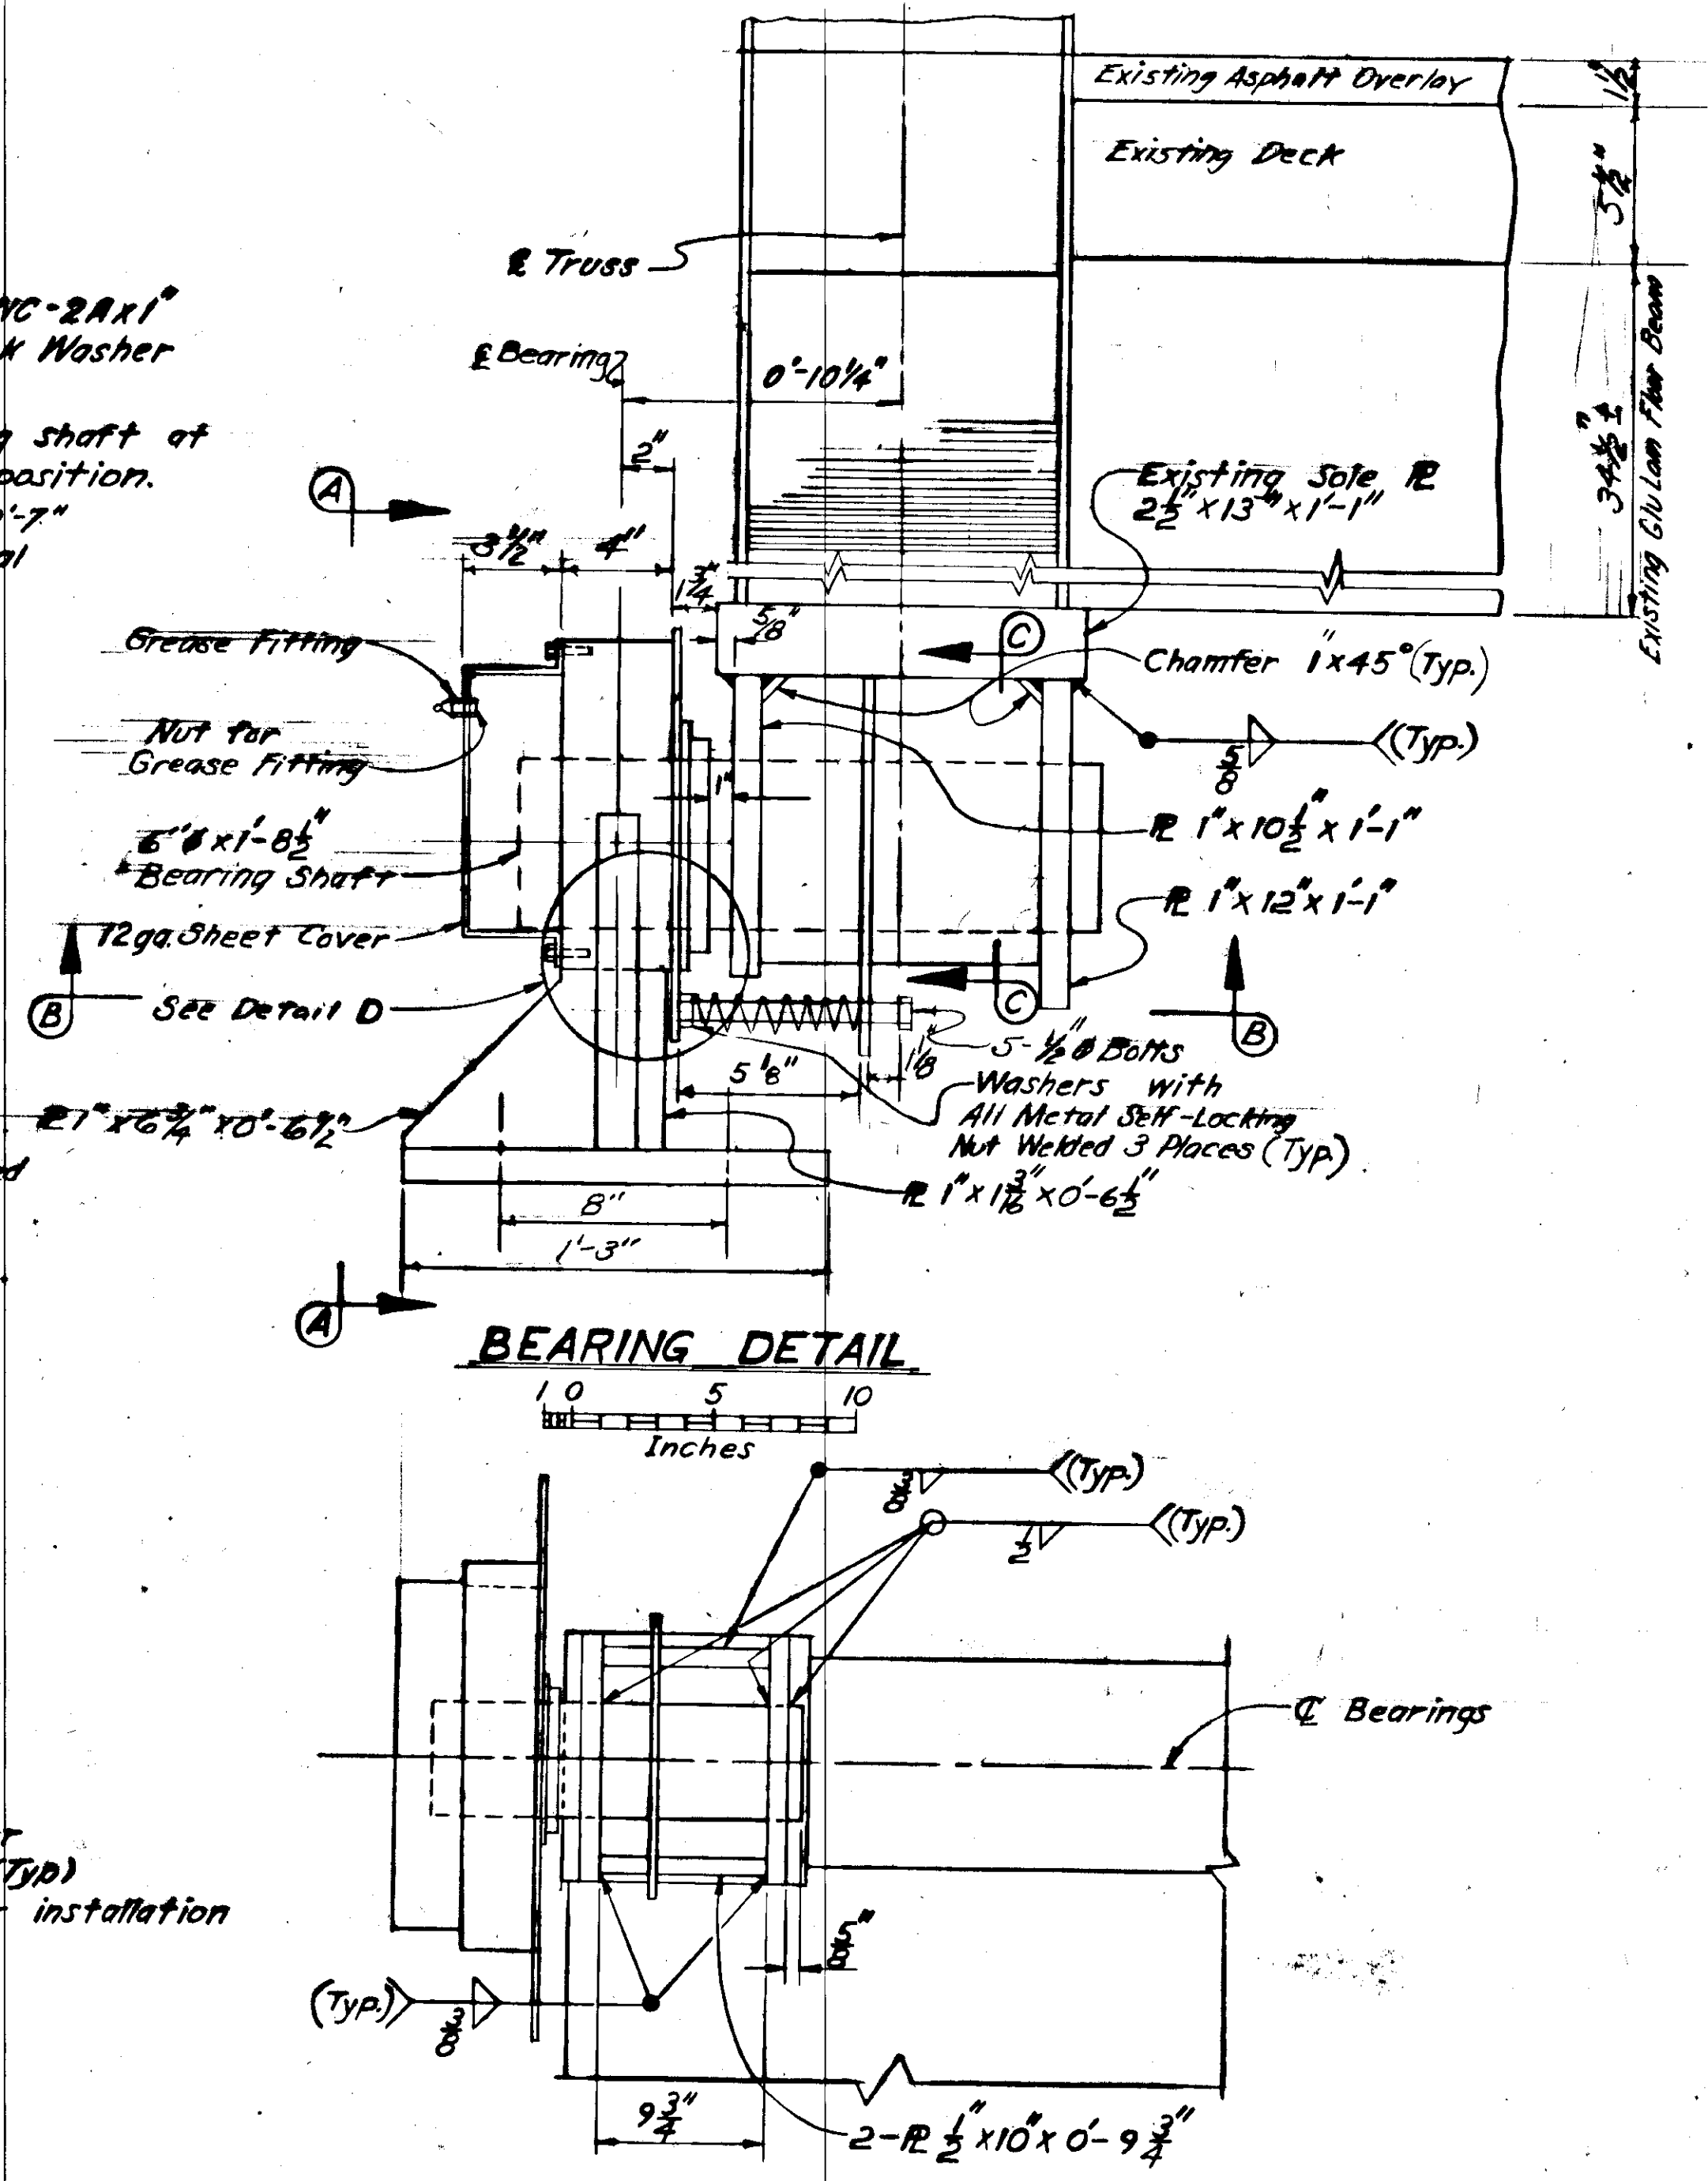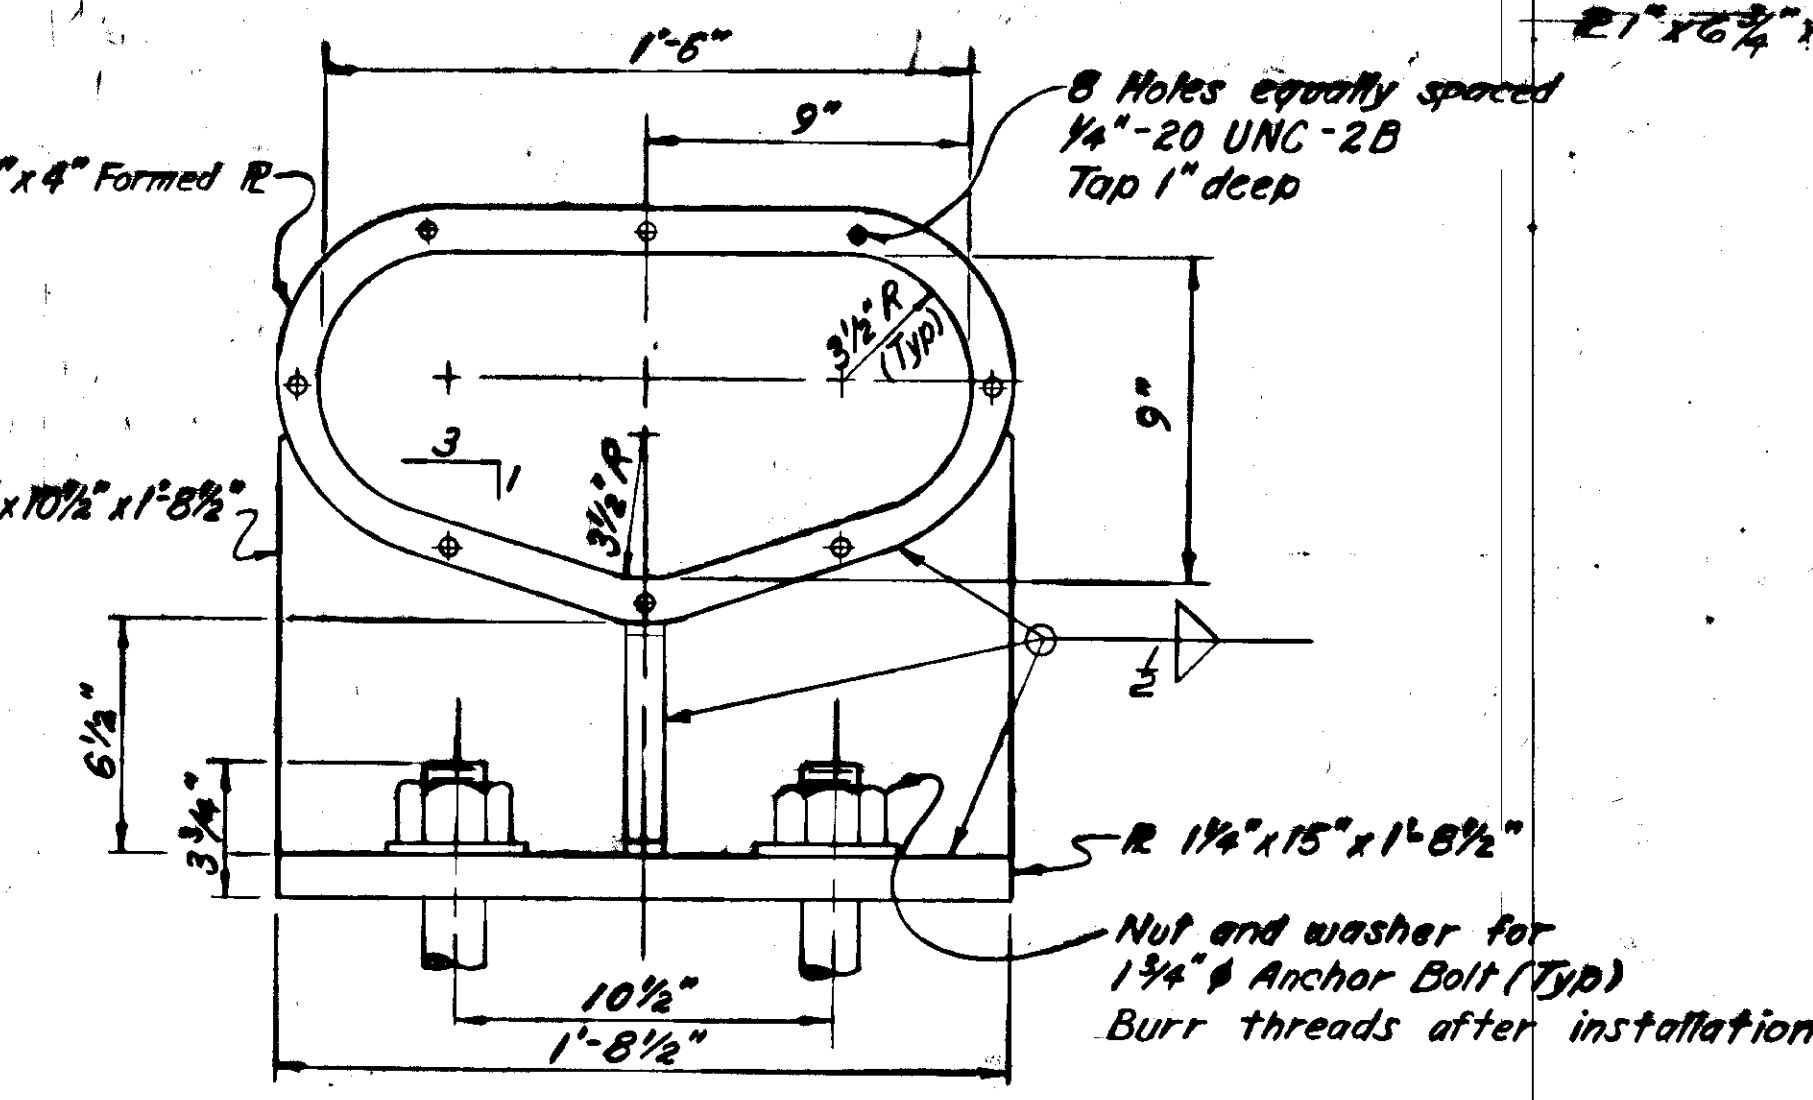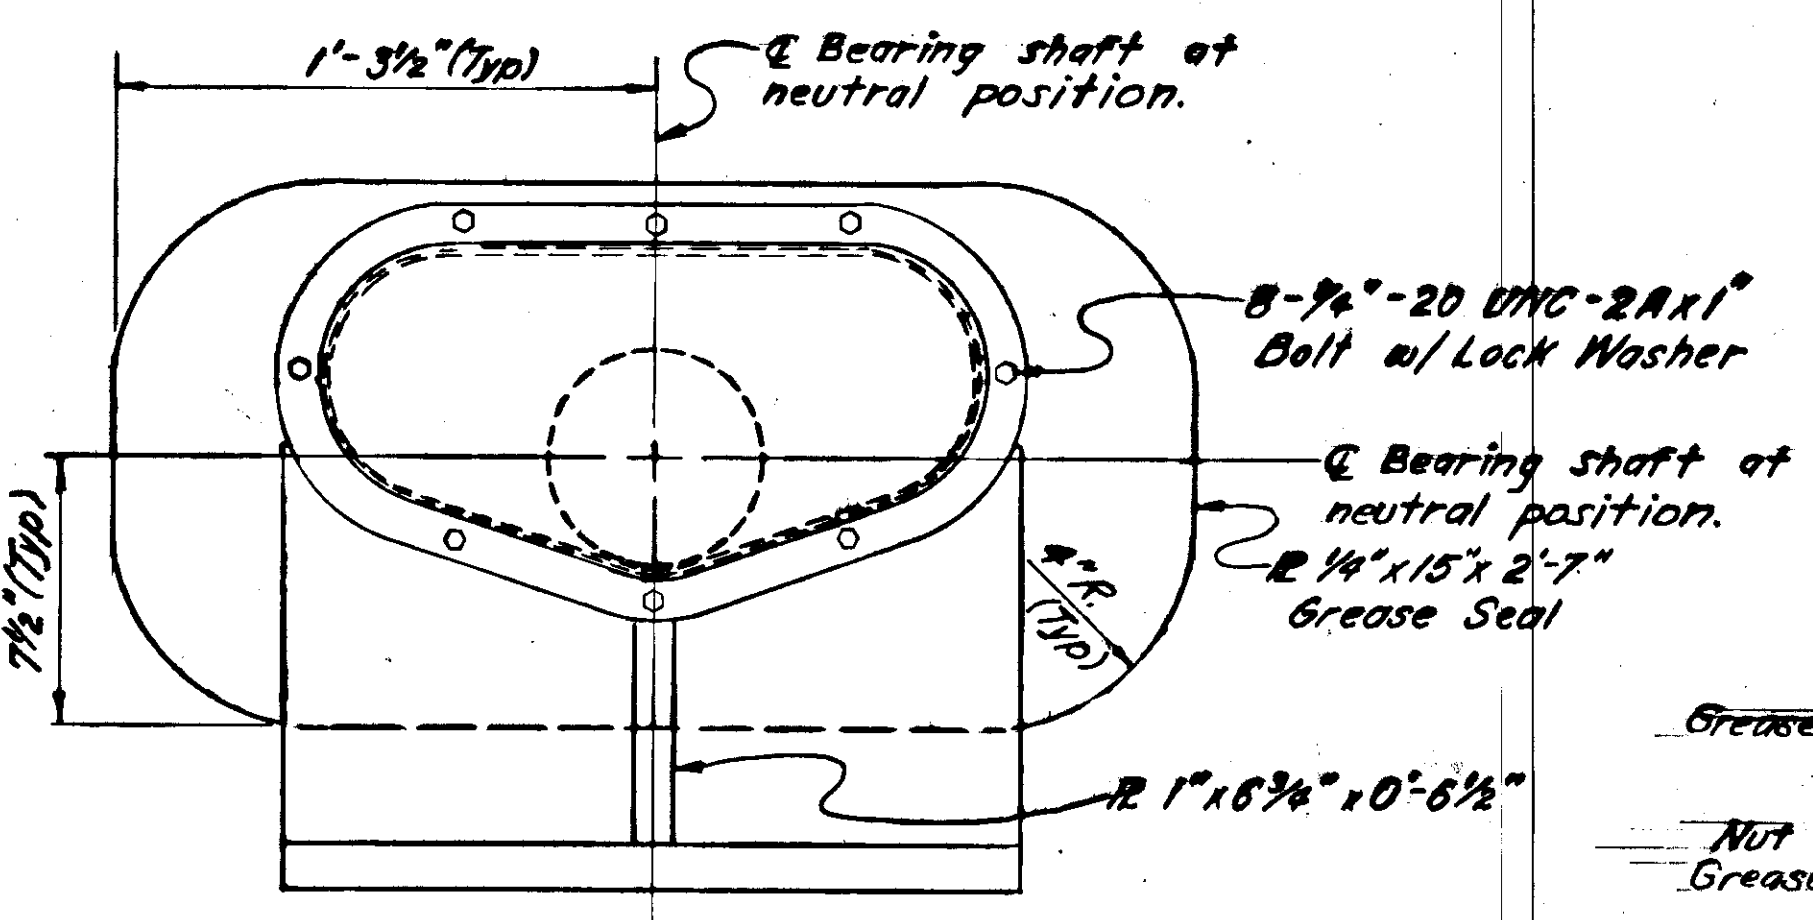

Bearings Modified by EWO No. 14

SKAGWAY TRANSFER BRIDGE  
ROUTE NO. F-97  
ABUTMENT BEARINGS








State of Alaska  
DEPARTMENT OF TRANSPORTATION  
and PUBLIC FACILITIES  
Juneau, Alaska

Date 8-17-78  
Approved [Signature]



BRIDGE NO. 805  
DWNG. NO. 3982

STATE	PROJECT DESIGNATION	YEAR	SHEET NO.	TOTAL SHEETS
ALASKA	F-097-2 (2)	1978	20	41

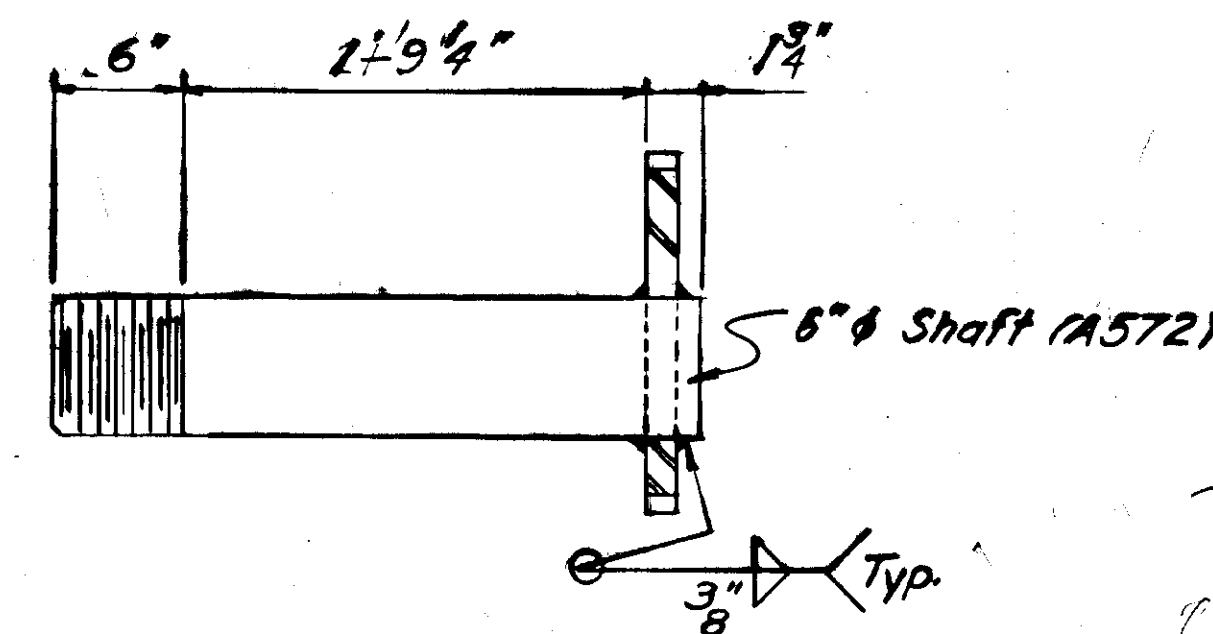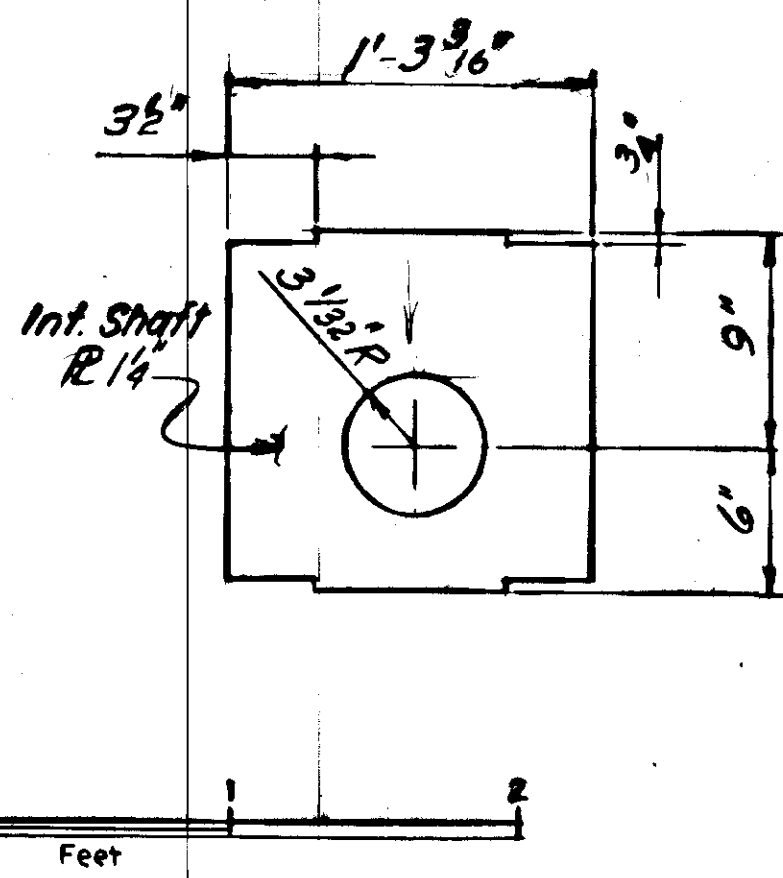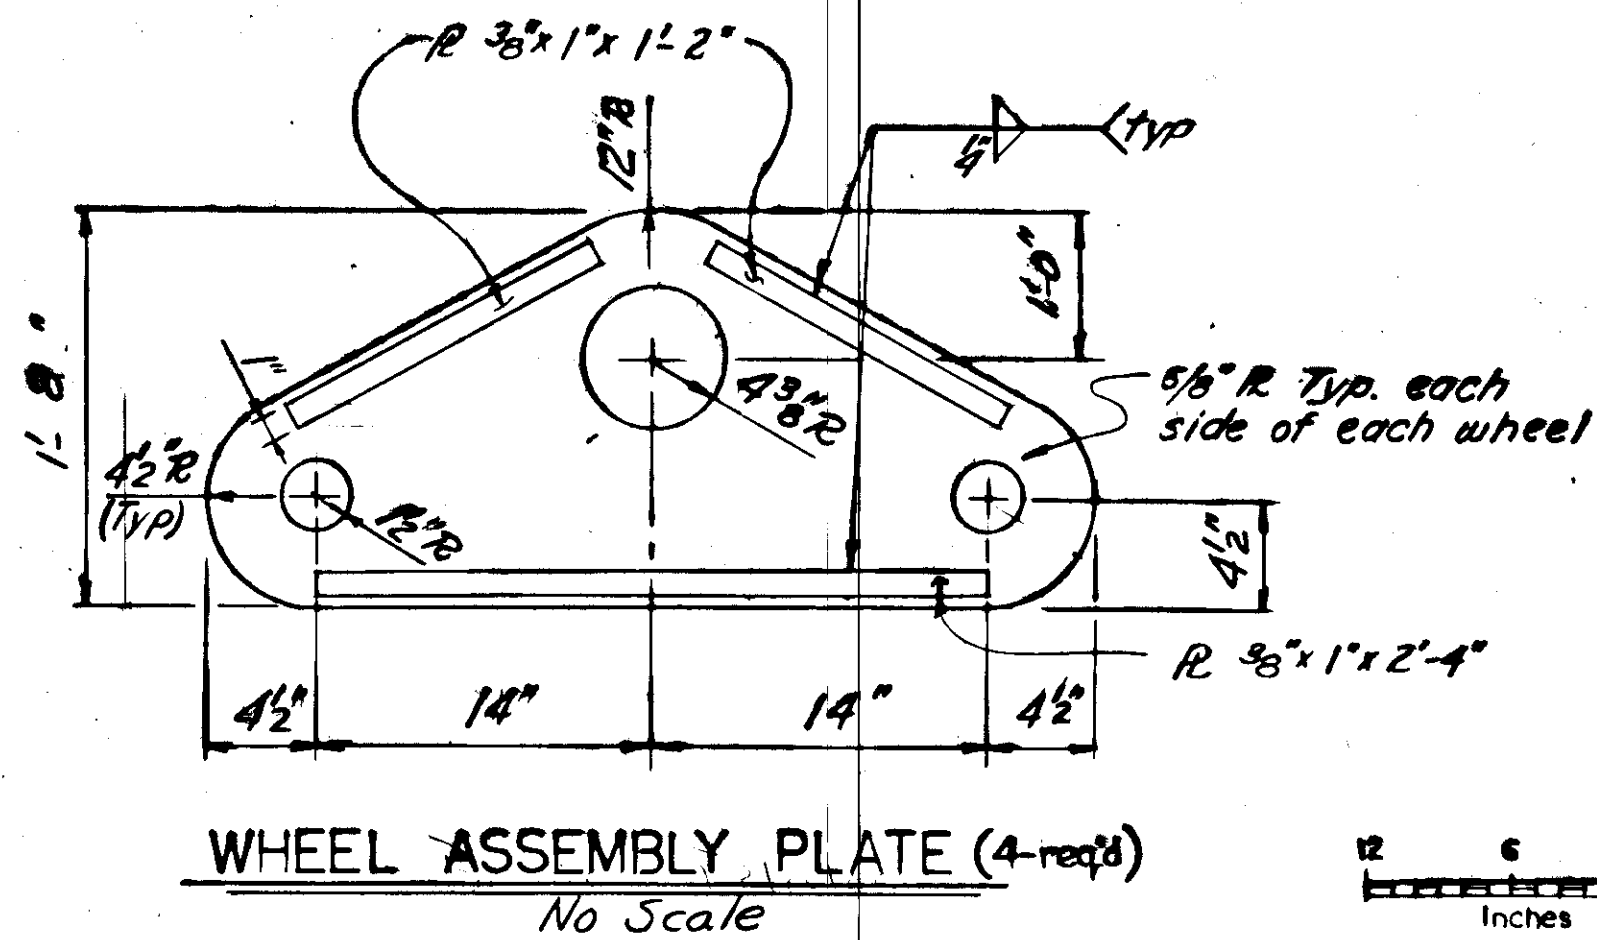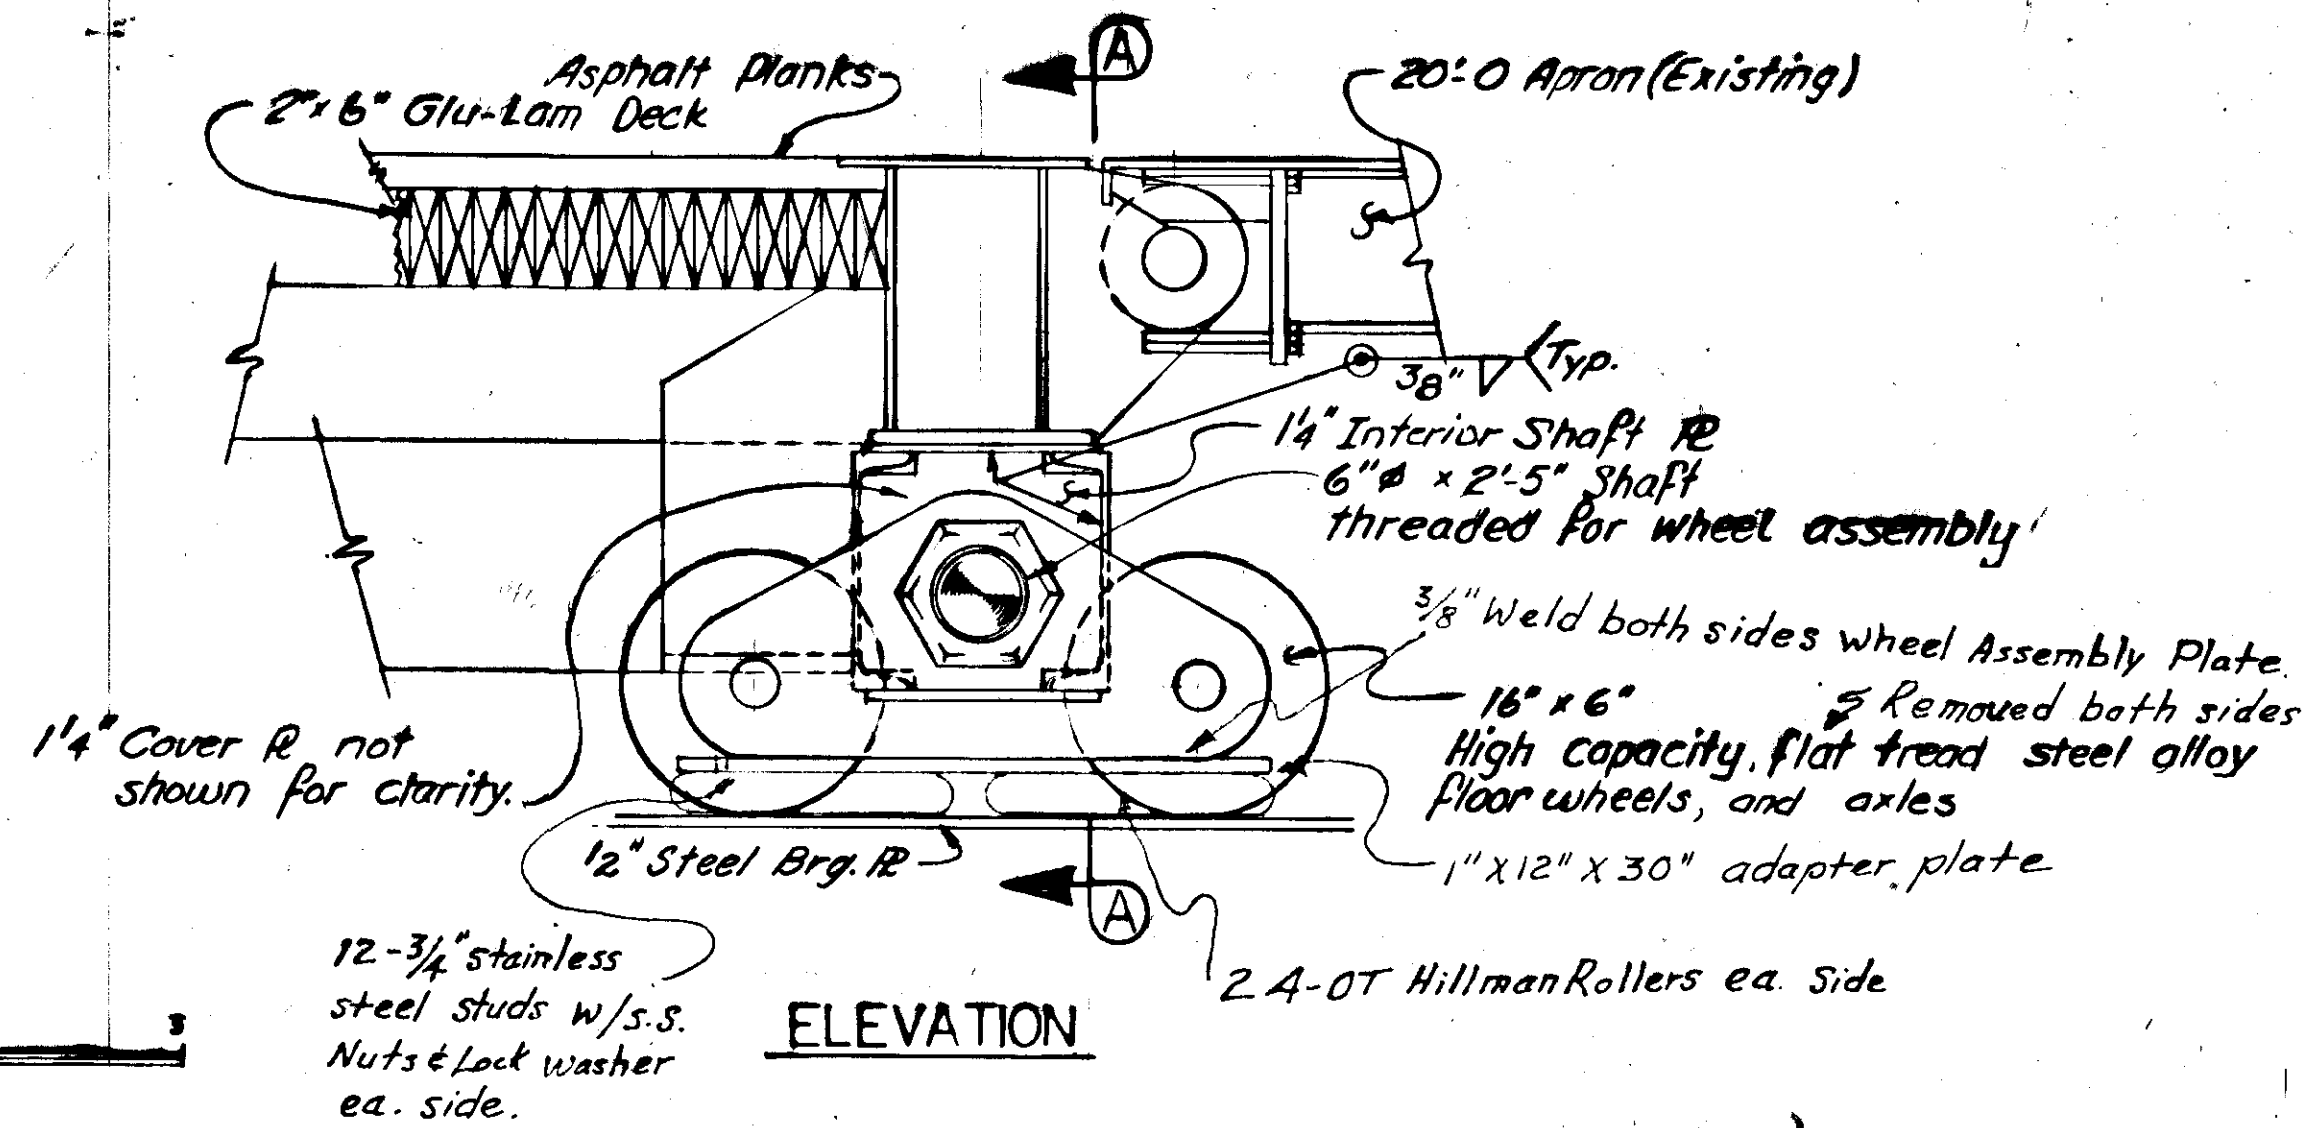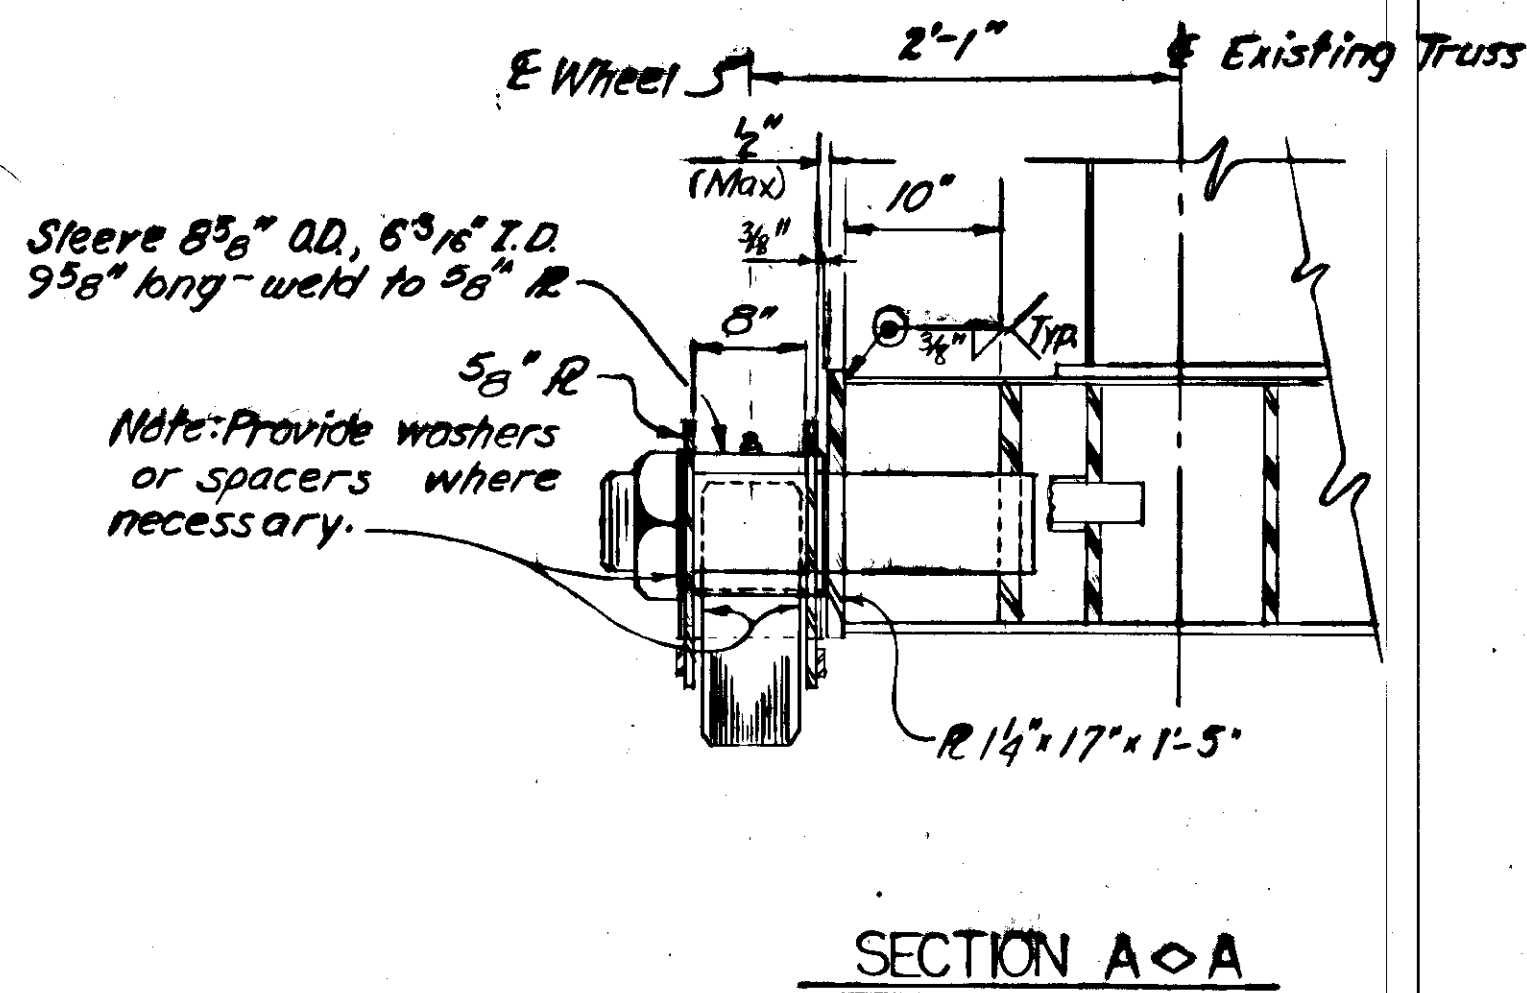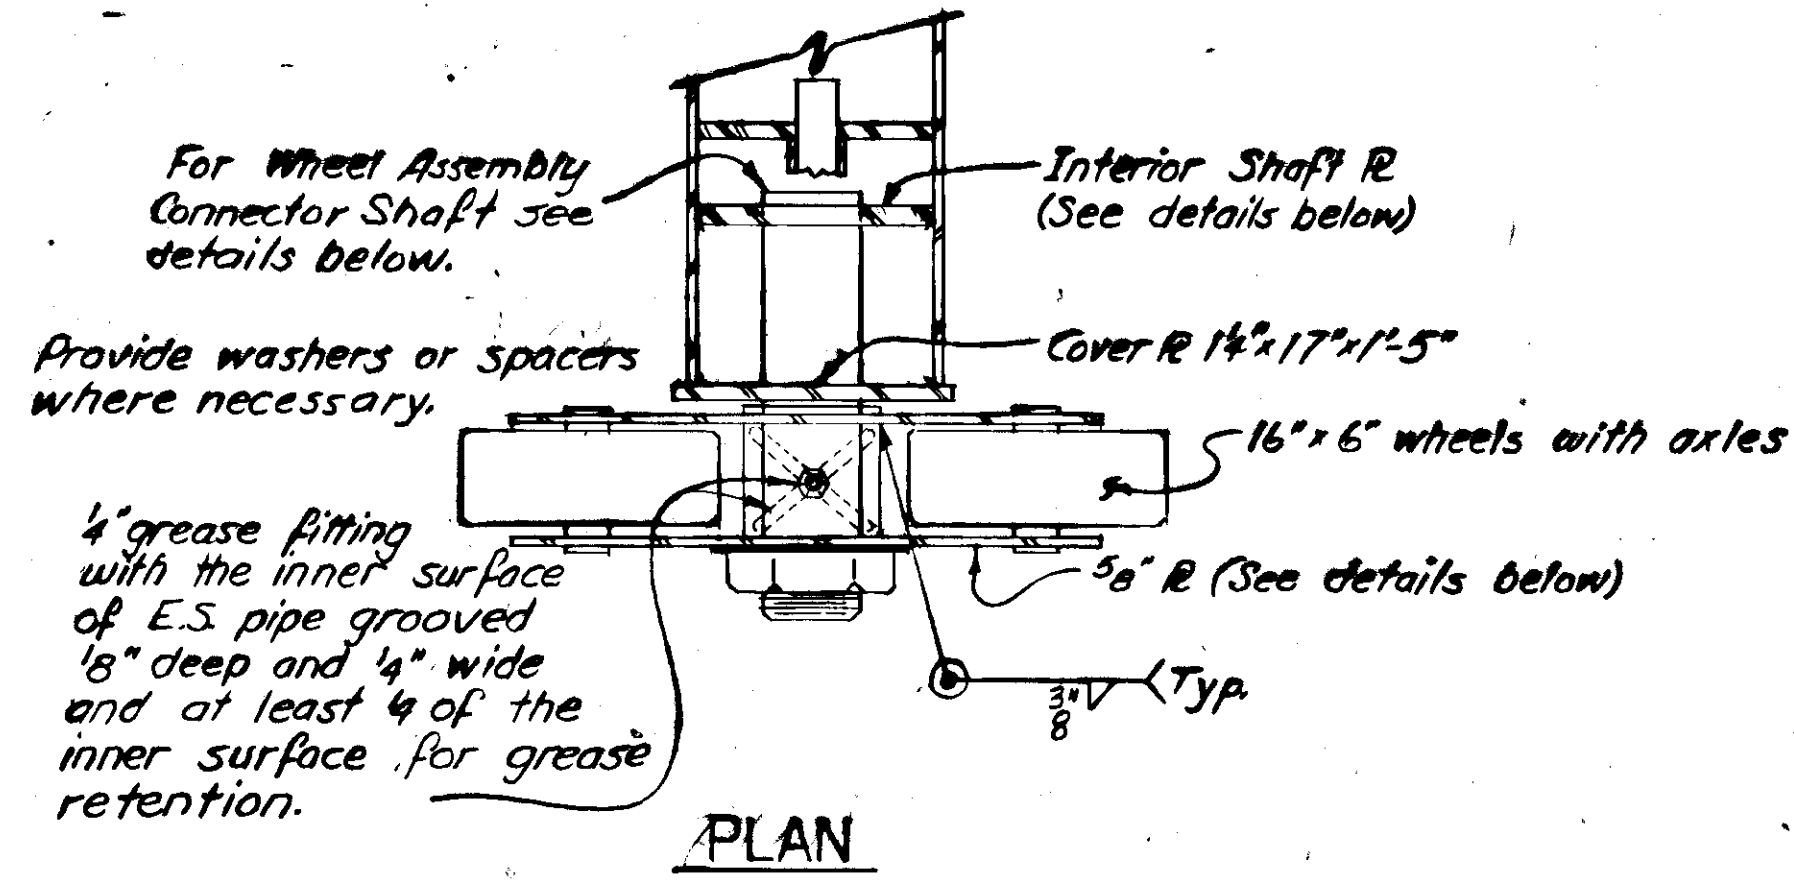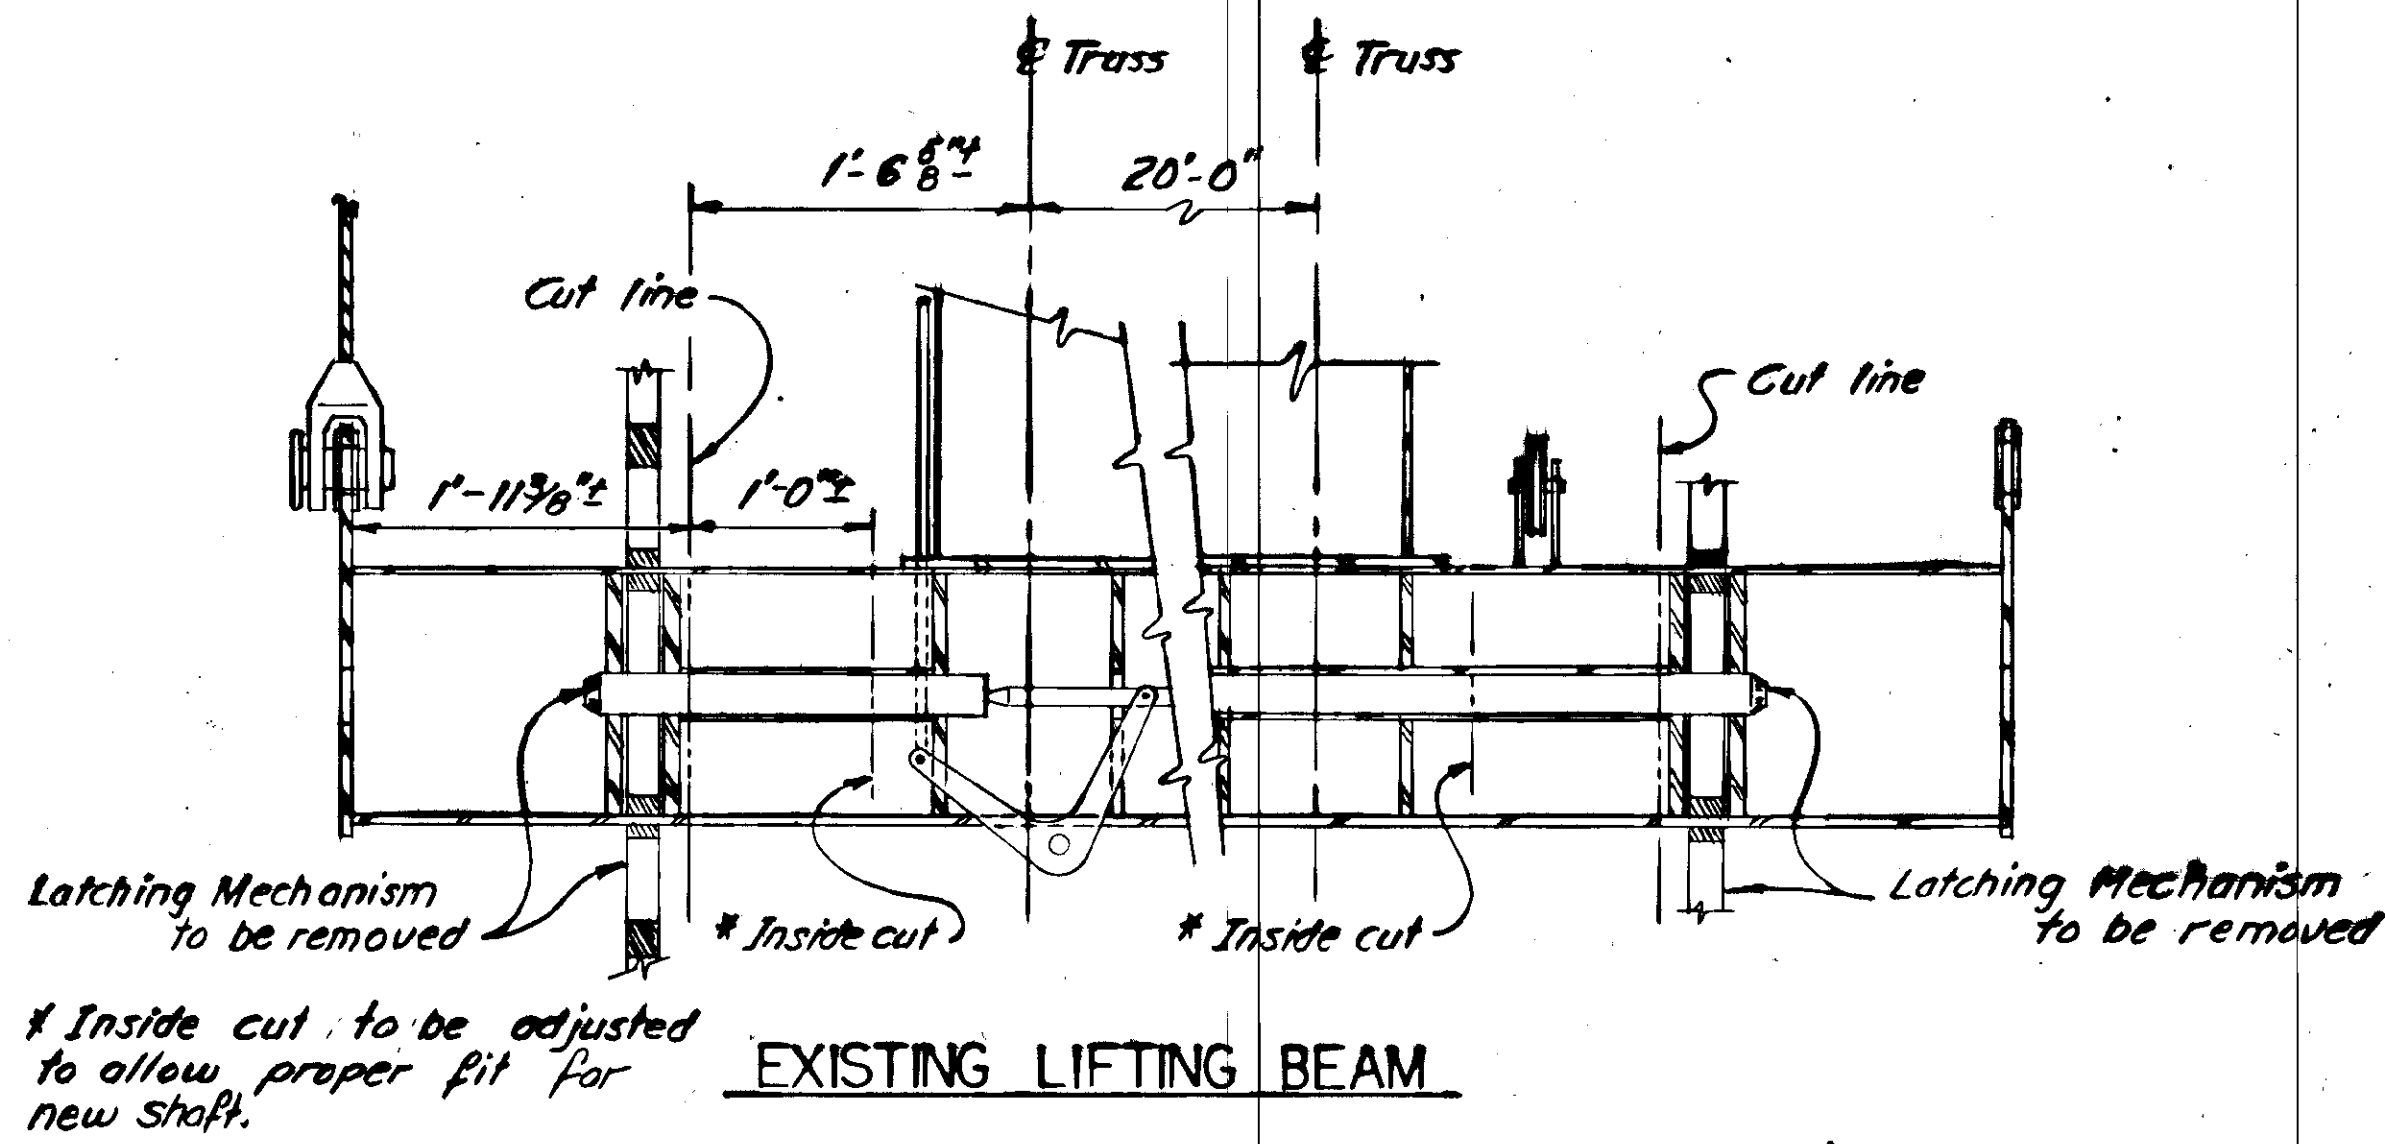


SKAGWAY TRANSFER BRIDGE  
ROUTE NO. F-97  
DOCK BEARINGS


State of Alaska  
DEPARTMENT OF TRANSPORTATION  
and PUBLIC FACILITIES  
Juneau, Alaska

Date 8-17-78  
Approved [Signature]

BRIDGE NO. 805  
DWG. NO. 3983

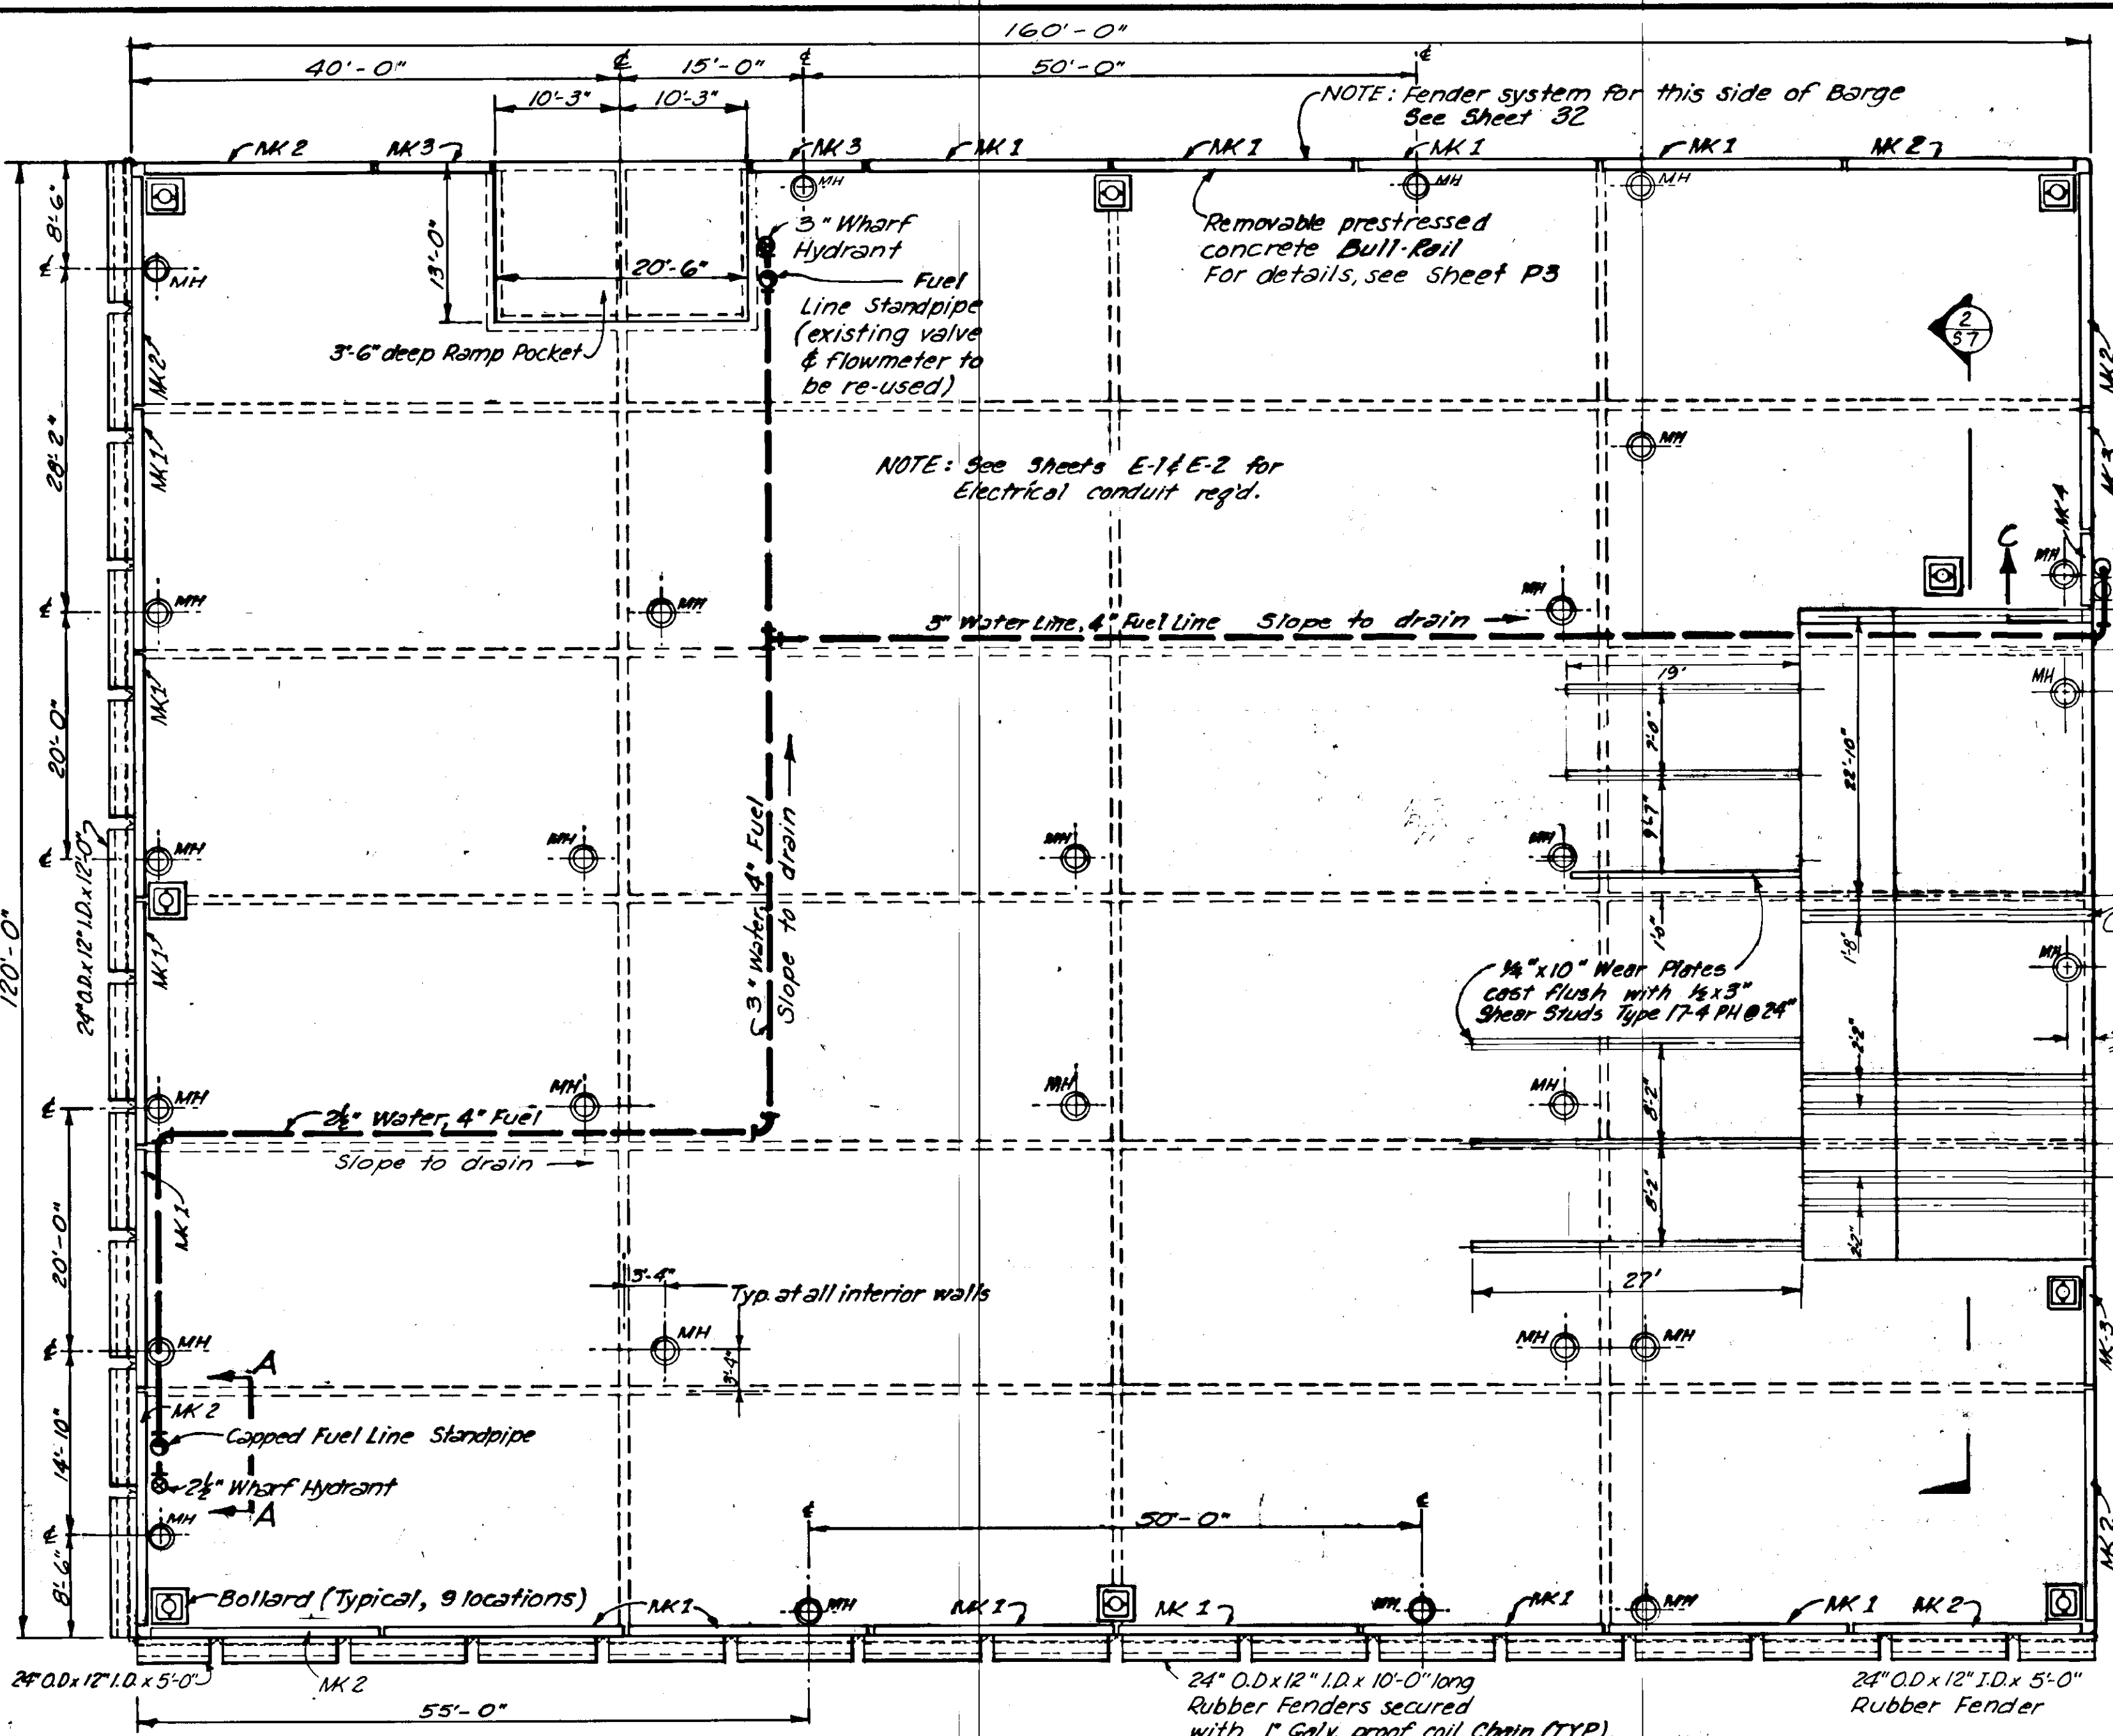


PLAN 1" = 10'

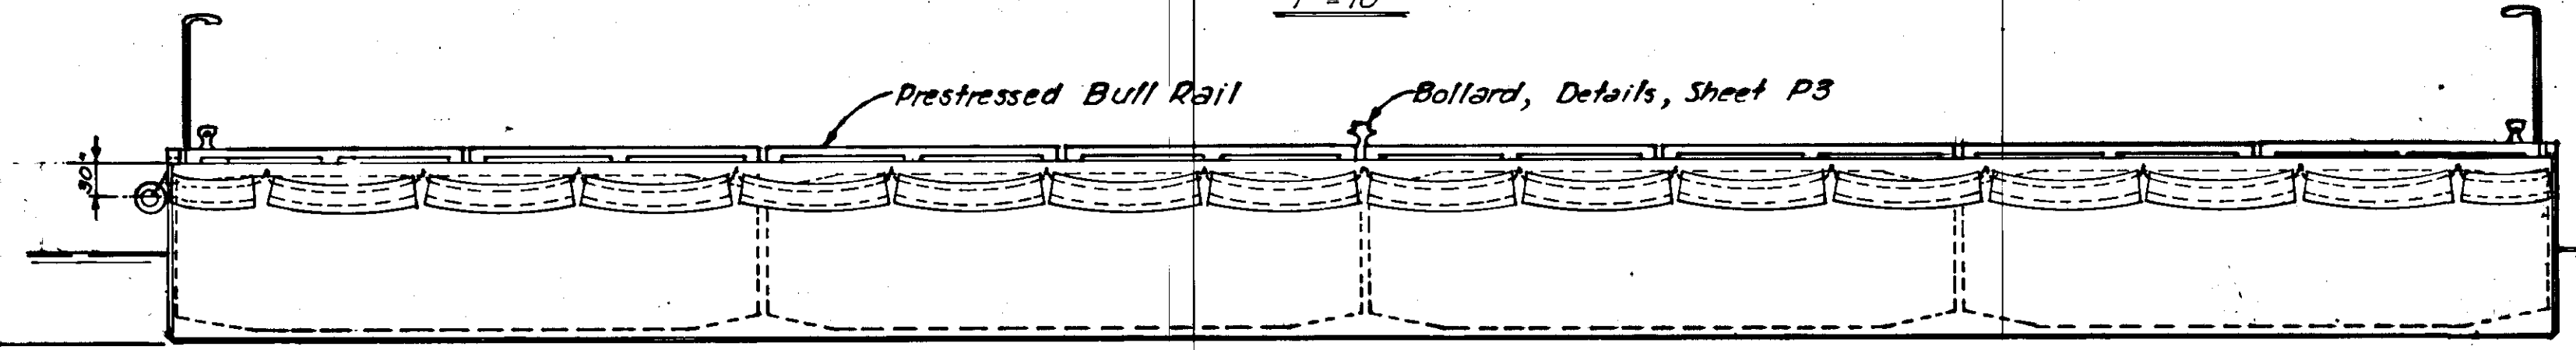


ELEVATION 1" = 10'

SEE SHEET P3 FOR DETAILS

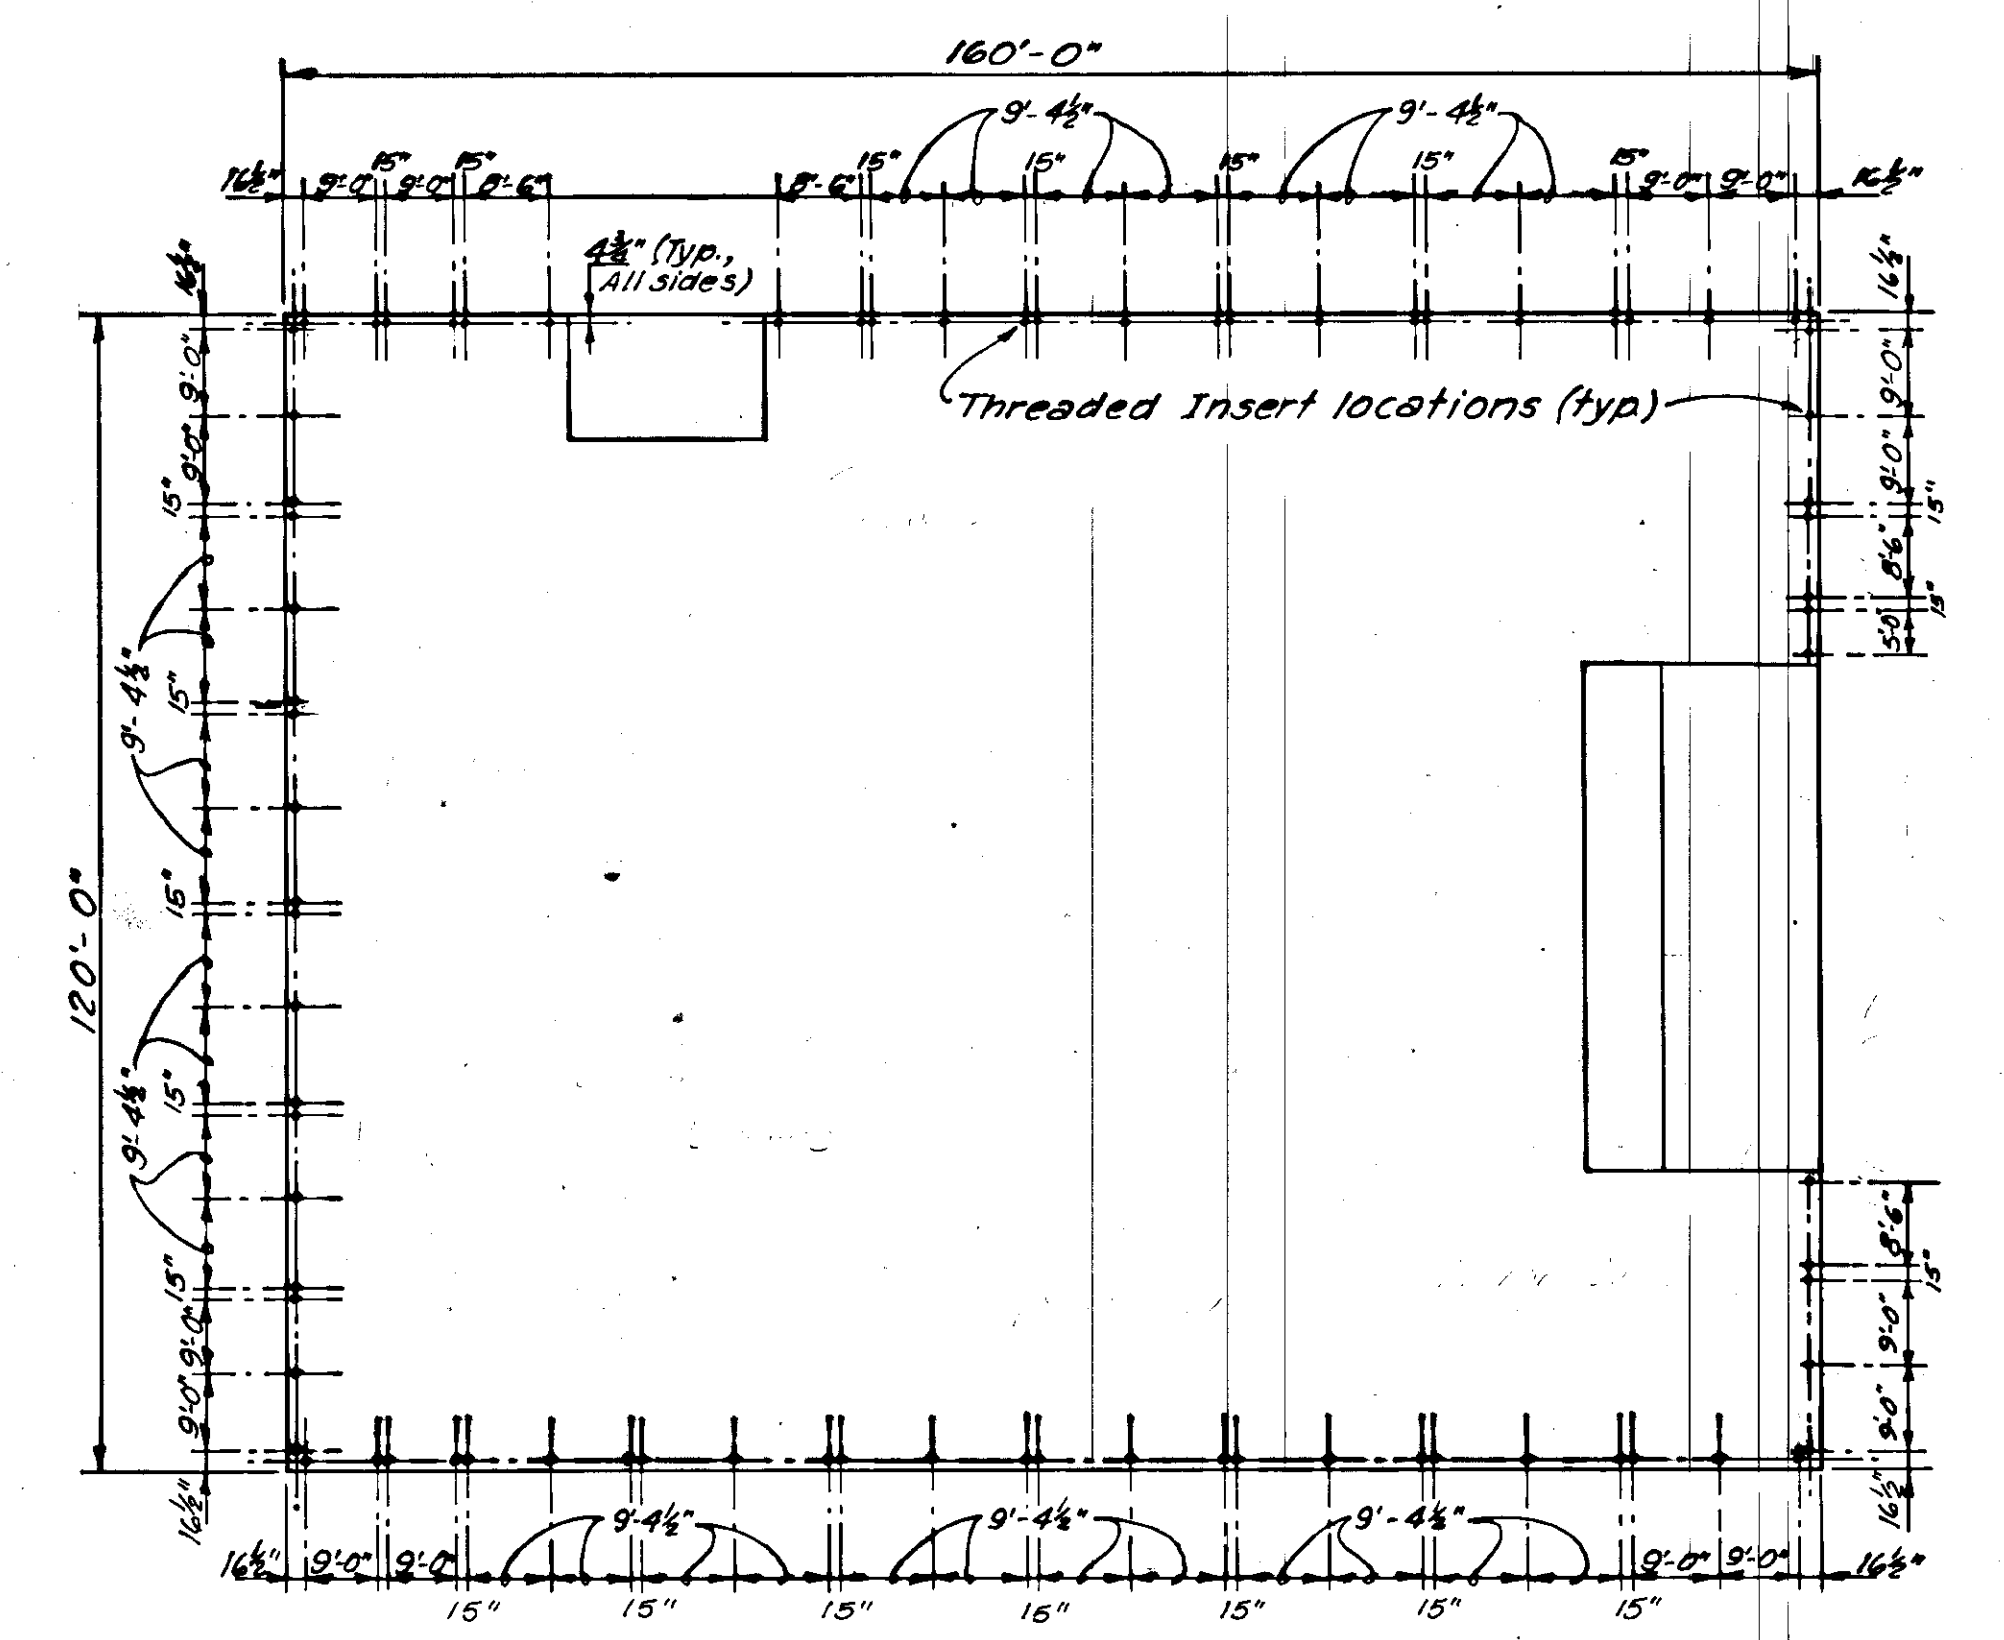


BULL-RAIL ATTACHMENT LAYOUT 1" = 20'


See Shop Drawings From Concrete Tech. & L.B. Foster On file @ Division of Harbor Design & Construction. Covers next 13 pages

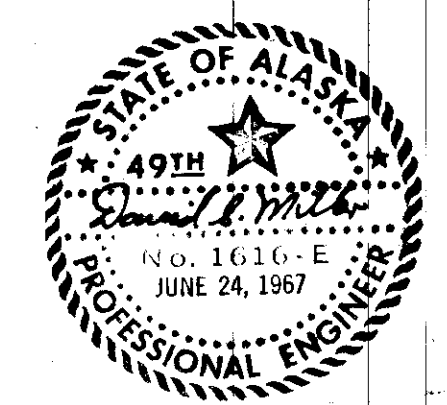


DESIGN	STARTING	AS-BUILT	HOR. VER.	DATE	BY	REVISION	FIELD BOOKS	DESIGNED	DSM	DRAWN	JT	CHECKED	RMH	DATE	7/20/78	SCALE	AS SHOWN	GRID	JOB NO.	7502.0	ENGINEERS/PLANNERS/SURVEYORS	JUNEAU ALASKA	TRUCK NYMAN & HAYES	BARGE FACILITY BARGE DETAILS	SKAGWAY ALASKA	SHEET	P1 of 3	FILE NO.	7502.0
--------	----------	----------	-----------	------	----	----------	-------------	----------	-----	-------	----	---------	-----	------	---------	-------	----------	------	---------	--------	------------------------------	---------------	---------------------	---------------------------------	----------------	-------	---------	----------	--------

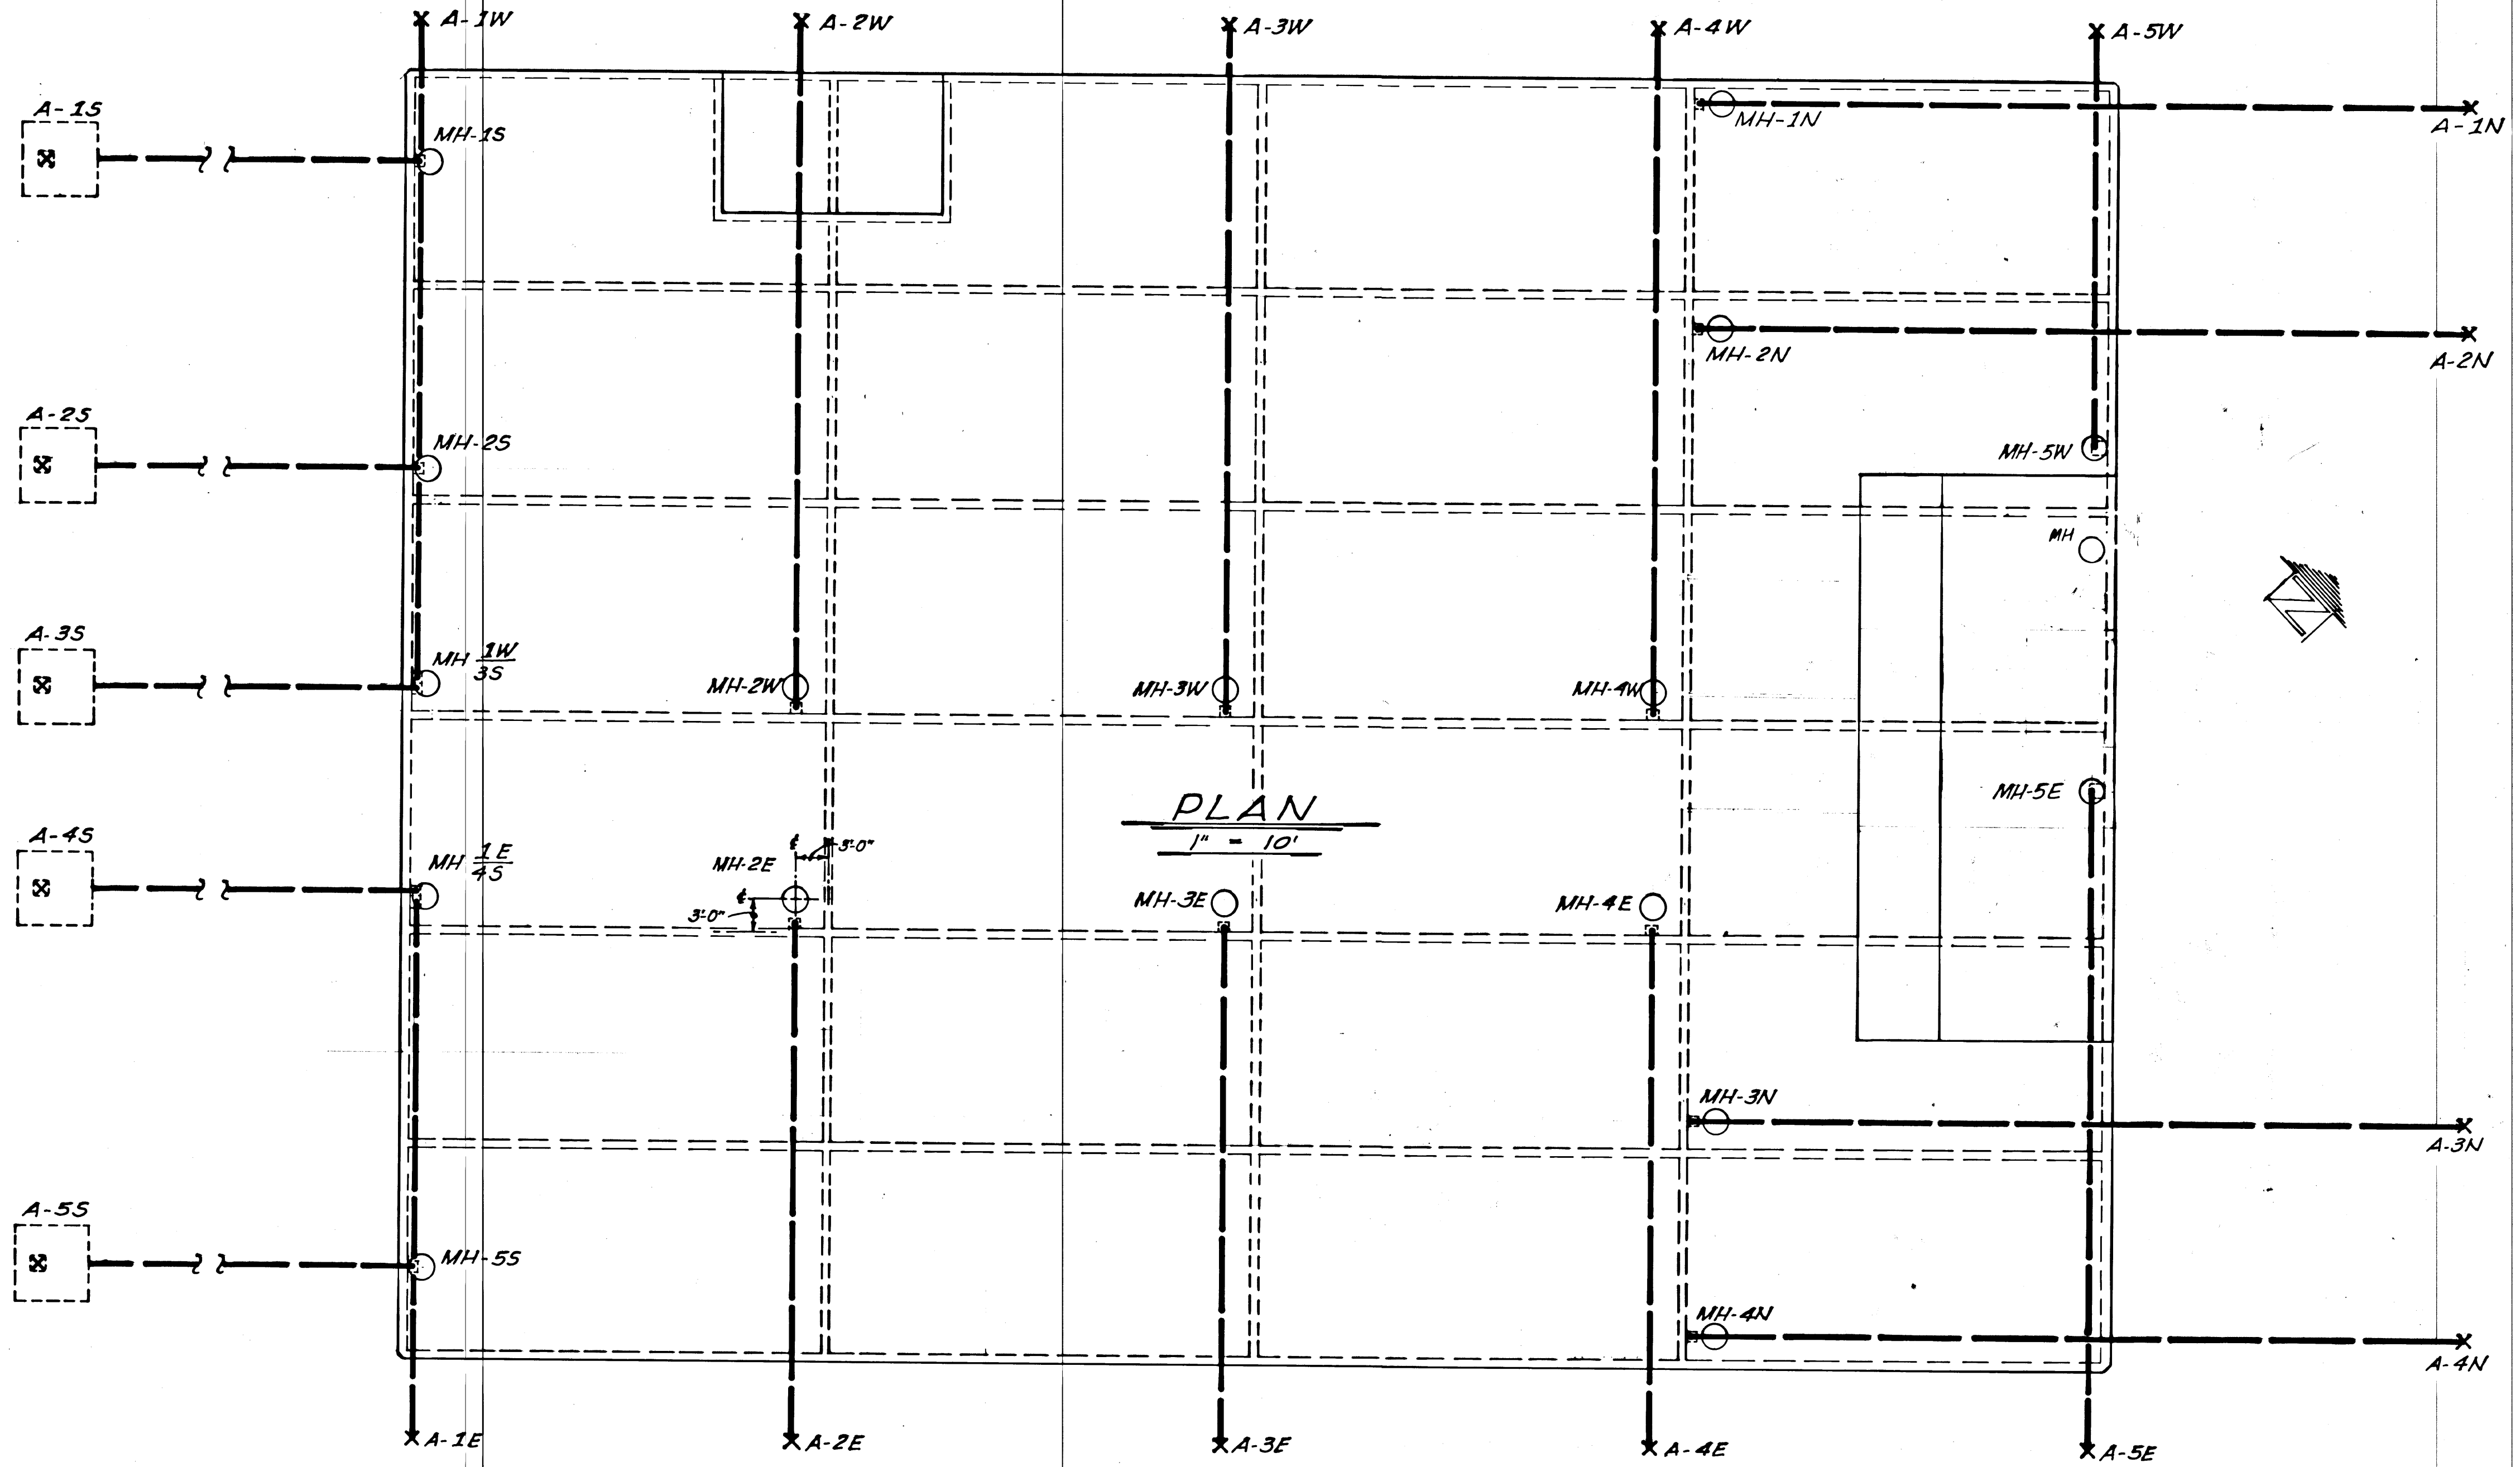

**PLAN**  
1" = 10'

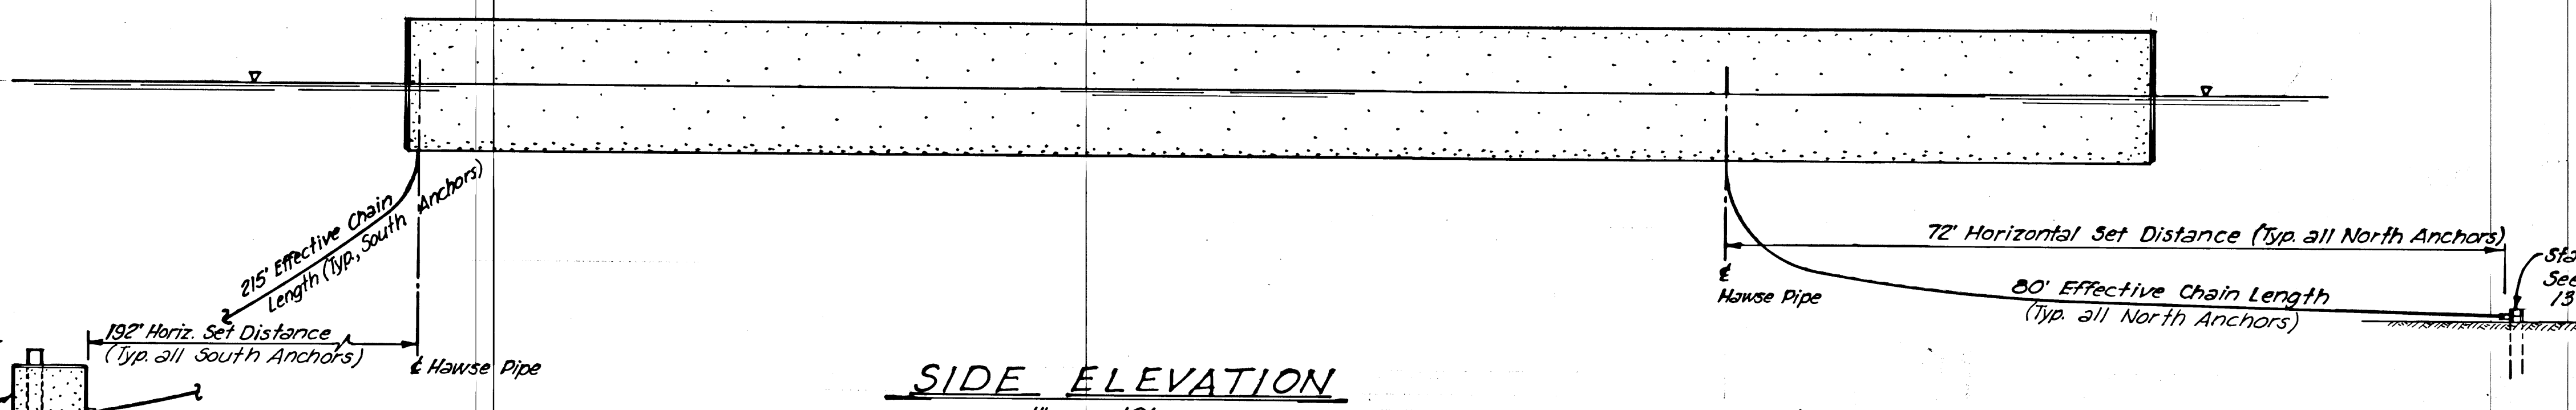

**SIDE ELEVATION**  
1" = 10'

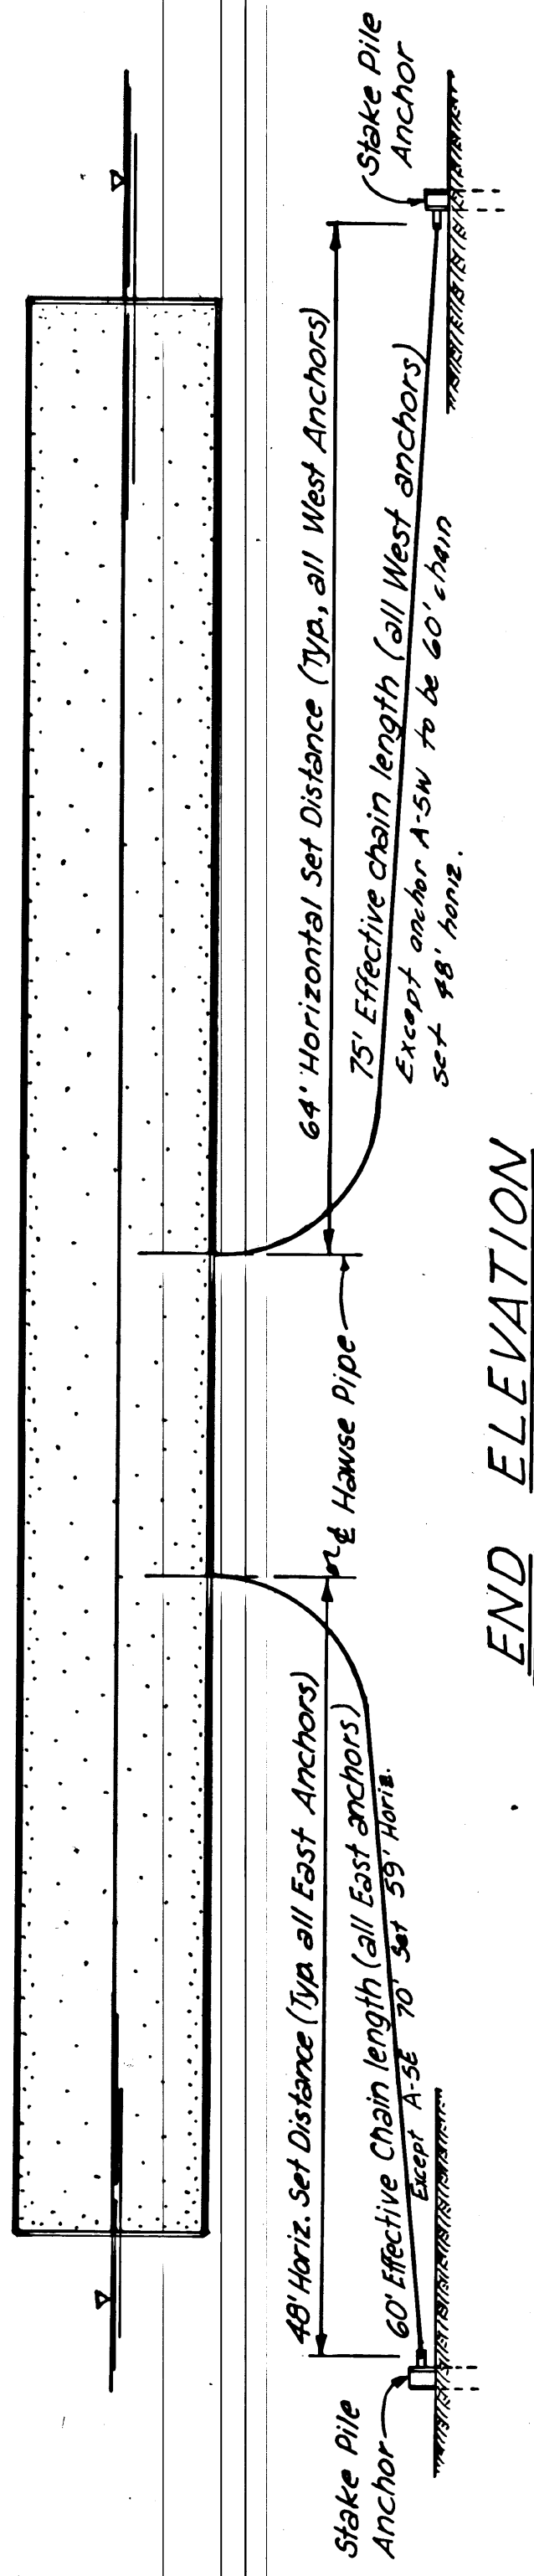

**END ELEVATION**  
1" = 10'

Conc. Anchor over Stake Pile. Typ. 5 locations. For details, see Sh. P3  
11' Penetration


Stake Pile Anchor See Detail, Sh. P3  
13' Penetration

REV.	DATE	BY	REVISION

**TRYCK NYMAN & HAYES**  
ENGINEERS/PLANNERS/SURVEYORS  
JUNEAU, ALASKA









**BARGE FACILITY ANCHOR LAYOUT**

SKAGWAY ALASKA

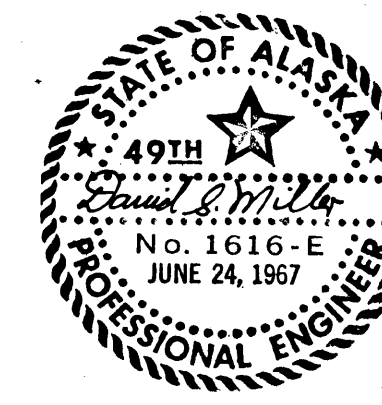

SHEET  
**P2** OF **3**  
FILE NO.  
**7502.0**


FIELD BOOKS  
DESIGNED **DSM**  
DRAWN **JT**  
CHECKED **RMH**  
DATE **7/20/78**  
SCALE  
GRID  
JOB NO. **7502.0**

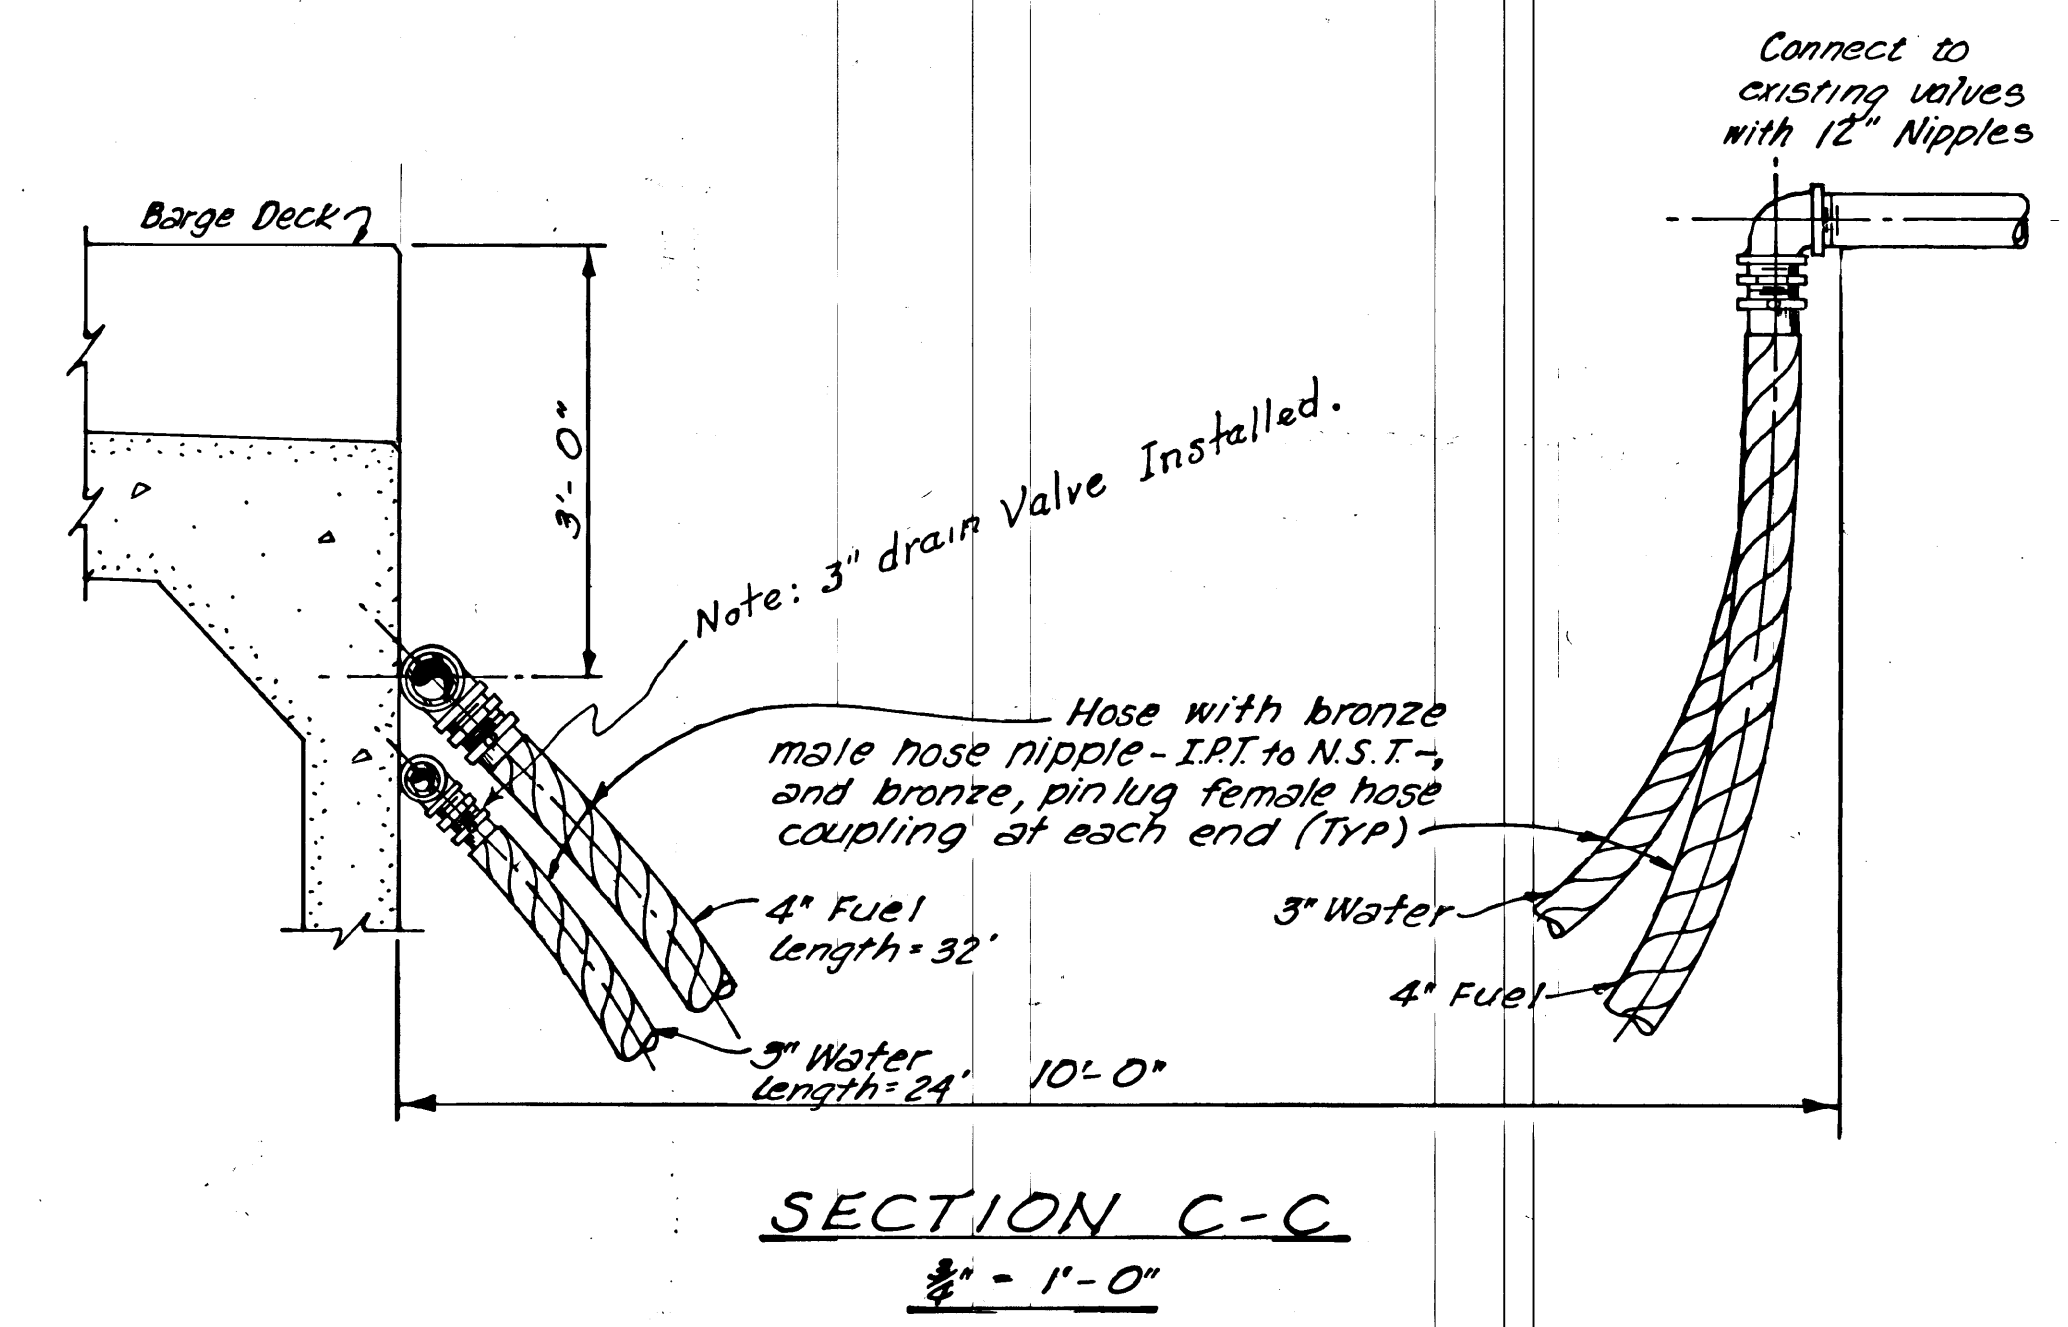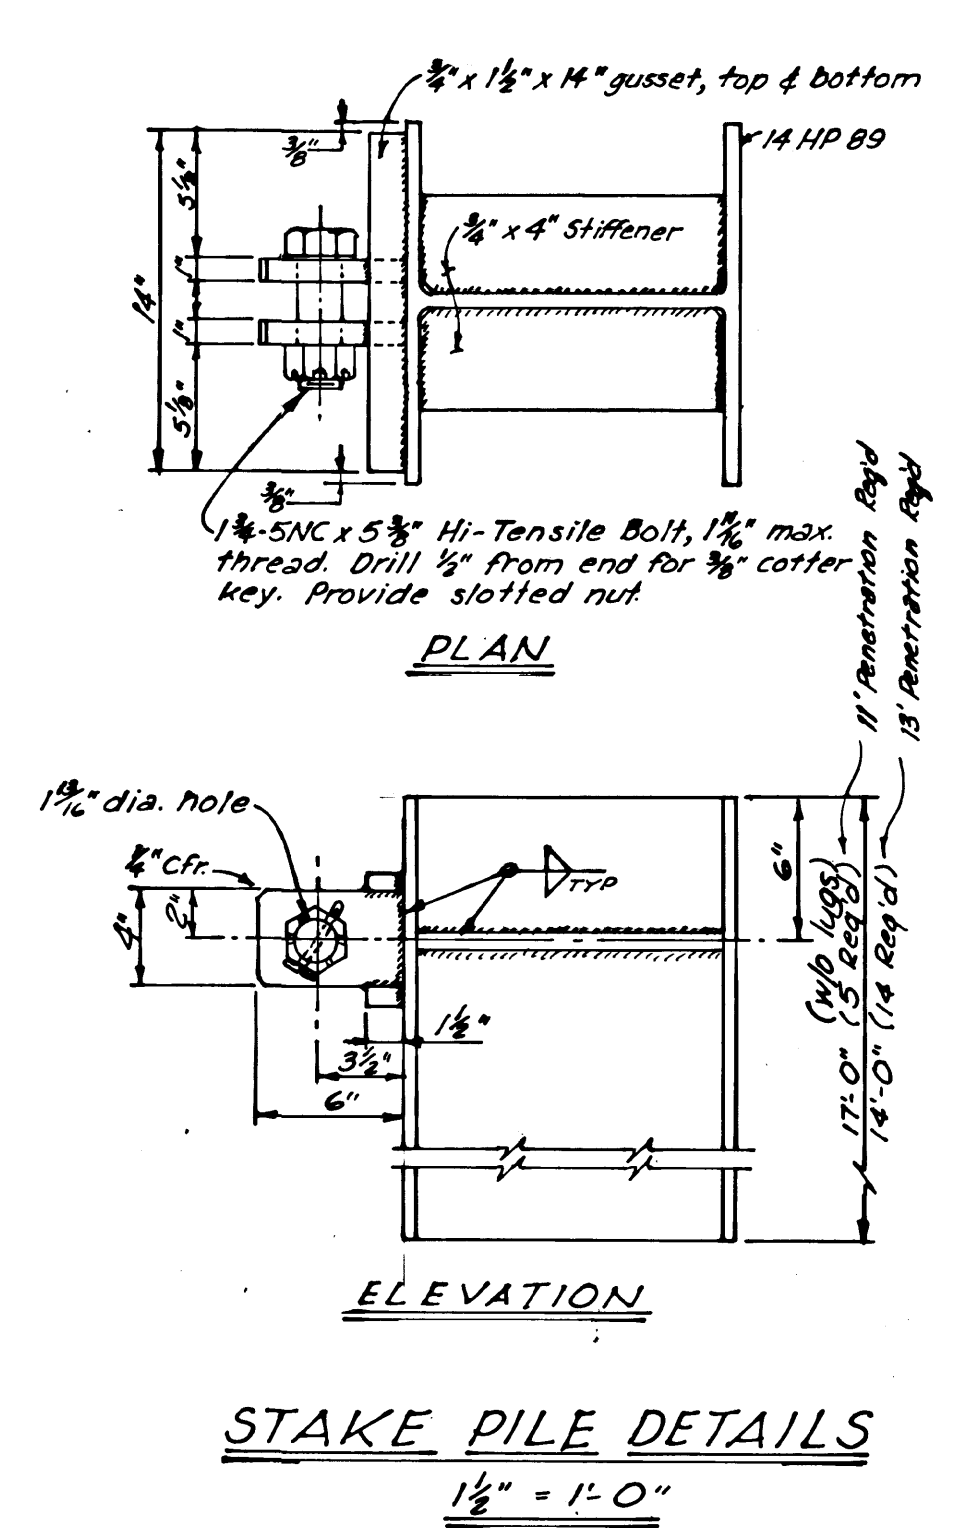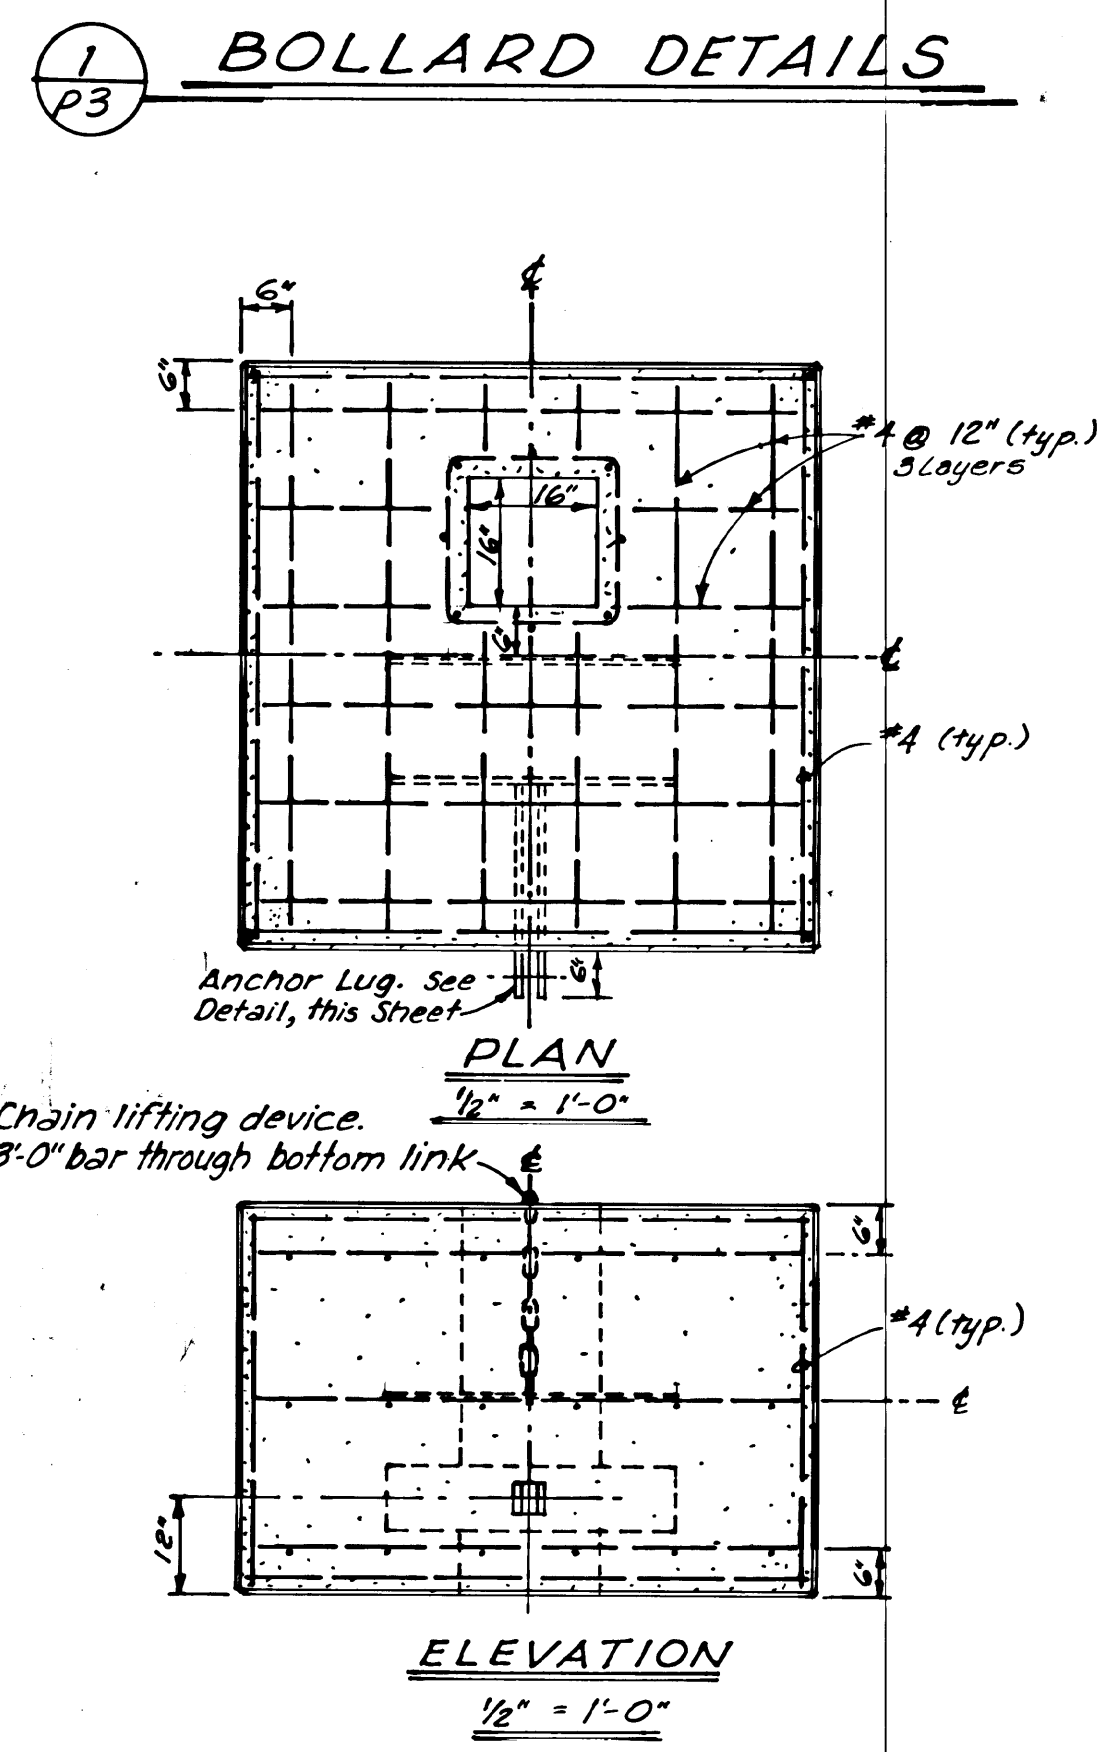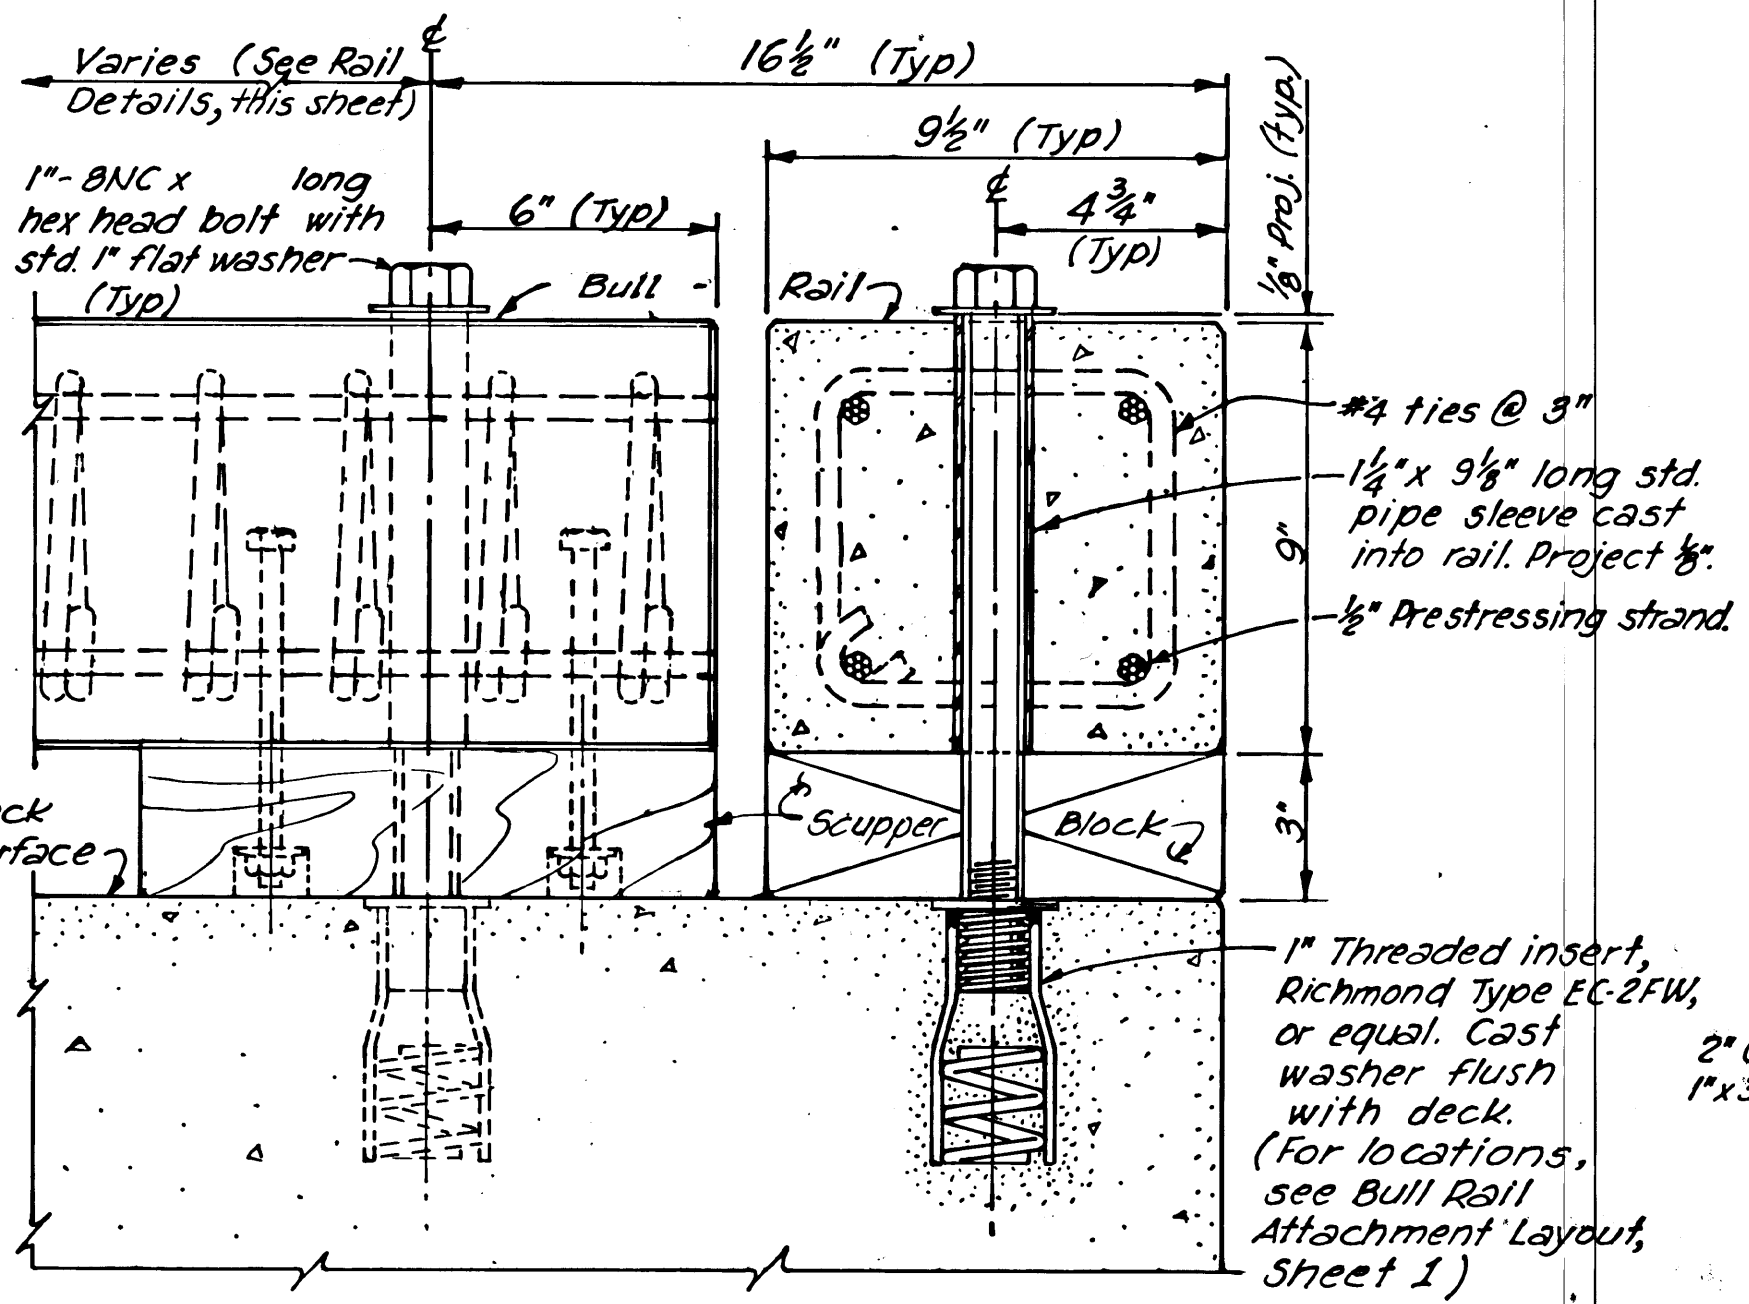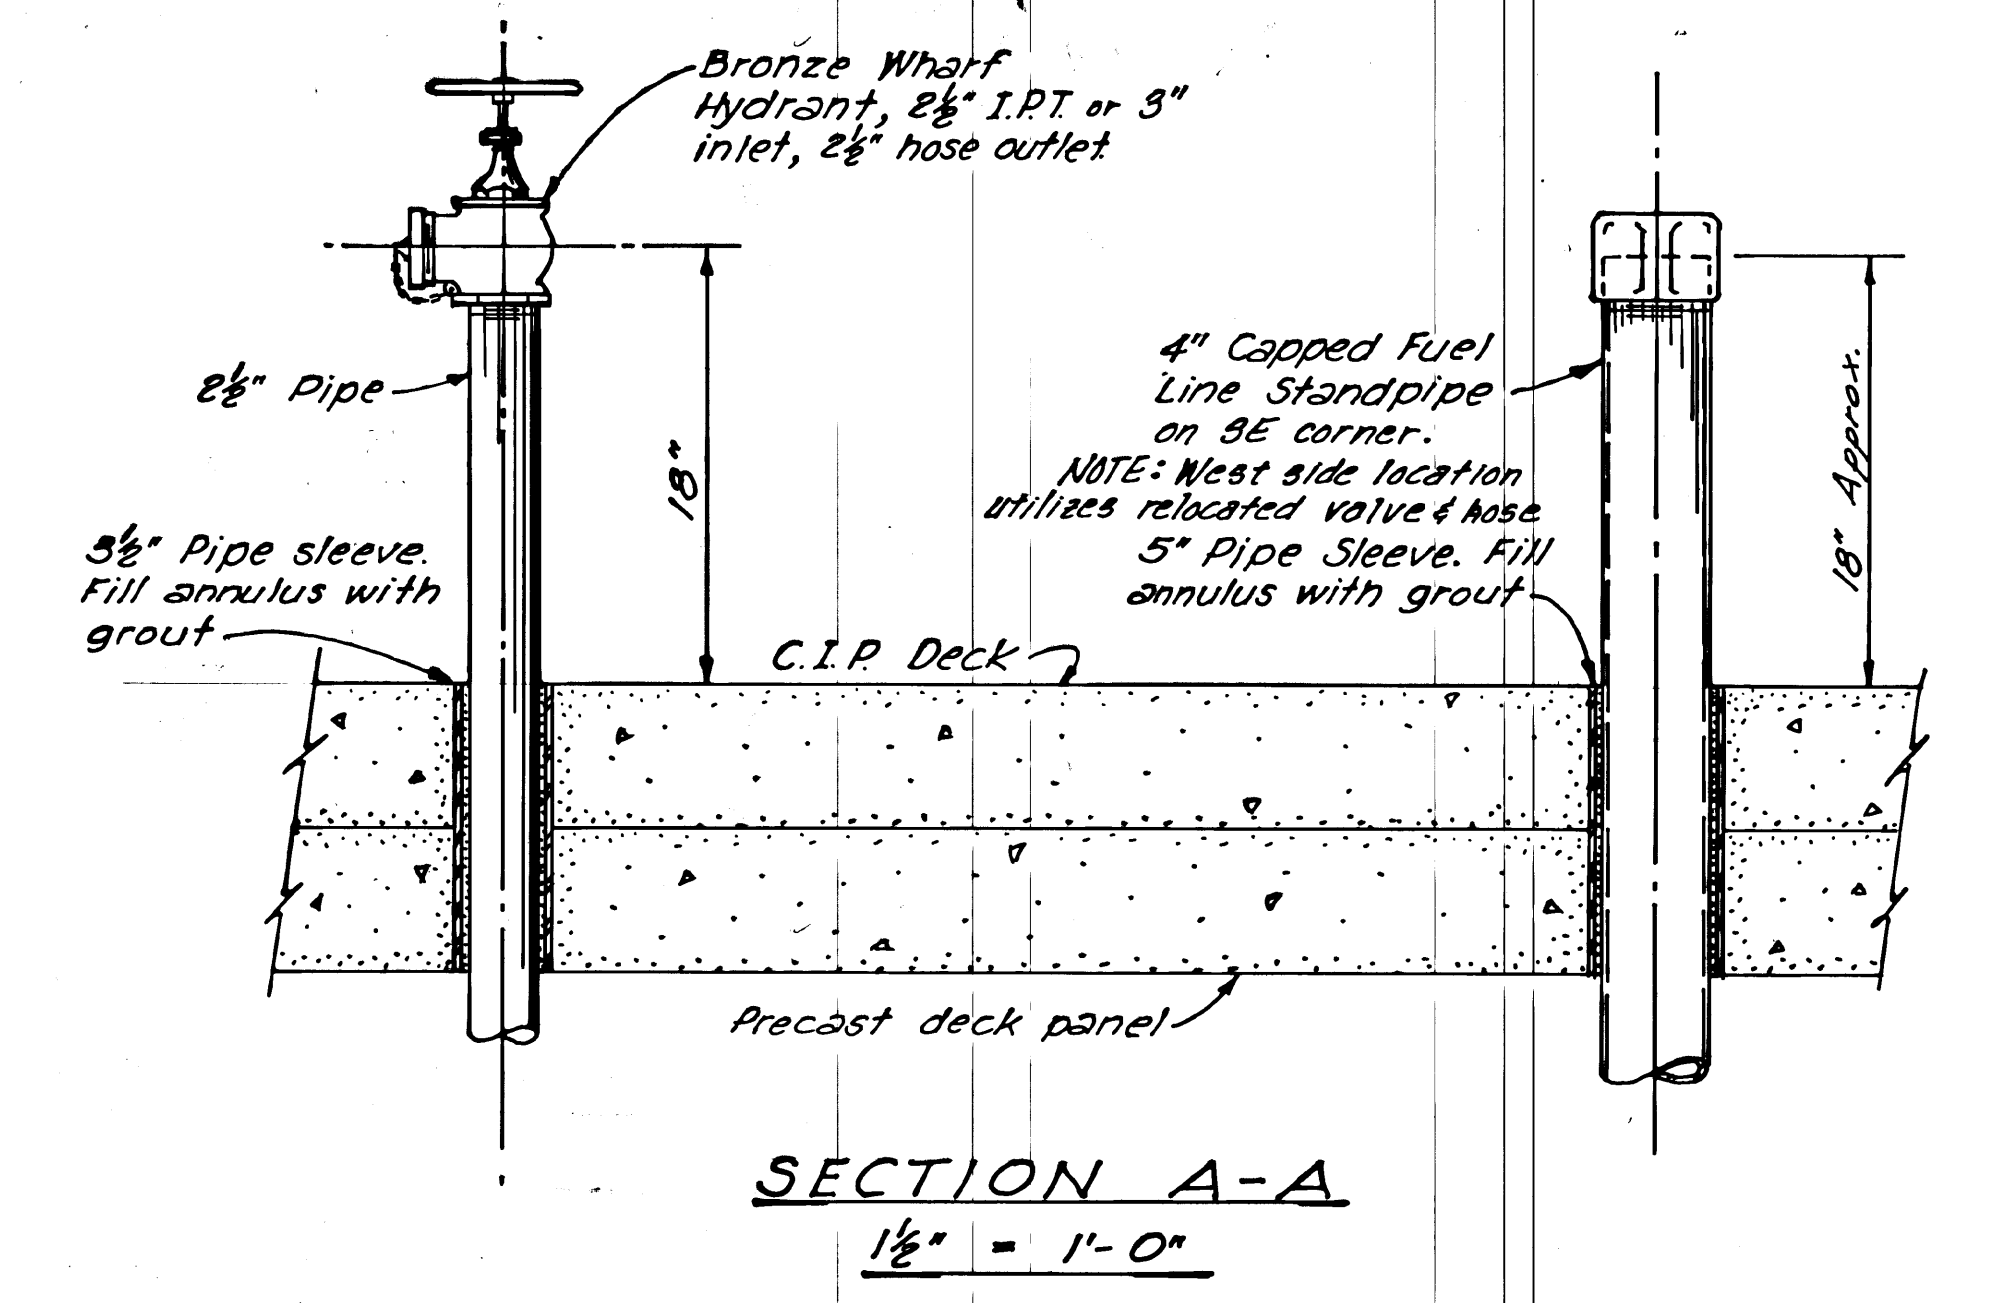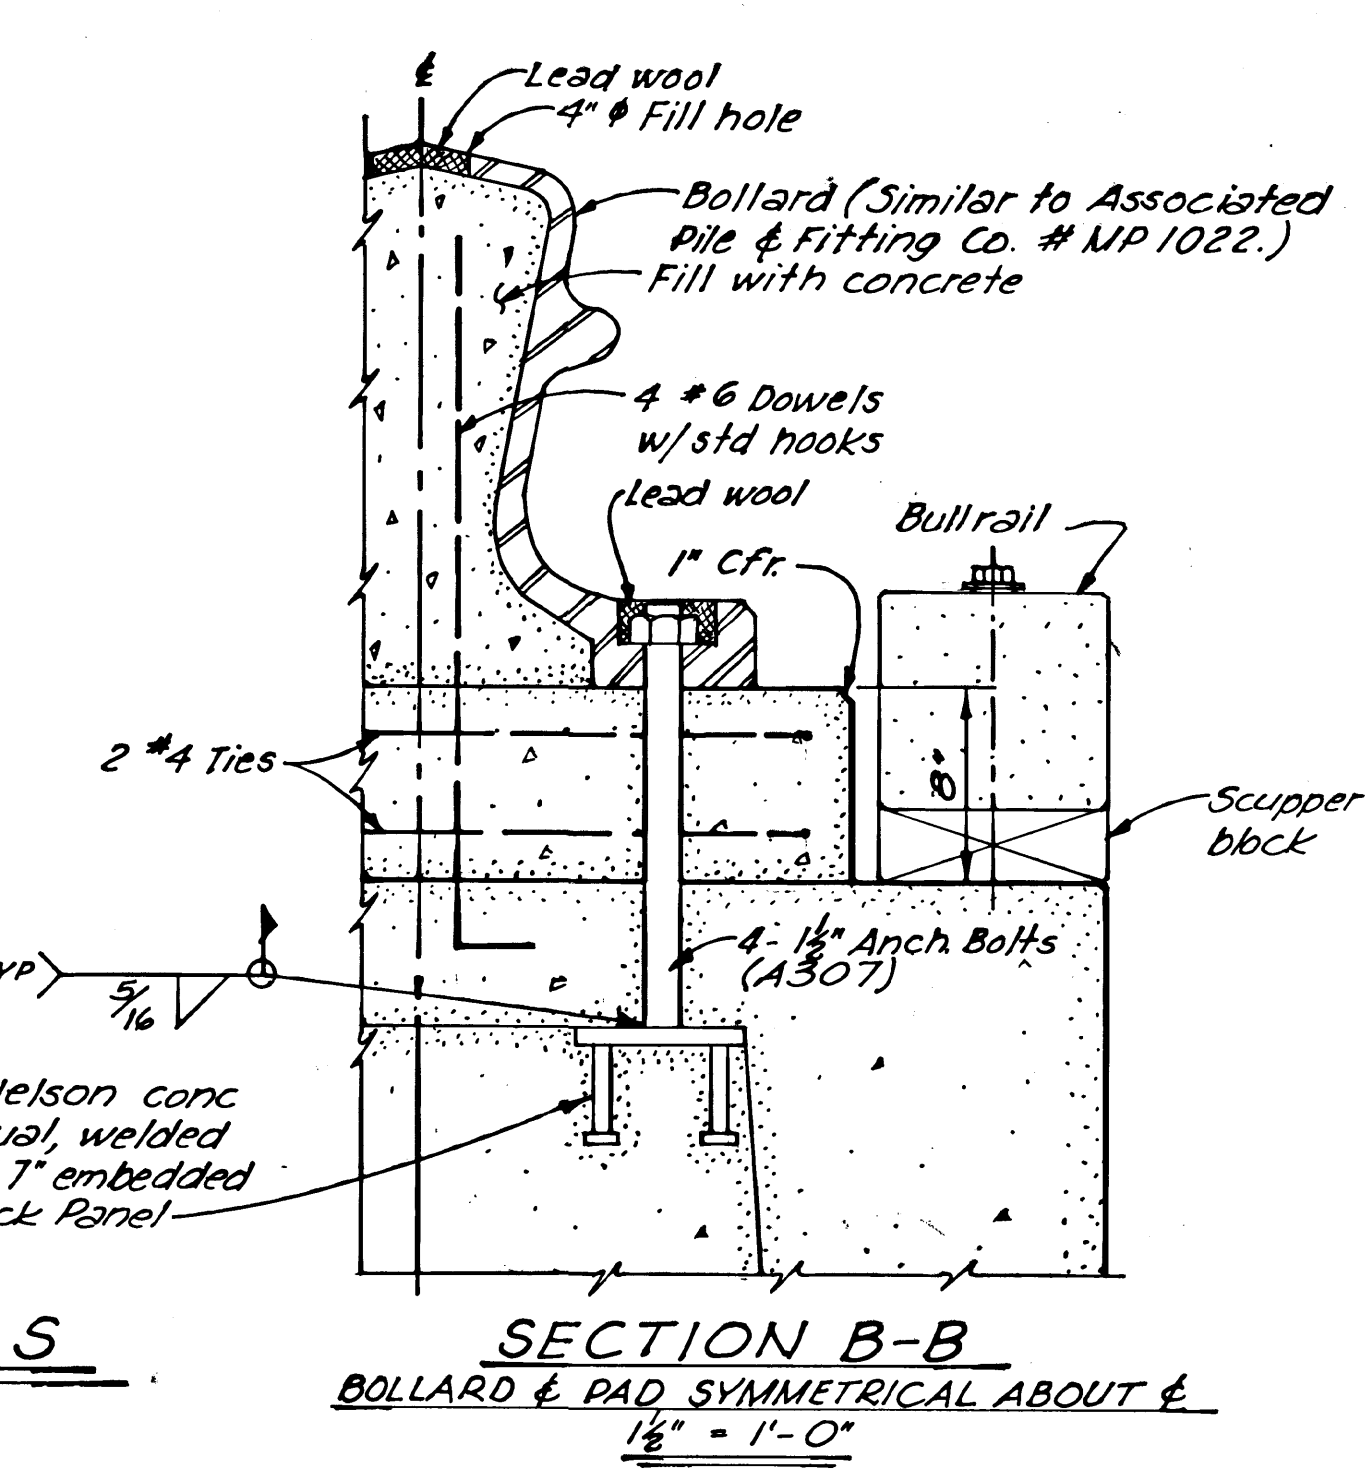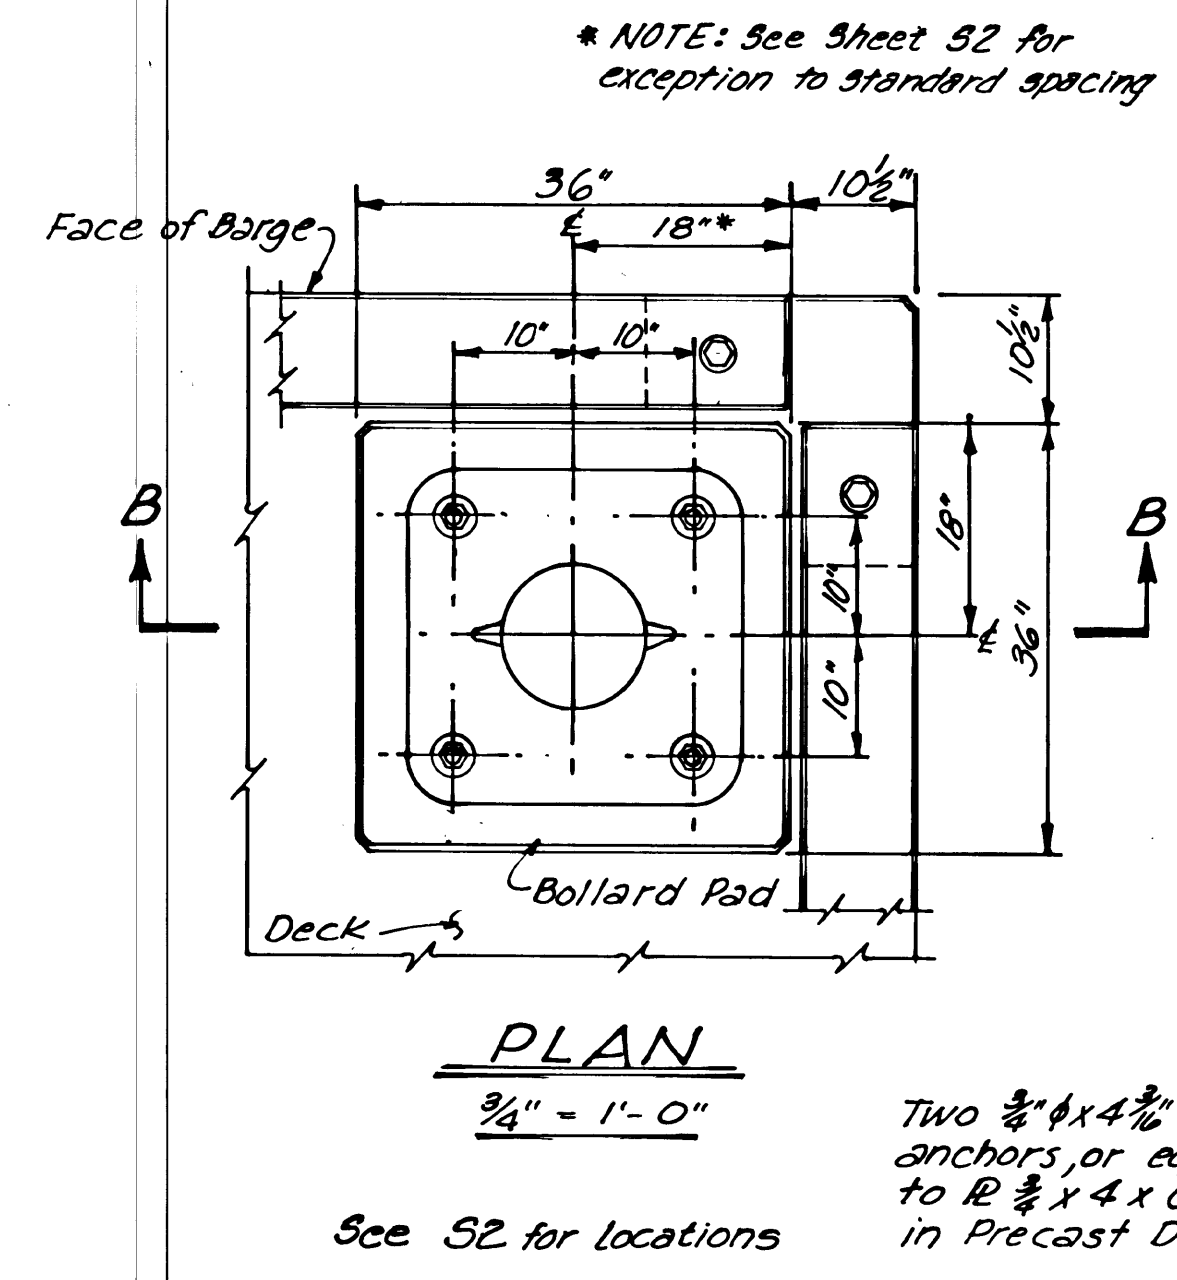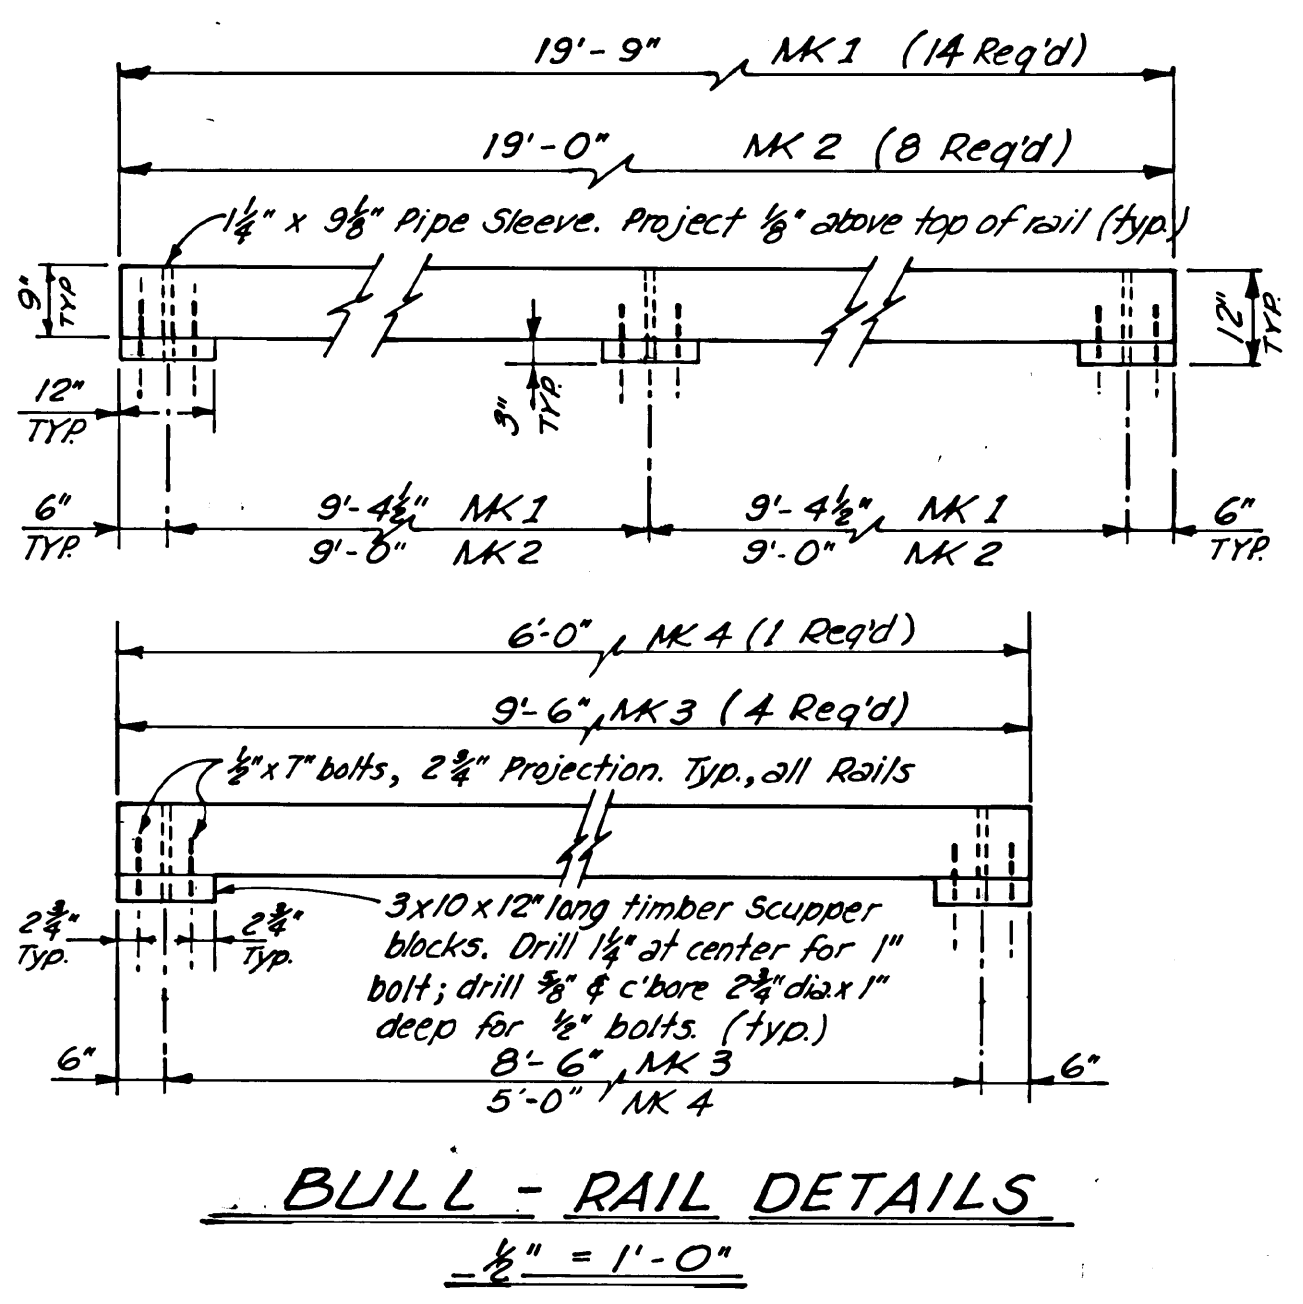

**NOTE:** Building & Ramp added EWO No. 15

1. Attach fuel line to an existing plugged 4" flow valve located on side of transfer bridge, which is approx. 13' from end of bridge. Provide Heavy Duty shock cord attachment for fuel hose approx. 22' from end of bridge.
2. Remove existing flow valve & hose assembly on bridge and relocate on dock as shown. Relocate fuel meter to Ferry Ramp also.
3. Existing waterline on bridge terminates in a gate valve approx. 6' from end of bridge. Cut line back to approx. 22' and reattach gate valve with elbow to side of bridge and connect new hose.


**NOTE:** Anchor dimensions may vary to accommodate available forms, as approved, but must be nominal 240 cu. ft. minimum, with maximum ht. of 5'.

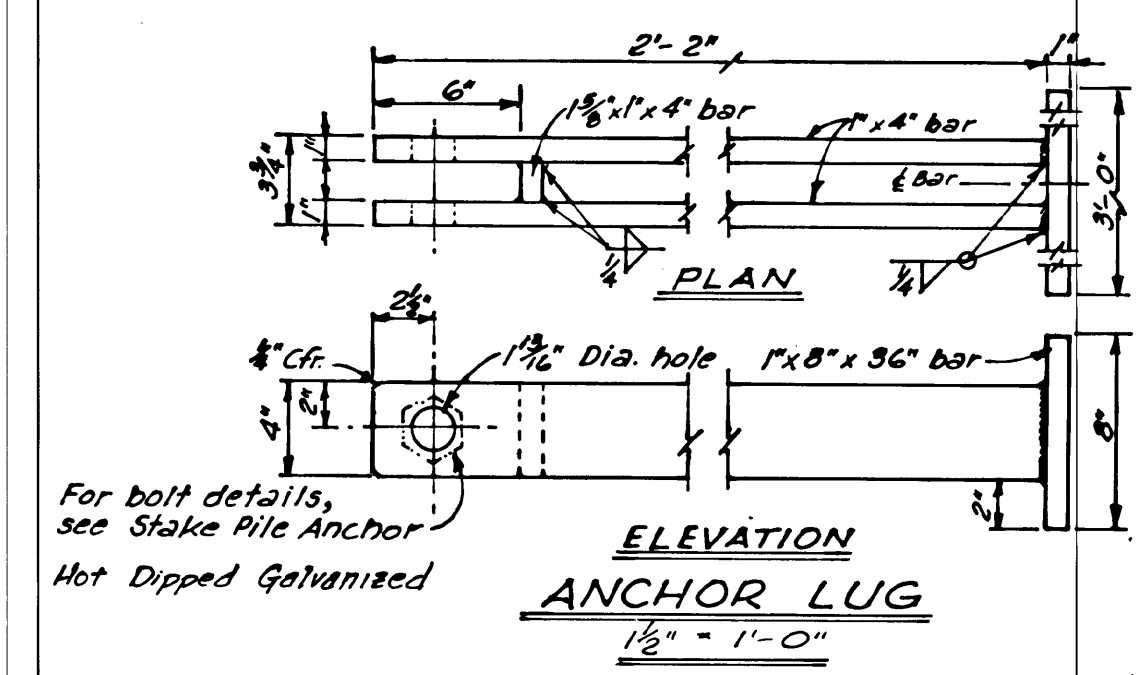

**ANCHOR DETAILS**

REV.	DATE	BY	REVISION


FIELD BOOKS	DESIGNED DSM	<b>TRYCK NYMAN &amp; HAYES</b> ENGINEERS, PLANNERS, SURVEYORS JUNEAU, ALASKA	BARGE FACILITY MISCELLANEOUS DETAILS SKAGWAY ALASKA	SHEET
DESIGN	DRAWN JT			P3 OF 3
STARTING	CHECKED RMH			
AS-BUILT	DATE 7/20/78			
HOR. SCALE	VER. AS SHOWN			
		JOB NO. 7502.0		7502.0

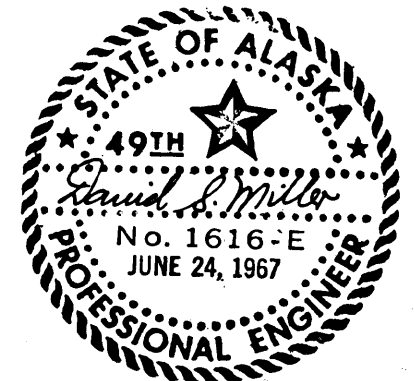



6 SPACES @ 20'-0" = 120'-0"

4 SPACES @ 40'-0" = 160'-0"

CALLLED NORTH

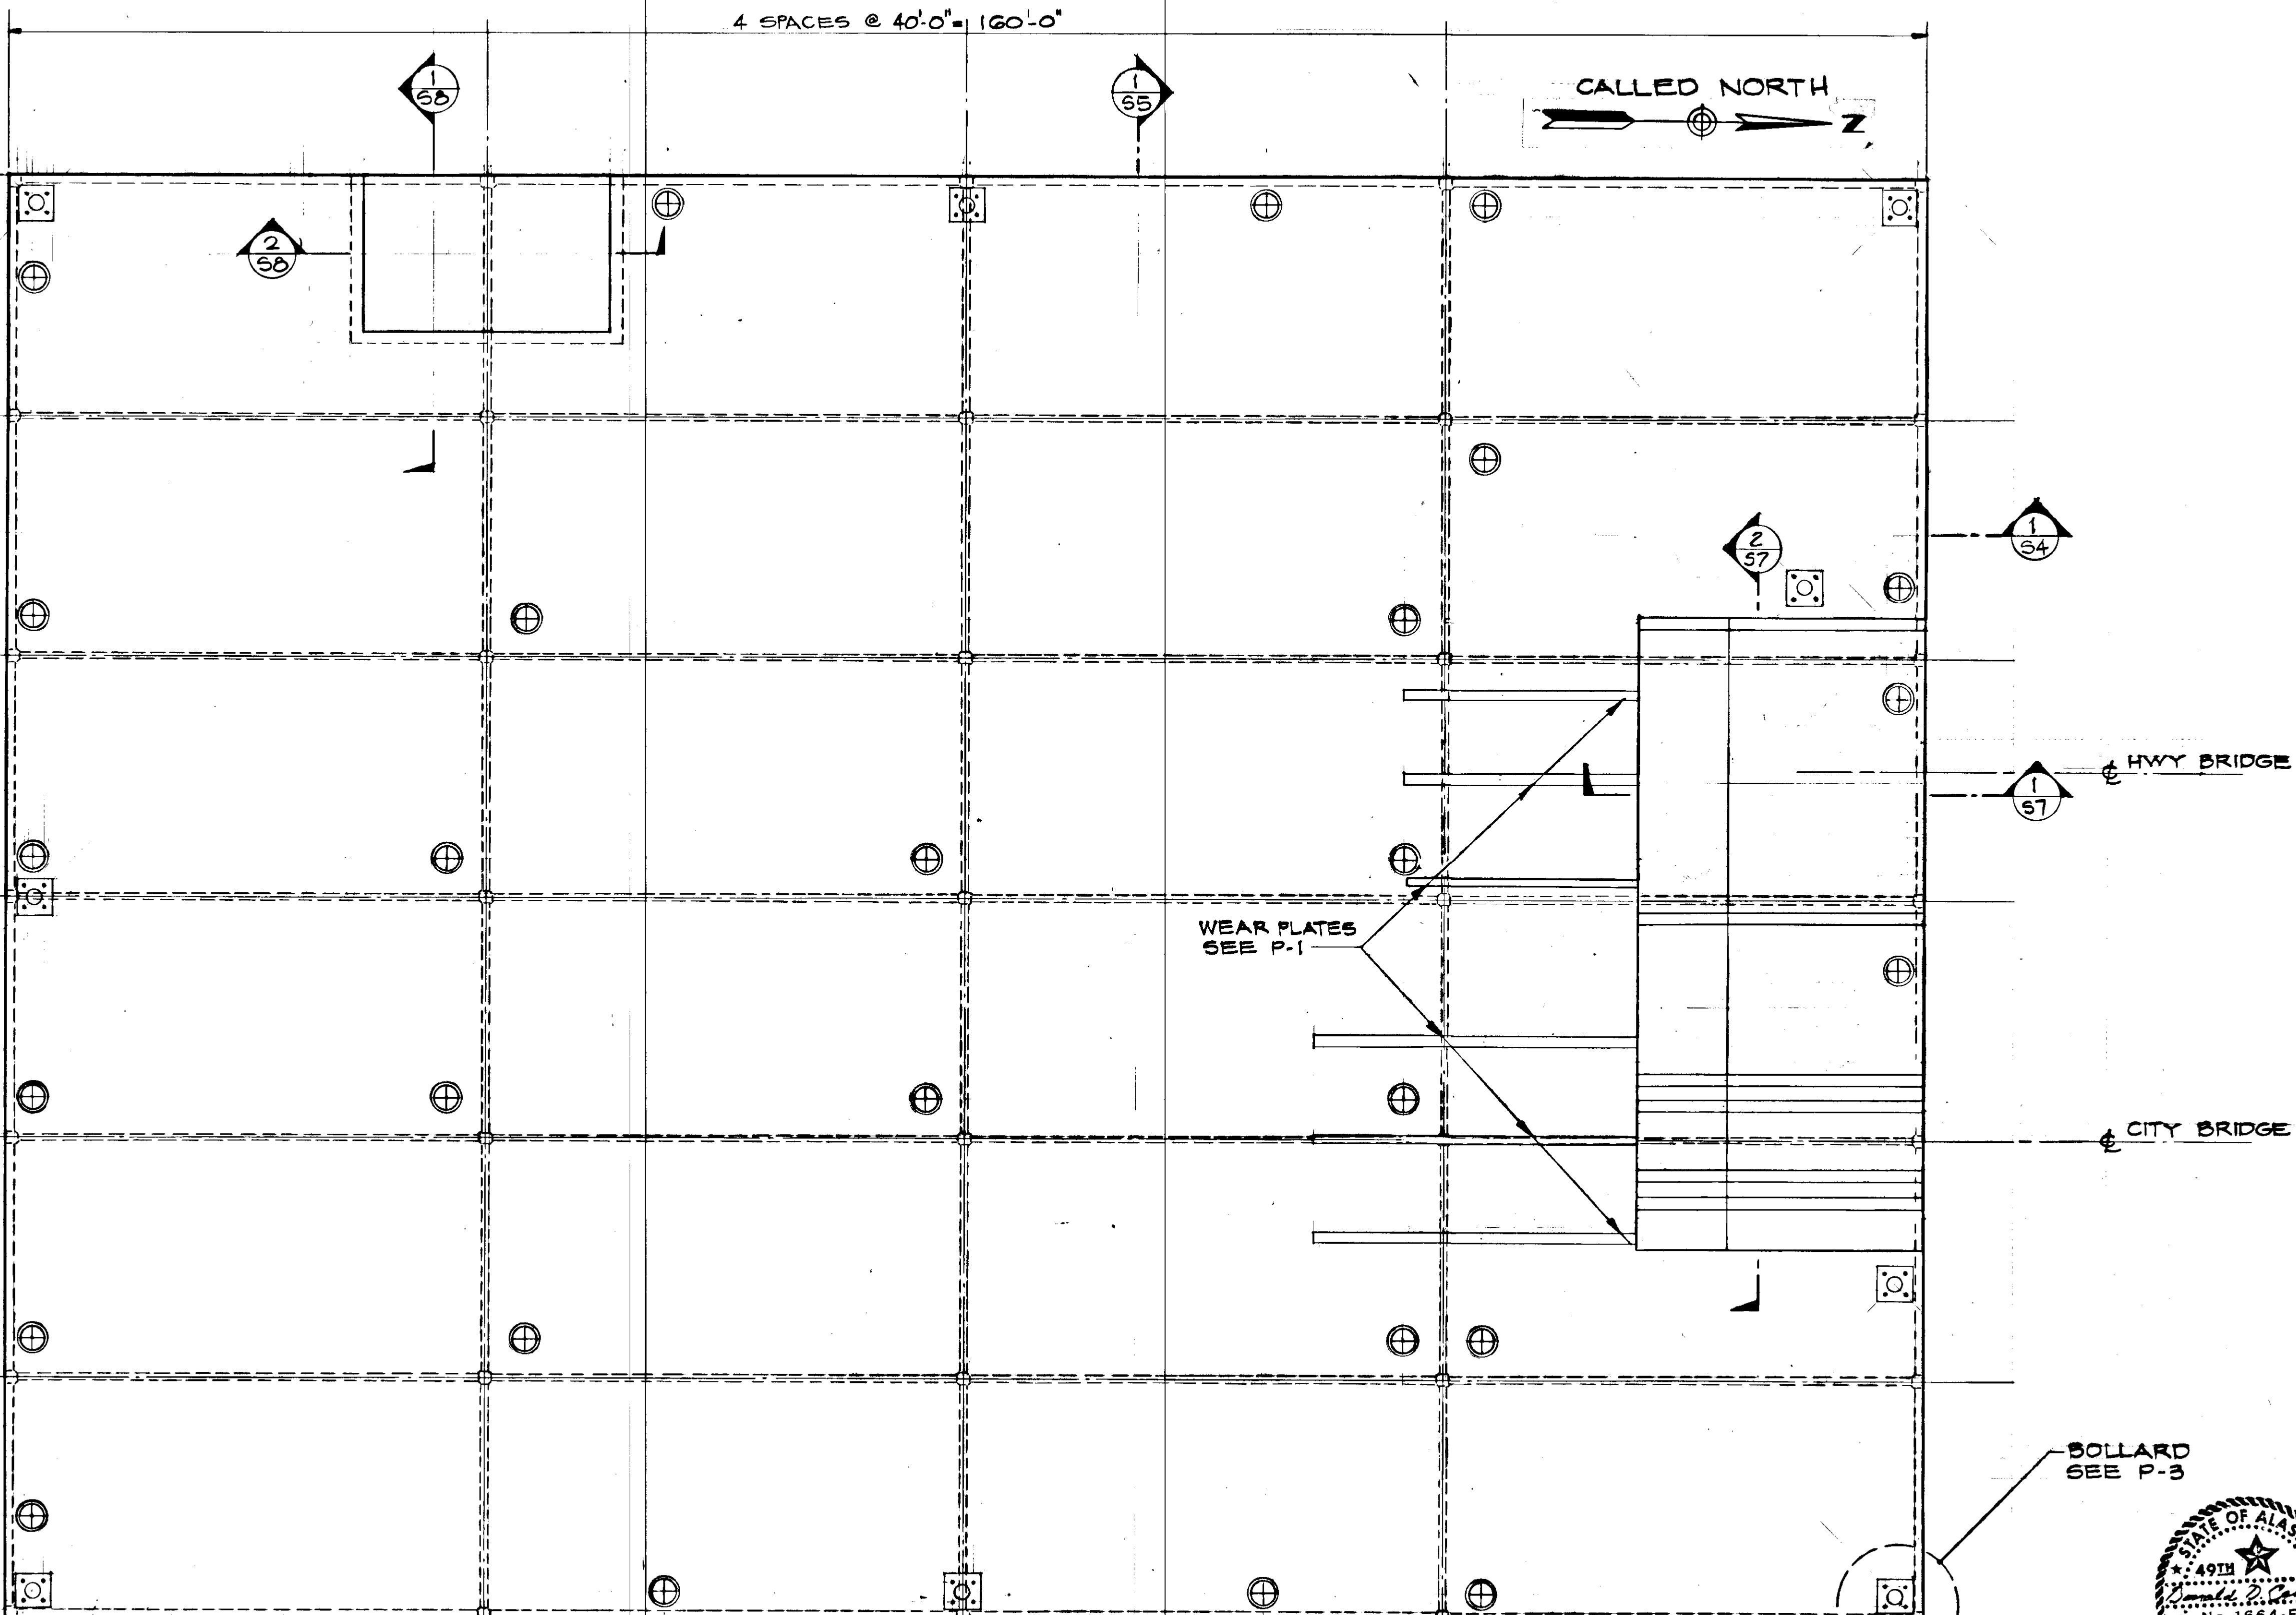

- I. DESIGN CONDITIONS
  - A. WAVE: HEIGHT = 8 FT.  
LENGTH = HULL LENGTH IN DIRECTION OF WAVE.
  - B. DECK LOADS: SEE BELOW
  - C. PLATING BELOW DECK: HYDROSTATIC PRESSURE WITH WATERLINE AT DECK LEVEL.
- II. DECK LOADS:
  - A. 800 PSF UNIFORM LOAD.
  - B. 2000 PSF CRANE OUTRIGGER ON 8 FT. X 8 FT. MAT.
  - C. HS20 AASHTO TRUCK OVERLOADED 33 PERCENT.
  - D. 195 KIP FORKLIFT AXLE LOAD. FORKLIFT 18 FT. - 6 IN. WHEEL BASE; 8 FT. TREAD TO CENTERLINE OF DUAL TIRES; EACH SET OF DUAL TIRES 40 IN. WIDE.
  - E. 160 KIP GROSS LOAD ON TRACKED EQUIPMENT. TRACK PRESSURE = 1500 PSF.
  - F. BRIDGE D.L. (TOTAL REACTION): HWY = 85K  
CITY = 80K
- III. LOAD COMBINATIONS
  - A. WAVE + II C, II D, OR II E.
  - B. STILLWATER:
    - 1. 200 PSF ON 10 FT. X 8 FT. DECK AREA.
    - 2. 450 PSF ON 4800 SF OF CONTIGUOUS DECK AREA.
    - 3. 50K ON BOLLARD.
- IV. HAWSE PIPE
  - A. 30 KIP LOAD AT 2:1 SCOPE.
- V. DESIGN CRITERIA
  - A. ACI 318-71 ULTIMATE STRENGTH DESIGN.
  - B. MULL GIRDER:
    - 1. LOAD FACTOR = 1.3 FOR DESIGN WAVE.
    - 2. MEMBRANE STRESSES = ZERO TENSION.
  - C. PLATING:
    - 1. PRESTRESSED SECTIONS: 0.45  $f_c$  COMPRESSION, 5  $f_c$  TENSION.
    - 2. DECK: 1.4 D. L. + 1.7 L. L.
    - 3. EXTERIOR AND INTERIOR BULKHEADS: 1.3 L. L.
    - 4. KEEL: 1.4 (D. L. + L. L.)
- VI. CONCRETE COVER
  - A. OUTSIDE SURFACES - 2 IN. EXCEPT DECK - 2 1/2"
  - B. INTERIOR SURFACES - 1 IN.
- VII. CONCRETE
  - A. ALL CONCRETE EXCEPT PRECAST INTERIOR BULKHEADS.
    - 1. NORMAL WEIGHT. EXCEPT PRECAST DECK SLABS MAX. WT. = 135 PCF.
    - 2. COMPRESSIVE STRENGTH,  $f_c$ , AT PRESTRESS TRANSFER = 3400 PSI.
    - 3. COMPRESSIVE STRENGTH,  $f_c$ , AT 28 DAYS = 6000 PSI.
  - B. PRECAST INTERIOR BULKHEADS.
    - 1. LIGHT WEIGHT = 120 PCF.
    - 2. COMPRESSIVE STRENGTH,  $f_c$ , AT 28 DAYS = 5000 PSI.
- VIII. REINFORCEMENT
  - A. DEFORMED BARS - ASTM A615, GRADE 60.
  - B. WELDED WIRE FABRIC - ASTM A185.
- IX. PRESTRESSING
  - A. SEVEN-WIRE, STRESS-RELIEVED STRAND - ASTM A416 ( $f_{pu}$  = 270 KSI).
  - B. FINAL STRESS AFTER ALL LOSSES EQUAL TO 0.6  $f_{pu}$ .
  - C. GROUTING PER SPECIFICATIONS.

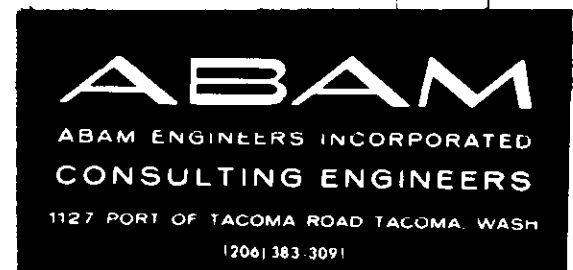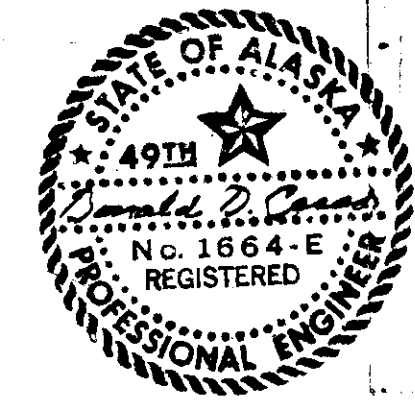

**TRYCK NYMAN & HAYES**  
ENGINEERS/PLANNERS/SURVEYORS

BARGE FACILITY  
SURFACE FEATURES PLAN  
AND GENERAL NOTES


SHEET  
51 OF 8  
FILE NO.

NOTE: SHEETS S1 THRU S8 DELINEATE THE STRUCTURAL FRAMING FOR THE BARGE AND MUST BE CO-ORDINATED WITH THE REQUIREMENTS OF OTHER SHEETS IN THIS SET OF PLANS.


① SURFACE FEATURES PLAN  
1/8" = 1'-0"

DESIGNED	JRS/WW
DRAWN	R. MOHN
CHECKED	DDM
DATE	JULY 18, '78
SCALE	AS NOTED
GRID	
JOB NO.	7502.0




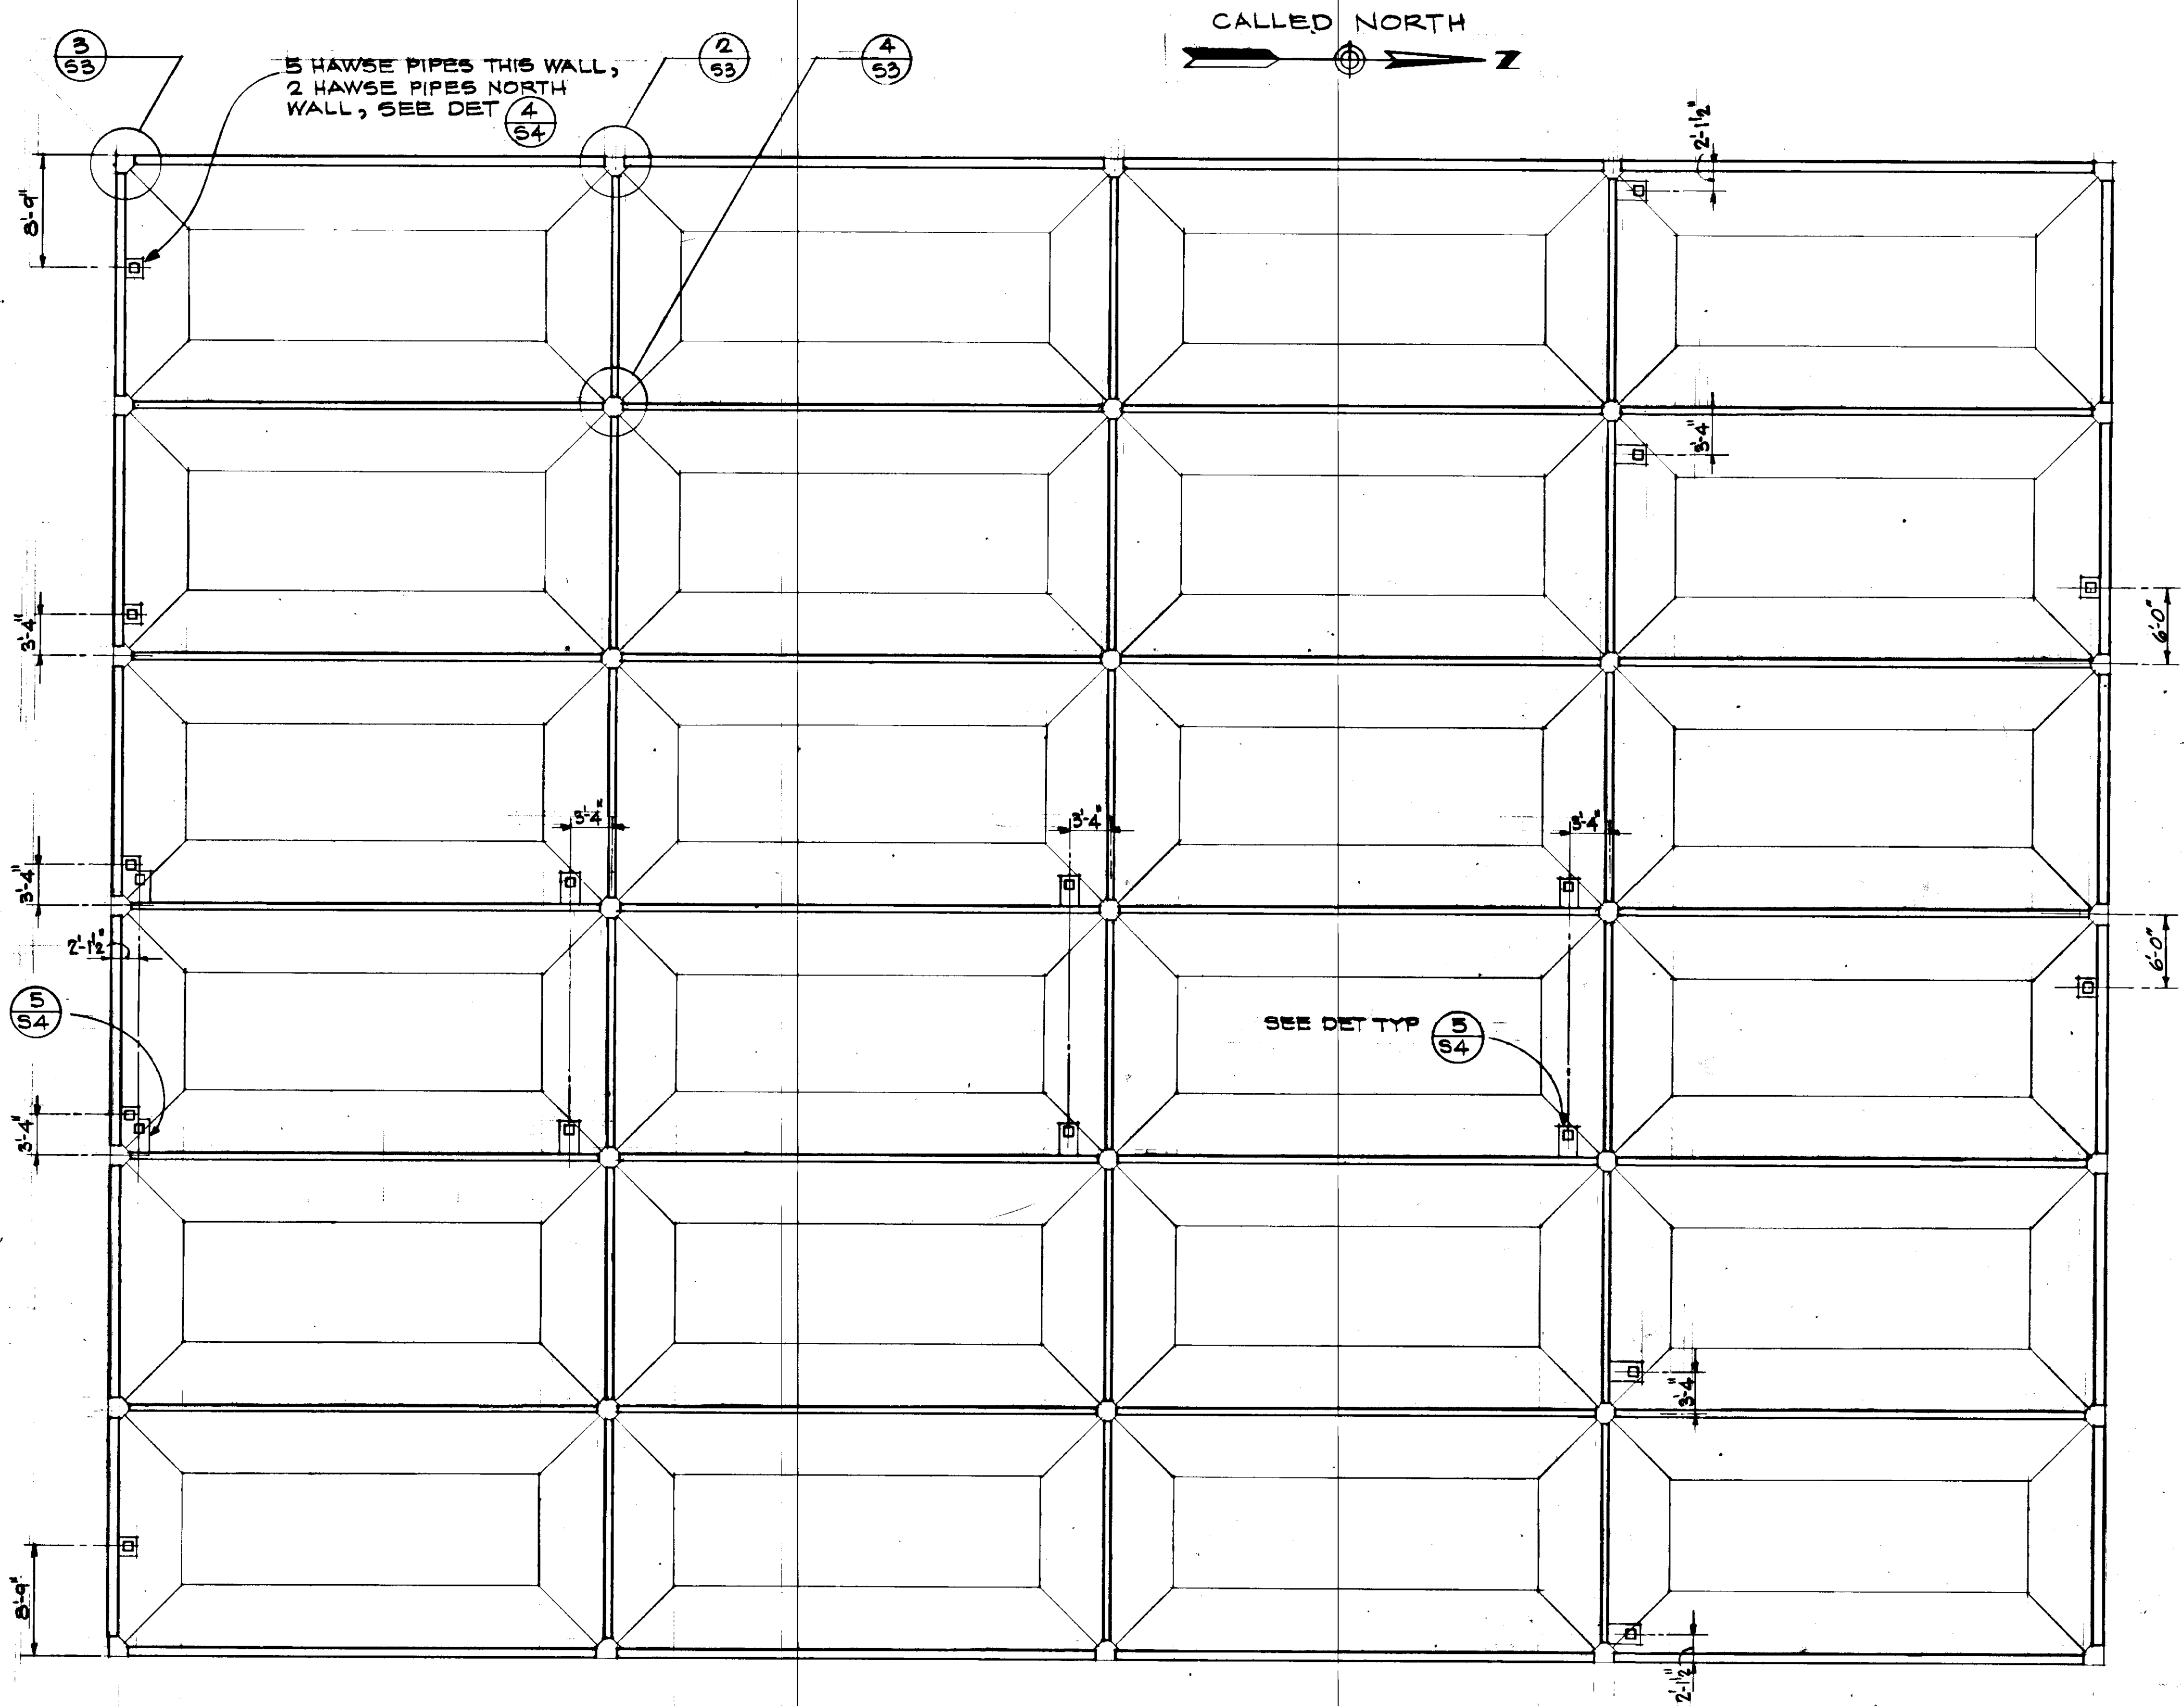


CALLED NORTH

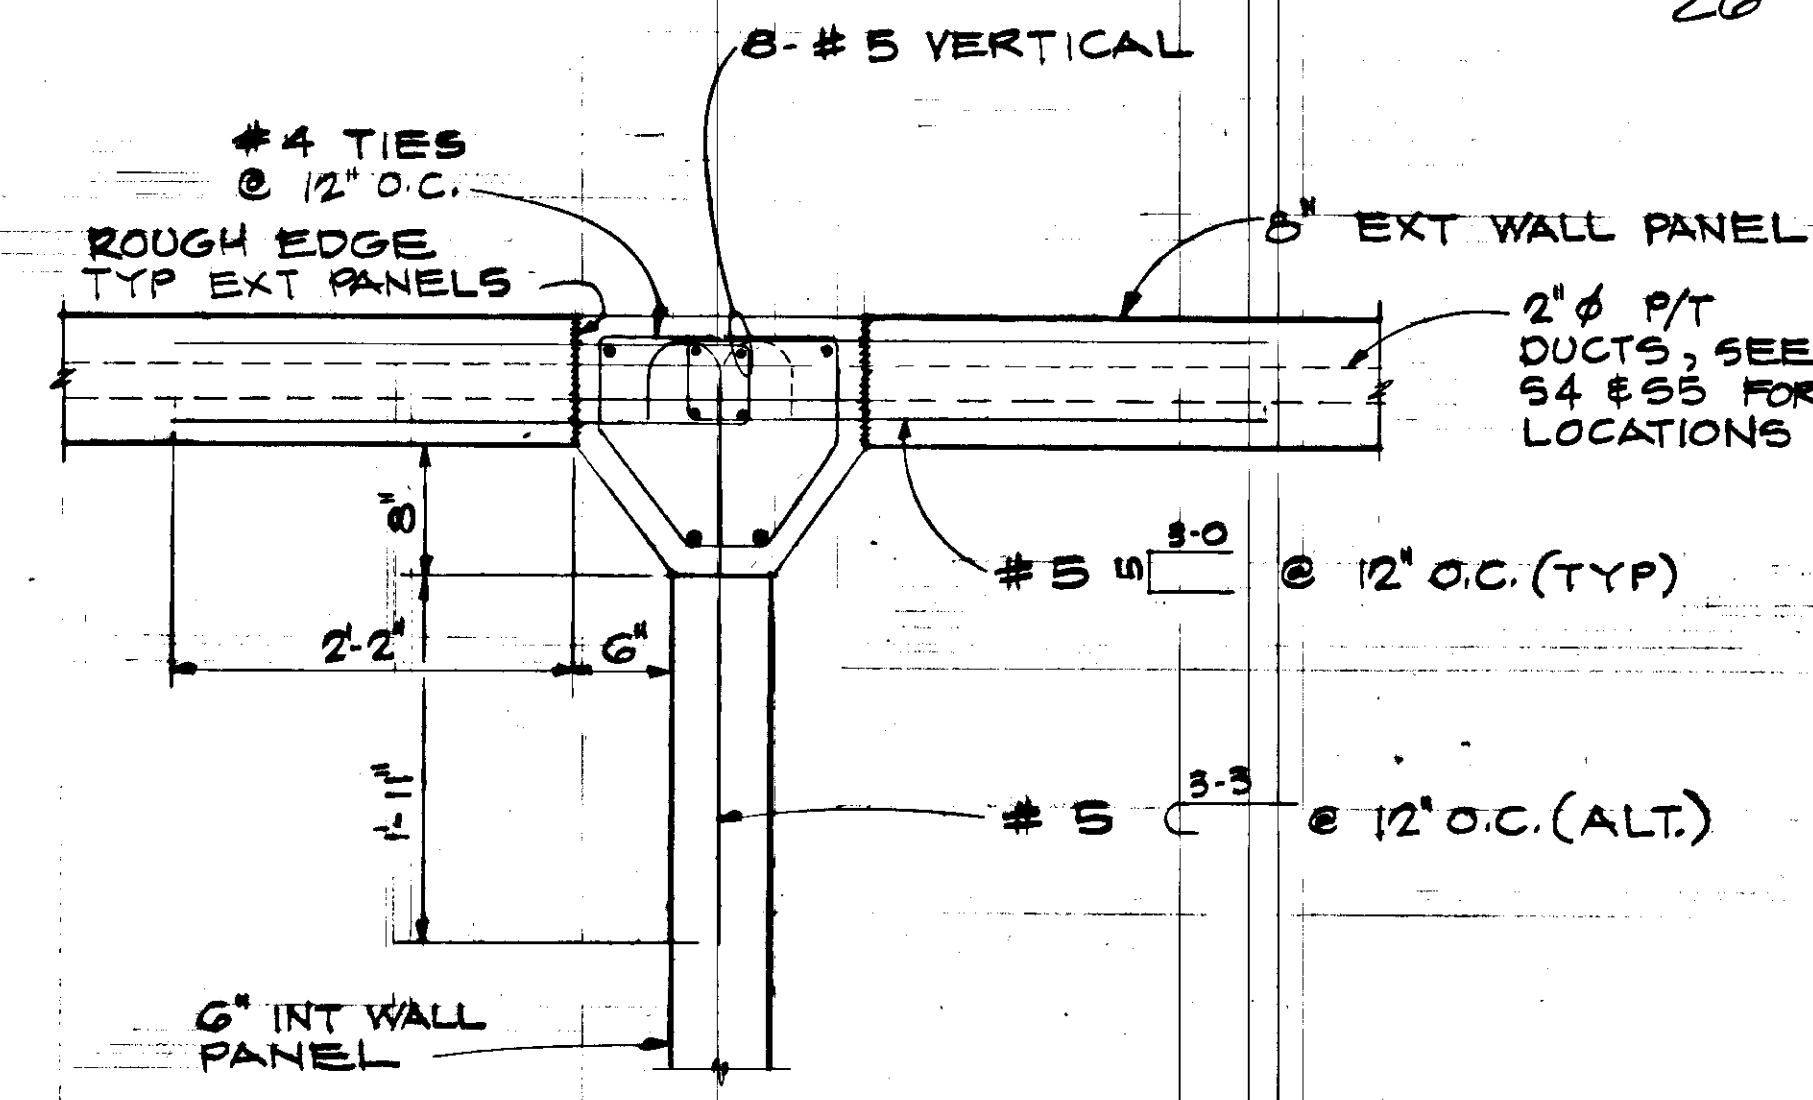


2 TYPICAL WALL PANEL CONNECTION  
 1" = 1'-0"

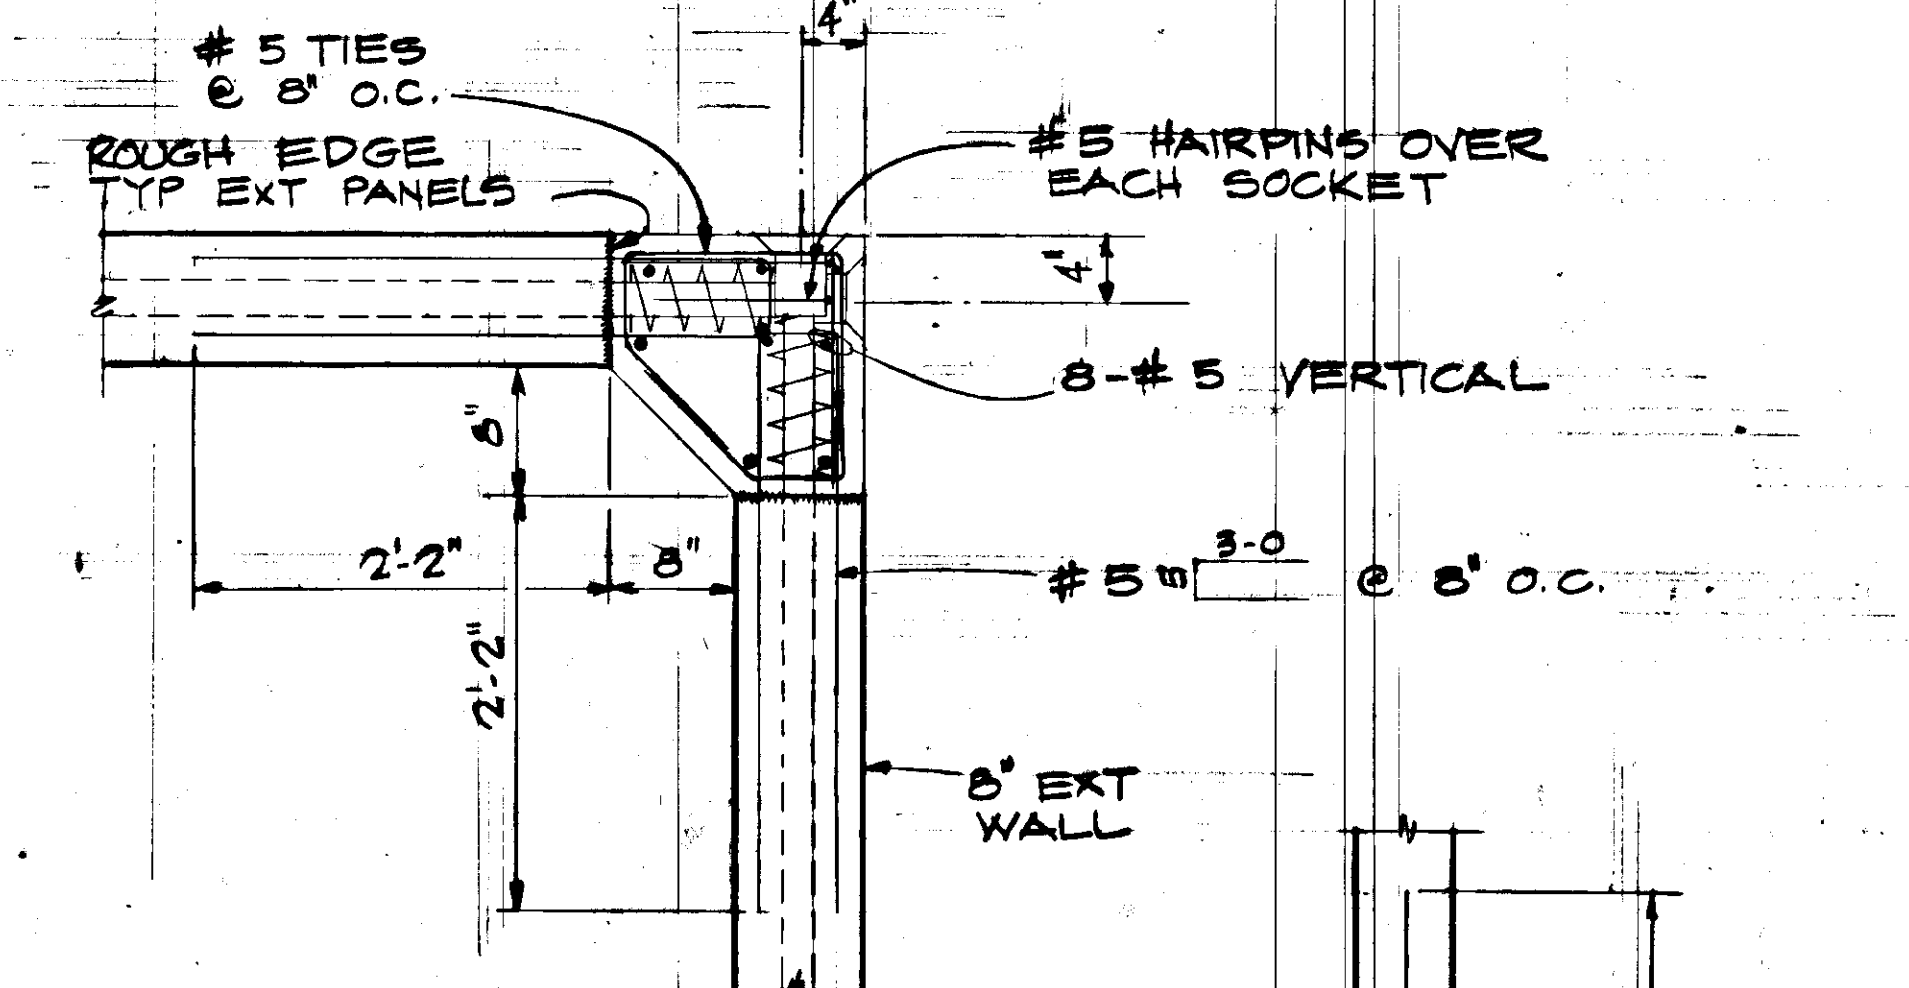

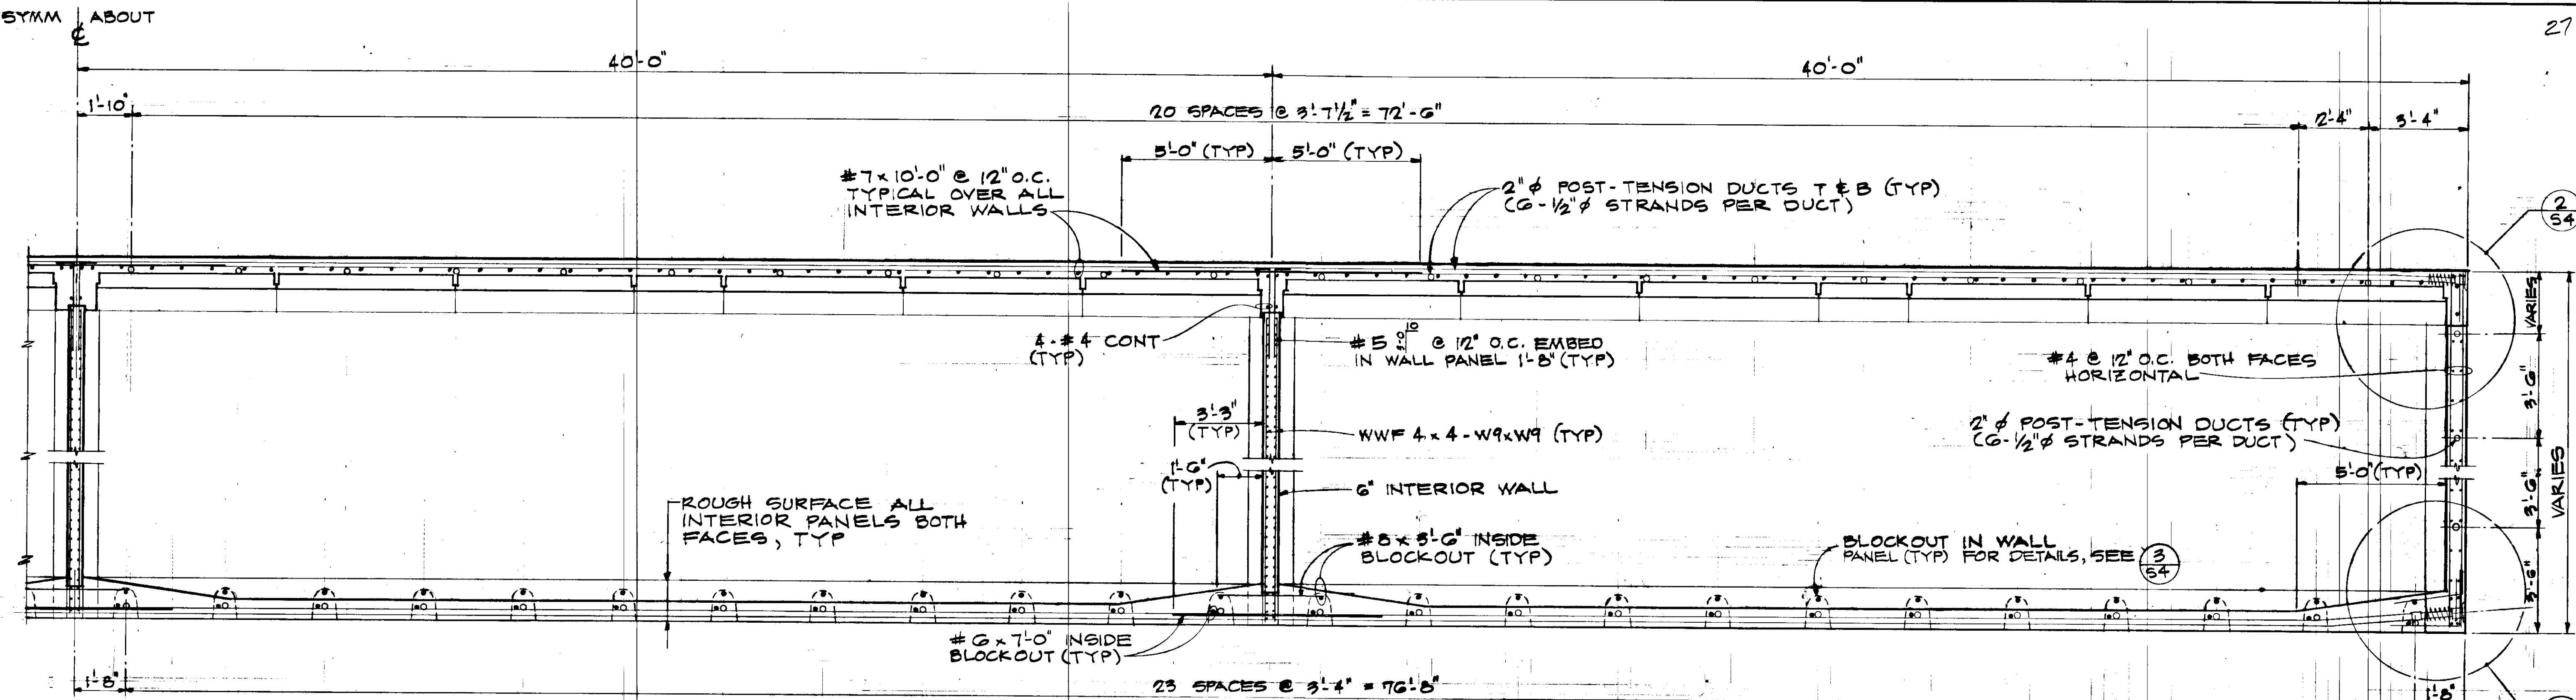


NOTE: FOR CLARITY, WWF NOT SHOWN IN DECK AND BOTTOM FLOOR.


1 TYPICAL LONGITUDINAL SECTION  
1/8" = 1'-0"

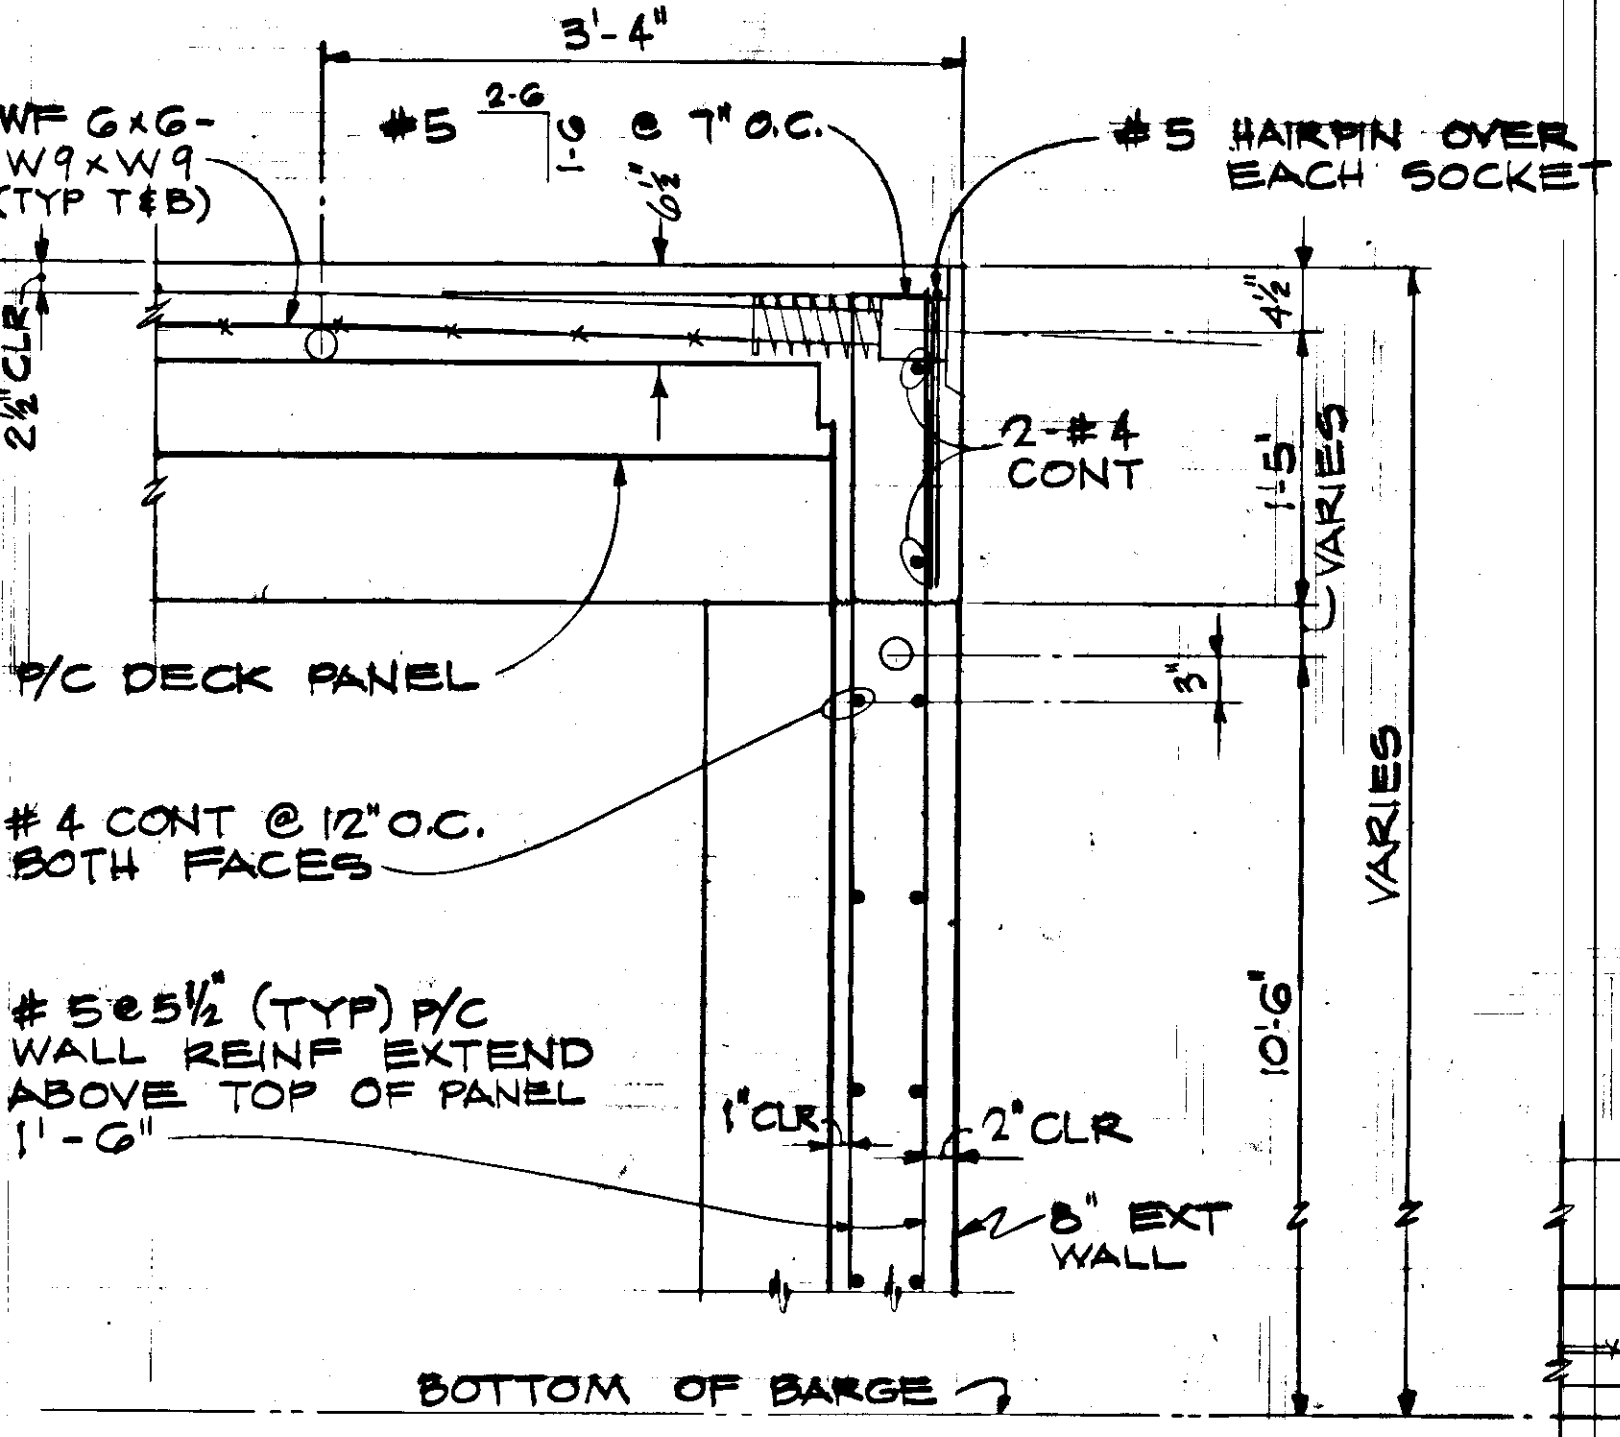


2 DETAIL  
1" = 1'-0"

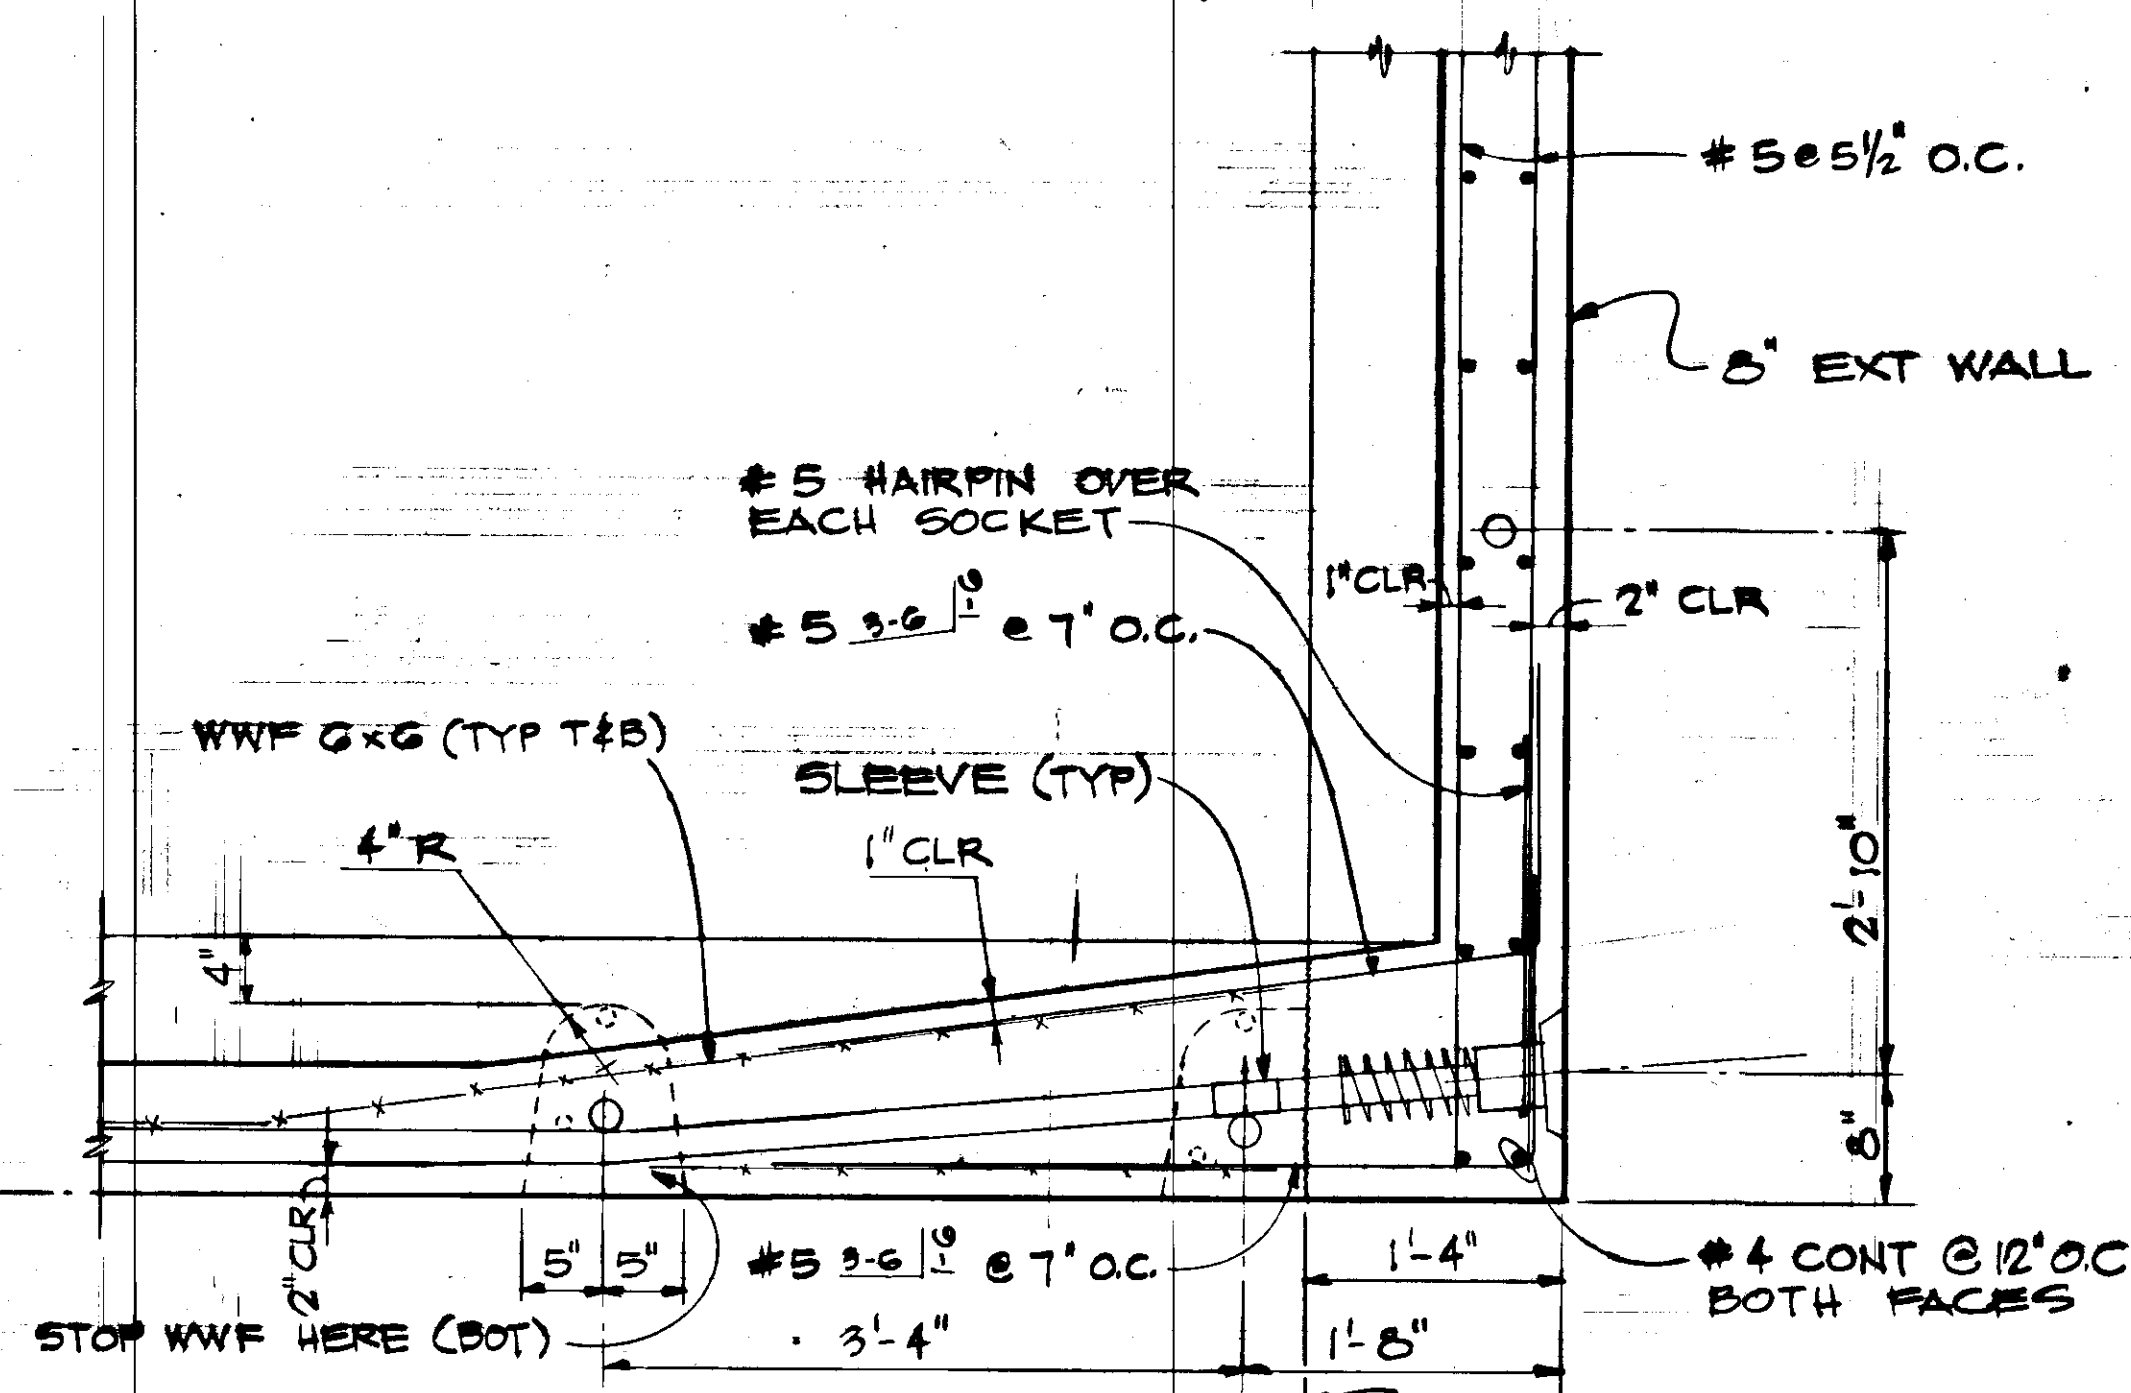

3 DETAIL  
1" = 1'-0"

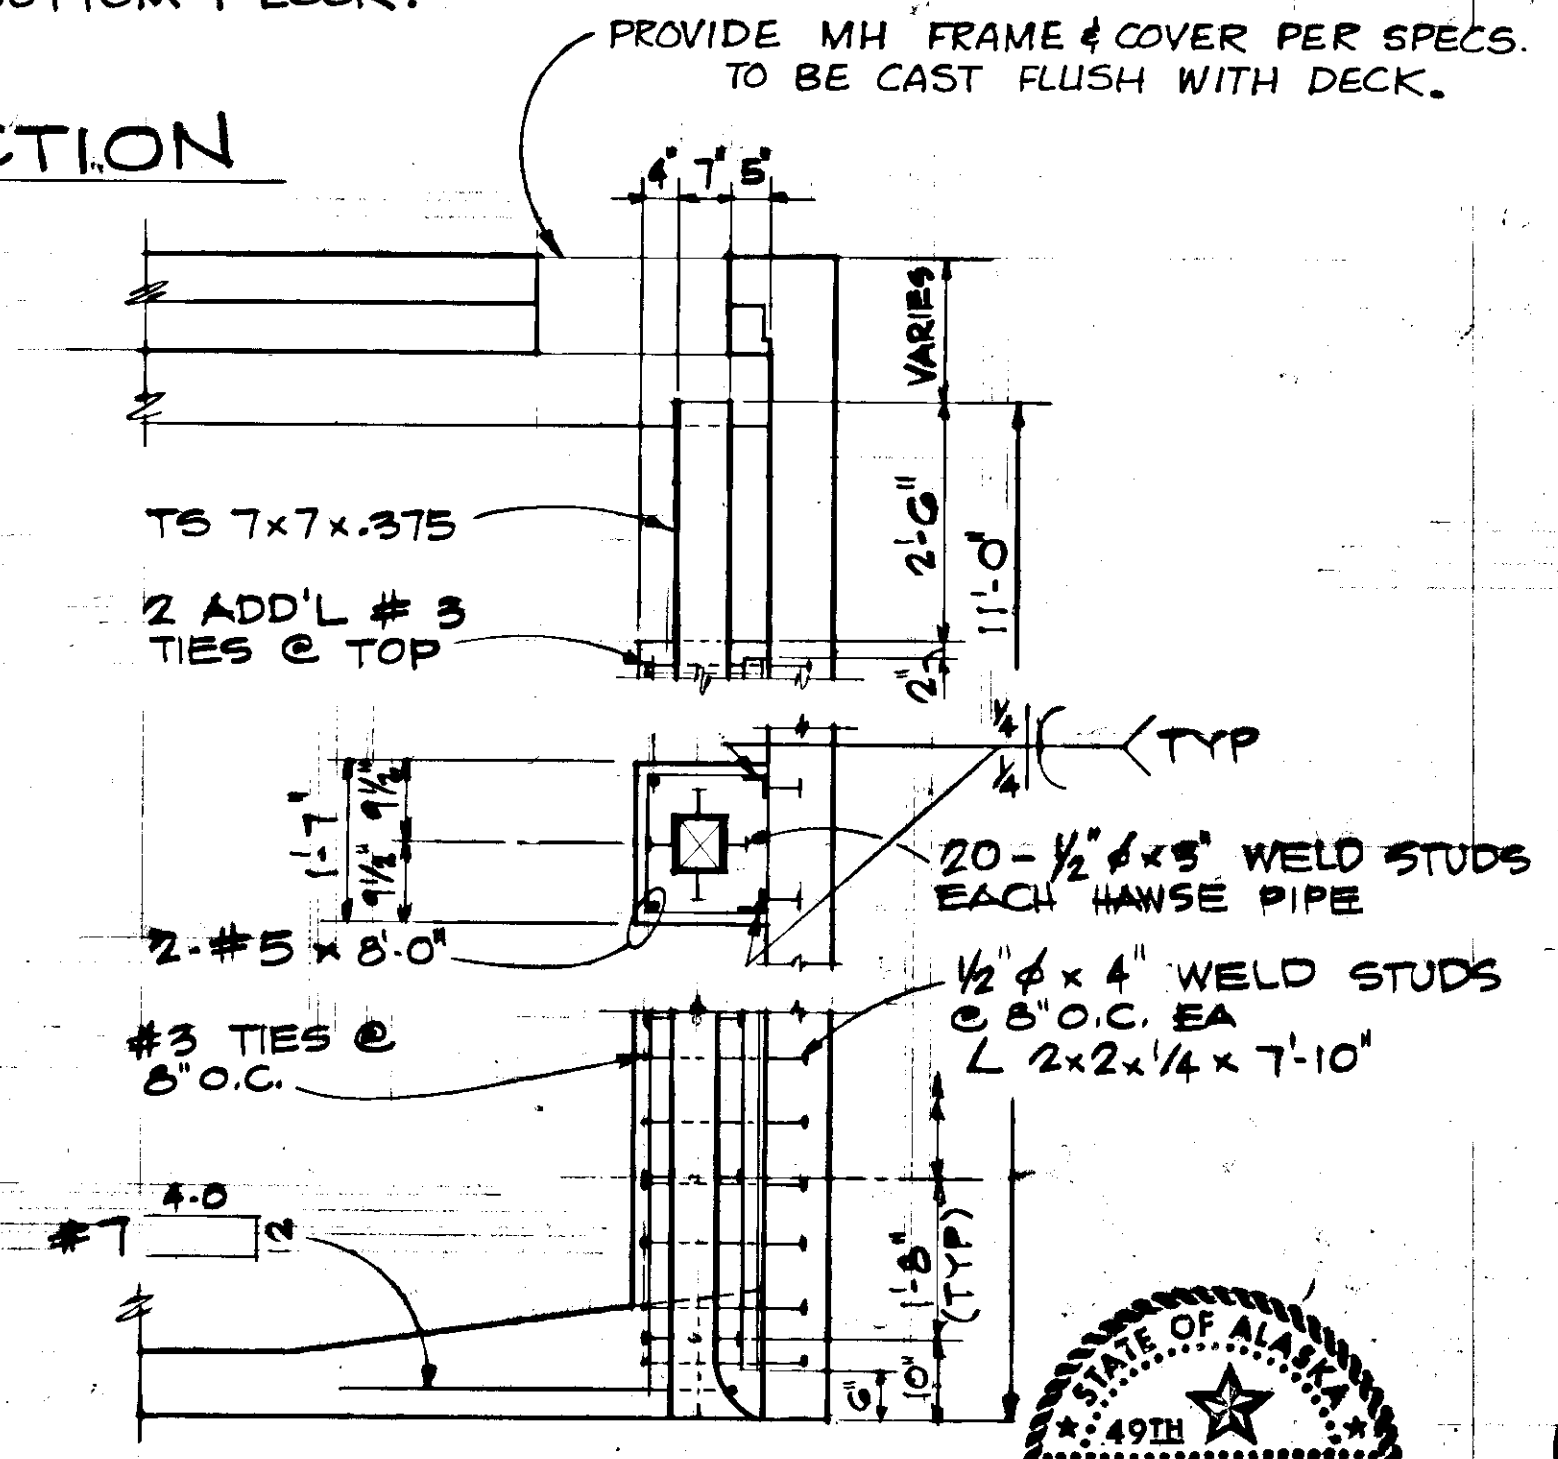


4 DETAIL-HAUSE PIPE  
1/2" = 1'-0"

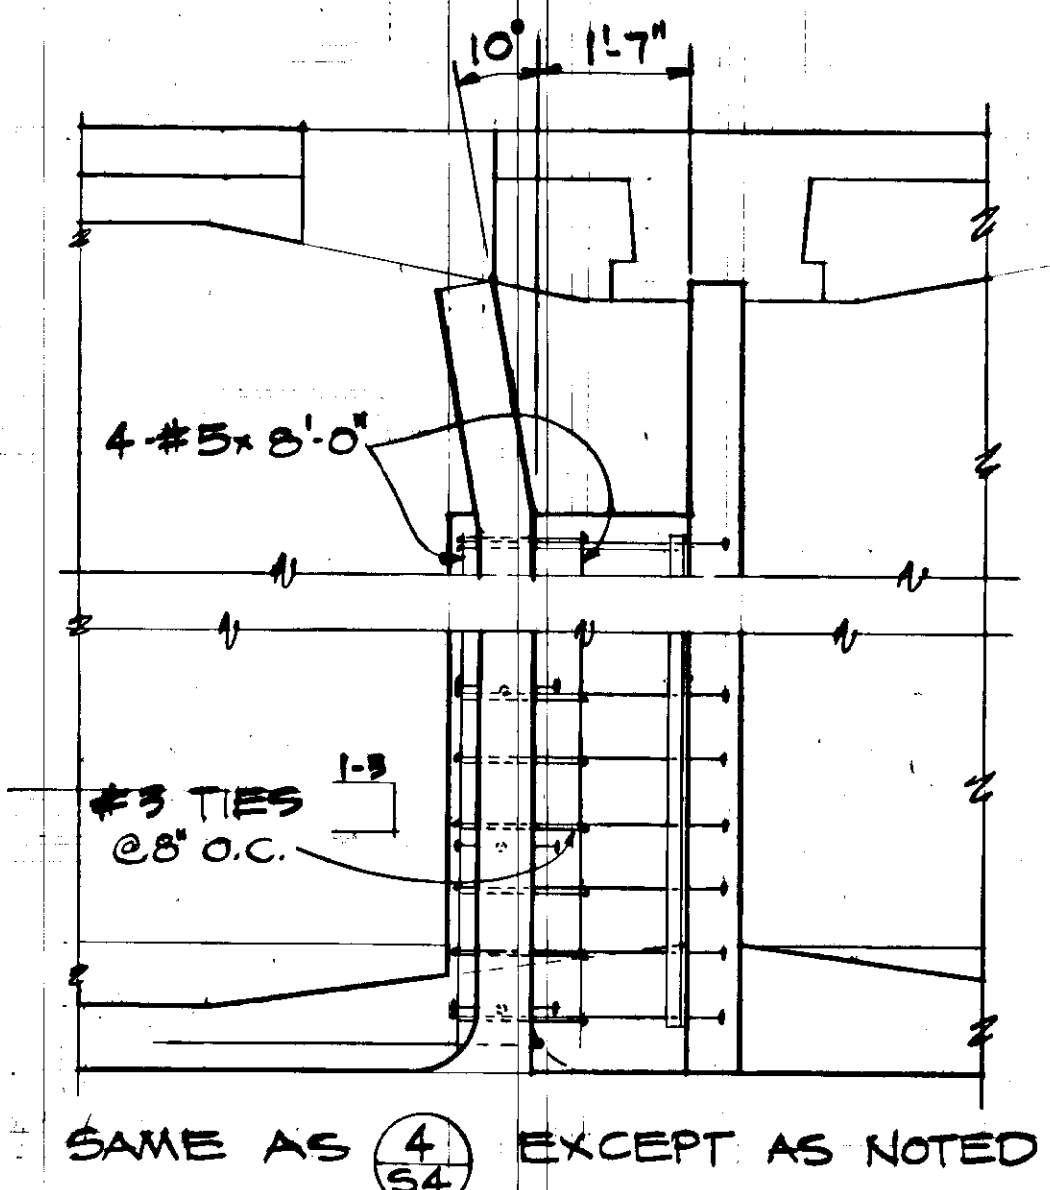

5 DETAIL-HAUSE PIPE  
1/2" = 1'-0"

NOTE: THE HAIRPINS & BARS ADJACENT TO ALL ANCHORAGES WITHIN 3" OF EXTERIOR SURFACE SHALL BE EPOXY COATED.

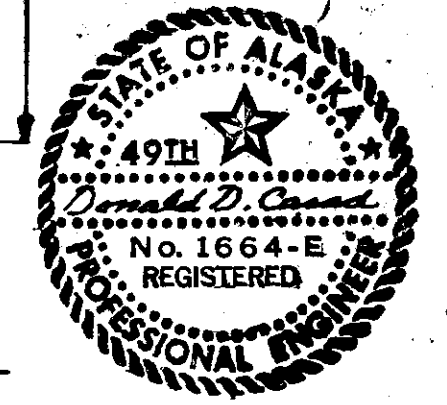

**ABAM**  
ABAM ENGINEERS INCORPORATED  
CONSULTING ENGINEERS  
27 PORT OF TACOMA ROAD, TACOMA, WASH.  
206-383-3091

**TRYCK NYMAN GHAYES**  
ENGINEERS/PLANNERS/SURVEYORS


BARGE FACILITY  
TYPICAL LONGITUDINAL  
SECTION & DETAILS

SHEET  
54 OF 8  
FILE NO.

REV.	DATE	BY	REVISION

FIELD BOOKS	DESIGNED JRS/WW
DESIGN	DRAWN R. MOHN
STAKING	CHECKED DDM
AS-BUILT	DATE JULY 18, 78
SCALE	GRID
HON. AS NOTED	JOB NO. 7502.0


SYMM ABOUT

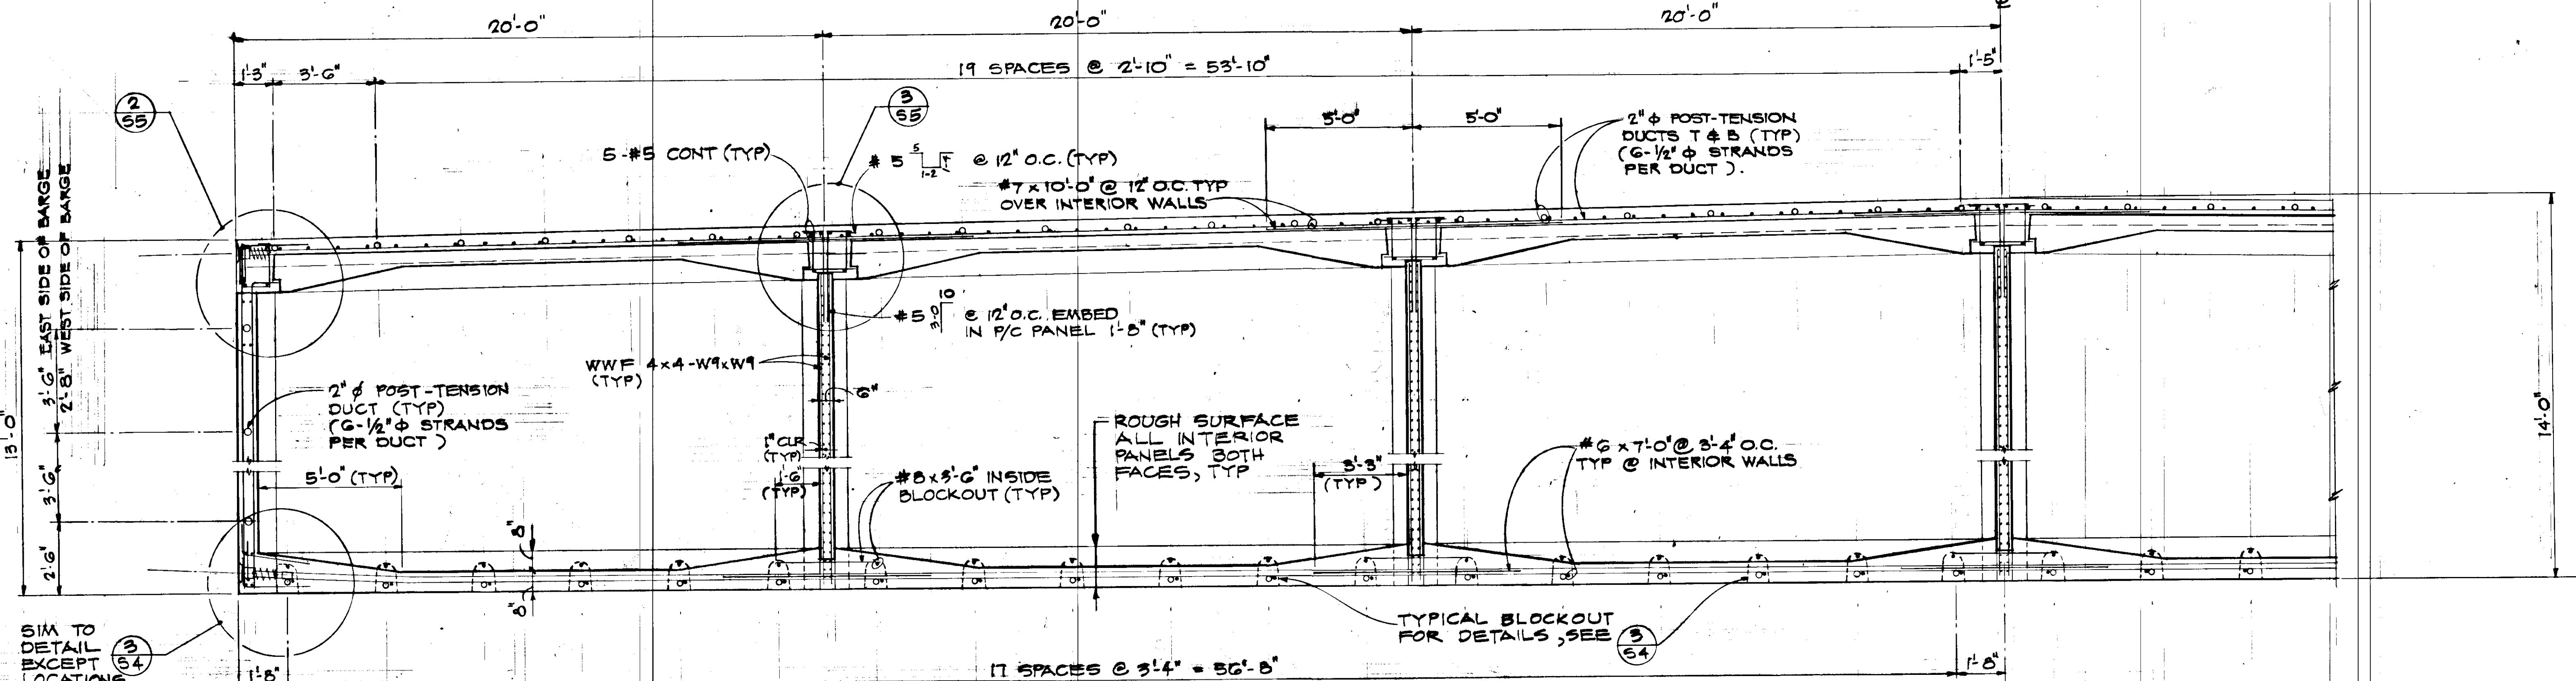


NOTE: BARS & HAIRPINS ADJACENT TO ALL ANCHORAGES WITHIN 3" OF EXTERIOR SURFACES SHALL BE EPOXY COATED.

NOTE: FOR CLARITY, WWF NOT SHOWN IN DECK AND BOTTOM FLOOR.


1 TYPICAL TRANSVERSE SECTION  
3/8" = 1'-0"

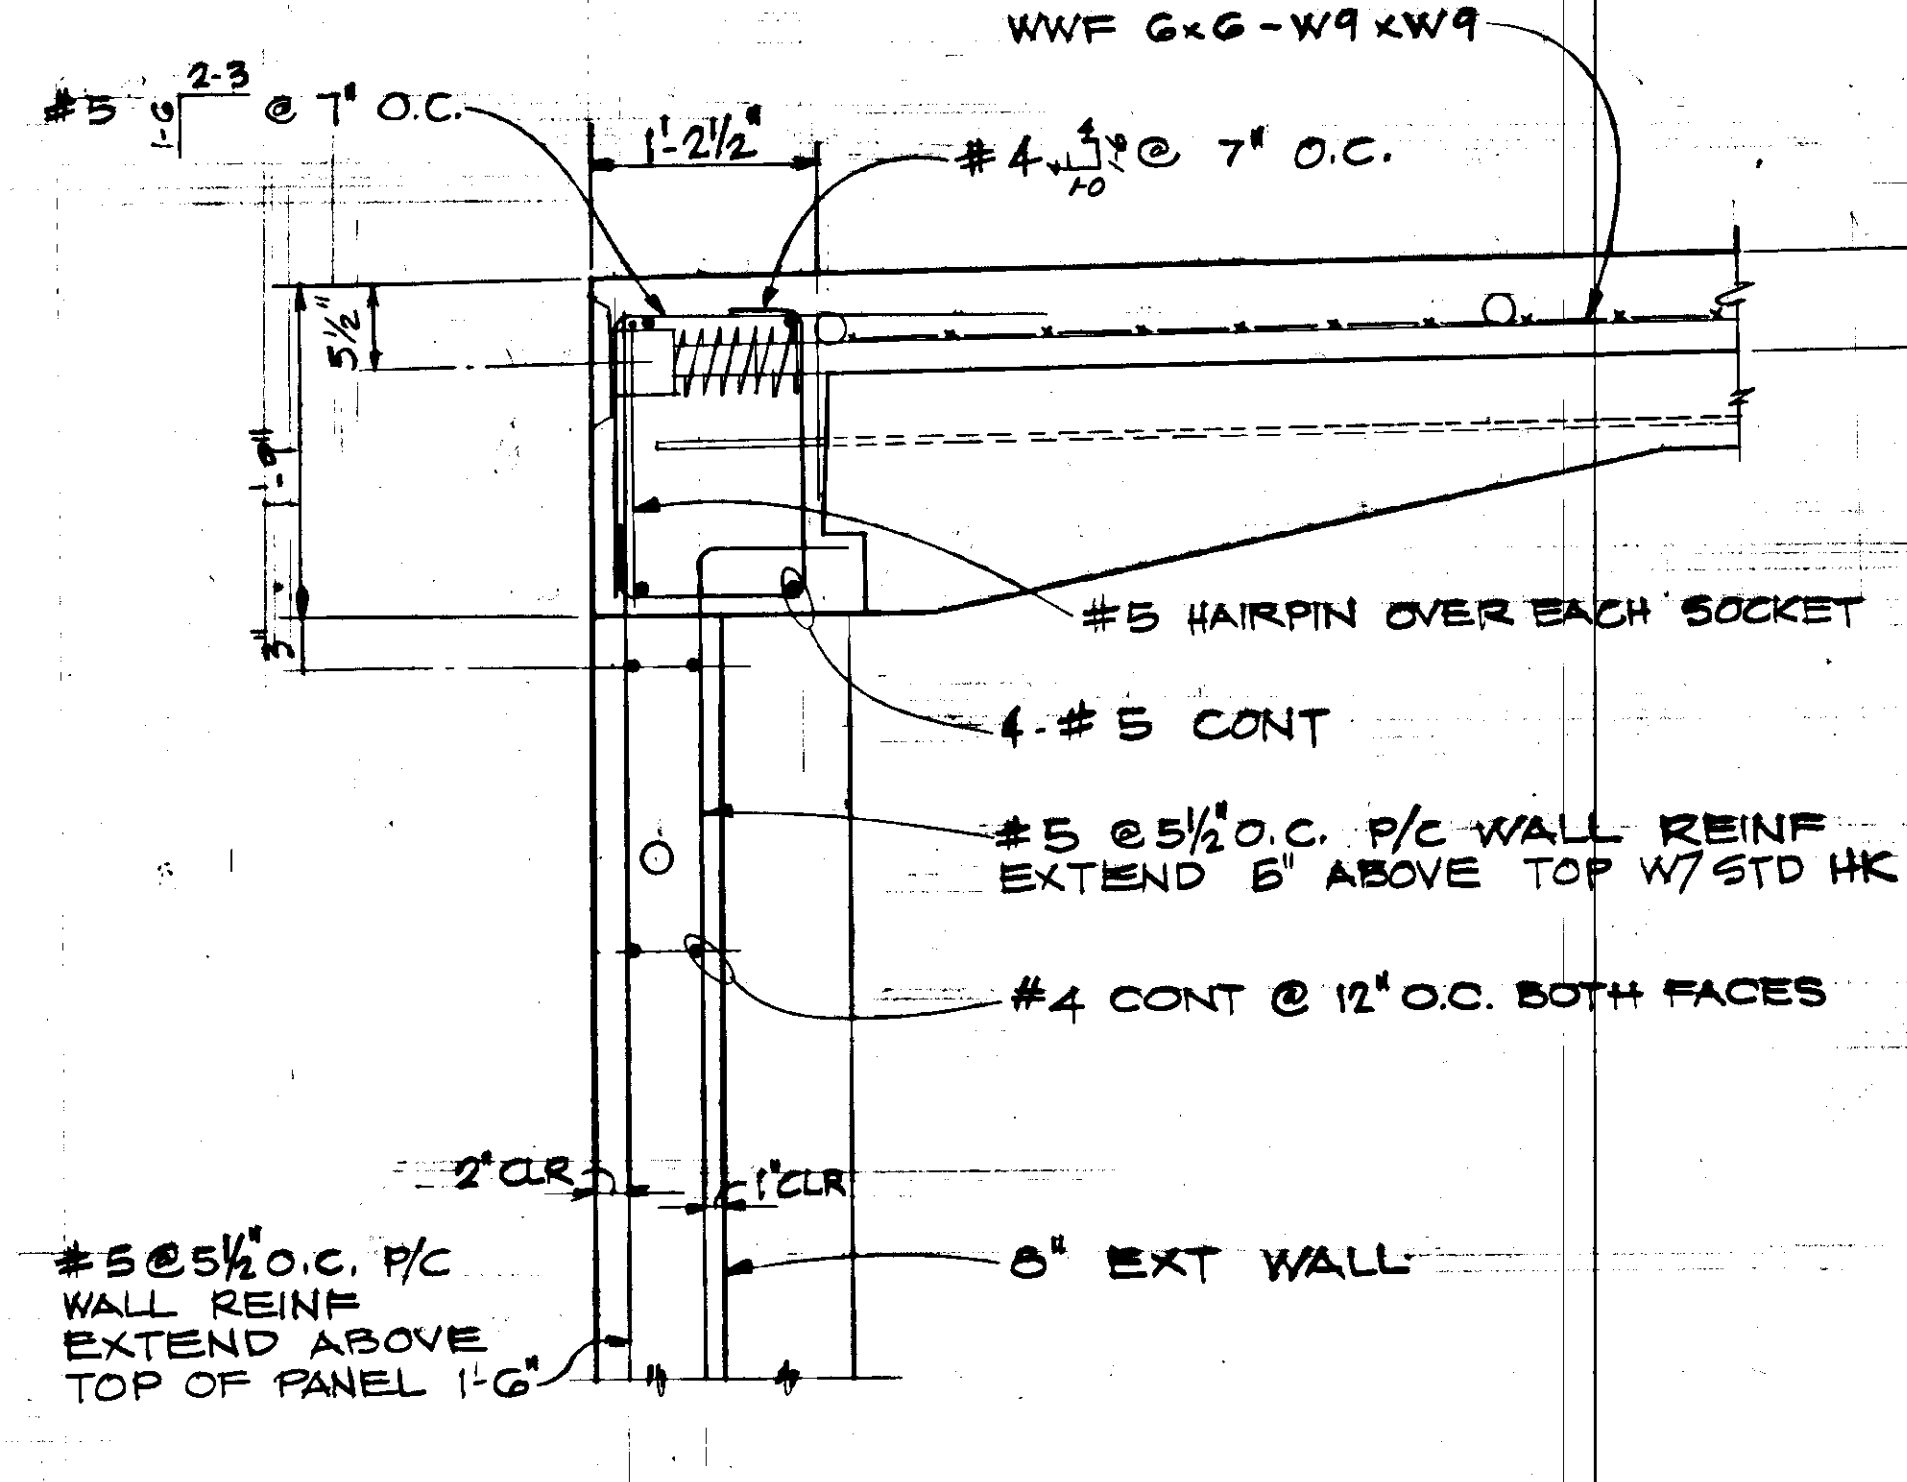

2 DETAIL  
1" = 1'-0"

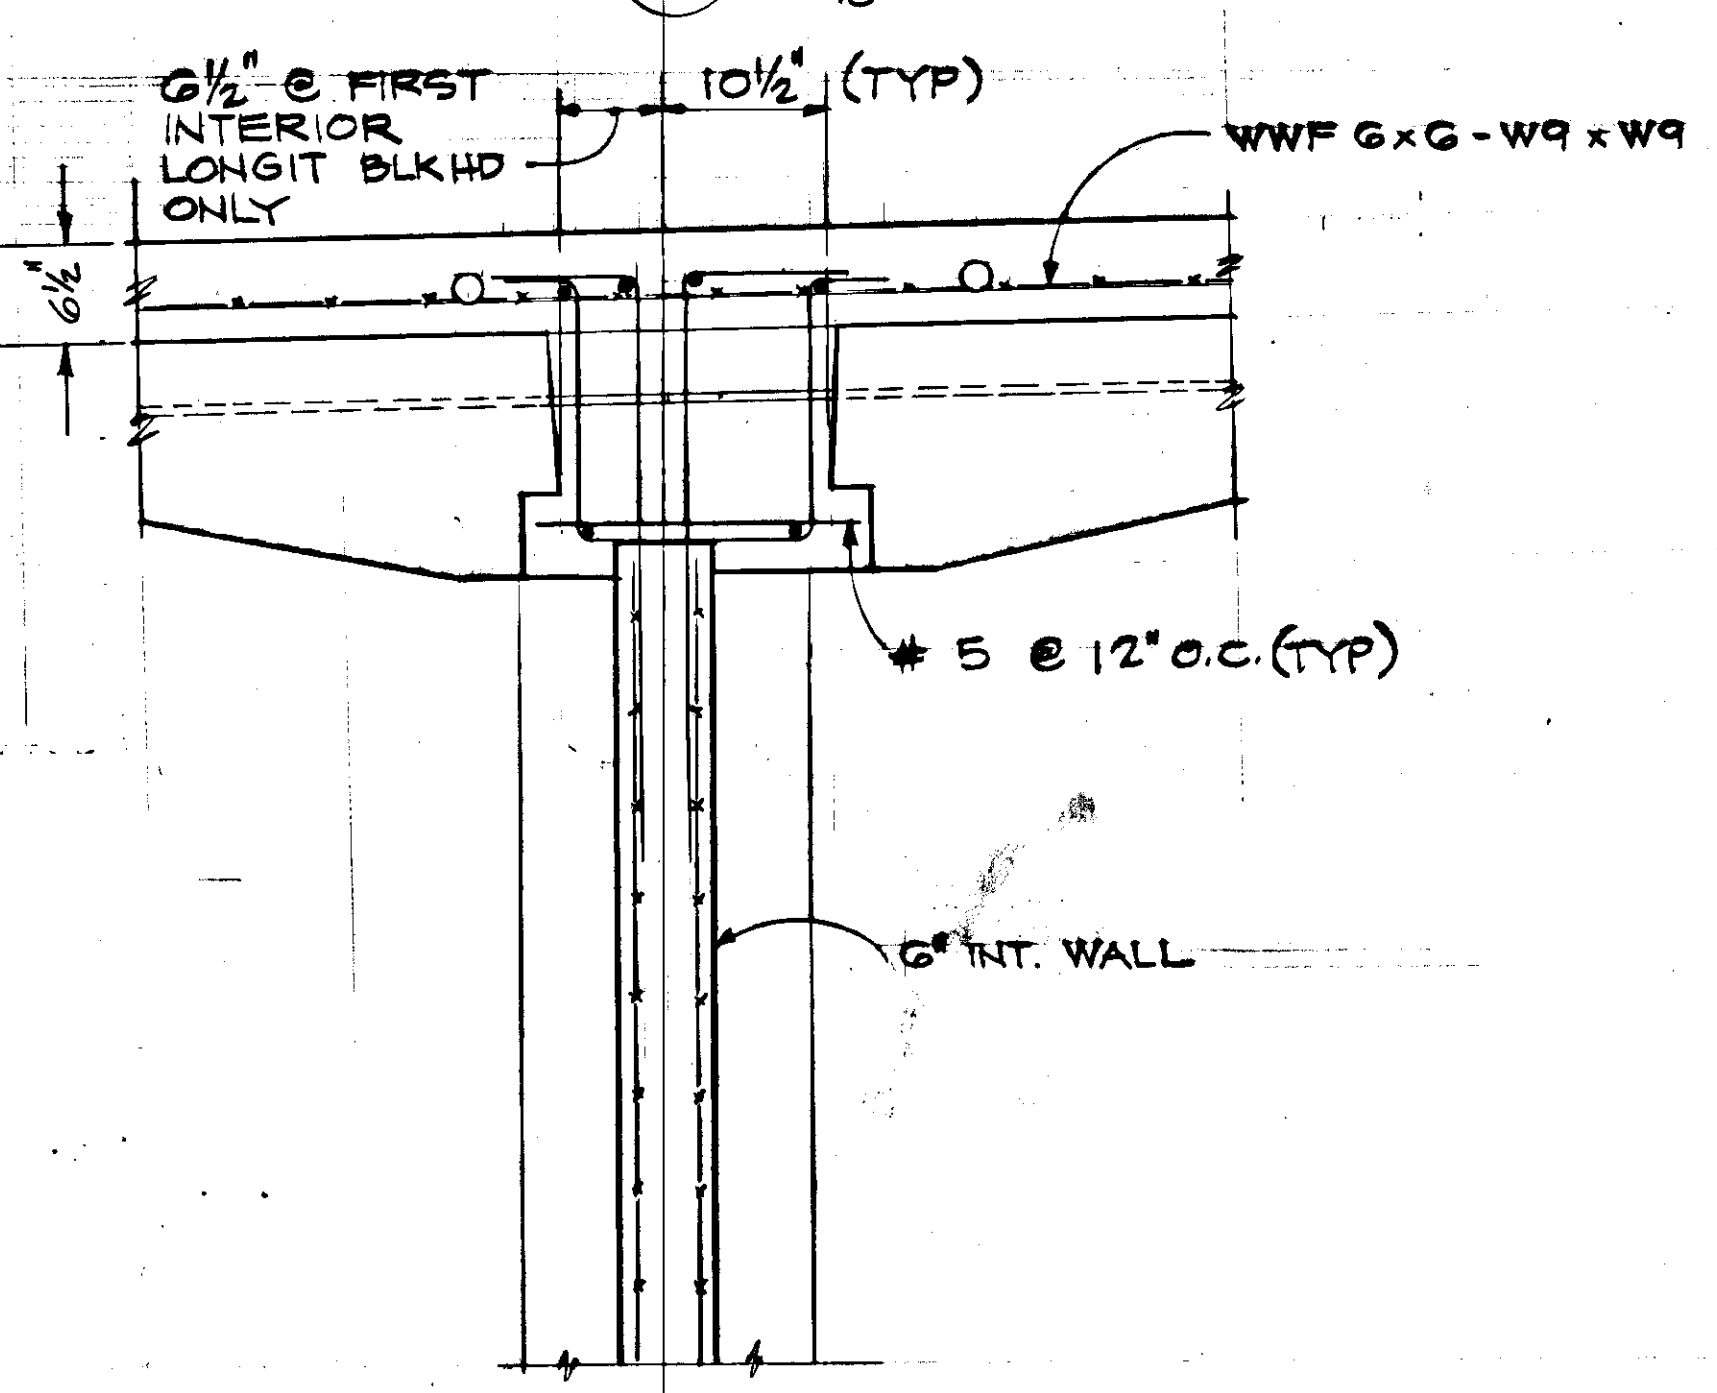

3 DETAIL  
1" = 1'-0"

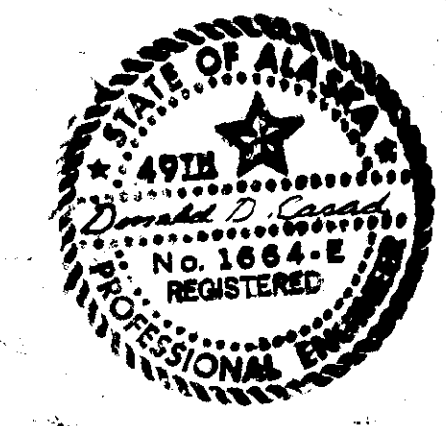

**ABAM**  
ABAM ENGINEERS INCORPORATED  
CONSULTING ENGINEERS  
1127 PORT OF TACOMA ROAD TACOMA, WASH.  
2041 382 3091



**TRYCK NYMAN GHAYES**  
ENGINEERS/PLANNERS/SURVEYORS

BARGE FACILITY  
TYPICAL TRANSVERSE  
SECTION & DETAILS



SHEET  
55 OF 8  
FILE NO.

REV.	DATE	BY	REVISION



FIELD BOOKS  
DESIGNED JRS/WW  
DRAWN R. MOHN  
CHECKED ODM  
DATE JULY 18, 1978  
SCALE  
GRID  
JOB NO. 7502.0

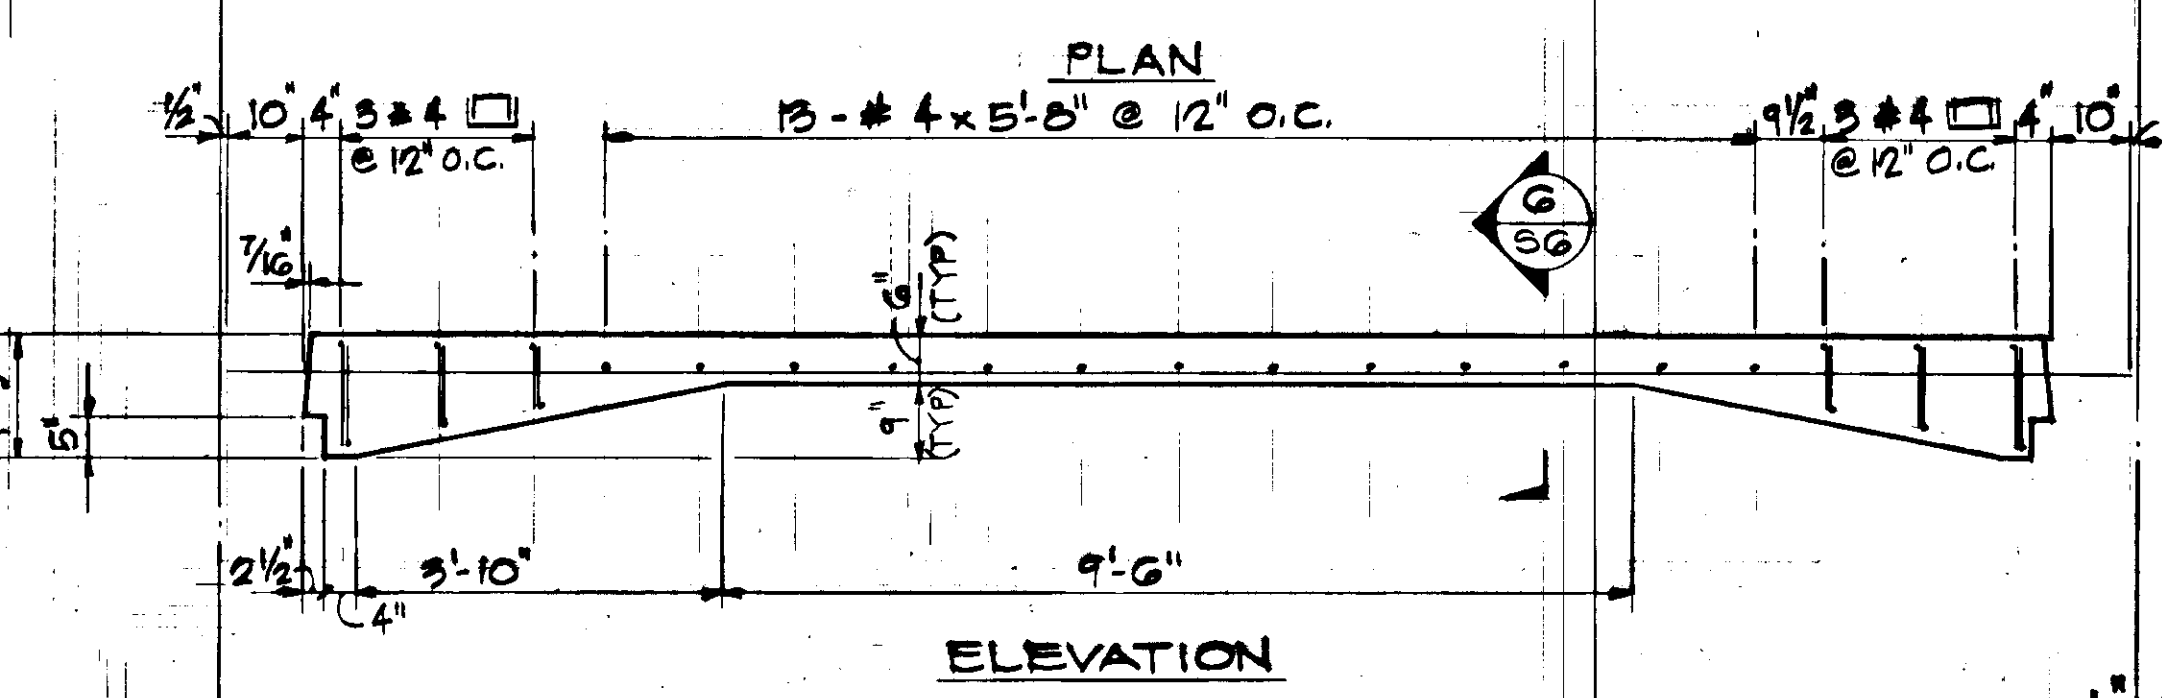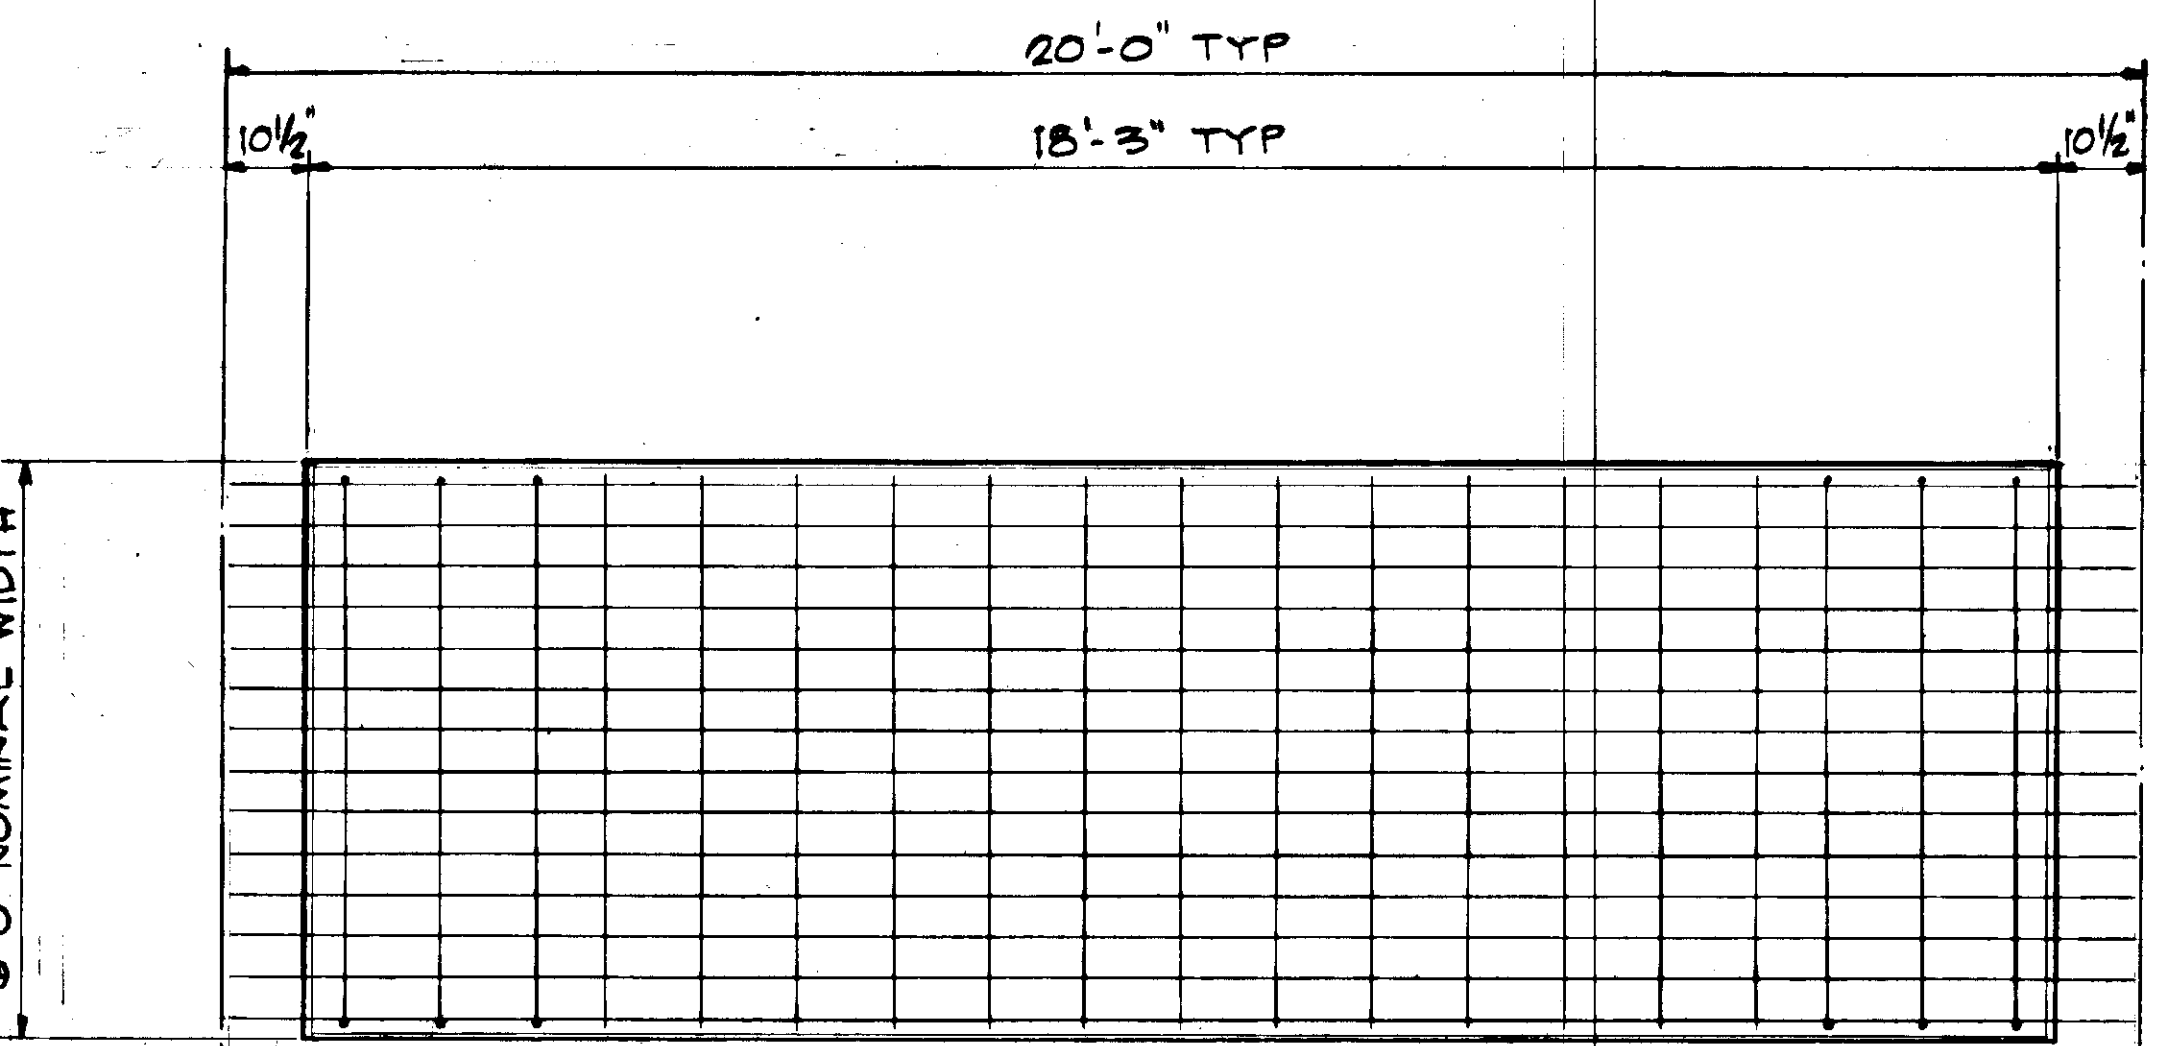


1 TYPE 'A' PANEL  
1/2" = 1'-0"

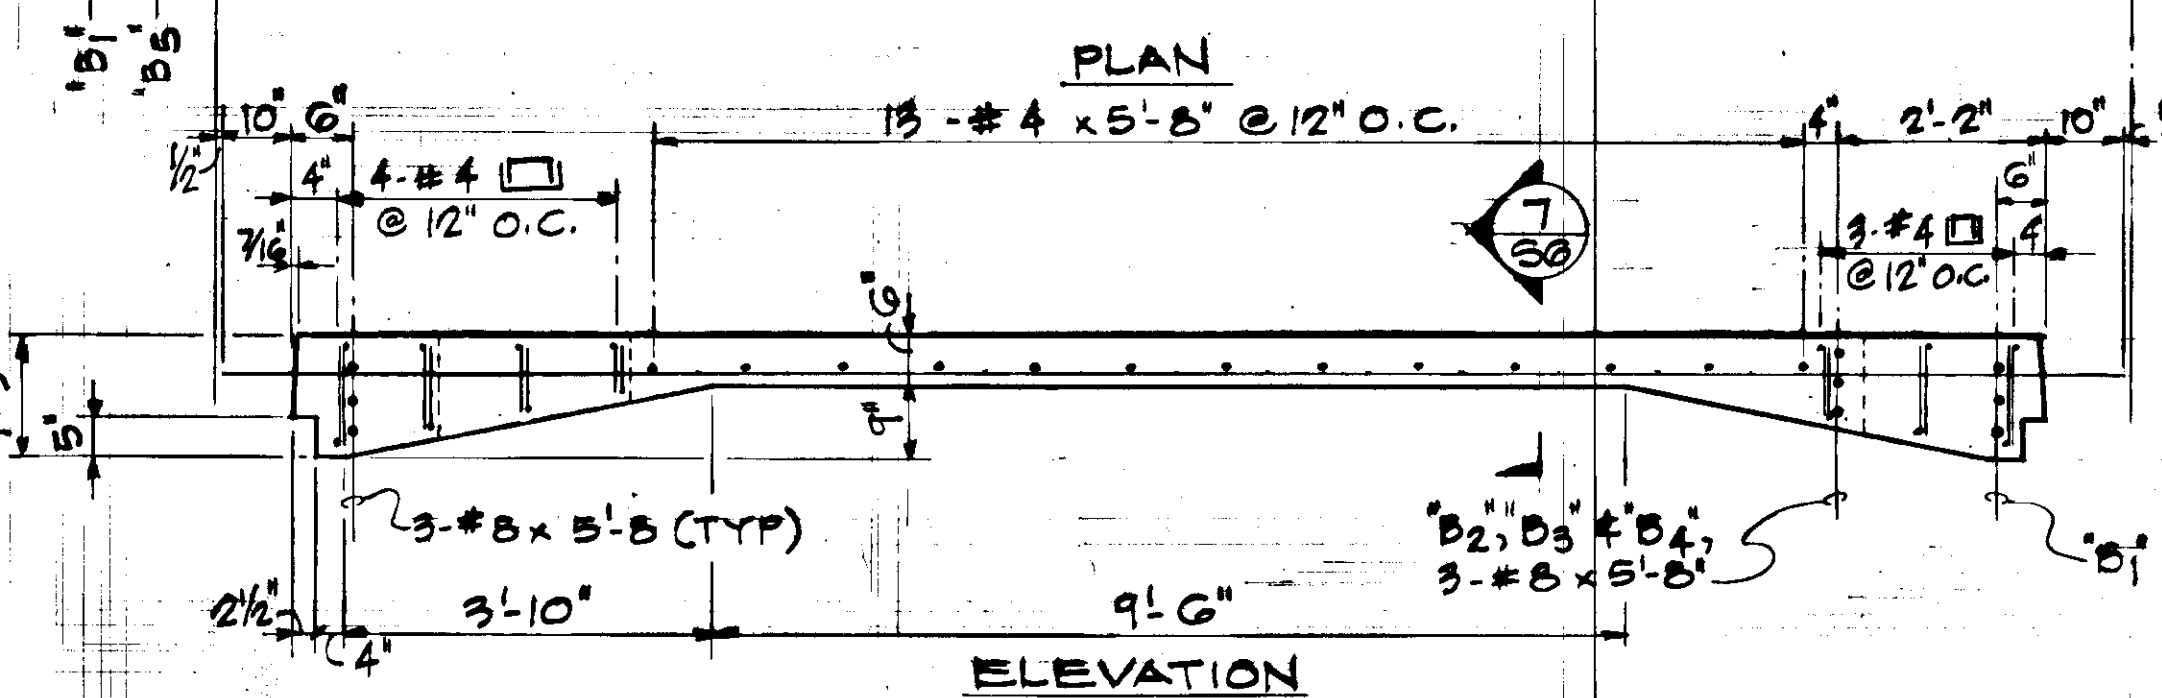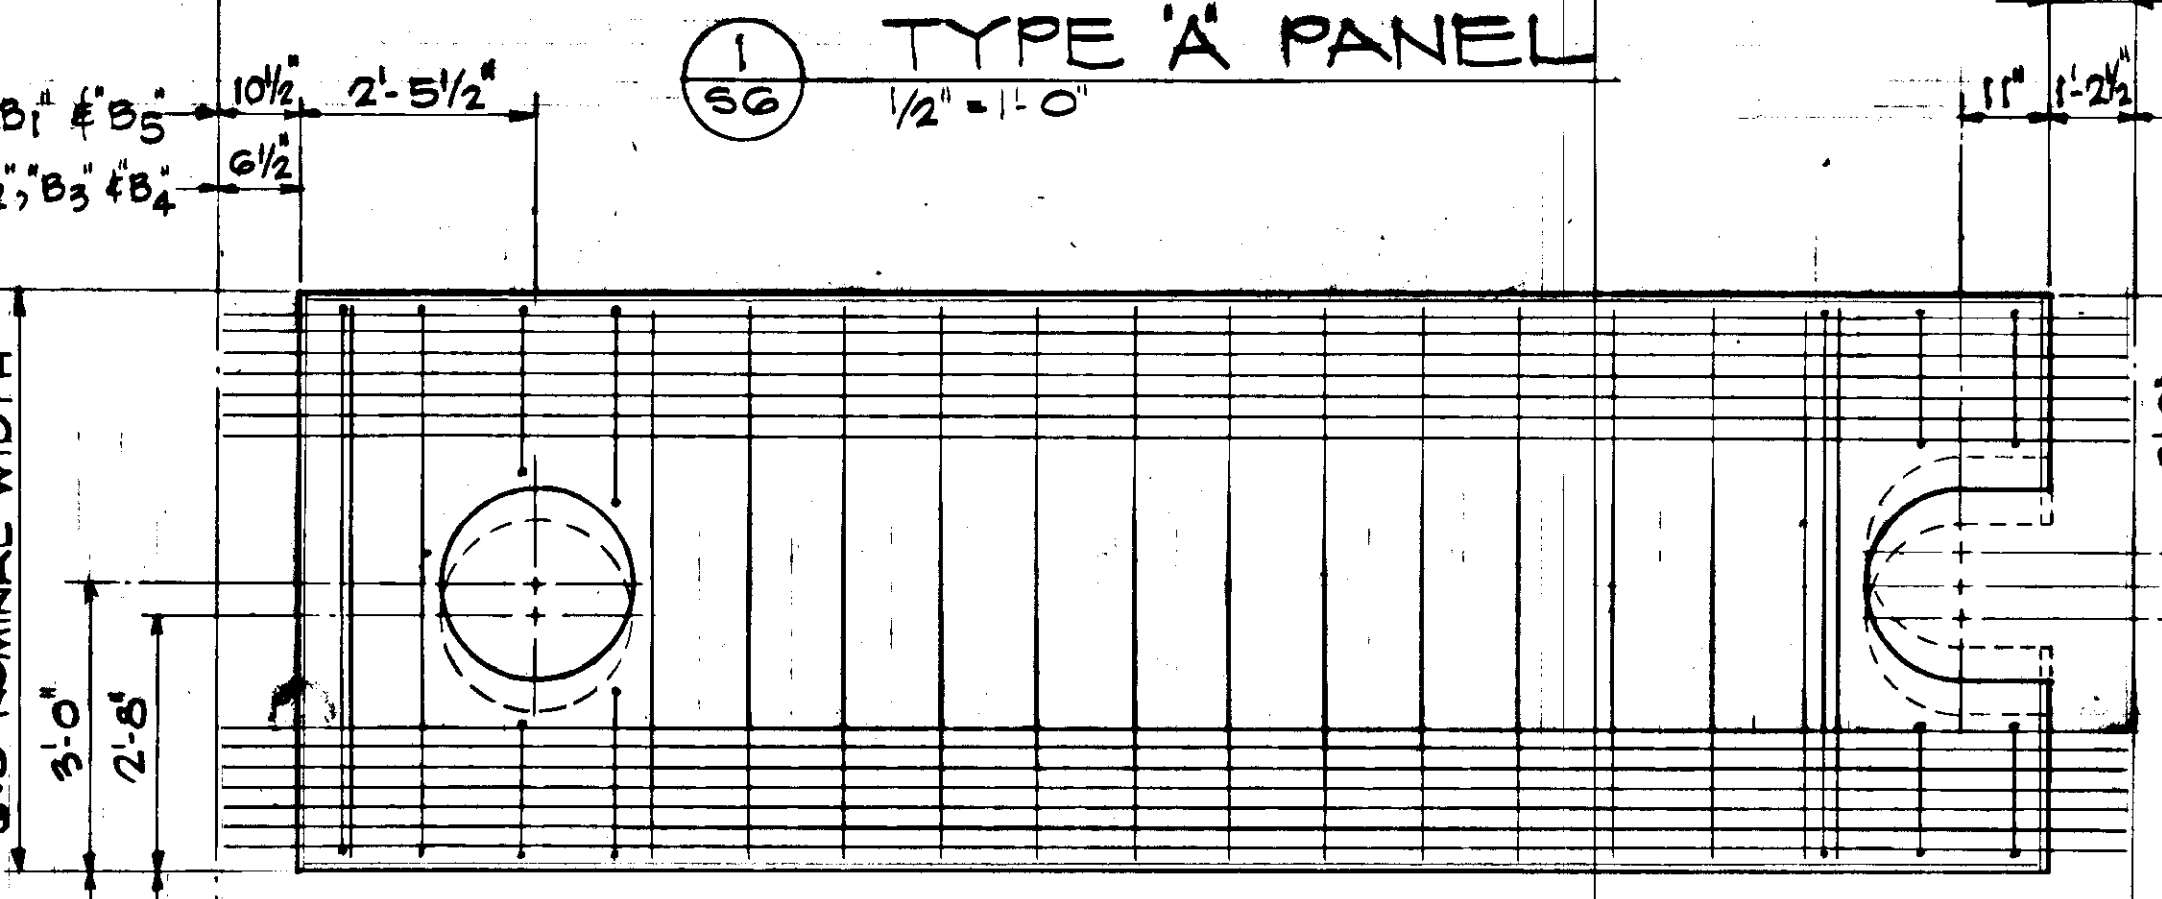


2 TYPE 'B' PANEL  
1/2" = 1'-0"

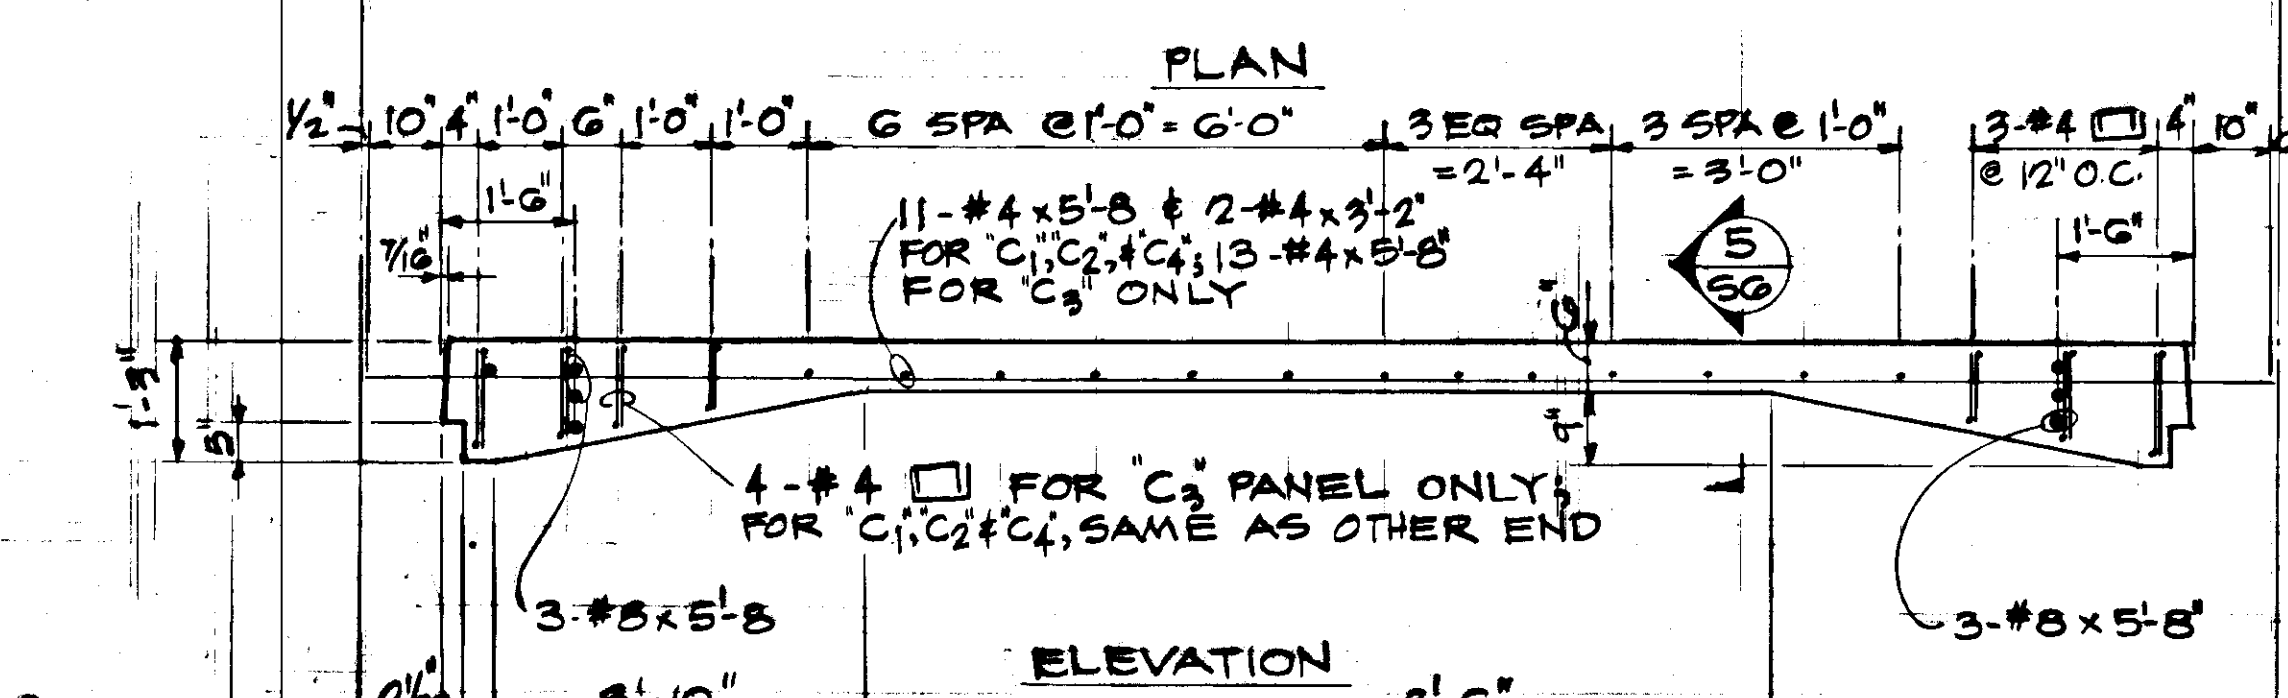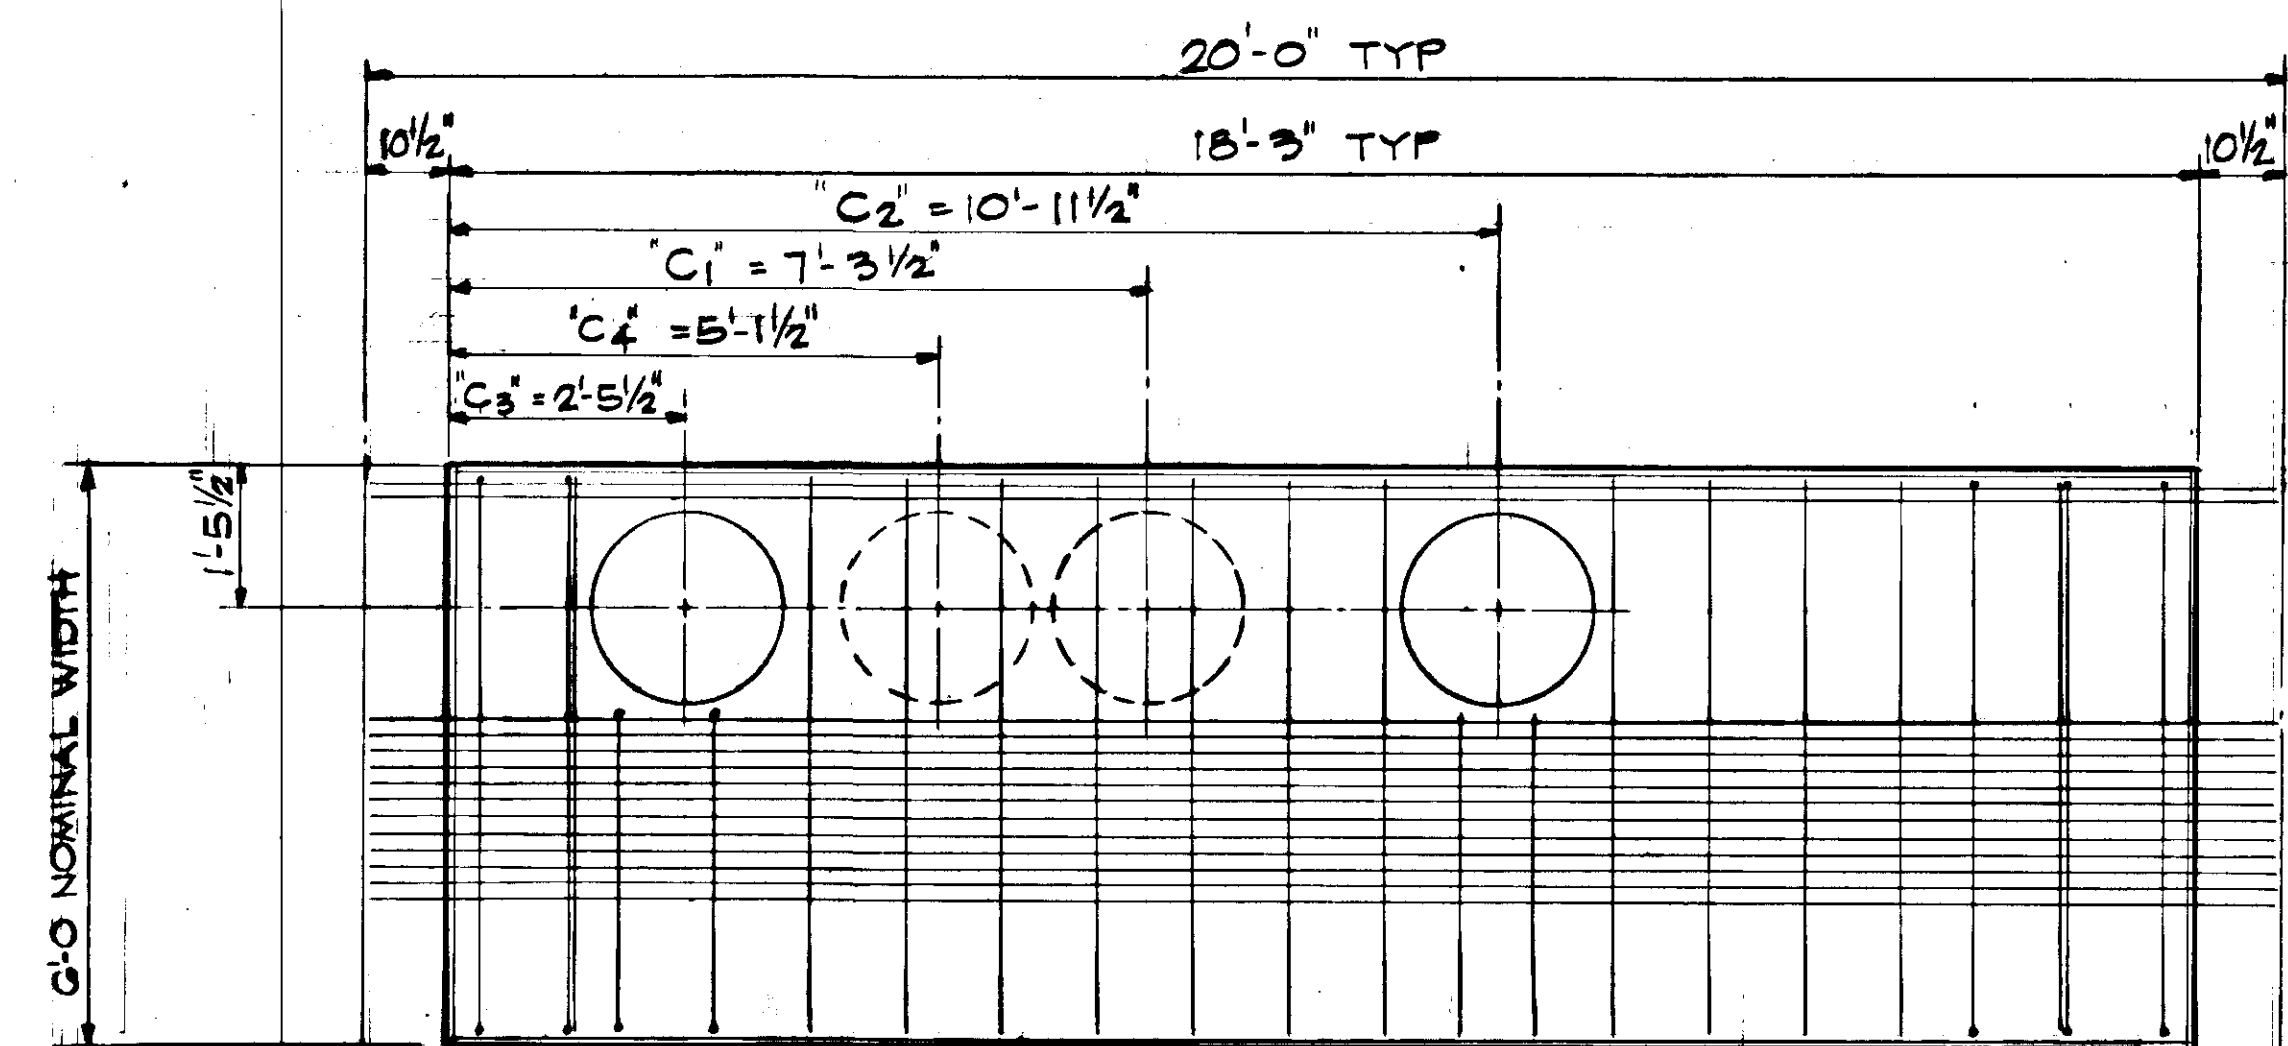


3 TYPE 'C' PANEL  
1/2" = 1'-0"

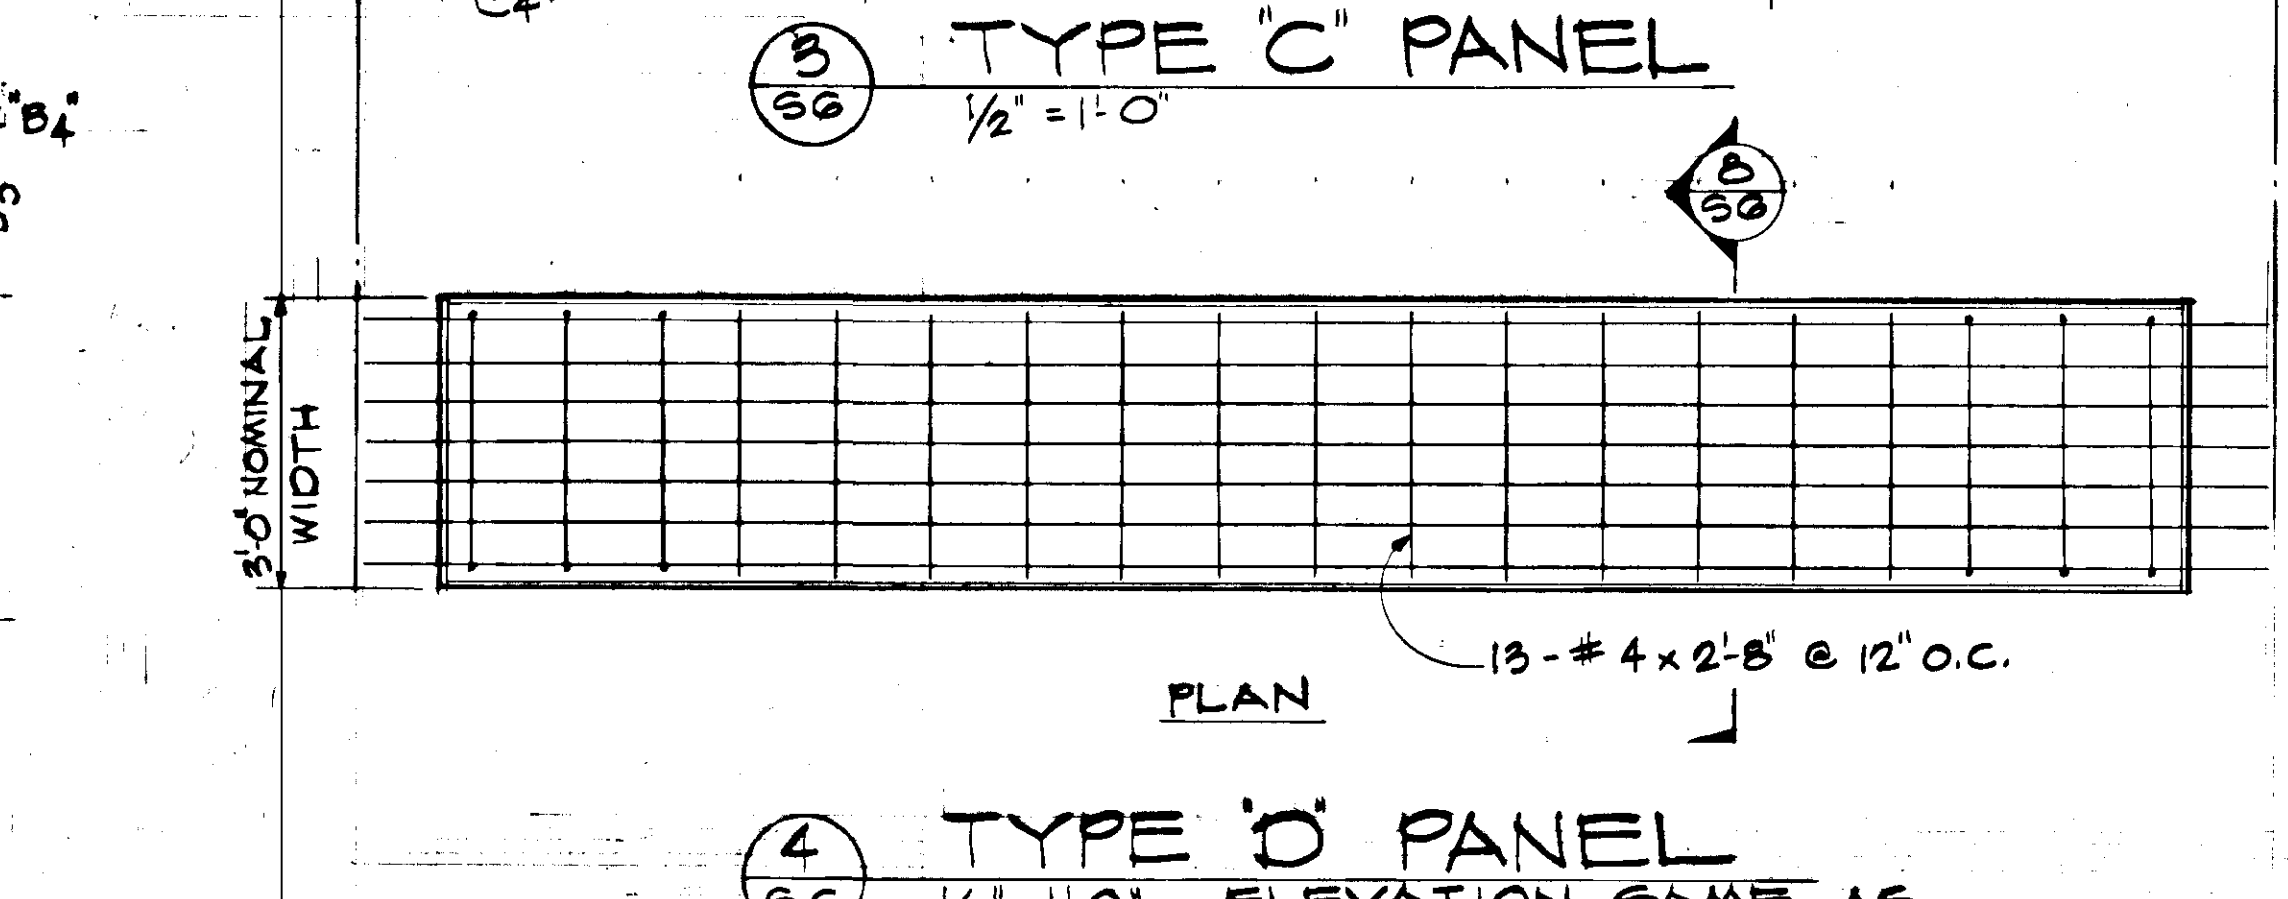


4 TYPE 'D' PANEL  
1/2" = 1'-0" ELEVATION SAME AS TYPE 'A' PANEL EXCEPT AS NOTED.

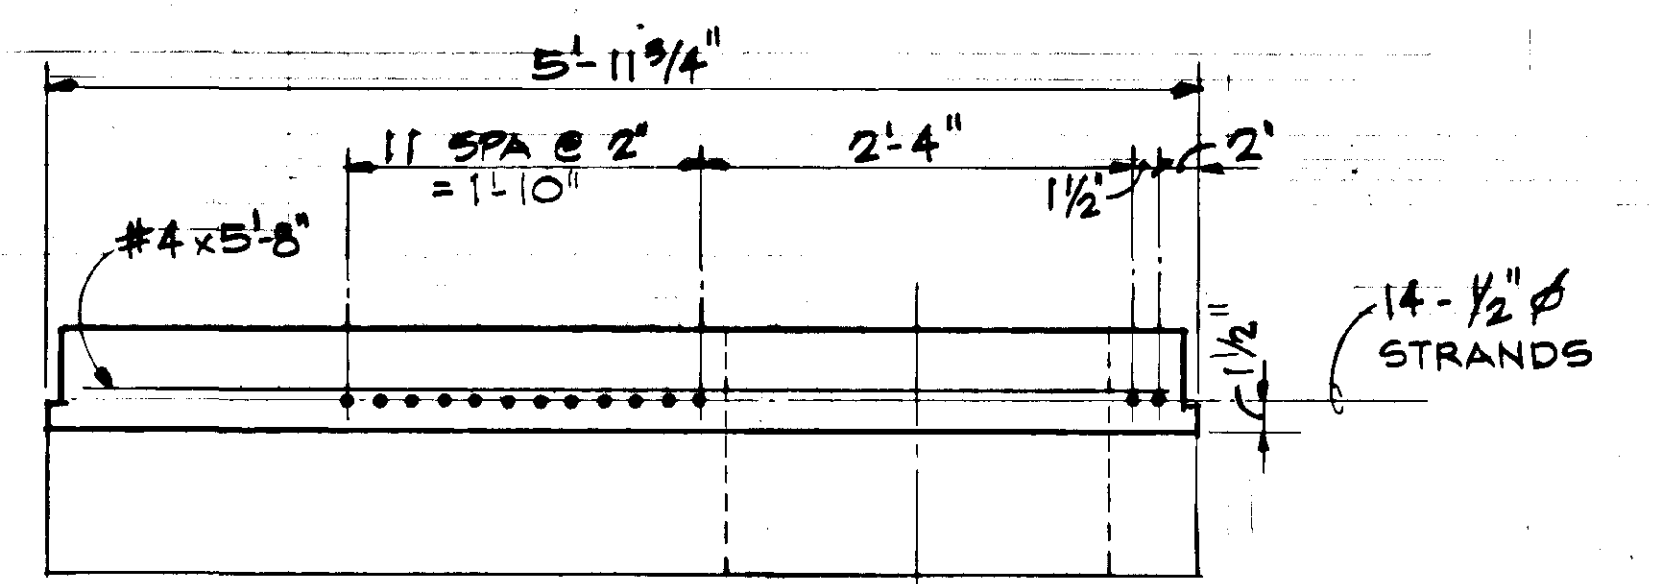


5 SECTION-TYPE 'C' PANEL  
1" = 1'-0"

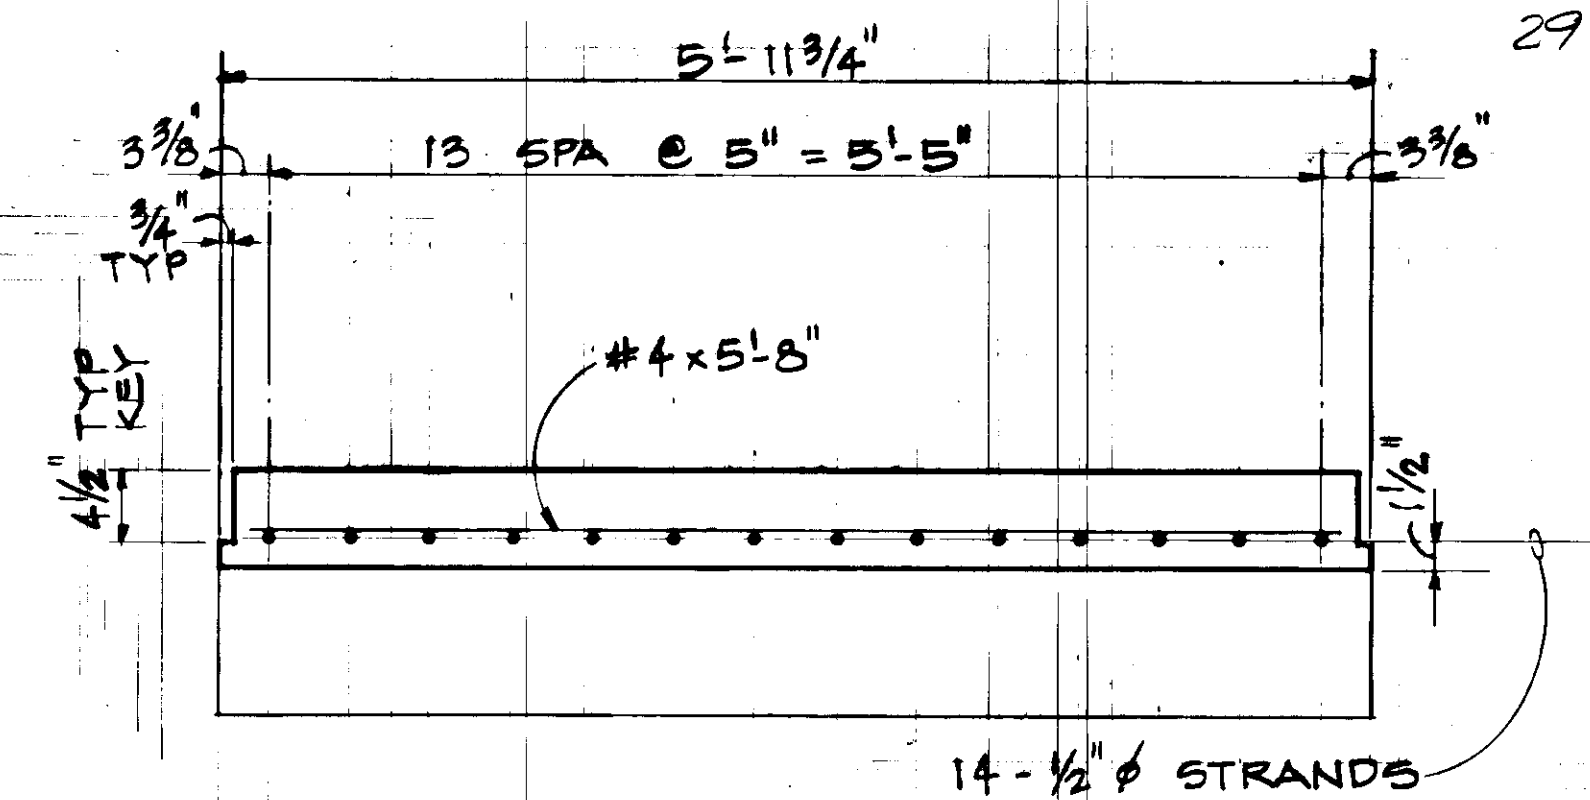

6 SECTION-TYPE 'A' PANEL  
1" = 1'-0"

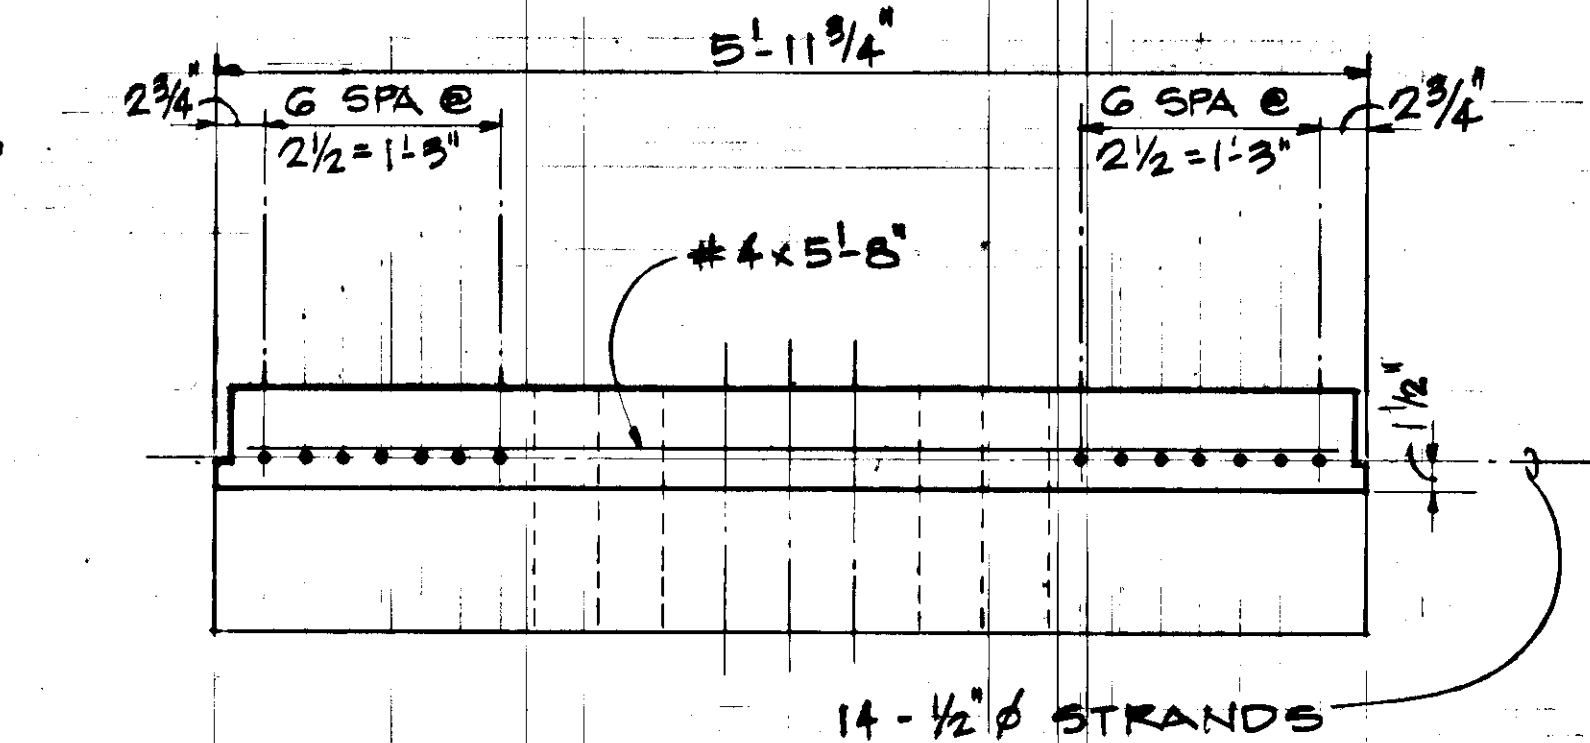


7 SECTION-TYPE 'B' PANEL  
1" = 1'-0"

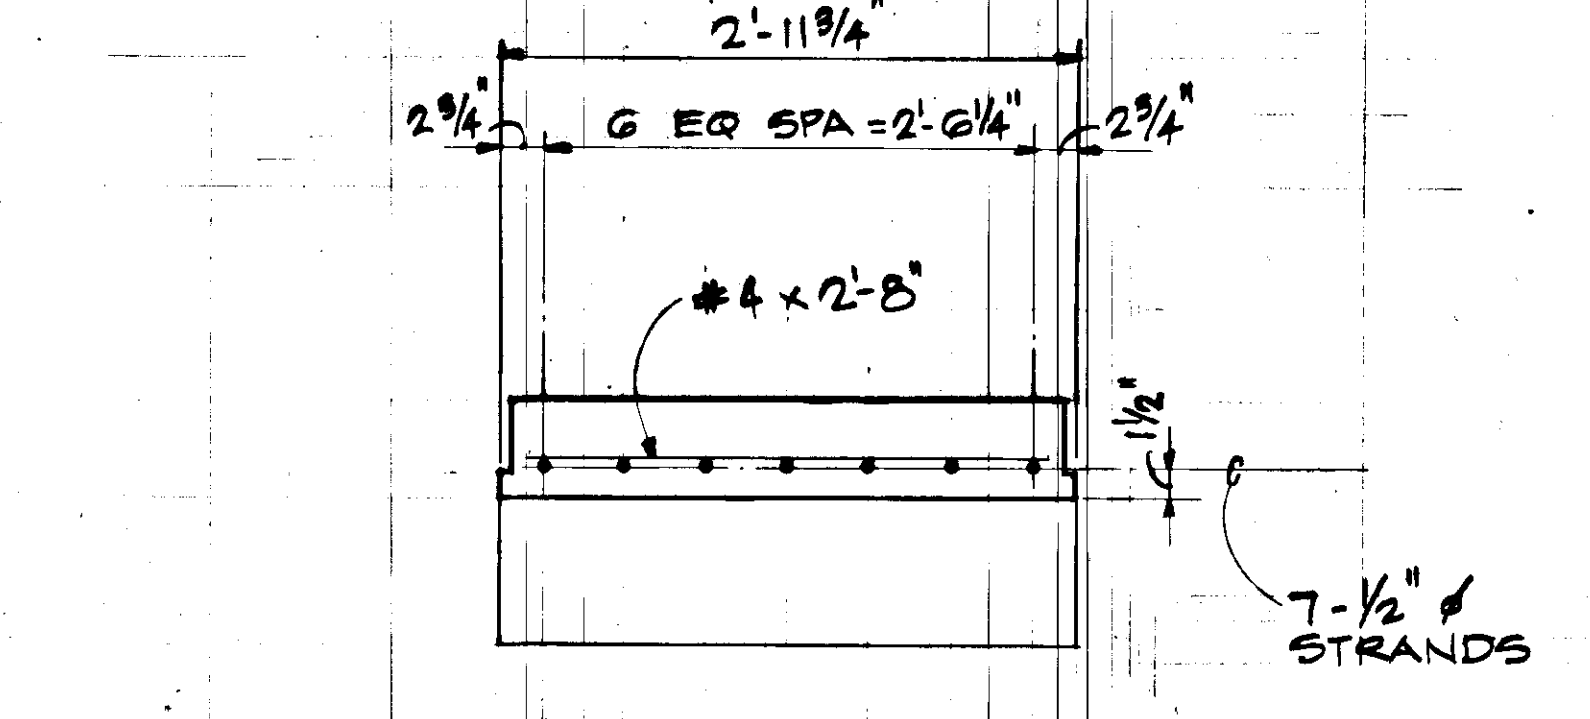

8 SECTION-TYPE 'D' PANEL  
1" = 1'-0"

- NOTES:
- TOP SURFACE AND ENDS OF ALL PANELS TO HAVE ROUGH SURFACE. SPLAY STRANDS EXTENDING FROM ENDS.
  - FOR LOCATIONS OF BOLLARD ANCHORS TO BE CAST INTO DECK PANELS SEE DRAWINGS S-2 AND P-3.

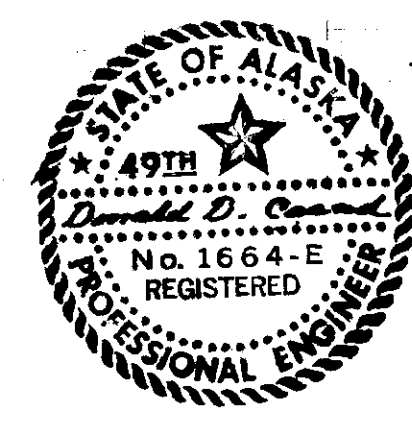

**ABAM**  
ABAM ENGINEERS INCORPORATED  
CONSULTING ENGINEERS  
1127 PORT OF TACOMA ROAD TACOMA, WASH.  
206183-2091



**TRYCK NYMAN GHAYES**  
ENGINEERS/PLANNERS/SURVEYORS

**BARGE FACILITY  
DECK PANEL  
DETAILS**

SHEET  
**56 OF 8**  
FILE NO.


DESIGN	FIELD BOOKS	DESIGNED JRS/WW
STARTING		DRAWN R. MOHN
AS-BUILT		CHECKED DDM
		DATE JULY 18, 78
		GRID
		JOB NO. 75020
REV.	DATE	BY
		REVISION



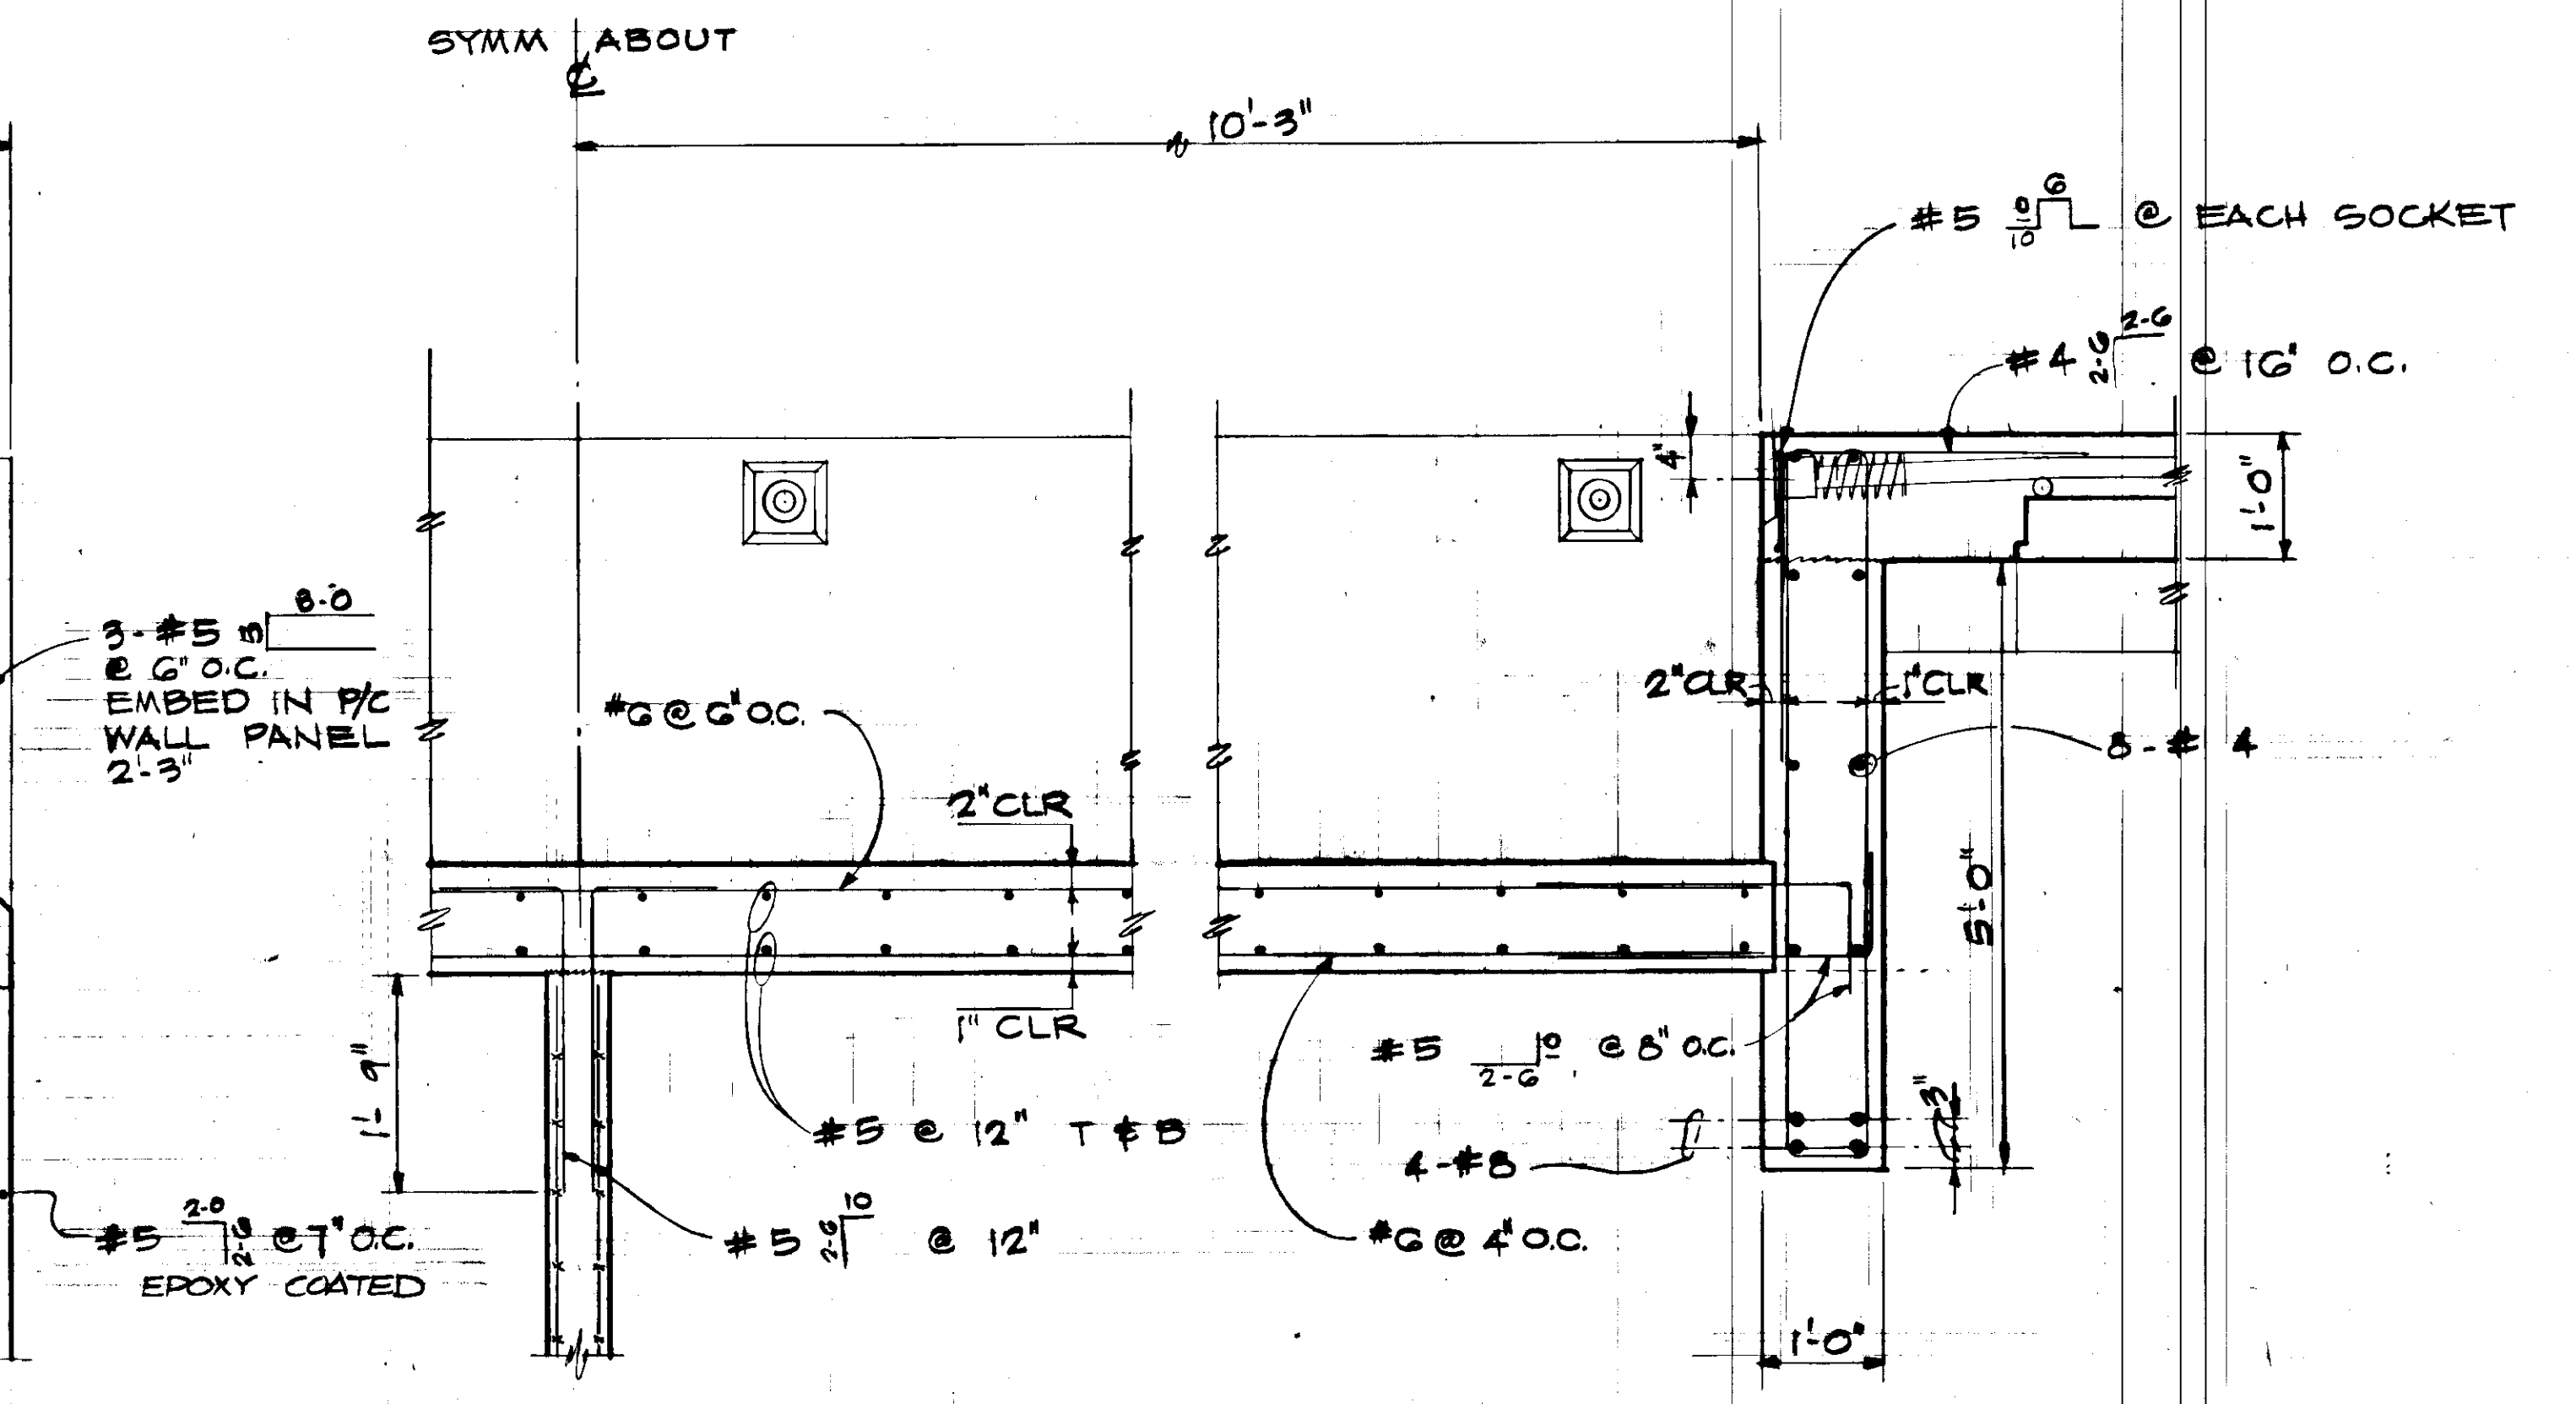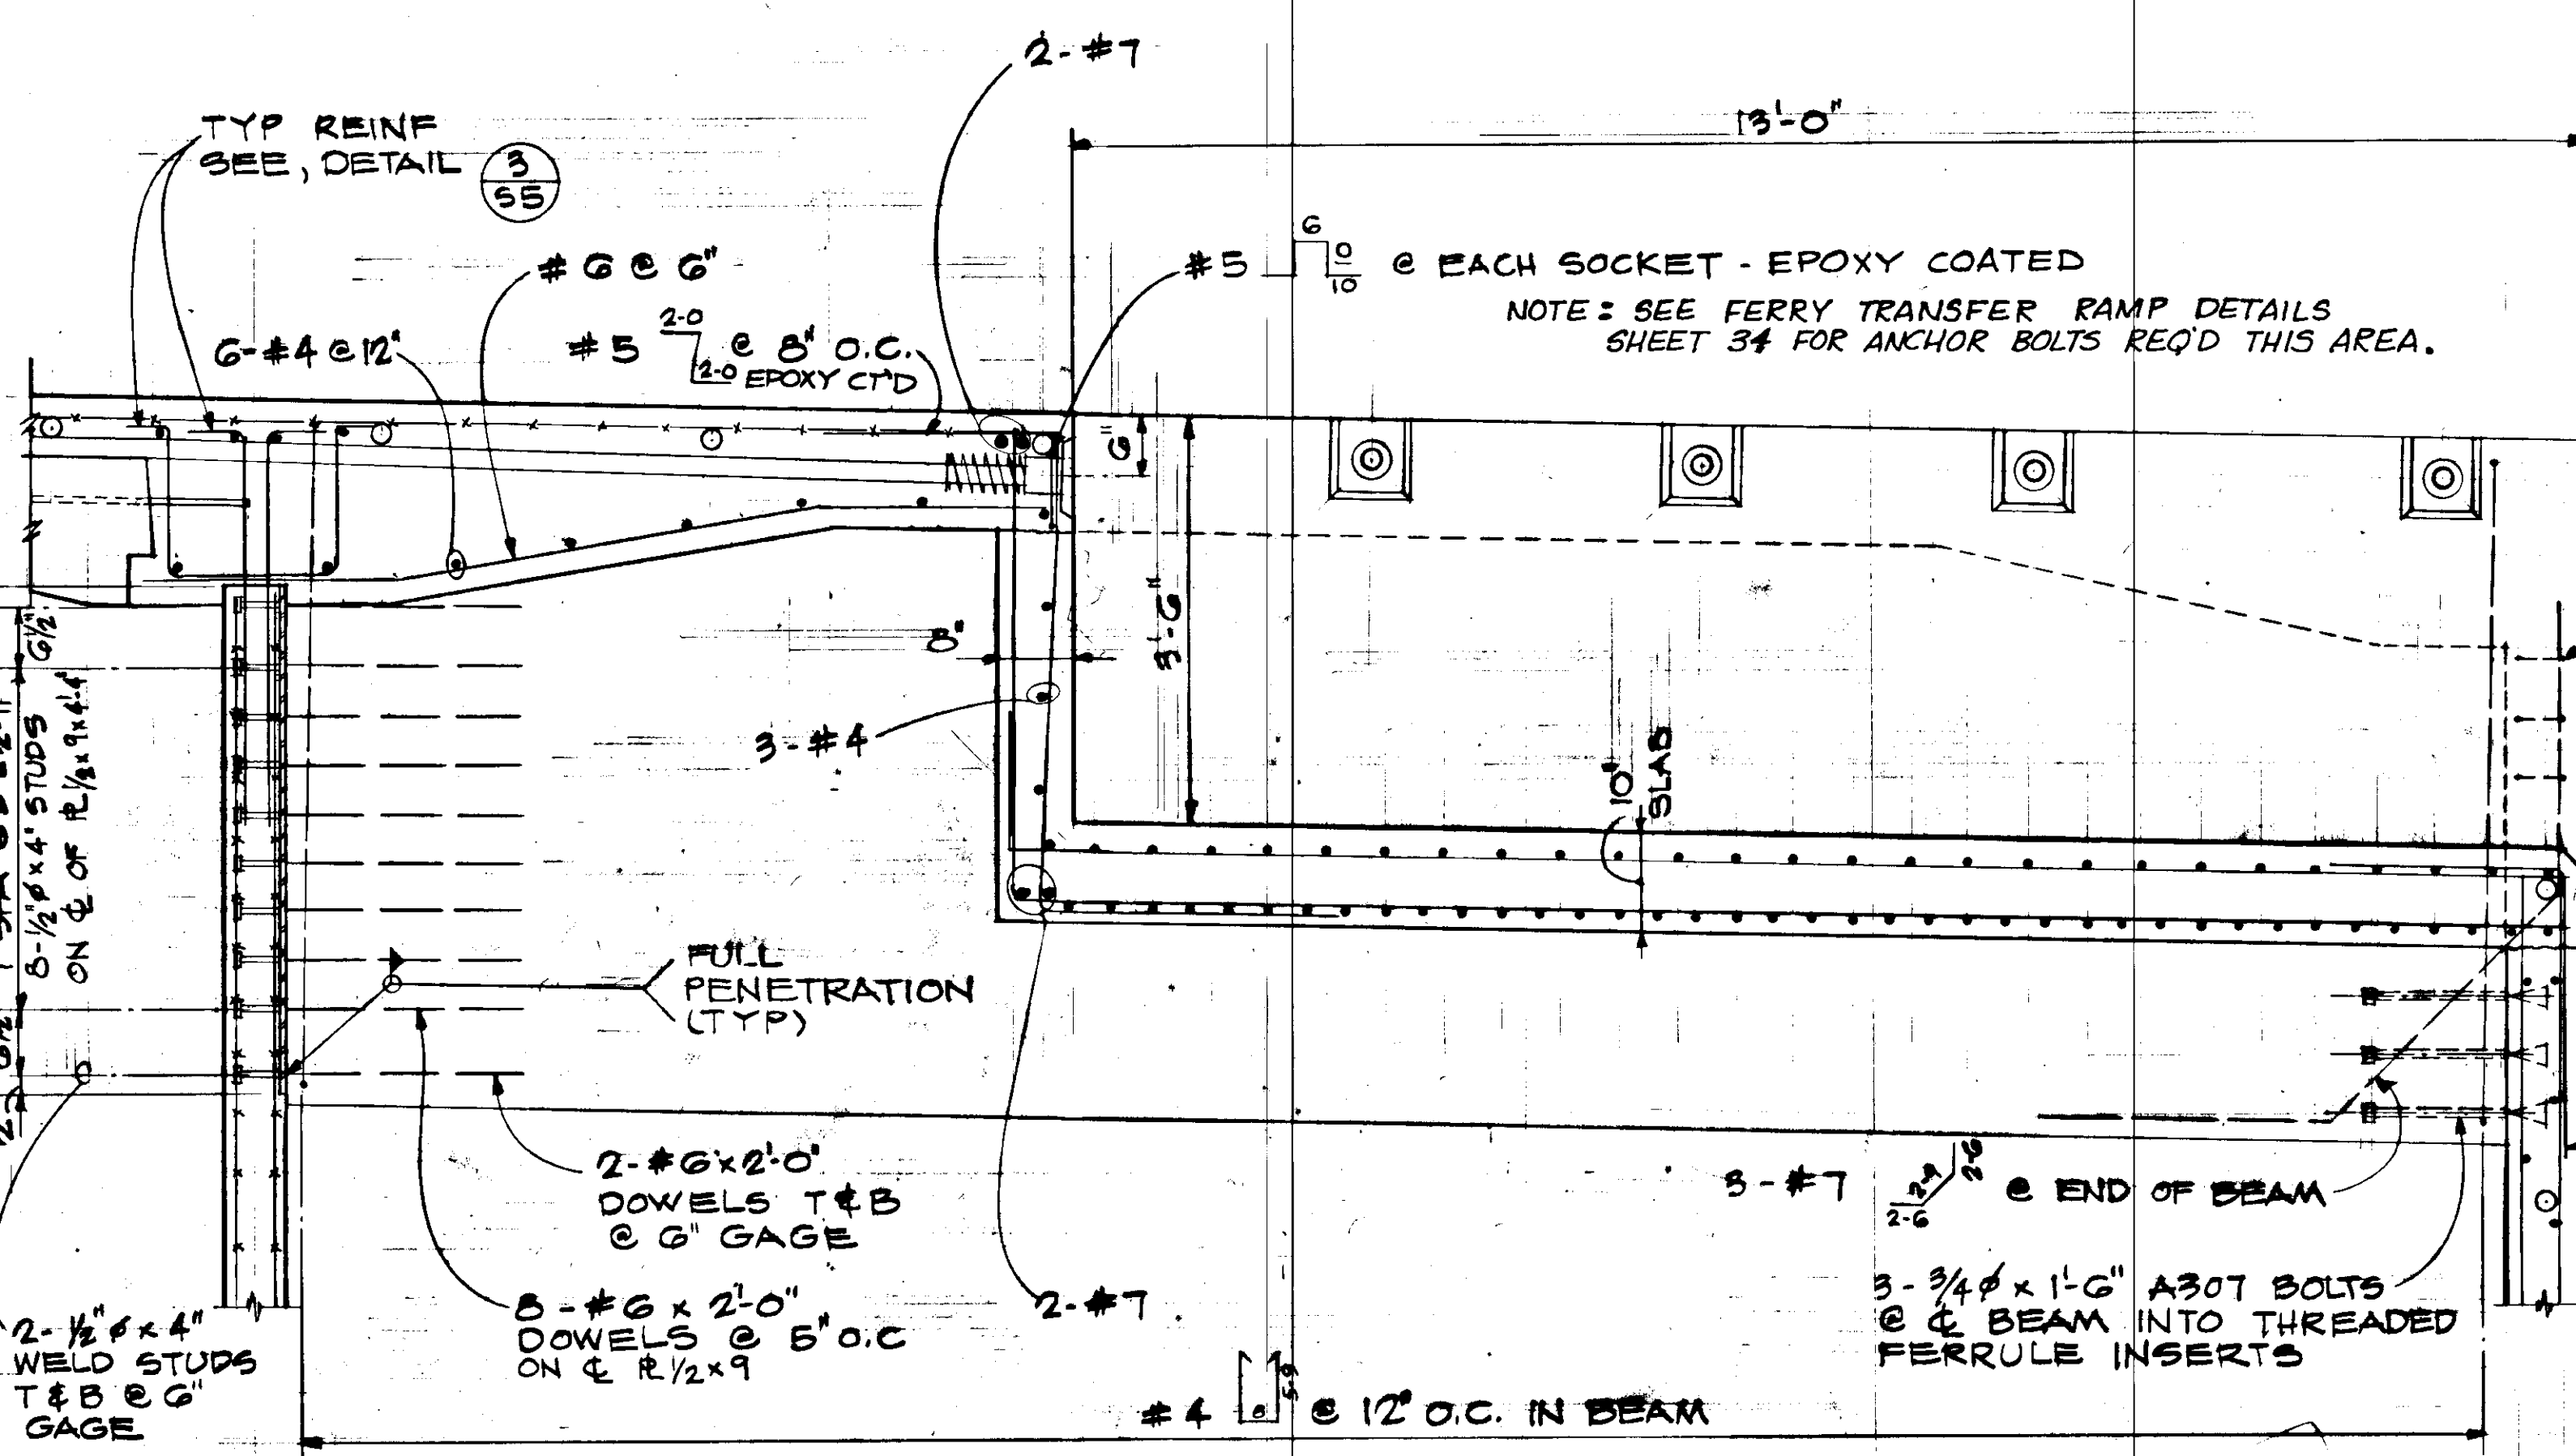


SECTION 1  
3/4" = 1'-0"

SECTION 2  
3/4" = 1'-0"

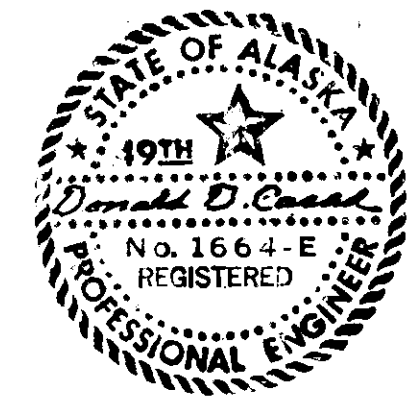


**ABAM**  
 ABAM ENGINEERS INCORPORATED  
 CONSULTING ENGINEERS  
 1127 PORT OF TACOMA ROAD TACOMA WASH.  
 2041 382 3091


DESIGNED	JRS	<b>TRYCK NYMAN GRAY</b> ENGINEERS / PLANNERS / SURVEYORS ANCHORAGE ALASKA	BARGE FACILITY TRANSFER RAMP DECK SLOT SECTIONS	SHEET <b>58</b> OF <b>8</b> FILE NO.
DRAWN	R. MOHN			
CHECKED	DDM			
DATE	JULY 18, 78			
SCALE	AS NOTED	GRID		
REV.	DATE	BY	REVISION	

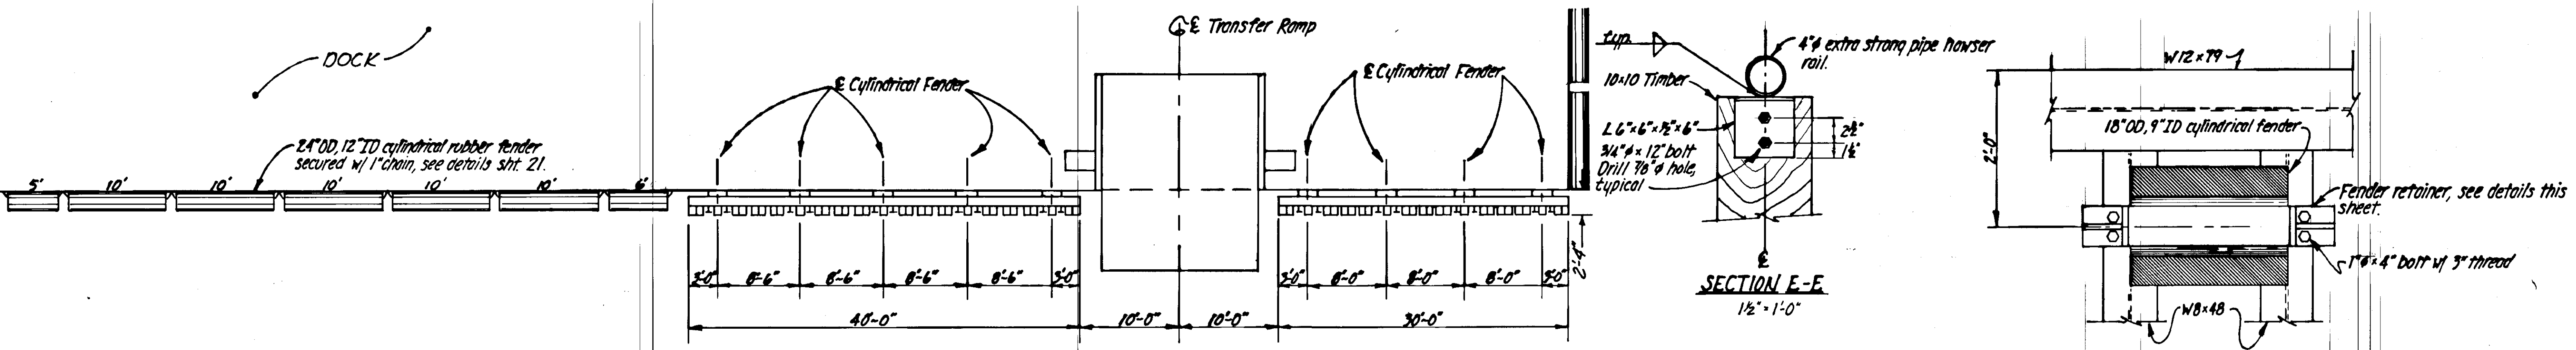

**PLAN**  
10' 3' 5' 7' 9' 10'  
SCALE 3/8" = 1'-0"

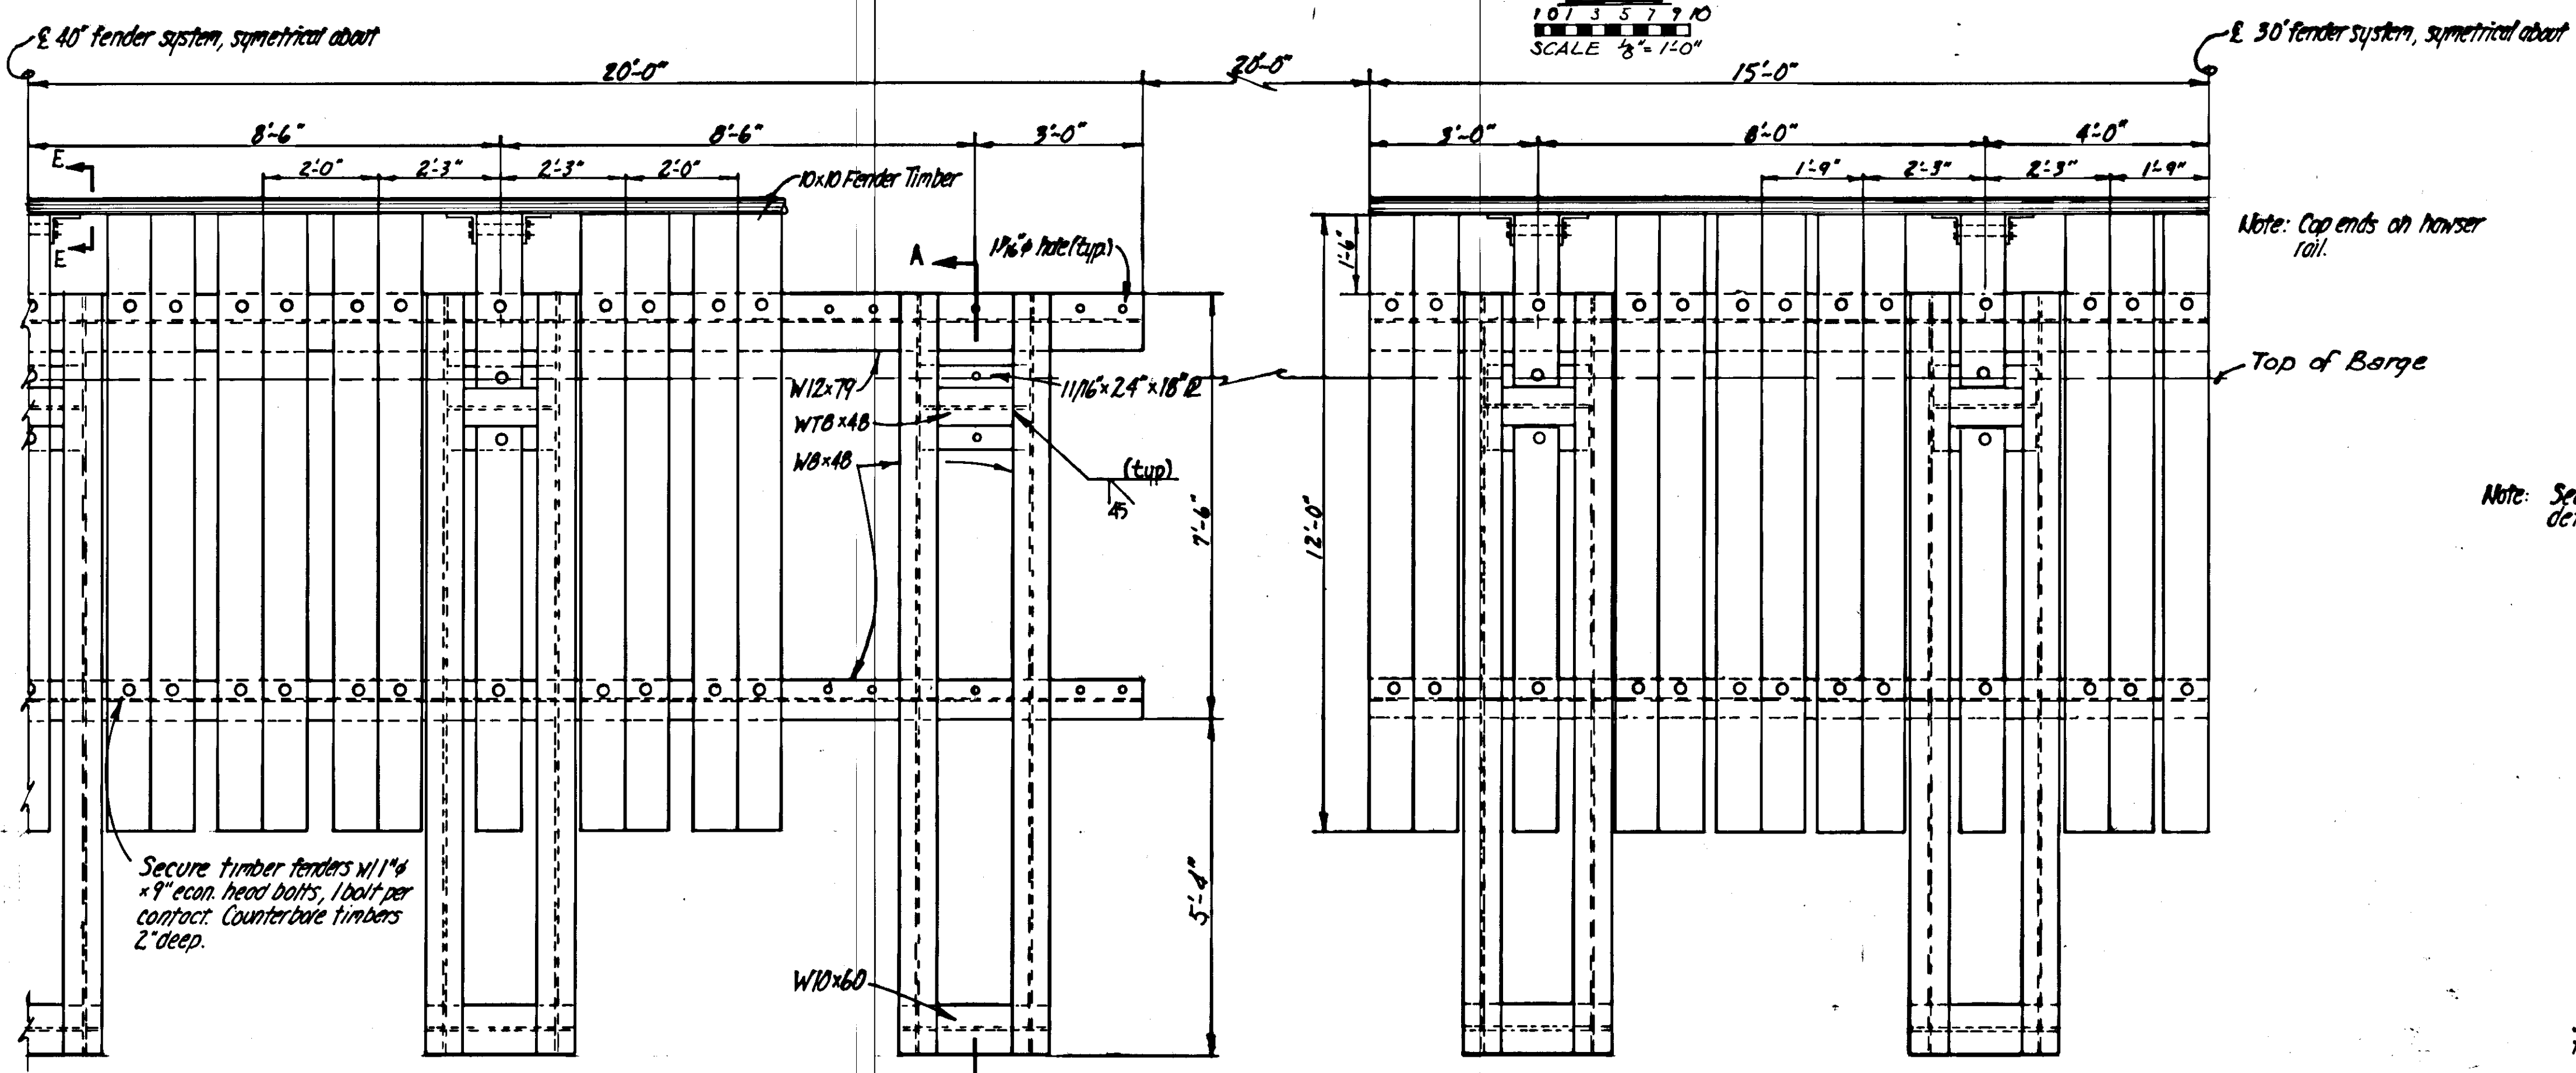


**ELEVATION**  
1/2" = 1'-0"

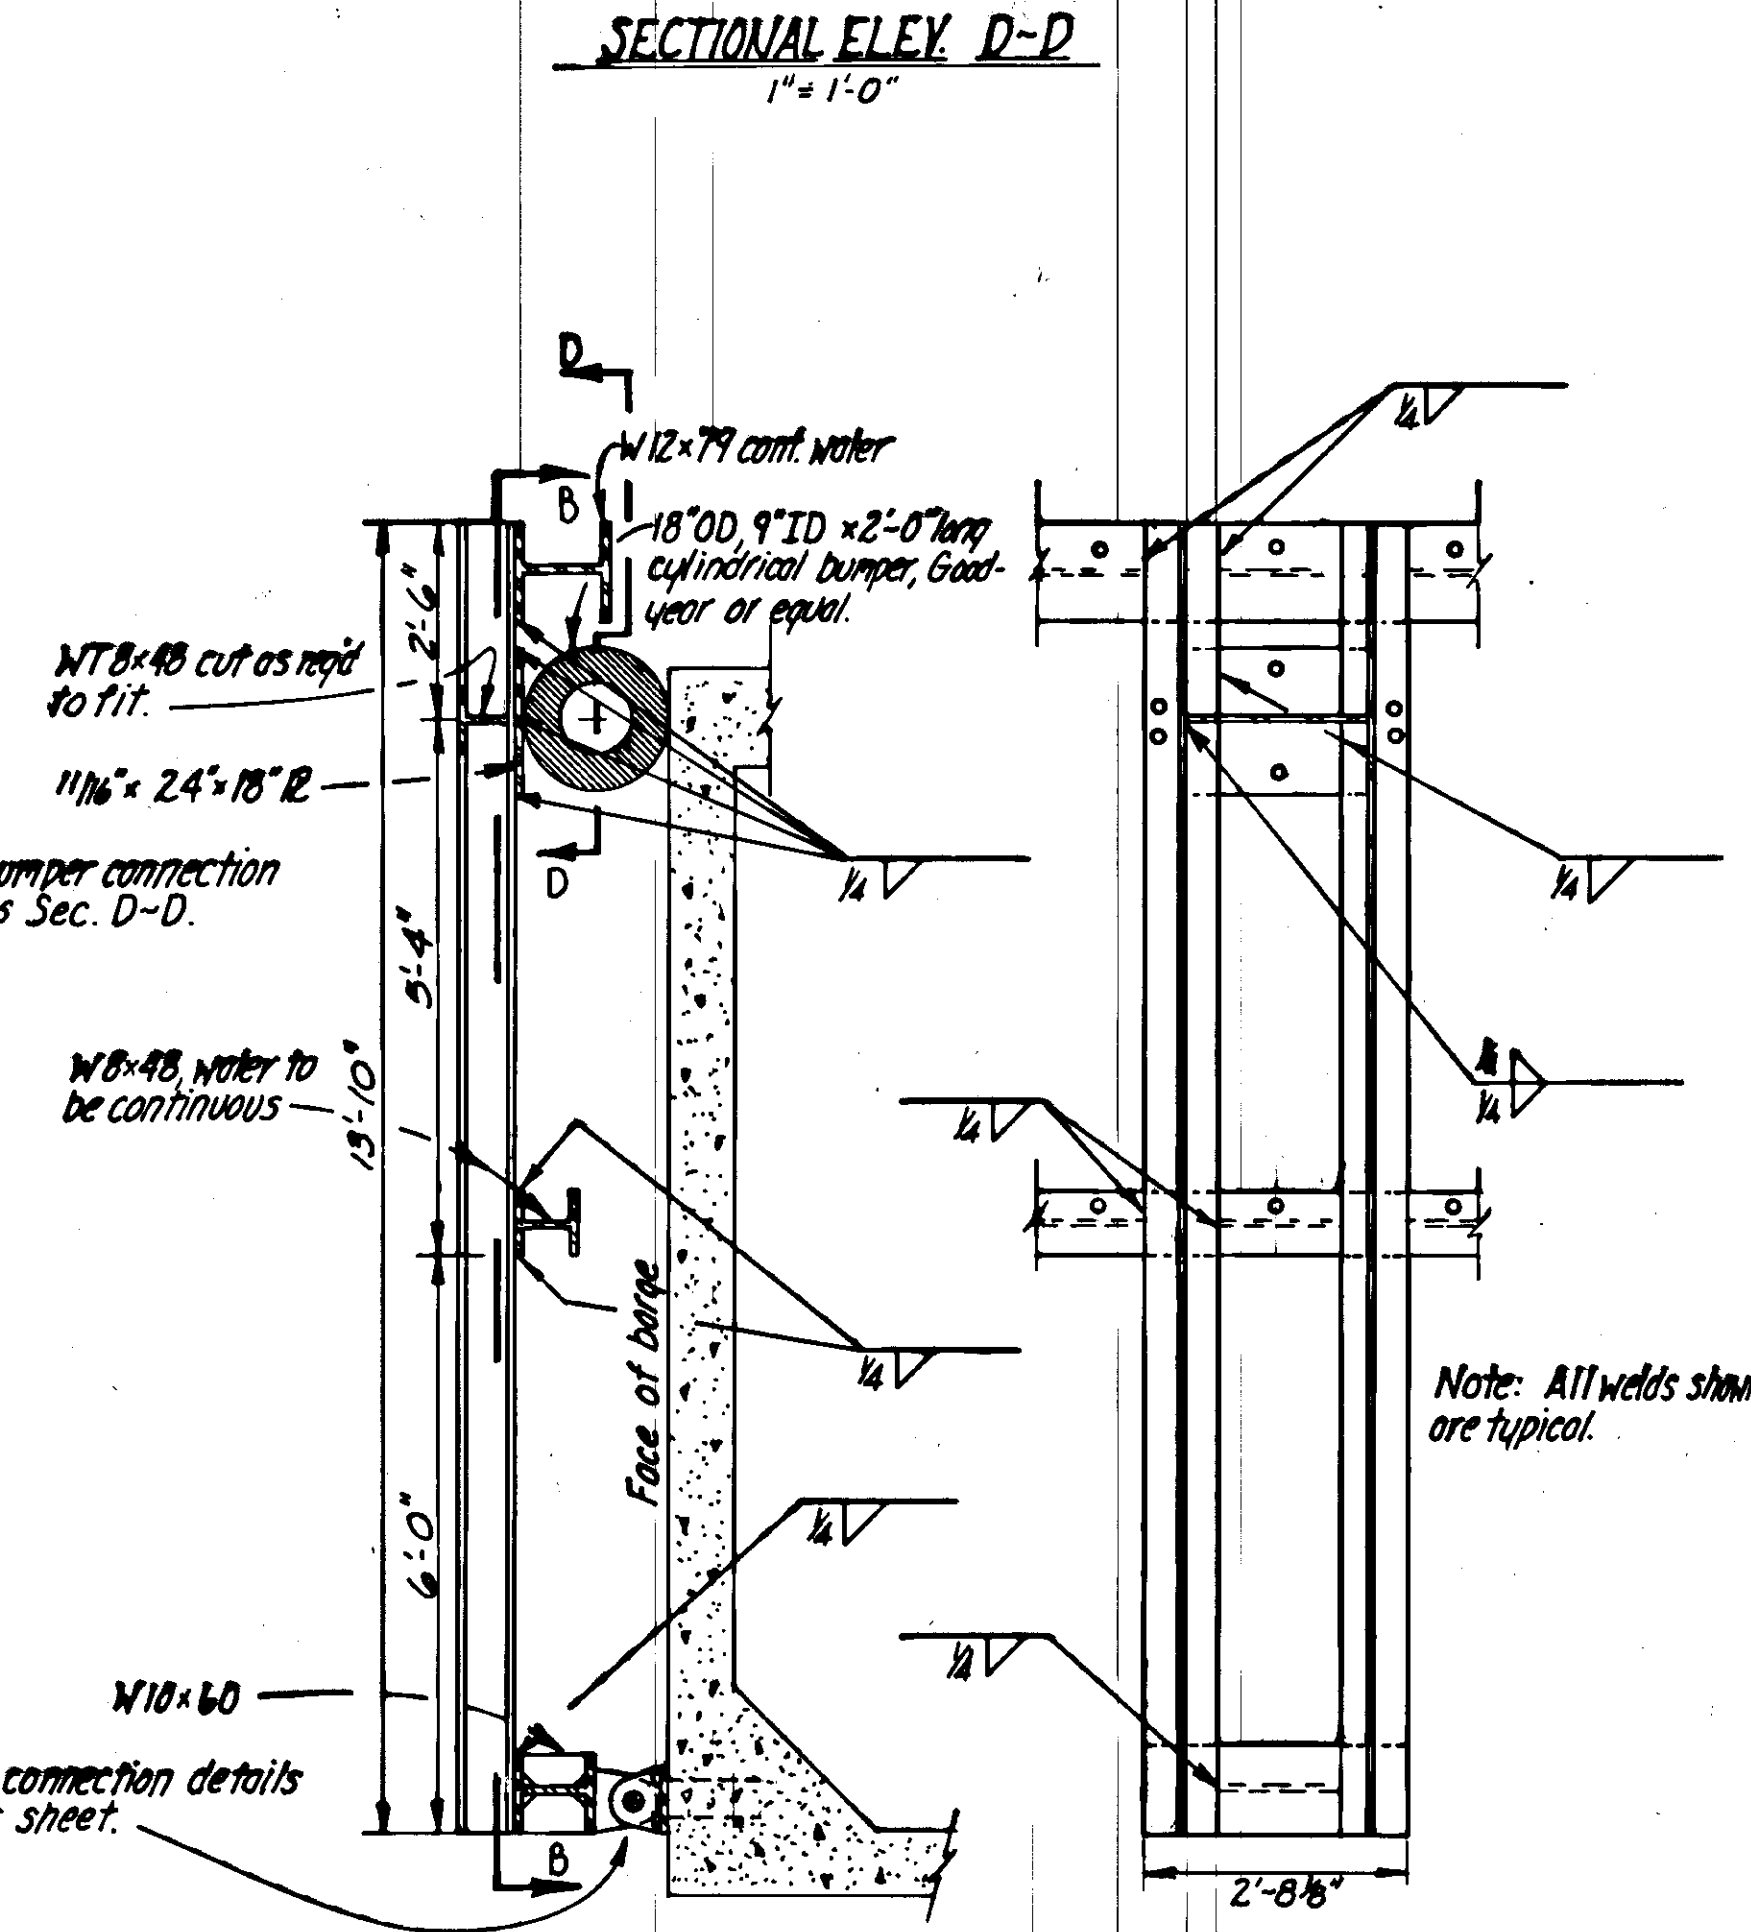


**SECTIONAL ELEV. A-A**  
1/2" = 1'-0"

**SECTIONAL ELEV. B-B**  
1/2" = 1'-0"

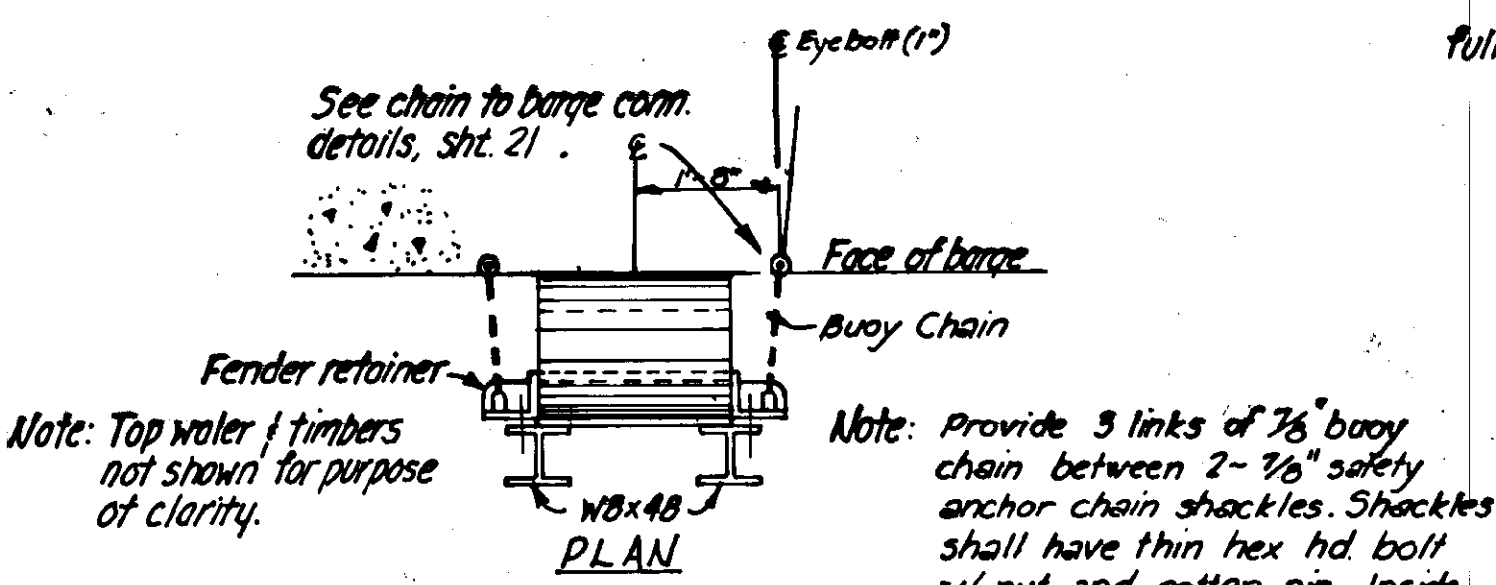


**RETAINING CHAINS**  
(9 req'd)  
1/2" = 1'-0"

Note: Provide 3 links of 7/8" buoy chain between 2-3/8" safety anchor chain shackles. Shackles shall have thin hex hd. bolt w/ nut and cotter pin. Inside length 16 1/8". Contractor may substitute hardware approved by the engineer, however, the length of completed assembly shall achieve a snug fit (1 3/8") between barge face and fender.

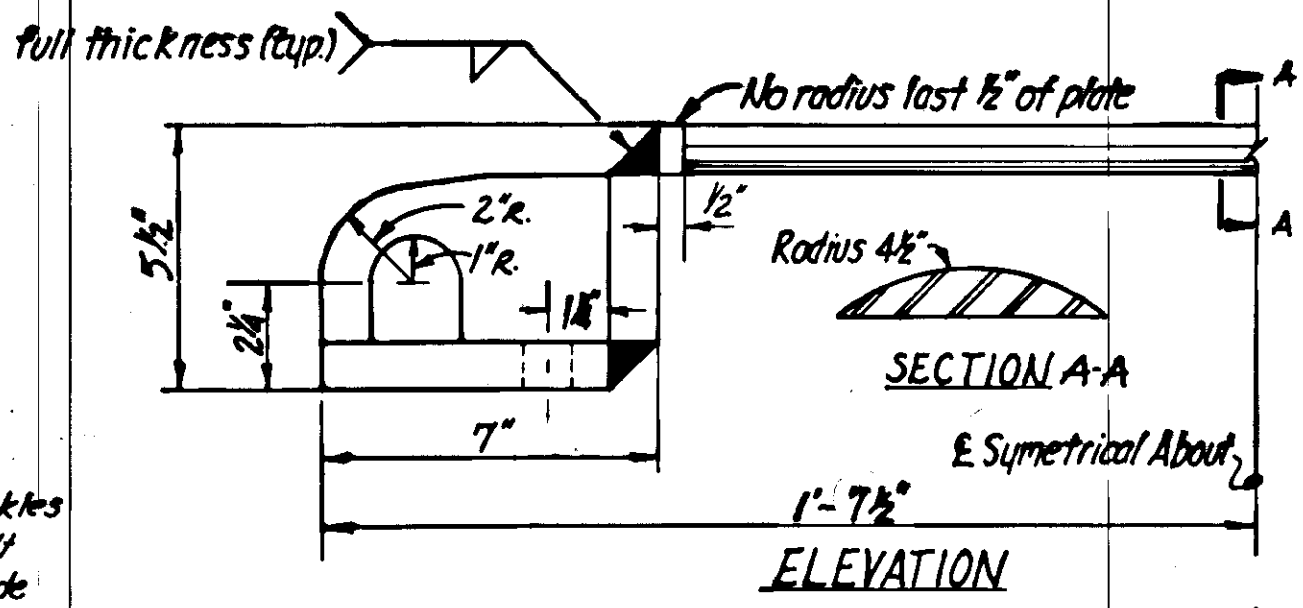


**SECTION A-A**  
E Symmetrical About

**ELEVATION**

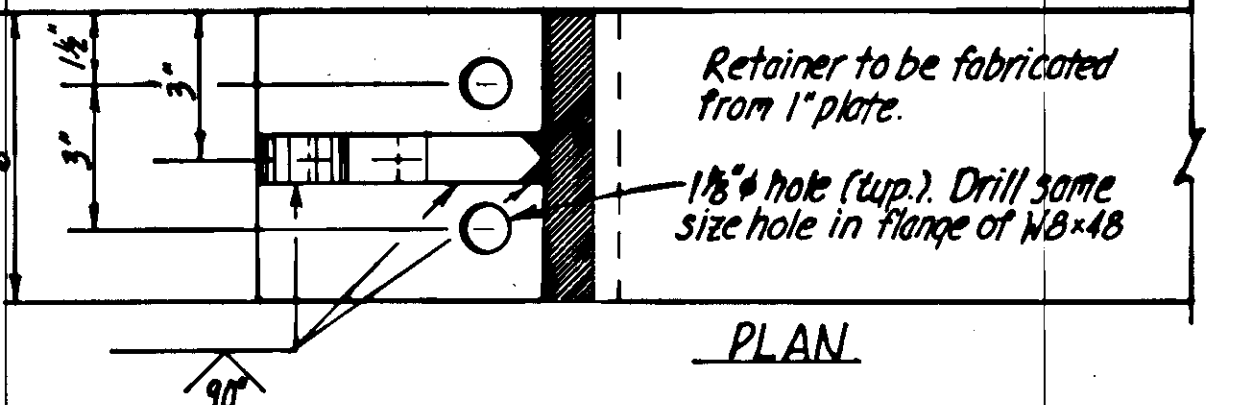

**PLAN**  
**FENDER RETAINER**  
3" = 1'-0"

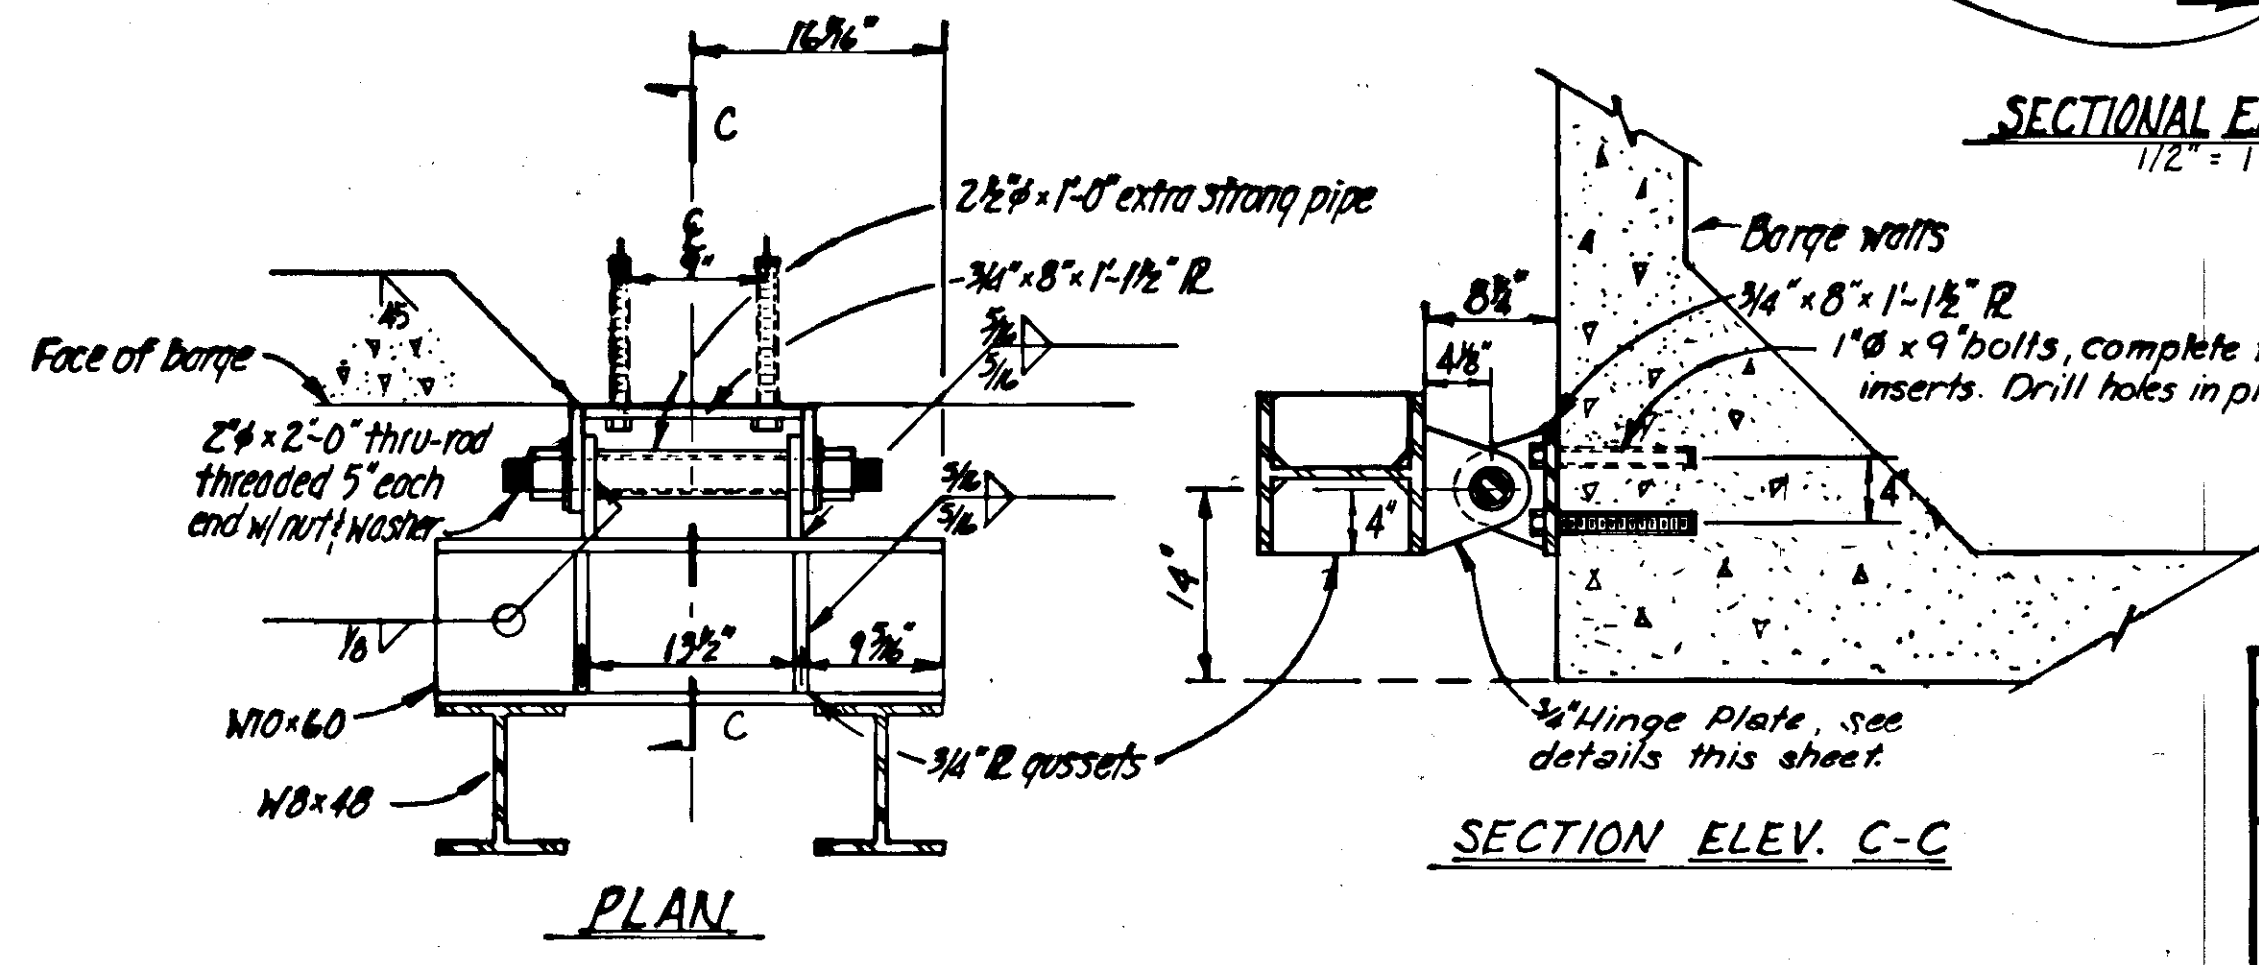



**PLAN**

**SECTION ELEV. C-C**







**FENDER SYSTEM TO BARGE CONNECTION**  
1" = 1'-0"

DO NOT SCALE THIS DRAWING - USE DIMENSIONS		
STATE OF ALASKA		
DIVISION OF HARBORS		
<b>FENDER SYSTEM FERRY TERMINAL</b>		
SCALE As noted	SURVEYED	APPROVED
DESIGNED JAL	DRAWN JAL	Don Statter
CHECKED	DATE 2/2/78	DIRECTOR
PROJECT NUMBER F-0972(2)	SHEET 32 OF 41	

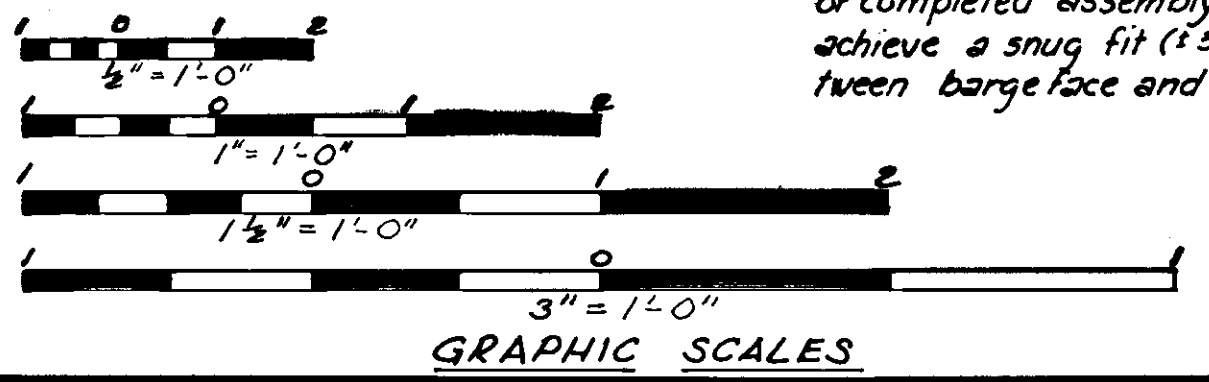

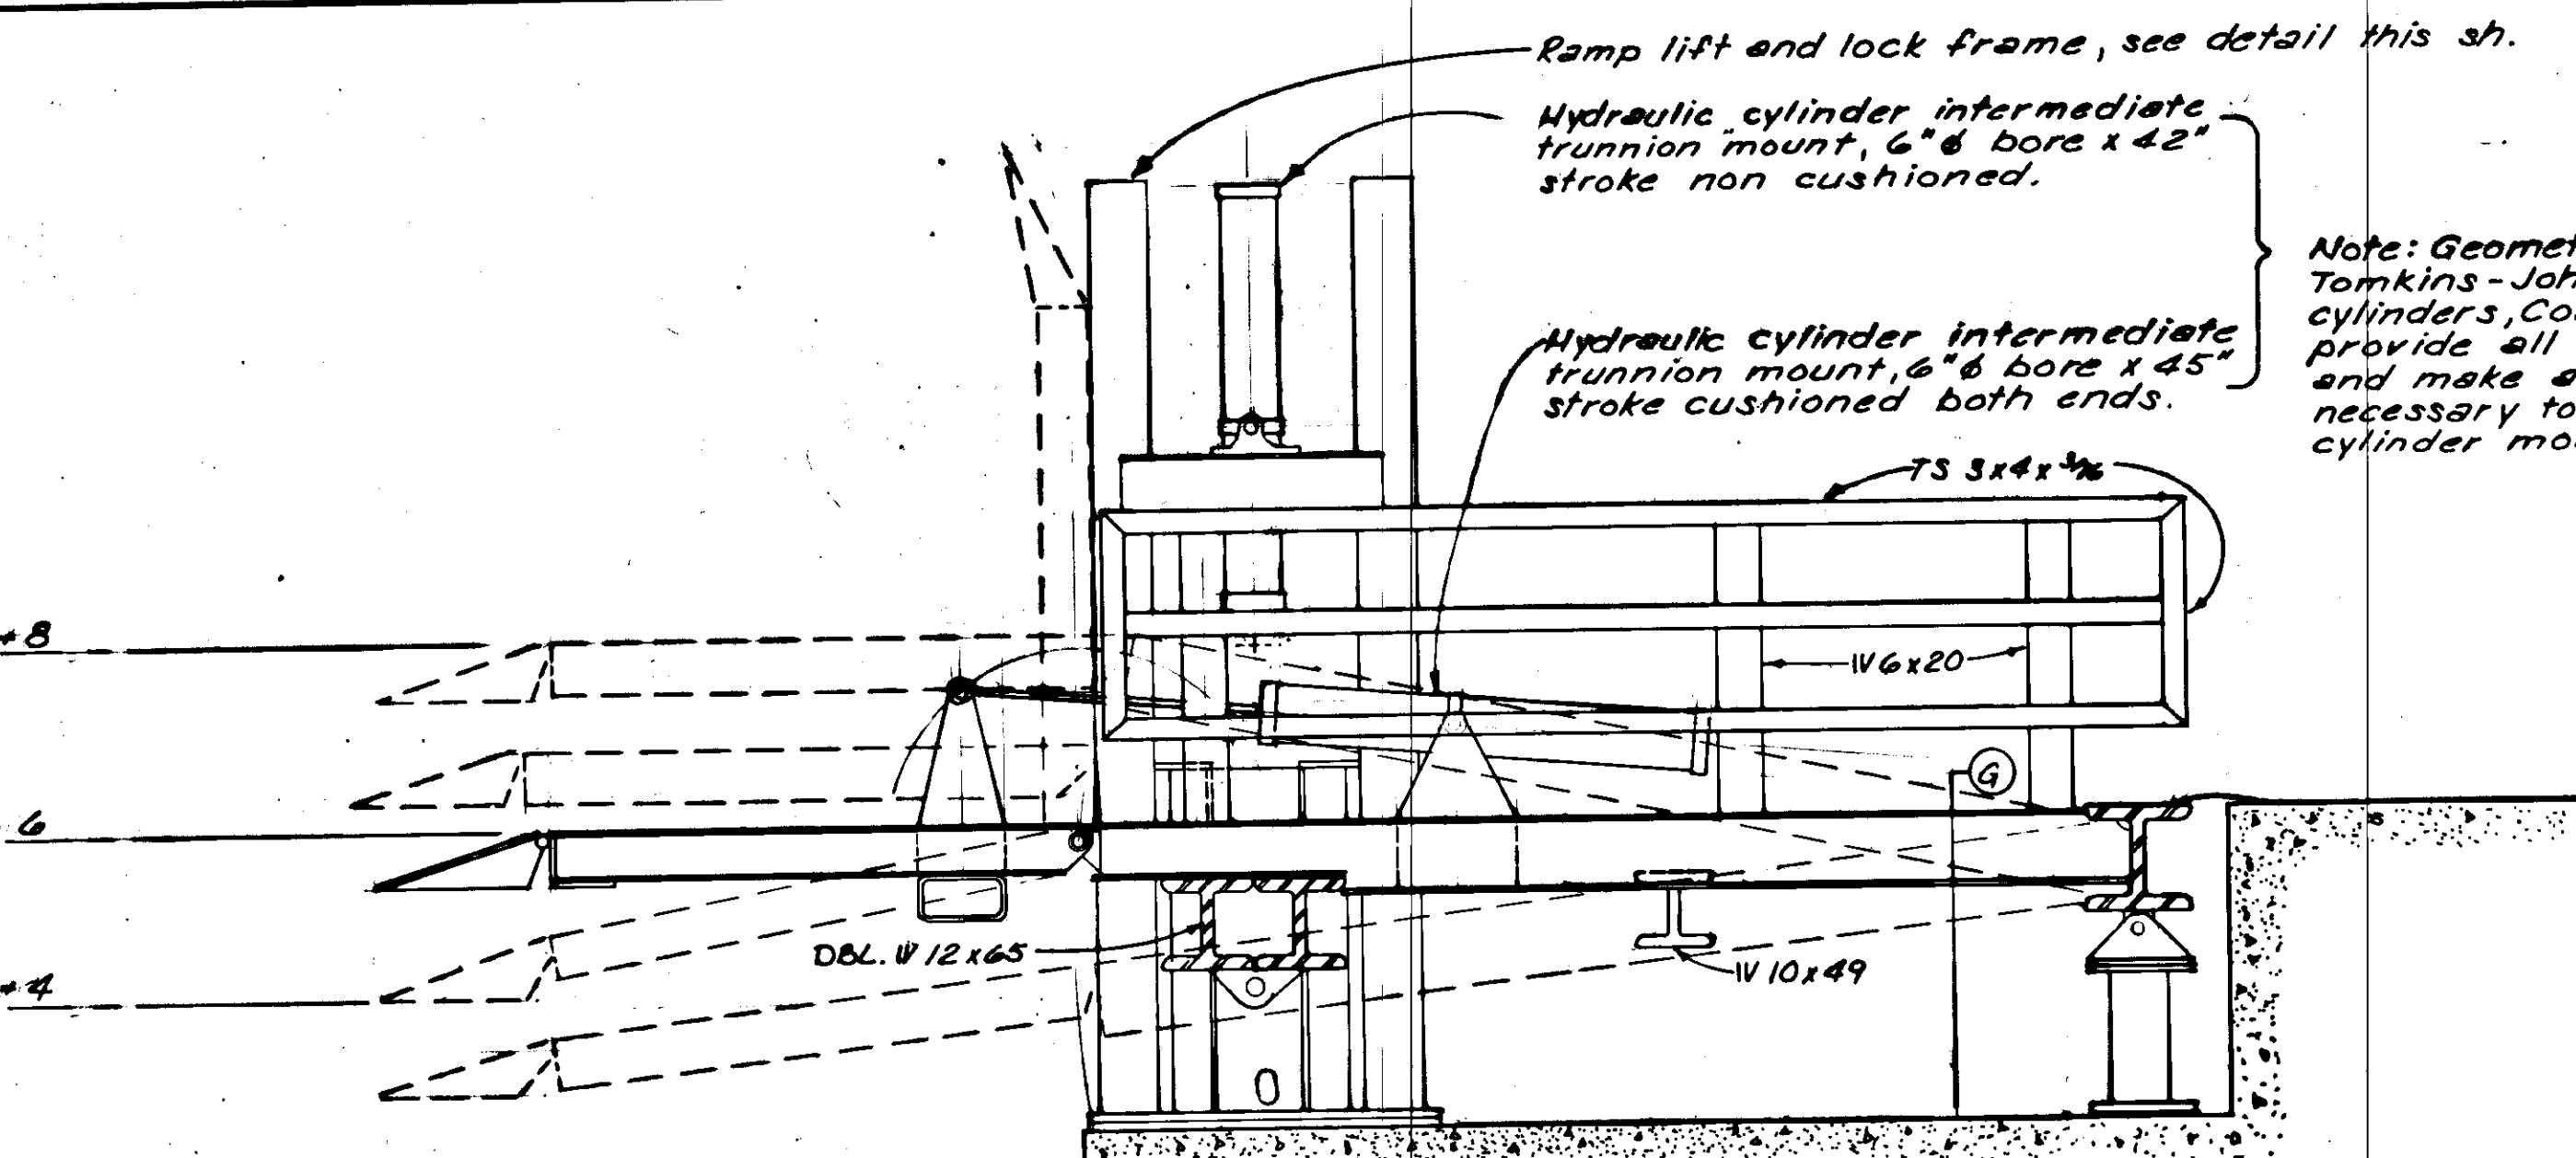


Note: Geometry based on Tomkins-Johnson hydraulic cylinders. Contractor shall provide all drawings & details and make adjustments necessary to accommodate cylinder model selected.

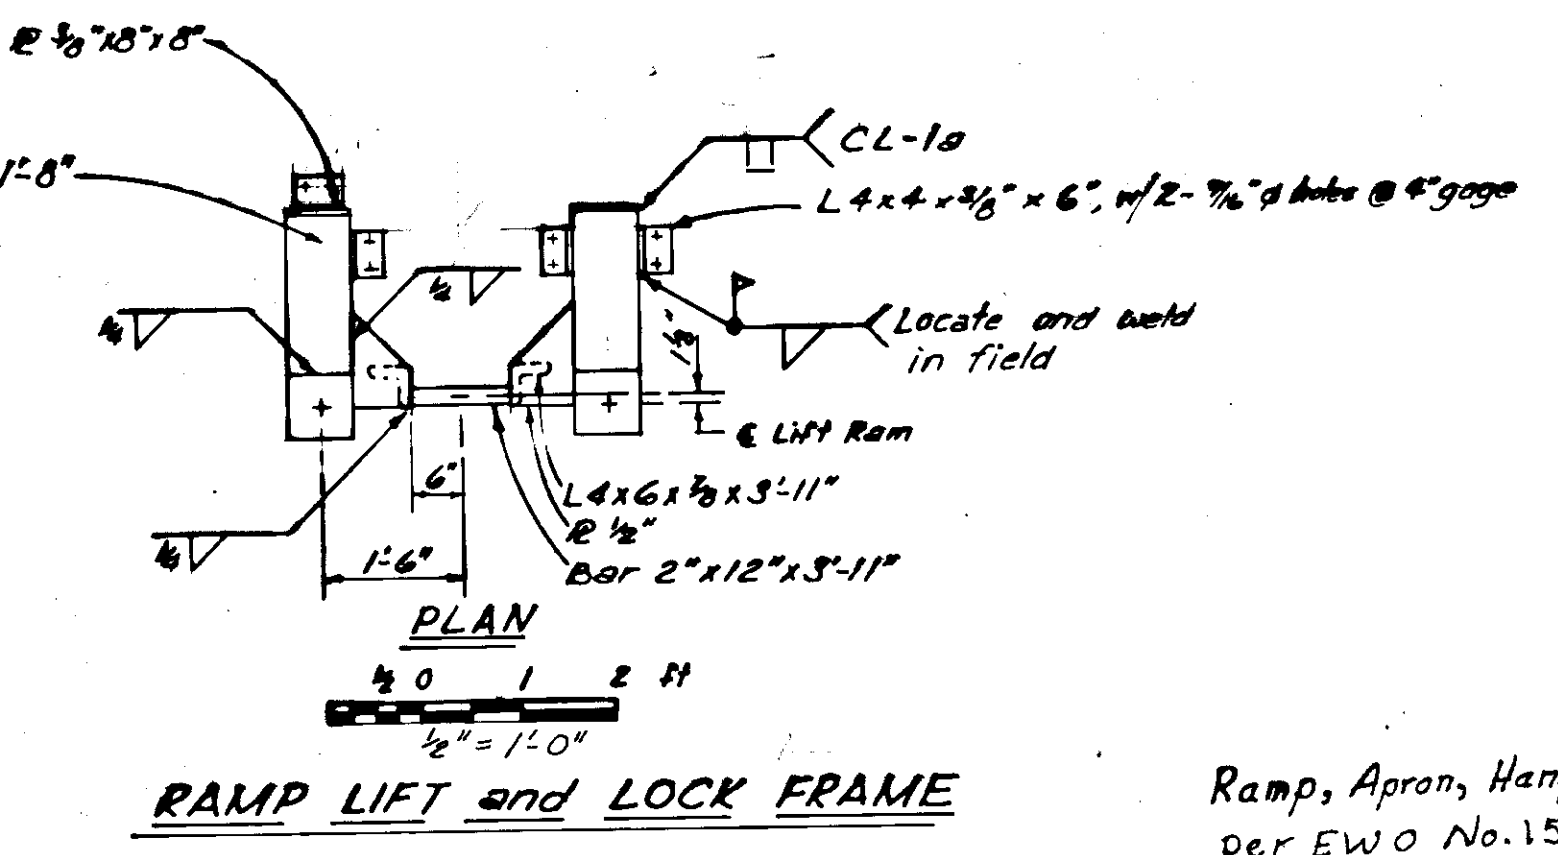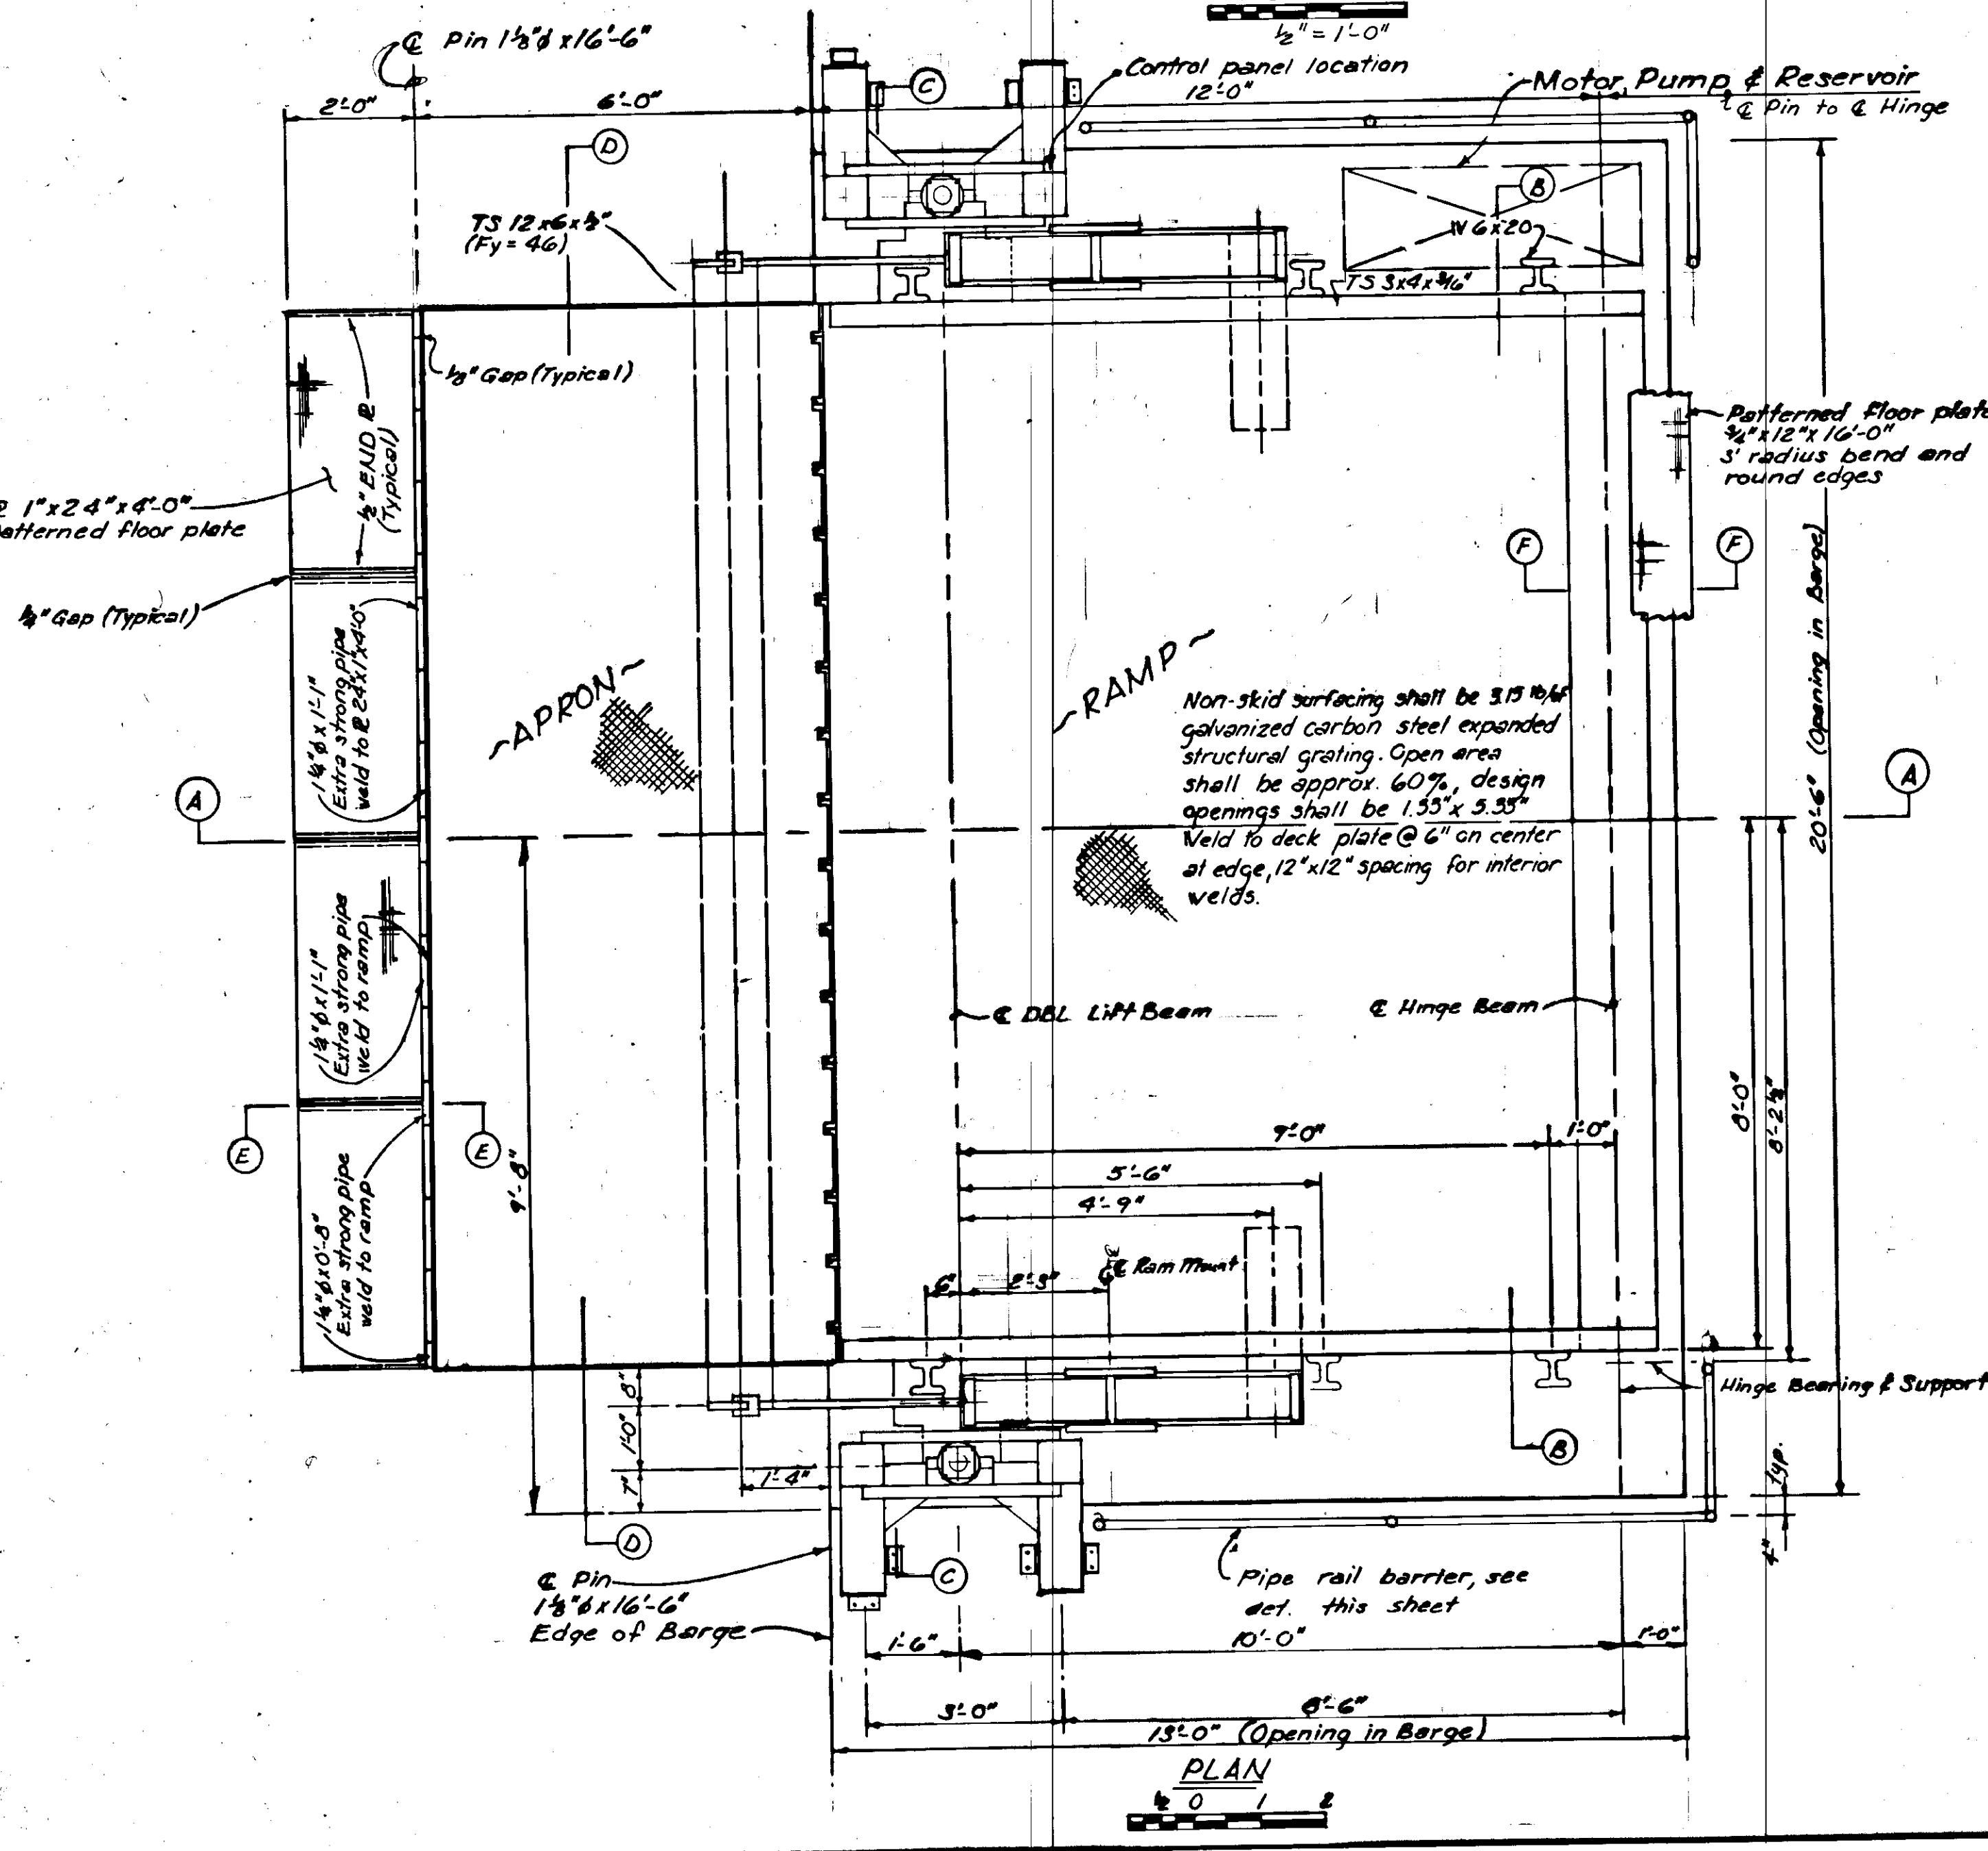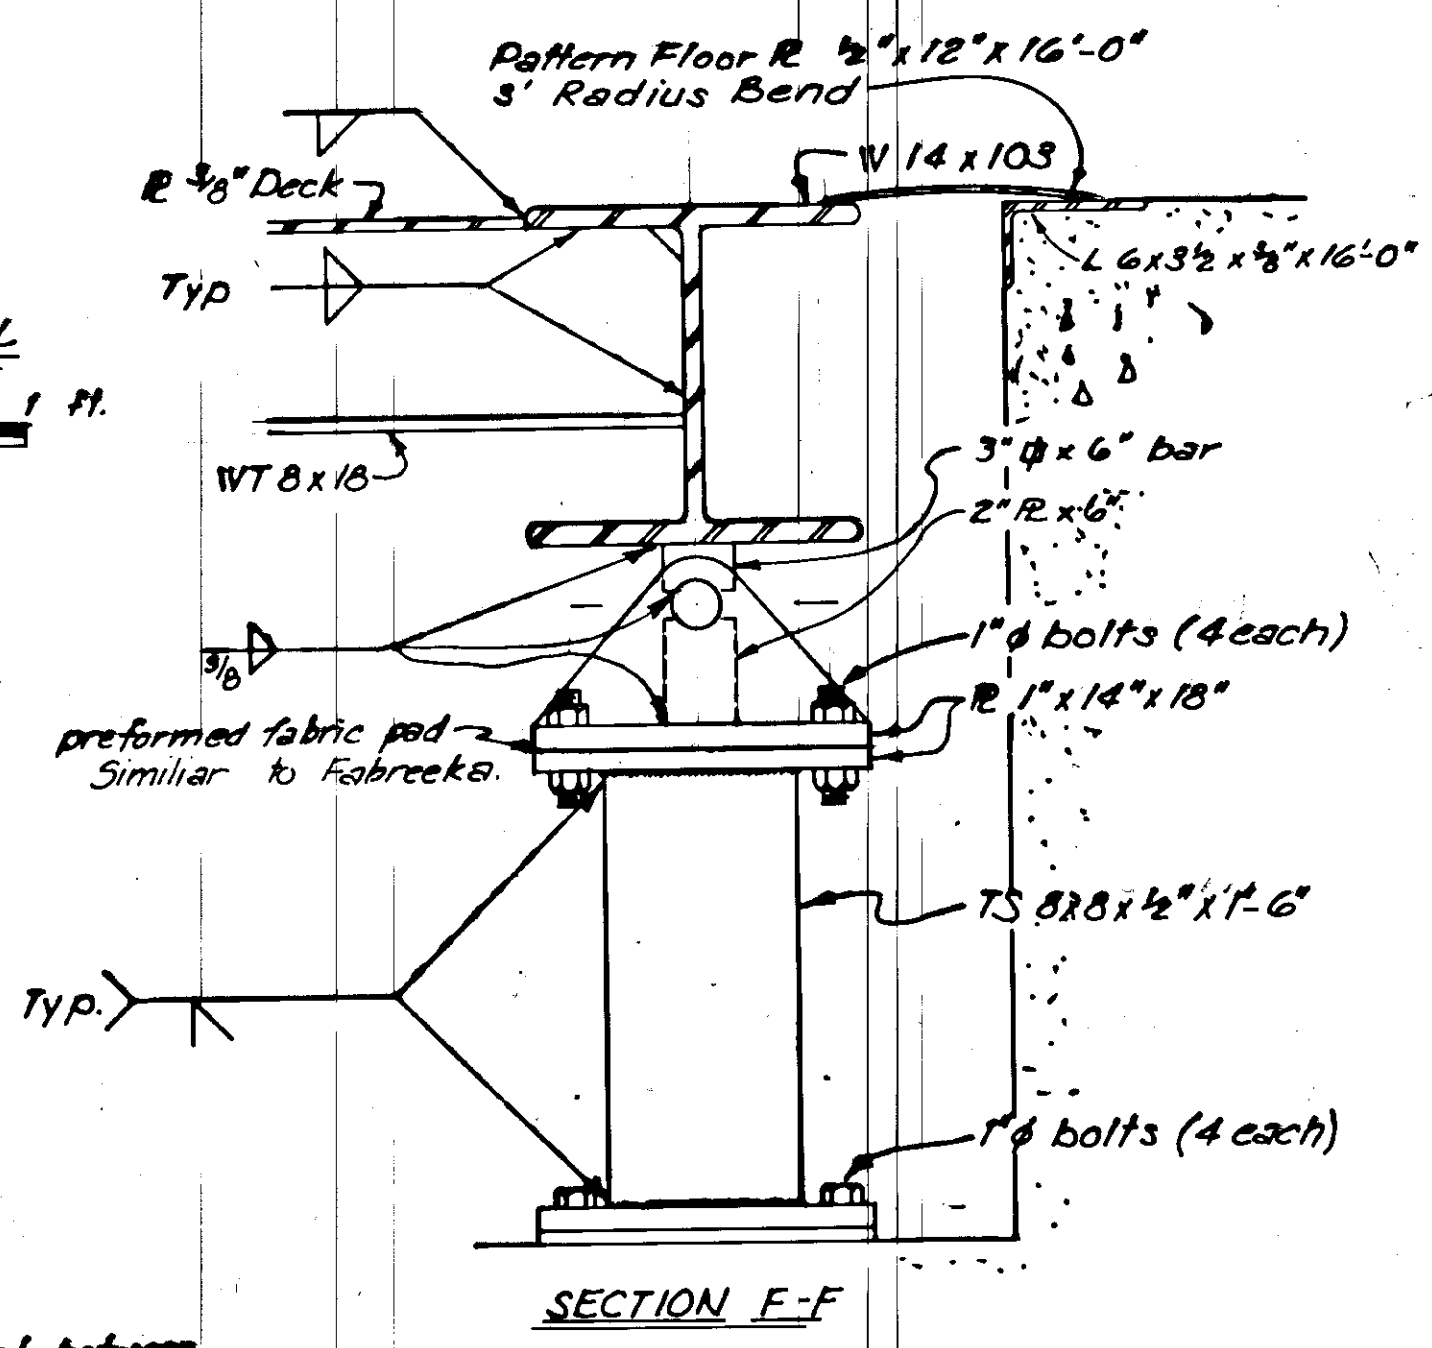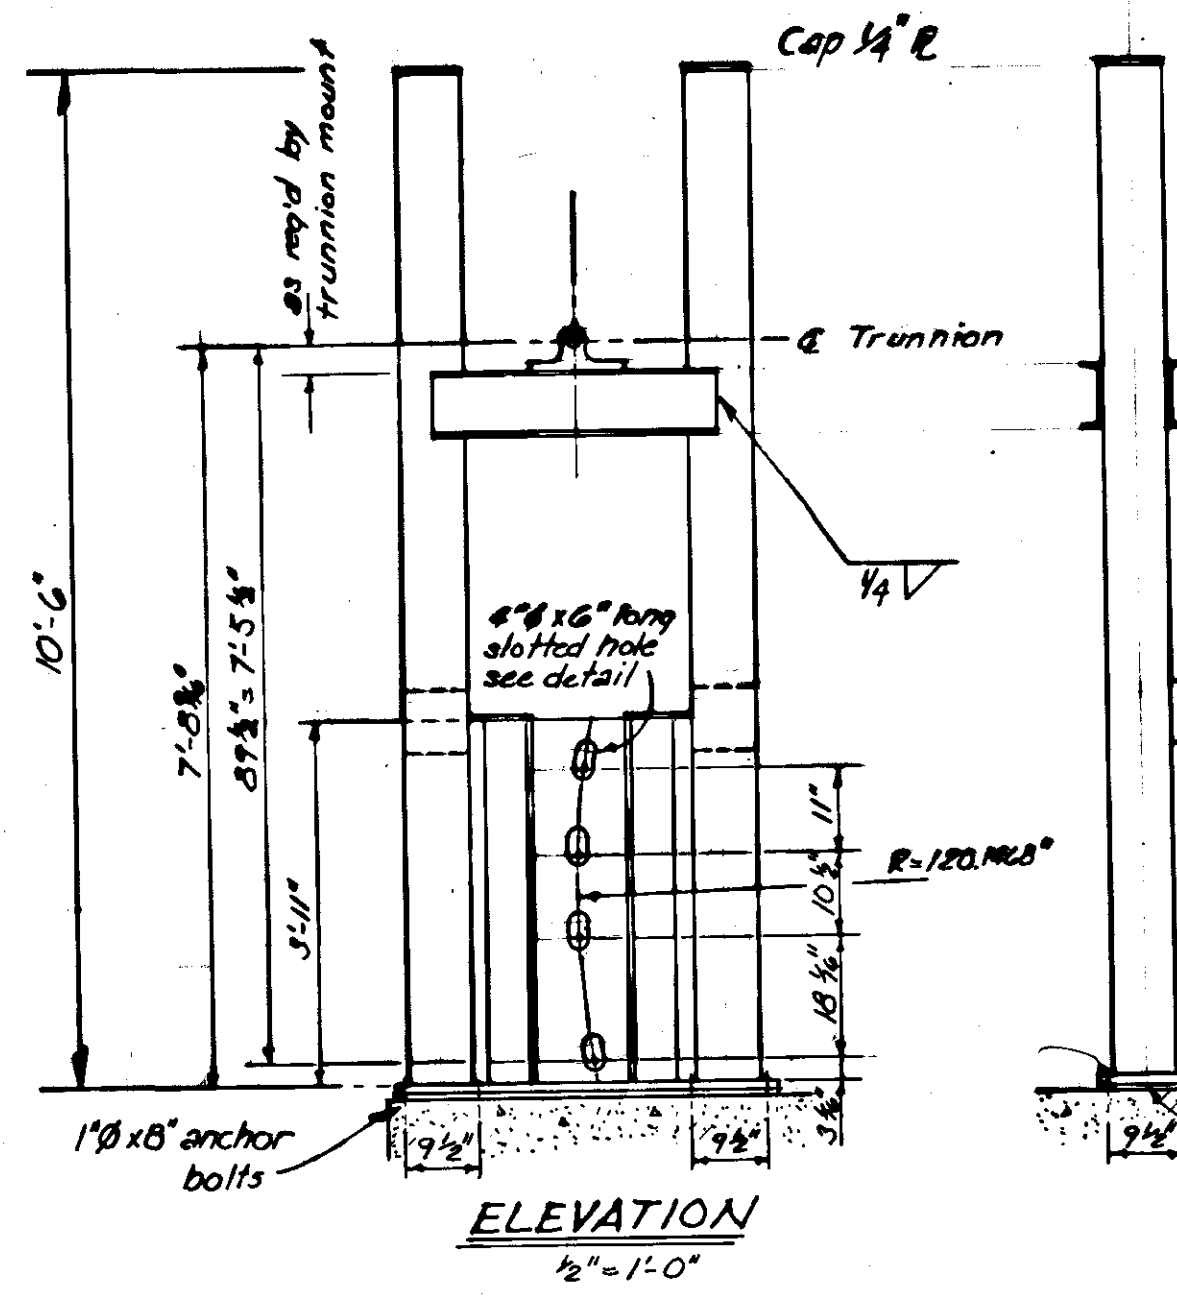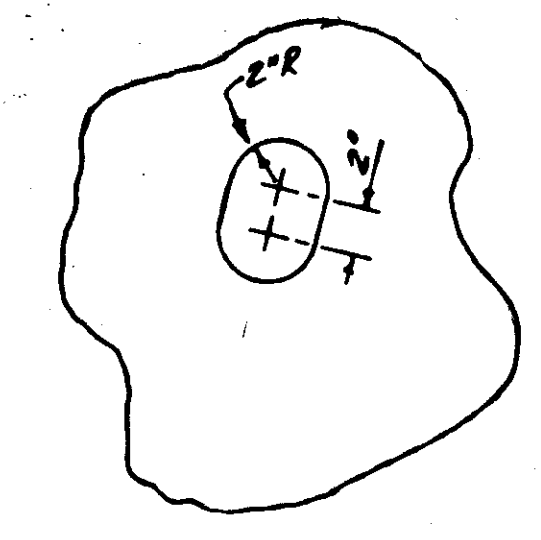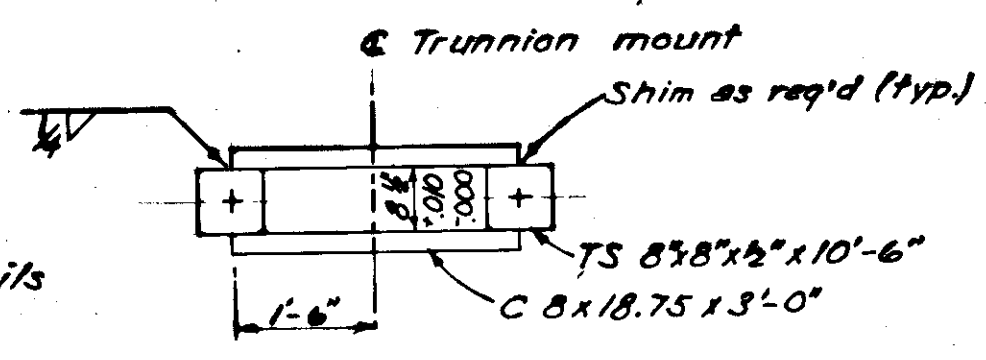


RAMP LIFT and LOCK FRAME

Ramp, Apron, Hanger Modifications per EWO No. 15

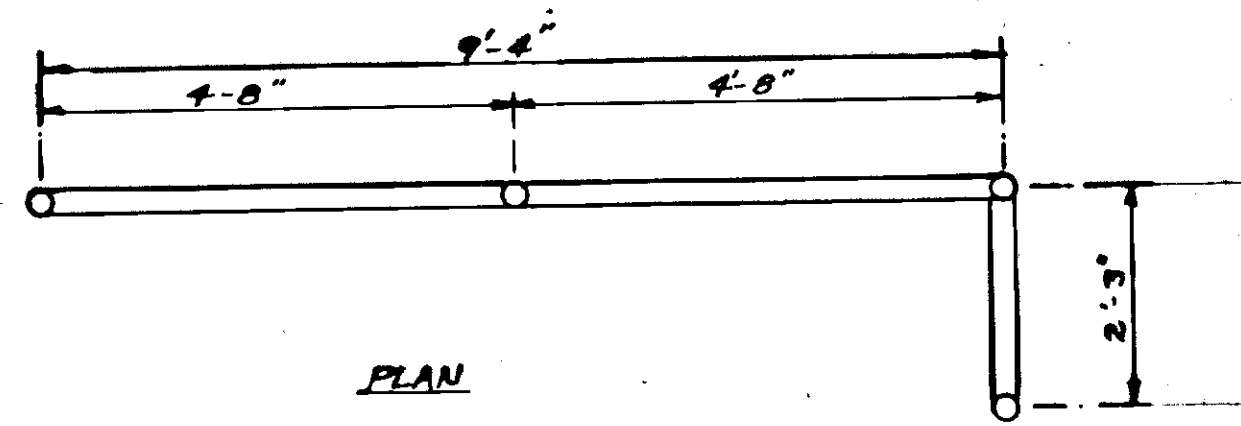


ELEVATION Pipe Rail Barrier not to scale

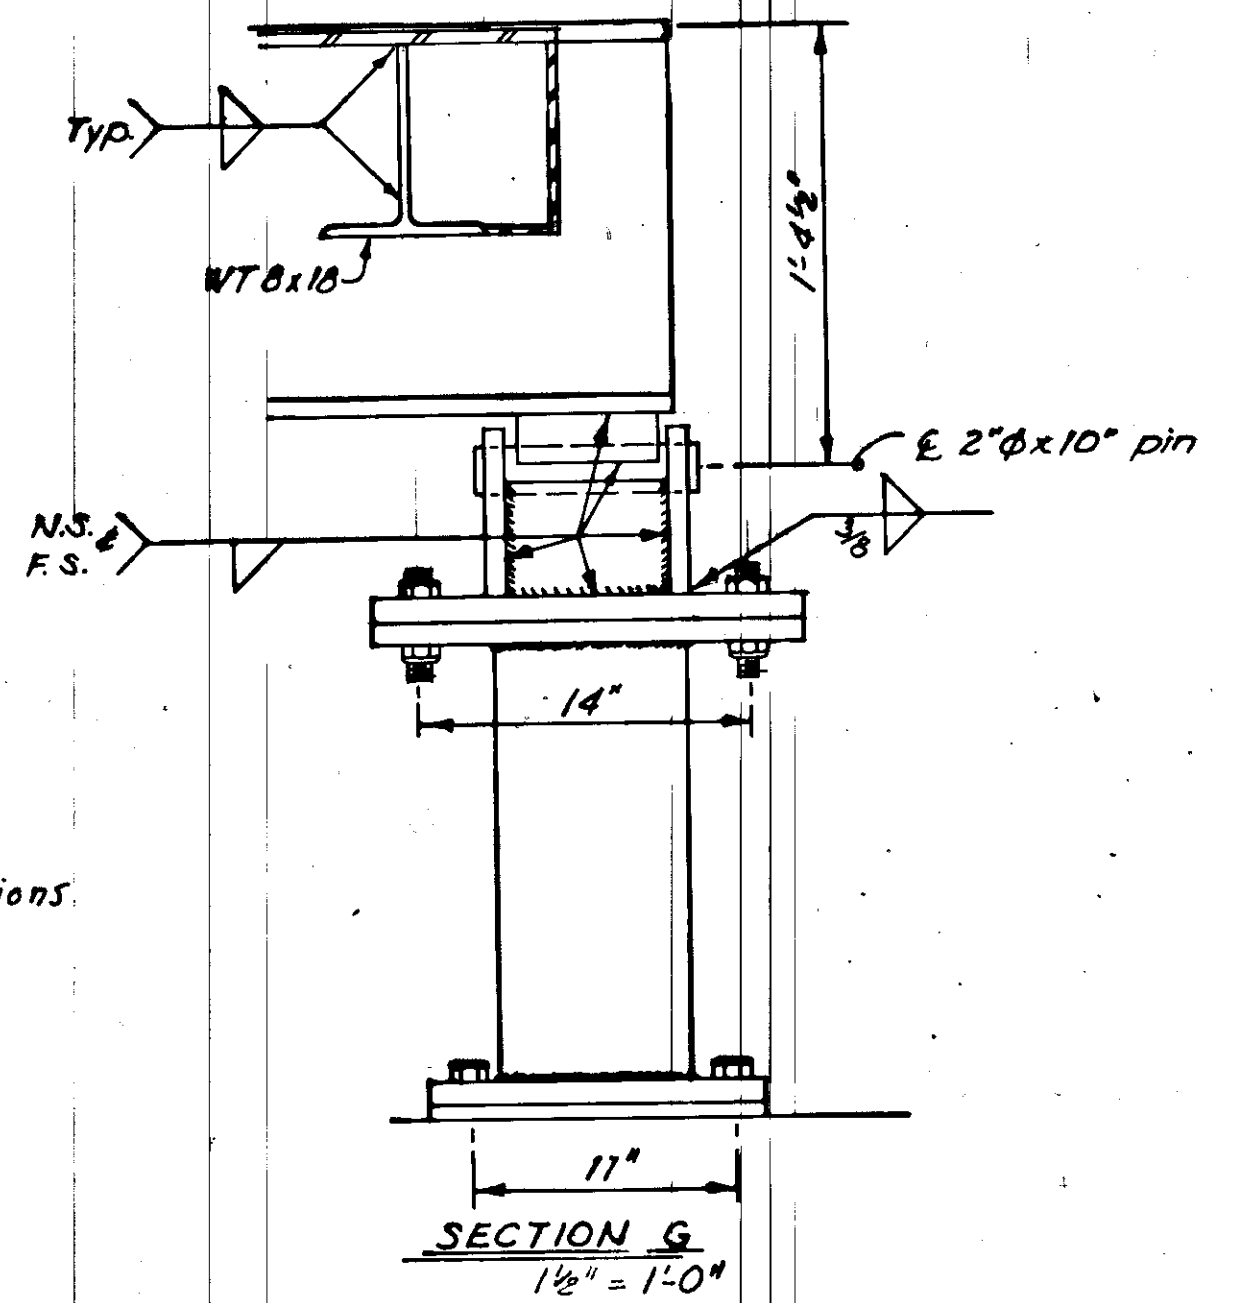


Design Loads: Maximum single-axle 32,000 lbs  
Impact: 30%  
Spacing: 6'-0" center to center of axles  
Approximate weight (less motor, pump and fluid reservoir) 26,000 lbs

DO NOT SCALE THIS DRAWING - USE DIMENSIONS		
STATE OF ALASKA		
DIVISION OF HARBORS		
<b>SKAGWAY FERRY TERMINAL</b>		
<b>TRANSFER RAMP &amp; DETAILS</b>		
SCALE: As Noted	SURVEYED: _____	APPROVED: _____
DESIGNED: HM	DRAWN: GRF	Don Stoffer DIRECTOR
CHECKED: RPB	DATE: FEB. 1978	
PROJECT NUMBER: F-0972(2)	SHEET 33 OF 41	




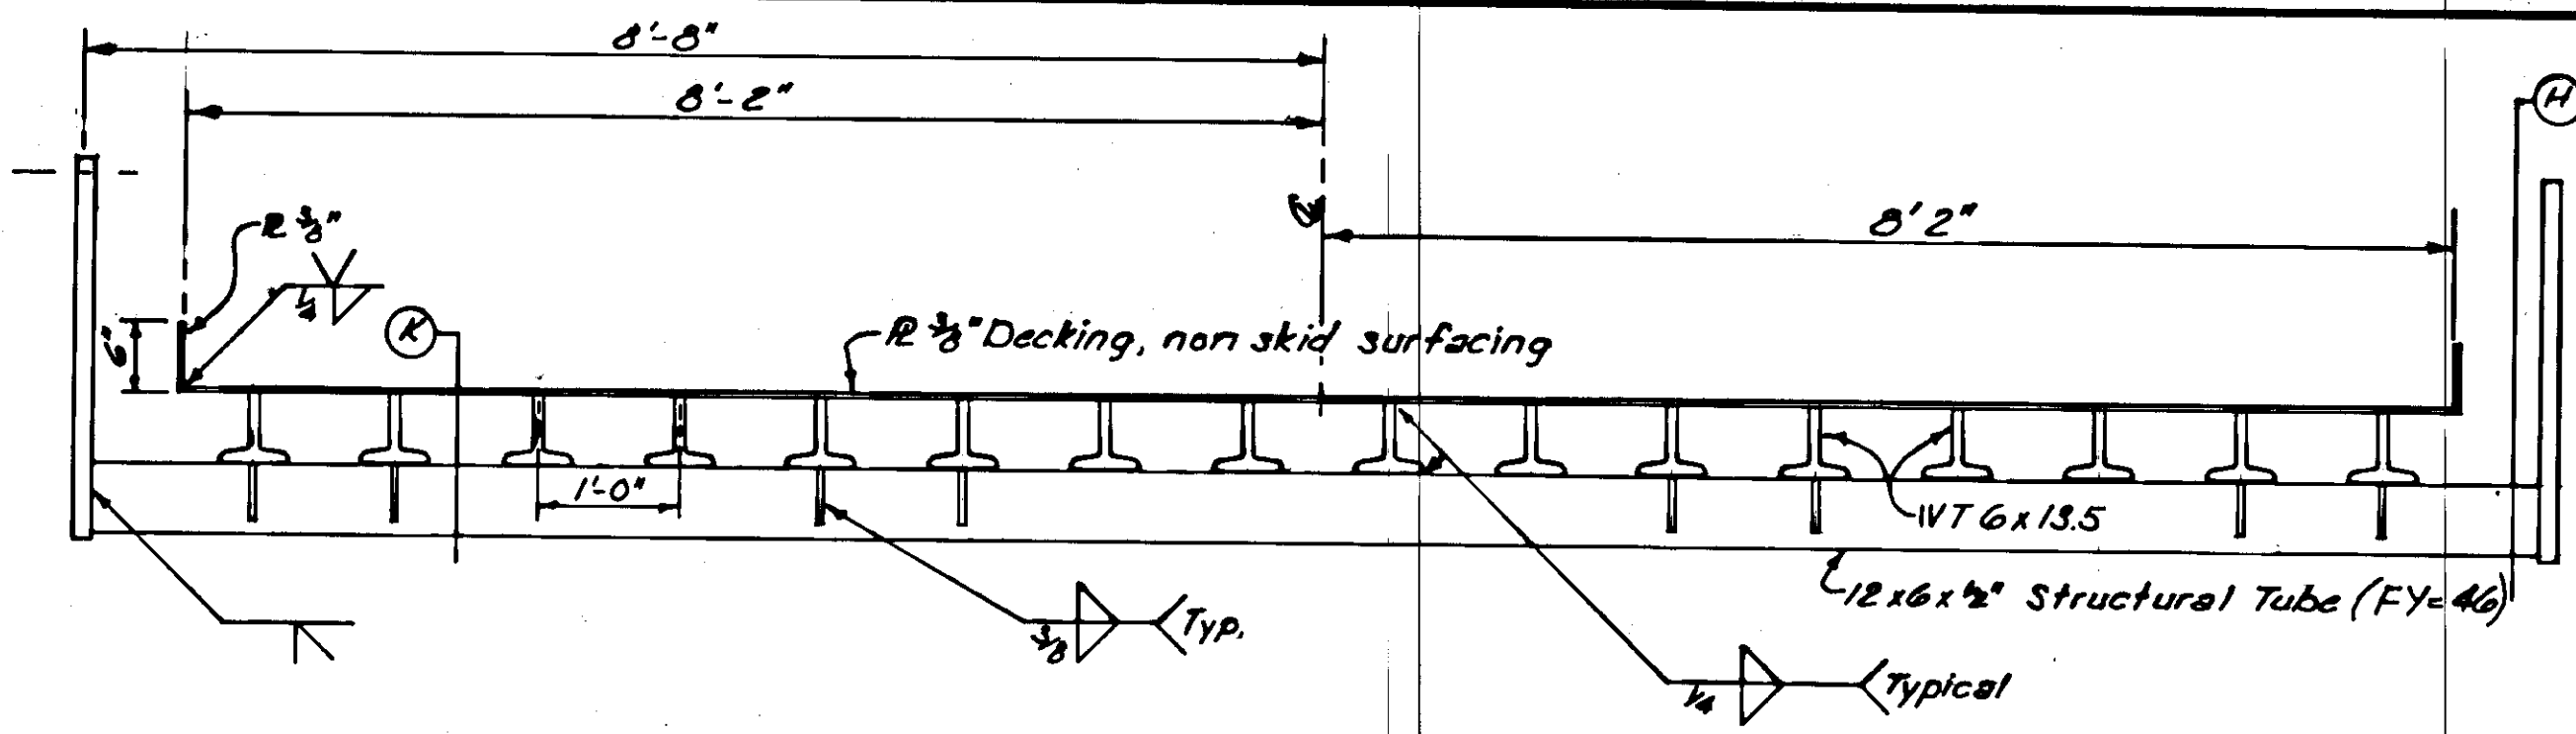


SECTION of APRON D-D  
SCALE IN FEET

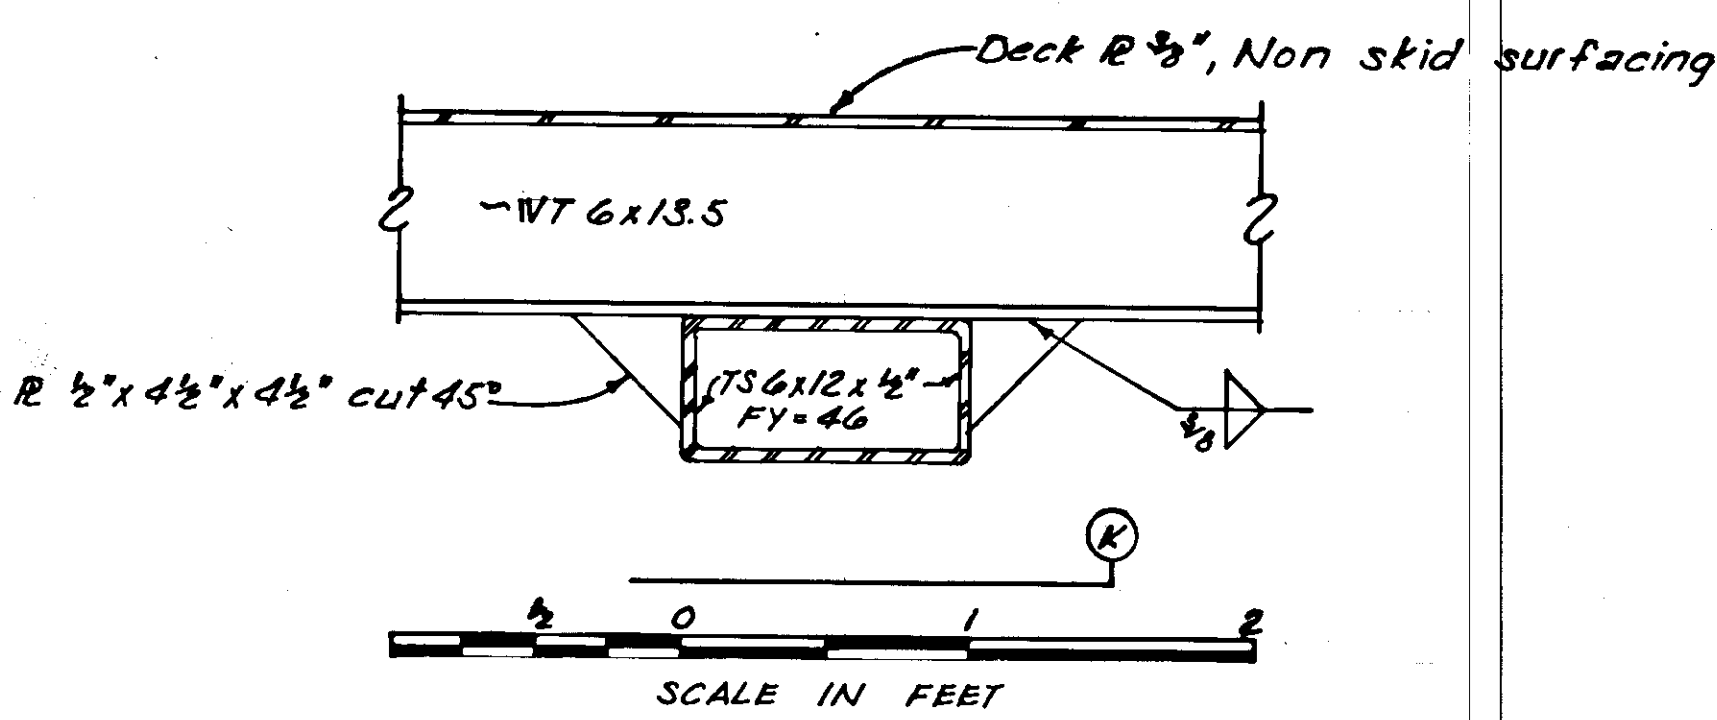



SCALE IN FEET

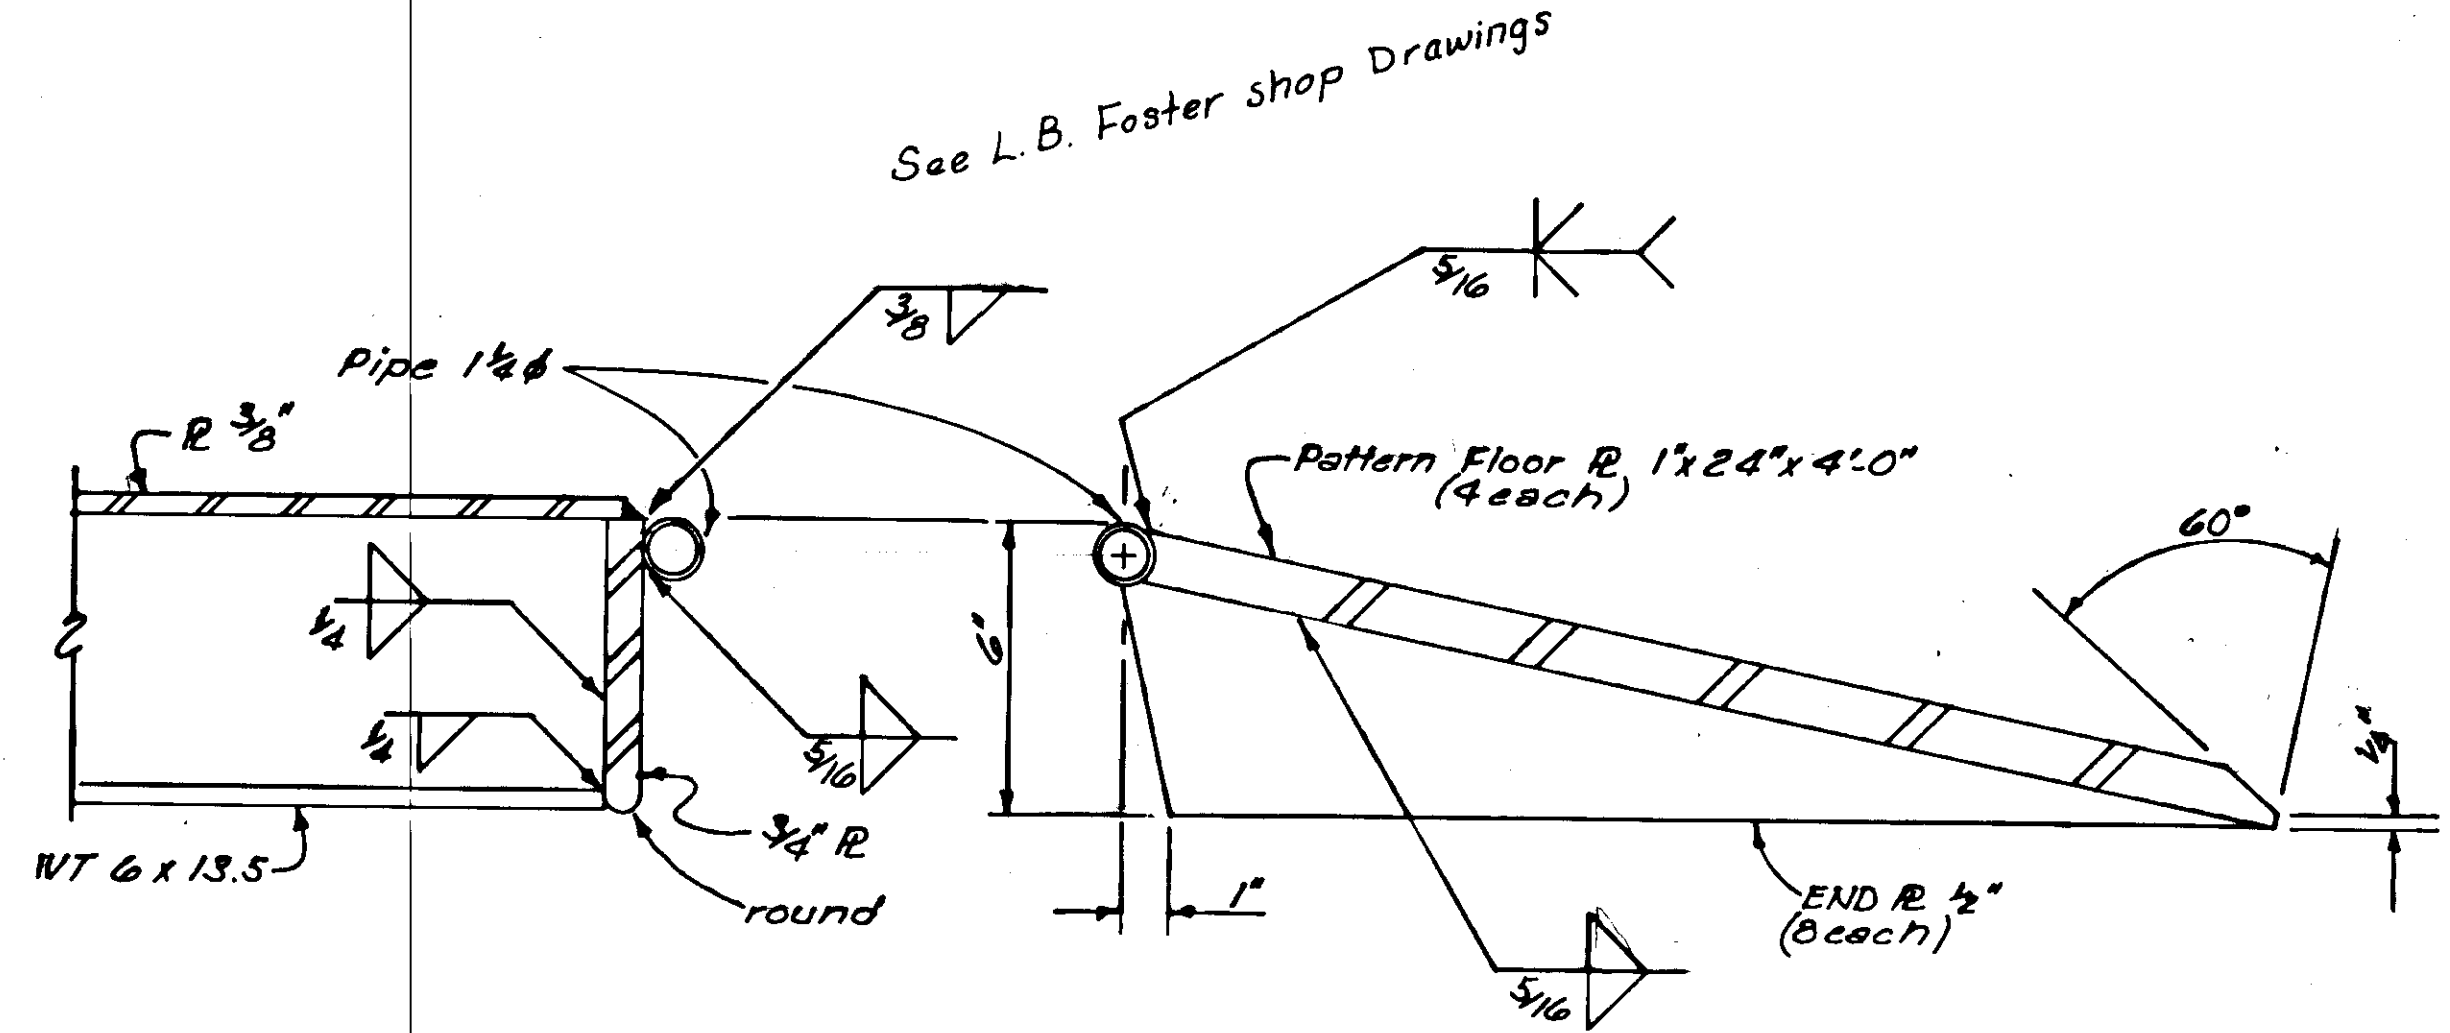


SECTION E-E  
SCALE IN FEET

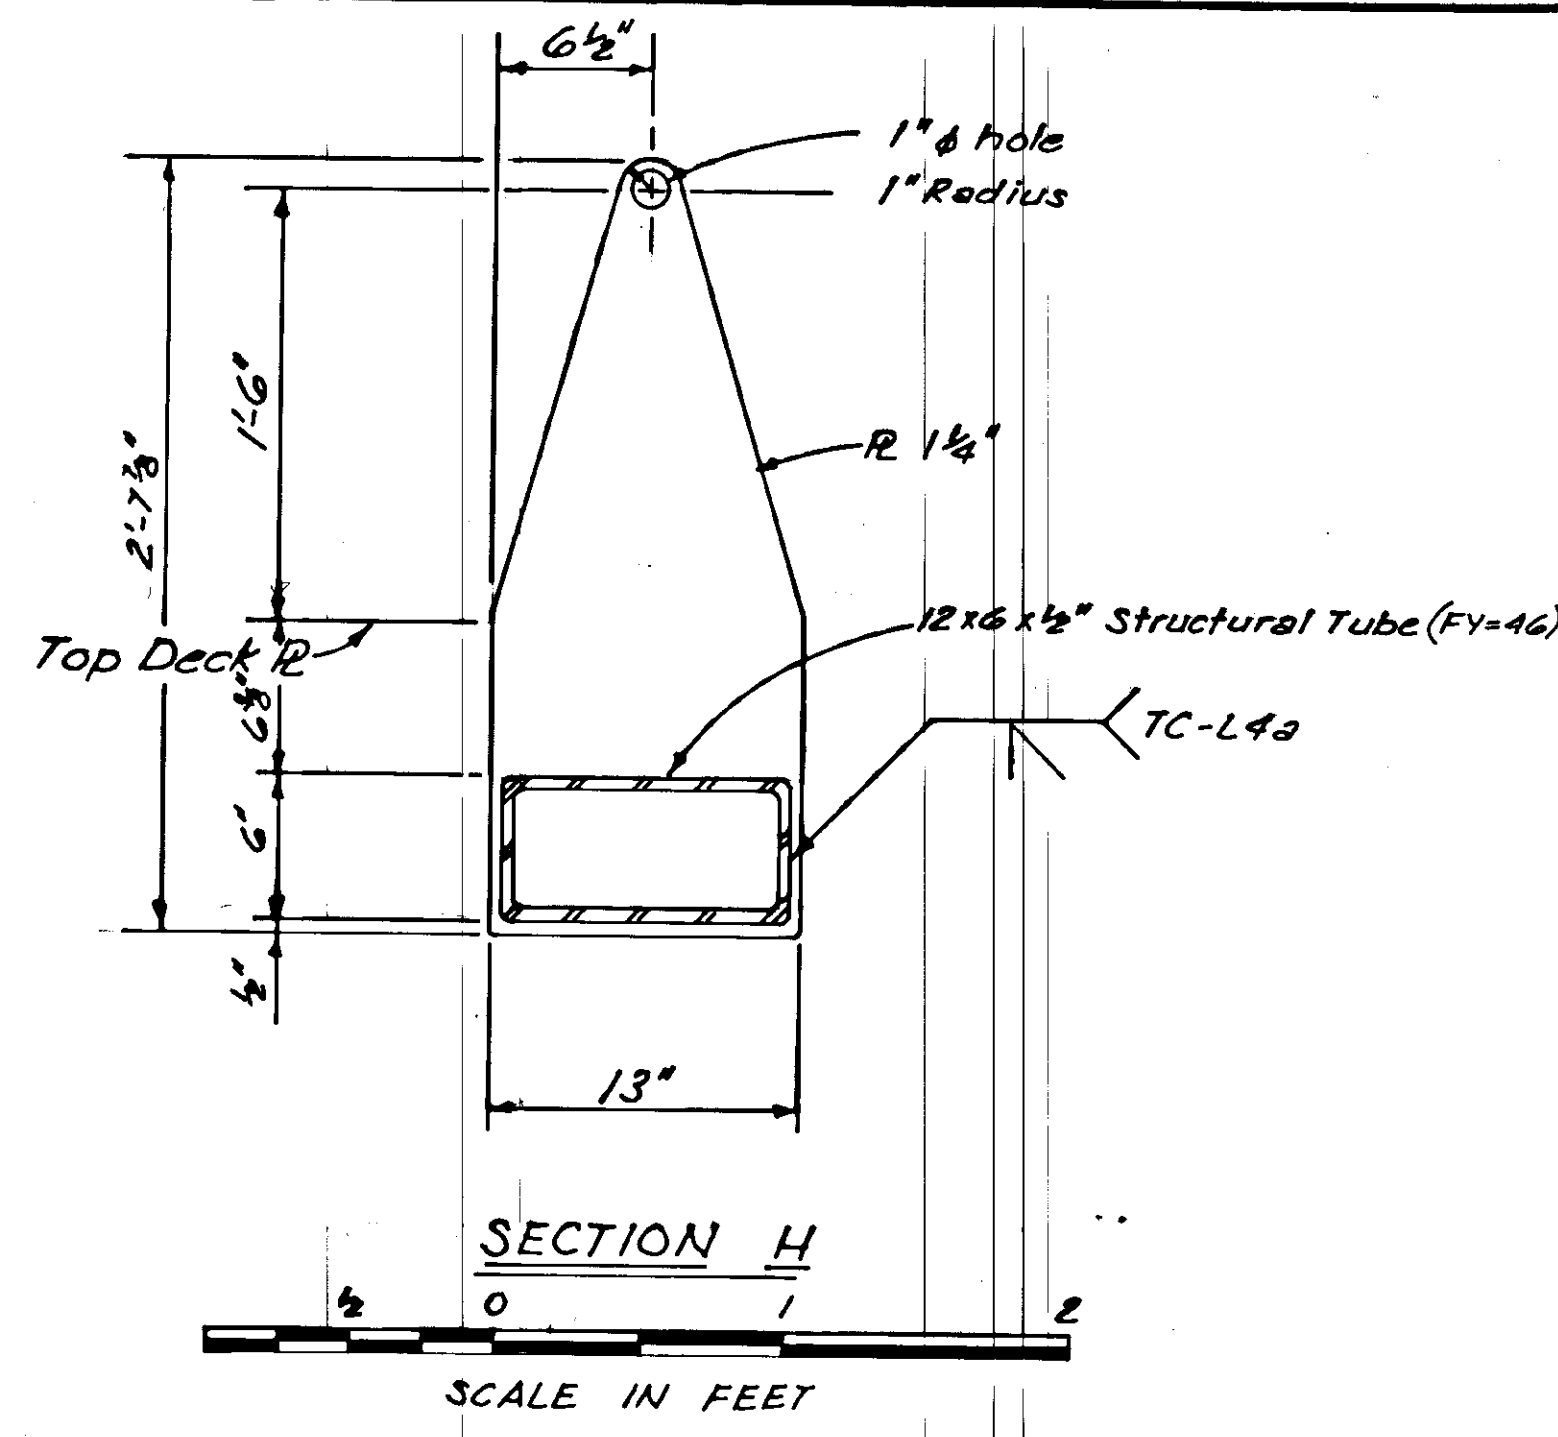


SECTION H  
SCALE IN FEET

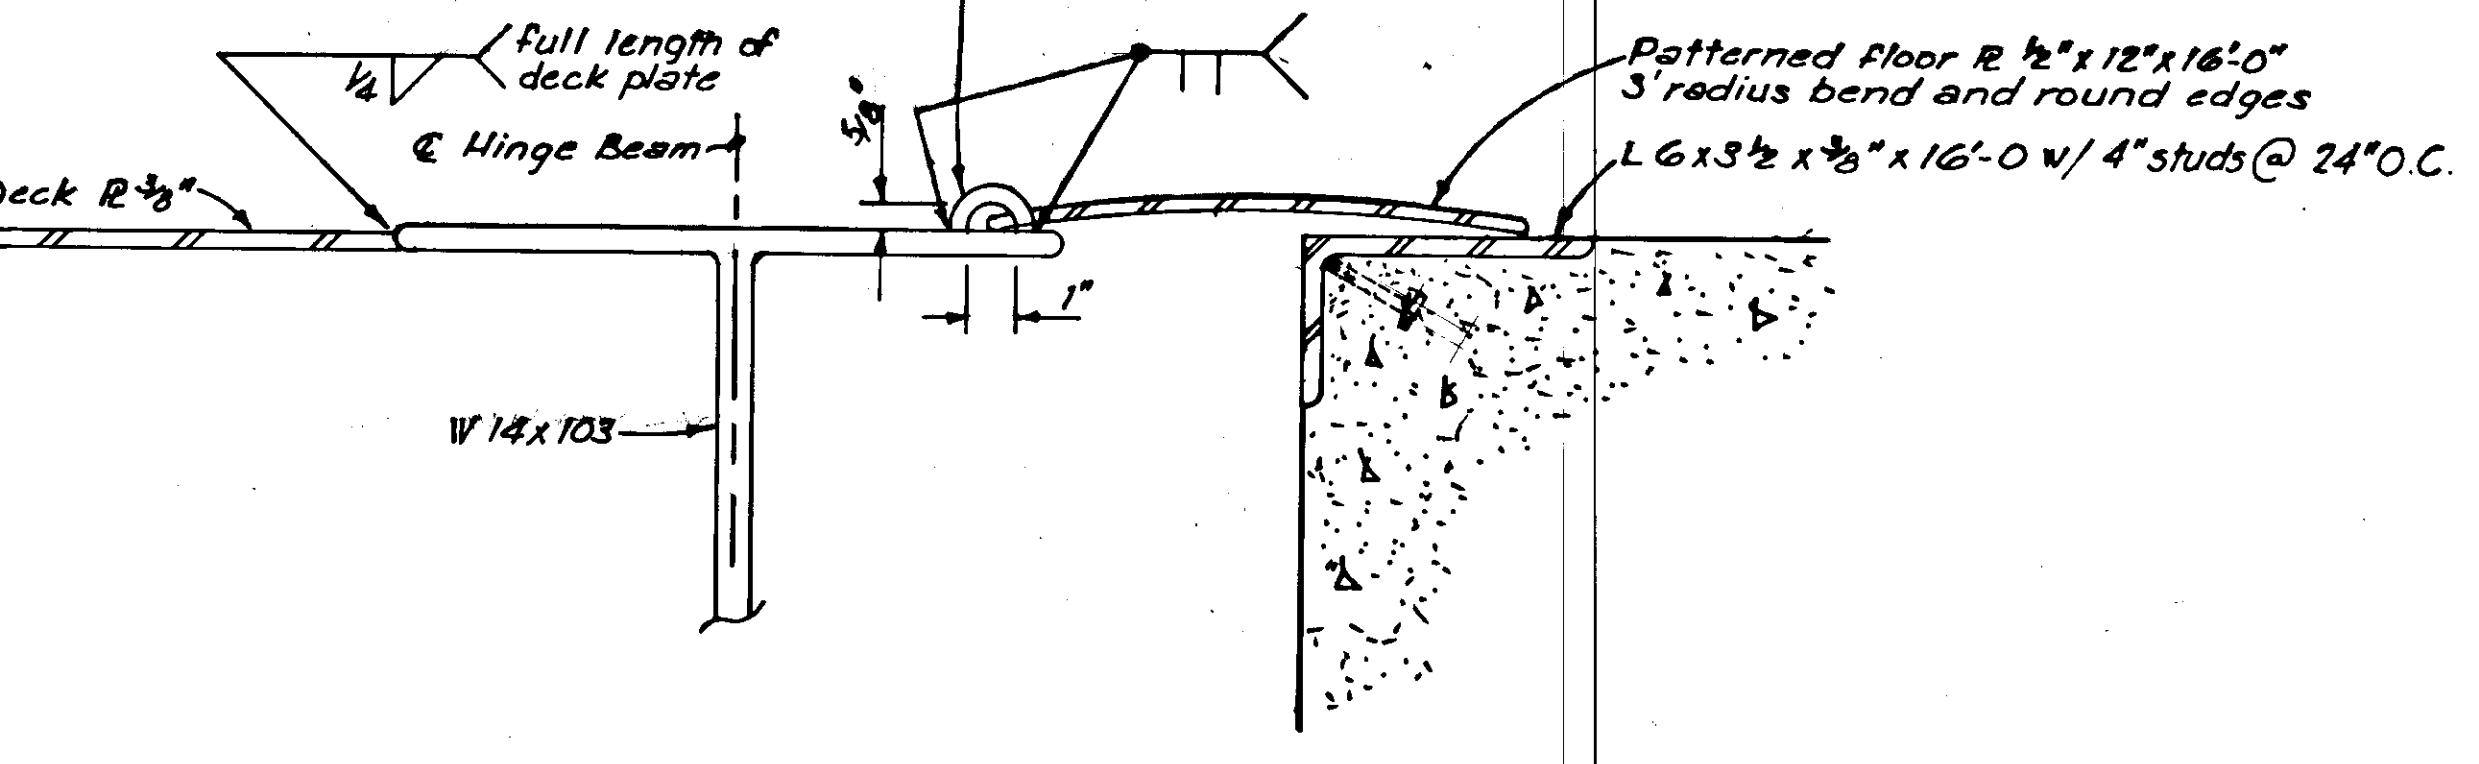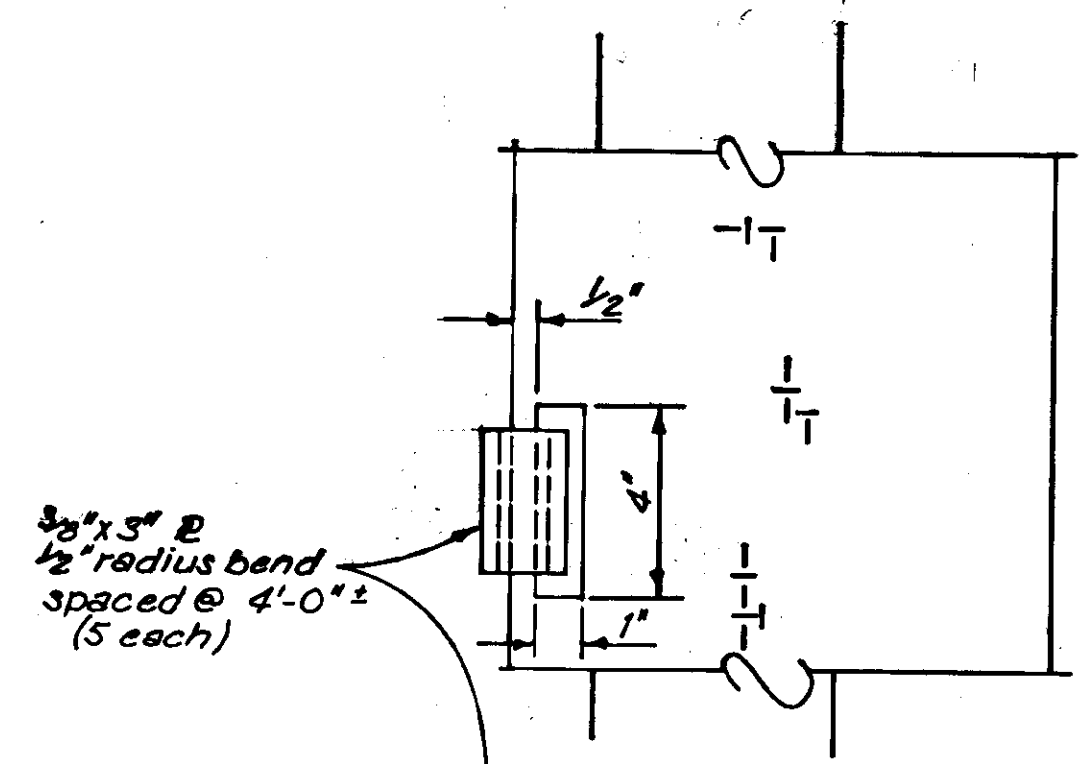







PARTIAL SECTION F-F @ COVER  
SCALE IN FEET

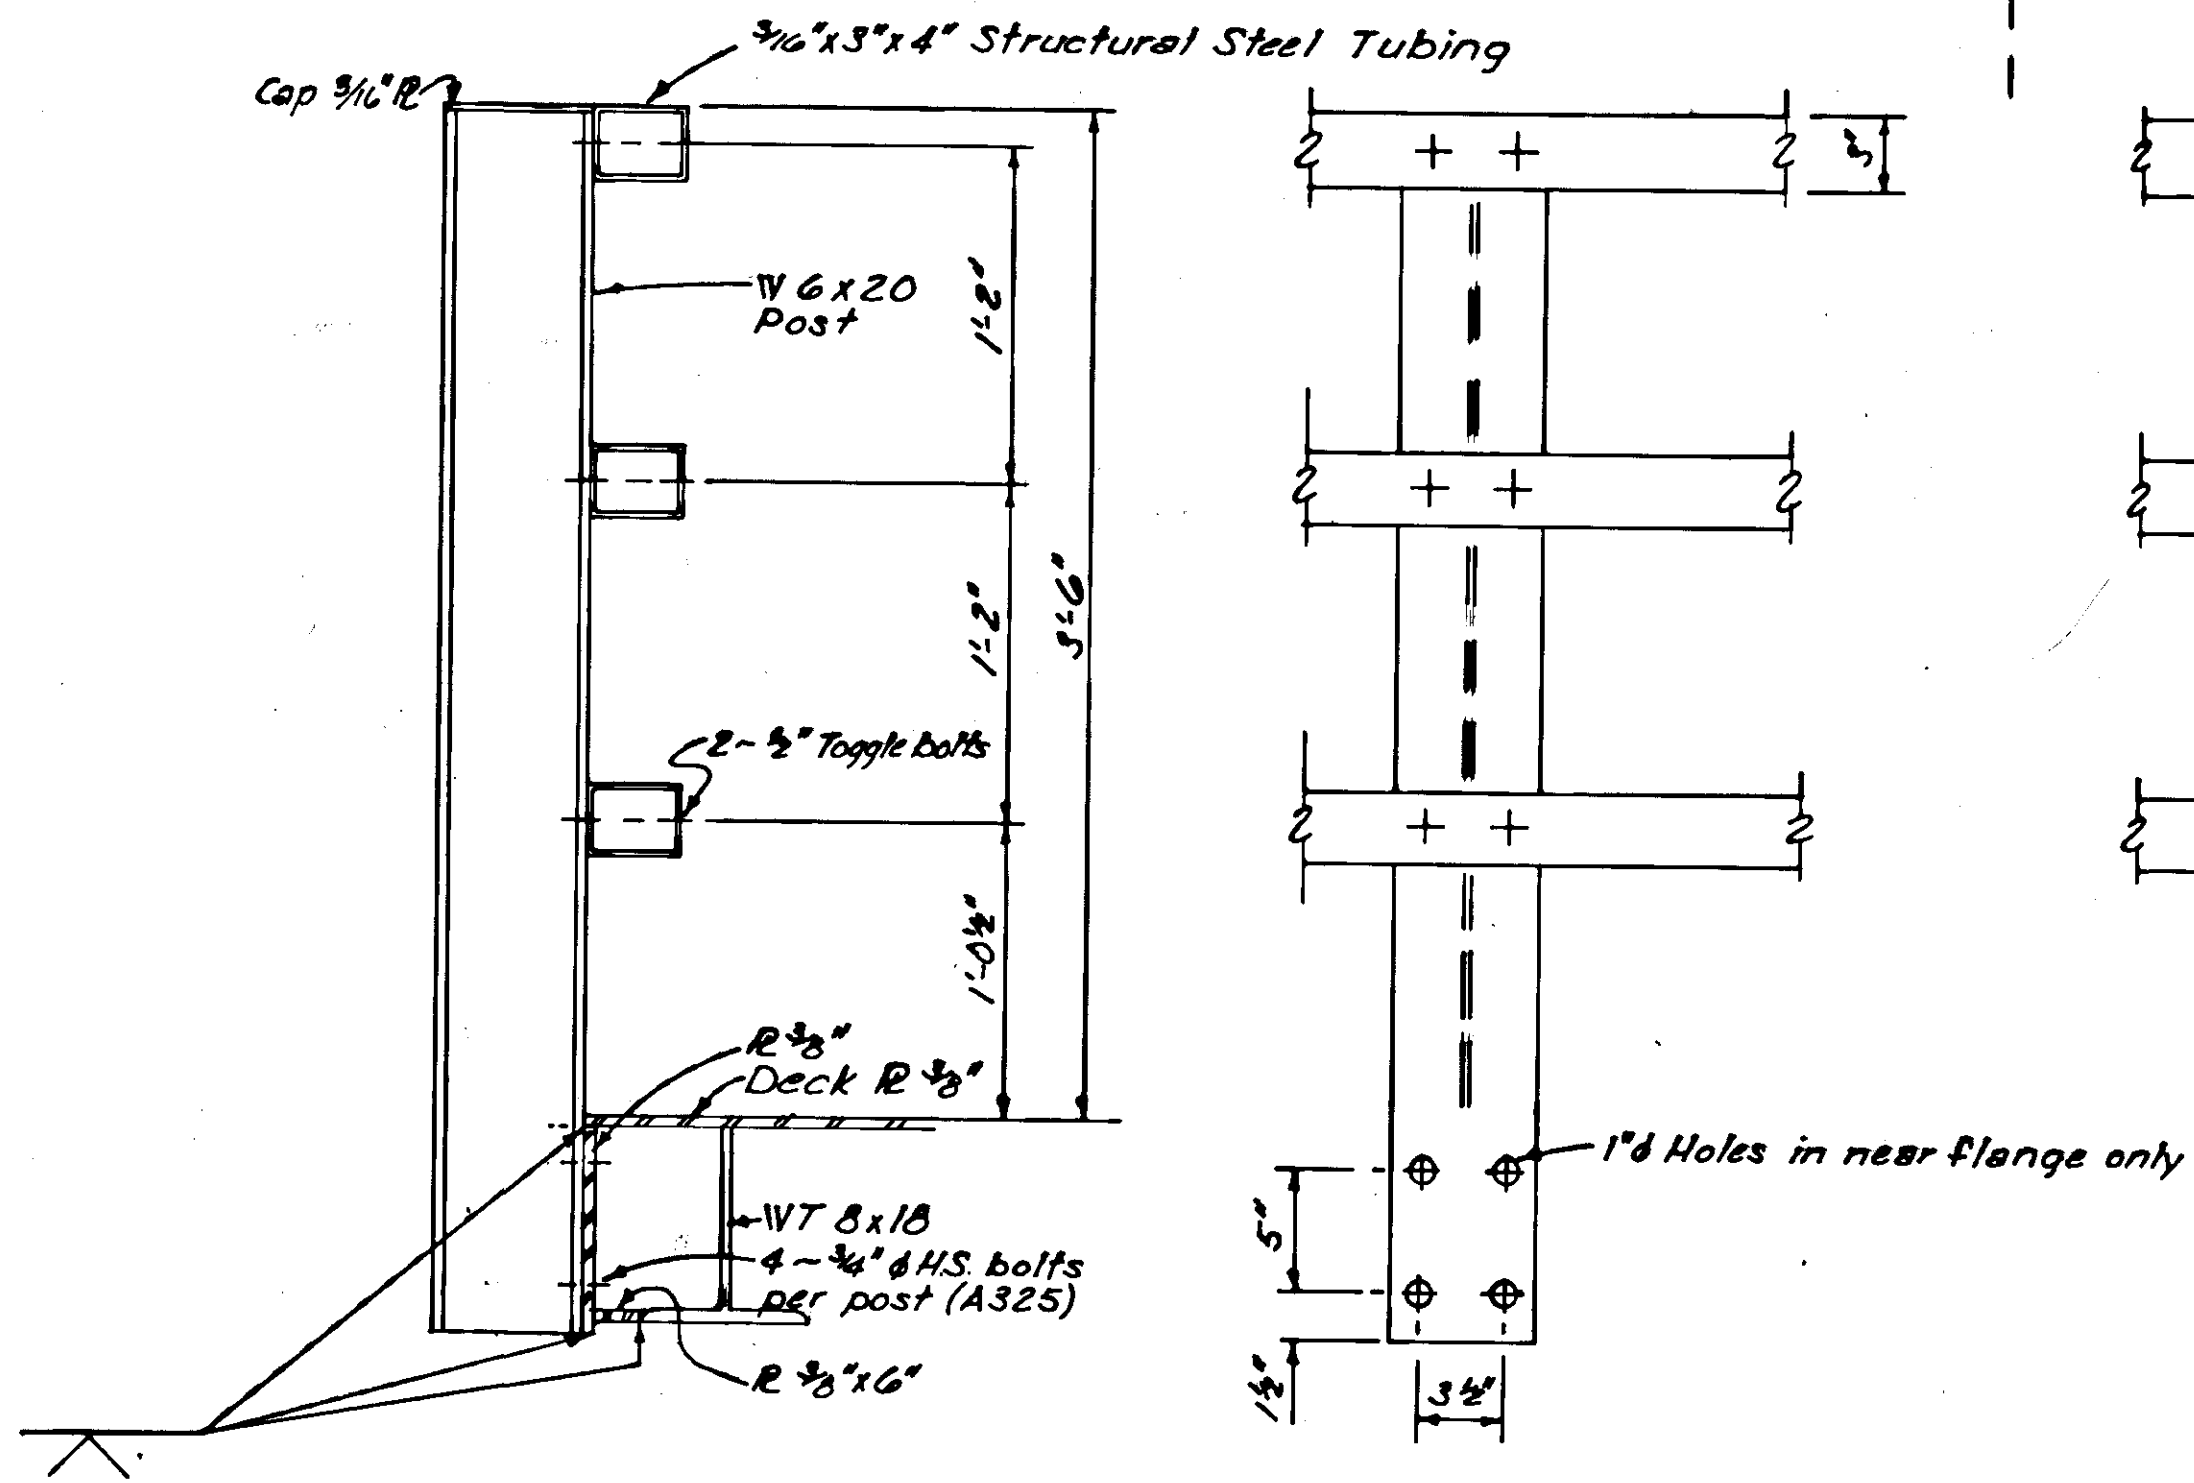

RAIL AND POST DETAILS  
SCALE IN FEET

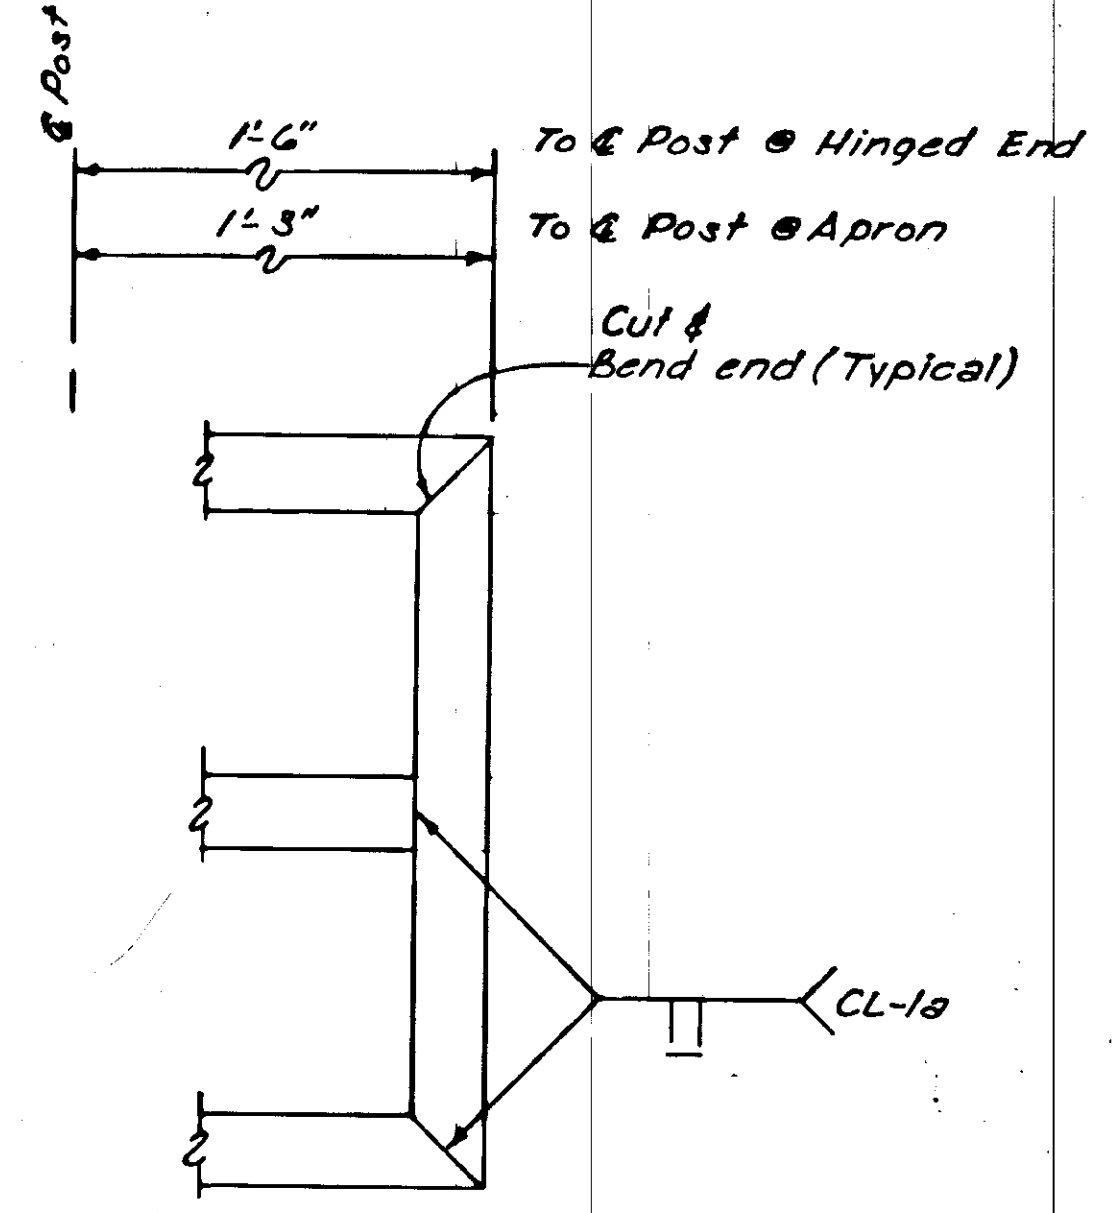

DO NOT SCALE THIS DRAWING - USE DIMENSIONS		
STATE OF ALASKA		
DIVISION OF HARBORS		
SKAGWAY FERRY TERMINAL		
APRON SECTION & DETAILS		
SCALE As Noted	SURVEYED	APPROVED
DESIGNED HM	DRAWN GRF	Don Statter
CHECKED RPB	DATE MAR. 1978	DIRECTOR
PROJECT NUMBER F 0972 (2)	SHEET 35 OF 41	

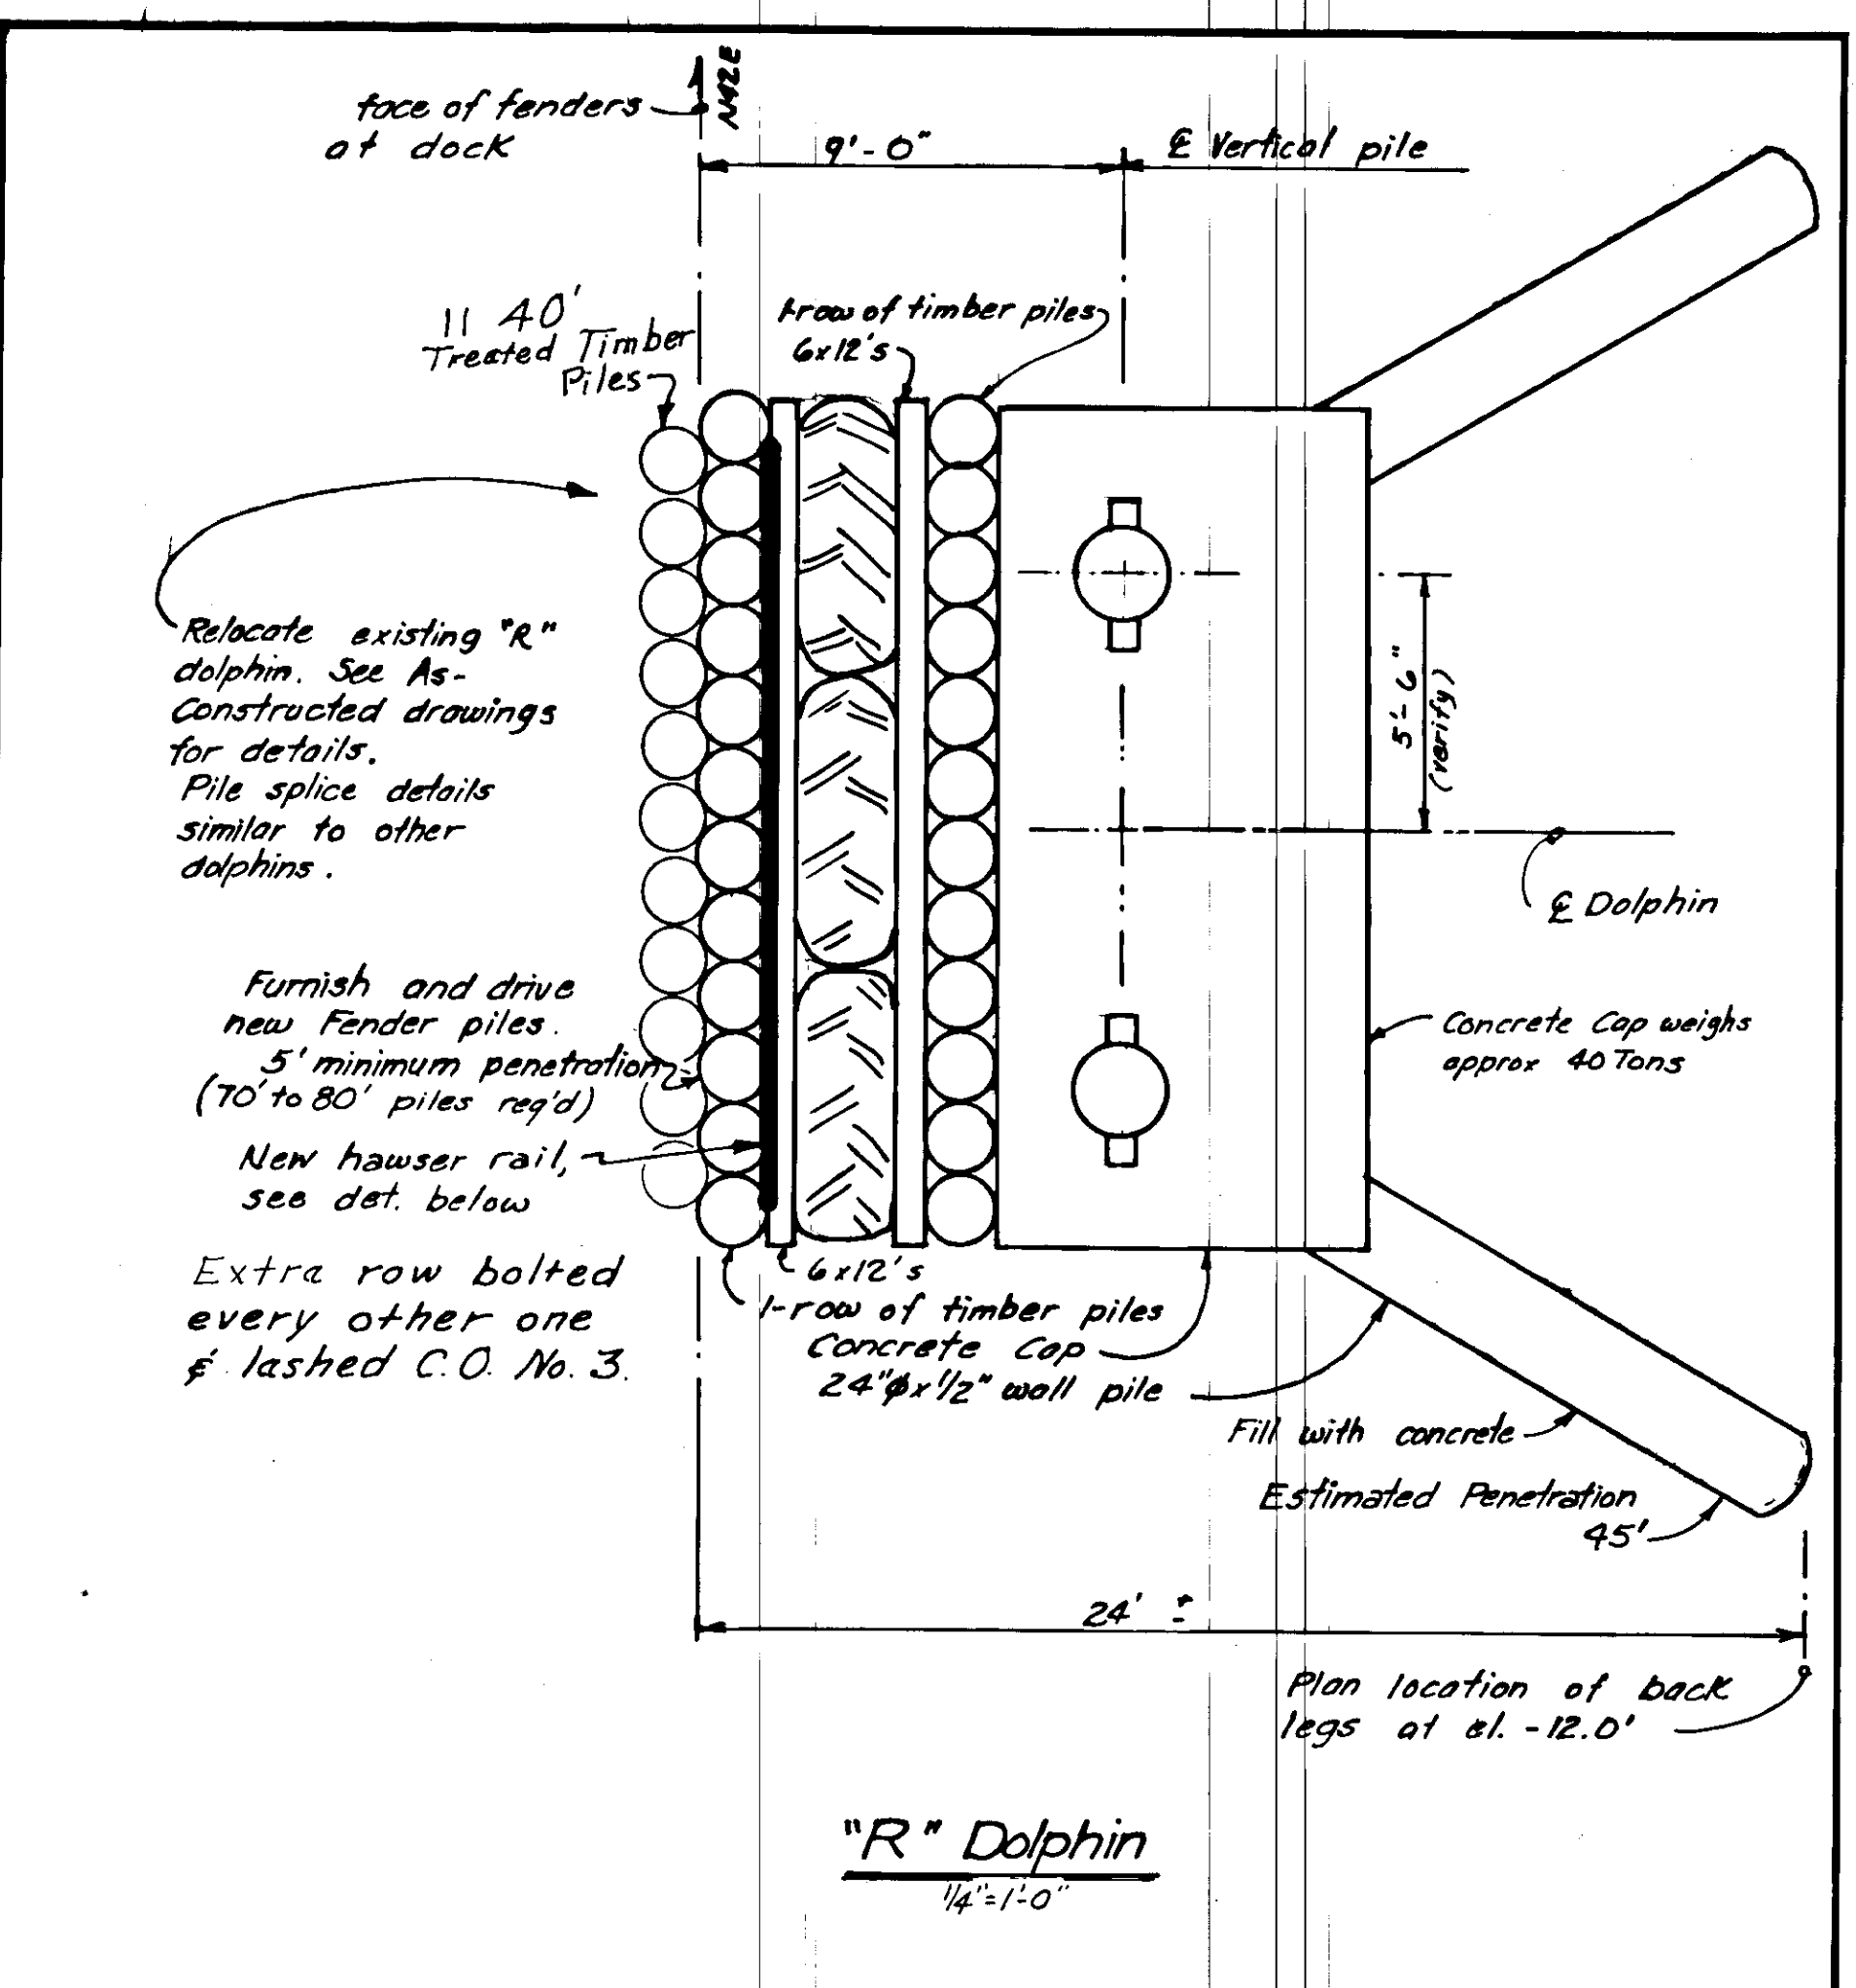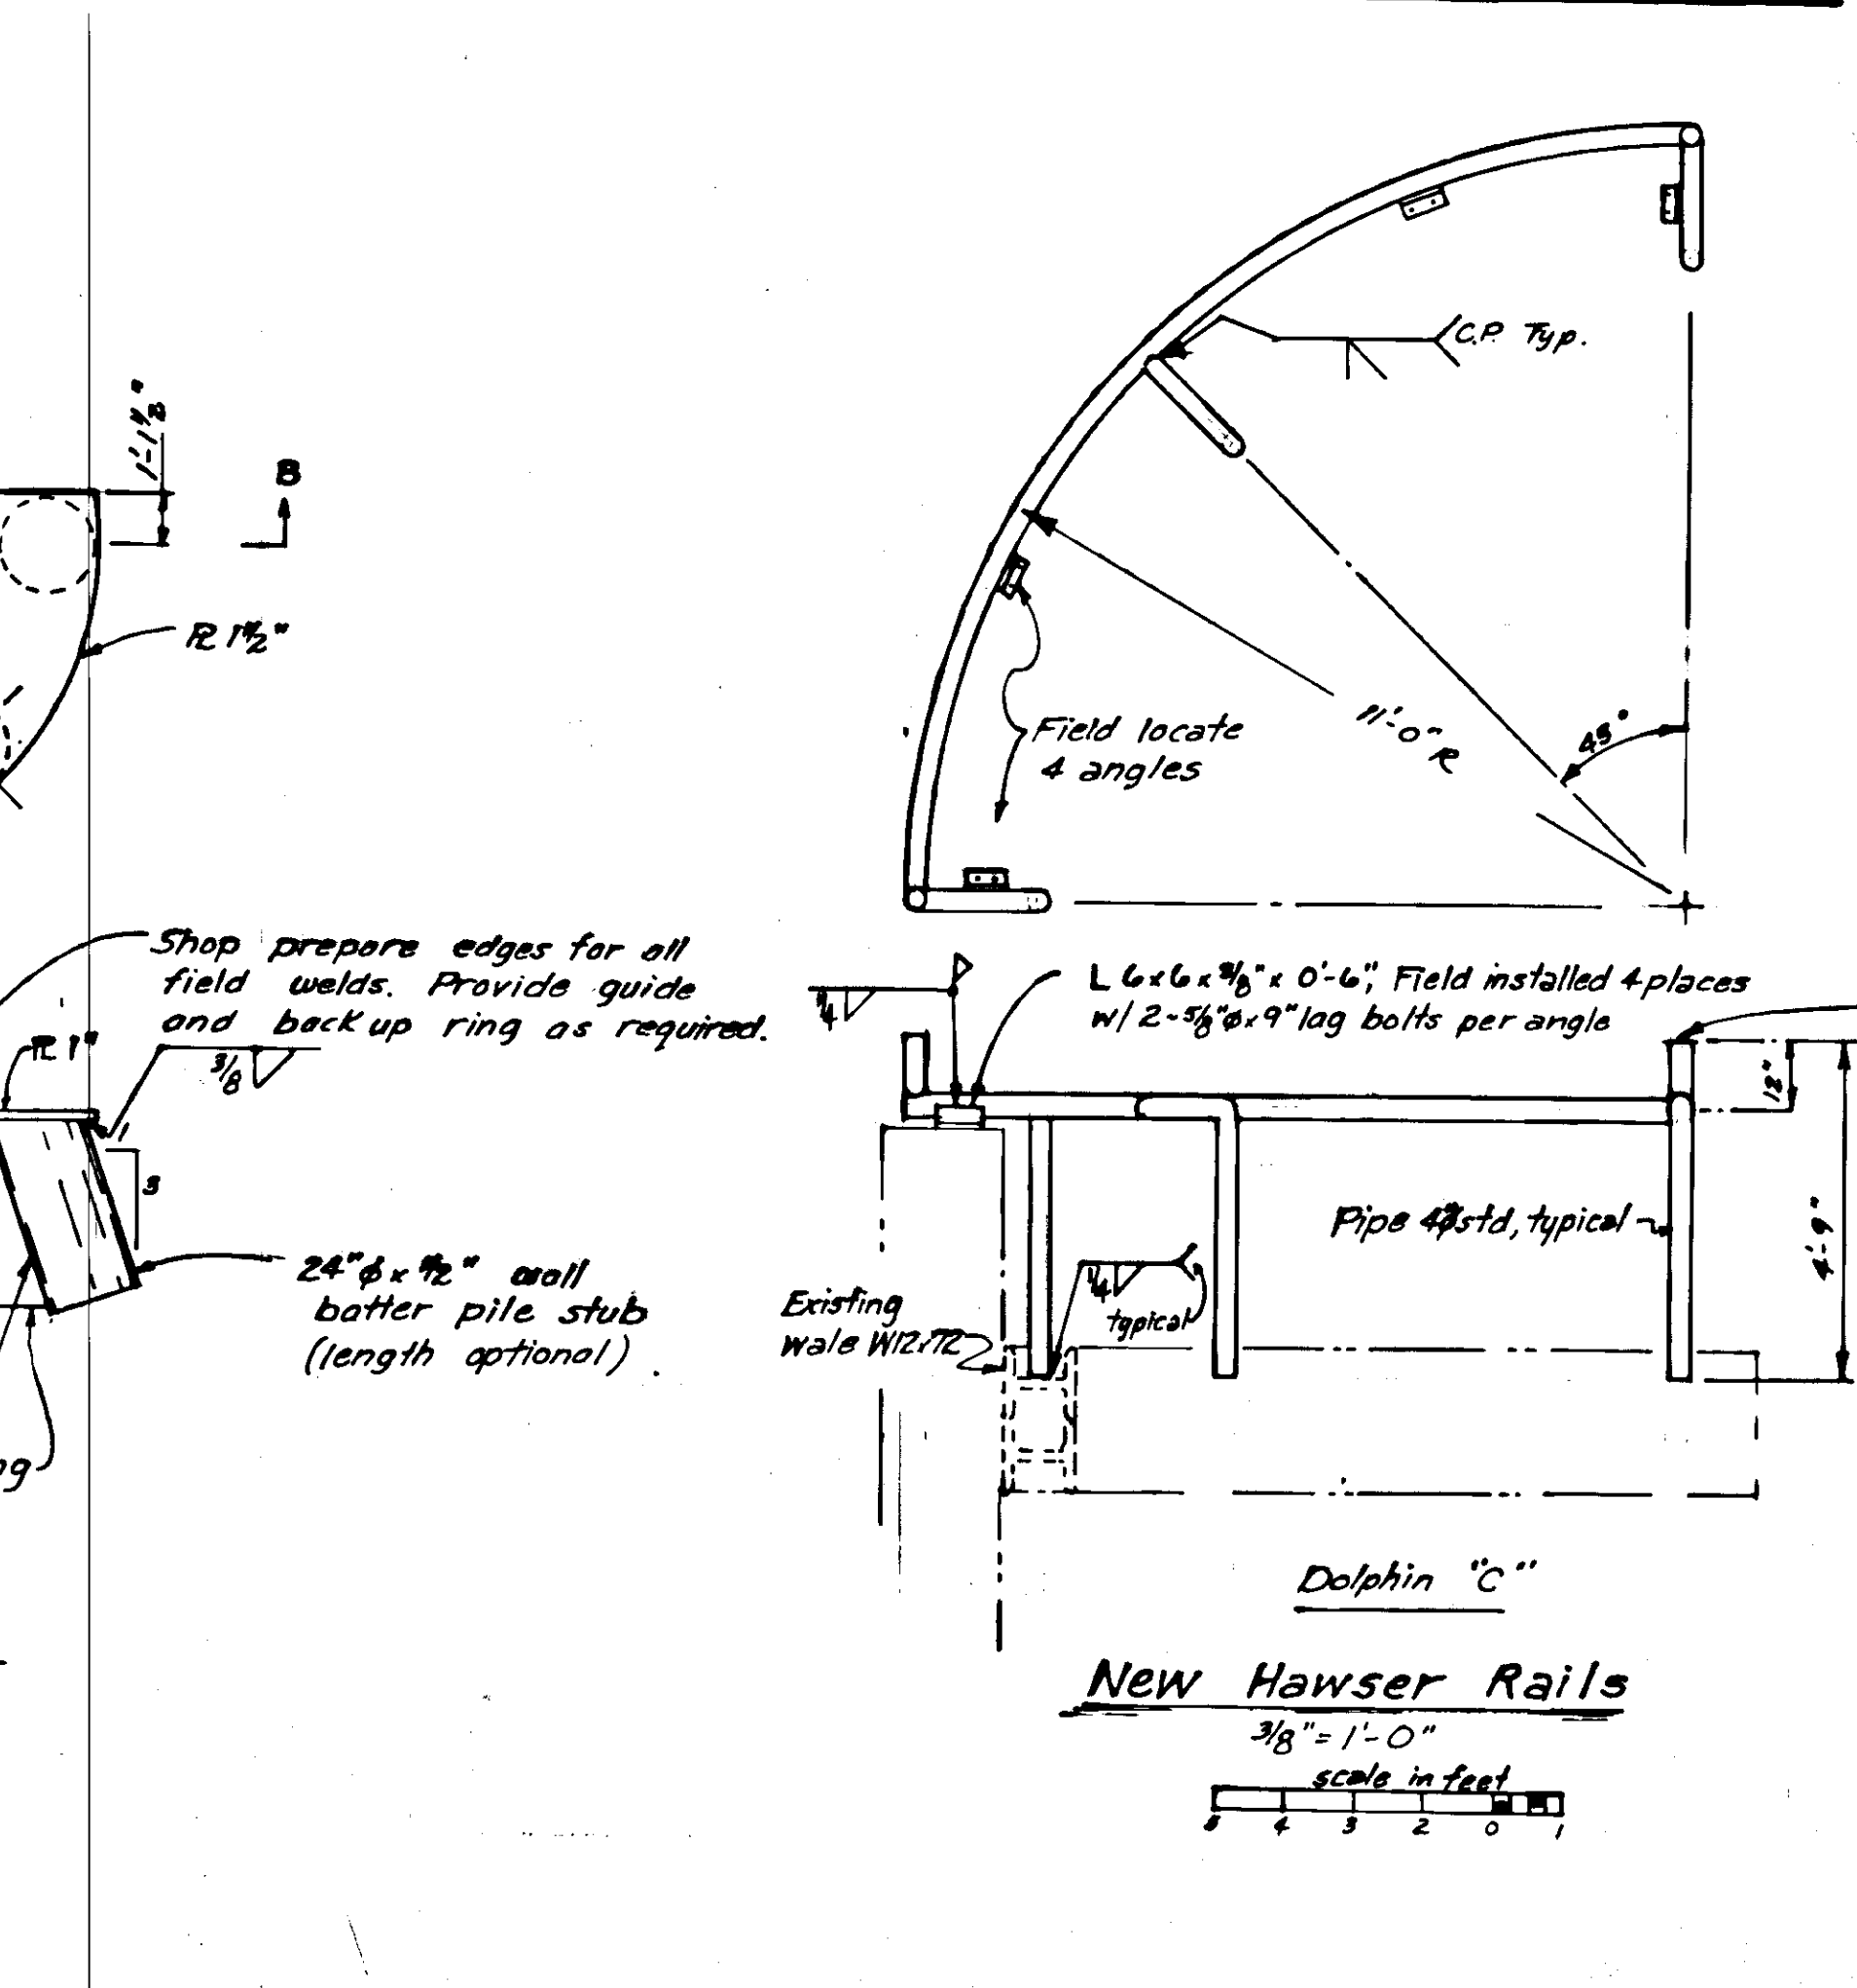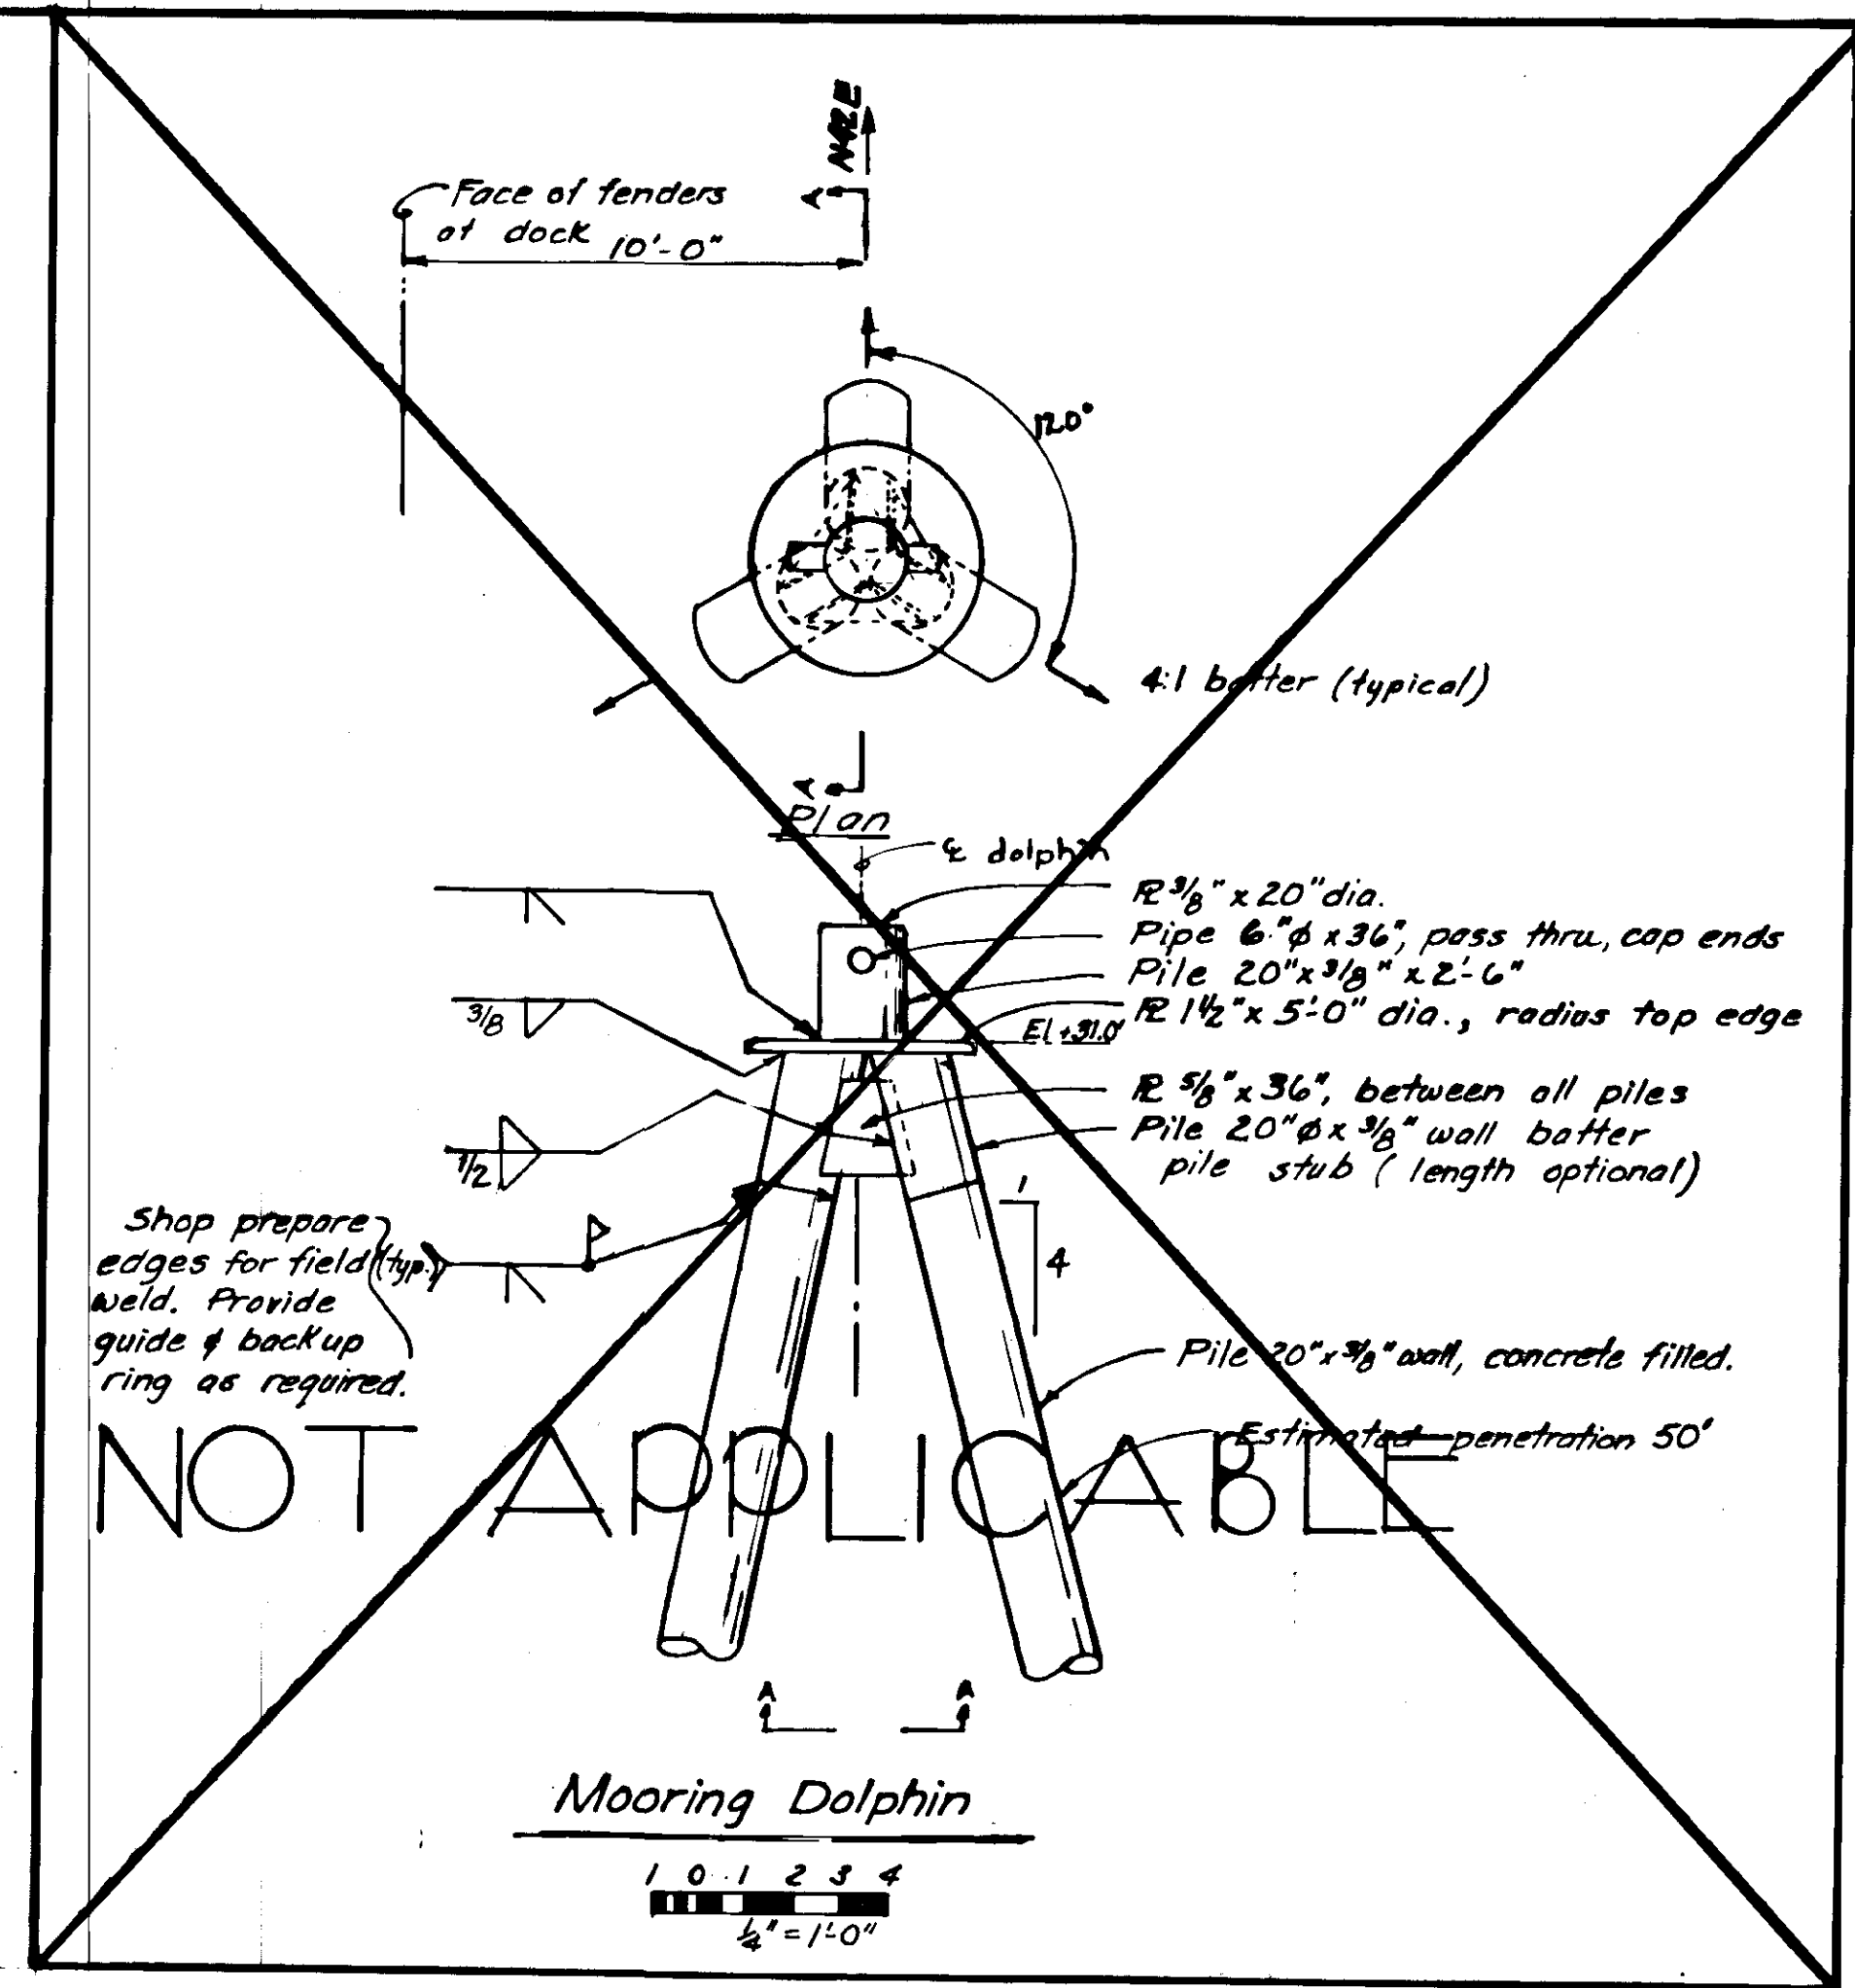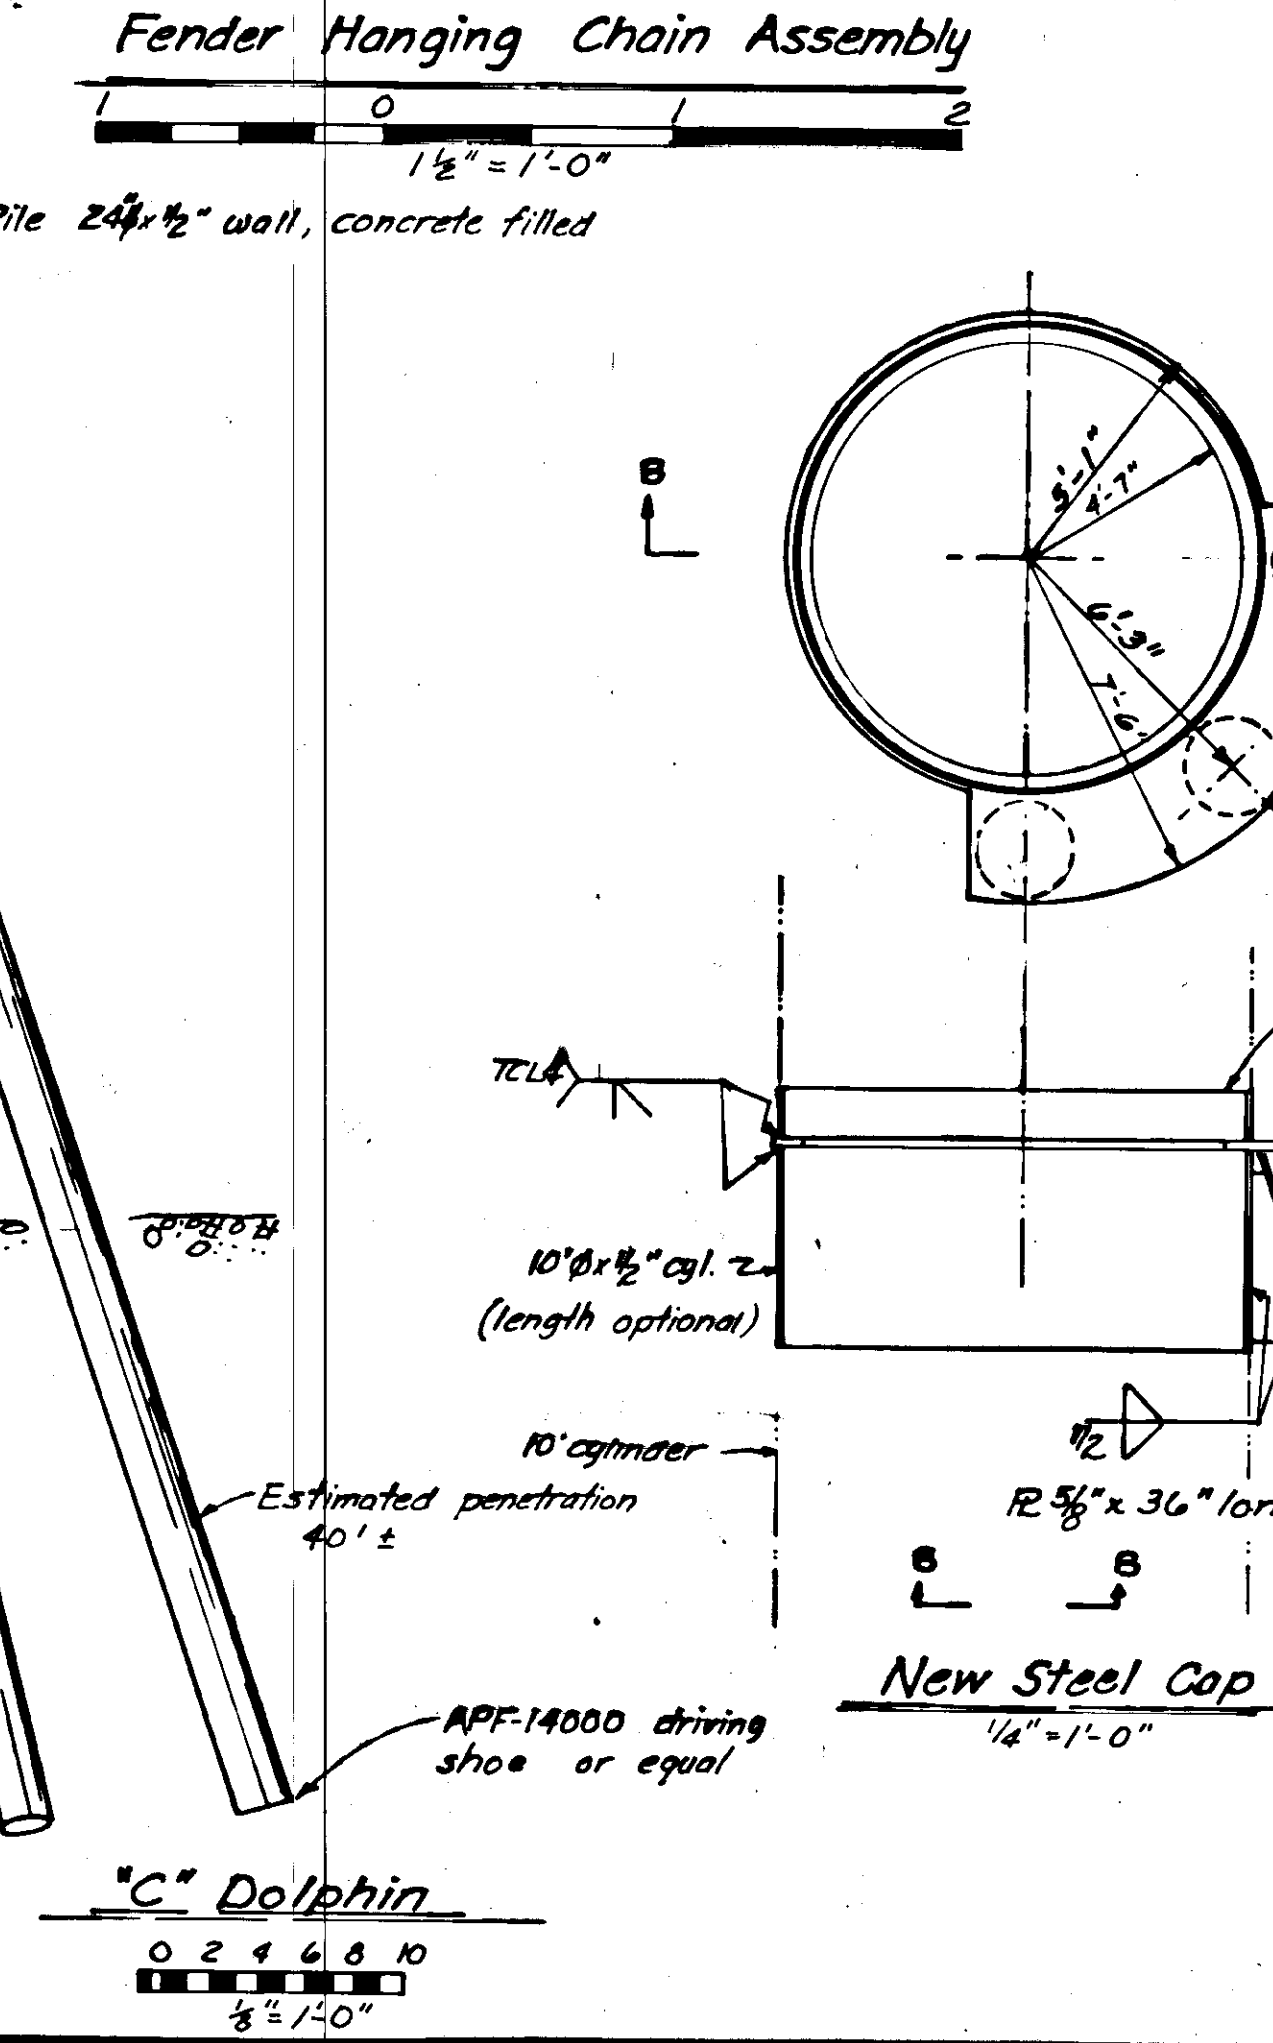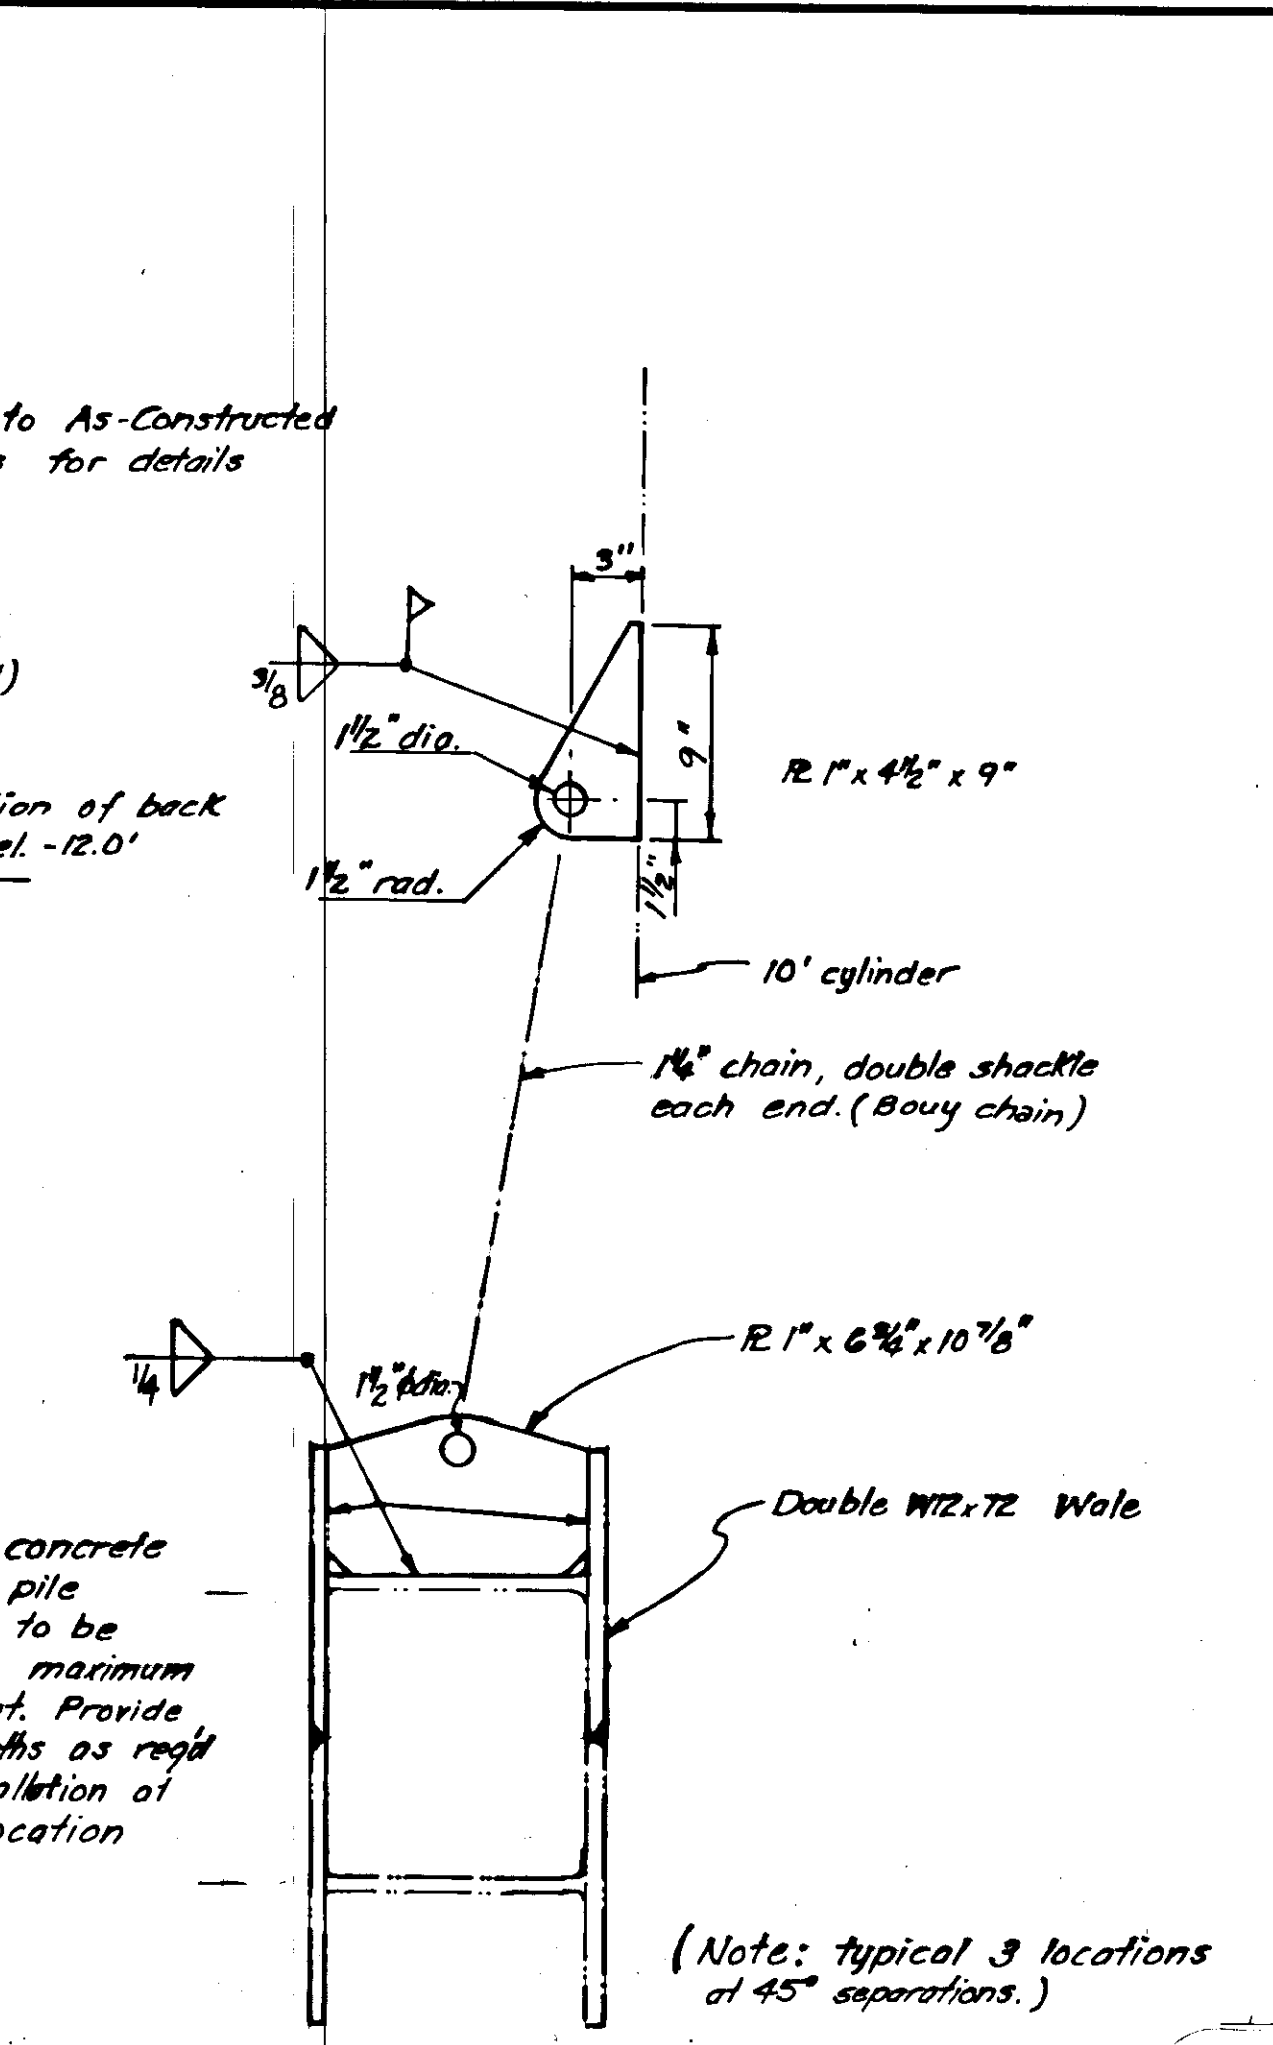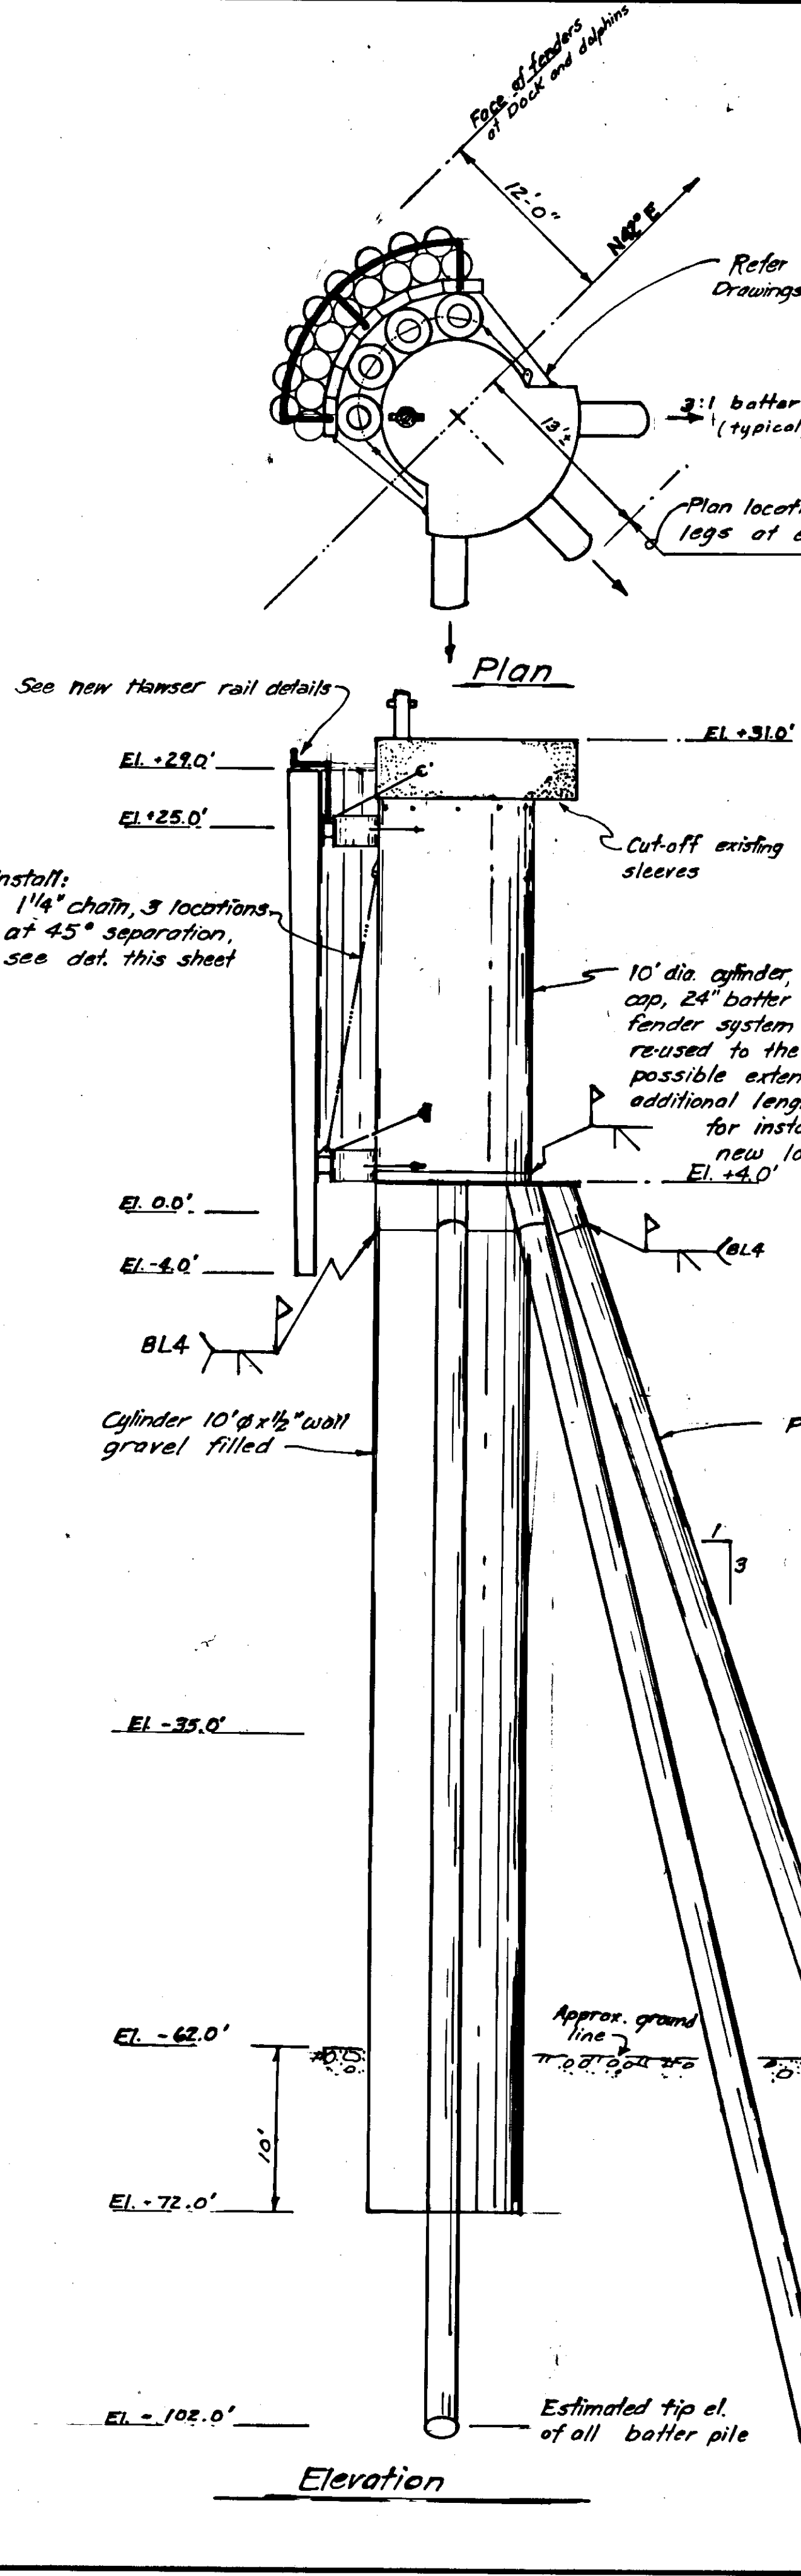

**General Notes:**

- All Piles 24" dia. or less shall be fitted with APF-14000 drive shoes or equal
- Welding of large diameter cylinder may be accomplished from inside, or prior to placement
- Welding size based on E70XX electrodes
- Alternate field splice methods may be submitted for approval.
- Dolphins "C" and "R" are Relocated and modified as indicated on this sheet. Construction shall be as indicated on Respective As-Constructed Drawings
- All batter pile shall be driven thru a template to insure good fit-up, and pile alignment as designed.
- All pile splice field welds NDT test per schedule in specs.

**Design Data:**

Dolphin "C"	Dolphin "R"
Kinetic Energy : 60 ft-Kips	30 ft Kips
Dolphin Reaction : 100 Kips	100 Kips
Ballard Load : 30 Kips	30 Kips
Vertical Pile Loads : 370 tons	110 tons
Batter Pile Loads : 150 tons	180 tons

Material Stress  $f_y = 36$  ksi  
 $f_c = 3000$  psi








DO NOT SCALE THIS DRAWING - USE DIMENSIONS

STATE OF ALASKA  
DIVISION OF HARBORS

Skogway Ferry Terminal Skogway Alaska

**Dolphin "C" & "R" Details**


SCALE As Noted	SURVEYED	APPROVED
DESIGNED HM, RE	DRAWN LM	Don Stoffer
CHECKED	DATE 2-17-78	DIRECTOR
PROJECT NUMBER F-0972(2)	SHEET 36 OF 41	

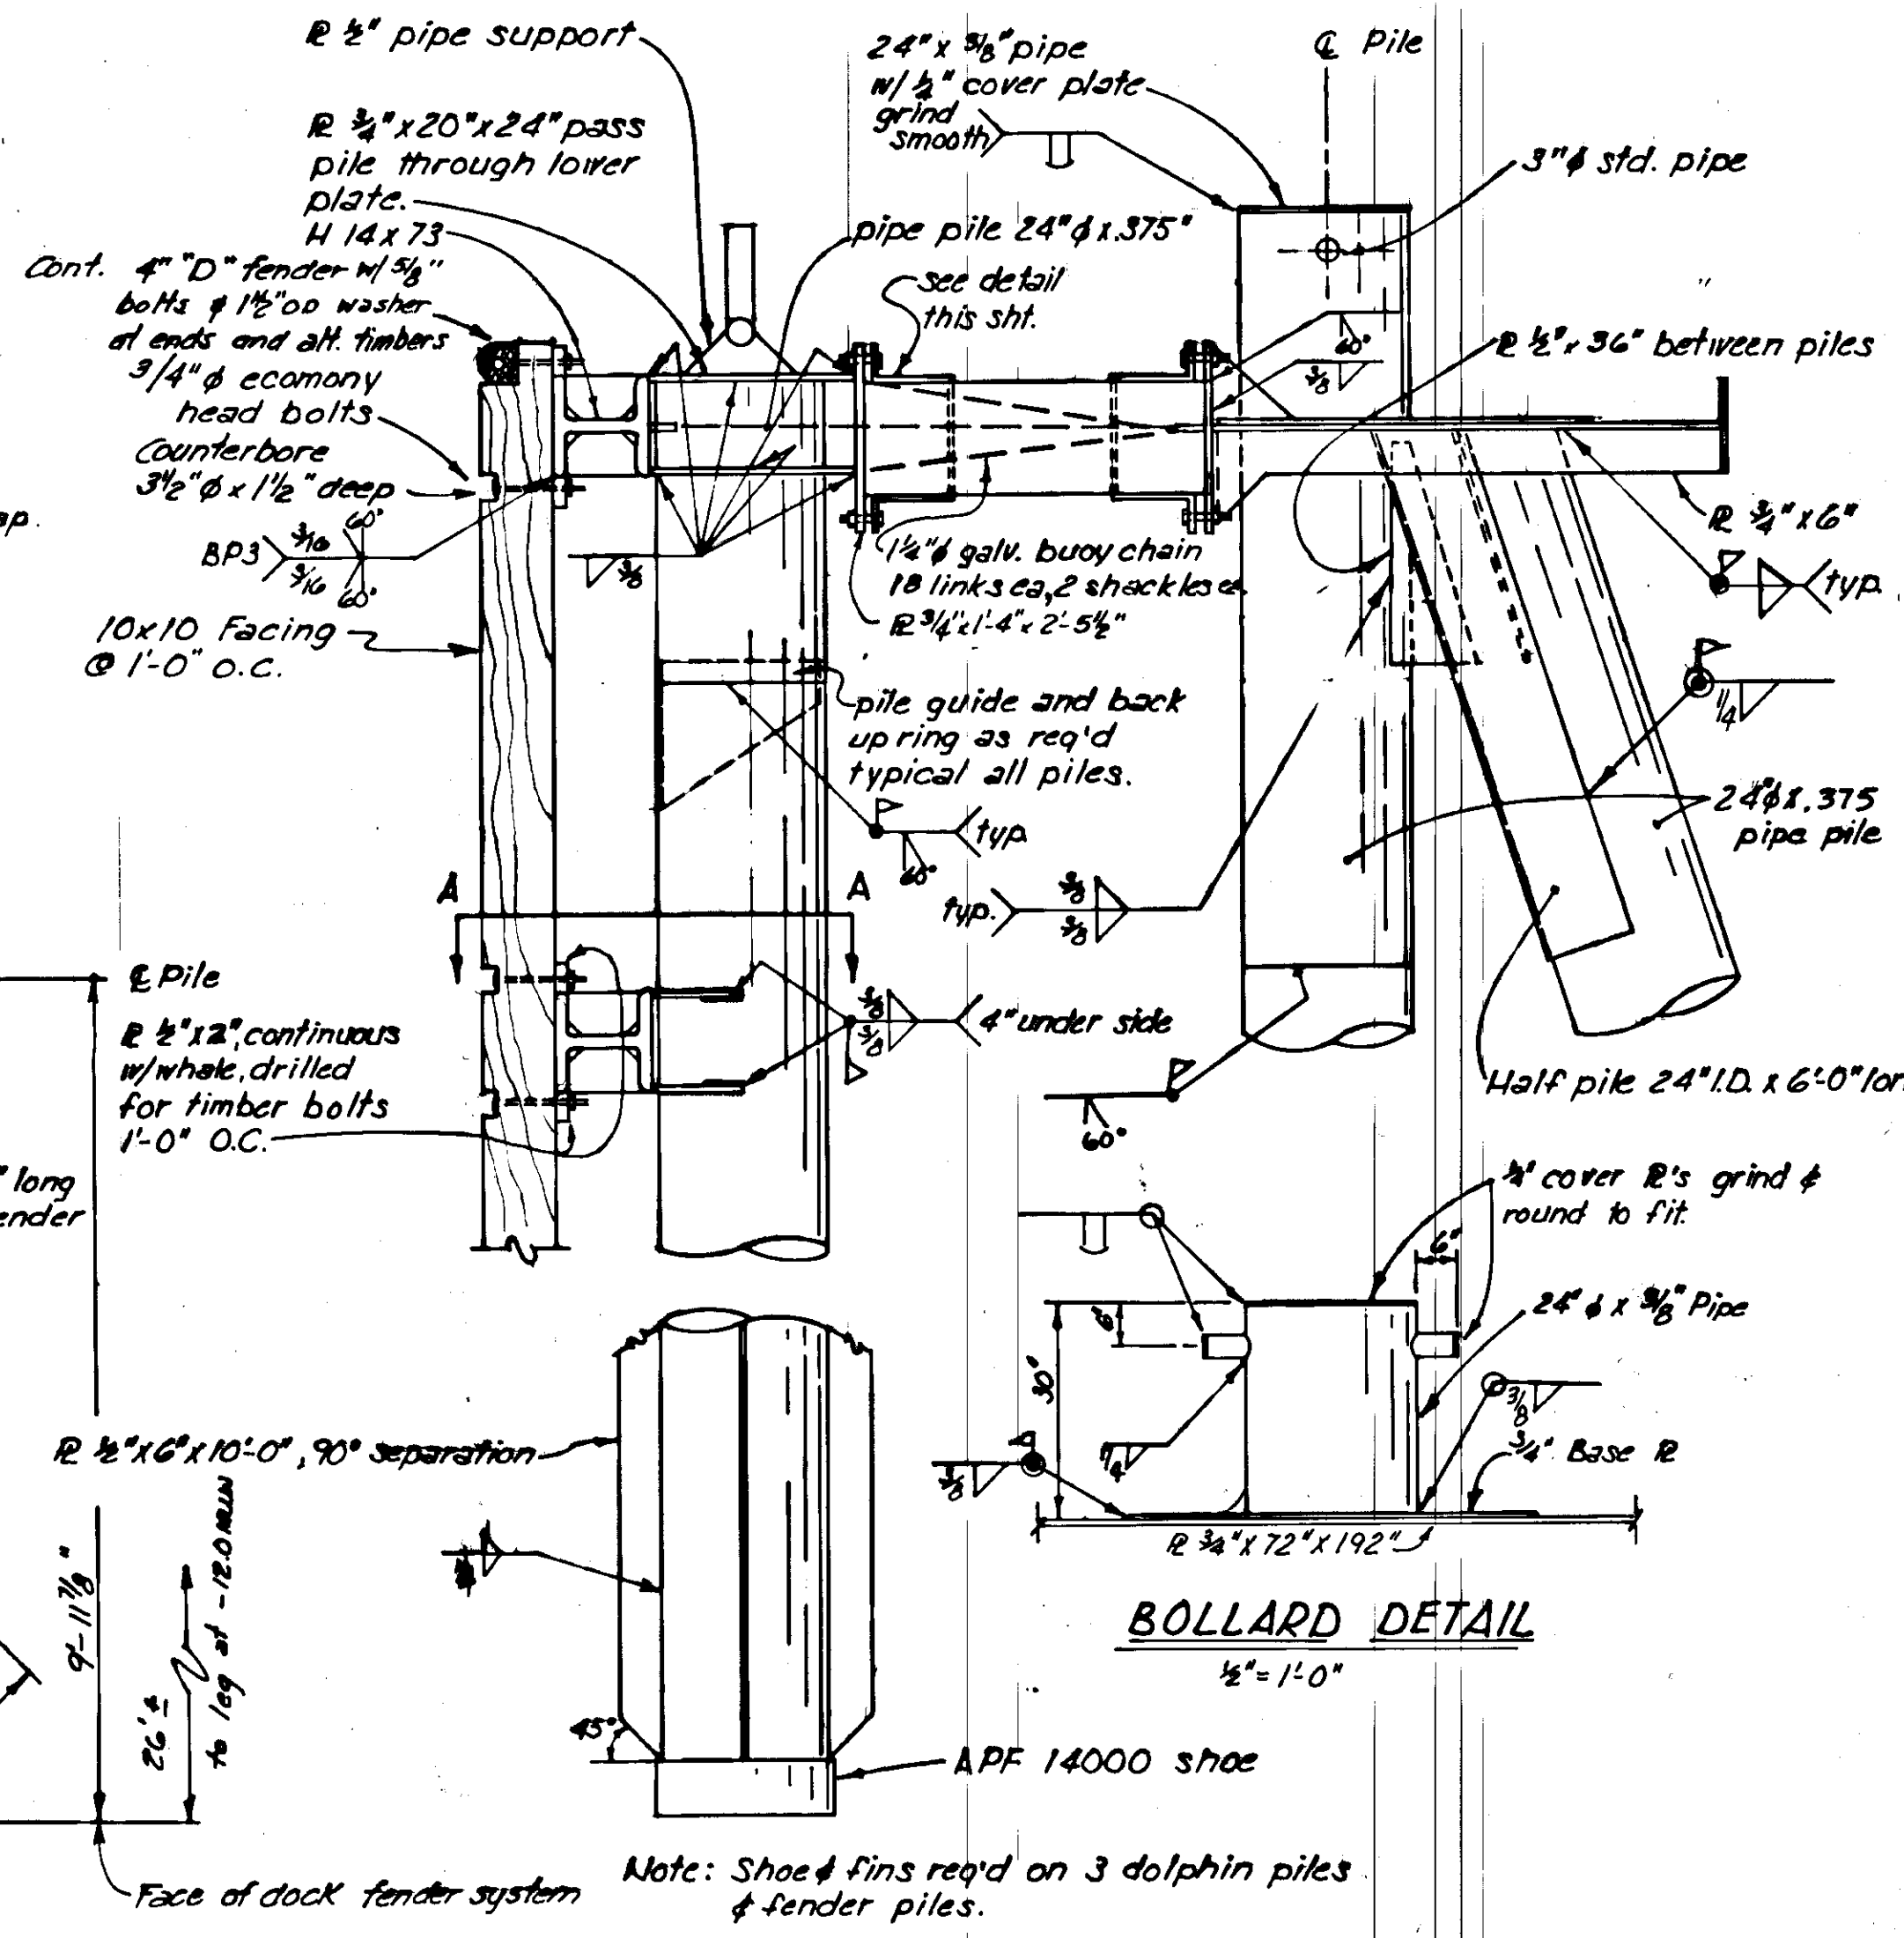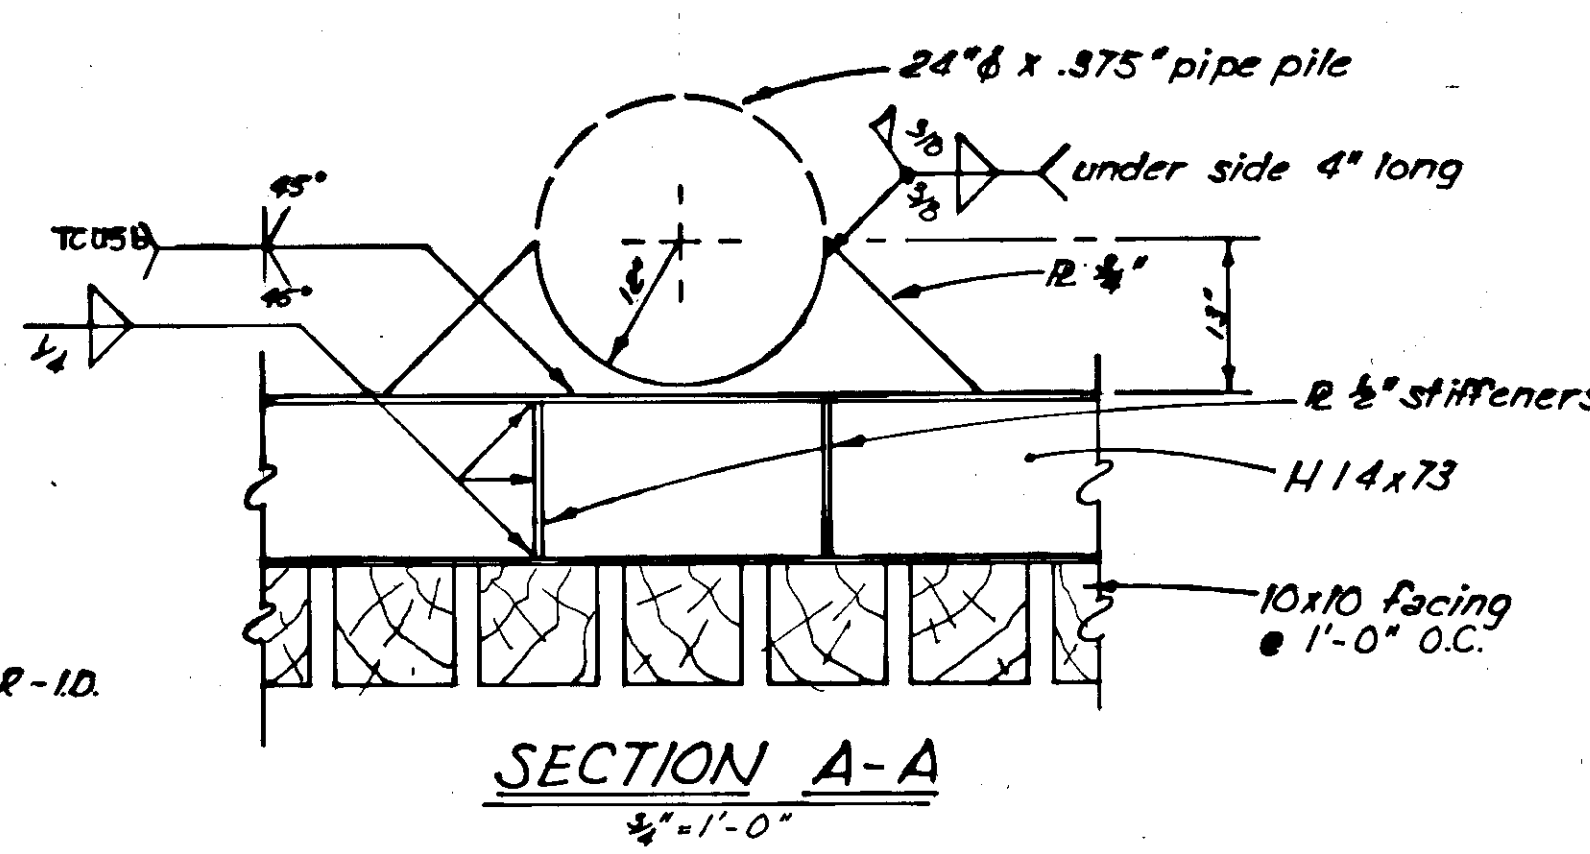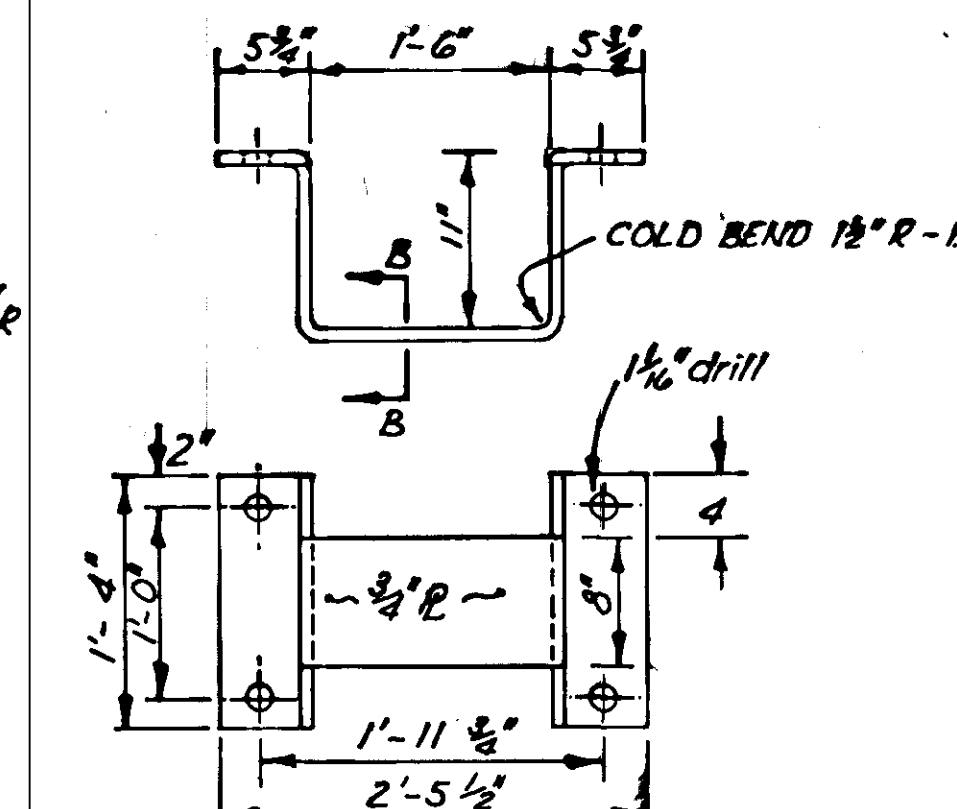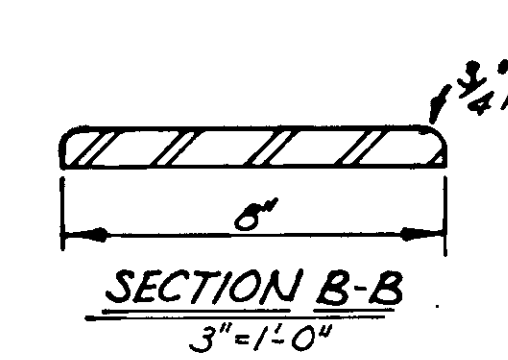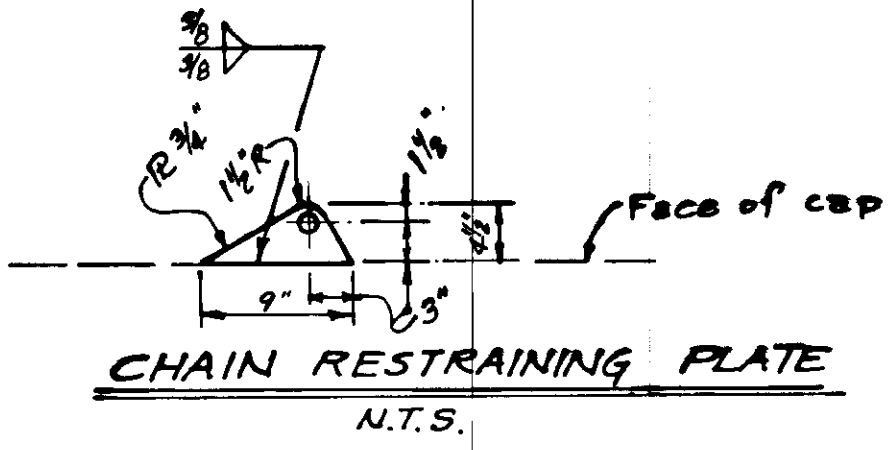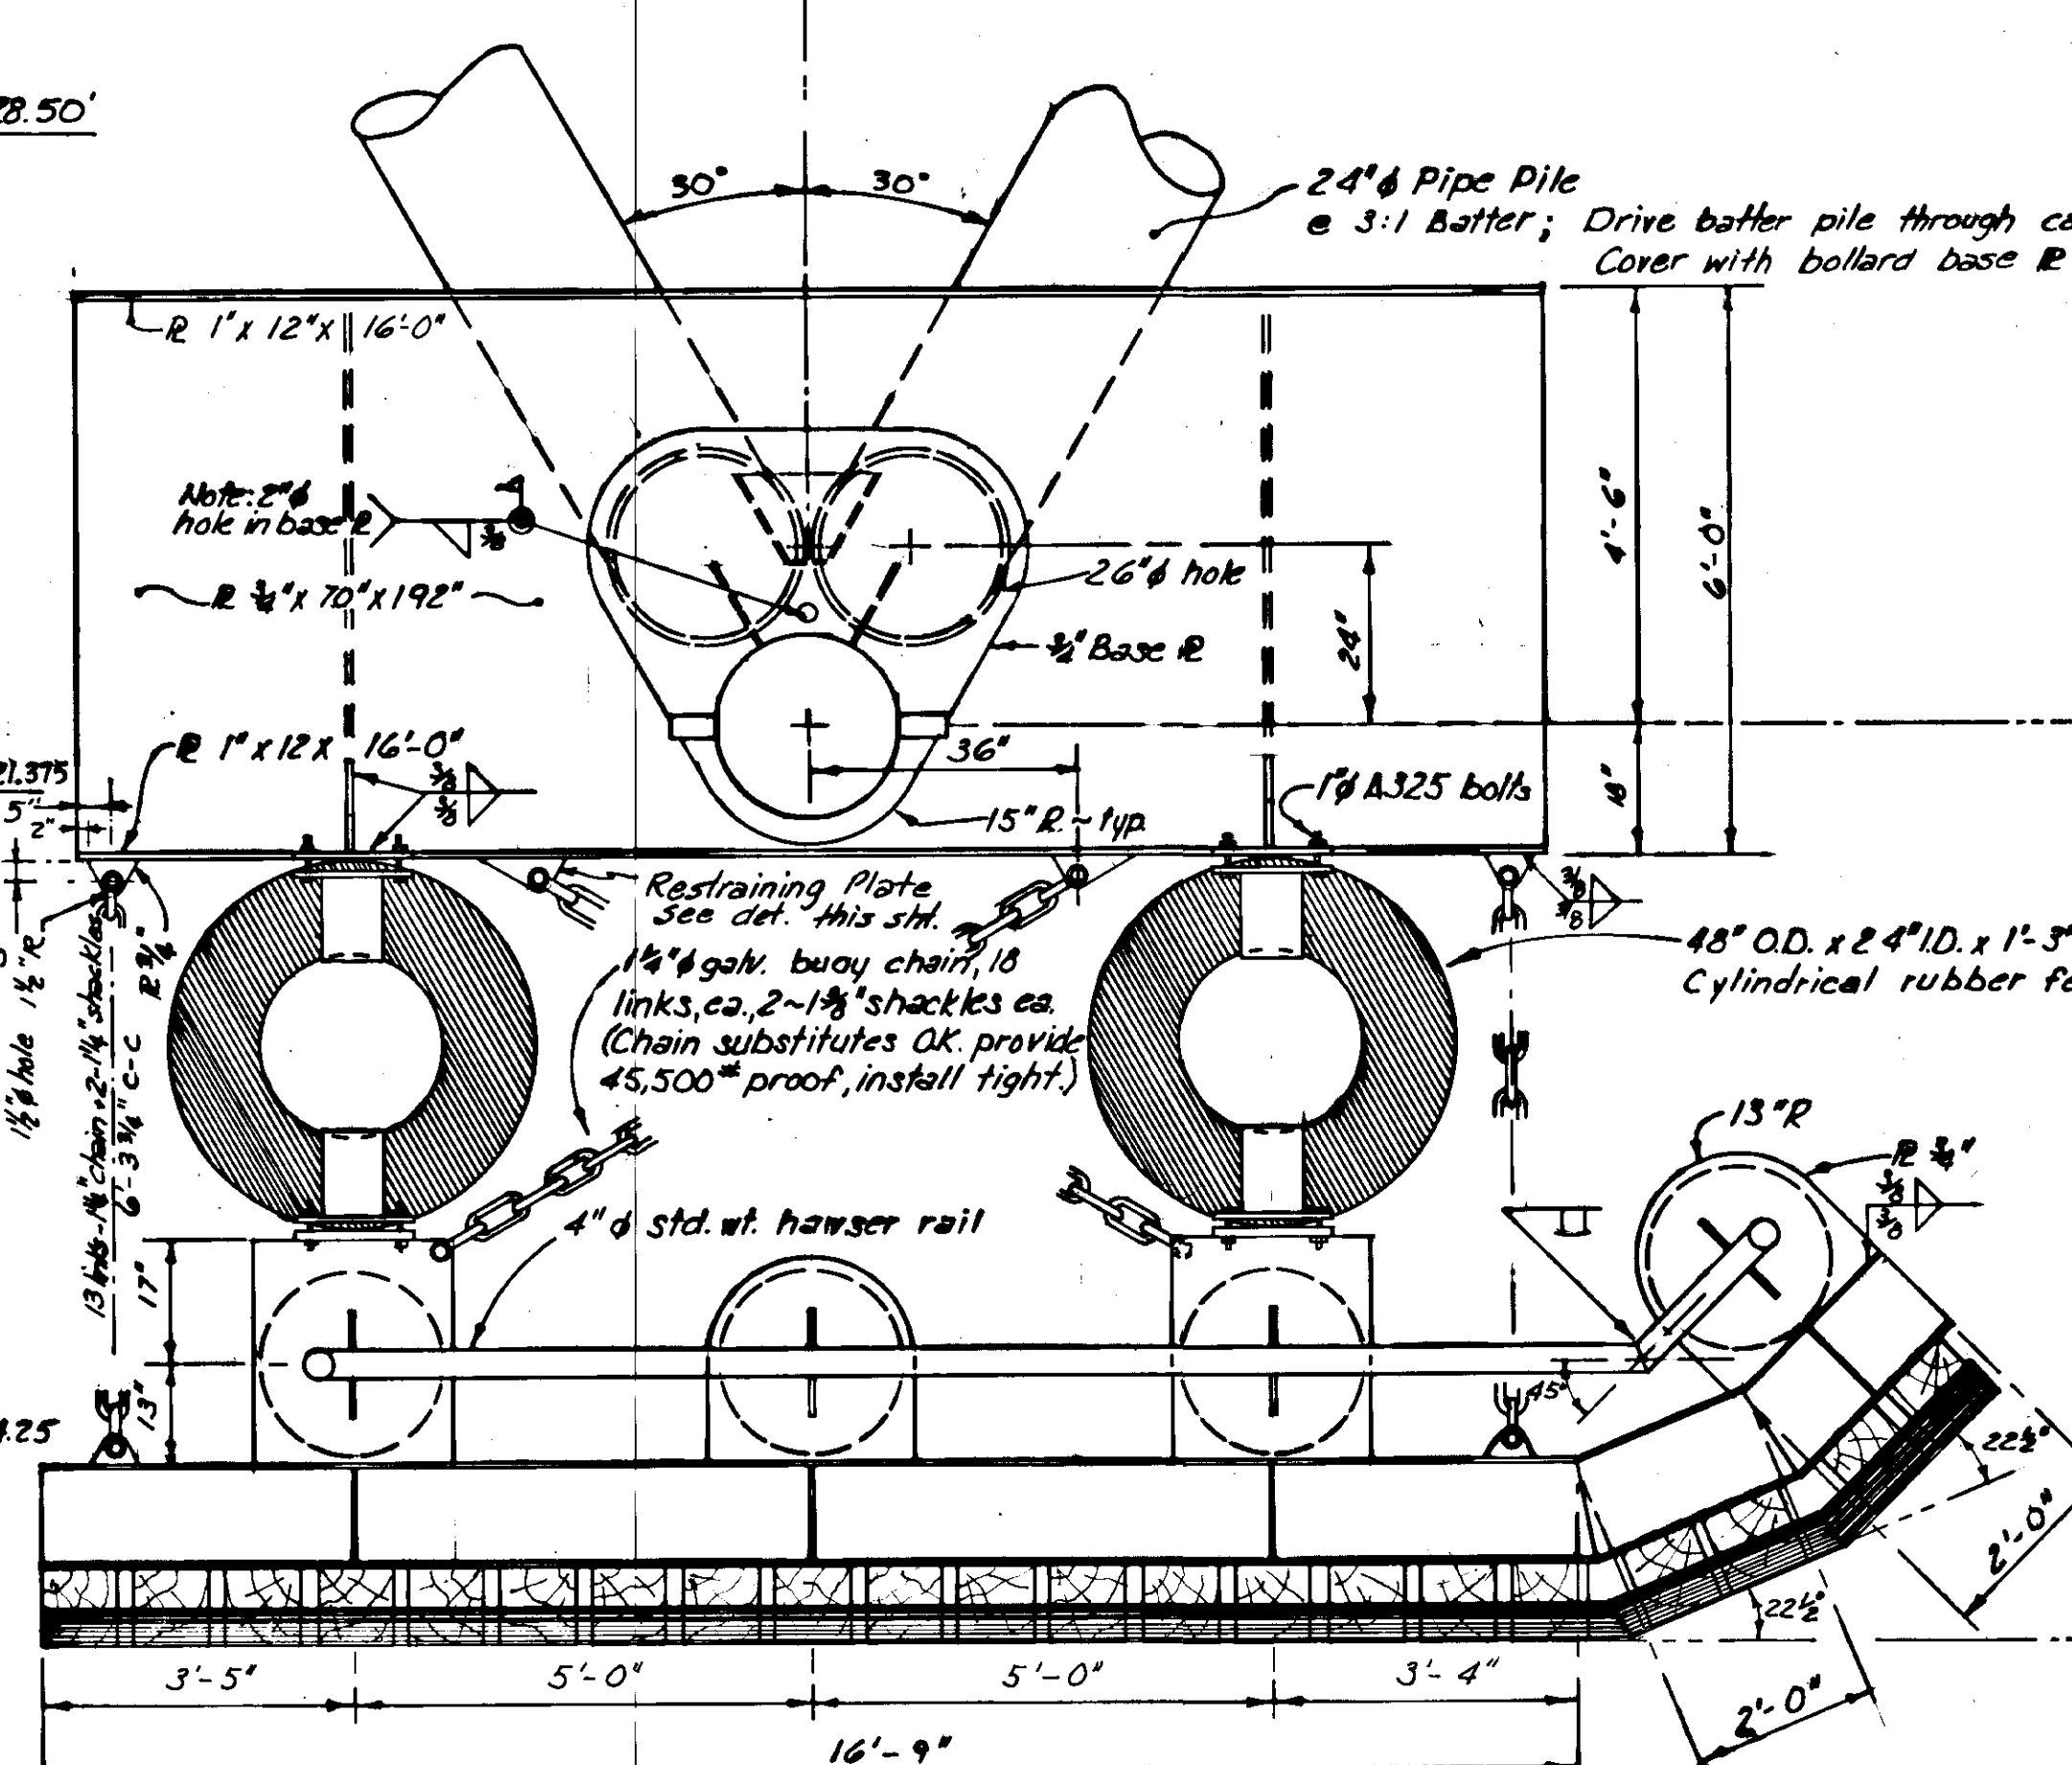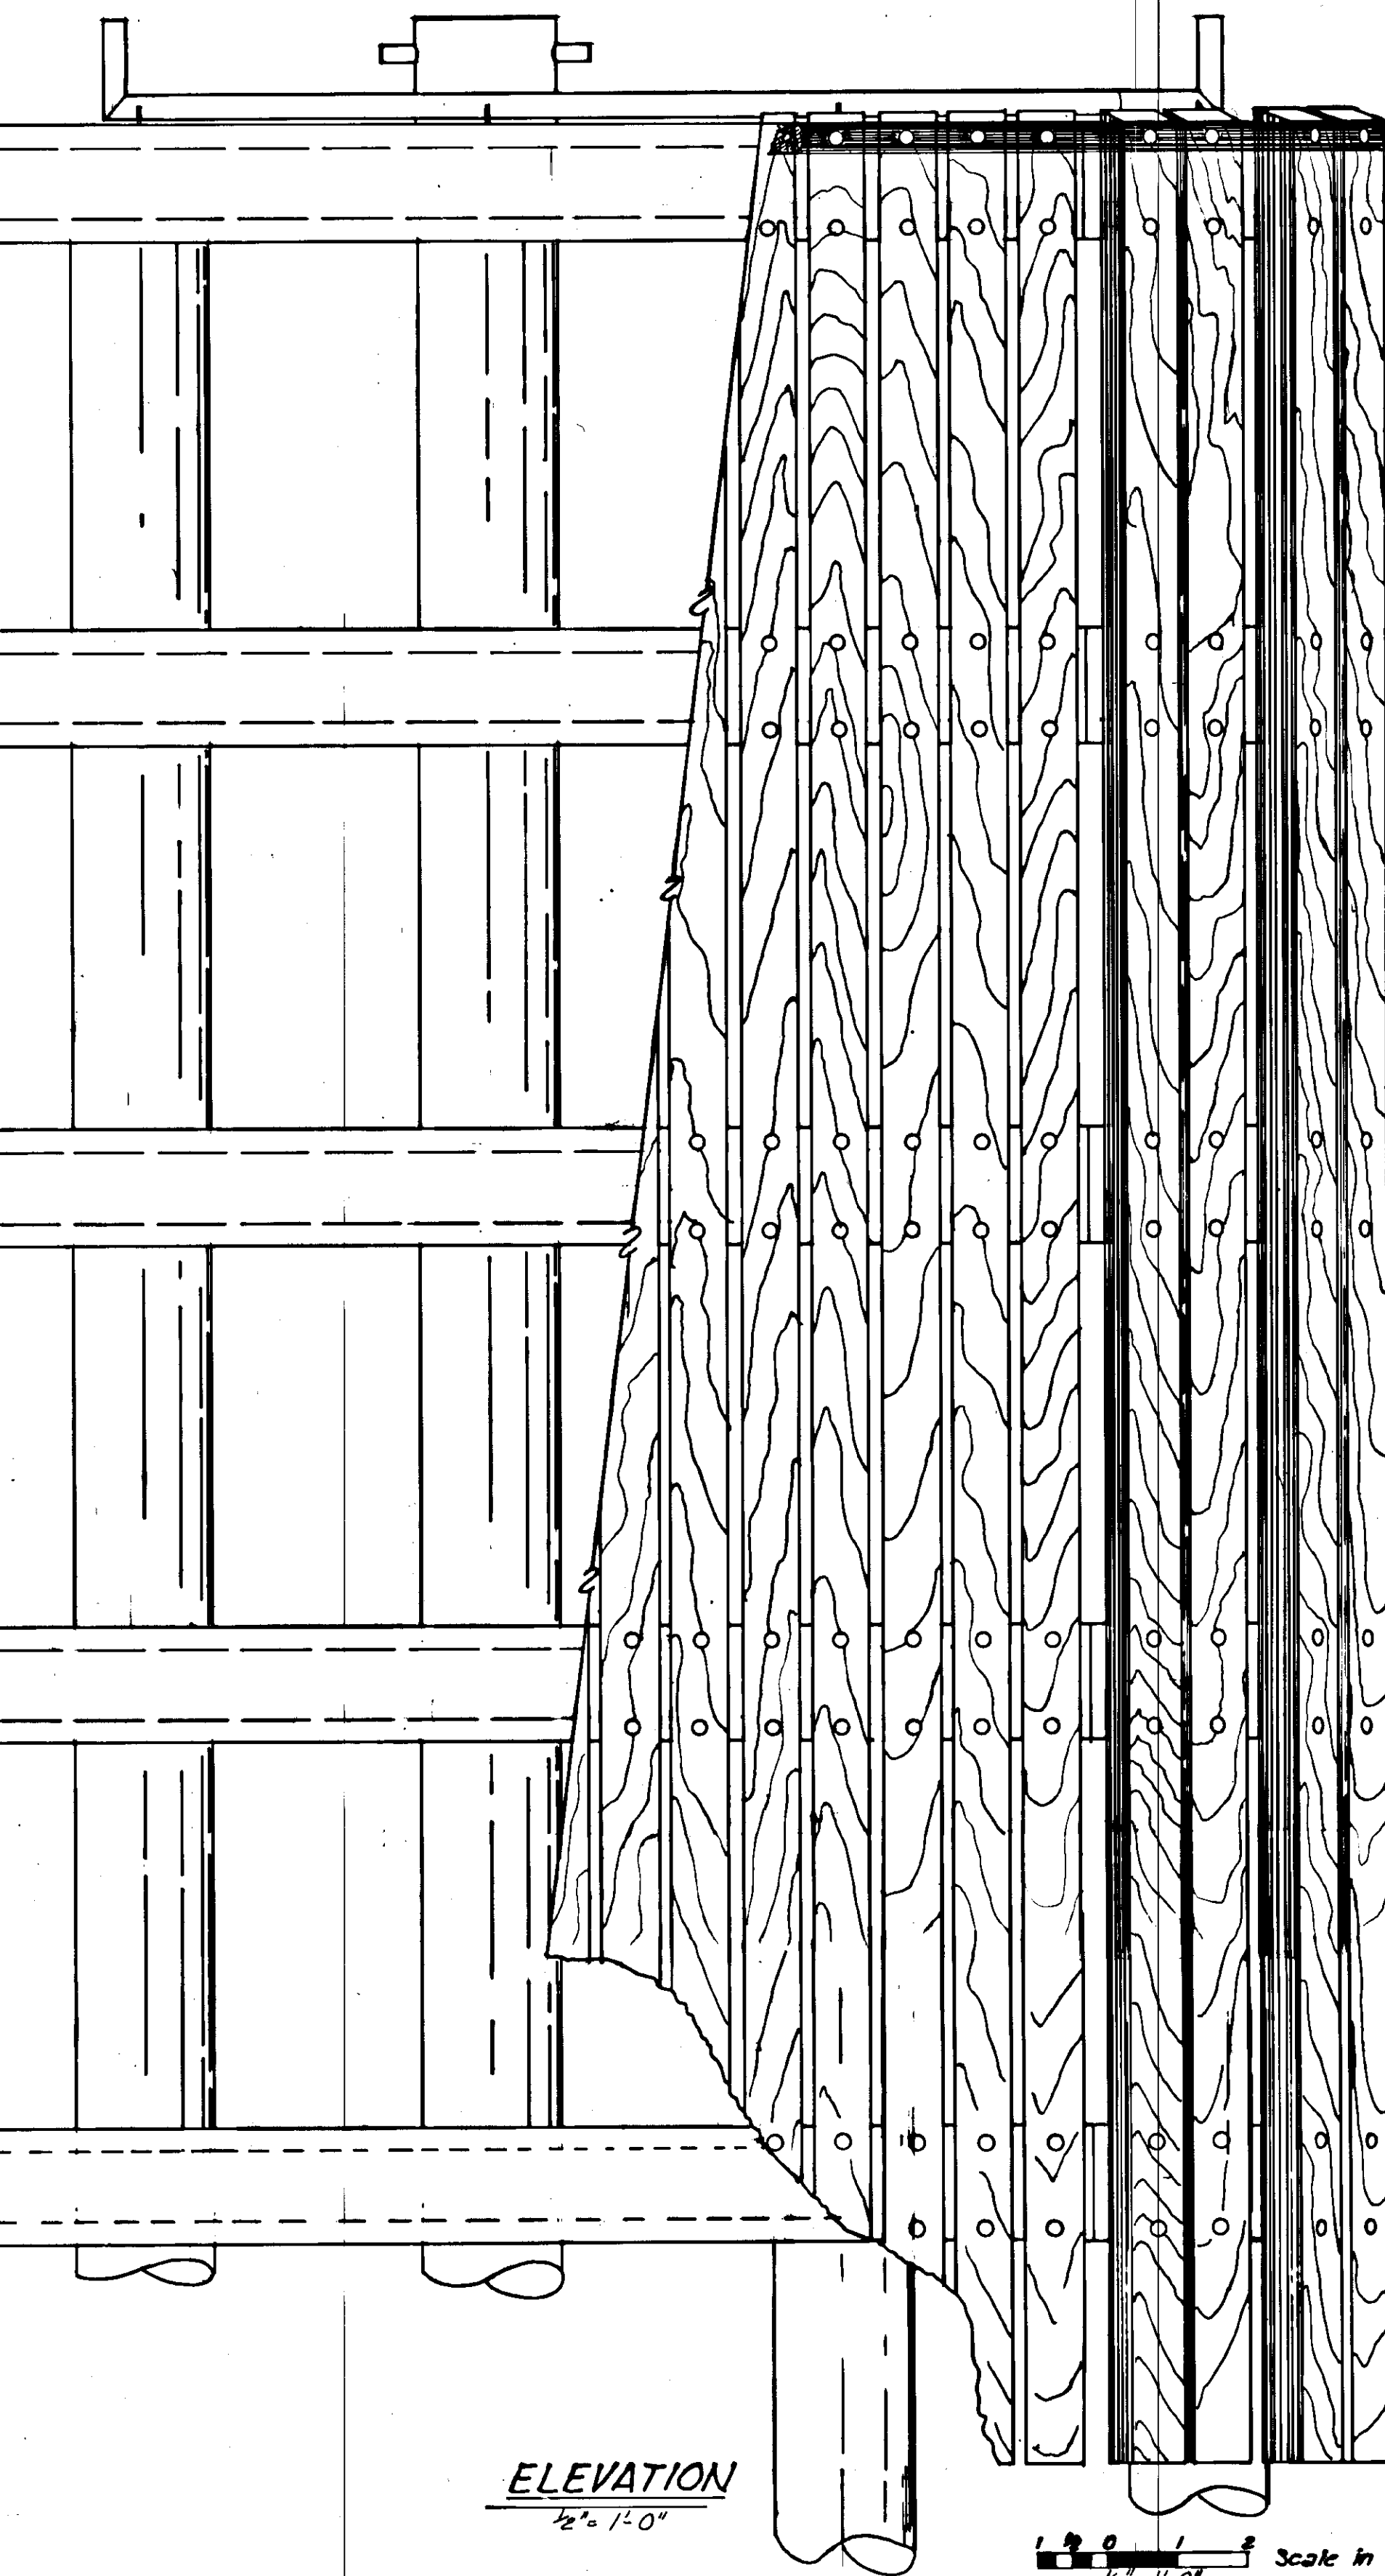


See L.B. Foster Shop Drawings  
On File @ Waters & Harbors

**Design Data:**  
KE = 60 ft-kips  
Ballard Load = 15 ton  
Vertical Pile 175 ton  
Batter Pile 100 ton  
Estimated Penetration 30'  
Fender pile drive to 15' penetration


DO NOT SCALE THIS DRAWING - USE DIMENSIONS	
STATE OF ALASKA DEPARTMENT OF TRANSPORTATION AND PUBLIC FACILITIES DIVISION OF HARBOR DESIGN AND CONSTRUCTION	
SKAGWAY FERRY TERMINAL	SKAGWAY, ALASKA
<b>DOLPHIN "A" DETAILS</b>	
SCALE <i>As Noted</i>	SURVEYED
DESIGNED <i>AM</i>	DRAWN <i>GRE</i>
CHECKED <i>R.P.B.</i>	DATE <i>May 1978</i>
PROJECT NUMBER <i>F-0972 (2)</i>	APPROVED <i>Don Stotter</i> DIRECTOR
	SHEET <i>37</i> OF <i>41</i>

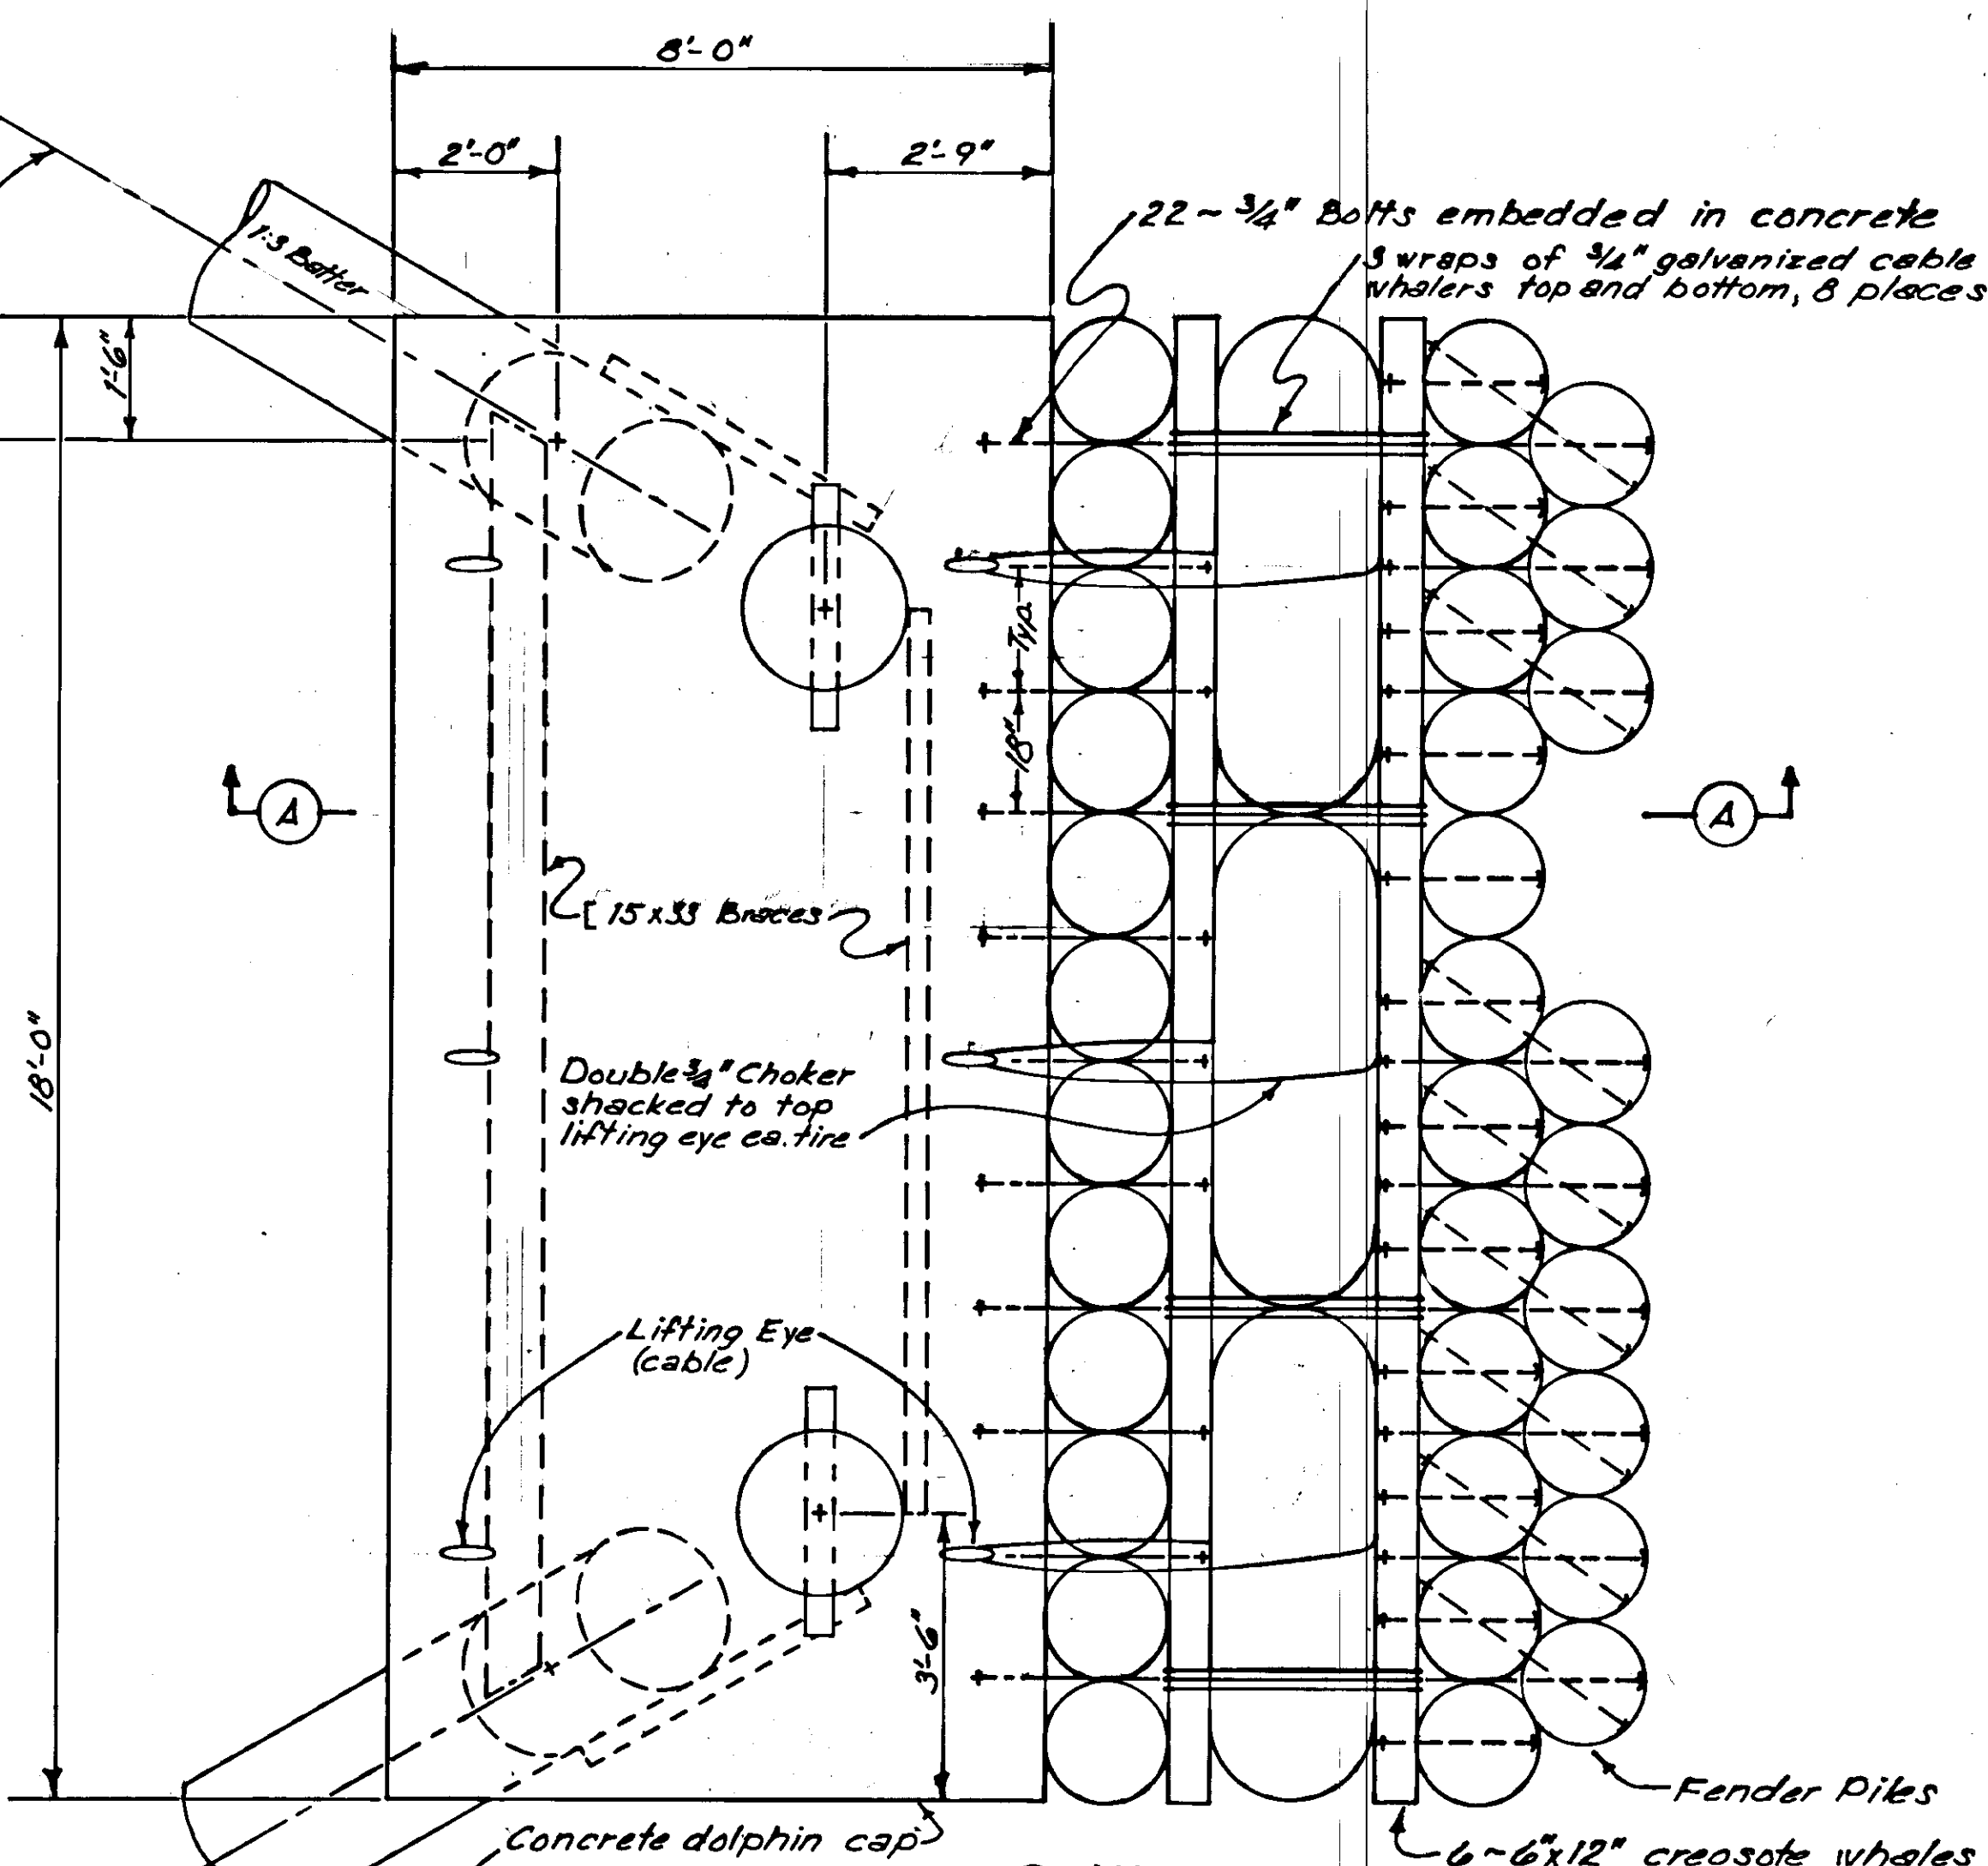


**PLAN**  
 1/2" = 1'-0"  
 Embed 4 rows of 3/4" bolts in concrete  
 2 rows of 6, 2 rows of 5, 22 total 3/4" Cable one wrap  
 elev. +31.0

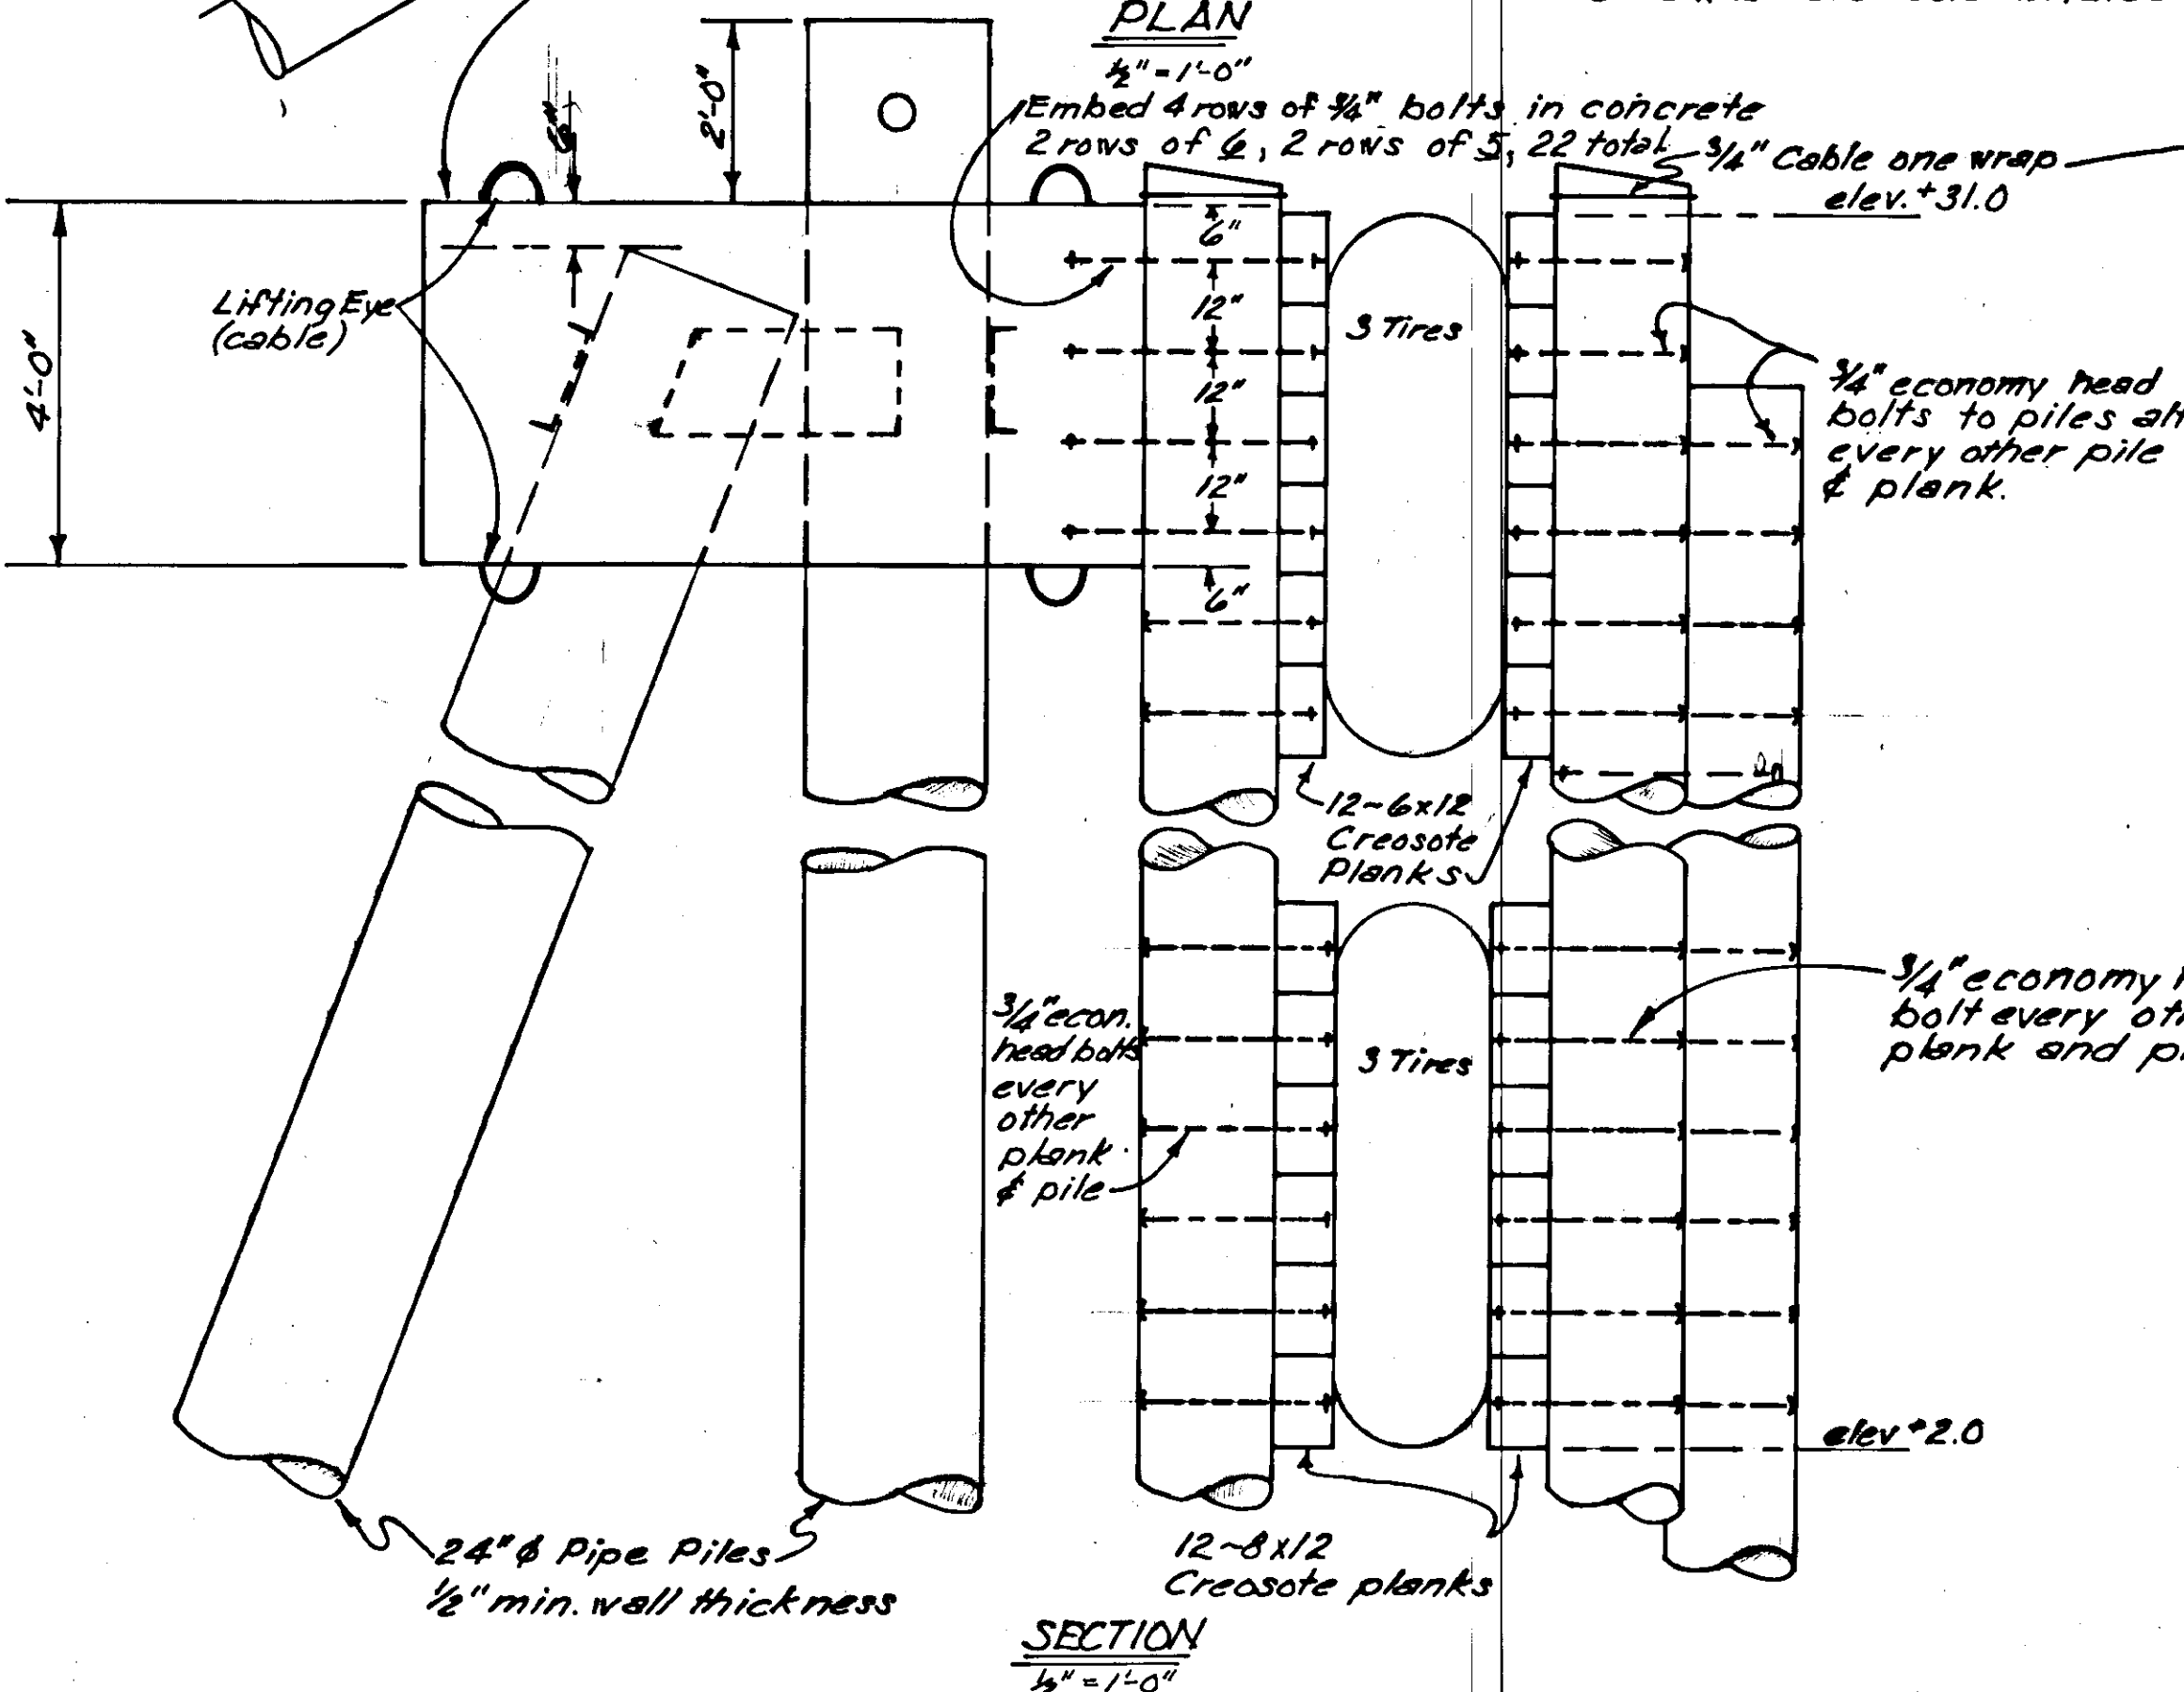

**SECTION A-A**  
 1/2" = 1'-0"

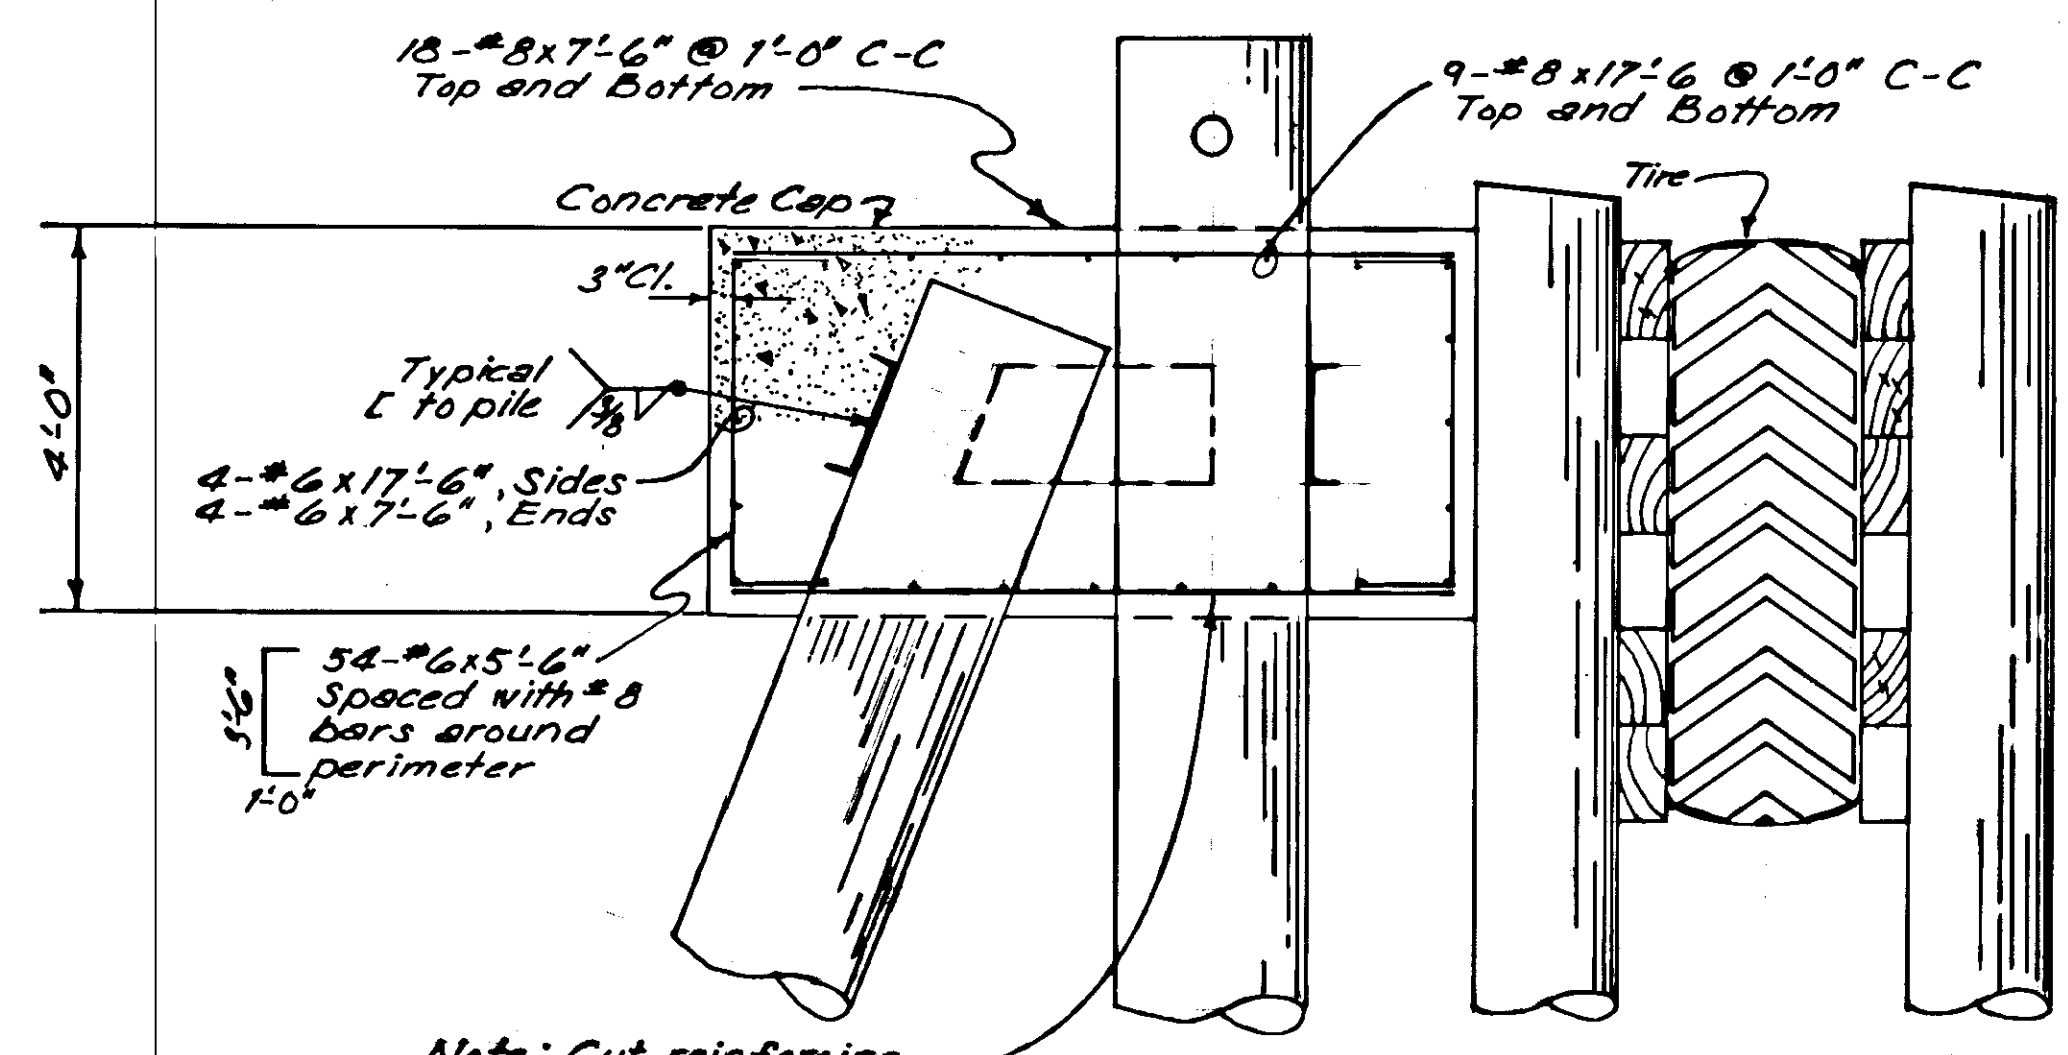


**SECTION A-A**  
 1/2" = 1'-0"

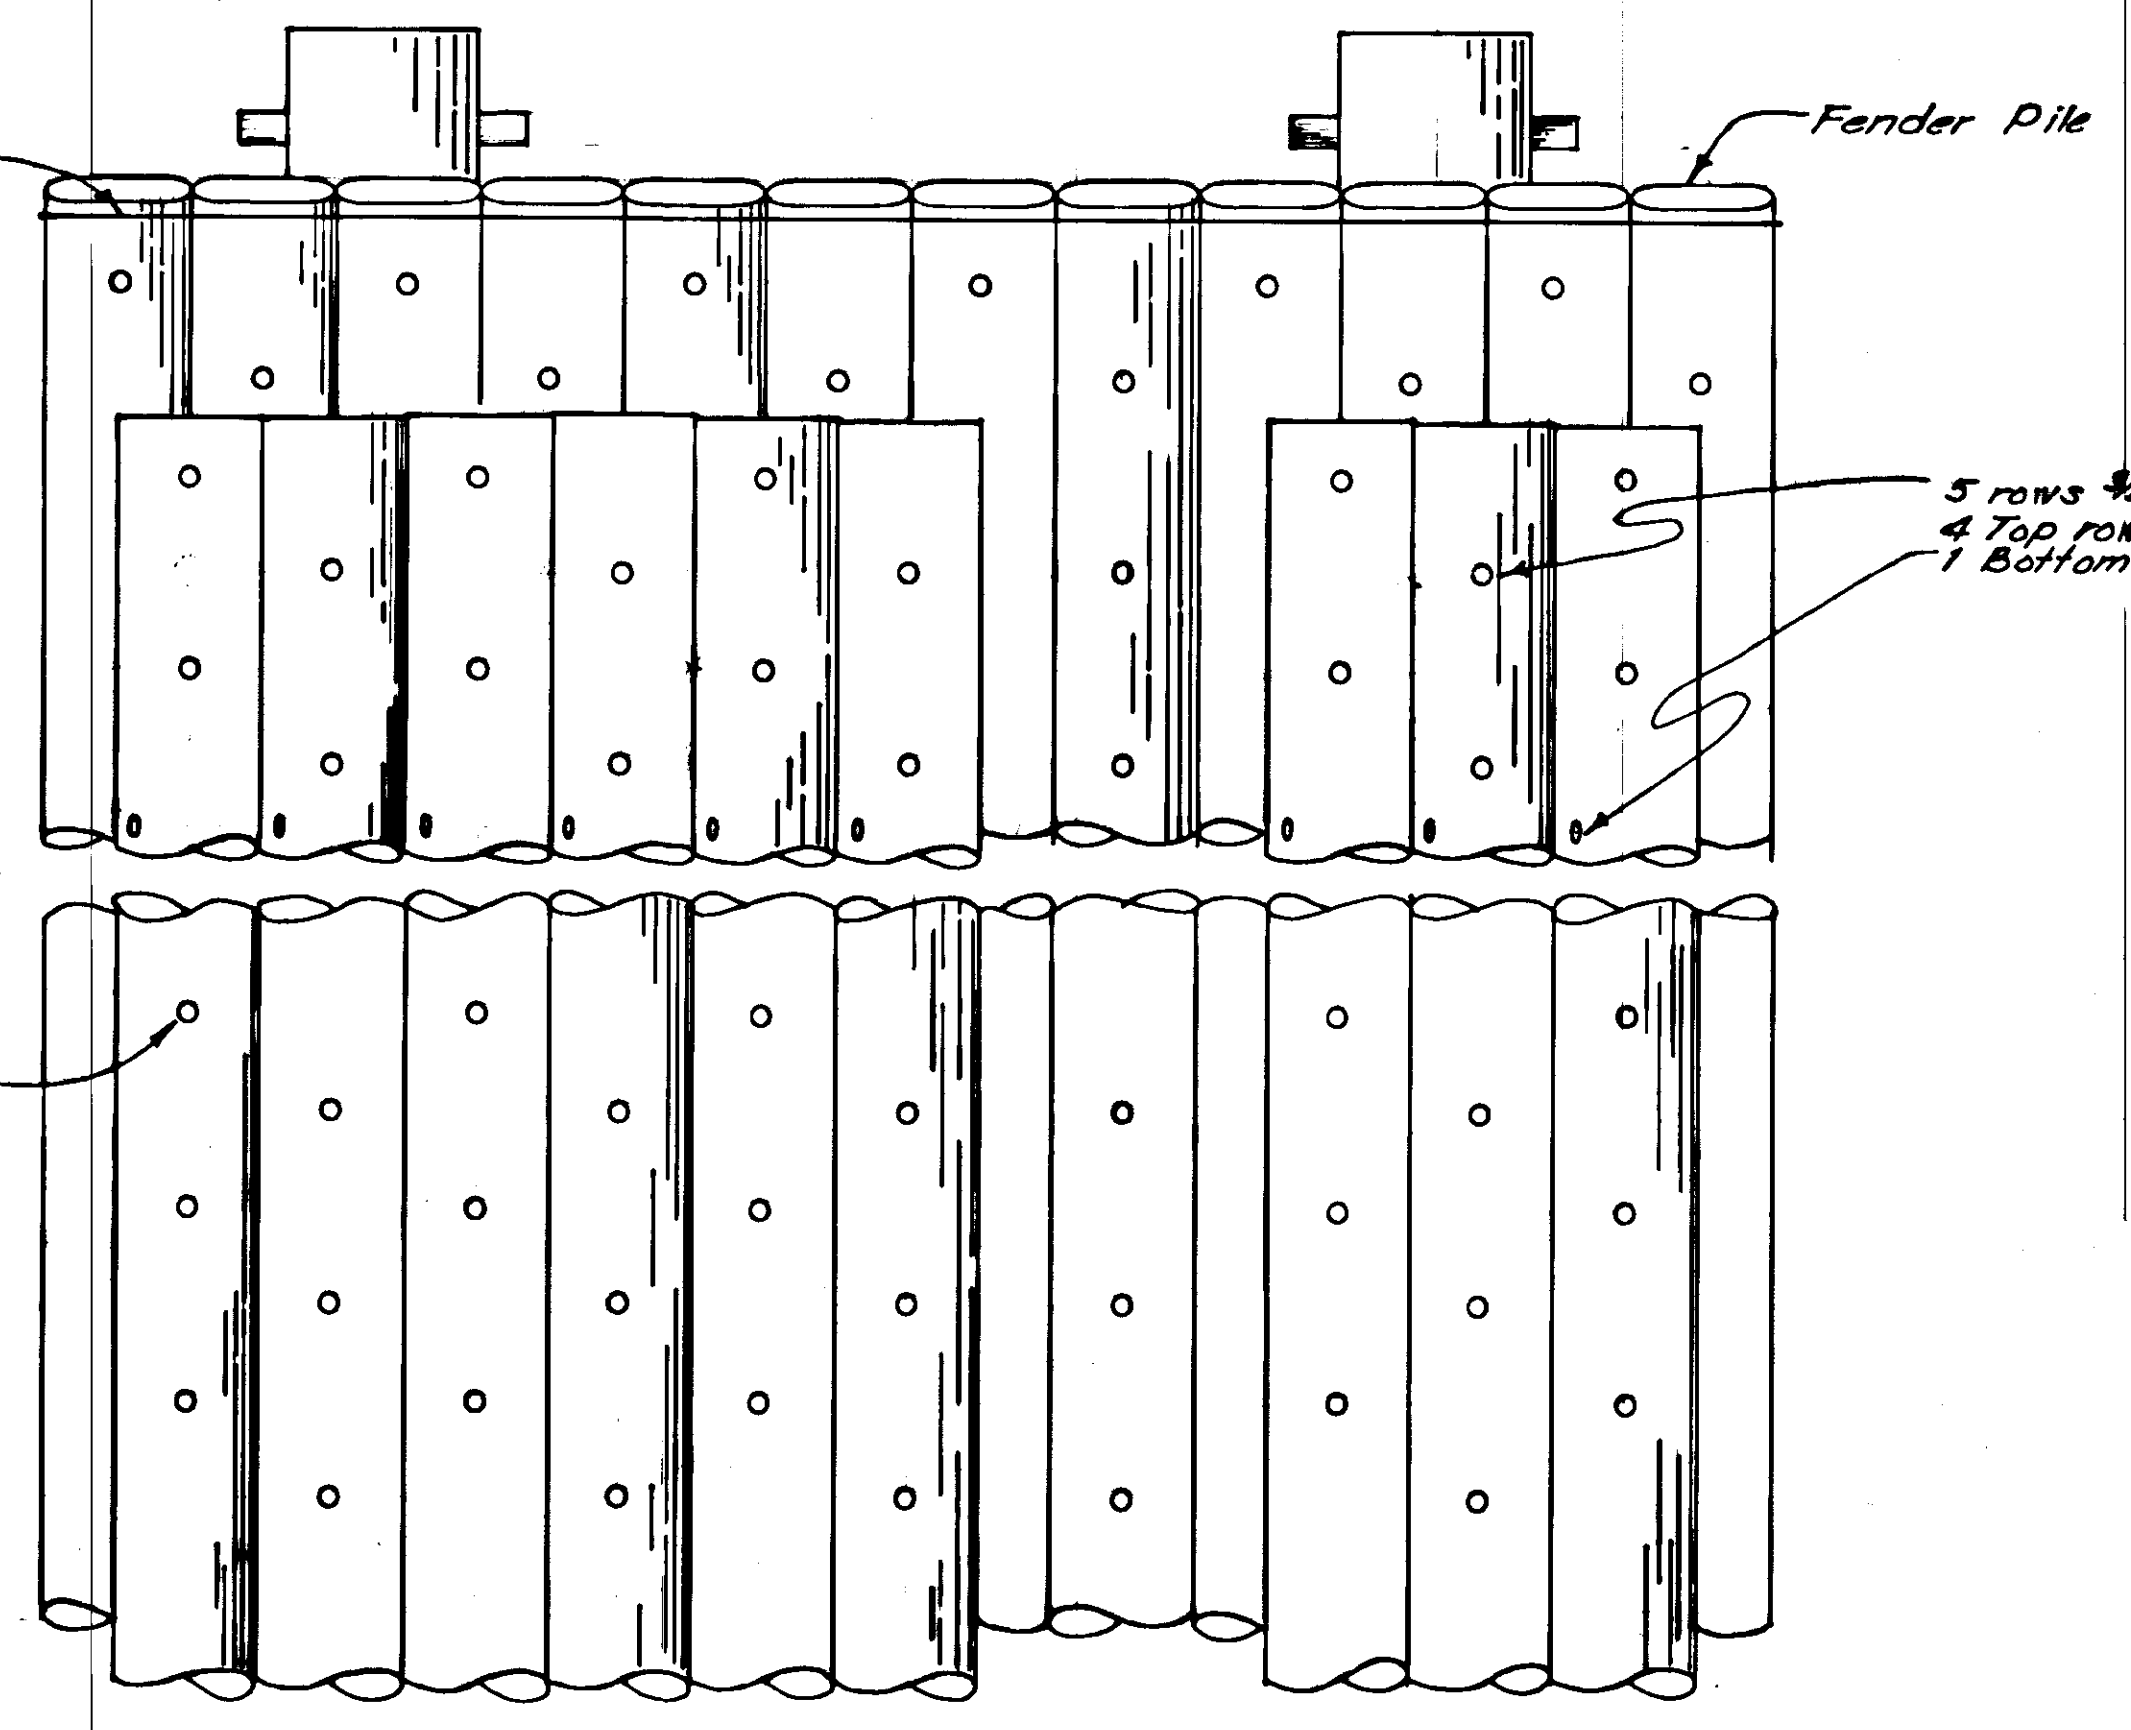

**ELEVATION**  
 1/2" = 1'-0"


**As Constructed**

DO NOT SCALE THIS DRAWING - USE DIMENSIONS		
STATE OF ALASKA DIVISION OF HARBORS		
SKAGWAY FERRY TERMINAL DOLPHIN "R" DETAILS		
SCALE <i>As Noted</i>	SURVEYED	APPROVED
DESIGNED -	DRAWN <i>G.R.F.</i>	<i>Don Statter</i> DIRECTOR
CHECKED <i>AM</i>	DATE <i>1-78</i>	
PROJECT NUMBER <i>6-73165</i>	SHEET <i>38</i> OF <i>41</i>	

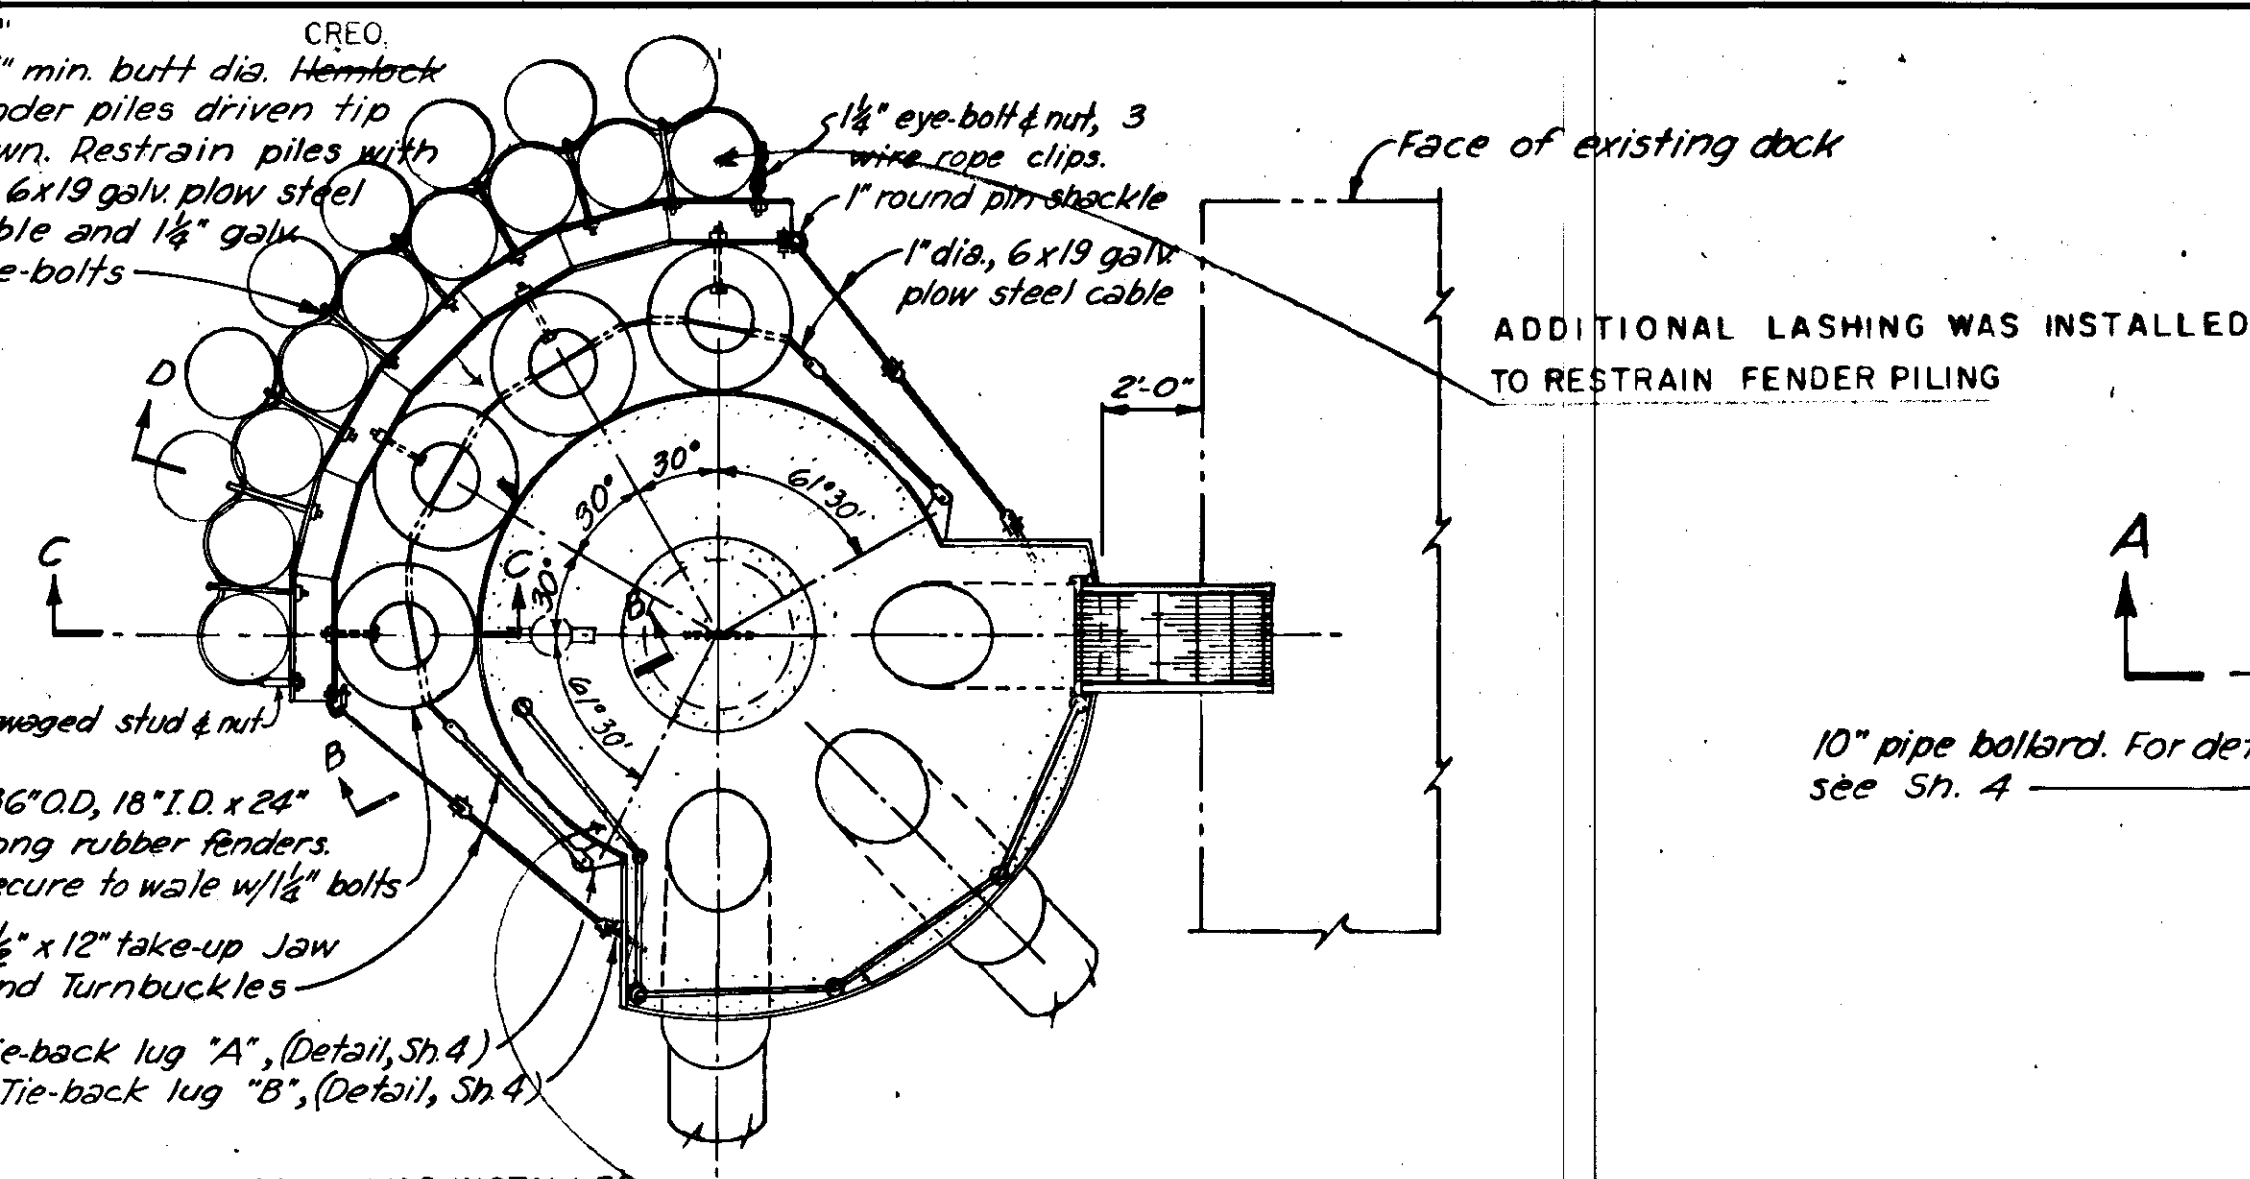


**PLAN**

10 CREO. FENDERS WERE DRIVEN & 8 NATIVE PILE TO THE TURNING DOLPHIN

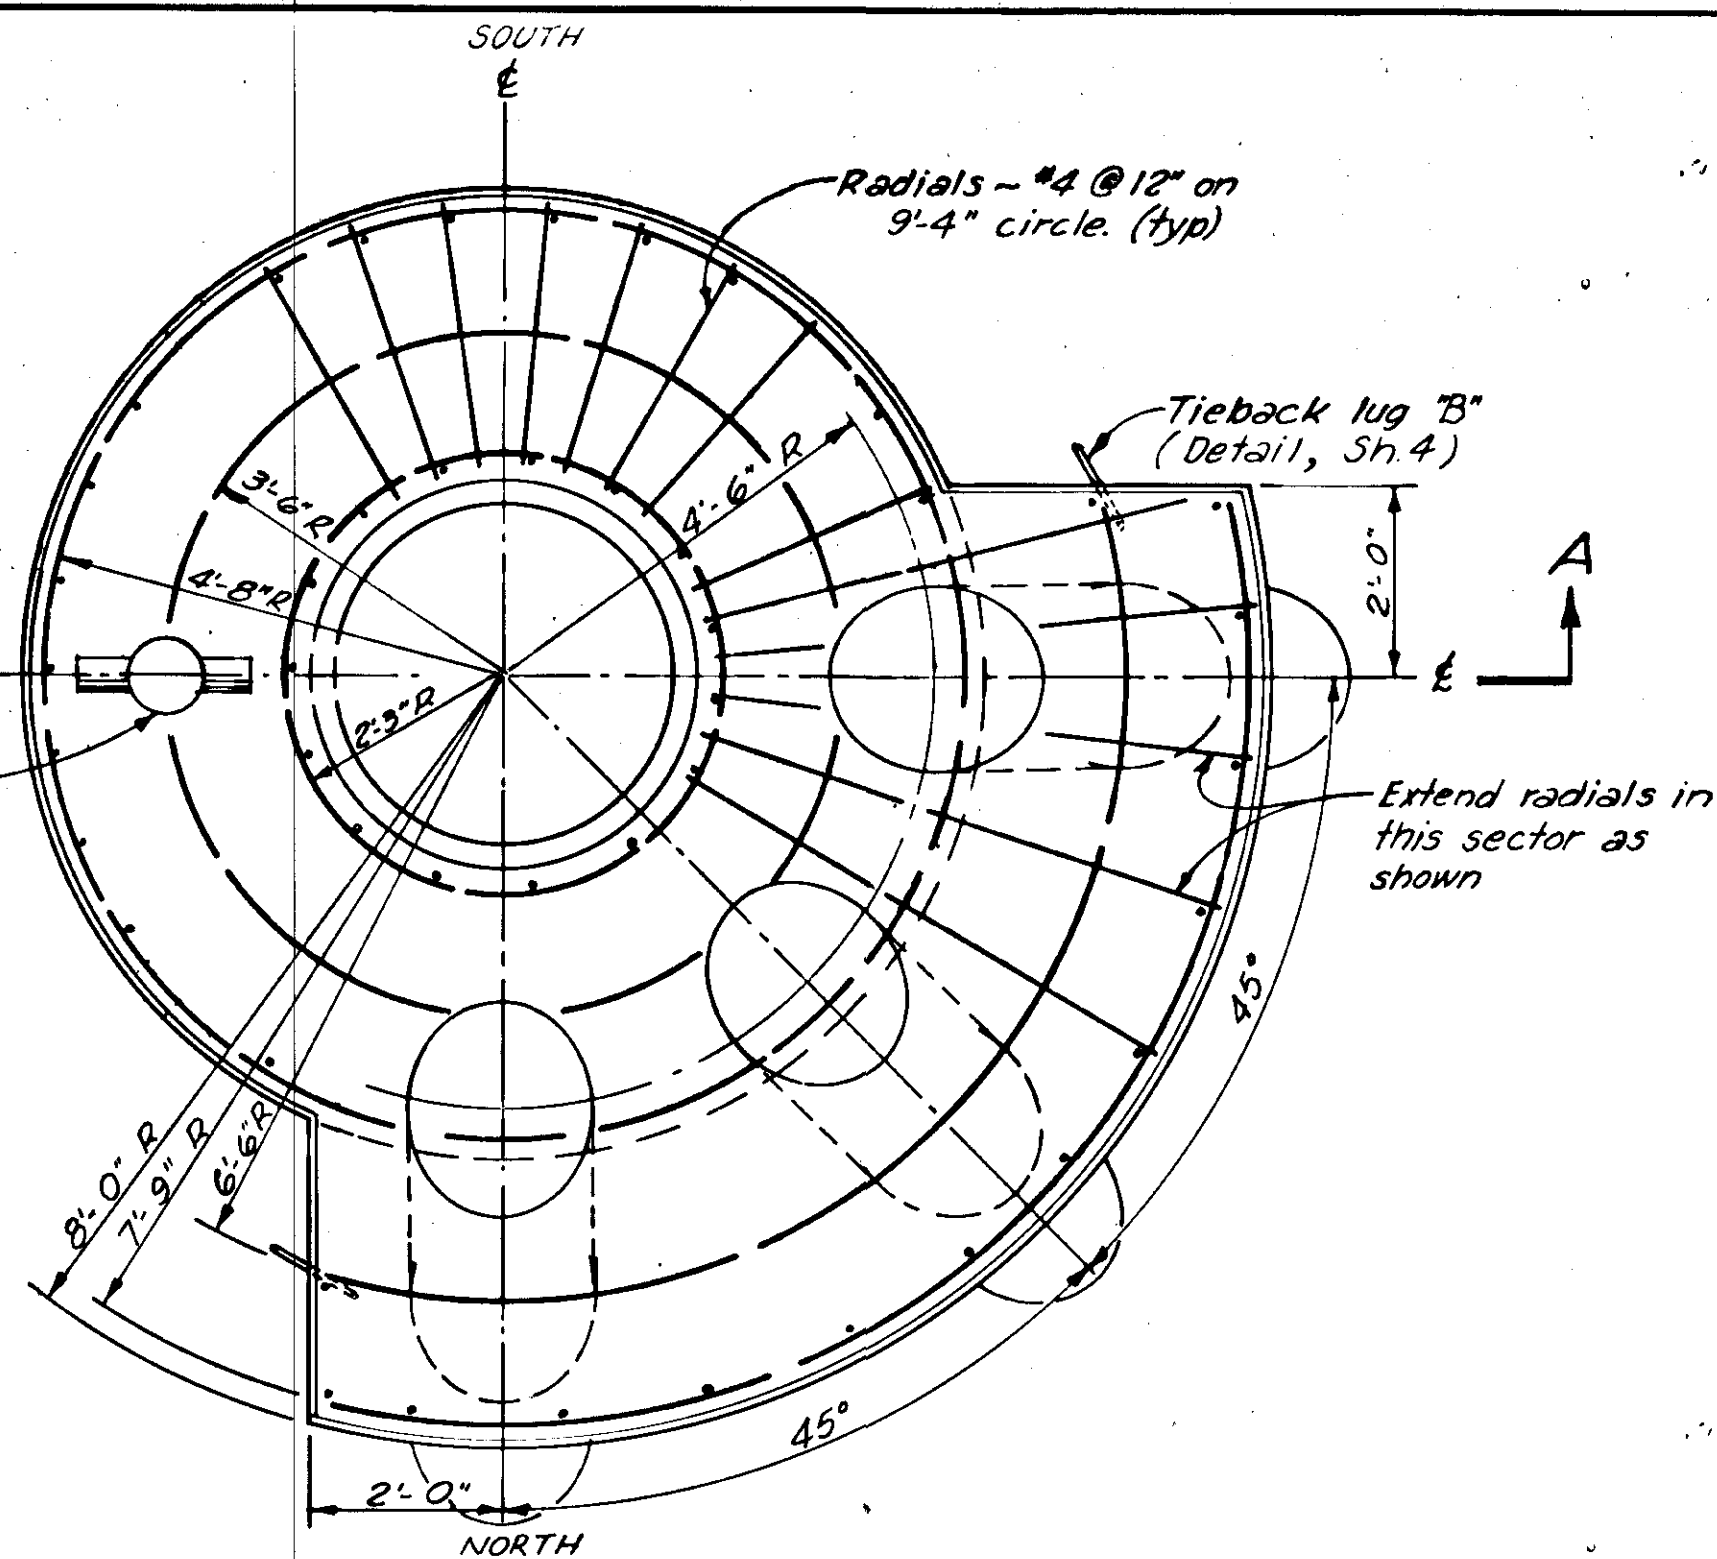


**DOLPHIN CAP - PLAN**

1/2" = 1'-0"

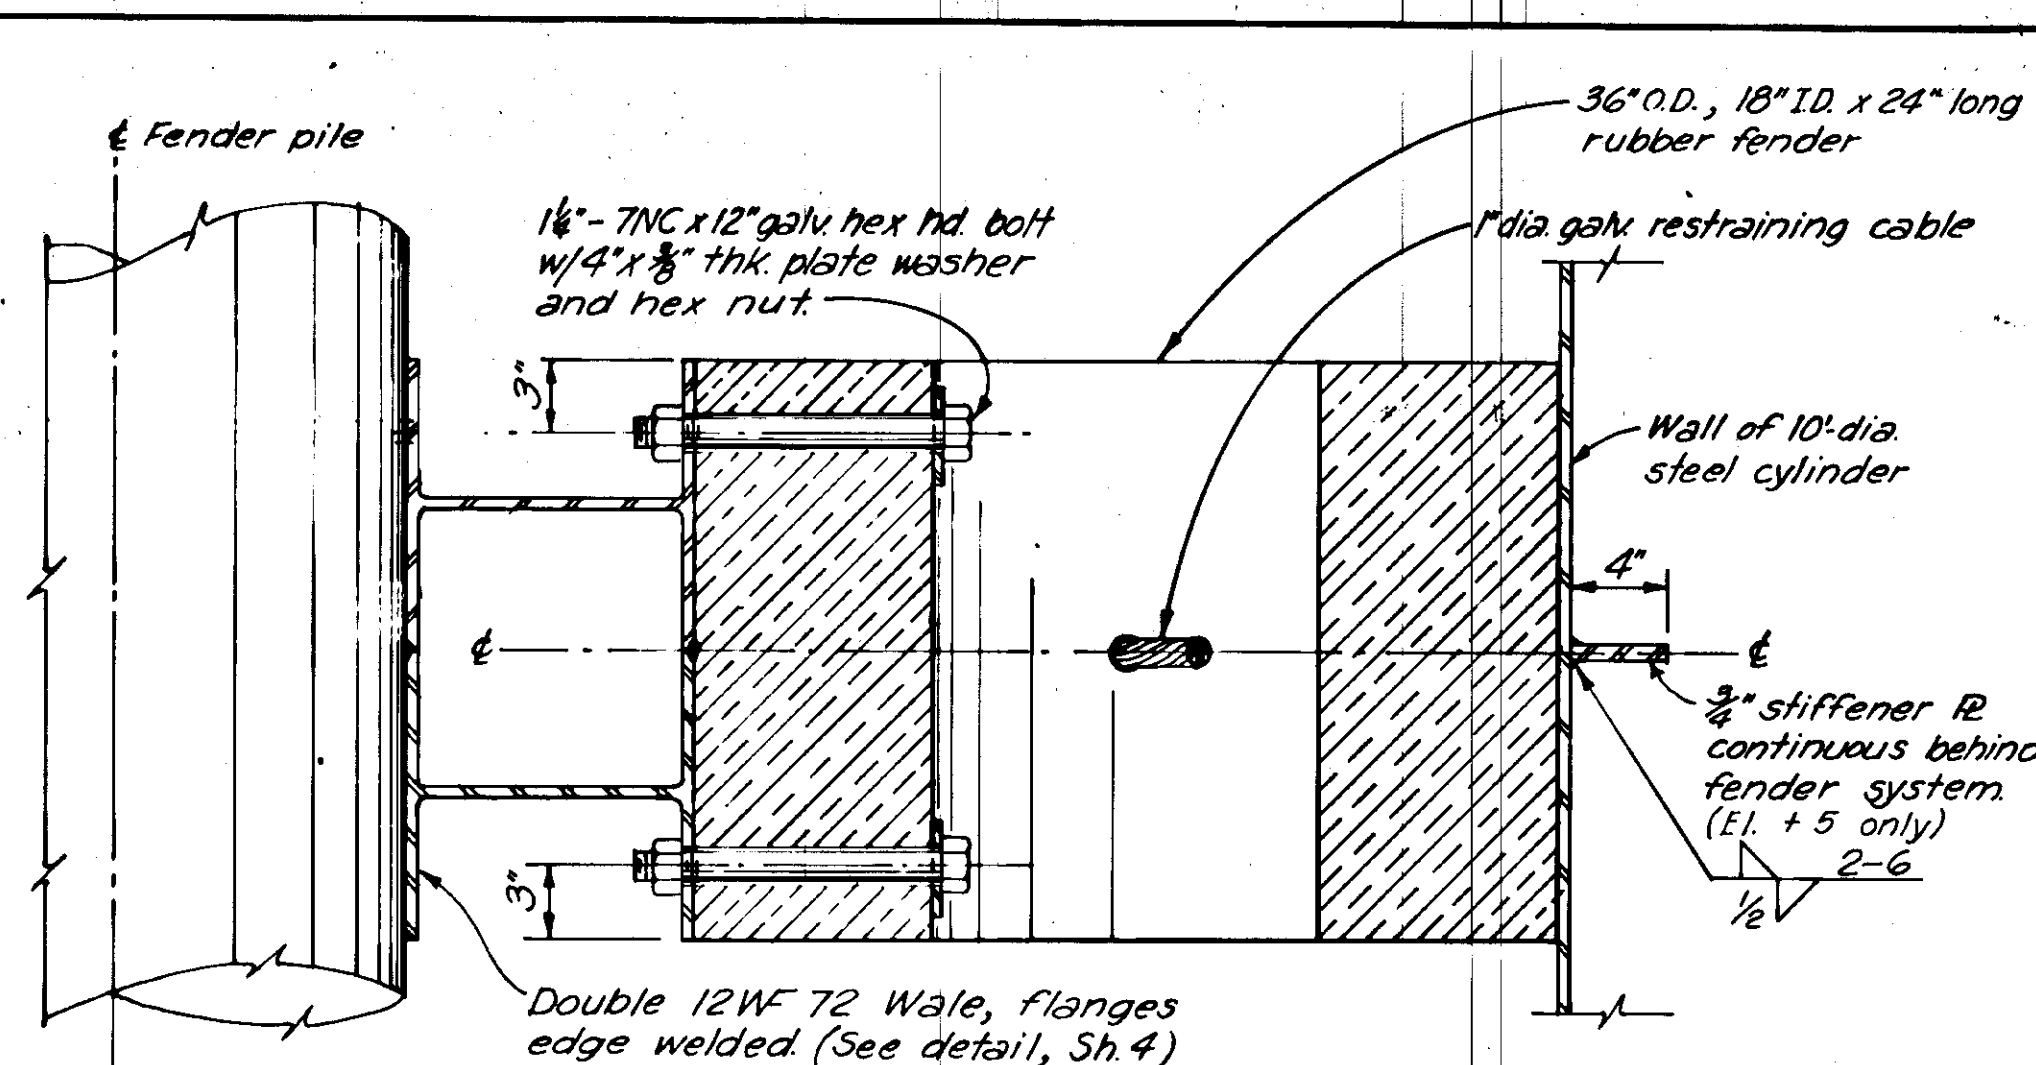

**SECTION C-C**


1/2" = 1'-0"  
(TYPICAL @ EL. +5.0' & +25.0')  
EXCEPT AS NOTED

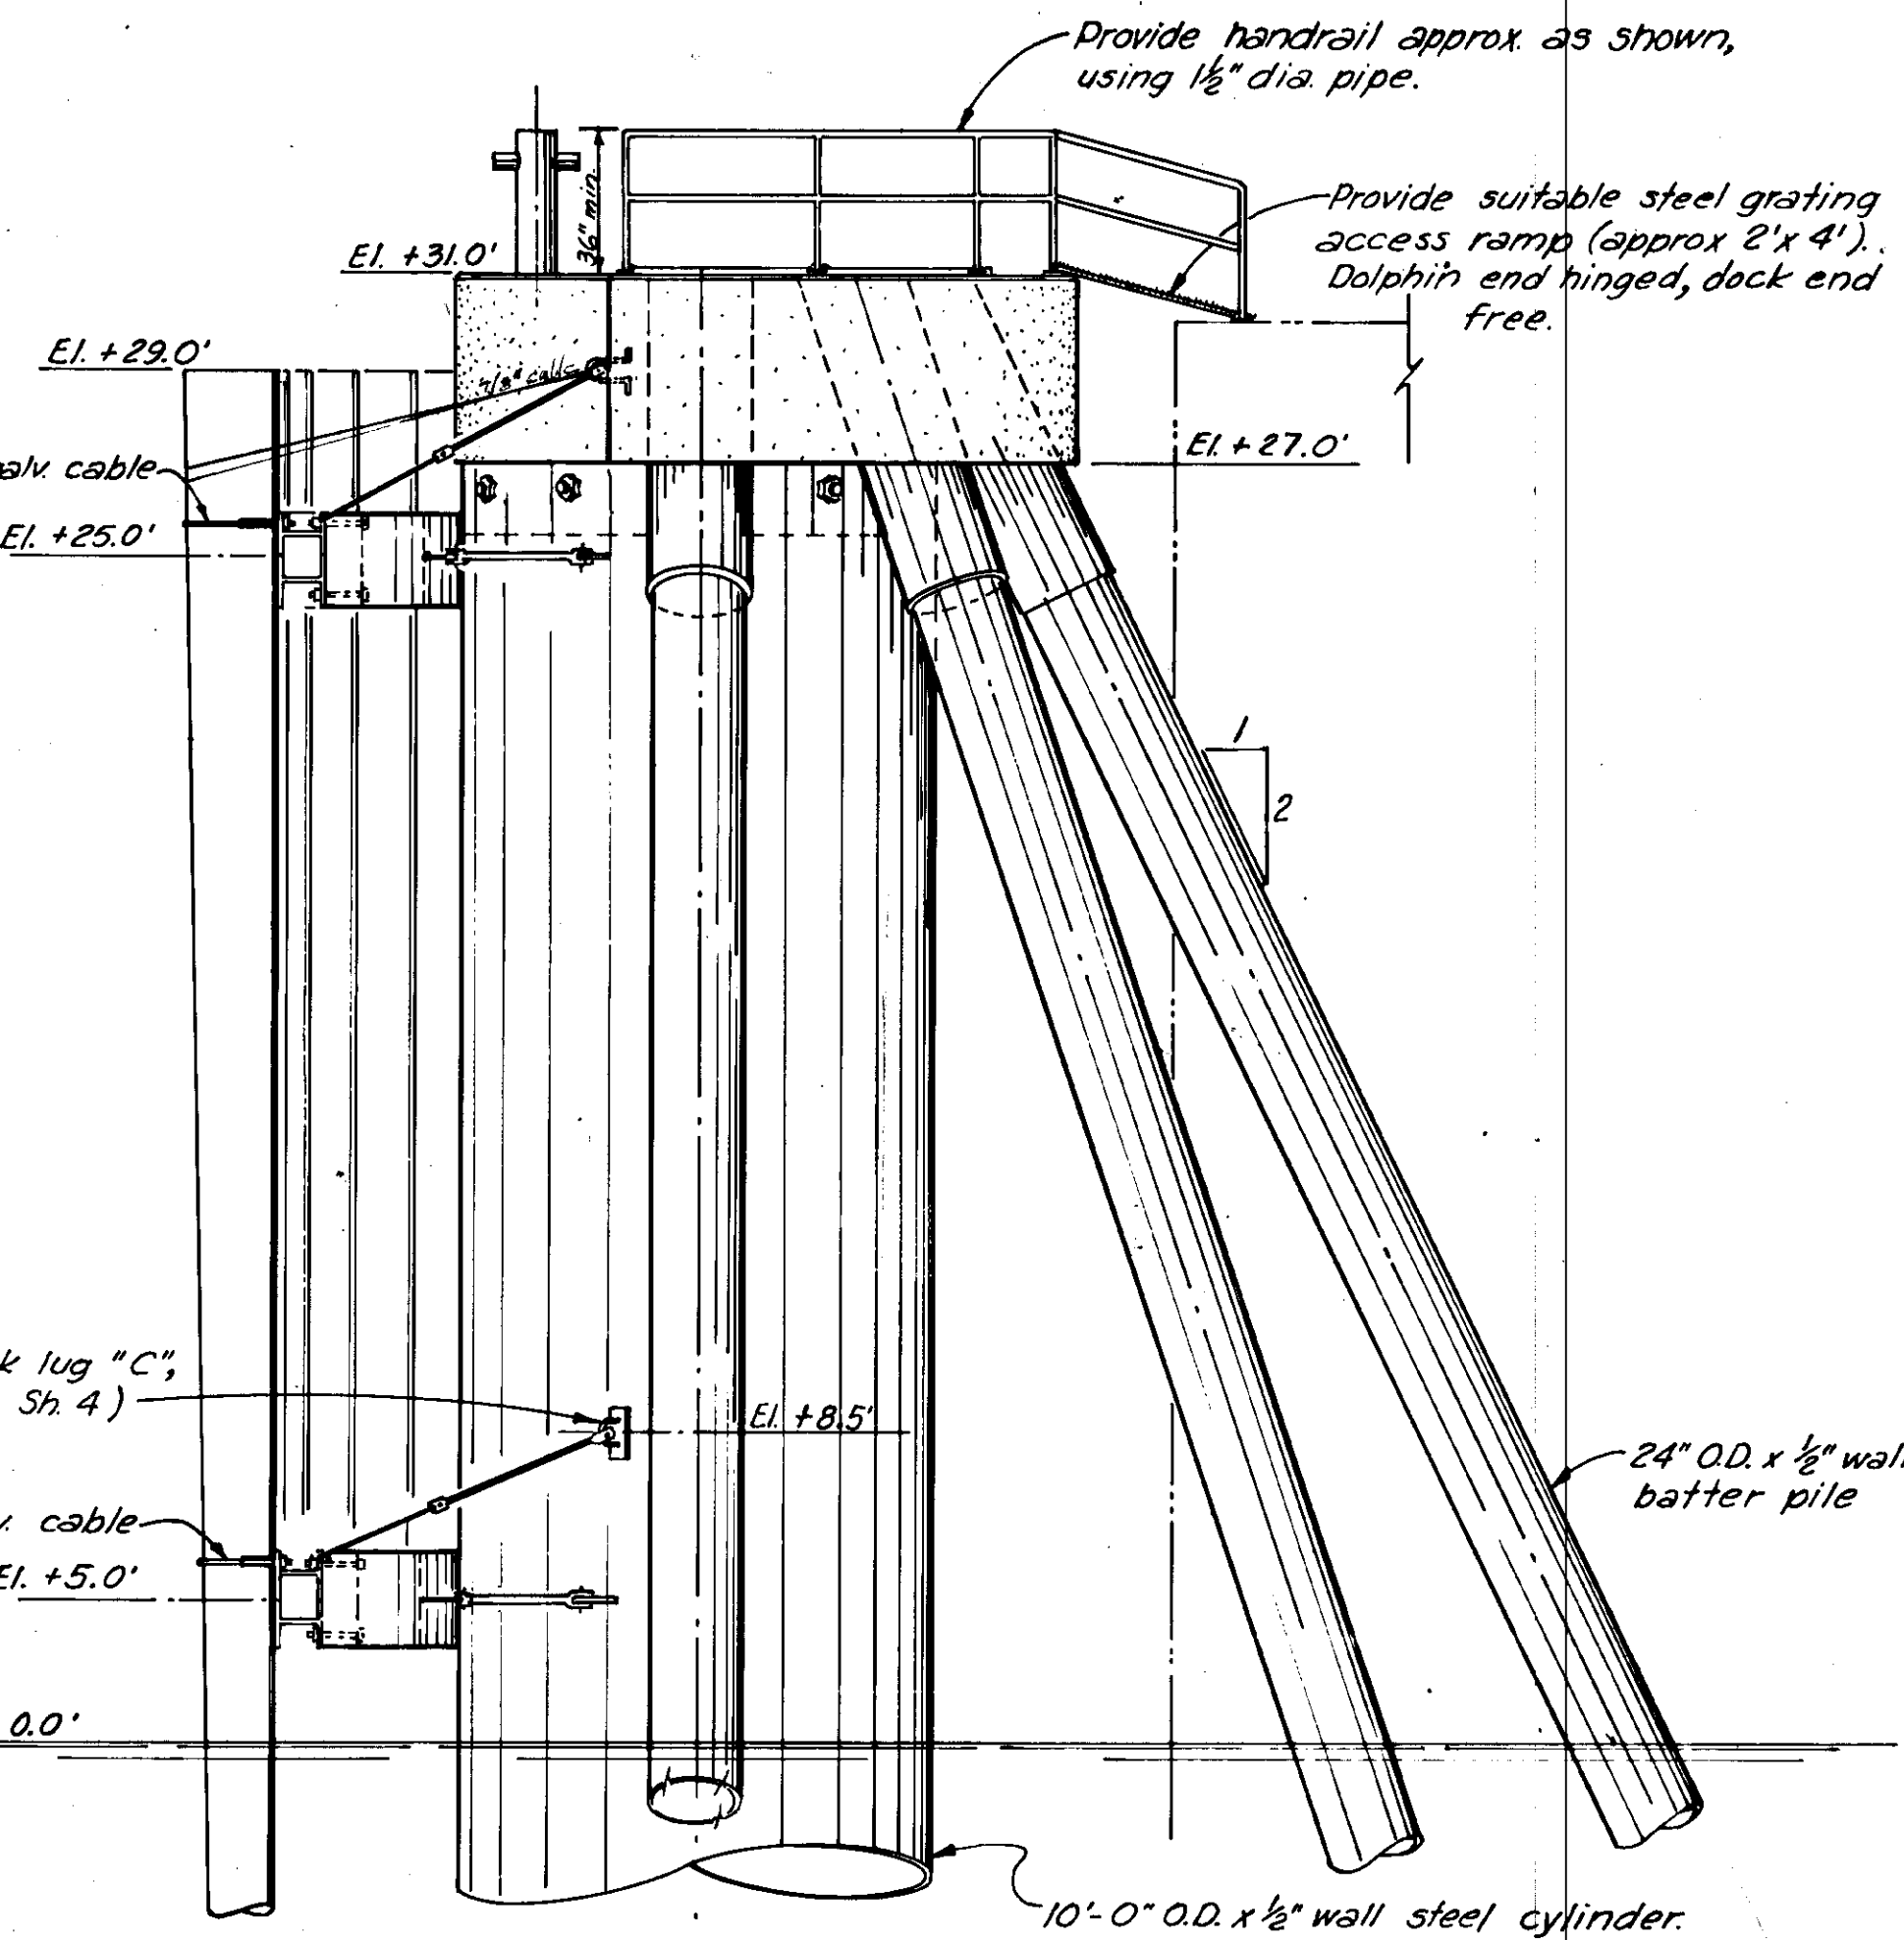

**ELEVATION**


**DOLPHIN DETAILS**

1/2" = 1'-0"

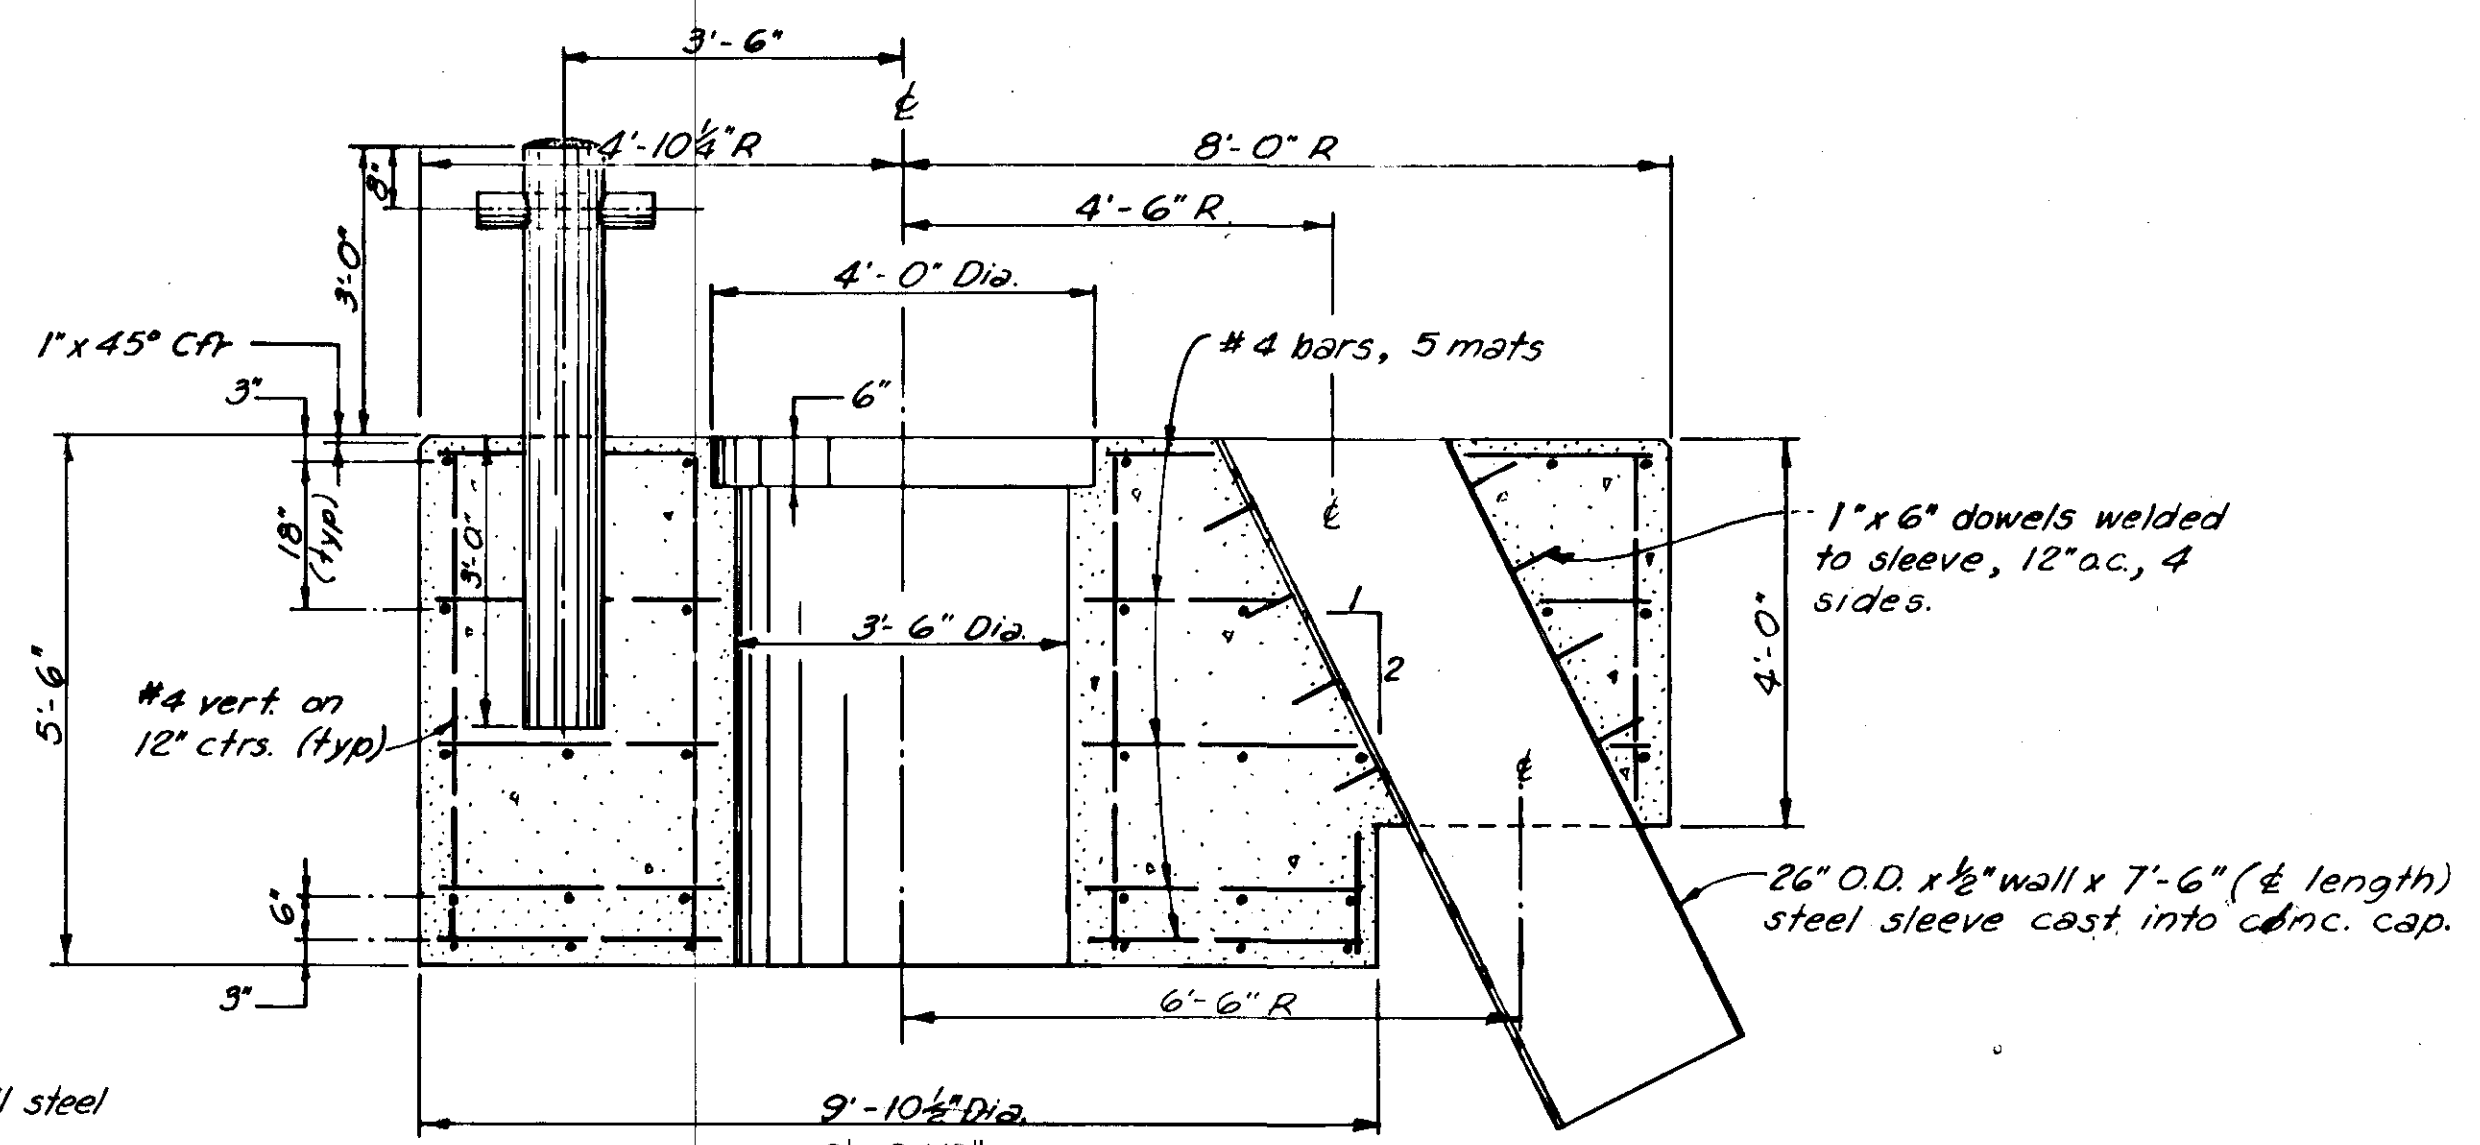


**SECTION A-A**

1/2" = 1'-0"

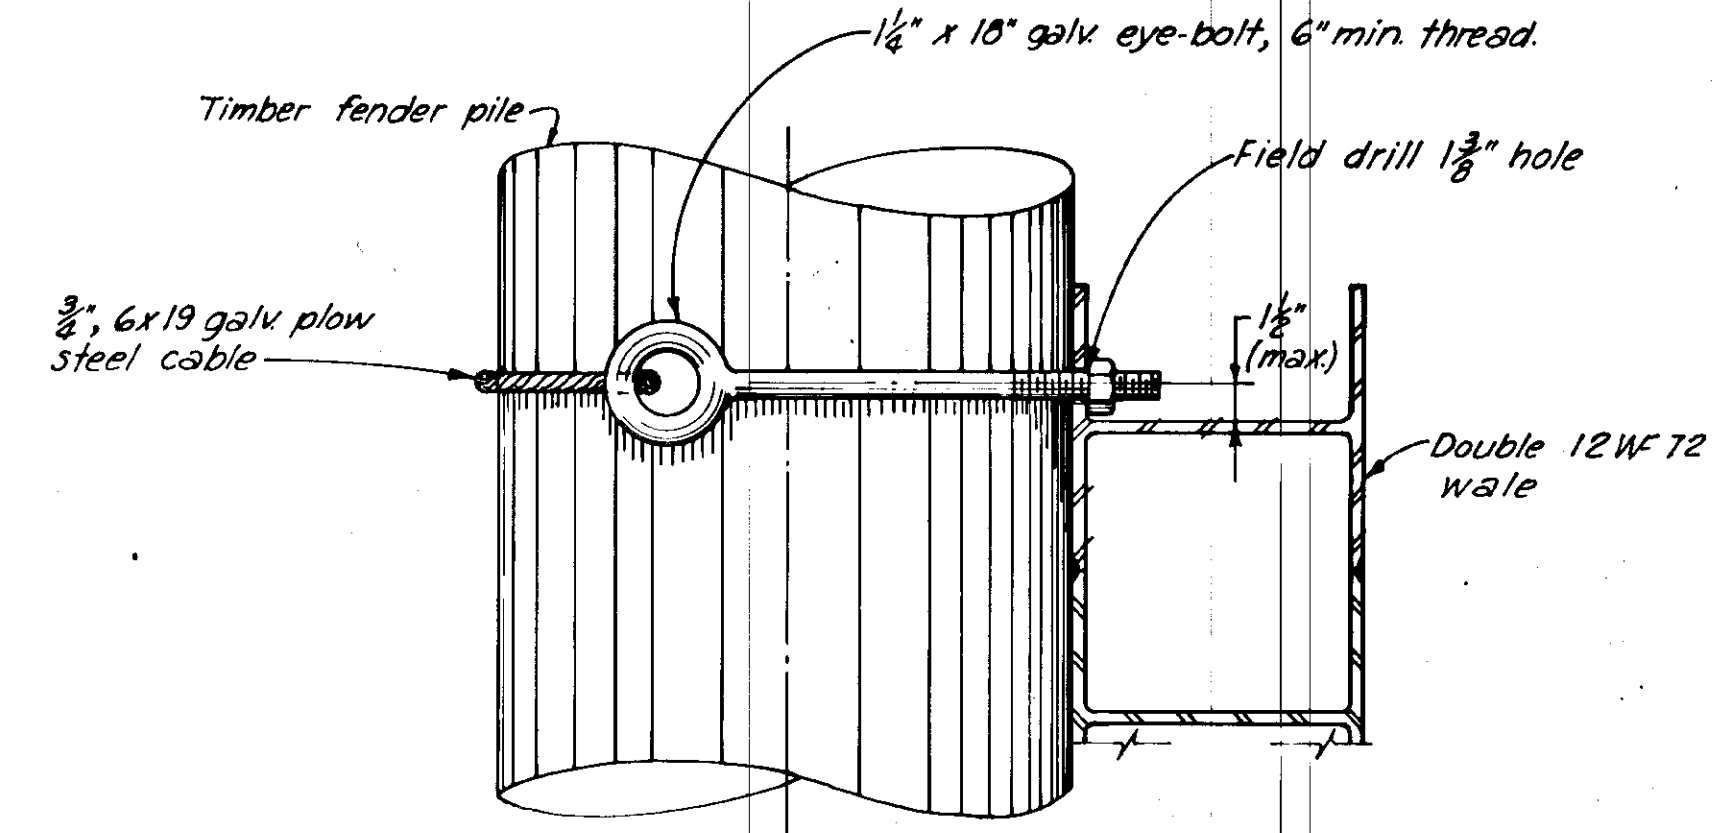

**SECTIONAL DETAIL "D"**

1/2" = 1'-0"

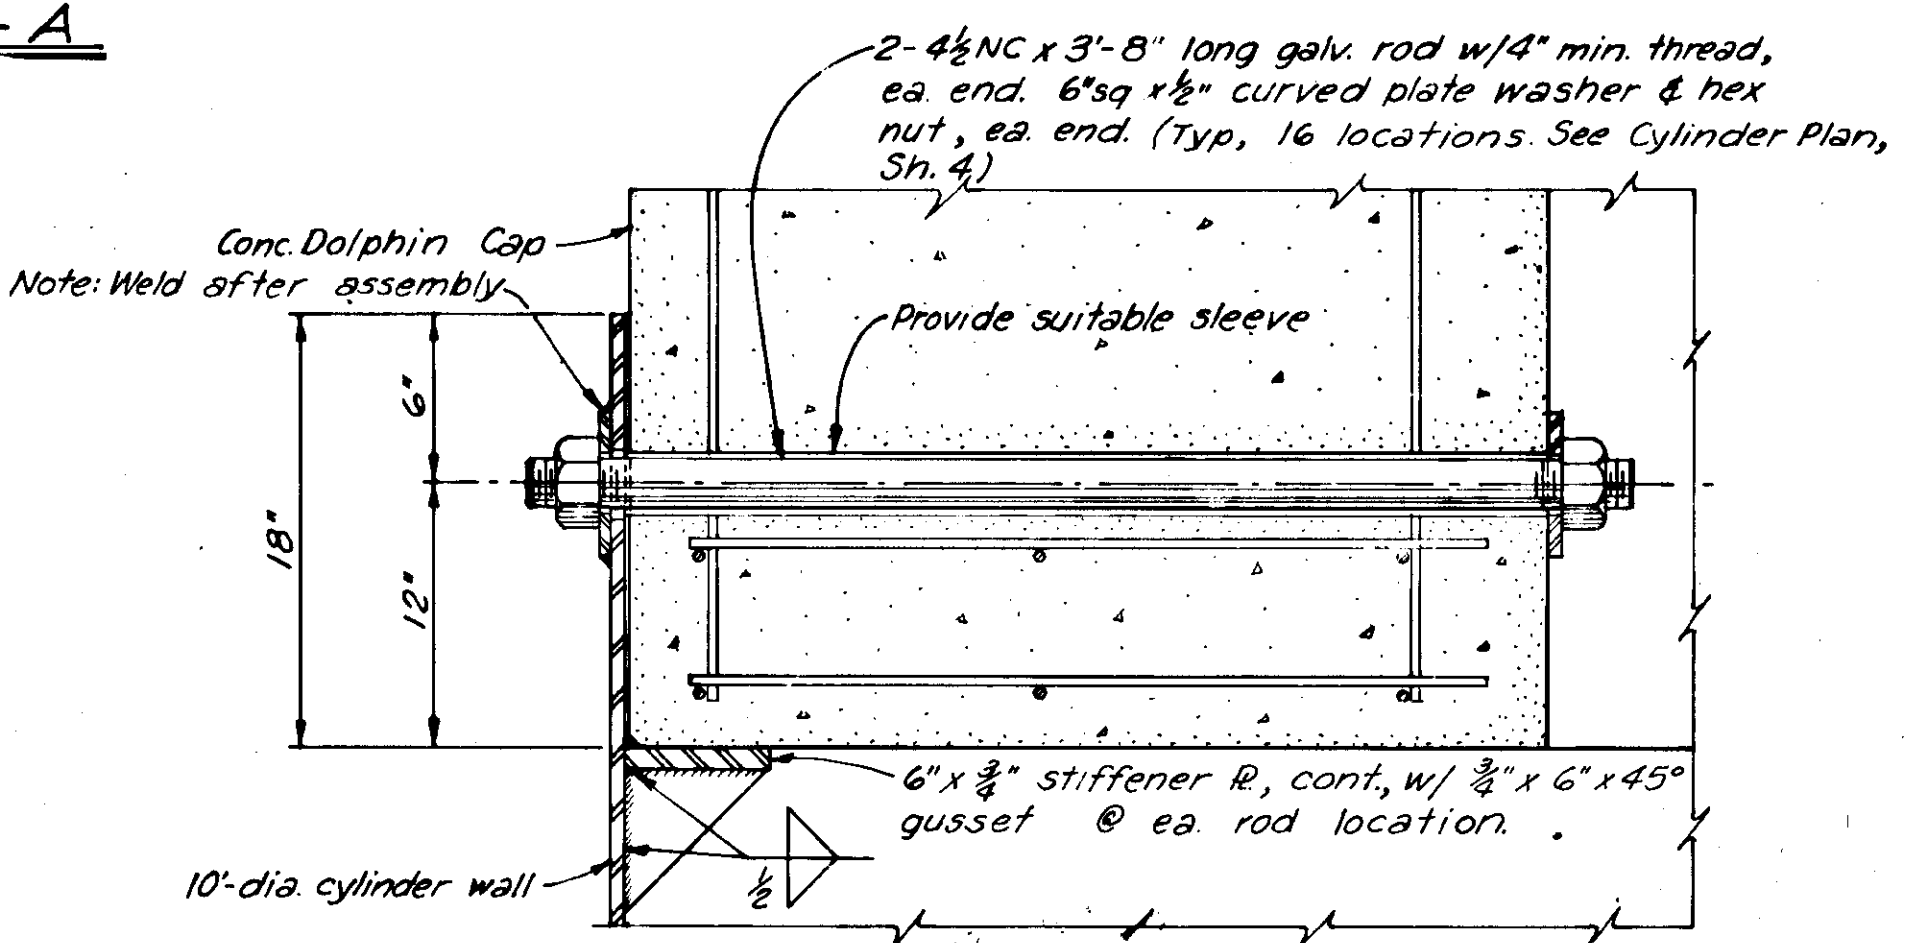


**SECTION B-B**

1/2" = 1'-0"


Note: Drive batter piles thru sleeves to depth specified. Insert 1/2" thick x 12" long quarter-segment shims at lower end of sleeve. Weld pile to sleeve with cont. weld. After pile is installed, cast concrete plug in top of sleeve to seal and provide smooth surface. (See Detail, Sh. 4).

**As Constructed**


DO NOT SCALE THIS DRAWING - USE DIMENSIONS		
STATE OF ALASKA DEPARTMENT OF PUBLIC WORKS DIVISION OF WATER AND HARBORS		
<b>DOLPHIN "C" DETAILS</b>		
SCALE <i>As shown</i>	SURVEYED <i>---</i>	APPROVED
DESIGNED <i>DM-DB-JT</i>	DRAWN <i>JET</i>	<i>Don Statter</i>
CHECKED <i>DSM</i>	DATE <i>12-20-73</i>	DIRECTOR
PROJECT NUMBER <i>6-73165</i>	SHEET <i>39</i> OF <i>41</i>	

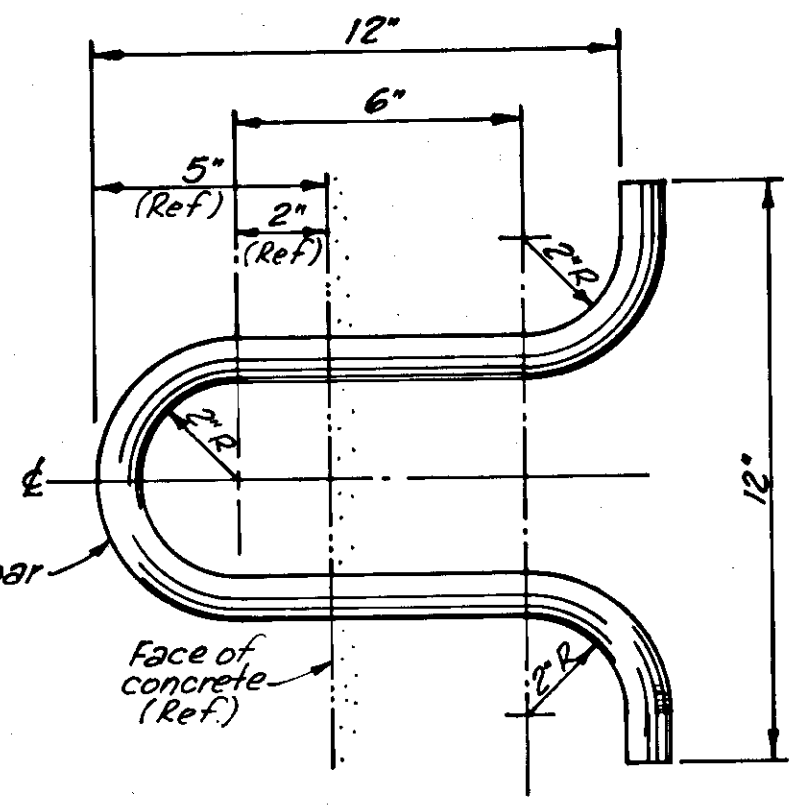


**TIEBACK LUG "A"**  
 $\frac{3}{8}'' = 1'-0''$   
 2 REQ'D

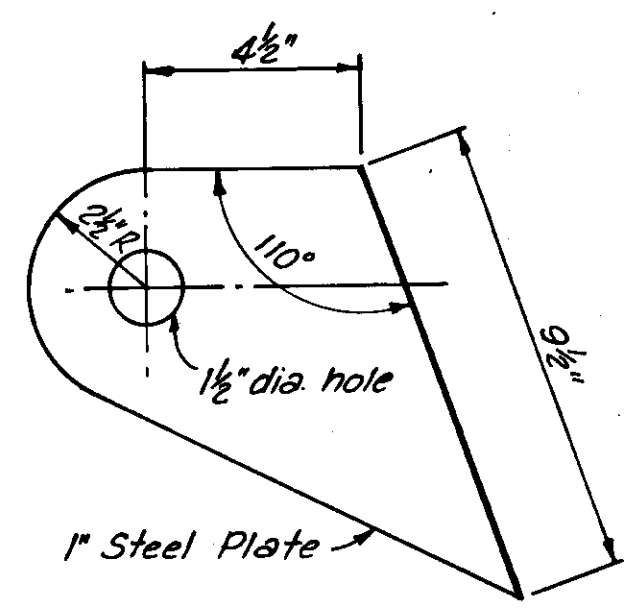


**TIEBACK LUG "B"**  
 $\frac{3}{8}'' = 1'-0''$   
 4 REQ'D

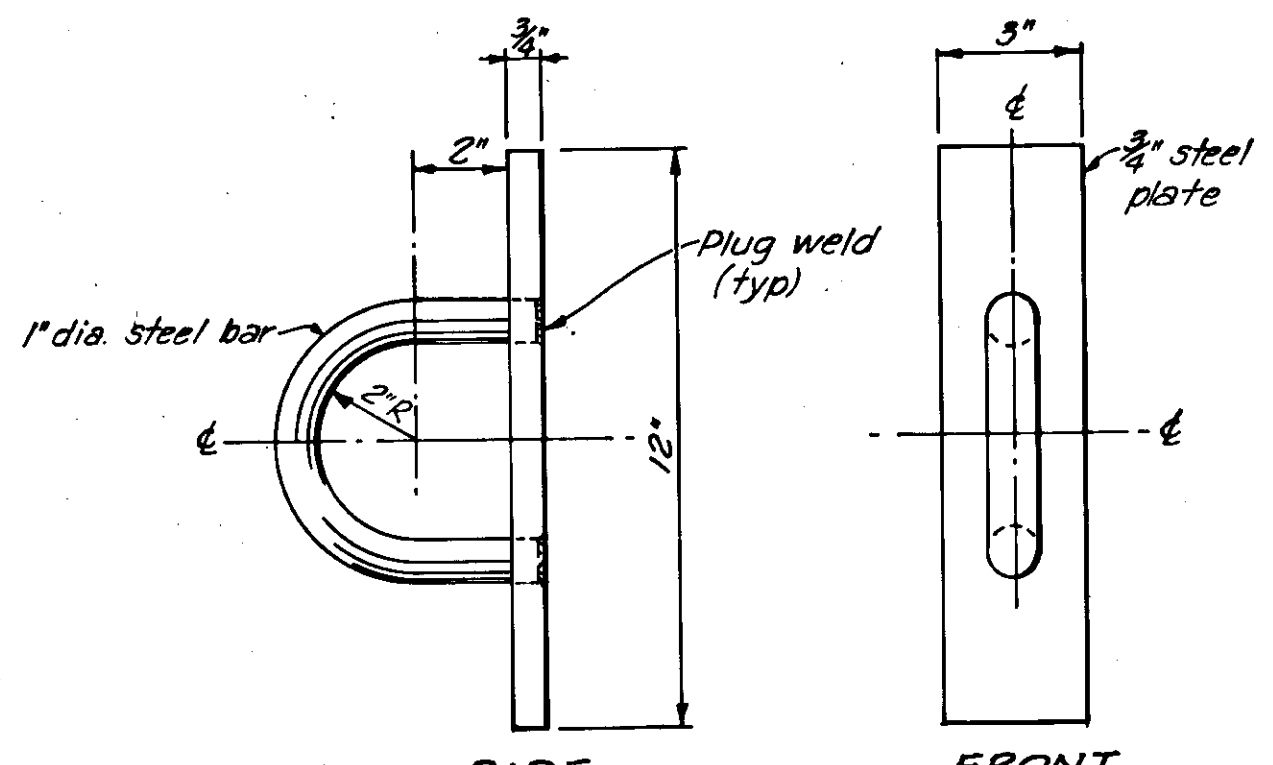


**TIEBACK LUG "C"**  
 $\frac{3}{8}'' = 1'-0''$   
 2 REQ'D

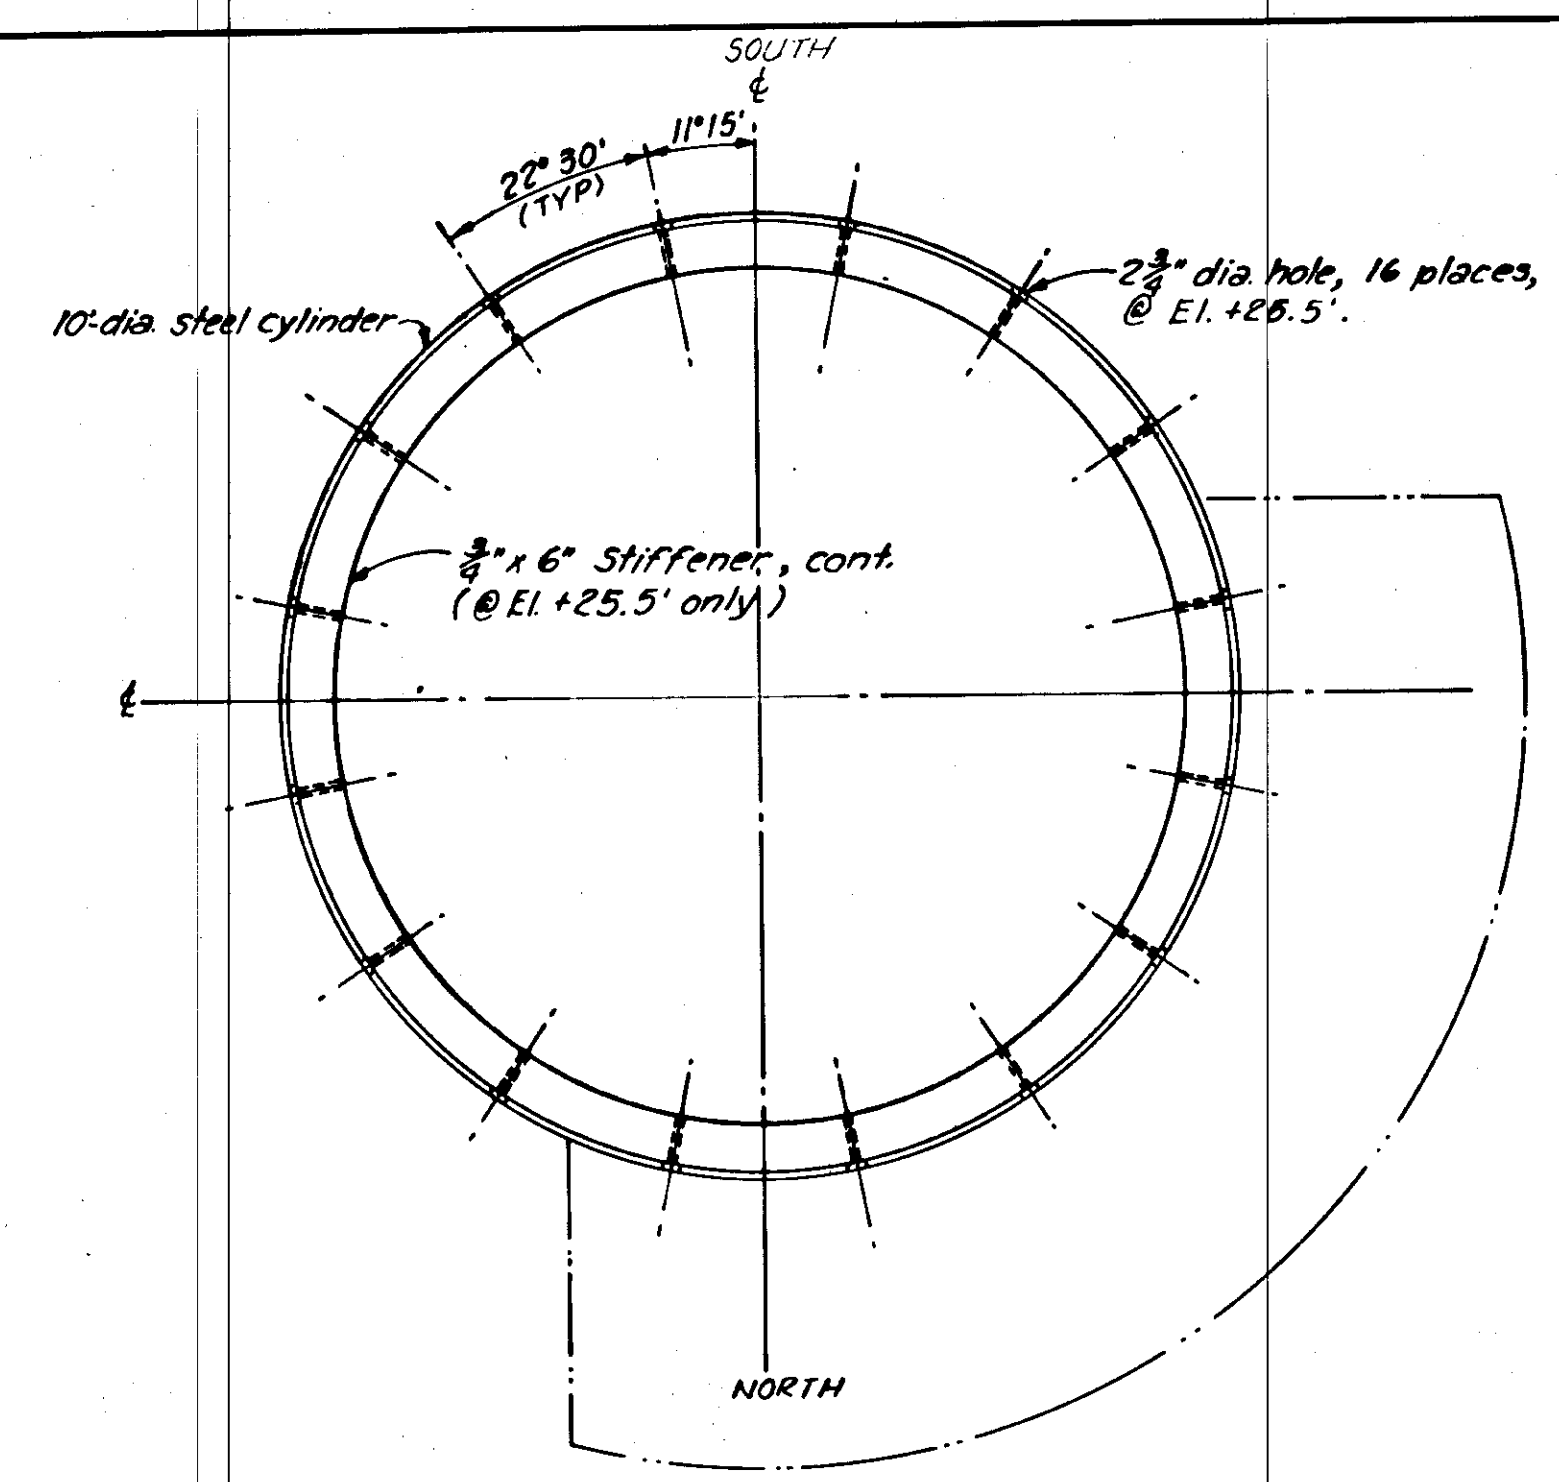


**10'-DIA. CYLINDER - PLAN**  
 $\frac{1}{8}'' = 1'-0''$

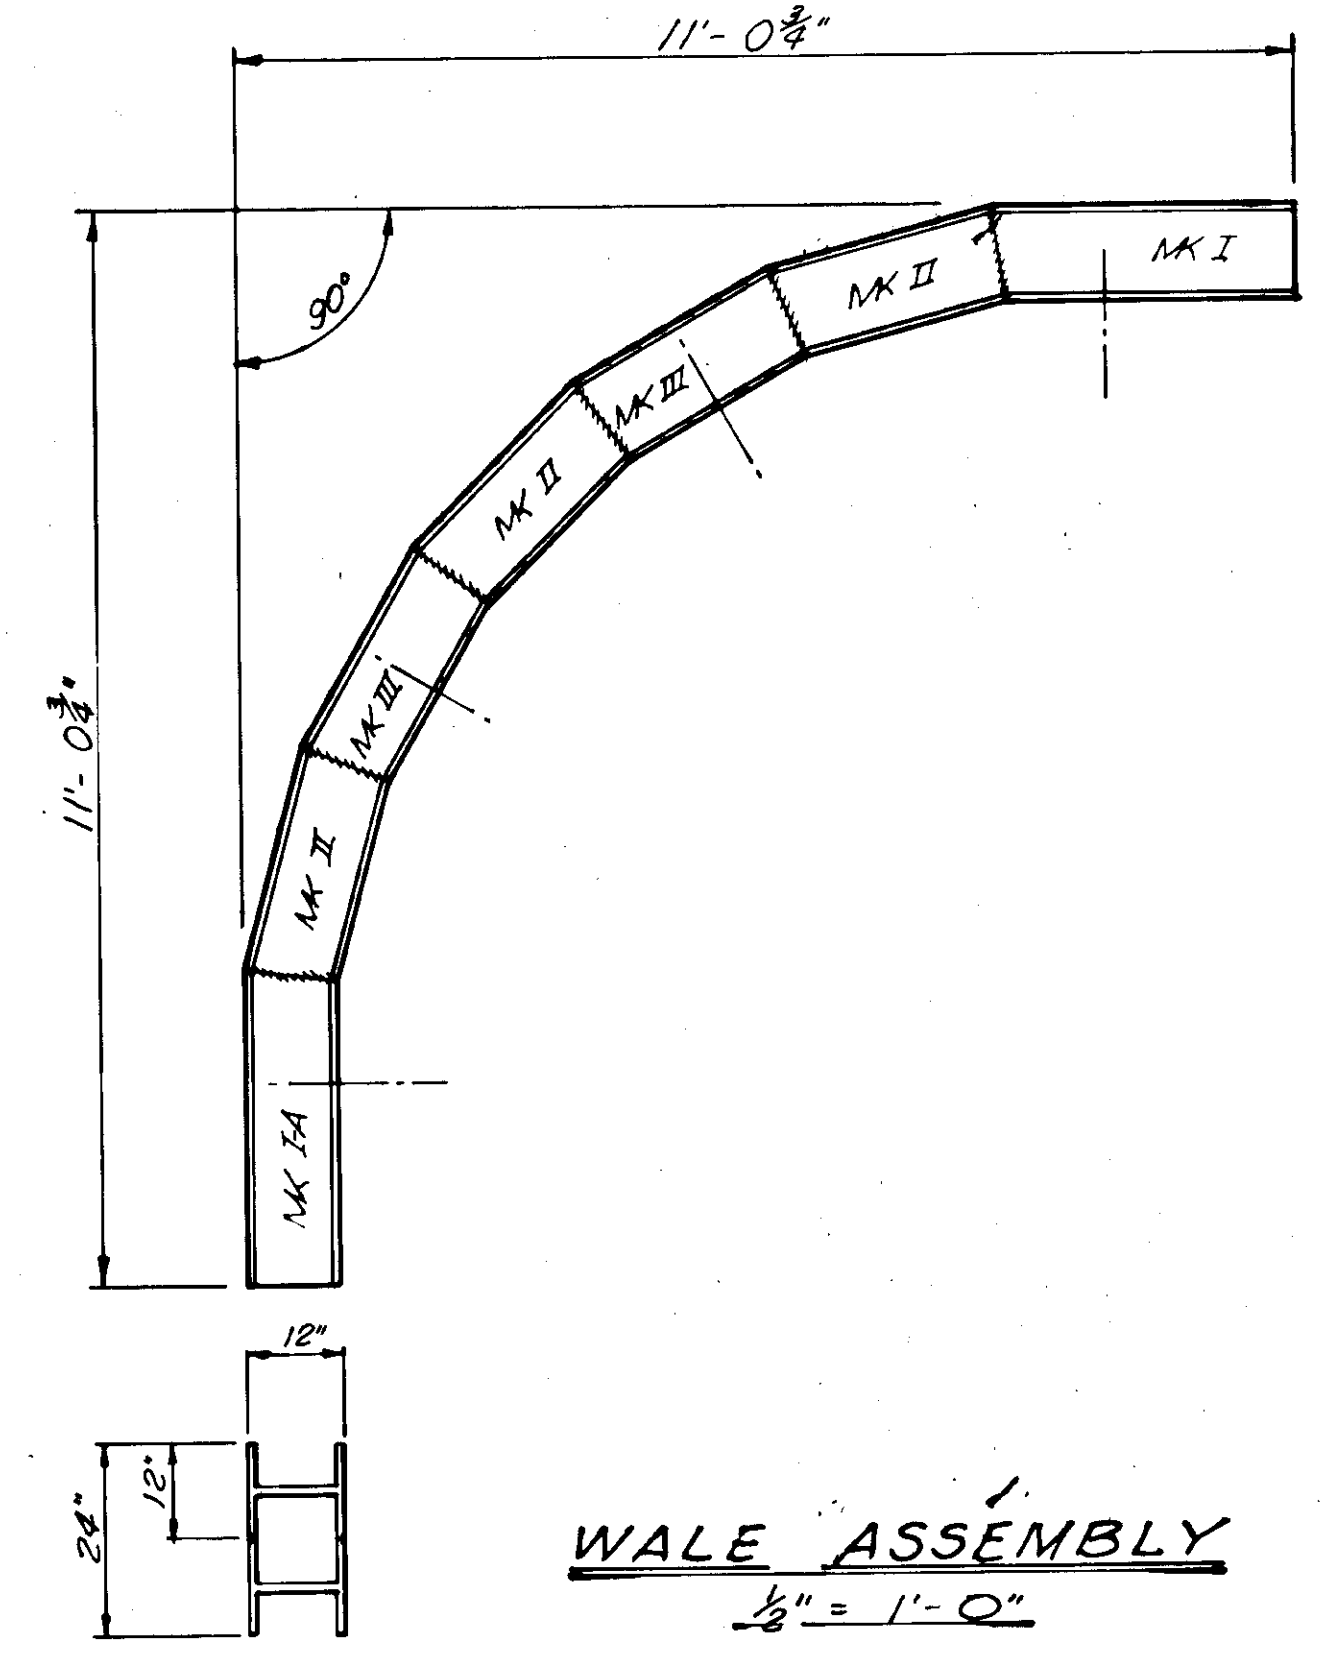


**WALE ASSEMBLY**  
 $\frac{1}{8}'' = 1'-0''$   
 (2 ASSEMBLIES REQ'D)

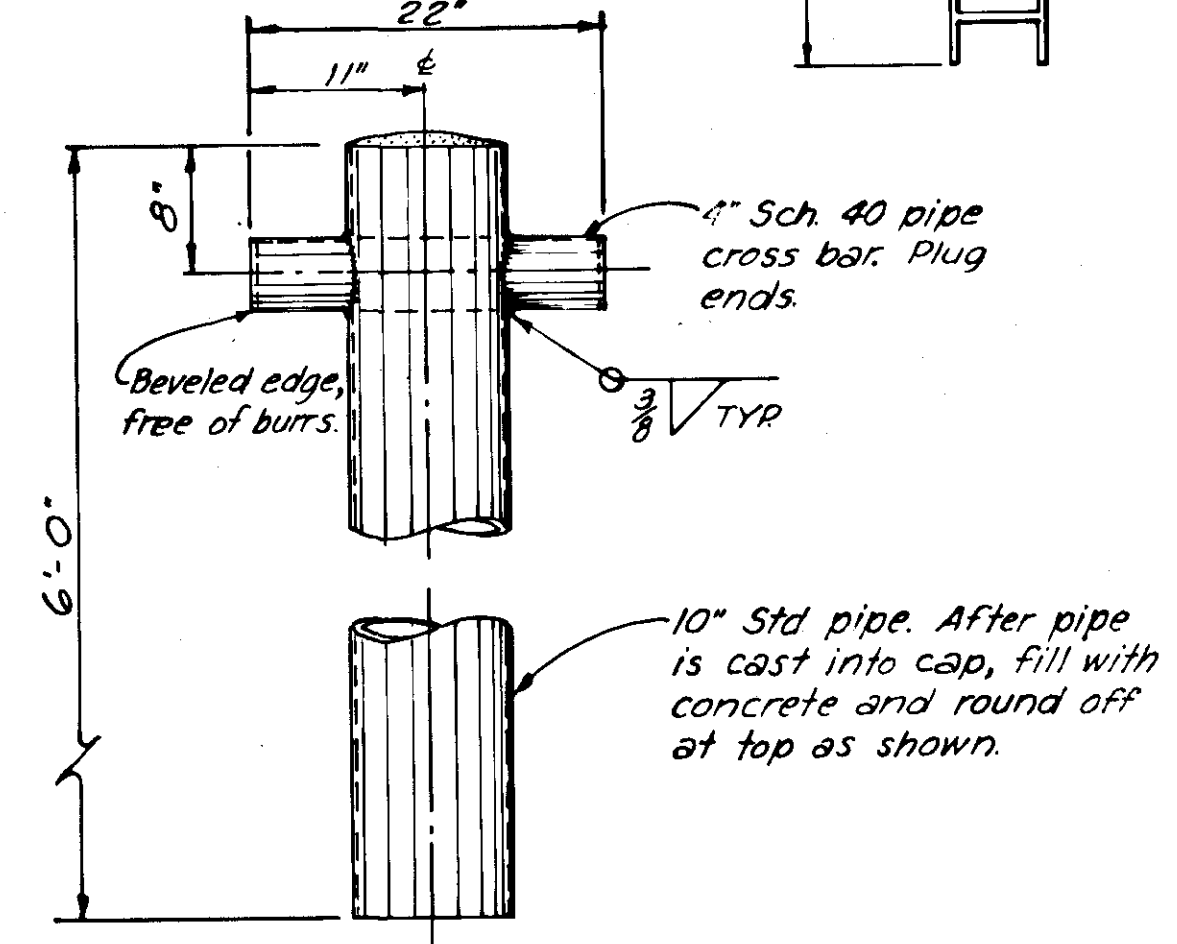




**BOLLARD DETAIL**  
 SH. 3 FOR LOCATION  
 $1'' = 1'-0''$

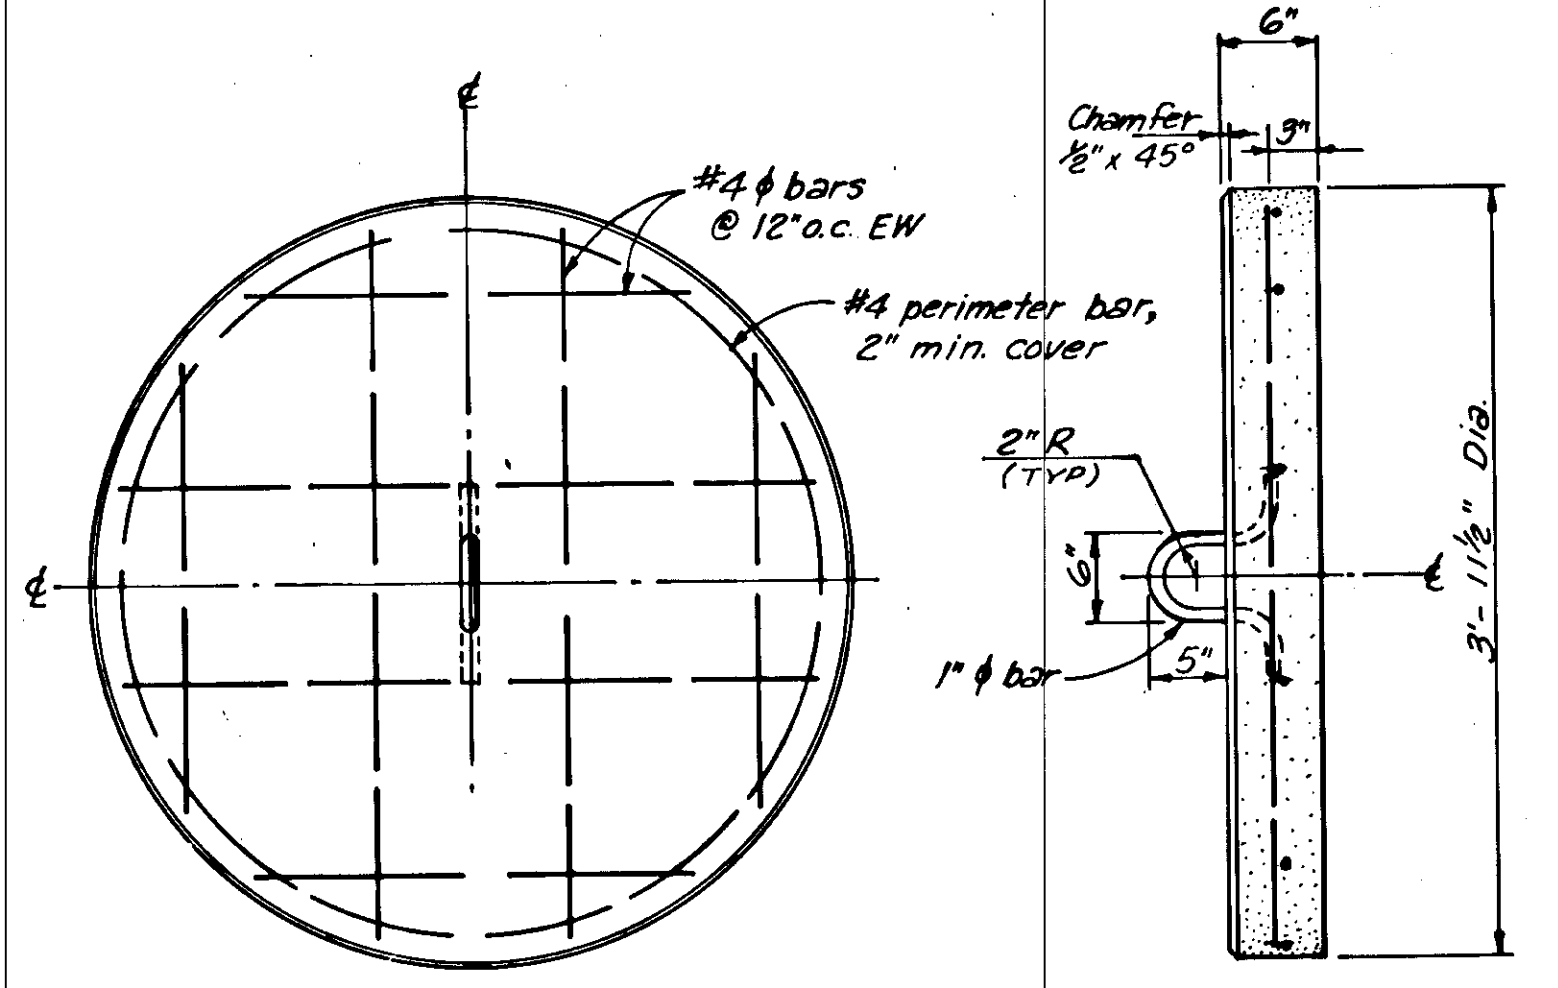

**DOLPHIN CAP PLUG**  
 $1'' = 1'-0''$

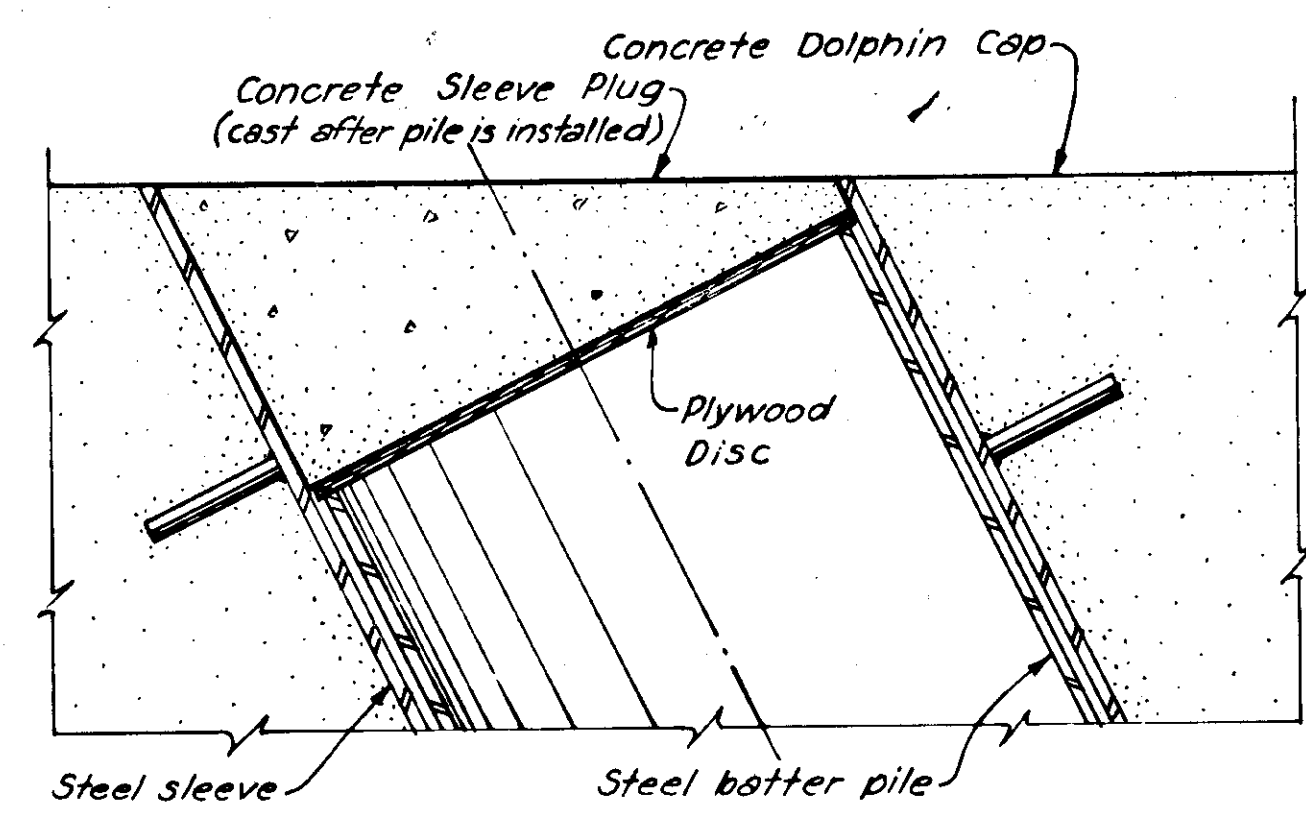

**SLEEVE PLUG DETAIL**  
 SUGGESTED METHOD  
 $\frac{1}{8}'' = 1'-0''$

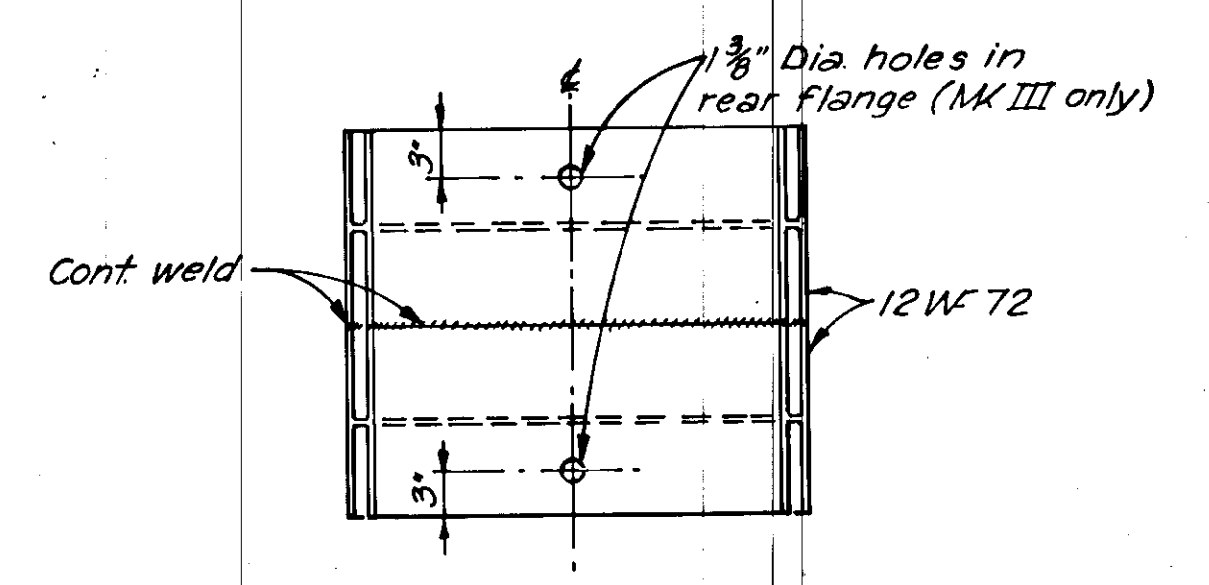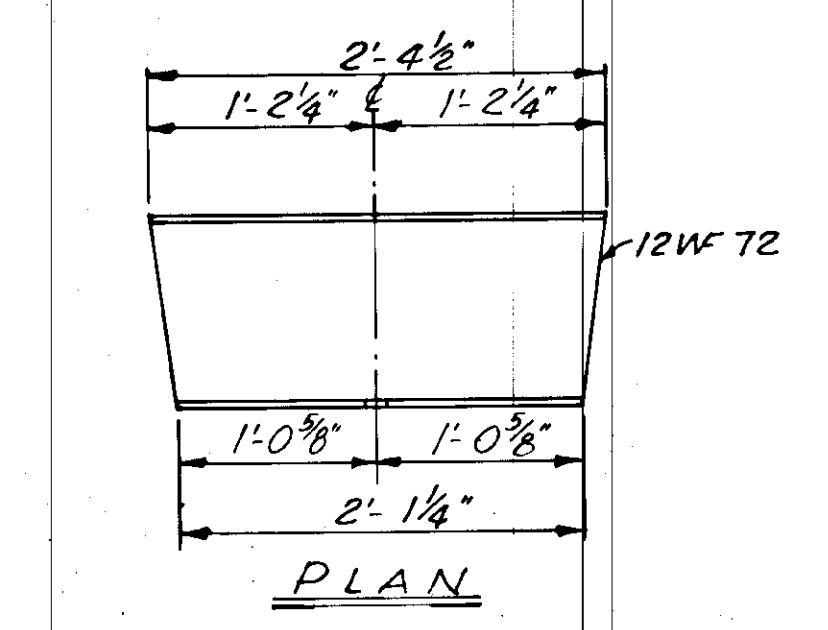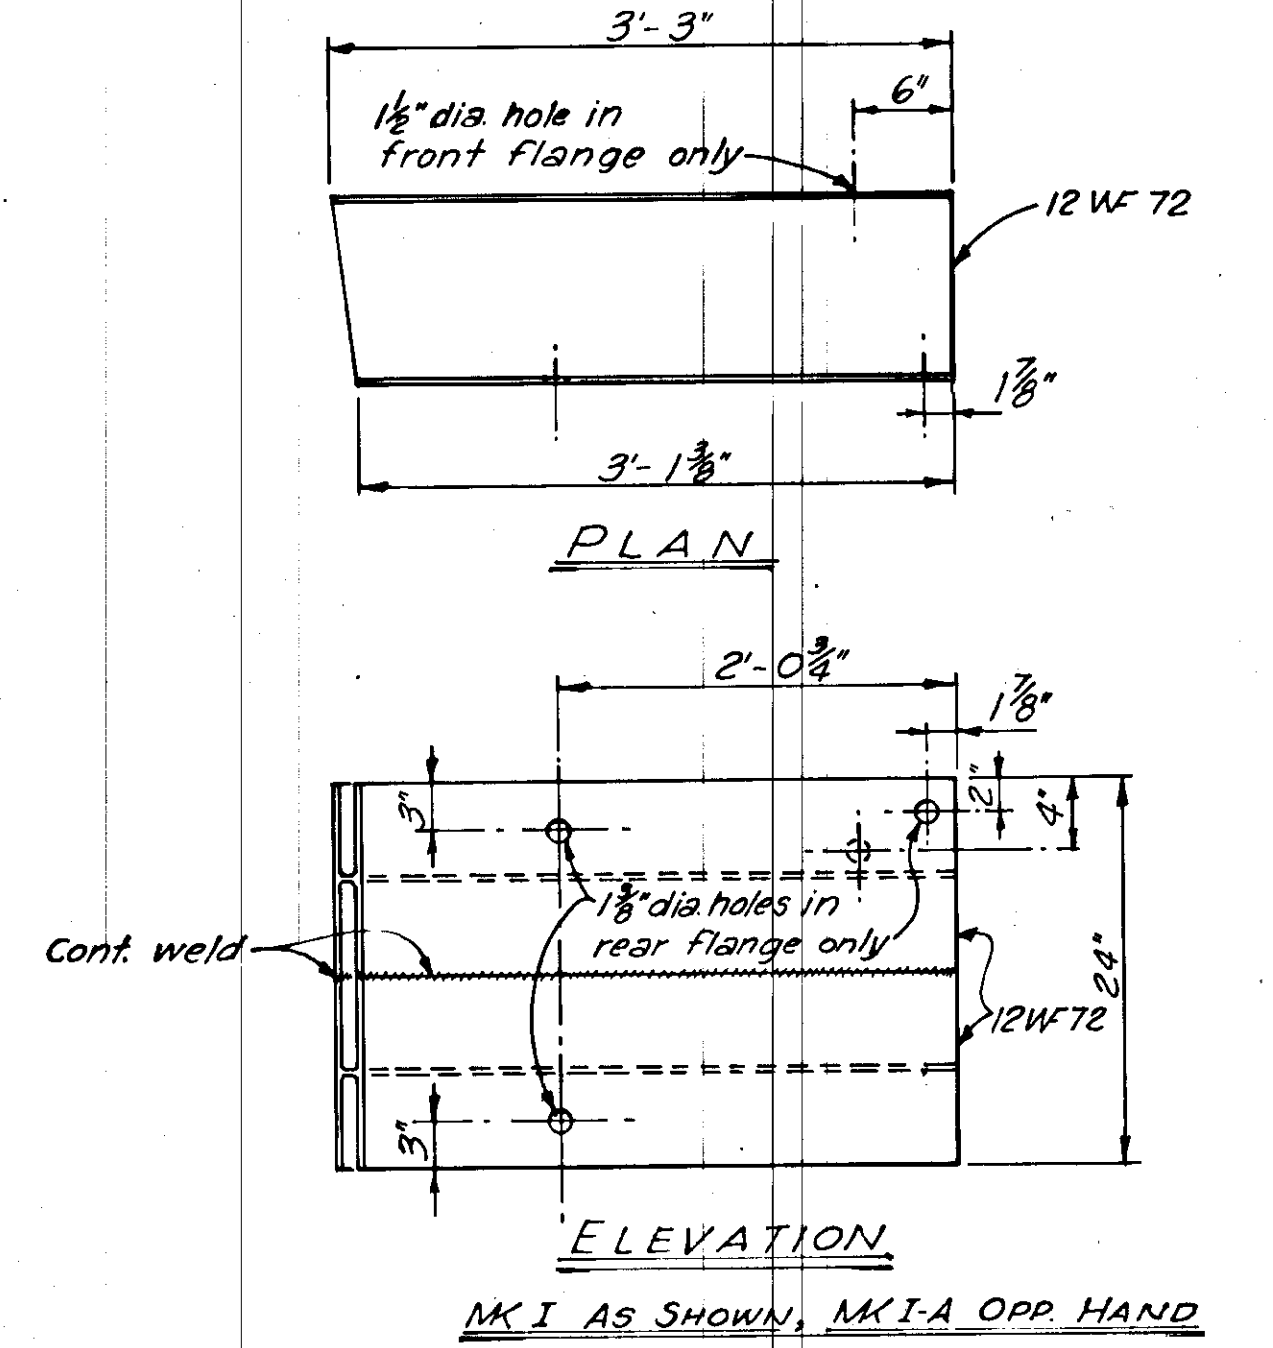


**WALE SEGMENT DETAILS**  
 $1'' = 1'-0''$

**As Constructed**


DO NOT SCALE THIS DRAWING - USE DIMENSIONS  
 STATE OF ALASKA  
 DEPARTMENT OF PUBLIC WORKS  
 DIVISION OF WATER AND HARBORS

**DOLPHIN "C"**

SCALE <i>As shown</i>	SURVEYED	APPROVED
DESIGNED <i>DSM/JT</i>	DRAWN <i>JET</i>	<i>Don Statter</i>
CHECKED <i>DSM</i>	DATE <i>12-20-73</i>	DIRECTOR
PROJECT NUMBER <i>6-73165</i>	SHEET <i>40</i> OF <i>41</i>	


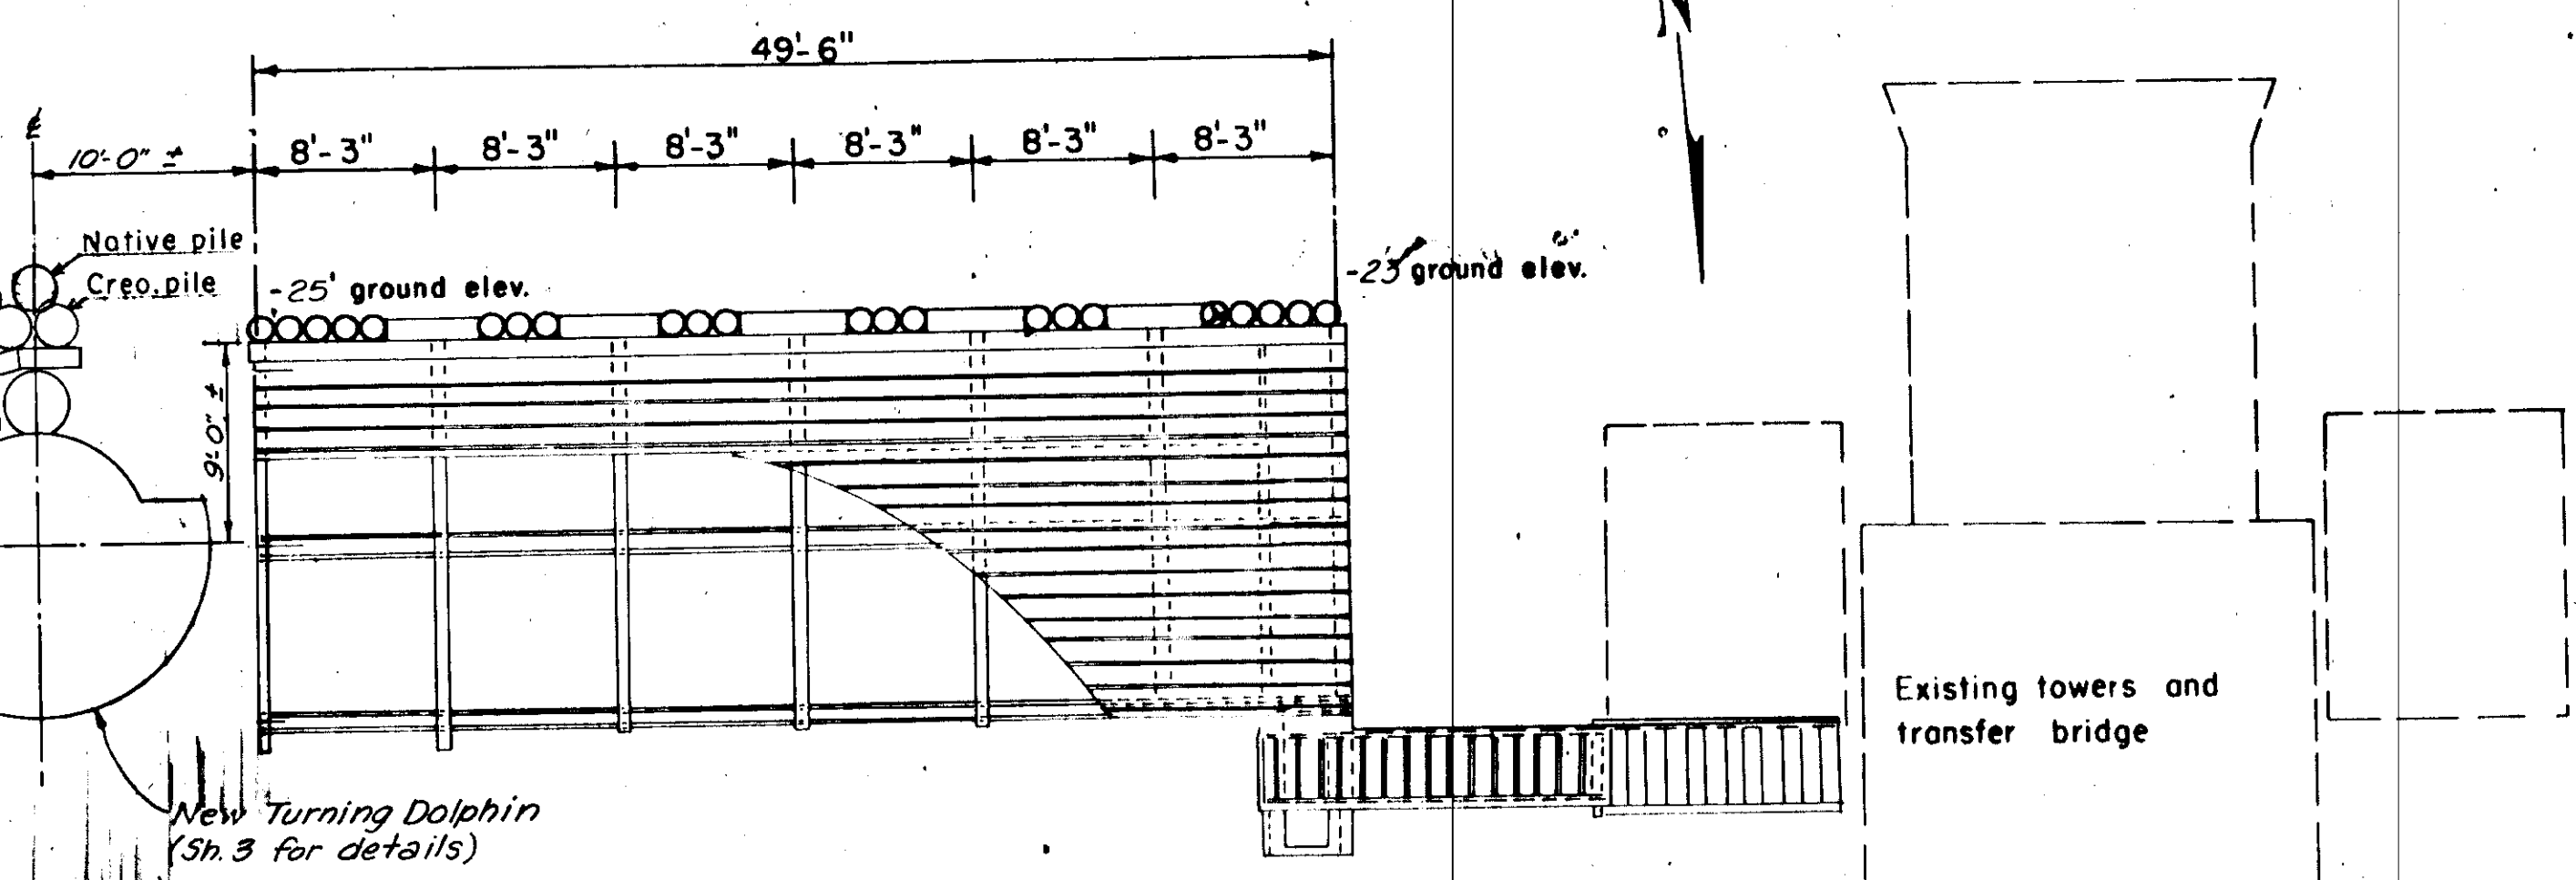


New Turning Dolphin  
(Sh. 3 for details)

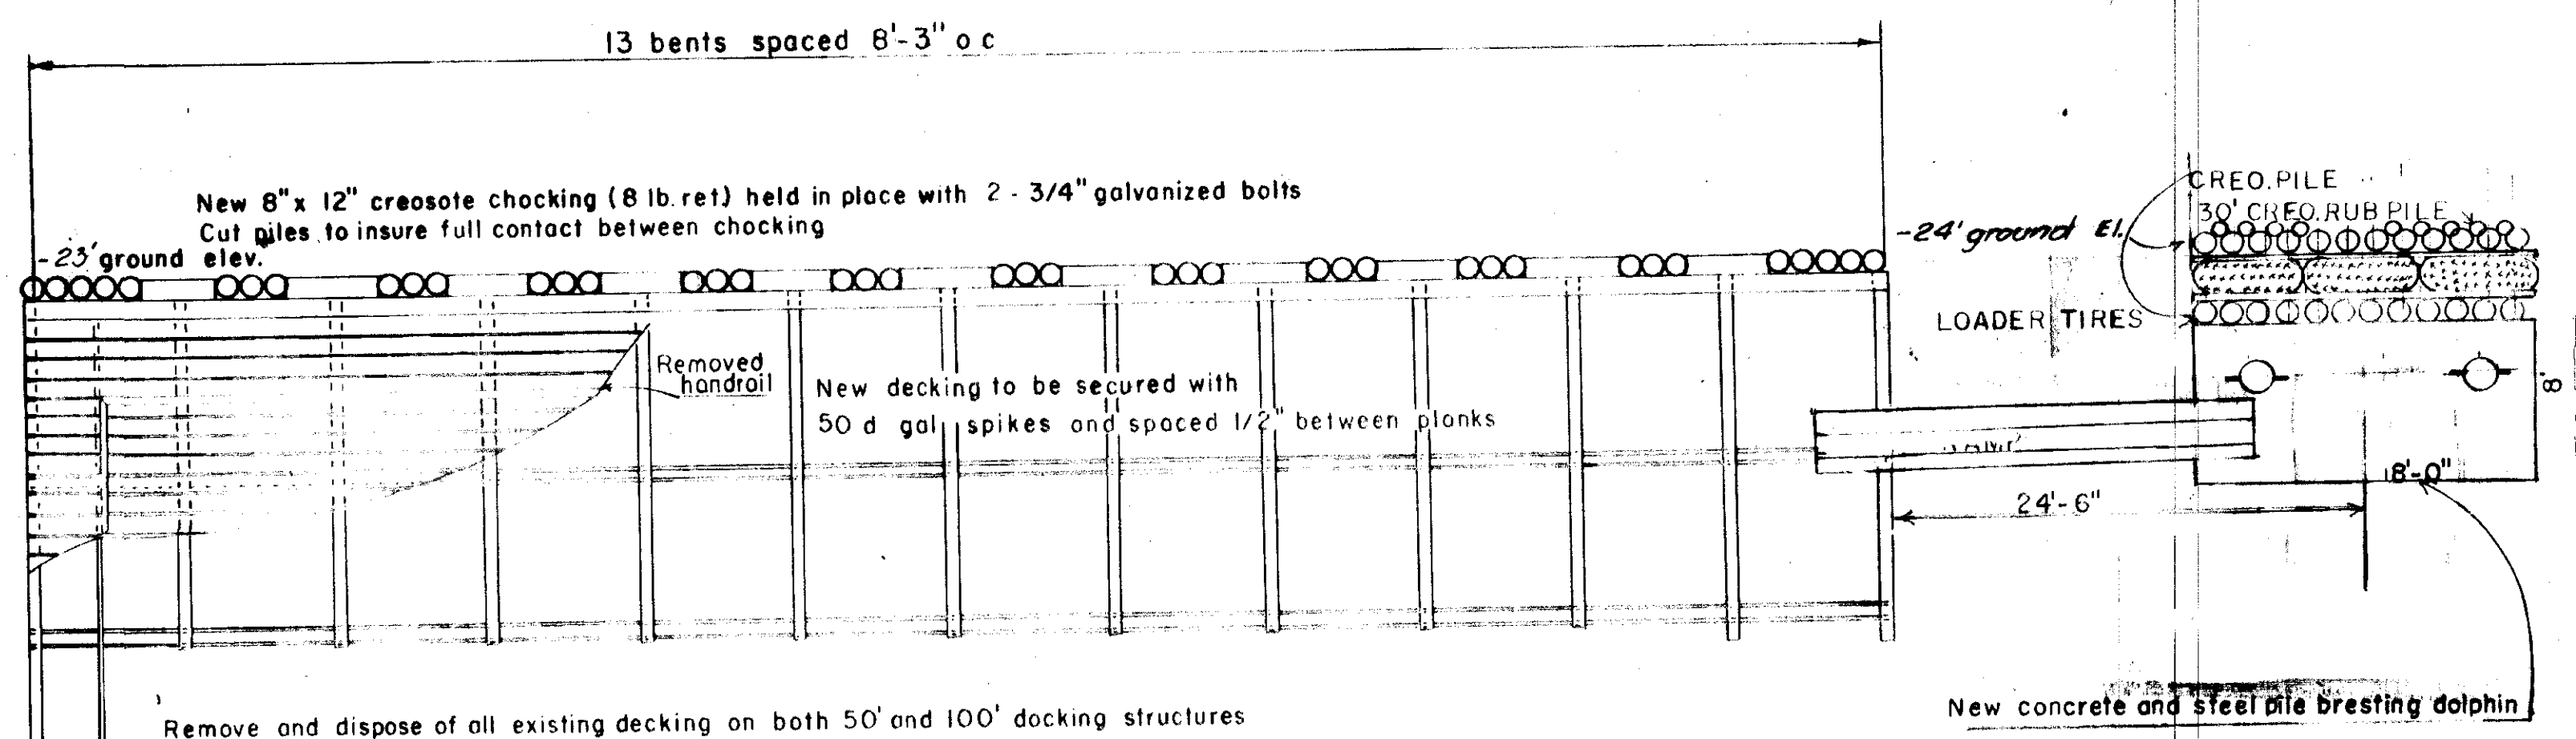

- Remove and dispose of all existing decking on both 50' and 100' docking structures
- Replace with 3" x 12" creosote S1S2E decking. Stagger all splices
- Remove and dispose of approx. 30 native fender piles and associated chocking
- Replace with 6 1/2" class A creosote treated piles (12 lb. ret.)
- Piles to be driven to 10' penetration or refusal
- Piles to be driven tip down

PLAN  
SCALE 1/8" = 1'-0"

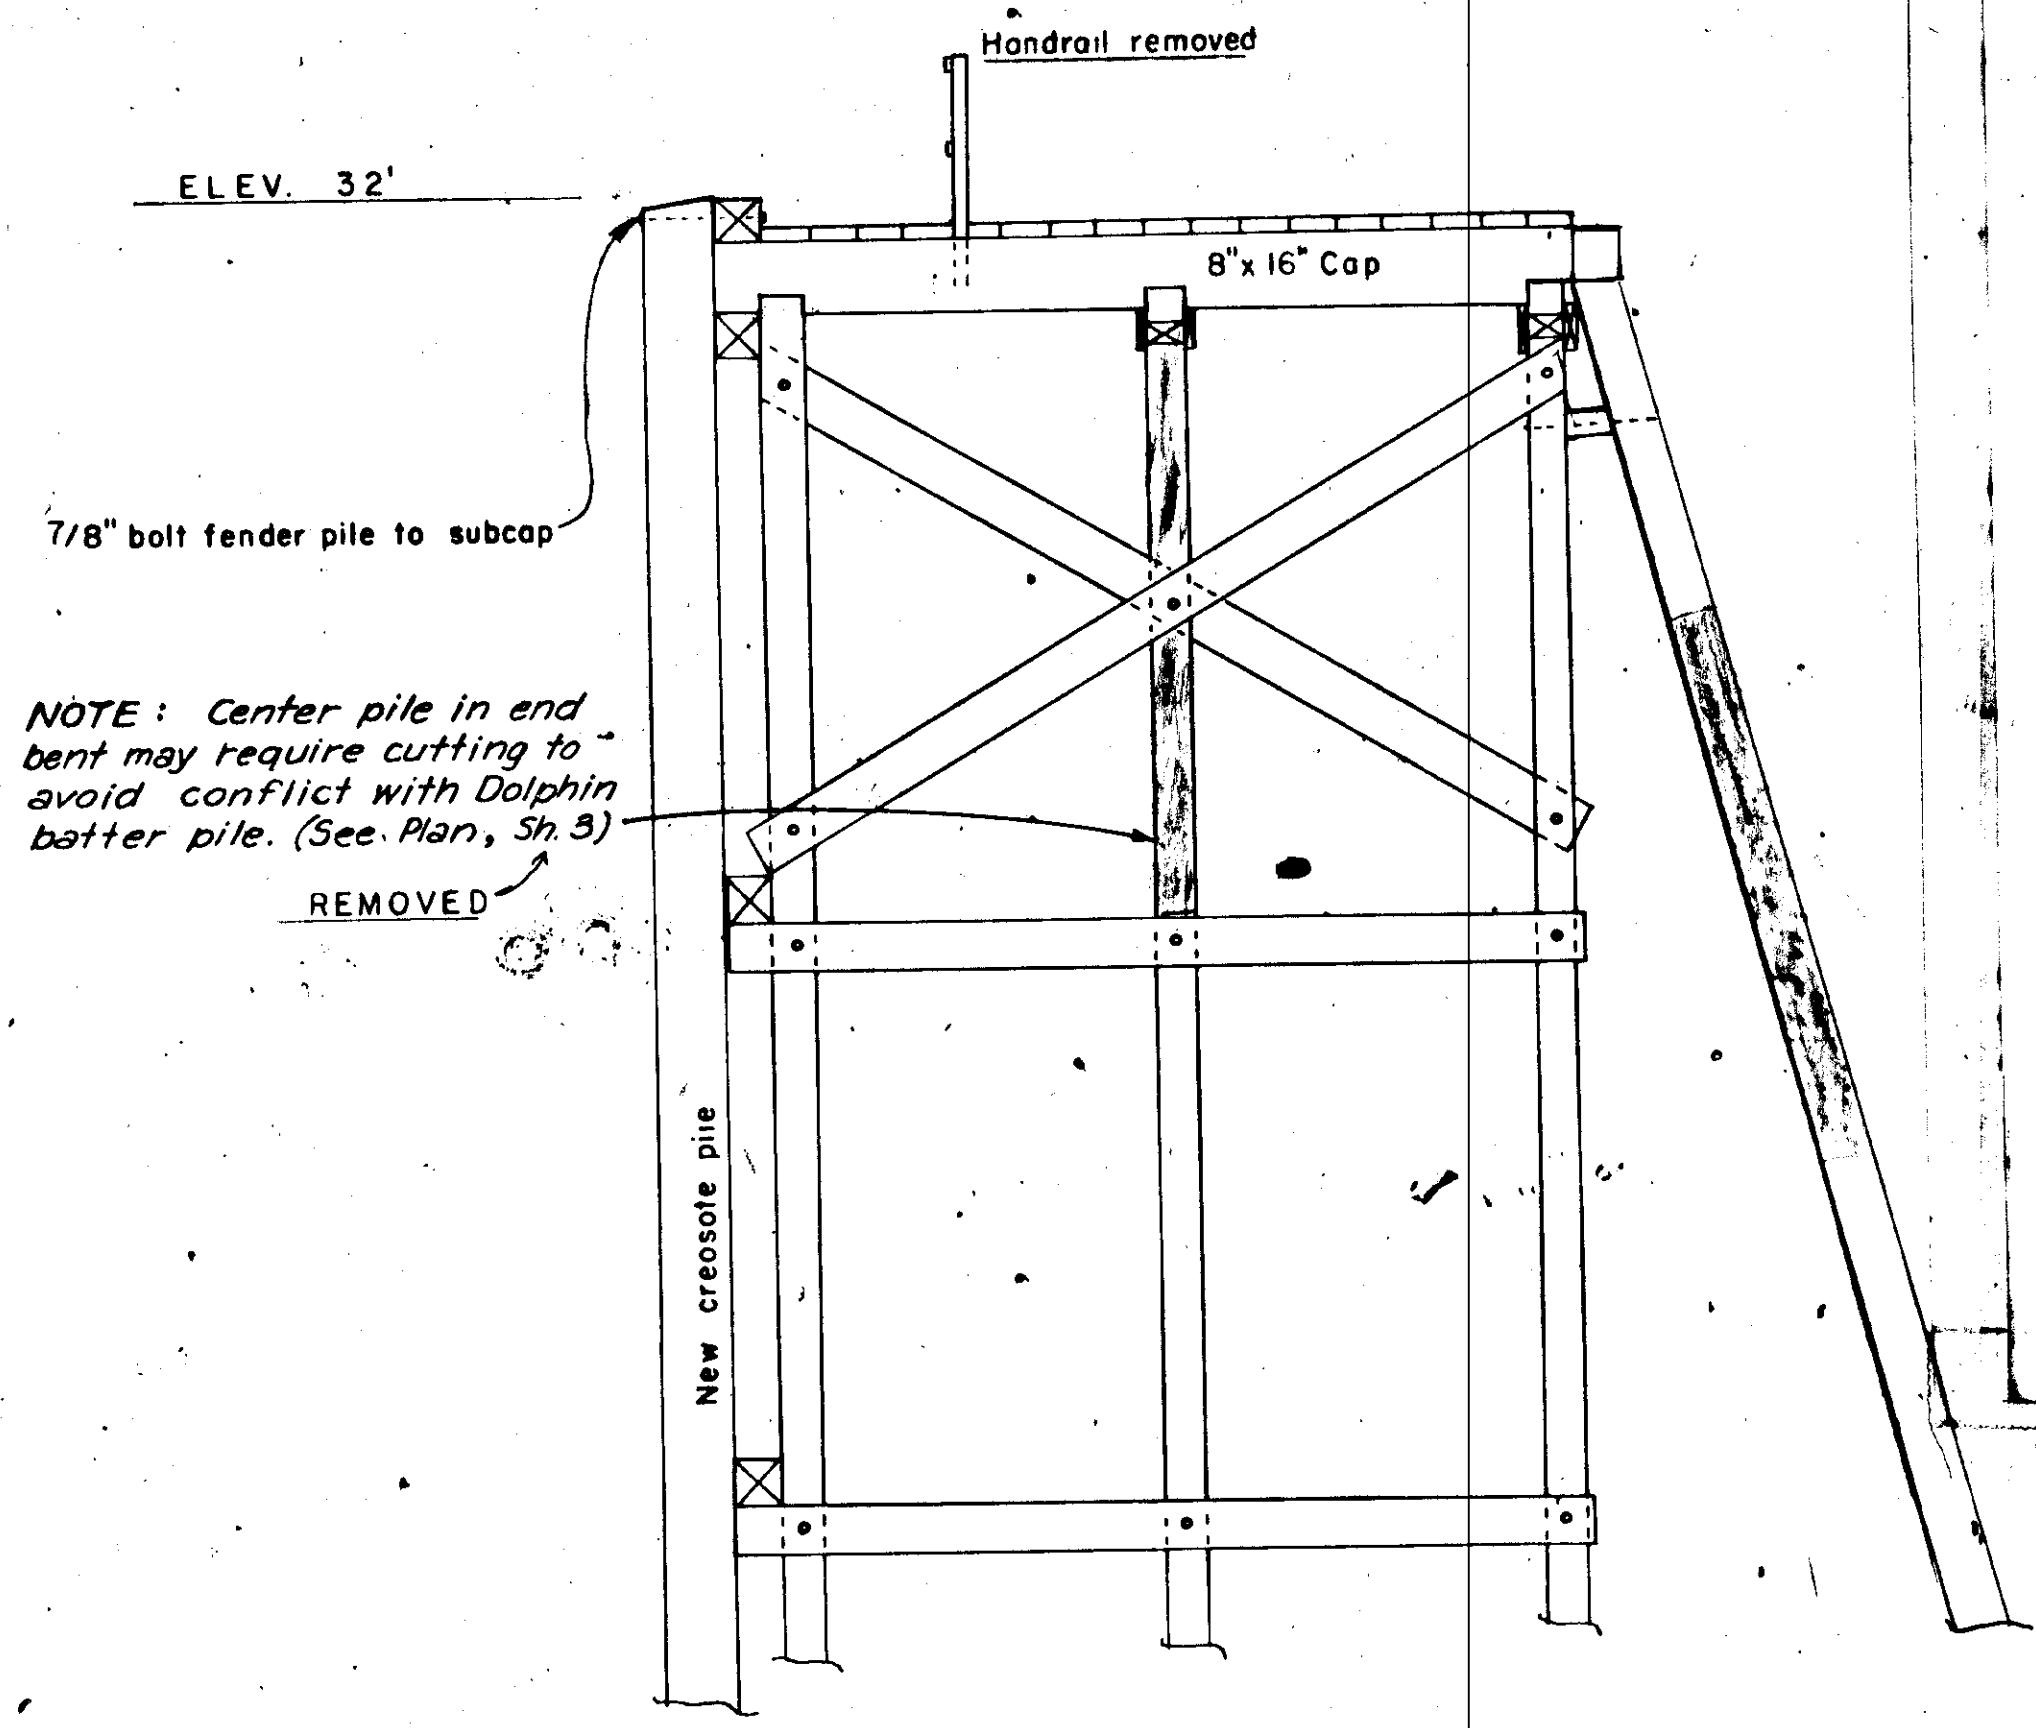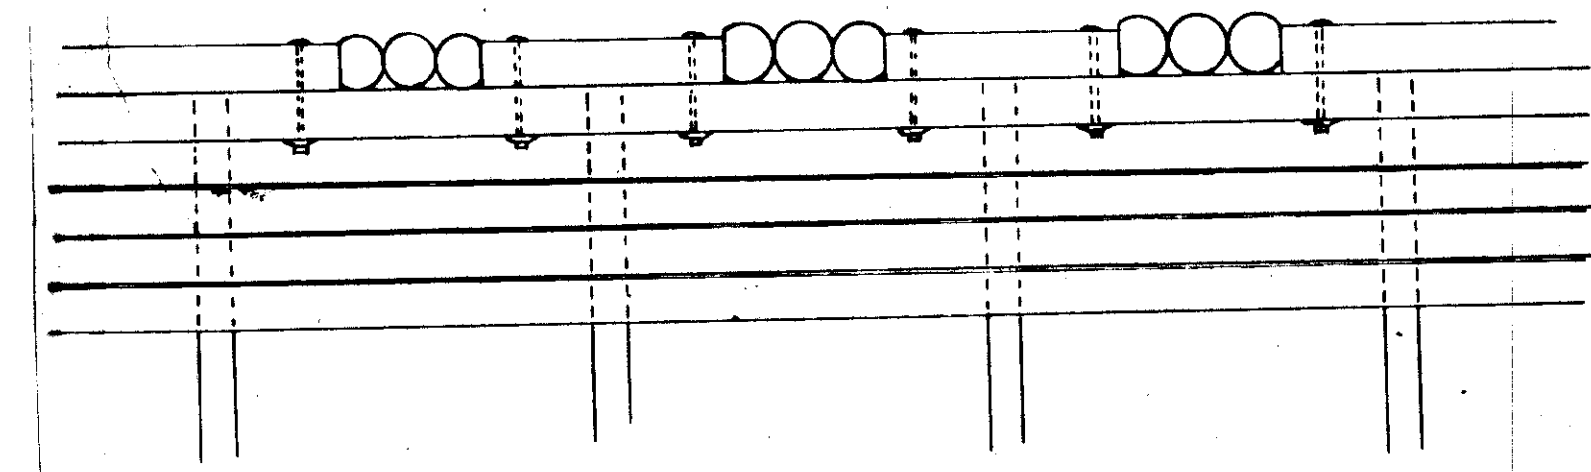

TYPICAL EXISTING BENT  
SCALE 1/4" = 1'-0"

As Constructed  
9/30/73

DO NOT SCALE THIS DRAWING - USE DIMENSIONS		
STATE OF ALASKA DEPARTMENT OF PUBLIC WORKS DIVISION OF WATER AND HARBORS		
TURNING DOLPHIN LOCATION DOCK RECONSTRUCTION		
SCALE As shown	SURVEYED	APPROVED
DESIGNED	DRAWN JET	Don Statter DIRECTOR
CHECKED DSM	DATE 12-20-73	
PROJECT NUMBER 6-73165	SHEET 41	OF 41