

STATE OF ALASKA  
DEPARTMENT OF HIGHWAYS

MICROFILMED

STATE	ROUTE	SECTION	YEAR	SHEET NO.	TOTAL SHEETS
ALASKA	999 (5)		1962	1	33
TYPE		6201	IMPROVEMENT		
TYPE		Y060	IMPROVEMENT		

Withdrawal DATE 9-8-66

PLAN AND PROFILE  
PROPOSED HIGHWAY PROJECT  
No S-0999 (5)  
SKAGWAY

CITY THRU ROUTE & FERRY TERMINAL FACILITY  
GRADING, DRAINAGE, & SURFACING

INDEX OF SHEETS

SHEET NO.	DESCRIPTION
1	TITLE SHEET
2-3	TYPICAL SECTIONS & ESTIMATE OF QUANTITIES
4	MISCELLANEOUS DETAILS
5	HOLDING AREA GENERAL PLAN
6	INTERSECTION DETAILS & PIT LOCATION SHEET
7-12	PLAN & PROFILE SHEETS
13-17	UTILITY ADJUSTMENT
18-24	CULVERT & MISCELLANEOUS WORK
25	STD. BRASS CAP MONUMENT & MONUMENT CASE
26	SUMMARY OF STANDARDS SIGNS
S-1	STANDARD CULVERTS
S-2	STANDARD METAL END SECTIONS
S-3	STANDARD APPROACHES
S-6	STANDARD PROJECT IDENTIFICATION SIGN
S-10	STD. DROP INLET, CATCH BASINS & MANHOLES
S-13	STANDARD CULVERT MARKER POSTS
S-16	STANDARD RAILROAD CROSSINGS

AS BUILT PLANS

CONTRACTOR: GREEN CONSTRUCTION CO.  
PROJECT ENGINEER: TED VANDER WEYET  
BEGAN PROJECT: AUG. 5, 1963  
ENDED PROJECT: AUG. 22, 1964

DESIGN DESIGNATION  
ADT (1960) = 507  
ADT (1980) = 1,000  
DHV = 150  
D = 65%  
T = 5%  
V = 25 mph

Field reports of the foundation soils and the type of materials found in the suggested pits for this project are available for inspection in the Dept. of Highways, District office at Juneau and the Headquarters office at Juneau.

Detail cross sections for this project are available for inspection in the Headquarters office at Juneau and the District office at Juneau.

PROJECT SUMMARY


WIDTH OF SUBGRADE	*
WIDTH OF SURFACING	*
LENGTH OF GRADING	7,159.56 7147.34' = 1.354 Mi.
LENGTH OF PAVING	7,471.03 7468.21' = 1.414 Mi.
LENGTH OF PROJECT	7,480.43 7477.61' = 1.416 Mi.

\* See Typical Sections

BEGIN PROJECT  
STA. 0+00.00

CONVENTIONAL SIGNS

PROPOSED CONSTRUCTION CENTERLINE	
RELIMINARY SURVEY LINE	
OWNSHIP LINE	
SECTION LINE	
PROPERTY LINE	
RIGHT-OF-WAY LINE	
ASEMENT LINE	
CORPORATED OR CITY LIMITS	
OWER LINE	
ELEPHONE OR TELEGRAPH LINE	
OLE ANCHOR	
IGHT POLE	
ATER LINE (IN PLACE)	
EWER LINE (IN PLACE)	
ALVE BOX	
CATCH BASIN	
ROP INLET	
ANHOLE	
CULVERT PROPOSED	
CULVERT EXISTING	
IRE HYDRANT	
RAVELED WAY	
WAMP	
ENCE	
URB CUT	
AND MONUMENT	
ORM SEWER LINE (PROPOSED)	

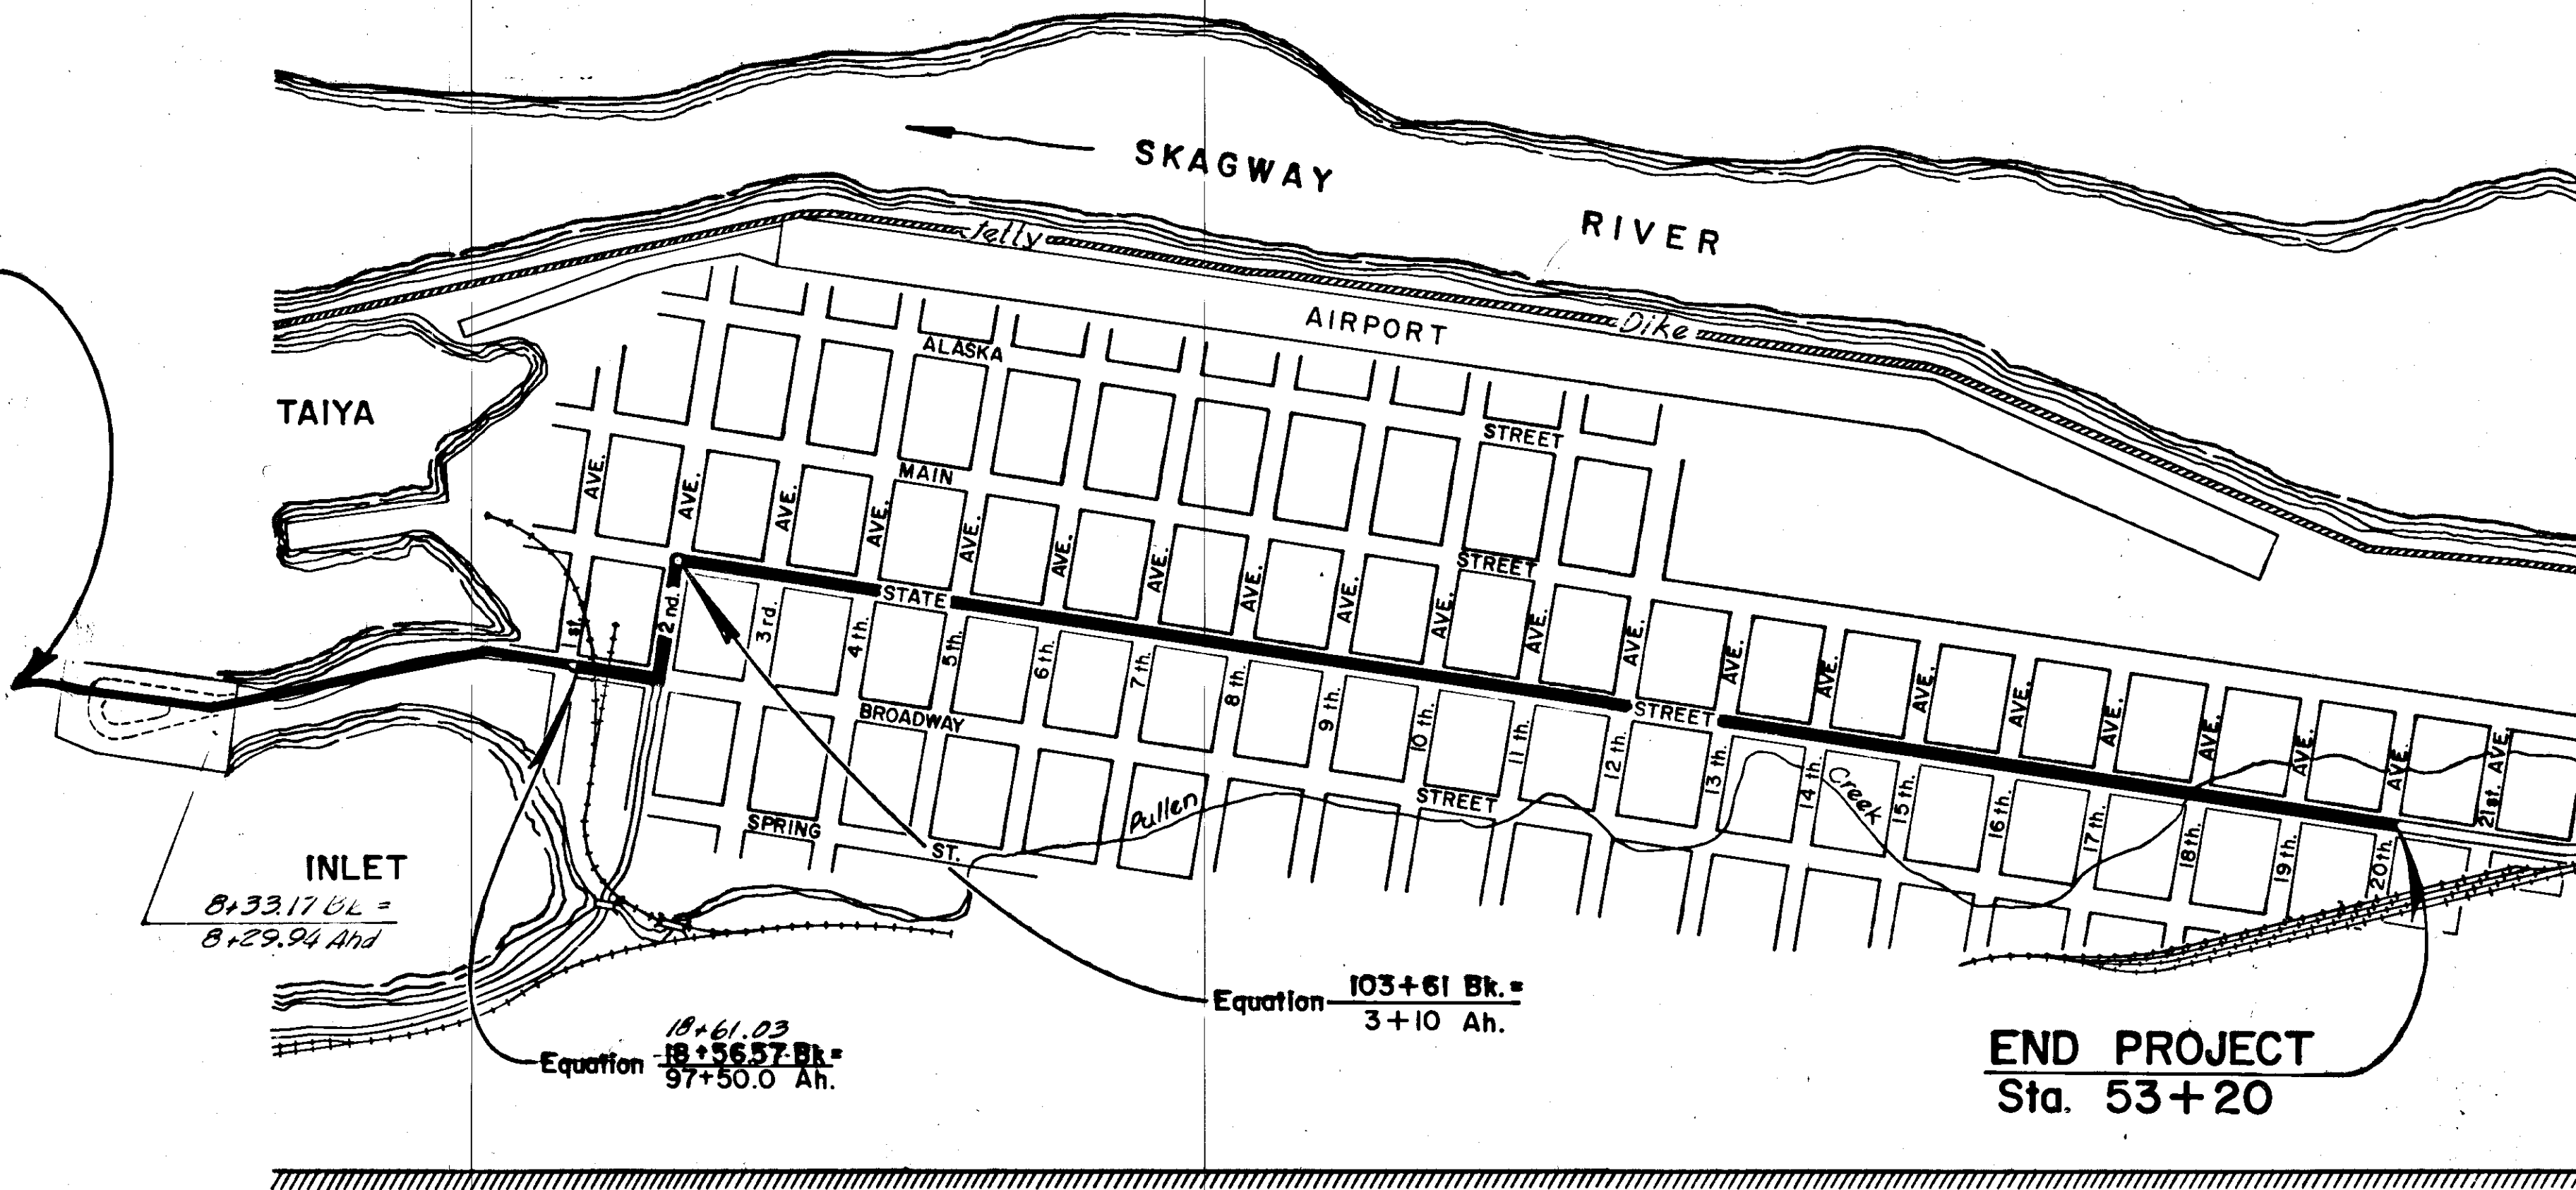

STATE OF ALASKA  
DEPARTMENT OF HIGHWAYS


APPROVED  
*[Signature]* Date 5/1/62  
COMMISSIONER OF HIGHWAYS

APPROVED  
\_\_\_\_\_  
Date \_\_\_\_\_  
REGIONAL ENGINEER  
BUREAU OF PUBLIC ROADS  
REGION TEN

As built entered 1-22-65

**MICROFILMED**


By *W. Withrow* DATE 9-5-00

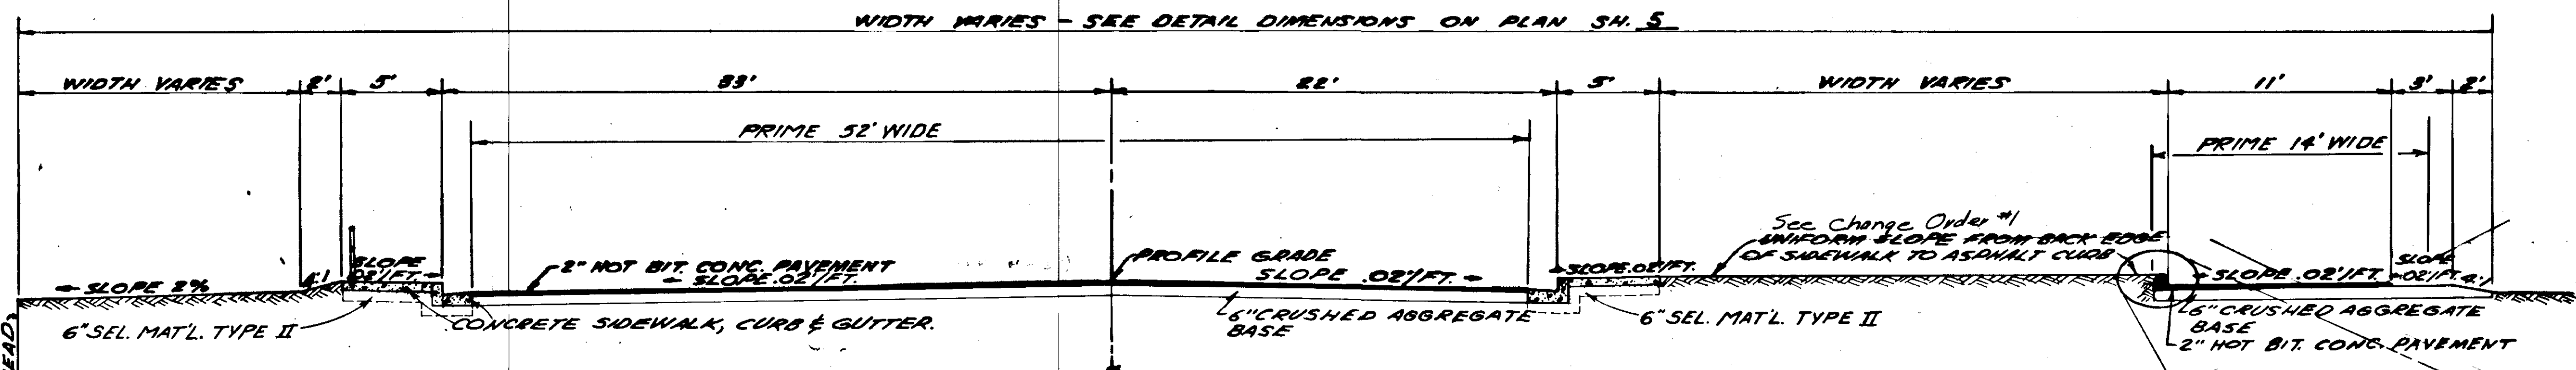

**TYPICAL SECTION OF IMPROVEMENTS AT FERRY TERMINAL**


STA. 5+20.87 TO STA. 8+16.08  
8+16.08 BL. = 8+29.96 AND

TIMBER CURBS & 4"x12" RISER SHALL BE REMOVED PRIOR TO PAVING TO FACILITATE COMPACTION OF THE BITUMINOUS PAVING. AND AFTER COMPACTION OF THE BITUMINOUS PAVING THE CURBS SHALL BE REPLACED. REMOVAL AND REPLACEMENT OF THE TIMBER CURBS SHALL BE INCIDENTAL TO ITEMS OF WORK PREFORMED UNDER SECTION 322.

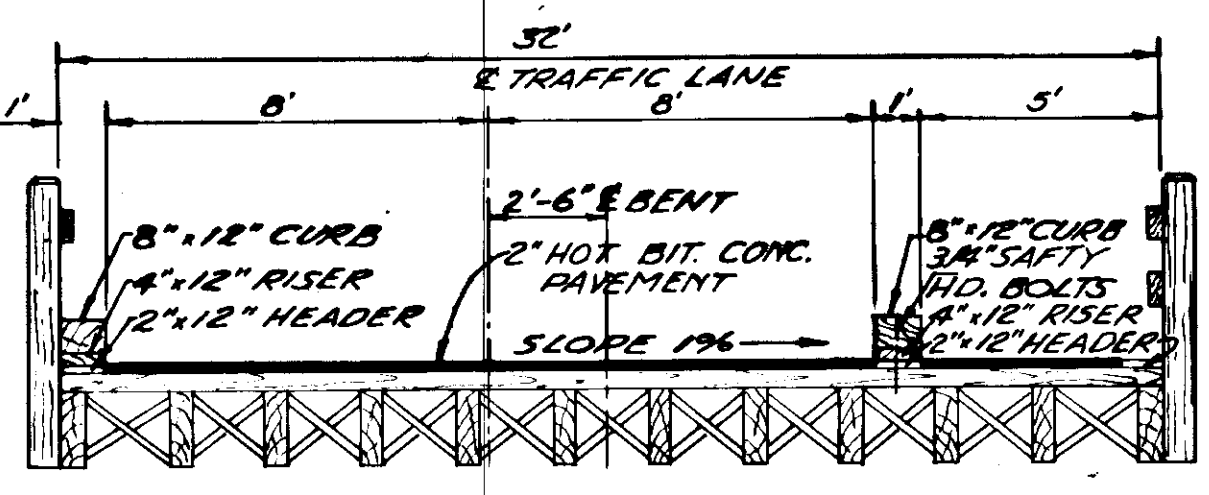


**TYPICAL SECTION FOR PAVING TRESTLE**

STA. 0+00 TO STA. 5+20.87  
(SEE DETAIL FOR WIRE MESH)

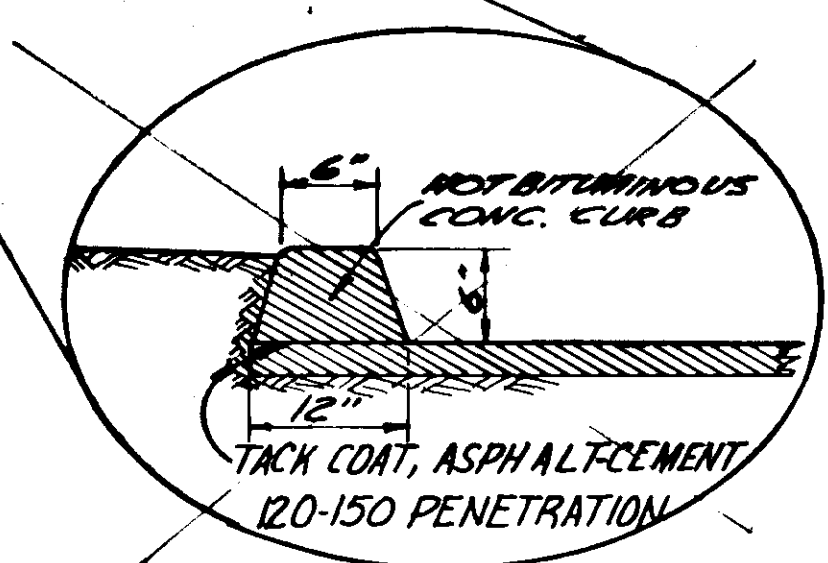

**DETAIL OF WIRE MESH FOR PAVING TRESTLE**

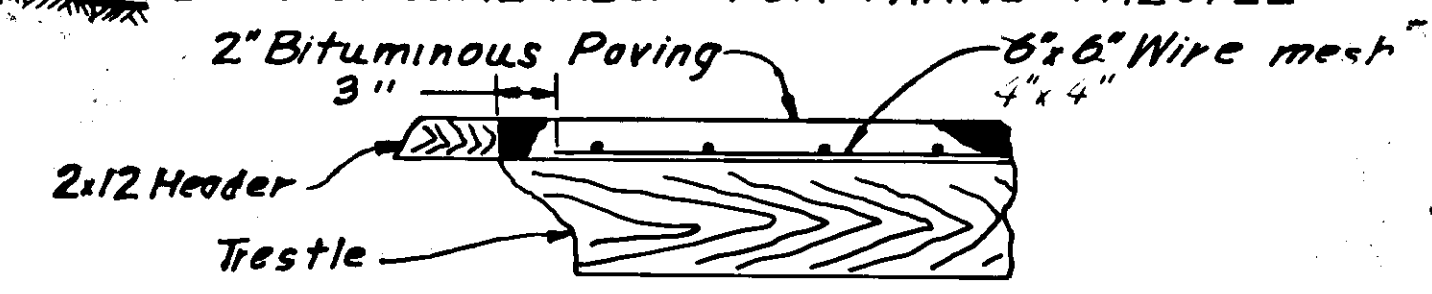


**RIPRAP TABLE**

STA. TO STA.	DIST. FROM CENTERLINE	LEFT OR RIGHT
8+30 TO 11+77	18.5	LEFT
15+22 TO 16+22	18.5	LEFT
15+55 TO 16+22	23.0	RIGHT

**ESTIMATE OF QUANTITIES ~ STA. 3+20.87 to STA. 18+56.57**

ITEM NO.	QUANTITY	UNIT	ITEM
102(1)	2800	C.Y.	UNCLASSIFIED EXCAVATION*
102(7A)	1500	TON	SELECTED MATERIAL, TYPE II BORROW, CASE 2, GRADING B
200(4)	2094	TON	CRUSHED AGGREGATE BASE, GRADING D-1
310(3)	1900	GAL.	ASPHALT, GRADE MC-70, PRIME COAT*
322(1)	745	TON	HOT BITUMINOUS CONCRETE PAVEMENT*
322(2)	10350	GAL.	ASPHALT CEMENT, 120-150 PENETRATION*
453(4E)	376	L.F.	18" Asbestos Bonded CORRUGATED METAL PIPE, 16 GAGE
453(4U)	78	L.F.	42" Asbestos Bonded CORRUGATED METAL PIPE, 12 GAGE
457(1)	150	L.F.	REMOVAL OF CULVERTS
510(1)	325	C.Y.	LOOSE RIPRAP
521(3)(L)	2	EACH	CATCH BASINS Inlet
524(3)	785	L.F.	CONCRETE CURB & GUTTER
530(1)	405	S.Y.	CONCRETE SIDEWALK
601	342	L.F.	PIPE HANDRAIL
103(1)	10	Cu. Yd.	Excavation for Structures
521(1)	1	Each	Manholes
589(1)	1070	Lin. Ft.	12" Asbestos Cement Pipe

\*See Totals, Sheet #3

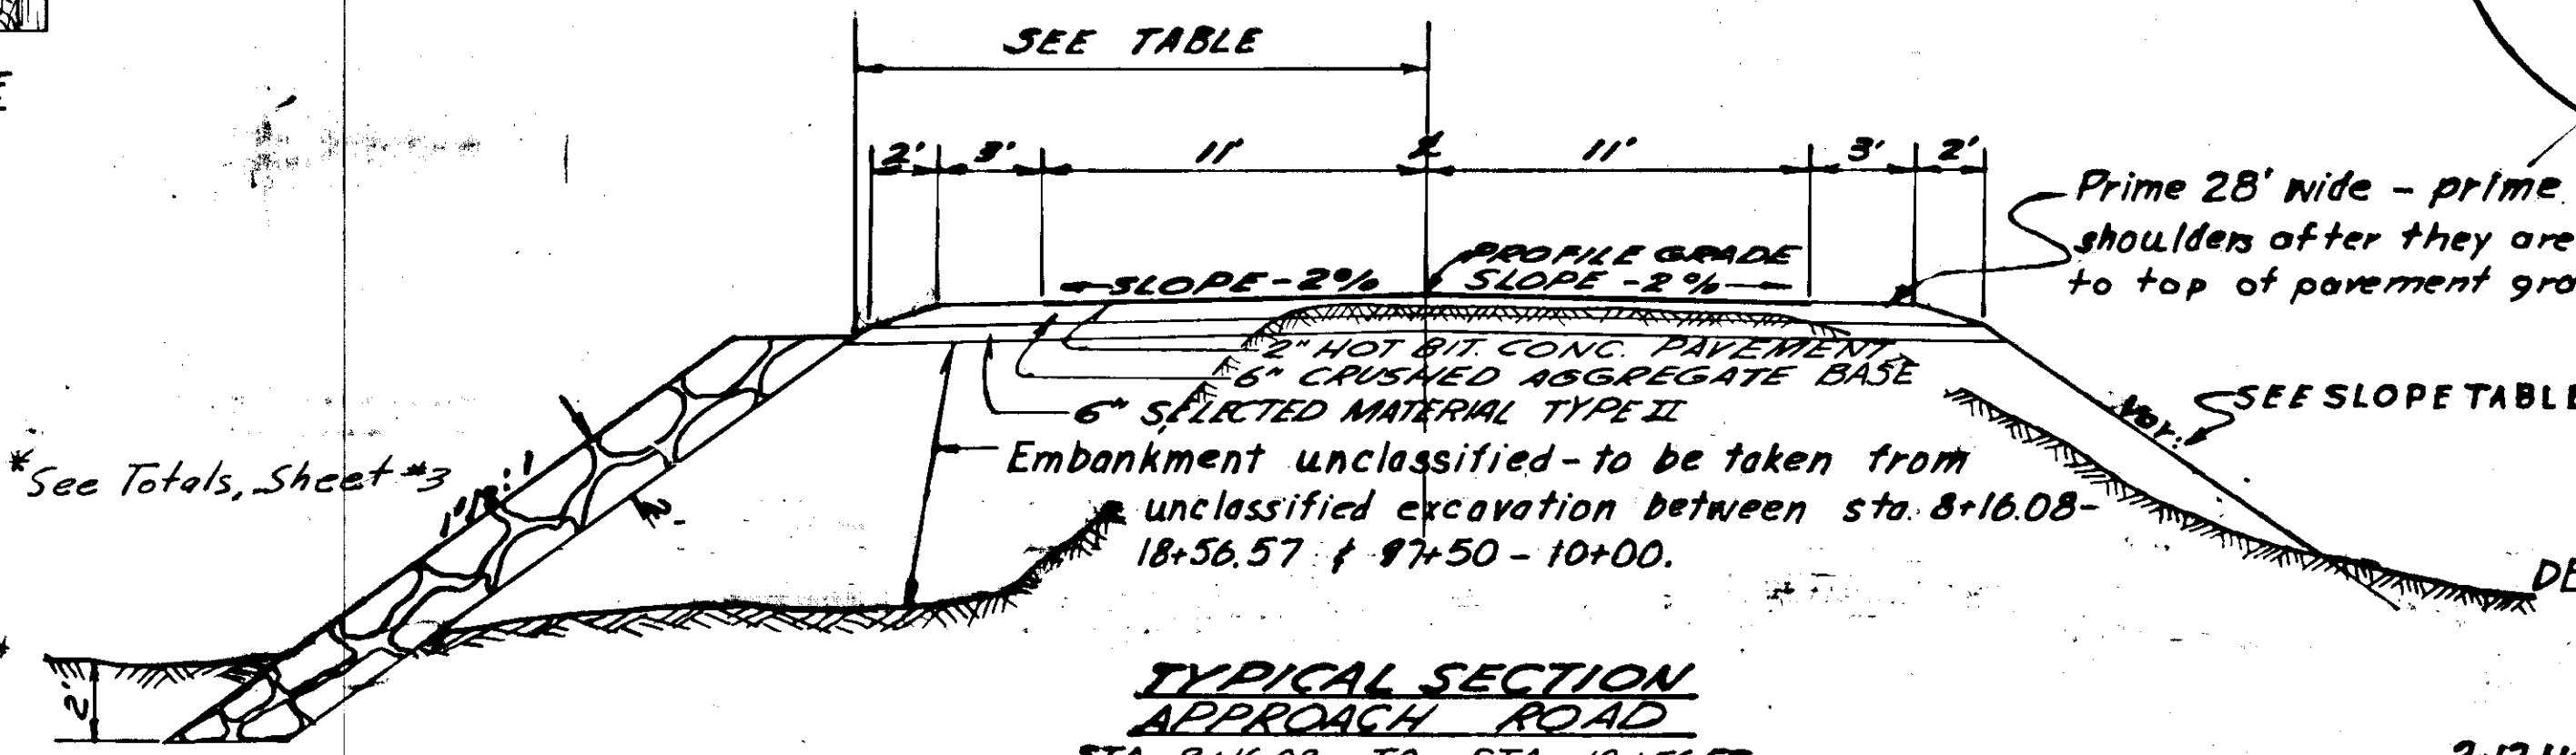


**TYPICAL SECTION APPROACH ROAD**


STA. 8+16.08 TO STA. 18+56.57  
8+29.96 AND

- Concrete shall be class A, air entrained and shall have a strength of 2500 PSI in 28 days.
- Preformed expansion joint shall conform to ASSHO-M-153 Type III.
- Asphalt sealing compound shall conform to ASSHO-M-173-60.


FOR RAILING DETAILS SEE SHEET #5

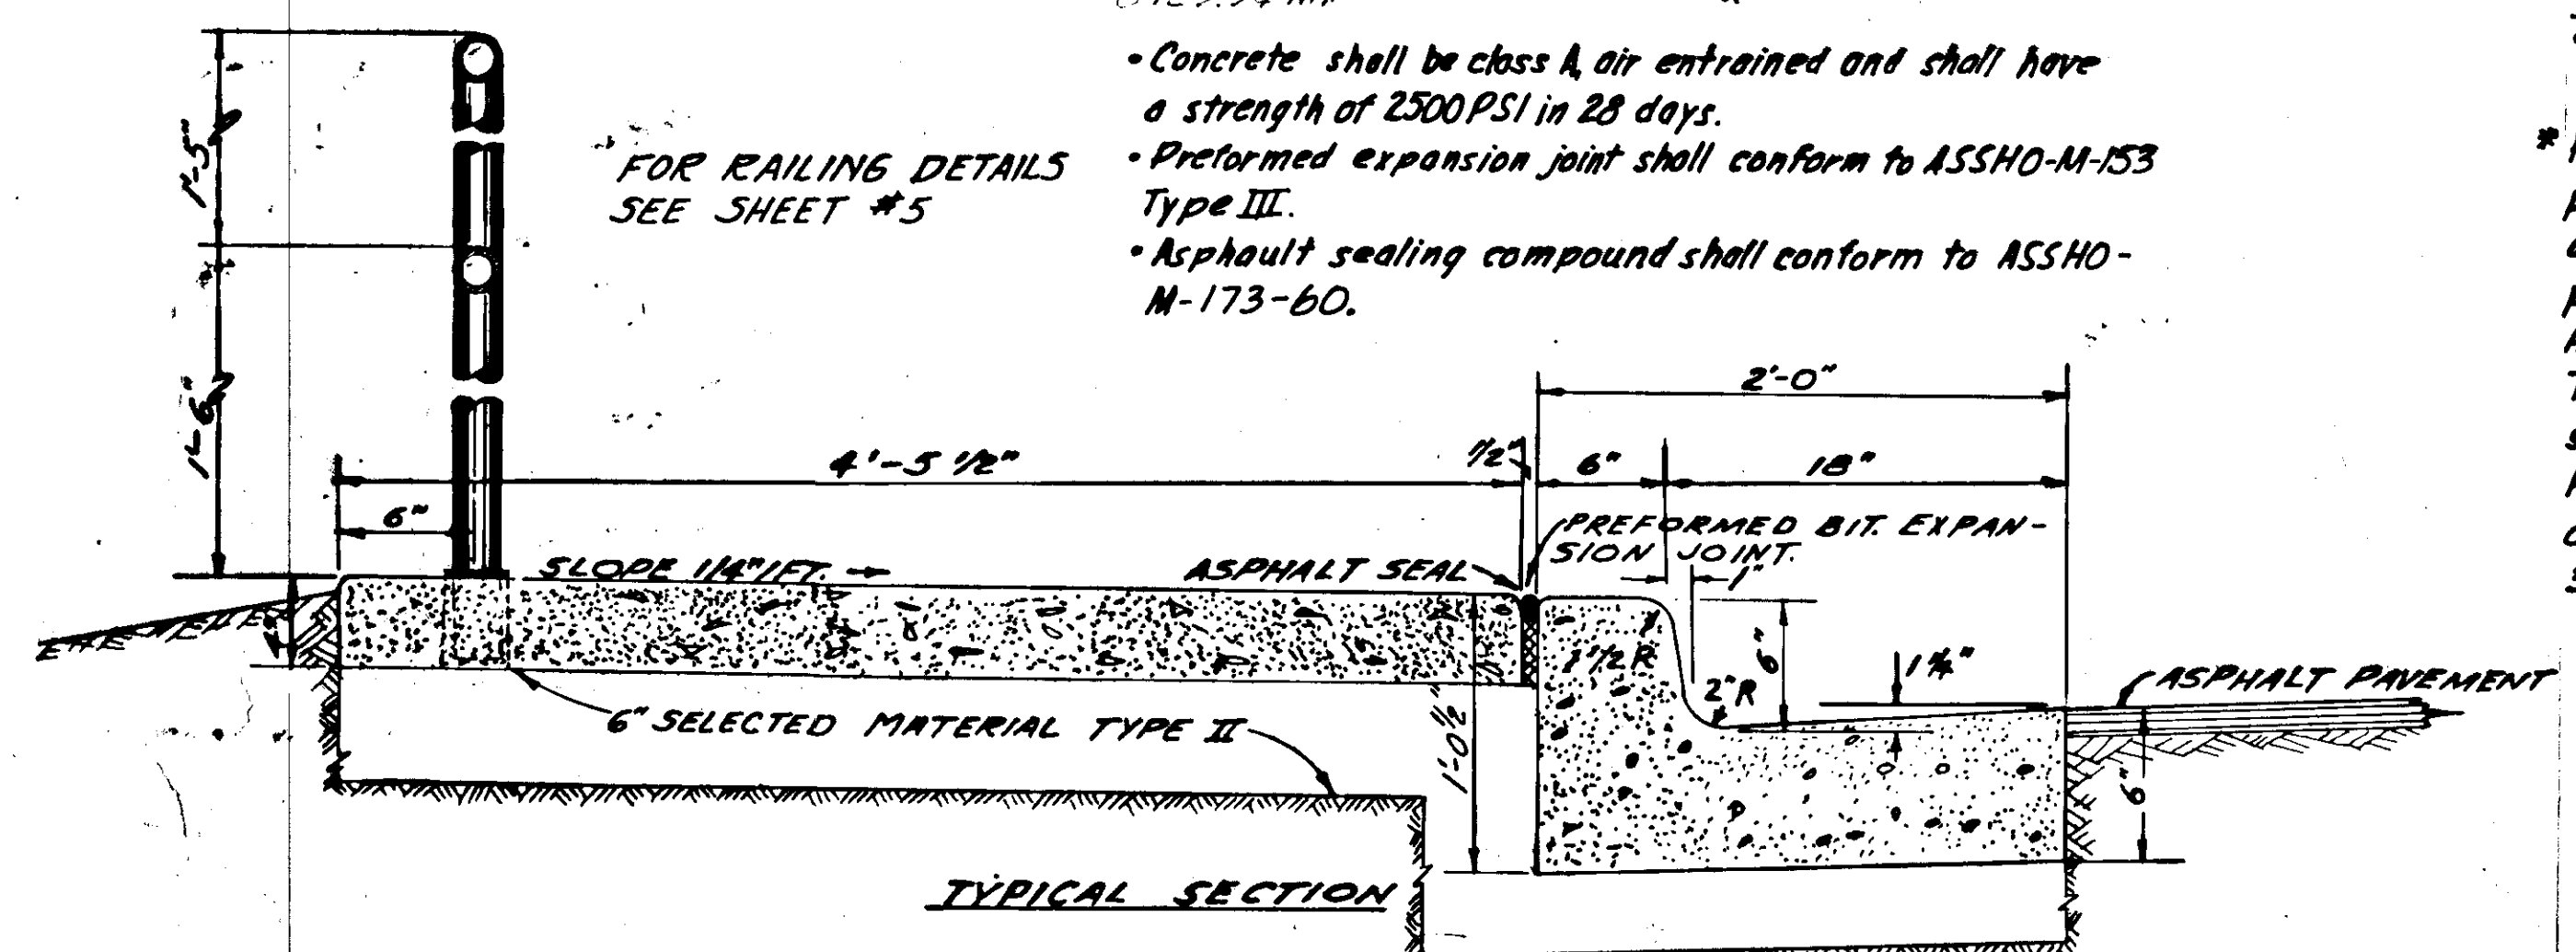

**TYPICAL SECTION**

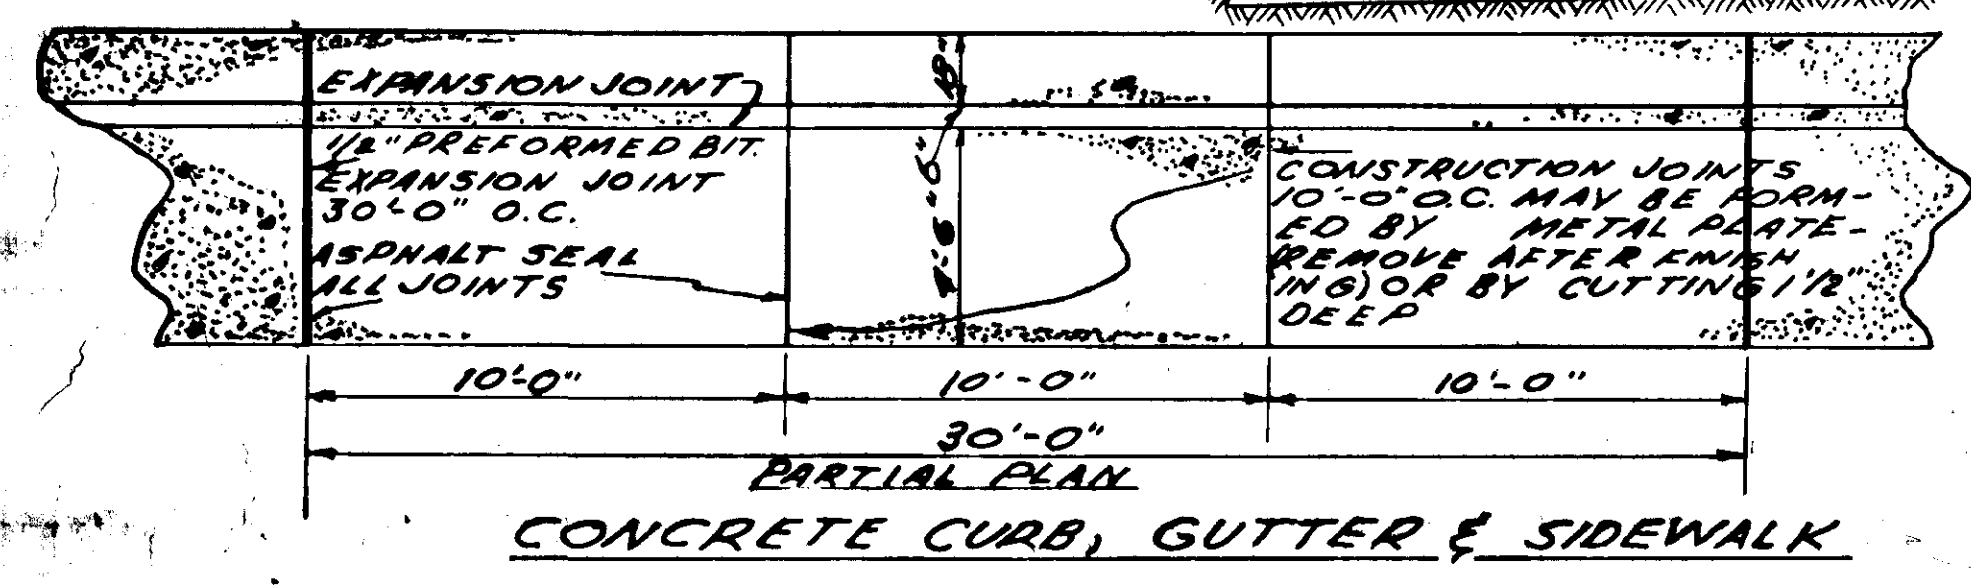

**CONCRETE CURB, GUTTER & SIDEWALK**

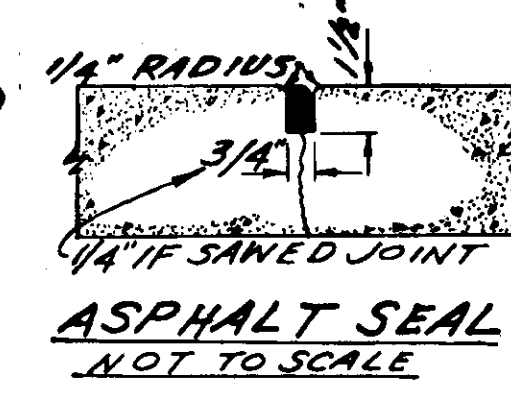

\*Place 6"x6" wire mesh, 14 gage, on trestle deck before placing plant mixture. Mesh shall be stapled on 24" centers and crimped as necessary to prevent buckling during placement of plant mixture. All joints shall be lapped 12". The wire mesh shall meet the requirements of AASHO specifications M55-60. Payment for furnishing and placing the mesh shall be considered incidental to pay items covered under section 322.

PLANS REVISED BY DEPT. OF HIGHWAYS

STATE OF ALASKA  
DEPARTMENT OF PUBLIC WORKS  
SOUTHEAST ALASKA FERRY SYSTEM  
SKAGWAY FERRY TERMINAL  
PROJECT NO. S-0999(5)  
**TYPICAL SECTIONS AND ESTIMATE OF QUANTITIES**  
Scale: As Noted Sheet 2. Of 33  
TONER & NORDLING Registered Engineers Juneau

**VARIABLE SLOPE TABLE**



STATION	LT.	RT.	STATION	LT.	RT.
8+77		*DL	13+25	*DL	3:1
9+25		*DL	13+76	*DL	3:1
9+75		*DL	14+25	*DL	3:1
10+25		*DL	14+77	3:1	4:1
10+75		3:1	15+28		*DL
11+30		3:1			
11+75	3:1	3:1	16+75	2:1	*DL
12+23		3:1	17+25		*DL
12+75		*DL	17+77		*DL

\*Daylight @ 24:1 for drainage.


AS BUILT

MICROFILMED

DATE 9-8-66

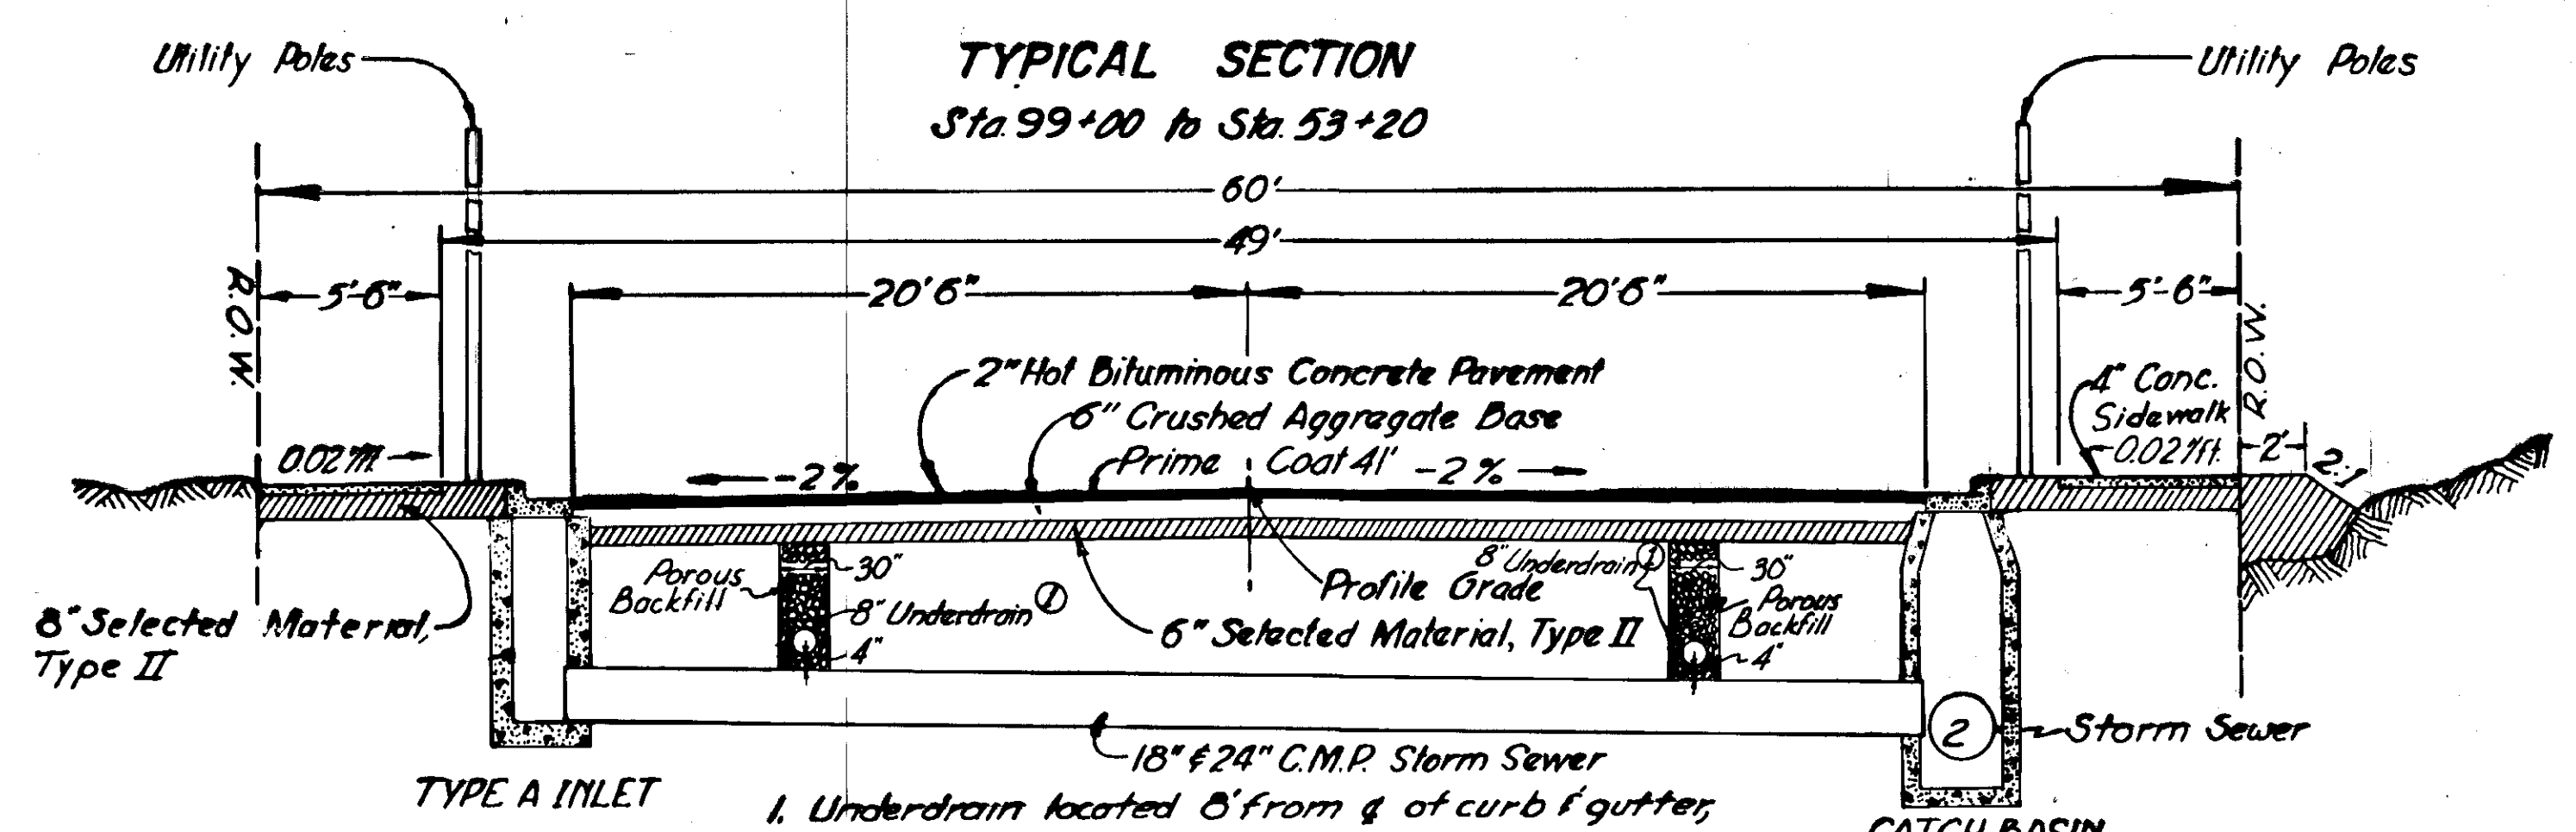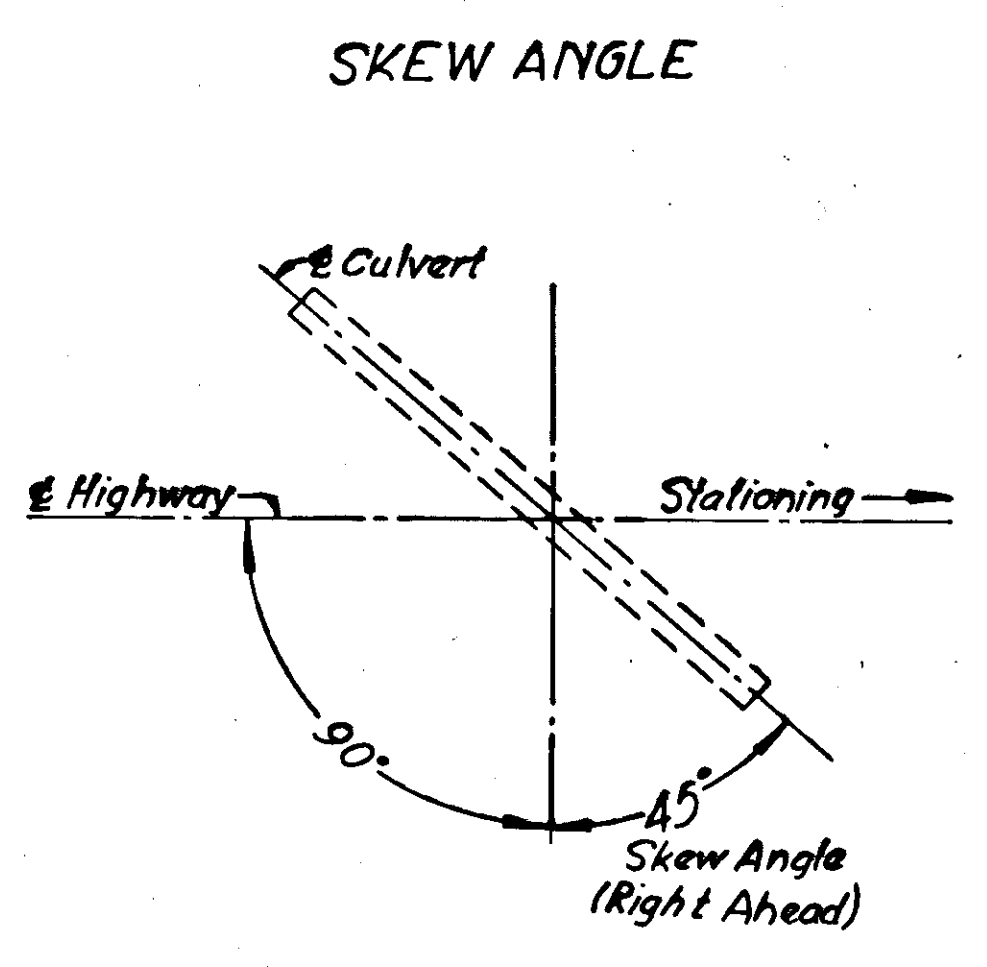

- Underdrain located 8' from & of curb & gutter, unless existing utilities interfere, then location may be adjusted, by approval of the engineer.
- Storm Sewer located on Lt. between Sta. 34+20 & Sta. 51+00

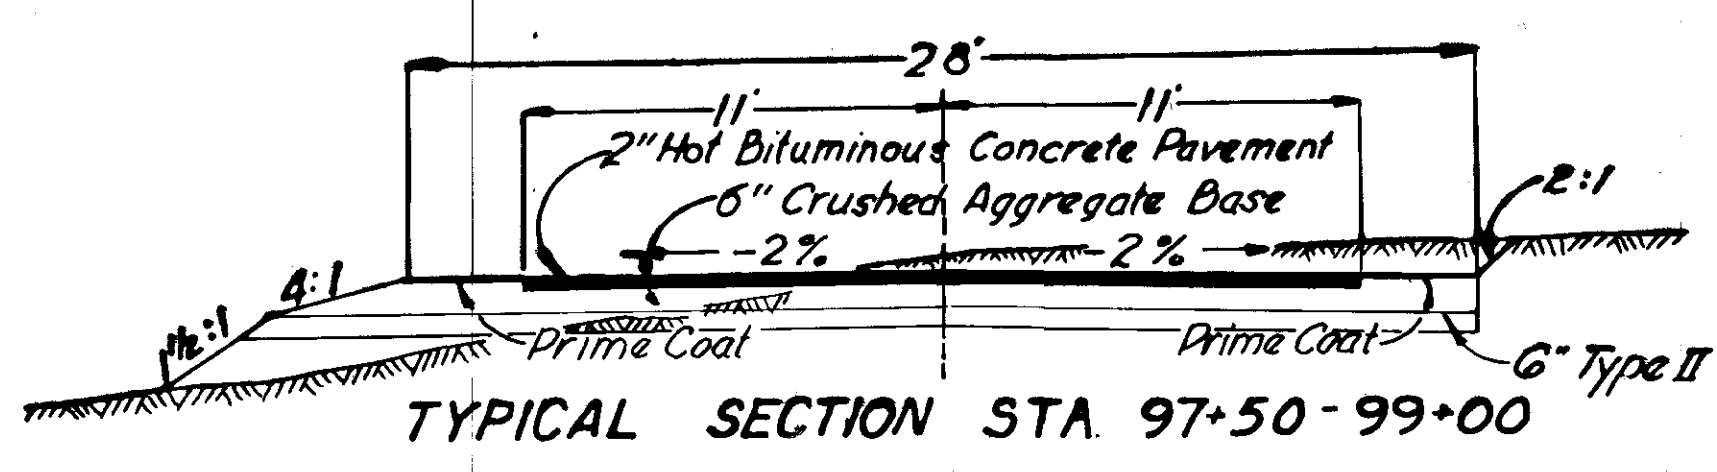

ESTIMATE OF QUANTITIES - STA. 97+50 TO END OF PROJECT

ITEM No.	QUANTITIES	UNIT	ITEM
10	All Req'd.	Lump Sum	Misc. Force Account Work as authorized under Articles 9.4 & 9.5
102(1)	17,500	Cu. Yd.	Unclassified Excavation
102(7A)	13,000	Ton	Selected Material, Type II Borrow, Case 2, Grading B
103(1)	11,079	Cu. Yd.	Excavation for Structures
200(4)	9,300	Ton	Crushed Aggregate Base, Grading D-1
310(3)	8,300	Gal.	Asphalt, Grade MC-70 Prime Coat
322(1)	3,200	Ton	Hot Bituminous Concrete Pavement
322(2)	48,000	Gal.	Asphalt Cement, 120-150 Penetration
453(1A)	22,300	Lin. Ft.	8" Galvanized Corrugated Metal Pipe, 16 Gage
453(1E)	4,166	Lin. Ft.	18" Galvanized Corrugated Metal Pipe, 16 Gage
453(1G)	1,506	Lin. Ft.	24" Galvanized Corrugated Metal Pipe, 16 Gage
453(2G)	500	Lin. Ft.	24" Bituminous Coated Corrugated Metal Pipe, 16 Gage
457(1)	258	Lin. Ft.	Removal of Culverts
460(2G)	3	Each	Metal End Sections for 24" Pipe Culverts
513(1)	10	Each	Adjusting Fire Hydrants
513(2)	85	Each	Valve Boxes
513(3)	50	Each	Water Valves
520(4)	10,476	Lin. Ft.	8" Perforated Corrugated Metal Pipe Under-Drain
521(1)	1	Each	Manholes
521(2)	18	Each	Inlets
521(3)	24	Each	Catch Basins
521(7)	15	Each	Adjusting Manholes
524(3)	10,366	Lin. Ft.	Concrete Curb and Gutter 6" Depth.
530(1)	5,704	Sq. Yd.	Concrete Sidewalk
530(2)	367	Sq. Yd.	Concrete Sidewalk and Driveway, 6" Depth.
560(3)	4	Each	Culvert Marker Posts
561(1)	2	Each	Monument Cases
584(1)	35	Each	Standard Signs
585(1)	2	Each	Railroad Crossings
* 305(2A)	1,500	Ton	Stockpiled Material Section 200, Grading D-1
305(2B)	2,000	Ton	Stockpiled Material Section 3/4, Grading E
* 453(11)	84	Lin. Ft.	36" Galvanized Corrugated Metal Pipe, 12 Gage
* 460(2I)	2	Each	Metal End Sections for 36" Pipe Culverts
700(1)	All Req'd.	Lump Sum	Utility Adjustments

**GENERAL NOTES**

**Expansion Joints:** Premolded expansion joint filler 1/2" thick complying to AASHTO designation M153, Type III shall be used at all expansion joints. Joints shall be located as follows:

**Curb & Gutter** - Expansion joints shall be at the end of the curved portion of the curb return and immediately following and preceding curb cuts. Thereafter expansion joints shall be spaced immediately at intervals of 60'; except where shorter sections are needed for closure. These shorter sections shall not be less than 30'.

**Sidewalks** - Expansion joints shall be opposite expansion joints in adjoining curb & gutter. Transverse contraction joints shall be at uniform intervals of 6' except where shorter sections are necessary for closures. These shorter sections shall not be less than 4'.

**Existing Utilities:** All water valve boxes to be left in place & sewer manholes that may fall within the limits of construction on this project will be adjusted to the proper grade prior to paving. Utility poles existing within construction limits to be moved by others, except where otherwise noted.

Alignment and Grades shown are subject to minor revisions

All thickness dimensions shown on Surfacing Courses are nominal.


All concrete shall be class A, air-entrained, and have a minimum compressive strength of 2500 P.S.I. in 28 days.

The culvert lengths shown are approximate.


Waste material shall be disposed of as shown on the plans or in the special provisions, and in a manner satisfactory to the Engineer.

Location of existing utilities as shown on plans are approximate only.

TYPICAL EXPANSION & CONTRACTION JOINT DETAIL

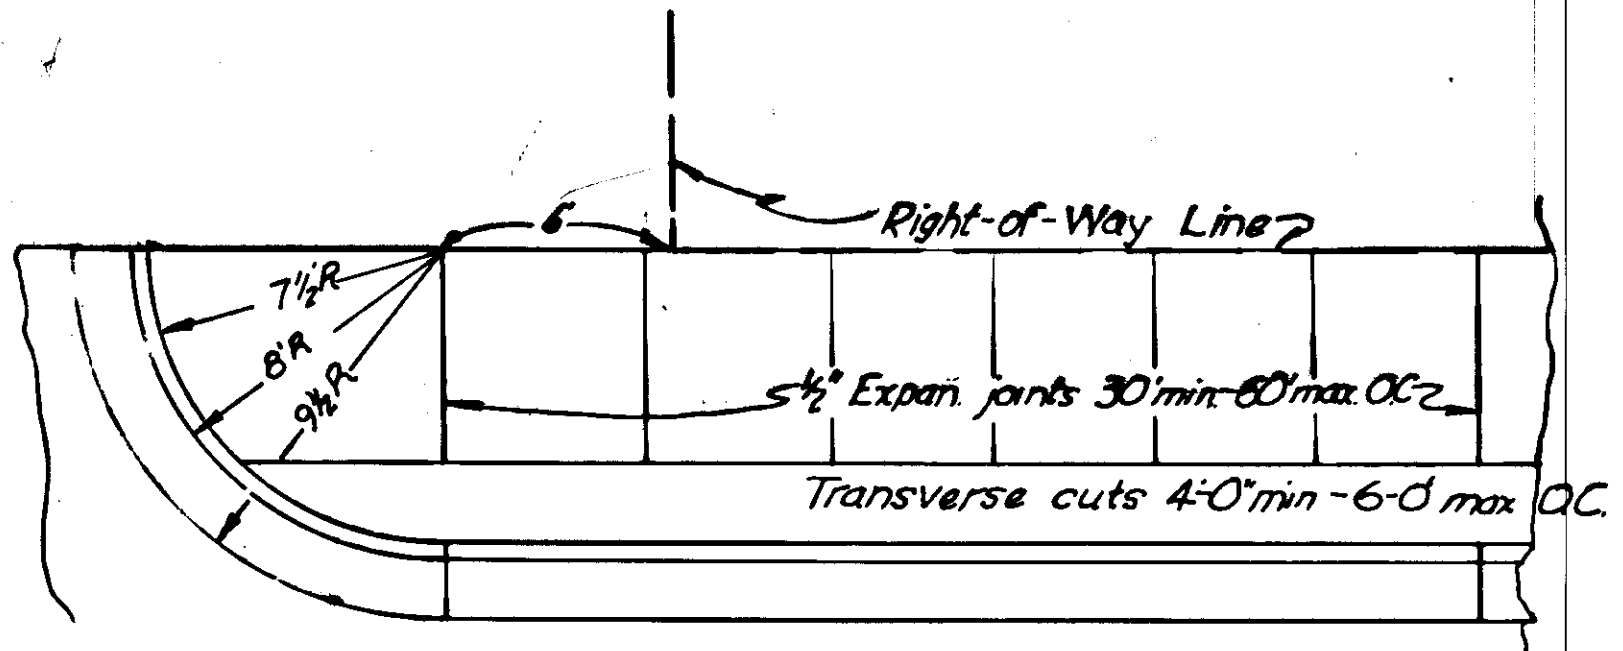

UNDERDRAIN DETAIL

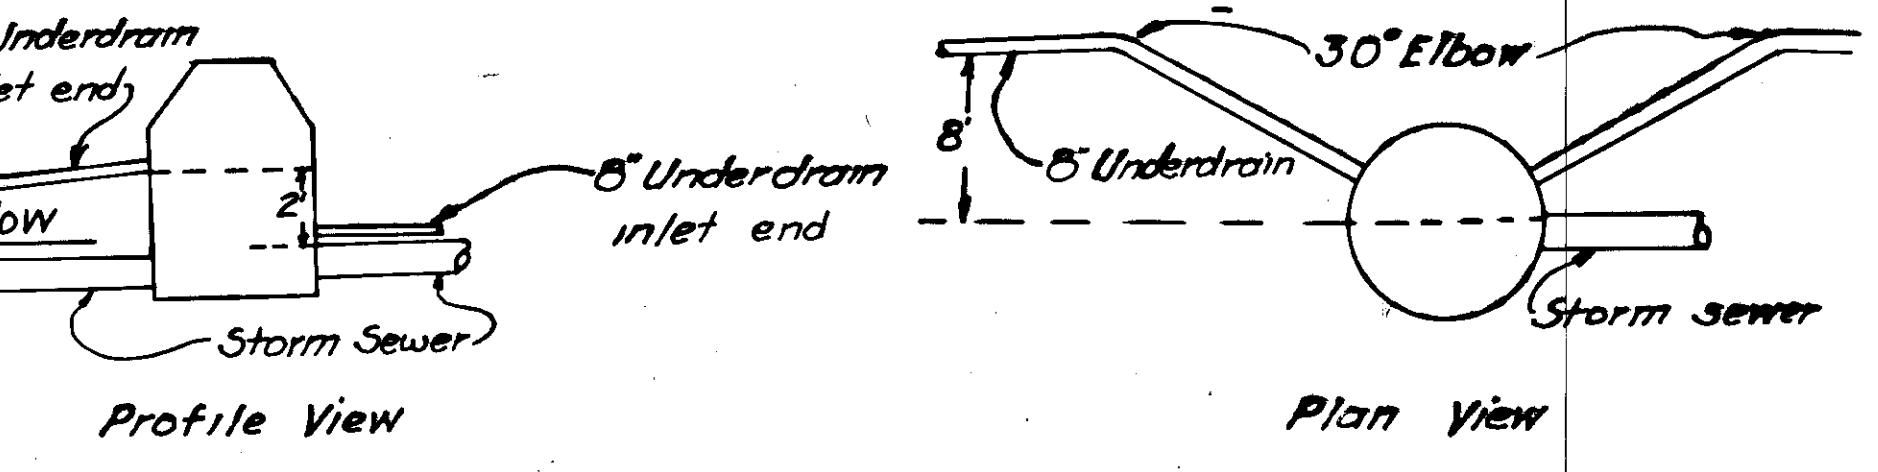

8" UNDERDRAIN QUANTITIES

8" Perforated C.M.P.		
Station to	Station	Lin. Ft.
98+80	99+80 Lt. & Rt.	200
100+32	102+00 & 103+40 Lt. & Rt.	616
3+40	46+95 & 47+00 Rt.	4360
3+40	47+45 & 47+50 Lt.	4410
48+50	48+35 & 53+20 Rt.	470
49+00	47+05 & 53+20 Lt.	420
Total		10,476
8" C.M.P.		
47+00	47+10 & 48+50 Rt.	160
47+50	47+10 & 47+20 Lt.	150
Total		300

- The underdrain will flow into the Catch basins & Inlets, beginning at sta. 45+40
- A 30° Elbow will be used to direct the underdrain into and out of the catch basins and inlets. The outlet end of the underdrain will be installed 2' above the top of the Storm sewer, or as directed by the engineer.
- Underdrain will convert to 8" C.M.P. between sta. 46+95 & 48+50 Rt. and 47+50 to 49+00 Lt.
- Min depth for Underdrains is 3.5' below top of Pavement


AS BUILT

MICROFILMED


Withdraw DATE 9-5-06

WATER VALVE DETAIL

Water Main Valve Box Detail

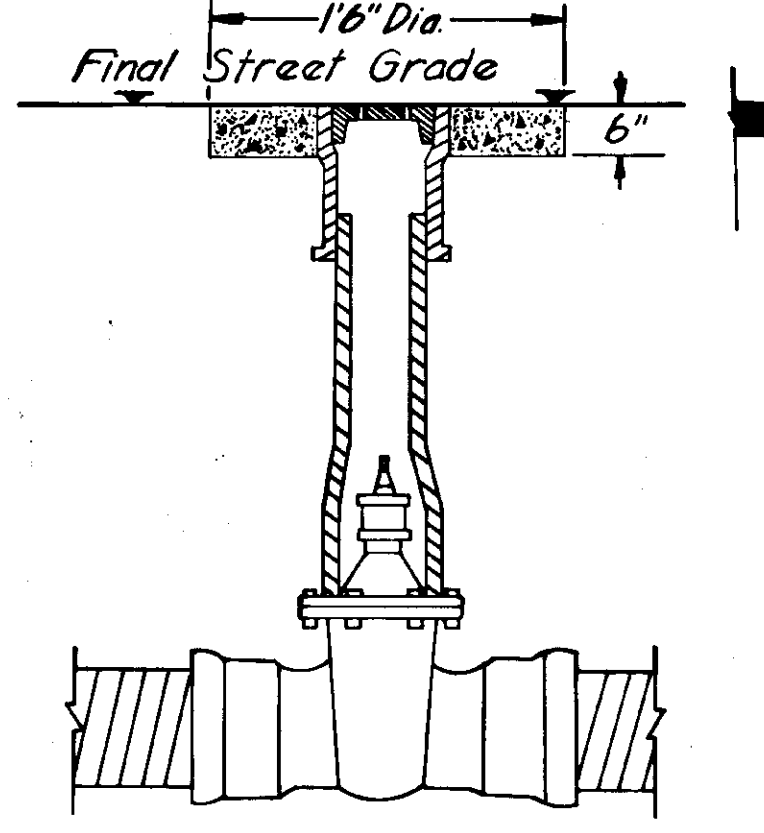

New Location of Service Valves

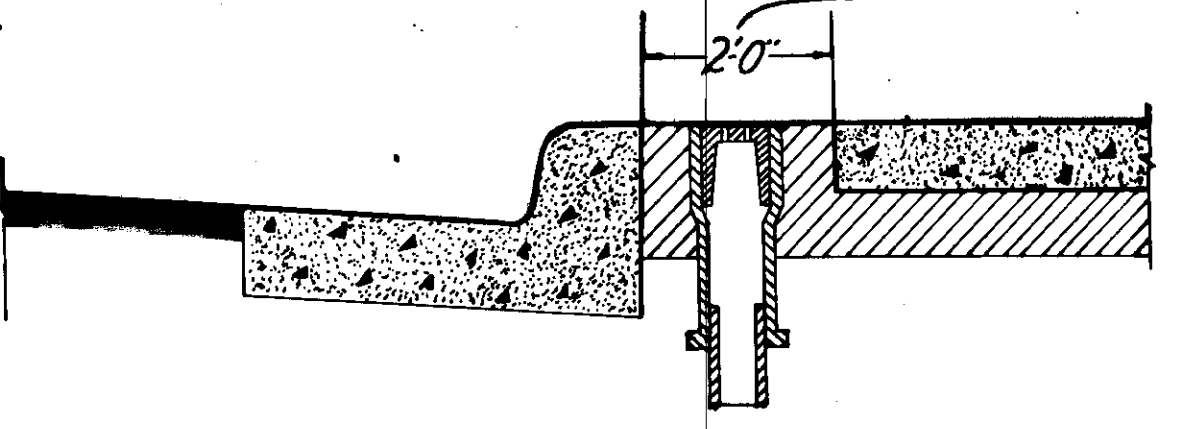


\* Shutoff valves for service connections shall be capped as shown and paid for as incidental to pay item 513(3)  
 New valve boxes shall be furnished and installed at locations shown in the table below. These include both water main and service connection valve boxes.

LIST OF VALVES


Station	Distance from E	Valve Box	New Valve
100+15.5	56.6' RI	1	1
100+15.7	57.8' RI	1	+0
100+16.1	70' RI	1	-
100+16.8	92.5' RI	1	1-
100+21.7	11.5' RI	1	
100+30.9	20.4' RI	1	
100+79.8	10.6' RI	1	+0
100+89.7	12.0' RI	1	1
101+46.9	10.5' RI	1	1
102+05.8	11.9' RI	1	1
102+06.7	21.8' RI	1	1
102+65.8	11.6' RI	1	1
2+80.3	9.6' RI	1	+0
3+20.1	10.1' LI	1	
6+01.0	2.9' RI	1	
6+20.5	17.4' RI	1	
7+04.3	13.4' RI	1	1
7+32.1	9.1' LI	1	+0
7+73.3	9.9' RI	1	1
8+80.9	2.0' LI	1	
8+81.1	14.2' RI	1	
8+89.1	30.8' RI	1	
9+01.7	10.0' RI	1	
9+34.9	10.5' RI	1	1
10+67.4	10.5' RI	1	1
10+92.3	5.0' RI	1	1
11+20.2	17.6' RI	1	
11+60.5	2.8' RI	1	
11+60.6	18.1' RI	1	
12+23.5	10.0' RI	1	+0
Cont.	Cont.	Cont.	Cont.

Station	Distance from E	Valve Box	New Valve
12+44.2	12.0' RI	1	1
13+16.1	8.5' RI	1	1
13+72.9	9.7' RI	1	1-
13+99.9	18.3' RI	1	
14+00.6	17.4' RI	1	
14+40.9	32.7' RI	1	
14+41.4	0.6' RI	1	
15+18.4	12.0' RI	1	+0
16+48.3	22.9' RI	1	+0
16+80.0	18.1' RI	1	+0
17+01.6	1.8' RI	1	
18+86.6	11.6' RI	1	1
19+35.0	10.9' RI	1	+0
19+80.1	17.9' RI	1	
19+80.3	1.2' RI	1	
20+21.7	19.3' LI	1	
20+66.4	6.1' LI	1	1
22+80.5	2.4' LI	1	
22+84.5	6.8' LI	1	
23+15.1	35.9' LI	1	+
23+45.3	7.3' LI	1	+0
24+45.0	7.5' LI	1	1
25+34.5	16.8' LI	1	
25+82.2	19.8' LI	1	
25+96.3	8.4' LI	1	1
26+10.4	8.2' LI	1	+0
27+34.4	7.9' LI	1	1
28+40.5	2.7' LI	1	
28+40.6	9.4' LI	1	
30+91.3	22.0' LI	1	
Cont.	Cont.	Cont.	Cont.

Station	Distance from E	Valve Box	New Valve
31+09.2	9.7' LI	1	
31+11.9	6.9' LI	1	
31+14.1	9.8' LI	1	
31+61.1	8.0' LI	1	+0
31+79.8	6.1' LI	1	1
32+06.8	5.4' LI	1	1
32+31.7	7.6' LI	1	1
33+01	6.5' LI	1	1
35+44.3	7.1' LI	1	+0
35+23.6	7.9' LI	1	+0
35+94.0	23.9' LI	1	+
35+94.4	8.6' LI	1	1
36+38.8	17.7' LI	1	
37+14.1	8.2' LI	1	1
38+74.7	9.2' LI	1	1
39+57.4	22.9' LI	1	+0
40+27.9	6.1' LI	1	1
42+01.6	18.1' LI	1	
43+42+34.7	7.8' LI	1	1
46+08.7	7.8' LI	1	1
46+90.8	6.9' LI	1	1
47+60.3	20.0' LI	1	
47+98.6	14.3' LI	1	+
48+02.3	23.1' LI	1	1
48+58.4	5.4' LI	1	1
50+52.0	6.5' LI	1	+0
100+57	6.6' LI	1	0
100+58	6.1' LI	1	0
100+59	6.3' LI	1	1
100+60	6.2' LI	1	1
101+02	6.5' LI	1	0
34+80	6.1' LI	1	0
37+40	6.1' LI	1	0
41+41	6.1' LI	1	0
41+81	6.1' LI	1	0

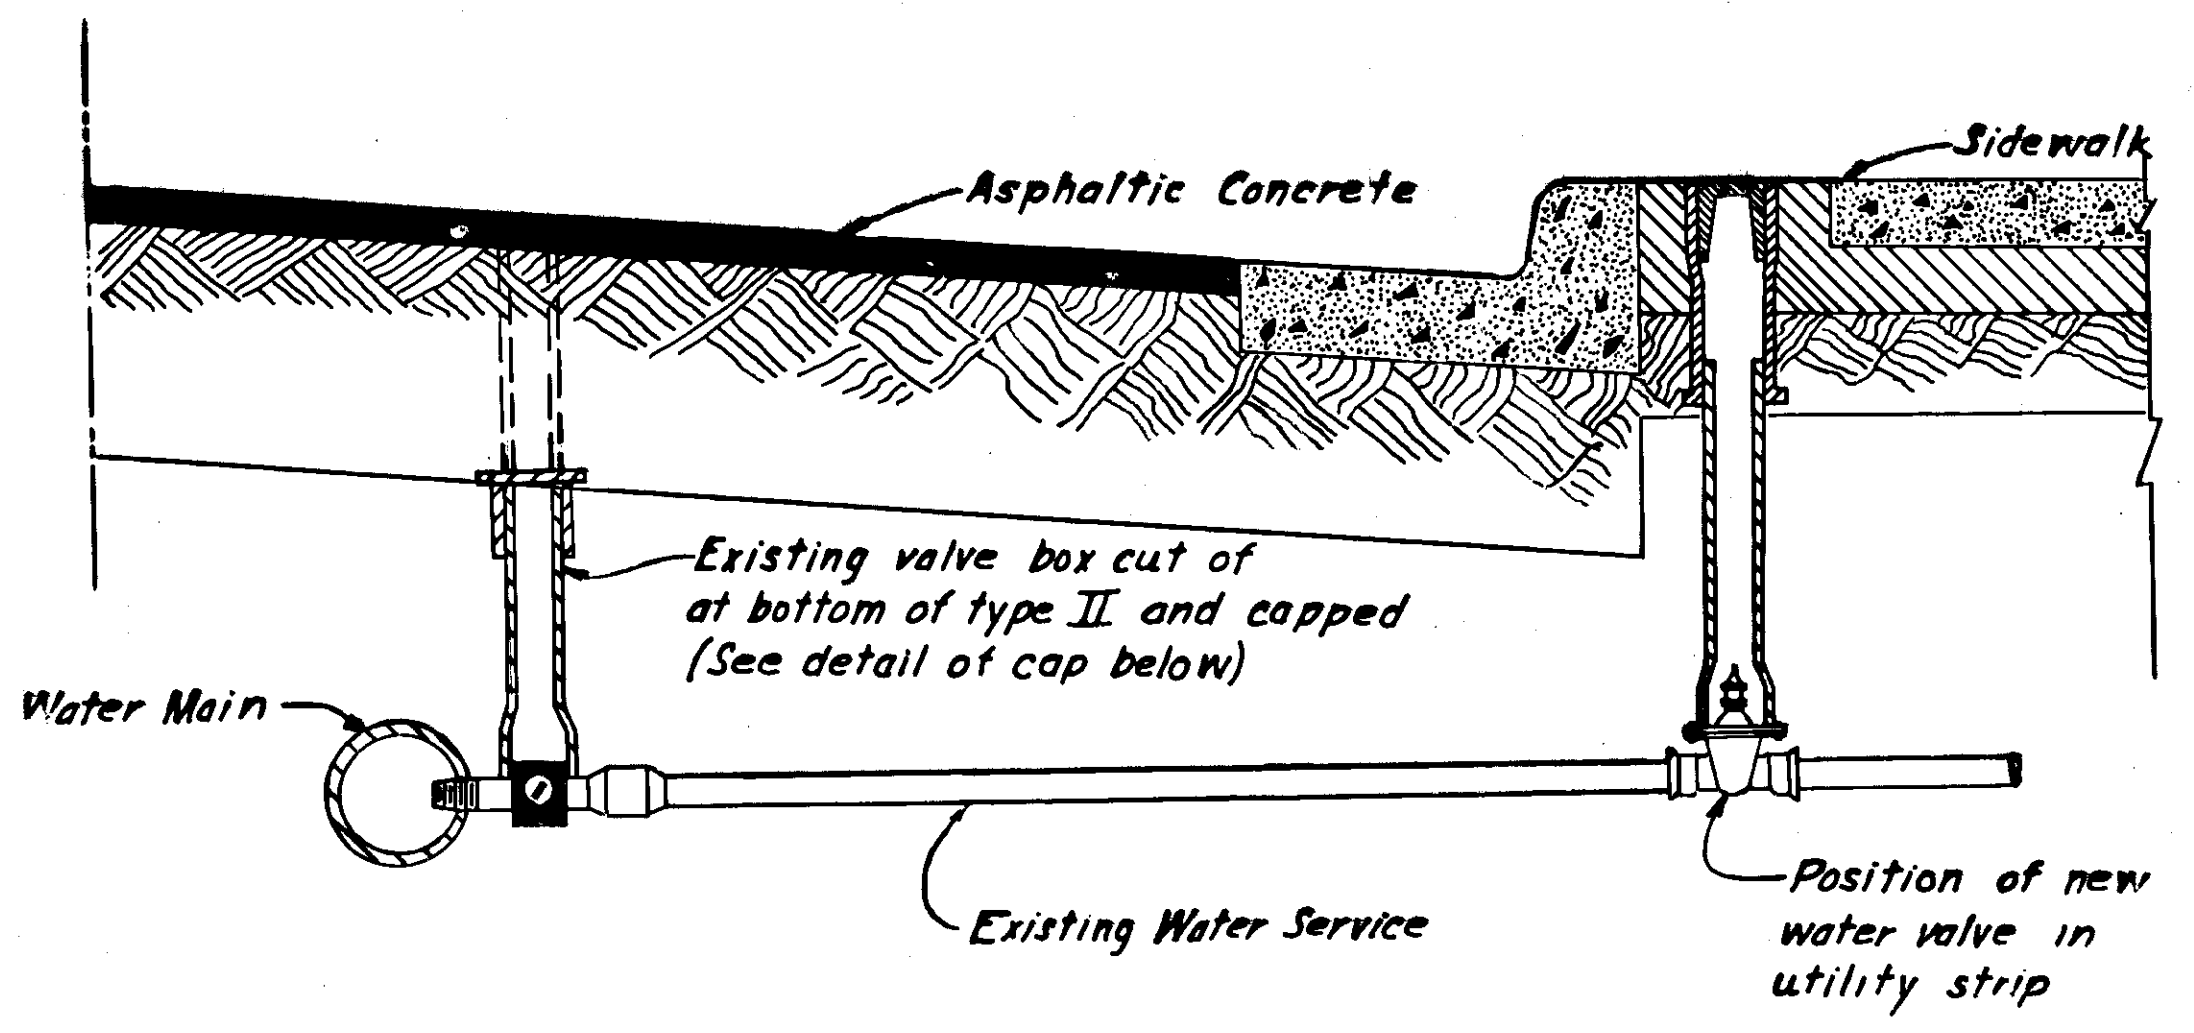

VALVE BOX CAP DETAIL

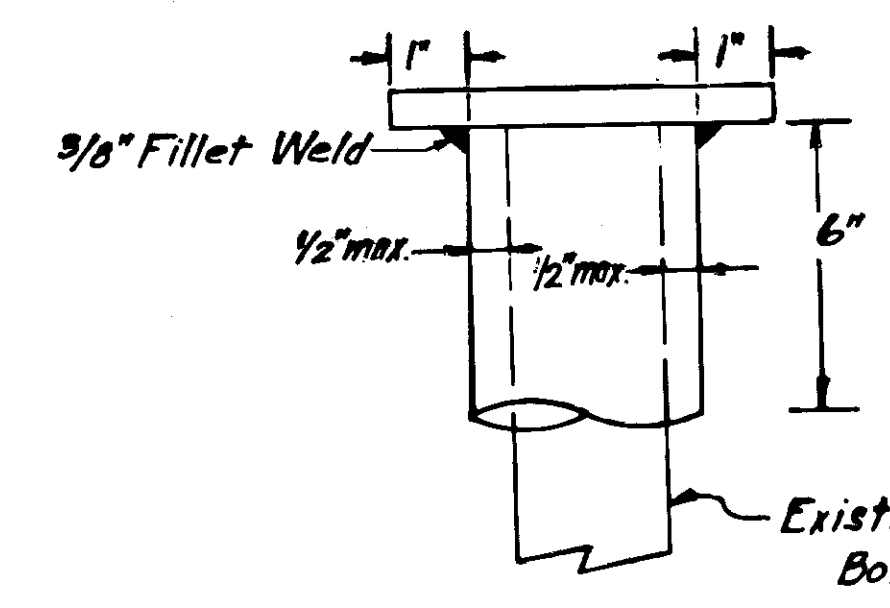

Cap Dimensions  
 Length - 6"  
 Diameter - Diameter of existing valve box + 1"  
 Gage (wall thickness) 0 gage


Cap Cover Dimensions  
 Thickness - 0 gage  
 Width - Diameter of cap + 2"  
 Length - Diameter of cap + 2"

Steel shall conform to ASTM 373 steel  
 All welding shall conform to American Welding Society Specifications.

The new valve and valve box shall be installed prior to the capping of the old valve box. The corporation cock valve shall be opened prior to the placement of the valve box cap.

**MICROFILMED**

BY V. W. THORNTON DATE 4-8-66

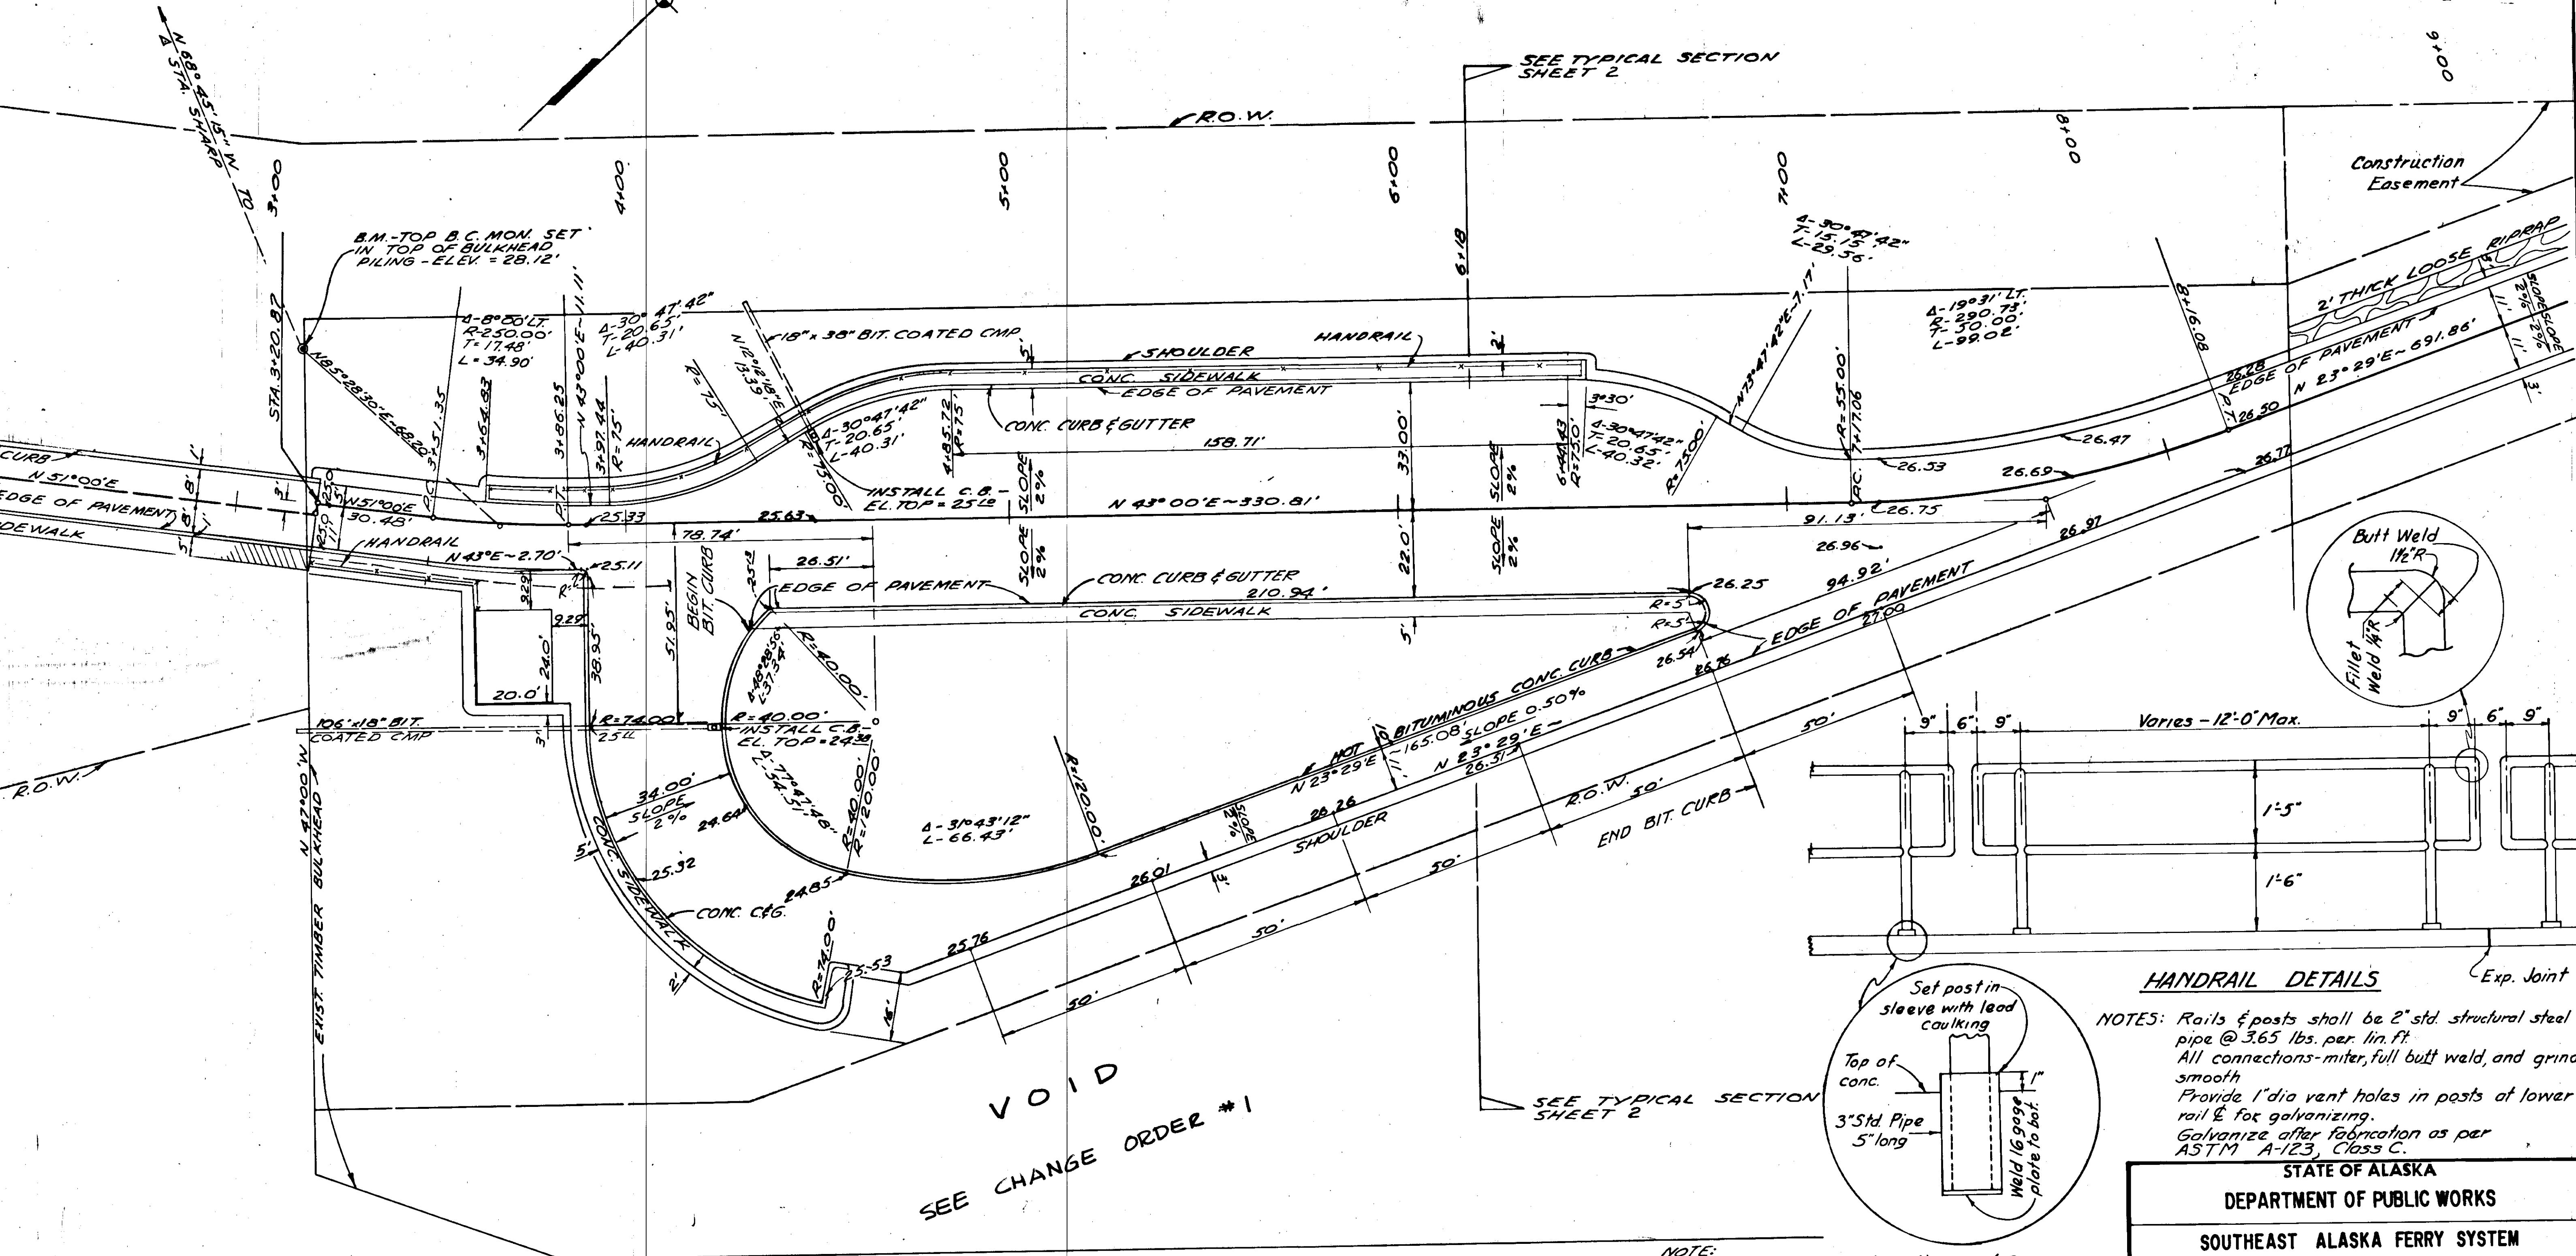

VOID  
SEE CHANGE ORDER #1



**HOLDING AREA - GENERAL PLAN**

PLANS REVISED BY DEPT. OF HIGHWAYS

SEE TYPICAL SECTION SHEET 2

SEE TYPICAL SECTION SHEET 2

NOTE:  
All elevations shown on base line are top of bituminous pavement.

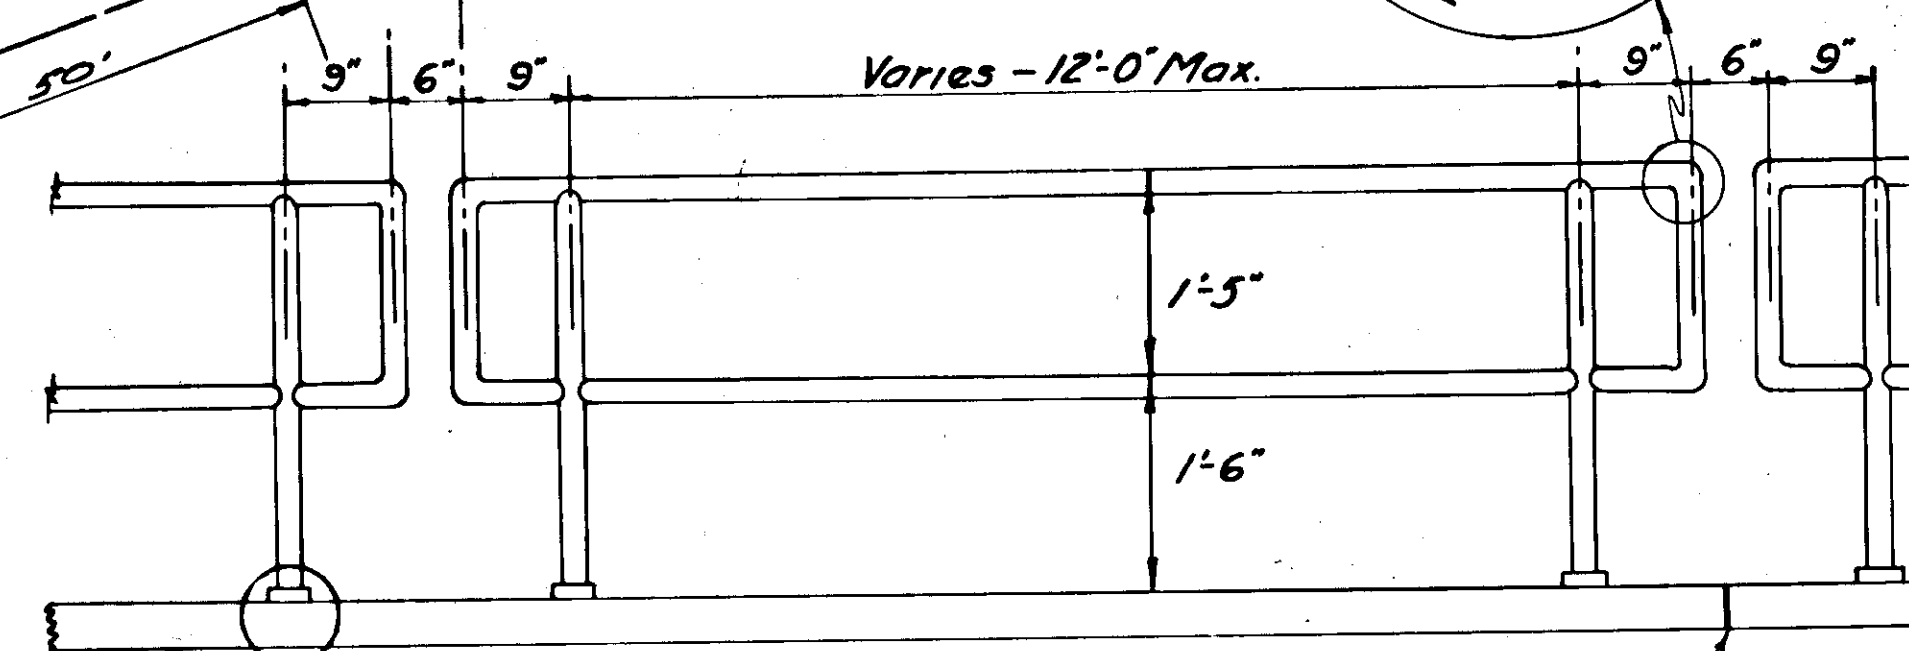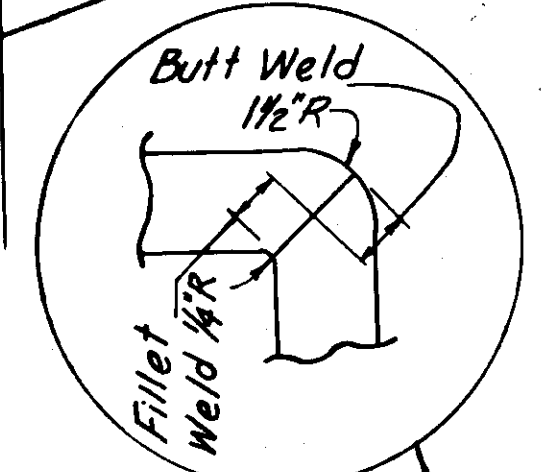


**HANDRAIL DETAILS**

NOTES: Rails & posts shall be 2" std. structural steel pipe @ 3.65 lbs. per lin. ft.  
 All connections - miter, full butt weld, and grind smooth.  
 Provide 1" dia vent holes in posts at lower rail & for galvanizing.  
 Galvanize after fabrication as per ASTM A-123, Class C.

STATE OF ALASKA  
 DEPARTMENT OF PUBLIC WORKS  
 SOUTHEAST ALASKA FERRY SYSTEM  
 SKAGWAY FERRY TERMINAL  
 PROJECT NO. S-0999  
**HOLDING AREA - GENERAL PLAN**  
 Scale As Noted Sheet 5 Of 33  
 TONER & NORDLING - Registered Engineers Juneau


AS BUILT  
MICROFILMED

DATE 9-8-66

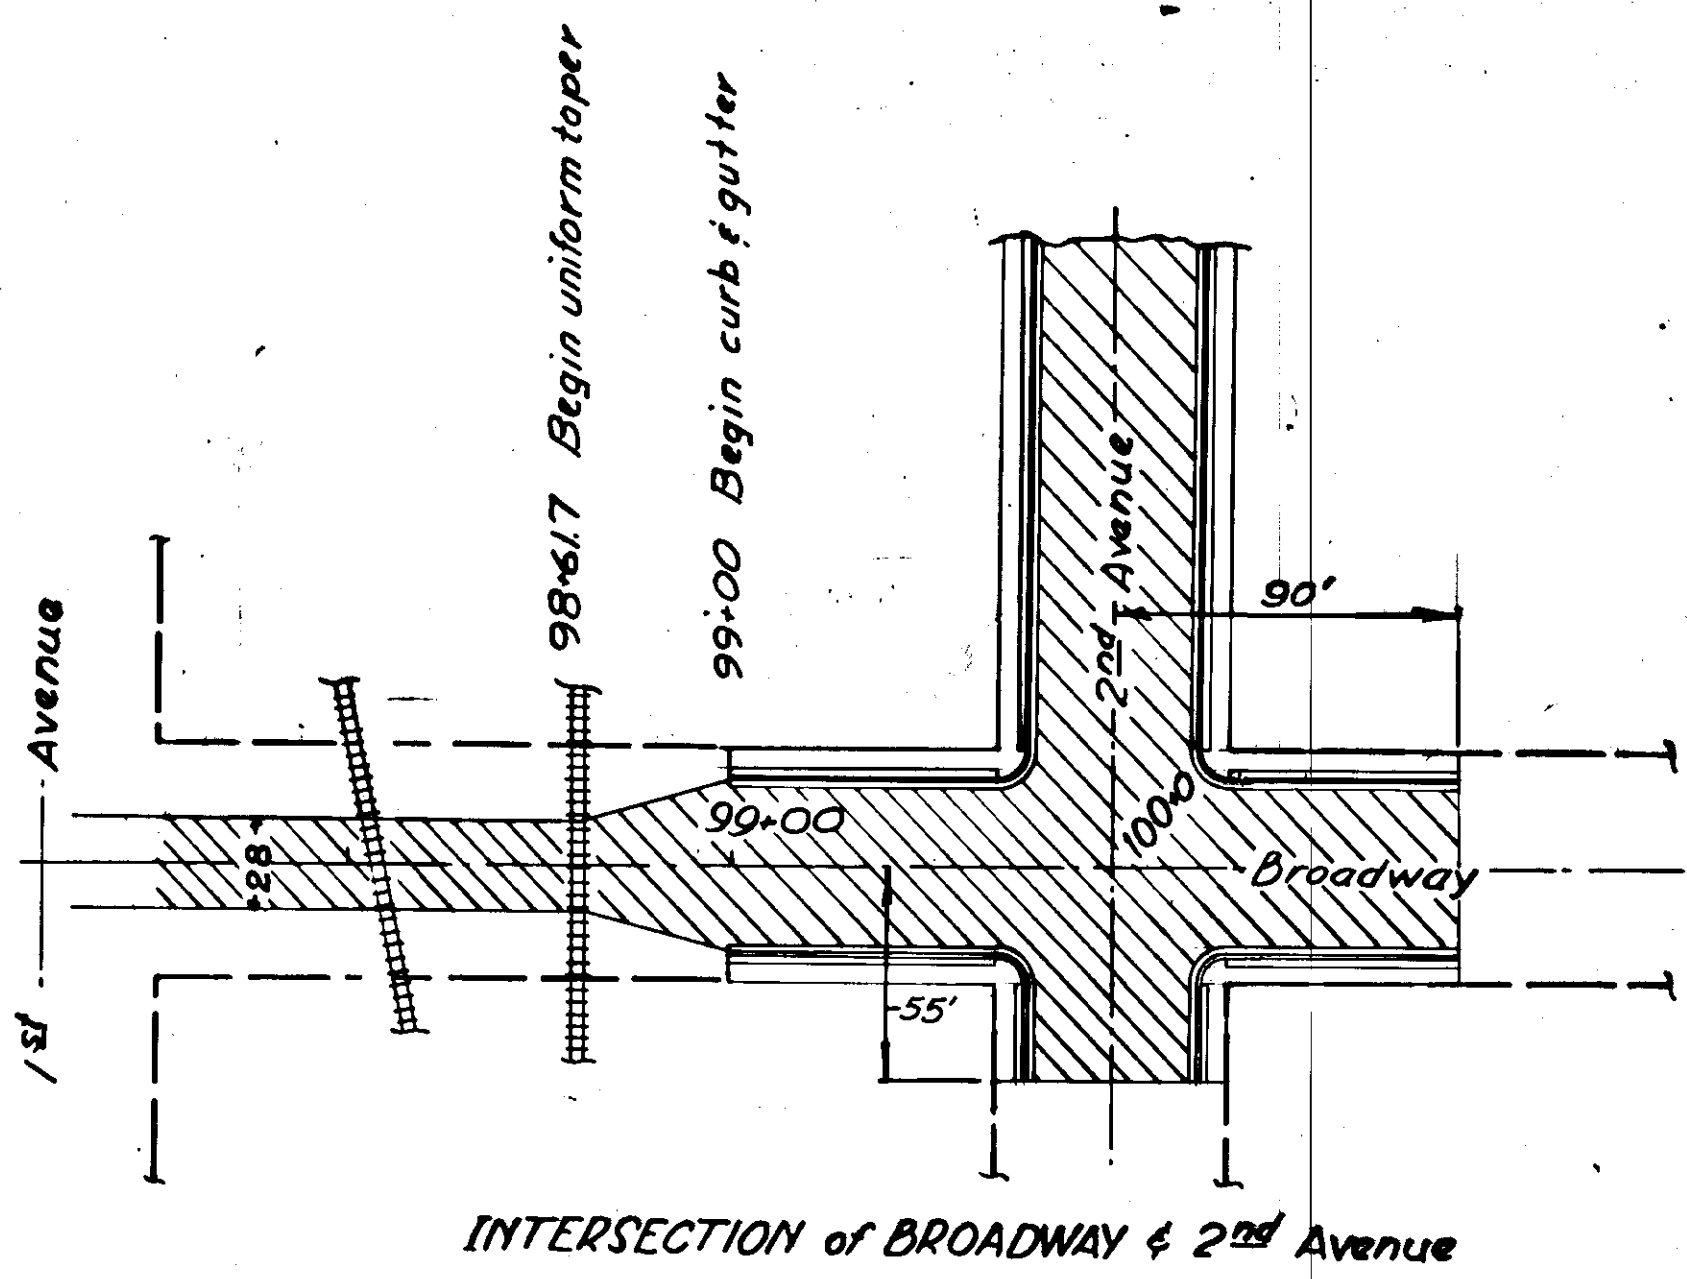


INTERSECTION of BROADWAY & 2nd Avenue


Station	Intersections
5+90	3rd Avenue and State Street
8+70	4th Avenue and State Street
11+50	5th Avenue and State Street
14+30	6th Avenue and State Street
17+10	7th Avenue and State Street
19+90	8th Avenue and State Street
22+70	9th Avenue and State Street
25+50	10th Avenue and State Street
28+29.95 Bk.	
28+30.00 Aa.	11th Avenue and State Street
31+10	12th Avenue and State Street
33+90	13th Avenue and State Street
36+70	14th Avenue and State Street
39+50	15th Avenue and State Street
42+30	16th Avenue and State Street
45+10	17th Avenue and State Street
47+90	18th Avenue and State Street
50+70	19th Avenue and State Street

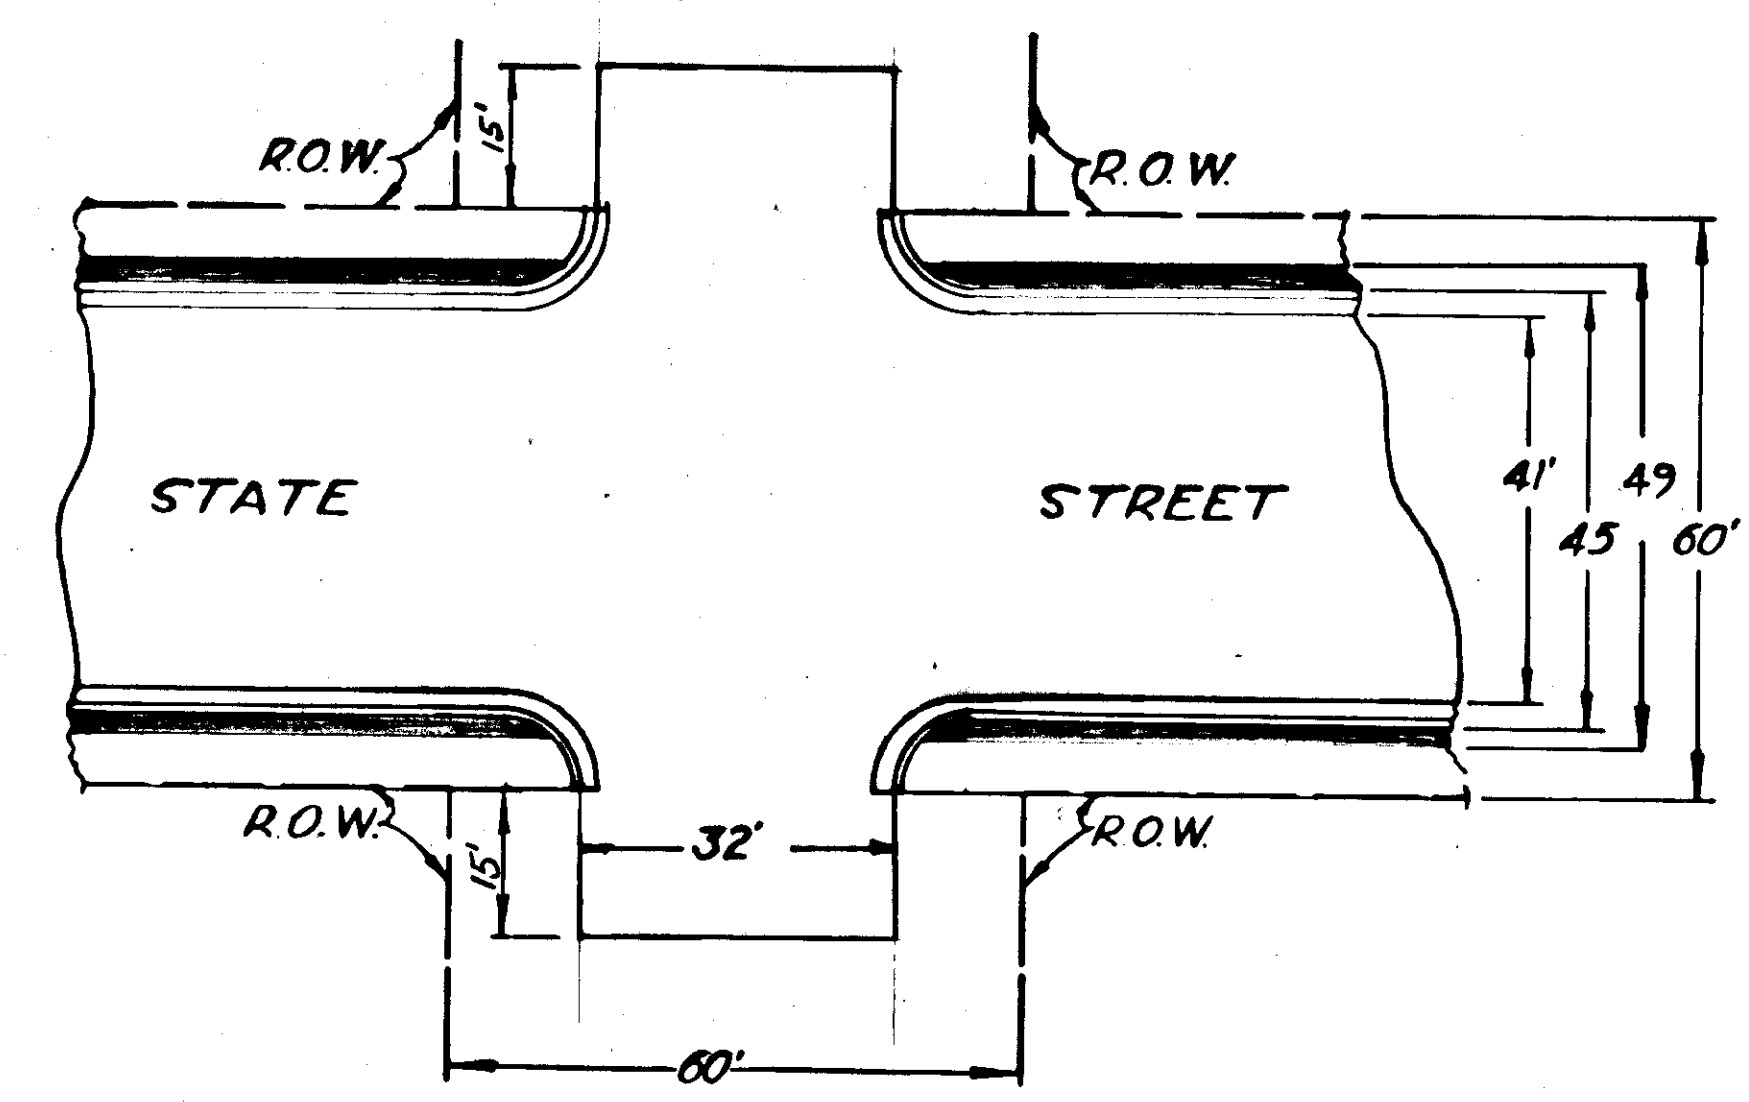

TYPE I-A INTERSECTION DETAIL

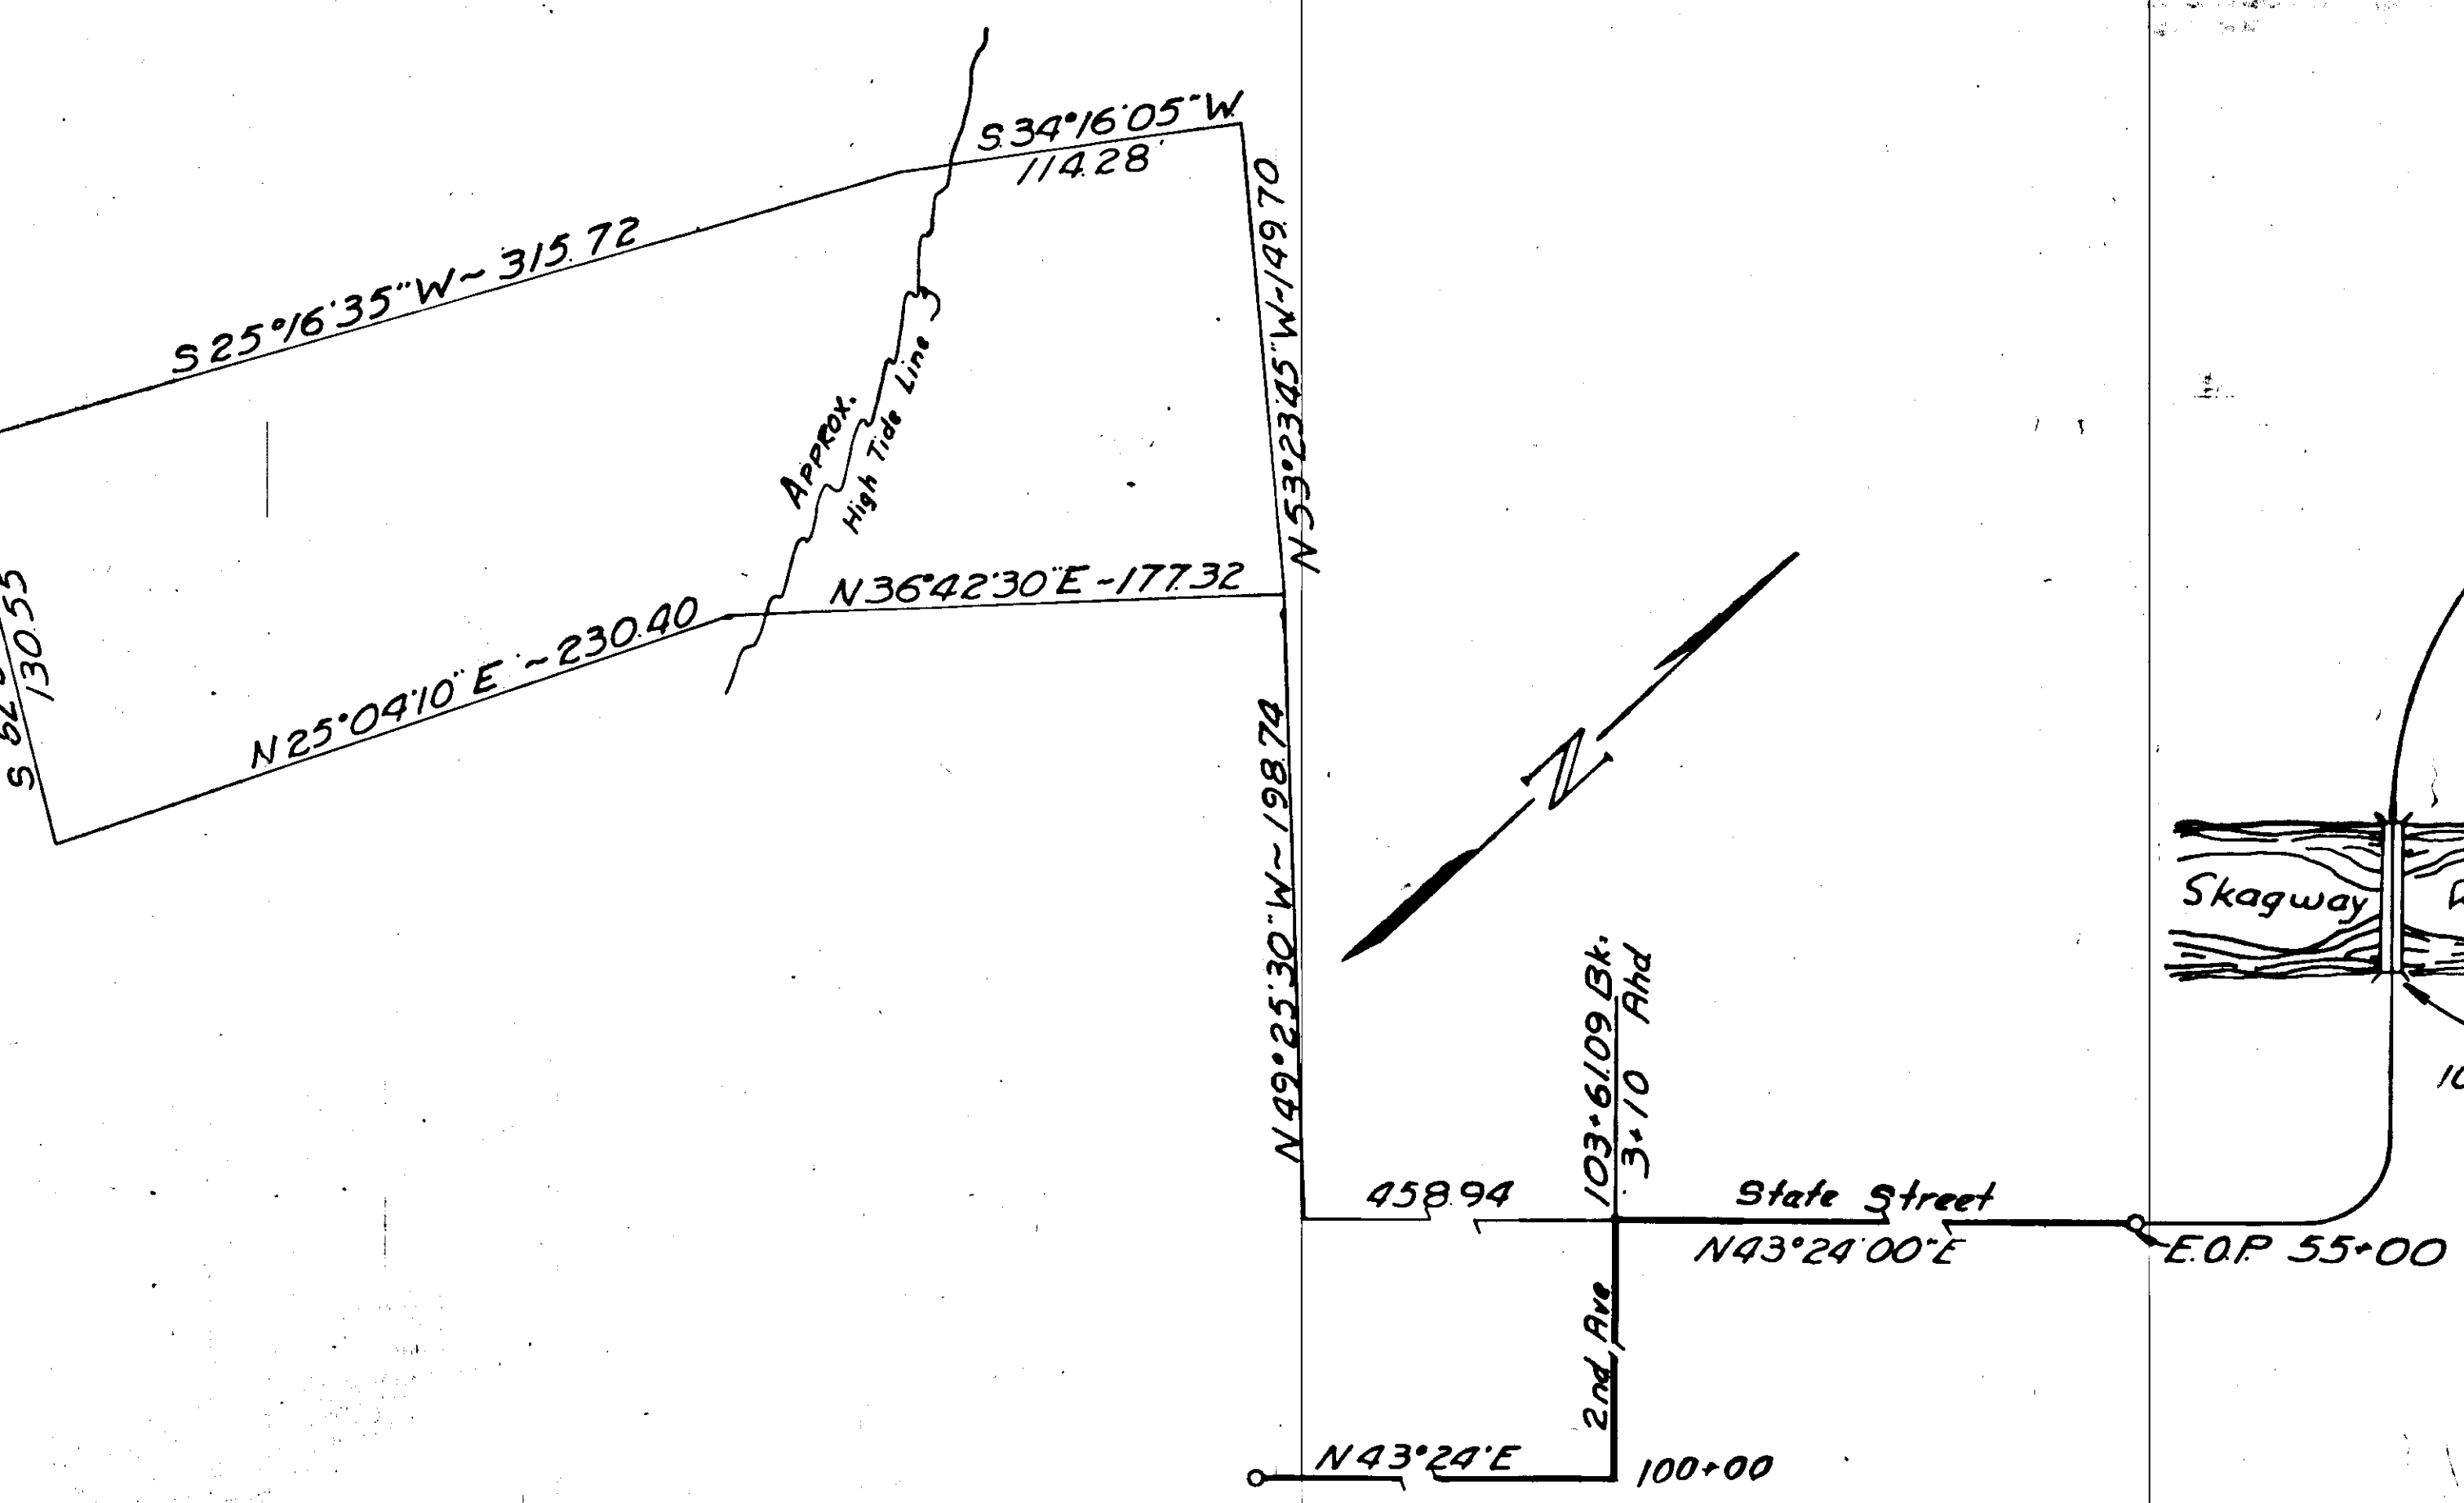

SUGGESTED SOURCE

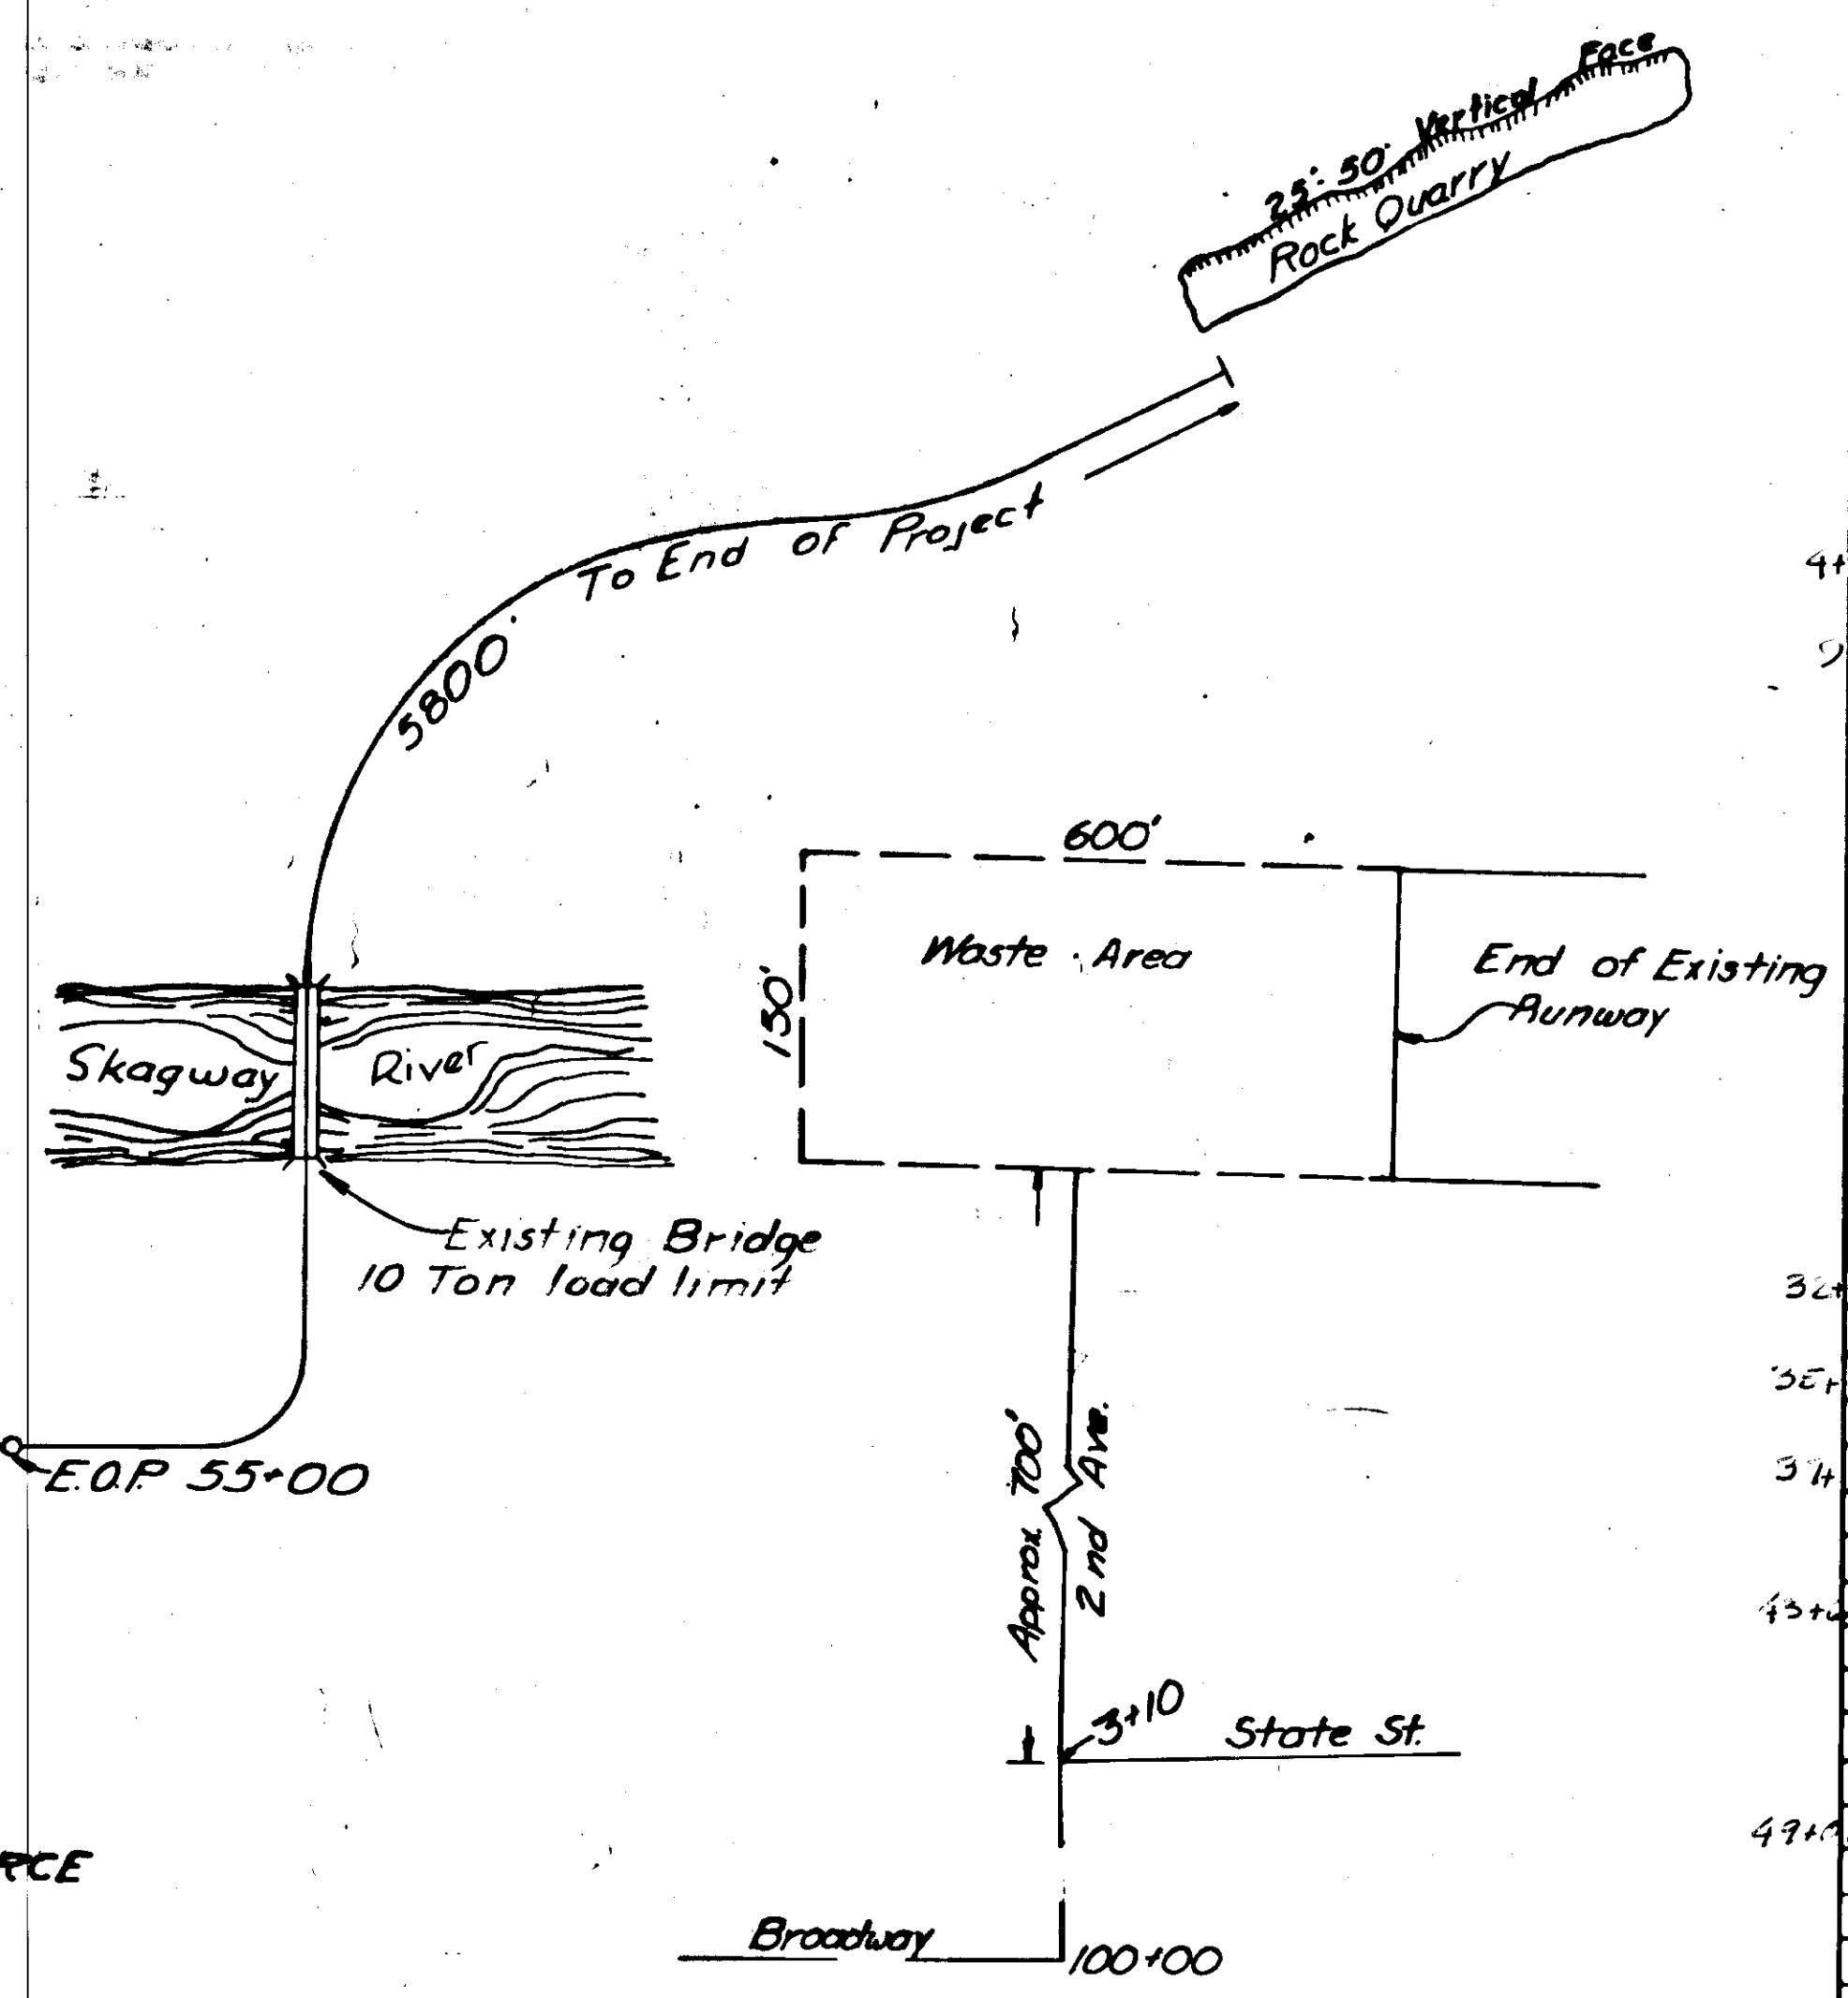


Waste Area Diagram

CURB CUTS

Station	Description	Station	Description
101+89	16' Curb cut Lt.	101+89	18' Curb cut Rt.
102+41	16' Curb cut Lt.	102+41	18' " " Lt.
102+50	16' Curb cut Rt.	102+50	18' " " Lt.
4+50	16' Curb cut Lt. & Rt.	102+50	18' " " Lt.
5+05	16' Curb cut Rt.	102+50	18' " " Lt.
7+30	16' Curb cut Lt. & Rt.	102+50	18' " " Lt.
10+10	16' Curb cut Lt. & Rt.	102+50	18' " " Lt.
12+90	16' Curb cut Lt. & Rt.	102+50	18' " " Lt.
15+67	16' Curb cut Lt. & Rt.	102+50	18' " " Lt.
18+50	16' Curb cut Lt. & Rt.	102+50	18' " " Lt.
19+00	16' Curb cut Rt.	102+50	18' " " Lt.
21+30	16' Curb cut Lt. & Rt.	102+50	18' " " Lt.
21+77	16' Curb cut Rt.	102+50	18' " " Lt.
24+11	16' Curb cut Lt.	102+50	18' " " Lt.
24+16	16' Curb cut Rt.	102+50	18' " " Lt.
24+83	16' Curb cut Rt.	102+50	18' " " Lt.
26+80	16' Curb cut Rt.	102+50	18' " " Lt.
26+90	16' Curb cut Lt.	102+50	18' " " Lt.
29+42	16' Curb cut Rt.	102+50	18' " " Lt.
29+70	16' Curb cut Lt. & Rt.	102+50	18' " " Lt.
31+24	24' Curb cut Rt.	102+50	18' " " Lt.
32+00	16' Curb cut Rt.	102+50	18' " " Lt.
32+50	16' Curb cut Rt.	102+50	18' " " Lt.
35+30	16' Curb cut Lt. & Rt.	102+50	18' " " Lt.
36+75	24' Curb cut Lt. & Rt.	102+50	18' " " Lt.
38+10	16' Curb cut Lt. & Rt.	102+50	18' " " Lt.
40+49	16' Curb cut Rt.	102+50	18' " " Lt.
44+35	16' Curb cut Rt.	102+50	18' " " Lt.
45+09	16' Curb cut Lt.	102+50	18' " " Lt.
46+50	16' Curb cut Lt. & Rt.	102+50	18' " " Lt.
47+78	16' Curb cut Lt.	102+50	18' " " Lt.
48+96	16' Curb cut Rt.	102+50	18' " " Lt.
49+31	16' Curb cut Lt. & Rt.	102+50	18' " " Lt.
50+38	16' Curb cut Rt.	102+50	18' " " Lt.
51+20	" " " Lt.	102+50	18' " " Lt.
52+40	16' Curb cut Rt.	102+50	18' " " Lt.
53+34	16' Curb cut Lt.	102+50	18' " " Lt.

STATE	PROJECT	YEAR	SHEET NO	TOTAL SHEETS
ALASKA	999(5)	1963	7	33

AS BUILT

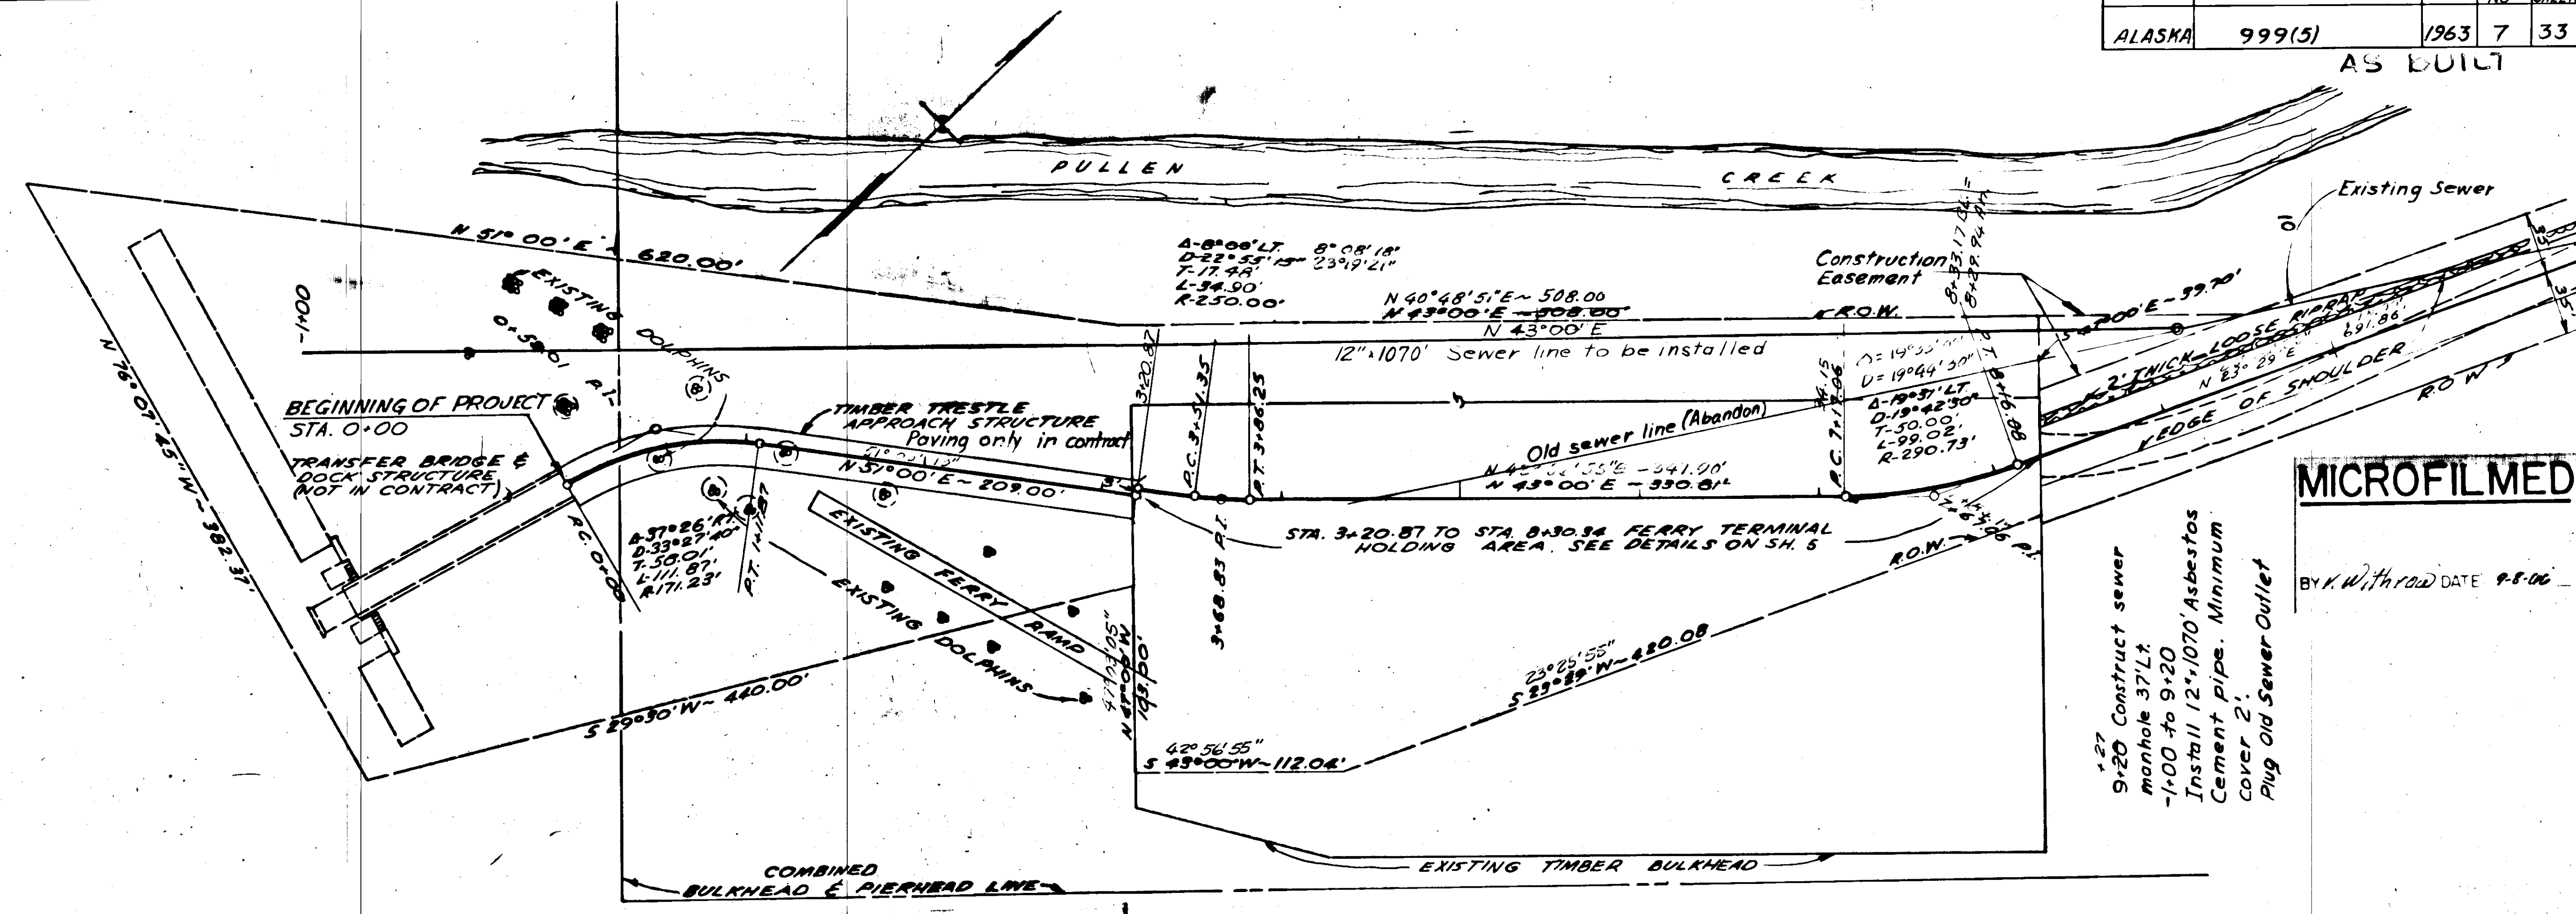

1.27 Construct sewer manhole 37" L x 1-100 to 9+20 Install 12" x 1070' Asbestos Cement pipe. Minimum cover 2'. Plug Old Sewer Outlet

**MICROFILMED**  
BY K. Withrow DATE 9-8-06

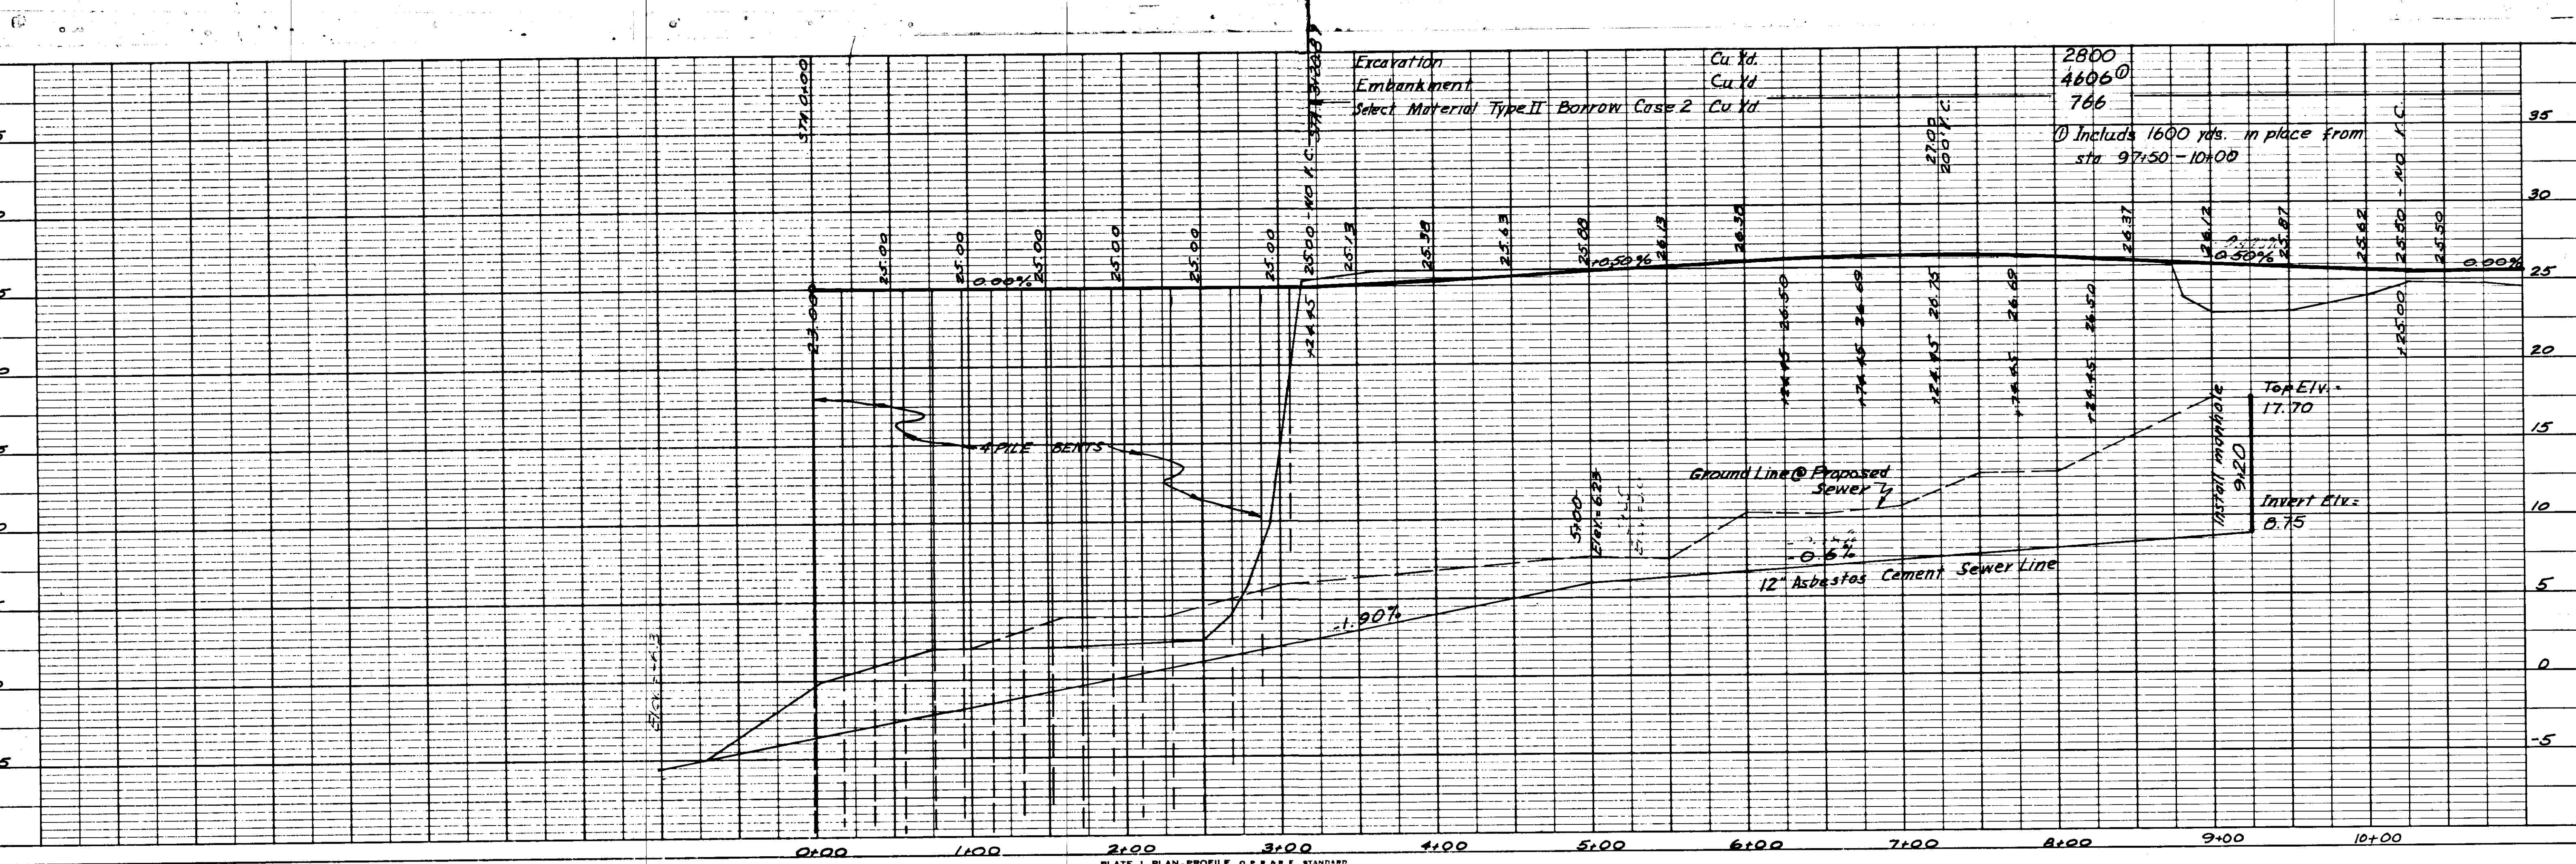



PLATE 1. PLAN - PROFILE O.P.R.A.R. STANDARD  
1328 S. GAGEPROOF FILM - MADE AND PRINTED IN U.S.A.  
BUSINE DIETZGEN CO.

STATE	ROUTE	YEAR	SHEET NO.	TOTAL SHEETS
ALASKA	S-999 (5)	1963	8	33

AS BUILT

**MICROFILMED**

By *V. Wilton* DATE 9.8.06

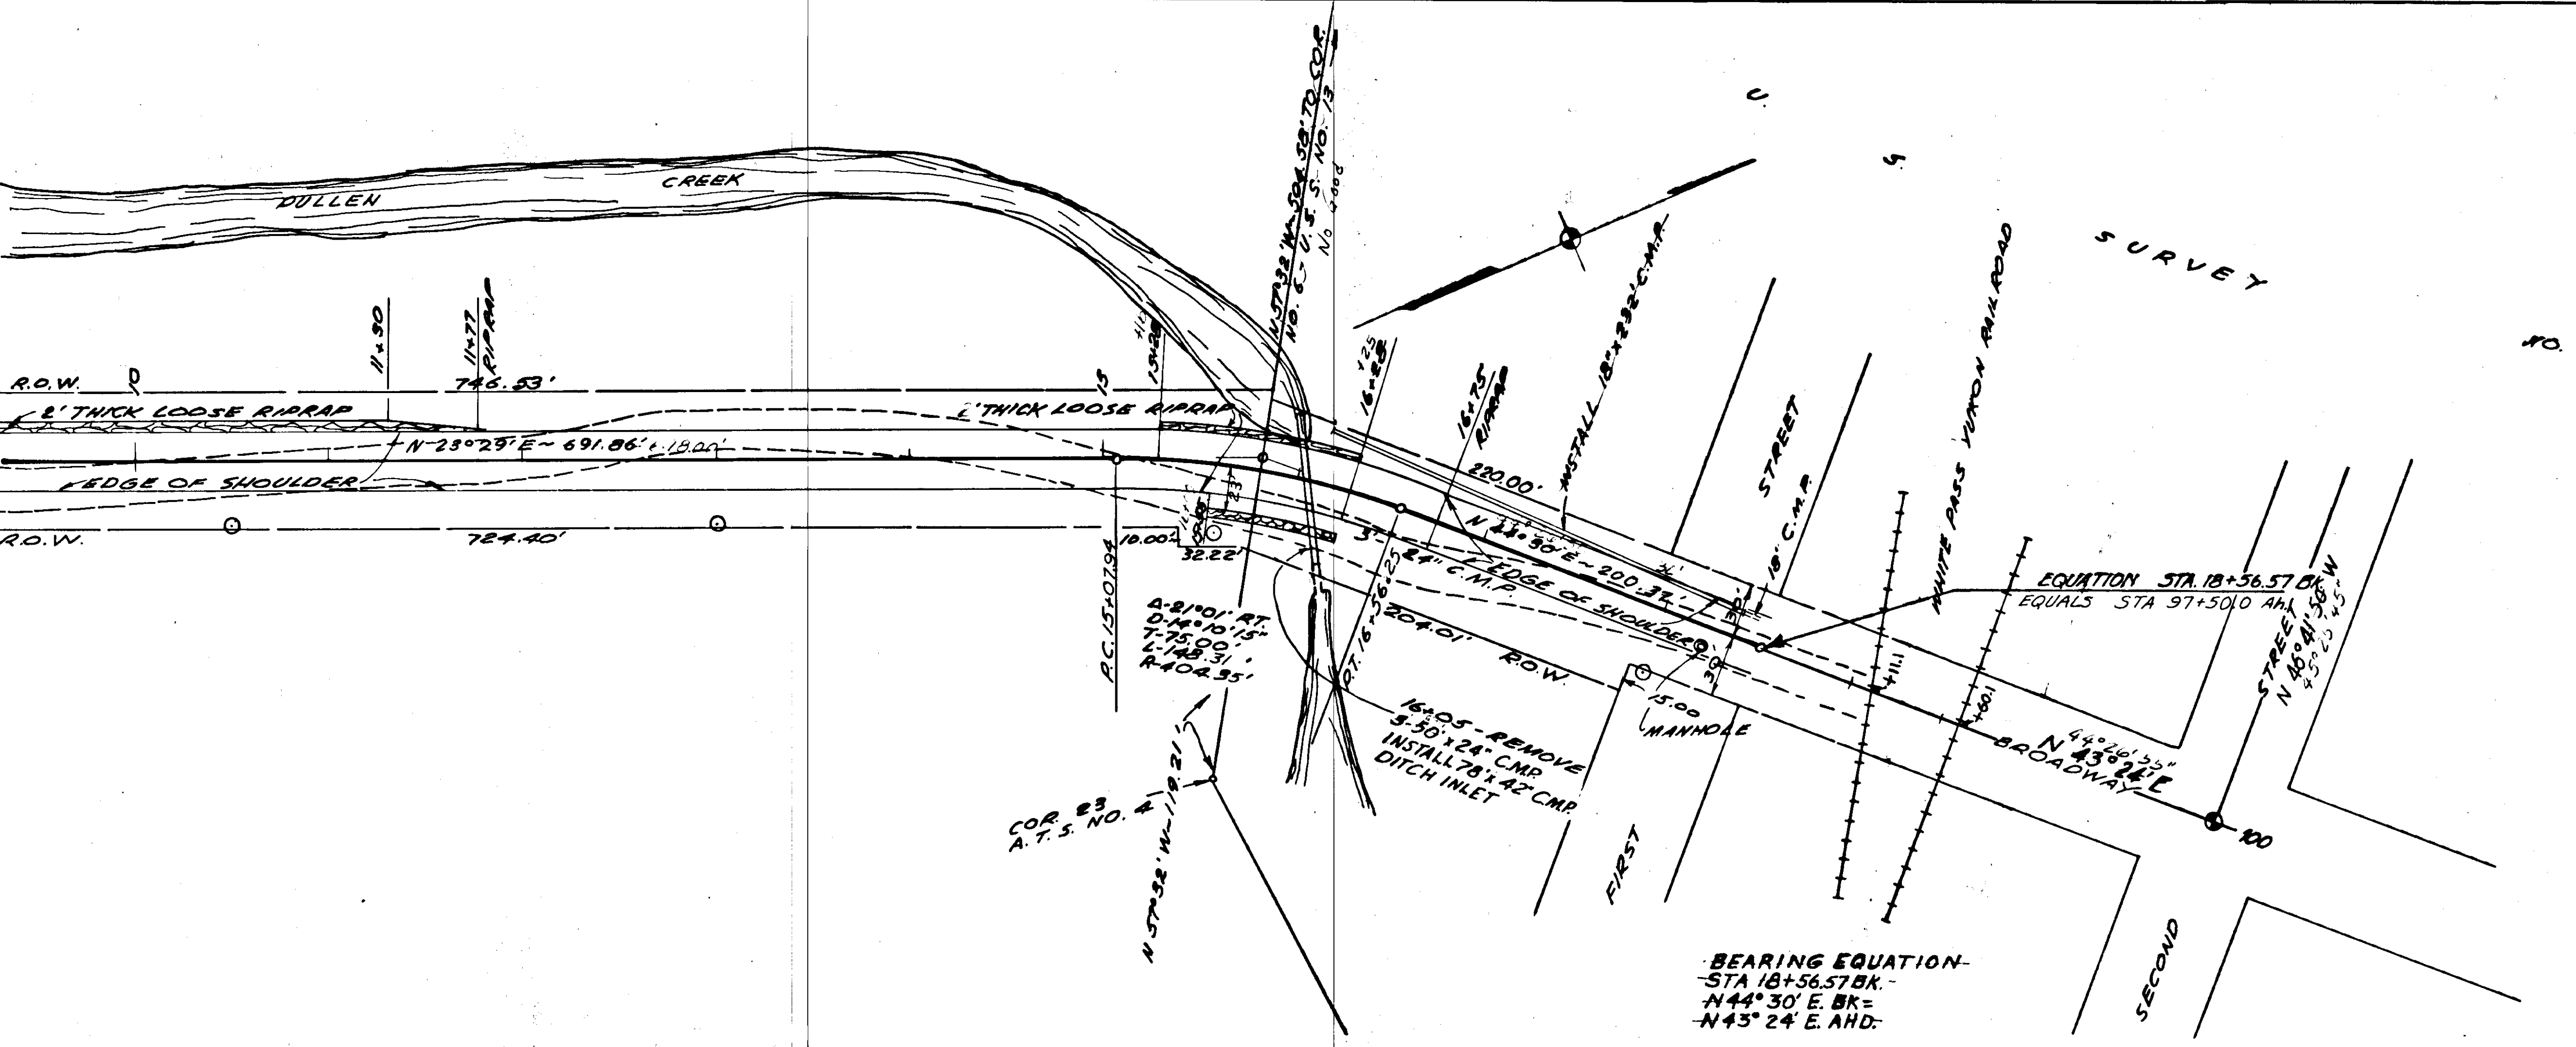

BEARING EQUATION-  
 STA 18+56.57 BK -  
 N44°30' E BK =  
 N43°24' E AND


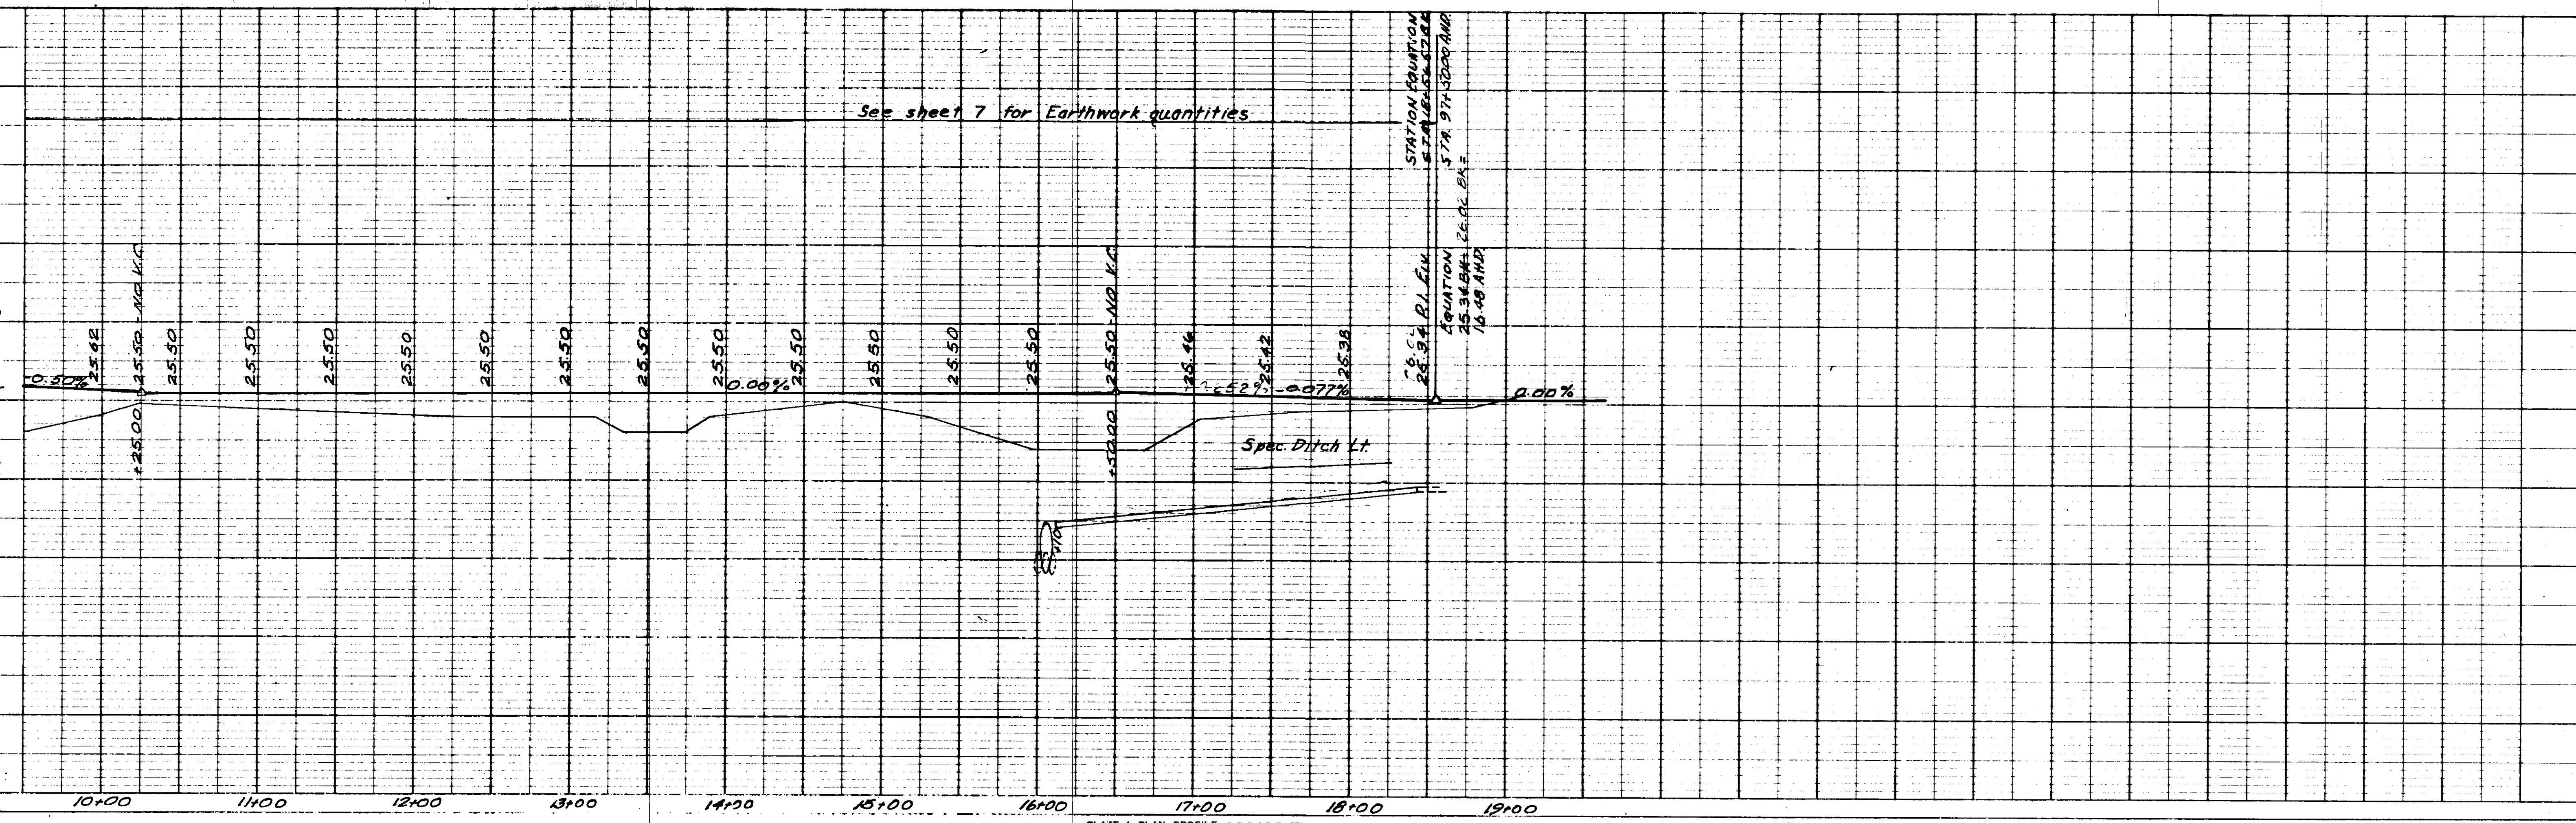


PLATE 1. PLAN, PROFILE OF P & B & E STANDARD  
 TYPE 2 GRAPHIC FILM MADE AND PRINTED IN U.S.A.  
 EUGENE DIETZGEN CO.

J-5

NOTE:  
See sheet N<sup>o</sup> 6 for list of curb cuts, for alleys, driveways and streets.  
See sheet N<sup>o</sup> 3 for detailed list of Underdrain quantities

STATE	PROJECT	YEAR	SHEET NO.	TOTAL SHEETS
ALASKA	999 (5)	1963	9	33

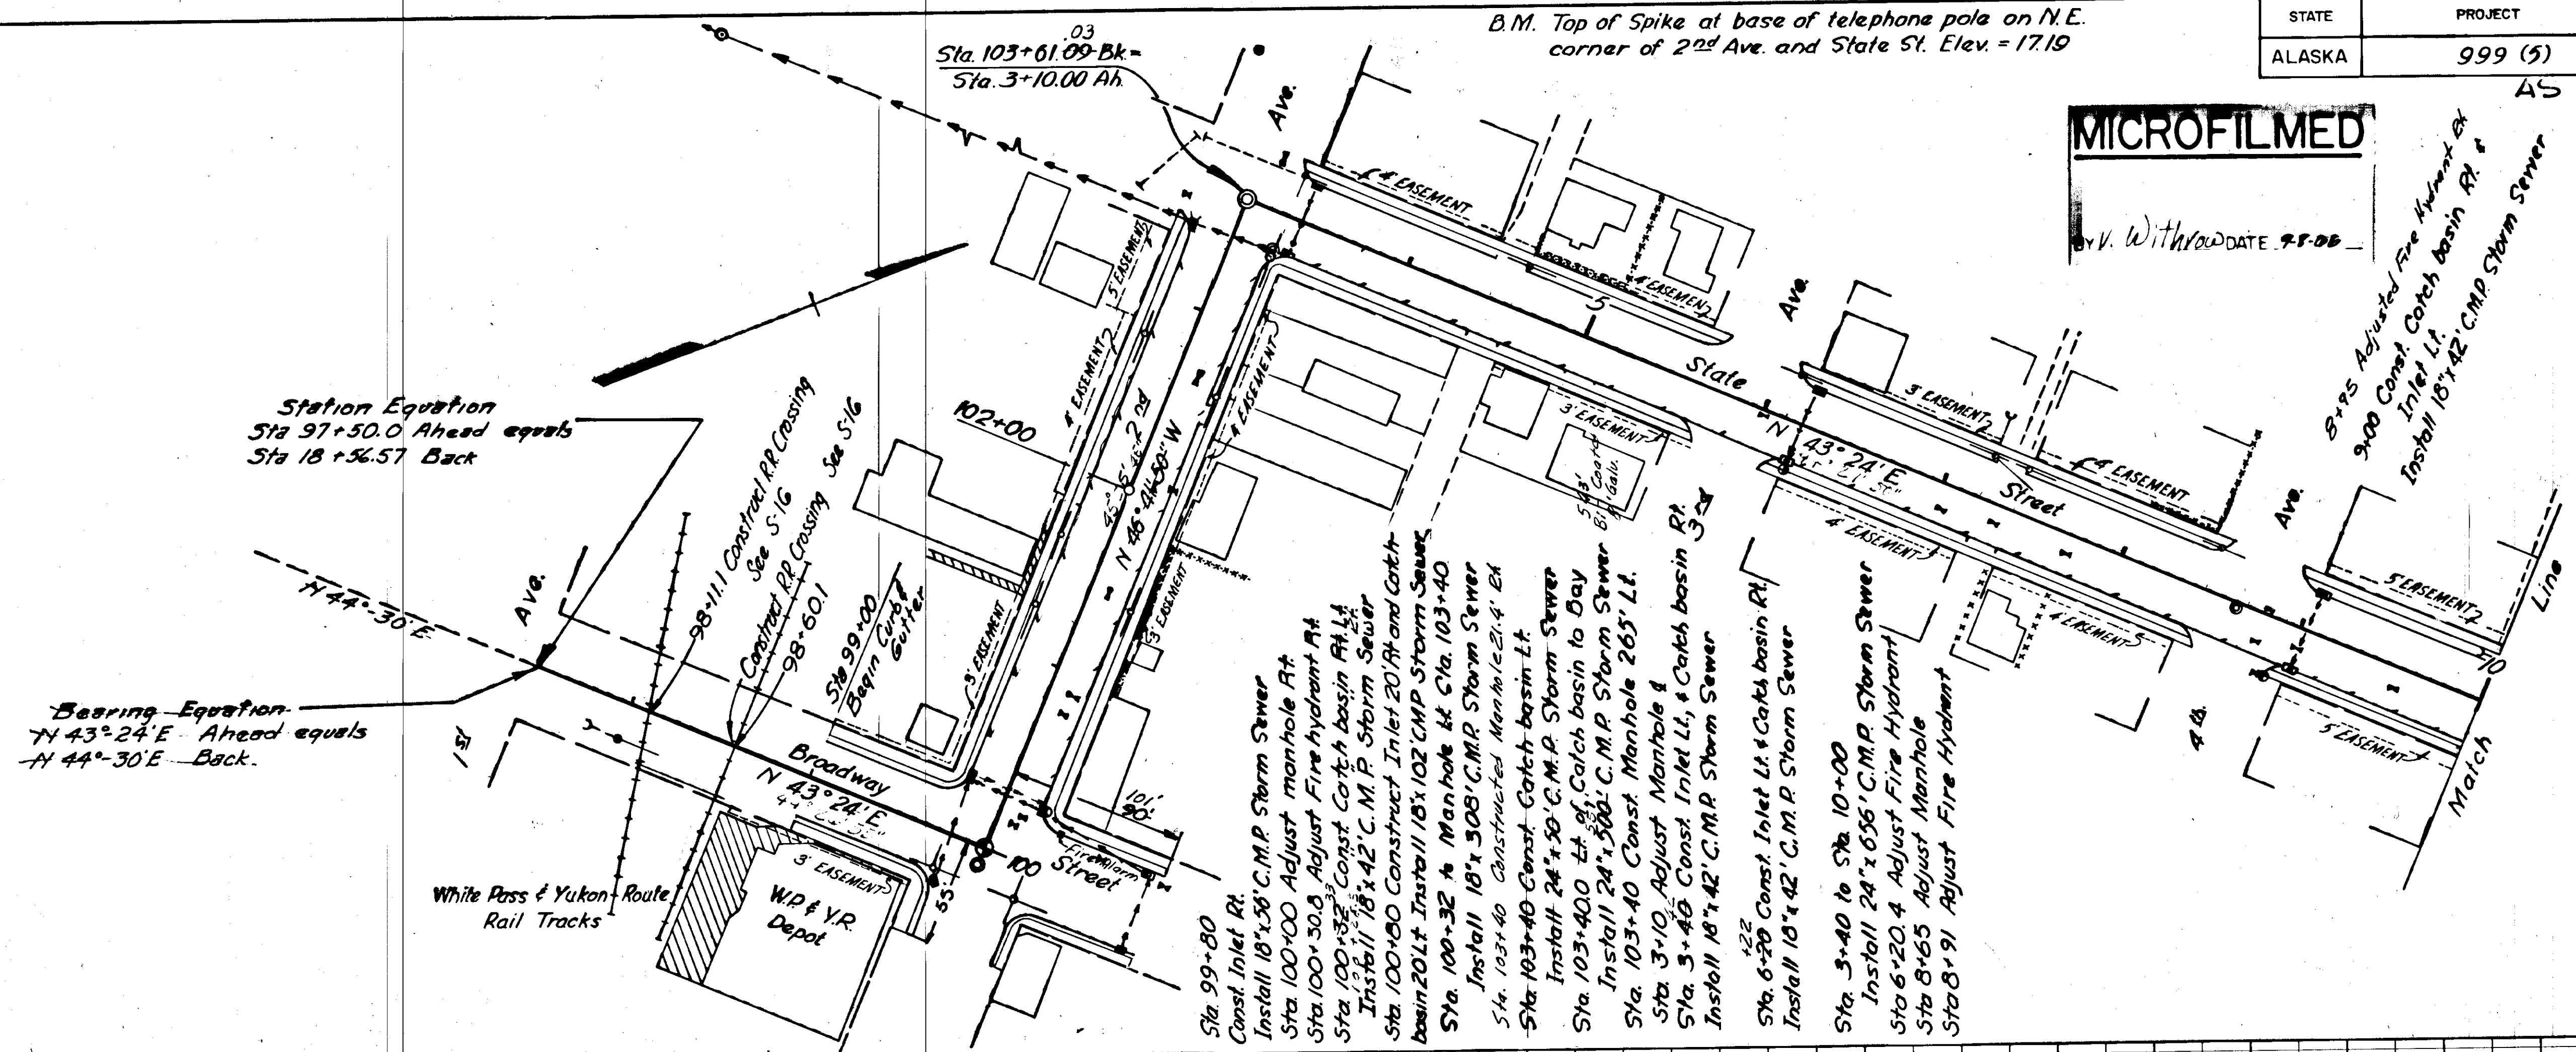

Station Equation  
Sta 97+50.0 Ahead equals  
Sta 18+56.57 Back

Bearing Equation  
N 43° 24' E Ahead equals  
N 44° 30' E Back.

B.M. Top of Spike at base of telephone pole on N.E. corner of 2<sup>nd</sup> Ave. and State St. Elev. = 17.19

**MICROFILMED**  
By V. Withrow DATE 9-8-66

AS BUILT  
8+95 Adjusted Fire Hydrant & Inlet Lt.  
9+00 Const. Catch basin Rt. & Install 18\"/>


- Sta 99+80 Const. Inlet Rt.
- Install 18\"/>
- Sta 100+00 Adjust Manhole Rt.
- Sta 100+30.8 Adjust Fire Hydrant Rt.
- Sta 100+32.3 Const. Catch basin Rt. Lt.
- Install 18\"/>
- Sta 100+80 Construct Inlet 20' and Catch basin 20' Lt.
- Install 18\"/>
- Sta 103+40 Const. Catch basin Lt.
- Install 24\"/>
- Sta 103+40 Const. Catch basin to Day
- Install 24\"/>
- Sta 3+10 Adjust Manhole & Inlet Lt.
- Install 18\"/>
- Sta 6+20 Const. Inlet Lt. & Catch basin Rt.
- Install 18\"/>
- Sta 3+40 to Sta 10+00
- Install 24\"/>
- Sta 6+20.4 Adjust Fire Hydrant
- Sta 8+65 Adjust Manhole
- Sta 8+91 Adjust Fire Hydrant

Elevation Datum Brass monument marked U.S. Coast and Geodetic survey dated 1910, located S.E. corner of old District Court house now the Skagway museum. Elev = 23.49  
Profile Grade is Finished Grade

Excavation Embankment Selected Material Type II Borrow Case 2

- 5,296 Cu. Yds.
- 1,450 Cu. Yds.
- 1,557 Cu. Yds.
- 2000 cu. yds. to be used on approach road to Ferry Terminal
- 3267 cu. yd. waste.


Station Equation  
Sta 97+50.0 Ahead equals  
Sta. 18+56.57 Back

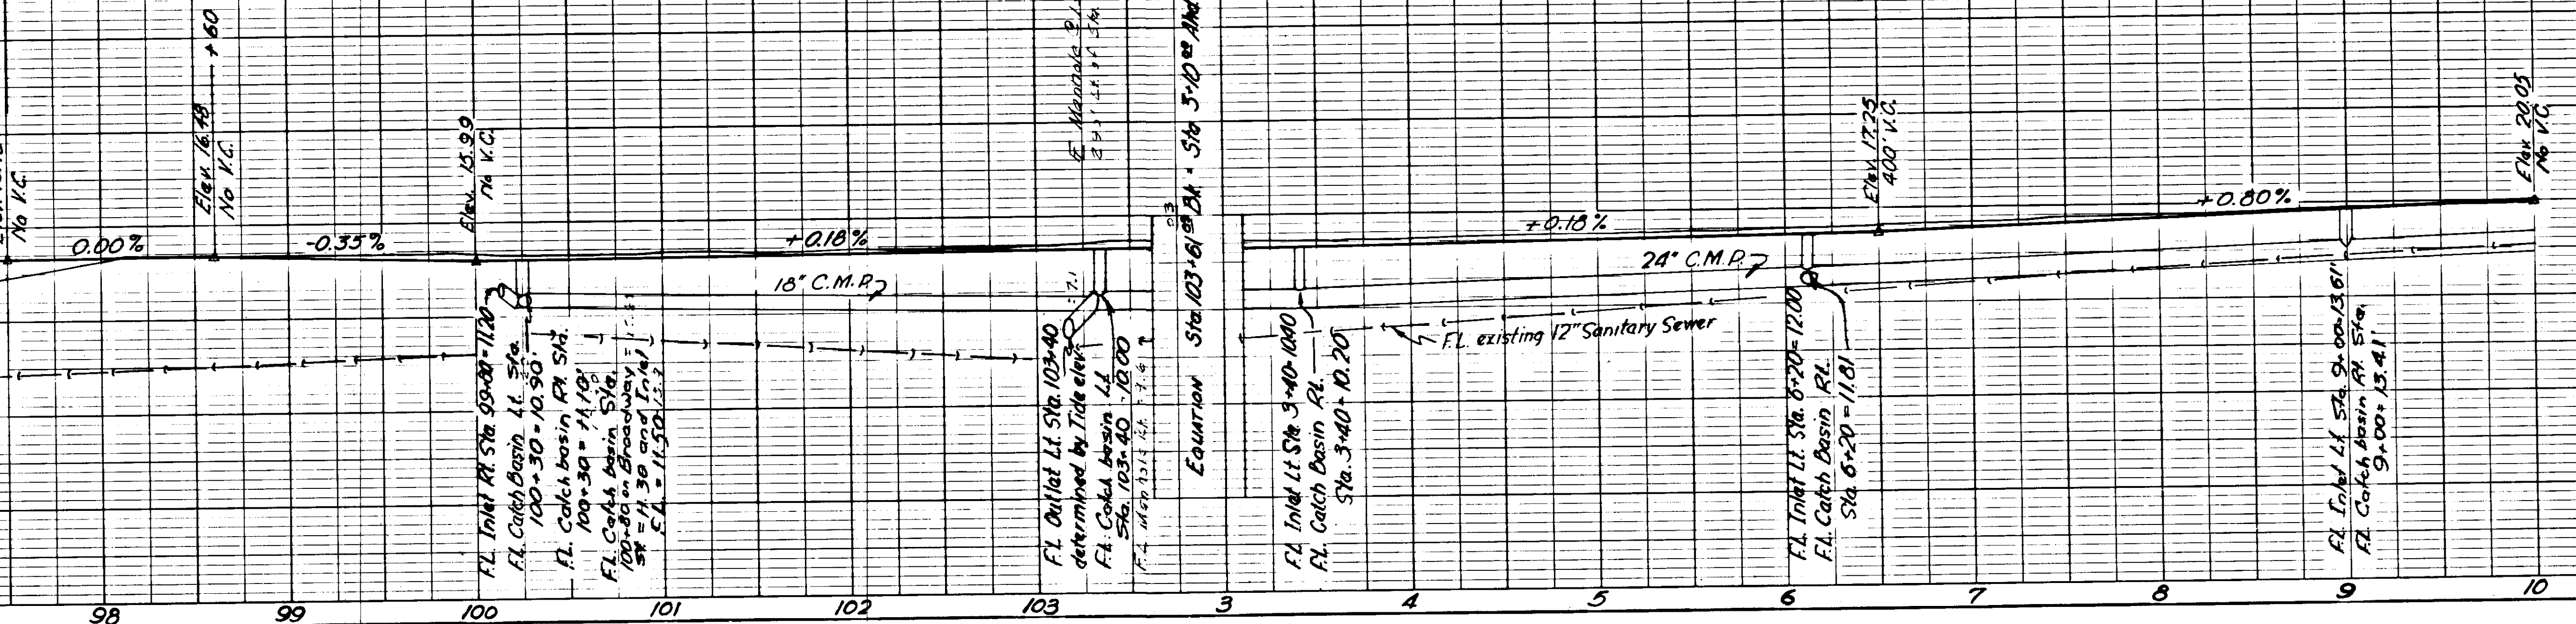

Elevation Equation  
Sta. 97+50 Ahead  
Elev. 16.43 Ahead  
Equals Elev. 23.34 Back

STATE	PROJECT	YEAR	SHEET NO.	TOTAL SHEETS
ALASKA	999 (5)	1963	10	33


**MICROFILMED**  
 BY V. W. Thrope DATE 9-8-06

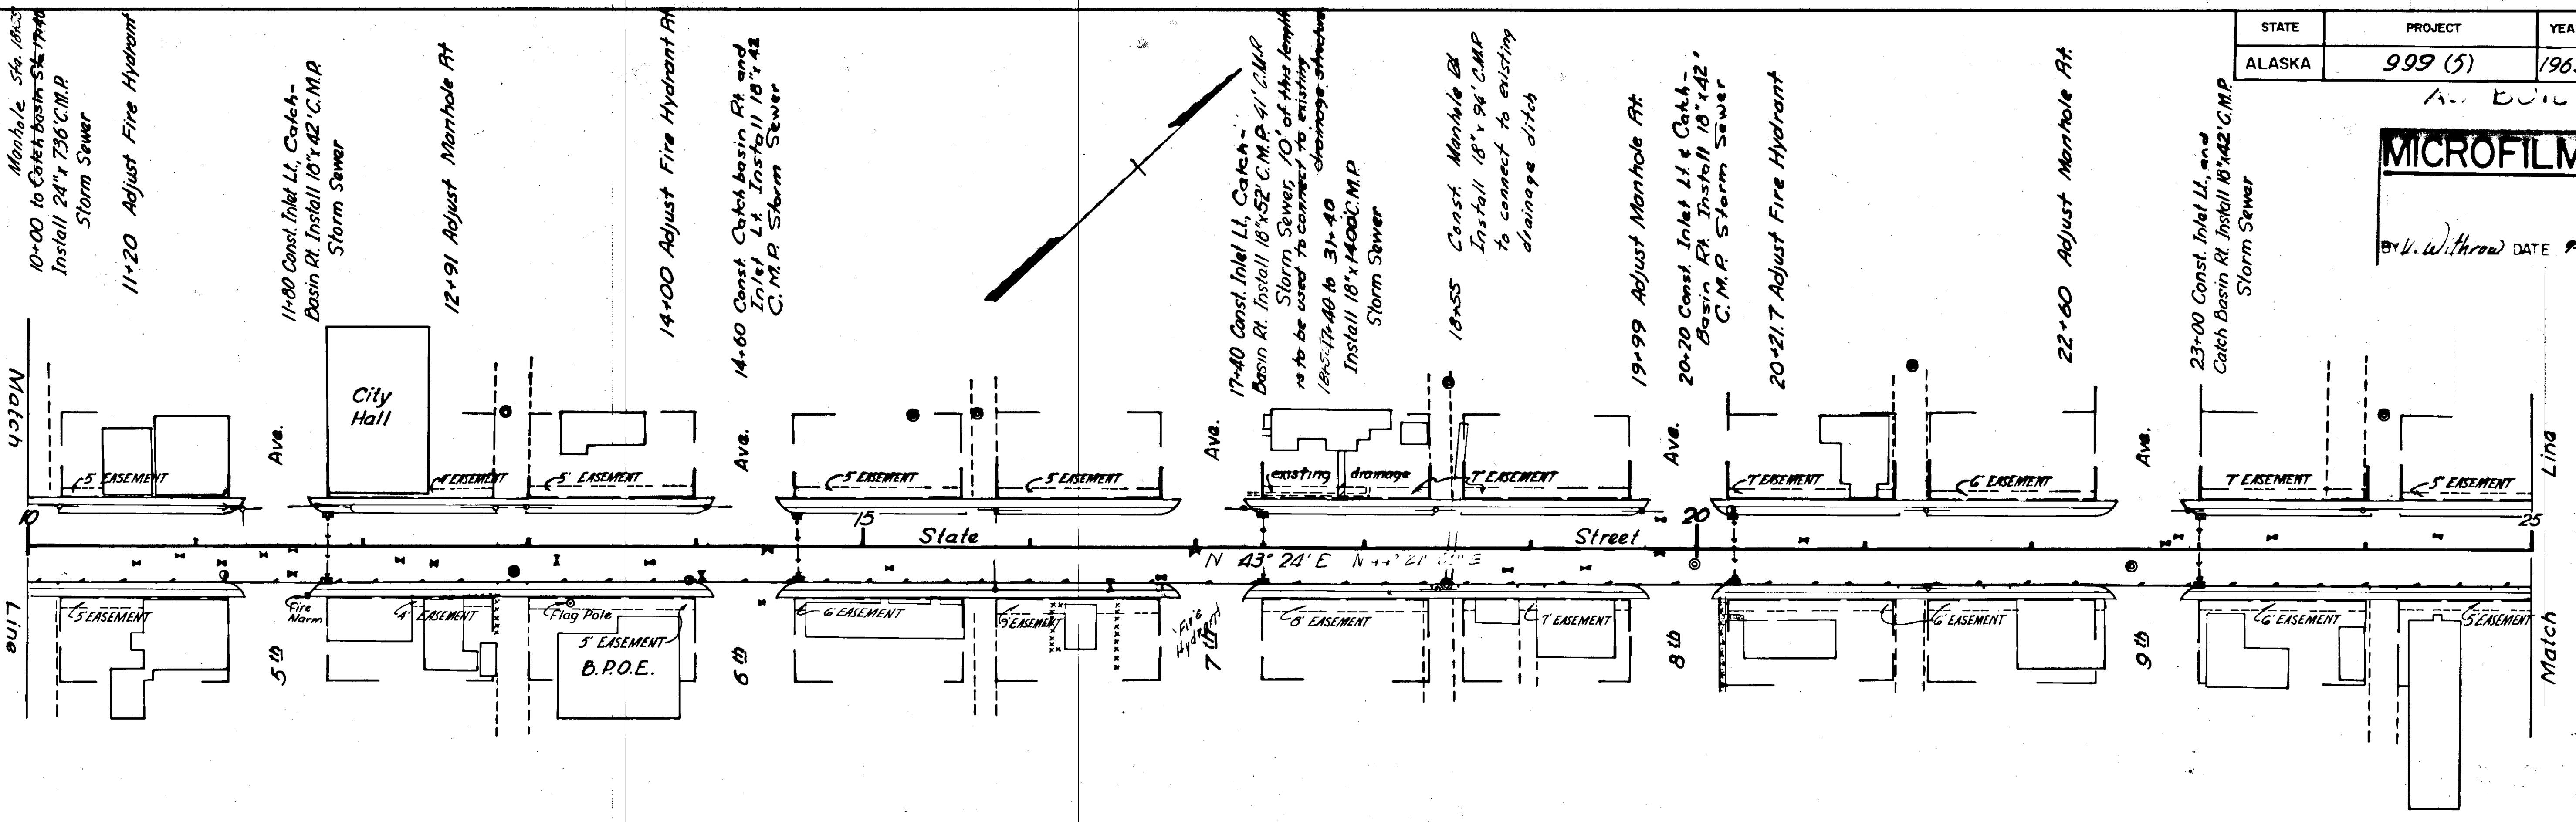

10+16 B.M. Top of spike at base of telephone pole located 26' Lt. Elev. = 20.55


17+25 B.M. Top of Spike at base of telephone pole 26' Lt. Elev. = 23.80

24+00 B.M. Top of Spike at base of telephone pole 26' Lt. Elev. = 27.58

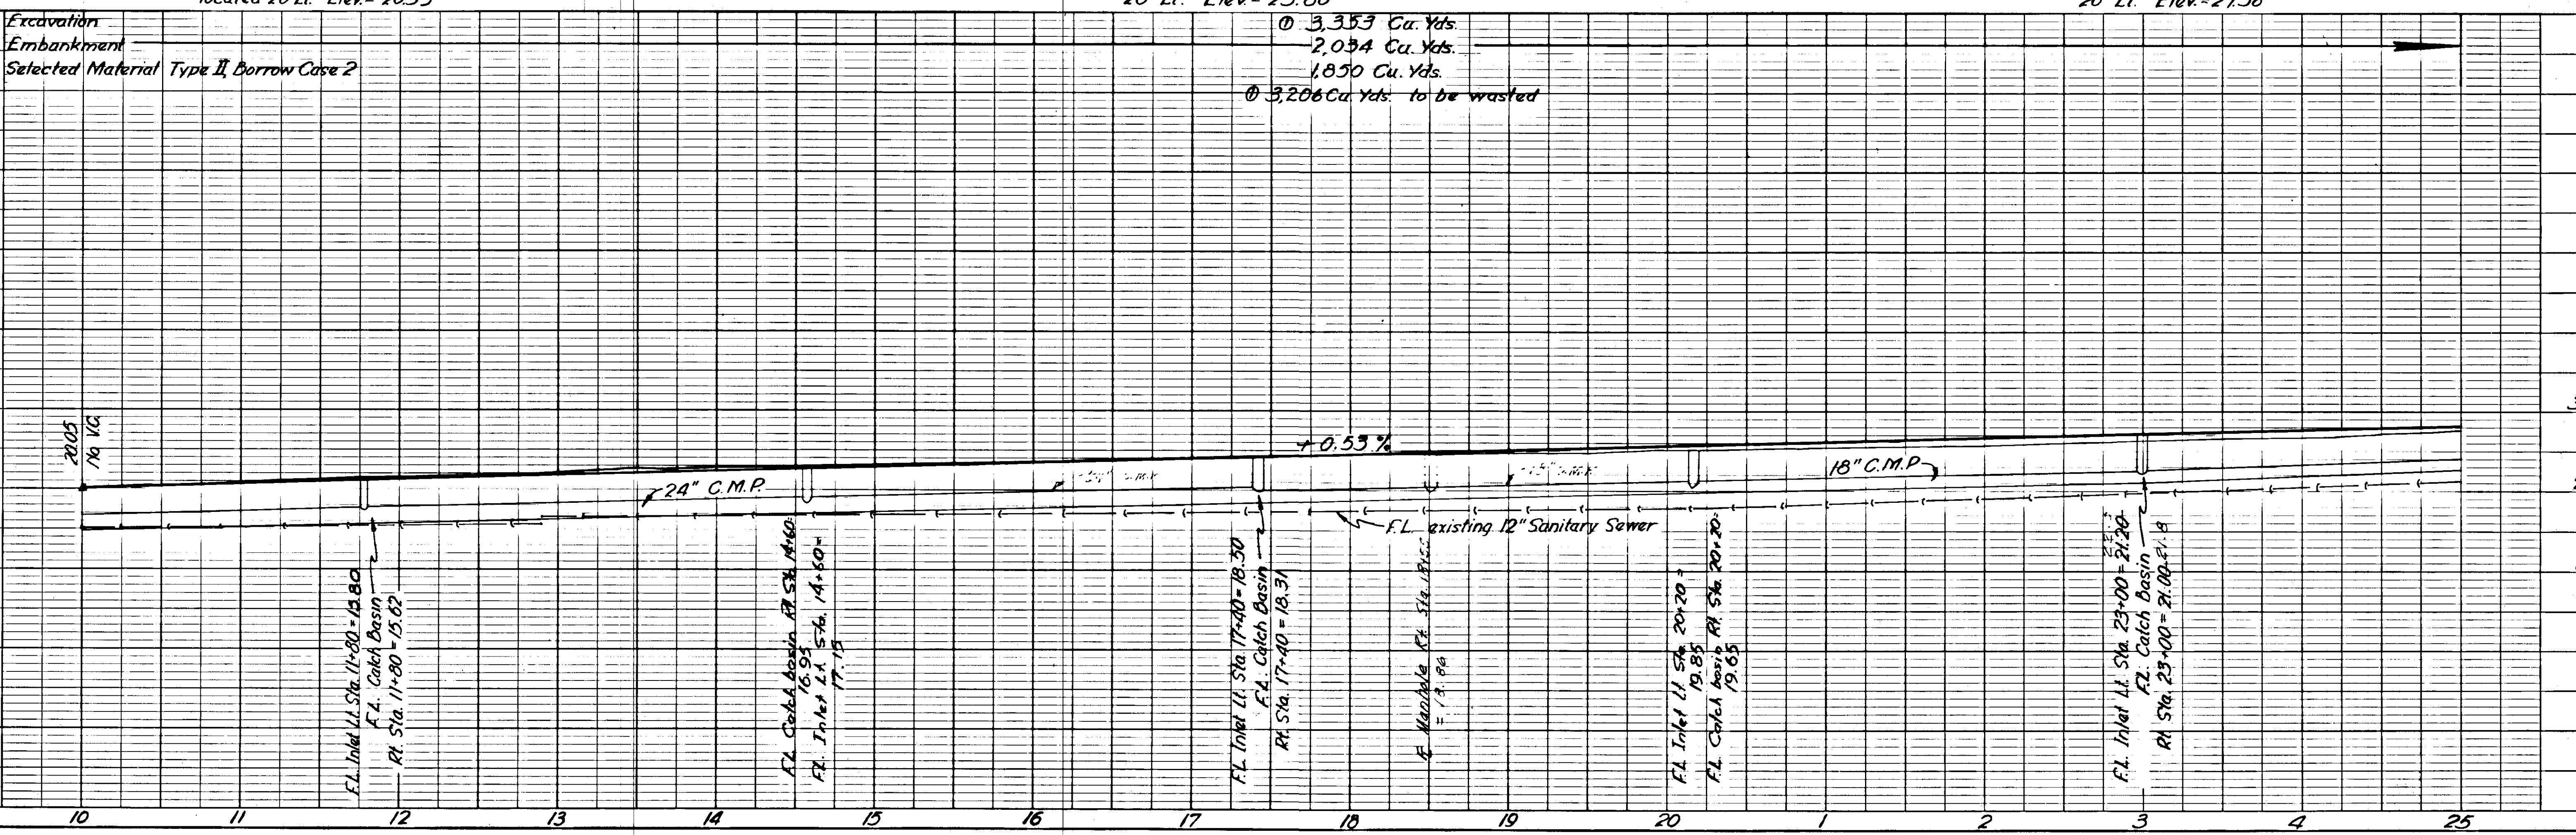


STATE	PROJECT	YEAR	SHEET #	TOTAL SHEETS
ALASKA	999 (5)	1963	11	33

4.5  
BUILT

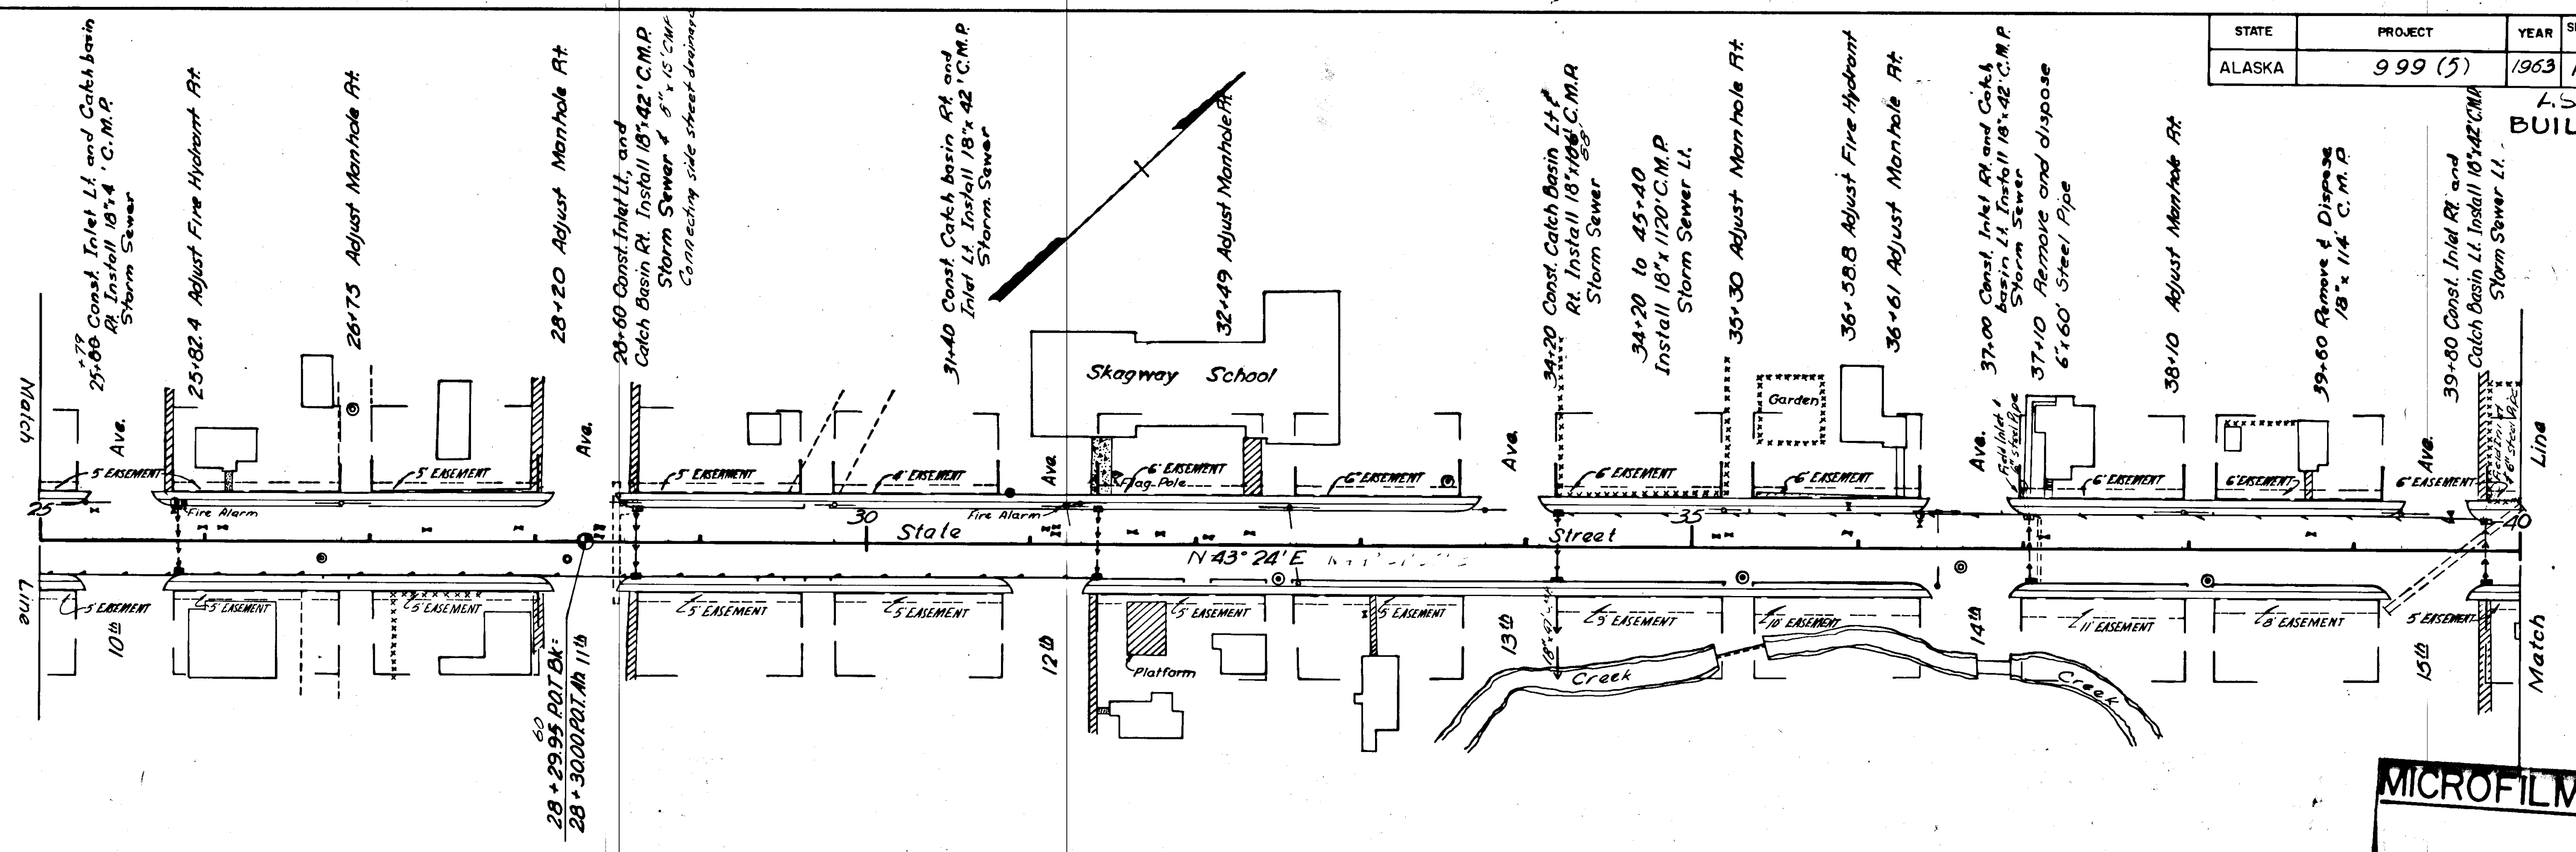

**MICROFILMED**  
By *W. With row* DATE 9-8-66

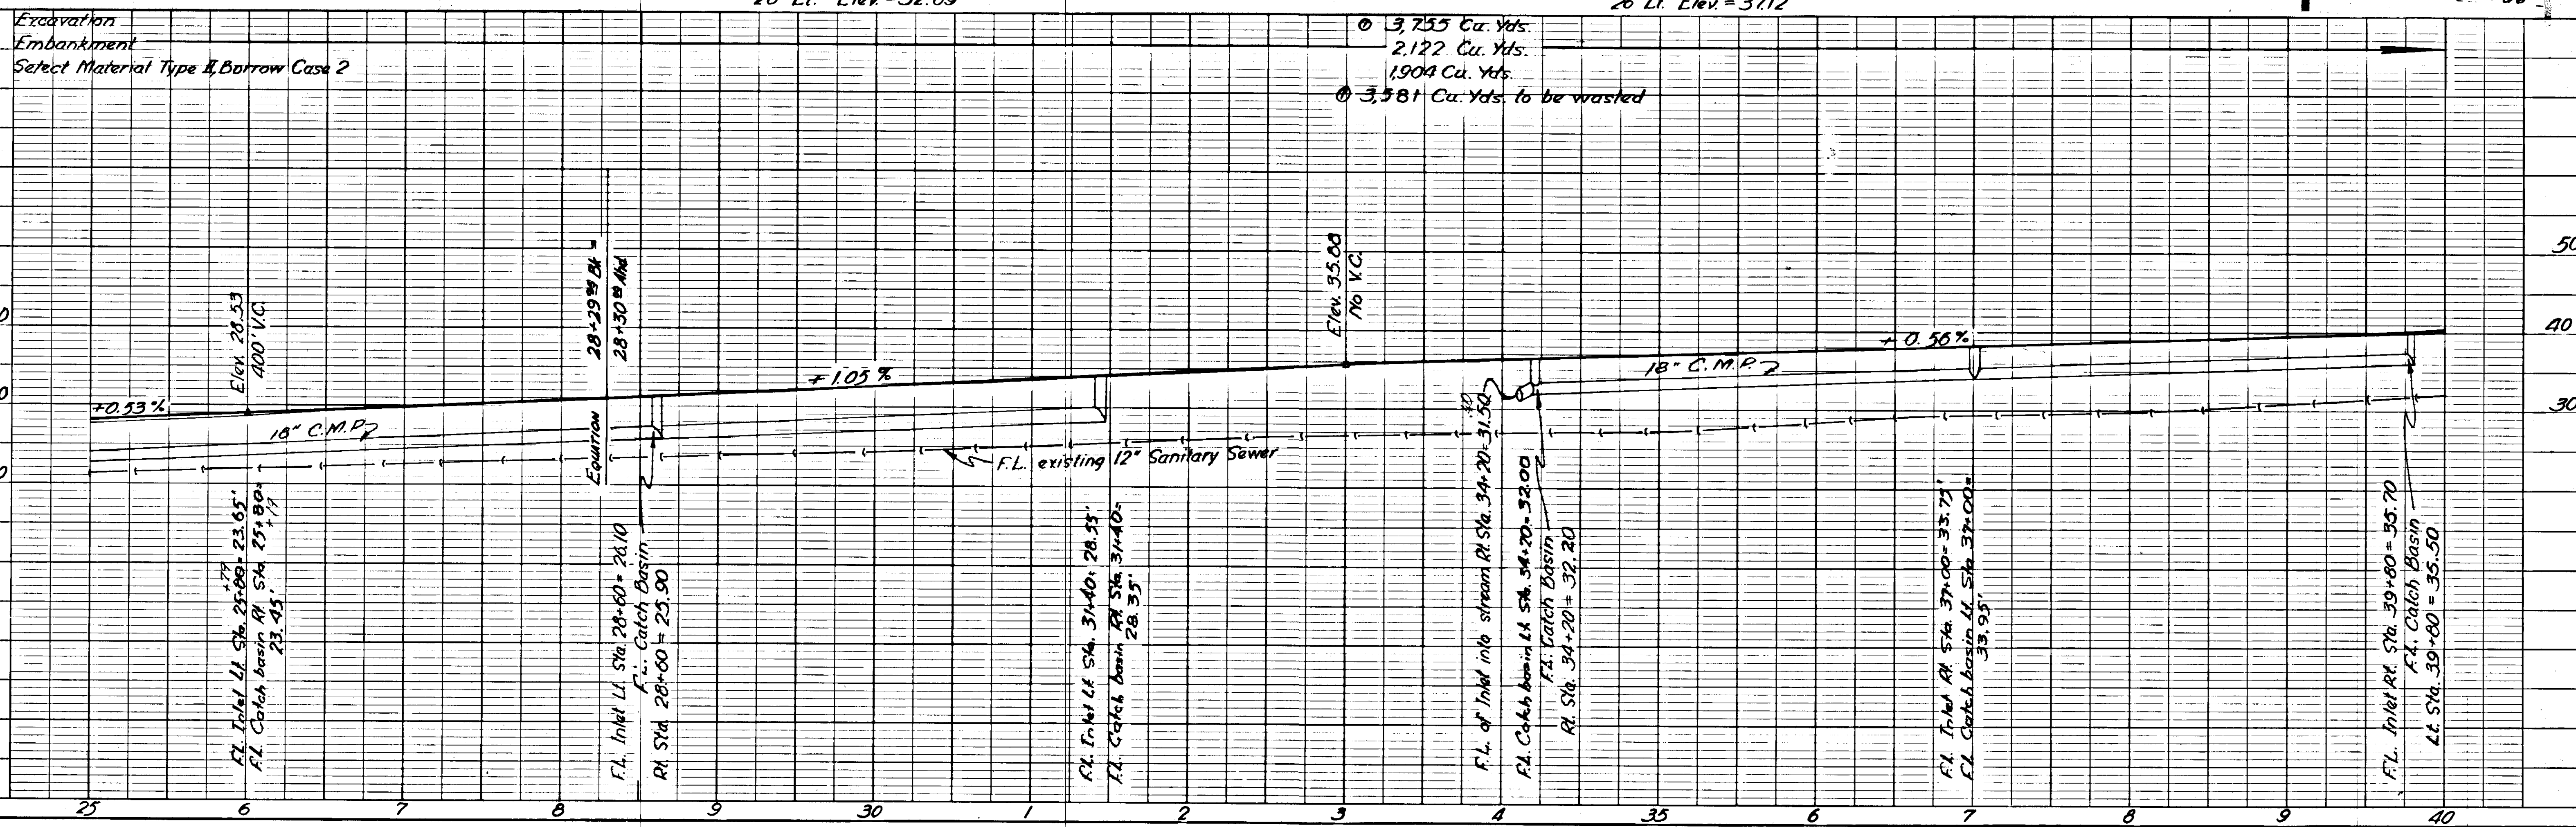


STATE	PROJECT	YEAR	SHEET NO.	TOTAL SHEETS
ALASKA	999 (5)	1963	12	33

A. D. ULLI

**MICROFILMED**

Withdrawn DATE 9-8-06

END OF PROJECT Sta. 53+20

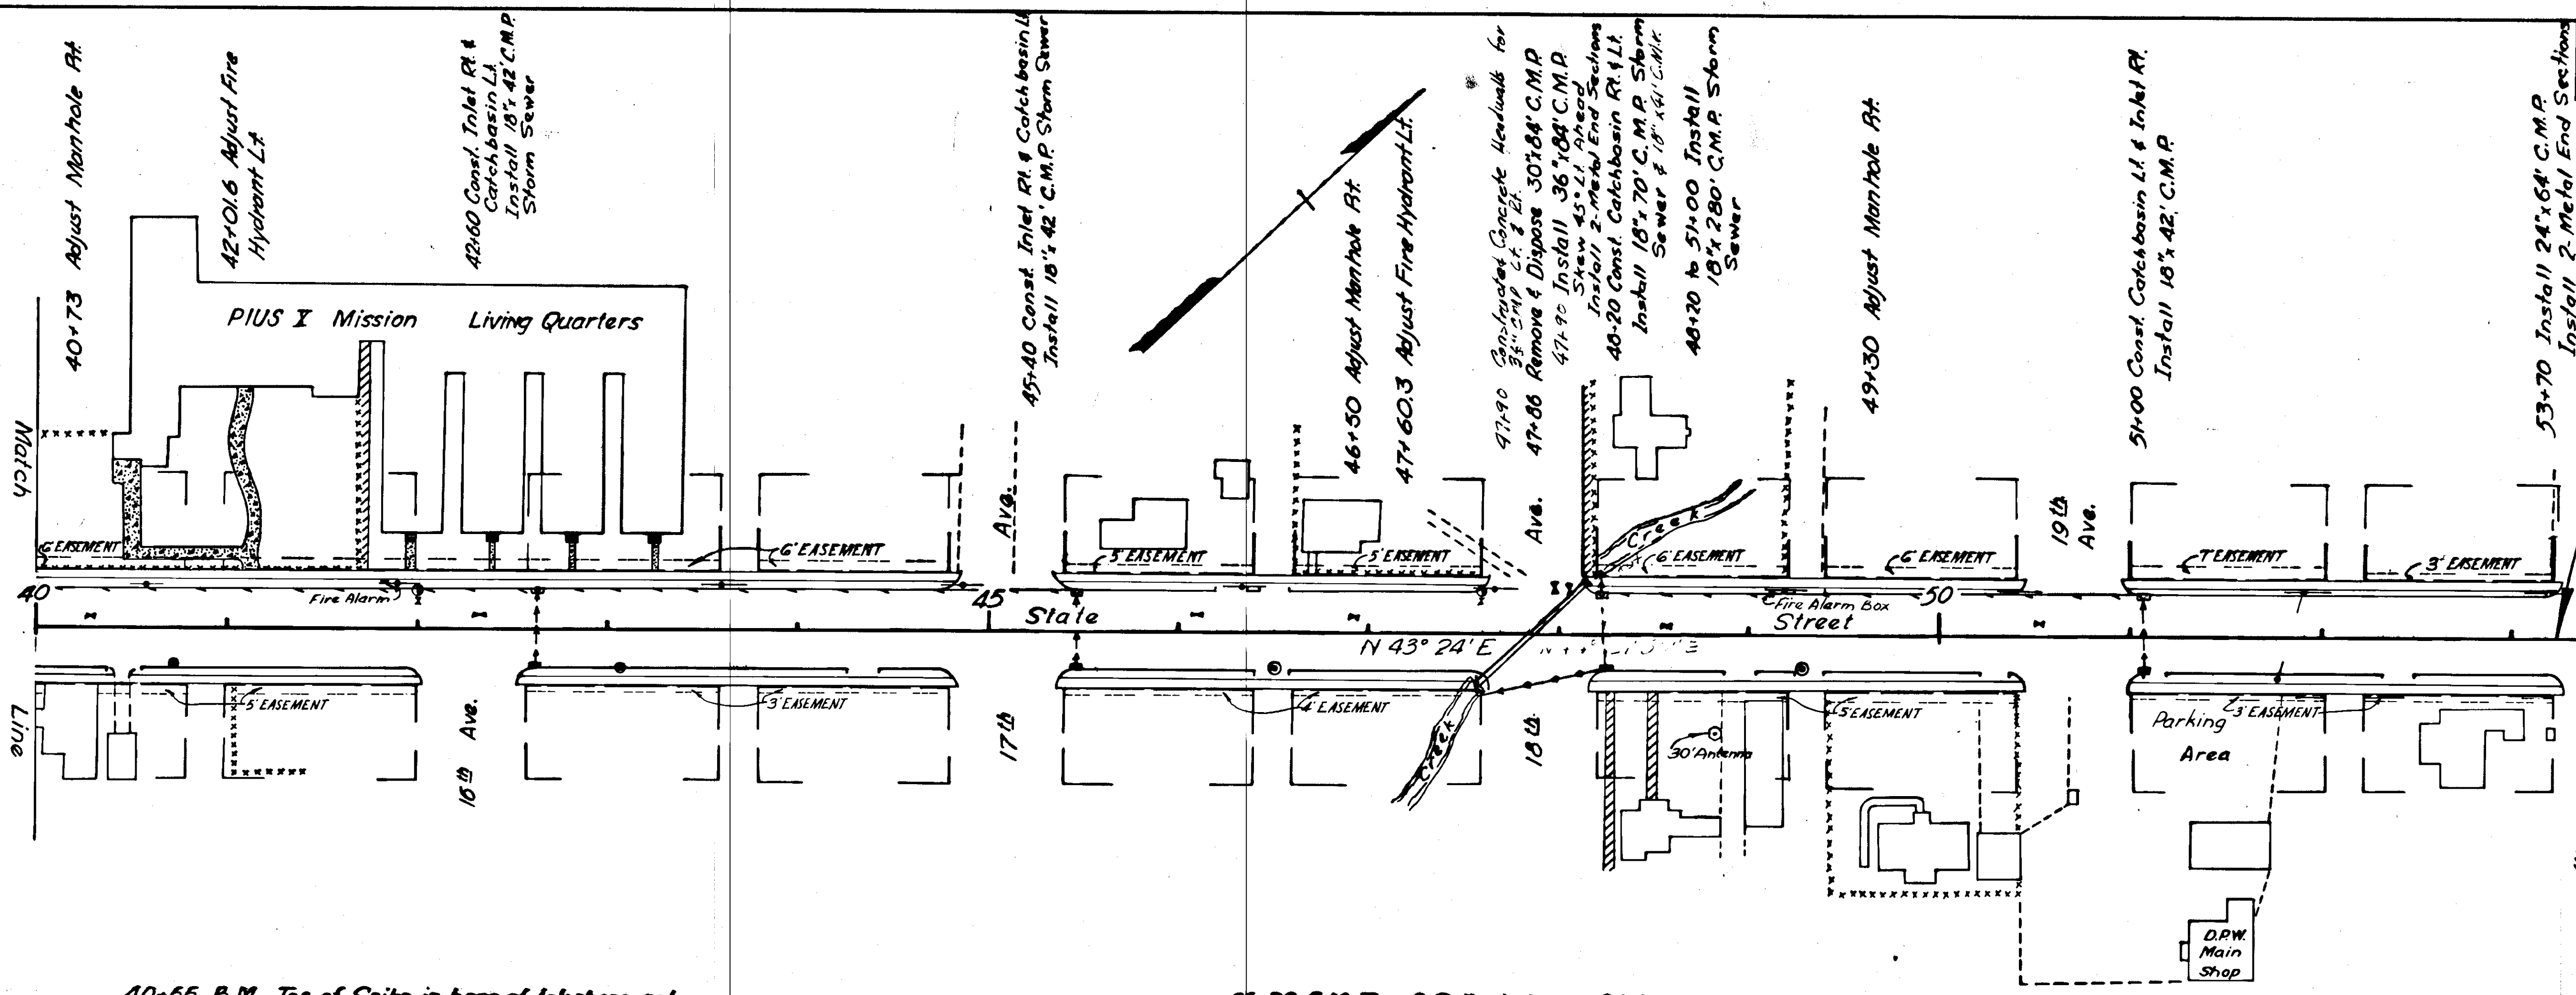


40+66 B.M. Top of Spike in base of telephone pole  
26' Lt. Elev. = 40.71

46+30 B.M. Top of Spike in base of telephone pole  
26' Lt. Elev. = 45.01

53+17 B.M. Top of Spike in telephone pole  
26' Lt., Elev. = 51.37

Excavation  
Embankment  
Select Material Type II Borrow Case 2

4,544 Cu. Yds.  
1,956 Cu. Yds.  
1,761 Cu. Yds.  
4,502 Cu. Yds. to be wasted

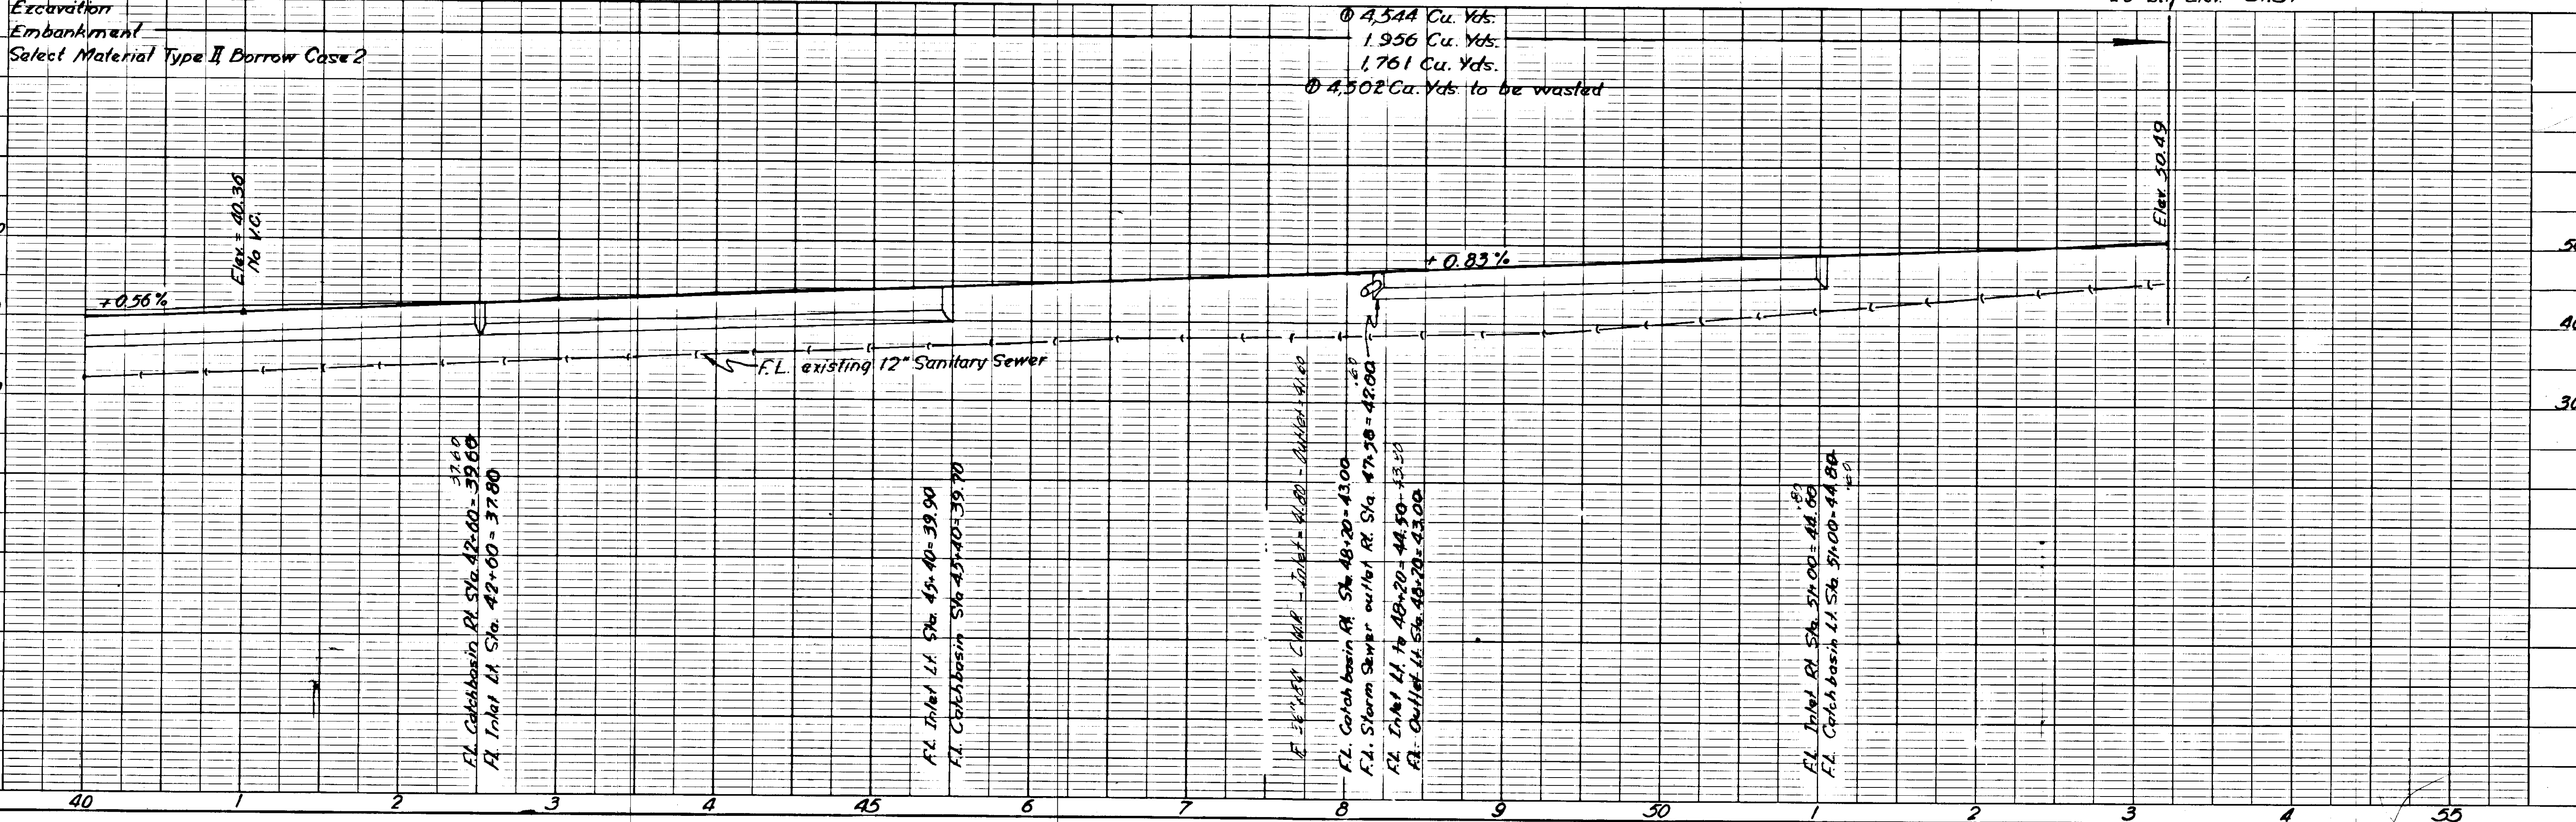

# UTILITY ADJUSTMENTS

STATE	ROUTE	SECTION	YEAR	SHEET NO.	TOTAL SHEETS
ALASKA	S-0999(5)		1963	13	33


AS BUILT

**MICROFILMED**

BY Withdraw DATE 9-5-00

## LEGEND

EXISTING CONSTRUCTION	NEW CONSTRUCTION
—E-III—	None Power line, primary, 3 phase, 2400 V. (—#—, indicates number of conductors)
—S-III—	None Power line, secondary, single phase, 120/240 V. (—#—, indicates number of conductors)
—T-II—	None Telephone line (—#—, indicates number of conductors)
—TC-II—	None Telephone cable (—#—, indicates number of cables)
○ 35-3	None Pole, height and class
—+—	Down guy and anchor
—OH—	None Overhead guy or span guy
□	None Telephone box
□	None Meter box, street light circuit
□	None Fire alarm box
□	None Transformer, single phase
○	None Street light
●	Existing pole relocated
18.4'	Indicates present height of vertical clearance from existing ground.

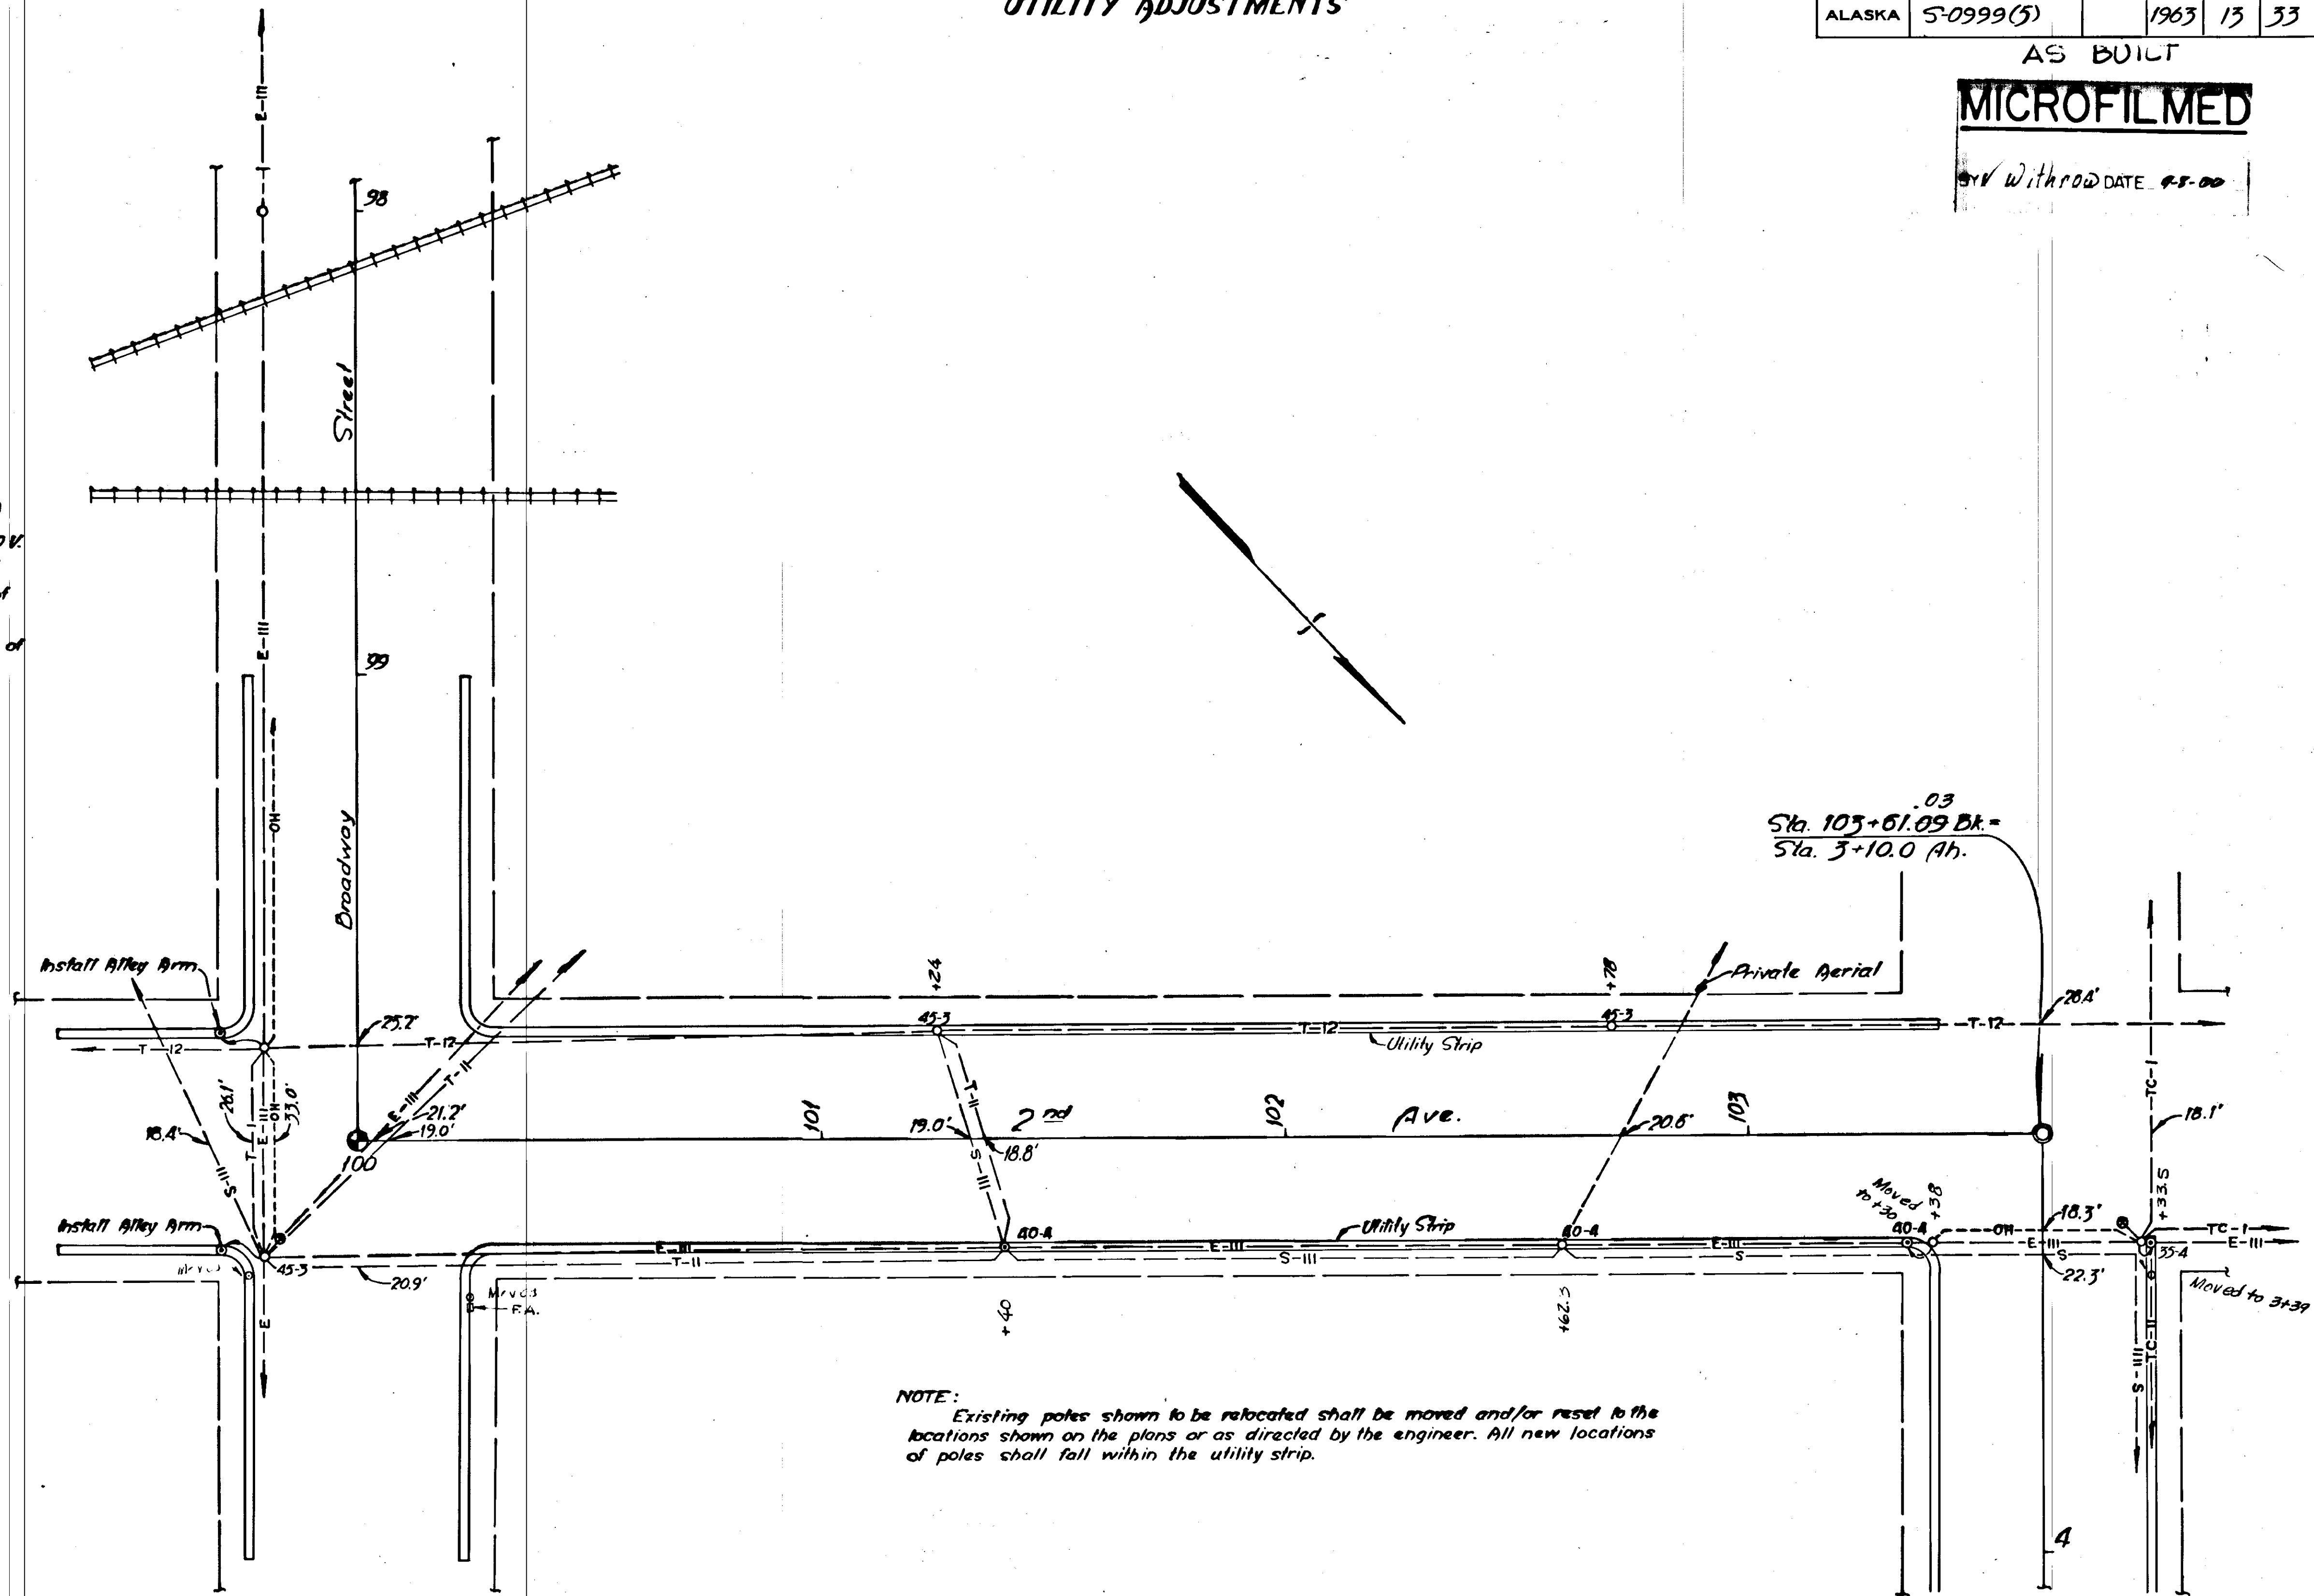

**NOTE:** Existing poles shown to be relocated shall be moved and/or reset to the locations shown on the plans or as directed by the engineer. All new locations of poles shall fall within the utility strip.




UTILITY ADJUSTMENTS

MICROFILMED

STATE	ROUTE	SECTION	YEAR	SHEET NO.	TOTAL SHEETS
ALASKA	S-0999(5)		1963	15	33

BY: Withrow DATE 9-1-66


AS BUILT

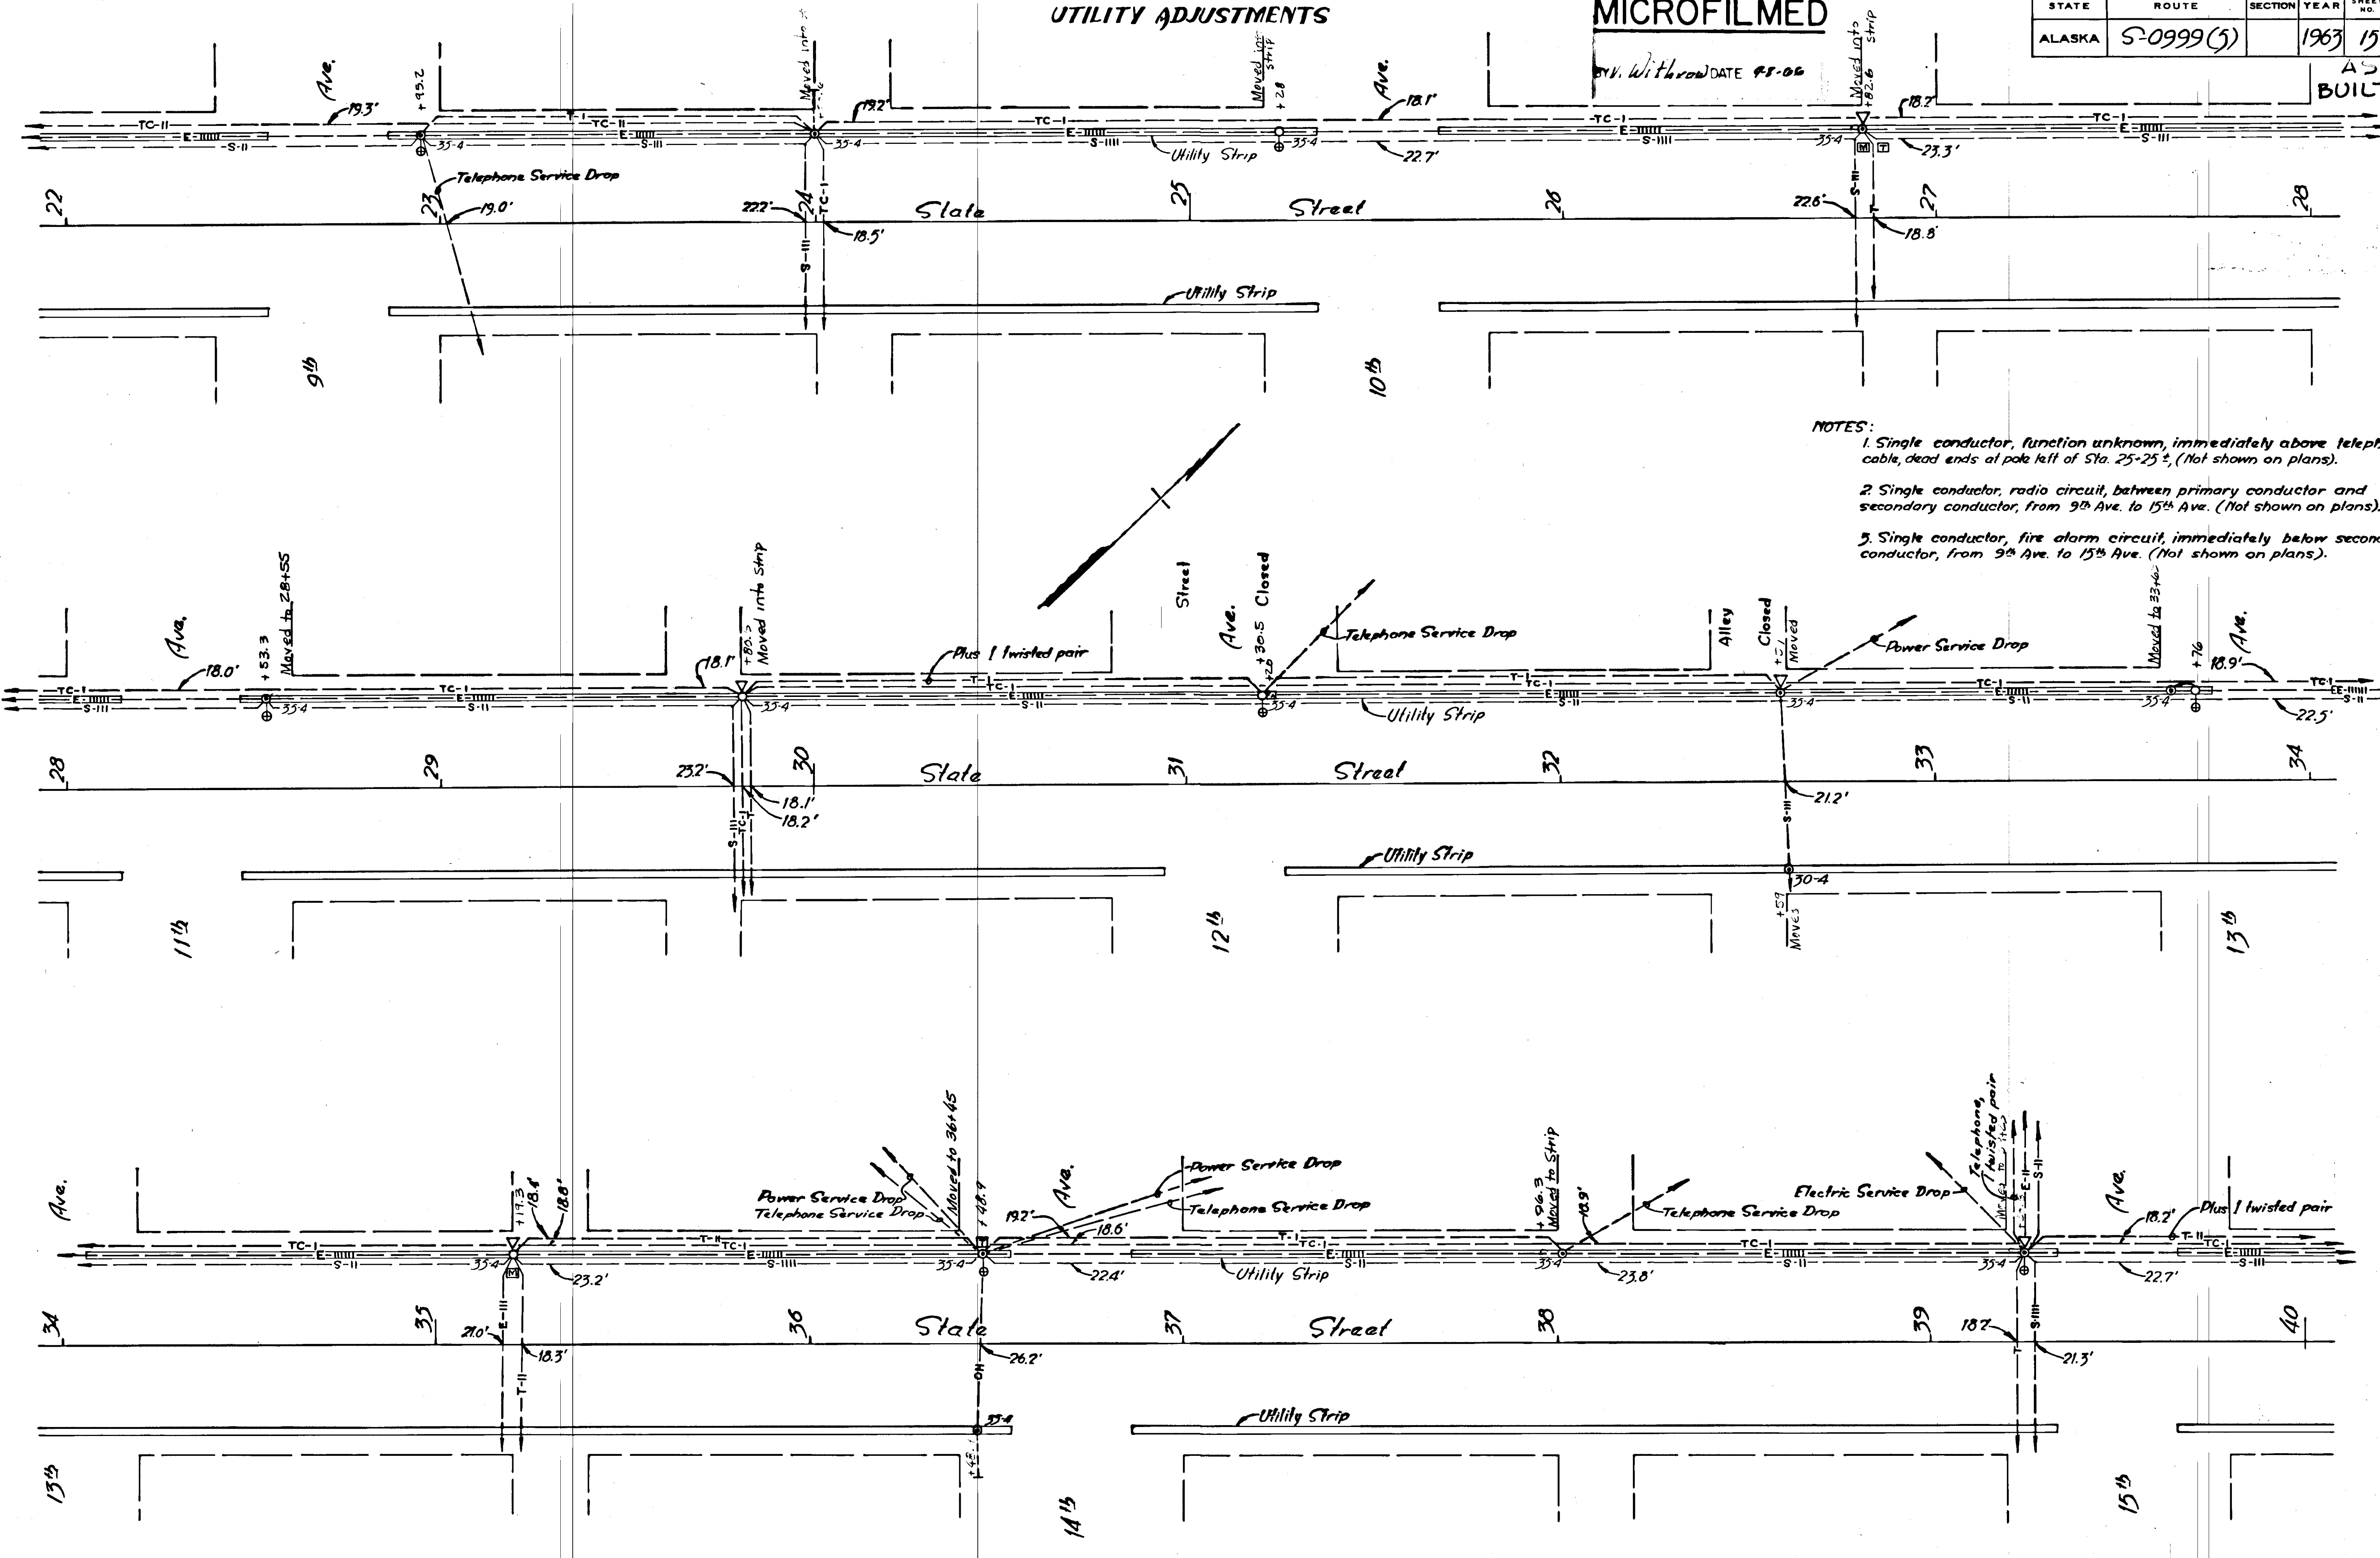

- NOTES:
1. Single conductor, function unknown, immediately above telephone cable, dead ends at pole left of Sta. 25+25.2. (Not shown on plans).
  2. Single conductor, radio circuit, between primary conductor and secondary conductor, from 9th Ave. to 15th Ave. (Not shown on plans).
  3. Single conductor, fire alarm circuit, immediately below secondary conductor, from 9th Ave. to 15th Ave. (Not shown on plans).

UTILITY ADJUSTMENTS

STATE	ROUTE	SECTION	YEAR	SHEET NO.	TOTAL SHEETS
ALASKA	S-0999 (5)		1963	16	53

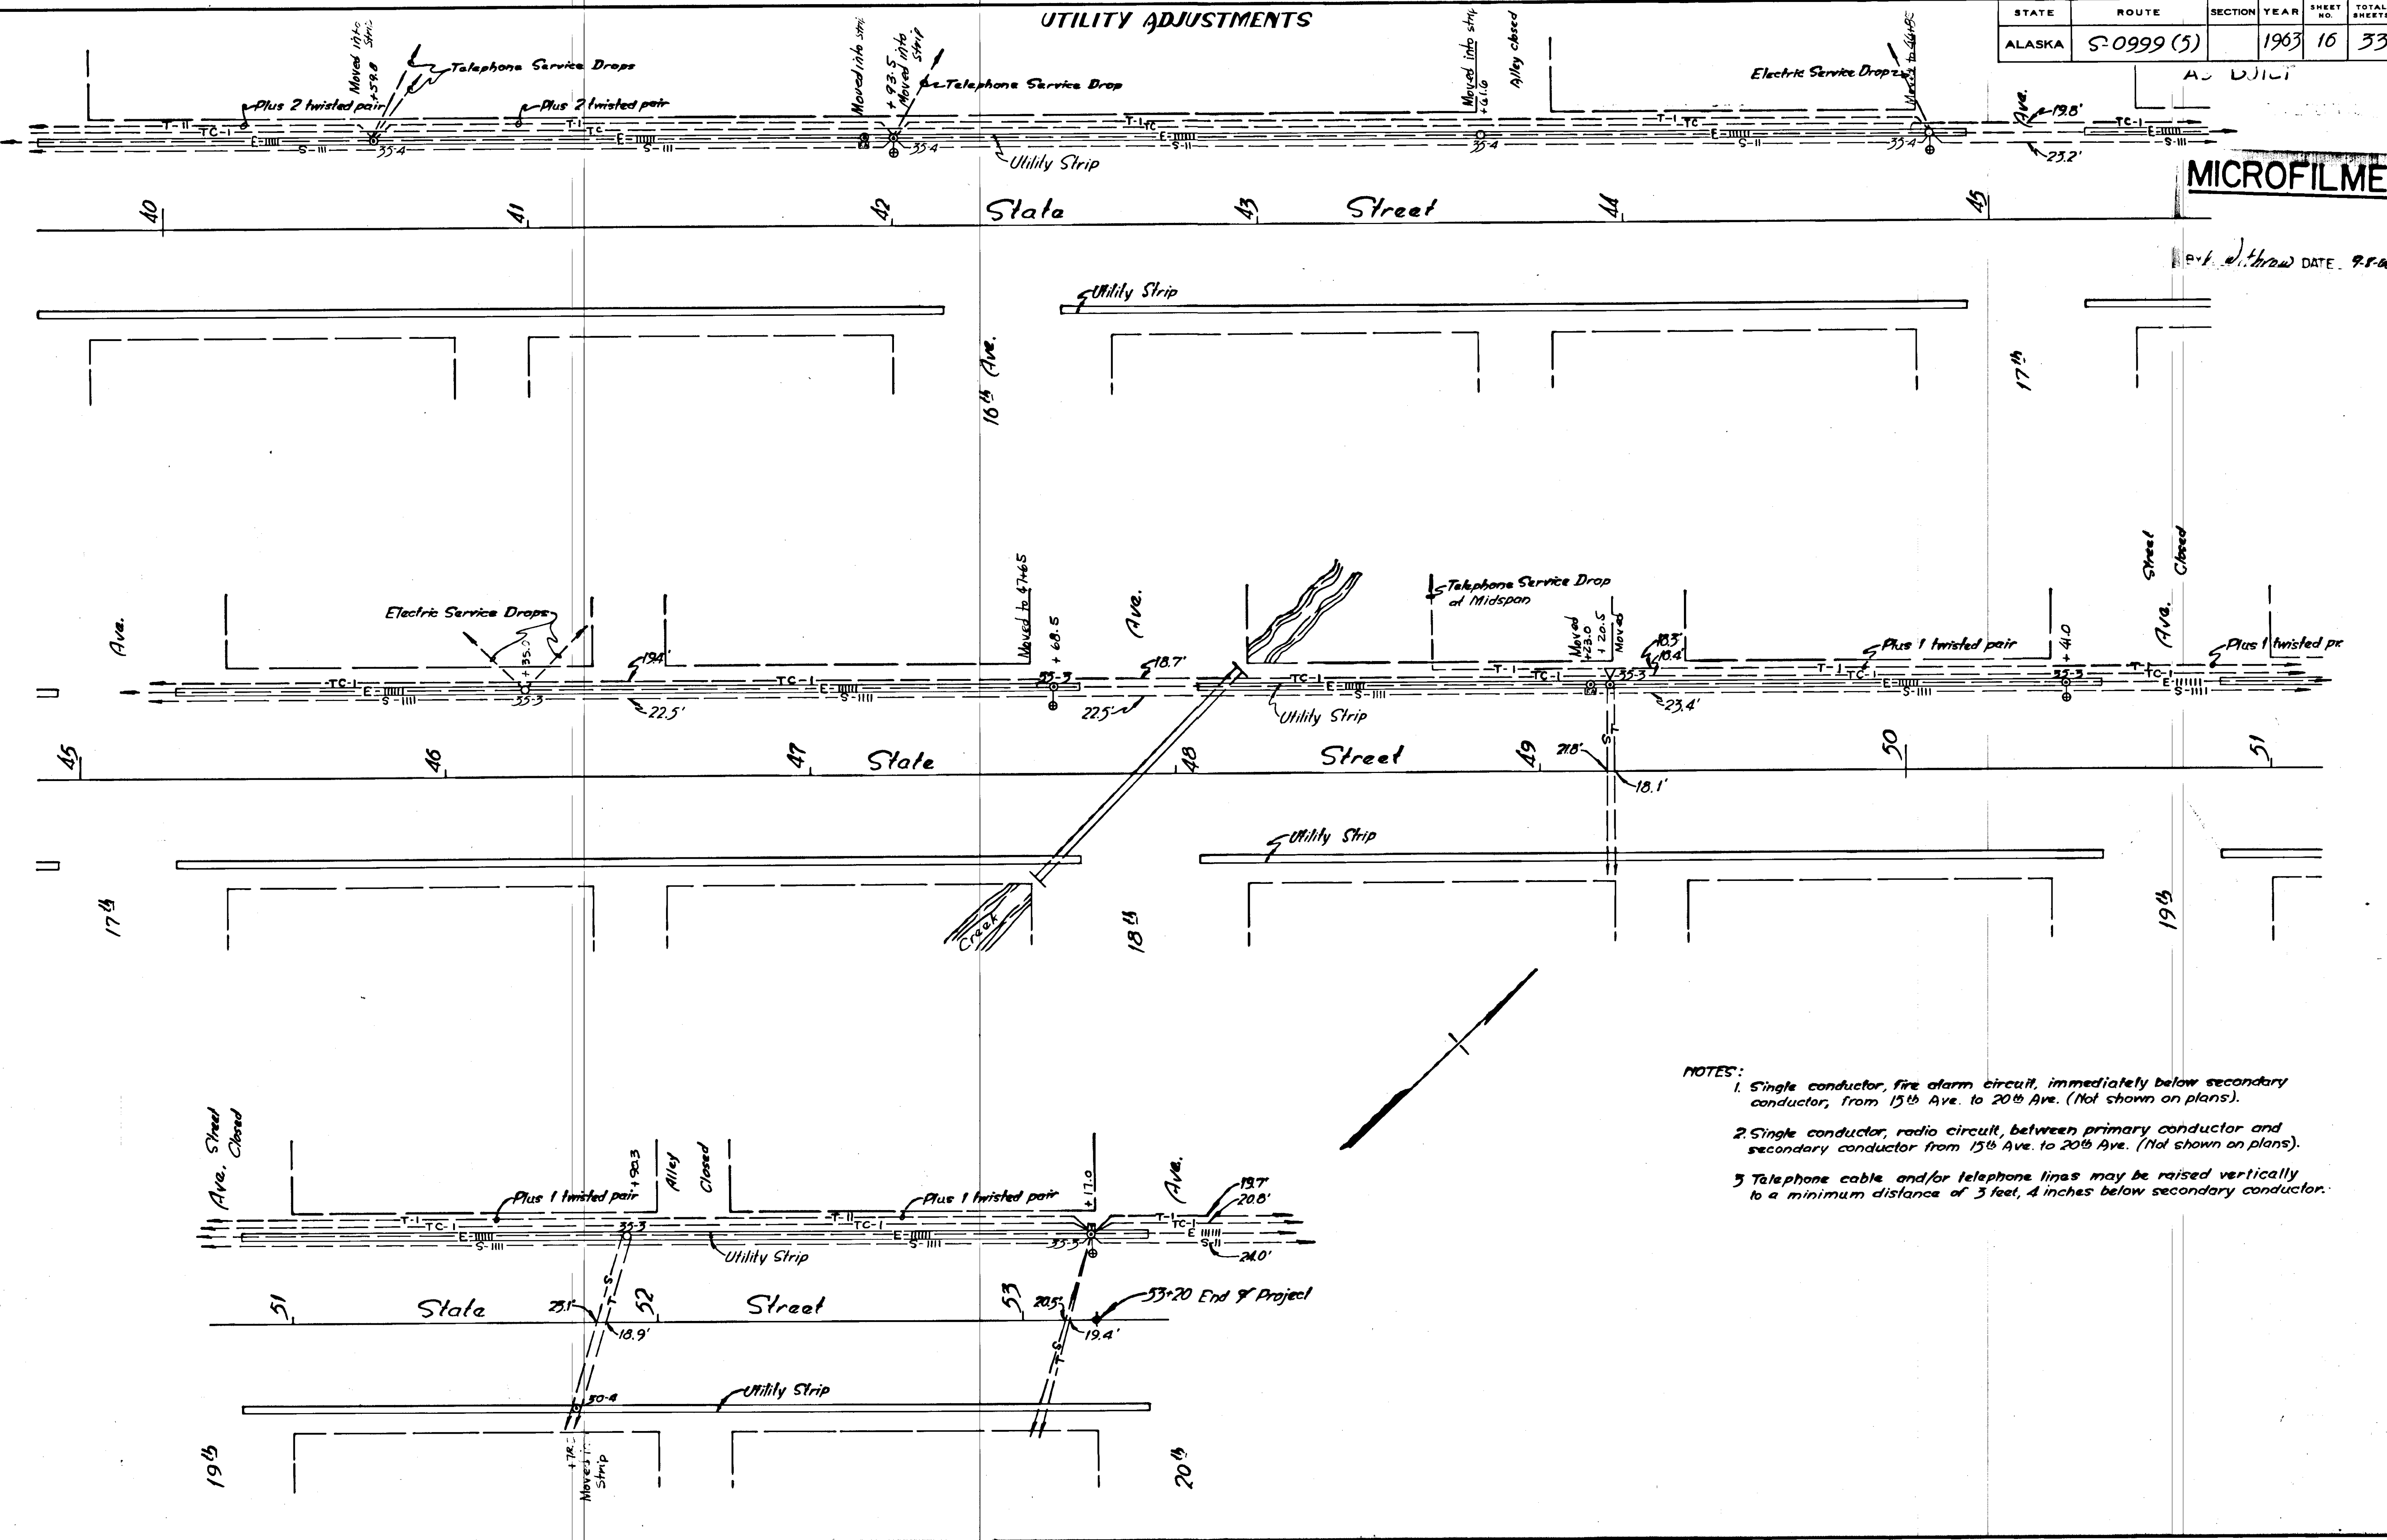

MICROFILMED

DATE 9-8-00

- NOTES:
1. Single conductor, fire alarm circuit, immediately below secondary conductor, from 15th Ave. to 20th Ave. (Not shown on plans).
  2. Single conductor, radio circuit, between primary conductor and secondary conductor from 15th Ave. to 20th Ave. (Not shown on plans).
  3. Telephone cable and/or telephone lines may be raised vertically to a minimum distance of 3 feet, 4 inches below secondary conductor.


UTILITY ADJUSTMENTS

STATE	ROUTE	SECTION	YEAR	SHEET NO.	TOTAL SHEETS
ALASKA	S-0999 (5)		1963	17	33

MICROFILMED

LINE CONSTRUCTION - 2400 VOLT


Number of Pin Positions used to be determined by N° of conductors as shown on Distribution Plans.

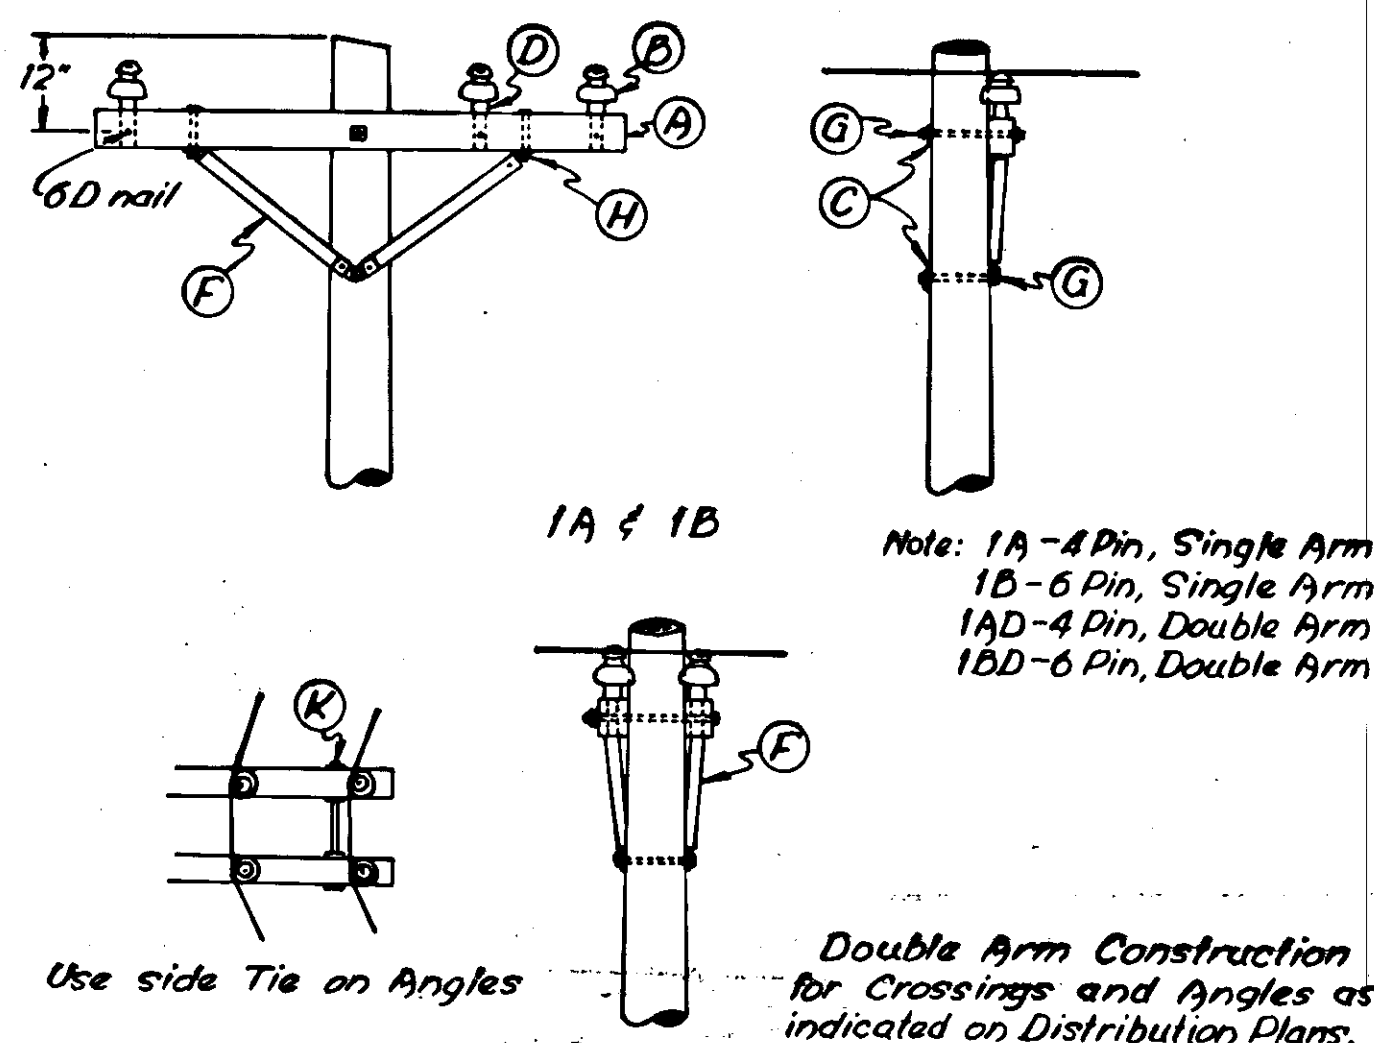

1AD & 1BD


ITEM	QUANTITY	1AD	1BD
A Cross Arms, 4 Pin or 6 Pin (See Note)	1	2	
B Insulators, Pin Type - 2400 V.	3	6	
C Washers, Square	3	10	
D Pins, Insulator, Wood	3	6	
E Washers, Round	2	4	
F Braces, Cross Arm, 42" Span	1 Pr.	2 Pr.	
G Bolts, Through 5/8"	2	2	
H Bolts, Machine 1/2"	2	4	
K Bolts, Double Arming		2	

DEAD END CONSTRUCTION - 2400 VOLT

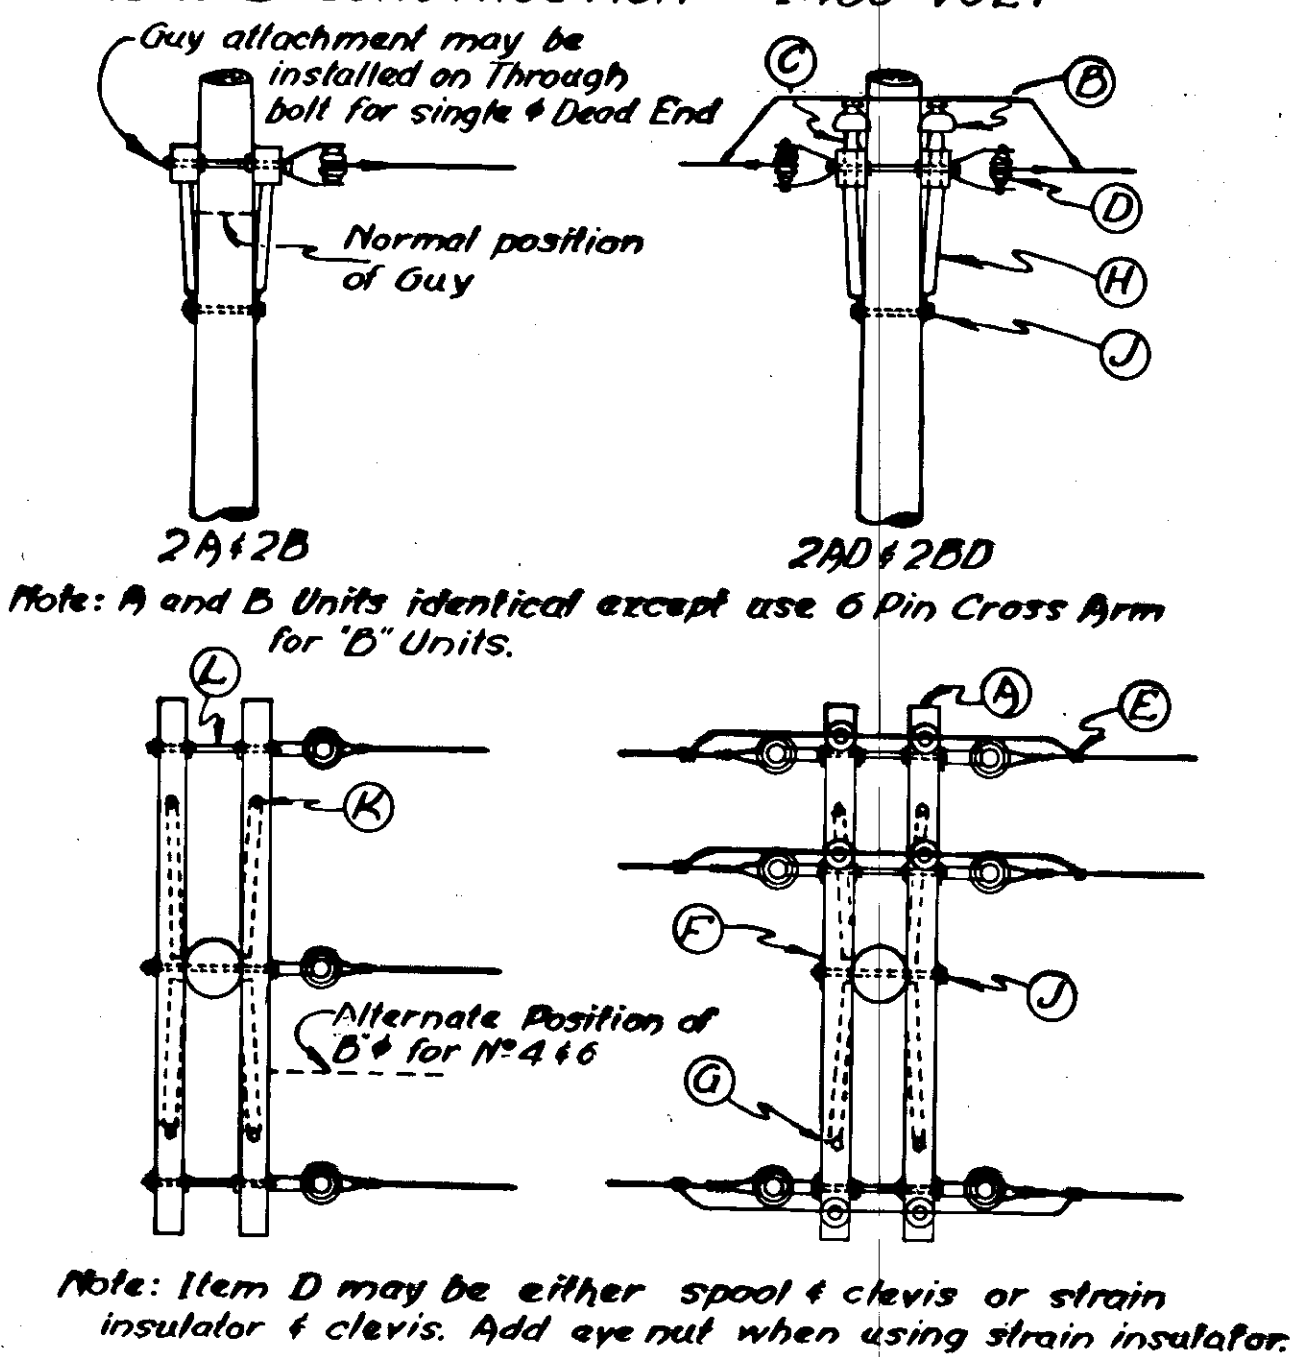


ITEM	2A	2B	2AD	2BD
A Cross Arms, 4 Pin or 6 Pin (See Note)				
B Insulators, Pin Type - 2400 V		6		
C Pins, Insulator, Wood		6		
D Insulated Clevis	5	6		
E Connectors, Solderless		6		
F Washers, Square	10	14		
G Washers, Round	4	4		
H Braces, Cross Arm, 42" Span	2 Pr.	2 Pr.		
J Bolts, Through	2	2		
K Bolts, Machine	4	4		
L Bolts, Double Arming	2	3		

LINE CONSTRUCTION - 2-2400 V. CIRCUITS CROSSARM - 6 PINS

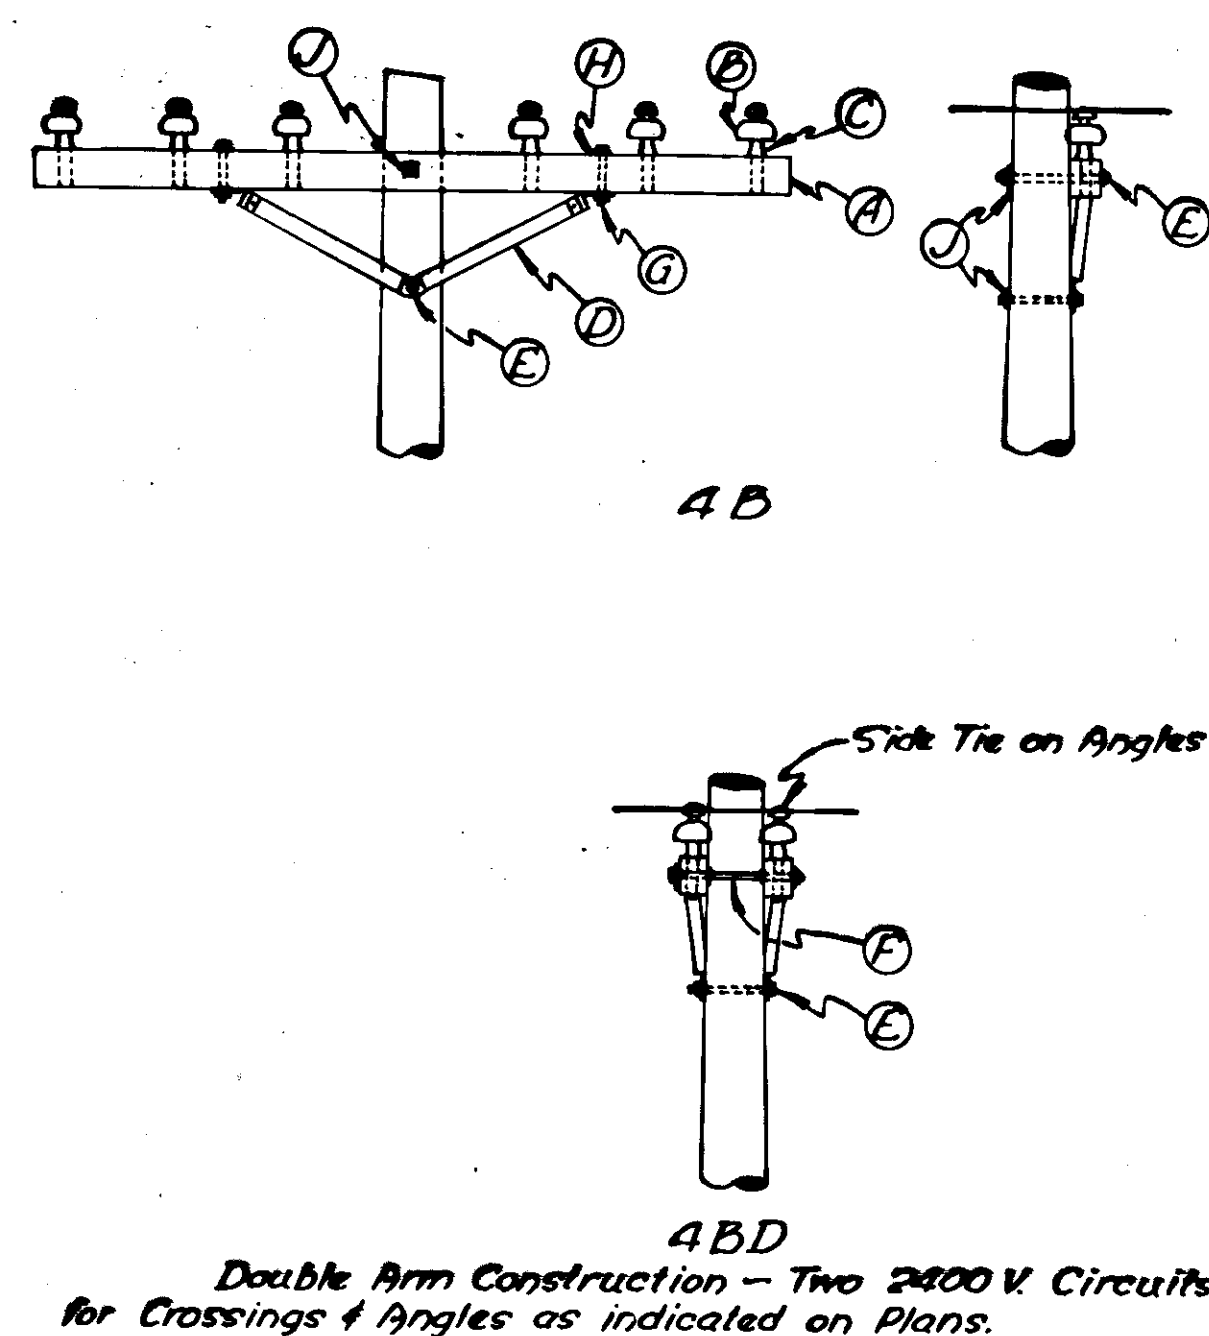

ITEM	4B	4BD
A Cross Arm, 6 Pin	1	2
B Insulator, Pin Type	6	12
C Pins, Insulator, Wood	6	12
D Brace, Cross Arm, 48" Span	1 Pr.	2 Pr.
E Bolt, Through, 5/8"	2	2
F Bolt, Double Arming, 5/8"	2	2
G Bolt, Machine, 1/2"	2	4
H Washer, Round	2	4
J Washer, Square	3	10


CROSSARM DETAILS

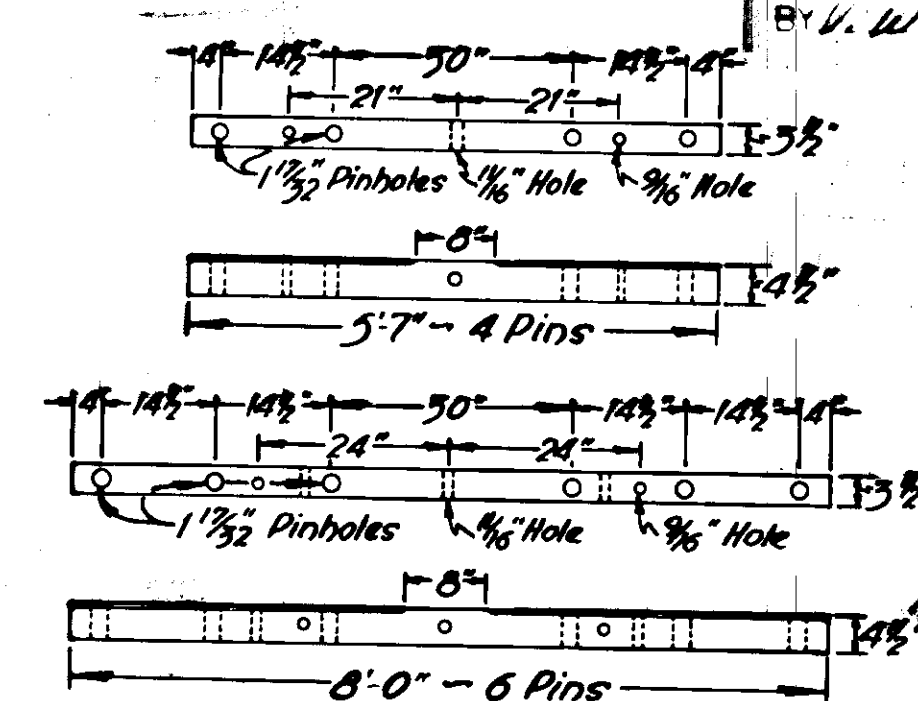

SAG CHART - FINAL SAG


TEMP. DEGREE F.	SAG in Inches for Span Length of					
	100'	125'	140'	150'	160'	175'
0°	8	11	14	16	18	21
20°	9.5	13	17	19	21	24.5
40°	11	15.5	19.5	22	24.5	28
60°	12.5	18	22	25	28	32
80°	14	20	25	28	31.5	36

Note: For conductor size N° 6 A.W.G. Copper to N° 2/0 A.W.G. Copper & N° 8 D.W.G. Galvanized Steel.

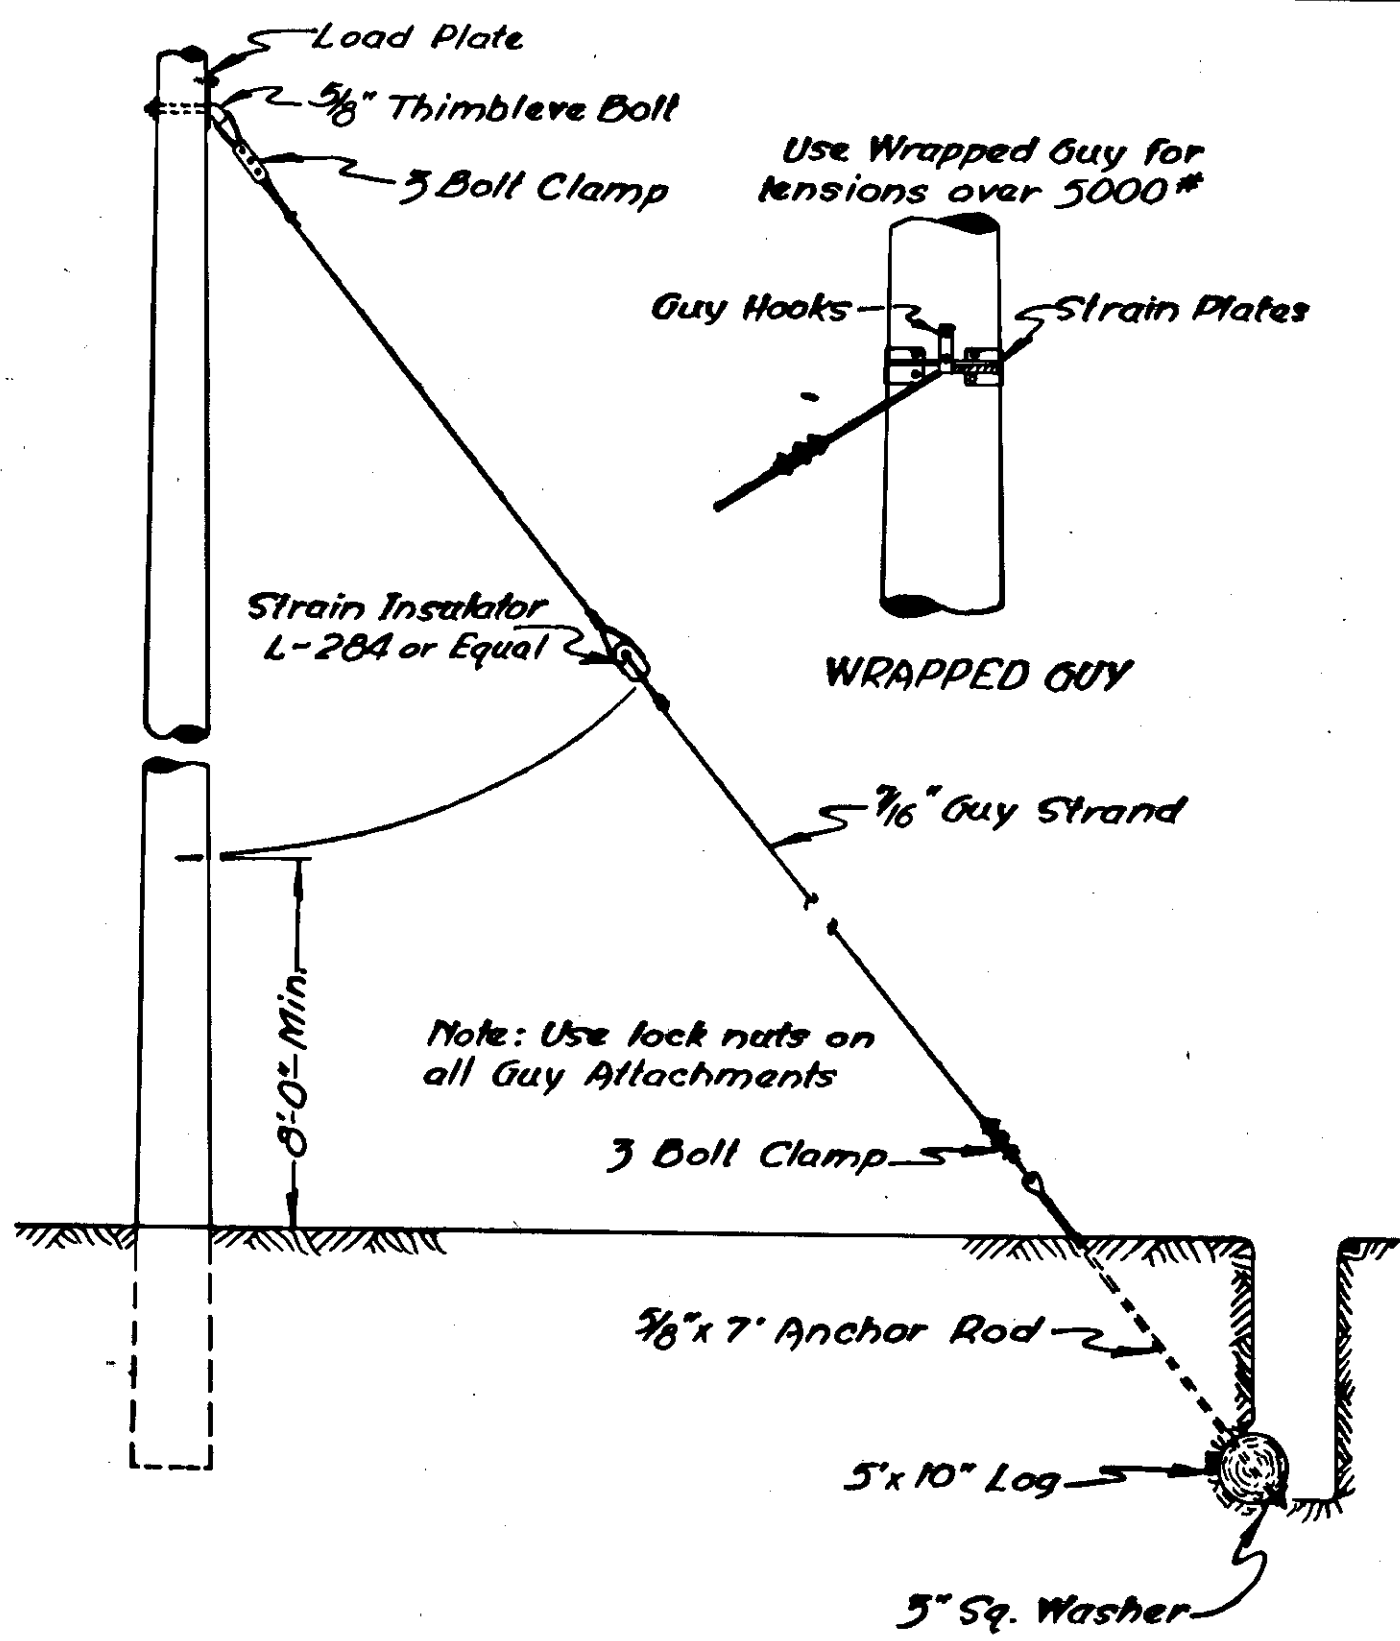

DOWN GUY & ANCHOR FOR HEAVY GUYING


Unit N° 14 with Eyebolt - Unit N° 14W with Wrapped Guy

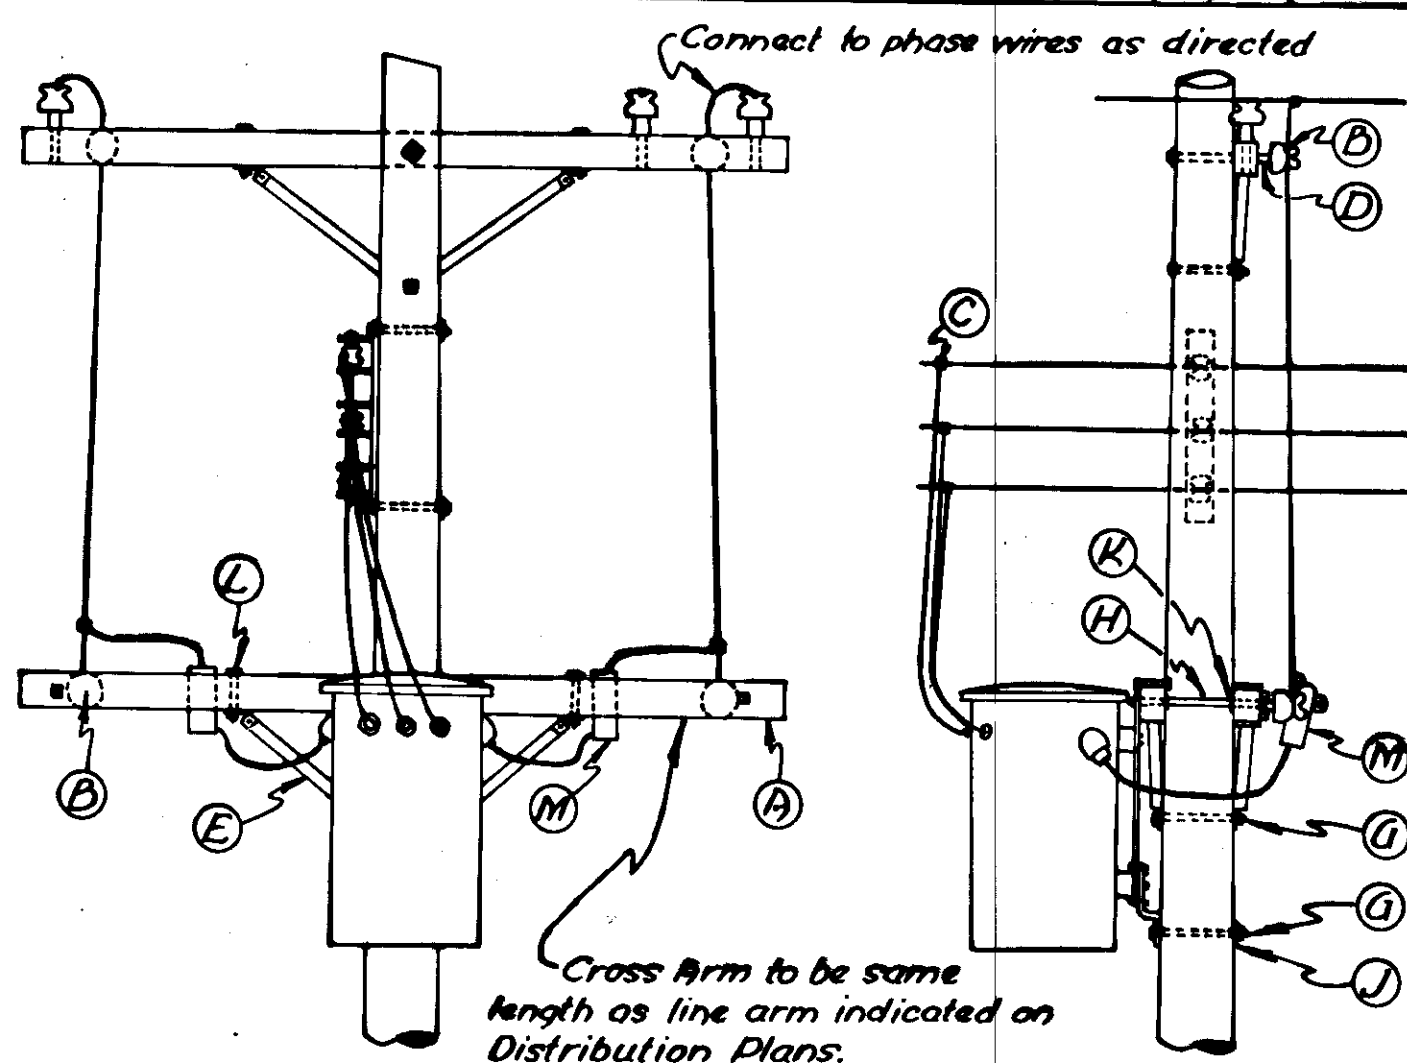

SINGLE POLE TRANSFORMER INSTALLATION CROSS ARM MOUNTED. FOR ONE-10 TO 37 1/2 KVA

Note: Assembly N° 21A same as N° 21 except install Transformer Arm 2'-0" below line arm & run secondary below Transformer.


ITEM	QUANTITY
A Cross Arm, 6' or 8' (See Note)	2
B Insulator, Pin Type	4
C Connector Solderless	7
D Pin, Transformer	4
E Brace, Cross Arm, 42" Span	2 Pr.
F Through Bolt 5/8"	2
H Bolt, Double Arming	2
J Washer, Square	11
K Washer, Round	4
L Bolt, Machine 1/2"	4
M Fused Cutout	2

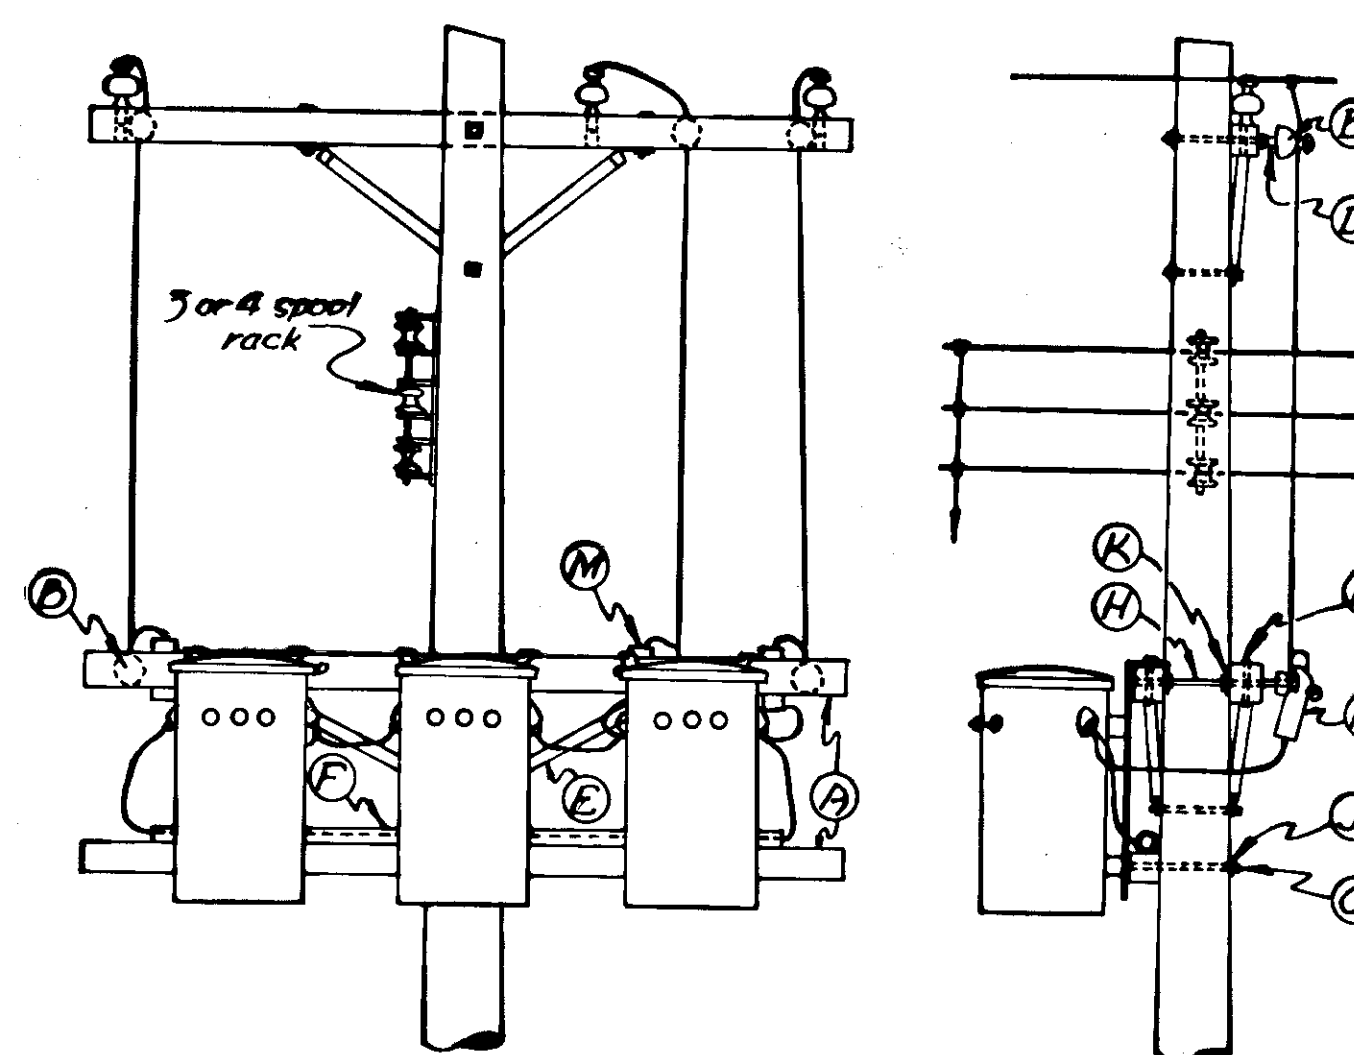

SINGLE POLE TRANSFORMER INSTALLATION FOR TWO or THREE - 5 TO 15 KVA TRANSFORMERS

Transformer Secondaries may be Delta or Wye connected as indicated on Distribution Plans. - Note: Assembly N° 22A same as N° 22 except install Transformer Arm 2'-0" below line arm & run secondary below Transformer.

ITEM	QUANTITY
A Cross Arm, 6 Pin	3
B Insulator, Pin Type	7
C Connector Solderless	7
D Pin, Transformer	7
E Brace, Cross Arm, 48" Span	2 Pr.
F Fibre Conduit	
G Through Bolt, 5/8"	5
H Bolt, Double Arming	2
J Washer, Square	13
K Washer, Round	4
M Fused Cutout	3
N Bolt, Machine 1/2"	4

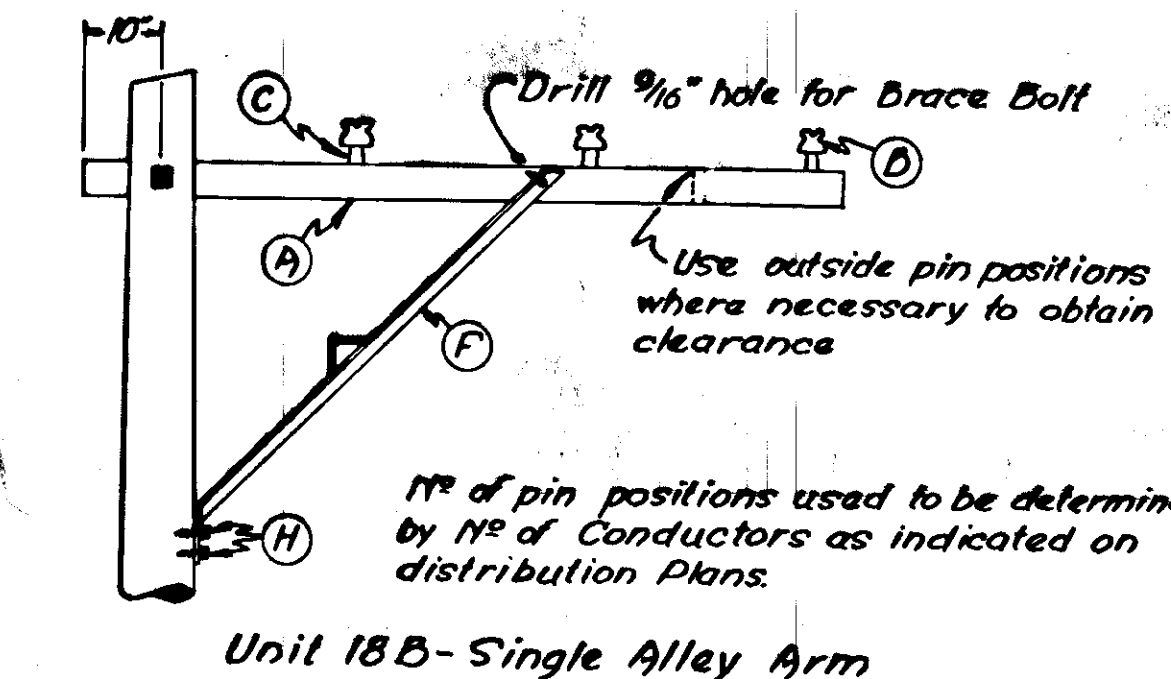

ITEM	18B	18BD
A Cross Arm, 6 Pin	1	2
B Insulator, Pin Type	3	6
C Pins, Insulator, Wood	3	6
D Washers, Square	2	6
E Washers, Round	1	2
F Braces, Alley Arm - 5'	1	2
G Bolts, Through, 5/8"	1	1
H Lag Screws 1/2" x 4" Fetter Drive	2	4
J Bolts, Machine 1/2"	1	2
K Bolts, Double Arming		1

# LIST OF CULVERTS AND MISCELLANEOUS WORK

STATE	PROJECT DESIGNATION	YEAR	SHEET NO.	TOTAL SHEETS
ALASKA	S-0999(5)	1963	18	33

STATION	DESCRIPTION	453(2F) <i>18" Bituminous Coated C.M.P. 16 gage</i>	453(2J) <i>42" Bituminous Coated C.M.P. 12 gage</i>	457(1) <i>Removal of Culverts. Lin. Ft.</i>	703(1) <i>Excavation for Structures Cu. Yd.</i>	521(1) <i>Manhole Each</i>	589(1) <i>12" Asbestos Cement Pipe. Lin. Ft.</i>	REMARKS
20.87 TO 22	INSTALL 18" x 106' C.M.P., 52' RIGHT OF C-L.	106						<div style="border: 2px solid black; padding: 5px; display: inline-block;"> <b>MICROFILMED</b> </div> BY <i>V. W. Howard</i> DATE <i>9-8-00</i>
50	INSTALL 18" x 38' C.M.P., 25' LEFT OF C-L.	38						
+05	REMOVE 24" x 150' C.M.P. INSTALL 42" x 78' C.M.P.		78	150			DITCH TO INLET END	
+12 TO +40	INSTALL 18" x 232' C.M.P., 20' LEFT OF C-L.	232						
STATION 3+20.87 TO STATION 18+56.57 TOTALS		376	78	150	10	1	970	
1+00 to +20	Install 12" x 970' Asbestos Cement Pipe						970	
2+20	Construct Manhole 37' Lt.				10	1		

# LIST OF CULVERTS AND MISCELLANEOUS WORK

STATION	DESCRIPTION	103(1)	453(A)	453(E)	453(N)	453(W)	457(1)	460(N)	513(1)	520(A)	521(1)	521(2)	521(3)	521(7)	560(B)	REMARKS
		Excavation for Structures Cu. Yds.	8" Galvanized C.M.P. Lin. Ft.	18" Galvanized C.M.P. Lin. Ft.	24" Galvanized C.M.P. Lin. Ft.	Asbestos Bonded C.M.P. 24" Lin. Ft.	Removal of Culverts Lin. Ft.	24" Metal End Section Each	Adjusting Fire Hydrants Each	8" Perforated Metal Pipe Lin. Ft.	Manholes Each	Inlets Each	Catch Basins Each	Adjusting Existing Manholes Each	Culvert Marker Posts Each	
8+80 TO 9+80	INSTALL 8" x 100' PERFORATED UNDERDRAIN LT. AND RT.	109								200						
9+80	CONSTRUCT INLET RT.										1					
9+80	INSTALL 18" x 56' CMP STORM SEWER	60		56												BY <i>J. Withrow</i> DATE <i>9-8-66</i>
00+00	ADJUST MANHOLE RT.												1			
00+22.4	ADJUST FIRE HYDRANT RT.							1								
100+32	CONSTRUCT CATCH BASIN RT. AND LT. INSTALL 18" x 42' CMP STORM SEWER	32		42								2				*ON SECOND AVE.
100+80	CONSTRUCT INLET 20' RT. AND CATCH BASIN 20' LT. INSTALL 18" x 102' CMP STORM SEWER	43		102							1	1				*ON BROADWAY ST.
100+32 TO 103+40	INSTALL 18" x 308' CMP STORM SEWER LT.	277		308												
100+32 TO 103+40	INSTALL 8" x 308' PERFORATED UNDERDRAIN LT. AND RT.	331								616						
103+40	CONSTRUCT CATCH BASIN LT. INSTALL 24" x 50' CMP STORM SEWER	60			50							1				
103+40	LT. OF CATCH BASIN TO BAY, INSTALL 24" x 500' CMP STORM SEWER. CONSTRUCT MANHOLE 265' LT.,	400				500					1					
								1								

MICROFILMED

# LIST OF CULVERTS AND MISCELLANEOUS WORK

STATE

PROJECT DESIGNATION

YEAR

SHEET NO.

TOTAL SHEETS

ALASKA

5-0999 (5)

1963

20

33

STATION	DESCRIPTION															REMARKS
		1030(1)	453(1A)	453(1E)	453(1G)	453(1H)	457(1)	460(1G)	513(1)	520(4)	521(1)	521(2)	521(3)	521(7)	560(3)	
		Excavation for Structures Cu. Yds.	8" Galvanized C.M.P. Lin. Ft.	18" Galvanized C.M.P. Lin. Ft.	24" Galvanized C.M.P. Lin. Ft.	Asbestos Bonded C.M.P. 24" Lin. Ft.	Removal of Culverts Lin. Ft.	24" Metal End Section Each	Adjusting Fire Hydrants Each	8" Perforated Metal Pipe Lin. Ft.	Manholes Each	Inlets Each	Catch Basins Each	Adjusting Existing Manholes Each	Culvert Marker Posts Each	
3+10	ADJUST MANHOLE E													1		
3+40	CONST. INLET LT. AND CATCH BASIN RT. INSTALL 18" x 42' CMP STORM SEWER	48		42								1	1			
3+40 TO 47+00	INSTALL 8" x 4360' PERFORATED UNDERDRAIN RT.	2371								4360						
3+40 TO 47+50	INSTALL 8" x 4410 PERFORATED UNDERDRAIN LT.	2398								4410						
3+40 TO 17+40	INSTALL 24" x 1392' CMP STORM SEWER	1546			1392											
6+20	CONSTRUCT INLET LT. AND CATCH BASIN RT. INSTALL 18" x 42' CMP STORM SEWER	40		42								1	1			
6+20.4	ADJUST FIRE HYDRANT								1							
8+65	ADJUST MANHOLE													1		
8+91	ADJUST FIRE HYDRANT								1							
9+00	CONSTRUCT CATCH BASIN RT. & INLET LT. Install 18"x42' C.M.P. Storm Sewer	40		42								1	1			
11+20	ADJUST FIRE HYDRANT								1							
11+80	CONSTRUCT INLET LT. & CATCH BASIN RT. INSTALL 18" x 42' CMP STORM SEWER	40		42								1	1			
12+91	ADJUST MANHOLE RT.													1		

**MICROFILMED**

BY: *Withwood* DATE 9-8-06

# LIST OF CULVERTS AND MISCELLANEOUS WORK

STATE  
ALASKA

PROJECT DESIGNATION  
S-0999 (5)

YEAR SHEET TOTAL  
1963 21 33

STATION	DESCRIPTION	ITEMS													REMARKS	
		103(1)	153(1A)	153(1E)	153(1B)	153(1C)	157(1)	440(1G)	513(1)	520(1A)	521(1)	521(2)	521(3)	521(7)		560(3)
		Excavation for Structures Cu. Yds.	8" Galvanized C.M.P. Lin. Ft.	18" Galvanized C.M.P. Lin. Ft.	24" Galvanized C.M.P. Lin. Ft.	Asbestos Bonded C.M.P. 24" Lin. Ft.	Removal of Culverts Lin. Ft.	24" Metal End Section Each	Adjusting Fire Hydrants Each	8" Perforated Metal Pipe Lin. Ft.	Manholes Each	Inlets Each	Catch Basins Each	Adjusting Existing Manholes Each	Culvert Marker Posts Each	
14+00	ADJUST FIRE HYDRANT RT.								1							
14+60	CONSTRUCT CATCH BASIN RT. & INLET LT. INSTALL 18" x 42' CMP STORM SEWER	40	42									1	1			
17+40	CONSTRUCT INLET LT. & CATCH BASIN RT. INSTALL 18" x 42' CMP STORM SEWER	40	42									1	1			
17+40 TO 31+40	INSTALL 18" x 1400' CMP STORM SEWER	1166	1400													
19+99	ADJUST MANHOLE RT.														1	
20+20	CONSTRUCT INLET LT. & CATCH BASIN RT. INSTALL 18" x 52' CMP STORM SEWER	40	52									1	1			
20+21.7	ADJUST FIRE HYDRANT								1							
22+60	ADJUST MANHOLE RT.														1	
23+00	CONSTRUCT INLET LT. & CATCH BASIN RT. INSTALL 18" x 42' CMP STORM SEWER	40	42									1	1			
25+80	CONSTRUCT INLET LT. AND CATCH BASIN RT. INSTALL 18" x 42' CMP STORM SEWER	40	42									1	1			
25+82.4	ADJUST FIRE HYDRANT RT.								1							
26+75.0	ADJUST MANHOLE RT.														1	
28+20	ADJUST MANHOLE RT.														1	

MICROFILMED

BY *Withrow* DATE 9-8-06

J-

# LIST OF CULVERTS AND MISCELLANEOUS WORK

STATE	PROJECT DESIGNATION	YEAR	SHEET NO.	TOTAL SHEETS
ALASKA	S-0999 (5)	1963	22	33

STATION	DESCRIPTION	103(1)	453(10)	453(11)	453(16)	453(4)	457(1)	460(10)	513(1)	520(4)	521(1)	521(2)	521(3)	521(7)	560(3)	REMARKS
		Excavation for Structures Cu. Yds.	8" Galvanized C.M.P. Lin. Ft.	16" Galvanized C.M.P. Lin. Ft.	24" Galvanized C.M.P. Lin. Ft.	Asbestos Bonded C.M.P. 24" Lin. Ft.	Removal of Culverts Lin. Ft.	24" Metal End Section Each	Adjusting Fire Hydrants Each	8" Perforated Metal Pipe Lin. Ft.	Manholes Each	Inlets Each	Catch Basins Each	Adjusting Existing Manholes Each	Culvert Marker Posts Each	
+60	CONSTRUCT INLET LT. & CATCH BASIN RT. INSTALL 18" x 42' CMP STORM SEWER	40		42								1	1			
+40	CONSTRUCT CATCH BASIN RT. & INLET LT. INSTALL 18" x 42' CMP STORM SEWER	40		42								1	1			BY <i>J. Withrow</i> DATE <i>9-8-66</i>
+49	ADJUST MANHOLE RT.													1		
+20	CONSTRUCT CATCH BASIN LT. & RT. INSTALL 18" x 106' CMP STORM SEWER	100		106									2			
+20 TO +40	INSTALL 18" x 1120' CMP STORM SEWER	622		1120												
+30	ADJUST MANHOLE RT.													1		
+58.8	ADJUST FIRE HYDRANT LT.							1								
+61	ADJUST MANHOLE RT.													1		
+00	CONSTRUCT INLET RT. AND CATCH BASIN LT. INSTALL 18" x 42' CMP STORM SEWER	40		42								1	1			
7+10	<i>Remove and Dispose 6" x 60' steel pipe</i>						60									
8+10	ADJUST MANHOLE RT.													1		
9+60	REMOVE AND DISPOSE 18" x 114' CMP						114									
9+80	CONSTRUCT INLET RT. & CATCH BASIN LT. INSTALL 18" x 42' CMP STORM SEWER	40		42								1	1			
10+73	ADJUST MANHOLE RT.													1		

MICROFILMED

# LIST OF CULVERTS AND MISCELLANEOUS WORK

STATE  
ALASKA

PROJECT DESIGNATION  
S-0999 (5)

YEAR  
1963

SHEET NO.  
23

TOTAL SHEETS  
33

STATION	DESCRIPTION	103(1)	453(1A)	453(1E)	453(1G)	453(1H)	457(1)	450(1G)	513(1)	520(4)	521(1)	521(2)	521(3)	521(7)	560(5)	453(1A)	460(1D)	REMARKS
		Excavation for Structures Cu Yds.	8" Galvanized C.M.P. Lin. Ft.	10" Galvanized C.M.P. Lin. Ft.	24" Galvanized C.M.P. Lin. Ft.	Asbestos Bonded C.M.P. 24" Lin. Ft.	Removal of Culverts Lin. Ft.	24" Metal End Sections Each	Adjusting Fire Hydrants Each	8" Perforated Metal Pipe Lin. Ft.	Manholes Each	Inlets Each	Catch Basins Each	Adjusting Existing Manholes Each	Culvert Marker Posts Each	36" Galvanized CMP Lin. Ft.	36" Metal End Sections Each	
42+01.6	ADJUST FIRE HYDRANT LT.								1									MICROFILMED
42+60	CONSTRUCT INLET RT. & CATCH BASIN LT. INSTALL 18" x 42' CMP STORM SEWER	40		42								1	1					
45+40	CONSTRUCT INLET RT. & CATCH BASIN LT. INSTALL 18" x 42' CMP STORM SEWER	40		42								1	1					
46+50	ADJUST MANHOLE RT.													1				
47+00 TO 48+50	INSTALL 8" x 150' CMP RT.	82	150															
47+50 TO 49+00	INSTALL 8" x 150' CMP LT.	82	150															
47+60.3	ADJUST FIRE HYDRANT LT.								1									
47+86	REMOVE AND DISPOSE 30" x 84' CMP INSTALL 36" x 84' CMP SKEW 45° LT. AH.	47					84								2	84	2	
48+20	CONSTRUCT CATCH BASIN RT. AND LT. INSTALL 18" x 70' STORM SEWER	50		70									2					
48+20 TO 51+00	INSTALL 18" x 280' CMP STORM SEWER	125		280														
48+50 TO 53+20	INSTALL 8" x 470' PERFORATED UNDERDRAIN RT.	255								470								
49+00 TO 53+20	INSTALL 8" x 420' PERFORATED UNDERDRAIN LT.	228								420								

MICROFILMED

BY: *Withrow* DATE 9-8-06

# LIST OF CULVERTS AND MISCELLANEOUS WORK


STATION	DESCRIPTION	103(1)	453(10)	453(1E)	453(1G)	453(1G)	457(1)	460(1G)	513(1)	520(1)	521(1)	521(2)	521(3)	521(1)	560(1)	453(11)	460(11)	REMARKS
		Excavation for Structures Cu Yds.	8" Galvanized C.M.P. Lin. Ft.	18" Galvanized C.M.P. Lin. Ft.	24" Galvanized C.M.P. Lin. Ft.	Asbestos Banded C.M.P. 24" Lin. Ft.	Removal of Culverts Lin. Ft.	24" Metal End Sections Each	Adjusting Fire Hydrants Each	8" Perforated Metal Pipe Lin. Ft.	Manholes Each	Inlets Each	Catch Basins Each	Adjusting Existing Manholes Each	Culvert Marker Posts Each	36" Galvanized C.M.P. Lin. Ft.	36" Metal End Sections Each	
49+30	ADJUST MANHOLE													1				
51+00	CONSTRUCT CATCH BASIN LT. & INLET RT. INSTALL 18" x 42" CMP STORM SEWER	40		42							1	1						
53+70	INSTALL 24" x 64" CMP	47			64			2							2			DITCH OUT TO CREEK
<b>Total</b>		11,079	300	4166	1506	500	258	3	10	10,476	1	18	24	15	4	84	2	

MICROFILMED

BY *V. W. Hayward* DATE *9-8-66*

J-


# STANDARD BRASS CAP MONUMENT & MONUMENT CASE

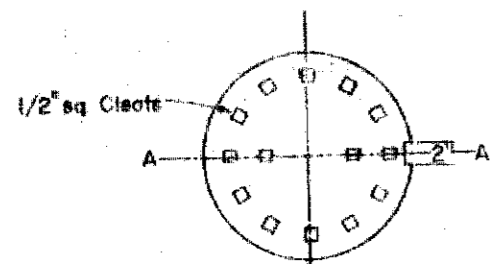

PLAN VIEW - COVER



SECTION A-A

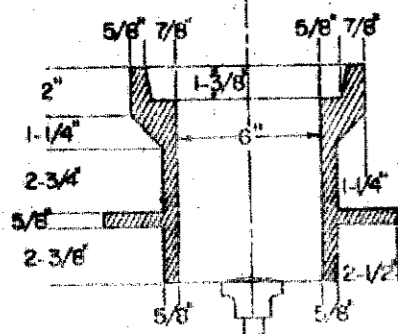

MONUMENT CASE




NOTE:  
 Where monument cases are to be placed in a bituminous paved or surfaced road, the top of the case shall be the same elevation as the top of the roadway.  
 Where monument cases are to be placed in a gravel surfaced roadway the top of the case shall be placed 1'-0" below the top of the surface of the roadway.

## SUMMARY OF BRASS CAP MONUMENTS & MONUMENT CASES

STATION	MON	MON CASE	REMARKS	STATION	MON	MON CASE	REMARKS
100+00.0		1					
28+30.0		1					
<b>TOTAL</b>		<b>2</b>					

**MICROFILMED**

BY *V.W. Hrown* DATE *9-8-66*

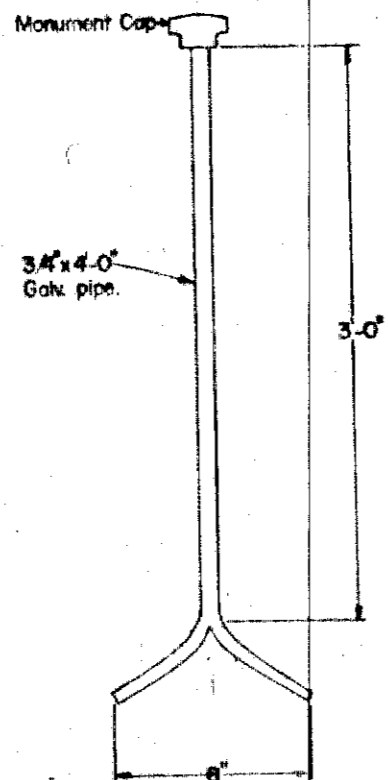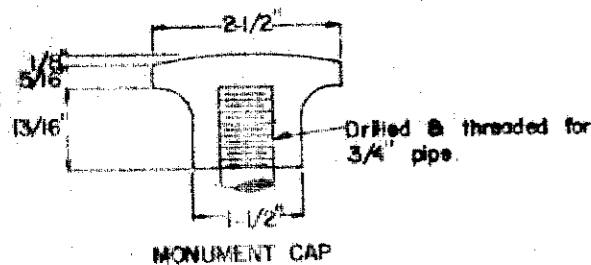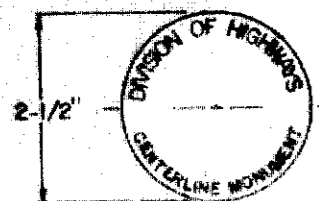

NOTE:  
 In solid rock, drill 2" dia hole a minimum of 1'-0", fill with mortar and set cap. 3/4"x9" galv pipe, designated length when set in mortar. The top of the monument shall be the same elevation as the bottom of the monument case.

**SUMMARY OF STANDARD SIGNS**

STATION	Dist. from C in ft.		SIGN NO.	TYPE OF SIGN	STATION	Dist. from C in ft.		SIGN NO.	TYPE OF SIGN	STATION	Dist. from C in ft.		SIGN NO.	TYPE OF SIGN
	LEFT	RIGHT				LEFT	RIGHT				LEFT	RIGHT		
09.51	18'		W 10-2	RAILROAD CROSS BUCK SIGN	33+70	23'		W 9-1	SCHOOL SIGN					
35		18'	W 10-2	RAILROAD CROSS BUCK SIGN	39+29	32.5'		R 1-1	STOP SIGN					
65	18'		W 10-2	RAILROAD CROSS BUCK SIGN										
00		23'	W 1-1	TURN SIGN										
50	23'		W 10-2	RAILROAD ADVANCE WARNING										
325AHD.		28'	R 1-1	STOP SIGN										
325AHD.21'			R 1-1	STOP SIGN										
00	23'		W 1-1	TURN SIGN										
61		23'	W 1-1	TURN SIGN										
40	32.5'		R 1-1	STOP SIGN										
89	28'		R 1-1	STOP SIGN										
10	23		W 1-1	TURN SIGN										
68	32.5'		R 1-1	STOP SIGN										
19		32.5'	R 1-1	STOP SIGN										
49	32.5'		<b>81-1</b>	STOP SIGN										
91		32.5'	R 1-1	STOP SIGN										
29	32.5'		R 1-1	STOP SIGN										
71		32.5'	R 1-1	STOP SIGN										
09	32.5'		R 1-1	STOP SIGN										
51		32.5'	R 1-1	STOP SIGN										
89	32.5'		R 1-1	STOP SIGN										
31		32.5'	R 1-1	STOP SIGN										
69	32.5'		R 1-1	STOP SIGN										
11		32.5'	R 1-1	STOP SIGN										
49	32.5'		R 1-1	STOP SIGN										
91		32.5'	R 1-1	STOP SIGN										
29	32.5'		R 1-1	STOP SIGN										
09	32.5		R 1-1	STOP SIGN										
51		32.5'	R 1-1	STOP SIGN										
00		23'	W 9-1	SCHOOL SIGN										
50		23'	W 9-2	SCHOOL CROSSING										
50	23'		W 9-2	SCHOOL CROSSING										
69	325'		R 1-1	STOP SIGN										

**MICROFILMED**

BY *V. W. Withrow* DATE 9-8-00