

FILE: C:\Civil 3D\Projects\24\70732-01\Civil\SA14-CT-A-CV-CWHM.dwg
 DATE: 8/16/2016 8:31 AM LAYOUT: A1
 DESIGNED: HOBBS
 CHECKED: KILPATRICK
 DRAFTED: WESTPHAL

STATE OF ALASKA

DEPARTMENT OF TRANSPORTATION AND PUBLIC FACILITIES



REVISIONS			STATE	PROJECT DESIGNATION	YEAR	SHEET NO.	TOTAL 'A' SHEETS
NO.	DATE	DESCRIPTION	ALASKA	0972016/Z684590000	2016	A1	4
						PLAN SET TOTAL	59
CDS ROUTE: 299500				MILEPOINT: 9.293 TO 9.800			
LATITUDE: N 59° 35' 12"				LONGITUDE: W 135° 11' 52"			

SKAGWAY - REPLACE CAPTAIN WILLIAM HENRY MOORE BRIDGE

PROJECT NO. 0972016/Z684590000

AS BUILTS

The undersigned hereby certifies that this duplicated document is an exact and true copy of the original.

Cody Sabin

GRADING, DRAINAGE, PAVING, PARKING, SIGNING & STRIPING

DESIGN DESIGNATIONS	
FUNCTIONAL CLASS	RURAL OTHER PRINCIPAL ARTERIAL
ADT (2014)	370
ADT (2028)	380
ADT (2038)	390
DHV (33.4%) EXISTING YEAR	120
DHV (33.4%) DESIGN YEAR (2028)	130
DHV (33.4%) DESIGN YEAR (2038)	130
PERCENT TRUCKS (T)	21.4%
DIRECTIONAL SPLIT (D)	55/45
DESIGN SPEED (V)	45 MPH
DESIGN ESAL'S (20 YEARS)	1,550,000

DESIGN DESIGNATIONS RCC	
FUNCTIONAL CLASS	RURAL OTHER PRINCIPAL ARTERIAL
ADT (2014)	370
ADT (2056)	410
ADT (2093)	450
DHV (33.4%) EXISTING YEAR	120
DHV (33.4%) DESIGN YEAR (2056)	140
DHV (33.4%) DESIGN YEAR (2093)	150
PERCENT TRUCKS (T)	21.4%
DIRECTIONAL SPLIT (D)	55/45
DESIGN SPEED (V)	45 MPH
DESIGN ESAL'S (75 YEARS) (RCC)	6,250,000

PROJECT SUMMARY	
KLONDIKE HIGHWAY MP 11 TO MP 11.5	
WIDTH OF PAVEMENT (WIDTH OF RCC)	36-FEET (40-FEET)
LENGTH OF GRADING	0.50 MILES
LENGTH OF PAVING	0.50 MILES
LENGTH OF PROJECT	0.50 MILES

USE THESE PLANS IN CONJUNCTION WITH THE STATE OF ALASKA STANDARD SPECIFICATIONS FOR HIGHWAY CONSTRUCTION, 2015 EDITION AND THE PROJECT SPECIAL PROVISIONS.

PLANS DEVELOPED BY: DOWL
 5368 COMMERCIAL BLVD. - JUNEAU, AK 99801
 907-780-3533 - #AECL848


STATE OF ALASKA
 DEPARTMENT OF TRANSPORTATION & PUBLIC FACILITIES

John Waisanen 6/9/20
 RSM CONSULTANTS
 PROJECT ENGINEER

APPROVED: *L. Pat Carroll*
 L. PAT CARROLL, P.E.
 REGIONAL PRECONSTRUCTION ENGINEER
 CONCUR: *[Signature]*

DATE: 8/17/16

FOR: *[Signature]*
 MICHAEL J. COFFEY
 DIRECTOR, SOUTHCOST REGION
 DATE: 8/12/16

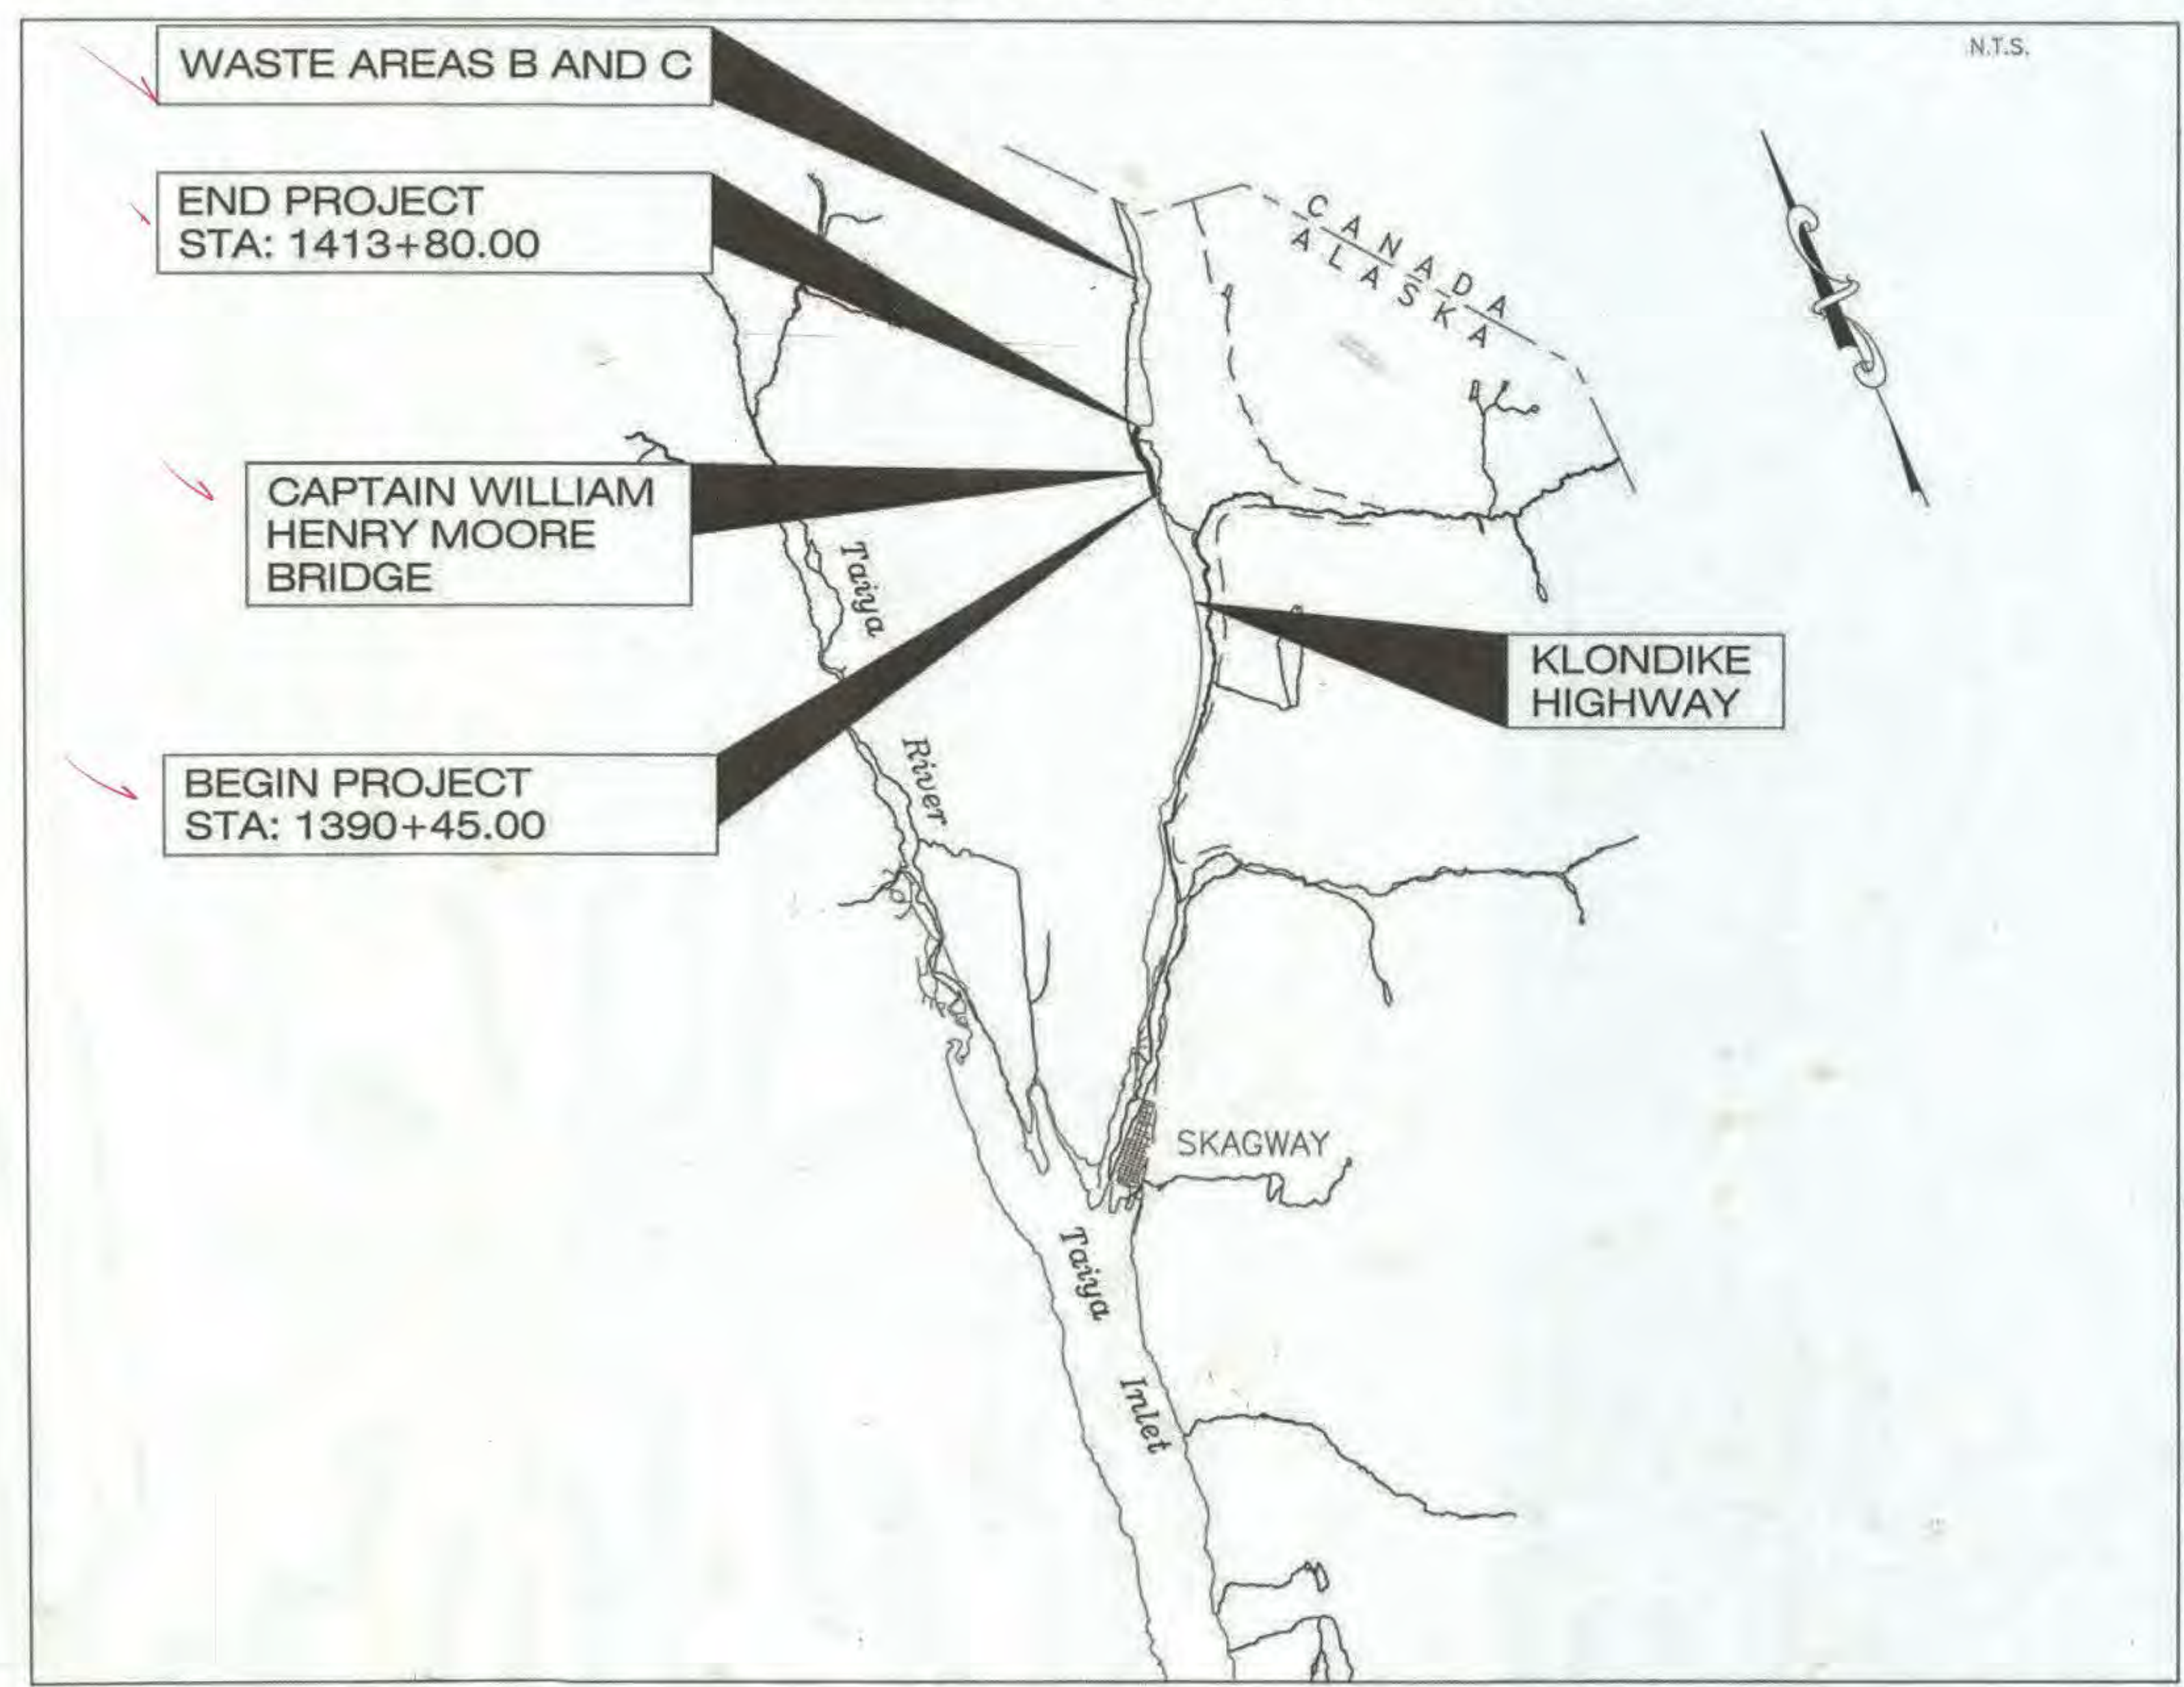

VICINITY MAP

March 30, 2017

JOHN WAISANEN, PROJECT ENGINEER P.E.
[Signature] 6/9/20
 HAMILTON CONSTRUCTION
 BEGIN WORK: 4/24/17
 END WORK: 10/16/2019


ANDREW CONRAD ADOT/PF PROJECT ENGINEER
 2017

EMILY DELANEY ADOT/PF PROJECT ENGINEER
 2018

FOR: *[Signature]*

FILE: C:\civ1\30 Projects\24\70732-01\Civil\SA14-CT-A-SH-CWHM.dwg DATE: 8/16/2016 14:46 LAYOUT: A2 DESIGNED: HOBBS CHECKED: NOBLE DRAFTED: WESTPHAL

NO.	DATE	REVISION	STATE	PROJECT DESIGNATION	YEAR	SHEET NO.	TOTAL SHEETS
			ALASKA	0972016/Z684590000	2016	A2	59

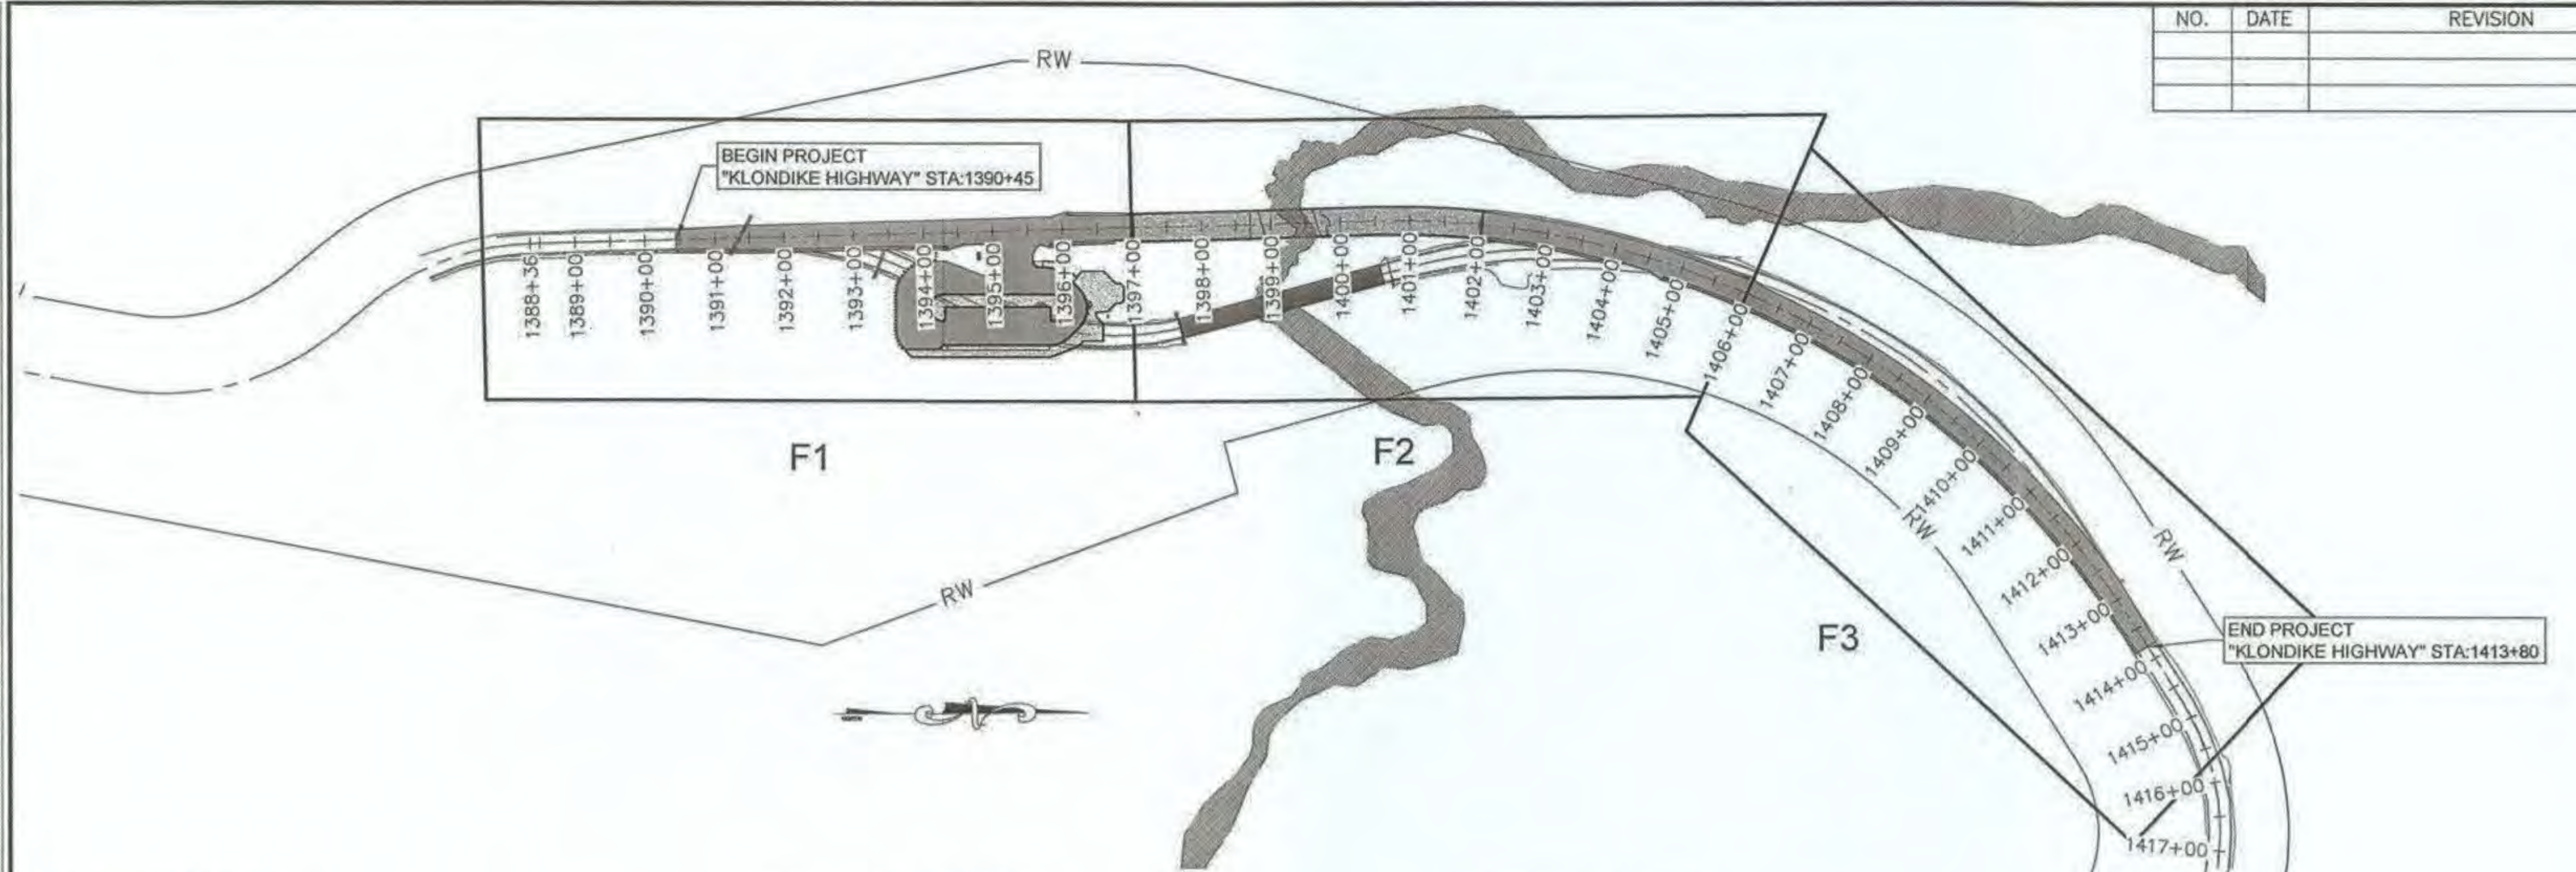


INDEX OF SHEETS	
SHEET NO.	DESCRIPTION
A1	TITLE SHEET
A2	INDEX, SHEET LAYOUT, AND ABBREVIATIONS
A3	LEGEND AND SYMBOLS
A4	SURVEY CONTROL
B1-B2	TYPICAL SECTIONS
C1-C2	ESTIMATE OF QUANTITIES
D1-D3	SUMMARY TABLES
E1	PAY LIMITS DIAGRAM
E2-E6	ROCK FOUNDATION DETAILS
E7	SNOW POLE AND RCC TEST SECTION DETAIL
E8	MULTI-PLATE ARCH DETAILS
E9-E11	RCC EMBANKMENT DETAILS
E12	DRIVE GATE DETAILS
E13-E14	WAYSIDE DETAILS
E15-E16	DITCH WIDENING, CULVERT, AND RIPRAP DETAILS
E17-E19	CONCRETE BARRIER AND TRANSITION DETAILS
F1-F3	PLAN AND PROFILE
G1-GB	EXCAVATION PLAN, PROFILE, AND SECTIONS
G9-G13	WAYSIDE PARKING
H1-H4	SIGNING AND STRIPING
P1-P5	EROSION SEDIMENT CONTROL PLAN
S1	CONSTRUCTION PHASING DIAGRAM
T1-T3	TRAFFIC CONTROL PLAN

ABBREVIATIONS

@	AT
&	AND
ACI	AMERICAN CONCRETE INSTITUTE
ADOT	ALASKA DEPARTMENT OF TRANSPORTATION
ADT	AVERAGE DAILY TRAFFIC
ANSI	AMERICAN NATIONAL STANDARDS INSTITUTE
APPROX	APPROXIMATE
ATB	ASPHALT TREATED BASE
BFS	BEGIN FULL SUPERELEVATION
BM	BENCH MARK
B.O.P.	BEGINNING OF PROJECT
BOT	BOTTOM
BRG	BEARING
BVCE	BEGIN VERTICAL CURVE ELEVATION
BVCS	BEGIN VERTICAL CURVE STATION
CC	CENTER TO CENTER
C&G	CURB AND GUTTER
CJ	CONSTRUCTION JOINT
CL	CENTER LINE
CLR	CLEAR
CMP	CORRUGATED METAL PIPE
CSP	CORRUGATED STEEL PIPE
CMU	CONCRETE MASONRY UNIT
CONC	CONCRETE
CONN	CONNECTION
CONT	CONTINUOUS, CONTINUATION
CPP	CORRUGATED POLYETHYLENE PIPE, TYPE S
CSP	CORRUGATED STEEL PIPE
CTE	CONNECT TO EXISTING
CTR	CENTER
CY	CUBIC YARD
DET	DETAIL
DHV	DESIGN HOURLY VOLUME
DIA OR Ø	DIAMETER
DOT&PF	DEPARTMENT OF TRANSPORTATION AND PUBLIC FACILITIES
DWG	DRAWING
E	EAST
EA	EACH
EFS	END FULL SUPERELEVATION

EG	EXISTING GRADE
EL	ELEVATION
ENGR	ENGINEER
E.O.P.	END OF PROJECT
EP	EDGE OF PAVEMENT
ESCP	EROSION SEDIMENT CONTROL PLAN
EXP	EXPOSED, EXPANSION
EXST, EX	EXISTING
FDN	FOUNDATION
FG	FINAL GRADE
FL	FLOW LINE (ELEV)
FT	FOOT OR FEET
FTG	FOOTING
GAL	GALLONS
GB	GRADE BREAK
GERCC	GROUT ENRICHED ROLLER COMPACTED CONCRETE
HDPE	HIGH DENSITY POLYETHYLENE
HMA	HOT MIX ASPHALT
HORIZ	HORIZONTAL
IN	INCH
INVT, INV	INVERT
J, JB	JUNCTION BOX
JT	JOINT
KIP	1000 POUNDS-FORCE
L	LEFT, LENGTH
LB	POUNDS
LF	LINEAR FOOT
LT	LEFT
LVC	LENGTH OF VERTICAL CURVE
MAX	MAXIMUM
ME	MATCH EXISTING
MEP	MATCH EXISTING PAVEMENT
MIN	MINIMUM
MISC	MISCELLANEOUS
MTE	MATCH TO EXISTING
MUTCD	MANUAL ON UNIFORM TRAFFIC CONTROL DEVICES
MDC	DEPRESSED CURB
N	NORTH
NO, #	NUMBER, NUMBERING
NOM	NOMINAL
NTS	NOT TO SCALE

O.C./OC	ON CENTER
OD	OUTSIDE DIAMETER
PI	POINT OF INTERSECTION
PL	PLACE, PLATE, PROPERTY LINE
PC, POC	POINT OF CURVATURE
POT, PT	POINT OF TANGENCY
PRC	POINT OF REVERSE CURVE
PST	PERFORATED STEEL TUBE
PVC	POLYVINYL CHLORIDE PLASTIC
PVI	POINT OF VERTICAL INTERSECTION
PVMT	PAVEMENT
R, RAD	RADIUS
RCC	ROLLER COMPACTED CONCRETE
RD	ROAD
REF	REFER OR REFERENCE
REINF	REINFORCED, REINFORCING, REINFORCED
REQD	REQUIRED
ROW, RW	RIGHT-OF-WAY
RT	RIGHT
S	SOUTH
SCH	SCHEDULE
SH, SHT	SHEET
SHLD	SHOULDER
SPECS	SPECIFICATIONS
STA	STATION
STD	STANDARD
T	SQUARE STEEL TUBE
TBC	TOP BACK OF CURB
TBG	TOP BACK OF GUTTER
TSW	TOP OF SIDEWALK
TCE	TEMPORARY CONSTRUCTION EASEMENT
TW	TOP OF WALL
TYP	TYPICAL
VBS	VEGETATED BUFFER STRIP
VC	VERTICAL CURVE
VERT, VT	VERTICAL
VPI	VERTICAL POINT OF INTERSECTION
W	WEST

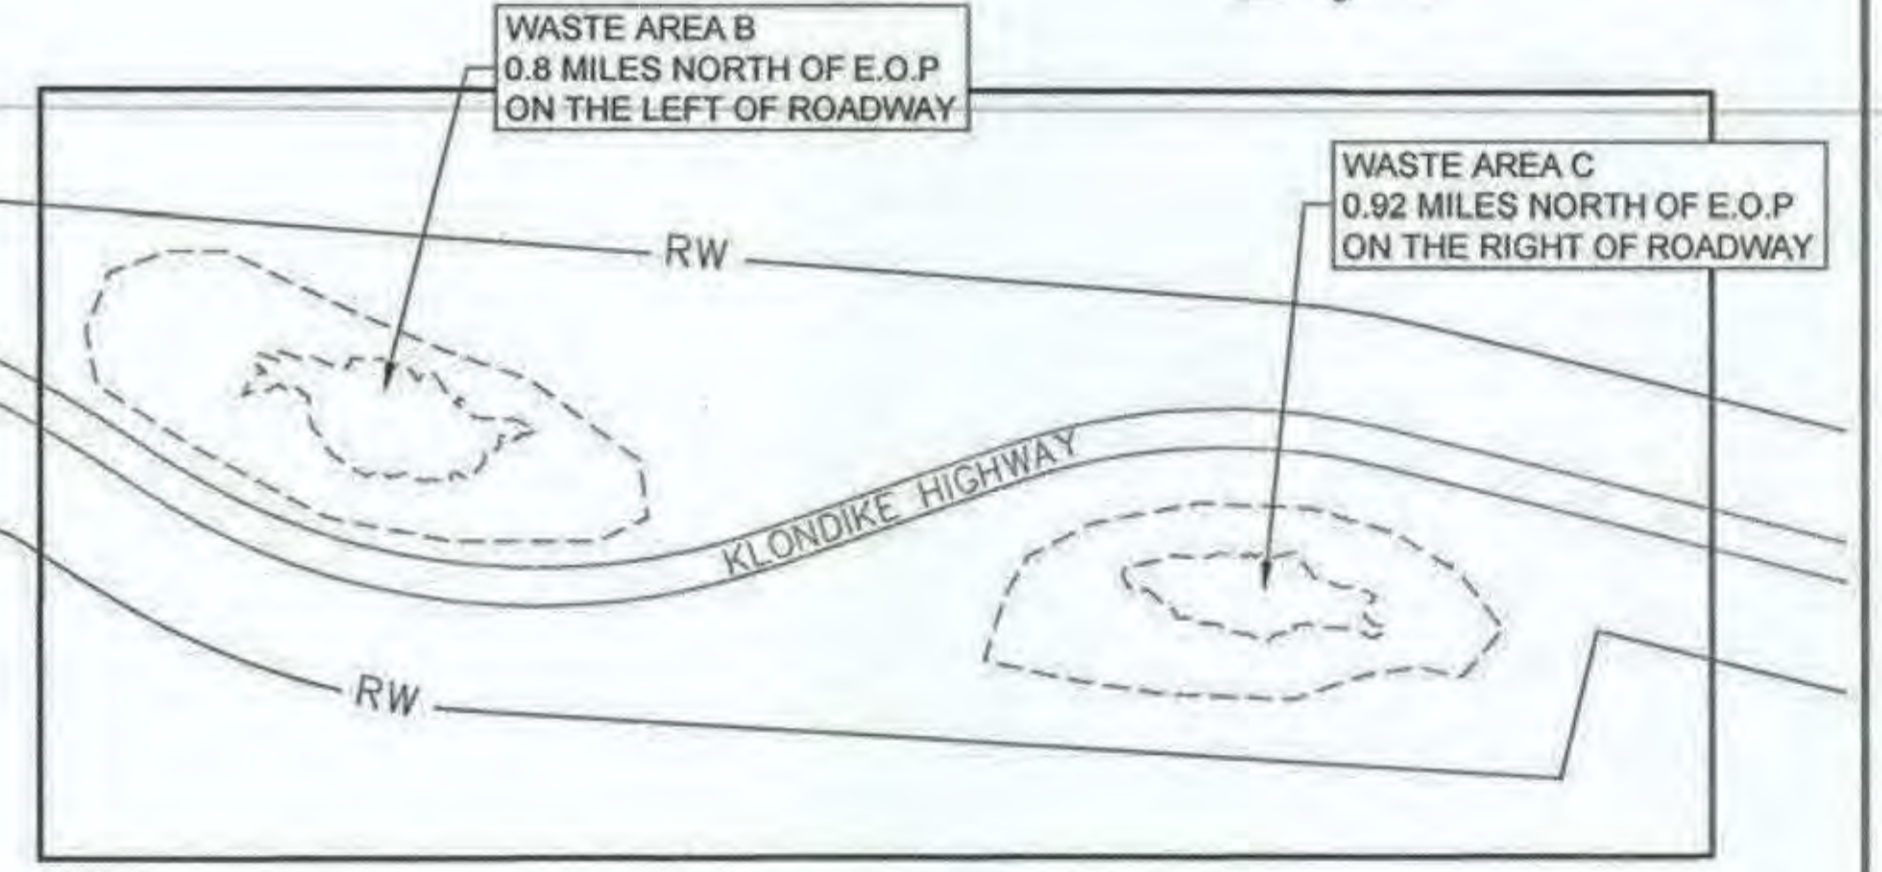


P5

THE FOLLOWING STANDARD DRAWINGS APPLY TO THIS PROJECT:

D-01.02	G-00.02	I-20.20	S-00.11	T-06.00
D-04.21	G-04.10S	I-22.10	S-05.01	T-20.03
	G-09.04S	I-30.10	S-20.10	T-21.03
	G-10.01	M-13.01	S-30.03	T-22.03
	G-20.11	M-16.01	S-31.01	
	G-28.00		S-32.00	
	G-31.01			

JD 6/9/20

PLANS DEVELOPED BY:
DOWL
5368 COMMERCIAL BLVD.
JUNEAU, AK 99801
(907) 780-3533
#AECL848

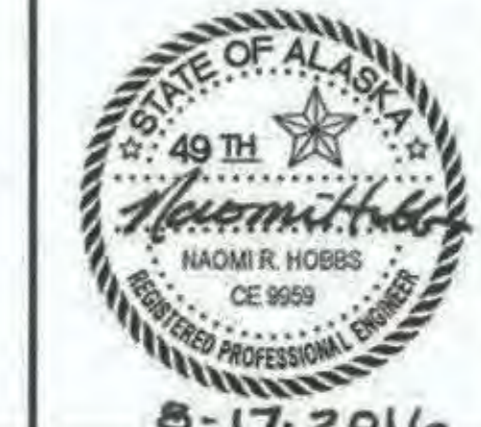

STATE OF ALASKA
DEPARTMENT OF TRANSPORTATION
AND PUBLIC FACILITIES
**SKAGWAY - REPLACE CAPTAIN
WILLIAM HENRY MOORE BRIDGE**
**INDEX, SHEET LAYOUT, AND
ABBREVIATIONS**

FILE C:\Civil\3D Projects\24\70732-01\Civil\SA14-CT-A-SY-DWHM.dwg
 DATE 8/12/2016 14:02 LAYOUT A3
 DESIGNED HOBBS
 CHECKED NOBLE
 DRAFTED WESTPHAL

NO.	DATE	REVISION	STATE	PROJECT DESIGNATION	YEAR	SHEET NO.	TOTAL SHEETS
			ALASKA	0972016/Z684590000	2016	A3	59

	RECOVERED	SET
BLM MONUMENT		
GLO MONUMENT		
USC&GS MONUMENT		
PRIMARY MONUMENT		
CENTERLINE MONUMENT IN CASING		
PRIMARY R.O.W. MONUMENT		
BEARING OBJECT		
MISCELLANEOUS MONUMENT		
LINE OF SIGHT MONUMENT		
CONCRETE R.O.W. MONUMENT		
BENCHMARK		
REBAR AND CAP		
REBAR		
IRON PIPE		
PK NAIL		
SPIKE		
HUB AND TACK		
CONSTRUCTION CENTERLINE		
MICELLANEOUS CENTERLINE		
STATION EQUATION	"L"48+97.23 POT BK= "O"48+97.23 PC AHD	
PROJECT RIGHT-OF-WAY LINE		
EXISTING RIGHT-OF-WAY LINE		
EXISTING PROPERTY LINE		
CONTROLLED ACCESS LINE		
EXISTING EASEMENT LINE		
PROPOSED EASEMENT LINE		
PROPOSED CUT SLOPE LIMIT		
PROPOSED FILL SLOPE LIMIT		
SECTION LINE		
1/4 SECTION LINE		
1/16 SECTION LINE		
TOWNSHIP & RANGE LINE	T. 2 N. T. 1 N. E. 1 E. E. 2 E.	
MEANDER LINE		

	EXISTING	PROPOSED
SANITARY SEWER (FLOW DIRECTION →)		
FUEL LINE		
GAS LINE		
WATER LINE		
METER, VALVE, FIRE HYDRANT		
EXISTING STORM DRAIN (FLOW DIRECTION →)		
PROPOSED STORM DRAIN		
FIBER OPTIC LINE		
DIRECT BURIAL TELEPHONE CABLE		
DIRECT BURIAL ELECTRIC CABLE		
ELECTRIC LINE (OVERHEAD)		
POWER POLE LINE		
JOINT USE POWER & TELEPHONE		
TELEPHONE POLE LINE		
POLE ANCHOR		
STUB POLE (POWER OR TELEPHONE)		
TELEPHONE DUCT		
TELEPHONE PEDESTAL		
BURIED CABLE MARKER		
PIPELINE MARKER OR VALVE		
CATCH BASIN OR DROP INLET		
MANHOLE		
SANITARY SEWER CLEAN OUT		
RIPRAP		
SPECIAL DITCH CENTERLINE		
DITCH CENTERLINE		
TREE LINE		
WATER BOUNDARY		
ORDINARY HIGH WATER LINE		
FLOW CENTERLINE		
FLOW DIRECTION		

	EXISTING	PROPOSED
ROADWAY/PAVEMENT EDGE		
ROADWAY/PAVEMENT HATCH		
RCC HATCH		
FENCE		
CURB AND GUTTER		
DETECTABLE WARNINGS		
GUARDRAIL		
GUARDRAIL END SECTION		
CULVERT PIPE		
SIGN		
MAILBOX		
RAILROAD TRACKS		
RAILROAD DEVICES		
WETLANDS		
EXISTING BUILDINGS		
POST OR BOLLARD		
WELL OR MONITORING WELL		
SEPTIC PIPE		
FUEL TANK FILL PIPE/VENT		
SATELLITE DISH		
TEST HOLE		
CONIFER TREE		
DECIDUOUS TREE		
GRAVE		
THERMOSIPHON		
PARKING METER		
VEHICLE PLUG-IN		
DELINEATOR/GUIDE MARKER		
BOULDER		

	EXISTING	PROPOSED
JUNCTION BOX, TYPE IA		
JUNCTION BOX, TYPE II		
JUNCTION BOX, TYPE III		
SIGNAL FACE, VEHICULAR		
SIGNAL FACE, BACKPLATE		
SIGNAL FACE, LEFT TURN, BACKPLATE		
SIGNAL FACE, PEDESTRIAN		
LOOP DETECTOR		
VIDEO DETECTOR		
RADAR DETECTOR		
OPTICOM DETECTOR		
PEDESTRIAN PUSH BUTTON		
SIGNAL POST W/O MAST ARM		
SIGNAL POLE W/MAST ARM		
SIGNAL CONTROLLER		
LOAD CENTER		
LUMINAIRE		
RIGID METAL CONDUIT		

H = HOUSE
 G = GARAGE
 M = MERCHANT/STORE
 B = BARN
 S = SHED
 P = PRIVY
 SS = SERVICE STATION
 W = WAREHOUSE

6/9/20

PLANS DEVELOPED BY:
 DOWL
 5368 COMMERCIAL BLVD.
 JUNEAU, AK 99801
 (907) 780-3533
 #AECL848



STATE OF ALASKA
 DEPARTMENT OF TRANSPORTATION
 AND PUBLIC FACILITIES
**SKAGWAY - REPLACE CAPTAIN
 WILLIAM HENRY MOORE BRIDGE**

LEGEND AND SYMBOLS

NO.	DATE	REVISION	STATE	PROJECT DESIGNATION	YEAR	SHEET NO.	TOTAL SHEETS
			ALASKA	0972016/Z684590000	2016	A4	59

SURVEY CONTROL						
POINT #	NORTHING	EASTING	ELEVATION	DESCRIPTION	STATION	OFFSET
552	579142.70	185069.40	2289.10	DOWL-1	1397+60.05	125.60
553	579236.81	184790.29	2267.60	DOWL-2	1398+62.11	-150.71
554	579381.93	184960.08	2295.95	DOWL-3	1400+02.32	23.17
555	579277.47	185129.19	2261.75	DOWL-4	1398+93.08	189.22
561	578430.30	184985.84	2243.66	DOWL-9	1390+50.34	21.71
562	578212.42	184989.96	2228.56	DOWL-10	N/A	N/A

BEGIN PROJECT
 STA: 1390+45
 N: 578424.3370
 E: 184964.3111

MONUMENTS						
POINT #	NORTHING	EASTING	ELEVATION	DESCRIPTION	STATION	OFFSET
1006	579459.81	185006.58	2312.73	GPS_ALCAP	1400+80.78	71.43
1007	578857.97	185056.06	2268.76	GPS_BC	1394+75.83	104.13
1008	578543.86	184960.84	2250.77	GPS_BC	1391+64.57	-0.04

CURVE #1
 PI STA = 1407+57.88
 $\Delta = 59^{\circ}16'35.85''$
 R = 1250.00'
 T = 711.20'
 L = 1293.21'

VERTICAL CONTROL
 THE VERTICAL DATUM FOR THIS PROJECT IS MLLW SKAGWAY ALASKA TIDAL DATUM BASED ON A DOT&PF PROVIDED ELEVATION OF 27.85 FT AT TIDAL BENCHMARK "BM 2400 C" SAID BENCHMARK ALSO BEING NATIONAL GEODETIC SURVEY PID No. "A14931"


HORIZONTAL CONTROL
 HORIZONTAL CONTROL FOR THIS PROJECT IS BASED UPON DOT&PF - ELDRED GRID 2003

ELDRED GRID 2003 IS A LOCAL COORDINATE SYSTEM AND IS DEFINED AS FOLLOWS:
 DATUM: NAD83 AK, CAN, CON-US (1996 ADJUSTMENT)
 ELLIPSOID: GRS80
 UNITS: US SURVEY FEET
 PROJECTION: TRANSVERSE MERCATOR
 CENTRAL MERIDIAN: -135^{\circ}07' LON
 ORIGIN: 58^{\circ} LAT
 FALSE NORTHING: 0.0 FT
 FALSE EASTING: 200,000.0 FT
 SCALE REDUCTION: 1.000003

END PROJECT
 STA: 1413+80
 N: 580537.4337
 E: 185550.7400

CURVE #2
 PI STA = 1416+77.84
 $\Delta = 60^{\circ}31'09.01''$
 R = 355.00'
 T = 207.11'
 L = 374.97'

- MONUMENT NOTES:**
- IF ANY PAIR OF CONTROL POINTS DISAGREES FROM PUBLISHED VALUE BY MORE THAN 1:10,000 HORIZONTALLY OR VERTICALLY THEN A THIRD NETWORK POINT MUST BE TIED TO ASCERTAIN WHICH POINT IS IN ERROR OR HAS BEEN DISTURBED.
 - WHETHER LISTED OR NOT, ALL PROPERTY MARKERS, OR ACCESSORIES THAT WILL BE DISTURBED OR BURIED SHALL BE REFERENCED PRIOR TO BEING DISTURBED, AND RE-ESTABLISHED IN THEIR ORIGINAL POSITION AND A RECORD OF MONUMENT FORM IN ACCORDANCE WITH A.S.34.65.040 SHALL BE SUBMITTED TO THE CONSTRUCTION ENGINEER FOR REVIEW PRIOR TO RECORDING. COORDINATE VALUES LISTED ARE FOR INFORMATIONAL PURPOSES, AND SHOULD ONLY BE USED AS A LAST RESORT FOR RESETTING MONUMENTS AND CORNERS.

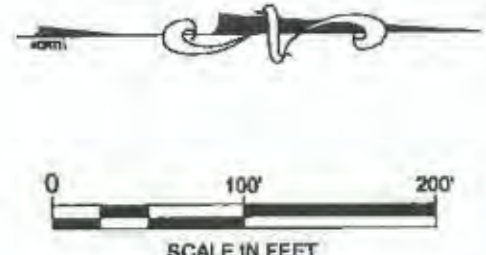

PLANS DEVELOPED BY:
 DOWL
 5368 COMMERCIAL BLVD,
 JUNEAU, AK 99801
 (907) 780-3533
 #AECL848




STATE OF ALASKA
 DEPARTMENT OF TRANSPORTATION
 AND PUBLIC FACILITIES
**SKAGWAY - REPLACE CAPTAIN
 WILLIAM HENRY MOORE BRIDGE**

SURVEY CONTROL


FILE: C:\Civil\3D Projects\24\70732-01\Civil\14\14-CT-A-CL-CWM.dwg
 DATE: 10/12/2016 15:05 LAYOUT: A4
 DESIGNED: HOBBS CHECKED: NOBLE DRAFTED: WESTPHAL

NO.	DATE	REVISION	STATE	PROJECT DESIGNATION	YEAR	SHEET NO.	TOTAL SHEETS
			ALASKA	0972016/Z684590000	2016	B1	59

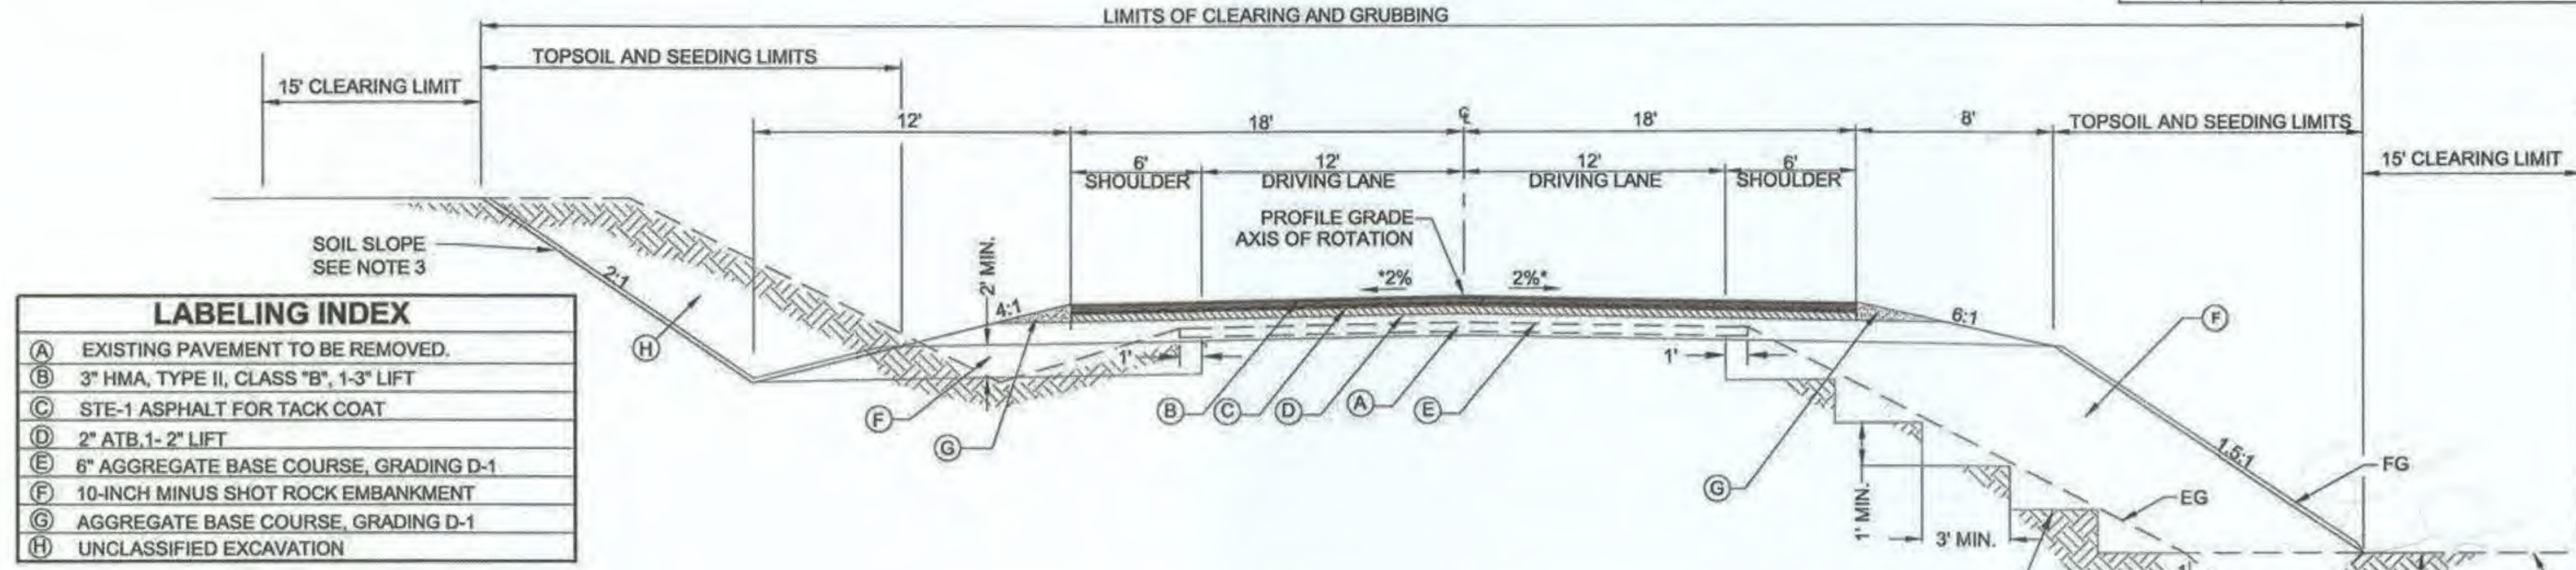


- NOTES:**
- REMOVE ALL VEGETATION, LOOSE AND DELETERIOUS MATERIALS FROM SURFACE OF EMBANKMENT FOUNDATION.
 - BENCH ALL EXISTING SLOPES STEEPER THAN 4H:1V SUBJECT TO FILL AS INDICATED IN TYPICAL SECTION 1.
 - MINIMUM BENCH WIDTH SHOWN. PROVIDE SUFFICIENT WIDTH FOR PLACING AND COMPACTING OPERATIONS.
 - SLOPE ALL CUTS IN SOIL AT 2H:1V TO EXISTING GRADE.

1 TYPICAL SECTION OF IMPROVEMENT
 CUT AND FILL TYPICAL EACH SIDE OF ROADWAY
 *CROSS SLOPE VARIES IN SUPERELEVATED SECTION, SEE DETAIL 3, SHEET B2

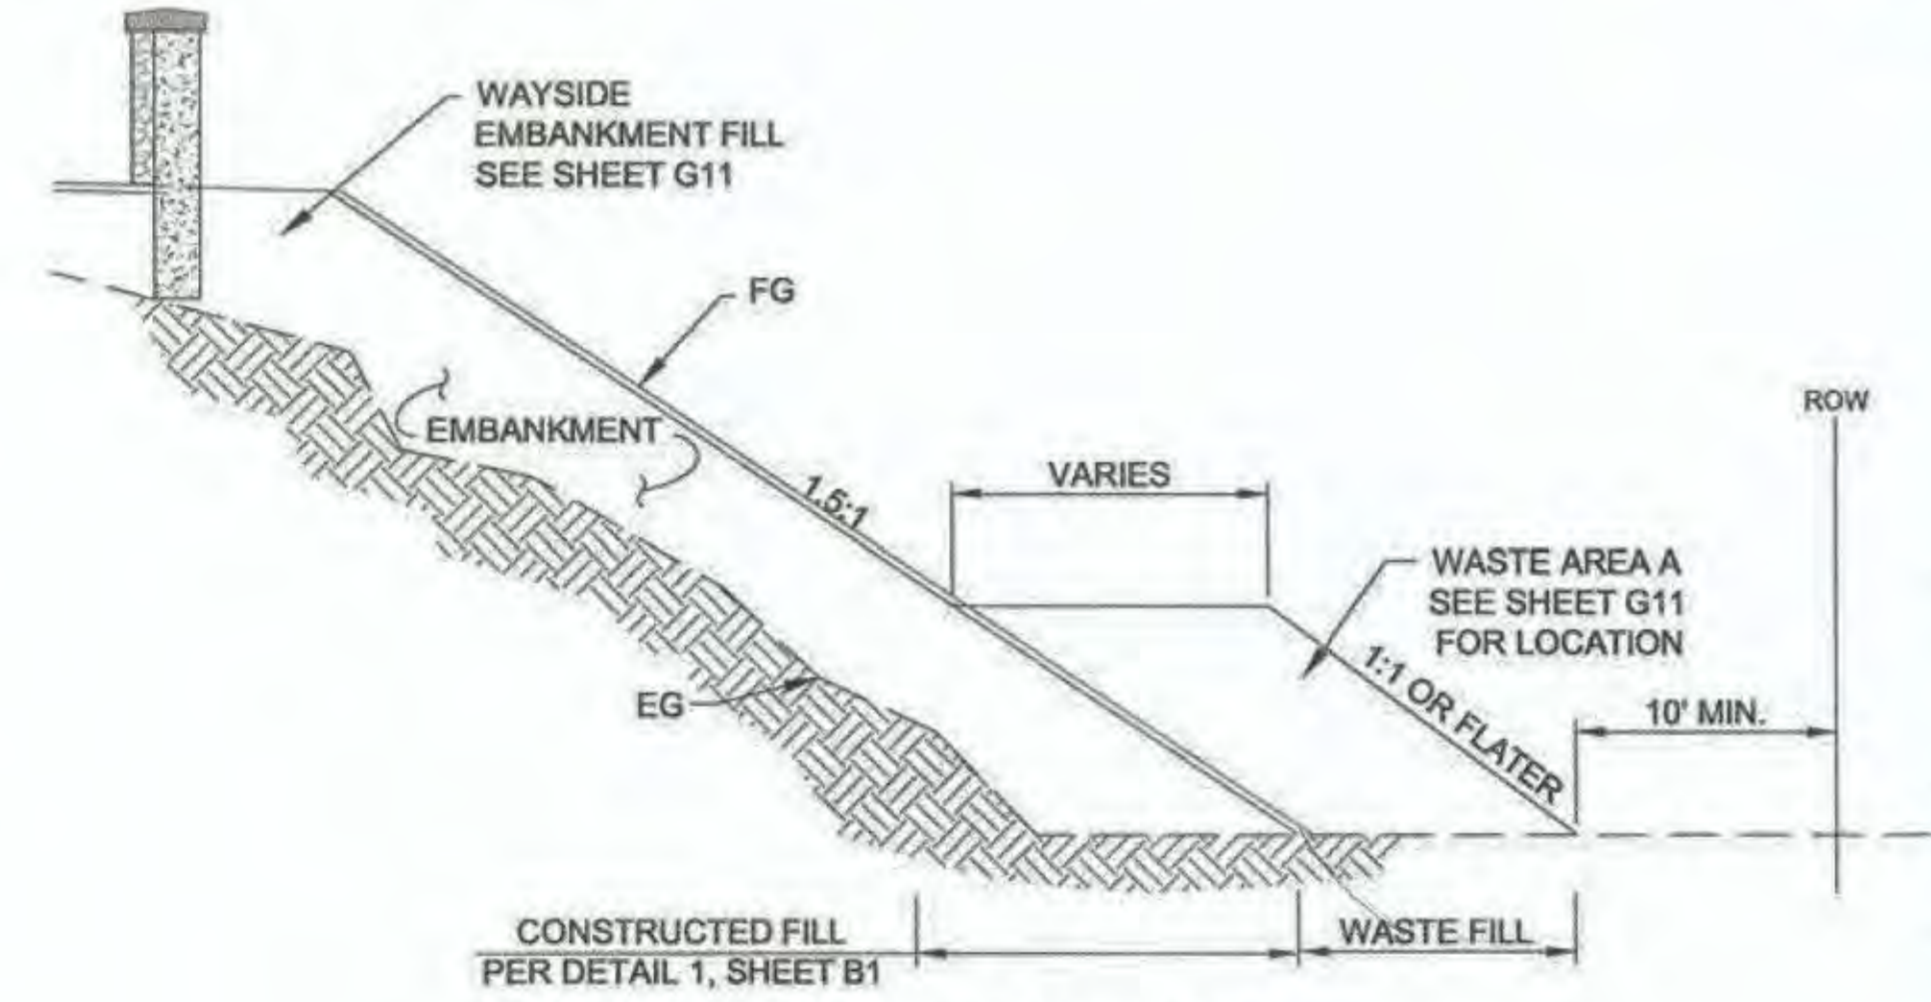

2 WASTE AREA A SECTION
 NTS

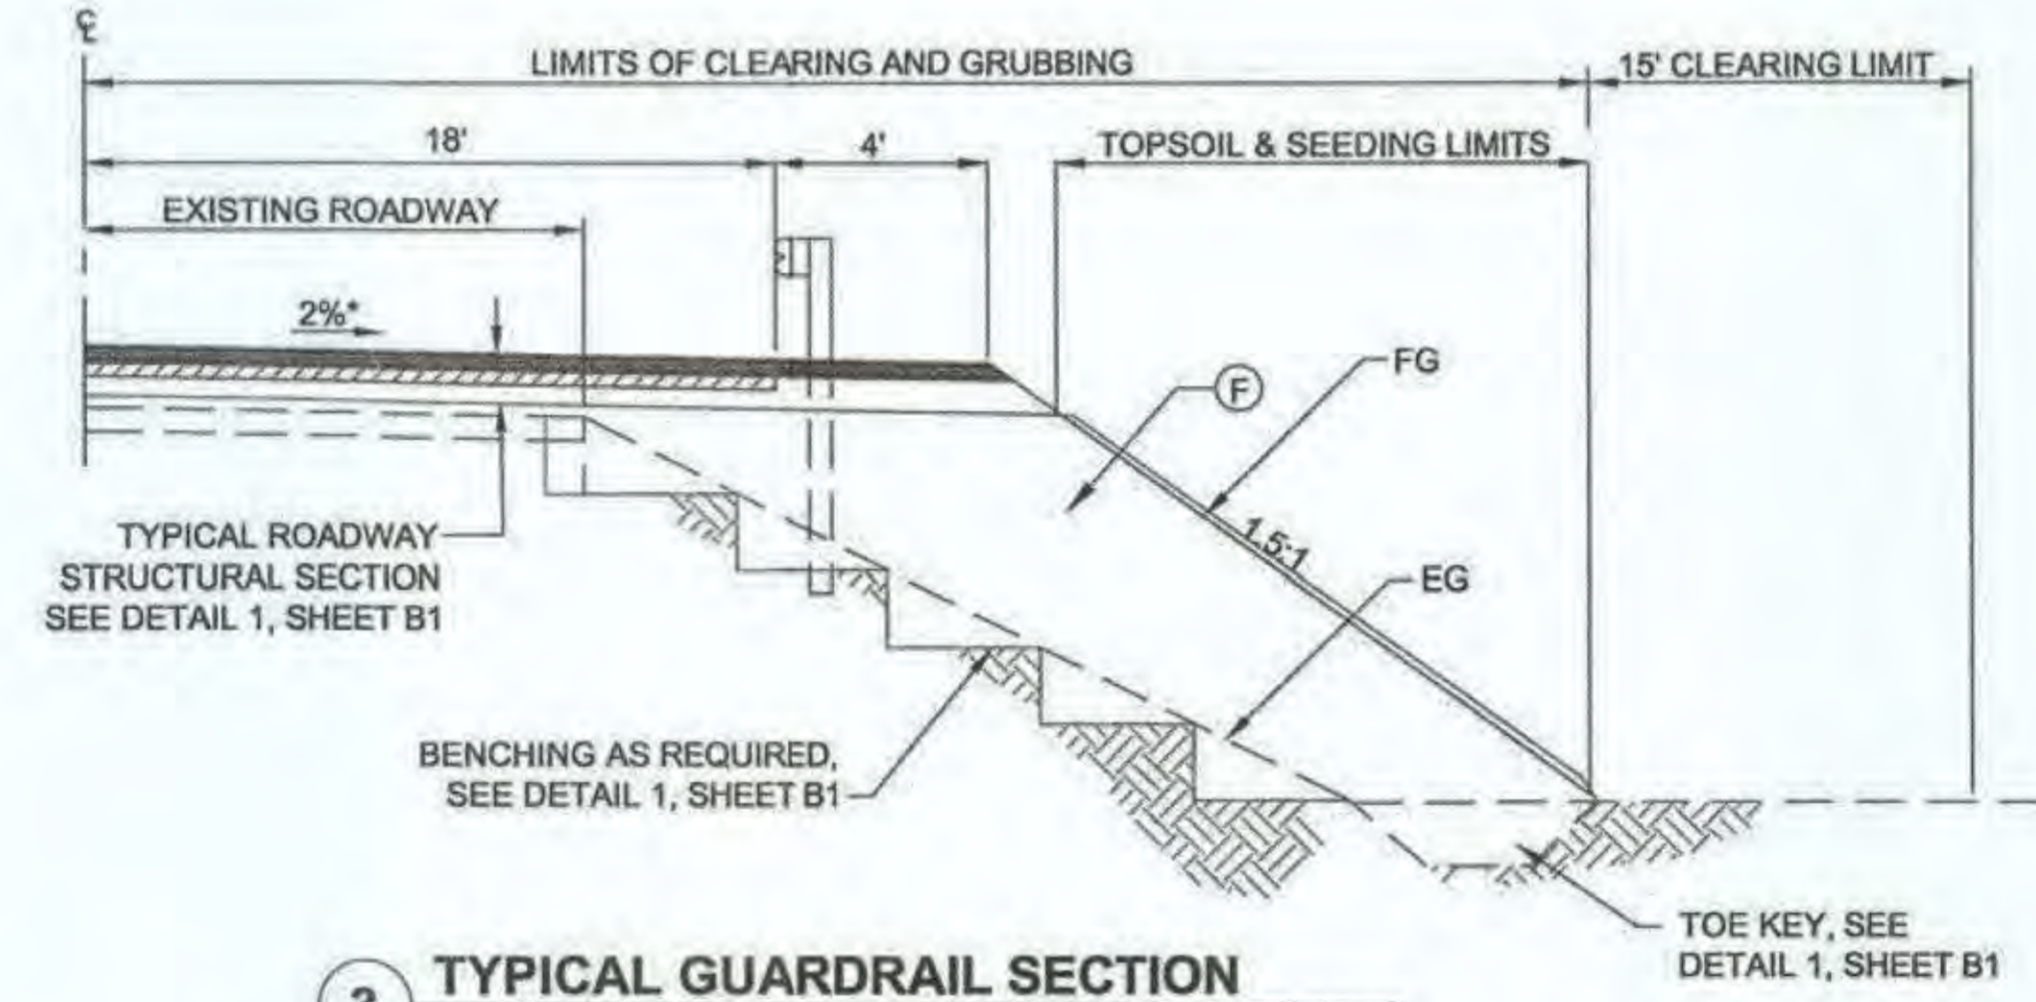


3 TYPICAL GUARDRAIL SECTION
 *CROSS SLOPE VARIES IN SUPERELEVATED SECTION, SEE DETAIL 3, SHEET B2

WIDENED CUTS

STATION TO STATION	WIDTH
1394+80 TO 1395+28	TRANSITION
1395+28 TO 1397+02	87.00'
1397+02 TO 1398+26	TRANSITION


- NOTES:**
- MAXIMUM ALLOWABLE CONTROLLED BLAST FACE HEIGHT IS 40-FEET PER LIFT. LIMIT WIDTH OF OFFSET BENCHES AS SHOWN.
 - SLOPE DRAINS TO BE SPACED AT NOMINAL 30 FOOT CENTER -TO-CENTER SPACING ALONG ALIGNMENT. SPACING MAY BE MODIFIED BY THE ENGINEER DURING CONSTRUCTION WHERE CONCENTRATED WATER SOURCES ARE ENCOUNTERED.
 - FOLLOWING EXCAVATION, PLACE WASTE MATERIAL AGAINST TEMPORARY BACKSLOPE WHERE STEEPER THAN 1.5H:1V TO PREVENT RAVELING OR ROCK FALL GENERATION.
 - DO NOT CONSTRUCT ANY ROCK CUTS OUTSIDE THE AREAS INDICATED IN THE PLANS.
 - PROVIDE ACCESS BENCH AND CLEARING LIMIT BEYOND WIDENED CUT.

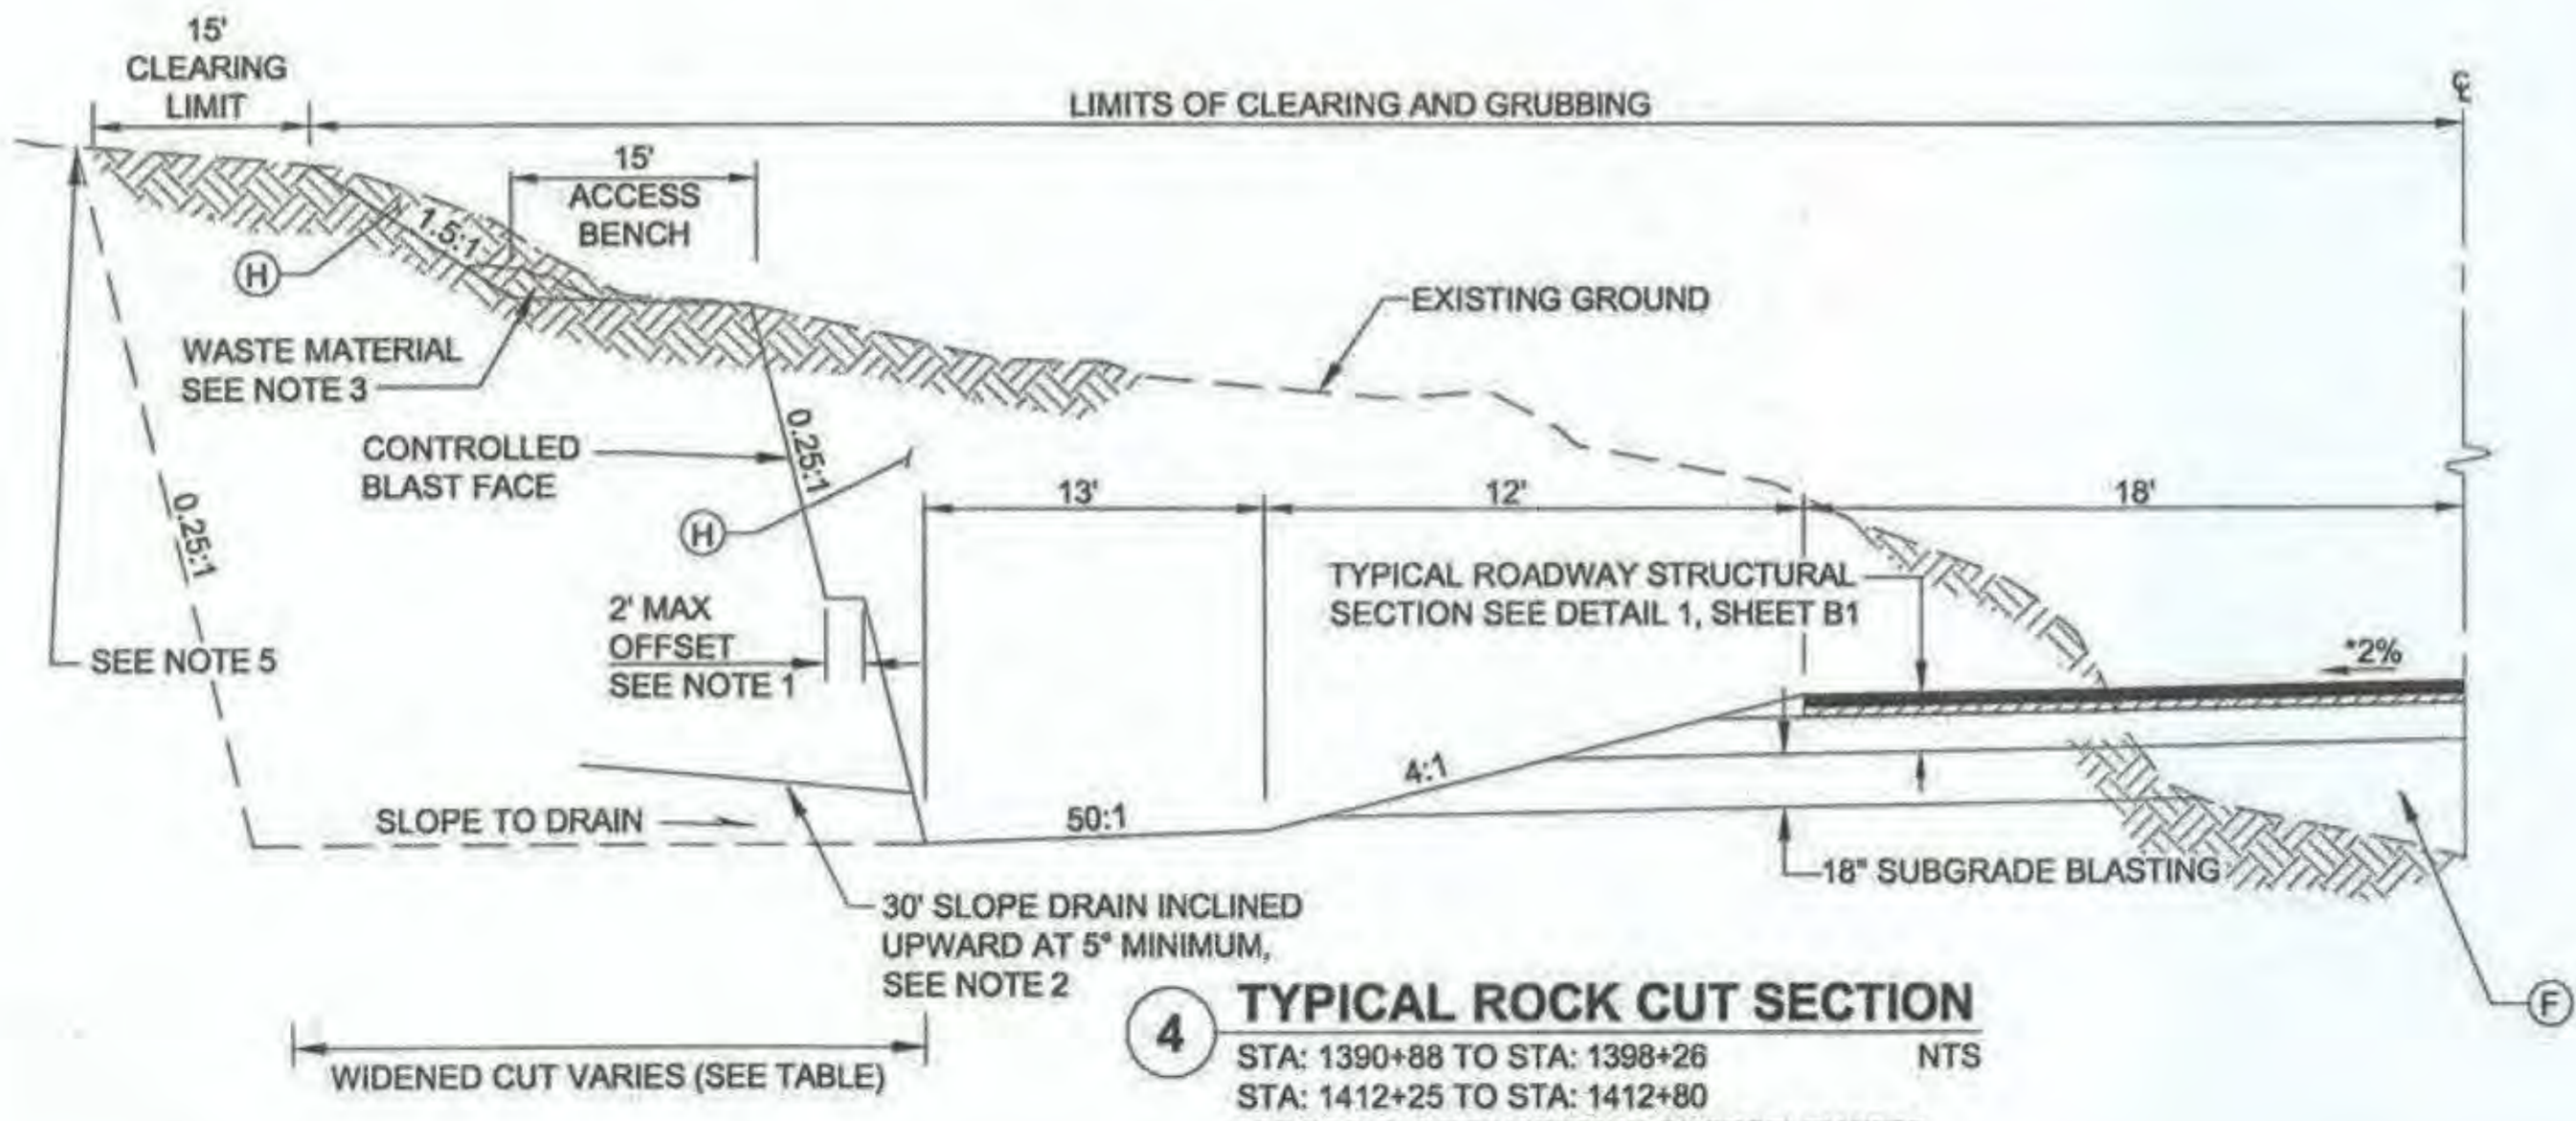

4 TYPICAL ROCK CUT SECTION
 STA: 1390+88 TO STA: 1398+26
 STA: 1412+25 TO STA: 1412+80
 *CROSS SLOPE VARIES IN SUPERELEVATED SECTION, SEE DETAIL 3, SHEET B2

Handwritten: 6/9/20

PLANS DEVELOPED BY:
 DOWL
 5368 COMMERCIAL BLVD,
 JUNEAU, AK 99801
 (907) 780-3533
 #AECL848

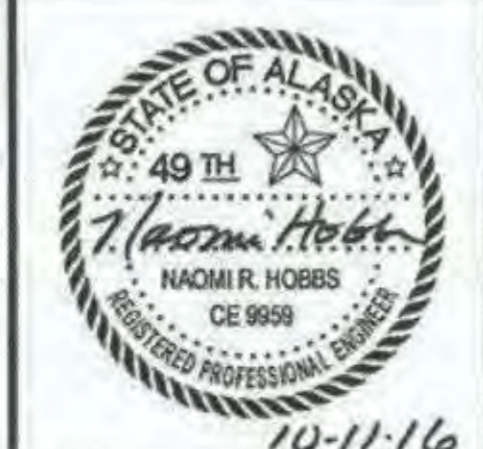


STATE OF ALASKA
 DEPARTMENT OF TRANSPORTATION
 AND PUBLIC FACILITIES
**SKAGWAY - REPLACE CAPTAIN
 WILLIAM HENRY MOORE BRIDGE**


TYPICAL SECTIONS

FILE: C:\CIVIL\30 Projects\24\70732-01\Civil\SA14-CT-B-TS-QWM.dwg
 DATE: 10/11/2016 10:40 LAYOUT: B1
 DESIGNED: HOBBS
 CHECKED: NOBLE
 DRAFTED: WESTPHAL

NO.	DATE	REVISION	STATE	PROJECT DESIGNATION	YEAR	SHEET NO.	TOTAL SHEETS
			ALASKA	0972016/Z684590000	2016	B2	59

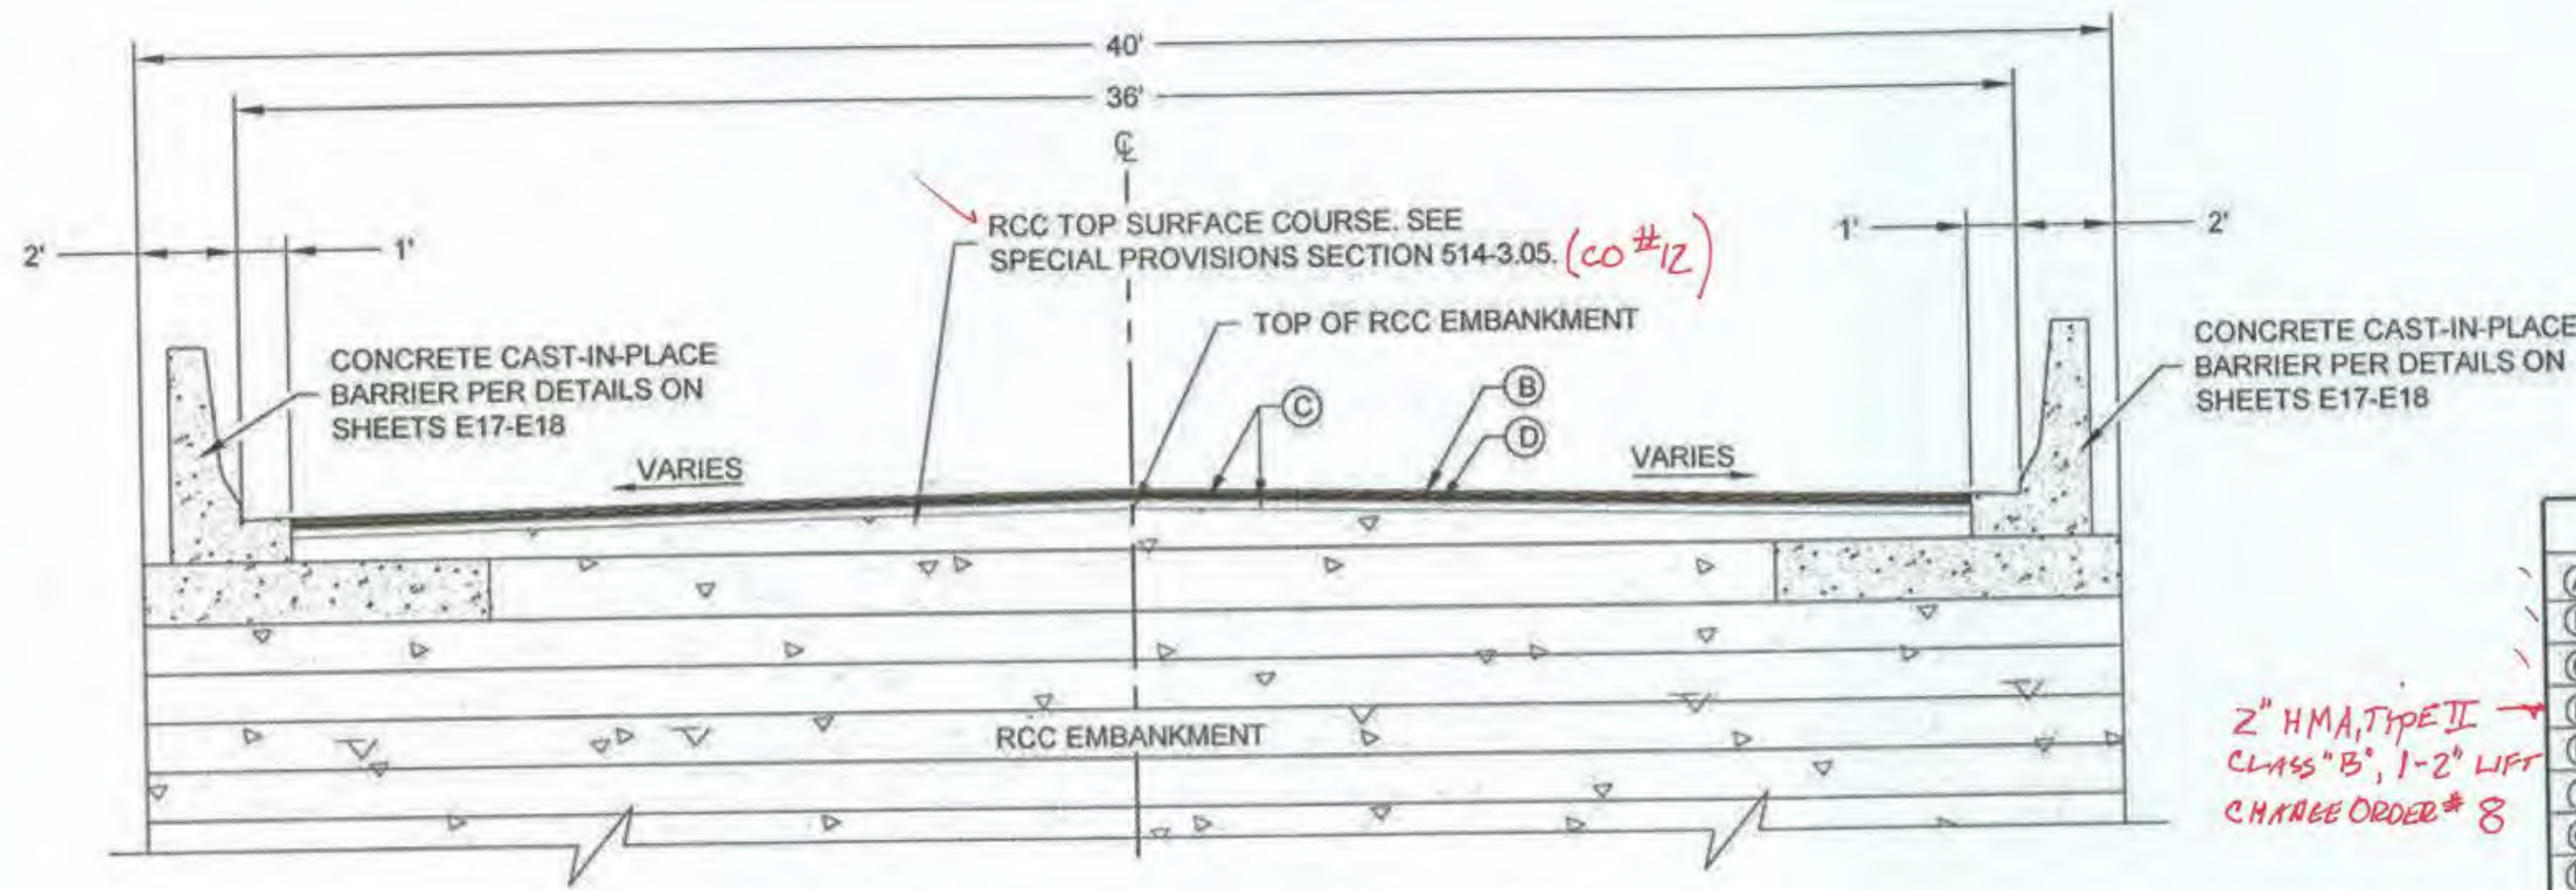


LABELING INDEX	
(A)	EXISTING PAVEMENT TO BE REMOVED.
(B)	3" HMA, TYPE II, CLASS "B", 1-3" LIFT
(C)	STE-1 ASPHALT FOR TACK COAT
(D)	2" ATB, 1-2" LIFT
(E)	6" AGGREGATE BASE COURSE, GRADING D-1
(F)	10-INCH MINUS SHOT ROCK EMBANKMENT
(G)	AGGREGATE BASE COURSE, GRADING D-1
(H)	UNCLASSIFIED EXCAVATION

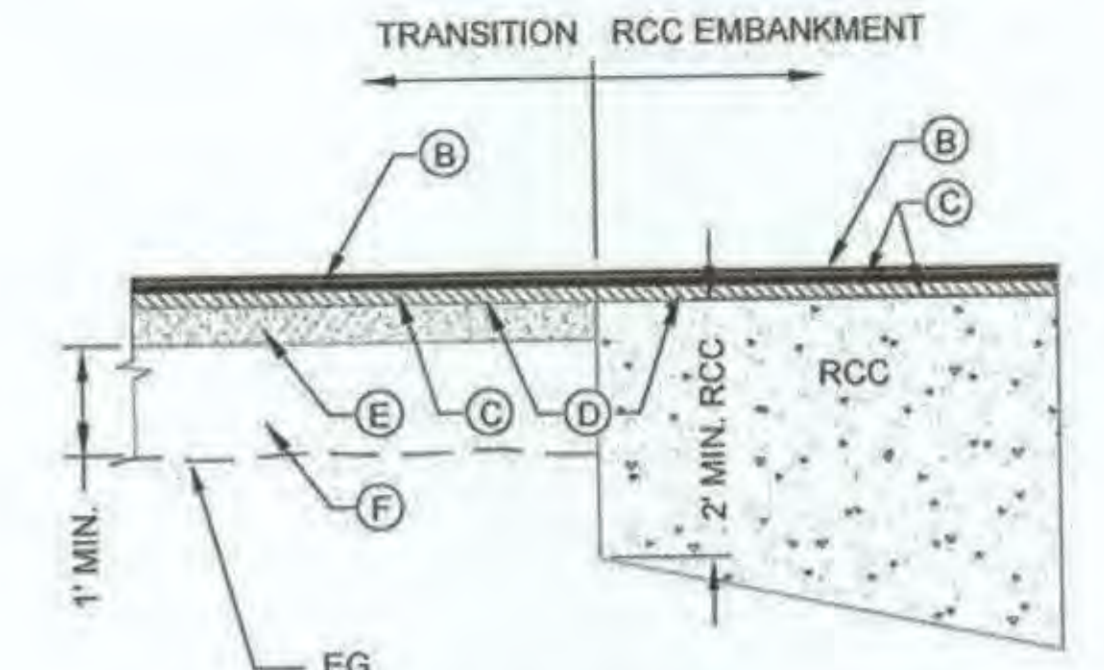


1 TYPICAL RCC SECTION
STA: 1397+02 TO STA: 1402+04 NTS

NOTE:
1. REFER TO DETAIL 2 THIS SHEET FOR TRANSITION FROM 36' TYPICAL ROADWAY SECTION TO 40' RCC EMBANKMENT SECTION.

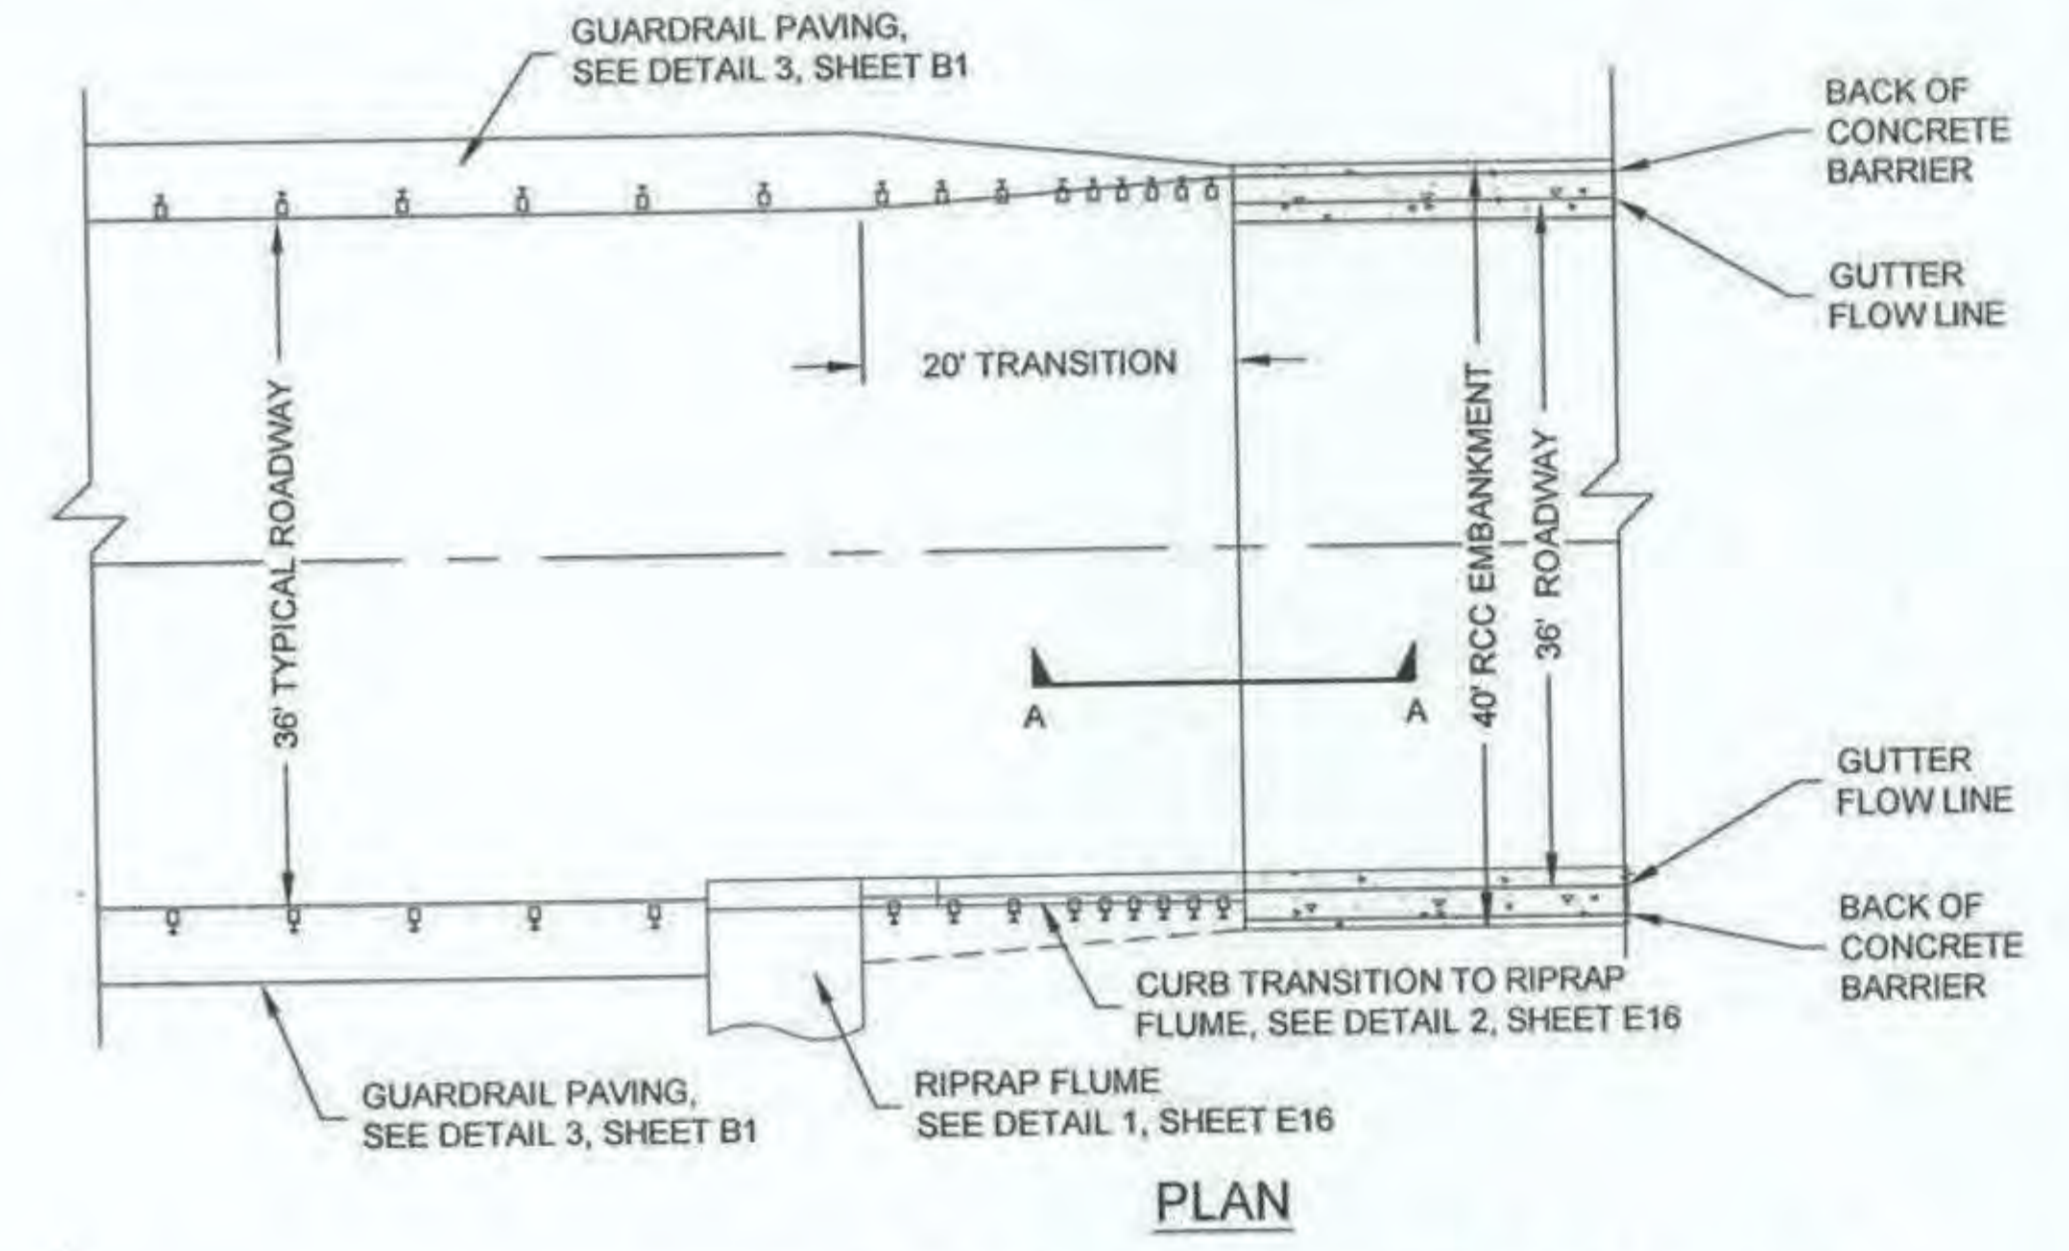

2 36' TYPICAL ROADWAY TO 40' RCC EMBANKMENT TRANSITION
CURB AND RIPRAP FLUME ON SOUTHEAST SIDE ONLY NTS

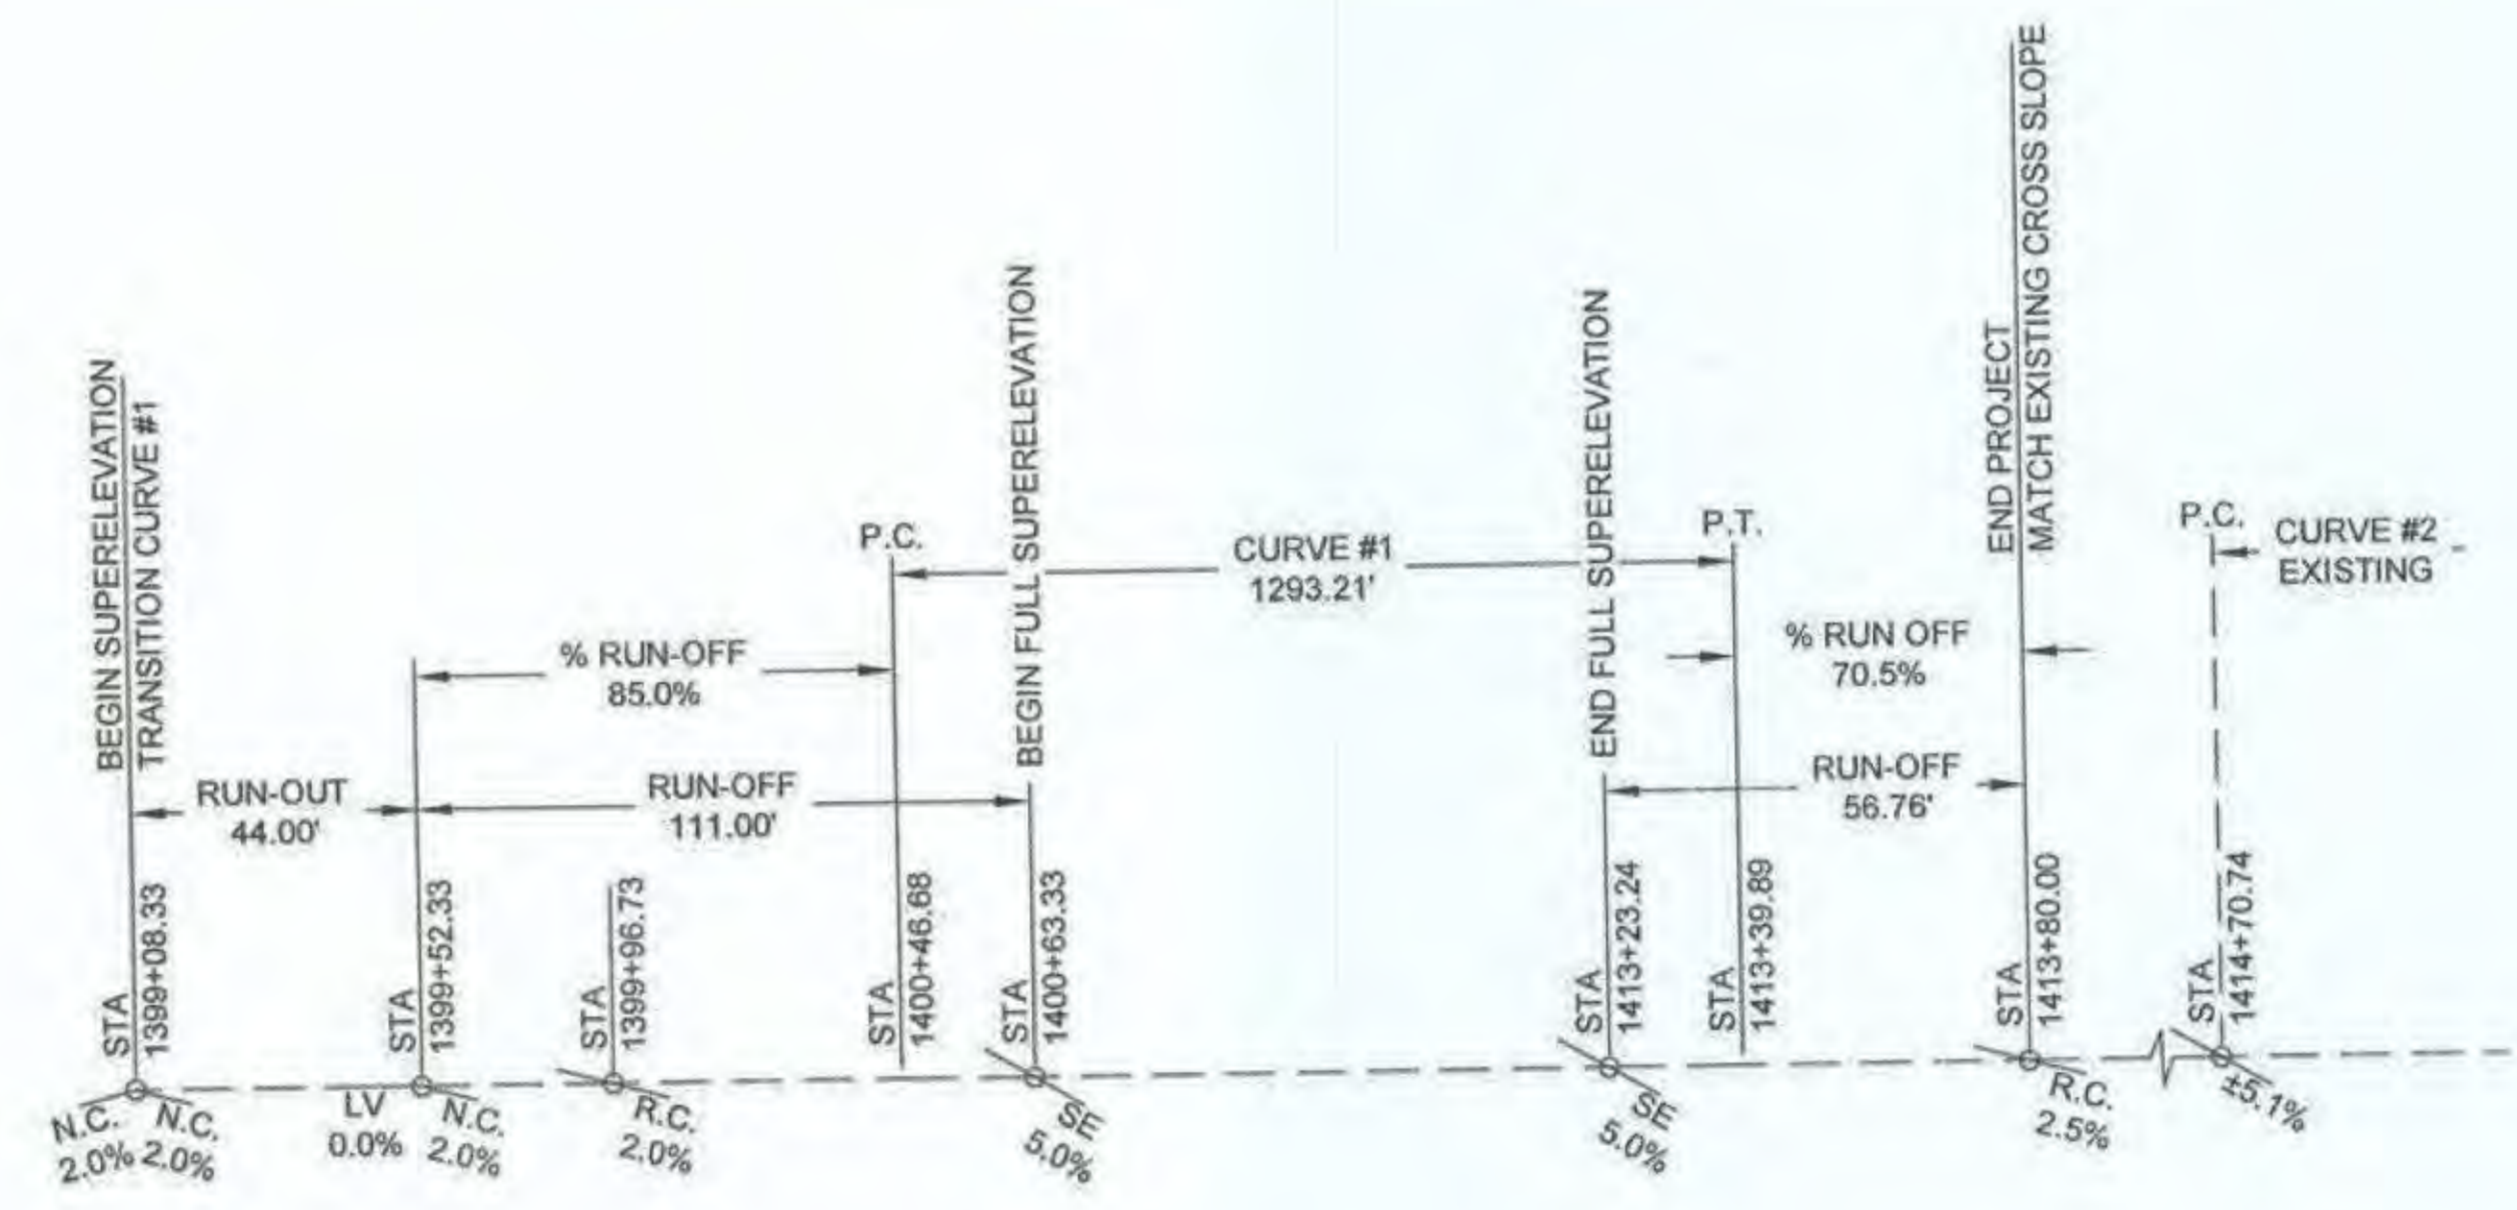

SUPERELEVATION DESIGN CRITERIA:

SOUTH END

- SUPERELEV. (C1=5.0%)
- RUN-OUT (C1=44.00')
- RUN-OFF (C1=111.00')
- RUN-OFF% (C1=85.0%)

NORTH END

- SUPERELEV. (C1=5.0%)
- RUN-OUT NA
- RUN-OFF (C1=56.76')
- RUN-OFF% (C1=70.5%)

SUPERELEVATION NOTES:

- BUILD SUPERELEVATION INTO SUBGRADE AND CARRY THROUGH SHOULDER.
- % RUN-OFF = PORTION OF RUN-OFF ON TANGENT.
- USE THE FOLLOWING DEFINITIONS FOR THE ABBREVIATED CROSS SLOPE CONDITIONS:
N.C. MEANS NORMAL CROWN (START=2.0%, END=NA)
LV MEANS LEVEL (0.0%)
SE MEANS SUPERELEVATED SECTION (5.0%)
R.C. MEANS ROTATED CROWN (START=2.0%, END=2.5%)

3 SUPERELEVATION TRANSITION
STA 1399+08.33 TO STA 1413+80.00

8/19/20

PLANS DEVELOPED BY: DOWL 5368 COMMERCIAL BLVD. JUNEAU, AK 99801 (907) 780-3533 #AECL848		STATE OF ALASKA DEPARTMENT OF TRANSPORTATION AND PUBLIC FACILITIES SKAGWAY - REPLACE CAPTAIN WILLIAM HENRY MOORE BRIDGE TYPICAL SECTIONS
--	--	--


FILE C:\Civ11 3D Projects\2470732-01\Civ11\SA14-C1-B-15-DRAW.dwg DATE 8/17/2016 11:20 LAYOUT B2 DESIGNED HOBBS CHECKED NOBLE DRAFTED WESTPHAL

FILE: C:\Civil\3D Projects\24\70732-01\Civil\SA14-CT-C-0T-CWHM.dwg DATE: 9/16/2016 13:52 LAYOUT: C1 DESIGNED: HOBBS CHECKED: NOBLE DRAFTED: WESTPHAL

NO.	DATE	REVISION	STATE	PROJECT DESIGNATION	YEAR	SHEET NO.	TOTAL SHEETS
			ALASKA	0972016/Z684590000	2016	C1	59

ESTIMATE OF QUANTITIES			
ITEM NO.	ITEM DESCRIPTION	PAY UNIT	TOTAL QUANTITY
201(3B)	CLEARING AND GRUBBING	LUMP SUM	ALL REQUIRED
201(7)	INVASIVE PLANT SPECIES CONTROL, REMOVAL, AND DISPOSAL	SQUARE YARD	833 697
202(2)	REMOVAL OF PAVEMENT	SQUARE YARD	7478 7,348
202(4)	REMOVAL OF CULVERT PIPE	LINEAR FOOT	28 101
203(2A)	ROCK EXCAVATION - SOUTH TRANSITION	CUBIC YARD	9,818 8,760
203(2B)	ROCK EXCAVATION - SOUTH ABUTMENT	CUBIC YARD	7,392 8,120
203(2C)	ROCK EXCAVATION - NORTH ABUTMENT	CUBIC YARD	830 348
203(2D)	ROCK EXCAVATION - NORTH TRANSITION	CUBIC YARD	1,745 300
203(3)	UNCLASSIFIED EXCAVATION	CUBIC YARD	106,649 93,400
203(9)	OBLITERATION OF ROADWAY	SQUARE YARD	693 669
203(10A)	CONTROLLED BLASTING - SOUTH APPROACH AND TRANSITION	LINEAR FOOT	20,368 58,400
203(10B)	CONTROLLED BLASTING - SOUTH ABUTMENT	LINEAR FOOT	2,537 6,200
203(10C)	CONTROLLED BLASTING - NORTH ABUTMENT	LINEAR FOOT	0 1,050
203(11)	DITCHLINE/SUBGRADE BLASTING	SQUARE YARD	600 3,640
203(12)	DRAIN HOLES	LINEAR FOOT	570 900
203(19)	10-INCH MINUS SHOT ROCK EMBANKMENT	CUBIC YARD	86,750 ✓
206(1)	FILTER BLANKET	CUBIC YARD	19 206
207(1)	ROCK SLOPE SCALING	SCALER-HOUR	17 275
208(1)	STABILIZATION - ROCK BOLT	LINEAR FOOT	2255 2,100
208(2)	STABILIZATION - FOUNDATION ROCK BOLT	LINEAR FOOT	921 875
208(3)	STABILIZATION - ROCK DOWEL	LINEAR FOOT	33 300
209(1)	TEMPORARY ROCKFALL PROTECTION	LUMP SUM	ALL REQUIRED ✓
301(1)	AGGREGATE BASE COURSE, GRADING D-1	TON	6670 5,040
306(1)	ATB (HMA, TYPE II, CLASS B)	TON	1569 1,320
401(1B)	HMA, TYPE II; CLASS B	TON	2552 2,260
401(4)	ASPHALT BINDER, GRADE PG 58-34	TON	233 185
401(8)	HMA PRICE ADJUSTMENT, TYPE II; CLASS B	CONTINGENT SUM	ALL REQUIRED ✓
401(9)	LONGITUDINAL JOINT DENSITY PRICE ADJUSTMENT	CONTINGENT SUM	ALL REQUIRED ✓
402(1)	STE-1 ASPHALT FOR TACK COAT	TON	2.07 5.32
507(6)	BRIDGE NUMBER PLATE	EACH	2 ✓
514(4)	RCC TEST SECTION	LUMP SUM	ALL REQUIRED ✓
514(5)	AGGREGATE FOR RCC AND BEDDING MORTAR	TON	42,377 39,927
514(6)	CEMENT FOR RCC, GROUT, AND BEDDING MORTAR	TON	2,591 2,125
514(7)	FLY ASH FOR RCC, GROUT, AND BEDDING MORTAR	TON	1,275 1,071
514(8)	ADMIXTURES FOR RCC, GROUT, AND BEDDING MORTAR	FLUID OUNCE	175,779 542,560
514(9)	RCC IN PLACE	CUBIC YARD	22,959 22,171
602(4)	STRUCTURAL PLATE ARCH 75' SPAN, 25' RISE, 1 GAGE	LUMP SUM	ALL REQUIRED ✓
603(1-36)	36 INCH CSP	LINEAR FOOT	0 85
606(1)	W-BEAM GUARDRAIL	LINEAR FOOT	1,695 ✓
606(6)	REMOVING AND DISPOSING OF GUARDRAIL	LINEAR FOOT	2,394 2,337
606(13)	PARALLEL GUARDRAIL TERMINAL	EACH	6 ✓
606(16)	TRANSITION RAIL	EACH	4 ✓
607(5)	DRIVE GATE	EACH	2 ✓

6/9/20

PLANS DEVELOPED BY: DWM 5368 COMMERCIAL BLVD, JUNEAU, AK 99801 (907) 780-3533 #AECL848	 <p>9-16-16</p>	STATE OF ALASKA DEPARTMENT OF TRANSPORTATION AND PUBLIC FACILITIES SKAGWAY - REPLACE CAPTAIN WILLIAM HENRY MOORE BRIDGE ESTIMATE OF QUANTITIES
---	--	---

FILE: C:\CIVIL\3D Projects\24\70732-01\CIVIL\SA14-01-C-01-QMM.dwg
 DATE 10/11/2016 10:18 LAYOUT C2 DESIGNED HOBBS CHECKED NOBLE DRAFTED WESTPHAL

NO.	DATE	REVISION	STATE	PROJECT DESIGNATION	YEAR	SHEET NO.	TOTAL SHEETS
			ALASKA	0972016/Z684590000	2016	C2	59

ESTIMATE OF QUANTITIES			
ITEM NO.	ITEM DESCRIPTION	PAY UNIT	TOTAL QUANTITY
608(1A)	CONCRETE SIDEWALK, 4 INCHES THICK	SQUARE YARD	540.83 540
608(6)	CURB RAMP	EACH	3 ✓
608(9)	COLORED CONCRETE SIDEWALK, 4 INCHES THICK	SQUARE YARD	791 790
609(2)	CURB AND GUTTER, TYPE 1	LINEAR FOOT	936 934
611(1A)	RIPRAP, CLASS I	CUBIC YARD	390 563
611(1B)	RIPRAP, CLASS II	CUBIC YARD	517 36
614(1)	CONCRETE BARRIER	LINEAR FOOT	1,003 ✓
615(1)	STANDARD SIGN	SQUARE FOOT	150.25 151
615(7)	OVERHEAD SNOW POLE	EACH	22 ✓
618(1)	SEEDING	ACRE	8.11
620(1)	TOPSOIL	SQUARE YARD	39,202
622(15)	BENCH	EACH	5 ✓
622(16)	BARRIER BOULDER	EACH	30 35
622(17)	BIKE RACK	EACH	2 ✓
622(18)	INTERPRETIVE SIGN SUPPORT - TYPE MASONRY	EACH	4 ✓
622(19)	CMU BLOCK WALL	LINEAR FOOT	550 545
622(20)	HISTORIC BRONZE PLAQUE	LUMP SUM	ALL REQUIRED ✓
622(21)	WAYSIDE SIGN	LUMP SUM	ALL REQUIRED ✓
629(1)	GUARDRAIL PAVING	LINEAR FOOT	2207 2,092
640(1)	MOBILIZATION AND DEMOBILIZATION	LUMP SUM	ALL REQUIRED ✓
640(4)	WORKER MEALS AND LODGING, OR PER DIEM	LUMP SUM	ALL REQUIRED ✓
641(1)	EROSION, SEDIMENT AND POLLUTION CONTROL ADMINISTRATION	LUMP SUM	ALL REQUIRED ✓
641(3)	TEMPORARY EROSION, SEDIMENT AND POLLUTION CONTROL	LUMP SUM	ALL REQUIRED ✓
641(5)	TEMPORARY EROSION SEDIMENT AND POLLUTION CONTROL BY DIRECTIVE	CONTINGENT SUM	ALL REQUIRED ✓
641(6)	WITHHOLDING	CONTINGENT SUM	ALL REQUIRED ✓
641(7)	SWPPP MANAGER	LUMP SUM	ALL REQUIRED ✓
642(1)	CONSTRUCTION SURVEYING	LUMP SUM	ALL REQUIRED ✓
642(3)	THREE PERSON SURVEY PARTY	HOUR	40.26 400
642(4)	SET PRIMARY MONUMENT	EACH	2 ✓
642(8)	ADJUST EXISTING MONUMENT	EACH	1 ✓
642(10)	MONUMENT CASE	EACH	2 ✓
643(2)	TRAFFIC MAINTENANCE	LUMP SUM	ALL REQUIRED ✓
643(3)	PERMANENT CONSTRUCTION SIGNS	LUMP SUM	ALL REQUIRED ✓
643(15)	FLAGGING	CONTINGENT SUM	ALL REQUIRED ✓
643(23)	TRAFFIC PRICE ADJUSTMENT	CONTINGENT SUM	ALL REQUIRED ✓
643(25)	TRAFFIC CONTROL	CONTINGENT SUM	ALL REQUIRED ✓
644(1)	FIELD OFFICE	LUMP SUM	ALL REQUIRED ✓
644(2)	FIELD LABORATORY	LUMP SUM	ALL REQUIRED ✓
644(15)	NUCLEAR TESTING EQUIPMENT STORAGE SHED	EACH	1 ✓
645(1)	TRAINING PROGRAM, TWO TRAINEES/APPRENTICES	HOUR	1,000
670(1)	PAINTED TRAFFIC MARKINGS	LUMP SUM	ALL REQUIRED ✓
670(8)	RECESSED PAVEMENT MARKER	EACH	49 ✓

ITEMS ADDED BY CHANGEORDER

CO#2 208(2A) FOUNDATION FILL ALL REQ'D
 CO#3 501(1A) MIX DESIGN ADJUSTMENT ALL REQ'D
 CO#4 208(2B) FOUNDATION FILL PRICE REDUCTION ALL REQ'D
 CO#4 604(4A) SPA PRE-WASH PRICE REDUCTION ALL REQ'D
 CO#4 604(4B) SPA POST-WASH PRICE REDUCTION ALL REQ'D
 CO#5 514(10) ELEVATION 2227 TO 2229 CONCRETE ALL REQ'D
 CO#7 203(2E) SOUTH CREEK CHANNEL EXCAVATION ALL REQ'D
 CO#7 611(1C) SOUTH CREEK CHANNEL RIP RAP ALL REQ'D
 CO#9 603(21-24) 24-INCH CPP 70.5 LF ALL REQ'D
 CO#10 614(2) CONCRETE BARRIER REFLECTOR ALL REQ'D
 CO#11 607(6) 4-FOOT CHAIN LINK FENCE ALL REQ'D
 CO#13 208(4) NONCONFORMING STABILIZATION/CROUT PRICE REDUCTION ALL REQ'D

BASIS OF ESTIMATE		
ITEM NO.	ITEM DESCRIPTION	ESTIMATING FACTOR
201(3B)	CLEARING	1.57 ACRE
	CLEARING AND GRUBBING	8.39 ACRE
301(1)	AGGREGATE BASE COURSE, GRADING D-1	2.18 TON/CY
306(1)	ATB	119 LB/SY PER INCH DEPTH
401(1B)	HOT MIX ASPHALT, TYPE II; CLASS B	119 LB/SY PER INCH DEPTH
401(4)	ASPHALT BINDER, GRADE PG 58-34	4.5% OF ITEM 306(1), 5.5% OF ITEM 401(1B)
402(1)	STE-1 ASPHALT FOR TACK COAT	0.00042 TON/SY
514(5)	AGGREGATE FOR RCC AND BEDDING MORTAR	2.13 TON/CY
602(4)	STRUCTURAL PLATE ARCH 75' SPAN, 25' RISE, 1 GAGE	520 CY (CLASS A CONCRETE) 1,253 CY (RCC IN PLACE)

Change Order 14 514(10) Nonconforming RCC Quality Control Plan - Missing Test Results, Reduced Price JSK 6/16/2023
 Change Order 15 111(1) Credit for Added Construction Engineering Costs until Substantial Completion

P 6/9/20

PLANS DEVELOPED BY: DOWL 5368 COMMERCIAL BLVD, JUNEAU, AK 99801 (907) 780-3533 #AECL848		STATE OF ALASKA DEPARTMENT OF TRANSPORTATION AND PUBLIC FACILITIES SKAGWAY - REPLACE CAPTAIN WILLIAM HENRY MOORE BRIDGE ESTIMATE OF QUANTITIES
--	---	---

FILE C:\Civ11 30 Projects\2470732-0\Civil\SA14-CT-D-SW-CWM.dwg
 DATE 8/17/2016 11:28 LAYOUT DT
 DESTIGNED HOBBS
 CHECKED NOBLE
 DRAFTED WESTPHAL

NO.	DATE	REVISION	STATE	PROJECT DESIGNATION	YEAR	SHEET NO.	TOTAL SHEETS
			ALASKA	0972016/Z684590000	2016	D1	59

201(3B) CLEARING AND GRUBBING

SHEET	FROM STATION	TO STATION	OFFSET	CLEARING AREA (ACRE)	CLEARING AND GRUBBING AREA (ACRE)	REMARKS
F1-F2	1390+44	1398+34	LT	0.32	---	
F1-F2	1390+46	1398+24	LT/RT	---	3.02	
F1	1390+49	1392+69	RT	---	0.04	
F1-F2	1390+50	1398+34	RT	0.51	---	
F1	1391+43	1396+46	RT	---	3.11	
F2-F3	1401+93	1413+80	LT	0.39	---	
F2-F3	1401+93	1413+80	RT	0.35	---	
F2	1402+04	1404+98	LT/RT	---	0.25	
F2-F3	1403+00	1413+80	RT	---	1.88	
F2-F3	1405+01	1406+65	LT	---	0.01	
F3	1409+84	1413+80	LT	---	0.08	
TOTAL:				1.57	8.39	ACRE

203(2D) ROCK EXCAVATION - NORTH TRANSITION

SHEET	FROM STATION	TO STATION	VOLUME (CY)	REMARKS
F2	1400+00	1402+00	300	
TOTAL:			300	CY

203(3) UNCLASSIFIED EXCAVATION

SHEET	FROM STATION	TO STATION	VOLUME (CY)	REMARKS
F1-F2	1390+45	1397+02	75,360	SOUTH OF RCC
F2-F3	1402+04	1413+80	14,860	NORTH OF RCC
F1	---	---	2,540	WAYSIDE
F2-F3	1403+75	1408+55	180	RIGHT SHOULDER IN CUT
F3	1413+70	1413+80	0	RIGHT SHOULDER IN CUT
F1-F2	1390+88	1397+02	160	LEFT SHOULDER IN CUT
F2	1402+04	1404+20	60	LEFT SHOULDER IN CUT
F2-F3	1404+60	1413+80	240	LEFT SHOULDER IN CUT
TOTAL:			93,400	CY

206(1) FILTER BLANKET

SHEET	FROM STATION	OFFSET	TO STATION	OFFSET	VOLUME (CY)	REMARKS
F1	1391+23	21' RT	1391+64	471' RT	188	
F1	1396+78	18' RT	1396+95	70' RT	18	
TOTAL:					206	CY

201(7) INVASIVE PLANT SPECIES CONTROL, REMOVAL AND DISPOSAL

SHEET	FROM STATION	TO STATION	OFFSET	AREA (SY)	REMARKS
P2	1391+00	1391+03	18' RT	1	
P2	1393+06	1394+73	85' RT	121	
P2-P3	1395+34	1397+52	157' RT	262	
P2-P3	1396+05	1397+55	128' RT	72	
P3	1400+76	1400+82	45' RT	2	
P3	1400+97	1401+01	87' RT	1	
P3	1402+37	1402+44	79' RT	5	
P4	1411+41	1411+45	40' LT	1	
P4	1412+18	1413+06	31' LT	226	
P4	1412+67	1412+78	13' RT	6	
TOTAL:				697	SY

203(9) OBLITERATION OF ROADWAY

SHEET	FROM STATION	TO STATION	OFFSET	AREA (SY)	REMARKS
F1	1392+92	1393+77	RT	302	
F1-F2	1396+55	1397+65	RT	367	
TOTAL:				669	SY

208(1) STABILIZATION - ROCK BOLT

SHEET	LOCATION	LENGTH (LF)	REMARKS
F1	SOUTH ABUTMENT	940	
F2	NORTH ABUTMENT	1,160	
TOTAL:		2,100	LF

202(2) REMOVAL OF PAVEMENT

SHEET	FROM STATION	TO STATION	AREA (SY)	REMARKS
F1	1390+45	1396+59	1,919	SOUTH END OF ROADWAY
F2-F3	1400+59	1413+80	5,429	NORTH END OF ROADWAY
TOTAL:			7,348	SY

203(10A) CONTROLLED BLASTING - SOUTH APPROACH AND TRANSITION

SHEET	LOCATION	LENGTH (LF)	REMARKS
F1	SOUTH APPROACH	46,000	PRE-SPLIT AND BUFFER HOLES
F1	SOUTH TRANSITION	4,000	PRE-SPLIT AND BUFFER HOLES
F1	SOUTH STAGING AREA	8,400	PRE-SPLIT AND BUFFER HOLES
TOTAL:		56,400	LF

208(2) STABILIZATION - FOUNDATION ROCK BOLT

SHEET	LOCATION	LENGTH (LF)	REMARKS
F1	SOUTH	625	
F2	NORTH	250	
TOTAL:		875	LF

202(4) REMOVAL OF CULVERT PIPE

SHEET	FROM STATION	OFFSET	TO STATION	OFFSET	LENGTH (LF)	REMARKS
F1	1393+48	12' RT	1393+27	63' RT	55	
F3	1412+91	23' LT	1412+79	21' RT	46	
TOTAL:					101	LF

203(10B) CONTROLLED BLASTING - SOUTH ABUTMENT

SHEET	LOCATION	LENGTH (LF)	REMARKS
F1-F2	SOUTH ABUTMENT	6,200	PRE-SPLIT AND BUFFER HOLES
TOTAL:		6,200	LF

208(3) STABILIZATION - ROCK DOWEL

SHEET	LOCATION	LENGTH (LF)	REMARKS
F1	SOUTH ABUTMENT	300	25x25 PATTERN, 15-FOOT DOWELS
TOTAL:		300	LF

203(2A) ROCK EXCAVATION - SOUTH TRANSITION

SHEET	FROM STATION	TO STATION	VOLUME (CY)	REMARKS
F2	1397+00	1398+75	8,760	
TOTAL:			8,760	CY

203(10C) CONTROLLED BLASTING - NORTH ABUTMENT

SHEET	LOCATION	LENGTH (LF)	REMARKS
F2	NORTH ABUTMENT	1,050	PRE-SPLIT AND BUFFER HOLES
TOTAL:		1,050	LF

301(1) AGGREGATE BASE COURSE, GRADING D-1

SHEET	FROM STATION	TO STATION	WEIGHT (TON)	REMARKS
F1-F2	1390+45	1397+02	1,230	
F2-F3	1402+04	1413+80	2,200	
F1	---	---	1,610	WAYSIDE PARKING AREA
TOTAL:			5,040	TON

203(2B) ROCK EXCAVATION - SOUTH ABUTMENT

SHEET	FROM STATION	TO STATION	VOLUME (CY)	REMARKS
F2	1398+50	1399+30	7,320	
F2	---	---	800	CONTINGENCY FOR ADDITIONAL REMOVAL
TOTAL:			8,120	CY

203(11) DITCHLINE/SUBGRADE BLASTING

SHEET	FROM STATION	TO STATION	AREA (SY)	REMARKS
F1	1390+45	1397+00	1,820	SOUTH APPROACH
F2-F3	1402+00	1408+55	1,820	NORTH APPROACH
TOTAL:			3,640	SY

306(1) ATB

SHEET	FROM STATION	TO STATION	WEIGHT (TON)	REMARKS
F1-F2	1390+45	1397+02	240	SOUTH OF RCC
F2	1397+02	1402+04	270	RCC
F2-F3	1402+04	1413+80	440	NORTH OF RCC
F1	---	---	370	WAYSIDE PARKING AREA
TOTAL:			1,320	TON

203(2C) ROCK EXCAVATION - NORTH ABUTMENT

SHEET	FROM STATION	TO STATION	VOLUME (CY)	REMARKS
F2	1399+50	1399+80	348	
TOTAL:			348	CY

203(12) DRAIN HOLES

SHEET	FROM STATION	TO STATION	LENGTH (LF)	REMARKS
F1	1391+00	1397+00	900	SOUTH APPROACH DRAINS
TOTAL:			900	LF

401(1B) HMA, TYPE II; CLASS B

SHEET	FROM STATION	TO STATION	WEIGHT (TON)	REMARKS
F1-F2	1390+45	1397+02	470	SOUTH OF RCC
F2	1397+02	1402+04	400	RCC
F2-F3	1402+04	1413+80	840	NORTH OF RCC
F1	---	---	550	WAYSIDE PARKING AREA
TOTAL:			2,260	TON

203(19) 10-INCH MINUS SHOT ROCK EMBANKMENT

SHEET	FROM STATION	TO STATION	VOLUME (CY)	REMARKS
F1-F2	1390+45	1397+02	290	SOUTH OF RCC
F2-F3	1402+04	1413+80	5,970	NORTH OF RCC
F1	---	---	80,490	WAYSIDE PARKING AREA
TOTAL:			86,750	CY

8/9/20

PLANS DEVELOPED BY:
DOWL
5368 COMMERCIAL BLVD.
JUNEAU, AK 99901
(907) 780-3533
#AECL848



STATE OF ALASKA
DEPARTMENT OF TRANSPORTATION
AND PUBLIC FACILITIES
**SKAGWAY - REPLACE CAPTAIN
WILLIAM HENRY MOORE BRIDGE**
SUMMARY TABLES

FILE C:\Civ11_30\Projects\24\70732-01\Civil\SA14-CT-0-SU-CWHM.dwg
 DATE 8/17/2016 11:28 LAYOUT D2
 DESIGNED HOBBS
 CHECKED NOBLE
 DRAFTED WESTPHAL

401(4) ASPHALT BINDER, GRADE PG 58-34 ✓

SHEET	ASPHALT TYPE	WEIGHT (TON)	REMARKS
F1-F3	ATB	60	
F1-F3	HMA, TYPE II, CLASS B	125	
TOTAL:		185	TON

232.62 TON

402(1) STE-1 ASPHALT FOR TACK COAT ✓

SHEET	FROM STATION	TO STATION	WEIGHT (TON)	REMARKS
F1-F2	1390+45	1397+02	1.10	SOUTH OF RCC
F2	1397+02	1402+04	0.94	RCC
F2-F3	1402+04	1413+80	1.98	NORTH OF RCC
F1	---	---	1.30	WAYSIDE PARKING AREA
TOTAL:			5.32	TON

2.87 TON

507(6) BRIDGE NUMBER PLATE ✓

SHEET	STATION	OFFSET	QUANTITY (EA)	REMARKS
F2	1397+02	RT	1	PLACED AT THE END OF THE PROPOSED BRIDGE
F2	1402+04	LT	1	PLACED AT THE END OF THE PROPOSED BRIDGE
TOTAL:			2	EA

514(5) AGGREGATE FOR RCC AND BEDDING MORTAR ✓

SHEET	FROM STATION	TO STATION	WEIGHT (TON)	REMARKS
F2	1397+00	1402+00	39,850	AGGREGATE FOR IN-PLACE RCC
F2	1397+00	1402+00	77	FLY ASH FOR IN-PLACE BEDDING MORTAR
TOTAL:			39,927	TON

42,316.61 TON

514(6) CEMENT FOR RCC, GROUT, AND BEDDING MORTAR ✓

SHEET	FROM STATION	TO STATION	WEIGHT (TON)	REMARKS
F2	1397+00	1402+00	1,993	CEMENT FOR IN-PLACE RCC
F2	1397+00	1402+00	14	CEMENT FOR IN-PLACE BEDDING MORTAR
F2	1397+00	1402+00	118	CEMENT FOR IN-PLACE GROUT
TOTAL:			2,125	TON

2591.20 TON

514(7) FLY ASH FOR RCC, GROUT, AND BEDDING MORTAR ✓

SHEET	FROM STATION	TO STATION	WEIGHT (TON)	REMARKS
F2	1397+00	1402+00	1,004	FLY ASH FOR IN-PLACE RCC
F2	1397+00	1402+00	8	FLY ASH FOR IN-PLACE BEDDING MORTAR
F2	1397+00	1402+00	59	FLY ASH FOR IN-PLACE GROUT
TOTAL:			1,071	TON

1275 TON

514(8) ADMIXTURES FOR RCC, GROUT, AND BEDDING MORTAR ✓

SHEET	DESCRIPTION	VOLUME (FL OZ)	REMARKS
F2	RCC ADMIXTURE	531,240	
F2	GROUT ADMIXTURE	3,720	
F2	MORTAR ADMIXTURE	7,600	
TOTAL:		542,560	FL OZ

975,779.31 OZ

514(9) RCC IN PLACE ✓

SHEET	FROM STATION	TO STATION	VOLUME (CY)	REMARKS
F2	1397+02	1402+04	22,171	RCC ABOVE ELEVATION 2,227' TO FG
TOTAL:			22,171	CY

23,276 CY

603(1-36) 36 INCH CSP ✓

SHEET	FROM STATION	OFFSET	TO STATION	OFFSET	LENGTH (LF)	REMARKS
F1	1391+54	32' LT	1391+23	23' RT	65	
TOTAL:					65	LF

606(1) W-BEAM GUARDRAIL ✓

SHEET	FROM STATION	TO STATION	OFFSET	LENGTH (LF)	REMARKS
F1	1390+45	1393+82	18' RT	337	MATCH TO EXISTING GUARDRAIL
F1	1396+34	1396+84	18' RT	50	CONNECT TO TRANSITION RAIL
F1	1396+59	1396+84	18' LT	25	CONNECT TO TRANSITION RAIL
F2	1402+22	1405+42	18' LT	320	CONNECT TO TRANSITION RAIL
F2	1402+23	1403+37	18' RT	114	CONNECT TO TRANSITION RAIL
F2-F3	1405+31	1413+80	18' RT	849	MATCH TO EXISTING GUARDRAIL
TOTAL:				1,695	LF

606(6) REMOVING AND DISPOSING OF GUARDRAIL ✓

SHEET	FROM STATION	TO STATION	OFFSET	LENGTH (LF)	REMARKS
F1-F2	1390+45	1397+70	RT	756	
F1-F2	1394+52	1397+64	RT	327	
F2	1400+55	1405+72	LT/RT	526	
F2	1400+62	1402+33	RT	165	
F3	1408+19	1413+80	RT	563	
TOTAL:				2,337	LF

2,394 LF

606(13) PARALLEL GUARDRAIL TERMINAL ✓

SHEET	FROM STATION	OFFSET	TO STATION	OFFSET	QUANTITY (EA)	REMARKS
F1	1393+82	18' RT	1394+35	20' RT	1	
F1	1395+81	20' RT	1396+34	18' RT	1	
F1	1396+06	20' LT	1396+59	18' LT	1	
F2	1403+37	18' RT	1403+90	20' RT	1	
F2	1404+78	20' RT	1405+31	18' RT	1	
F2	1405+42	18' LT	1405+91	20' LT	1	
TOTAL:					6	EA

606(16) TRANSITION RAIL ✓

SHEET	FROM STATION	OFFSET	TO STATION	OFFSET	QUANTITY (EA)	REMARKS
F1	1396+84	18' RT	1397+05	18' RT	1	20.75' IN LENGTH
F1	1396+84	18' LT	1397+05	18' LT	1	20.75' IN LENGTH
F2	1402+02	18' RT	1402+23	18' RT	1	20.75' IN LENGTH
F2	1402+02	18' LT	1402+22	18' LT	1	20.75' IN LENGTH
TOTAL:					4	EA

607(5) DRIVE GATE ✓

SHEET	STATION	OFFSET	QUANTITY (EA)	REMARKS
F2	1397+65	RT	1	
F2	1400+71	RT	1	
TOTAL:			2	EA

608(1A) CONCRETE SIDEWALK, 4 INCHES THICK ✓

SHEET	FROM STATION	TO STATION	AREA (SY)	REMARKS
G9	1394+06	1396+02	440	WAYSIDE MEDIAN
G9	1394+17	1395+76	100	WAYSIDE BUS DROPOFF
TOTAL:			540	SY

608(6) CURB RAMP ✓

SHEET	STATION	OFFSET	QUANTITY (EA)	REMARKS
G9	1395+66	111' RT	1	WAYSIDE PARKING AREA
G9	1395+95	113' RT	1	WAYSIDE PARKING AREA
G9	1396+36	108' RT	1	WAYSIDE PARKING AREA
TOTAL:			3	EA

608(9) COLORED CONCRETE SIDEWALK, 4 INCHES THICK ✓

SHEET	FROM STATION	TO STATION	AREA (SY)	REMARKS
G9	1393+69	1396+84	790	WAYSIDE PARKING AREA
TOTAL:			790	SY

791 SY

609(2) CURB AND GUTTER, TYPE 1 ✓

SHEET	FROM STATION	TO STATION	LENGTH (LF)	REMARKS
G9	1394+06	1396+02	469	WAYSIDE PARKING AREA - MEDIAN
G9	1393+69	1396+33	434	WAYSIDE PARKING AREA
G9	1396+74	1397+02	28	CURB TRANSITION TO RIPRAP FLUME
TOTAL:			931	LF

936 LF

611(1A) RIPRAP, CLASS I ✓

SHEET	FROM STATION	OFFSET	TO STATION	OFFSET	VOLUME (CY)	REMARKS
F1	1391+23	21' RT	1391+64	471' RT	563	
TOTAL:					563	CY

389.6 CY

611(1B) RIPRAP, CLASS II ✓

SHEET	FROM STATION	OFFSET	TO STATION	OFFSET	VOLUME (CY)	REMARKS
F1	1396+78	18' RT	1396+95	70' RT	36	
TOTAL:					36	CY

376.8 CY

614(1) CONCRETE BARRIER ✓

SHEET	FROM STATION	TO STATION	OFFSET	LENGTH (LF)	REMARKS
F2	1397+02	1402+04	18' LT	502	
F2	1397+02	1402+04	18' RT	501	
TOTAL:				1,003	LF

6/9/2016

PLANS DEVELOPED BY:
DOWL
5368 COMMERCIAL BLVD.
JUNEAU, AK 99801
(907) 780-3533
#AECL848



STATE OF ALASKA
DEPARTMENT OF TRANSPORTATION
AND PUBLIC FACILITIES
**SKAGWAY - REPLACE CAPTAIN
WILLIAM HENRY MOORE BRIDGE**

SUMMARY TABLES

FILE: C:\Civil\30 Proj\lects\24\70732-01\Civil\Sa14-CT-0-SU-QRM.dwg
 DATE: 8/17/2016 11:28 LAYOUT: D3
 DESIGNED: HOBBS
 CHECKED: NOBLE
 DRAFTED: WESTPHAL

NO.	DATE	REVISION	STATE	PROJECT DESIGNATION	YEAR	SHEET NO.	TOTAL SHEETS
			ALASKA	0972016/Z684590000	2016	D3	59

615(7) OVERHEAD SNOW POLE ✓

SHEET	STATION	OFFSET	QUANTITY (EA)	REMARKS
H1	1390+50	LT	1	NO BARRIER
H1	1391+56	RT	1	BEHIND BARRIER
H1	1392+41	LT	1	NO BARRIER
H1	1393+00	RT	1	BEHIND BARRIER
H1	1394+32	LT	1	NO BARRIER
H1	1394+33	RT	1	BEHIND BARRIER
H1	1395+90	RT	1	BEHIND BARRIER
H1	1396+23	LT	1	BEHIND BARRIER
H1	1397+00	RT	1	BEHIND BARRIER
H1	1402+18	LT	1	BEHIND BARRIER
H1	1403+20	RT	1	BEHIND BARRIER
H1	1403+91	LT	1	BEHIND BARRIER
H1	1405+11	RT	1	BEHIND BARRIER
H1	1405+63	LT	1	BEHIND BARRIER
H1	1407+02	RT	1	BEHIND BARRIER
H1	1407+54	LT	1	NO BARRIER
H1	1408+93	RT	1	BEHIND BARRIER
H1	1409+45	LT	1	NO BARRIER
H1	1410+84	RT	1	BEHIND BARRIER
H1	1411+36	LT	1	NO BARRIER
H1	1412+75	RT	1	BEHIND BARRIER
H1	1413+27	LT	1	NO BARRIER
TOTAL:			22	EA

622(16) BARRIER BOULDER ✓

SHEET	FROM STATION	OFFSET	TO STATION	OFFSET	QUANTITY (EA)	REMARKS
G9	1393+65	166' RT	1394+19	24' RT	35	
TOTAL:					35 30	EA

622(17) BIKE RACK ✓

SHEET	STATION	OFFSET	QUANTITY (EA)	REMARKS
G9	1396+49	69' RT	1	
G9	1396+33	69' RT	1	
TOTAL:			2	EA

622(18) INTERPRETIVE SIGN SUPPORT - TYPE MASONRY ✓

SHEET	STATION	OFFSET	QUANTITY (EA)	REMARKS
G9	1394+97	176' RT	1	WAYSIDE PARKING AREA
G9	1396+50	150' RT	1	WAYSIDE PARKING AREA
G9	1396+66	109' RT	1	WAYSIDE PARKING AREA
G9	1396+80	94' RT	1	WAYSIDE PARKING AREA
TOTAL:			4	EA

622(19) CMU BLOCK WALL ✓

SHEET	FROM STATION	TO STATION	LENGTH (LF)	REMARKS
G9	1393+70	1396+85	545	WAYSIDE PARKING AREA
TOTAL:			545 550	LF

618(1) SEEDING ✓

SHEET	FROM STATION	TO STATION	OFFSET	AREA (ACRE)	REMARKS
F1-F2	1390+45	1398+24	LT	3.25	
F1-F2	1390+49	1398+24	RT	3.04	
F1-F2	1402+04	1413+80	LT	0.54	
F2	1402+04	1413+80	RT	1.28	
TOTAL:				8.11 3.6	ACRE

629(1) GUARDRAIL PAVING ✓

SHEET	FROM STATION	TO STATION	OFFSET	LENGTH (LF)	REMARKS
F1	1390+45	1394+35	RT	390	
F1	1395+81	1397+05	RT	124	
F1	1396+06	1397+05	LT	99	
F2	1402+02	1405+91	LT	389	
F2	1402+02	1403+90	RT	188	
F2-F3	1404+78	1413+80	RT	902	
TOTAL:				2,092 2,207	EA

620(1) TOPSOIL ✓

SHEET	FROM STATION	TO STATION	OFFSET	AREA (SY)	REMARKS
F1-F2	1390+45	1398+24	LT	15,709	
F1-F2	1390+49	1398+24	RT	14,691	
F1-F2	1402+04	1413+80	LT	2,613	
F2	1402+04	1413+80	RT	6,189	
TOTAL:				39,202 13,225	SY

642(4) SET PRIMARY MONUMENT ✓

SHEET	STATION	OFFSET	QUANTITY (EA)	REMARKS
F1	1394+75.83	104.13' RT	1	POINT #1007
F2	1400+80.78	71.43' RT	1	POINT #1006
TOTAL:			2	EA

642(8) ADJUST EXISTING MONUMENT

SHEET	STATION	OFFSET	QUANTITY (EA)	REMARKS
F1	1391+64.57	0.04' LT	1	POINT #1008
TOTAL:			1	EA

642(10) MONUMENT CASE

SHEET	STATION	OFFSET	QUANTITY (EA)	REMARKS
F1	1394+75.83	104.13' RT	1	POINT #1007
F2	1400+80.78	71.43' RT	1	POINT #1006
TOTAL:			2	EA

622(15) BENCH ✓

SHEET	STATION	OFFSET	QUANTITY (EA)	REMARKS
G9	1394+47	173' RT	1	WAYSIDE PARKING AREA
G9	1395+46	176' RT	1	WAYSIDE PARKING AREA
G9	1396+37	145' RT	1	WAYSIDE PARKING AREA
G9	1396+49	83' RT	1	WAYSIDE PARKING AREA
G9	1396+58	99' RT	1	WAYSIDE PARKING AREA
TOTAL:			5	EA

670(1) PAINTED TRAFFIC MARKINGS

SHEET	FROM STATION	TO STATION	OFFSET	TYPE	LENGTH (MI)	AREA (SF)	QUANTITY (EA)	REMARKS
H1	1390+45	1413+80	LT	4" W	0.44	---	---	EDGE OF TRAVELED WAY
H1	1390+45	1413+80	CL	2 - 4" Y	0.44	---	---	DOUBLE STRIPE CENTERLINE
H1	1390+45	1413+80	RT	4" W	0.44	---	---	EDGE OF TRAVELED WAY
H1	---	---	RT	4" W	0.15	---	---	PARKING AREA
H1	---	---	RT	4" B	0.02	---	---	HANDICAP SYMBOL
H1	1395+33	1395+65	RT	24" W	---	66	---	STOP BAR
H1	1396+01	1396+32	RT	24" W	---	62	---	CROSSWALK/STOP BAR
H1	1396+01	1396+33	RT	24" W	---	62	---	CROSSWALK/STOP BAR
H1	1395+57	---	RT	---	---	---	1	HANDICAP SYMBOL
H1	1395+75	---	RT	---	---	---	1	HANDICAP SYMBOL
TOTAL:					1.49	190	2	

670(8) RECESSED PAVEMENT MARKER ✓

SHEET	STATION	OFFSET	QUANTITY (EA)	REMARKS
H1	1390+69	CL	1	
H1	1391+49	CL	1	
H1	1392+29	CL	1	
H1	1393+09	CL	1	
H1	1393+89	CL	1	
H1	1394+29	CL	1	
H1	1394+69	CL	1	
H1	1395+09	CL	1	
H1	1395+57	CL	1	
H1	1395+97	CL	1	
H1	1396+37	CL	1	
H1	1396+77	CL	1	
H1	1397+57	CL	1	
H1	1398+37	CL	1	
H1	1399+17	CL	1	
H1	1399+97	CL	1	
H1	1400+47	CL	1	
H1	1400+87	CL	1	
H1	1401+27	CL	1	
H1	1401+67	CL	1	
H1	1402+07	CL	1	
H1	1402+47	CL	1	
H1	1402+87	CL	1	
H1	1403+27	CL	1	
H1	1403+67	CL	1	
H1	1404+07	CL	1	
H1	1404+47	CL	1	
H1	1404+87	CL	1	
H1	1405+27	CL	1	
H1	1405+67	CL	1	
H1	1406+07	CL	1	
H1	1406+47	CL	1	
H1	1406+87	CL	1	
H1	1407+27	CL	1	
H1	1407+67	CL	1	
H1	1408+07	CL	1	
H1	1408+47	CL	1	
H1	1408+87	CL	1	
H1	1409+27	CL	1	
H1	1409+67	CL	1	
H1	1410+07	CL	1	
H1	1410+47	CL	1	
H1	1410+87	CL	1	
H1	1411+27	CL	1	
H1	1412+07	CL	1	
H1	1412+47	CL	1	
H1	1412+87	CL	1	
H1	1413+27	CL	1	
H1	1413+67	CL	1	
TOTAL:			49	EA

Handwritten: 6/9/20

PLANS DEVELOPED BY:
 DOWL
 5368 COMMERCIAL BLVD,
 JUNEAU, AK 99801
 (907) 780-3533
 #AECL848




STATE OF ALASKA
 DEPARTMENT OF TRANSPORTATION
 AND PUBLIC FACILITIES
**SKAGWAY - REPLACE CAPTAIN
 WILLIAM HENRY MOORE BRIDGE**

SUMMARY TABLES


FILE: C:\Civ11\30 Projects\24\70732-01\Civ11\SA14-CT-E-DT-CRHM.dwg
 DATE: 8/16/2016 16:27 LAYOUT: E1
 DESIGNED: HOBBS
 CHECKED: NOBLE
 DRAFTED: WESTPHAL

NO.	DATE	REVISION	STATE	PROJECT DESIGNATION	YEAR	SHEET NO.	TOTAL SHEETS
			ALASKA	0972016/Z684590000	2016	E1	59

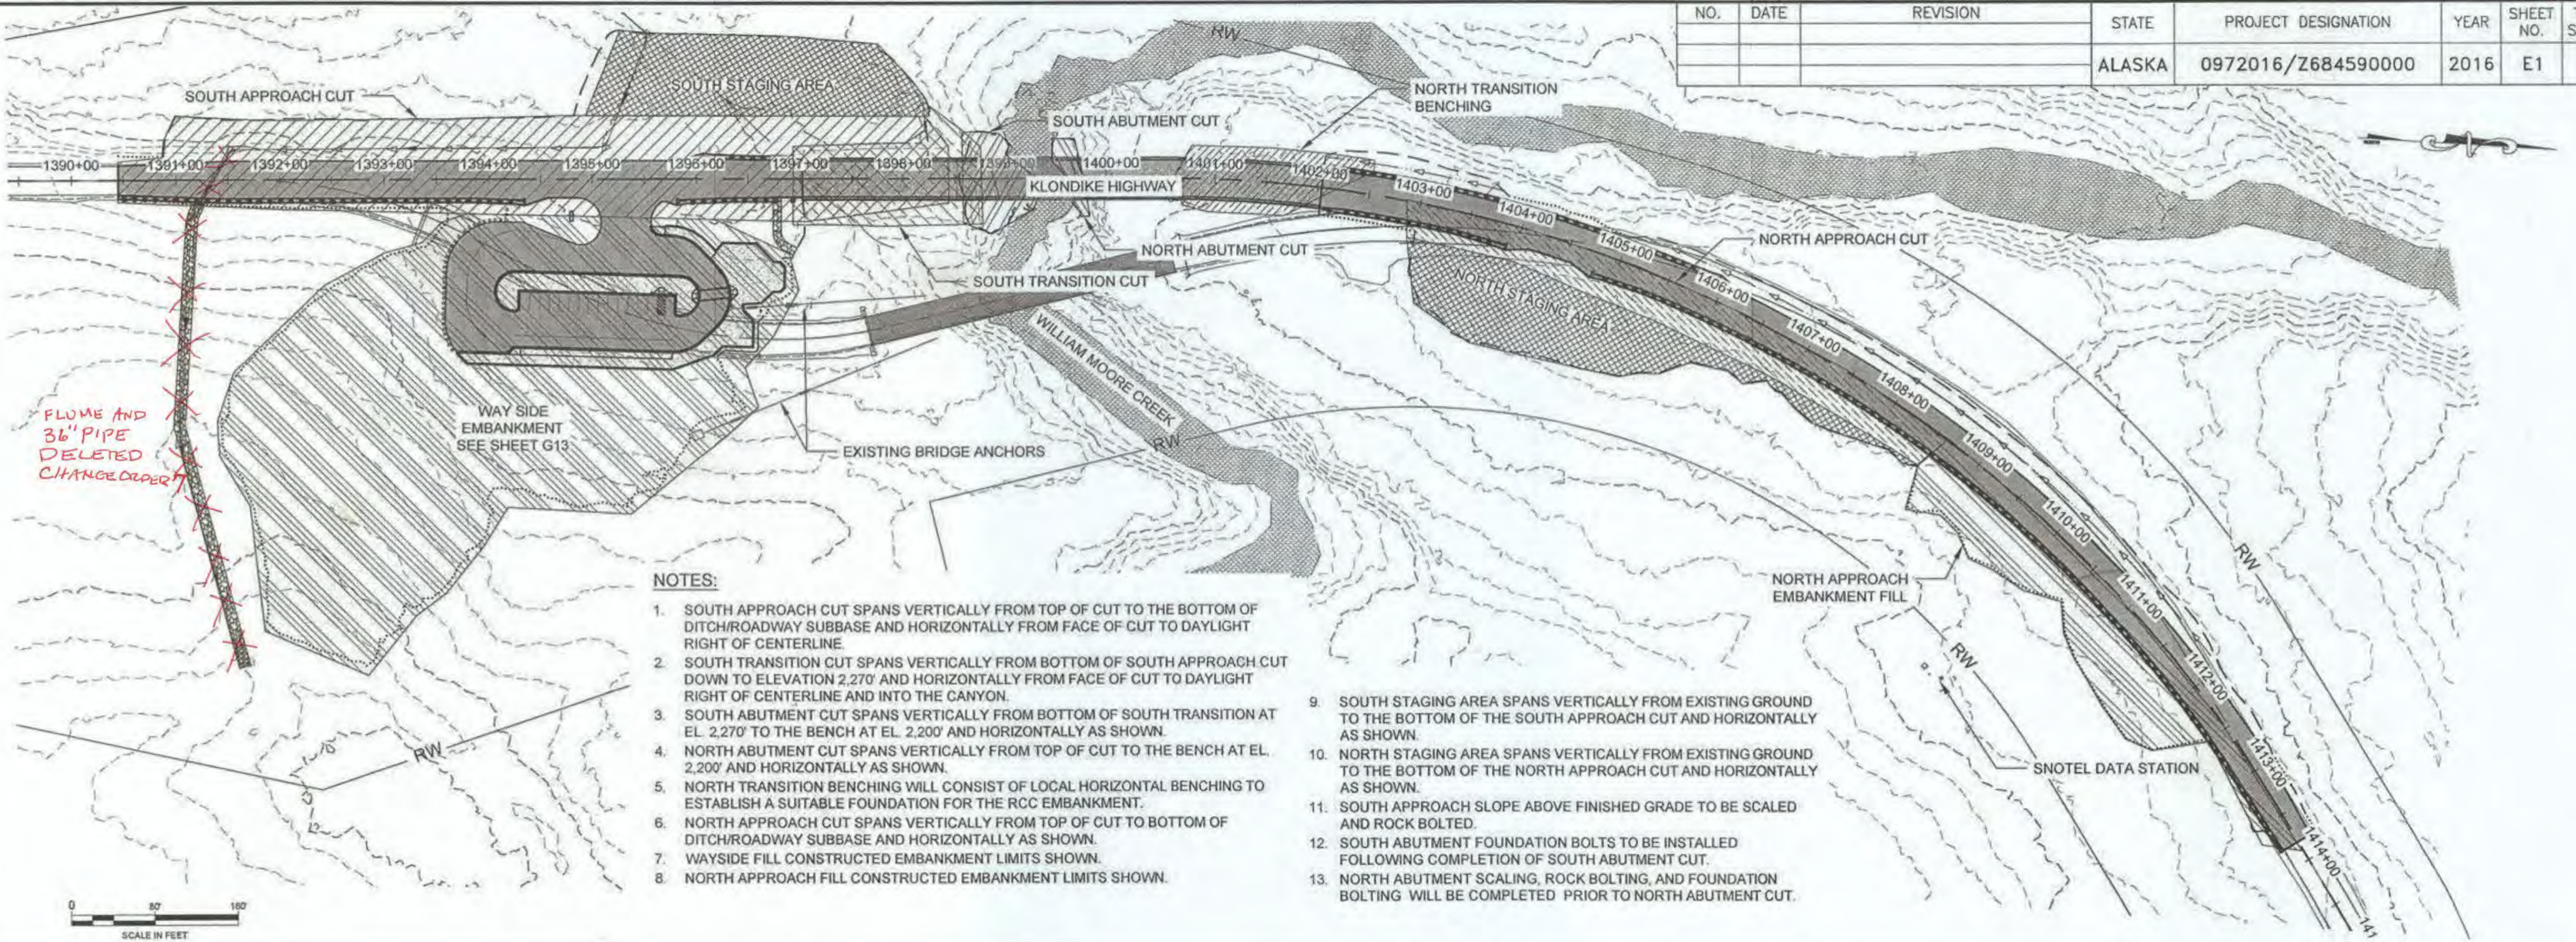

NOTES:

1. SOUTH APPROACH CUT SPANS VERTICALLY FROM TOP OF CUT TO THE BOTTOM OF DITCH/ROADWAY SUBBASE AND HORIZONTALLY FROM FACE OF CUT TO DAYLIGHT RIGHT OF CENTERLINE.
2. SOUTH TRANSITION CUT SPANS VERTICALLY FROM BOTTOM OF SOUTH APPROACH CUT DOWN TO ELEVATION 2.270' AND HORIZONTALLY FROM FACE OF CUT TO DAYLIGHT RIGHT OF CENTERLINE AND INTO THE CANYON.
3. SOUTH ABUTMENT CUT SPANS VERTICALLY FROM BOTTOM OF SOUTH TRANSITION AT EL. 2.270' TO THE BENCH AT EL. 2.200' AND HORIZONTALLY AS SHOWN.
4. NORTH ABUTMENT CUT SPANS VERTICALLY FROM TOP OF CUT TO THE BENCH AT EL. 2.200' AND HORIZONTALLY AS SHOWN.
5. NORTH TRANSITION BENCHING WILL CONSIST OF LOCAL HORIZONTAL BENCHING TO ESTABLISH A SUITABLE FOUNDATION FOR THE RCC EMBANKMENT.
6. NORTH APPROACH CUT SPANS VERTICALLY FROM TOP OF CUT TO BOTTOM OF DITCH/ROADWAY SUBBASE AND HORIZONTALLY AS SHOWN.
7. WAYSIDE FILL CONSTRUCTED EMBANKMENT LIMITS SHOWN.
8. NORTH APPROACH FILL CONSTRUCTED EMBANKMENT LIMITS SHOWN.
9. SOUTH STAGING AREA SPANS VERTICALLY FROM EXISTING GROUND TO THE BOTTOM OF THE SOUTH APPROACH CUT AND HORIZONTALLY AS SHOWN.
10. NORTH STAGING AREA SPANS VERTICALLY FROM EXISTING GROUND TO THE BOTTOM OF THE NORTH APPROACH CUT AND HORIZONTALLY AS SHOWN.
11. SOUTH APPROACH SLOPE ABOVE FINISHED GRADE TO BE SCALED AND ROCK BOLTED.
12. SOUTH ABUTMENT FOUNDATION BOLTS TO BE INSTALLED FOLLOWING COMPLETION OF SOUTH ABUTMENT CUT.
13. NORTH ABUTMENT SCALING, ROCK BOLTING, AND FOUNDATION BOLTING WILL BE COMPLETED PRIOR TO NORTH ABUTMENT CUT.

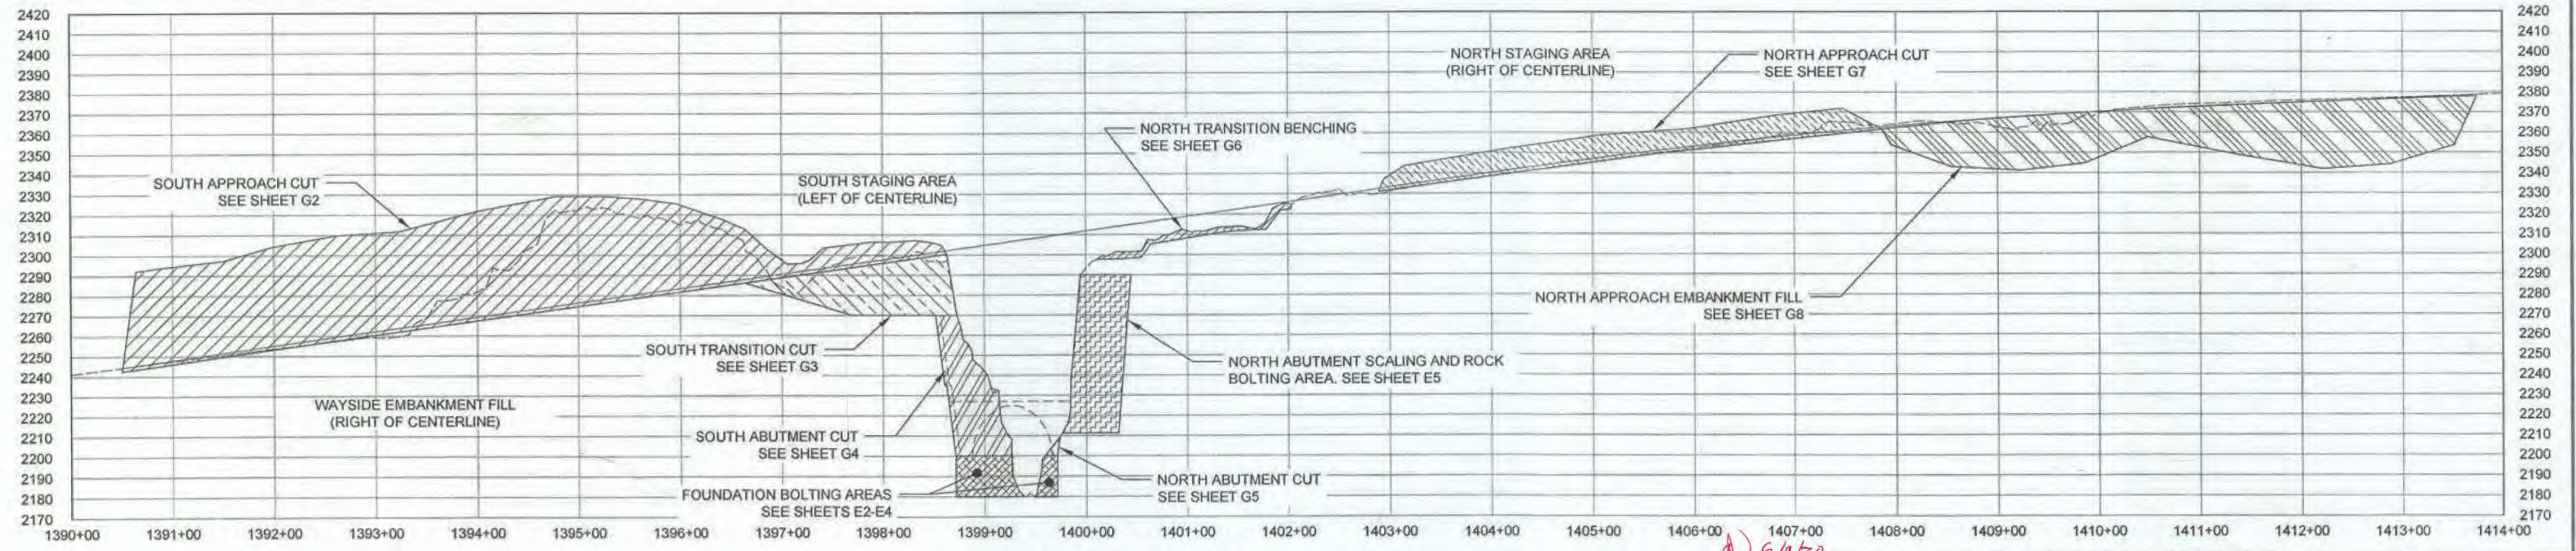

1 PAY LIMIT DIAGRAM PLAN AND PROFILE

NTS

PLANS DEVELOPED BY:
 DOWL
 5368 COMMERCIAL BLVD.
 JUNEAU, AK 99801
 (907) 780-3533
 #AECCL848





8-17-2016

STATE OF ALASKA
 DEPARTMENT OF TRANSPORTATION
 AND PUBLIC FACILITIES
**SKAGWAY - REPLACE CAPTAIN
 WILLIAM HENRY MOORE BRIDGE**


PAY LIMIT PLAN DIAGRAM

FILE: C:\Civ\1_30\Projects\24\70732-01\Civil\SA14-CT-E-DT-CWHM.dwg DATE: 8/12/2016 10:39 LAYOUT: E2 DESIGNED: HOBBS CHECKED: NOBLE DRAFTED: WESTPHAL

NO.	DATE	REVISION	STATE	PROJECT DESIGNATION	YEAR	SHEET NO.	TOTAL SHEETS
			ALASKA	0972016/Z684590000	2016	E2	59

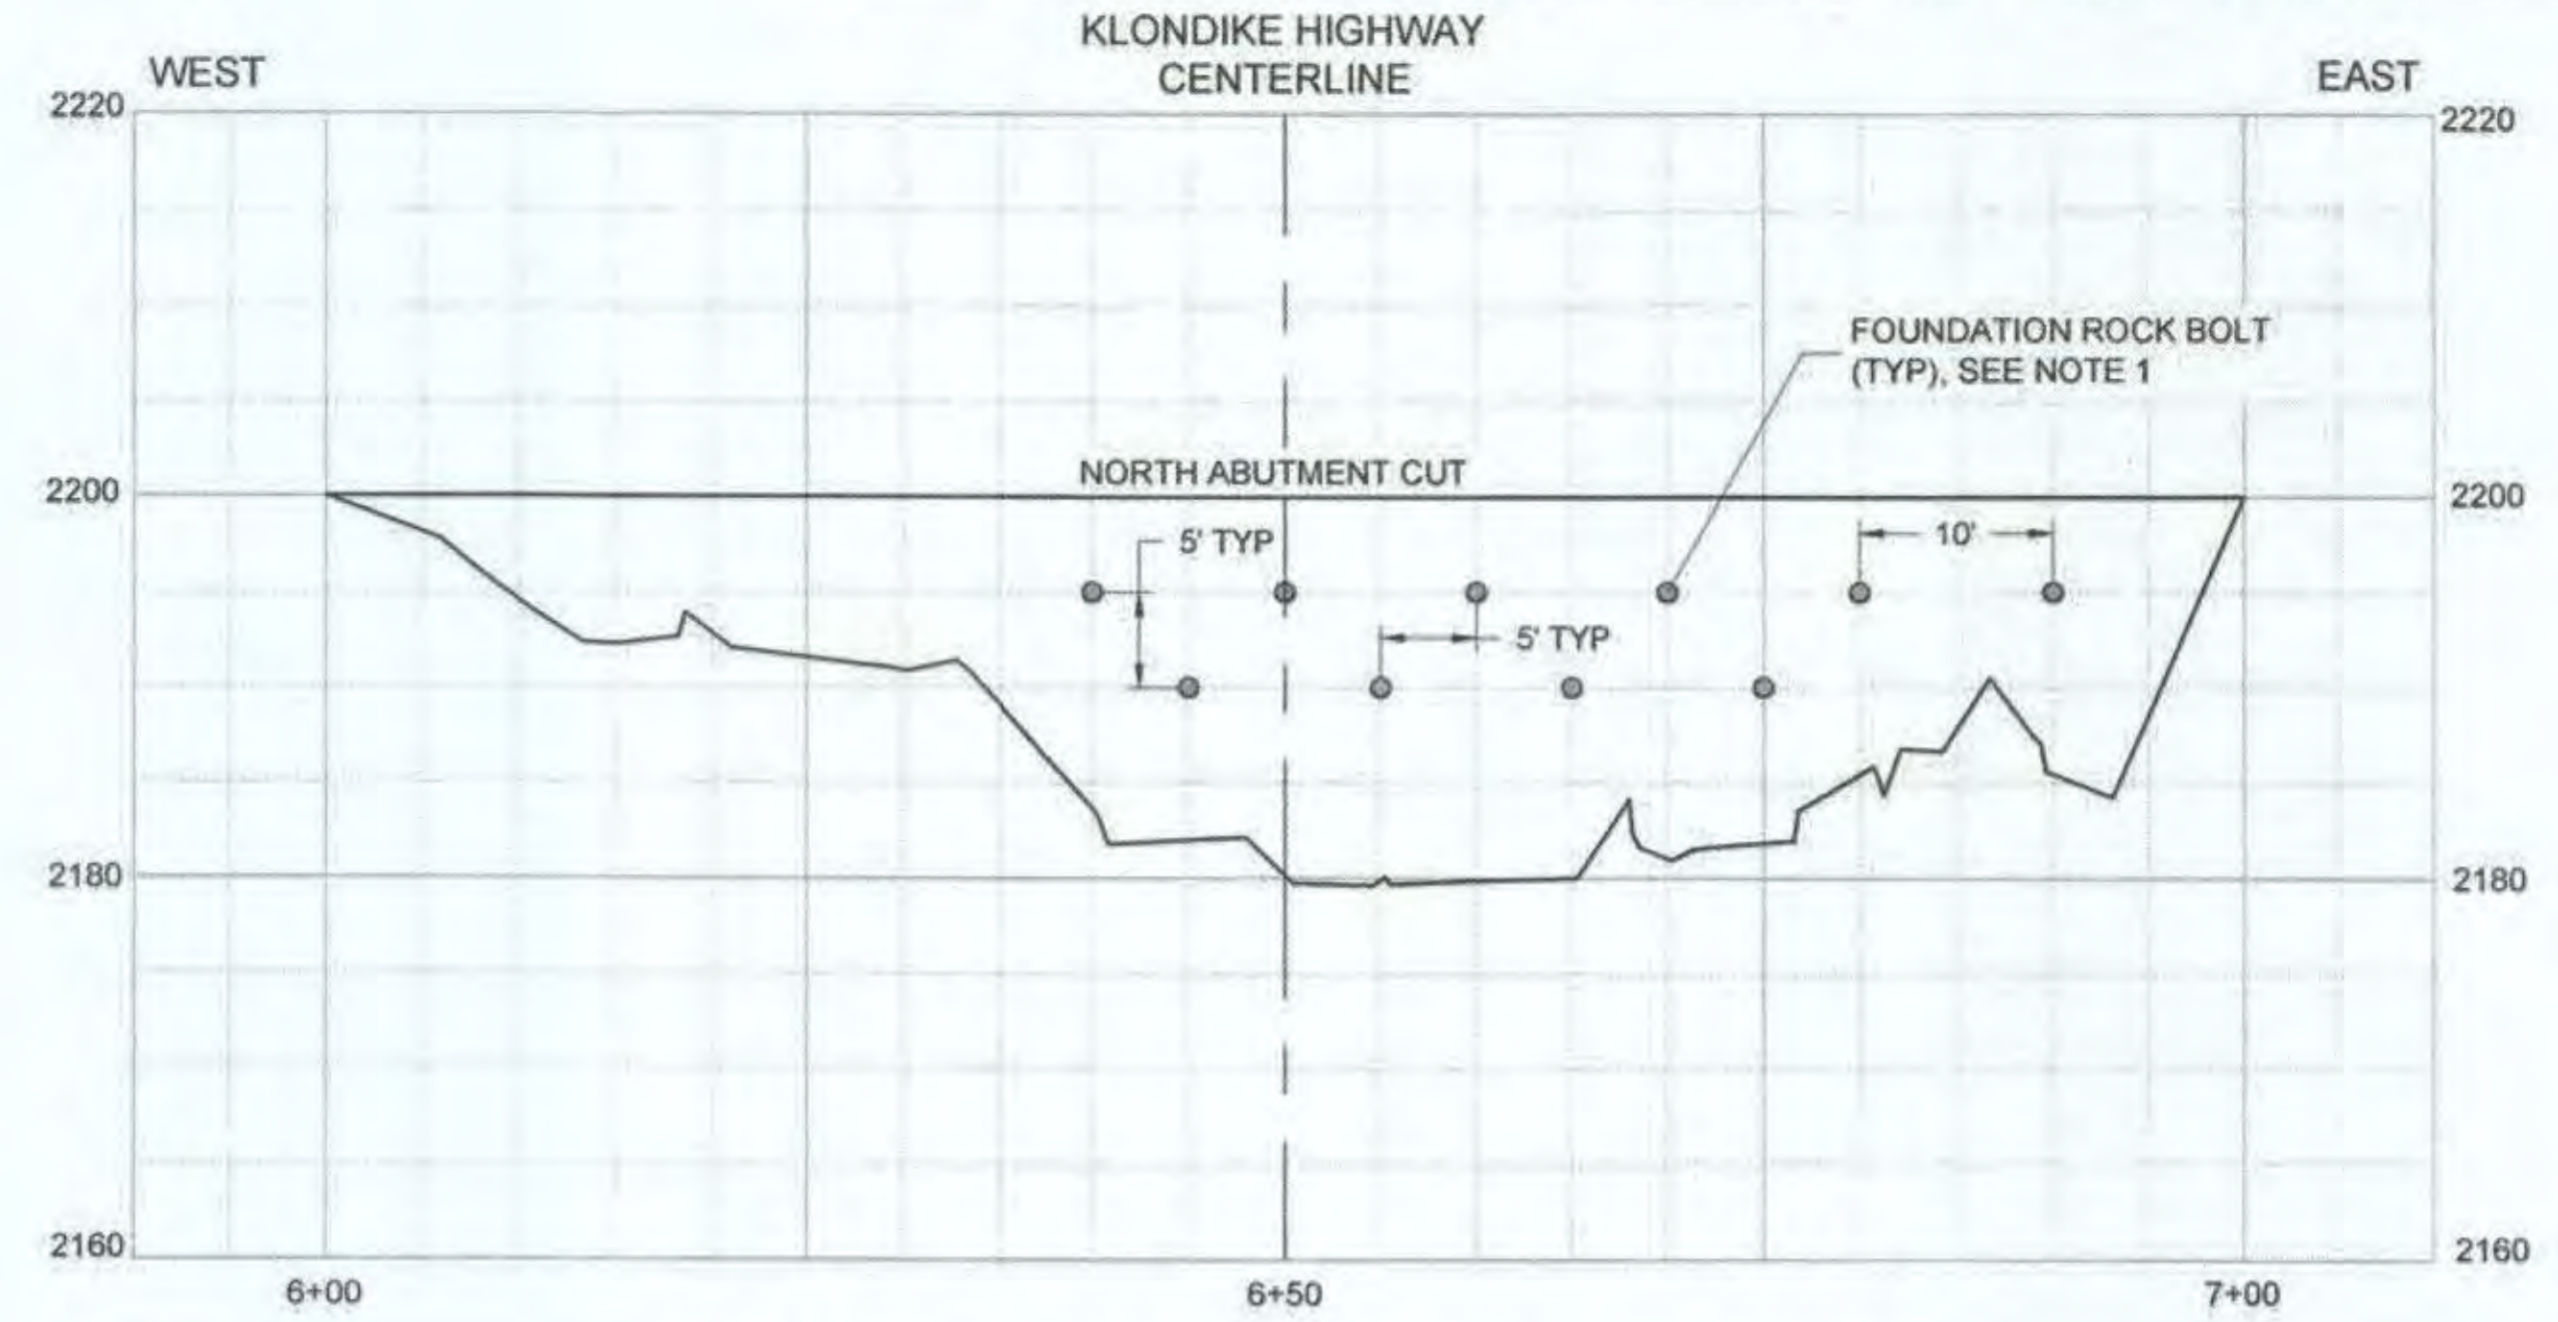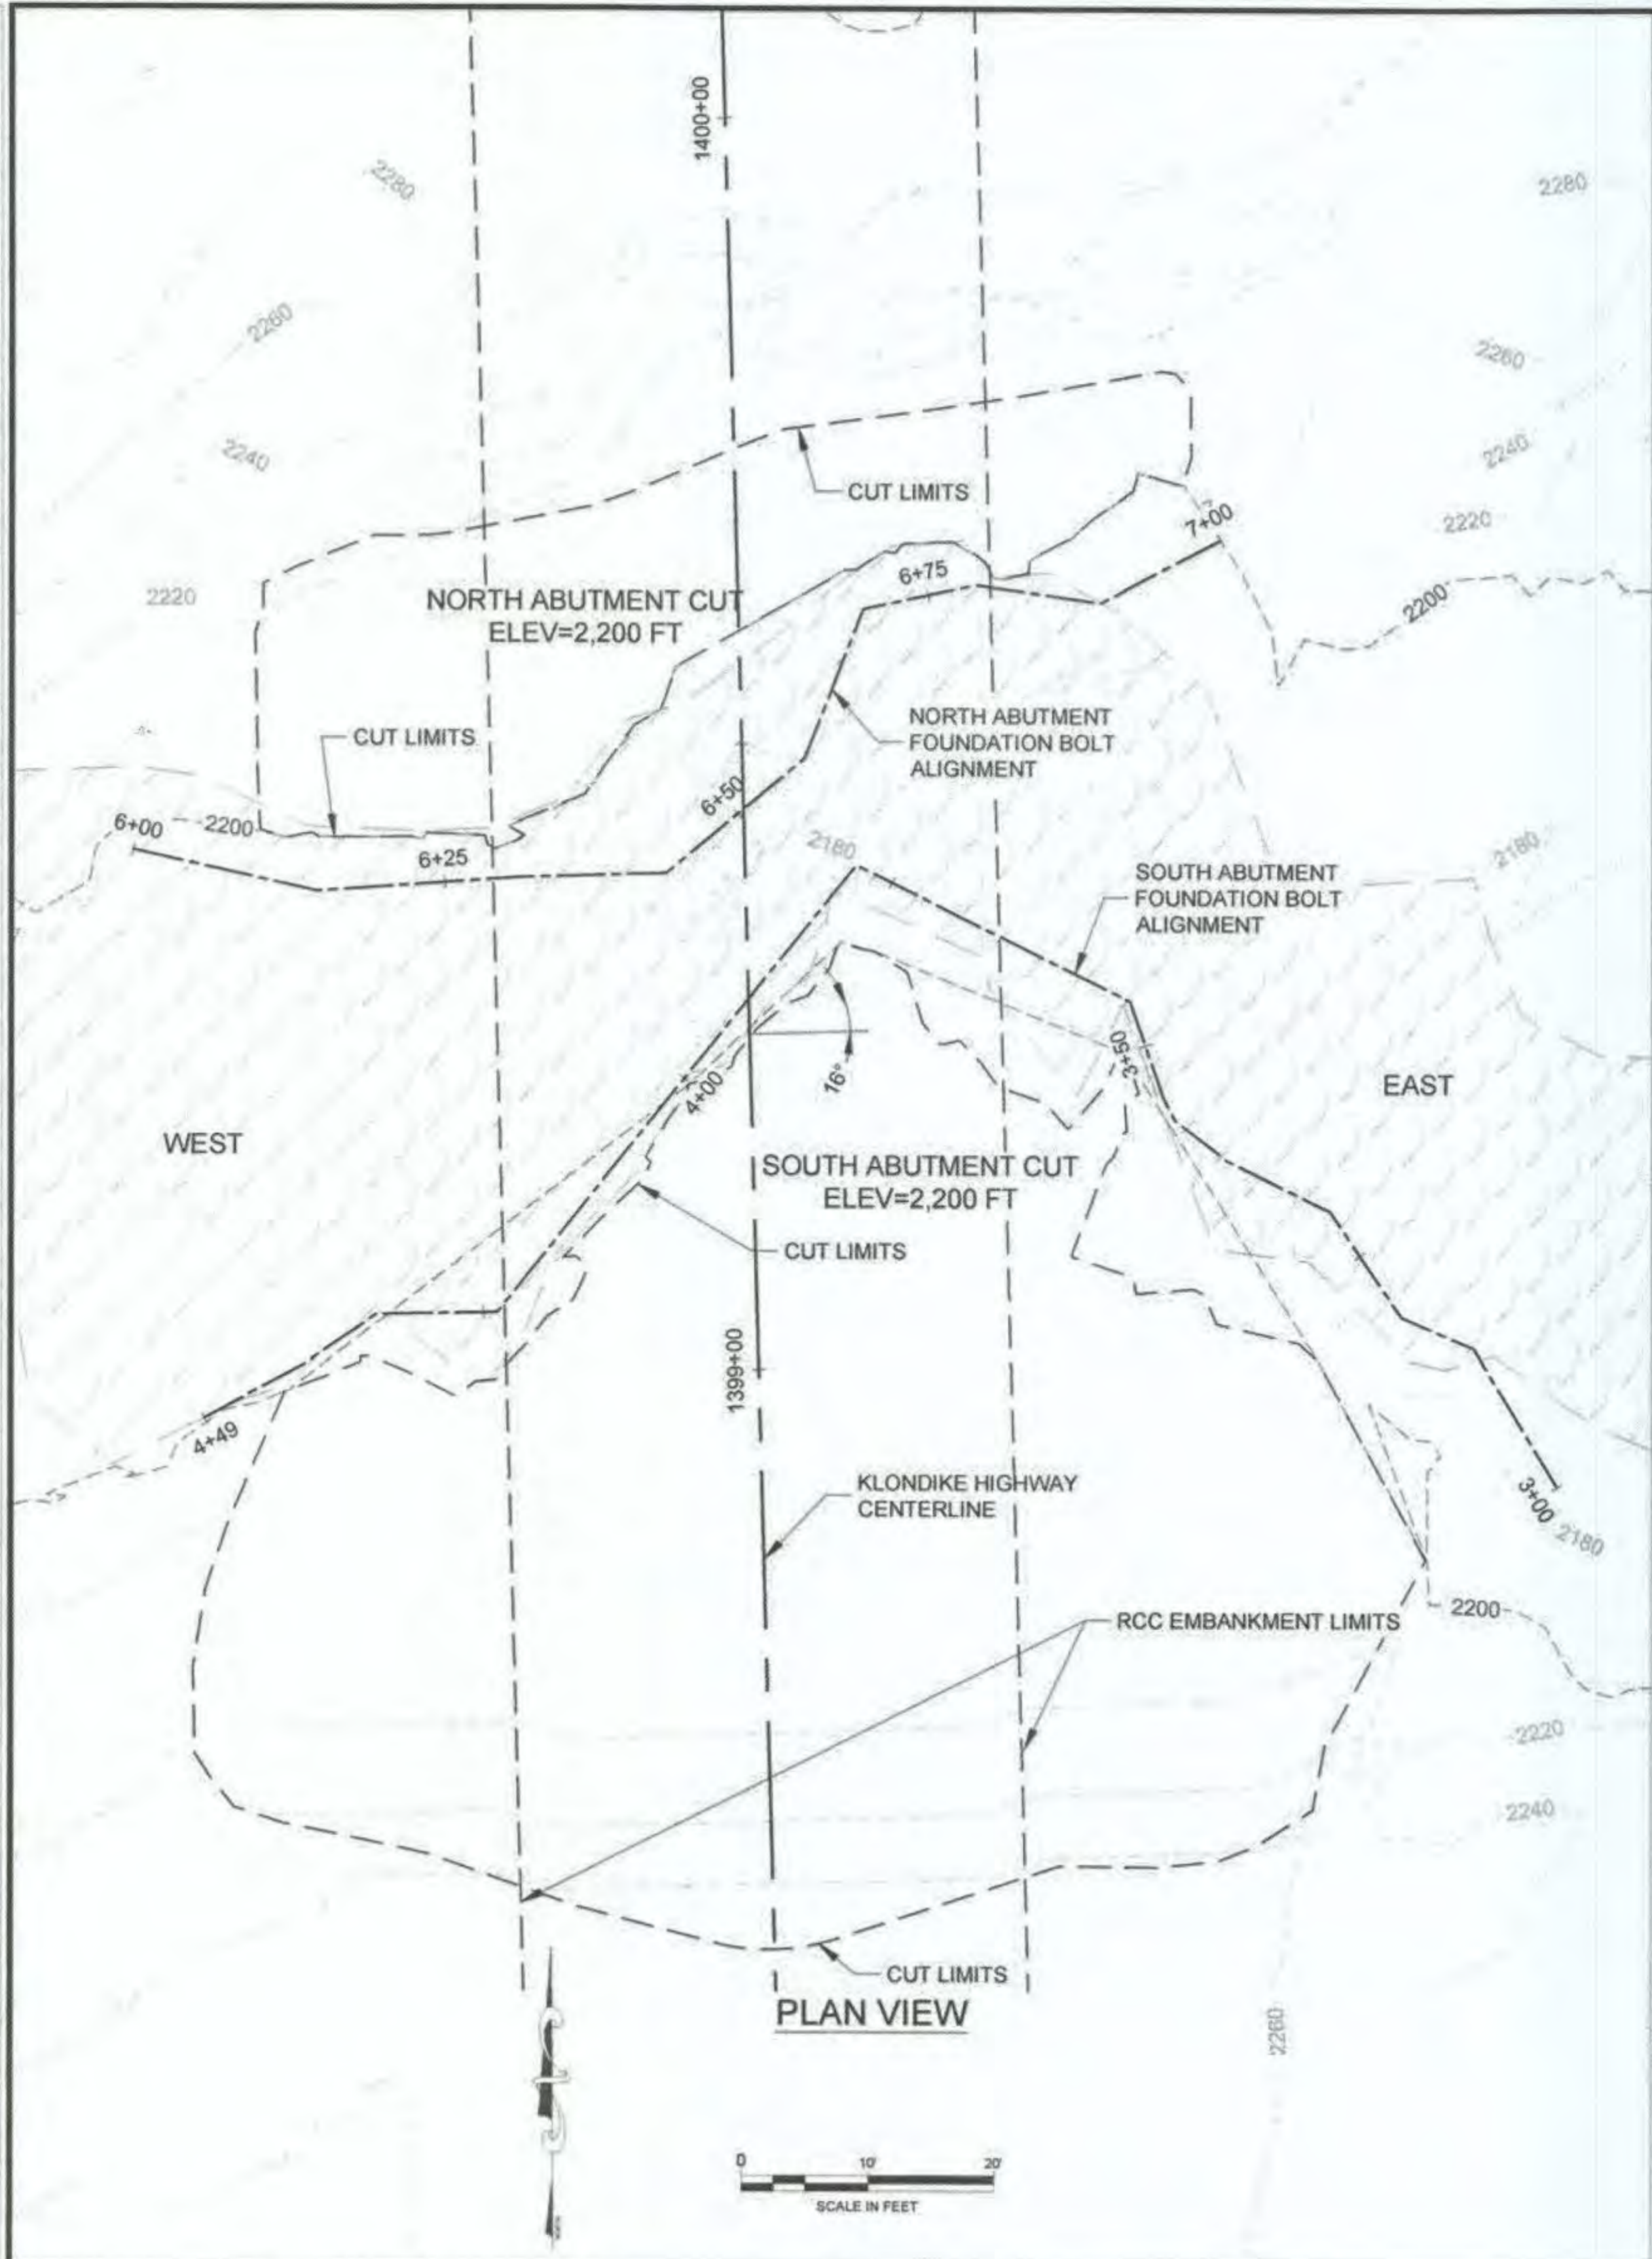

NORTH ABUTMENT FOUNDATION BOLT PROFILE

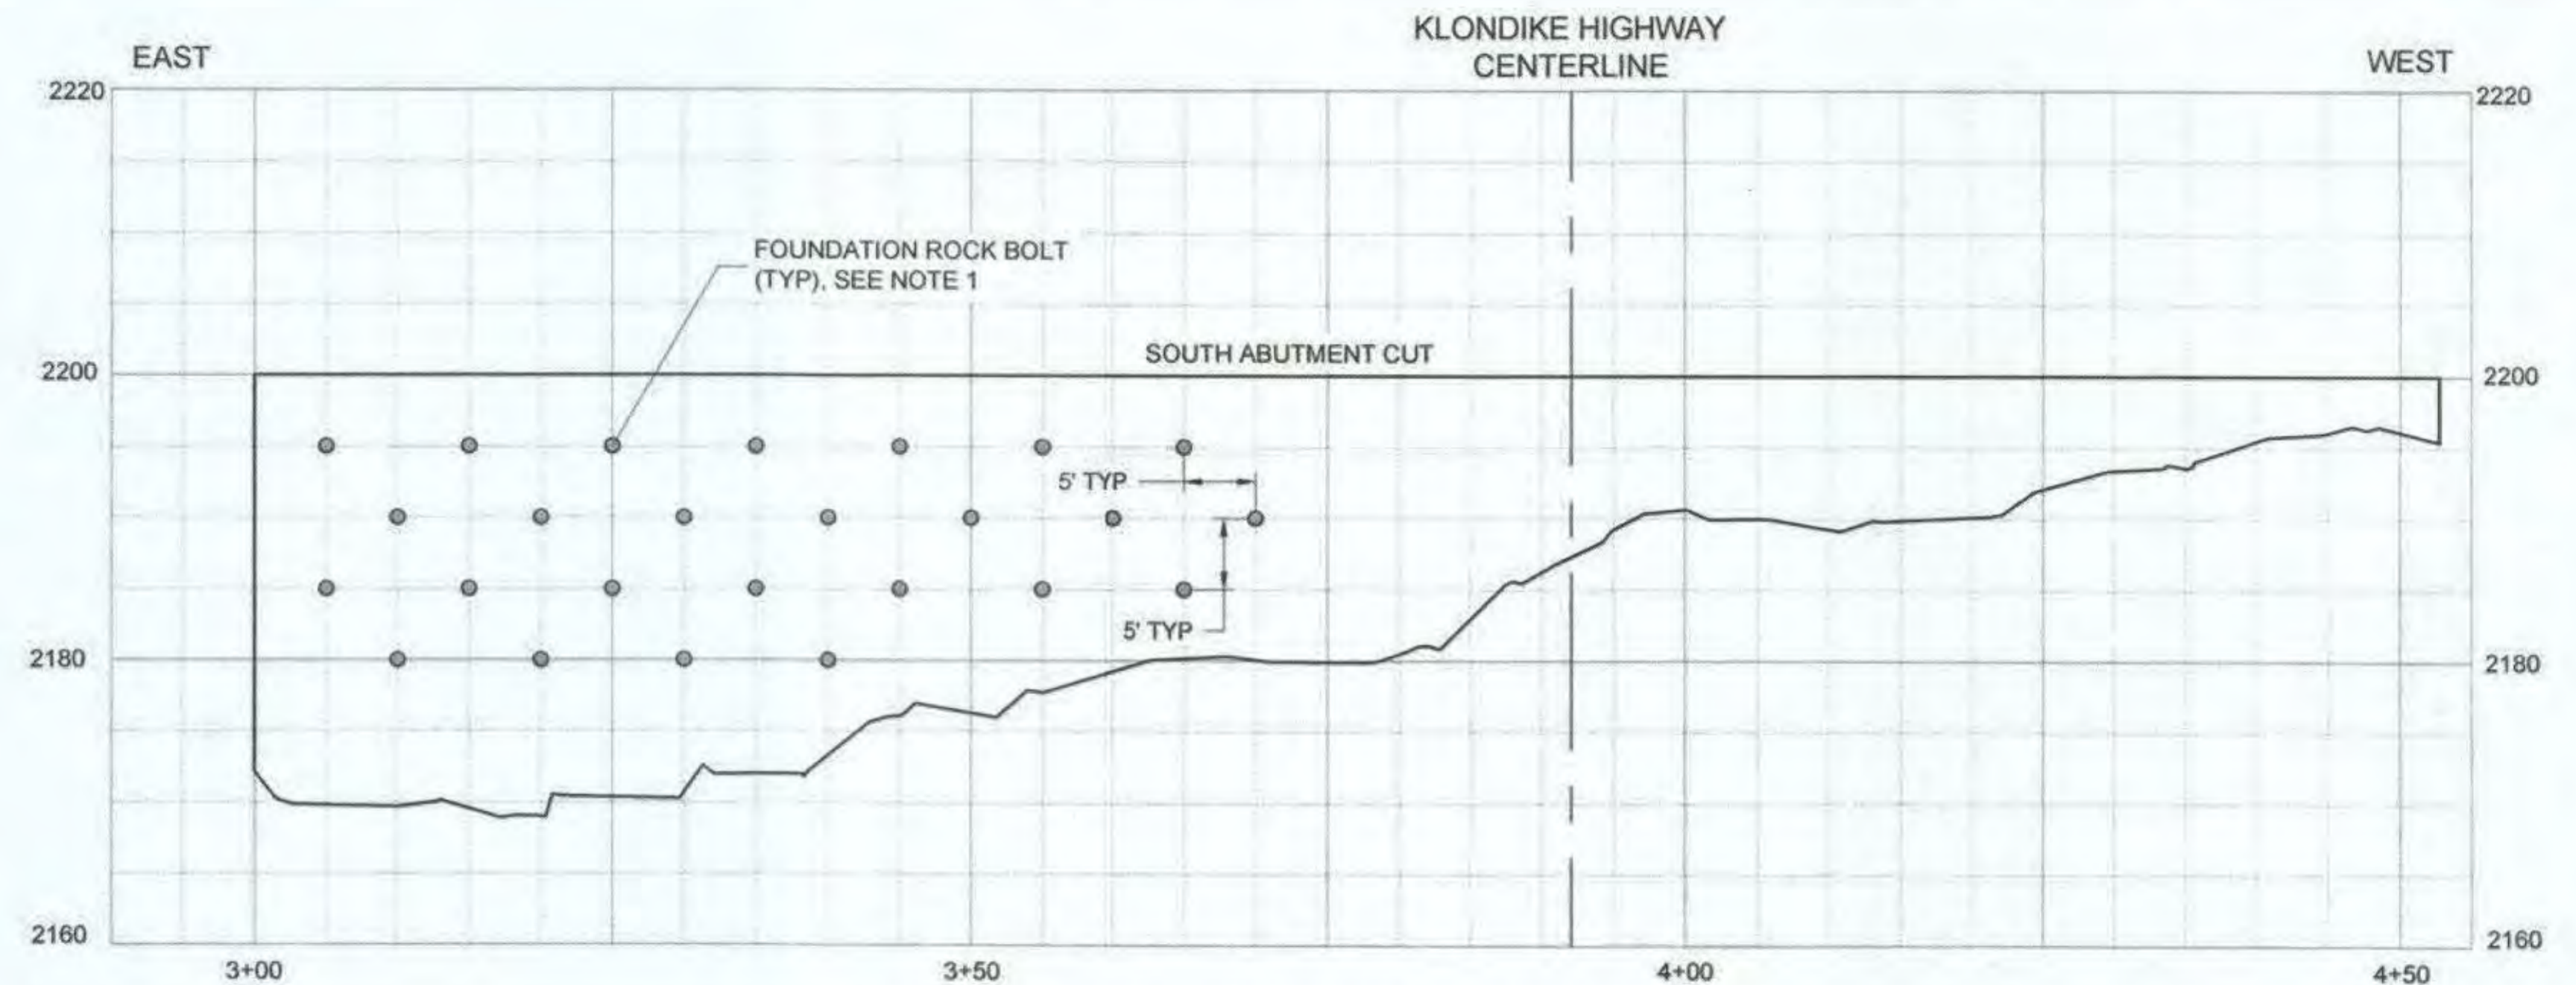

SOUTH ABUTMENT FOUNDATION BOLT PROFILE

- TEMPORARY STABILIZATION NOTES:**
- LOCATE REINFORCING ROCK BOLTS WITHIN 18 INCHES OF THE LOCATIONS SHOWN ON THE 5-FT BY 5-FT PATTERN. LARGER ADJUSTMENTS MAY BE PROPOSED, BUT REQUIRE APPROVAL BY THE ENGINEER TO ASSURE THE STABILIZATION PATTERN MEETS REQUIRED REINFORCEMENT.
 - SEE DETAIL 1 AND 2, SHEET E6 FOR FOUNDATION ROCK BOLT DETAIL.

1 FOUNDATION ROCK BOLT PLAN AND PROFILE

SCALE AS NOTED

PLANS DEVELOPED BY:
LANDSLIDE TECHNOLOGY
10250 SW GREENBURG RD,
SUITE 111,
PORTLAND, OR 97223
(503) 452-1200
#AEC777



STATE OF ALASKA
DEPARTMENT OF TRANSPORTATION
AND PUBLIC FACILITIES
**SKAGWAY - REPLACE CAPTAIN
WILLIAM HENRY MOORE BRIDGE**
FOUNDATION BOLT PLAN DETAILS

Handwritten: 6/9/20

FILE: C:\Users\j... Projects\24\70725-01\AGI\1\AS14-01-E3-01-000.dwg DATE: 8/12/2016 11:30 LAYOUT: E3 DESIGNED: HBSG CHECKED: M/BLB DRAWN: WESTPHAL

NO.	DATE	REVISION	STATE	PROJECT DESIGNATION	YEAR	SHEET NO.	TOTAL SHEETS
			ALASKA	0972016/Z684590000	2016	E3	59

- SOUTH ABUTMENT FOUNDATION ROCK BOLTING NOTES:**
- FOUNDATION ROCK BOLT LOCATIONS SHOWN ON SHEET E2.
 - FOUNDATION ROCK BOLT LOCATIONS WILL BE ADJUSTED BY THE ENGINEER AFTER THE SOUTH ABUTMENT EXCAVATION IS COMPLETE.



LEGEND
 NORTH ABUTMENT PHOTO LOCATION

6/9/20


<p>PLANS DEVELOPED BY: LANDSLIDE TECHNOLOGY 10250 SW CREEDBURG RD. SUITE 111 PORTLAND, OR 97222 (503) 452-1200 #AEC0777</p>		<p>STATE OF ALASKA DEPARTMENT OF TRANSPORTATION AND PUBLIC FACILITIES</p> <p>SKAGWAY - REPLACE CAPTAIN WILLIAM HENRY MOORE BRIDGE</p> <p>SOUTH ABUTMENT FOUNDATION BOLTING</p>
---	---	--

FILE: C:\A\11 35 Projects\24\2016\01\13\14-CT-E4-01-000.dwg DATE: 8/12/2016 11:52 LAYOUT: 1-4 CHECKED: APRLE DESIGNED: ROBBS DRAFTED: WESTOVER

NO.	DATE	REVISION	STATE	PROJECT DESIGNATION	YEAR	SHEET NO.	TOTAL SHEETS
			ALASKA	0972016/Z684590000	2016	E4	59

NORTH ABUTMENT FOUNDATION ROCK BOLTING NOTES:

1. FOUNDATION ROCK BOLT LOCATIONS SHOWN IN PHOTO ARE APPROXIMATE. REFER TO FOUNDATION ROCK BOLT PLAN ON SHEET E2.
2. FOUNDATION ROCK BOLTS MAY BE ADJUSTED BY THE ENGINEER AFTER SCALING.
3. NORTH ABUTMENT FOUNDATION ROCK BOLTS TO BE INSTALLED AND TENSIONED PRIOR TO NORTH ABUTMENT CUT.

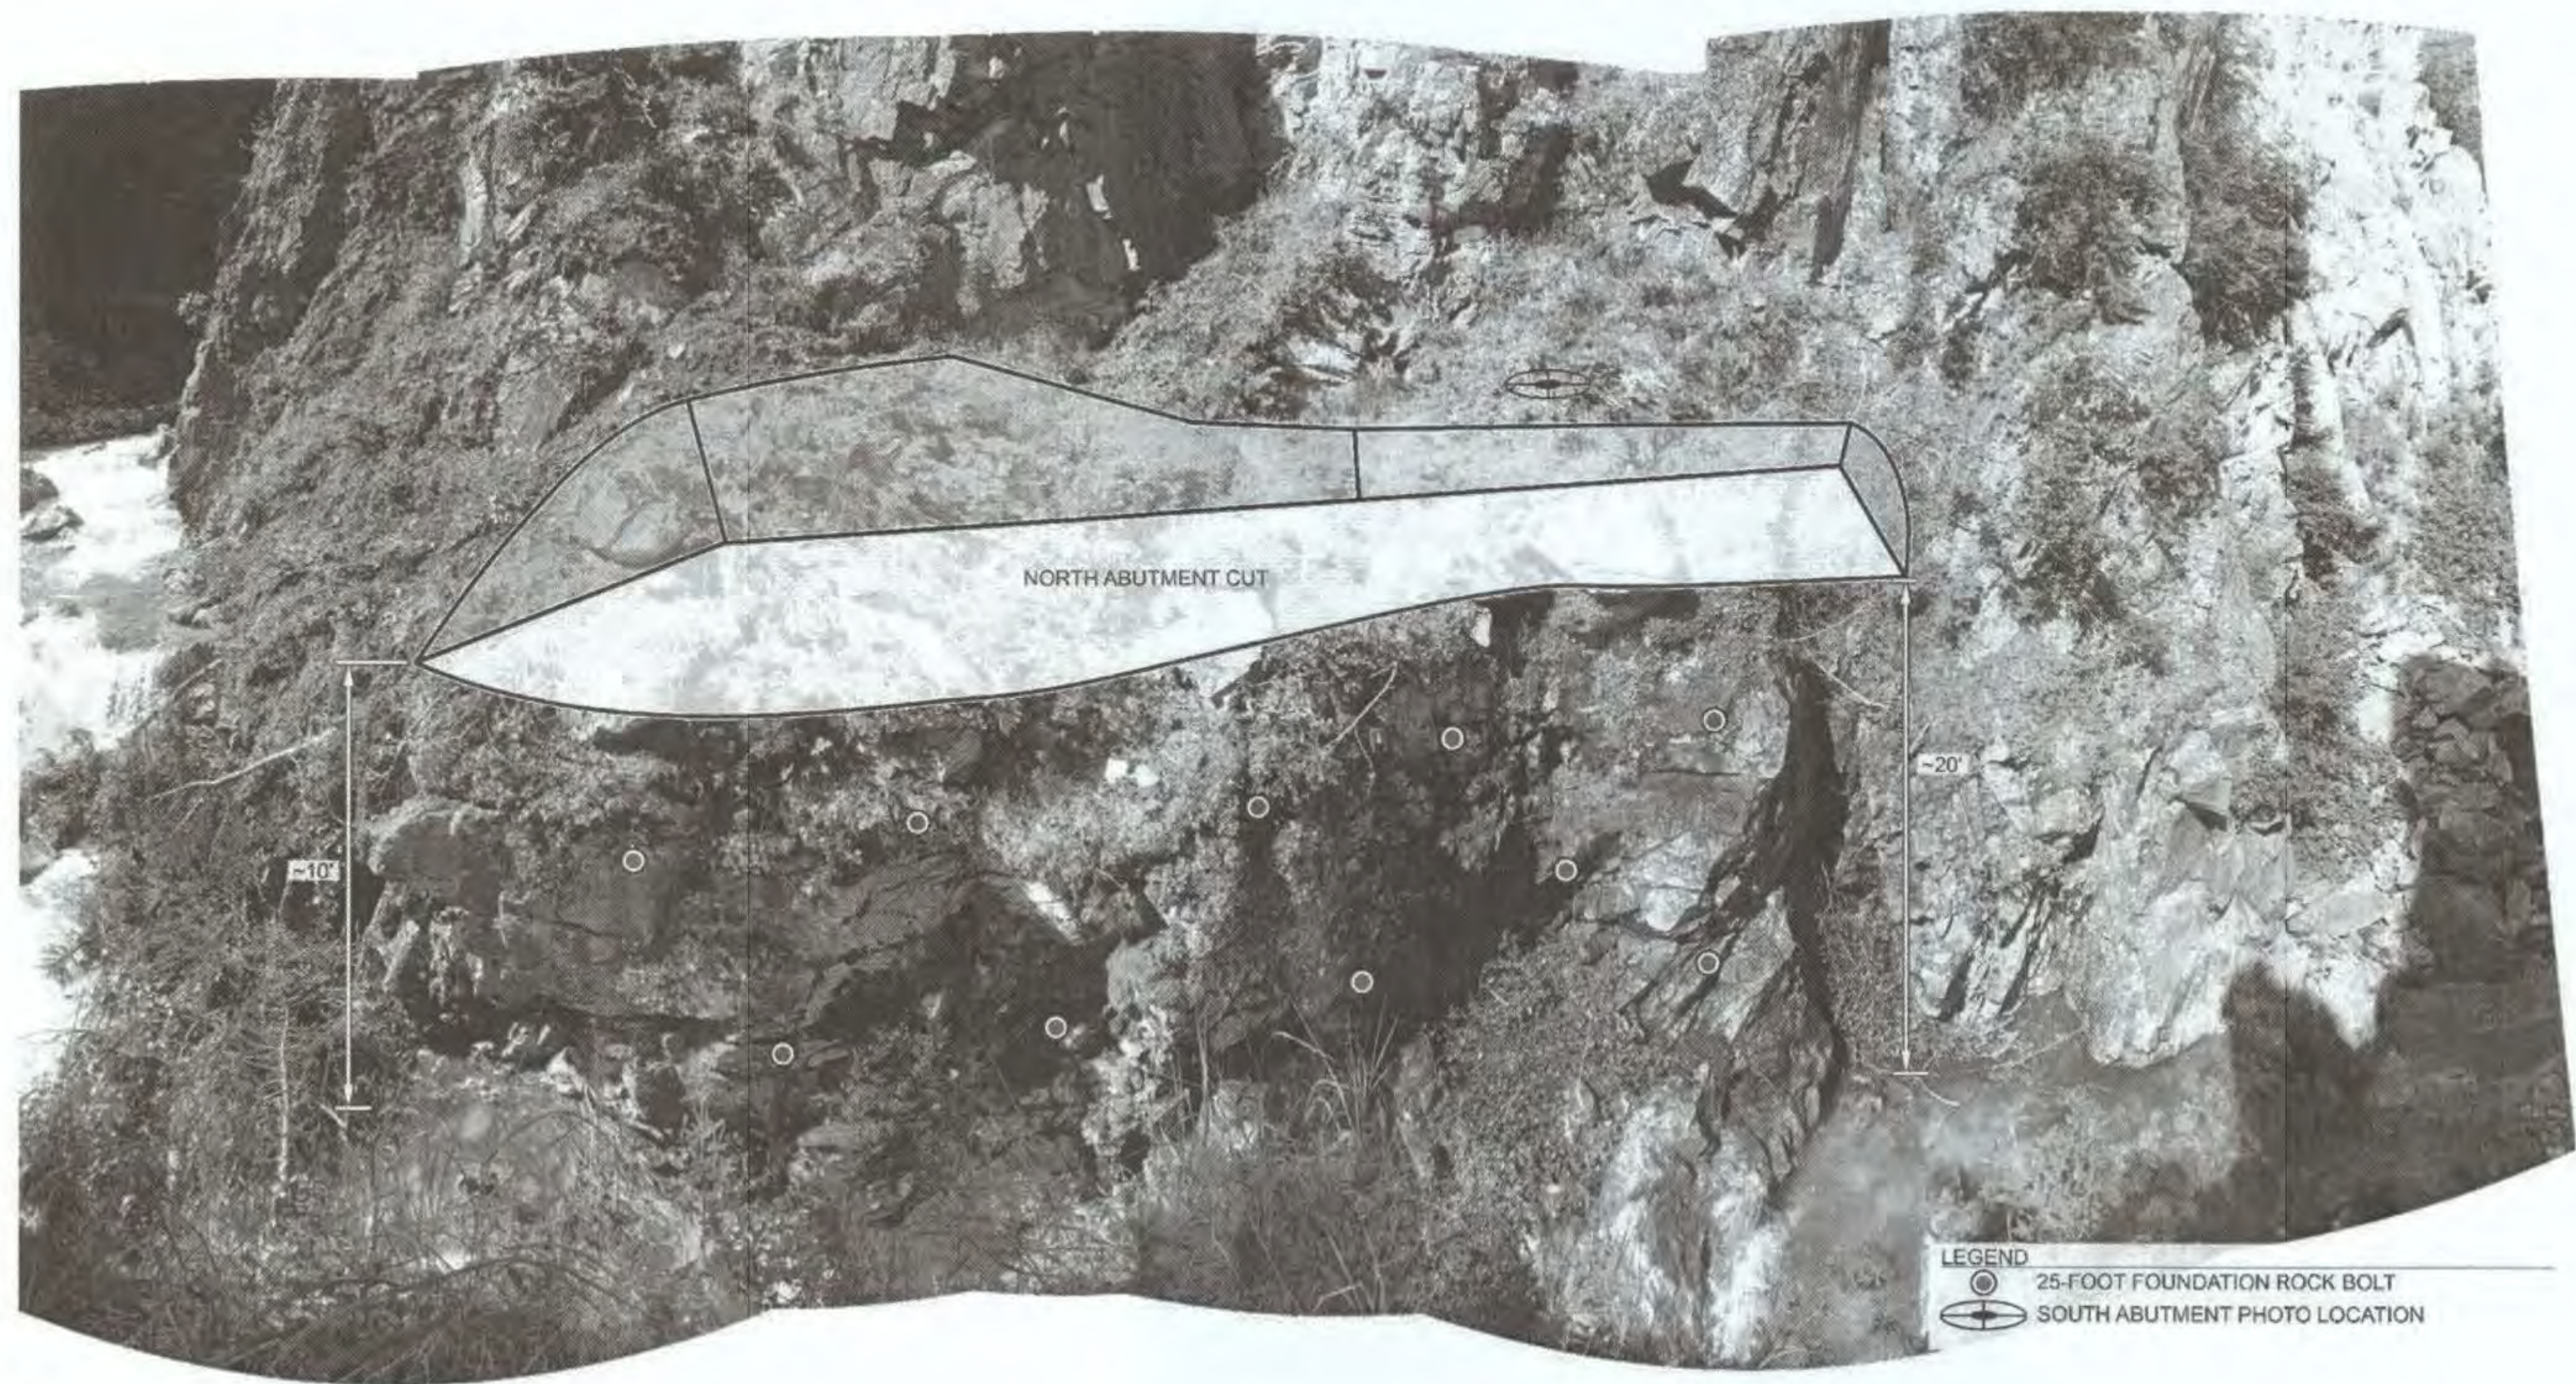

PD 6/9/20

PLANS DEVELOPED BY: LANDSLIDE TECHNOLOGY 10250 SW GREENBURG RD. SUITE 111 PORTLAND, OR 97223 (503) 452-1200 #AEC0777		STATE OF ALASKA DEPARTMENT OF TRANSPORTATION AND PUBLIC FACILITIES SKAGWAY - REPLACE CAPTAIN WILLIAM HENRY MOORE BRIDGE NORTH ABUTMENT FOUNDATION BOLTING
--	--	---

FILE C:\A1111\3D\600\644\2016\01\13\14\15\16\17\18\19\20\21\22\23\24\25\26\27\28\29\30\31\32\33\34\35\36\37\38\39\40\41\42\43\44\45\46\47\48\49\50\51\52\53\54\55\56\57\58\59\60\61\62\63\64\65\66\67\68\69\70\71\72\73\74\75\76\77\78\79\80\81\82\83\84\85\86\87\88\89\90\91\92\93\94\95\96\97\98\99\100\101\102\103\104\105\106\107\108\109\110\111\112\113\114\115\116\117\118\119\120\121\122\123\124\125\126\127\128\129\130\131\132\133\134\135\136\137\138\139\140\141\142\143\144\145\146\147\148\149\150\151\152\153\154\155\156\157\158\159\160\161\162\163\164\165\166\167\168\169\170\171\172\173\174\175\176\177\178\179\180\181\182\183\184\185\186\187\188\189\190\191\192\193\194\195\196\197\198\199\200\201\202\203\204\205\206\207\208\209\210\211\212\213\214\215\216\217\218\219\220\221\222\223\224\225\226\227\228\229\230\231\232\233\234\235\236\237\238\239\240\241\242\243\244\245\246\247\248\249\250\251\252\253\254\255\256\257\258\259\260\261\262\263\264\265\266\267\268\269\270\271\272\273\274\275\276\277\278\279\280\281\282\283\284\285\286\287\288\289\290\291\292\293\294\295\296\297\298\299\300\301\302\303\304\305\306\307\308\309\310\311\312\313\314\315\316\317\318\319\320\321\322\323\324\325\326\327\328\329\330\331\332\333\334\335\336\337\338\339\340\341\342\343\344\345\346\347\348\349\350\351\352\353\354\355\356\357\358\359\360\361\362\363\364\365\366\367\368\369\370\371\372\373\374\375\376\377\378\379\380\381\382\383\384\385\386\387\388\389\390\391\392\393\394\395\396\397\398\399\400\401\402\403\404\405\406\407\408\409\410\411\412\413\414\415\416\417\418\419\420\421\422\423\424\425\426\427\428\429\430\431\432\433\434\435\436\437\438\439\440\441\442\443\444\445\446\447\448\449\450\451\452\453\454\455\456\457\458\459\460\461\462\463\464\465\466\467\468\469\470\471\472\473\474\475\476\477\478\479\480\481\482\483\484\485\486\487\488\489\490\491\492\493\494\495\496\497\498\499\500\501\502\503\504\505\506\507\508\509\510\511\512\513\514\515\516\517\518\519\520\521\522\523\524\525\526\527\528\529\530\531\532\533\534\535\536\537\538\539\540\541\542\543\544\545\546\547\548\549\550\551\552\553\554\555\556\557\558\559\560\561\562\563\564\565\566\567\568\569\570\571\572\573\574\575\576\577\578\579\580\581\582\583\584\585\586\587\588\589\590\591\592\593\594\595\596\597\598\599\600\601\602\603\604\605\606\607\608\609\610\611\612\613\614\615\616\617\618\619\620\621\622\623\624\625\626\627\628\629\630\631\632\633\634\635\636\637\638\639\640\641\642\643\644\645\646\647\648\649\650\651\652\653\654\655\656\657\658\659\660\661\662\663\664\665\666\667\668\669\670\671\672\673\674\675\676\677\678\679\680\681\682\683\684\685\686\687\688\689\690\691\692\693\694\695\696\697\698\699\700\701\702\703\704\705\706\707\708\709\710\711\712\713\714\715\716\717\718\719\720\721\722\723\724\725\726\727\728\729\730\731\732\733\734\735\736\737\738\739\740\741\742\743\744\745\746\747\748\749\750\751\752\753\754\755\756\757\758\759\760\761\762\763\764\765\766\767\768\769\770\771\772\773\774\775\776\777\778\779\780\781\782\783\784\785\786\787\788\789\790\791\792\793\794\795\796\797\798\799\800\801\802\803\804\805\806\807\808\809\810\811\812\813\814\815\816\817\818\819\820\821\822\823\824\825\826\827\828\829\830\831\832\833\834\835\836\837\838\839\840\841\842\843\844\845\846\847\848\849\850\851\852\853\854\855\856\857\858\859\860\861\862\863\864\865\866\867\868\869\870\871\872\873\874\875\876\877\878\879\880\881\882\883\884\885\886\887\888\889\890\891\892\893\894\895\896\897\898\899\900\901\902\903\904\905\906\907\908\909\910\911\912\913\914\915\916\917\918\919\920\921\922\923\924\925\926\927\928\929\930\931\932\933\934\935\936\937\938\939\940\941\942\943\944\945\946\947\948\949\950\951\952\953\954\955\956\957\958\959\960\961\962\963\964\965\966\967\968\969\970\971\972\973\974\975\976\977\978\979\980\981\982\983\984\985\986\987\988\989\990\991\992\993\994\995\996\997\998\999\1000

NO.	DATE	REVISION	STATE	PROJECT DESIGNATION	YEAR	SHEET NO.	TOTAL SHEETS
			ALASKA	0972016/Z684590000	2016	E5	59



NORTH ABUTMENT ROCK BOLTING PHOTO NOTES:

1. PERFORM SCALING WORK PRIOR TO INSTALLING ROCK BOLTS, AS APPROVED BY THE ENGINEER.
2. ROCK BOLT LOCATIONS, ORIENTATION, AND LENGTHS ARE APPROXIMATE AND MAY BE MODIFIED DURING CONSTRUCTION BY THE ENGINEER.
3. ROCK BOLT LOCATIONS WITHIN TARGETED SCALING AREAS WILL BE ADJUSTED BY THE ENGINEER AFTER SCALING HAS BEEN COMPLETED.
4. PERFORM GENERAL SLOPE SCALING WITHIN 50 FEET OF CENTERLINE EACH WAY. PERFORM INTENSIVE SCALING IN AREAS INDICATED.

LEGEND

- 15-FOOT ROCK BOLT LOCATION
- △ 20-FOOT ROCK BOLT LOCATION
- △ ROCK BOLTS BEHIND SCALING AREAS
- INTENSIVE SCALING AREA

P 6/9/20

PLANS DEVELOPED BY:
 LANDSLIDE TECHNOLOGY
 10250 SW GREENBURG RD.
 SUITE 111
 PORTLAND, OR 97225
 (503) 452-1200
 #AEC0777




STATE OF ALASKA
 DEPARTMENT OF TRANSPORTATION
 AND PUBLIC FACILITIES
**SKAGWAY - REPLACE CAPTAIN
 WILLIAM HENRY MOORE BRIDGE**


**NORTH ABUTMENT
 ROCK BOLTING**

FILE: C:\CIVIL\3D Projects\2470732-01\Civil\SA14-CT-E-DT-QWM.dwg DATE: 8/12/2016 10:39 LAYOUT: E6 DESIGNED: HOBBS CHECKED: NOBLE DRAFTED: WESTPHAL

NO.	DATE	REVISION	STATE	PROJECT DESIGNATION	YEAR	SHEET NO.	TOTAL SHEETS
			ALASKA	0972016/Z684590000	2016	E6	59

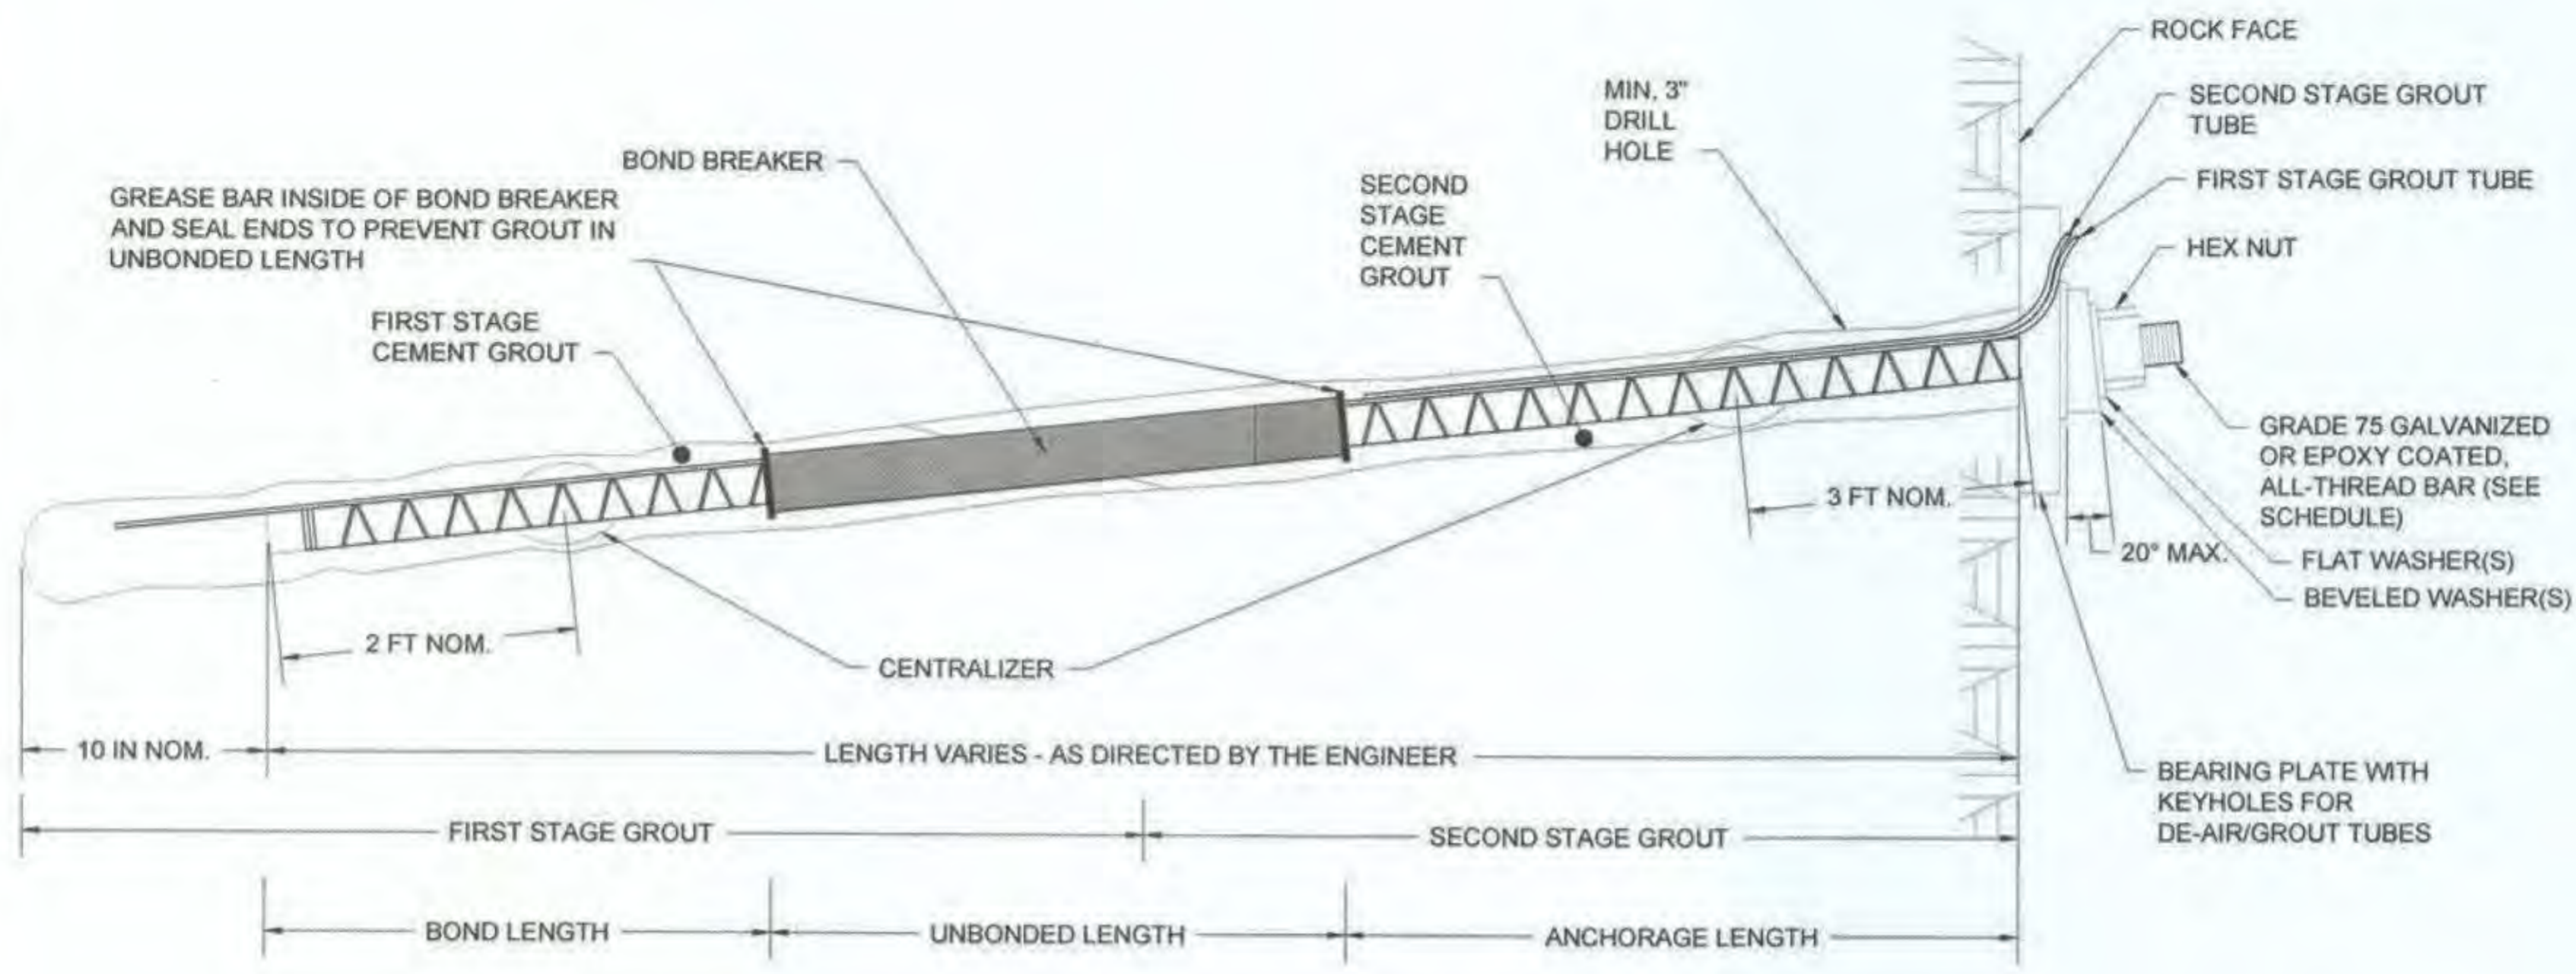

1 FOUNDATION BOLT / ROCK BOLT DETAIL
NTS

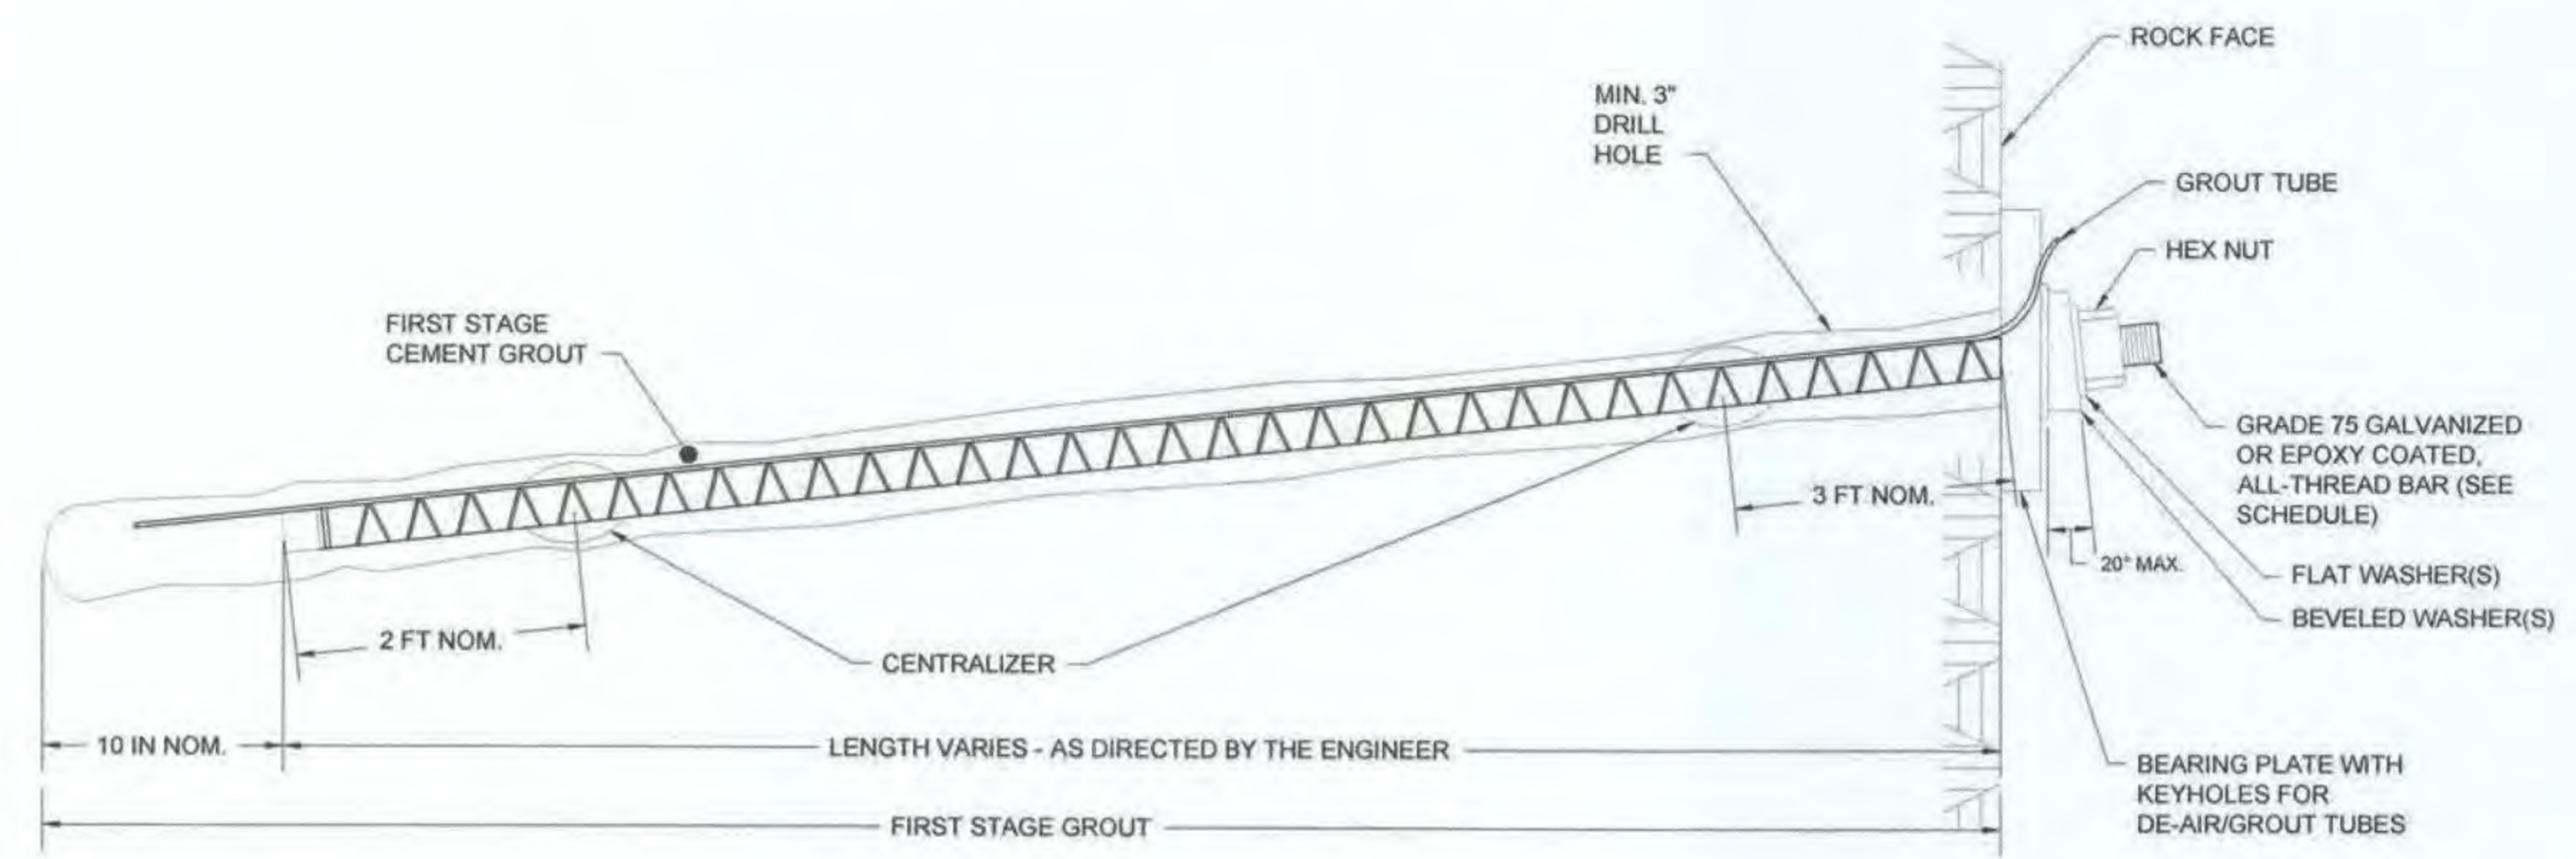

2 ROCK DOWEL DETAIL
NTS

TYPE	BOND LENGTH	UNBONDED LENGTH	ANCHORAGE LENGTH	GRADE	BAR SIZE
FOUNDATION ROCK BOLTS	10 FEET	10 FEET	5 FEET	75	MIN #11
ROCK BOLTS	5 FEET	8 FEET	VARIES	75	MIN #8
ROCK DOWEL	VARIES	N/A	N/A	75	MIN #8

- NOTES:
- BOND LENGTH ASSUMES 3 INCH MINIMUM HOLE DIAMETER DRILLED USING ROTARY PERCUSSION TECHNIQUES. CONTRACTOR IS RESPONSIBLE FOR MODIFYING BOND LENGTHS TO SUIT THEIR SELECTED DRILLING TECHNIQUE AND HOLE DIAMETER.
 - FOR NORTH ABUTMENT ROCK BOLT LENGTHS, SEE DRAWING E5.
 - LOCATION OF SOUTH APPROACH ROCK BOLTS AND DOWELS WILL BE DETERMINED IN THE FIELD FOLLOWING BLASTING AND SCALING.
 - LENGTH AND LOCATION OF SOUTH APPROACH ROCK BOLTS AND ROCK DOWELS WILL BE DETERMINED IN THE FIELD AFTER BLASTING AND SCALING, BUT WILL BE NO LESS THAN 15 FEET AND WILL NOT EXCEED 40 FEET.
 - MINIMUM BAR SIZES REQUIRED. CONTRACTOR MAY USE DIFFERENT BAR PROVIDED IT IS ABLE TO OBTAIN THE TEST LOAD WITHOUT BENDING OR YIELDING.

TYPE	TEST LOAD	LOCK-OFF LOAD
FOUNDATION ROCK BOLTS	96 KIPS	80 KIPS
ROCK BOLTS	48 KIPS	40 KIPS
ROCK DOWEL	10 KIPS	10 KIPS

- NOTES:
- INSTALL ROCK BOLTS AT THE LOCATIONS, ORIENTATIONS, AND LENGTHS AS DETERMINED BY THE ENGINEER IN THE FIELD.
 - ORIENT THE KEYHOLES ON BEARING PLATE UPWARD FOR MAXIMUM GROUT RETENTION.
 - FIRST STAGE GROUT TO FILL ROCK BOLT BOND LENGTH AND HALF OF UNBONDED LENGTH.
 - SECOND STAGE GROUT ROCK BOLT FOLLOWING SUCCESSFUL TESTING AND LOCK-OFF.

6/9/20


PLANS DEVELOPED BY:
LANDSLIDE TECHNOLOGY
10250 SW GREENBURG RD,
SUITE 111,
PORTLAND, OR 97223
(503) 452-1200
#AECC777



STATE OF ALASKA
DEPARTMENT OF TRANSPORTATION
AND PUBLIC FACILITIES
**SKAGWAY - REPLACE CAPTAIN
WILLIAM HENRY MOORE BRIDGE**
**FOUNDATION AND ROCK BOLT AND
ROCK DOWEL DETAILS**

FILE: C:\Civil\30 Projects\24\70732-01\Civil\SA14-CT-E-DT-CMM.dwg
 DATE: 8/16/2016 16:27 LAYOUT: E7
 DESIGNED: HOBBS
 CHECKED: NOBLE
 DRAFTED: WESTPHAL



NO.	DATE	REVISION	STATE	PROJECT DESIGNATION	YEAR	SHEET NO.	TOTAL SHEETS
			ALASKA	0972016/Z684590000	2016	E7	59

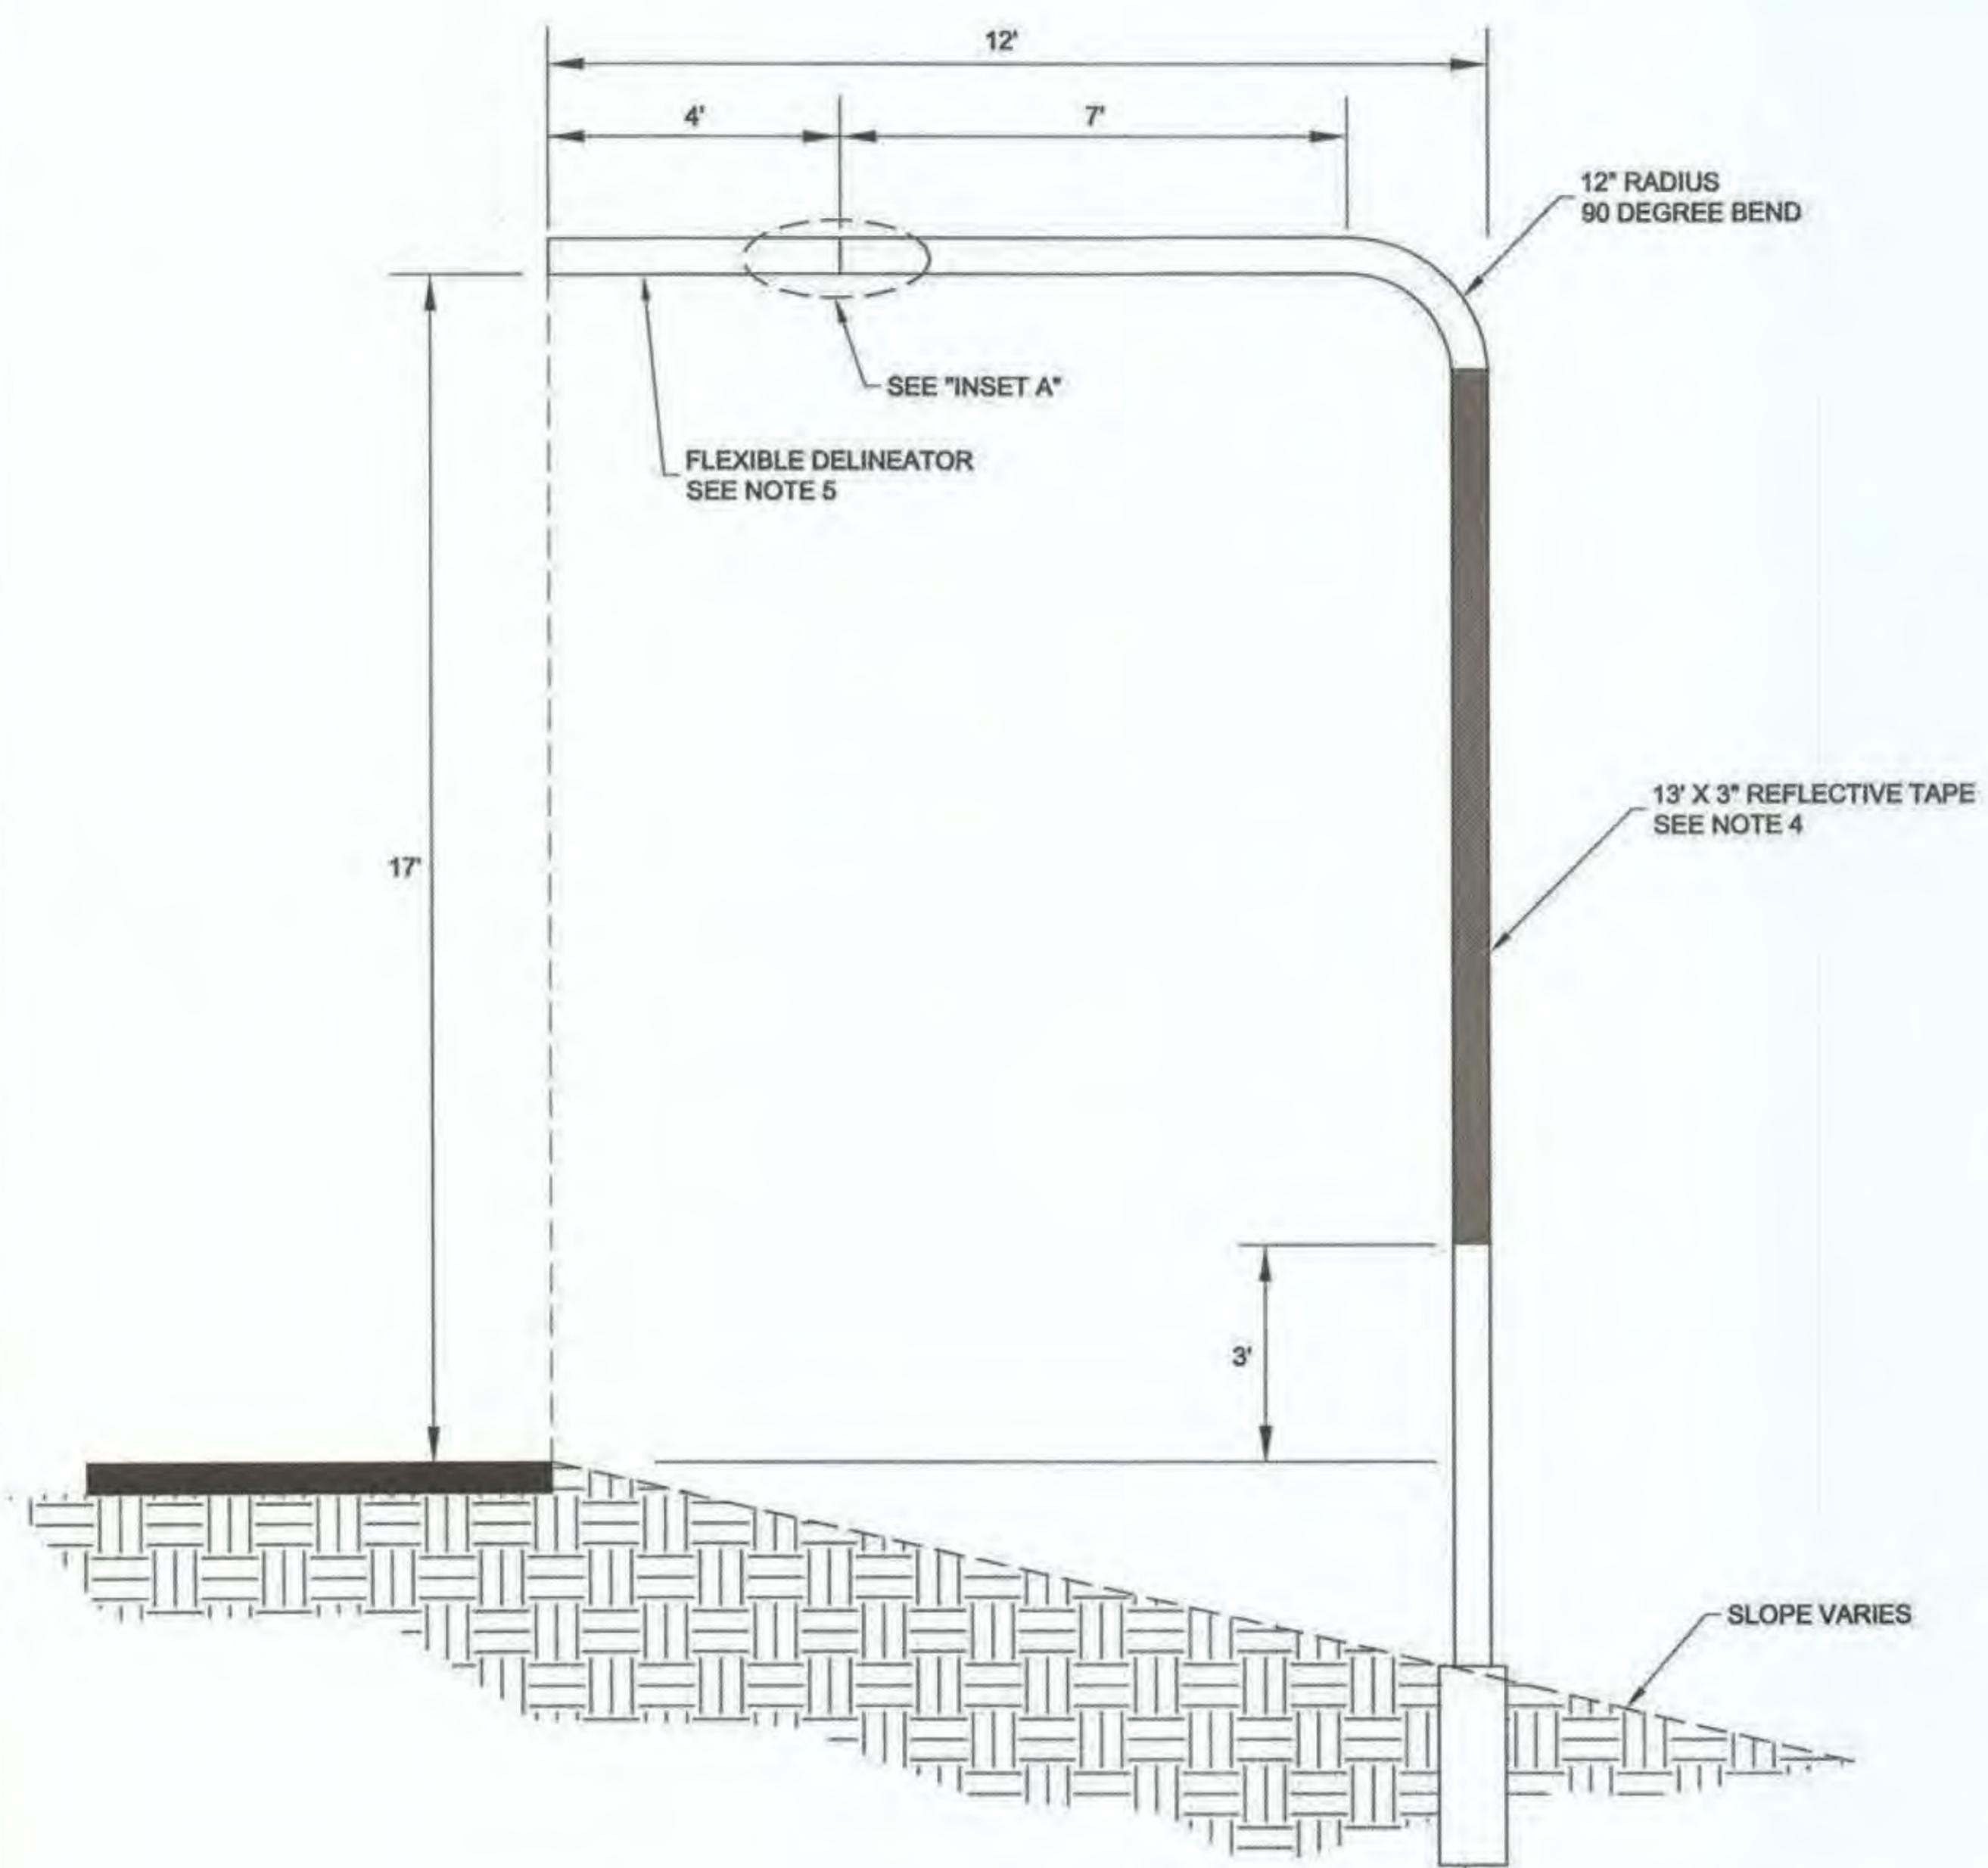

1 OVERHEAD SNOW POLE

NOTES:

- INSTALL SNOW POLES AT LOCATIONS INDICATED ON THE PLANS. LOCATIONS ARE SUBJECT TO ADJUSTMENT IN THE FIELD BY THE ENGINEER.
- STAKE SNOW POLE LOCATIONS PRIOR TO INSTALLATION, PROVIDE THE ENGINEER 7 DAYS TO REVIEW AND ADJUST SNOW POLE LOCATIONS PRIOR TO INSTALLATION
- SNOW POLES ARE 2.5-IN SCHEDULE 80 GALVANIZED STEEL PIPE.
- REFLECTIVE TAPE MUST MATCH COLOR OF EDGE LINE.
- FLEXIBLE DELINEATOR FOR SNOW POLES PER 615-2.01. INSTALL 36" X 4" WHITE REFLECTOR ON APPROACH SIDE AND 12 X 4" WHITE REFLECTOR ON DEPARTURE SIDE.
- DRILL ALL BOLT HOLES. COAT HOLES WITH ZINC RICH PAINT, FLAME CUTTING IS NOT PERMITTED.
- USE FRANGIBLE COUPLING SYSTEM FOR SQUARE STEEL TUBES DETAIL PER STANDARD DRAWING S-31.01 WITH THE FOLLOWING MODIFICATIONS (APPLIES ONLY TO SNOW POLES):
 - FOUNDATION SIZE AND REINFORCEMENT PER FOUNDATION TABLE WILL BE EQUIVALENT TO 2 1/2" TUBE.
 - ADD BRACKET ADAPTORS AT BASE TO MAKE BOLT ON FLANGES FIT WITH PIPE POSTS. NOTE 10 ON STANDARD DRAWING S-31.01 APPLIES TO THESE BRACKETS.
 - DELETE FRANGIBLE FUSE PLATE AND POST HINGE.

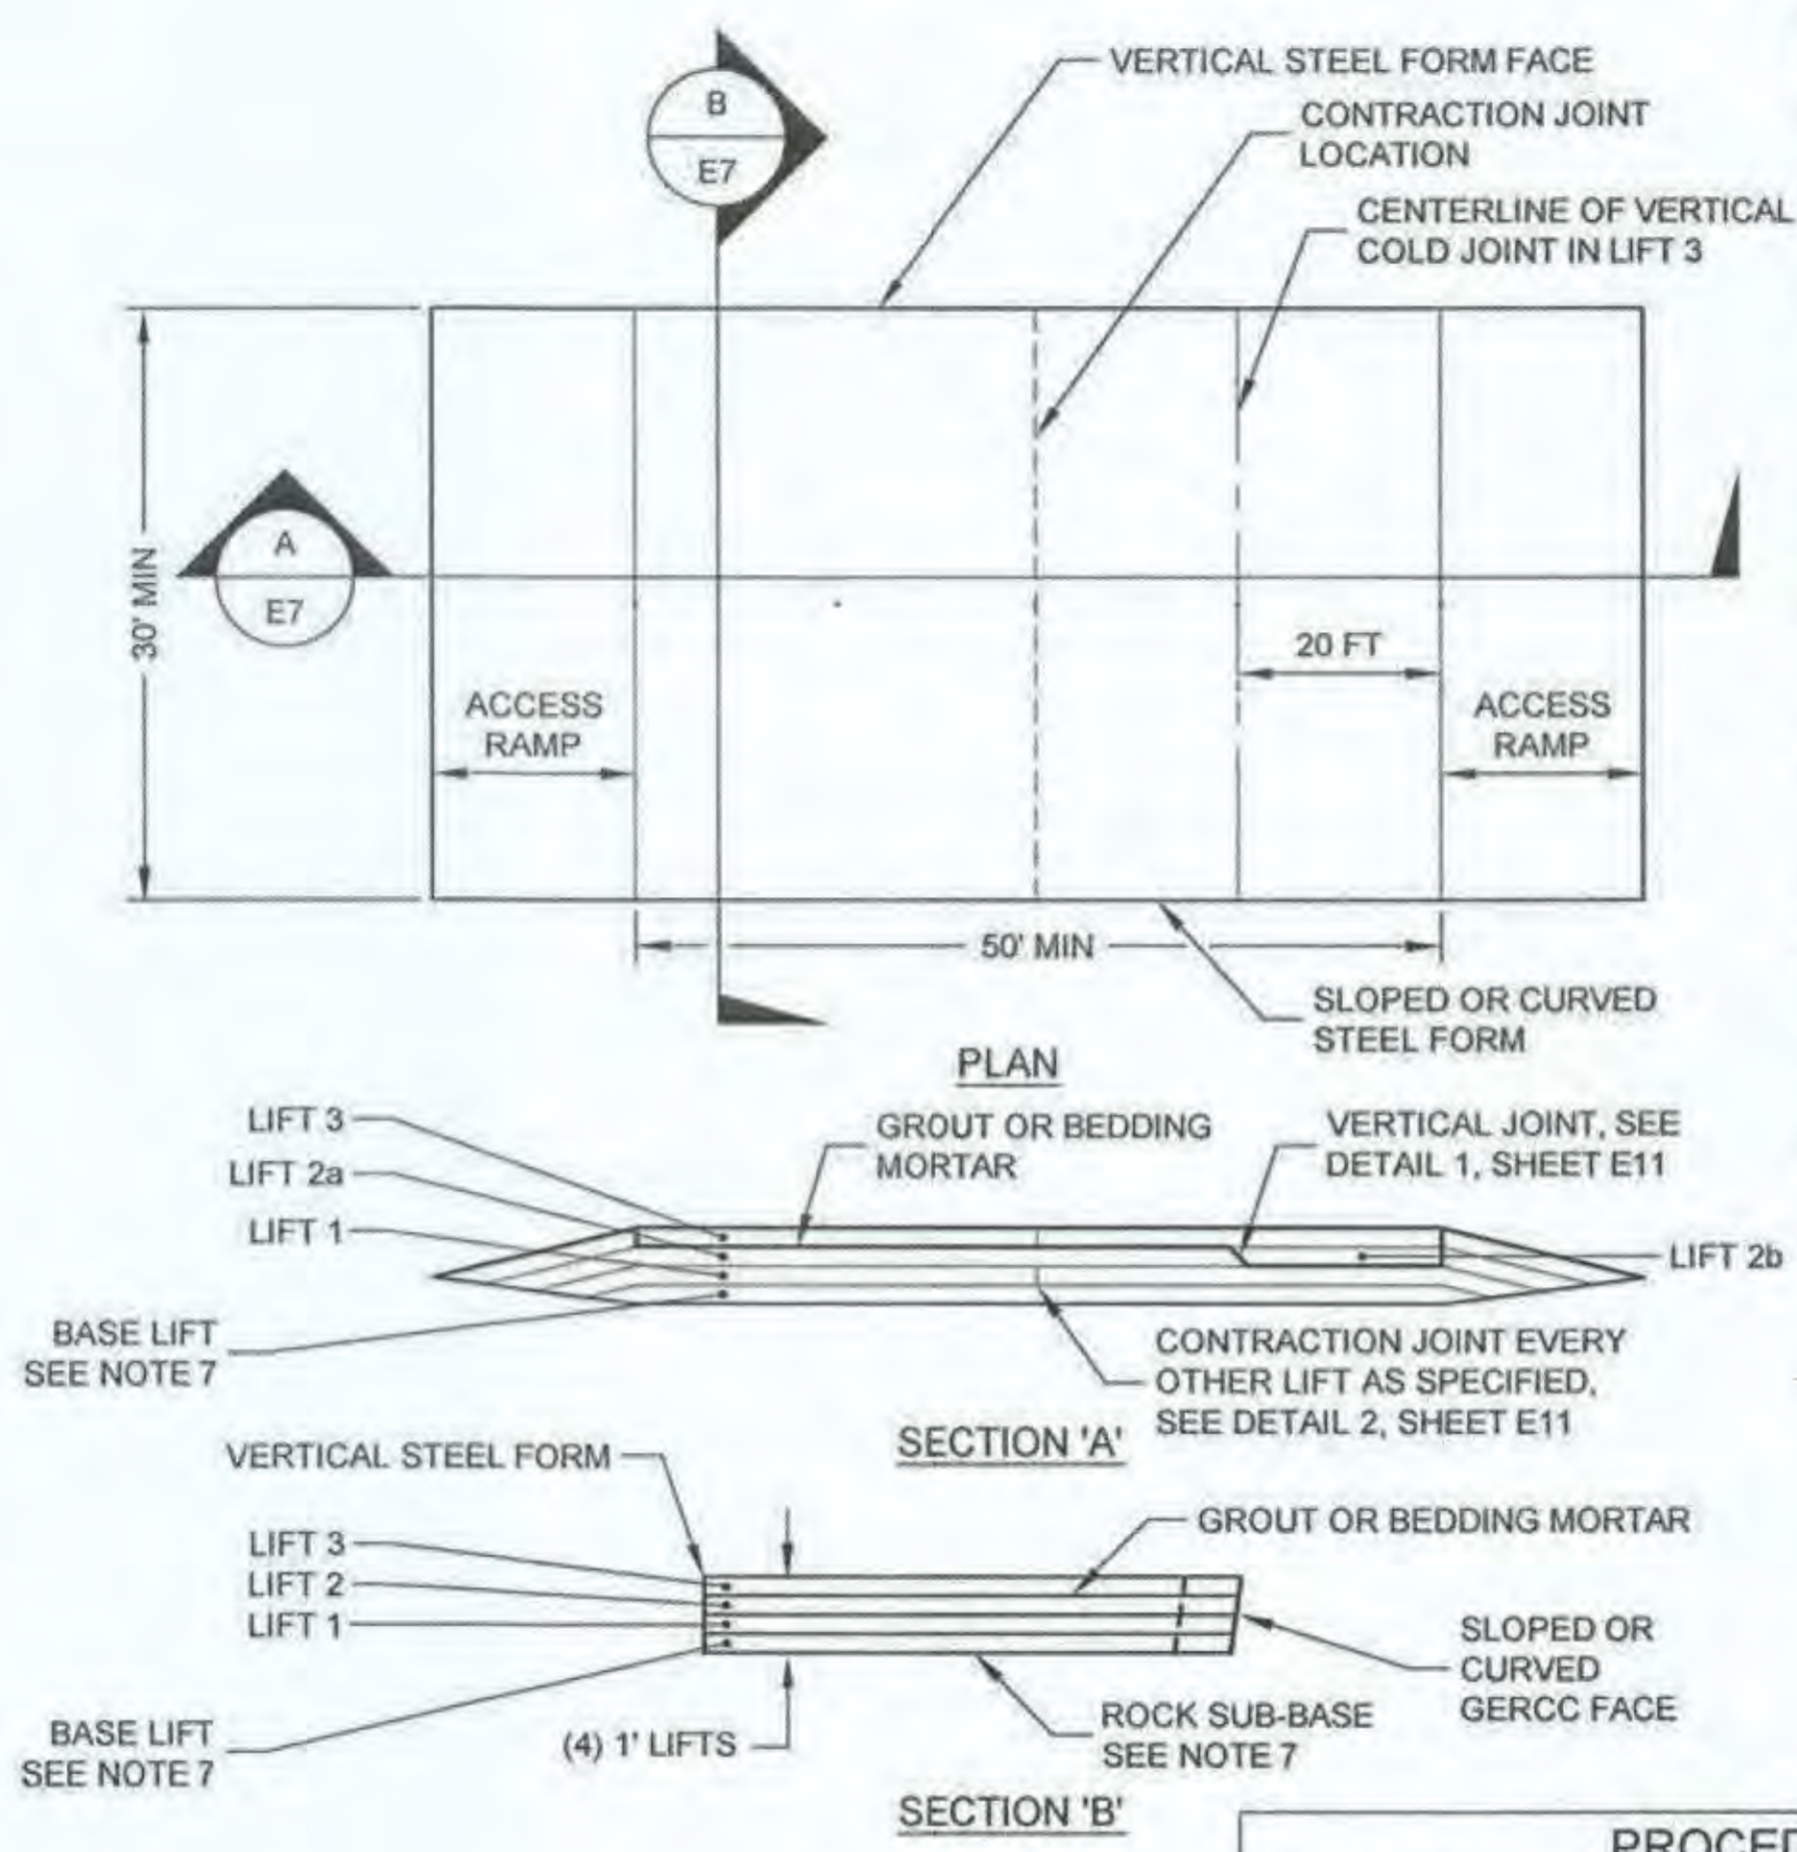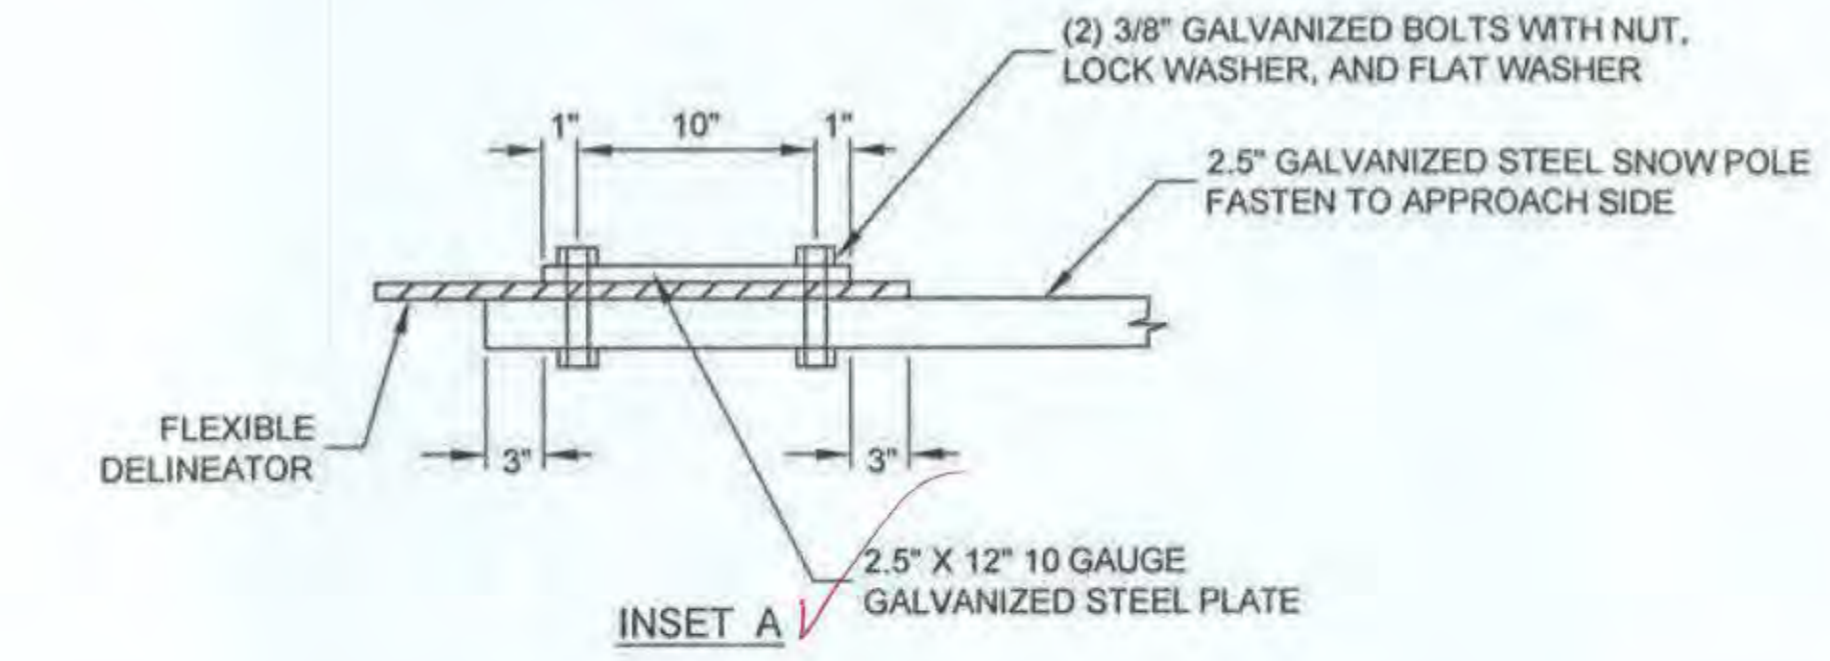

RCC TEST SECTION CONSTRUCTION NOTES:

- PRIOR TO THE START OF RCC PLACEMENT IN THE TEST SECTION CONSTRUCTION, TEST STRIPS SHALL BE CONSTRUCTED TO EVALUATE PERFORMANCE OF THE RCC MIX AND COMPACTION EQUIPMENT. RCC SPECIFICATION 514-305(e).
- IN ADDITION TO THE PROCEDURES SHOWN IN THE DETAIL THE FOLLOWING PROCEDURES WILL BE EVALUATED DURING TEST SECTION CONSTRUCTION:
 - BATCH PLANT OPERATION
 - DELIVERY, DUMPING AND SPREADING OF RCC
 - DAYTIME AND OVERNIGHT CURING
- CONTRACTOR SHALL LOCATE THE TEST SECTION AT WASTE SITE AREA B. CONTRACTOR TO COORDINATE WITH PROJECT ENGINEER FOR EXACT LOCATION.
- CALIBRATION OF THE PLANT AND EQUIPMENT, PERFORMANCE OF UNIFORMITY TESTING, AND TEST STRIPS SHALL BE SATISFACTORILY PERFORMED PRIOR TO THE TEST SECTION.
- ACCESS RAMPS MAY BE RCC OR COMPACTED AGGREGATE BASE.
- INSTALL A STARTER PIPE FOR WIRE SAWING AT LOCATION DIRECTED BY THE ENGINEER.
- IF A ROCK SUB-BASE IS NOT AVAILABLE, A BASE LIFT OF RCC PLACED ON A COMPACTED AGGREGATE BASE MAY BE USED.
- FORMING SHALL BE CONSISTENT WITH THE SYSTEM TO BE USED DURING THE BRIDGE CONSTRUCTION.
- BRIEF MEETINGS WILL BE HELD PRIOR TO STARTING THE TEST SECTION AND EACH LIFT TO DISCUSS METHODS AND EQUIPMENT TO BE USED FOR THAT LIFT. DURING THE INITIAL MEETING THE SCOPE AND ACTIVITIES MAY BE ADJUSTED BY THE ENGINEER BASED ON DISCUSSIONS WITH THE CONTRACTOR. IN ADDITION A MEETING WILL FOLLOW THE TEST SECTION TO DISCUSS HOW FINDINGS WILL BE APPLIED DURING RCC CONSTRUCTION.
- WIRE SAWING SHALL BE DONE 14 TO 21 DAYS AFTER FINAL TEST SECTION RCC PLACEMENT.

PROCEDURES TABLE		
DAY	LIFT NO.	OPERATIONS
1	1	A. ROCK SURFACE PREPARATION INCLUDING BEDDING MORTAR APPLICATION. B. GERCC AT FORM FACES C. CONTRACTION JOINT INSTALLATION
1	2a	A. LIFT JOINT PREPARATION (HOT JOINT) B. OPTIMUM COMPACTION DENSITY TEST C. GERCC AT FORM FACES D. TERMINATE LIFT 20 FEET FROM END OF TEST SECTION E. INSTALL VERTICAL JOINT
2	2b	A. LIFT JOINT PREPARATION WITH GROUT (COLD JOINT) B. GERCC AT FORM FACES C. DENSITY TESTS
2	3	A. LIFT JOINT PREPARATION WITH GROUT (COLD JOINT - TOP OF LIFT 2a) B. LIFT JOINT PREPARATION (HOT JOINT - TOP OF LIFT 2b) C. DENSITY TESTS D. GERCC AT FORMED FACES E. CONTRACTION JOINT INSTALLATION

2 RCC TEST SECTION CONSTRUCTION

6/9/20

PLANS DEVELOPED BY:
DOWL
5368 COMMERCIAL BLVD.
JUNEAU, AK 99801
(907) 780-3533
#AECL848




STATE OF ALASKA
DEPARTMENT OF TRANSPORTATION
AND PUBLIC FACILITIES
**SKAGWAY - REPLACE CAPTAIN
WILLIAM HENRY MOORE BRIDGE**

**RCC TEST SECTION AND SNOW
POLE DETAILS**


8-17-2016

FILE: C:\CIVIL\3D Projects\24\70732-01\CIVIL\SA14-CT-E-01-CNM.dwg
 DATE: 8/17/2016 7:00 LAYOUT: EB
 DESIGNED: HOBBS
 CHECKED: NOBLE
 DRAFTED: WESTPHAL

NO.	DATE	REVISION	STATE	PROJECT DESIGNATION	YEAR	SHEET NO.	TOTAL SHEETS
			ALASKA	0972016/Z684590000	2016	E8	59

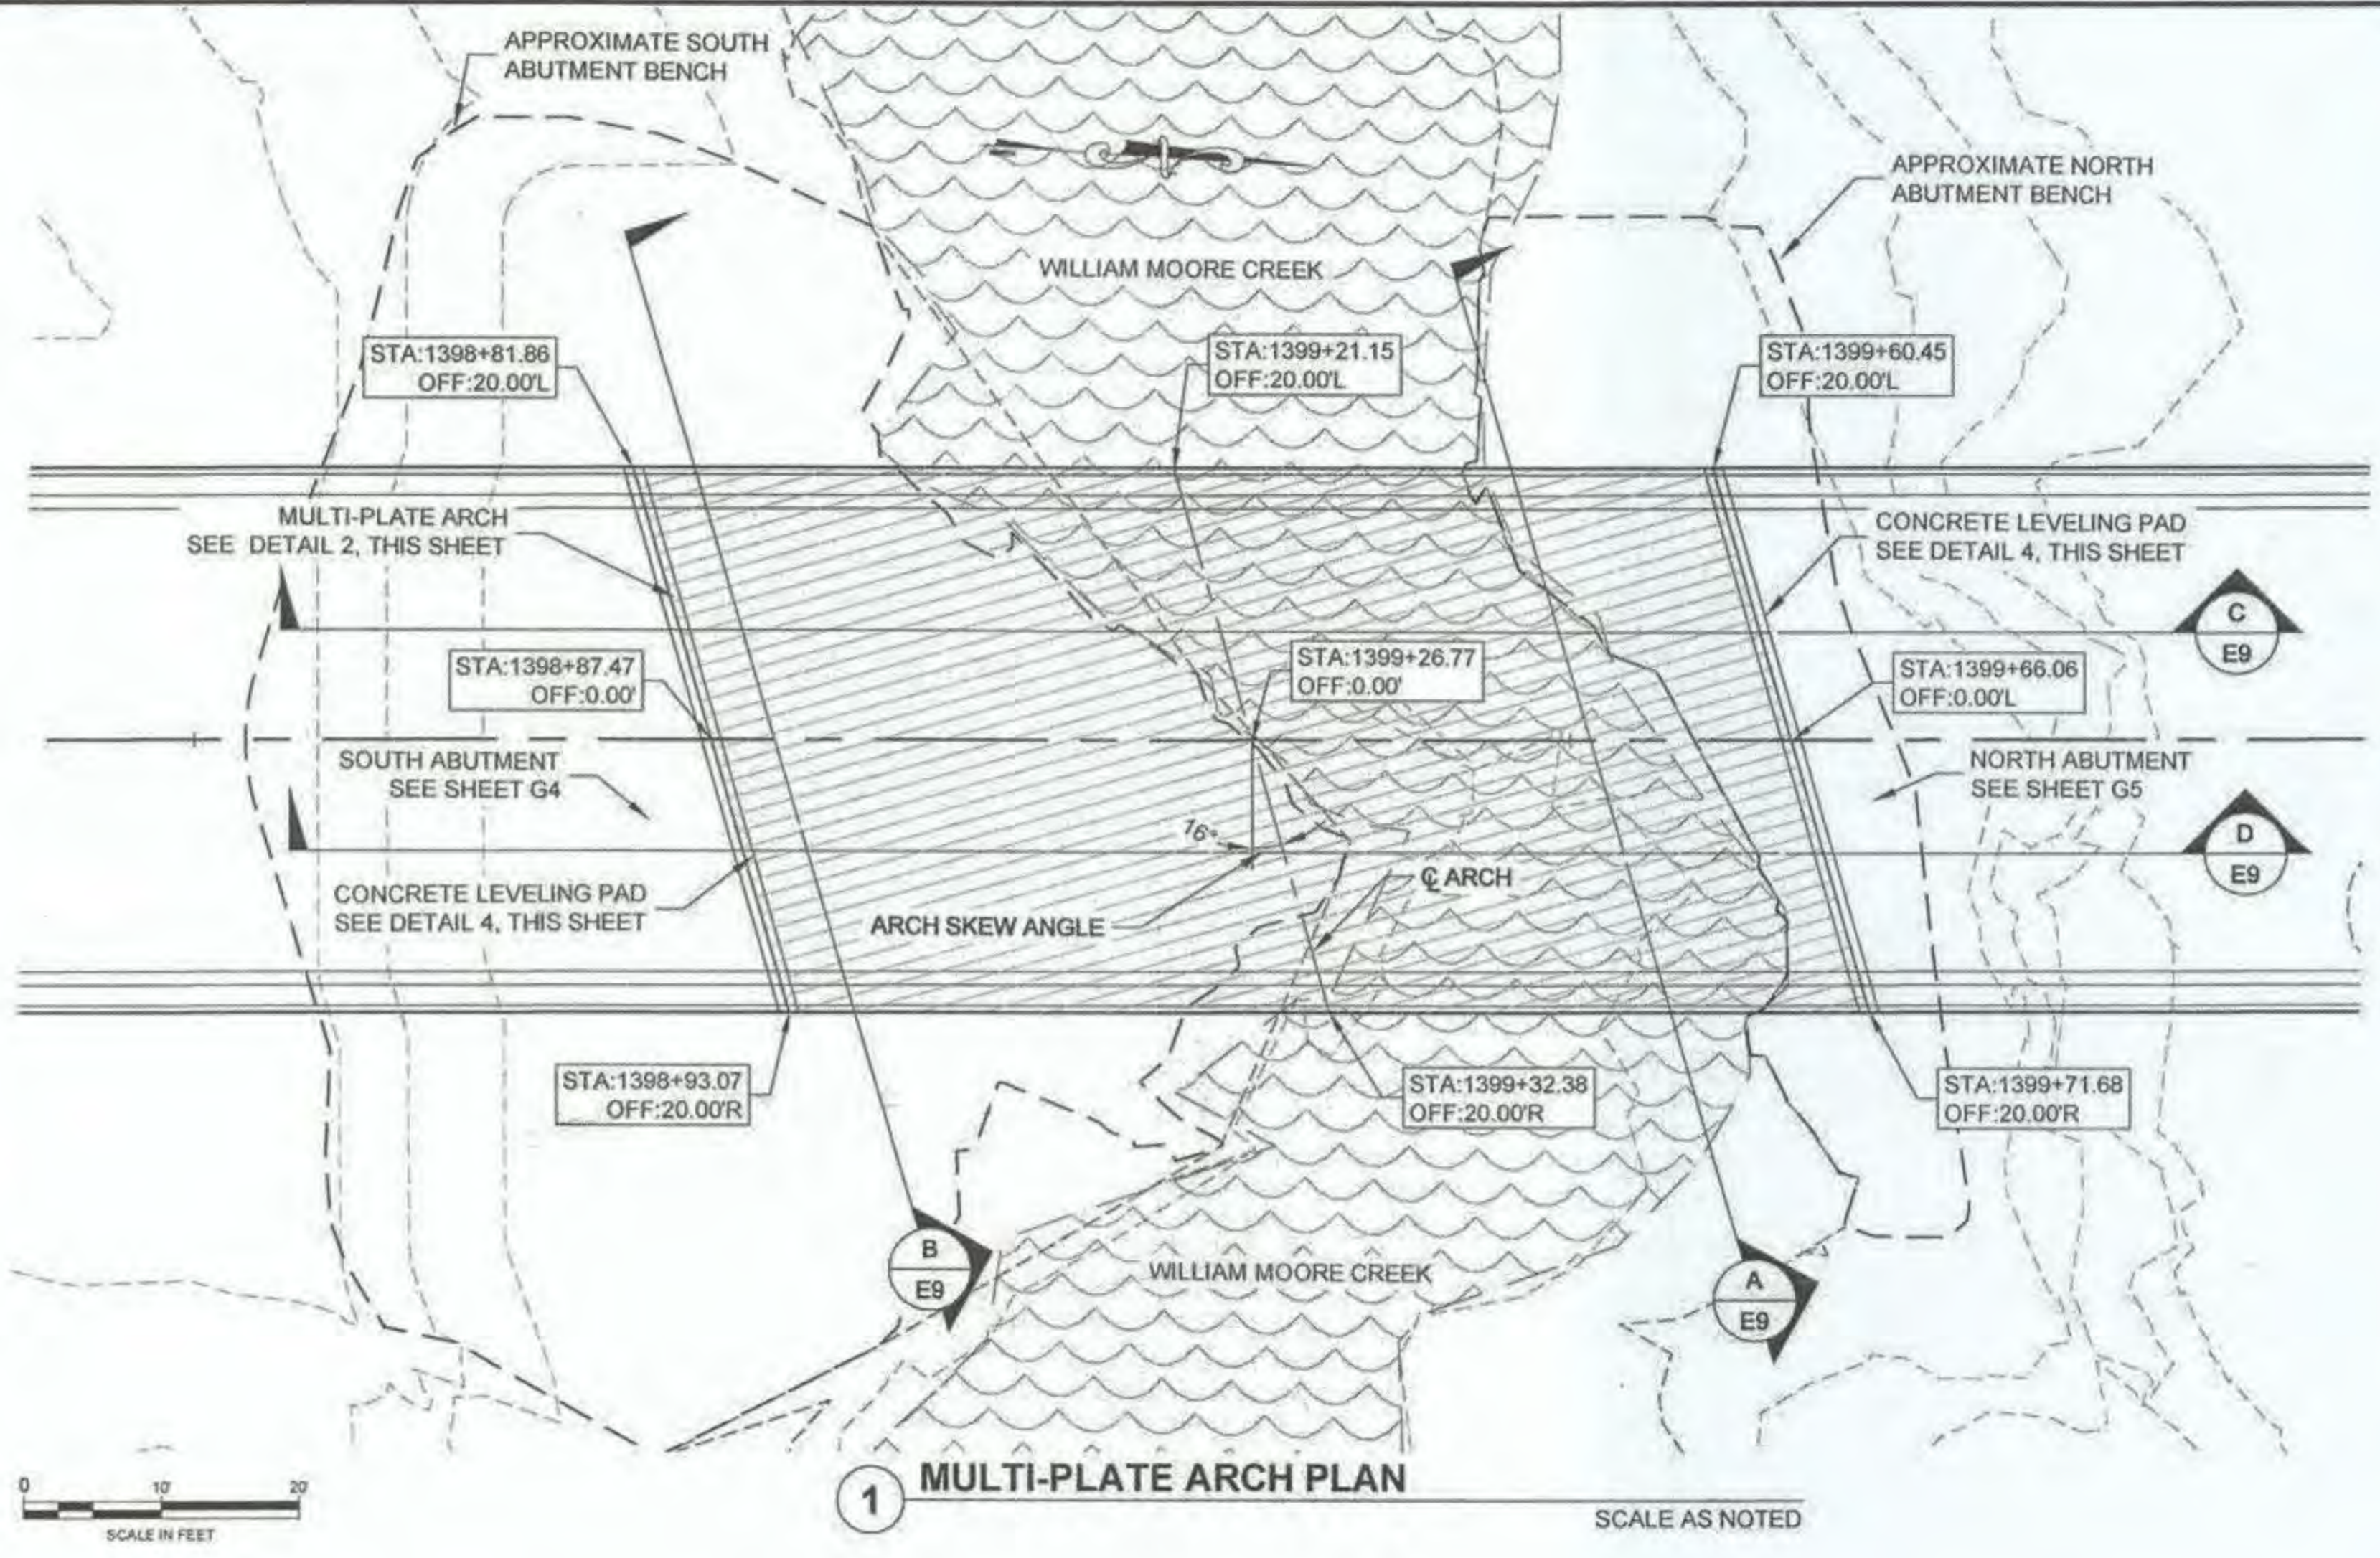


1 MULTI-PLATE ARCH PLAN
SCALE AS NOTED

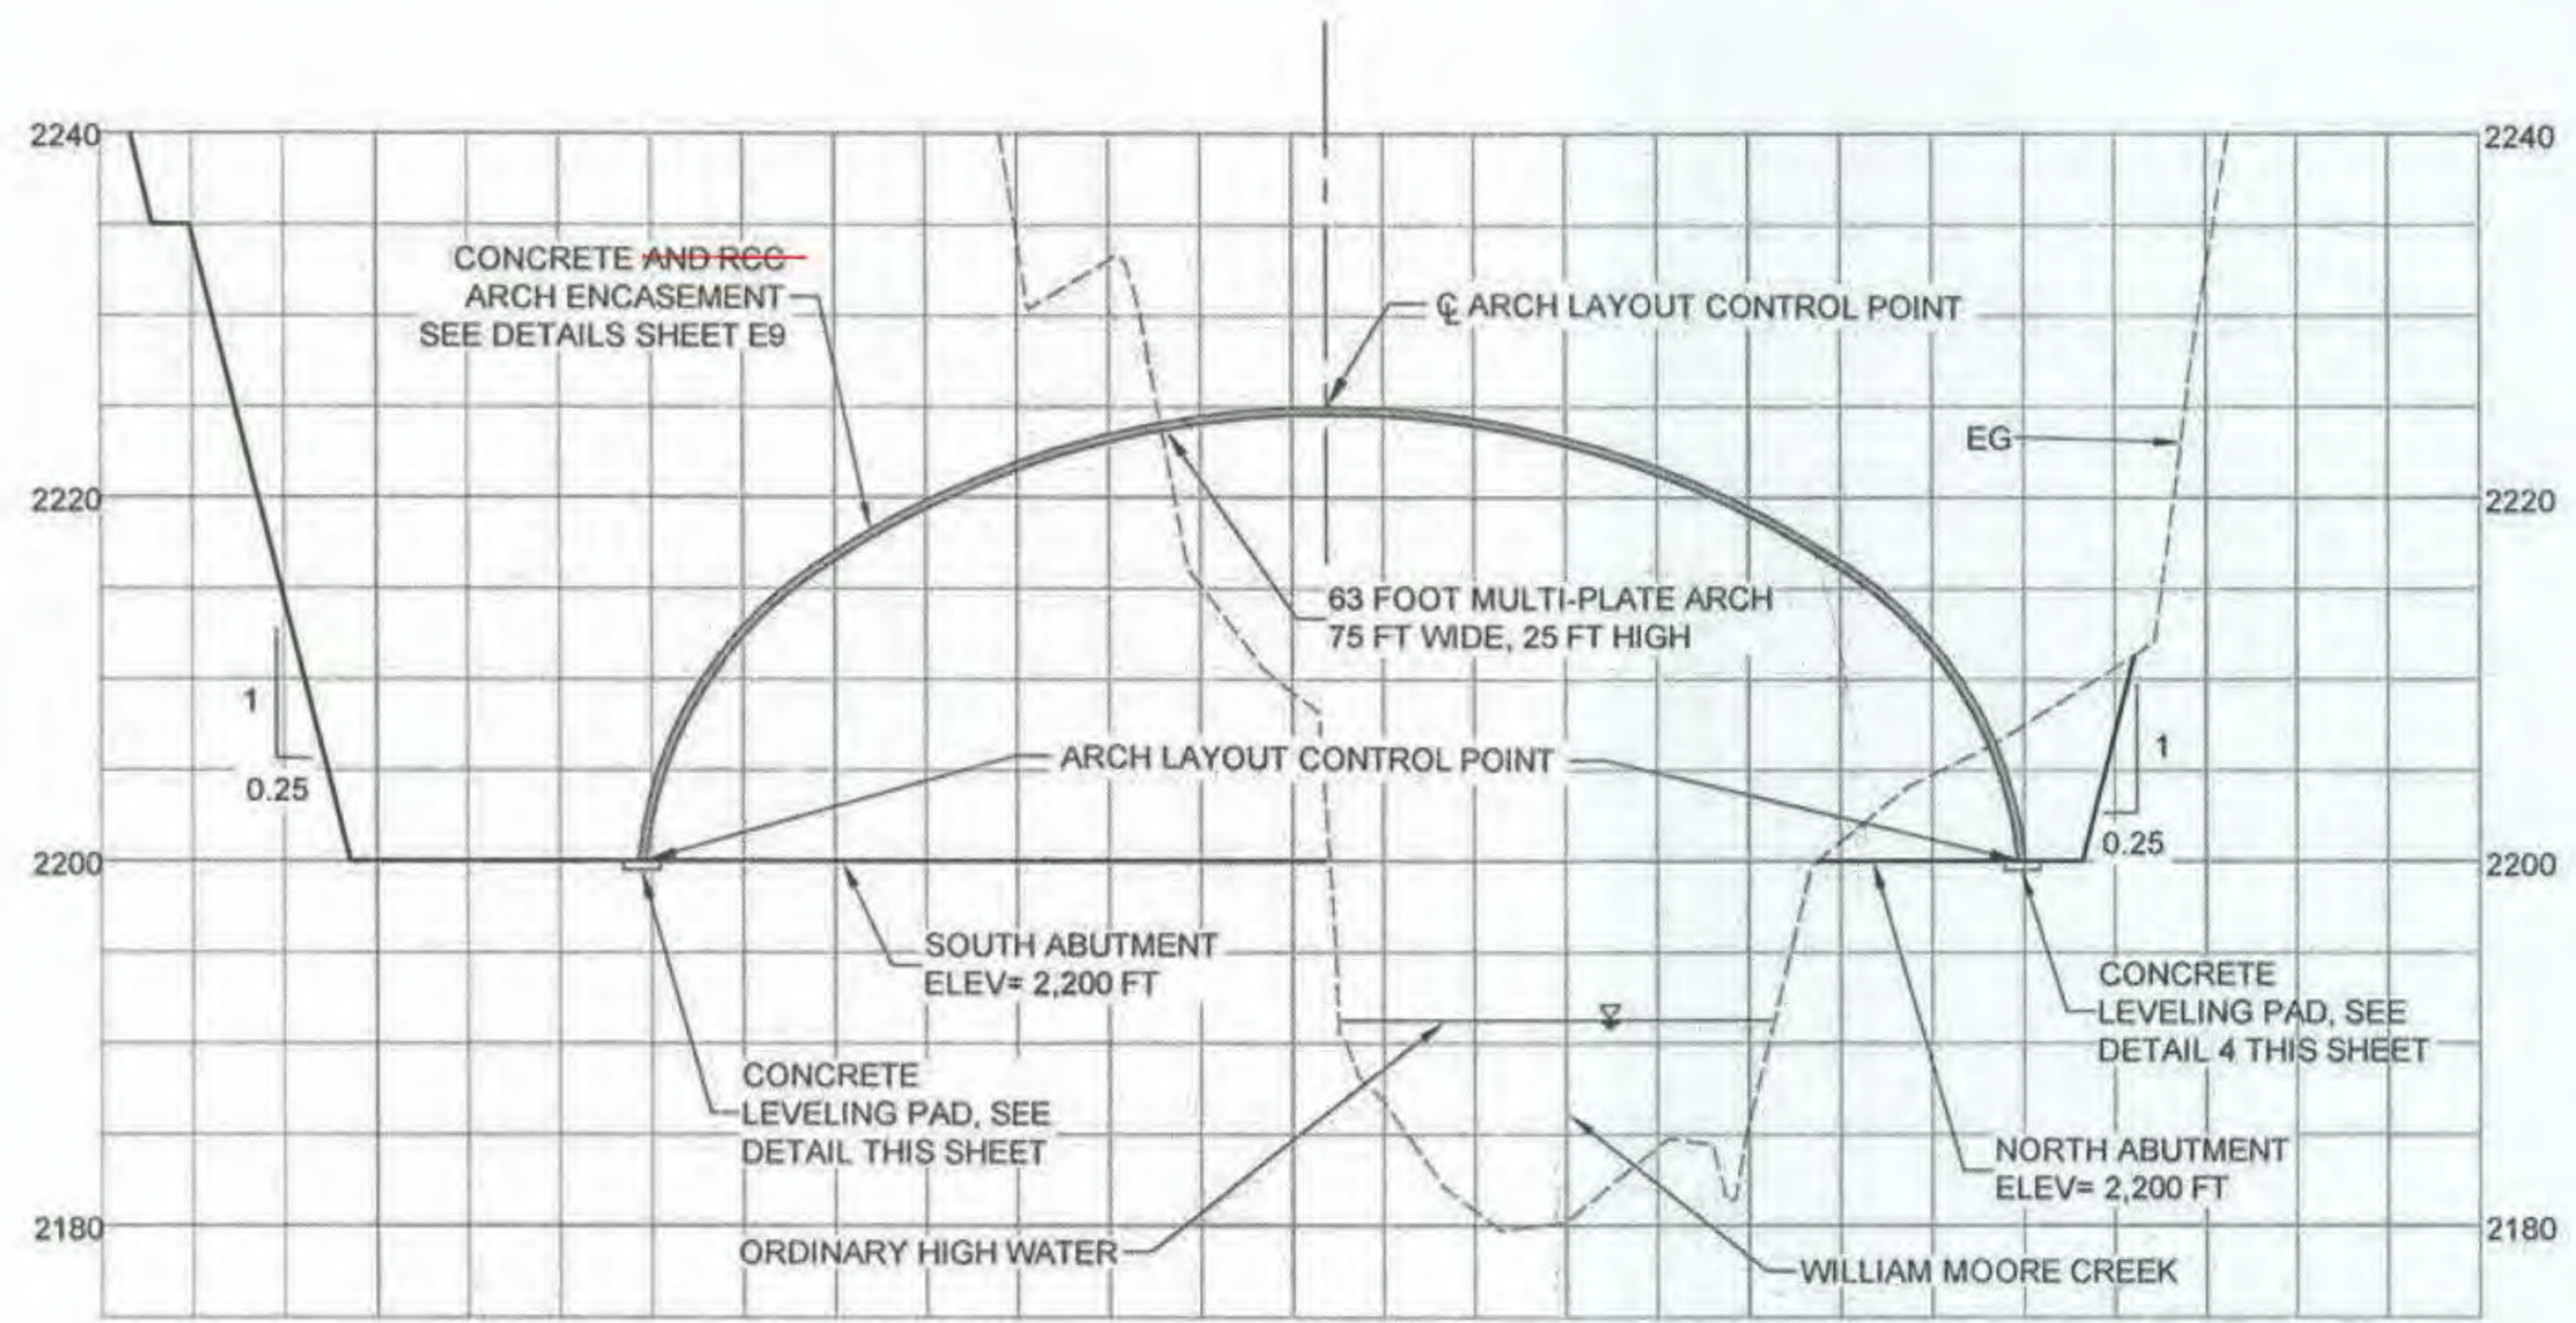

2 MULTI-PLATE ARCH SECTION
SCALE AS NOTED

HYDRAULIC AND HYDROLOGIC SUMMARY - WILLIAM MOORE CREEK				
DRAINAGE AREA	11.9 SQUARE MILES			
EXCEEDENCE PROBABILITY	2% (DESIGN EVENT)	1%	0.2%	REGULATORY FLOOD
RETURN PERIOD	50 YEAR (Q50)	100 YEAR (Q100)	500 YEAR (Q500)	N/A
DESIGN DISCHARGE	1,810 CFS	2,060 CFS	2,660 CFS	N/A
DESIGN HIGH WATER ELEVATION	2,200.1	2,201.0	2,202.2	N/A
ANTICIPATED ADDITIONAL BACKWATER AT Q100 = 0.0 FEET				


3 HYDRAULIC DATA

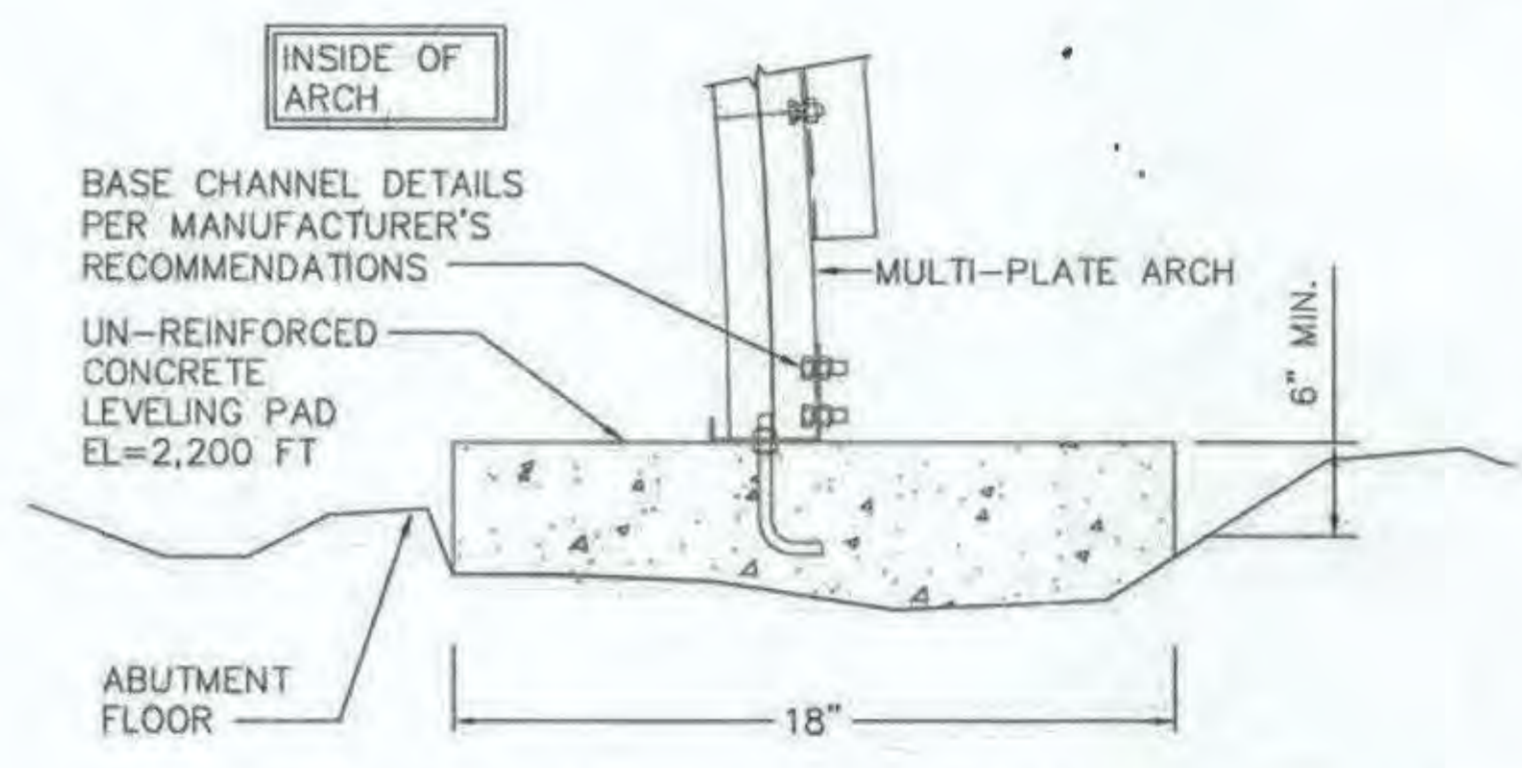

4 MULTI-PLATE ARCH CONCRETE LEVELING PAD
NTS

6/9/20

PLANS DEVELOPED BY:
DOWL
5368 COMMERCIAL BLVD.
JUNEAU, AK 99801
(907) 780-3533
#AECL848

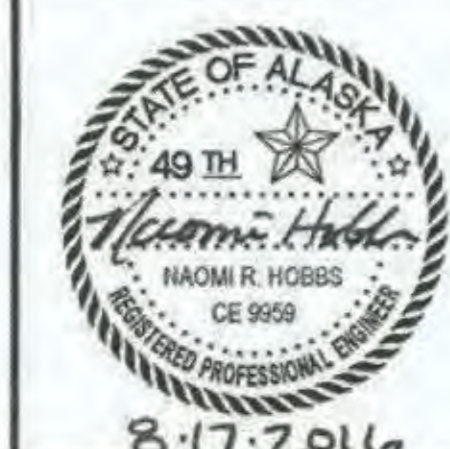


STATE OF ALASKA
DEPARTMENT OF TRANSPORTATION
AND PUBLIC FACILITIES
**SKAGWAY - REPLACE CAPTAIN
WILLIAM HENRY MOORE BRIDGE**


MULTI-PLATE ARCH DETAILS

FILE: C:\CIVIL\3D Projects\24\70732-01\CIVIL\SA14-CT-E-DT-CMM.dwg
 DATE: 8/17/2016 7:19 LAYOUT: E9
 DESIGNED: HOBBS
 CHECKED: NOBLE
 DRAFTED: WESTPHAL

NO.	DATE	REVISION	STATE	PROJECT DESIGNATION	YEAR	SHEET NO.	TOTAL SHEETS
			ALASKA	0972016/Z684590000	2016	E9	59

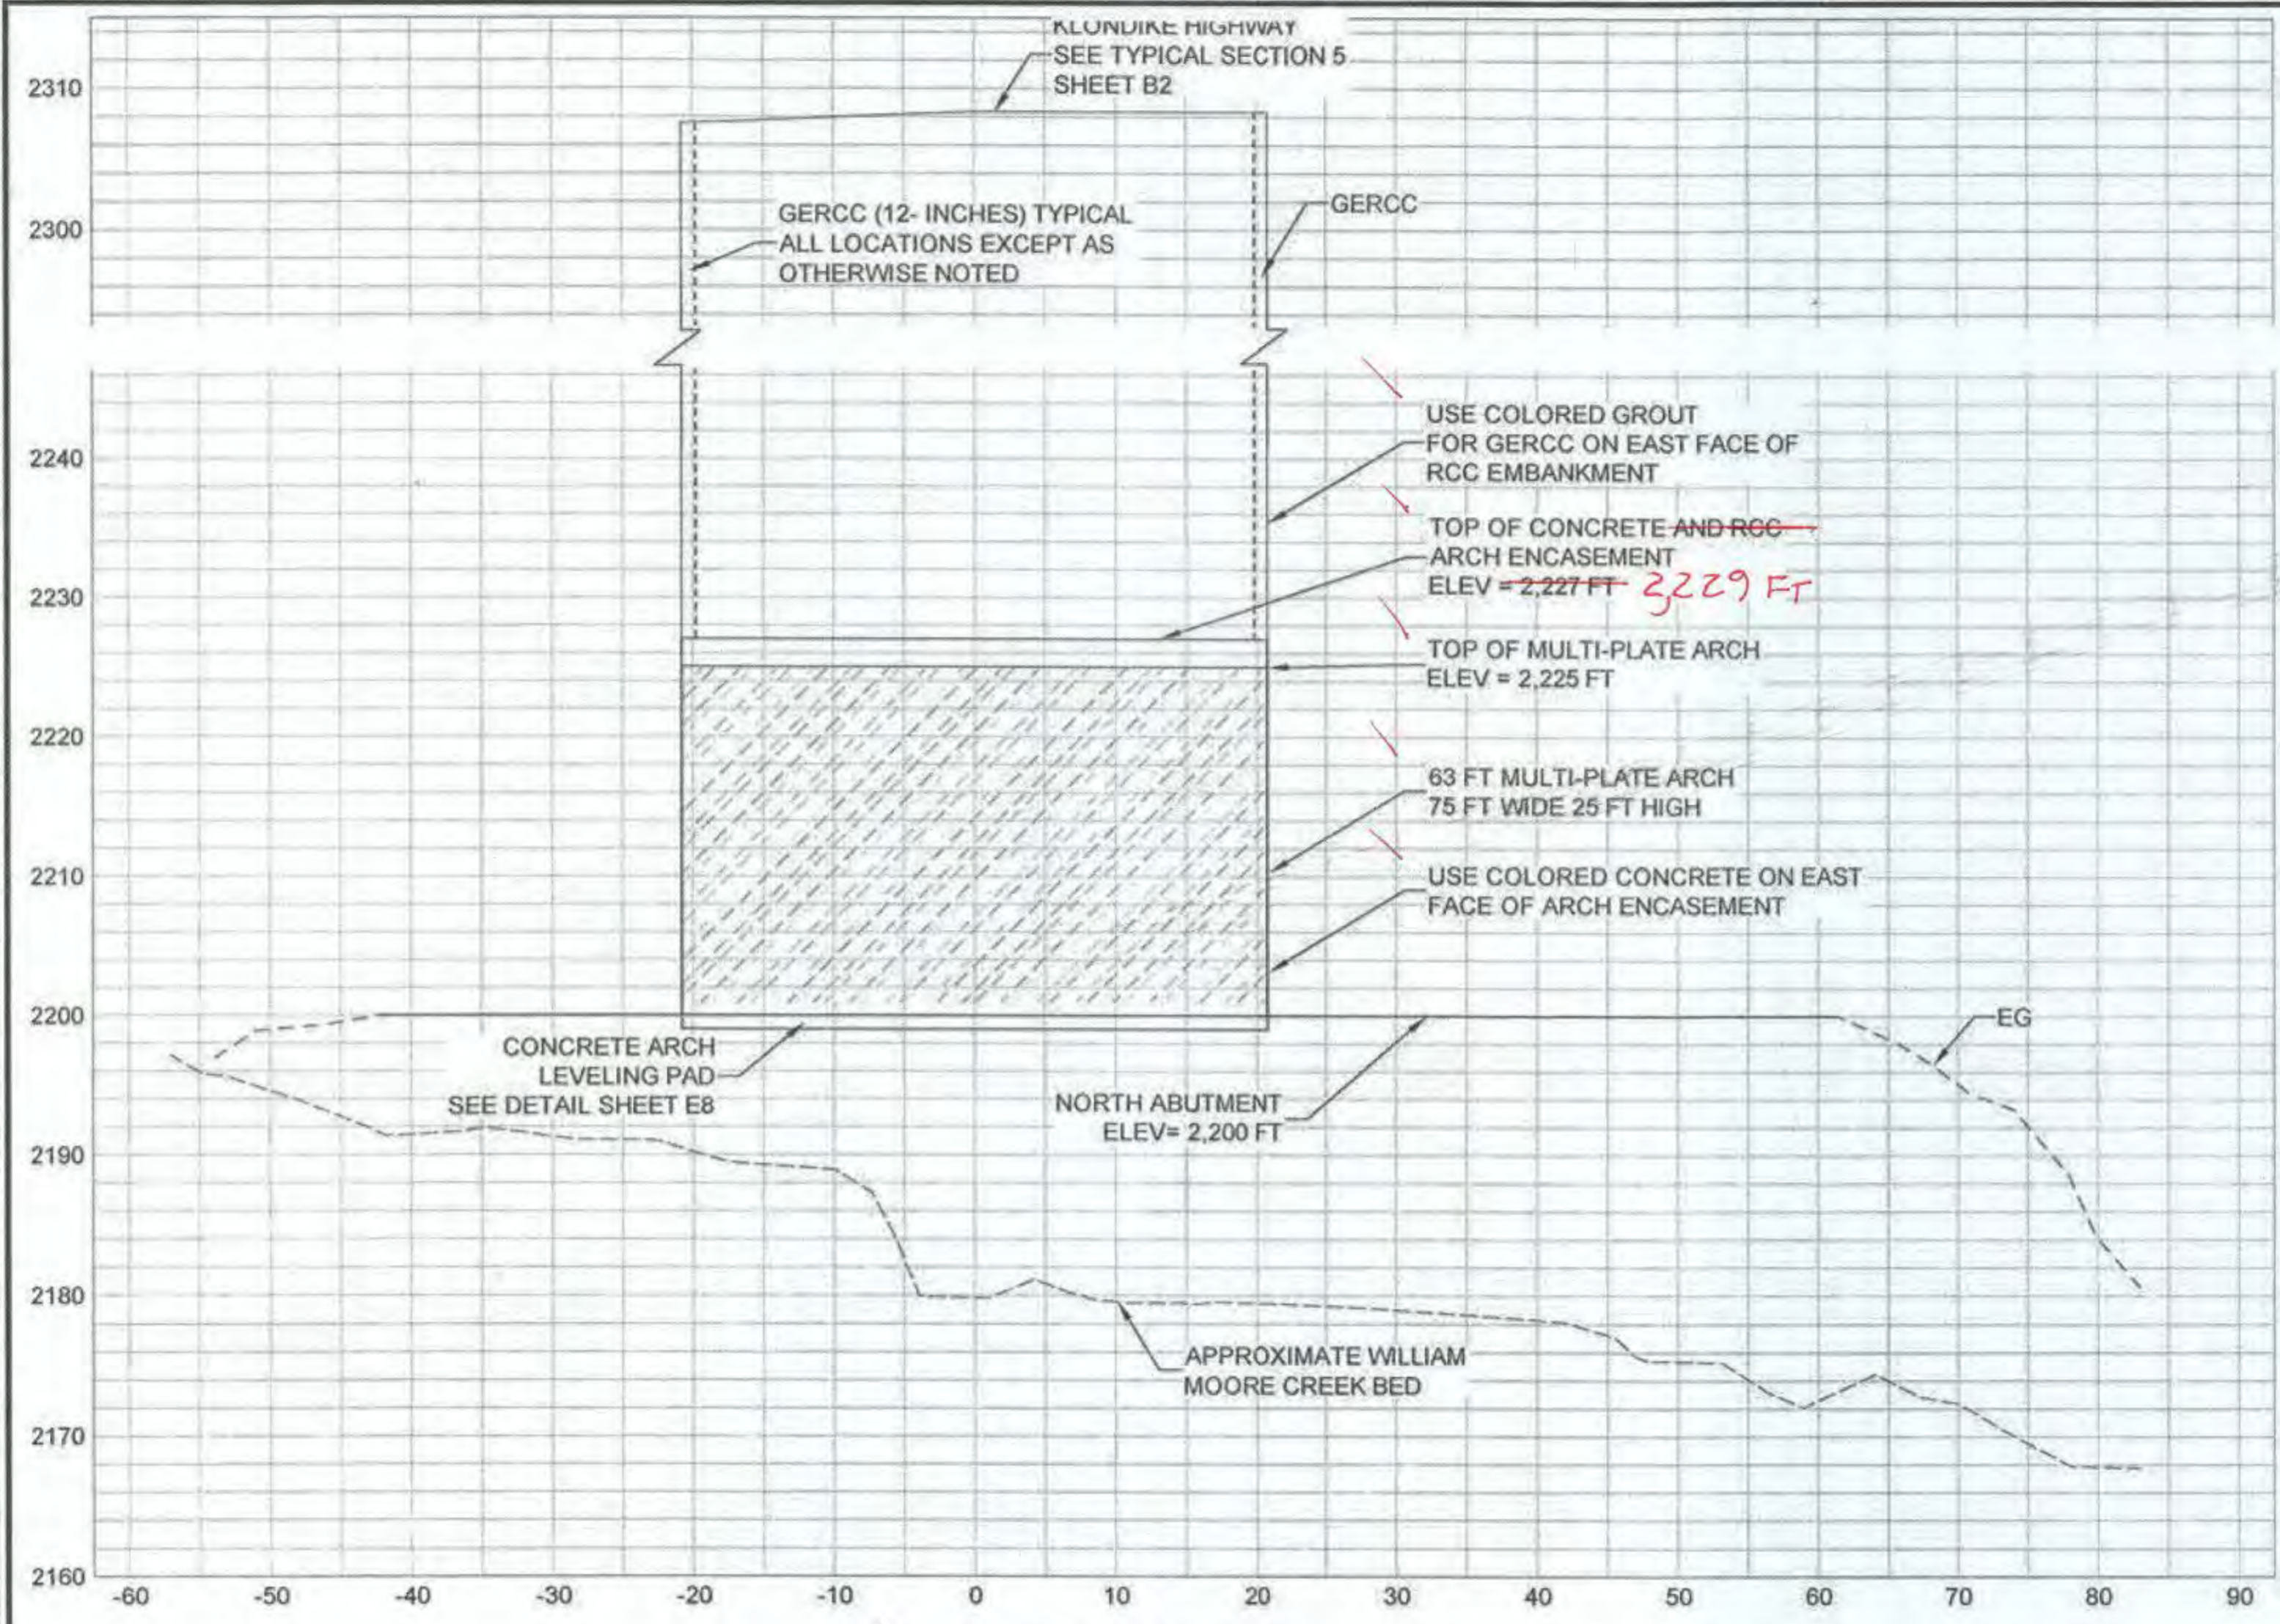

A SECTION
SCALE AS NOTED

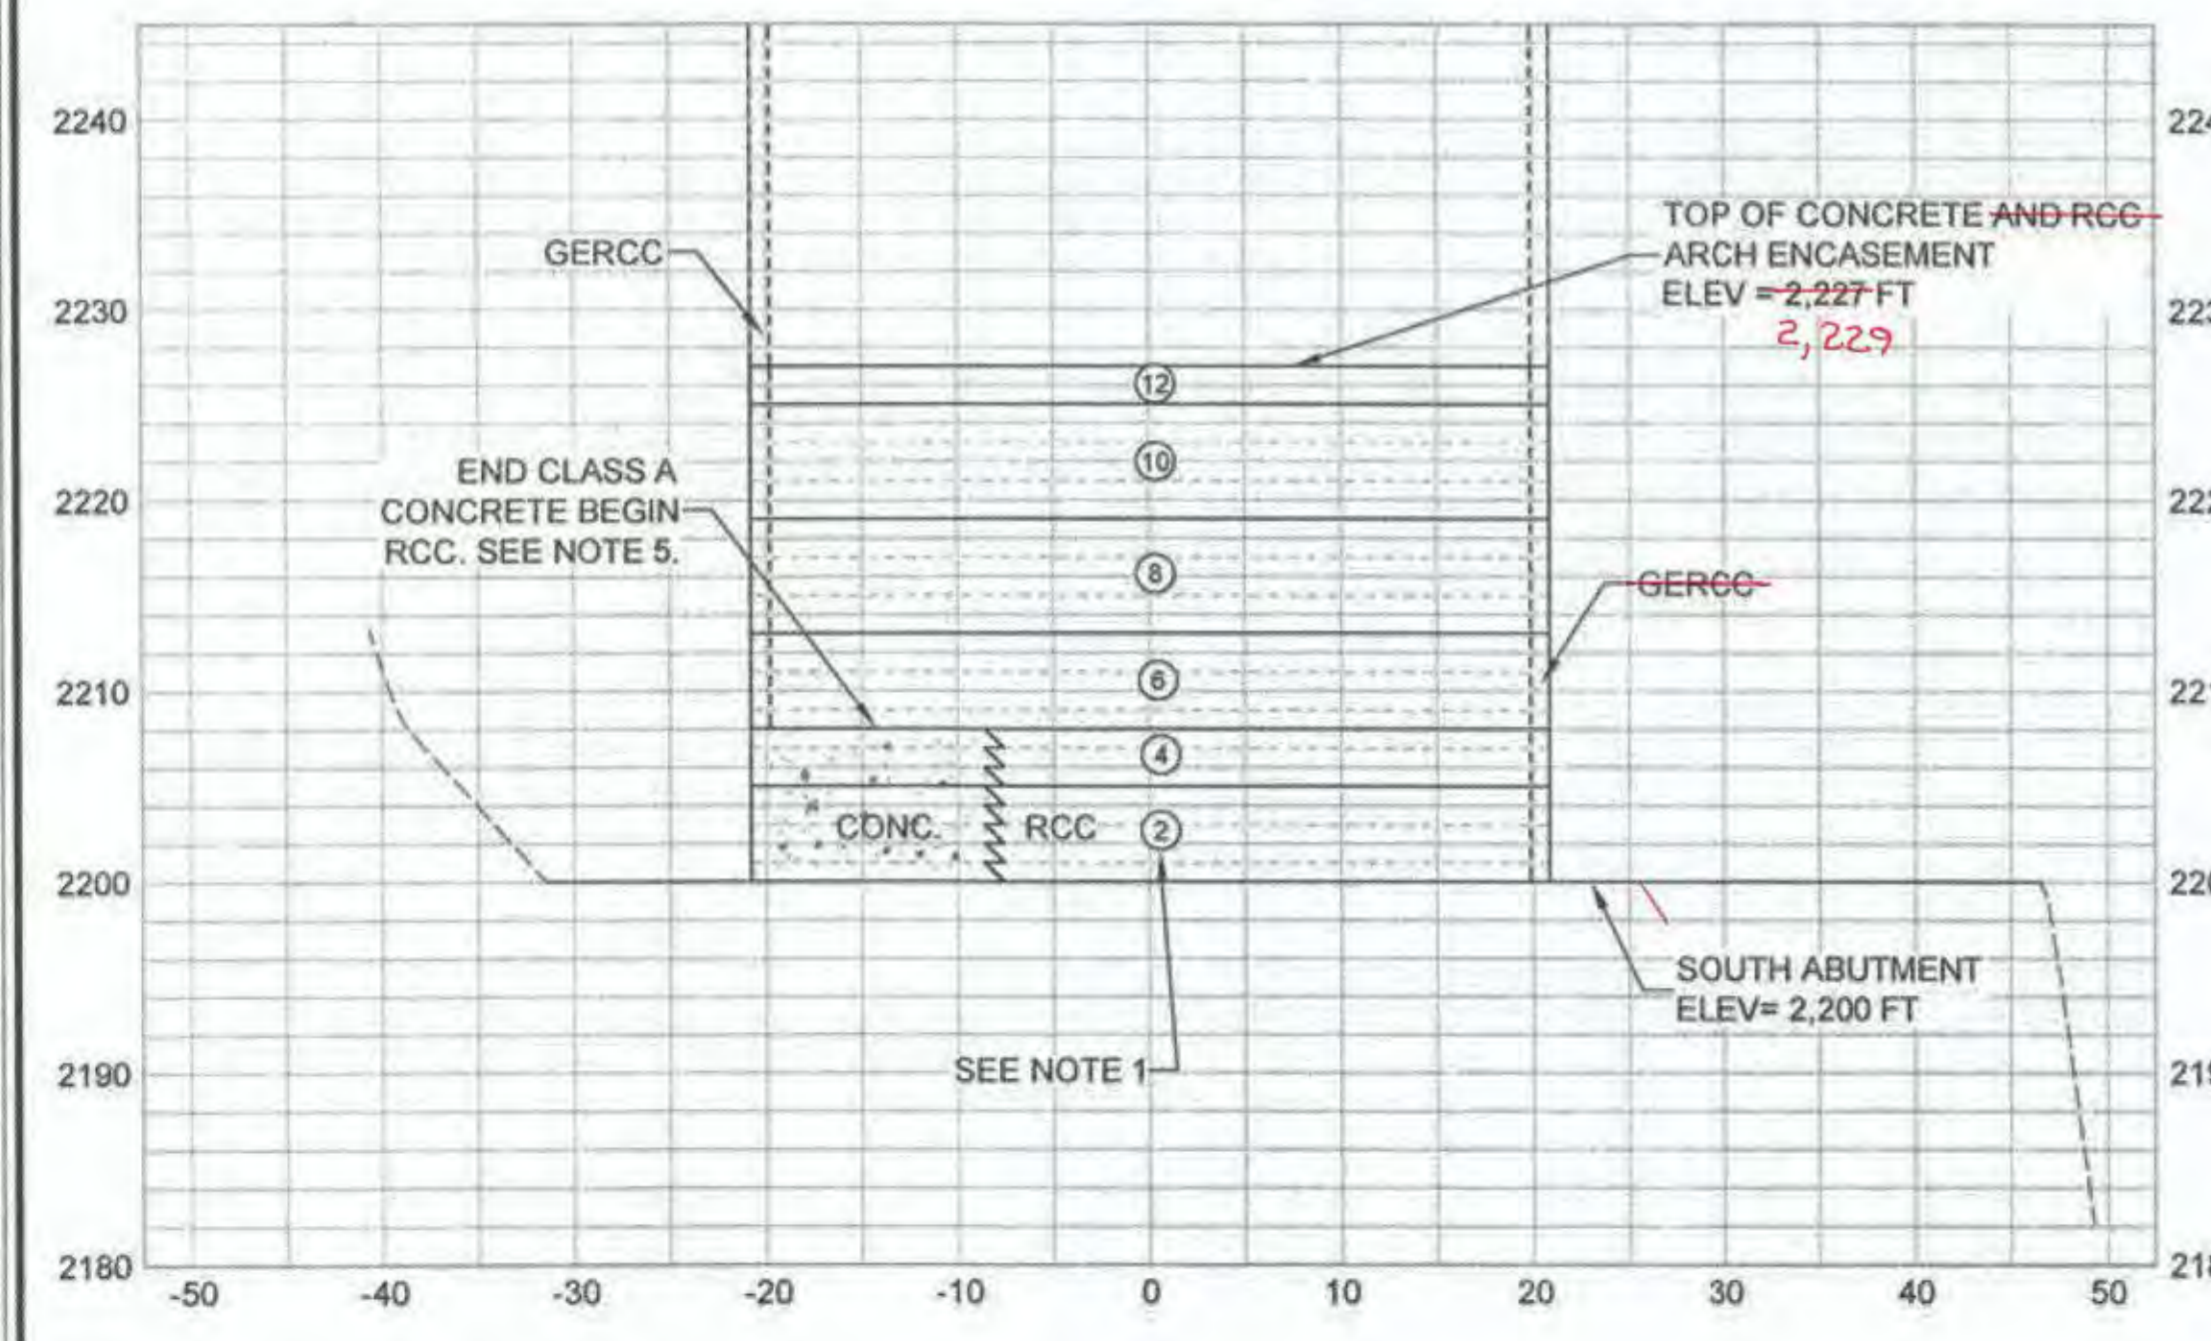


B SECTION
SCALE AS NOTED


NOTES:

- REFER TO MANUFACTURER'S RECOMMENDATIONS FOR ARCH ENCASEMENT PLACEMENT SEQUENCING. NUMBERS SHOWN ON PLACEMENT ZONES REPRESENT A SUGGESTED PLACING SEQUENCE THAT WILL MAINTAIN A 3 FOOT MAXIMUM DIFFERENTIAL FROM SIDE TO SIDE OF THE ARCH.
- GERCC AND CONCRETE FACING SHALL BE USED IN DESIGNATED AREAS AS SHOWN IN SECTIONS B, C, AND D.
- EQUIPMENT SHALL NOT BE OPERATED AND RCC SHALL NOT BE PLACED OVER THE TOP OF THE ARCH UNTIL THE UNDERLYING CONCRETE ACHIEVES ADEQUATE DESIGN STRENGTH AS DETERMINED BY THE ARCH MANUFACTURER.
- VIBRATORY ROLLERS SHALL AT ALL TIMES REMAIN A MINIMUM OF 12-INCHES FROM THE ARCH.
- USE CLASS A CONCRETE INSTEAD OF RCC WHERE RCC COMPACTION EQUIPMENT WON'T FIT BETWEEN THE ROCK SLOPE AND ARCH. THE NORTH SIDE OF THE ARCH REQUIRES CONCRETE UP TO 2210 FT ELEVATION FOR THE LENGTH OF THE ARCH. THE SOUTH SIDE OF THE ARCH REQUIRES CONCRETE UP TO 2208 FT ELEVATION (ONLY ON THE WEST END) AS SHOWN IN SECTION B.
- THERE ARE ISOLATED AREAS WHERE THERE MAY BE OVERHANGING ROCK AT THE ABUTMENT FACE. THE WIDTH OF GERCC SHALL BE INCREASED AS NECESSARY TO ALLOW ROOM FOR COMPACTION EQUIPMENT.


PER MANUFACTURER'S RECOMMENDATIONS, ARCH ENCASED IN CONVENTIONAL CLASS A CONCRETE.

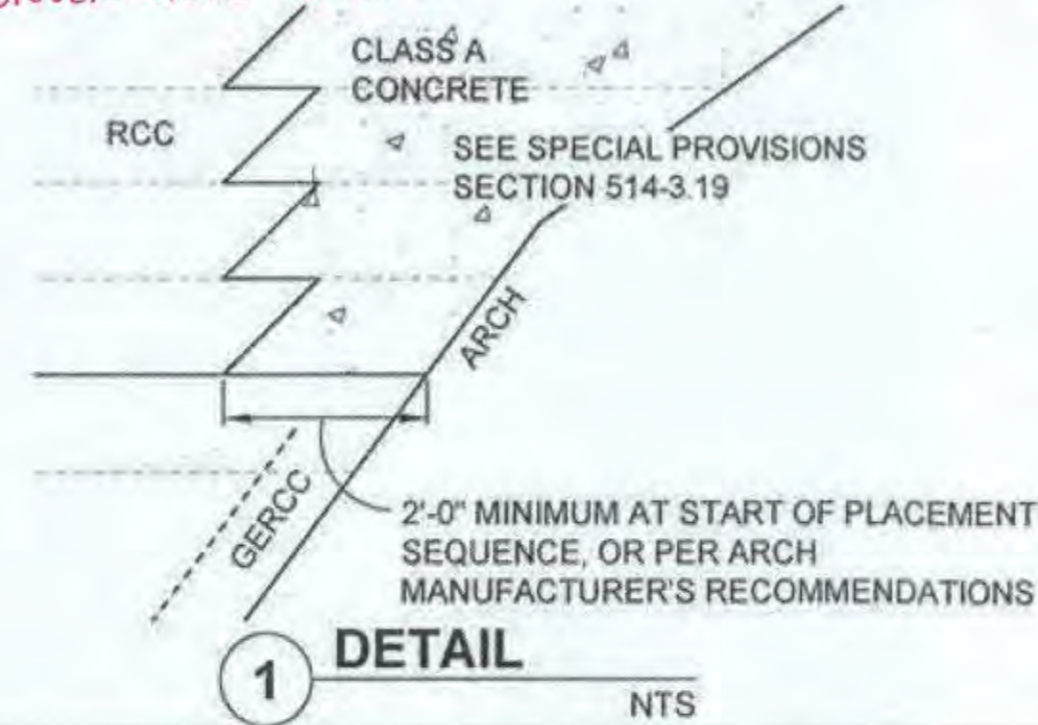

1 DETAIL
NTS

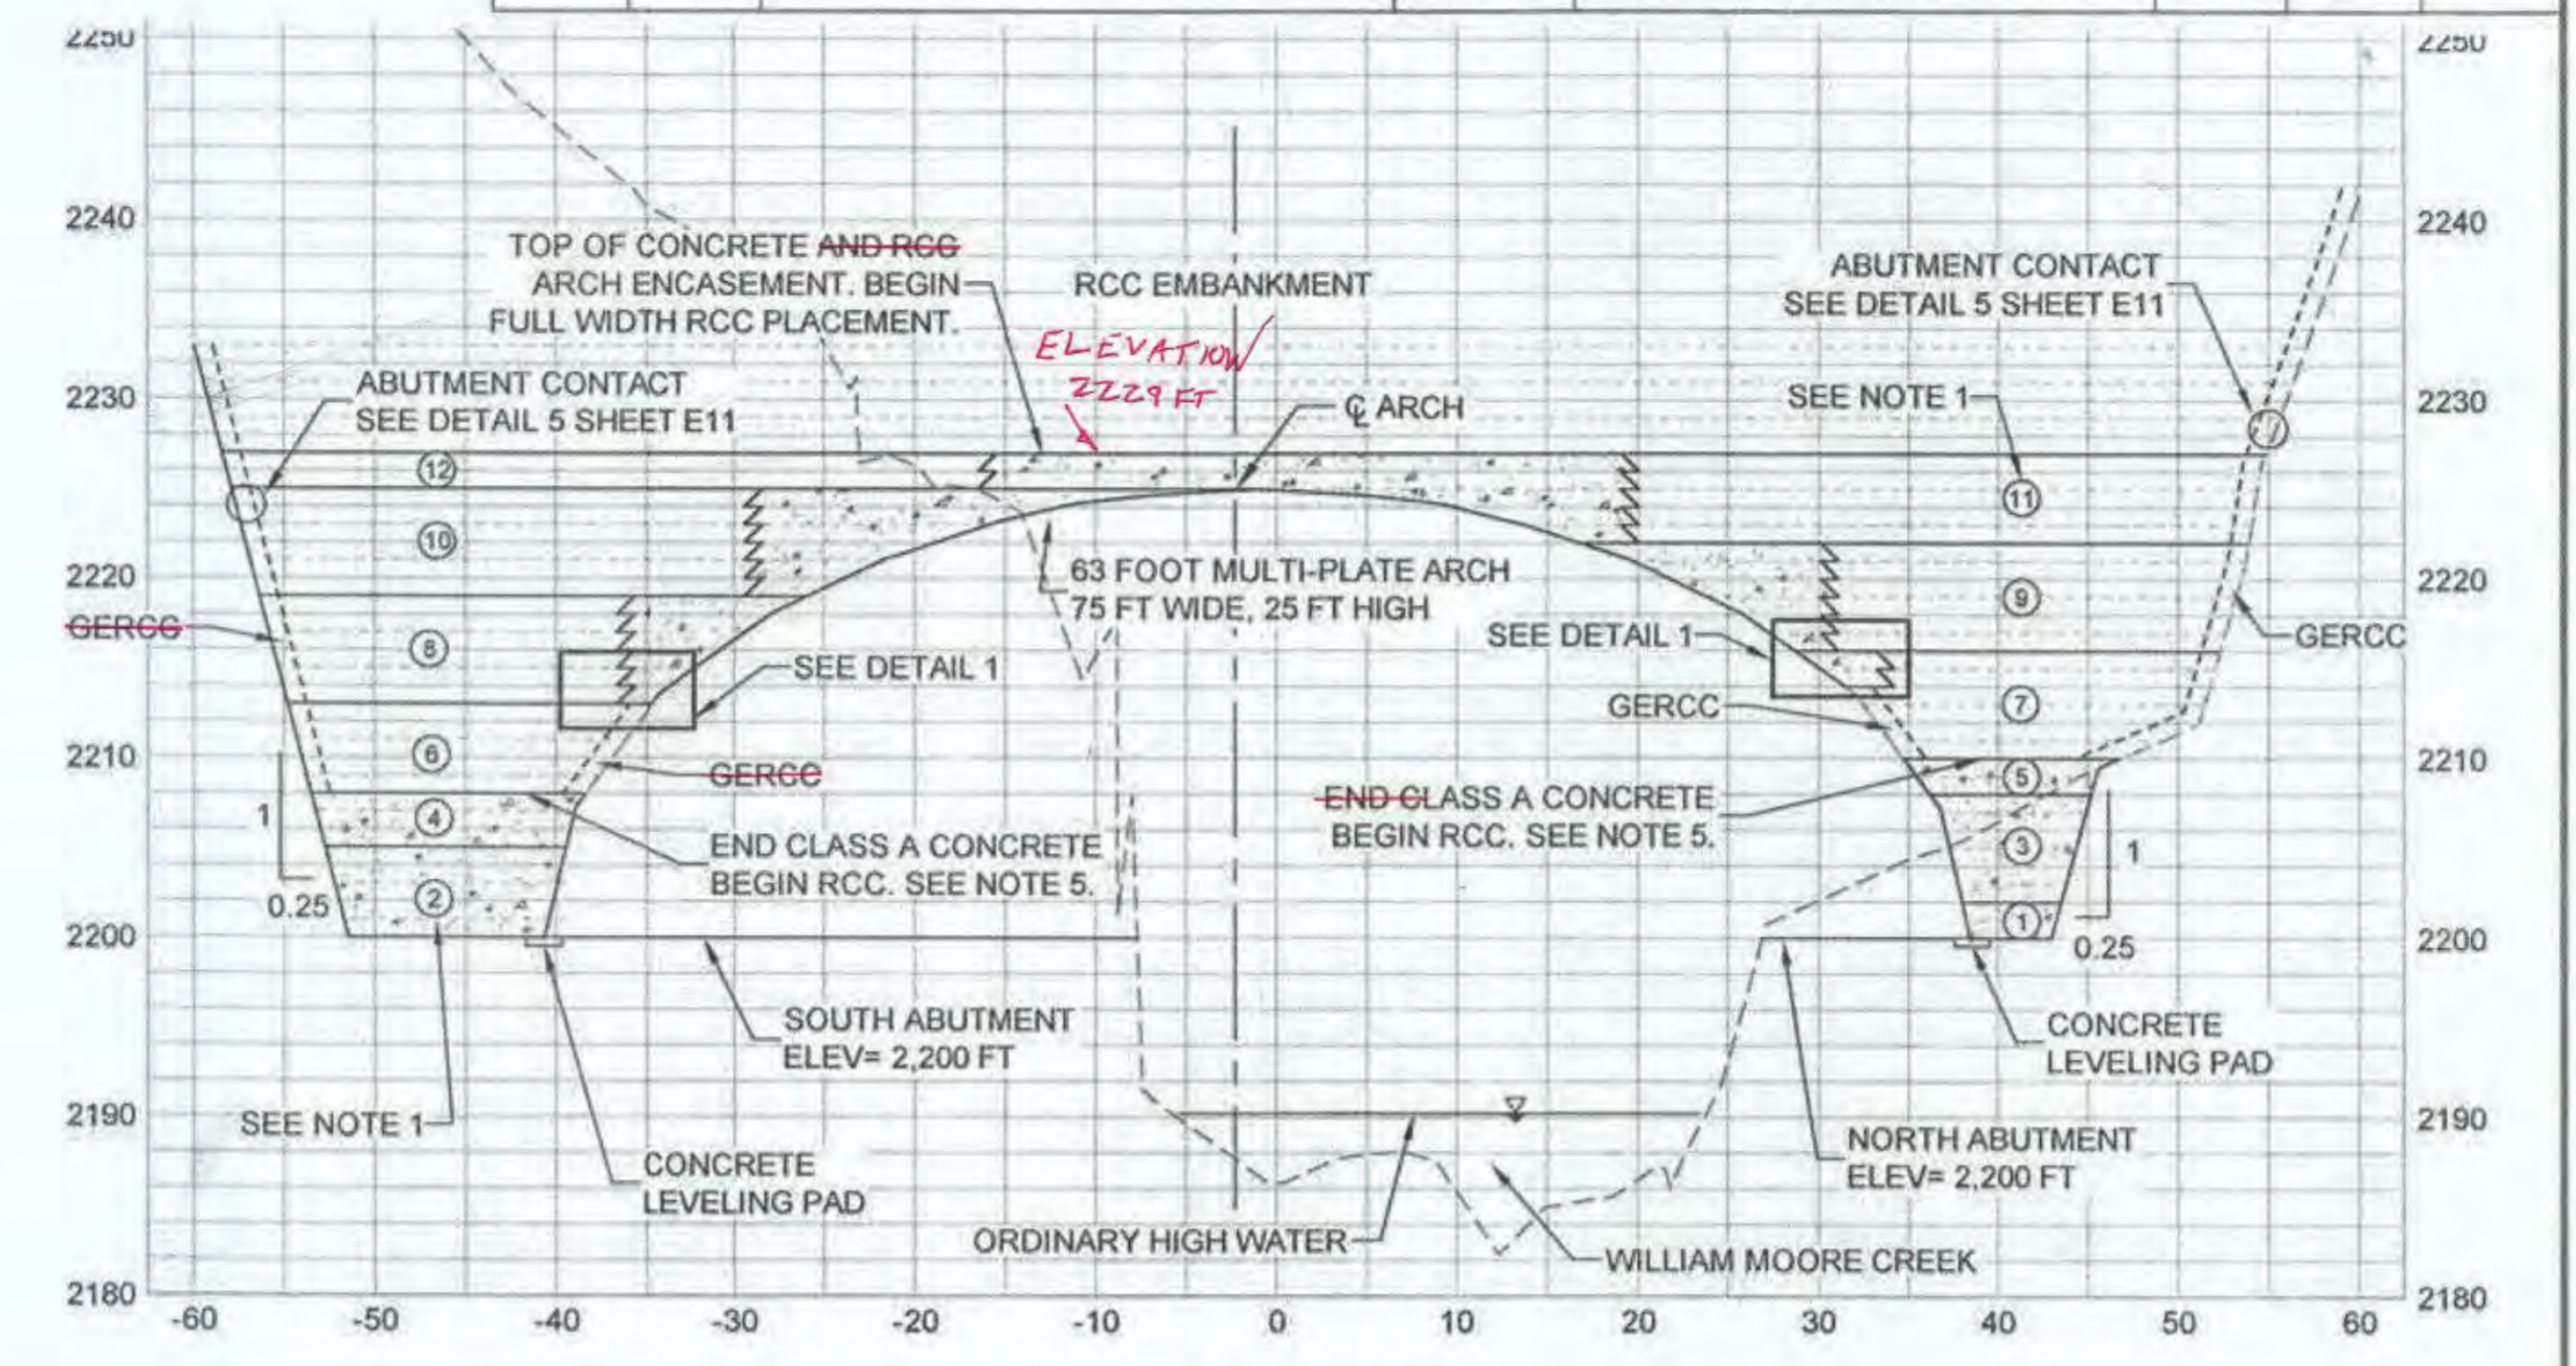

C SECTION
SCALE AS NOTED

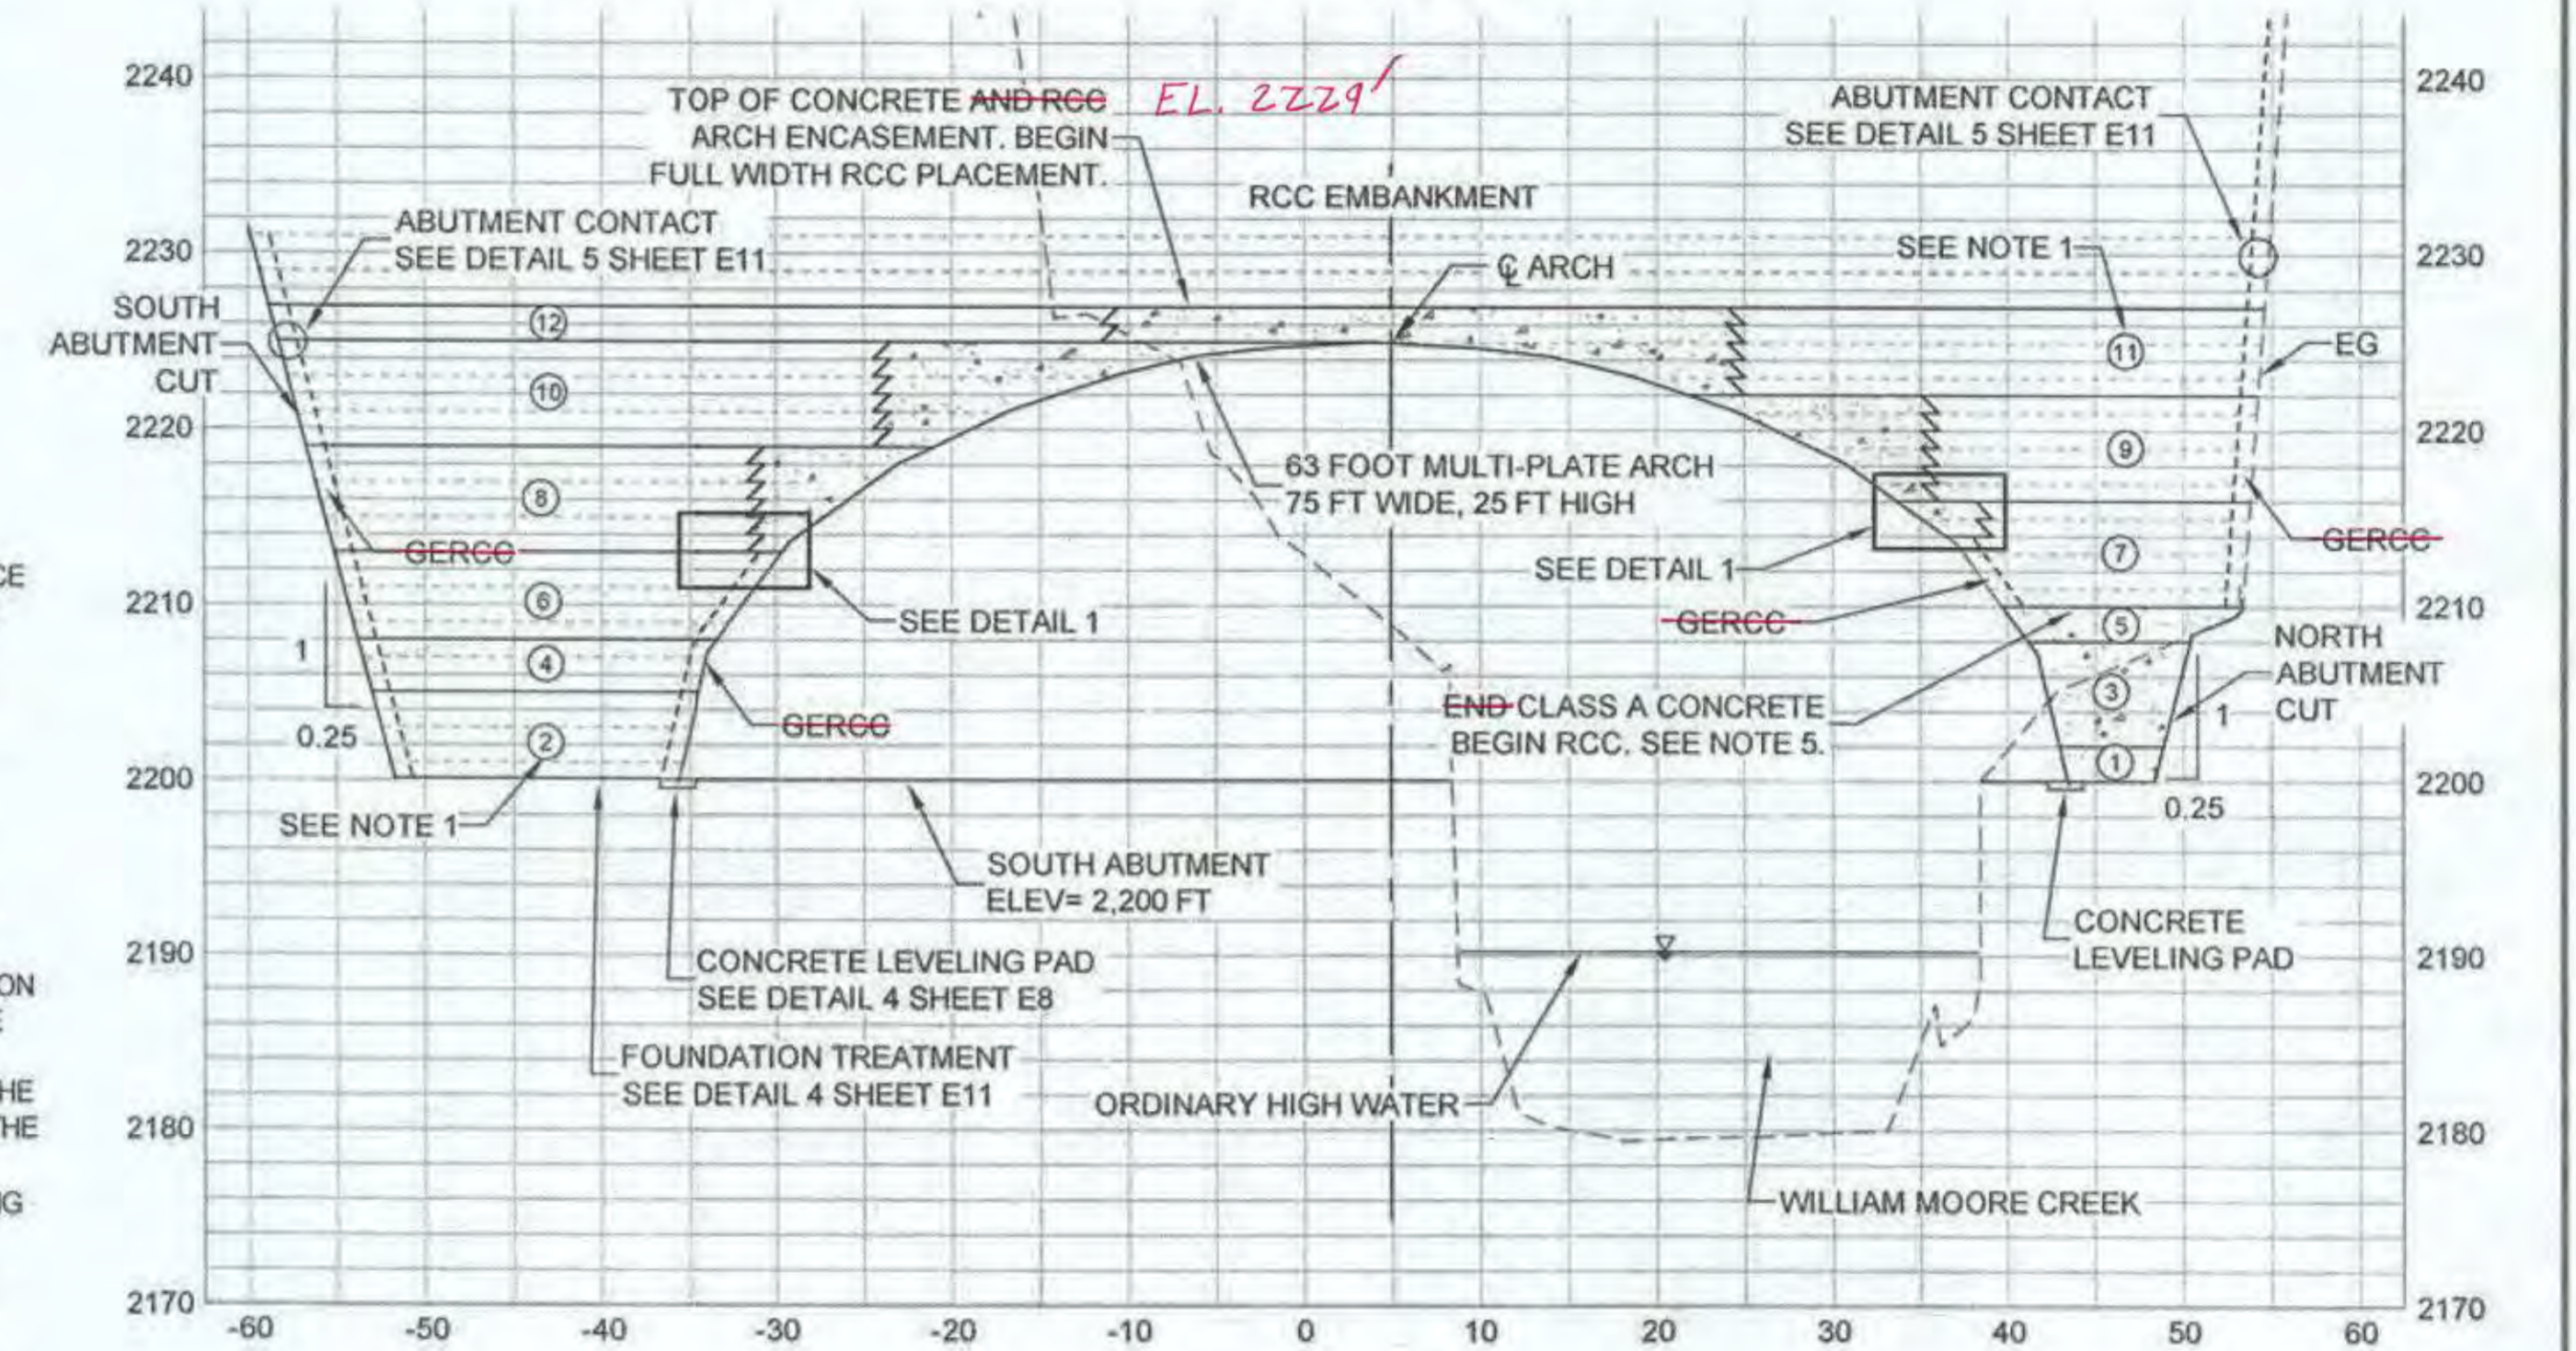

D SECTION
SCALE AS NOTED


PLANS DEVELOPED BY:
DOWL
5368 COMMERCIAL BLVD,
JUNEAU, AK 99801
(907) 780-3533
#AECL848





STATE OF ALASKA
DEPARTMENT OF TRANSPORTATION
AND PUBLIC FACILITIES
**SKAGWAY - REPLACE CAPTAIN
WILLIAM HENRY MOORE BRIDGE**
**RCC EMBANKMENT AND ARCH
ENCASEMENT DETAILS**

FILE: C:\CIVIL 3D Projects\24\70732-01\Civil\SA14-CT-E-01-CWM.dwg
 DATE: 8/17/2016 7:22 LAYOUT: E10
 DESIGNED: HOBBS
 CHECKED: NOBLE
 DRAFTED: WESTPHAL

NO.	DATE	REVISION	STATE	PROJECT DESIGNATION	YEAR	SHEET NO.	TOTAL SHEETS
			ALASKA	0972016/Z684590000	2016	E10	59

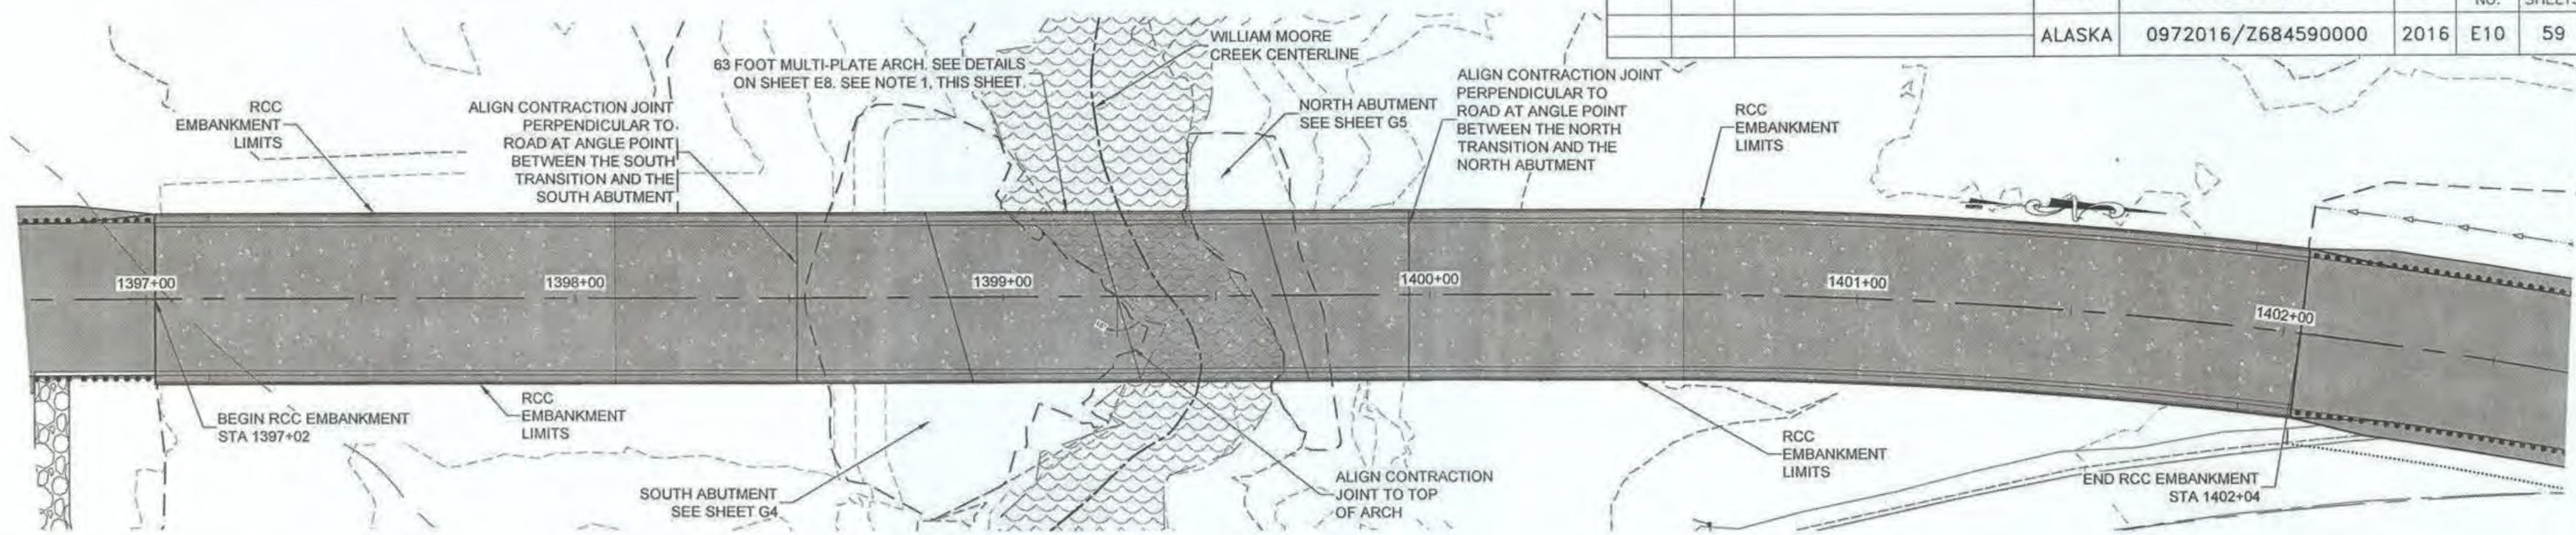

- NOTE:**
- THE FULL LENGTH OF THE MULTI-PLATE ARCH IS 63 FEET. THE ARCH IS SKEWED TO FIT THE ROCK ABUTMENTS AND MUST BE CUT AT EACH END TO BE PARALLEL WITH THE KLONDIKE HIGHWAY.
 - PLACE CONTRACTION JOINT MATERIAL IN EVERY OTHER LIFT. SEE DETAIL 2 AND 3, SHEET E11.

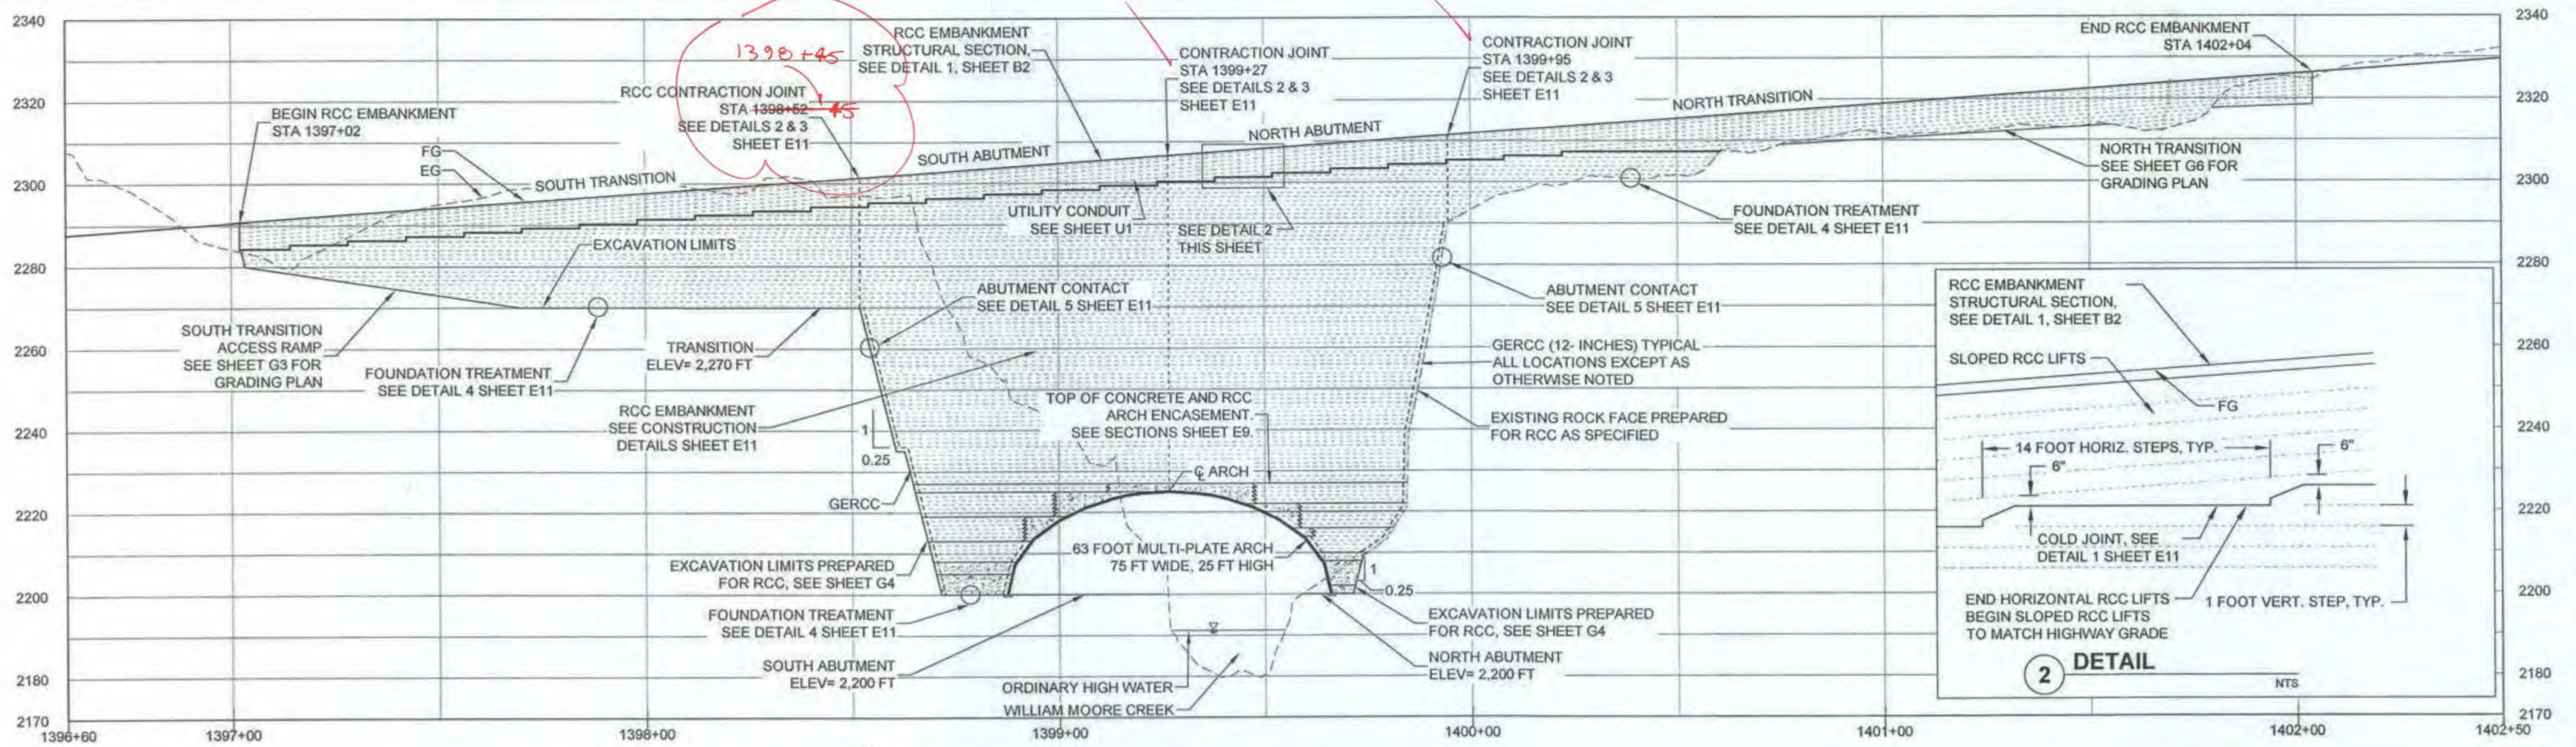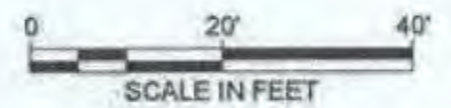

1 RCC EMBANKMENT PLAN AND PROFILE DETAIL
SCALE AS NOTED

9/20

PLANS DEVELOPED BY:
DOWL
5388 COMMERCIAL BLVD.
JUNEAU, AK 99801
(907) 780-3533
#AECL848







STATE OF ALASKA
DEPARTMENT OF TRANSPORTATION
AND PUBLIC FACILITIES
**SKAGWAY - REPLACE CAPTAIN
WILLIAM HENRY MOORE BRIDGE**

RCC EMBANKMENT DETAILS

8.17.2016

NO.	DATE	REVISION	STATE	PROJECT DESIGNATION	YEAR	SHEET NO.	TOTAL SHEETS
			ALASKA	0972016/Z684590000	2016	E12	59

FILE: C:\civil\3D\Projects\2A\70732-01\Civil\1\SA14-CT-E-01-CM4.dwg
 DATE: 8/17/2016 7:22
 LAYOUT: E12
 DESIGNED: HOBBS
 CHECKED: NOBLE
 DRAFTED: WESTPHAL

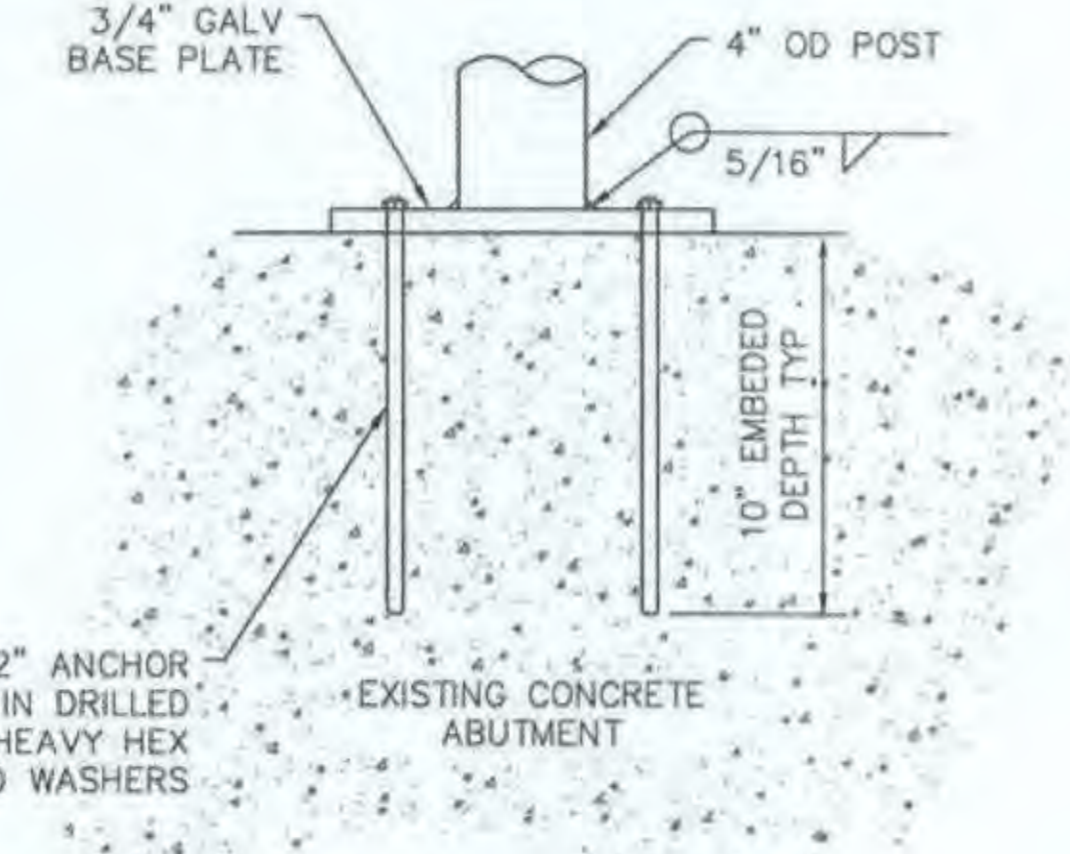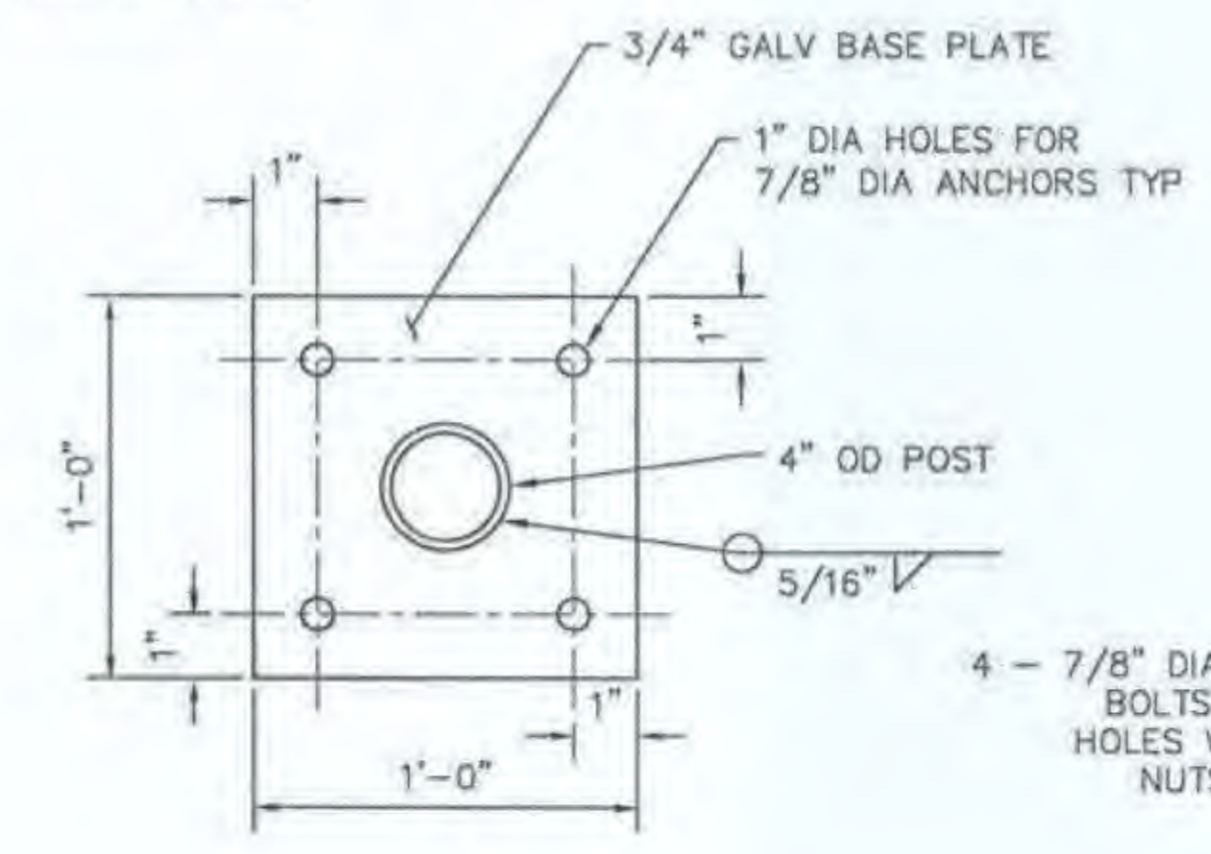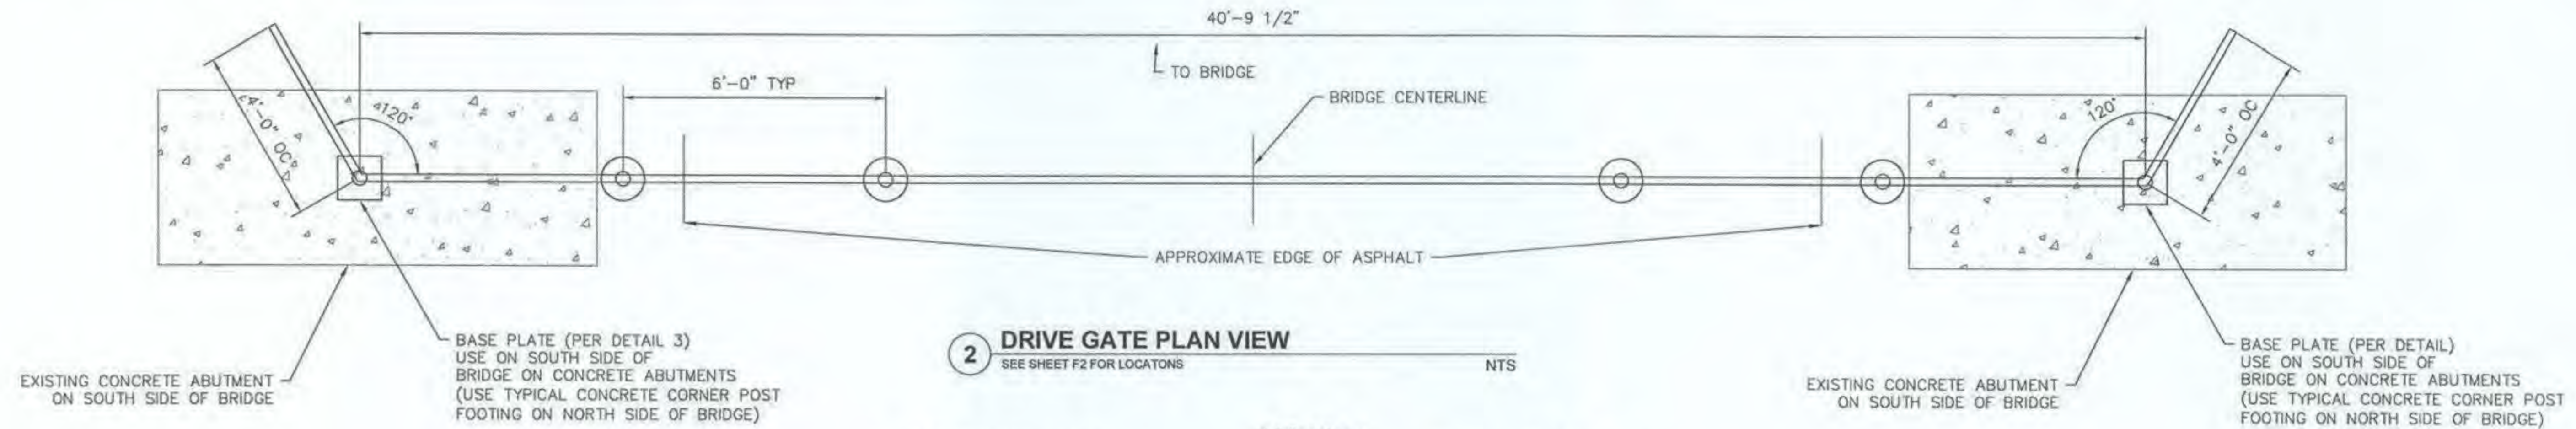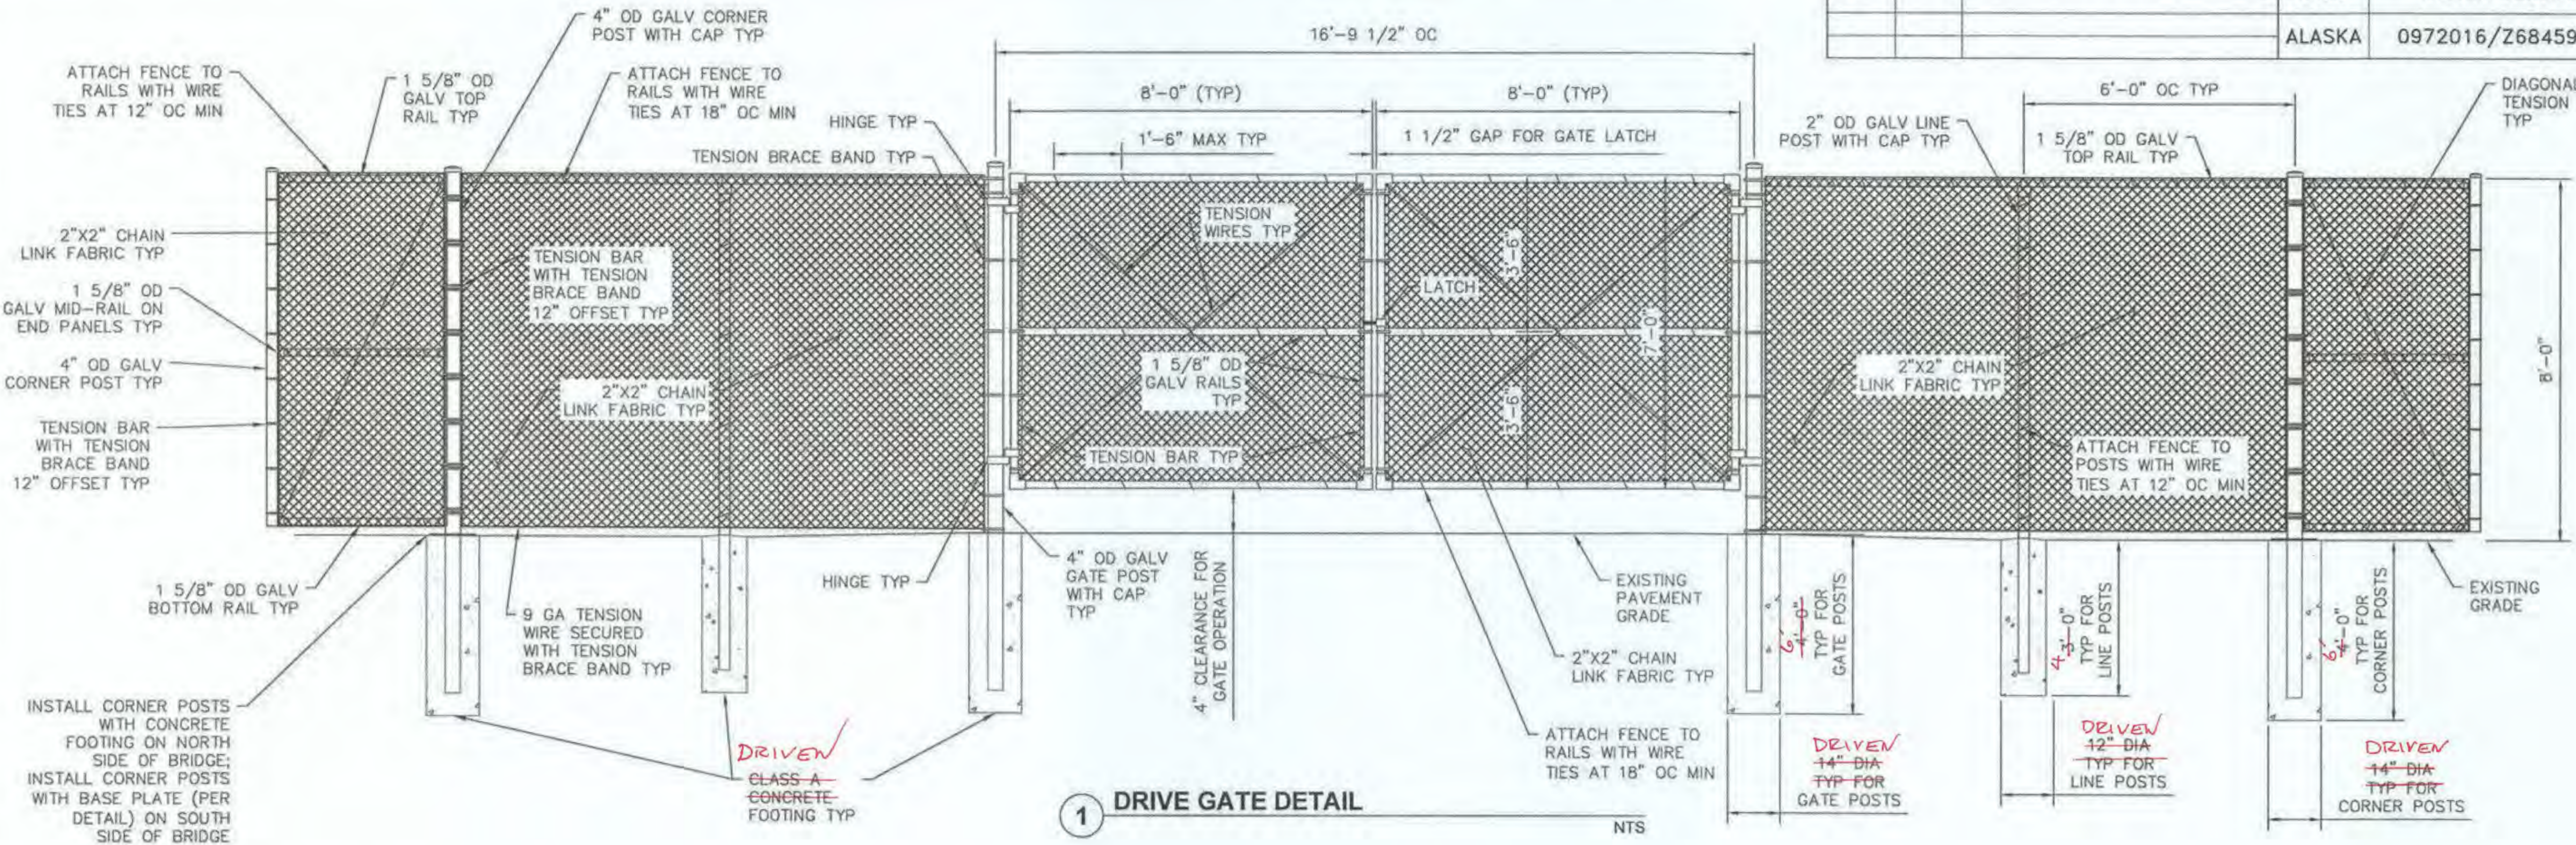



PLANS DEVELOPED BY:
DOWL
5368 COMMERCIAL BLVD,
JUNEAU, AK 99801
(907) 780-3533
#AECL848



STATE OF ALASKA
DEPARTMENT OF TRANSPORTATION
AND PUBLIC FACILITIES
**SKAGWAY - REPLACE CAPTAIN
WILLIAM HENRY MOORE BRIDGE**


FILE C:\Civil\3D Projects\24\70732-01\Civil\SA14-CT-E-DT-CRM.dwg DATE 8/17/2016 7:22 LAYOUT E13 CHECKED NOBLE DRAFTED WESTPHAL

NO.	DATE	REVISION	STATE	PROJECT DESIGNATION	YEAR	SHEET NO.	TOTAL SHEETS
			ALASKA	0972016/Z684590000	2016	E13	59

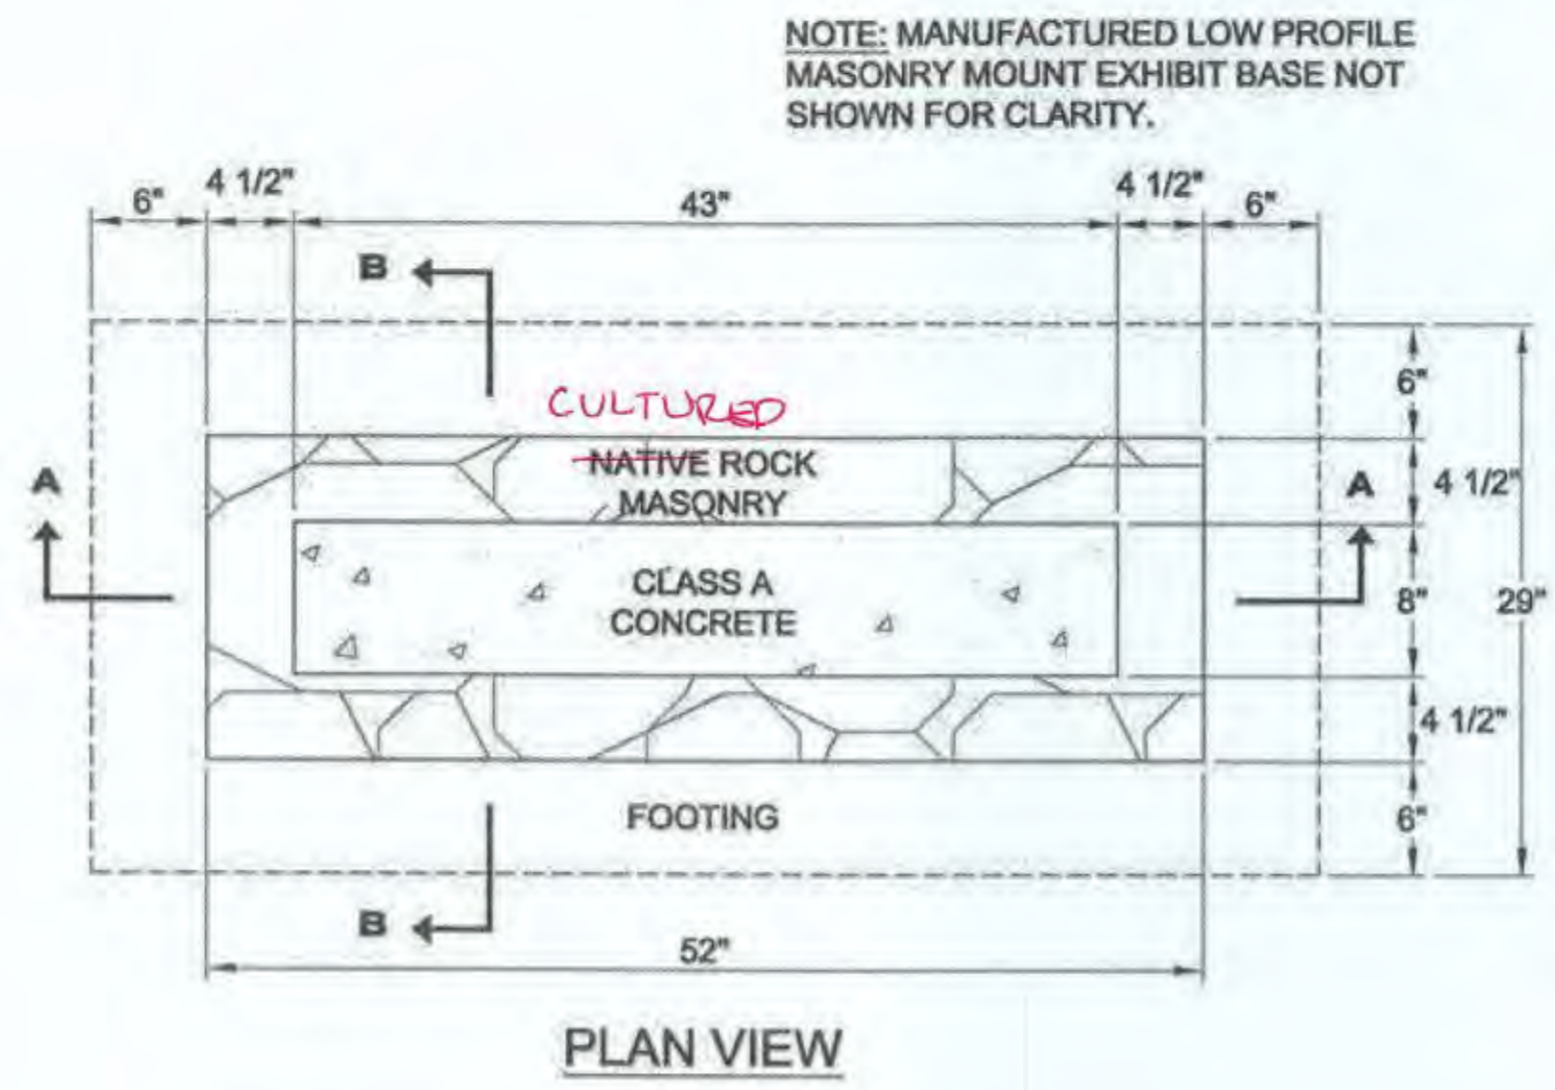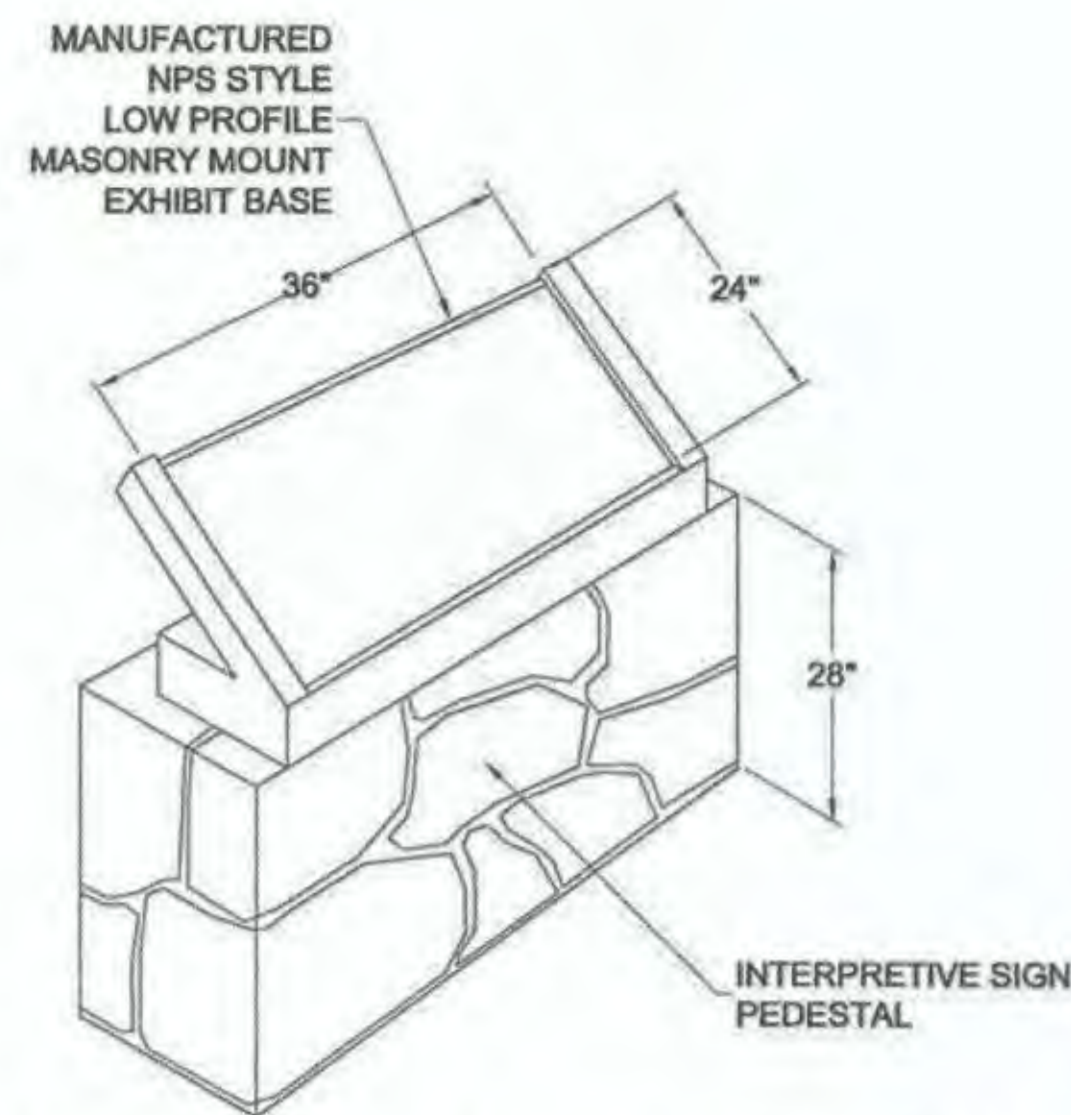


NOTE: MANUFACTURED LOW PROFILE MASONRY MOUNT EXHIBIT BASE NOT SHOWN FOR CLARITY.

1 CONCEPTUAL INTERPRETIVE SIGN EXHIBIT
NTS

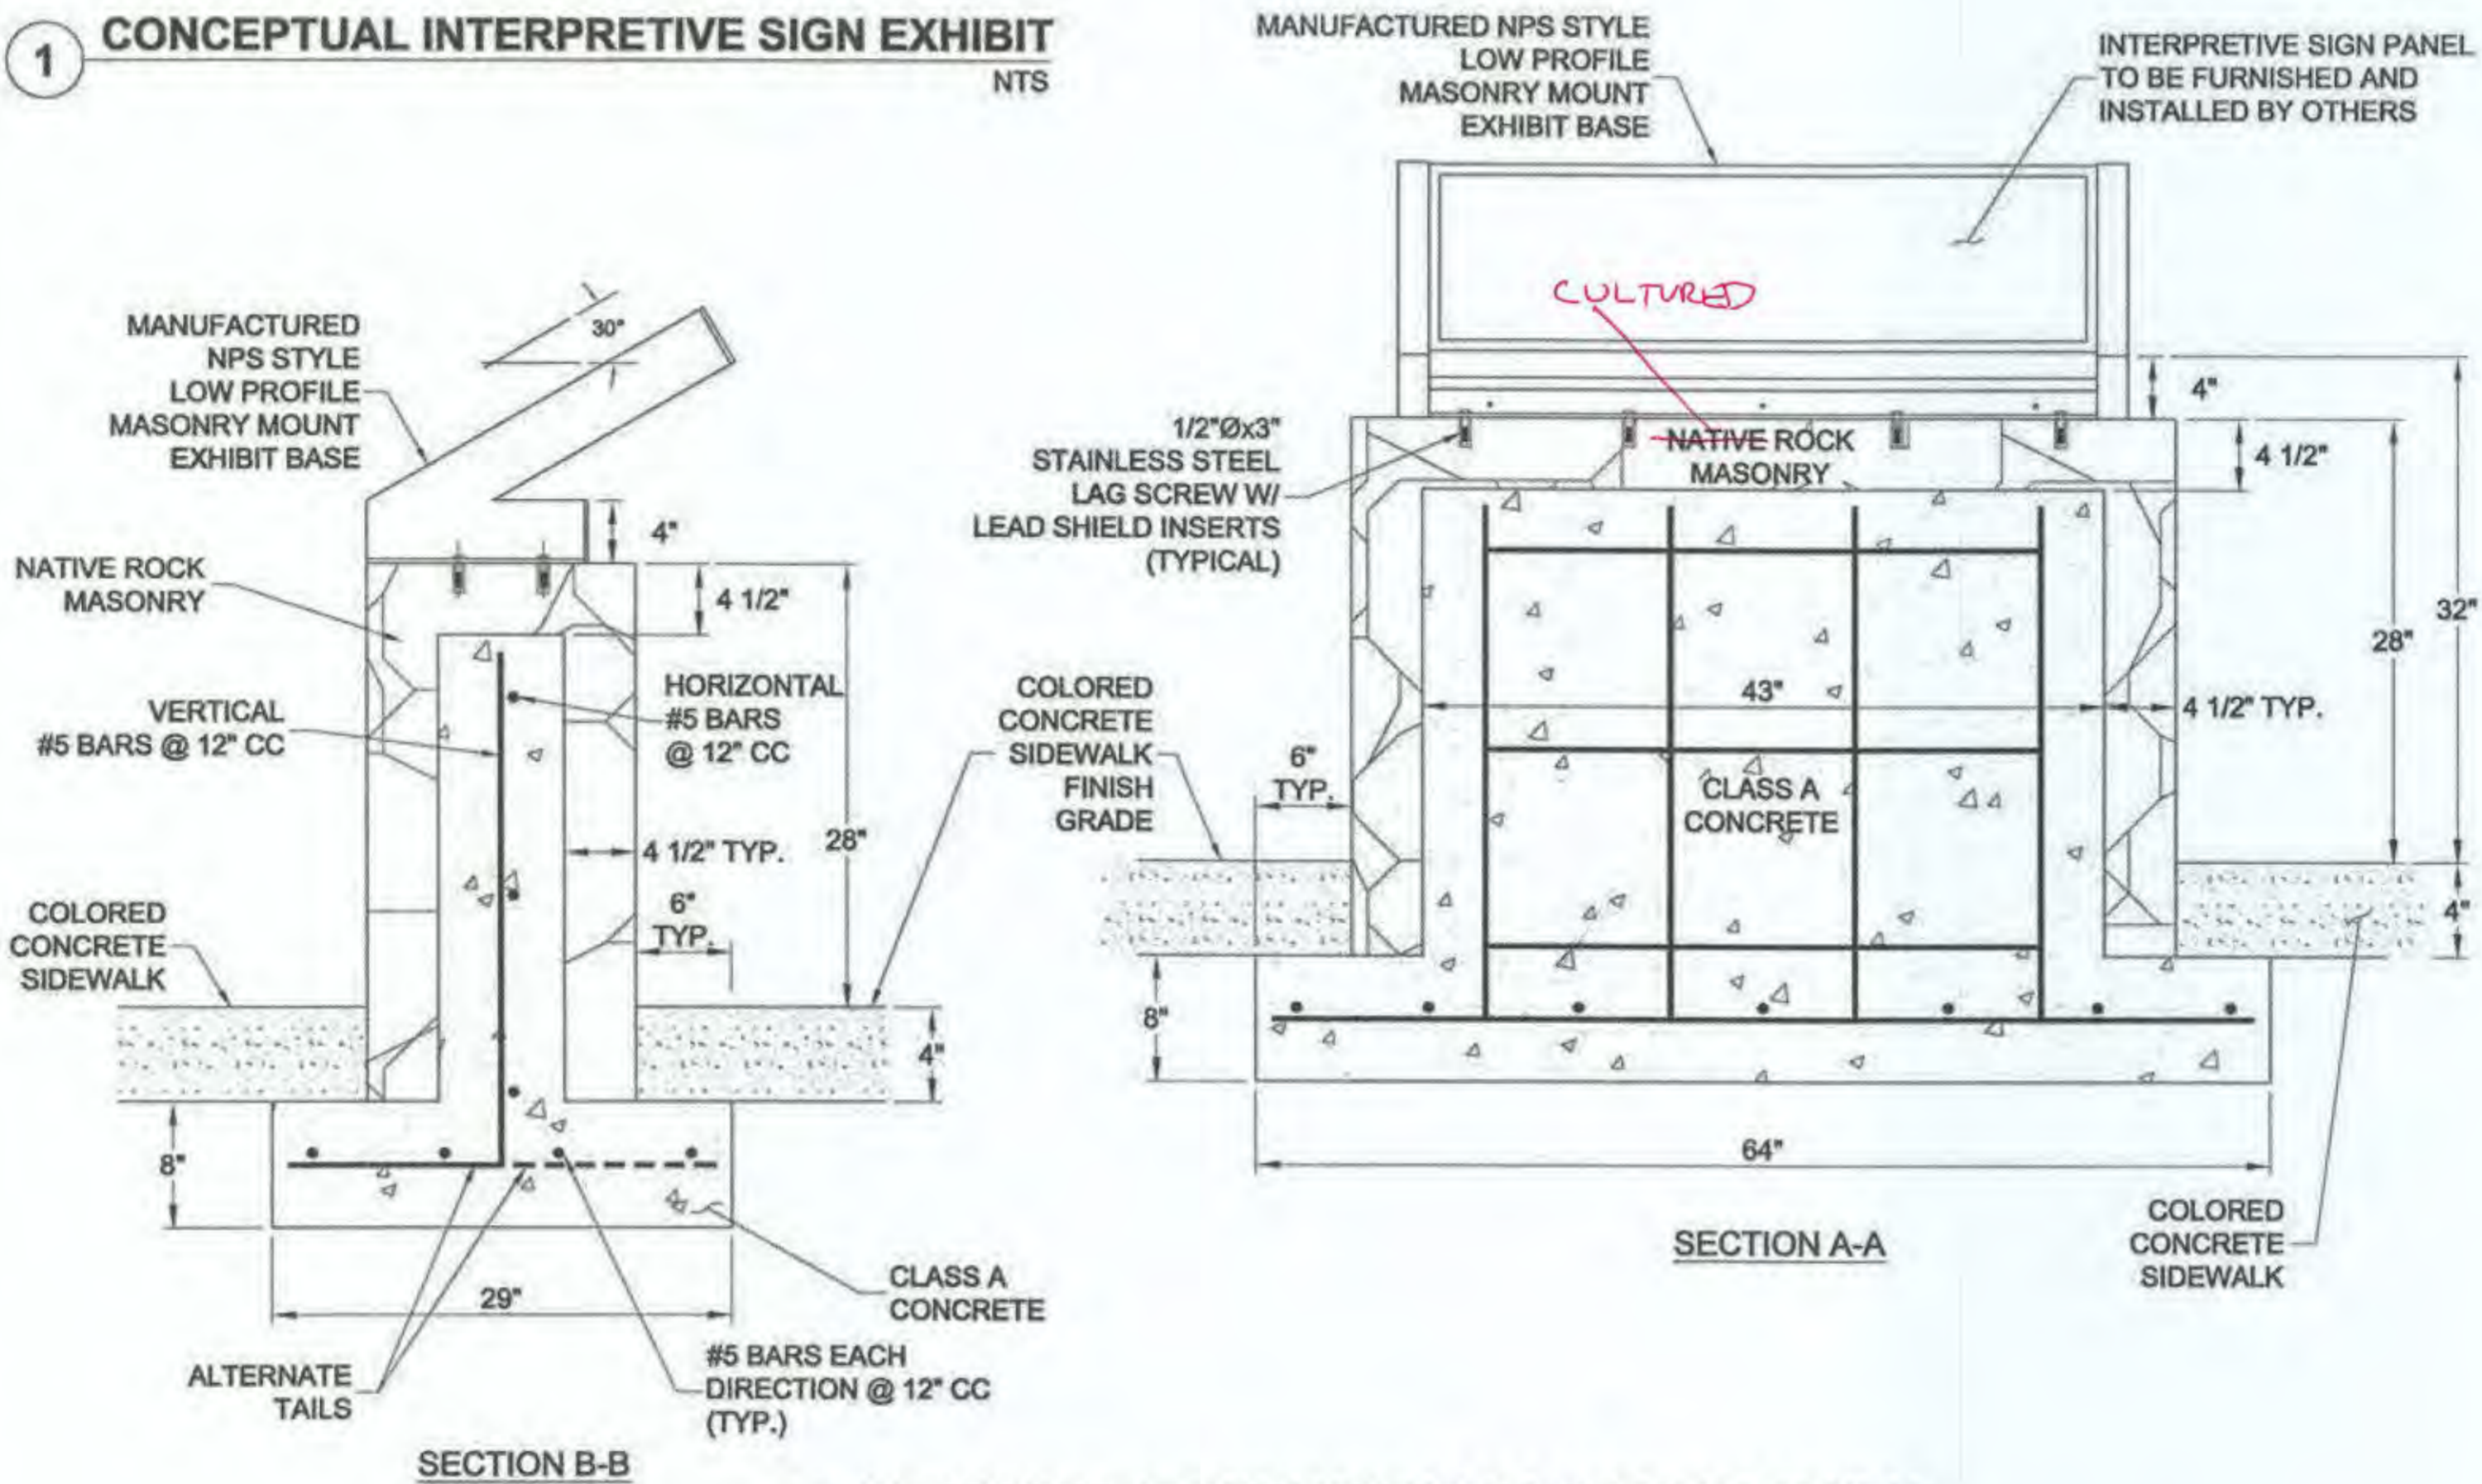


2 INTERPRETIVE SIGN PEDESTAL-TYPE MASONRY
NTS

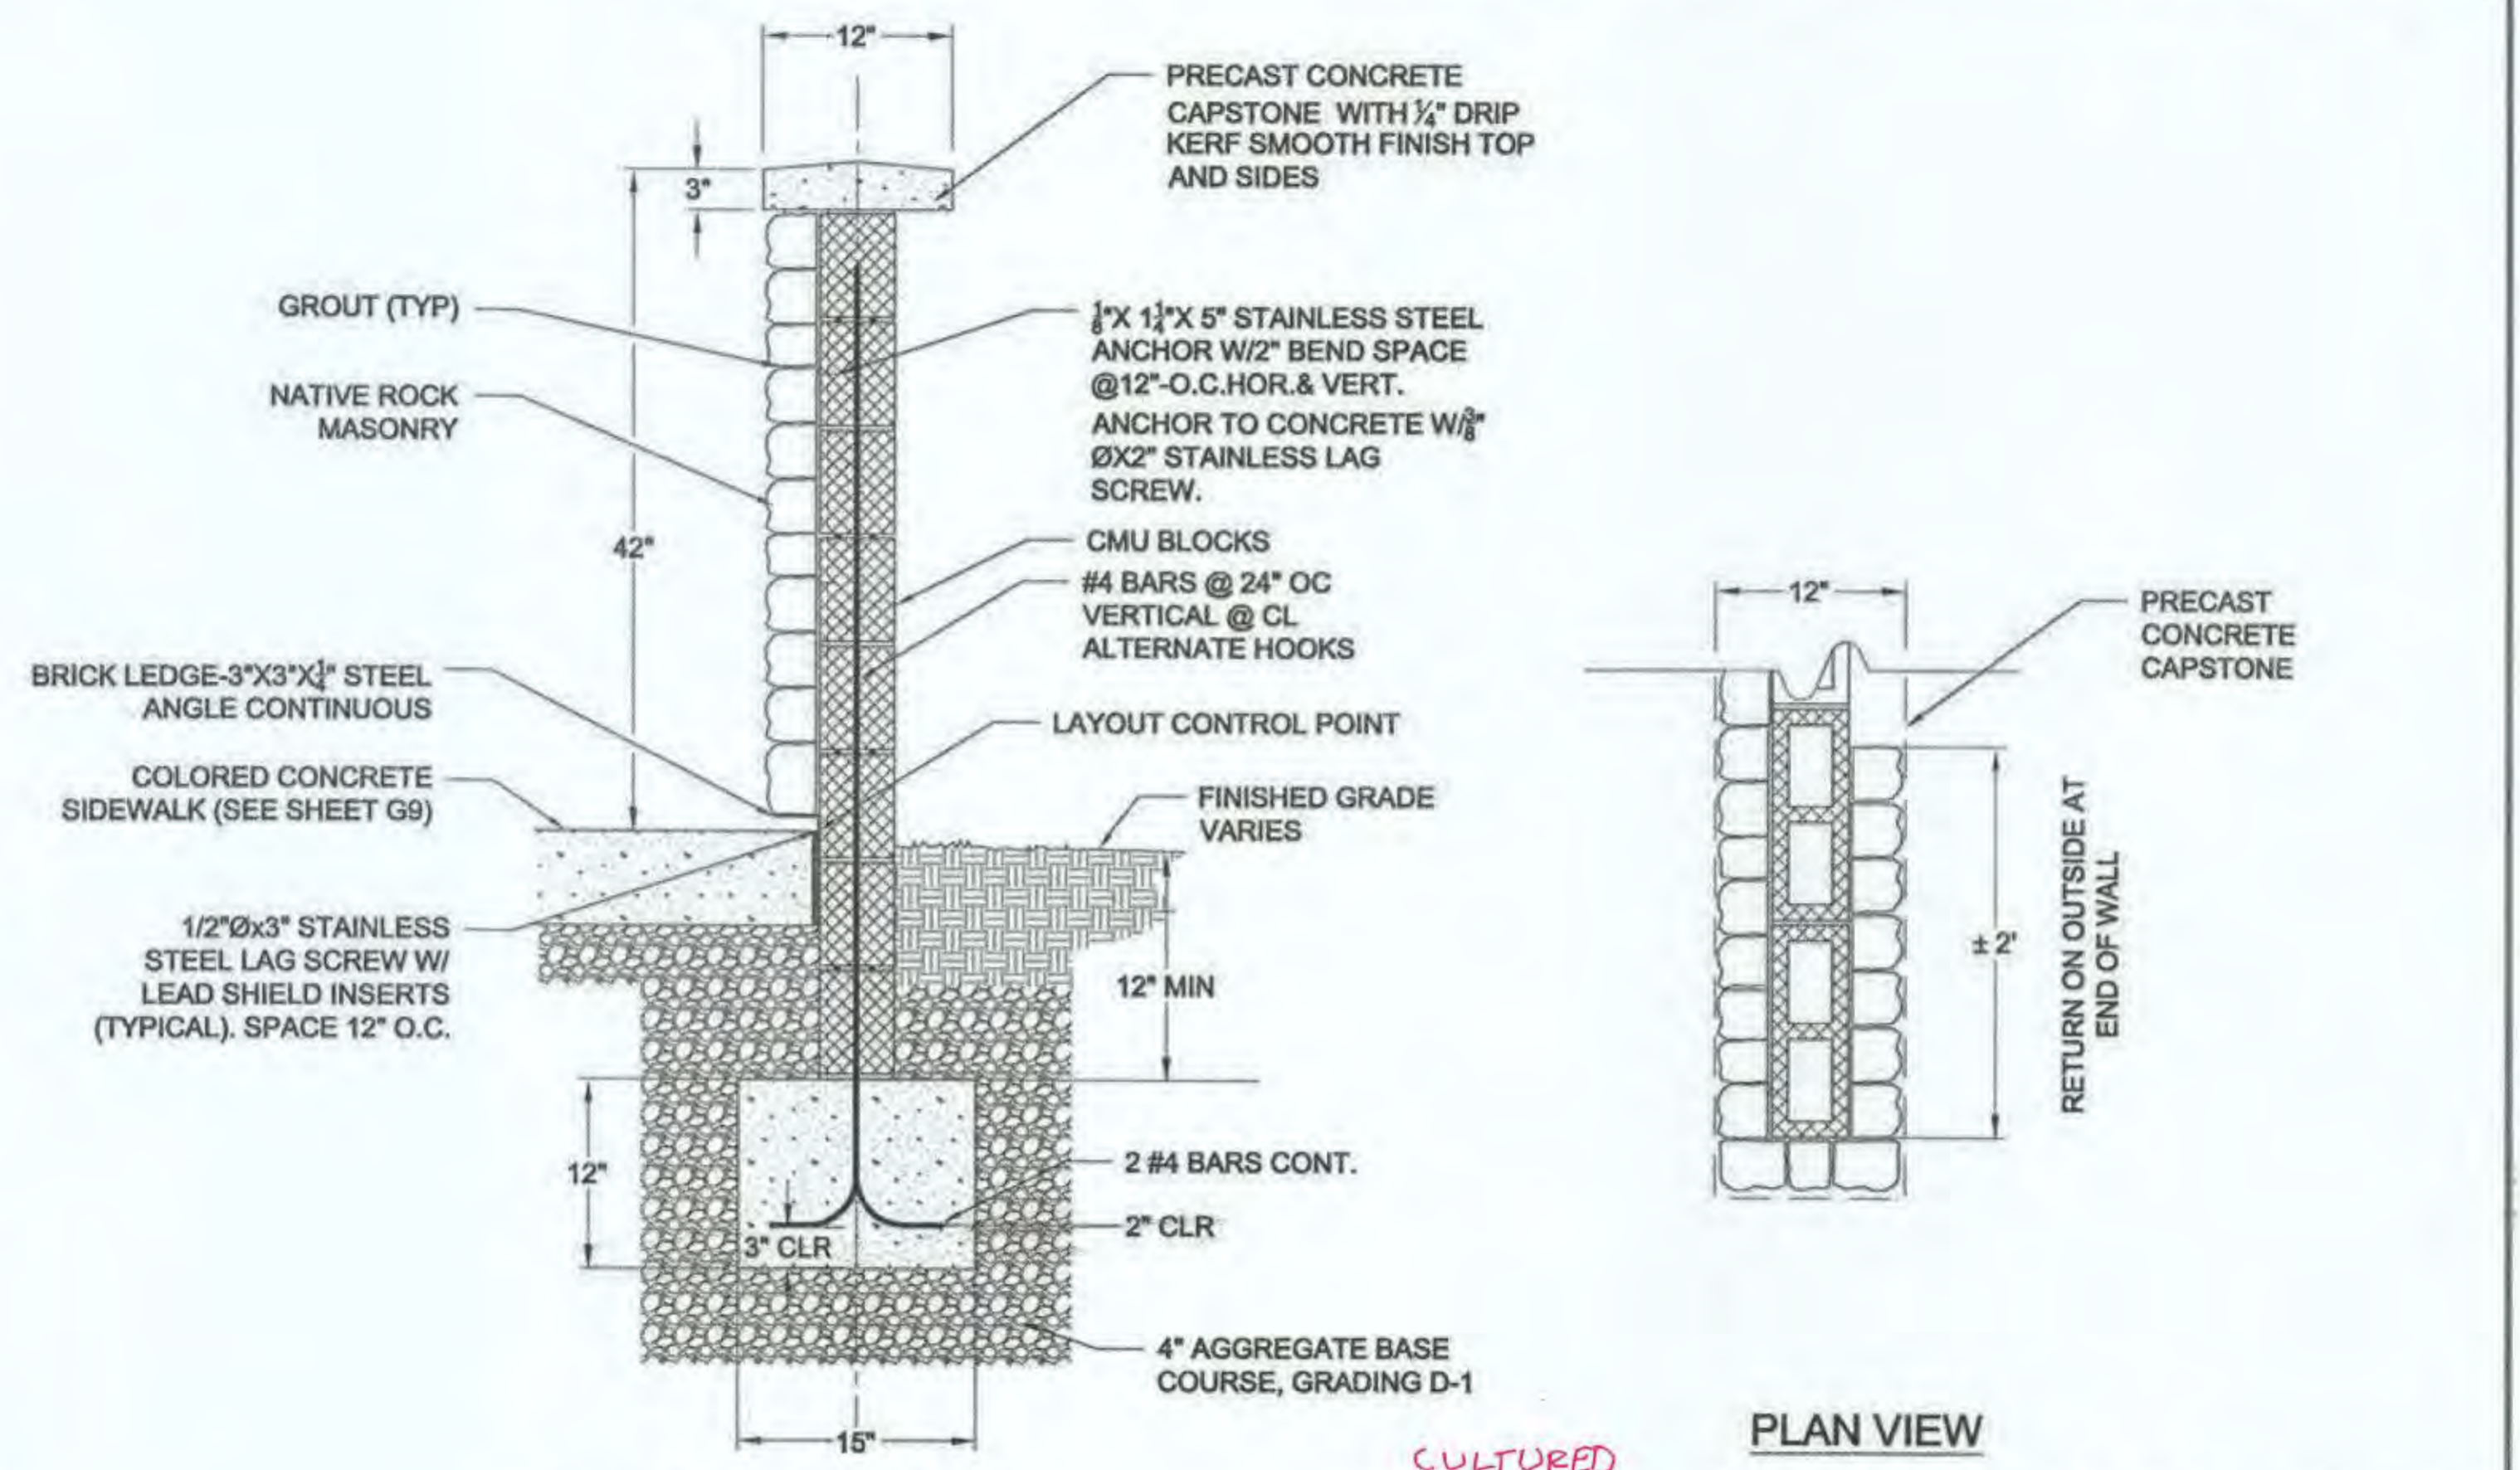

3 CMU BLOCK WALL
NTS

4 NATIVE ROCK MASONRY WALL END TREATMENT
NTS

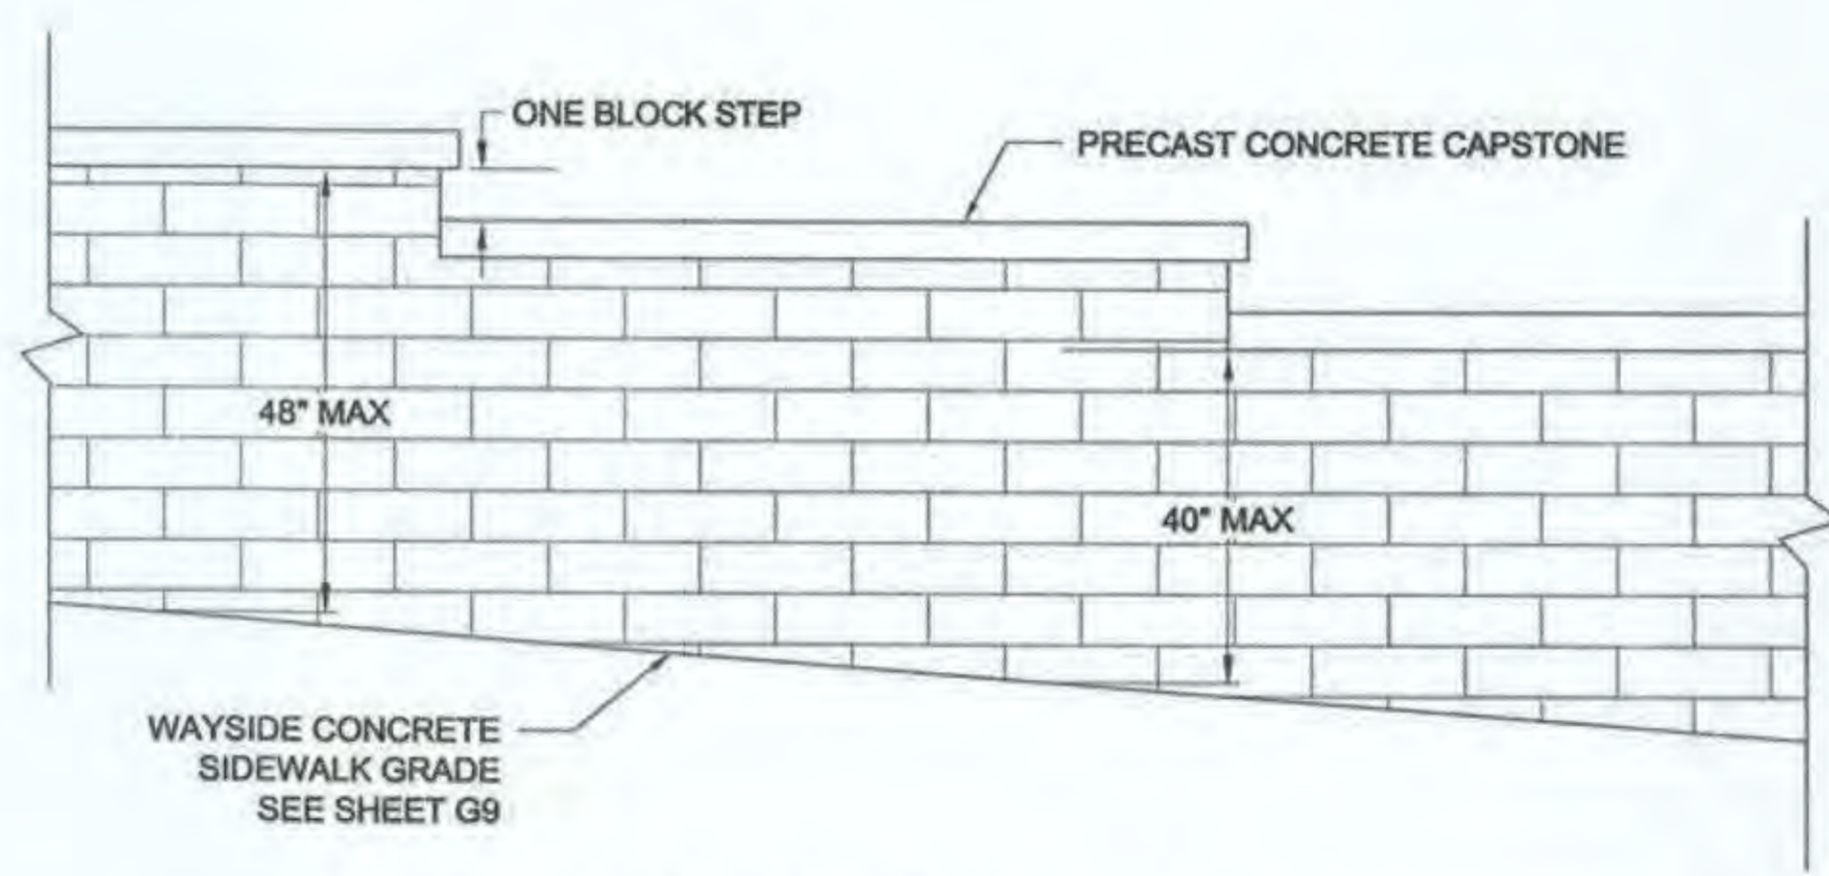

5 CMU BLOCK WALL ELEVATION VIEW
NTS

NOTES:
1. CONTRACTOR SHALL CONSTRUCT CMU BLOCK WALLS LEVEL. HEIGHT OF CMU BLOCK WALL MAY VARY BETWEEN 40" AND 48". CONTRACTOR SHALL STEP THE WALL AT ONE-BLOCK INTERVALS AT REQUIRED LOCATIONS DETERMINED BY THE CONTRACTOR.

VP 8/20/16 8/9/20

PLANS DEVELOPED BY:
DOWL
5368 COMMERCIAL BLVD.
JUNEAU, AK 99801
(907) 780-3533
#AECL848




8.17.2016

STATE OF ALASKA
DEPARTMENT OF TRANSPORTATION
AND PUBLIC FACILITIES
**SKAGWAY - REPLACE CAPTAIN
WILLIAM HENRY MOORE BRIDGE**



WAYSIDE DETAILS

NO.	DATE	REVISION	STATE	PROJECT DESIGNATION	YEAR	SHEET NO.	TOTAL SHEETS
			ALASKA	0972016/Z684590000	2016	E14	59



FILE: J:\DOT-16-02 Moore Bridge Sign\2 - CAD\Corvus-Sheets.dwg
 DATE: 8/11/2016 11:14 LAYOUT: E14
 DESIGNED: PB
 CHECKED: PB
 DRAFTED: PB

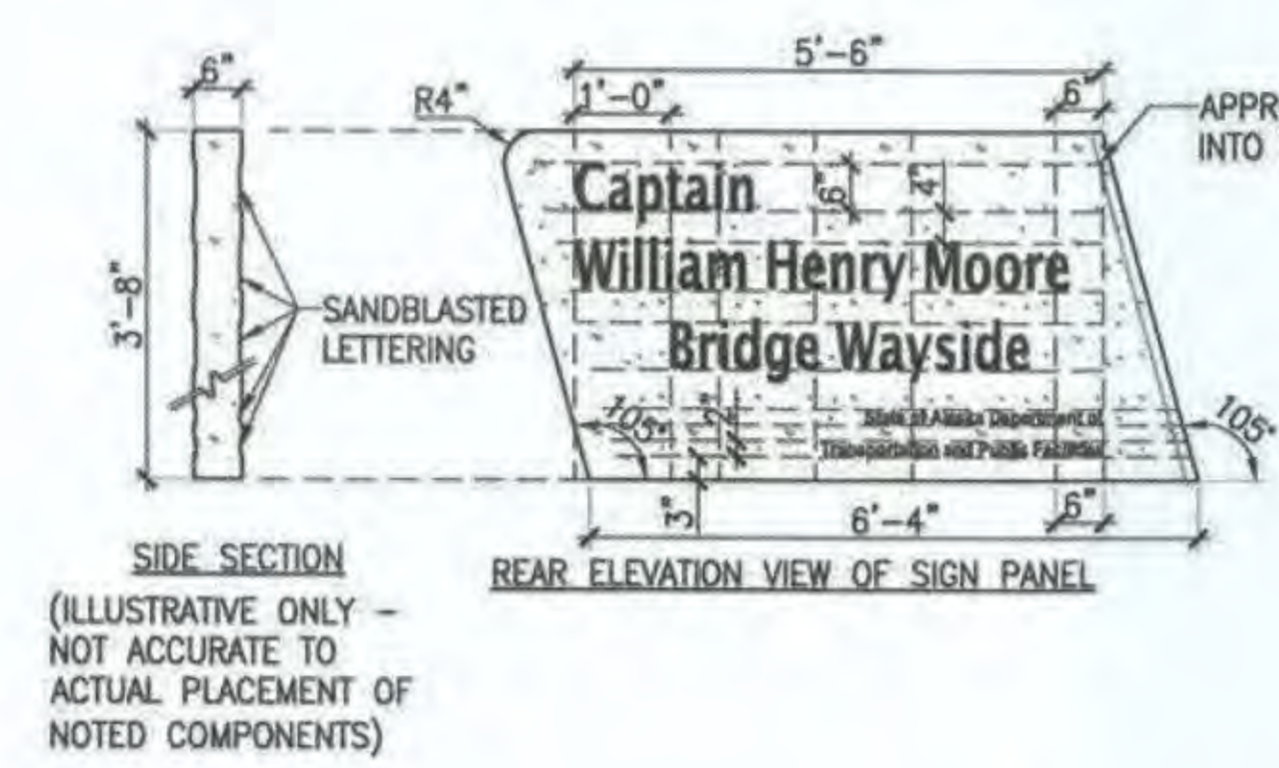

SIDE SECTION
(ILLUSTRATIVE ONLY - NOT ACCURATE TO ACTUAL PLACEMENT OF NOTED COMPONENTS)

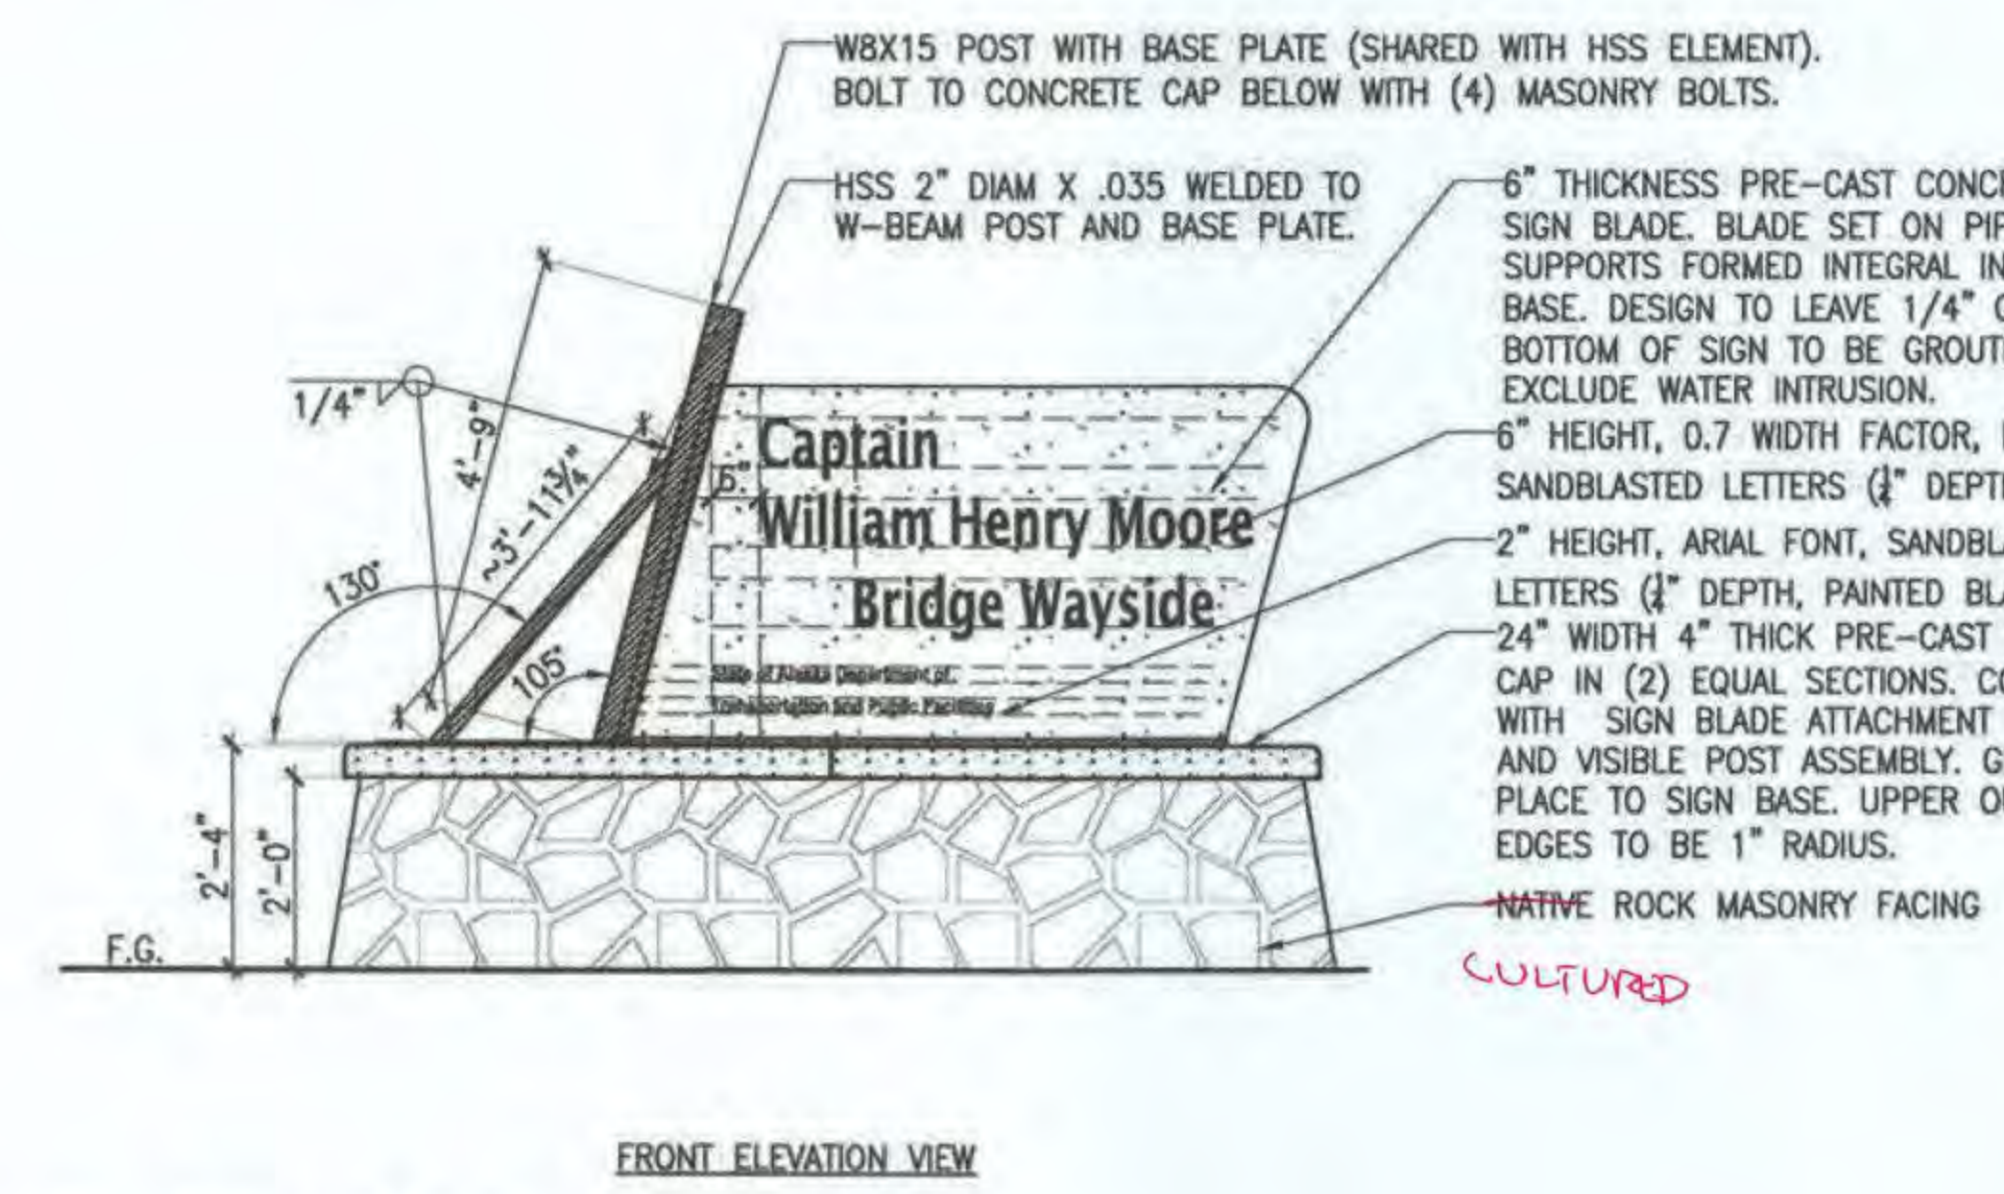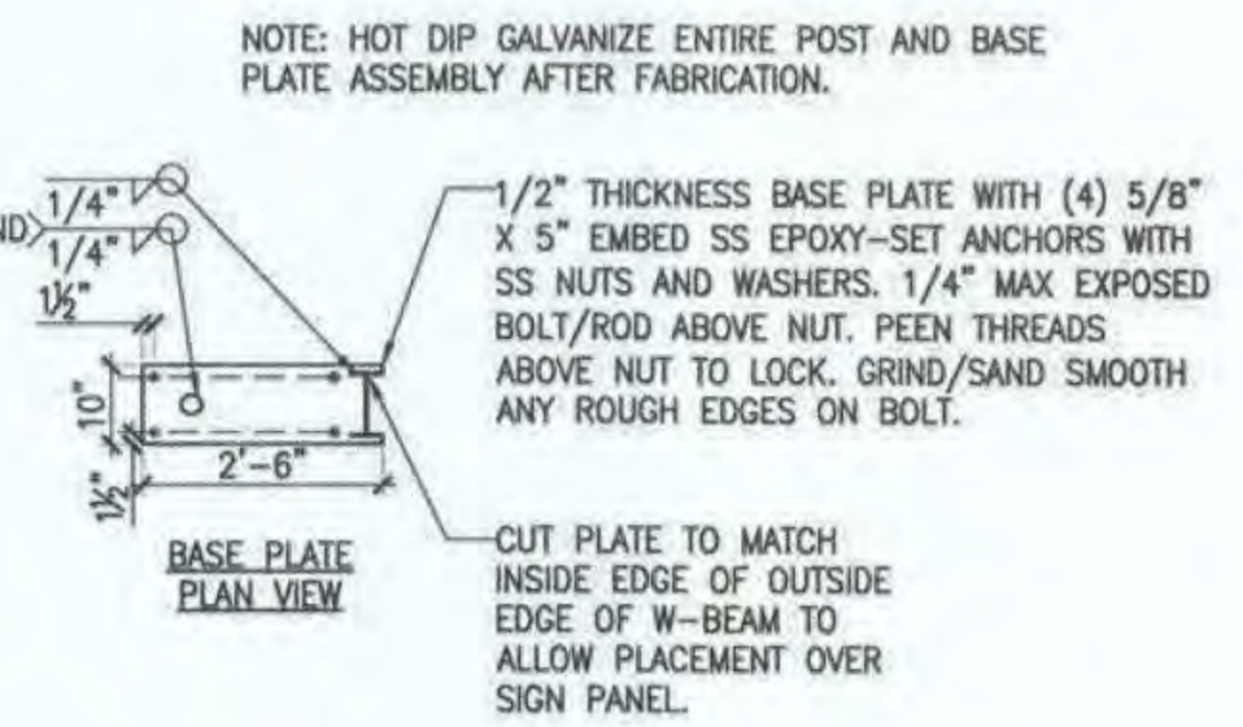

1 WAYSIDE SIGN
SCALE: NTS (USE DIMENSIONS)

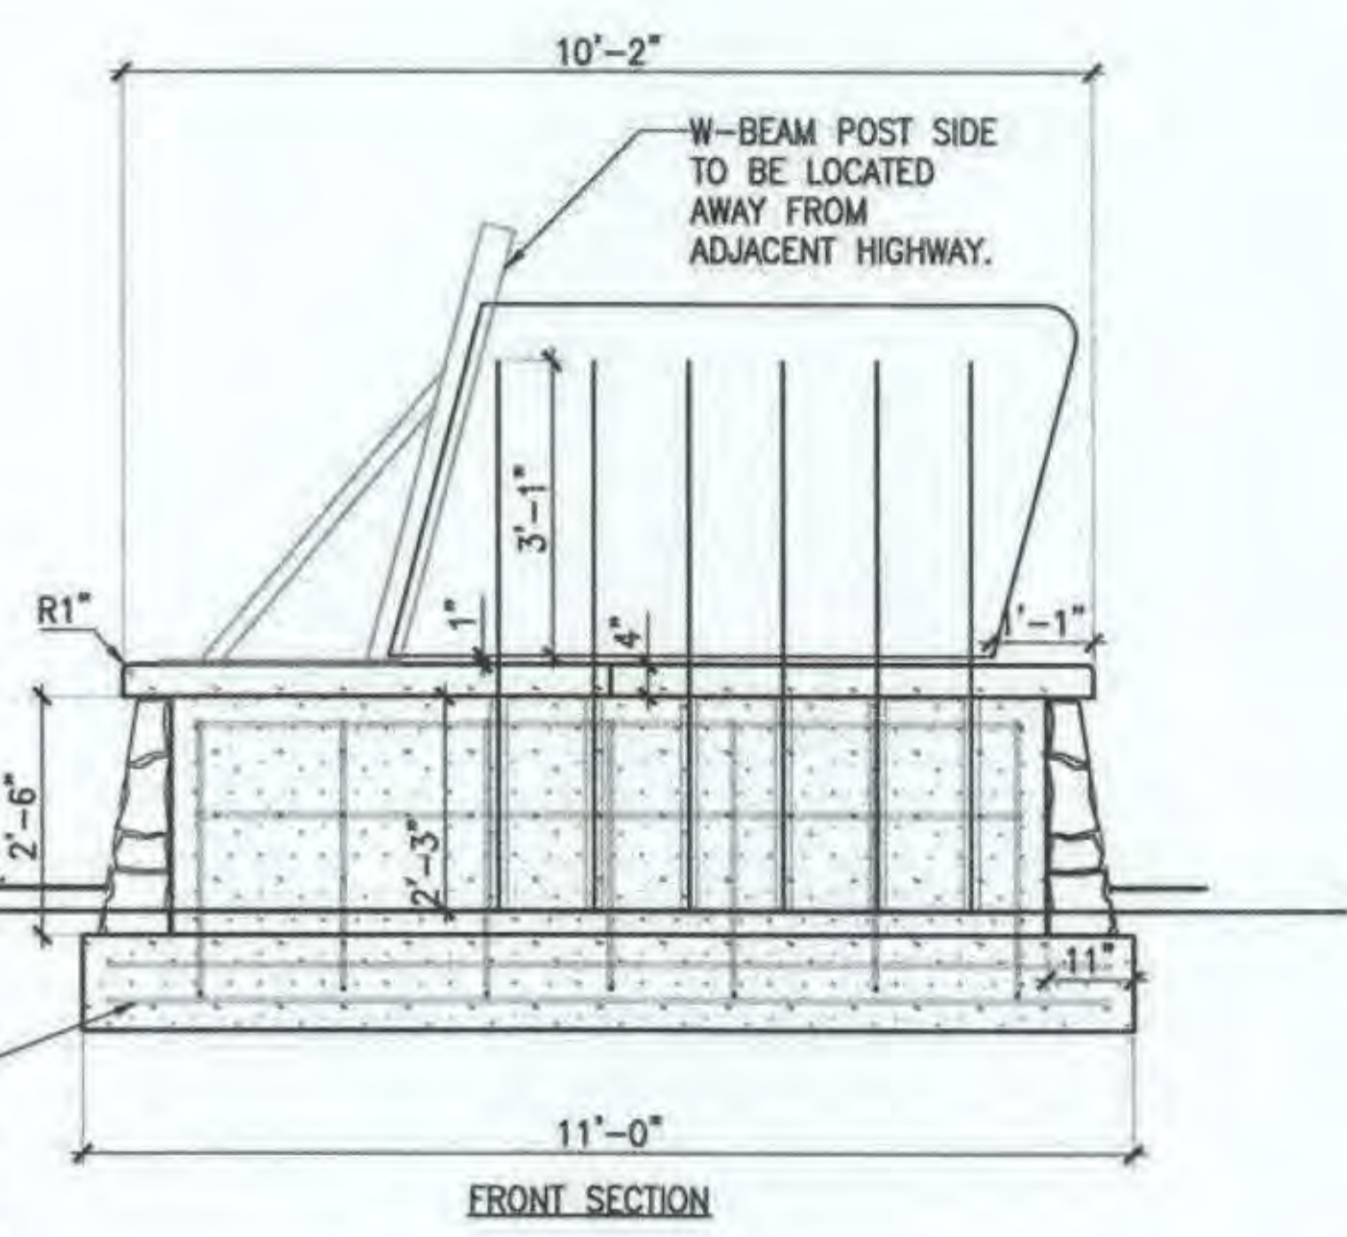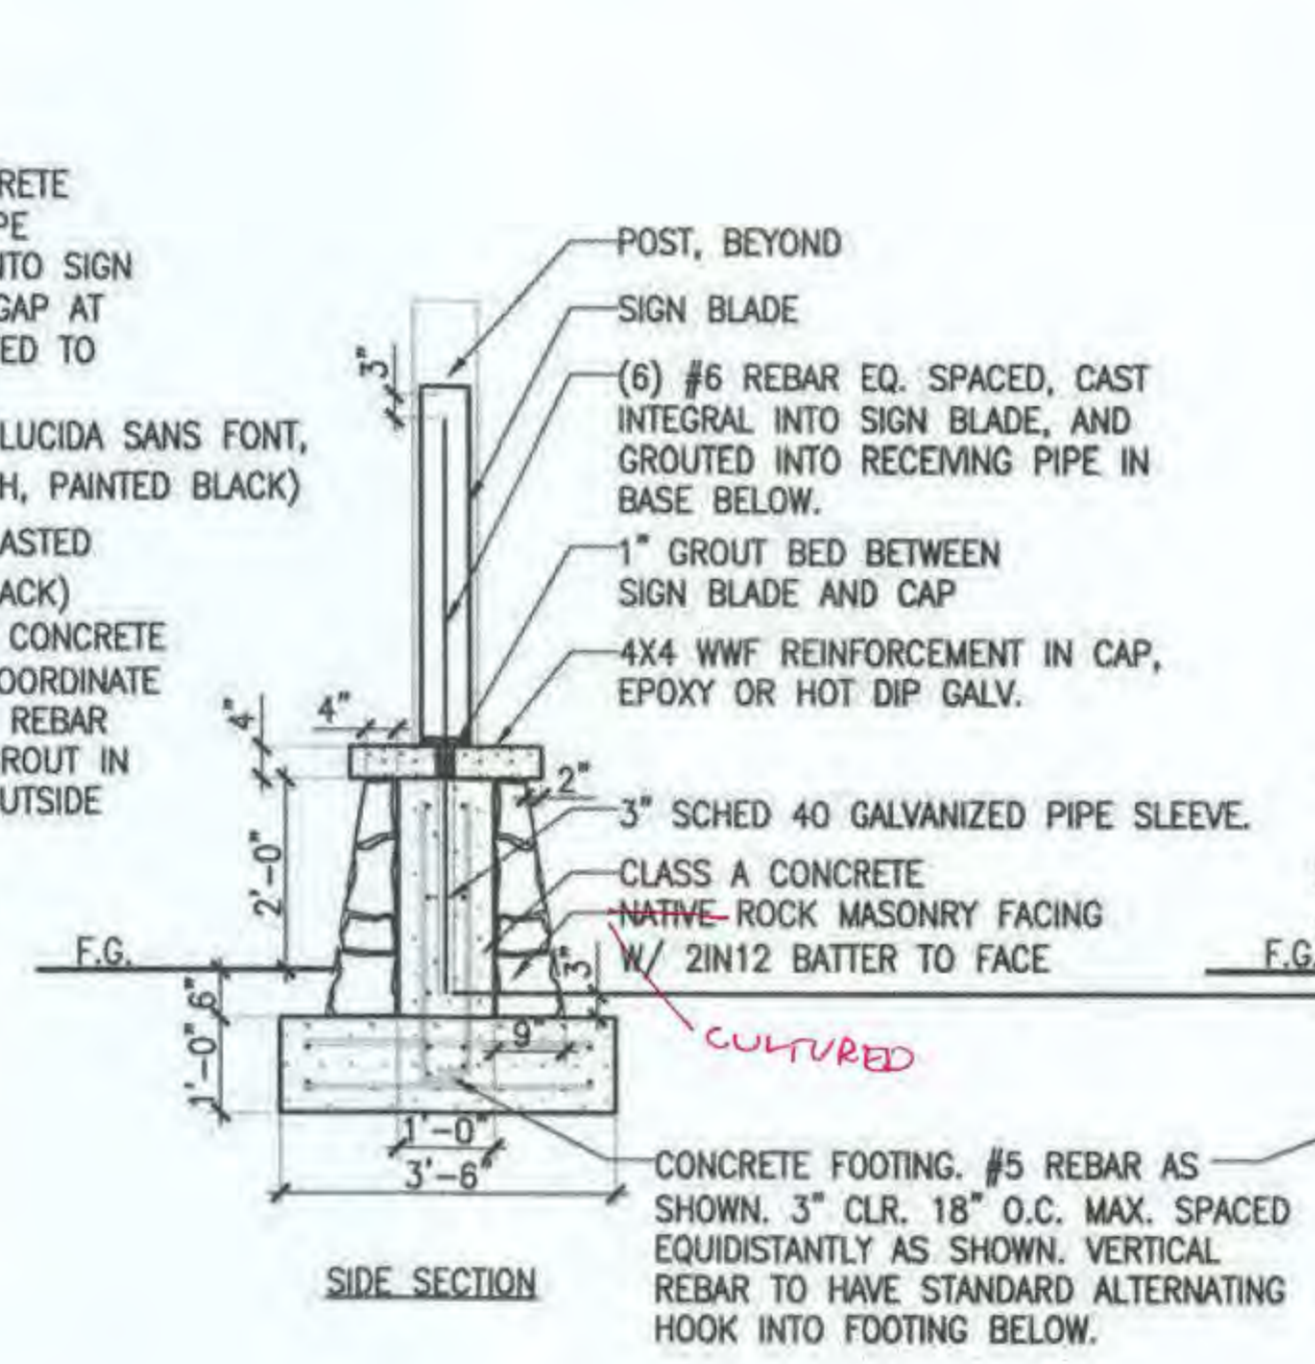

RP 6/9/20

PLANS DEVELOPED BY:
CORVUS DESIGN
2506-B FAIRBANKS ST.
ANCHORAGE, AK 99503
(907) 222-2859
#AECC1195

119 SEWARD ST. UNIT 15
JUNEAU, AK 99801
(907) 988-9000




STATE OF ALASKA
DEPARTMENT OF TRANSPORTATION
AND PUBLIC FACILITIES

**SKAGWAY - REPLACE CAPTAIN
WILLIAM HENRY MOORE BRIDGE**

WAYSIDE SIGN DETAILS


NO.	DATE	REVISION	STATE	PROJECT DESIGNATION	YEAR	SHEET NO.	TOTAL SHEETS
			ALASKA	0972016/Z684590000	2016	E15	59

FILE: C:\Civ11\3D Project\2470732-01\Civ11\SA14-CT-E-DT-CW\4.dwg
 DATE: 8/17/2016 7:22
 LAYOUT: E15
 DESIGNED: HOBBS
 CHECKED: NOBLE
 DRAFTED: WESTPHAL

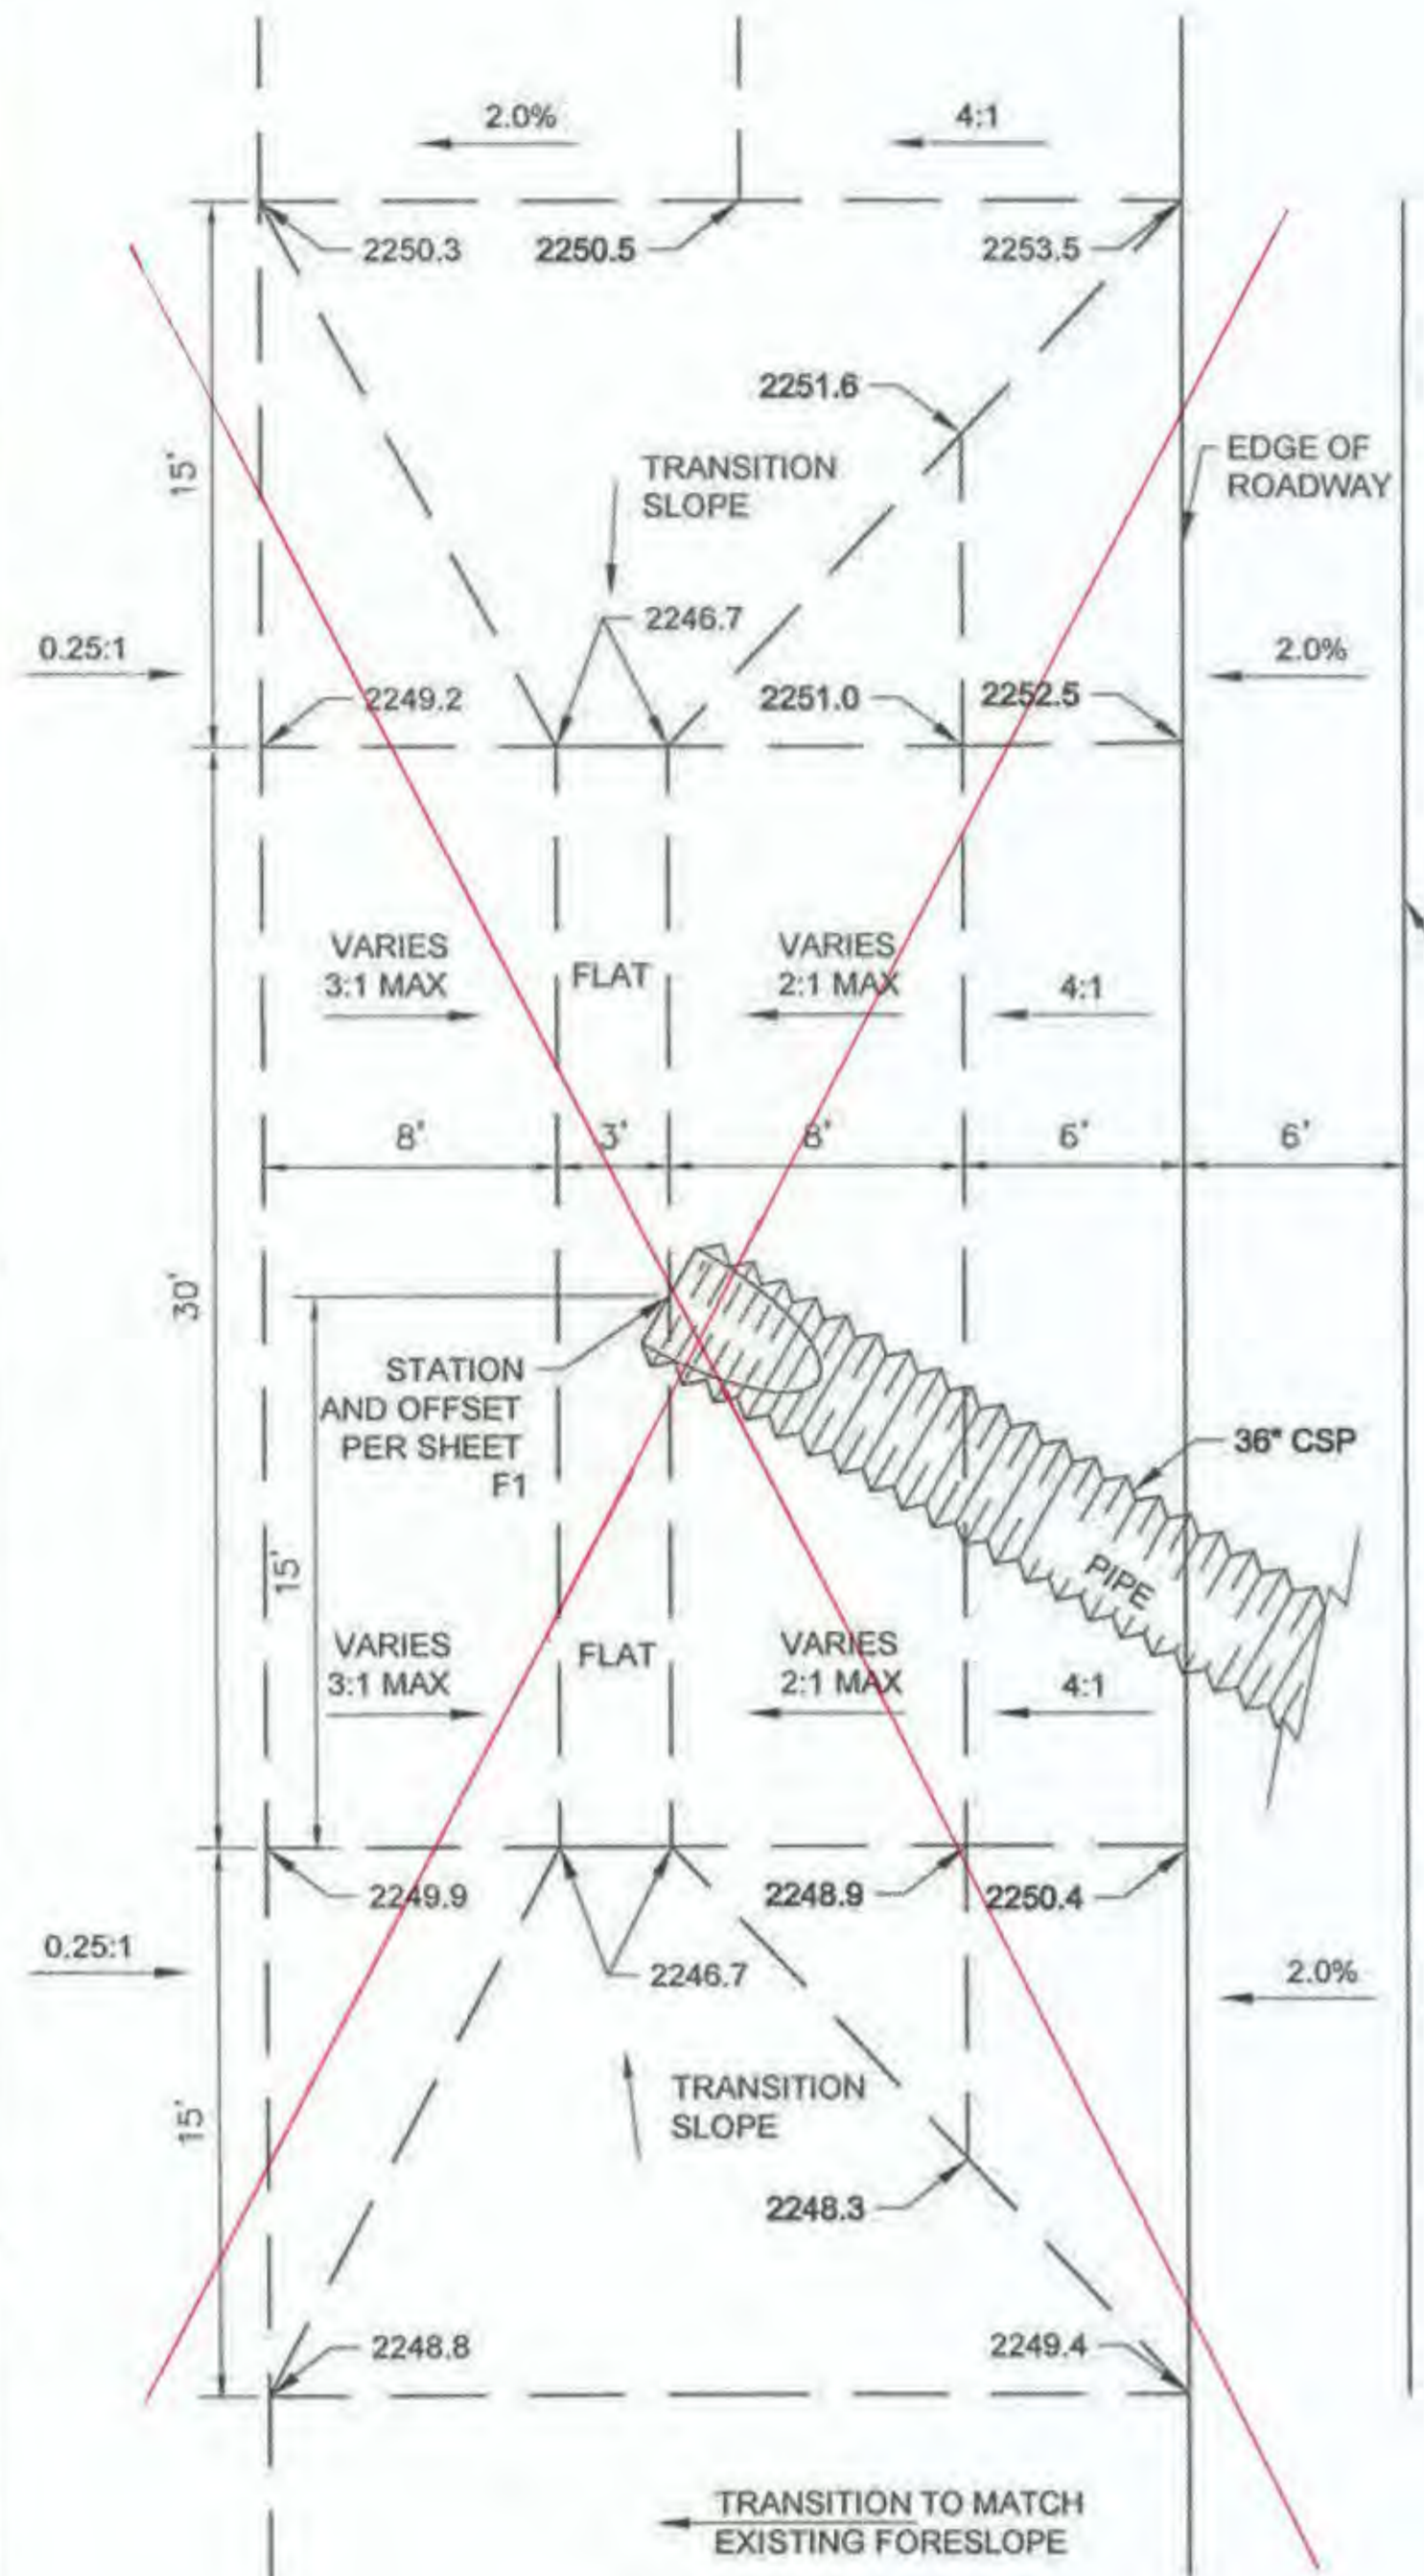


DITCH WIDENING NOTES:
 1. STANDARD DITCH GRADE TRANSITIONS FROM TYPICAL DITCH SECTION TO 3 FT. FLAT BOTTOM DITCH.


1 DITCH WIDENING DETAIL
 DELETED By CO #7 NTS

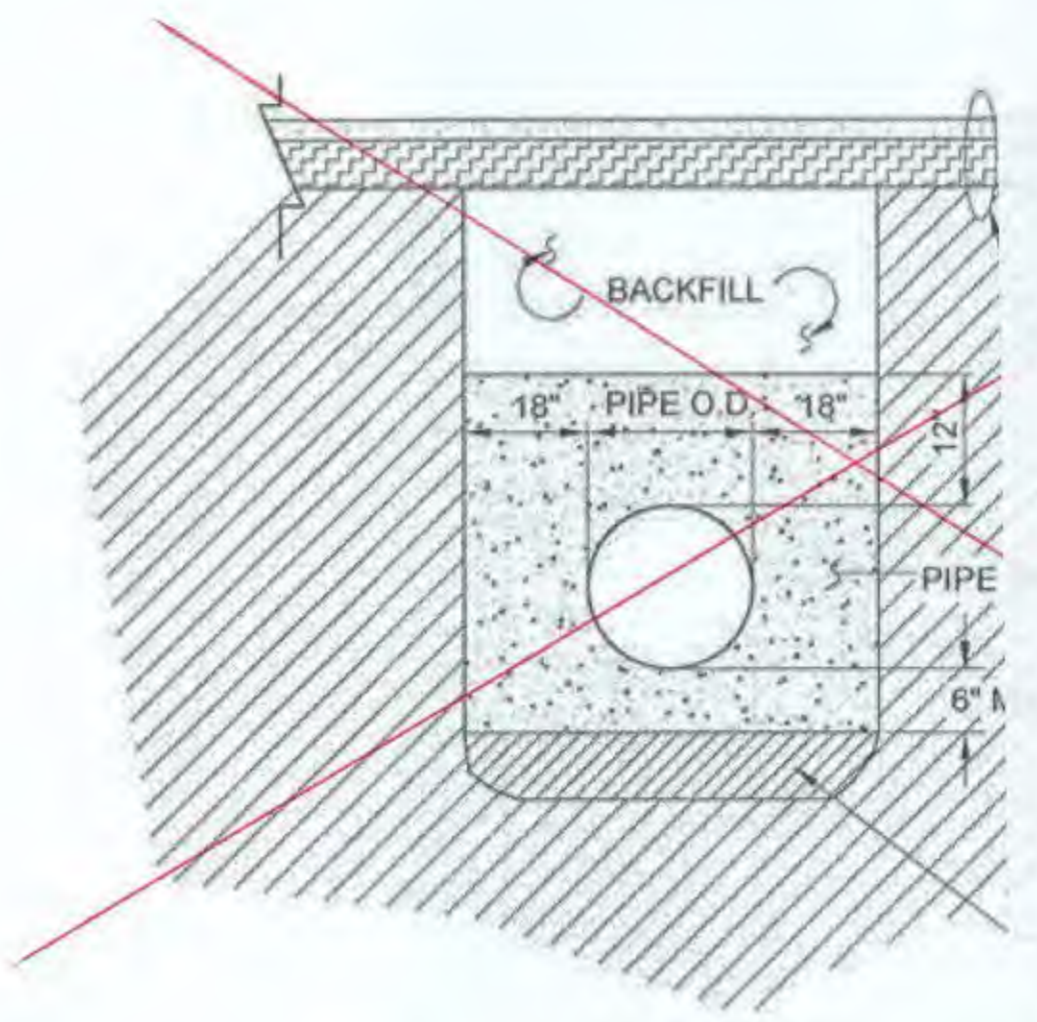



2 CULVERT BEDDING/BACKFILL
 DELETED By CO #7

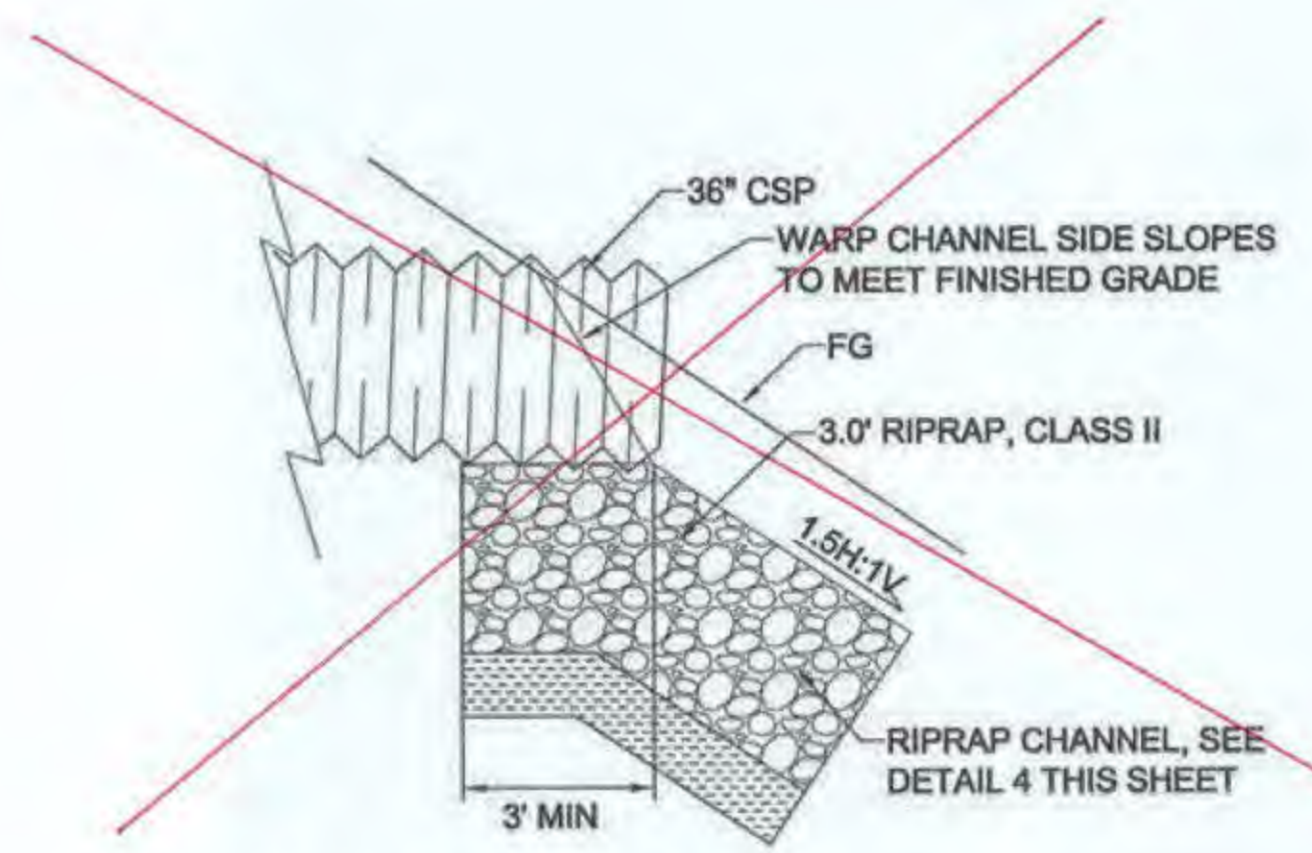

3 SOUTH CULVERT OUTLET DETAIL
 DELETED By CO #7 NTS

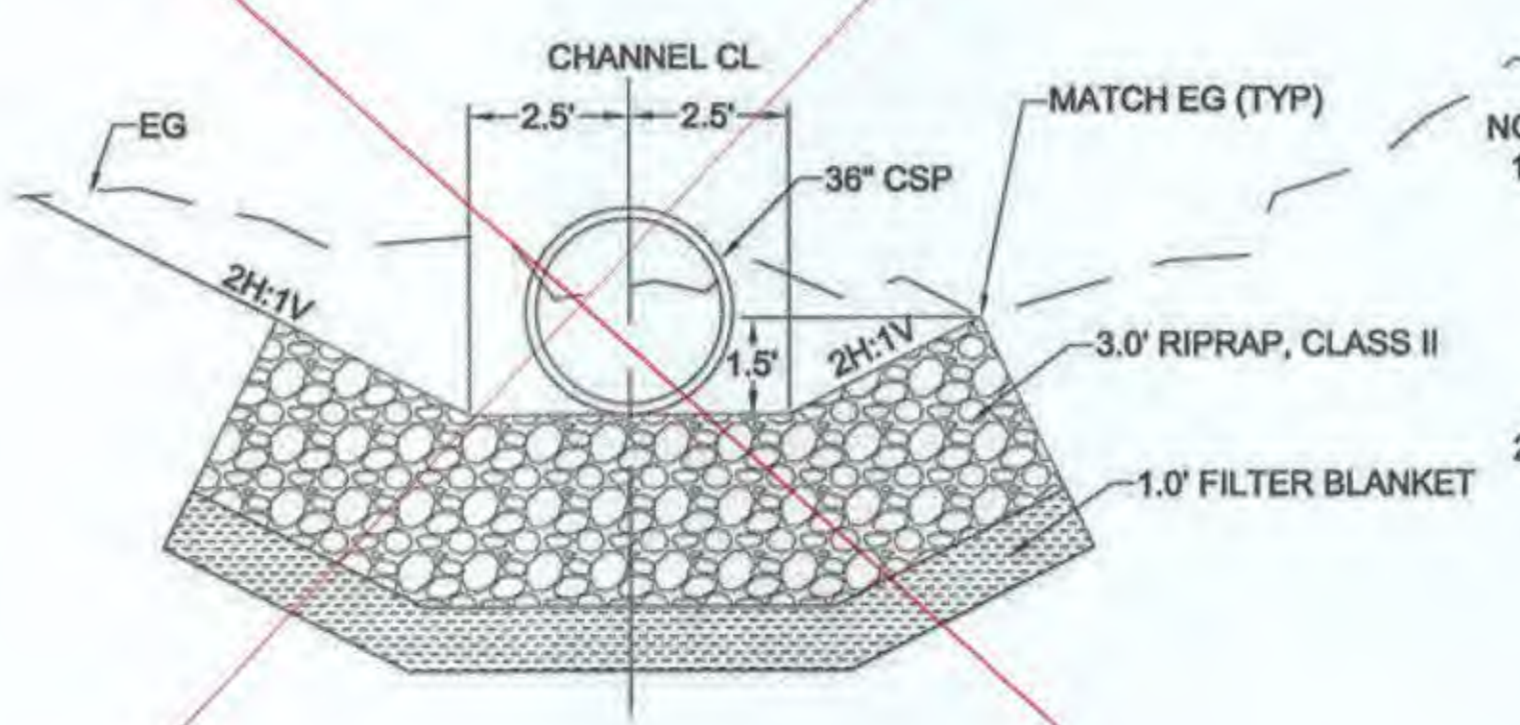

4 RIPRAP CHANNEL DETAIL
 DELETED By CO #7 NTS

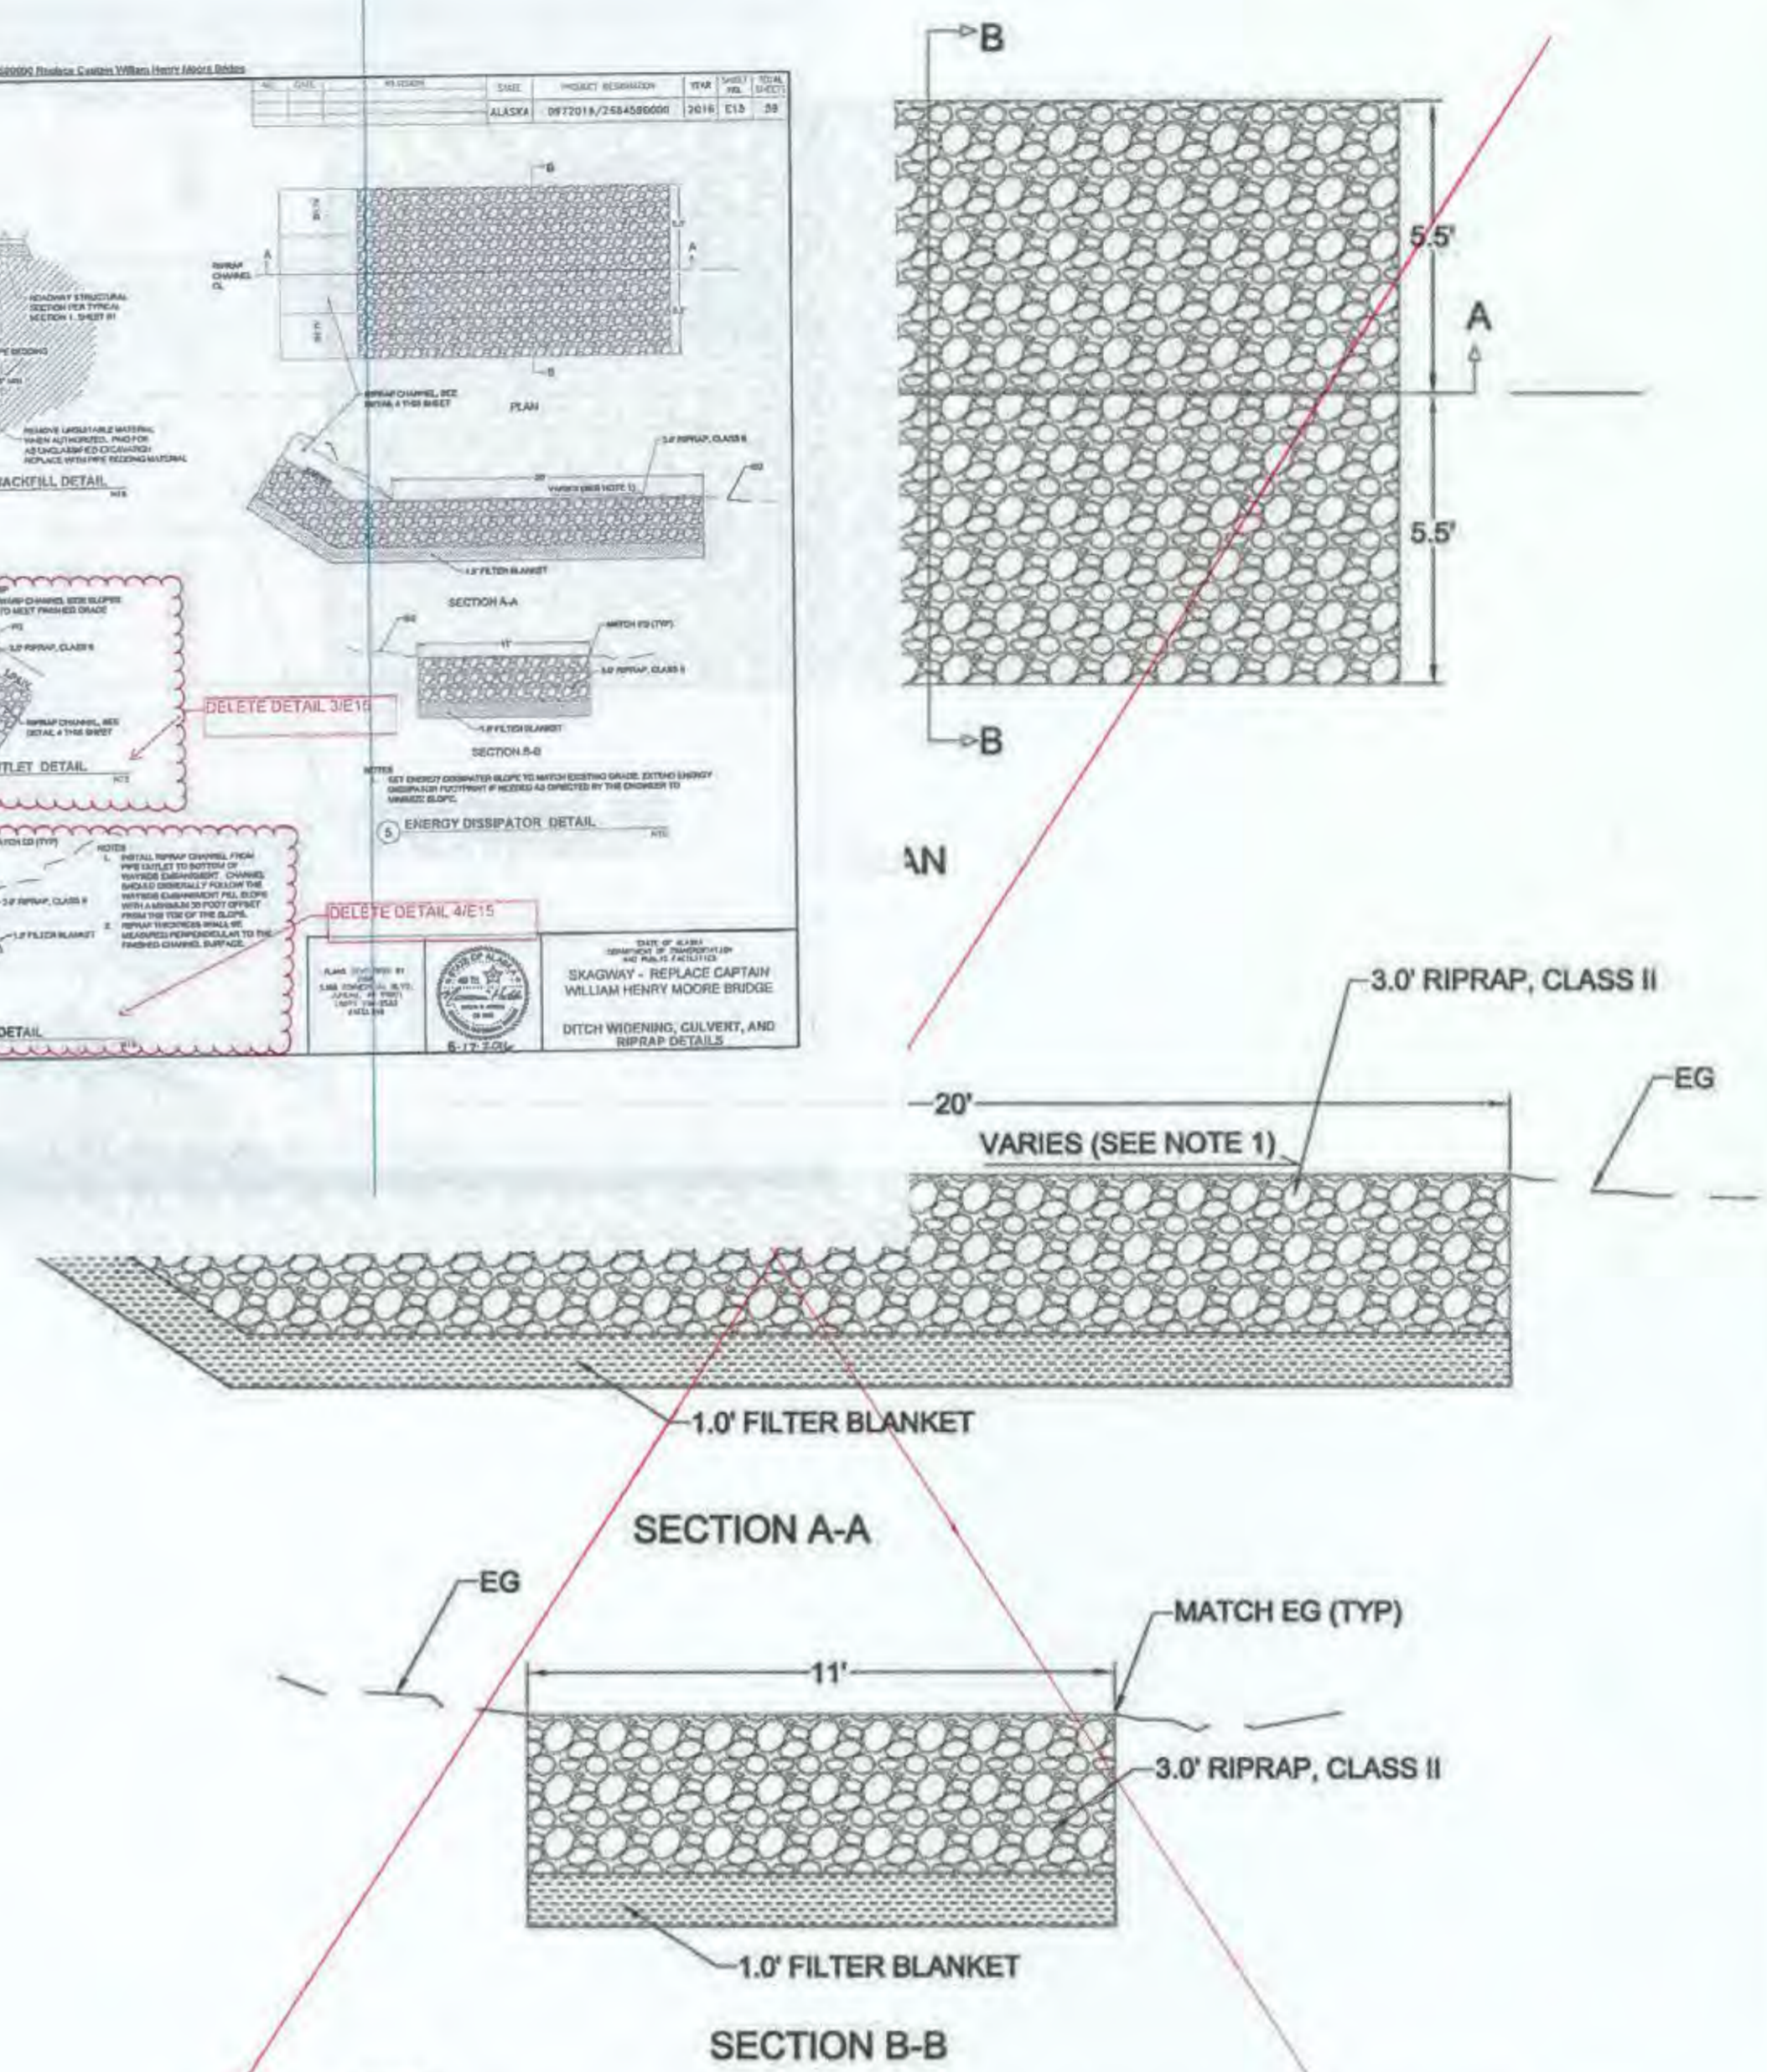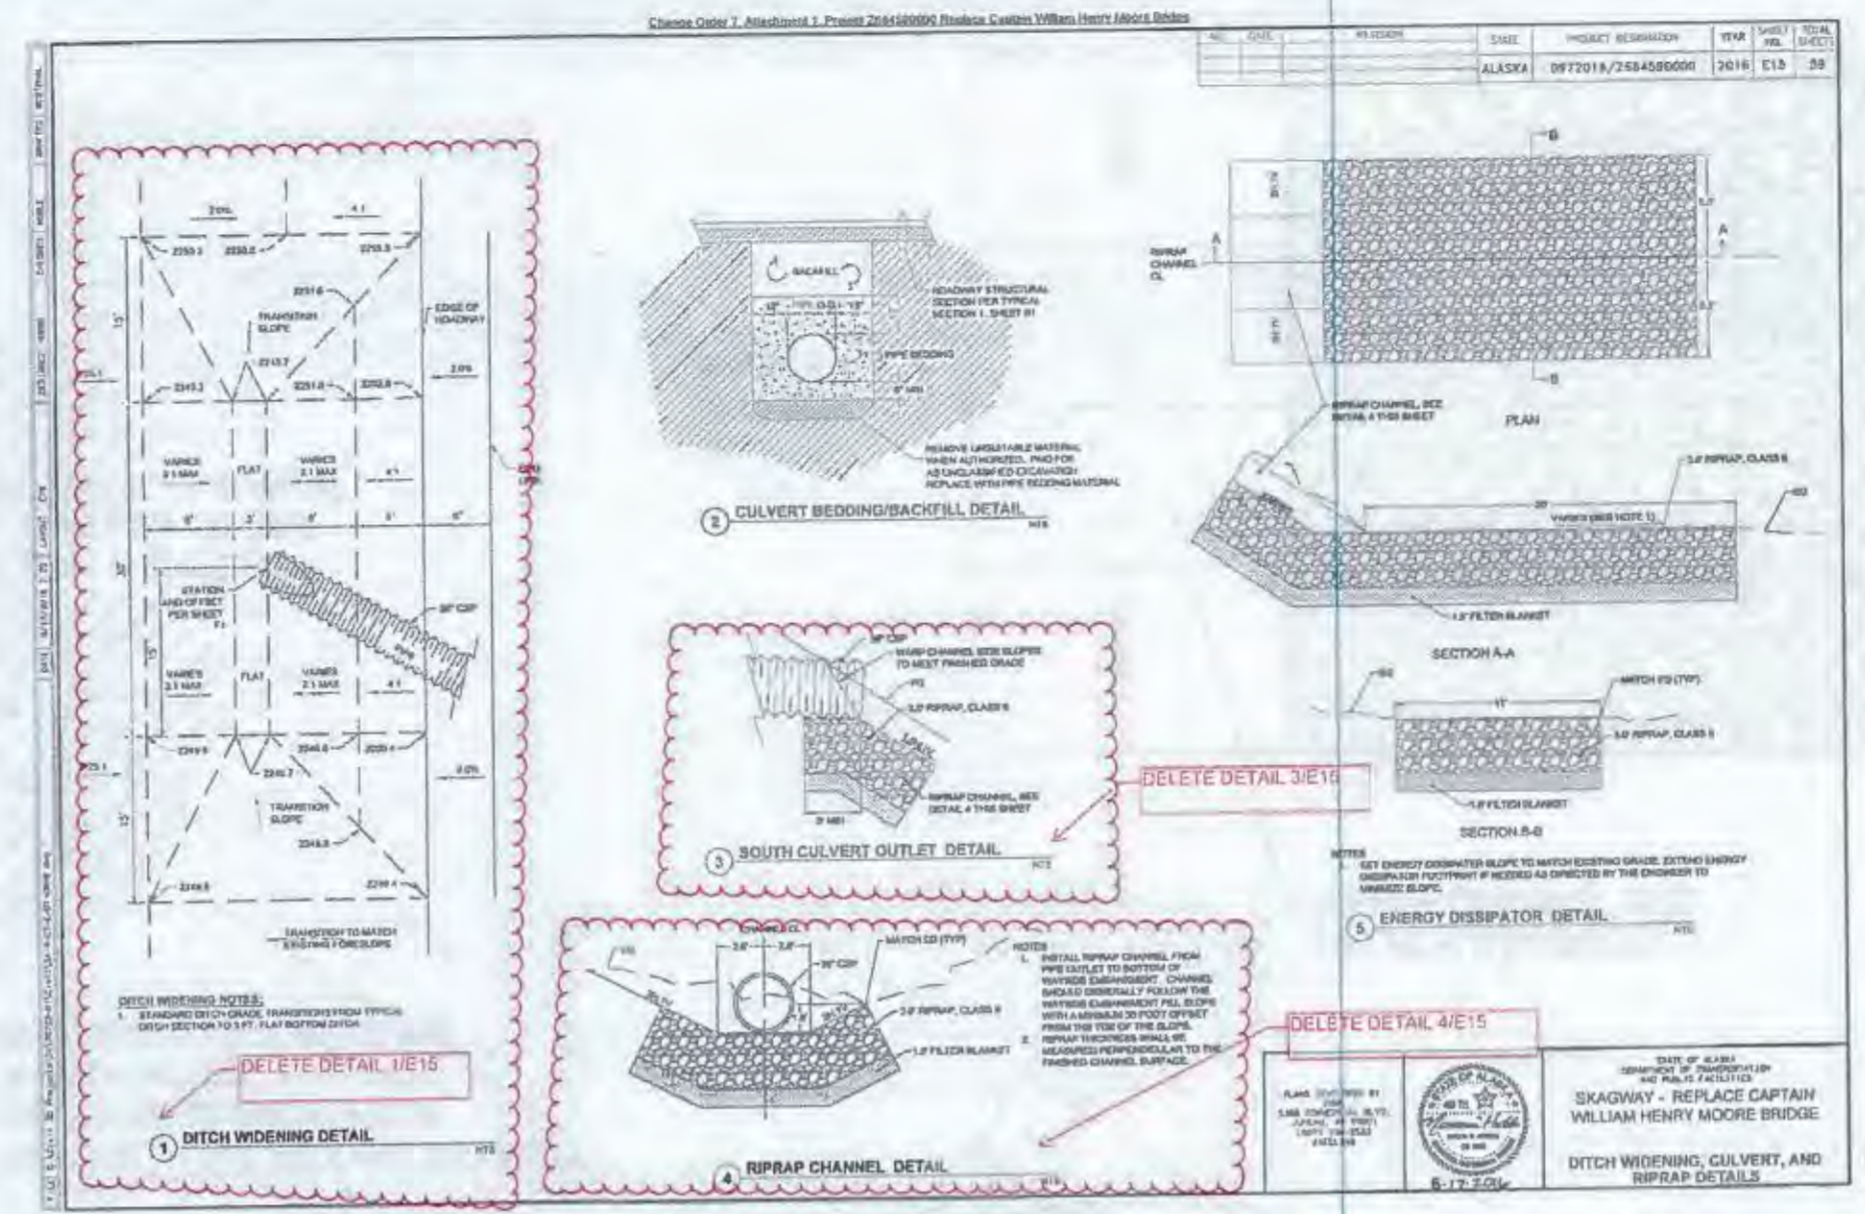


NOTES
 1. SET ENERGY DISSIPATER SLOPE TO MATCH EXISTING GRADE. EXTEND ENERGY DISSIPATOR FOOTPRINT IF NEEDED AS DIRECTED BY THE ENGINEER TO MINIMIZE SLOPE.

5 ENERGY DISSIPATOR DETAIL
 DELETED By CO #7 NTS

NOTES
 1. INSTALL RIPRAP CHANNEL FROM PIPE OUTLET TO BOTTOM OF WAYSIDE EMBANKMENT. CHANNEL SHOULD GENERALLY FOLLOW THE WAYSIDE EMBANKMENT FILL SLOPE WITH A MINIMUM 30 FOOT OFFSET FROM THE TOE OF THE SLOPE.
 2. RIPRAP THICKNESS SHALL BE MEASURED PERPENDICULAR TO THE FINISHED CHANNEL SURFACE.

6/9/20


PLANS DEVELOPED BY:
 DOW
 5368 COMMERCIAL BLVD.
 JUNEAU, AK 99801
 (907) 780-3533
 #AECL848

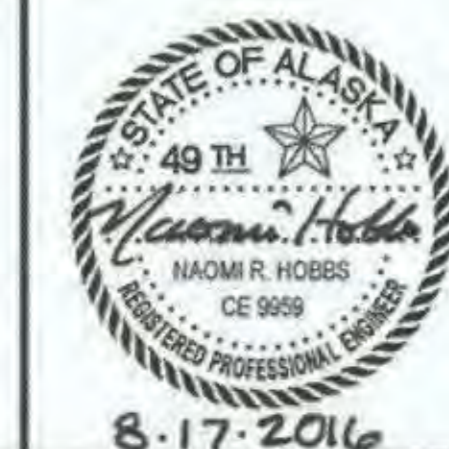

STATE OF ALASKA
 DEPARTMENT OF TRANSPORTATION
 AND PUBLIC FACILITIES
**SKAGWAY - REPLACE CAPTAIN
 WILLIAM HENRY MOORE BRIDGE**
 DITCH WIDENING, CULVERT, AND
 RIPRAP DETAILS


FILE: C:\Civ11_3D Projects\24\70732-01\Civ11\SA14-CT-E-DT-CWHM.dwg
 DATE: 8/17/2016 7:30 LAYOUT: E16
 DESIGNED: HOBBS
 CHECKED: NOBLE
 DRAFTED: WESTPHAL

NO.	DATE	REVISION	STATE	PROJECT DESIGNATION	YEAR	SHEET NO.	TOTAL SHEETS
			ALASKA	0972016/Z684590000	2016	E16	59

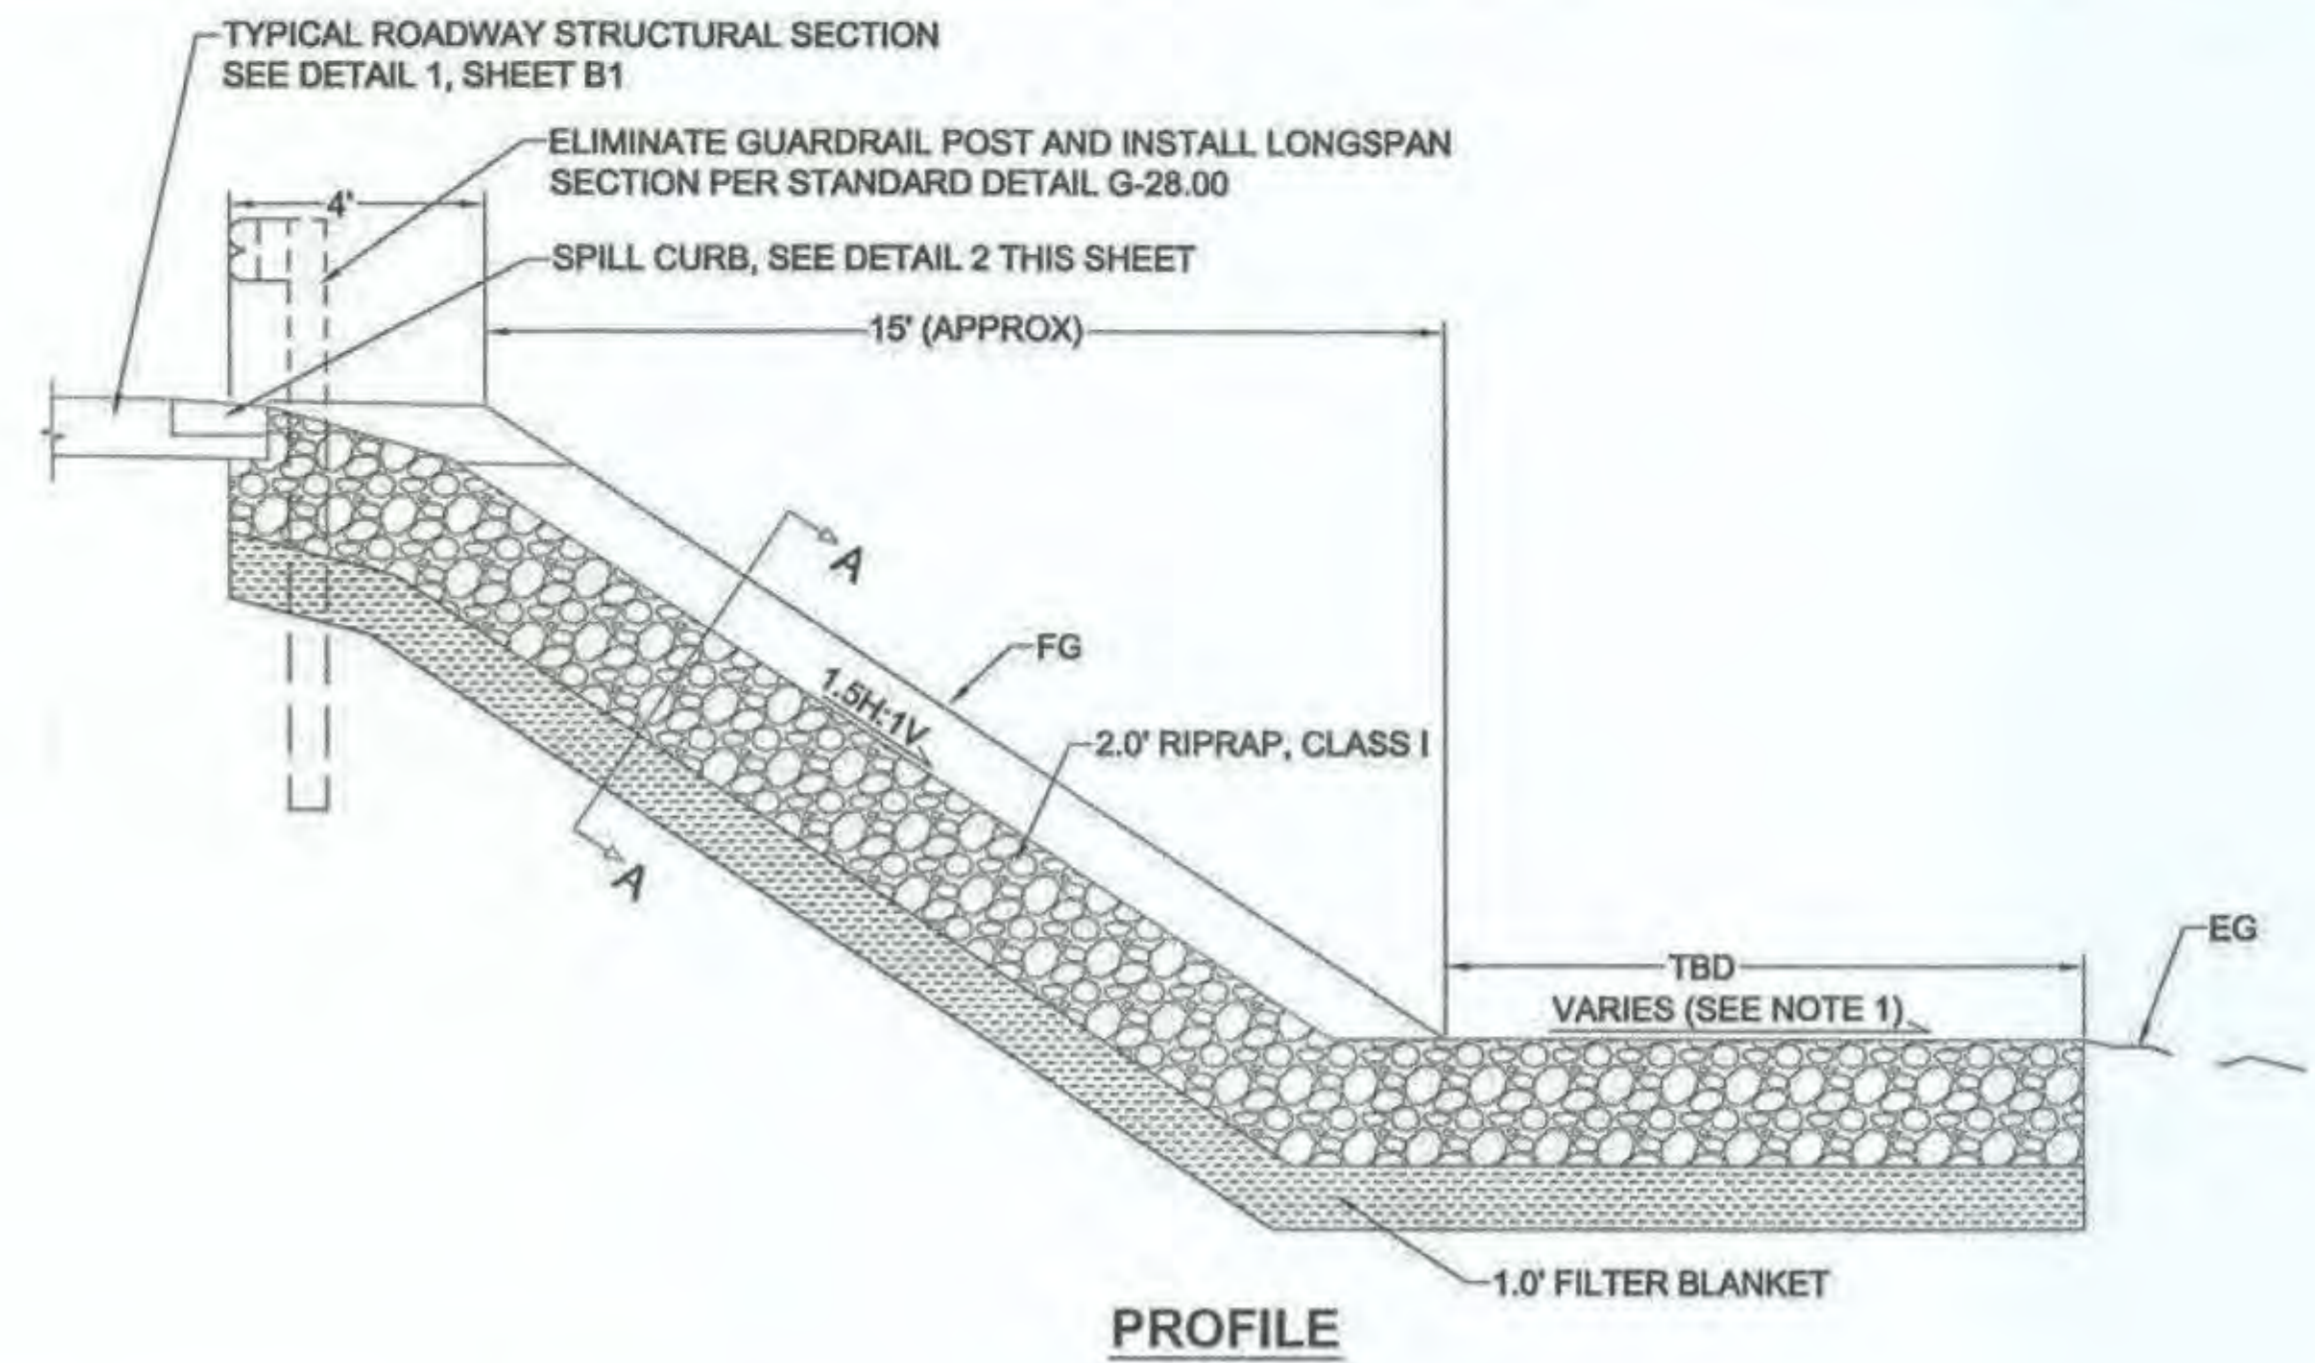


PROFILE

- NOTES**
1. SET RIPRAP FLUME ENERGY DISSIPATER SLOPE TO MATCH EXISTING GRADE. EXTEND ENERGY DISSIPATOR FOOTPRINT IF NEEDED AS DIRECTED BY THE ENGINEER TO MINIMIZE SLOPE.
 2. ADJUST RIPRAP FLUME ENERGY DISSIPATOR ALIGNMENT AND BERM OUTSIDE OF BEND TO MINIMIZE THE POTENTIAL FOR EROSION AS DIRECTED BY THE ENGINEER.
 3. RIPRAP THICKNESS SHALL BE MEASURED PERPENDICULAR TO THE FINISHED FLUME SURFACE.

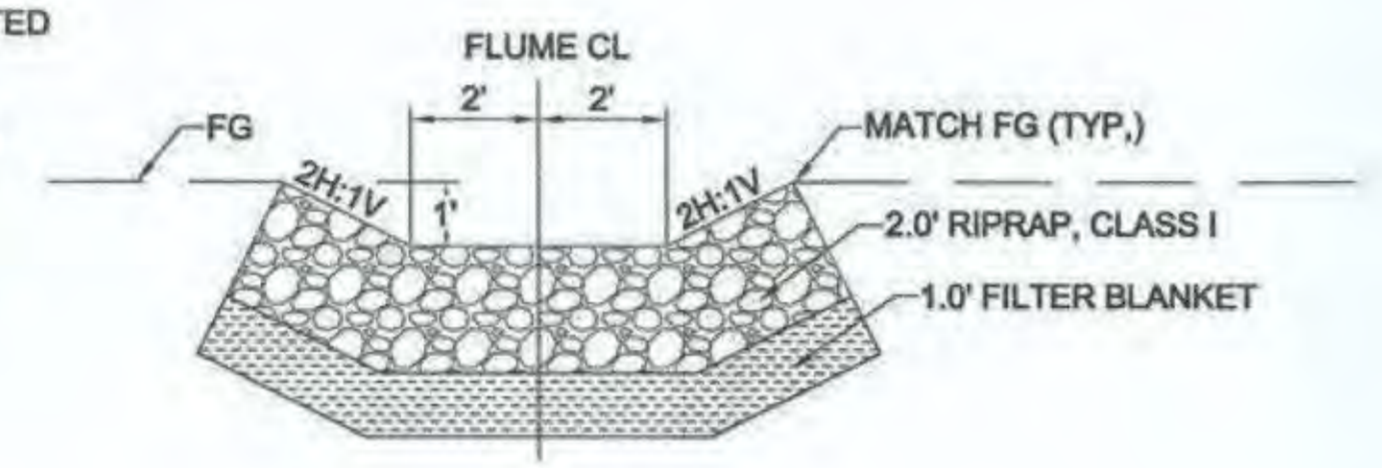


SECTION A - A


1 RIPRAP FLUME DETAIL NTS

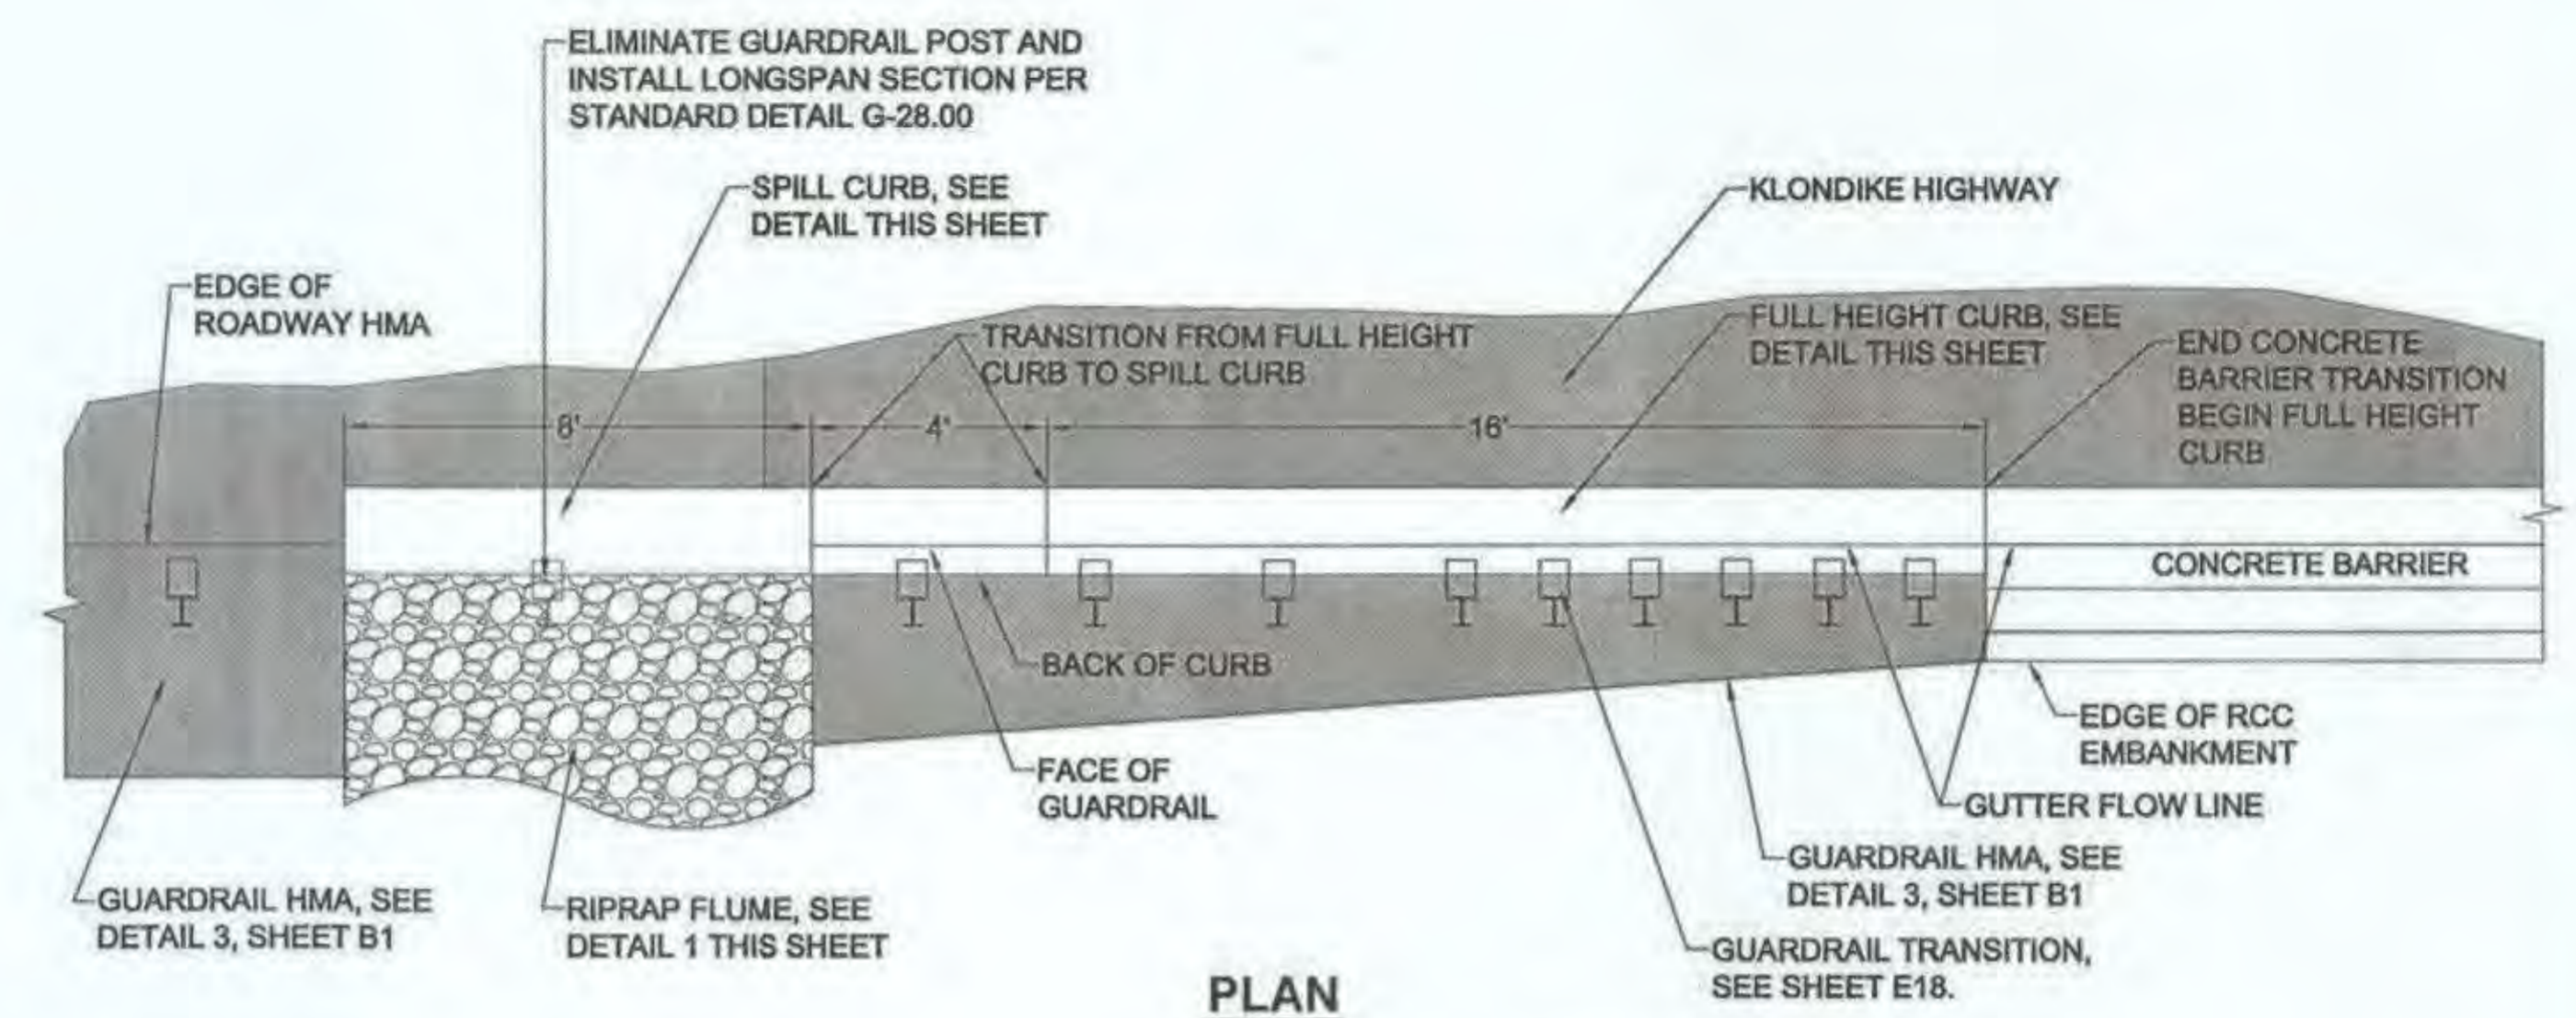

PLAN

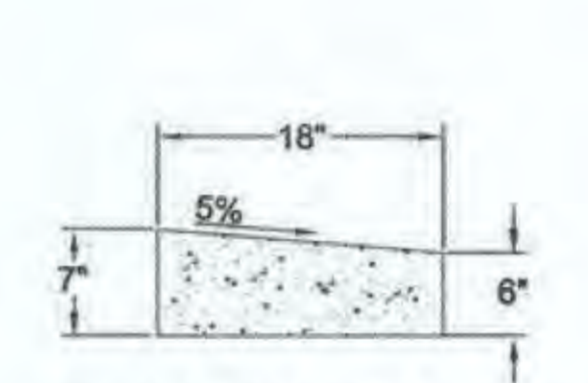

SPILL CURB DETAIL

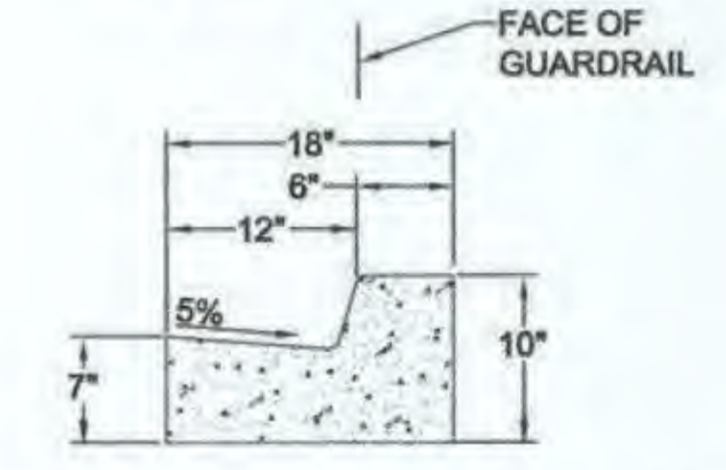

FULL HEIGHT CURB DETAIL

2 CURB TRANSITION TO RIPRAP FLUME DETAIL NTS

Handwritten: 6/9/20

PLANS DEVELOPED BY:
 DOW
 5368 COMMERCIAL BLVD.
 JUNEAU, AK 99801
 (907) 780-3533
 #AECL848




STATE OF ALASKA
 DEPARTMENT OF TRANSPORTATION
 AND PUBLIC FACILITIES
**SKAGWAY - REPLACE CAPTAIN
 WILLIAM HENRY MOORE BRIDGE**

RIPRAP FLUME DETAILS


FILE C:\Civ11\30 Projects\24\70732-01\Civ11\SA14-CT-E-DT-CWHM.dwg DATE 8/17/2016 7:30 LAYOUT E17 CHECKED NOBLE DRAFTED WESTPHAL

NO.	DATE	REVISION	STATE	PROJECT DESIGNATION	YEAR	SHEET NO.	TOTAL SHEETS
			ALASKA	0972016/Z684590000	2016	E17	59

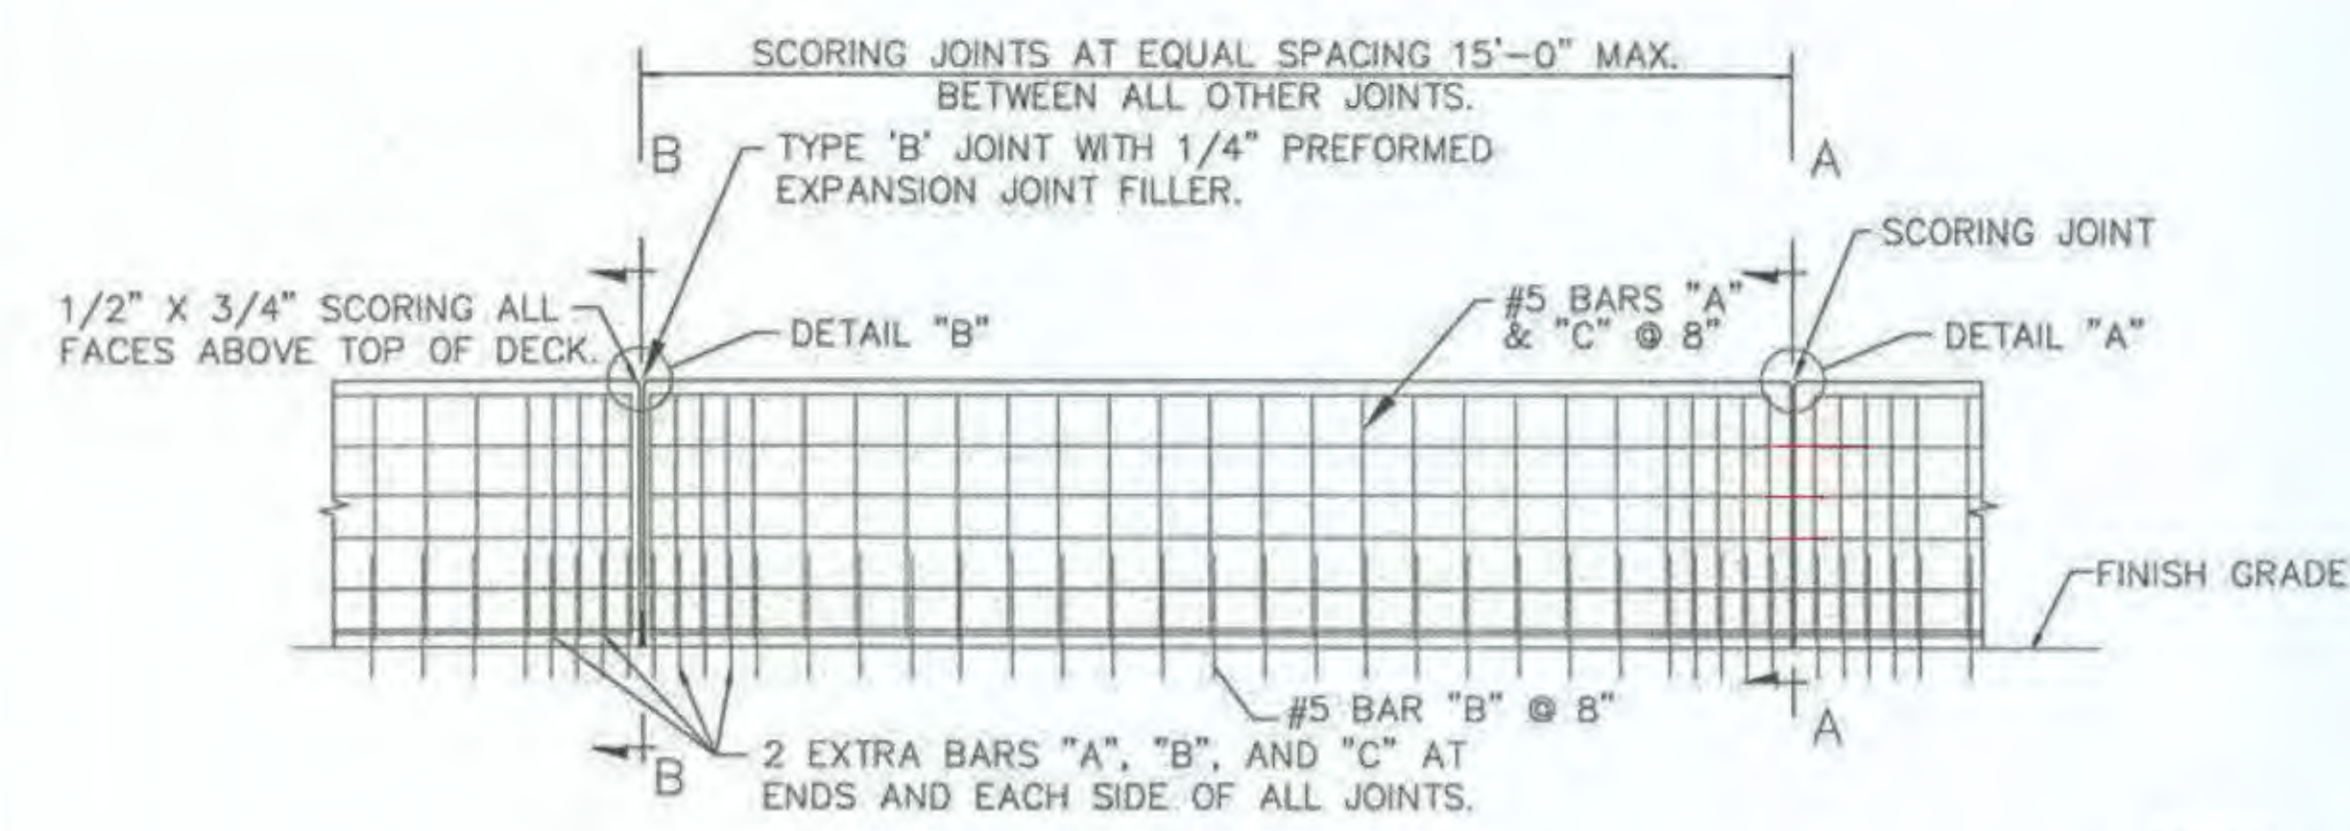


1 ELEVATION: CONCRETE BARRIER NTS


NOTES:
 *TOP OF PARAPET SHALL BE 3'-6" ABOVE FINISHED GRADE.
 SEE SHEET E18 FOR BARRIER ON END PANEL.

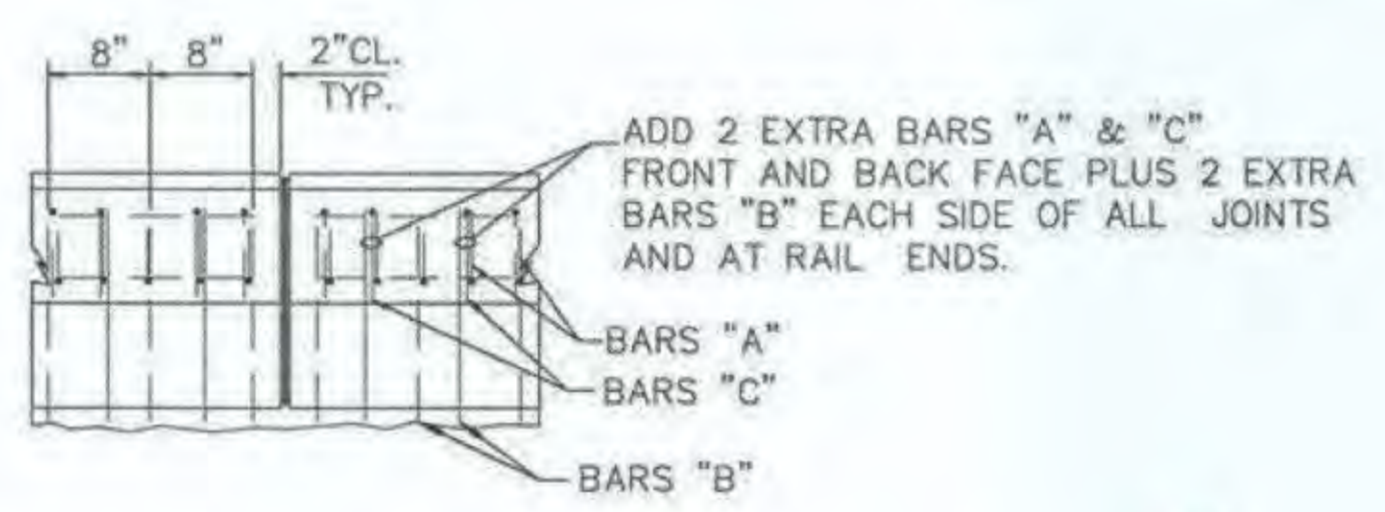


2 PLAN: BARS AT JOINTS AND BARRIER ENDS NTS

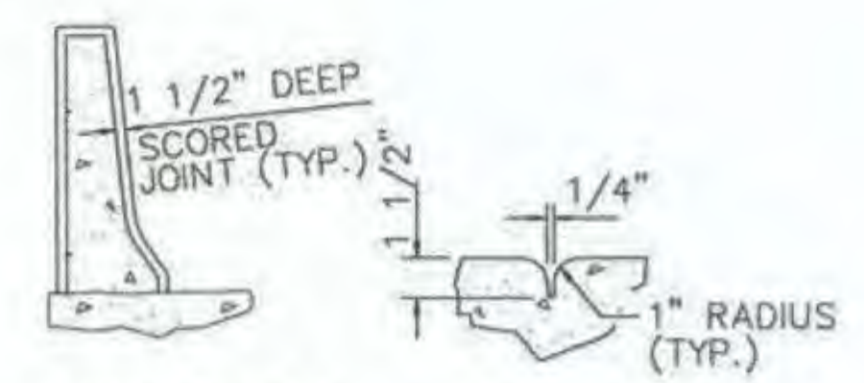


3 SECTION A-A DETAIL "A" SCORING JOINT DETAIL NTS

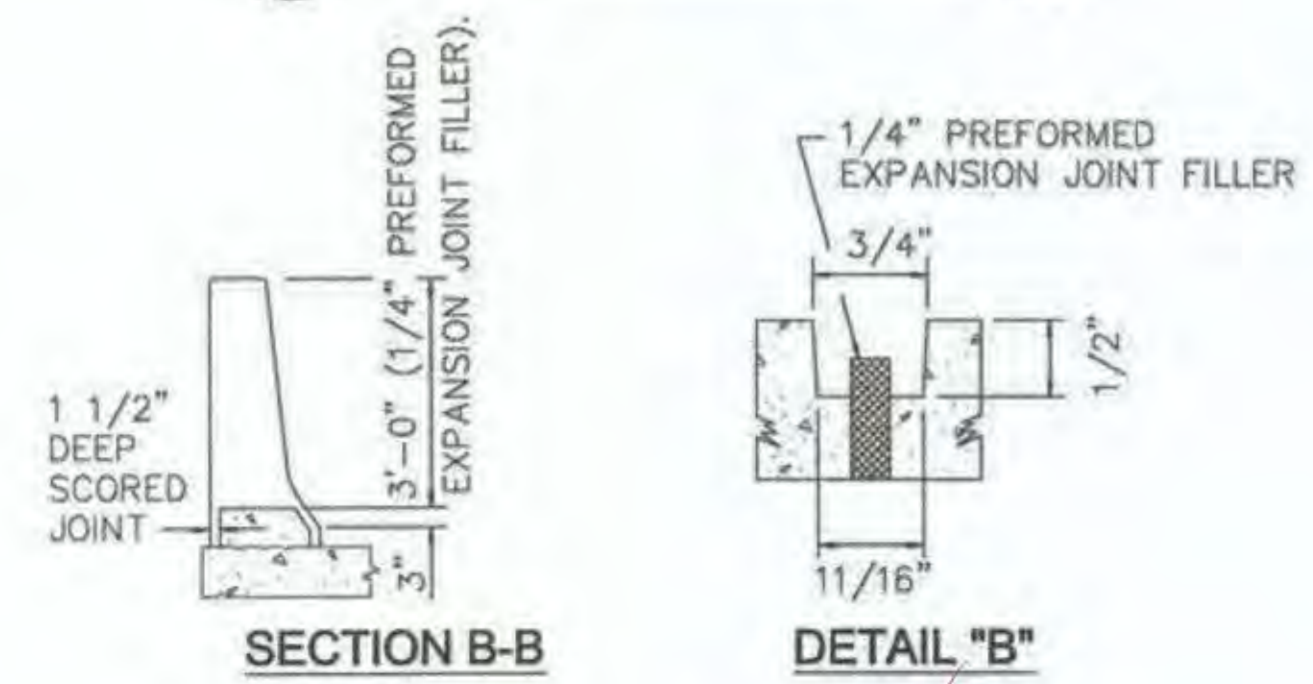

4 TYPE 'B' JOINT DETAIL NTS

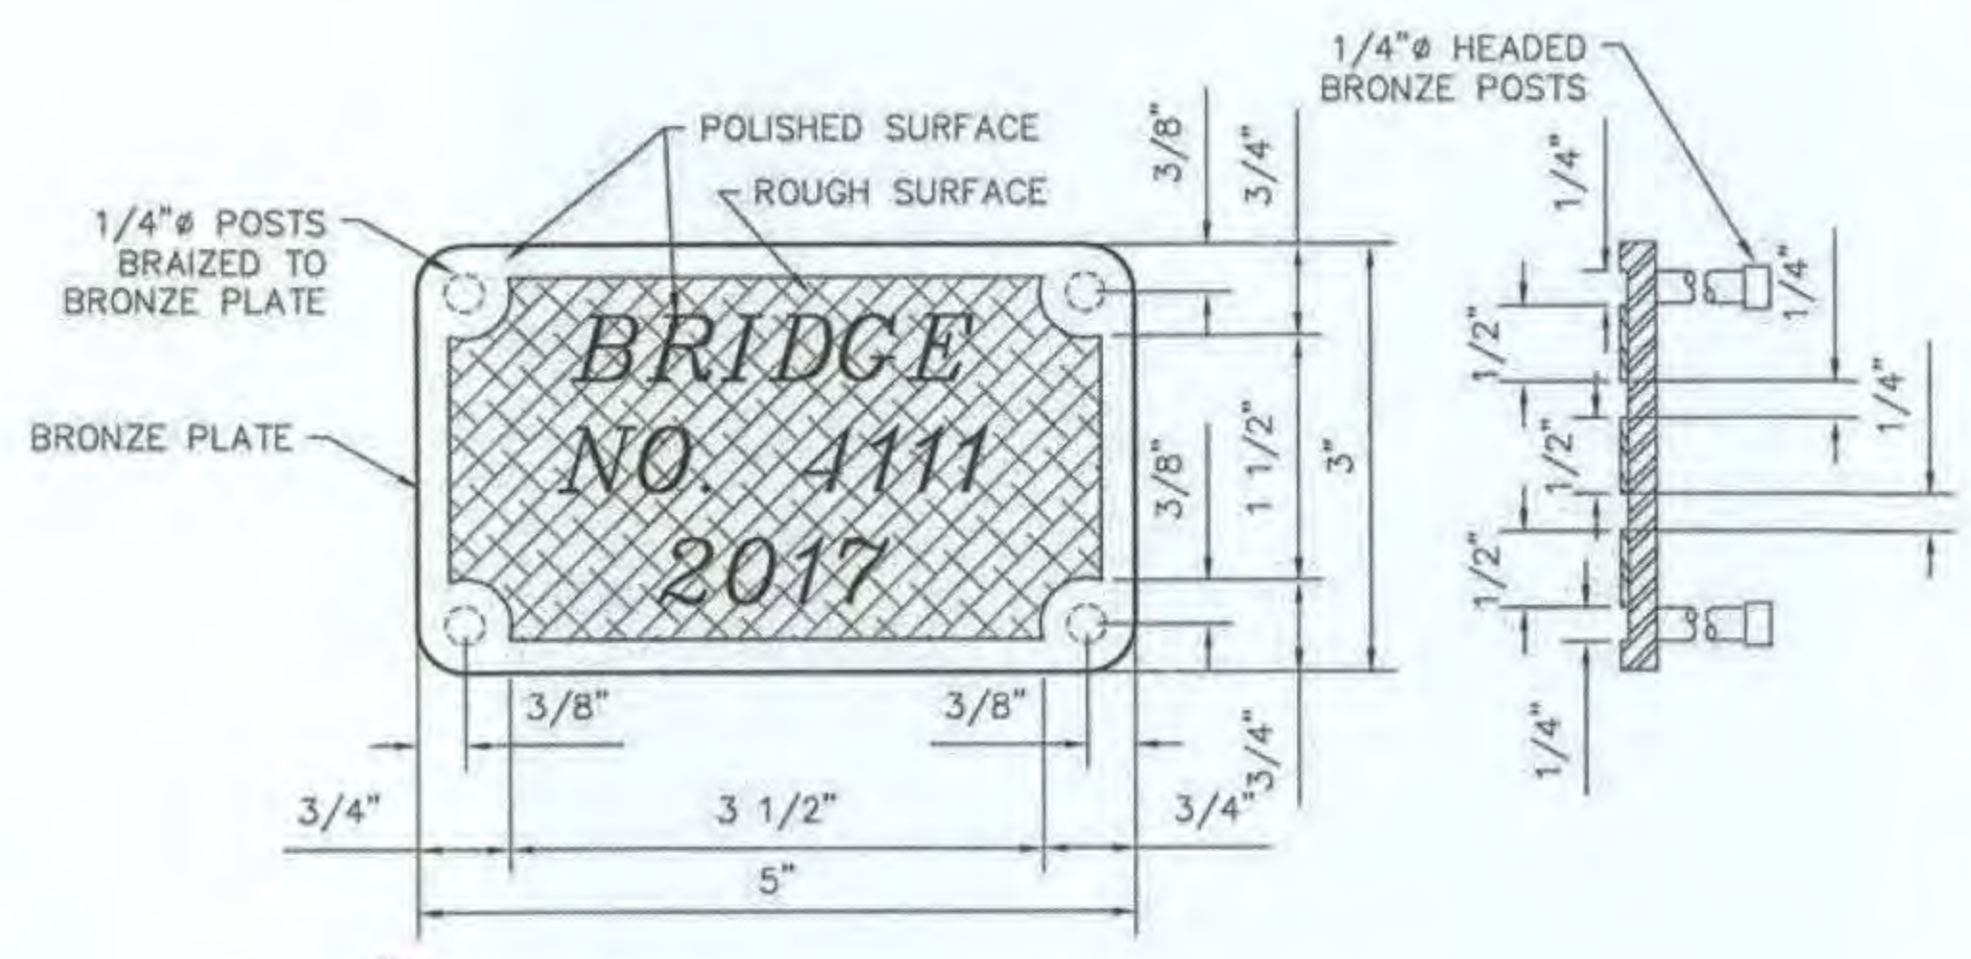

5 BRIDGE NUMBER PLATE NTS

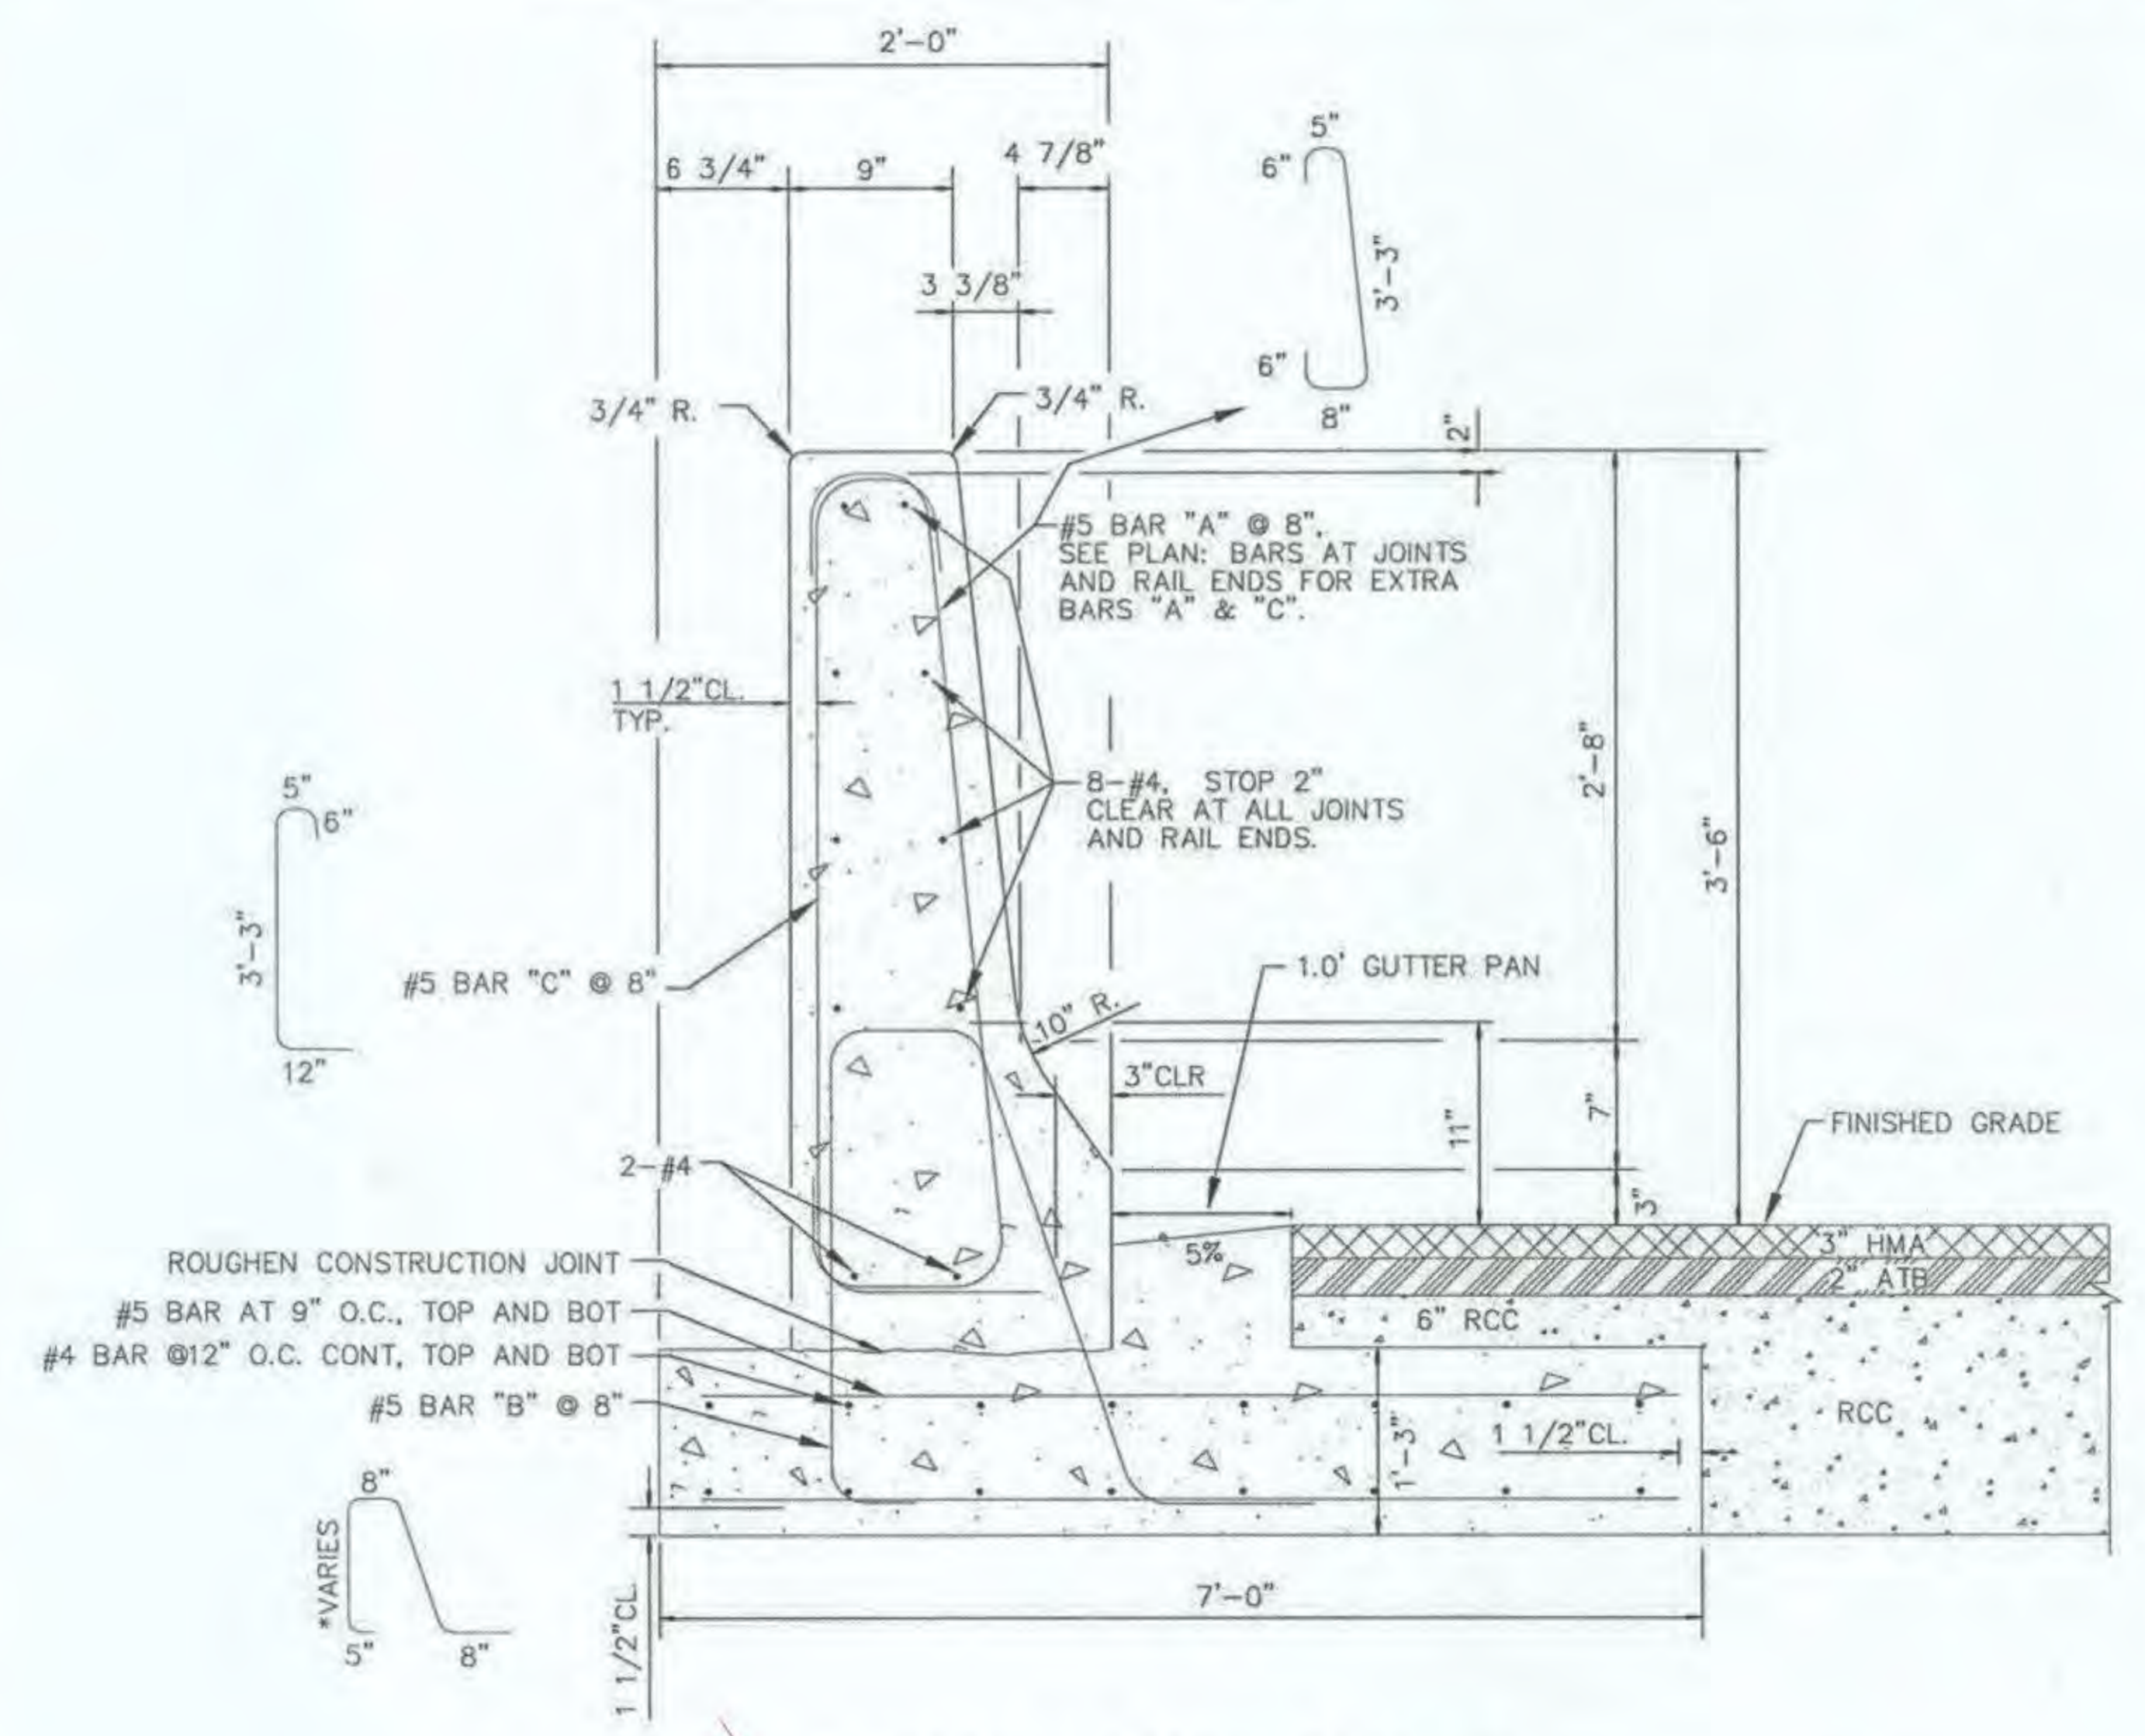

6 CONCRETE BARRIER SECTION NTS

GENERAL NOTES:

1. BARRIER DESIGNED AND CRASH TESTED TO MEET NCHRP 350 TL-5 REQUIREMENTS.
2. PROVIDE REINFORCING STEEL CONFORMING TO ASTM A706 OR AASHTO M31 (ASTM A615) GRADE 60.
3. SPLICE #4 BARS 1'-4" MIN., SPLICE #5 BARS 1'-8" MIN.
4. PROVIDE CLASS A CONCRETE.
5. PROVIDE STEEL COVER PLATES CONFORMING AASHTO M183, (ASTM A36), HOT-DIP GALVANIZE AFTER FABRICATION.










PLANS DEVELOPED BY:
 DOWL
 5368 COMMERCIAL BLVD.
 JUNEAU, AK 99801
 (907) 780-3533
 #AECL848



STATE OF ALASKA
 DEPARTMENT OF TRANSPORTATION
 AND PUBLIC FACILITIES
**SKAGWAY - REPLACE CAPTAIN
 WILLIAM HENRY MOORE BRIDGE**
**CONCRETE BARRIER DETAILS
 AND BRIDGE NUMBER PLATE**

NO.	DATE	REVISION	STATE	PROJECT DESIGNATION	YEAR	SHEET NO.	TOTAL SHEETS
			ALASKA	0972016/Z684590000	2016	E18	59

FILE: C:\Civ11_30 Projects\24\70732-01\Civ11\SA14-CT-E-DT-CRM.dwg
 DATE: 8/17/2016 7:32 LAYOUT: E18
 DESIGNED: HOBBS
 CHECKED: NOBLE
 DRAFTED: WESTPHAL

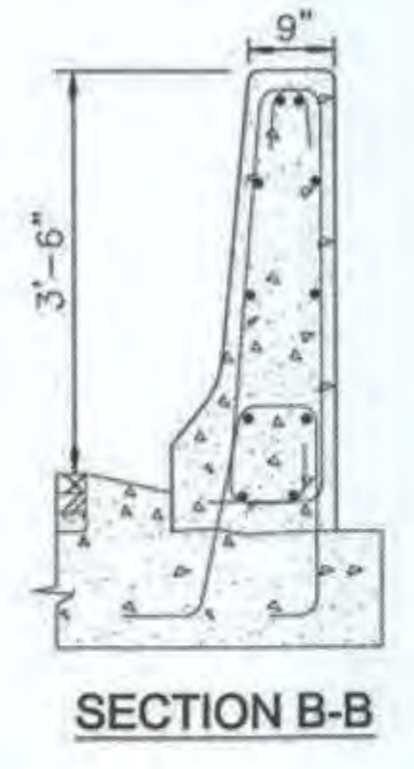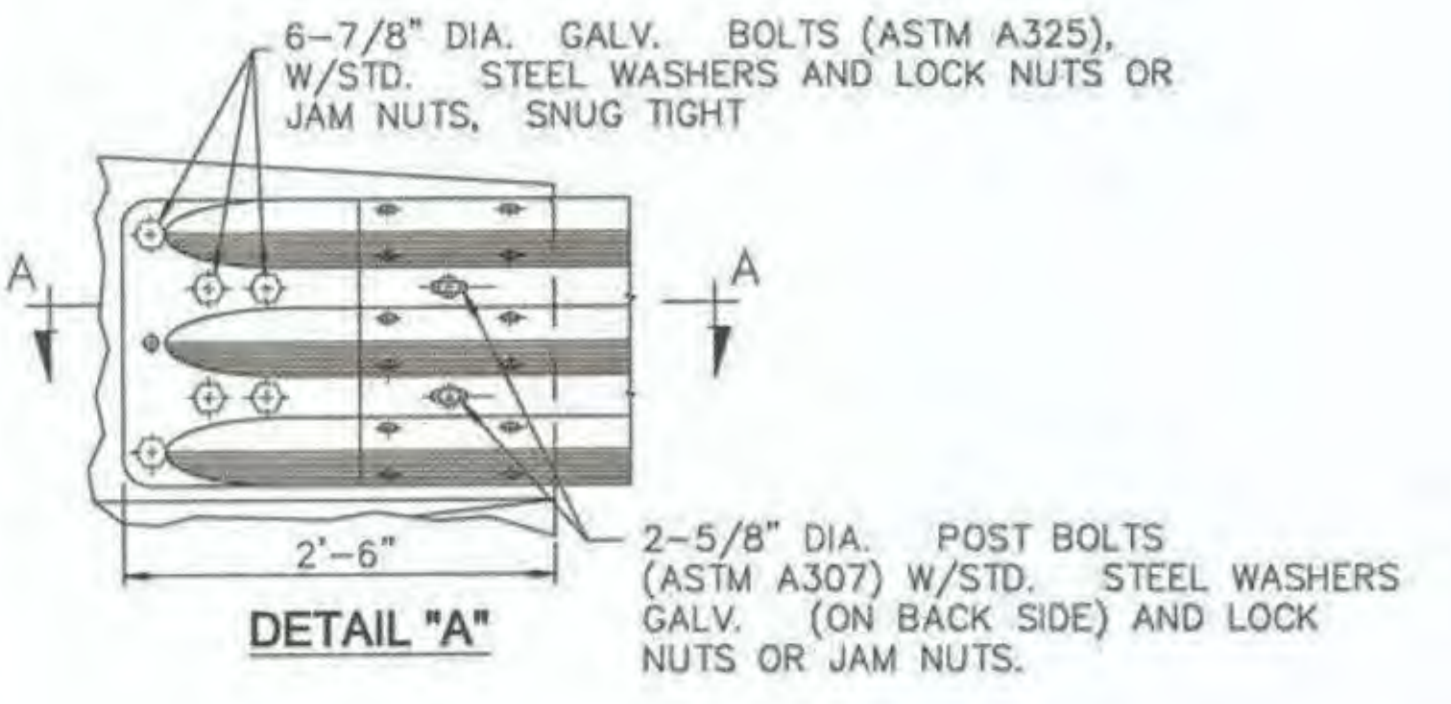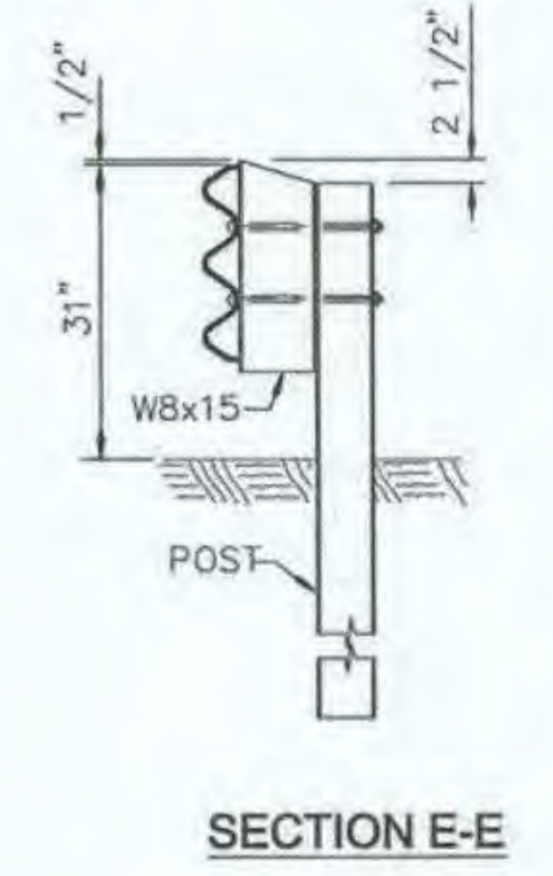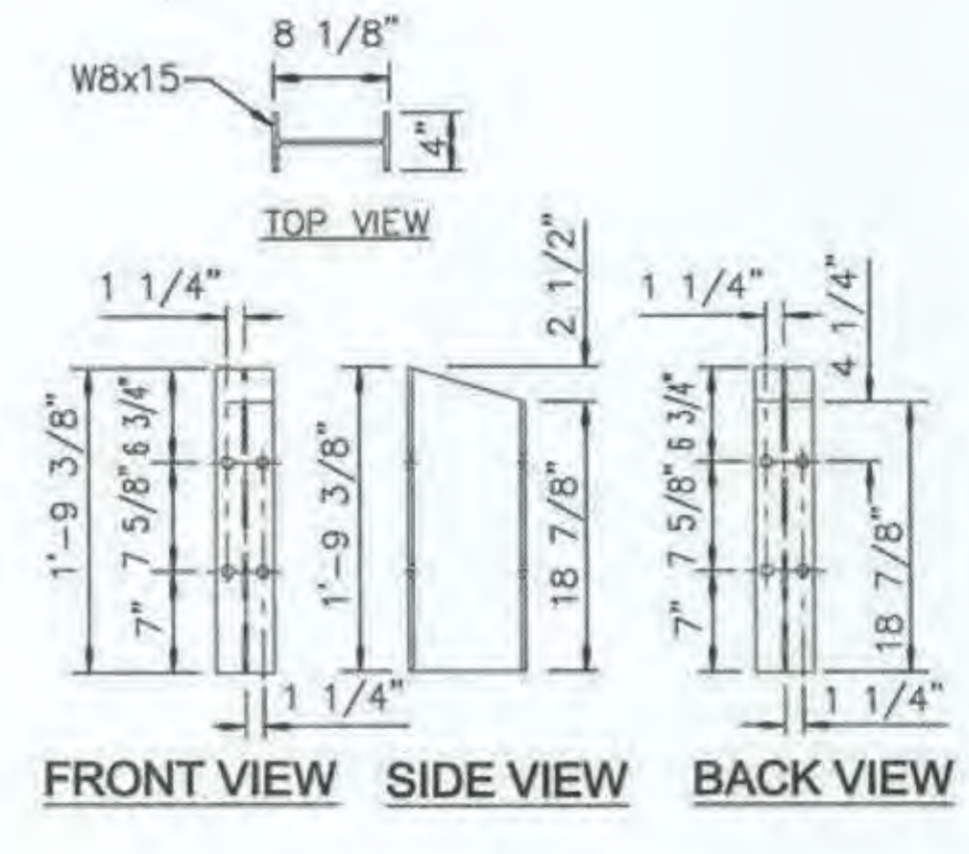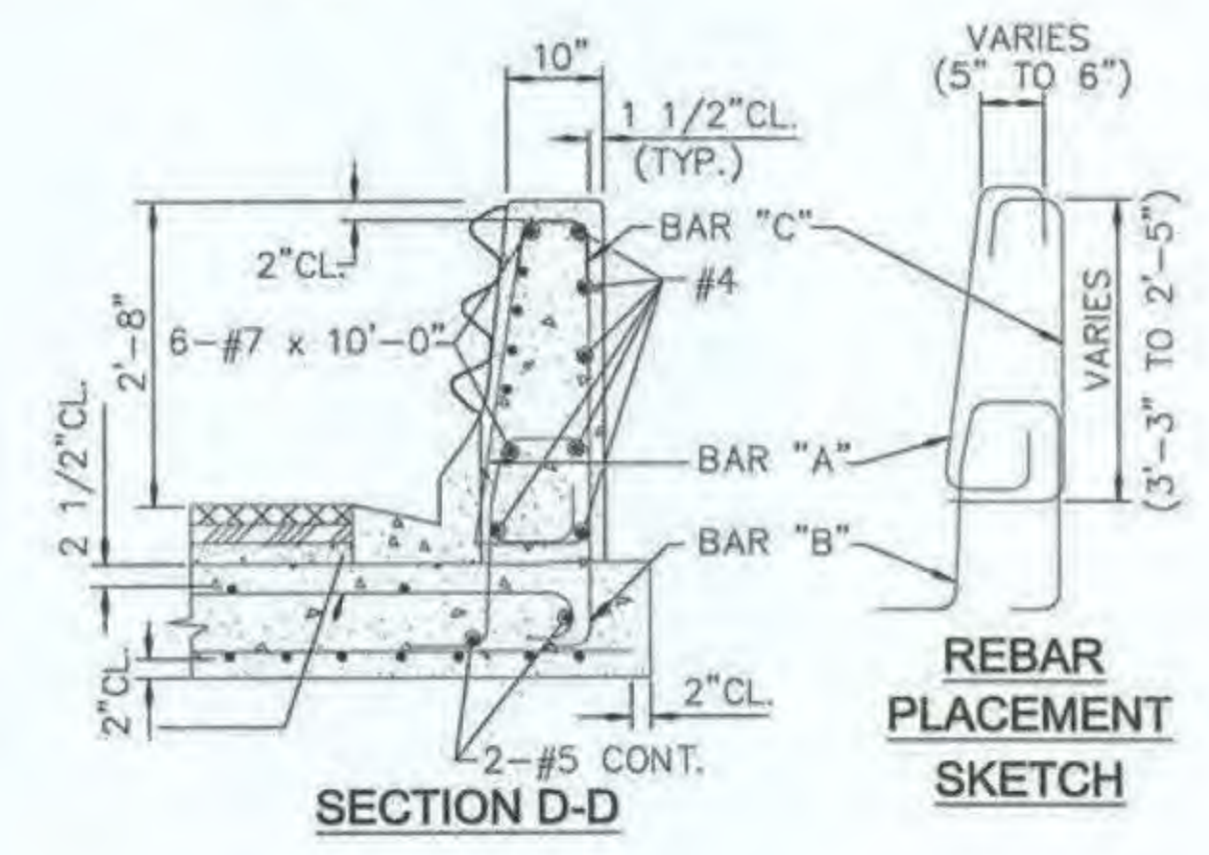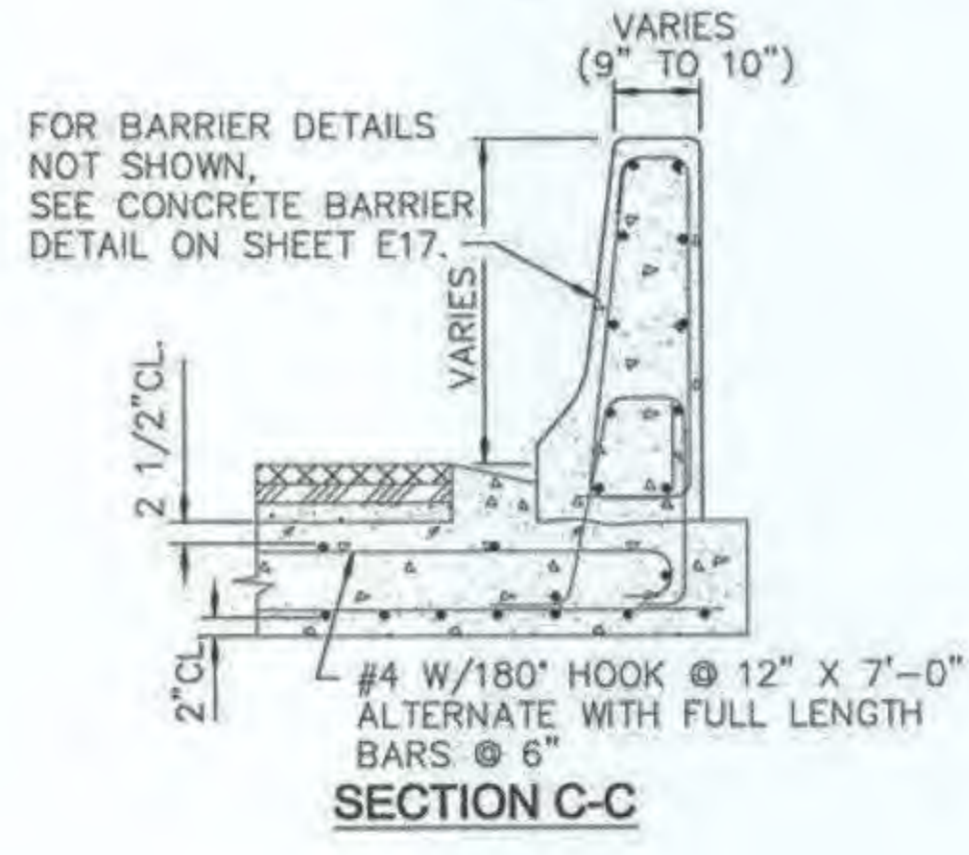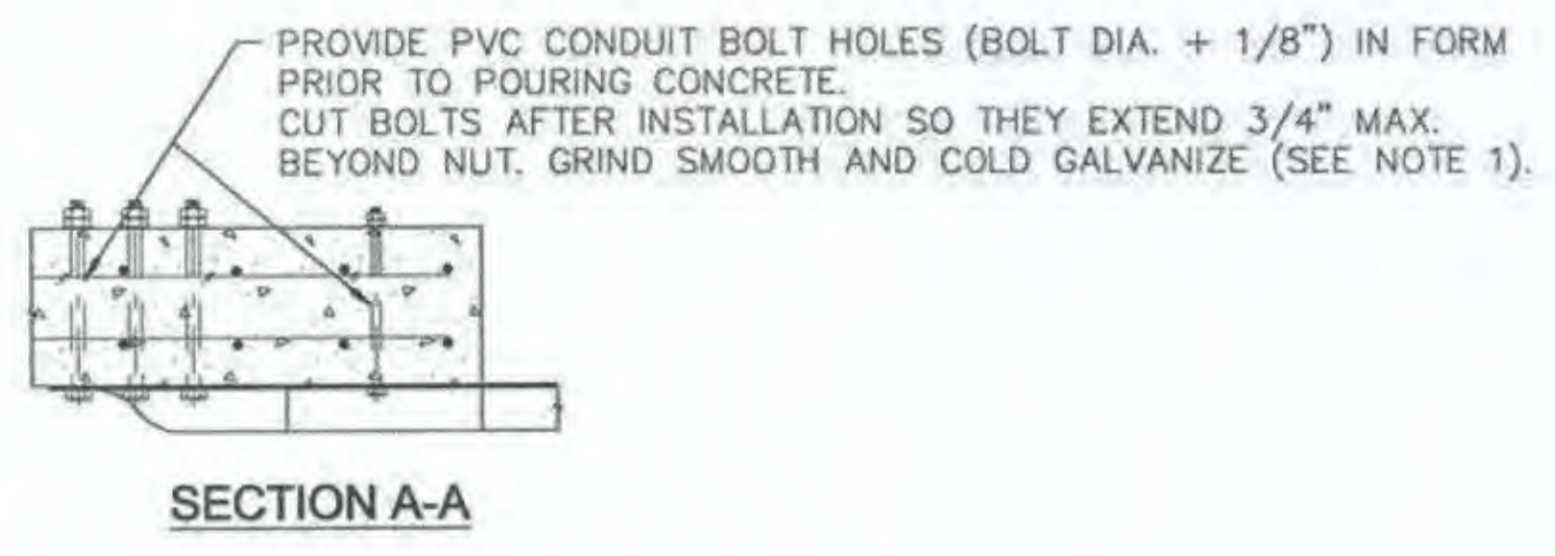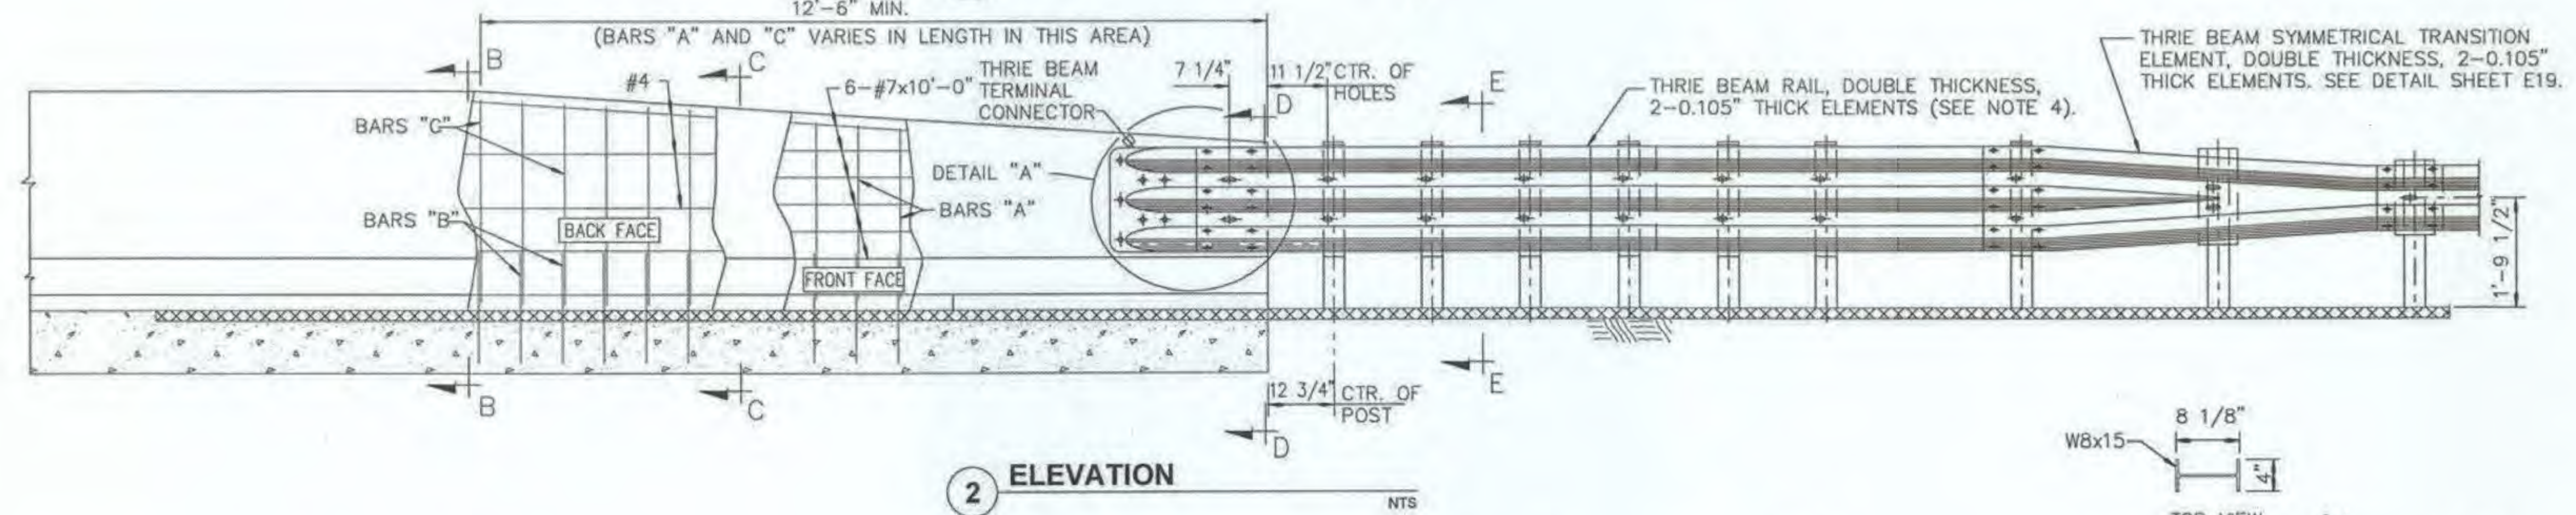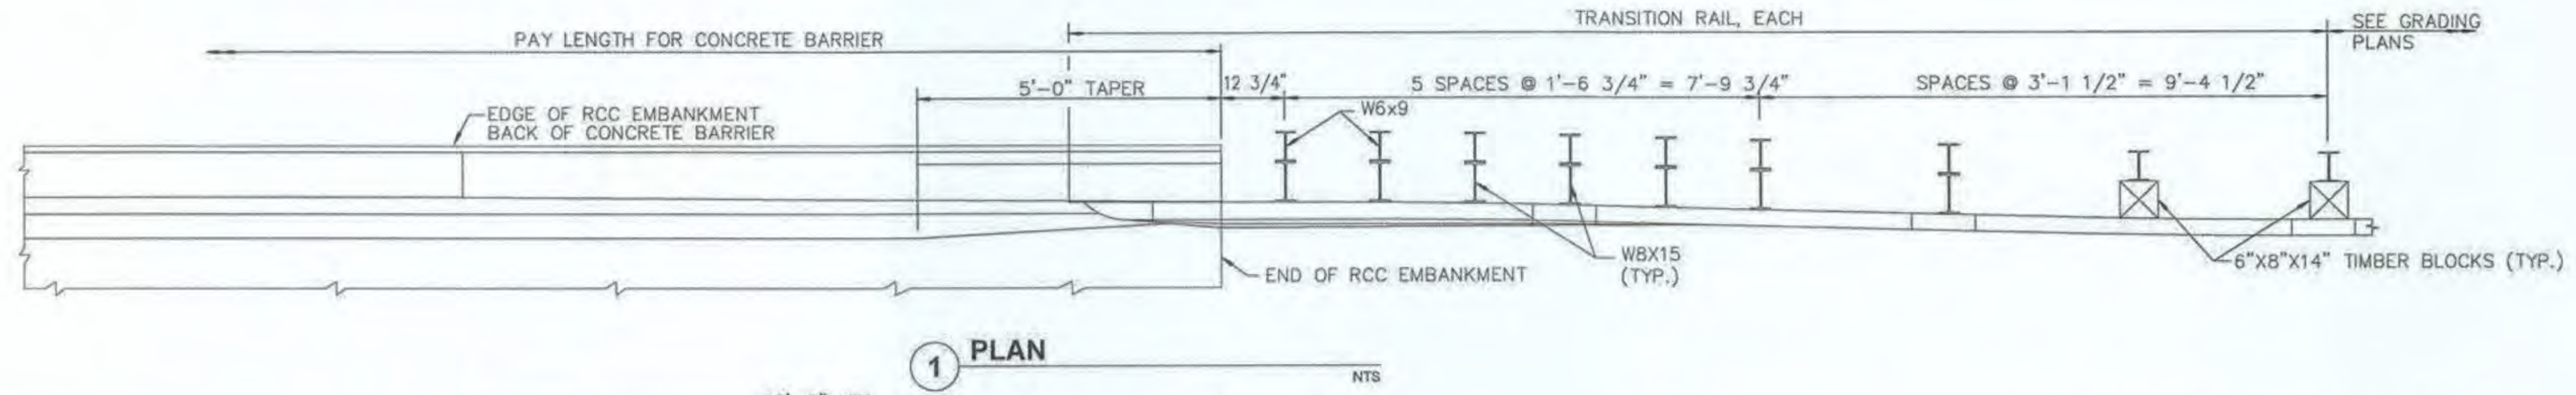

- GENERAL NOTES:**
1. PROVIDE STEEL FOR WIDE-FLANGE POSTS CONFORMING TO AASHTO M183 (ASTM A36). HOT DIP GALVANIZE AFTER FABRICATION.
 2. ALL GUARDRAIL AND GUARDRAIL CONNECTION HARDWARE TO CONFORM TO AASHTO M-180. ALL H.S. BOLTS TO CONFORM TO ASTM A325. ALL OTHER STEEL TO CONFORM TO ASTM A709 GRADE 36.
 3. CONFORM TO STANDARD DRAWINGS FOR ALL GUARDRAIL DETAILS NOT SHOWN.
 4. LAP APPROACH GUARDRAIL TO PREVENT SNAGS FROM ON COMING TRAFFIC.
 5. PROVIDE GUTTER PAN ALONG CONCRETE BARRIER AS SHOWN ON SHEET E17.

PLANS DEVELOPED BY:
 DOWL
 5368 COMMERCIAL BLVD.
 JUNEAU, AK 99801
 (907) 780-3533
 #AECL848





STATE OF ALASKA
 DEPARTMENT OF TRANSPORTATION
 AND PUBLIC FACILITIES

**SKAGWAY - REPLACE CAPTAIN
 WILLIAM HENRY MOORE BRIDGE**

**CONCRETE BARRIER TRANSITION
 DETAILS**


NO.	DATE	REVISION	STATE	PROJECT DESIGNATION	YEAR	SHEET NO.	TOTAL SHEETS
			ALASKA	0972016/Z684590000	2016	E19	59

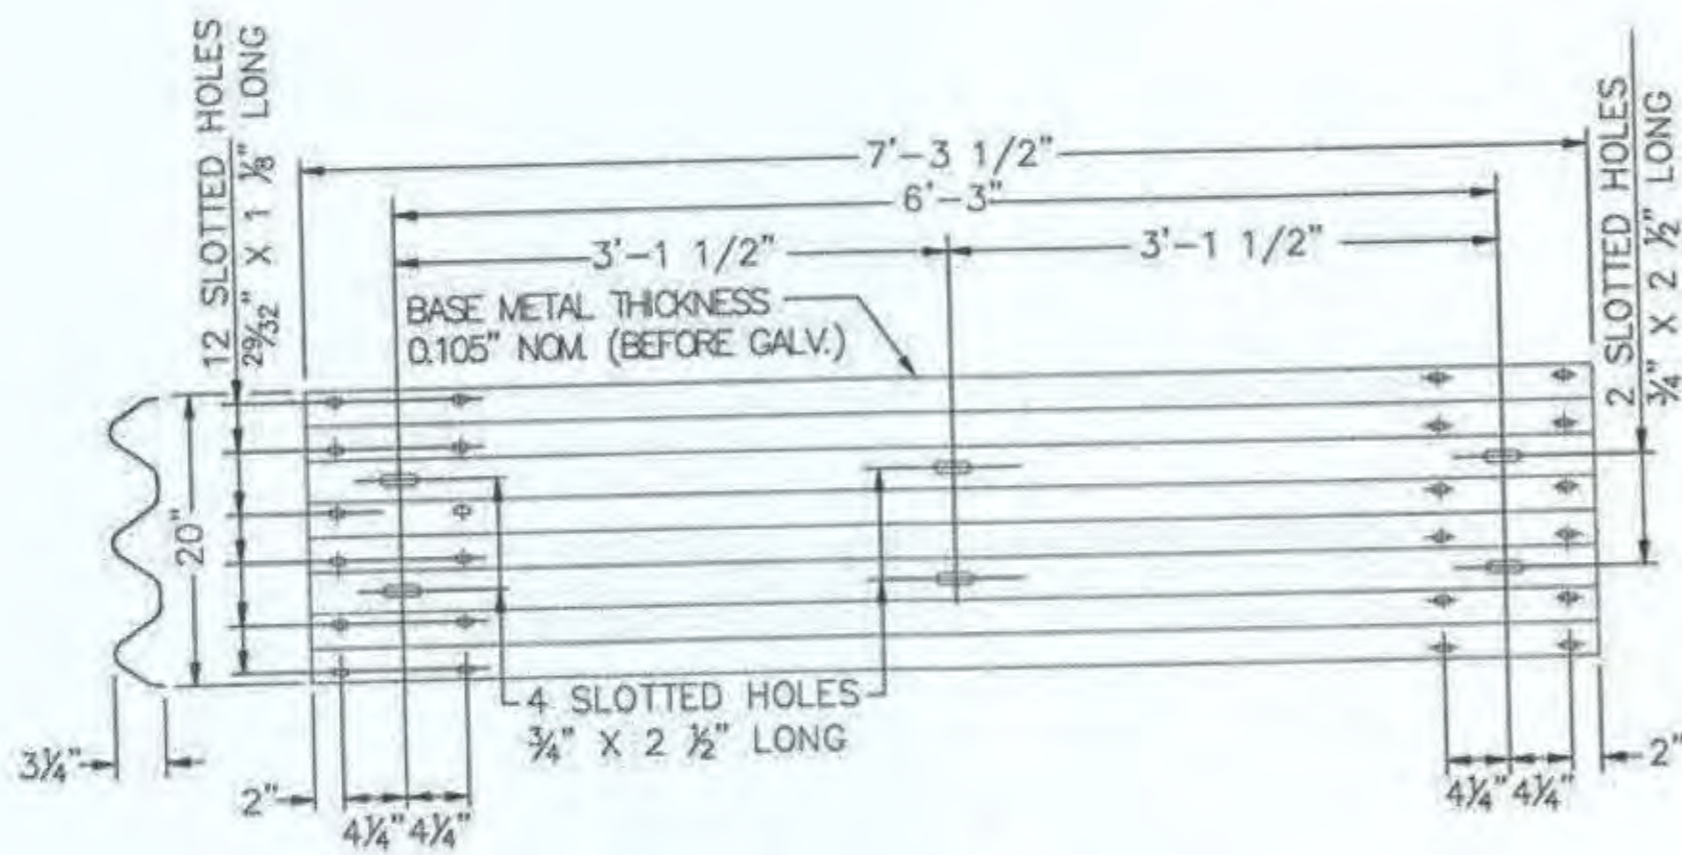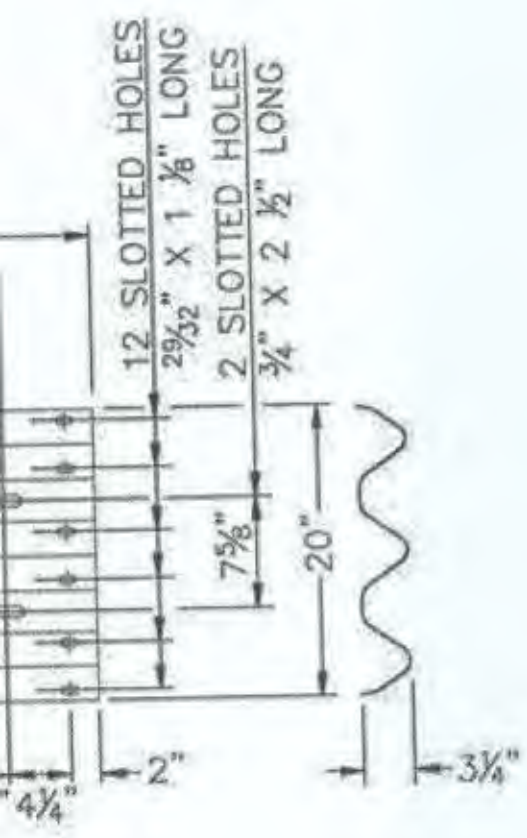

5 ELEVATION - RAIL ELEMENT



NTS

NTS

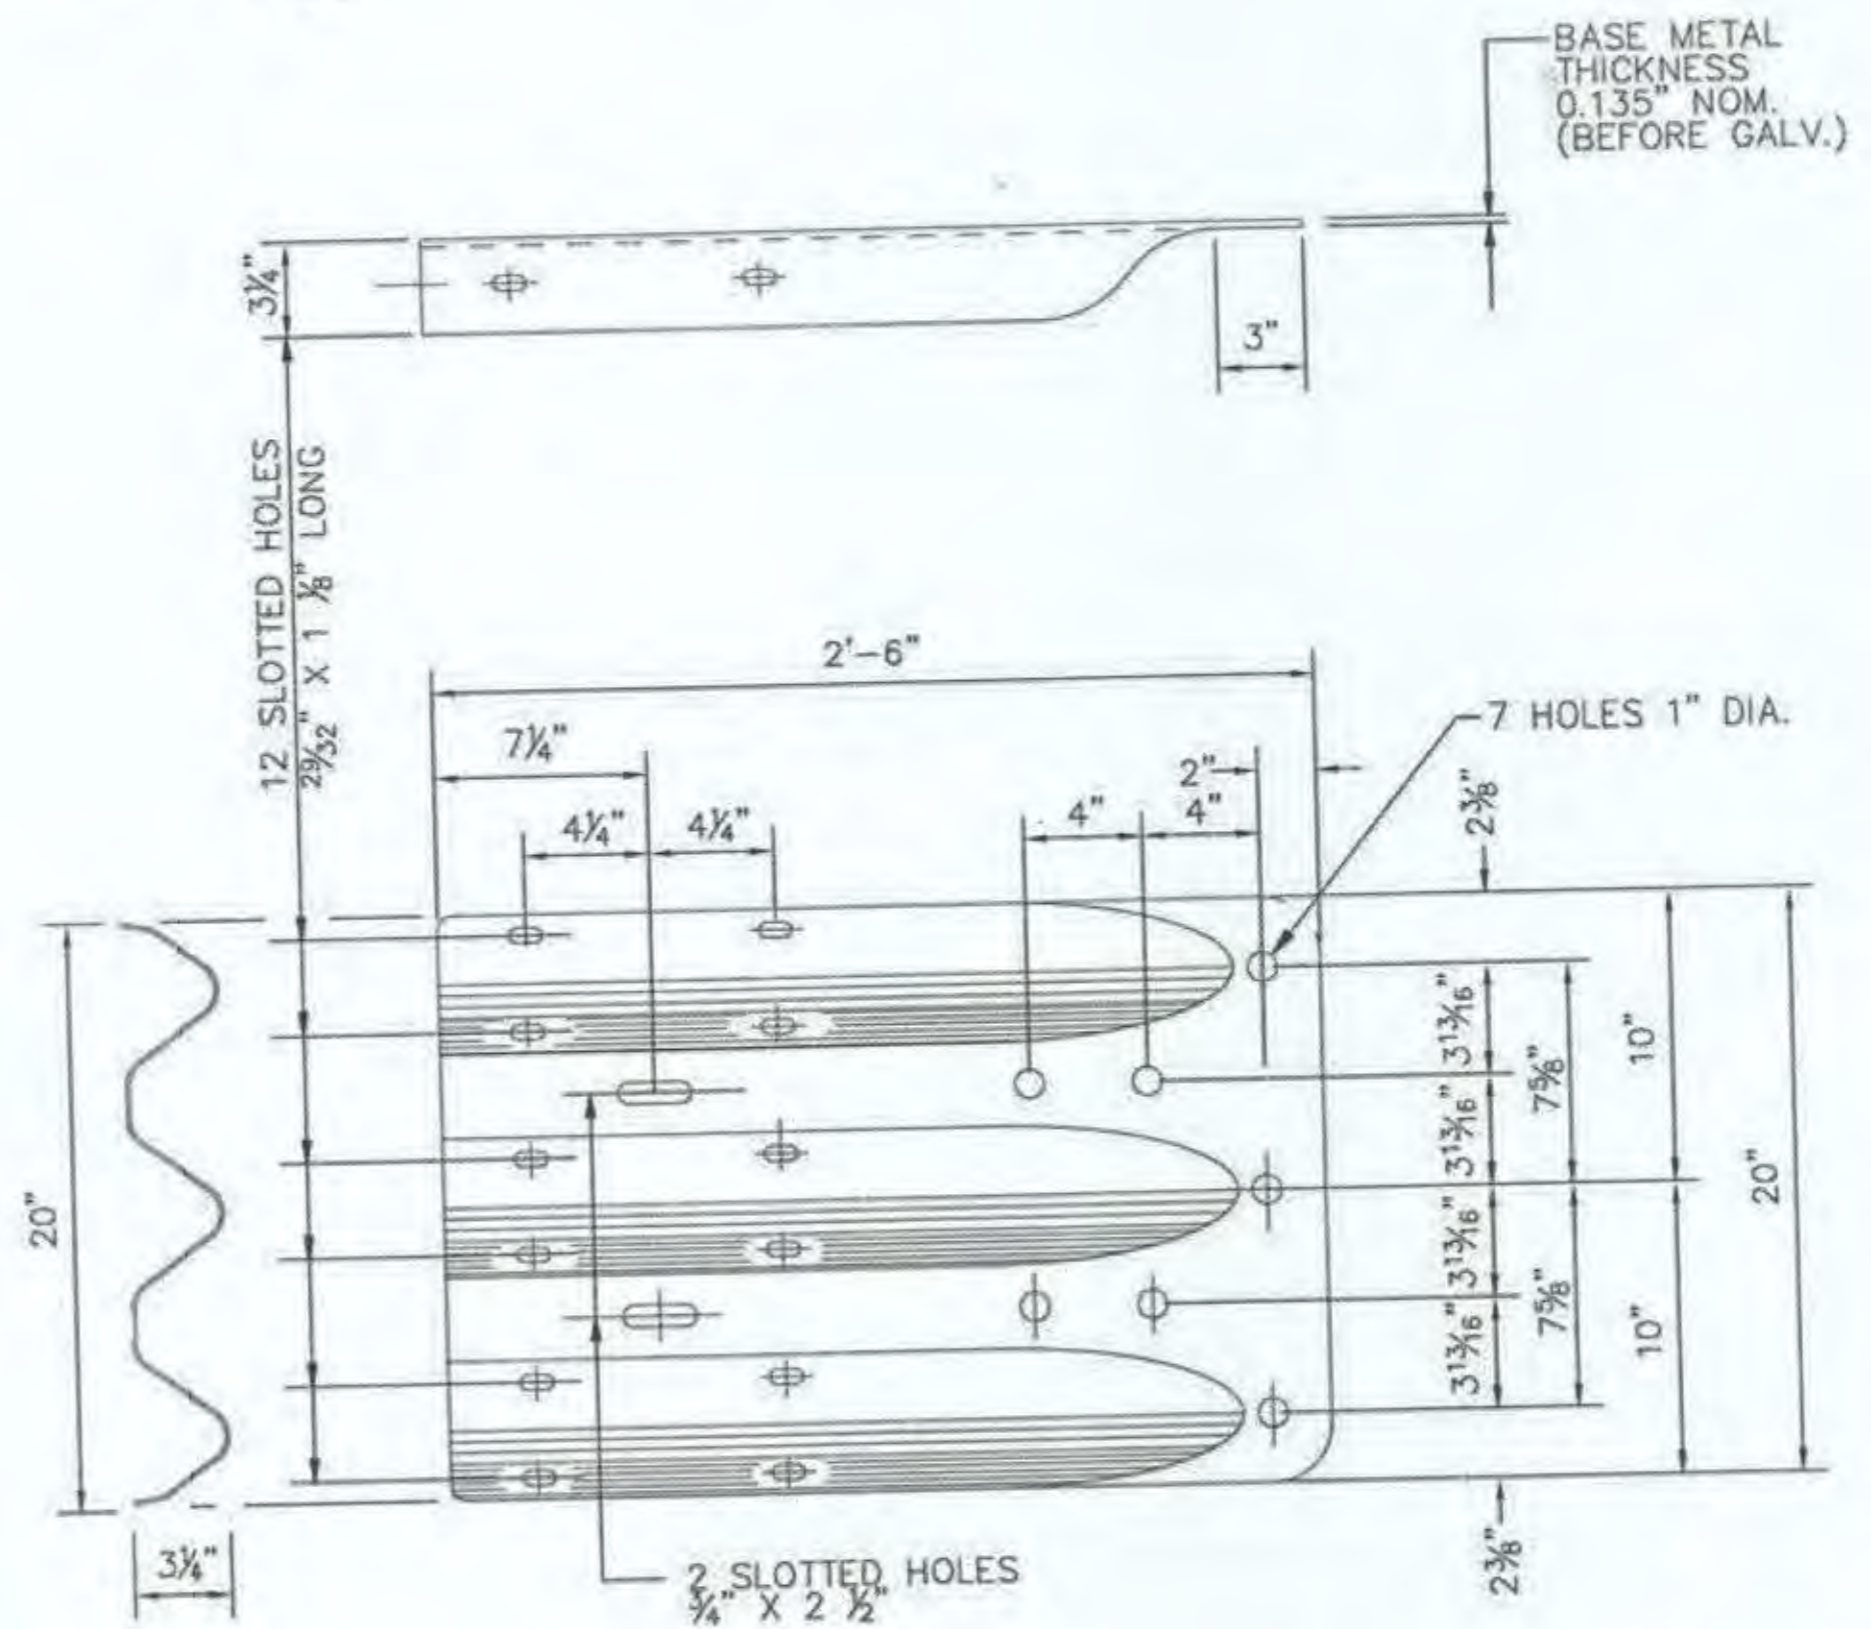

6 TERMINAL CONNECTOR

NTS

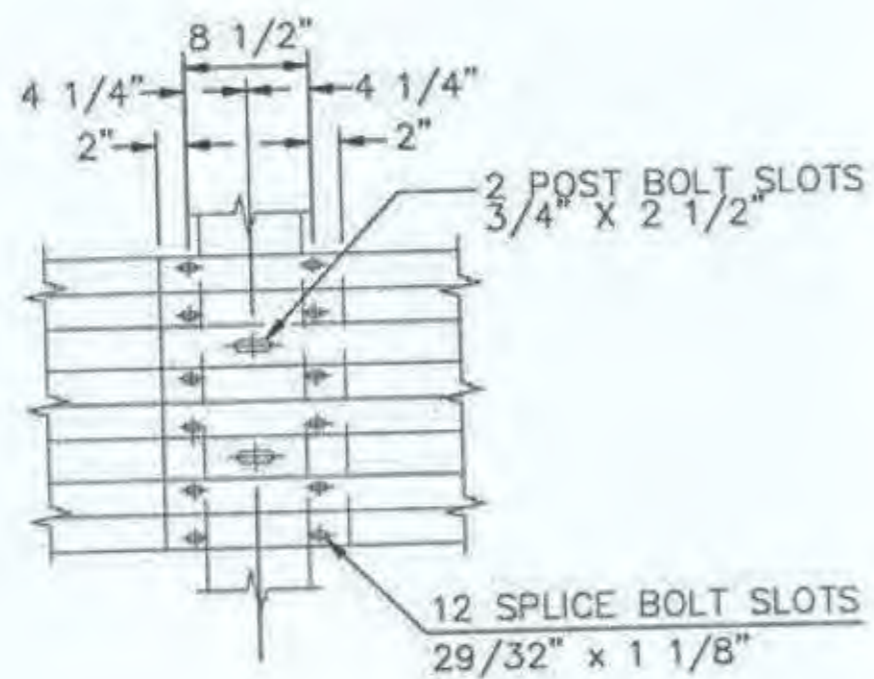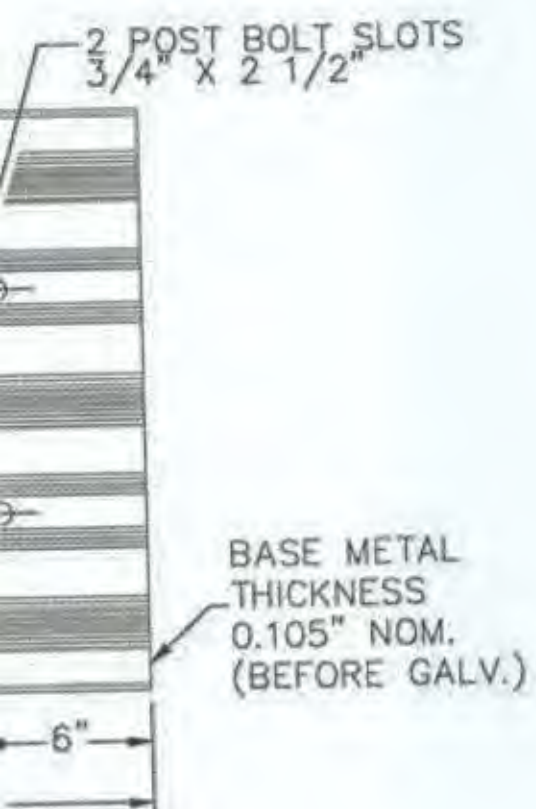

4 BEAM SPLICE

NTS

BEAM BACK-UP PLATE

NTS

PLANS DEVELOPED BY:
DOWL
5368 COMMERCIAL BLVD.
JUNEAU, AK 99801
(907) 780-3533
#AECL848



8.17.2016




STATE OF ALASKA
DEPARTMENT OF TRANSPORTATION
AND PUBLIC FACILITIES

SKAGWAY - REPLACE CAPTAIN
WILLIAM HENRY MOORE BRIDGE

THREE BEAM TRANSITION RAIL
DETAILS




FIRM DOW
 FILE C:\civil\3D Projects\2\70732-01\Civil\1\SC14-CT-F-PP-CMM.dwg
 ADDRESS 5368 COMMERCIAL BLVD., JUNEAU, AK 99801
 PHONE (907) 780-3533
 DESIGNED HOBBS
 CHECKED NOBLE
 DRAFTED WESTPHAL
 DATE 8/17/2016 7:51 LAYOUT F1

NO.	DATE	REVISION	STATE	PROJECT DESIGNATION	YEAR	SHEET NO.	TOTAL SHEETS
			ALASKA	0972016/Z684590000	2016	F1	59

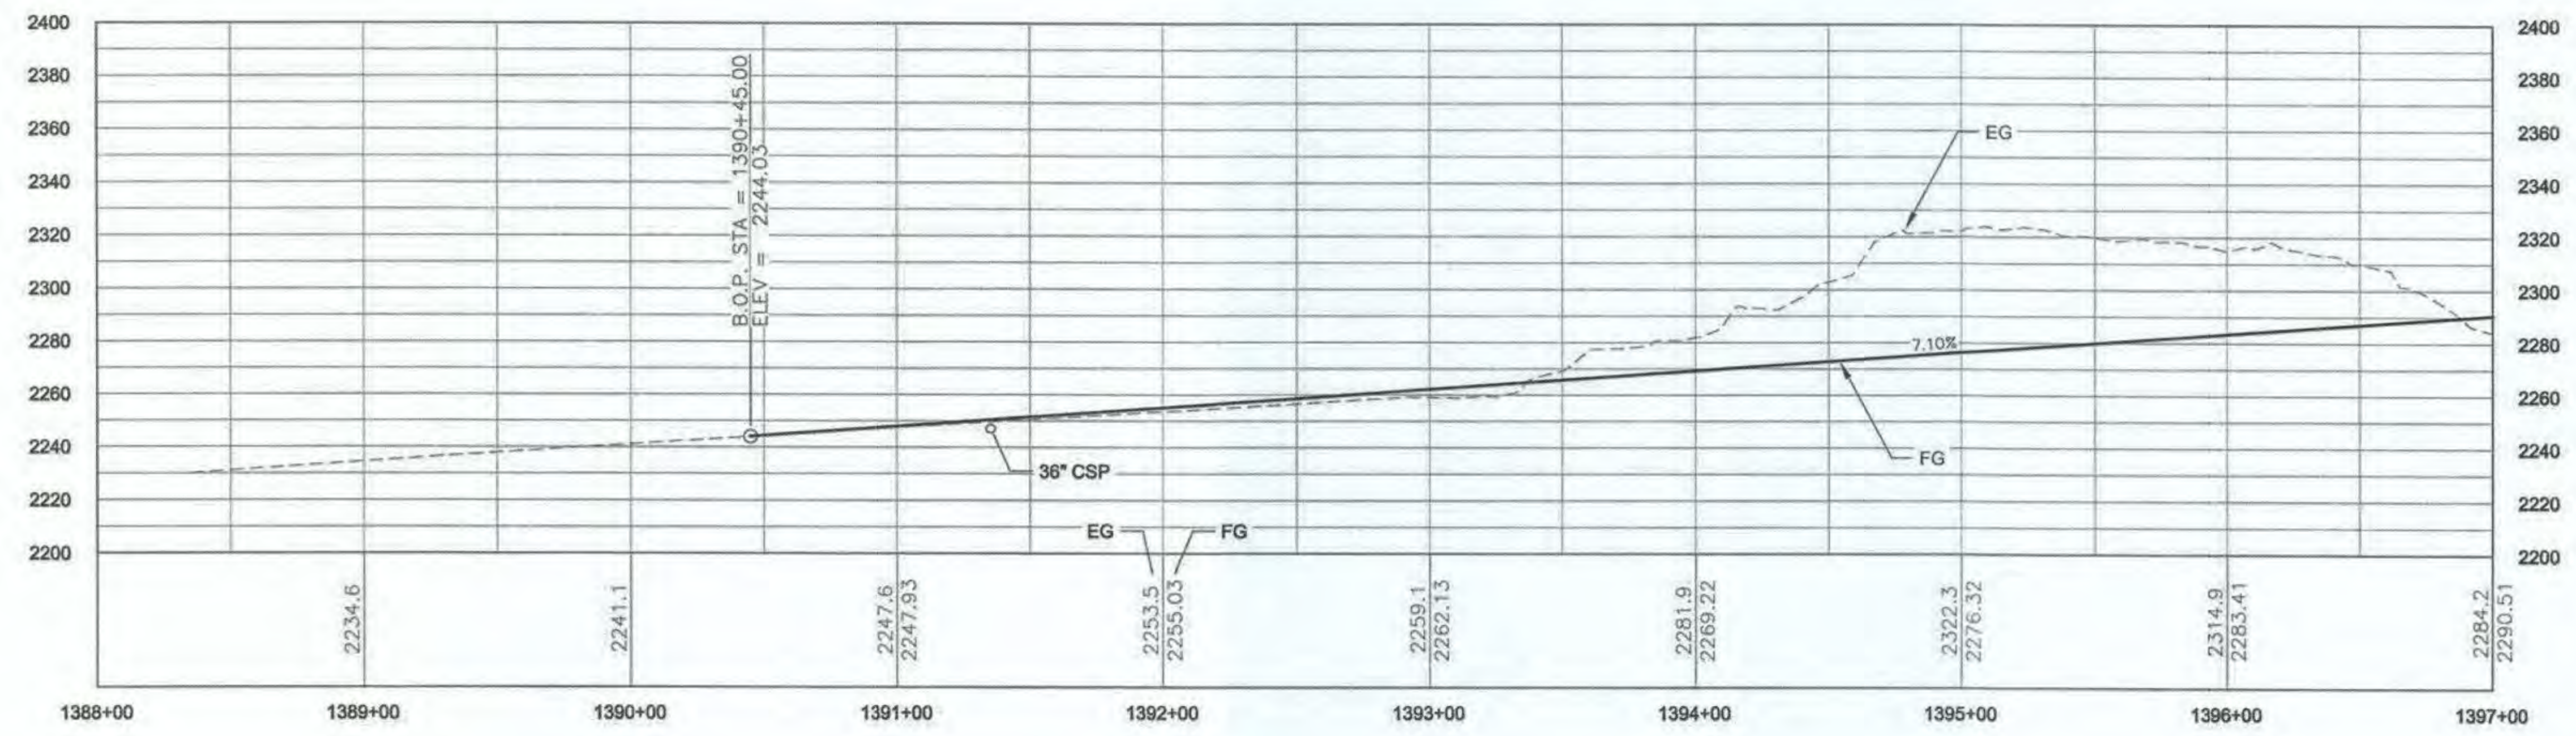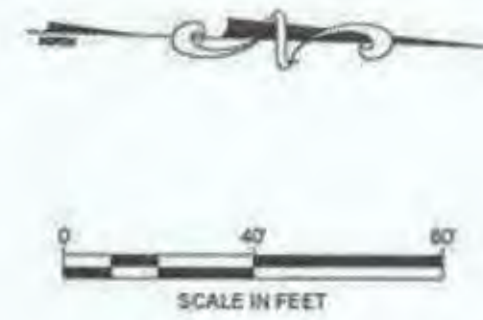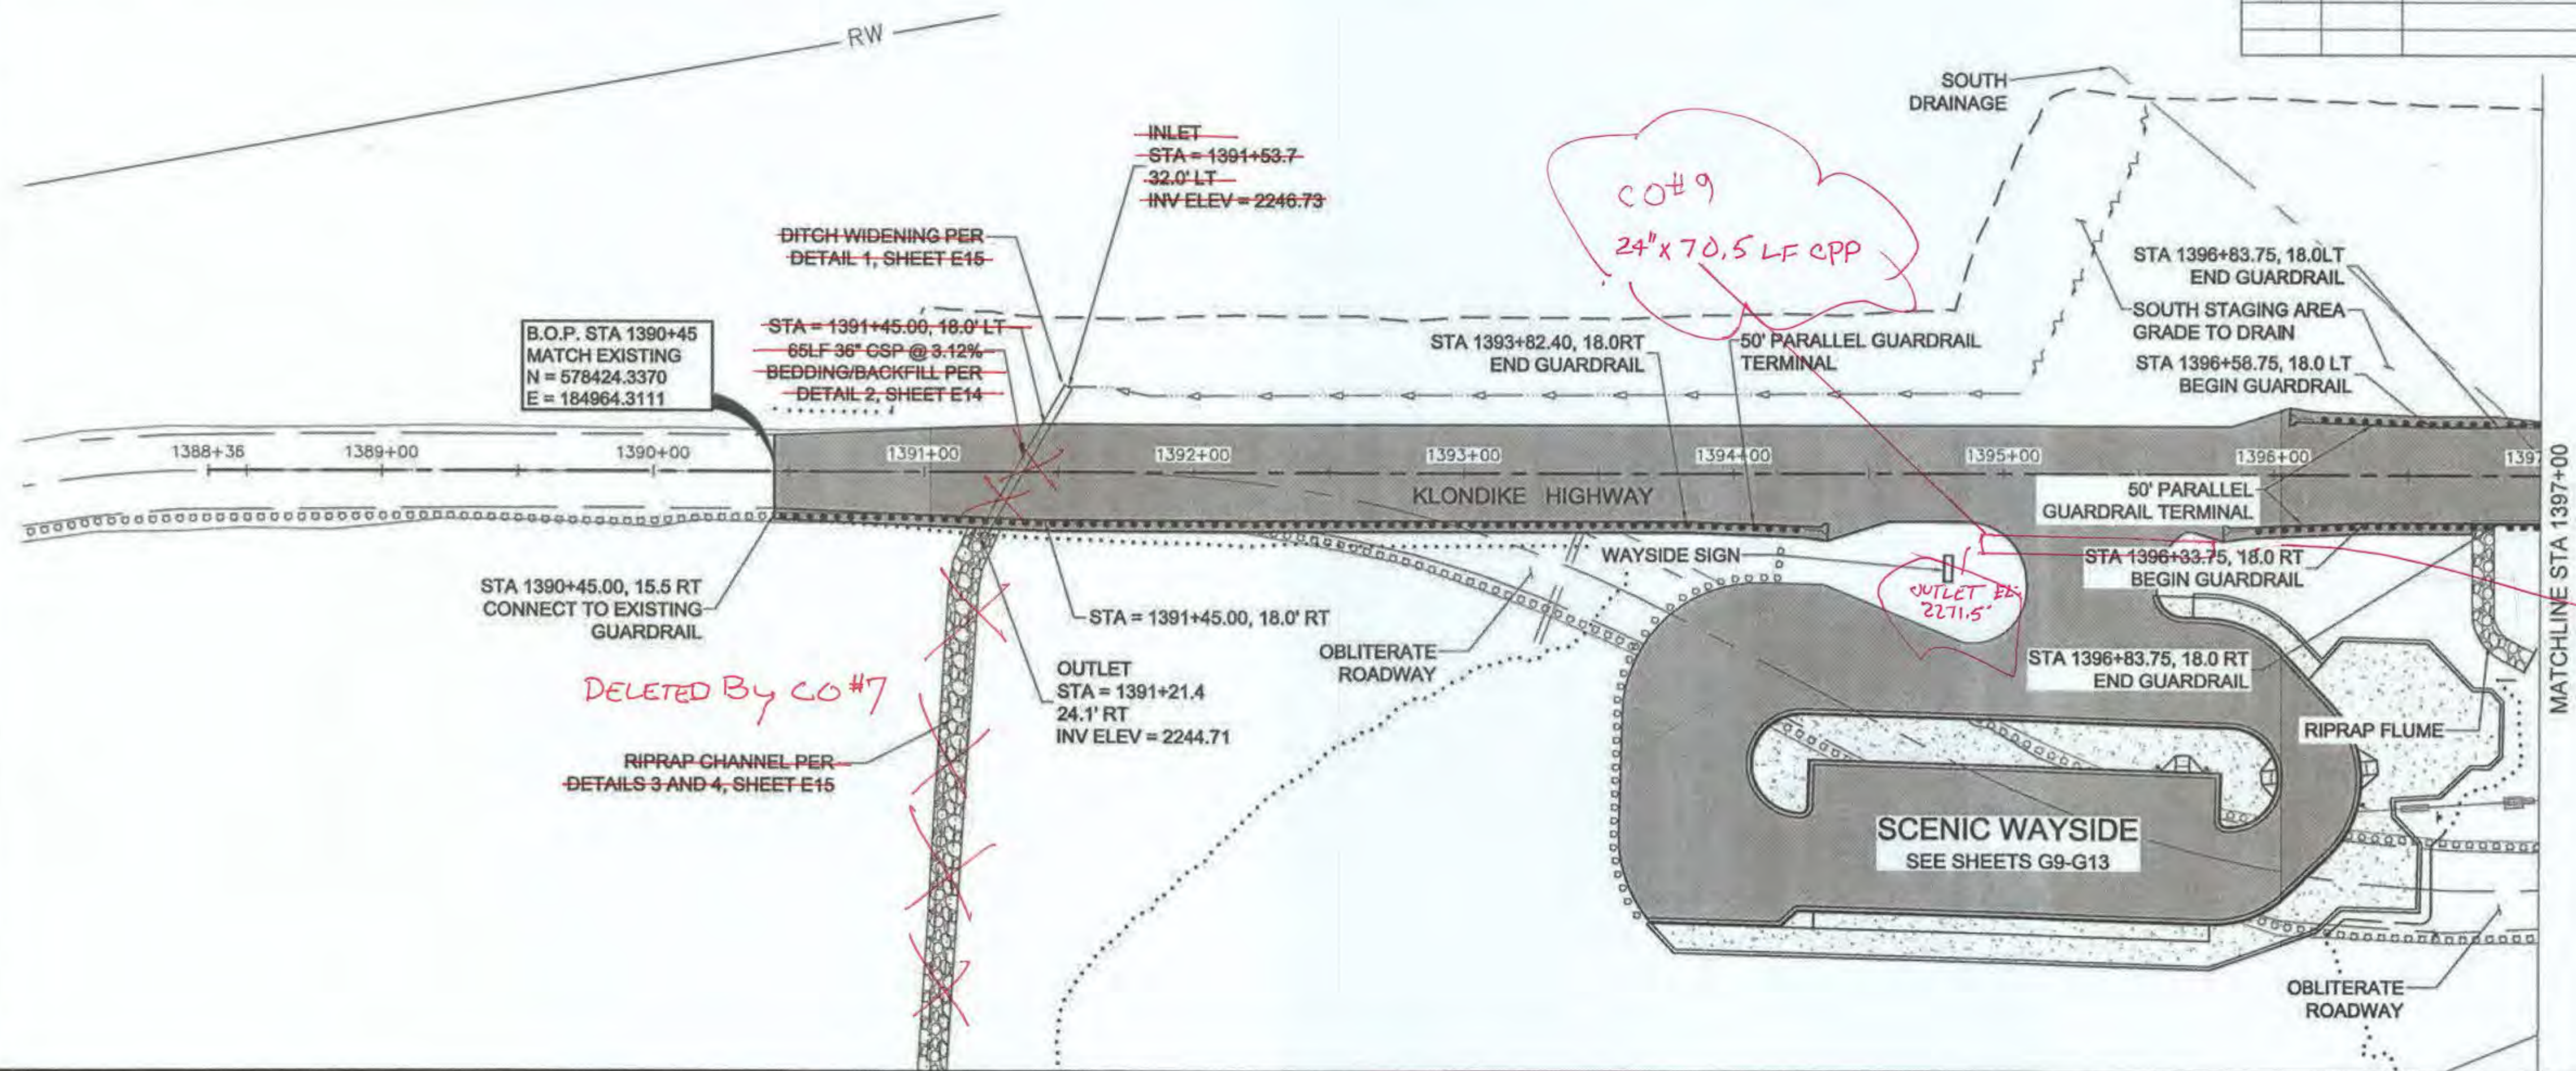

Handwritten signature/initials and date: 8/17/2016

NO.	DATE	REVISION	STATE	PROJECT DESIGNATION	YEAR	SHEET NO.	TOTAL SHEETS
			ALASKA	0972016/Z684590000	2016	F2	59

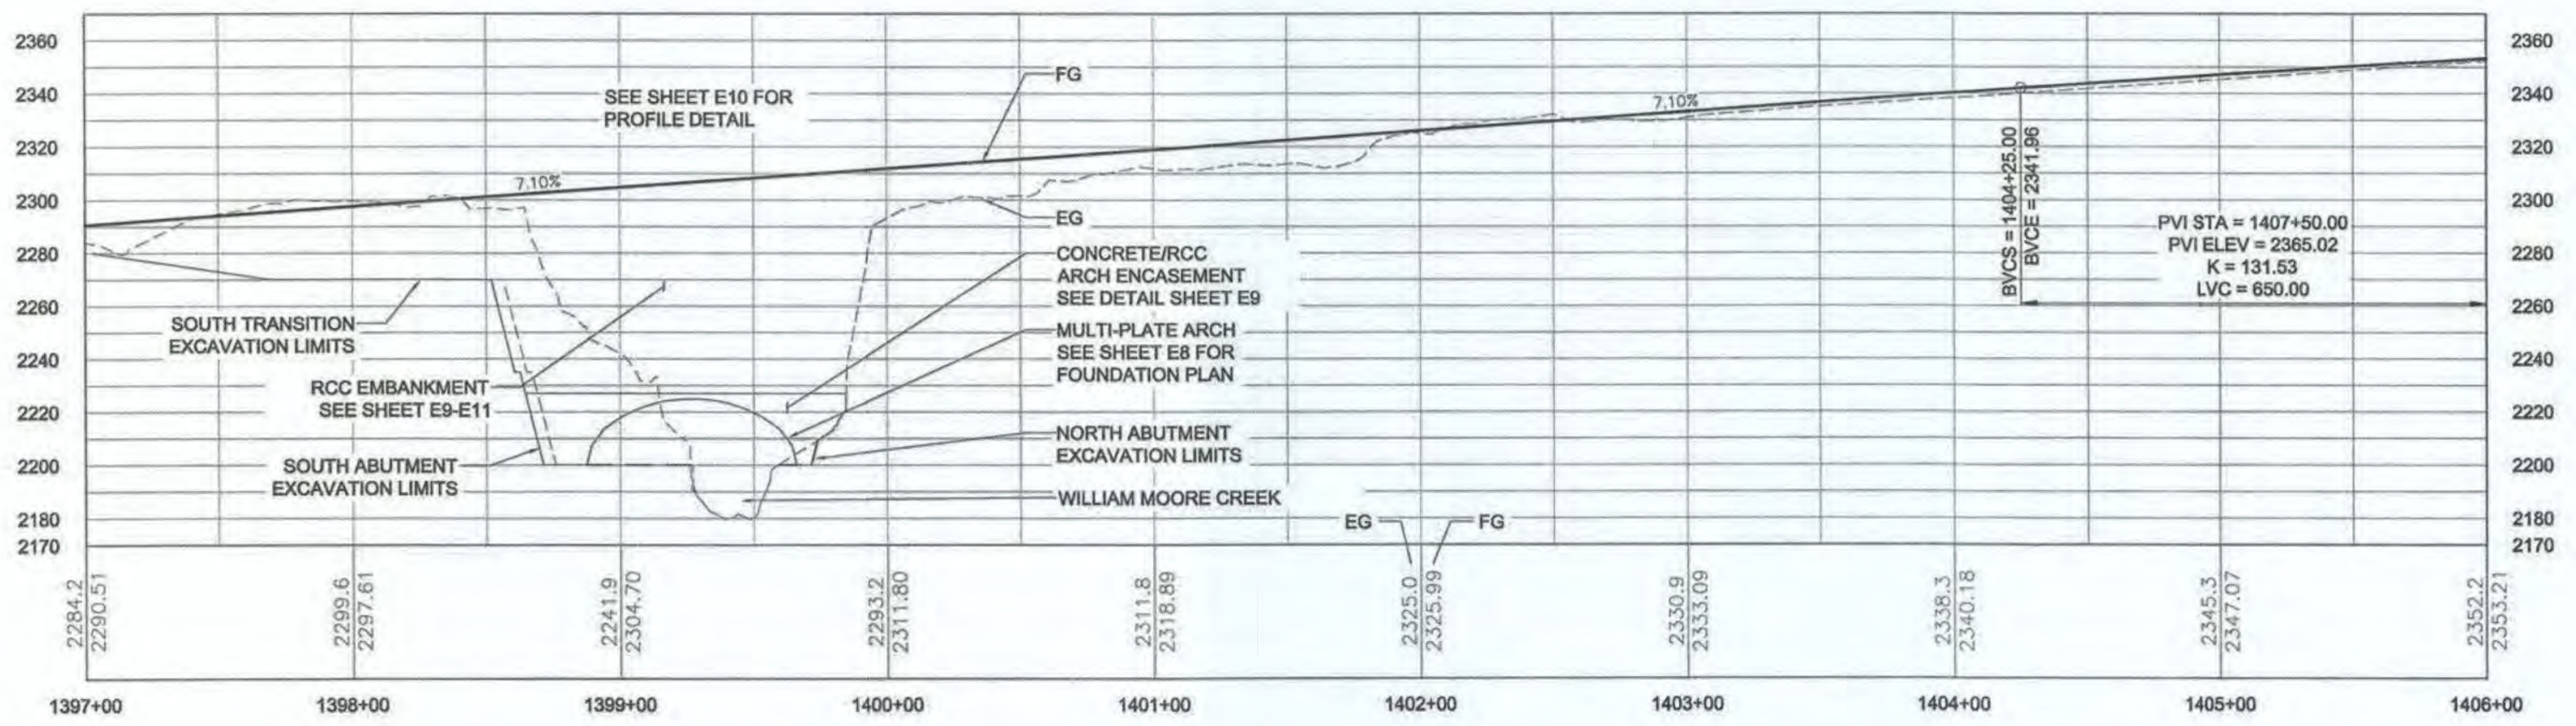
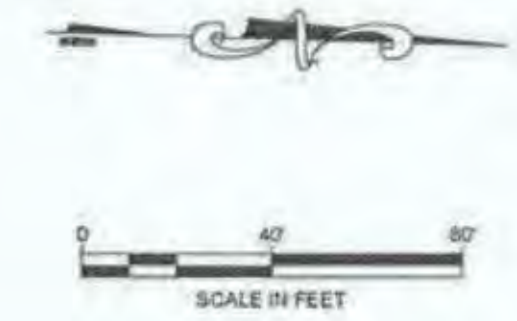
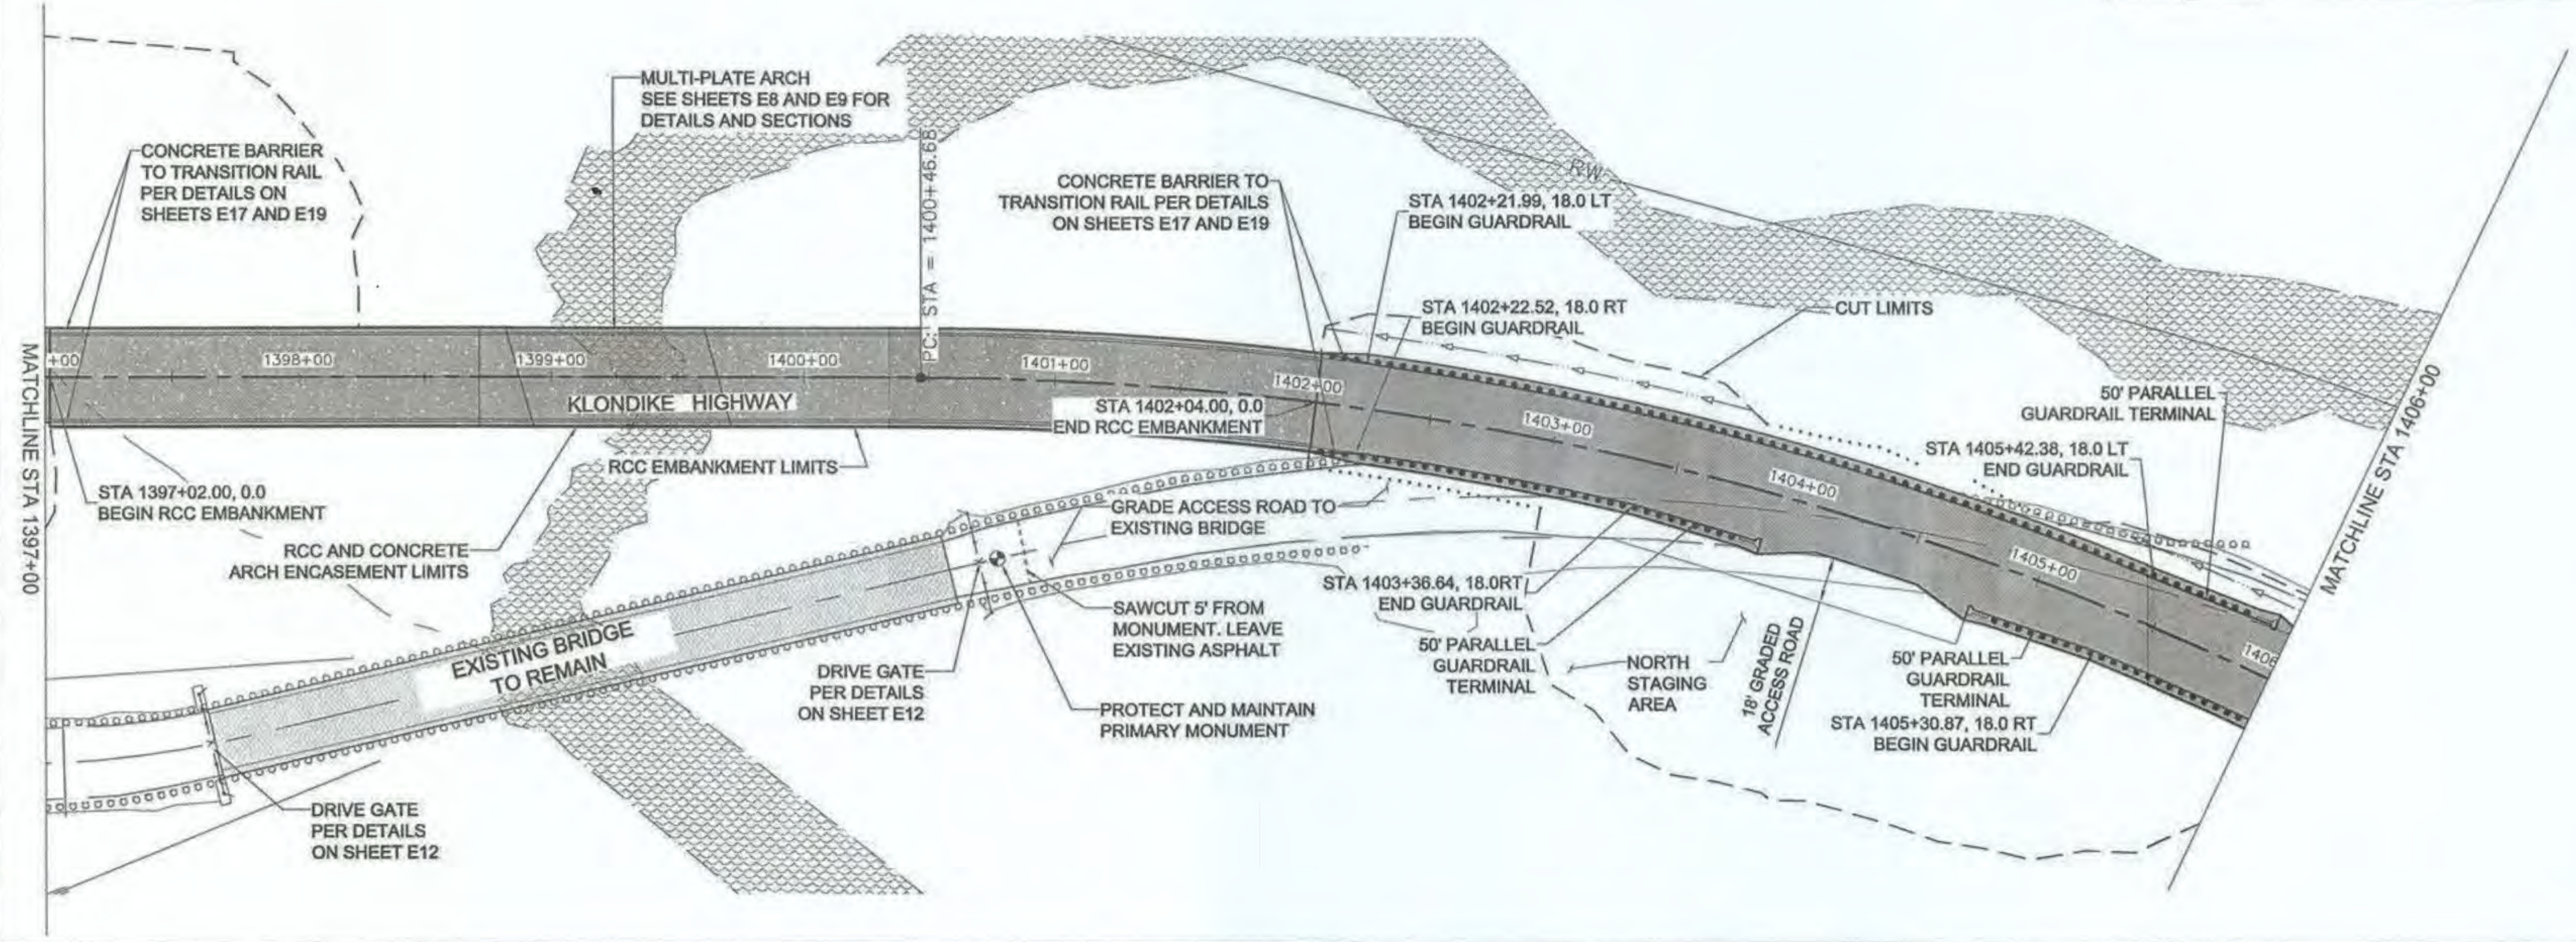


Handwritten signature and date: 6/9/20

FIRM DOWL
 FILE C:\Civil\3D Projects\2470732-01\Civil\SC14-CT-F-PP-DWHM.dwg
 ADDRESS 5368 COMMERCIAL BLVD., JUNEAU, AK 99801
 PHONE (907) 780-3533
 DESIGNED HOBBS
 CHECKED NOBLE
 DRAFTED WESTPHAL
 CERTIFICATE OF AUTH # : AECLB48
 DATE 8/16/2016 15:03 LAYOUT F2
 DATE 8/16/2016 15:03 LAYOUT F2


FIRM DOWL
 FILE C:\Civ\1 3D Project\24\70732-01\Civ\1\SC14-CT-F-PP-CWM.dwg
 ADDRESS 5368 COMMERCIAL BLVD., JUNEAU, AK 99801
 PHONE (907) 780-3533
 DESIGNED HOBBS
 CHECKED NOBLE
 DRAFTED WESTPHAL
 CERTIFICATE OF AUTH # : AECLB4B
 DATE 8/16/2016 15:03 LAYOUT F3

NO.	DATE	REVISION	STATE	PROJECT DESIGNATION	YEAR	SHEET NO.	TOTAL SHEETS
			ALASKA	0972016/Z684590000	2016	F3	59

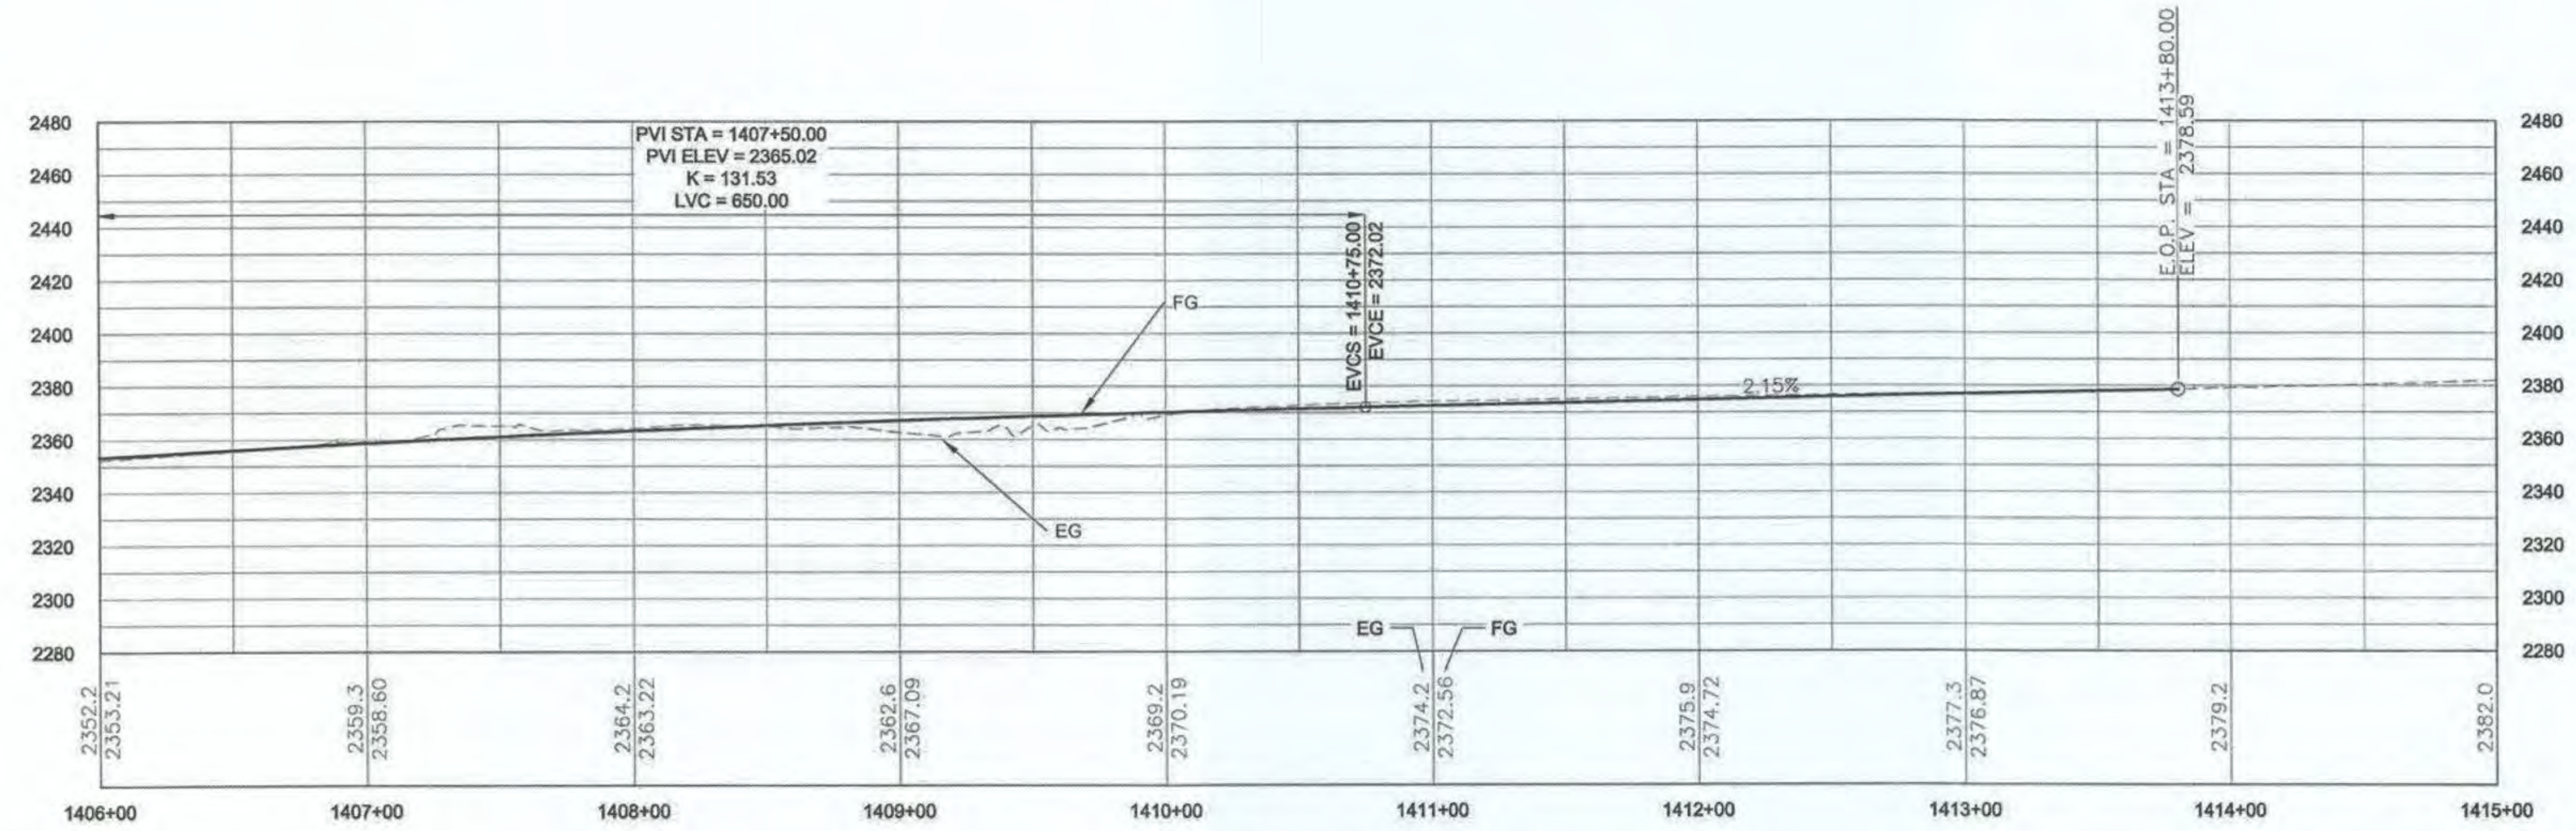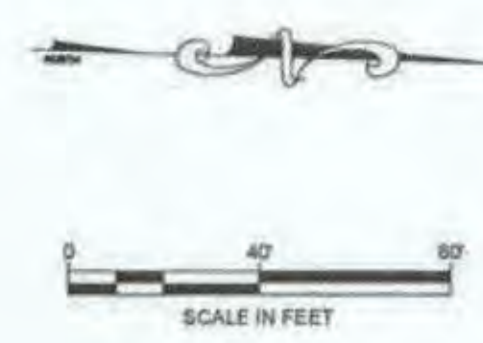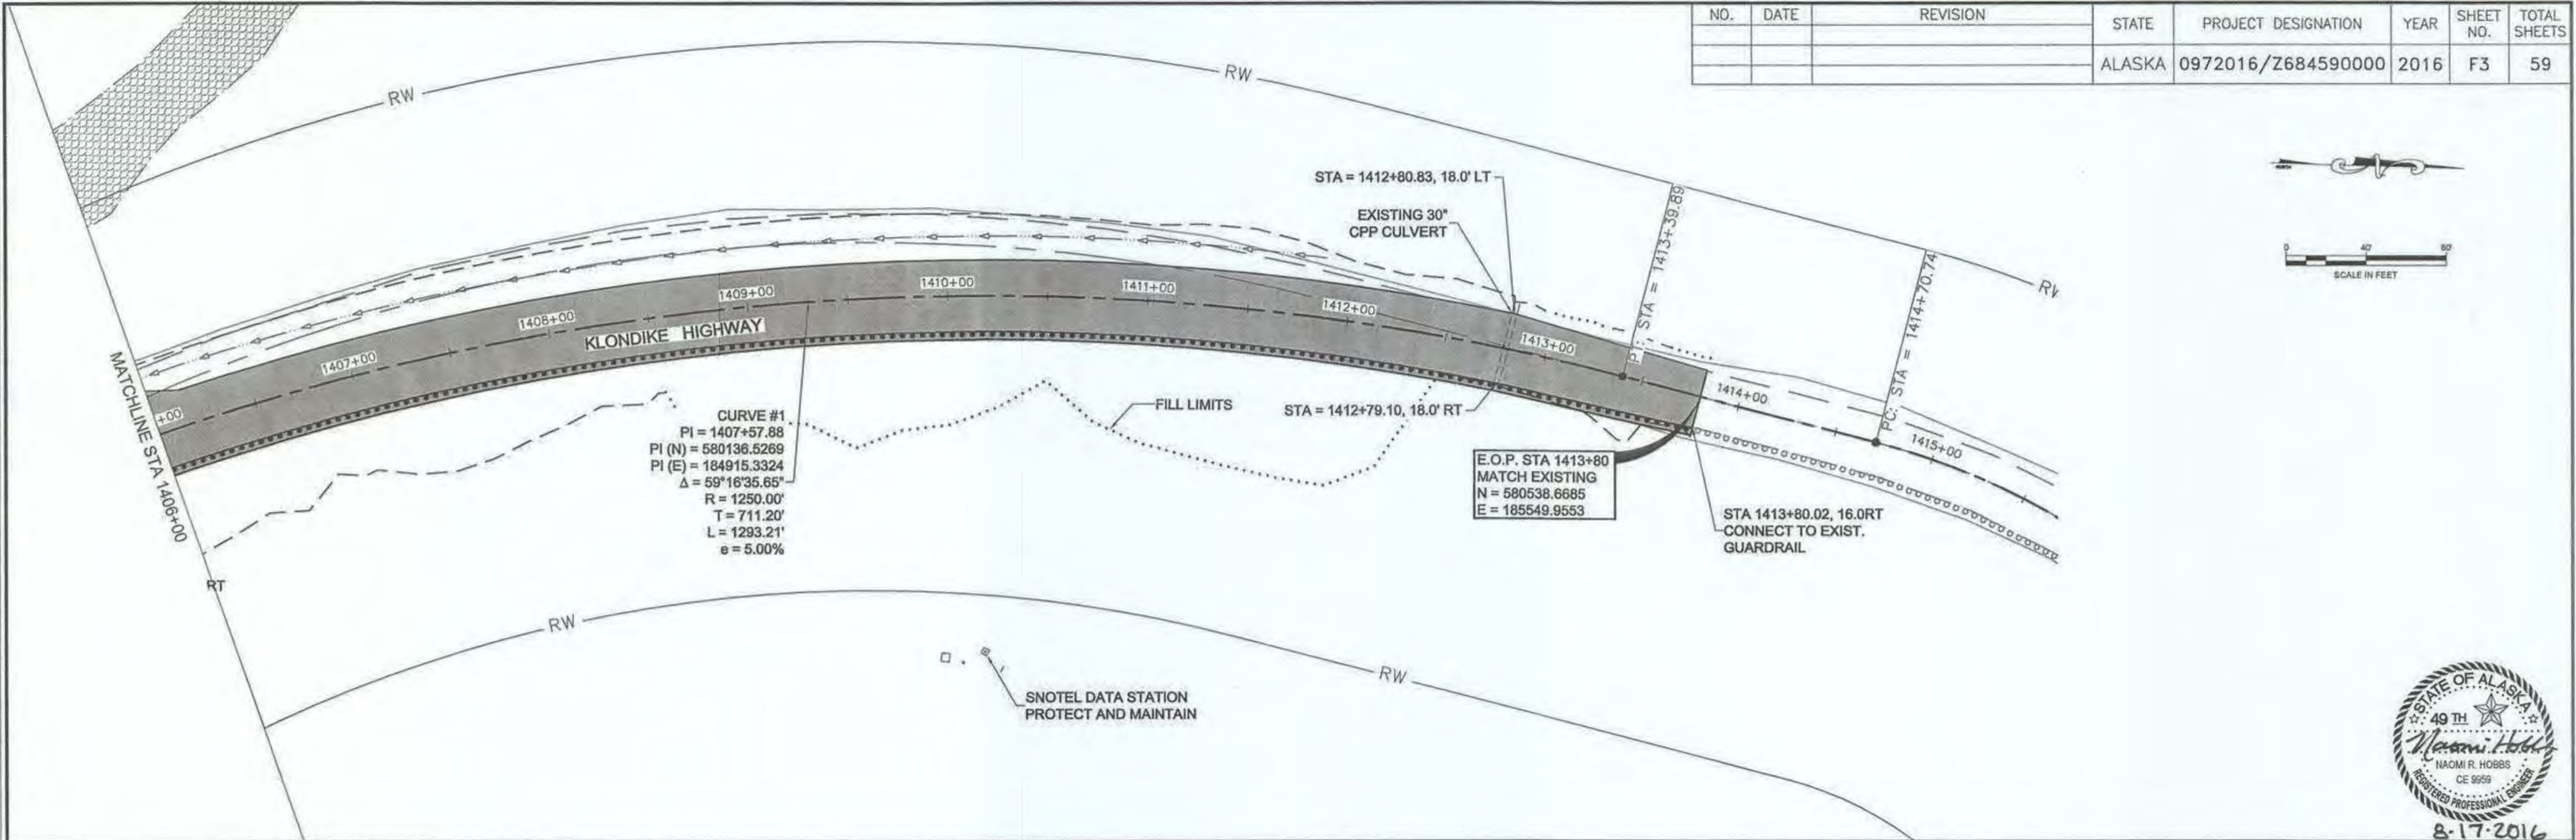

8/19/20

NO.	DATE	REVISION	STATE	PROJECT DESIGNATION	YEAR	SHEET NO.	TOTAL SHEETS
			ALASKA	0972016/Z684590000	2016	G1	59

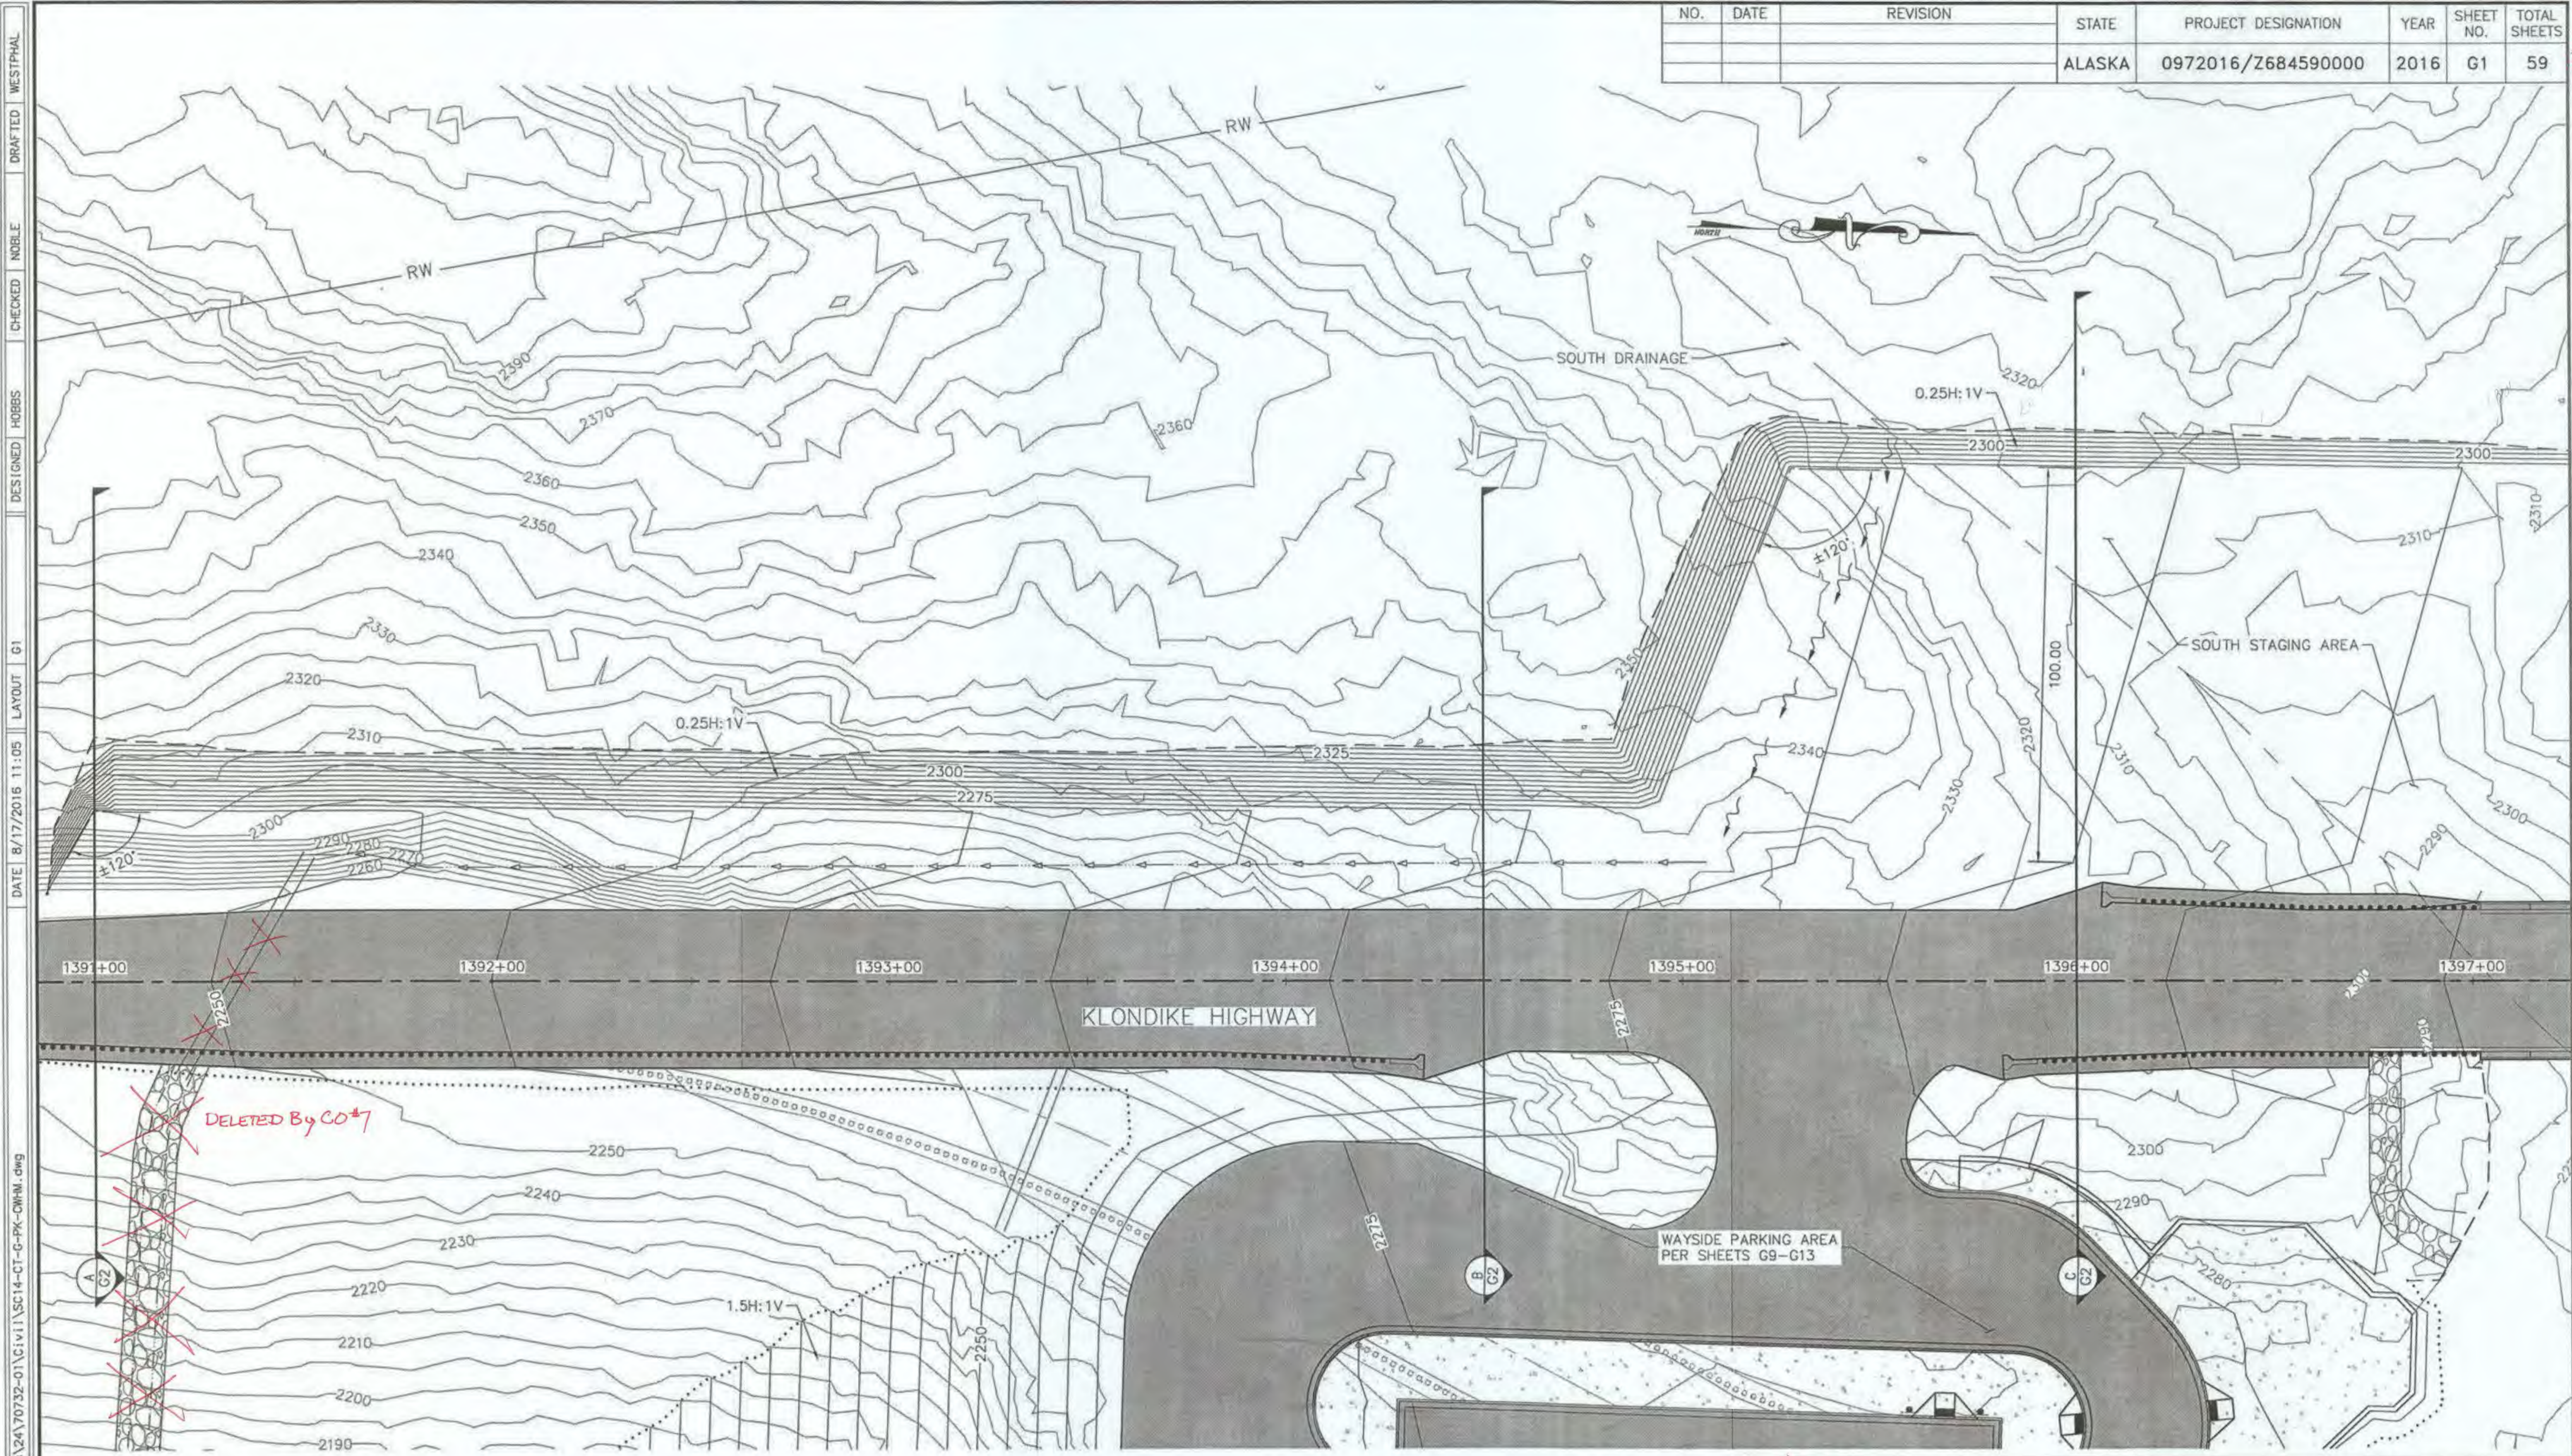

FILE: C:\Civ11_3D Projects\24\70732-01\Civ11\SC14-CT-G-PK-QNM.dwg
 DATE: 8/17/2016 11:05 LAYOUT: G1
 DESIGNED: HOBBS
 CHECKED: NOBLE
 DRAFTED: WESTPHAL

1 SOUTH APPROACH CUT PLAN
 SCALE AS NOTED



6/9/26
 PLANS DEVELOPED BY:
 DOWL
 5368 COMMERCIAL BLVD.
 JUNEAU, AK 99801
 (907) 780-3533
 #AECL848




STATE OF ALASKA
 DEPARTMENT OF TRANSPORTATION
 AND PUBLIC FACILITIES
**SKAGWAY - REPLACE CAPTAIN
 WILLIAM HENRY MOORE BRIDGE**

SOUTH APPROACH PLAN


8-17-2016

NO.	DATE	REVISION	STATE	PROJECT DESIGNATION	YEAR	SHEET NO.	TOTAL SHEETS
			ALASKA	0972016/Z684590000	2016	G2	59


FILE: C:\CIVIL\3D Projects\24\70732-01\CIVIL\SC14-CT-C-PK-CMM.dwg
 DATE: 8/17/2016 11:05 LAYOUT: G2
 DESIGNED: HOBBS
 CHECKED: NOBLE
 DRAFTED: WESTPHAL

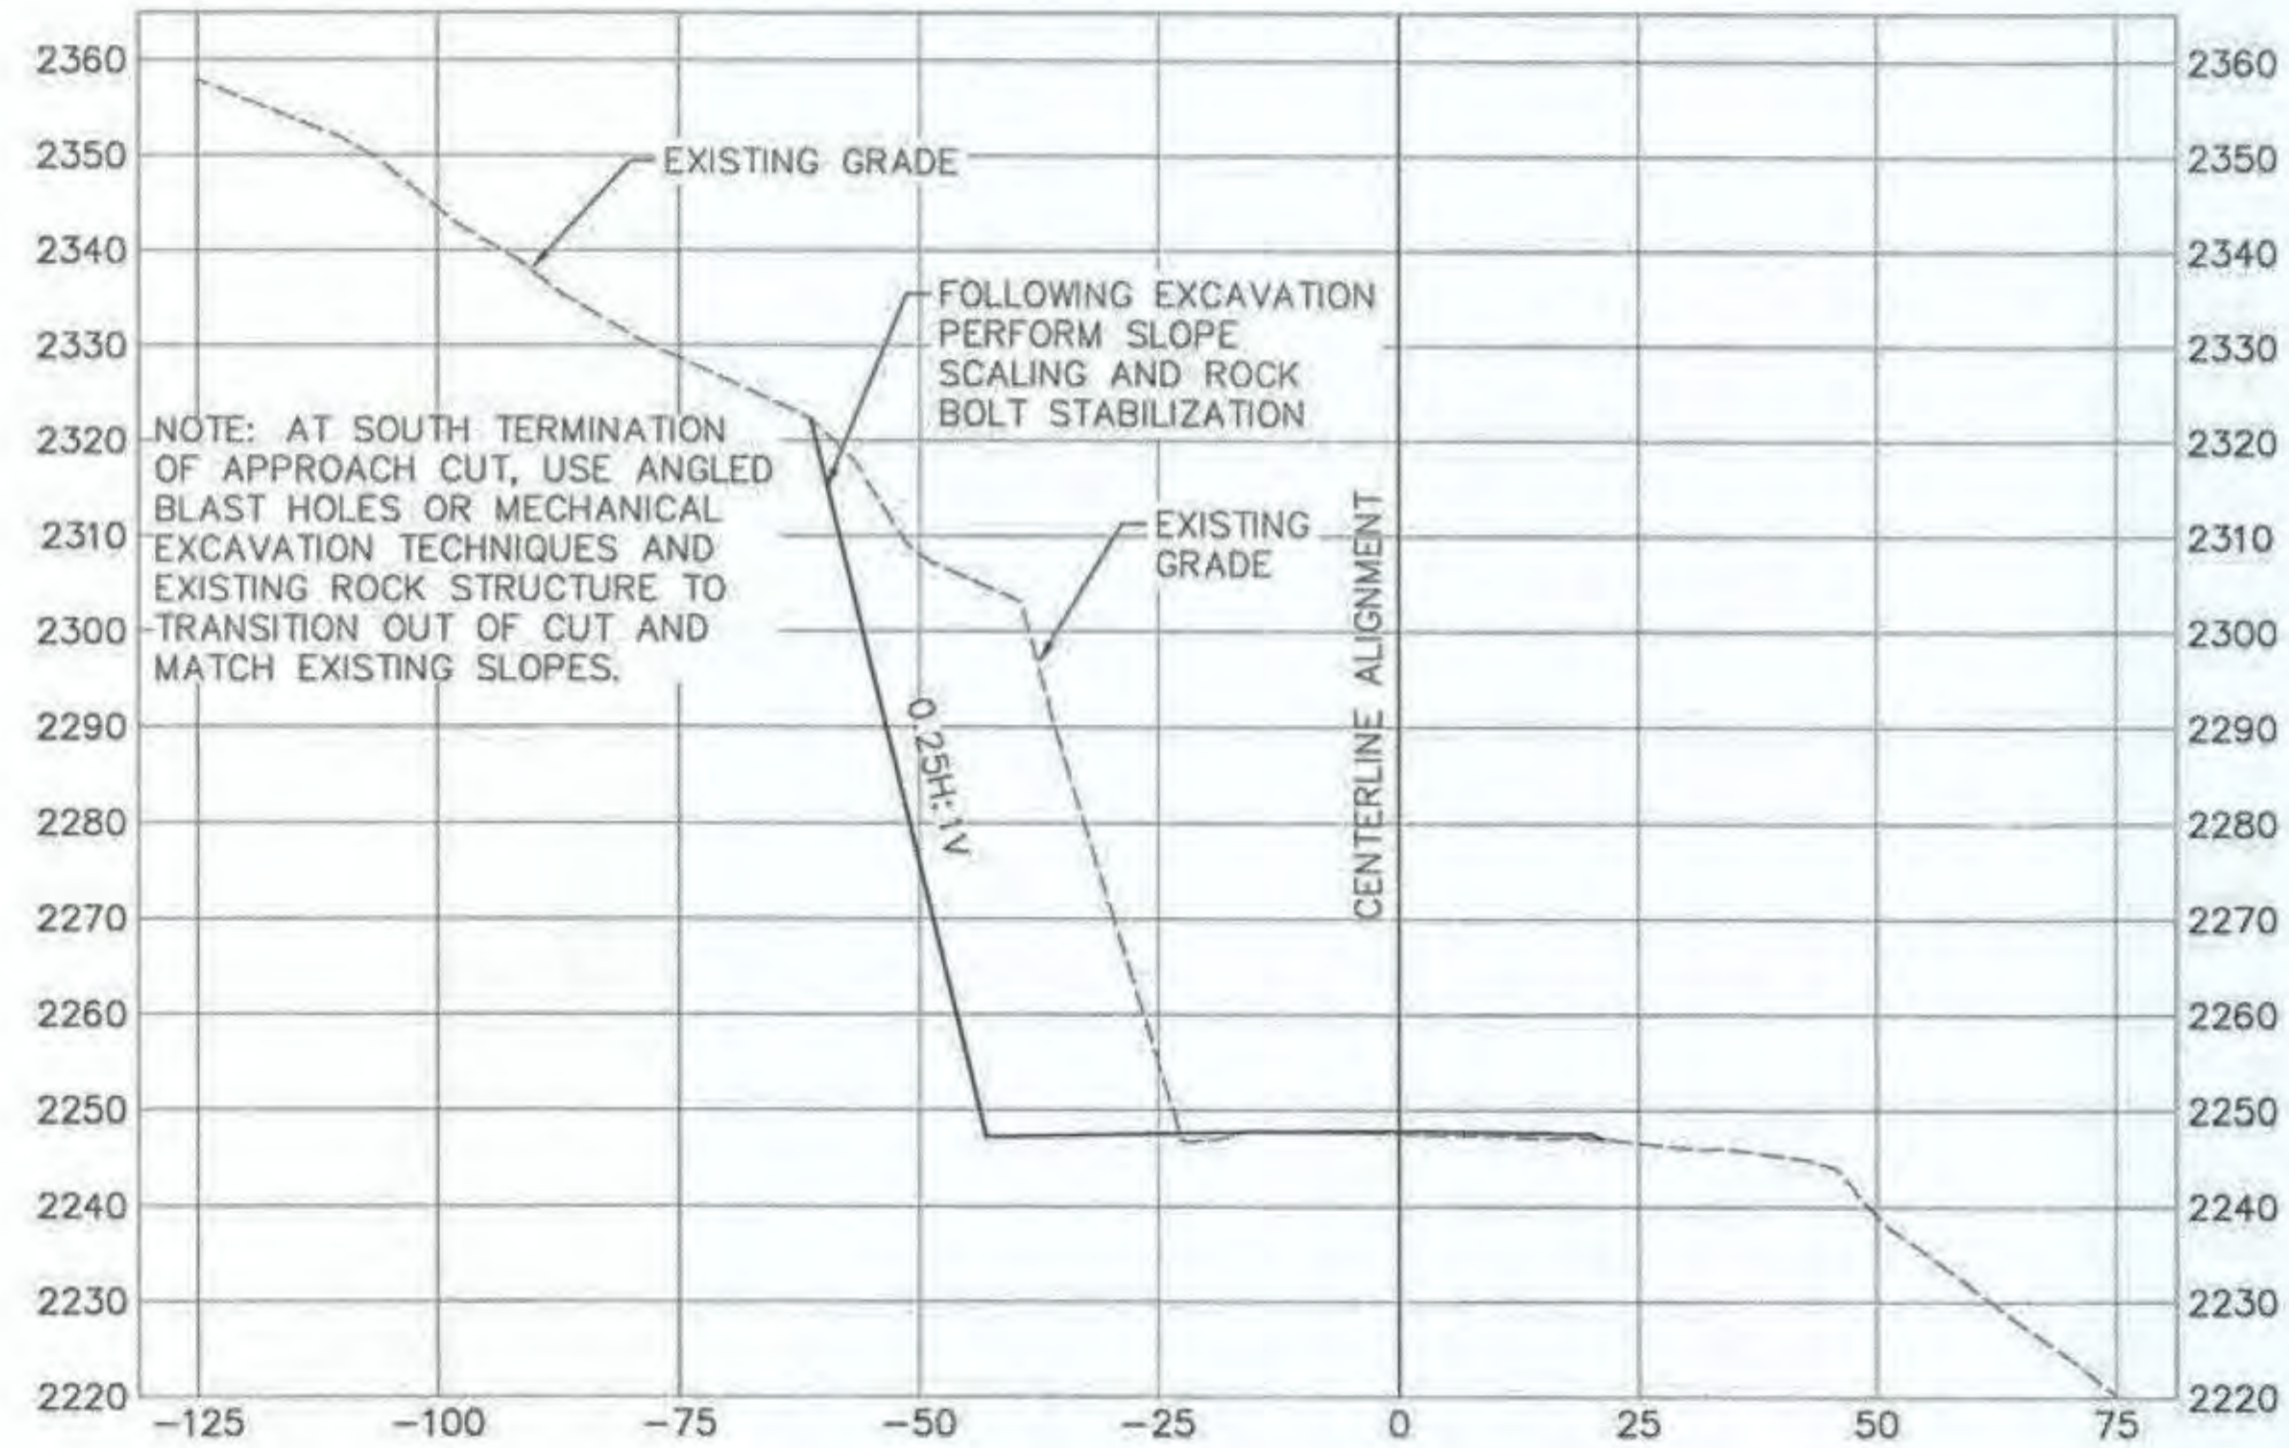

A TYPICAL SOUTH APPROACH CUT TERMINATION SECTION
 STATIONS 1390+85 TO 1391+05
 SCALE AS NOTED

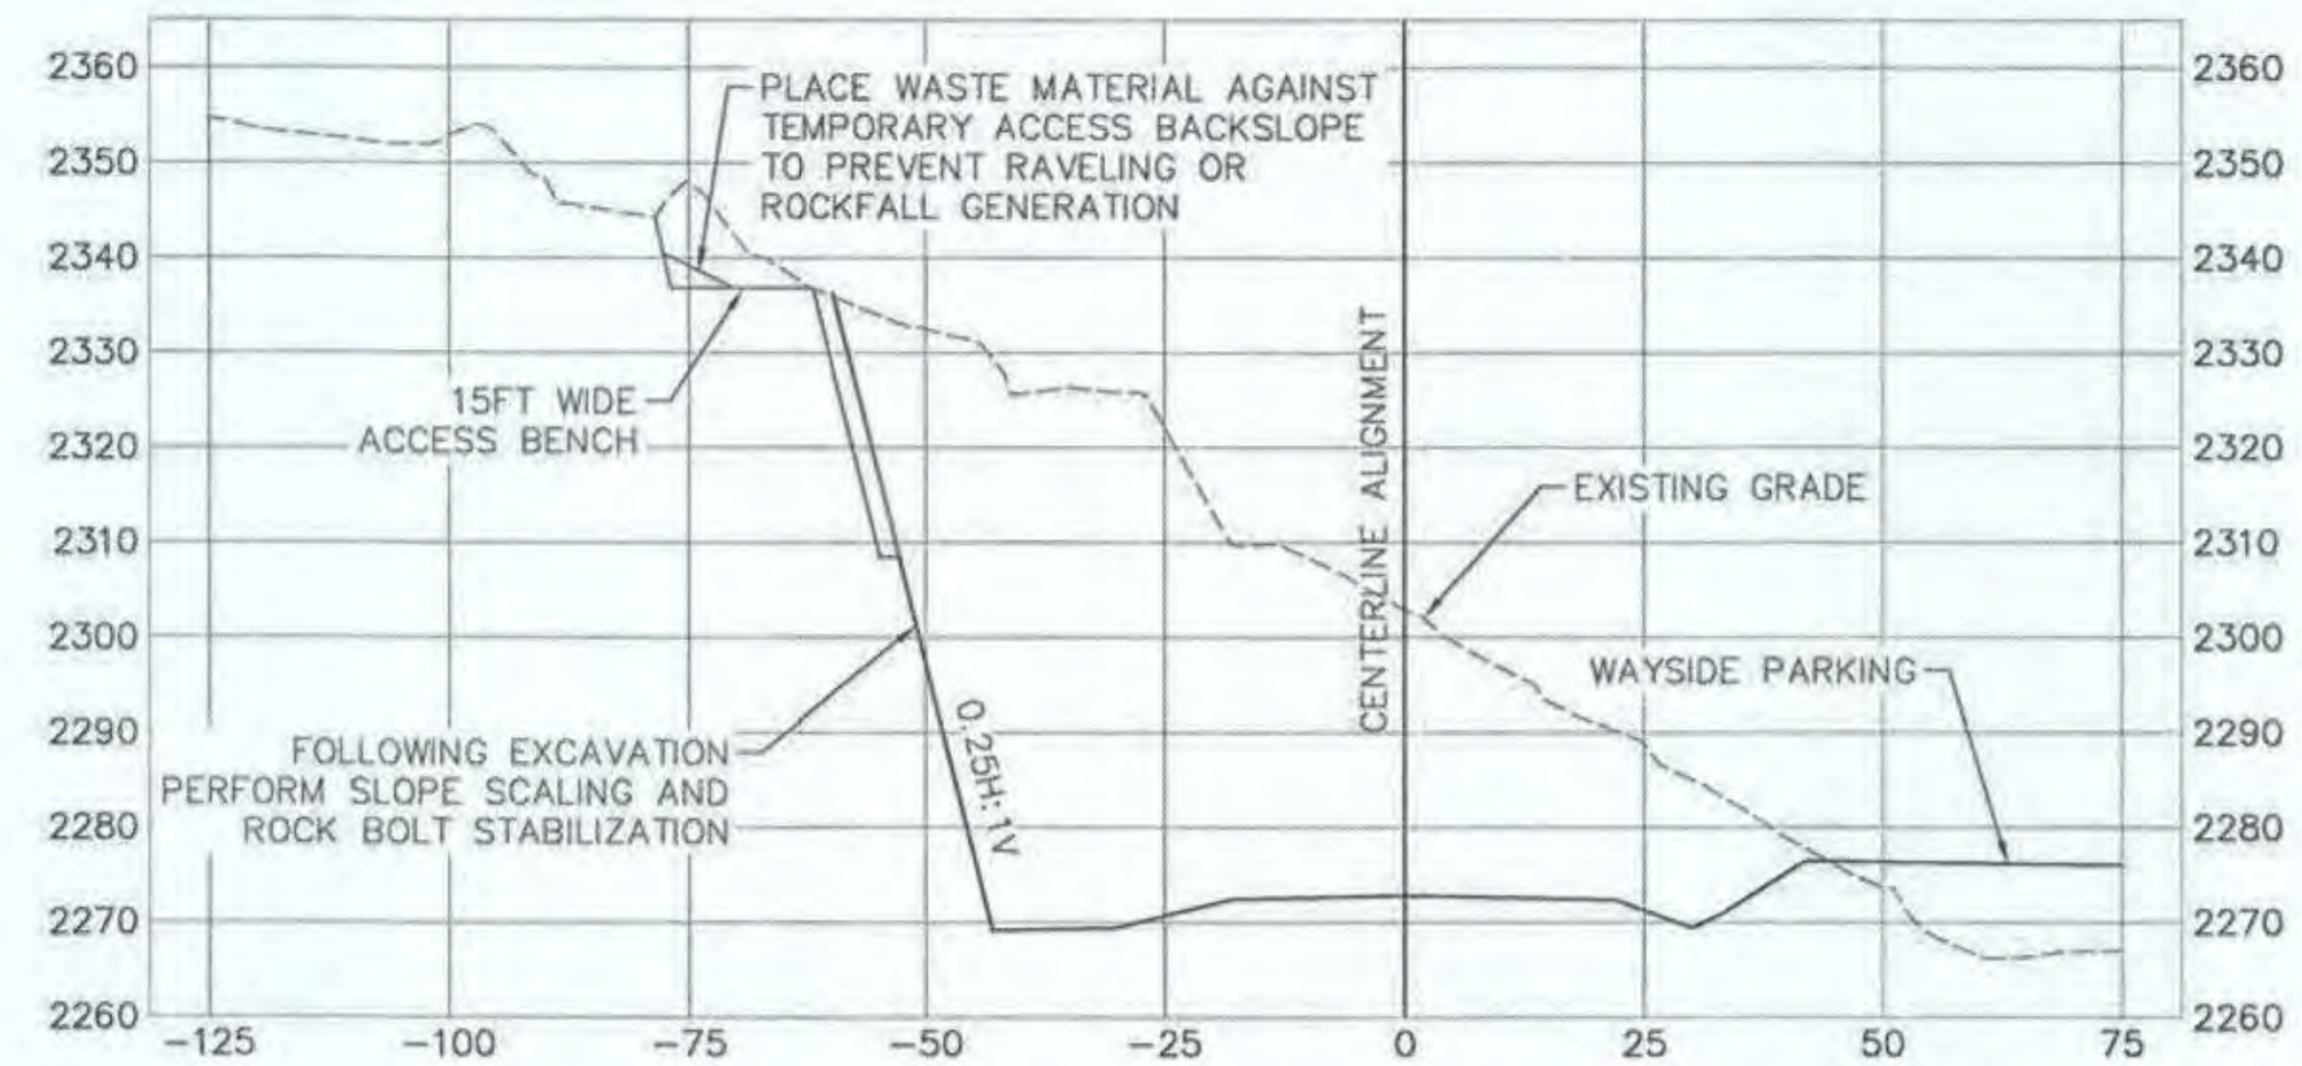


B TYPICAL SOUTH APPROACH CUT SECTION
 STATIONS 1391+05 TO 1394+90
 SCALE AS NOTED

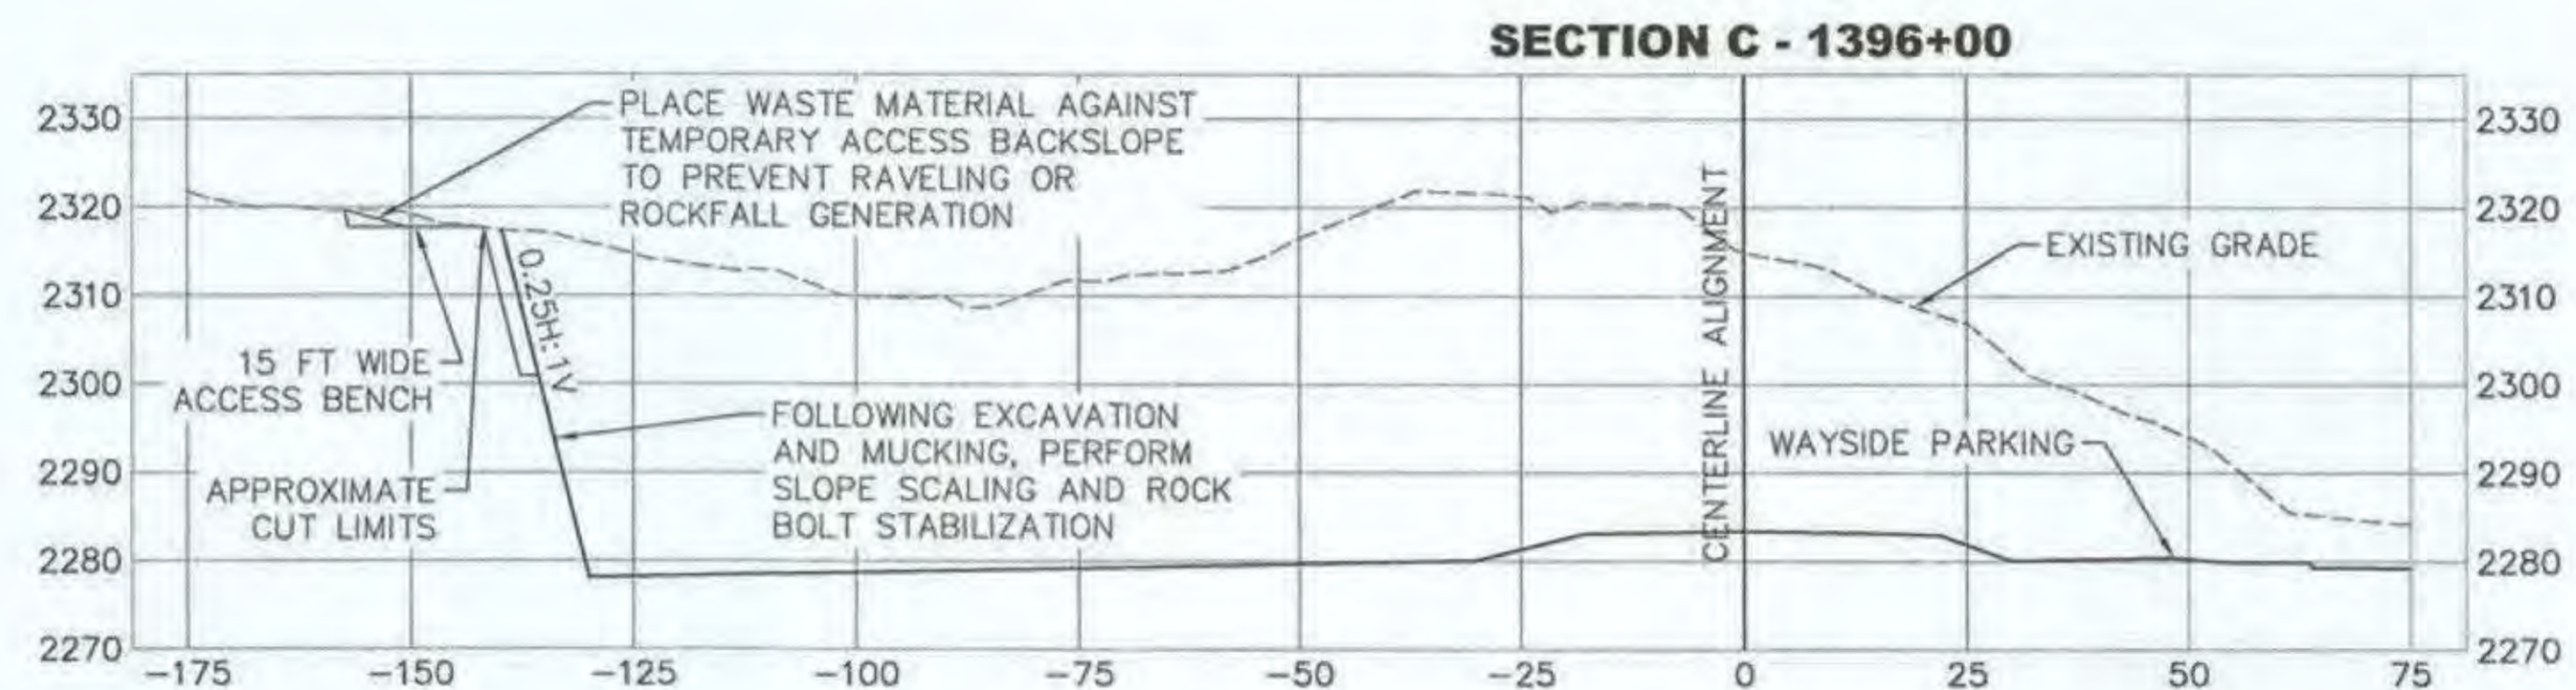

C TYPICAL SOUTH APPROACH WIDENED CUT SECTION
 STATIONS 1394+90 TO 1397+70
 SCALE AS NOTED

Handwritten: M 8/17/20

PLANS DEVELOPED BY:
 DOWL
 5368 COMMERCIAL BLVD.
 JUNEAU, AK 99801
 (907) 780-3533
 #AECL848



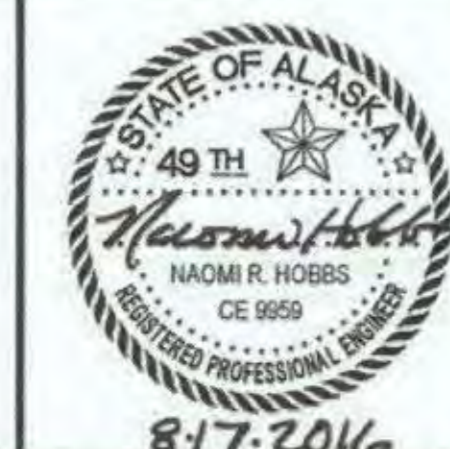


8-17-2016

STATE OF ALASKA
 DEPARTMENT OF TRANSPORTATION
 AND PUBLIC FACILITIES
**SKAGWAY - REPLACE CAPTAIN
 WILLIAM HENRY MOORE BRIDGE**
**SOUTH APPROACH TYPICAL
 CROSS SECTIONS**


NO.	DATE	REVISION	STATE	PROJECT DESIGNATION	YEAR	SHEET NO.	TOTAL SHEETS
			ALASKA	0972016/Z684590000	2016	G3	59

FILE: C:\Civil\3D Projects\24\70732-01\Civil\SC14-CT-G-PK-CNML.dwg
 DATE: 8/17/2016 11:05 LAYOUT: G3
 DESIGNED: HOBBS
 CHECKED: NOBLE
 DRAFTED: WESTPHAL

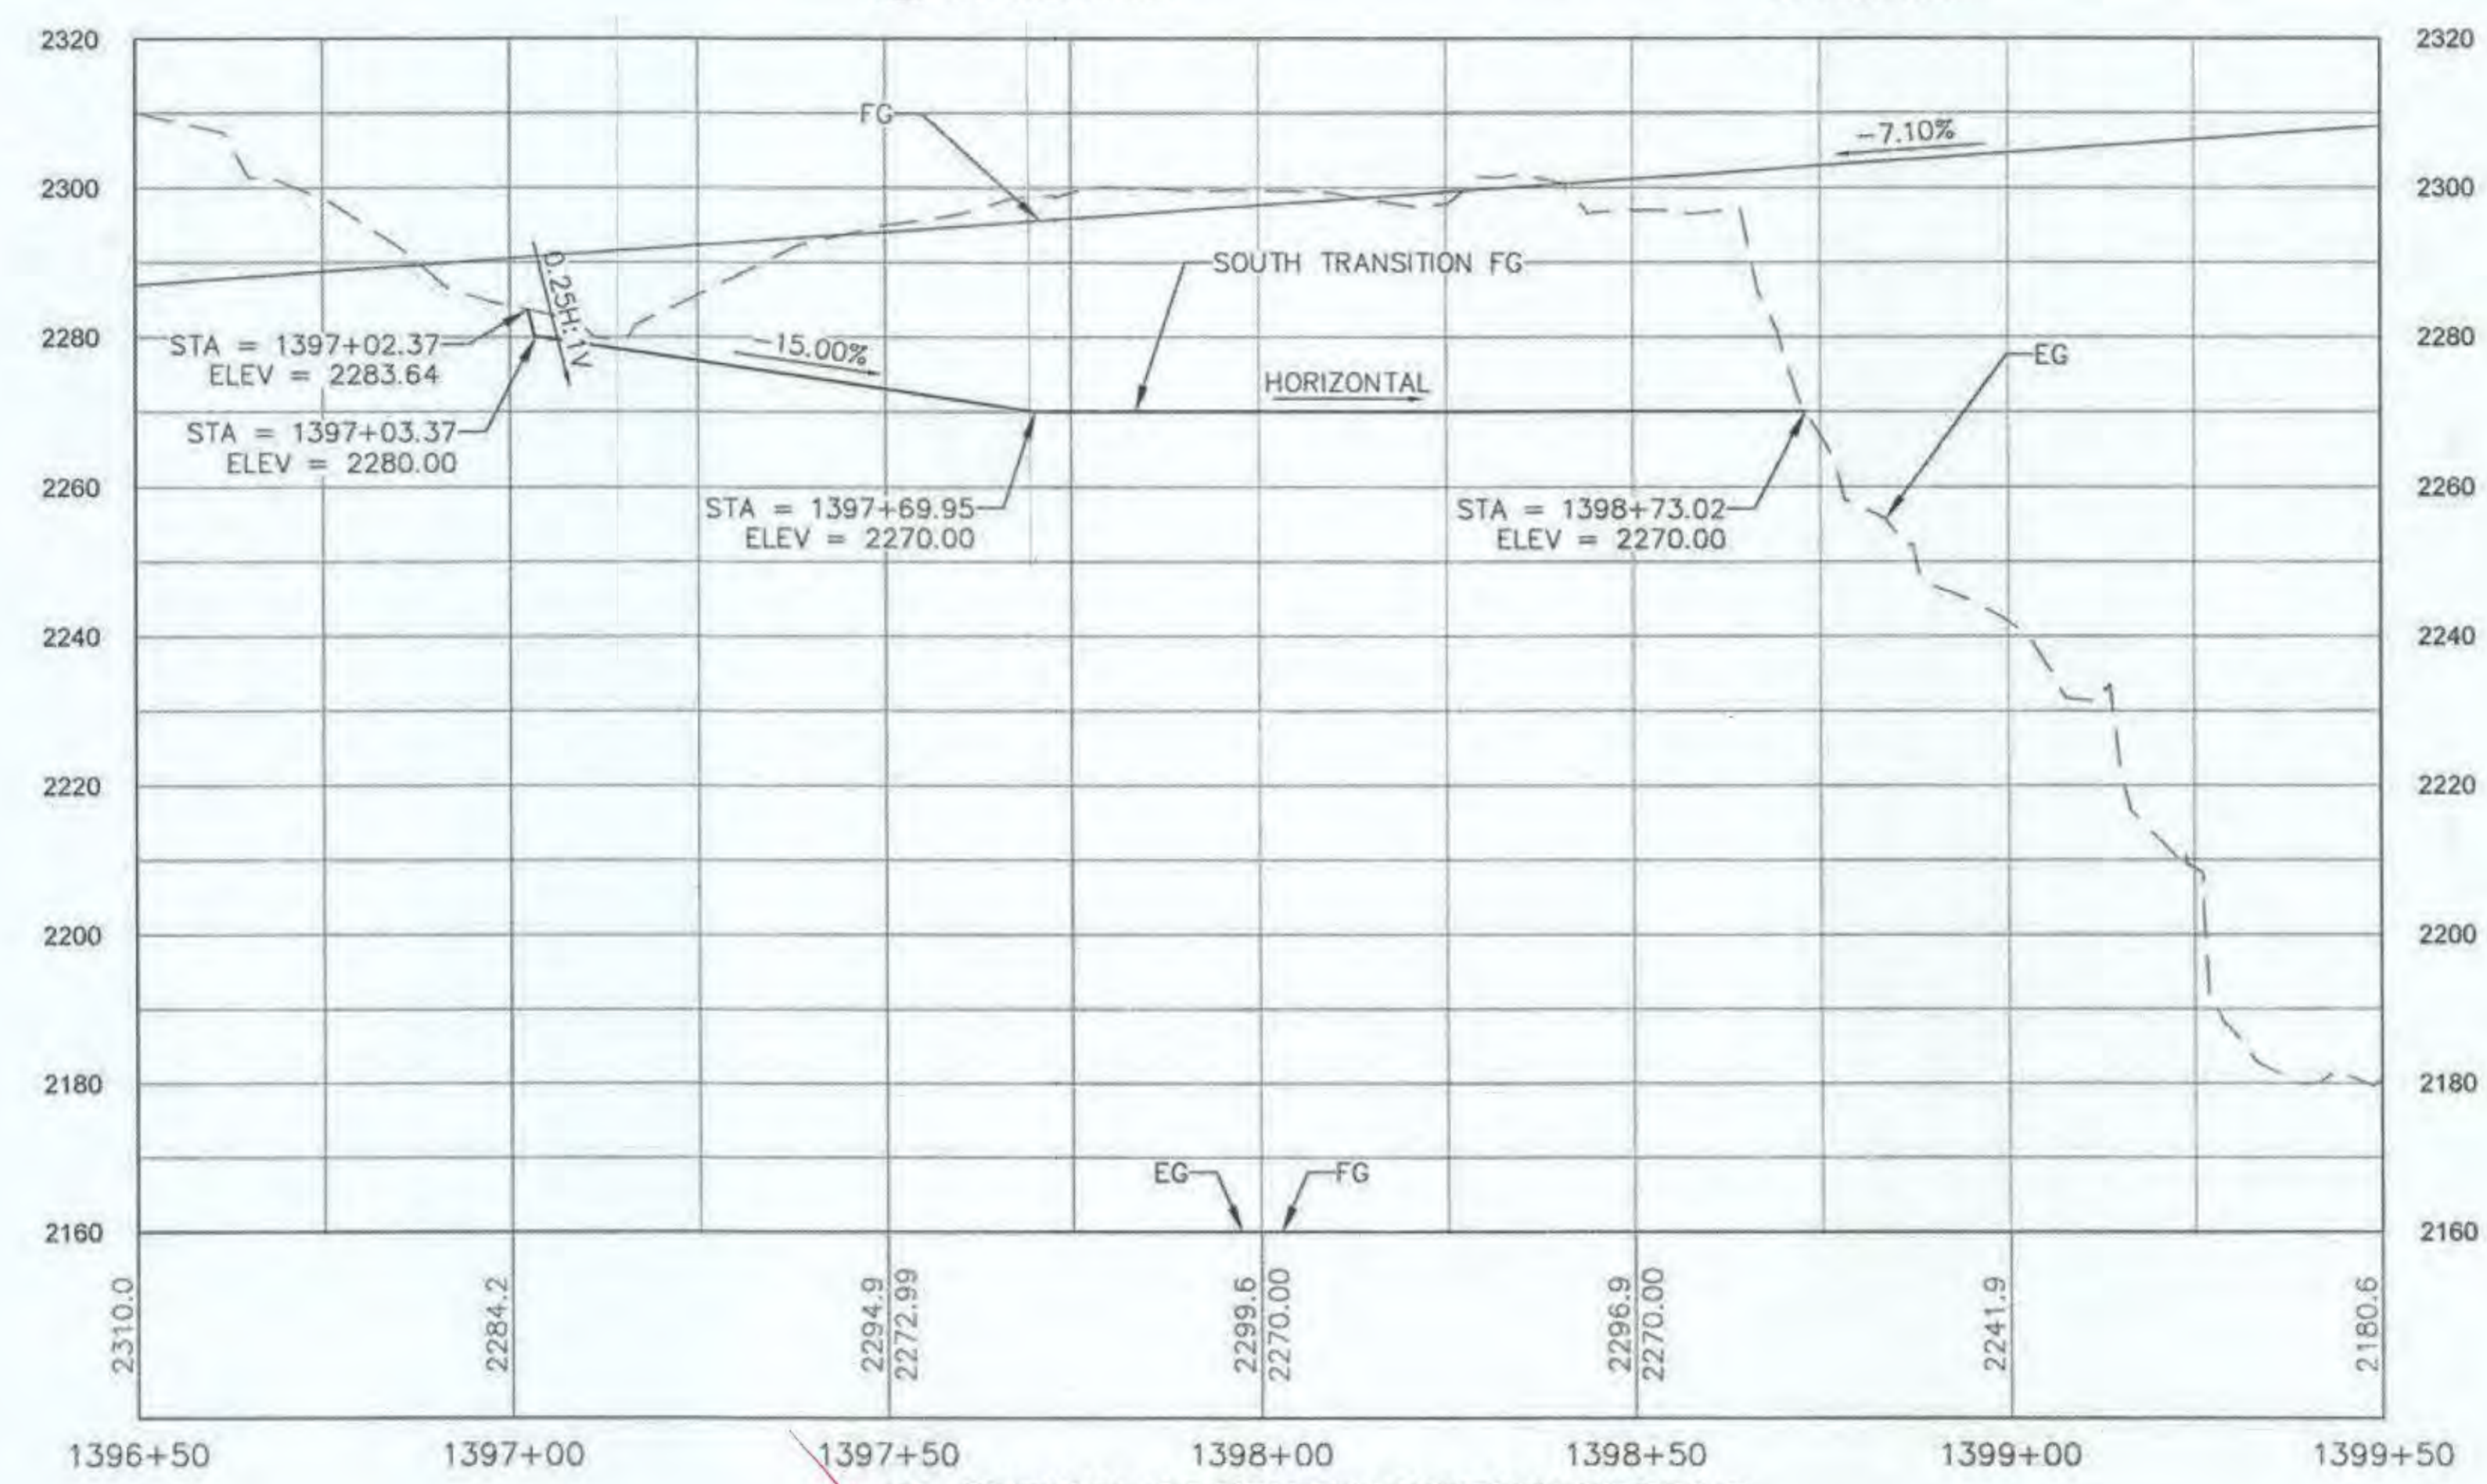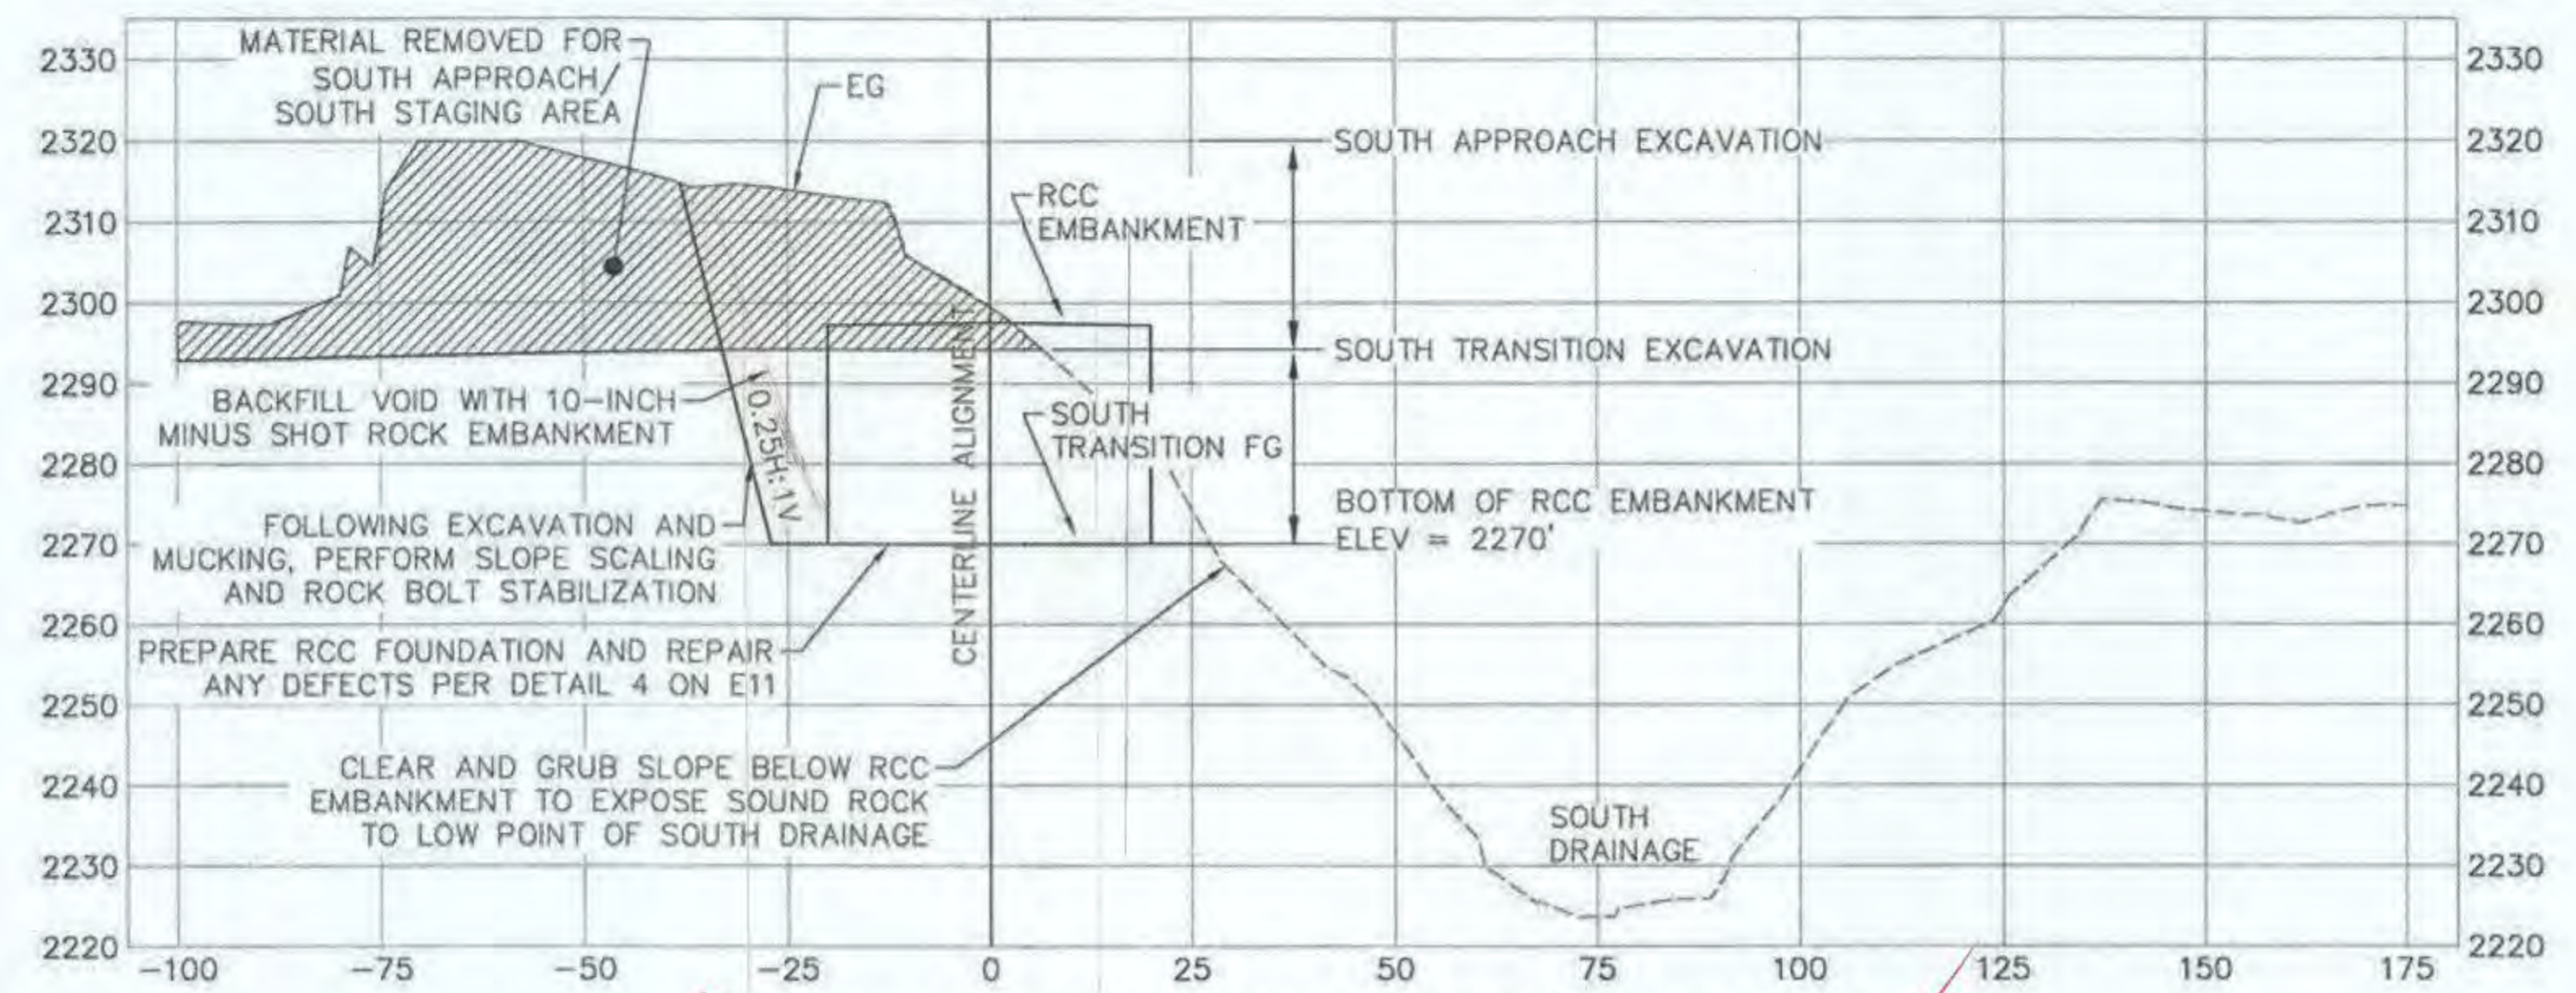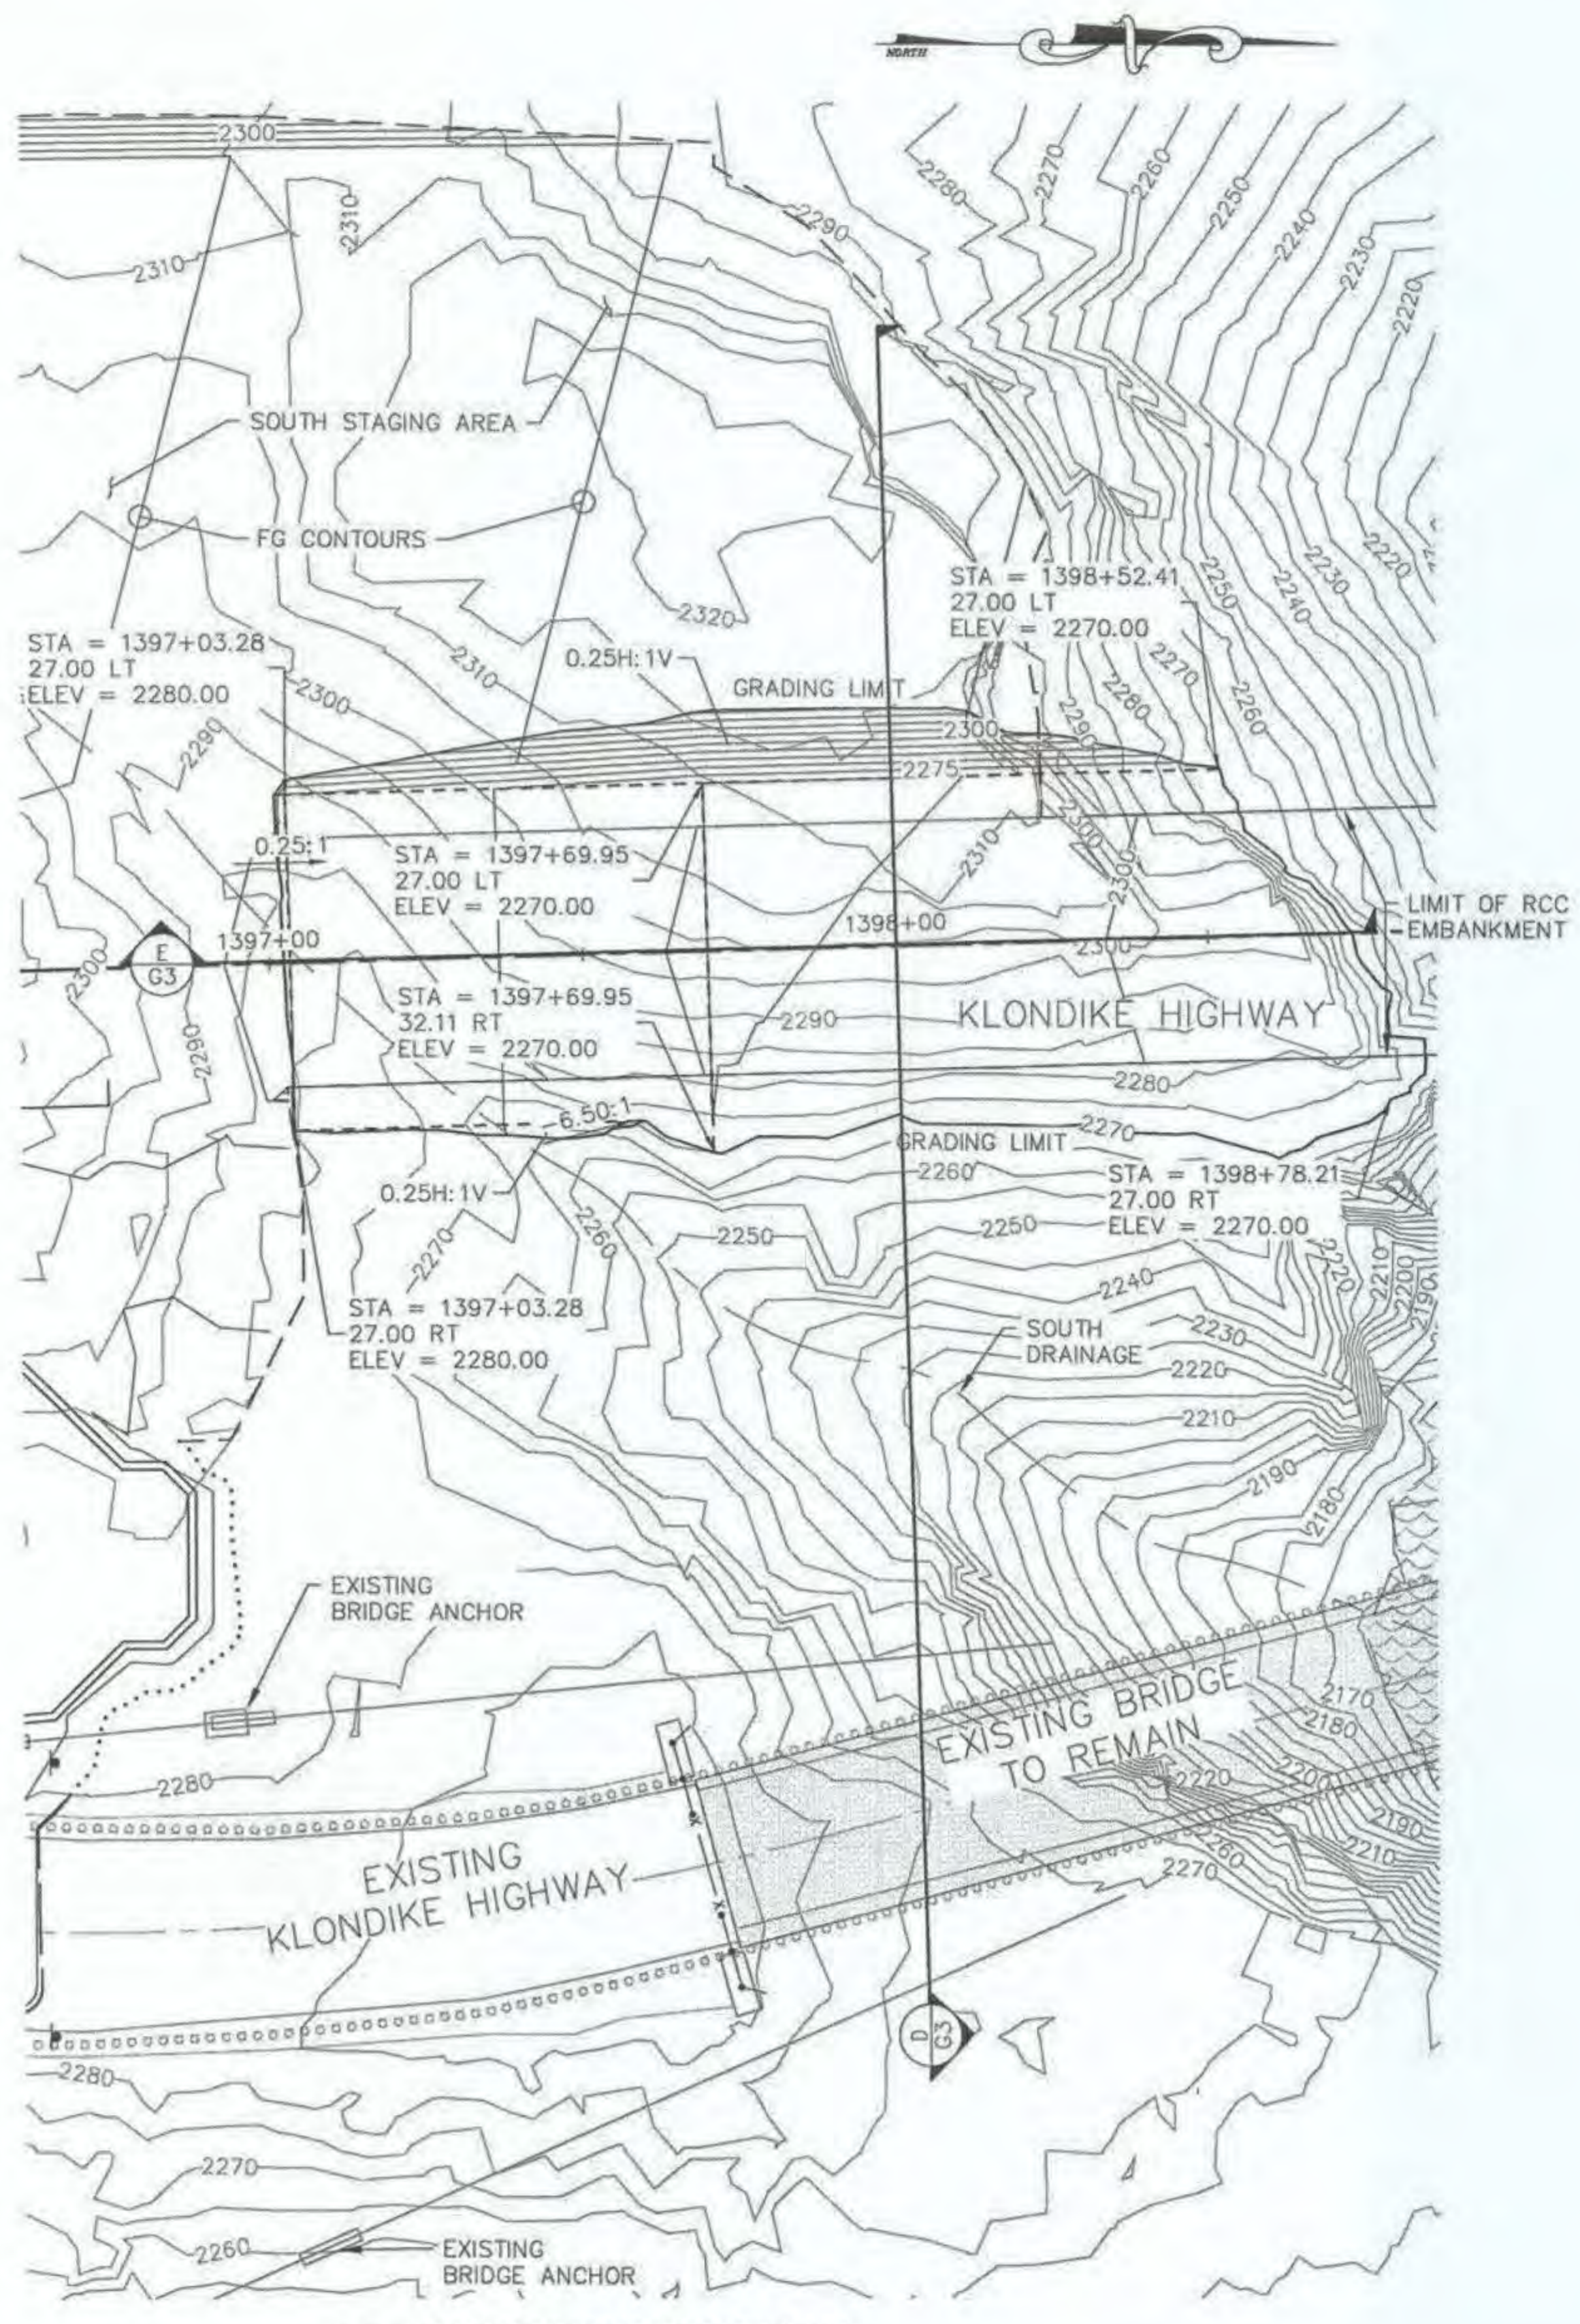

Pc/1/9/20

PLANS DEVELOPED BY:
DOWL
5368 COMMERCIAL BLVD.,
JUNEAU, AK 99801
(907) 780-3533
#AECL848

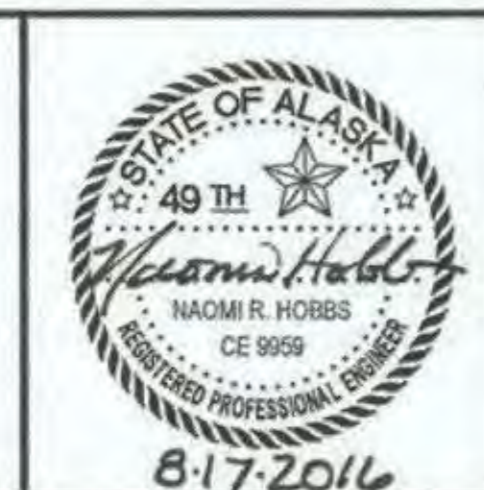


STATE OF ALASKA
DEPARTMENT OF TRANSPORTATION
AND PUBLIC FACILITIES

**SKAGWAY - REPLACE CAPTAIN
WILLIAM HENRY MOORE BRIDGE**

**SOUTH TRANSITION PLAN,
PROFILE, AND CROSS SECTION**

NO.	DATE	REVISION	STATE	PROJECT DESIGNATION	YEAR	SHEET NO.	TOTAL SHEETS
			ALASKA	0972016/Z684590000	2016	G4	59


FILE C:\Civi1 3D Projects\2\70732-01\Civi1\SC14-CT-G-PR-CMNM.dwg
 DATE 11/19/2016 14:52 LAYOUT G4
 DESIGNED HOBBS
 CHECKED NOBLE
 DRAFTED WESTPHAL

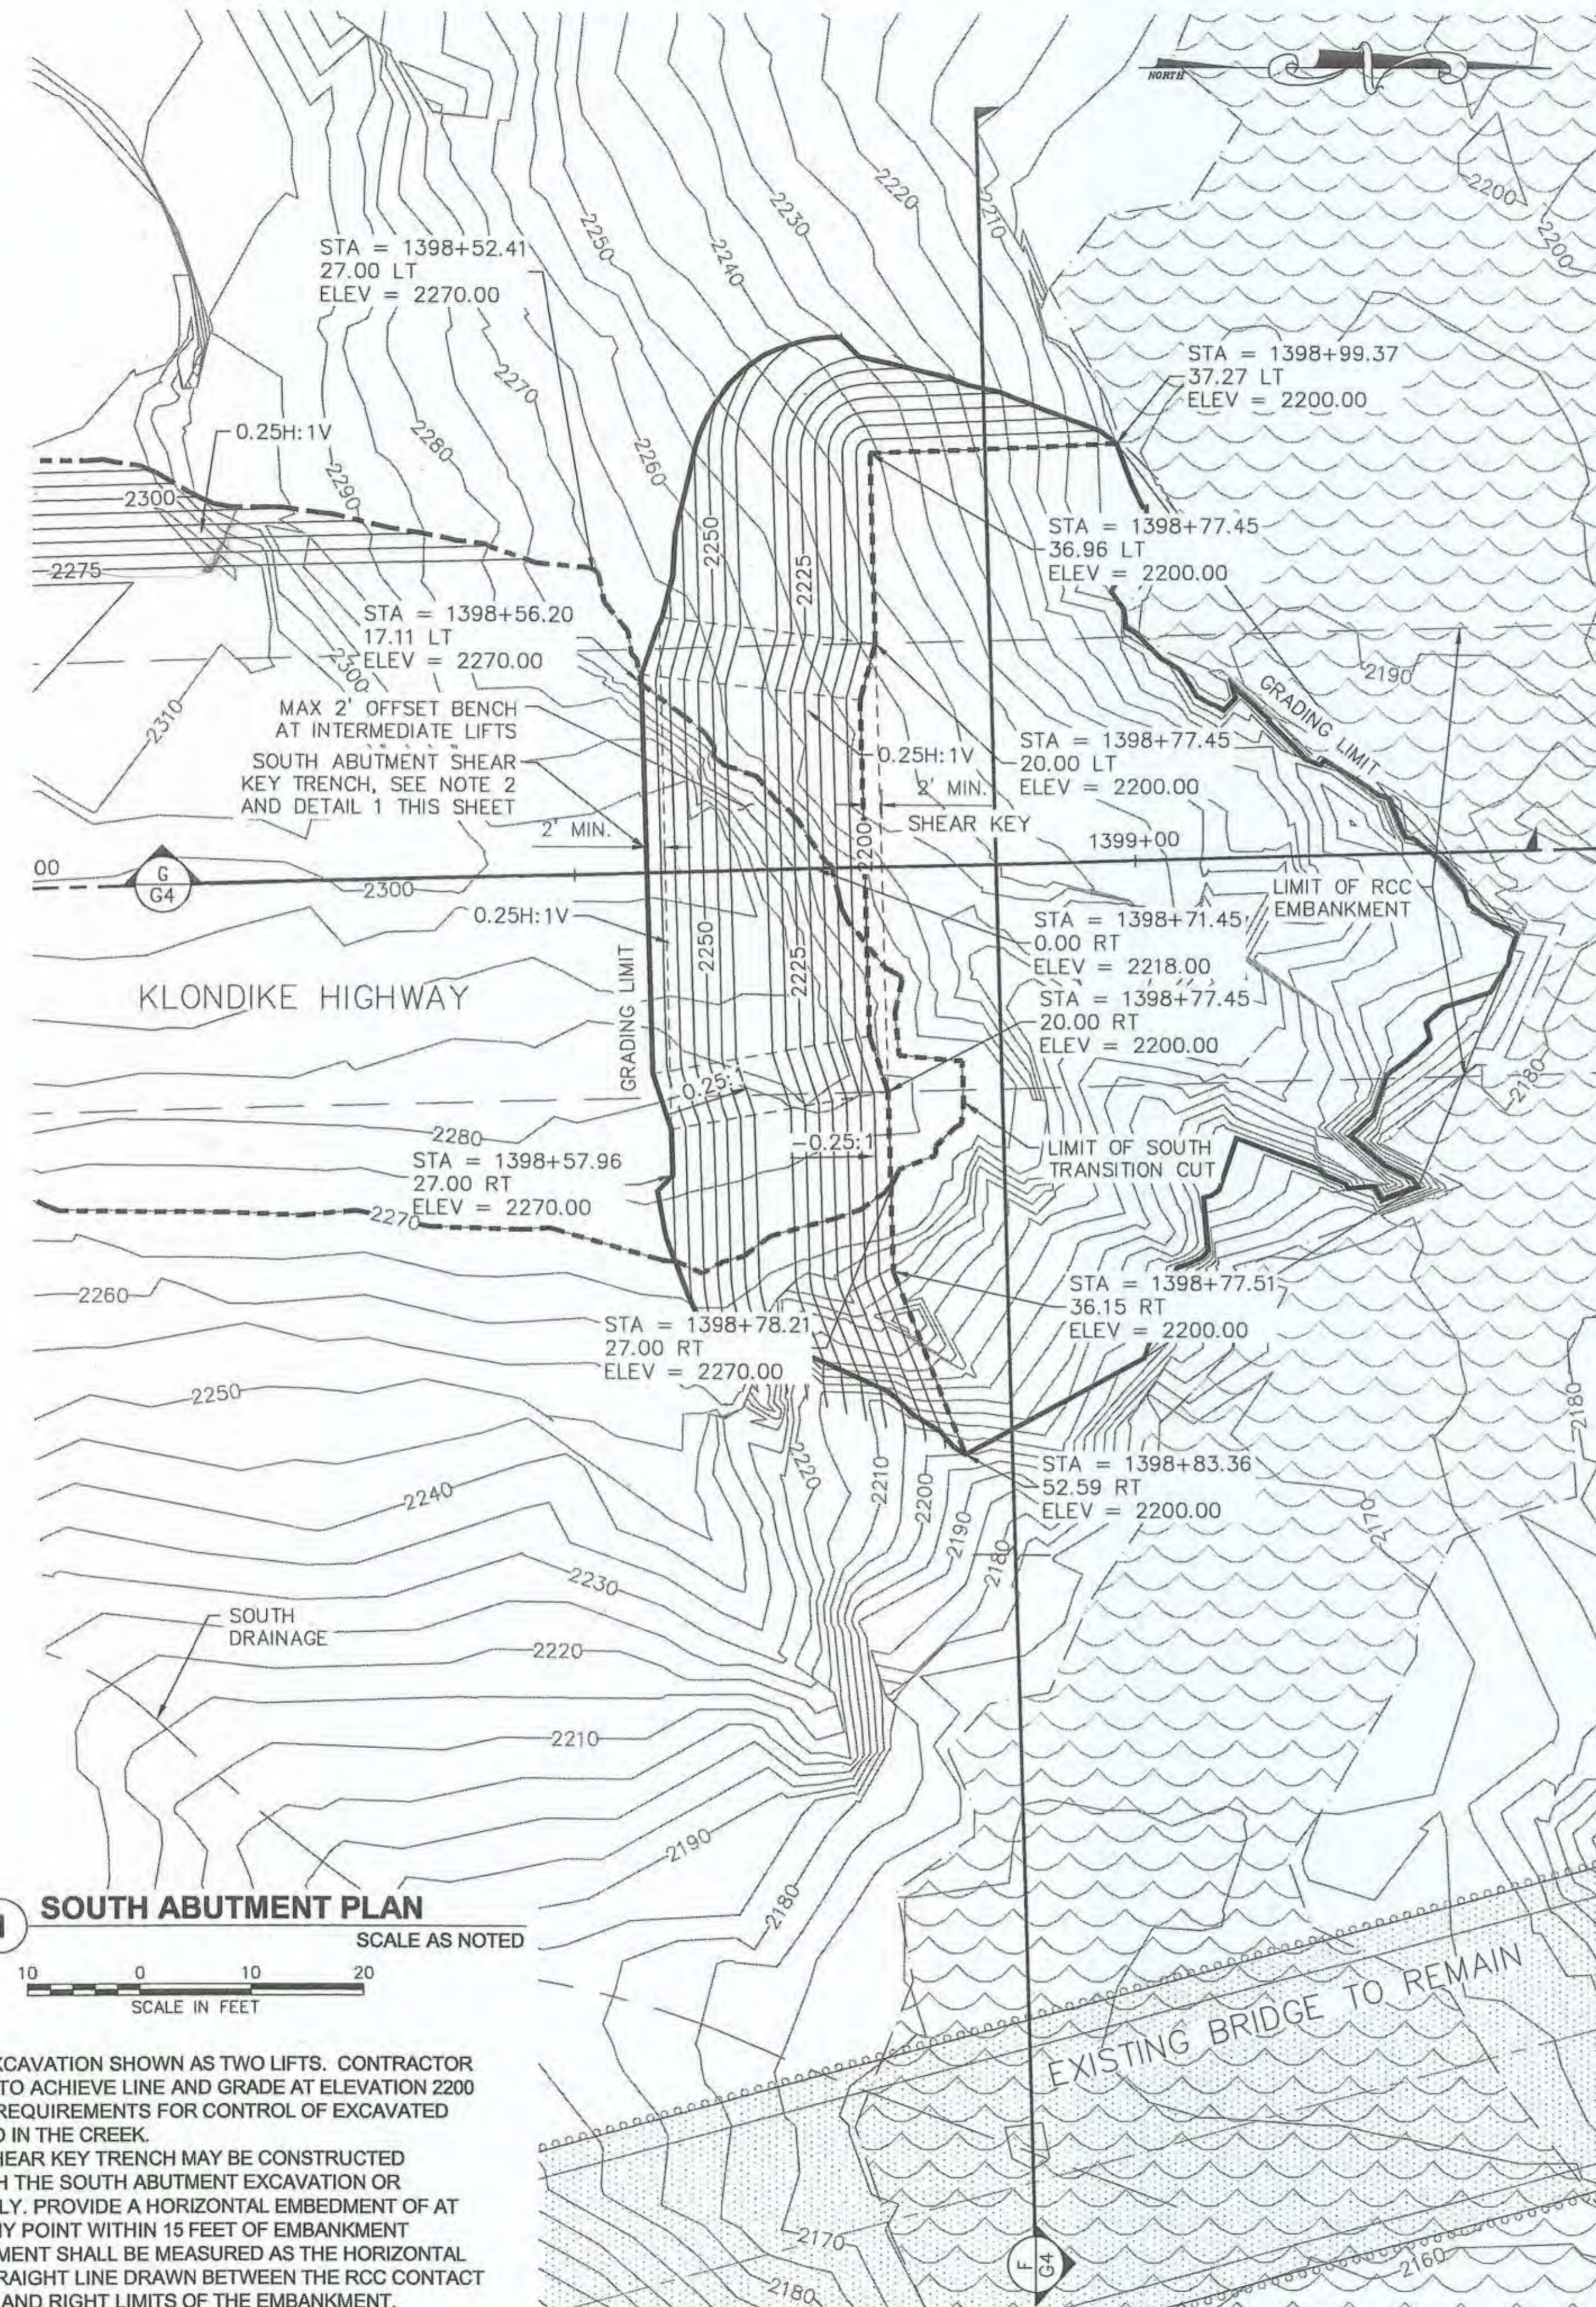


1 SOUTH ABUTMENT PLAN
SCALE AS NOTED
SCALE IN FEET

NOTES:


- SOUTH ABUTMENT EXCAVATION SHOWN AS TWO LIFTS. CONTRACTOR TO CONSTRUCT CUT TO ACHIEVE LINE AND GRADE AT ELEVATION 2200 WHILE MEETING ALL REQUIREMENTS FOR CONTROL OF EXCAVATED MATERIAL DEPOSITED IN THE CREEK.
- SOUTH ABUTMENT SHEAR KEY TRENCH MAY BE CONSTRUCTED CONCURRENTLY WITH THE SOUTH ABUTMENT EXCAVATION OR REMOVED SEPARATELY. PROVIDE A HORIZONTAL EMBEDMENT OF AT LEAST 2 FEET FOR ANY POINT WITHIN 15 FEET OF EMBANKMENT CENTERLINE. EMBEDMENT SHALL BE MEASURED AS THE HORIZONTAL DISTANCE PAST A STRAIGHT LINE DRAWN BETWEEN THE RCC CONTACT POINTS ON THE LEFT AND RIGHT LIMITS OF THE EMBANKMENT.

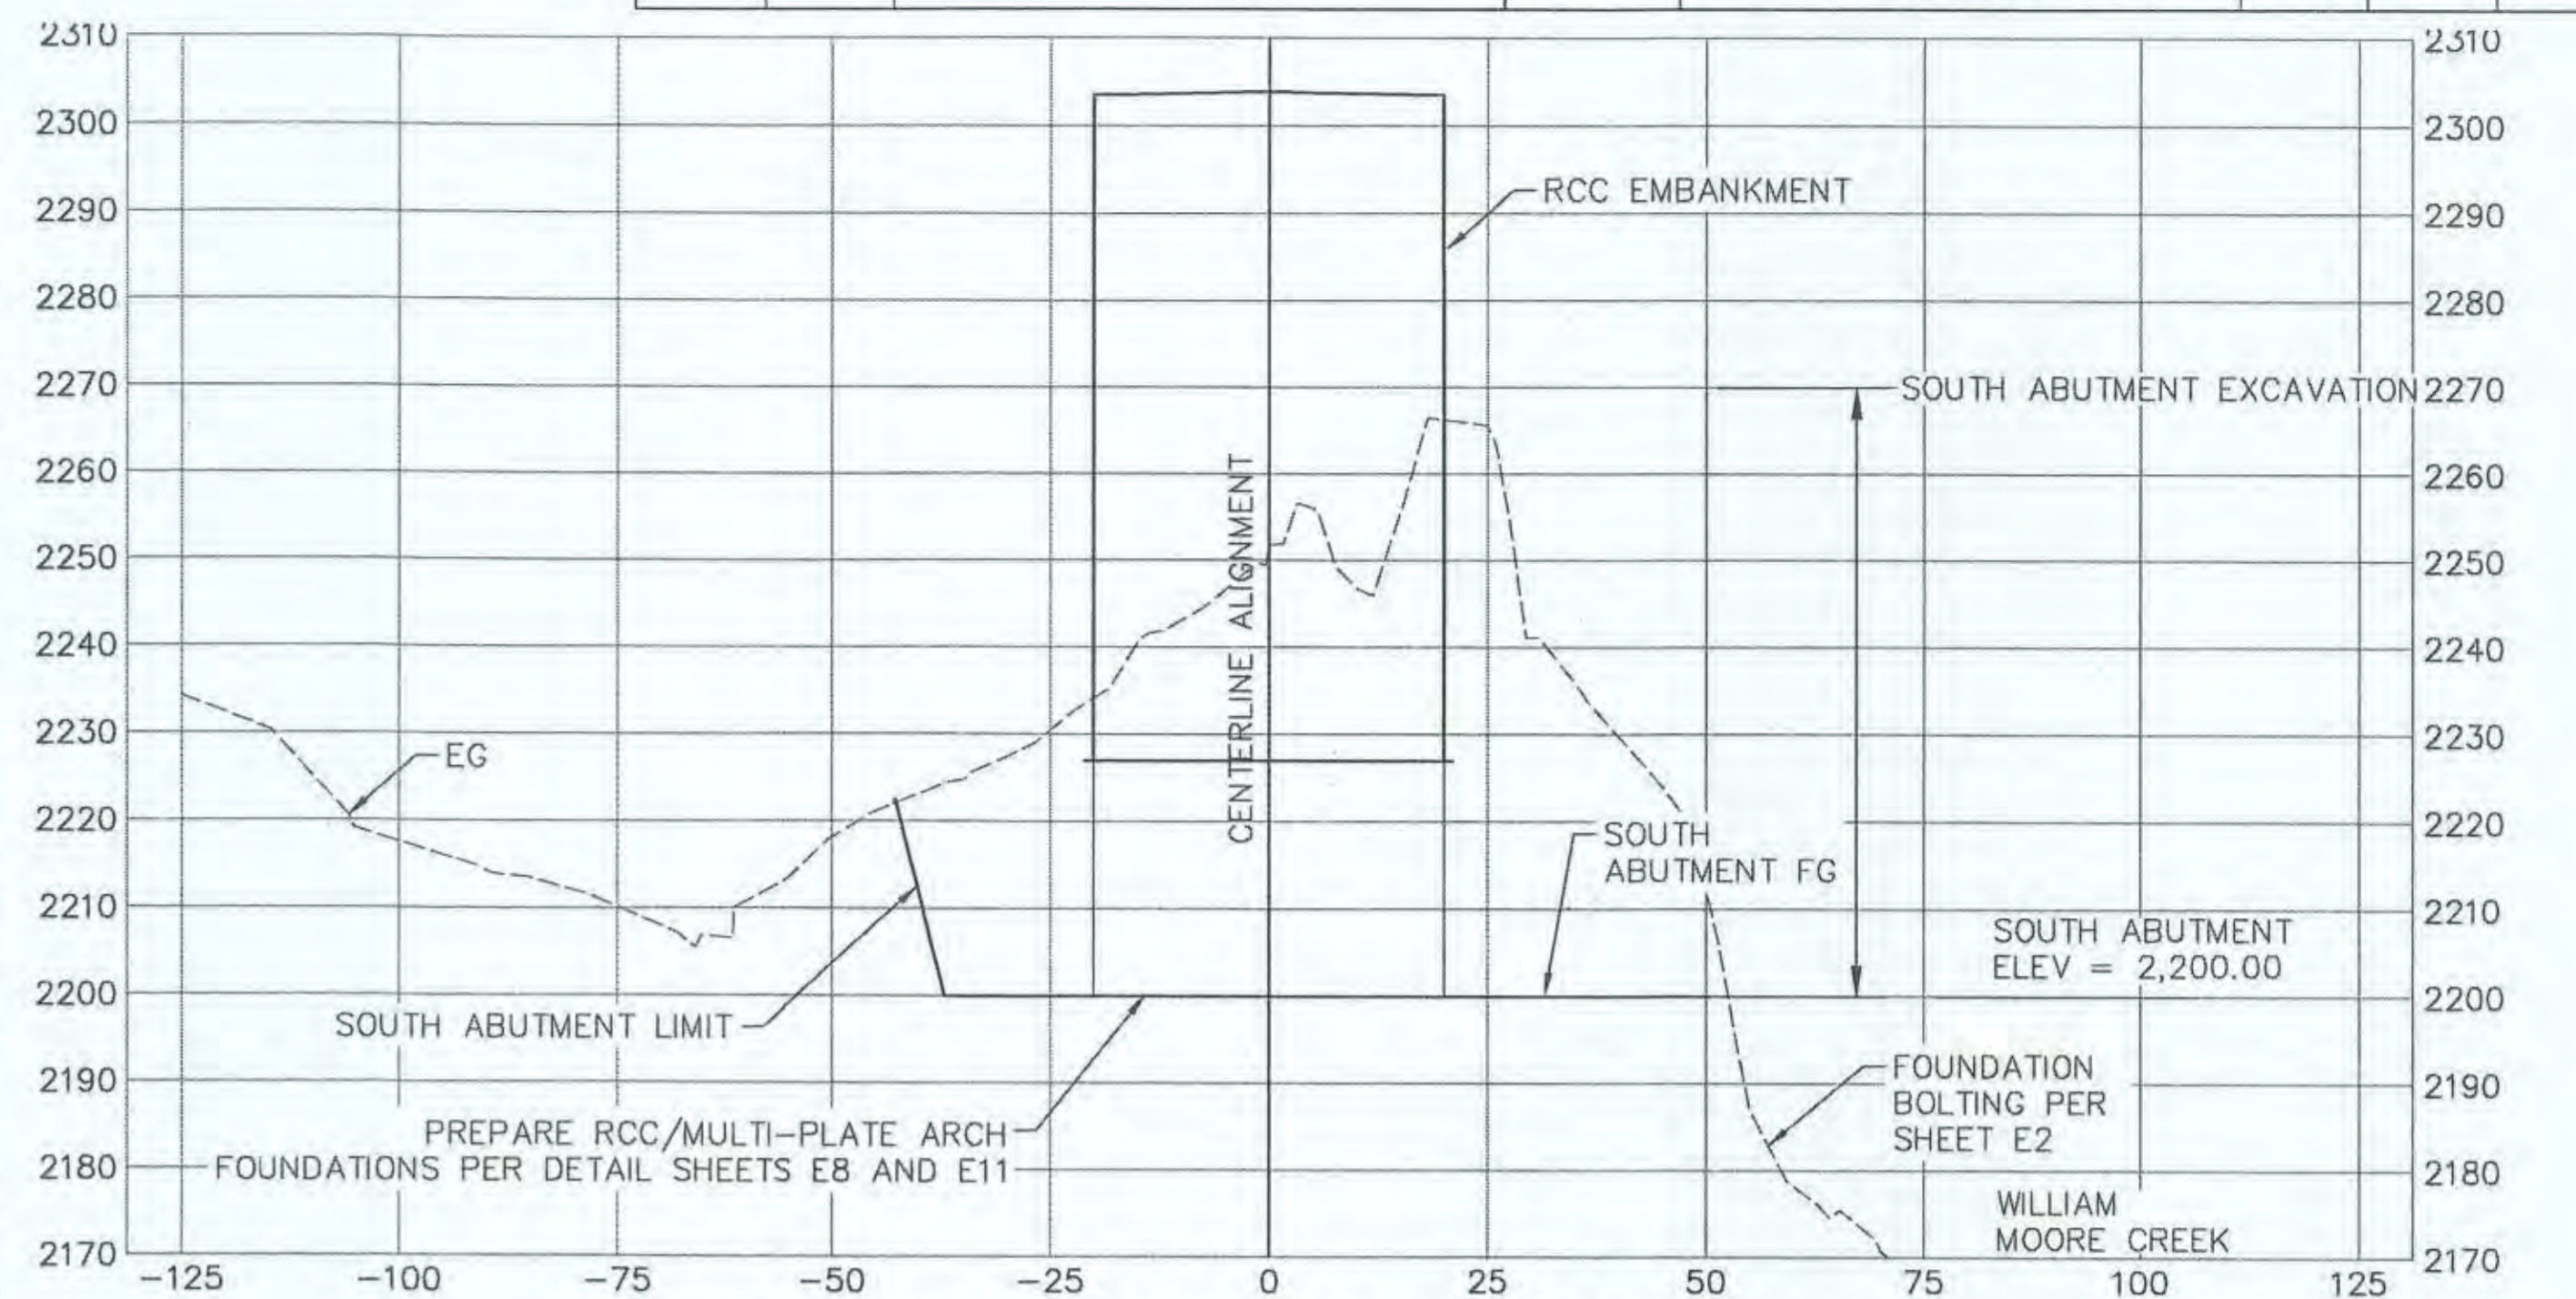

F TYPICAL SOUTH ABUTMENT CUT SECTION
STATIONS 1398+80 TO 1399+00
SCALE AS NOTED

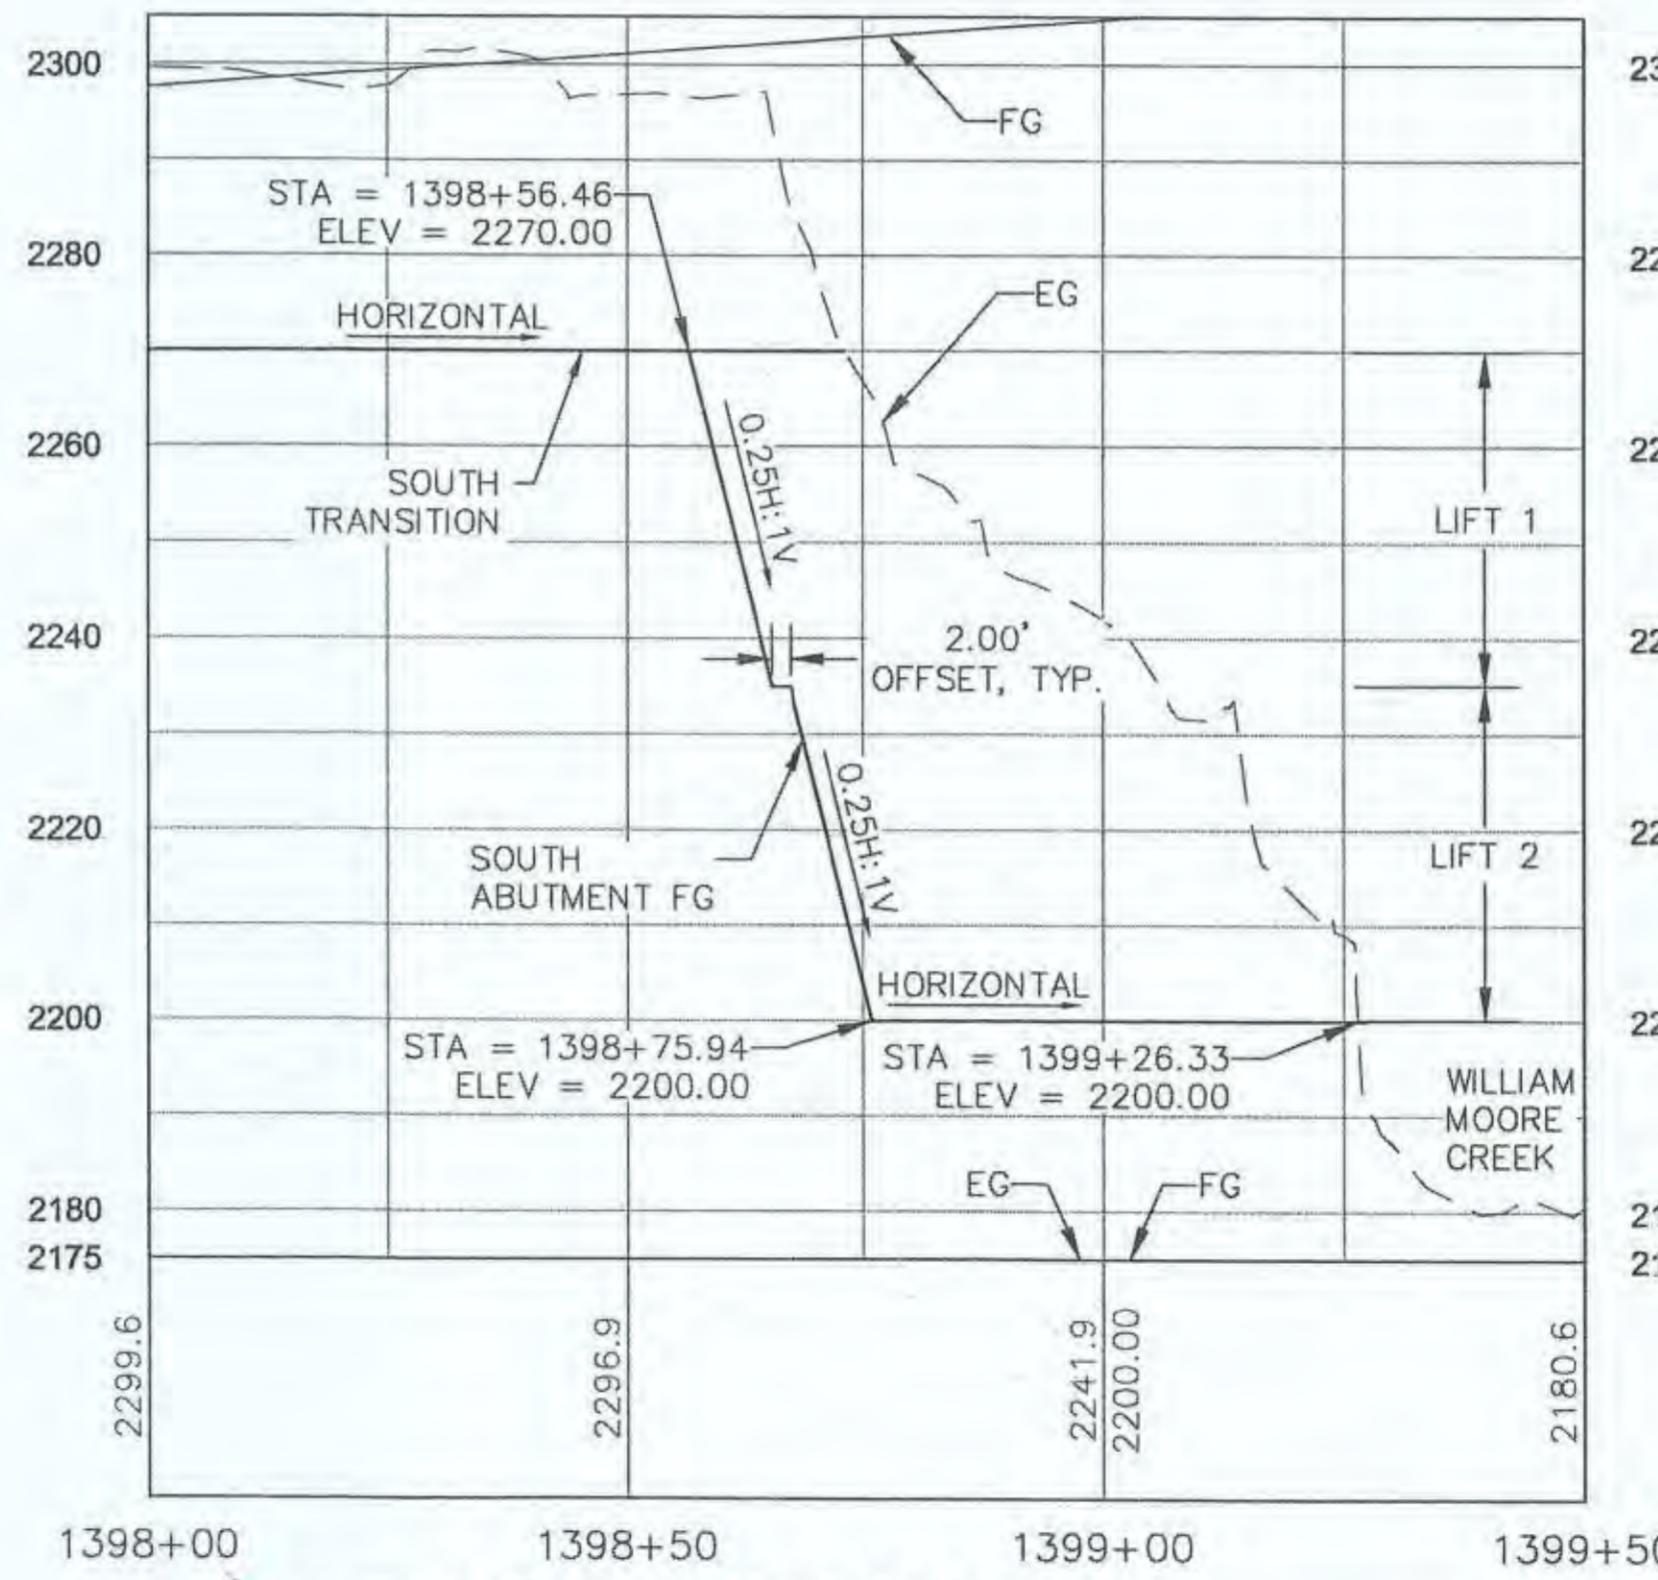

G SOUTH ABUTMENT PROFILE
SCALE AS NOTED

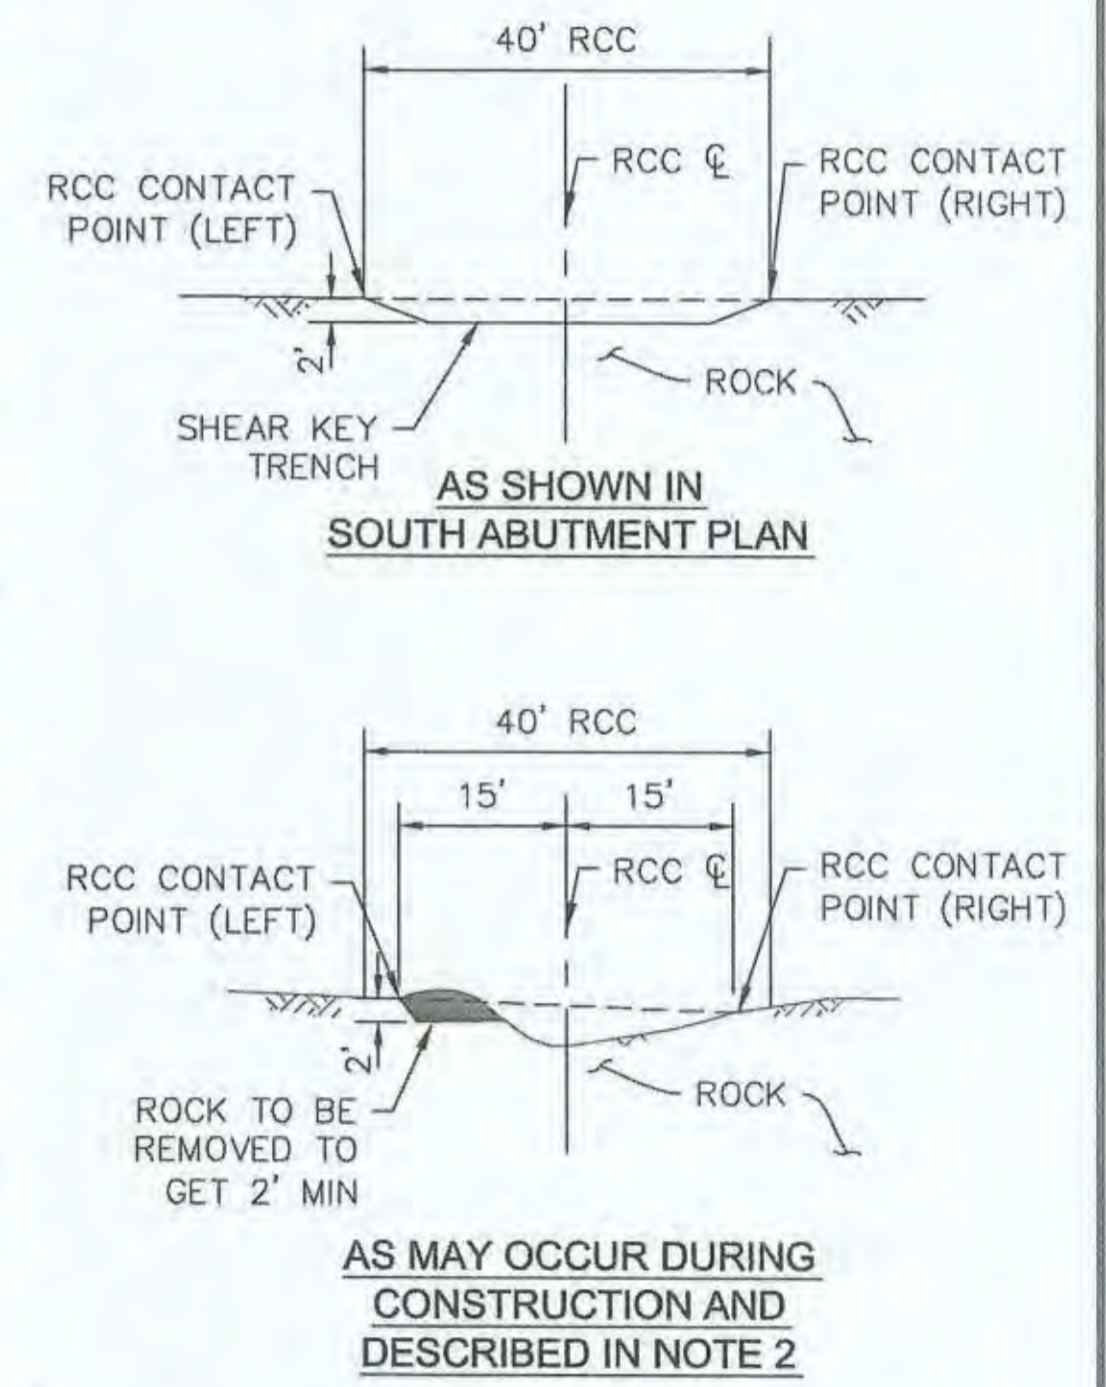

1 SHEAR KEY TRENCH DETAIL
SCALE AS NOTED


PLANS DEVELOPED BY:
DOWL
5368 COMMERCIAL BLVD,
JUNEAU, AK 99801
(907) 780-3533
#AECL848



STATE OF ALASKA
DEPARTMENT OF TRANSPORTATION
AND PUBLIC FACILITIES
**SKAGWAY - REPLACE CAPTAIN
WILLIAM HENRY MOORE BRIDGE**
**SOUTH ABUTMENT PLAN, PROFILE,
AND CROSS SECTION**

NO.	DATE	REVISION	STATE	PROJECT DESIGNATION	YEAR	SHEET NO.	TOTAL SHEETS
			ALASKA	0972016/Z684590000	2016	G5	59


FILE: C:\CIVIL\3D Projects\24\70732-01\Civil\SC14-CT-G-PR-CWHM.dwg
 DATE: 8/17/2016 11:01 LAYOUT: G5
 DESIGNED: HOBBS
 CHECKED: NOBLE
 DRAFTED: WESTPHAL

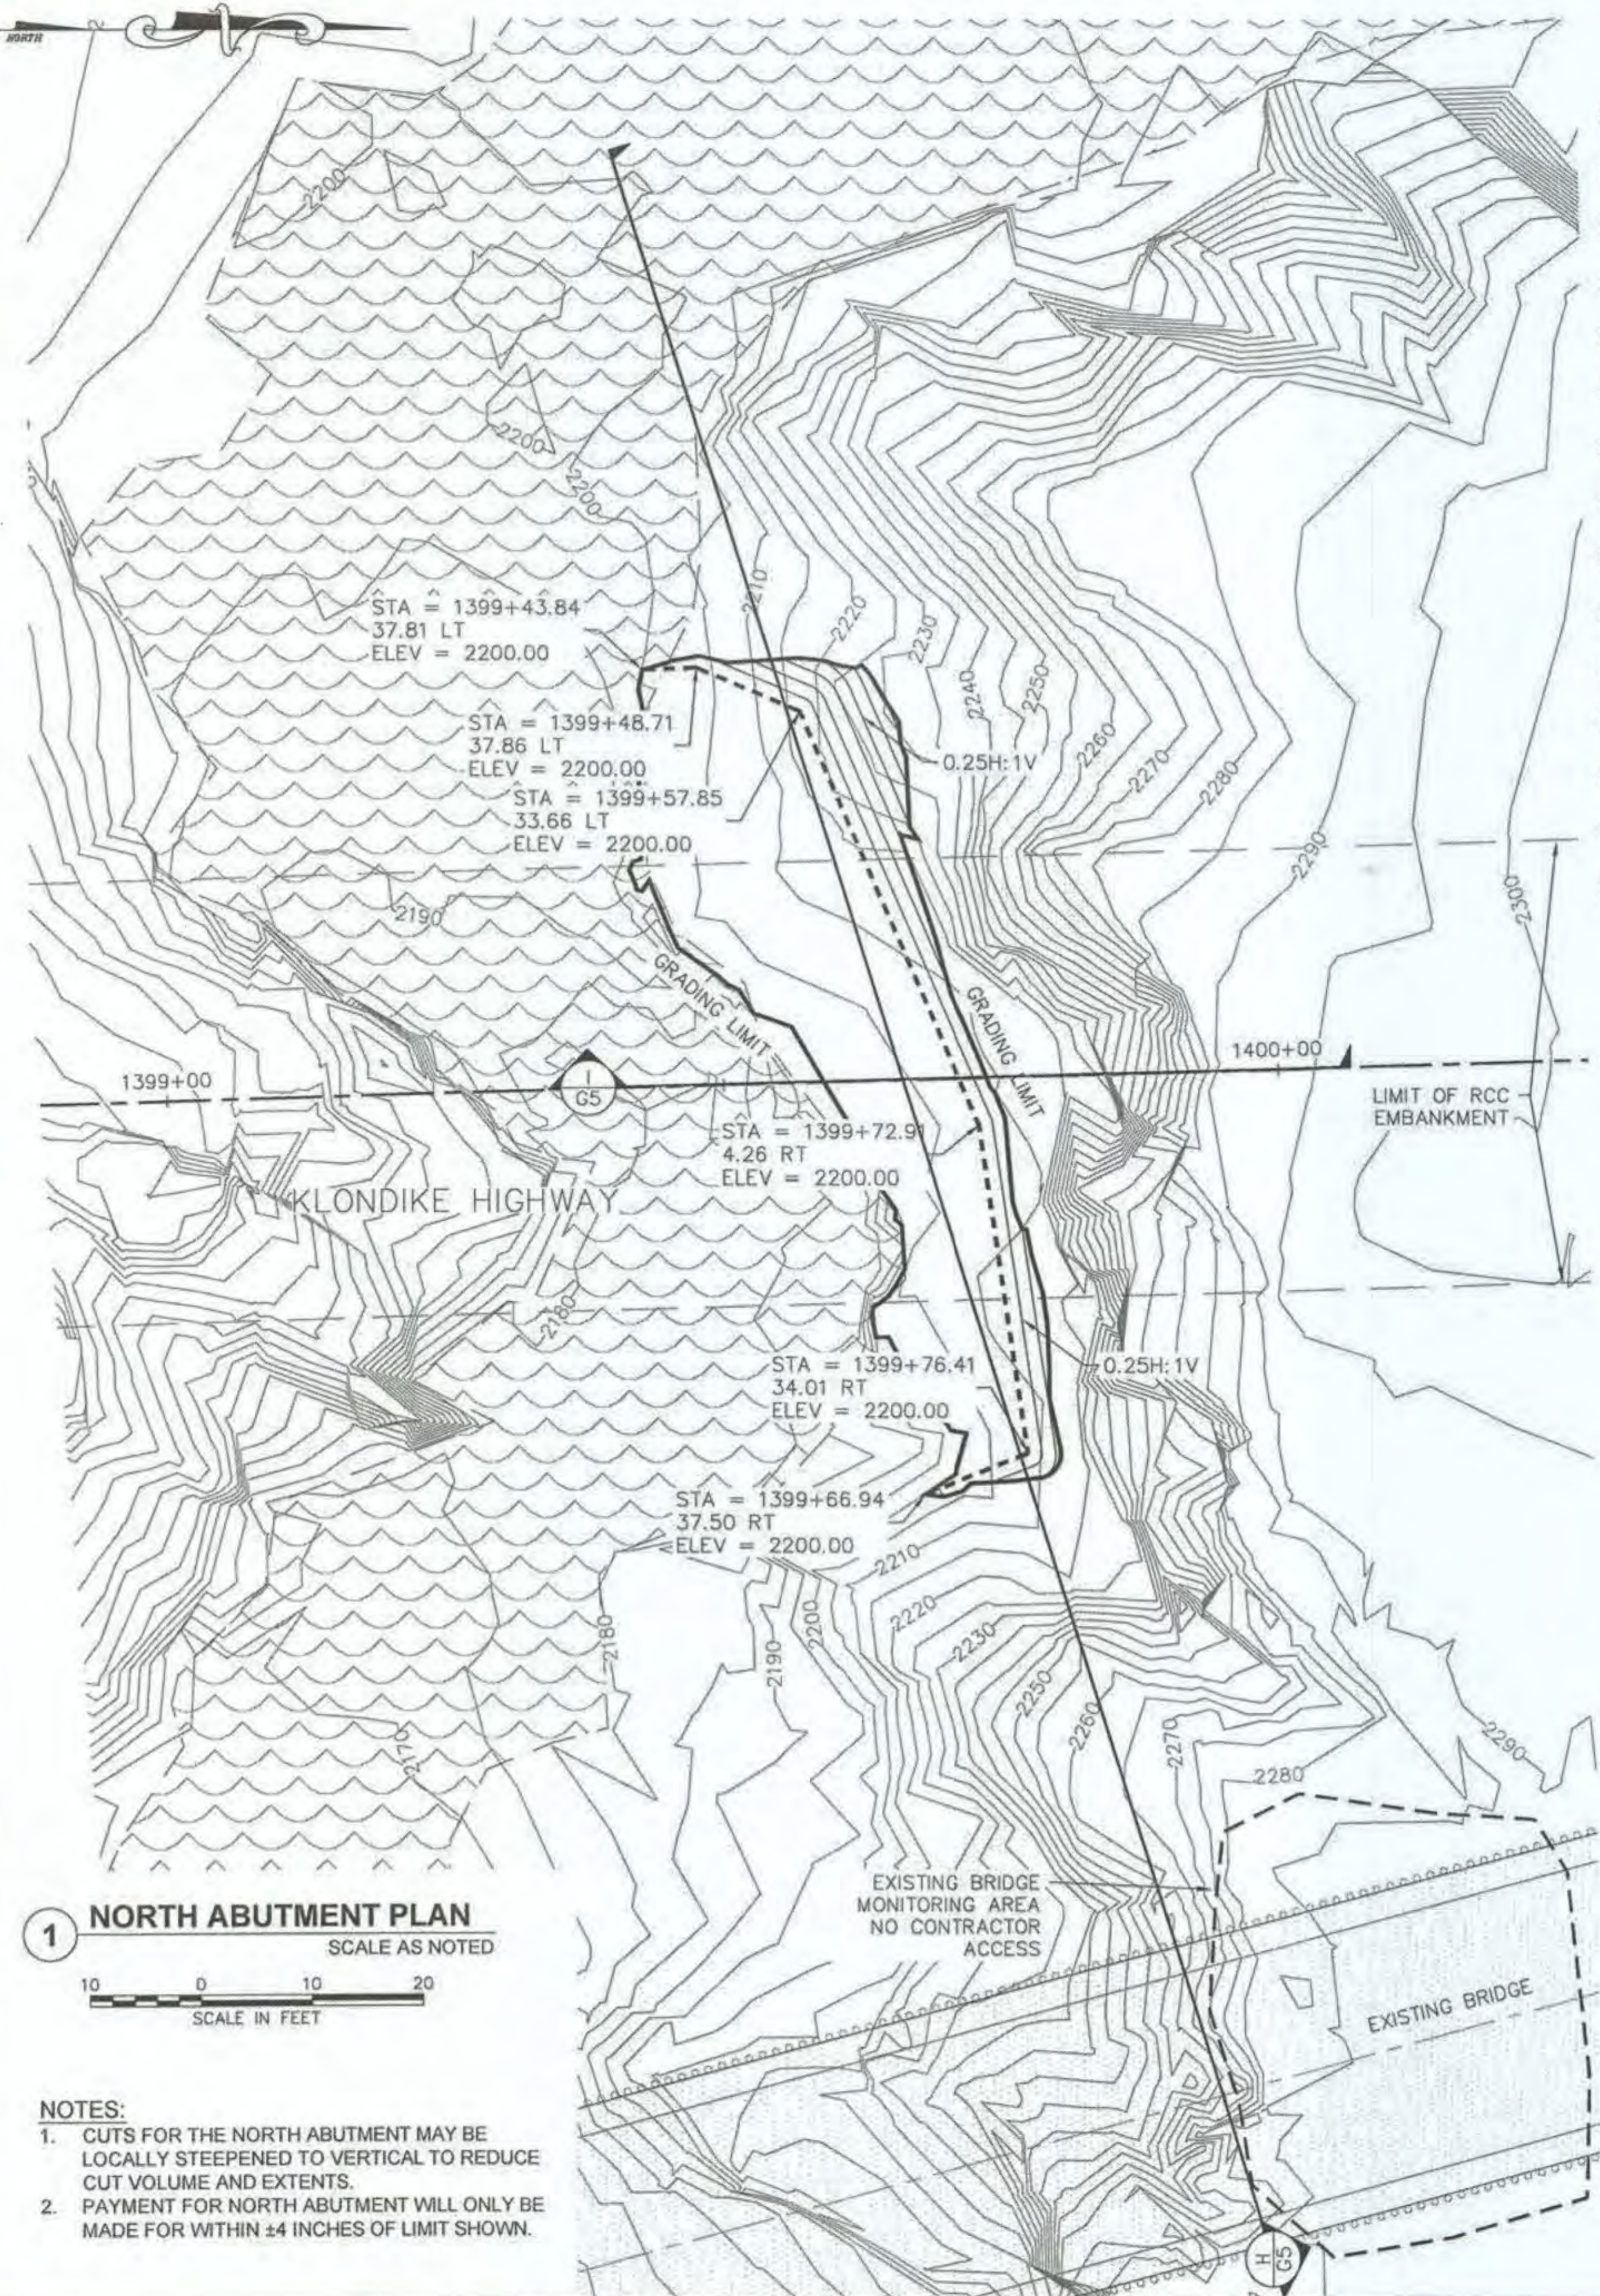


1 NORTH ABUTMENT PLAN
SCALE AS NOTED



- NOTES:**
- CUTS FOR THE NORTH ABUTMENT MAY BE LOCALLY STEEPENED TO VERTICAL TO REDUCE CUT VOLUME AND EXTENTS.
 - PAYMENT FOR NORTH ABUTMENT WILL ONLY BE MADE FOR WITHIN ±4 INCHES OF LIMIT SHOWN.

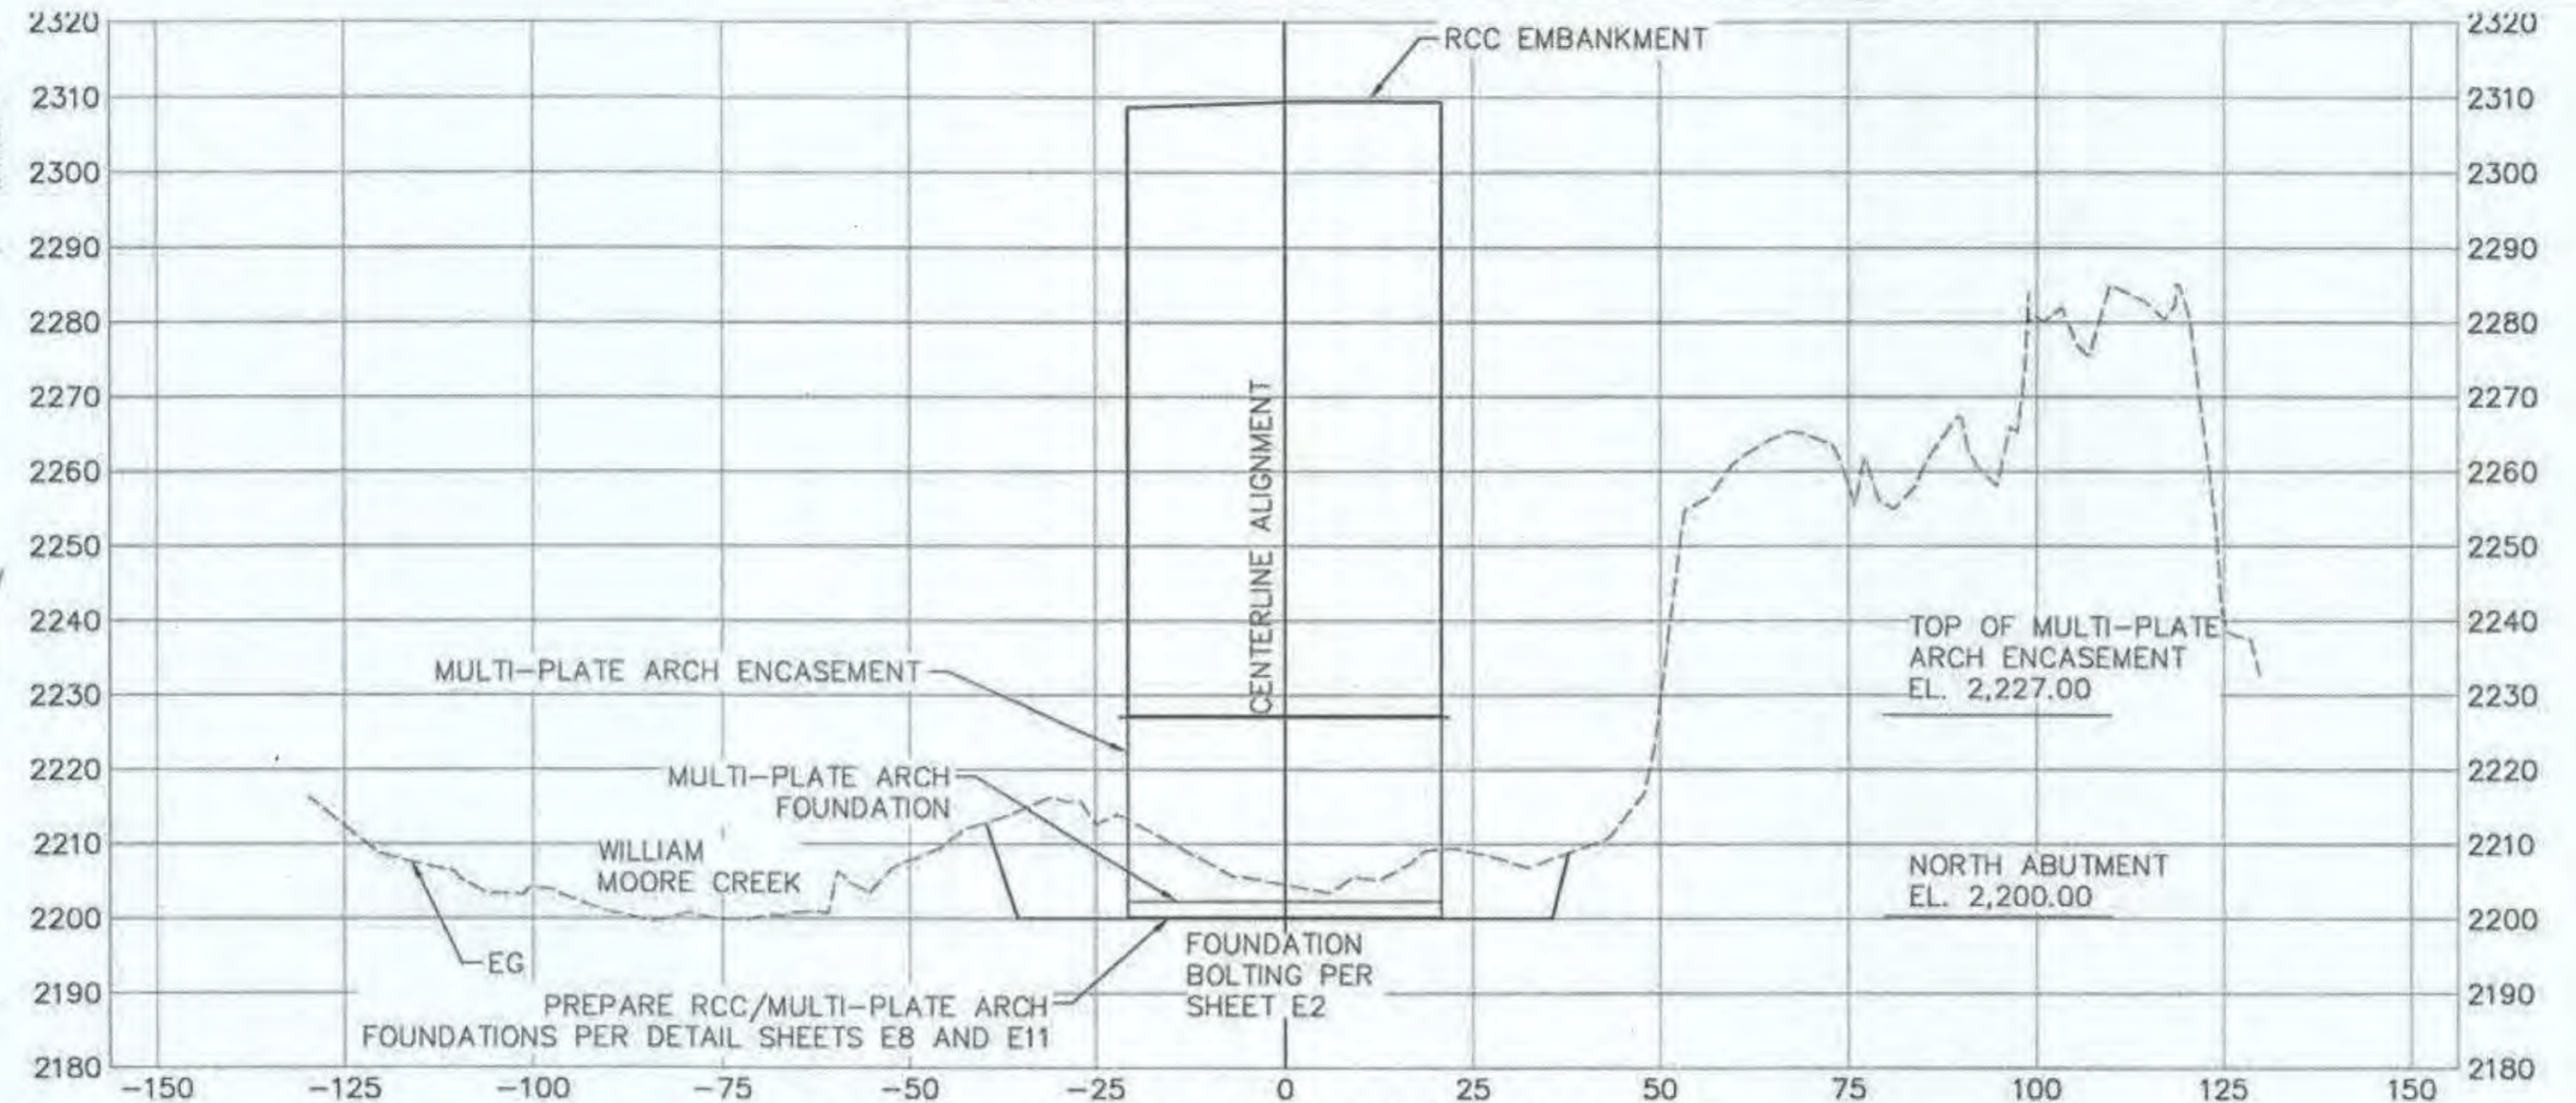

H TYPICAL NORTH ABUTMENT CUT SECTION
STATIONS 1399+95 TO 1402+85
SCALE AS NOTED

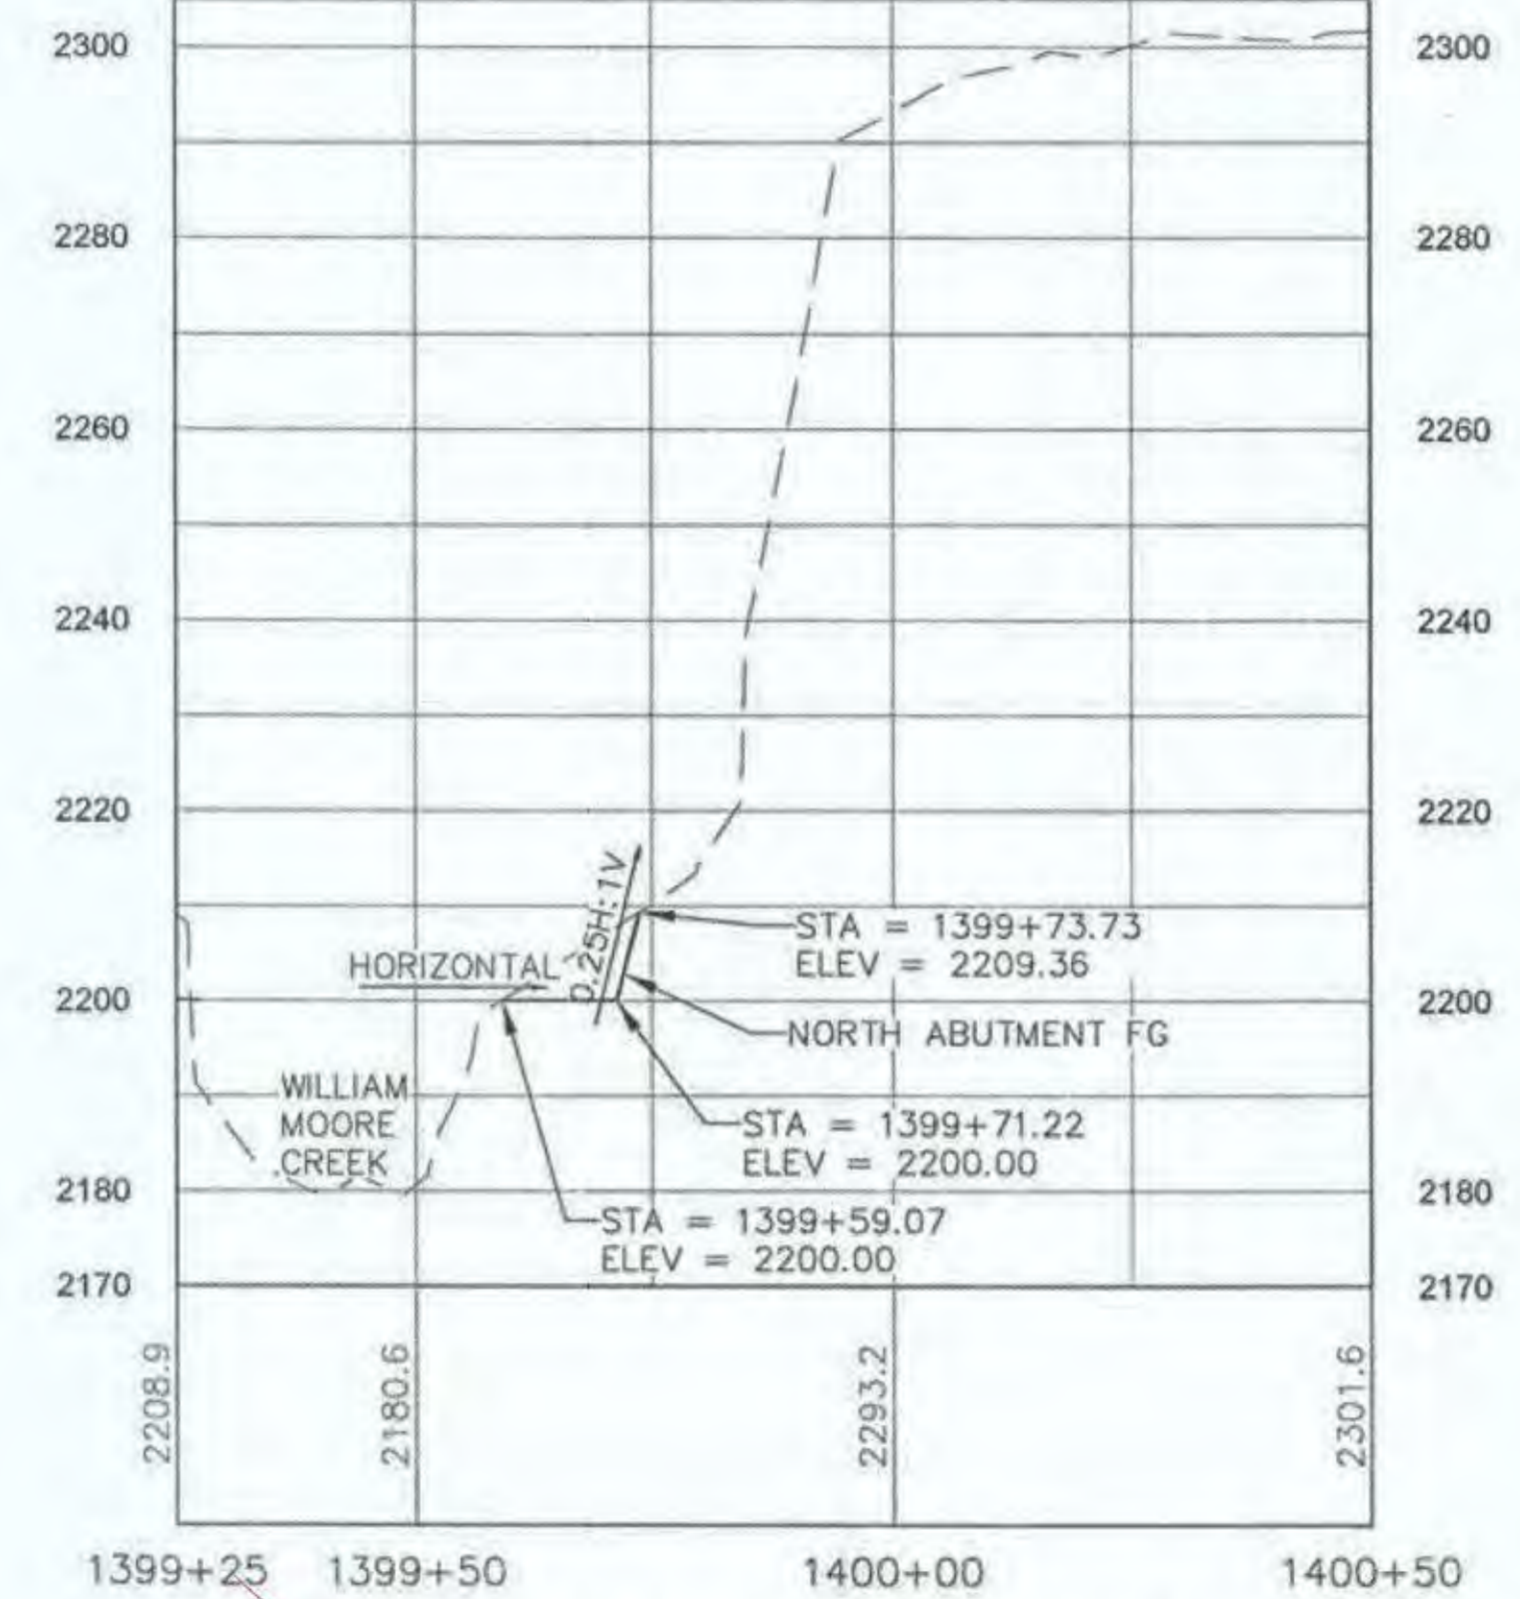

I NORTH ABUTMENT PROFILE
SCALE AS NOTED

6/9/20

PLANS DEVELOPED BY:
DOWL
5368 COMMERCIAL BLVD,
JUNEAU, AK 99801
(907) 780-3533
#AECL848



STATE OF ALASKA
DEPARTMENT OF TRANSPORTATION
AND PUBLIC FACILITIES


**SKAGWAY - REPLACE CAPTAIN
WILLIAM HENRY MOORE BRIDGE**

**NORTH ABUTMENT PLAN, PROFILE,
AND CROSS SECTION**


8-17-2016

FILE: C:\CIVIL\3D Projects\24\70732-01\CIVIL\SC14-CT-C-PR-CWHM.dwg DATE: 8/17/2016 10:59 LAYOUT: 66 DESIGNED: HOBBS CHECKED: NOBLE DRAFTED: WESTPHAL


NO.	DATE	REVISION	STATE	PROJECT DESIGNATION	YEAR	SHEET NO.	TOTAL SHEETS
			ALASKA	0972016/Z684590000	2016	G6	59

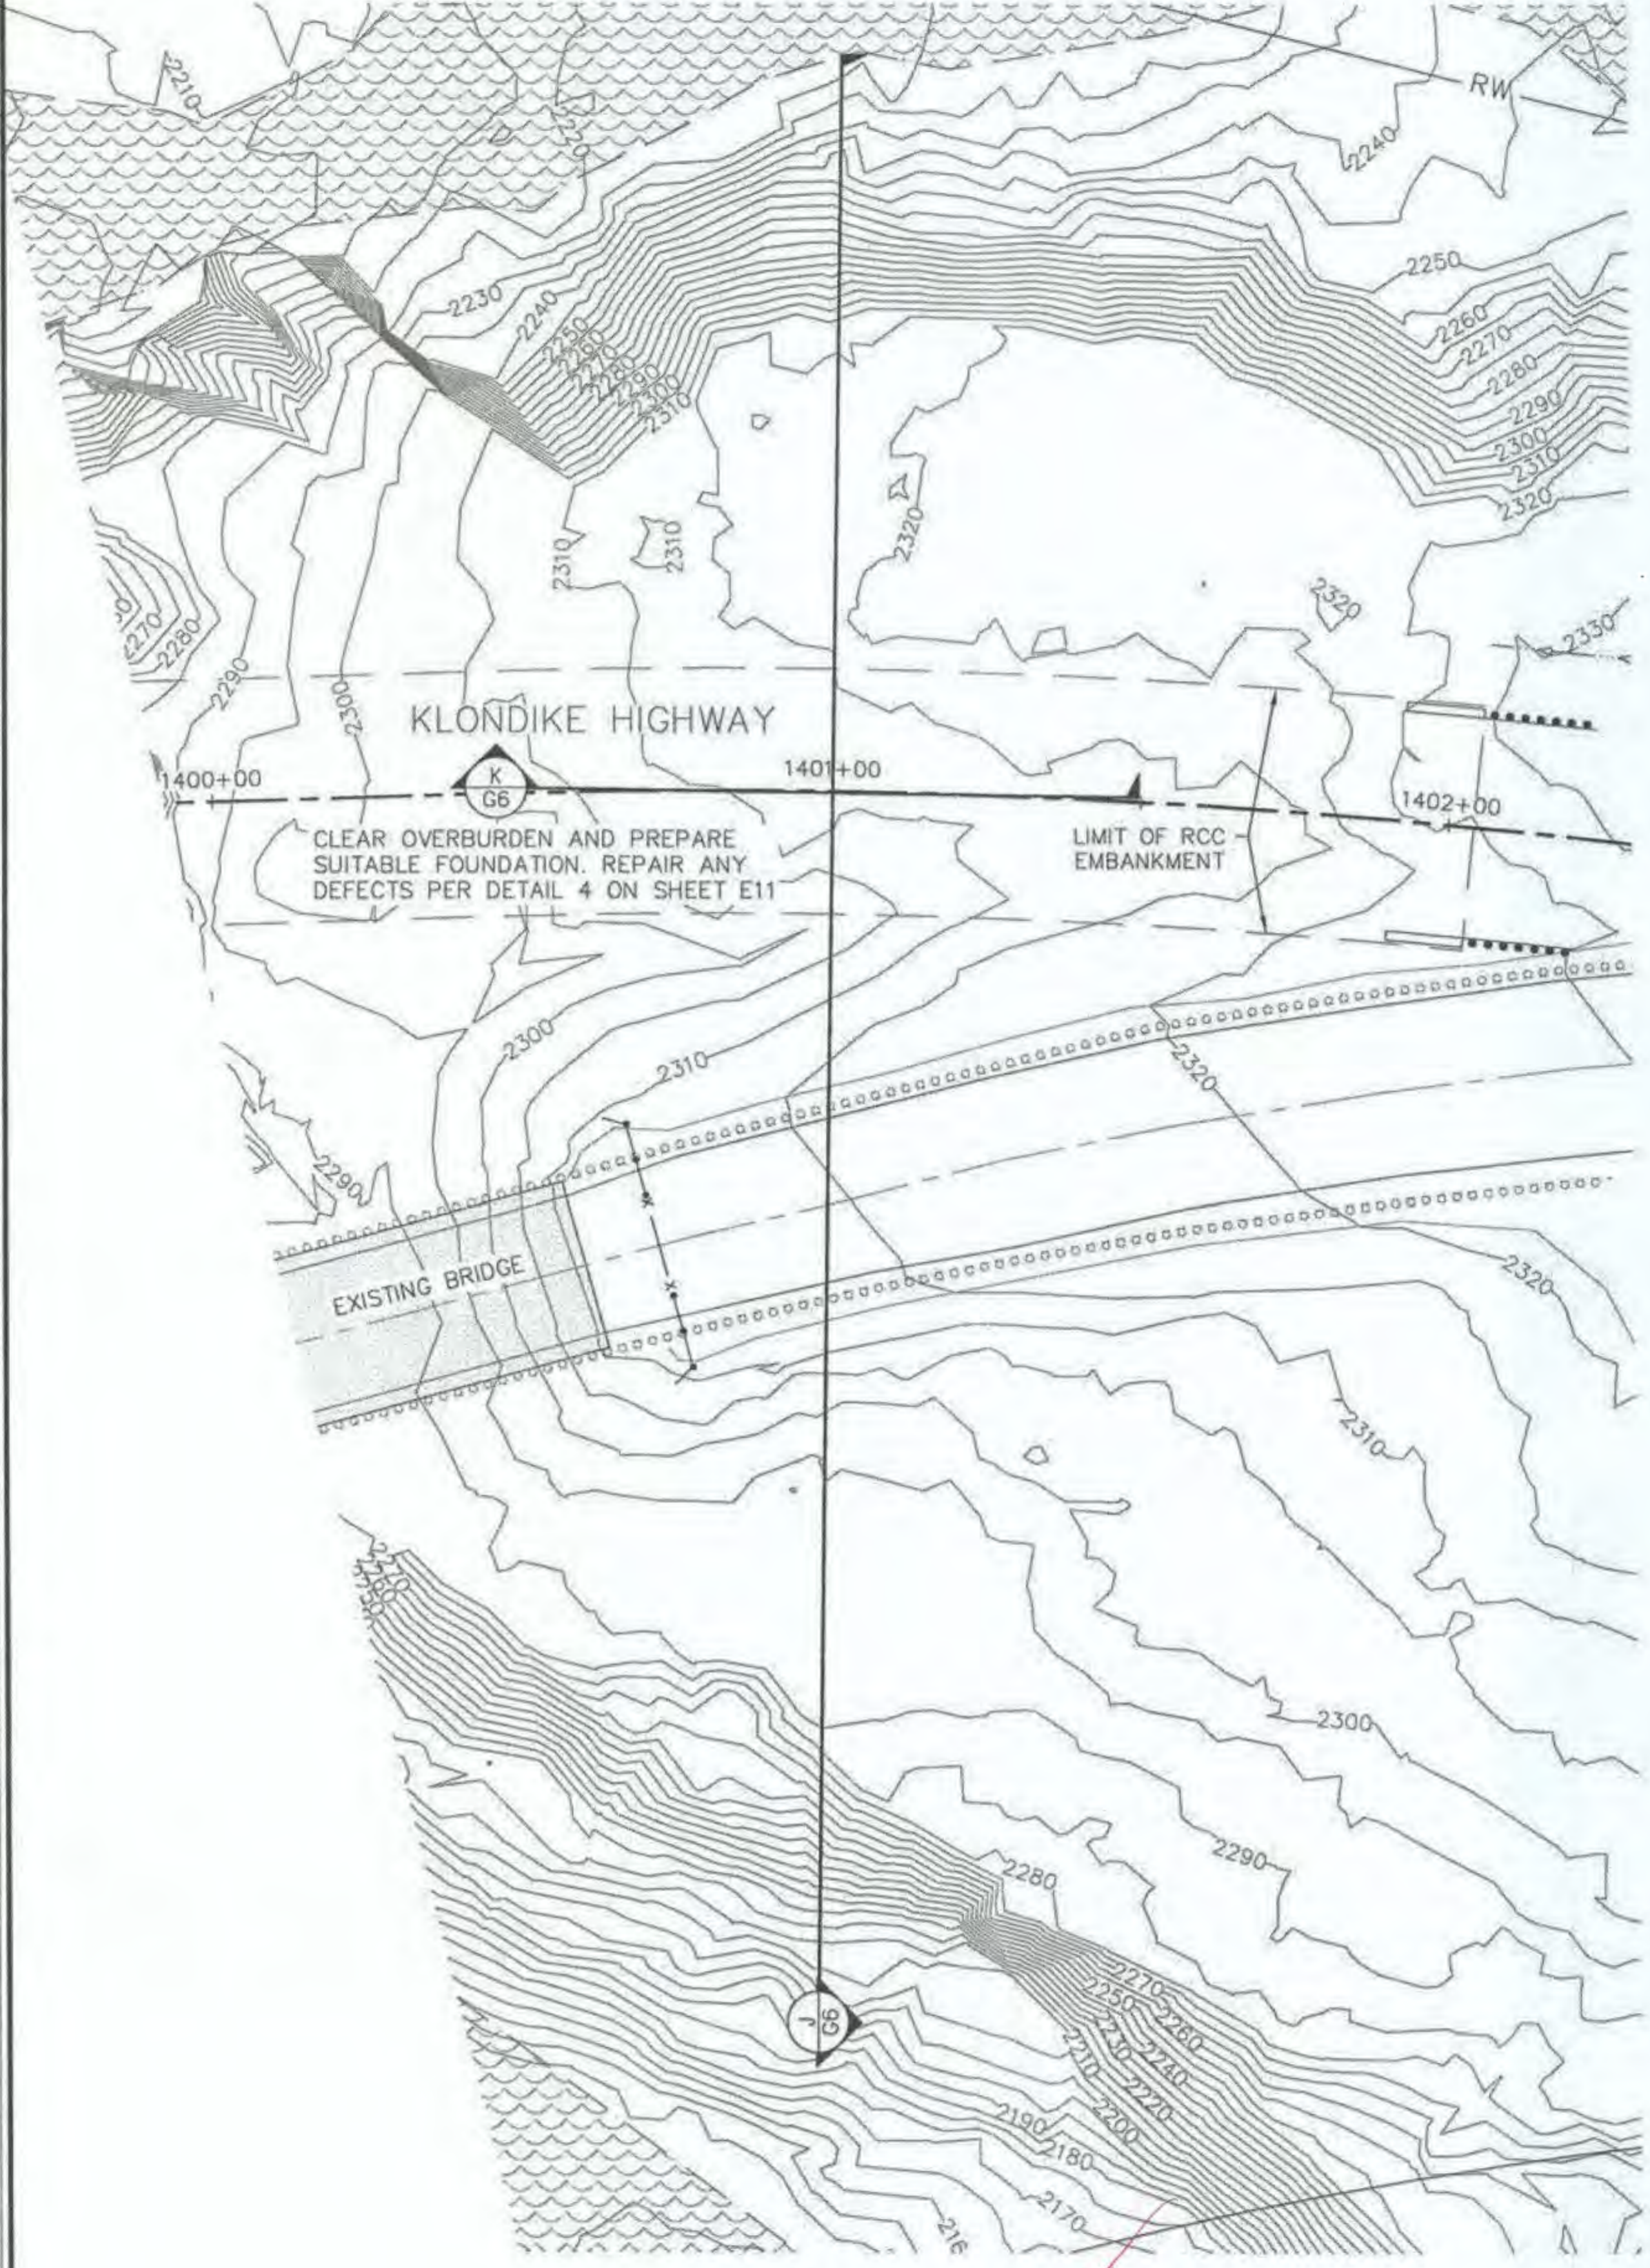

1 NORTH TRANSITION PLAN
SCALE AS NOTED

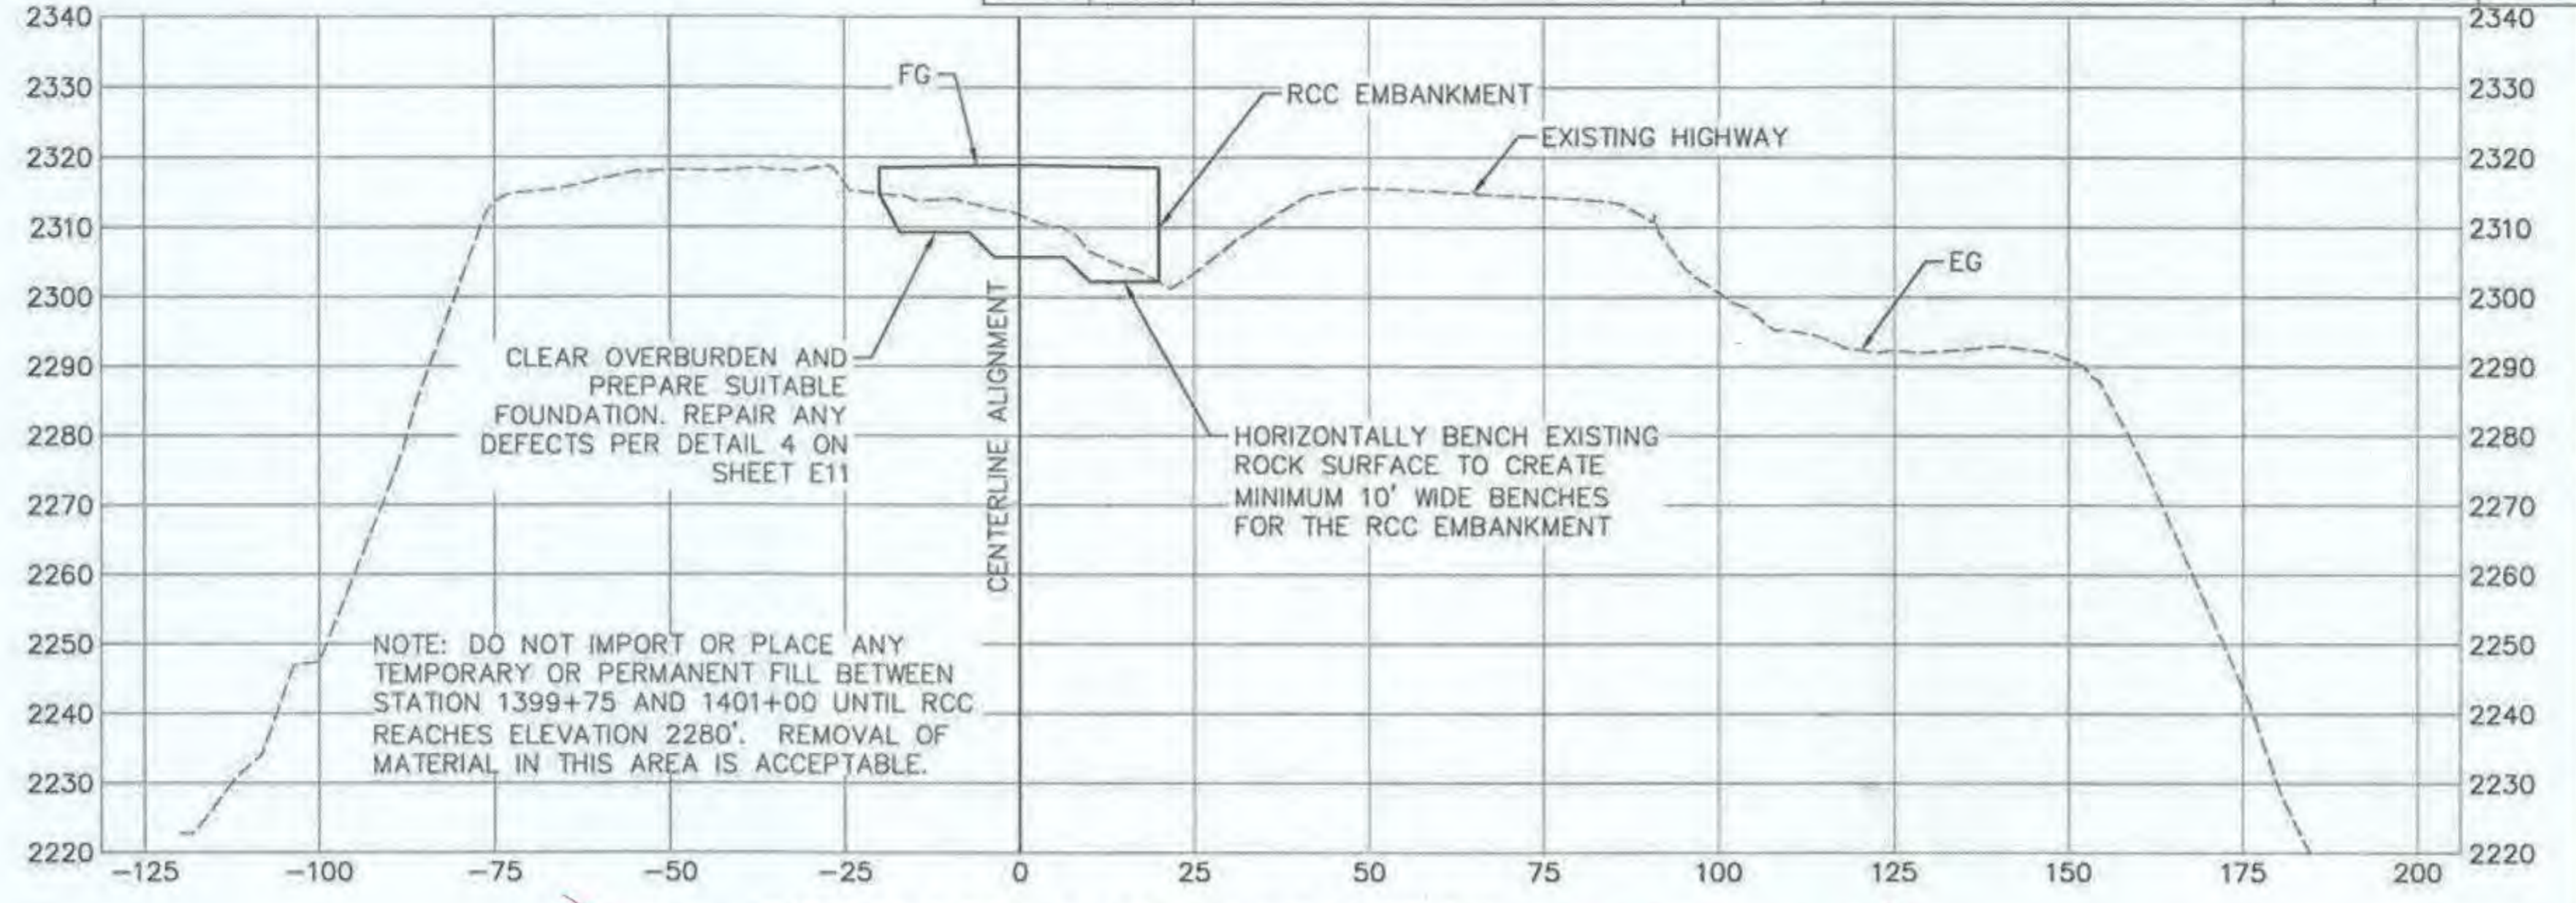


J TYPICAL NORTH TRANSITION SECTION
STATIONS 1401+00 TO 1408+50
SCALE AS NOTED *SEE ATTACHED*

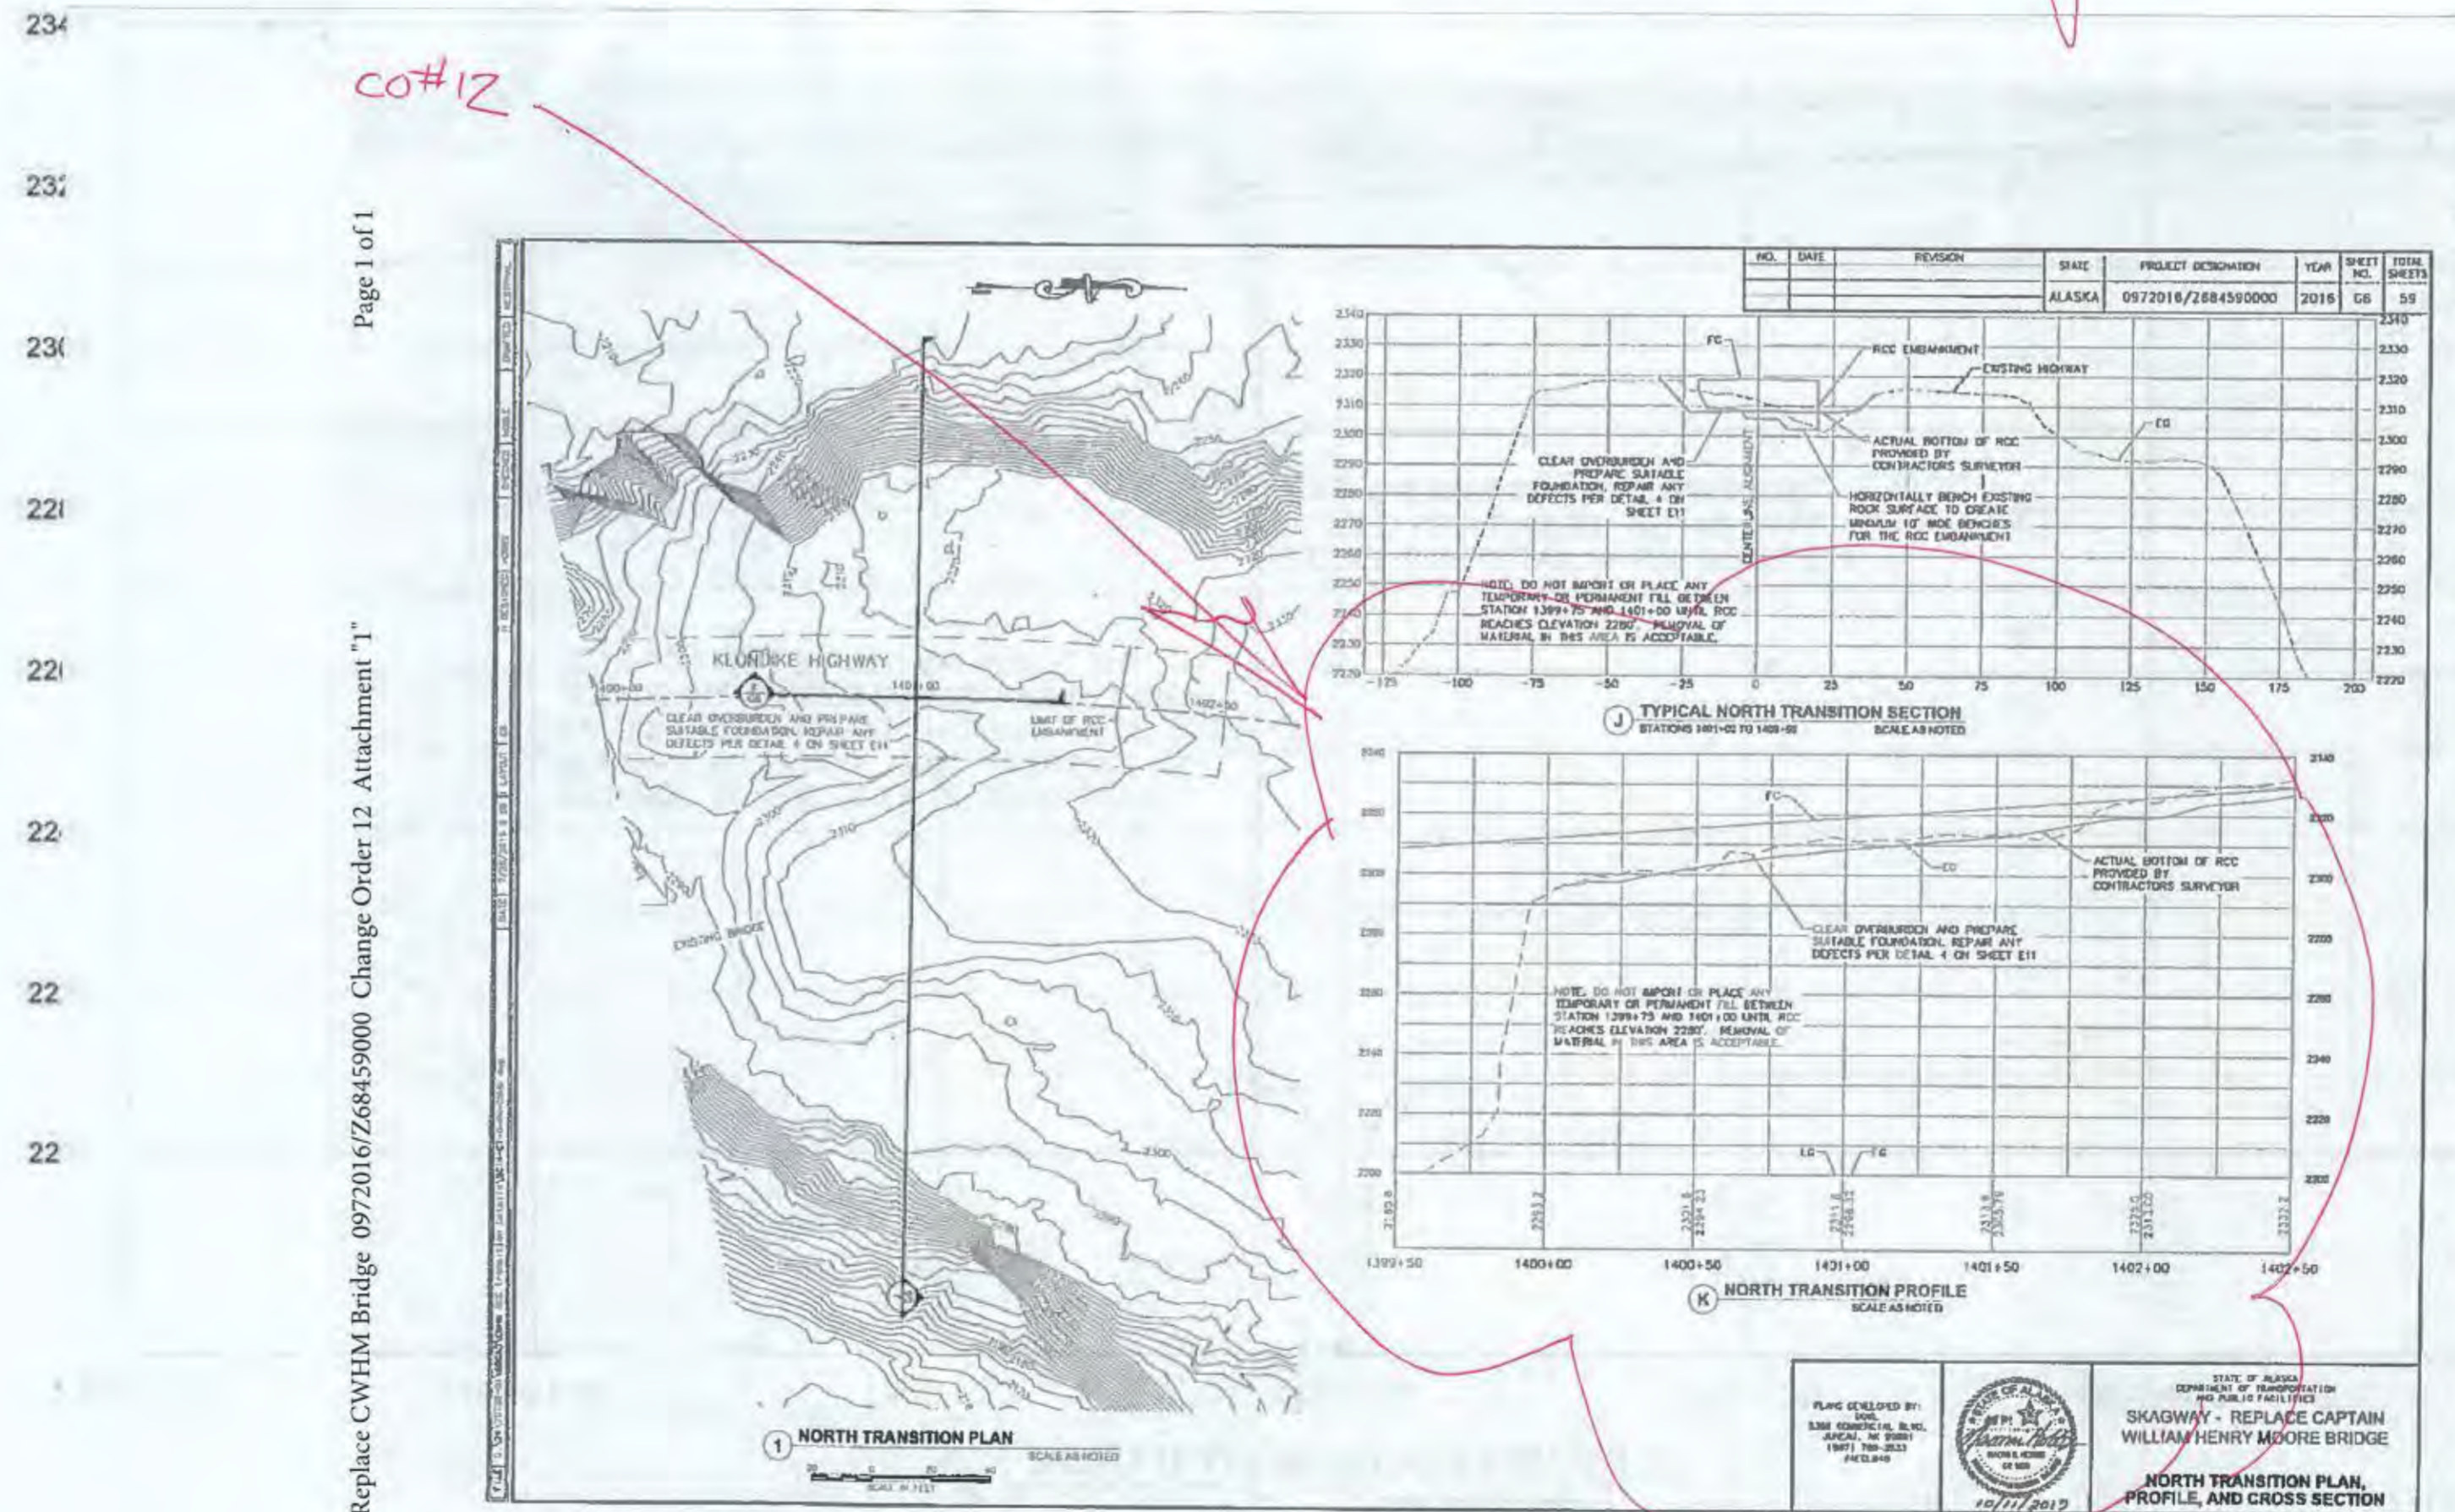

Skagway Replace CWHM Bridge 0972016/Z68459000 Change Order 12 Attachment "1"

5368 COMMERCIAL BLVD.
JUNEAU, AK 99801
(907) 780-3533
#AECL848

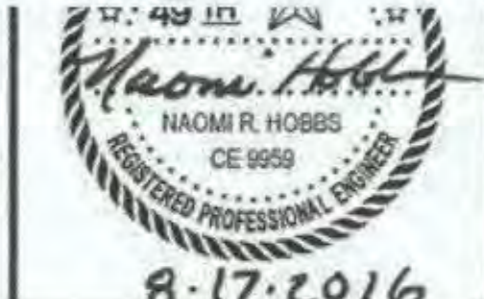


SKAGWAY - REPLACE CAPTAIN
WILLIAM HENRY MOORE BRIDGE
**NORTH TRANSITION PLAN,
PROFILE, AND CROSS SECTION**

6/9/20


8-17-2016

NO.	DATE	REVISION	STATE	PROJECT DESIGNATION	YEAR	SHEET NO.	TOTAL SHEETS
			ALASKA	0972016/Z684590000	2016	G7	59

FILE: C:\Civil\3D Projects\24\70732-01\Civil\SC14-CT-G-PK-CMM.dwg
 DATE: 8/17/2016 11:05 LAYOUT: G7
 DESIGNED: HOBBS
 CHECKED: NOBLE
 DRAFTED: WESTPHAL

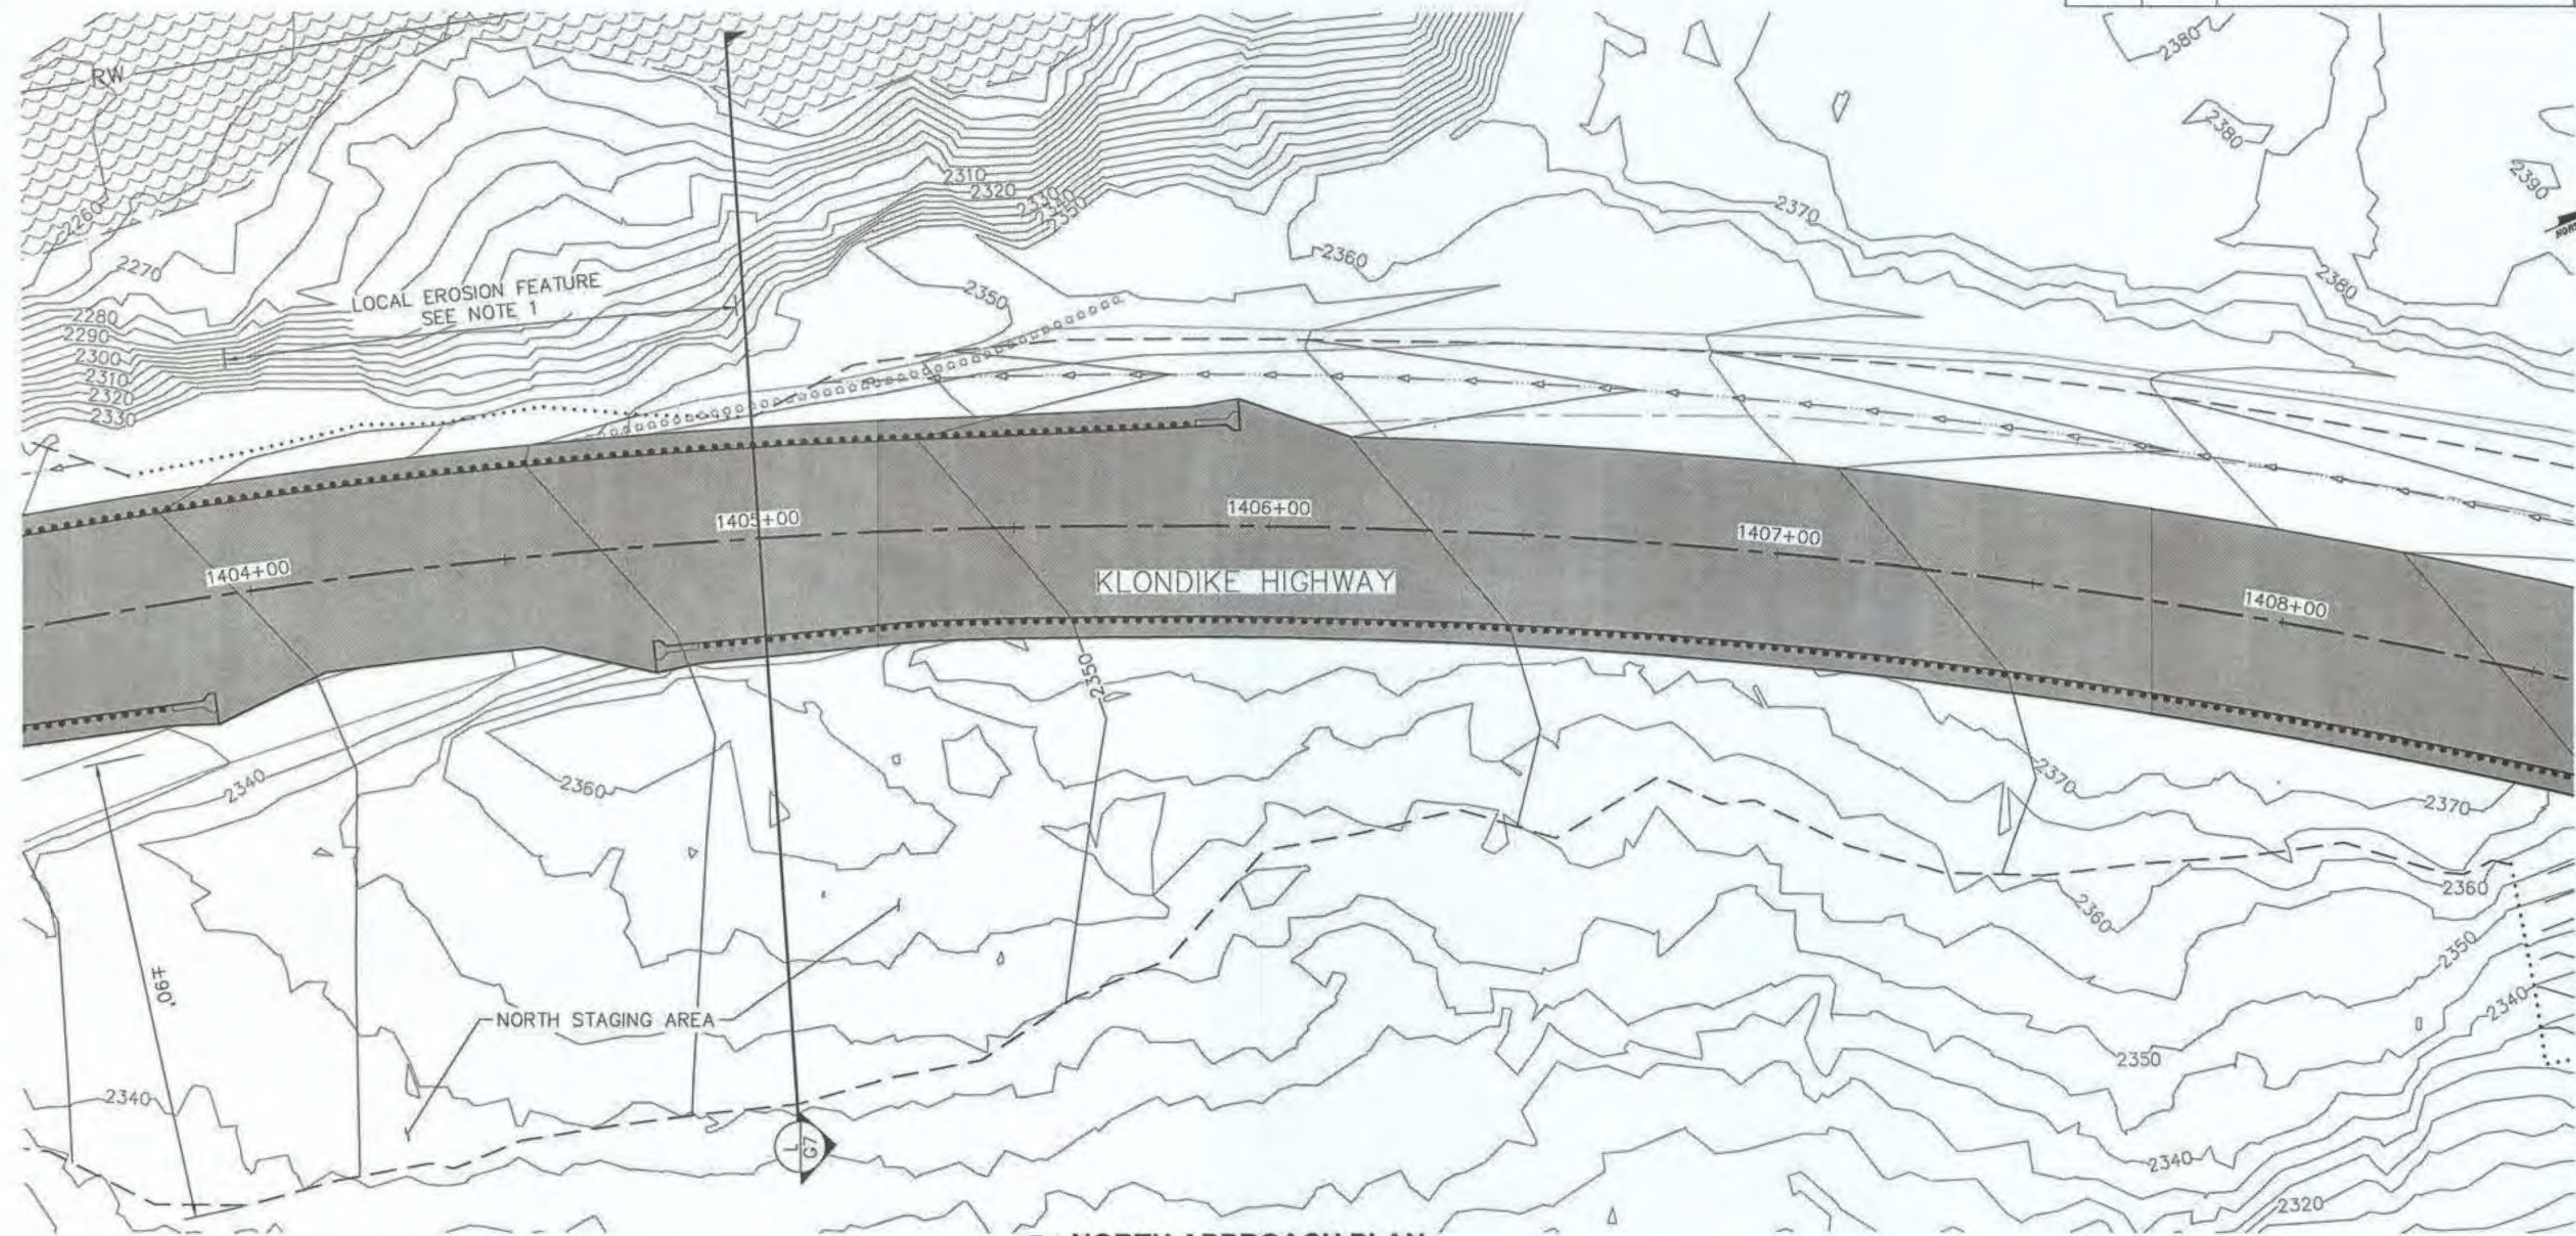

1 NORTH APPROACH PLAN
 SCALE AS NOTED
 SCALE IN FEET

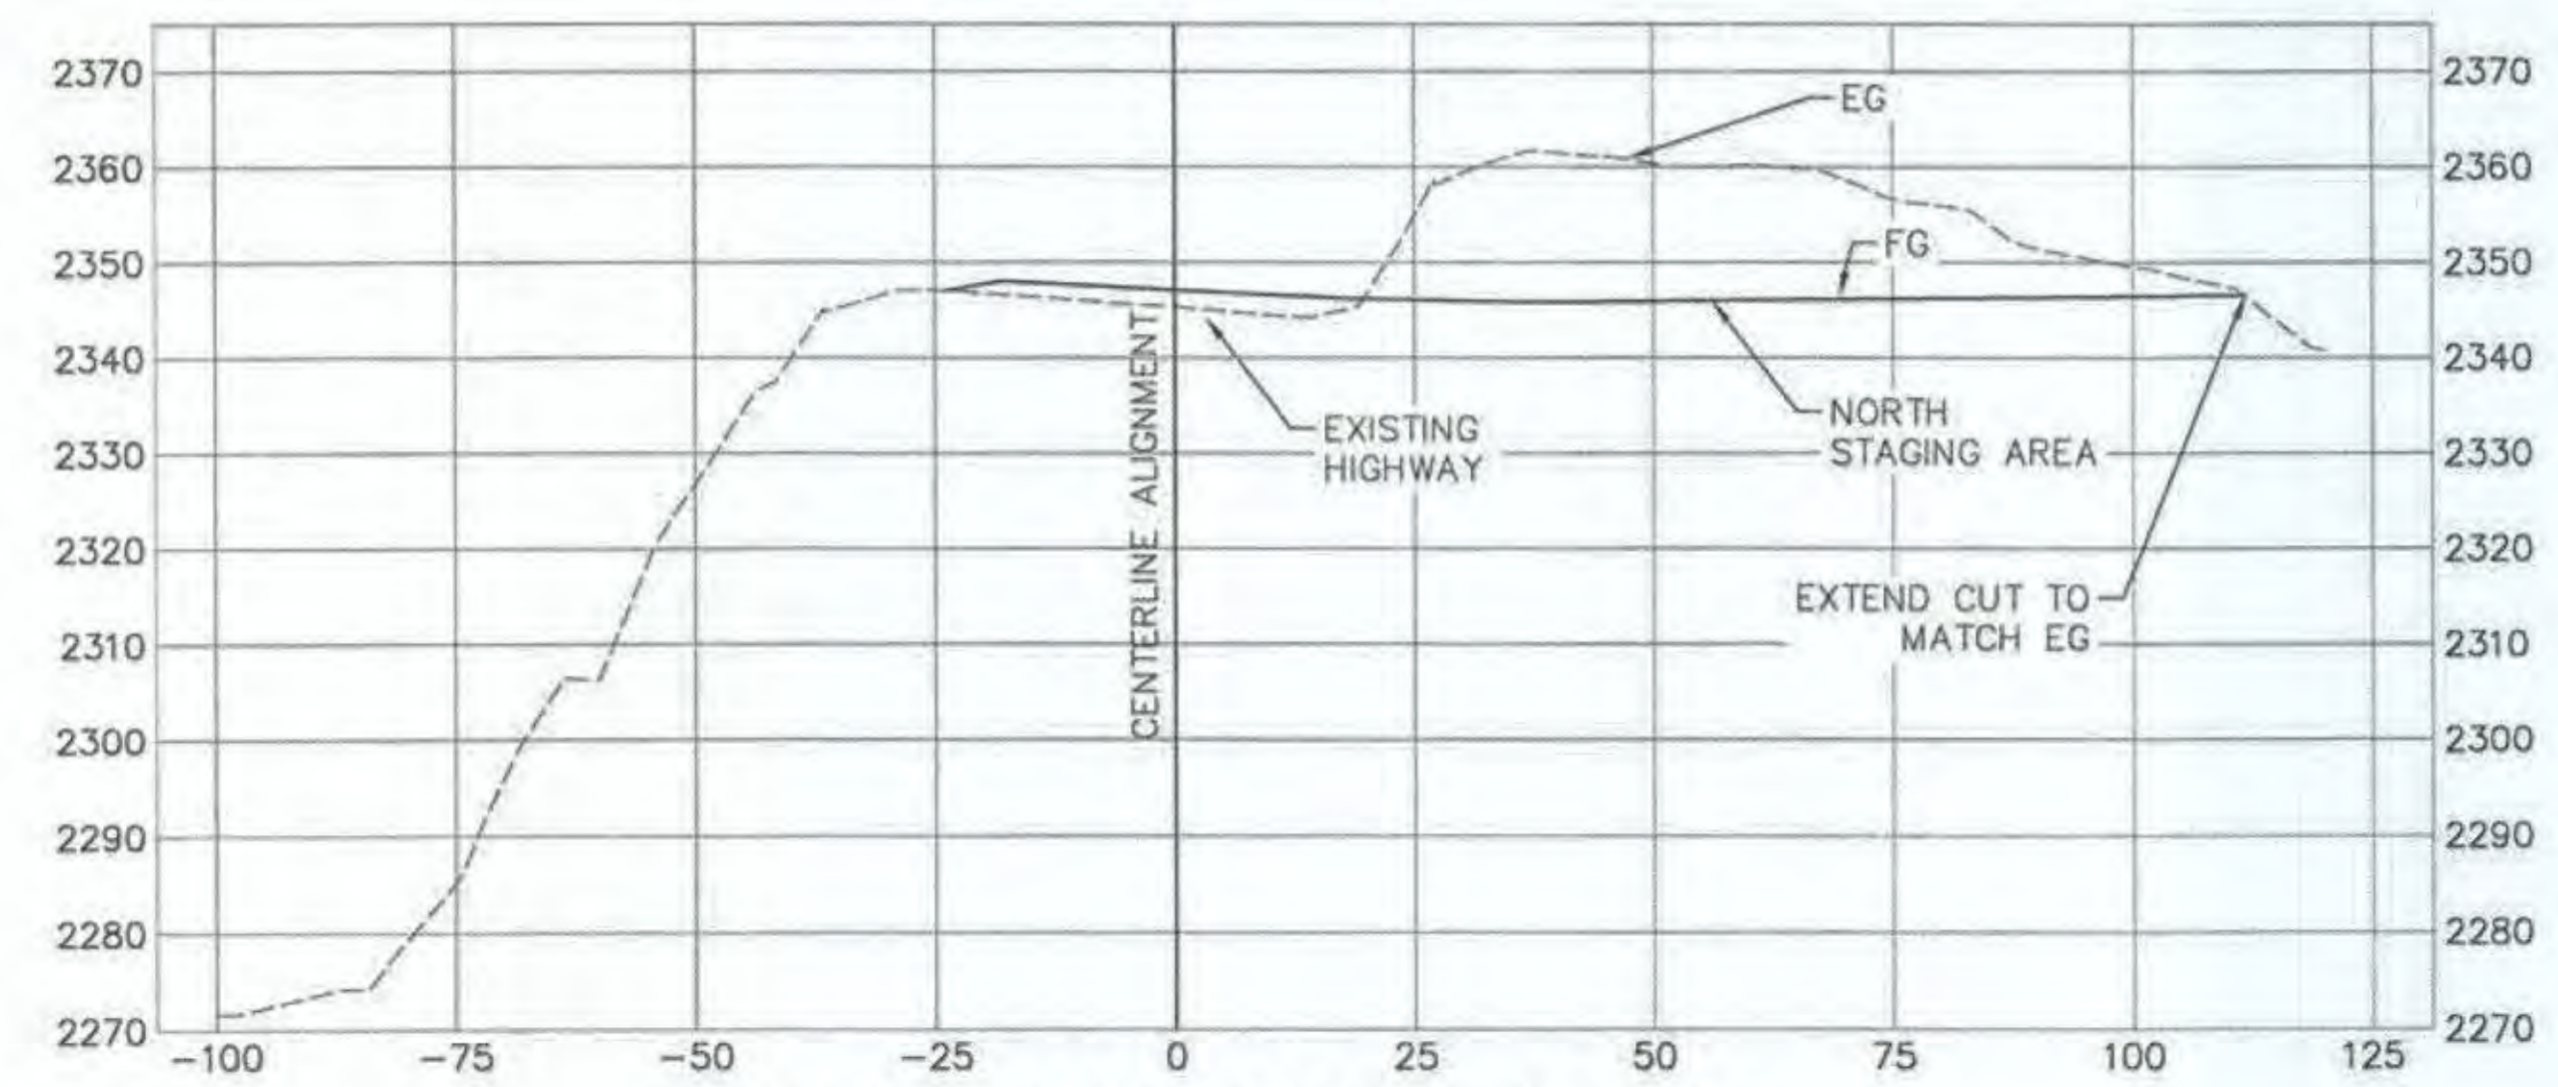

L TYPICAL NORTH APPROACH SECTION
 STATIONS 1405+00 TO 1408+55
 SCALE AS NOTED

- NOTES:**
- EXISTING SHOULDER RAVELING OBSERVED IN THIS AREA. EXCAVATE TO FIRM ROCK AND KEY IN EMBANKMENT MATERIALS TO CONSTRUCT STABLE FILL.

6/9/20

PLANS DEVELOPED BY:
 DOWL
 5368 COMMERCIAL BLVD.
 JUNEAU, AK 99801
 (907) 780-3533
 #AECL848




STATE OF ALASKA
 DEPARTMENT OF TRANSPORTATION
 AND PUBLIC FACILITIES

**SKAGWAY - REPLACE CAPTAIN
 WILLIAM HENRY MOORE BRIDGE**


**NORTH APPROACH PLAN AND
 CROSS SECTION**

FILE: C:\Civ\1_30 Projects\24\70732-01\Civ\1\SC14-CT-G-PK-CWM.dwg
 DATE: 8/17/2016 10:56
 LAYOUT: G8
 DESIGNED: HOBBS
 CHECKED: NOBLE
 DRAFTED: WESTPHAL

NO.	DATE	REVISION	STATE	PROJECT DESIGNATION	YEAR	SHEET NO.	TOTAL SHEETS
			ALASKA	0972016/Z684590000	2016	G8	59

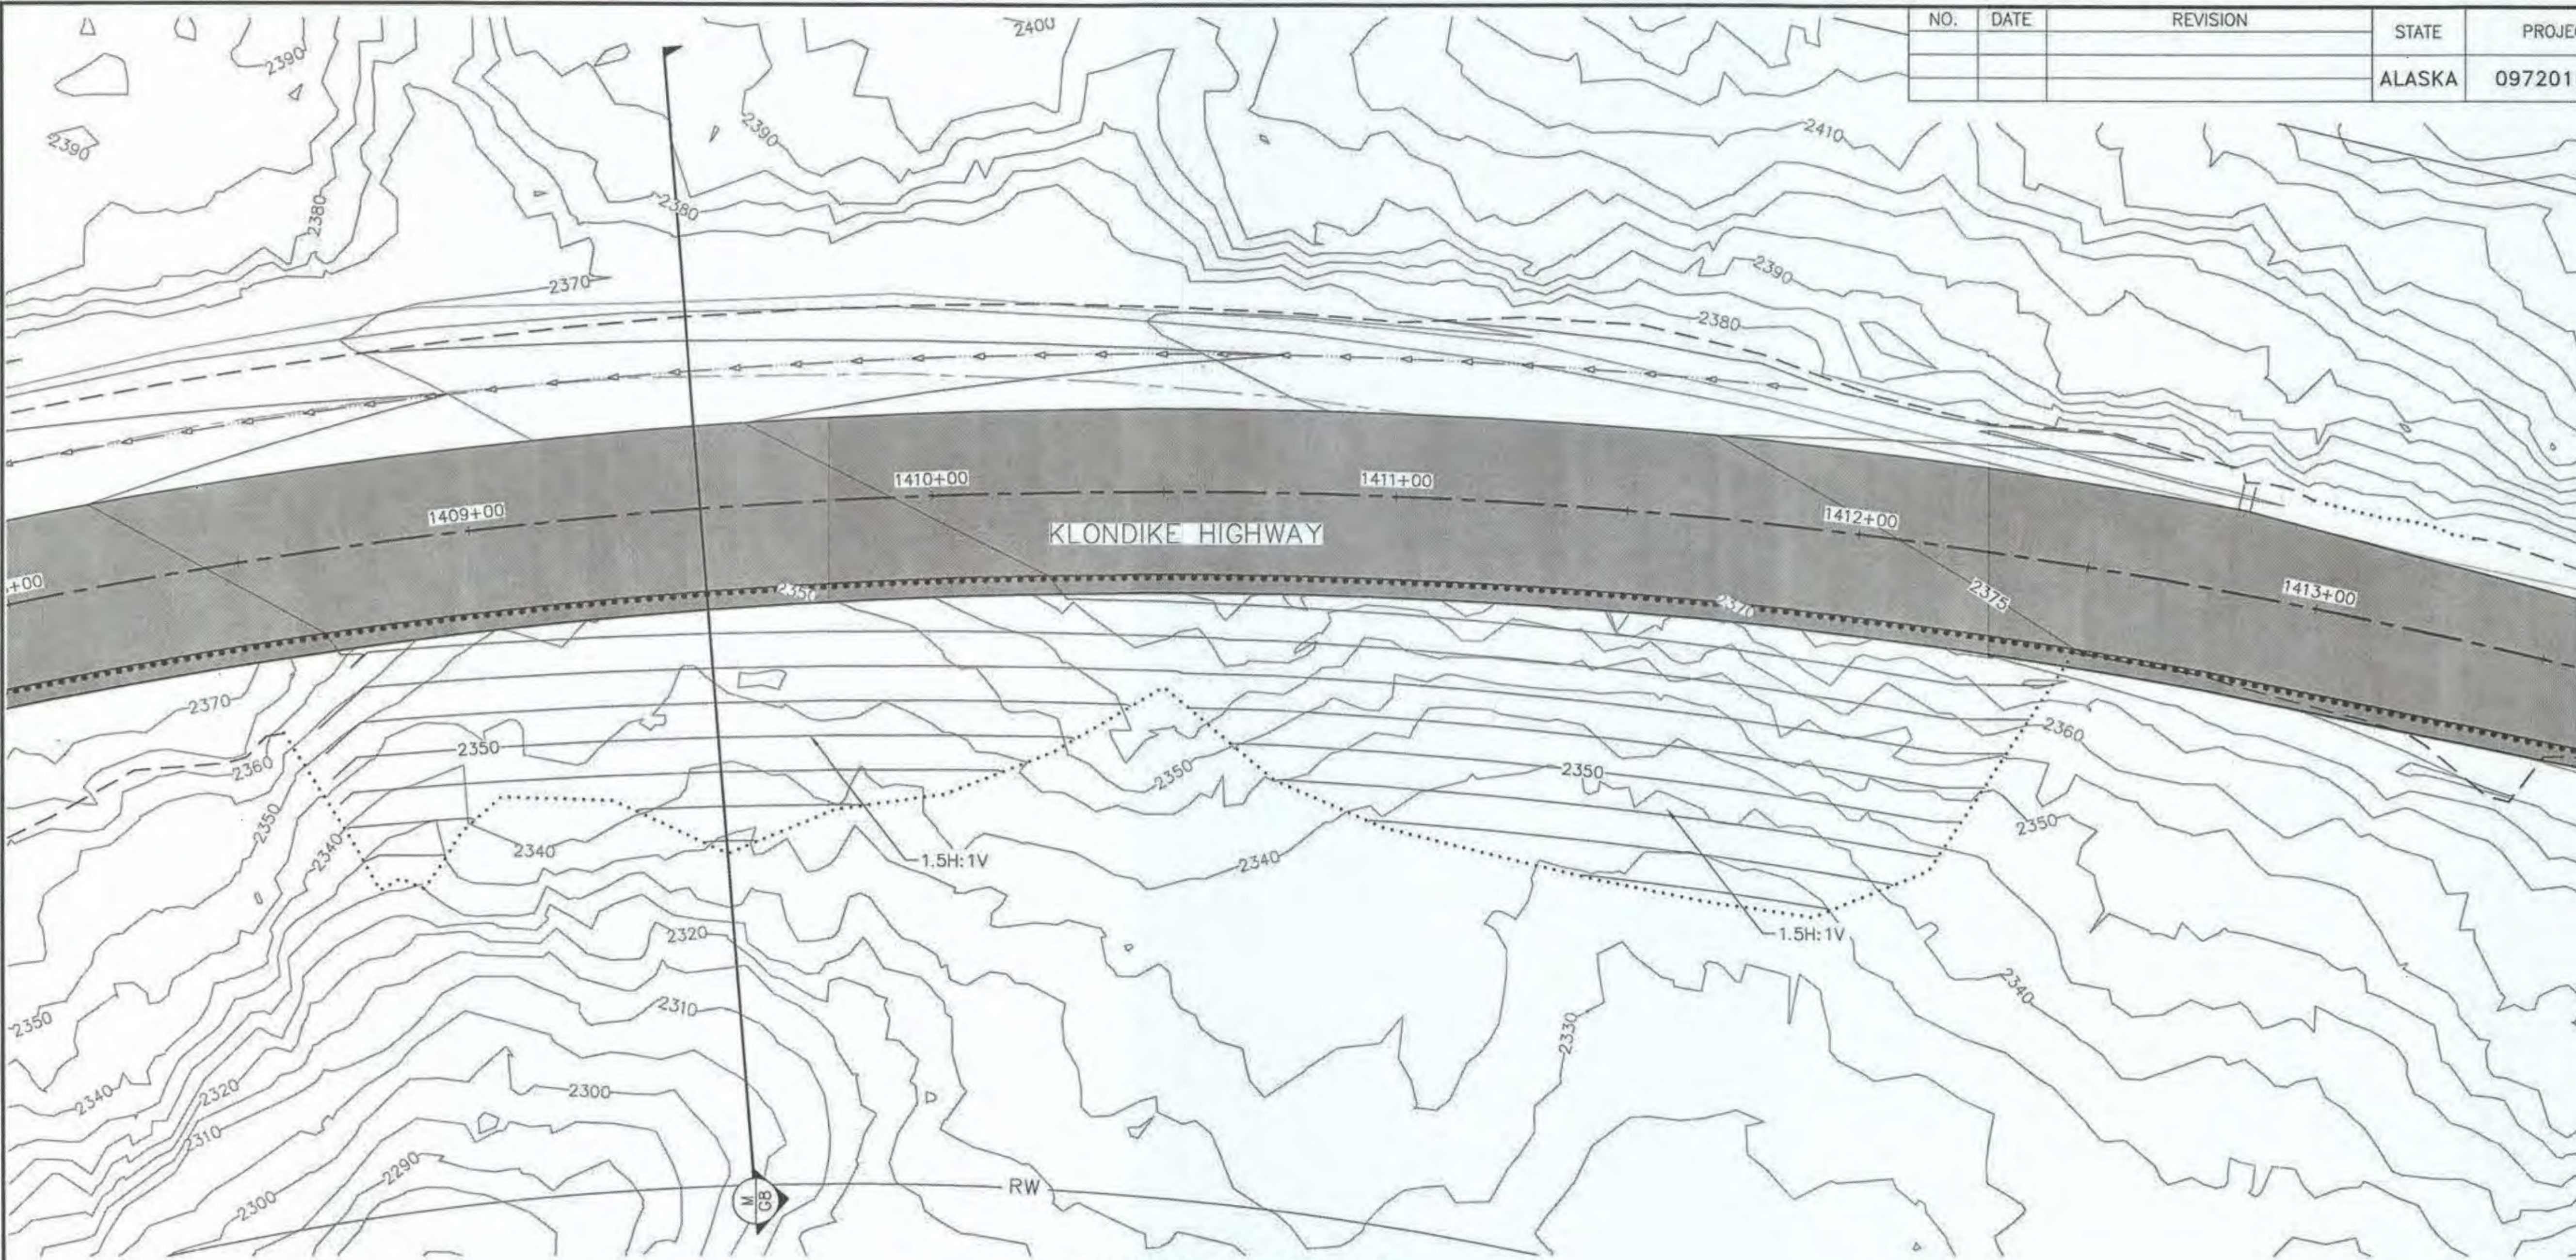

1 NORTH APPROACH PLAN
 SCALE AS NOTED
 SCALE IN FEET: 0, 20, 40

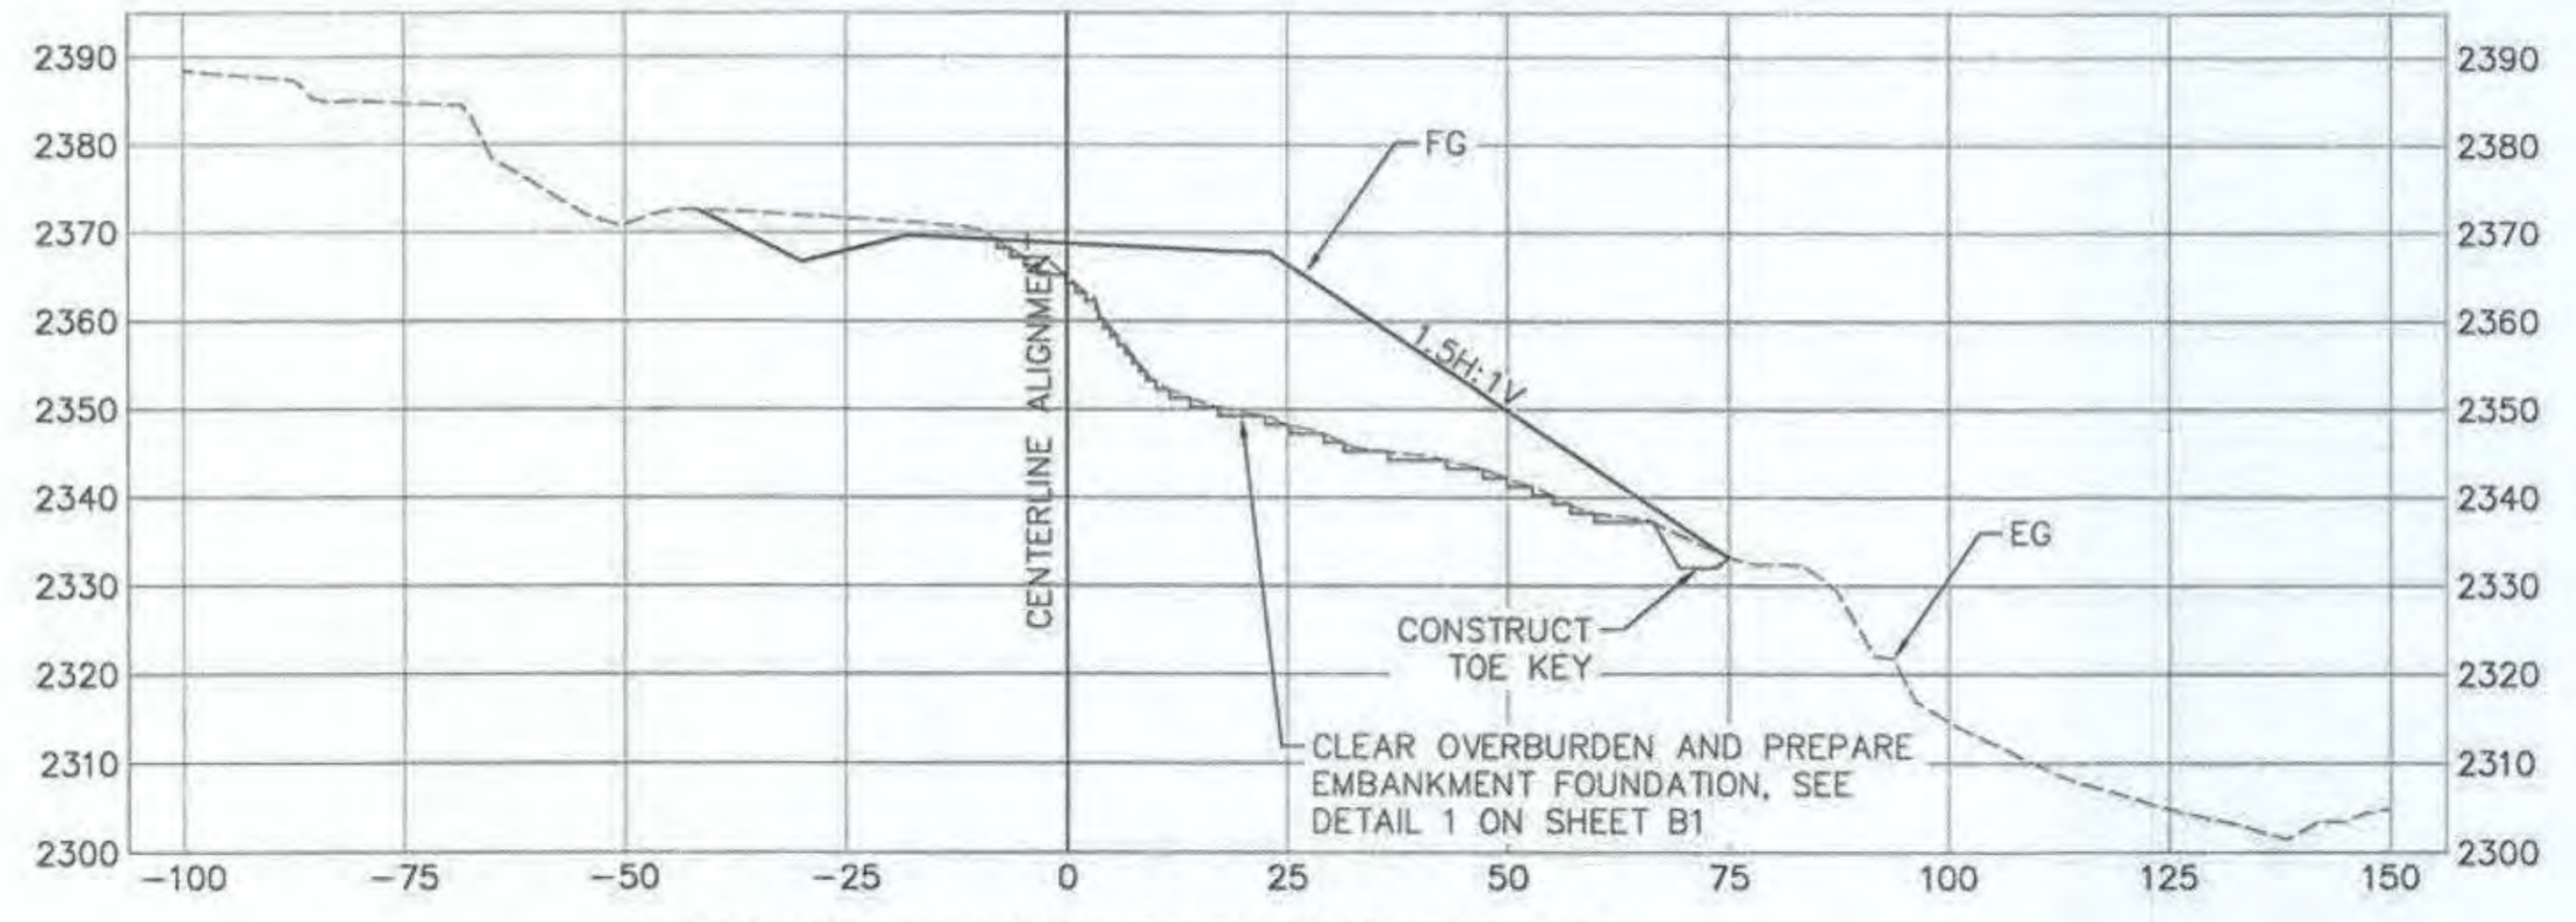

M TYPICAL NORTH APPROACH SECTION
 STATIONS 1409+50 TO 1413+00
 SCALE AS NOTED

Handwritten: 6/9/19


PLANS DEVELOPED BY:
 DOWL
 5368 COMMERCIAL BLVD,
 JUNEAU, AK 99801
 (907) 780-3533
 #AECL848



STATE OF ALASKA
 DEPARTMENT OF TRANSPORTATION
 AND PUBLIC FACILITIES
**SKAGWAY - REPLACE CAPTAIN
 WILLIAM HENRY MOORE BRIDGE**
**NORTH APPROACH PLAN AND
 CROSS SECTION**
 8-17-2016

NO.	DATE	REVISION	STATE	PROJECT DESIGNATION	YEAR	SHEET NO.	TOTAL SHEETS
			ALASKA	0972016/Z684590000	2016	G9	59

FILE: C:\CIVIL\3D Projects\24\70732-01\CIVIL\NSC14-CT-C-PK-CMHR.dwg
 DATE: 8/17/2016 10:54 LAYOUT: G9
 DESIGNED: HOBBS
 CHECKED: NOBLE
 DRAFTED: WESTPHAL

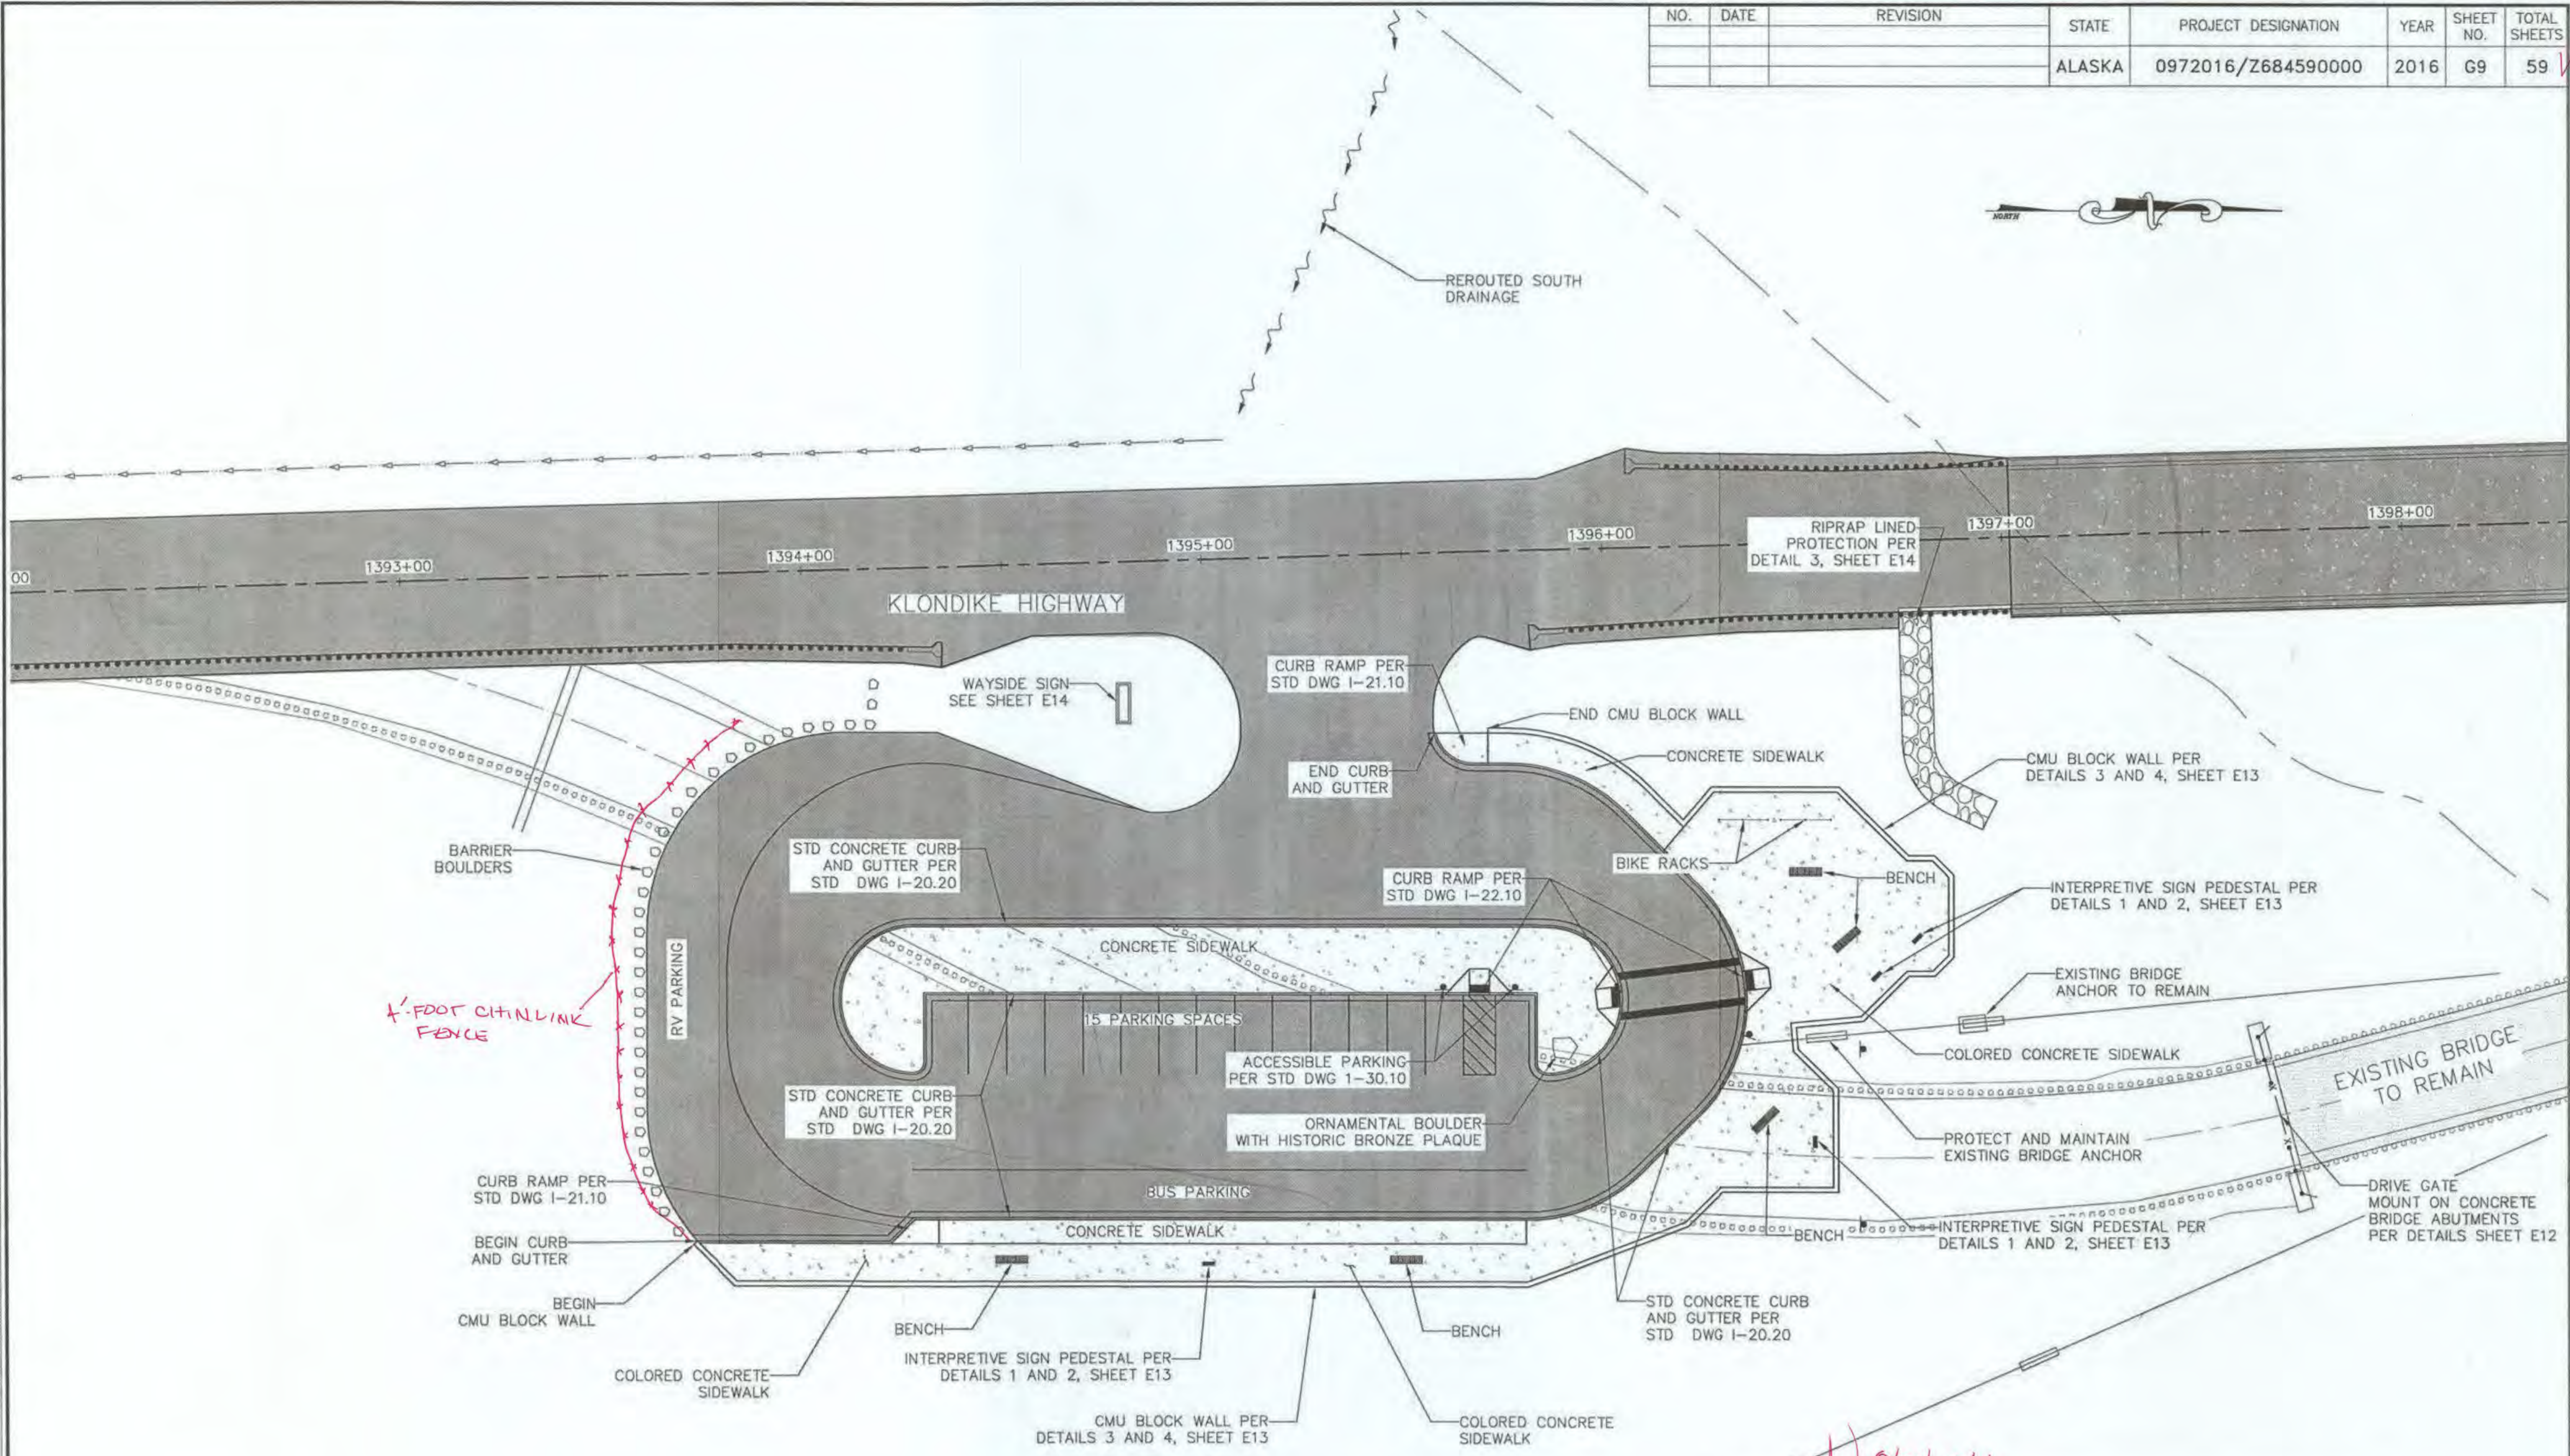

1 WAYSIDE PLAN
 SCALE AS NOTED
 20 0 20 40
 SCALE IN FEET

PLANS DEVELOPED BY:
 DOWL
 5368 COMMERCIAL BLVD.
 JUNEAU, AK 99801
 (907) 780-3533
 #AECL848





STATE OF ALASKA
 DEPARTMENT OF TRANSPORTATION
 AND PUBLIC FACILITIES
**SKAGWAY - REPLACE CAPTAIN
 WILLIAM HENRY MOORE BRIDGE**

WAYSIDE PLAN


FILE: C:\Civil\3D Projects\24\70732-01\GIS\11\SC14-CT-C-PK-OWM.dwg
 DATE: 8/17/2016 10:54 LAYOUT: G10 DESIGNED: HOBBS CHECKED: NOBLE DRAFTED: WESTPHAL

POINT TABLE				
POINT	STATION	OFFSET	ELEVATION	DESCRIPTION
1	1394+86.20	18.00	2274.98	EDGE OF ASPHALT
2	1395+08.70	40.54	2276.11	EDGE OF ASPHALT
3	1395+08.69	43.11	2277.14	EDGE OF ASPHALT
4	1394+88.08	63.07	2277.77	EDGE OF ASPHALT
5	1394+85.51	62.99	2277.67	EDGE OF ASPHALT
6	1394+58.78	52.07	2276.69	EDGE OF ASPHALT
7	1394+33.12	41.38	2275.75	EDGE OF ASPHALT
8	1394+10.46	40.68	2274.84	EDGE OF ASPHALT
9	1393+58.95	89.13	2272.80	EDGE OF ASPHALT
10	1393+57.59	133.57	2272.80	EDGE OF ASPHALT
11	1393+69.05	168.97	2272.80	FACE OF CURB
12	1394+17.30	168.45	2274.73	FACE OF CURB
13	1394+23.48	162.64	2274.91	FACE OF CURB
14	1394+84.98	164.52	2277.37	FACE OF CURB
15	1395+76.21	167.31	2278.74	FACE OF CURB
16	1396+04.84	156.46	2278.94	FACE OF CURB
17	1396+20.03	142.17	2279.08	FACE OF CURB
18	1396+21.76	85.63	2279.39	FACE OF CURB
19	1396+03.59	66.31	2279.38	FACE OF CURB
20	1395+75.68	53.74	2279.23	FACE OF CURB
21	1395+66.39	53.46	2279.18	FACE OF CURB
22	1395+56.69	43.44	2278.92	FACE OF CURB
23	1395+56.70	40.46	2278.28	FACE OF CURB
24	1395+65.99	22.29	2280.61	EDGE OF ASPHALT
25	1395+83.66	94.00	2278.66	FACE OF CURB
26	1394+87.22	91.05	2277.21	FACE OF CURB
27	1394+25.73	89.17	2274.75	FACE OF CURB
28	1394+06.42	107.34	2273.87	FACE OF CURB
29	1394+24.58	126.65	2274.55	FACE OF CURB
30	1394+27.67	123.75	2274.70	FACE OF CURB
31	1394+28.19	106.76	2274.87	FACE OF CURB
32	1394+86.69	108.54	2277.21	FACE OF CURB
33	1395+80.12	111.40	2278.61	FACE OF CURB
34	1395+79.60	128.39	2278.44	FACE OF CURB
35	1395+82.51	131.48	2278.46	FACE OF CURB
36	1396+01.82	113.32	2278.79	FACE OF CURB
37	1394+86.08	128.53	2277.01	PAVEMENT
38	1393+78.61	177.27	2273.79	SIDEWALK/WALL
39	1394+84.49	180.51	2278.03	SIDEWALK/WALL
40	1395+76.06	183.31	2279.40	SIDEWALK/WALL


POINT TABLE				
POINT	STATION	OFFSET	ELEVATION	DESCRIPTION
41	1396+15.79	169.33	2279.70	SIDEWALK/WALL
42	1396+24.87	160.81	2279.79	SIDEWALK/WALL
43	1396+53.21	161.62	2280.07	SIDEWALK/WALL
44	1396+53.91	137.28	2279.95	SIDEWALK/WALL
45	1396+44.36	127.17	2279.85	SIDEWALK/WALL
46	1396+43.89	120.06	2279.85	SIDEWALK/WALL
47	1396+73.27	107.87	2280.43	SIDEWALK/WALL
48	1396+79.71	108.06	2280.52	SIDEWALK/WALL
49	1396+83.83	104.17	2280.58	SIDEWALK/WALL
50	1396+84.39	84.64	2280.58	SIDEWALK/WALL
51	1396+80.50	80.53	2280.52	SIDEWALK/WALL
52	1396+74.06	80.35	2280.46	SIDEWALK/WALL
53	1396+57.22	62.65	2280.32	SIDEWALK/WALL
54	1396+26.05	61.76	2280.14	SIDEWALK/WALL
55	1396+18.39	70.36	2280.07	SIDEWALK/WALL
56	1395+75.92	45.74	2279.90	SIDEWALK/WALL
57	1395+70.23	45.57	2279.87	SIDEWALK/WALL
58	1395+66.13	110.97	2278.40	CENTER OF RAMP
59	1396+32.44	109.16	2279.77	CENTER OF RAMP
60	1396+01.82	112.15	2278.80	CENTER OF RAMP
61	1395+57.19	108.71	2278.77	SIGN
62	1395+75.19	109.25	2279.04	SIGN
63	1396+33.39	68.87	2280.12	BIKE RACK
64	1396+49.06	69.32	2280.21	BIKE RACK
65	1396+48.66	83.31	2280.12	FRONT/CENTER OF BENCH
66	1396+37.42	144.90	2279.87	FRONT/CENTER OF BENCH
67	1395+45.93	175.89	2278.88	FRONT/CENTER OF BENCH
68	1394+47.39	172.87	2276.47	FRONT/CENTER OF BENCH
69	1393+89.04	167.59	2273.60	CENTER OF RAMP
70	1396+33.34	122.54	2279.73	SIGN
72	1396+61.52	118.89	2280.15	SIDEWALK/WALL
79	1396+57.76	98.63	2280.22	FRONT/CENTER OF BENCH
80	1394+79.55	35.44	2274.53	WAYSIDE SIGN

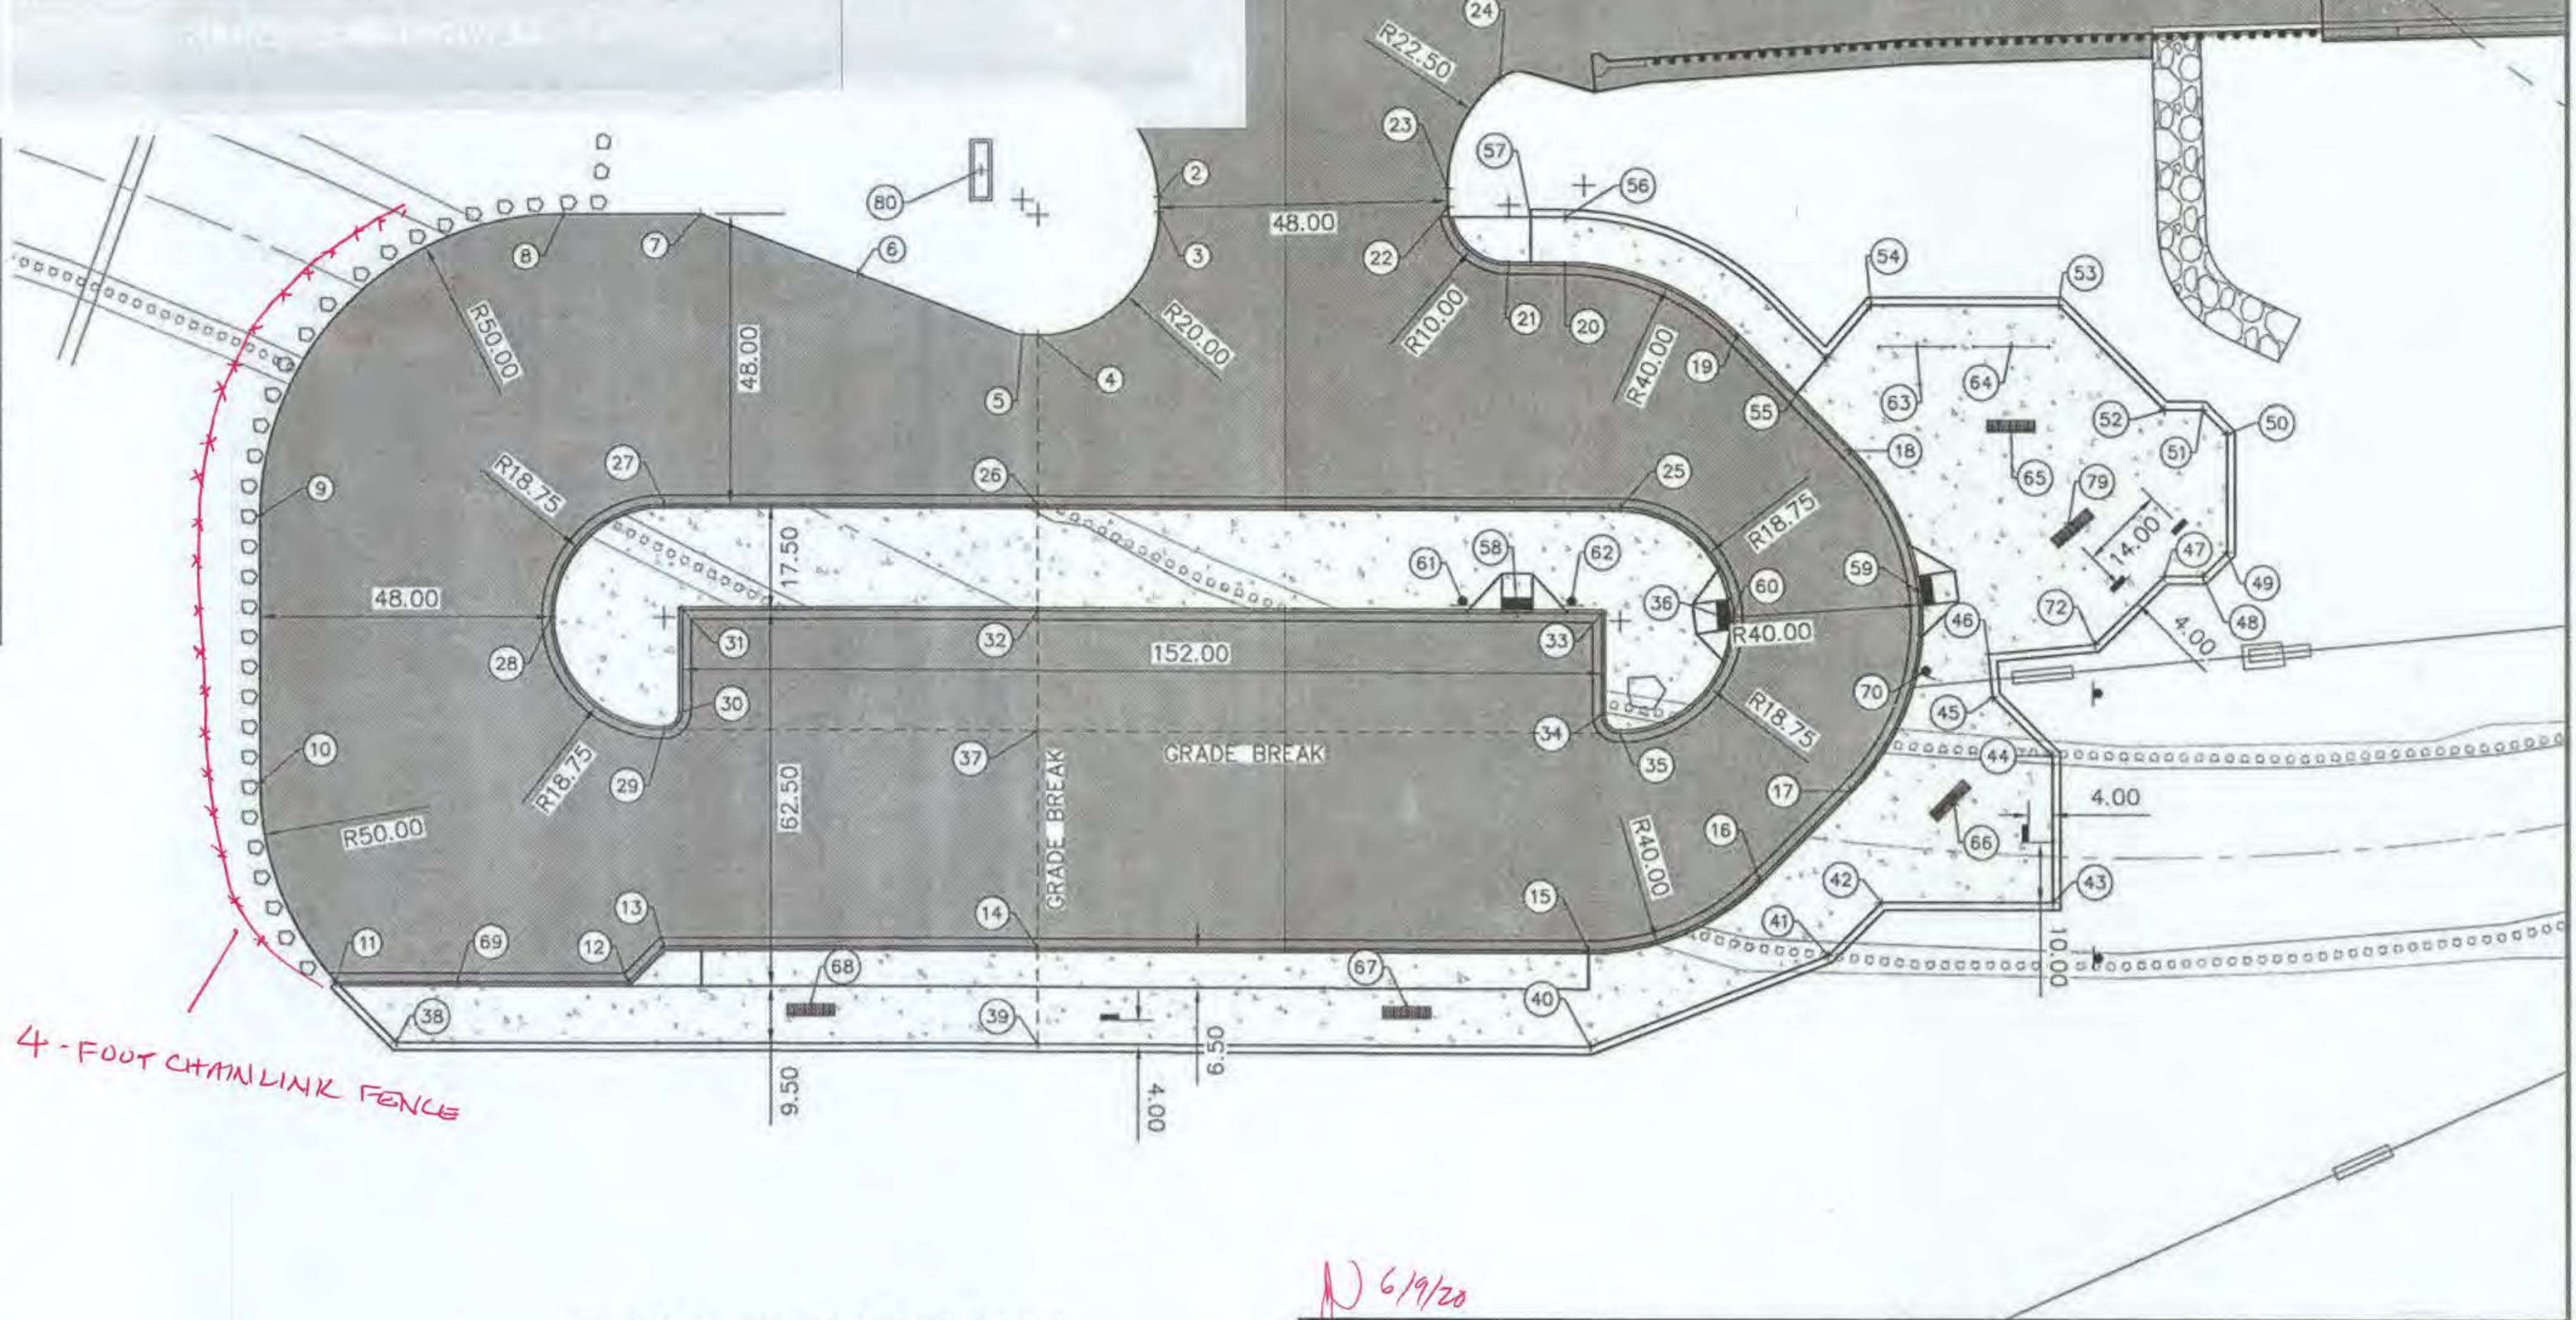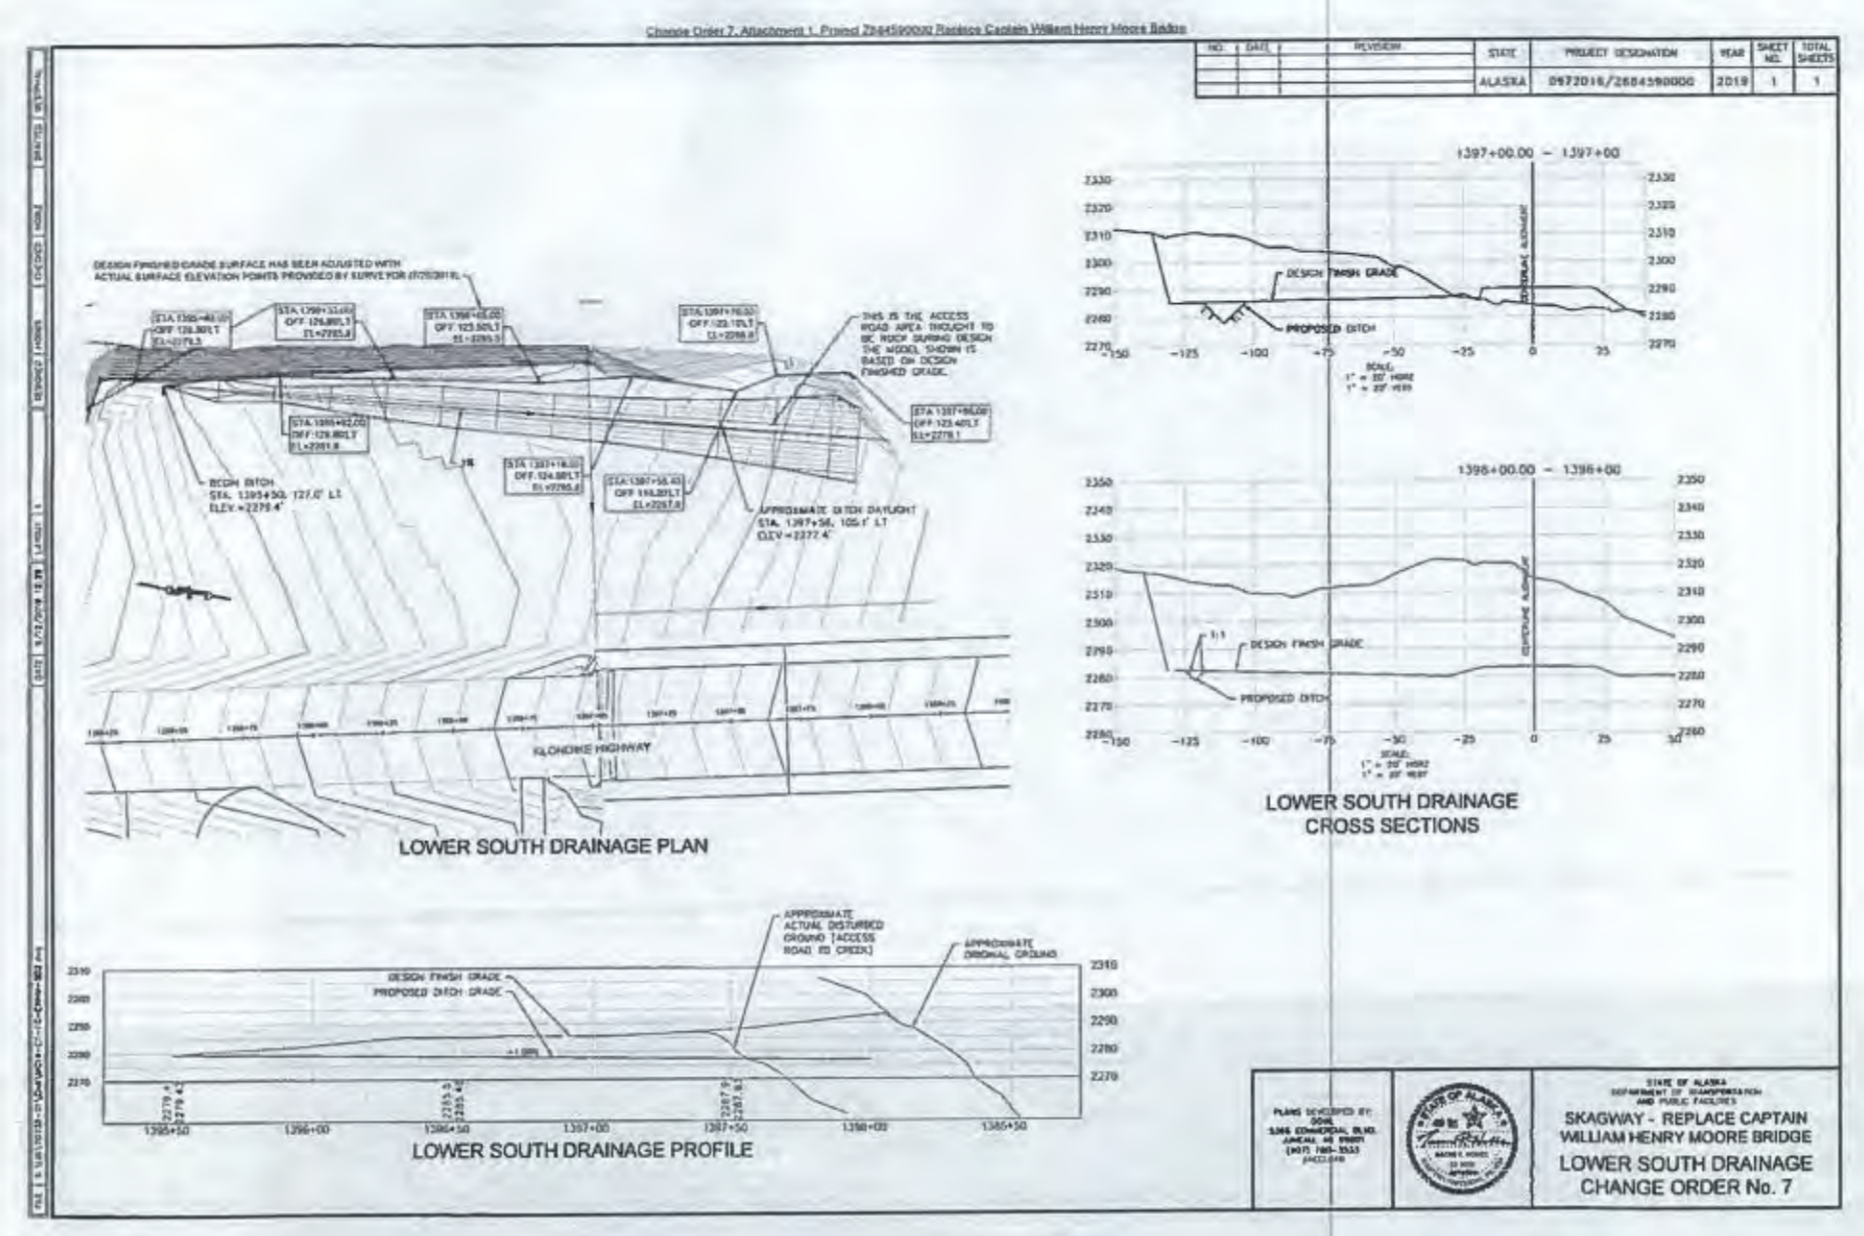

DATE	REVISION	STATE	PROJECT DESIGNATION	YEAR	SHEET NO.	TOTAL SHEETS
		ALASKA	0972016/Z684590000	2016	G10	59

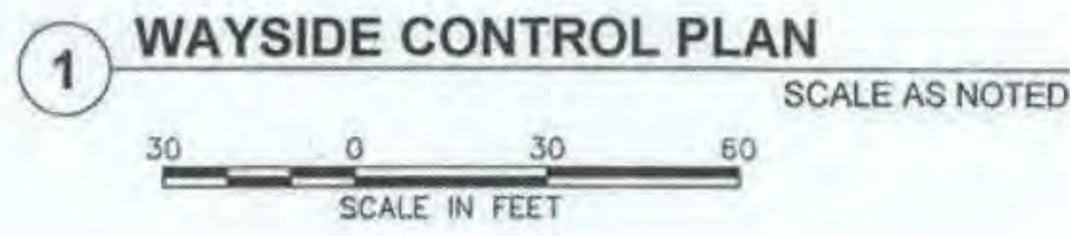

PLANS DEVELOPED BY:
 DOWL
 5368 COMMERCIAL BLVD.
 JUNEAU, AK 99801
 (907) 780-3533
 #AECL848

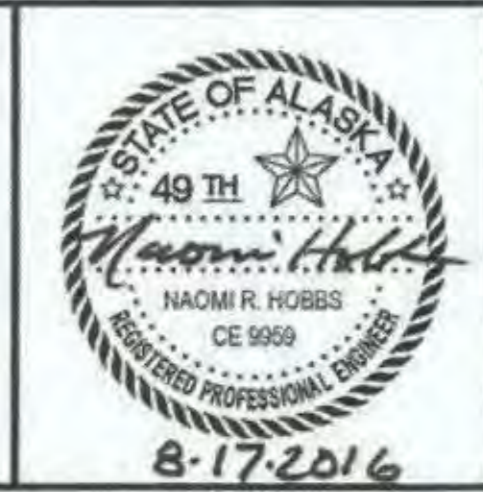


STATE OF ALASKA
 DEPARTMENT OF TRANSPORTATION
 AND PUBLIC FACILITIES

SKAGWAY - REPLACE CAPTAIN
 WILLIAM HENRY MOORE BRIDGE

WAYSIDE CONTROL PLAN

FILE: C:\civil\3D Projects\24\70732-01\Civil1\SC14-CT-G-PK-CWHM.dwg DATE 10/11/2016 10:35 LAYOUT G11 DESIGNED: HOBBS CHECKED: NOBLE DRAFTED: WESTPHAL

NO.	DATE	REVISION	STATE	PROJECT DESIGNATION	YEAR	SHEET NO.	TOTAL SHEETS
			ALASKA	0972016/Z684590000	2016	G11	59

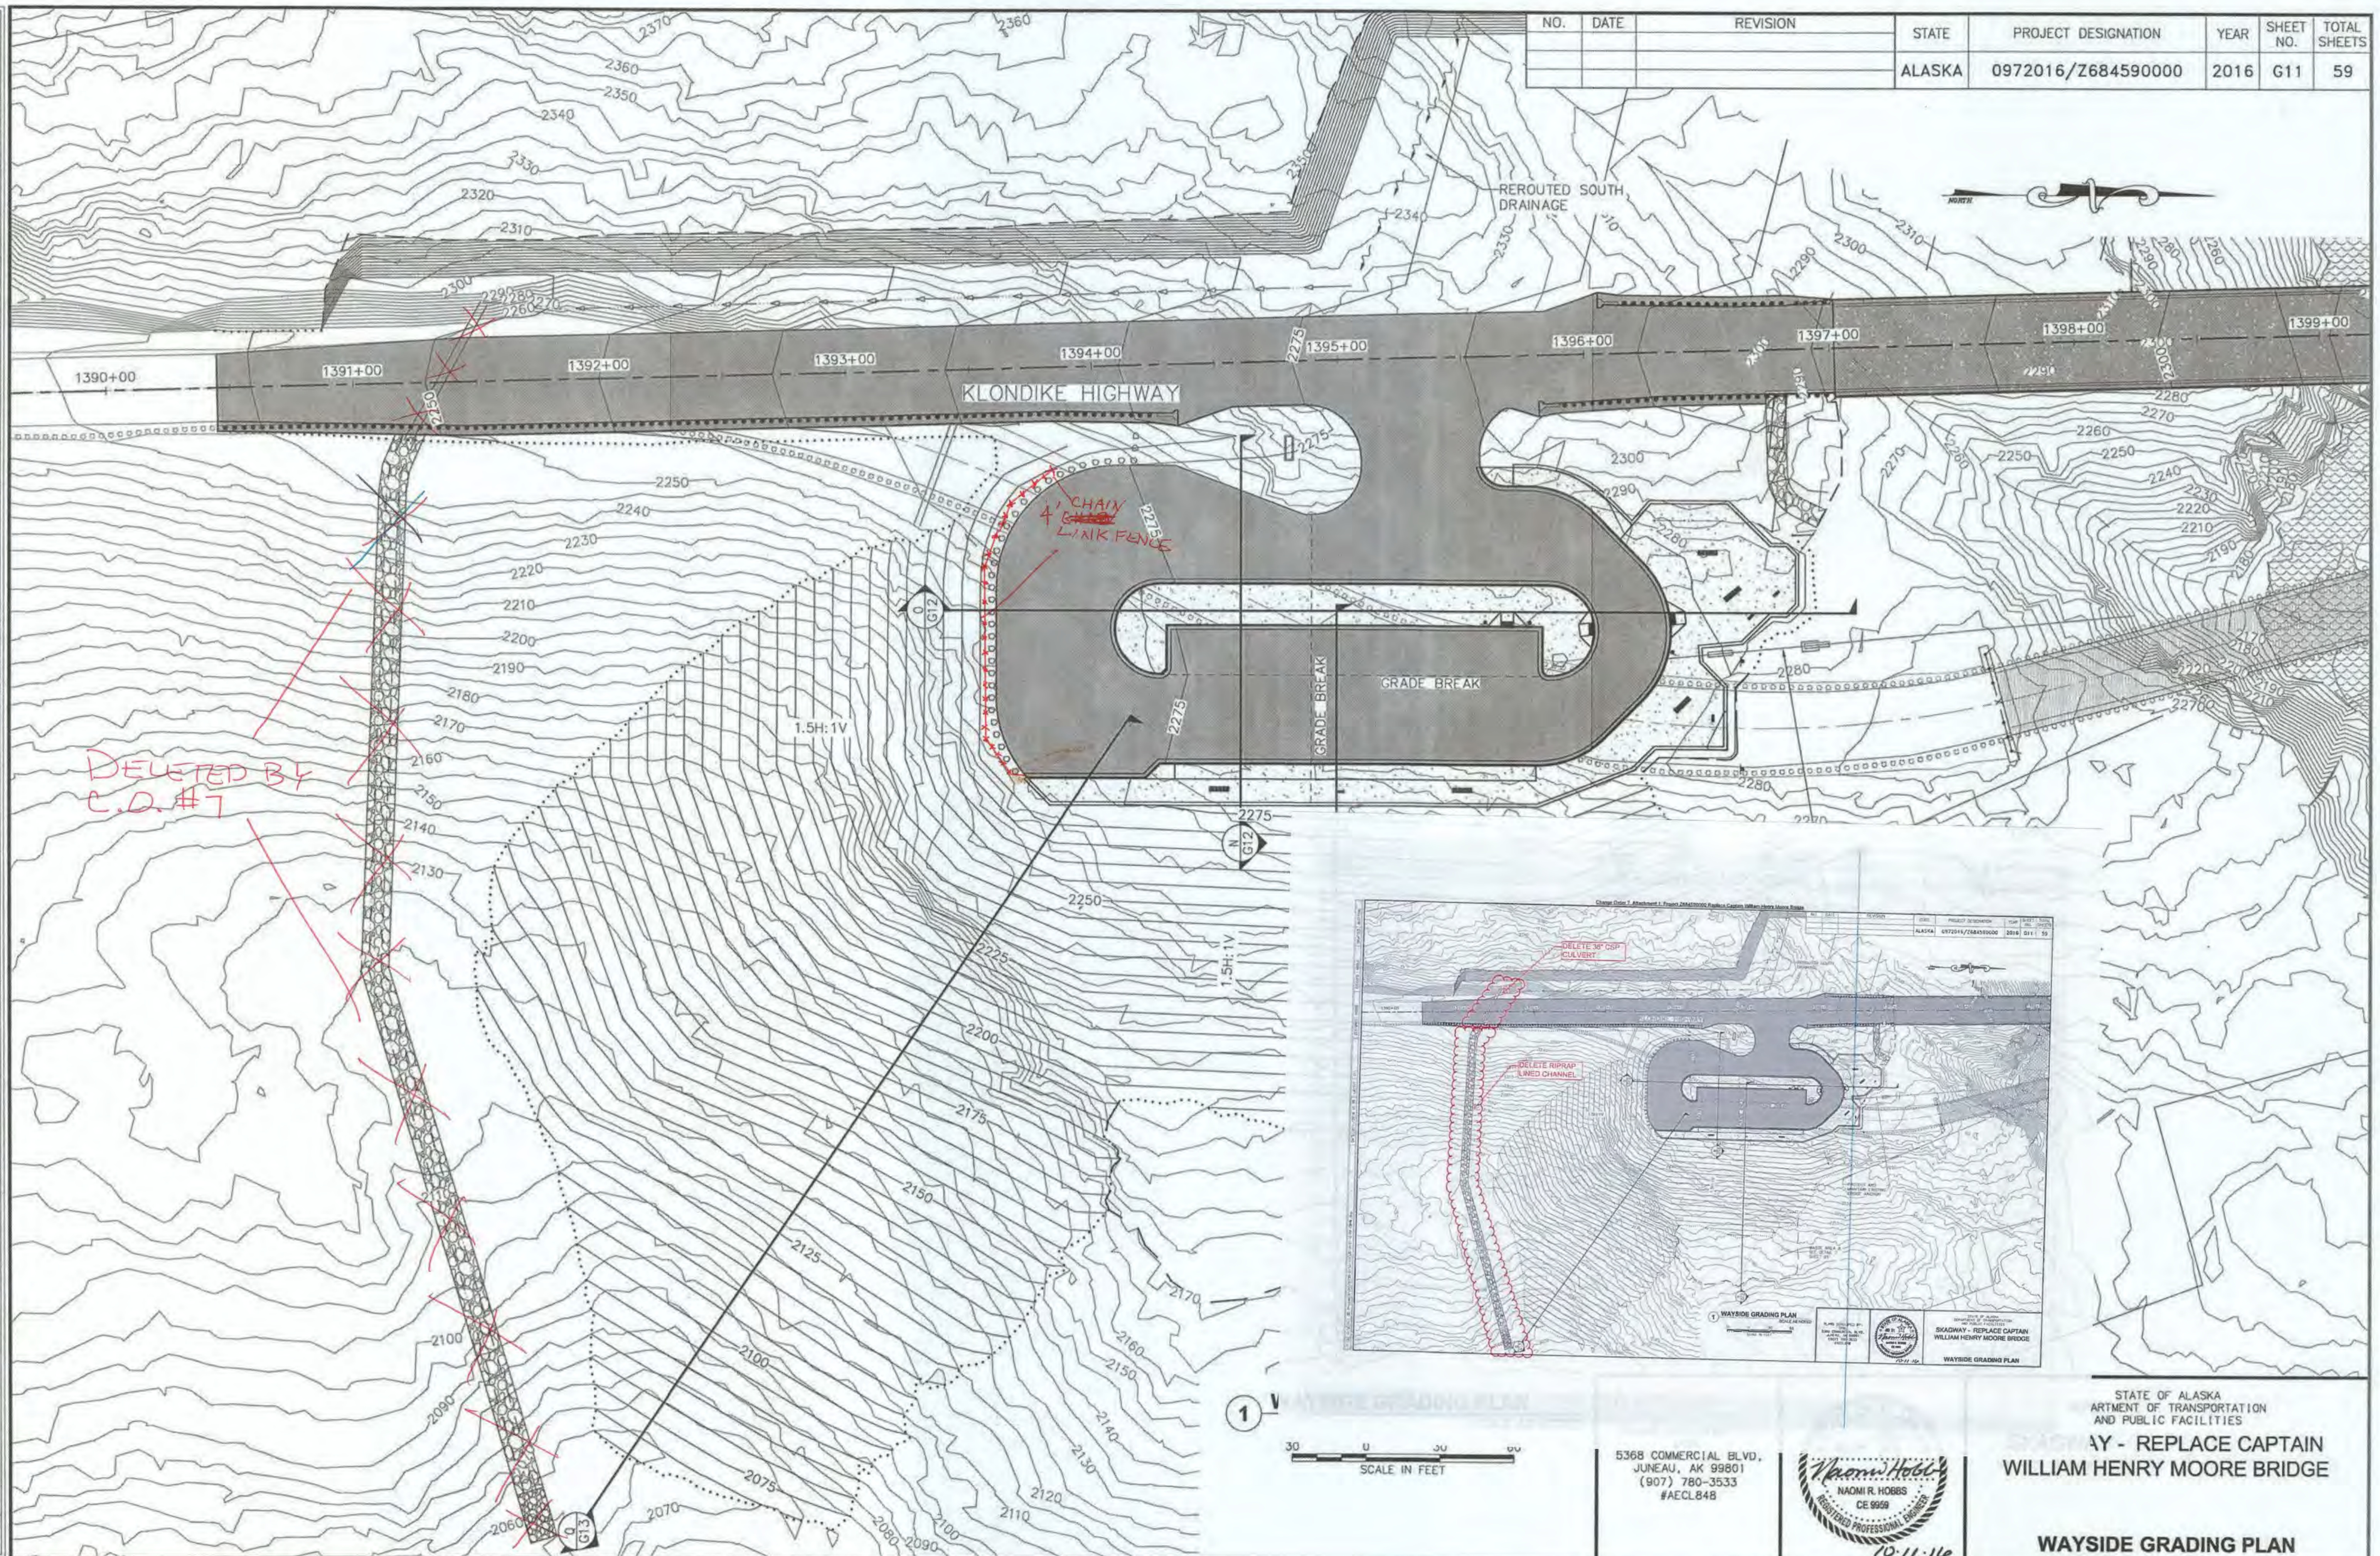

DELETED BY C.D.#7

KLONDIKE HIGHWAY

REROUTED SOUTH DRAINAGE


CHAIN & LINK FENCE

GRADE BREAK

1.5H:1V

G12

1

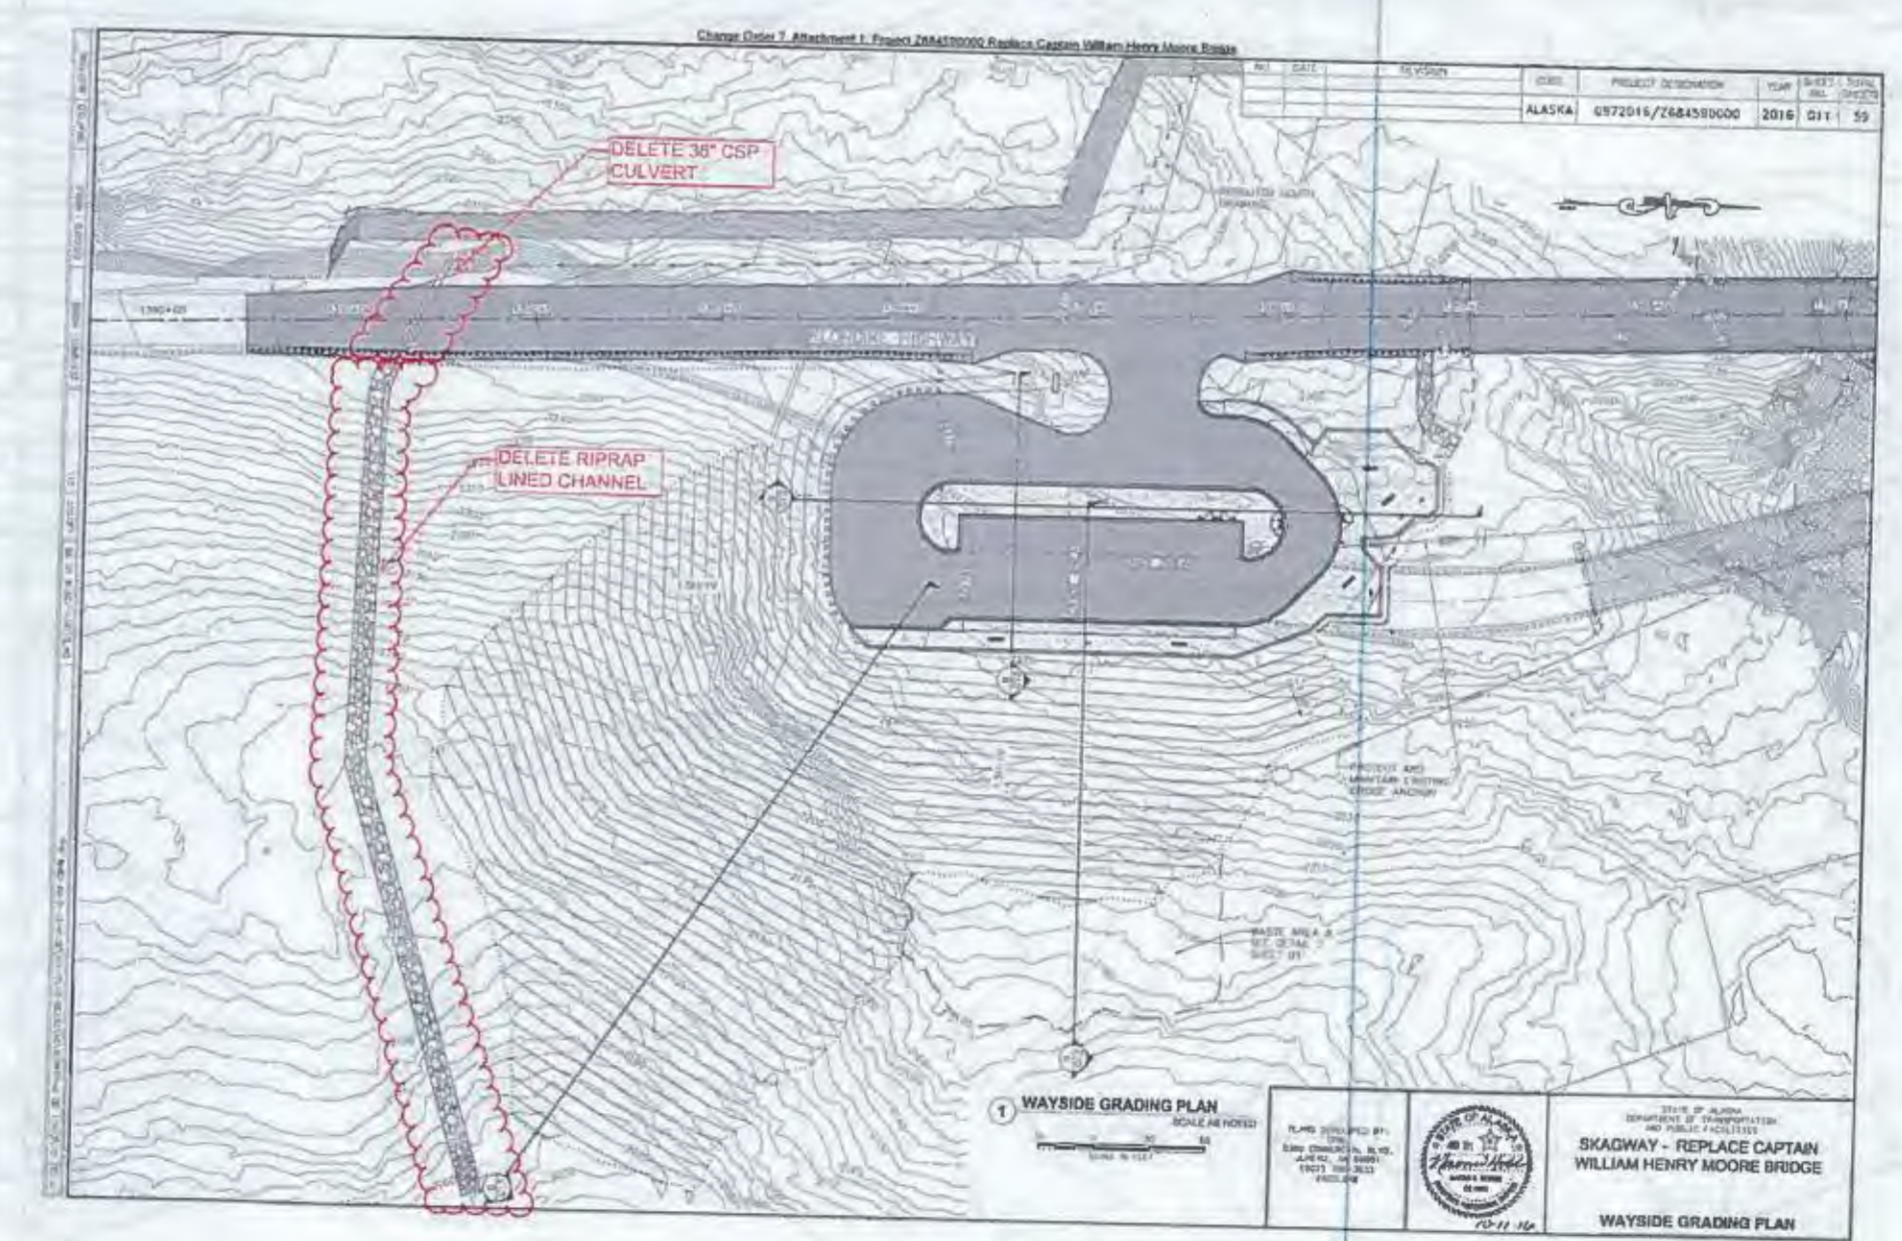

5368 COMMERCIAL BLVD,
 JUNEAU, AK 99801
 (907) 780-3533
 #AEC1848




STATE OF ALASKA
 DEPARTMENT OF TRANSPORTATION
 AND PUBLIC FACILITIES
 AY - REPLACE CAPTAIN
 WILLIAM HENRY MOORE BRIDGE


WAYSIDE GRADING PLAN

NO.	DATE	REVISION	STATE	PROJECT DESIGNATION	YEAR	SHEET NO.	TOTAL SHEETS
			ALASKA	0972016/Z684590000	2016	G12	59

FILE: C:\CIVIL\3D Projects\24\70732-01\Civil\SC14-CT-C-PK-CMHW.dwg
 DATE: 8/17/2016 10:44 LAYOUT: 612
 DESIGNED: HOBBS
 CHECKED: NOBLE
 DRAFTED: WESTPHAL

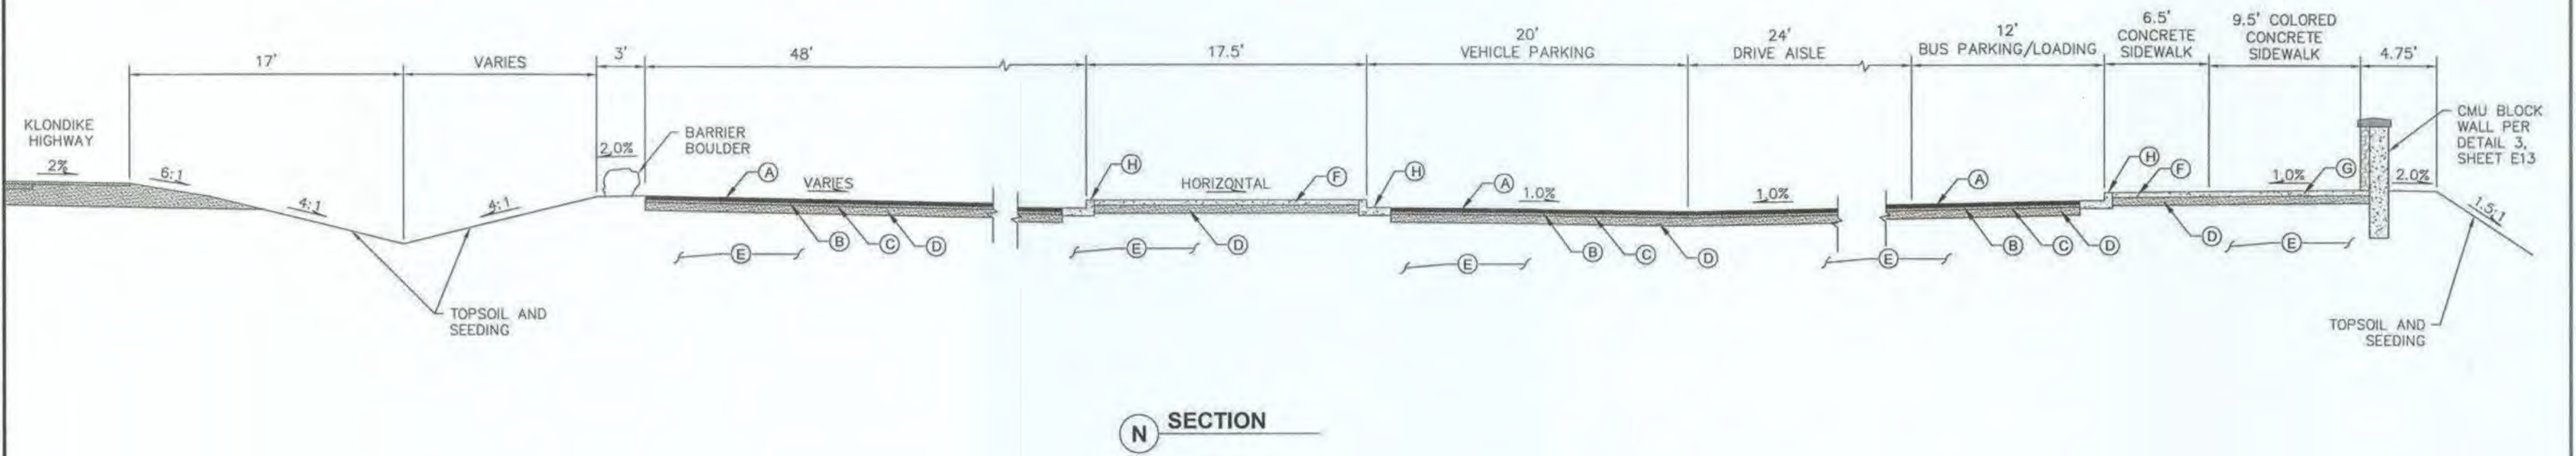

N SECTION

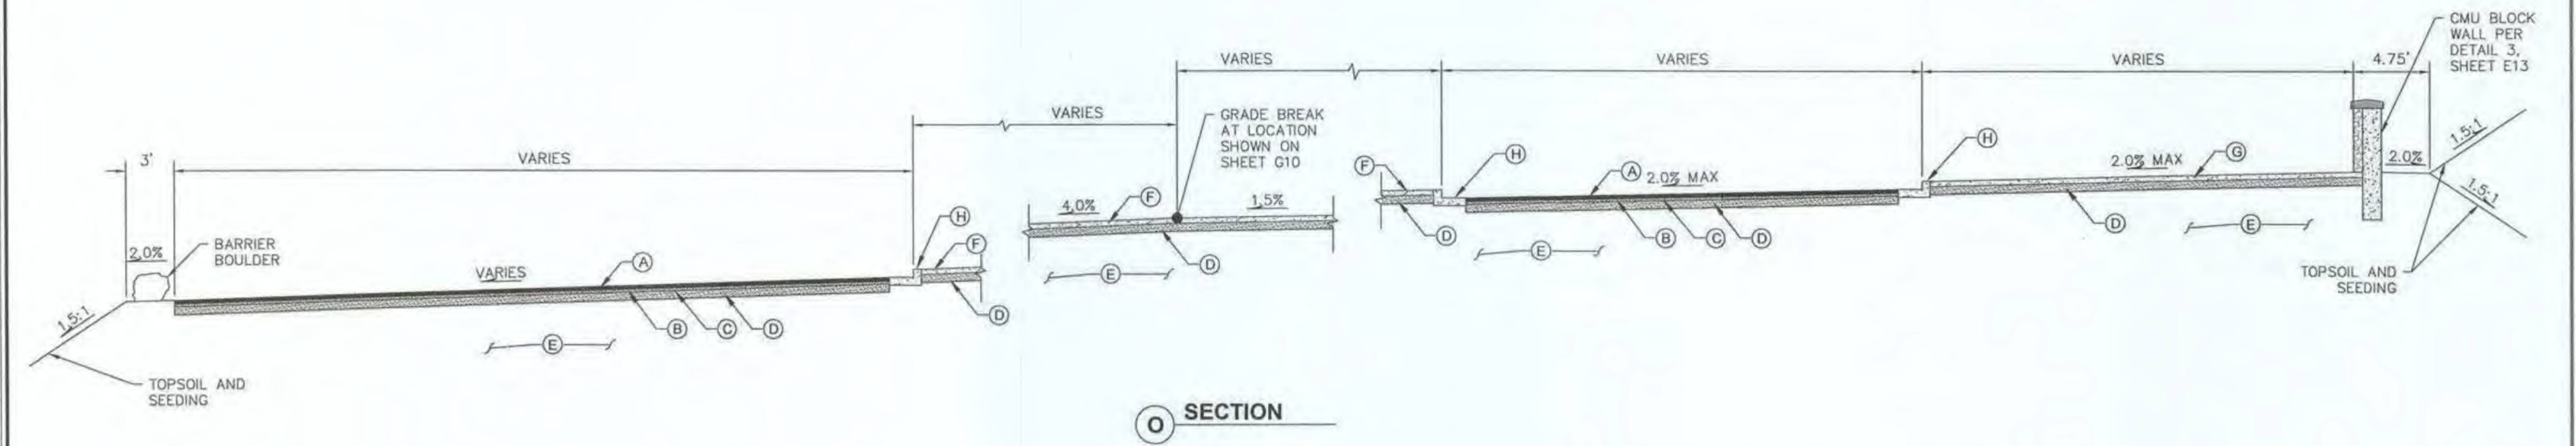

O SECTION

LABELING INDEX	
(A)	3" HMA, TYPE II, CLASS "B", 1-3" LIFT
(B)	STE-1 ASPHALT FOR TACK COAT
(C)	2" ATB-1-2" LIFT (HMA, TYPE II, CLASS "B")
(D)	6" AGGREGATE BASE COURSE, GRADING D-1
(E)	10-INCH MINUS SHOT ROCK EMBANKMENT
(F)	4" CONCRETE SIDEWALK
(G)	4" COLORED CONCRETE SIDEWALK
(H)	STANDARD CURB AND GUTTER

NOTE:
 1. MATERIAL UNDER ALL WAYSIDE PARKING IMPROVEMENTS; INCLUDING SIDEWALK, WALKWAY, WALLS, AND PAVEMENT SHALL BE 10" MINUS SHOT ROCK EMBANKMENT.

P 6/9/20


PLANS DEVELOPED BY:
 DOWL
 5368 COMMERCIAL BLVD.
 JUNEAU, AK 99801
 (907) 780-3533
 #AECL848




STATE OF ALASKA
 DEPARTMENT OF TRANSPORTATION
 AND PUBLIC FACILITIES
**SKAGWAY - REPLACE CAPTAIN
 WILLIAM HENRY MOORE BRIDGE**
**SCENIC WAYSIDE TYPICAL
 CROSS SECTIONS**

FILE C:\CIVIL_3D Projects\24\70732-01\CIVIL\SC14-CT-C-PK-CHM.dwg
 DATE 8/17/2016 10:44 LAYOUT G13
 DESIGNED HOBBS
 CHECKED NOBLE
 DRAFTED WESTPHAL

NO.	DATE	REVISION	STATE	PROJECT DESIGNATION	YEAR	SHEET NO.	TOTAL SHEETS
			ALASKA	0972016/Z684590000	2016	G13	59

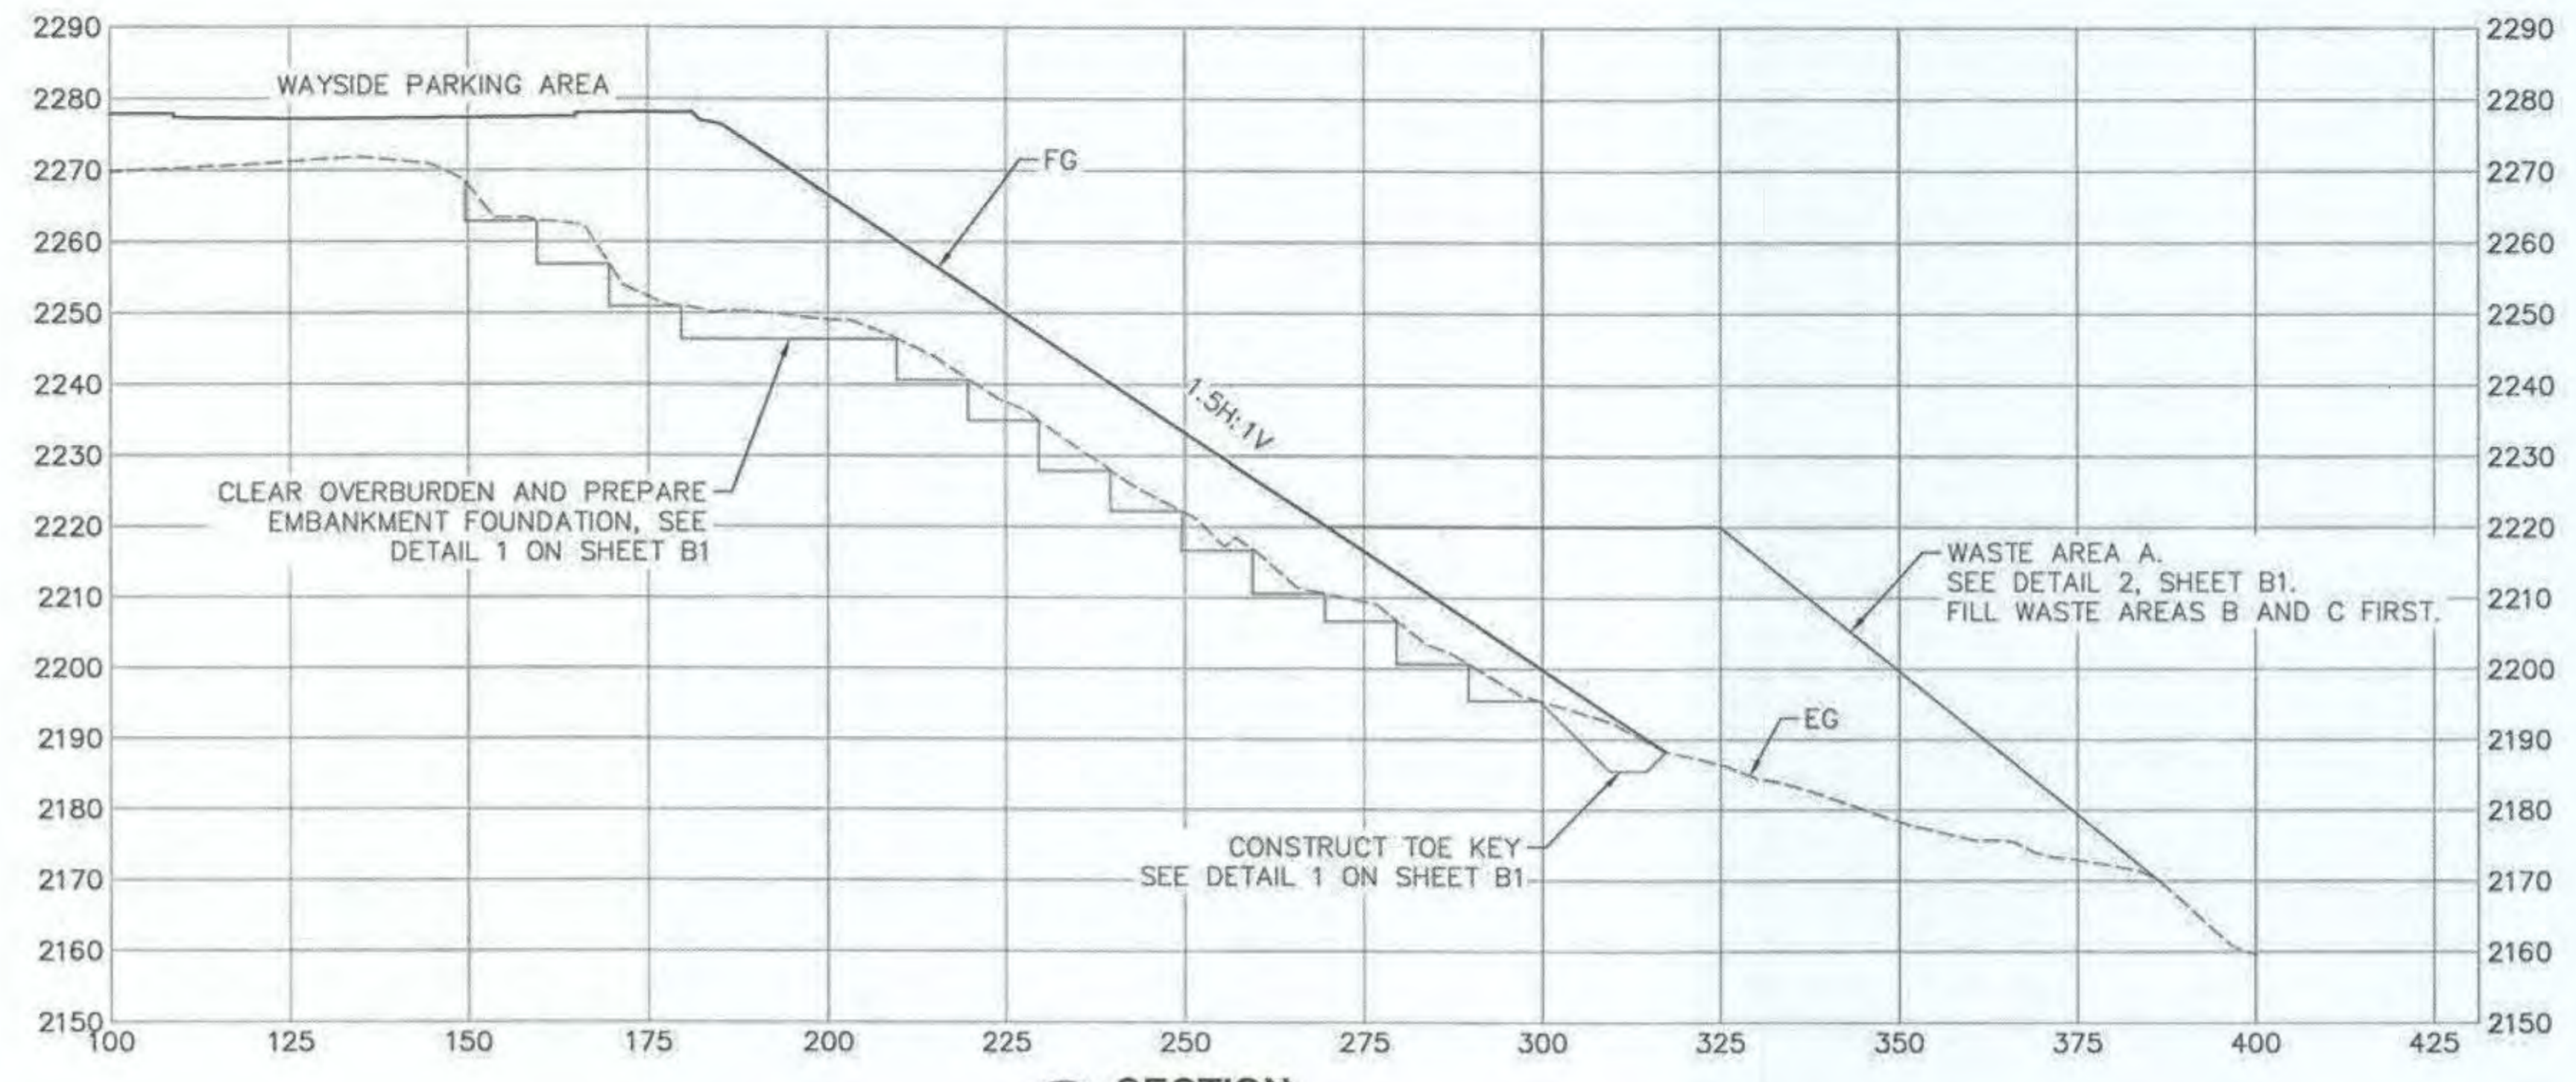


P SECTION
1"=20'

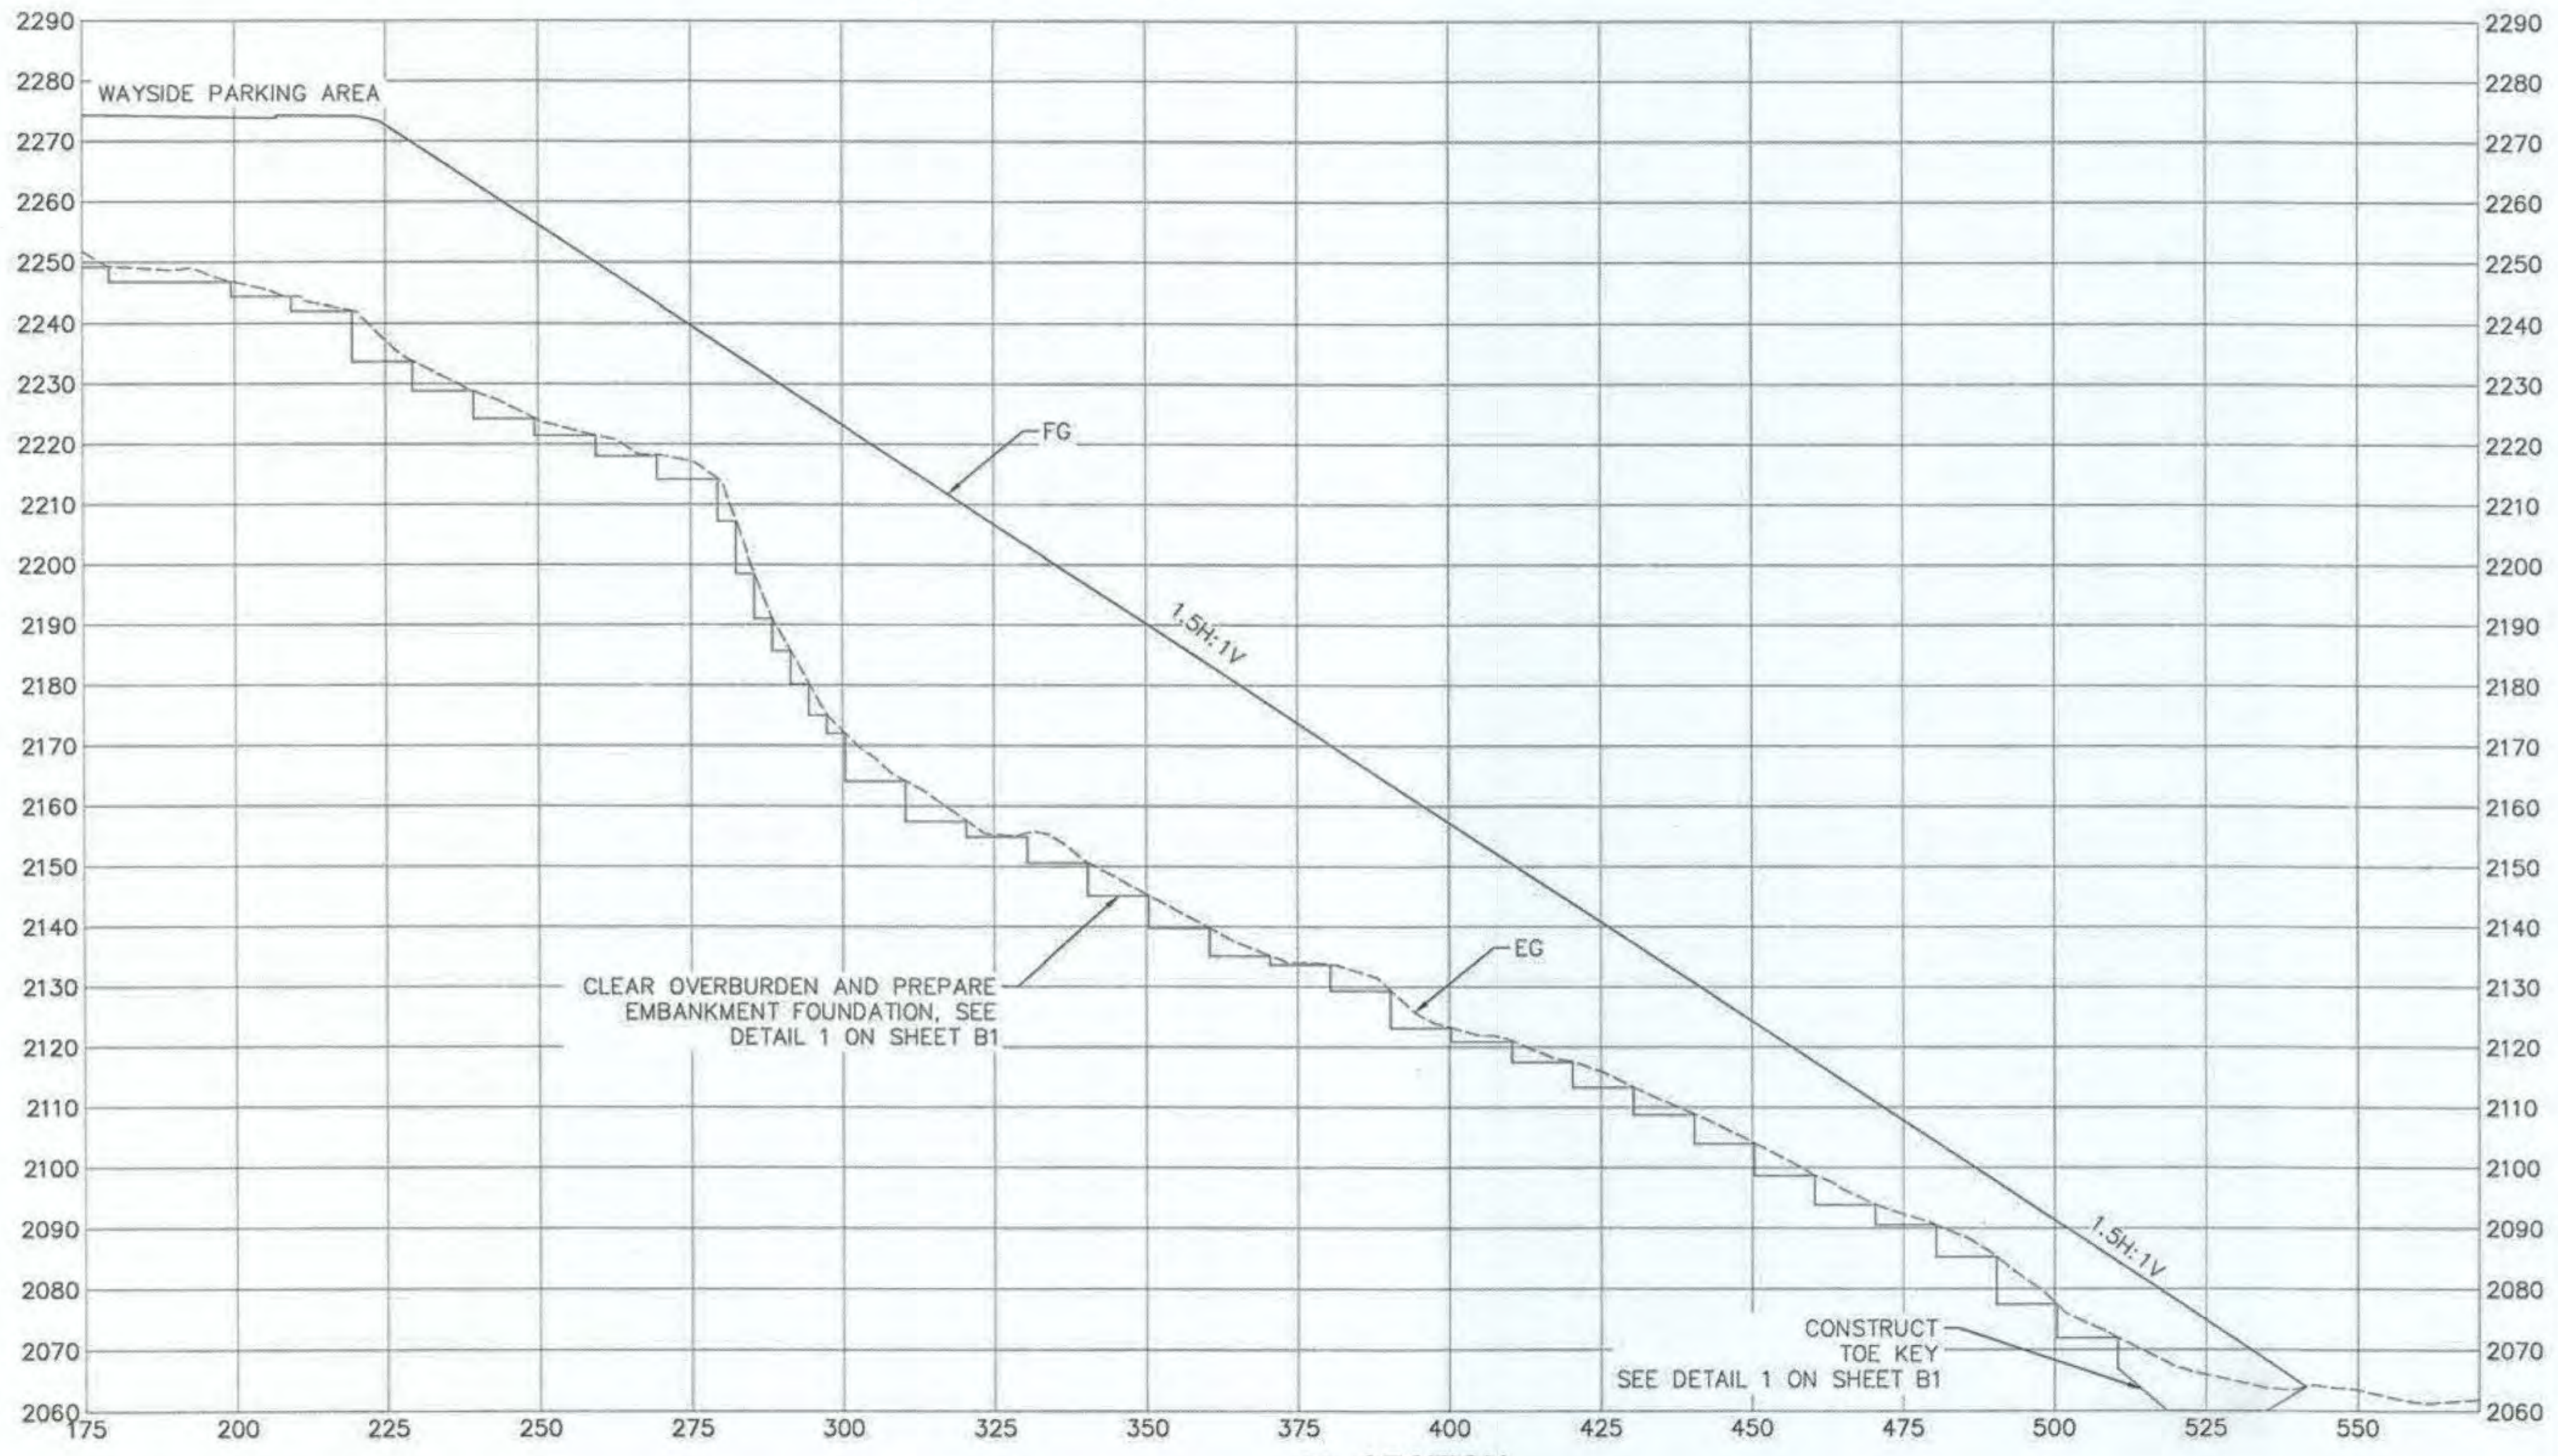

Q SECTION
1"=20'

P 6/9/20


PLANS DEVELOPED BY:
 DOWL
 5368 COMMERCIAL BLVD.
 JUNEAU, AK 99801
 (907) 780-3533
 #AECL848

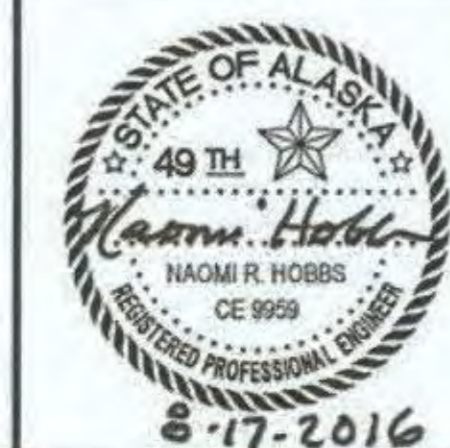

STATE OF ALASKA
 DEPARTMENT OF TRANSPORTATION
 AND PUBLIC FACILITIES
**SKAGWAY - REPLACE CAPTAIN
 WILLIAM HENRY MOORE BRIDGE**
**WAYSIDE EMBANKMENT
 CROSS SECTIONS**

NO.	DATE	REVISION	STATE	PROJECT DESIGNATION	YEAR	SHEET NO.	TOTAL SHEETS
			ALASKA	0972016/Z684590000	2016	H1	59

FILE: C:\civil\3D Projects\24\70732-01\Civil\1\SA14-CT-H-SC-CM.dwg
 DATE: 8/16/2016 11:17 LAYOUT: H1
 DESIGNED: HOBBS
 CHECKED: NOBLE
 DRAFTED: WESTPHAL

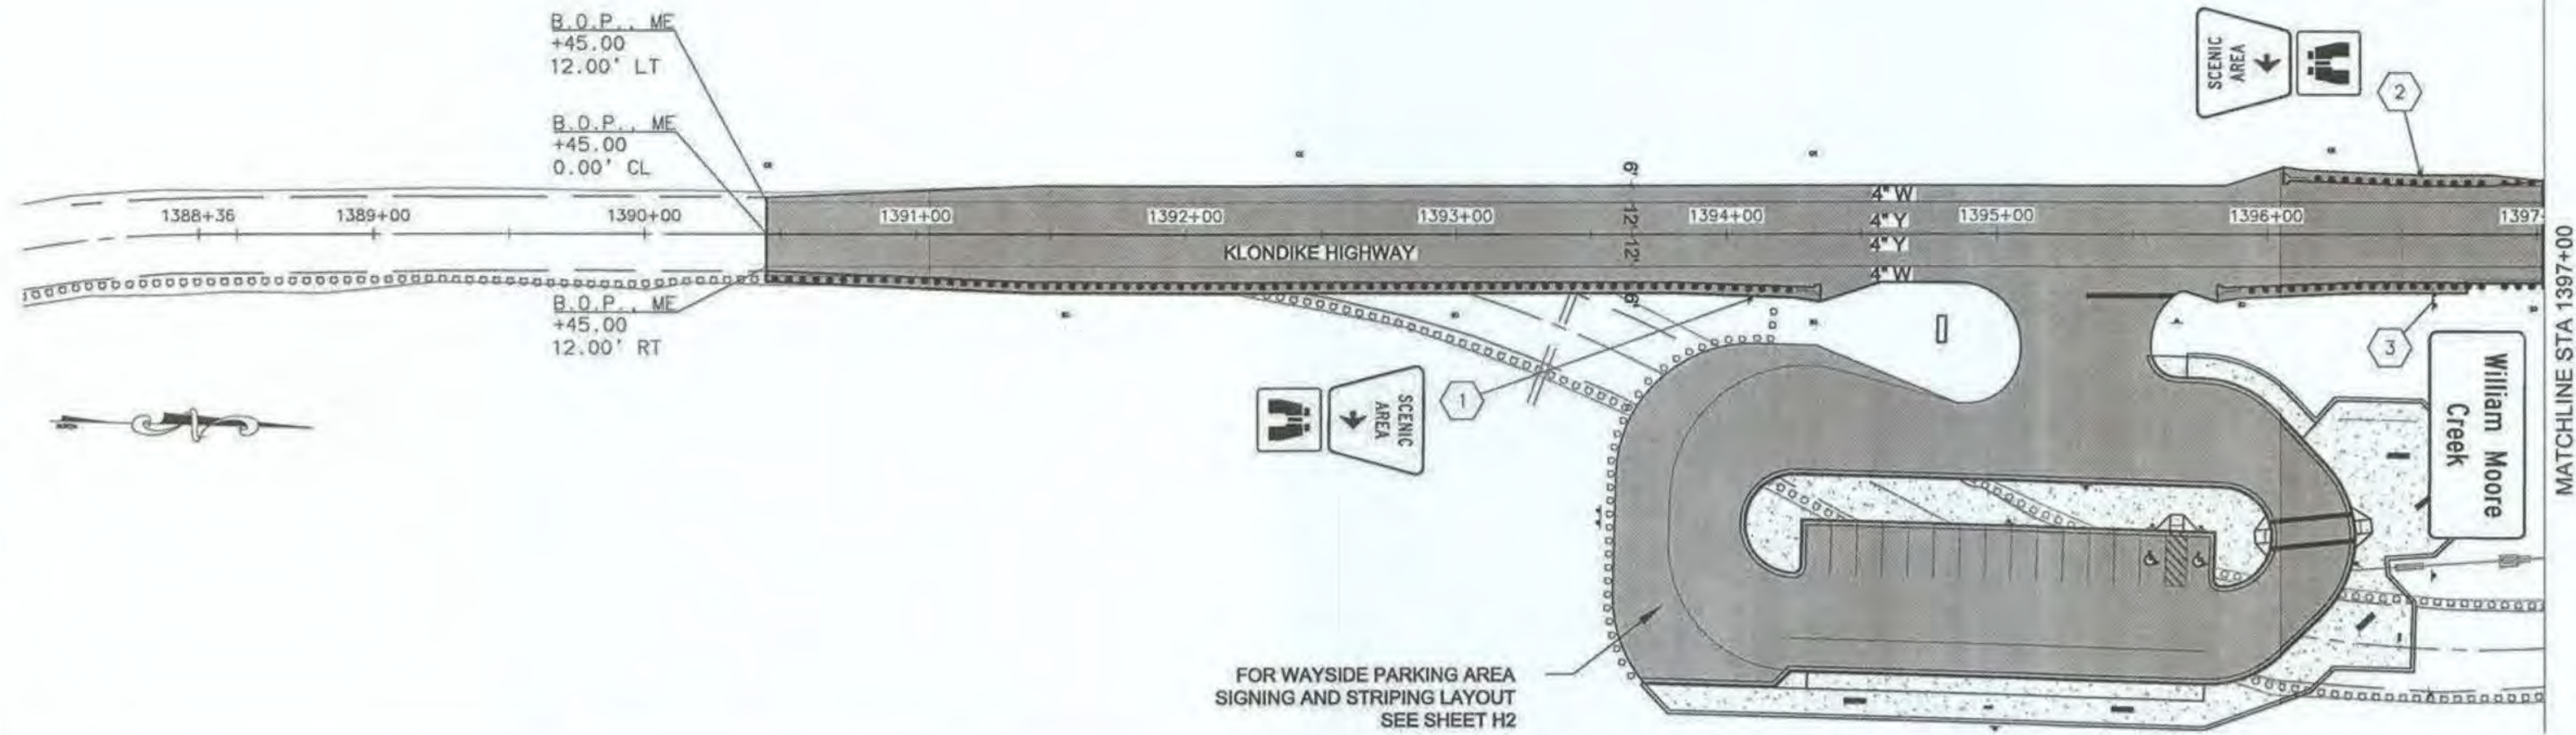


SYMBOL LEGEND


EXISTING	PROPOSED	
		SINGLE SIGN POST & NUMBER
		DOUBLE SIGN POST & NUMBER
		DELINEATOR SNOW POLE

PAVEMENT MARKING LEGEND

PROPOSED		
	PROJECT CENTERLINE	
	4" WHITE SOLID STRIPE	
	4" YELLOW SOLID STRIPE	
	4" BLUE SOLID STRIPE	
	2' CROSSWALK OR STOP BAR	

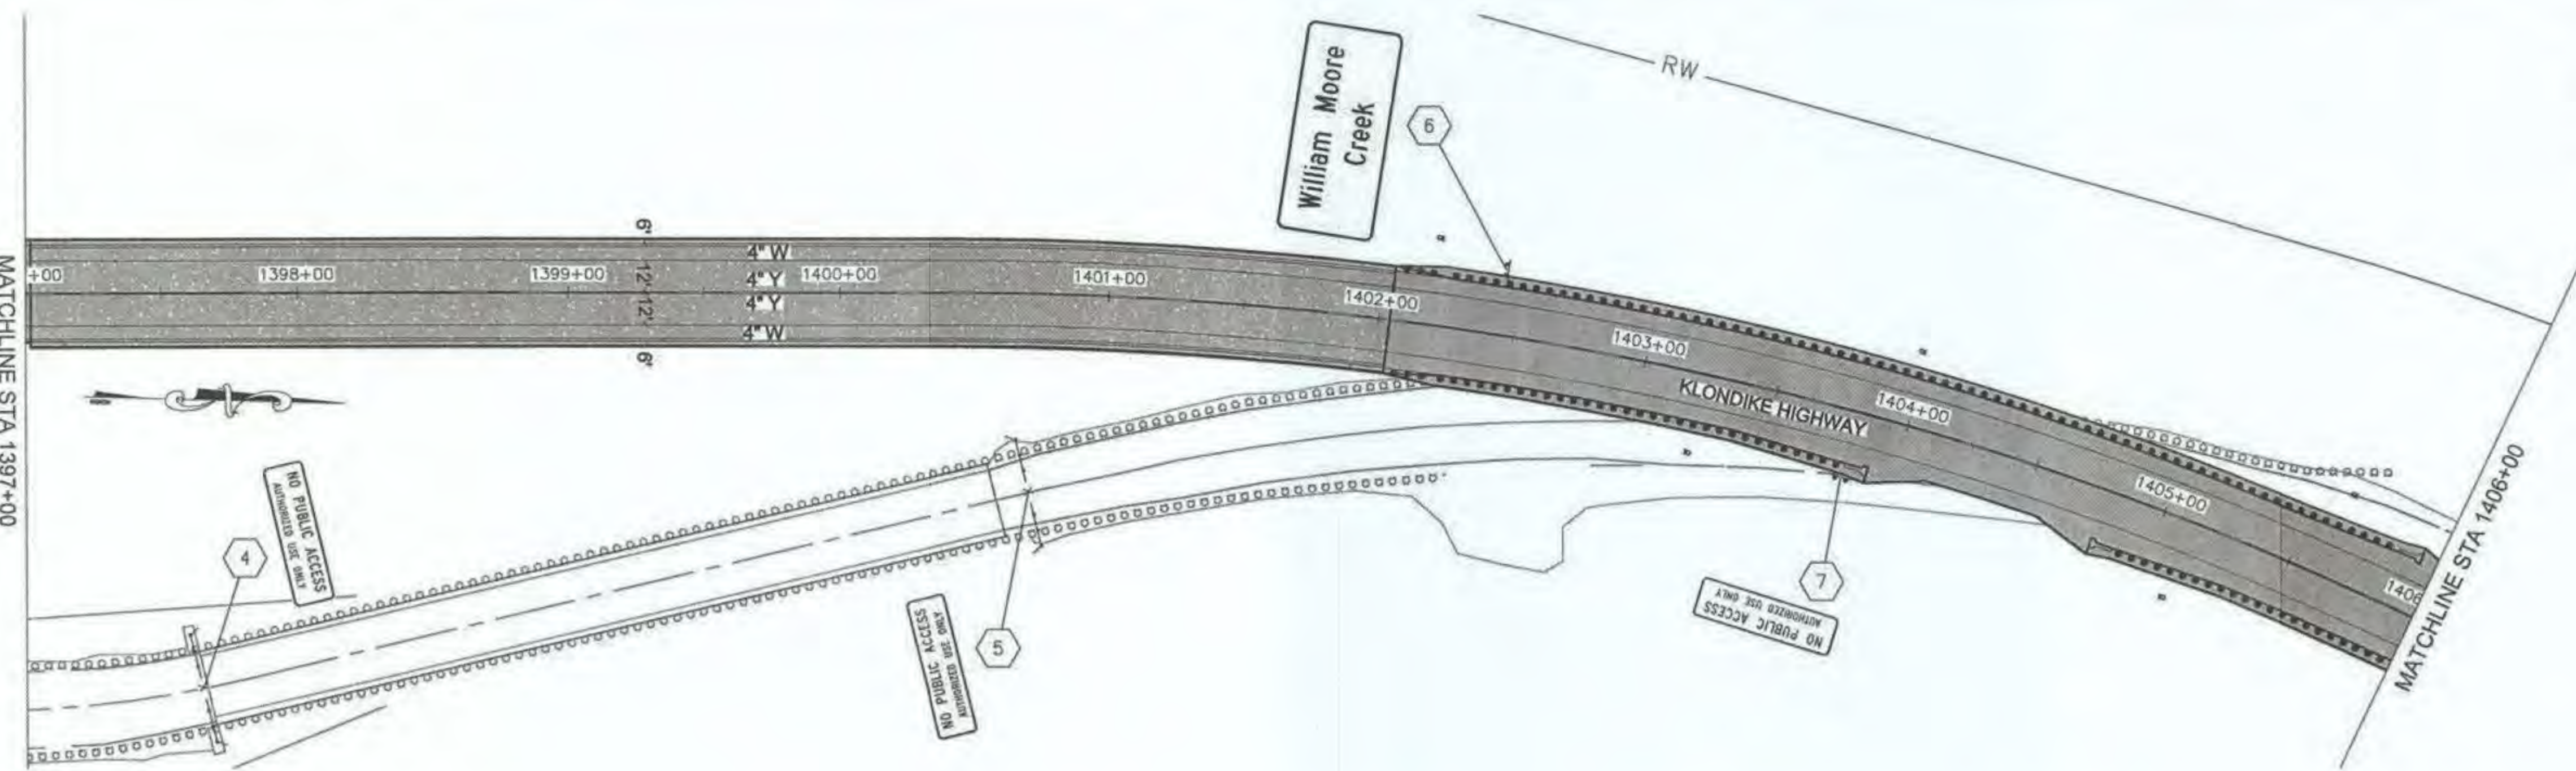


- ### SIGNING & STRIPING NOTES:
- ALL STATION LOCATIONS FOR SIGN INSTALLATION ARE APPROXIMATE. INSTALL SIGNS AT LOCATIONS AS DIRECTED BY THE ENGINEER.
 - USE THE FOLLOWING DEFINITIONS TO DECIPHER THE ABBREVIATED SIGN POST TYPES IN THE SIGN SUMMARY SHEETS.
 A. PST MEANS A PERFORATED STEEL TUBE.
 B. T MEANS A SQUARE STEEL TUBE.
 - IF THE NEW AND EXISTING PAVEMENT MARKINGS ARE NOT ALIGNED AT MATCH LINE, TRANSITION BETWEEN THE TWO USING A 100:1 TAPER ON THE NEW PAVEMENT.
 - PLACEMENT FOR RECESSED PAVEMENT MARKERS SHALL FOLLOW IN ACCORDANCE WITH THE STANDARD DRAWING T-06.00 DETAIL.

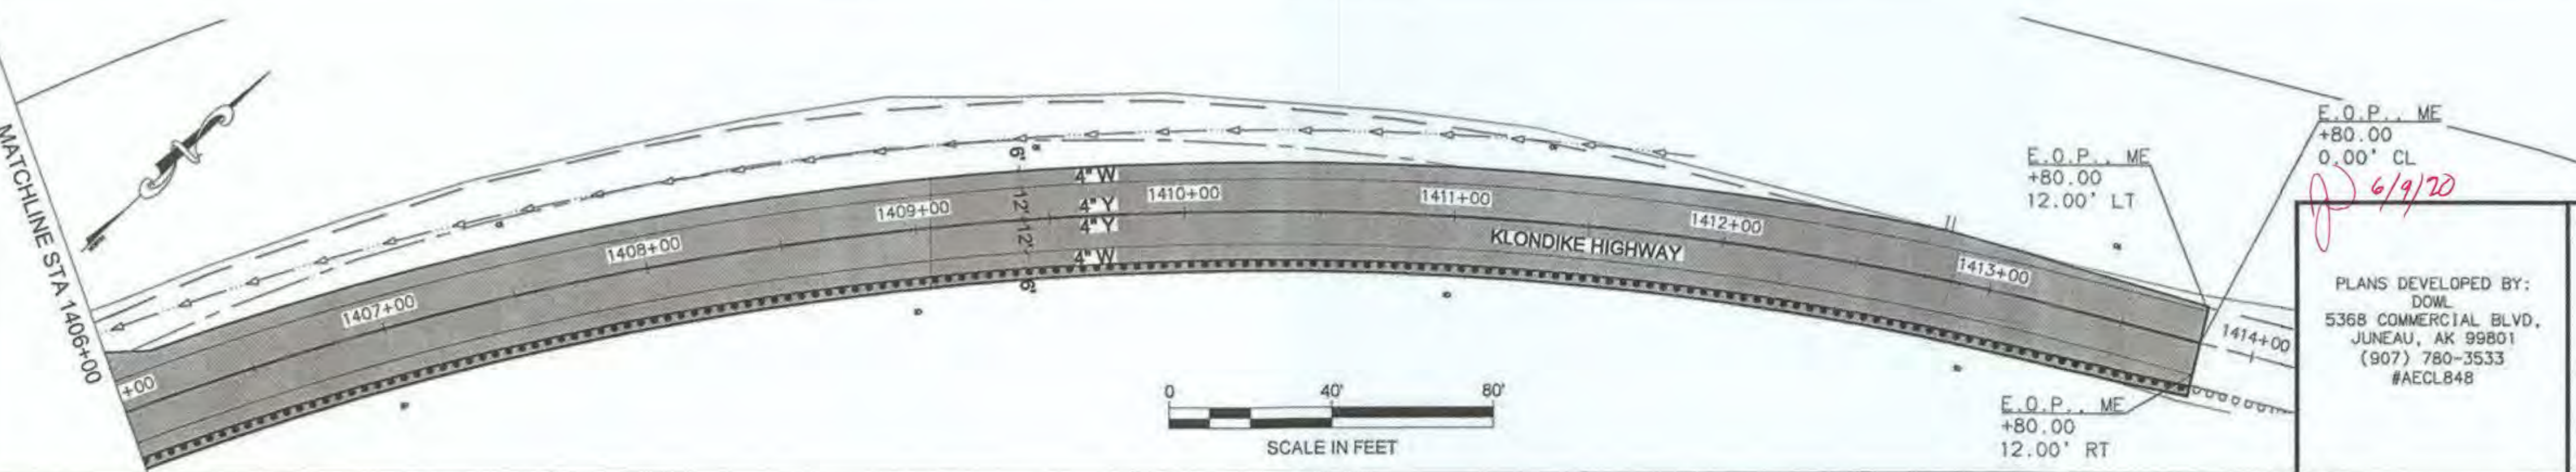

E.O.P. ME
 +80.00
 0.00' CL
 12.00' LT
 6/9/20


E.O.P. ME
 +80.00
 12.00' RT

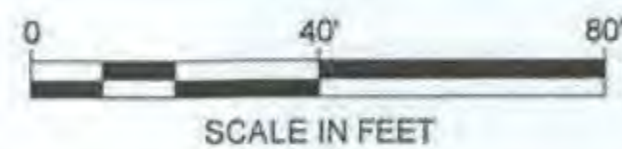


PLANS DEVELOPED BY: DOWL 5368 COMMERCIAL BLVD. JUNEAU, AK 99801 (907) 780-3533 #AECL848		STATE OF ALASKA DEPARTMENT OF TRANSPORTATION AND PUBLIC FACILITIES SKAGWAY - REPLACE CAPTAIN WILLIAM HENRY MOORE BRIDGE KLONDIKE HIGHWAY SIGNING AND STRIPING
--	--	---

8.17.2016

NO.	DATE	REVISION	STATE	PROJECT DESIGNATION	YEAR	SHEET NO.	TOTAL SHEETS
			ALASKA	0972016/Z684590000	2016	H2	59

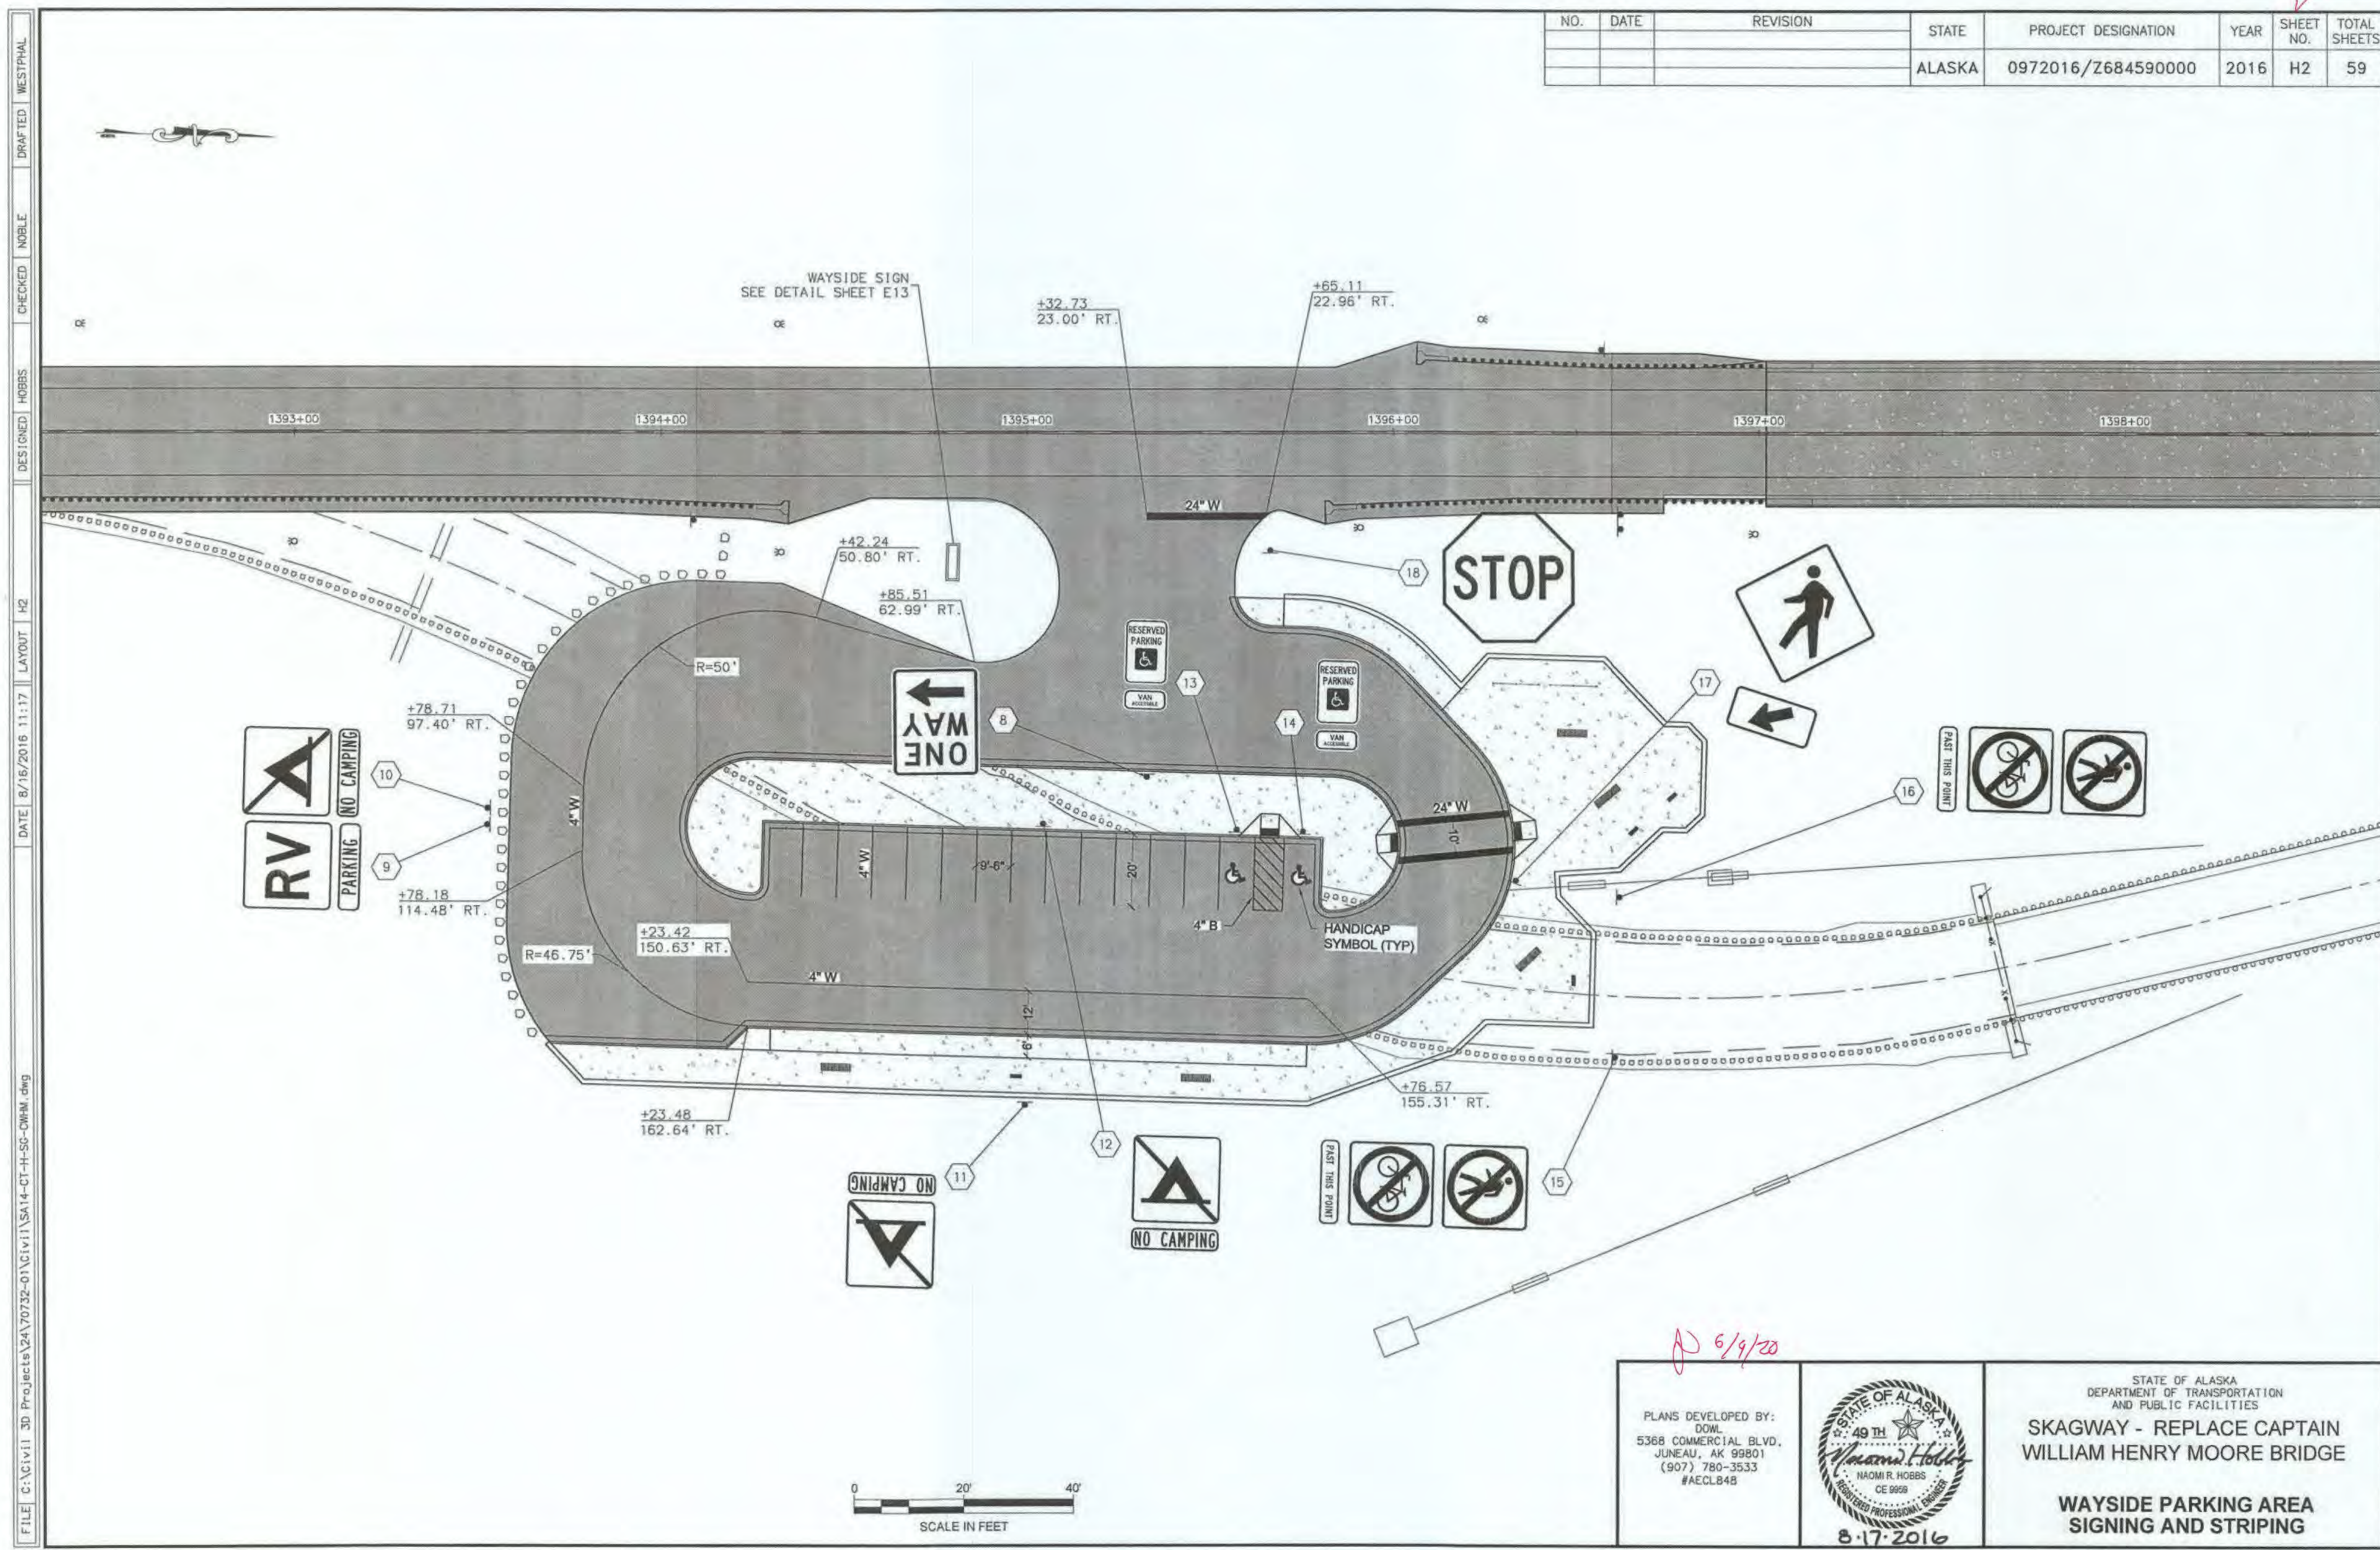

PLANS DEVELOPED BY:
DOWL
5368 COMMERCIAL BLVD.
JUNEAU, AK 99801
(907) 780-3533
#AECL848

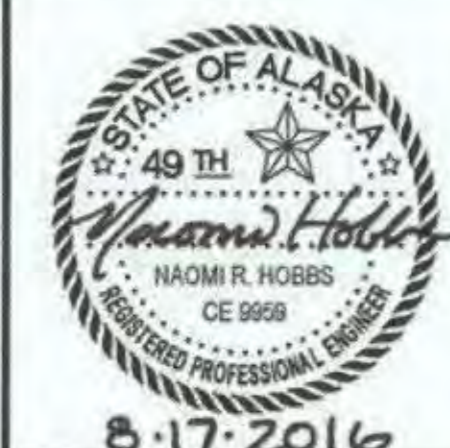

STATE OF ALASKA
DEPARTMENT OF TRANSPORTATION
AND PUBLIC FACILITIES

SKAGWAY - REPLACE CAPTAIN
WILLIAM HENRY MOORE BRIDGE

WAYSIDE PARKING AREA
SIGNING AND STRIPING

6/9/20

FILE: C:\Civ11_3D Project\24\70732-01\Civ11\SA14-CT-H-SG-CWHM.dwg
 DATE: 8/16/2016 11:17 LAYOUT: H3 DESIGNED: HOBBS CHECKED: NOBLE DRAFTED: WESTPHAL

NO.	DATE	REVISION	STATE	PROJECT DESIGNATION	YEAR	SHEET NO.	TOTAL SHEETS
			ALASKA	0972016/Z684590000	2016	H3	59













SHEET	POST NO.	STATION	CL OFFSET	CL REF	TYPE	LEGEND	SIZE (IN)		AREA (FT2)	SIGN FACES	POST NO., SIZE, & TYPE	FRAMED		REMARKS
							WIDTH	HEIGHT				YES	NO	
H1	1	1394+08.72	24.05'	RT.	MODIFIED D7-105R		42	36	10.50	S	1-4.0" T	X		
					RG-1000		24	24	4.00	S			X	
H1	2	1396+56.70	23.08'	LT.	MODIFIED D7-105L		42	36	10.50	N	1-4.0" T	X		
					RG-1000		24	24	4.00	N			X	
H1	3	1396+62.00	24.25'	RT.	I-3		78	36	19.50	S	2-3.0" T	X		
H1	4	1397+65.27	146.59'	RT.	CUSTOM		54	16	6.00	S		X		MOUNT ON GATE
H1	5	1400+71.35	73.83'	RT.	CUSTOM		54	16	6.00	N		X		MOUNT ON GATE
H1	6	1402+44.00	24.23'	LT.	I-3		78	36	19.50	N	2-3.0" T	X		
H1	7	1403+81.01	25.85'	RT.	CUSTOM		54	16	6.00	NW	2-2.0" T	X		
H2	8	1395+32.61	94.44'	RT.	R6-2R		24	30	5.00	W	1-2.5" PST		X	
H2	9	1393+52.39	107.44'	RT.	MODIFIED D9-105		24	24	4.00	N	1-2.5" PST		X	
							24	6	1.00	N			X	
H2	10	1393+52.53	102.94'	RT.	D9-309		24	24	4.00	N	1-2.5" PST		X	
							24	6	1.00	N			X	
H2	11	1394+99.04	184.21'	RT.	D9-309		24	24	4.00	W	1-2.5" PST		X	
							24	6	1.00	W			X	

8/9/20


PLANS DEVELOPED BY: DOWL 5368 COMMERCIAL BLVD. JUNEAU, AK 99801 (907) 780-3533 #AECL848		STATE OF ALASKA DEPARTMENT OF TRANSPORTATION AND PUBLIC FACILITIES SKAGWAY - REPLACE CAPTAIN WILLIAM HENRY MOORE BRIDGE SIGN SUMMARY
--	--	---

FILE C:\Civil_3D Projects\24\70732-01\Civil\SA14-CT-H-SG-OWN.dwg DATE 8/16/2016 11:17 LAYOUT H4 DESIGNED HOBBS CHECKED NIBLE DRAFTED WESTPHAL

NO.	DATE	REVISION	STATE	PROJECT DESIGNATION	YEAR	SHEET NO.	TOTAL SHEETS
			ALASKA	0972016/Z684590000	2016	H4	59

SHEET	POST NO.	STATION	CL OFFSET	CL REF	TYPE	LEGEND	SIZE (IN)		AREA (FT ²)	SIGN FACES	POST NO., SIZE, & TYPE	FRAMED		REMARKS
							WIDTH	HEIGHT				YES	NO	
H2	12	1395+04.22	107.09'	RT.	D9-309		24	24	4.00	E	1-2.5" PST		X	
						(NO CAMPING)	24	6	1.00	E			X	
H2	13	1395+57.19	108.71'	RT.	R7-8		12	18	1.50	E	1-2.0" PST		X	
					R7-8A		12	6	0.50				X	
H2	14	1395+75.19	109.25'	RT.	R7-8		12	18	1.50	E	1-2.0" PST		X	
					R7-8A		12	6	0.50				X	
H2	15	1396+60.46	170.99'	RT.	R9-3A		24	24	4.00	S	1-2.5" T		X	
					R5-6		24	24	4.00				X	
					CUSTOM	(PAST THIS POINT)	24	6	1.00				X	
H2	16	1396+61.72	127.01'	RT.	R9-3A		24	24	4.00	S	1-2.5" T		X	
					R5-6		24	24	4.00				X	
					CUSTOM	(PAST THIS POINT)	24	6	1.00				X	
H2	17	1396+33.34	122.54'	RT.	W11-2		30	30	6.25	SE	1-2.5" T		X	
					W16-7PL		24	12	2.00				X	
H2	18	1395+66.39	32.28'	RT.	R1-1		36	36	9.00	E	1-3.0" T	X		
							SIGN AREA: 150.25							

6/9/20

PLANS DEVELOPED BY: DOWL 5368 COMMERCIAL BLVD. JUNEAU, AK 99801 (907) 780-3533 #AECL848		STATE OF ALASKA DEPARTMENT OF TRANSPORTATION AND PUBLIC FACILITIES SKAGWAY - REPLACE CAPTAIN WILLIAM HENRY MOORE BRIDGE SIGN SUMMARY
--	---	---













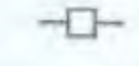


FILE C:\Civil 3D Projects\24\70732-01\Civil\SC14-CT-P-EC-QWM.dwg DATE 8/16/2016 17:40 LAYOUT P1 DESIGNED HOBBS CHECKED NOBLE DRAFTED WESTPHAL

NO.	DATE	REVISION	STATE	PROJECT DESIGNATION	YEAR	SHEET NO.	TOTAL SHEETS
			ALASKA	0972016/Z684590000	2016	P1	59

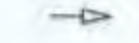ESCP NOTES:

1. THE ESCP SHEETS ARE NOT A COMPREHENSIVE REPRESENTATION OF ALL BMPs REQUIRED TO MAINTAIN COMPLIANCE WITH THE CONSTRUCTION GENERAL PERMIT (CGP). BMPs SHOWN ON THE ESCP SHEETS ARE ONLY A STARTING POINT FOR THE CONTRACTOR. THE CONTRACTOR IS RESPONSIBLE FOR IMPLEMENTING ANY ADDITIONAL BMPs TO ACCOUNT FOR THEIR PHASING AND METHODS OF CONDUCTING WORK.
2. EROSION CONTROL MEASURES WILL BE EVALUATED BY THE ENGINEER BASED ON EFFECTIVENESS. IF INSPECTION REVEALS EROSION CONTROL MEASURES ARE INEFFECTIVE, THE CONTRACTOR SHALL IMMEDIATELY IMPLEMENT CORRECTIVE ACTION, AS NECESSARY, TO CORRECT THE DEFICIENCY.
3. CONTRACTOR SHALL ESTABLISH MATERIAL STORAGE AND STAGING AREAS WITHIN THE ROW.
4. PRESERVE EXISTING VEGETATION WHEN PRACTICAL.
5. THE CONTRACTOR SHALL USE CONTROL MEASURES TO ENSURE THAT CONSTRUCTION ACTIVITIES HAVE MINIMAL IMPACTS ON THE NATURAL BUFFER AREAS OF RECEIVING WATERS. ALL DISTURBED PROJECT AREAS ADJACENT TO IN-WATER WORK SHALL BE RESTORED TO THEIR FUNCTIONAL CAPACITY, OR PLANNED DESIGN, UNLESS DIRECTED BY THE ENGINEER.
6. ALL DISTURBED AREAS NOT RECEIVING ROCK CUT, ROCK FILL, HMA PAVEMENT OR RIPRAP SHALL RECEIVE HYDROSEED WITH MULCH AS A FINAL STABILIZATION MEASURE, UNLESS OTHER TREATMENTS ARE REQUIRED BY PERMIT CONDITIONS.
7. REMOVE ALL TEMPORARY EROSION AND SEDIMENT CONTROL MEASURES AND DEVICES AFTER PROJECT COMPLETION.
8. THE PROJECT LIMITS ARE SURROUNDED BY NATURAL VEGETATION WHICH SERVES AS A VEGETATIVE BUFFER STRIP.
9. CONTRACTOR WILL MINIMIZE OFF-SITE VEHICLE TRACKING OF SEDIMENT FROM WHEELS TO PREVENT TRACK-OUT ONTO PAVED SURFACES. SEDIMENT THAT ESCAPES THE CONSTRUCTION SITE, MUST BE REMOVED AT A FREQUENCY TO MINIMIZE OFF-SITE IMPACTS.

ESCP LEGEND



-  CULVERT INLET/OULET SEDIMENT BARRIER
-  CHECK DAM
-  PERIMETER CONTROL SEDIMENT BARRIER
-  PROJECT RIGHT OF WAY
-  VEGETATIVE BUFFER STRIP
-  CULVERT FLOW
-  PROFILE FLOW
-  SURFACE FLOW
-  DITCH LINE
-  OBLITERATION OF ROADWAY
-  DISCHARGE POINT
-  CUT LIMIT
-  FILL LIMIT
-  RIPRAP
-  INVASIVE SPECIES

P 6/9/20

<p>PLANS DEVELOPED BY: DOWL 5368 COMMERCIAL BLVD. JUNEAU, AK 99801 (907) 780-3533 #AECL848</p>	<p>ESCP NOT SEALED IN ACCORDANCE WITH ALASKA HIGHWAY PRECONSTRUCTION MANUAL SECTION 1120.7.3 DATED NOVEMBER 15, 2013</p>	<p style="text-align: center;">STATE OF ALASKA DEPARTMENT OF TRANSPORTATION AND PUBLIC FACILITIES</p> <p style="text-align: center;">SKAGWAY - REPLACE CAPTAIN WILLIAM HENRY MOORE BRIDGE</p> <p style="text-align: center;">EROSION SEDIMENT CONTROL PLAN LEGEND AND NOTES</p>
--	--	---

FILE C:\civil\3D Projects\24\70732-01\Civil\1\SC14-CT-P-EC-OWM.dwg DATE 8/18/2016 7:54 LAYOUT P2 DESIGNED HOBBS CHECKED NOBLE DRAFTED WESTPHAL

NO.	DATE	REVISION	STATE	PROJECT DESIGNATION	YEAR	SHEET NO.	TOTAL SHEETS
			ALASKA	0972016/Z684590000	2016	P2	59

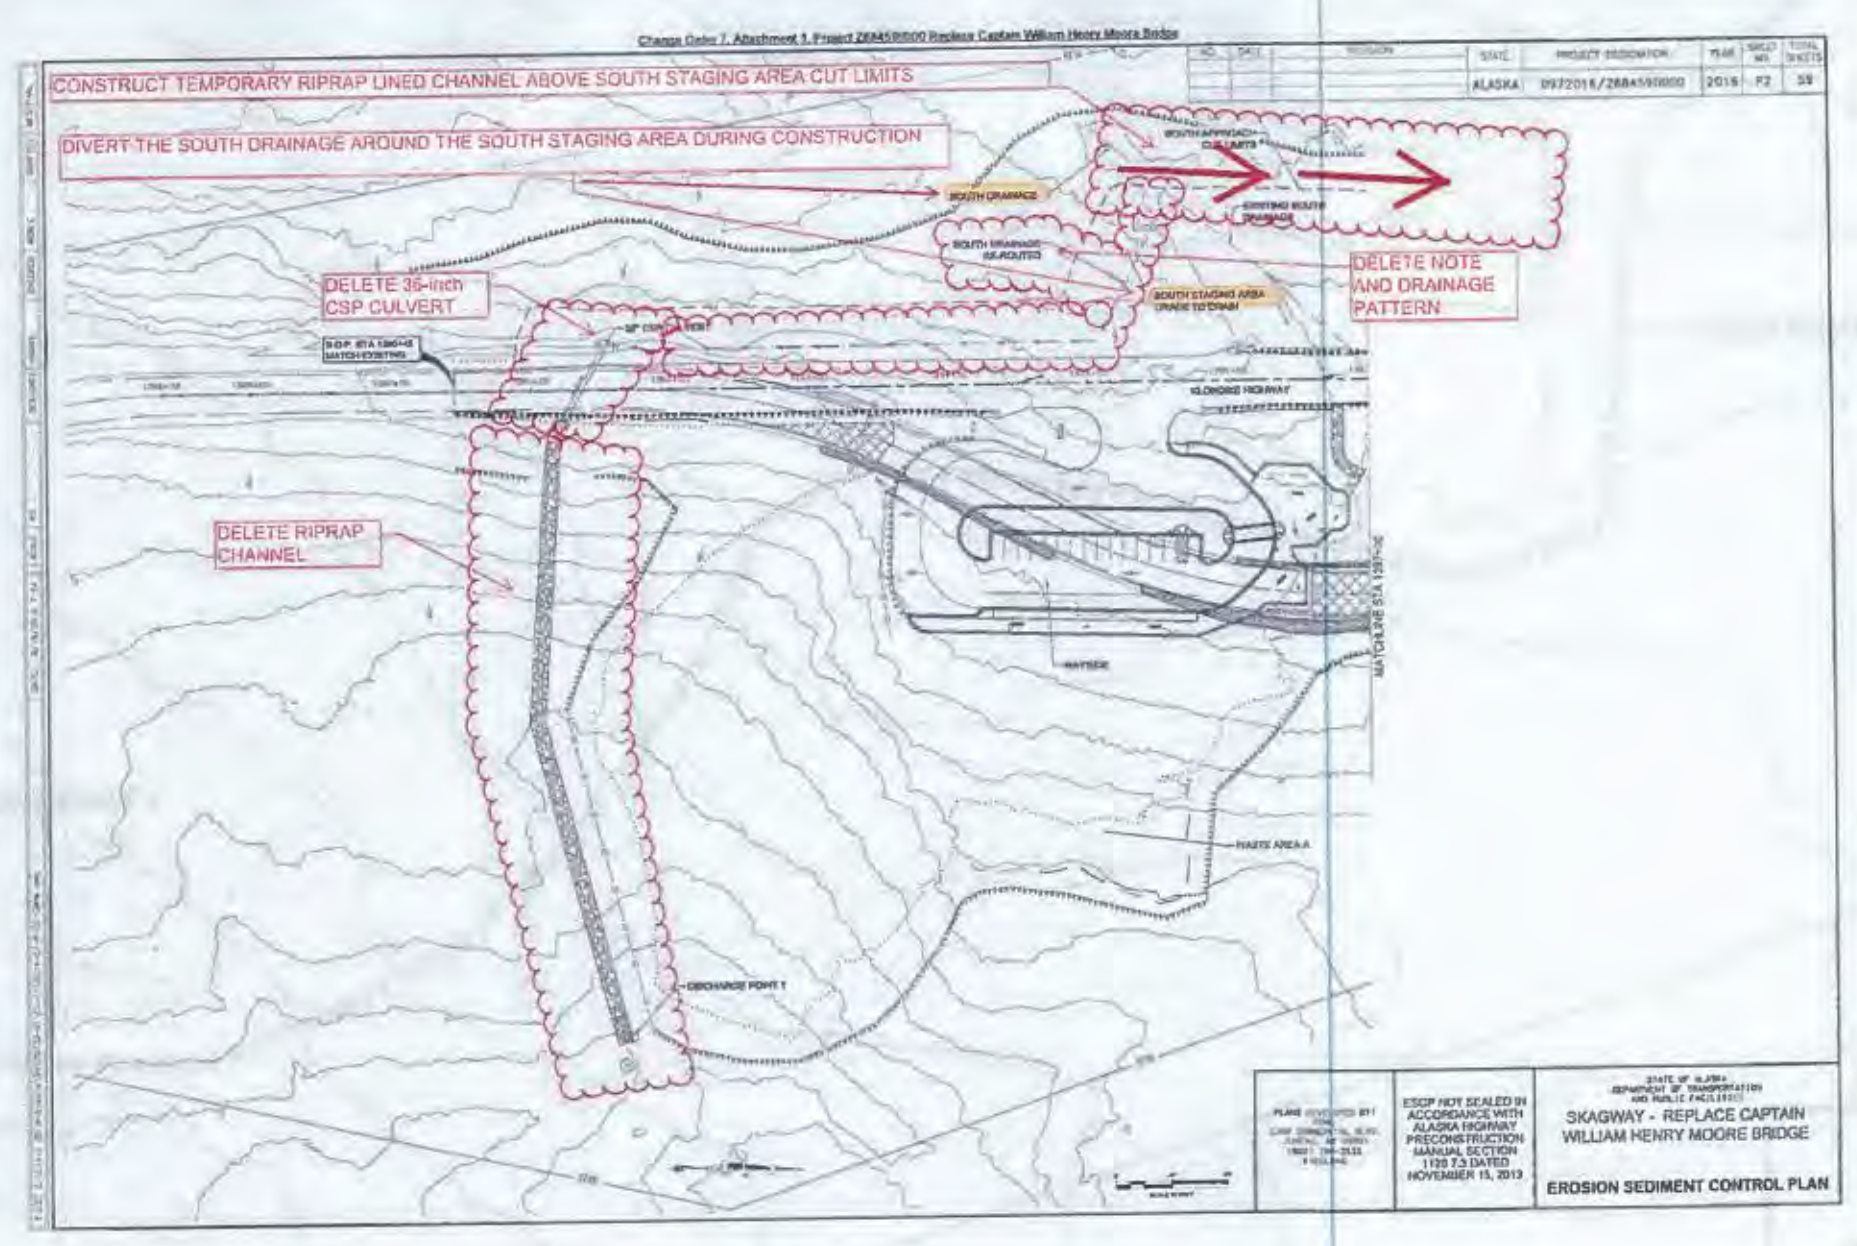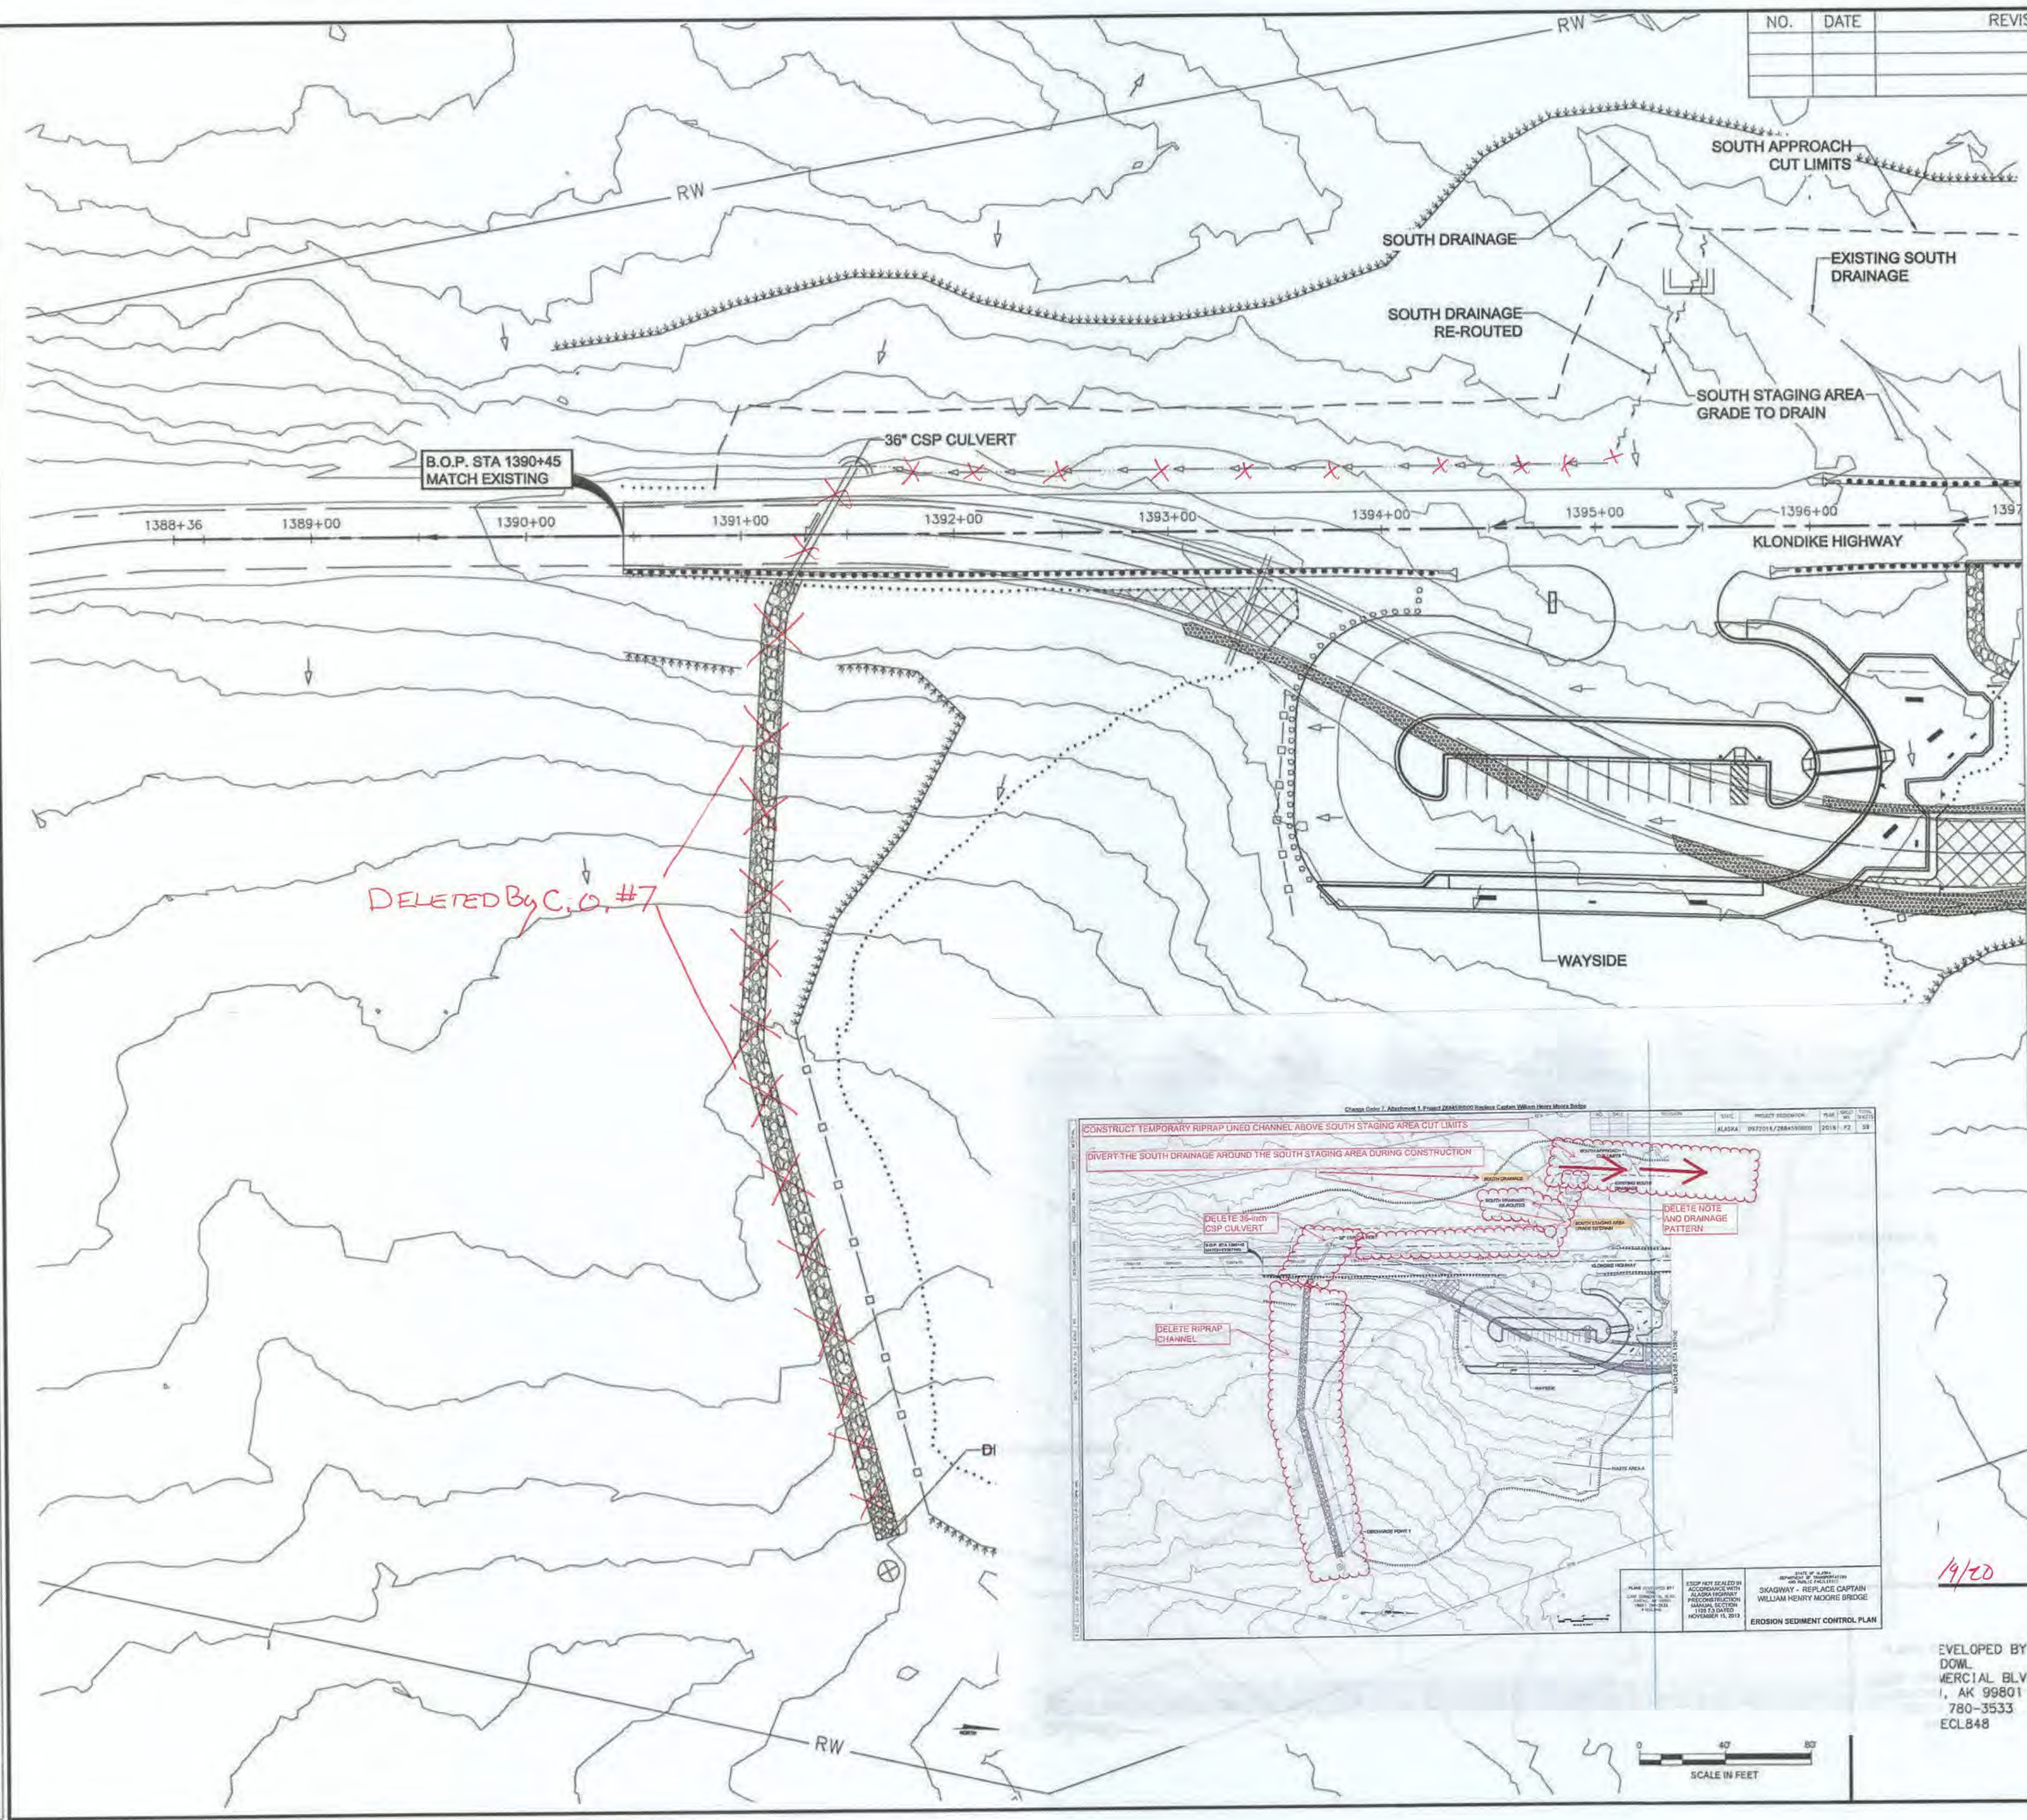

1/9/20

DEVELOPED BY:
DOW
MERCIAL BLVD.
AK 99801
780-3533
ECL848

ESCP NOT SEALED IN ACCORDANCE WITH ALASKA HIGHWAY PRECONSTRUCTION MANUAL SECTION 1120.7.3 DATED NOVEMBER 15, 2013



STATE OF ALASKA
DEPARTMENT OF TRANSPORTATION
AND PUBLIC FACILITIES
SKAGWAY - REPLACE CAPTAIN
WILLIAM HENRY MOORE BRIDGE

EROSION SEDIMENT CONTROL PLAN



FILE: C:\Civil\3D Projects\24\70732-01\Civil\SC14-CT-P-EC-QWM.dwg DATE: 8/16/2016 17:40 LAYOUT: P3 DESIGNED: HOBBS CHECKED: NOBLE DRAFTED: WESTPHAL

NO.	DATE	REVISION	STATE	PROJECT DESIGNATION	YEAR	SHEET NO.	TOTAL SHEETS
			ALASKA	0972016/Z684590000	2016	P3	59

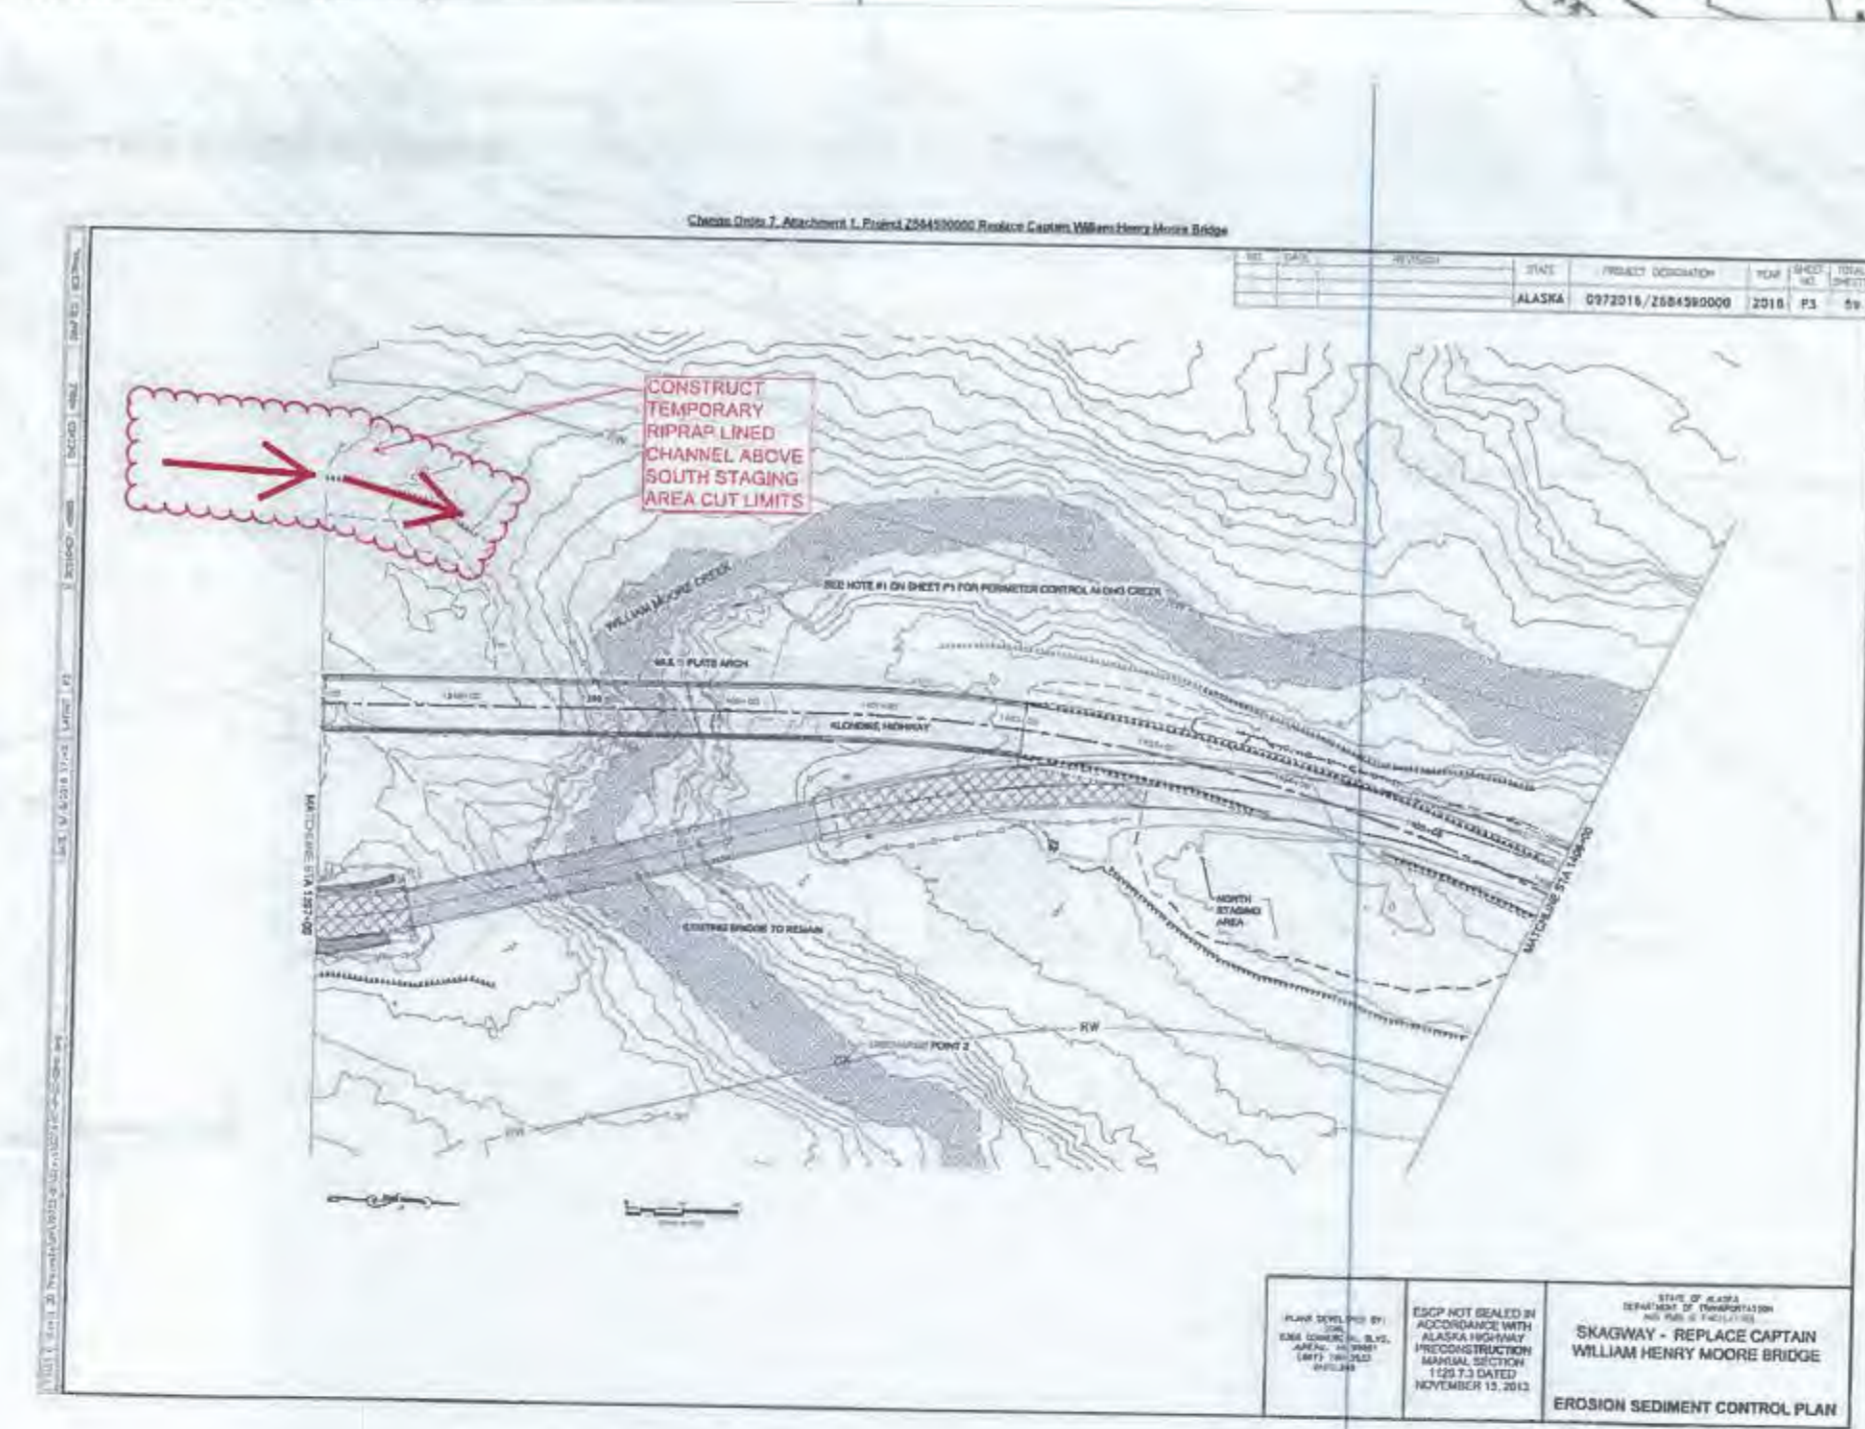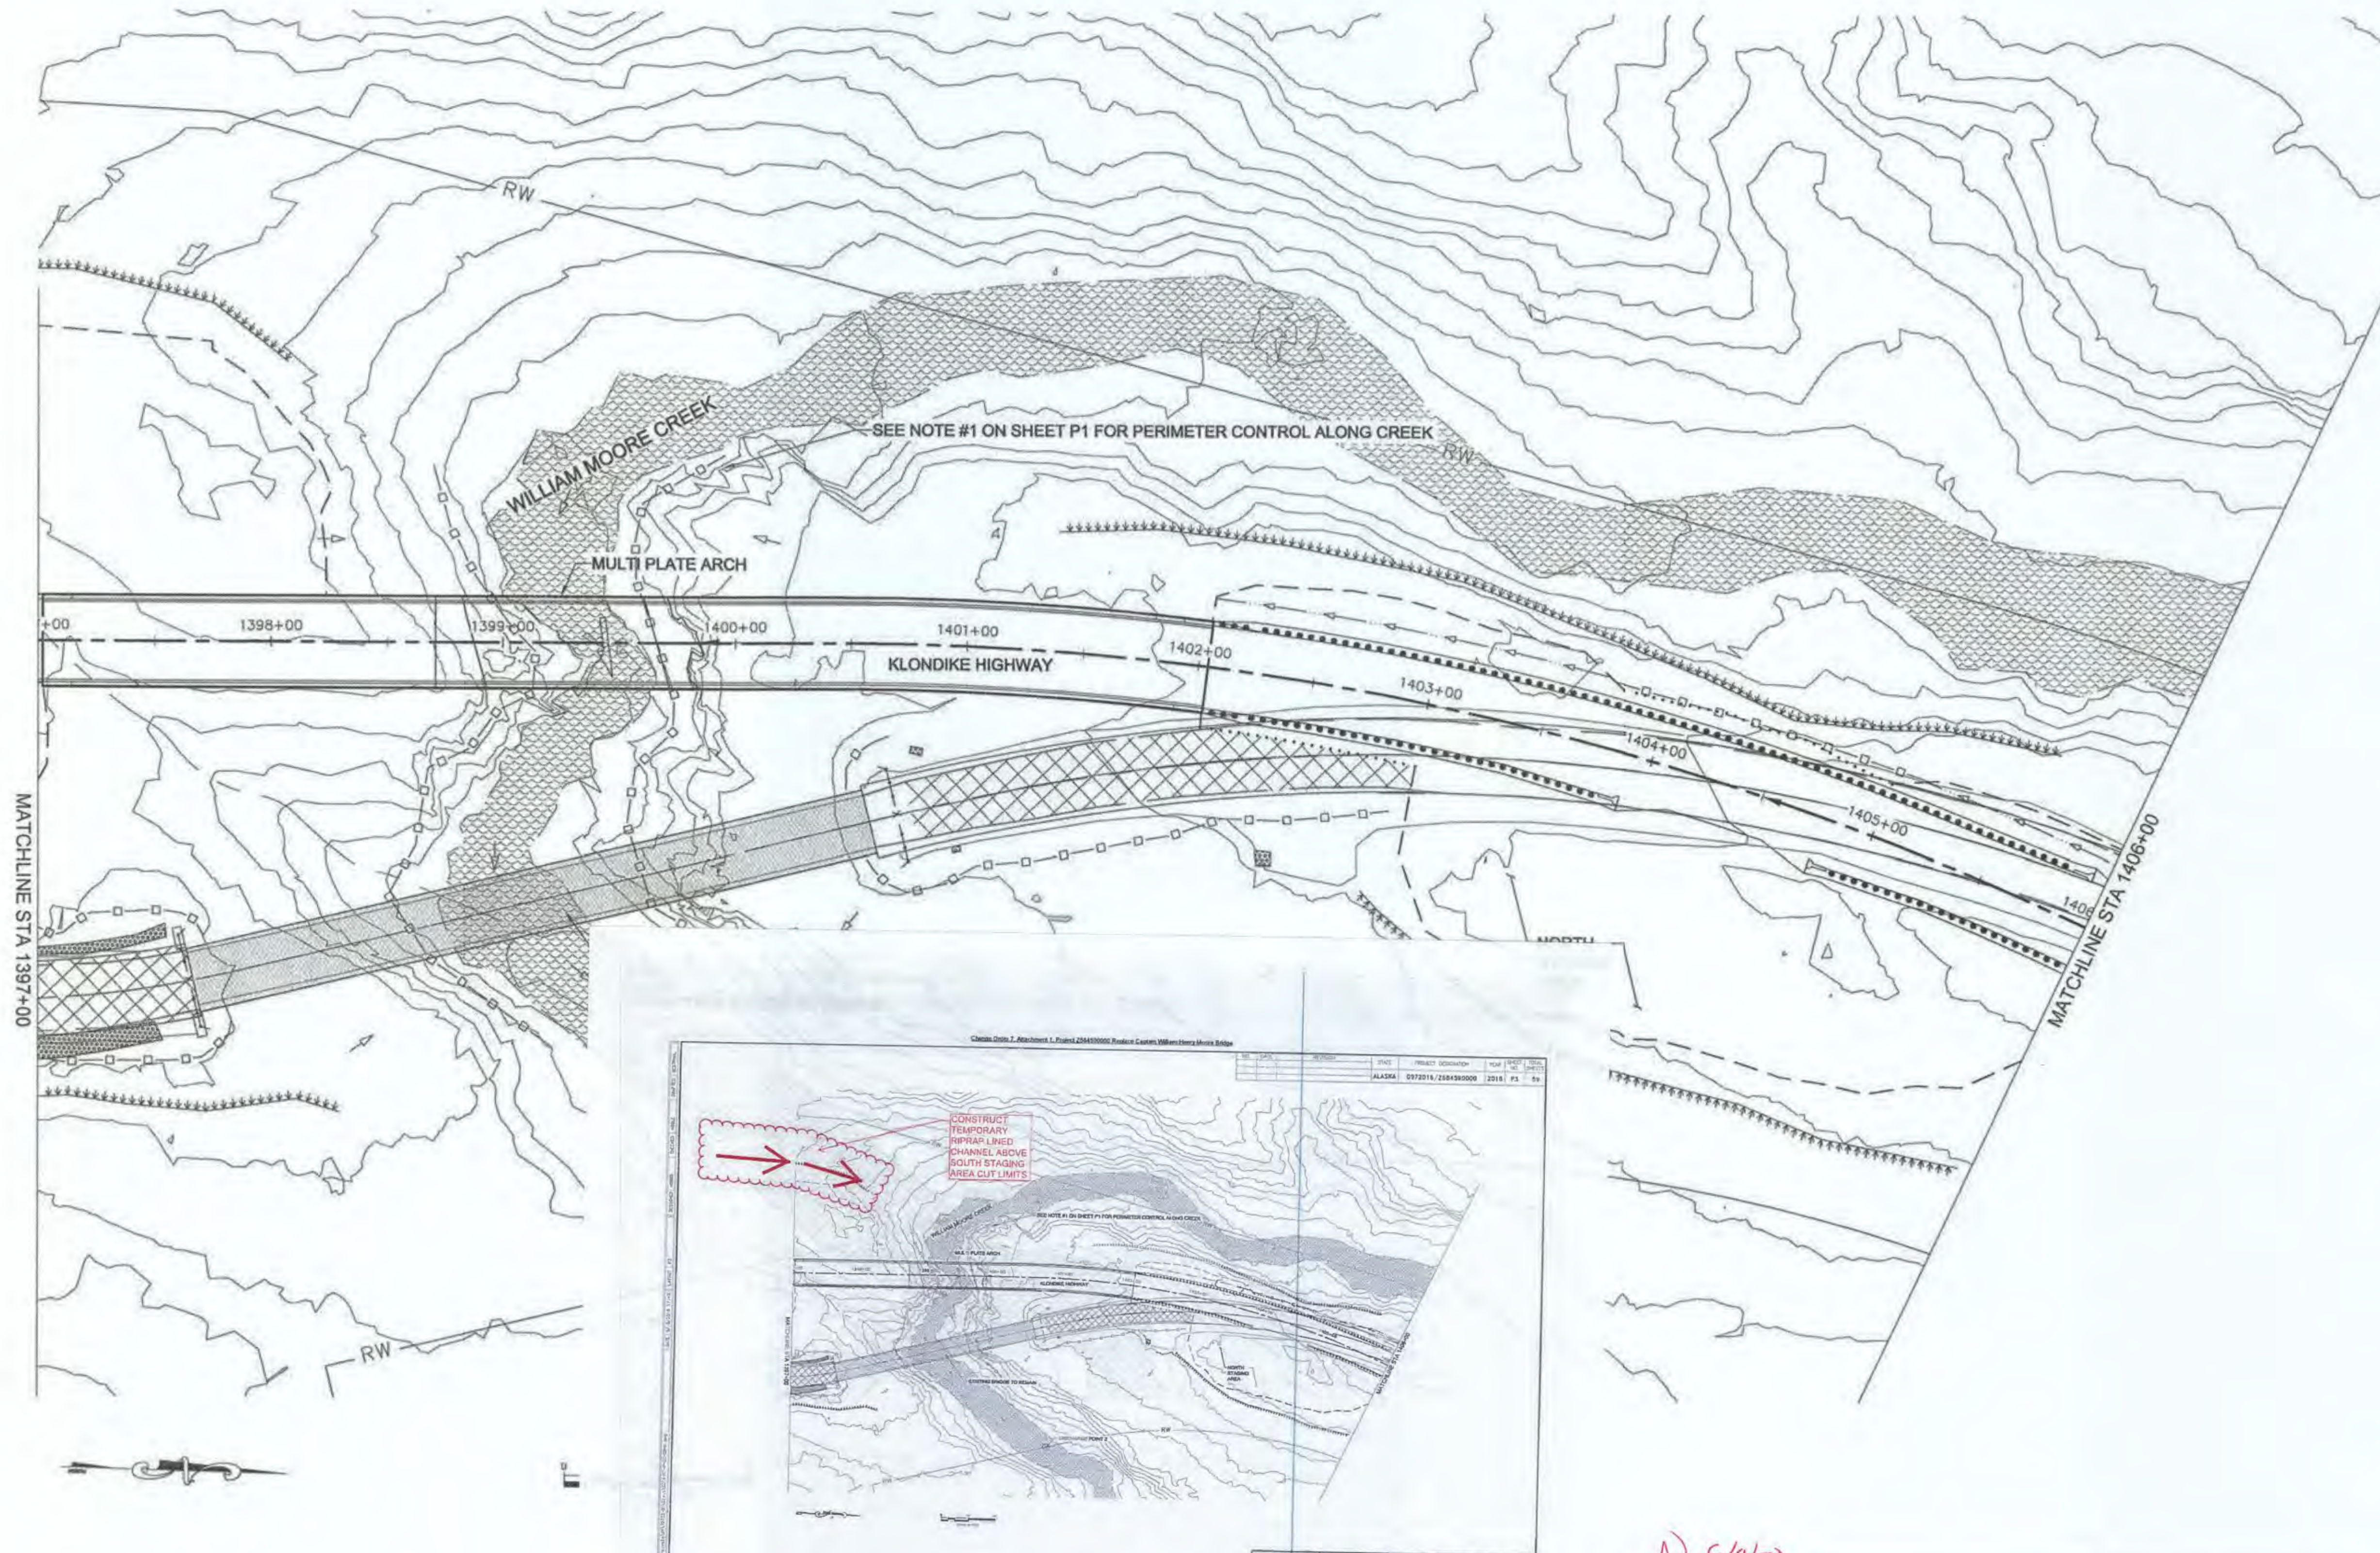


6/9/20

<p>PLANS DEVELOPED BY: DWM 5368 COMMERCIAL BLVD. JUNEAU, AK 99801 (907) 780-3533 #AECL848</p>	<p>ESCP NOT SEALED IN ACCORDANCE WITH ALASKA HIGHWAY PRECONSTRUCTION MANUAL SECTION 1120.7.3 DATED NOVEMBER 15, 2013</p>	<p>STATE OF ALASKA DEPARTMENT OF TRANSPORTATION AND PUBLIC FACILITIES SKAGWAY - REPLACE CAPTAIN WILLIAM HENRY MOORE BRIDGE EROSION SEDIMENT CONTROL PLAN</p>
---	--	--

FILE C:\civil\3D Projects\24\70732-01\Civil\1\SC14-CT-P-EC-CRM.dwg DATE 8/16/2016 17:40 LAYOUT P4 DESIGNED HOBBS CHECKED NOBLE DRAFTED WESTPHAL

NO.	DATE	REVISION	STATE	PROJECT DESIGNATION	YEAR	SHEET NO.	TOTAL SHEETS
			ALASKA	0972016/Z684590000	2016	P4	59

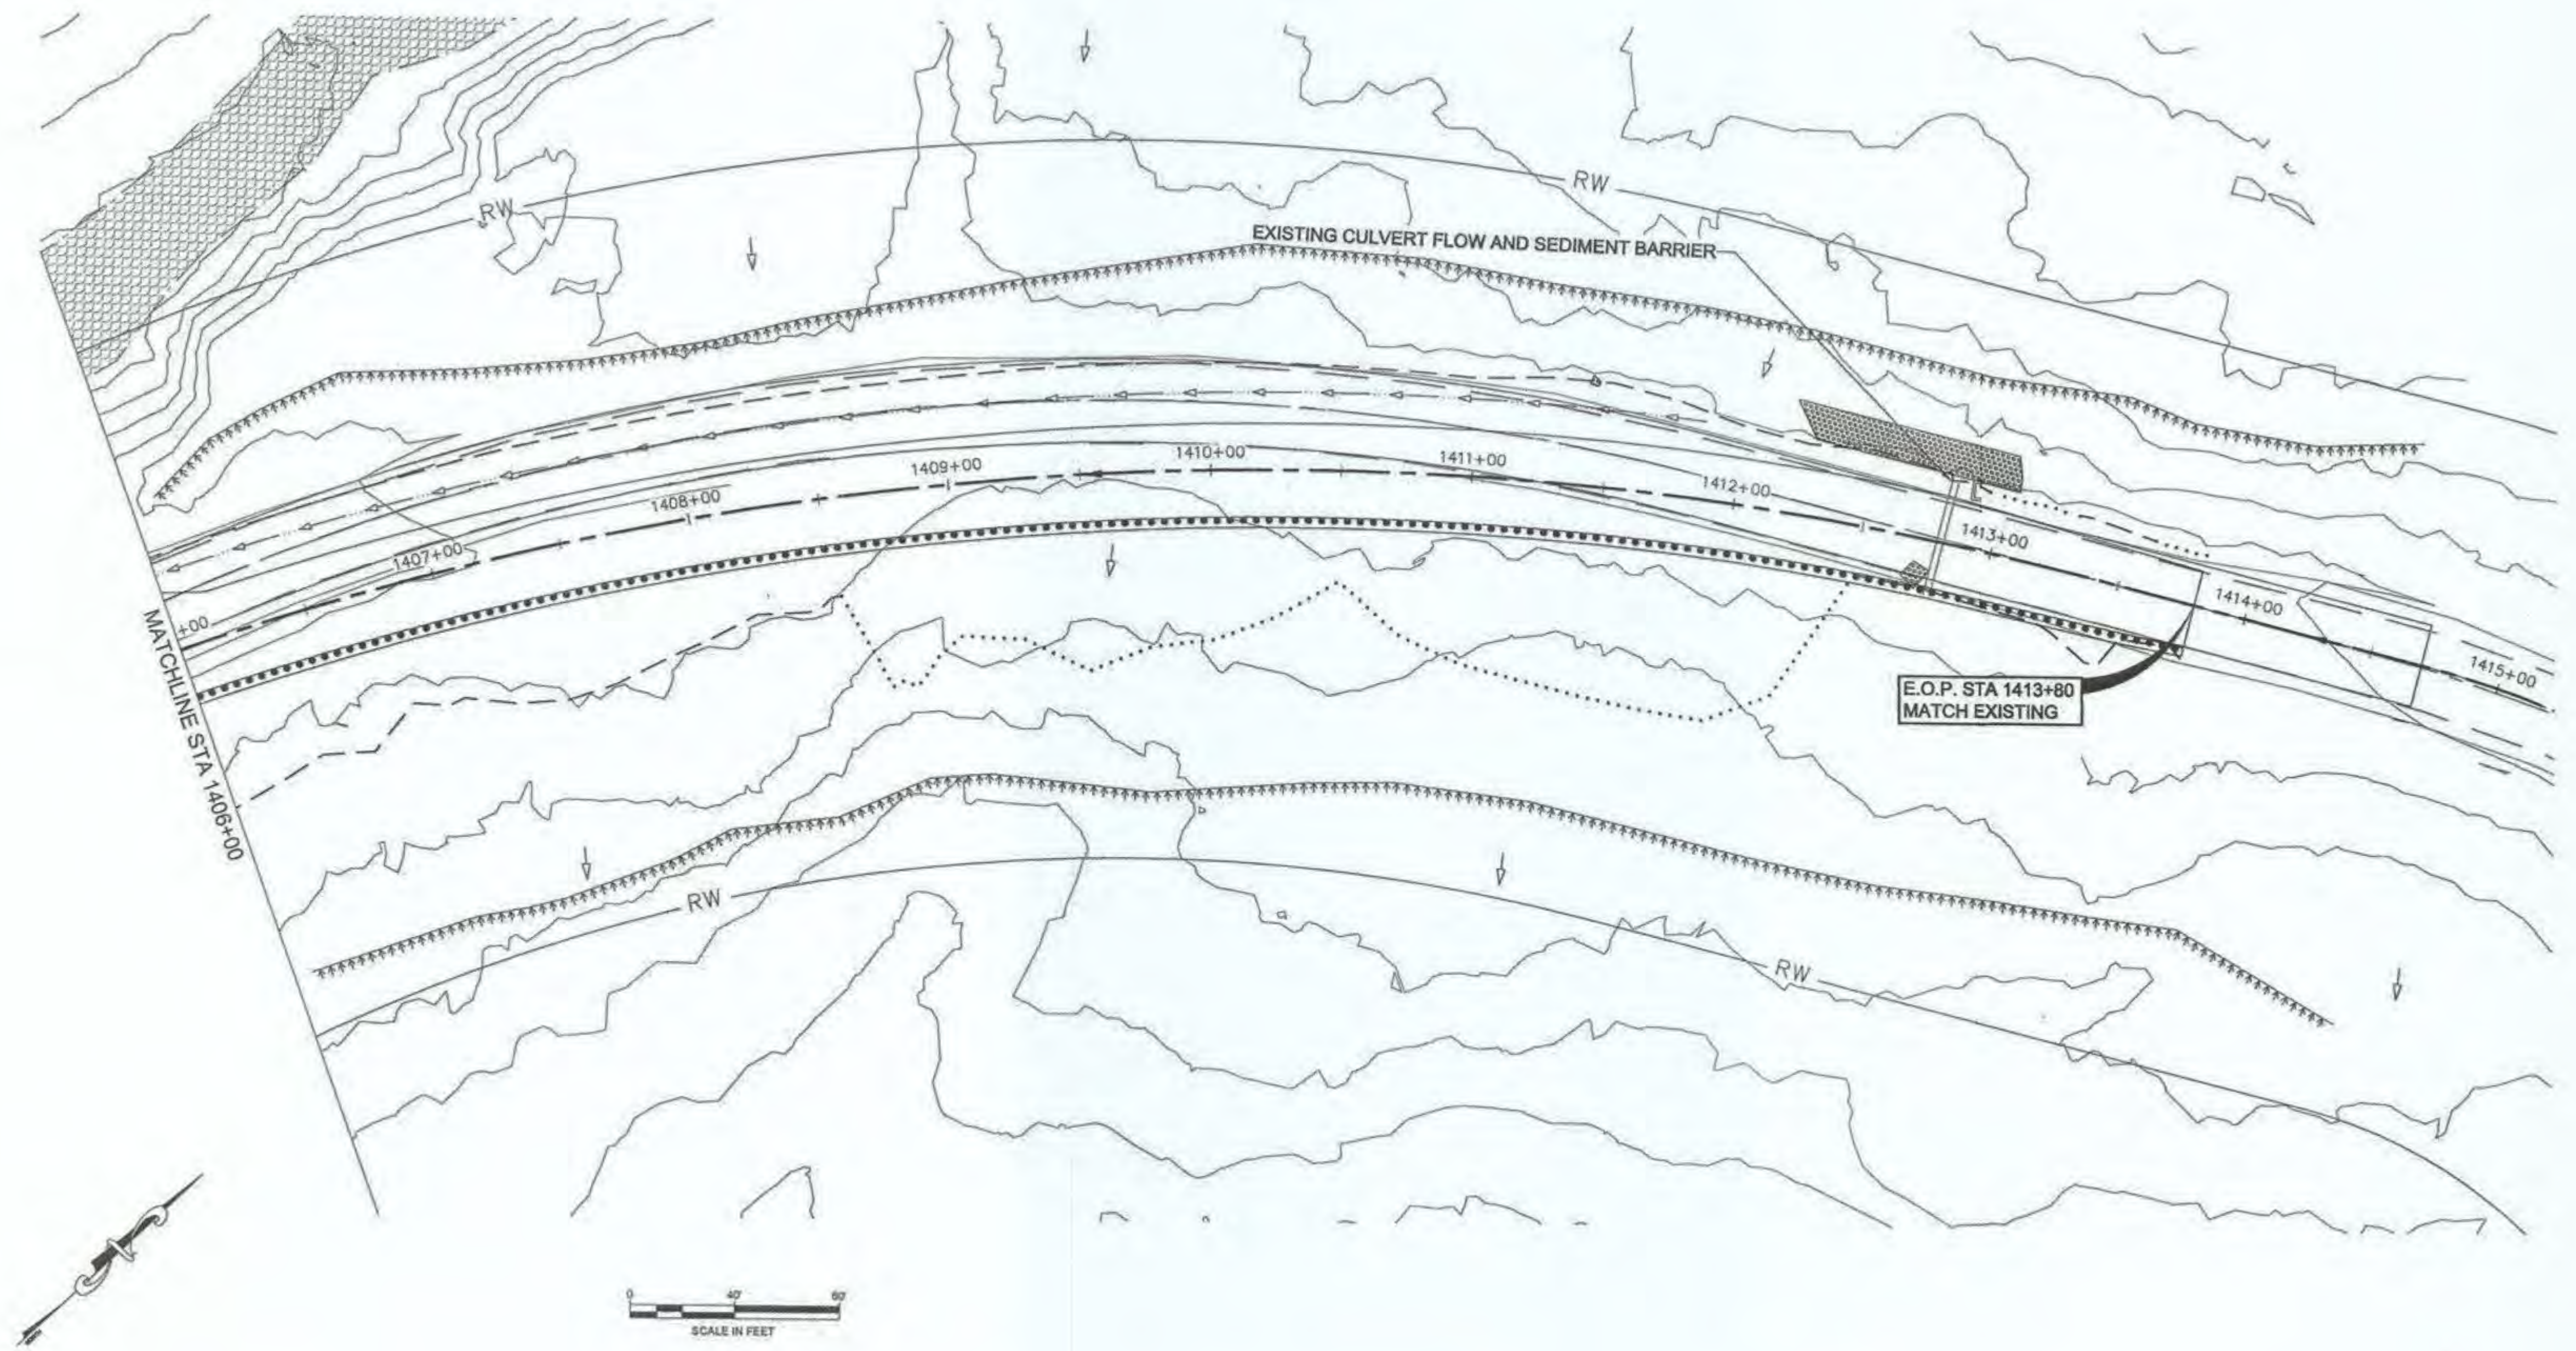


P 6/9/20

<p>PLANS DEVELOPED BY: DOWL 5368 COMMERCIAL BLVD., JUNEAU, AK 99801 (907) 780-3533 #AECL848</p>	<p>ESCP NOT SEALED IN ACCORDANCE WITH ALASKA HIGHWAY PRECONSTRUCTION MANUAL SECTION 1120.7.3 DATED NOVEMBER 15, 2013</p>	<p>STATE OF ALASKA DEPARTMENT OF TRANSPORTATION AND PUBLIC FACILITIES SKAGWAY - REPLACE CAPTAIN WILLIAM HENRY MOORE BRIDGE EROSION SEDIMENT CONTROL PLAN</p>
---	--	--

NO.	DATE	REVISION	STATE	PROJECT DESIGNATION	YEAR	SHEET NO.	TOTAL SHEETS
			ALASKA	0972016/Z684590000	2016	P5	59

FILE: C:\Civil\30 Projects\24\70732-01\Civil\1\SC14-CT-P-EC-CMM.dwg
 DATE: 8/29/2016 10:28
 LAYOUT: P5
 DESIGNED: HOBBS
 CHECKED: NOBLE
 DRAFTED: WESTPHAL

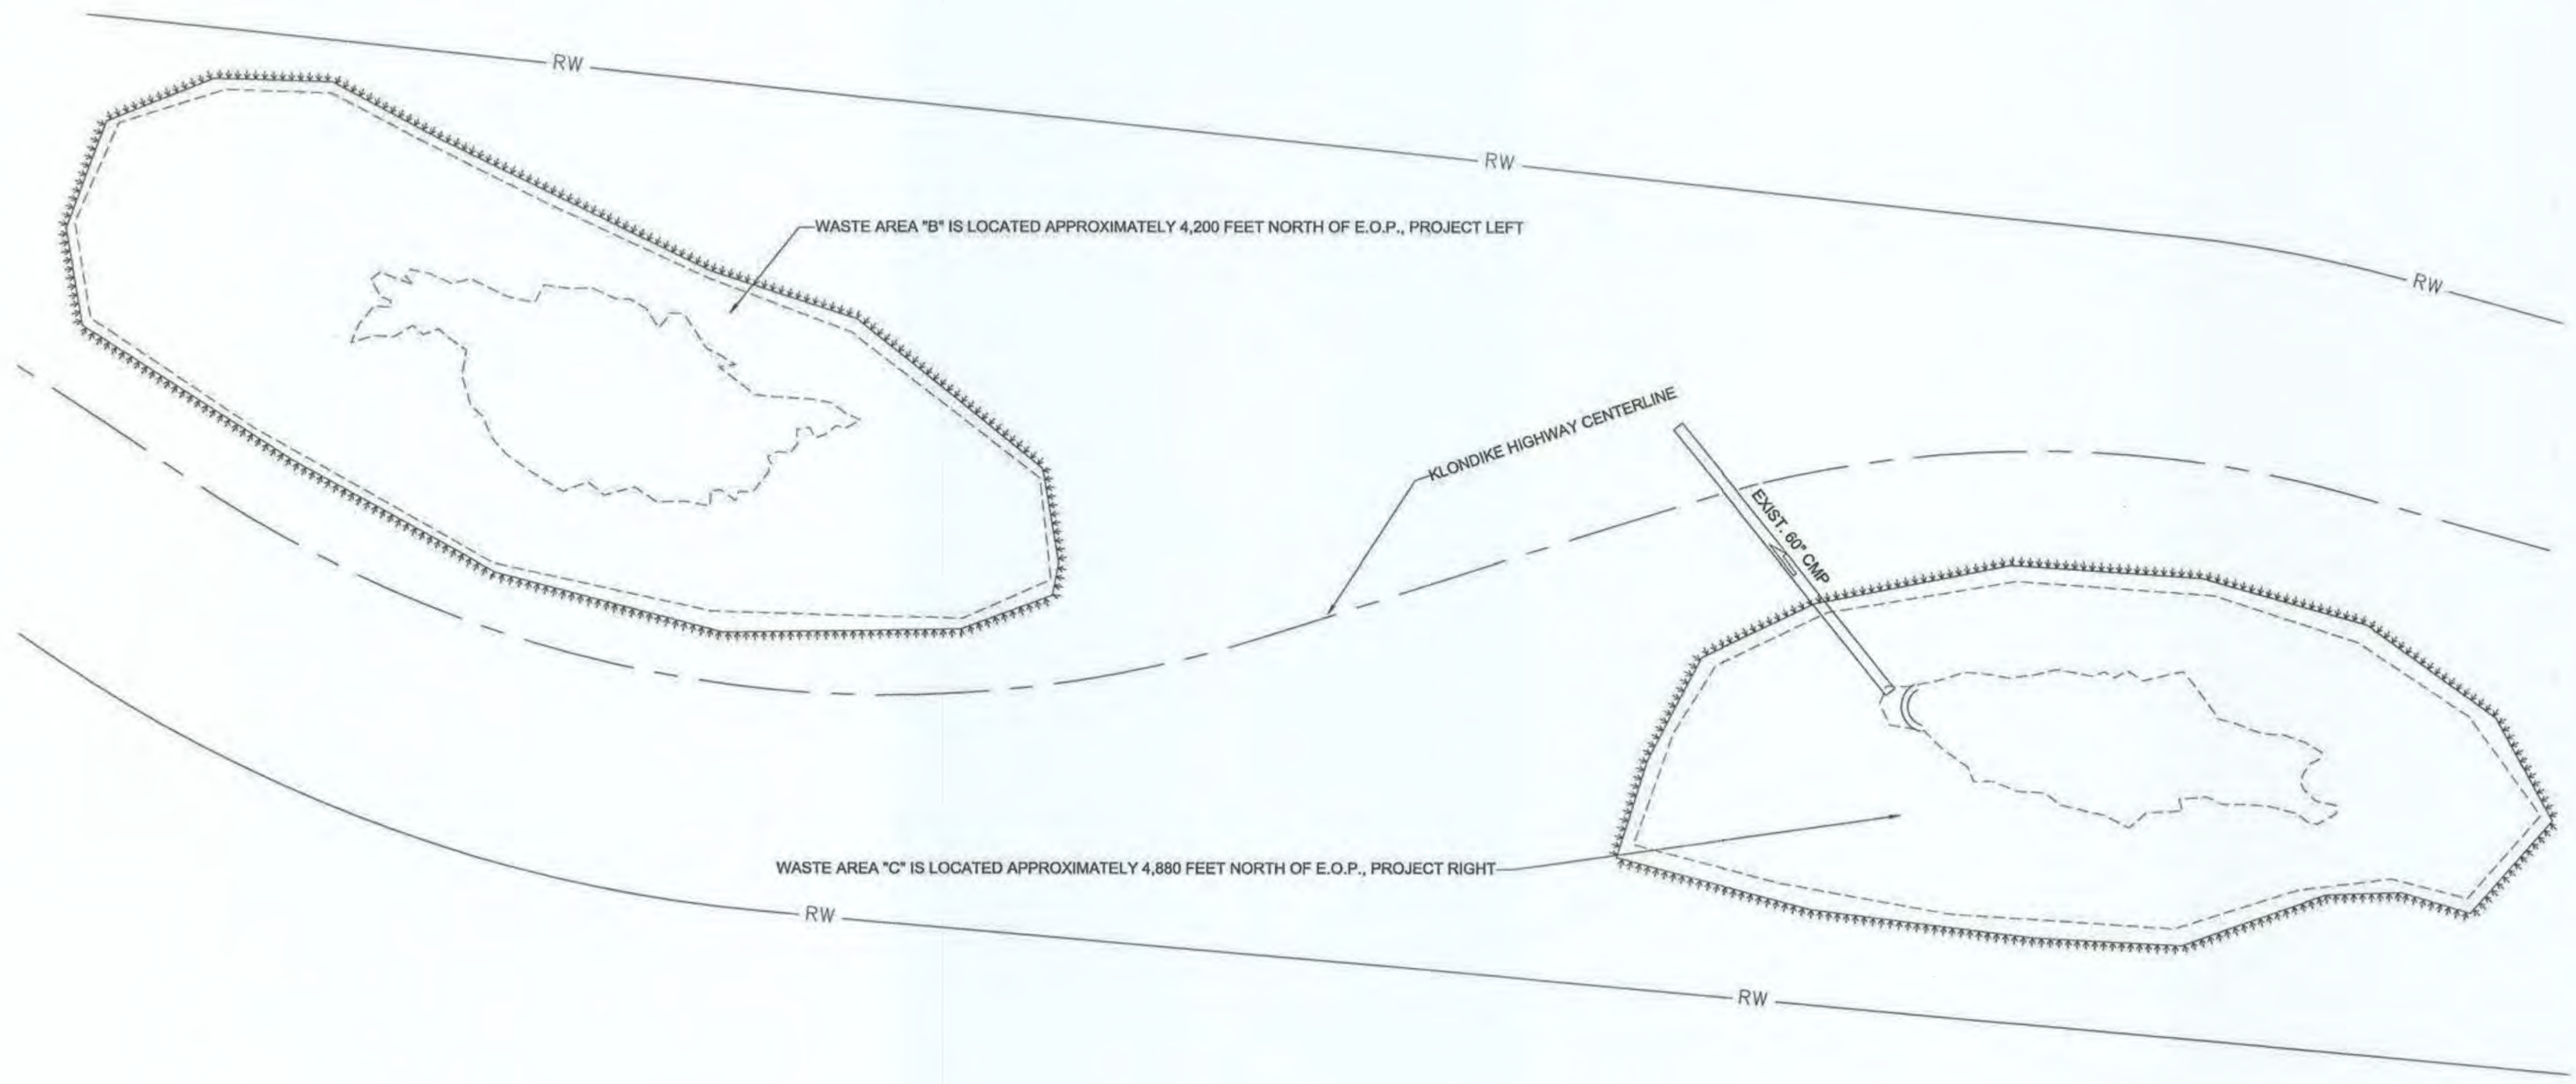

NOTES:
 WASTE AREAS ARE CONSIDERED PART OF THE DISTURBED AREA AND APPROPRIATE BMPs WILL BE INSTALLED TO PREVENT SEDIMENT CONTAMINATION TO WATERS. PROTECT ALL DISCHARGE POINTS NEAR WASTE AREAS.




J 8/9/20

PLANS DEVELOPED BY: DOWL 5368 COMMERCIAL BLVD. JUNEAU, AK 99801 (907) 780-3533 #AECL848	ESCP NOT SEALED IN ACCORDANCE WITH ALASKA HIGHWAY PRECONSTRUCTION MANUAL SECTION 1120.7.3 DATED NOVEMBER 15, 2013	STATE OF ALASKA DEPARTMENT OF TRANSPORTATION AND PUBLIC FACILITIES SKAGWAY - REPLACE CAPTAIN WILLIAM HENRY MOORE BRIDGE EROSION SEDIMENT CONTROL PLAN
--	---	--



NO.	DATE	REVISION	STATE	PROJECT DESIGNATION	YEAR	SHEET NO.	TOTAL SHEETS
			ALASKA	0972016/Z684590000	2016	S1	59

WASTE AREA NOTES

- WASTE AREAS B AND C ARE LOCATED NORTH OF THE PROJECT AREA AS SHOWN IN THE MAP BELOW. WASTE AREA B IS APPROXIMATELY 1.35 ACRES IN SIZE AND IS ESTIMATED TO ACCOMMODATE 25,000 CUBIC YARDS OF WASTE MATERIAL. AREA C IS APPROXIMATELY 1.07 ACRES AND IS ESTIMATED TO ACCOMMODATE 17,000 CUBIC YARDS OF WASTE MATERIAL. FILL WASTE AREAS B AND C BEFORE USING WASTE AREA A.
- THE FINAL ELEVATION OF BOTH WASTE AREAS SHALL BE THREE FEET BELOW THE KLONDIKE HIGHWAY ELEVATION ADJACENT TO THE WASTE AREA AND BE GRADED TO DRAIN. LEAVE THE CULVERT OUTLET FROM WASTE AREA C CLEAR TO DRAIN. COORDINATE FINAL CONDITION OF THIS AREA WITH THE ENGINEER.

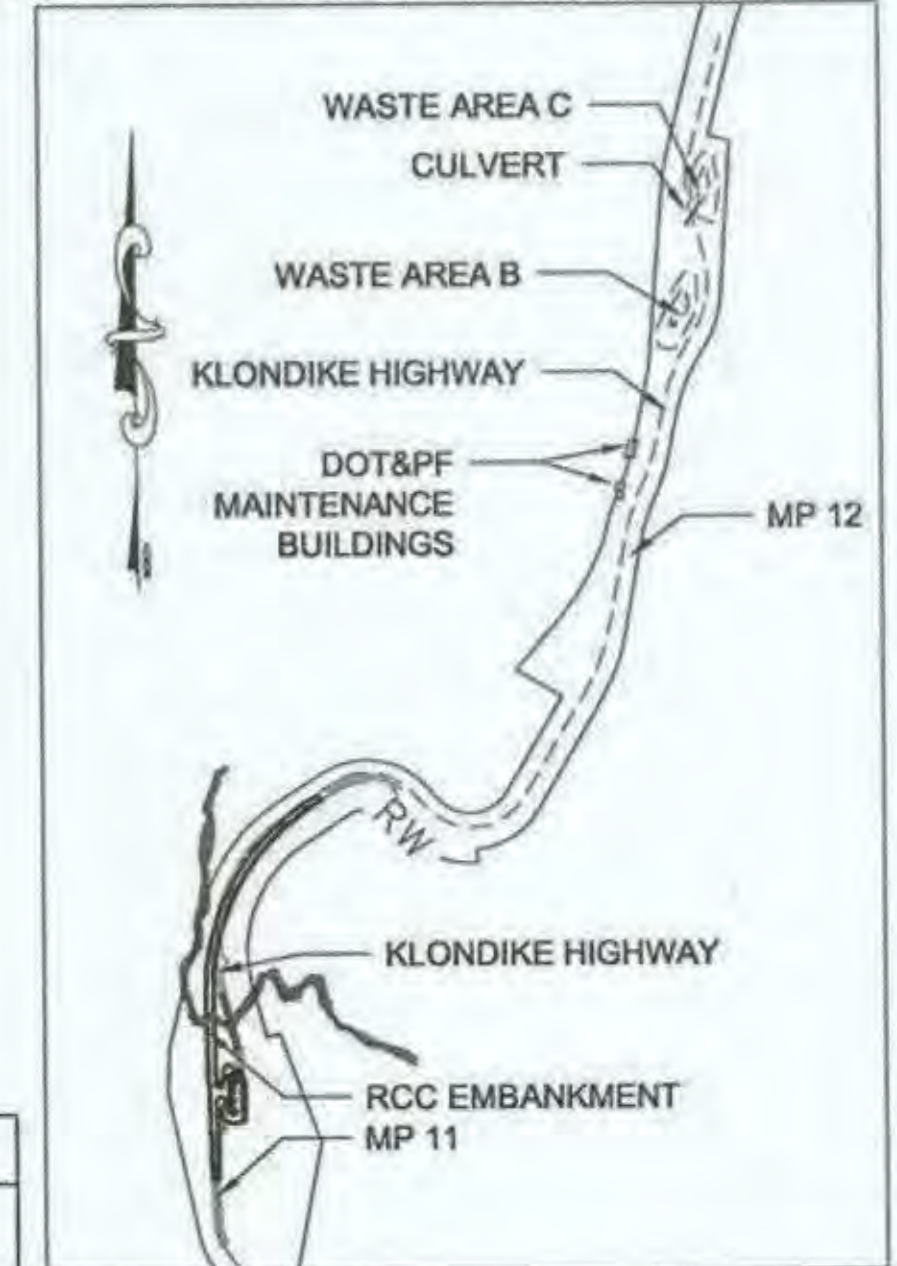

WASTE AREA LOCATIONS

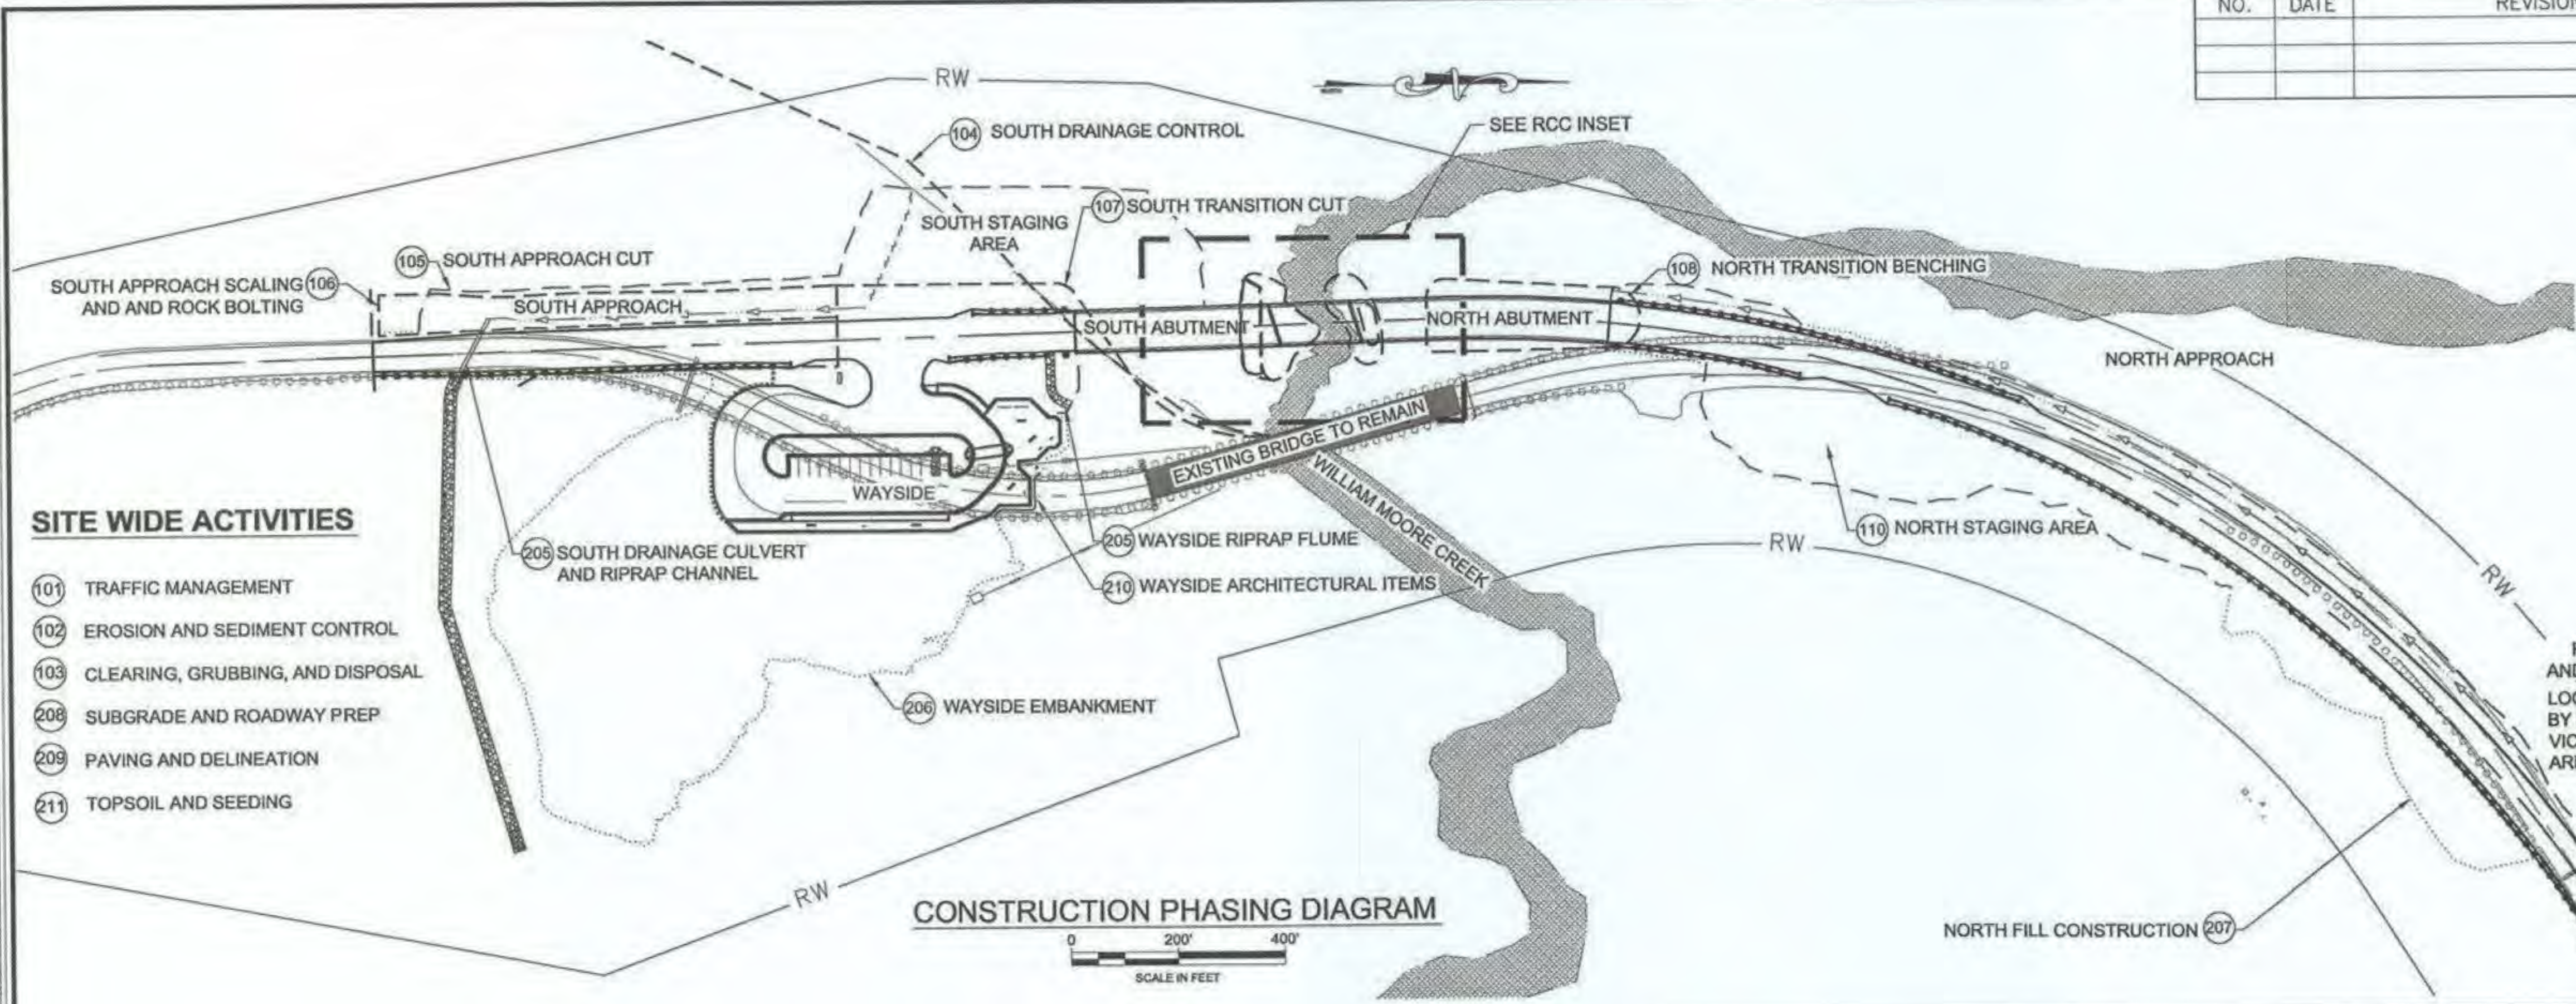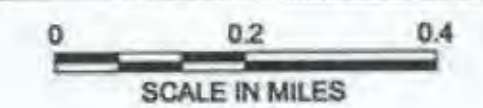

SITE WIDE ACTIVITIES

- 101 TRAFFIC MANAGEMENT
- 102 EROSION AND SEDIMENT CONTROL
- 103 CLEARING, GRUBBING, AND DISPOSAL
- 208 SUBGRADE AND ROADWAY PREP
- 209 PAVING AND DELINEATION
- 211 TOPSOIL AND SEEDING

CONSTRUCTION PHASING DIAGRAM



DEPENDENCY TABLE


COMPLETE		BEFORE STARTING	
WORK ITEM #	TITLE	WORK ITEM #	TITLE
105	SOUTH APPROACH CUT	109	SOUTH ABUTMENT CUT
107	SOUTH TRANSITION CUT		
112	NORTH ABUTMENT ROCK BOLTS	114	NORTH ABUTMENT CUT
113	NORTH ABUTMENT FOUNDATION BOLTING		
111	SOUTH ABUTMENT FOUNDATION BOLTING	203	MULTI-PLATE ARCH CONCRETE LEVELING PAD
113	NORTH ABUTMENT FOUNDATION BOLTING		
201	RCC TEST STRIP AND TEST SECTION	204	RCC EMBANKMENT PLACEMENT

WORK ITEM TABLE

ANTICIPATED SEASON 1 ITEMS	
WORK ITEM #	TITLE
101	TRAFFIC MANAGEMENT
102	EROSION AND SEDIMENT CONTROL
103	CLEARING, GRUBBING, AND DISPOSAL
104	SOUTH DRAINAGE CONTROL
105	SOUTH APPROACH AND STAGING AREA CUT
106	SOUTH APPROACH SCALING AND ROCK BOLTING
107	SOUTH TRANSITION CUT
108	NORTH TRANSITION BENCHING
109	SOUTH ABUTMENT CUT
110	NORTH STAGING AREA CUT
111	TEMPORARY ROCKFALL PROTECTION
112	SOUTH ABUTMENT FOUNDATION BOLTING
113	NORTH ABUTMENT ROCK BOLTING
114	NORTH ABUTMENT FOUNDATION BOLTING
115	NORTH ABUTMENT CUT
116	REMOVAL OF EXCAVATION SPOIL FROM STREAMBED
206	WAYSIDE EMBANKMENT
207	NORTH FILL CONSTRUCTION

WORK ITEM TABLE (CONT.)

ANTICIPATED SEASON 2 ITEMS	
WORK ITEM #	TITLE
201	RCC TEST STRIP AND TEST SECTION
202	MULTI-PLATE ARCH CONCRETE LEVELING PAD
203	MULTI-PLATE ARCH CONSTRUCTION
204	RCC EMBANKMENT
205	SOUTH DRAINAGE CULVERT/RIPRAP CHANNEL AND WAYSIDE RIPRAP FLUME
206	WAYSIDE EMBANKMENT (CONTINUED)
207	NORTH FILL CONSTRUCTION (CONTINUED)
208	SUBGRADE AND ROADWAY PREP
209	PAVING AND DELINEATION
210	WAYSIDE ARCHITECTURAL ITEMS
211	TOPSOIL AND SEEDING

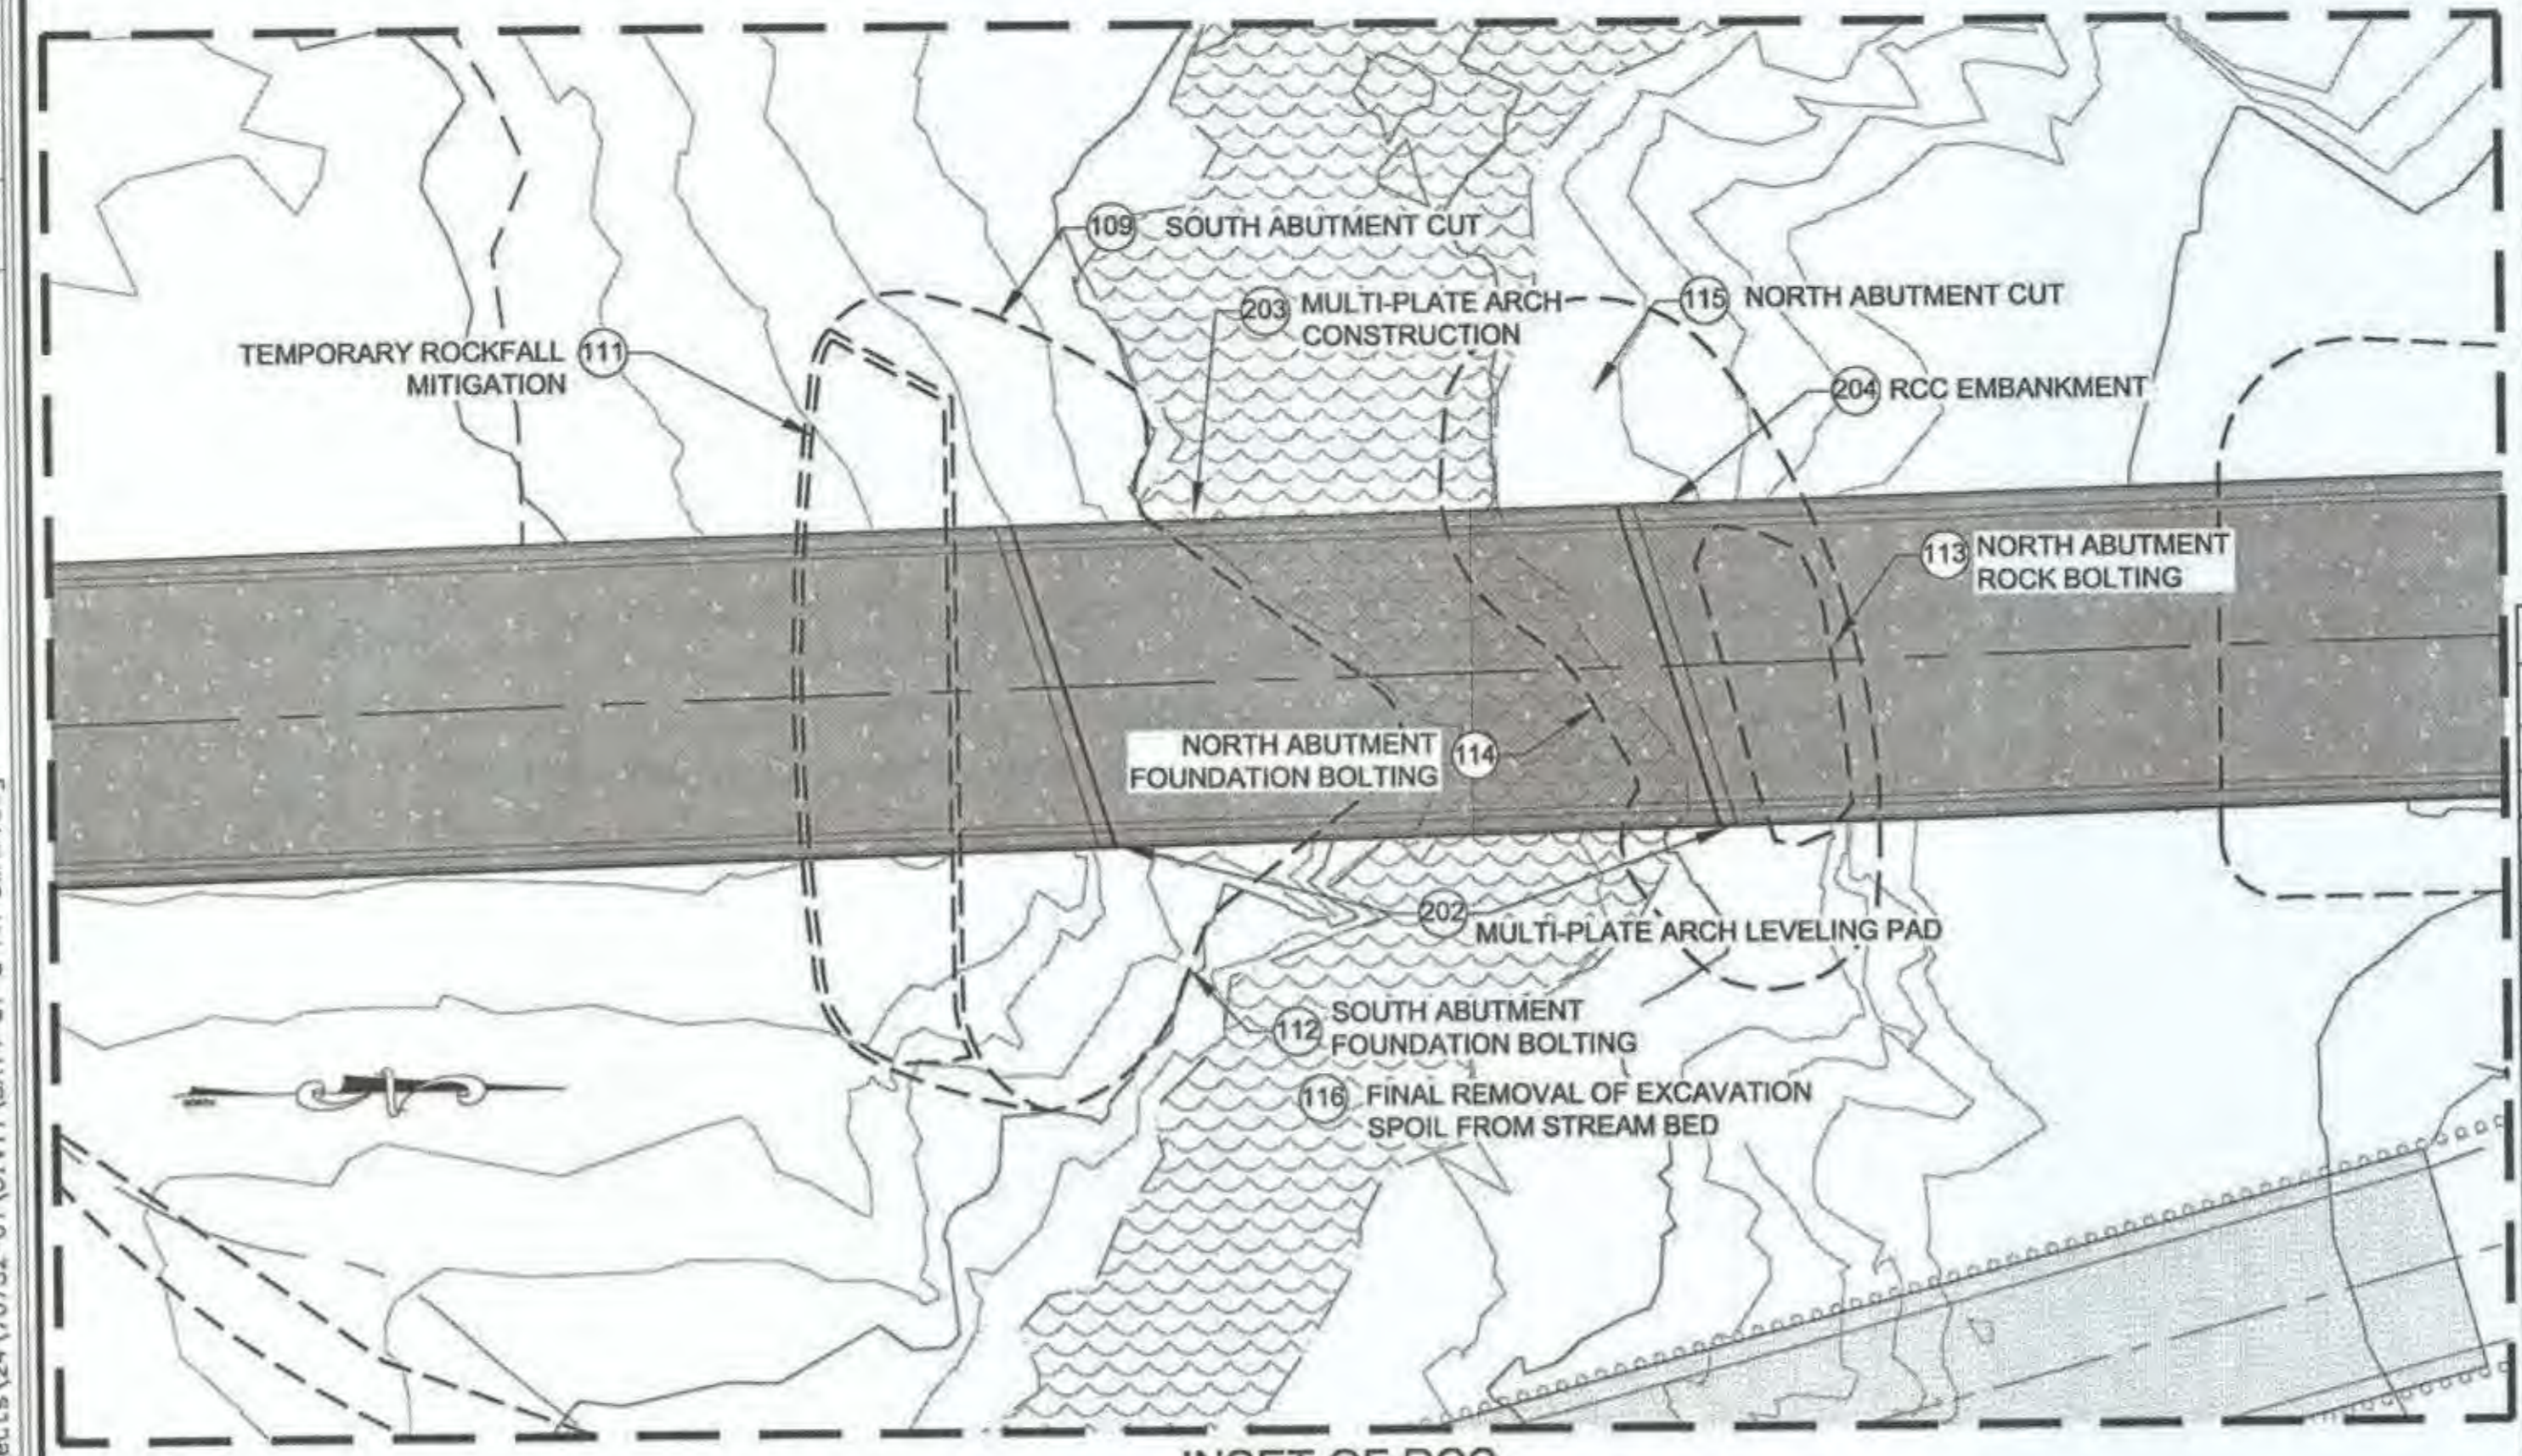

INSET OF RCC



PLANS DEVELOPED BY:
DWM
5368 COMMERCIAL BLVD.
JUNEAU, AK 99801
(907) 780-3533
#AECL848



STATE OF ALASKA
DEPARTMENT OF TRANSPORTATION
AND PUBLIC FACILITIES
**SKAGWAY - REPLACE CAPTAIN
WILLIAM HENRY MOORE BRIDGE**
**CONSTRUCTION PHASING
DIAGRAM**


DATE: 8/29/2016 10:57 LAYOUT: S1 CHECKED: NOBLE DRAFTED: WESTPHAL FILE: C:\Civ\1_3D Projects\24\70732-01\Civ\1\SA14-CT-S-PR-CWM.dwg

TRAFFIC CONTROL NOTES

- IT IS THE INTENT OF THIS TRAFFIC CONTROL PLAN (TCP) TO ILLUSTRATE SOME BUT NOT ALL OF THE TRAFFIC CONTROL CONFIGURATIONS THAT WILL BE REQUIRED BY THIS PROJECT. TRAFFIC CONTROL PLANS FOR CONFIGURATIONS NOT COVERED BY THIS TCP SHALL BE DEVELOPED BY THE CONTRACTOR. ALL TCP'S MUST BE SUBMITTED FOR APPROVAL BY THE ENGINEER PRIOR TO USE.
- TWO LANES SHALL BE MAINTAINED AT ALL TIMES IN NON-WORK AREAS AND DURING NON-WORKING HOURS. FLAGGERS MUST BE PRESENT FOR ANY LANE CLOSURES. FLAGGER STATIONS MUST BE ILLUMINATED AT NIGHT.
- TEMPORARY TRAFFIC LANES SHALL BE A MINIMUM OF 11 FEET WIDE.
- CONSTRUCTION SIGNING SHALL BE IN PLACE ONLY WHEN THE CONDITIONS EXIST FOR WHICH THE SIGNS ARE INTENDED. CONSTRUCTION SIGNS SHALL BE PLACED SUCH THAT THEY DO NOT OBSCURE EXISTING TRAFFIC SIGNS.
- THE UNEVEN LANES (W8-11) SIGN SHOULD BE USED DURING OPERATIONS THAT CREATE A DIFFERENCE IN ELEVATION OF 2 INCHES OR GREATER BETWEEN ADJACENT LANES.
- TYPE C WARNING LIGHTS SHALL BE USED ON ALL CHANNELIZING DEVICES PLACED ALONG OR AROUND ROADWAY HAZARDS.
- KEEP THE PUBLIC INFORMED OF CONSTRUCTION ACTIVITIES. SEE SECTION 643-3.03 OF THE SPECIAL PROVISIONS.
- EXPECT HIGHER TRAFFIC VOLUMES ASSOCIATED WITH THE ARRIVAL & DEPARTURE OF FERRIES AT THE ALASKA MARINE HIGHWAY TERMINAL IN SKAGWAY.
- ALL TRAFFIC CONTROL PLANS SUBMITTED BY THE CONTRACTOR SHALL BE NUMBERED. ALL TRAFFIC CONTROL PLANS THAT USE A TYPICAL APPLICATION AS DESCRIBED IN THE MUTCD SHALL REFERENCE THE TYPICAL APPLICATION. EXAMPLE: TCP 3, MUTCD TA-10.
- DO NOT RESTRICT TRAFFIC DURING THE TIMES, EVENTS, DATES AND SEASONS FOUND IN SECTION 643-3.08 OF THE SPECIAL PROVISIONS.
- PROVIDE PCMBs FOR PERMANENT CONSTRUCTION SIGNING TWO WEEKS PRIOR TO START OF WORK THROUGH ONE WEEK AFTER COMPLETION. USE THE PCMB TO INFORM THE PUBLIC OF CONSTRUCTION STATUS. MESSAGE AND LOCATION WILL BE AS INDICATED IN THE APPROVED TCP.


NO.	DATE	REVISION	STATE	PROJECT DESIGNATION	YEAR	SHEET NO.	TOTAL SHEETS
			ALASKA	0972016/Z684590000	2016	T1	59

TCP LEGEND

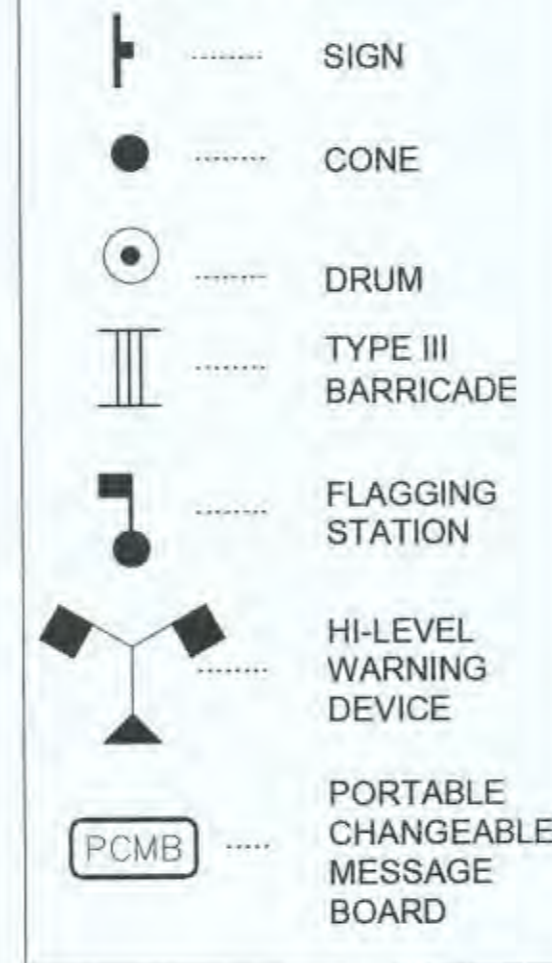

TCP SETUP TABLE

POSTED SPEED OR ANTICIPATED OPERATING SPEED (MPH)	MIN MERGING TAPER LENGTH (L) IN FEET FOR A GIVEN WIDTH OF OFFSET (W) IN FEET			MIN NUMBER OF DEVICES FOR A GIVEN WIDTH OF OFFSET (W) IN FEET			MAX DEVICE SPACING IN FEET		BUFFER SPACE (FT)
	10	11	12	10	11	12	ALONG TAPER	ALONG TANGENT	
20 OR BELOW	70	75	80	5	5	5	25	50	115
25	105	115	125	6	6	6	25	50	155
30	150	165	180	6	7	7	30	60	200
35	205	225	245	7	8	8	35	70	250
40	270	295	320	8	9	9	40	80	305
45	450	495	540	11	12	13	45	90	360

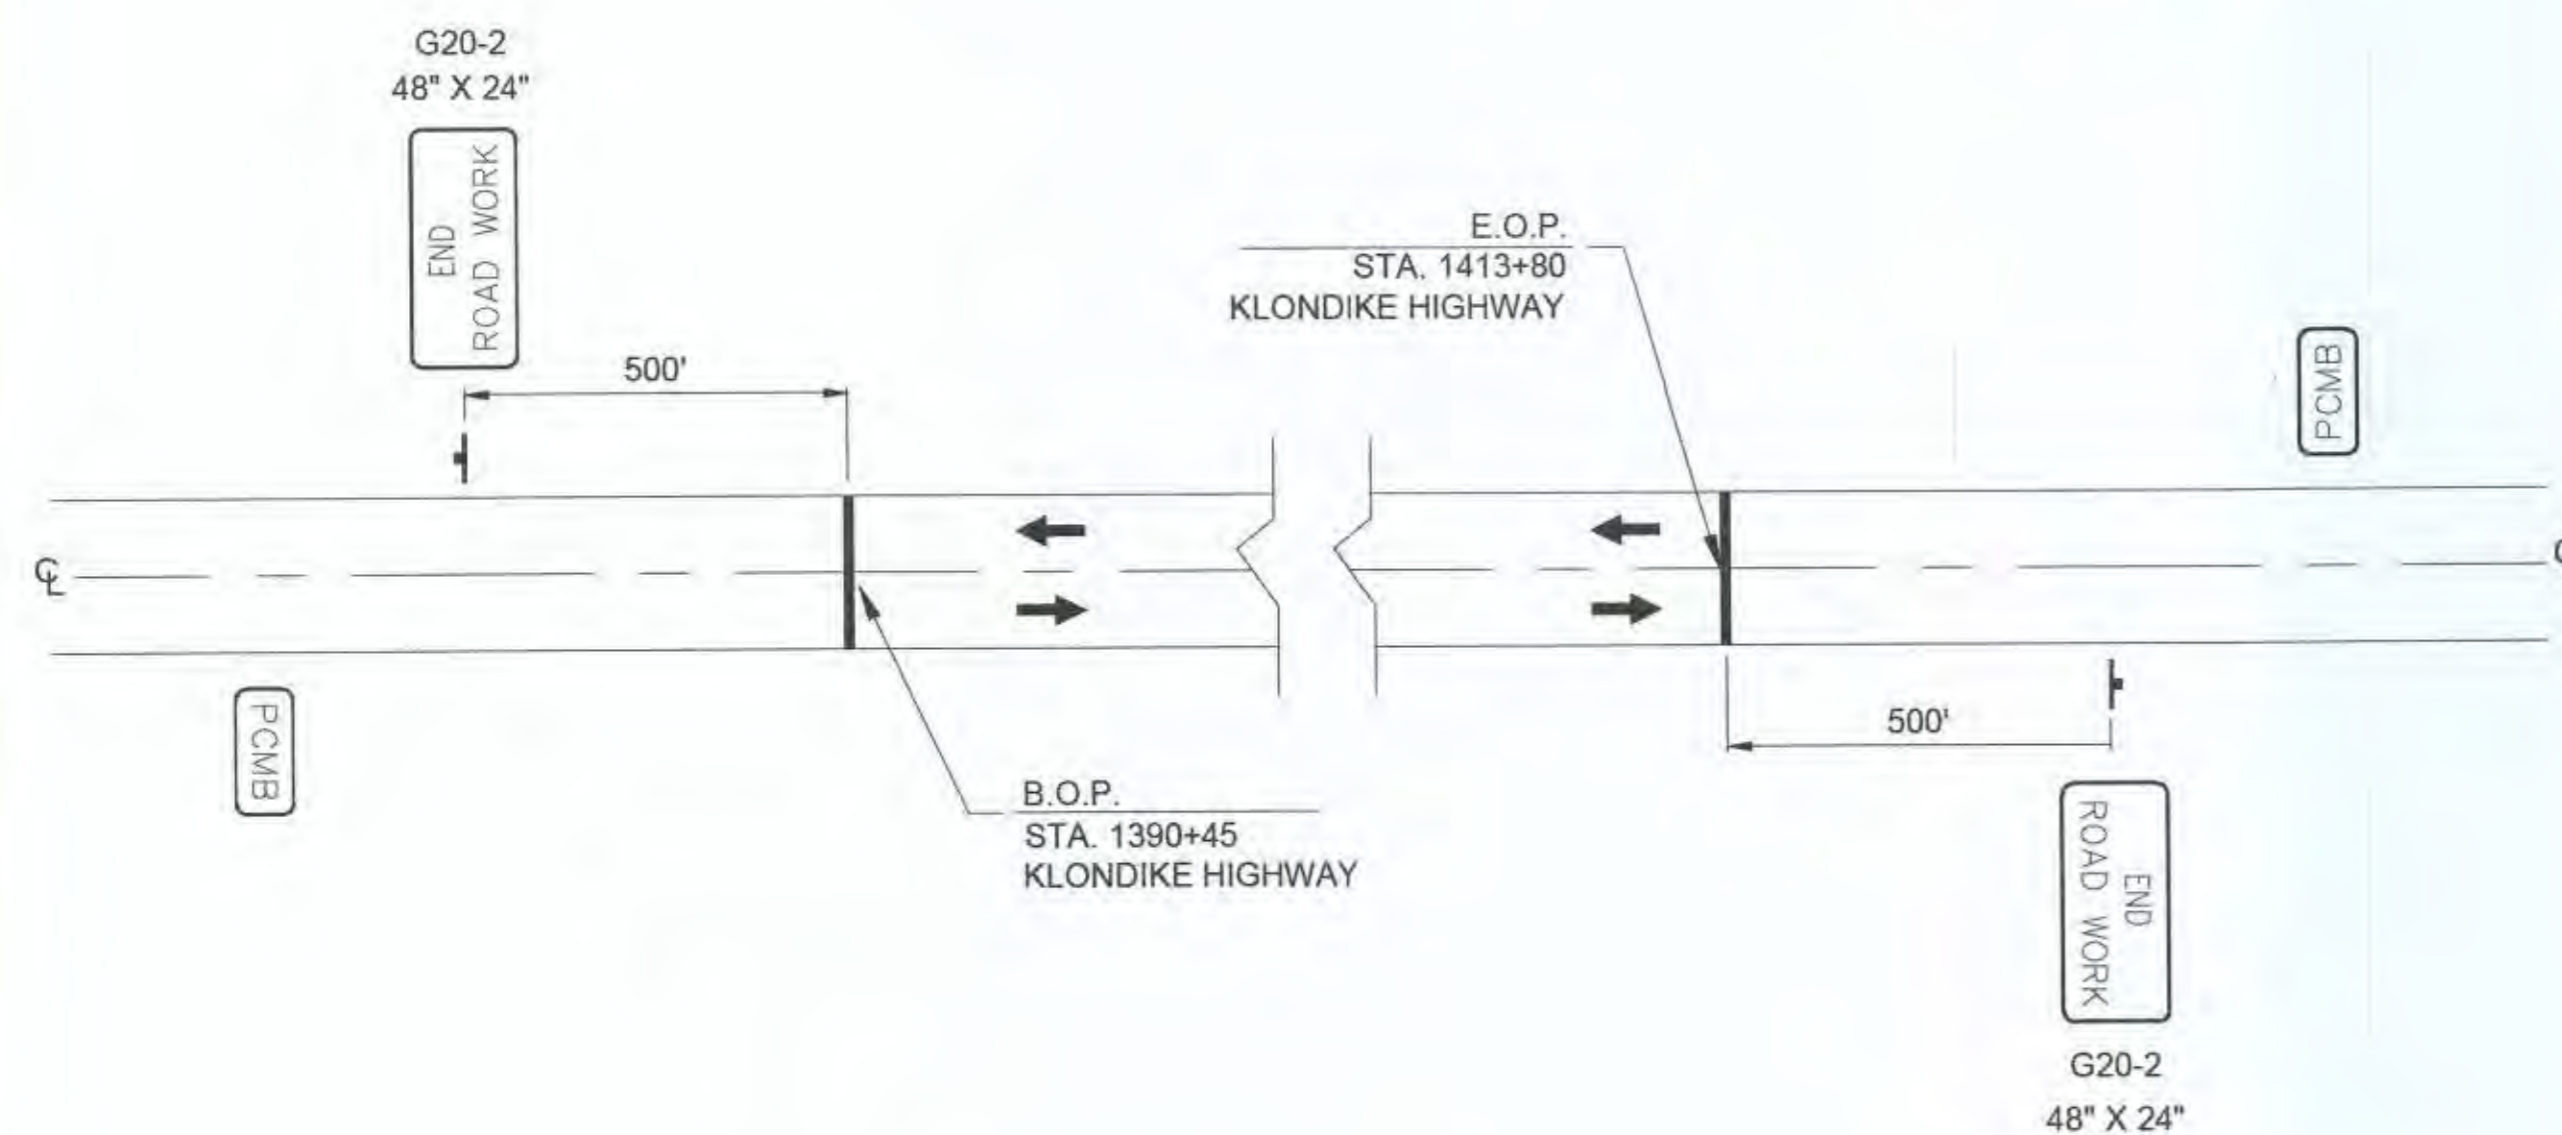

PERMANENT CONSTRUCTION SIGNING



SIGN FOR 48 HOUR ADVANCED NOTICE OF BLASTING

SIGNS SHALL BE ORANGE BACKGROUND WITH BLACK BORDER AND TEXT. SIGNS SHALL INCLUDE THE DAY OF CLOSURE, BEGINNING TIME OF CLOSURE, AND EXPECTED TIME THE ROAD WILL REOPEN. SIGNS SHALL BE IN PLACE A MINIMUM OF 48 HOURS PRIOR TO ROAD CLOSURE. REMOVABLE PANELS MAY BE USED TO CHANGE THE DAY AND TIME. SIGN LETTERING IS DESIGNATED BY SIZE AND FHWA "SERIES 2000" LETTER SERIES. (EG "6C" MEANS A LETTER HEIGHT OF 6 INCHES WITH A SERIES C WIDTH)

PLANS DEVELOPED BY:
DOWL
5368 COMMERCIAL BLVD.
JUNEAU, AK 99801
(907) 780-3533
#AECLB48


TCP NOT SEALED IN ACCORDANCE WITH ALASKA HIGHWAY PRECONSTRUCTION MANUAL SECTION 1400.3.5 DATED JANUARY 30, 2012

STATE OF ALASKA
DEPARTMENT OF TRANSPORTATION AND PUBLIC FACILITIES
SKAGWAY - REPLACE CAPTAIN WILLIAM HENRY MOORE BRIDGE


TRAFFIC CONTROL PLAN

FILE: C:\Civil\3D Projects\24\70732-01\Civil\SC14-C1-T-TC-CWHM.dwg DATE: 8/16/2016 12:14 LAYOUT: T2 DESIGNED: HOBBS CHECKED: NOBLE DRAFTED: WESTPHAL


NO.	DATE	REVISION	STATE	PROJECT DESIGNATION	YEAR	SHEET NO.	TOTAL SHEETS
			ALASKA	0972016/Z684590000	2016	T2	59

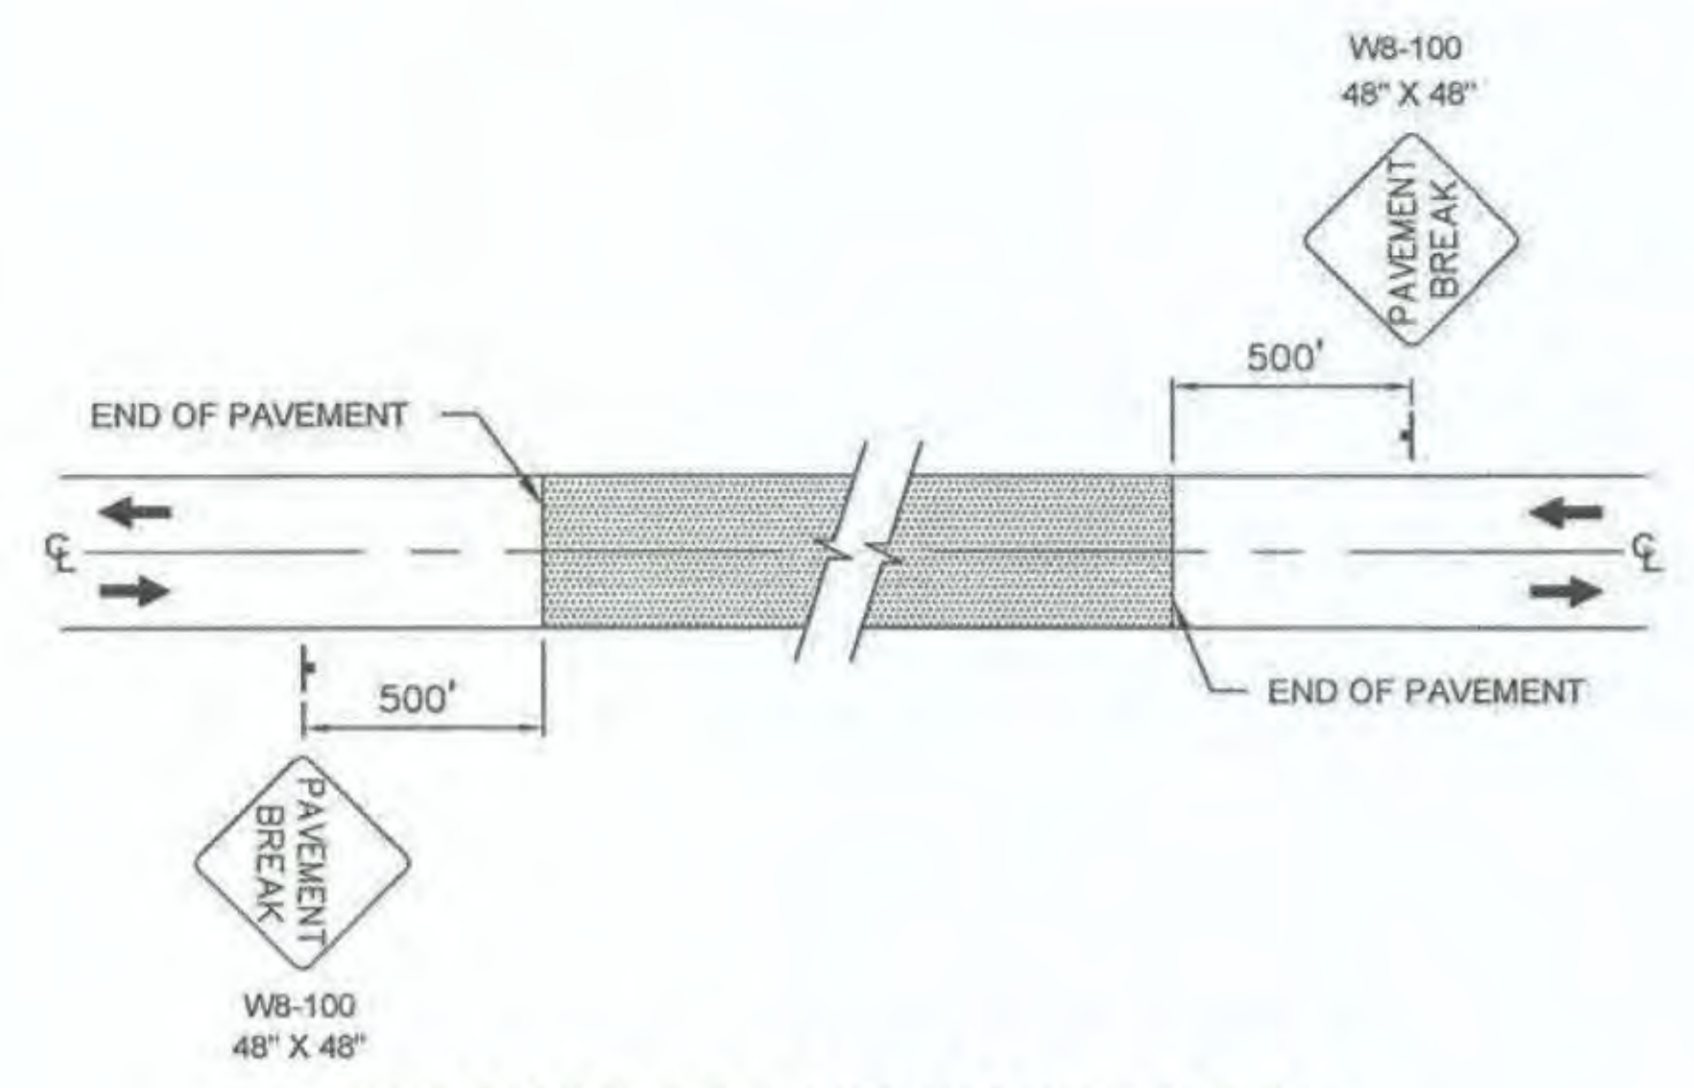

SIGNING FOR UNPAVED AREA

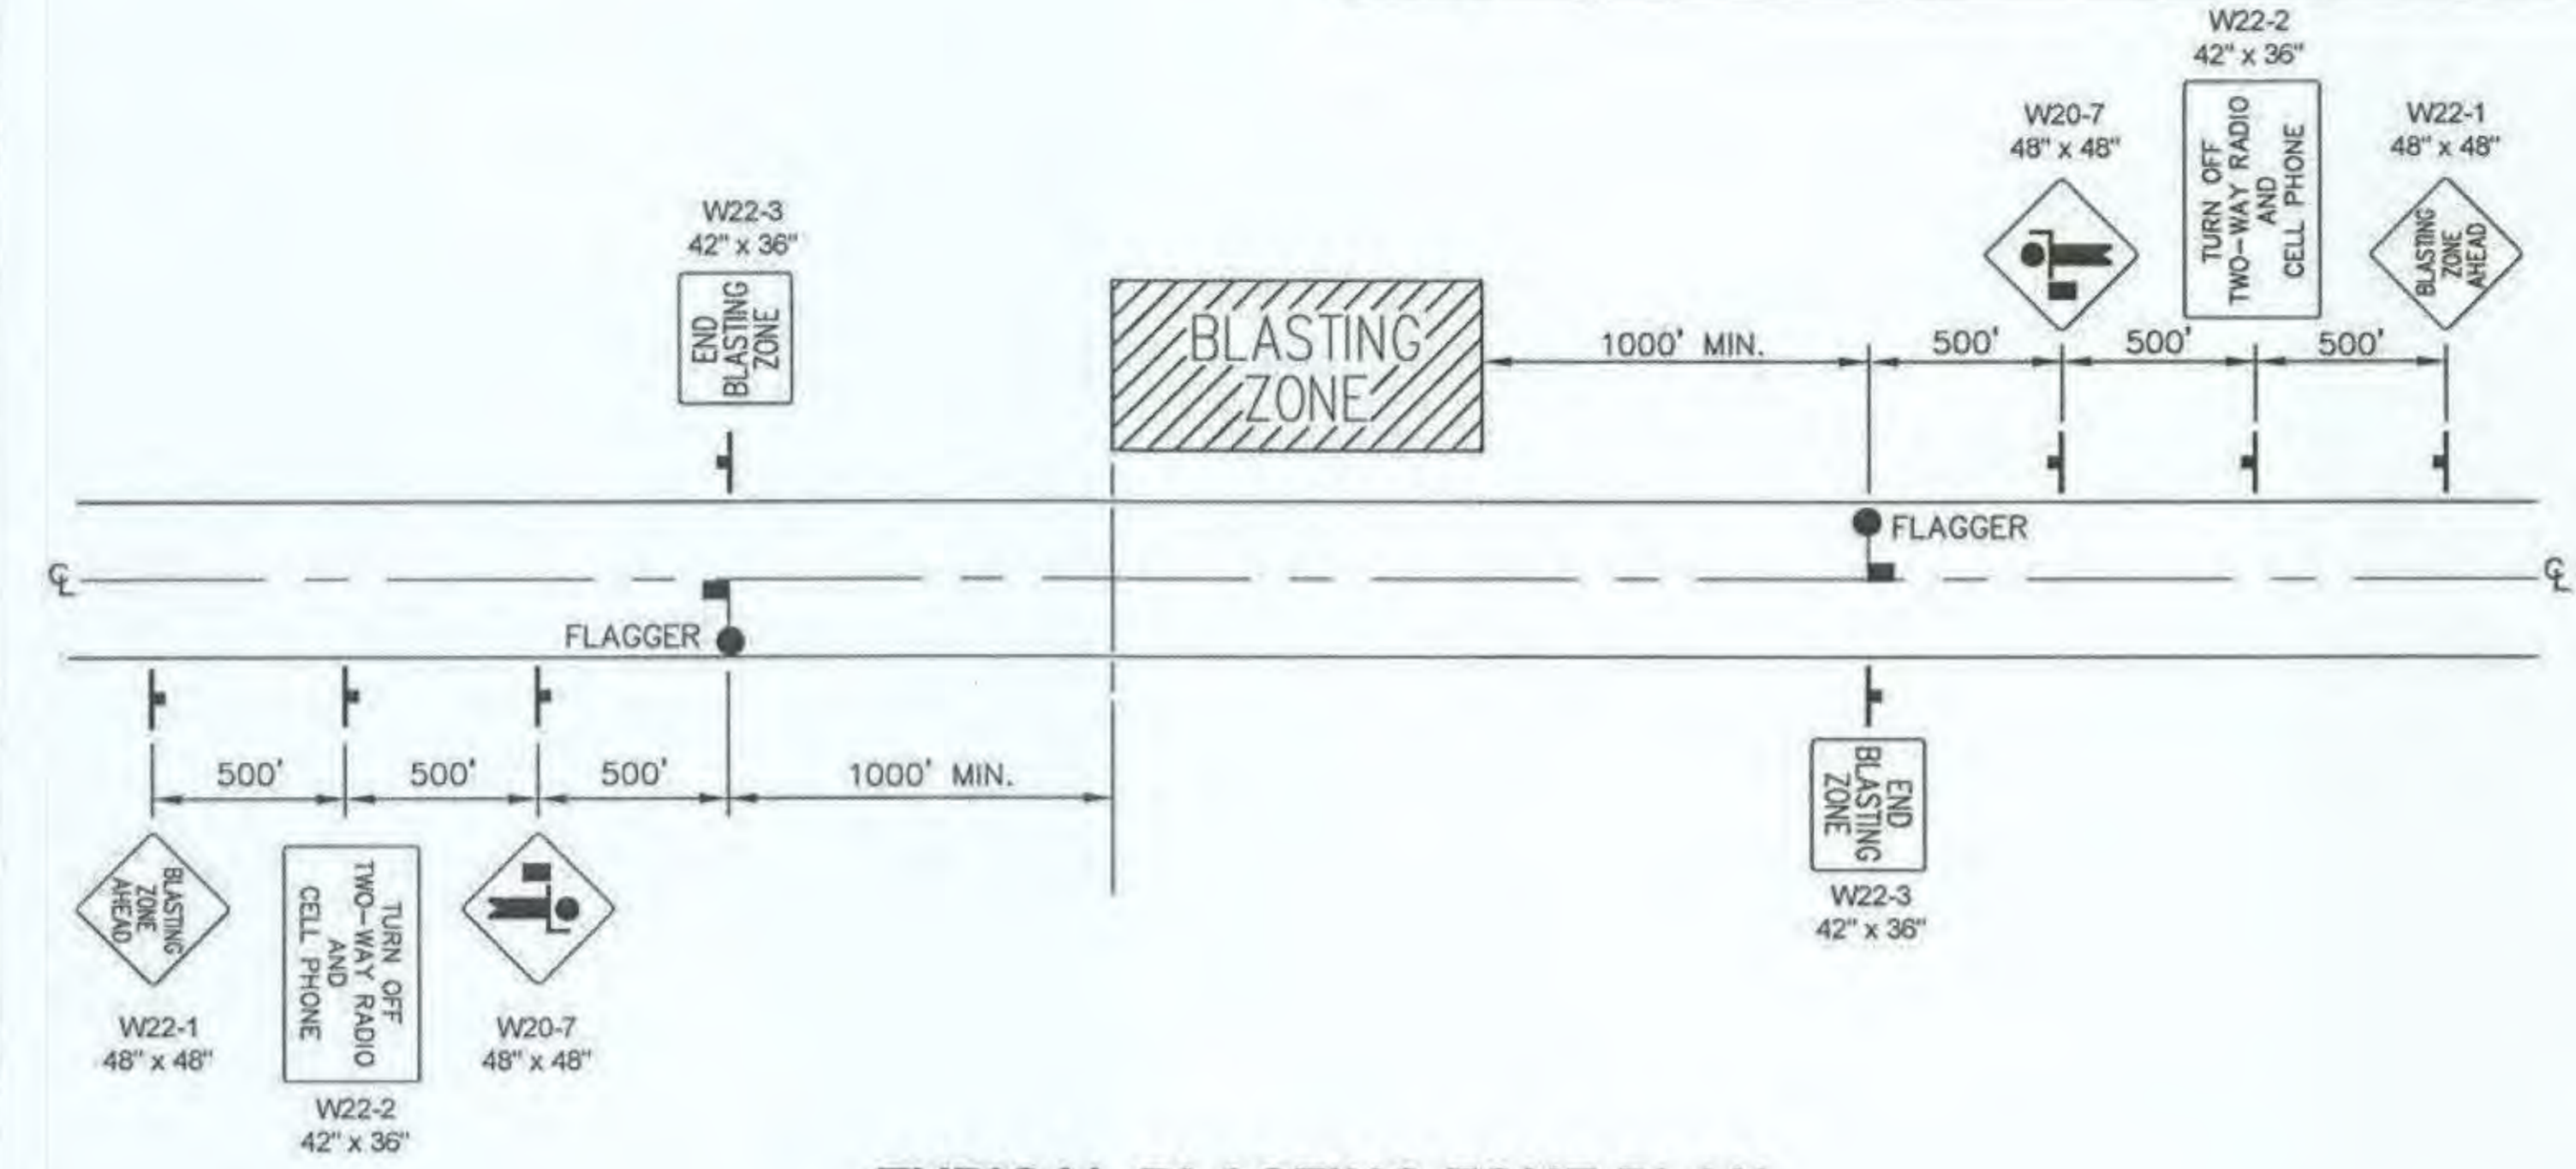

TYPICAL BLASTING ZONE PLAN

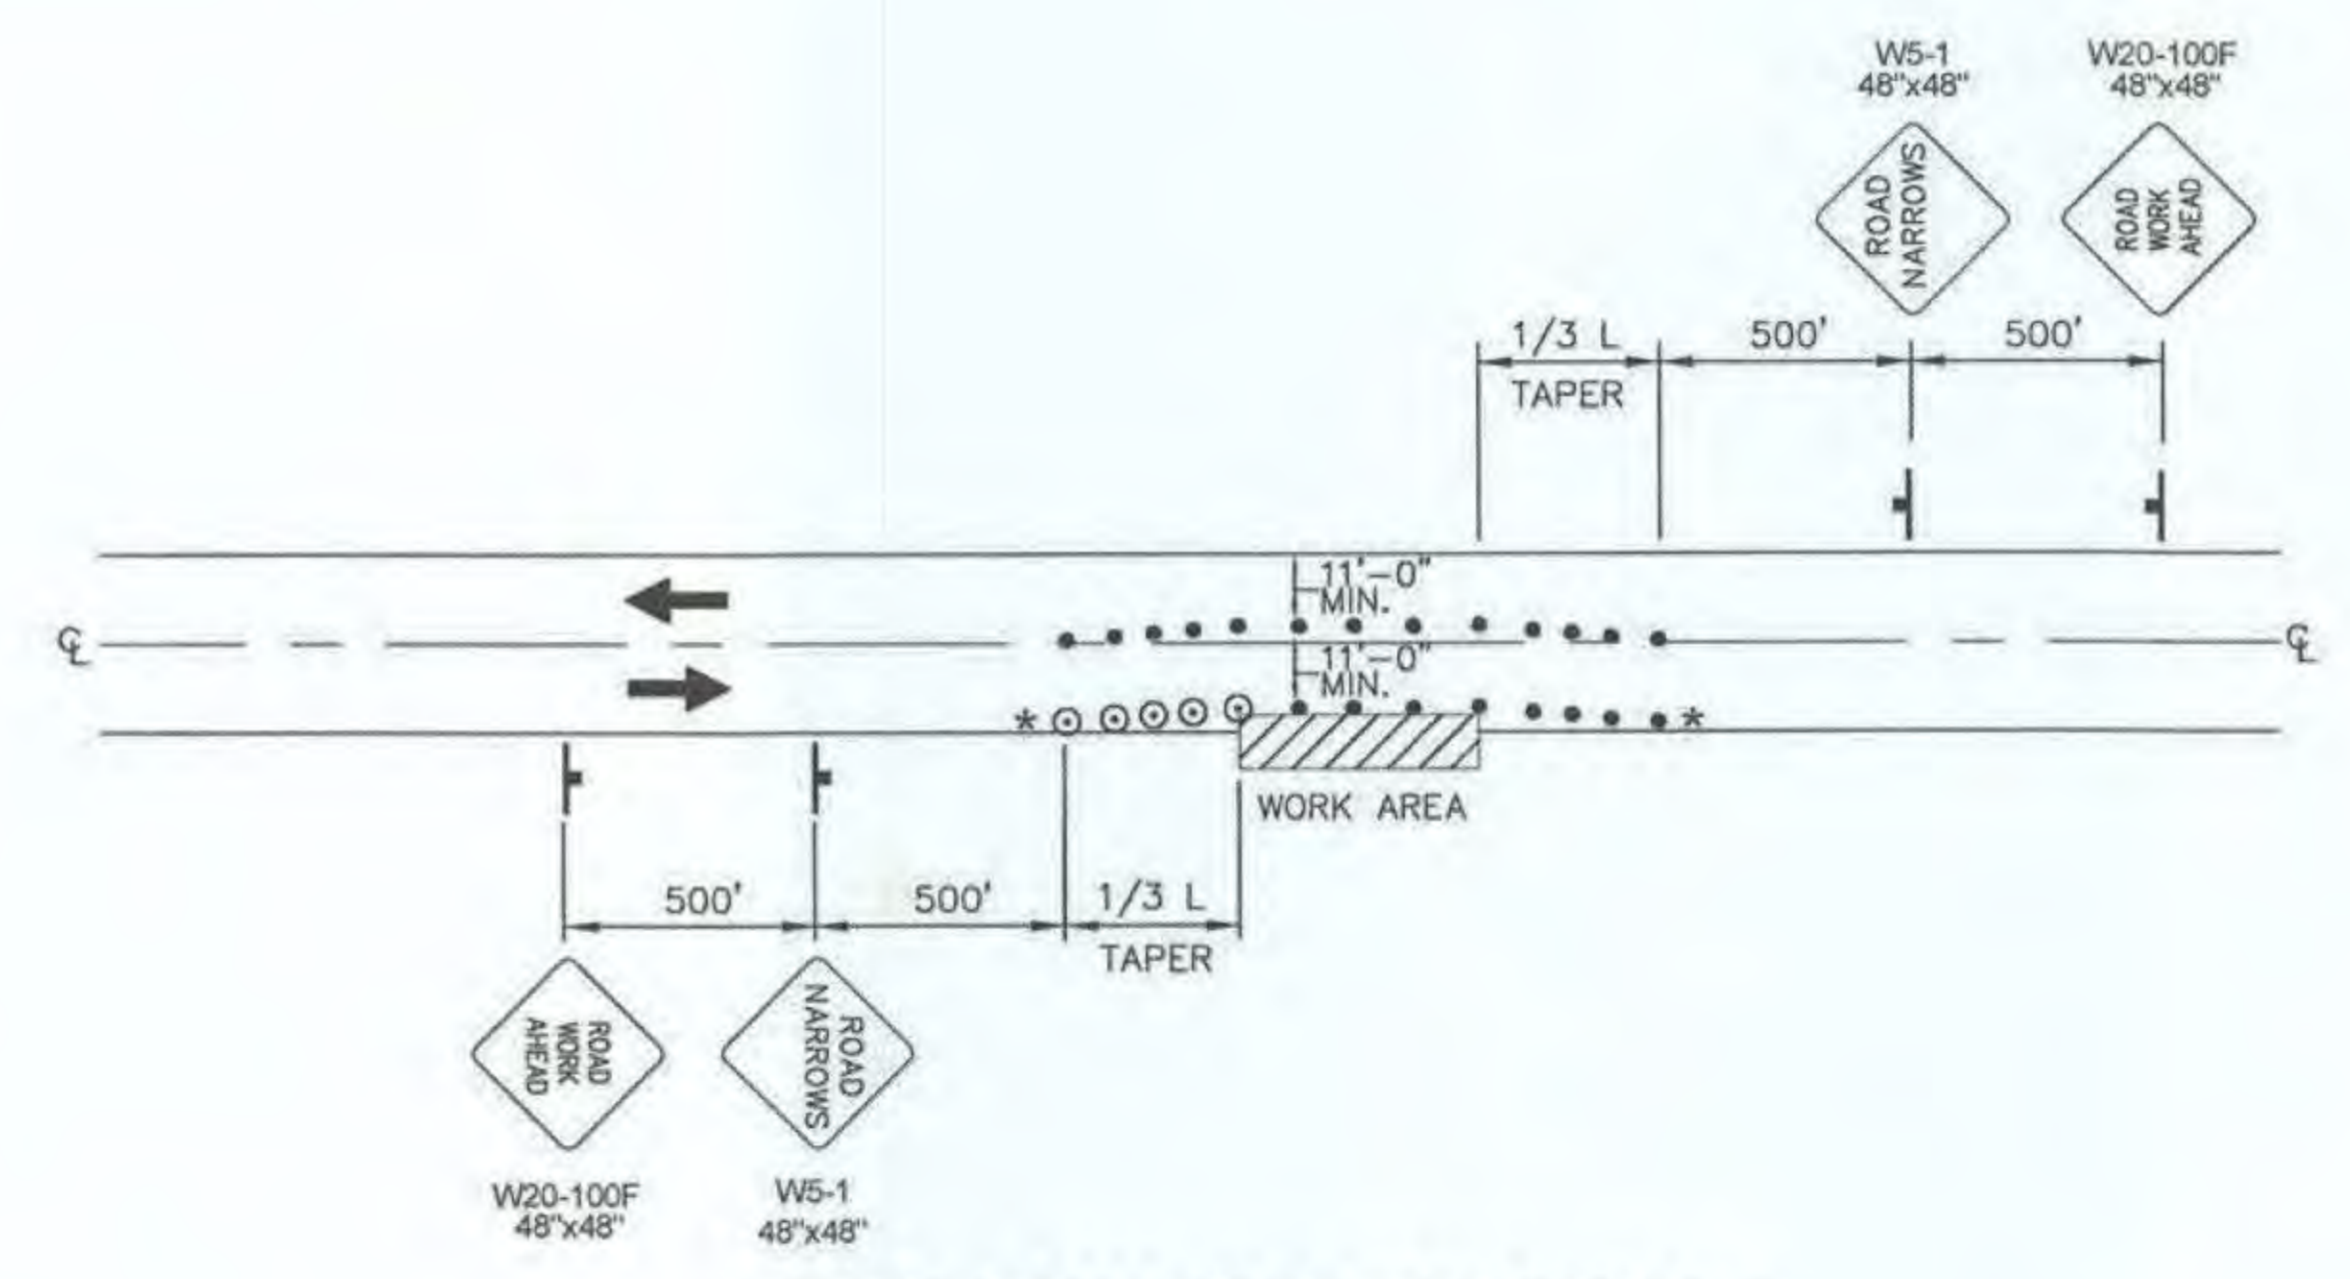

ROADWAY ENCROACHMENT


NOTE:
 IF ONLY ONE LANE IS AFFECTED BY ROAD WORK (THAT IS, THE CONES ALONG THE WORK AREA ARE NO CLOSER THAN 10' TO CENTERLINE) THE CENTERLINE CONES FOR THE OPPOSING LANE SHALL BE DELETED.
 * NO PARKING WITHIN 200' OF CONES OR DRUMS

9/9/20

<p>PLANS DEVELOPED BY: DOWL 5368 COMMERCIAL BLVD. JUNEAU, AK 99801 (907) 780-3533 #AECL848</p>	<p>TCP NOT SEALED IN ACCORDANCE WITH ALASKA HIGHWAY PRECONSTRUCTION MANUAL SECTION 1400.3.5 DATED JANUARY 30, 2012</p>	<p>STATE OF ALASKA DEPARTMENT OF TRANSPORTATION AND PUBLIC FACILITIES SKAGWAY - REPLACE CAPTAIN WILLIAM HENRY MOORE BRIDGE TRAFFIC CONTROL PLAN</p>
---	---	--

FILE: C:\CIVIL\3D Project\24\70732-01\Civil\1\SC14-CT-T-TC-CW.M.dwg DATE: 8/16/2016 12:14 LAYOUT: T3 DESIGNED: HOBBS CHECKED: NOBLE DRAFTED: WESTPHAL

NO.	DATE	REVISION	STATE	PROJECT DESIGNATION	YEAR	SHEET NO.	TOTAL SHEETS
			ALASKA	0972016/Z684590000	2016	T3	59

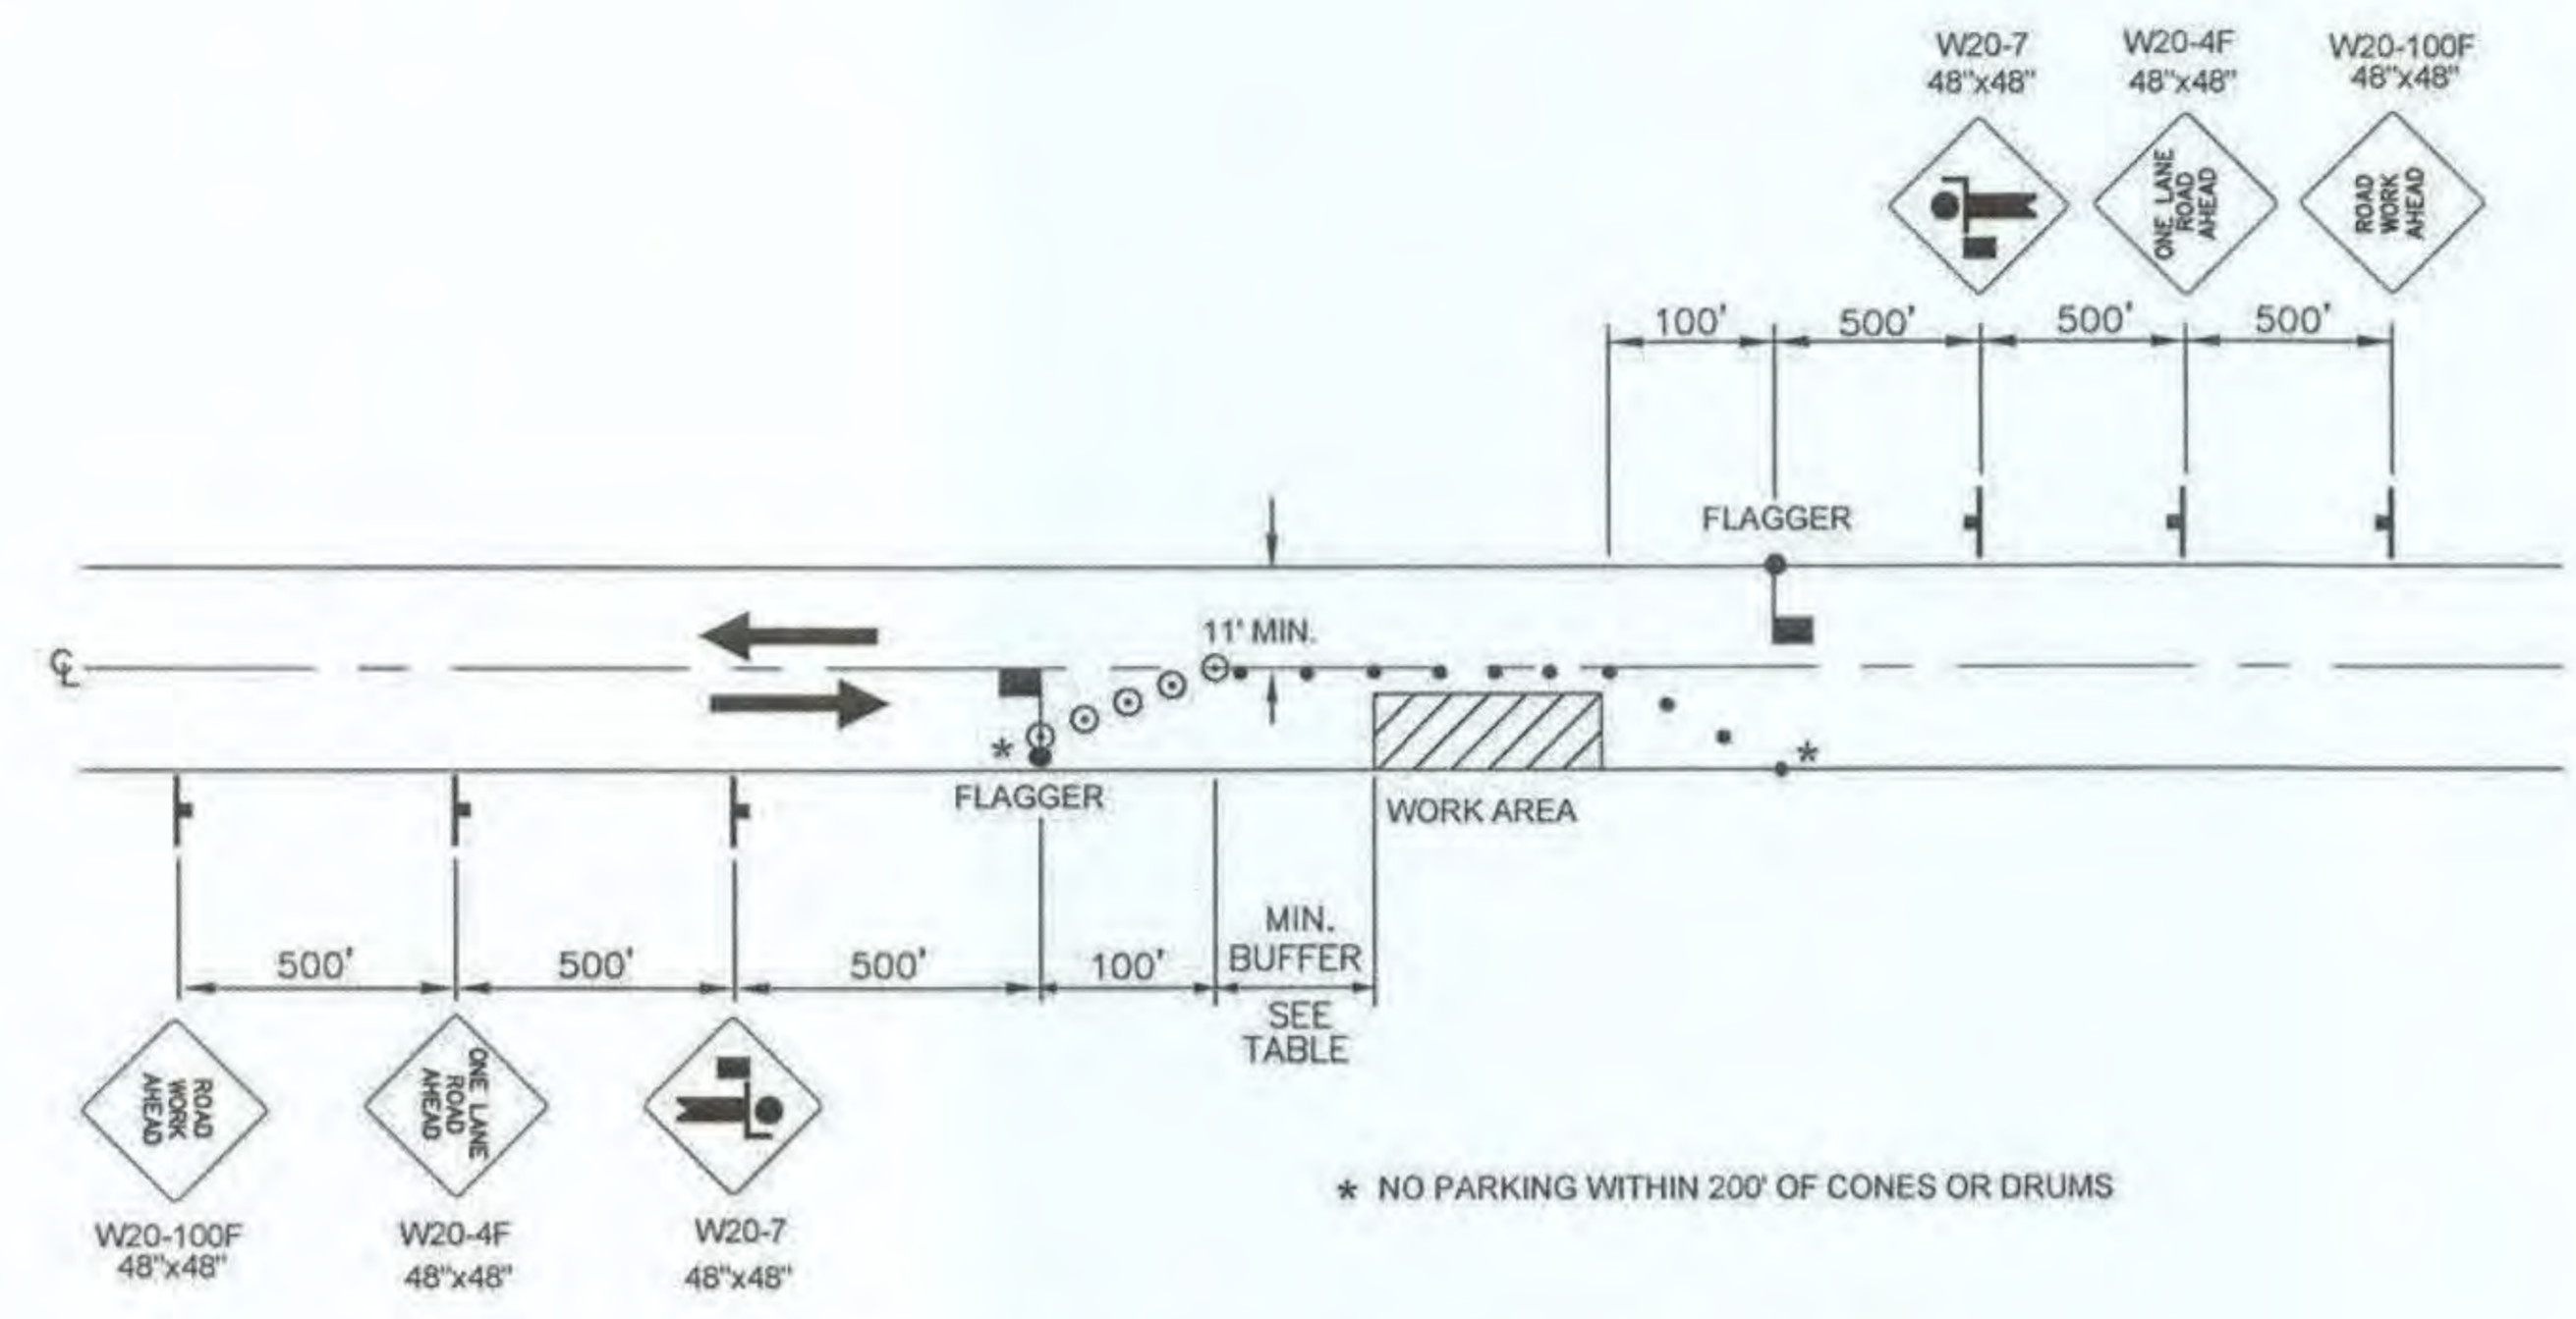


TWO LANE ROAD - SINGLE LANE CLOSURE
DOUBLE FLAGGER


* NO PARKING WITHIN 200' OF CONES OR DRUMS

P 6/9/20


<p>PLANS DEVELOPED BY: DOWL 5368 COMMERCIAL BLVD. JUNEAU, AK 99801 (907) 780-3533 #AECL848</p>	<p>TCP NOT SEALED IN ACCORDANCE WITH ALASKA HIGHWAY PRECONSTRUCTION MANUAL SECTION 1400.3.5 DATED JANUARY 30, 2012</p>	<p>STATE OF ALASKA DEPARTMENT OF TRANSPORTATION AND PUBLIC FACILITIES SKAGWAY - REPLACE CAPTAIN WILLIAM HENRY MOORE BRIDGE TRAFFIC CONTROL PLAN</p>
---	--	--

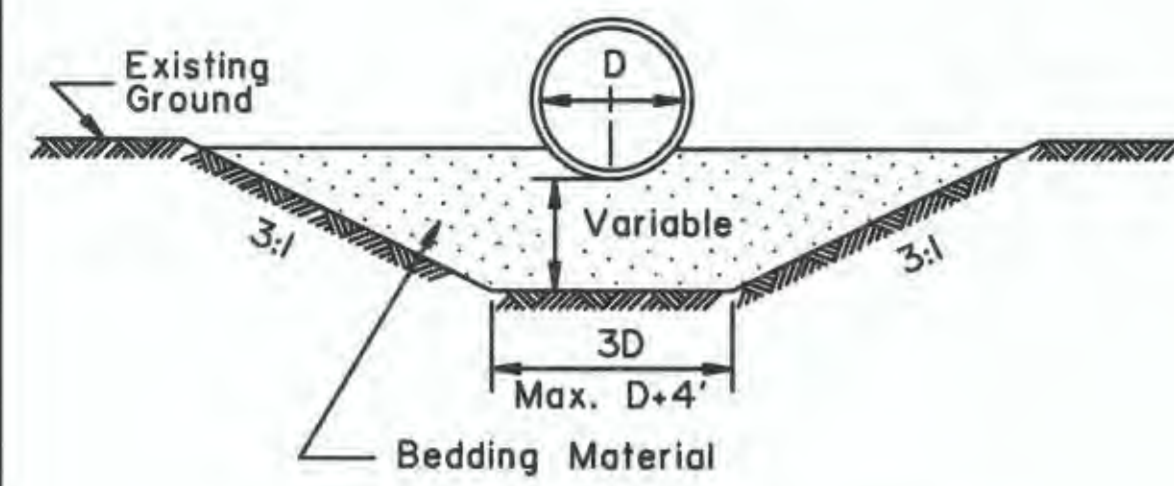


TYPE "A"
FOUNDATION STABILIZATION
To be used in unstable areas as directed by the Engineer.

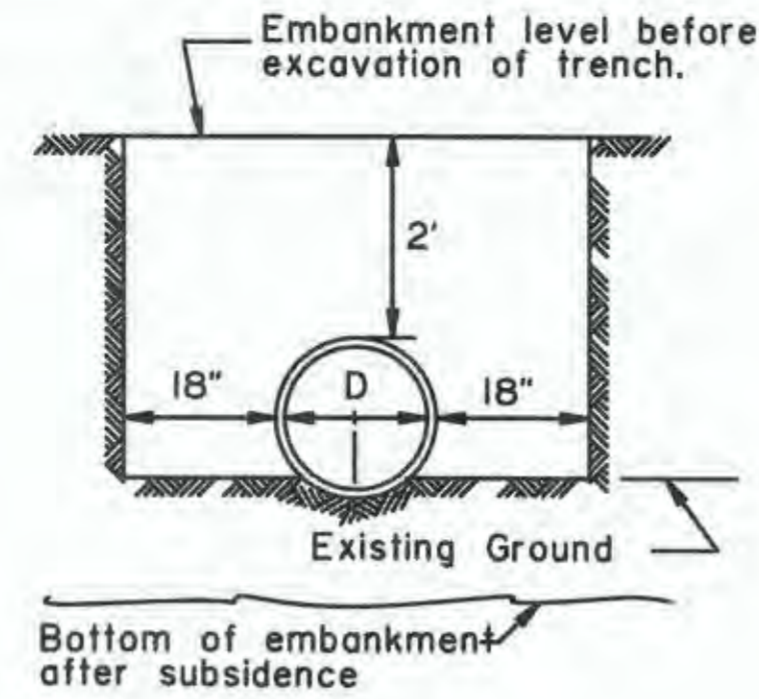


TYPE "B"

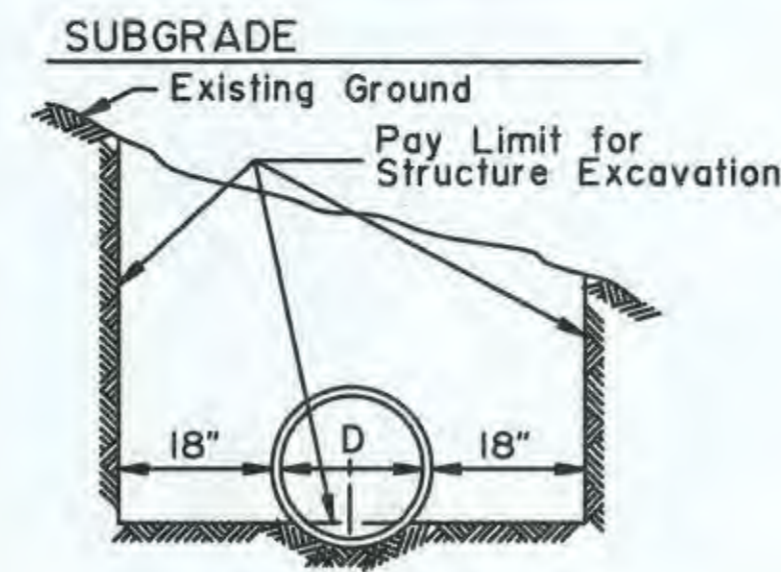


TYPE "C"

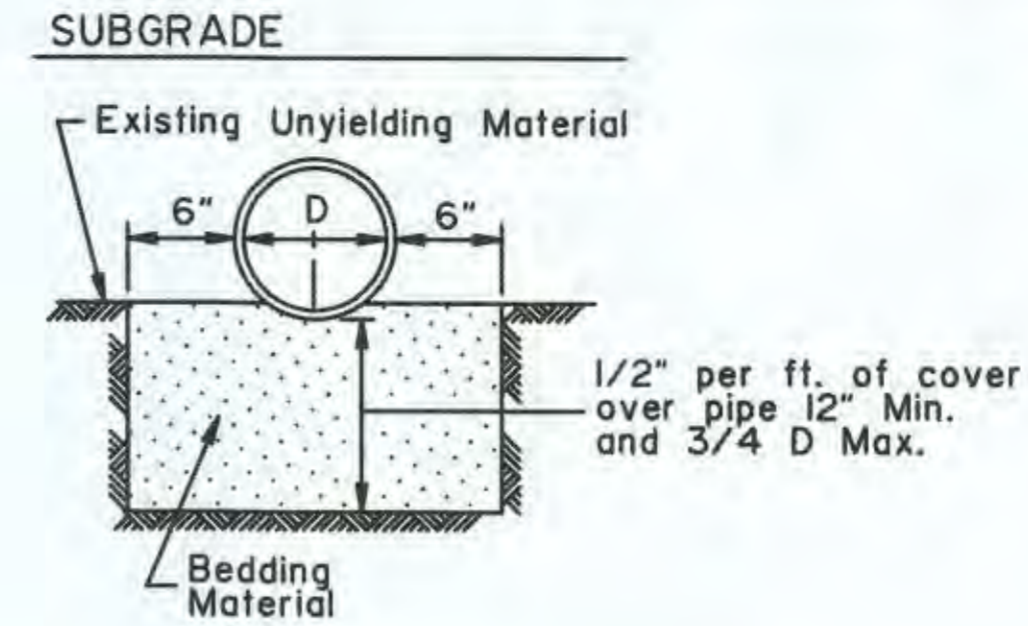


TYPE "D"
ROCK OR UNYIELDING MATERIAL

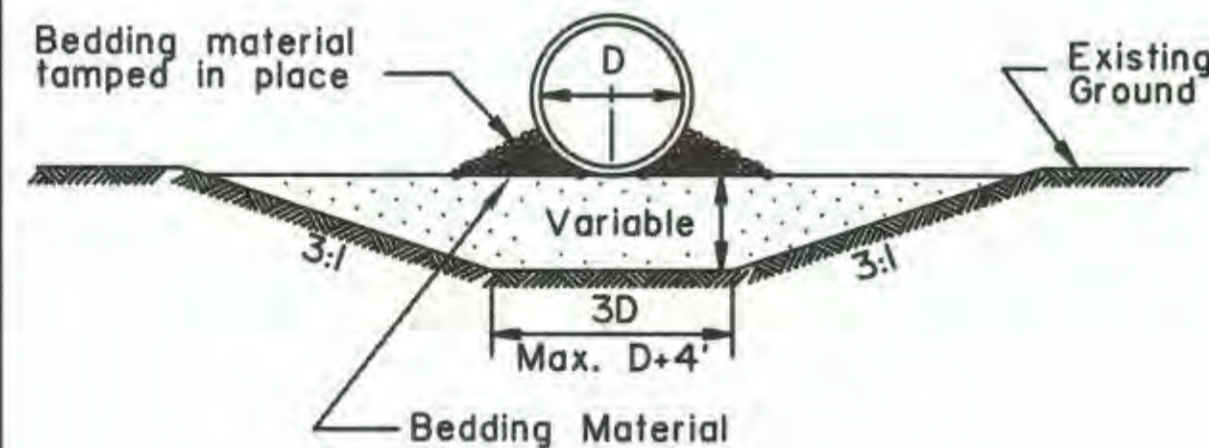


'ALTERNATE' TYPE "A"
FOUNDATION STABILIZATION
To be used in unstable areas as directed by the Engineer.

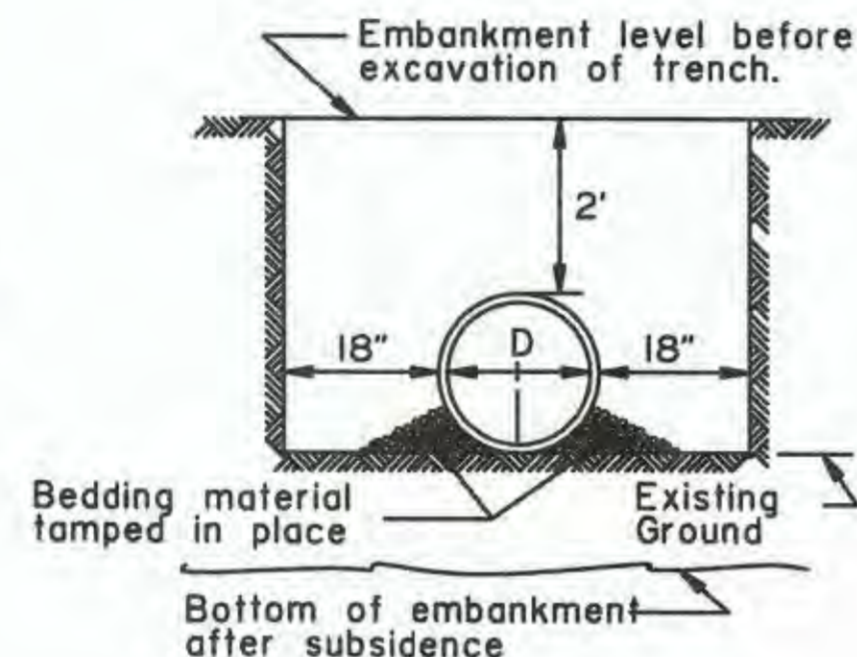

'ALTERNATE' TYPE "B"

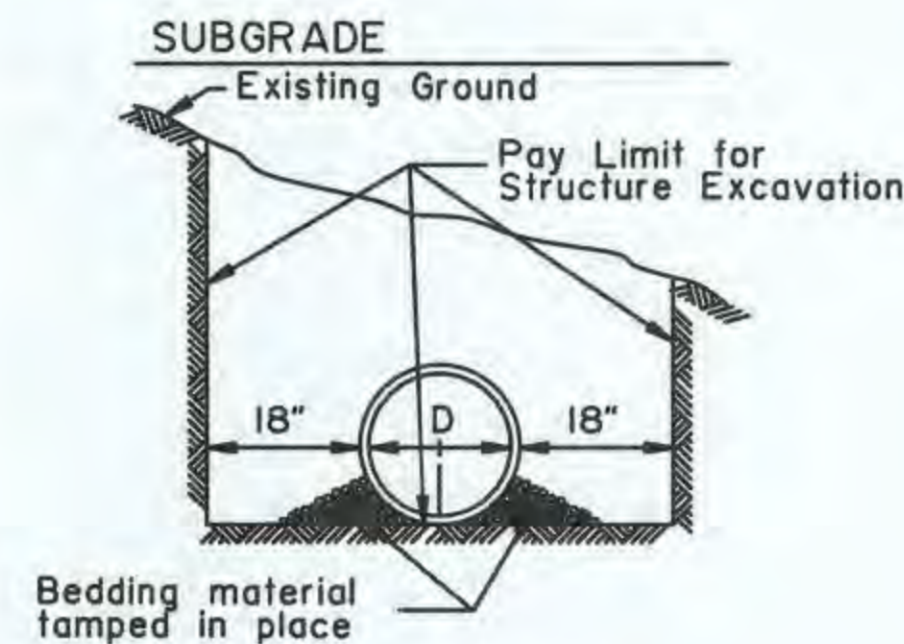


'ALTERNATE' TYPE "C"

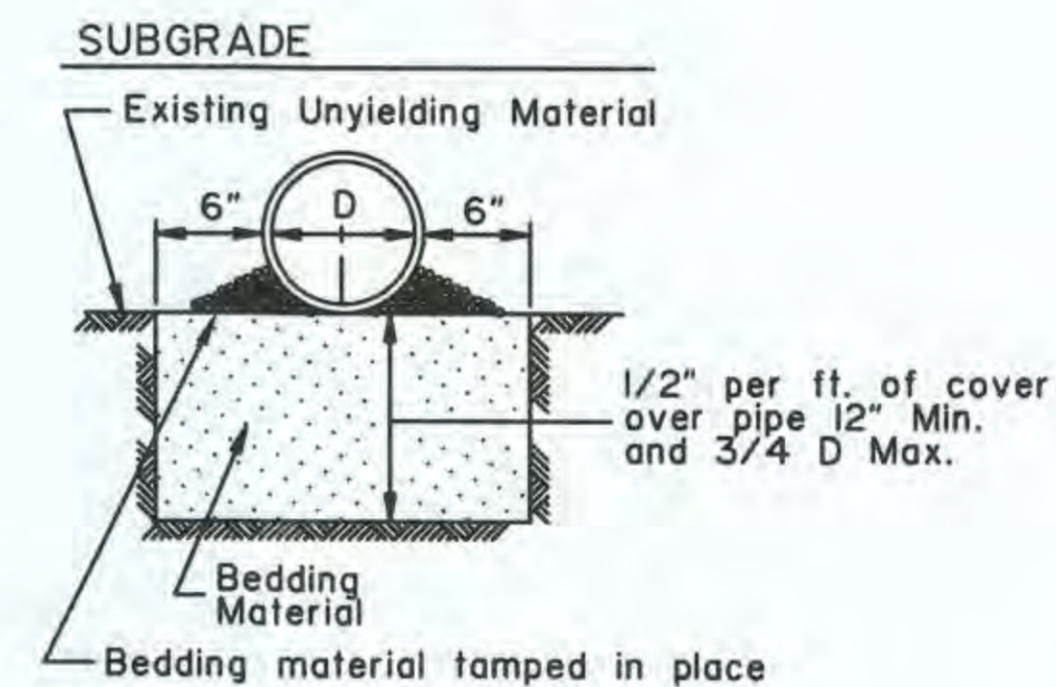


'ALTERNATE' TYPE "D"
ROCK OR UNYIELDING MATERIAL

D = Nominal Pipe Diameter

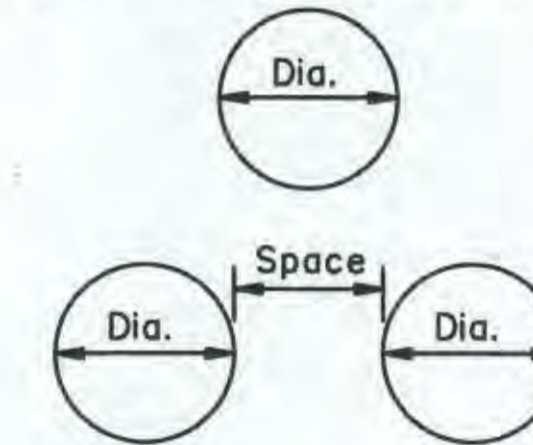


MULTIPLE INSTALLATIONS	
Dia.	Minimum Space Between Pipes
0" - 42"	24"
48" & Over	1/2 Dia. of pipe or 3', whichever is less.

S = Nominal Pipe Arch Span

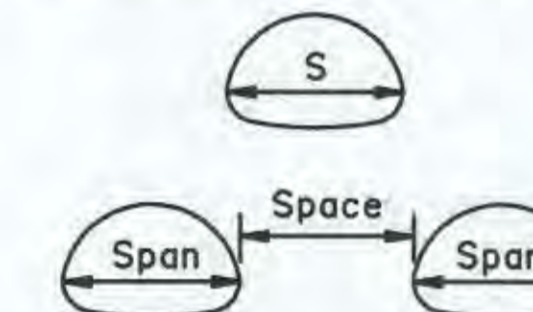


MULTIPLE INSTALLATIONS	
Dia.	Minimum Space Between Pipes
0" - 42"	24"
48" & Over	1/2 Span of pipe arch or 3', whichever is less.


CULVERT PIPE

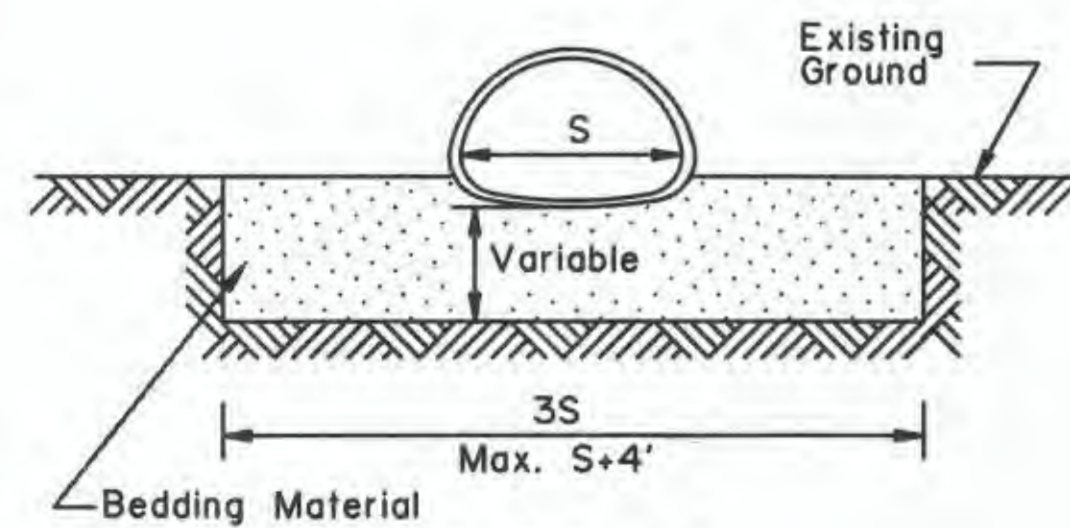


TYPE "A"
FOUNDATION STABILIZATION
To be used in unstable areas as directed by the Engineer.

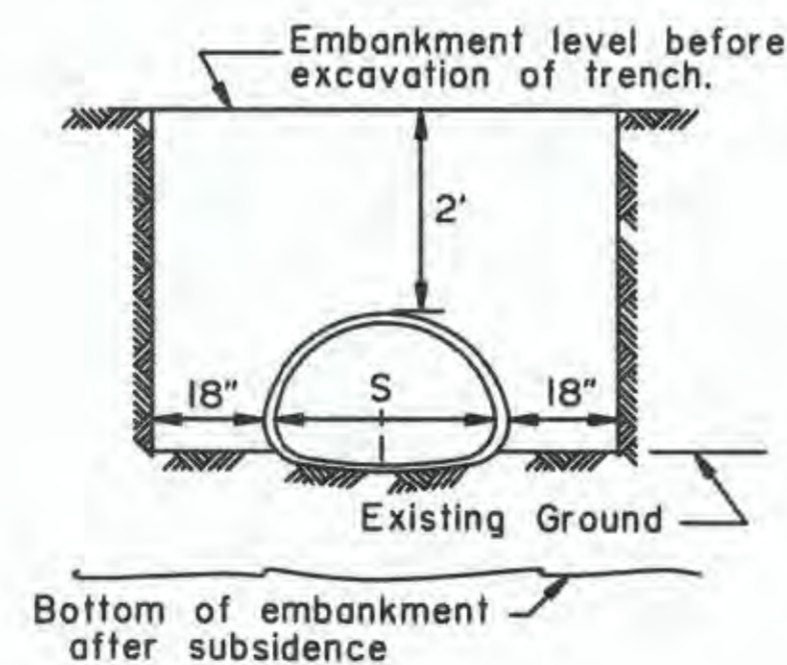

TYPE "B"

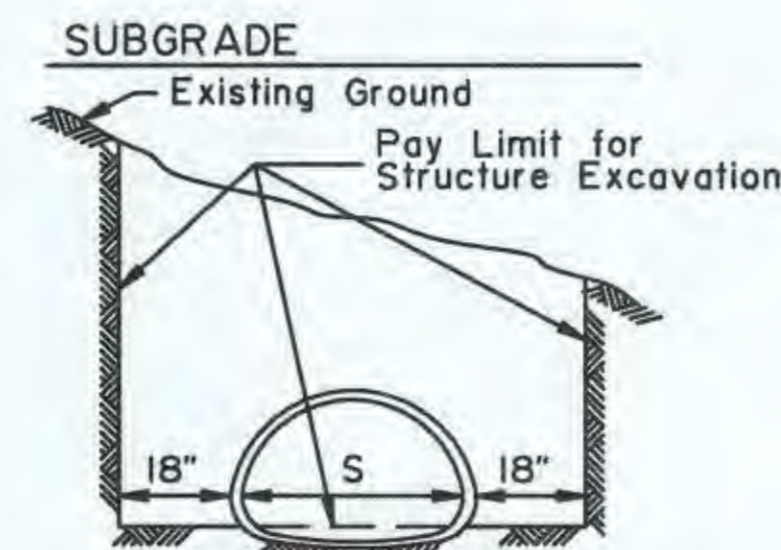

TYPE "C"

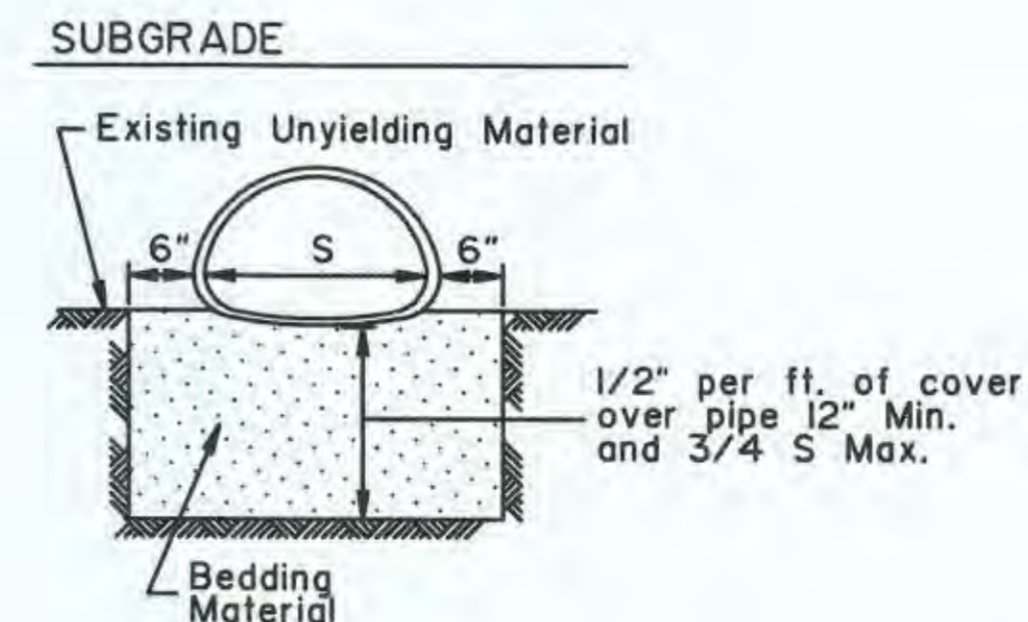

TYPE "D"
ROCK OR UNYIELDING MATERIAL

ARCH

GENERAL NOTES:

1. Sidefill shall be placed and compacted with care under haunches of pipe and shall be brought up evenly and simultaneously on both sides of pipe to 1 foot above the top of the full length of the pipe.
2. Alternate installation methods may only be used when specified or approved by the Engineer.

REVISIONS		
Date	Description	By
12/1/87	Delete ref. to Specs.	Gdo
4/1/93	Delete All Arch	Gdo

State of Alaska
Department of Transportation
& Public Facilities
**CULVERT PIPE & ARCH
INSTALLATION DETAILS**



Date 7/15/82