
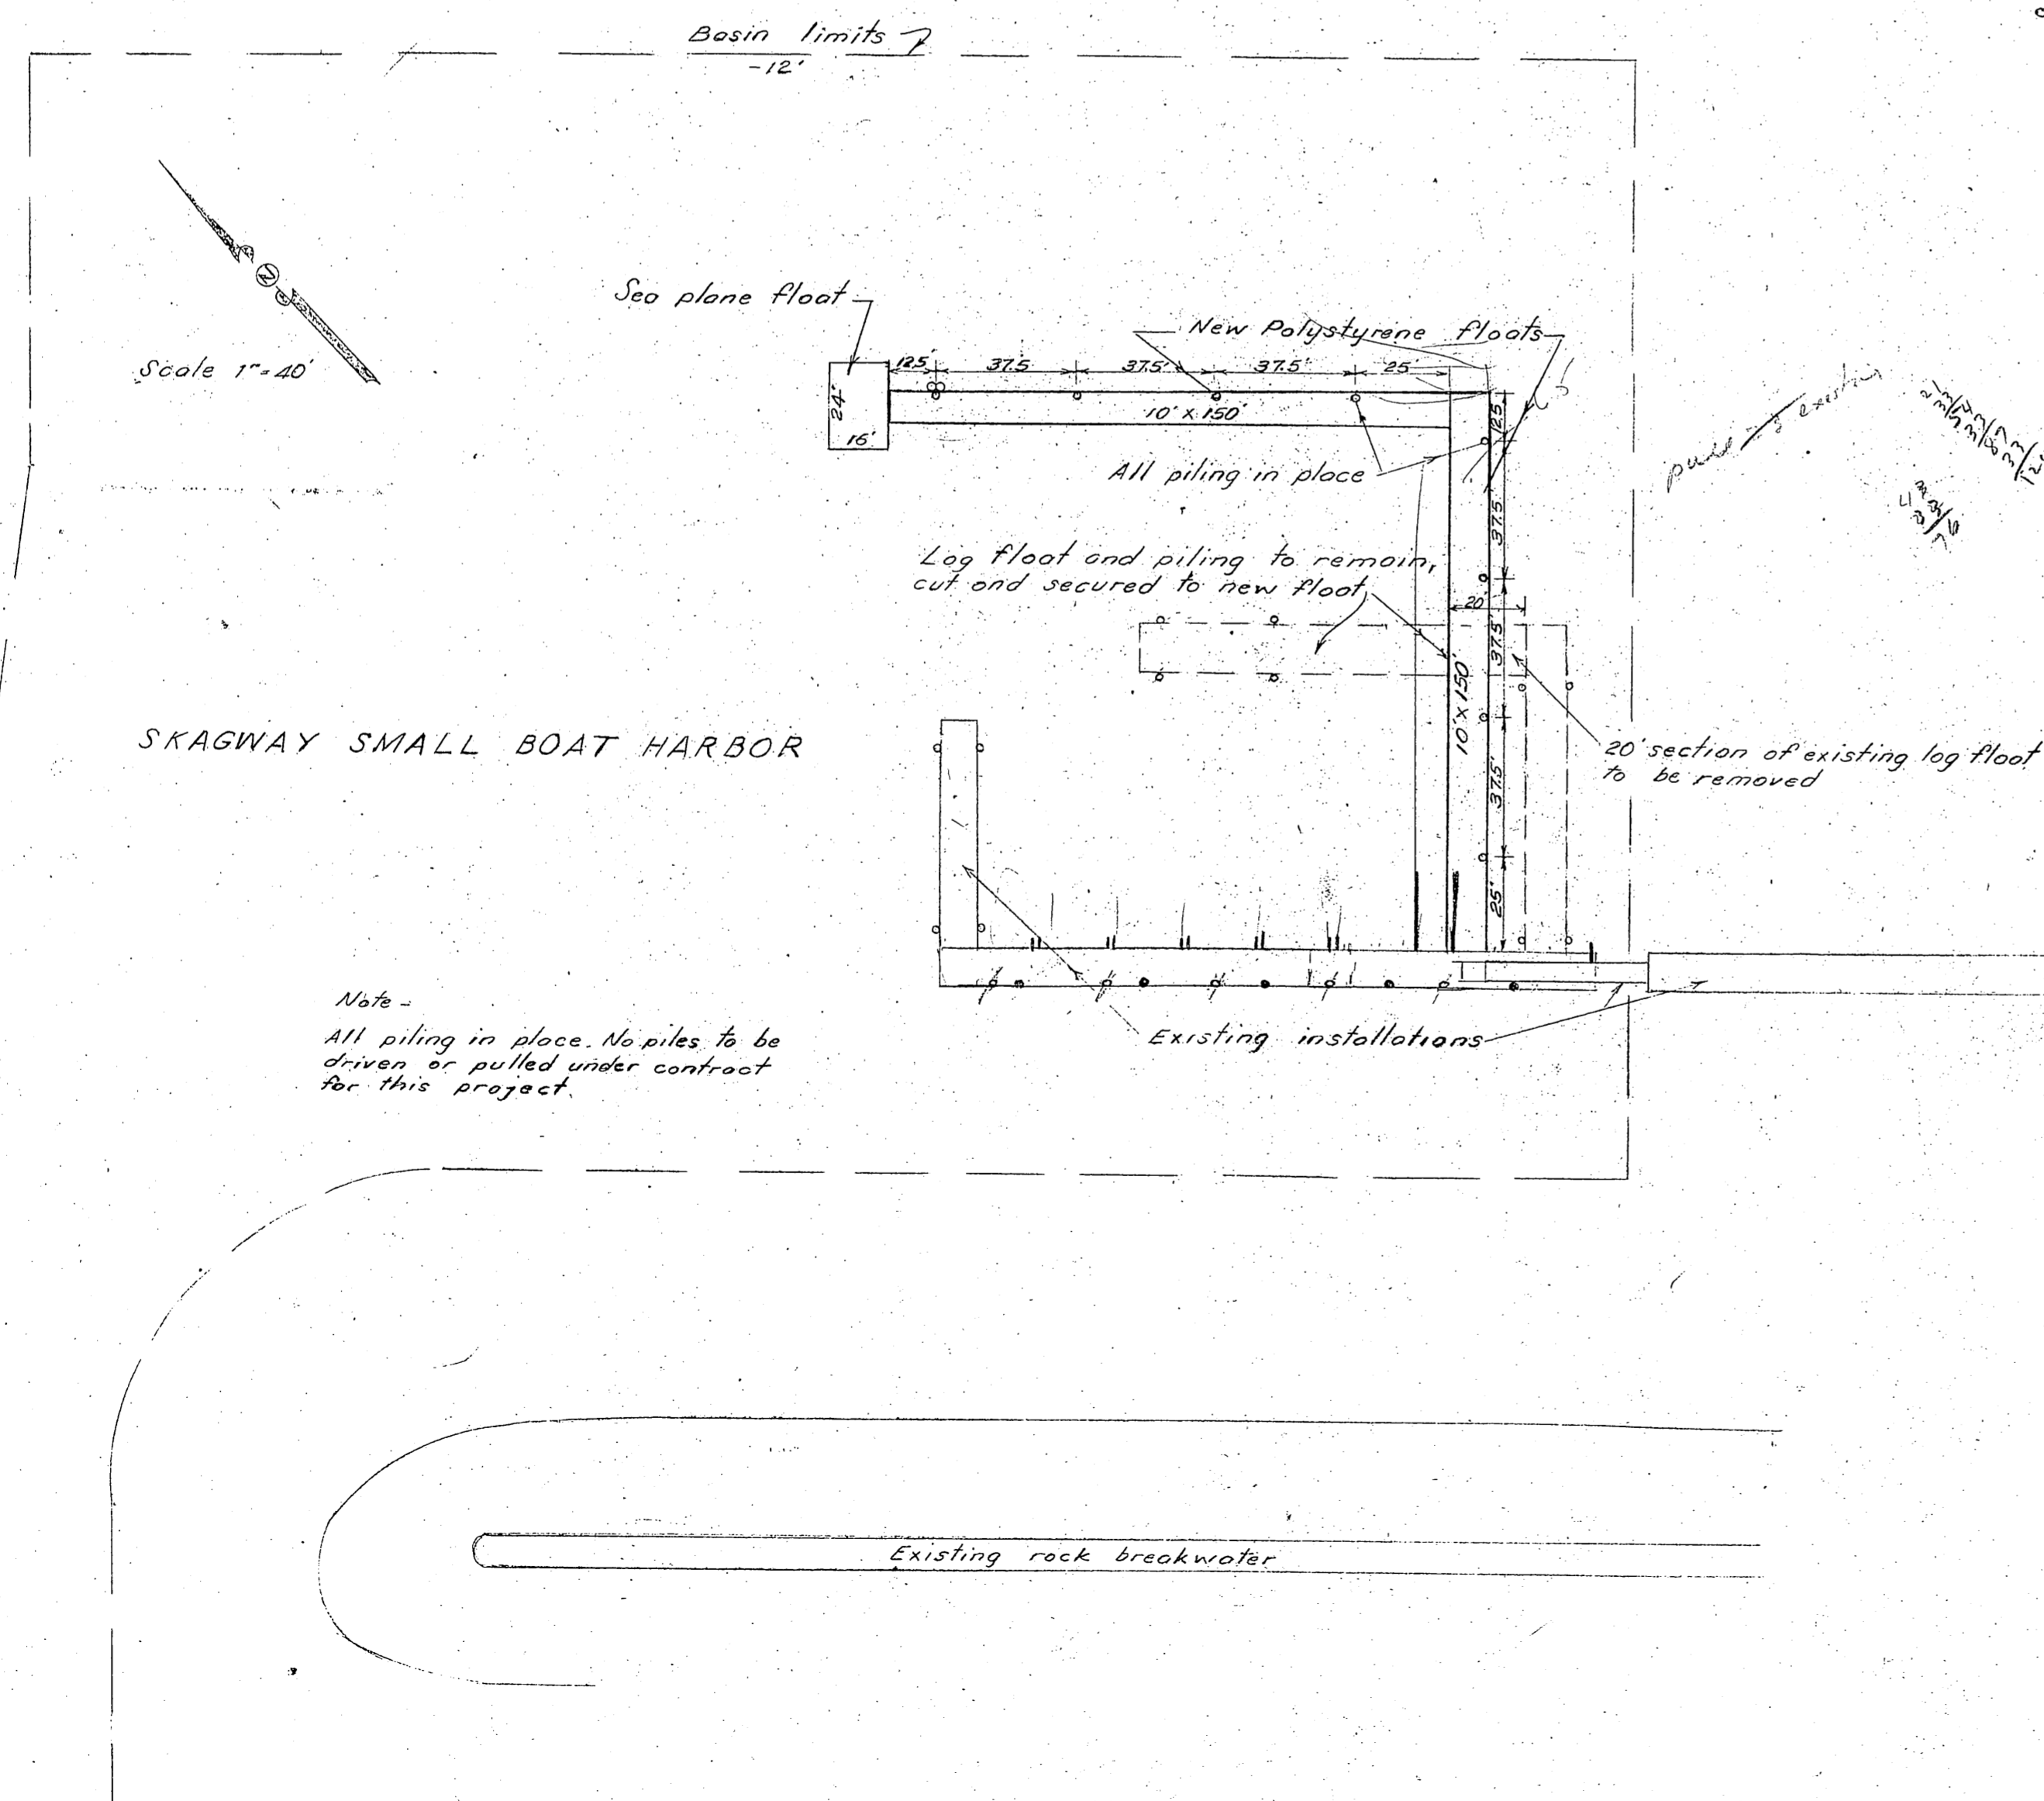


STATE OF ALASKA

DEPARTMENT OF PUBLIC WORKS

DIVISION OF WATER & HARBORS

SKAGWAY FLOATS
PROJECT NO. W6221

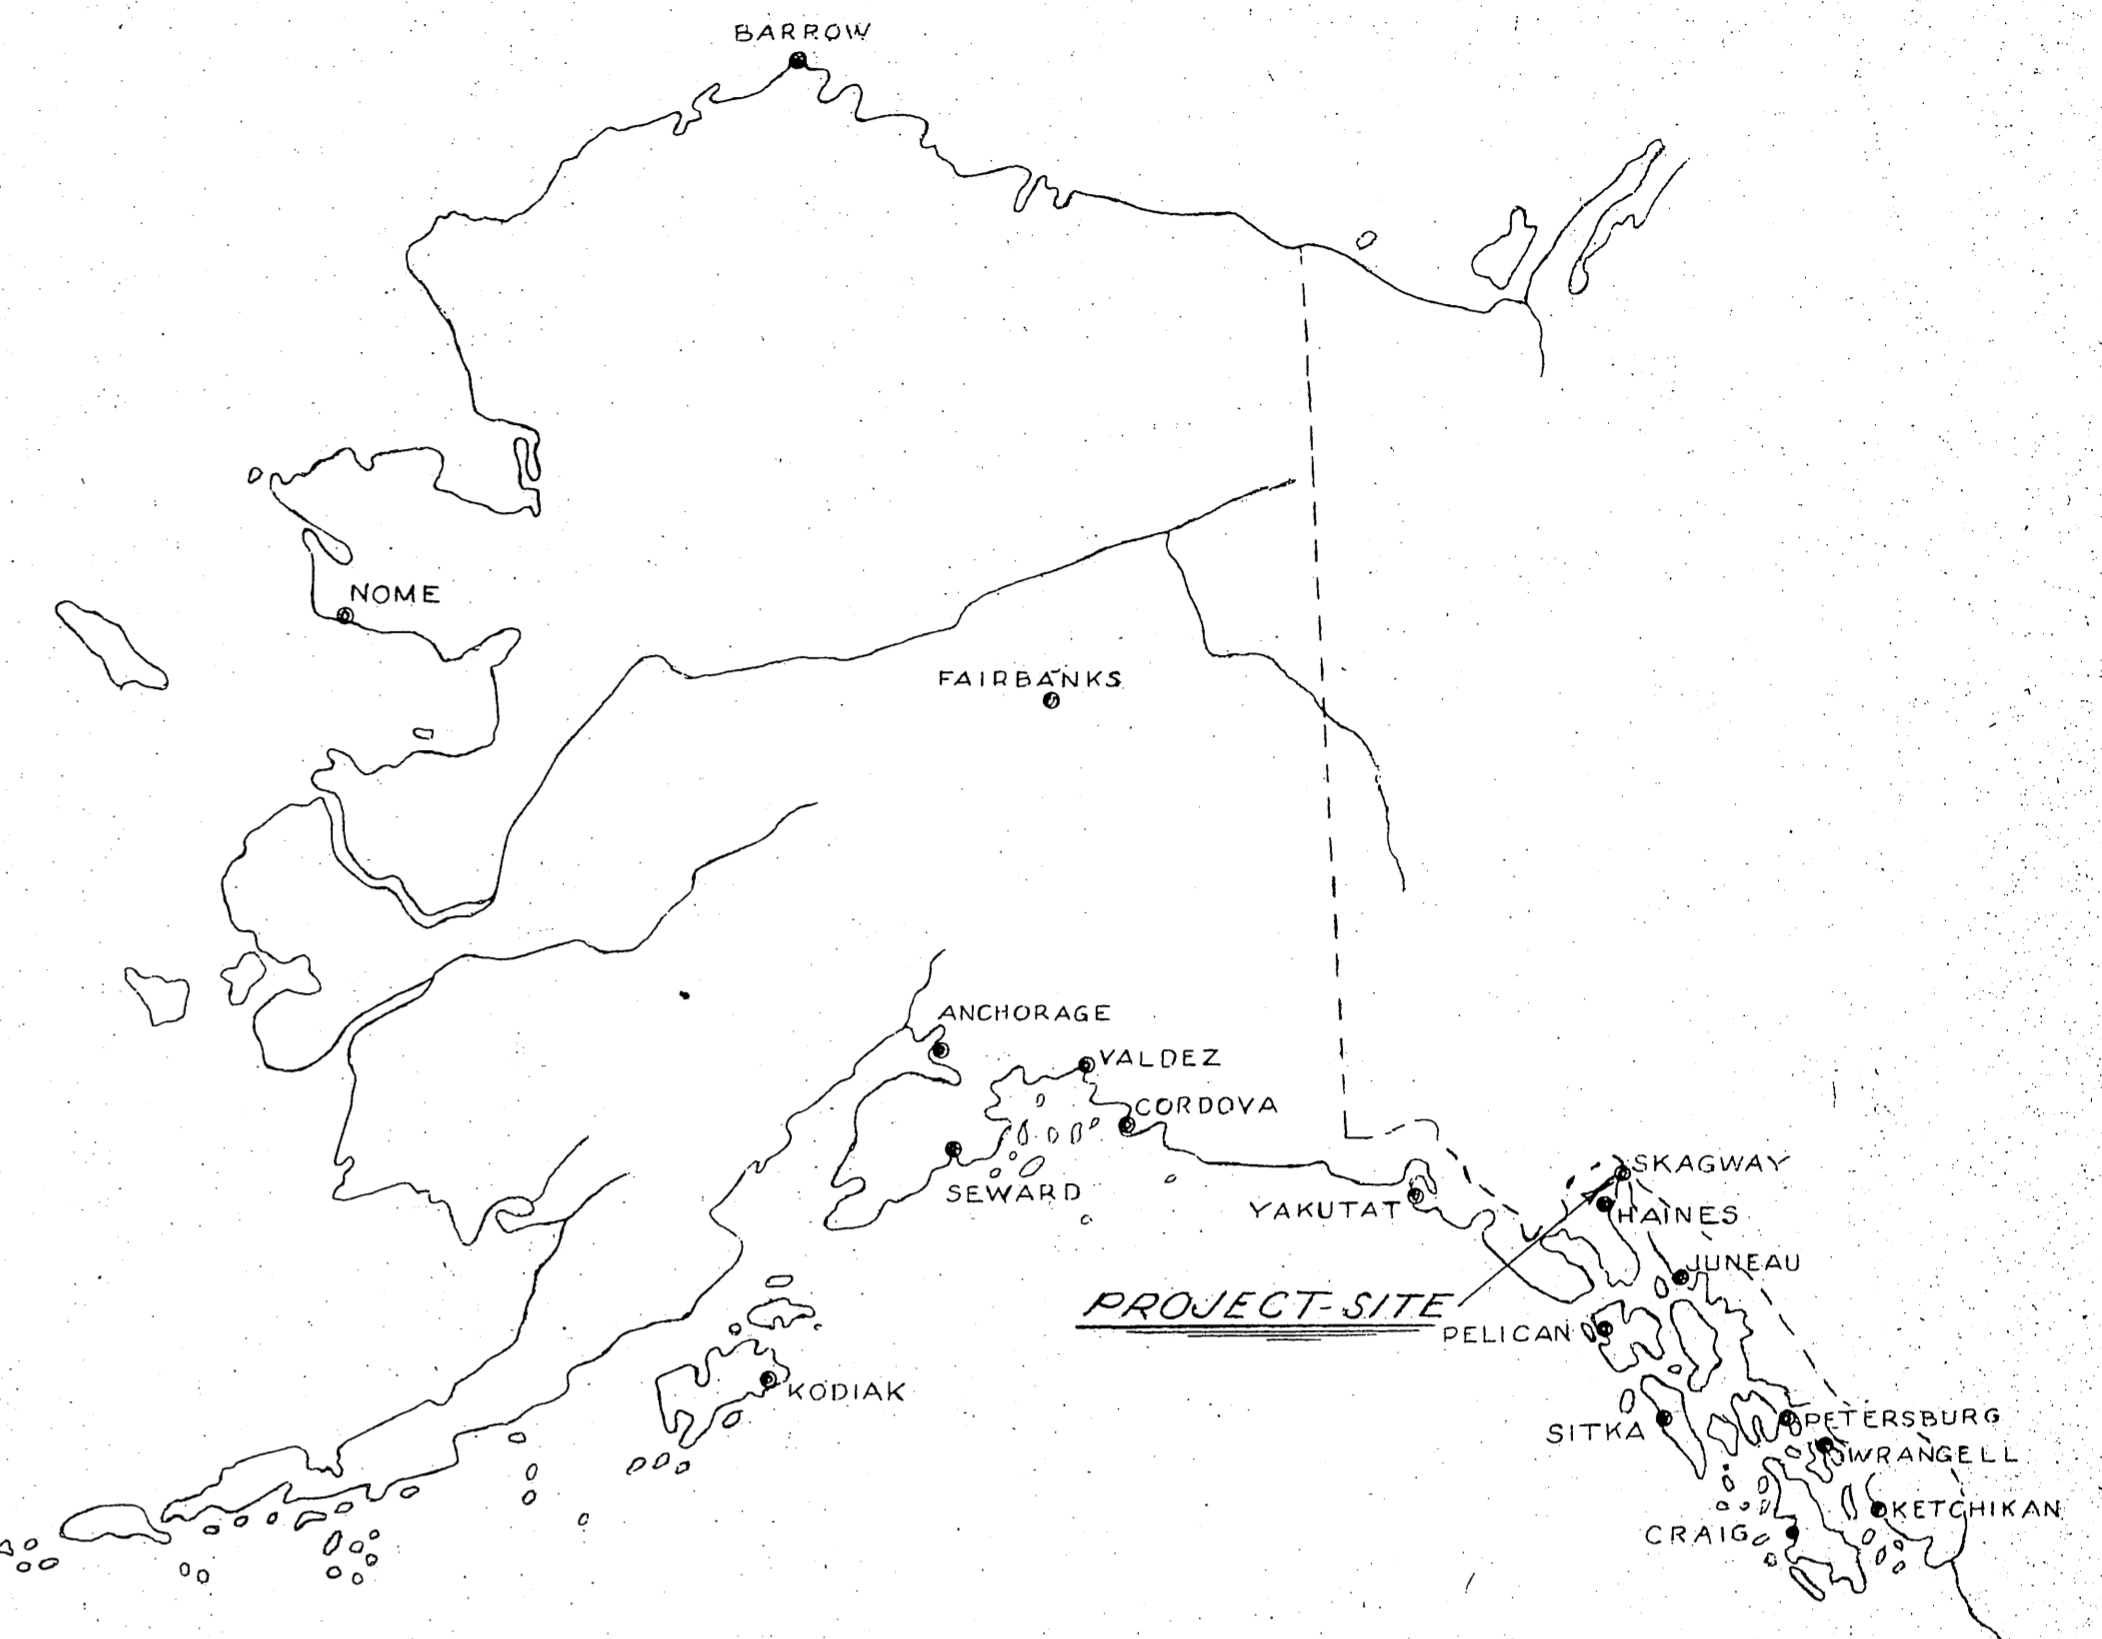

Scale 1"=40'

SKAGWAY SMALL BOAT HARBOR

Note -
All piling in place. No piles to be driven or pulled under contract for this project.

WORK SUMMARY

The major units of this project shall consist of the construction and installation of 3000 sq. ft. of Polystyrene boat mooring floats, 384 sq. ft. of sea plane float and the removal of 20 ft. of existing float

INDEX TO SHEETS

Title and plan	1
Typical floats	2
Typical seaplane float	3



DATE May 29, 62 APPROVED *[Signature]* COMMISSIONER