


STATE OF ALASKA
DEPARTMENT OF PUBLIC WORKS
DIVISION OF WATER & HARBORS

SITKA HARBOR FACILITIES


PROJECT NO. 3-68164

PROJECT NO. 3-68125



PROJECT NO. 3-68183

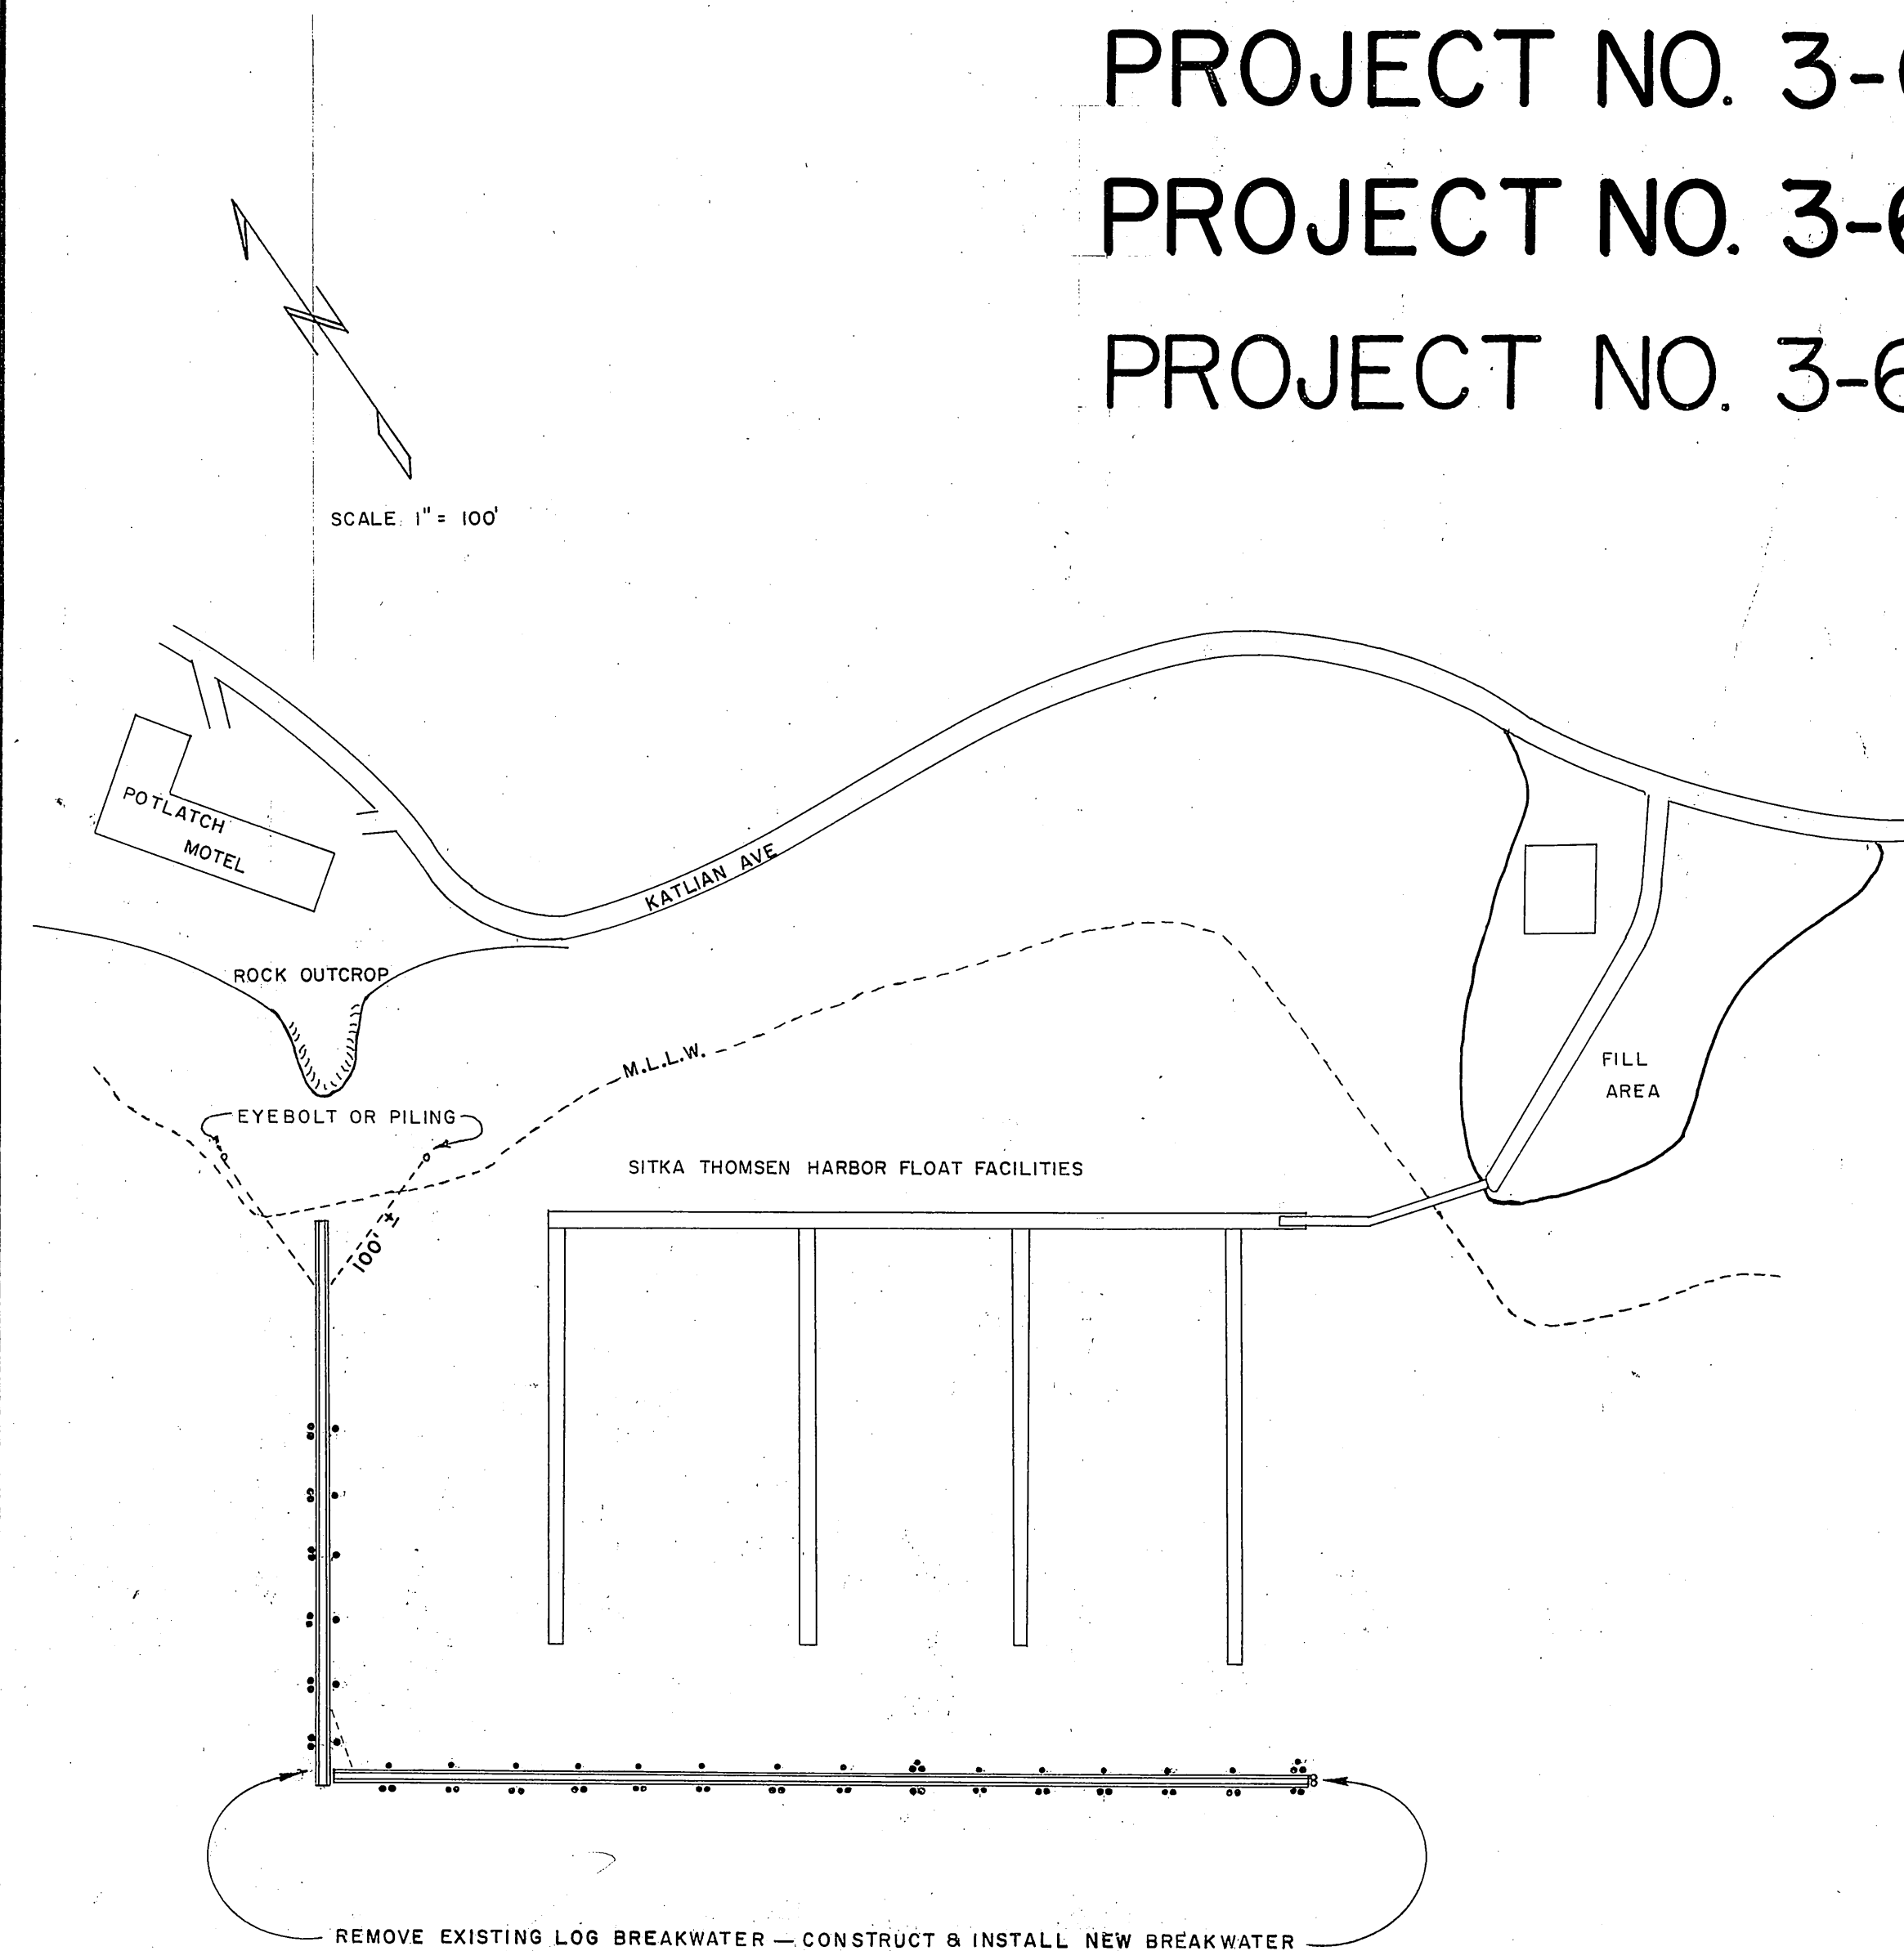

SITKA THOMSEN HARBOR PROJECT
PROJECT NO. 3-68164
1" = 100'

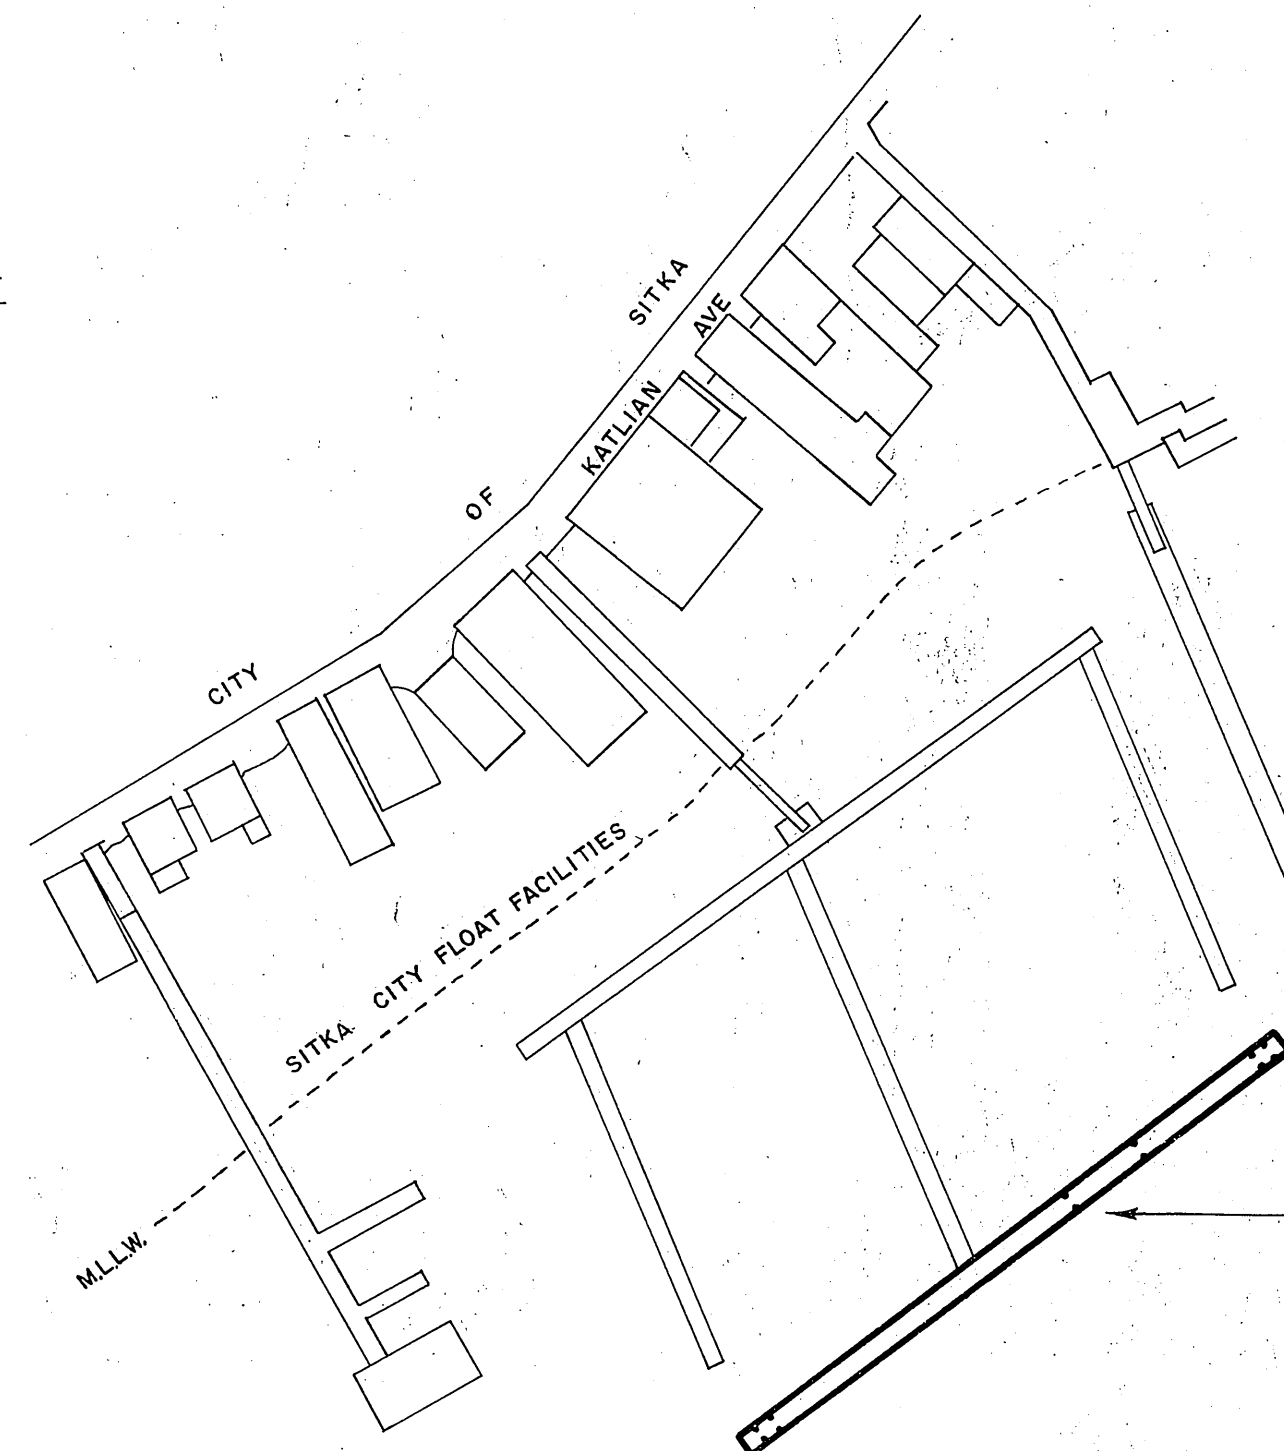

SITKA CITY FLOAT PROJECT
PROJECT NO. 3-68125
1" = 100'

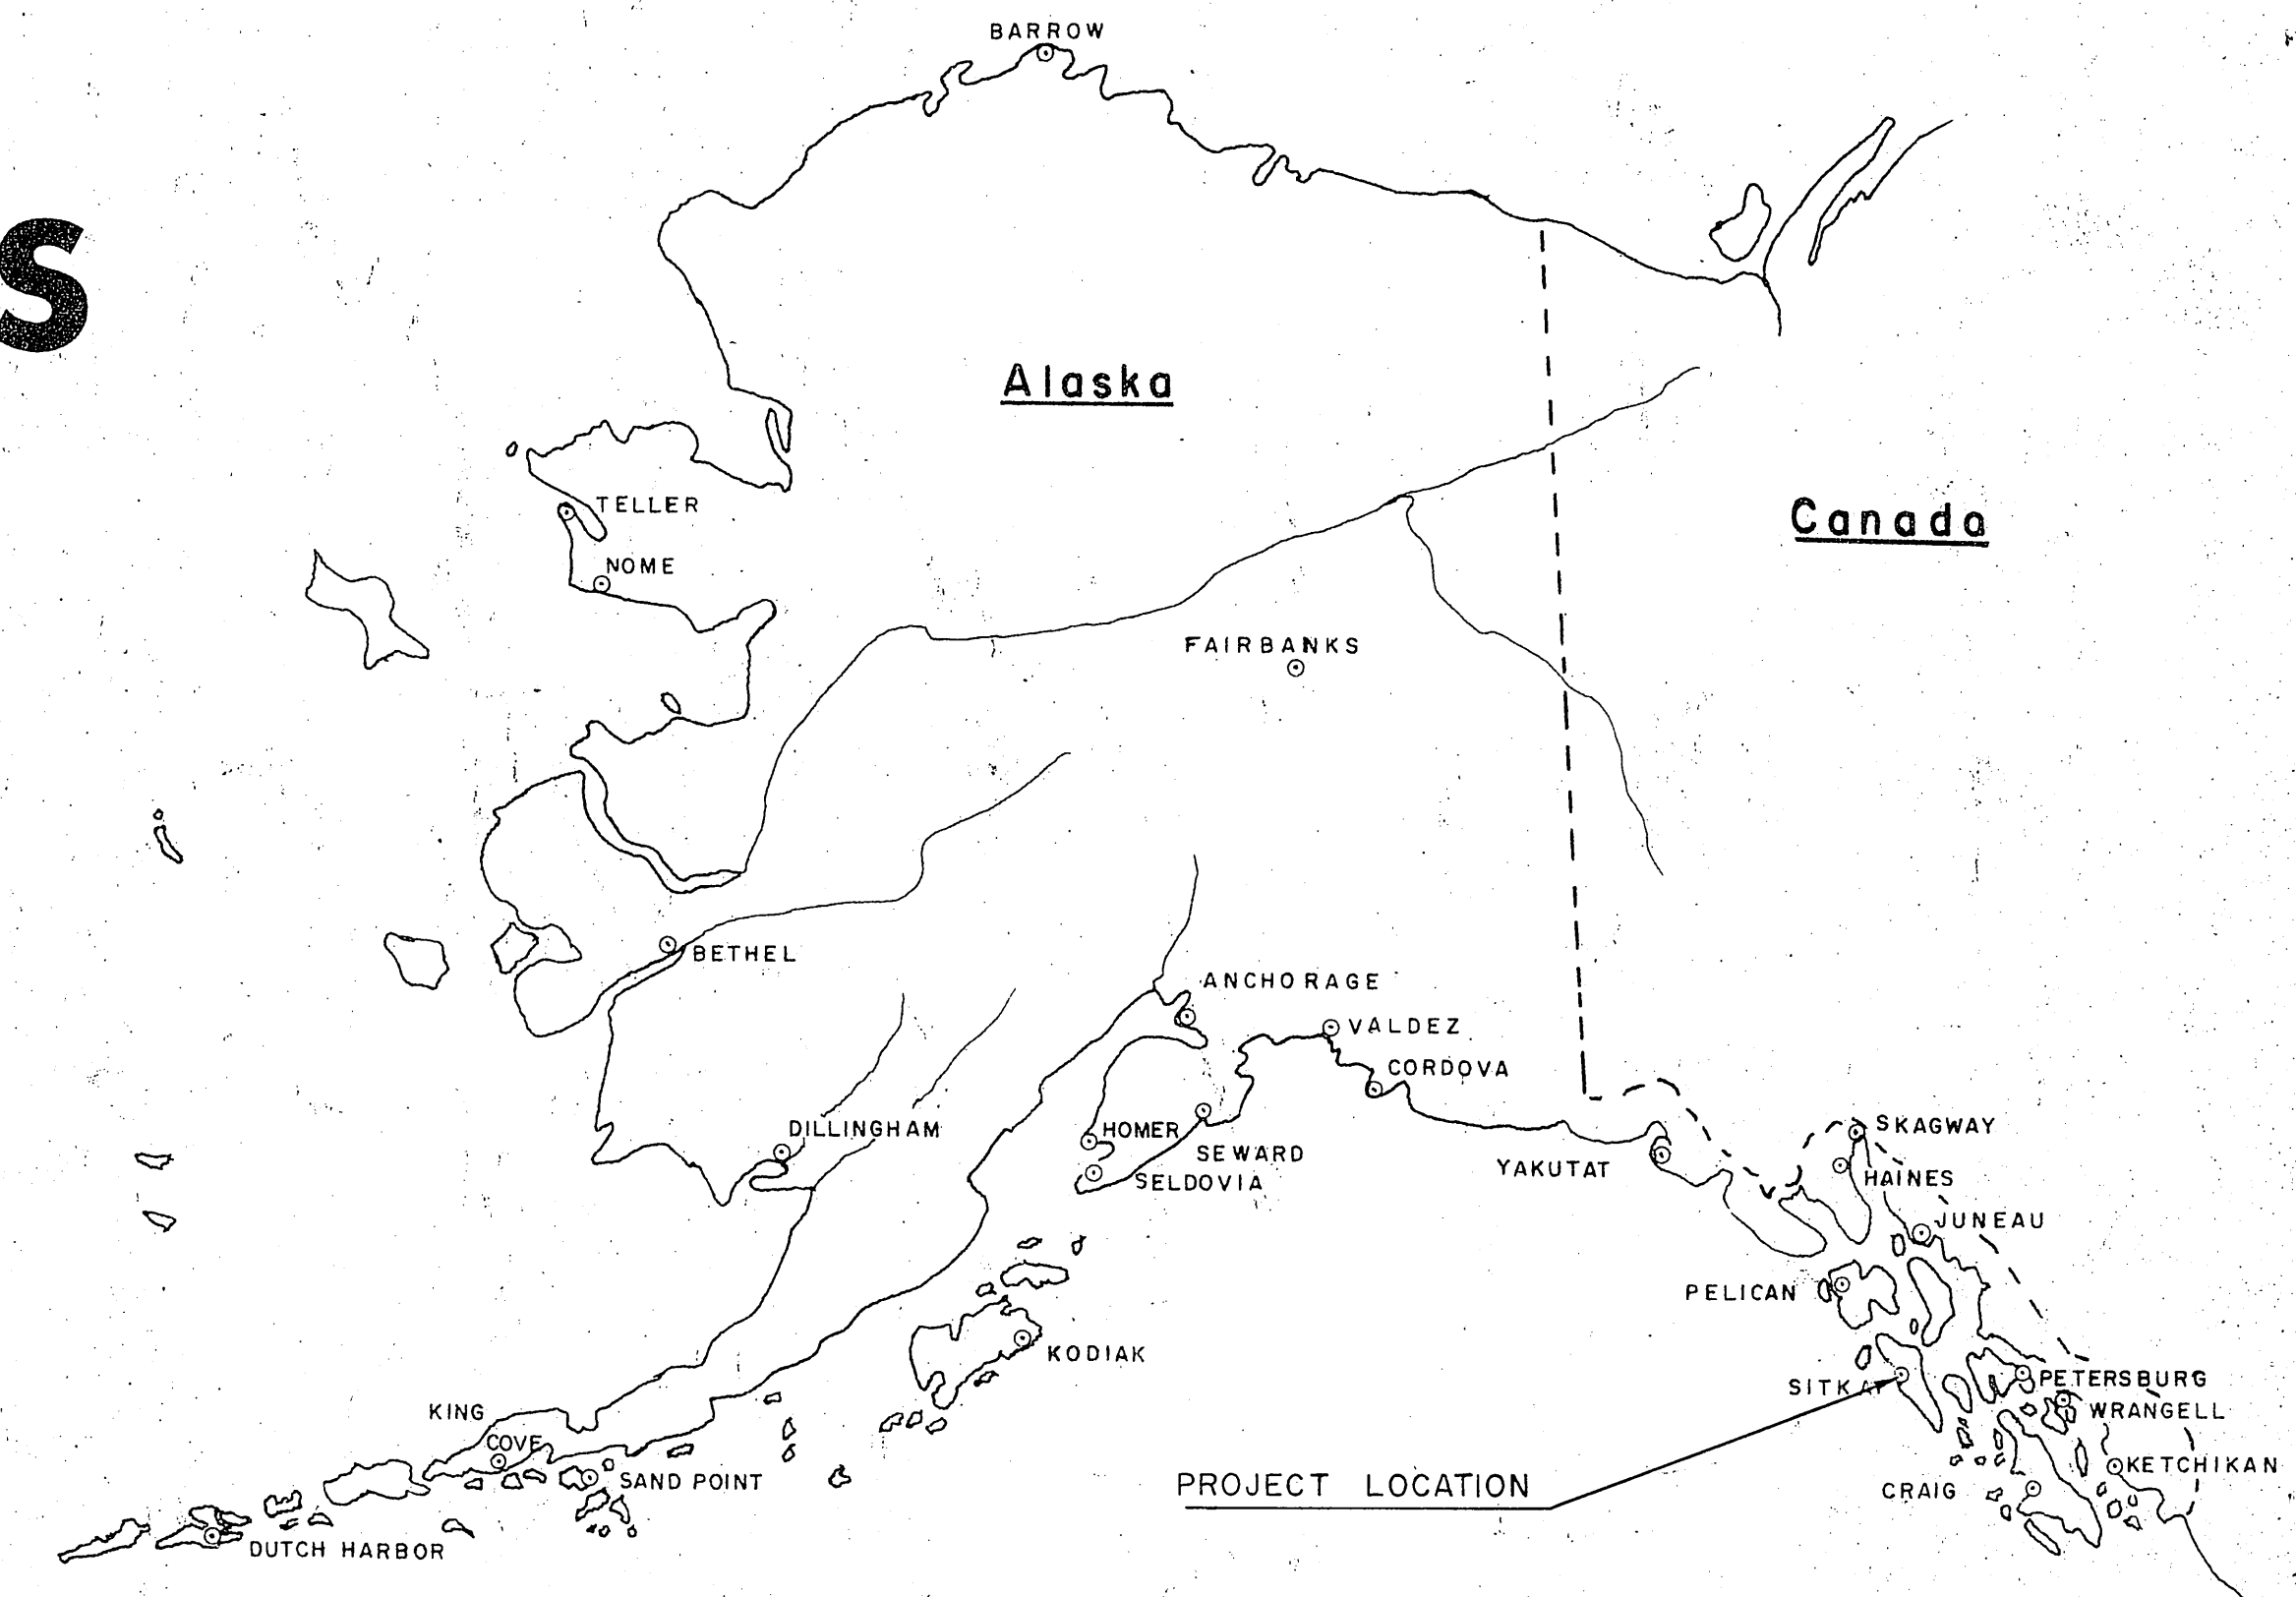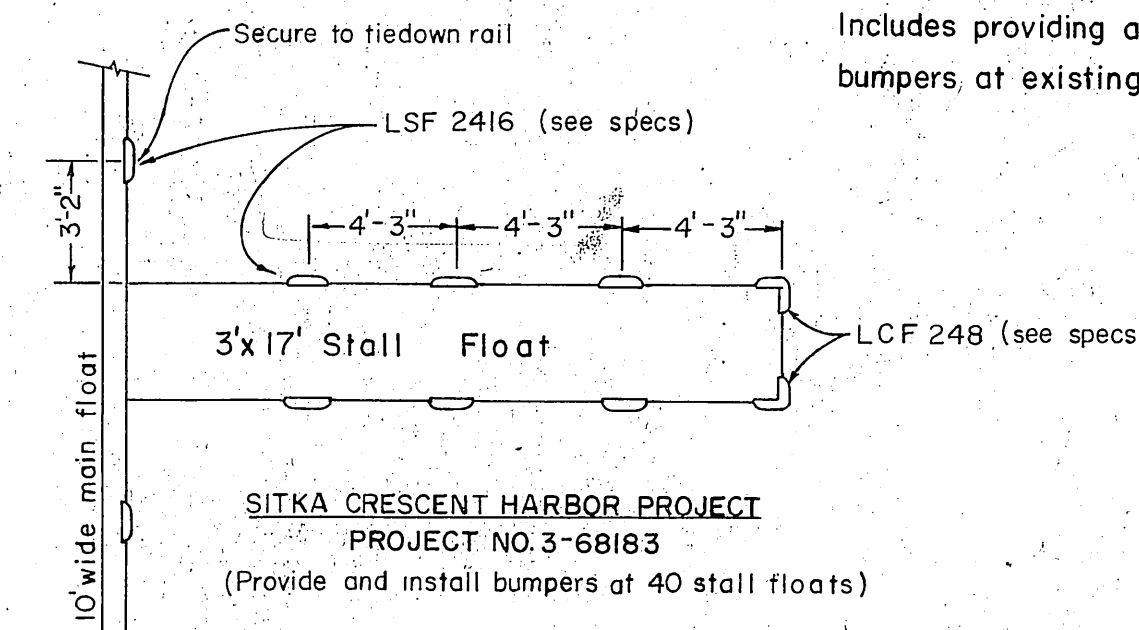

WORK SUMMARY

SITKA CITY FLOAT FACILITIES, PROJECT NO. 3-68125
Includes removal & disposal of the existing log float and construction and installation of 4550 S.F. of 13' wide log reinforced float.

SITKA THOMSEN HARBOR FACILITIES, PROJECT NO. 3-68164
Includes removal & disposal of the existing log breakwater, construction and installation of 990 L.F. of 3-log breakwater, modification of approximately 21 existing breakwater dolphins, driving of 2 new piling (144 L.F.) and the installation of miscellaneous breakwater mooring gear.

SITKA CRESCENT HARBOR FACILITIES, PROJECT NO. 3-68183
Includes providing and installing 400 vinyl plastic float bumper bumpers, at existing stall floats.

INDEX TO SHEETS

TITLE & LOCATION	SHEET NO. 1
CONSTRUCTION DETAILS	
BREAKWATER LAYOUT	
FLOAT STRINGER & LOG LAYOUT	
PILE & BRACING MODIFICATION	SHEET NO. 2
TYPICAL FLOATS	SHEET NO. 3

AS BUILT

DATE 1/3/68 APPROVED *George MacPherson* COMMISSIONER

