



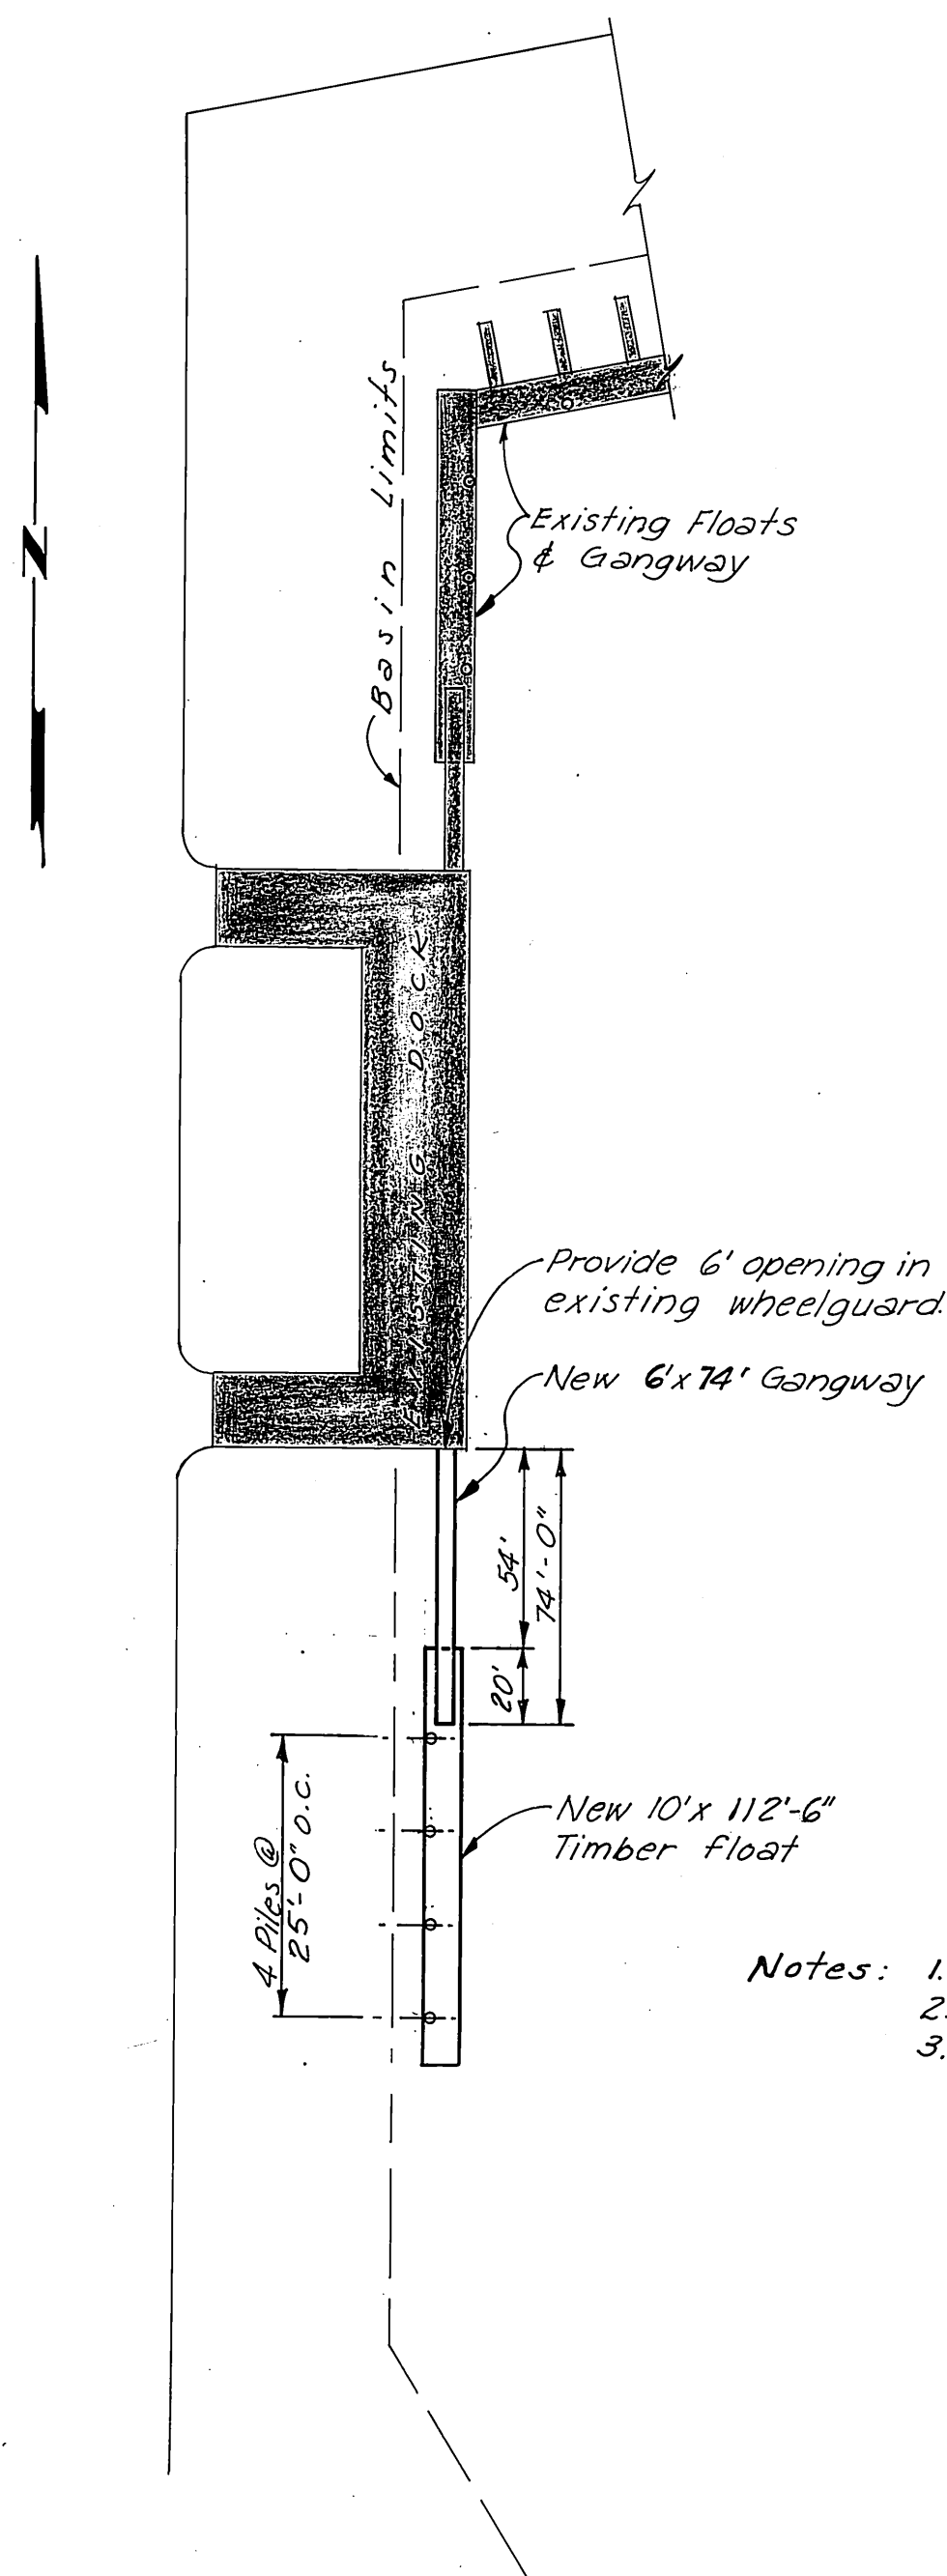

PROJECT LAYOUT

1" = 50'

- Notes:
1. Top of pile cut-off elev. +22'.
 2. Basin dredged to elev. -12'.
 3. Penetration req'd 15 feet.

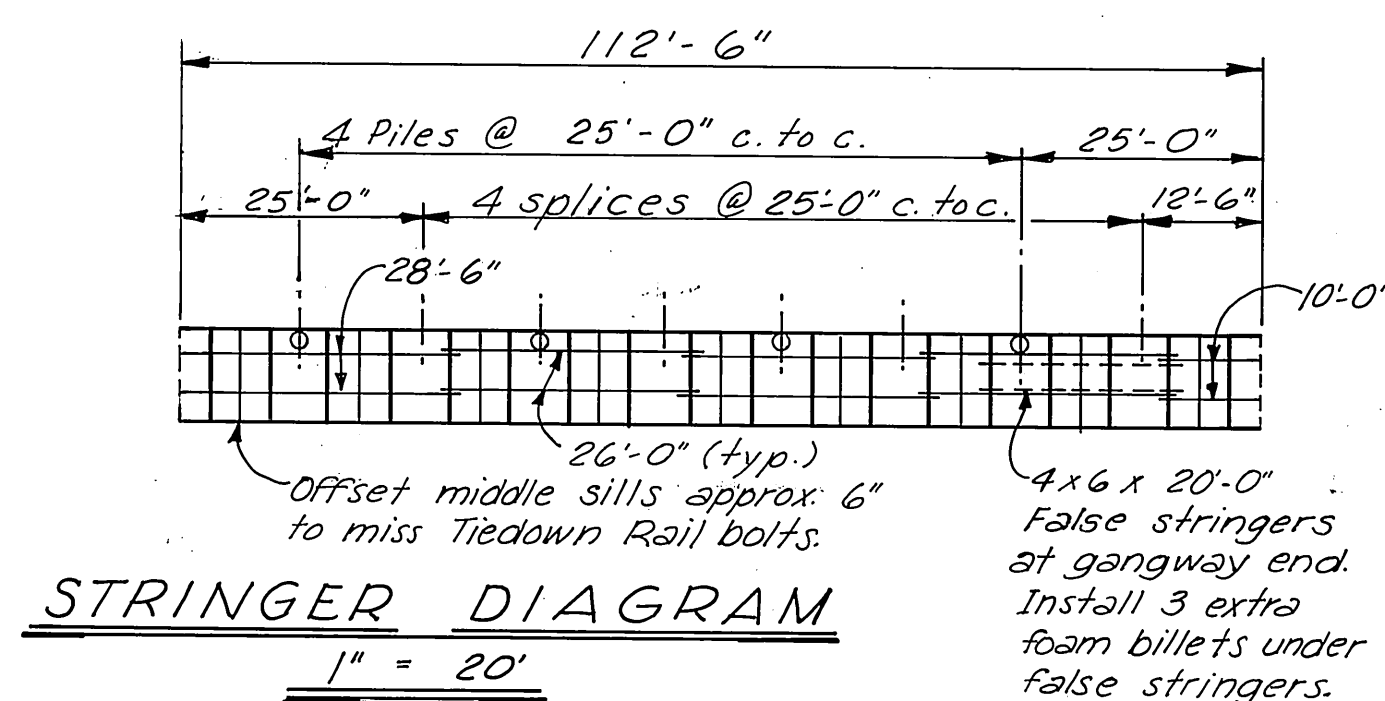


As Constructed

DO NOT SCALE THIS DRAWING - USE DIMENSIONS		
STATE OF ALASKA DEPARTMENT OF PUBLIC WORKS DIVISION OF WATER AND HARBORS		
<u>SITKA ~ CRESCENT HARBOR</u> <u>PROJECT LAYOUT</u> <u>STRINGER DIAGRAM</u>		
SCALE <u>As shown</u>	SURVEYED <u>~</u>	APPROVED
DESIGNED <u>~</u>	DRAWN <u>JT</u>	
CHECKED <u>~</u>	DATE <u>~</u>	<u>Don Statter</u> DIRECTOR
PROJECT NUMBER <u>3-76164 - C.O. 1</u>	SHEET <u>1</u> OF <u>3</u>	

SITKA

THOMSEN HARBOR FACILITIES

PROJECT NO. 3-76164











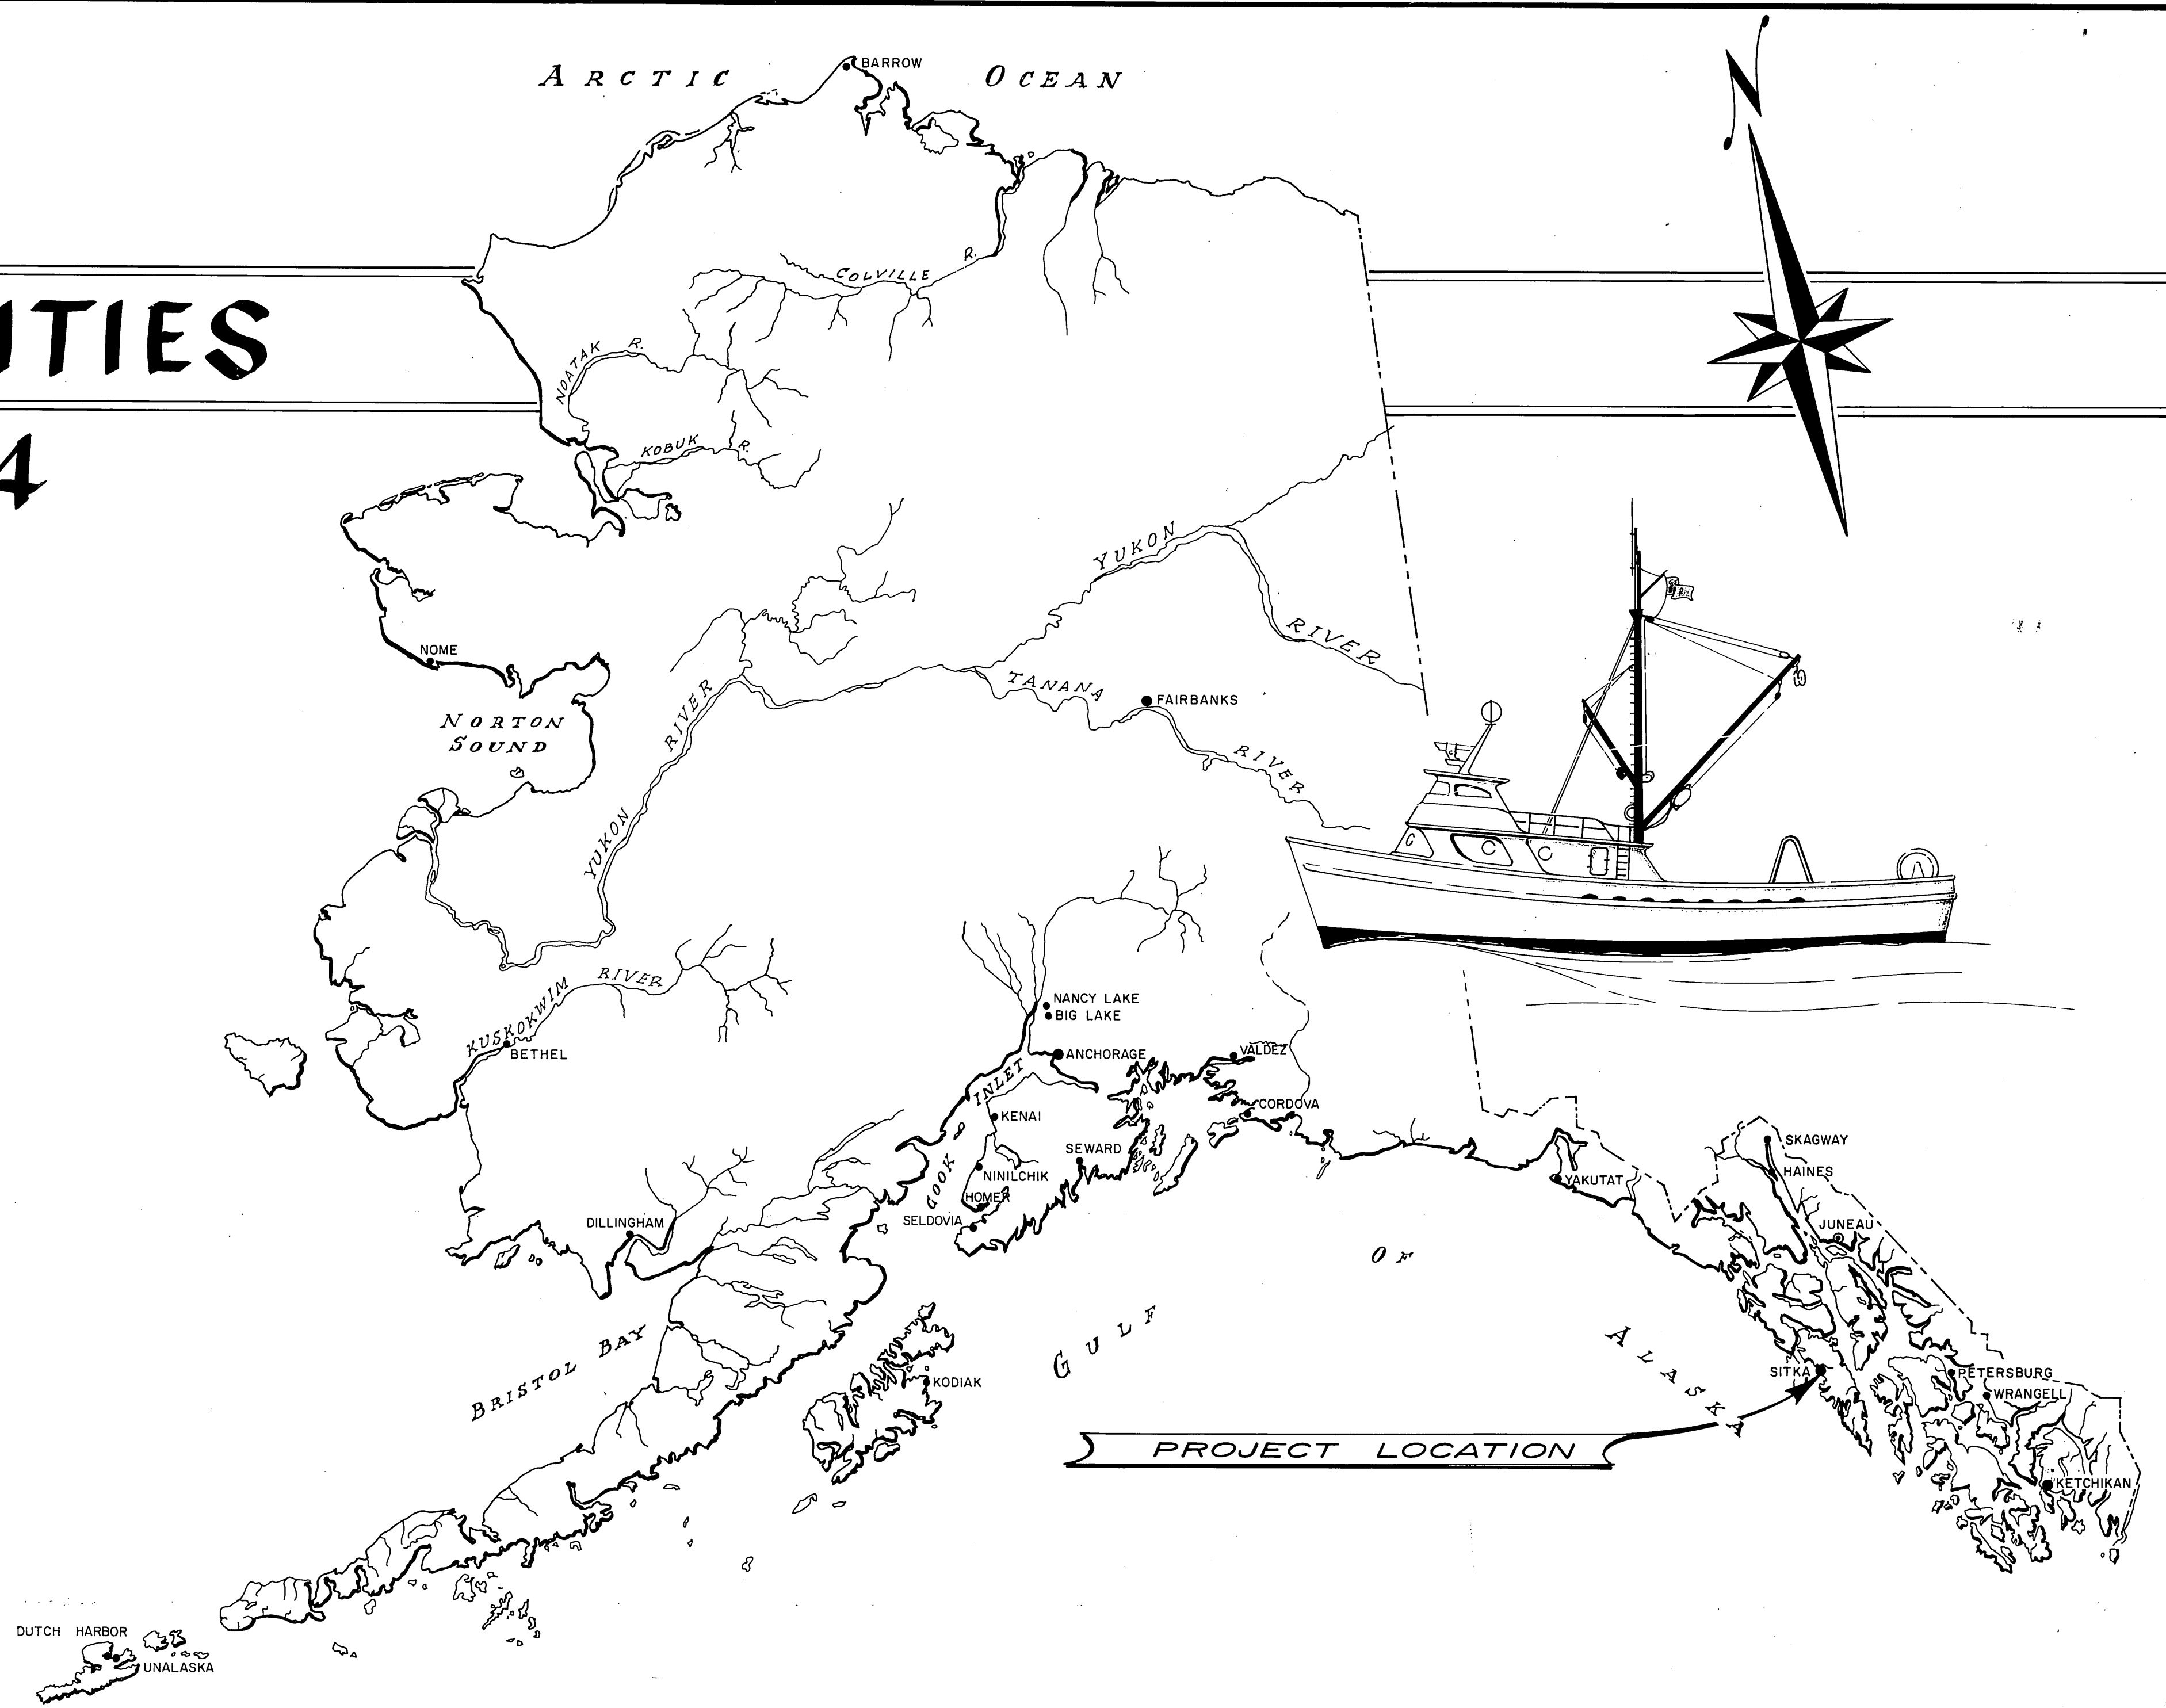


WORK SUMMARY

This project consists of: Removal of existing float system; furnishing and installing 26,000 sq. ft. of new timber floats, 4105 lin. ft. of new timber float piles, and a new 6' x 50' steel gangway; Reconstruction of the existing 6' x 100' timber approach structure.


As Constructed
As Constructed

INDEX TO SHEETS			
1	TITLE & LOCATION	7	TYPICAL 6' FLOAT W/STALLS
2	PROJECT LAYOUT & DETAILS	8	MISCELLANEOUS DETAILS
3	STRINGER DIAGRAMS	9	APPROACH RECONSTRUCTION
4	TYPICAL FLOATS	10	TYPICAL GANGWAY, SH. A
5	TYPICAL STALL FLOATS	11	TYPICAL GANGWAY, SH. B
6	TYPICAL 8' FLOAT W/STALLS		

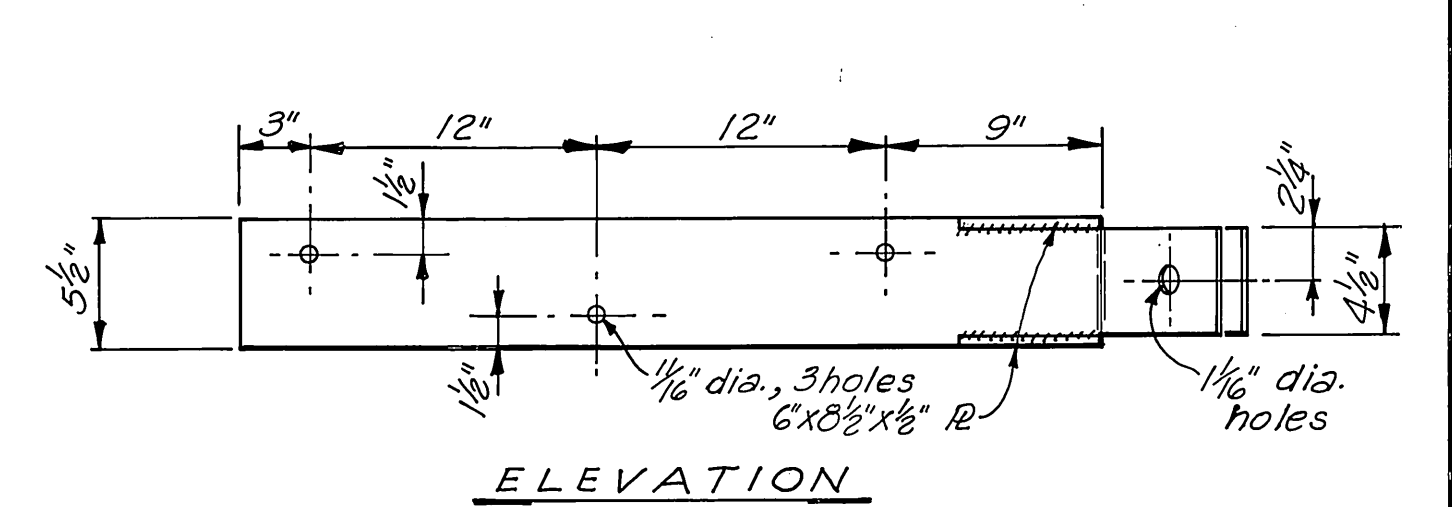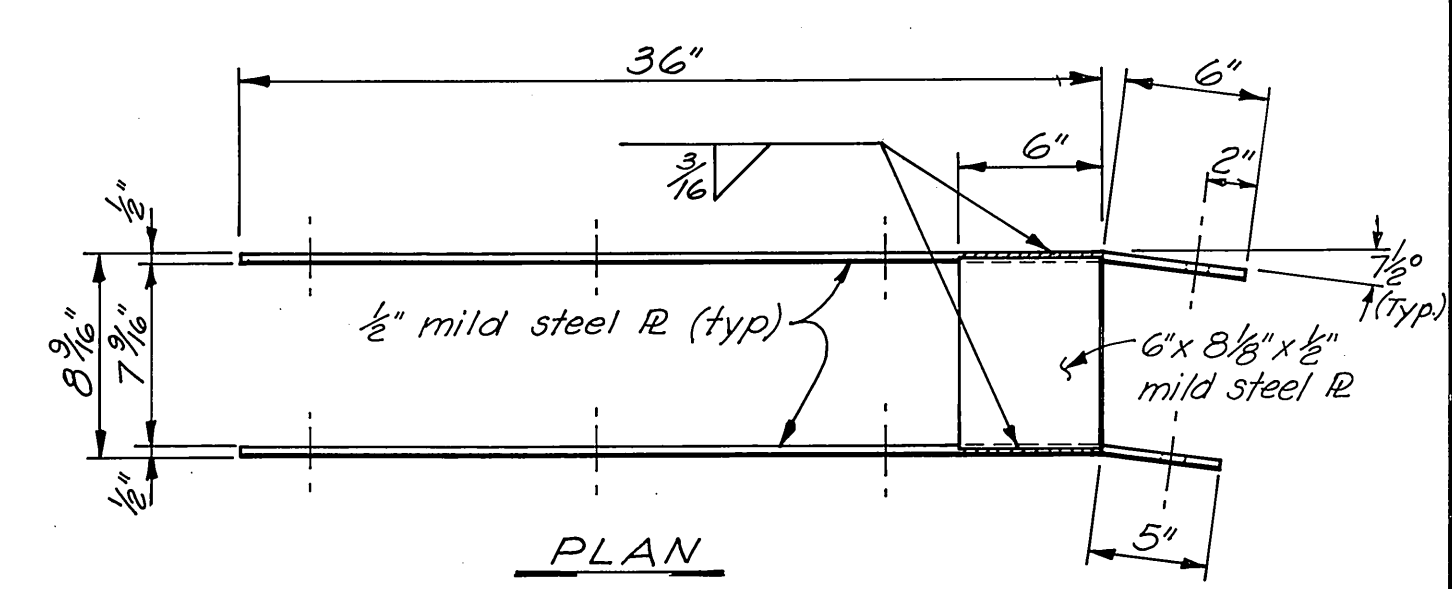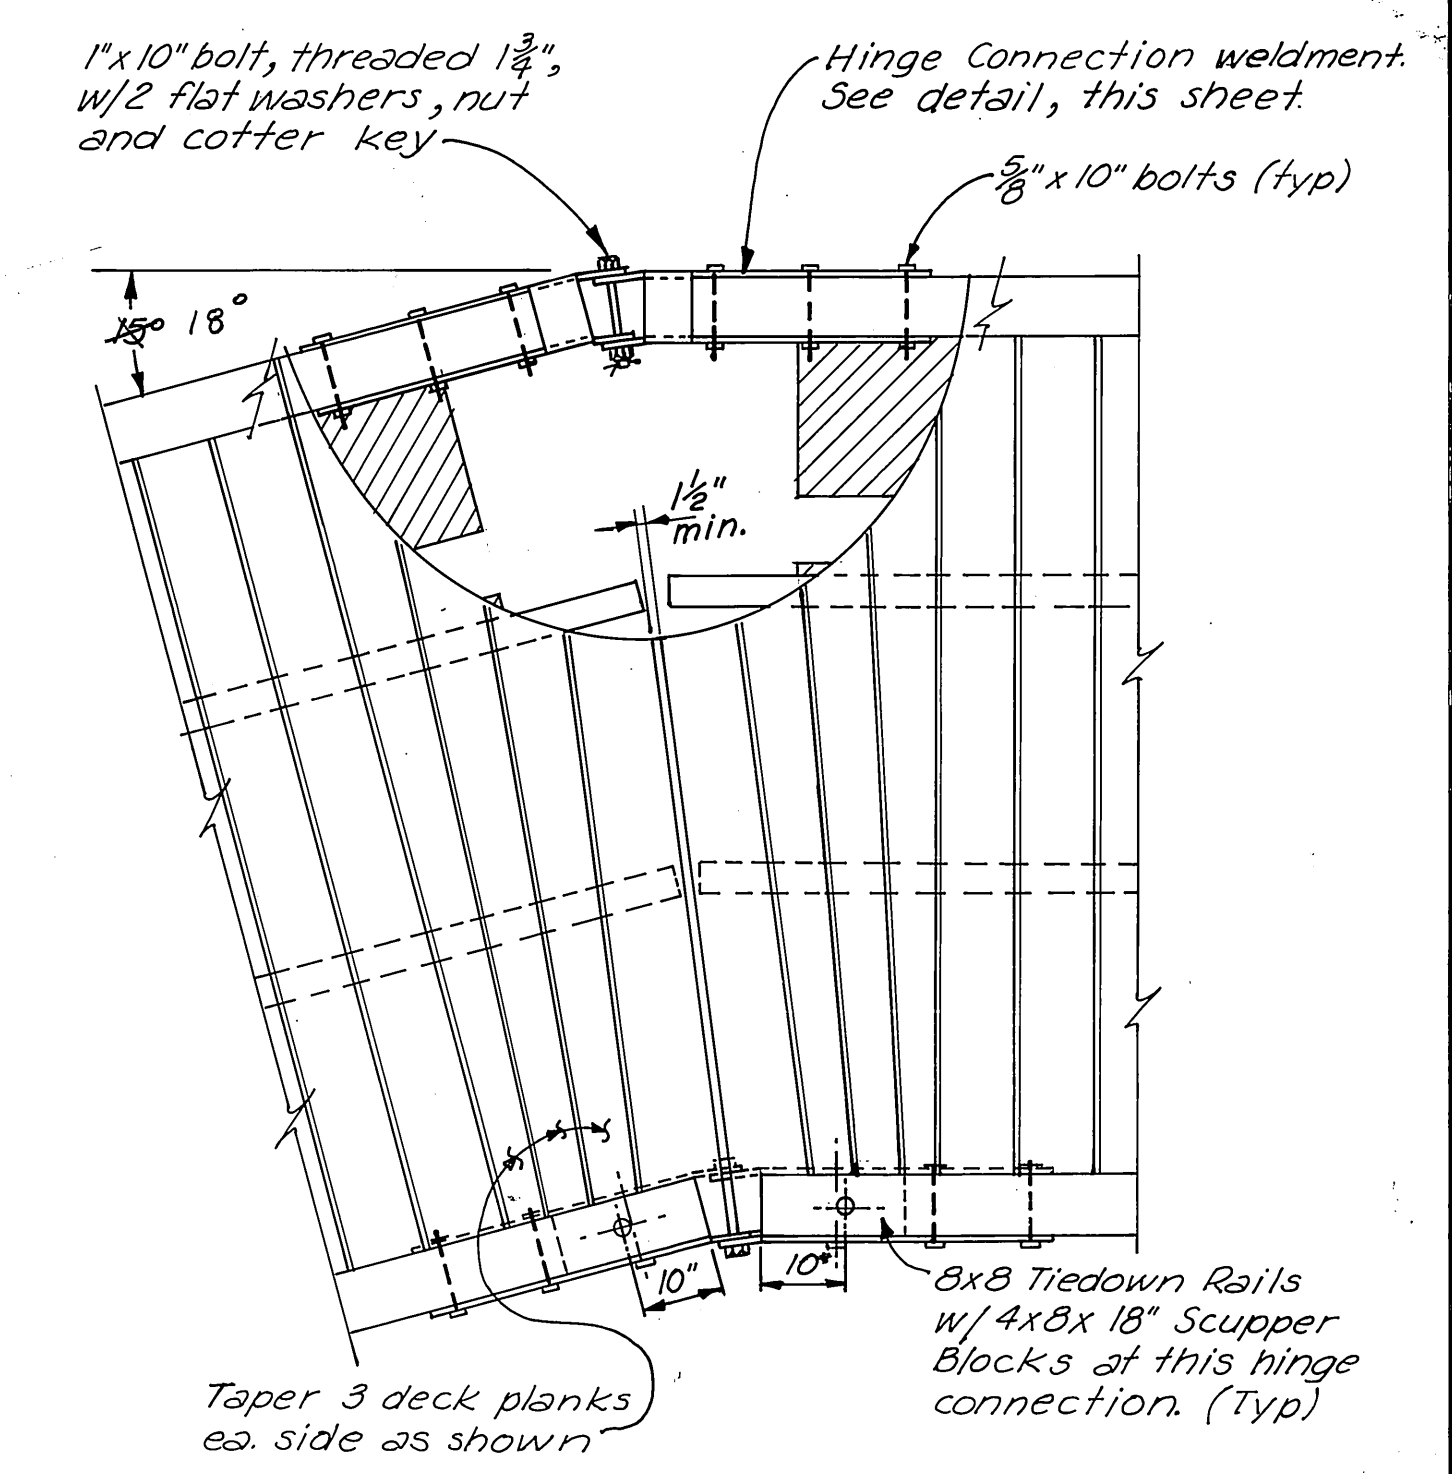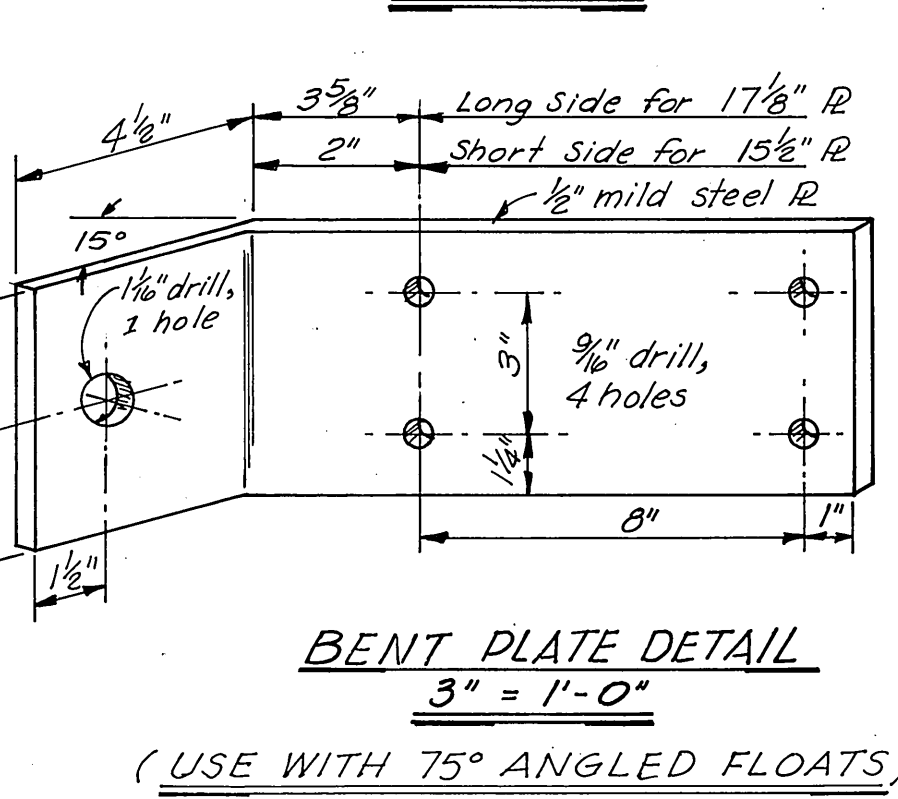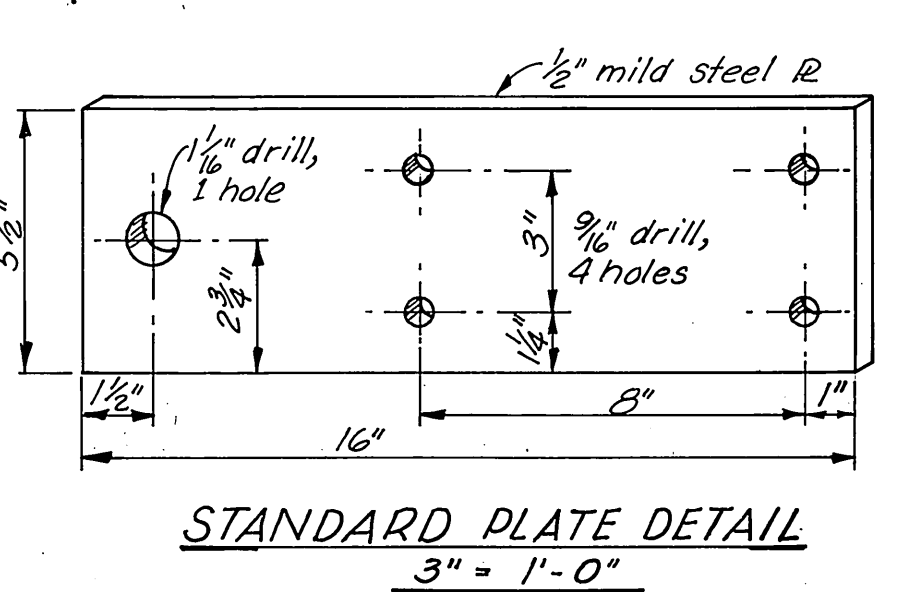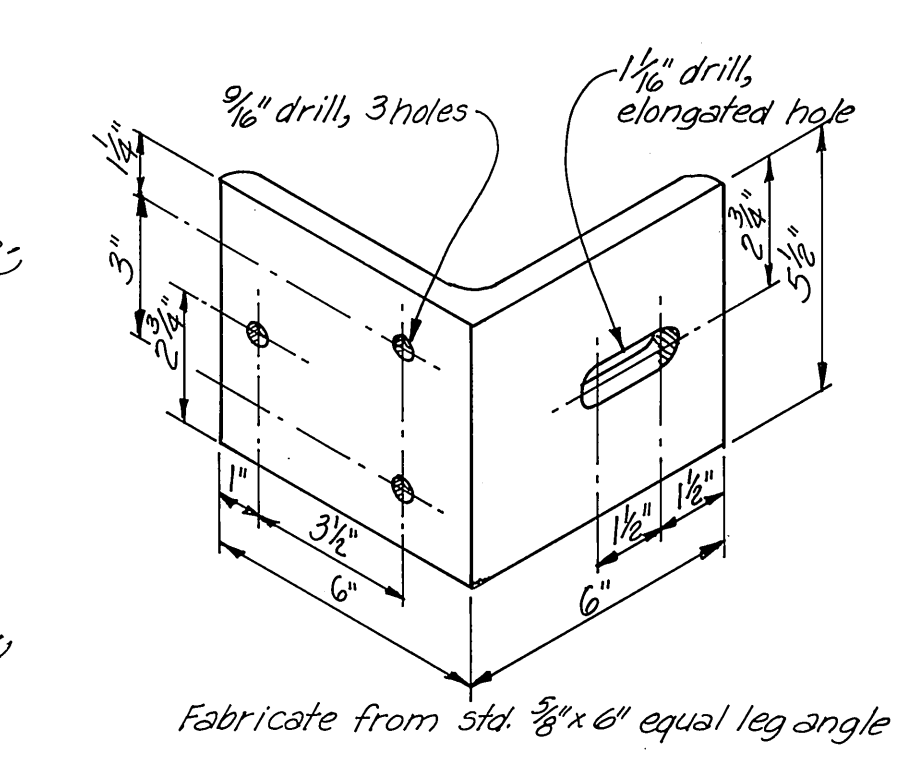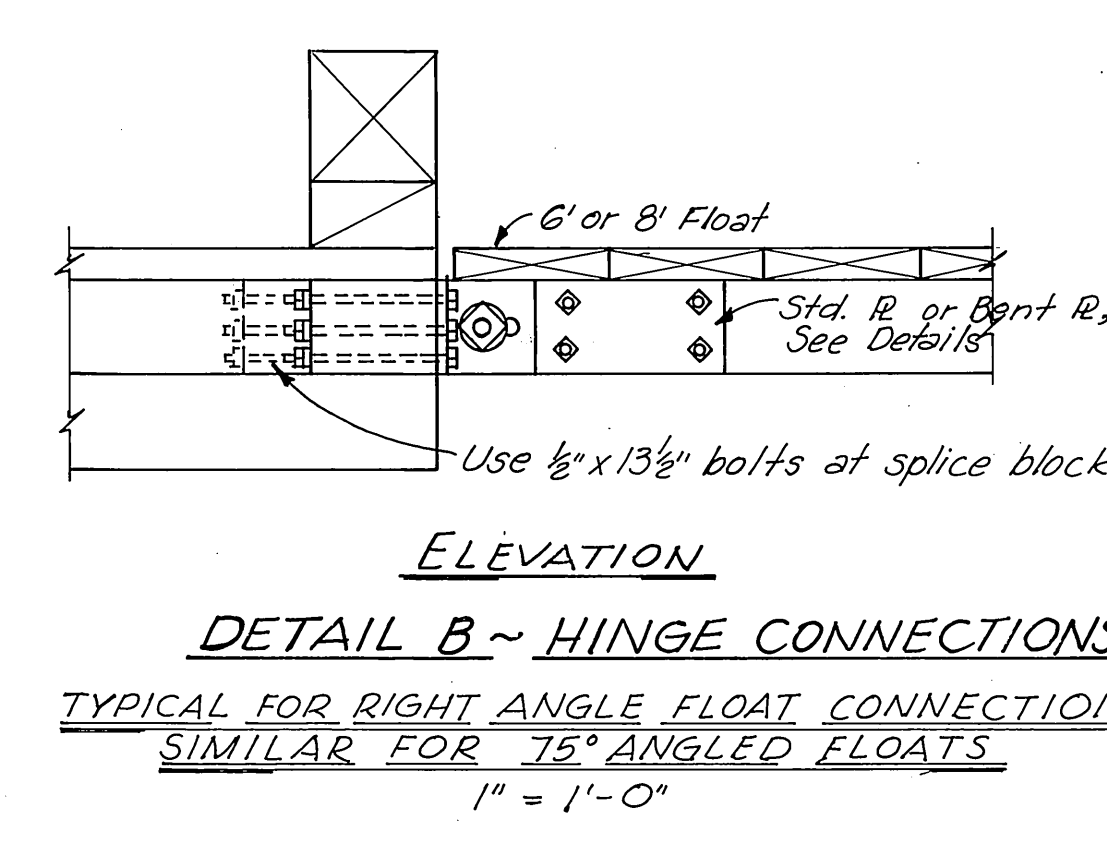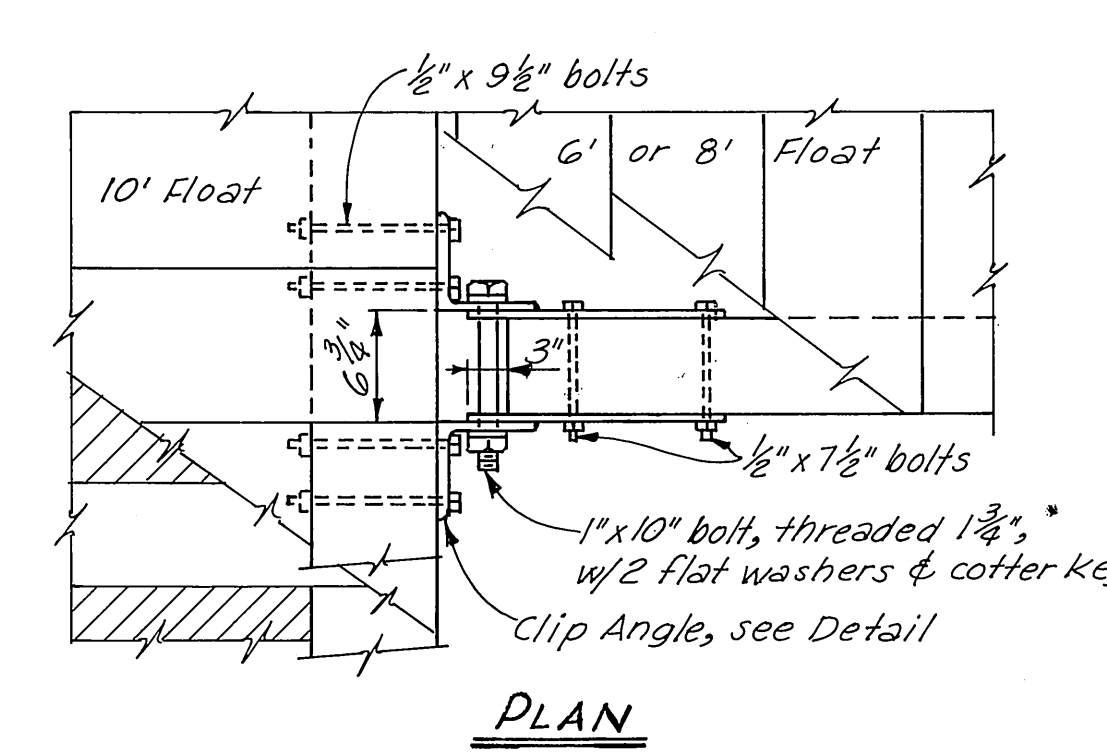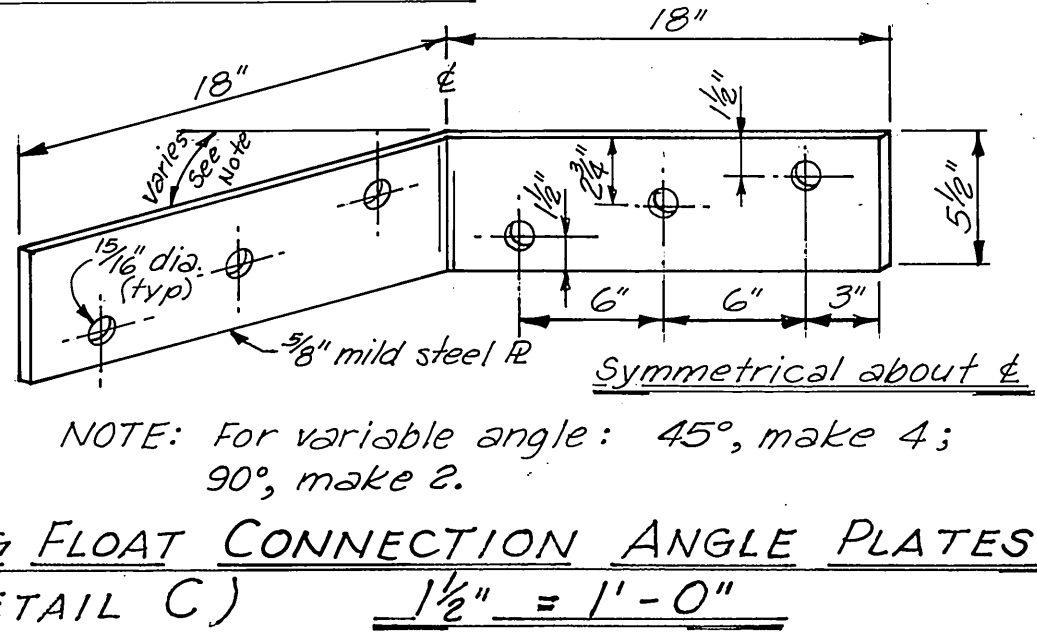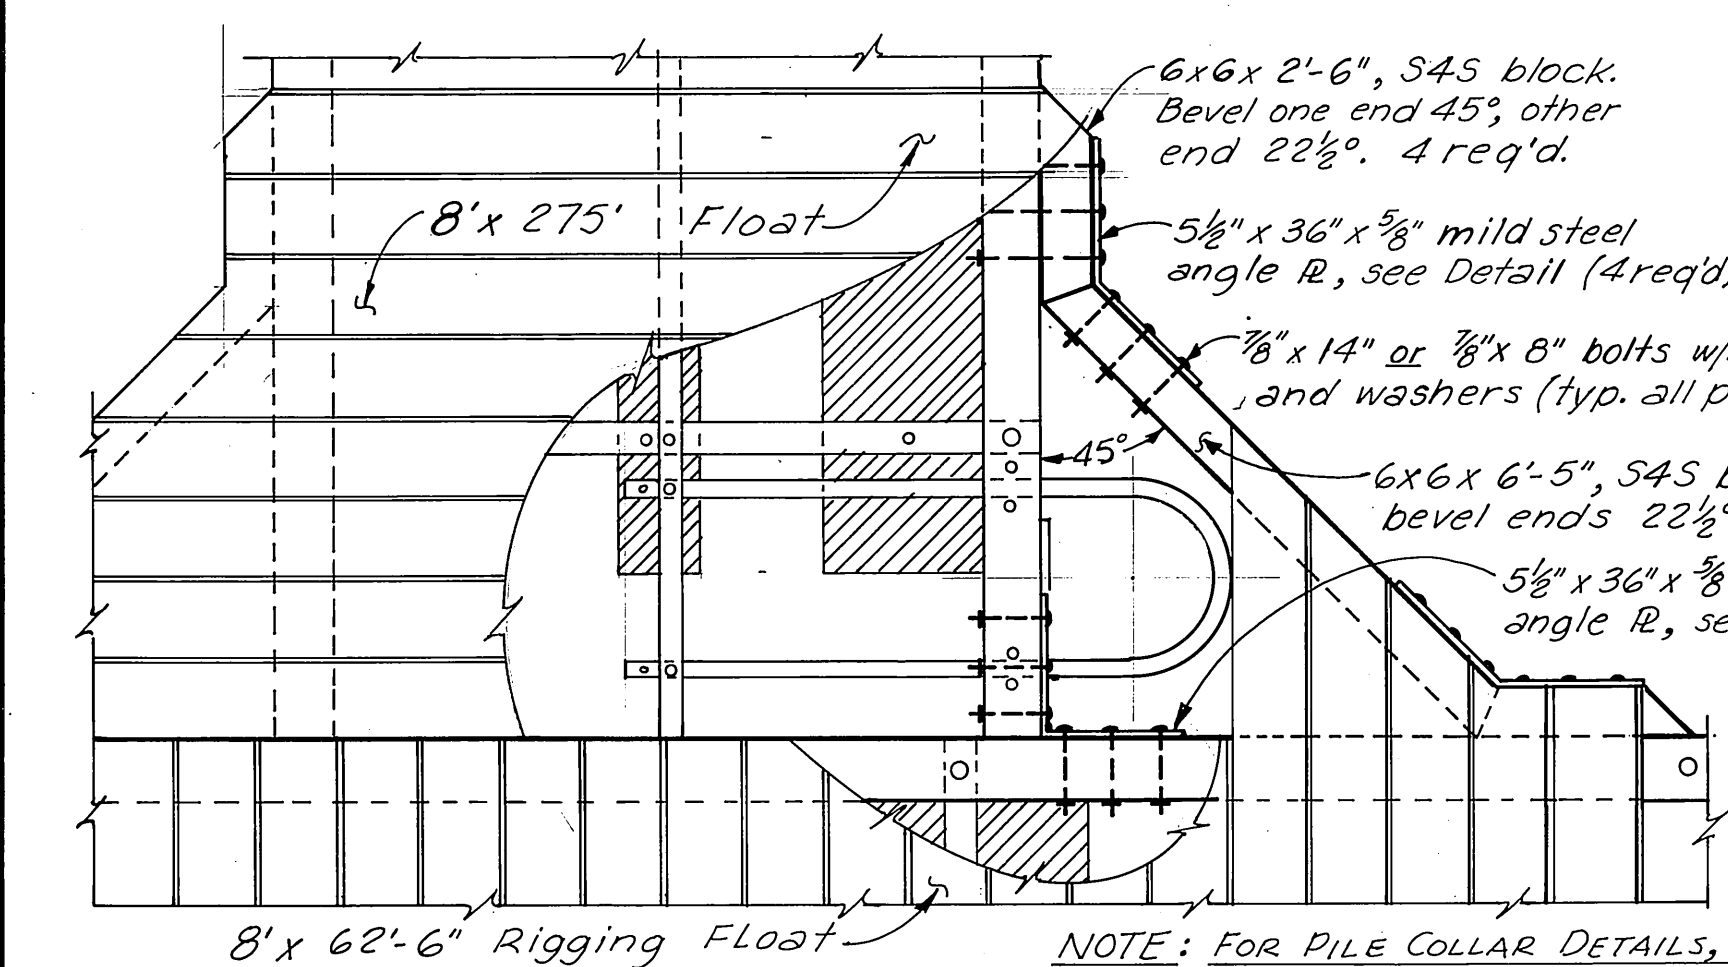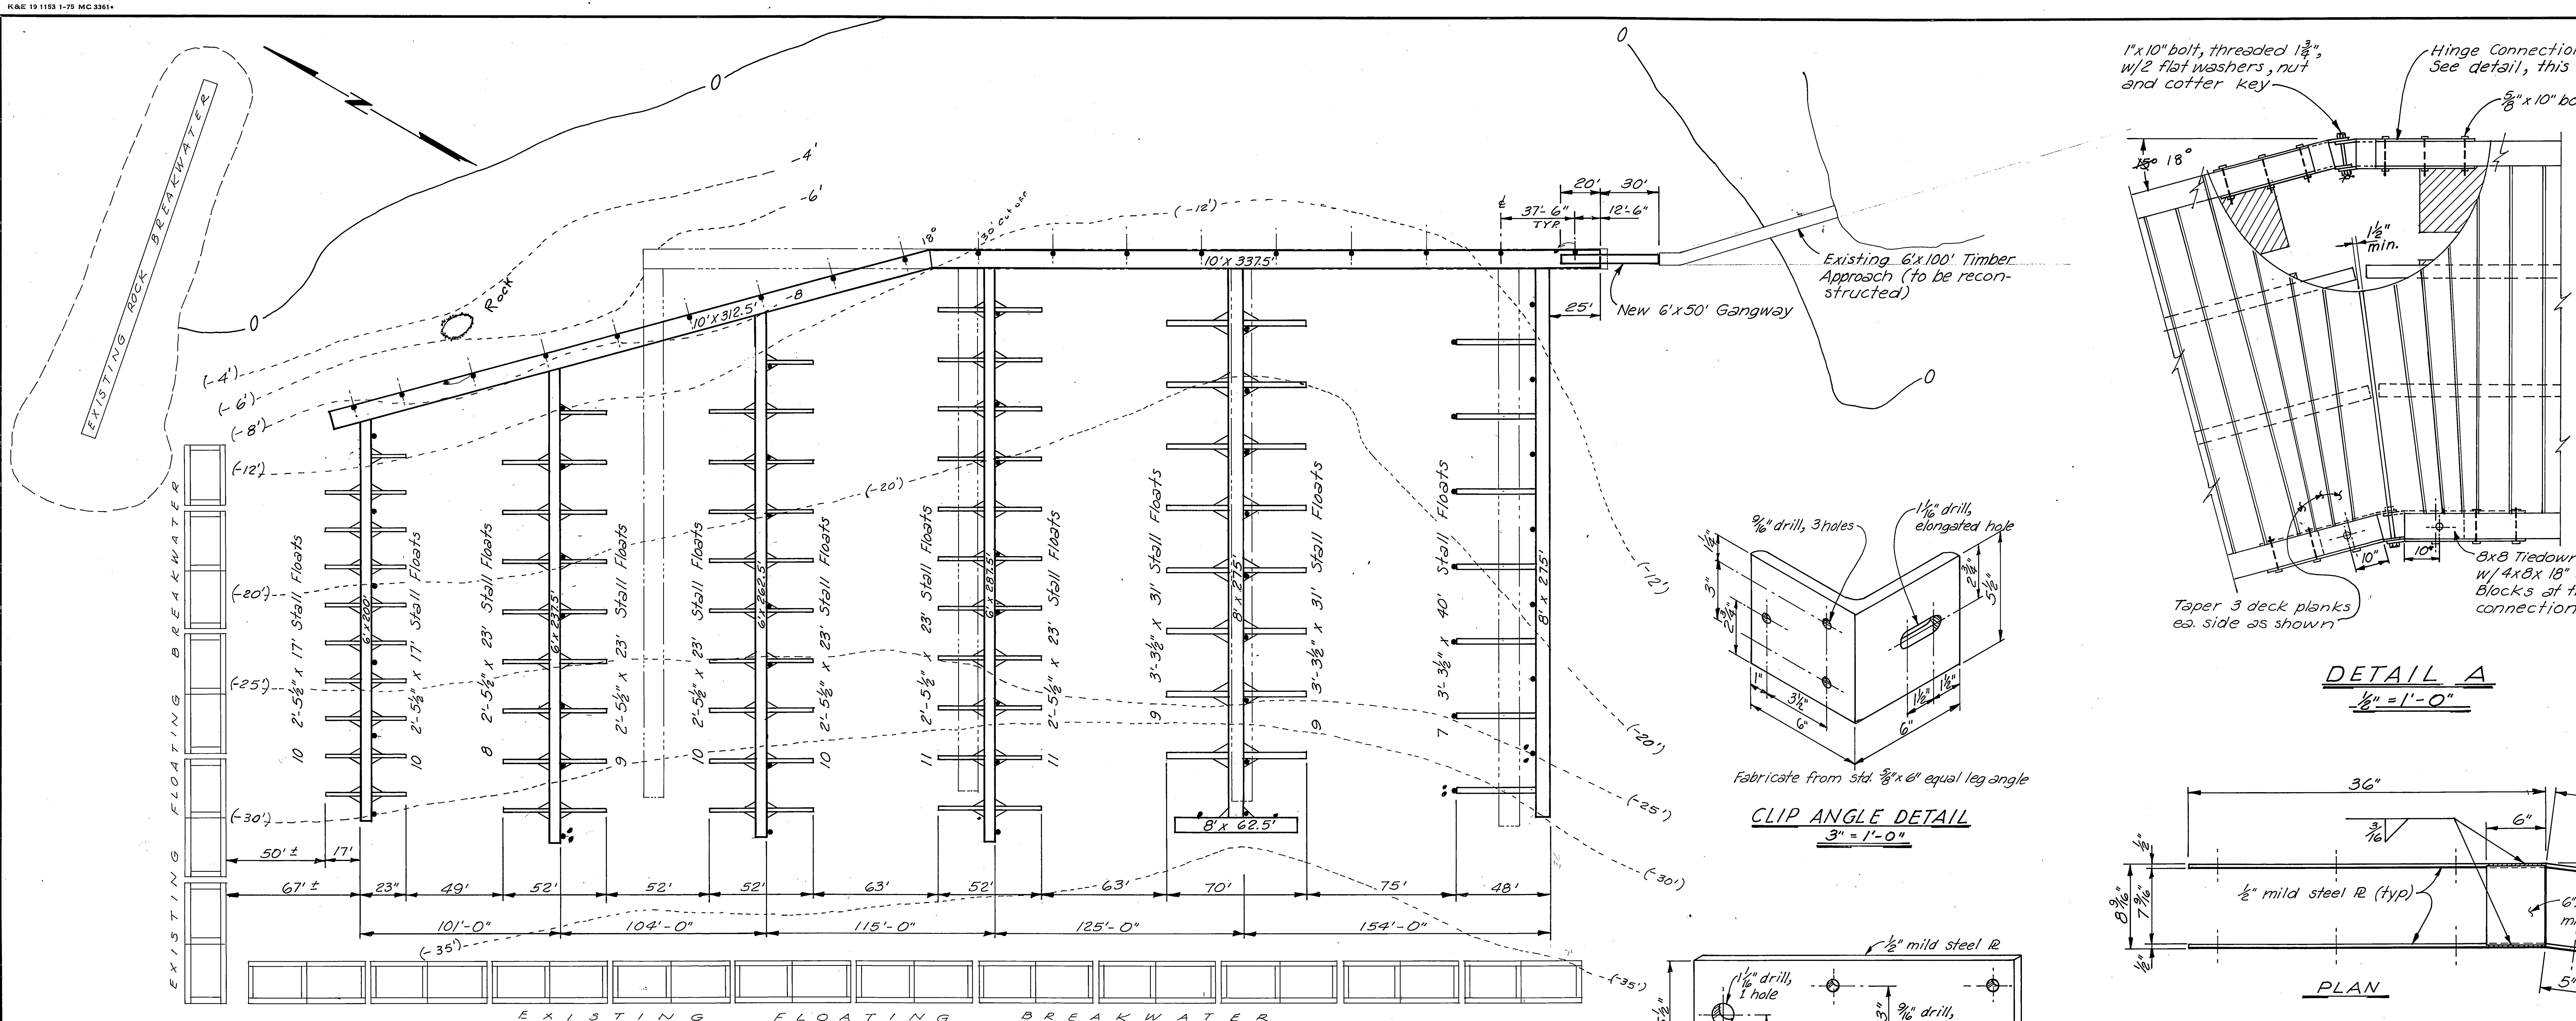




HINGE CONNECTION WELDMENT 1/2" = 1'-0"

DO NOT SCALE THIS DRAWING - USE DIMENSIONS		
STATE OF ALASKA DEPARTMENT OF PUBLIC WORKS DIVISION OF WATER AND HARBORS		
<u>PROJECT LAYOUT</u> <u>MISCELLANEOUS DETAILS</u>		
SCALE <i>As shown</i>	SURVEYED <i>~</i>	APPROVED
DESIGNED _____	DRAWN <i>JT</i>	<i>Don Statter</i> _____ DIRECTOR
CHECKED _____	DATE _____	
PROJECT NUMBER <i>3-76164</i>	SHEET <i>2</i> OF <i>11</i>	

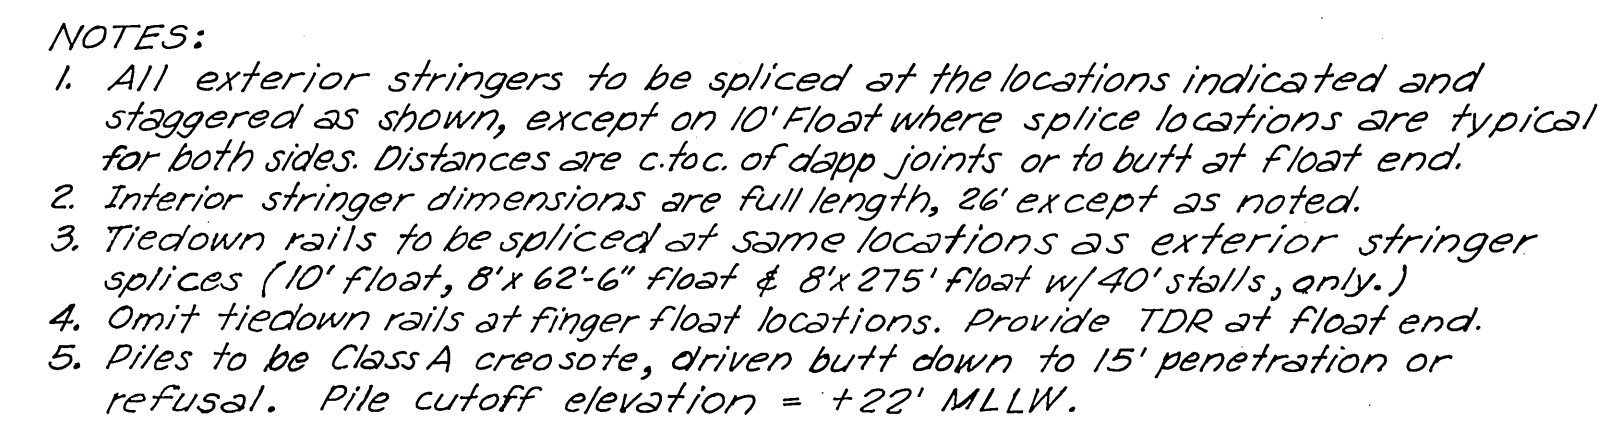


STATE OF ALASKA
DEPARTMENT OF PUBLIC WORKS
DIVISION OF WATER AND HARBORS


SCALE <u>1" = 20'</u>	SURVEYED <u>~</u>	APPROVED
DESIGNED <u>JT</u>	DRAWN <u>JT</u>	<u>Don Statter</u>
CHECKED _____	DATE _____	DIRECTOR
PROJECT NUMBER <u>3-76164</u>	SHEET <u>3</u> OF <u>11</u>	

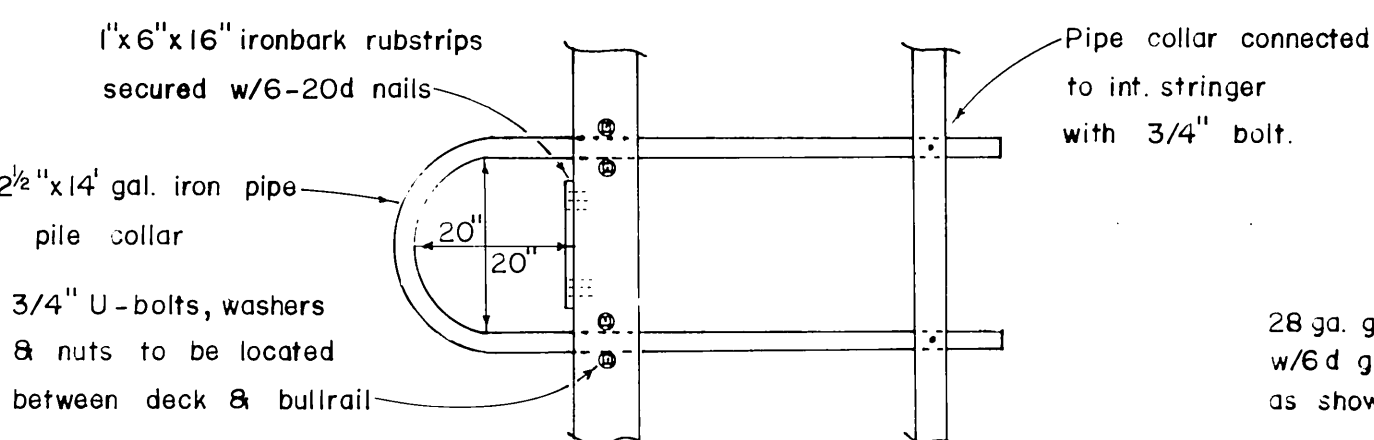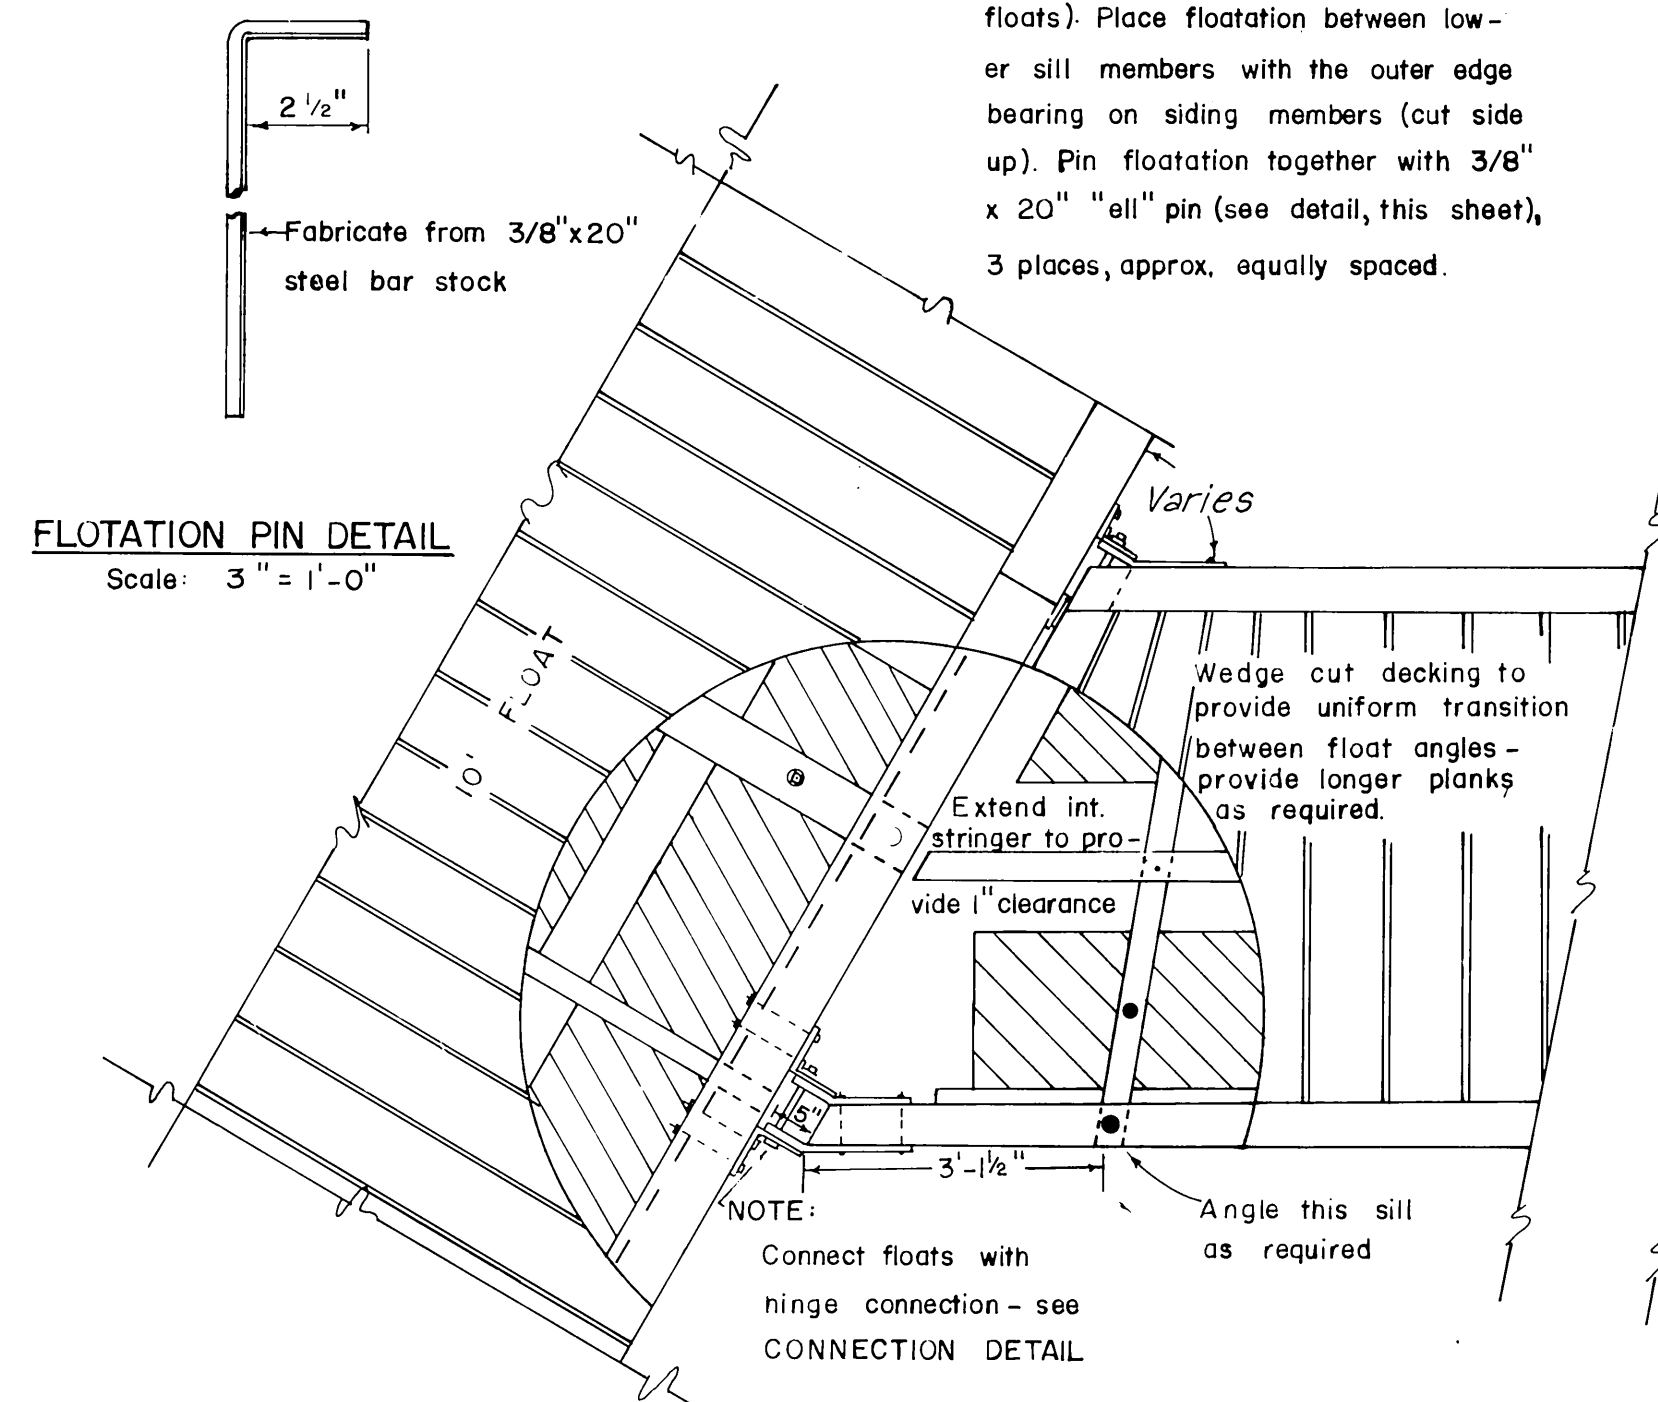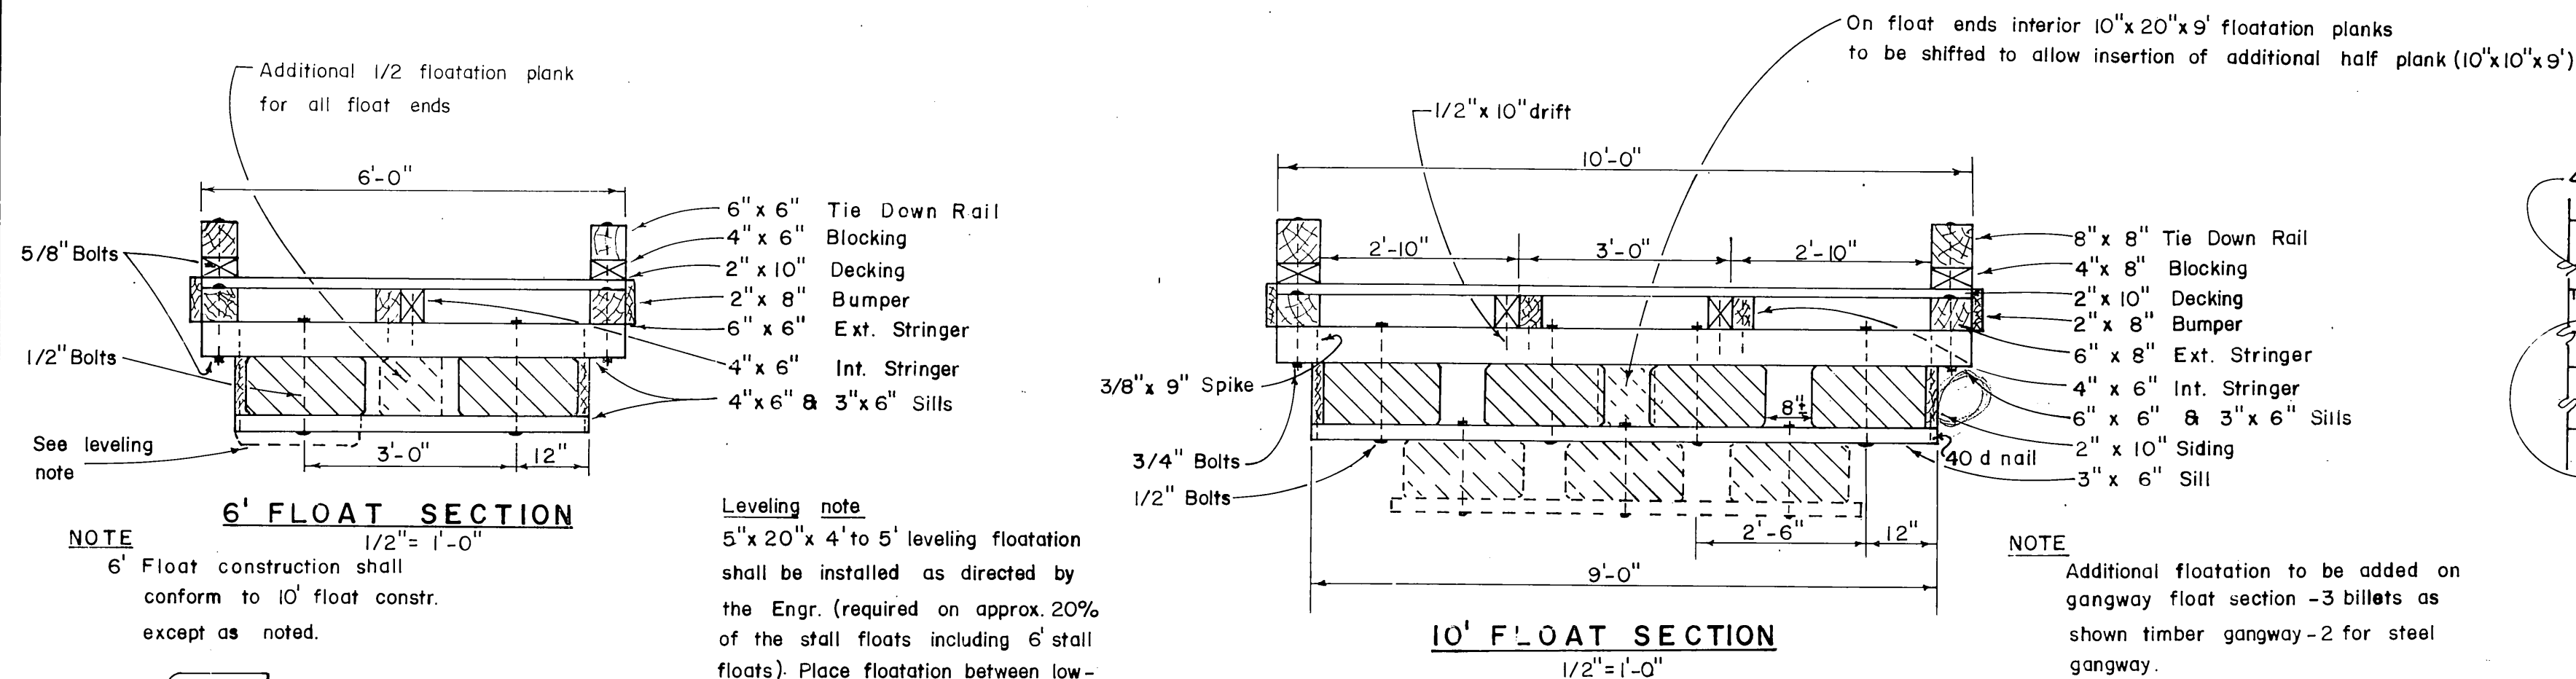

PIPE PILE COLLAR DETAIL

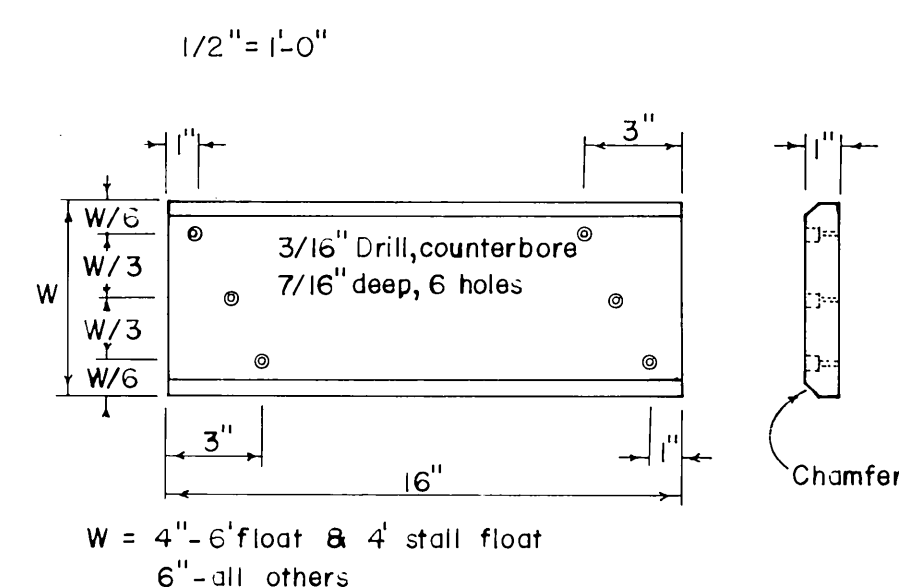

CONNECTION & COLLAR DETAIL

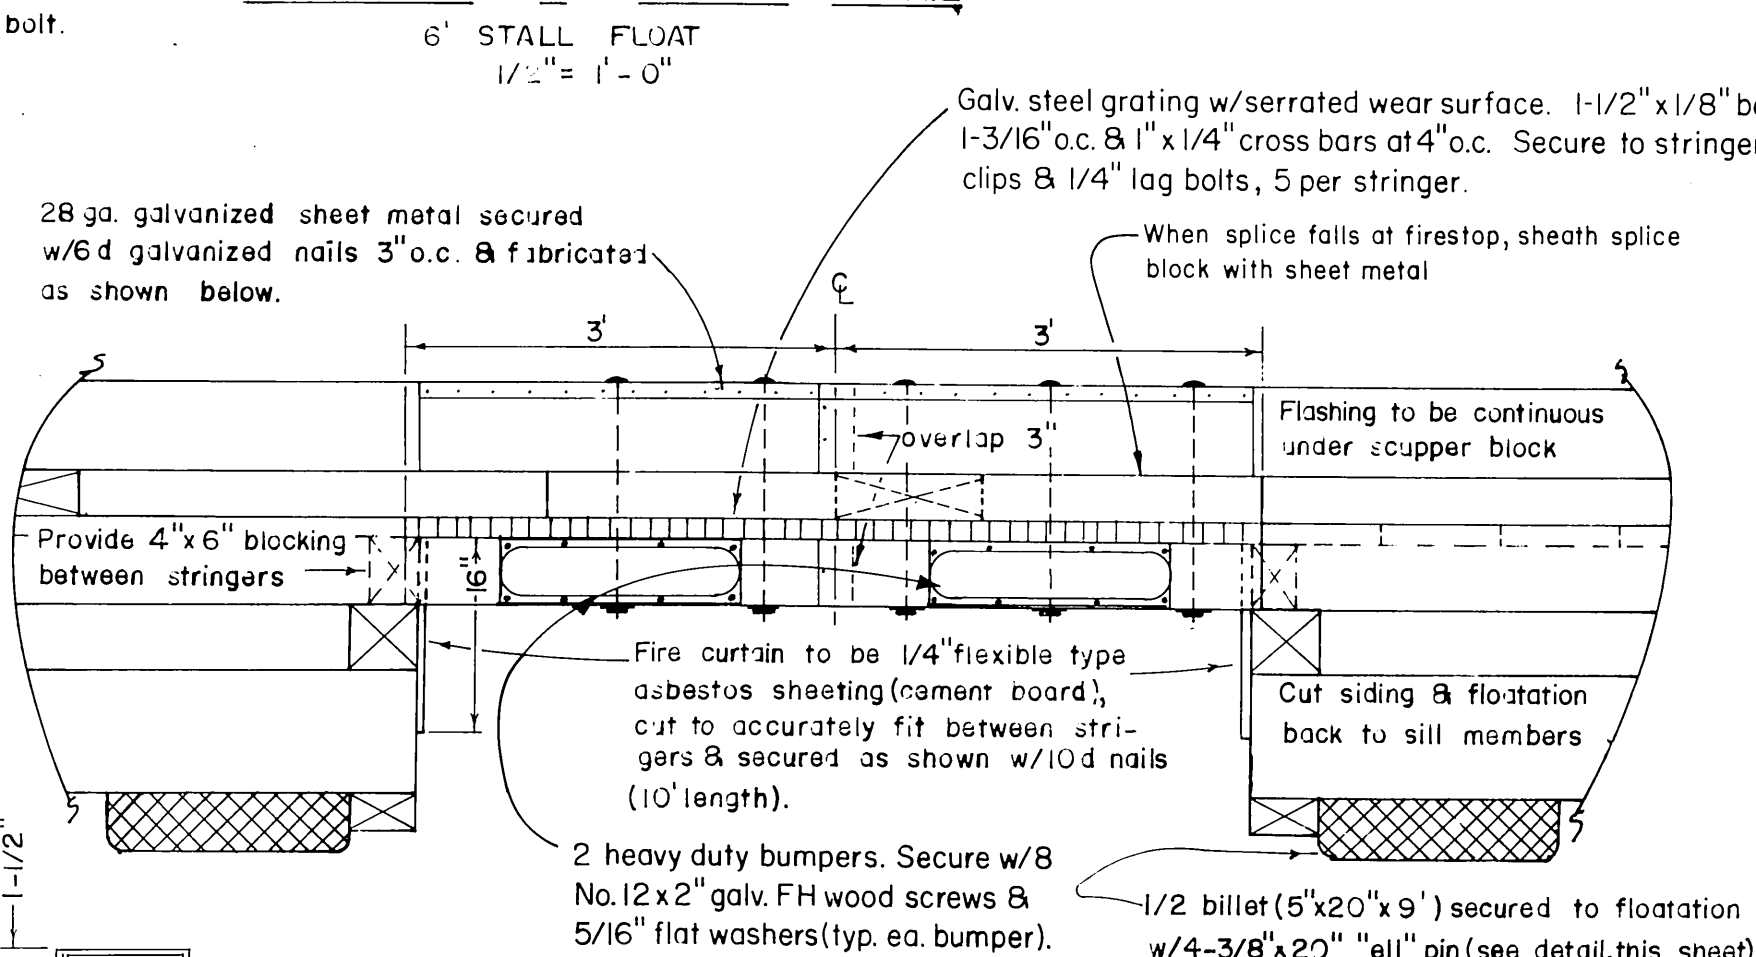


FIRE STOP DETAILS


Scale 3/4" to 1'-0"

NOTES:

Secure grating to stringers with saddle clips & 1/4" lag bolts - 5 at each stringer per 6' width

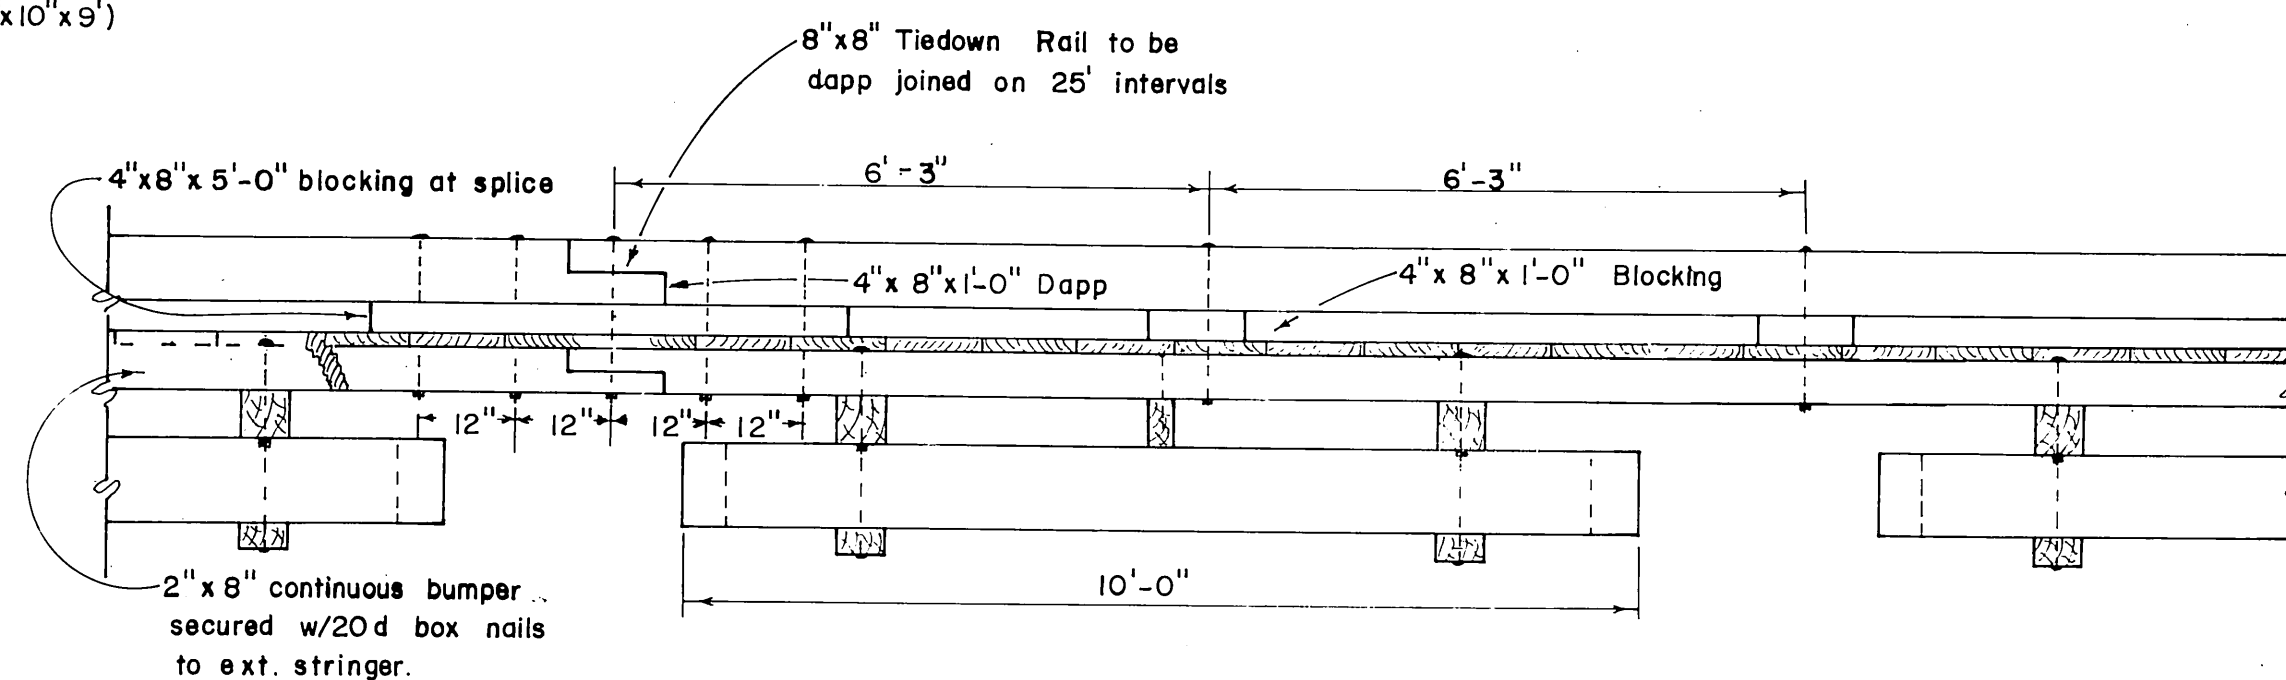

ELEVATION

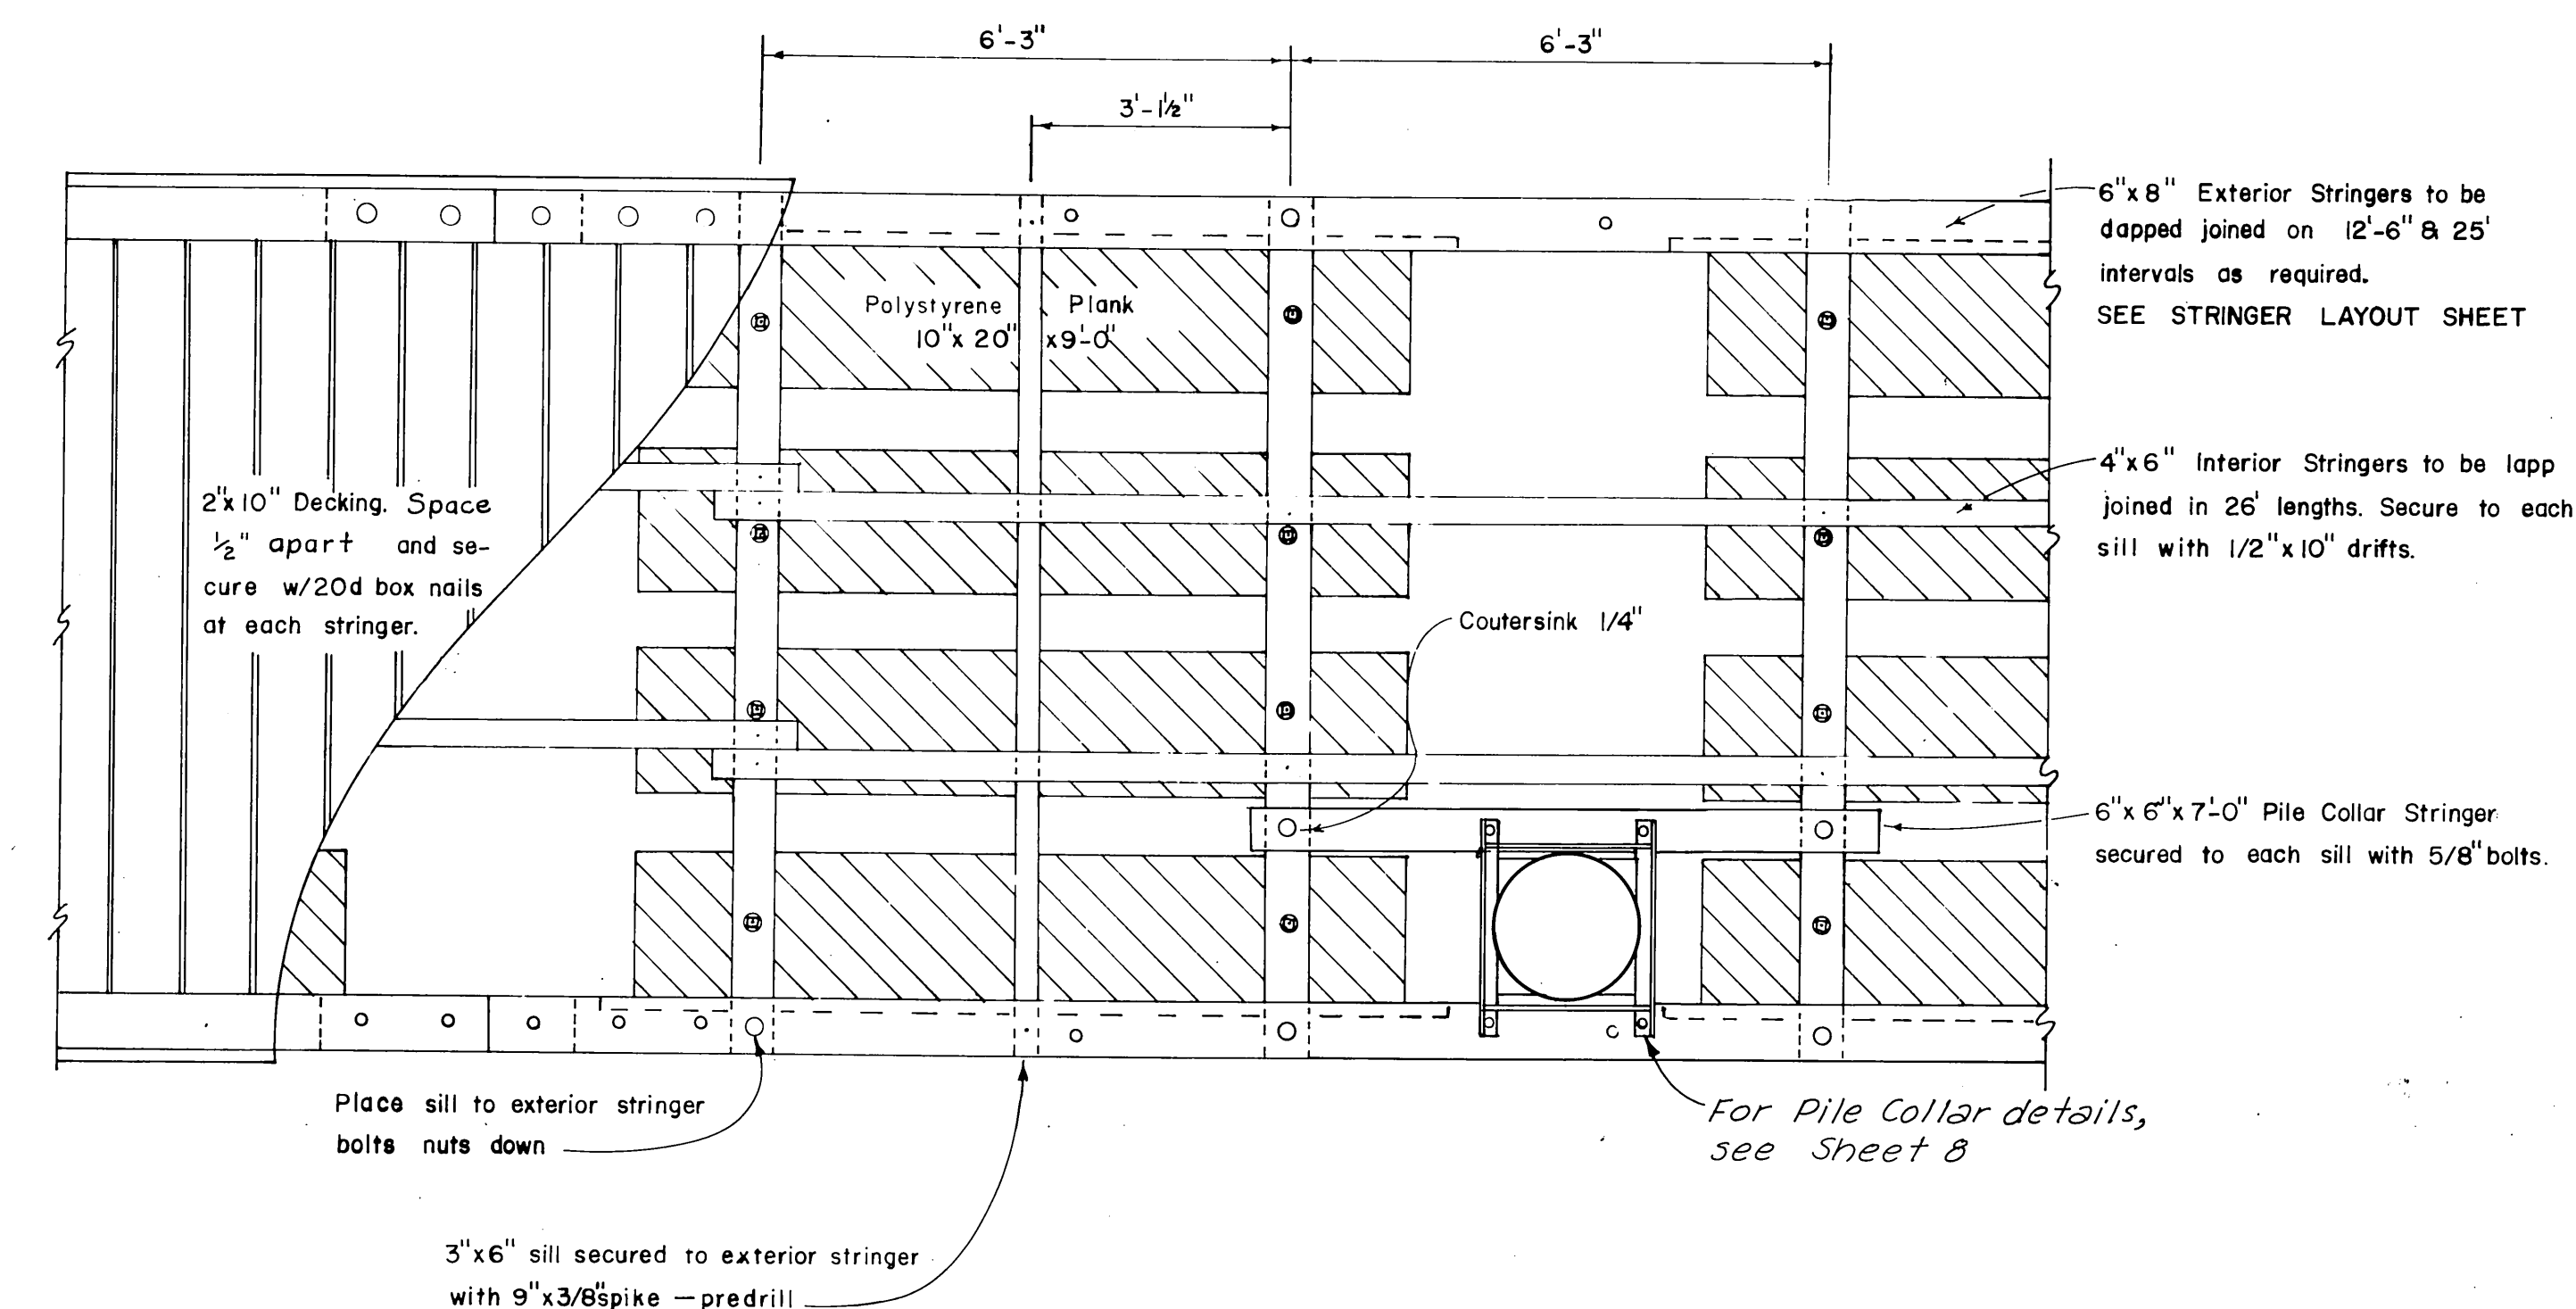

PLAN VIEW 10' FLOAT

PRE-DRILLED BOLT HOLES

COLLAR MEMBERS - all holes
SILLS - holes for floatation plank bolts
STRINGERS - 1. holes for stringer to sill bolts

TIE DOWN RAIL - all holes
PILE COLLAR STRINGER - 10' FLOAT - all holes

FIELD DRILLED BOLT HOLES

SILLS - 1. holes for stringer to sill bolts
 2. pile collar stringer to sill
PILE COLLAR INT. STRINGER - 6' FLOAT - all holes
RAIL BLOCKING - all holes
COLLAR PLATES - all holes
EXT. STRINGER - 1. holes for tie down rail bolts
 2. " " pile collar plate bolt

* Exact width to conform to width of floatation material

ITEM	DRESSING	TREATMENT
3" x 6" - 4" x 6" & 6" x 6" upper sill	S-1-E 1/8" off	10 lbs. ret. (LP-55)
2" x 10" Siding	" " " "	" " " "
3" x 6" Lower Sill	Rough	" " " "
4" x 4" & 3" x 6" Collar Plates	Rough	" " " "
4" x 6" Collar Members	S-2-E	" " " "
4" x 6" Interior Stringers	" "	8 lbs ret. (LP-5)
6" x 6" & 6" x 8" Ext. Stringers	S-4-S	" " " "
2" x 8" Bumpers	" " "	0.5 lb. Penta
6" x 6" Collar Stringers	" " "	8 lb. ret. (LP-5)
2" x 10" Decking	Milled	0.5 lb. Penta
4" x 6" & 4" x 8" Blocking	S-4-S	" " " "
6" x 6" & 6" x 8" Rail	" " "	" " " "

All material to be Dense No. 1 grade Douglas Fir
 All piling will be Class A creosoted to 20 lbs. retention (MP-2)




NOTES

All hardware to be hot-dipped galvanized. A malleable iron washer shall be placed between all nut and wood surfaces. All bolts to be of the economy headed type. Bolt holes to be drilled 1/16" oversize except sill bolt holes for floatation planks 1/8" oversize. Drift holes to be drilled 1/16" undersize. All field drill holes shall be treated with hot creosote oil. All pressure treated creosote material shall be cut to size prior to treatment. Tie down rails shall extend across all float ends except under gangway. All bolt heads facing decking shall be countersunk 1/4" previous to treatment. Field drill all drift bolt holes. A barrier of 6 mil black polyethylene shall be placed between the contact surfaces of all creosote timber and floatation material (except float siding members).

DO NOT SCALE THIS DRAWING - USE DIMENSIONS
 STATE OF ALASKA
 DEPARTMENT OF PUBLIC WORKS
 DIVISION OF WATER AND HARBORS


TYPICAL FLOATS

SCALE <i>As shown</i>	SURVEYED <i>MM/JET</i>	APPROVED
DESIGNED <i>DN/DS</i>	DRAWN <i>MM/JET</i>	<i>Don Statter</i>
CHECKED <i>DS</i>	DATE <i>4-68</i>	DIRECTOR
PROJECT NUMBER <i>3-76164</i>	SHEET <i>4</i> OF <i>11</i>	

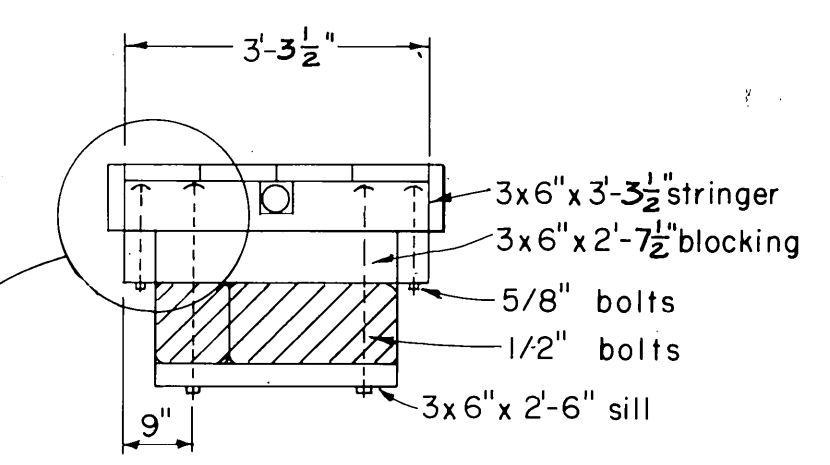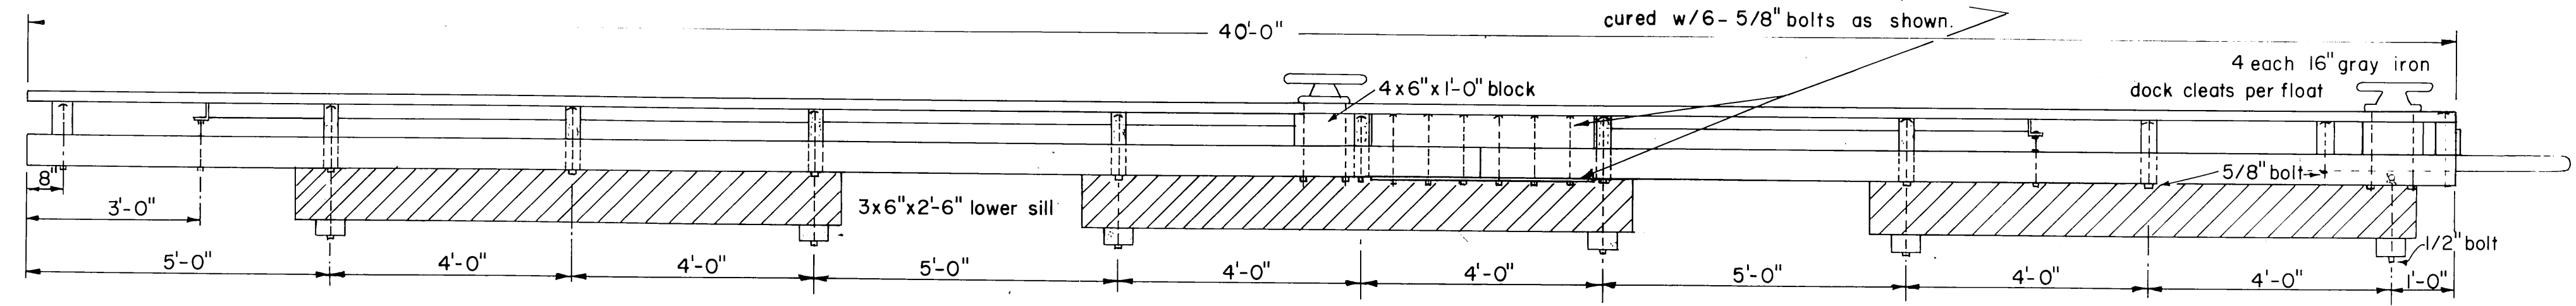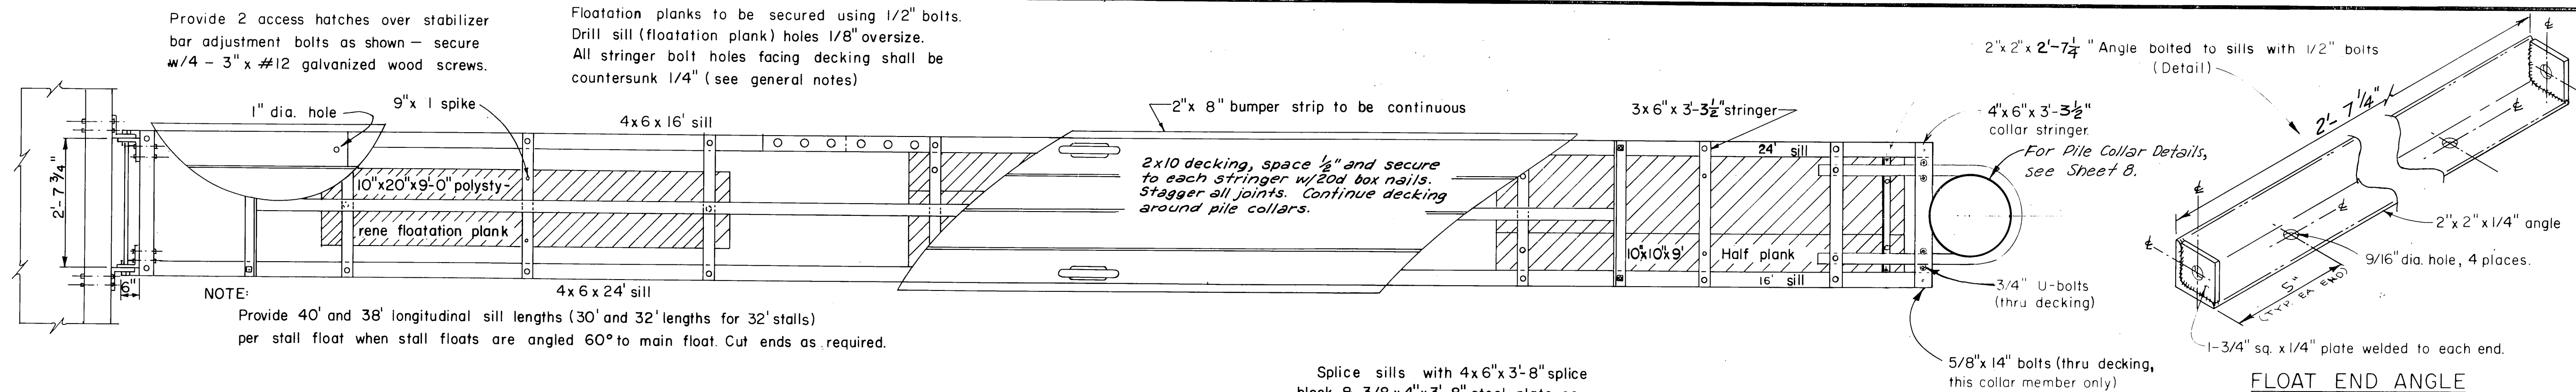


3'-3 1/2" x 40'-0" STALL FLOAT
1/2" = 1'-0"

TYPICAL 3'-3 1/2" FLOAT SECTION

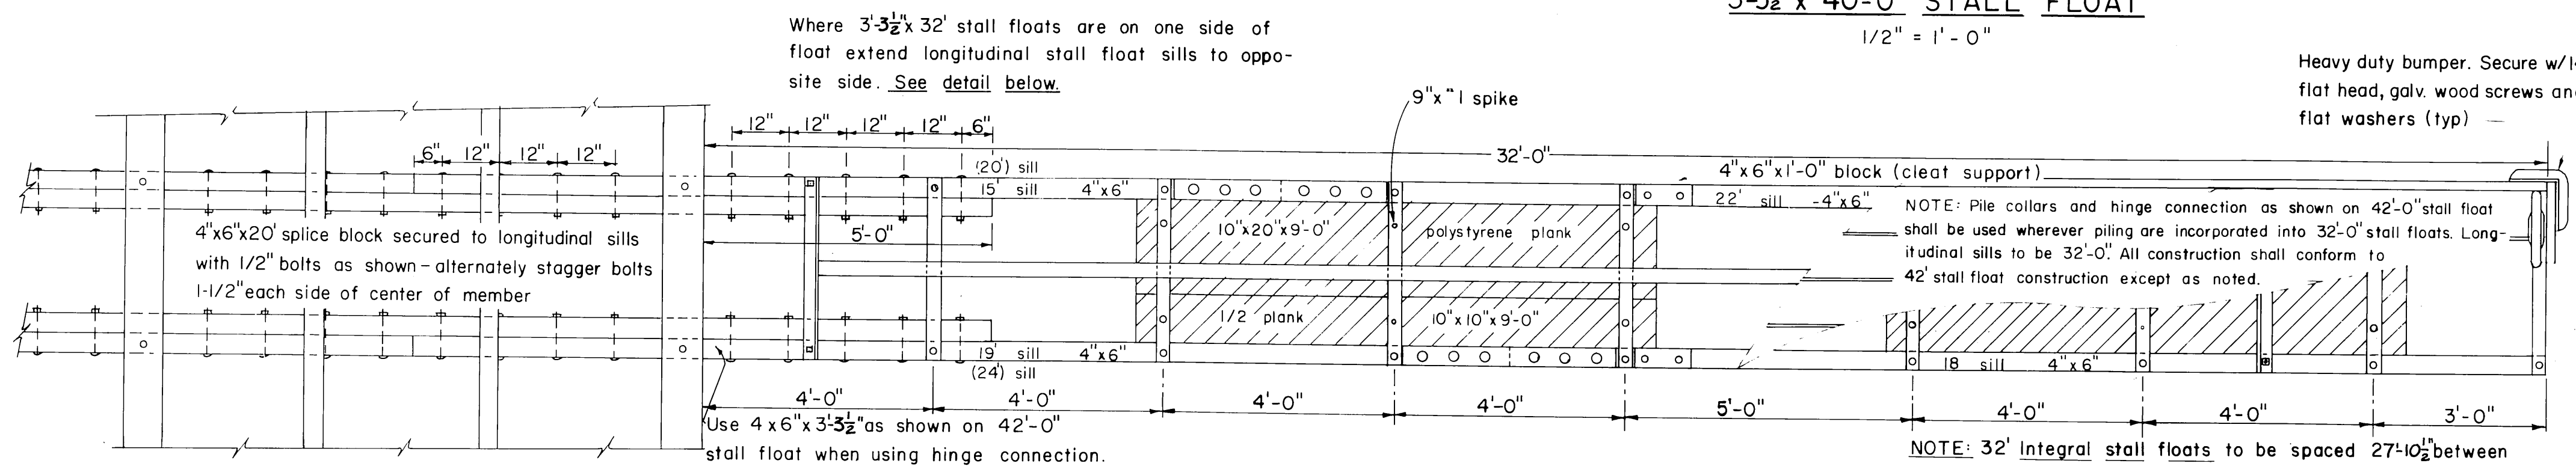


3'-3 1/2" x 32'-0" STALL FLOAT
(Showing installation with no mooring piling)
1/2" = 1'-0"


NOTE: 32' integral stall floats to be spaced 27'-10 1/2" between floats. Decking shall span between stall & 10' float stagger splices. Longitudinal sills may be provided in continuous lengths (no splices).

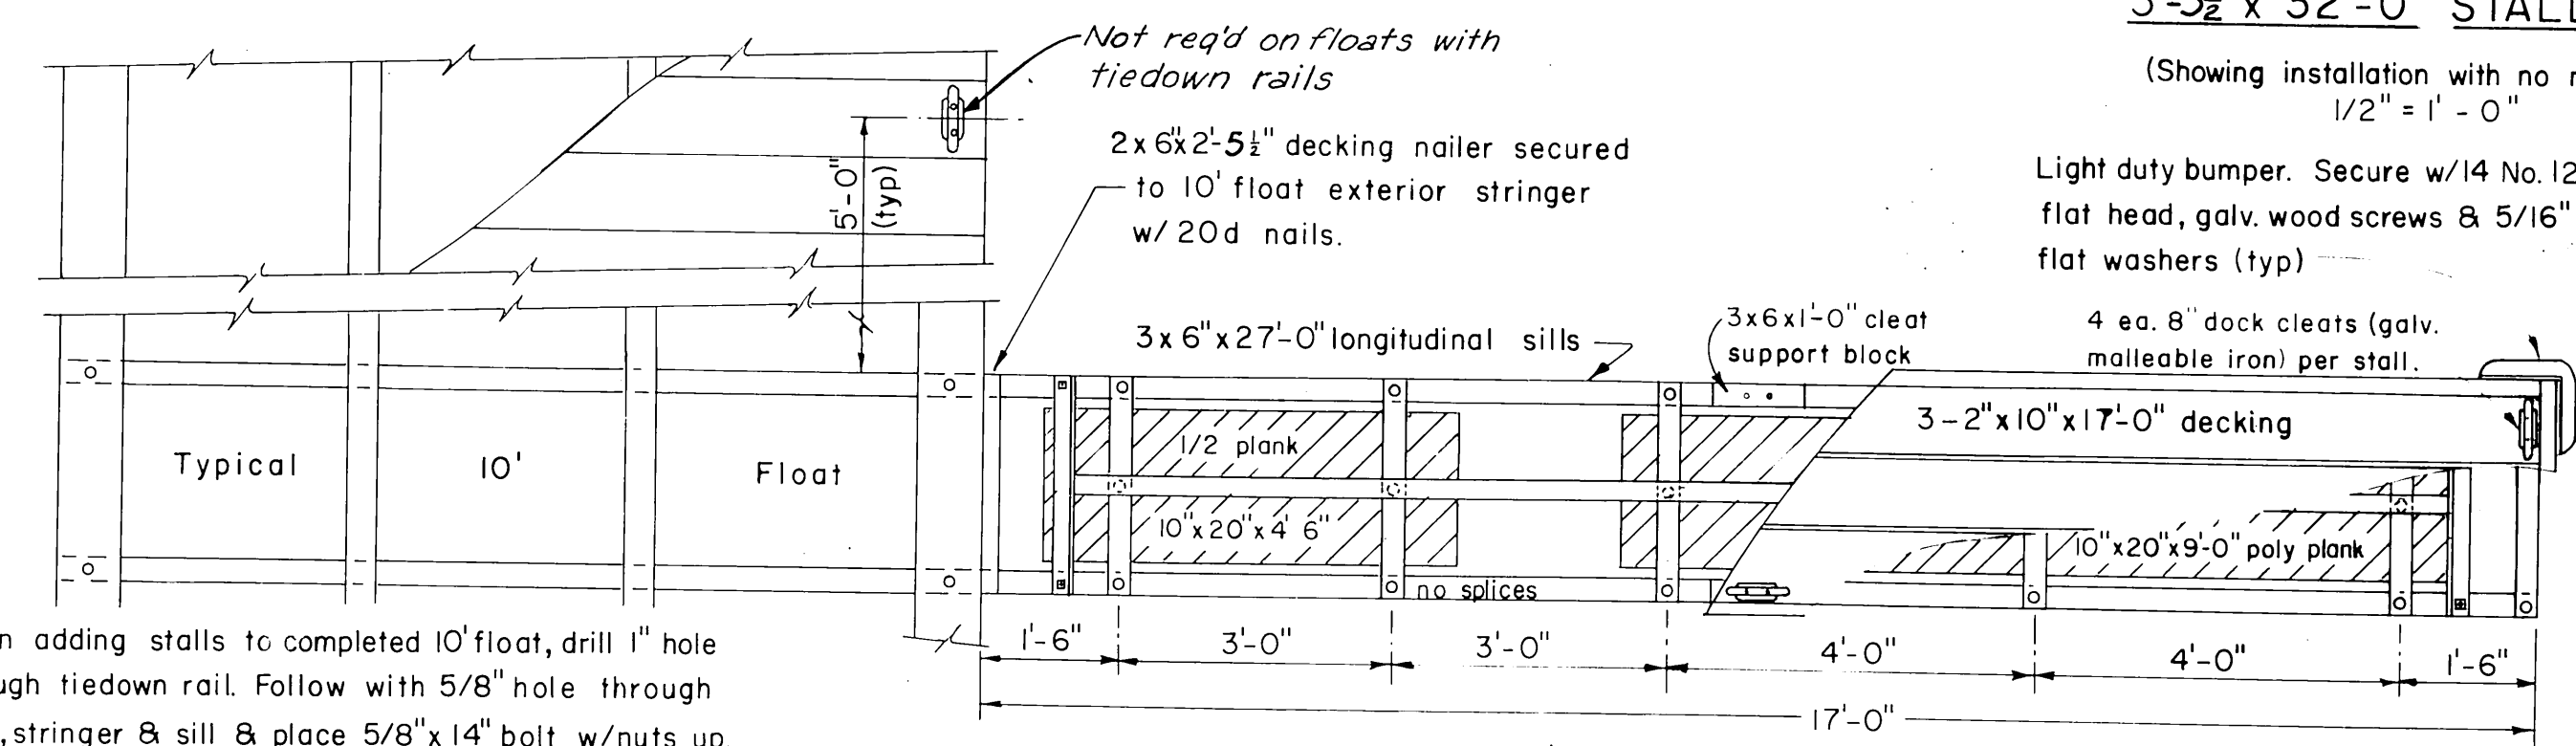


2'-5 1/2" x 17'-0" STALL FLOAT
1/2" = 1'-0"

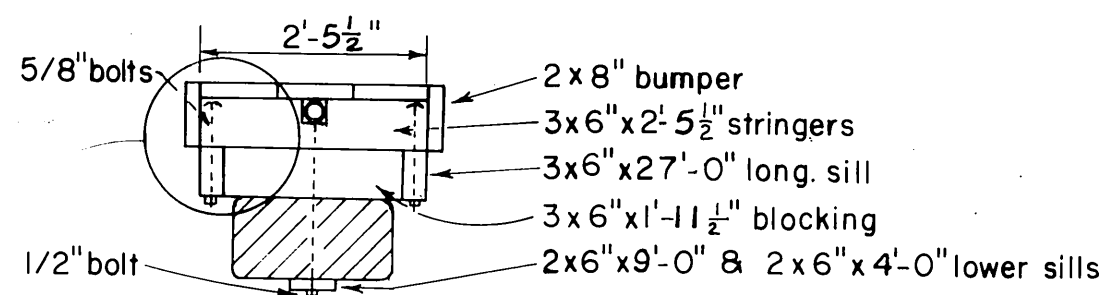


TYPICAL 2'-5 1/2" FLOAT SECTION

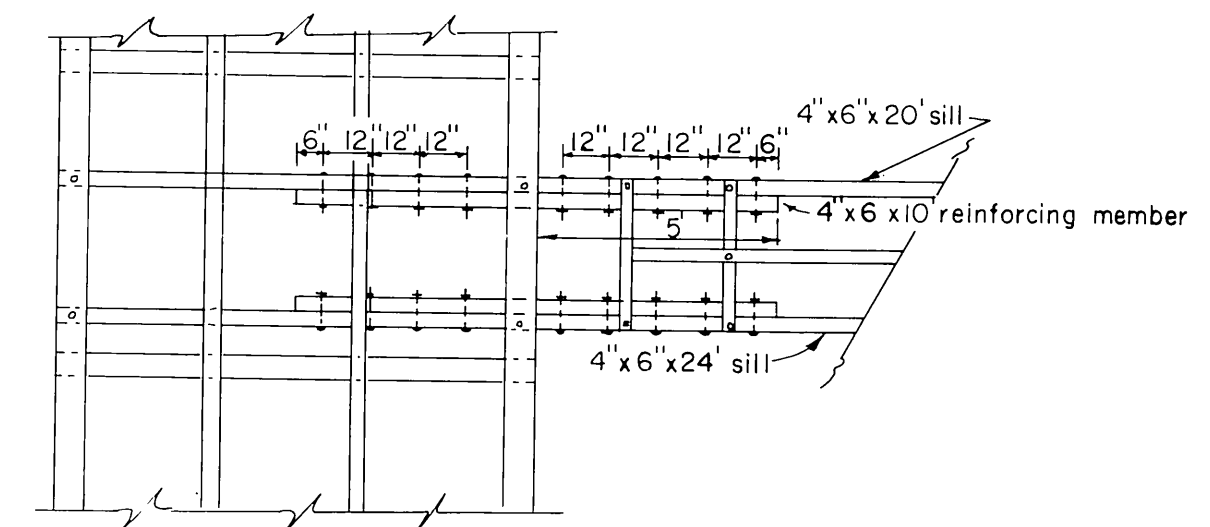

3'-3 1/2" x 32' STALL FLOAT DETAIL ONE SIDE INSTALLATION
1/4" = 1'-0"

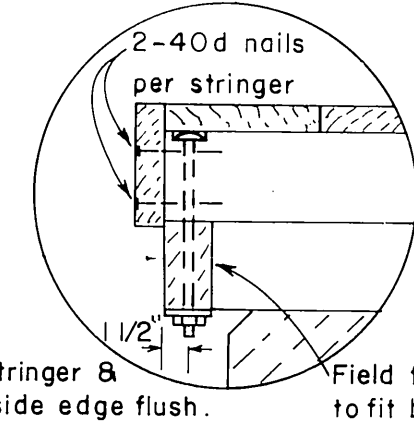

Assemble stringer & sill with outside edge flush. Field trim ends of blocking to fit between sills if necessary.

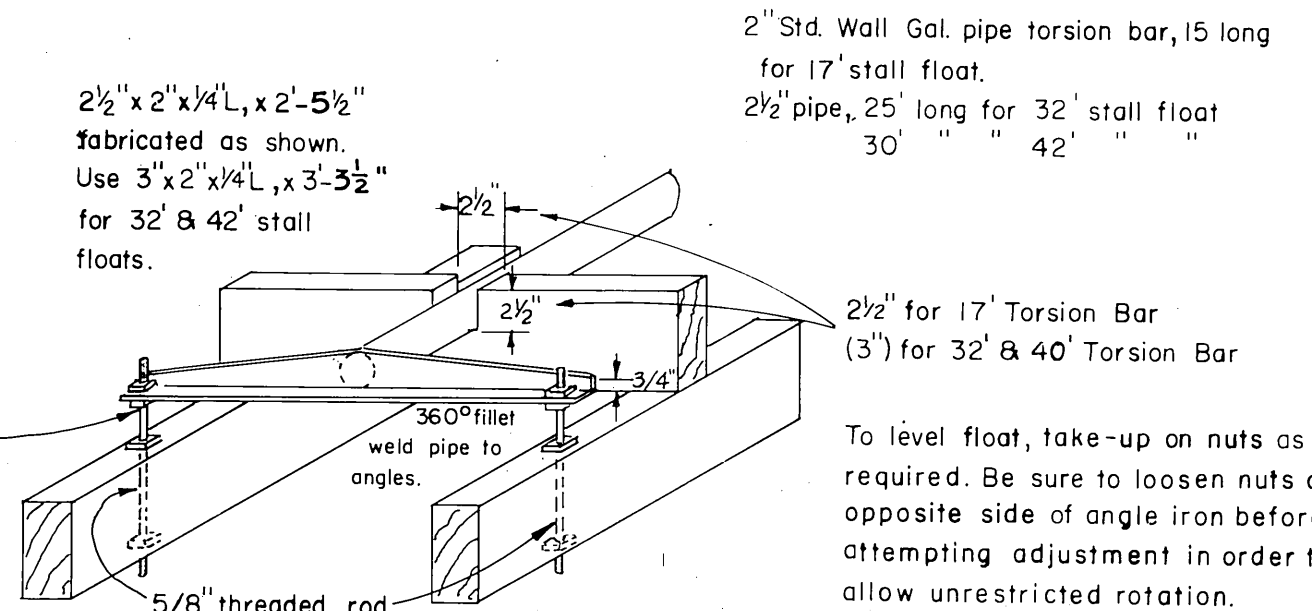

STALL FLOAT STABILIZER DETAILS
Scale 1" = 1'-0"










MATERIALS		
ITEM	DRESSING	TREATMENT
PILING - CLASS "A"		20" Rel (MP-2)
3x6" LOWER SILLS	S-2-E	10" (LP-55)
3x6" STRINGERS	"	8" (LP-5)
3x6" COLLARS	"	"
3x6" BLOCKING	"	10" (LP-55)
4x6" SPLICE BLOCKS	"	8" (LP-5)
4x6" & 3x6" LONGIT. SILLS	"	10" (LP-5)
2x8" BUMPERS	S-1-S-2-E	0.5lb. Penta
2x10" DECKING	Milled	"

ALL TIMBER MATERIAL TO BE DENSE NO. 1 GRADE DOUGLAS FIR

GENERAL NOTES

All hardware to be hot dip galvanized. A malleable washer shall be placed between all nut and wood surfaces. All bolts to be of economy headed type. Bolt holes to be drilled 1/16" oversize except sill bolt holes for floatation planks 1/8" oversize. Spike holes to be drilled 1/16" undersize. All drill holes shall be treated with hot creosote oil. All pressure treated creosote material shall be cut to size prior to treatment. All bolts to be 5/8" except 1/2" floatation plank bolts. Omit tie down rails where stall floats join 10' floats, add blocking and bolt tie down rail to exterior stringer. All bolt holes to be predrilled except holes in splice block (integral stall float installation). Field drill all 9" spike holes. 5/8" bolt holes countersunk 3/16" deep x 2-1/4" diameter 1/2" bolt holes countersunk 1/4" deep x 2" diameter.

DO NOT SCALE THIS DRAWING - USE DIMENSIONS			
STATE OF ALASKA DEPARTMENT OF PUBLIC WORKS DIVISION OF WATER AND HARBORS			
TIMBER STALL FLOATS			
SCALE <i>As noted</i>	SURVEYED <i>—</i>	APPROVED <i>Don Statter</i>	
DESIGNED <i>DS</i>	DRAWN <i>MH/JET</i>	DIRECTOR	
CHECKED <i>DS</i>	DATE <i>8-66</i>		
PROJECT NUMBER <i>3-76164</i>		SHEET <i>5</i> OF <i>11</i>	
1 Changed treatment for decking to 0.5lb. Penta. Spaced deck planks 1/2". Changed float width.		7-29-71 JET	
Revision		Date By	

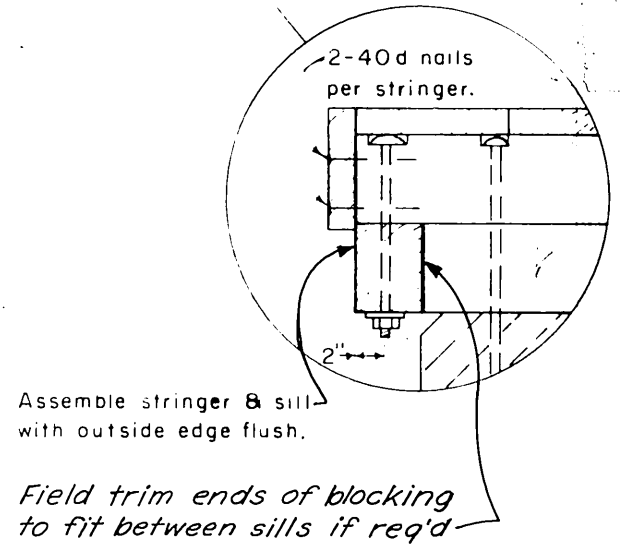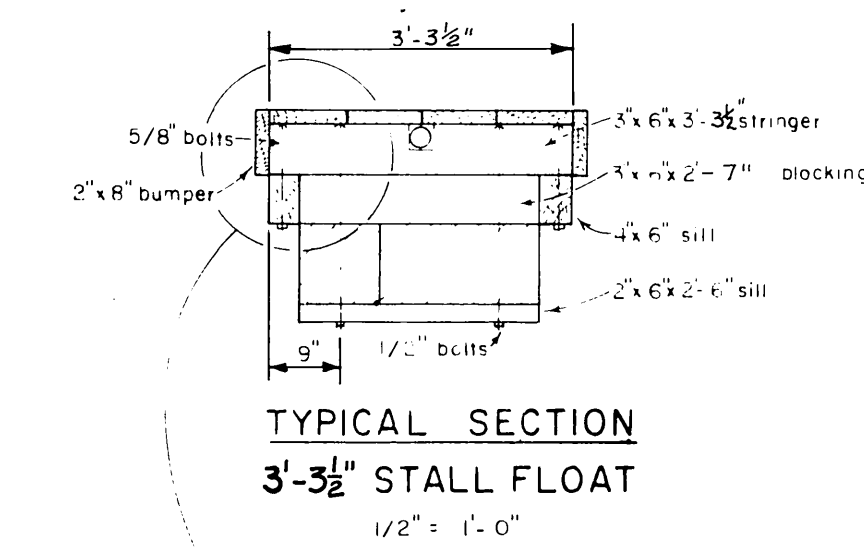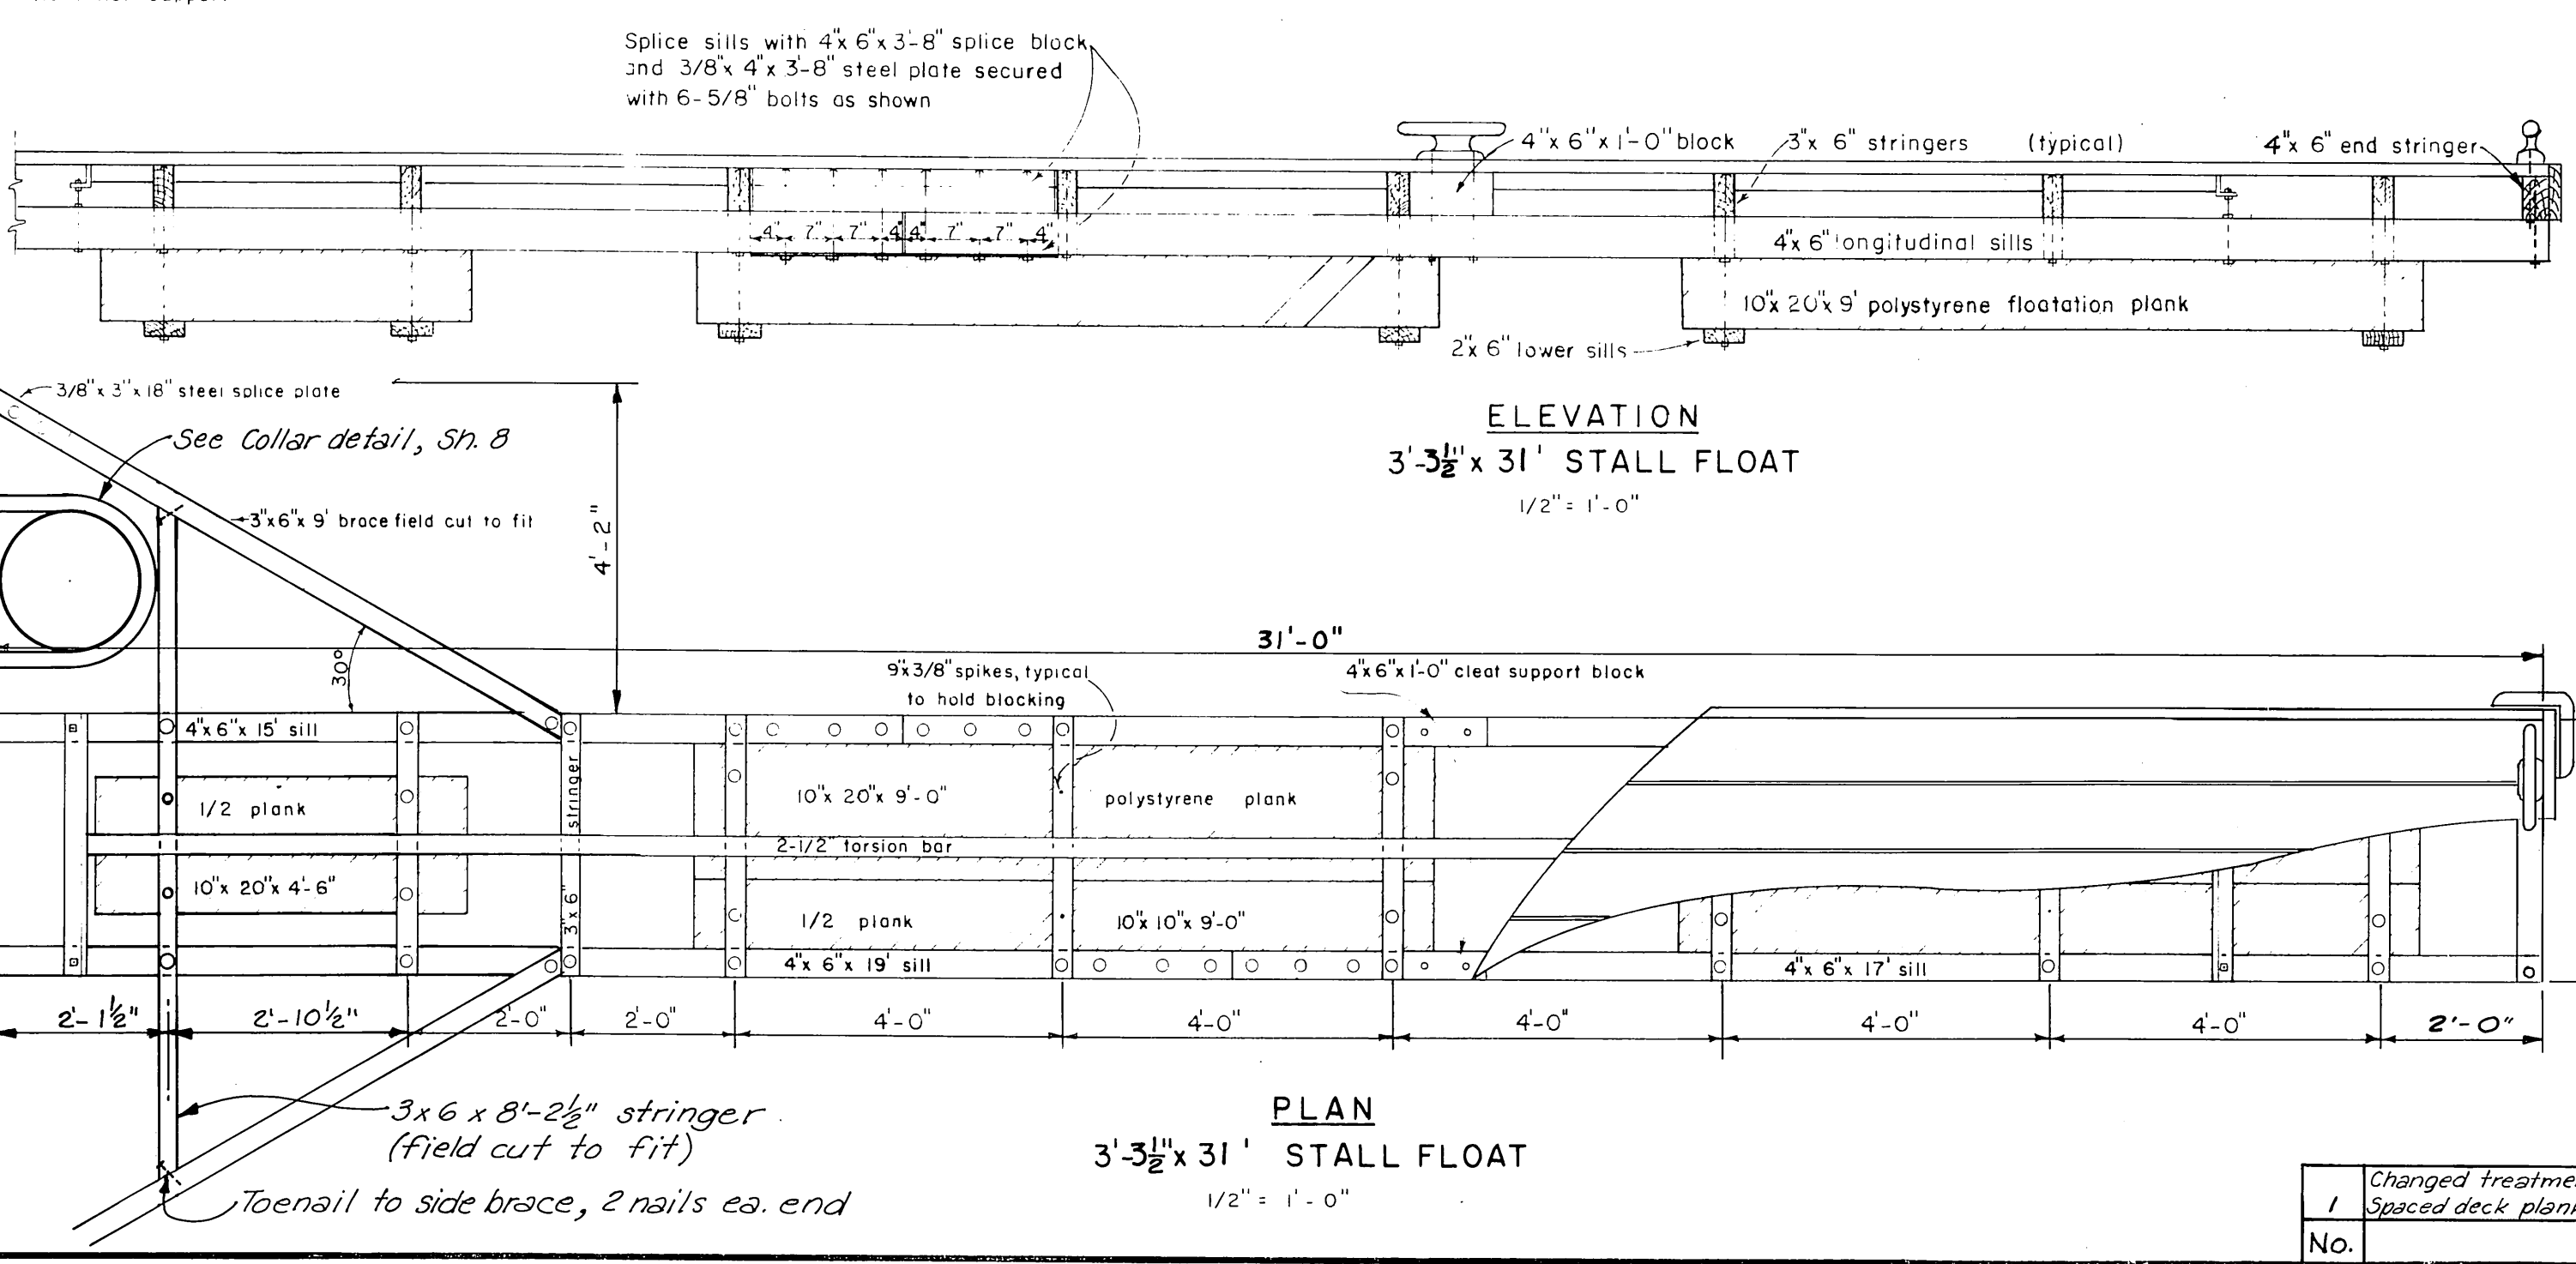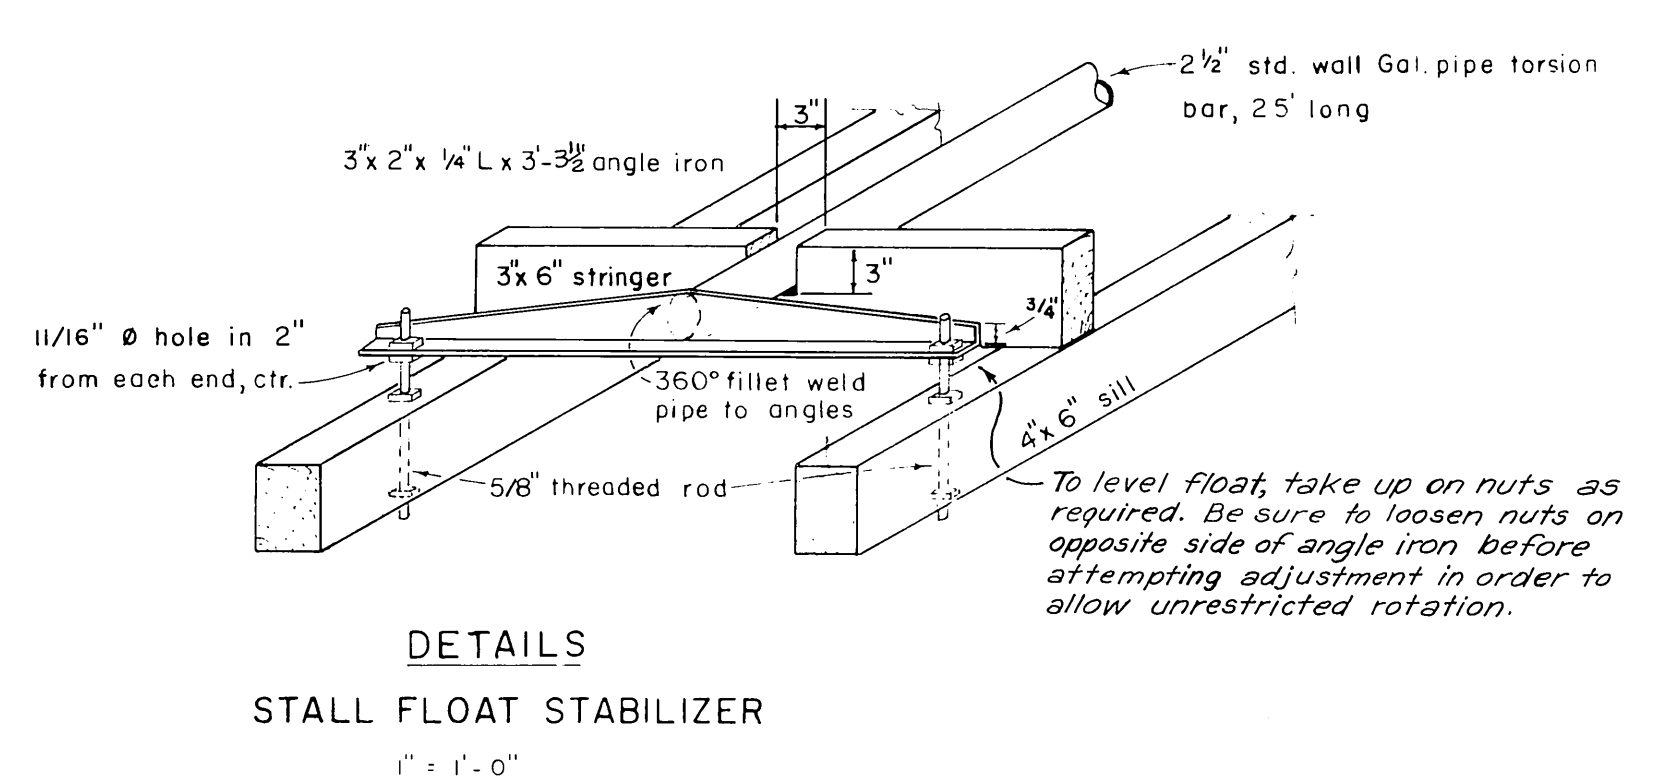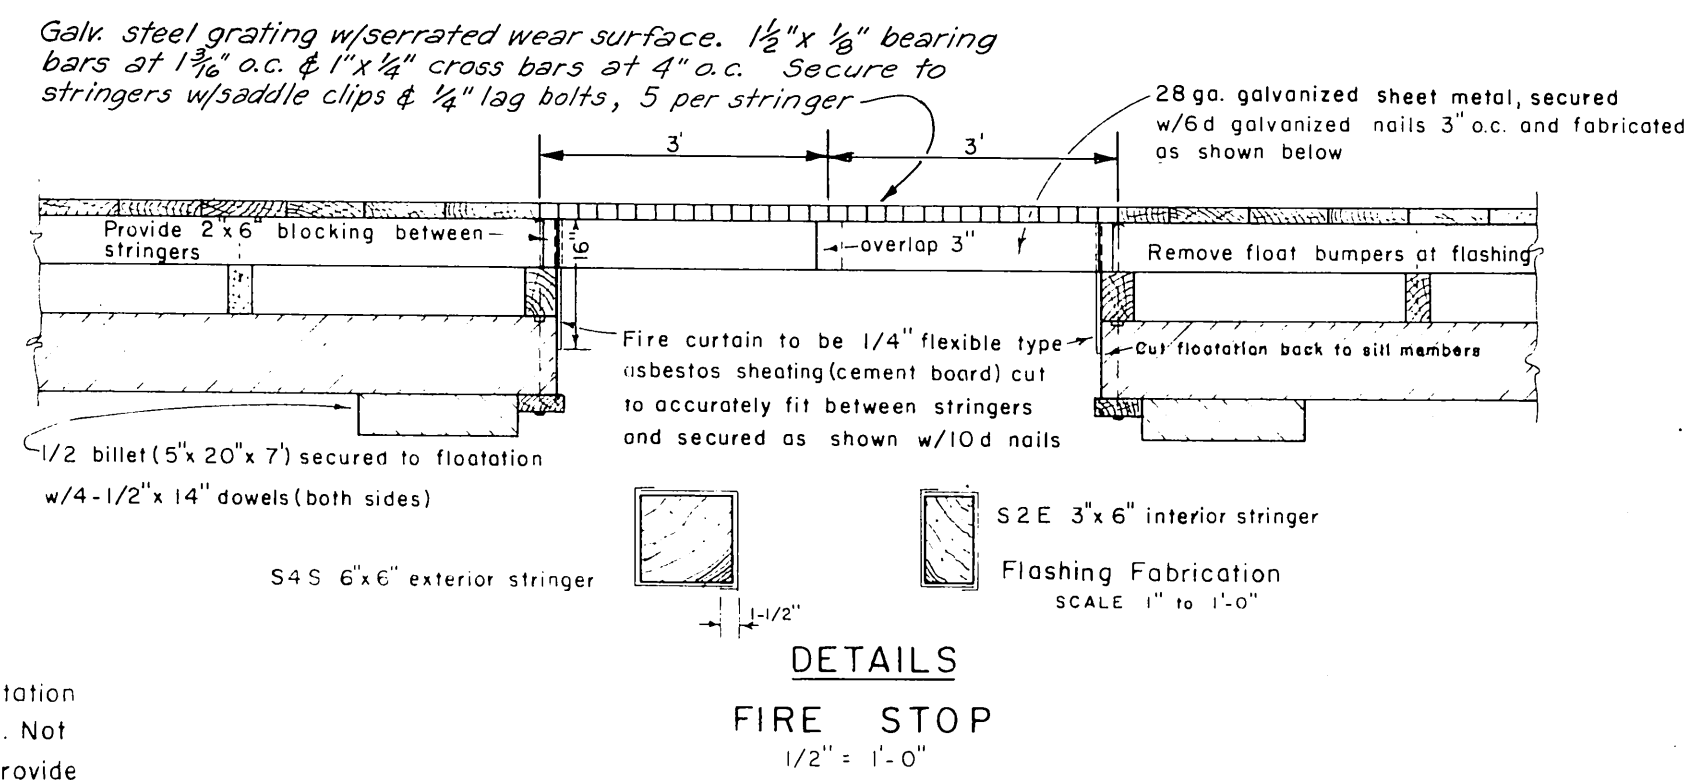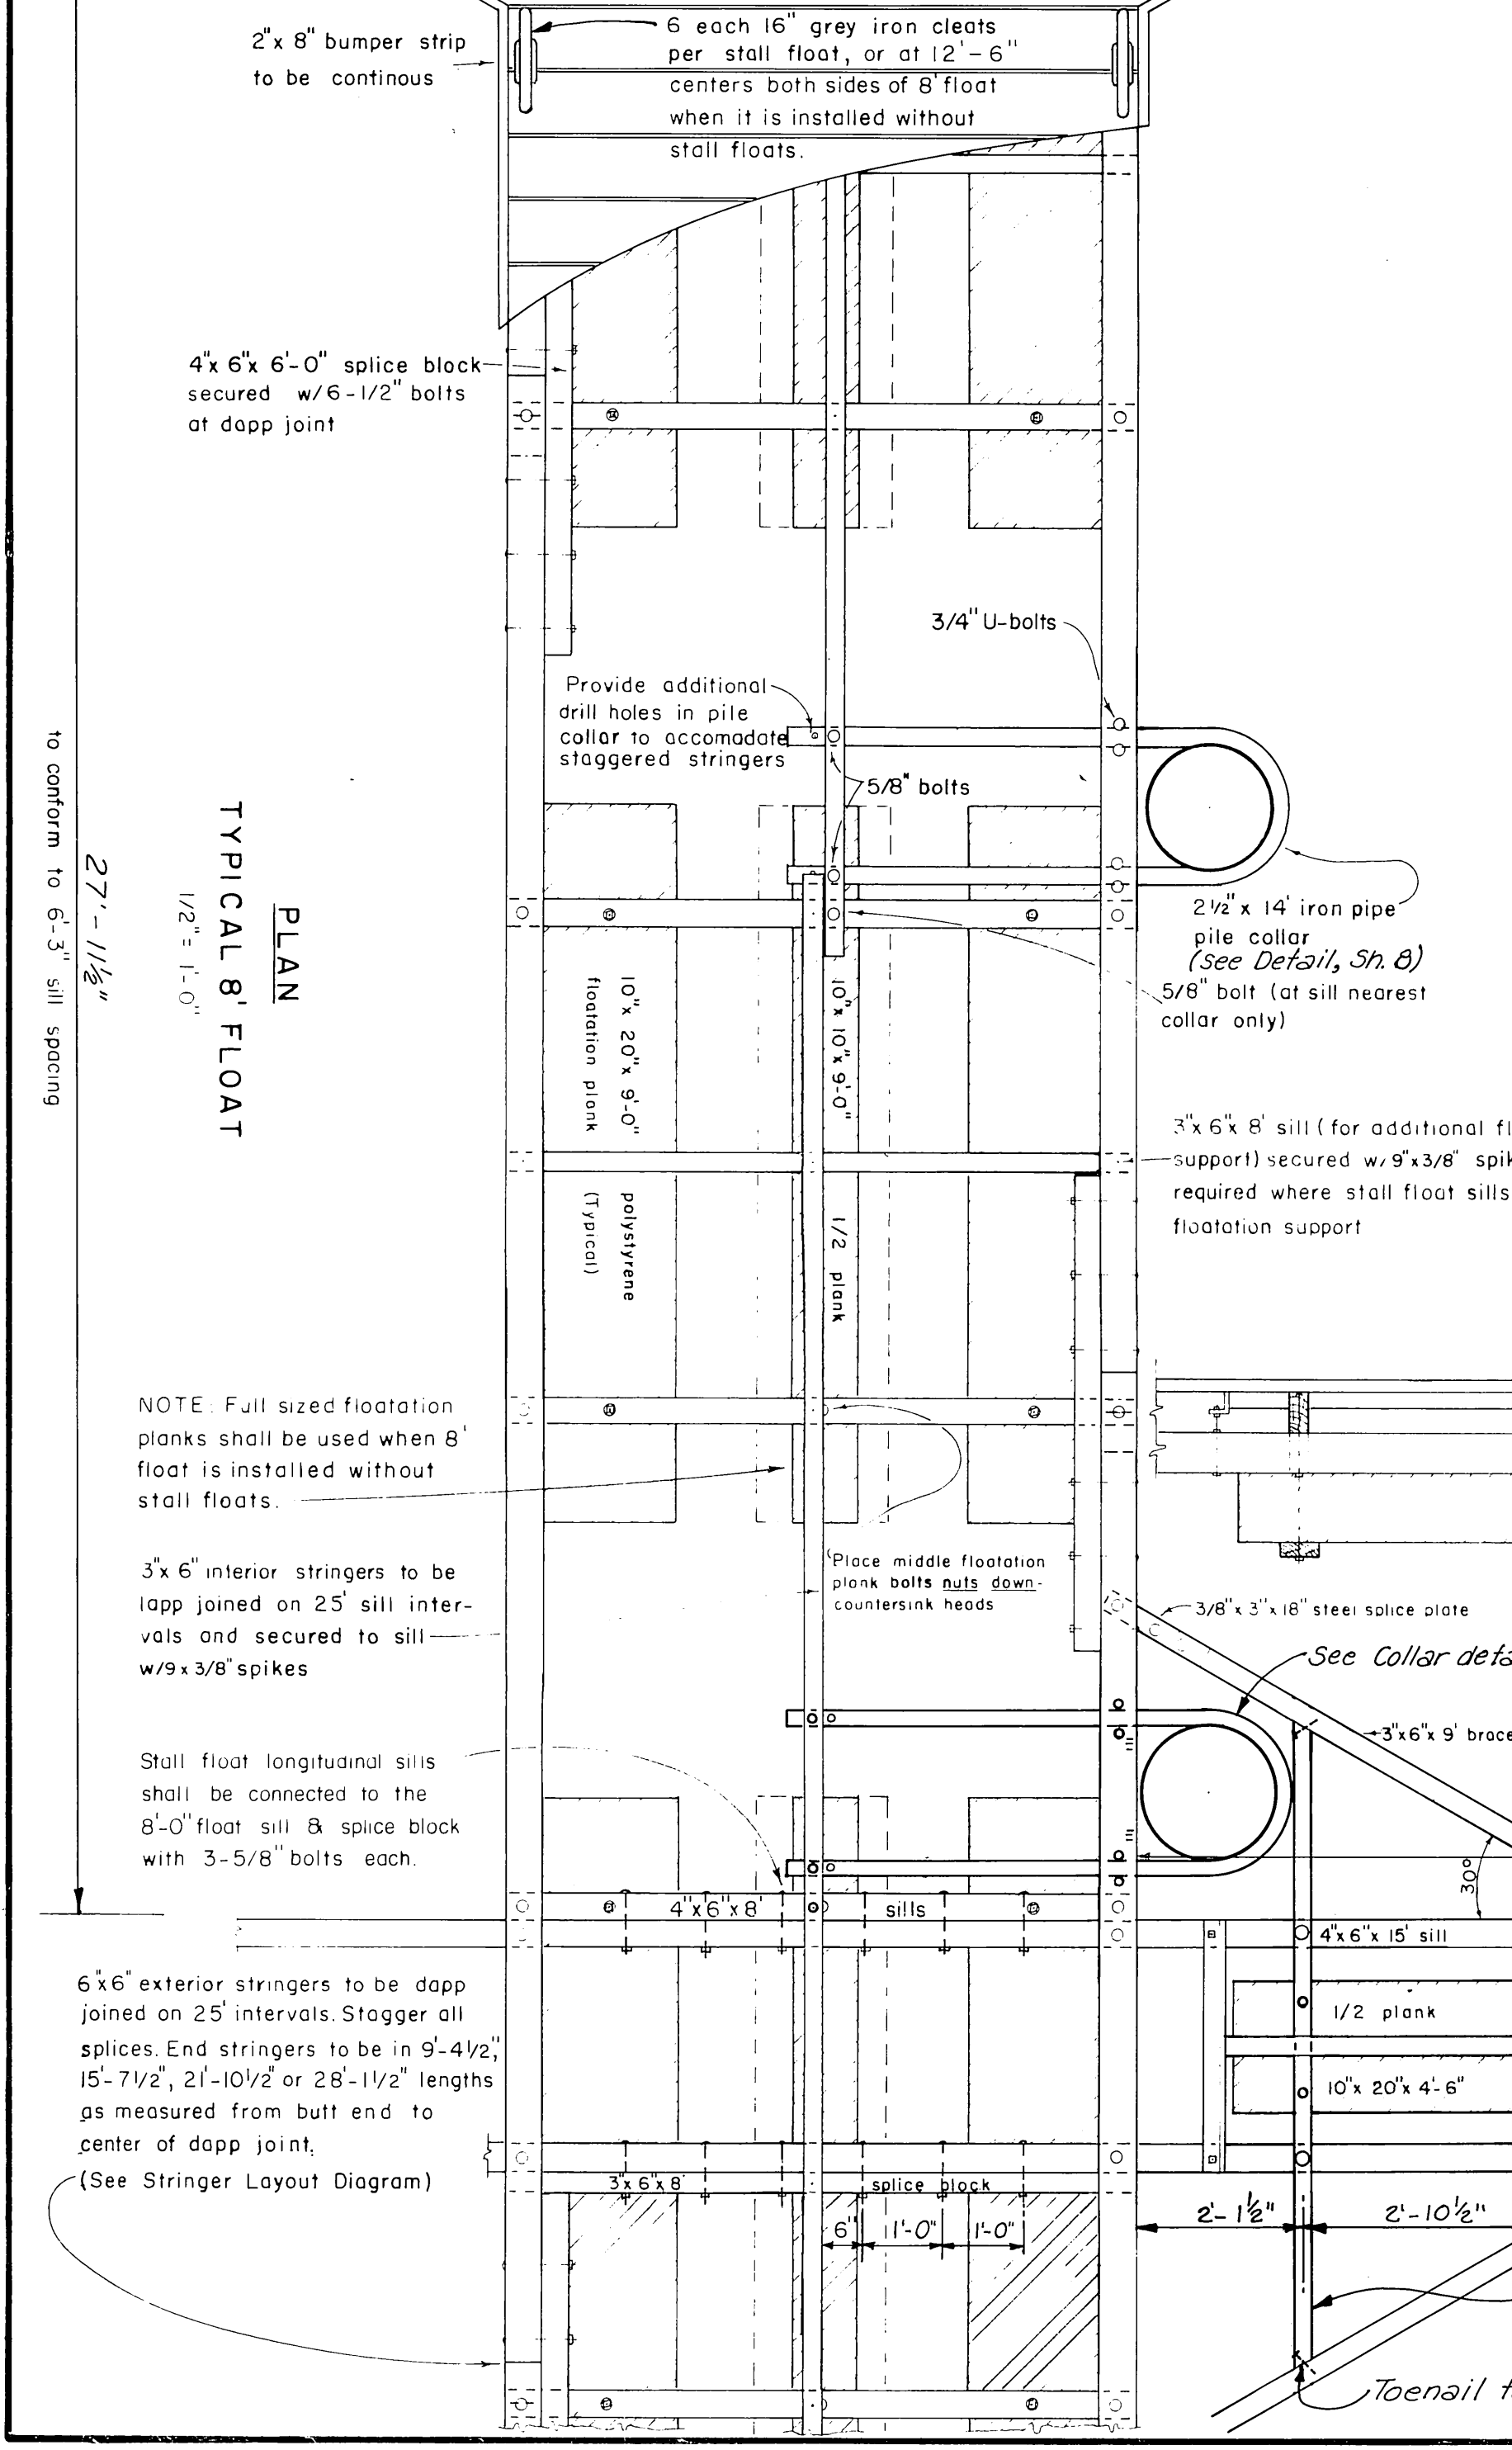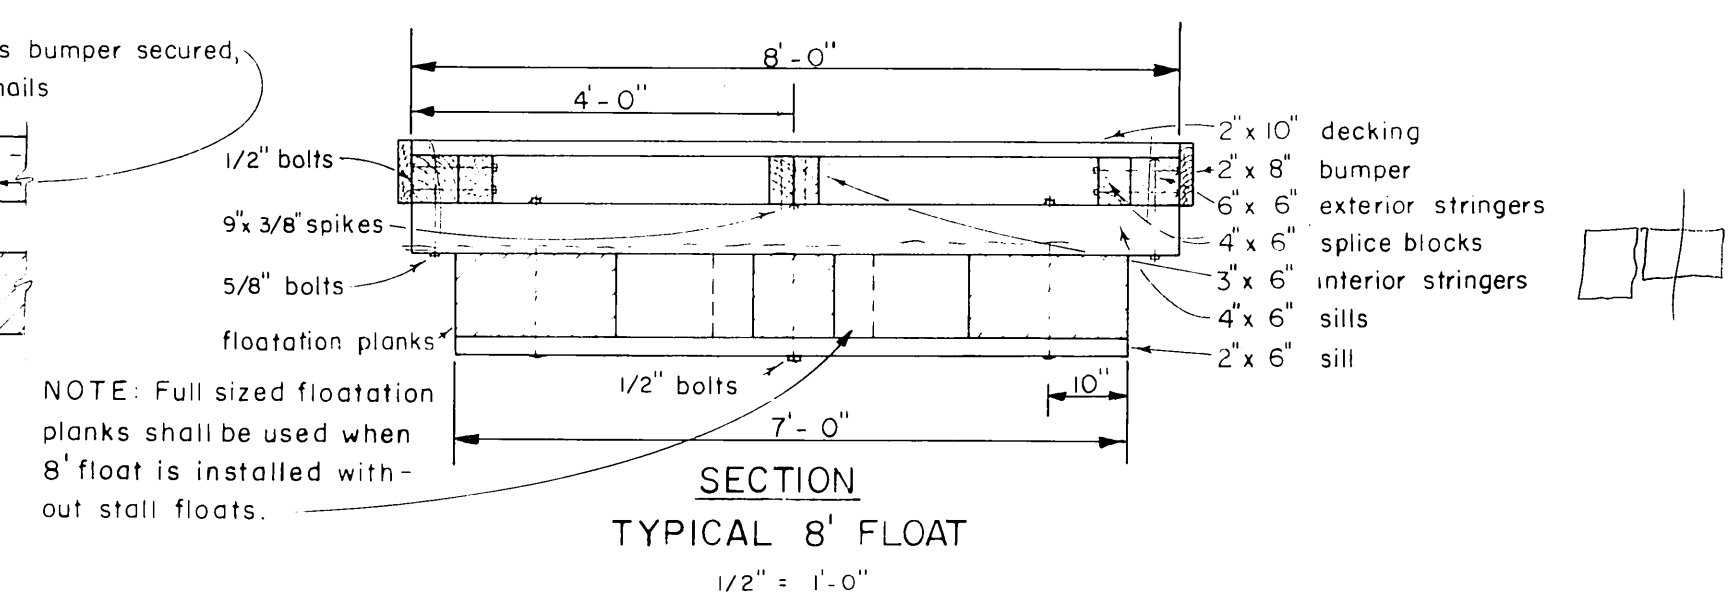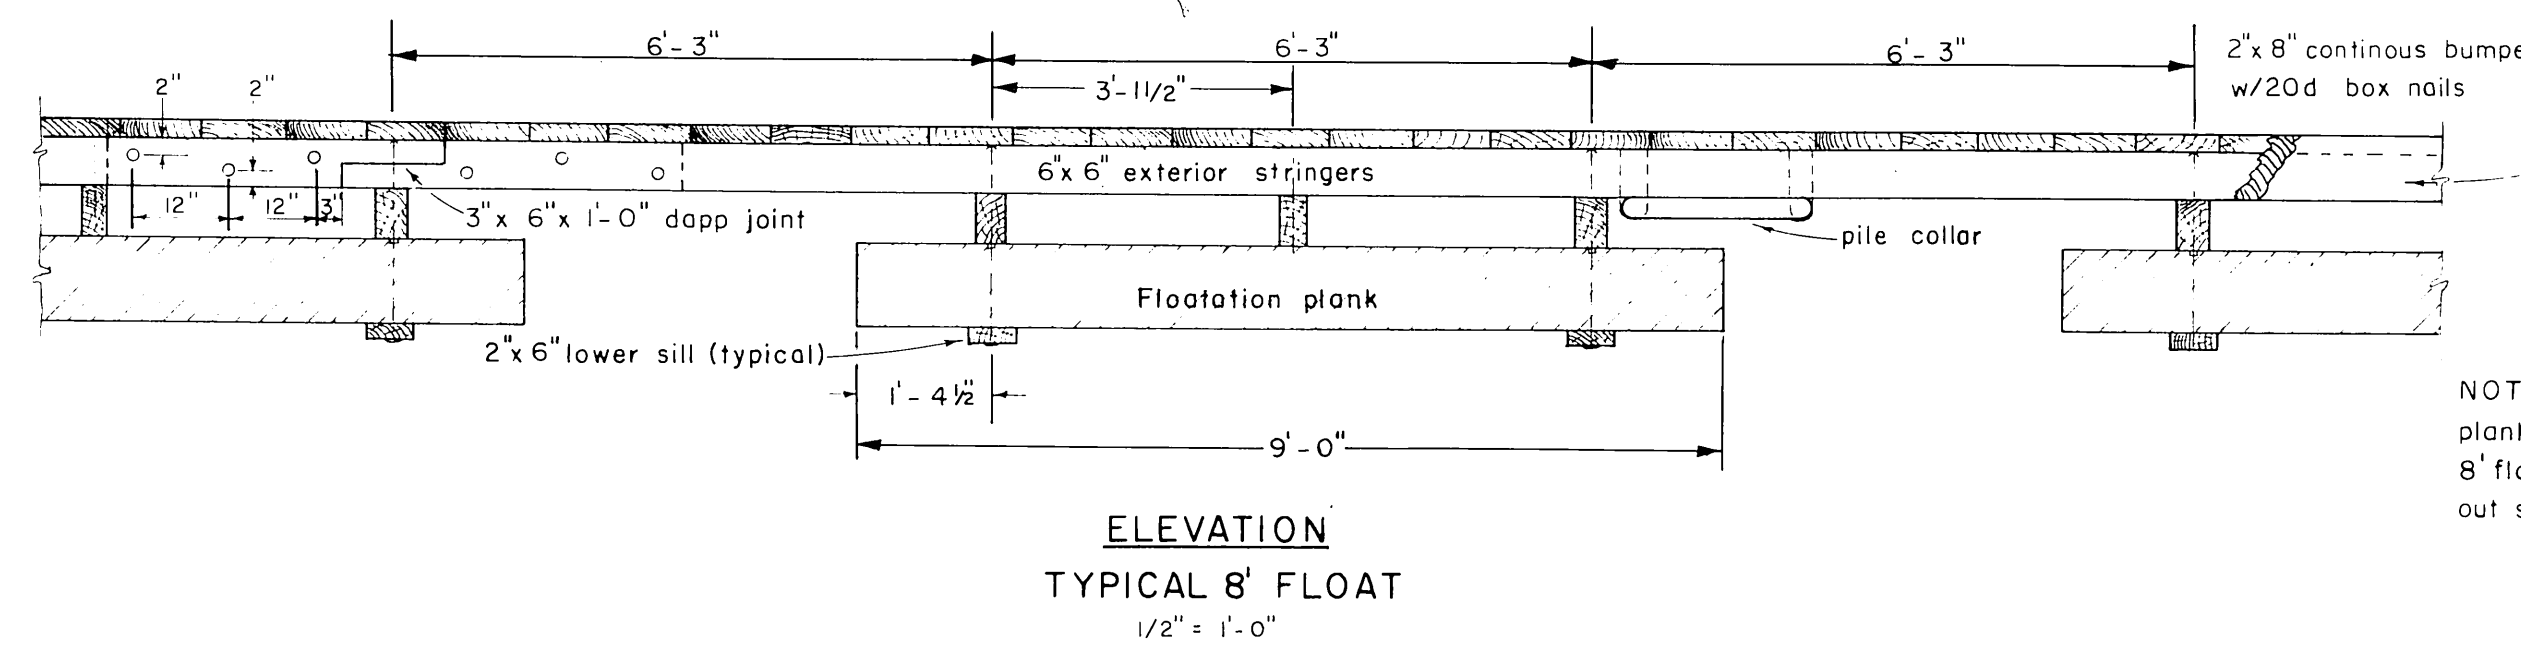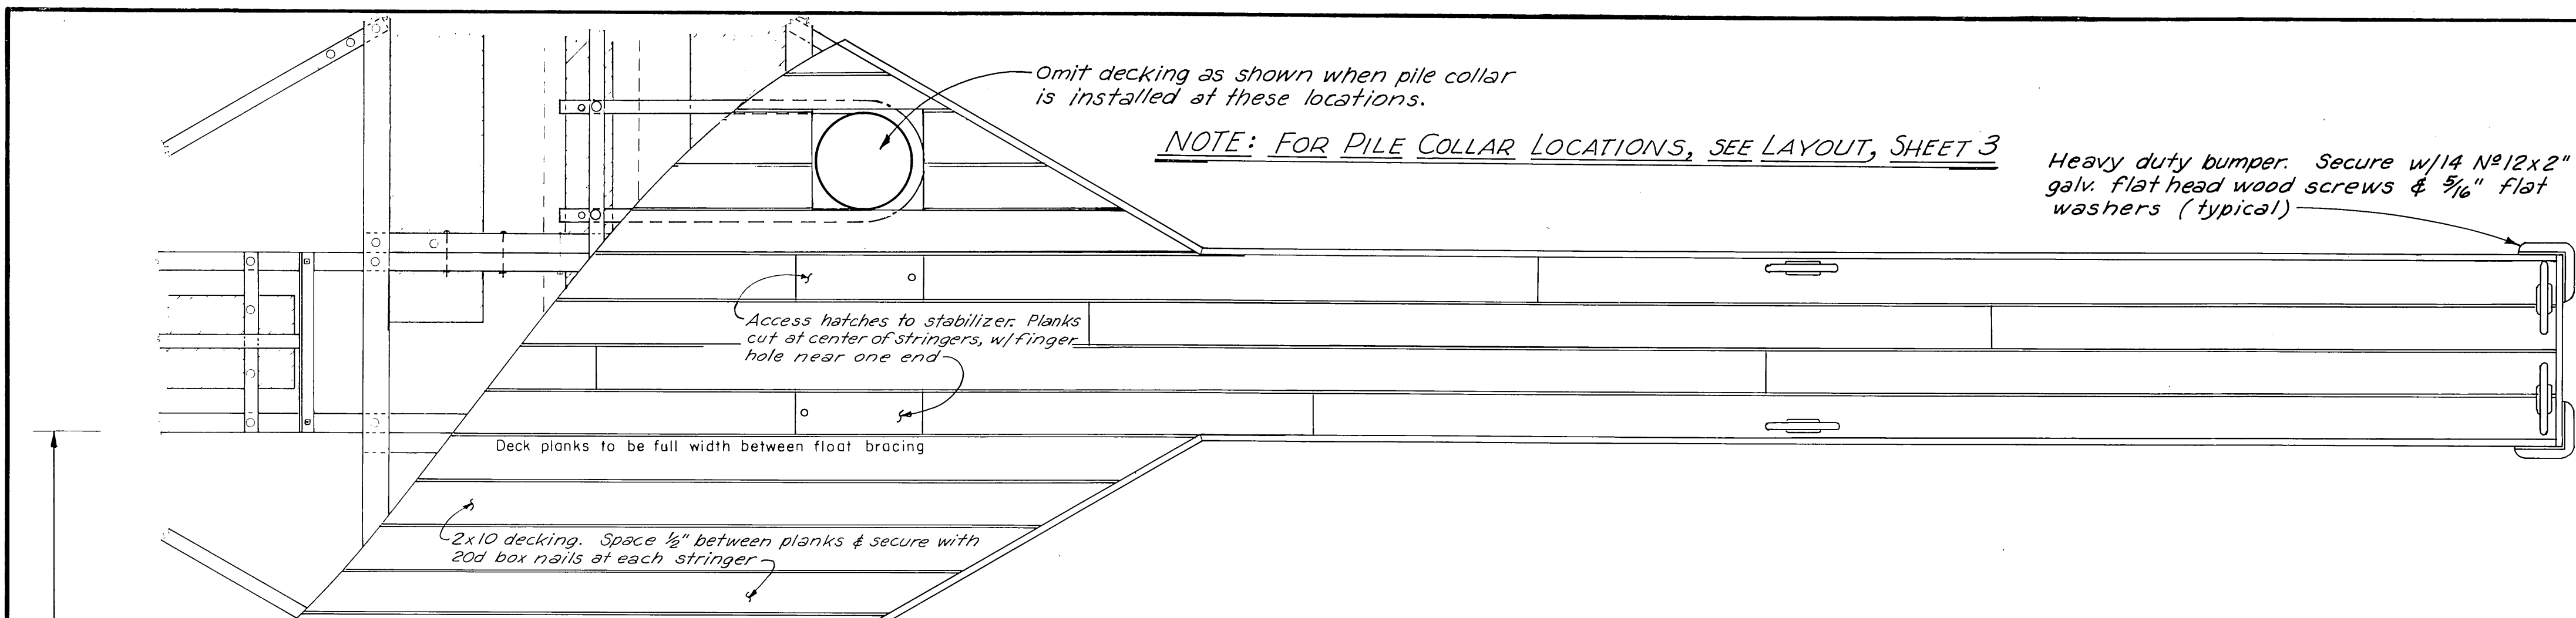

- 9' FLOAT BOLT HOLES
- PRE-DRILL
- SILLS- holes for floatation plank bolts
- STRINGERS- 1. holes for stringer to sill bolts
2. splice block holes
- FIELD DRILL
- SILLS- holes for stringer to sill bolts
- STRINGERS- 1. pile collar holes
2. holes for exterior stringers to longitudinal stall float sill bolts
- SPLICE BLOCKS- all holes
- STALL FLOAT BOLT HOLES
- PRE-DRILL
- STRINGERS- all holes
- BLOCKING- all holes
- LONGITUDINAL SILLS- 1. stringer to sill holes
2. splice block holes
- FIELD DRILL
- LONGITUDINAL SILLS- holes for 8' float exterior stringer bolts and float stabilizer
- SPLICE BLOCK & BRACES- all holes
- field drill all 9' spike holes
- NOTE: Install 6 grey iron cleats at 2'-6" centers along 8' float (both sides) when it is installed without stall floats

ITEM		MATERIALS		TREATMENT	
		DRESSING			
PILING				20 lb. ret. (MP-2)	
3" x 6" x 4' x 6" UPPER SILLS	S-1-E	1/8" off	IQ	"	(LP-55)
2" x 6" LOWER SILLS	ROUGH				
3" x 6" x 8' SPLICE BLKS.	S-2-E		8lb	"	(LP-5)
4" x 6" LONGITUDINAL					
STALL FLOAT SILLS	S-2-E				
3" x 6" BLOCKING	S-2-E				
6" x 6" EXT. STRINGERS	S-4-S				
3" x 6" INT. STRINGERS	S-2-E				
2" x 10" DECKING	Milled		0.5lb.	Penta	
2" x 8" BUMPERS	S-4-S				
4" x 6" SPLICE BLOCKS	S-2-E		8lb. ret.	(LP-5)	

All timber material to be DENSE NO. 1 GRADE DOUGLAS FIR.

NOTES

All hardware to be hot dip galvanized. A malleable washer shall be placed between all nut and wood surfaces. All bolts to be of the economy head type. Bolt holes to be drilled 1/16" oversize, except holes for floatation planks 1/8" oversize, 9" spike holes to be drilled 1/16" undersize. All drill holes shall be treated with hot creosote oil. All pressure treated creosote material shall be cut to size prior to treatment. All bolts to be 5/8" except floatation plank bolts and exterior stringer splice block bolts. 5/8" bolt holes facing decking to be countersunk 1/4" deep by 2-1/8" diameter. 1/2" bolt holes 1/4" x 1-3/4" prior to treatment. Connect 8' float to main float with hinge connection as shown on connection detail sheet. A barrier of 6 mill polyethylene shall be placed between the contact surfaces of all creosote timber and floatation material.

DO NOT SCALE THIS DRAWING - USE DIMENSIONS

STATE OF ALASKA
DEPARTMENT OF PUBLIC WORKS
DIVISION OF WATER AND HARBORS

TYPICAL 8' FLOAT WITH INTEGRAL STALLS

SCALE As noted
DESIGNED D.W.
CHECKED D.W.

SURVEYED E.S.
DATE Feb. '68
















APPROVED
Don Statter
DIRECTOR

PROJECT NUMBER 3-76164
SHEET 6 OF 11

7-29-71 JET
Date By

1 Changed treatment for Decking & Bumpers to 0.5lb. Penta. Spaced deck planks 1/8", changed float width.

No. Revision

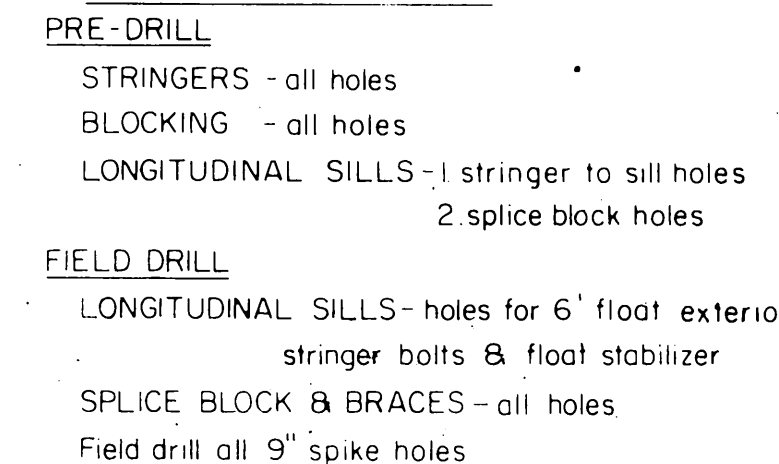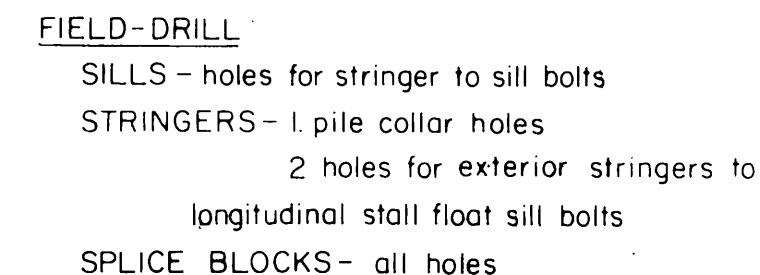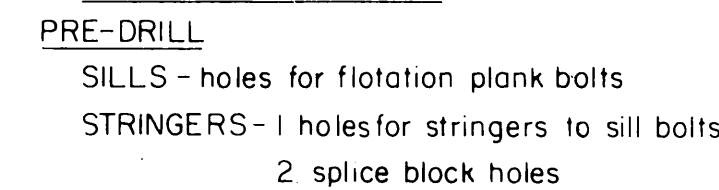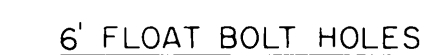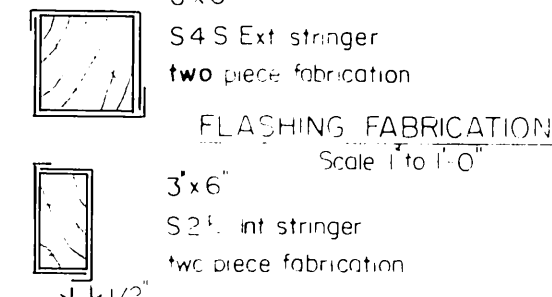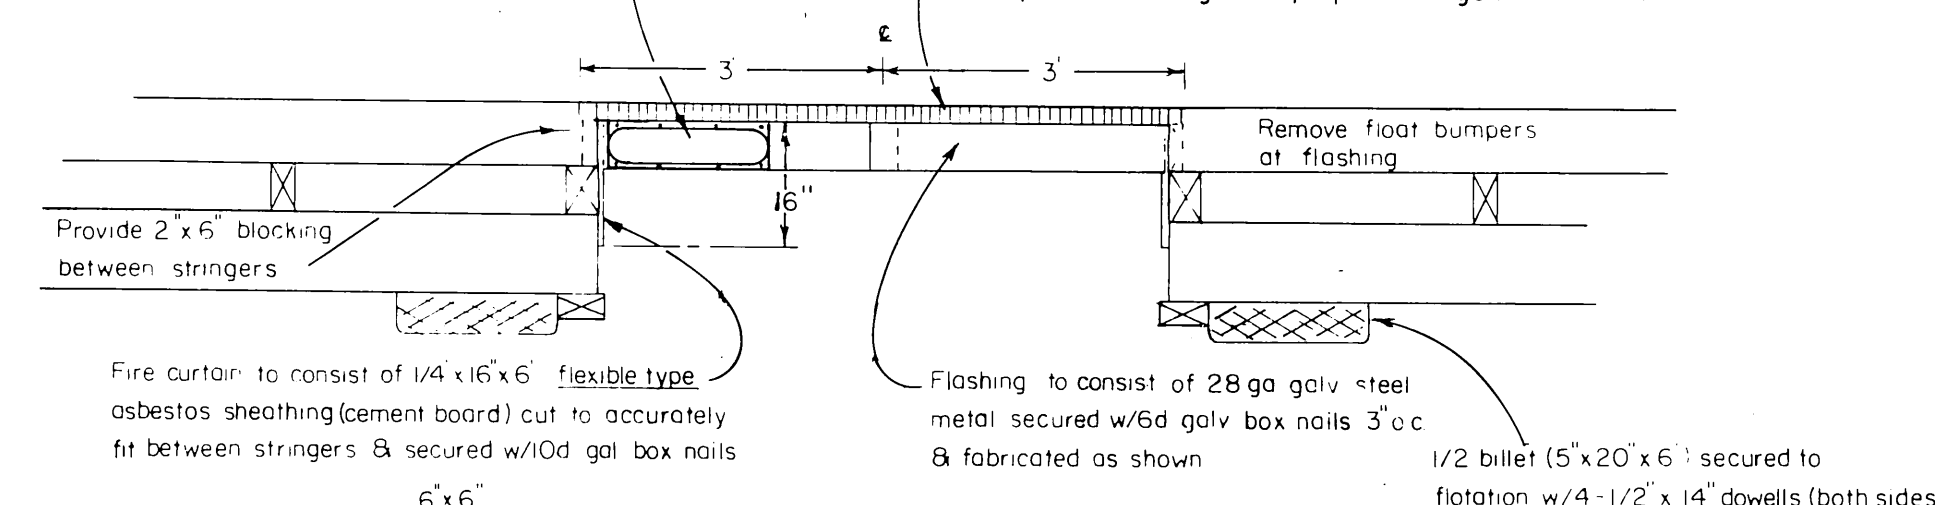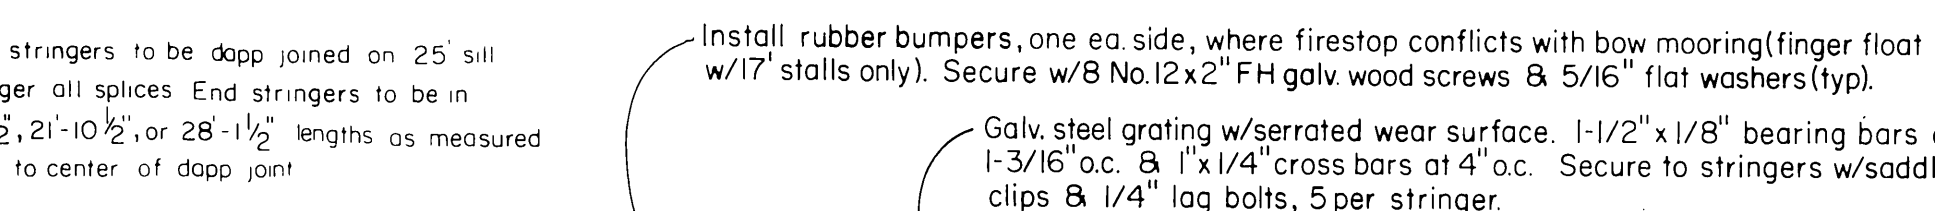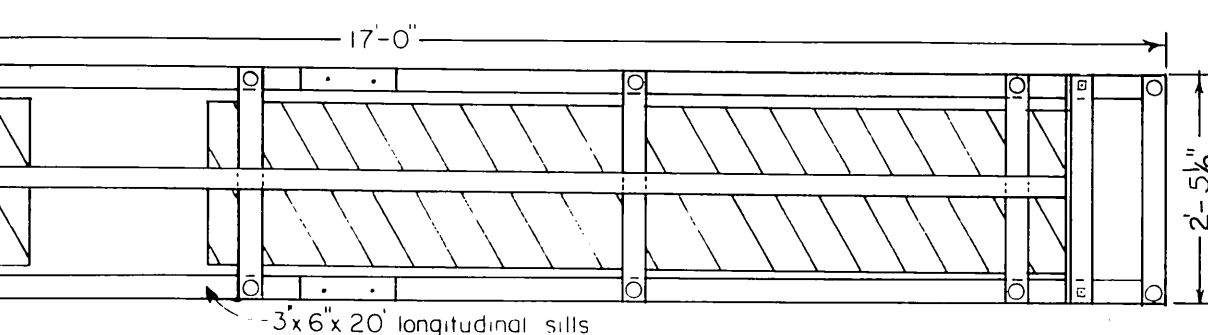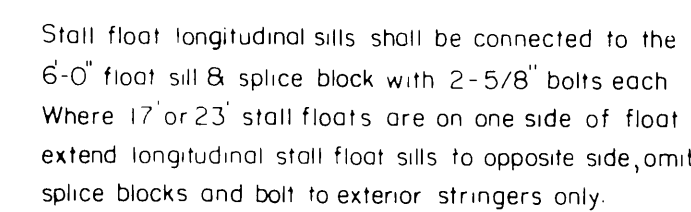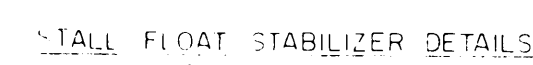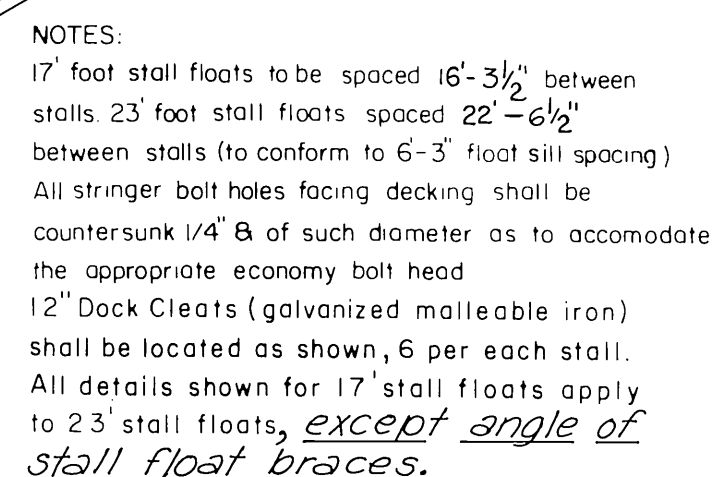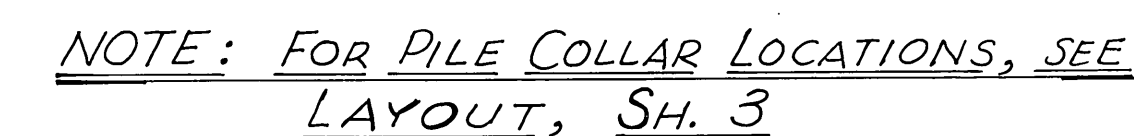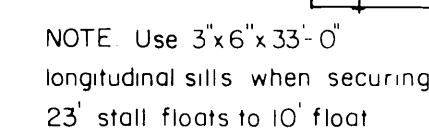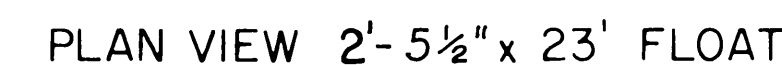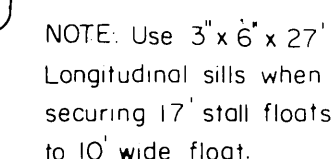


MATERIALS		
ITEM	DRESSING	TREATMENT
PILING		20 lb creol. (MP-2)
3'x6" 8'x6" UPPER SILLS	ROUGH	10 lb " (LP-55)
2'x6" LOWER SILLS	ROUGH	" " "
3'x6"x6" SPLICE BLKS	S-2-E	8 lb " (LP-2)
3'x6" LONGITUDINAL	S-2-E	" " "
STALL FLOAT SILLS		
3'x6" BLOCKING	S-2-E	" " "
6'x6" EXT. STRINGERS	S-4-S	" " " "
3'x6" INT. STRINGERS	S-2-E	" " " "
2'x10" DECKING	Milled	0.5 lb. Penta.
2'x8" BUMBERS	S-4-S	" " "
4'x6" SPLICE BLOCKS	S-2-E	8 lb. creol. (LP-2)


NOTES

All hardware to be hot dip Galvanized A malleable washer shall be placed between all nut and wood surfaces All bolts to be of the economy head type Bolt holes to be drilled 1/16" O S except holes for flotation planks 1/8" oversize 9" spike holes to be drilled 1/16" undersize All drill holes shall be treated with hot creosote oil All pressure treated creosote material shall be cut to size prior to treatment All bolts to be 5/8" except flotation plank bolts and exterior stringer spike block bolts 5/8" bolt holes facing deck to be countersunk 1/4" deep by 2-1/8" diameter -1/2" bolt holes 1/4"x 3/4" prior to treatment. Connect 6" float to main float with hinge connection as shown on connection detail sheet A barrier of 6 mil polyethylene shall be placed between the contact surfaces of all creos timber and flotation material

1	<i>Changed treatment for Decking & Bumpers to 1/2" x 5/8" Penix. Spaced deck planks 1/2". Changed float width.</i>	7-29-71	JLT
No.	Revision	Date	By
STATE OF ALASKA DEPARTMENT OF PUBLIC WORKS DIVISION OF WATER AND HARBORS			
TYPICAL 6' FLOAT w/INTEGRAL STALLS			
SCALE	1/2" = 1'-0"		
DATE	AUGUST 1966		
PROJECT NO.	3-76164		
	APPROVED	DON D. STATTER	DIRECTOR
DESIGNED BY	D.S.	DRAWN BY	C.D.
		CHECKED BY	D.S.

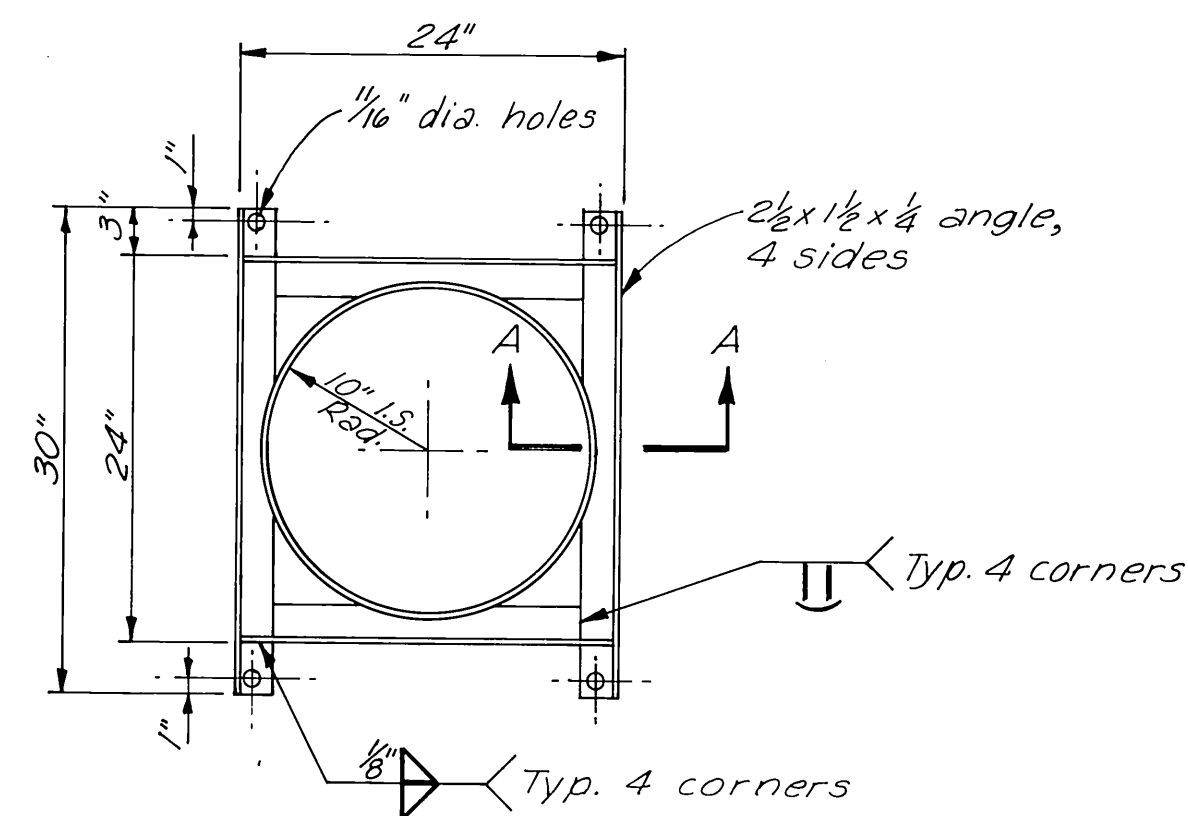


PLAN
1" = 1'-0"

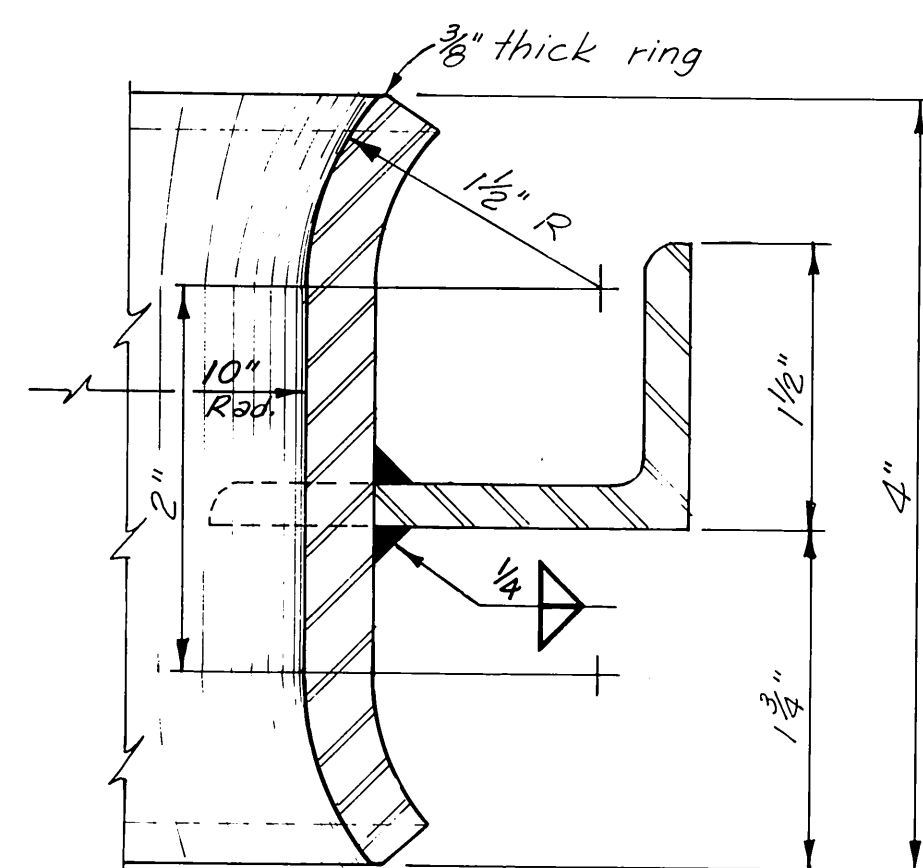


NOTE: All welds on inside of ring shall be ground smooth.

SECTION A-A
Full Size

INTERNAL PILE COLLAR

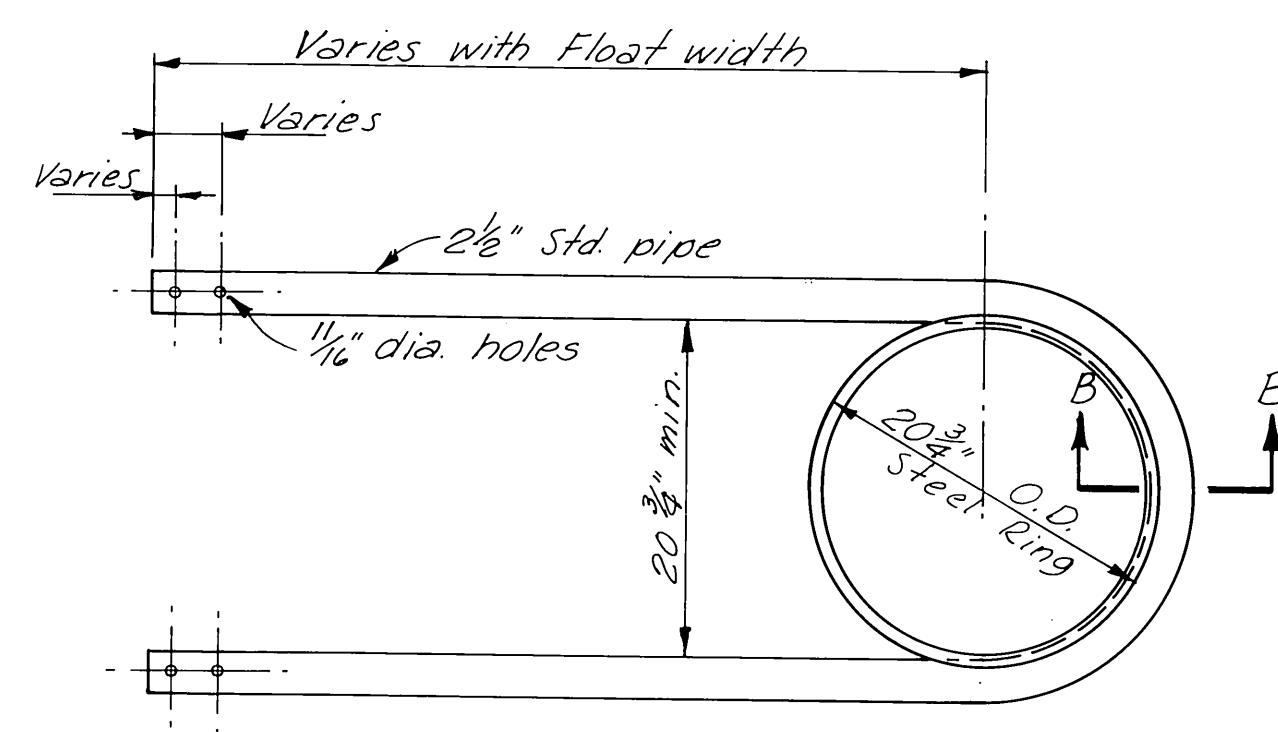

PLAN
1" = 1'-0"

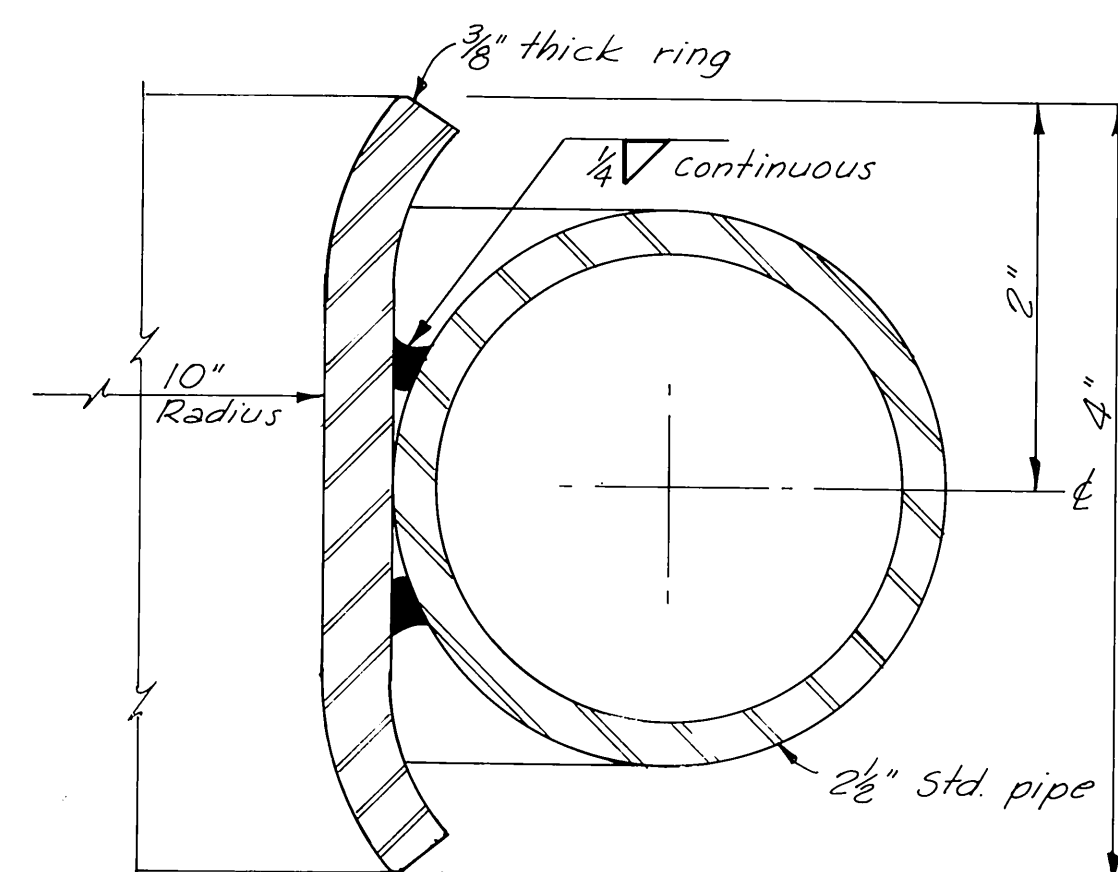

NOTE: For details of ring see Section A-A

SECTION B-B
Full Size



STEEL PIPE PILE COLLAR

DO NOT SCALE THIS DRAWING - USE DIMENSIONS

STATE OF ALASKA
DEPARTMENT OF PUBLIC WORKS
DIVISION OF WATER AND HARBORS




MISCELLANEOUS DETAILS

SCALE <u>As shown</u>	SURVEYED <u>~</u>	APPROVED
DESIGNED <u>~</u>	DRAWN <u>JT</u>	
CHECKED <u>~</u>	DATE <u>5-4-76</u>	<u>Don Statter</u> DIRECTOR
PROJECT NUMBER <u>3-76164</u>	SHEET <u>8</u> OF <u>11</u>	

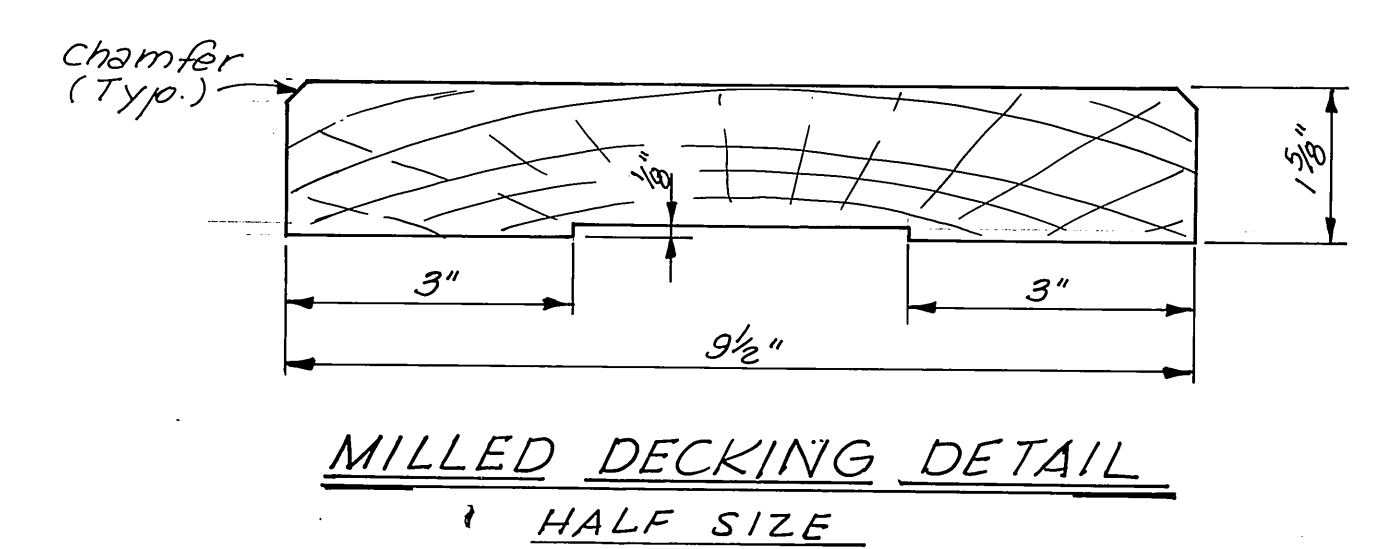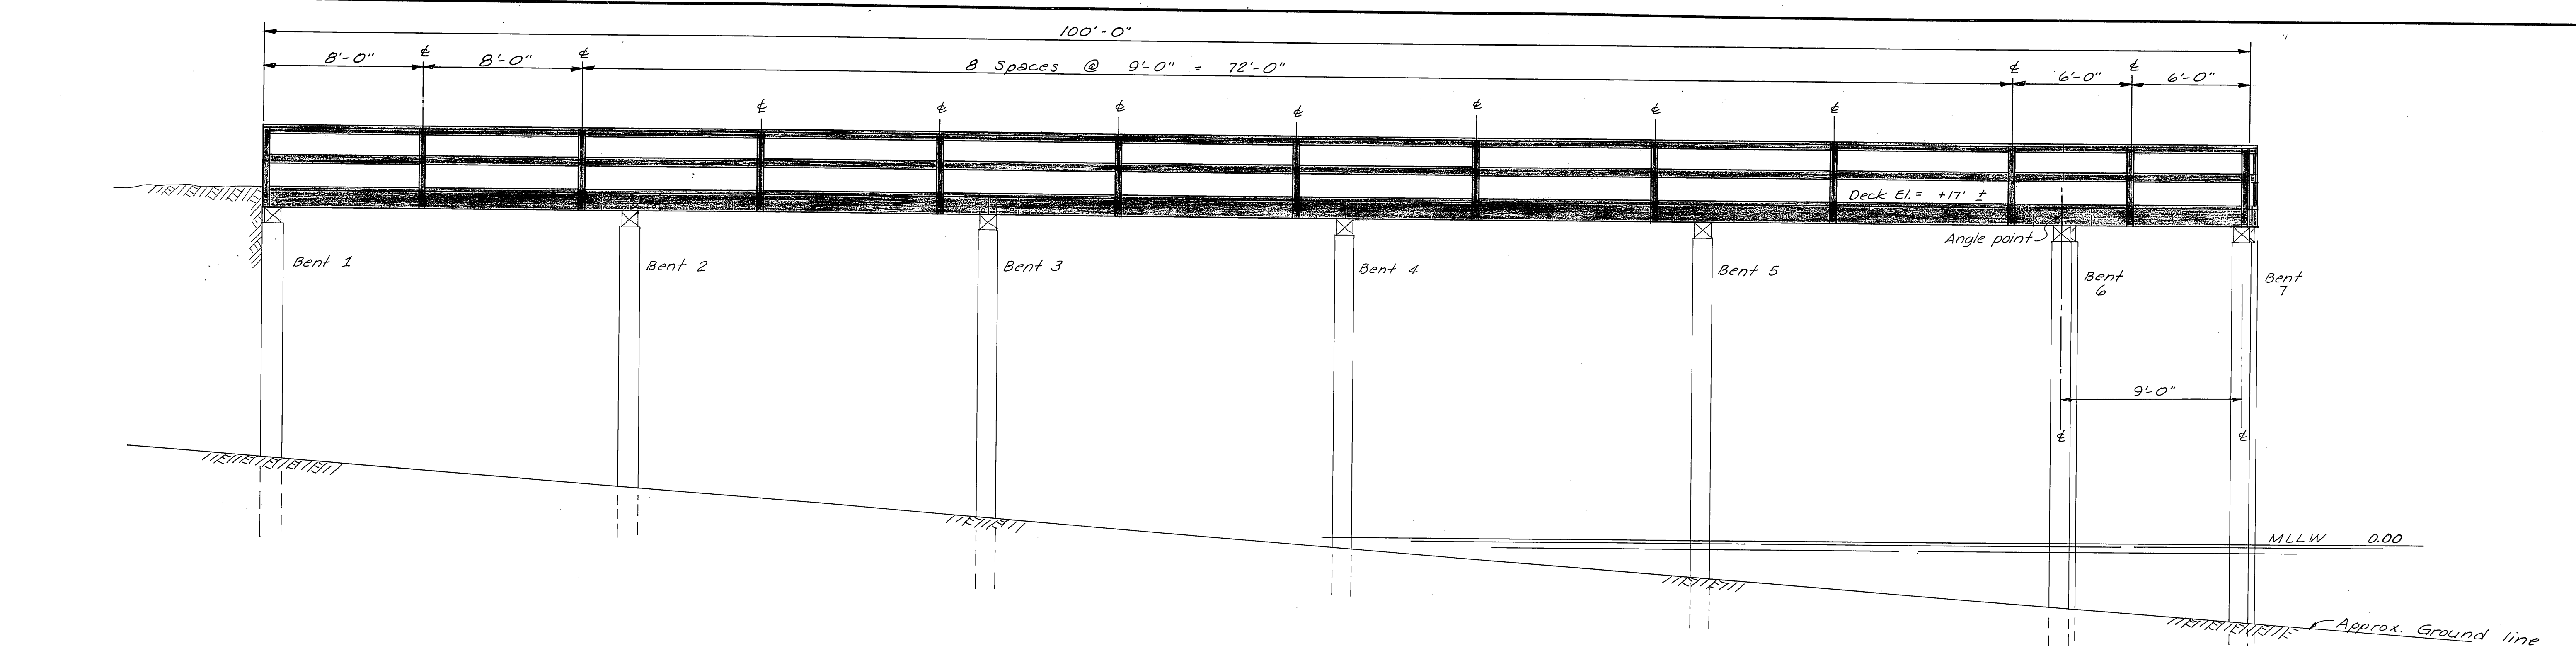

PROFILE
1/4" = 1'-0"






- SPECIAL NOTES:**
1. All stringers shall be of sufficient length to allow for unequal bent spacing.
 2. Field fit stringers at angle point. Salvage existing steel splice plates for re-use on new splices.
 3. All members to be replaced shown shaded.

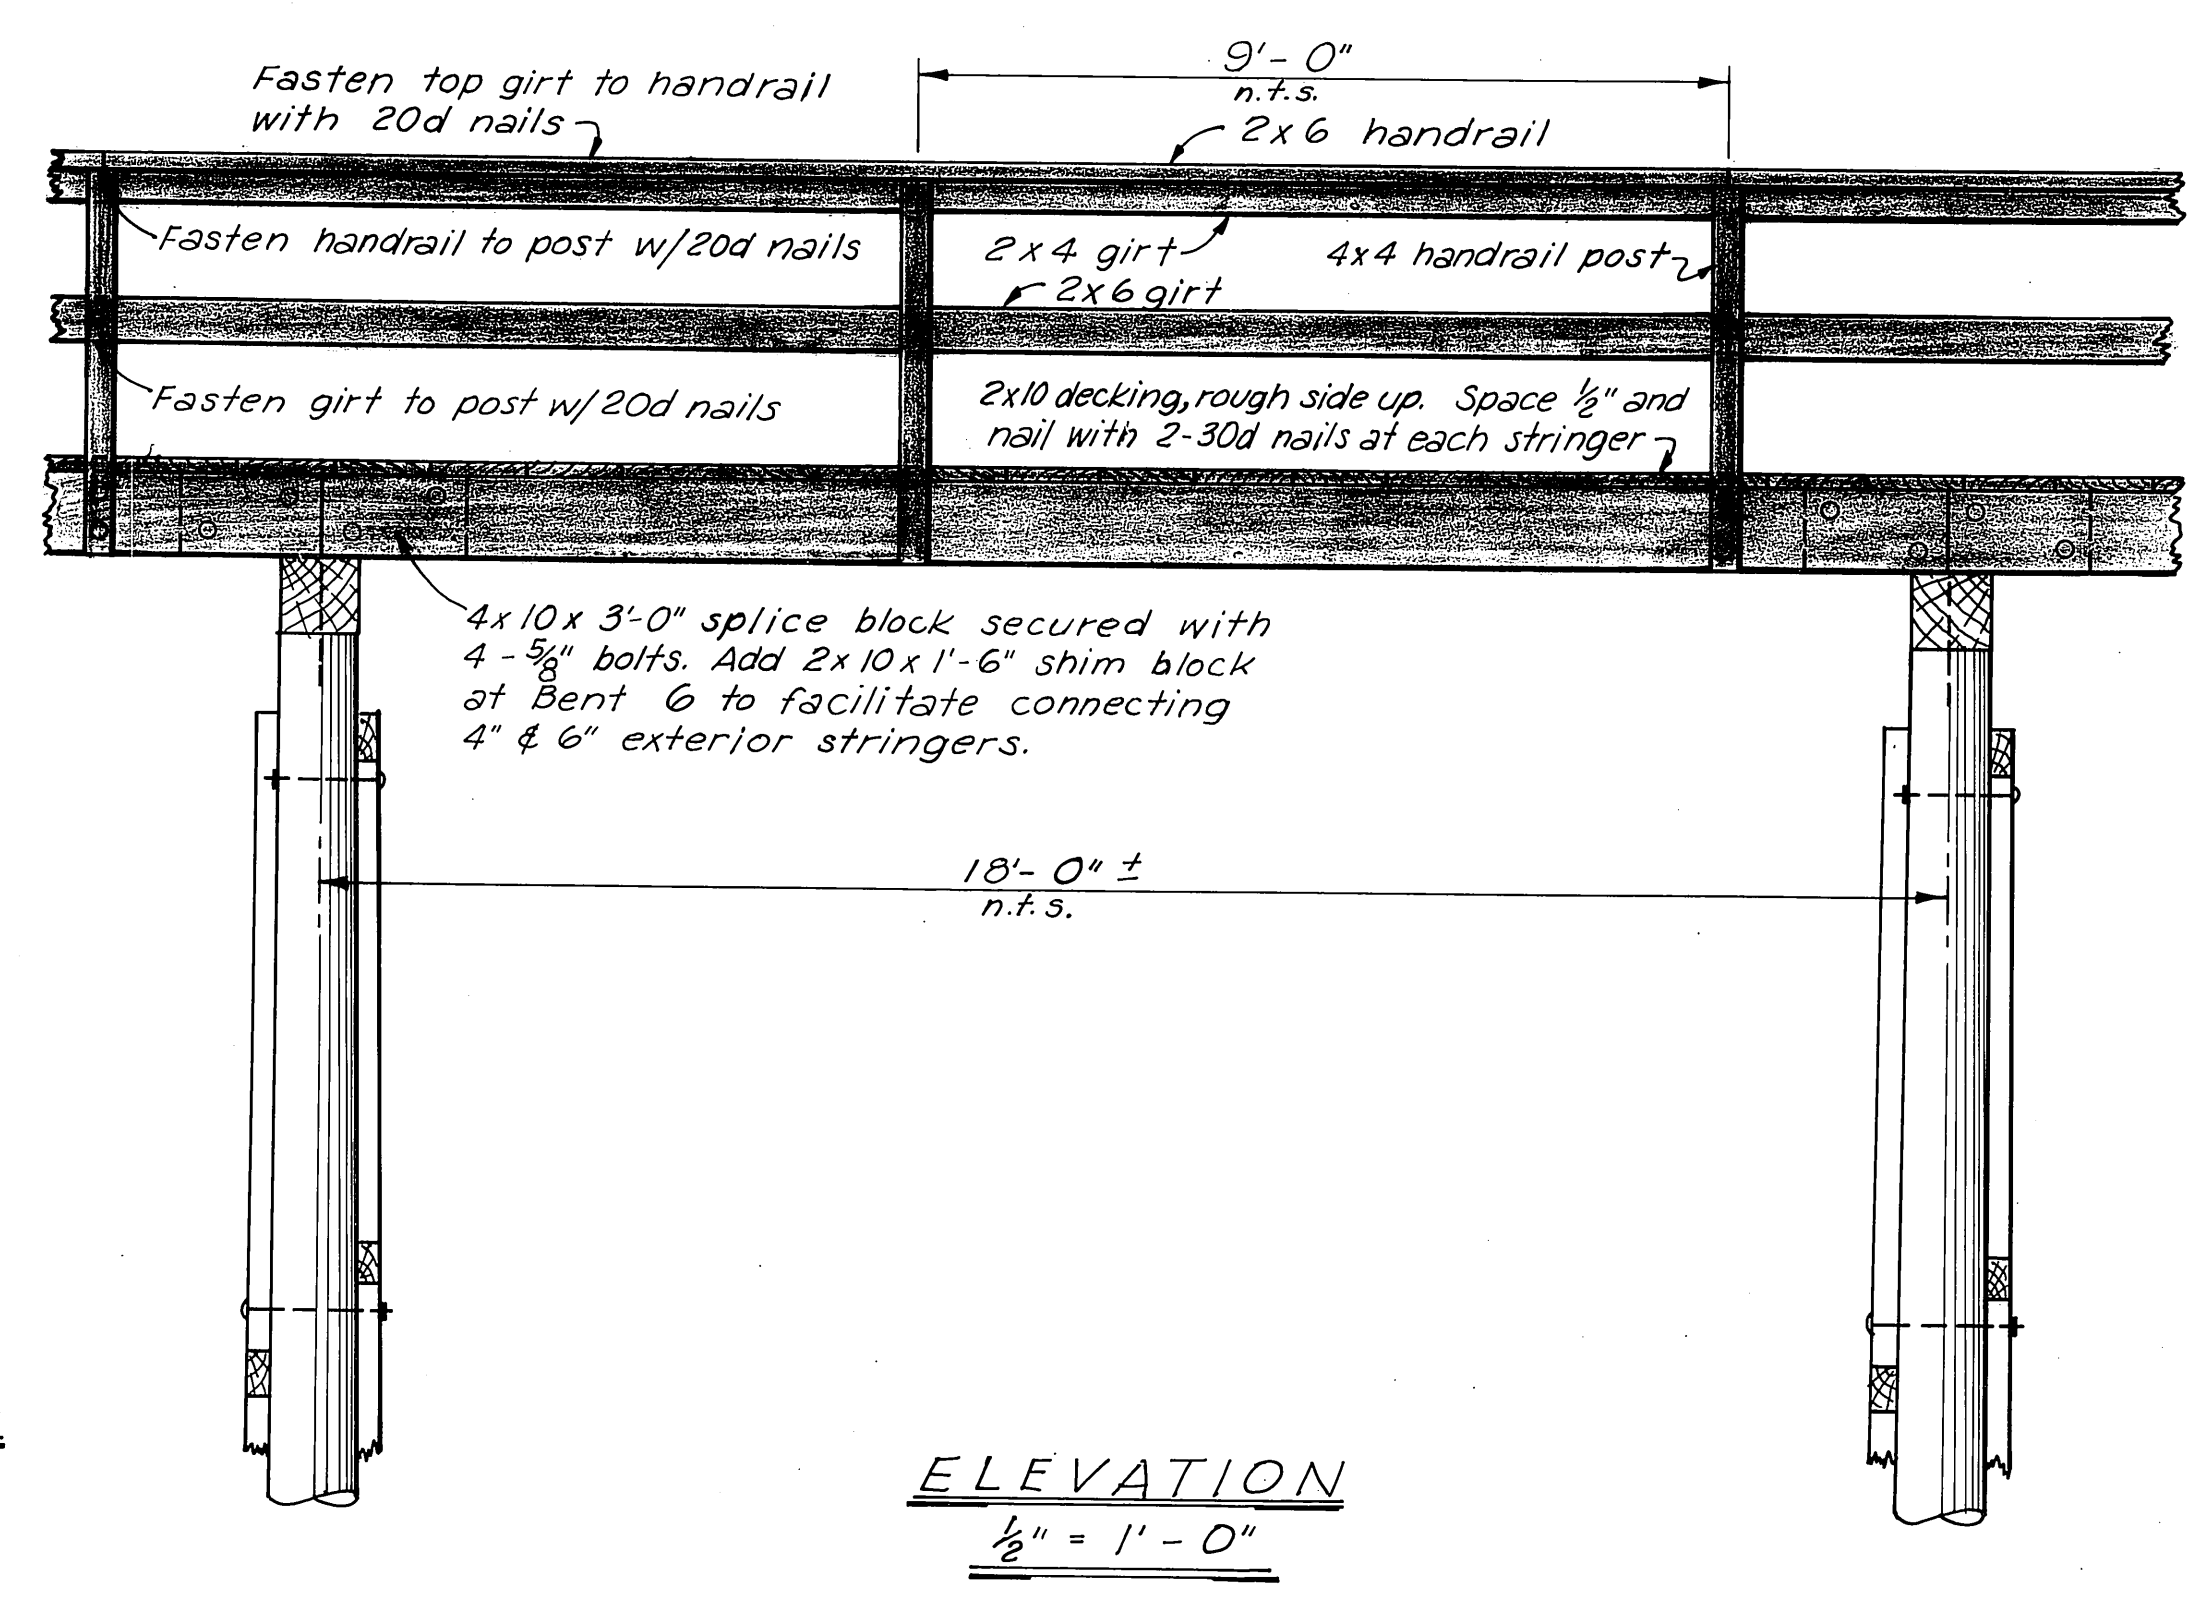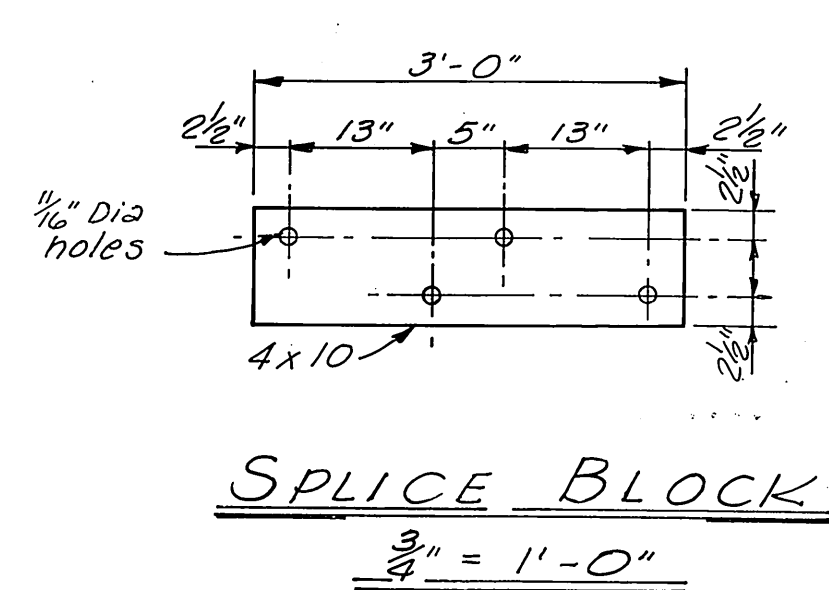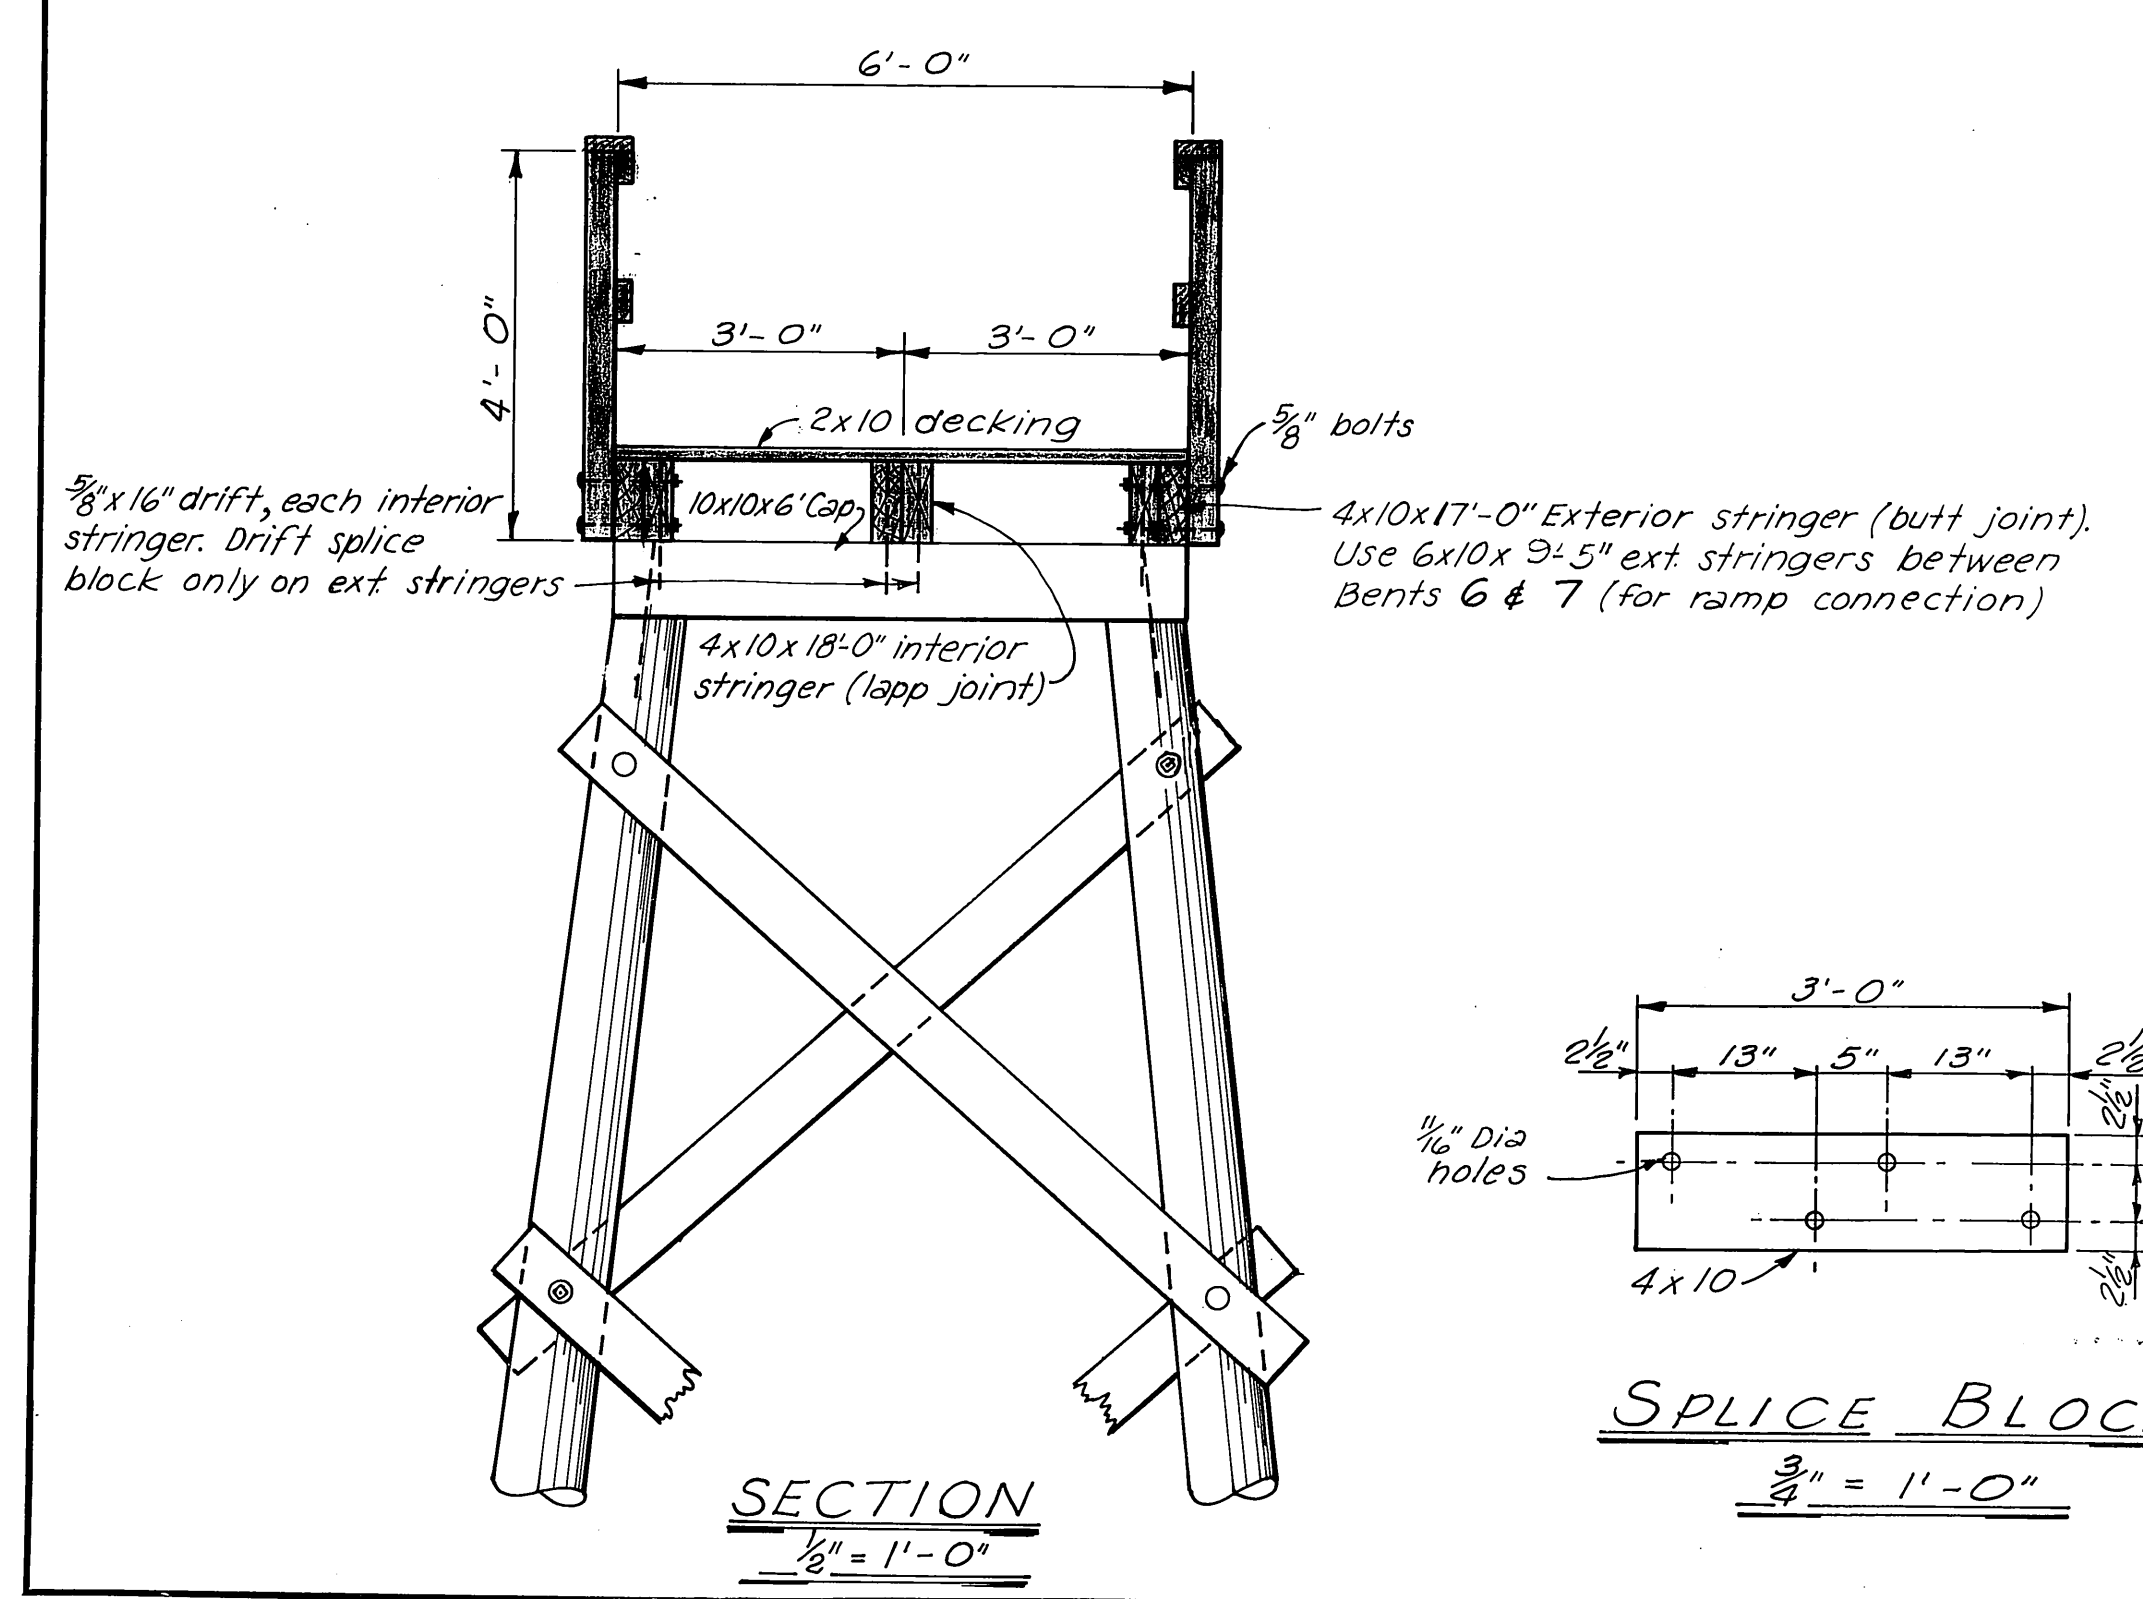

- NOTES:**
1. All hardware to be hot dip galvanized. A malleable iron washer shall be placed between all nut and wood surfaces.
 2. All bolts to be of the economy head type. Bolt holes to be 1/16" oversize.
 3. Drift holes to be 1/16" undersize.
 4. All pressure treated materials to be cut to size prior to treatment.
 5. Drift holes in stringers & splice blocks, and bolt holes in exterior stringers for splice block, shall be drilled prior to treatment. All other holes may be field drilled.
 6. All field cuts or field drilled holes shall be treated with hot creosote oil or Pentachlorophenol.

MATERIALS		
ITEM	DRESSING	TREATMENT
Plates		12-lb. Creos.
Bracing	Rough	" "
Caps	S4S	8-lb. Creos.
Stringers	S2E	8-lb. creos. (LP5)
Splice Block	"	"
Decking	Milled	W.R. Penta (or equal)
Handrail	S4S	" " "
Handrail Post	"	" " "
Girts	"	" " "

DO NOT SCALE THIS DRAWING - USE DIMENSIONS		
STATE OF ALASKA DEPARTMENT OF PUBLIC WORKS DIVISION OF WATER AND HARBORS		
EXISTING 6' APPROACH RECONSTRUCTION DETAILS		
SCALE <u>As shown</u>	SURVEYED <u>~</u>	APPROVED
DESIGNED <u>~</u>	DRAWN <u>JT</u>	<u>Don Statter</u>
CHECKED <u>~</u>	DATE <u>~</u>	DIRECTOR
PROJECT NUMBER <u>3-76164</u>	SHEET <u>9</u> OF <u>11</u>	

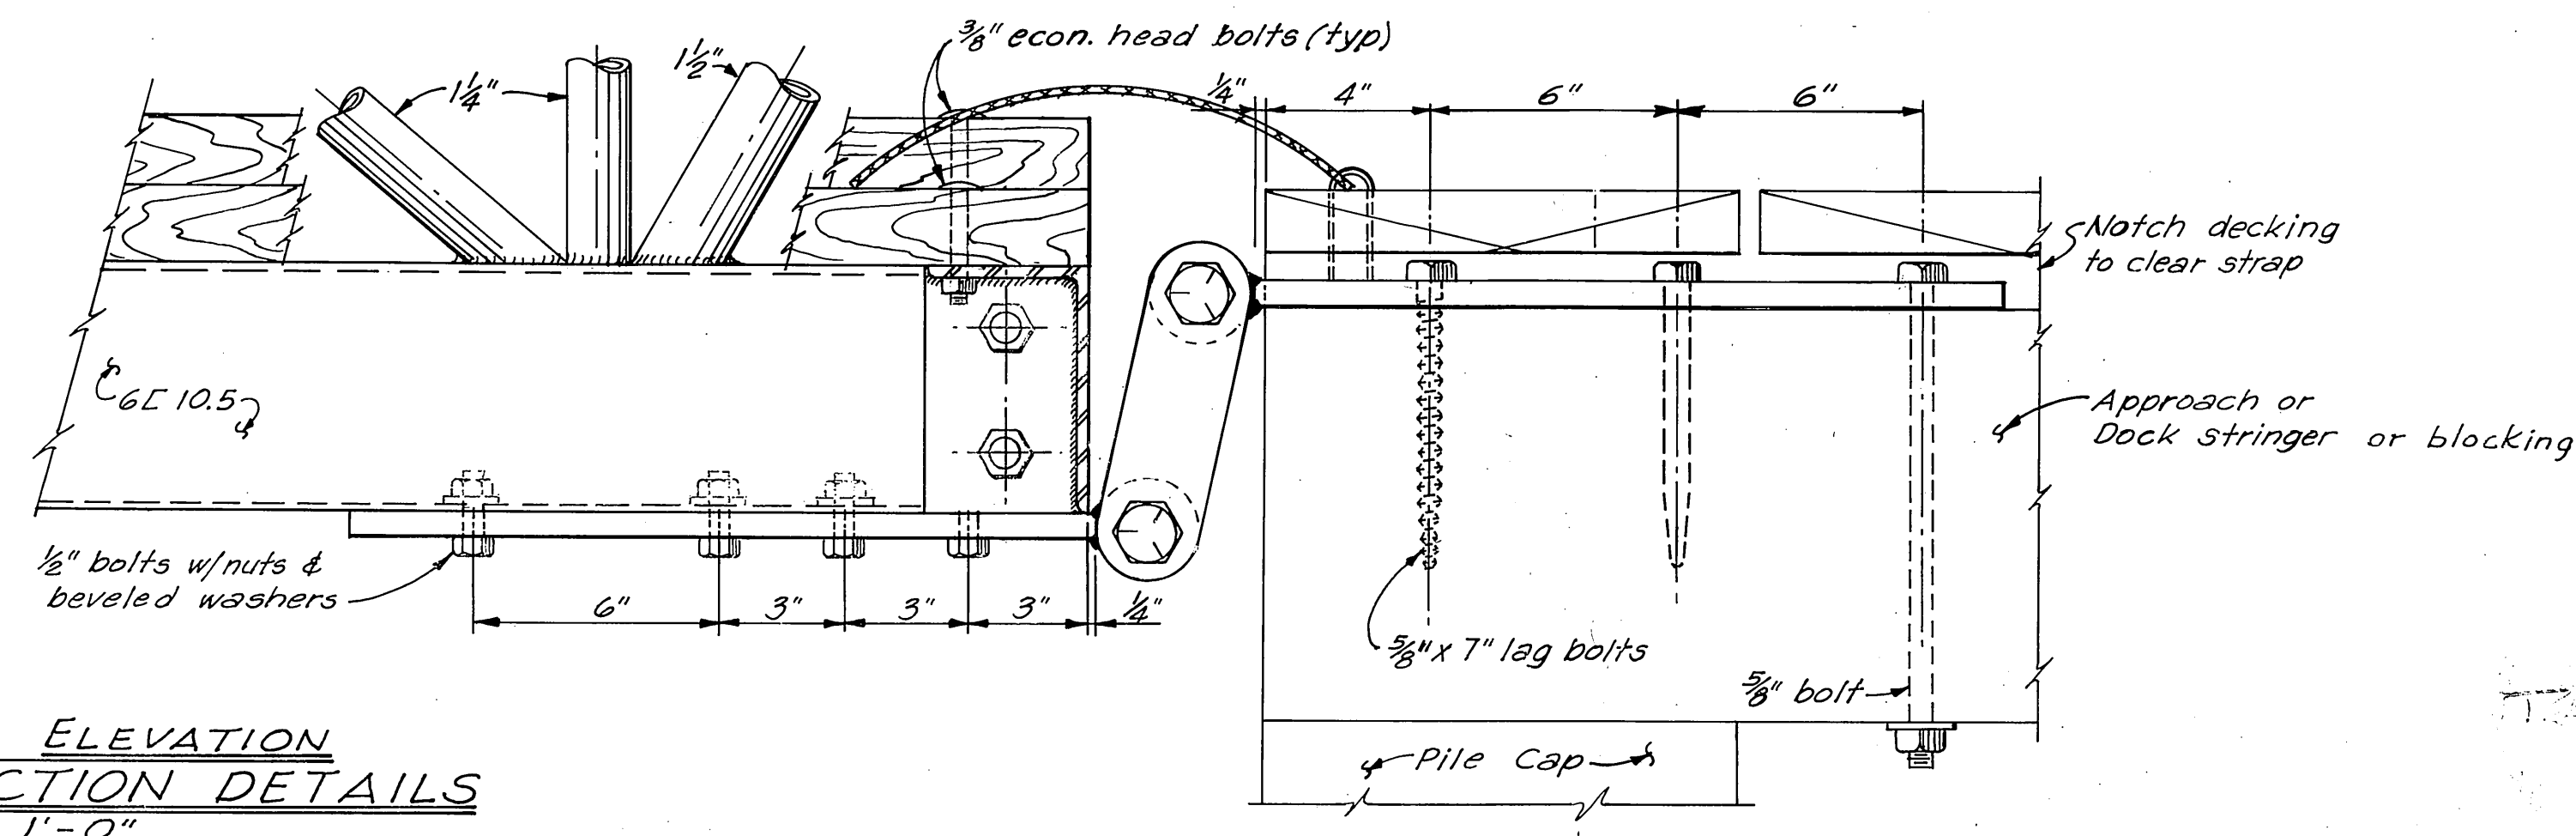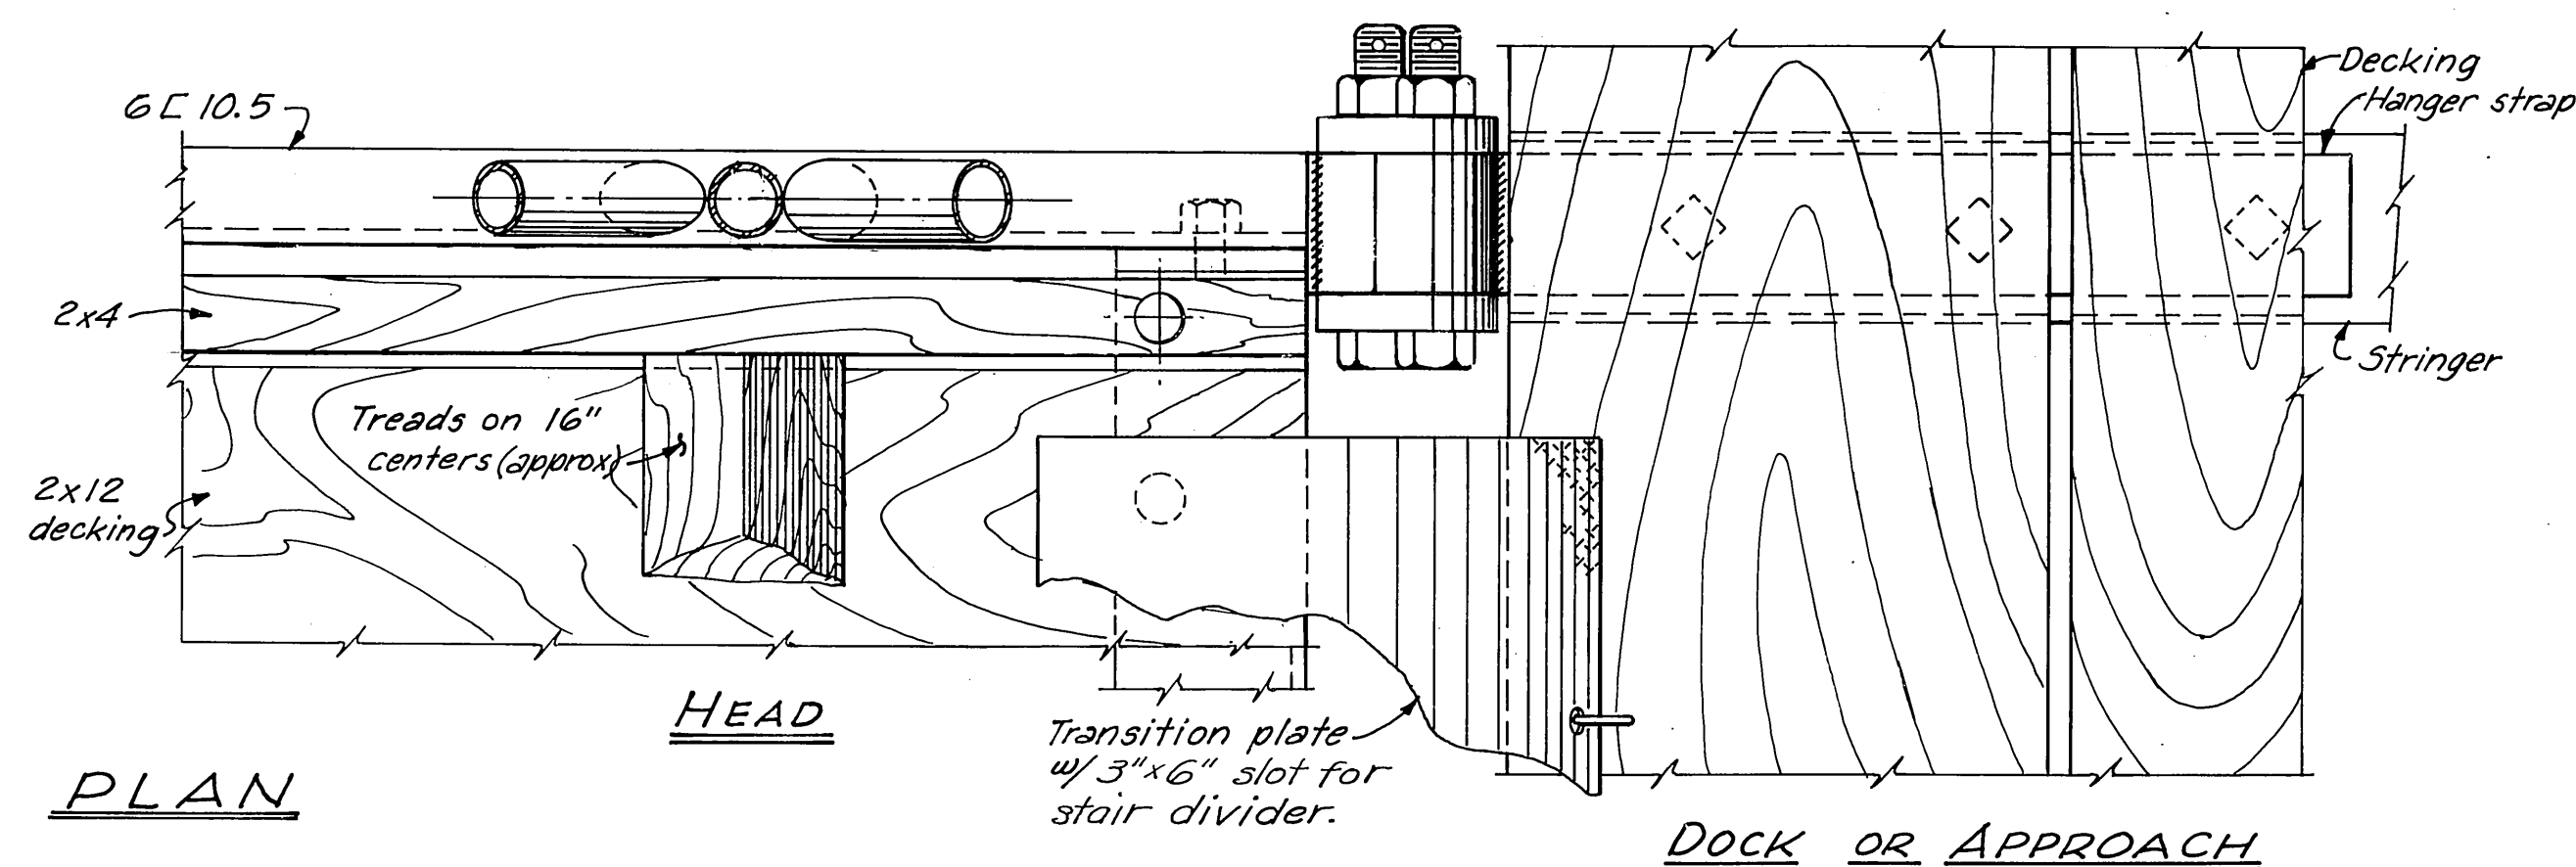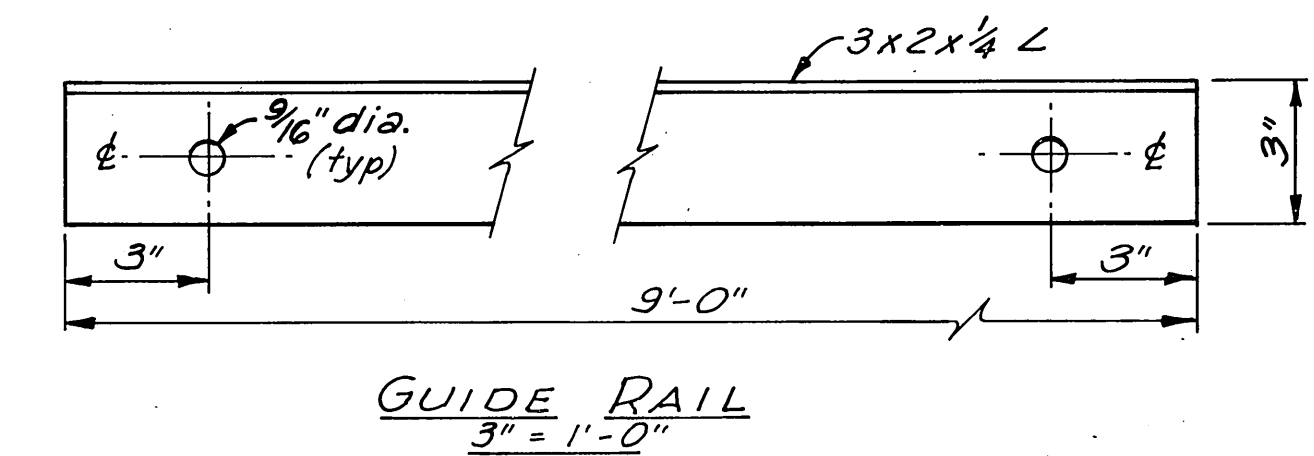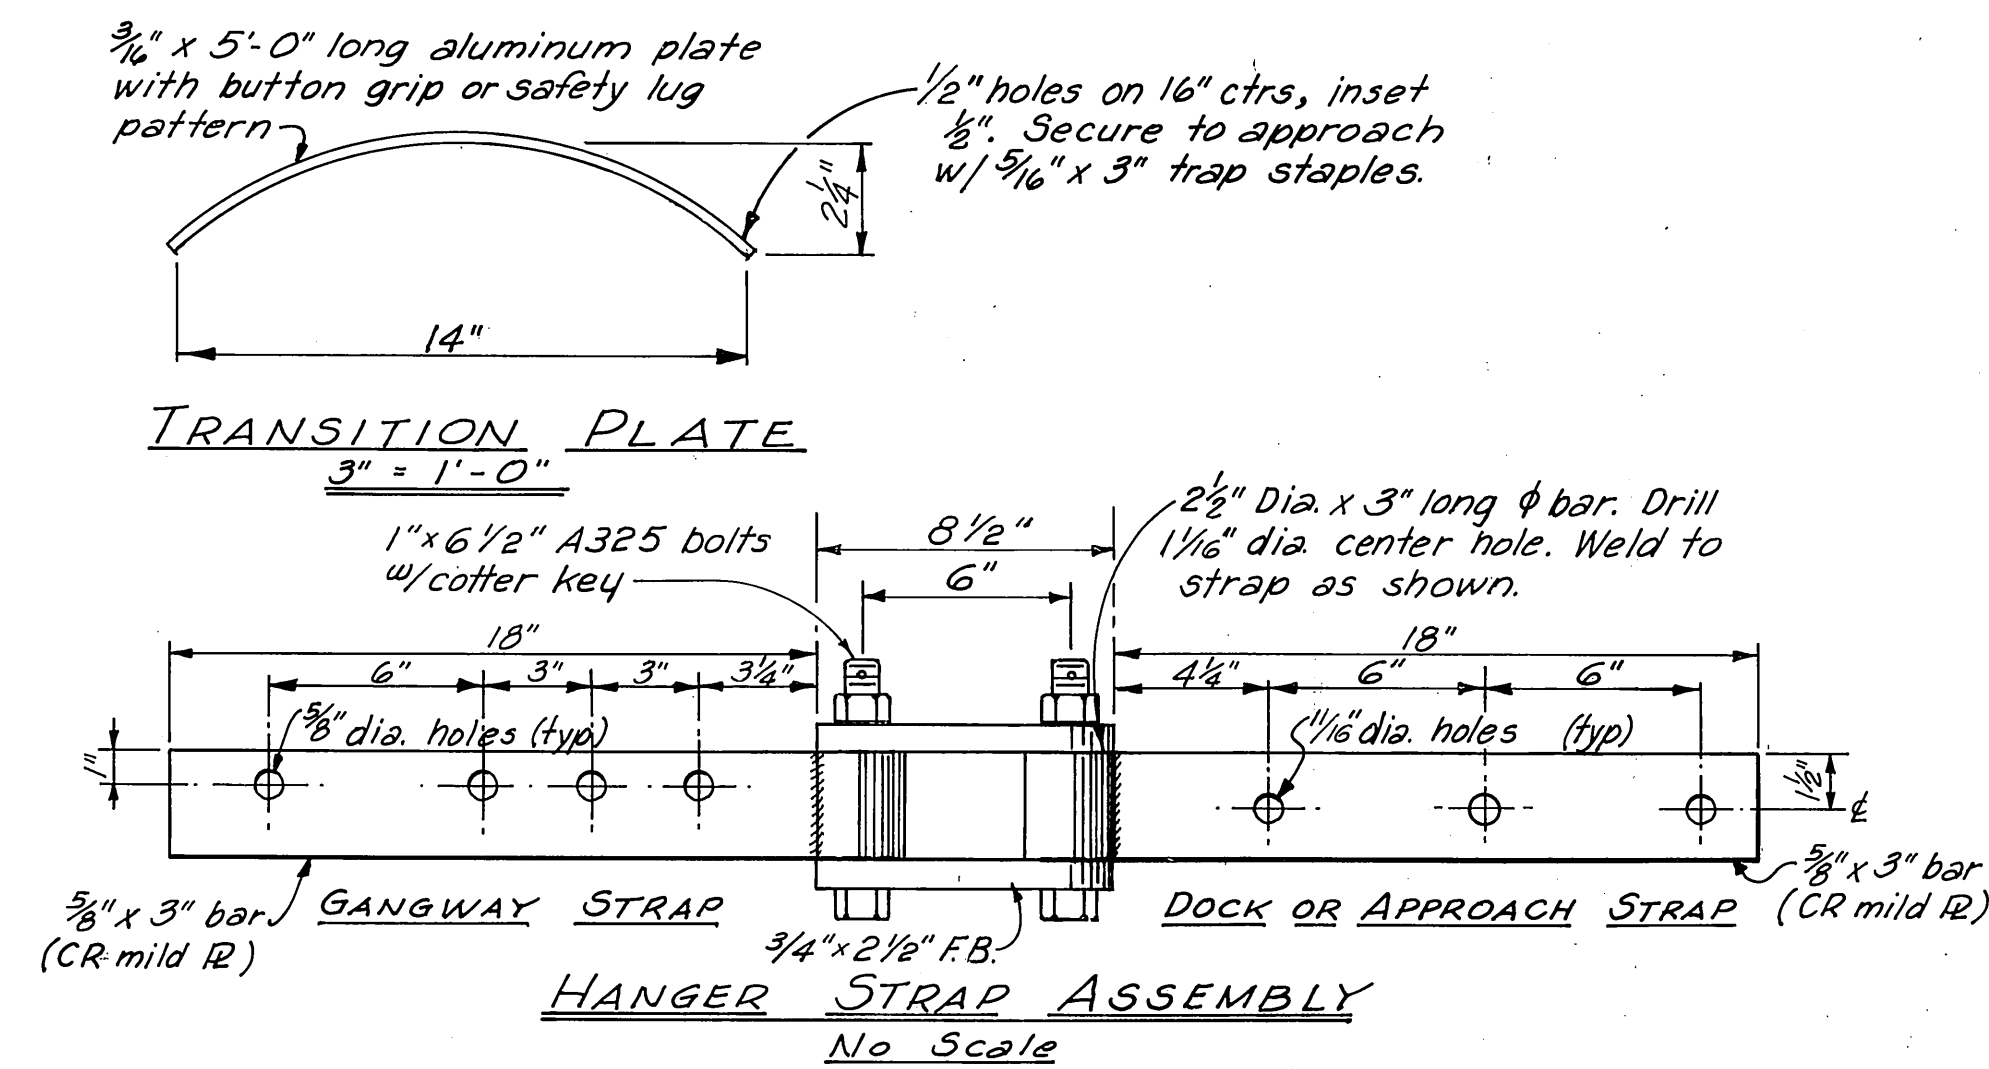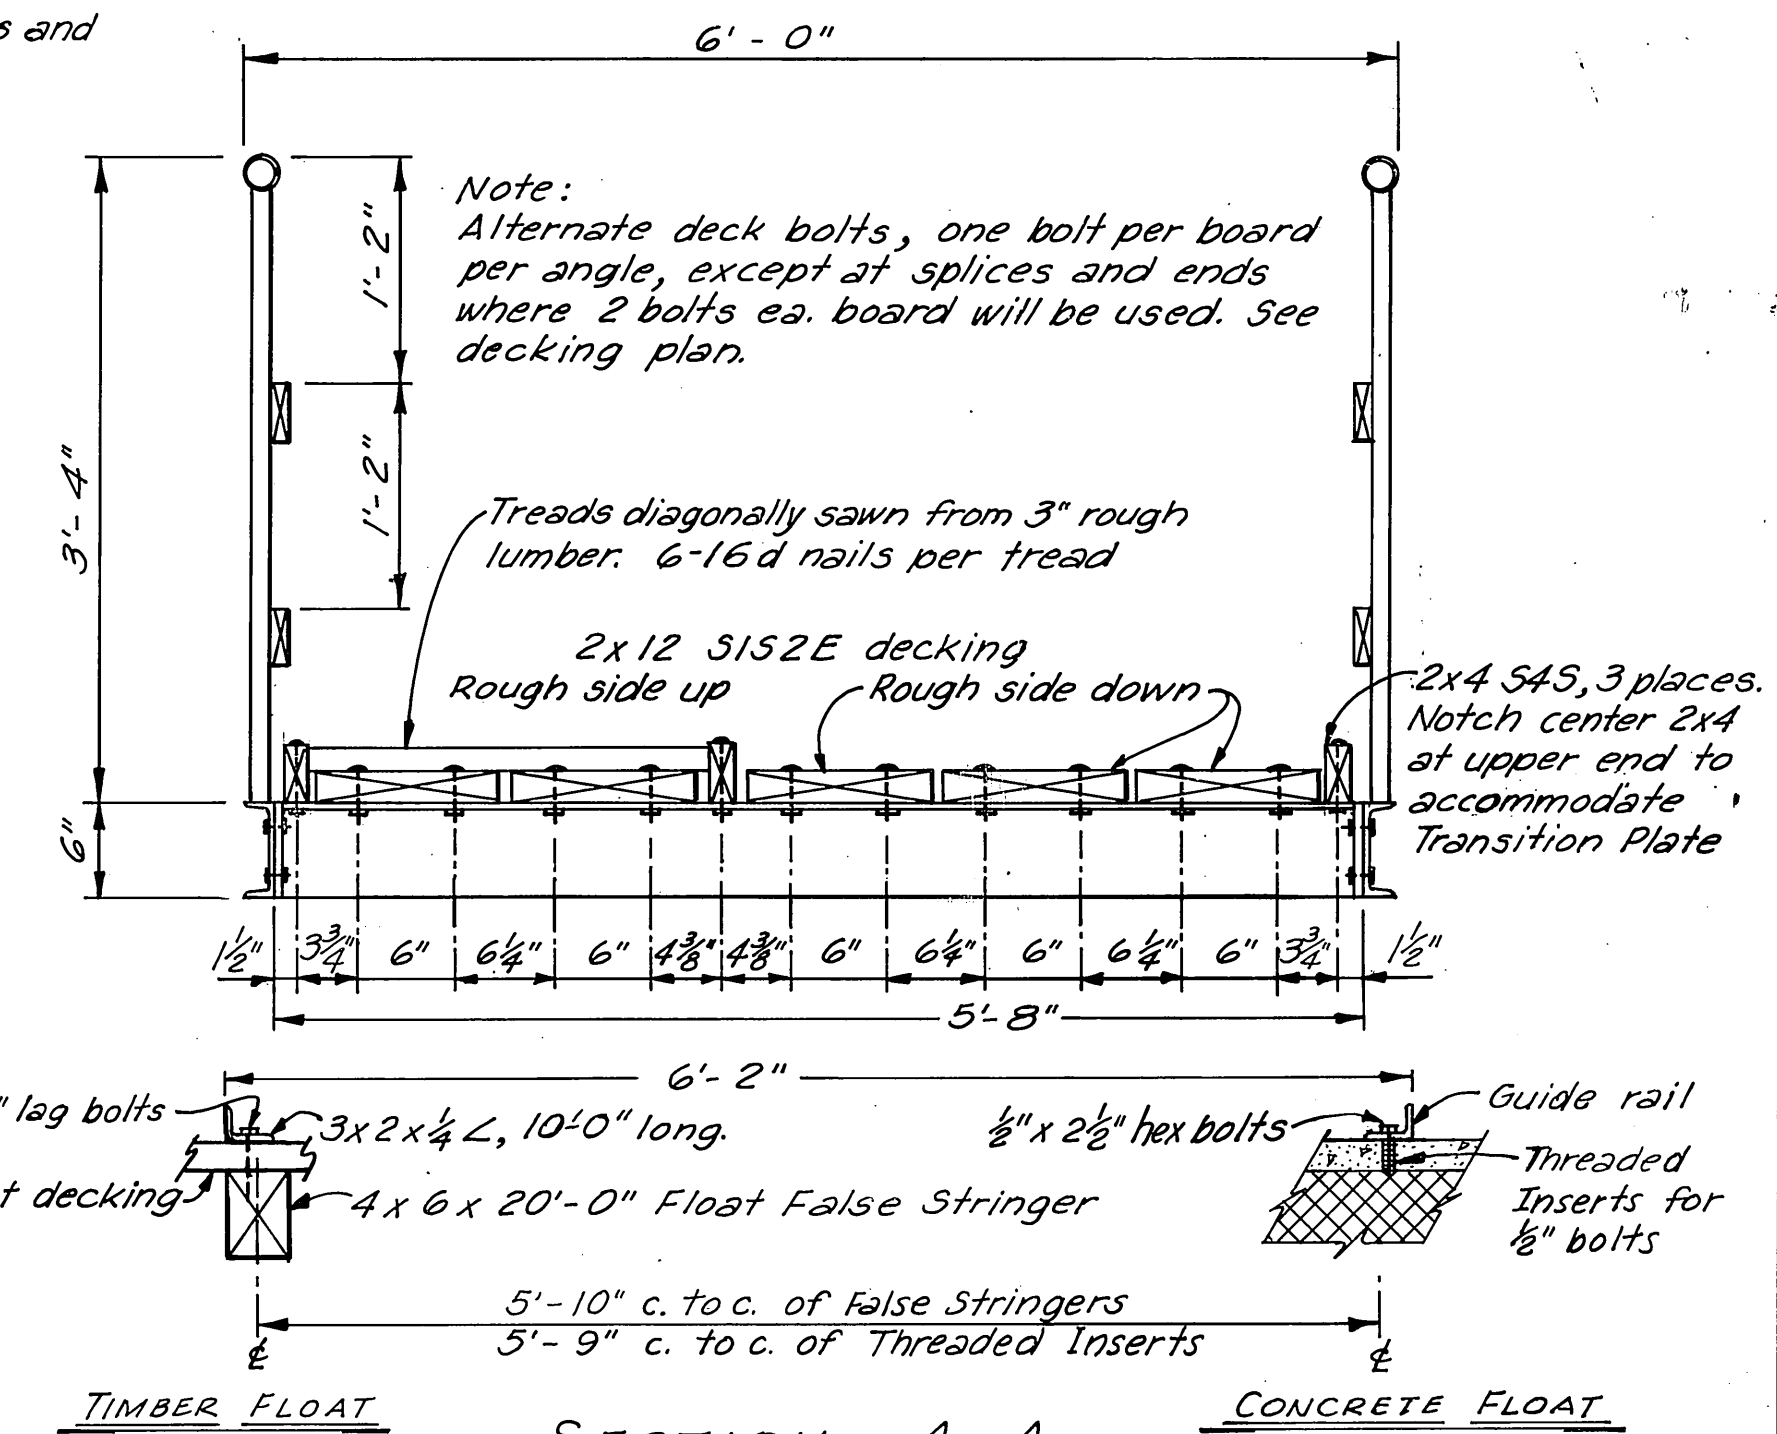

NOTES:

1. All seamless pipe shall conform to ASTM A-53.
2. All channels, angles & plates shall conform to ASTM A-36.
3. Trusses shall be shop fabricated & assembled including hangers.
4. Splices shall be held to a minimum and, where necessary, shall be made in a manner that will not reduce the strength of the truss.
5. No tubing or channel splices will be permitted within the middle half of the truss structure.
6. Trusses & transverse beams shall be hot dipped galvanized after fabrication and in accordance with ASTM A-123, A-384, A-385 & A-386.
7. All steel hardware & fasteners shall be hot dipped galvanized in accordance with ASTM A-153.
8. Decking & deck spacers shall be Dense No 1 grade Douglas fir, W.R. Penta or equivalent pressure treated to 0.5 lb. cu. ft. retention, and shall be field drilled to match shop drilled holes in transverse members.

Revised 3-12-73 Hanger linkage
Lumber grade
Penta. retent
Misc. holes, no. & size
Revised 4-7-71. Removed Tension Wires.






ELS
IFN

DO NOT SCALE THIS DRAWING - USE DIMENSIONS

STATE OF ALASKA
DEPARTMENT OF PUBLIC WORKS
DIVISION OF WATER AND HARBORS

TYPICAL STEEL GANGWAY
CONSTRUCTION DETAILS
(SHEET A)

SCALE <i>As shown</i>	SURVEYED <i>-</i>	APPROVED
DESIGNED <i>JT/RB</i>	DRAWN <i>JET</i>	<i>Don Statter</i>
CHECKED <i>DSM</i>	DATE <i>Dec. 1970</i>	DIRECTOR
PROJECT NUMBER <i>3-76164</i>	SHEET <i>10</i> OF <i>11</i>	

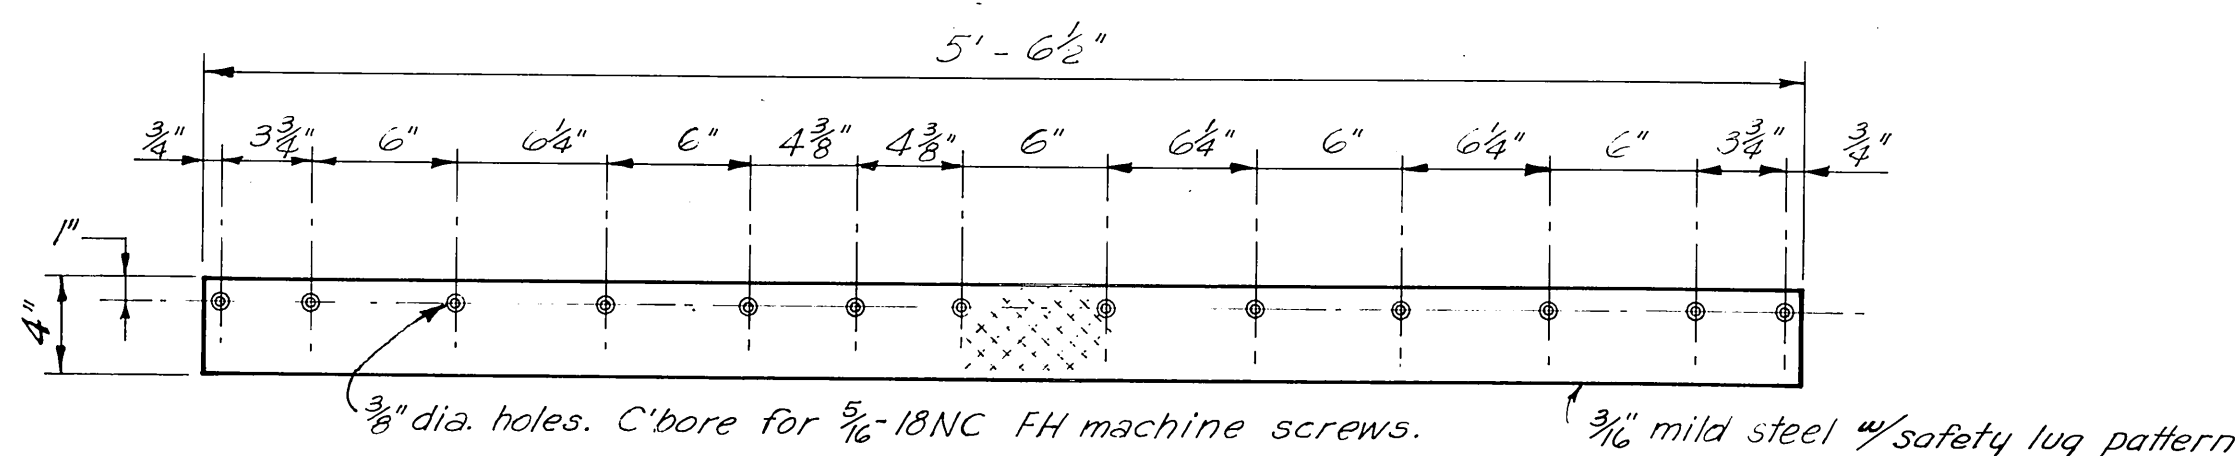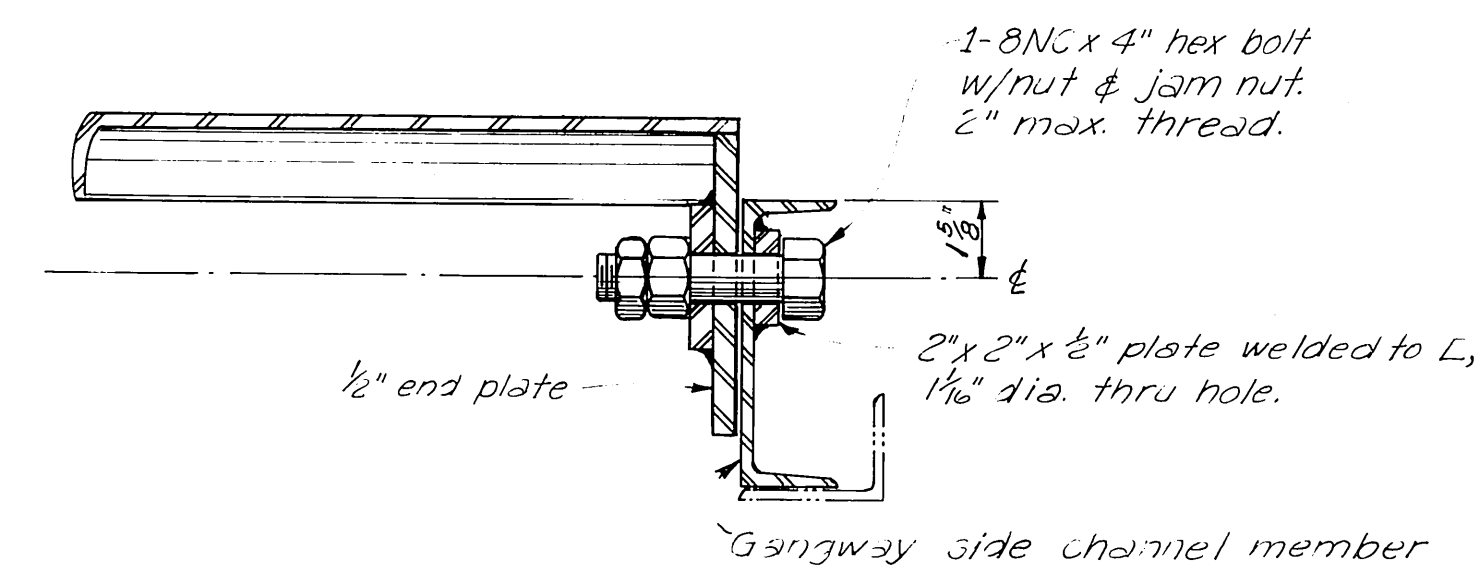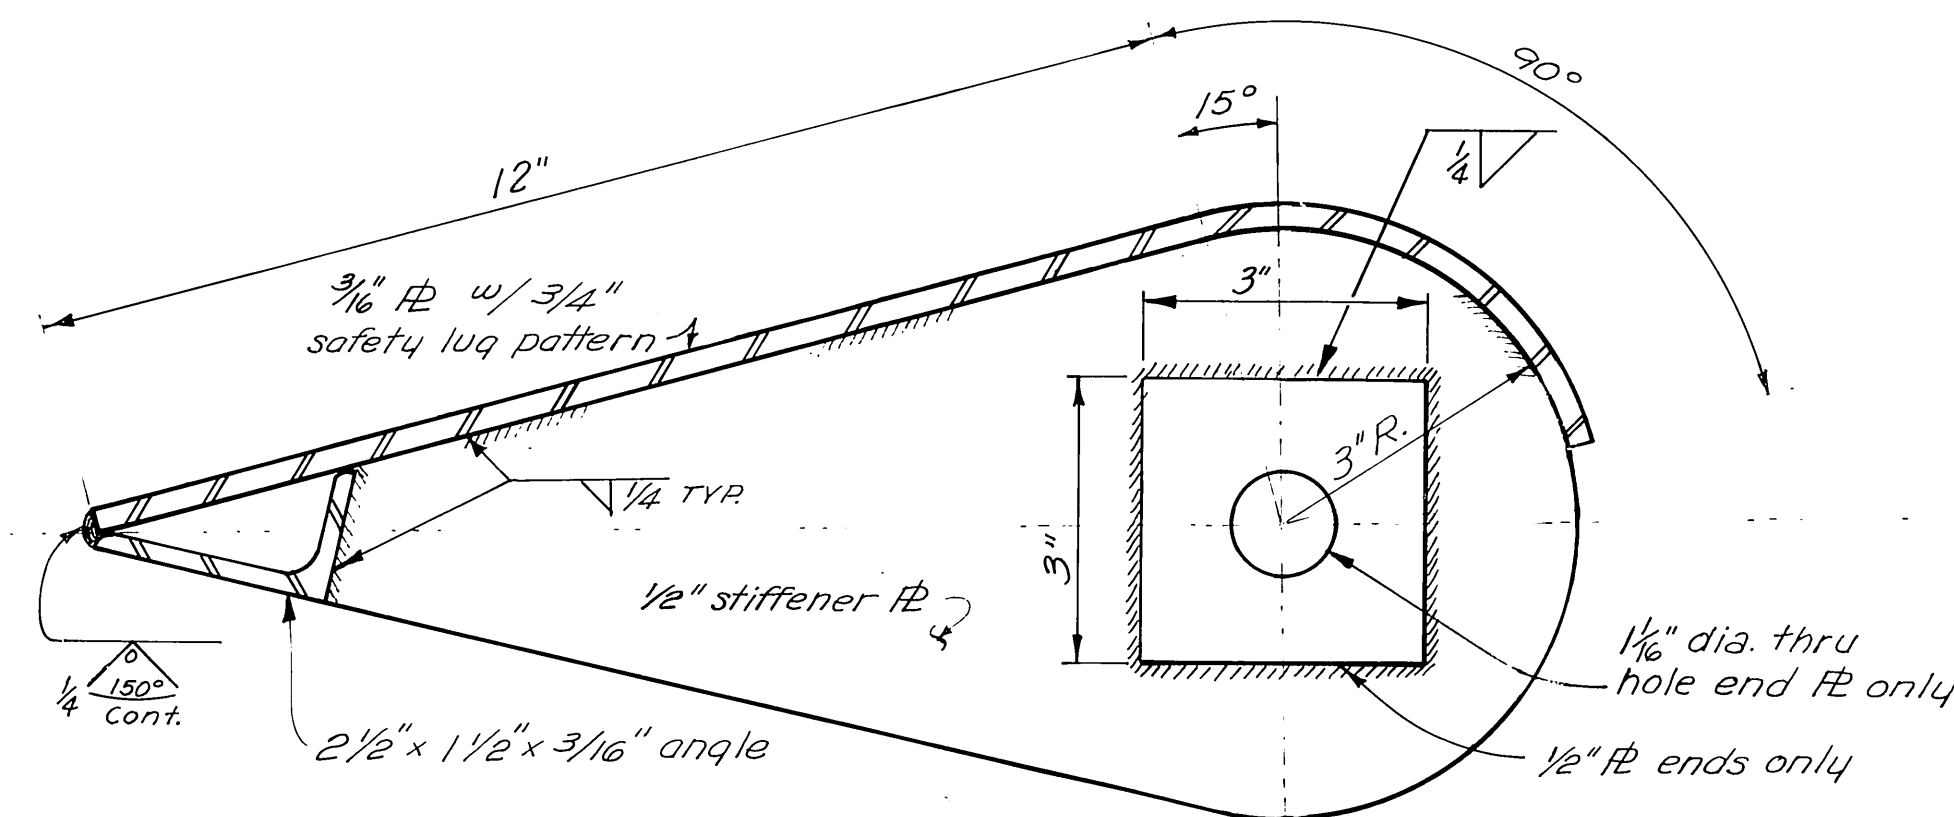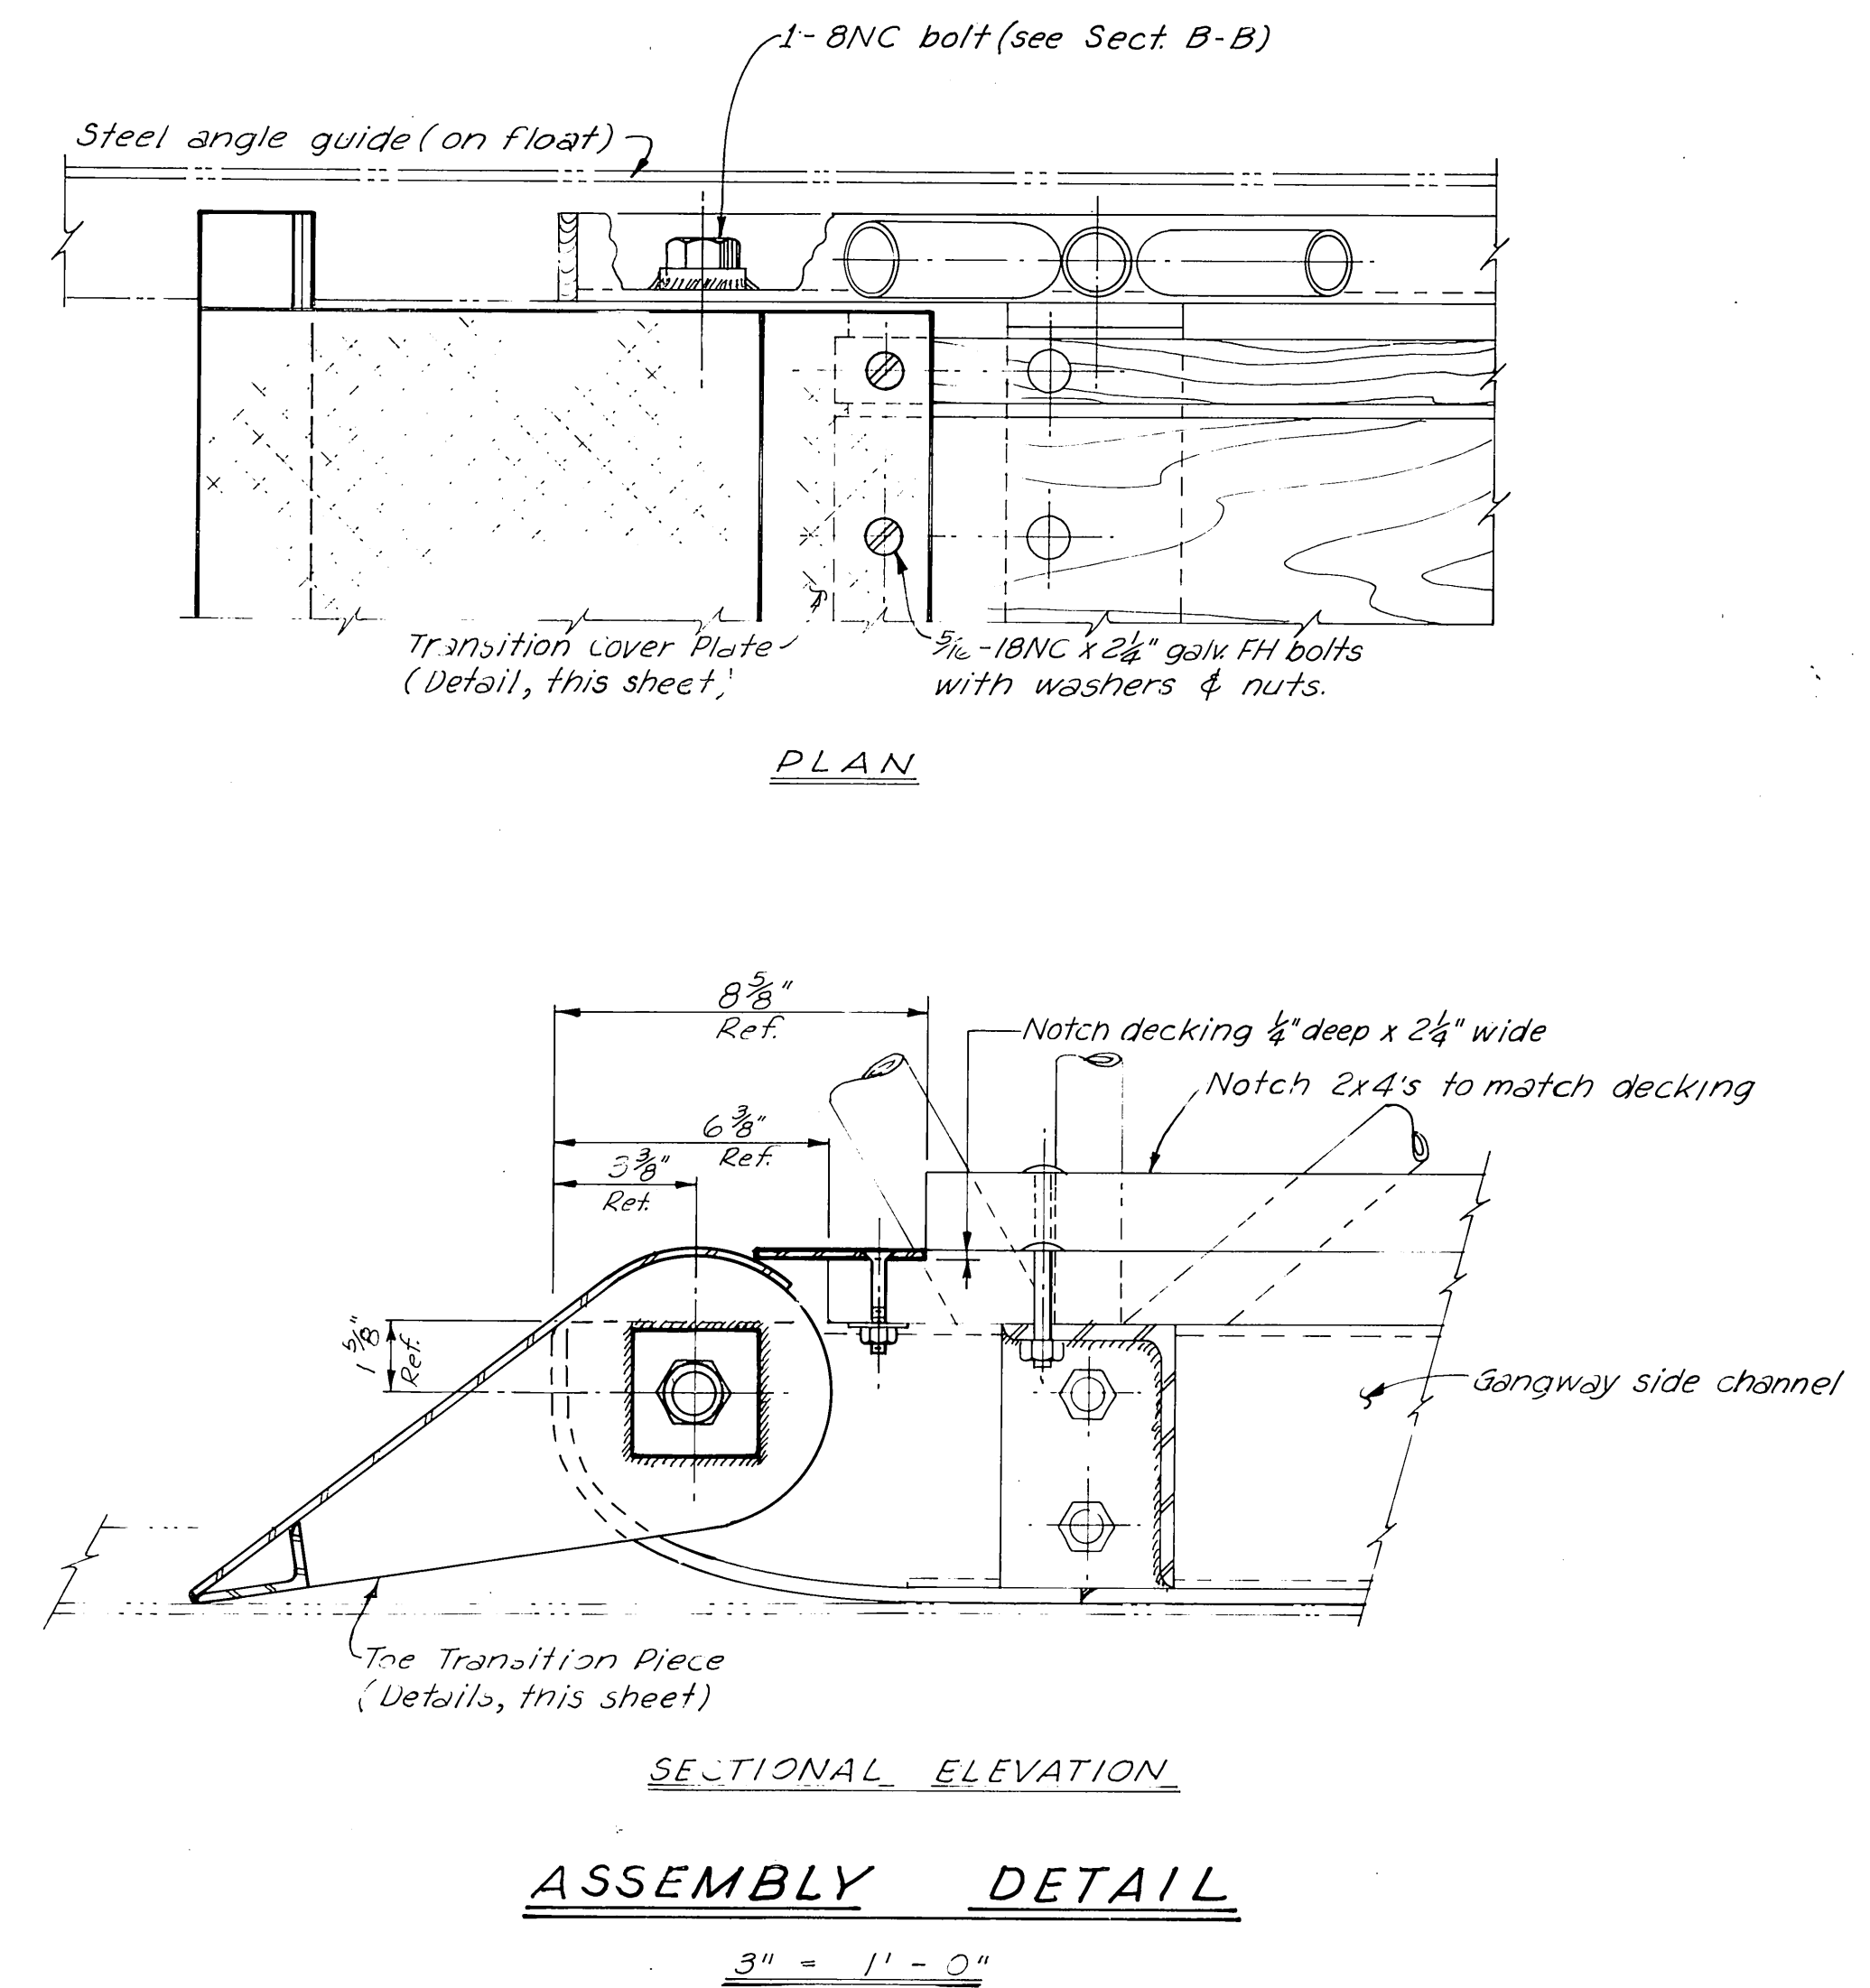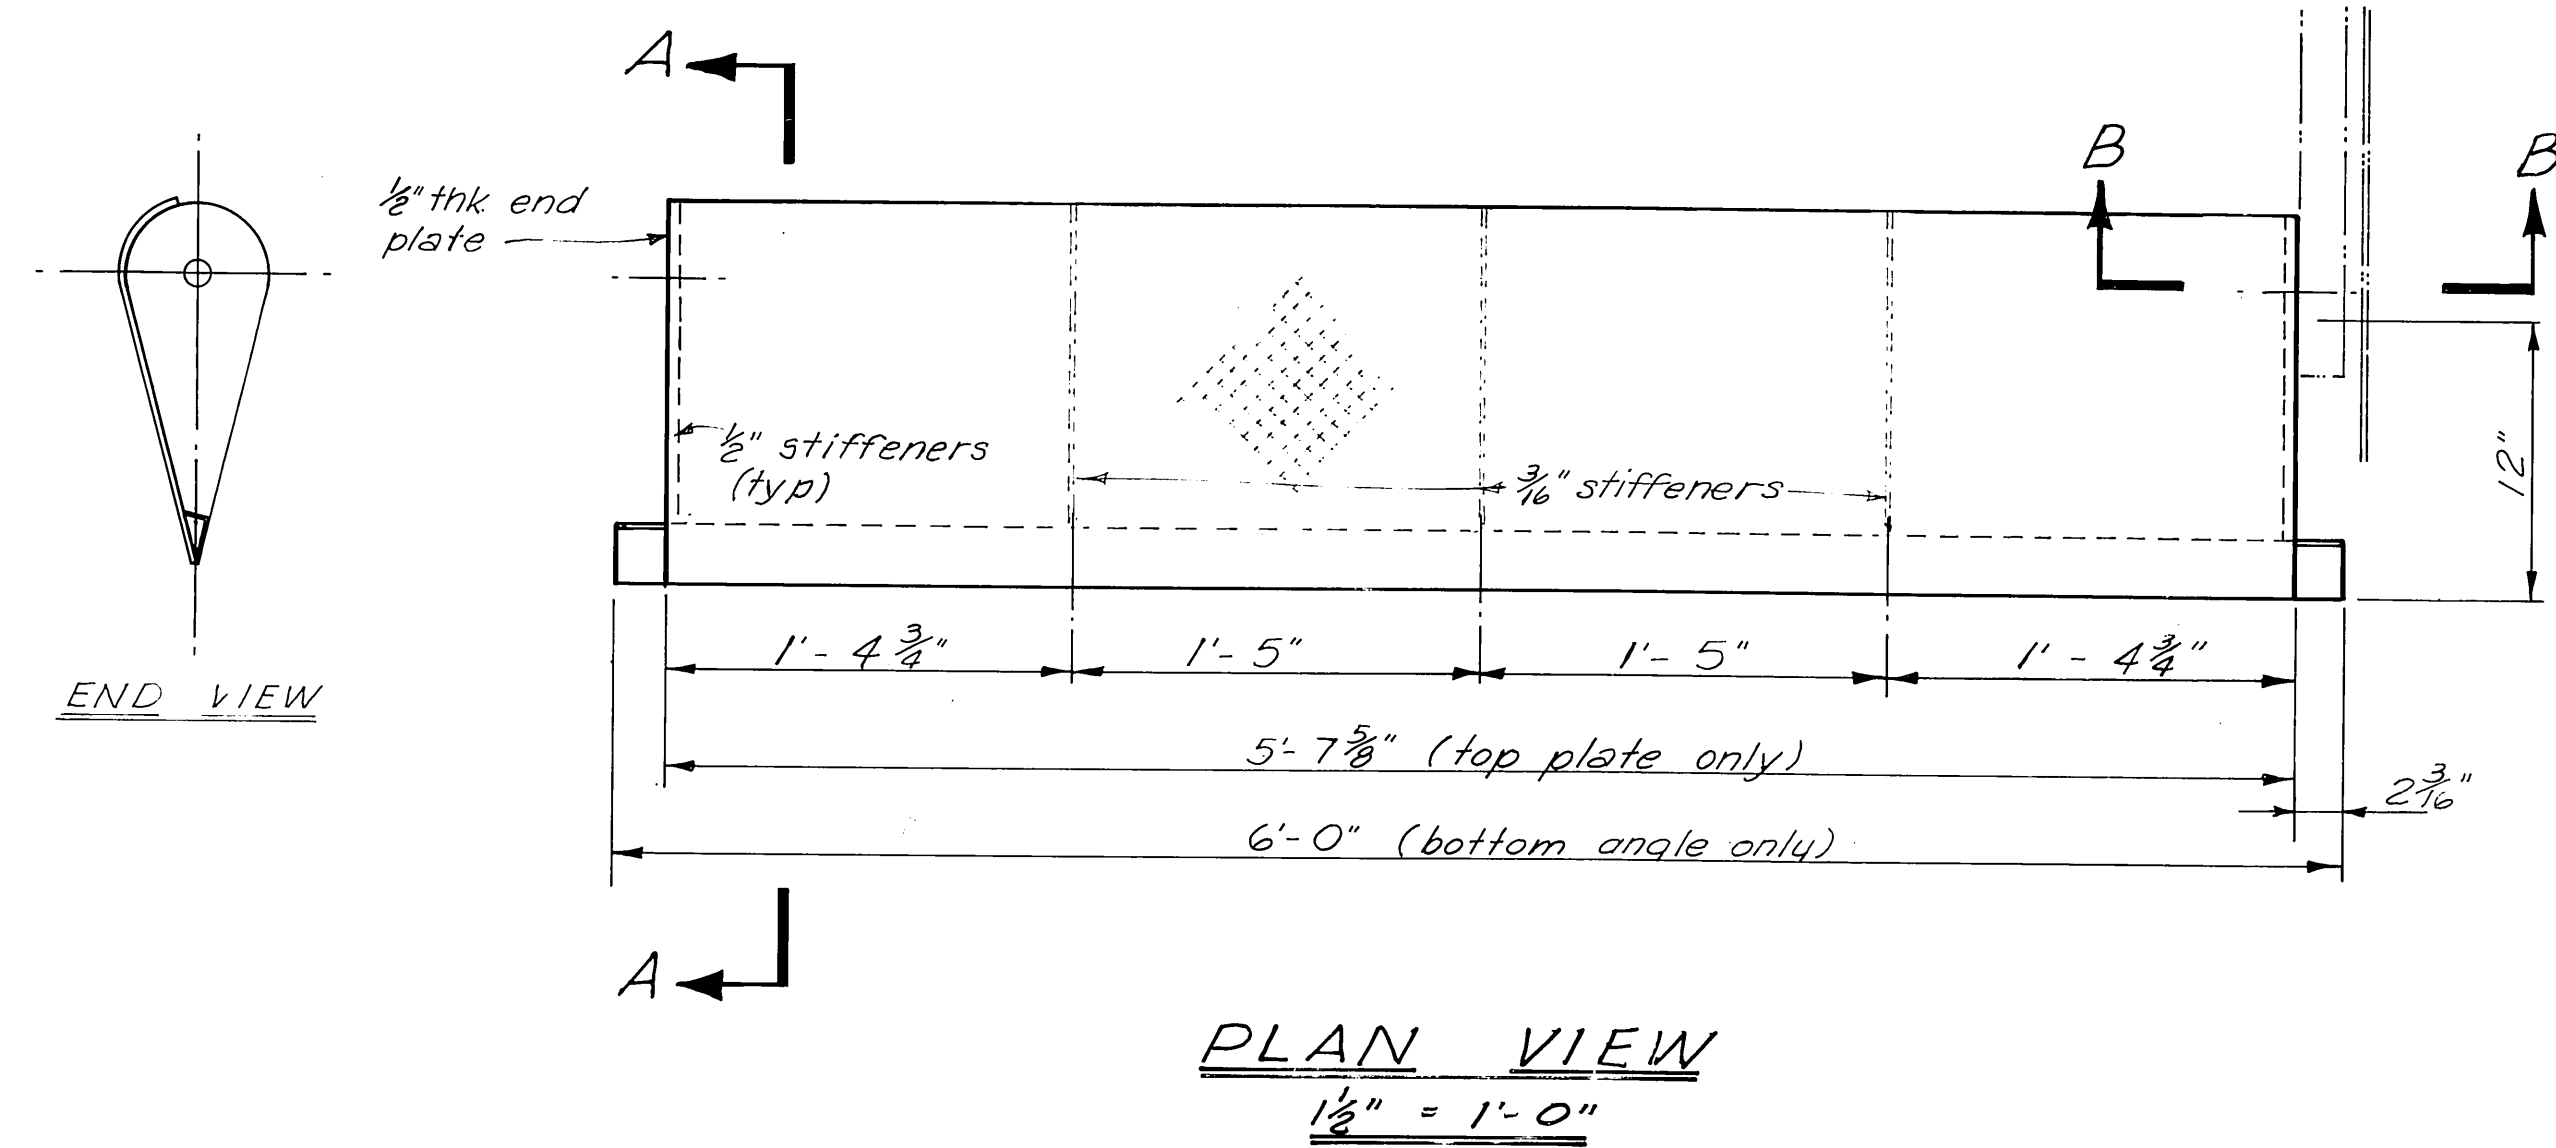

NOTES:
For notes pertaining to fabrication and galvanizing,
see Sheet A

Revised 1-28-75 Removed 6" pipe ELS

DO NOT SCALE THIS DRAWING - USE DIMENSIONS

STATE OF ALASKA
DEPARTMENT OF PUBLIC WORKS
DIVISION OF WATER AND HARBORS

TYPICAL STEEL GANGWAY
TRANSITION PIECE DETAILS
(SHEET B)

SCALE <u>As shown</u>	SURVEYED <u>-</u>	APPROVED
DESIGNED <u>JET</u>	DRAWN <u>JET</u>	<u>Don Statter</u>
CHECKED <u>DSM</u>	DATE <u>2-11-74</u>	DIRECTOR
PROJECT NUMBER <u>3-76164</u>	SHEET <u>11</u> OF <u>11</u>	