


State of Alaska

Department of Transportation
and Public Facilities


Southeast Region

SITKA, ALASKA SAWMILL CREEK ROAD UPGRADE

PHASE III - WHALE PARK TO SAWMILL CREEK BRIDGE
PROJECT No. 68216\MSG-STP-0933(21)
SITKA TELECOMMUNICATIONS CONDUIT
RSA No. 69615

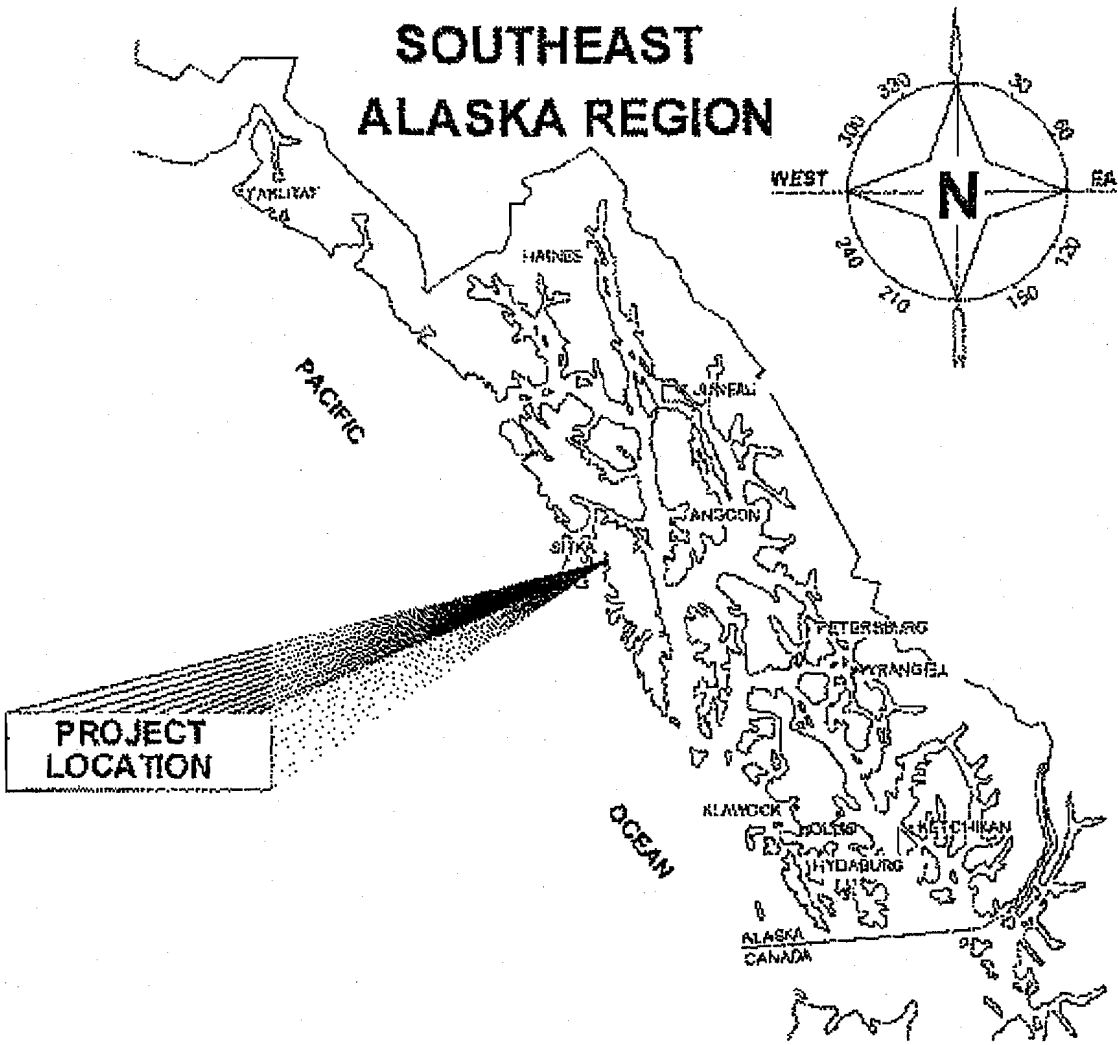

"As Built" Plans
Contractor: Quality Asphalt Products, Inc.
Project Engineer: Todd Fleming
Begin Construction: 3/14/13
End Construction: 7/23/14

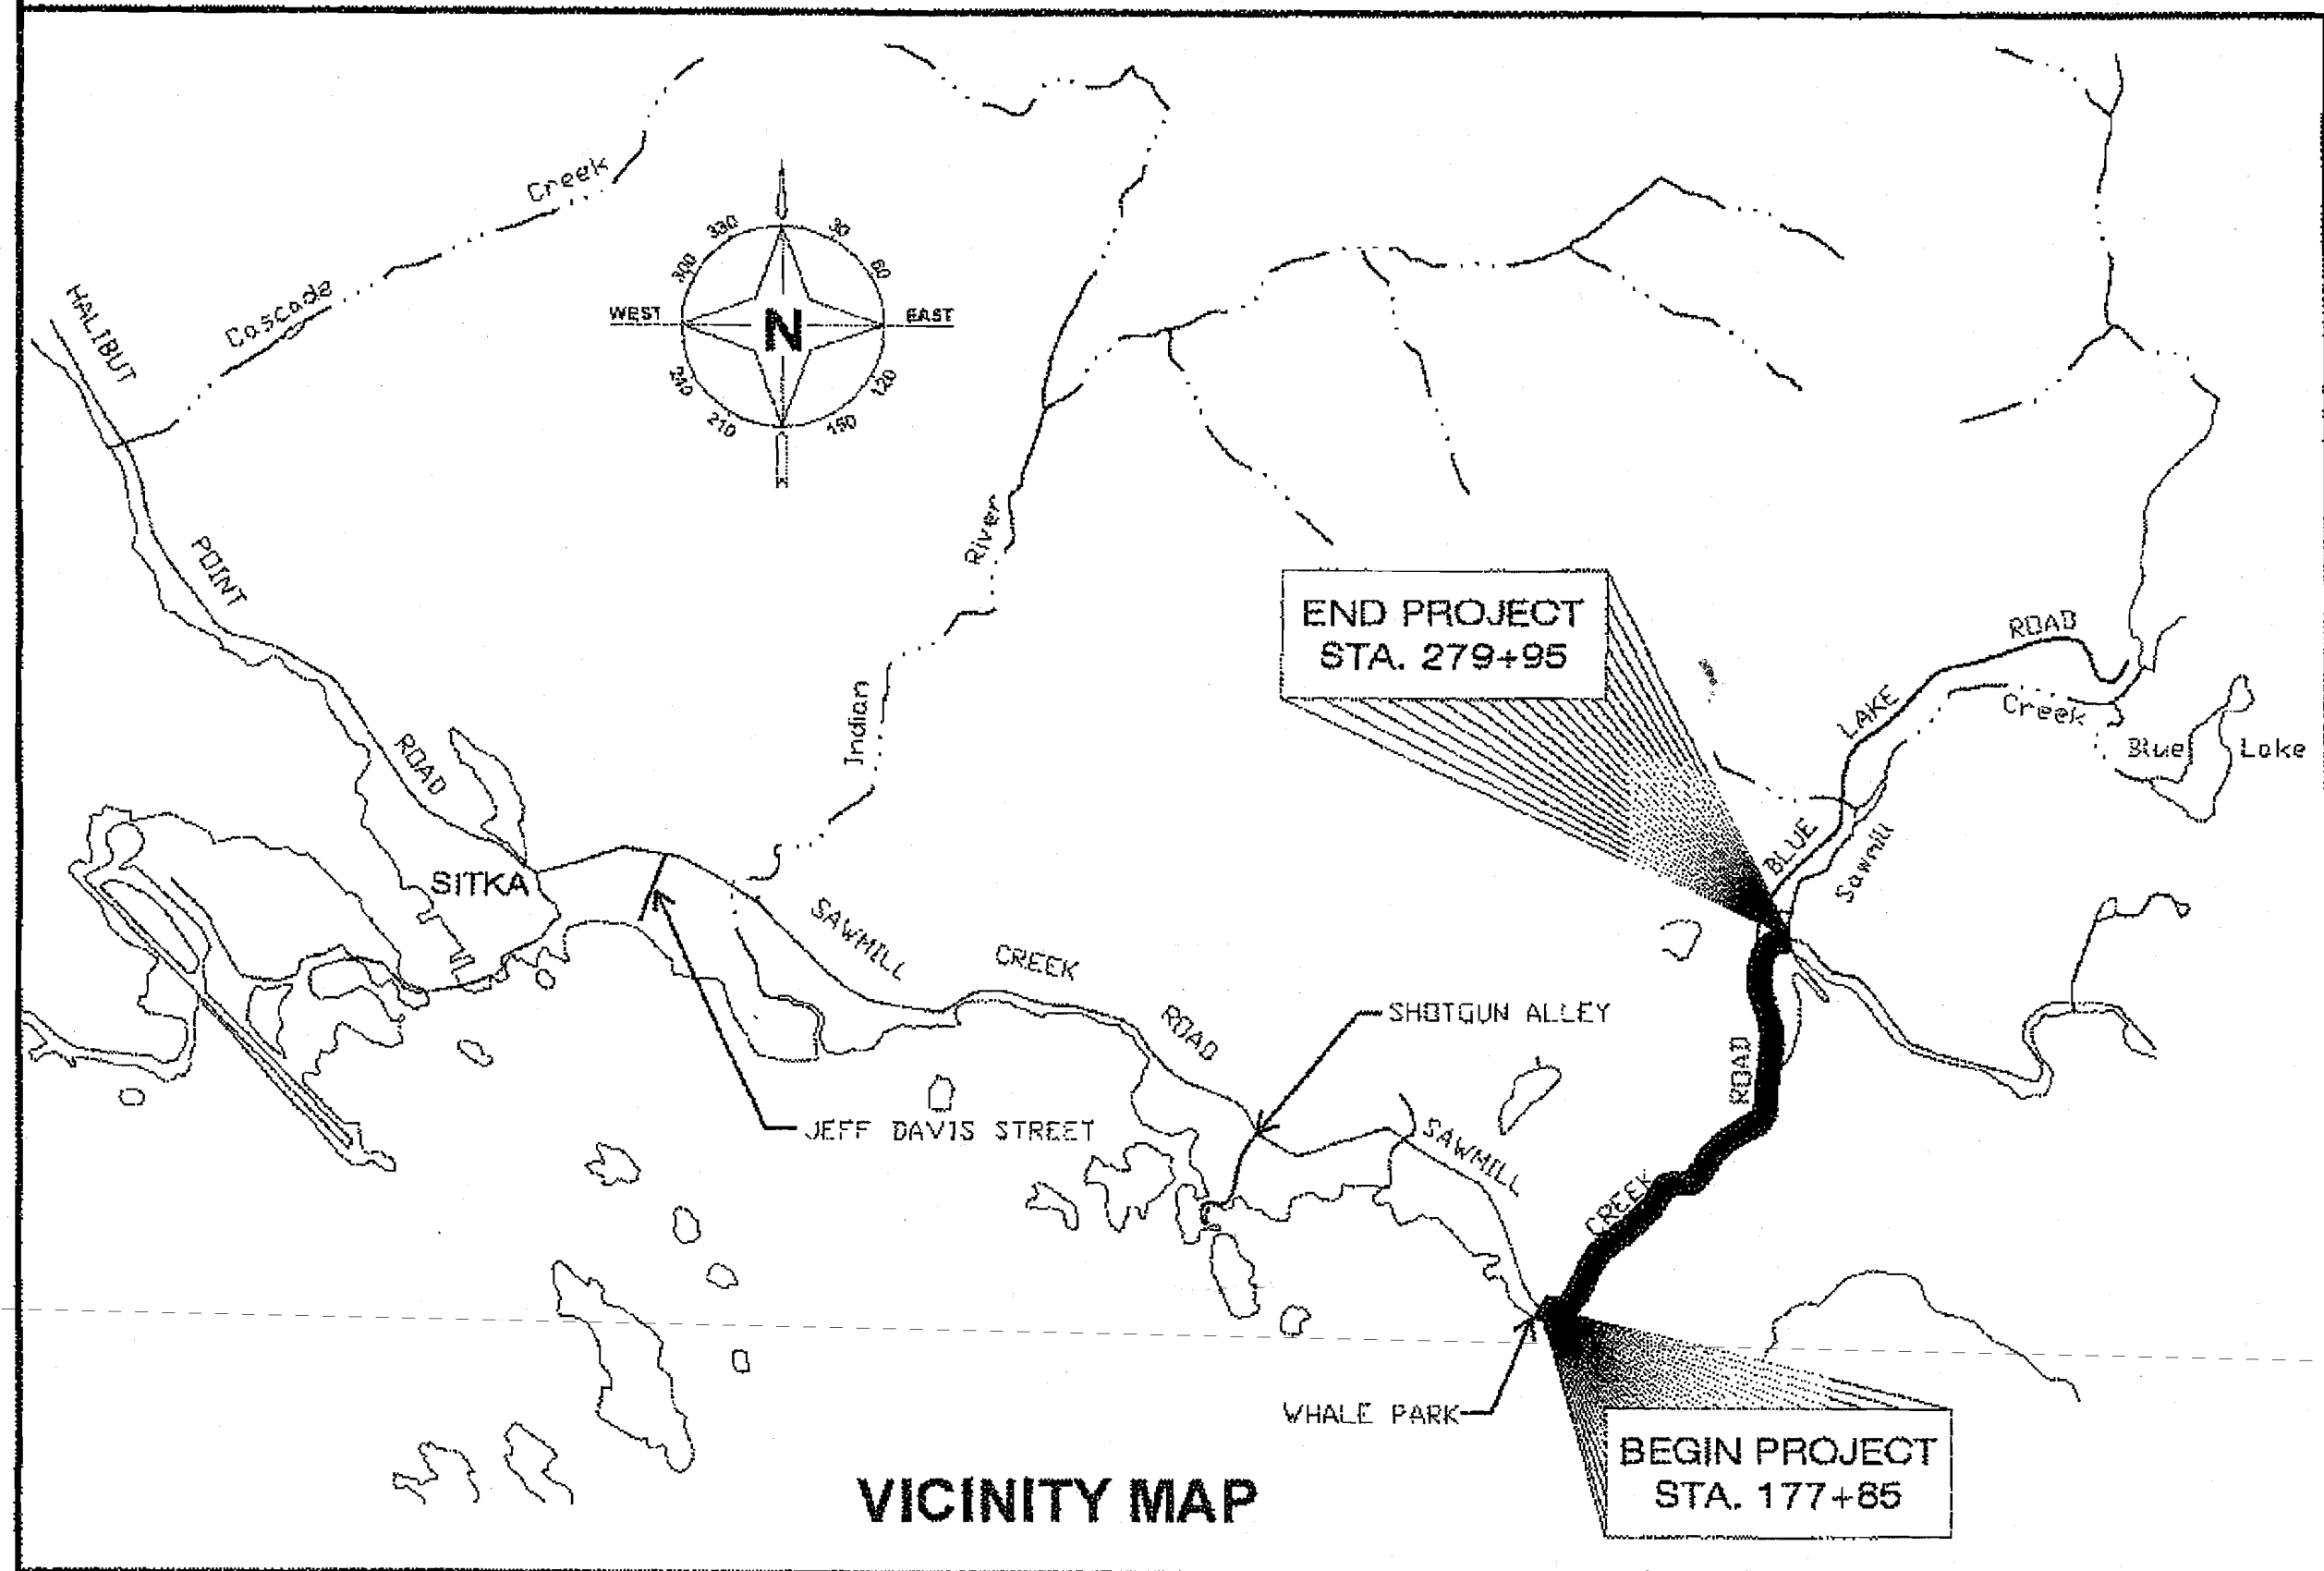

PROJECT SUMMARY-SCR SAWMILL CREEK ROAD

CDS ROUTE NO = 295500
CDS MILEPOINT = 3.8 TO 5.6
LENGTH OF GRADING = 1.8 MILES
LENGTH OF PAVING = 1.8 MILES
WIDTH OF PAVING = 30 FT
LENGTH OF PROJECT = 1.8 MILES

DESIGN CRITERIA RECONSTRUCTION (3R)

DESIGN DESIGNATION SAWMILL CREEK ROAD

V = 55 MPH
A.D.T. 2009 = 700
A.D.T. 2021 = 740
A.D.T. 2031 = 780
D.H.V. % (2031) = 10.3
TRUCKS % = 5.5
E.S.A.L. = 100,000
DESIGN VEHICLE = WB-50
DESIGN LOAD VEHICLE FOR RETAINING WALLS = HL-93

THE FOLLOWING STANDARD DRAWINGS APPLY TO THIS PROJECT:

A-1	C-03.10	C-04.12	C-05.10	D-01.02	D-04.21
D-20.03	D-22.01	D-23.01	D-24.00	D-26.02	D-35.00
D-36.00	E-00.00	E-09.00	G-00.01	G-04.06S	G-09.04S
G-10.01	G-13.00	G-20.10	I-20.13	I-21.01	I-22.01
I-81.00	M-13.01	M-16.01	S-00.10	S-05.01	S-20.10
S-30.03	T-05.10	T-06.00	T-20.02	T-21.02	T-22.03
U-03.00					

INDEX

SHEET NO.	DESCRIPTION
PHASE III - WHALE PARK TO SAWMILL CREEK BRIDGE (68216)	
A1	TITLE SHEET
A2-A3	SURVEY CONTROL
A4	SHEET LAYOUT
B1-B5	TYPICAL SECTIONS
C1-C3	ESTIMATE OF QUANTITIES
D1-D5	SUMMARY TABLES
E1-E11	DETAILS
F1-F20	ROADWAY PLAN & PROFILE
G1-G4	INTERSECTION DETAILS
H1-H9	RETAINING WALL DETAILS
K1-K3	TRAFFIC CONTROL PLAN
P1-P9	EROSION & SEDIMENT CONTROL PLAN
S1-S11	SIGNING & STRIPING
T1-T3	BRIDGE REPAIR PLANS
U0-U21	ELECTRICAL UTILITY PLANS

PATH: W:\N\FILE2\JOBS\1153805\DWG\SC\1\SHEETS\A01.DWG TAB: A1
Friday, March 23, 2012 10:25:26 AM
PLOT: PSPACE OR MSPACE: 1=1(F)

STATE OF ALASKA
DEPARTMENT OF TRANSPORTATION
& PUBLIC FACILITIES




APPROVED: *Chuck Correa* 8/24/12
REGIONAL PRE-CONSTRUCTION ENGINEER
CHUCK CORREA, P.E. DATE

APPROVED: *Albert H. Clough* 8/27/12
for DIRECTOR, SOUTHEAST REGION
ALBERT H. CLOUGH, CPG DATE

CERTIFIED TRUE & CORRECT AS-BUILT OF ACTUAL FIELD
CONDITION:

CONSTRUCTION PROJECT MANAGER DATE

STATE	PROJECT DESIGNATION	YEAR	SHEET NO.	TOTAL SHEETS
ALASKA	68216\MSG-STP-0933(21)	2012	A1	109

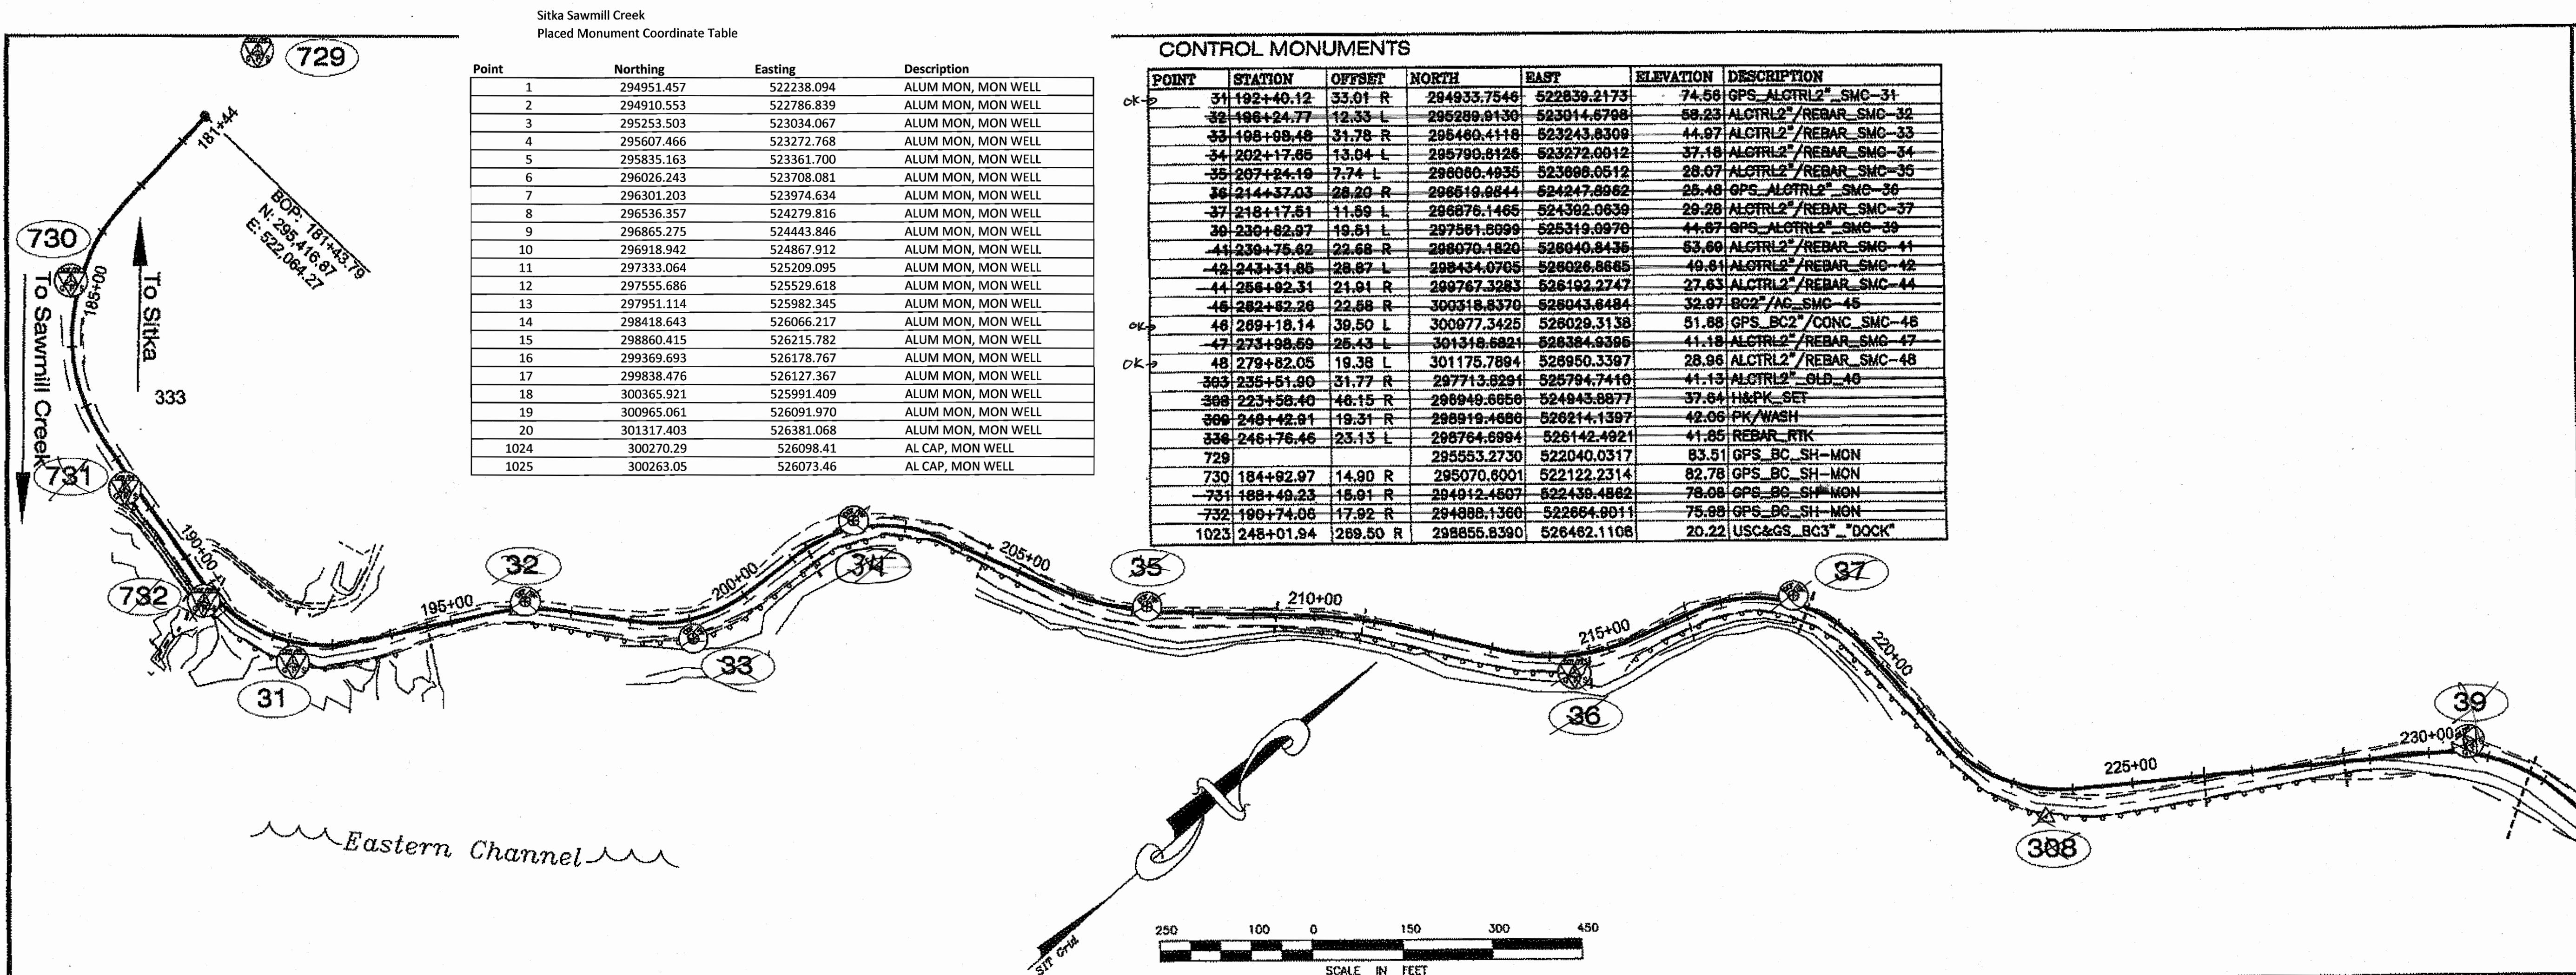

Sitka Sawmill Creek
Placed Monument Coordinate Table


Point	Northing	Easting	Description
1	294951.457	522238.094	ALUM MON, MON WELL
2	294910.553	522786.839	ALUM MON, MON WELL
3	295253.503	523034.067	ALUM MON, MON WELL
4	295607.466	523272.768	ALUM MON, MON WELL
5	295835.163	523361.700	ALUM MON, MON WELL
6	296026.243	523708.081	ALUM MON, MON WELL
7	296301.203	523974.634	ALUM MON, MON WELL
8	296536.357	524279.816	ALUM MON, MON WELL
9	296865.275	524443.846	ALUM MON, MON WELL
10	296918.942	524867.912	ALUM MON, MON WELL
11	297333.064	525209.095	ALUM MON, MON WELL
12	297555.686	525529.618	ALUM MON, MON WELL
13	297951.114	525982.345	ALUM MON, MON WELL
14	298418.643	526066.217	ALUM MON, MON WELL
15	298860.415	526215.782	ALUM MON, MON WELL
16	299369.693	526178.767	ALUM MON, MON WELL
17	299838.476	526127.367	ALUM MON, MON WELL
18	300365.921	525991.409	ALUM MON, MON WELL
19	300965.061	526091.970	ALUM MON, MON WELL
20	301317.403	526381.068	ALUM MON, MON WELL
1024	300270.29	526098.41	AL CAP, MON WELL
1025	300263.05	526073.46	AL CAP, MON WELL

CONTROL MONUMENTS

POINT	STATION	OFFSET	NORTH	EAST	ELEVATION	DESCRIPTION
31	192+40.12	33.01 R	294933.7546	522839.2173	74.56	GPS ALGRL2 SMC-31
32	198+24.77	12.33 L	295289.8130	523014.6798	88.23	ALGRL2 REBAR SMC-32
33	198+08.48	31.78 R	295480.4118	523243.8308	44.87	ALGRL2 REBAR SMC-33
34	202+17.68	13.84 L	295790.8126	523272.8812	37.18	ALGRL2 REBAR SMC-34
35	207+24.19	7.74 L	296060.4935	523886.0512	28.07	ALGRL2 REBAR SMC-35
36	214+37.03	28.20 R	296618.8844	524247.8862	25.48	GPS ALGRL2 SMC-36
37	218+17.51	11.59 L	296876.1466	524392.0639	29.28	ALGRL2 REBAR SMC-37
38	230+75.82	22.68 R	297561.6099	525319.8970	44.87	GPS ALGRL2 SMC-38
39	230+75.82	22.68 R	298070.1820	526040.8436	53.68	ALGRL2 REBAR SMC-39
40	243+31.85	28.87 L	298434.0705	526026.8885	49.81	ALGRL2 REBAR SMC-40
41	256+82.31	21.01 R	299767.3283	526192.2747	27.63	ALGRL2 REBAR SMC-41
42	262+82.28	22.68 R	300318.8370	526043.6484	32.97	BC2 AC SMC-42
43	289+18.14	39.50 L	300977.3425	526029.3138	51.88	GPS BC2 CONG SMC-43
44	273+88.60	25.43 L	301318.6821	526384.8385	41.18	ALGRL2 REBAR SMC-44
45	279+82.05	19.38 L	301175.7894	526950.3397	28.96	ALGRL2 REBAR SMC-45
46	235+51.80	31.77 R	297715.8291	525794.7410	41.13	ALGRL2 OLD-46
47	223+58.40	48.15 R	296949.8656	524843.8877	37.84	H&PK SET
48	248+42.81	19.31 R	298818.4688	526214.1397	42.06	PK WASH
49	246+76.46	23.13 L	298764.8984	526142.4921	41.85	REBAR RTK
729			295553.2730	522040.0317	83.51	GPS BC SH-MON
730	184+82.97	14.90 R	295070.8001	522122.2314	82.78	GPS BC SH-MON
731	188+49.23	18.91 R	294912.4887	522438.4882	78.08	GPS BC SH-MON
732	190+74.06	17.92 R	294888.1360	522684.8011	75.98	GPS BC SH-MON
1023	248+01.94	289.50 R	298855.8390	526482.1108	20.22	USC&GS BC3 DOCK

PROPERTY MONUMENTS

POINT	STATION	OFFSET	NORTH	EAST	DESCRIPTION	REMARKS
403	187+83.32	80.89 L	294995.5742	522382.0085	ALSEC1.5"	DO NOT DISTURB
400	196+06.12	87.13 L	295300.1275	522886.4809	ALSEC1.5"	DO NOT DISTURB
488	236+17.65	59.44 L	297823.8250	525771.0470	BC 3.5"	DO NOT DISTURB
690	234+71.10	115.37R	297588.7919	525771.4349	BC 3.5"	DO NOT DISTURB
1024	281+98.04	84.79 R	300270.2843	526098.4146	ALSEC2 ROW/L23_6304S	REPLACE
1025	281+98.71	38.79 R	300263.0446	526073.4473	ALSEC2 ROW/L23_6304S	REPLACE
1026	258+48.48	38.93 R	300021.3055	526143.8037	ALSEC2 L23_6304S	DO NOT DISTURB
1027	254+44.97	48.97 R	299514.8960	526213.1887	ALCAP3.25" SCIP1_6304S	DO NOT DISTURB
1028	257+67.03	84.33 R	299854.9434	526218.5183	REBAR5/8 SPINHOLE	DO NOT DISTURB
1029	268+72.43	72.15 R	300895.4263	526117.2570	REBAR_5/8	DO NOT DISTURB
1030	270+42.99	45.88 R	301048.8844	526162.8441	ALSEC1.5 ROW/L18_6304S	DO NOT DISTURB
1031	270+80.10	43.31 R	301078.8847	526180.5483	ALSEC1.5 ROW/L19_6304S	DO NOT DISTURB
1032	273+08.80	43.10 R	301220.1003	526330.5012	ALSEC1.5 ROW/L19_6304S	DO NOT DISTURB
1033	274+20.17	42.07 R	301259.7448	526424.0185	ALSEC1.5 ROW/L18_6304S	DO NOT DISTURB
1034	274+19.79	68.10 R	301234.4834	526430.2926	ALSEC1.5 ROW/L17/L18_6304S	DO NOT DISTURB
1035	275+42.08	68.35 R	301245.8885	526531.7413	ALSEC1.5 ROW/L17_6304S	DO NOT DISTURB
1036	278+68.06	87.08 R	301230.1804	526627.5049	ALSEC1.5 ROW/L6_6304S	DO NOT DISTURB
1037	268+72.57	49.48 R	300903.0412	526095.9001	ALSEC1.5 ROW_6304S	DO NOT DISTURB

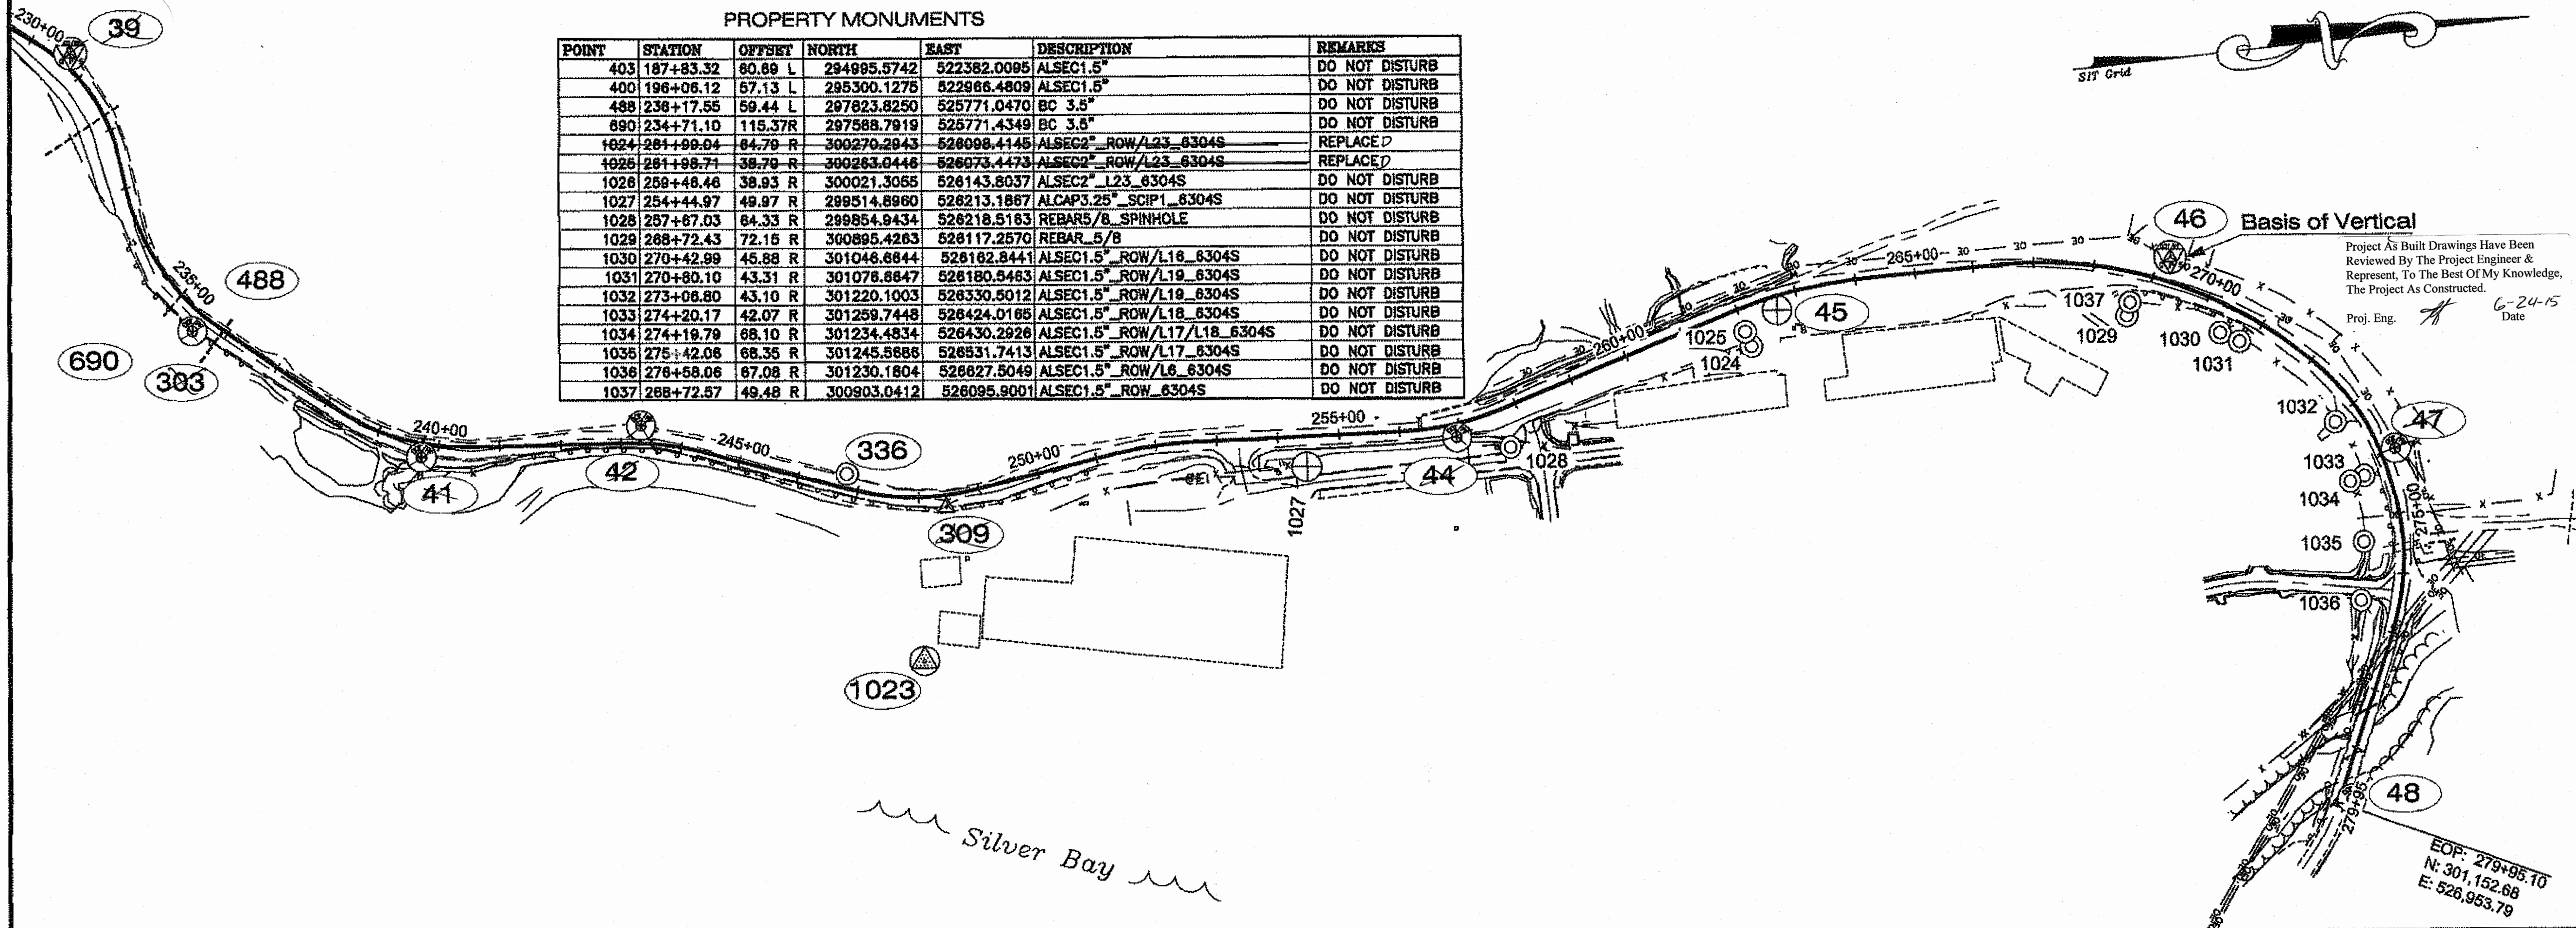

PATH:
Q:\SIT\68216\PHASE_3\DWG\FROM_USKHA2-A

Monday, August 27, 2012 9:38:09 AM

TAB: A2

ADDENDUM NUMBER

ATTACHMENT NUMBER

RECORD OF REVISIONS

No.	DATE	DESCRIPTION
-----	------	-------------

SAWMILL CREEK ROAD PHASE III
WHALE PARK TO SAWMILL CREEK BRIDGE
68216

SURVEY CONTROL

PREPARED BY: Alaska DOT/PF

CHECKED BY: R. DAVIS

DESIGNED BY: T. REED

DRAWN BY: T. REED

STATE OF ALASKA
DEPARTMENT OF TRANSPORTATION
& PUBLIC FACILITIES
SOUTHEAST REGION

SURVEY CONTROL

PROJECT DESIGNATION

68216

STATE	YEAR
ALASKA	2012

SHEET NUMBER	TOTAL SHEETS
A2	109

HORIZONTAL CONTROL

Basis of Horizontal control is NGS station BM-16, a "B" order NGS station located near the Pioneers Home with held NAD83 (1992) coordinates of N57-02-59.71512 W135-20-20.43691.

The basis of coordinates is "BM-16" while the basis of bearing is geodetic north based on GPS observations and applied convergence angle of -1°25'39.4" for the Sitka 2000 Grid.

Sitka 2000 Local Grid

The DOT/PF Sitka Grid 2000 was developed for use on the entire Sitka road system. Scale and convergence angles have been optimized to minimize project distortions area wide.

Basis of rotation and scale is NGS First order station "SIT-C"

Zone = NAD83 AKSPC ZONE 1

Grid Scale = 0.99997551

Convergence Angle = -1°25'39.4"

Translation about NGS station "SIT-C"

Grid North = 1,908,220.83142 FT US

Grid East = 2,348,010.11103 FT US

Local North = 300,000.0000 FT US

Local East = 500,000.0000 FT US

Project Specific Basis of Horizontal Control

#731 : 2 1/2" Brass cap in well case located in the outbound shoulder of Sawmill Creek Road approximately 320' beyond Whale Park.

SIT00-Grid	N 294912.4507'	E 522439.4862'
AKSPC	N 1902575.9436'	E 2370315.3348'

#732 : 2 1/2" Brass cap in well case located in the outbound shoulder of Sawmill Creek Road approximately 530' beyond Whale Park.

SIT00-Grid	N 294888.1360'	E 522664.9011'
AKSPC	N 1902546.0213'	E 2370540.0685'

VERTICAL CONTROL:

MLLW based on NOAA tidal benchmark series 9451600. NOS monument BM-16 is 20.36' above MLLW on the 1960-1978 tidal epoch as published 10/31/1984.

Project Specific Basis of Vertical Control

For this project, SMC-46 has been established with an elevation of 51.68' above MLLW relative to BM-16. SMC-46 is a 2" Brass Cap set in a concrete utility vault adjacent to the in-bound lane of Sawmill Creek Road approximately 580' before the Y to Blue Lake.

MONUMENT NOTES:

1. If any pair of control points disagrees from published value by more than 1:10,000 horizontally or vertically then a third network point must be tied to ascertain which point is in error or has been disturbed.

2. Whether listed or not, all monuments, property markers, or accessories that will be disturbed or buried shall be referenced prior to being disturbed, and re-established in their original position and a record of monument form in accordance with A.S.34.65.040 shall be submitted to the construction engineer for review prior to recording. Coordinate values listed are for informational purposes and should be used to reset monuments only as a last resort.

Sawmill Creek Stage 3 Alignment Report

BOP: 181+43.79 N: 295418.8713 E: 522084.2743

Tangent Data
Length: 188.66 Course: S 05° 57' 27" E

Circular Curve Data
Delta: 77° 59' 37" Type: LEFT
Radius: 318.00
Length: 432.88 Tangent: 257.48
Mid-Ord: 70.86 External: 91.17
Chord: 490.22 Course: S 44° 57' 16" E

Tangent Data
Length: 271.57 Course: S 83° 57' 05" E

Circular Curve Data
Delta: 67° 09' 27" Type: LEFT
Radius: 250.00
Length: 293.03 Tangent: 165.97
Mid-Ord: 41.72 External: 50.07
Chord: 276.54 Course: N 62° 28' 12" E

Tangent Data
Length: 229.63 Course: N 28° 53' 28" E

Circular Curve Data
Delta: 20° 39' 01" Type: RIGHT
Radius: 340.00
Length: 122.54 Tangent: 61.84
Mid-Ord: 5.51 External: 5.60
Chord: 121.88 Course: N 39° 12' 58" E

Tangent Data
Length: 115.88 Course: N 49° 32' 29" E

Circular Curve Data
Delta: 45° 44' 02" Type: LEFT
Radius: 250.00
Length: 199.55 Tangent: 105.43
Mid-Ord: 19.65 External: 21.32
Chord: 194.30 Course: N 26° 40' 28" E

Tangent Data
Length: 105.70 Course: N 03° 48' 28" E

Circular Curve Data
Delta: 61° 17' 06" Type: RIGHT
Radius: 230.00
Length: 246.01 Tangent: 136.26
Mid-Ord: 32.12 External: 37.33
Chord: 234.45 Course: N 34° 27' 01" E

Tangent Data
Length: 196.91 Course: N 65° 05' 34" E

Circular Curve Data
Delta: 22° 20' 13" Type: LEFT
Radius: 530.00
Length: 206.82 Tangent: 104.64
Mid-Ord: 10.04 External: 10.23
Chord: 205.32 Course: N 53° 55' 27" E

Tangent Data
Length: 230.22 Course: N 42° 45' 21" E

Circular Curve Data
Delta: 11° 34' 50" Type: RIGHT
Radius: 800.00
Length: 161.70 Tangent: 81.12
Mid-Ord: 4.08 External: 4.10
Chord: 161.42 Course: N 48° 32' 46" E

Tangent Data
Length: 170.48 Course: N 54° 20' 11" E

Circular Curve Data
Delta: 37° 39' 51" Type: LEFT
Radius: 340.00
Length: 223.50 Tangent: 115.96
Mid-Ord: 18.20 External: 19.23
Chord: 219.50 Course: N 35° 30' 16" E

Tangent Data
Length: 106.52 Course: N 16° 40' 20" E

Circular Curve Data
Delta: 73° 07' 42" Type: RIGHT
Radius: 240.00
Length: 308.32 Tangent: 178.01
Mid-Ord: 47.23 External: 58.81
Chord: 285.85 Course: N 53° 14' 12" E

Tangent Data
Length: 198.15 Course: N 89° 48' 03" E

Circular Curve Data
Delta: 53° 59' 11" Type: LEFT
Radius: 250.00
Length: 244.88 Tangent: 132.44
Mid-Ord: 28.32 External: 31.79
Chord: 236.02 Course: N 62° 48' 27" E

Tangent Data
Length: 595.96 Course: N 35° 48' 52" E

Circular Curve Data
Delta: 47° 05' 11" Type: RIGHT
Radius: 300.00
Length: 245.54 Tangent: 130.71
Mid-Ord: 24.87 External: 27.24
Chord: 239.66 Course: N 59° 21' 27" E

Tangent Data
Length: 55.24 Course: N 82° 54' 03" E

Circular Curve Data
Delta: 42° 24' 35" Type: LEFT
Radius: 380.00
Length: 281.27 Tangent: 147.43
Mid-Ord: 25.73 External: 27.60
Chord: 274.90 Course: N 61° 41' 45" E

Tangent Data
Length: 228.73 Course: N 40° 28' 27" E

Circular Curve Data
Delta: 35° 52' 34" Type: LEFT
Radius: 380.00
Length: 237.94 Tangent: 123.02
Mid-Ord: 18.47 External: 19.42
Chord: 234.07 Course: N 22° 33' 10" E

Tangent Data
Length: 259.03 Course: N 04° 36' 53" E

Circular Curve Data
Delta: 15° 45' 35" Type: RIGHT
Radius: 460.00
Length: 126.52 Tangent: 63.66
Mid-Ord: 4.34 External: 4.38
Chord: 126.13 Course: N 12° 29' 40" E

Tangent Data
Length: 286.97 Course: N 20° 22' 27" E

Circular Curve Data
Delta: 28° 27' 27" Type: LEFT
Radius: 400.00
Length: 198.57 Tangent: 101.43
Mid-Ord: 12.27 External: 12.68
Chord: 196.53 Course: N 06° 08' 43" E

Tangent Data
Length: 242.93 Course: N 08° 05' 00" W

Circular Curve Data
Delta: 11° 31' 50" Type: RIGHT
Radius: 600.00
Length: 120.75 Tangent: 60.58
Mid-Ord: 3.03 External: 3.05
Chord: 120.54 Course: N 02° 19' 06" W

Tangent Data
Length: 349.46 Course: N 03° 26' 49" E

Circular Curve Data
Delta: 19° 39' 20" Type: LEFT
Radius: 500.00
Length: 171.53 Tangent: 86.61
Mid-Ord: 7.34 External: 7.45
Chord: 170.69 Course: N 06° 22' 51" W

Tangent Data
Length: 412.51 Course: N 16° 12' 31" W

Circular Curve Data
Delta: 17° 05' 41" Type: RIGHT
Radius: 813.00
Length: 242.56 Tangent: 122.19
Mid-Ord: 9.03 External: 9.13
Chord: 241.67 Course: N 07° 39' 40" W

Tangent Data
Length: 216.24 Course: N 00° 33' 10" E

Circular Curve Data
Delta: 43° 08' 34" Type: RIGHT
Radius: 700.00
Length: 527.09 Tangent: 278.75
Mid-Ord: 49.03 External: 52.72
Chord: 514.73 Course: N 22° 27' 27" E

Tangent Data
Length: 16.07 Course: N 44° 01' 44" E

Circular Curve Data
Delta: 71° 25' 12" Type: RIGHT
Radius: 420.00
Length: 523.54 Tangent: 301.81
Mid-Ord: 78.97 External: 97.25
Chord: 480.29 Course: N 79° 44' 20" E

Tangent Data
Length: 280.88 Course: S 64° 33' 04" E

EDP: 279+95.10 N: 301152.6802 E: 528863.7943

PATH:
I:\1153808\DWG\IC\SHEETS\A02-A03.DWG

Friday, August 17, 2012 4:55:20 PM
TAB: A3

ADDENDUM NUMBER

ATTACHMENT NUMBER

RECORD OF REVISIONS

No.	DATE	DESCRIPTION

SAWMILL CREEK ROAD PHASE III
WHALE PARK TO SAWMILL CREEK BRIDGE
68216


SURVEY CONTROL

Project As Built Drawings Have Been
Reviewed By The Project Engineer &
Represent, To The Best Of My Knowledge,
The Project As Constructed.

Proj. Eng. *[Signature]* 6-24-16
Date

PREPARED BY: Alaska DOT/PF

CHECKED BY: R. DAVIS

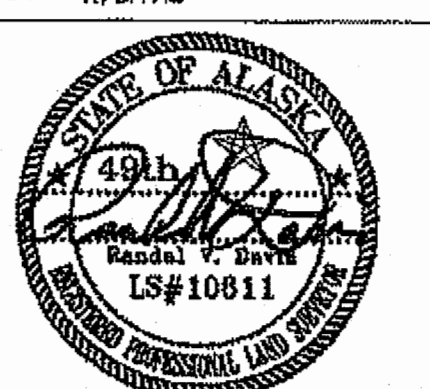

DESIGNED BY: T. REED

DRAWN BY: T. REED

STATE OF ALASKA
DEPARTMENT OF TRANSPORTATION
& PUBLIC FACILITIES
SOUTHEAST REGION


SURVEY CONTROL

PROJECT DESIGNATION

68216

STATE	YEAR
ALASKA	2012

SHEET NUMBER	TOTAL SHEETS
A3	109

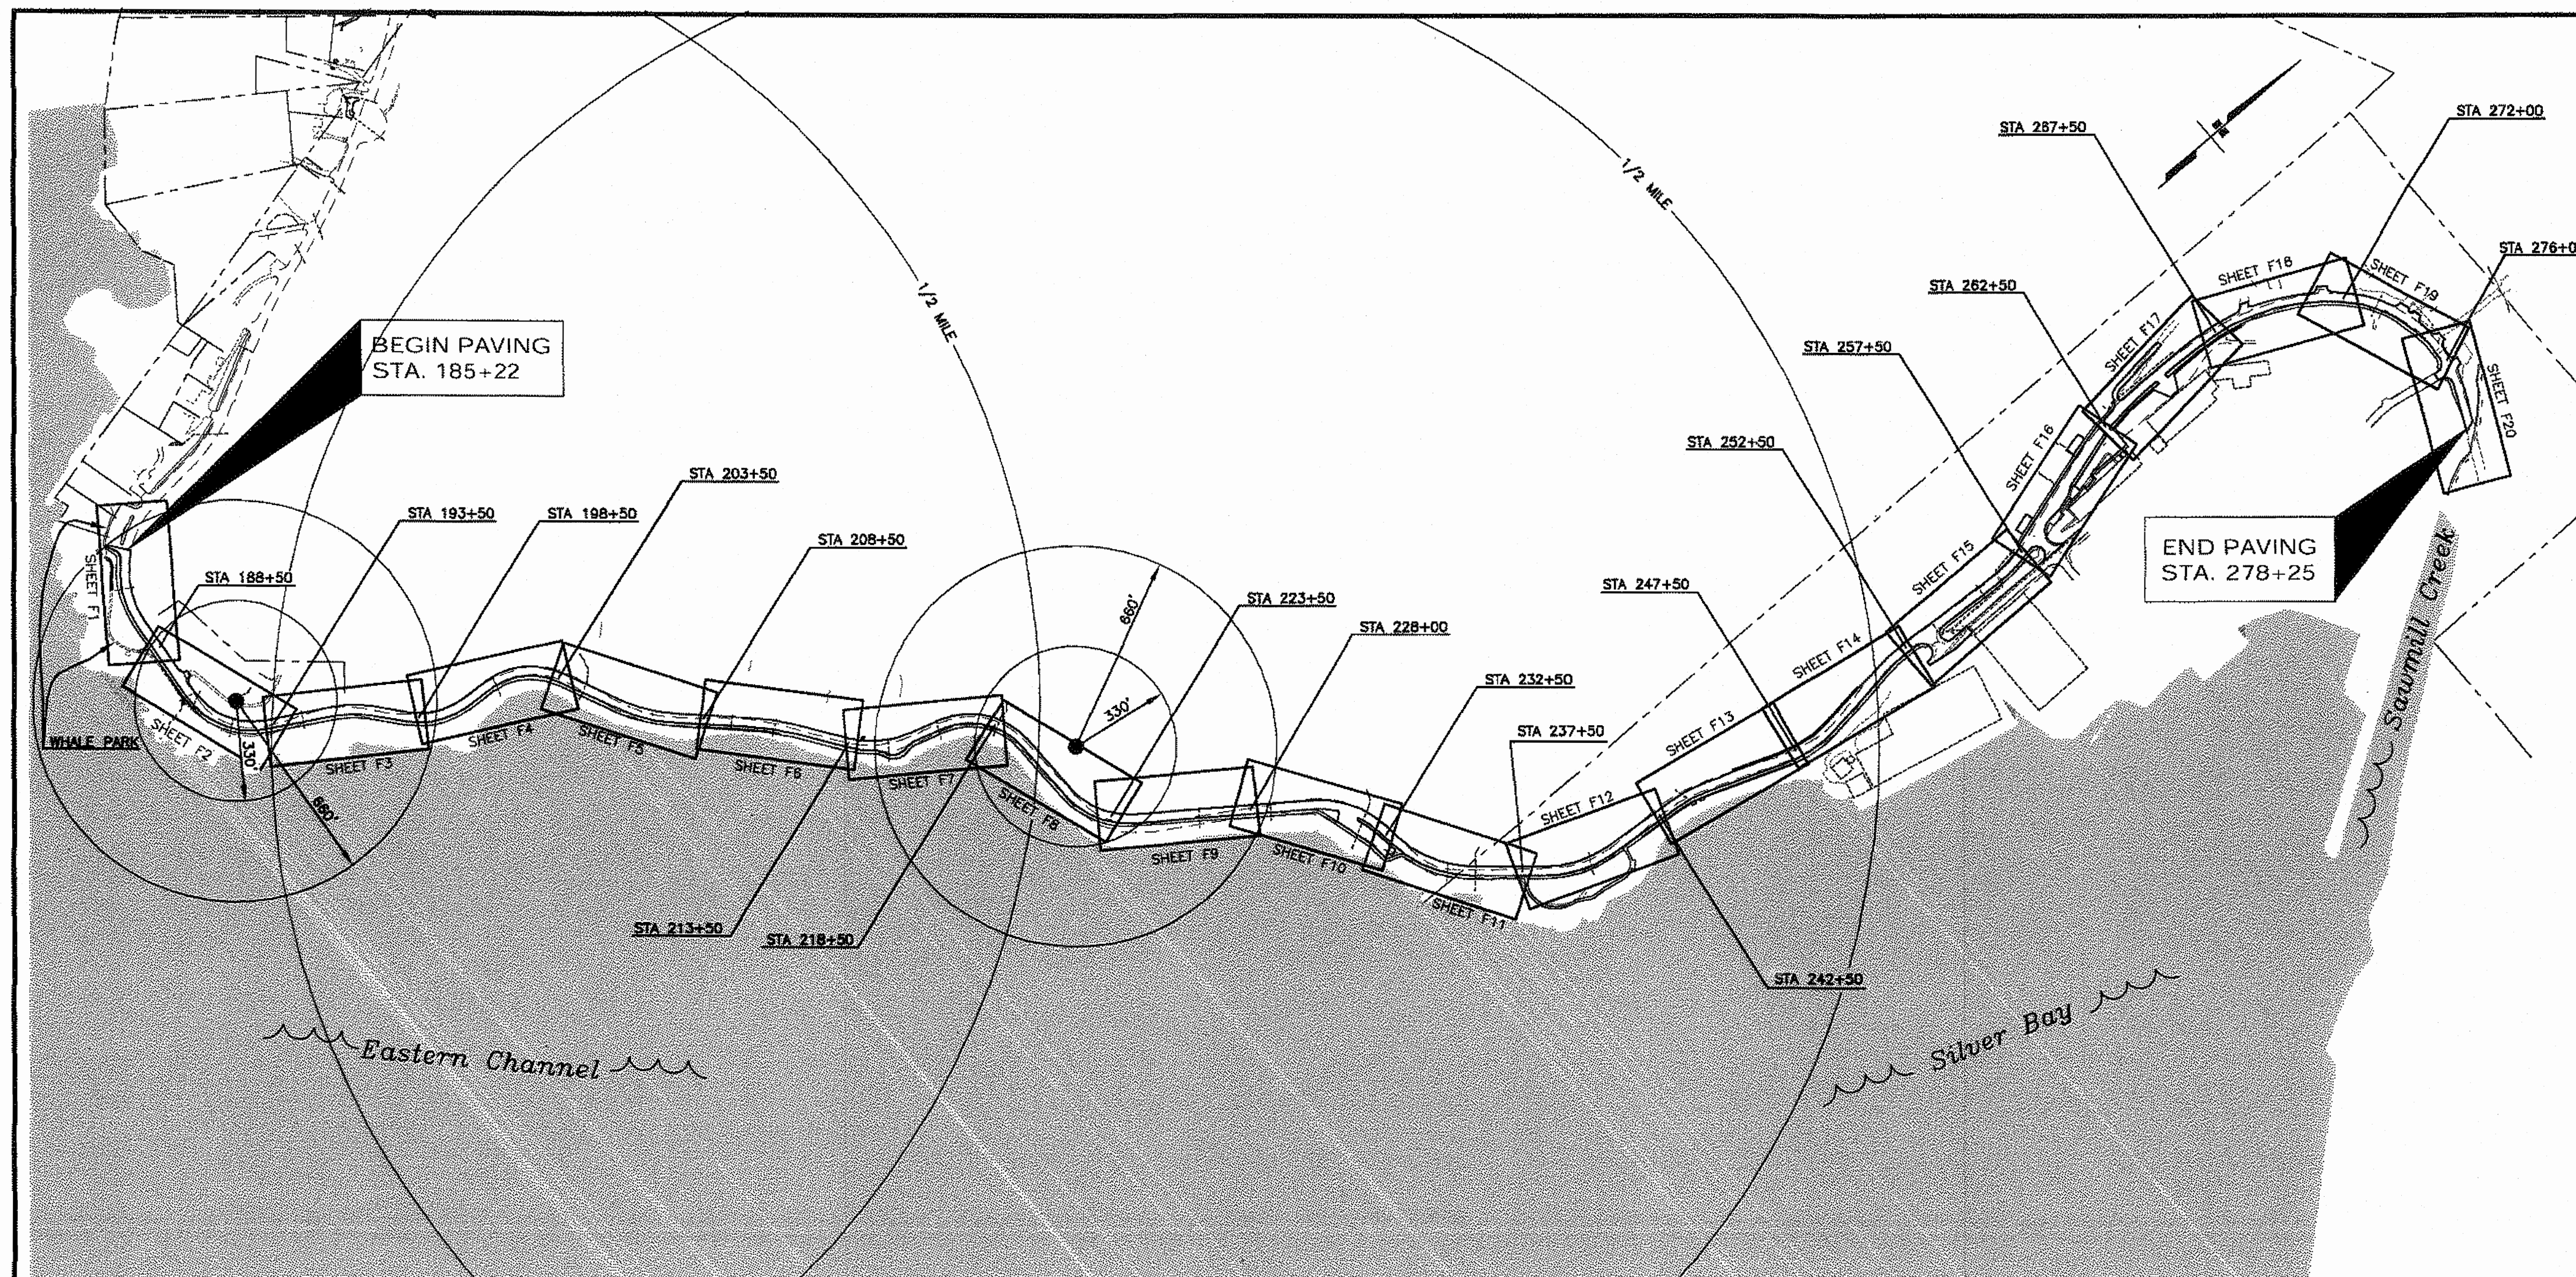

GENERAL NOTES:


- TOPOGRAPHIC INFORMATION IS BASED ON SURVEYS PERFORMED BY USKH INC. SUMMER 2002, SUMMER 2003, FEBRUARY 2004 AND PICK-UP SURVEY BY ADOT&PF SEPTEMBER, 2006. LIDAR BY AEROMETRIC DECEMBER 2009, PICK-UP SURVEY BY ADOT&PF JANUARY 2010, MARCH 2010, JANUARY 2011, FEBRUARY 2011.
- SOILS INFORMATION IS TAKEN FROM GEOTECHNICAL INVESTIGATION AND REPORT BY GOLDER ASSOCIATES DATED SEPTEMBER 2003, SUPPLEMENTAL GEOTECHNICAL REPORT BY ADOT&PF DATED JULY 2010. GEOLOGY DATA REPORT - PROPOSED RETAINING WALL INVESTIGATION BY ADOT&PF DATED MARCH 2011. SUPPLEMENTAL GEOTECHNICAL REPORT - ADDENDUM 1-ROCKFALL BY ADOT&PF DATED AUGUST 2011. ROCK CUT OVERBURDEN PROBING BY ADOT&PF DATED JANUARY 2012. COPIES ARE AVAILABLE UPON REQUEST.
- RIGHT-OF-WAY LINES AND PROPERTY LINES ARE SHOWN FOR GENERAL INFORMATIONAL PURPOSES ONLY. SEE RIGHT-OF-WAY MAPS FOR LOCATION AND SURVEY CONTROL FOR PROPERTY LINES AND RIGHT-OF-WAY.
- LOCATION OF EXISTING UTILITIES ARE APPROXIMATE ONLY. THE CONTRACTOR SHALL VERIFY EXACT LOCATION BY OBTAINING UTILITY LOCATES, FIELD LOCATES AND EXERCISING CAUTION DURING EXCAVATION.
- VERTICAL AND HORIZONTAL ALIGNMENTS SHOWN ON THESE PLANS ARE SUBJECT TO MINOR REVISIONS BY THE ENGINEER.
- PIPE LENGTHS AND LOCATIONS ARE APPROXIMATE ONLY AND SUBJECT TO MINOR REVISIONS BY THE ENGINEER.
- UNLESS OTHERWISE NOTED, DIMENSIONS AND ELEVATIONS SHOWN ON THE PLANS ARE EDGE OF PAVEMENT ON PAVED ROADS AND EDGE OF GRAVEL ON GRAVEL ROADS.

Project As Built Drawings Have Been Reviewed By The Project Engineer & Represent, To The Best Of My Knowledge, The Project As Constructed.
 Proj. Eng. *[Signature]* Date 6-24-15

PATH: I:\NUPFILE2\JOBS\1153805\DWG\SC\1\SHEET SIA04.DWG		
TAB A4		
ADDENDUM NUMBER		
ATTACHMENT NUMBER		
RECORD OF REVISIONS		
No.	DATE	DESCRIPTION
SAWMILL CREEK ROAD UPGRADE PHASE III - WHALE PARK TO SAWMILL CREEK BRIDGE 68216MSG-STP-0933(21) SITKA TELECOMMUNICATIONS CONDUIT RSA NO. 69615		
SHEET LAYOUT		
PREPARED BY: USKH		
CHECKED BY: NCL		
DESIGNED BY: WJP		
DRAWN BY: WJP, MTH		
STATE OF ALASKA DEPARTMENT OF TRANSPORTATION & PUBLIC FACILITIES SOUTHEAST REGION		
PROJECT DESIGNATION		
68216MSG-STP-0933(21)		
STATE	YEAR	
ALASKA	2012	
SHEET NUMBER	TOTAL SHEETS	
A4	109	

DO NOT SCALE FROM THESE DRAWINGS USE DIMENSIONS

-

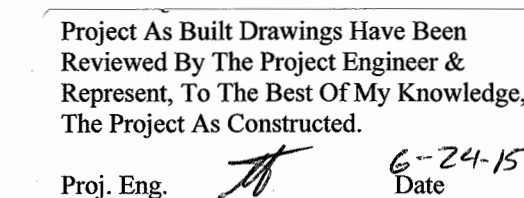

DO NOT SCALE FROM THESE DRAWINGS USE DIMENSIONS

PATH:
\\NWFILE2\JOBS\1153805\DWGS\IC\SHEETS\B01_B05

TAB: B1

ADDENDUM NUMBER

ATTACHMENT NUMBER

RECORD OF REVISIONS


No.	DATE	DESCRIPTION

SAWMILL CREEK ROAD UPGRADE
PHASE III - WHALE PARK TO SAWMILL CREEK BRIDGE
68216MSG-STP-0933(21)
SITKA TELECOMMUNICATIONS CONDUIT
RSA NO. 69615

TYPICAL SECTIONS

PREPARED BY: USKH

CHECKED BY: NCL

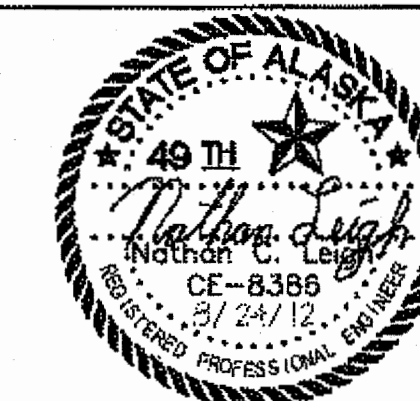

DESIGNED BY: NCL

DRAWN BY: WIP


STATE OF ALASKA
DEPARTMENT OF TRANSPORTATION
& PUBLIC FACILITIES
SOUTHEAST REGION

TYPICAL SECTIONS


PROJECT DESIGNATION

68216\MSG-STP-0933(21)

STATE	YEAR
ALASKA	2012
SHEET NUMBER	TOTAL SHEETS
B1	109

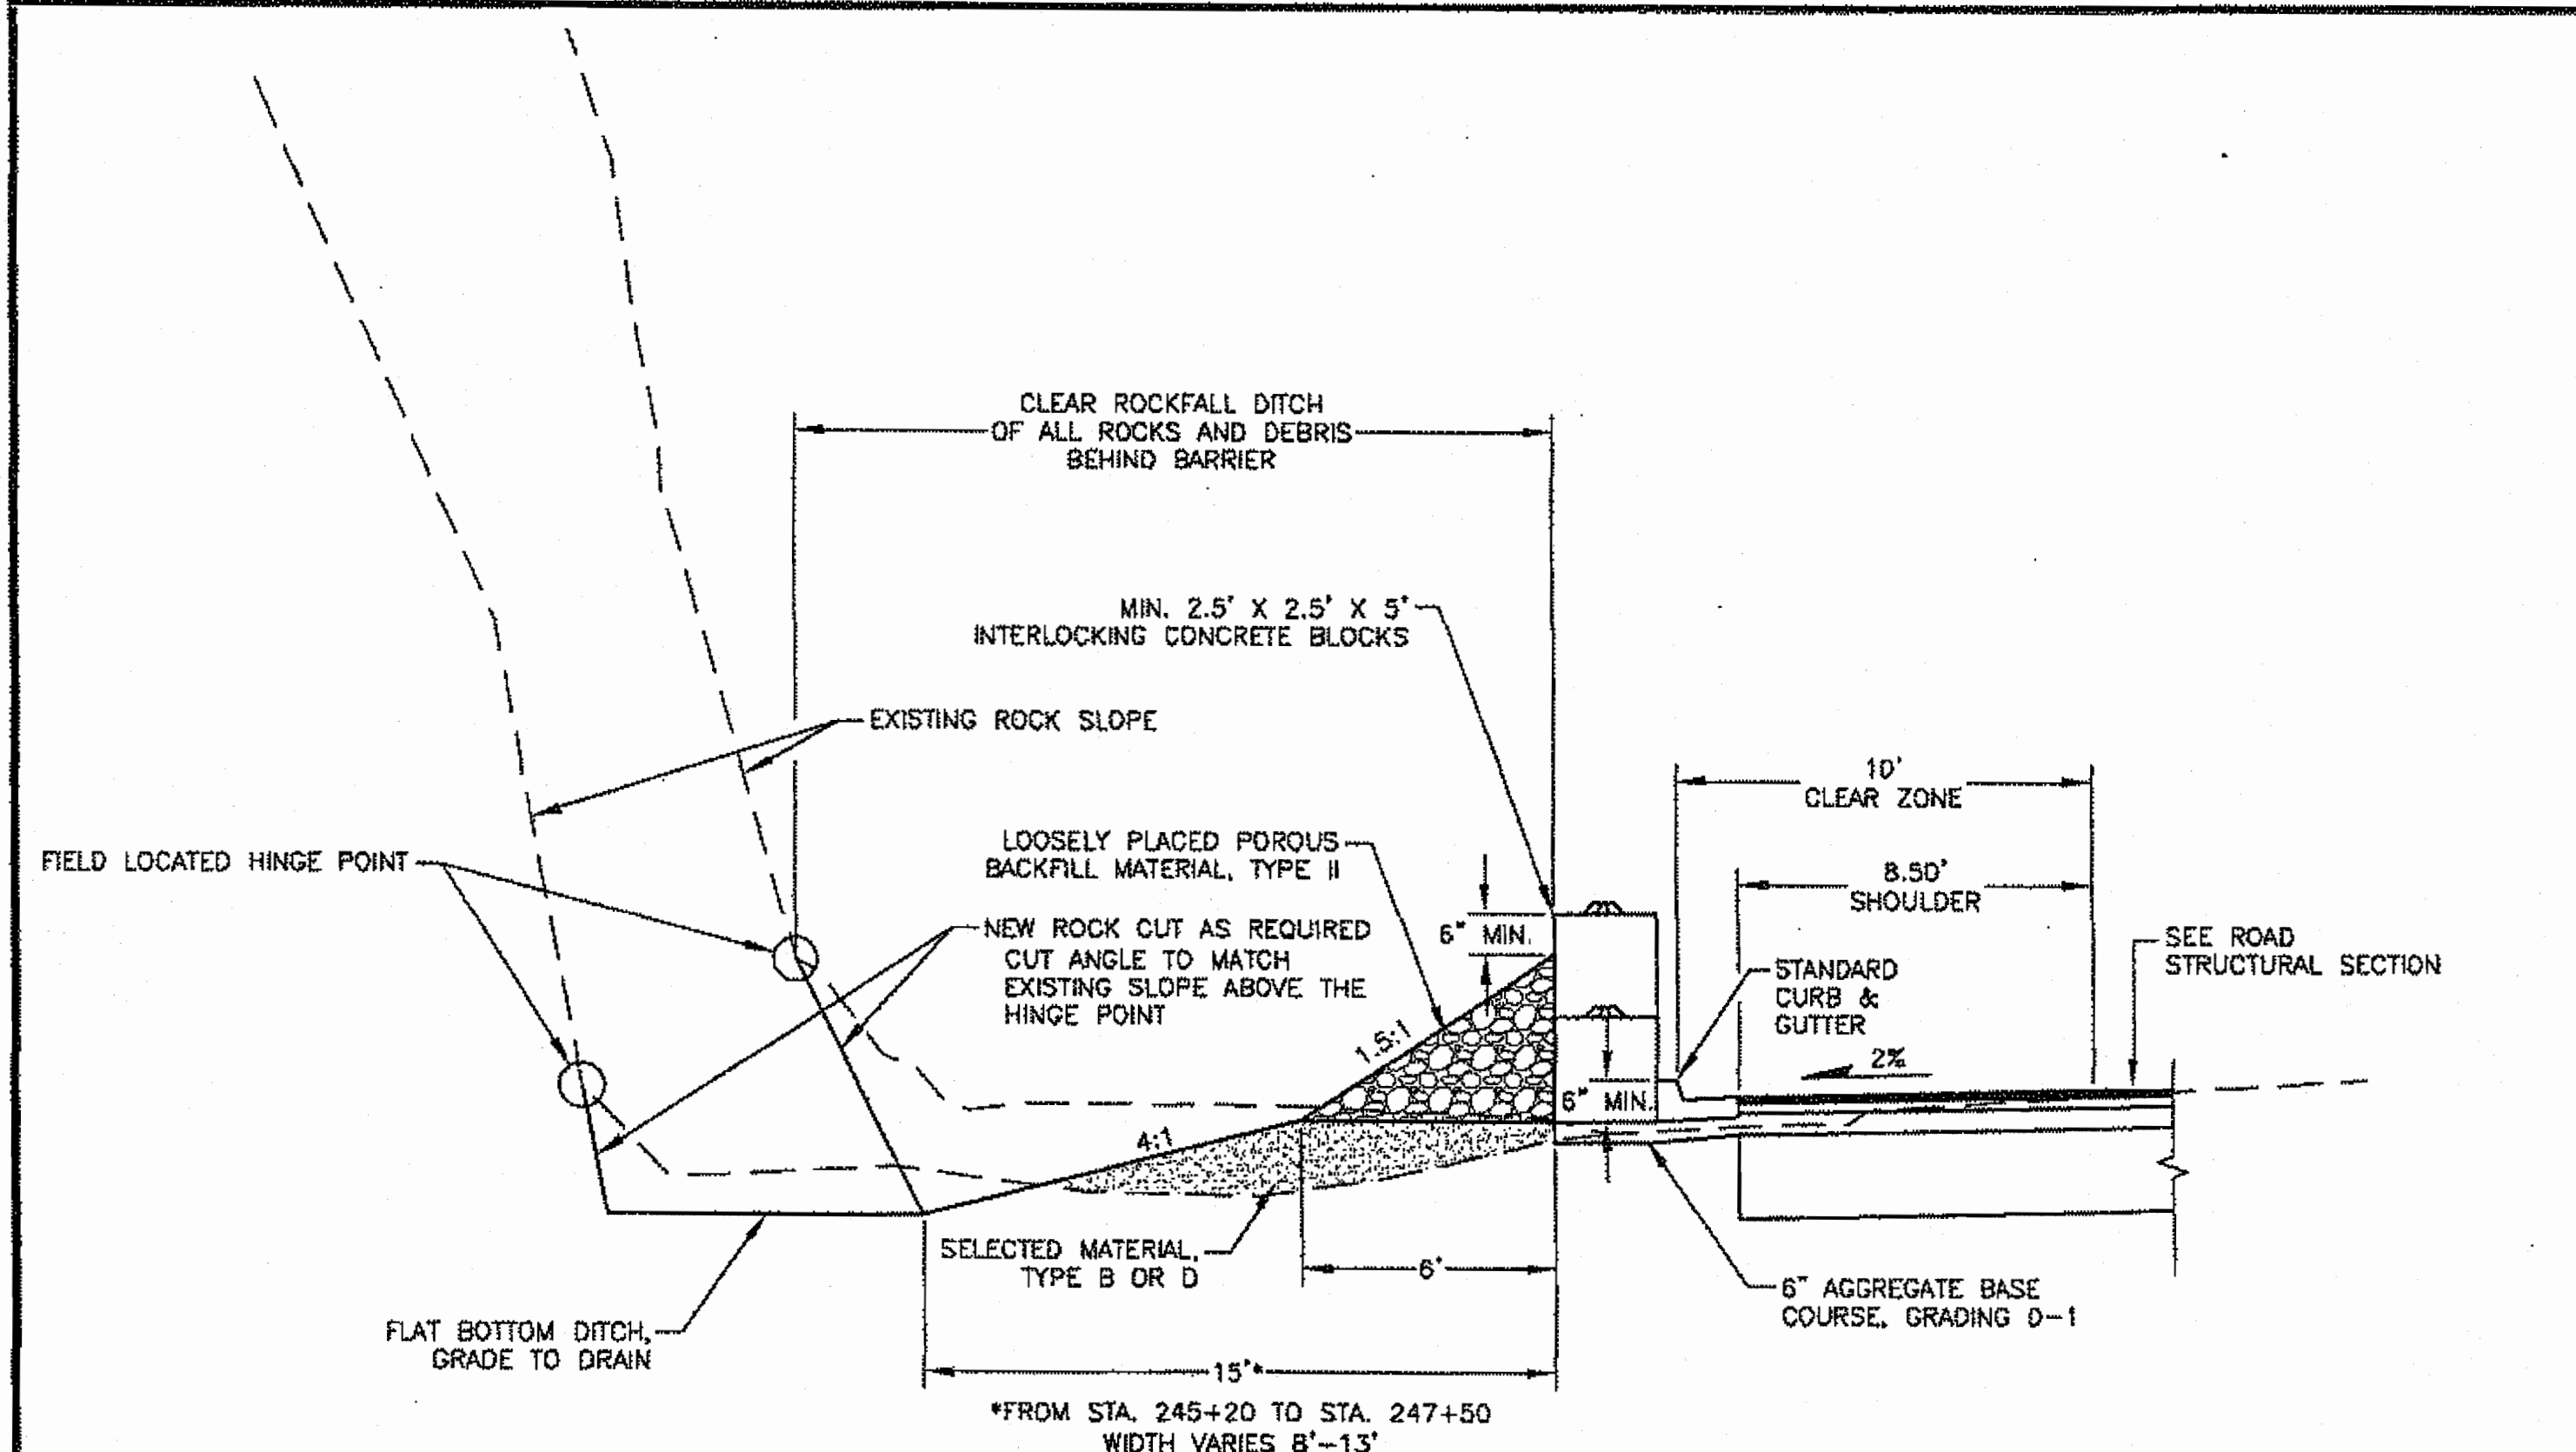


ROCK FALL BARRIER
STA. 245+32 TO STA. 250+45

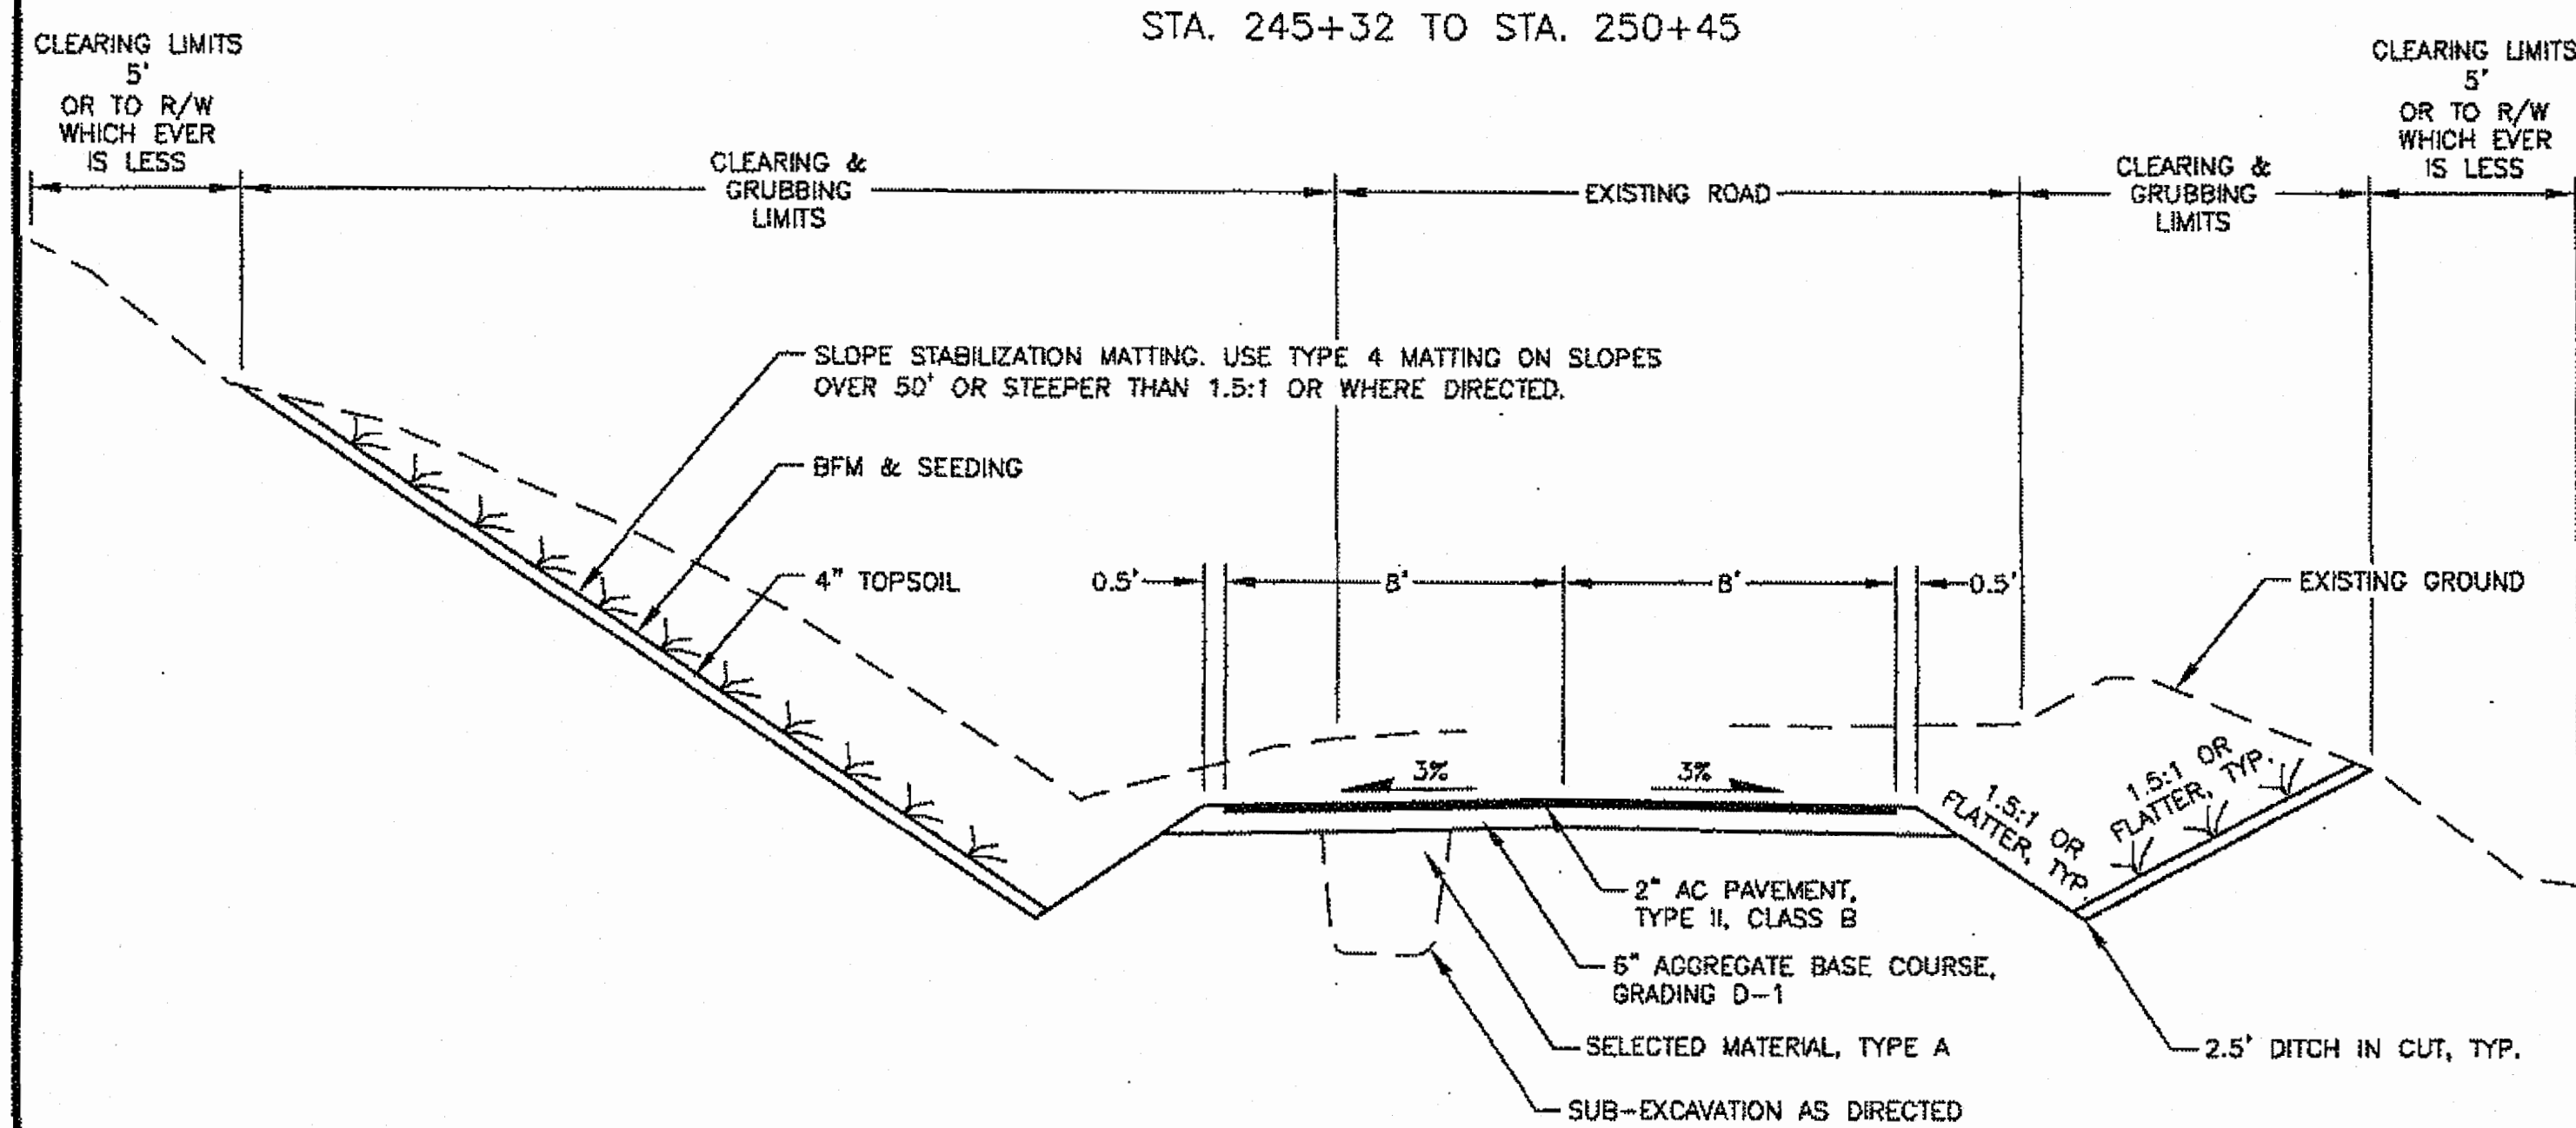


**TYPICAL SECTION
BLUE LAKE ROAD**


SLOPE EXCEPTION TABLE 1-B2					
LEFT SIDE			RIGHT SIDE		
STATION		EXCEPTION	STATION		EXCEPTION
FROM	TO		FROM	TO	
200+63	202+37	MATCH EXISTING PULLOUT & CUT DITCH TO DRAIN, SEE SHEET F4	187+25	187+75	CUT EMBANKMENT AT 1:1, GRADE TO DRAIN
207+00	208+60	HOLD FILL SLOPE INSIDE ROW	273+85	274+25	HOLD FILL SLOPE INSIDE ROW
216+20	216+90	HOLD FILL SLOPE INSIDE ROW			
259+50	260+00	HOLD CUT SLOPE INSIDE ROW			

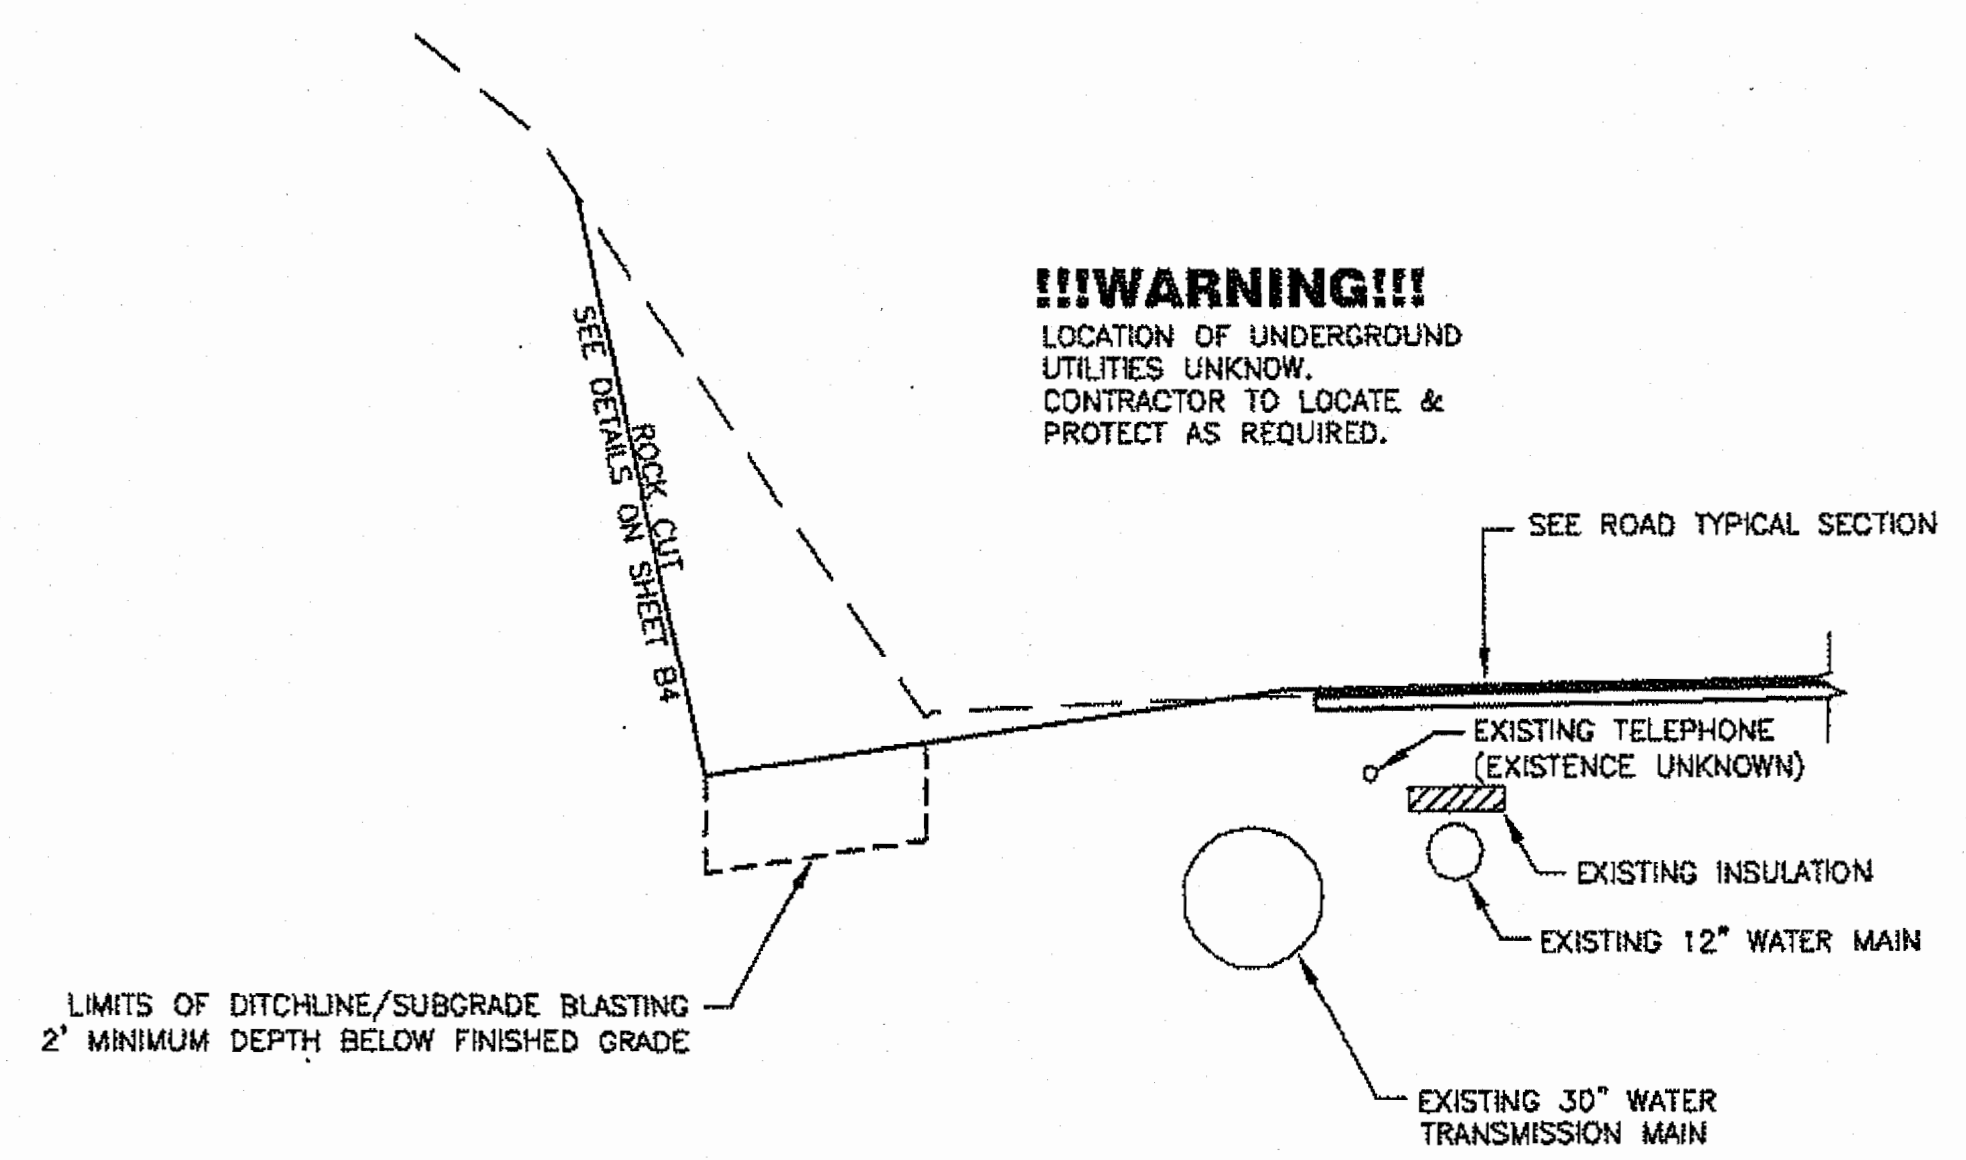

DITCHLINE/SUBGRADE BLASTING DETAIL

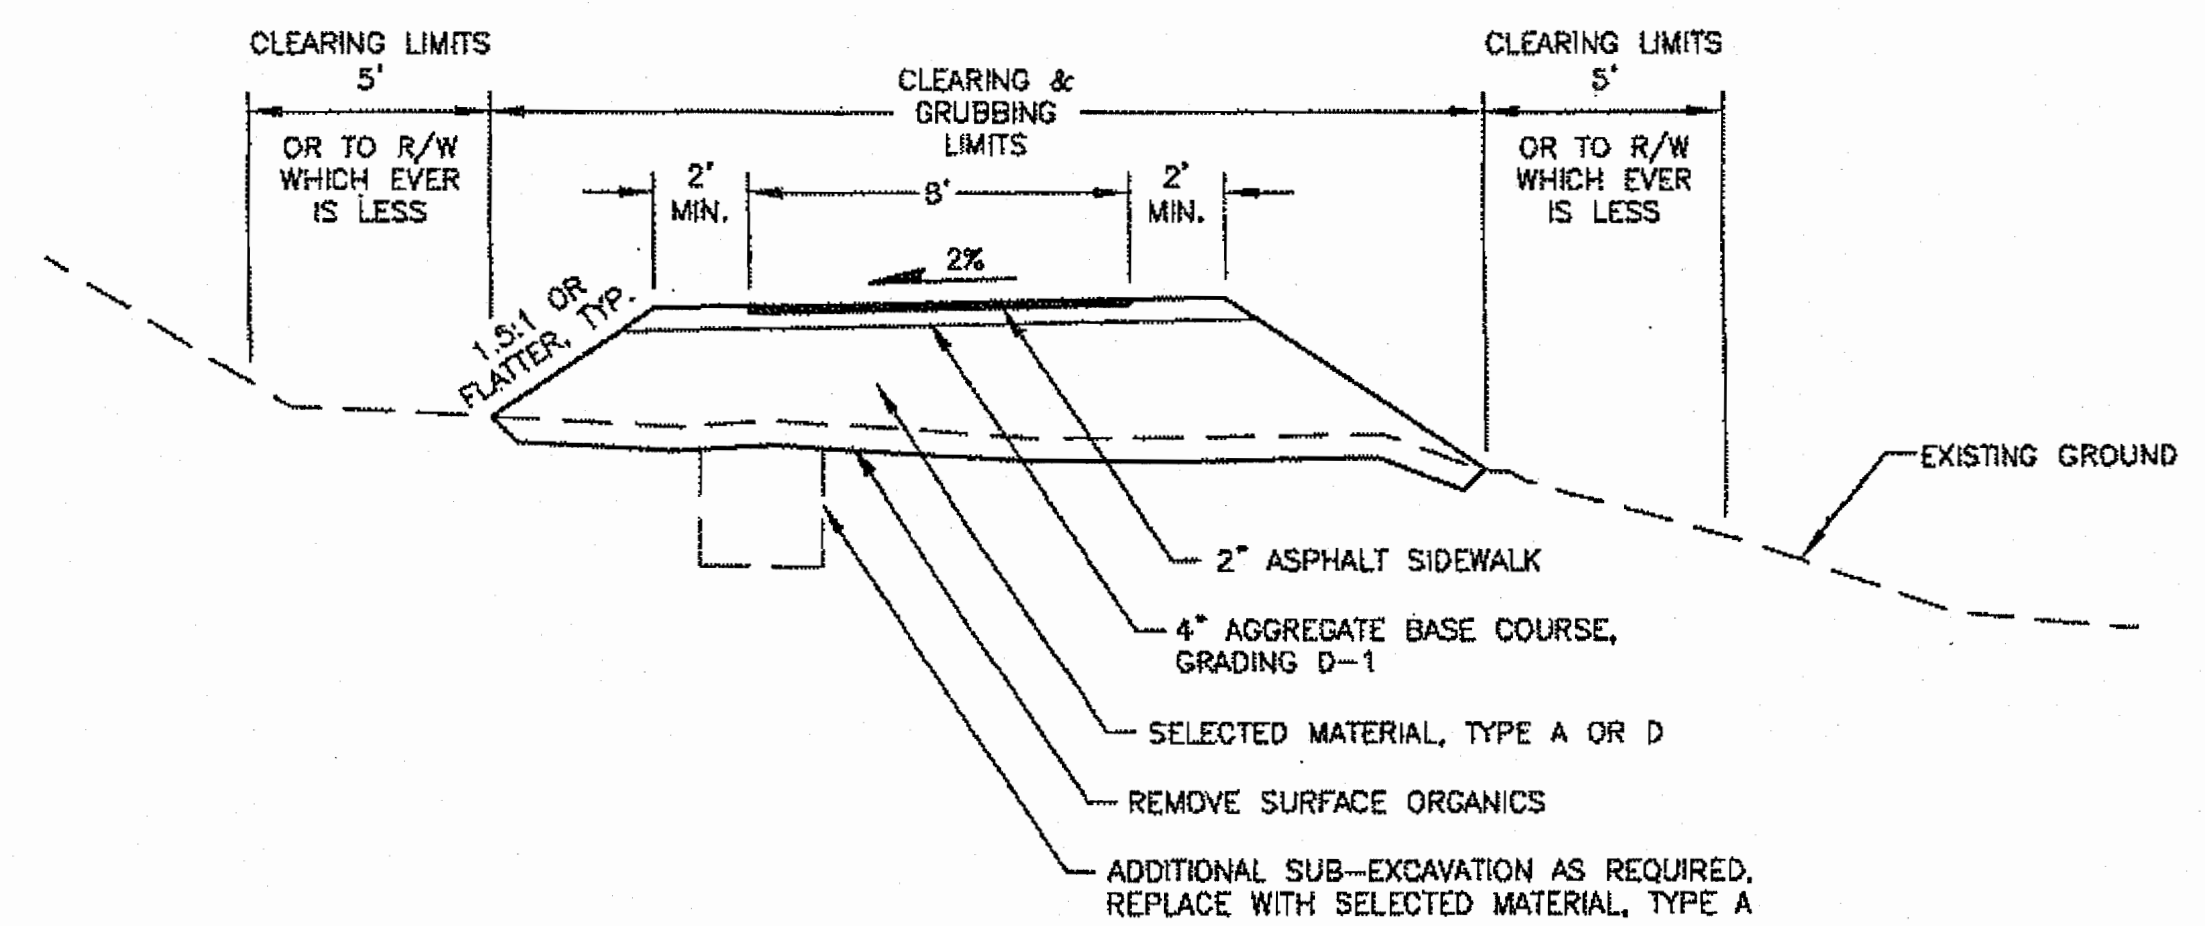

PEDESTRIAN PATH

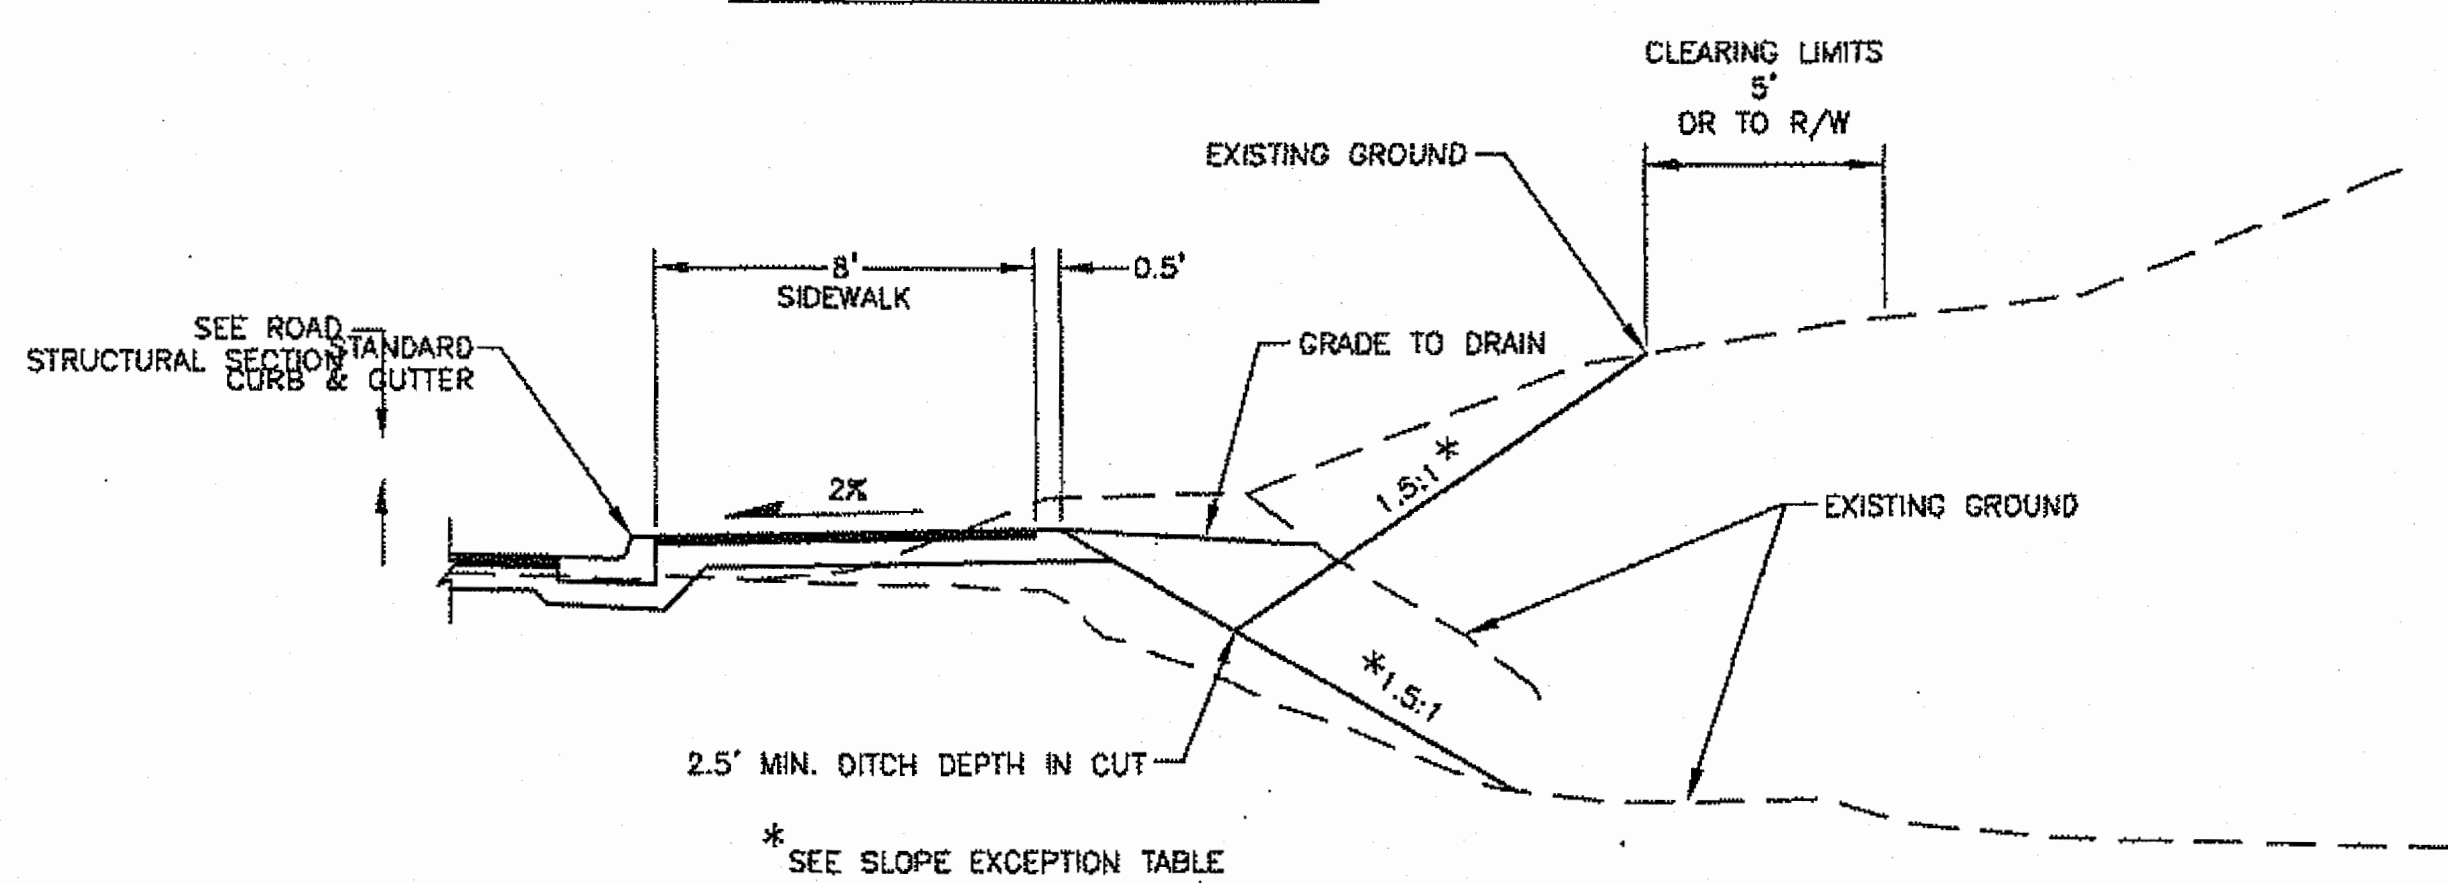

**TYPICAL SECTION - NO GUARDRAIL RIGHT
SAWMILL CREEK ROAD**

BOP TO STA. 185+53
STA. 186+75 TO STA. 188+60
STA. 222+50 TO STA. 227+50
STA. 229+00 TO STA. 233+65
STA. 236+50 TO STA. 241+60
STA. 250+95 TO STA. 259+53
STA. 267+48 TO STA. 268+72
STA. 270+94 TO STA. 273+90
STA. 276+05 TO STA. 277+77

Project As Built Drawings Have Been Reviewed By The Project Engineer & Represent, To The Best Of My Knowledge, The Project As Constructed.
Proj. Eng. *[Signature]* 6-24-15 Date

DO NOT SCALE FROM THESE DRAWINGS USE DIMENSIONS

PATH: \\NUNFILEZ\JOBS\1153805\DWG\CS\1\SHEETS\B2_1_B04

Friday, August 17, 2012 7:13:06 PM

TAB: B2

ADDENDUM NUMBER


ATTACHMENT NUMBER

RECORD OF REVISIONS

No.	DATE	DESCRIPTION

SAWMILL CREEK ROAD UPGRADE
PHASE III - WHALE PARK TO SAWMILL CREEK BRIDGE
68216MSG-STP-0933(21)
SITKA TELECOMMUNICATIONS CONDUIT
RSA NO. 69615

PREPARED BY: USKH
CHECKED BY: NCL

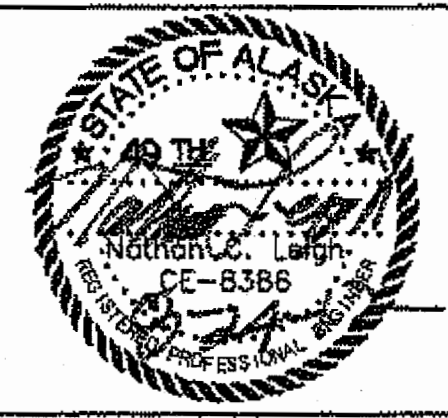

DESIGNED BY: NCL
DRAWN BY: WJP


STATE OF ALASKA
DEPARTMENT OF TRANSPORTATION
& PUBLIC FACILITIES
SOUTHEAST REGION

TYPICAL SECTIONS


PROJECT DESIGNATION
68216MSG-STP-0933(21)

STATE	YEAR
ALASKA	2012


SHEET NUMBER	TOTAL SHEETS
B2	109

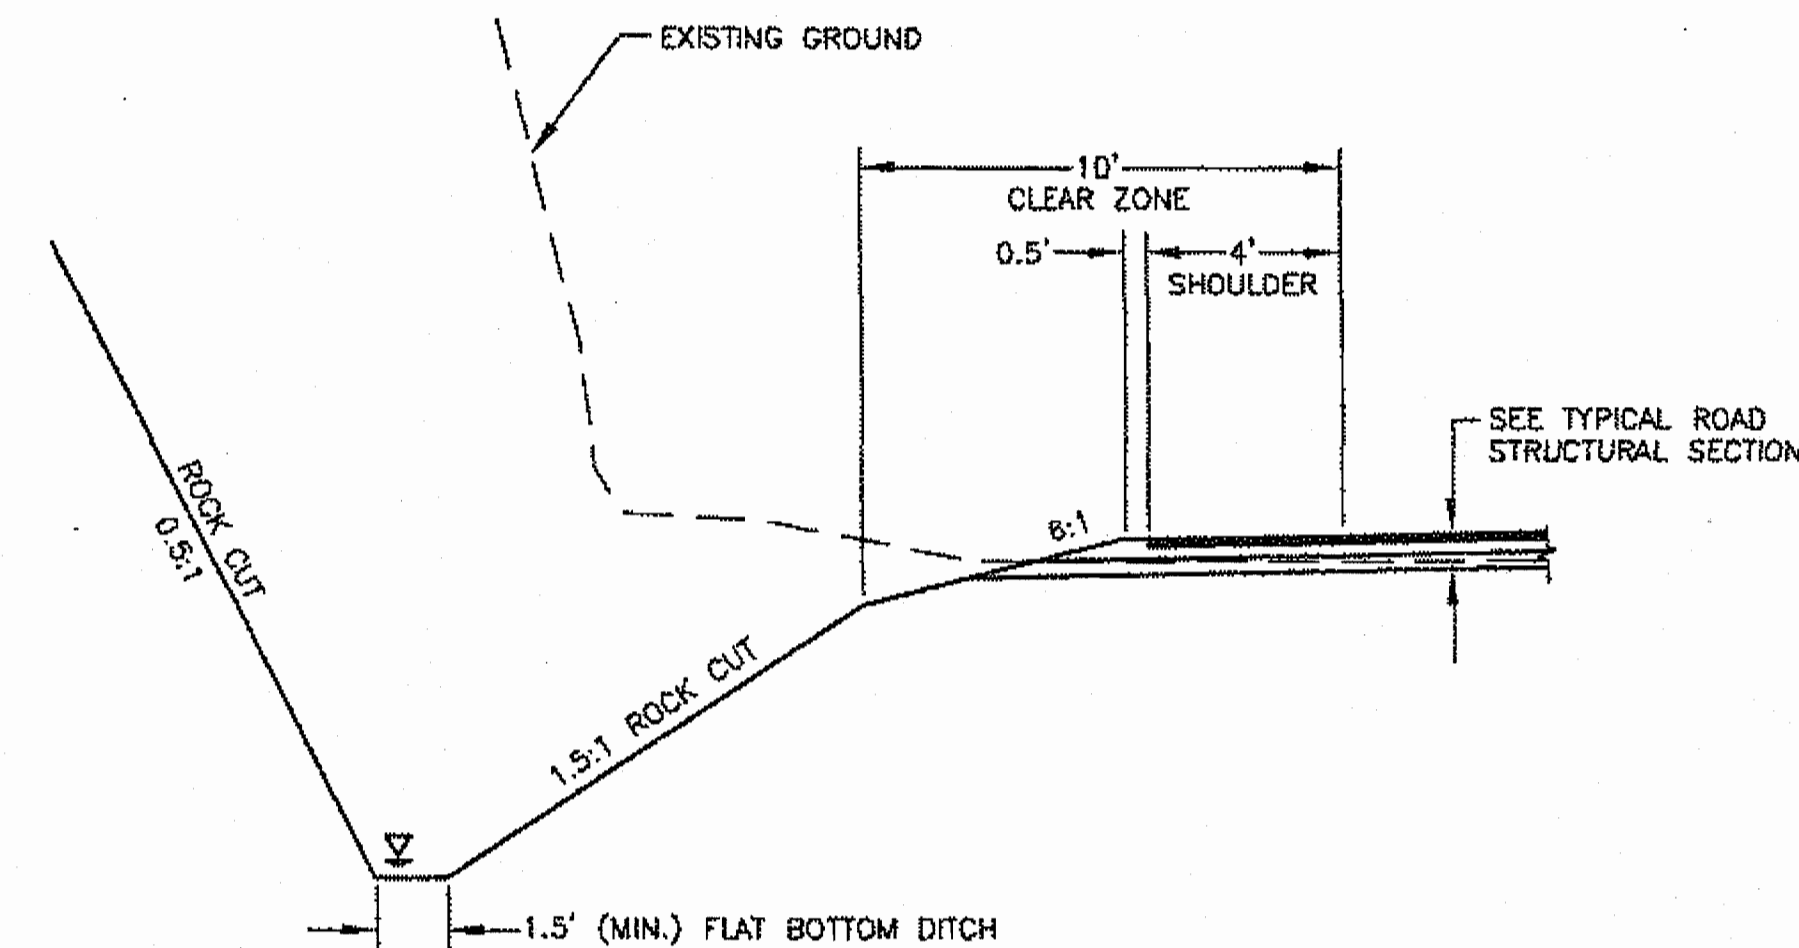


DRAINAGE DITCH
STA. 256+35 TO STA. 257+63

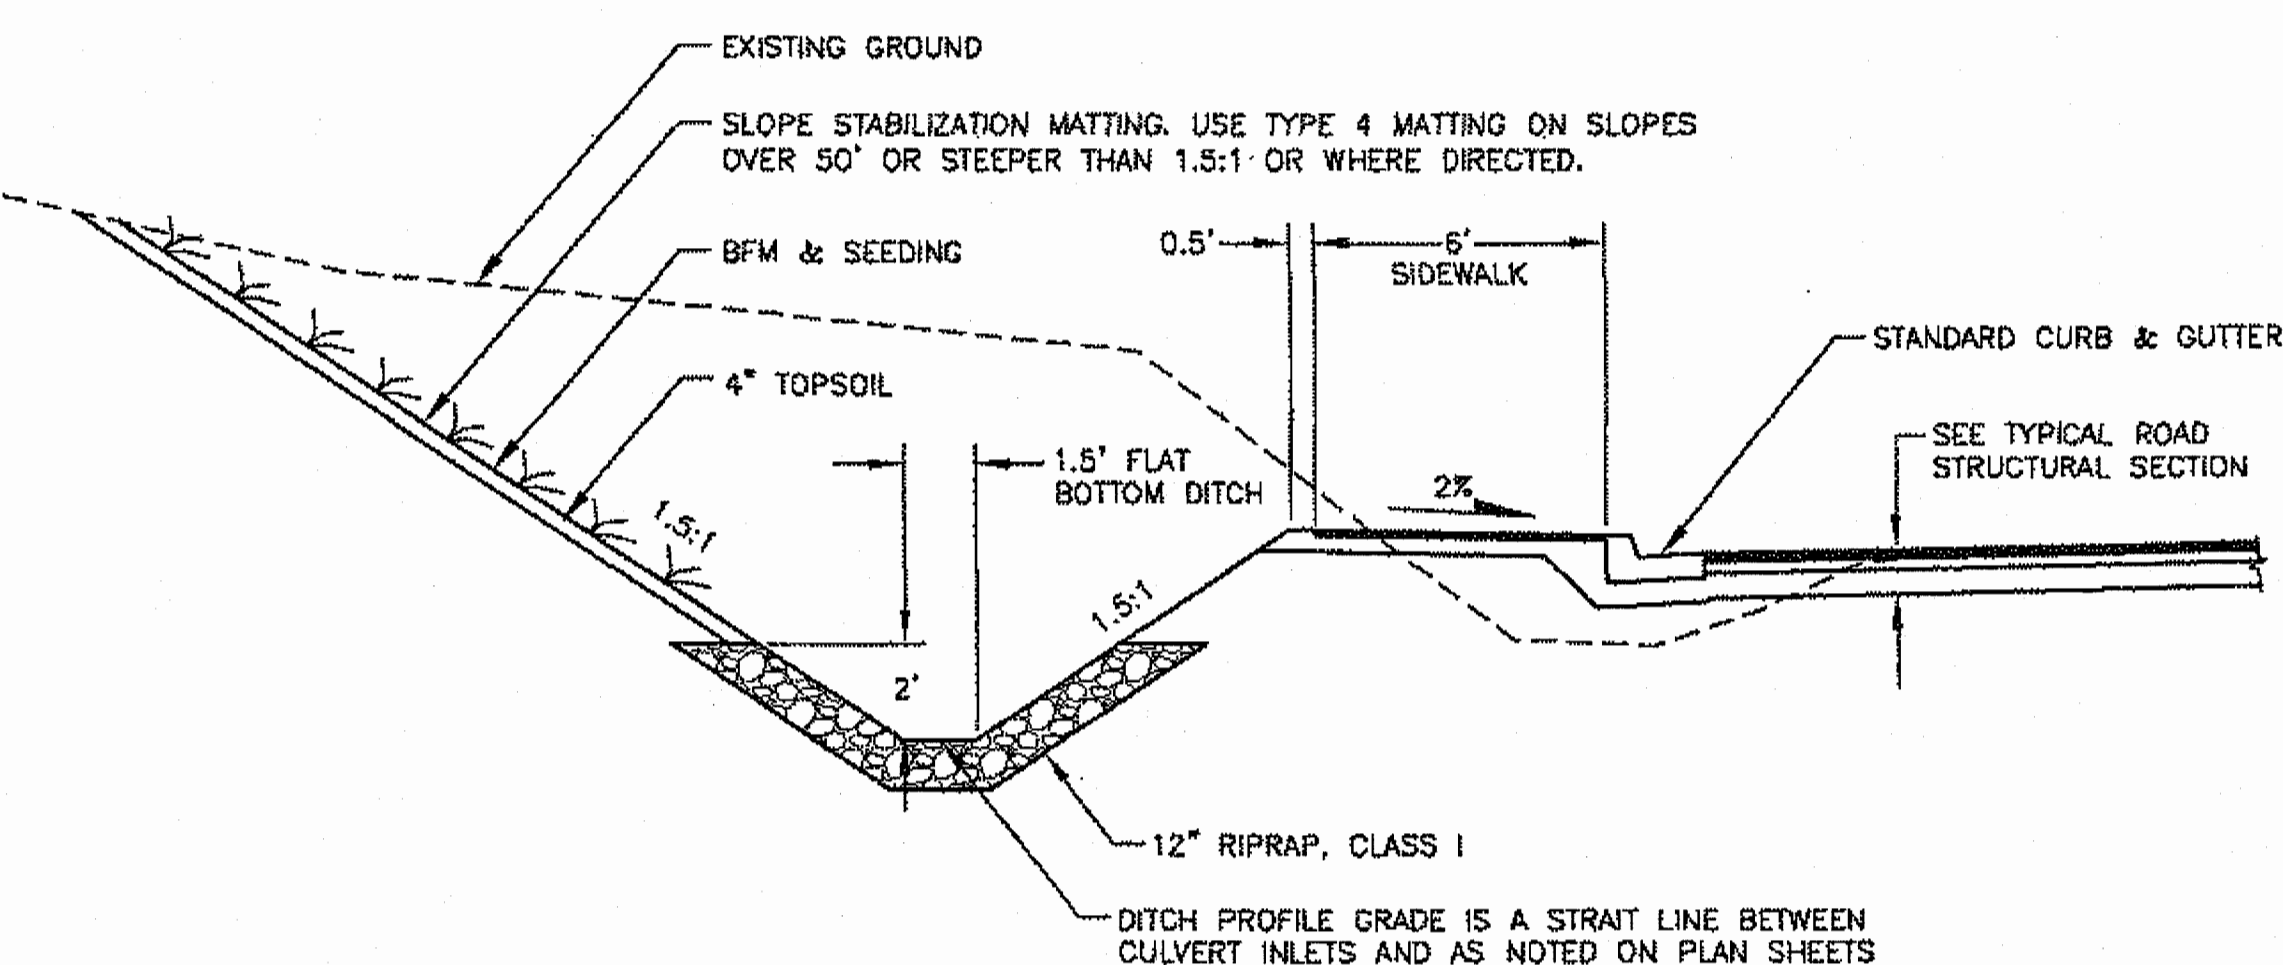

DRAINAGE DITCH
STA. 257+63 TO 266+00

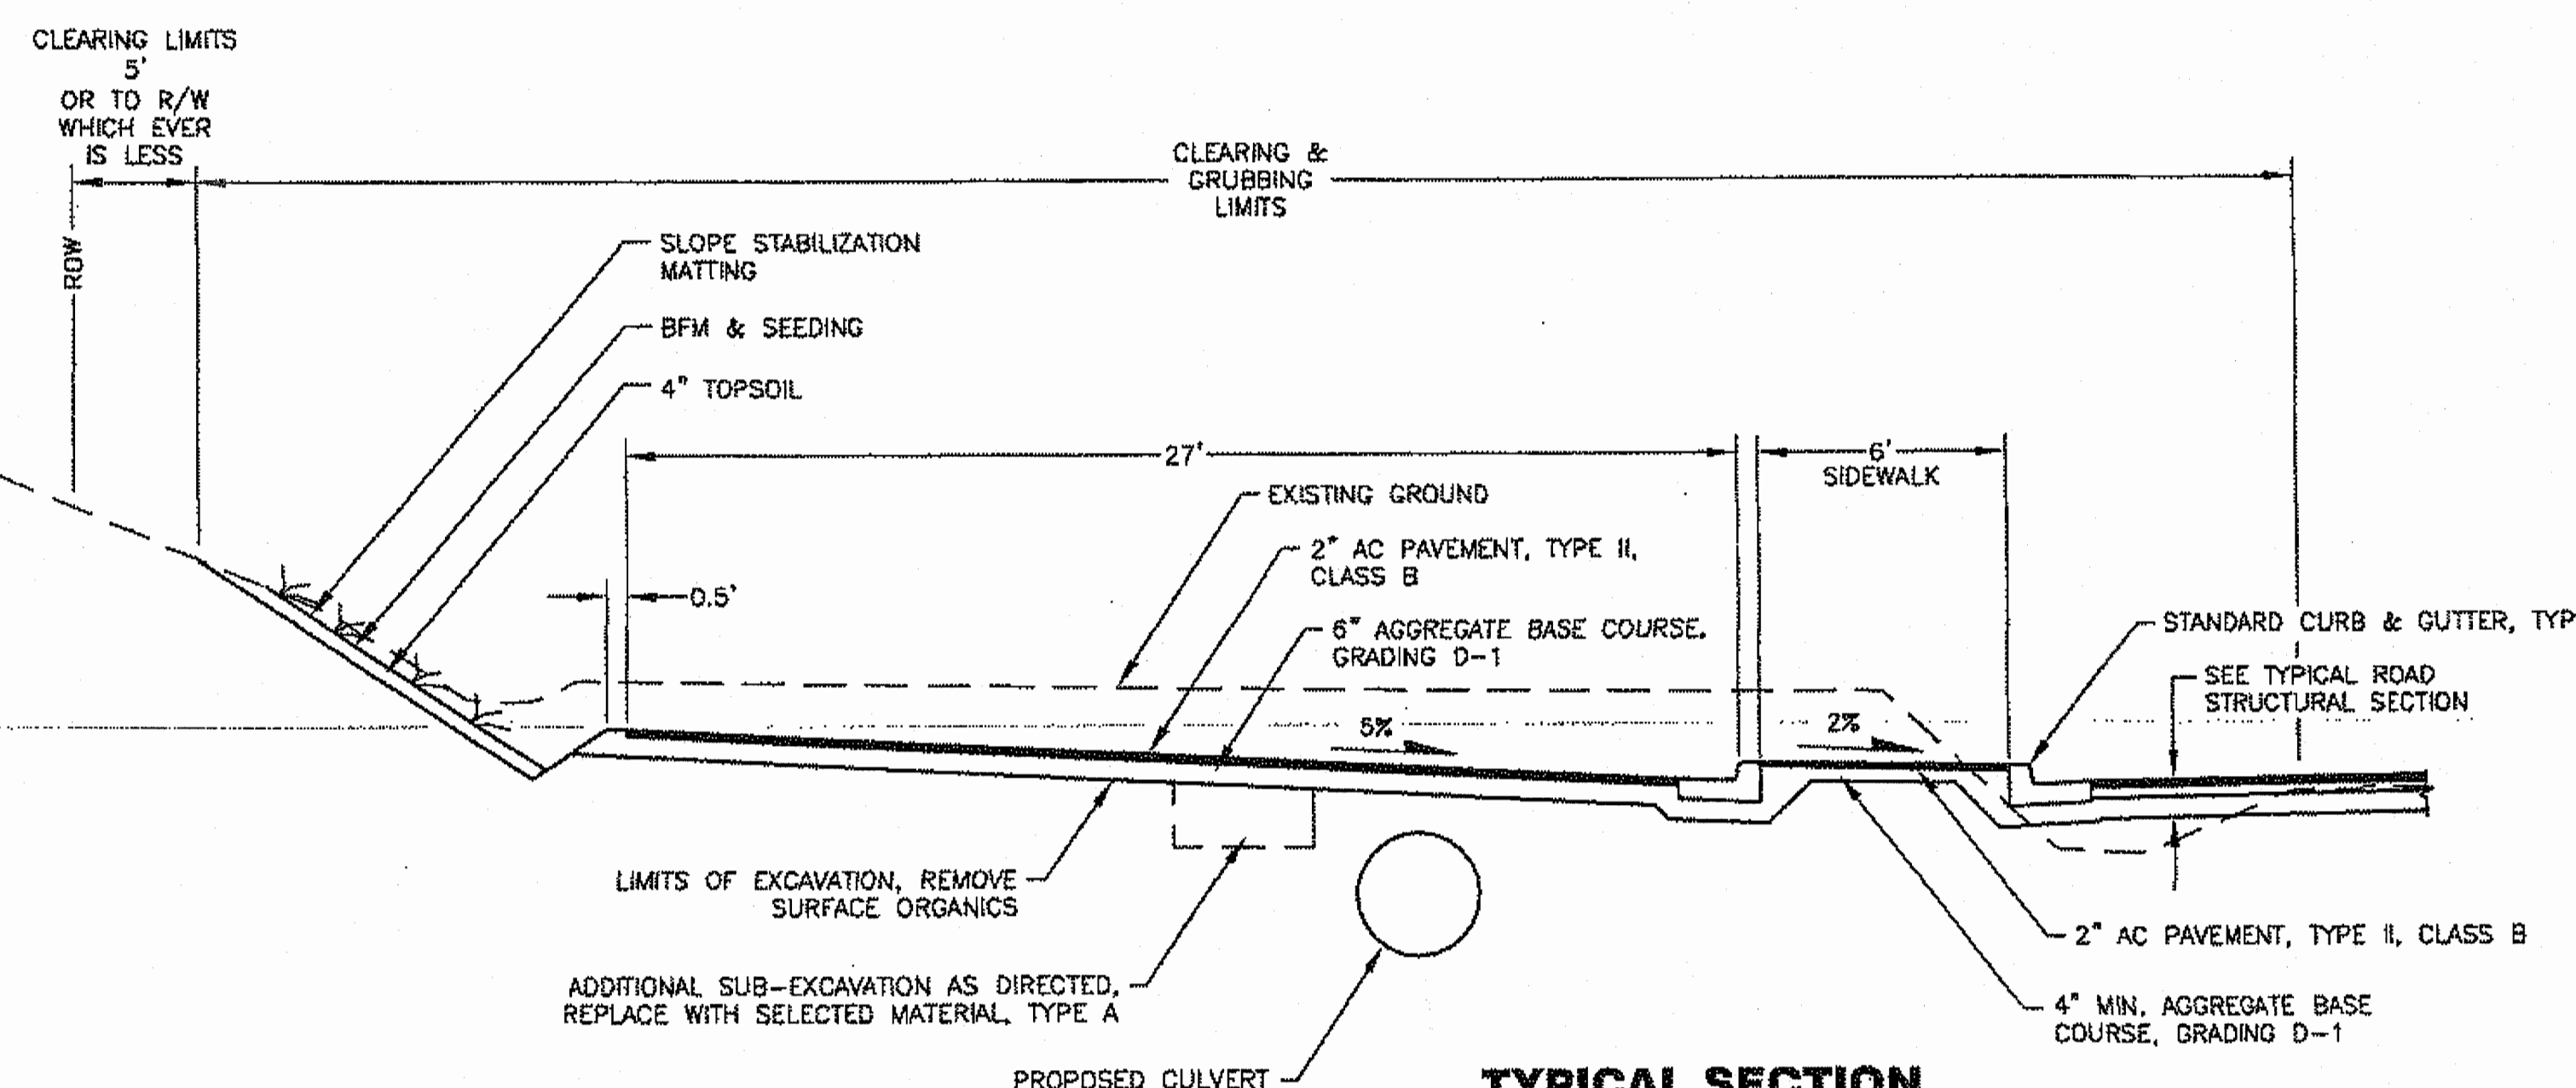

TYPICAL SECTION
NEW PARKING
STA. 258+00 TO STA. 258+64
STA. 261+15 TO STA. 261+79

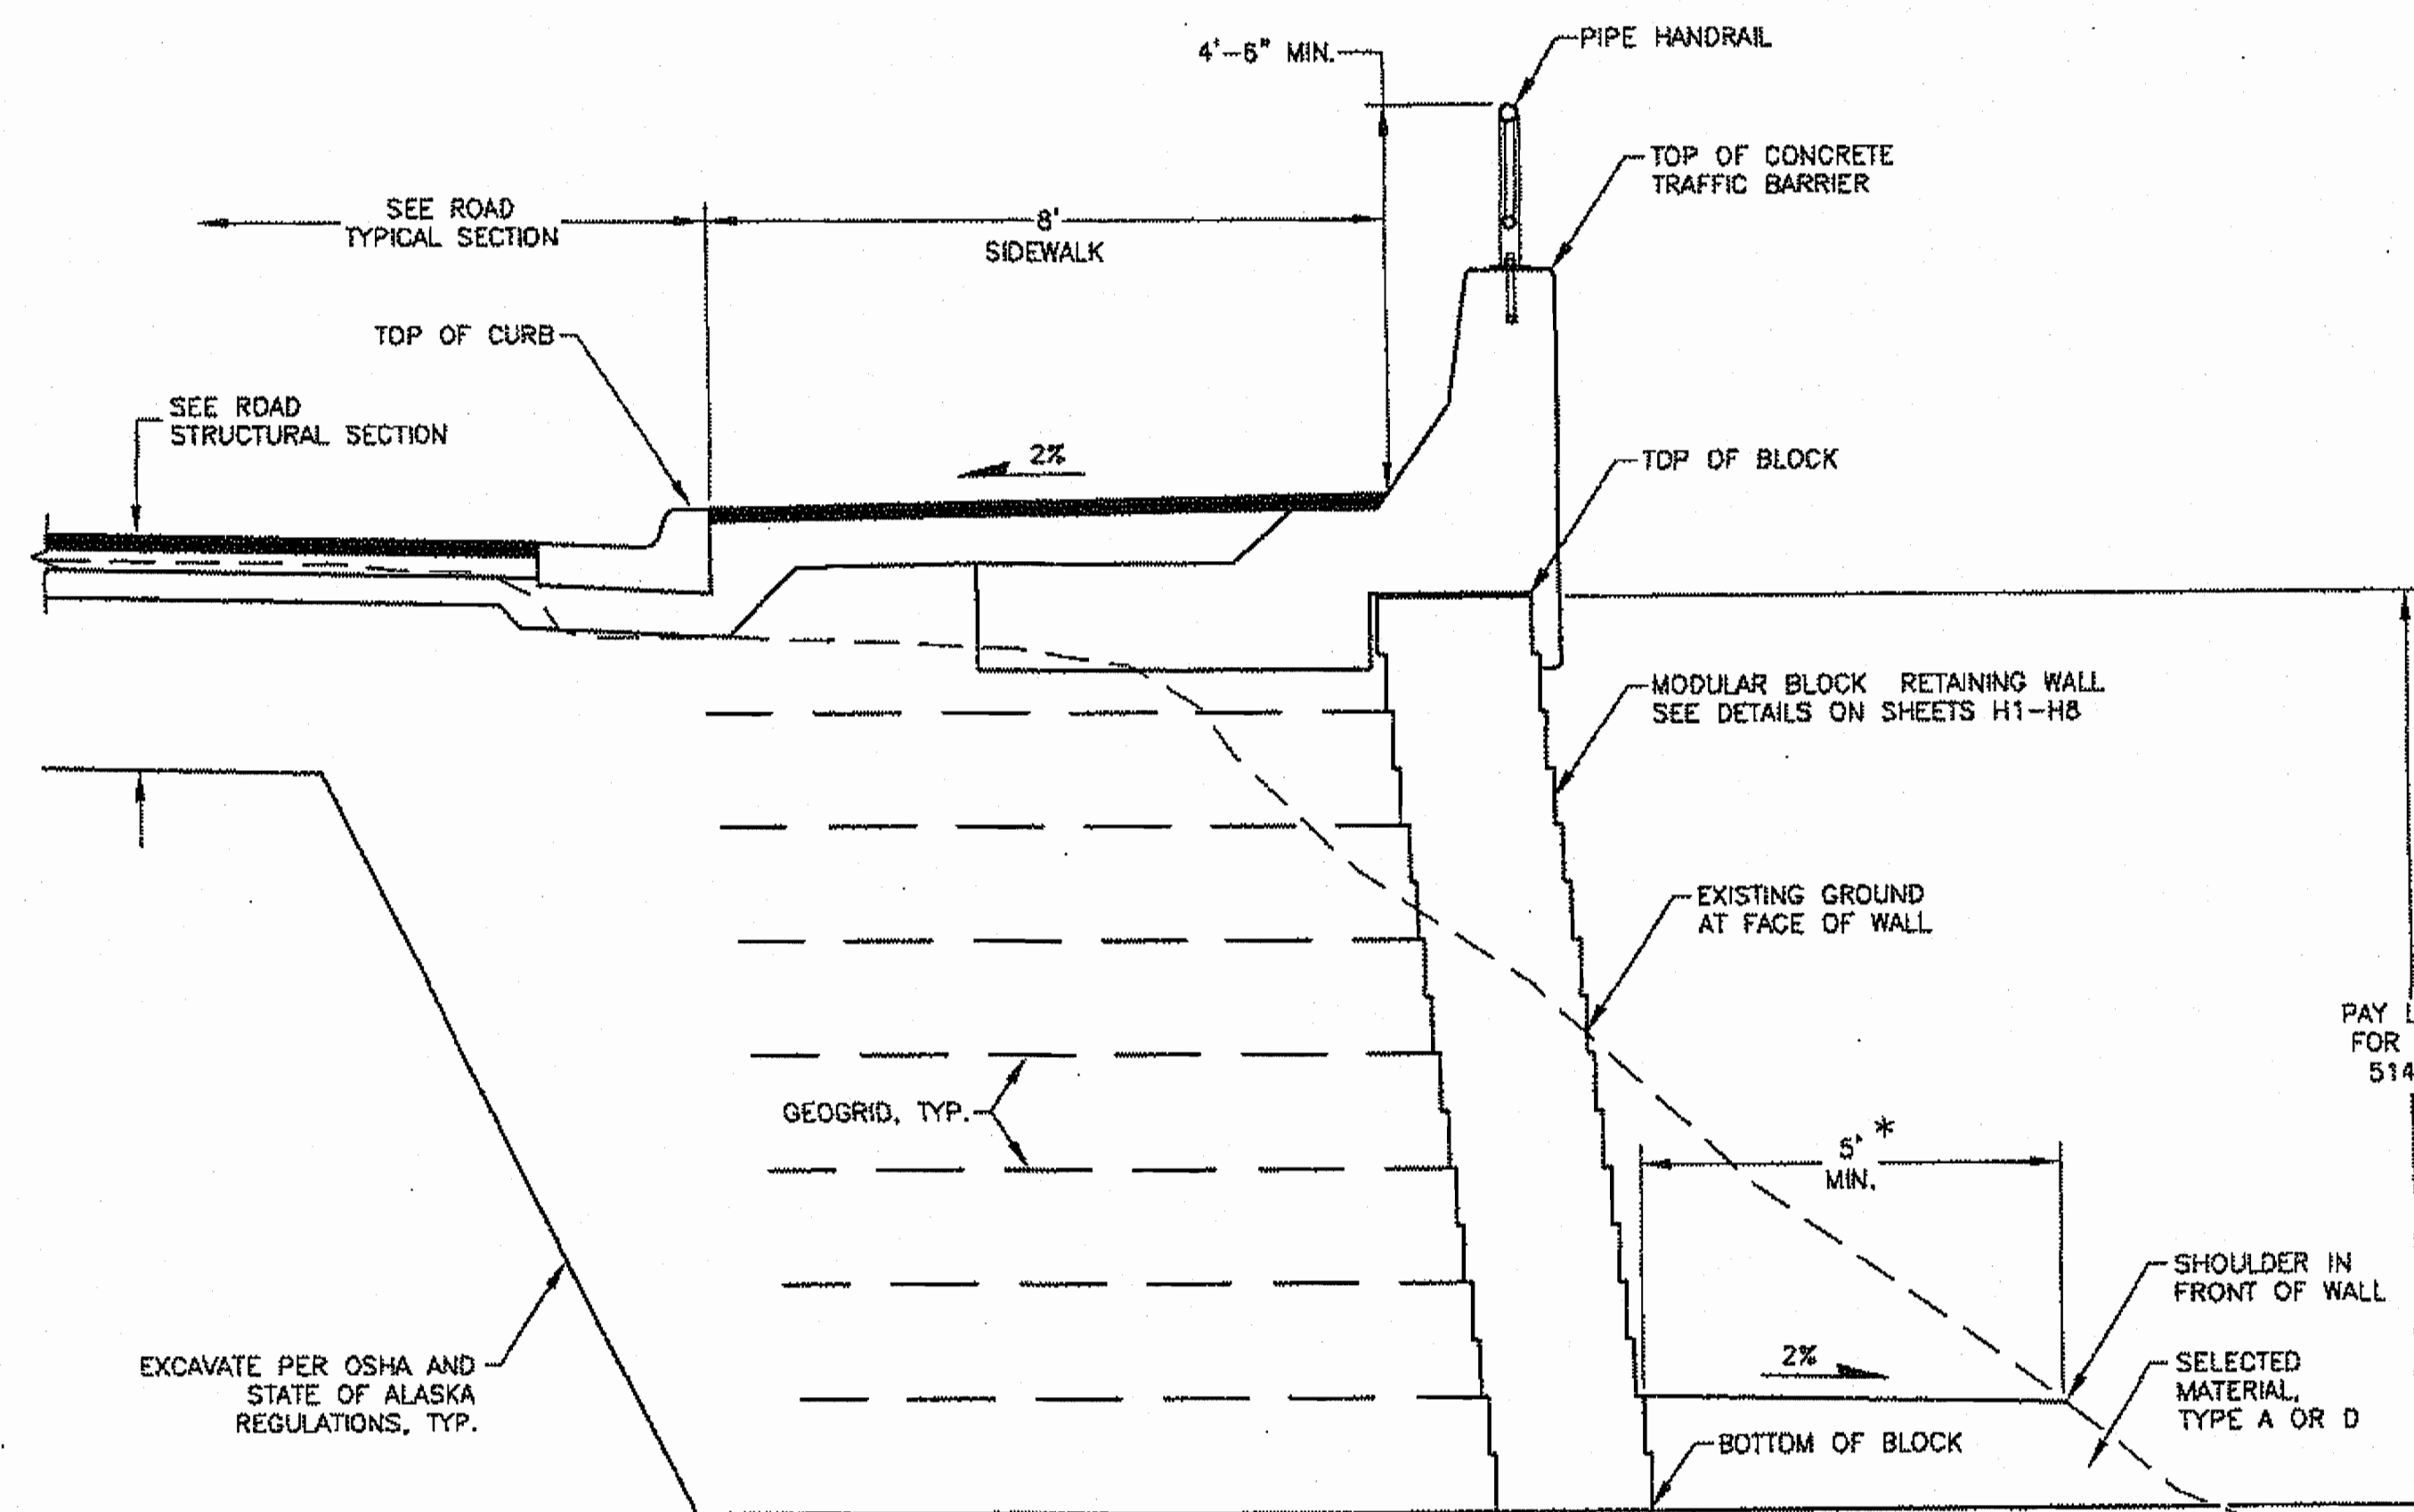

MODULAR BLOCK RETAINING WALL WITH TRAFFIC BARRIER

STA. 189+20 TO STA. 191+10
STA. 208+60 TO STA. 210+60
STA. 241+60 TO STA. 247+20

Project As Built Drawings Have Been Reviewed By The Project Engineer & Represent, To The Best Of My Knowledge The Project As Constructed.
Proj. Eng. *[Signature]* Date 6-24-15


PATH: \\1153805\DWGS\IC\SHETS\B01_B05.DWG
Monday, August 20, 2012 1:41:33 PM
TAB: B3

RECORD OF REVISIONS		
No.	DATE	DESCRIPTION

SAWMILL CREEK ROAD UPGRADE
PHASE III - WHALE PARK TO SAWMILL CREEK BRIDGE
68216MSG-STP-0933(21)
SITKA TELECOMMUNICATIONS CONDUIT
RSA NO. 68615

TYPICAL SECTIONS

PREPARED BY: USKH
CHECKED BY: NCL

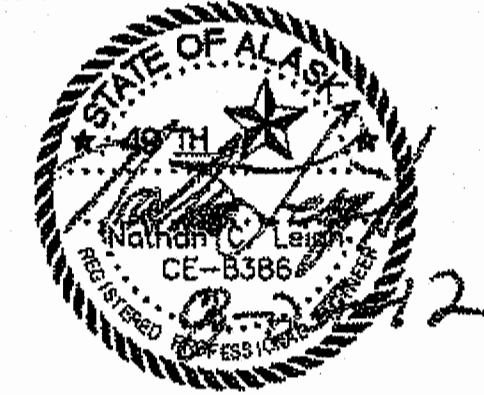

DESIGNED BY: NCL
DRAWN BY: WJP

STATE OF ALASKA
DEPARTMENT OF TRANSPORTATION
& PUBLIC FACILITIES
SOUTHEAST REGION

TYPICAL SECTIONS

PROJECT DESIGNATION
68216MSG-STP-0933(21)

STATE	YEAR
ALASKA	2012
SHEET NUMBER	TOTAL SHEETS
B3	109

DO NOT SCALE FROM THESE DRAWINGS USE DIMENSIONS

No.	DATE	DESCRIPTION

SAWMILL CREEK ROAD UPGRADE
PHASE III - WHALE PARK TO SAWMILL CREEK BRIDGE
68216MSG-STP-0933(21)
SITKA TELECOMMUNICATIONS CONDUIT
RSA NO. 69615

TYPICAL SECTIONS

PREPARED BY: USKH

CHECKED BY: NCL



DESIGNED BY: NCL

DRAWN BY: VU/P

STATE OF ALASKA
DEPARTMENT OF TRANSPORTATION
& PUBLIC FACILITIES
SOUTHEAST REGION

TYPICAL SECTIONS

PROJECT DESIGNATION
68216MSG-STP-0933(21)


STATE ALASKA
YEAR 2012

SHEET NUMBER TOTAL SHEETS
B4 109

TABLE 1-B4 ZONE DESCRIPTION

ZONE 1	• EXCAVATE ALL OVERBURDEN SOILS TO BEDROCK. • ON OPTIONS 1, 2 & 3 WIDTH MAY BE REDUCED FROM 10 FEET WHEN APPROVED BY THE ENGINEER.
ZONE 2	• FOR OVERBURDEN SOILS LESS THAN 3 FEET* SLOPES MAY BE CUT AT 1:1 AND SEEDED. • FOR OVERBURDEN SOILS GREATER THAN 3 FEET*, CUT AT 2:1 WHEN POSSIBLE AND SEED. • SEE TYPICAL SECTIONS ON SHEET B5.
ZONE 3	• CLEAR ALL TREES TO THE ENGINEER SPECIFIED CLEARING LIMITS OR 5' FROM THE DAYLIGHT OF THE ZONE 2 CUT. • LEAVE STUMPS AND ORGANIC MAT IN PLACE. • MINIMUM EXTENTS OF ZONE 3 ARE 20 FEET FROM TOP OF THE ROCK CUT.


* OVERBURDEN THICKNESS MEASURED FROM THE VERTICAL

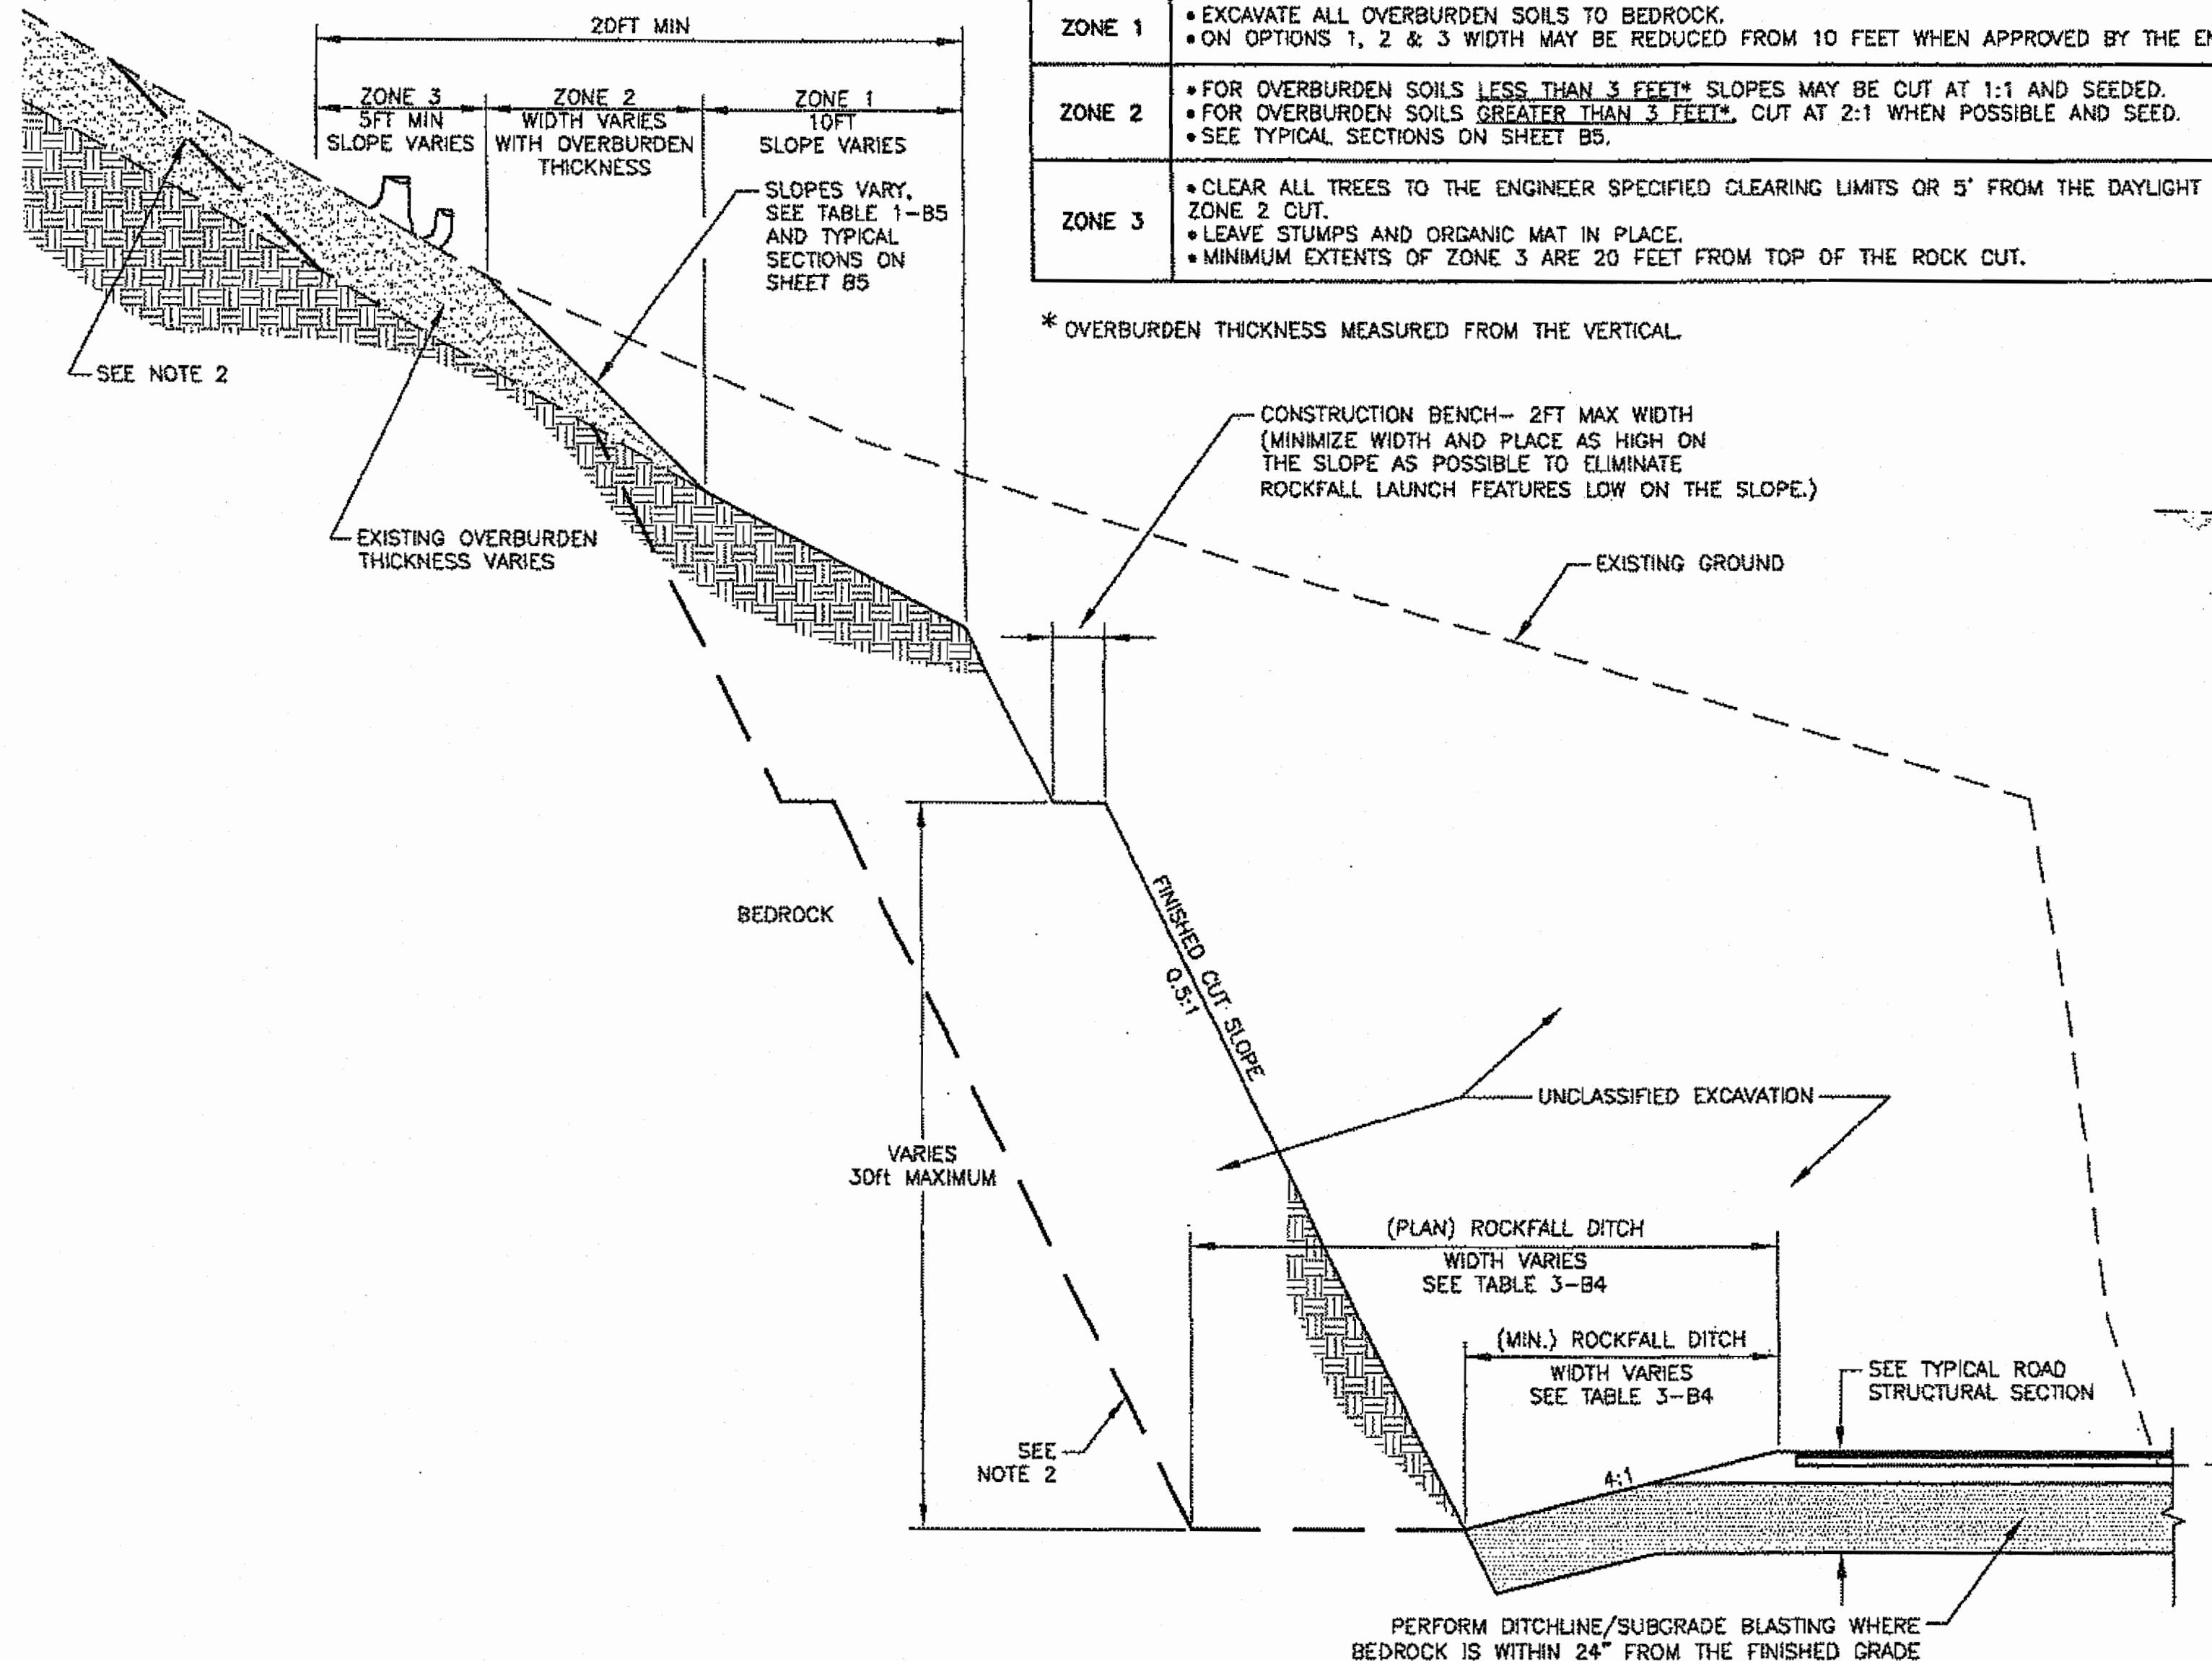

TYPICAL ROCK CUT FOR 0.5:1 SLOPES

NOTES FOR ROCK CUTS & OVERBURDEN SOILS TREATMENT OPTIONS:

- DESIGN ROCKFALL DITCH WIDTHS ARE BASED ON AVAILABLE INFORMATION FROM GEOTECHNICAL REPORTS ON ROCK WALL HEIGHT, OVERBURDEN DEPTH AND ROCK STABILITY. THE ENGINEER WILL MODIFY ACTUAL ROCKFALL DITCH WIDTHS DEPENDING UPON OBSERVED FIELD CONDITIONS.
- MINIMUM ROCKFALL DITCH WIDTHS ARE BASED ON THE MINIMUM WIDTH NEEDED FOR FALLING ROCKS. PLAN ROCKFALL DITCH WIDTHS INCLUDE AN ADDITIONAL WIDTH TO ACCOMMODATE TYPICAL ROCK DRILLING EQUIPMENT. UNCLASSIFIED EXCAVATION NEAT LINE MEASUREMENTS ARE BASED ON PLAN ROCKFALL DITCH WIDTHS.
- OPTIONS FOR TREATMENT OF OVERBURDEN SOIL CUTS ARE BASED ON AVAILABLE INFORMATION PROVIDED IN THE GEOTECHNICAL REPORT. OVERBURDEN TREATMENT OPTIONS WILL BE ADJUSTED DURING CONSTRUCTION TO ACCOMMODATE ACTUAL CONDITIONS ENCOUNTERED IN THE FIELD.
- DISTURBANCE OF ZONES 3 & 2 IS TO BE KEPT AT A MINIMUM. THIS INCLUDES KEEPING PIONEER ACCESS ROADS OUT OF ZONES 3 & 2. SUBSURFACE DISTURBANCE OF ZONES 3 & 2 MUST BE REPAIRED TO THE SATISFACTION OF THE ENGINEER AT THE CONTRACTORS EXPENSE.

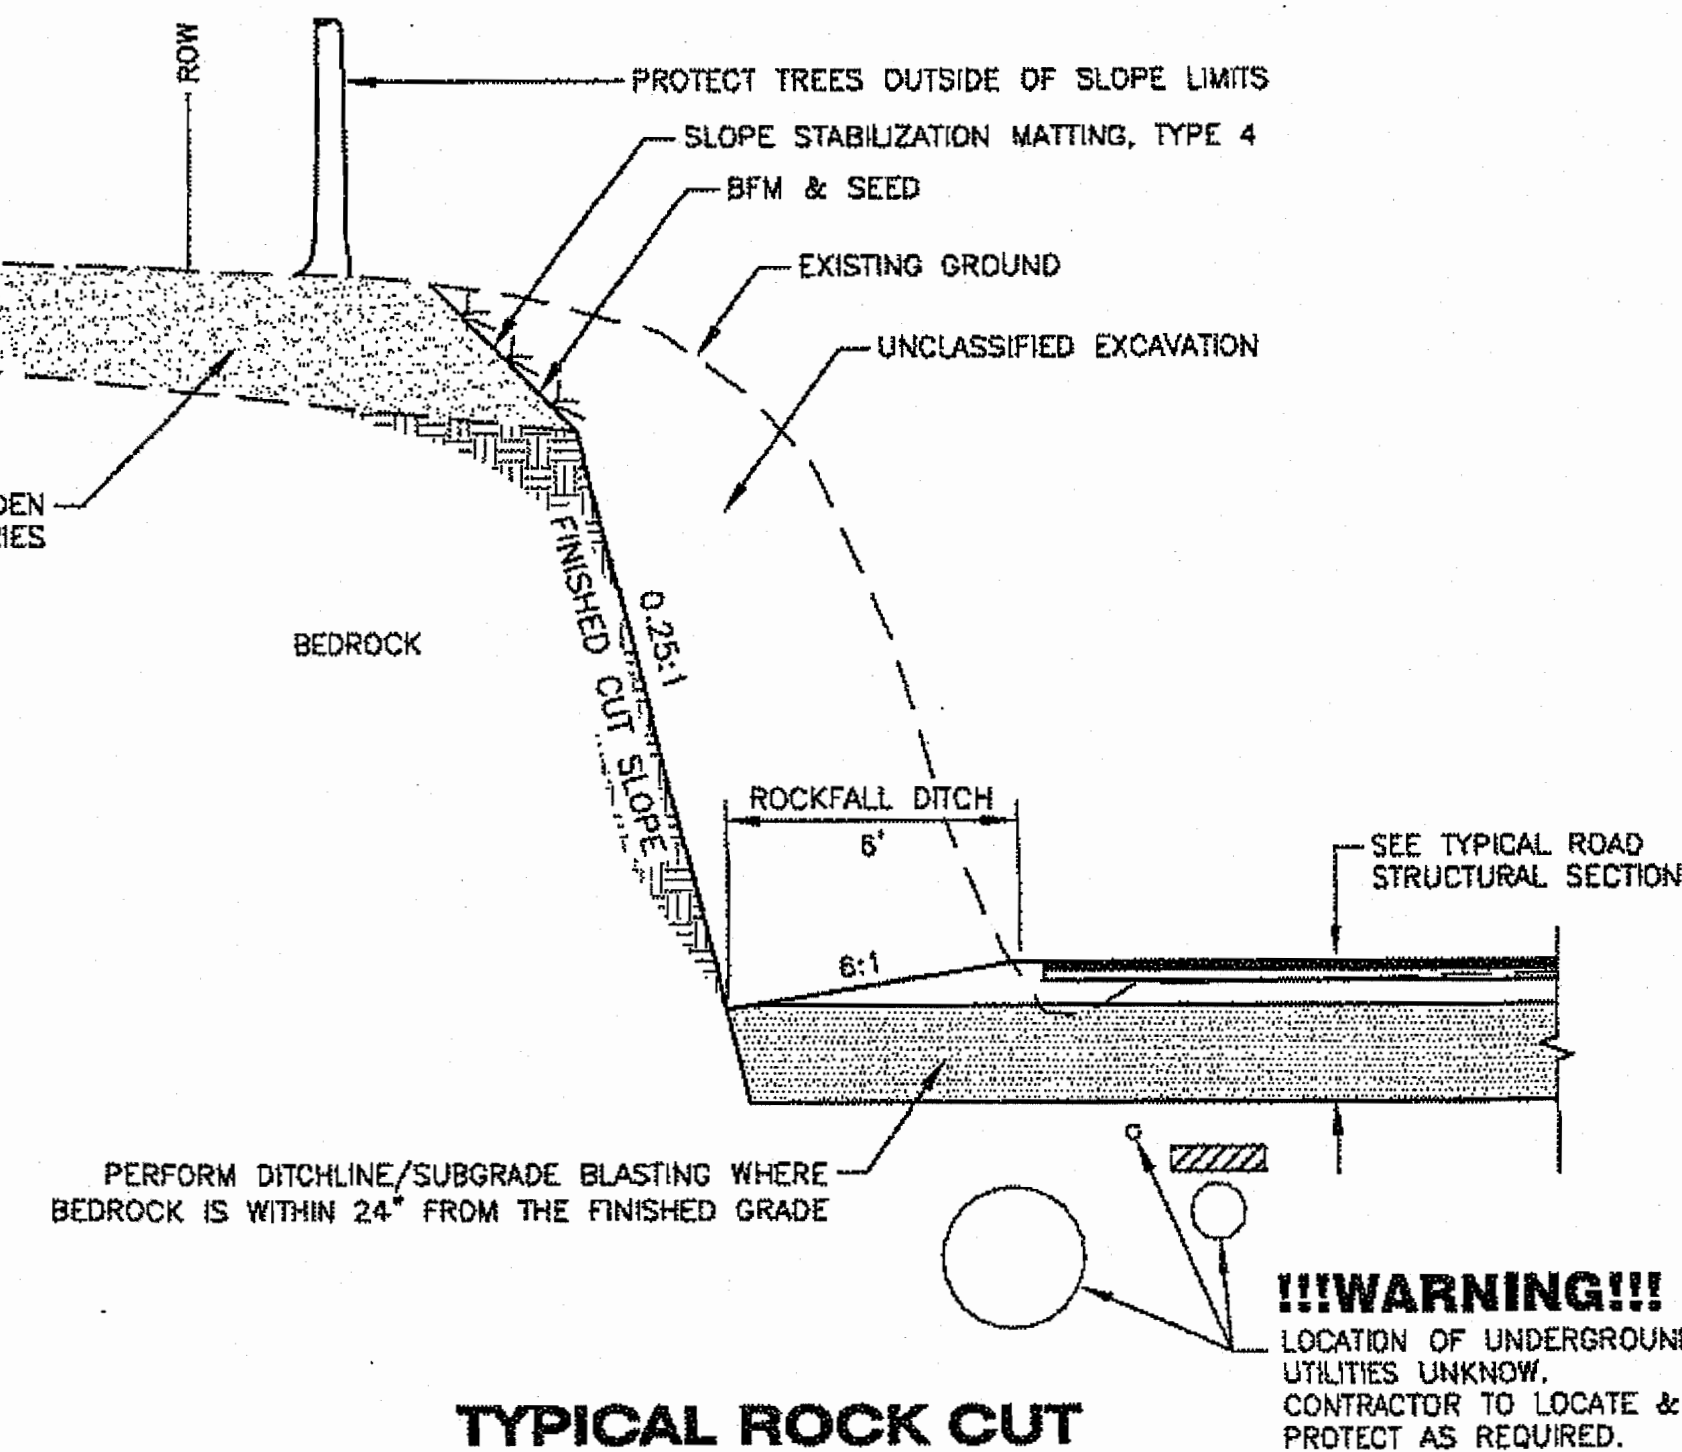

TYPICAL ROCK CUT

STA. 191+10 TO STA. 194+00

Project As Built Drawings Have Been Reviewed By The Project Engineer & Represent, To The Best Of My Knowledge The Project As Constructed.
Proj. Eng. 6-24-15 Date

TABLE 3-B4
ROCKFALL DITCH WIDTH AT 0.5:1 ROCK CUTS

BEGIN STATION	END STATION	MINIMUM		PLAN	
		CUT HEIGHT (ft)	DITCH WIDTH (ft)	CUT HEIGHT (ft)	DITCH WIDTH (ft)
204+40	208+40	60-90	10	90-110	19.5
210+80	212+50	60-90	10	-	-
** 212+50		60-90	10	60-90	19.5
212+50	216+20	60-90	10	-	-
216+60	217+50	30-60	8	-	-
219+00	222+50	60-90	10	60-90	20
223+00	226+00	30-60	8	-	-
226+50	230+75	30-60	8	60-90	19.5
233+75	234+50	0-30	10	-	-
237+60	238+30	0-30	6	-	-
256+40	257+40	0-30	DRAINAGE DITCH SEE DETAIL ON SHEET B3	-	-

** FOR PLAN DITCH WIDTH AT THIS LOCATION: TRANSITION FROM STA. 211+50 TO STA. 212+50 AND FROM STA. 212+50 TO STA. 213+50.

DO NOT SCALE FROM THESE DRAWINGS USE DIMENSIONS

PATH:
\\JNUFILE2\JOBS\1153805\DWGS\IC\1\SHEETS\B01_B02

TAB: B5

ADDENDUM NUMBER

ATTACHMENT NUMBER

RECORD OF REVISIONS


No.	DATE	DESCRIPTION

SAWMILL CREEK ROAD UPGRADE
PHASE III - WHALE PARK TO SAWMILL CREEK BRIDGE
68216MSG-STP-0933(21)
SITKA TELECOMMUNICATIONS CONDUIT
RSA NO. 69615

TYPICAL SECTIONS

PREPARED BY: USKH

CHECKED BY: NCL

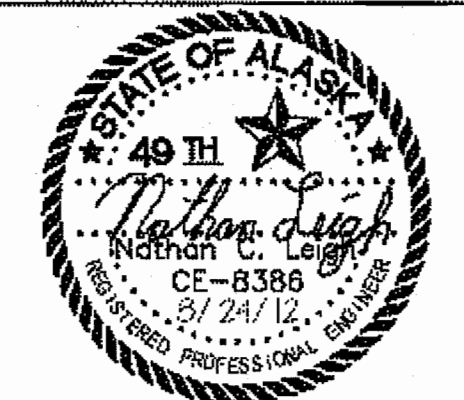

DESIGNED BY: NGI

DRAWN BY: 10117

STATE OF ALASKA
DEPARTMENT OF TRANSPORTATION
& PUBLIC FACILITIES
SOUTHEAST REGION


TYPICAL SECTIONS

PROJECT DESIGNATION
68216\MSG-STP-0933(21)


STATE	YEAR
ALASKA	2012

SHEET NUMBER	TOTAL SHEETS
--------------	--------------


B5	109
----	-----

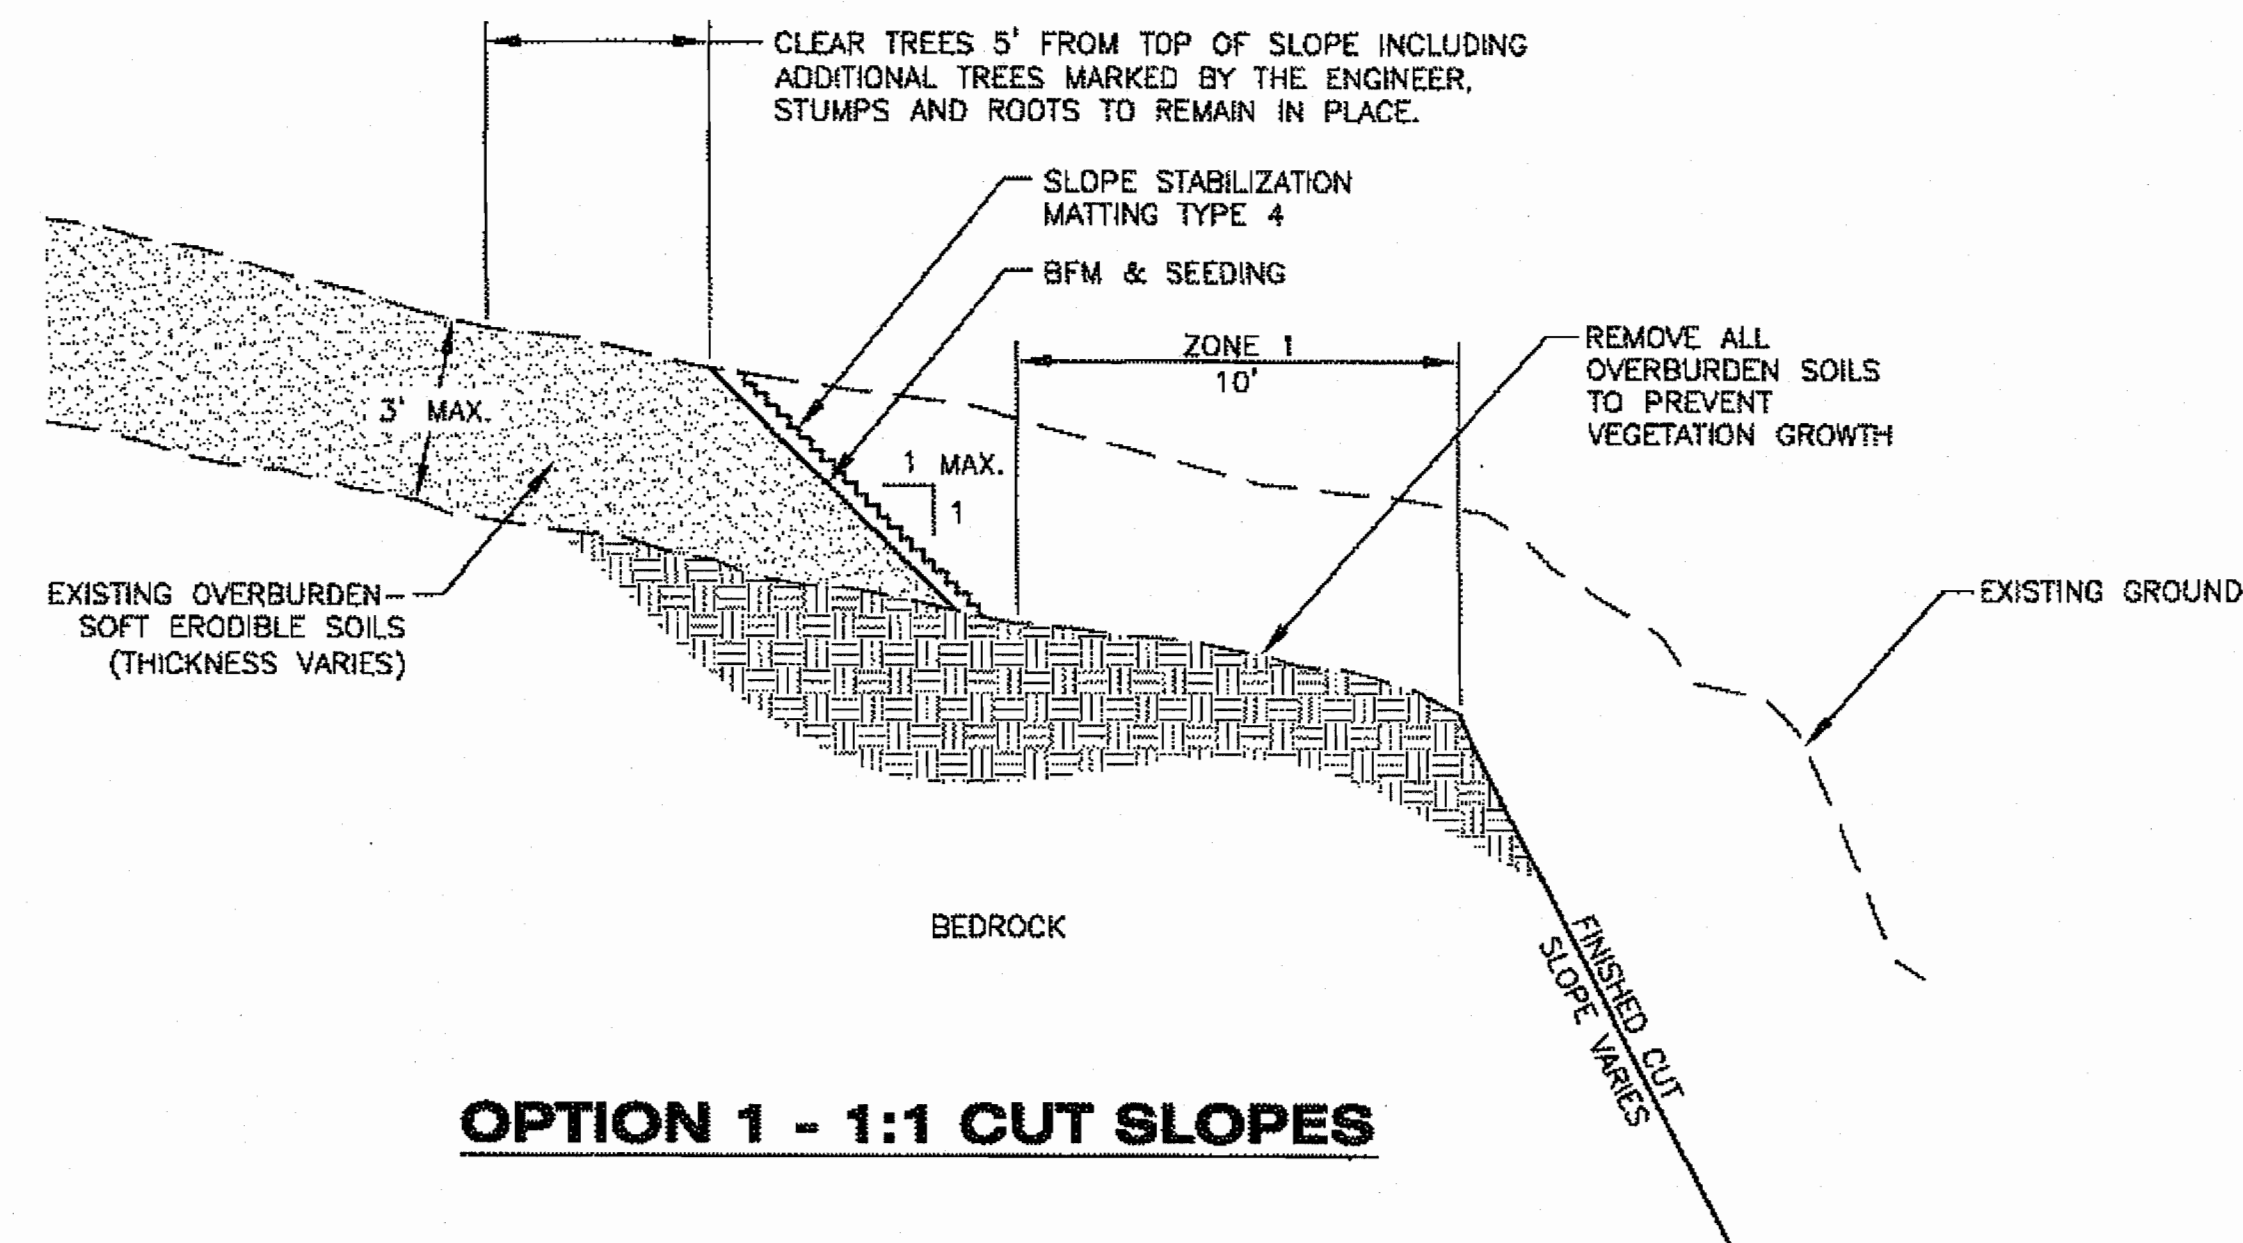


OPTION 1 - 1:1 CUT SLOPES

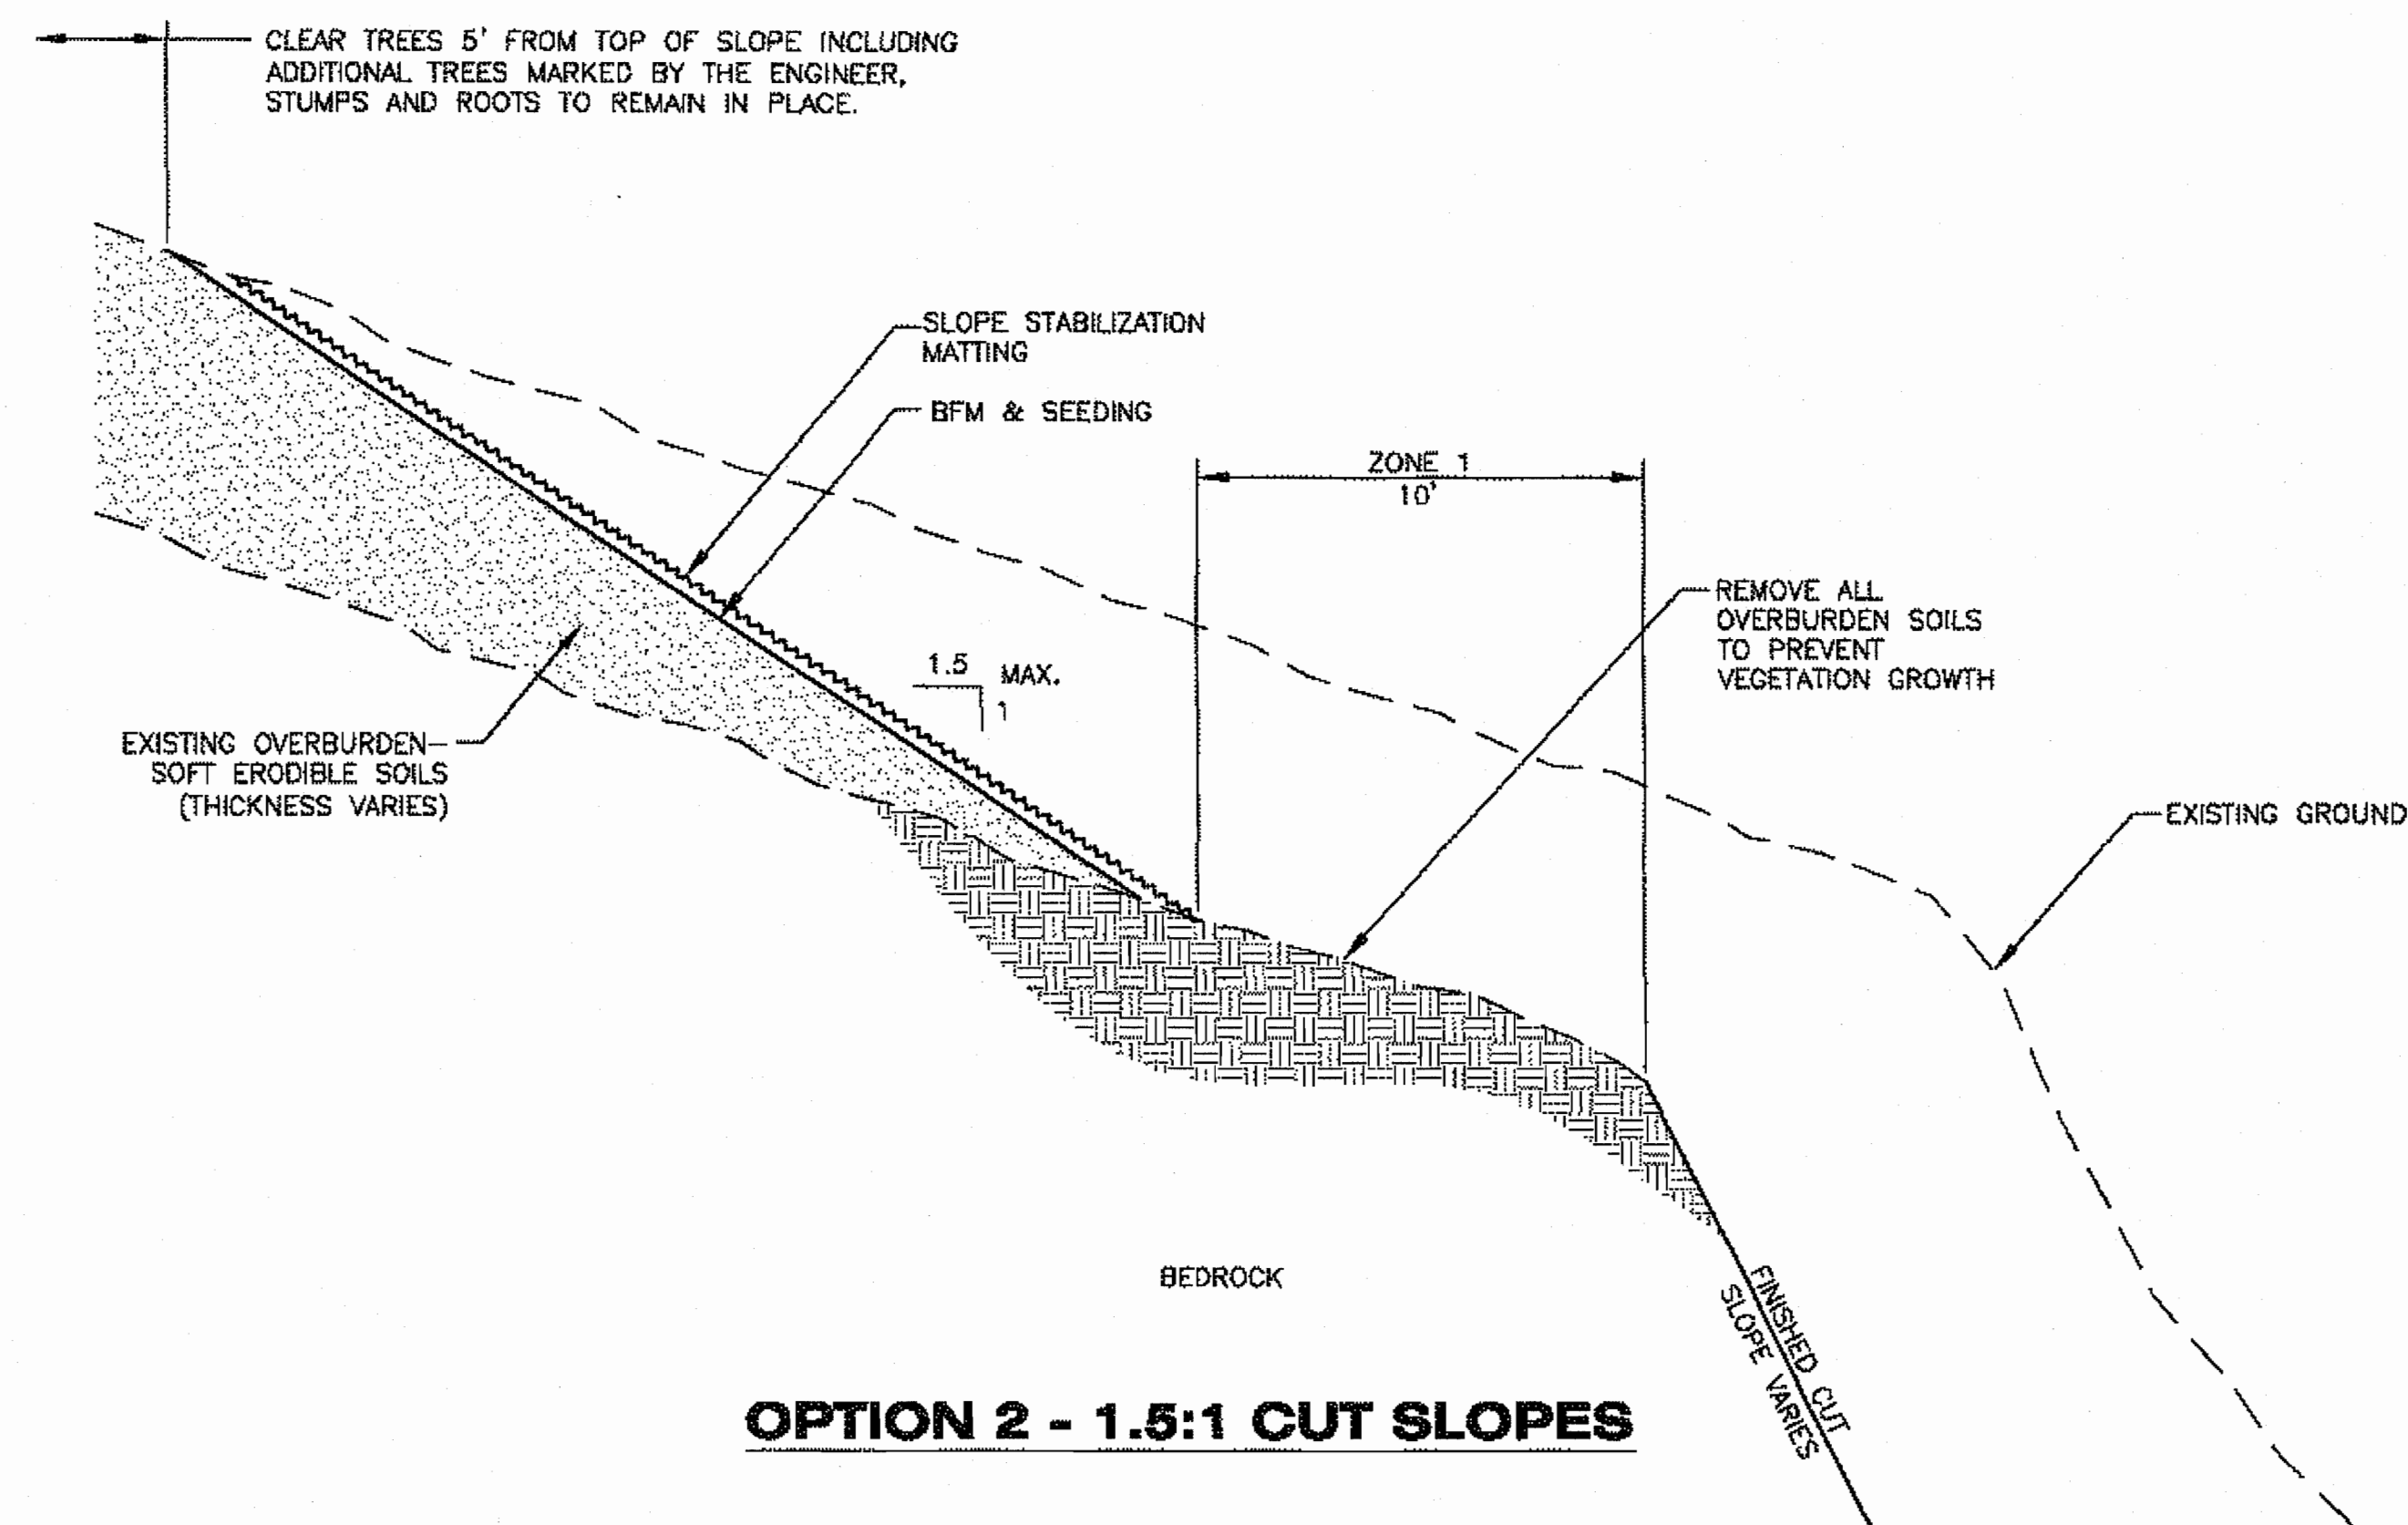

OPTION 2 - 1.5:1 CUT SLOPES

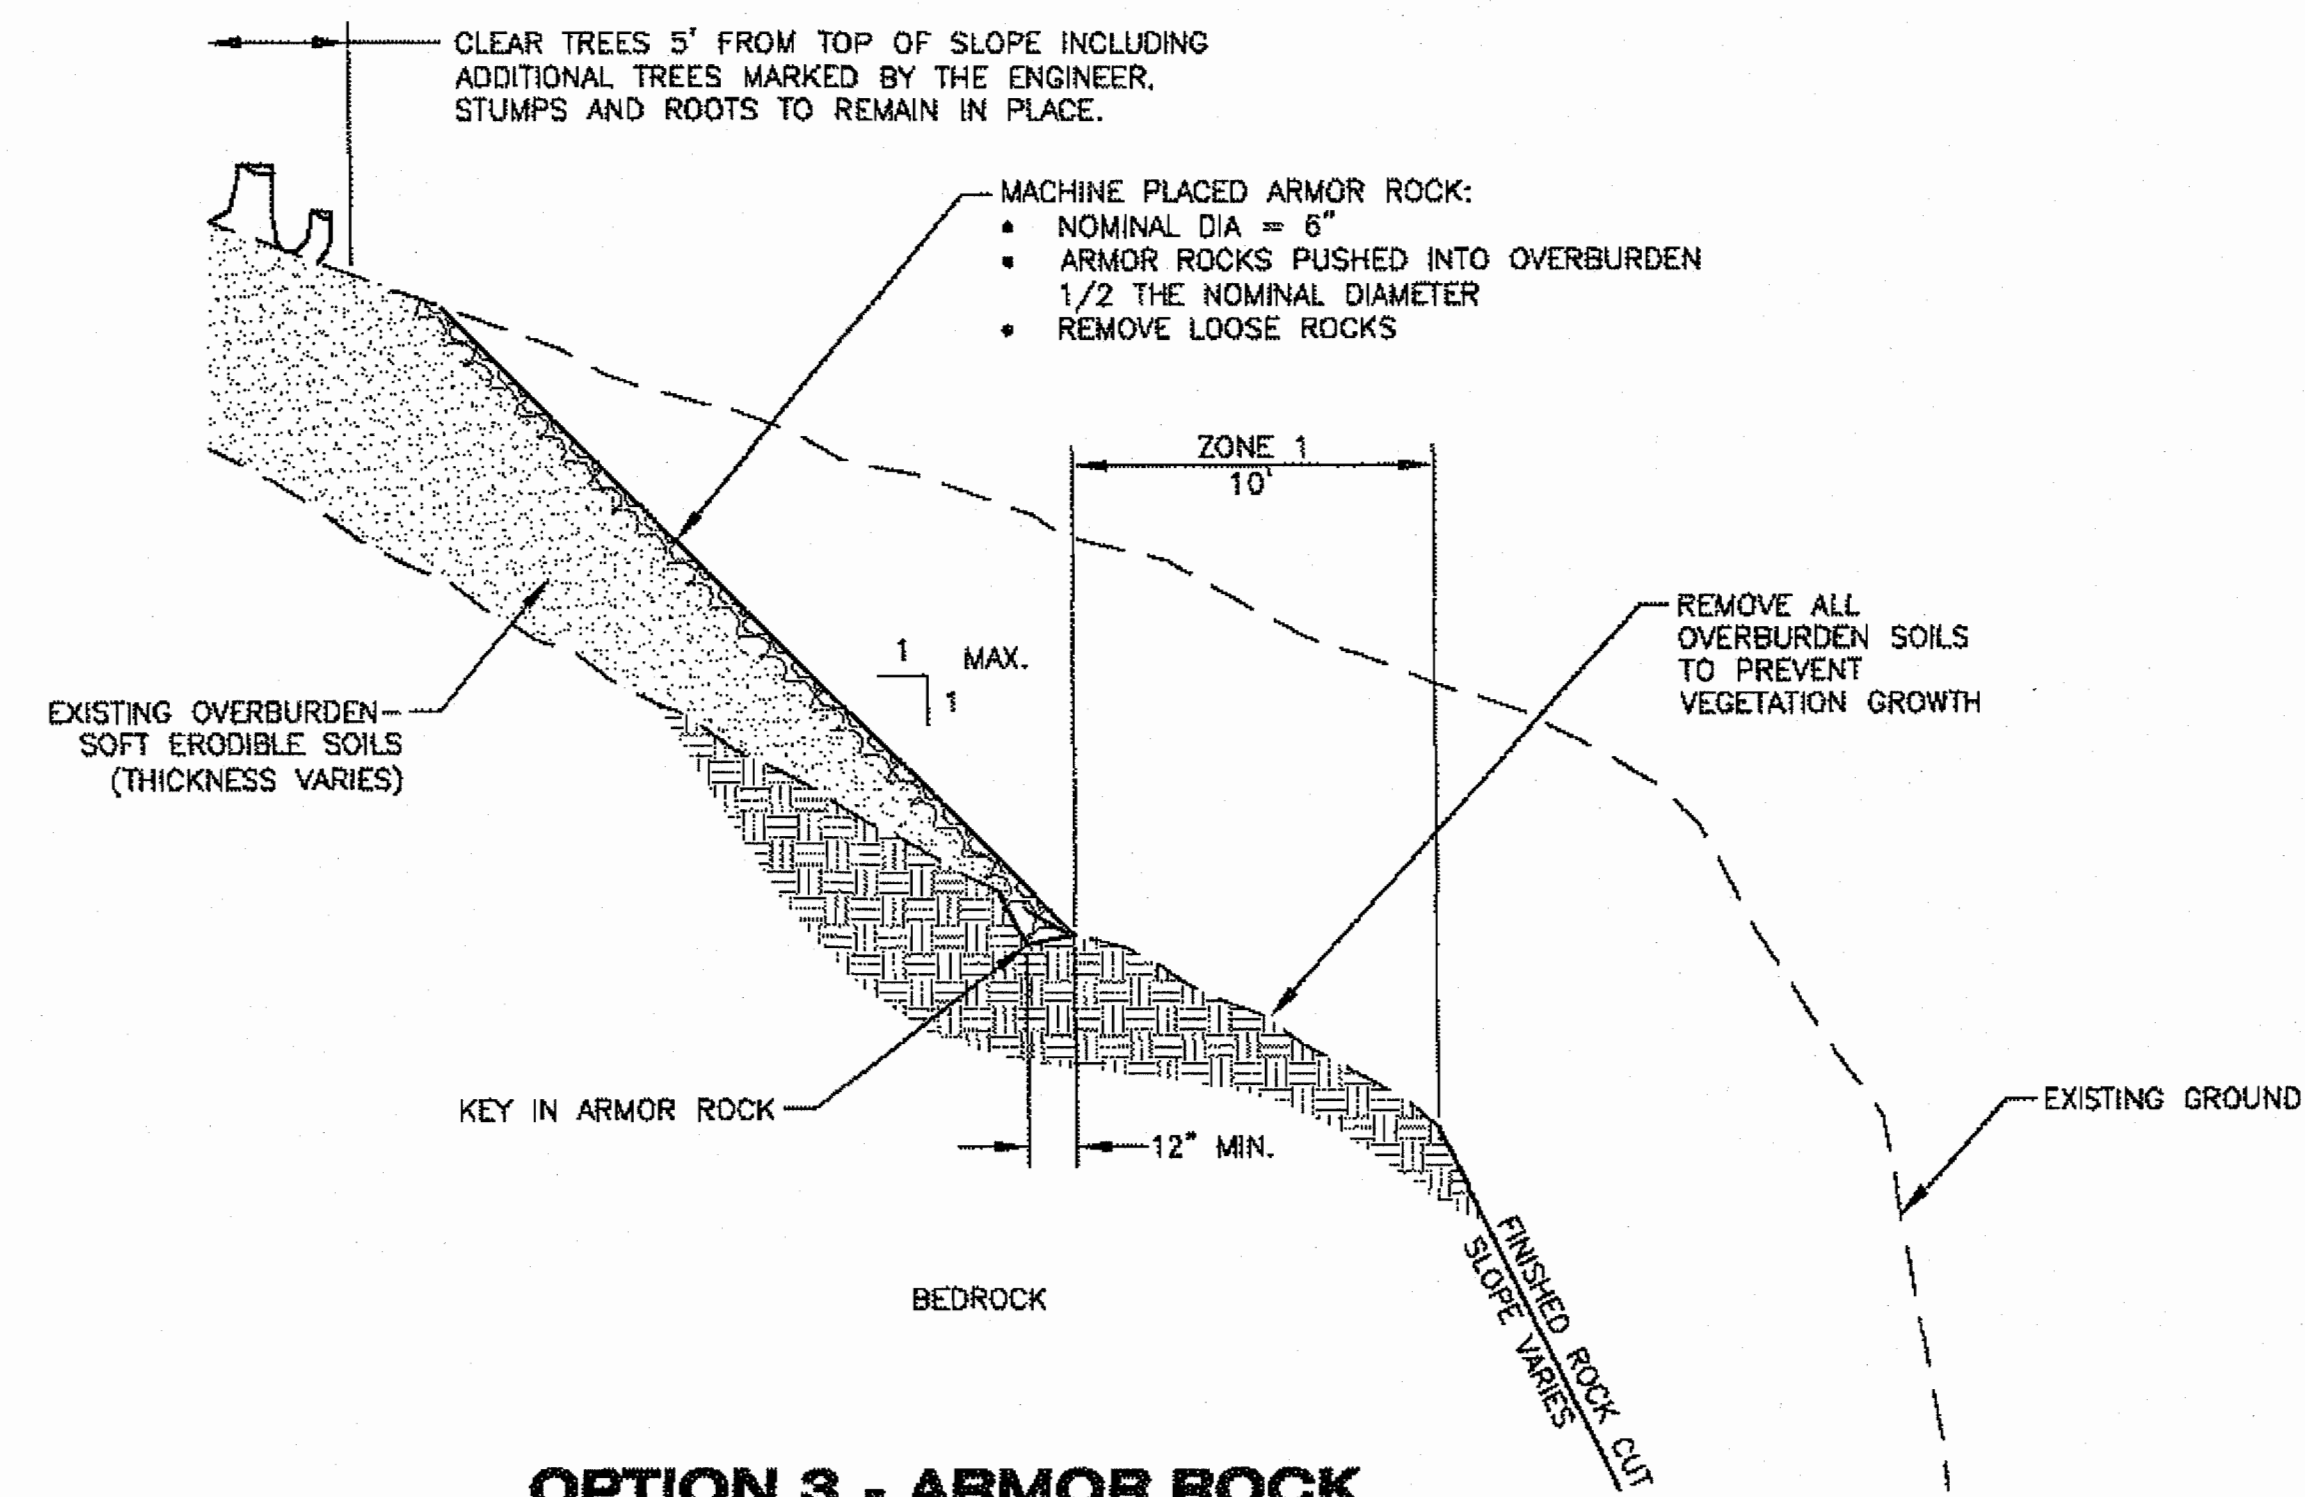

OPTION 3 - ARMOR ROCK

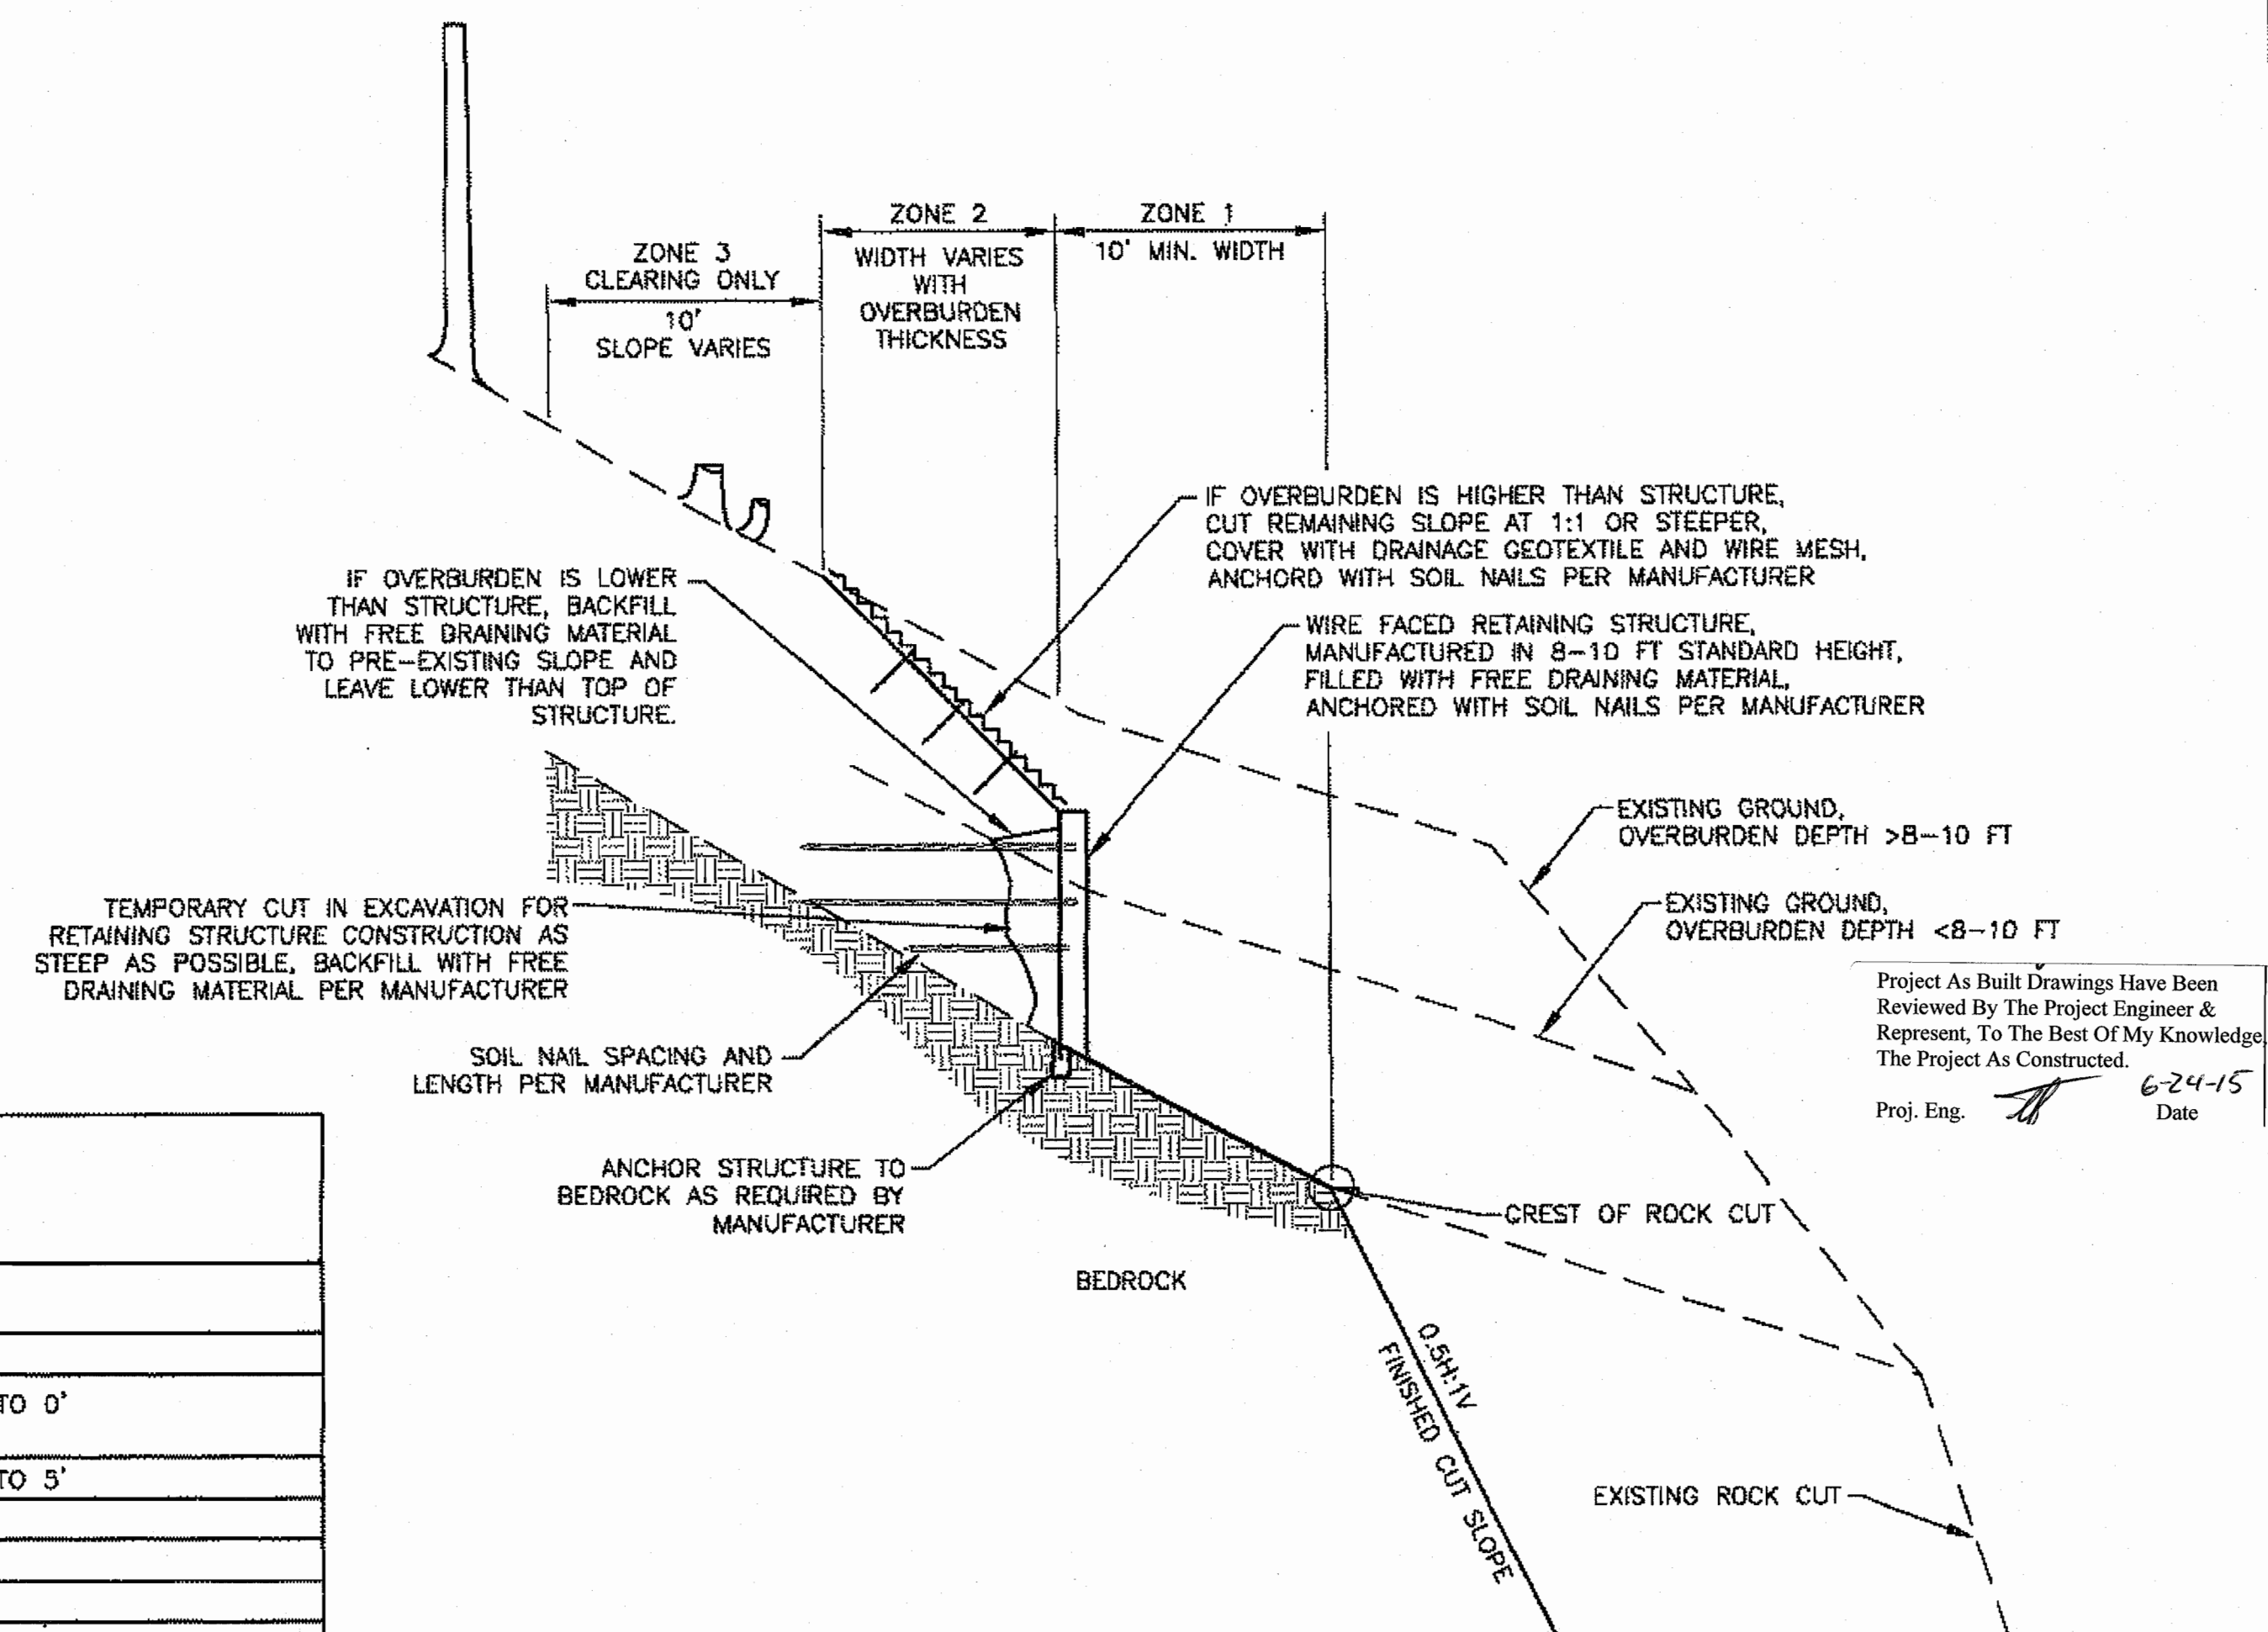

OPTION 4 - SOIL NAIL SLOPES

OPTION 4 TO BE USED WHEN DIRECTED BY THE ENGINEER AND WHEN
OPTION 3 REQUIRES SLOPE LENGTHS GREATER THAN 20± FEET FOR ZONE 2

TABLE 1-B5 APPLICATION OF OVERBURDEN SOIL TREATMENT OPTIONS							
BEGIN STATION	END STATION	OPTION	REMARKS	BEGIN STATION	END STATION	OPTION	REMARKS
204+40	205+15	1		216+60	217+50	2	
205+25	206+25	4		219+00	222+75	3	THE WIDTH OF ZONE 1 IS REDUCED TO 0' FROM STA. 220+15 TO STA. 221+20
206+25	208+40	3		222+00		3	THE WIDTH OF ZONE 1 IS REDUCED TO 5'
208+00		-	MODIFY ZONE WIDTHS TO MATCH BEDROCK OUTCROP	222+75	223+10	2	
210+80	211+75	1		223+10	227+75	1	
211+75	212+75	3		227+75	230+75	3	
212+50		3	THE WIDTH OF ZONE 1 IS REDUCED TO 0'	233+75	234+50	1	THE WIDTH OF ZONE 1 IS REDUCED TO 0' FOR THIS REGION
212+75	213+25	4		237+60	238+30	1	THE WIDTH OF ZONE 1 IS REDUCED TO 0' FOR THIS REGION
213+25	214+35	3		256+40	257+40	2	
214+00		3	THE WIDTH OF ZONE 1 IS REDUCED TO 7'				
214+35	216+20	2					

SEE SHEET B4 FOR NOTES

DO NOT SCALE FROM THESE DRAWINGS USE DIMENSIONS

AS BUILT

Item No	Pay Item	Pay Unit	* Quantity
201(3B)	Clearing and Grubbing	Lump Sum	All Required
202(1)	Removal of Structures and Obstructions	Lump Sum	All Required
202(2)	Removal of Pavement	Square Yard	33,848 34,700
202(3)	Removal of Sidewalk	Square Yard	144
202(4)	Removal of Culvert Pipe	Linear Foot	2,688
202(6)	Removal of Manhole	Each	1
202(8)	Removal of Inlet	Each	7
202(9)	Removal of Curb and Gutter	Linear Foot	555
202(13)	Removal of Boardwalk	Linear Foot	396 768
202(14)	Removal of Fence	Linear Foot	916 1,874
203(3B)	Unclassified Excavation	Lump Sum	130,980
203(5)(C)	Borrow, Type A SELECT MATERIAL, TYPE A	Cubic Yard	4,000 500
203(10)/203(10)	Controlled Blasting / MODIFIED BLASTING TIME	Linear Foot / Each	36,716 56,400
203(11A)	Ditchline/Subgrade Blasting	Square Yard	4,600
203(12)	Drain Holes	Linear Foot	2,429 4,600
203(19A)	Ditch Reconditioning	Linear Foot	3,085
203(20)	Backfill Culvert Pipe in-Place	Lump Sum	All Required
203(22)	Pre Blast Survey	Each	6 12
203(23)	Contractor's Blasting Consultant	Lump Sum	All Required
205(5)	Porous Backfill Material, Type II	Cubic Yard	330 500
207(1)	Rock Bolt	Each	10
207(2)	Rock Dowel	Each	10
301(1)/301(1A)	Aggregate Base Course, Grading D-1	Ton	15,719 17,453
308(1)	ATB	Ton	5,400
401(1)	Asphalt Concrete, Type II, Class B	Ton	5,072 4,500
401(2)	Asphalt Cement, Grade PG 58-28	Ton	555
401(6)	Asphalt Price Adjustment	Contingent Sum	All Required
401(10)	Asphalt Material Price Adjustment	Contingent Sum	All Required
402(1)	STE-1 Asphalt for Tack Coat	Ton	16
501(9)	Drill and Bond Dowels	Each	160
501(10)	Class R Concrete	Lump Sum	All Required
503(2)	Epoxy-Coated Reinforcing Steel	Lump Sum	All Required
506(10)	Reconstruction of Boardwalk	Lump Sum	All Required
511(1)	Mechanically Stabilized Earth Wall	Square Foot	12,750 11,000
514(1)	SNS Stabilization	Square Foot	2,000
515(1)	Concrete Splash Apron	Each	1 2
603(17-12)	12 Inch Pipe	Linear Foot	35
603(17-18)	18 Inch Pipe	Linear Foot	1,277
603(17-24)	24 Inch Pipe	Linear Foot	1,400

104 (1) DIFFERING SITE CONDITIONS

Lump Sum All Required (C.O.#5)

(C.O.#4)
Addendum #6
ITEM NOT USED

(C.O.#4)
ITEM NOT USED

(C.O.#4)
ITEM NOT USED

Addendum #6
ITEM NOT USED

ITEM NOT USED

632 (TWA#F/C.O.#4)

ITEM NOT USED

Item No	Pay Item	Pay Unit	* Quantity
603(17-30)	30 Inch Pipe	Linear Foot	391
603(17-36)	36 Inch Pipe	Linear Foot	187
603(17-42)	42 Inch Pipe	Linear Foot	121
604(1A)	Storm Sewer Manhole, Type I	Each	1
604(4)	Adjust Existing Manhole	Each	2 0
604(5)	Inlet Type A	Each	26
606(1)	W-Beam Guardrail	Linear Foot	3,654
606(6)	Removing and Disposing of Guardrail	Linear Foot	5,827
606(12)	Guardrail/Bridge Rail Connection	Each	8
606(13)	Parallel Guardrail Terminal	Each	12 16
607(10)	Removable Bollard	Each	4
608(1A)	Concrete Sidewalk, 4 Inches Thick	Square Yard	220
608(3)	Asphalt Sidewalk	Square Yard	9,880
608(6)	Curb Ramp	Each	13
609(2)	Curb and Gutter, Type 1	Linear Foot	12,069
611(1A)	Riprap, Class I	Cubic Yard	577 900
611(1B)	Riprap, Class II	Cubic Yard	1,000
611(1C-D)	Riprap, Class III	Lump Sum	All Required 7,500
611(5)	Armor Rock	Cubic Yard	300
614(2)	Concrete Barrier for Top of Walls	Linear Foot	947 984
614(3)	Rock Fall Barrier	Linear Foot	501
615(1)	Standard Sign	Square Foot	144
615(2)	Remove and Relocate Existing Sign	Each	17
615(5)	Delineator, Flexible	Each	120 140
615(6)	Salvage Sign	Each	10 14
618(1)	Seeding	Acre	0.2 2.5
619(2)	Matting	Square Yard	77 6,700
619(3)	Matting, Type 4	Square Yard	412 3,000
619(4)	Bonded Fiber Matrix (BFM)	Pound	778 10,400
620(1)	Topsoil	Square Yard	522 10,400
621(1)	Tree	Each	6
622(20)	Precast Concrete Bench	Each	2
622(21)	Precast Concrete Picnic Table	Each	1
625(1A)	Pipe Hand Rail	Linear Foot	1,345
625(1B)	Pipe Rail on Retaining Wall Barrier	Linear Foot	954
627(6)	Fire Hydrant Relocation	Each	2
627(10)	Adjustment of Valve Box	Each	9
627(11)	Relocate Drain Port Assembly	Each	1
630(1)	Geotextile, Separation, Class IV	Square Yard	75 5,000

* NOTE: FINAL QTY. IN RED

Project As Built Drawings Have Been Reviewed By The Project Engineer & Represent, To The Best Of My Knowledge The Project As Constructed.
Proj. Eng. *[Signature]* 6-24-15
Date


PATH: \\JANUFILE2\JOBS\1153805\DWG\SC\1\SHEETS\SC01-C02		
TAB: C01		
ADDENDUM NUMBER		
ATTACHMENT NUMBER		
RECORD OF REVISIONS		
No.	DATE	DESCRIPTION

SAWMILL CREEK ROAD UPGRADE
PHASE III - WHALE PARK TO SAWMILL CREEK BRIDGE
68216MSG-STP-0933(21)
SITKA TELECOMMUNICATIONS CONDUIT
RSA NO. 69615

ESTIMATE OF QUANTITIES

PREPARED BY: USKH

CHECKED BY: NCL

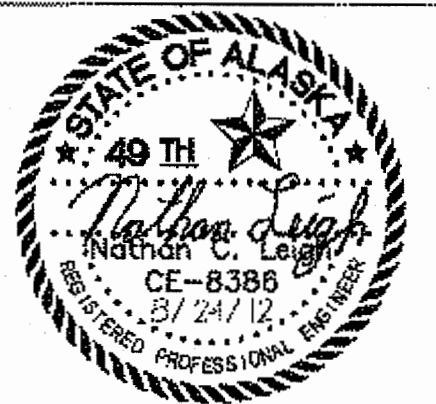

DESIGNED BY: NCL

DRAWN BY: WJP

STATE OF ALASKA
DEPARTMENT OF TRANSPORTATION
& PUBLIC FACILITIES
SOUTHEAST REGION

ESTIMATE OF QUANTITIES

PROJECT DESIGNATION
68216MSG-STP-0933(21)

STATE	YEAR
ALASKA	2012
SHEET NUMBER	TOTAL SHEETS
C1	109

DO NOT SCALE FROM THESE DRAWINGS USE DIMENSIONS

AS BUILT

Item No	Pay Item	Pay Unit	* Quantity
632(1)	Paving Fabric	Square Yard	828 846
633(1)	Silt Fence	Linear Foot	1,100
633(2)	Sediment Barrier	Linear Foot	5,298 4,636
634(1)	Geogrid, Type Biaxial	Square Yard	7,410 ITEM NOT USED
635(1)	Insulation Board	MBM	1.171 4
639(10)	Driveway / Approach	Each	17
640(1)	Mobilization and Demobilization	Lump Sum	All Required
640(4)	Worker Meals and Lodging, or Per Diem	Lump Sum	All Required
641(1)	Erosion, Sediment and Pollution Control Administration	Lump Sum	All Required
641(3)	Temporary Erosion, Sediment and Pollution Control	Contingent Sum	All Required
641(5)	Temporary Erosion, Sediment and Pollution Control Additives	Contingent Sum	All Required
641(6)	Withholding	Contingent Sum	All Required
641(7)	SWPPP Manager	Lump Sum	All Required
641(8)	Temporary Sawmill Creek Diversion	Lump Sum	All Required
641(9)	Check Dam	Each	28 461
641(10)	Rock Filter Dam	Each	1 99
641(11)	Temporary BFM	Pound	592 2,400
641(12)	Temporary Seeding	Square Yard	1,200
641(13)	Culvert Bypass	Each	2 ITEM NOT USED
641(14)	Slope Drain	Each	2
641(15)	Catch Basin Insert	Each	9 42
641(16)	Gravel Filter Berm	Linear Foot	1,400
641(17)	Interception/Diversion Ditch	Linear Foot	500
641(18)	Plastic Covering	Square Yard	300
641(19)	Portable Sediment Tank	Lump Sum	4 ITEM NOT USED
642(1)	Construction Surveying	Lump Sum	All Required
642(3)	Three Person Survey Party	Hour	200
642(4)	Set Primary Monument	Each	28 2
643(2)	Traffic Maintenance	Lump Sum	All Required
643(3)	Permanent Construction Signs	Lump Sum	All Required
643(15)	Flagging	Contingent Sum	All Required
643(23)	Traffic Price Adjustment	Contingent Sum	All Required
643(25)	Traffic Control	Contingent Sum	All Required
644(1)	Field Office	Lump Sum	All Required
644(6)	Vehicles	Lump Sum	All Required
645(1)	Training Program, 2 Trainees/Apprentices	Hour	950 4,000 ADDENDUM #6
646(1)	CMP Scheduling	Lump Sum	All Required
662(1)	Communications Conduit and Vault System Installation	Lump Sum	All Required
670(1)	Painted Traffic Markings	Lump Sum	All Required
670(6)	Recessed Pavement Marker	Each	190 183

* NOTE: FINAL QTY. IN RED

ITEM NOT USED

ITEM NOT USED

ITEM NOT USED

ITEM NOT USED

ADDENDUM #6

Project As Built Drawings Have Been
Reviewed By The Project Engineer &
Represent, To The Best Of My Knowledge
The Project As Constructed.
Proj. Eng. *[Signature]* 6-24-15
Date


PATH: \\UNUFILE2\JOBS\1153805\DWG\SCIS\SHEETS\SC01-C02		
TAB: C02		
ADDENDUM NUMBER		
ATTACHMENT NUMBER		
RECORD OF REVISIONS		
No.	DATE	DESCRIPTION

SAWMILL CREEK ROAD UPGRADE
PHASE III - WHALE PARK TO SAWMILL CREEK BRIDGE
68216\MSG-STP-0933(21)
SITKA TELECOMMUNICATIONS CONDUIT
RSA NO. 69615

ESTIMATE OF QUANTITIES

PREPARED BY: USKH

CHECKED BY: NCL

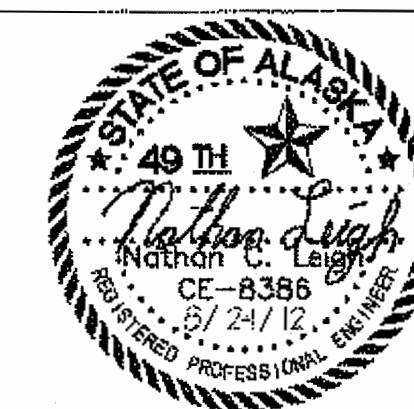

DESIGNED BY: NCL

DRAWN BY: WJP

STATE OF ALASKA
DEPARTMENT OF TRANSPORTATION
& PUBLIC FACILITIES
SOUTHEAST REGION

ESTIMATE OF QUANTITIES

PROJECT DESIGNATION
68216\MSG-STP-0933(21)

STATE	YEAR
ALASKA	2012
SHEET NUMBER	TOTAL SHEETS
C2	109

DO NOT SCALE FROM THESE DRAWINGS USE DIMENSIONS

Table with 4 columns: BEGIN STATION, END STATION, QUANTITY, REMARKS. Title: 207(2) ROCK DOWEL - EACH. Includes a note: NOTE: CREST DOWELS AS CALLED OUT ON PLANS ARE PAID FOR UNDER THIS ITEM.

Table with 6 columns: WALL NO., BEGIN STATION, BEGIN OFFSET, END STATION, END OFFSET, QUANTITY, REMARKS. Title: 511(1) MECHANICALLY STABILIZED EARTH WALL - SQUARE FOOT.

Table with 6 columns: BEGIN STATION, BEGIN OFFSET, END STATION, END OFFSET, QUANTITY, REMARKS. Title: 514(1) SNS STABILIZATION - SQUARE FOOT.

Main table with 14 columns: PIPE NO., LENGTH AND SIZE (603(17-12) 12", 603(17-18) 18", 603(17-24) 24", 603(17-30) 30", 603(17-36) 36", 603(17-42) 42"), INLET (STATION, OFFSET, INVERT ELEVATION), OUTLET (STATION, OFFSET, INVERT ELEVATION), GRADE (FT./FT.), REMARKS. Includes handwritten notes: 'Deleted', 'Added by Directive #7', 'HSE wall #1'. Includes a note at the bottom: 'LOCATION OF EXISTING UTILITIES ARE UNKNOWN. EXISTING CULVERTS ARE TO BE REPLACED AT THE SAME LINE AND GRADE WHICH SHOULD NOT HAVE CONFLICTS WITH THE EXISTING UTILITIES. NOTIFY THE ENGINEER IF ANY CONFLICTS ARISE.'


Table with 3 columns: No., DATE, DESCRIPTION. Title: RECORD OF REVISIONS.

SAWMILL CREEK ROAD UPGRADE
PHASE III - WHALE PARK TO SAWMILL CREEK BRIDGE
68216MSG-STP-0933(21)
SITKA TELECOMMUNICATIONS CONDUIT
RSA NO. 69615

SUMMARY TABLES

PREPARED BY: USK-H

CHECKED BY: NCL

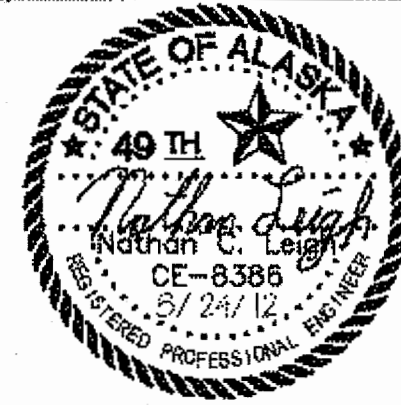

DESIGNED BY: NCL

DRAWN BY: WJP

STATE OF ALASKA
DEPARTMENT OF TRANSPORTATION
& PUBLIC FACILITIES
SOUTHEAST REGION

SUMMARY TABLES

Table with 2 columns: STATE, YEAR. Title: PROJECT DESIGNATION. Includes: 68216MSG-STP-0933(21), ALASKA, 2012, D2, 109.

DO NOT SCALE FROM THESE DRAWINGS USE DIMENSIONS

604 (1A) (5) STORM SEWER MANHOLE, TYPE I, AND INLET, TYPE A - EACH							
STRUCTURE NO.	STRUCTURE TYPE	STATION	OFFSET	RIM ELEVATION	TYPE OF CASTING	REMARKS	
	604(1A) STORM DRAIN MANHOLE TYPE I	604(5) STORM DRAIN INLET TYPE A					
S-01	X	180+25.00	16.00 RT	78.77	GCCI	ADDED INLET	
S-02	X	197+50.00	16.00 RT	50.17	GCCI		
S-03	X	204+40.00	16.00 RT	33.00	GCCI		
S-04	X	212+75.00	16.00 RT	24.14	GCCI		
S-05	X	215+50.00	16.00 RT	25.34	GCCI		
S-06	X	220+50.00	16.00 RT	30.91	GCCI		
S-07	X	225+00.00	16.00 RT	38.24	GCCI		
S-09	X	232+00.00	67.76 RT	38.63	GCCI		
S-10	X	244+50.00	16.00 RT	46.16	GCCI	Relocated	
S-11	X	247+50.00	16.00 RT	43.46	GCCI	ADDED INLET	
S-12	X	248+75.00	20.50 LT	40.51	GCCI		
S-13	X	252+83.10	16.00 RT	31.51	GCCI		
S-14	X	253+65.94	35.44 RT	28.84	GIFG		
S-15	X	256+25.00	16.00 RT	28.24	GCCI		
S-26	X	269+43.56	28.00 RT	26.07	GCCI		
S-27	X	260+31.34	24.00 RT	27.34	GCCI		
S-28	X	261+19.04	24.00 RT	29.38	GCCI		
S-29	X	262+00.00	50.00 RT	30.47	FIFG		
S-30	X	262+63.77	16.00 RT	33.37	GCCI		
S-31	X	263+84.93	16.00 RT	36.93	GCCI		
S-32	X	265+29.00	16.00 RT	41.55	GCCI		
S-33	X	267+83.11	16.00 RT	45.16	GCCI		
S-34	X	272+82.75	16.00 RT	43.83	GCCI		
S-35	X	273+91.37	16.00 RT	40.37	GCCI		
S-36	X	275+00.00	16.00 RT	36.56	GCCI		
S-37	X	275+82.17	16.00 RT	33.78	GCCI		
S-38	X	208+39.68	22.57 LT	26.38	FIFG		
TOTAL:	1	26					

FIFG = FIELD INLET FRAME AND GRATE, MHFL = MANHOLE FRAME AND LID,
GCCI = GRATE AND CURB BOX INLET, GIFG = GUTTER INLET FRAME AND GRATE

604(4) ADJUST EXISTING MANHOLE - EACH		
STATION	OFFSET	REMARKS
229+58.00	19.00 RT	
253+67.27	26.92 RT	INSTALL GRATE AND CURB BOX INLET
254+29.49	62.26 RT	REGRADE AREA TO DRAIN AS NEEDED - N.A. -
254+63.00	63.81 RT	N.A. -
254+64.78	88.84 RT	N.A. -
258+03.68	85.13 RT	
TOTAL:	2	

606(1) W-BEAM GUARDRAIL - LINEAR FOOT				
BEGIN STATION	END STATION	OFFSET	QUANTITY	REMARKS
185+53.20	186+78.65	RT	57.42	
188+64.35	189+20.00	RT	0	CONNECT TO RETAINING WALL TRAFFIC BARRIER
191+19.80	208+80.67	RT	1790.17	CONNECT TO RETAINING WALL TRAFFIC BARRIER
210+80.25	222+50.00	RT	1141.75	
226+49.14	228+99.89	RT	170.277	
233+64.19	236+48.31	RT	128.227	
241+04.35	241+60.00	RT	0	
247+28.00	250+95.80	RT	337.329	CONNECT TO RETAINING WALL TRAFFIC BARRIER
258+72.03	270+93.90	RT	138	DELETED
273+88.91	275+83.88	RT	108	DELETED
TOTAL:			3004.37	

NOTE: STATION GIVEN AT TERMINAL ENDS.
QUANTITY DOES NOT INCLUDE LENGTH OF TERMINALS ASSUMED AT 37.5 FEET.
QUANTITY DOES NOT INCLUDE LENGTH OF GUARDRAIL/BIDGE RAIL CONNECTION ASSUMED AT 18.15 FEET.

606(6) REMOVING AND DISPOSING OF GUARDRAIL - LINEAR FOOT				
BEGIN STATION	END STATION	OFFSET	QUANTITY	REMARKS
185+38	186+68	RT	142.146	
188+60	194+14	RT	598.588	
196+19	214+49	RT	1889.163	
215+13	228+82	RT	1384.370	
233+66	238+66	RT	518.324	
241+28	250+96	RT	972.8	
268+72	270+94	RT	218.8	
273+90	276+15	RT	281.278	
275+33	276+02	LT	68.70	
TOTAL:			5,827.61	

606(12) GUARDRAIL/BIDGE RAIL CONNECTION - EACH		
BEGIN STATION	OFFSET	REMARKS
189+20.00	RT	
191+10.50	RT	
208+60.00	RT	
210+80.25	RT	
241+60.00	RT	
245+32.56	LT	
247+20.00	RT	
250+44.35	LT	
TOTAL:	8	

NOTE: STATION GIVEN AT POINT OF CONNECTION TO BARRIER.
MEASUREMENT / PAY LENGTH OF CONNECTION IS 18.15 FEET.

606(13) PARALLEL GUARDRAIL TERMINAL - EACH		
STATION	OFFSET	REMARKS
185+53.20	RT	
186+75.06	RT	
188+64.35	RT	
222+50.00	RT	
227+48.14	RT	
229+83.93	RT	
233+64.13	RT	
236+48.31	RT	
241+04.35	RT	
244+76.91	LT	
250+95.80	RT	
251+00.00	LT	
258+72.03	RT	DELETED
270+93.90	RT	"
273+88.91	RT	"
275+83.88	RT	"
TOTAL:	18	

NOTE: STATION GIVEN AT TERMINAL ENDS. LENGTH OF TERMINALS ASSUMED AT 37.5 FEET.

607(10) REMOVABLE BOLLARD - EACH		
STATION	OFFSET	REMARKS
237+53	27 RT	
237+57	27 RT	
240+88	27 RT	
240+92	27 RT	
TOTAL:	4	

608(6) CURB RAMP - EACH			
STATION	OFFSET	TYPE	REMARKS
232+17.46	87.85 RT	PARALLEL	
253+11.70	33.84 RT	PARALLEL	
263+68.09	30.98 RT	PARALLEL	
257+82.92	31.83 RT	PARALLEL	
258+43.85	32.55 RT	PARALLEL	
261+79.62	80.97 RT	PARALLEL	
262+26.88	20.00 RT	PARALLEL	
262+55.69	20.00 RT	PARALLEL	
263+28.05	29.47 LT	PARALLEL	
265+00.00	20.00 RT	PARALLEL	RELINQUISHED TO HIGHWAY DEPARTMENT
265+36.41	21.00 RT	PARALLEL	RELINQUISHED TO HIGHWAY DEPARTMENT
276+11.70	31.82 RT	PARALLEL	
276+49.11	28.30 RT	PARALLEL	
TOTAL:	13		

NOTE: STATION AND OFFSET REFERENCE POINT IS THE MIDDLE OF LANDING AT FLOWLINE

Project As Built Drawings Have Been
Reviewed By The Project Engineer &
Represent, To The Best Of My Knowledge,
The Project As Constructed.
Proj. Eng. *[Signature]* Date 6-24-15

PATH: \\JUNIFILE\Z\JOBS\1153805\DWG\CS\CS\SHEETS\SD01.DWG

TAB: D3

ADDENDUM NUMBER

ATTACHMENT NUMBER

RECORD OF REVISIONS

No.	DATE	DESCRIPTION

SAWMILL CREEK ROAD UPGRADE
PHASE III - WHALE PARK TO SAWMILL CREEK BRIDGE
68216MSG-STP-0933(21)
SITKA TELECOMMUNICATIONS CONDUIT
RSA NO. 69615

PREPARED BY: USKH
CHECKED BY: NCL

DESIGNED BY: NCL
DRAWN BY: WJP

STATE OF ALASKA
49th
Nathan C. Leigh
CE-8386
2/24/12
REGISTERED PROFESSIONAL ENGINEER

STATE OF ALASKA
DEPARTMENT OF TRANSPORTATION
& PUBLIC FACILITIES
SOUTHEAST REGION

SUMMARY TABLES

PROJECT DESIGNATION
68216MSG-STP-0933(21)

STATE	YEAR
ALASKA	2012
SHEET NUMBER	TOTAL SHEETS
D3	109

DO NOT SCALE FROM THESE DRAWINGS USE DIMENSIONS

609(2)		CURB & GUTTER, TYPE 1 - LINEAR FOOT			
Begin		End			
Station	Offset	Station	Offset	Qty.	Comments
185+24	69' Rt.	204+40	15' Rt.	1,968.0	To S-3 @ 204+40 Rt.
204+40	15' Rt.	214+22	15' Rt.	983.5	To Begin TOR
214+22	15' Rt.	230+88	19.5' Rt.	1,686.0	To Begin Parking Rt.
230+88	19.5' Rt.	231+58	19.5' Rt.	357.5	To End Parking Rt.
231+58	19.5' Rt.	252+83	16' Rt.	2,129.0	To S-13 @ 252+83 Rt.
252+83	16' Rt.	252+75	75' Rt.	120.0	To Rt. Raduis end
254+83	62' Rt.	257+62	72' Rt.	630.0	To SMC W. Ent. Raduis end
258+66	103' Rt.	262+27	16.5' Rt.	480.0	To SCIP Office Parking Rt.
262+27	16.5' Rt.	262+46	95' Rt.	473.5	To SCIP Office Parking NE Cor.
262+56	20' Rt.	275+82	16' Rt.	1,298.0	To S-37 @ 275+82 Rt.
262+56	20' Rt.	27' Rt.	230.0		To end of 6' paved sidewalk
265+40	16' Rt.	268+19	32' Rt.	184.5	To inside (east) end of curb
275+82	16' Rt.	276+20		59.0	To Rt. Raduis end
276+40	?? Rt.	277+50	15' Rt.	129.0	To end of Crub Rt. (before bridge)
232+00	15' Rt.	232+03	15' Rt.	3.0	Saw Cut for drainage & replaced
233+00	62' Rt.	233+12	58' Rt.	17.0	Removed @ SE Cor. Of parking area
245+33	21' Lt.	250+44	21' Lt.	504.0	Lt. C&G for Rock Fall Barrier
248+71	20.5' Lt.	248+79	20.5' Lt.	8.0	Removed @ S-12/Sta. 248+75 Lt.
257+67	24' Lt.	263+30	32' Lt.	572.0	To Blue Lake Rd.
258+00	31' Lt.	258+64	31' Lt.	64.0	To end Lt. Parking area #1
261+20	31' Lt.	261+85	31' Lt.	64.0	To end Lt. Parking area #2
Total =				12,060.0	

611(1A) RIPRAP CLASS I - CUBIC YARD		
STA. 257+63 TO STA. 266+00		300 577
TOTAL:		300 577

611(1B) RIPRAP CLASS II - CUBIC YARD		
FOR CULVERT OUTLET SPILLWAY PROTECTION		
NUMBER OF LOCATIONS	VOLUME PER LOCATION	QUANTITY
20	50	1,000
	TOTAL:	1,000

64 (10-D) RIPRAP CLASS III - Lump Sum - CO #4			
64 (10-D) RIPRAP CLASS III, FOR SLOPE REHABILITATION - CUBIC			
YARD Lump Sum			
STATION	OFFSET	QUANTITY	REMARKS
200+87.50	-	0	
201+00.00	61.88' RT	23	
201+50.00	59.82' RT	275	
202+00.00	59.04' RT	278	
202+50.00	56.57' RT	292	
203+00.00	55.16' RT	350	
203+50.00	54.1' RT	360	
204+00.00	53.84' RT	311	- Lump Sum -
204+50.00	53.32' RT	298	
205+00.00	56.62' RT	265	
205+50.00	56.32' RT	266	
206+00.00	52.16' RT	257	
206+50.00	51.31' RT	243	REGION 1
207+00.00	50.47' RT	272	
207+50.00	50.66' RT	292	
208+00.00	50.69' RT	221	
208+50.00	50.31' RT	249	
209+00.00	49.01' RT	281	
209+50.00	34.55' RT	252	
210+00.00	35.17' RT	325	
210+50.00	39.03' RT	293	
211+00.00	41.4' RT	253	
211+50.00	40.7' RT	220	
211+62.60	-	34	
215+87.50	-	0	
216+00.00	46.98' RT	20	
216+50.00	48.59' RT	317	
217+00.00	51.34' RT	397	
217+50.00	48.57' RT	230	REGION 2
218+00.00	46.44' RT	167	
218+50.00	47.28' RT	90	
219+00.00	47.82' RT	183	
219+50.00	-	120	
	TOTAL:	7,500	

611(5) ARMOR ROCK - CUBIC YARD			
BEGIN STATION	END STATION	QUANTITY	REMARKS
205+15	208+40	124	
211+75	214+35	102	
219+00	222+00	31	
227+75	229+50	43	
	TOTAL	300	

614(2) CONCRETE BARRIER FOR TOP OF WALLS - LINEAR FOOT					
BEGIN		END		QUANTITY	REMARKS
STATION	OFFSET	STATION	OFFSET		
189+20.00	RT	191+10.50	RT	191	197.5
208+60.00	RT	210+80.25	RT	209	194.8
241+60.00	RT	247+20.25	RT	266	537.2
TOTAL:				666	947.6

614(3) ROCK FALL BARRIER - LINEAR FOOT				
BEGIN STATION	END STATION	OFFSET	QUANTITY	REMARKS
245+32	250+45	1 FT	901.57	

EXISTING LOCATION		PROPOSED LOCATION		REMARKS
STATION	OFFSET	STATION	OFFSET	
-	-	260+06	39 RT	TRANSPLANT <i>NEW</i>
260+58	62 RT	260+00	40 RT	NEW
260+31	66 RT	261+85	98 RT	TRANSPLANT <i>NEW</i>
-	-	260+80	77 RT	NEW
261+61	73 RT	262+11	104 RT	TRANSPLANT <i>NEW</i>
261+65	81 RT	262+34	108 RT	TRANSPLANT <i>NEW</i>
TOTAL:	6 ✓			

TRANSPLANT EXISTING TREES WHEN POSSIBLE. INSTALL NEW TREE OF SAME SPECIES IF UNABLE TO TRANSPLANT EXISTING TREE.

625(1A)		PIPE HAND RAIL -- LINEAR FOOT			
BEGIN		END			
STATION	OFFSET	STATION	OFFSET	QUANTITY	COMMENTS
68+00	Rt.	70+25	Rt.	225.0	
81+00	Rt.	82+44	Rt.	144.0	
83+75	Rt.	84+57	Rt.	82.0	
84+75	Rt.	85+98	Rt.	123.0	
90+70	Rt.	91+50	Rt.	80.0	
95+25	Rt.	97+50	Rt.	225.0	
97+80	Rt.	100+70	Rt.	290.0	
232+80	Rt.	233+35	Rt.	61.6	Paved Parking Area
238+35	Rt.	238+65	Rt.	61.0	Picnic Area Path
239+40	Rt.	239+65	Rt.	40.1	Picnic Area Path
240+40	Rt.	240+70	Rt.	61.4	Picnic Area Path
			Total	1,393.1	

625(1B) PIPE RAIL ON RETAINING WALL BARRIER - LINEAR FOOT					
BEGIN		END		QUANTITY	REMARKS
STATION	OFFSET	STATION	OFFSET		
189+20.00	RT	191+10.50	RT	192.7	181
208+60.00	RT	210+60.25	RT	192.2	200
241+60.00	RT	247+20.25	RT	554.6	500
TOTAL:				941.5	951

NOTE: SEE DETAIL ON SHEET #6

627(6) FIRE HYDRANT RELOCATION - EACH				
FROM		TO		REMARKS
STATION	OFFSET	STATION	OFFSET	
213+78	14 LT	213+78	20 LT	NEEDS ACCESS PAD
261+59	62 RT	261+59	83 RT	
TOTAL:			2	

Project As Built Drawings Have Been Reviewed By The Project Engineer & Represent, To The Best Of My Knowledge, The Project As Constructed.

Proj. Eng.  6-24-15
Date

PATH:
\\UNUFILE2\JOBS\1153805\DWGS\IC\SHEETS\ID01.DWG

TAB: D4

ADDENDUM NUMBER

ATTACHMENT NUMBER

RECORD OF REVISIONS


No.	DATE	DESCRIPTION

SAWMILL CREEK ROAD UPGRADE
PHASE III - WHALE PARK TO SAWMILL CREEK BRIDGE
68216MSG-STP-0933(21)
SITKA TELECOMMUNICATIONS CONDUIT
RSA NO. 69615

SUMMARY TABLES

PREPARED BY: USKH

CHECKED BY: NCL

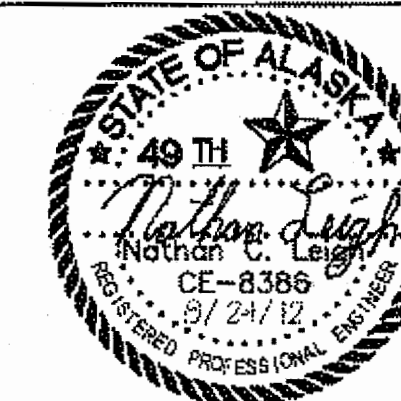

DESIGNED BY: NCL

DRAWN BY: WJP

STATE OF ALASKA
DEPARTMENT OF TRANSPORTATION
& PUBLIC FACILITIES
SOUTHEAST REGION

SUMMARY TABLES

PROJECT DESIGNATION

68216\MSG-STP-0933(21)

STATE	YEAR
ALASKA	2012
SHEET NUMBER	TOTAL SHEETS
D4	109

DO NOT SCALE FROM THESE DRAWINGS USE DIMENSIONS

627(10) ADJUSTMENT OF VALVE BOX - EACH		
STATION	OFFSET	REMARKS
193+51	2 RT	
214+14	2 LT	
229+07	18 LT	
240+12	19 LT	IN FRONT OF AIRVAC ASSEMBLY
255+72	13 LT	
257+99	76 RT	
258+13	28 RT	
258+16	49 RT	
261+65	64 RT	
TOTAL	22	

627(11) RELOCATE DRAIN PORT ASSEMBLY - EACH		
STATION	OFFSET	REMARKS
213+71	13 LT	

624(10) ADJUSTMENT OF VALVE BOX			
STATION	OFFSET	REMARKS	#
213+78.0	11.0 Lt.	Concrete Collar	1
217+06.5	11.0 Lt.	Concrete Collar	2
233+73.0	16.7 Rt.	CBS Blow Off - in path	3
233+76.0	17.5 Rt.	CBS Blow Off - in path	4
240+11.5	18.8 Lt.		5
240+20.5	14.5 Lt.	Edge of pavement	6
254+37.5	65.0 Rt.	CL Valley Gutter	7
254+38.3	17.8 Lt.	In D-1 on shoulder	8
254+42.5	96.8 Rt.	In Approach	9
254+46.5	92.8 Rt.	In Approach	10
255+37.2	16.9 Lt.	In D-1 on shoulder	11
257+99.0	75.7 Rt.	In Approach	12
258+12.5	48.5 Rt.	In Approach	13
258+16.0	49.0 Rt.	In Approach	14
261+65.5	62.0 Rt.	In SCIP parking lot	15
270+83.3	14.8 Lt.	Edge of pavement	16
271+33.1	21.3 Lt.	In D-1 on shoulder	17
273+15.0	19.2 Lt.	5-Valve Cluster	18
273+16.3	24.3 Lt.	5-Valve Cluster	19
273+17.0	20.5 Lt.	5-Valve Cluster	20
273+20.6	20.0 Lt.	5-Valve Cluster	21
273+20.6	24.1 Lt.	5-Valve Cluster	22
TOTAL	22		

632(1) PAVING FABRIC - SQUARE YARD					
BEGIN			END		QUANTITY
STATION	OFFSET		STATION	OFFSET	
189+20.00	RT		191+10.50	RT	169
208+60.00	RT		210+50.25	RT	178
241+50.00	RT		247+20.25	RT	498
TOTAL					845

NOTE: FOR ASPHALT SIDEWALK ALLONG RETAINING WALLS, SEE SHEET H6

634(1) GEOGRID, TYPE BIALXIAL - SQUARE YARD					
BEGIN STATION	END STATION	OFFSET	QUANTITY	REMARKS	
192+42.00	193+74.00	9.5' RT	810		
197+39.00	198+50.00	9.0' RT	920		
202+55.00	202+91.00	9.0' LT	480		
211+45.00	212+63.00	6.5' RT	180		
219+93.00	214+18.00	13.5' RT	170		
225+16.00	226+01.00	13.5' RT	550		
247+64.00	249+49.00	4.0' LT	2340		
250+91.00	251+58.00	16.5' LT	1100		
TOTAL				7,410	

639(10) DRIVEWAY / APPROACH - EACH											
STATION	OFFSET	WIDTH	RADIUS		RADIUS POINT		PAVING LIMIT	GRADING LIMIT	LANDING		REMARKS
			LT	RT	LT	RT			GRADE	LENGTH	
189+94.00	LT	18									
231+22.88	RT										SEE PLAN SHEET F10
253+40.10	RT										SEE INTERSECTION GRADING SHEET G1
258+14.77	RT										SEE INTERSECTION GRADING SHEET G2
258+32.00	LT	24	CURB CUT								SEE TYPICAL SECTION SHEET B3, AND PLAN SHEET F16
261+47.00	LT	24	CURB CUT								SEE TYPICAL SECTION SHEET B3, AND PLAN SHEET F16
262+41.28	RT										SEE PLAN SHEET F16
263+35.00	LT										SEE INTERSECTION GRADING SHEET G3
265+20.00	RT	34					265+72.0 1.82.51 RT	265+72.0 62.51 RT	-2%	12	CENTER ON WAREHOUSE CARGO BAY - RELOCATED TO MATCH CIVIL GUY
270+07.98	LT	28	20	10	270+22.26 35.00 LT	270+78.43 35.00 LT	270+56.06 35.00 LT	270+56.06 35.00 LT	+0.5%	12	RELOCATED - FORTRESS OF THE BEAR EXIT
271+07.98	LT	34	20	20	270+72.74 35.00 LT	271+43.22 35.00 RT	271+07.98 35.00 LT	271+07.98 58.49 LT	-2%	12	FORTRESS OF THE BEAR ENTRANCE
273+10.50	RT	34	CURB CUT								PROVIDE CURB CUT FOR FUTURE DRIVEWAY
273+80.72	LT	34	20	10	273+46.57 35.00 LT	274+06.97 35.00 LT	273+80.72 35.00 LT	273+80.72 59.65 LT	+1.21%	13	
274+26.62	LT	24	10	20	274+06.97 35.00 LT	274+56.16 35.00 LT	274+26.62 35.00 LT	274+26.62 54.93 LT	+2%	12	
275+27.00	LT	28	20	20	274+95.59 35.00 LT	275+88.41 35.00 LT	275+27.00 35.00 LT	275+27.00 63.11 LT	-0.5%	12	
276+20.00	LT	24	20	20	275+90.44 35.00 LT	276+49.56 35.00 LT	276+20.00 35.00 LT	276+20.00 50.74 LT	-0.35%	12	
276+27.63	RT	24	30	25	275+83.88 45.00 RT	276+71.92 40.00 RT	276+32.54 58.82 RT	276+32.54 58.82 RT	-2%	30	MATCH EXISTING ACCESS ROAD
TOTAL		17									

642(4) SET PRIMARY MONUMENT - EACH			
POINT	STATION	OFFSET	REMARKS
31	192+40	RT	
32	196+25	LT	
33	198+99	RT	
34	202+18	LT	
35	207+24	LT	
36	214+37	RT	
37	218+18	LT	
39	230+63	LT	
41	239+76	RT	
42	243+32	LT	
44	256+92	RT	
45	262+62	RT	
46	269+18	LT	
47	273+99	LT	
48	279+82	LT	
303	235+32	RT	
306	223+58	RT	
309	248+43	RT	
336	246+77	LT	
731	188+49	RT	
732	190+74	RT	
1023	248+02	RT	
1024	261+99	RT	
1025	261+99	RT	
TOTAL		24	

NOTES:
1. INSTALL MONUMENT CASE PER DETAIL ON SHEET E10 FOR ALL MONUMENTS IN AC SURFACE.
2. THE LOCATION OF THE PROPOSED CONTROL MONUMENT IS APPROXIMATE. SET PRIMARY MONUMENTS AND CASES IN THE PAVED SHOULDER IN LINE-OF-SIGHT WITH EACH OTHER AND APPROXIMATELY THREE FEET FROM THE EDGE OF PAVEMENT. THE INTENT IS TO PROVIDE A MONUMENTED TRAVERSE LINE FOR THE PROJECT CORRIDOR.

642(4) SET PRIMARY MONUMENT				
POINT	STATION	OFFSET	REMARKS	#
AP 1	186+51	Rt.	In Paved Path by Whale Park	1
AP 2	191+89	Rt.	In Paved Path	2
AP 3	196+07	Rt.	In Paved Path	3
AP 4	200+37	Rt.	In Paved Path	4
AP 5	203+14	Rt.	In Paved Path	5
AP 6	207+09	Rt.	In Paved Path	6
AP 7	210+93	Rt.	In Paved Path	7
AP 8	214+65	Rt.	In Paved Path by Pull Out Rt.	8
AP 9	218+58	Rt.	In Paved Path	9
AP 10	222+90	Rt.	In Paved Path	10
AP 11	228+20	Rt.	In Paved Path	11
AP 12	232+70	Rt.	In Paved Path @ Parking Area	12
AP 13	238+49	Rt.	In Paved Path	13
AP 14	243+20	Rt.	At MSE Wall #3	14
AP 15	247+86	Rt.	In Paved Path	15
AP 16	252+97	Rt.	In Paved Path by Approach	16
AP 17	257+75	Lt.	By Lt. Parking Lot	17
1024	261+99	Rt.	In SCIP Office Parking Lot	18
1025	261+99	Rt.	In SCIP Office Parking Lot	19
AP 18	263+16	Lt.	In Paved Path by Blue Lake Rd.	20
AP 19	269+31	Rt.	In Paved Path	21
AP 20	273+94	Lt.	By Fire Hydrant Lt.	22
Total				22

Project As Built Drawings Have Been Reviewed By The Project Engineer & Represent, To The Best Of My Knowledge, The Project As Constructed.
Proj. Eng. *[Signature]* Date 6-24-15

PATH: \\UNUFILE2\JOBS\1153806\DWG\SC\1\SHEETS\001_005

TAB: D5

ADDENDUM NUMBER

ATTACHMENT NUMBER

RECORD OF REVISIONS

No.	DATE	DESCRIPTION

SAWMILL CREEK ROAD UPGRADE
PHASE III - WHALE PARK TO SAWMILL CREEK BRIDGE
68216MSG-STP-0933(21)
SITKA TELECOMMUNICATIONS CONDUIT
RSA NO. 69615

PREPARED BY: USK-H
CHECKED BY: NCL

DESIGNED BY: NCL
DRAWN BY: WJP

STATE OF ALASKA
DEPARTMENT OF TRANSPORTATION & PUBLIC FACILITIES
SOUTHEAST REGION







SUMMARY TABLES

PROJECT DESIGNATION
68216MSG-STP-0933(21)

STATE	YEAR
ALASKA	2012

SHEET NUMBER	TOTAL SHEETS
D5	109

DO NOT SCALE FROM THESE DRAWINGS USE DIMENSIONS

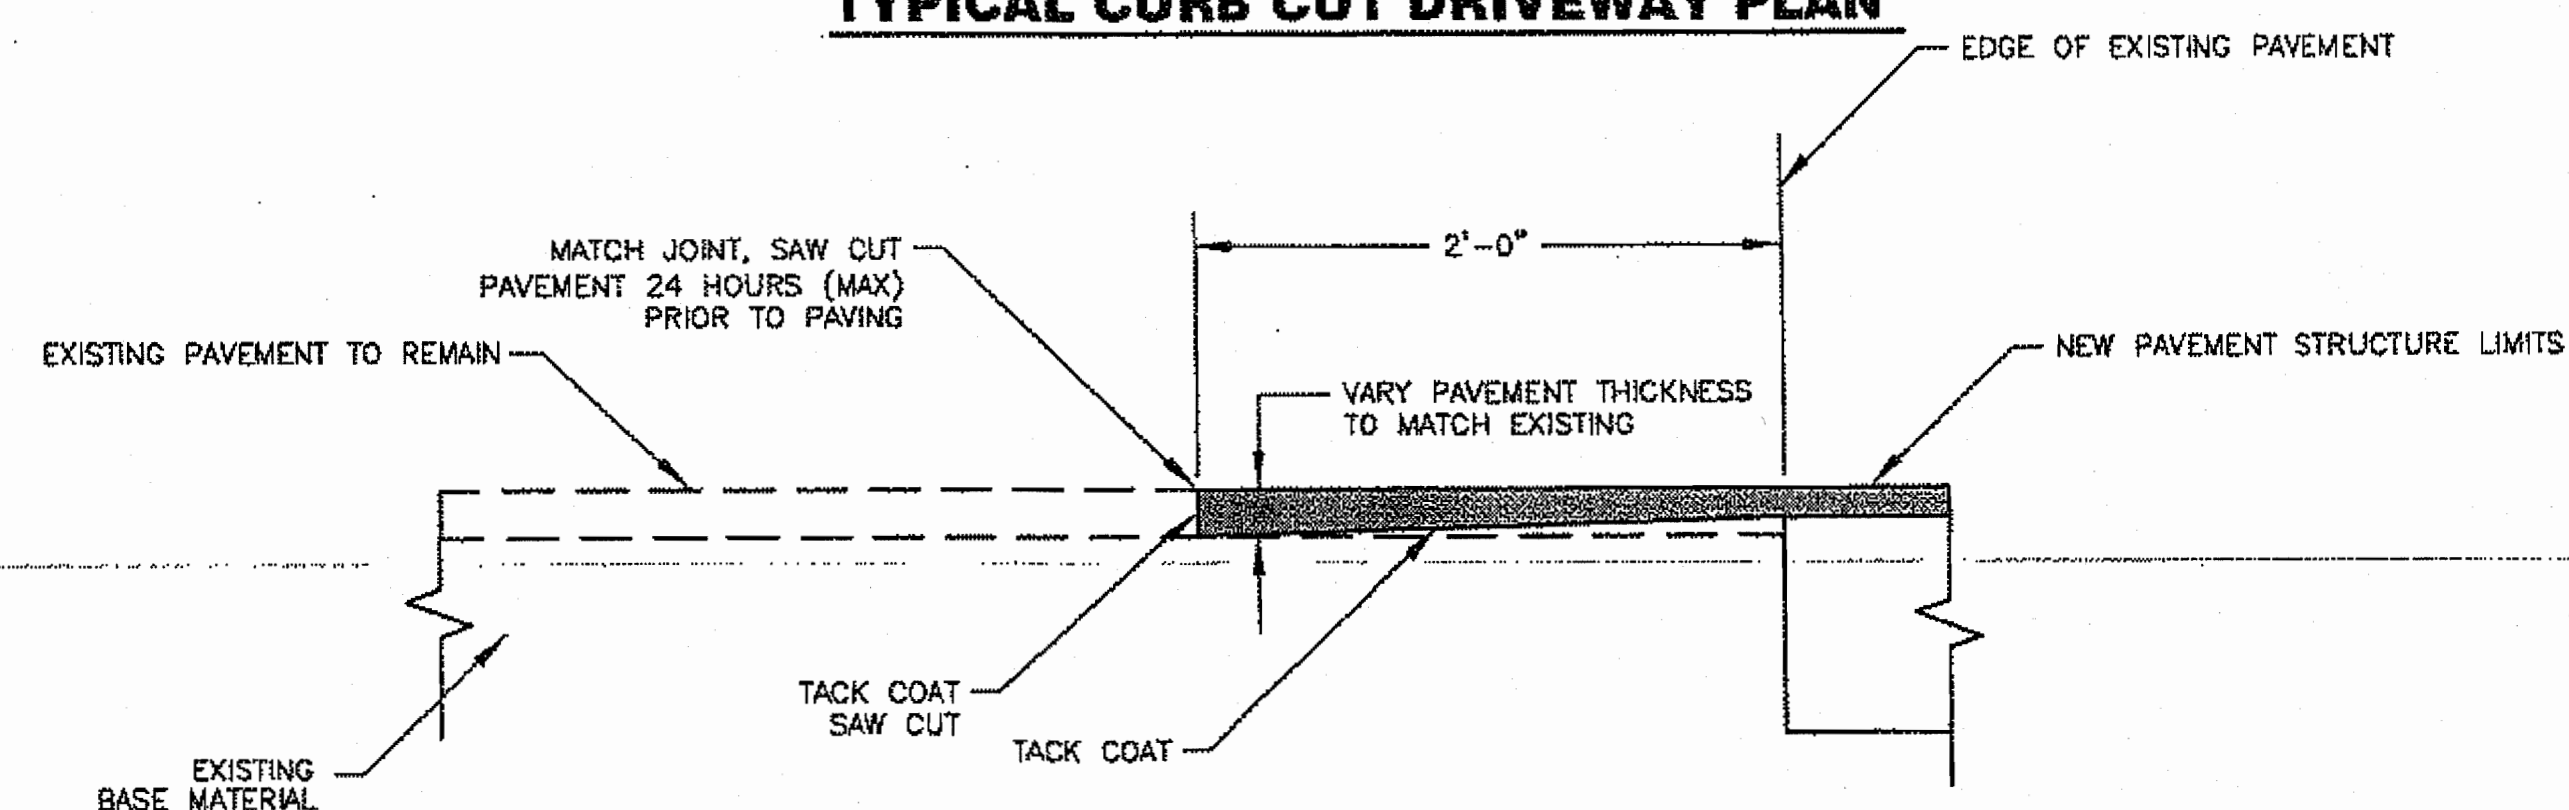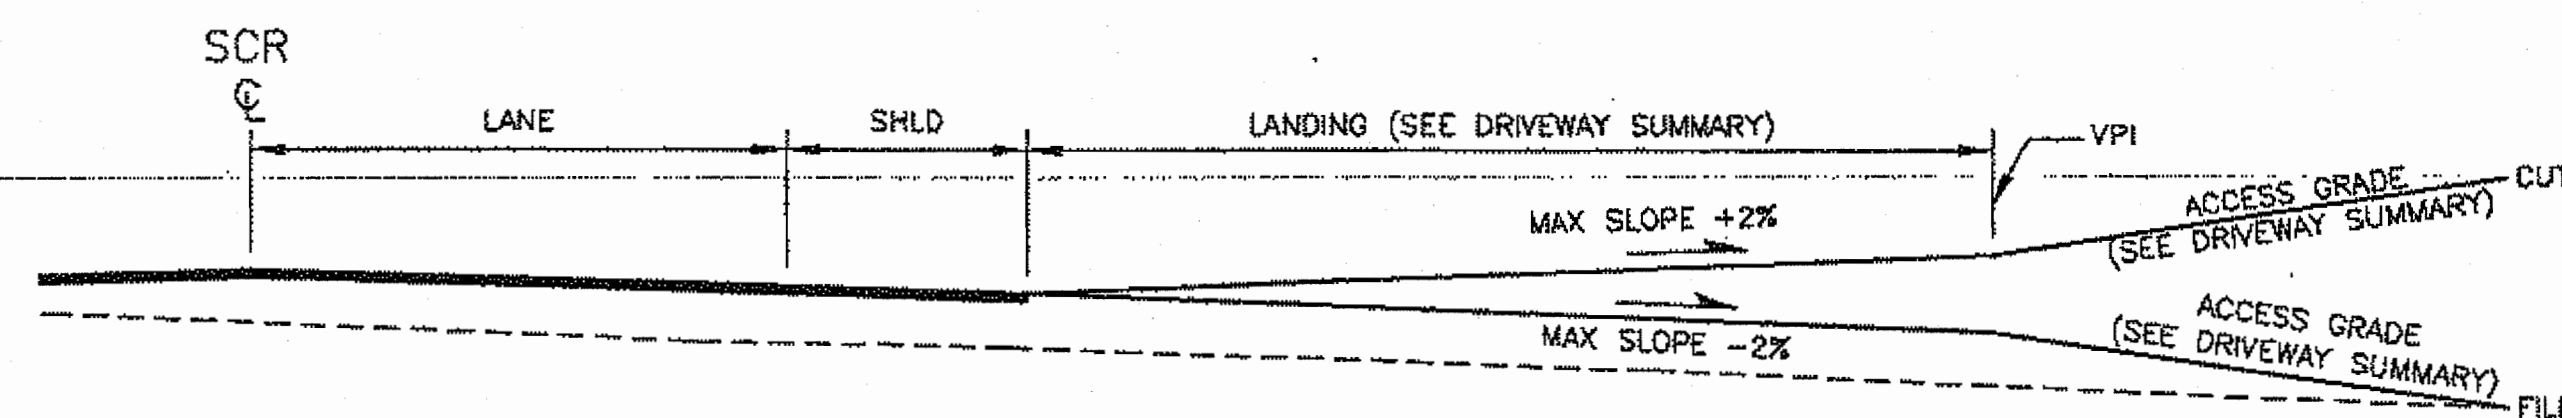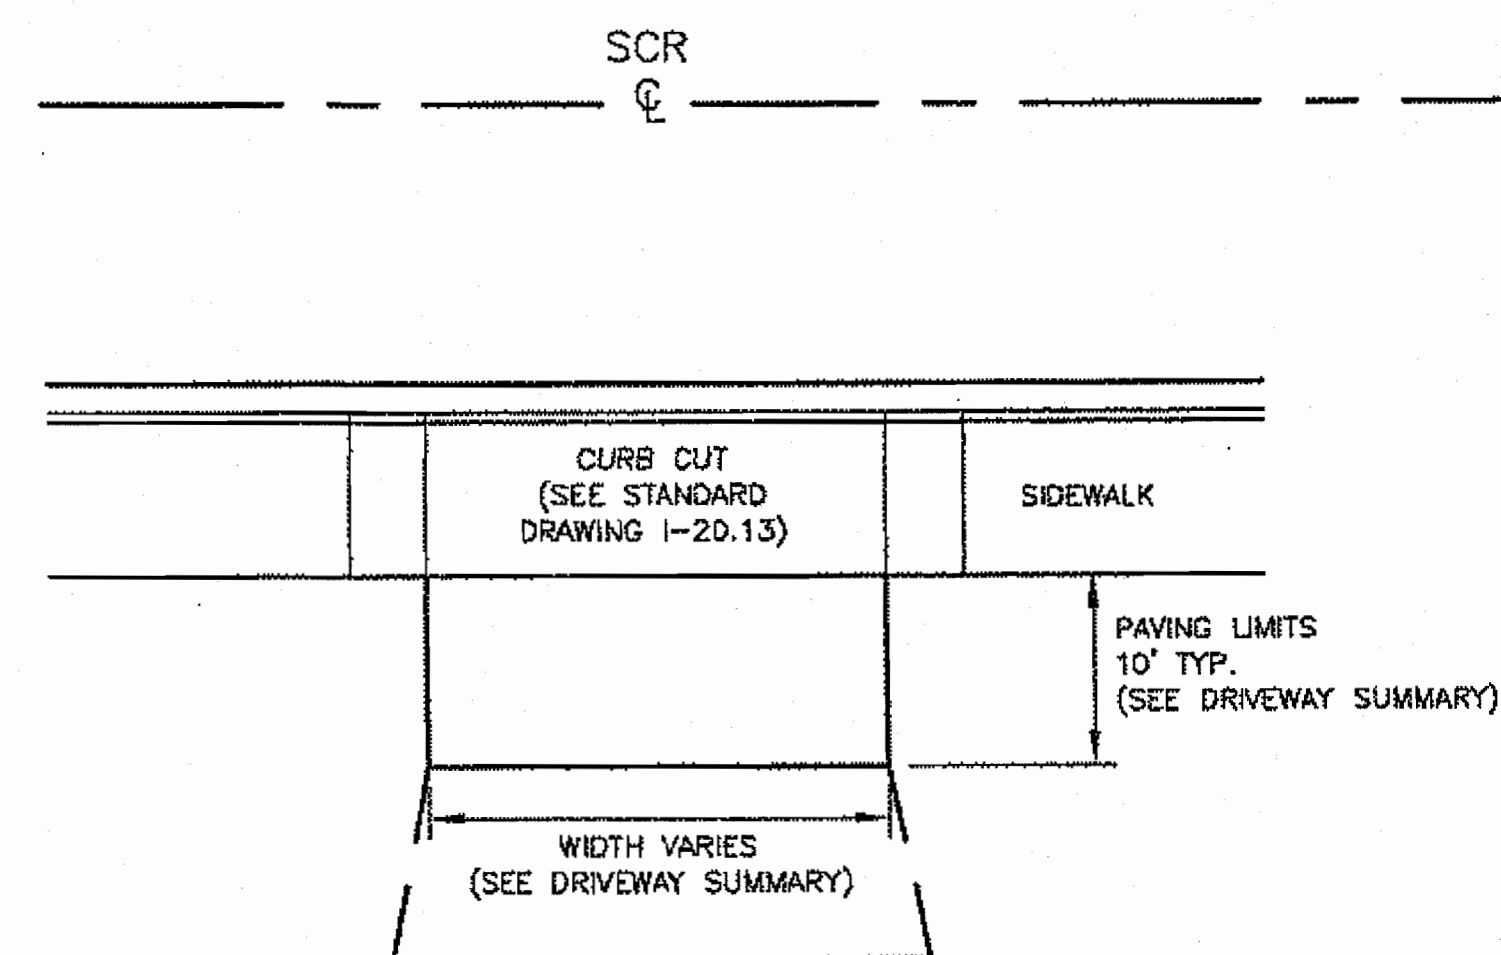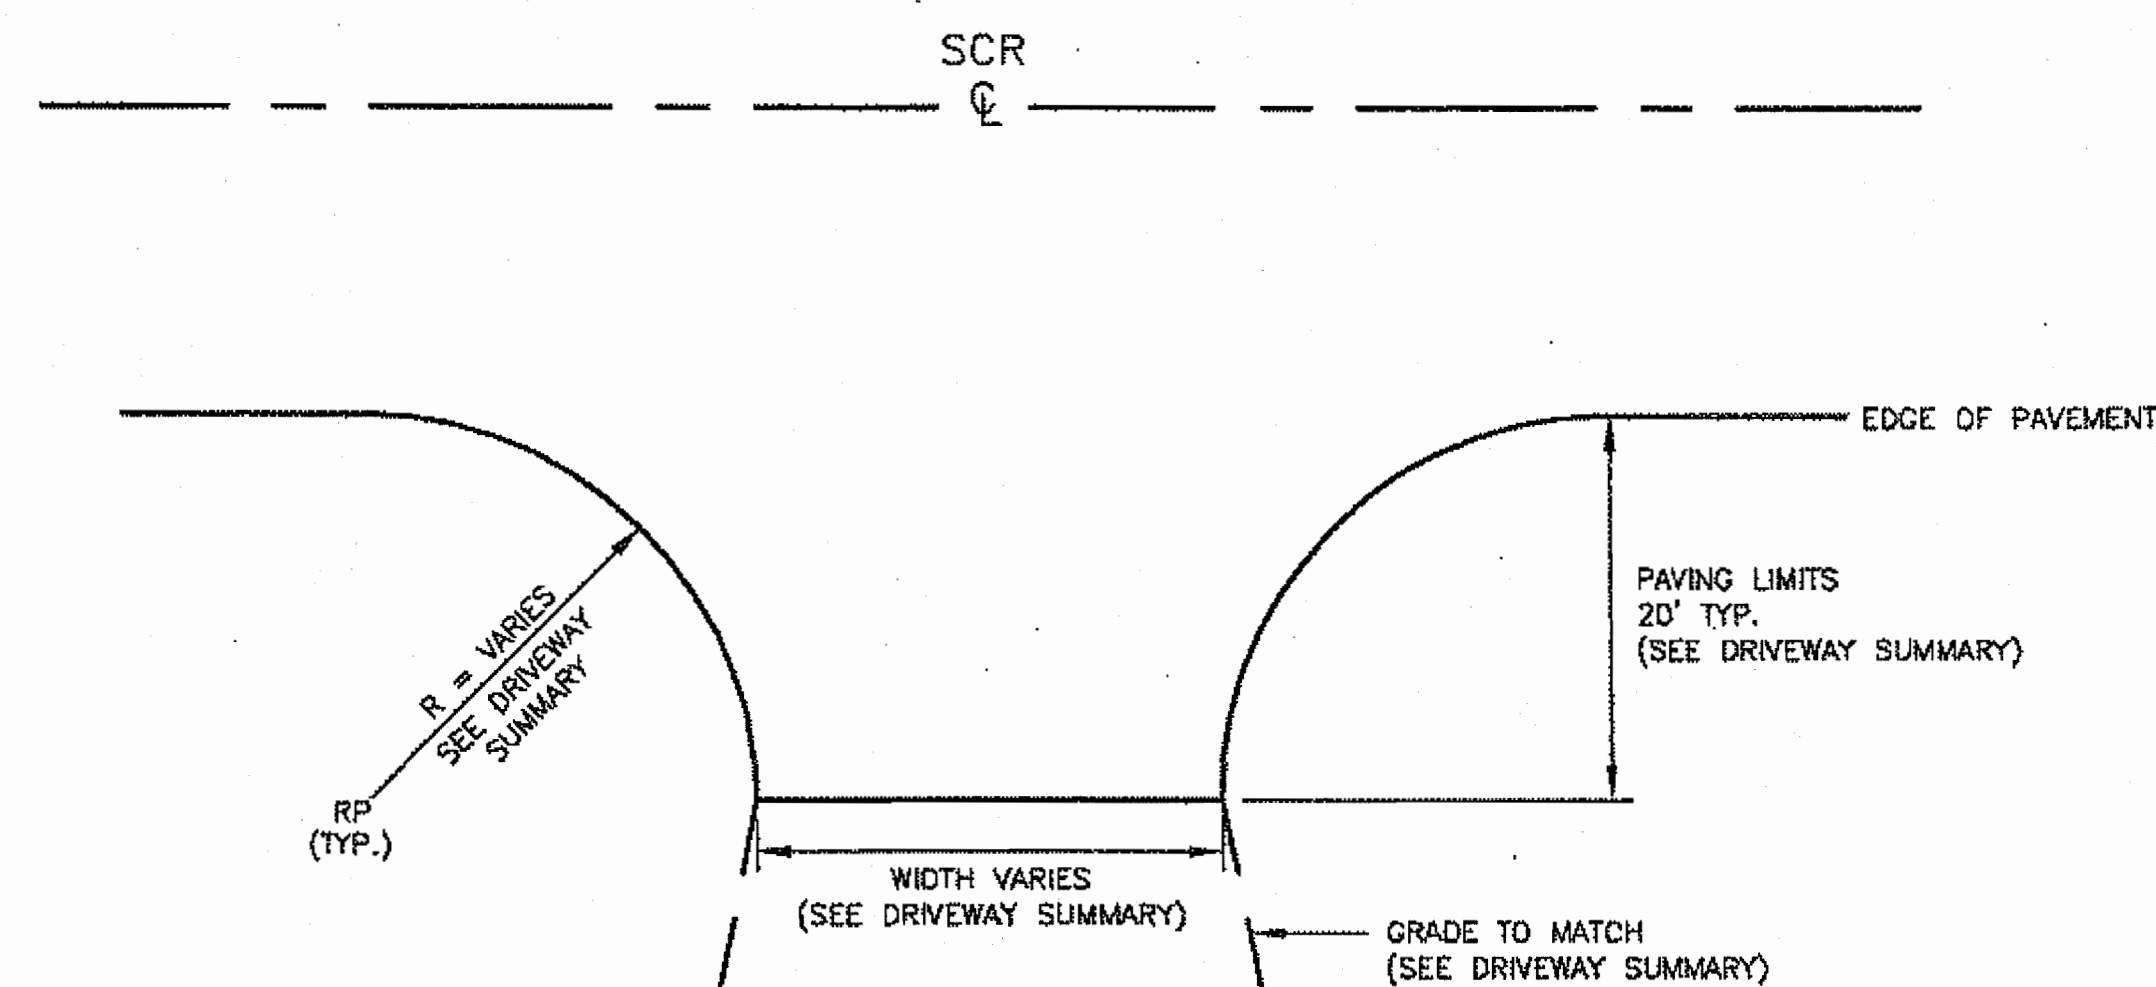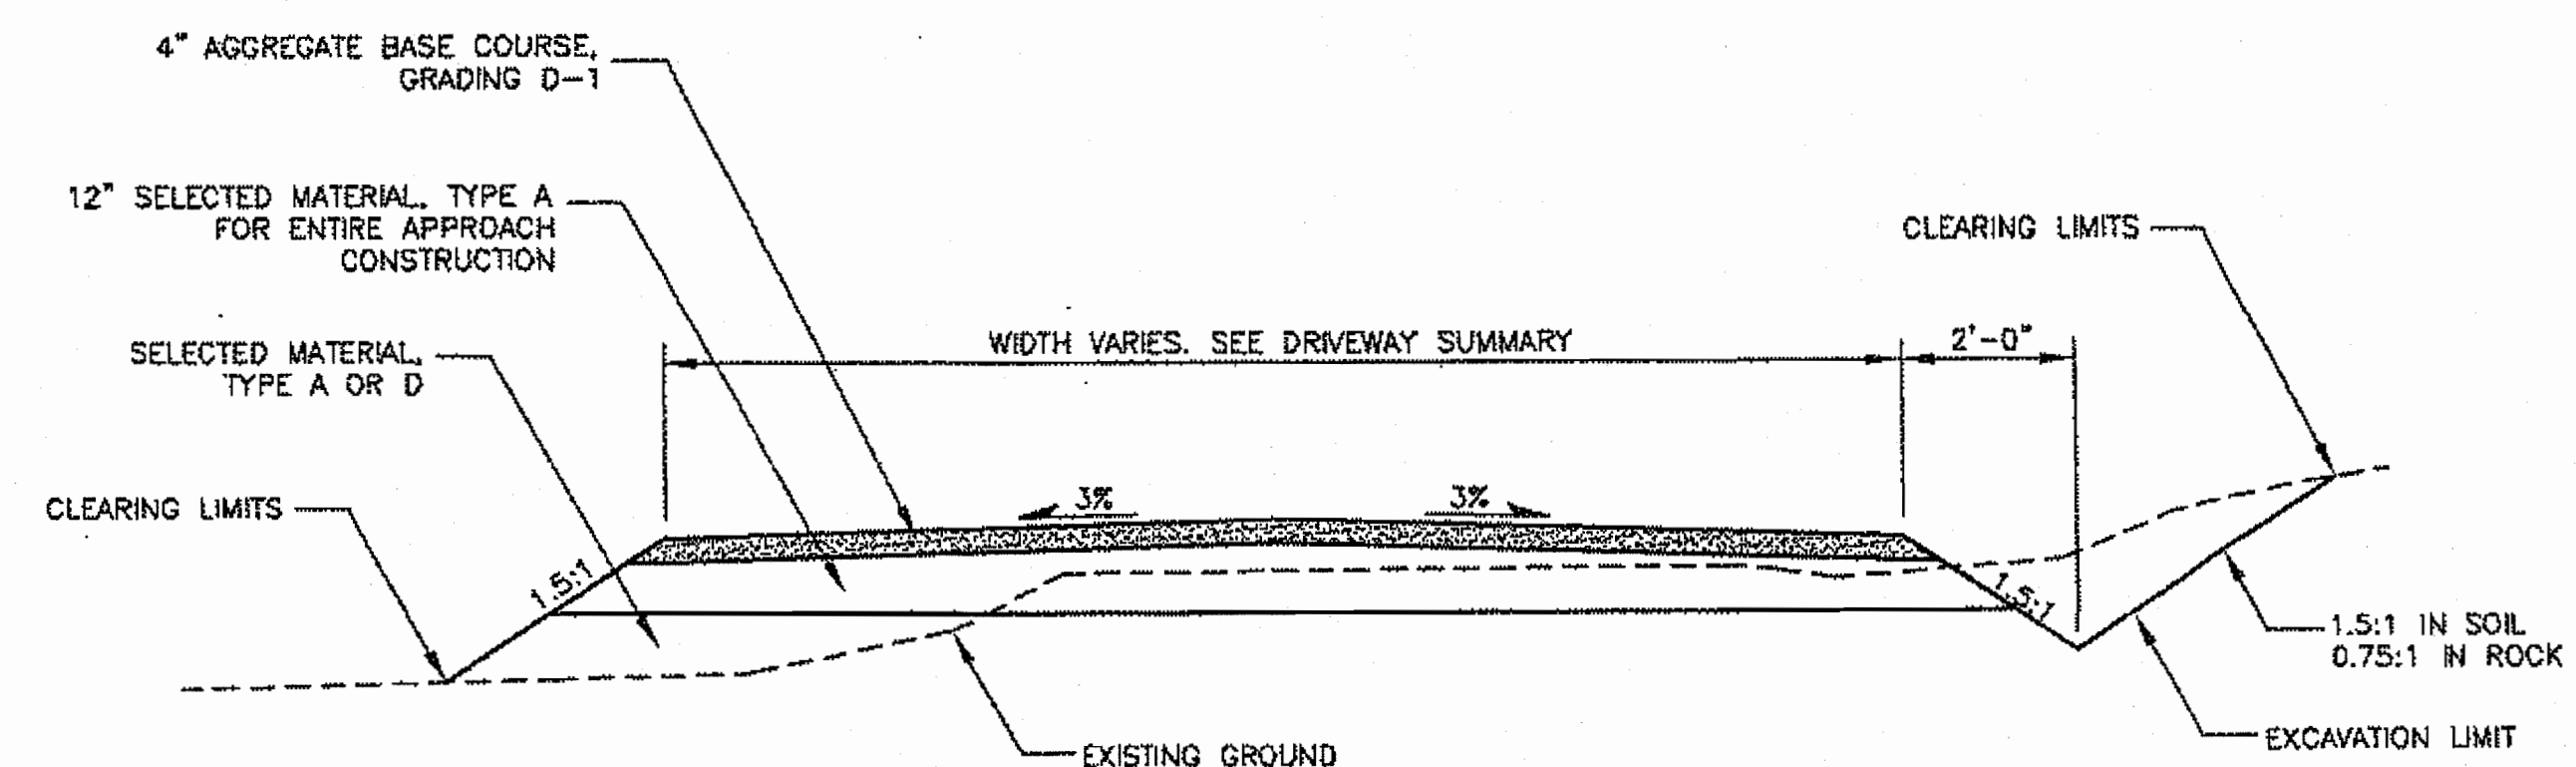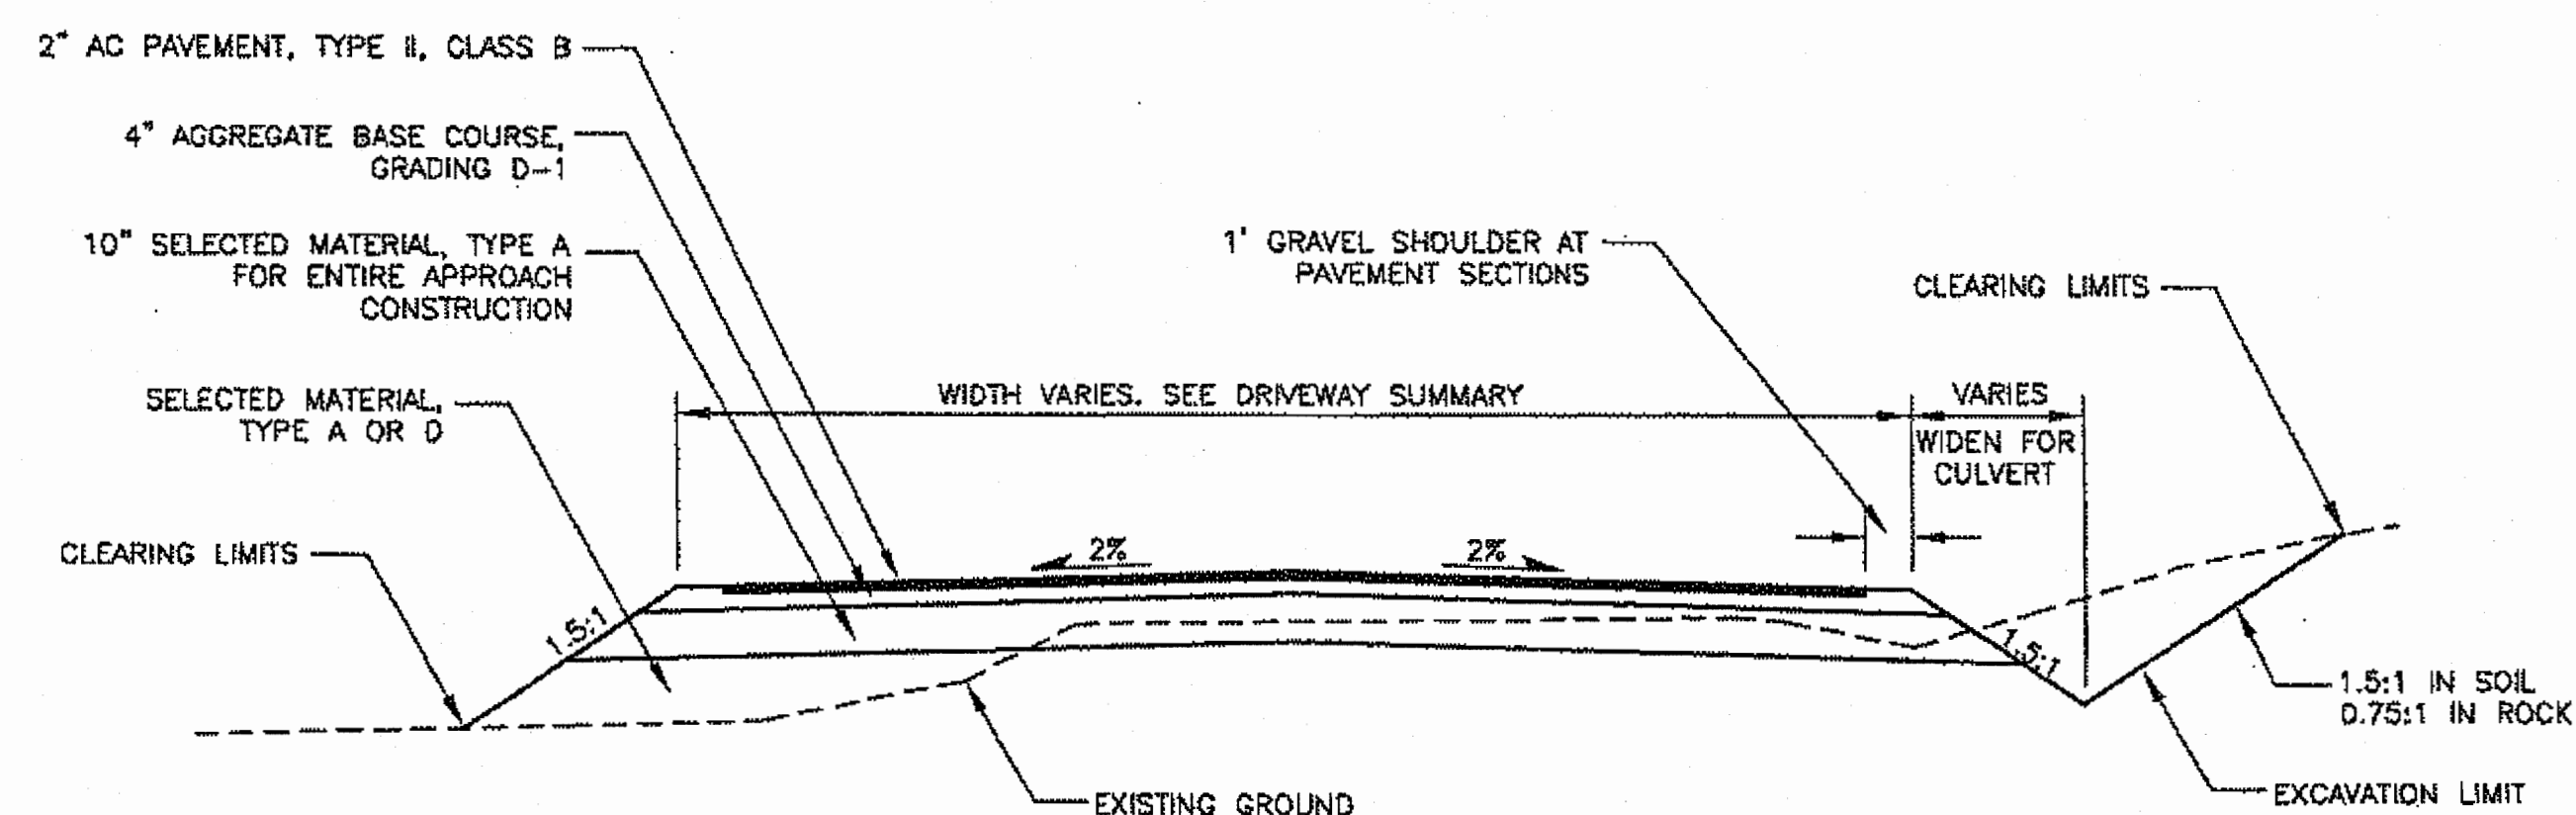

STA 185+22 (BOP)
STA 257+00 TO STA 269+00 SAWMILL CREEK INDUSTRIAL AREA

DO NOT SCALE FROM THESE DRAWINGS USE DIMENSIONS

PATH:
\\UNUFILE2\WOB5\1153805\DWGS\C\ISHEETS\F01.DWG

Friday, August 17, 2012 7:13:35 PM
TAB: E1

ADDENDUM NUMBER

ATTACHMENT NUMBER

RECORD OF REVISIONS


No	DATE	DESCRIPTION
----	------	-------------

SAWMILL CREEK ROAD UPGRADE
PHASE III - WHALE PARK TO SAWMILL CREEK BRIDGE
68216WMSG-STP-0933(21)
SITKA TELECOMMUNICATIONS CONDUIT
RSA NO. 69615

DETAILS

PREPARED BY: USKH

CHECKED BY: NCL

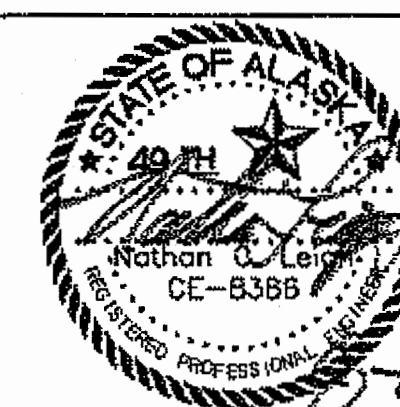

DESIGNED BY: NCJ

DRAWN BY: 10/10

STATE OF ALASKA
DEPARTMENT OF TRANSPORTATION
& PUBLIC FACILITIES
SOUTHEAST REGION

DETAILS

PROJECT DESIGNATION

68216\MSG-STP-0933(21)

STATE

YEAR

ALASKA

2012

SHEET NUMBER

TOTAL SHEETS

E1


109

RECORD OF REVISIONS		
No.	DATE	DESCRIPTION

SAWMILL CREEK ROAD UPGRADE
PHASE III - WHALE PARK TO SAWMILL CREEK BRIDGE
68216MSG-STP-0933(21)
SITKA TELECOMMUNICATIONS CONDUIT
RSA NO. 69615

DETAILS

PREPARED BY: USKH
CHECKED BY: NCL

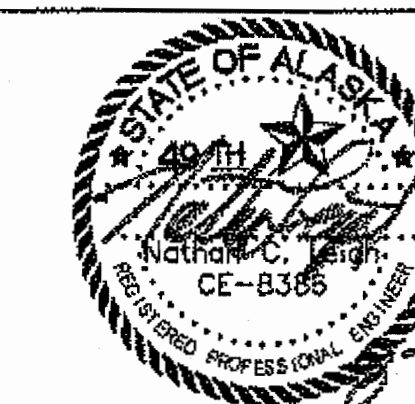


DESIGNED BY: NCL
DRAWN BY: WJP

STATE OF ALASKA
DEPARTMENT OF TRANSPORTATION
& PUBLIC FACILITIES
SOUTHEAST REGION


DETAILS

PROJECT DESIGNATION
68216MSG-STP-0933(21)

STATE	YEAR
ALASKA	2012
SHEET NUMBER	TOTAL SHEETS
E2	109

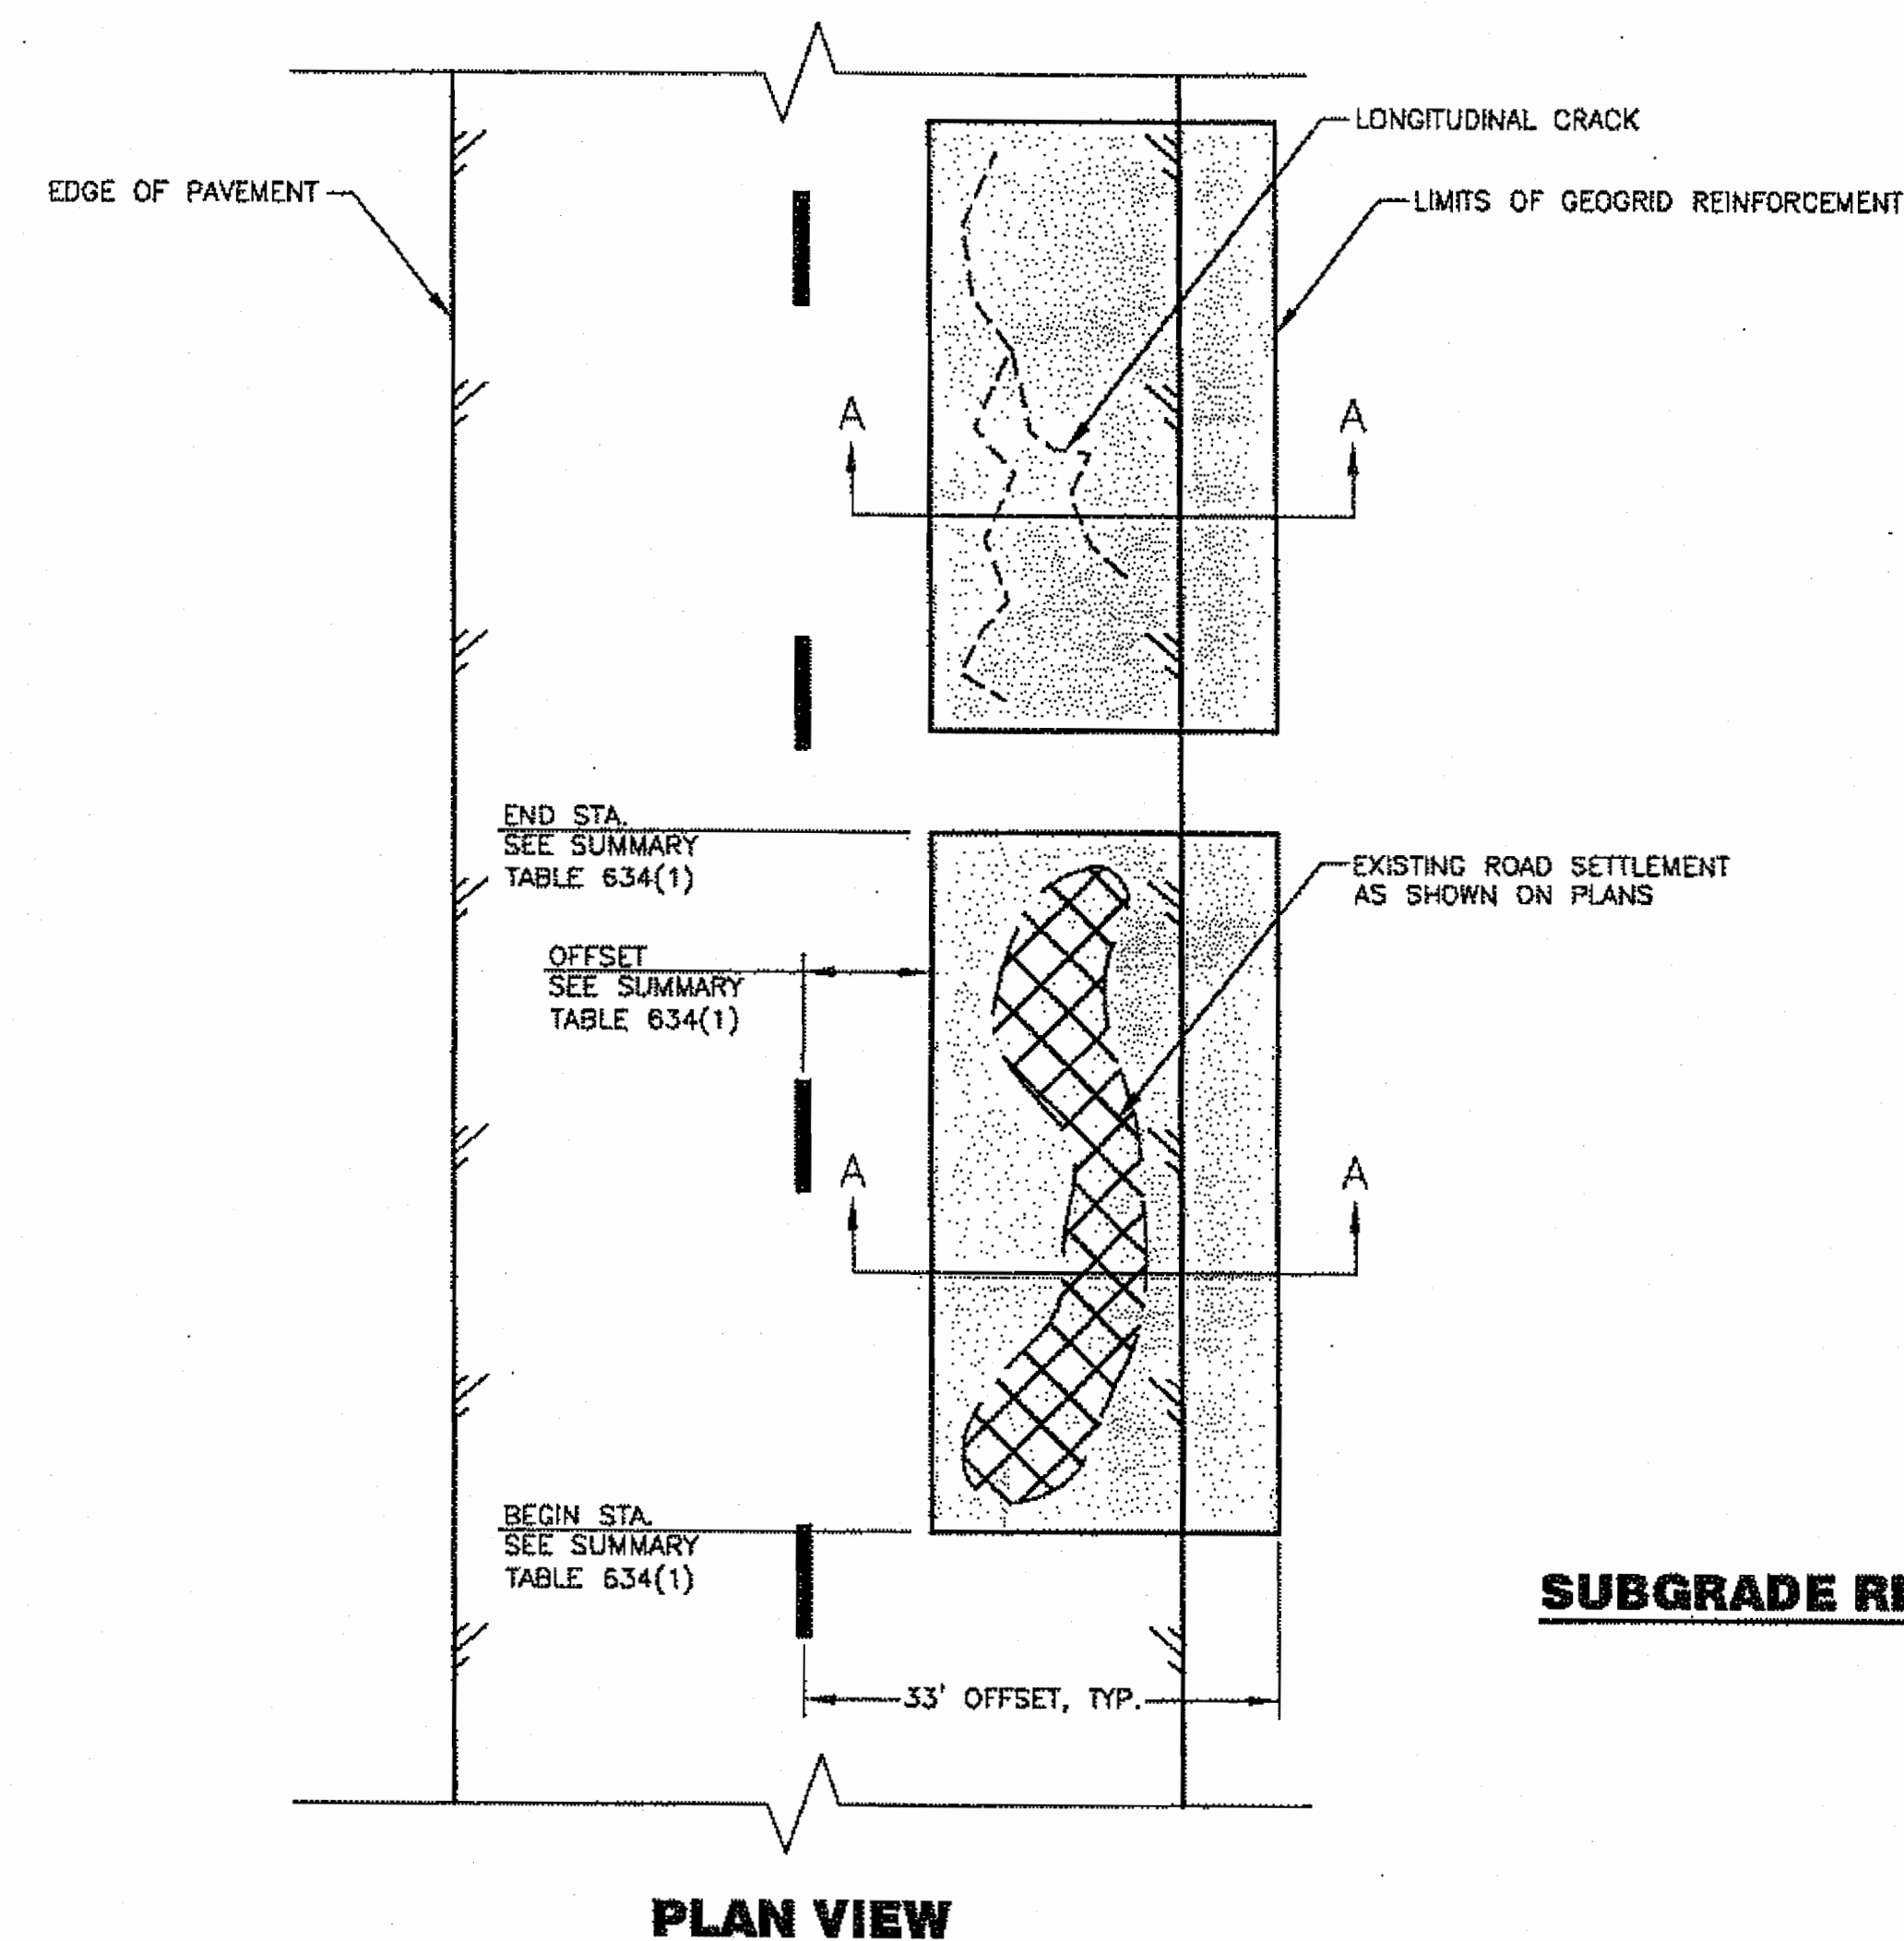


PLAN VIEW

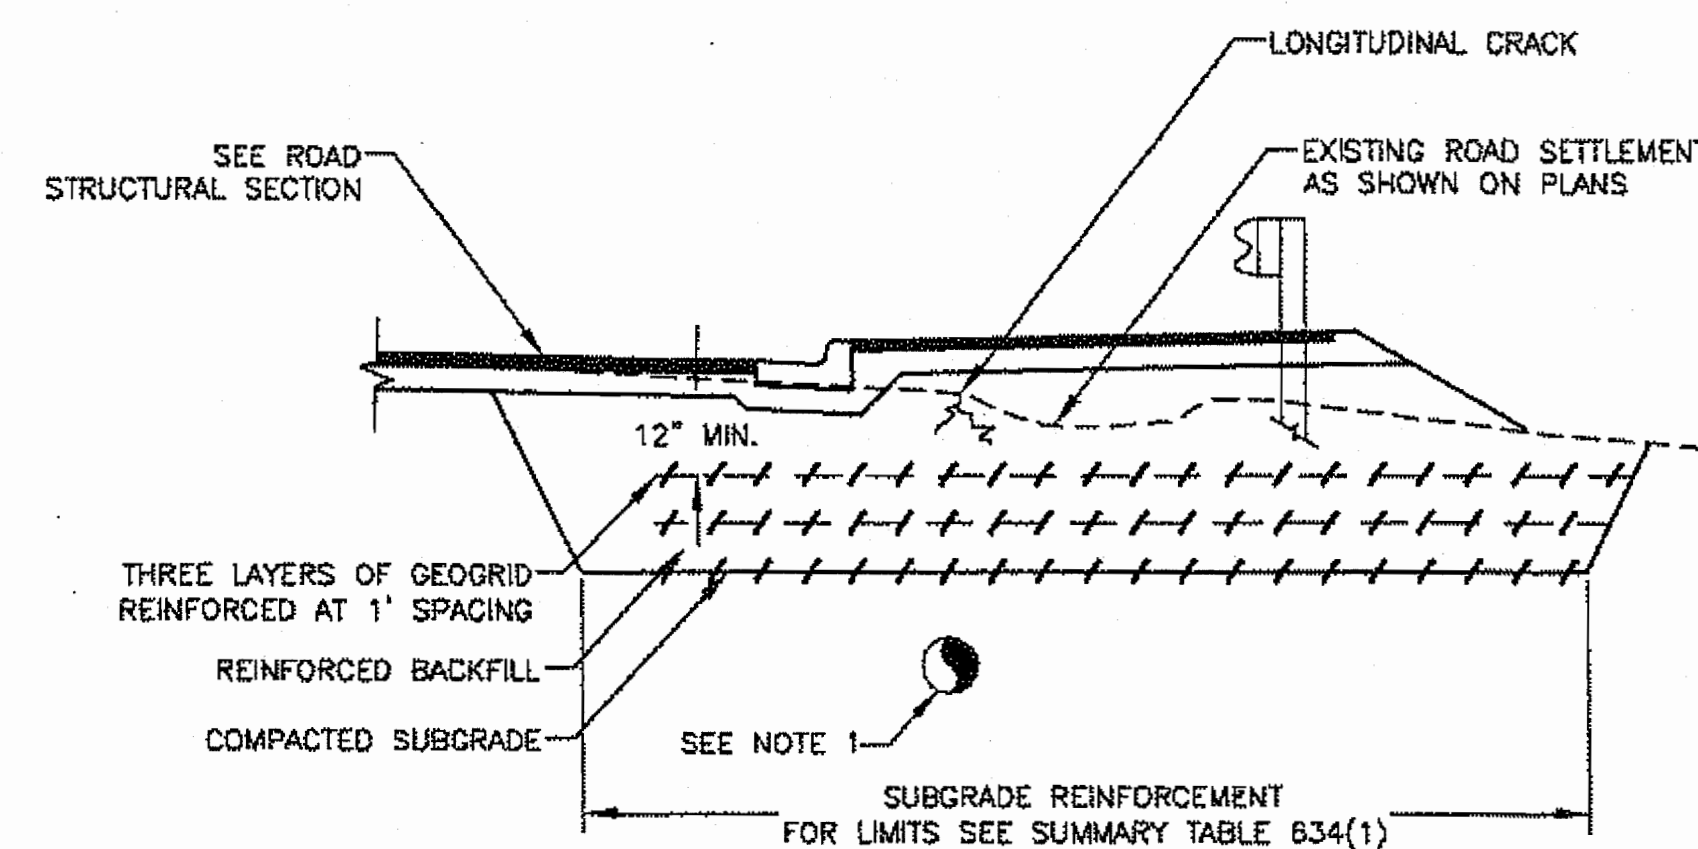

SECTION VIEW A-A


- NOTES:
1. LOCATION OF UNDERGROUND UTILITIES ARE UNKNOWN. WHEN SUBGRADE REINFORCEMENT CONFLICTS WITH EXISTING UTILITIES, CONTACT THE ENGINEER FOR POSSIBLE MODIFICATION TO THE SUBGRADE REINFORCEMENT DESIGN.
 2. LOCATION AND LIMITS OF SUBGRADE REINFORCEMENT ARE APPROXIMATE ONLY. THE CONTRACTOR SHALL DIG 3-6 TEST PITS AT EACH LOCATION FOR THE ENGINEER TO DETERMINE THE LIMITS OF SUBGRADE REINFORCEMENT.

SUBGRADE REINFORCEMENT DETAIL

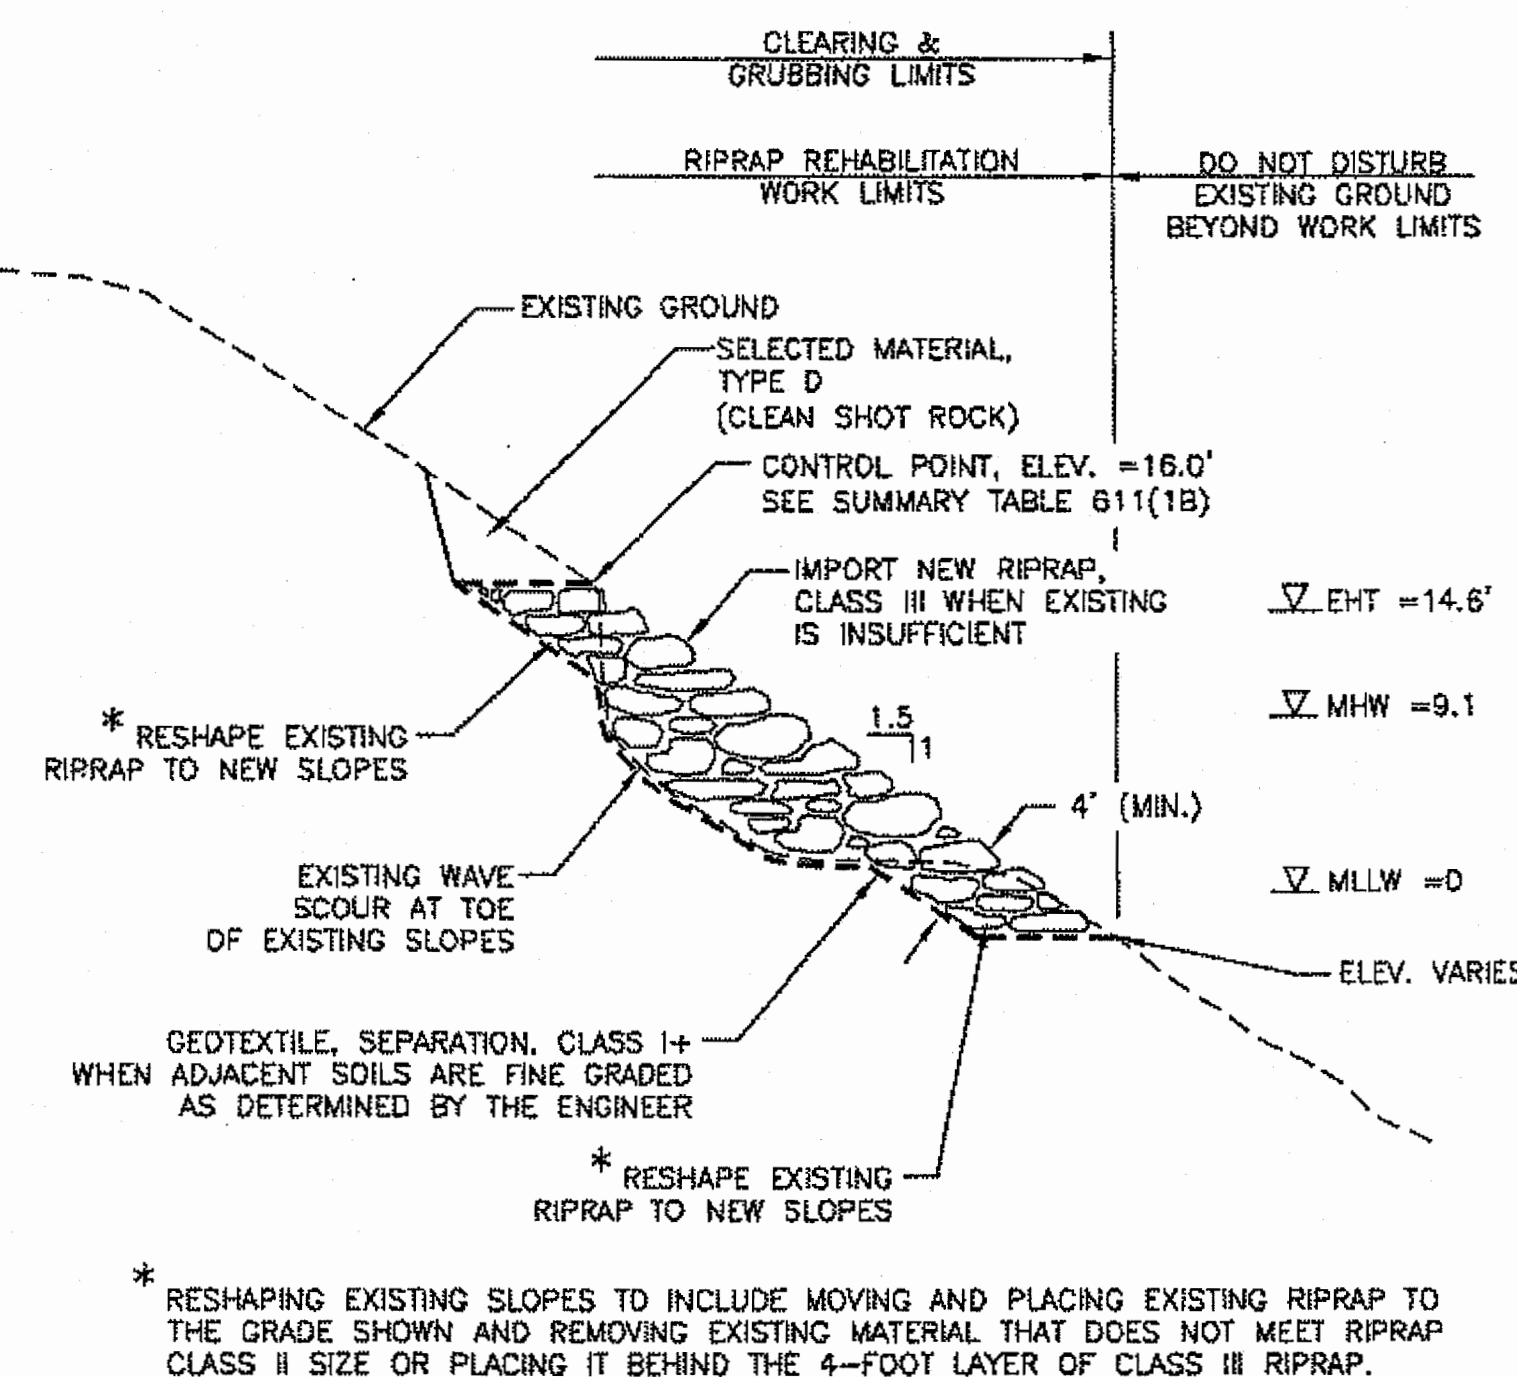


RIPRAP SLOPE REHABILITATION

!!!WARNING!!!
LOCATION OF UNDERGROUND UTILITIES UNKNOWN. CONTRACTOR TO LOCATE & PROTECT AS REQUIRED.

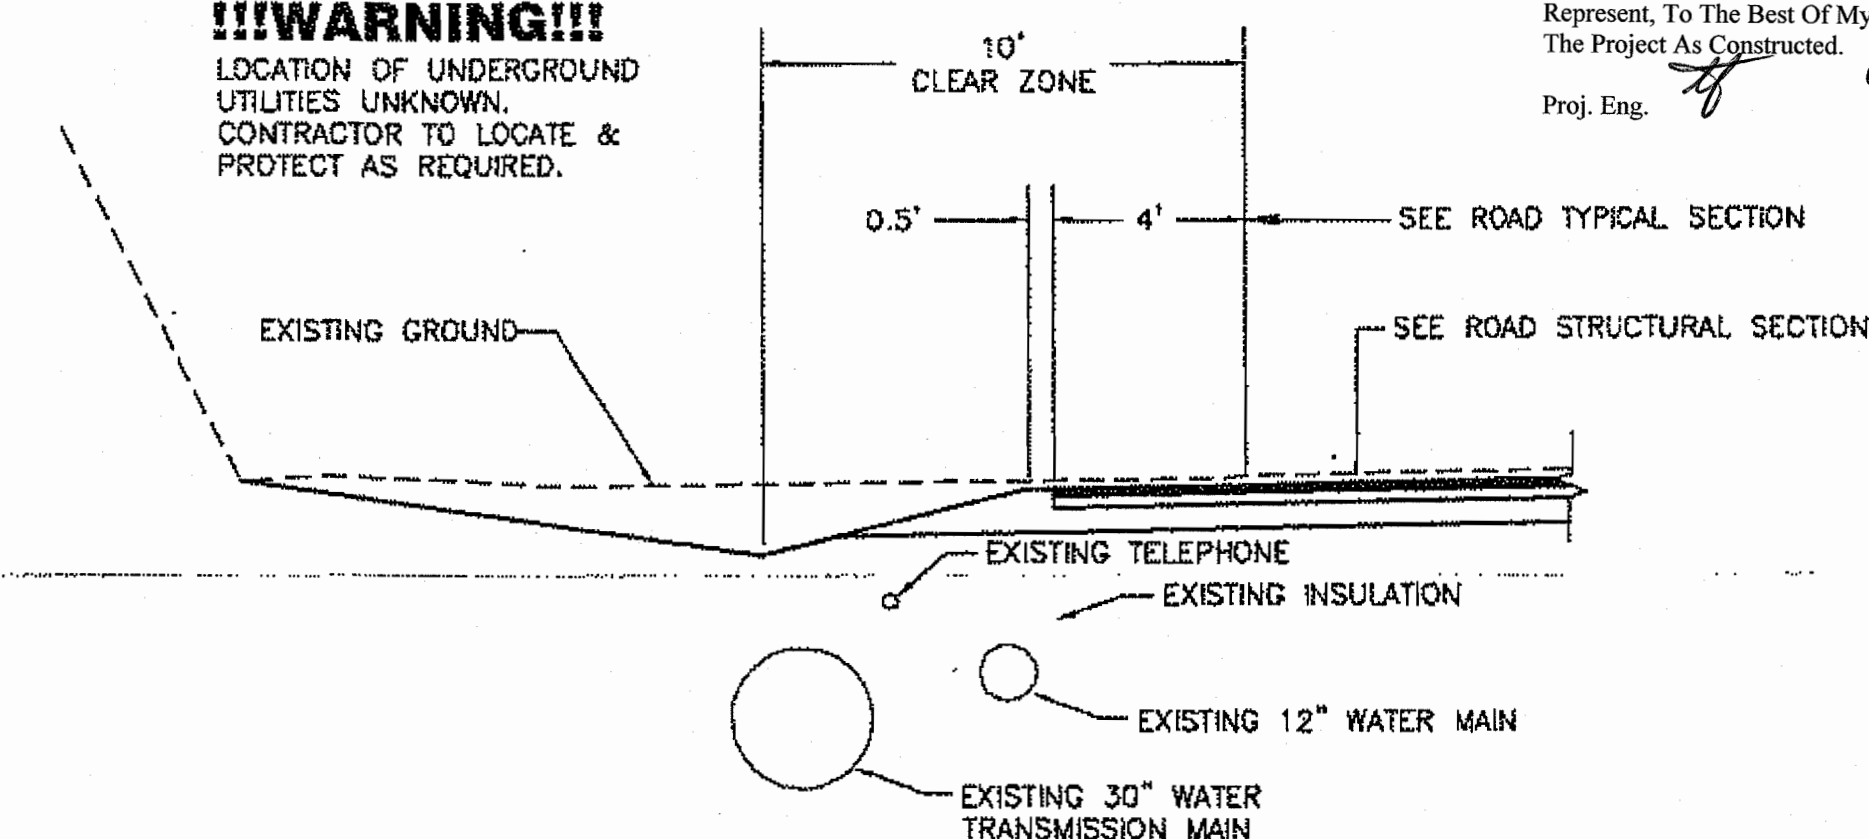

EXISTING UTILITIES IN DITCHLINE


DO NOT SCALE FROM THESE DRAWINGS USE DIMENSIONS

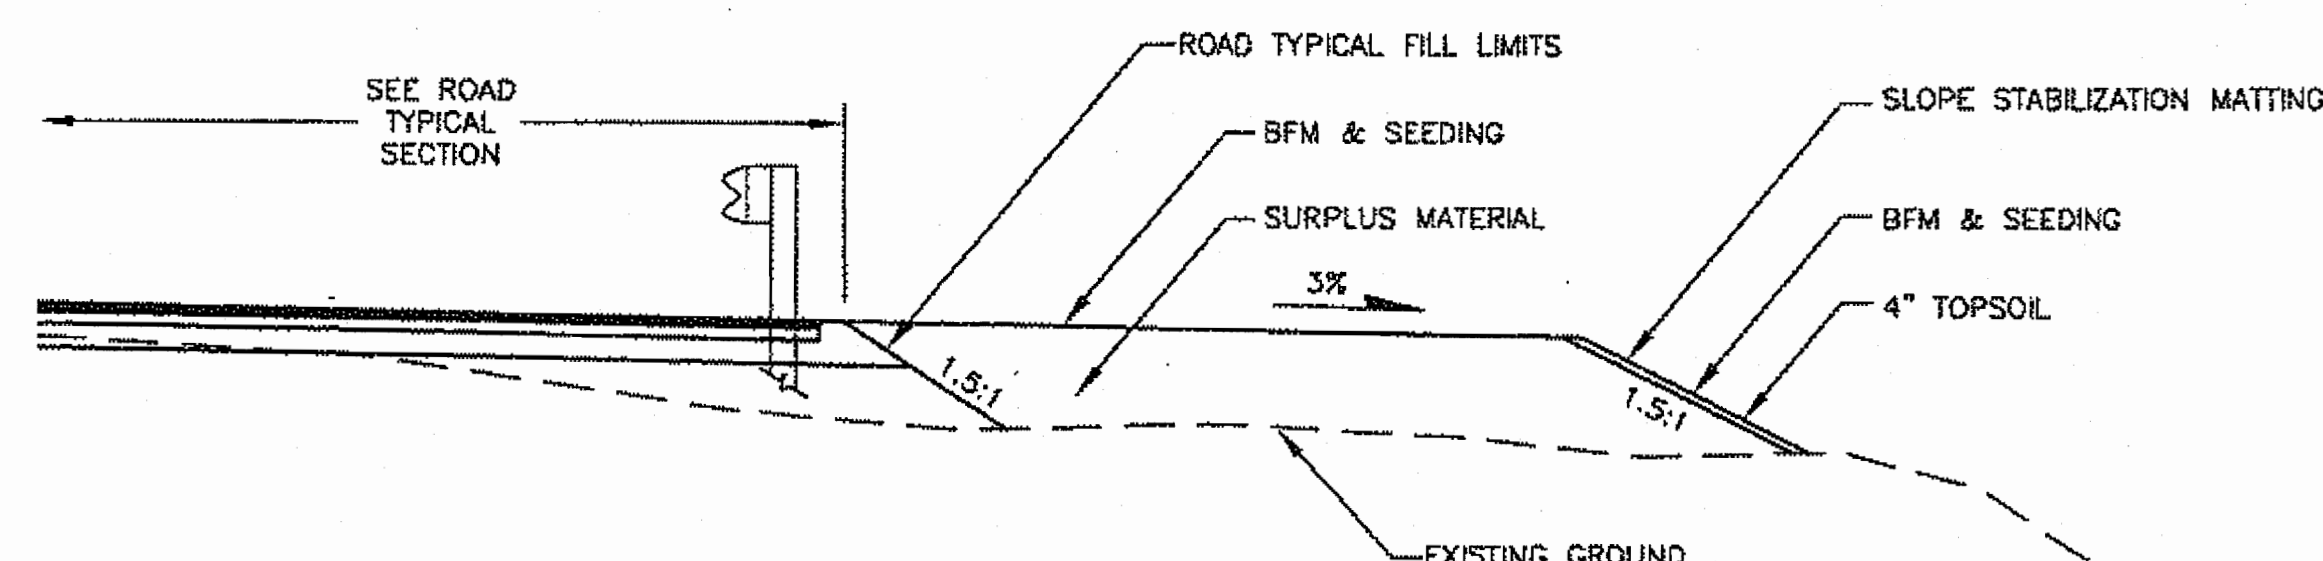

SURPLUS MATERIAL DISPOSAL DETAIL


ON SITE SURPLUS MATERIAL DISPOSAL

BEGIN STATION	END STATION	APPROX. VOLUME (CY)
194+00	198+50	1,200
206+50	208+50	300
211+50	214+25	200
220+00	230+50	2,000
238+25	241+50	1,300
TOTAL:		5,000

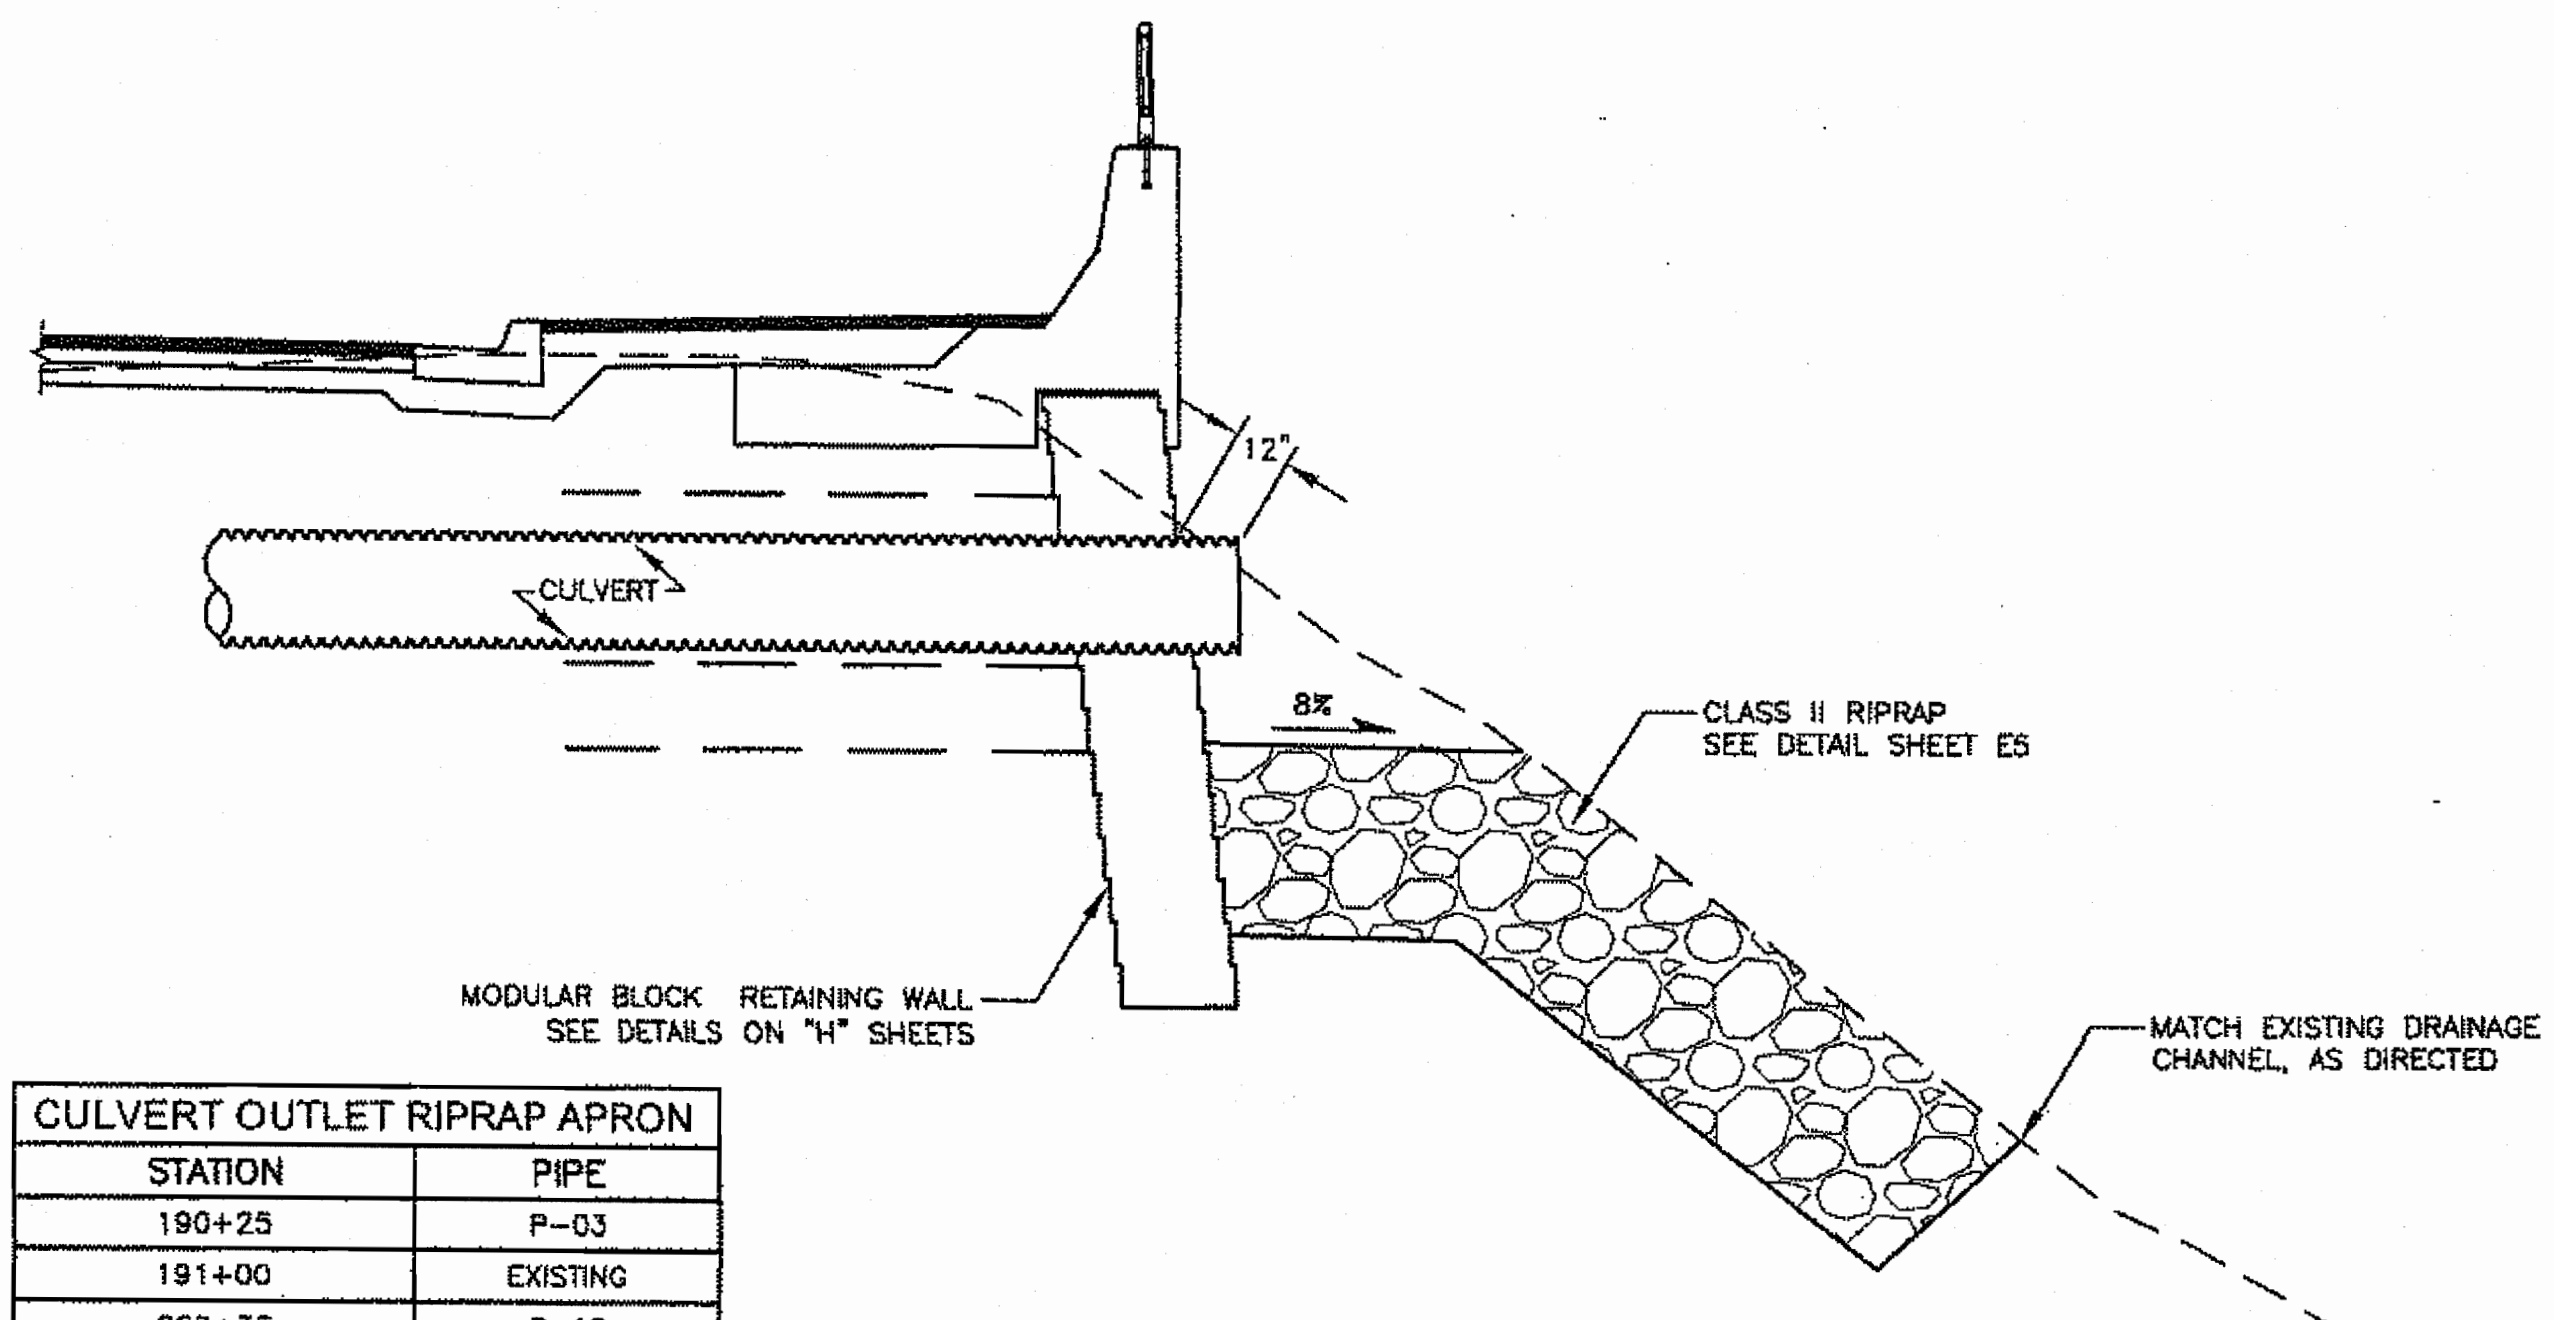


CULVERT OUTLET RIPRAP APRON	
STATION	PIPE
190+25	P-03
191+00	EXISTING
209+35	P-10
247+00	P-31

**CULVERT OUTLET
RIPRAP APRON DETAIL**

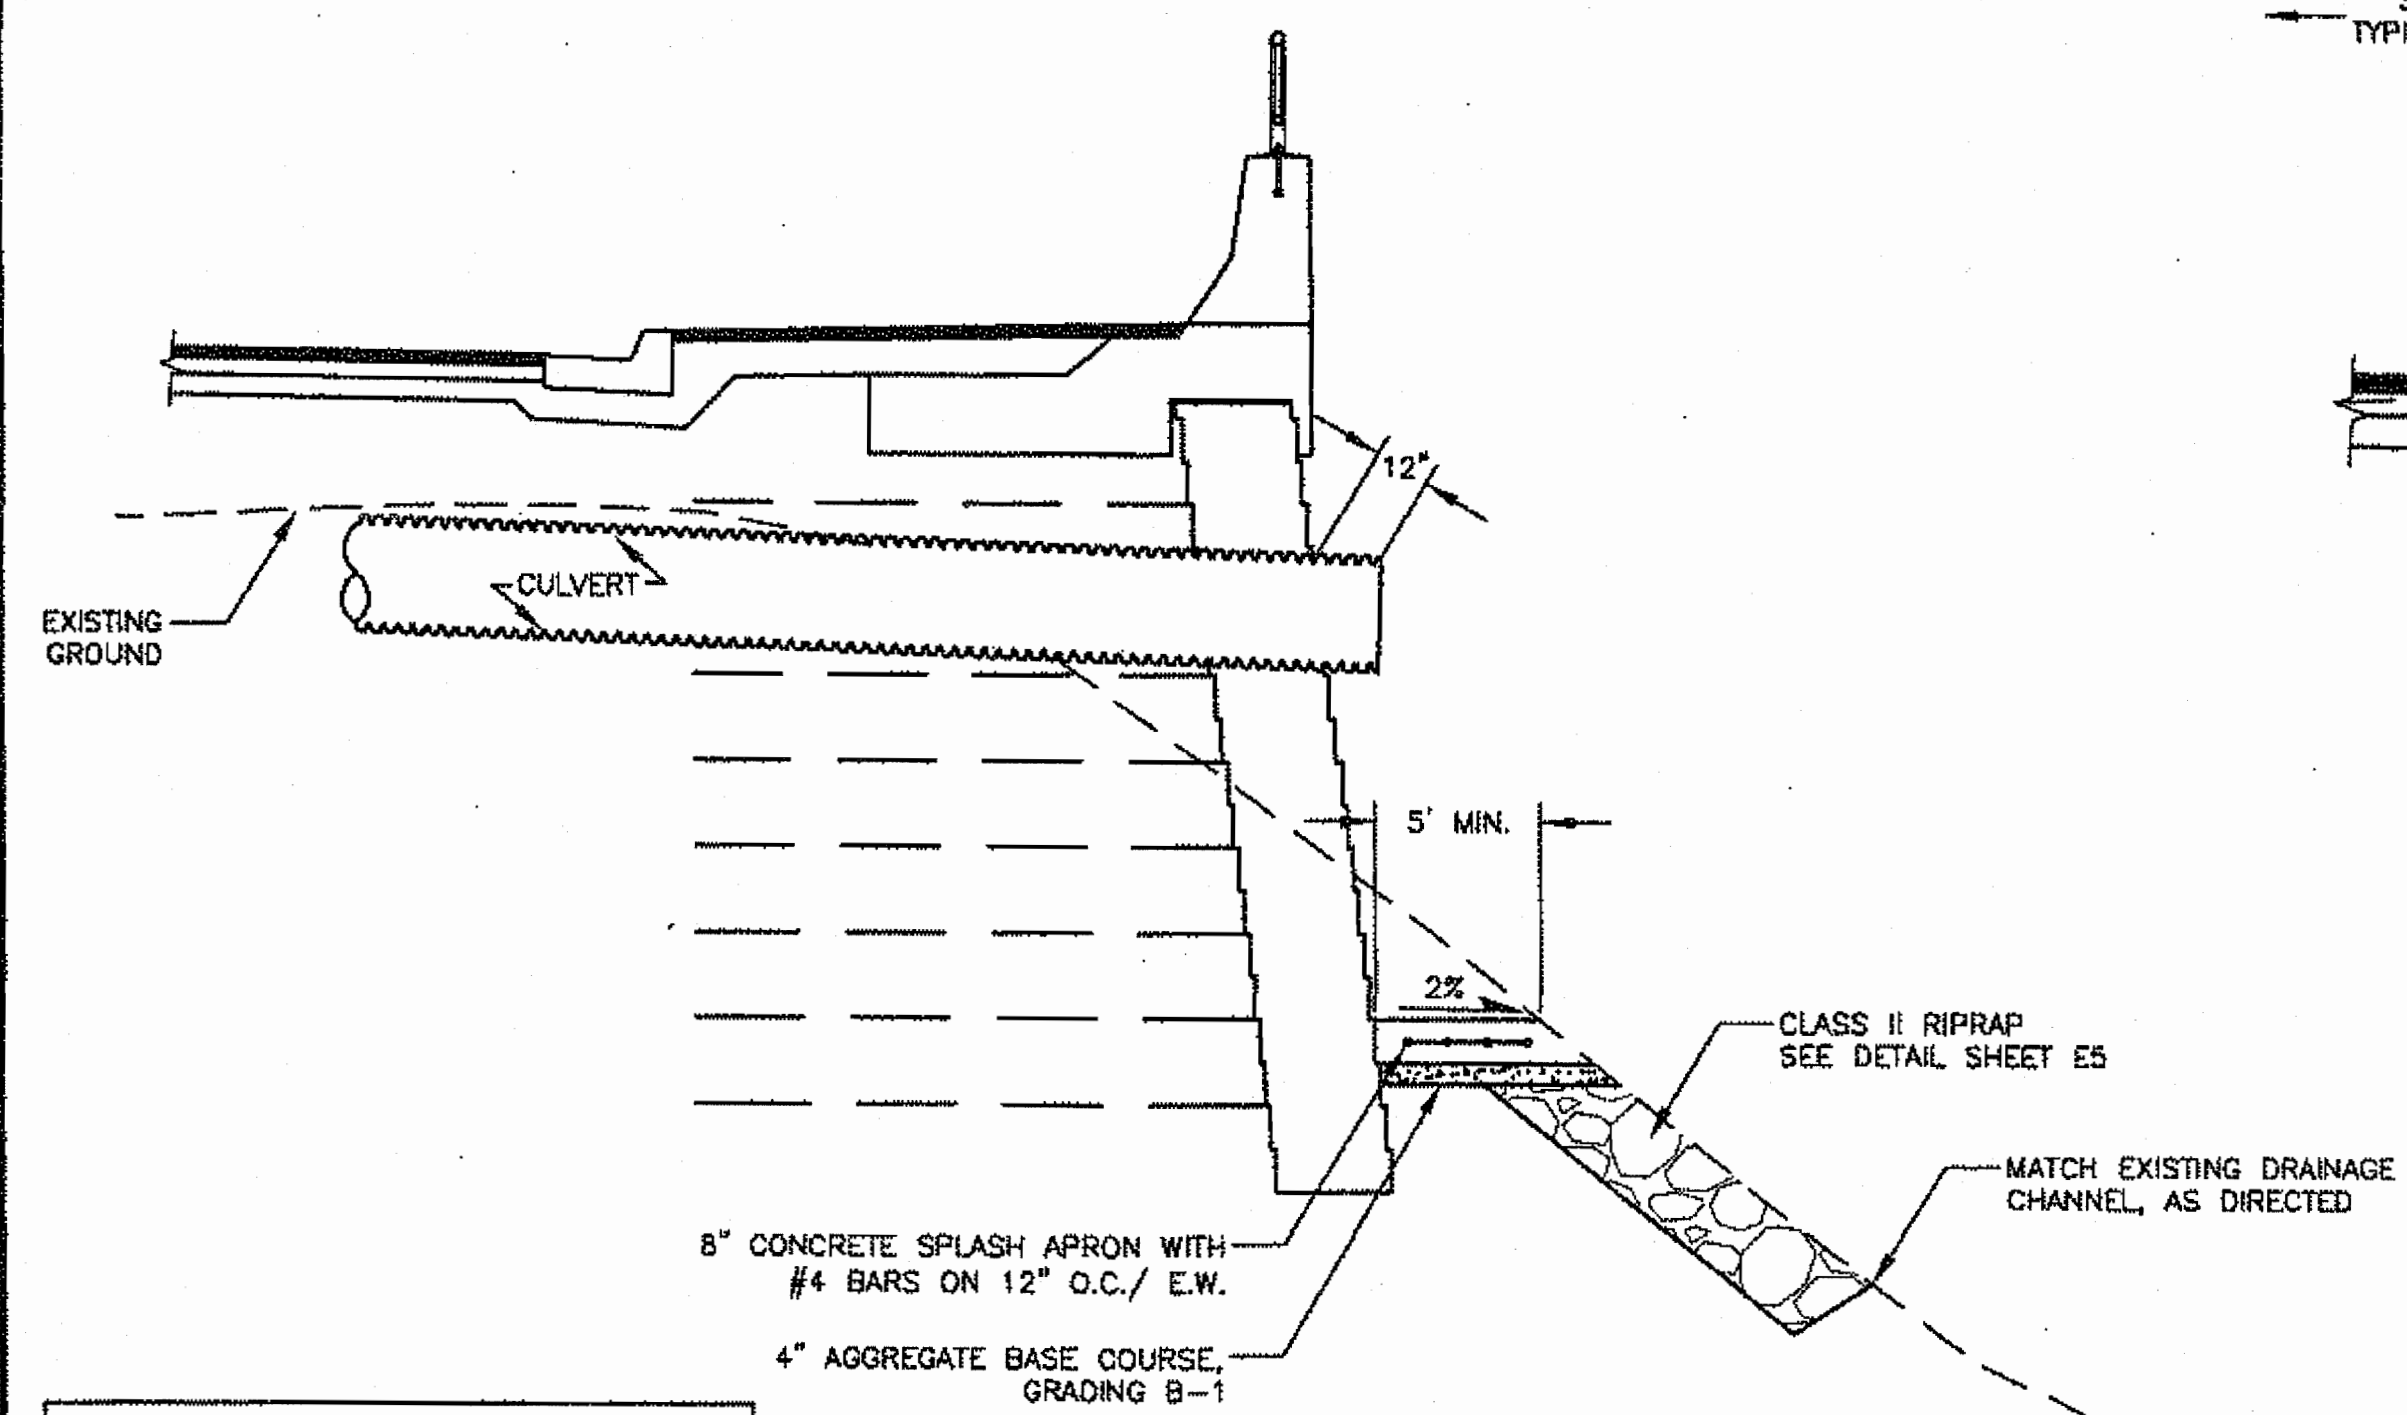


CULVERT OUTLET SPLASH APRON	
STATION	PIPE
243+67	P-29
244+00	P-30

**CULVERT OUTLET
SPLASH APRON DETAIL**

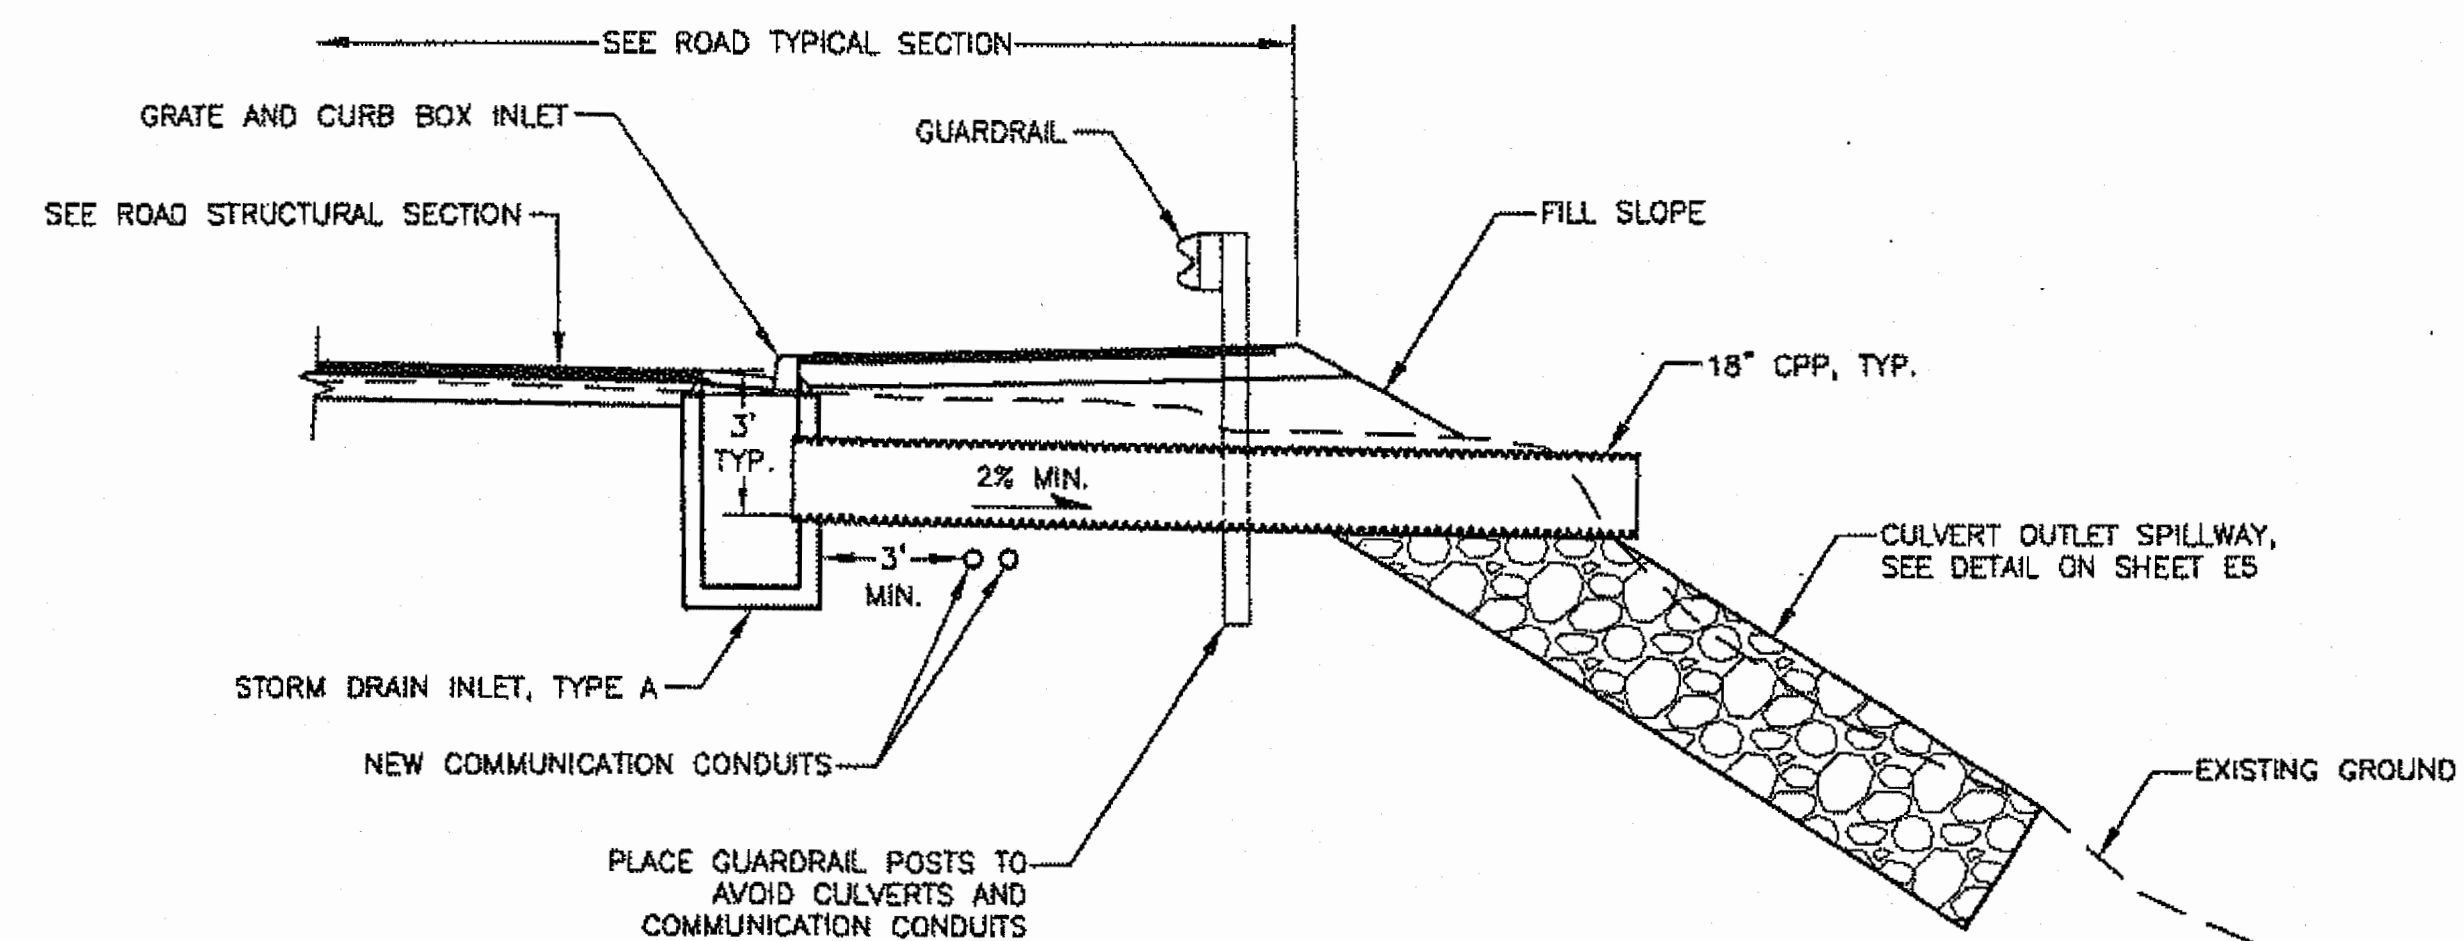

CURB LINE DRAINAGE DETAIL

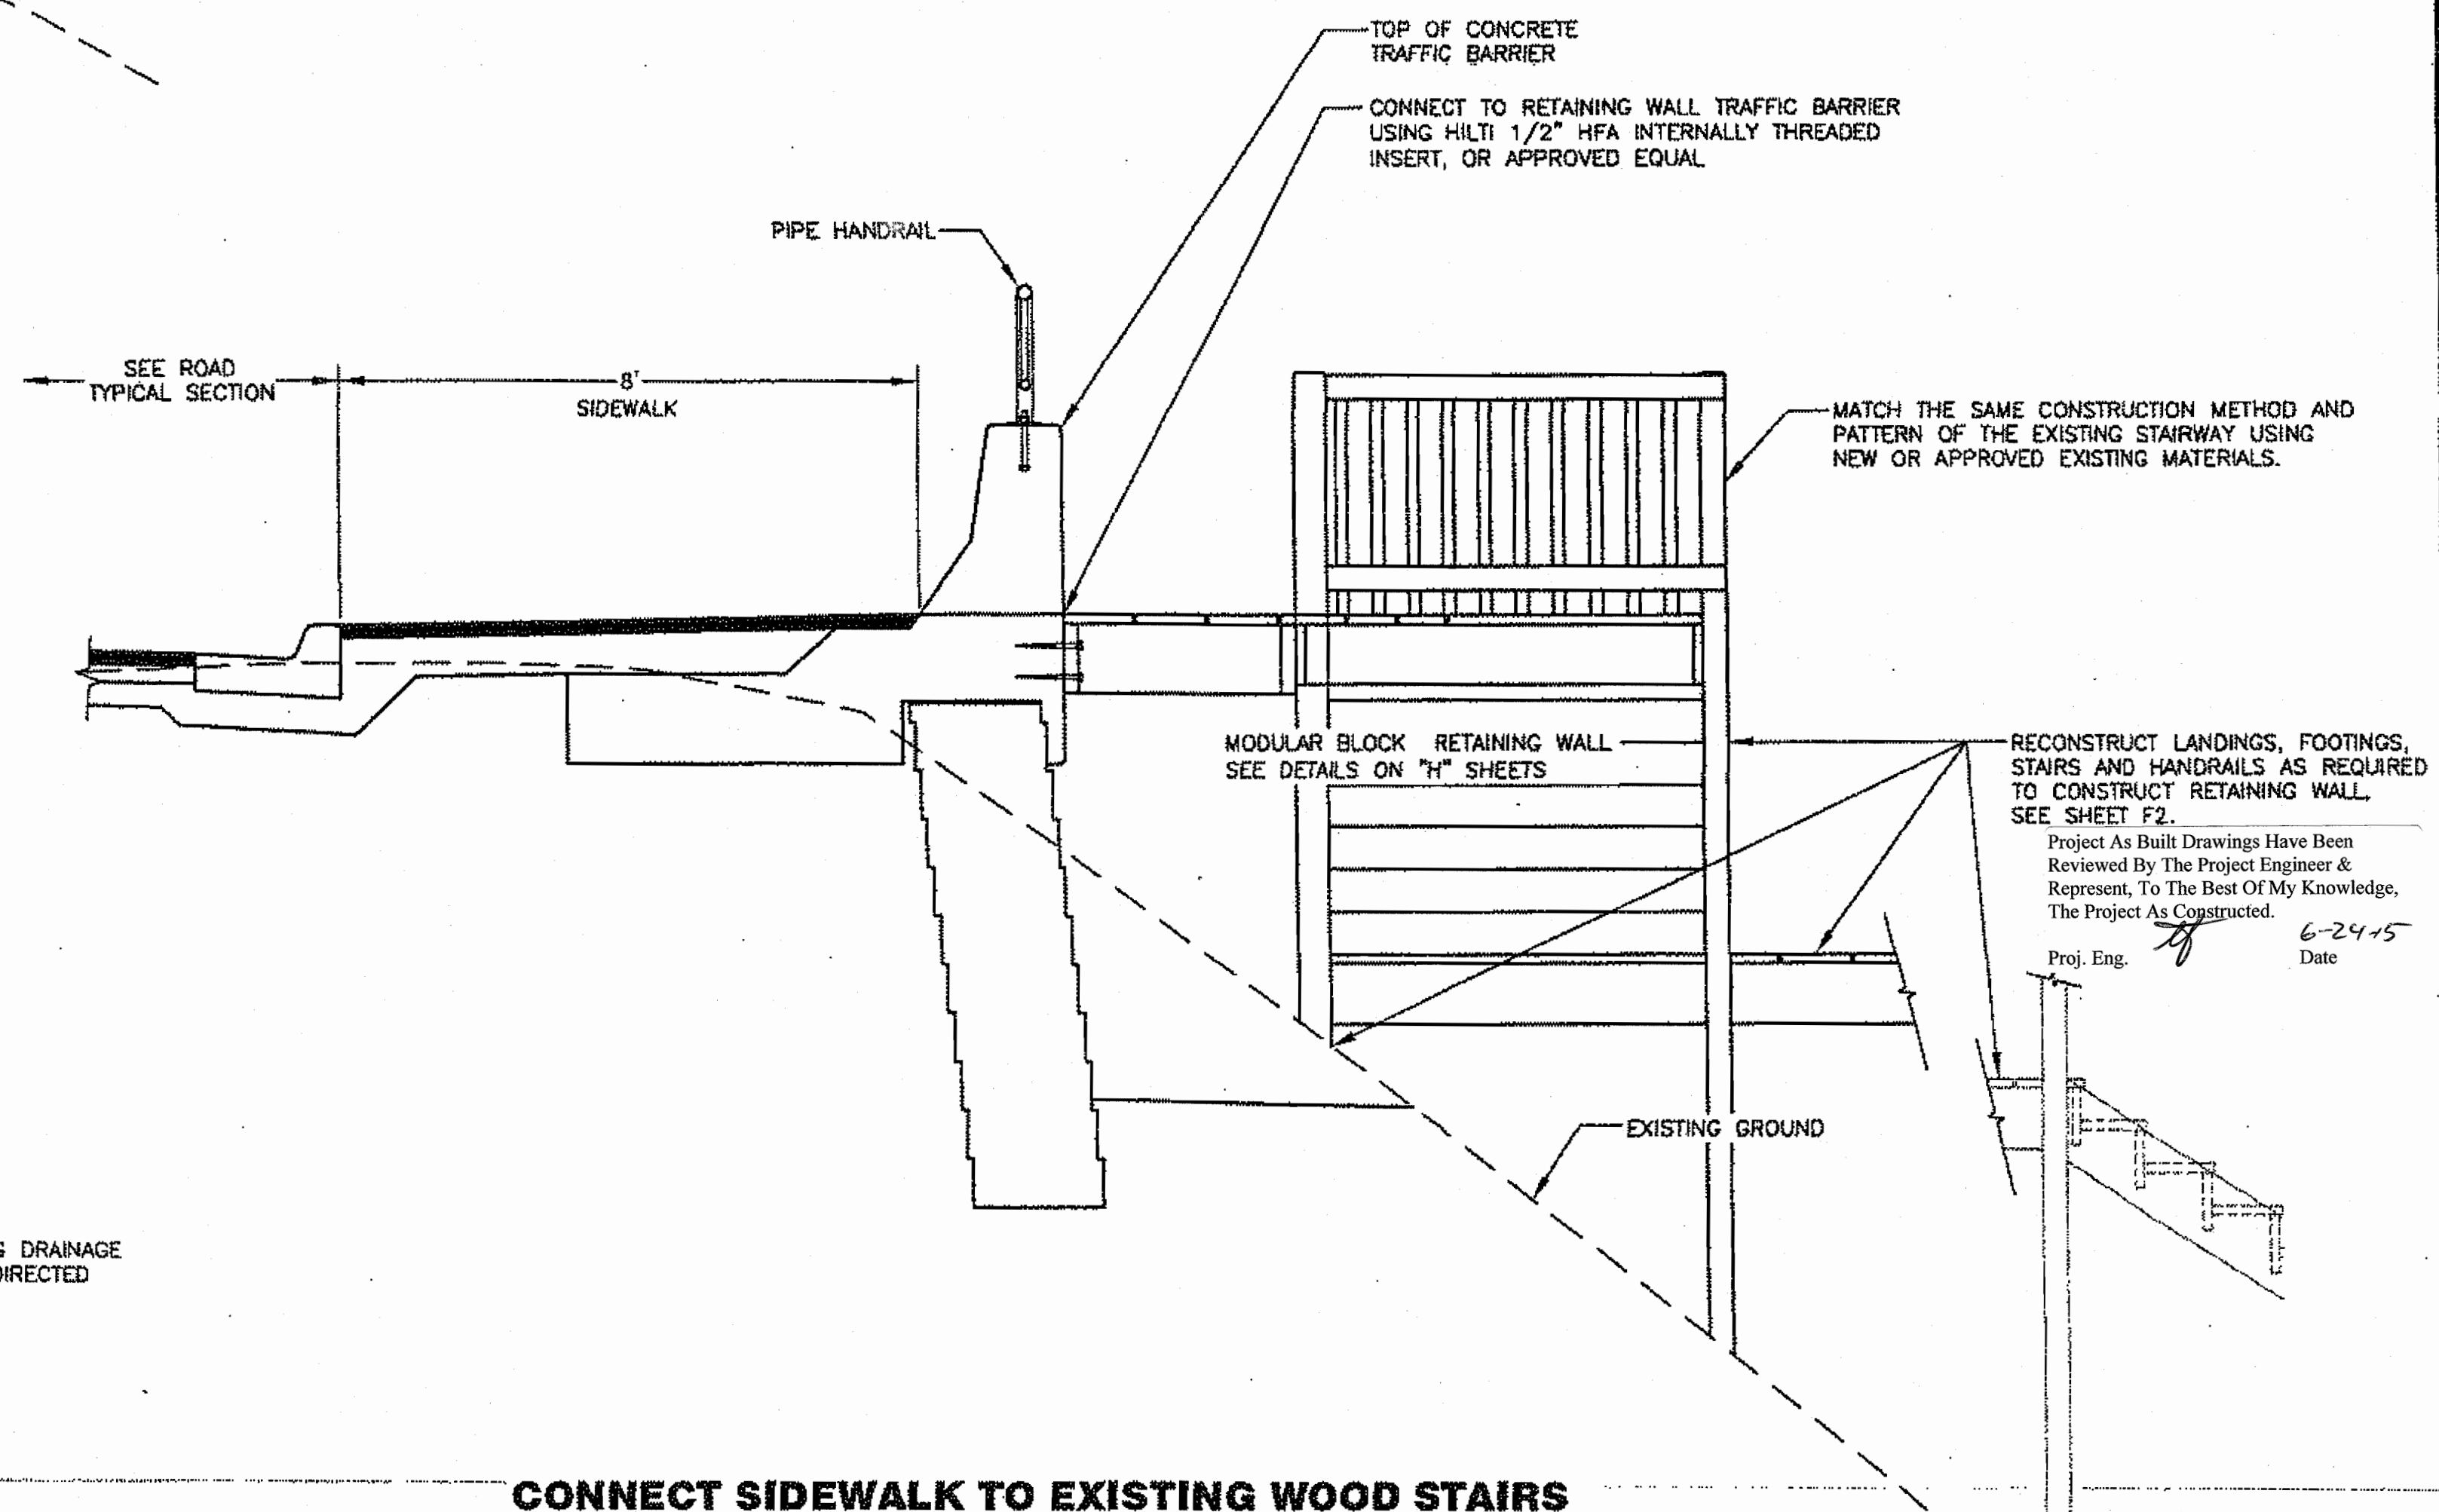

CONNECT SIDEWALK TO EXISTING WOOD STAIRS

DO NOT SCALE FROM THESE DRAWINGS USE DIMENSIONS


PATH: \\UNFILE2\JOBS\1153805\DWG\SVCS\SHETS\E03.DWG Thursday, August 23, 2012 1:18:59 PM TAB: E03		
ADDENDUM NUMBER		
ATTACHMENT NUMBER		
RECORD OF REVISIONS		
No.	DATE	DESCRIPTION
SAWMILL CREEK ROAD UPGRADE PHASE III - WHALE PARK TO SAWMILL CREEK BRIDGE 68216\MSG-STP-0933(21) SITKA TELECOMMUNICATIONS CONDUIT RSA NO. 69615		
PREPARED BY: USKH CHECKED BY: NCL		
		
DESIGNED BY: NCL DRAWN BY: WJP		
STATE OF ALASKA DEPARTMENT OF TRANSPORTATION & PUBLIC FACILITIES SOUTHEAST REGION		
DETAILS		
PROJECT DESIGNATION		
68216\MSG-STP-0933(21)		
STATE	YEAR	
ALASKA	2012	
SHEET NUMBER	TOTAL SHEETS	
E3	109	

DETAILS


TOTAL SHEETS

NOTE:


CULVERT CLEANOUT BASINS SHALL BE CONSTRUCTED WHERE BEDROCK ENCROACHES ON CULVERT INLETS

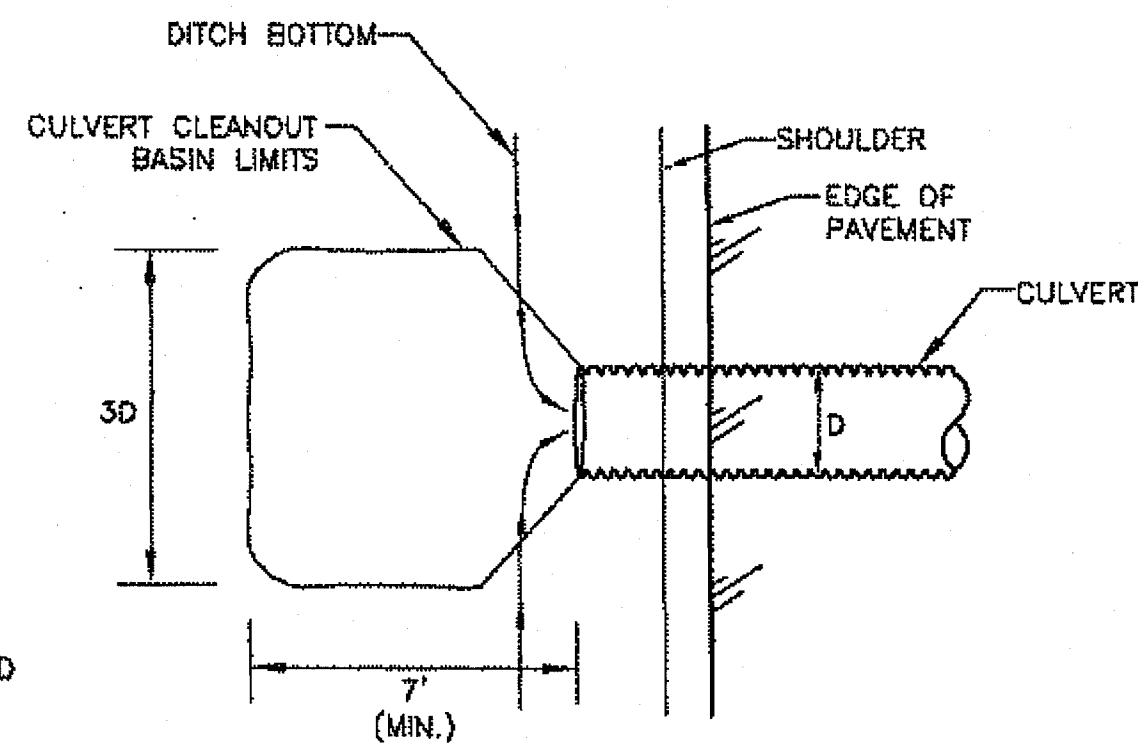


CULVERT INLET IN ROCK - PLAN VIEW

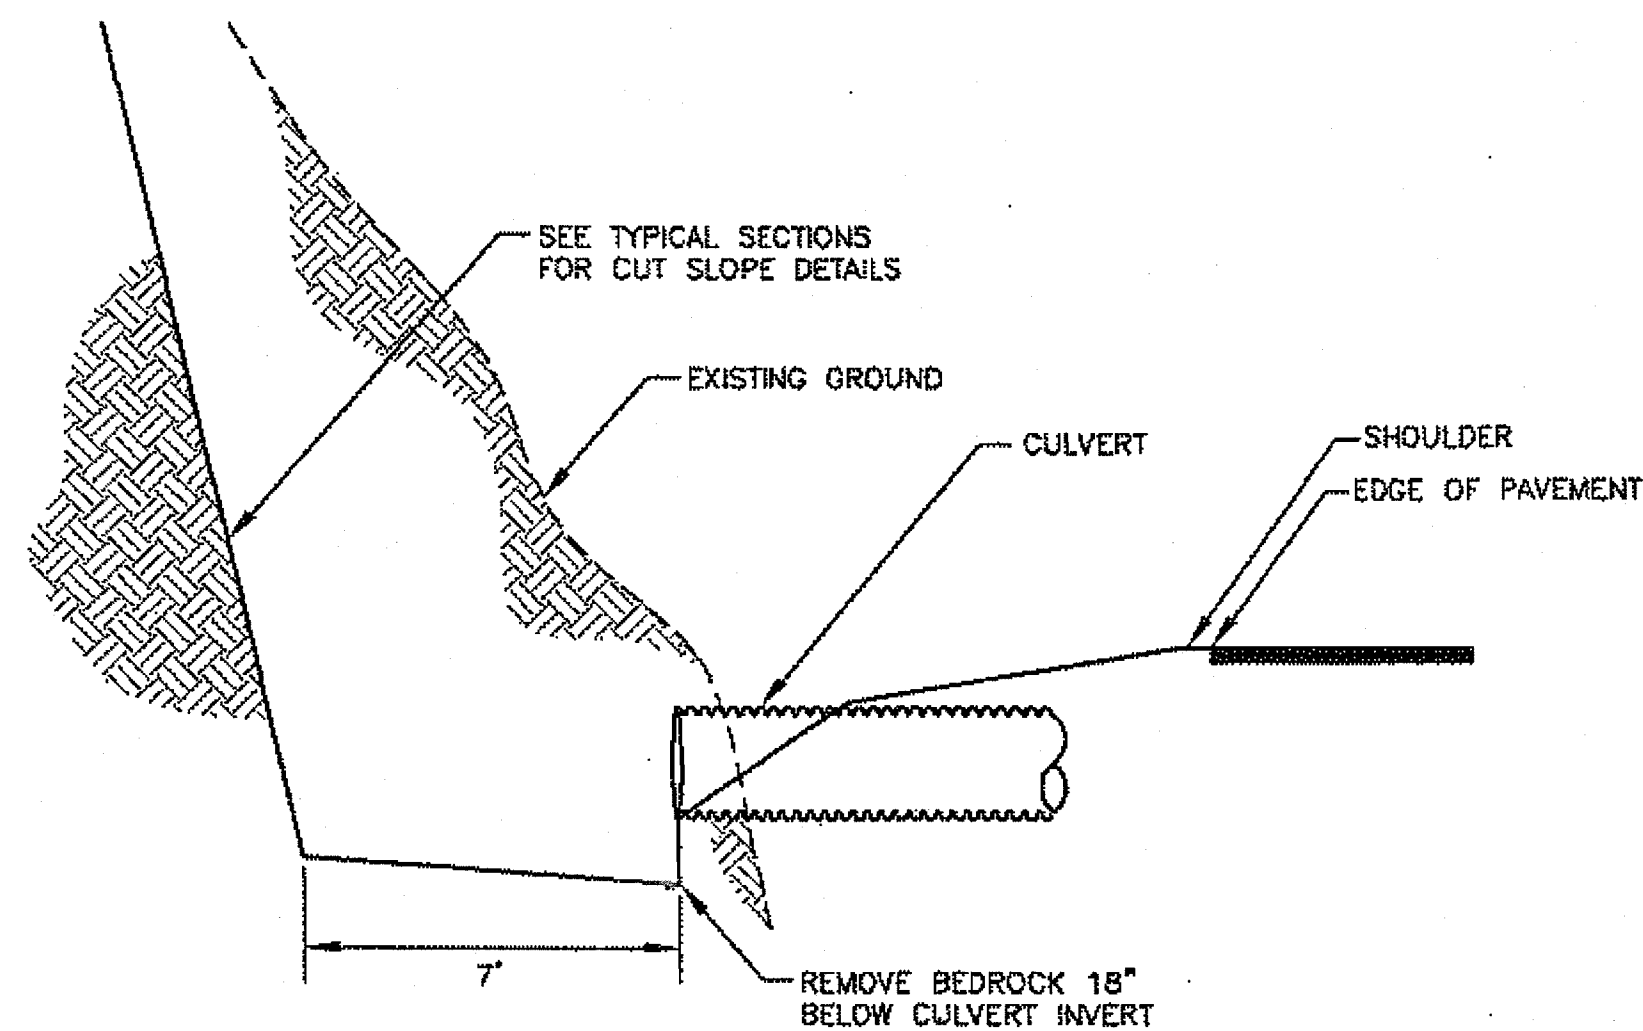


CULVERT INLET IN ROCK - PROFILE VIEW

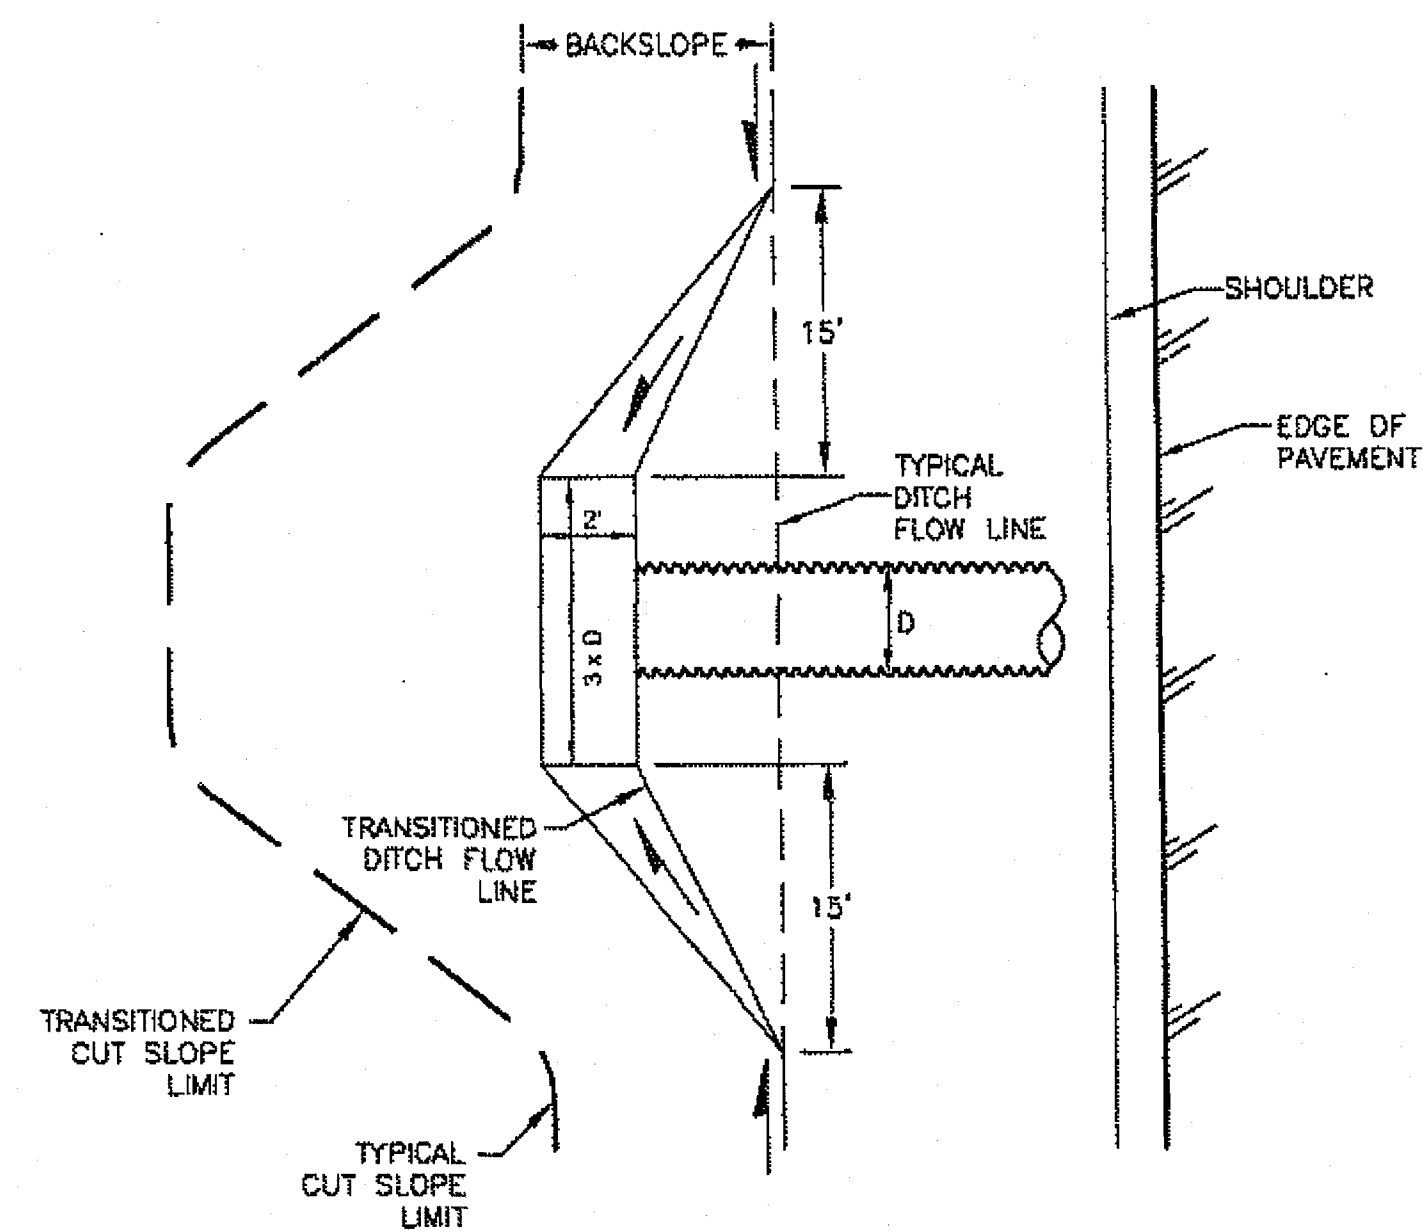

CULVERT INLET IN SOIL - PLAN VIEW

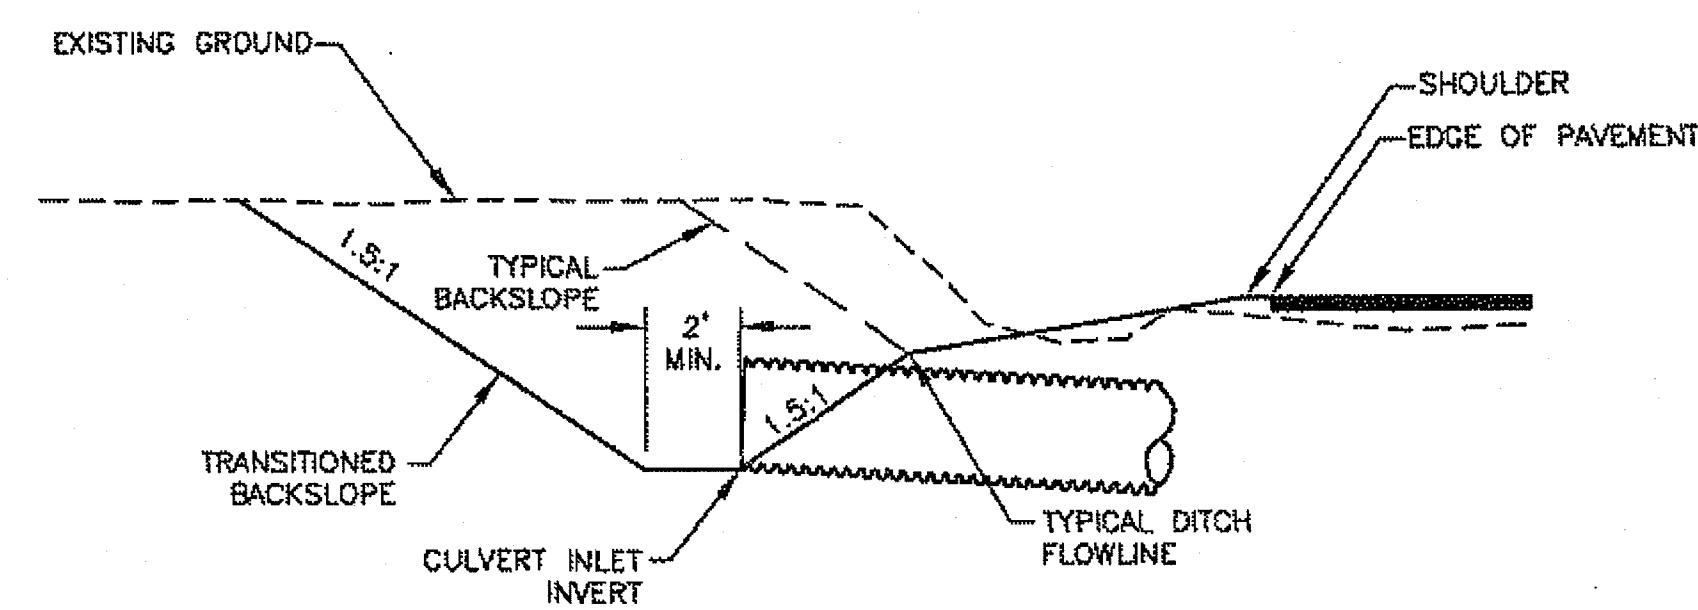

CULVERT INLET IN SOIL - PROFILE VIEW

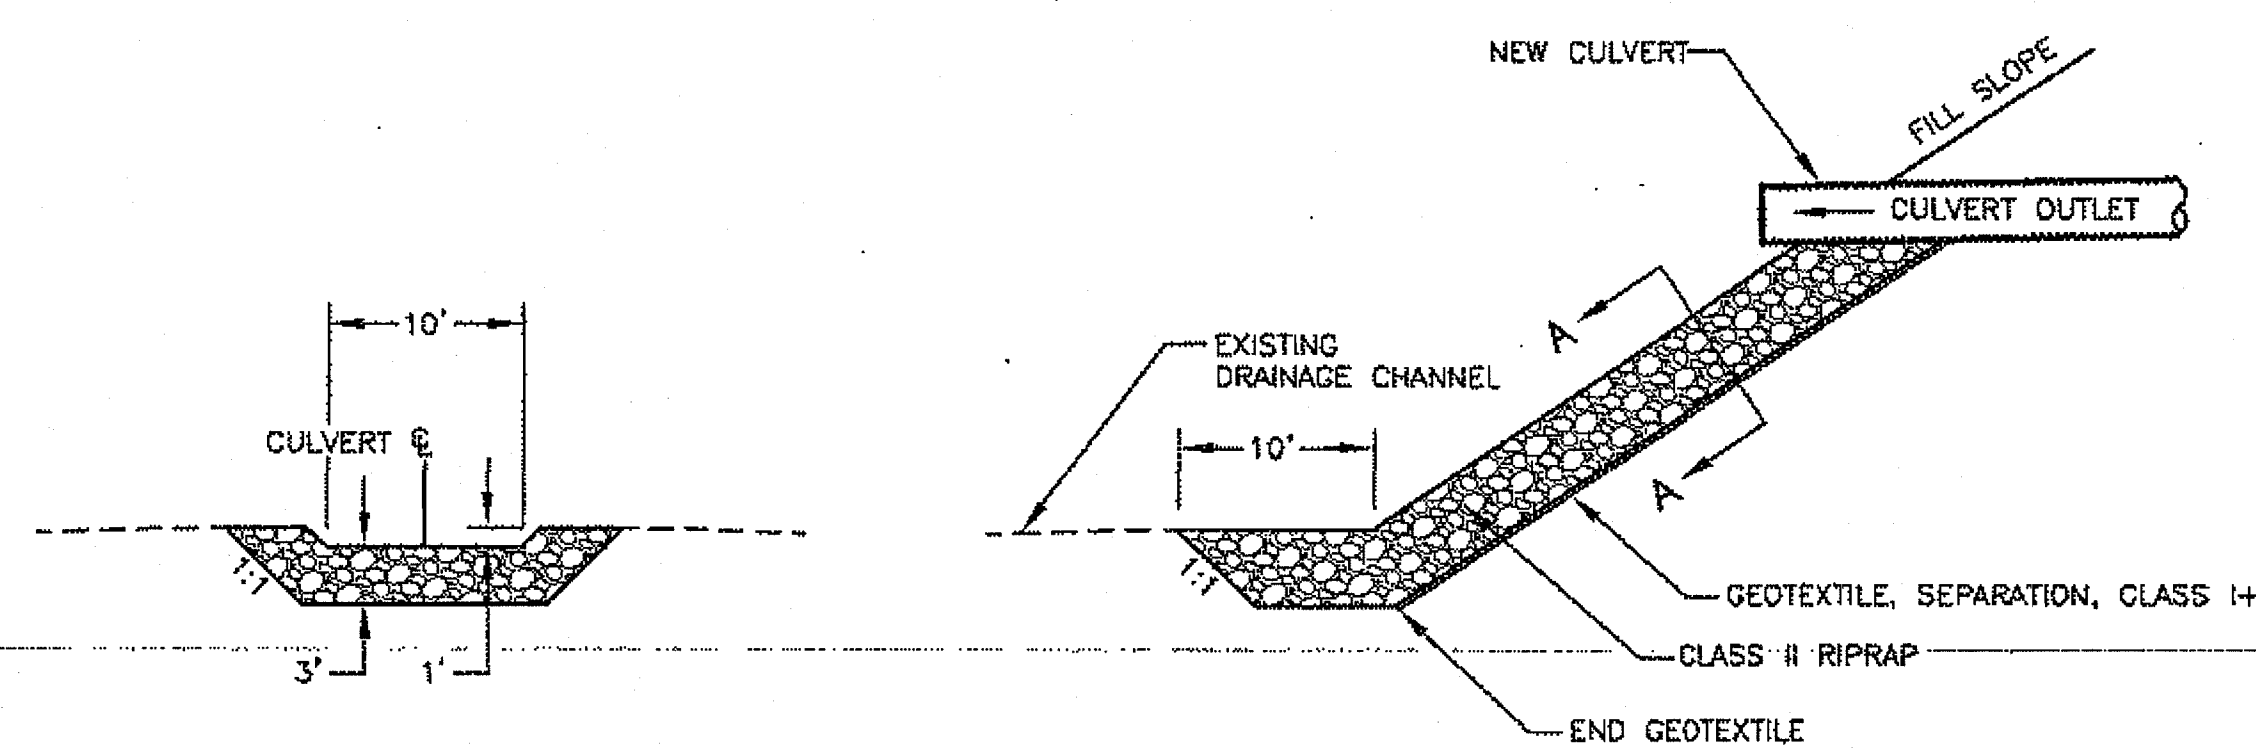


SECTION A-A

SECTION

NOTES:


1. CONSTRUCT CULVERT OUTLET SPILLWAYS ON CULVERT OUTLETS AS DIRECTED. CULVERT OUTLET SPILLWAY DIMENSIONS MAY BE ADJUSTED TO ACCOMMODATE FIELD CONDITIONS AS DIRECTED.
2. CULVERT OUTLET SPILLWAYS WILL BE MEASURED AND PAID FOR UNDER ITEM 611(1B) RIPRAP CLASS II. NO OTHER MEASUREMENT OR PAYMENT WILL BE MADE.

CULVERT OUTLET SPILLWAY DETAILS

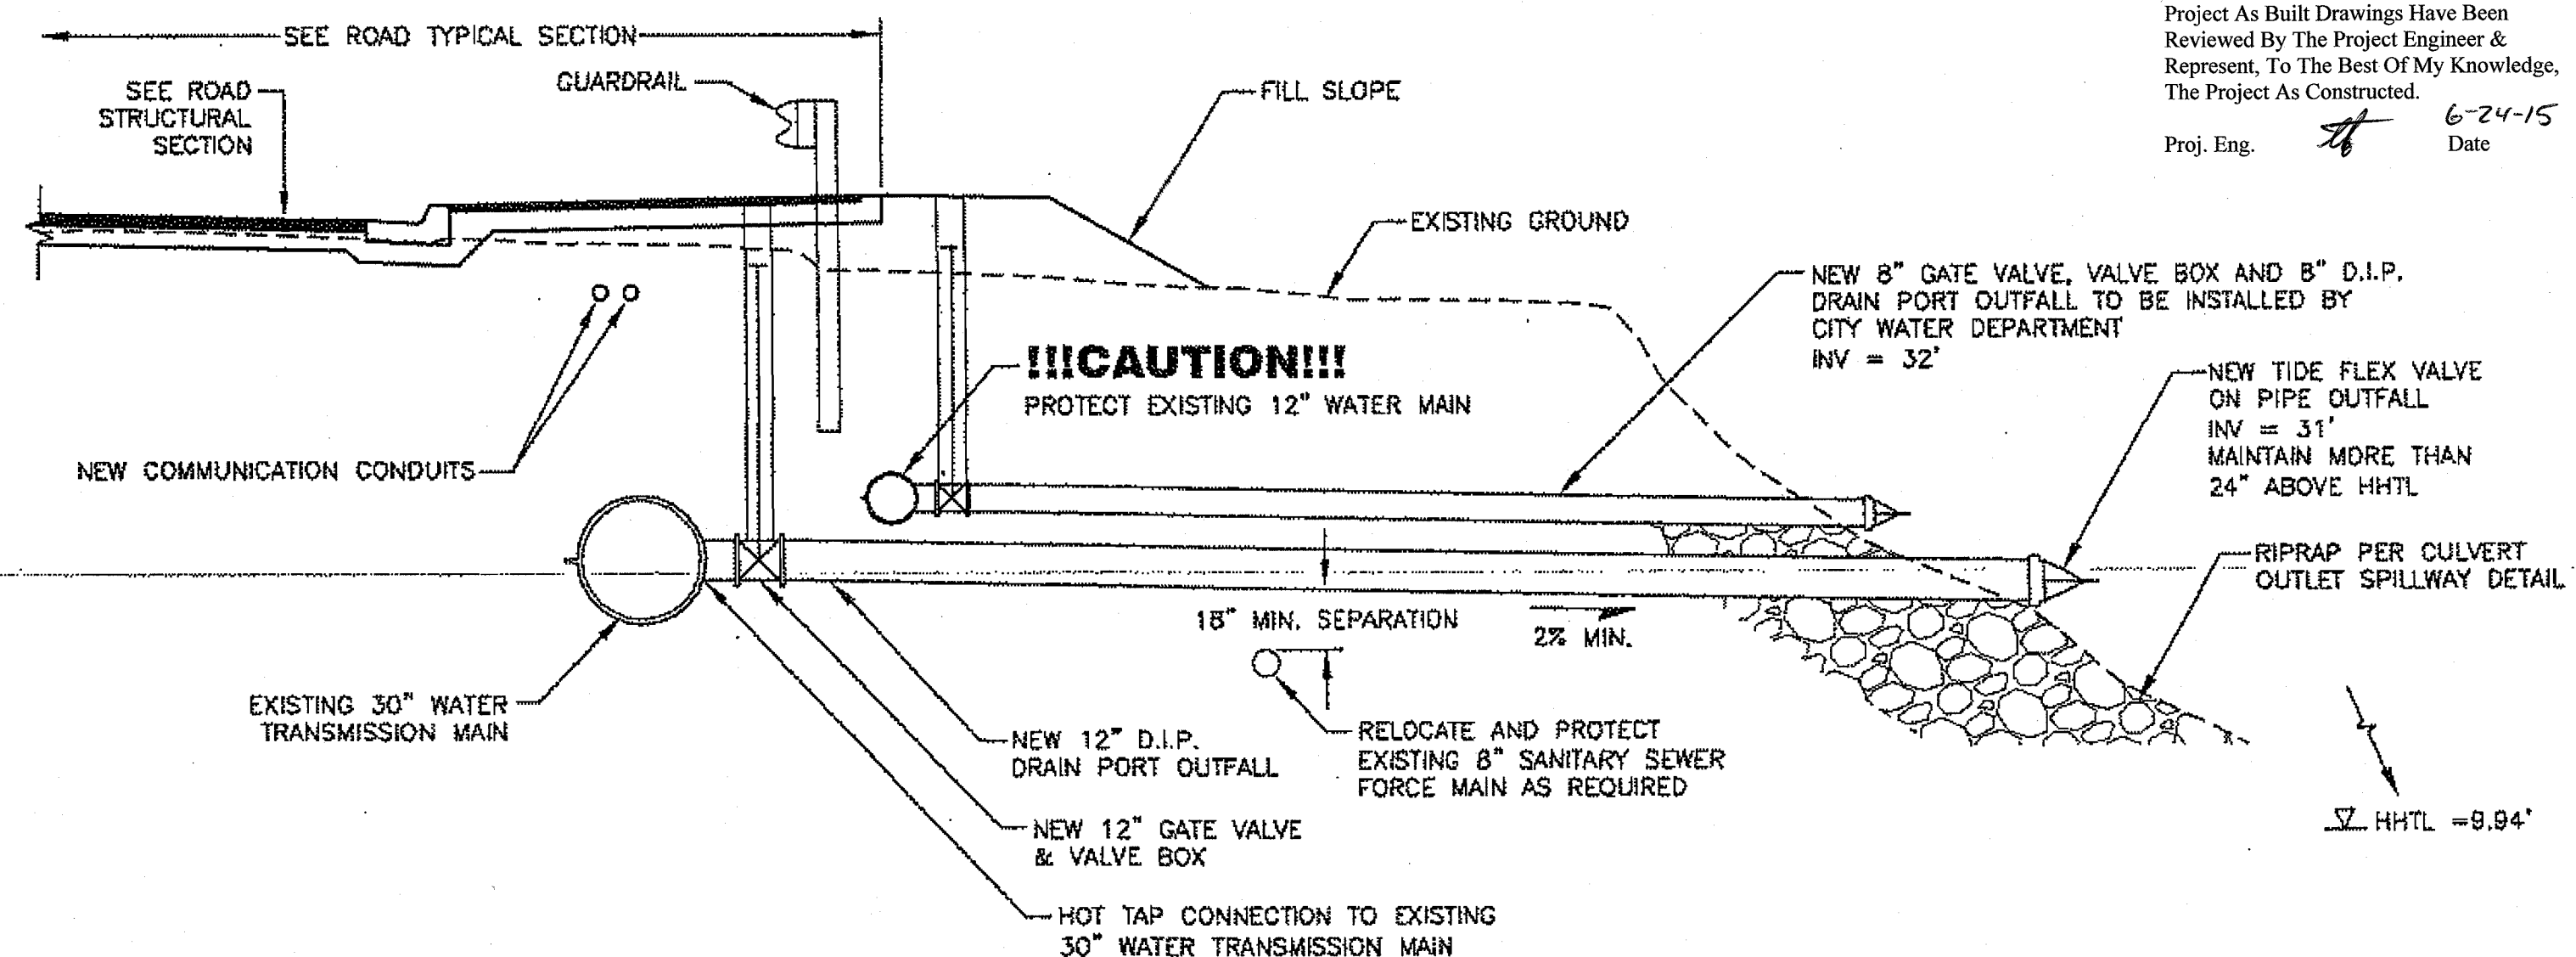


DRAIN PORT DETAIL


DO NOT SCALE FROM THESE DRAWINGS USE DIMENSIONS

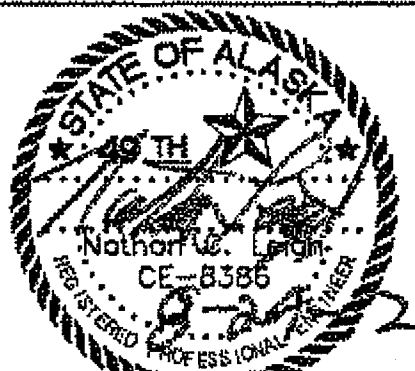PATH: \\UNUFILE2\JOBS\1153805\DWG\SC\SHETS\05.DWG Friday, August 17, 2012 7:13:49 PM TAB: E05		
ADDENDUM NUMBER		
ATTACHMENT NUMBER		
RECORD OF REVISIONS		
No.	DATE	DESCRIPTION
SAWMILL CREEK ROAD UPGRADE PHASE III - WHALE PARK TO SAWMILL CREEK BRIDGE 68216MSG-STP-0933(21) SITKA TELECOMMUNICATIONS CONDUIT RSA NO. 69615		
PREPARED BY: USKH CHECKED BY: NCL		
		
DESIGNED BY: NCL		
DRAWN BY: WJP		
STATE OF ALASKA DEPARTMENT OF TRANSPORTATION & PUBLIC FACILITIES SOUTHEAST REGION		
DETAILS		
PROJECT DESIGNATION		
68216MSG-STP-0933(21)		
STATE	YEAR	
ALASKA	2012	
SHEET NUMBER	TOTAL SHEETS	
E5	109	


DETAILS

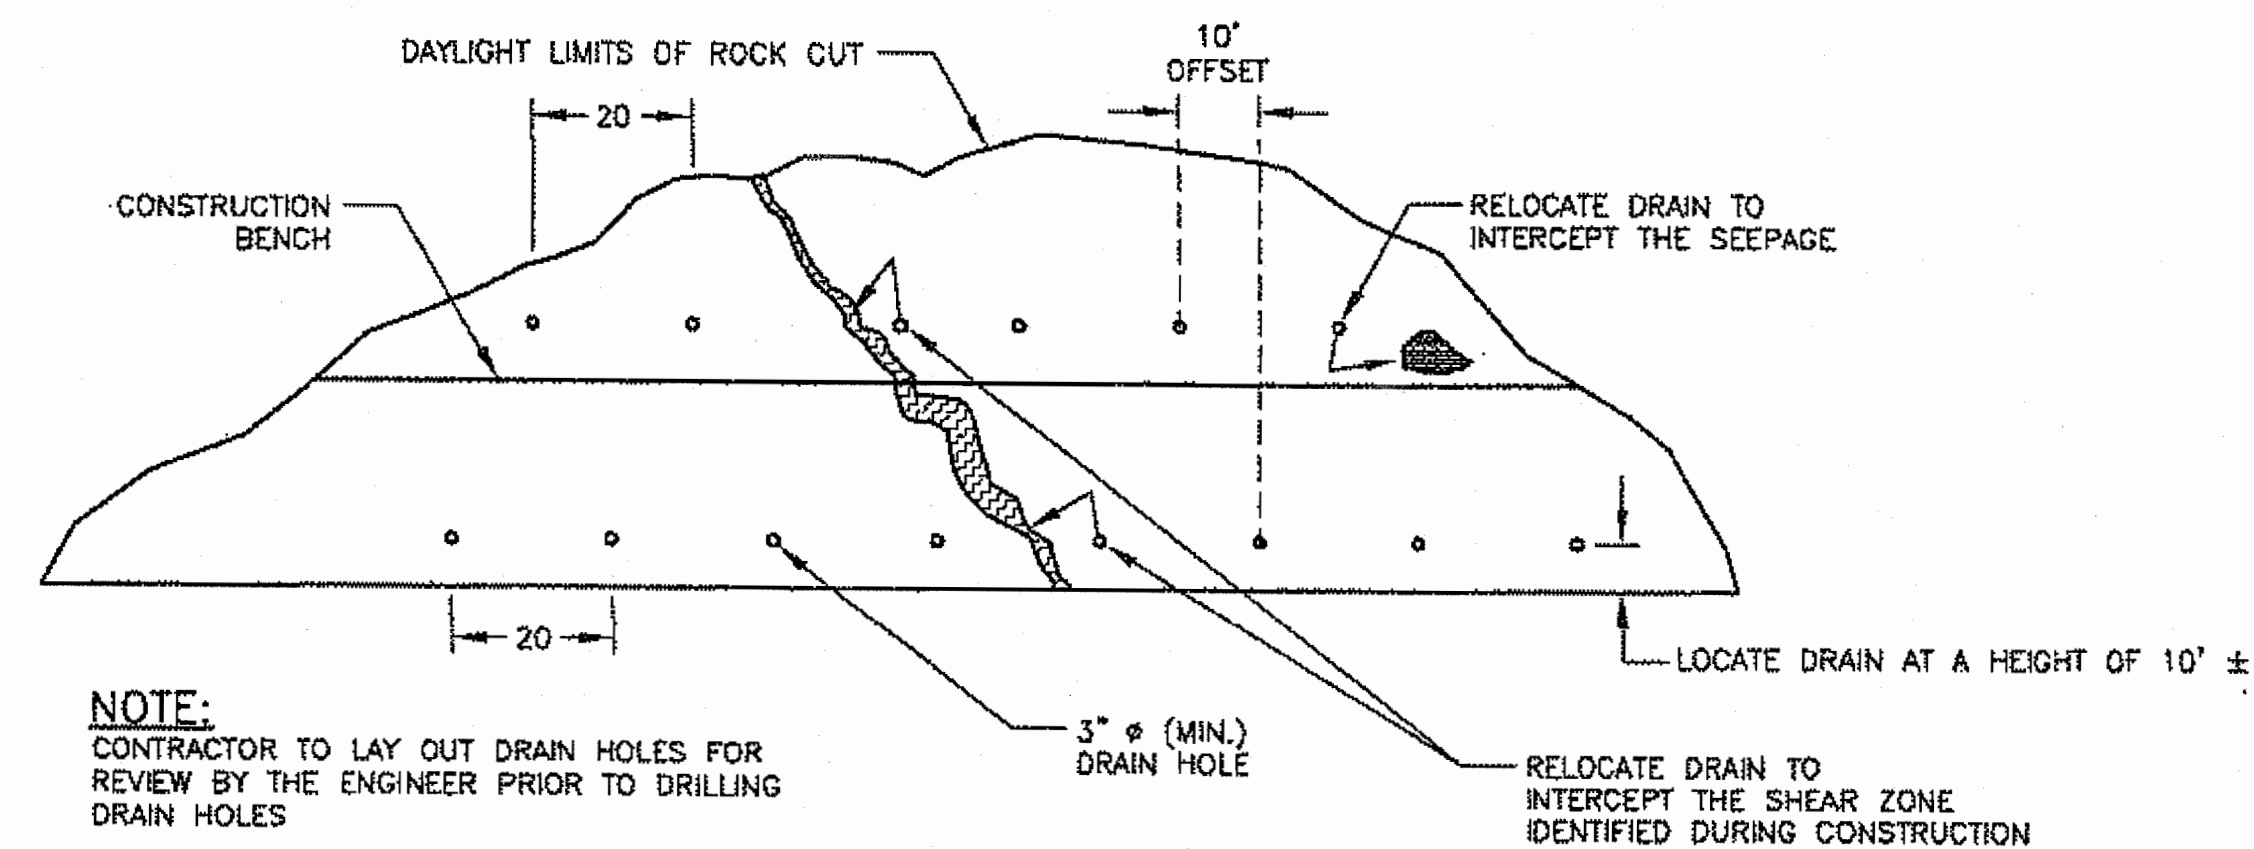


DRAIN HOLE LAYOUT

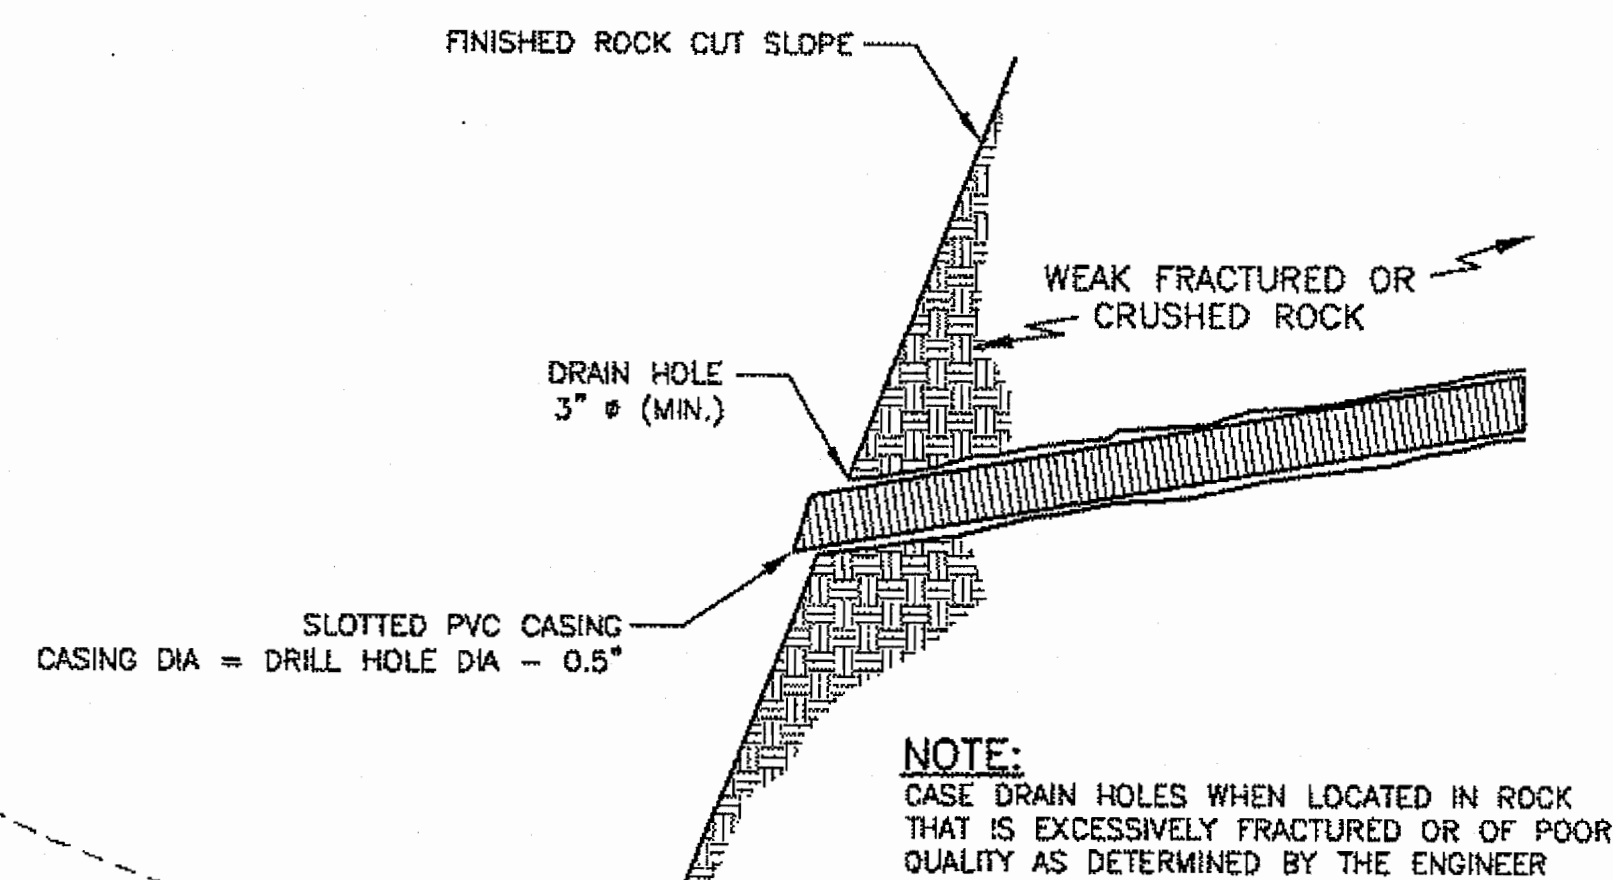

CASED DRAIN HOLE

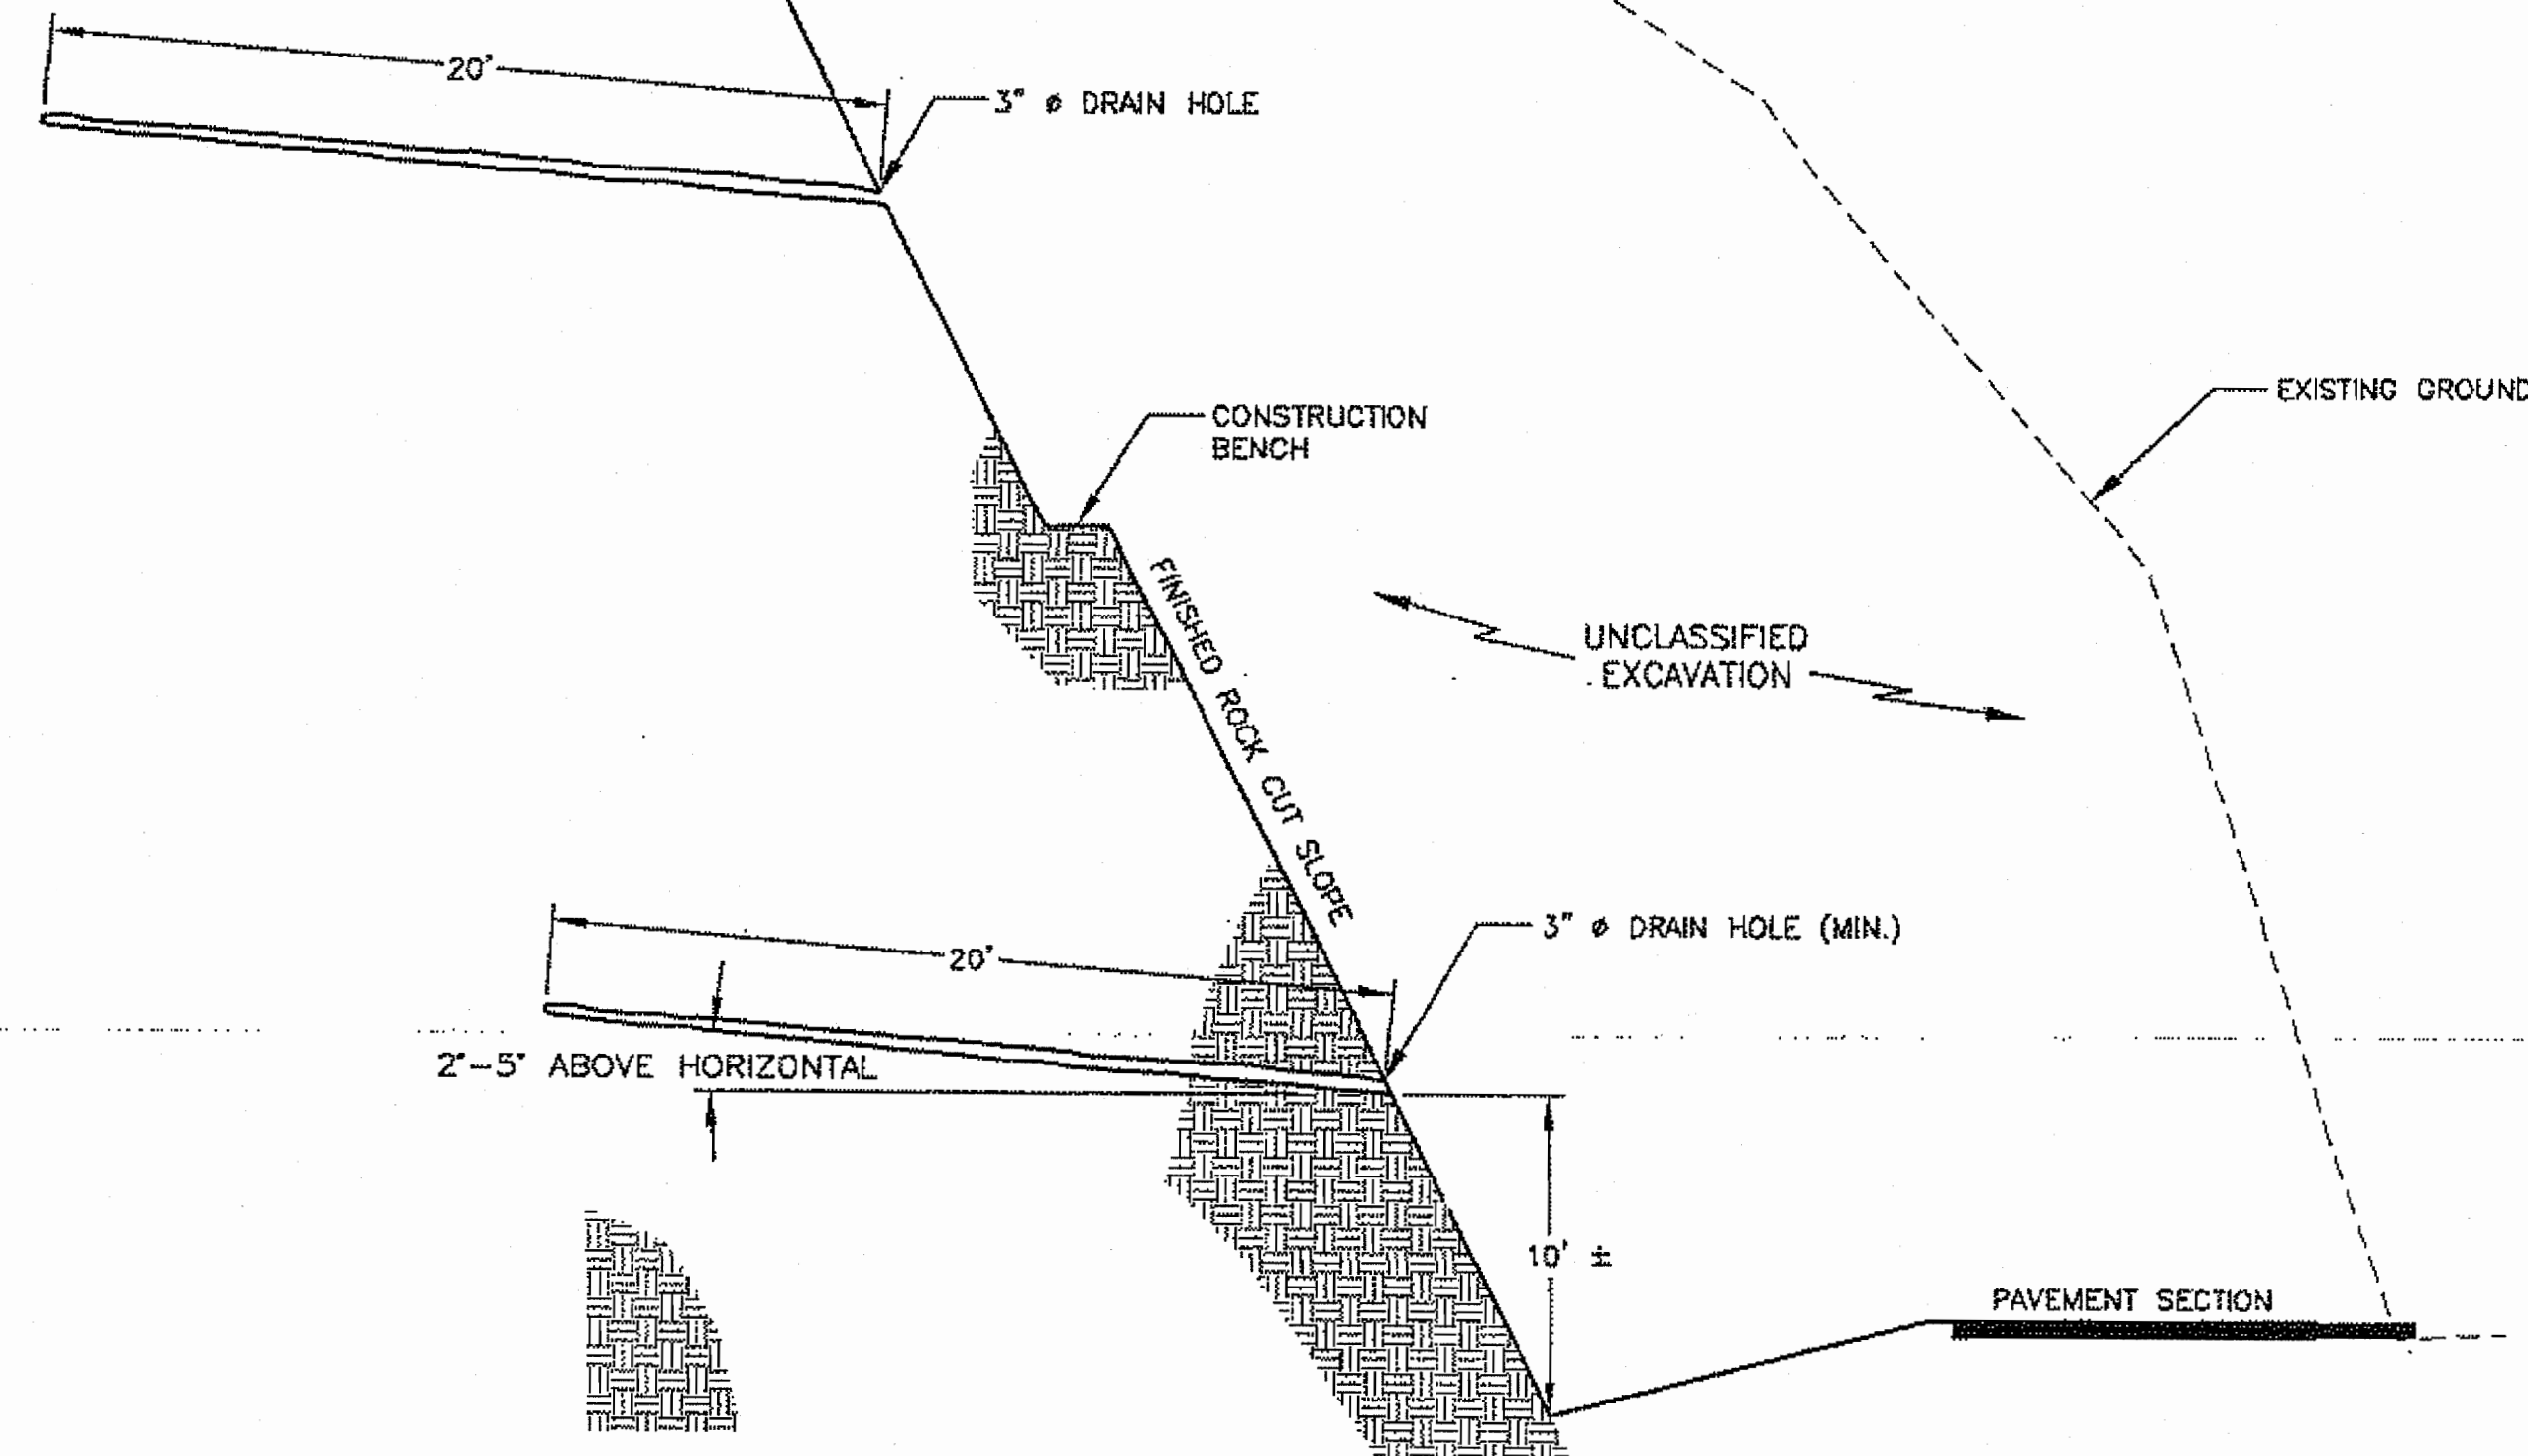


DRAIN HOLE INSTALLATION

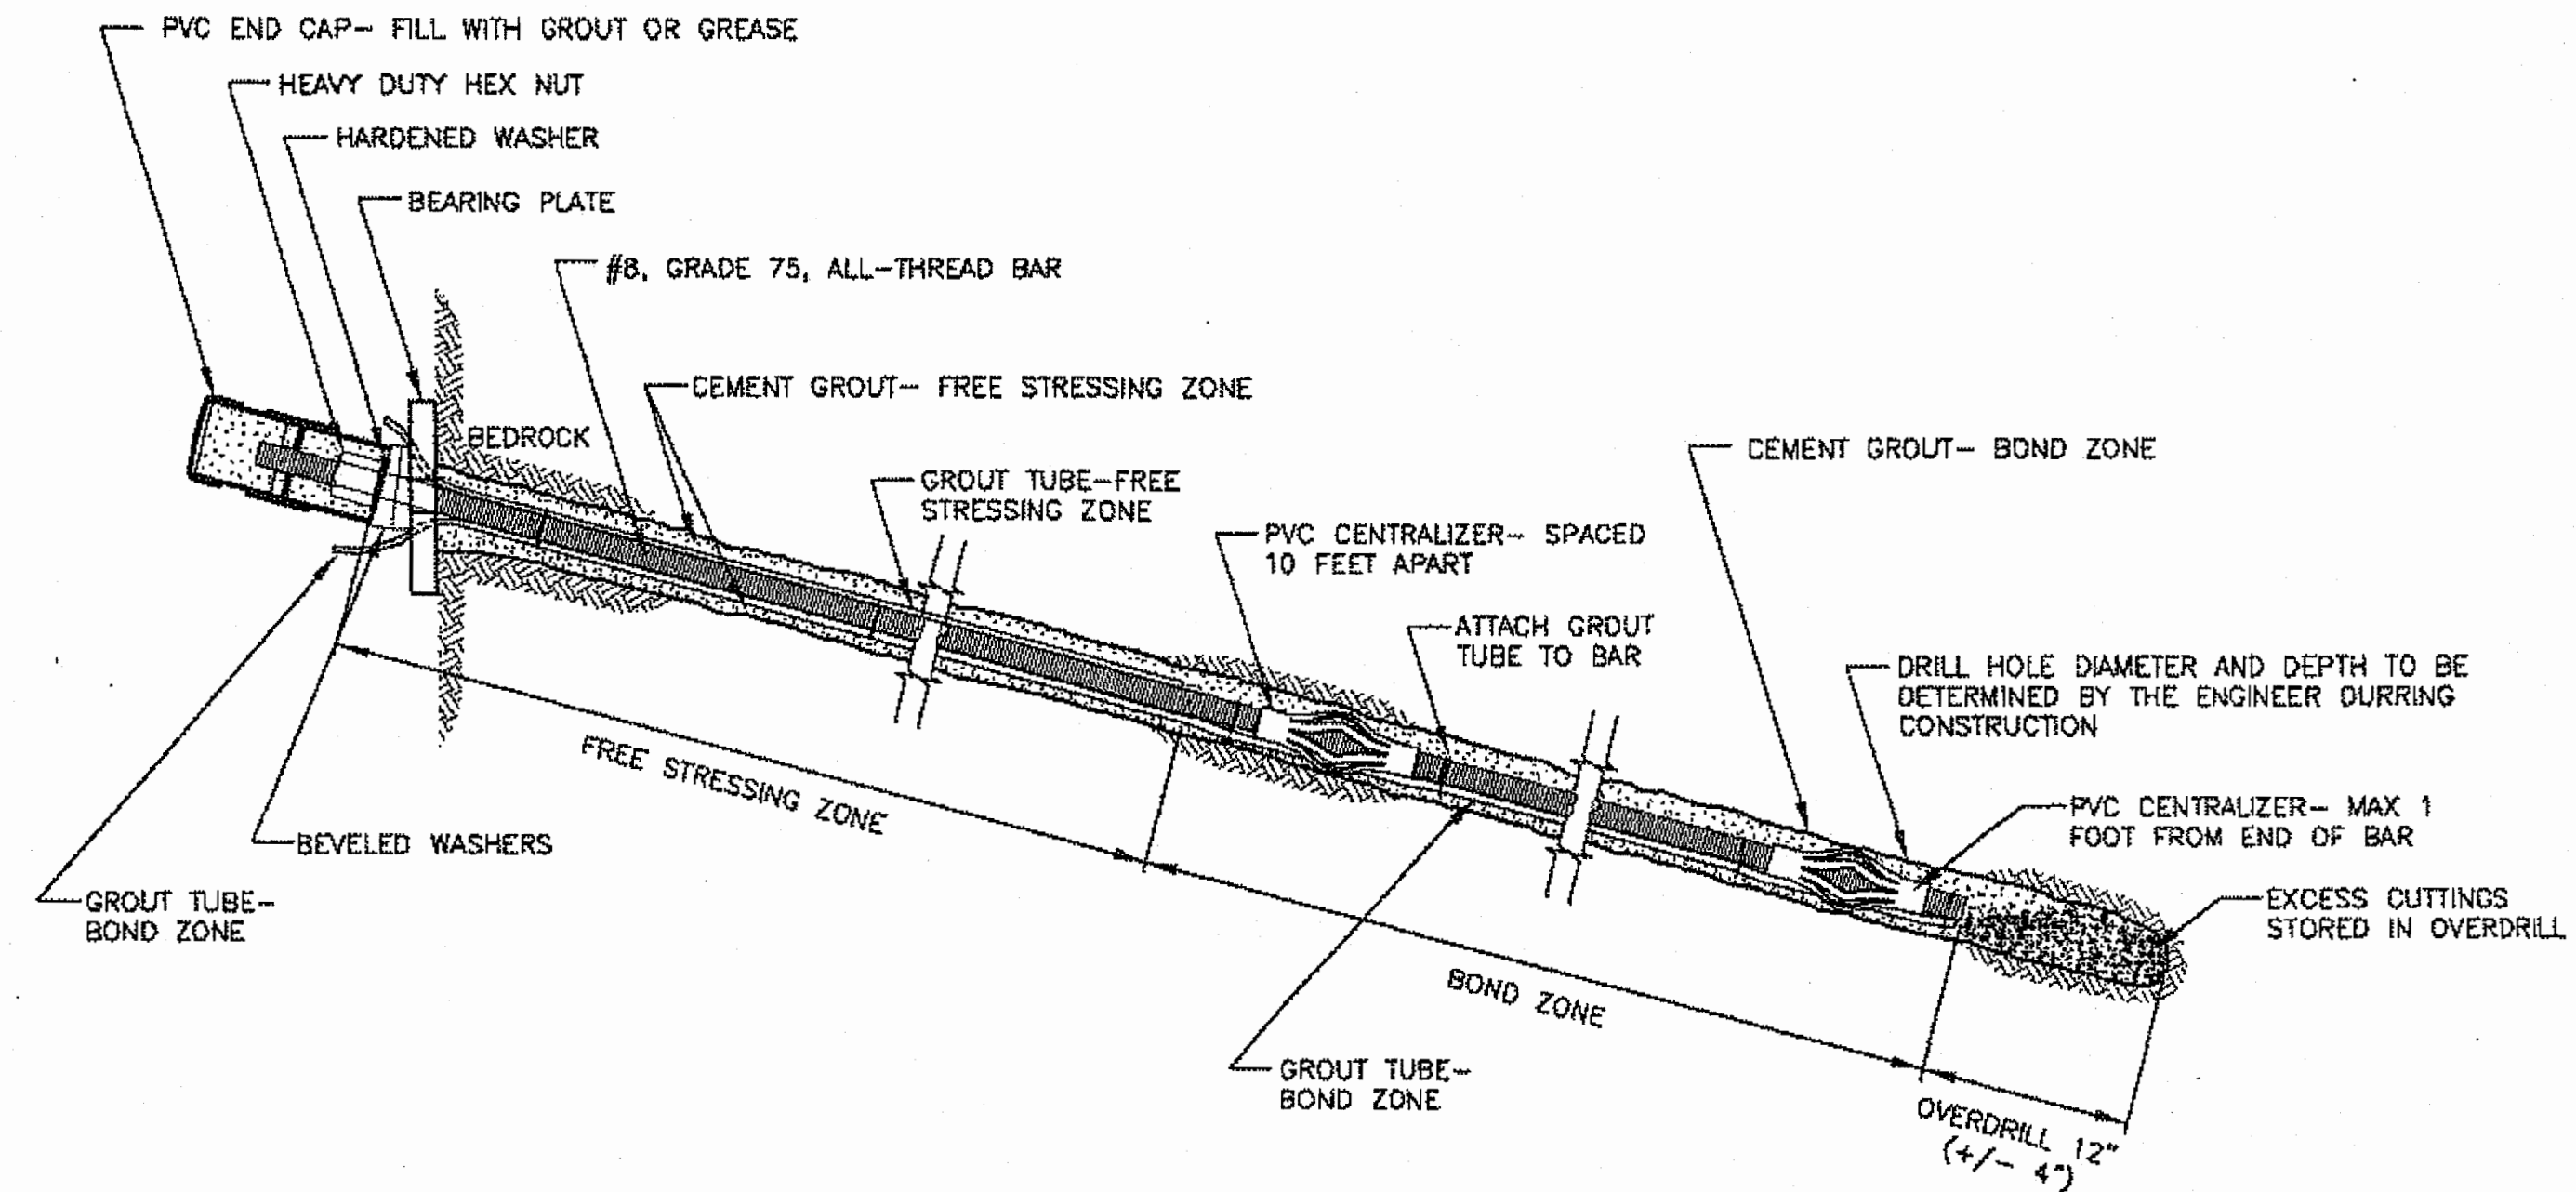

ROCK BOLT NOTE:
THE ENGINEER WILL PERFORM ROCK MAPPING AND DEVELOP A ROCK BOLTING PLAN TO SHOW LENGTH, LOCATION AND DESIGN LOAD OF THE ROCK BOLTS. THE CONTRACTOR SHALL ALLOW THE ENGINEER 10 DAYS TO PERFORM ROCK MAPPING WHILE THE ROCK FACE IS ACCESSIBLE.


TYPICAL ROCK BOLT INSTALLATION

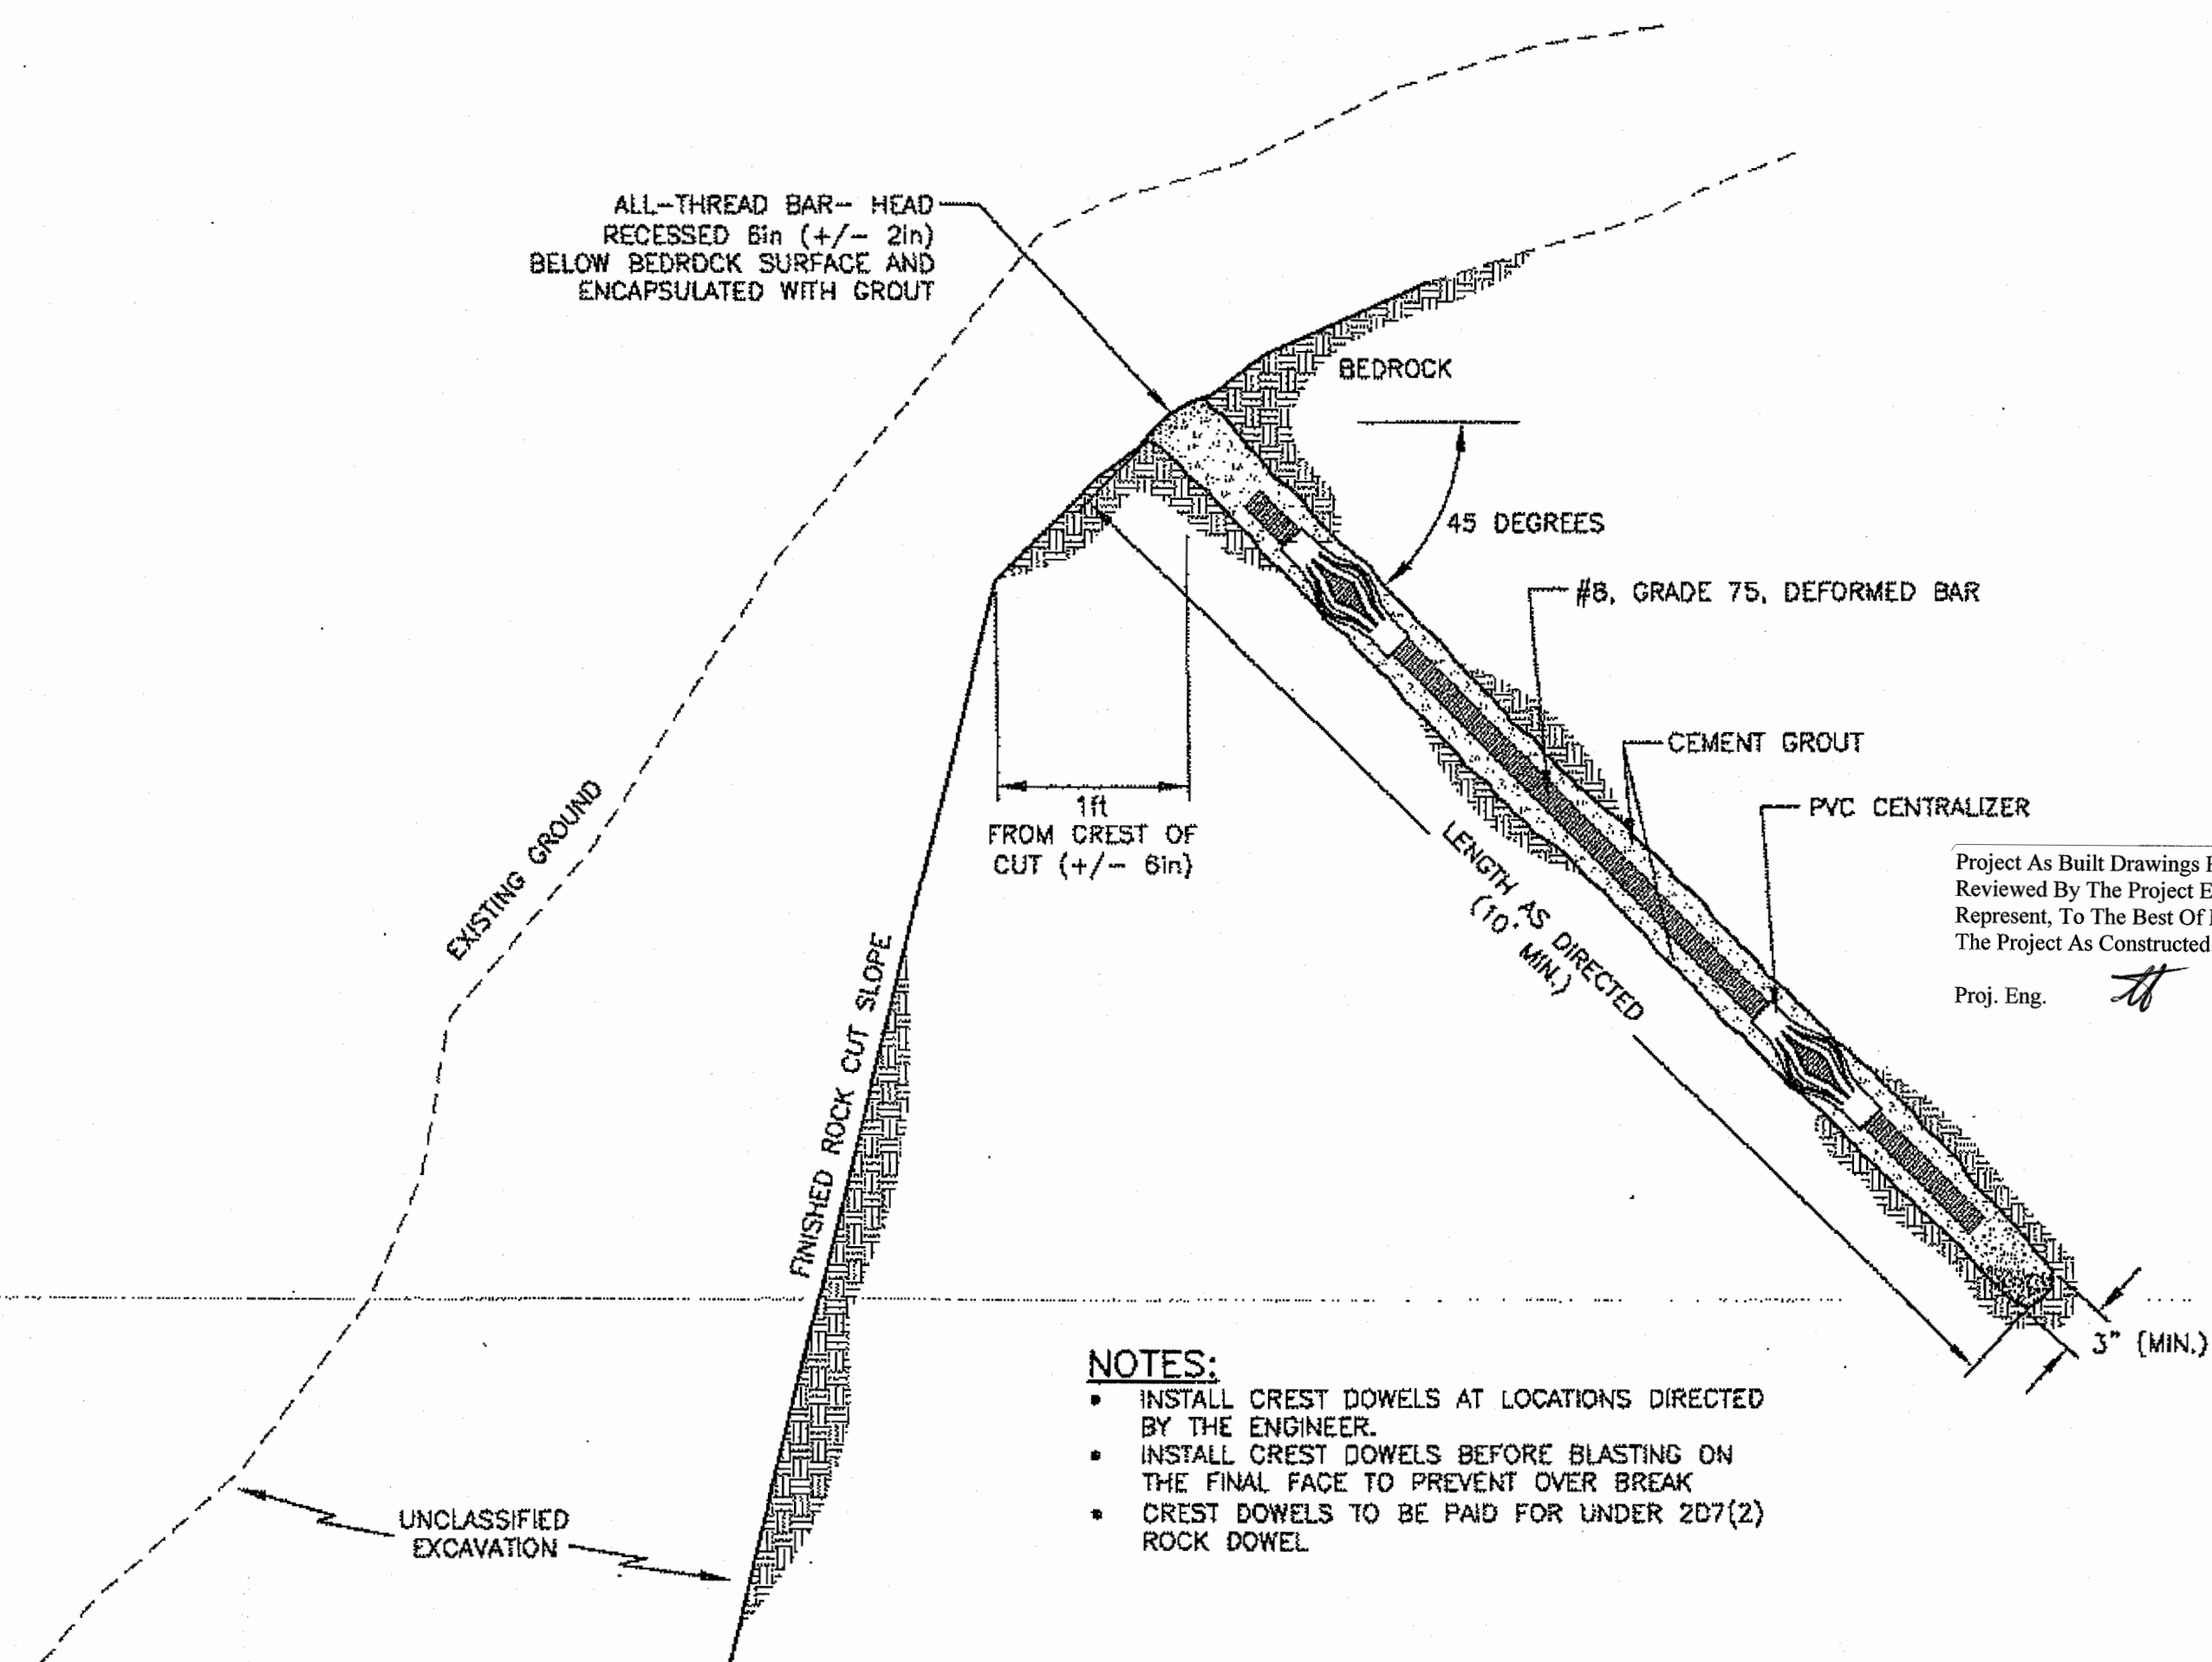

NOTES:
• INSTALL CREST DOWELS AT LOCATIONS DIRECTED BY THE ENGINEER.
• INSTALL CREST DOWELS BEFORE BLASTING ON THE FINAL FACE TO PREVENT OVER BREAK
• CREST DOWELS TO BE PAID FOR UNDER 2D7(2) ROCK DOWEL


TYPICAL CREST DOWEL INSTALLATION

DO NOT SCALE FROM THESE DRAWINGS USE DIMENSIONS

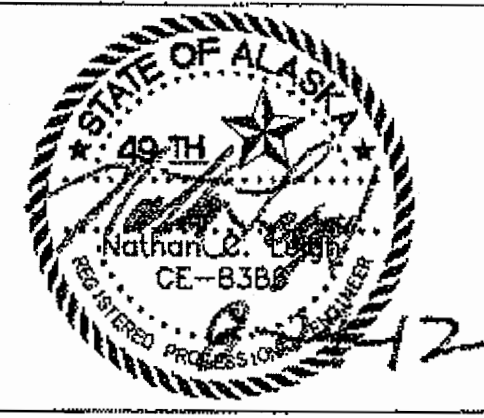
PATH: \\NUNFILE2\JOBS\1153806\DWG\CS\SHEETS\ED6.DWG		
Friday, August 17, 2012 7:13:53 PM		
TAB: E06		
ADDENDUM NUMBER		
ATTACHMENT NUMBER		
RECORD OF REVISIONS		
No.	DATE	DESCRIPTION
SAWMILL CREEK ROAD UPGRADE PHASE III - WHALE PARK TO SAWMILL CREEK BRIDGE 68216MSG-STP-0933(21) SITKA TELECOMMUNICATIONS CONDUIT RSA NO. 69615		
PREPARED BY: USKH		
CHECKED BY: NCL		
		
DESIGNED BY: NCL		
DRAWN BY: WJP		
STATE OF ALASKA DEPARTMENT OF TRANSPORTATION & PUBLIC FACILITIES SOUTHEAST REGION		
DETAILS		
PROJECT DESIGNATION		
68216MSG-STP-0933(21)		
STATE	YEAR	
ALASKA	2012	
SHEET NUMBER	TOTAL SHEETS	
E6	109	

HANDRAIL NOTES:


- HANDRAIL STATIONING IS APPROXIMATE. THE CONTRACTOR SHALL MARK POST HOLE FOUNDATION LOCATIONS BEFORE INSTALLING FOUNDATIONS. ADJUST POST HOLE LOCATIONS AS NECESSARY TO ENSURE THAT NO POST HOLE LOCATIONS CONFLICT WITH UNDERGROUND UTILITIES.
- CONTRACTOR SHALL PROVIDE SHOP DRAWINGS OF ALL PEDESTRIAN RAILING, PRIOR TO FABRICATION, FOR THE ENGINEER'S REVIEW AND APPROVAL.
- THE SHOULDER SECTION IS NARROW WITH MUCH STEEPER SLOPE THAN SHOWN ON TYPICAL SECTION AT MANY LOCATIONS. INSTALL HANDRAIL FOUNDATIONS IN THIS SECTION DIRECTLY ADJACENT TO THE ASPHALT SIDEWALK. IF THE ENGINEER DETERMINES NECESSARY, REMOVE UP TO 4" OF THE ASPHALT SIDEWALK TO PLACE PIPE HANDRAIL FOUNDATION.
- THE 6" DIMENSION BETWEEN PIPE RAIL SECTIONS IS TYPICAL. THE CONTRACTOR MAY ADJUST THE SPACING BETWEEN RAIL SECTIONS $\pm 3"$ AS REQUIRED TO AVOID UNDERGROUND UTILITIES AND OTHER CONFLICTS.
- IF THE ROCK FOUNDATION DETAIL IS USED, USE A ROCK DRILL WITH A 3.5" OR LARGER BIT TO DRILL A HOLE THROUGH THE RIPRAP. REMOVE THE ROCK DUST AND FLUSH WITH WATER. POUR GROUT IN THE HOLE, DISPLACING THE WATER. INSTALL THE PIPE SLEEVE IN THE GROUT-FILLED HOLE AND BOLT THE PIPE HANDRAIL TO THE SLEEVES ONCE ALL THREE SLEEVES ARE IN PLACE.

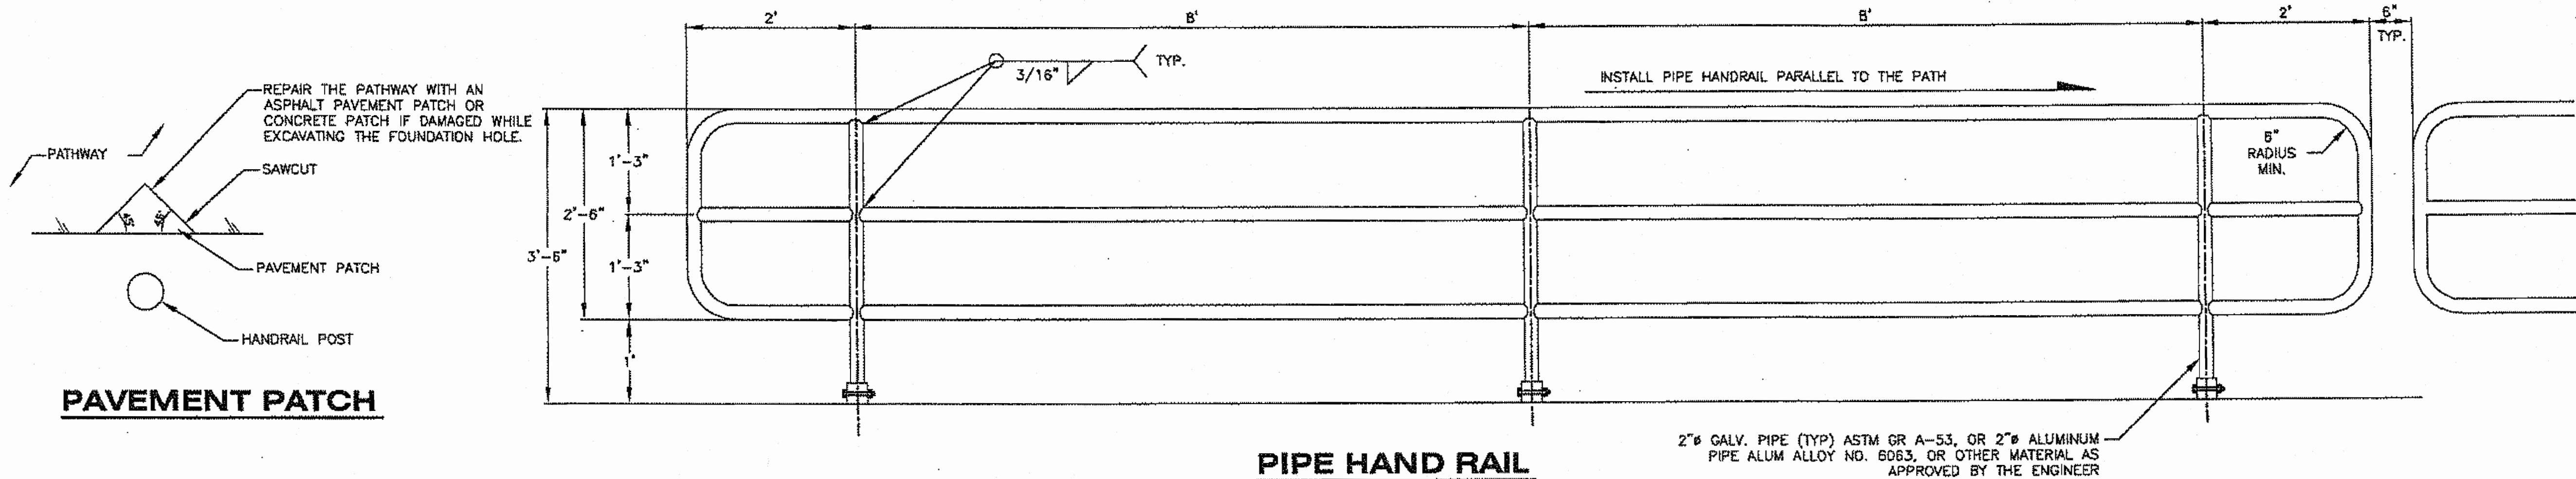


NOTE:
GALV. STEEL INSERT (TYP) ASTM GR A-53 OR ALUMINUM ALLOY PIPE NO. 6063. NOTE THIS INSERT SHALL MATCH THE 2" RAILING MATERIAL ABOVE.

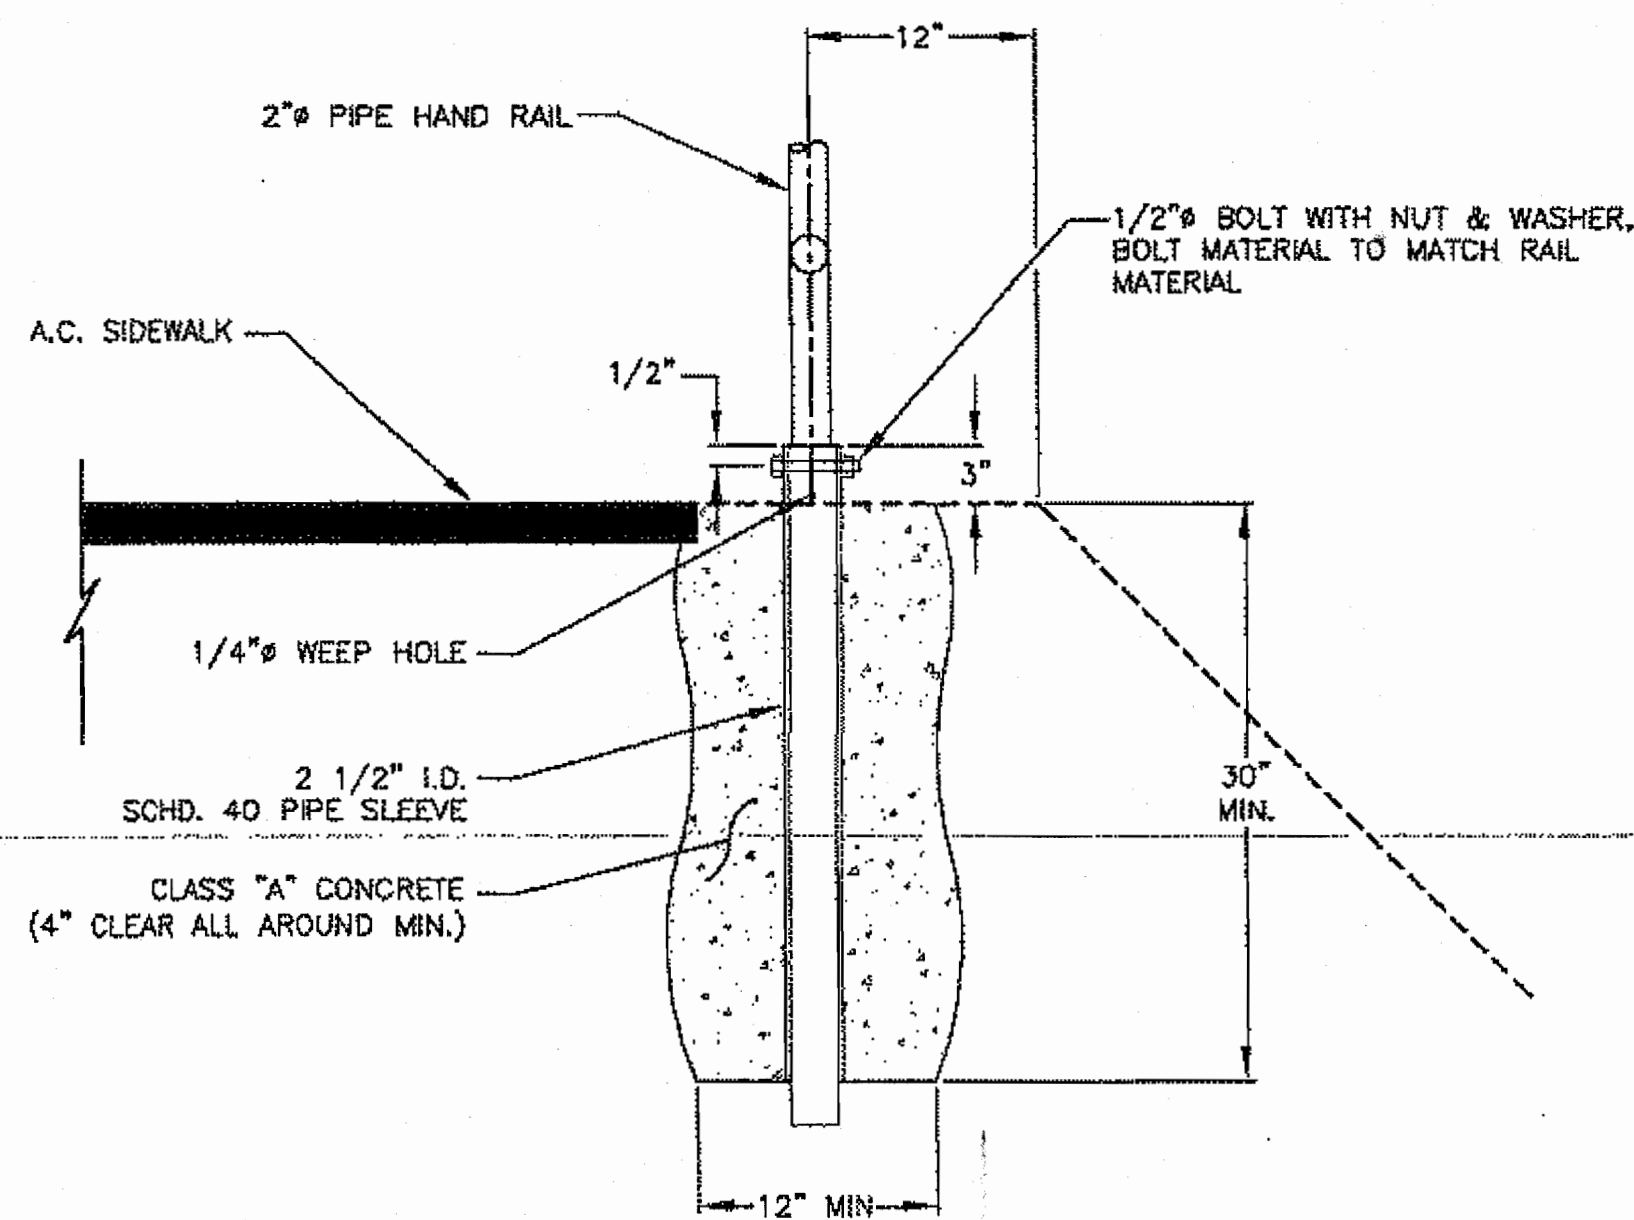

CAST IN PLACE FOUNDATION

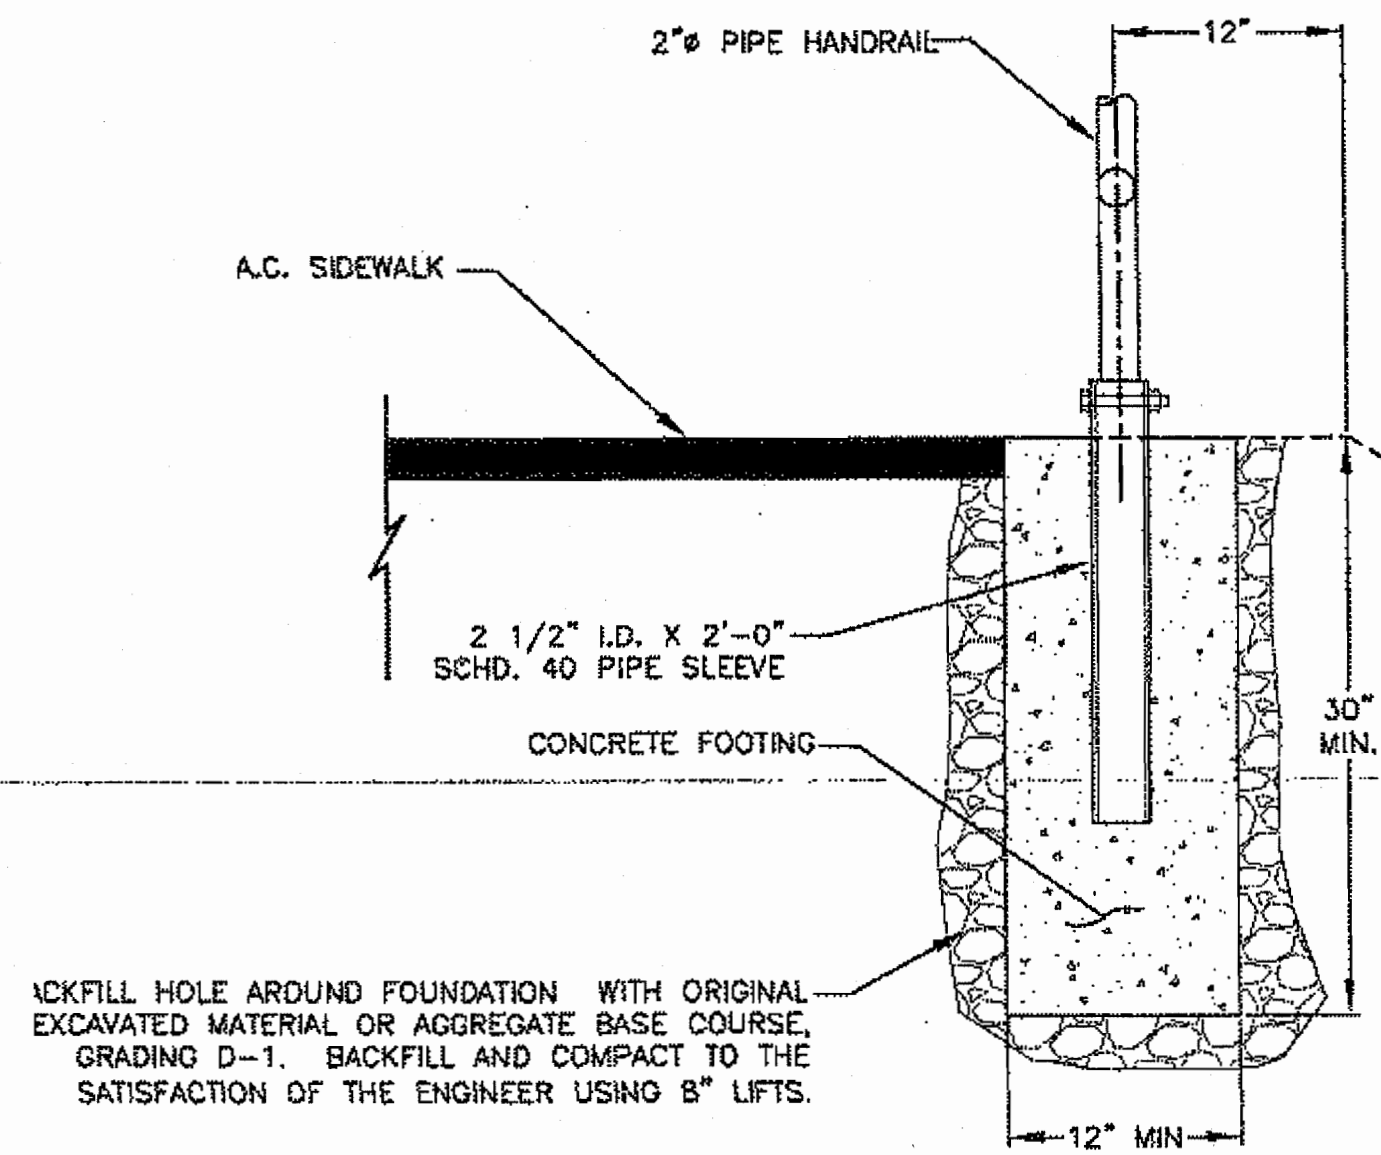

ENCASED CONCRETE FOUNDATION

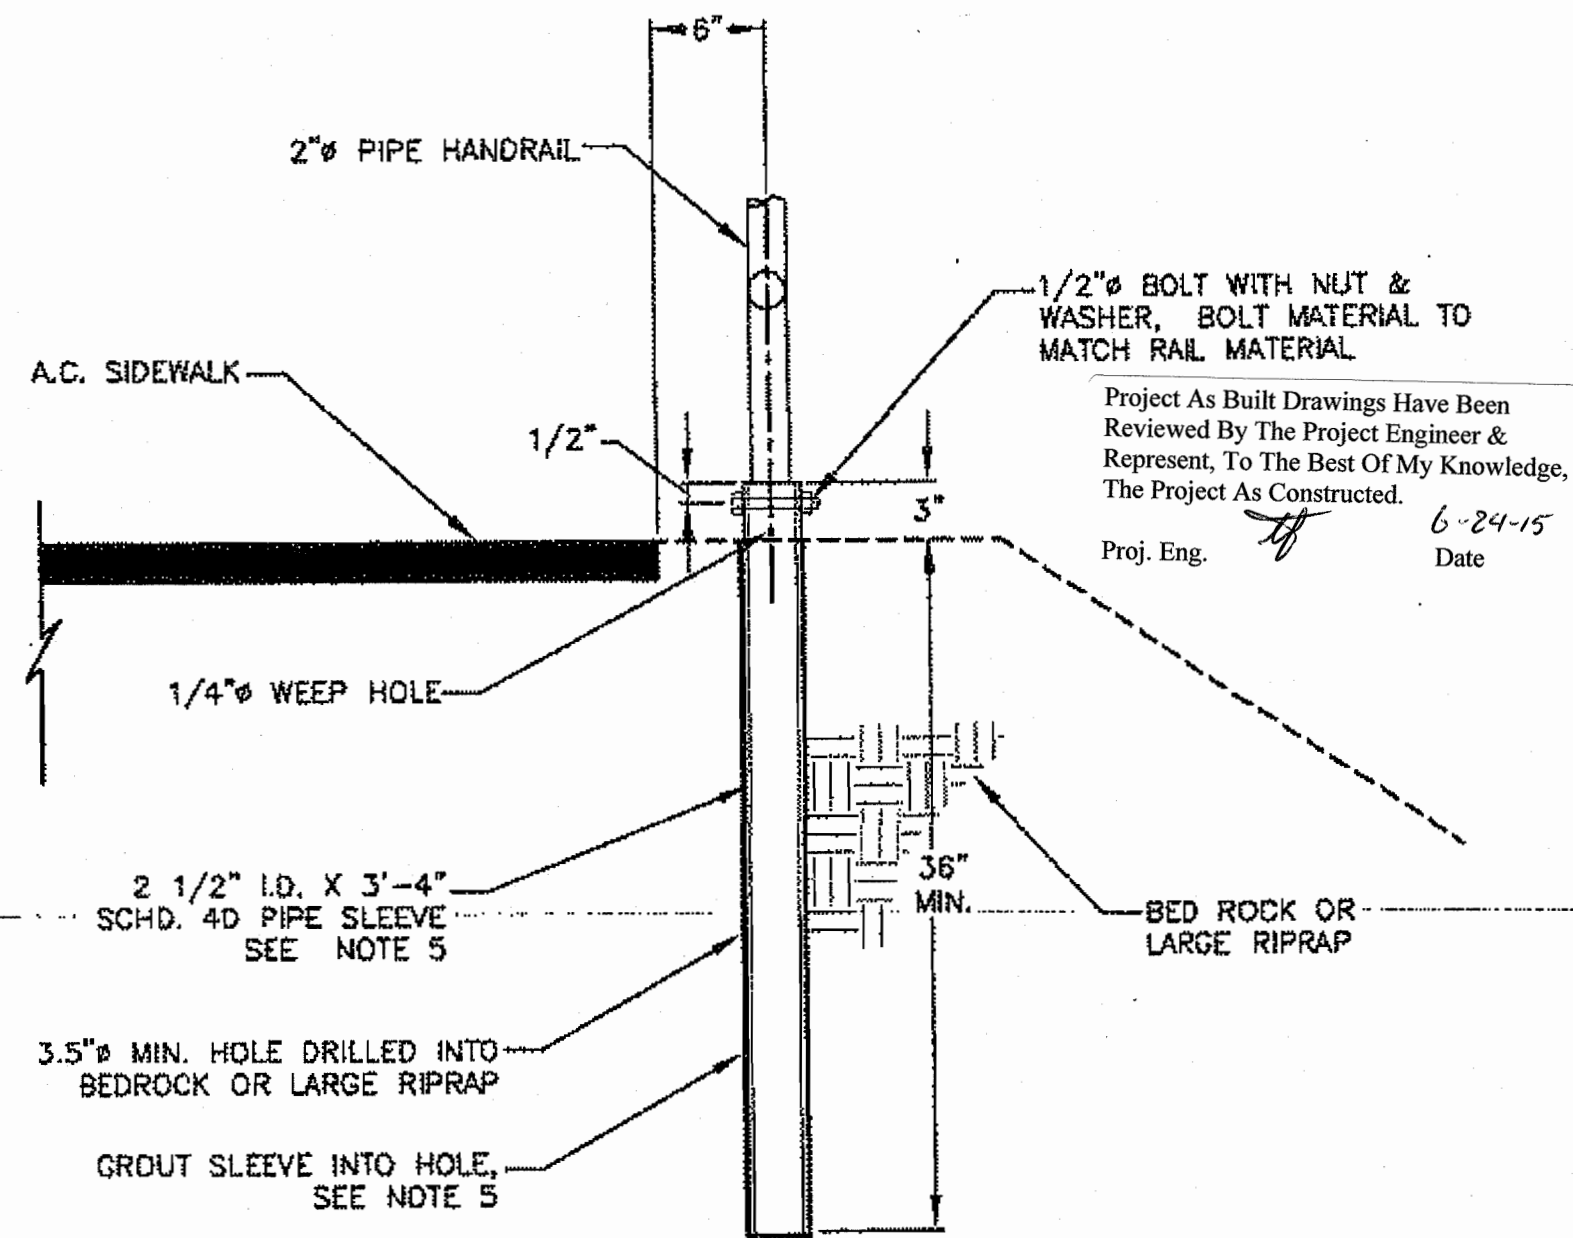

ROCK FOUNDATION

DO NOT SCALE FROM THESE DRAWINGS USE DIMENSIONS

PATH: \\JUNIFILE\Z\JOBS\1153805\DWGS\CIS\8SHEETS\07.DWG

Friday, August 17, 2012 7:13:57 PM

TAB: E7

ADDENDUM NUMBER

ATTACHMENT NUMBER

RECORD OF REVISIONS

No.	DATE	DESCRIPTION

SAWMILL CREEK ROAD UPGRADE
PHASE III - WHALE PARK TO SAWMILL CREEK BRIDGE
68216MSG-STP-0933(21)
SITKA TELECOMMUNICATIONS CONDUIT
RSA NO. 69615

PREPARED BY: USKH

CHECKED BY: NCL

DESIGNED BY: WJP

DRAWN BY: WJP

STATE OF ALASKA
DEPARTMENT OF TRANSPORTATION
& PUBLIC FACILITIES
SOUTHEAST REGION


DETAILS

PROJECT DESIGNATION
68216MSG-STP-0933(21)


STATE	YEAR
ALASKA	2012

SHEET NUMBER	TOTAL SHEETS
E7	109


DETAILS

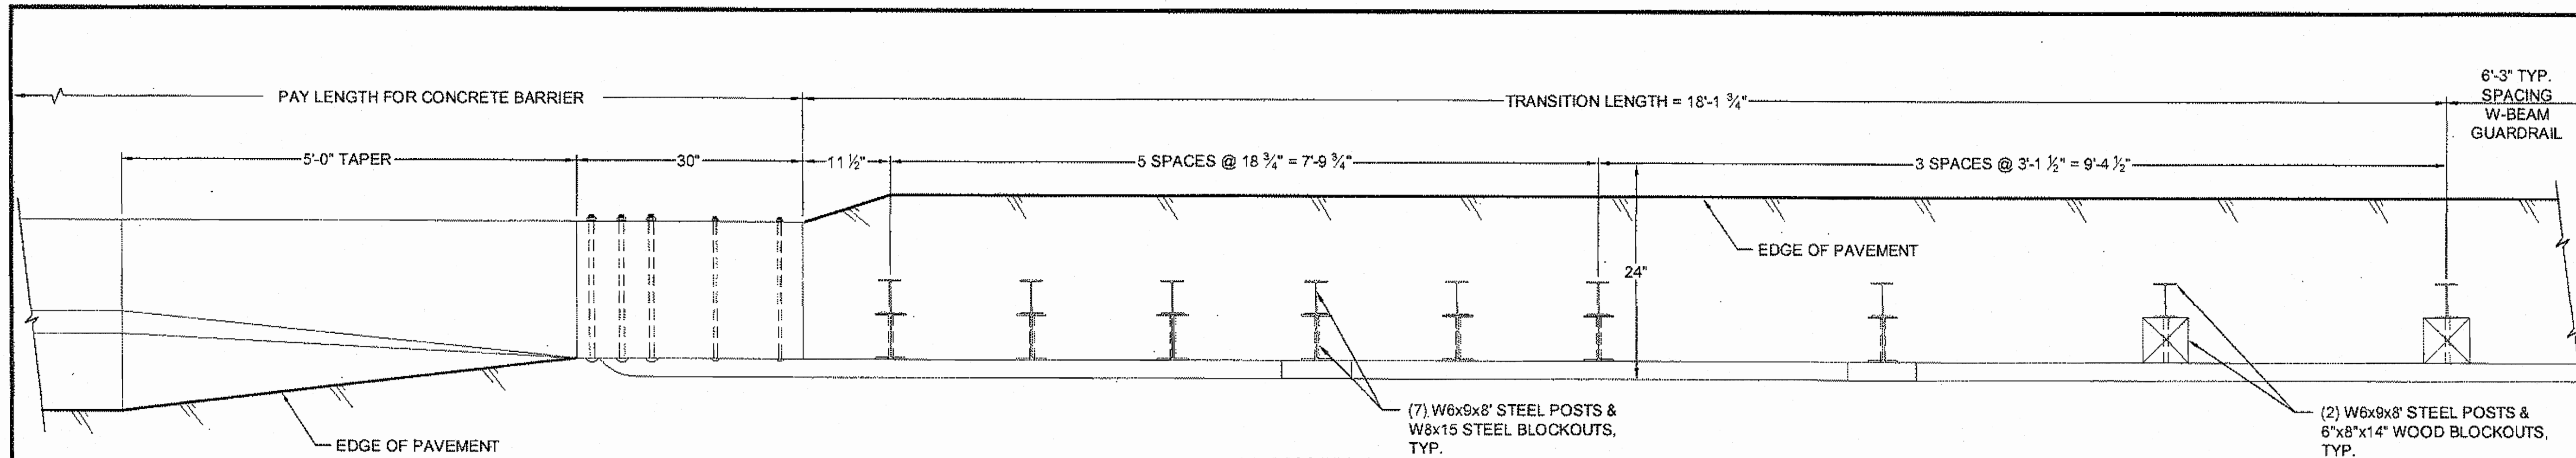


PLAN VIEW
N.T.S.

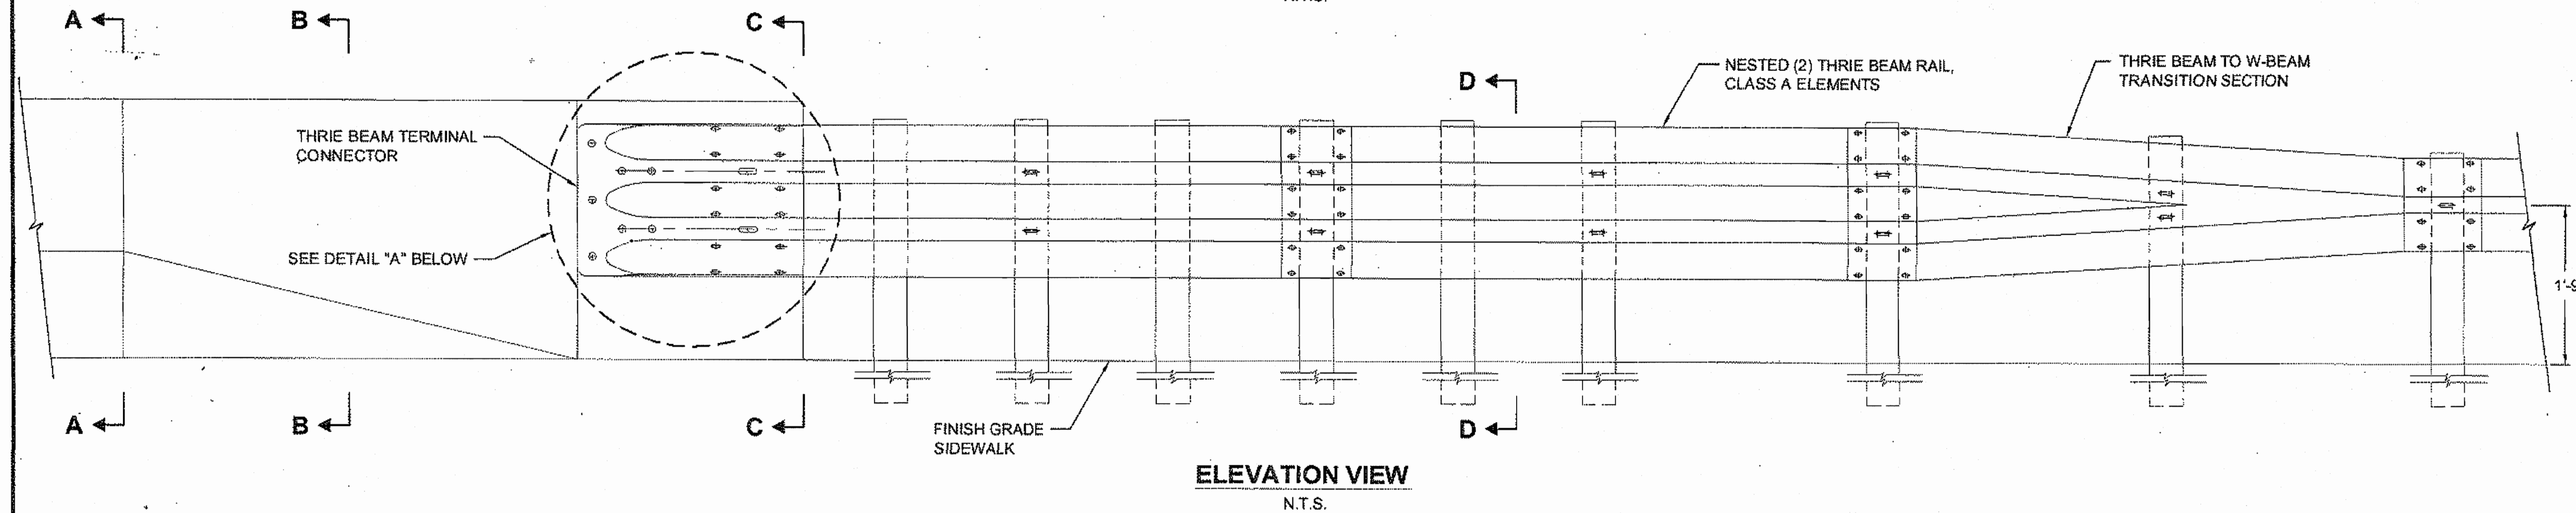


ELEVATION VIEW
N.T.S.

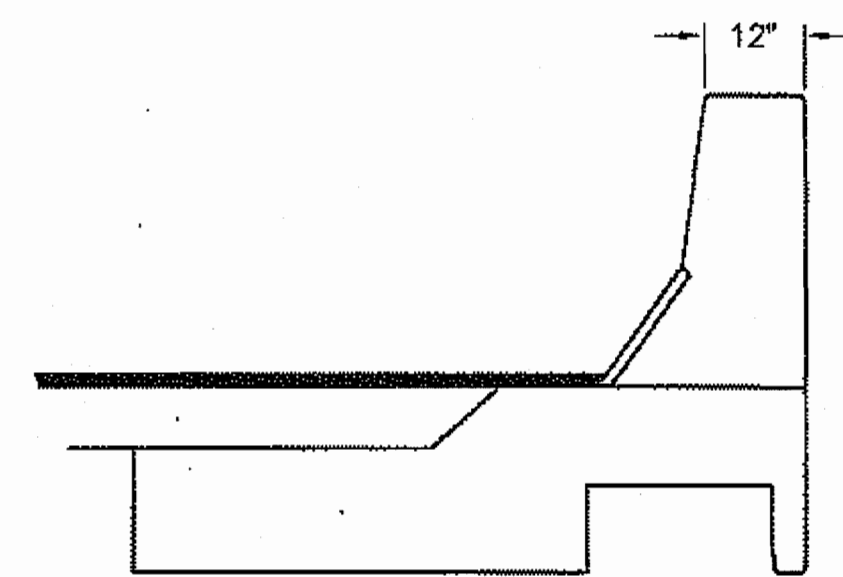


SECTION A-A

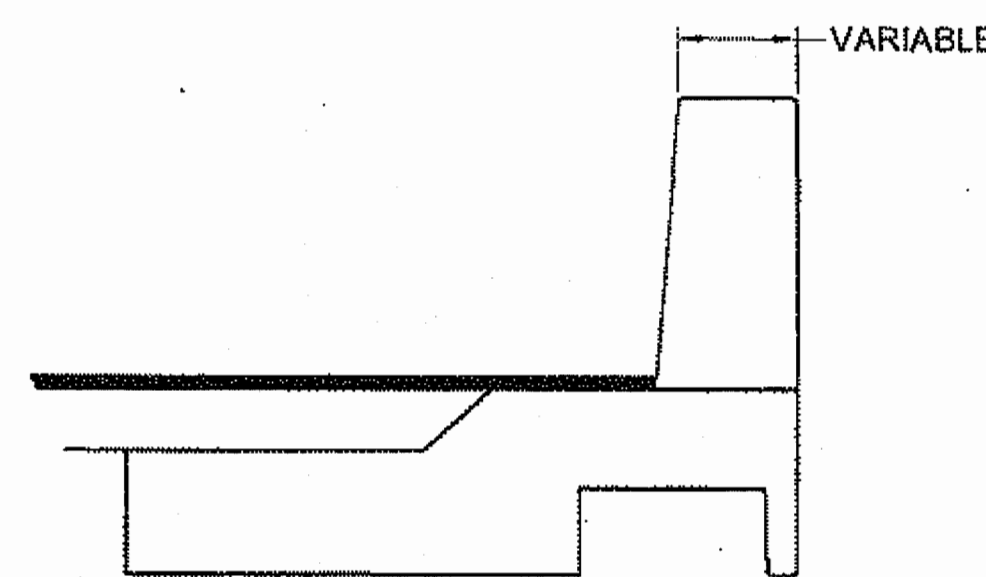

SECTION B-B

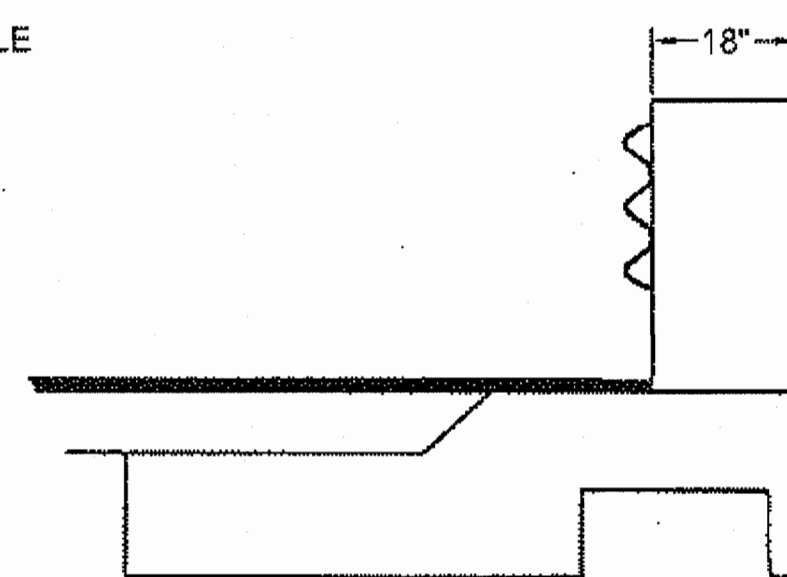


SECTION C-C

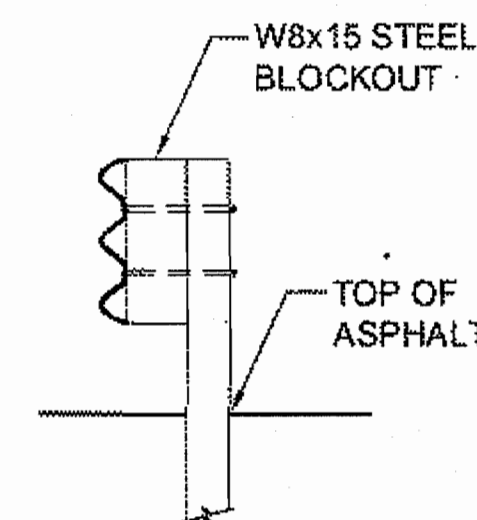


SECTION D-D

(2) 3/8\" GALV. POST BOLTS (ASTM A307) W/ STD. STEEL WASHERS
GALV. (ON BACK SIDE) AND LOCK NUTS OR JAM NUTS

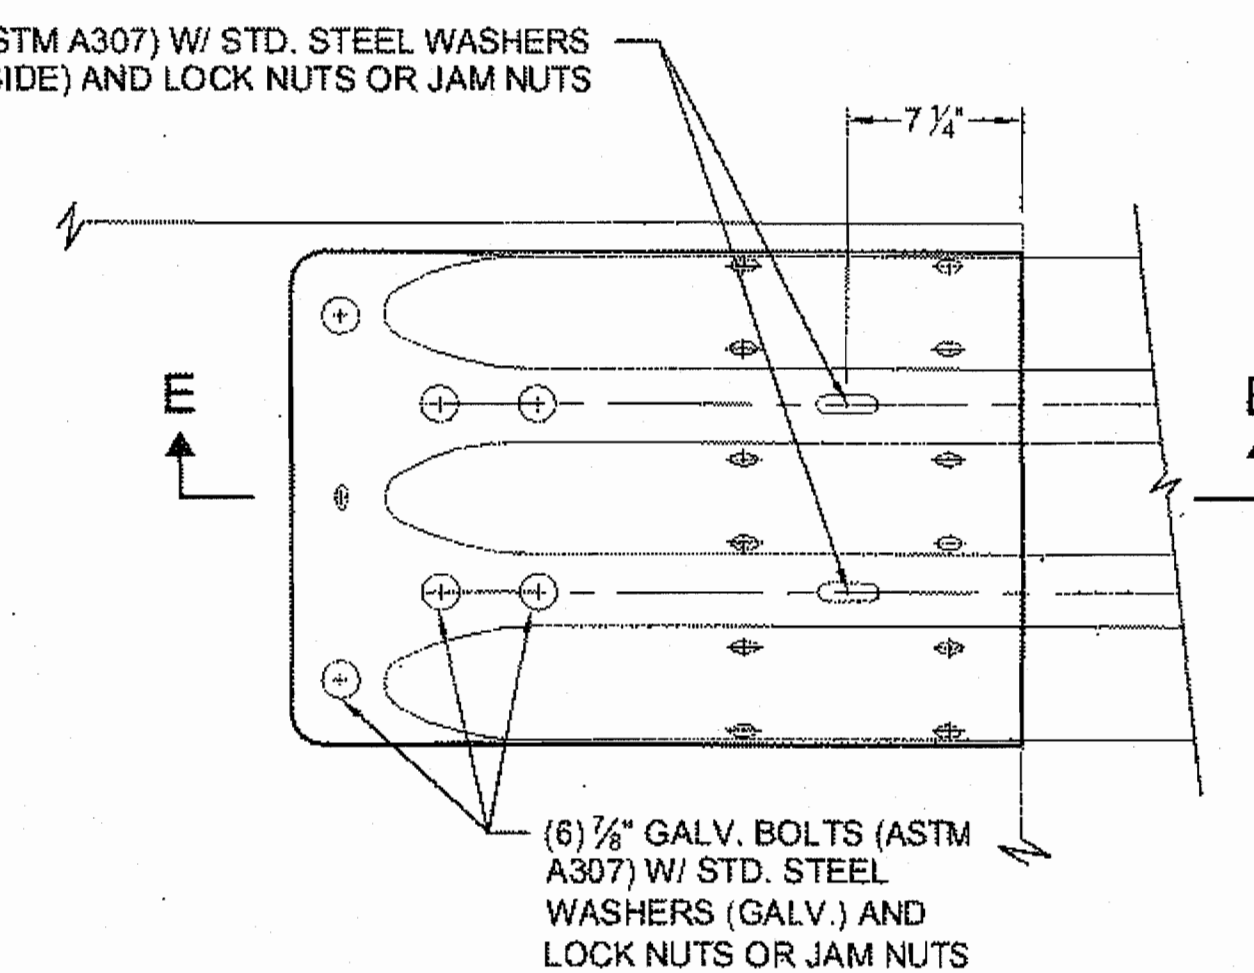

DETAIL "A"

DRILL HORIZONTAL BOLT HOLES (BOLT DIA. + 1/8\")
IN HARDENED CONCRETE WITH NON-IMPACT ROTARY DRILL

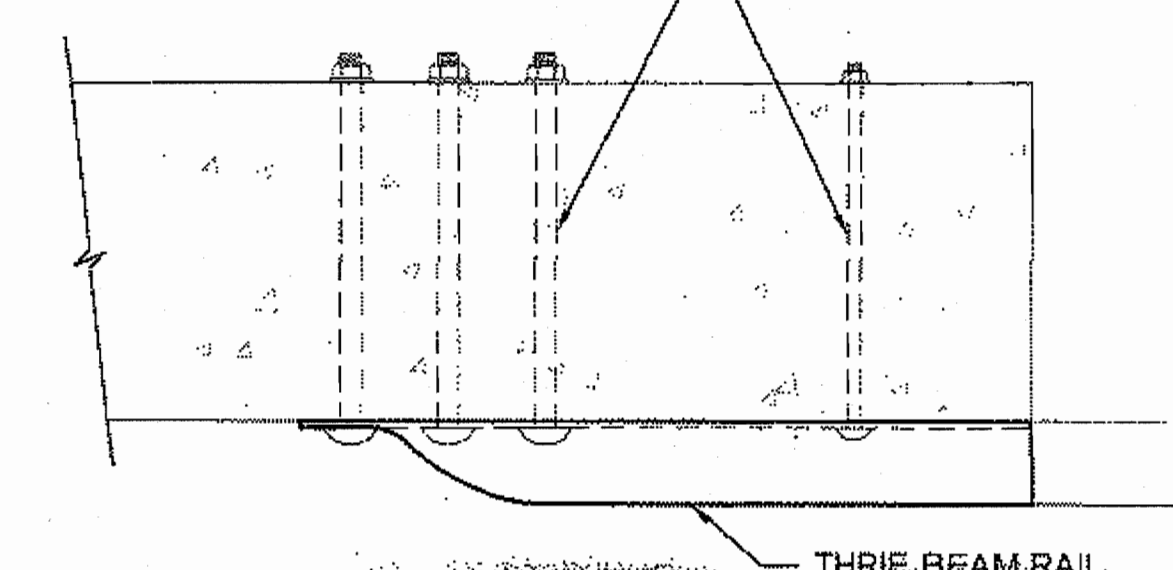

SECTION E-E


GENERAL NOTES:

1. ALL REINF. STEEL SHALL CONFORM TO ASTM A706 OF AASHTO M31 (ASTMA615) GRADE 420.
2. CONCRETE CLEAR COVER FOR STEEL BARS SHALL BE A MINIMUM OF TWO INCHES UNLESS SHOWN OTHERWISE.
3. ALL GUARDRAIL AND GUARDRAIL CONNECTION HARDWARE TO CONFORM TO AASHTO M-180. ALL H.S. BOLTS CONFORM TO ASTM A325. ALL OTHER STEEL TO CONFORM TO ASTM A709 GRADE 36.
4. CONFORM TO G-00.01 & G-04.06S FOR ALL GUARDRAIL DETAILS NOT SHOWN.
5. LAP APPROACH GUARDRAIL TO PREVENT SNAGS FROM ONCOMING TRAFFIC.
6. PROVIDE 4 1/2\" HORIZONTAL SLOT IN APPROACH GUARDRAIL. ADJUST GUARDRAIL BOLTS FOR SLIDING FIT.

GUARDRAIL TO CONCRETE BARRIER CONNECTION DETAILS

DO NOT SCALE FROM THESE DRAWINGS USE DIMENSIONS


PATH: \\WU\FILE2\JOBS\1153805\DWG\CS\SHEETS\E08.DWG		
TAB: E08		
ADDENDUM NUMBER		
ATTACHMENT NUMBER		
RECORD OF REVISIONS		
No.	DATE	DESCRIPTION
SAWMILL CREEK ROAD UPGRADE PHASE III - WHALE PARK TO SAWMILL CREEK BRIDGE 68216MSG-STP-0933(21) SITKA TELECOMMUNICATIONS CONDUIT RSA NO. 69615		
PREPARED BY: USKH CHECKED BY: NCL		
DESIGNED BY: WJP DRAWN BY: WJP		
STATE OF ALASKA DEPARTMENT OF TRANSPORTATION & PUBLIC FACILITIES SOUTHEAST REGION		
DETAILS		
PROJECT DESIGNATION 68216MSG-STP-0933(21)		
STATE	YEAR	
ALASKA	2012	
SHEET NUMBER	TOTAL SHEETS	
E8	109	

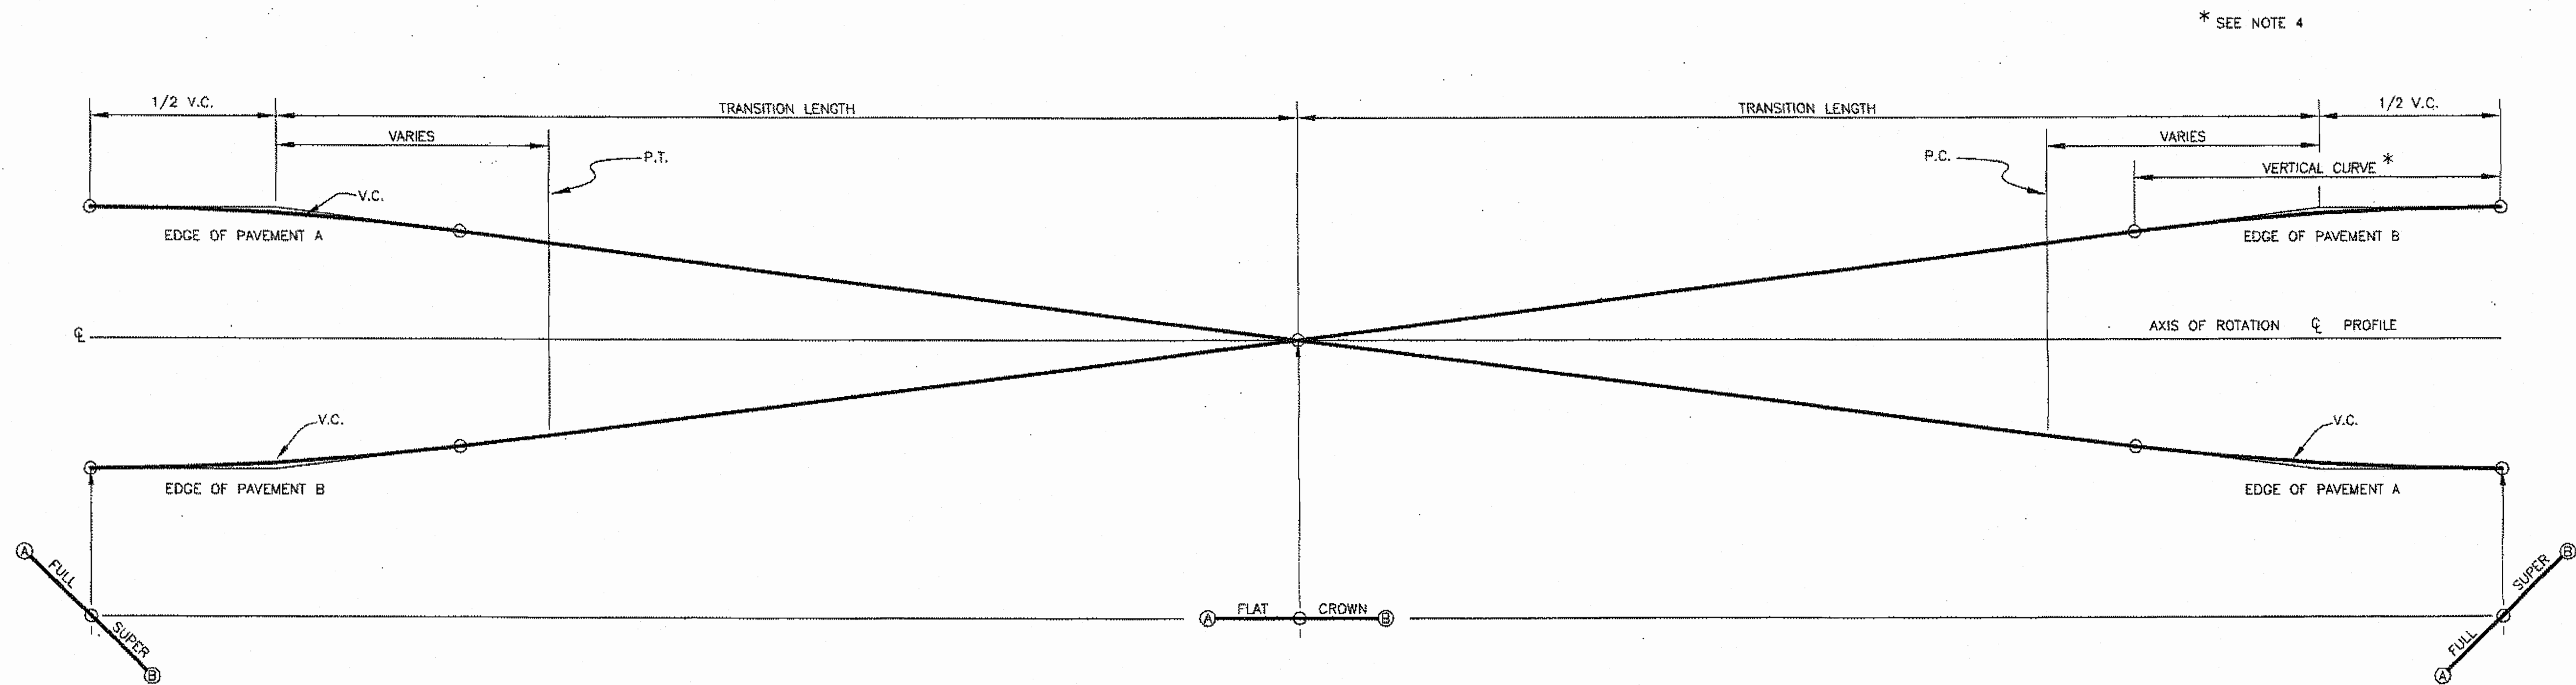

NOTES:

1. THIS SUPERELEVATION TRANSITION IS TO BE USED WHEN ADJACENT CURVES SHOW A "FLAT" STATION. CURVES WITH A BST/EST STATION SHALL HAVE THEIR SUPERELEVATION TRANSITION FOLLOW CASE 1 OF STANDARD DRAWING I-81.00.
2. LOCATION OF TRANSITION LENGTH RELATIVE TO HORIZONTAL CURVES IS SHOWN ON THE PLANS.
3. WIDENING FOR GUARDRAIL OR CURVATURE WILL NOT CHANGE THE LOCATION OF THE AXIS OF ROTATION.
4. MINIMUM VERTICAL CURVE (V.C.) LENGTH IN FEET SHALL BE THE NUMERICAL VALUE OF THE DESIGN SPEED IN MPH.
5. SUPERELEVATION SHALL BE BUILT INTO THE SUBGRADE AND CARRIED THROUGH THE SHOULDERS.

SUPERELEVATION TRANSITION WITHOUT RETURNING TO NORMAL CROWN FOR CURVES WITH A "FLAT" TRANSITION STATION

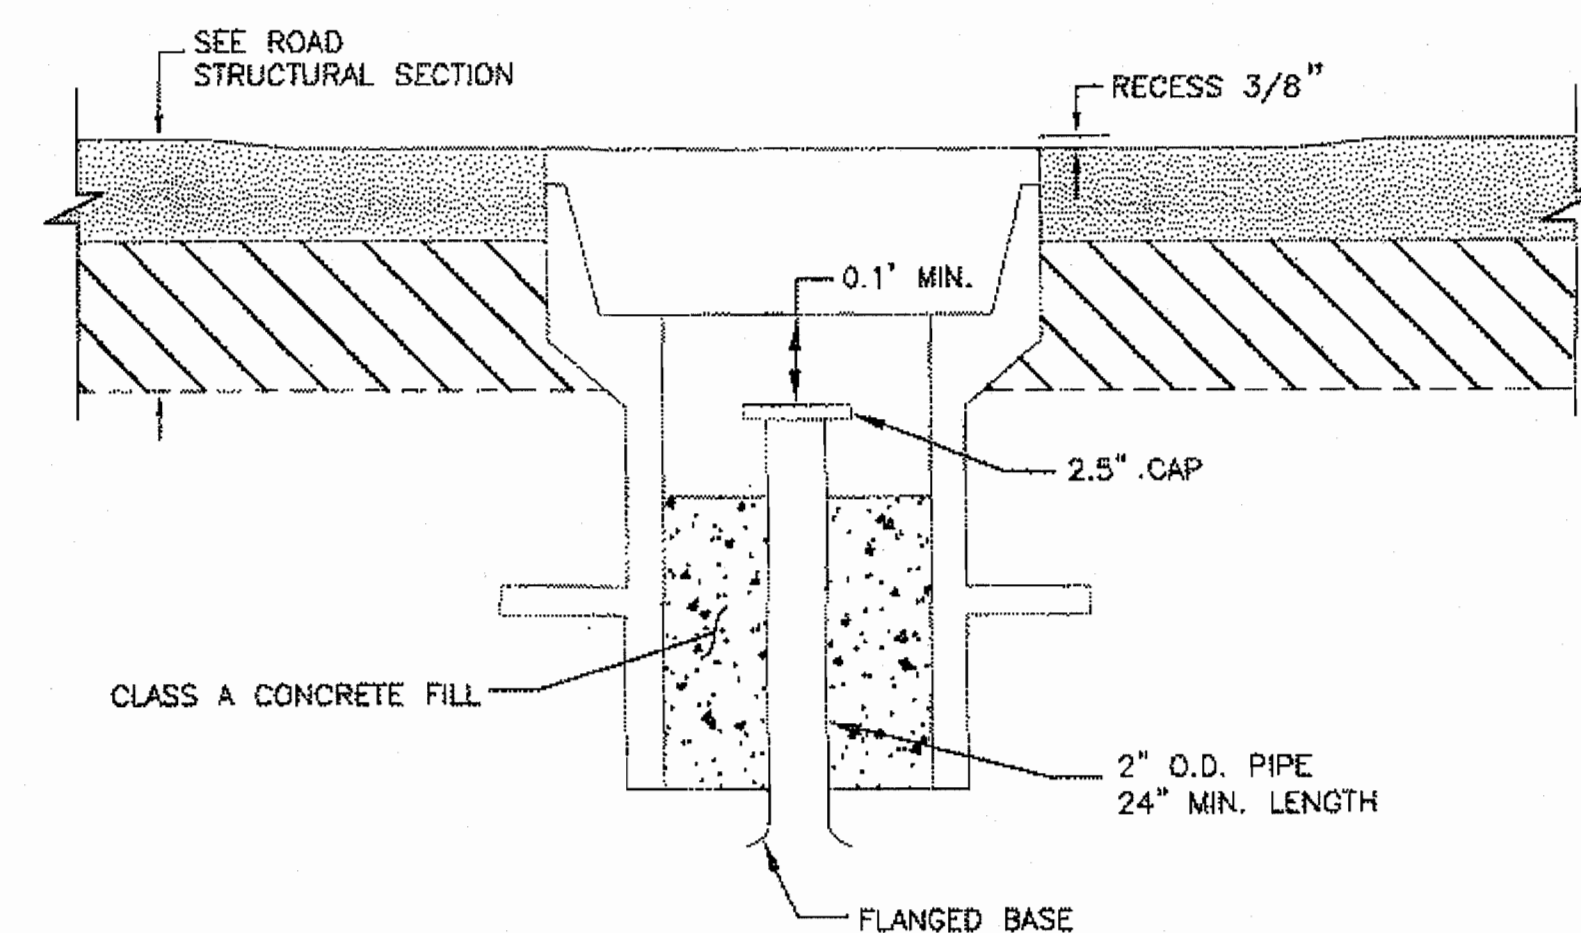

Project As Built Drawings Have Been
Reviewed By The Project Engineer &
Represent, To The Best Of My Knowledge,
The Project As Constructed.
Proj. Eng. *[Signature]* Date 6-24-15

MONUMENT DETAIL

DO NOT SCALE FROM THESE DRAWINGS USE DIMENSIONS

PATH:
W:\NUPFILE2\JOBS\1153805\DWGS\IC\SHEETS\E10.DWG

TAB: E10

ADDENDUM NUMBER

ATTACHMENT NUMBER

RECORD OF REVISIONS

No.	DATE	DESCRIPTION

SAWMILL CREEK ROAD UPGRADE
PHASE III - WHALE PARK TO SAWMILL CREEK BRIDGE
68216MSG-STP-0933(21)
SITKA TELECOMMUNICATIONS CONDUIT
RSA NO. 69615

DETAILS

PREPARED BY: USKH

CHECKED BY: NCL



DESIGNED BY: NCL


DRAWN BY: WJP

STATE OF ALASKA
DEPARTMENT OF TRANSPORTATION
& PUBLIC FACILITIES
SOUTHEAST REGION


DETAILS

PROJECT DESIGNATION
68216MSG-STP-0933(21)


STATE	YEAR
ALASKA	2012
SHEET NUMBER	TOTAL SHEETS
E10	109

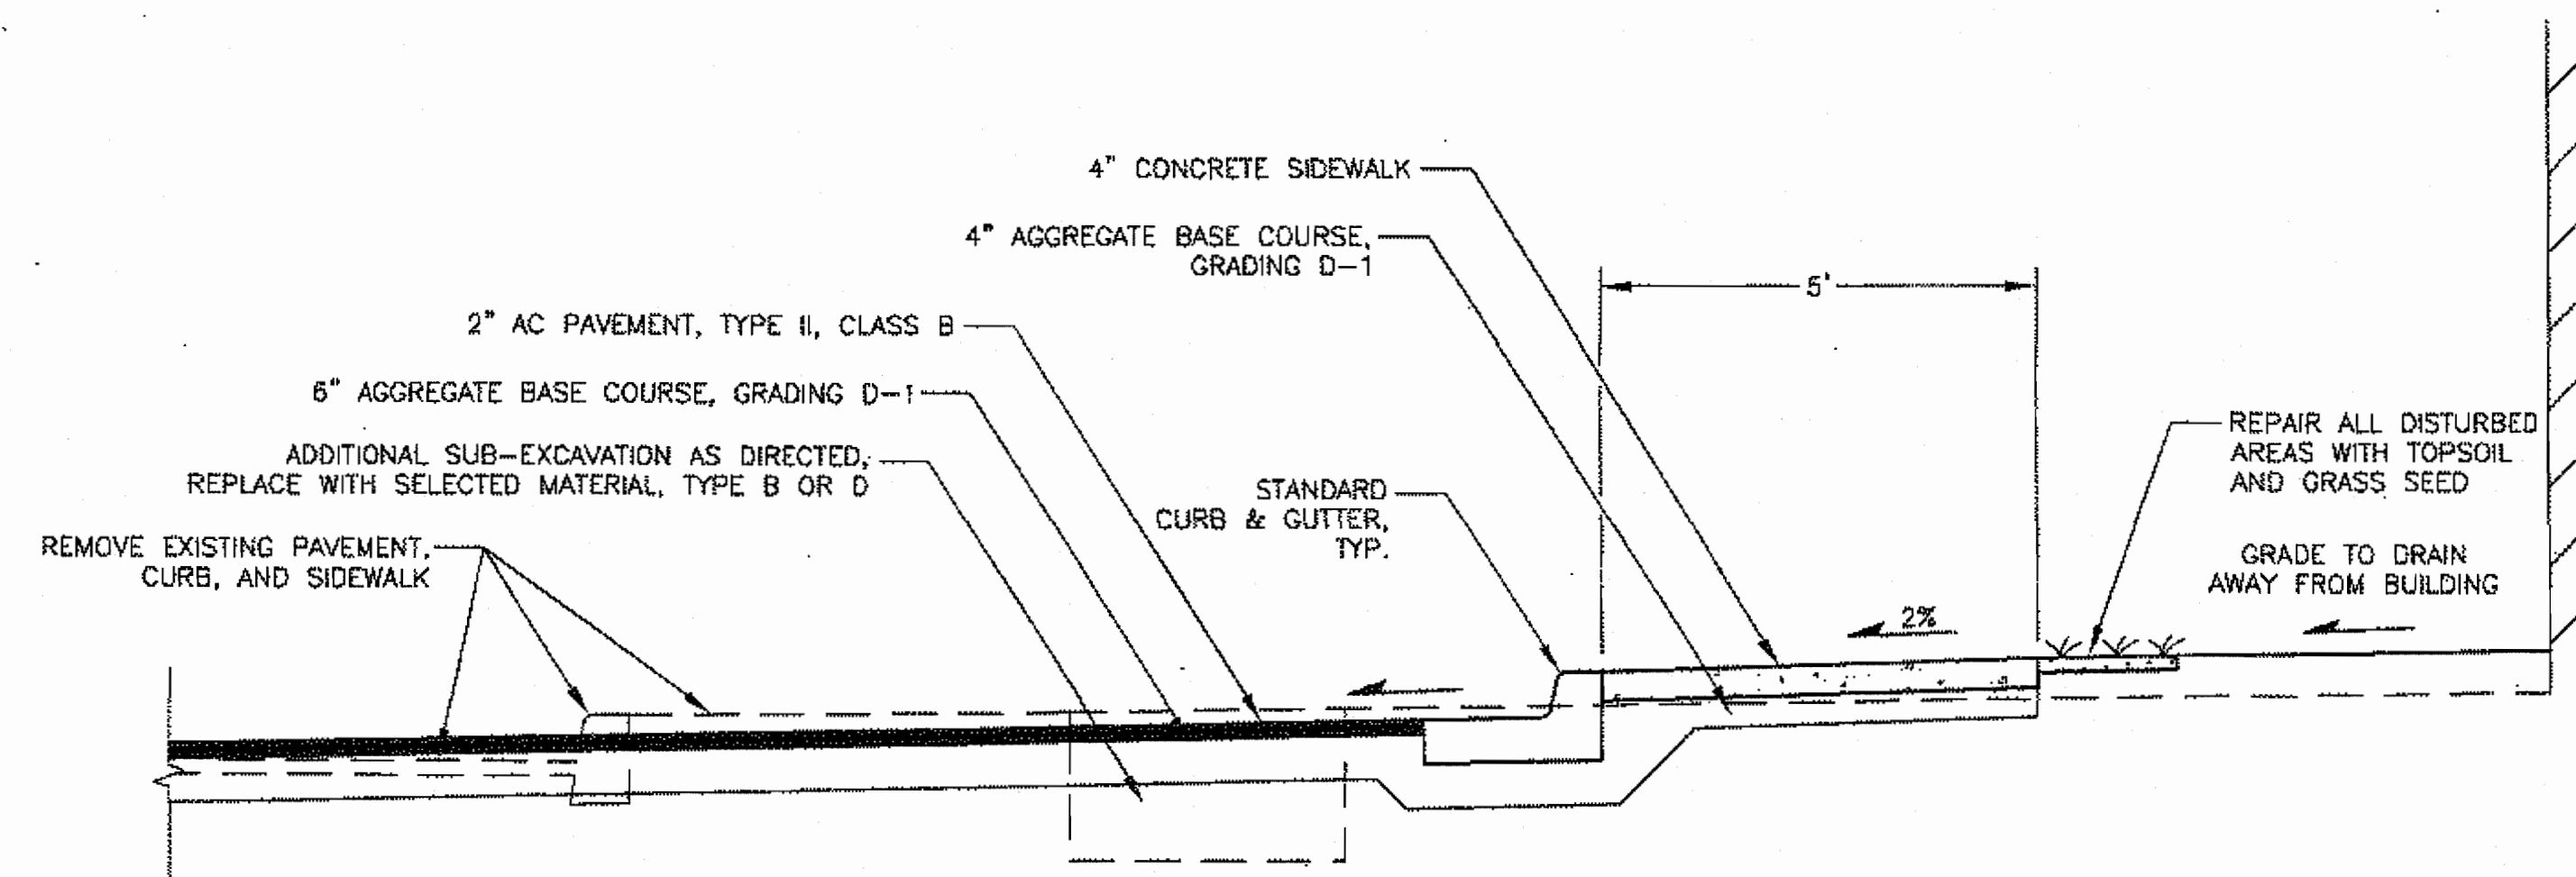

**SIDEWALK AND PARKING AREA IMPROVEMENTS
AT SAWMILL COVE INDUSTRIAL PARK
ADMINISTRATIVE BUILDING**

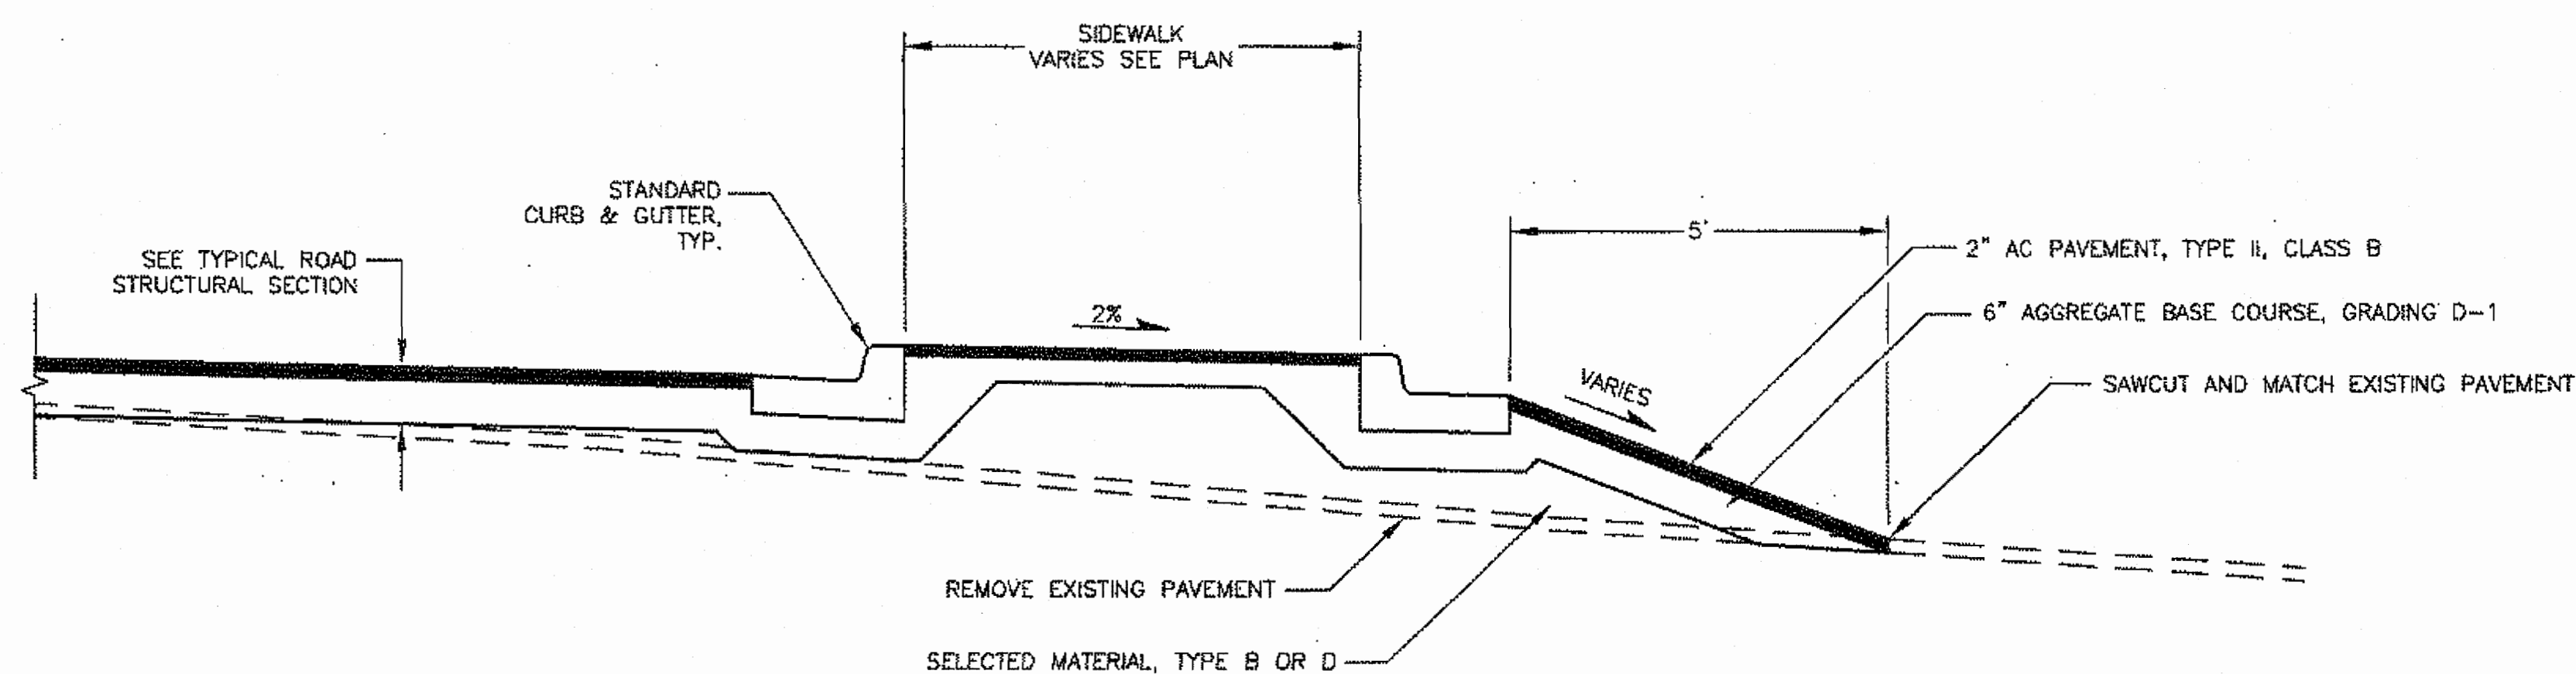


PAVEMENT MATCH

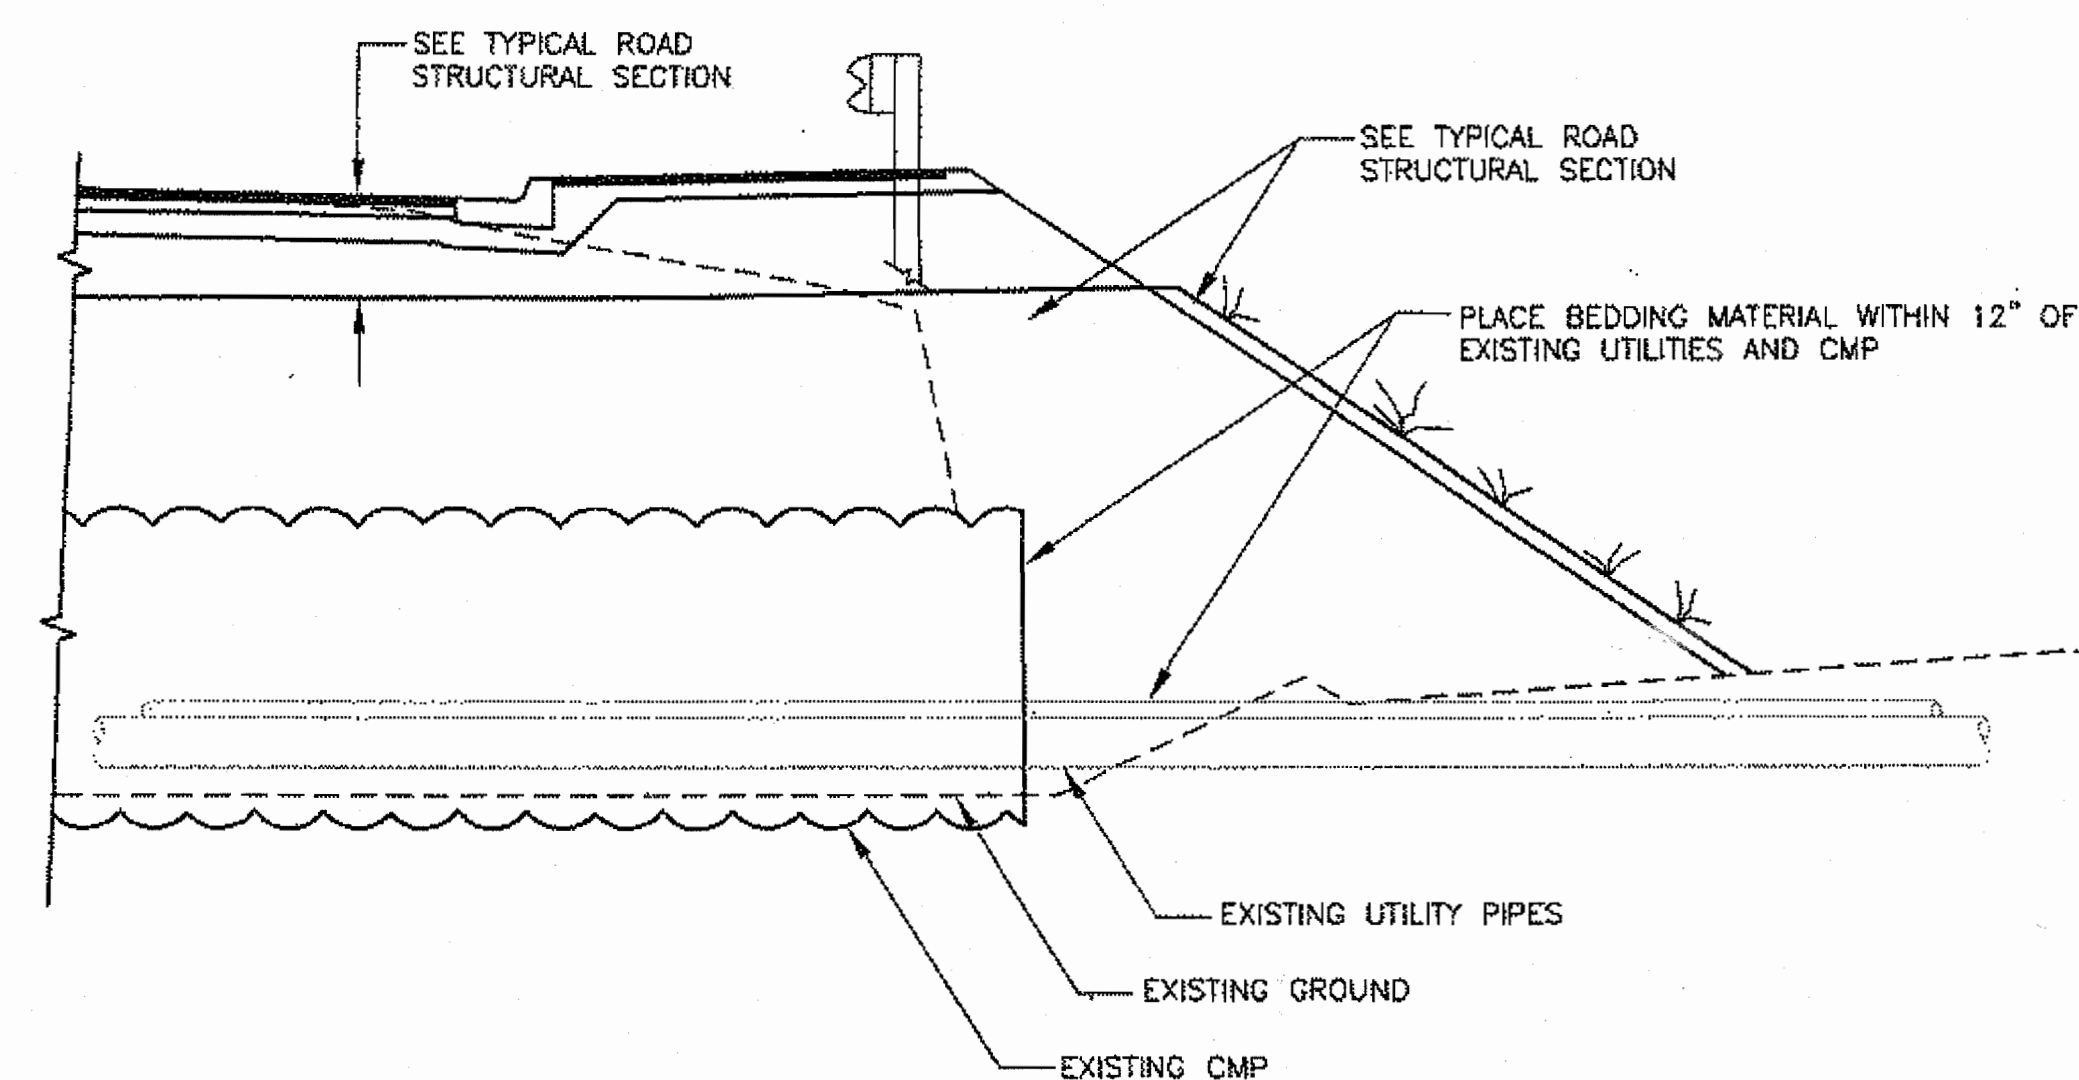

**FILL AT EXISTING UTILITY CROSSING
STA. 276+60 RT**

Project As Built Drawings Have Been Reviewed By The Project Engineer & Represent, To The Best Of My Knowledge, The Project As Constructed.
Proj. Eng. *[Signature]* Date 6-24-15

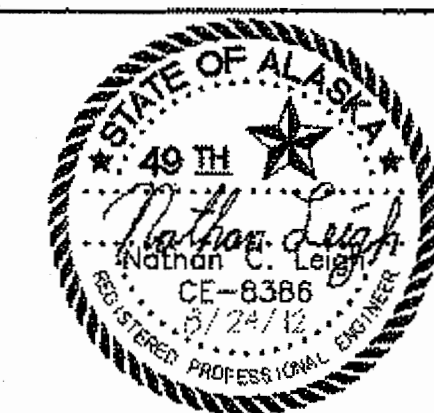

DESIGNED BY: NCL
DRAWN BY: WJP

STATE OF ALASKA
DEPARTMENT OF TRANSPORTATION
& PUBLIC FACILITIES
SOUTHEAST REGION

DETAILS

PROJECT DESIGNATION
68216\MSG-STP-0933(21)

STATE	YEAR
ALASKA	2012
SHEET NUMBER	TOTAL SHEETS
E11	109

DO NOT SCALE FROM THESE DRAWINGS USE DIMENSIONS

DETAILS

SAWMILL CREEK ROAD UPGRADE
PHASE III - WHALE PARK TO SAWMILL CREEK BRIDGE
68216\MSG-STP-0933(21)
SITKA TELECOMMUNICATIONS CONDUIT
RSA NO. 69615

PATH:
\\UNFILE2\JOBS\1153866\DWG\SC\1\SHEETS\E11.DWG



TAB: E11

ADDENDUM NUMBER

ATTACHMENT NUMBER

RECORD OF REVISIONS

No.	DATE	DESCRIPTION

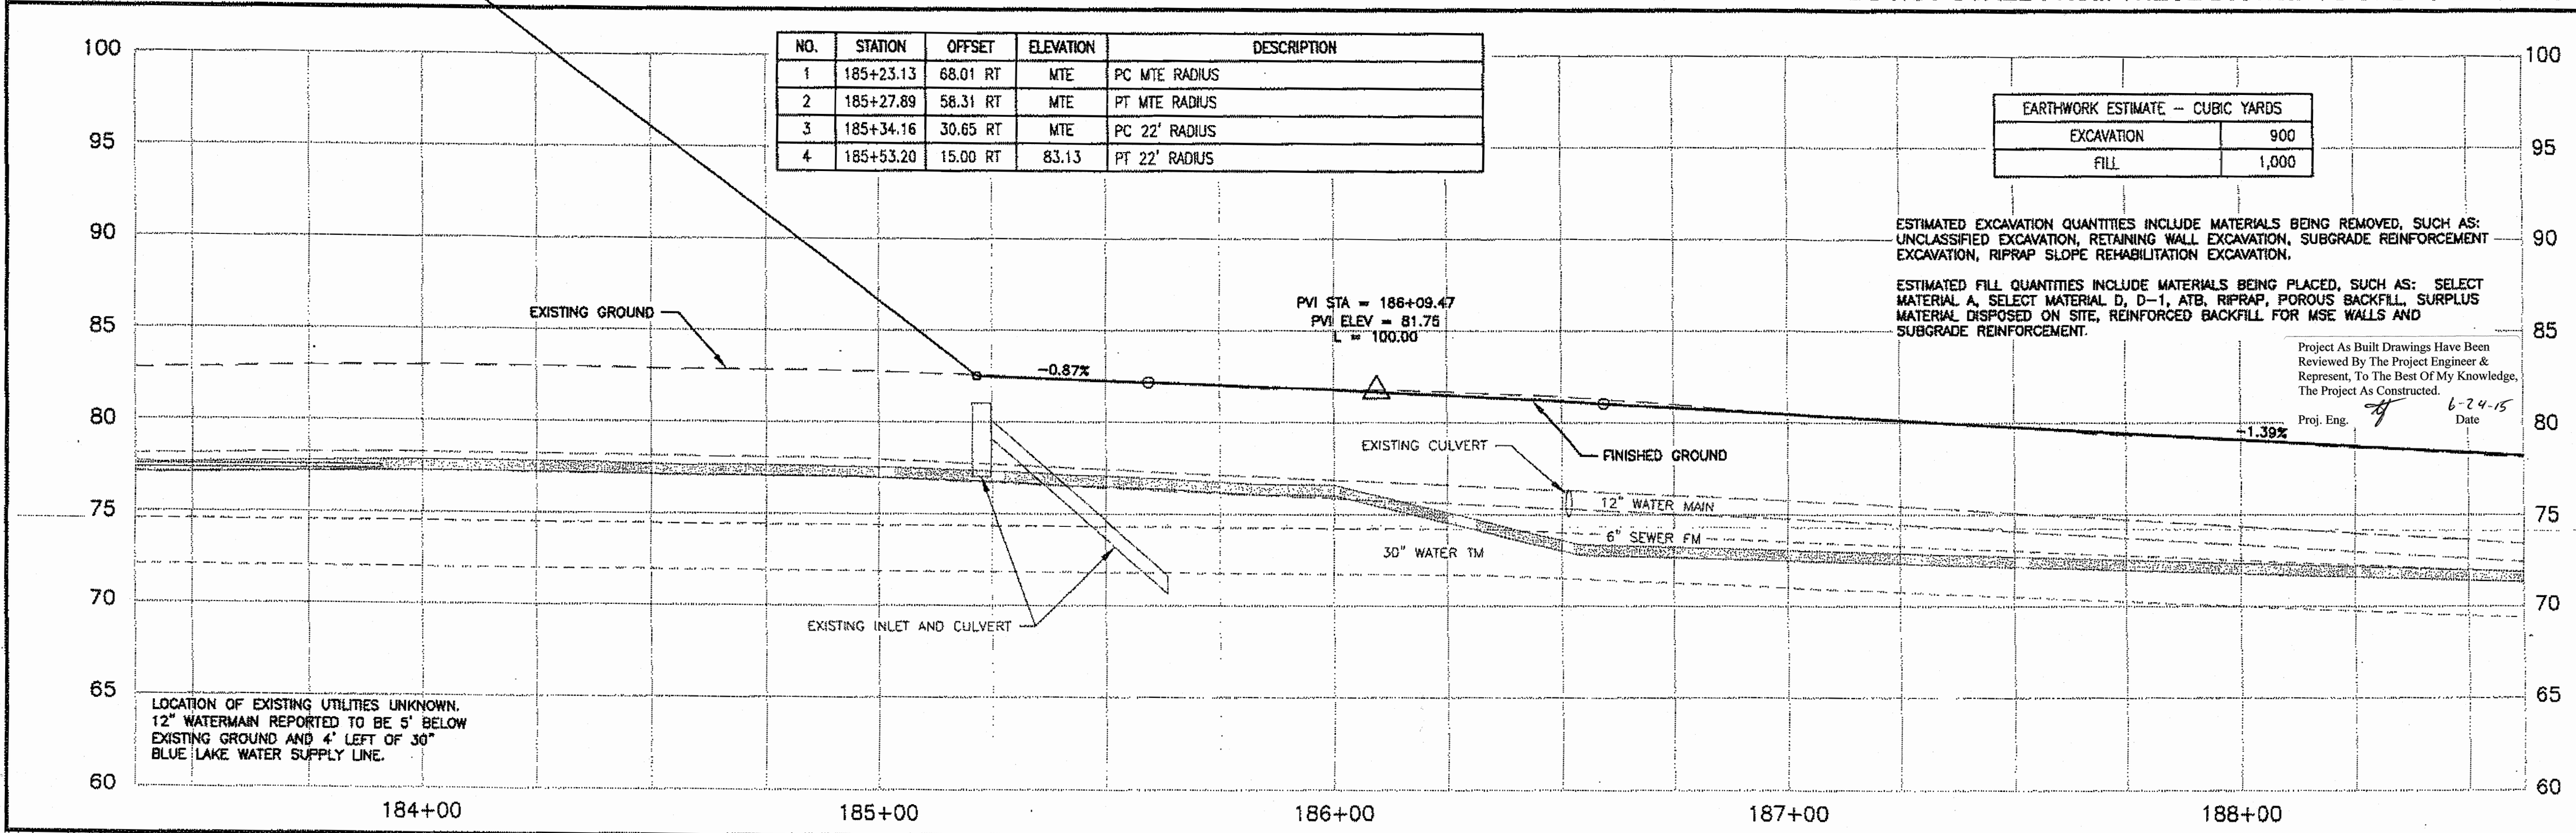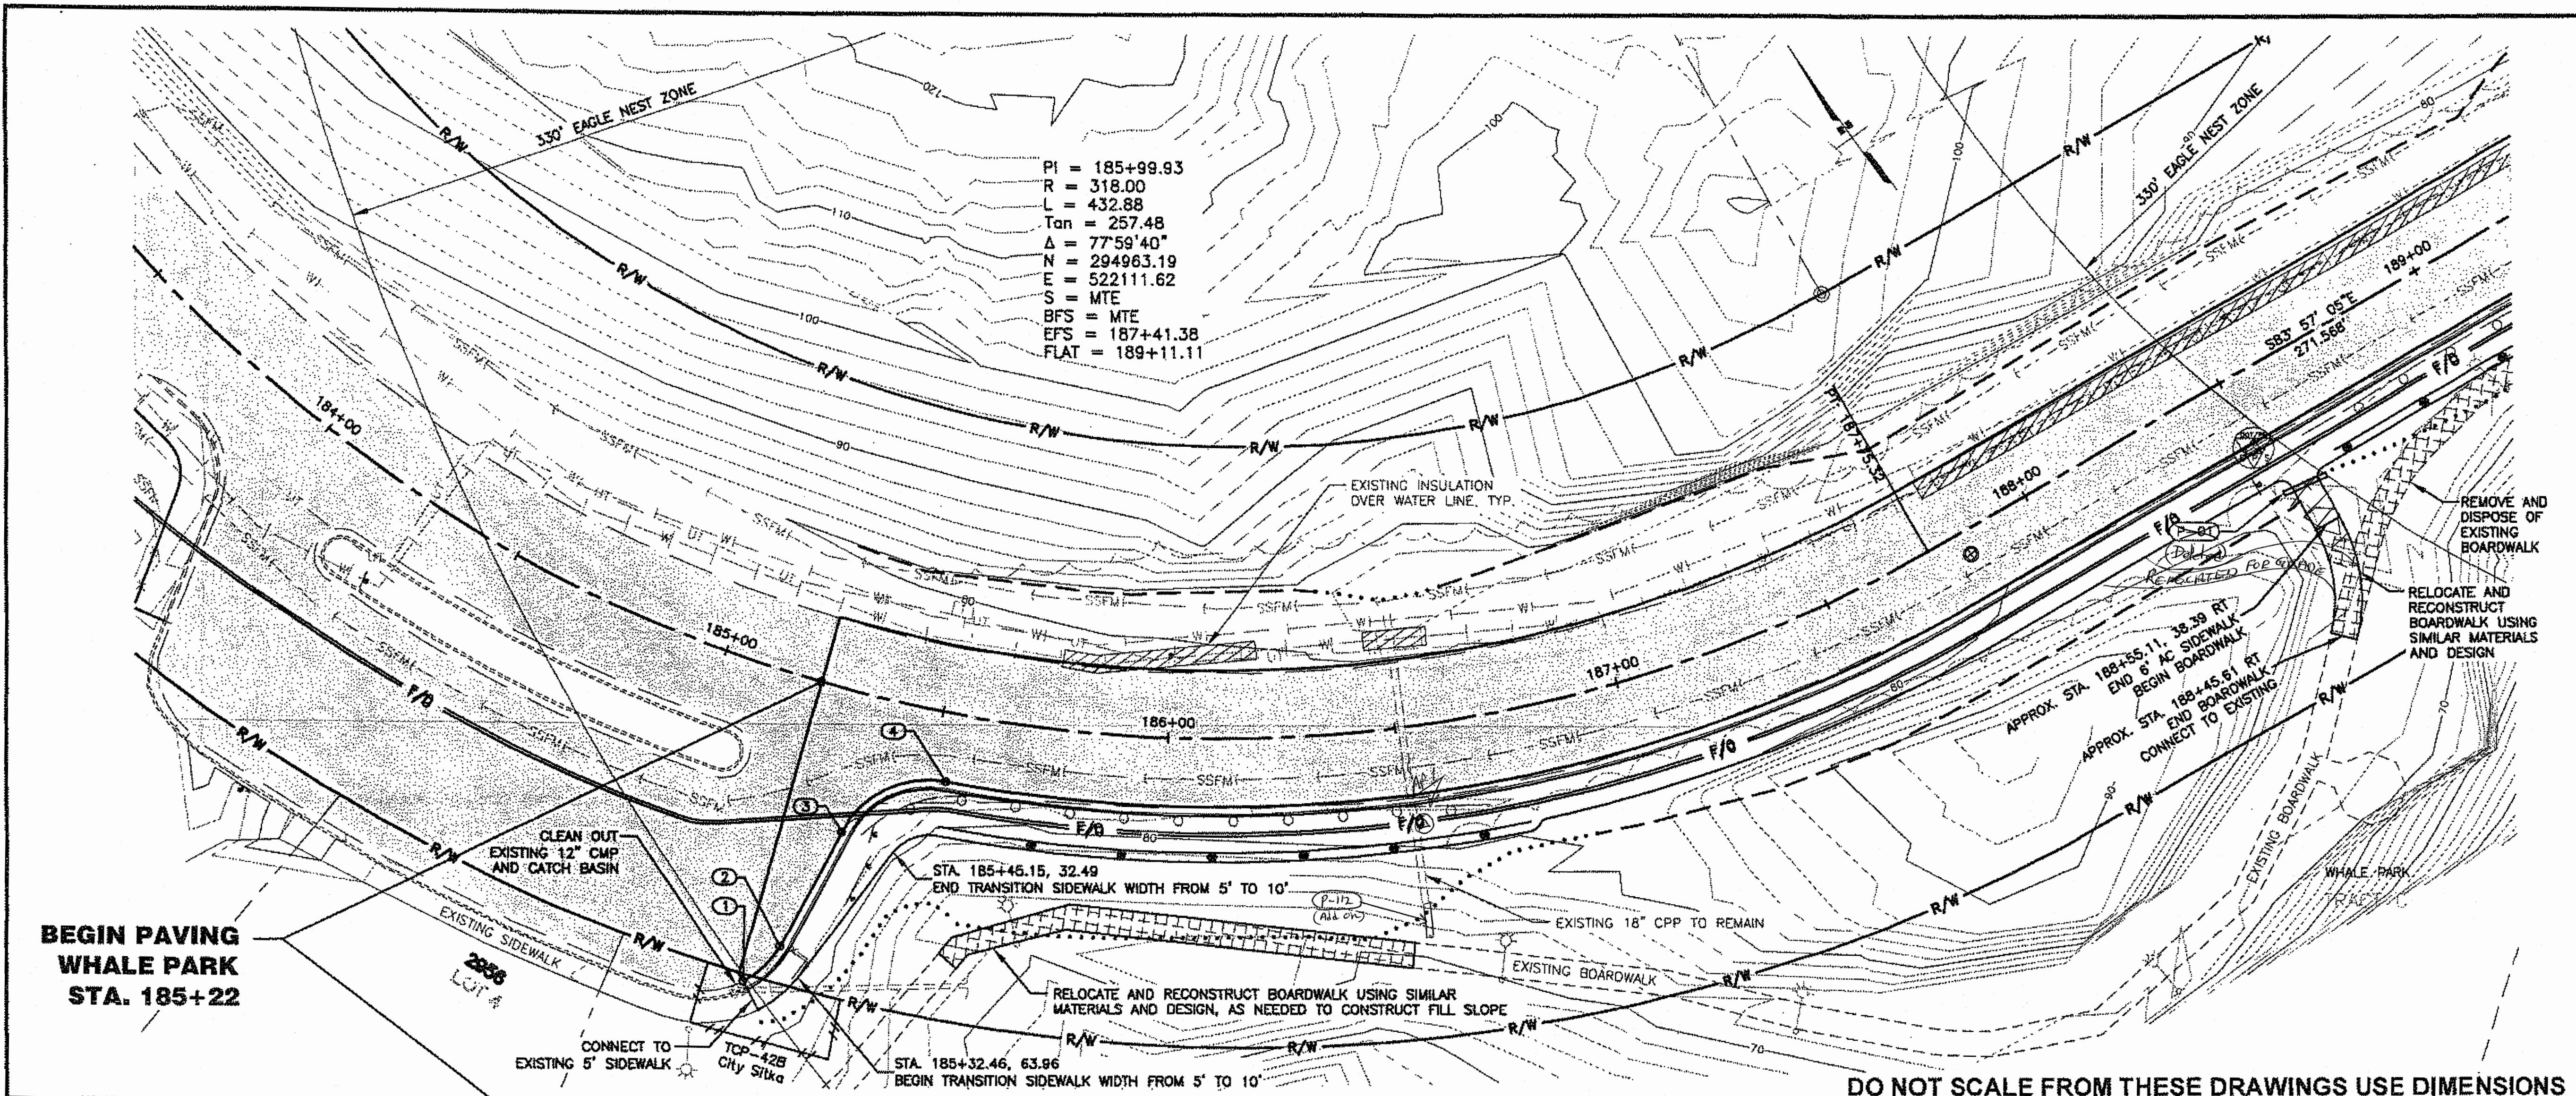

PATH: I:\115389\DWGS\ISHEETS\F01-F20.DWG
 Wednesday, August 22, 2012 8:33:29 AM
 TAB: F01

ADDENDUM NUMBER
 ATTACHMENT NUMBER

RECORD OF REVISIONS
 No. DATE DESCRIPTION

SAWMILL CREEK ROAD UPGRADE
 PHASE III - WHALE PARK TO SAWMILL CREEK BRIDGE
 68216MSG-STP-0933(21)
 SITKA TELECOMMUNICATIONS CONDUIT
 RSA NO. 69615

ROADWAY PLAN & PROFILE

PREPARED BY: USKH
 CHECKED BY: NCL


DESIGNED BY: NCL
 DRAWN BY: WJP

STATE OF ALASKA
 DEPARTMENT OF TRANSPORTATION
 & PUBLIC FACILITIES
 SOUTHEAST REGION

ROADWAY PLAN & PROFILE
BOP TO
STA. 188+50

PROJECT DESIGNATION
68216MSG-STP-0933(21)


STATE	YEAR
ALASKA	2012
SHEET NUMBER	TOTAL SHEETS
F1	109

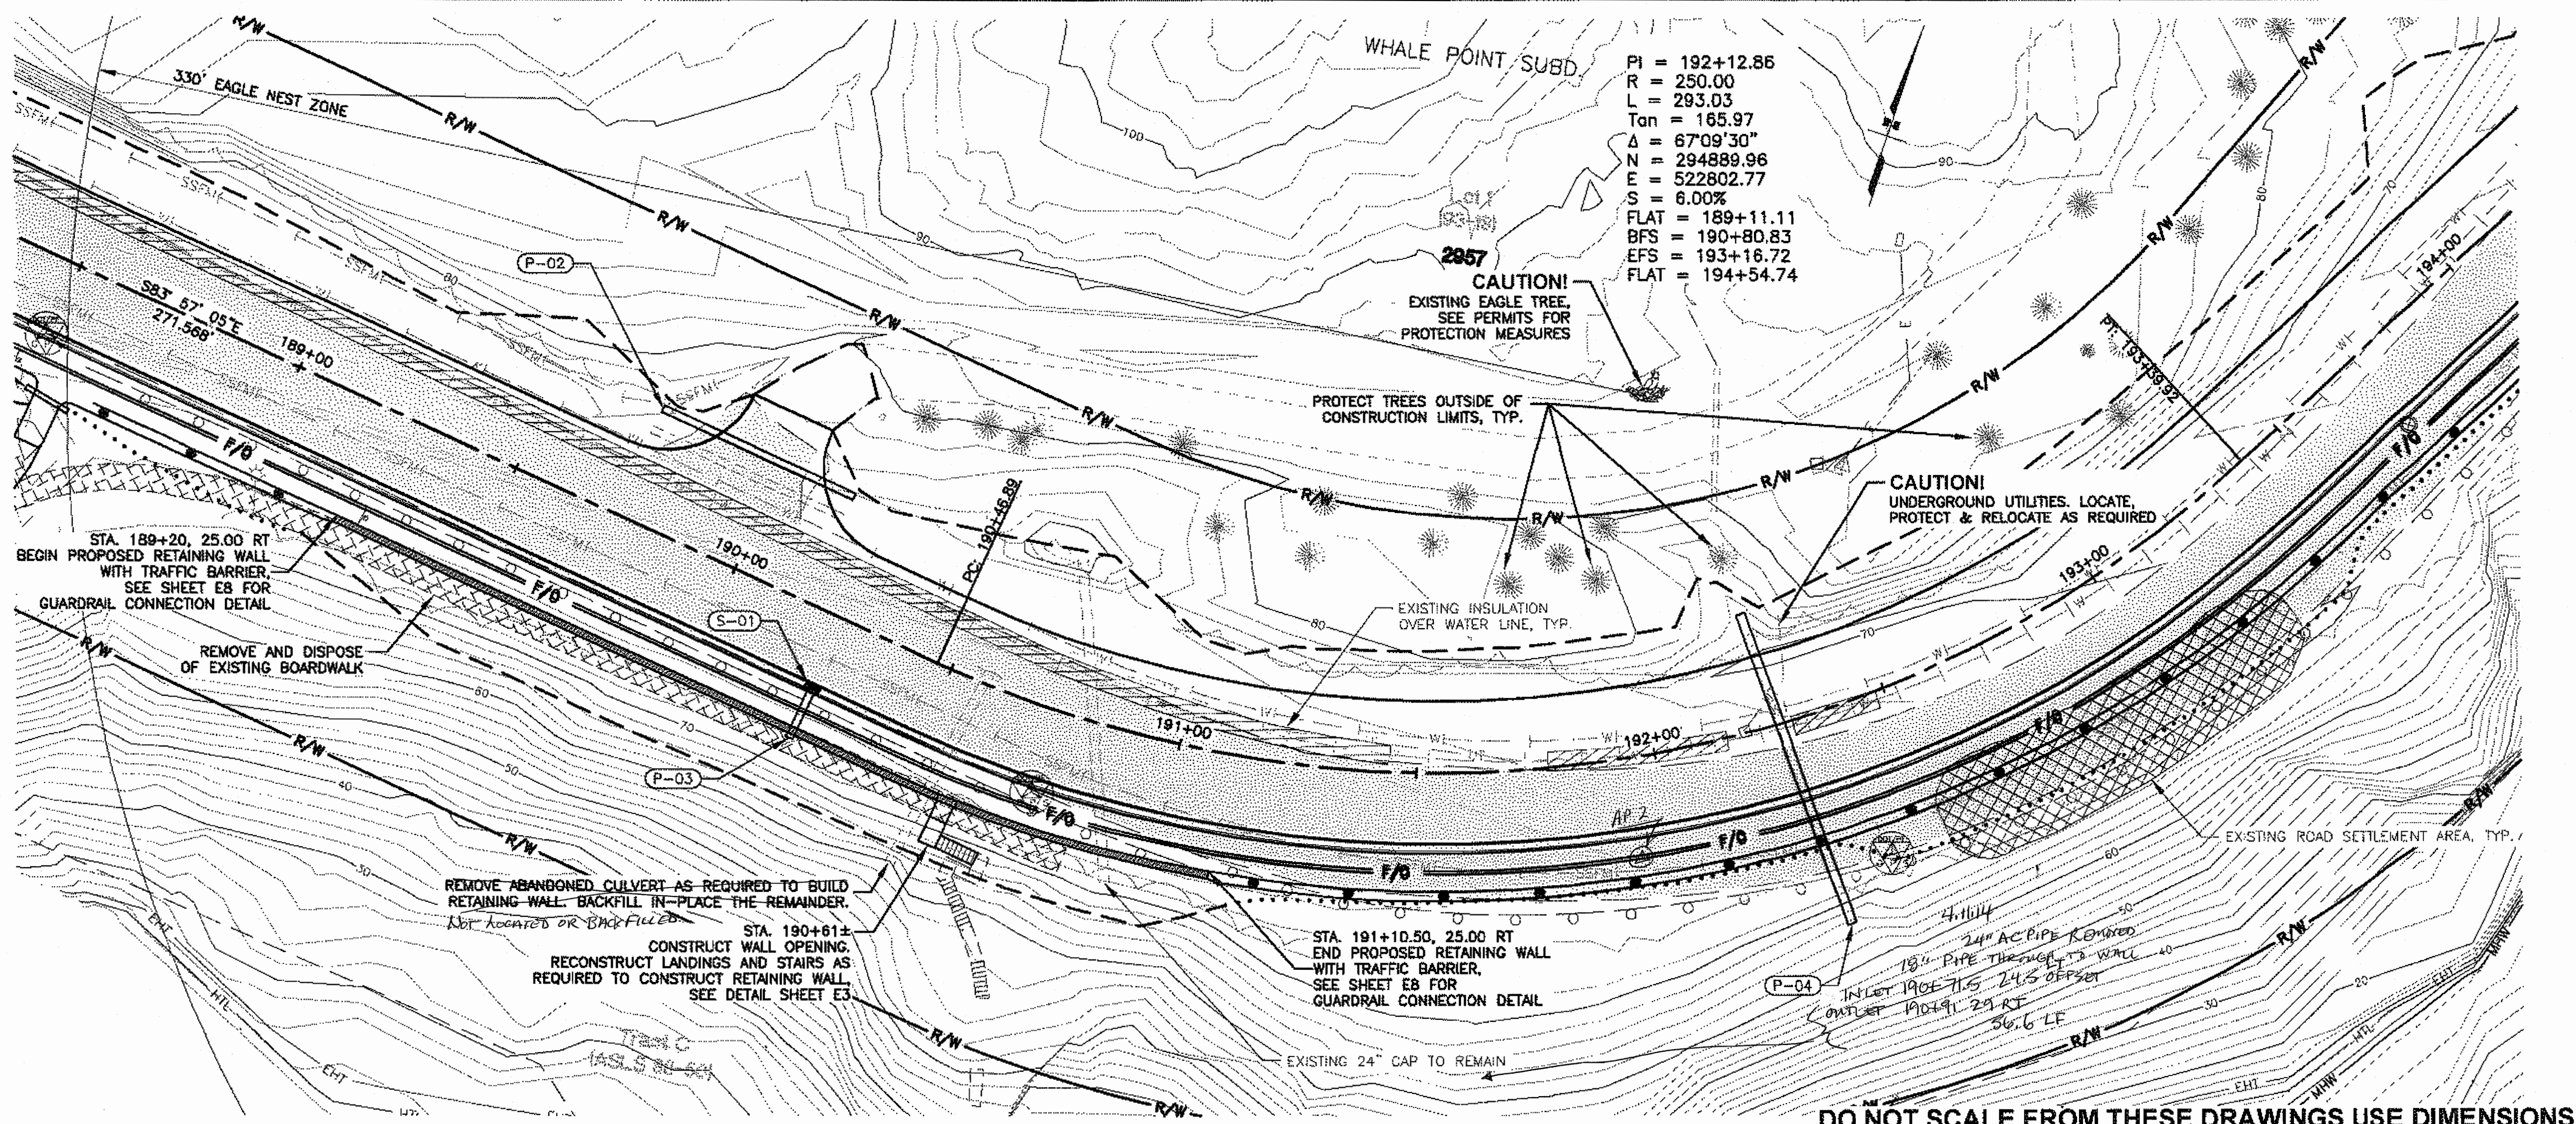

PATH: \\NUNFILE2\JOBS\1153806\DWG\SC\1\SHEETS\F01-F20		
TAB: F02		
ADDENDUM NUMBER		
ATTACHMENT NUMBER		
RECORD OF REVISIONS		
No.	DATE	DESCRIPTION

SAWMILL CREEK ROAD UPGRADE
 PHASE III - WHALE PARK TO SAWMILL CREEK BRIDGE
 68216MSG-STP-0933(21)
 SITKA TELECOMMUNICATIONS CONDUIT
 RSA NO. 69615


ROADWAY PLAN & PROFILE

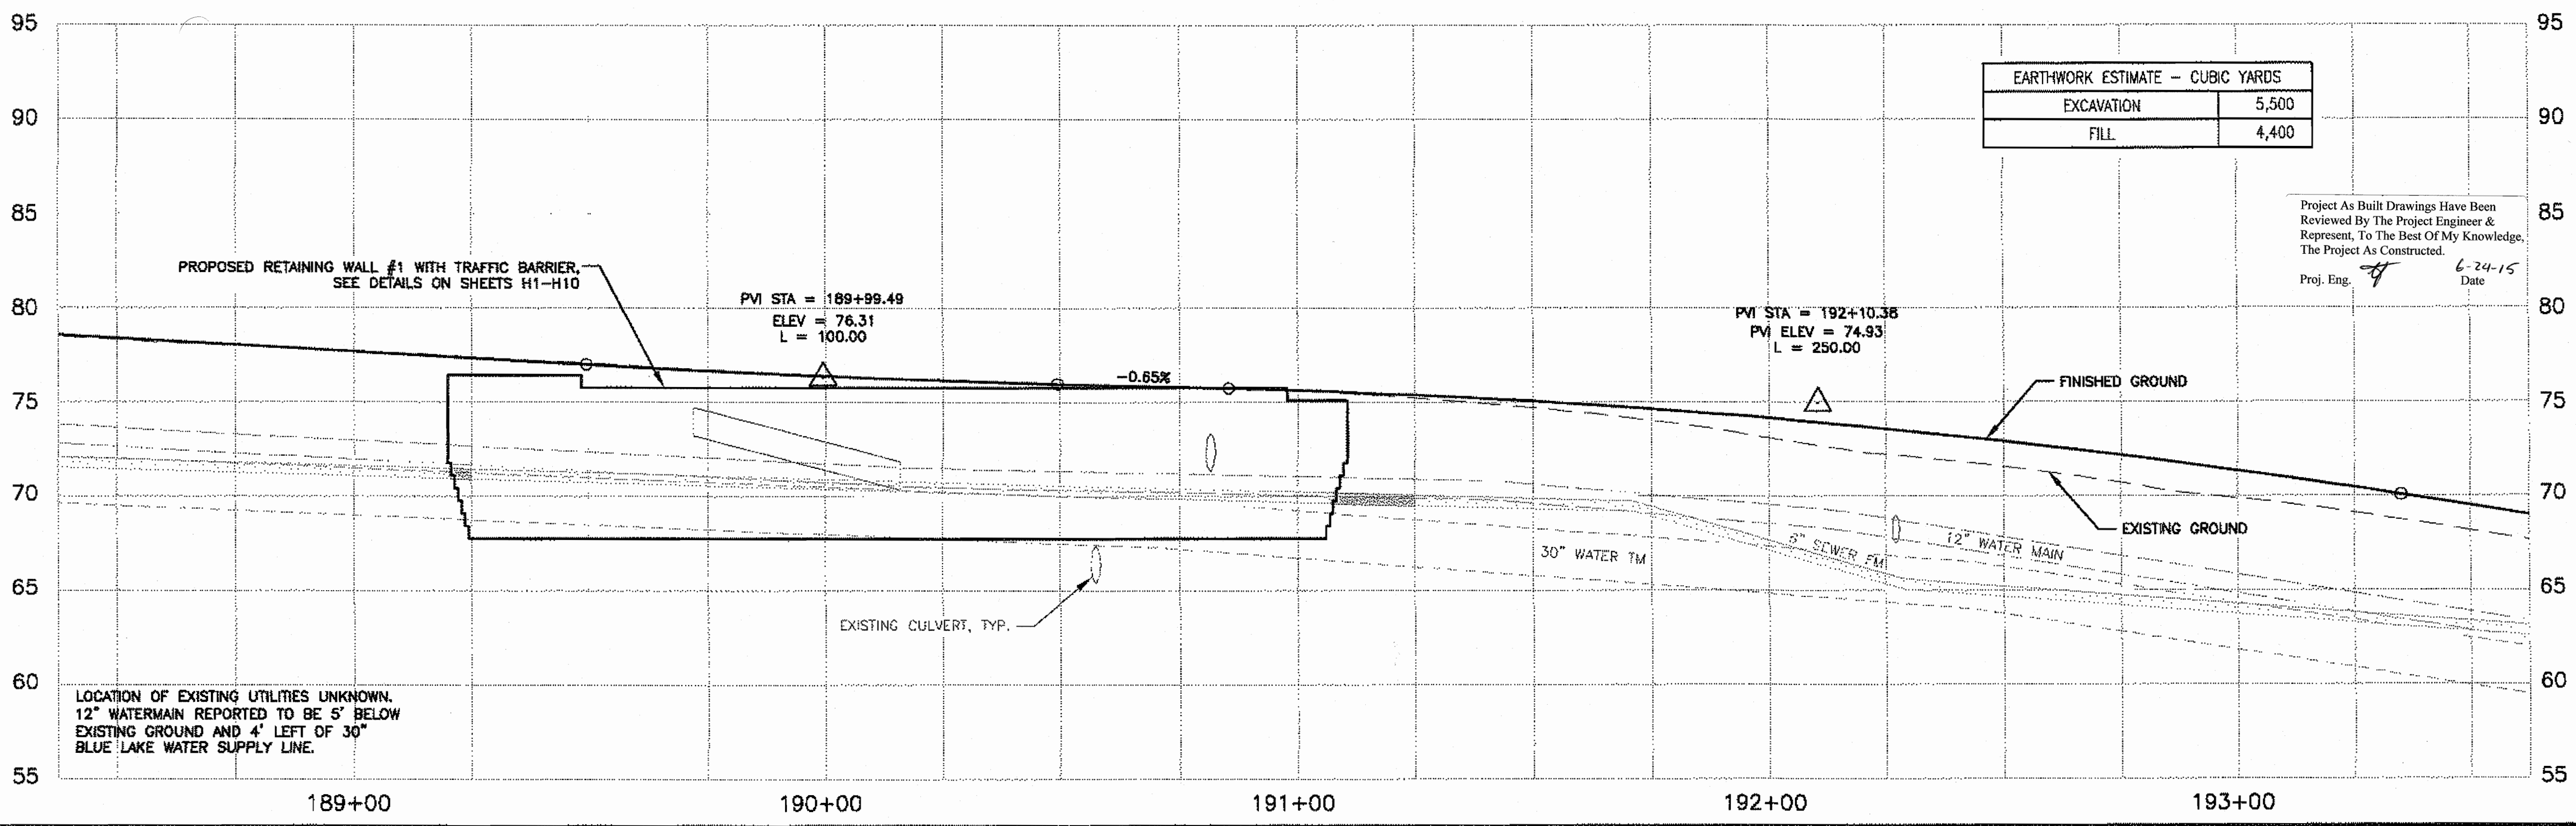

EARTHWORK ESTIMATE - CUBIC YARDS	
EXCAVATION	5,500
FILL	4,400

Project As Built Drawings Have Been
 Reviewed By The Project Engineer &
 Represent, To The Best Of My Knowledge,
 The Project As Constructed.
 Proj. Eng. *[Signature]* 6-24-15
 Date

PREPARED BY: USKH
 CHECKED BY: NCL

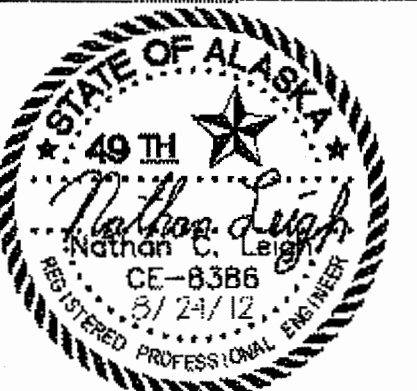


DESIGNED BY: NCL
 DRAWN BY: WUP

STATE OF ALASKA
 DEPARTMENT OF TRANSPORTATION
 & PUBLIC FACILITIES
 SOUTHEAST REGION

ROADWAY PLAN
 & PROFILE
 STA. 188+50 TO
 STA. 193+50


PROJECT DESIGNATION
 68216MSG-STP-0933(21)

STATE	YEAR
ALASKA	2012
SHEET NUMBER	TOTAL SHEETS
F2	109

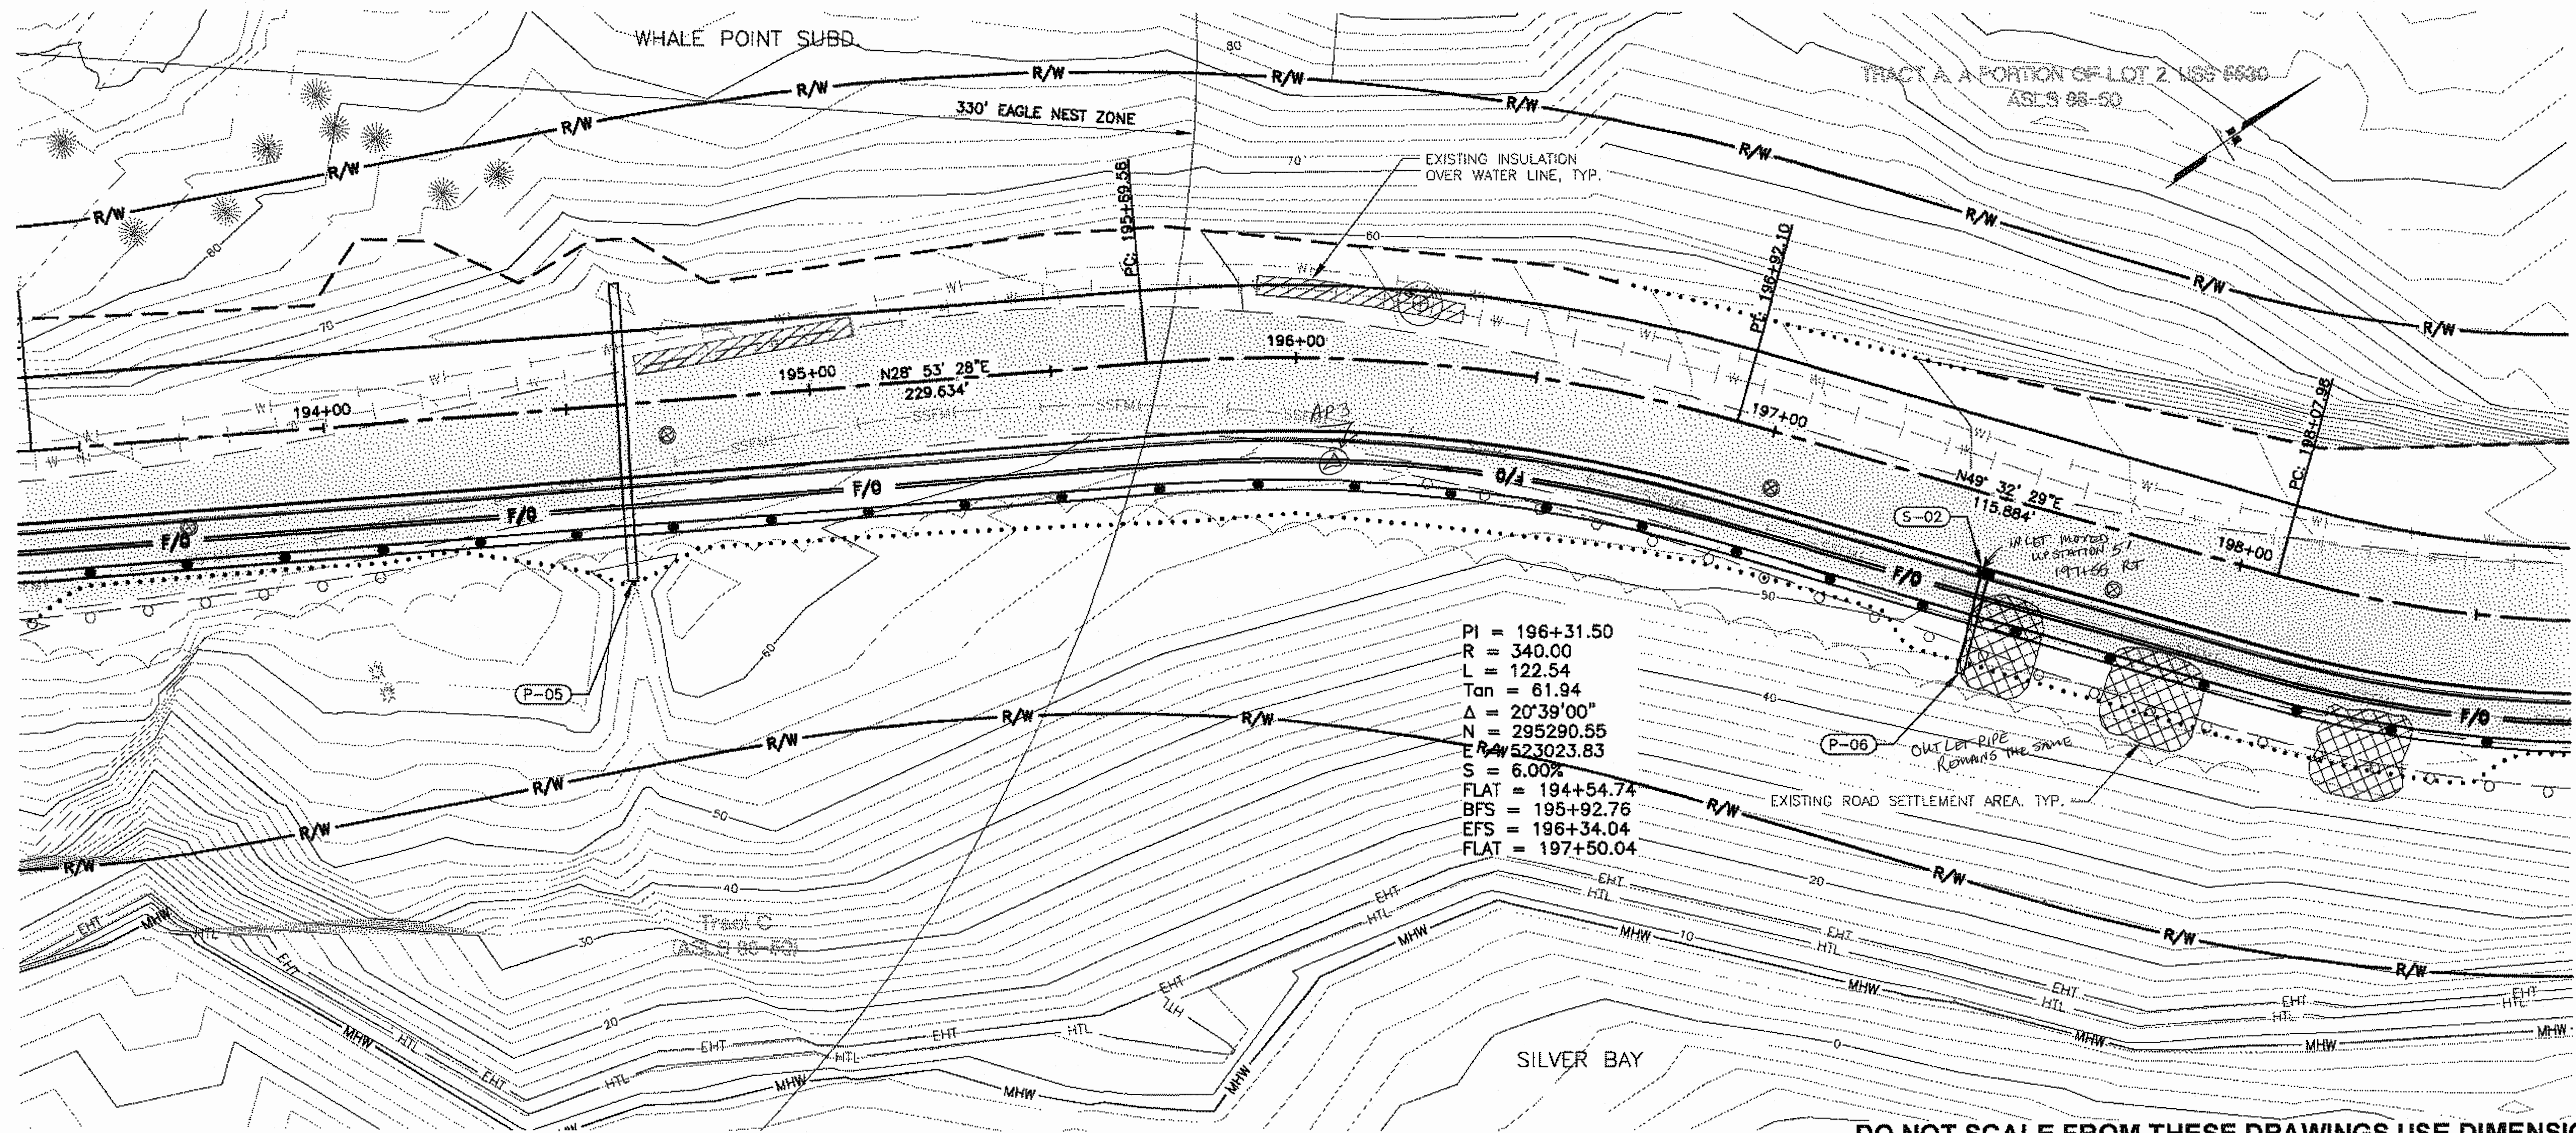

PI = 196+31.50
R = 340.00
L = 122.54
Tan = 61.94
Δ = 20°39'00\"/>
N = 295290.55
E = 523023.83
S = 6.00%
FLAT = 194+54.74
BFS = 195+92.76
EFS = 196+34.04
FLAT = 197+50.04

DO NOT SCALE FROM THESE DRAWINGS USE DIMENSIONS

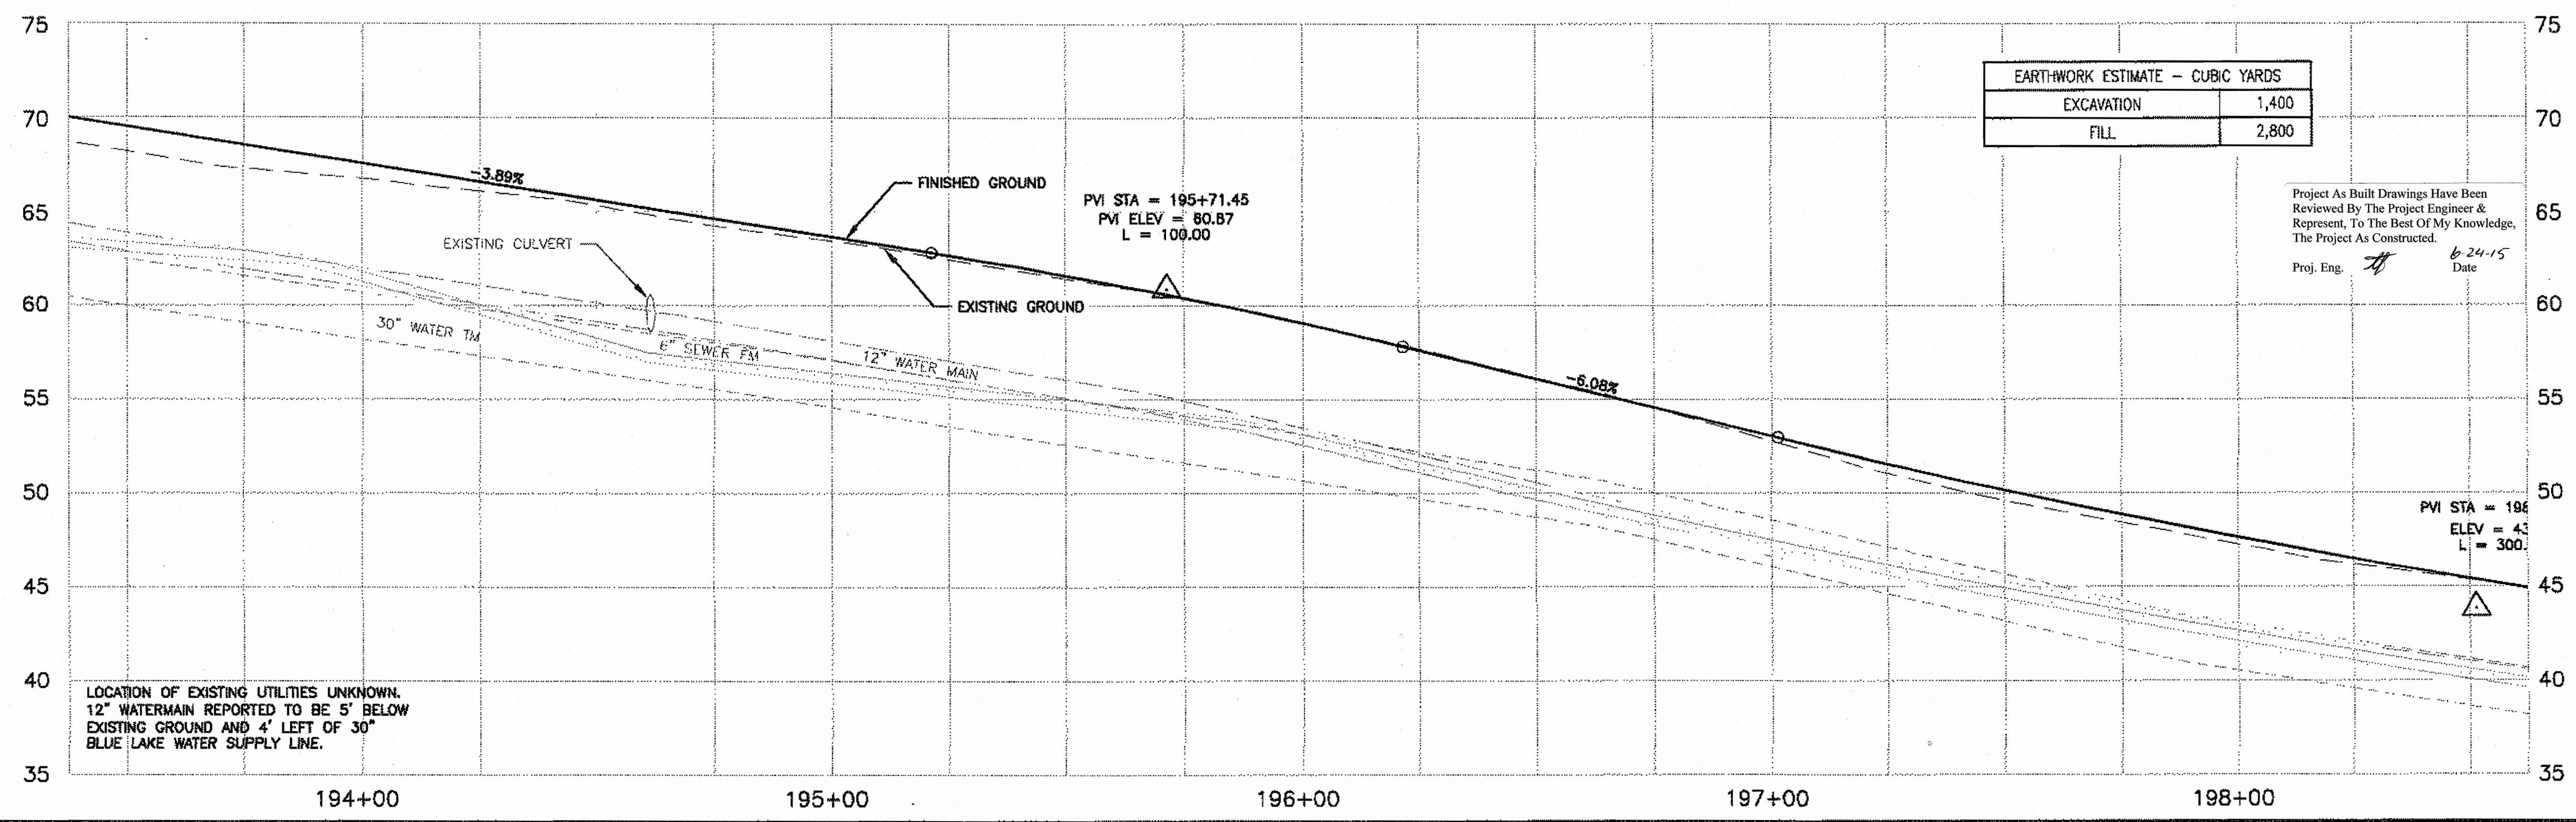

PATH:
\\UNIFILE2\JOBS\1153805\DWG\SCHEETS\F01-F20

TAB: F03

ADDENDUM NUMBER		
ATTACHMENT NUMBER		
RECORD OF REVISIONS		
No.	DATE	DESCRIPTION

SAWMILL CREEK ROAD UPGRADE
PHASE III - WHALE PARK TO SAWMILL CREEK BRIDGE
68216MSG-STP-0933(21)
SITKA TELECOMMUNICATIONS CONDUIT
RSA NO. 69615

ROADWAY PLAN & PROFILE

PREPARED BY: USKH
CHECKED BY: NCL


DESIGNED BY: NCL
DRAWN BY: WJP

STATE OF ALASKA
DEPARTMENT OF TRANSPORTATION
& PUBLIC FACILITIES
SOUTHEAST REGION

ROADWAY PLAN
& PROFILE
STA. 193+50 TO
STA. 198+50

PROJECT DESIGNATION
68216MSG-STP-0933(21)

STATE	YEAR
ALASKA	2012
SHEET NUMBER	TOTAL SHEETS
F3	109

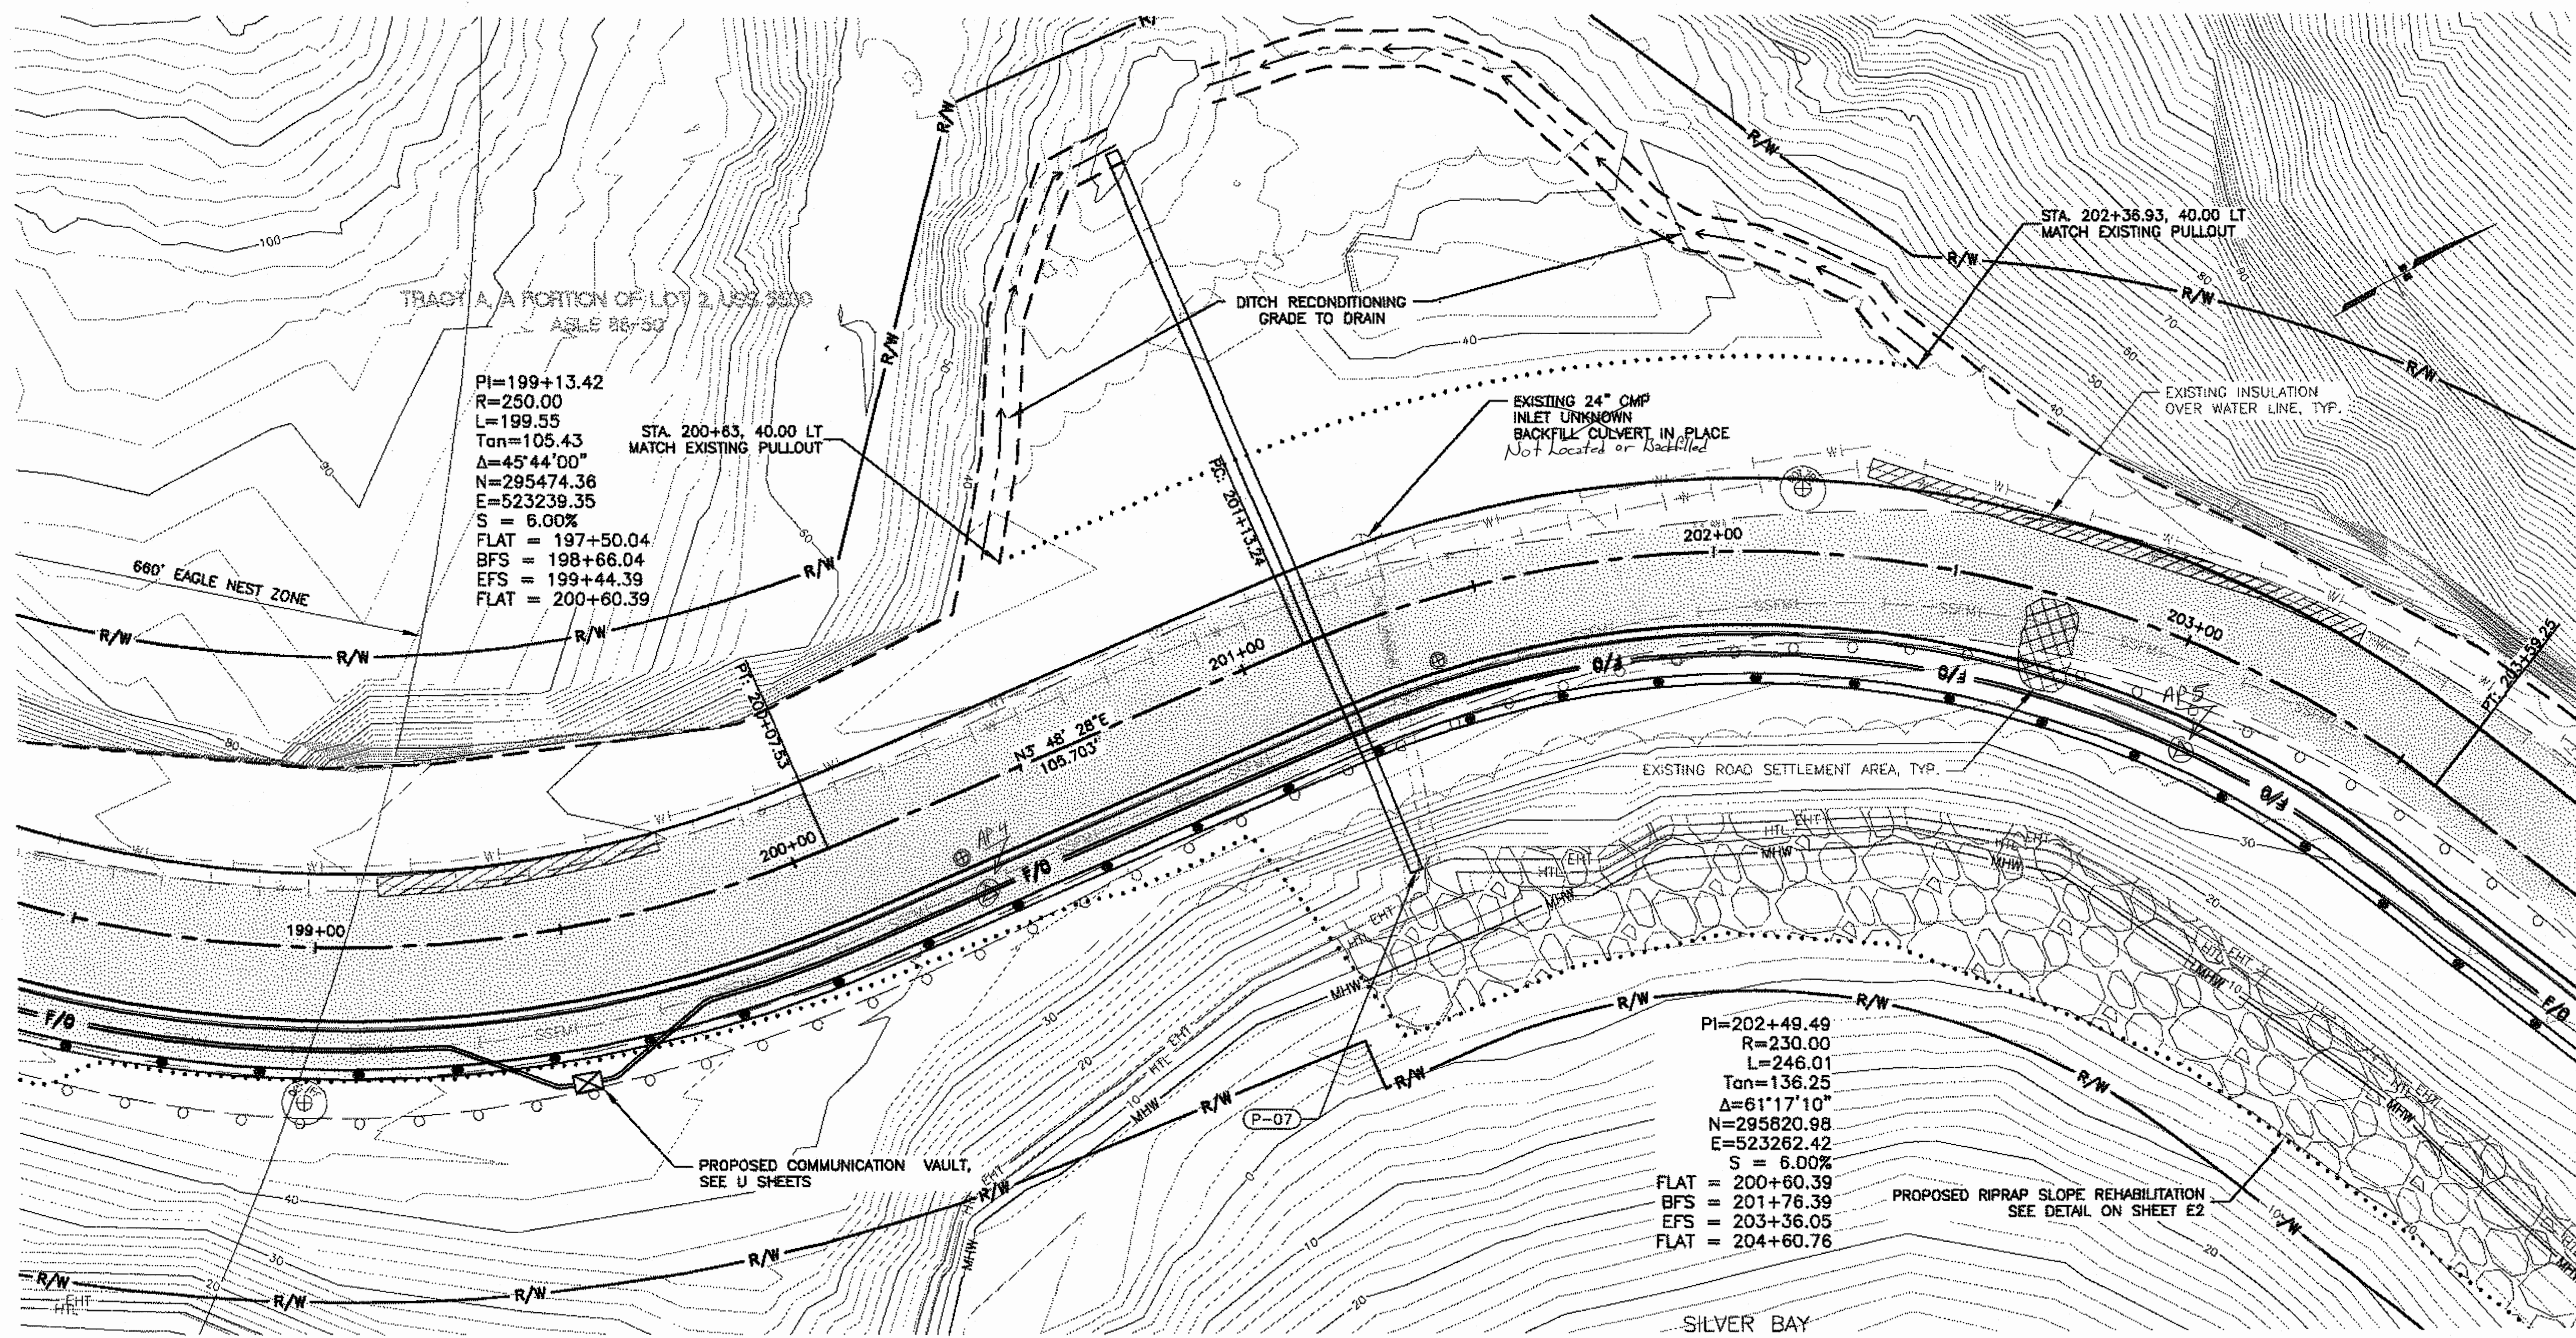


PATH: U:\NURFILE2\JOBS\1153805\DWGS\CIS\SHEETS\F01-F20		
TAB: F04		
ADDENDUM NUMBER		
ATTACHMENT NUMBER		
RECORD OF REVISIONS		
No.	DATE	DESCRIPTION

SAWMILL CREEK ROAD UPGRADE
PHASE III - WHALE PARK TO SAWMILL CREEK BRIDGE
68216\MSG-STP-0933(21)
SITKA TELECOMMUNICATIONS CONDUIT
RSA NO. 69615

ROADWAY PLAN & PROFILE

PREPARED BY: USKH

CHECKED BY: NCL

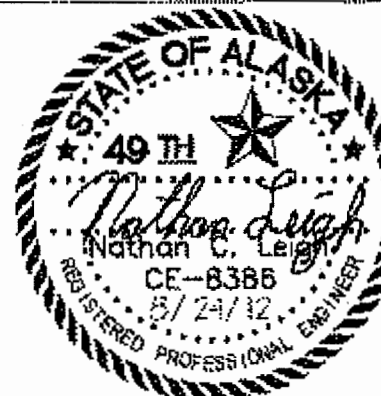

DESIGNED BY: NCL


DRAWN BY: WJP

STATE OF ALASKA
DEPARTMENT OF TRANSPORTATION
& PUBLIC FACILITIES
SOUTHEAST REGION

ROADWAY PLAN
& PROFILE
STA. 198+50 TO
STA. 203+50

PROJECT DESIGNATION
68216\MSG-STP-0933(21)

STATE	YEAR
ALASKA	2012
SHEET NUMBER	TOTAL SHEETS
F4	109

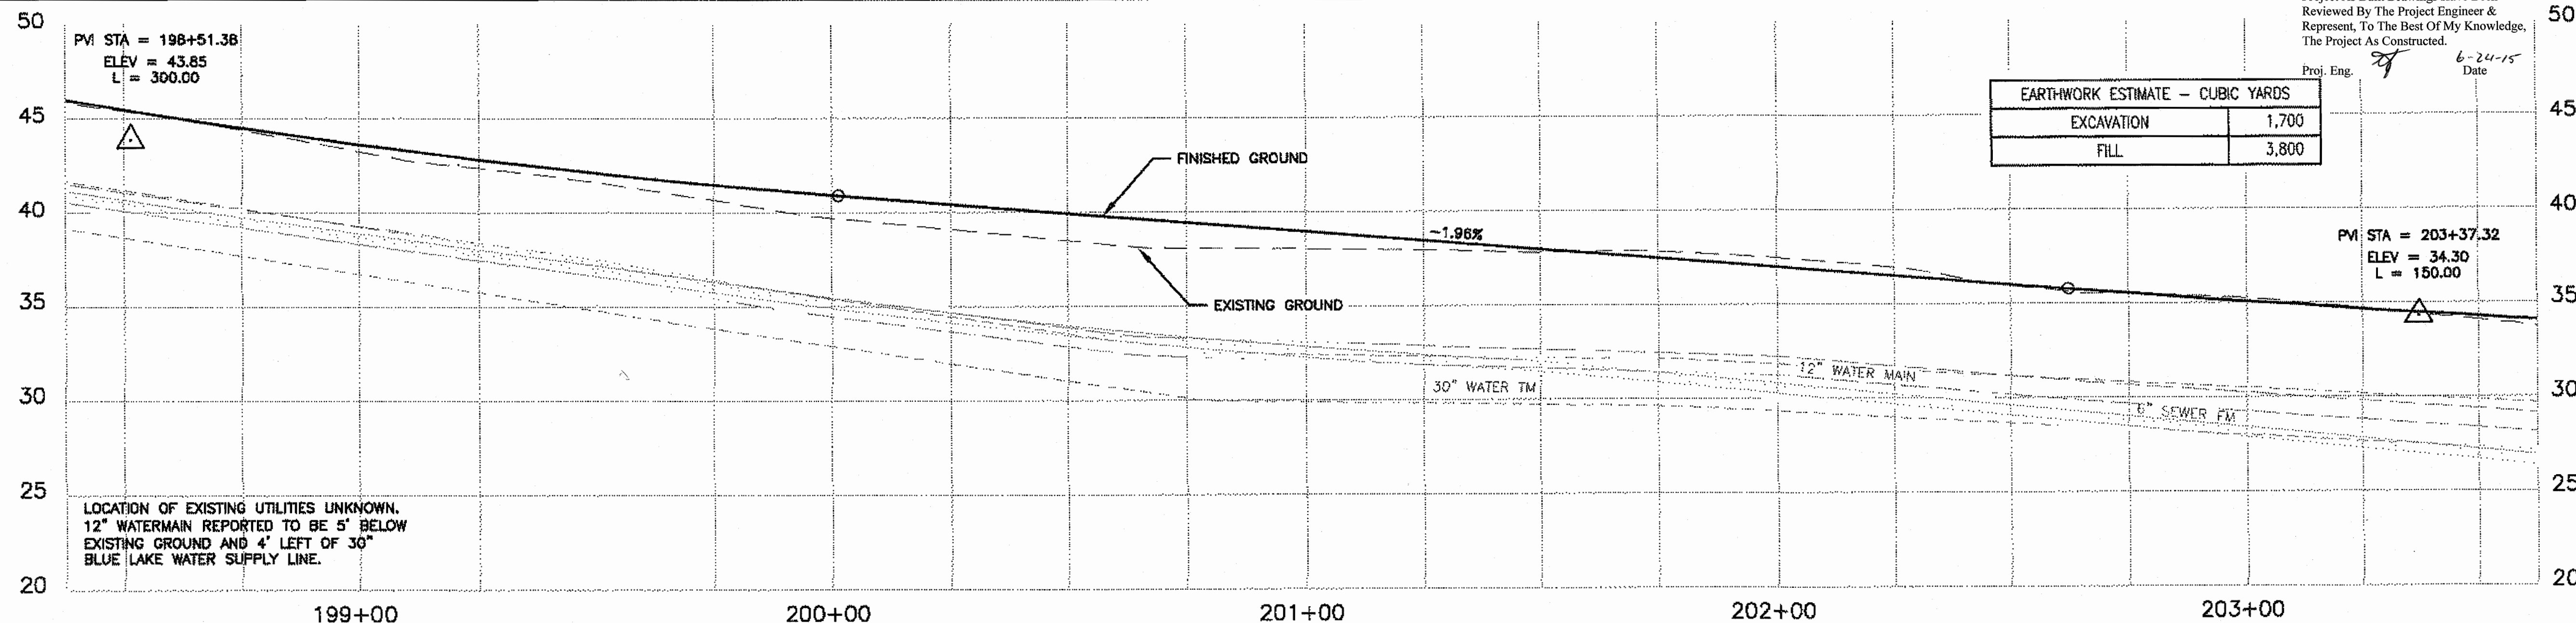

PATH: \\UNFILE2\JOBS\1153805\DWG\SC\SHETS\F01-F20

TAB: F05

ADDENDUM NUMBER

ATTACHMENT NUMBER

RECORD OF REVISIONS


No.	DATE	DESCRIPTION

SAWMILL CREEK ROAD UPGRADE
PHASE III - WHALE PARK TO SAWMILL CREEK BRIDGE
68216MSG-STP-0933(21)
SITKA TELECOMMUNICATIONS CONDUIT
RSA NO. 68615

ROADWAY PLAN & PROFILE

PREPARED BY: USKH

CHECKED BY: NCL

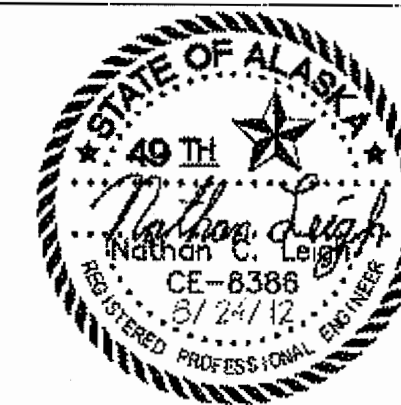

DESIGNED BY: NCL

DRAWN BY: WJP

STATE OF ALASKA
DEPARTMENT OF TRANSPORTATION
& PUBLIC FACILITIES
SOUTHEAST REGION

ROADWAY PLAN
& PROFILE
STA. 203+50 TO
STA. 208+50

PROJECT DESIGNATION
68216MSG-STP-0933(21)

STATE ALASKA


YEAR 2012

SHEET NUMBER

TOTAL SHEETS

F5

109

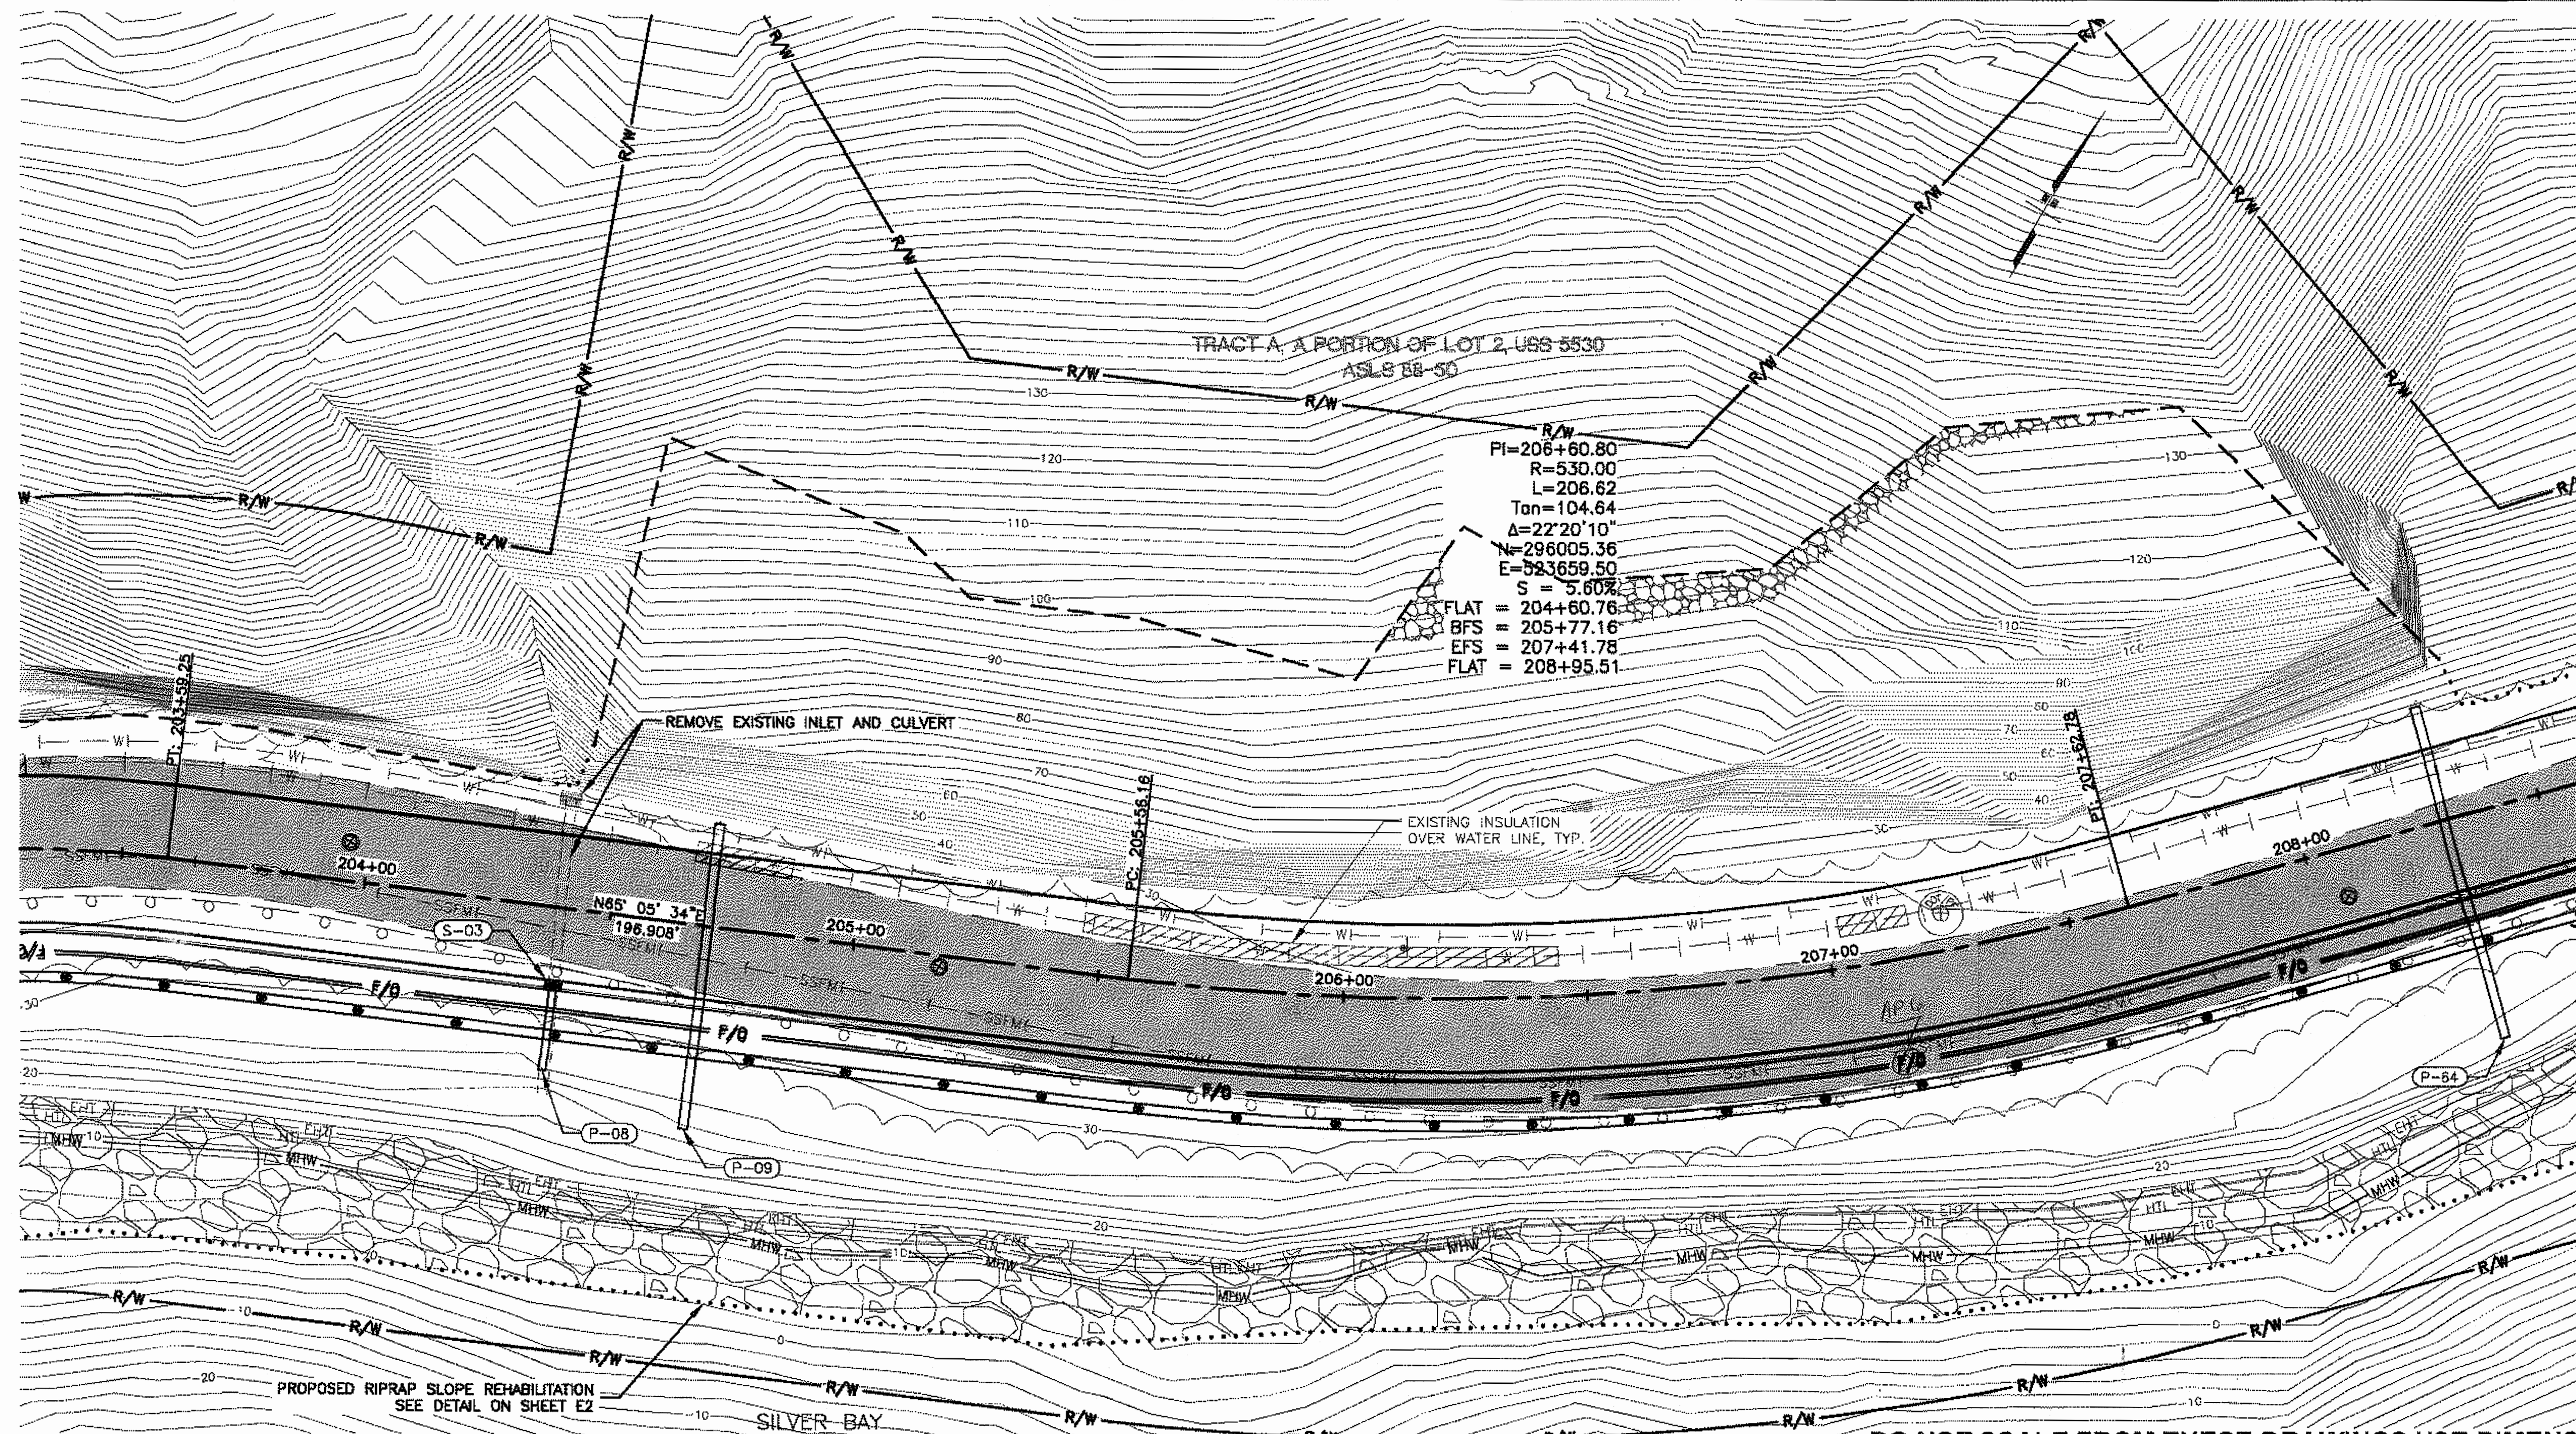



DO NOT SCALE FROM THESE DRAWINGS USE DIMENSIONS

Project As Built Drawings Have Been
Reviewed By The Project Engineer &
Represent, To The Best Of My Knowledge,
The Project As Constructed.

Proj. Eng. *ty* Date 6-24-15

EARTHWORK ESTIMATE - CUBIC YARDS	
EXCAVATION	26,800
FILL	5,200

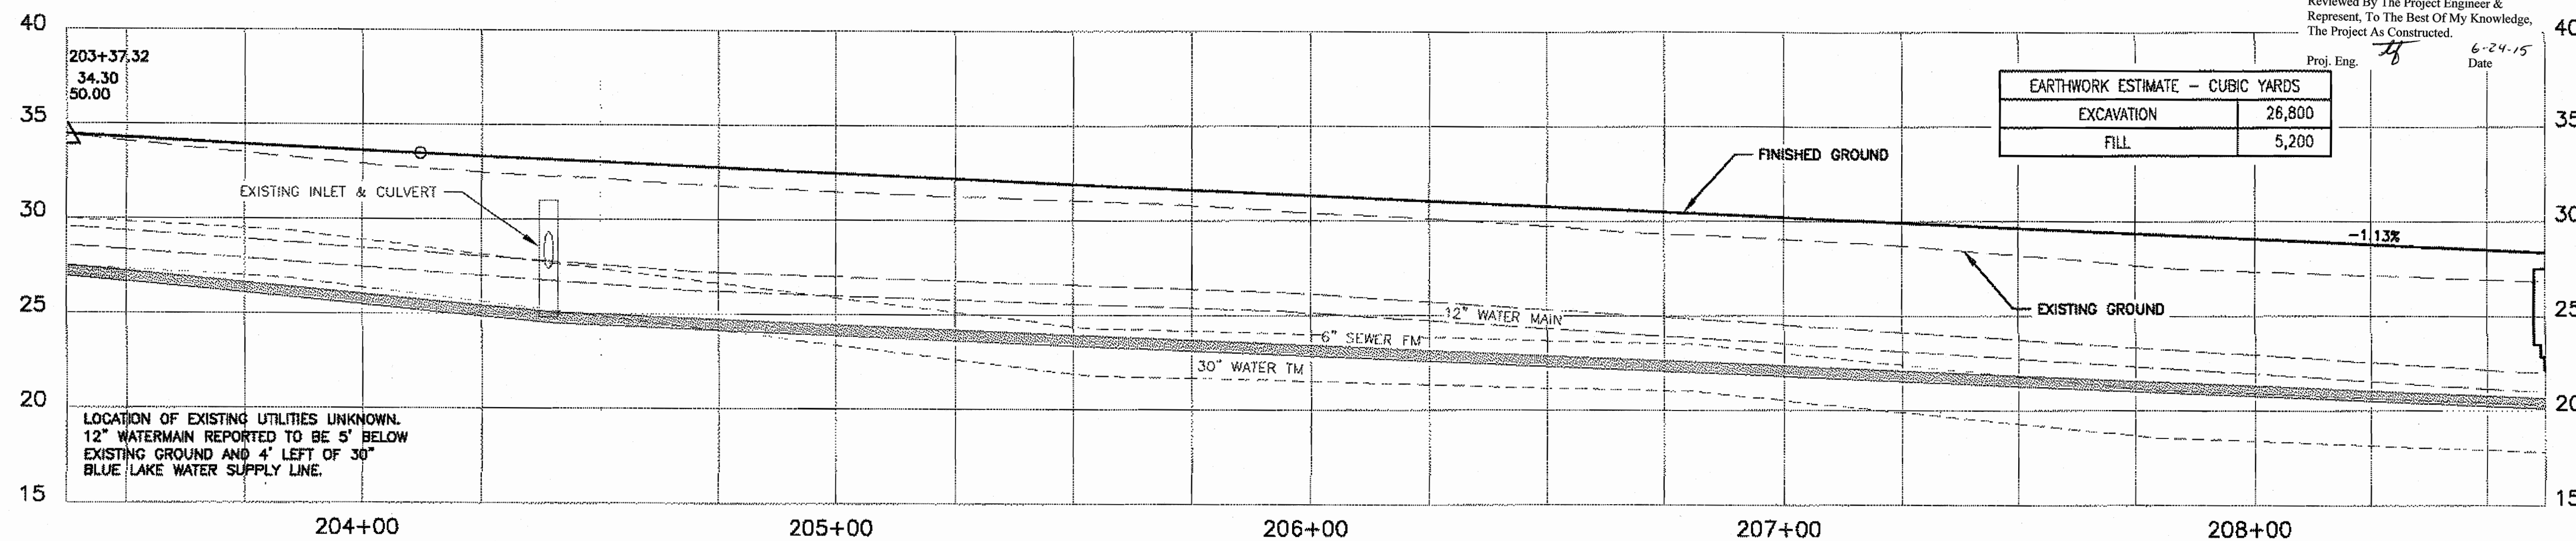

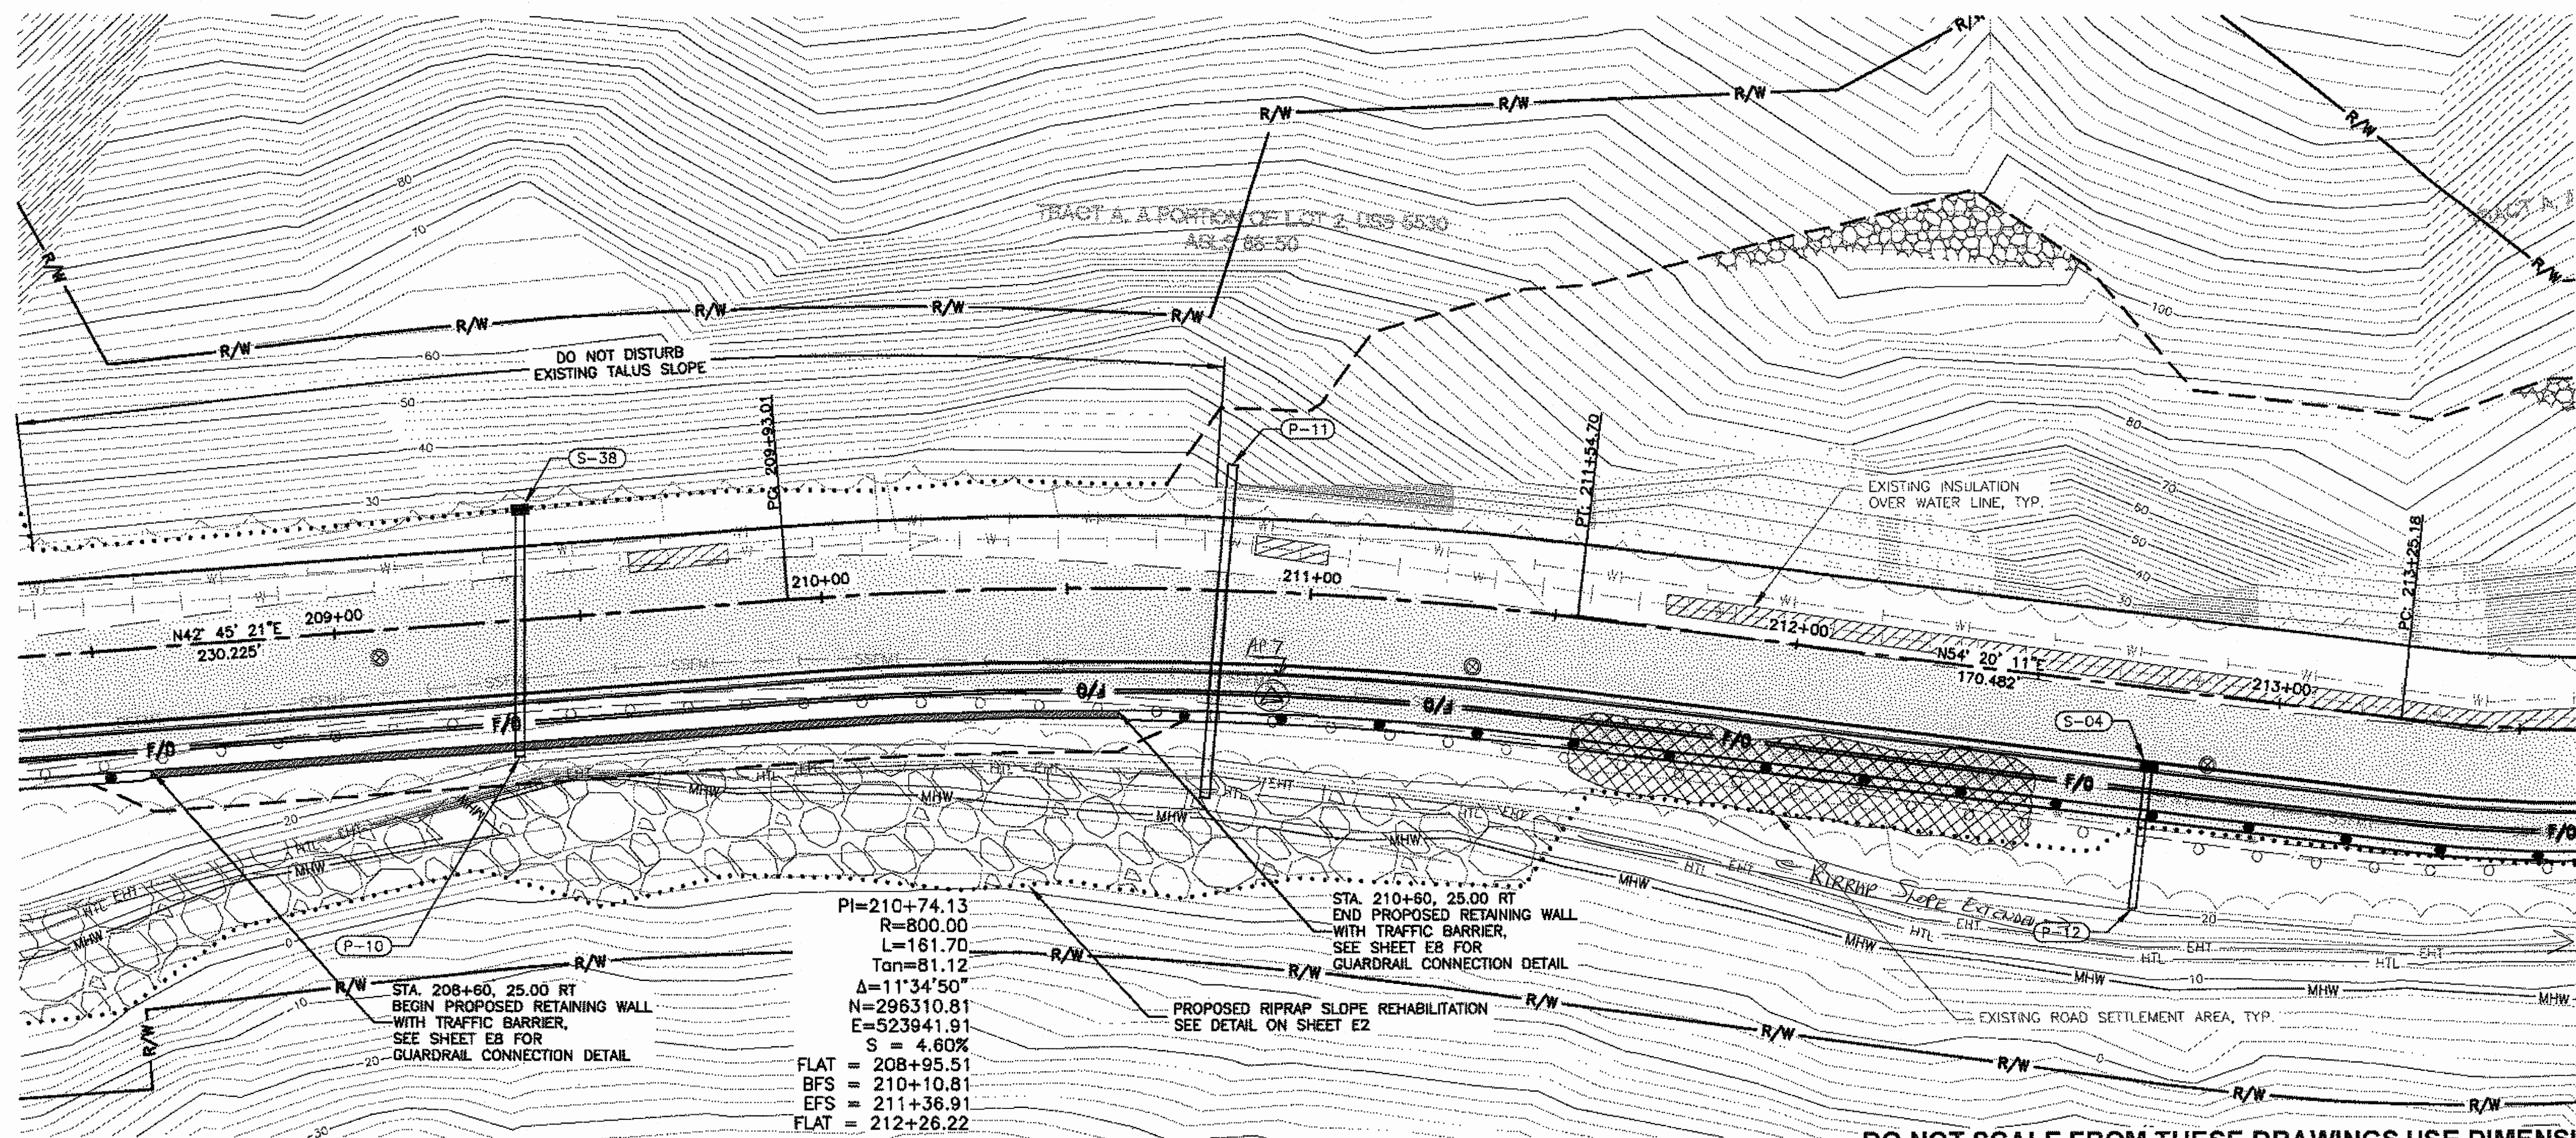

PATH:
I:\1153805\DWGS\CS\SHETS\F01-F20.DWG

TAB: F06

ADDENDUM NUMBER

ATTACHMENT NUMBER

RECORD OF REVISIONS


No.	DATE	DESCRIPTION

SAWMILL CREEK ROAD UPGRADE
PHASE III - WHALE PARK TO SAWMILL CREEK BRIDGE
68216MSG-STP-0933(21)
SITKA TELECOMMUNICATIONS CONDUIT
RSA NO. 69615

ROADWAY PLAN & PROFILE

PREPARED BY: USKH

CHECKED BY: NCL

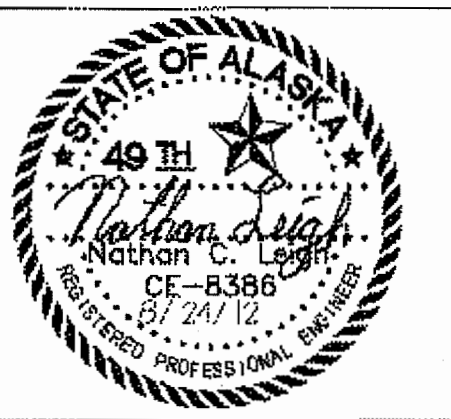

DESIGNED BY: NCL

DRAWN BY: WJP


STATE OF ALASKA
DEPARTMENT OF TRANSPORTATION
& PUBLIC FACILITIES
SOUTHEAST REGION

ROADWAY PLAN
& PROFILE
STA. 208+50 TO
STA. 213+50

PROJECT DESIGNATION

68216MSG-STP-0933(21)

STATE	YEAR
ALASKA	2012
SHEET NUMBER	TOTAL SHEETS
F6	109

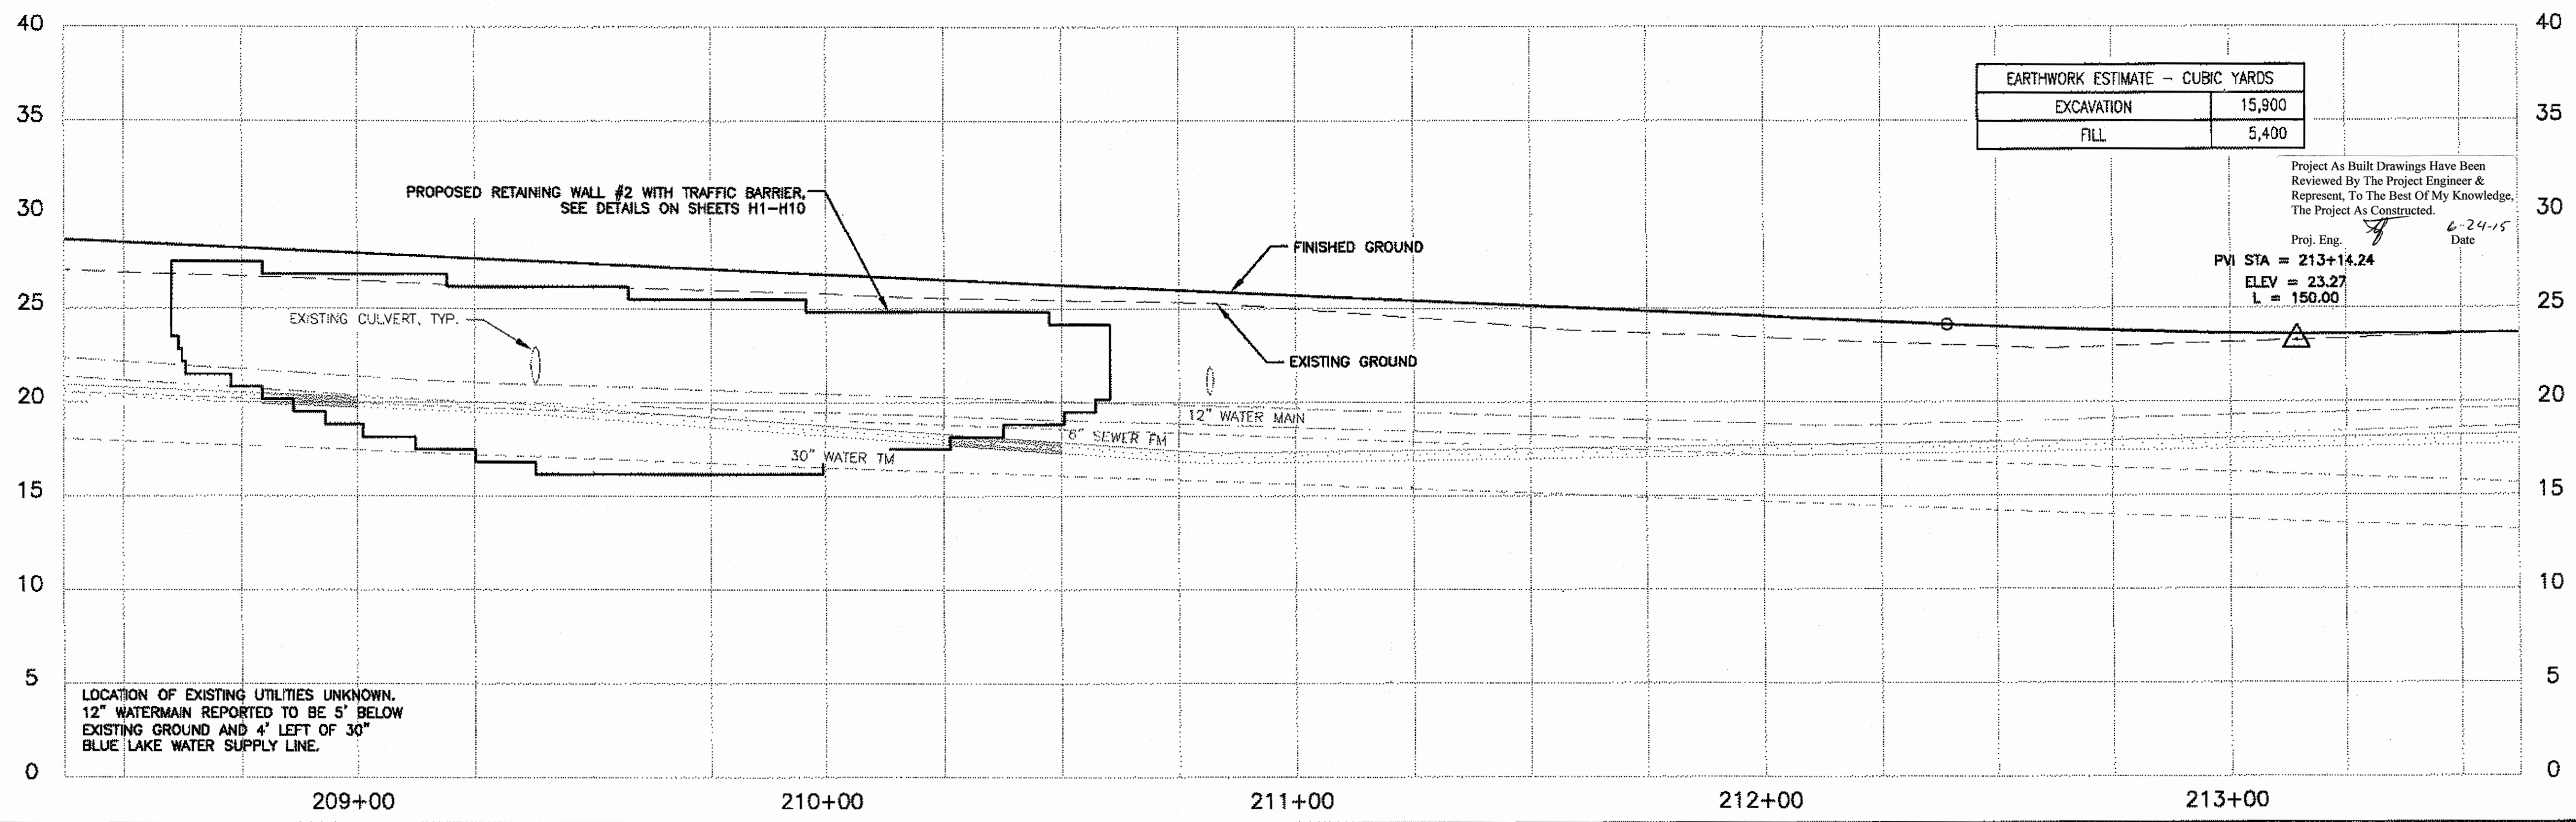

PATH:
\\UNFILE2\JOBS\1153805\DWG\SIC\SHEETS\F01-F20

TAB: F08

ADDENDUM NUMBER

ATTACHMENT NUMBER

RECORD OF REVISIONS


No.	DATE	DESCRIPTION

SAWMILL CREEK ROAD UPGRADE
PHASE III - WHALE PARK TO SAWMILL CREEK BRIDGE
68216MSG-STP-0933(21)
SITKA TELECOMMUNICATIONS CONDUIT
RSA NO. 69615

ROADWAY PLAN & PROFILE

PREPARED BY: USKH

CHECKED BY: NCL

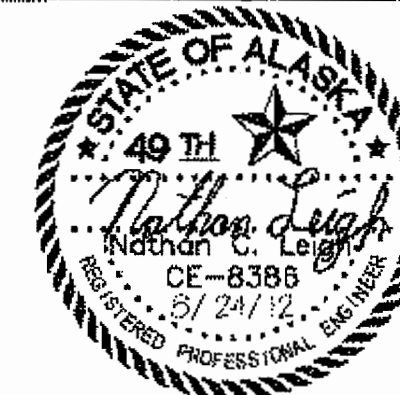

DESIGNED BY: NCL

DRAWN BY: WJP

STATE OF ALASKA
DEPARTMENT OF TRANSPORTATION
& PUBLIC FACILITIES
SOUTHEAST REGION

ROADWAY PLAN
& PROFILE
STA. 218+50 TO
STA. 223+50

PROJECT DESIGNATION

68216MSG-STP-0933(21)

STATE
ALASKA



YEAR
2012




SHEET NUMBER

F8



TOTAL SHEETS

109

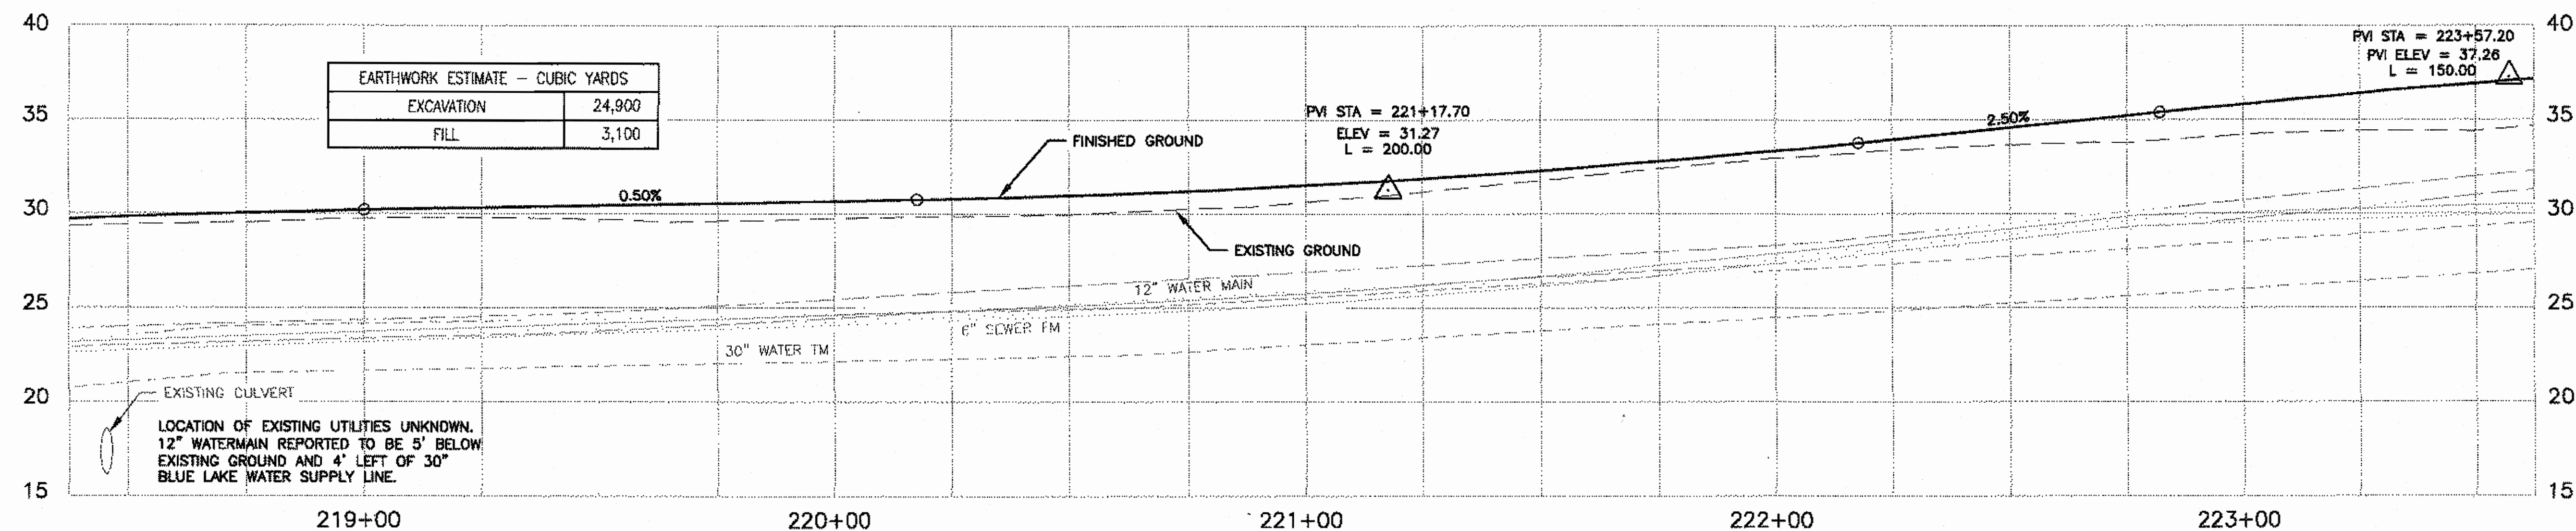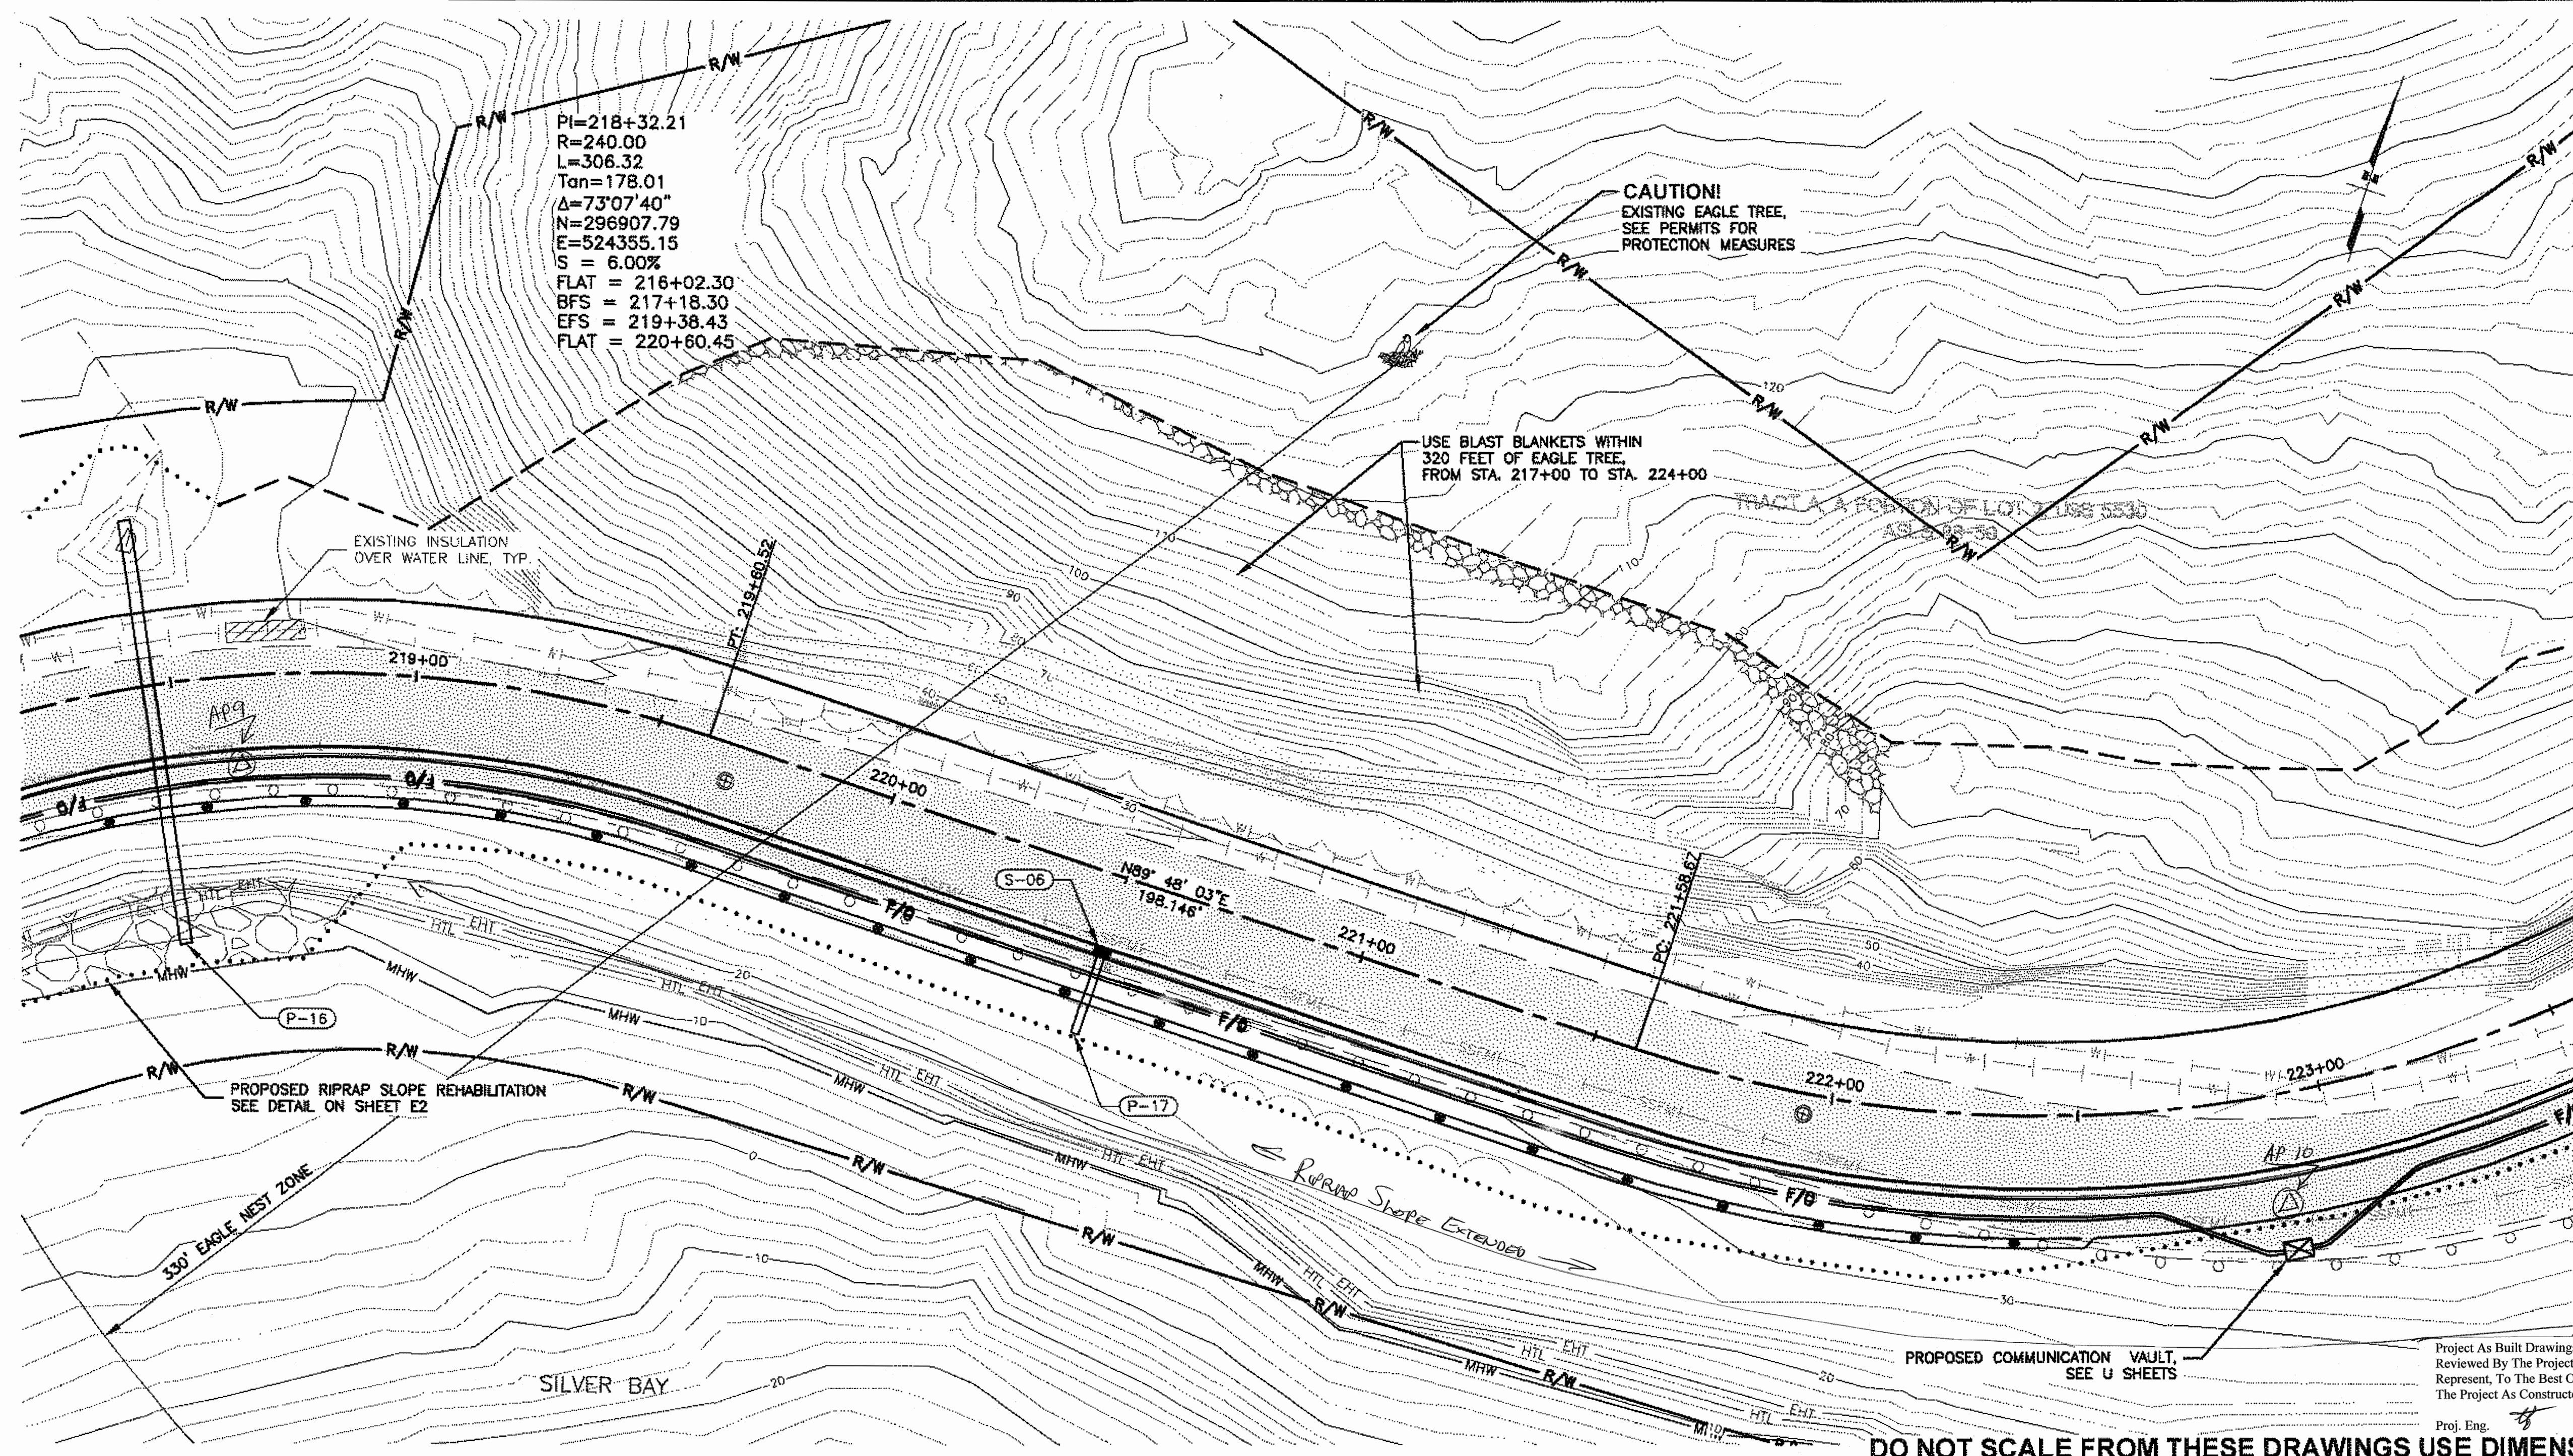

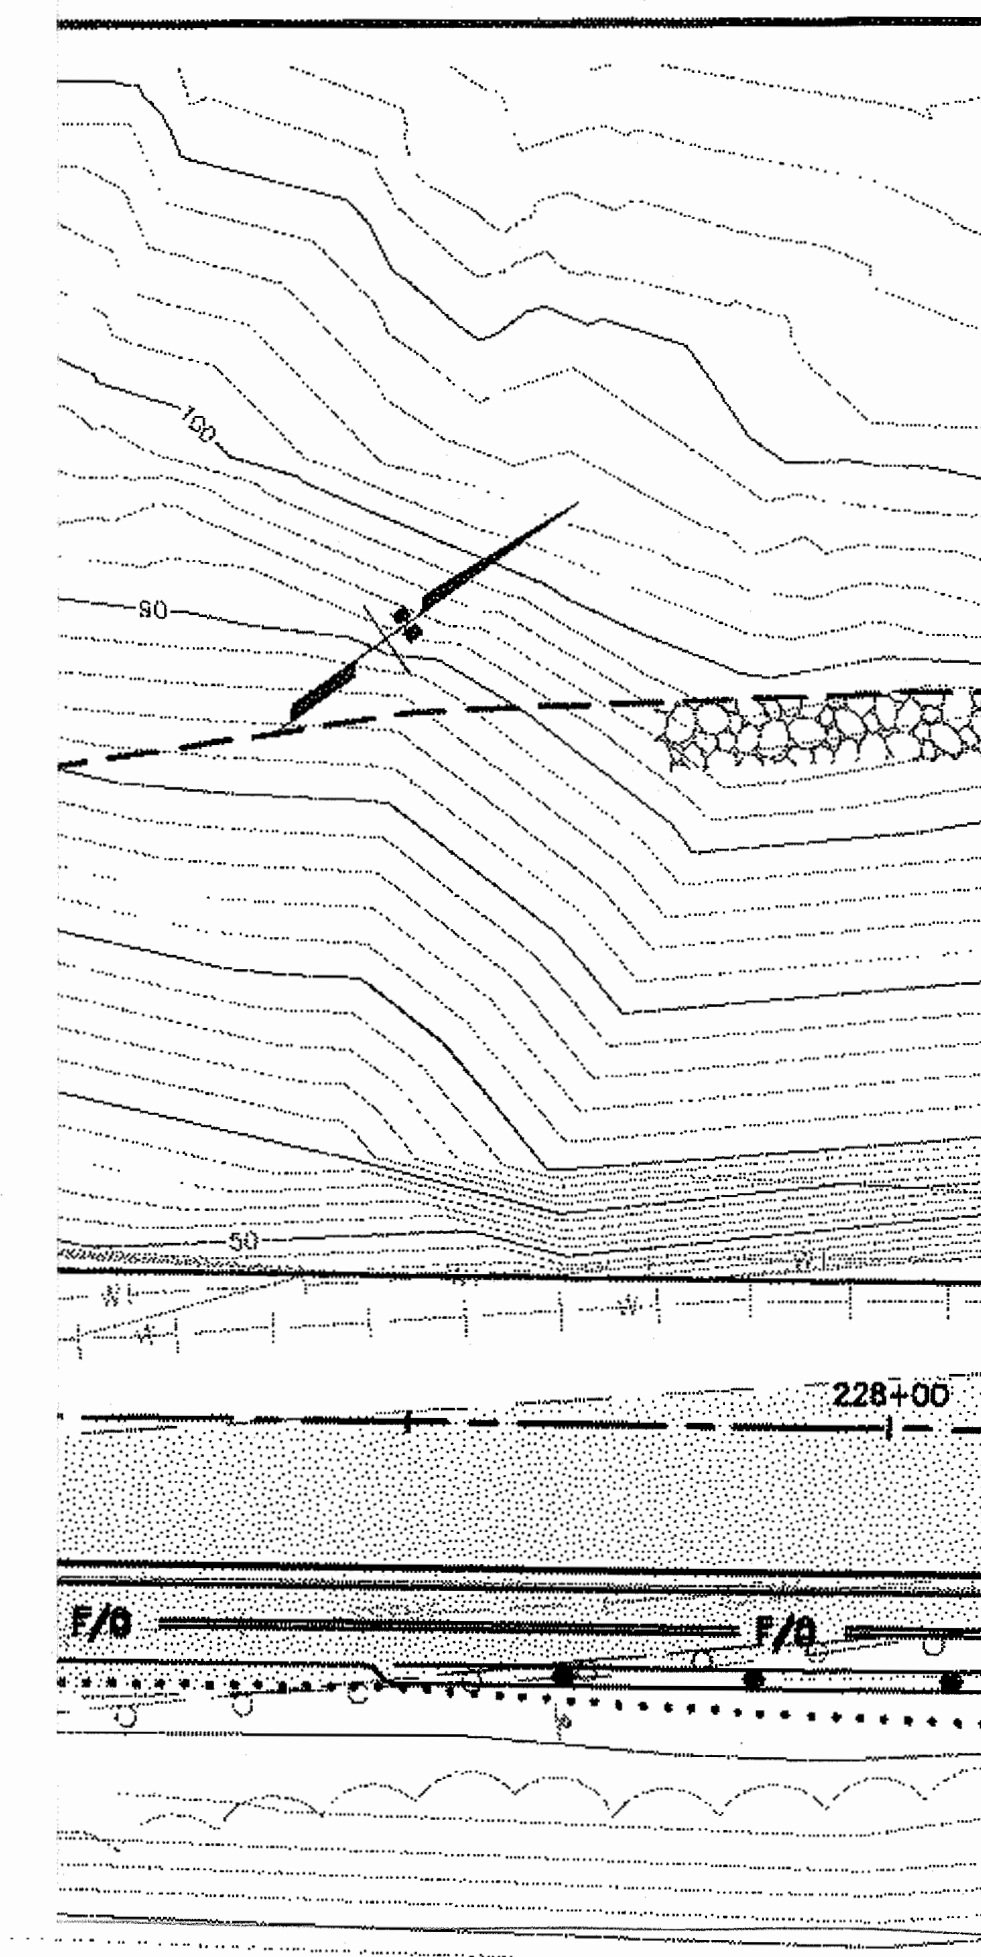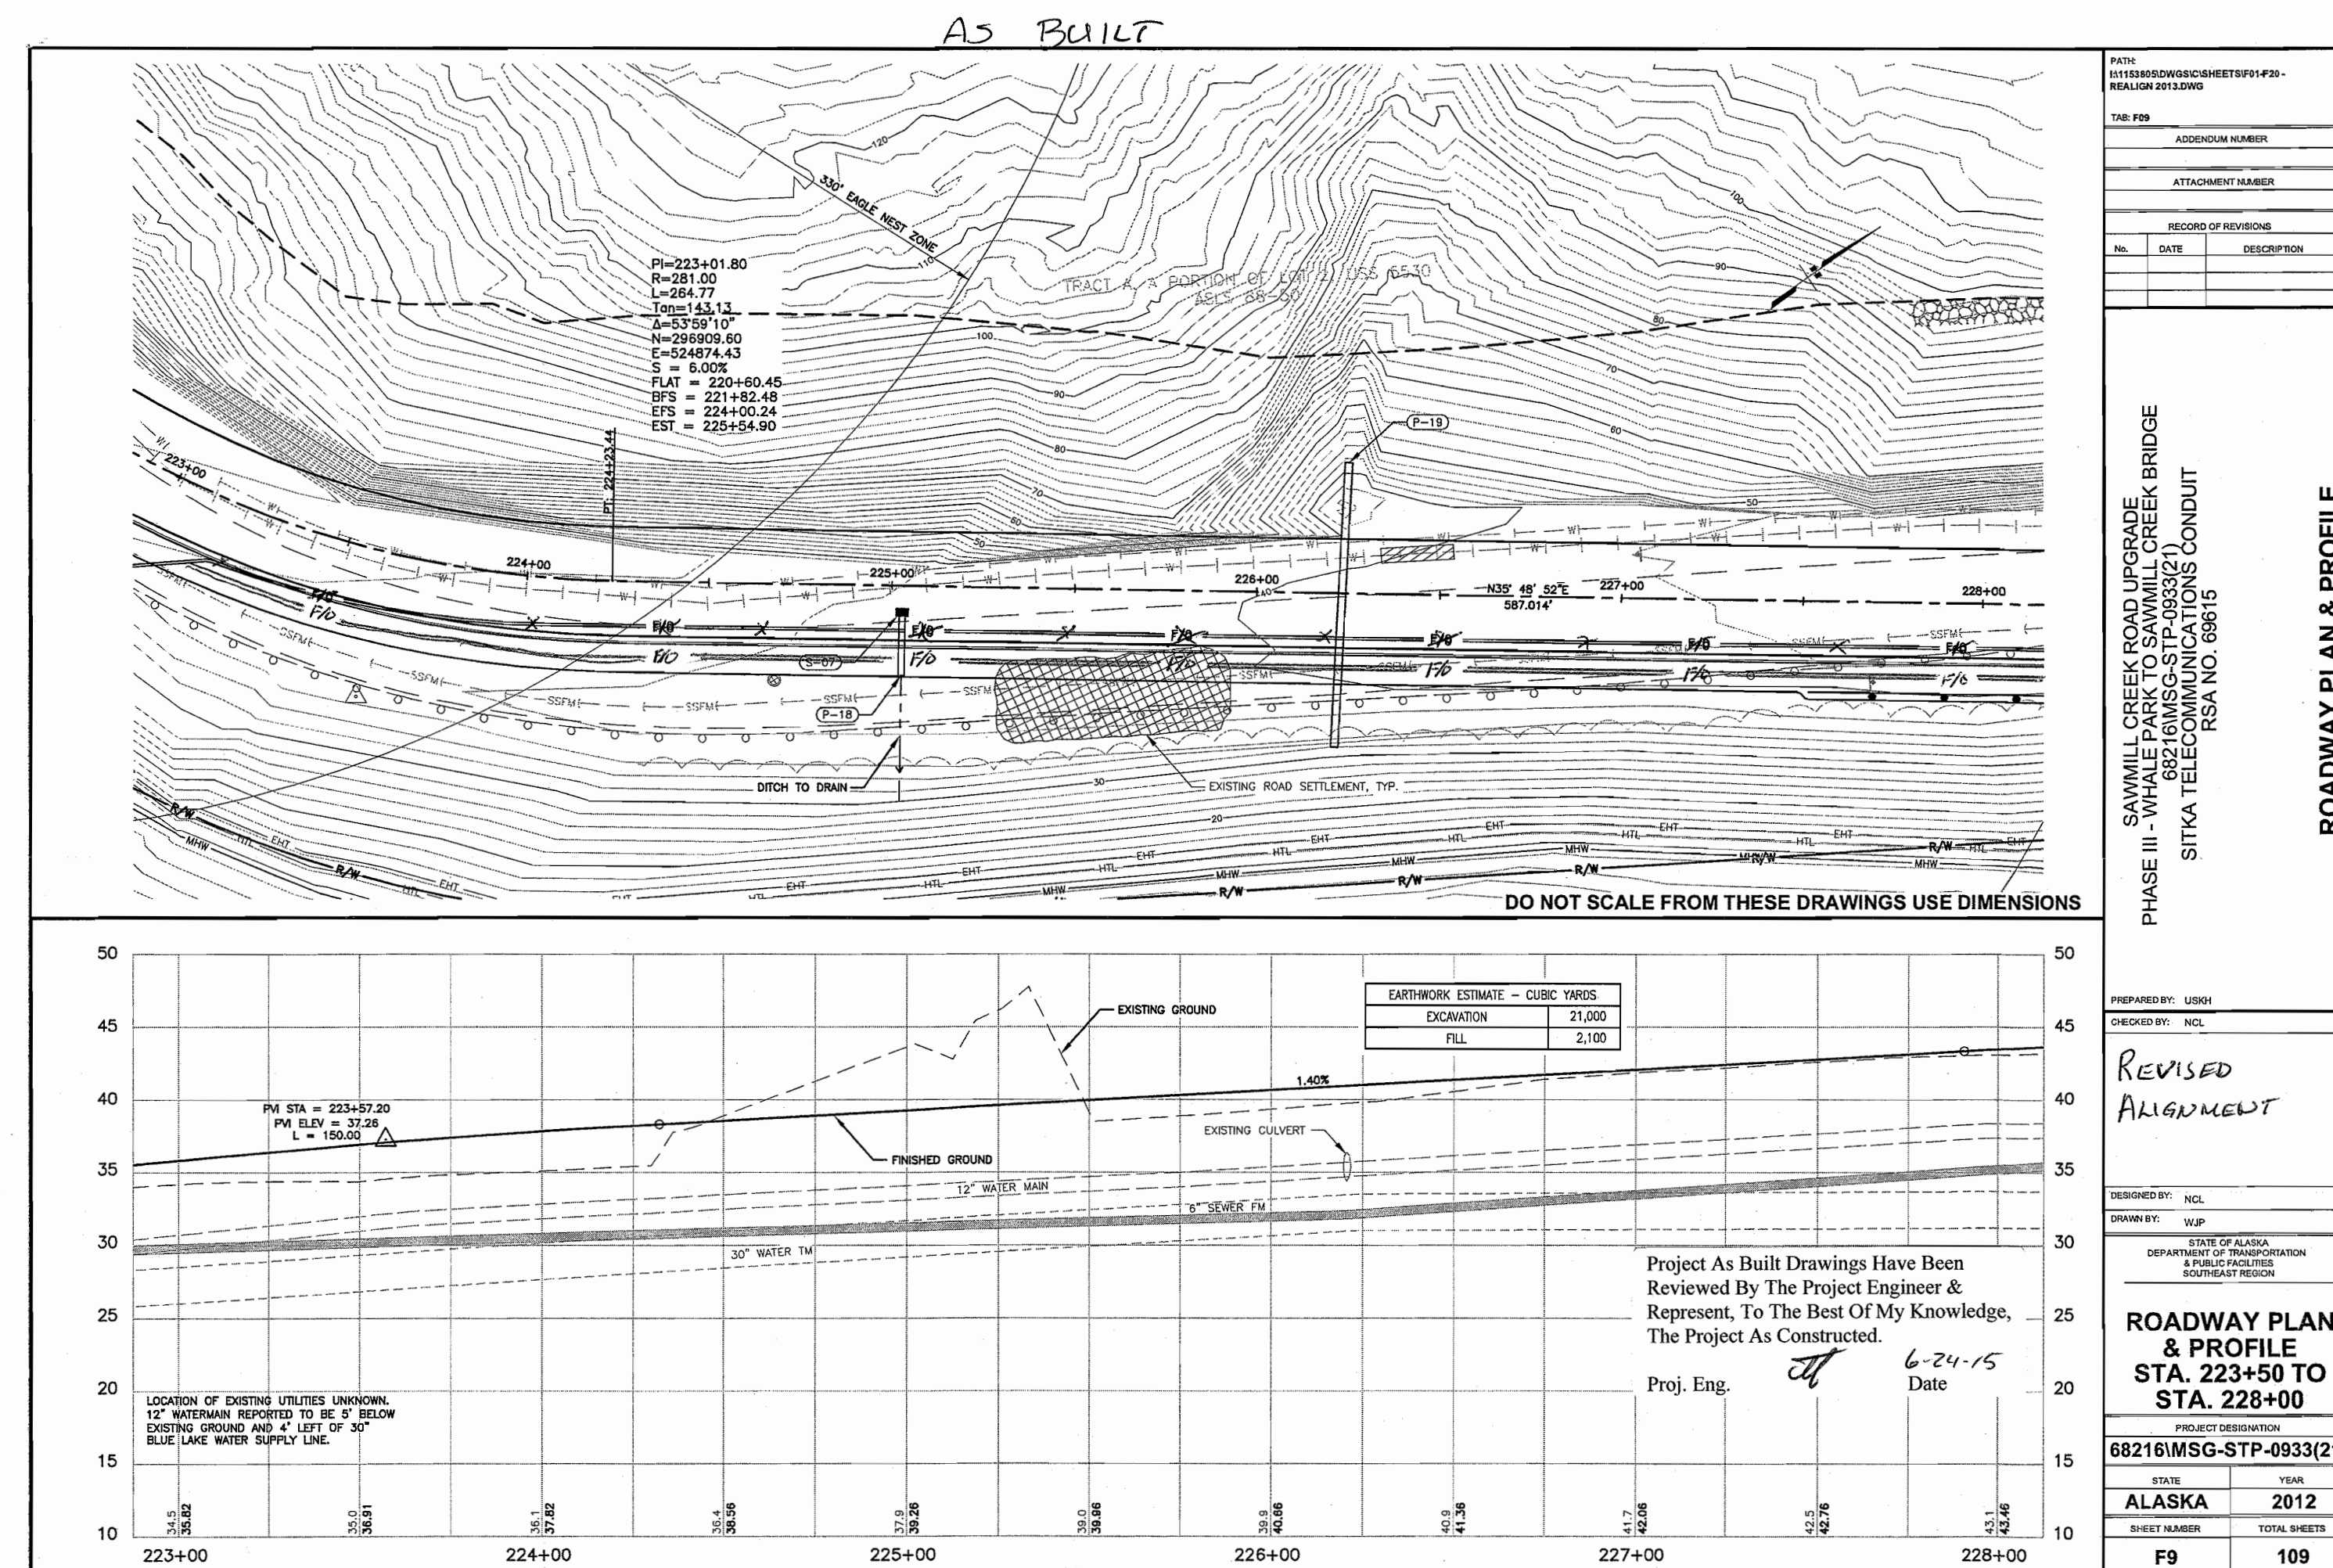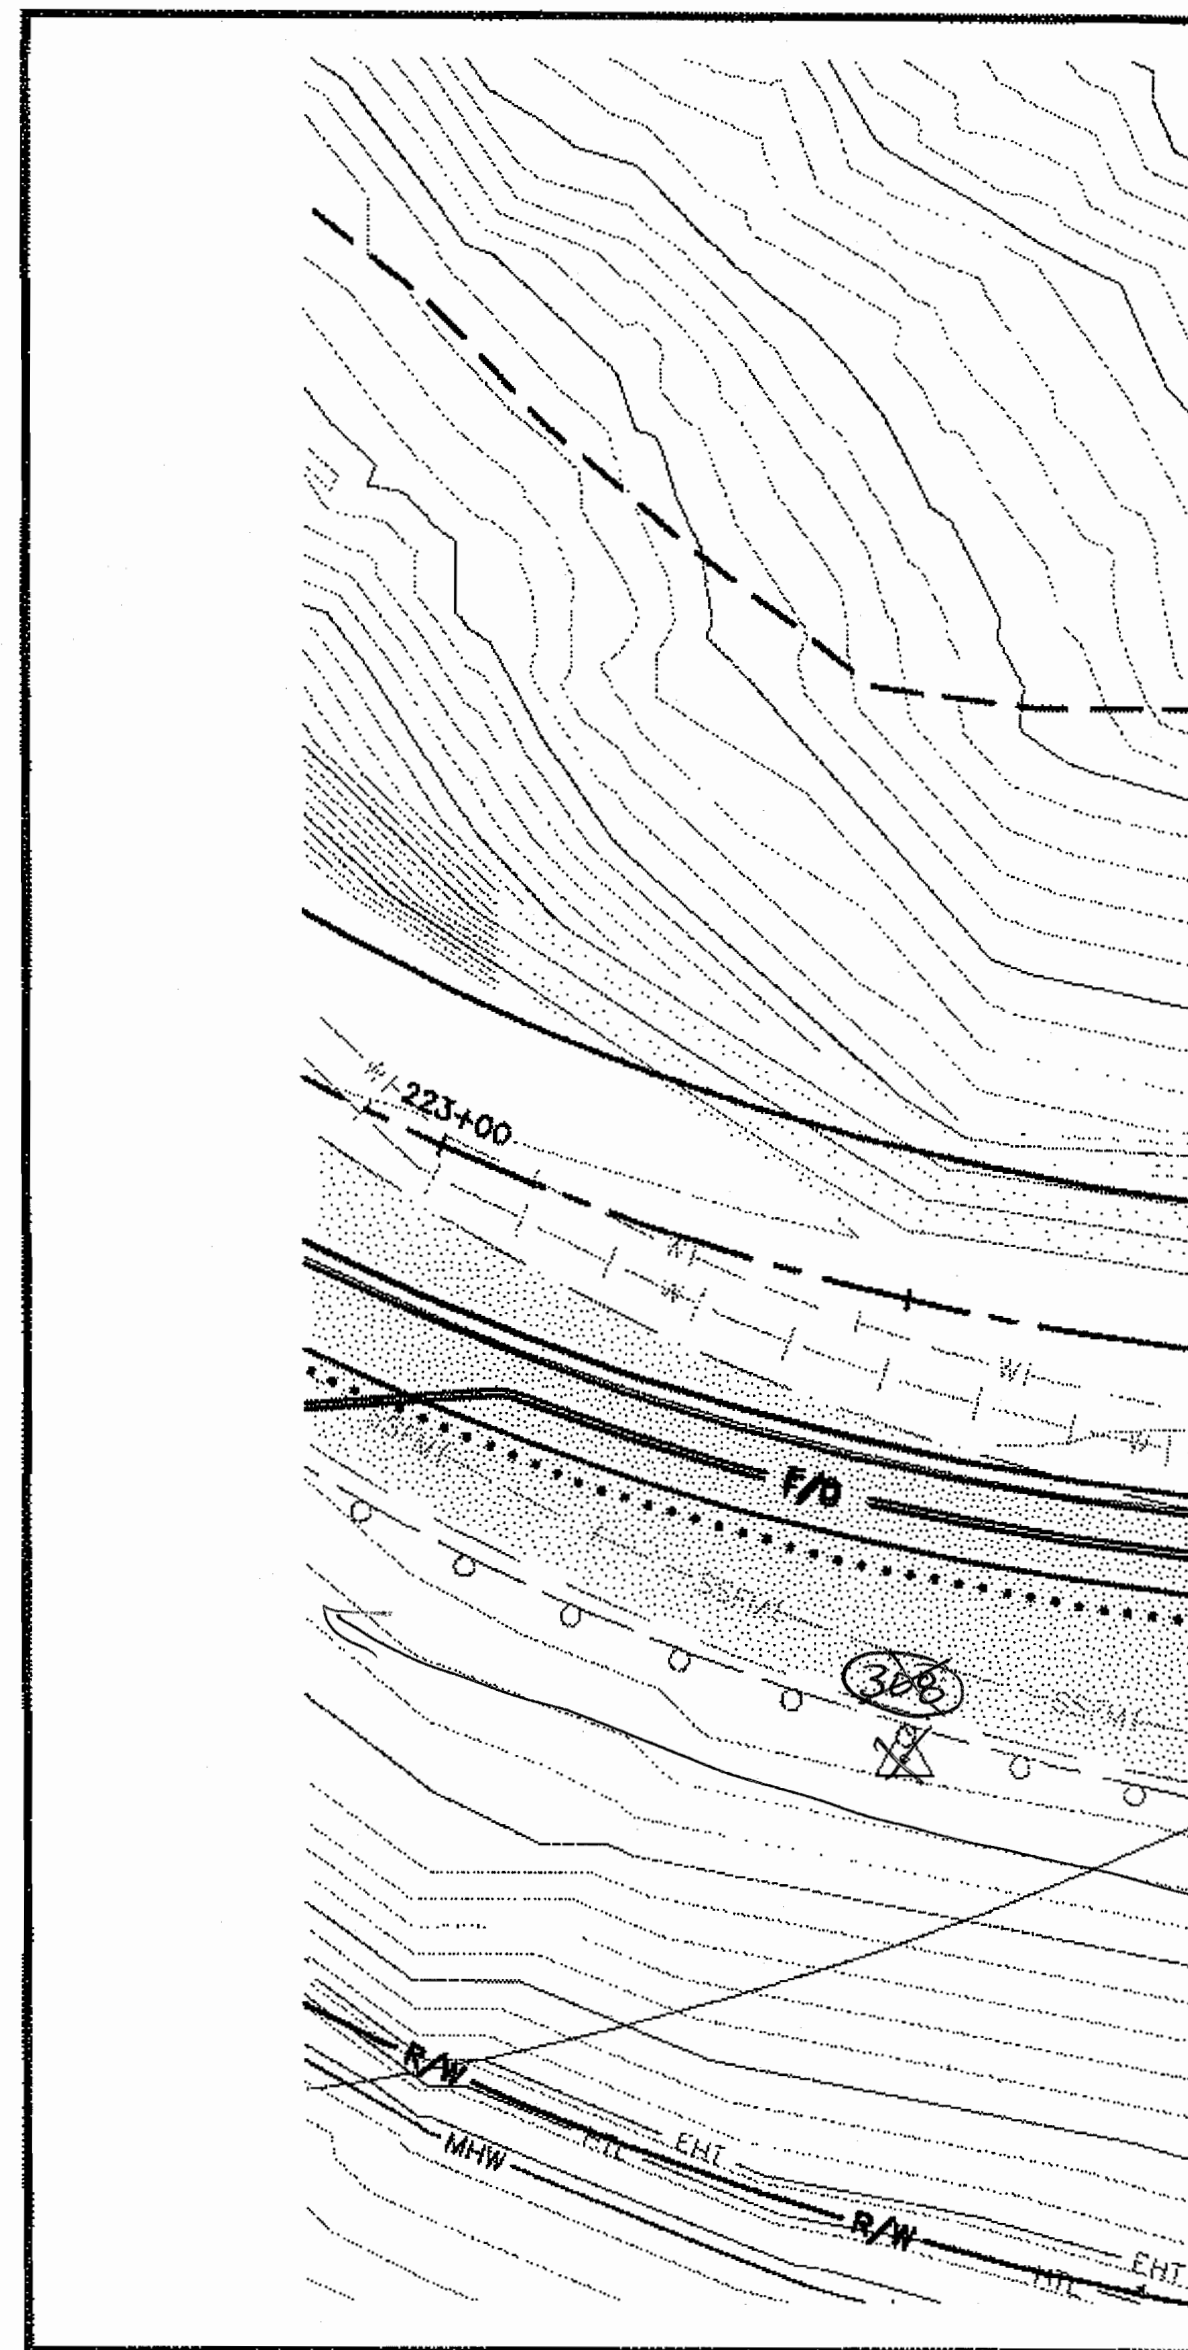

Sheet Revised with
Centerline Offset Right

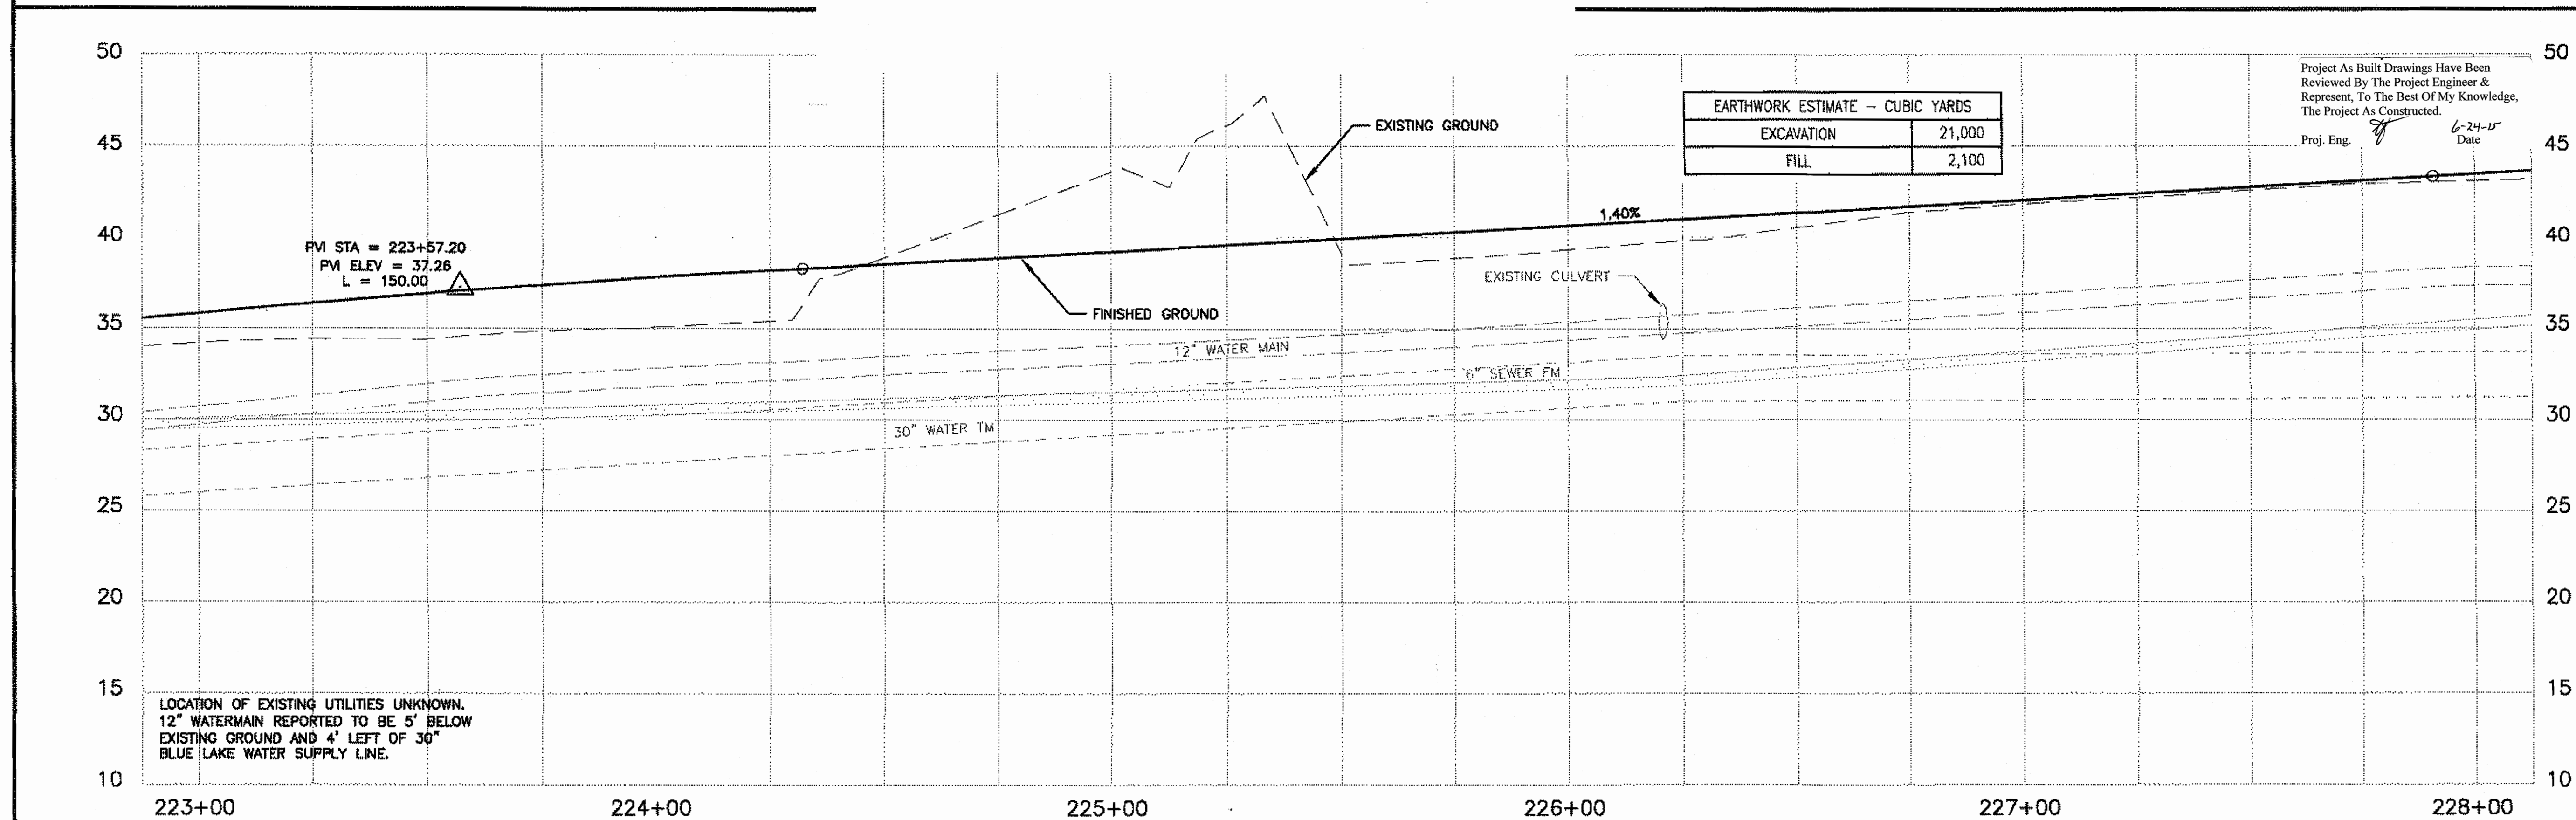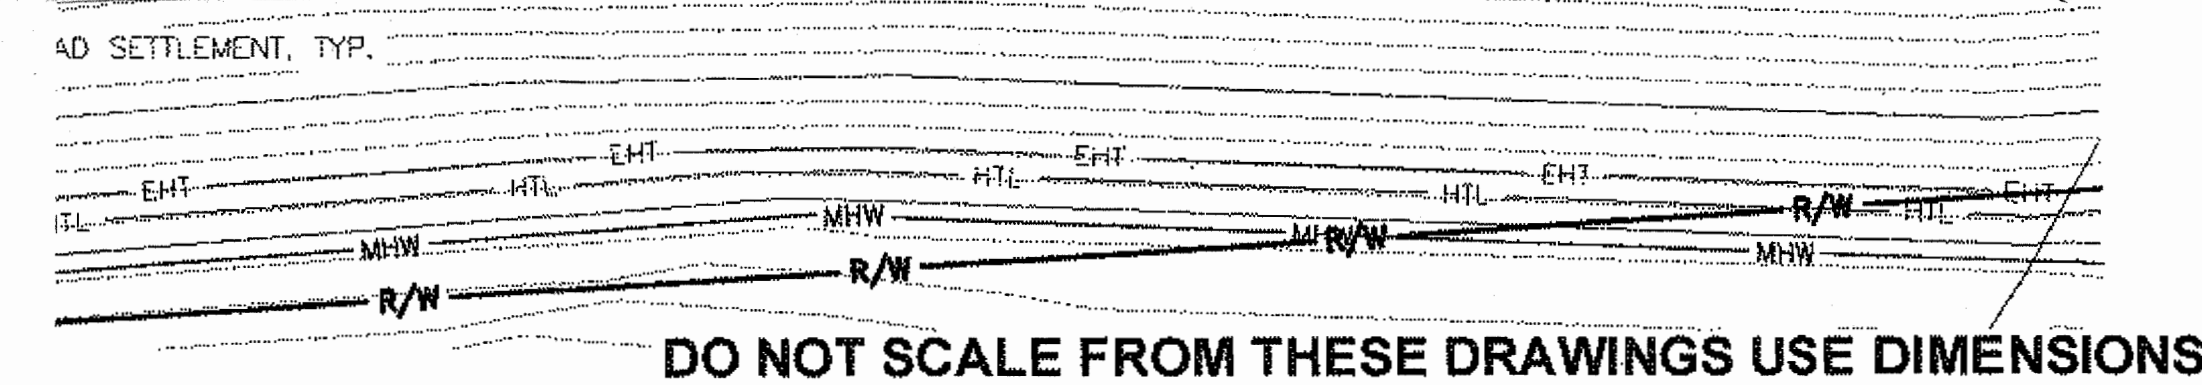

PATH: \\UNIFILE2\JOBS\1153805\DWG\CS\SHETS\F01-F20

TAB: F09

ADDENDUM NUMBER

ATTACHMENT NUMBER

RECORD OF REVISIONS

No.	DATE	DESCRIPTION
-----	------	-------------

SAWMILL CREEK ROAD UPGRADE
PHASE III - WHALE PARK TO SAWMILL CREEK BRIDGE
68216MSG-STP-0933(21)
SITKA TELECOMMUNICATIONS CONDUIT
RSA NO. 69615

ROADWAY PLAN & PROFILE

PREPARED BY: USKH

CHECKED BY: NCL

DESIGNED BY: NCL

DRAWN BY: WJP




STATE OF ALASKA
DEPARTMENT OF TRANSPORTATION
& PUBLIC FACILITIES
SOUTHEAST REGION

ROADWAY PLAN
& PROFILE
STA. 223+50 TO
STA. 228+00


PROJECT DESIGNATION
68216MSG-STP-0933(21)

STATE	YEAR
ALASKA	2012

SHEET NUMBER	TOTAL SHEETS
F9	109

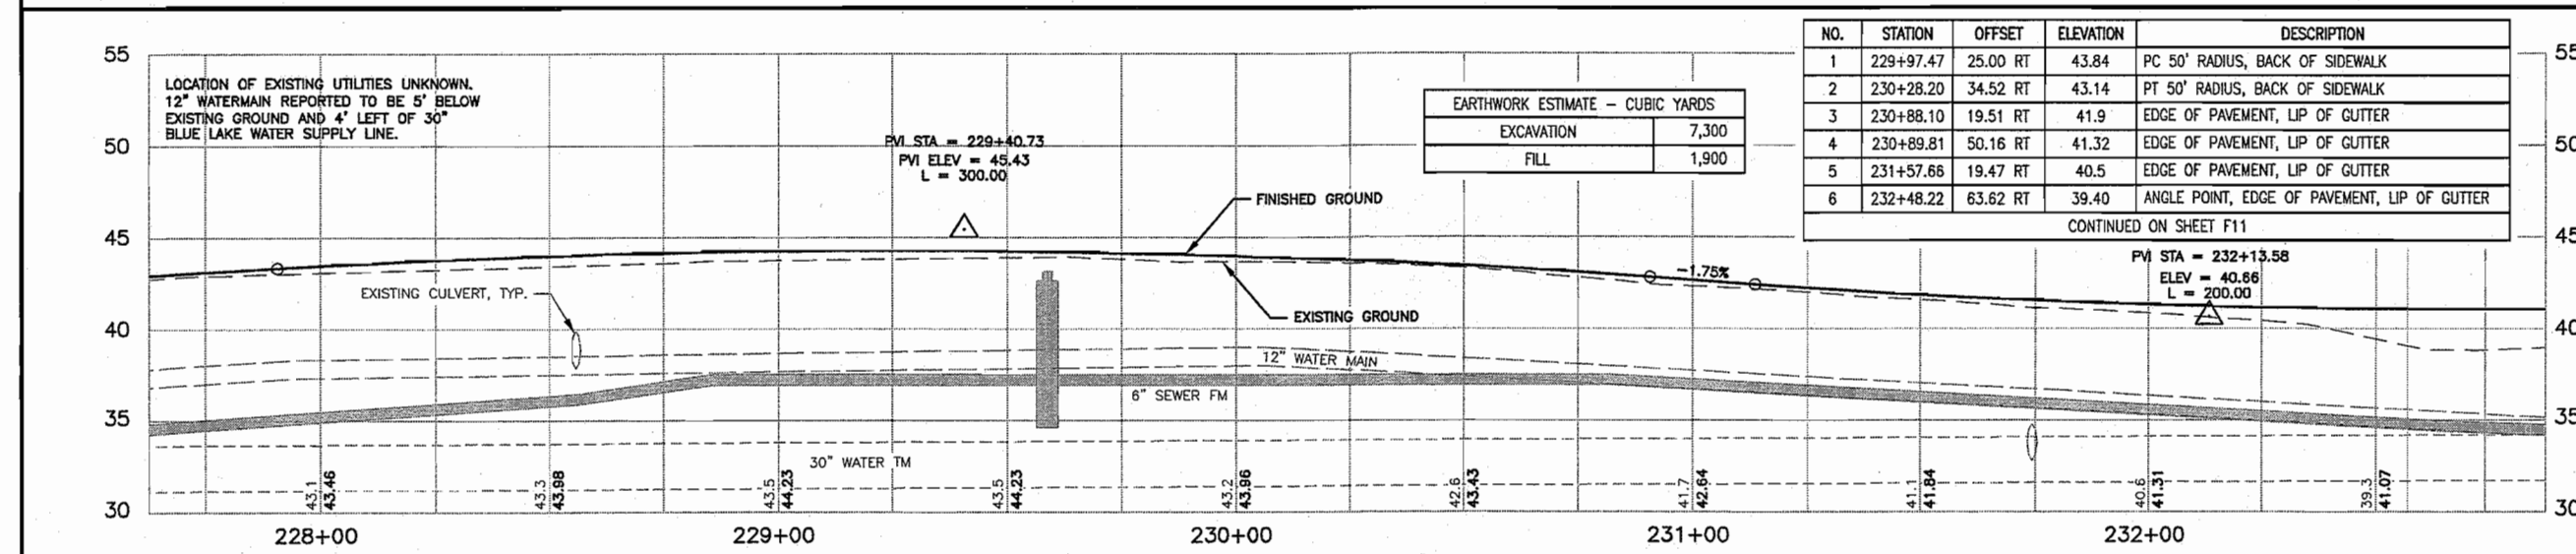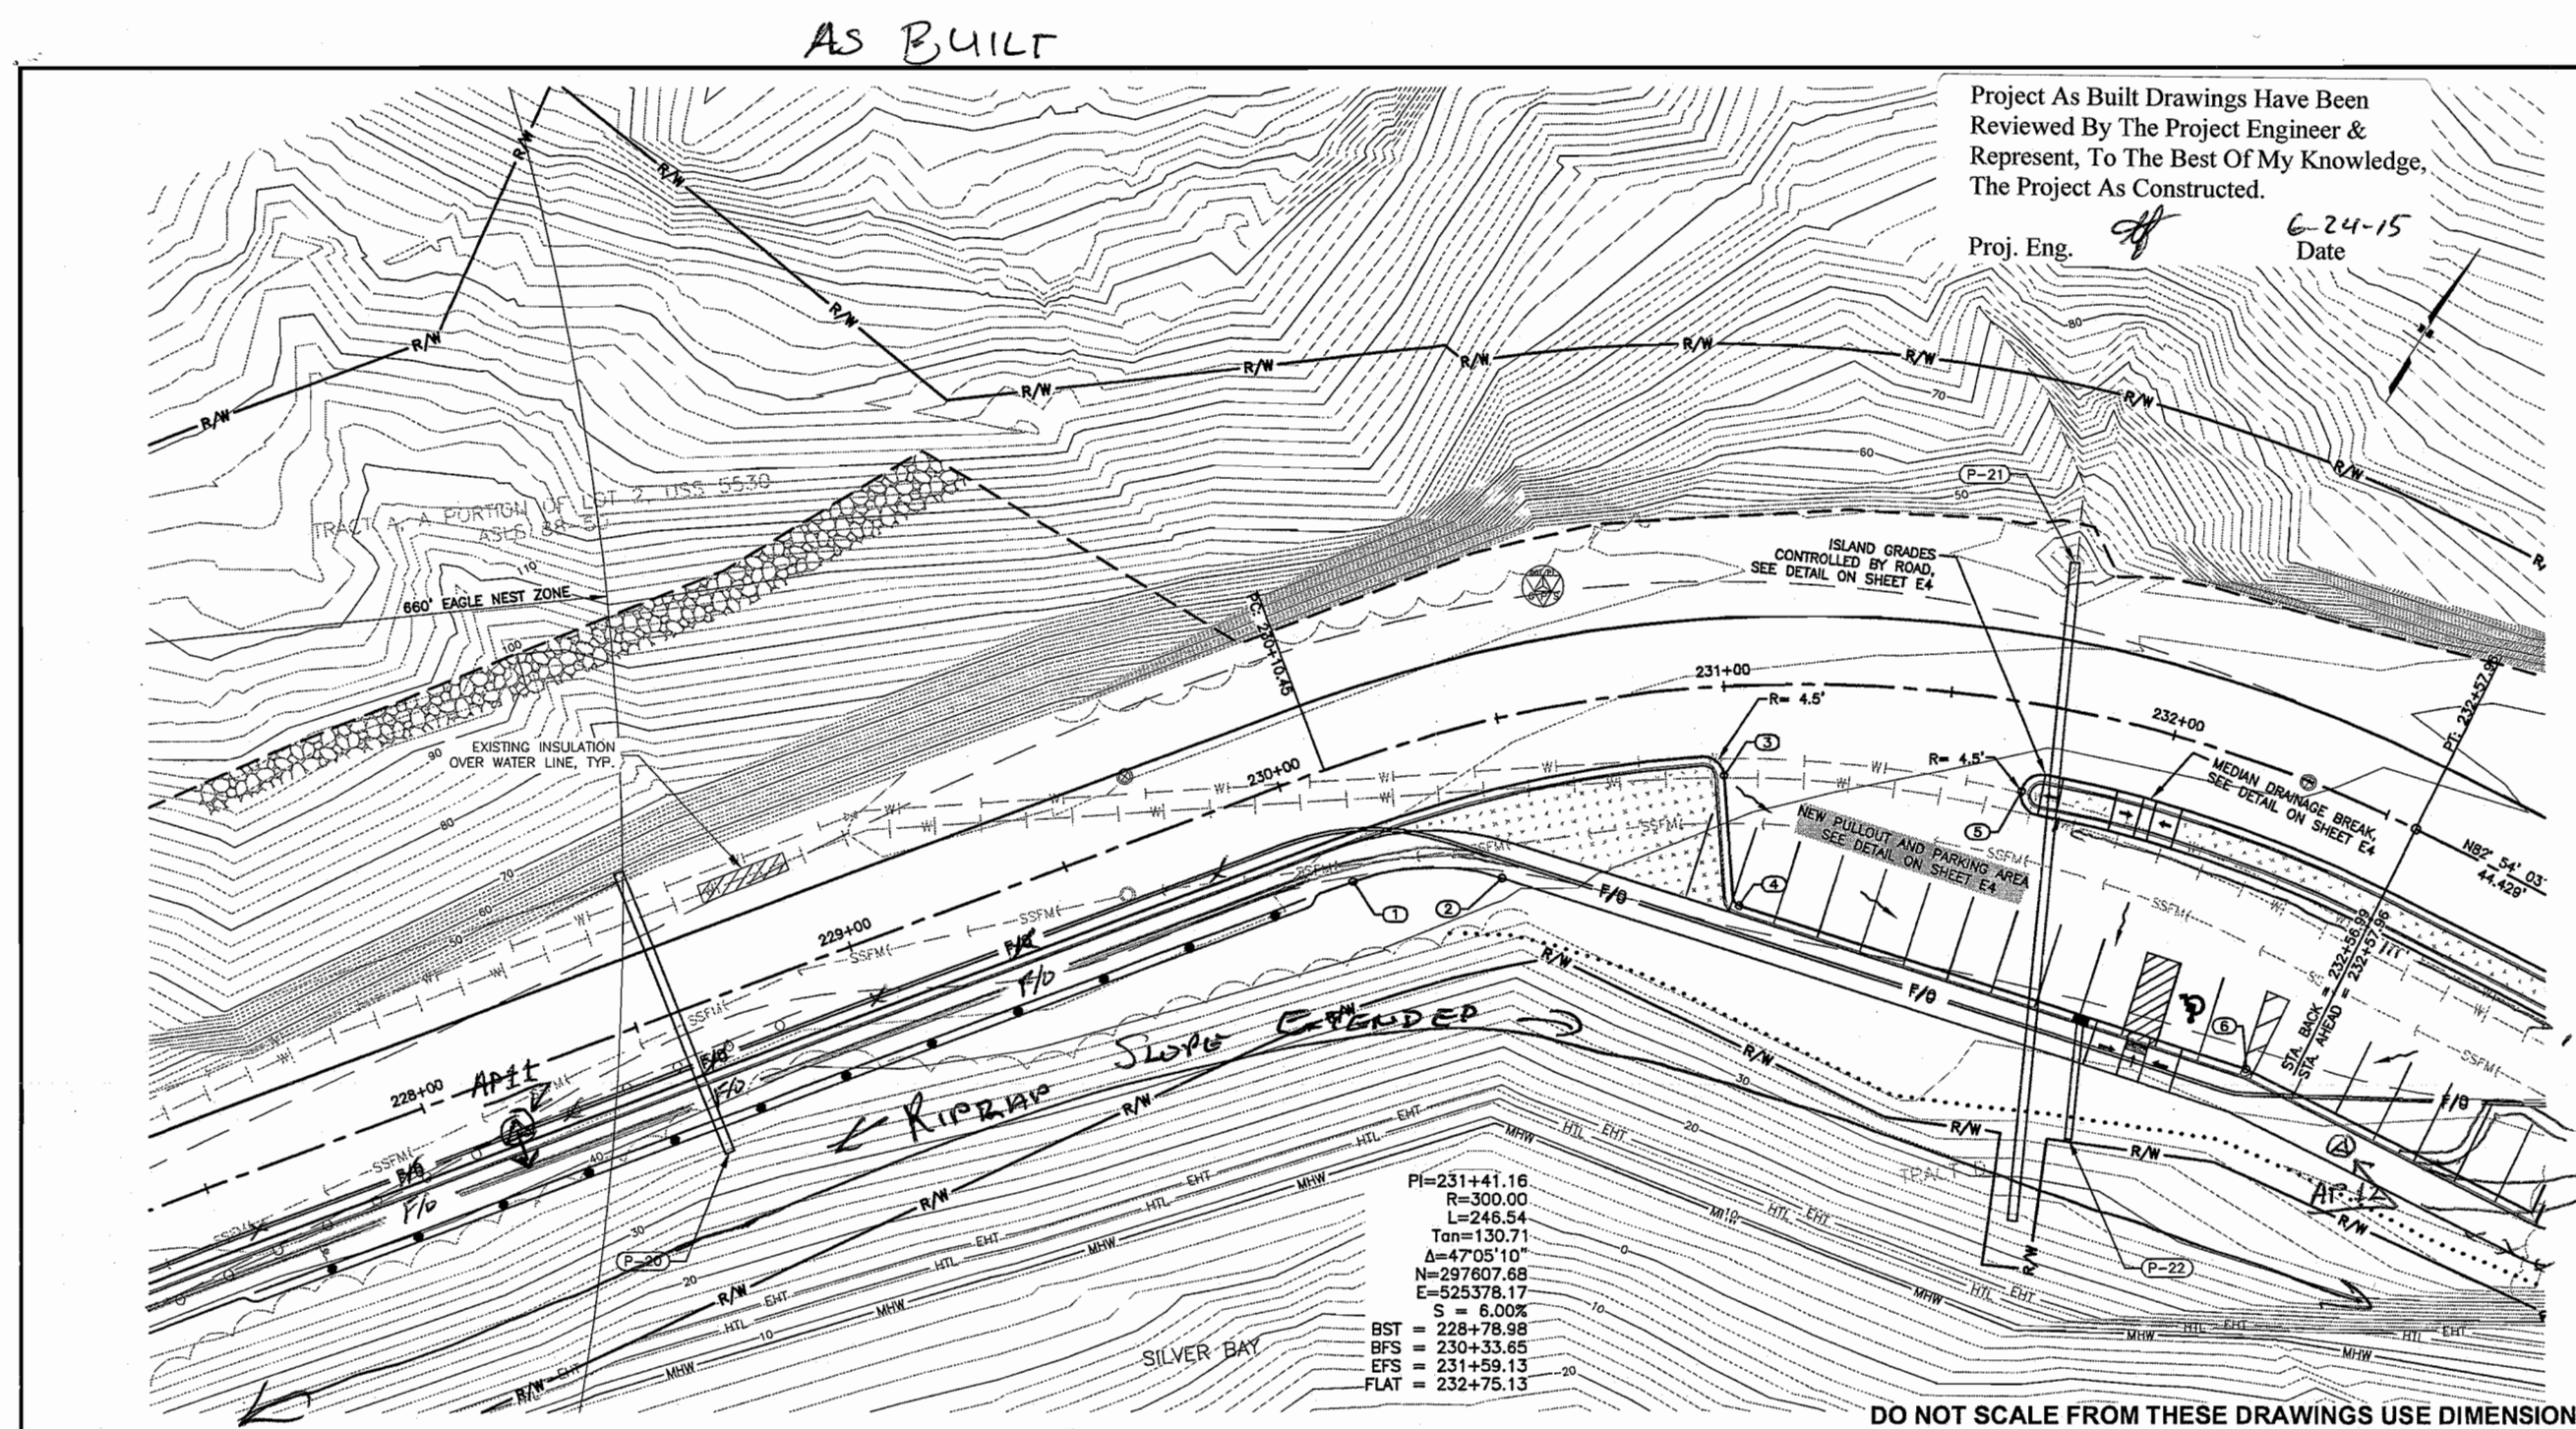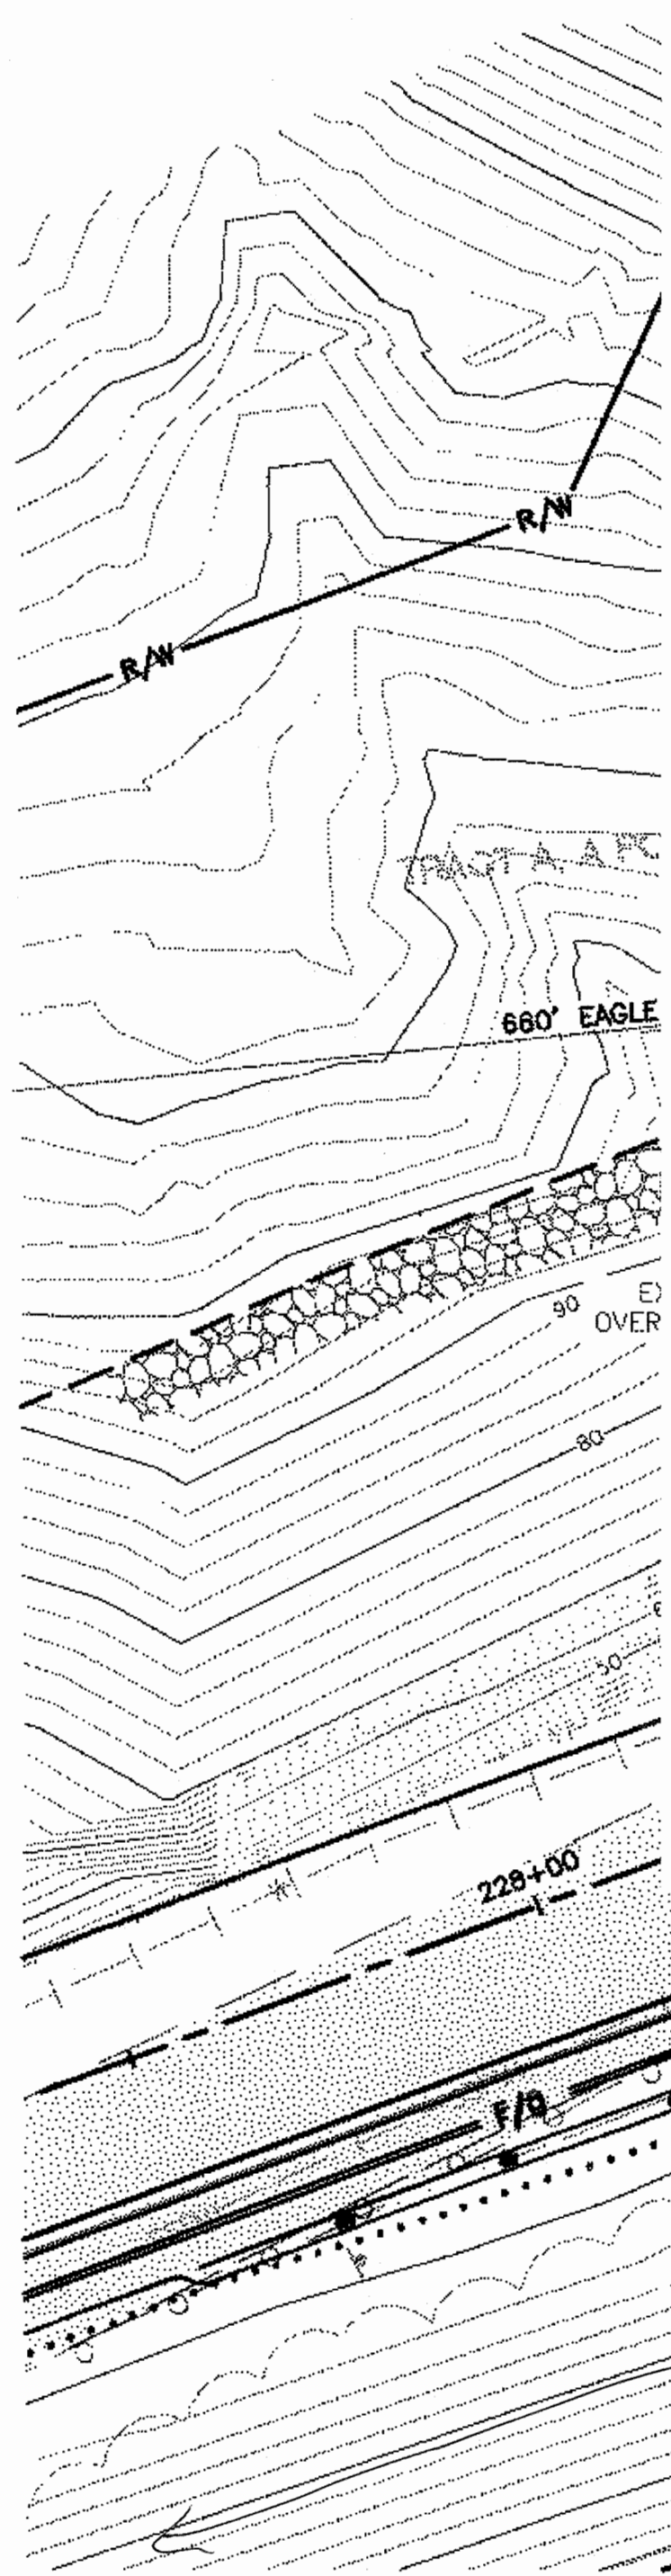

NO.	STATION	OFFSET	ELEVATION	DESCRIPTION
1	229+97.47	25.00 RT	43.84	PC 50' RADIUS, BACK OF SIDEWALK
2	230+28.20	34.52 RT	43.14	PT 50' RADIUS, BACK OF SIDEWALK
3	230+88.10	19.51 RT	41.9	EDGE OF PAVEMENT, LIP OF GUTTER
4	230+89.81	50.16 RT	41.32	EDGE OF PAVEMENT, LIP OF GUTTER
5	231+57.66	19.47 RT	40.5	EDGE OF PAVEMENT, LIP OF GUTTER
6	232+48.22	63.62 RT	39.40	ANGLE POINT, EDGE OF PAVEMENT, LIP OF GUTTER

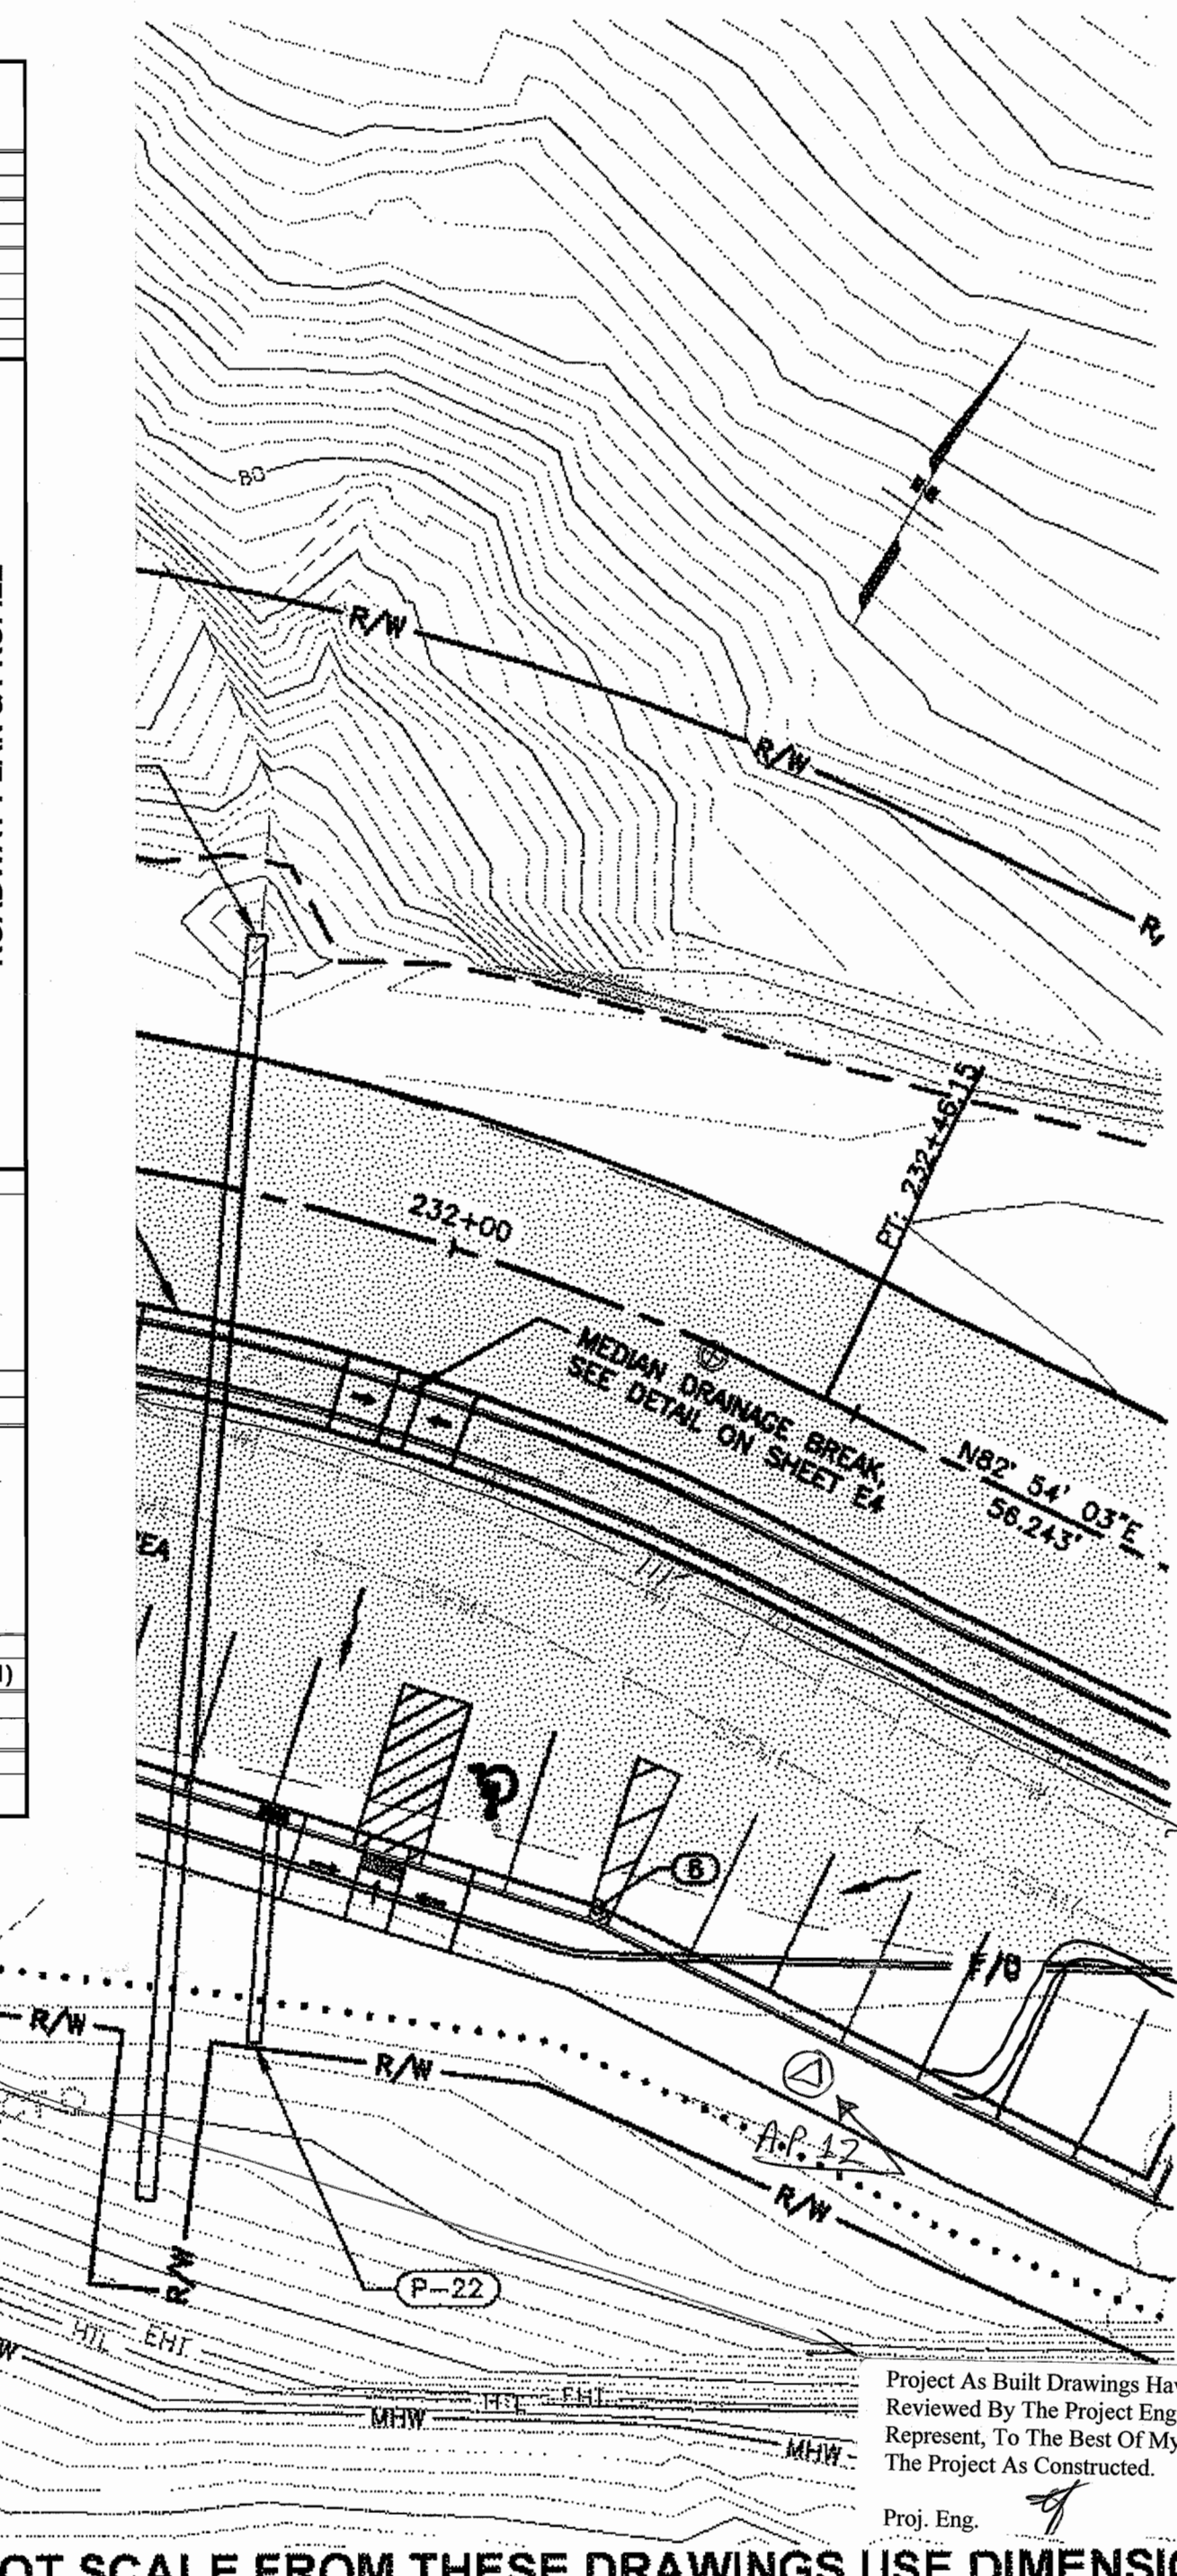

PATH:
\\NUNFILE2\JOBS\1153805\DWG\IC\SHETS\F01-F20

TAB: F10

ADDENDUM NUMBER

ATTACHMENT NUMBER

RECORD OF REVISIONS

No. DATE DESCRIPTION

SAWMILL CREEK ROAD UPGRADE
PHASE III - WHALE PARK TO SAWMILL CREEK BRIDGE
68216MSG-STP-0933(21)
SITKA TELECOMMUNICATIONS CONDUIT
RSA NO. 69615

ROADWAY PLAN & PROFILE

PREPARED BY: USKH

CHECKED BY: NCL

DESIGNED BY: NCL

DRAWN BY: WJP

STATE OF ALASKA
DEPARTMENT OF TRANSPORTATION
& PUBLIC FACILITIES
SOUTHEAST REGION


ROADWAY PLAN
& PROFILE
STA. 228+00 TO
STA. 232+50




PROJECT DESIGNATION
68216MSG-STP-0933(21)

STATE ALASKA
YEAR 2012


SHEET NUMBER F10
TOTAL SHEETS 109

Sheet Revised with
Centerline Offset Right

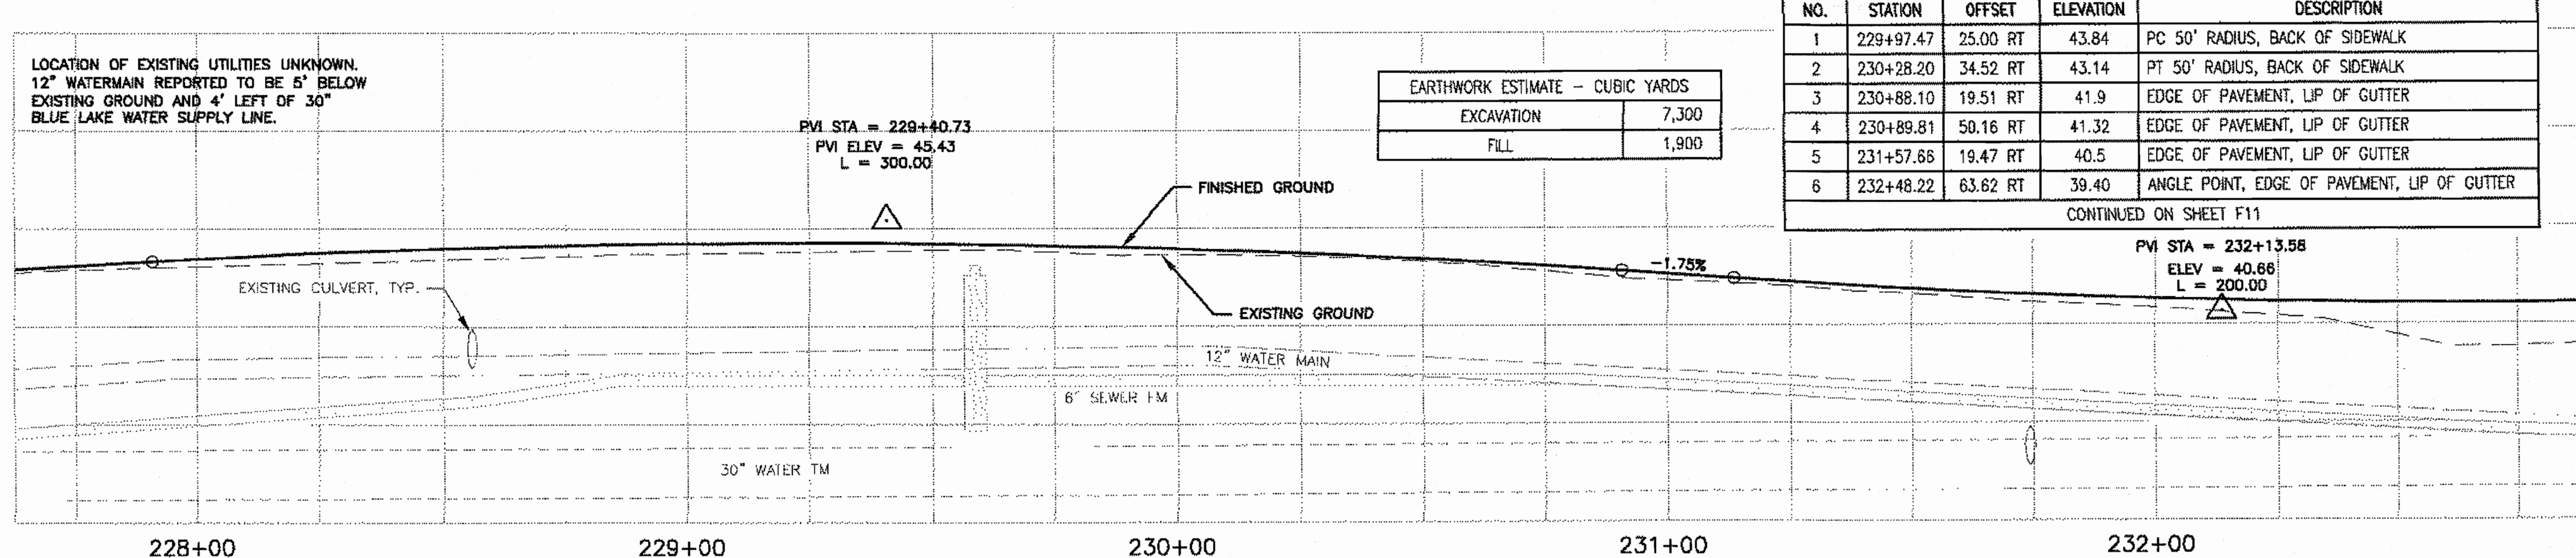

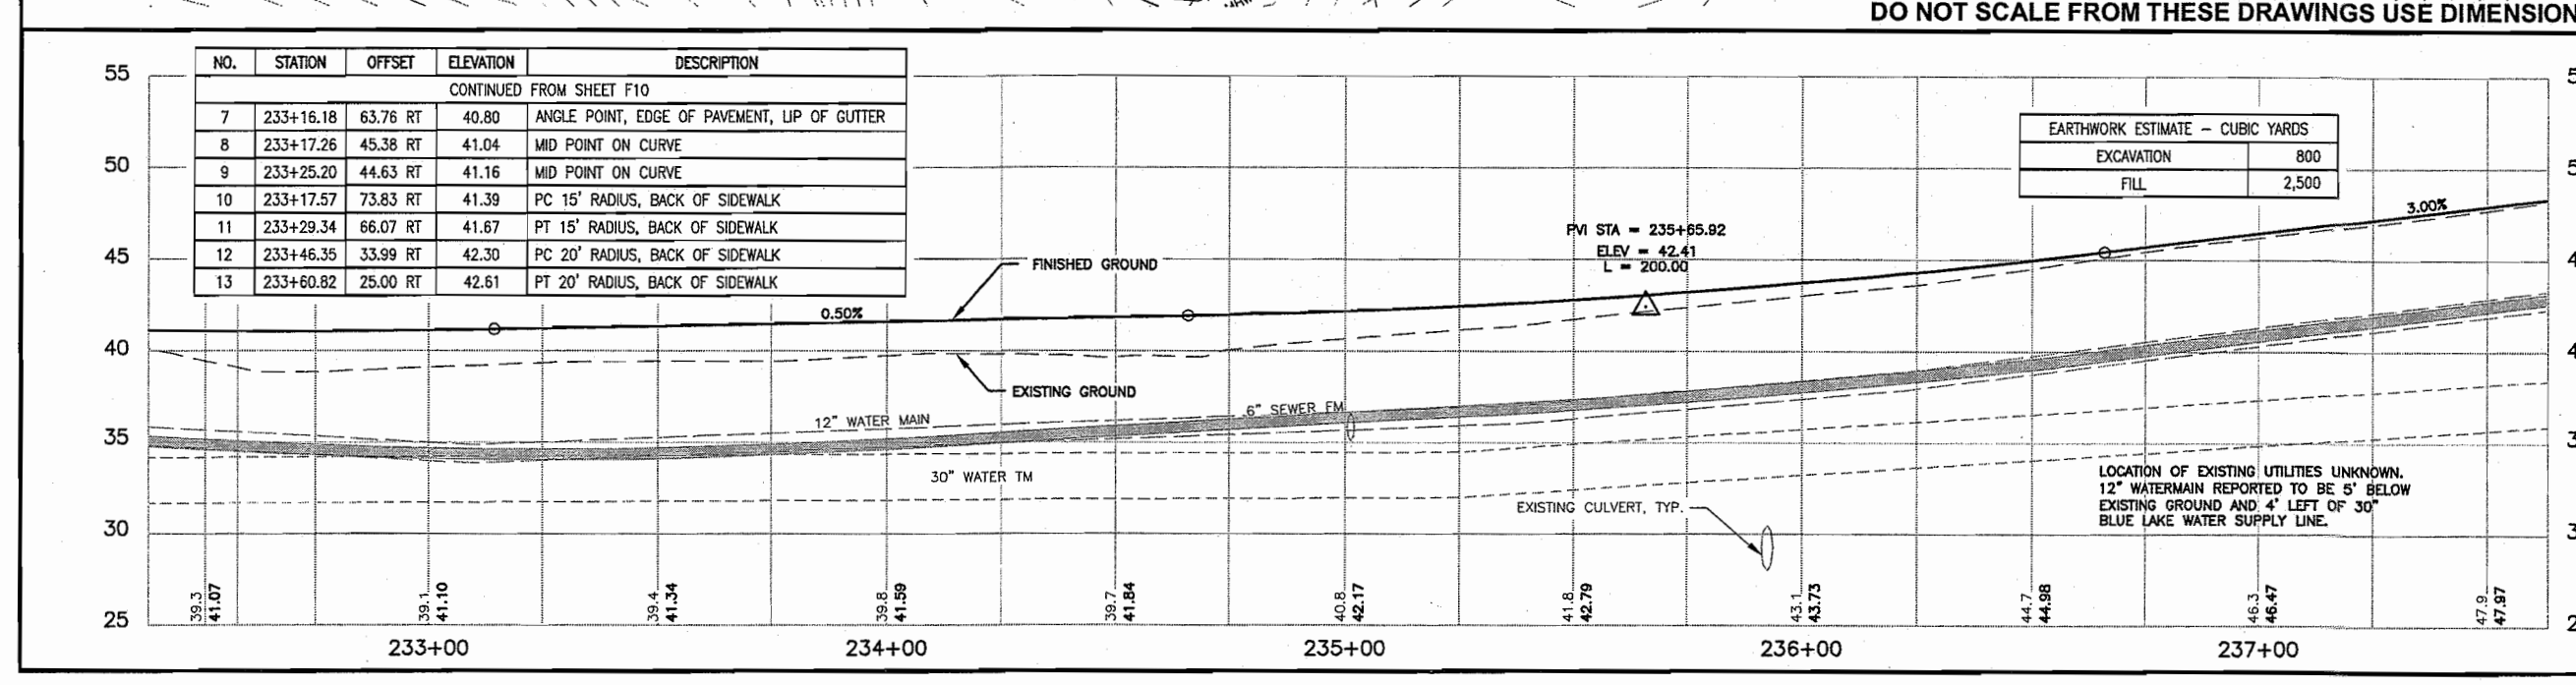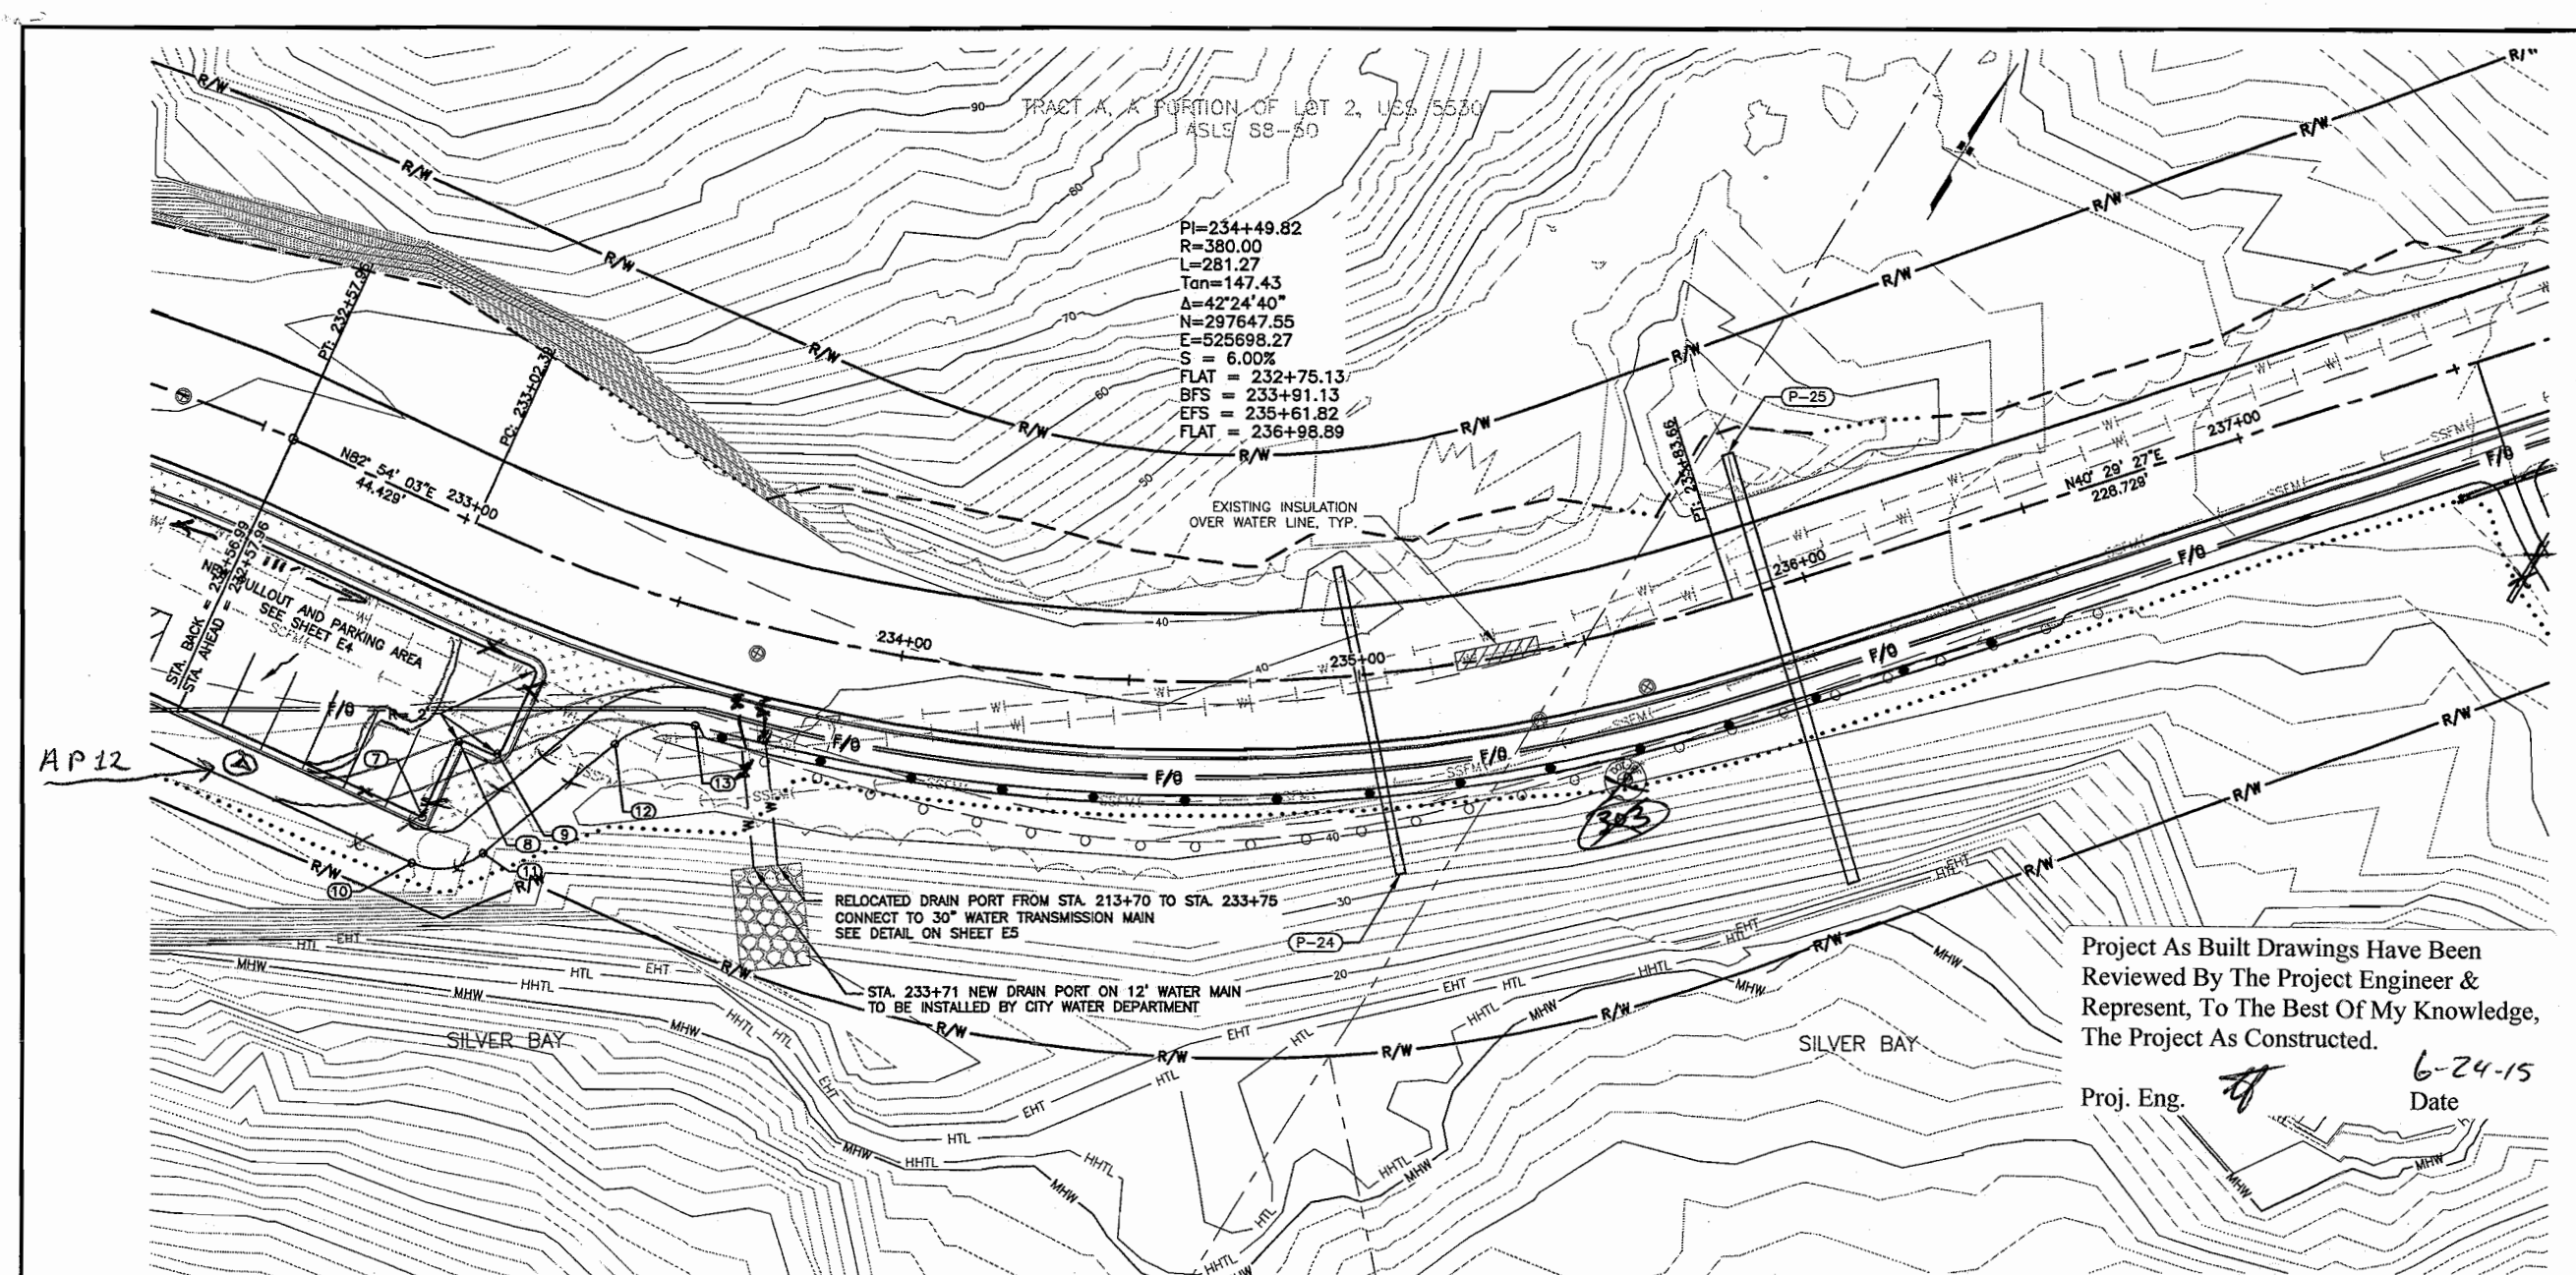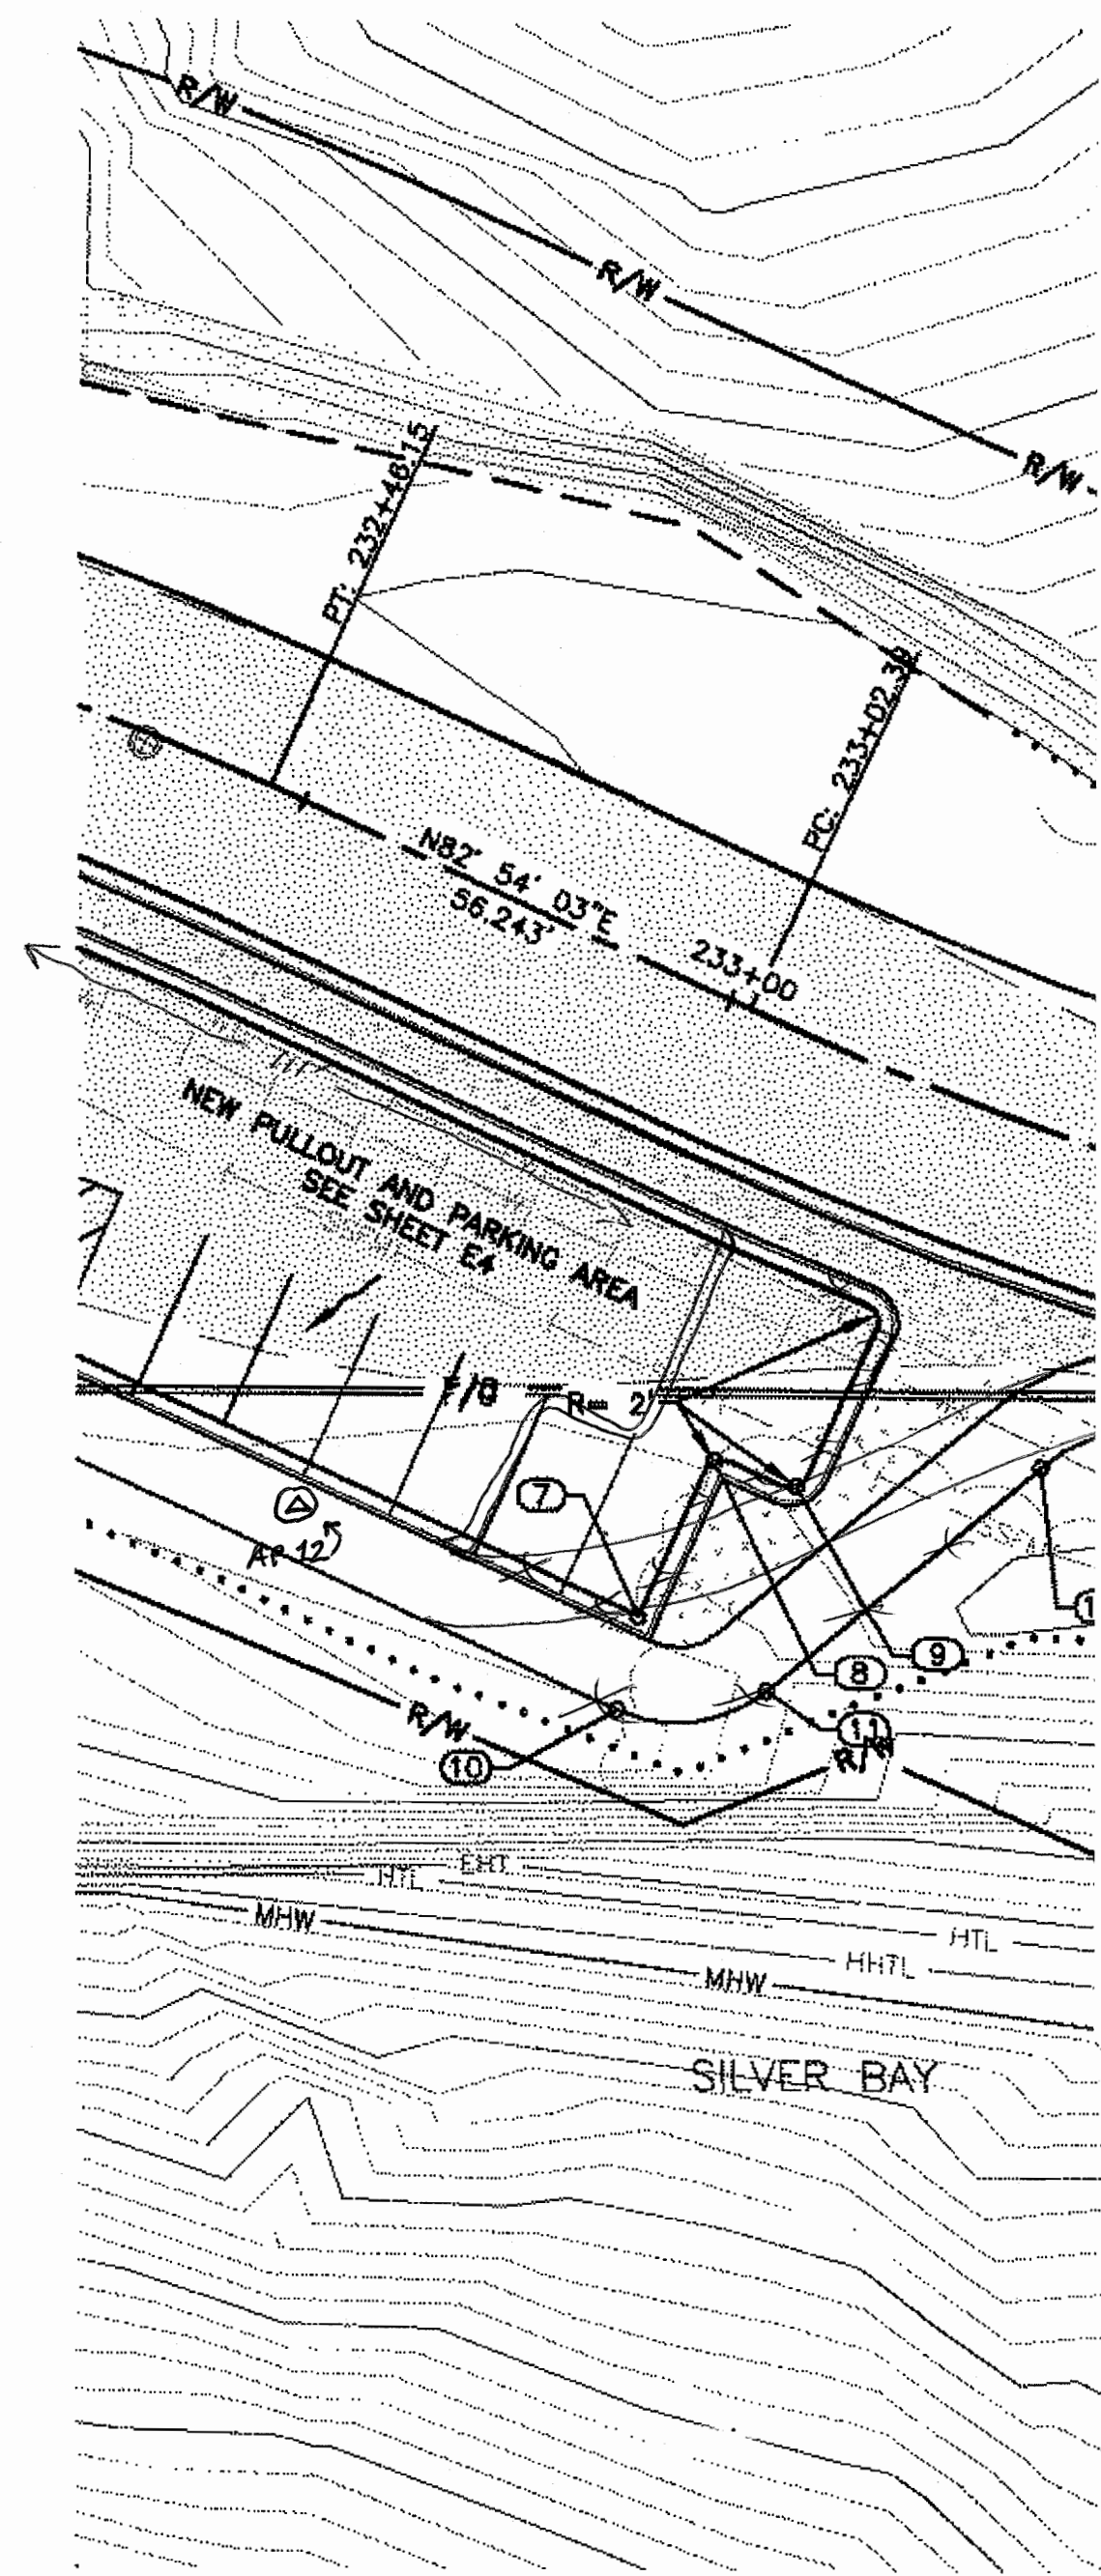


PATH: \\JN\FILE2\JOBS\1153805\DWG\CS\SHETS\F01-F20	
TAB: F11	
ADDENDUM NUMBER	
ATTACHMENT NUMBER	
RECORD OF REVISIONS	
No.	DATE
DESCRIPTION	
SAWMILL CREEK ROAD UPGRADE PHASE III - WHALE PARK TO SAWMILL CREEK BRIDGE SITKA TELECOMMUNICATIONS CONDUIT RSA NO. 69615	
ROADWAY PLAN & PROFILE	
REVISED ALIGNMENT	
DESIGNED BY: USKH	
CHECKED BY: NCL	
DRAWN BY: WJP	
STATE OF ALASKA DEPARTMENT OF TRANSPORTATION & PUBLIC FACILITIES SOUTHEAST REGION	
ROADWAY PLAN & PROFILE STA. 232+50 TO STA. 237+50	
PROJECT DESIGNATION 68216\MSG-STP-0933(21)	
STATE	YEAR
ALASKA	2012
SHEET NUMBER	TOTAL SHEETS
F11	109

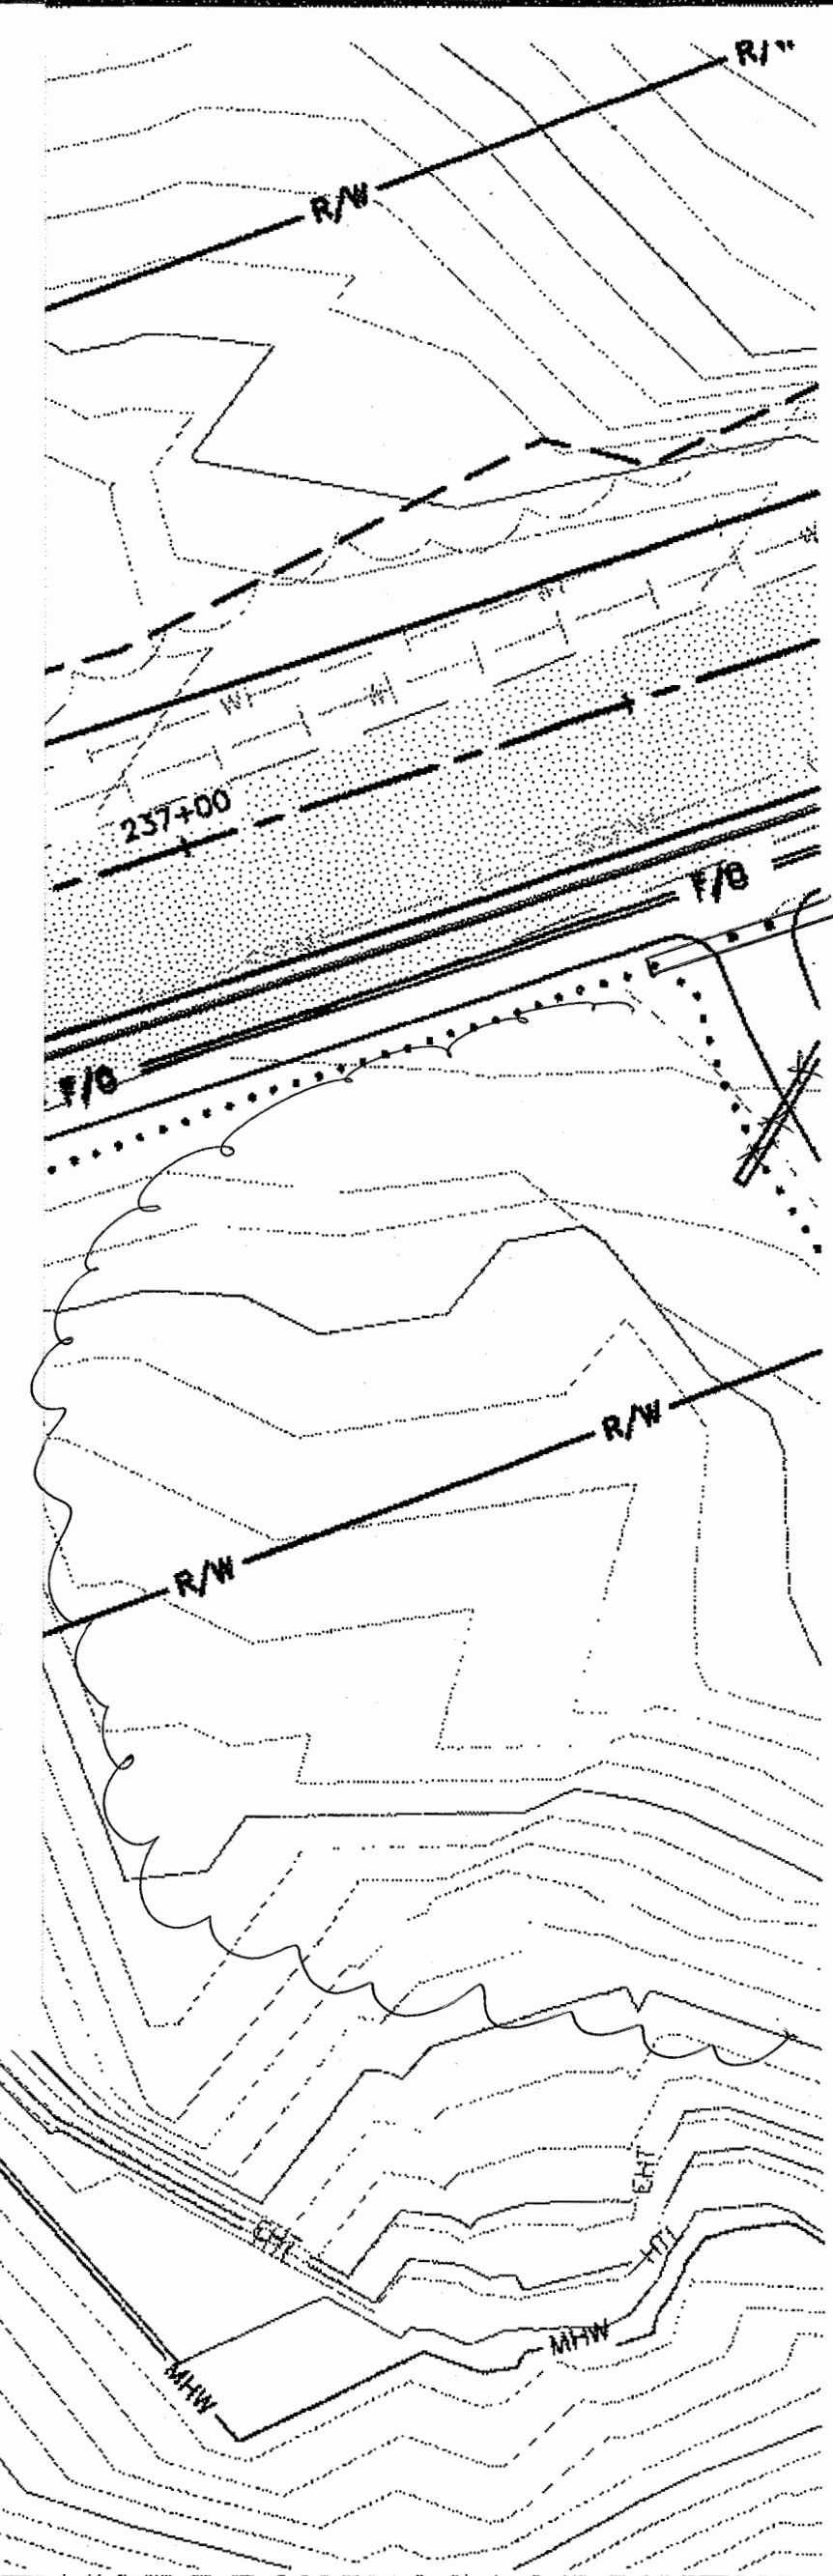



Sheet Revised with
Centerline Offset Right

DO NOT SCALE FROM THESE DRAWINGS USE DIMENSIONS

NO.	STATION	OFFSET	ELEVATION	DESCRIPTION
CONTINUED FROM SHEET F10				
7	233+16.18	63.76 RT	40.80	ANGLE POINT, EDGE OF PAVEMENT, LIP OF GUTTER
8	233+17.26	45.38 RT	41.04	MID POINT ON CURVE
9	233+25.20	44.63 RT	41.16	MID POINT ON CURVE
10	233+17.57	73.83 RT	41.39	PC 15' RADIUS, BACK OF SIDEWALK
11	233+29.34	66.07 RT	41.67	PT 15' RADIUS, BACK OF SIDEWALK
12	233+46.35	33.99 RT	42.30	PC 20' RADIUS, BACK OF SIDEWALK
13	233+60.82	25.00 RT	42.61	PT 20' RADIUS, BACK OF SIDEWALK

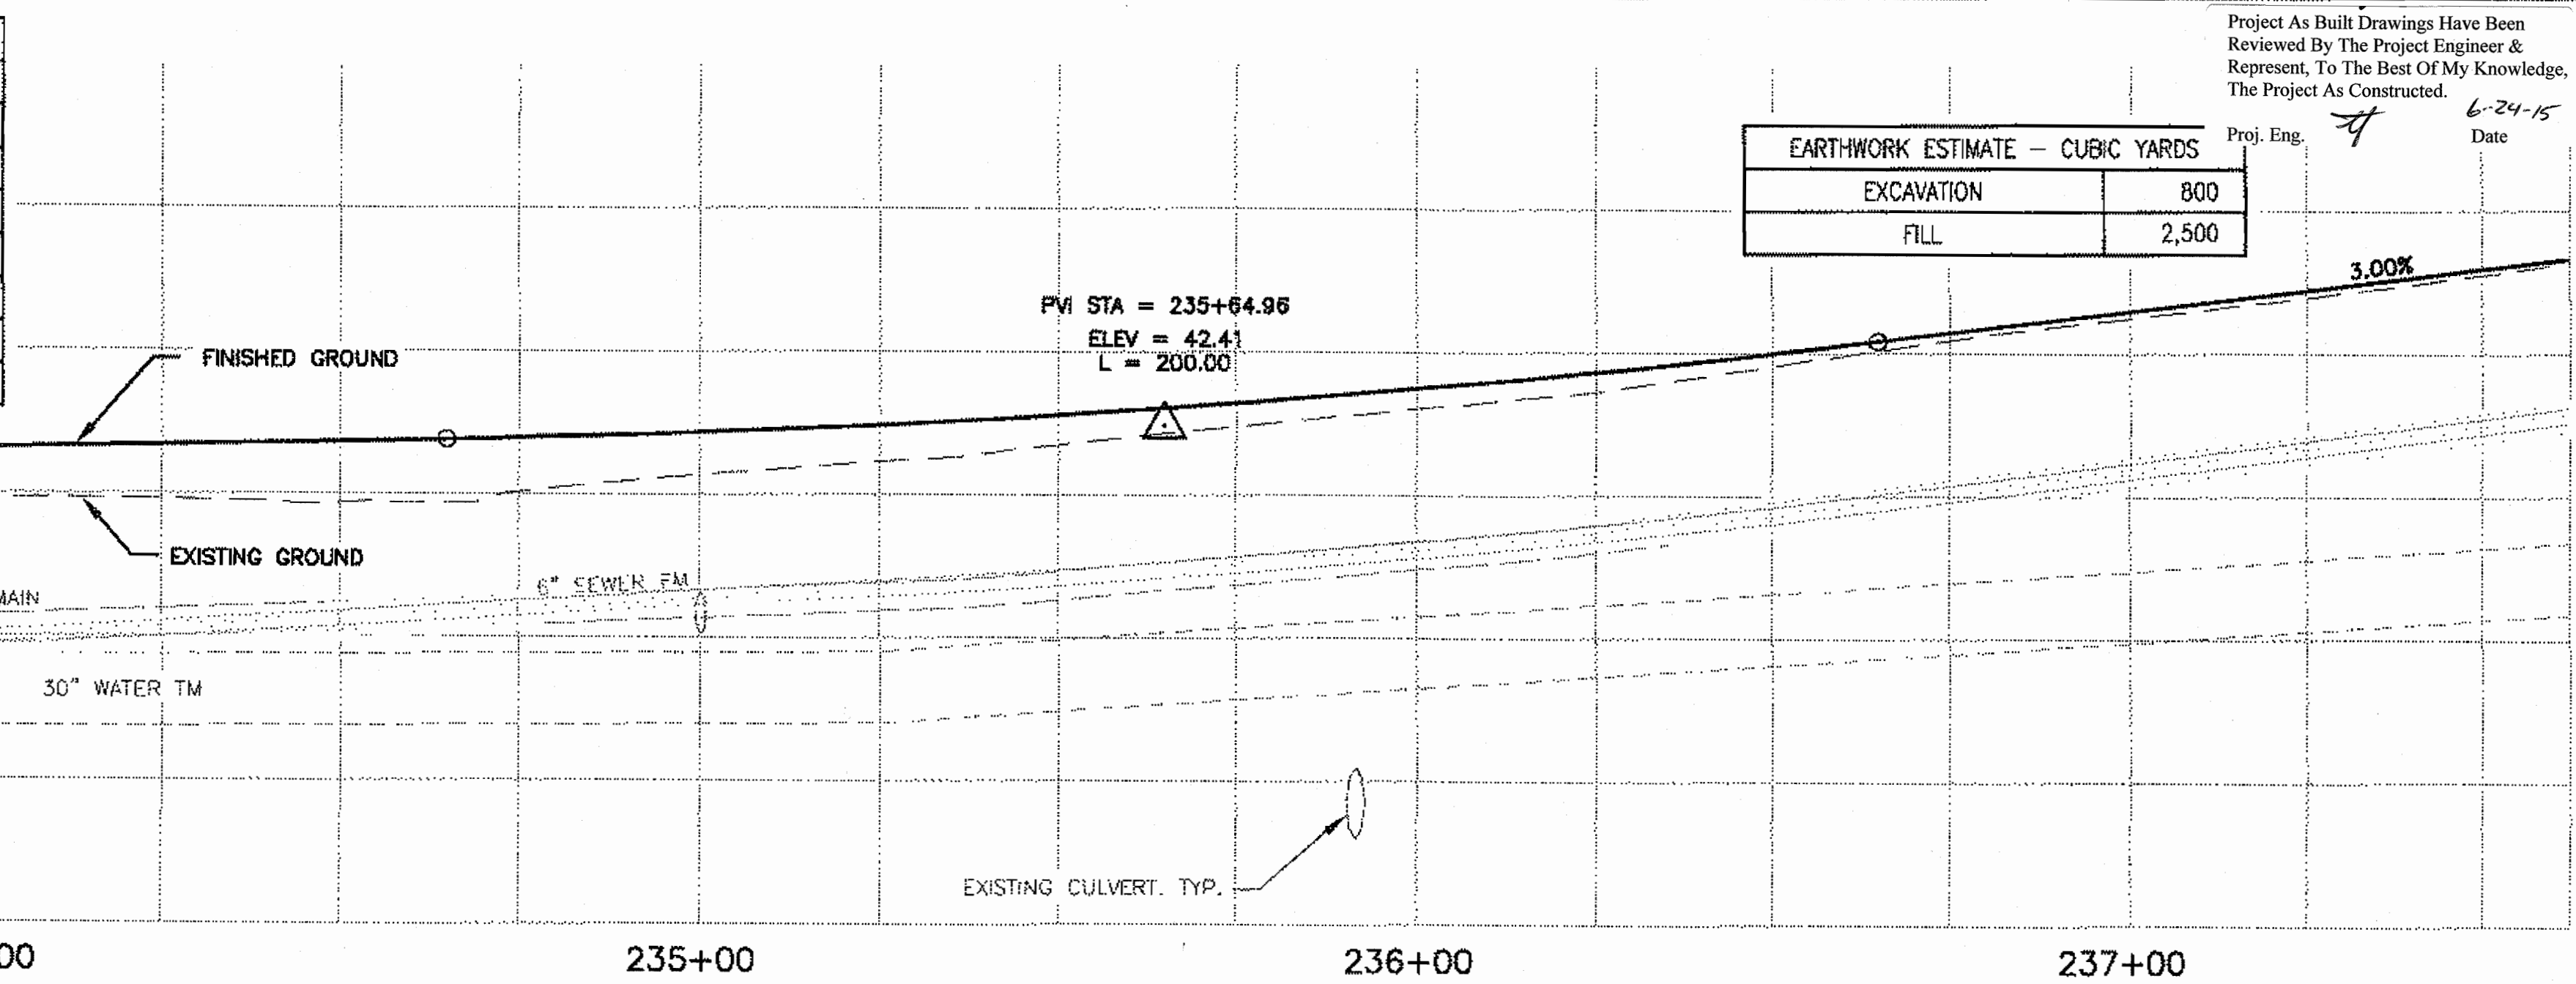

PATH: \\JN\FILE2\JOBS\1153805\DWG\CS\SHETS\F01-F20	
TAB: F11	
ADDENDUM NUMBER	
ATTACHMENT NUMBER	
RECORD OF REVISIONS	
No.	DATE
DESCRIPTION	
SAWMILL CREEK ROAD UPGRADE PHASE III - WHALE PARK TO SAWMILL CREEK BRIDGE 88216\MSG-STP-0933(21) SITKA TELECOMMUNICATIONS CONDUIT RSA NO. 69615	
ROADWAY PLAN & PROFILE	
REVISED ALIGNMENT	
DESIGNED BY: USKH	
CHECKED BY: NCL	
DRAWN BY: WJP	
STATE OF ALASKA DEPARTMENT OF TRANSPORTATION & PUBLIC FACILITIES SOUTHEAST REGION	
ROADWAY PLAN & PROFILE STA. 232+50 TO STA. 237+50	
PROJECT DESIGNATION 68216\MSG-STP-0933(21)	
STATE	YEAR
ALASKA	2012
SHEET NUMBER	TOTAL SHEETS
F11	109

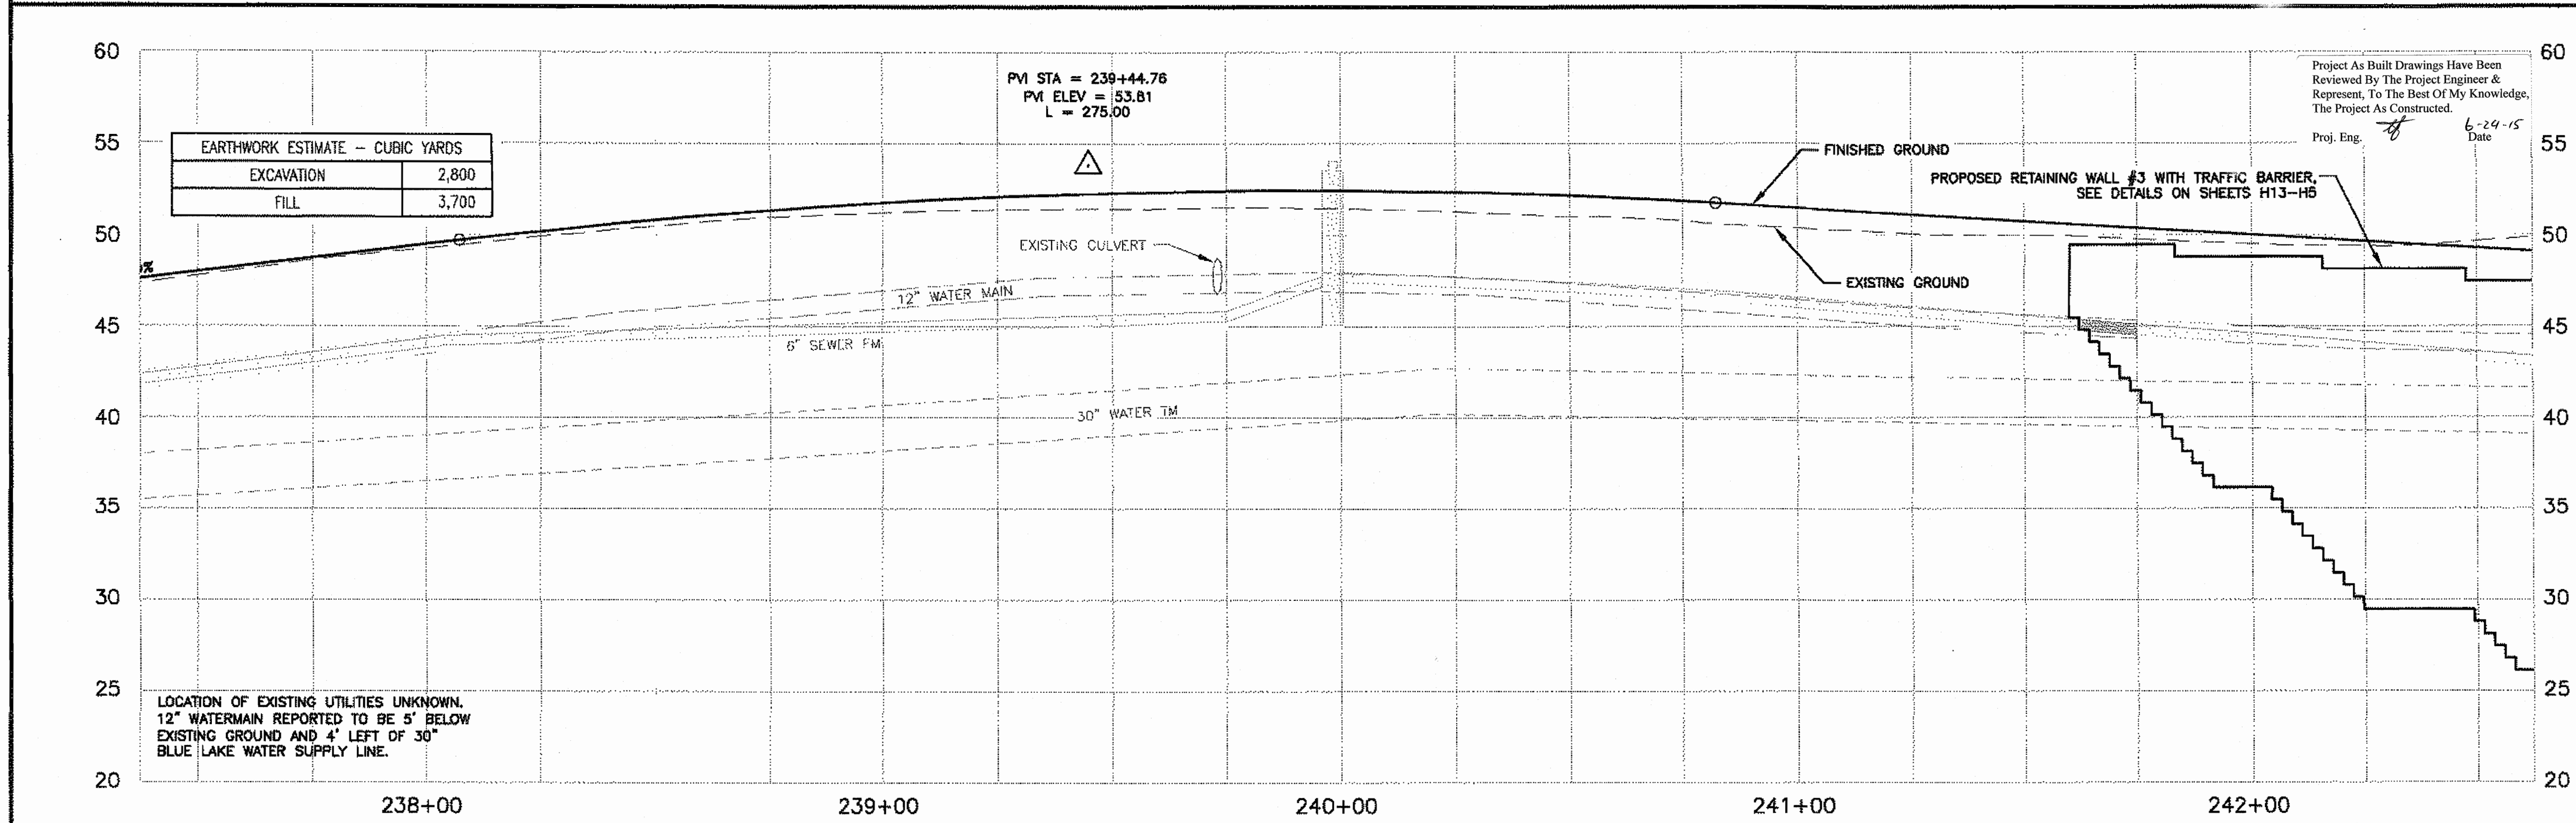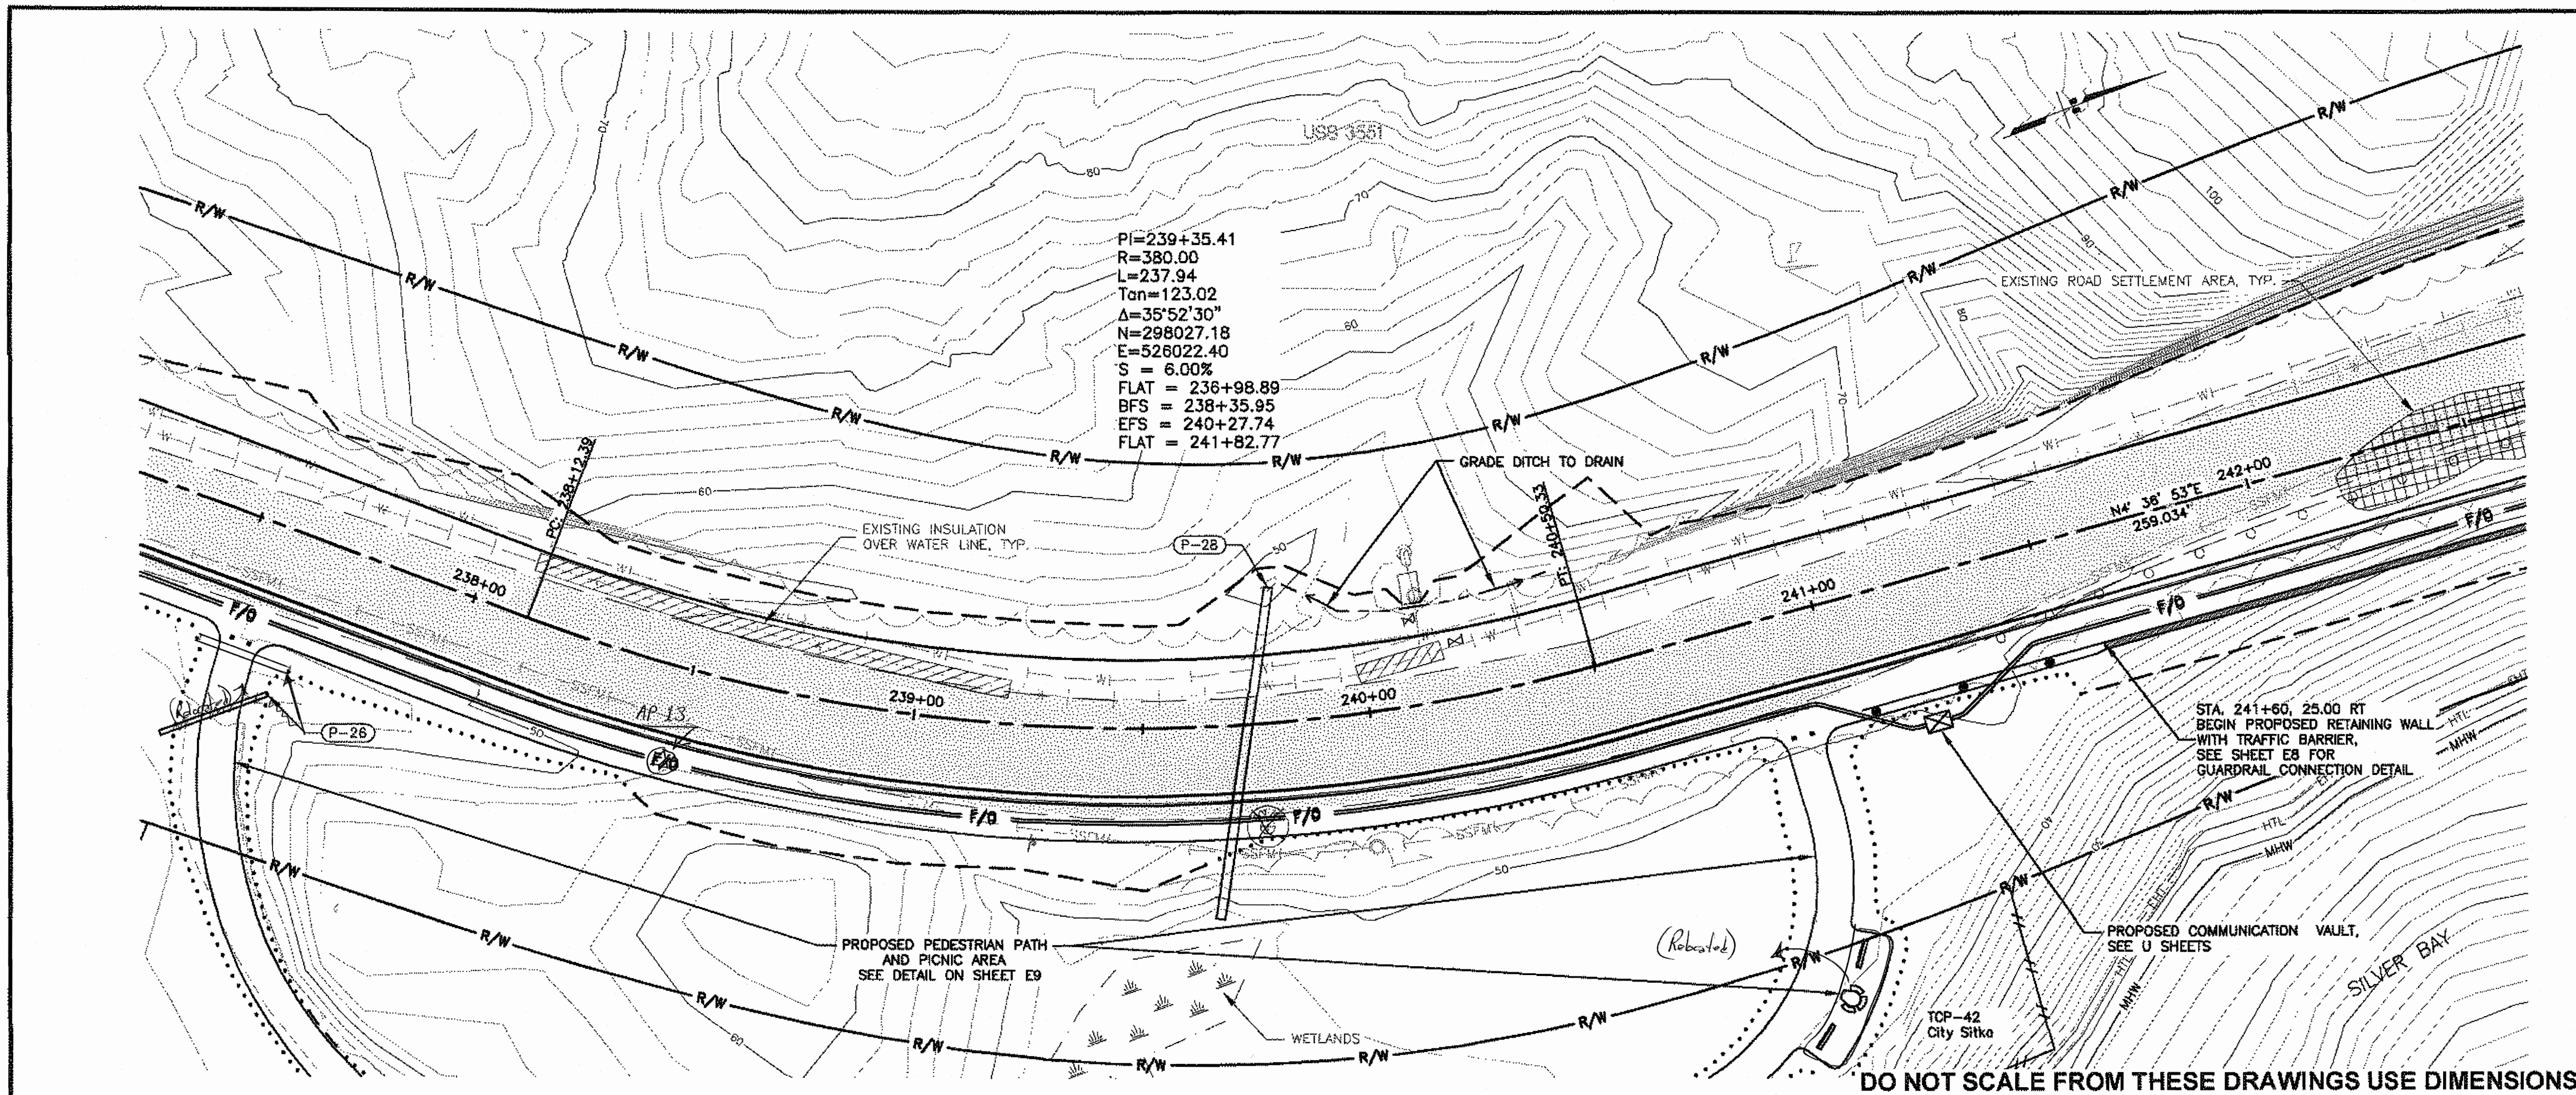

PATH: \\UNUFILE2\JOBS\1153805\DWG\SCIS\SHEETS\F01-F20

TAB: F12

ADDENDUM NUMBER

ATTACHMENT NUMBER

RECORD OF REVISIONS

No.	DATE	DESCRIPTION

SAWMILL CREEK ROAD UPGRADE
 PHASE III - WHALE PARK TO SAWMILL CREEK BRIDGE
 68216MSG-STP-0933(21)
 SITKA TELECOMMUNICATIONS CONDUIT
 RSA NO. 69615

ROADWAY PLAN & PROFILE

PREPARED BY: USKH

CHECKED BY: NCL

DESIGNED BY: NCL

DRAWN BY: WJP


STATE OF ALASKA
 DEPARTMENT OF TRANSPORTATION
 & PUBLIC FACILITIES
 SOUTHEAST REGION

ROADWAY PLAN
 & PROFILE
 STA. 237+50 TO
 STA. 242+50


PROJECT DESIGNATION
 68216MSG-STP-0933(21)

STATE	YEAR
ALASKA	2012

SHEET NUMBER	TOTAL SHEETS
F12	109

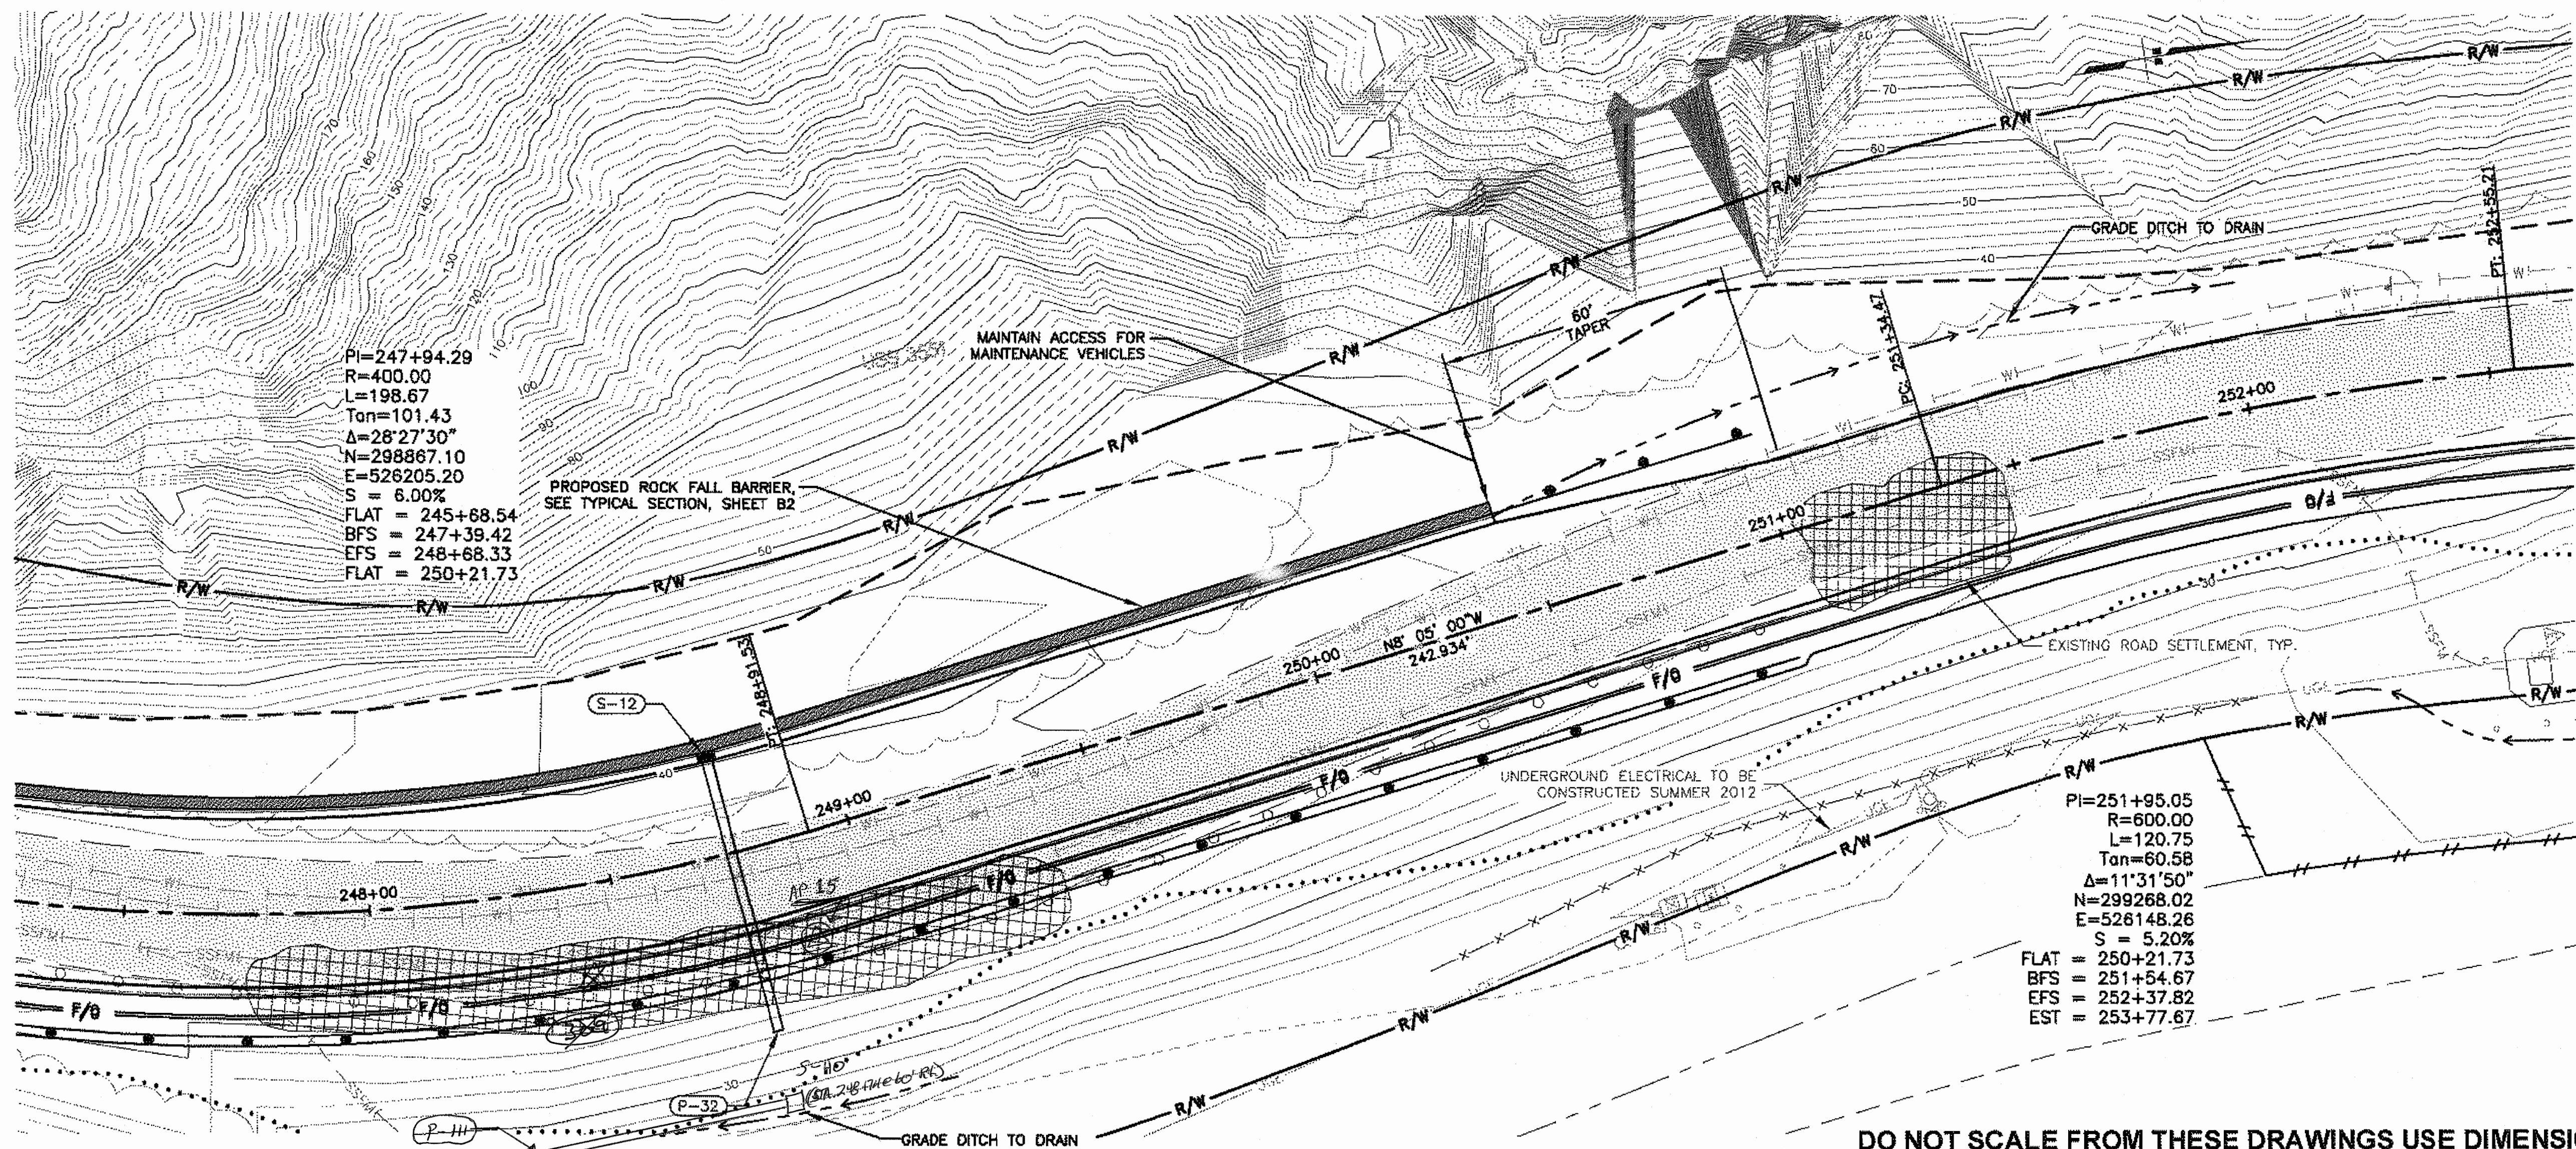

DO NOT SCALE FROM THESE DRAWINGS USE DIMENSIONS

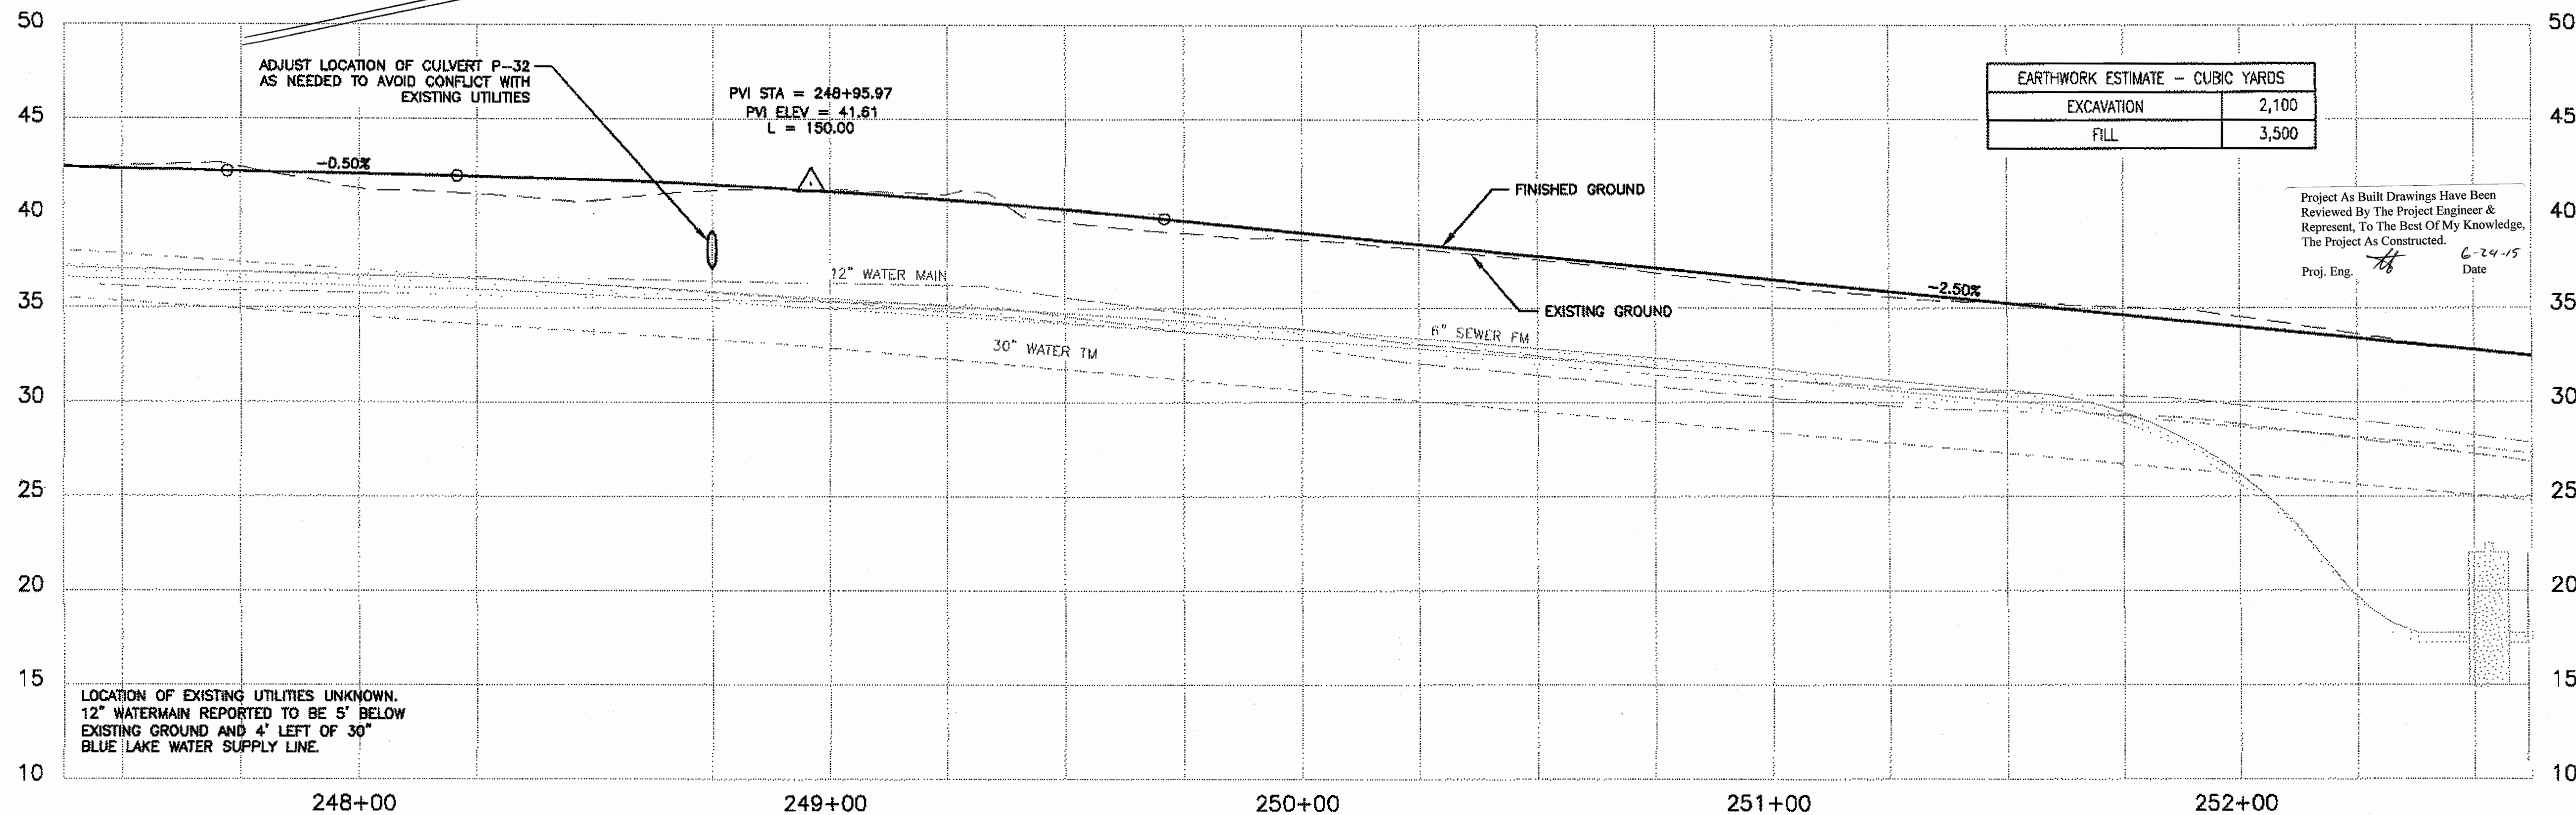

EARTHWORK ESTIMATE - CUBIC YARDS	
EXCAVATION	2,100
FILL	3,500

Project As Built Drawings Have Been Reviewed By The Project Engineer & Represent, To The Best Of My Knowledge, The Project As Constructed.
 Proj. Eng. *[Signature]* Date 6-24-15

PATH: \\JUNIFILE2\JOBS\1153805\DWG\ICIS\SHEETS\F01-F20

RECORD OF REVISIONS		
No.	DATE	DESCRIPTION

SAWMILL CREEK ROAD UPGRADE
 PHASE III - WHALE PARK TO SAWMILL CREEK BRIDGE
 68216MSG-STP-0933(21)
 SITKA TELECOMMUNICATIONS CONDUIT
 RSA NO. 69615

ROADWAY PLAN & PROFILE

PREPARED BY: USKH
 CHECKED BY: NCL




DESIGNED BY: NCL
 DRAWN BY: WJP

STATE OF ALASKA
 DEPARTMENT OF TRANSPORTATION
 & PUBLIC FACILITIES
 SOUTHEAST REGION

**ROADWAY PLAN
 & PROFILE
 STA. 247+50 TO
 STA. 252+50**


PROJECT DESIGNATION
68216MSG-STP-0933(21)

STATE	YEAR
ALASKA	2012
SHEET NUMBER	TOTAL SHEETS
F14	109

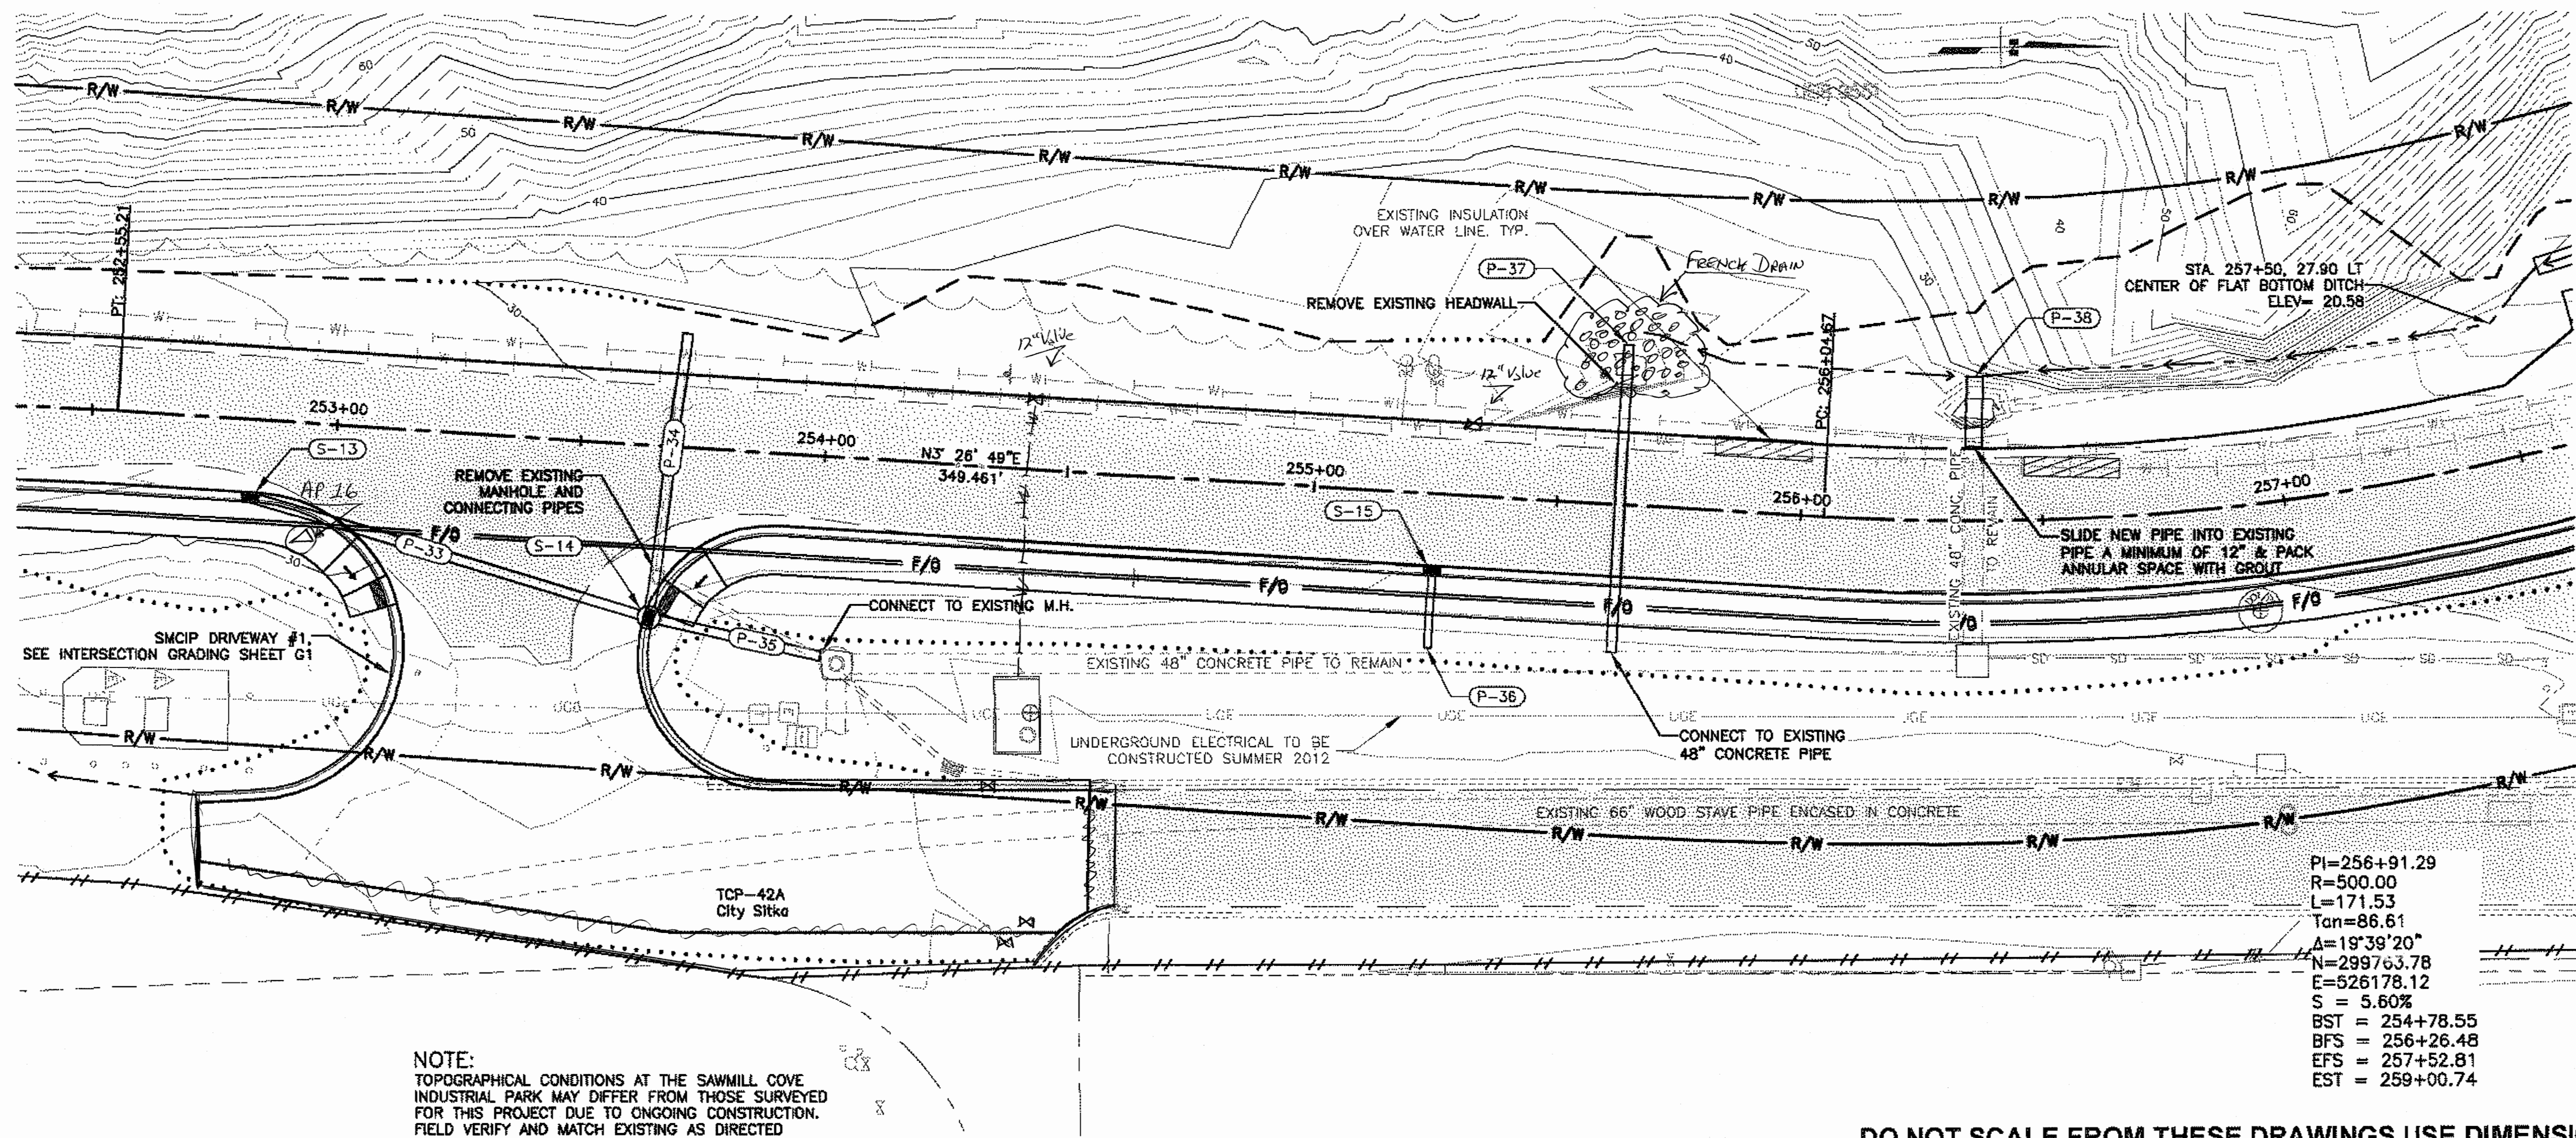

NOTE:
TOPOGRAPHICAL CONDITIONS AT THE SAWMILL COVE INDUSTRIAL PARK MAY DIFFER FROM THOSE SURVEYED FOR THIS PROJECT DUE TO ONGOING CONSTRUCTION. FIELD VERIFY AND MATCH EXISTING AS DIRECTED

DO NOT SCALE FROM THESE DRAWINGS USE DIMENSIONS

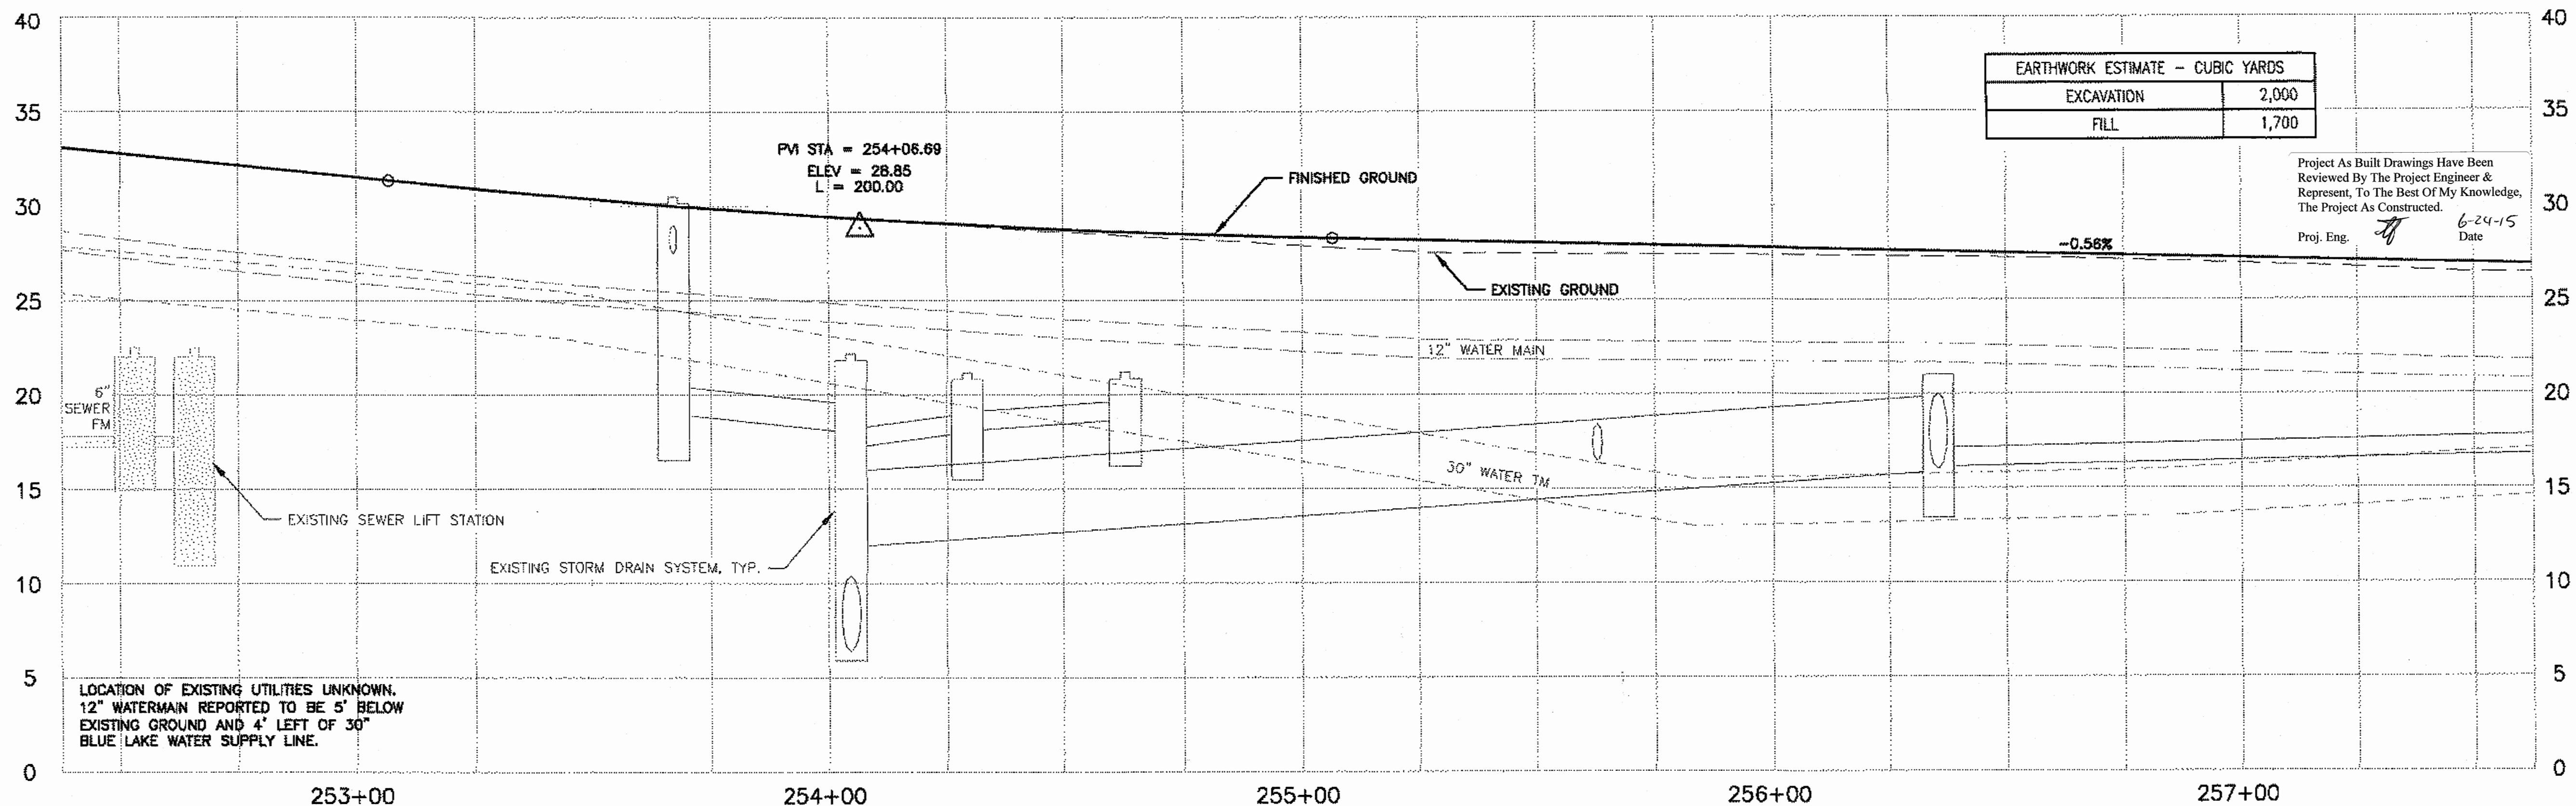

EARTHWORK ESTIMATE - CUBIC YARDS	
EXCAVATION	2,000
FILL	1,700

Project As Built Drawings Have Been Reviewed By The Project Engineer & Represent, To The Best Of My Knowledge, The Project As Constructed.
Proj. Eng. *[Signature]* Date 6-24-15

PATH:
UNUNFILE2\JOBS\1153805\DWG\CS\SHETS\F01-F20

TAB: F15


RECORD OF REVISIONS		
No.	DATE	DESCRIPTION

SAWMILL CREEK ROAD UPGRADE
PHASE III - WHALE PARK TO SAWMILL CREEK BRIDGE
68216MSG-STP-0933(21)
SITKA TELECOMMUNICATIONS CONDUIT
RSA NO. 69615

ROADWAY PLAN & PROFILE

PREPARED BY: USKH

CHECKED BY: NCL

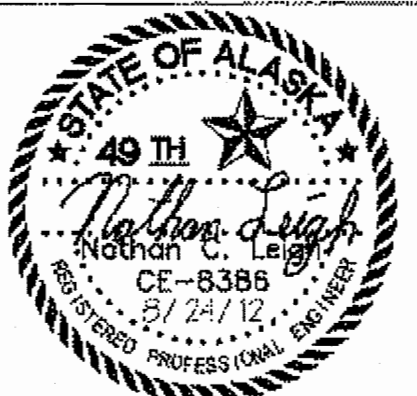

DESIGNED BY: NCL


DRAWN BY: WJP

STATE OF ALASKA
DEPARTMENT OF TRANSPORTATION
& PUBLIC FACILITIES
SOUTHEAST REGION

ROADWAY PLAN
& PROFILE
STA. 252+50 TO
STA. 257+50

PROJECT DESIGNATION
68216MSG-STP-0933(21)

STATE	YEAR
ALASKA	2012
SHEET NUMBER	TOTAL SHEETS
F15	109

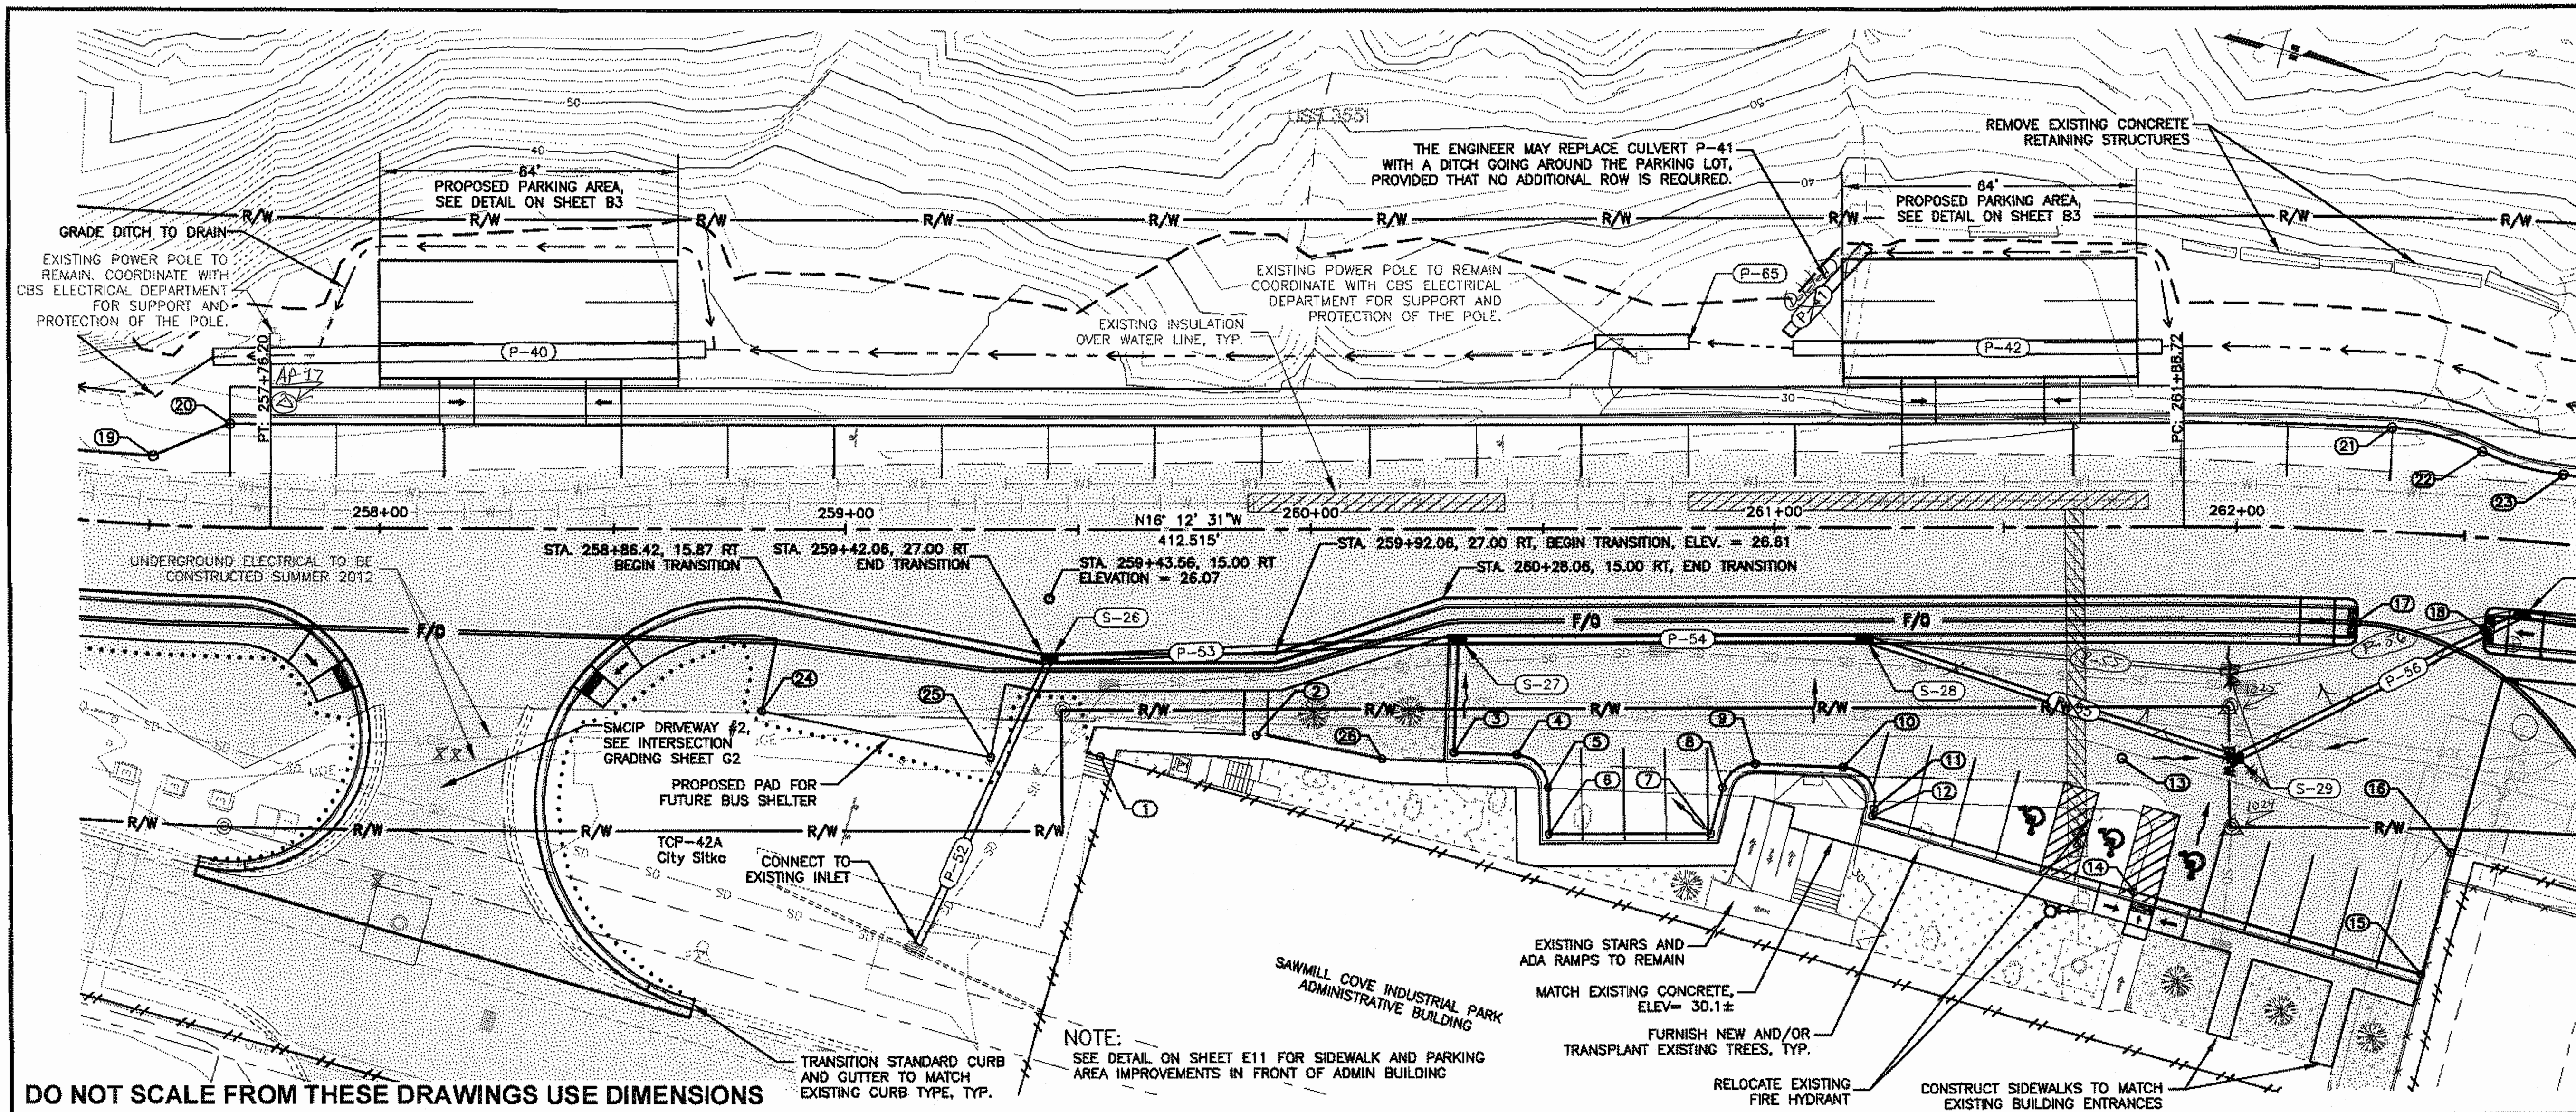

PATH:
\\NUPFILE2\JOBS\1153806\DWG\CS\SHETS\F01-F20

TAB: F16

ADDENDUM NUMBER	
ATTACHMENT NUMBER	
RECORD OF REVISIONS	
No.	DATE
DESCRIPTION	


SAWMILL CREEK ROAD UPGRADE
PHASE III - WHALE PARK TO SAWMILL CREEK BRIDGE
68216MSG-STP-0933(21)
SITKA TELECOMMUNICATIONS CONDUIT
RSA NO. 69615

ROADWAY PLAN & PROFILE


NO.	STATION	OFFSET	ELEVATION	DESCRIPTION
1	259+54.57	49.11 RT	MTE	TOP OF STAIRS
2	259+88.05	44.59 RT	MTE	SIDEWALK
3	260+30.33	48.33 RT	27.81	ANGLE POINT, EDGE OF PAVEMENT, LIP OF GUTTER
4	260+43.95	48.88 RT	28.32	PC 7' RADIUS
5	260+50.67	55.87 RT	28.72	PT 7' RADIUS
6	260+50.67	66.00 RT	29.10	ANGLE POINT, EDGE OF PAVEMENT, LIP OF GUTTER
7	260+85.69	66.00 RT	29.21	ANGLE POINT
8	260+88.51	56.05 RT	29.10	PC 7' RADIUS
9	260+95.53	50.96 RT	29.01	PT 7' RADIUS
10	261+14.39	51.73 RT	29.32	PC 7' RADIUS

NO.	STATION	OFFSET	ELEVATION	DESCRIPTION
11	261+18.91	60.09 RT	29.52	PT 7' RADIUS
12	261+17.91	63.63 RT	29.55	ANGLE POINT
13	261+75.00	50.00 RT	30.72	TOP OF PAVEMENT
14	261+77.17	78.81 RT	31.92	GRADE BREAK, EDGE OF PAVEMENT, LIP OF GUTTER
15	262+46.34	95.18 RT	31.92	EDGE OF PAVEMENT, LIP OF GUTTER
16	262+51.96	68.41 RT	31.92	EDGE OF PAVEMENT
17	262+26.88	20.00 RT	32.22	END SIDEWALK / CURB RAMP
18	262+55.69	2.00 RT	33.06	BEGIN SIDEWALK / CURB RAMP
19	257+50.00	15.00 LT	-	ANGLE POINT, BEGIN ROAD WIDENING

NO.	STATION	OFFSET	ELEVATION	DESCRIPTION
20	257+67.00	22.50 LT	-	BEGIN CURB, GUTTER, AND SIDEWALK
21	262+32.80	22.50 LT	-	PC 50' RADIUS
22	262+52.43	18.53 LT	-	PRC 50' RADIUS
23	262+70.00	15.00 LT	-	PT 50' RADIUS
24	258+81.71	39.41 RT	27.03	EDGE OF PAVEMENT / FUTURE BUS SHELTER
25	259+30.74	49.21 RT	26.87	EDGE OF PAVEMENT / FUTURE BUS SHELTER
26	260+14.90	49.71 RT	27.77	SIDEWALK ANGLE POINT

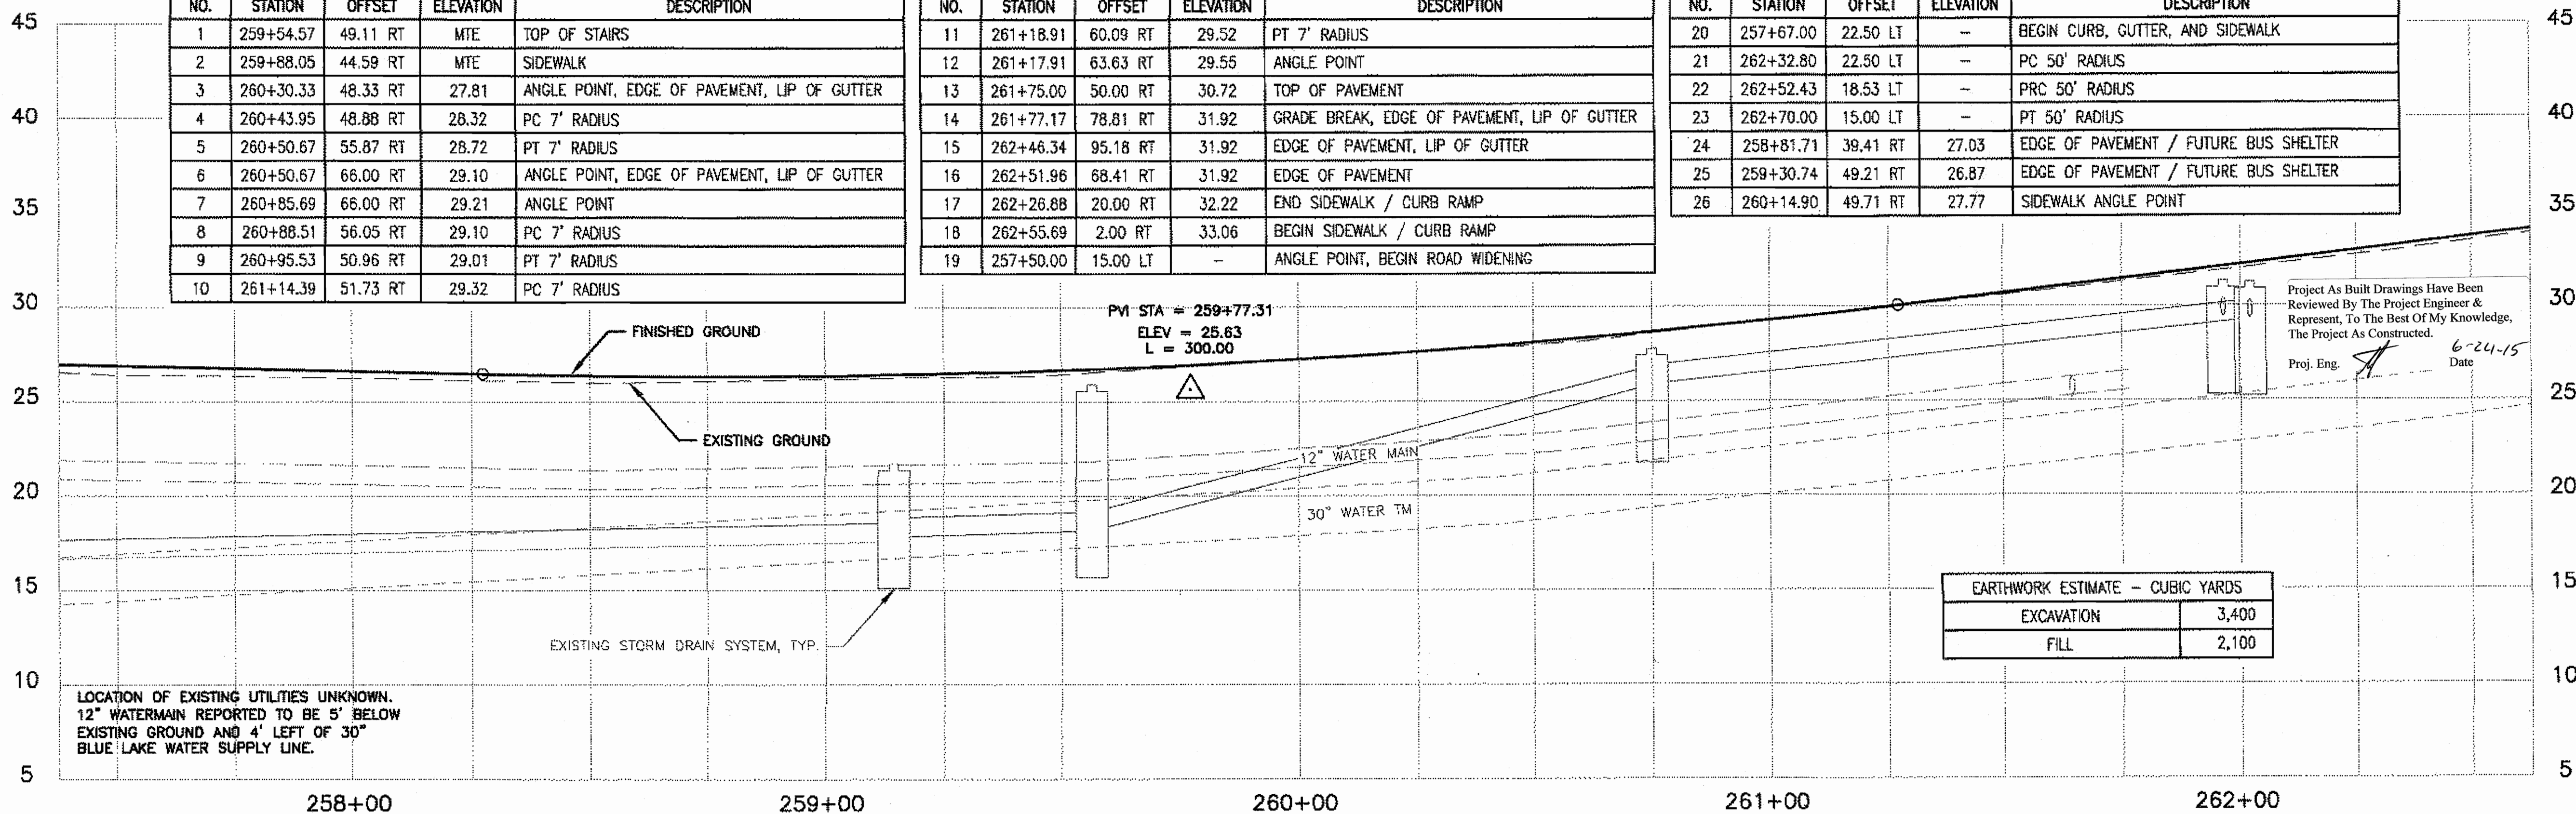

PREPARED BY: USKH
CHECKED BY: NCL

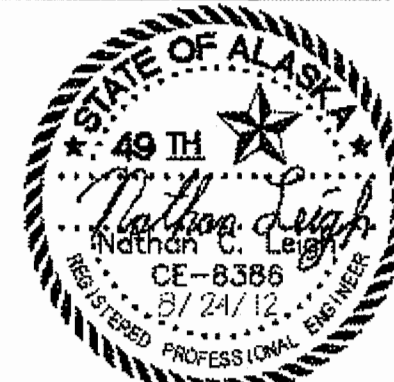


DESIGNED BY: NCL
DRAWN BY: WJP

STATE OF ALASKA
DEPARTMENT OF TRANSPORTATION
& PUBLIC FACILITIES
SOUTHEAST REGION

ROADWAY PLAN
& PROFILE
STA. 257+50 TO
STA. 262+50

PROJECT DESIGNATION
68216MSG-STP-0933(21)


STATE	YEAR
ALASKA	2012
SHEET NUMBER	TOTAL SHEETS
F16	109

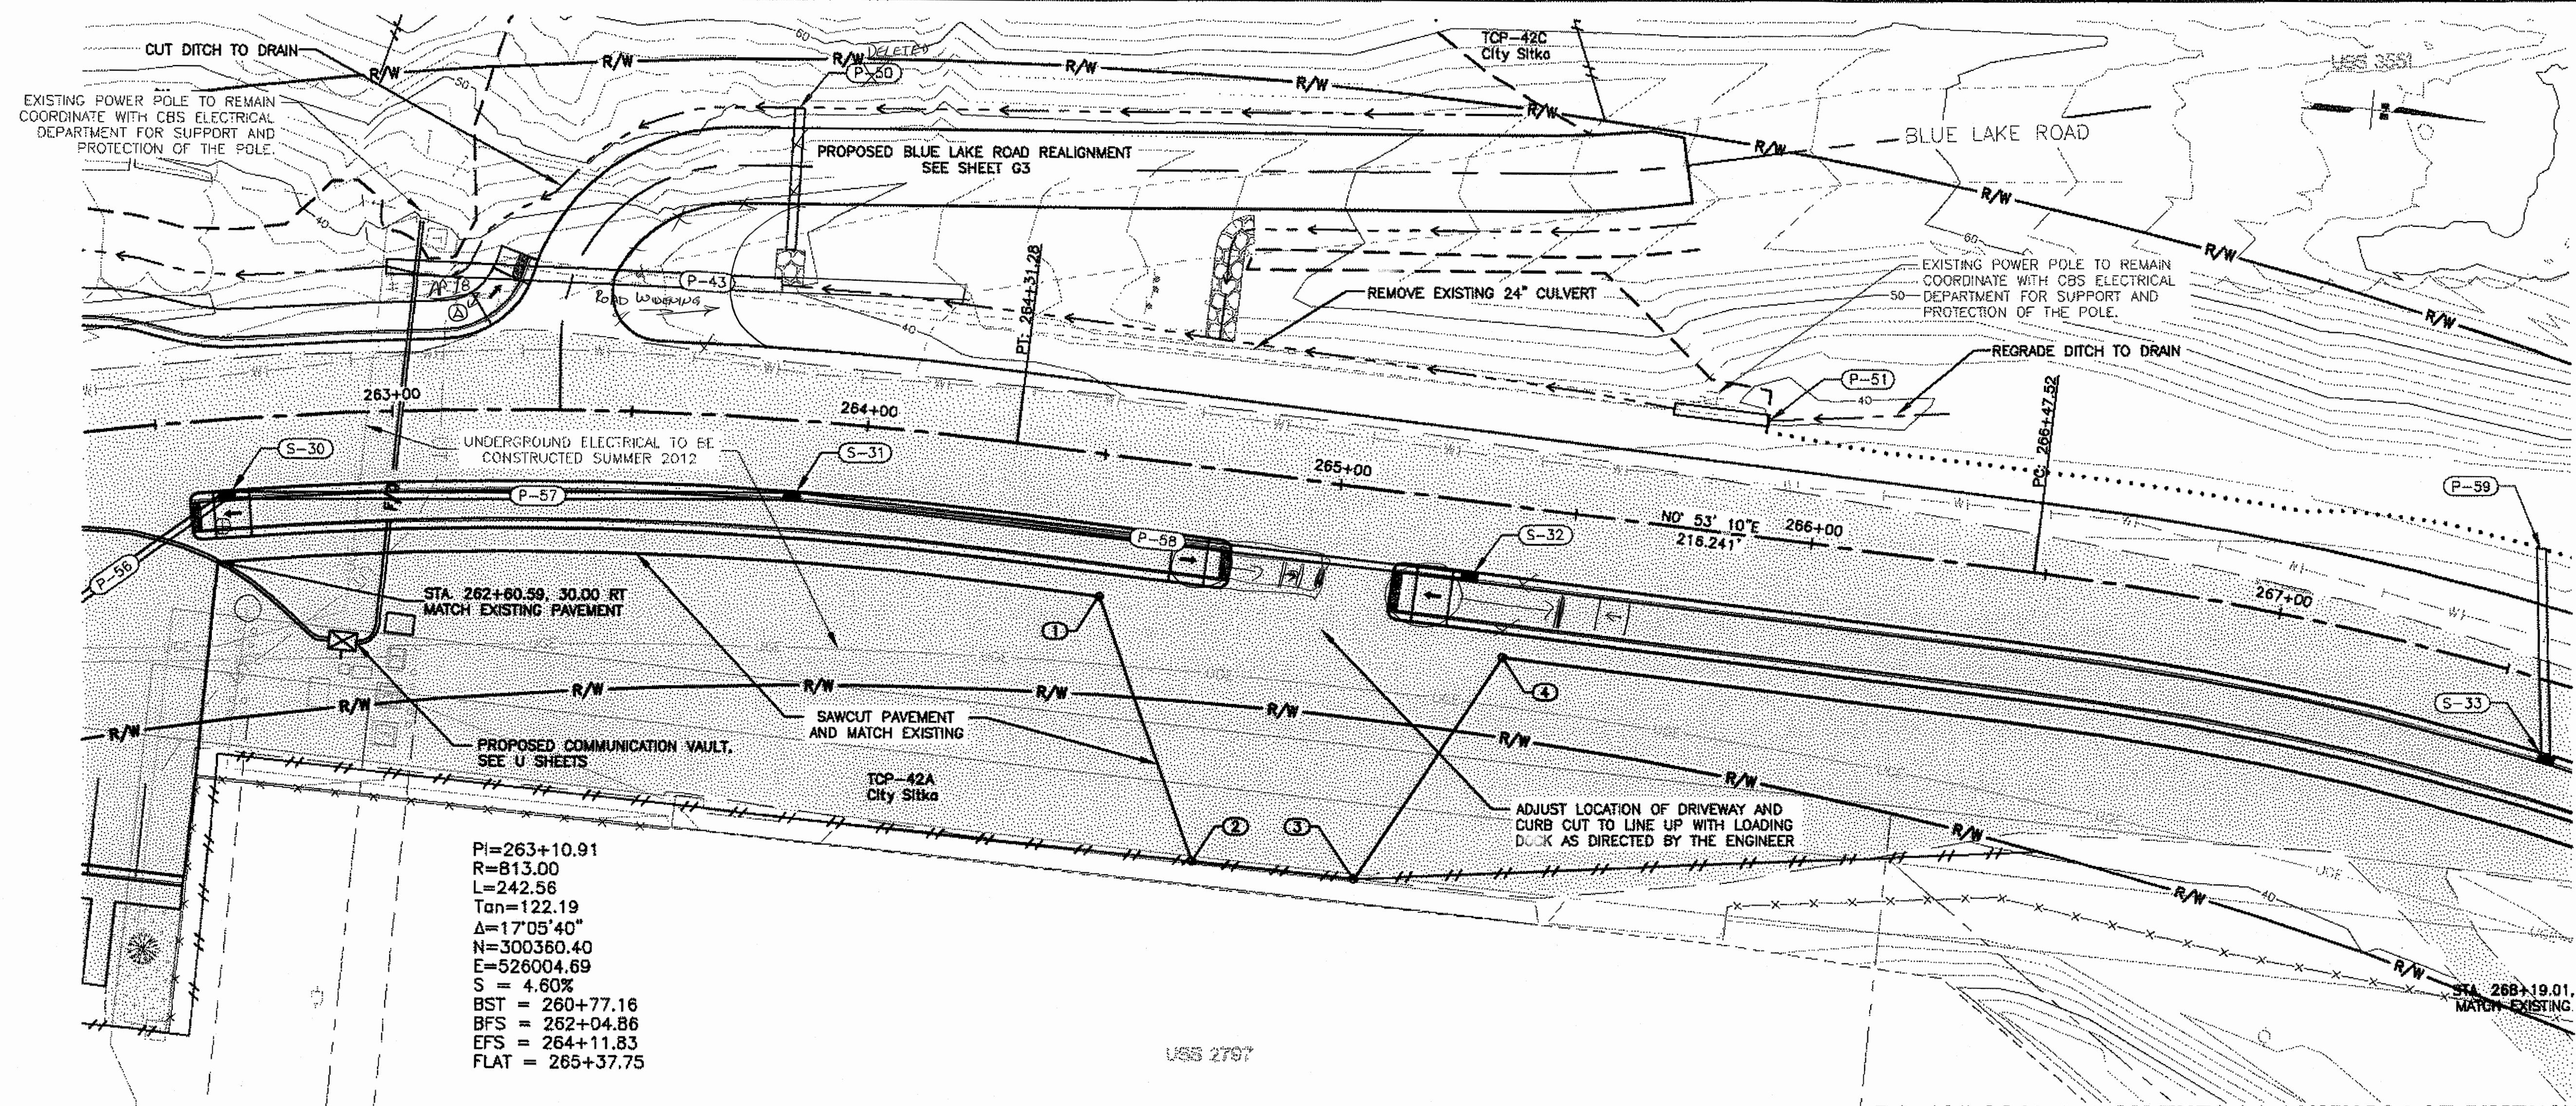

$PI=263+10.91$
 $R=813.00$
 $L=242.58$
 $Tan=122.19$
 $\Delta=17^{\circ}05'40''$
 $N=300360.40$
 $E=526004.69$
 $S = 4.60\%$
 $BST = 260+77.16$
 $BFS = 262+04.86$
 $EFS = 264+11.83$
 $FLAT = 265+37.75$

USS 2797

DO NOT SCALE FROM THESE DRAWINGS USE DIMENSIONS

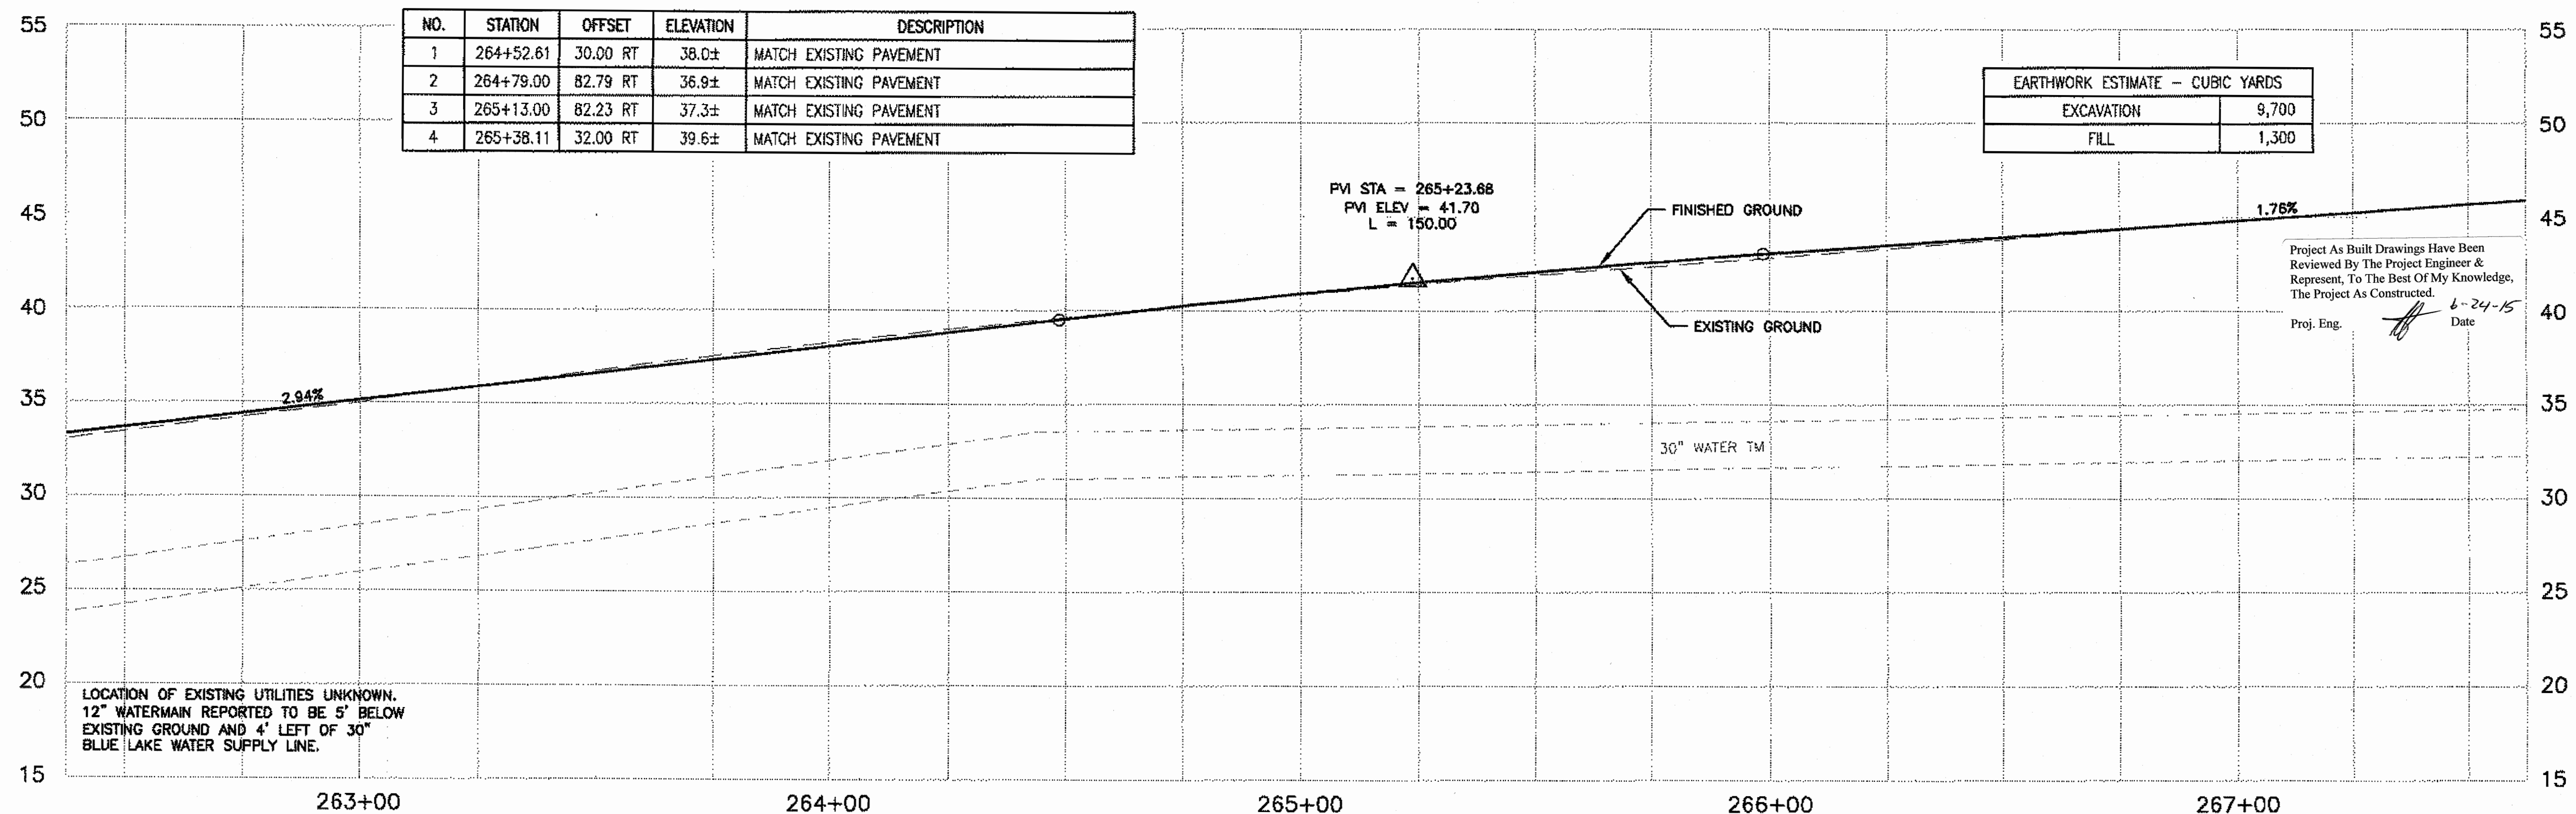


NO.	STATION	OFFSET	ELEVATION	DESCRIPTION
1	264+52.61	30.00 RT	38.0±	MATCH EXISTING PAVEMENT
2	264+79.00	82.79 RT	36.9±	MATCH EXISTING PAVEMENT
3	265+13.00	82.23 RT	37.3±	MATCH EXISTING PAVEMENT
4	265+38.11	32.00 RT	39.6±	MATCH EXISTING PAVEMENT

EARTHWORK ESTIMATE - CUBIC YARDS	
EXCAVATION	9,700
FILL	1,300


Project As Built Drawings Have Been
 Reviewed By The Project Engineer &
 Represent, To The Best Of My Knowledge,
 The Project As Constructed.
 Proj. Eng. *[Signature]* Date 6-24-15

PATH: \\JNFILE2\JOBS\1153805\DWG\CS\SHETS\F01-F20
 TAB: F17
 ADDENDUM NUMBER
 ATTACHMENT NUMBER
 RECORD OF REVISIONS
 No. DATE DESCRIPTION
 SAWMILL CREEK ROAD UPGRADE
 PHASE III - WHALE PARK TO SAWMILL CREEK BRIDGE
 68216MSG-STP-0933(21)
 SITKA TELECOMMUNICATIONS CONDUIT
 RSA NO. 69615
 ROADWAY PLAN & PROFILE
 PREPARED BY: USKH
 CHECKED BY: NCL
 DESIGNED BY: NCL
 DRAWN BY: WJUP
 STATE OF ALASKA
 DEPARTMENT OF TRANSPORTATION
 & PUBLIC FACILITIES
 SOUTHEAST REGION
 ROADWAY PLAN
 & PROFILE
 STA. 262+50 TO
 STA. 267+50
 PROJECT DESIGNATION
 68216MSG-STP-0933(21)
 STATE YEAR
 ALASKA 2012
 SHEET NUMBER TOTAL SHEETS
 F17 109

CONTRACTOR TO VERIFY THAT FENCE HAS BEEN RELOCATED OUTSIDE OF ROW. IF FENCE REMAINS INSIDE OF ROW, SALVAGE EXISTING FENCE AND STORE AS DIRECTED.

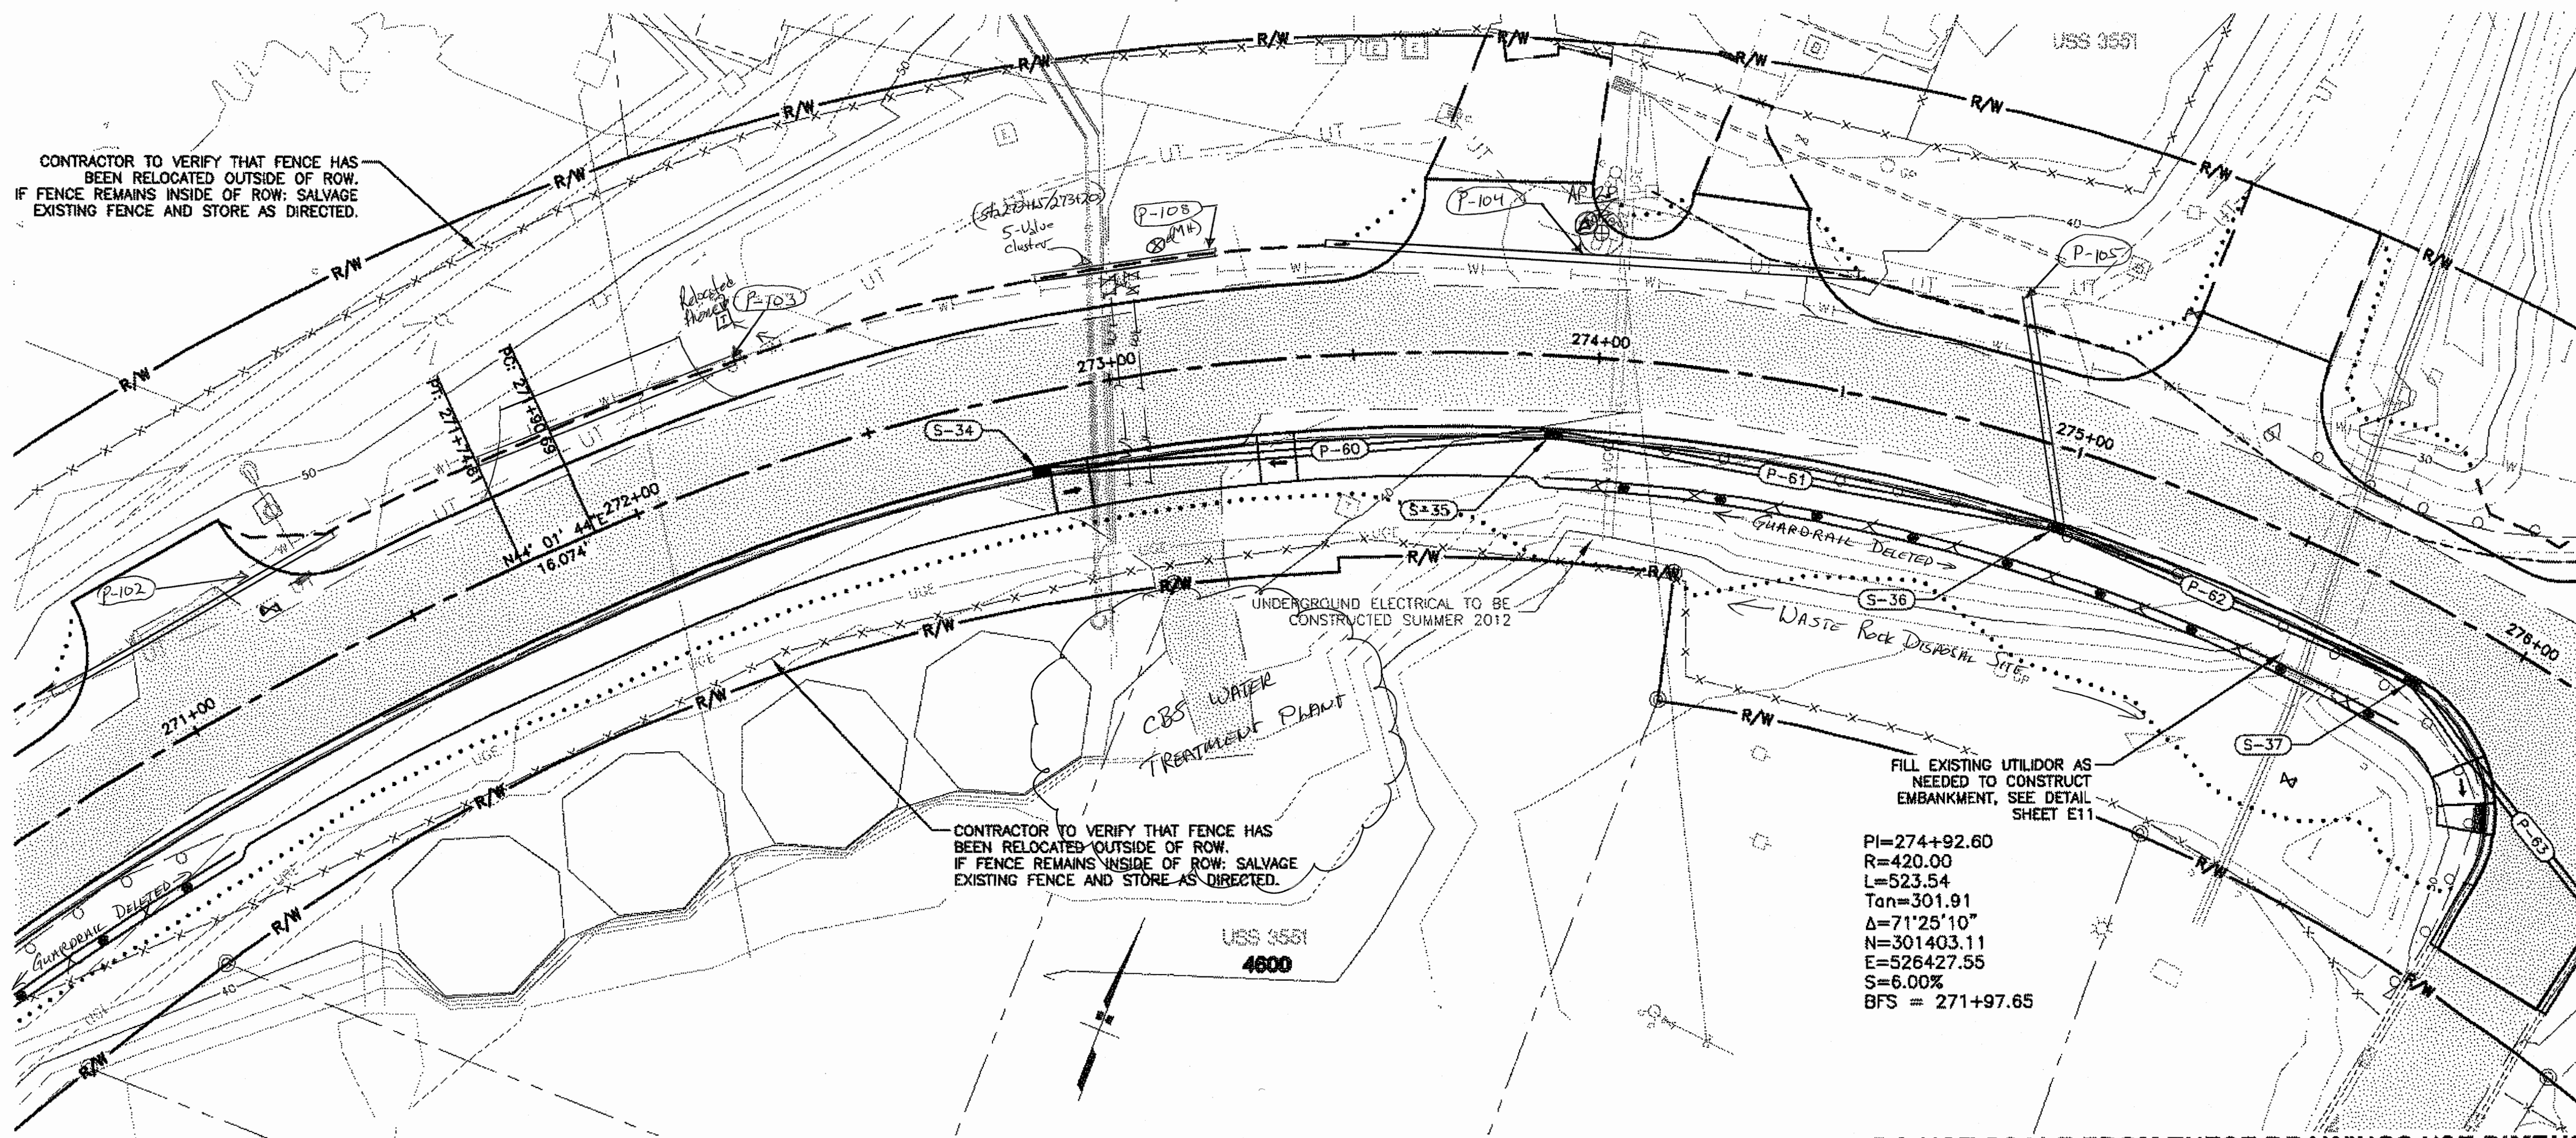

DO NOT SCALE FROM THESE DRAWINGS USE DIMENSIONS

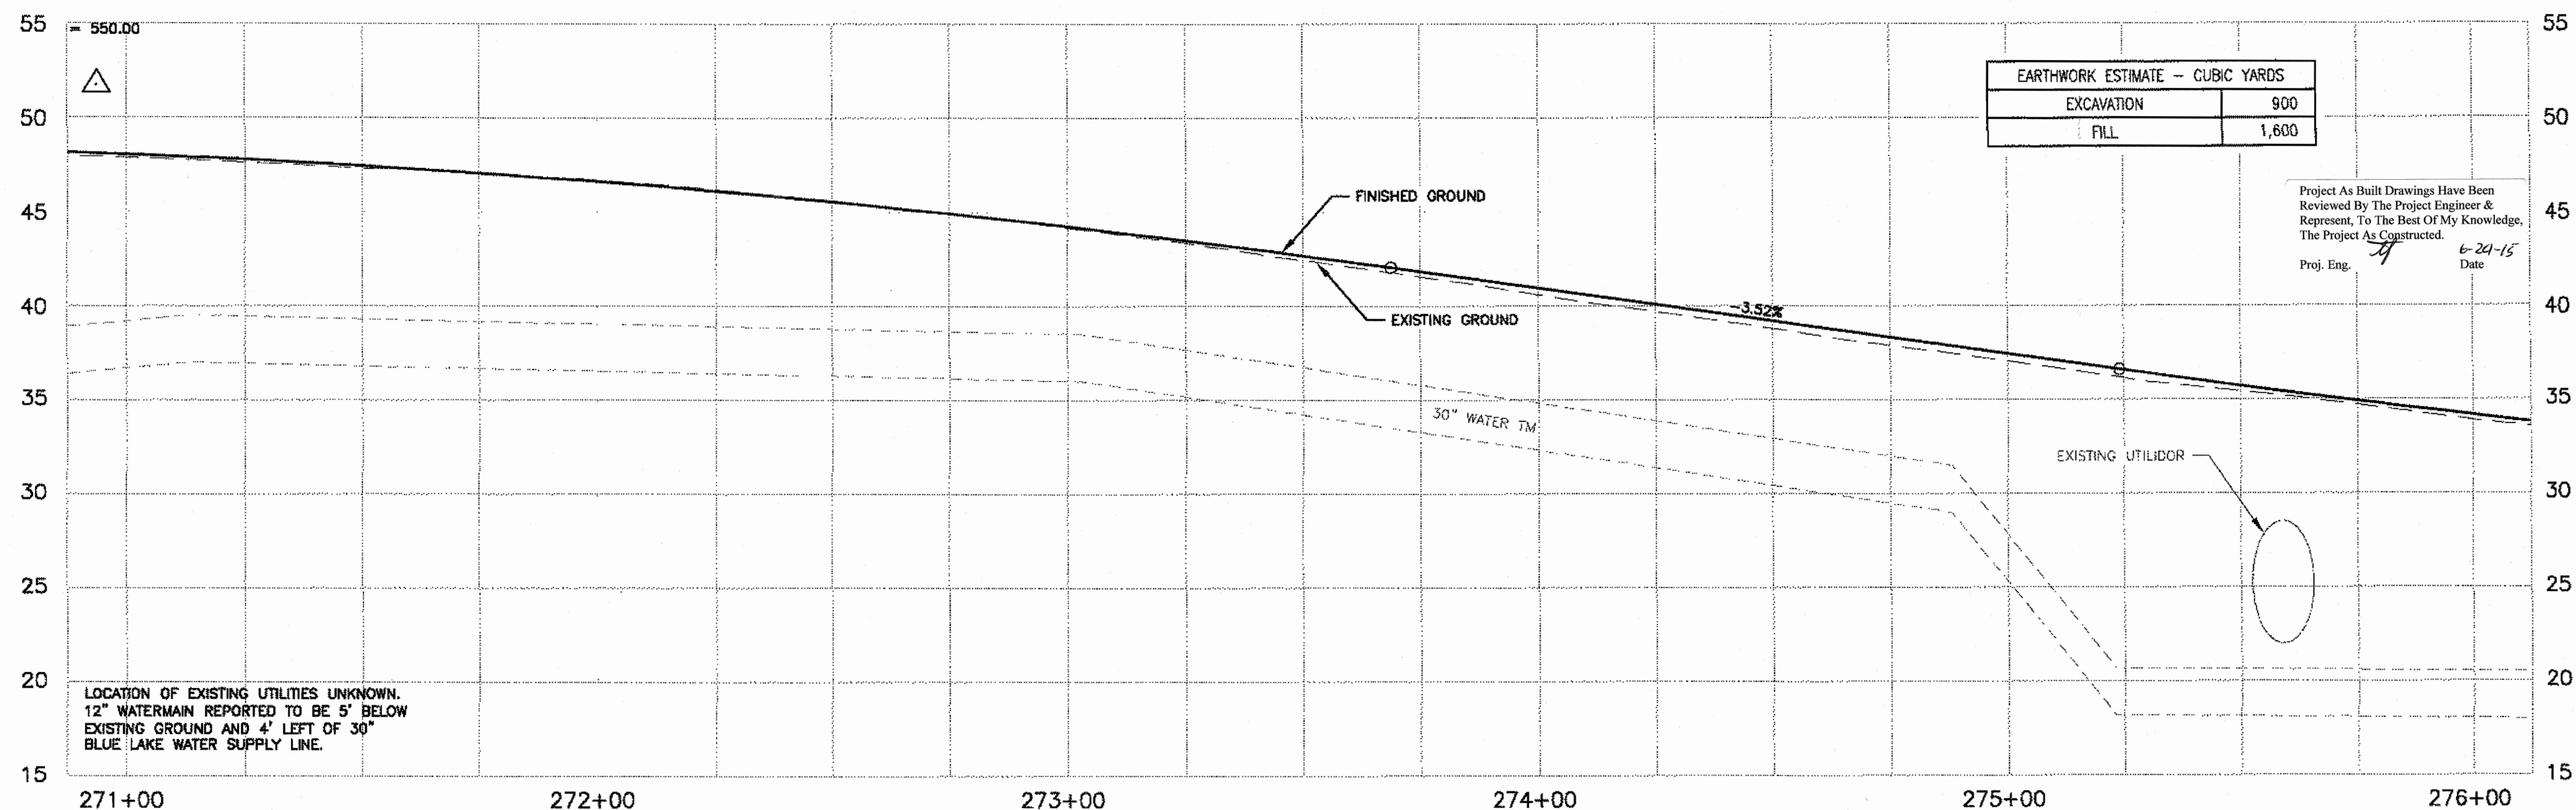

PATH:
\\NWFILE2\JOBS\1153806\DWG\CS\SHETS\F01-F20

TAB: F19


RECORD OF REVISIONS		
No.	DATE	DESCRIPTION

SAWMILL CREEK ROAD UPGRADE
PHASE III - WHALE PARK TO SAWMILL CREEK BRIDGE
68216MSG-STP-0933(21)
SITKA TELECOMMUNICATIONS CONDUIT
RSA NO. 69615

ROADWAY PLAN & PROFILE

PREPARED BY: USKH

CHECKED BY: NCL

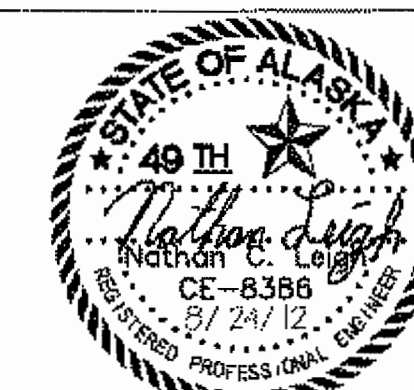

DESIGNED BY: NCL

DRAWN BY: WJP

STATE OF ALASKA
DEPARTMENT OF TRANSPORTATION
& PUBLIC FACILITIES
SOUTHEAST REGION

ROADWAY PLAN
& PROFILE
STA. 272+00 TO
STA. 276+00

PROJECT DESIGNATION
68216MSG-STP-0933(21)

STATE	YEAR
ALASKA	2012
SHEET NUMBER	TOTAL SHEETS
F19	109

PATH:
I:\115300\RD\WG\SG\CS\HEETS\F01-F20.DWG

Wednesday, August 22, 2012 8:32:37 AM
TAB: F20

ADDENDUM NUMBER

ATTACHMENT NUMBER

RECORD OF REVISIONS


No.	DATE	DESCRIPTION

SAWMILL CREEK ROAD UPGRADE
PHASE III - WHALE PARK TO SAWMILL CREEK BRIDGE
68216MSG-STP-0933(21)
SITKA TELECOMMUNICATIONS CONDUIT
RSA NO 69615

ROADWAY PLAN & PROFILE

PREPARED BY: USKH

CHECKED BY: NCL

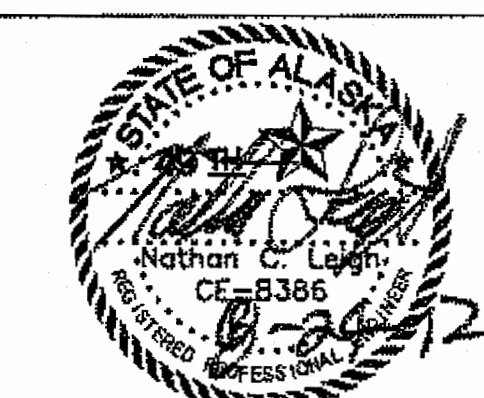

DESIGNED BY: NCL

DRAWN BY: WJP

STATE OF ALASKA
DEPARTMENT OF TRANSPORTATION
& PUBLIC FACILITIES
SOUTHEAST REGION

ROADWAY PLAN
& PROFILE
STA. 276+00 TO
STA. EOP

PROJECT DESIGNATION

68216MSG-STP-0933(21)

STATE YEAR

ALASKA 2012

SHEET NUMBER TOTAL SHEETS

F20 109

UNDERGROUND ELECTRICAL TO BE
CONSTRUCTED SUMMER 2012

SAWMILL CREEK BRIDGE
PIER COLUMN REPAIRS,
SEE T SHEETS

SAWMILL

SAWMILL CREEK BRIDGE

CREEK

END PAVING
STA 278+25

CONTRACTOR TO VERIFY THAT FENCE HAS
BEEN RELOCATED OUTSIDE OF ROW.
IF FENCE REMAINS INSIDE OF ROW, SALVAGE
EXISTING FENCE AND STORE AS DIRECTED.


US 3551


DO NOT SCALE FROM THESE DRAWINGS USE DIMENSIONS

EARTHWORK ESTIMATE - CUBIC YARDS	
EXCAVATION	600
FILL	700

Project As Built Drawings Have Been
Reviewed By The Project Engineer &
Represent, To The Best Of My Knowledge,
The Project As Constructed.

Proj. Eng. *[Signature]* Date 6-24-15

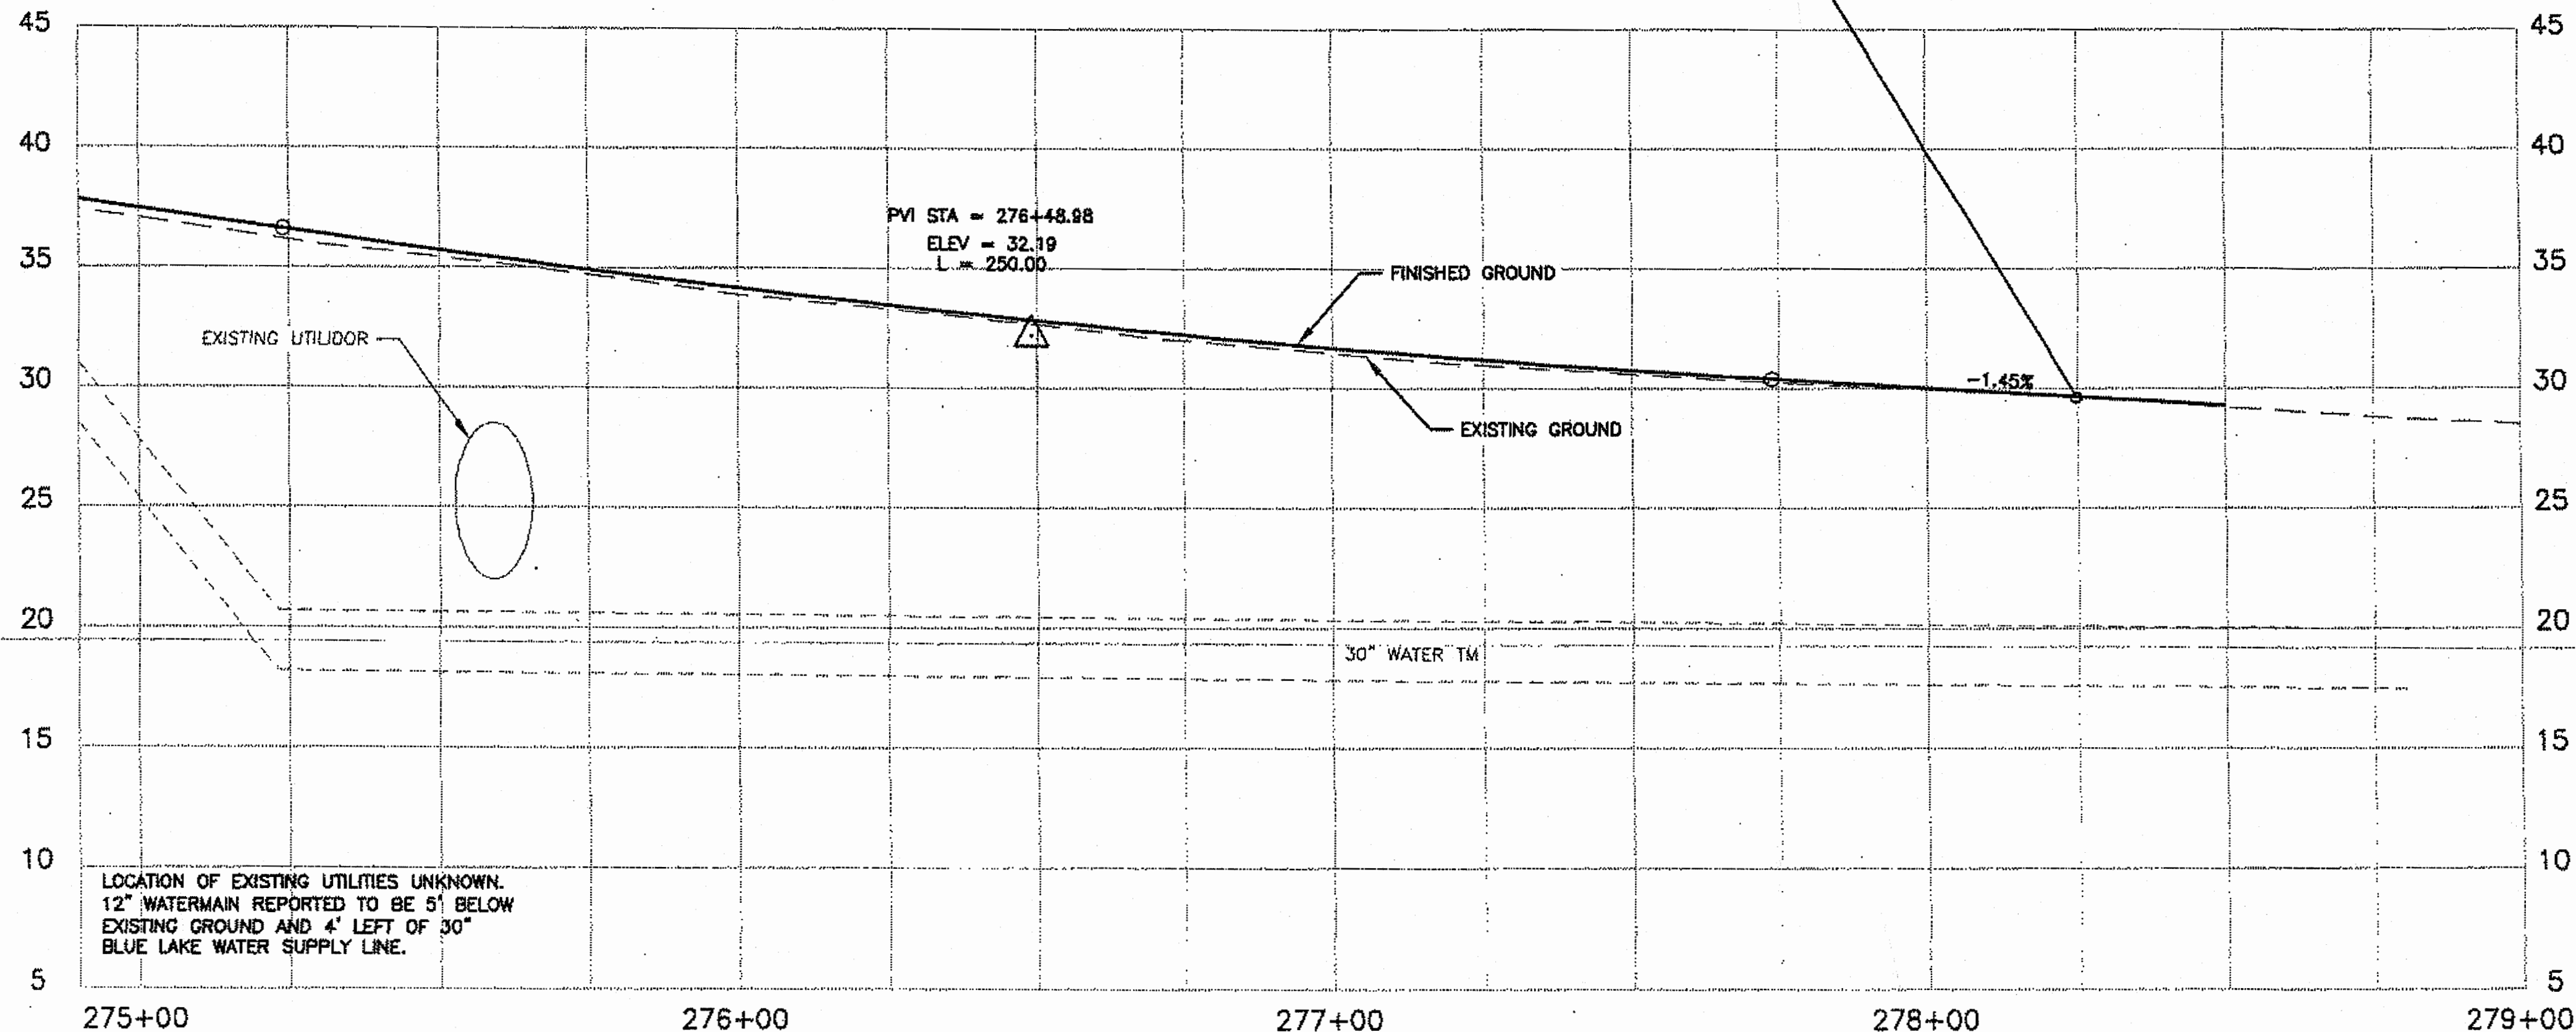

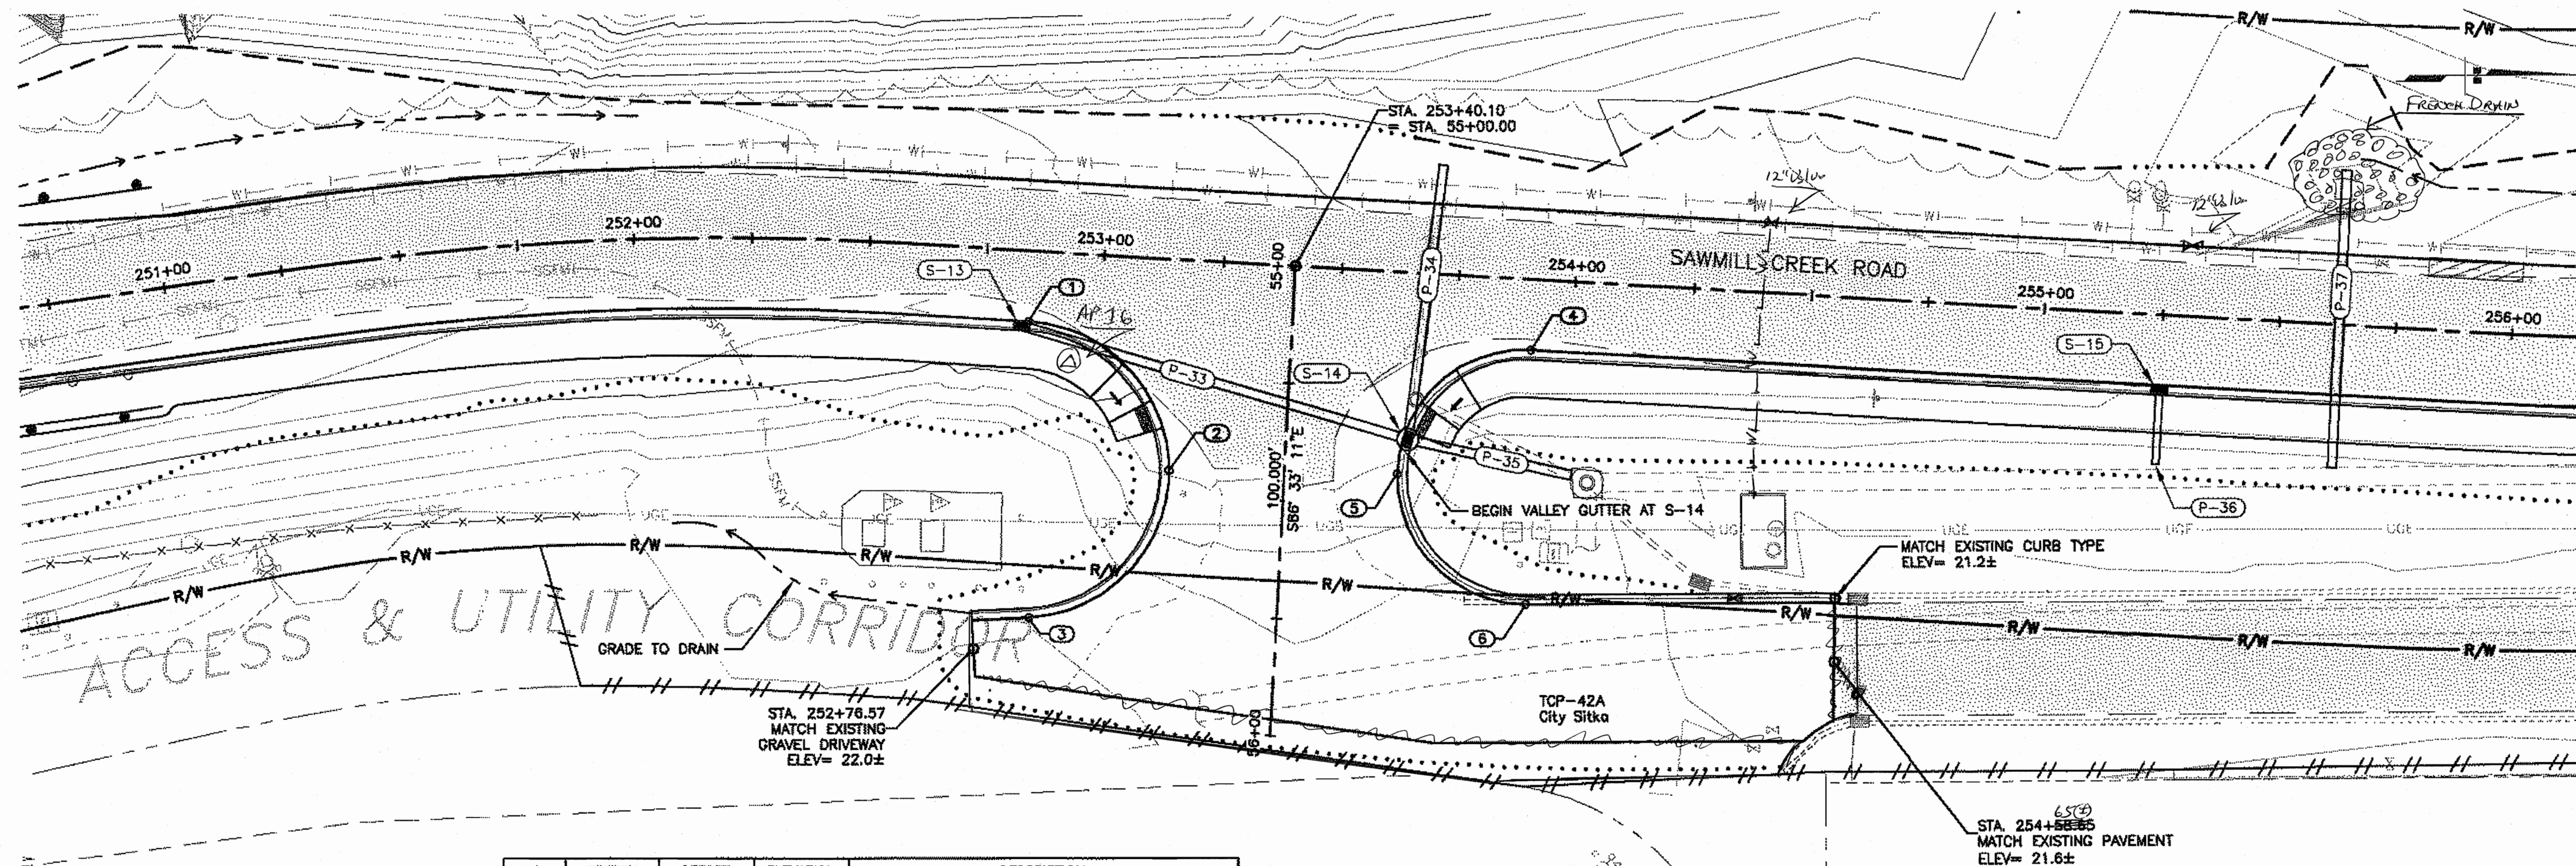


NO.	STATION	OFFSET	ELEVATION	DESCRIPTION
1	252+82.63	15' RT	31.48	PT, BEGIN 31.5' RADIUS
2	55+44.79	24' RT	28.5	MID POINT ON RADIUS
3	252+88.00	78' RT	23.35	PC, END 31.5' RADIUS
4	253+91.10	15' RT	29.29	PT, BEGIN 27' RADIUS
5	55+42.83	24' LT	28.5	MID POINT ON RADIUS
6	253+92.76	69' RT	25.67	PT, END 27' RADIUS

LOT 10

NOTE:
TOPOGRAPHICAL CONDITIONS AT THE SAWMILL COVE INDUSTRIAL PARK MAY DIFFER FROM THOSE SURVEYED FOR THIS PROJECT DUE TO ONGOING CONSTRUCTION. FIELD VERIFY AND MATCH EXISTING AS DIRECTED

LOT 5

DO NOT SCALE FROM THESE DRAWINGS USE DIMENSIONS

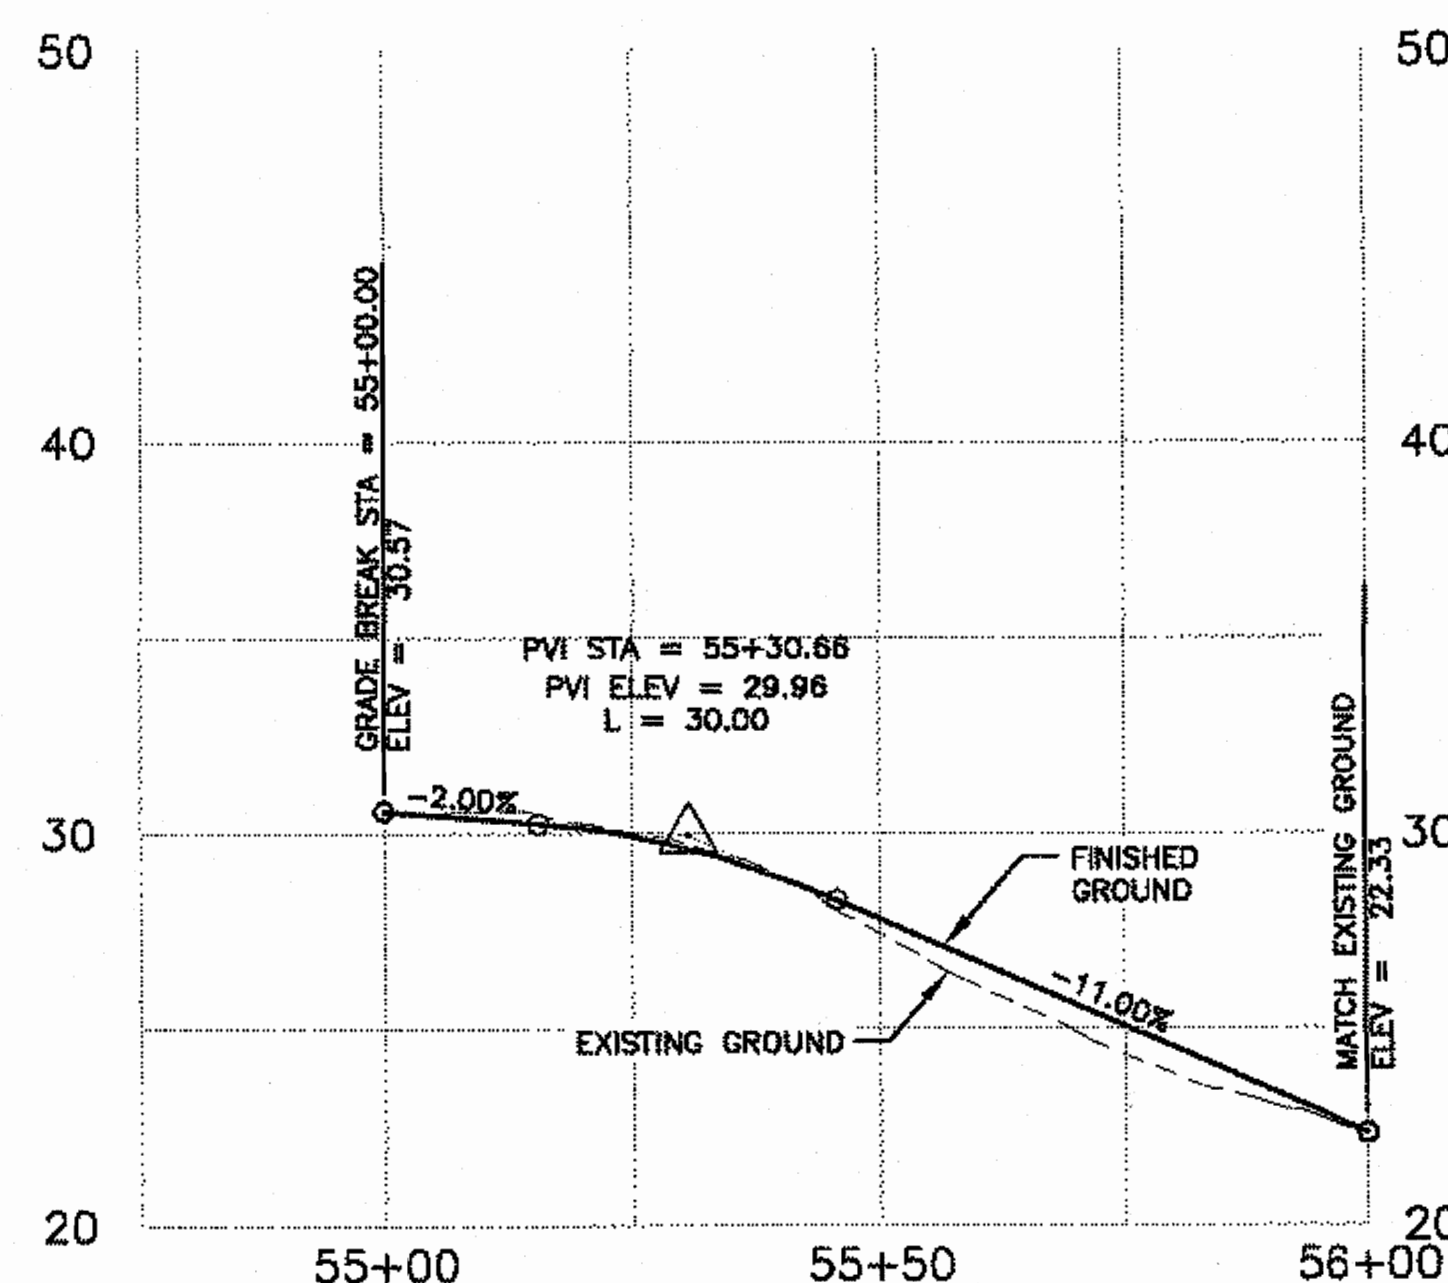

Project As Built Drawings Have Been Reviewed By The Project Engineer & Represent, To The Best Of My Knowledge, The Project As Constructed.
Proj. Eng. *[Signature]* Date 6-24-15

PATH: I:\JUNIFILE\Z\JOBS\1153806\DWG\GIS\SHEETS\G1 SHEETS.DWG

TAB: G01

ADDENDUM NUMBER

ATTACHMENT NUMBER

RECORD OF REVISIONS


No. DATE DESCRIPTION

SAWMILL CREEK ROAD UPGRADE
PHASE III - WHALE PARK TO SAWMILL CREEK BRIDGE
68216MSG-STP-0933(21)
SITKA TELECOMMUNICATIONS CONDUIT
RSA NO. 69615

INTERSECTION GRADING SMCIP DRIVEWAY #1

PREPARED BY: USKH

CHECKED BY:

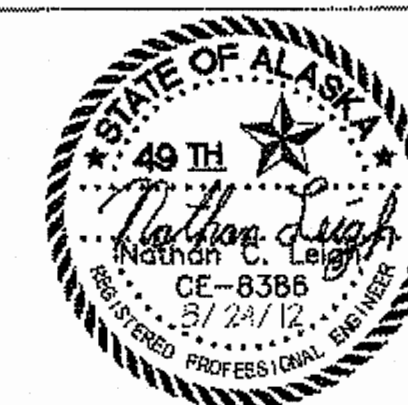

DESIGNED BY:

DRAWN BY:


STATE OF ALASKA
DEPARTMENT OF TRANSPORTATION
& PUBLIC FACILITIES
SOUTHEAST REGION

INTERSECTION
GRADING
SMCIP
DRIVEWAY #1

PROJECT DESIGNATION


68216MSG-STP-0933(21)

STATE	YEAR
ALASKA	2012
SHEET NUMBER	TOTAL SHEETS
G1	109

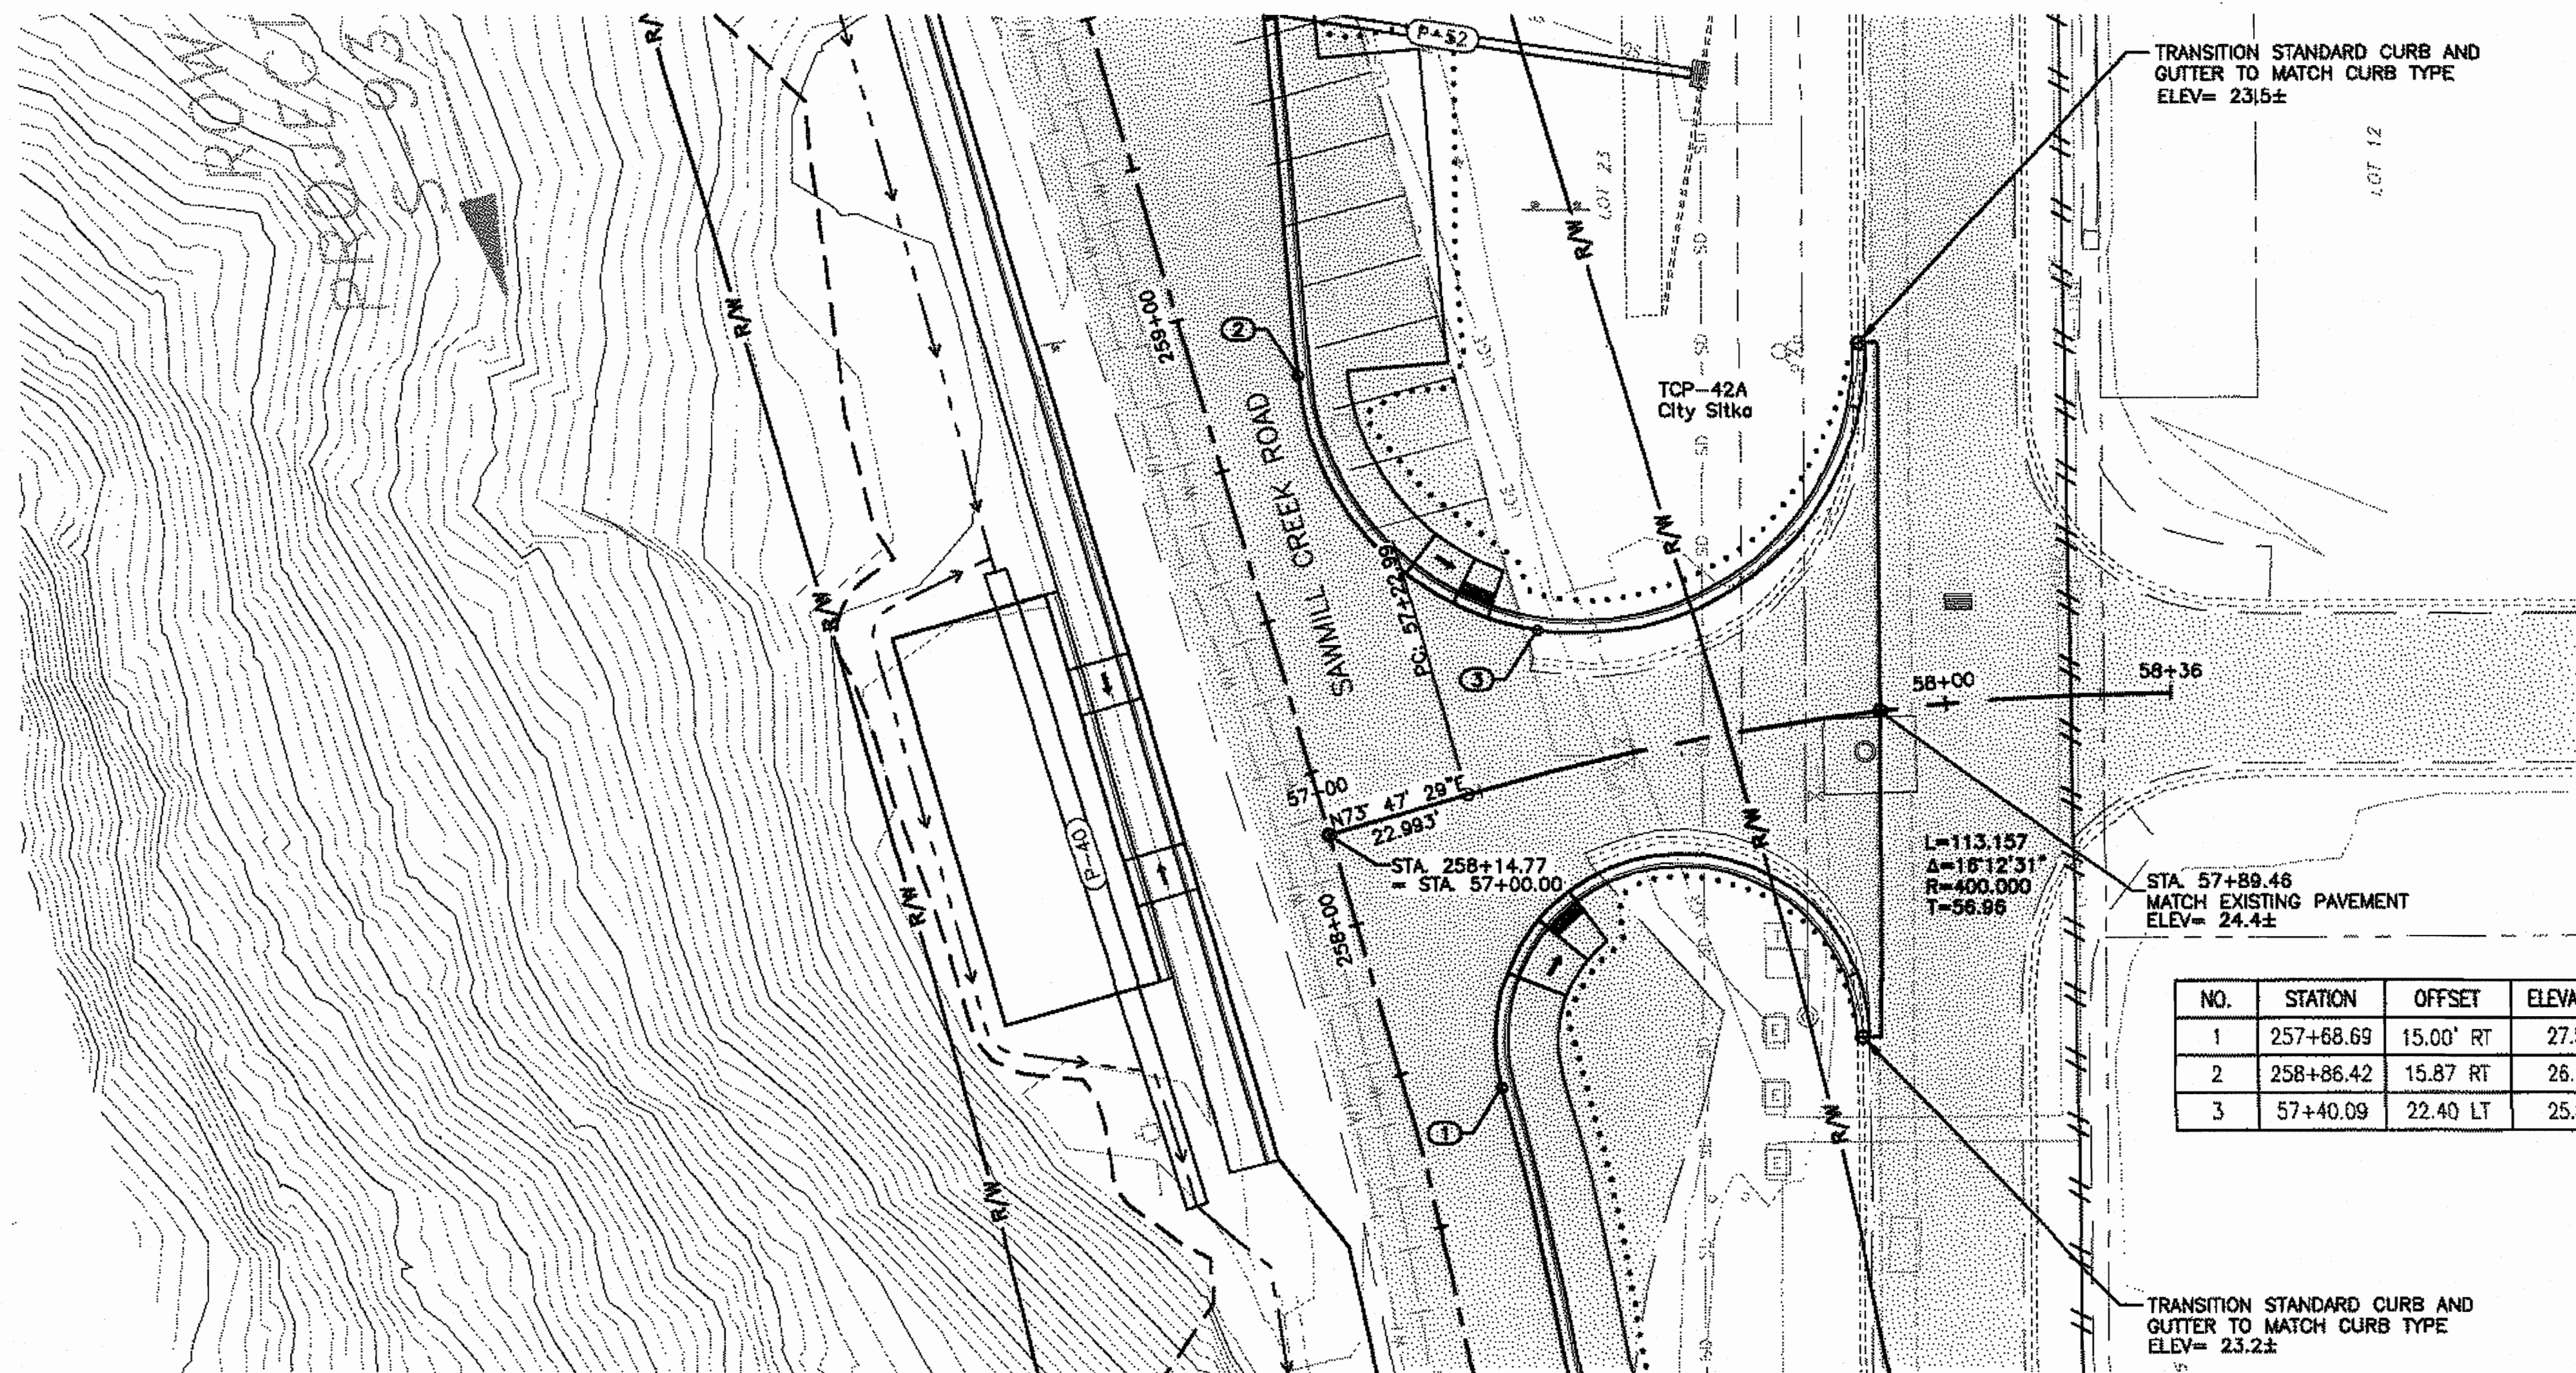

NO.	STATION	OFFSET	ELEVATION	DESCRIPTION
1	257+68.69	15.00' RT	27.52	PC, BEGIN 45' RADIUS
2	258+86.42	15.87 RT	26.15	PC, BEGIN 29.5' RADIUS
3	57+40.09	22.40 LT	25.85	POINT ON CURVE

DO NOT SCALE FROM THESE DRAWINGS USE DIMENSIONS

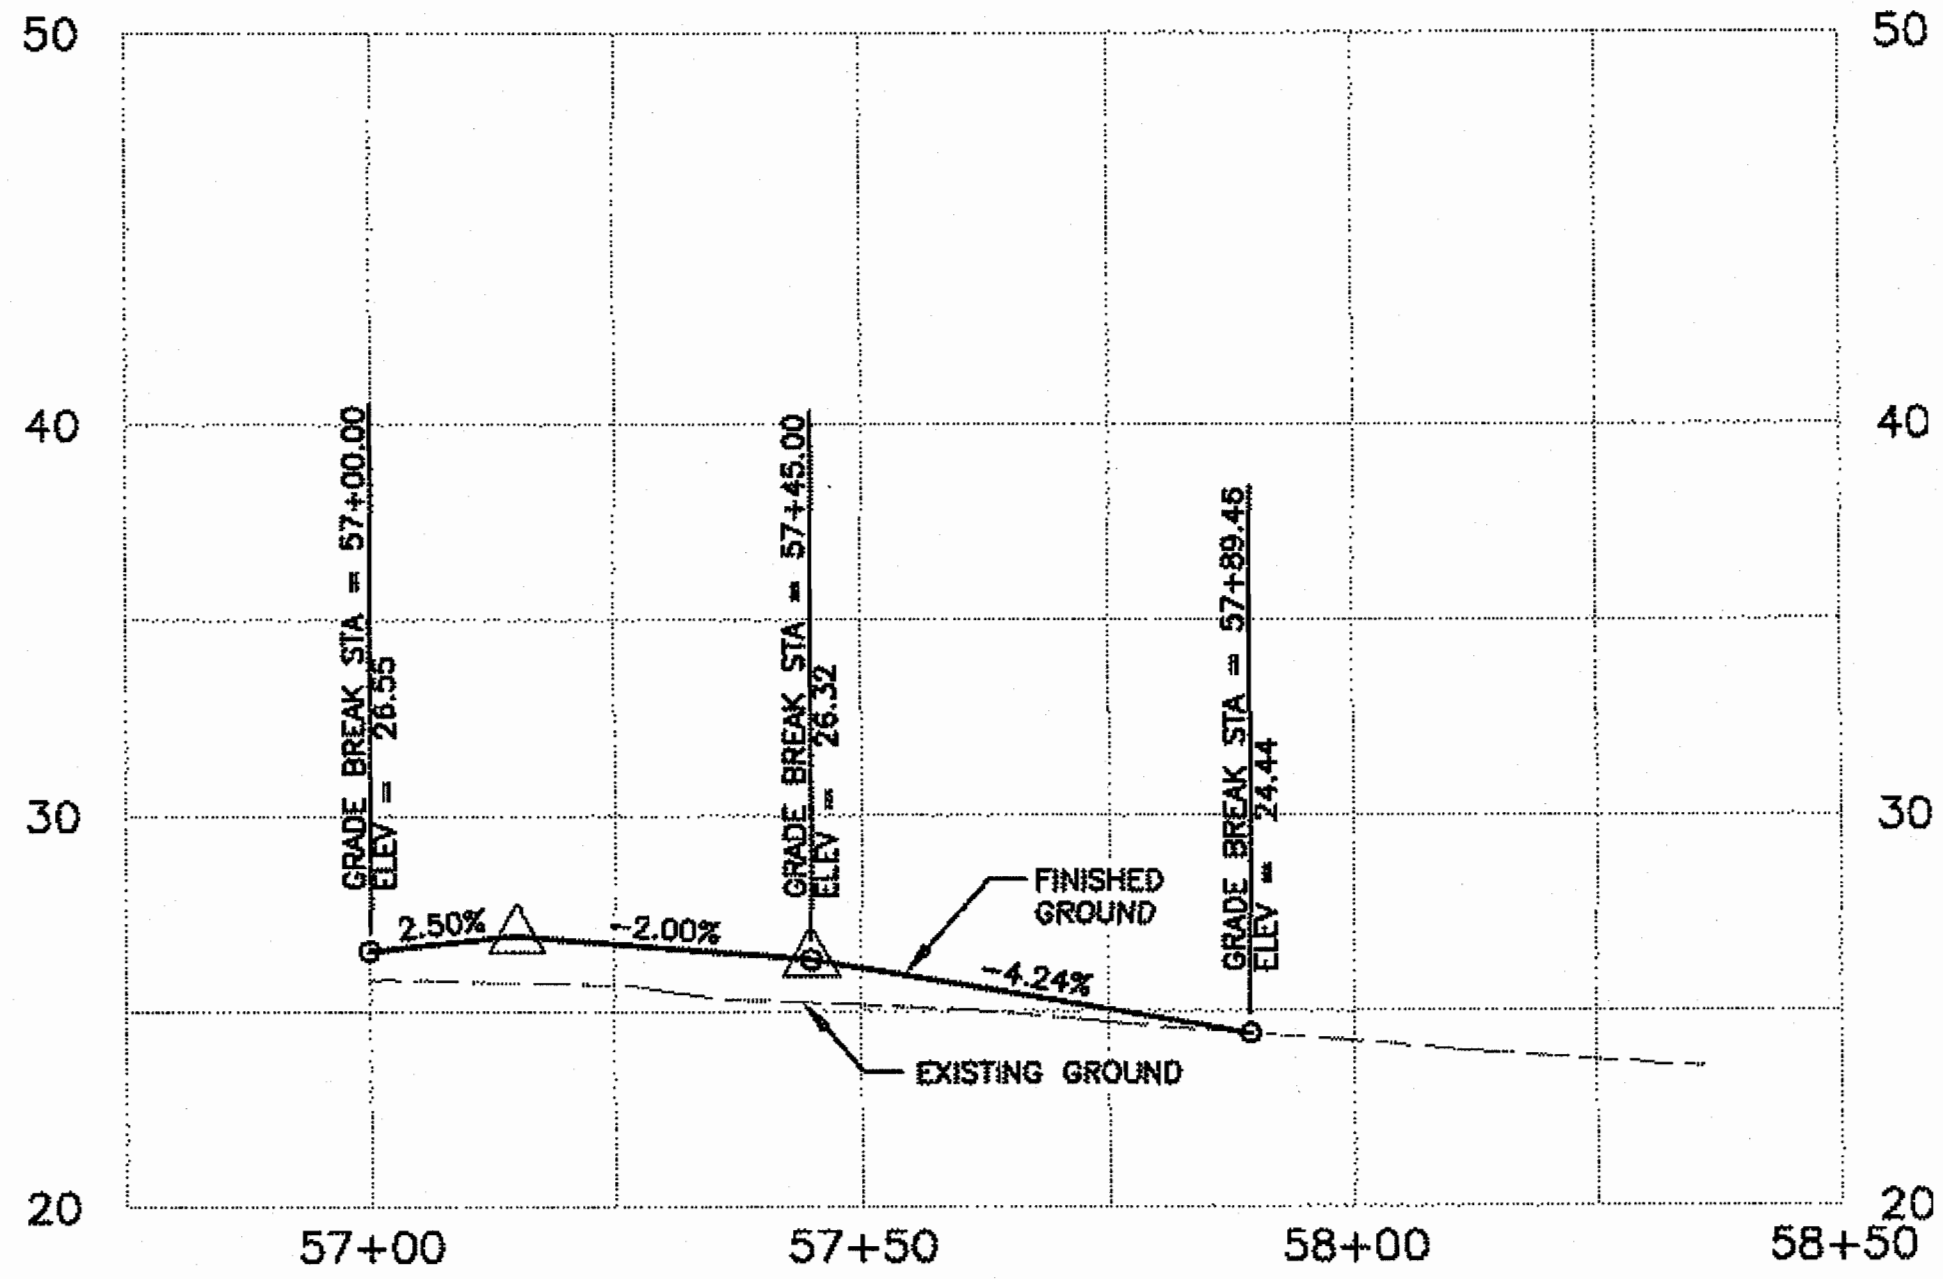

Project As Built Drawings Have Been Reviewed By The Project Engineer & Represent, To The Best Of My Knowledge, The Project As Constructed.
Proj. Eng. *[Signature]* 6-24-15 Date

PATH: \\UNIFILE2\JOBS\1153805\DWG\SG\SGSHEETS\SG SHEETS.DWG

TAB: G02

ADDENDUM NUMBER

ATTACHMENT NUMBER

RECORD OF REVISIONS

No.	DATE	DESCRIPTION

SAWMILL CREEK ROAD UPGRADE
PHASE III - WHALE PARK TO SAWMILL CREEK BRIDGE
68216MSG-STP-0933(21)
SITKA TELECOMMUNICATIONS CONDUIT
RSA NO. 69615

INTESECTION GRADING SMCIP DRIVEWAY #2

PREPARED BY: USKH

CHECKED BY:

DESIGNED BY:

DRAWN BY:


STATE OF ALASKA
DEPARTMENT OF TRANSPORTATION
& PUBLIC FACILITIES
SOUTHEAST REGION

INTESECTION
GRADING
SMCIP
DRIVEWAY #2


PROJECT DESIGNATION
68216MSG-STP-0933(21)

STATE	YEAR
ALASKA	2012

SHEET NUMBER	TOTAL SHEETS
G2	109

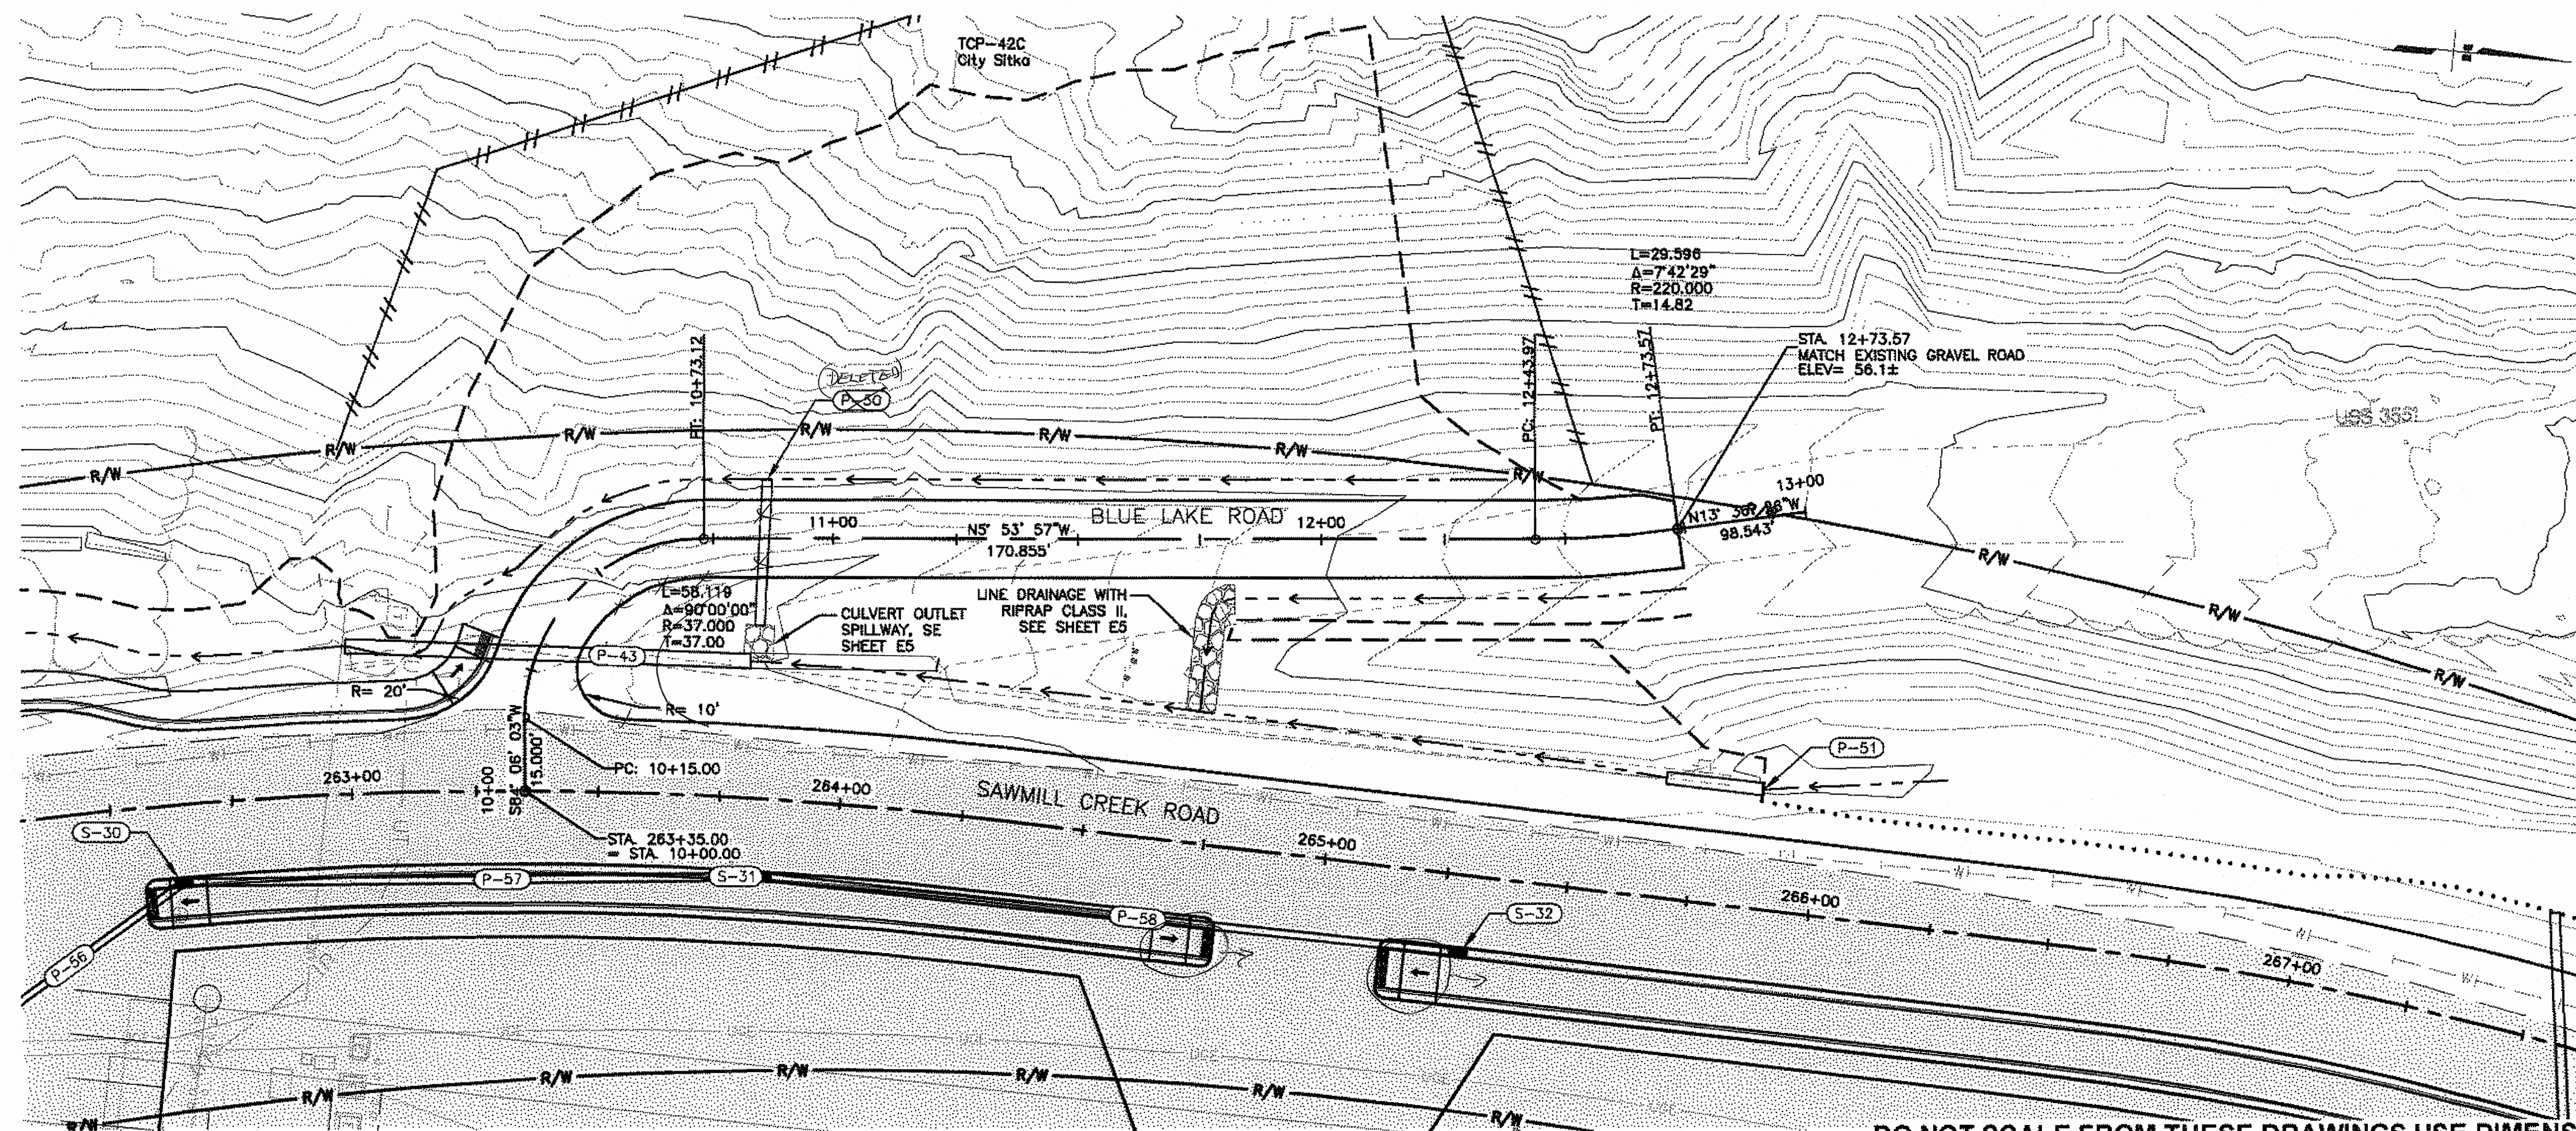

DO NOT SCALE FROM THESE DRAWINGS USE DIMENSIONS

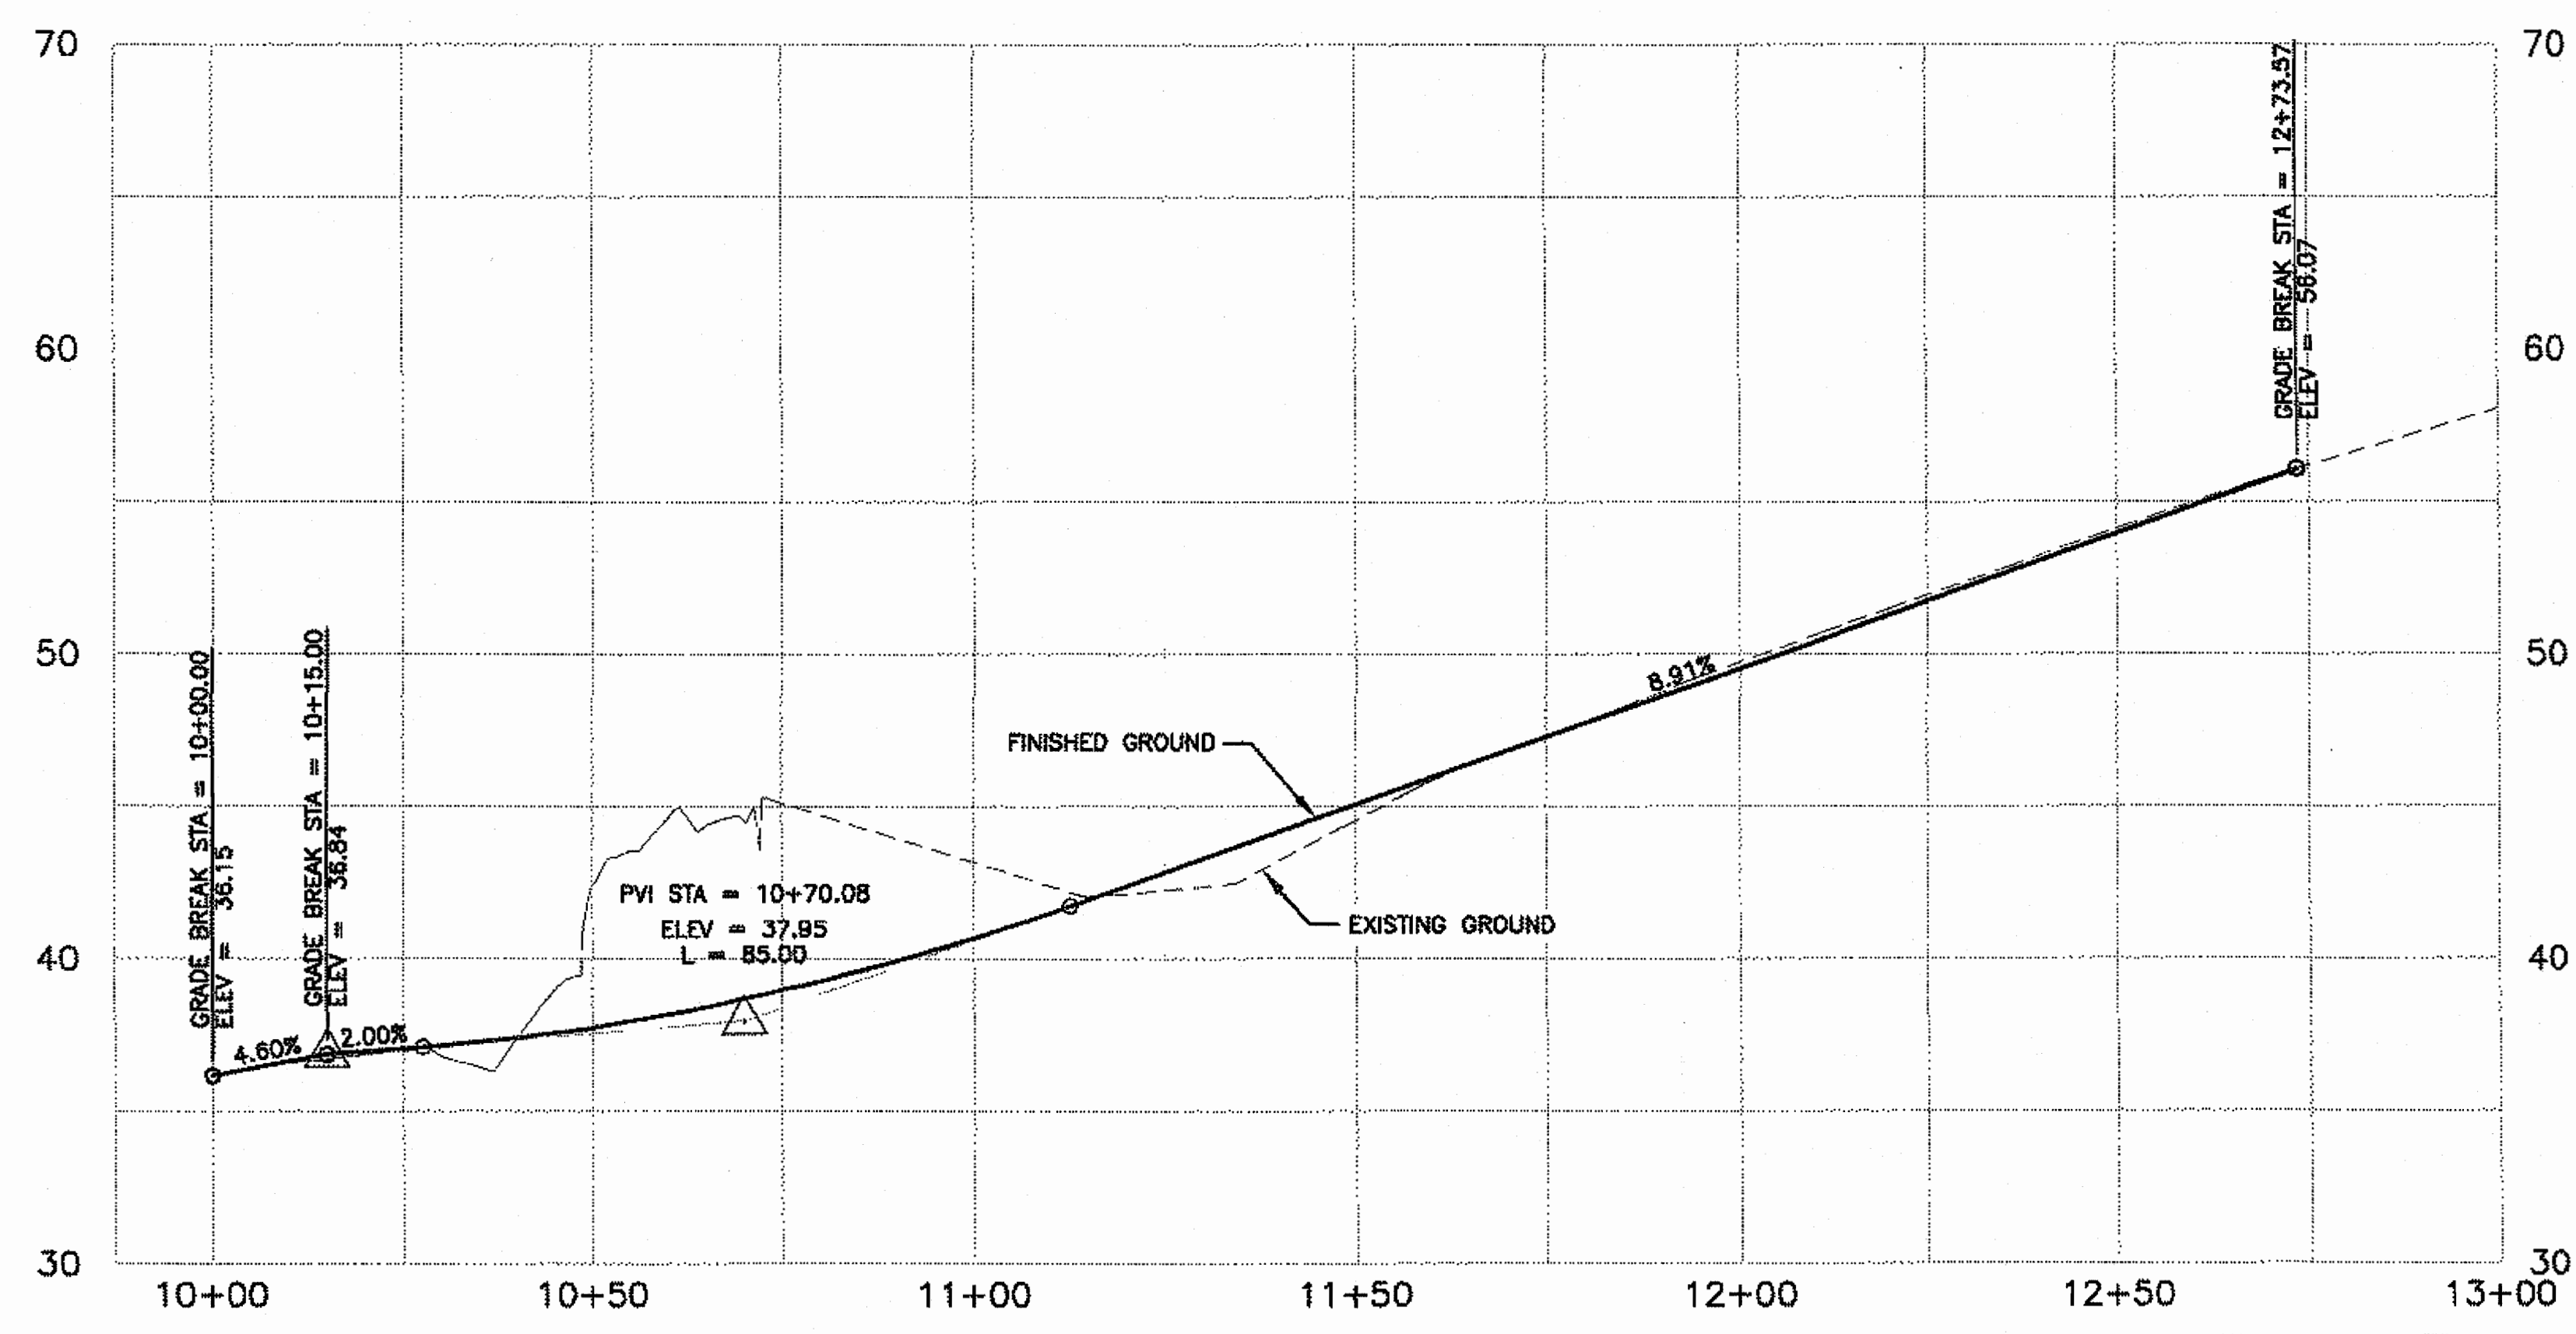

Project As Built Drawings Have Been Reviewed By The Project Engineer & Represent, To The Best Of My Knowledge, The Project As Constructed.
 Proj. Eng. *[Signature]* Date 6-24-15

PATH: \\JN\FILE2\JOBS\1153805\DWG\GIS\SHEETS\G SHEETS.DWG

TAB: G03

ADDENDUM NUMBER

ATTACHMENT NUMBER

RECORD OF REVISIONS

No.	DATE	DESCRIPTION

SAWMILL CREEK ROAD UPGRADE
PHASE III - WHALE PARK TO SAWMILL CREEK BRIDGE
68216MSG-STP-0933(21)
SITKA TELECOMMUNICATIONS CONDUIT
RSA NO. 69615

PREPARED BY: USKH

CHECKED BY:

STATE OF ALASKA

40TH

North C. Leigh

CE-8388

6/24/15

REGISTERED PROFESSIONAL ENGINEER

DESIGNED BY:

DRAWN BY:



STATE OF ALASKA
 DEPARTMENT OF TRANSPORTATION
 & PUBLIC FACILITIES
 SOUTHEAST REGION

**INTERSECTION GRADING
 BLUE LAKE
 ROAD**

PROJECT DESIGNATION
68216MSG-STP-0933(21)

STATE	YEAR
ALASKA	2012
SHEET NUMBER	TOTAL SHEETS
G3	109

INTERSECTION GRADING BLUE LAKE ROAD

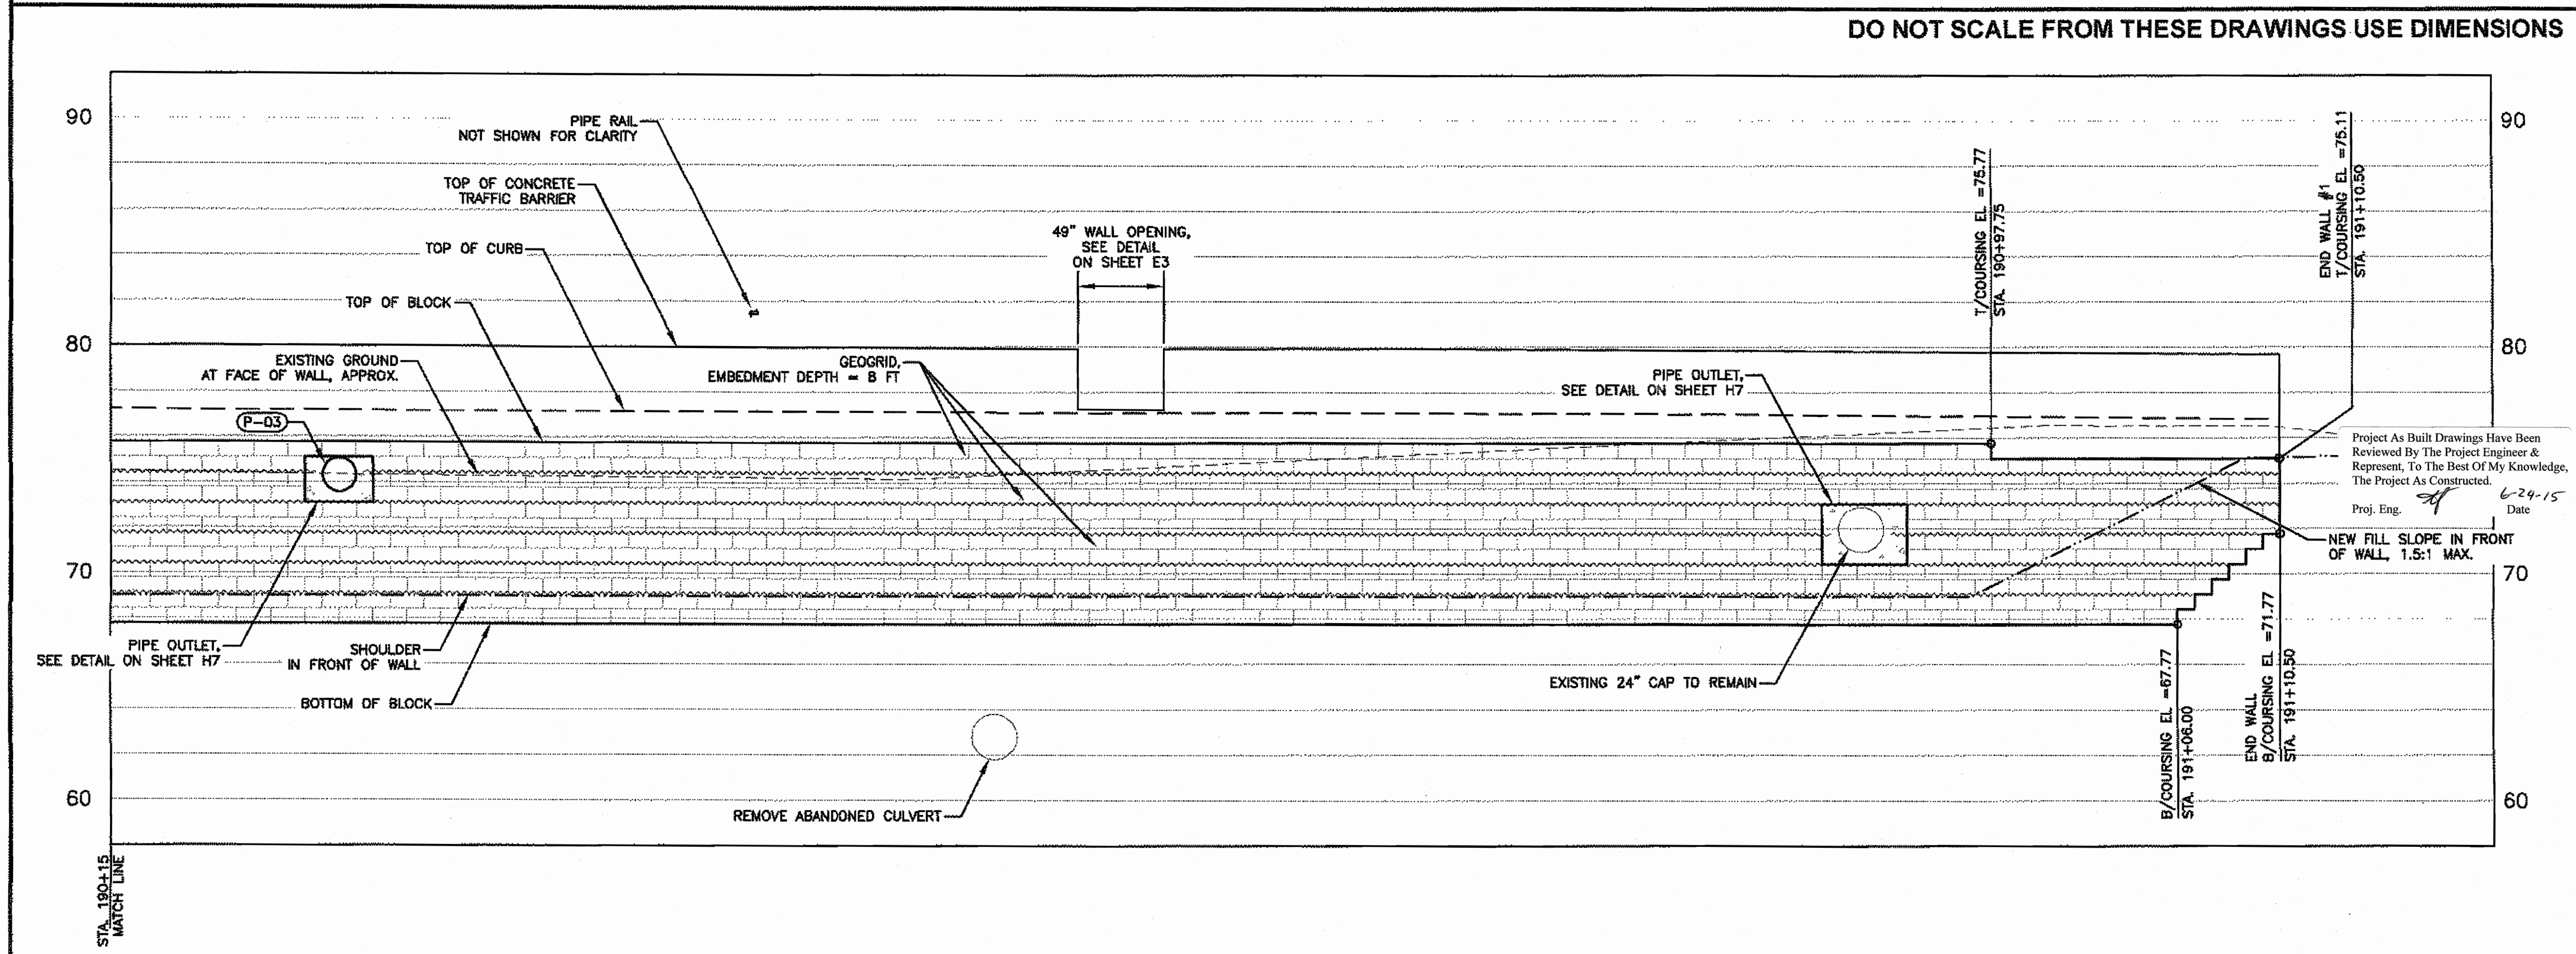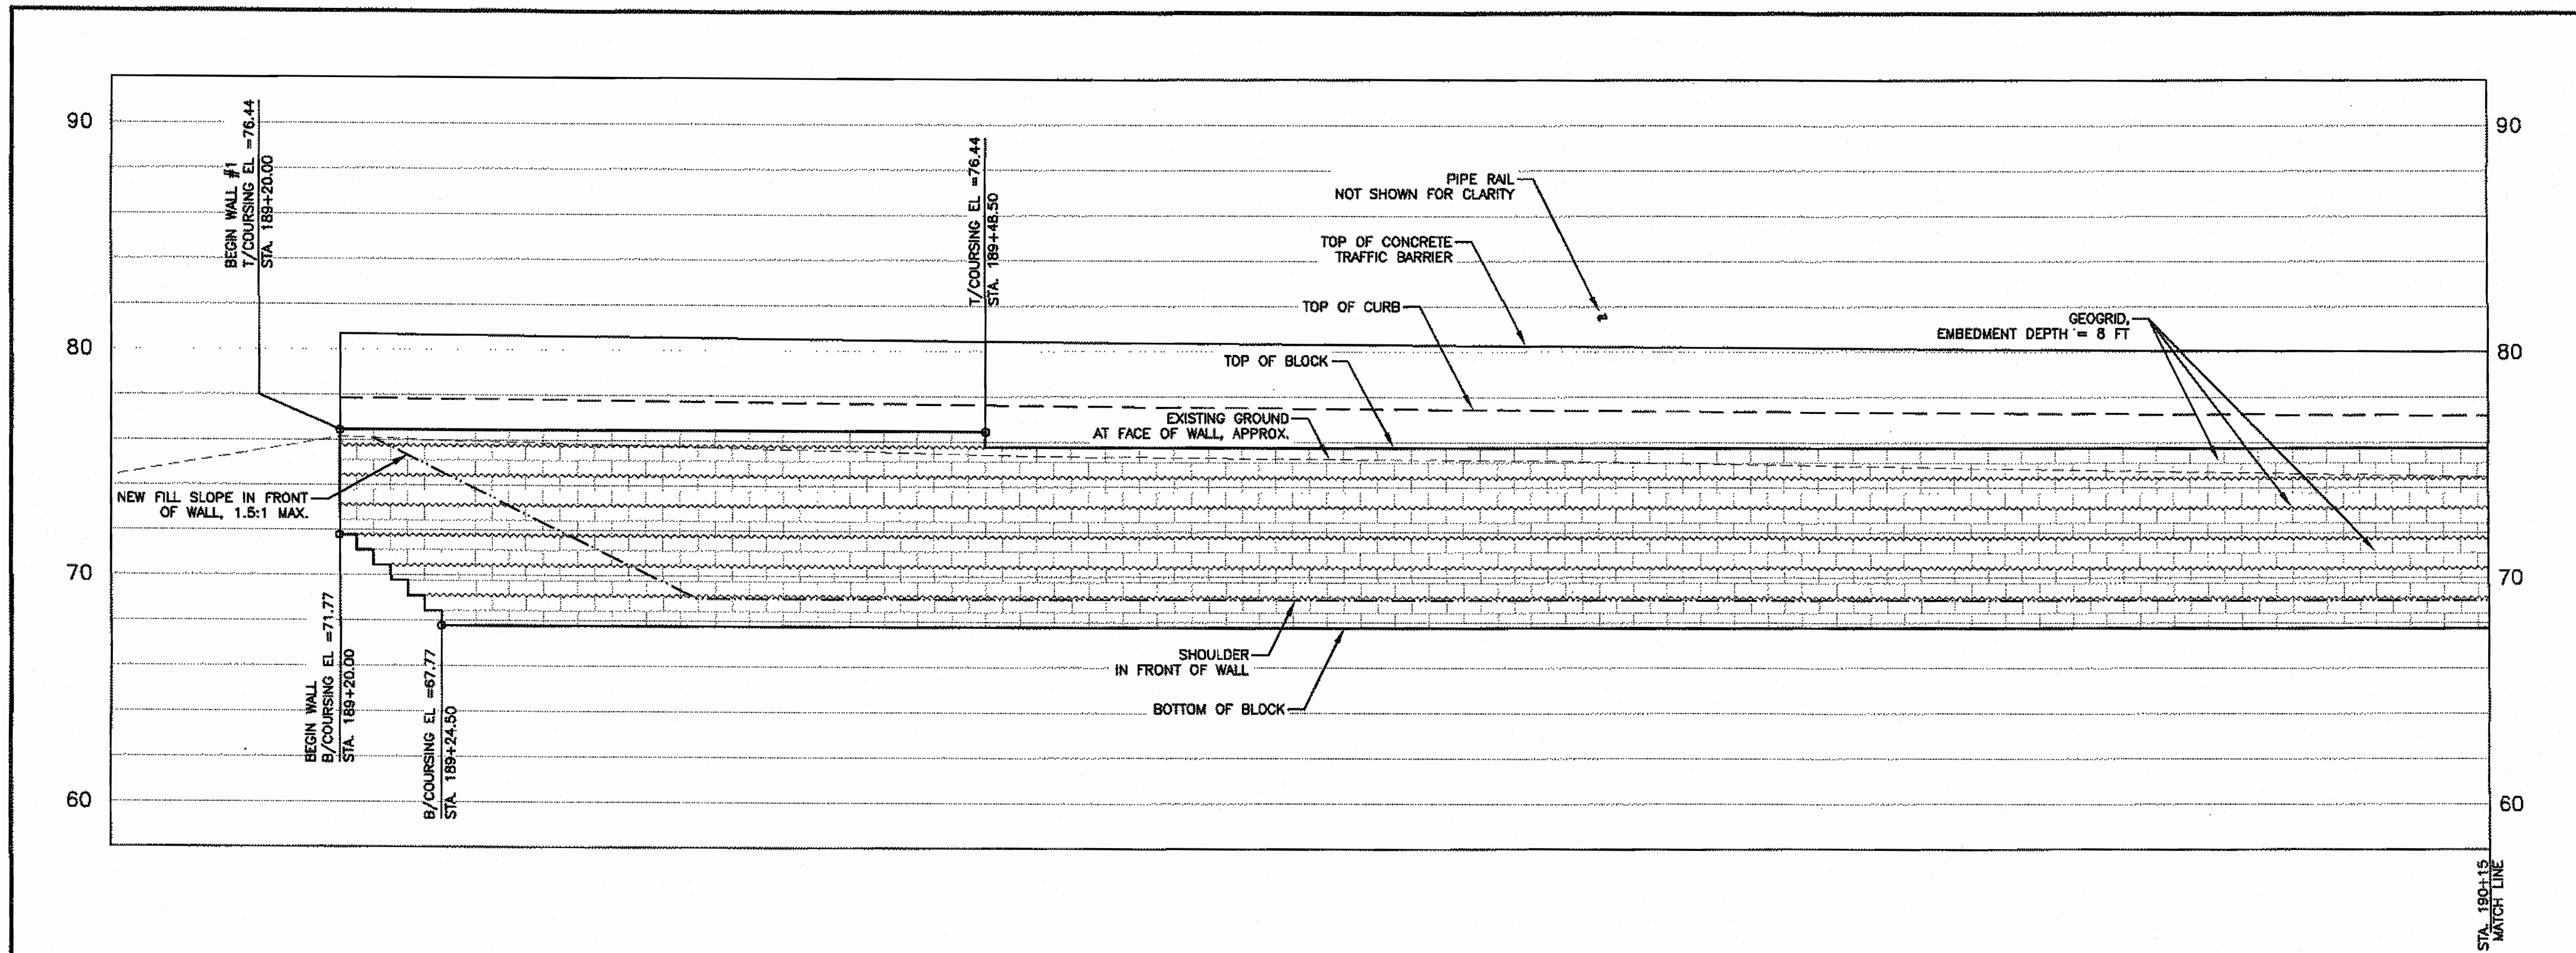

PATH: \\UNFILE2\JOBS\1153805\DWGS\CIS\H01-H05

TAB: H01

ADDENDUM NUMBER

ATTACHMENT NUMBER

RECORD OF REVISIONS

No.	DATE	DESCRIPTION

SAWMILL CREEK ROAD UPGRADE
PHASE III - WHALE PARK TO SAWMILL CREEK BRIDGE
88216MSG-STP-0933(21)
SITKA TELECOMMUNICATIONS CONDUIT
RSA NO. 68615

RETAINING WALL DETAILS

PREPARED BY: USKH

CHECKED BY: BH

DESIGNED BY: NCL

DRAWN BY: WJP


STATE OF ALASKA
DEPARTMENT OF TRANSPORTATION
& PUBLIC FACILITIES
SOUTHEAST REGION

RETAINING WALL DETAILS


PROJECT DESIGNATION
88216MSG-STP-0933(21)

STATE	YEAR
ALASKA	2012

SHEET NUMBER	TOTAL SHEETS
H1	109

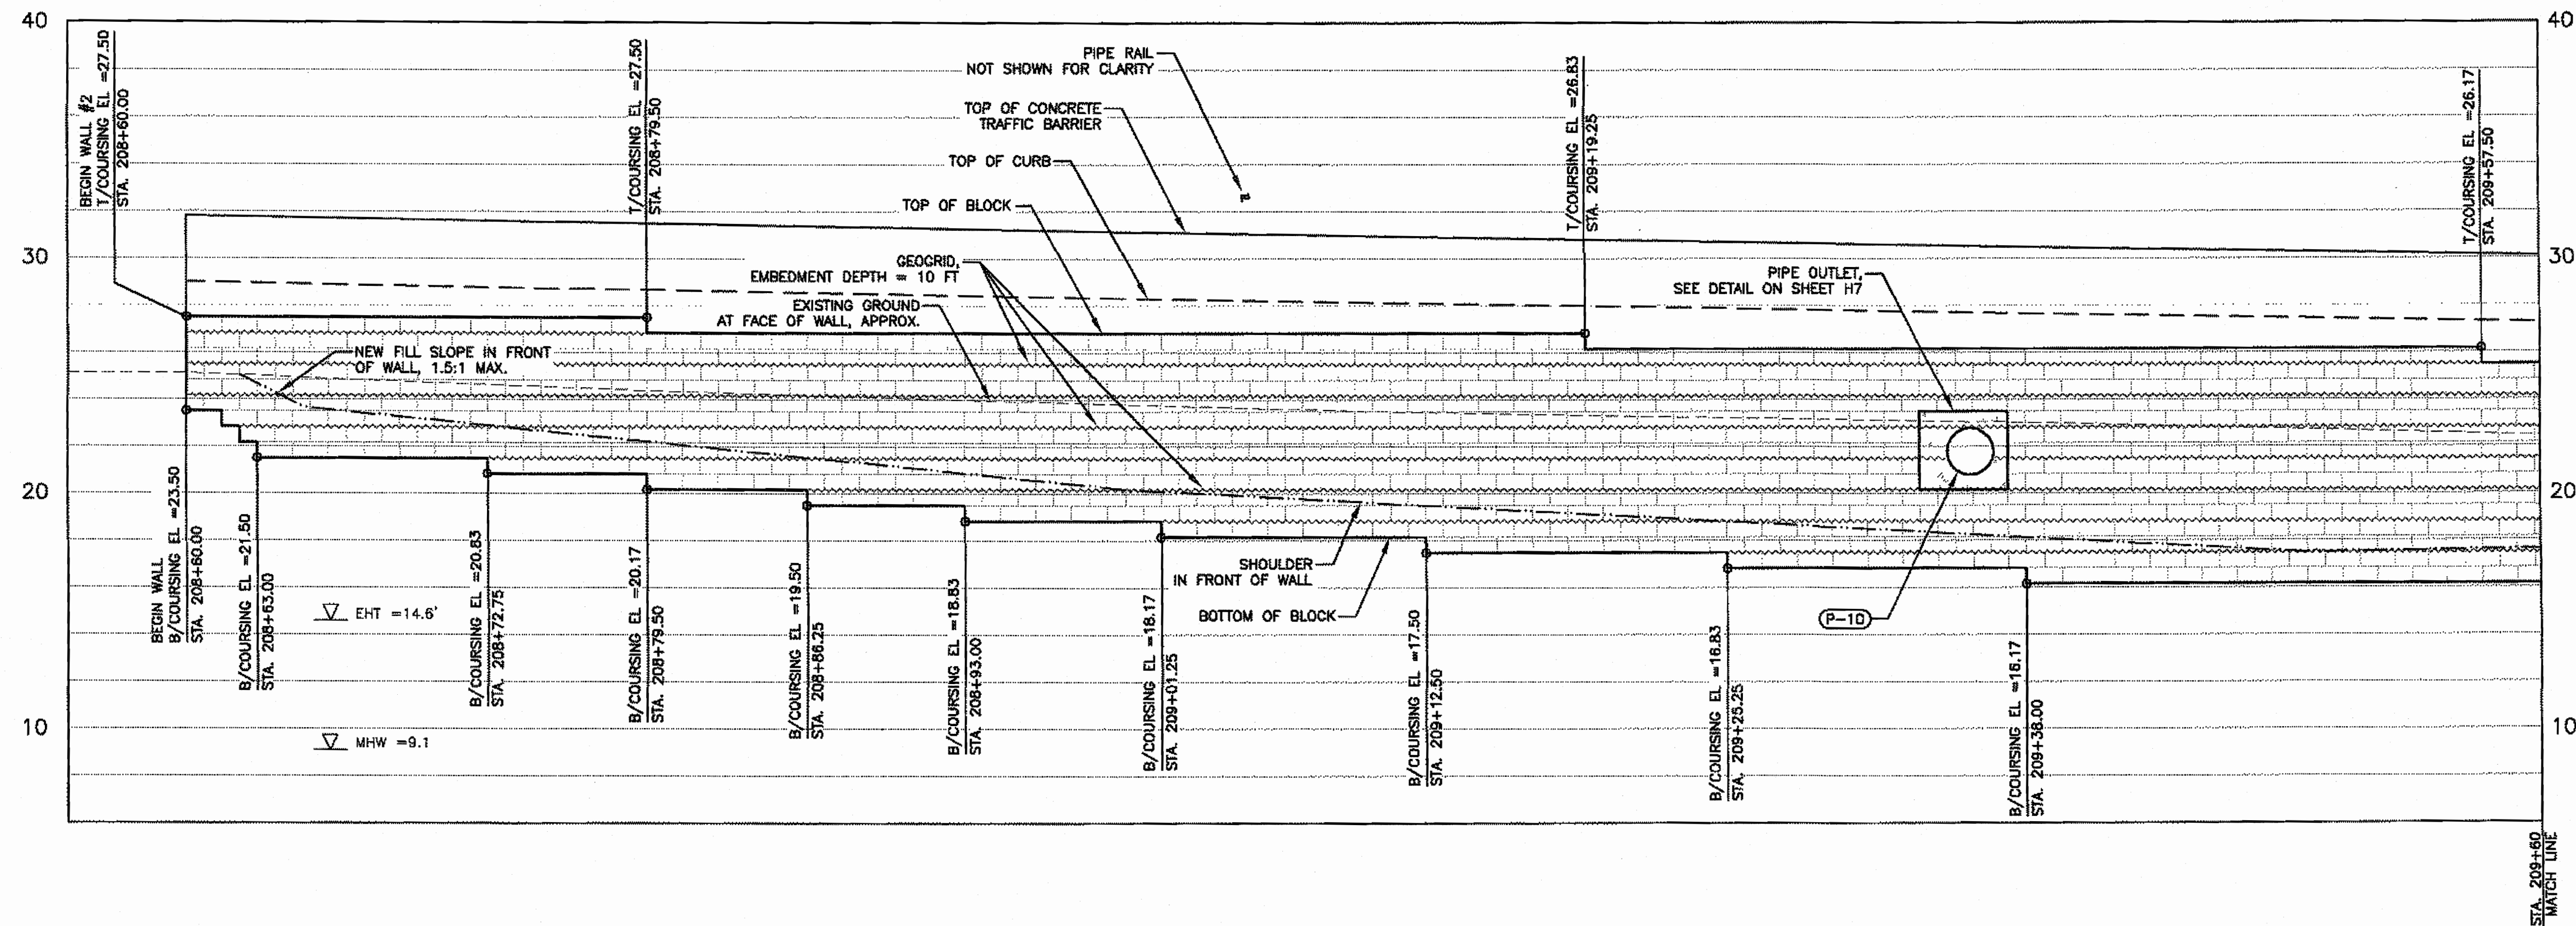


DO NOT SCALE FROM THESE DRAWINGS USE DIMENSIONS

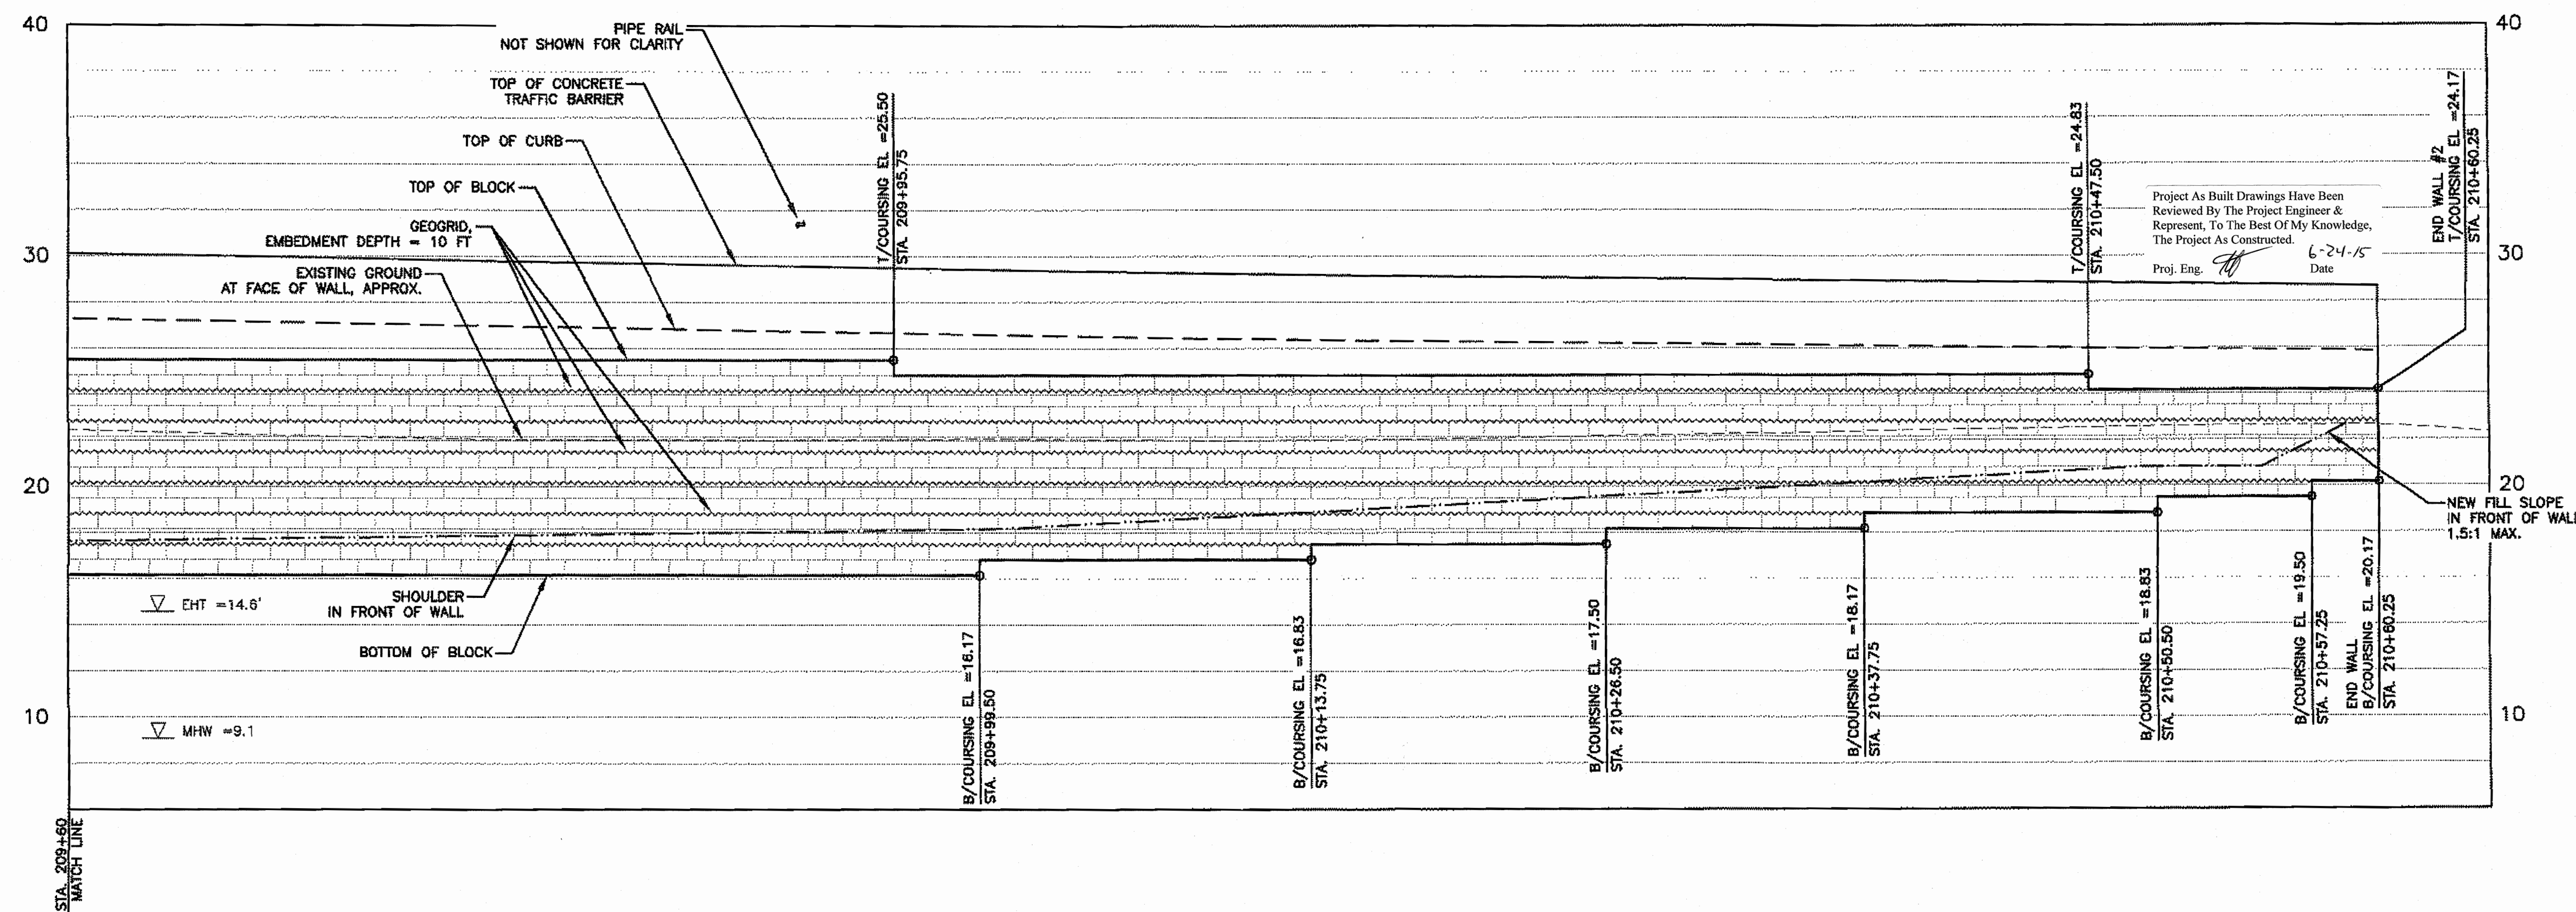


PATH: \\NUNFILE\JOBS\1153805\DWG\CS\H01-H05		
TAB: H02		
ADDENDUM NUMBER		
ATTACHMENT NUMBER		
RECORD OF REVISIONS		
No.	DATE	DESCRIPTION
SAWMILL CREEK ROAD UPGRADE PHASE III - WHALE PARK TO SAWMILL CREEK BRIDGE 68216MSG-STP-0933(21) SITKA TELECOMMUNICATIONS CONDUIT RSA NO. 69615		
RETAINING WALL DETAILS		
PREPARED BY: USKH		
CHECKED BY: BH		
DESIGNED BY: NCL		
DRAWN BY: WJP		
STATE OF ALASKA DEPARTMENT OF TRANSPORTATION & PUBLIC FACILITIES SOUTHEAST REGION		
RETAINING WALL DETAILS		
PROJECT DESIGNATION 68216MSG-STP-0933(21)		
STATE	YEAR	
ALASKA	2012	
SHEET NUMBER	TOTAL SHEETS	
H2	109	

SHOP DRAWINGS - MSE WALL #3

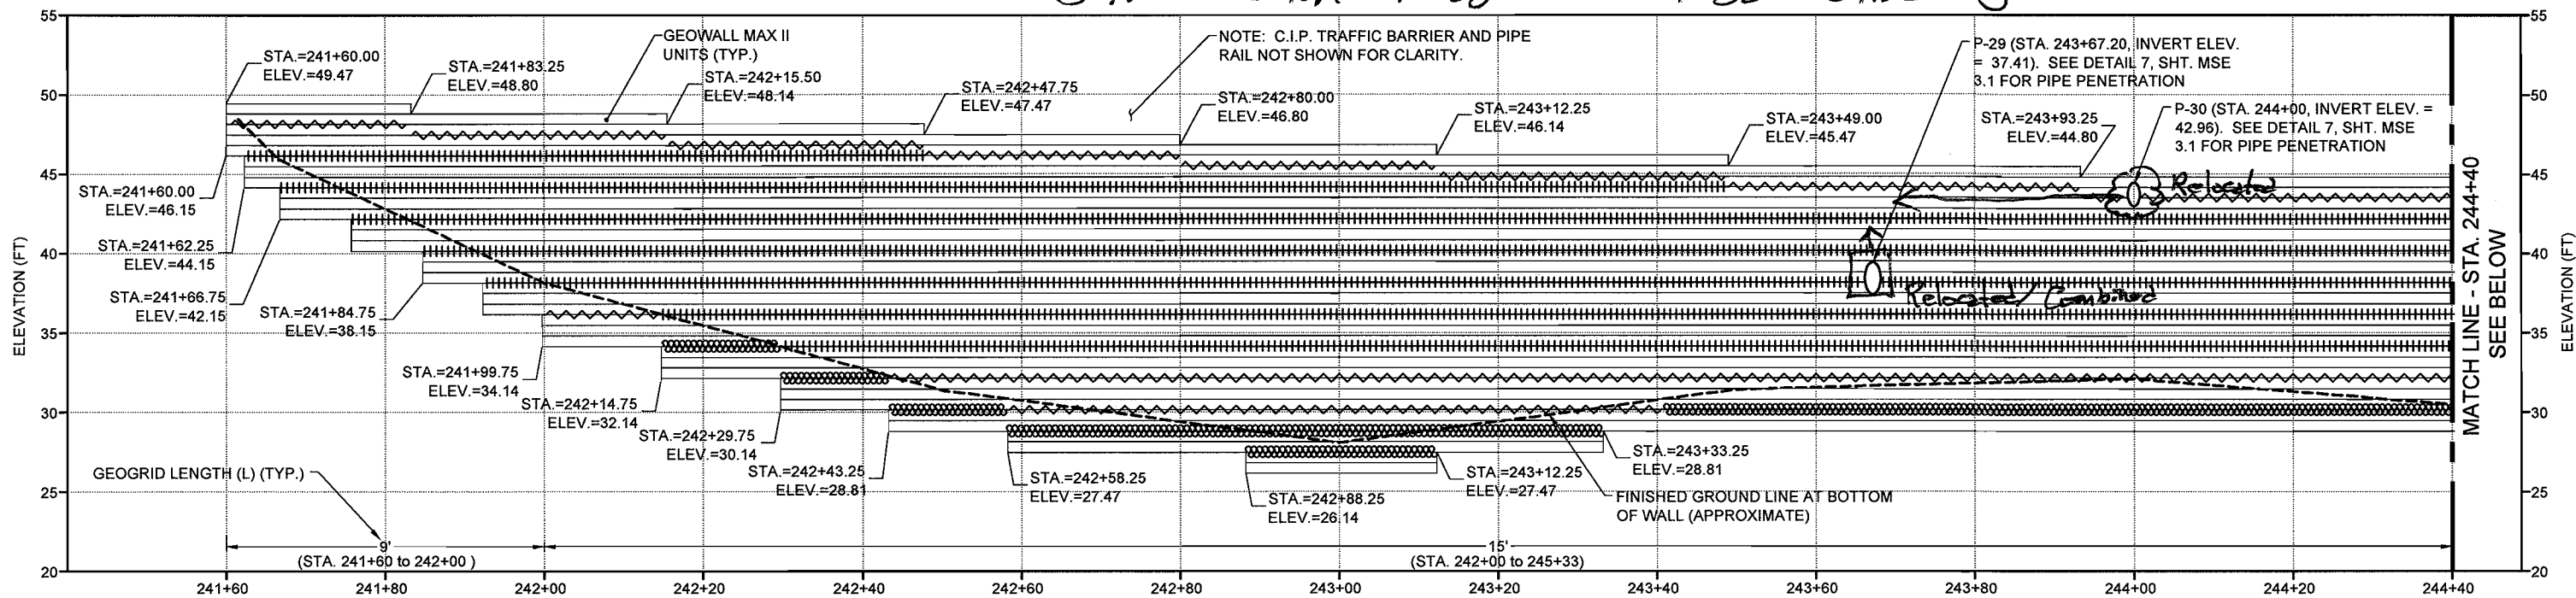

Project As Built Drawings Have Been Reviewed By The Project Engineer & Represent, To The Best Of My Knowledge, The Project As Constructed.

Proj. Eng. *[Signature]* Date 6-24-15

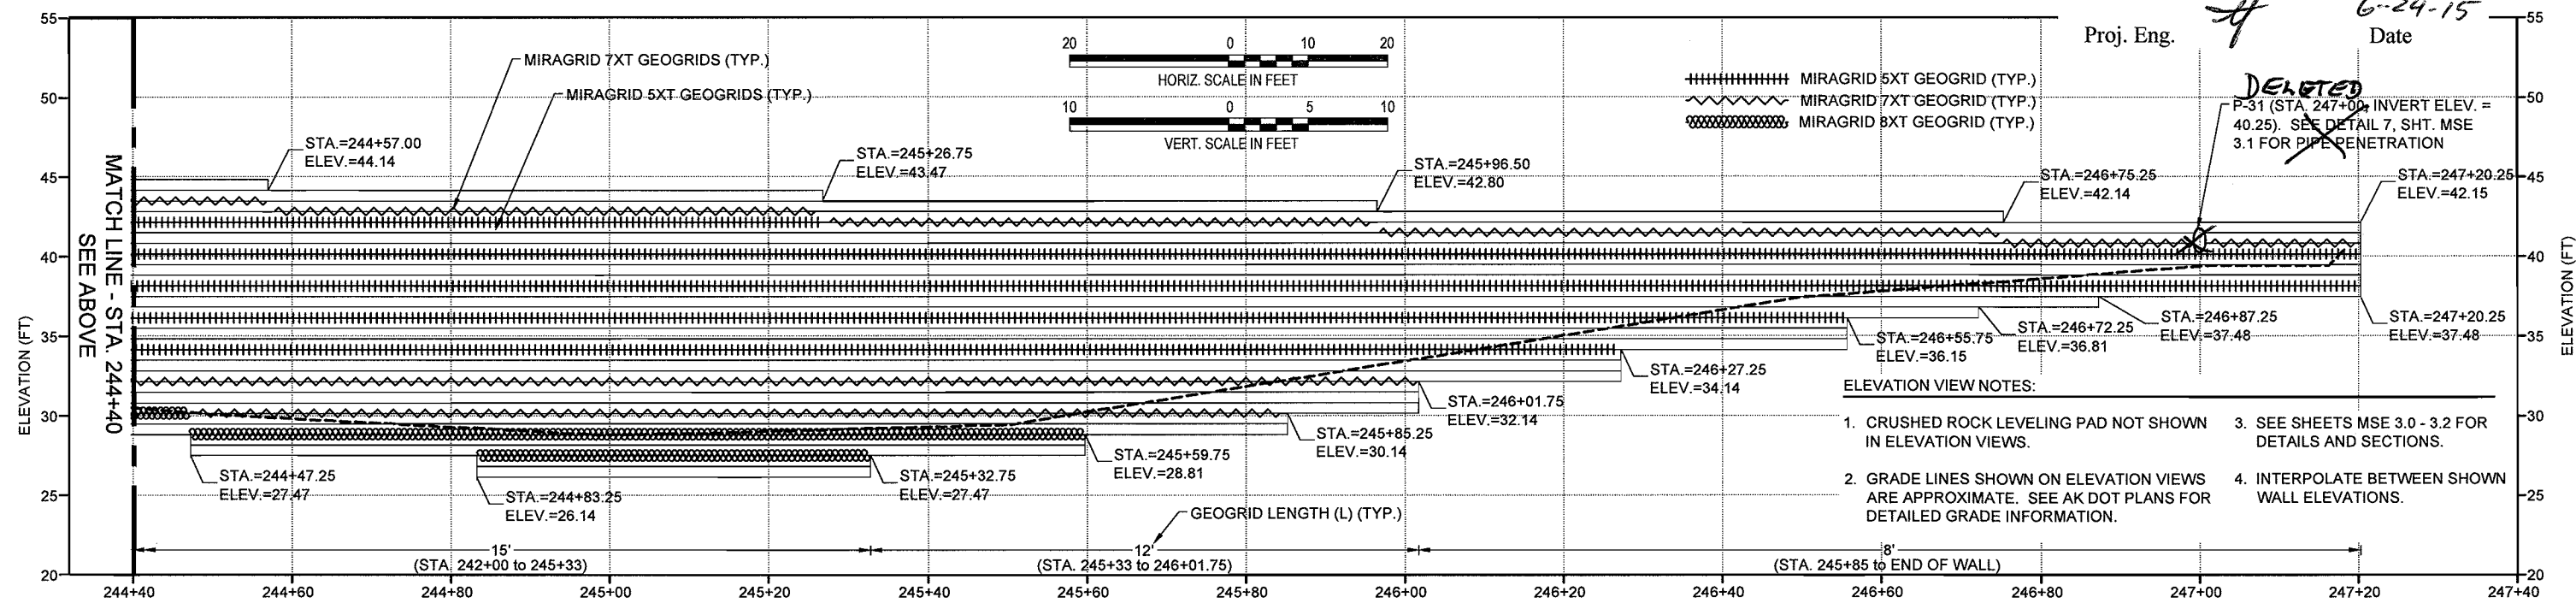


- ELEVATION VIEW NOTES:
1. CRUSHED ROCK LEVELING PAD NOT SHOWN IN ELEVATION VIEWS.
 2. GRADE LINES SHOWN ON ELEVATION VIEWS ARE APPROXIMATE. SEE AK DOT PLANS FOR DETAILED GRADE INFORMATION.
 3. SEE SHEETS MSE 3.0 - 3.2 FOR DETAILS AND SECTIONS.
 4. INTERPOLATE BETWEEN SHOWN WALL ELEVATIONS.

1 WALL #3 ELEVATION VIEW (FRONT FACE OF WALL)

C:\Users\ZGA\Projects\1051-1100\1050.01 Sawmill (SIT)K Creek Road SEWMSWorking Folder\Drawings\Wall Design (Working).dwg

SUBMITTAL RECORD				DESIGNED: RAR			ZGA Zipper Geo Associates, LLC		SAWMILL CREEK ROAD UPGRADE PHASE III		DRAWING	
				DRAWN: RAR			Geotechnical and Environmental Consultants		MECHANICALLY STABILIZED EARTH WALLS		MSE 21	
				CHECKED: TAJ					(AKDOT 68216/MSG-STP-0933(21))		SHEET	
				SCALE: AS NOTED							3	
				DATE: 04/16/13							OF	
4/16/13 RAR INITIAL SUBMITTAL				PRJCT. NO. 1090.01		19023 36th Avenue West, Suite D Lynnwood, WA 98036				7		
				PLOT DATE: 4/16/13		PH: (425) 582-9928 Fax: (425) 582-9930 www.zippergeo.com						
				LAST EDIT: Base Station								

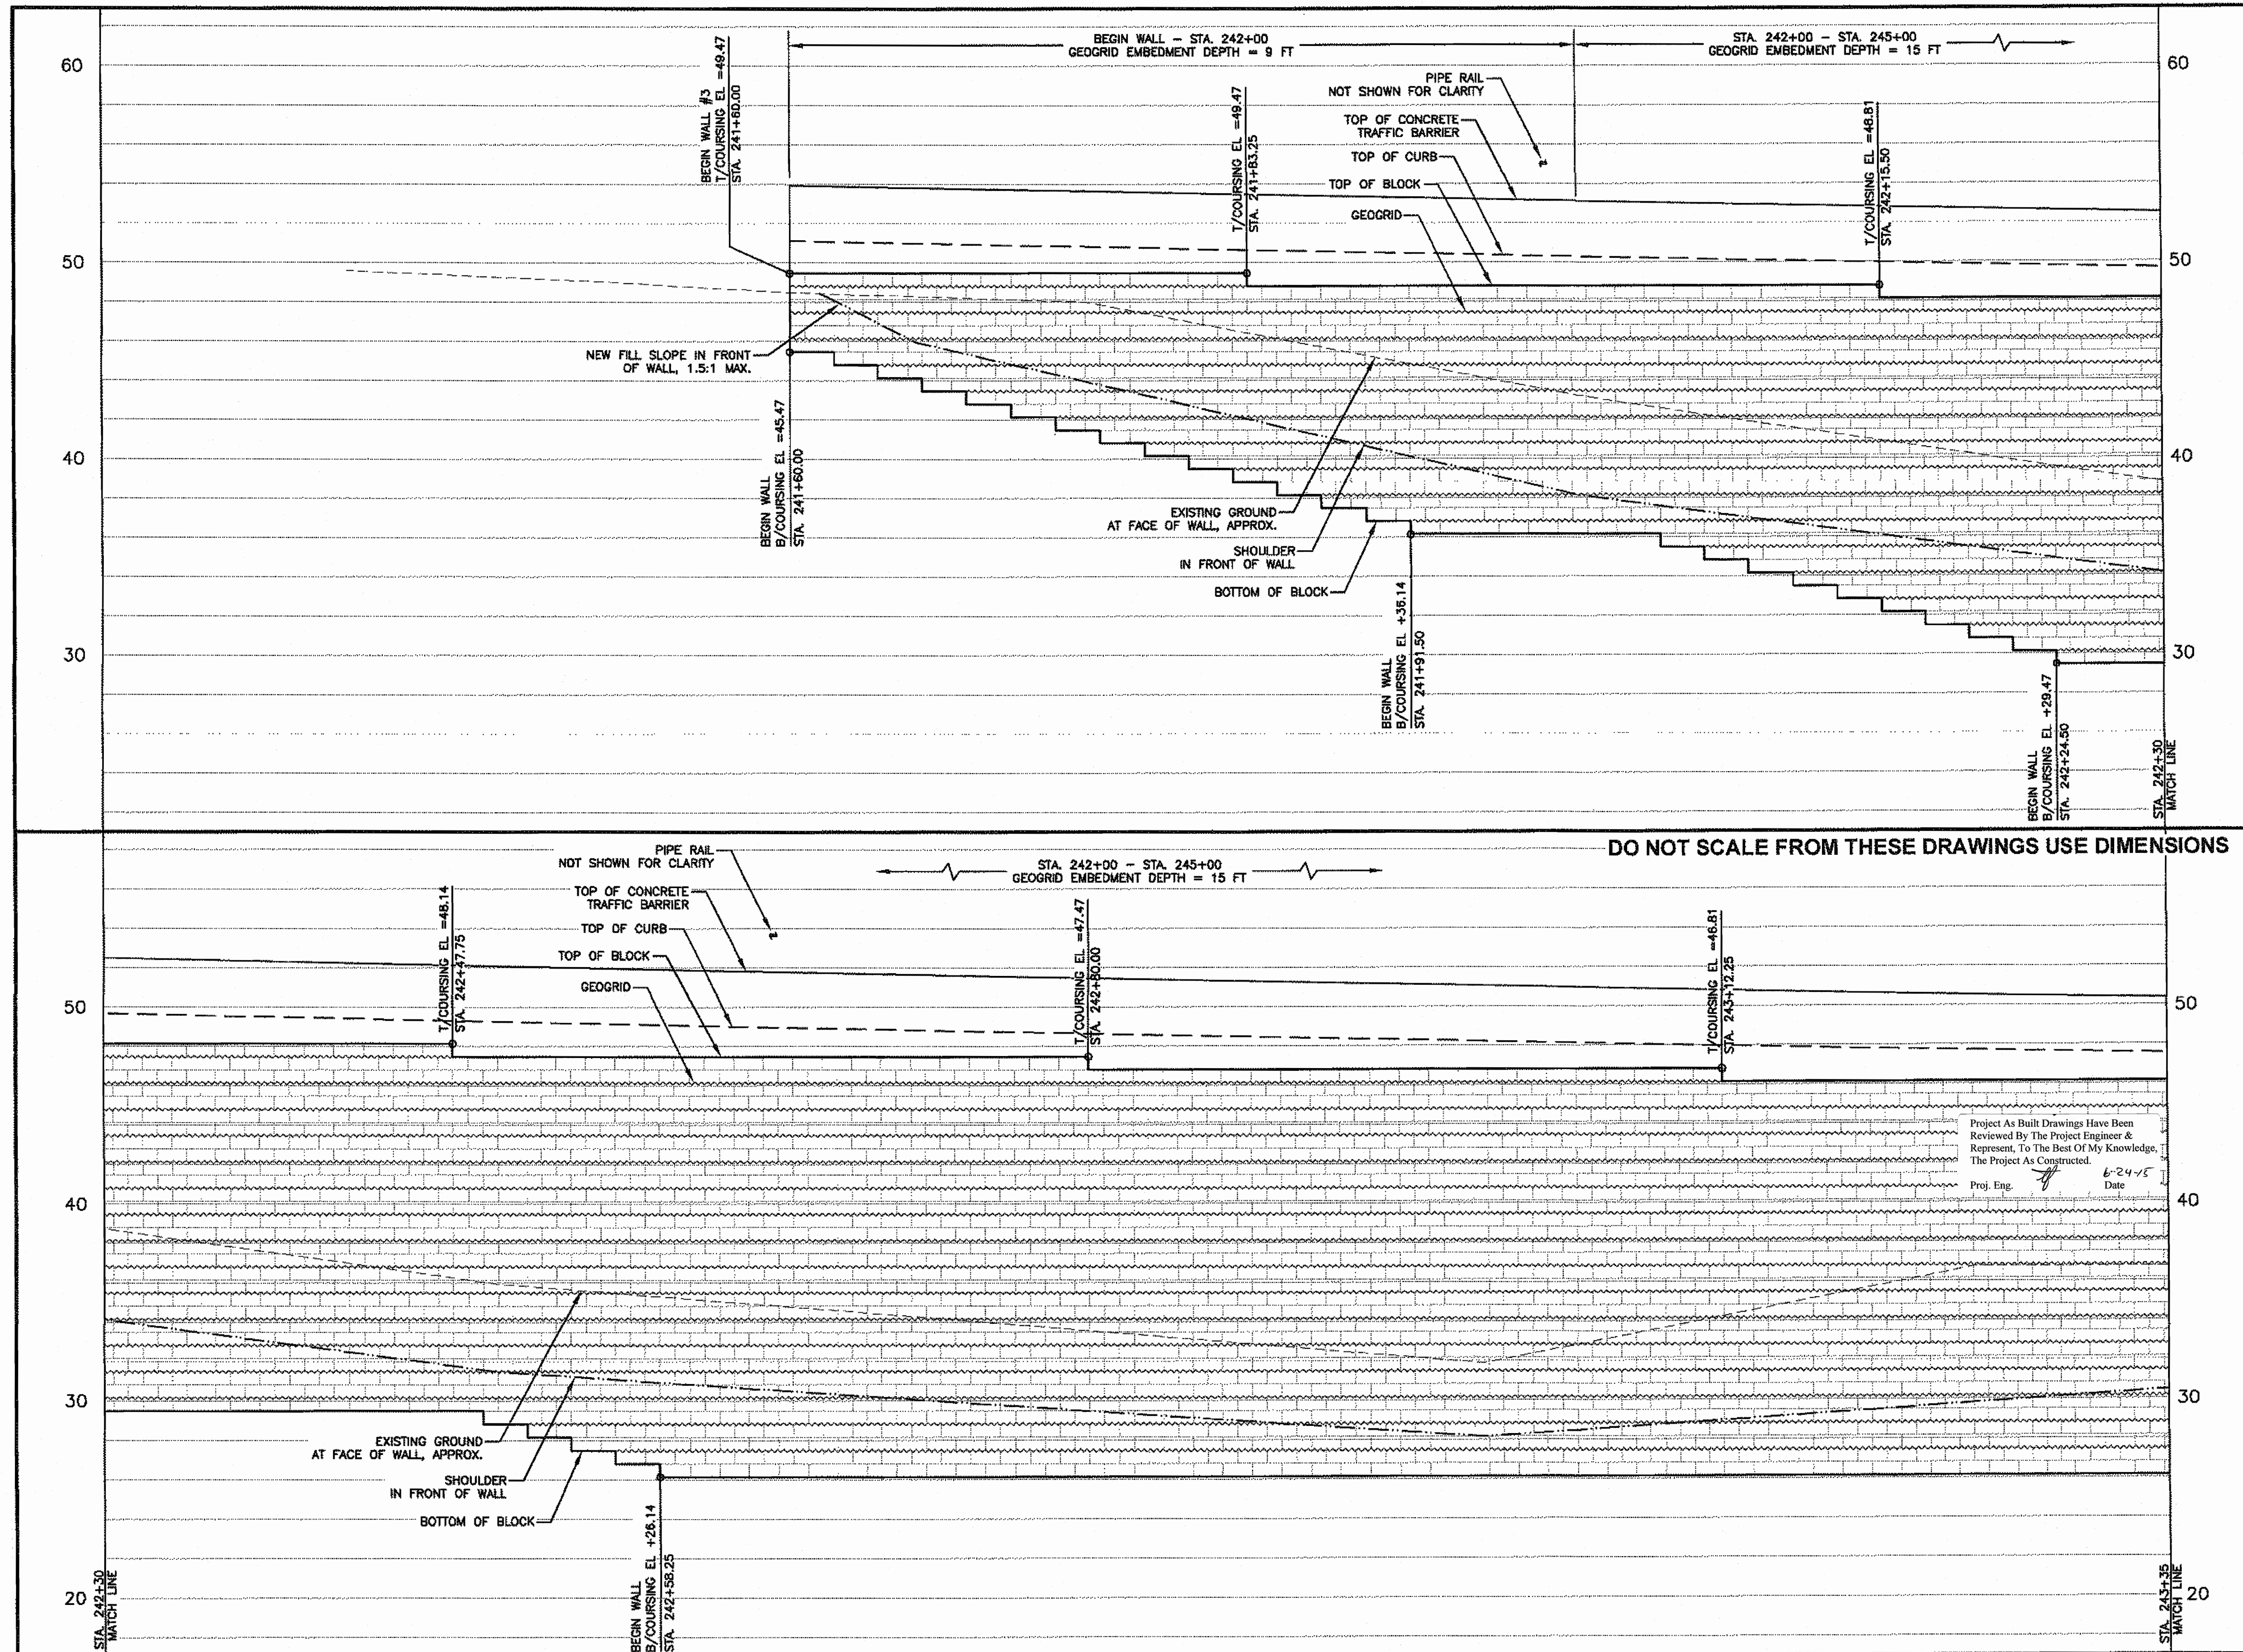

PATH: \\UNUFILE2\JOBS\1153805\DWG\SC\SHETS\H01-H05

TAB: H03

ADDENDUM NUMBER

ATTACHMENT NUMBER

RECORD OF REVISIONS

No.	DATE	DESCRIPTION

SAWMILL CREEK ROAD UPGRADE
PHASE III - WHALE PARK TO SAWMILL CREEK BRIDGE
68216MSG-STP-0933(21)
SITKA TELECOMMUNICATIONS CONDUIT
RSA NO. 69615

RETAINING WALL DETAILS

PREPARED BY: USKH
CHECKED BY: BH

Project As Built Drawings Have Been Reviewed By The Project Engineer & Represent To The Best Of My Knowledge The Project As Constructed.
Proj. Eng. *[Signature]* Date 6-24-15

DESIGNED BY: NCL
DRAWN BY: WJP


STATE OF ALASKA
DEPARTMENT OF TRANSPORTATION & PUBLIC FACILITIES
SOUTHEAST REGION

RETAINING WALL DETAILS


PROJECT DESIGNATION
68216MSG-STP-0933(21)

STATE	YEAR
ALASKA	2012

SHEET NUMBER	TOTAL SHEETS
H3	109

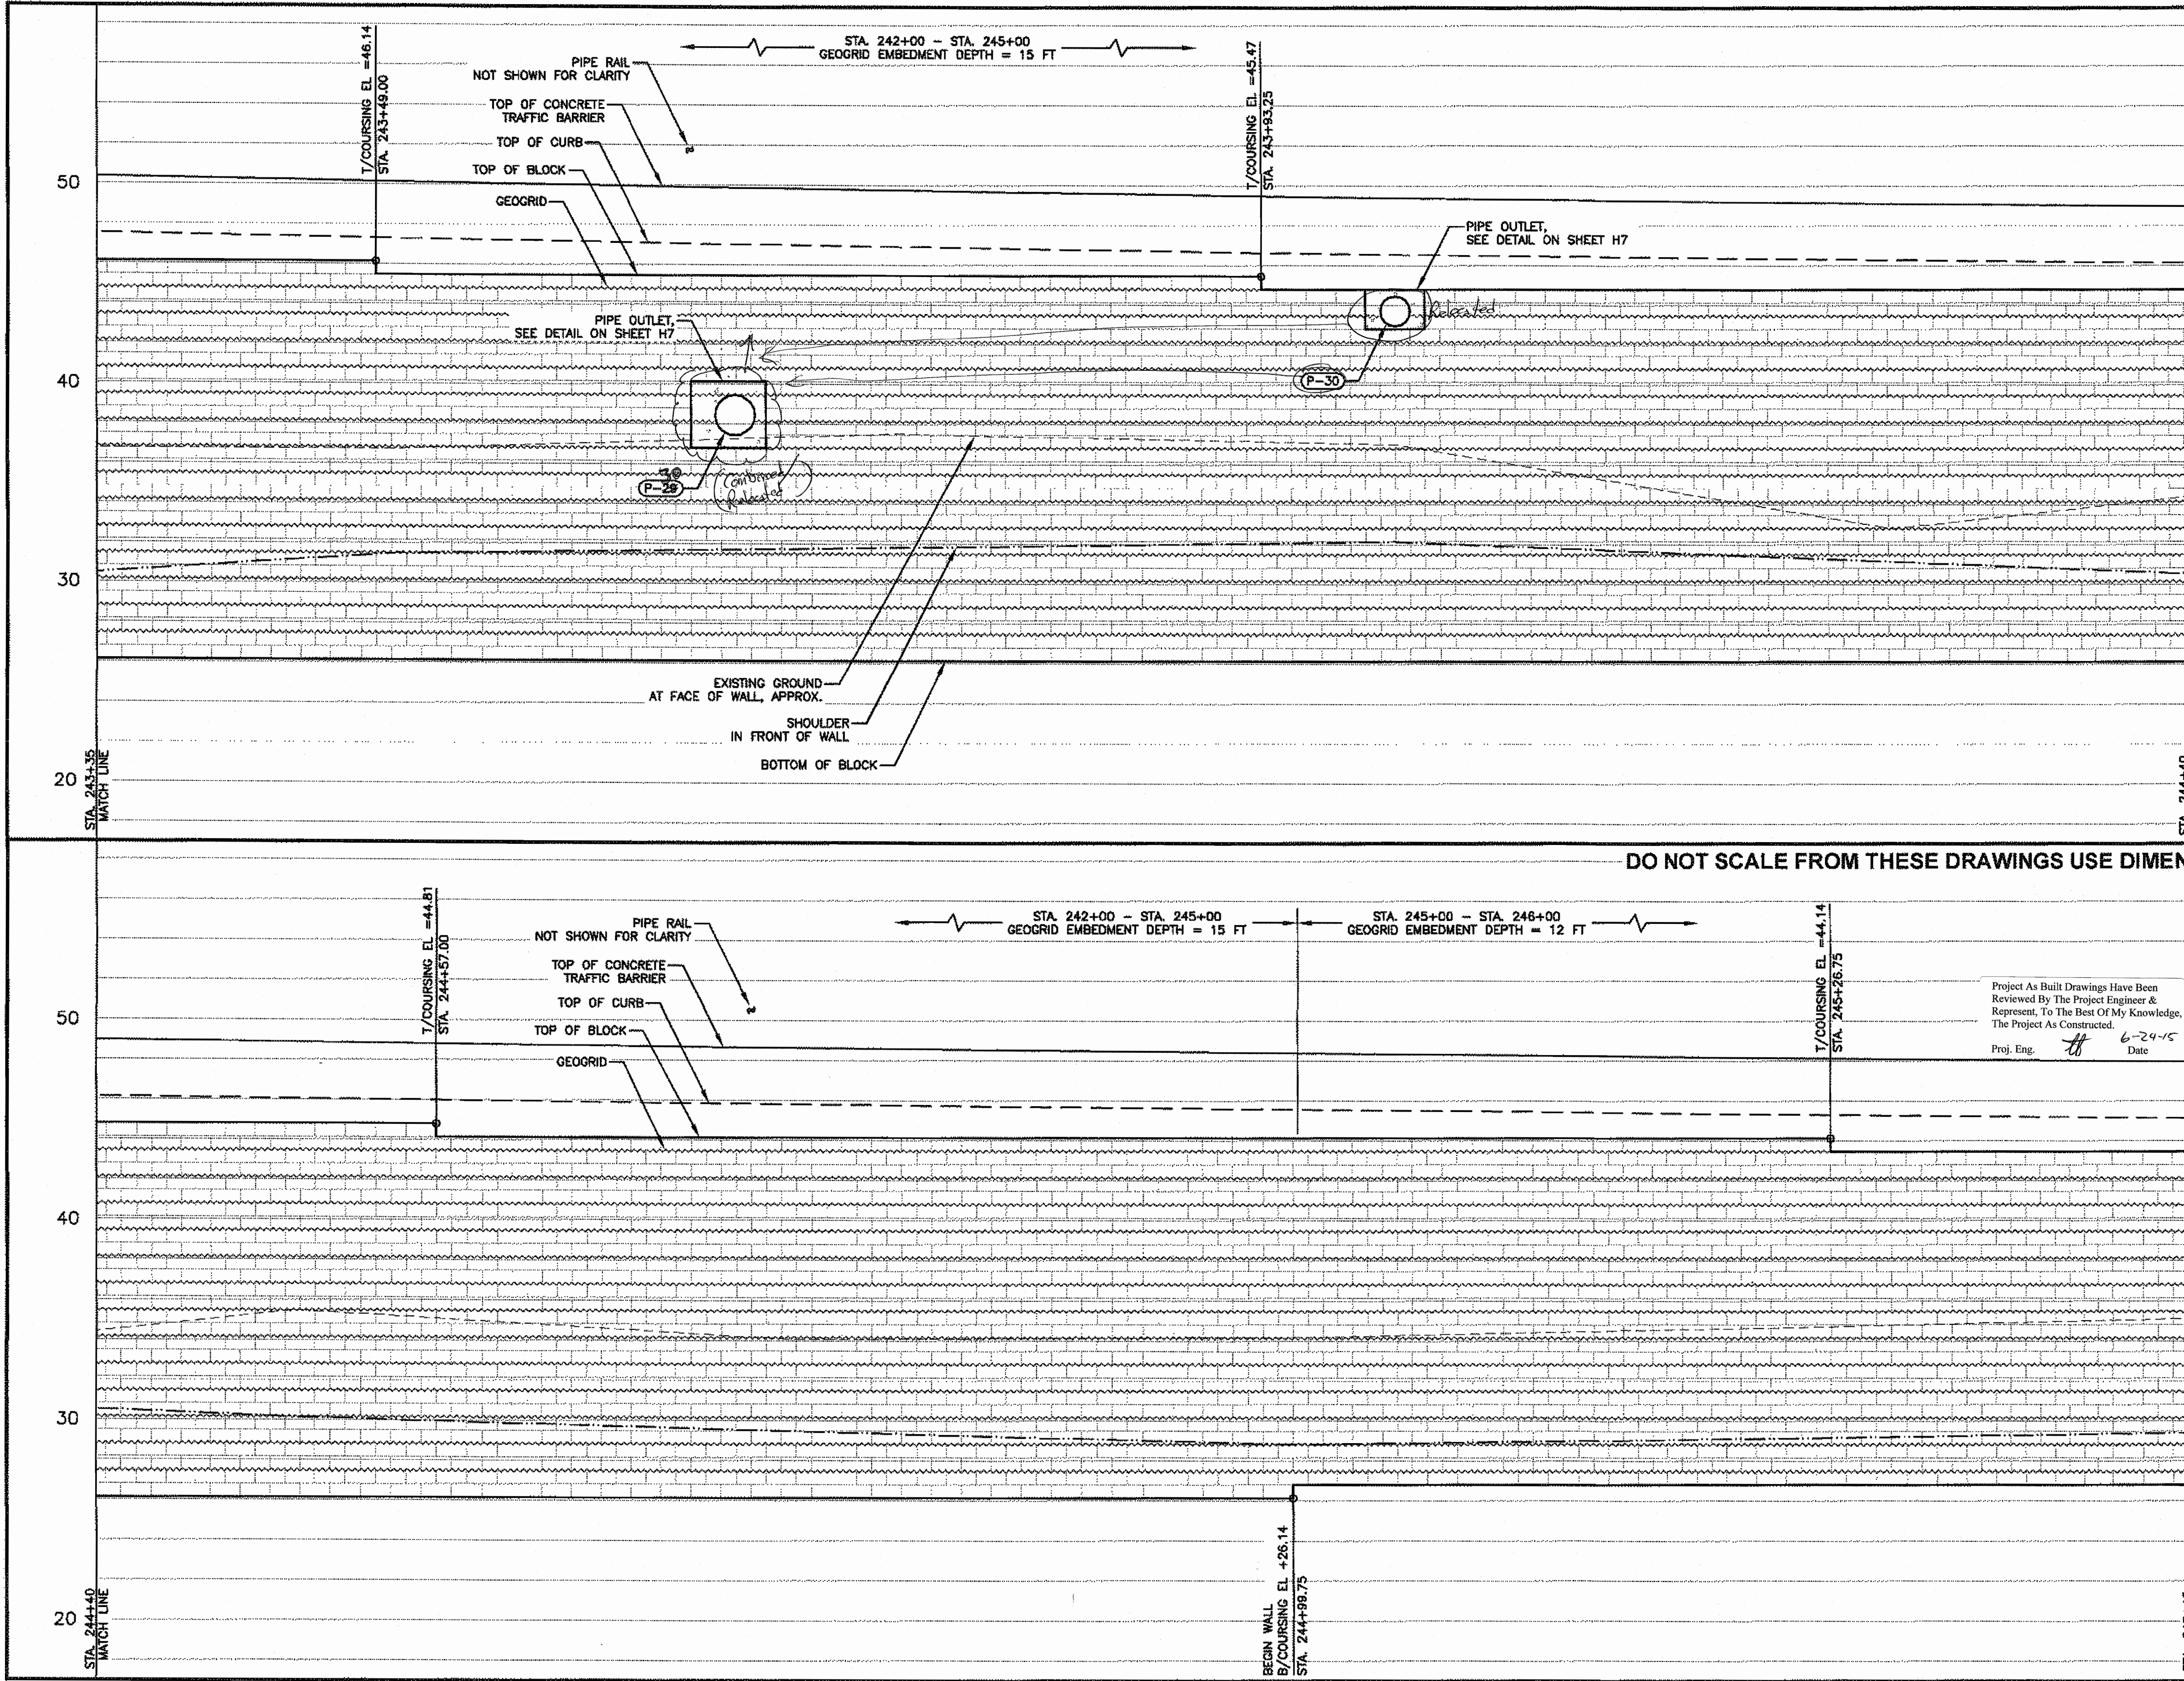

PATH: \\UNFILE2\JOBS\1153895\DWG\SC\SHETS\H01-H05		
TAB: H04		
ADDENDUM NUMBER		
ATTACHMENT NUMBER		
RECORD OF REVISIONS		
No.	DATE	DESCRIPTION
SAWMILL CREEK ROAD UPGRADE PHASE III - WHALE PARK TO SAWMILL CREEK BRIDGE 68216MSG-STP-0933(21) SITKA TELECOMMUNICATIONS CONDUIT RSA NO. 69615		
RETAINING WALL DETAILS		
PREPARED BY: USKH		
CHECKED BY: GH		
DESIGNED BY: NCL		
DRAWN BY: WJP		
STATE OF ALASKA DEPARTMENT OF TRANSPORTATION & PUBLIC FACILITIES SOUTHEAST REGION		
RETAINING WALL DETAILS		
PROJECT DESIGNATION 68216MSG-STP-0933(21)		
STATE	YEAR	
ALASKA	2012	
SHEET NUMBER	TOTAL SHEETS	
H4	109	

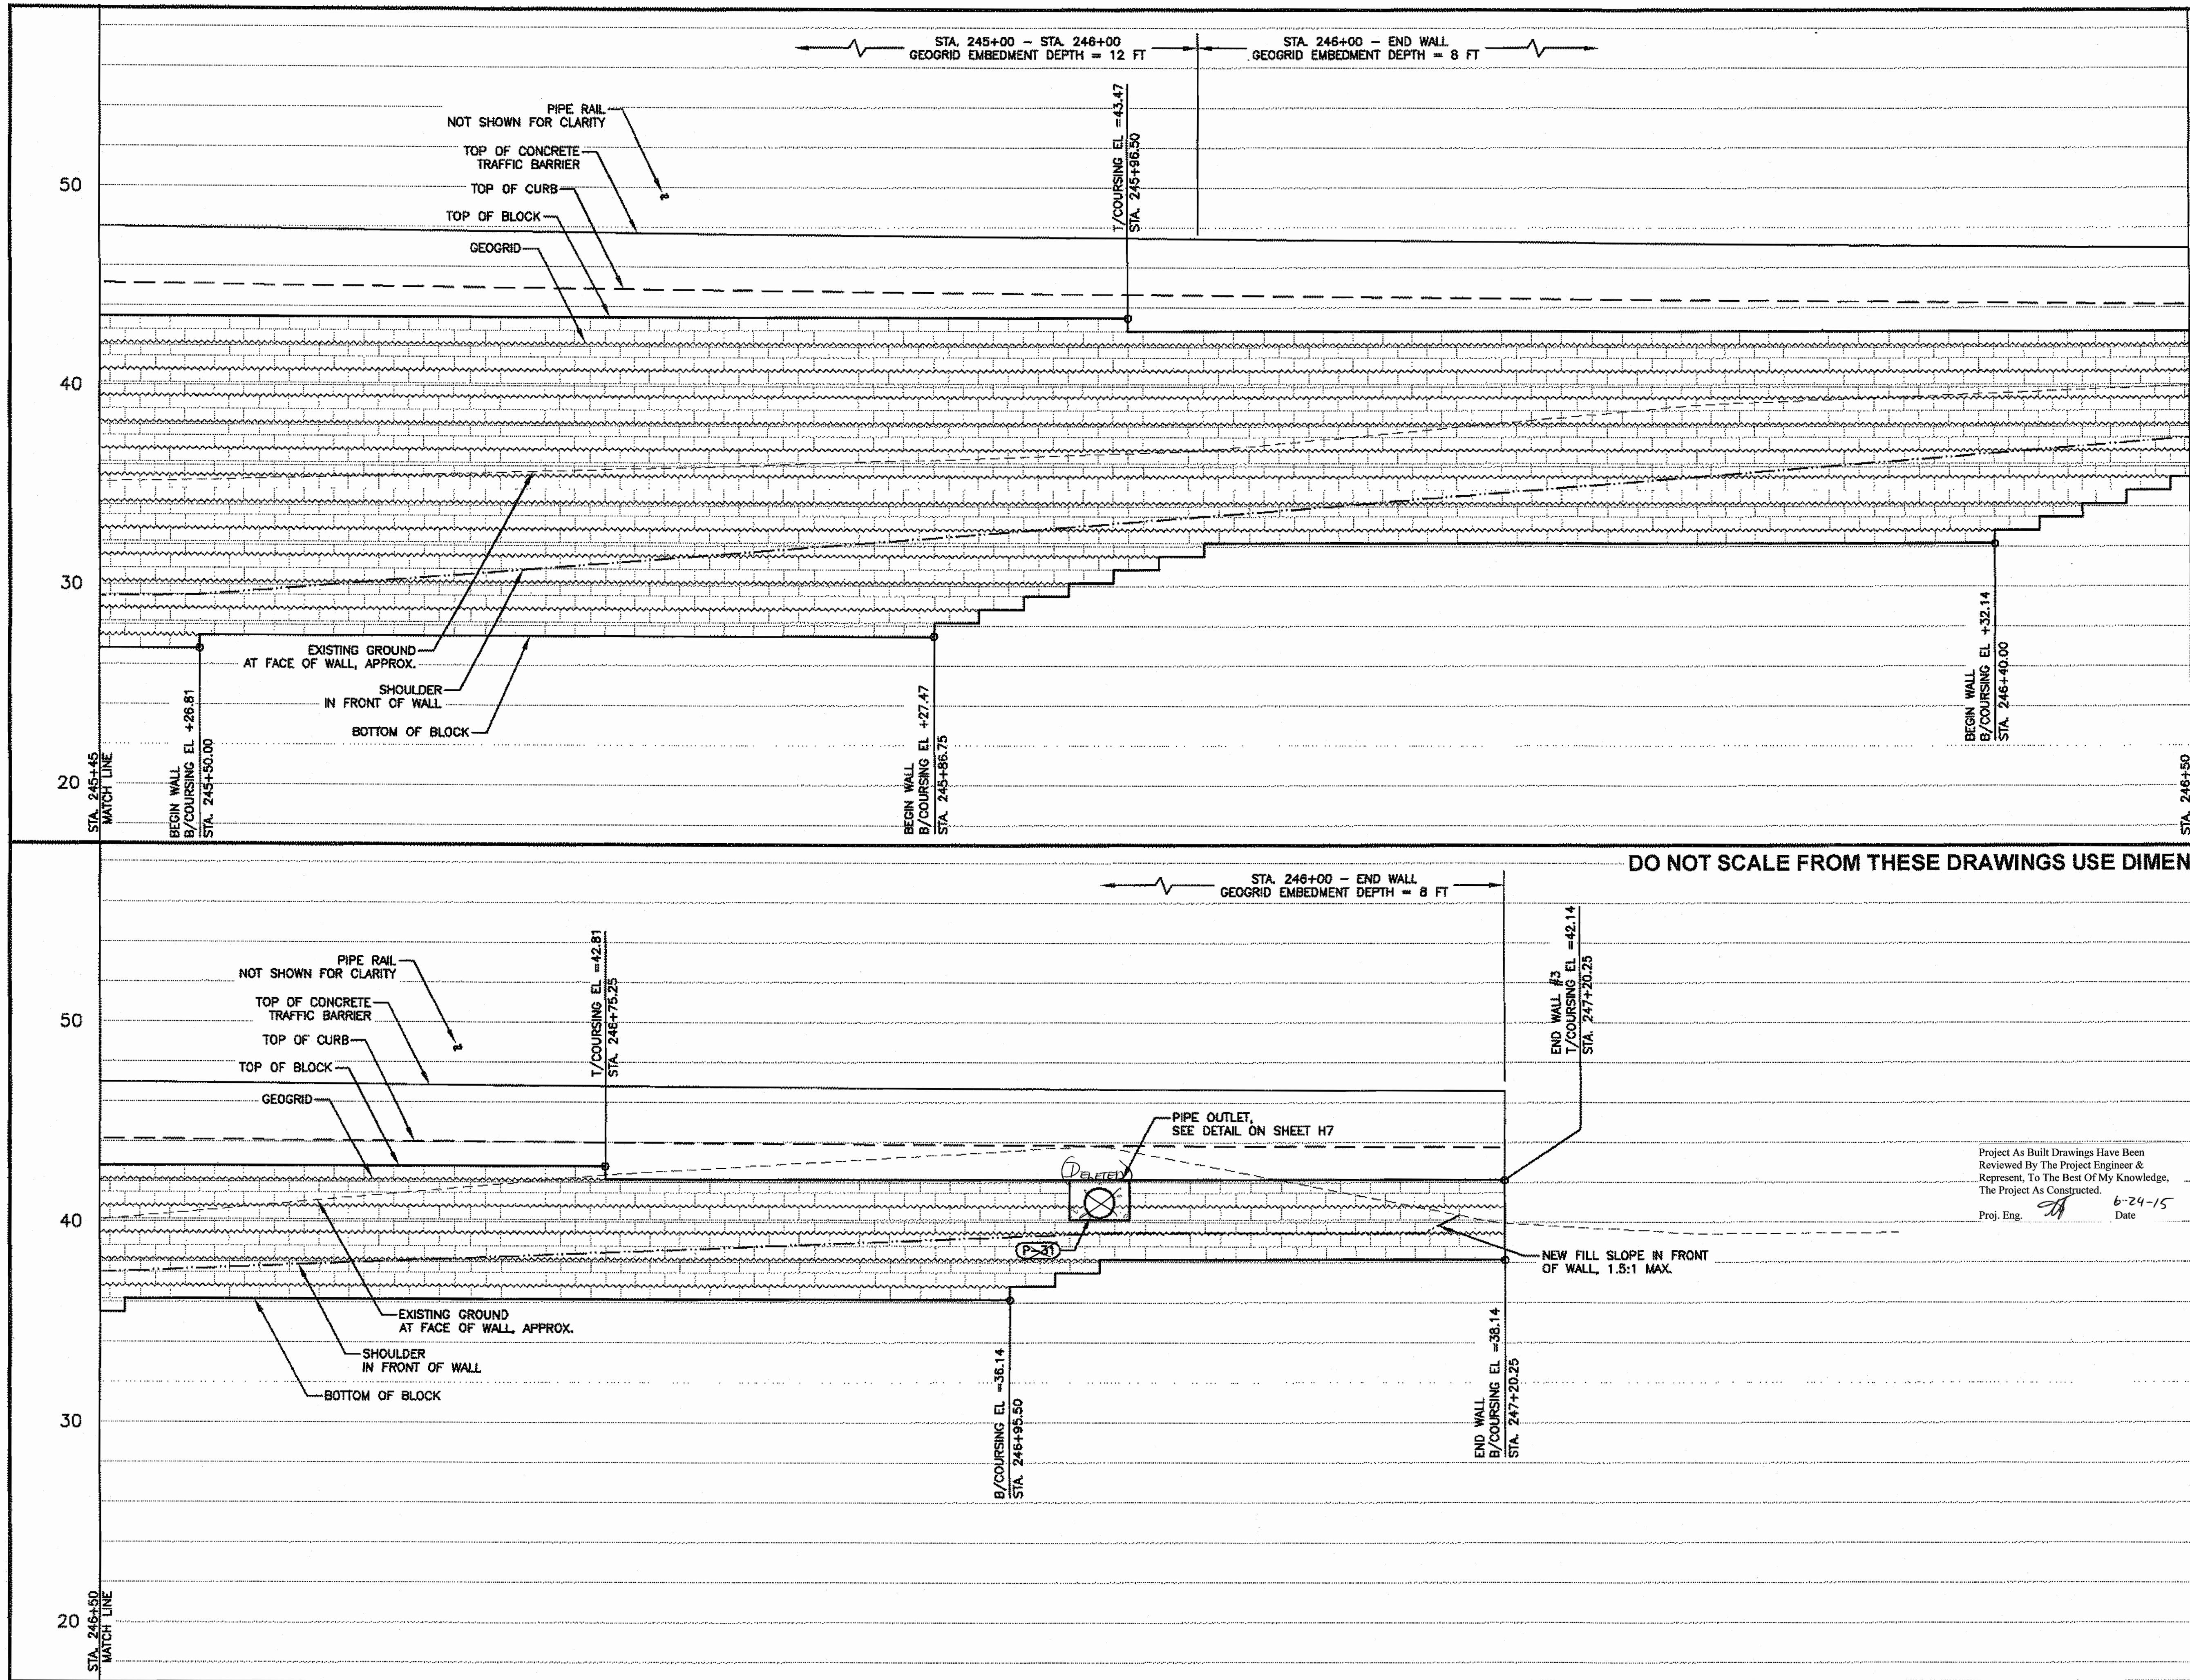


PATH: \\JN\FILE2\JOBS\1153805\DWG\SC\1\SHEETS\H01-H05		
TAB: H05		
ADDENDUM NUMBER		
ATTACHMENT NUMBER		
RECORD OF REVISIONS		
No.	DATE	DESCRIPTION

SAWMILL CREEK ROAD UPGRADE
PHASE III - WHALE PARK TO SAWMILL CREEK BRIDGE
68216MSG-STP-0933(21)
SITKA TELECOMMUNICATIONS CONDUIT
RSA NO. 69615

RETAINING WALL DETAILS

PREPARED BY: USKH
CHECKED BY: BH

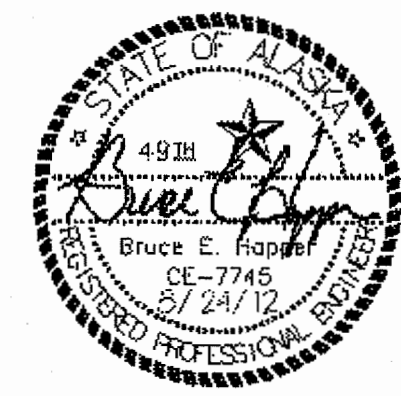


DESIGNED BY: NCL
DRAWN BY: WJP

STATE OF ALASKA
DEPARTMENT OF TRANSPORTATION
& PUBLIC FACILITIES
SOUTHEAST REGION


RETAINING
WALL DETAILS

PROJECT DESIGNATION
68216MSG-STP-0933(21)


STATE	YEAR
ALASKA	2012
SHEET NUMBER	TOTAL SHEETS
H5	109

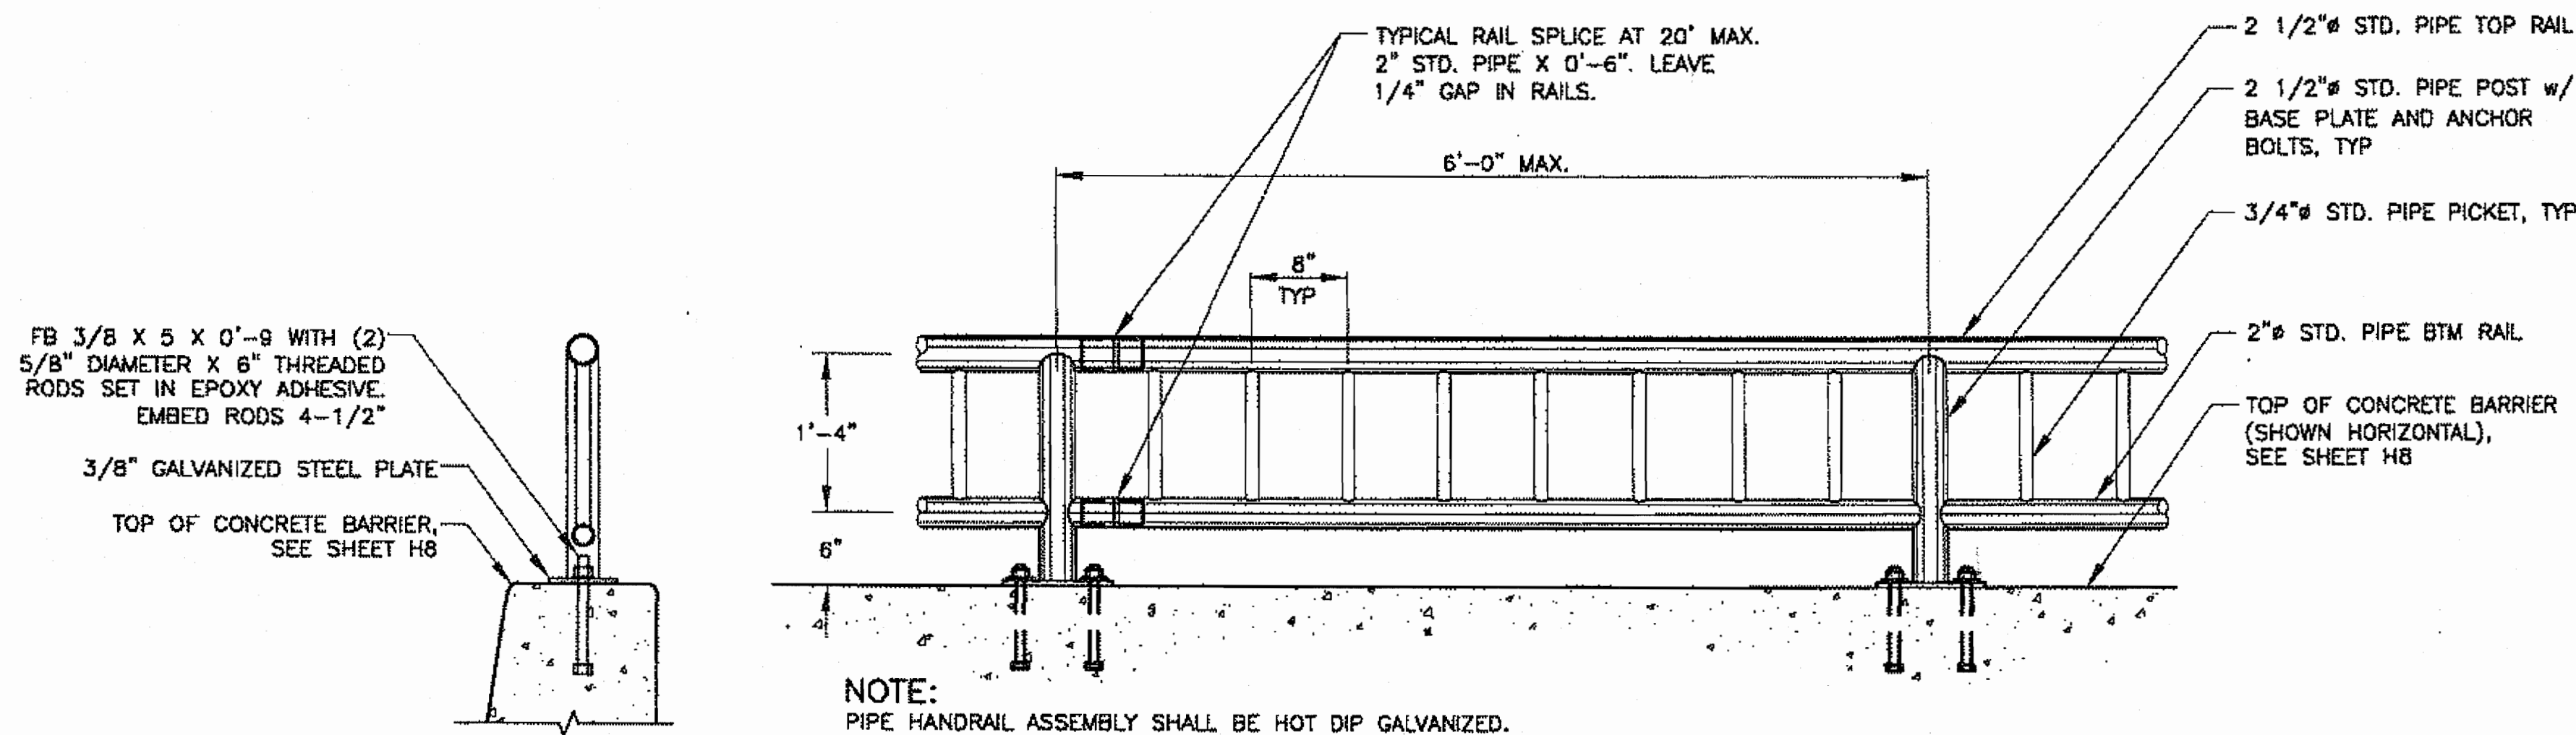


TYPICAL PIPE RAIL ELEVATION

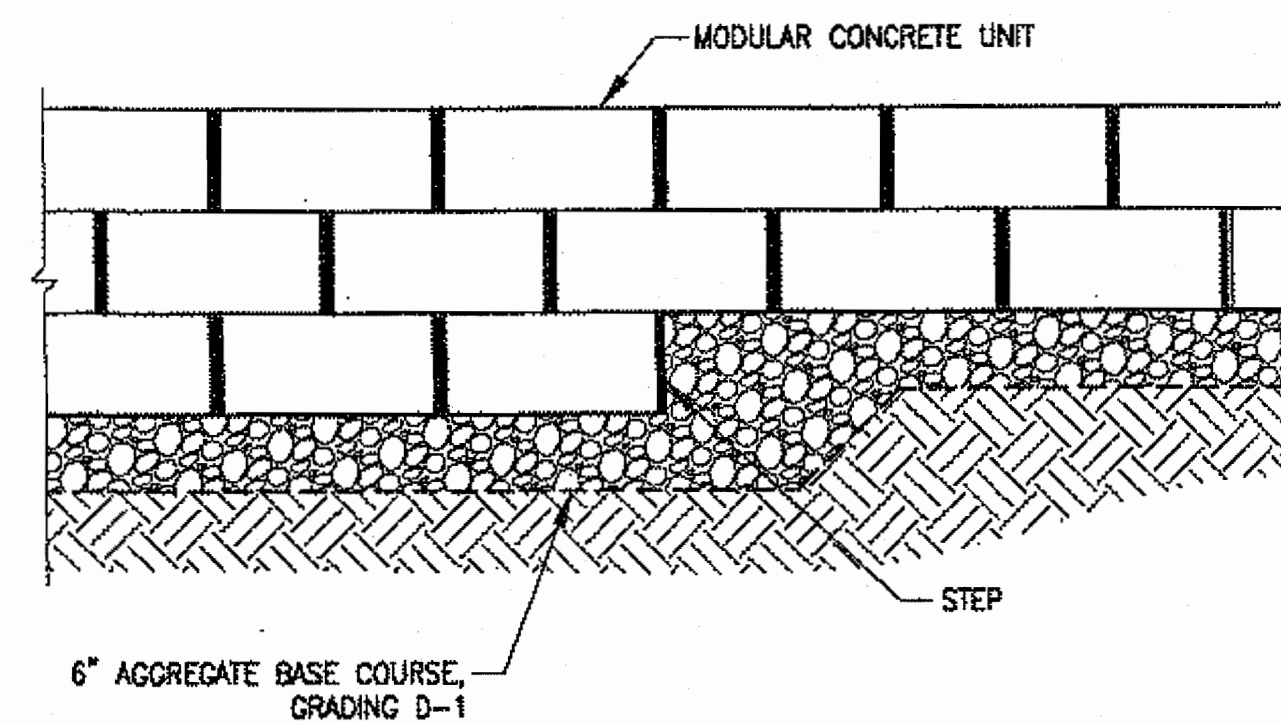


LEVELING PAD DETAIL

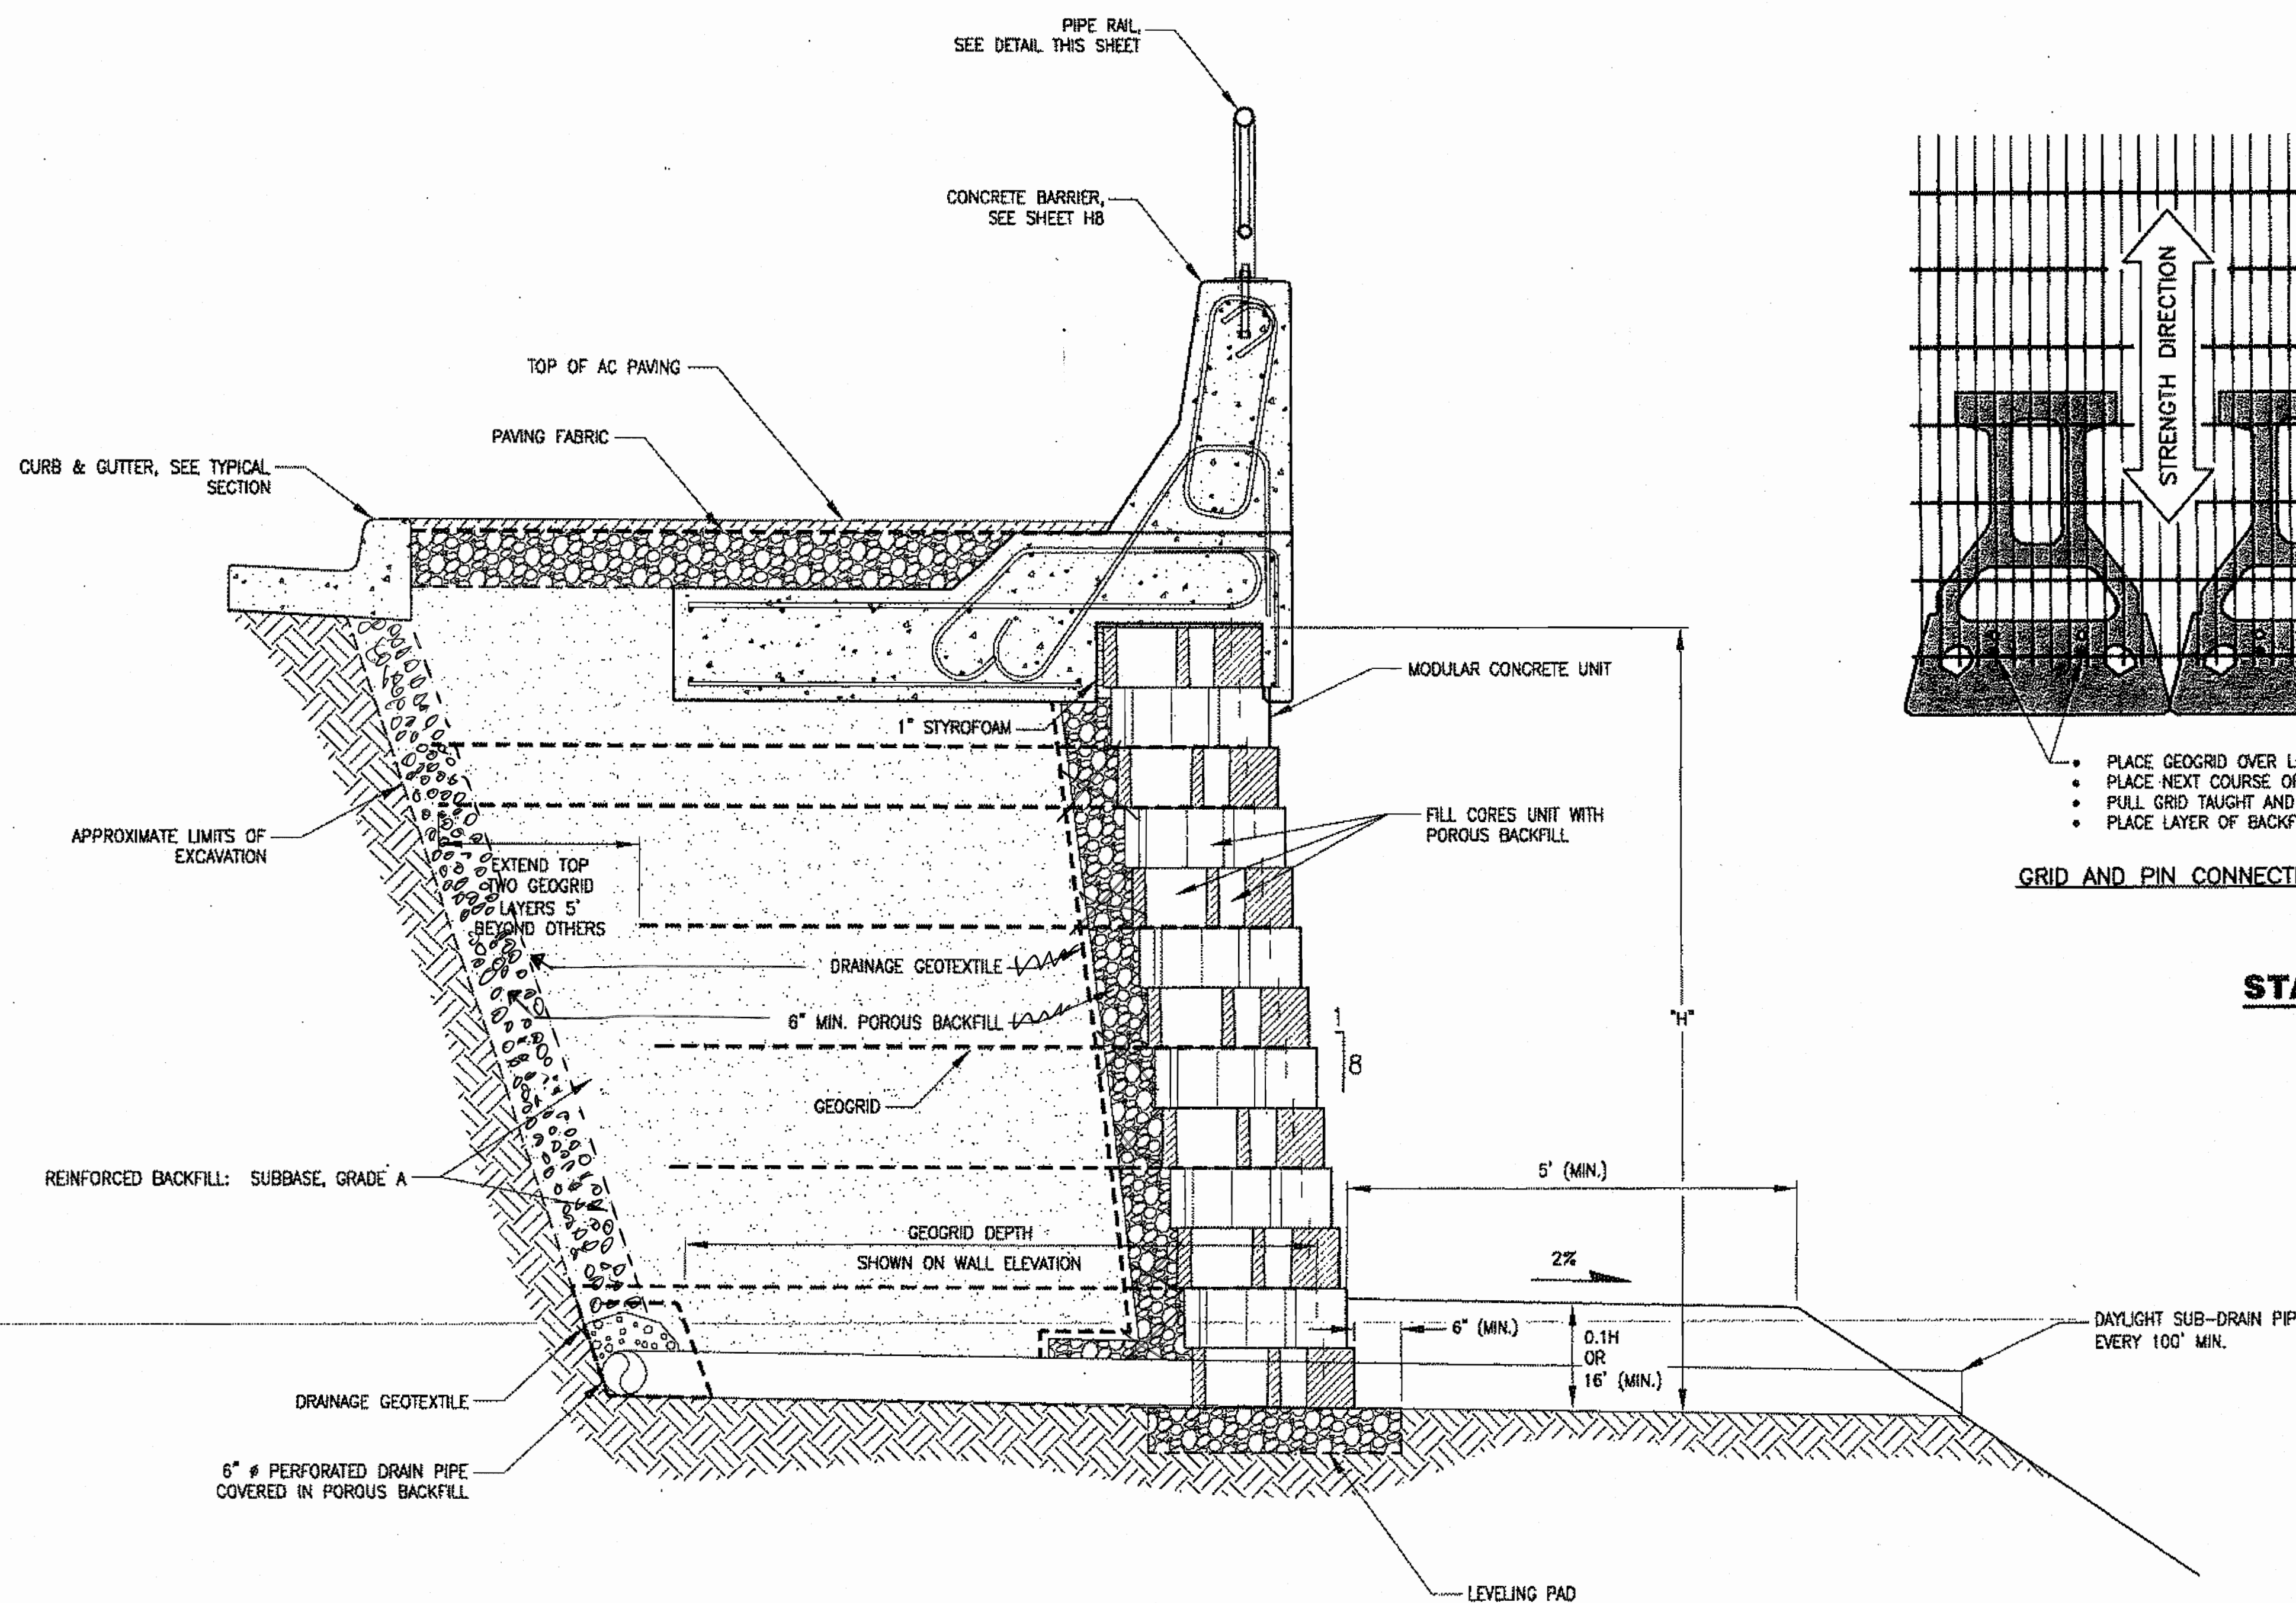

TYPICAL MECHANICALLY STABILIZED EARTH (MSE) WALL SECTION

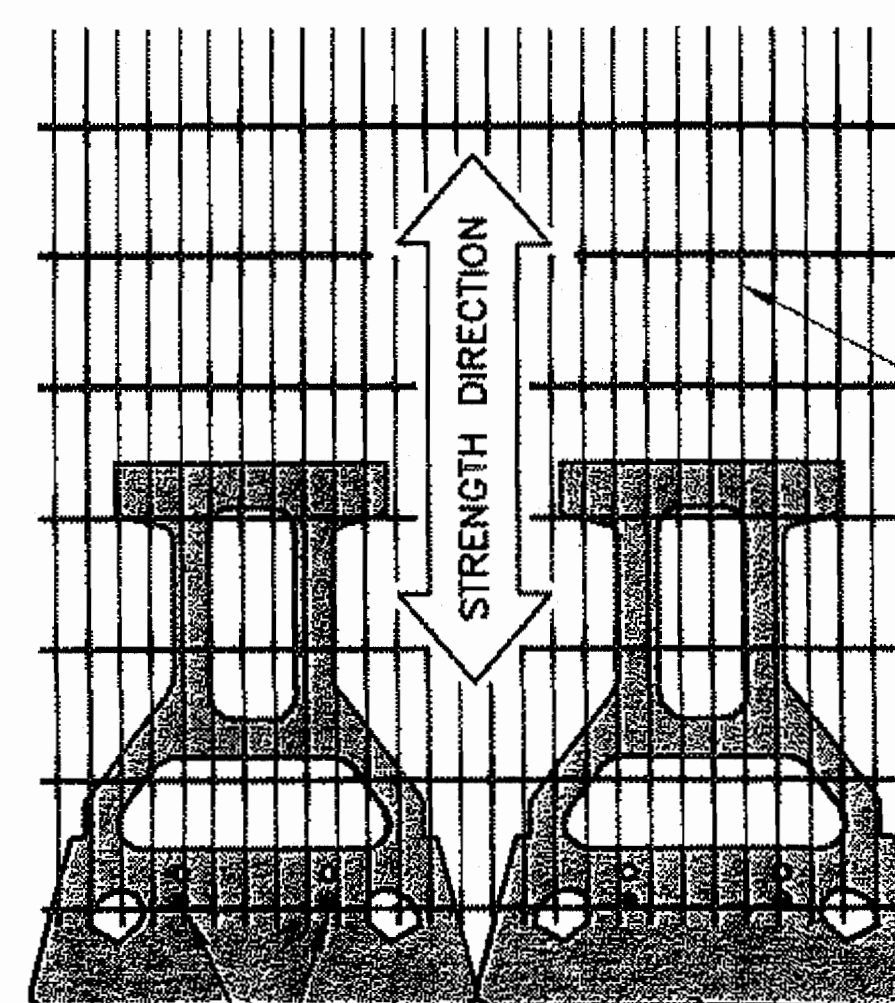

GRID AND PIN CONNECTION

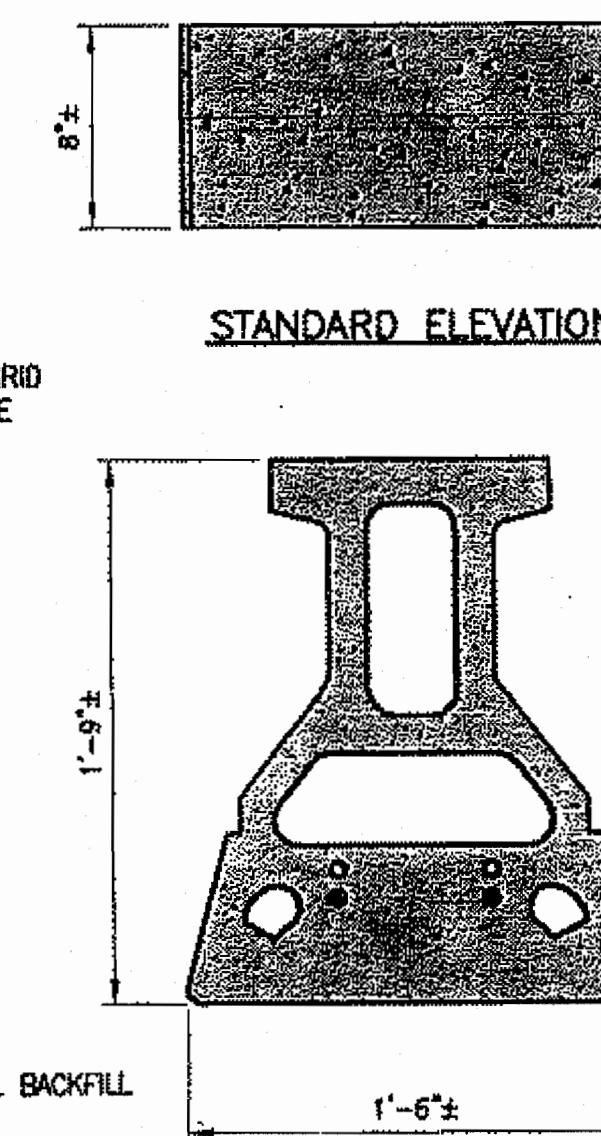

STANDARD PLAN

STANDARD UNIT PLAN & LAYOUT

Project As Built Drawings Have Been Reviewed By The Project Engineer & Represent, To The Best Of My Knowledge, The Project As Constructed.
 Proj. Eng. *76* Date *6-24-15*

NOTE:
 THE BASIS OF DESIGN FOR THE MECHANICALLY STABILIZED EARTH WALL IS A MODULAR BLOCK FACE WALL SYSTEM BY KEYSTONE RETAINING WALL SYSTEMS. SEE SPECIFICATION SECTION 511 FOR SUBMITTING ON OTHER MSE WALL SYSTEMS.

DO NOT SCALE FROM THESE DRAWINGS USE DIMENSIONS

UNFILED JOB: 1183805DWG81C9SHEETS/H06.D

TAB: H6

ADDENDUM NUMBER

ATTACHMENT NUMBER

RECORD OF REVISIONS

No.	DATE	DESCRIPTION

SAWMILL CREEK ROAD UPGRADE
 PHASE III - WHALE PARK TO SAWMILL CREEK BRIDGE
 68216MSG-STP-0933(21)
 SITKA TELECOMMUNICATIONS CONDUIT
 RSA NO. 69615

PREPARED BY: USKH
 CHECKED BY: BH

DESIGNED BY: NCL
 DRAWN BY: WJP

STATE OF ALASKA
 DEPARTMENT OF TRANSPORTATION
 & PUBLIC FACILITIES
 SOUTHEAST REGION


RETAINING WALL DETAILS

PROJECT DESIGNATION
68216MSG-STP-0933(21)


STATE	YEAR
ALASKA	2012

SHEET NUMBER	TOTAL SHEETS
H6	109

RETAINING WALL DETAILS

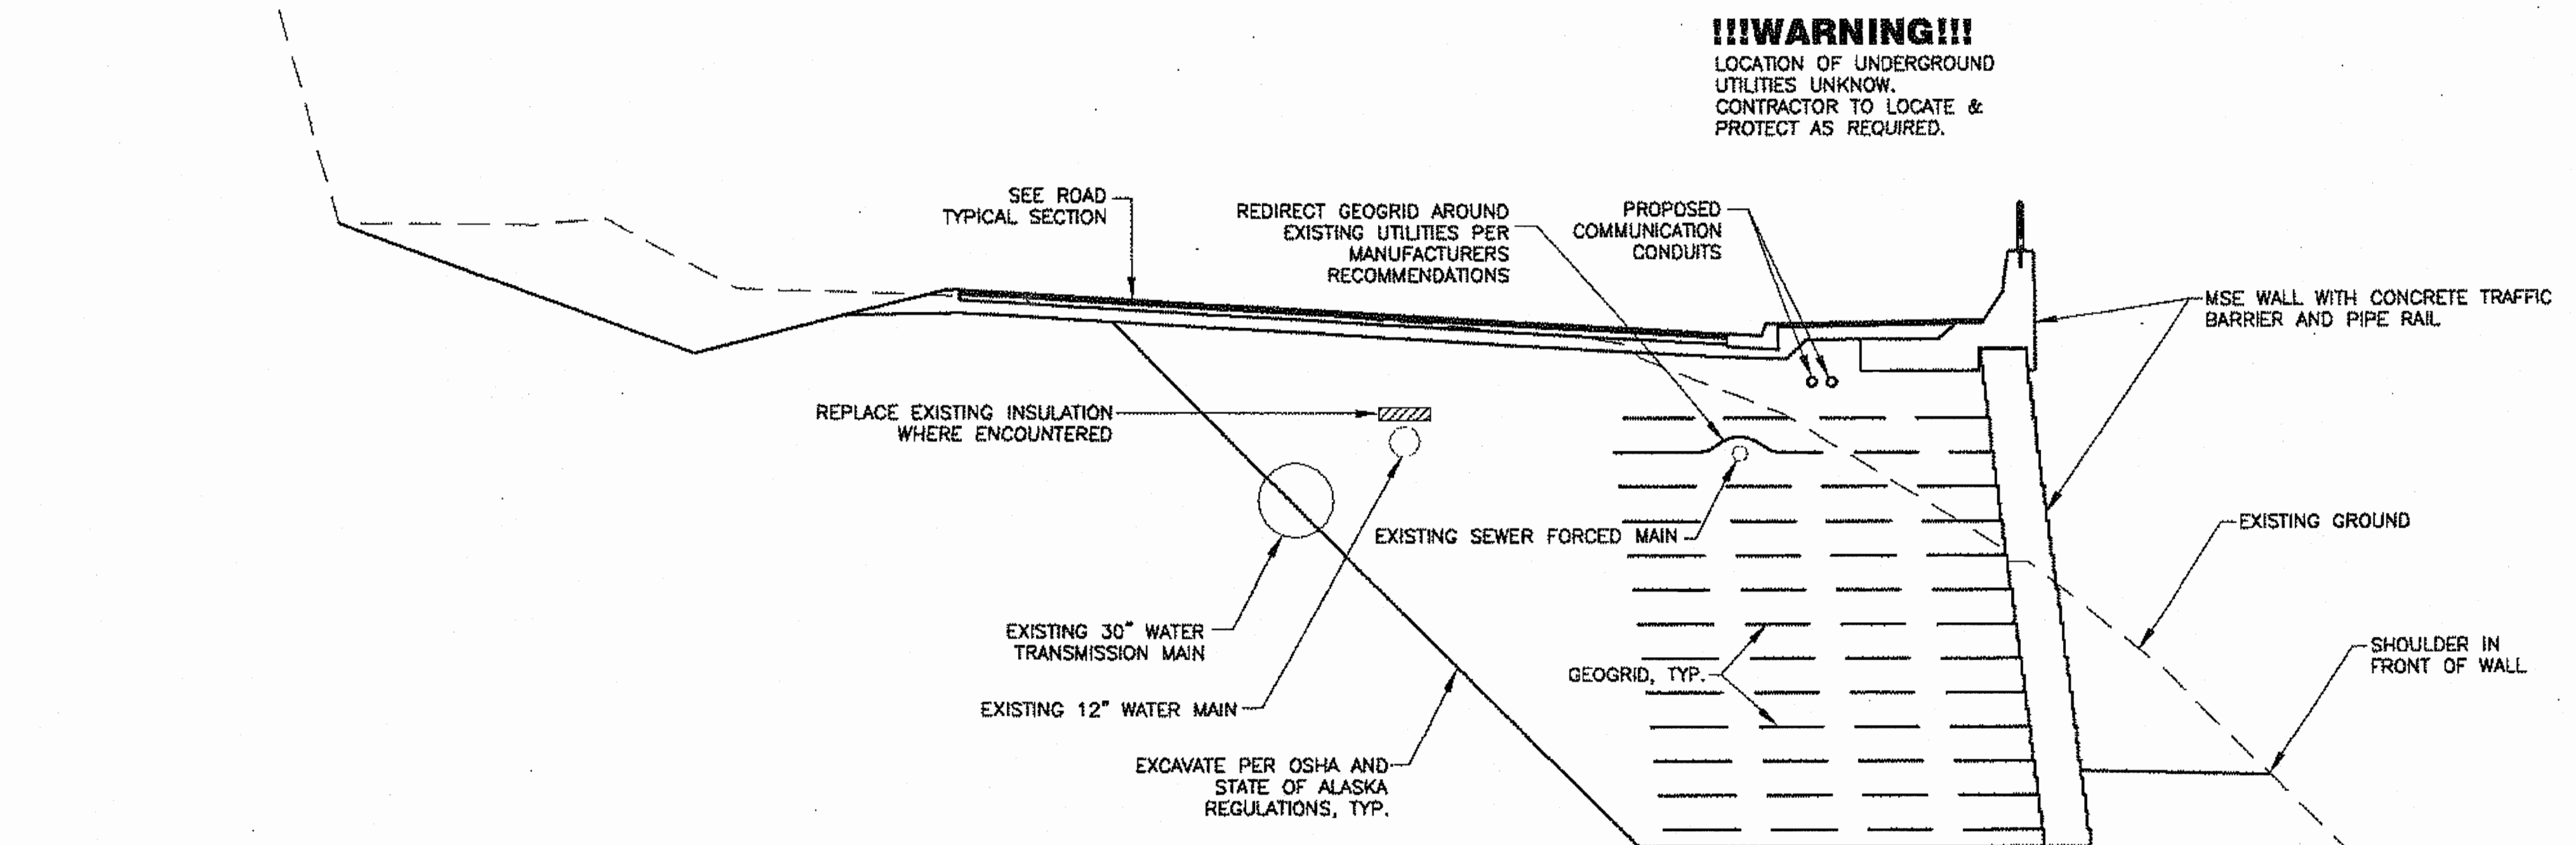

MSE RETAINING WALL - UTILITIES - COORDINATION

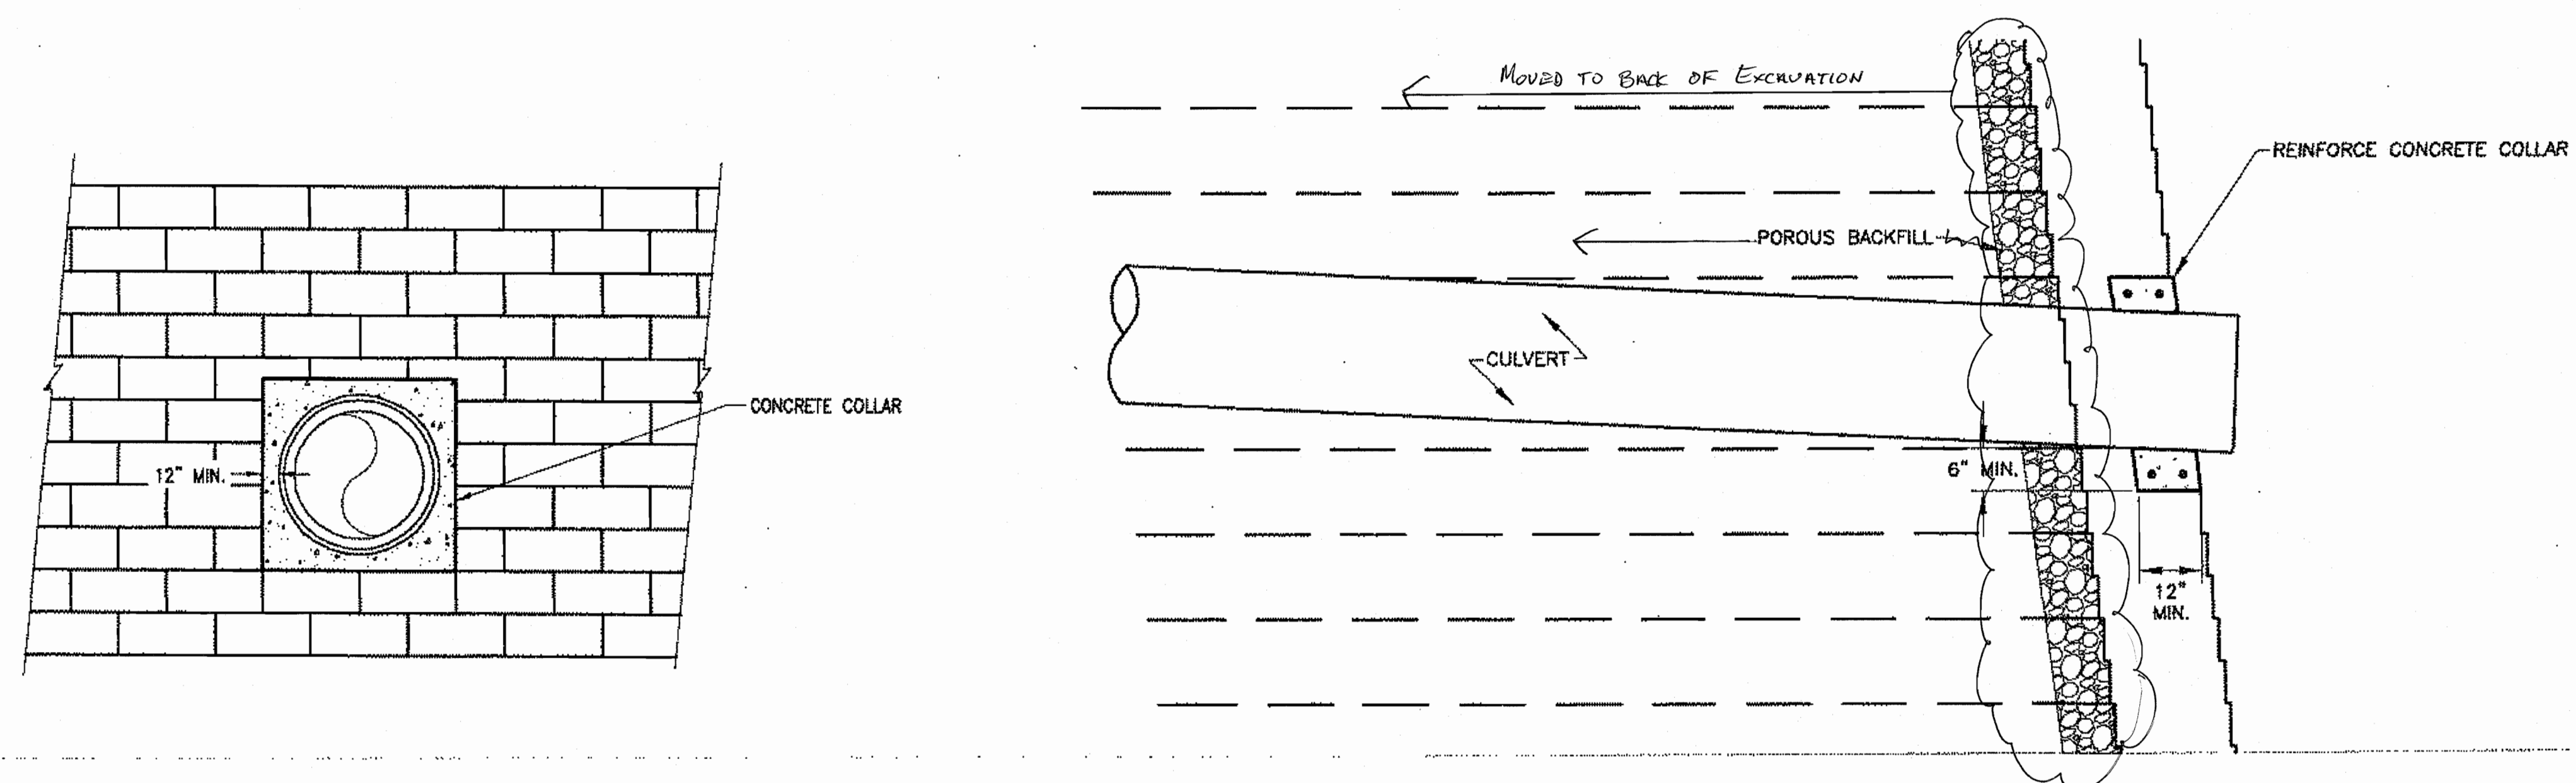


CONCRETE COLLAR
ELEVATION

CONCRETE COLLAR
SECTION

CONCRETE COLLAR

Project As Built Drawings Have Been
Reviewed By The Project Engineer &
Represent, To The Best Of My Knowledge,
The Project As Constructed.
Proj. Eng. *[Signature]* Date 6-24-15

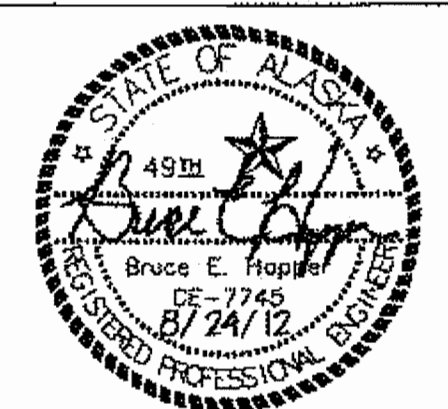

DESIGNED BY: NCL
DRAWN BY: WJP



STATE OF ALASKA
DEPARTMENT OF TRANSPORTATION
& PUBLIC FACILITIES
SOUTHEAST REGION

RETAINING WALL DETAILS

PROJECT DESIGNATION	
68216MSG-STP-0933(21)	
STATE	YEAR
ALASKA	2012
SHEET NUMBER	TOTAL SHEETS
H7	109






DO NOT SCALE FROM THESE DRAWINGS USE DIMENSIONS

FILE: WINUFILE2\JOB\1153806\DWG\1C\1SHEETS\H7.D		
TAB: H07		
ADDENDUM NUMBER		
ATTACHMENT NUMBER		
RECORD OF REVISIONS		
No.	DATE	DESCRIPTION
SAWMILL CREEK ROAD UPGRADE PHASE III - WHALE PARK TO SAWMILL CREEK BRIDGE 68216MSG-STP-0933(21) SITKA TELECOMMUNICATIONS CONDUIT RSA NO. 69615		
RETAINING WALL DETAILS		
PREPARED BY: USKH CHECKED BY: BH		
DESIGNED BY: NCL DRAWN BY: WJP		
STATE OF ALASKA DEPARTMENT OF TRANSPORTATION & PUBLIC FACILITIES SOUTHEAST REGION		
RETAINING WALL DETAILS		
PROJECT DESIGNATION		
68216MSG-STP-0933(21)		
STATE	YEAR	
ALASKA	2012	
SHEET NUMBER	TOTAL SHEETS	
H7	109	

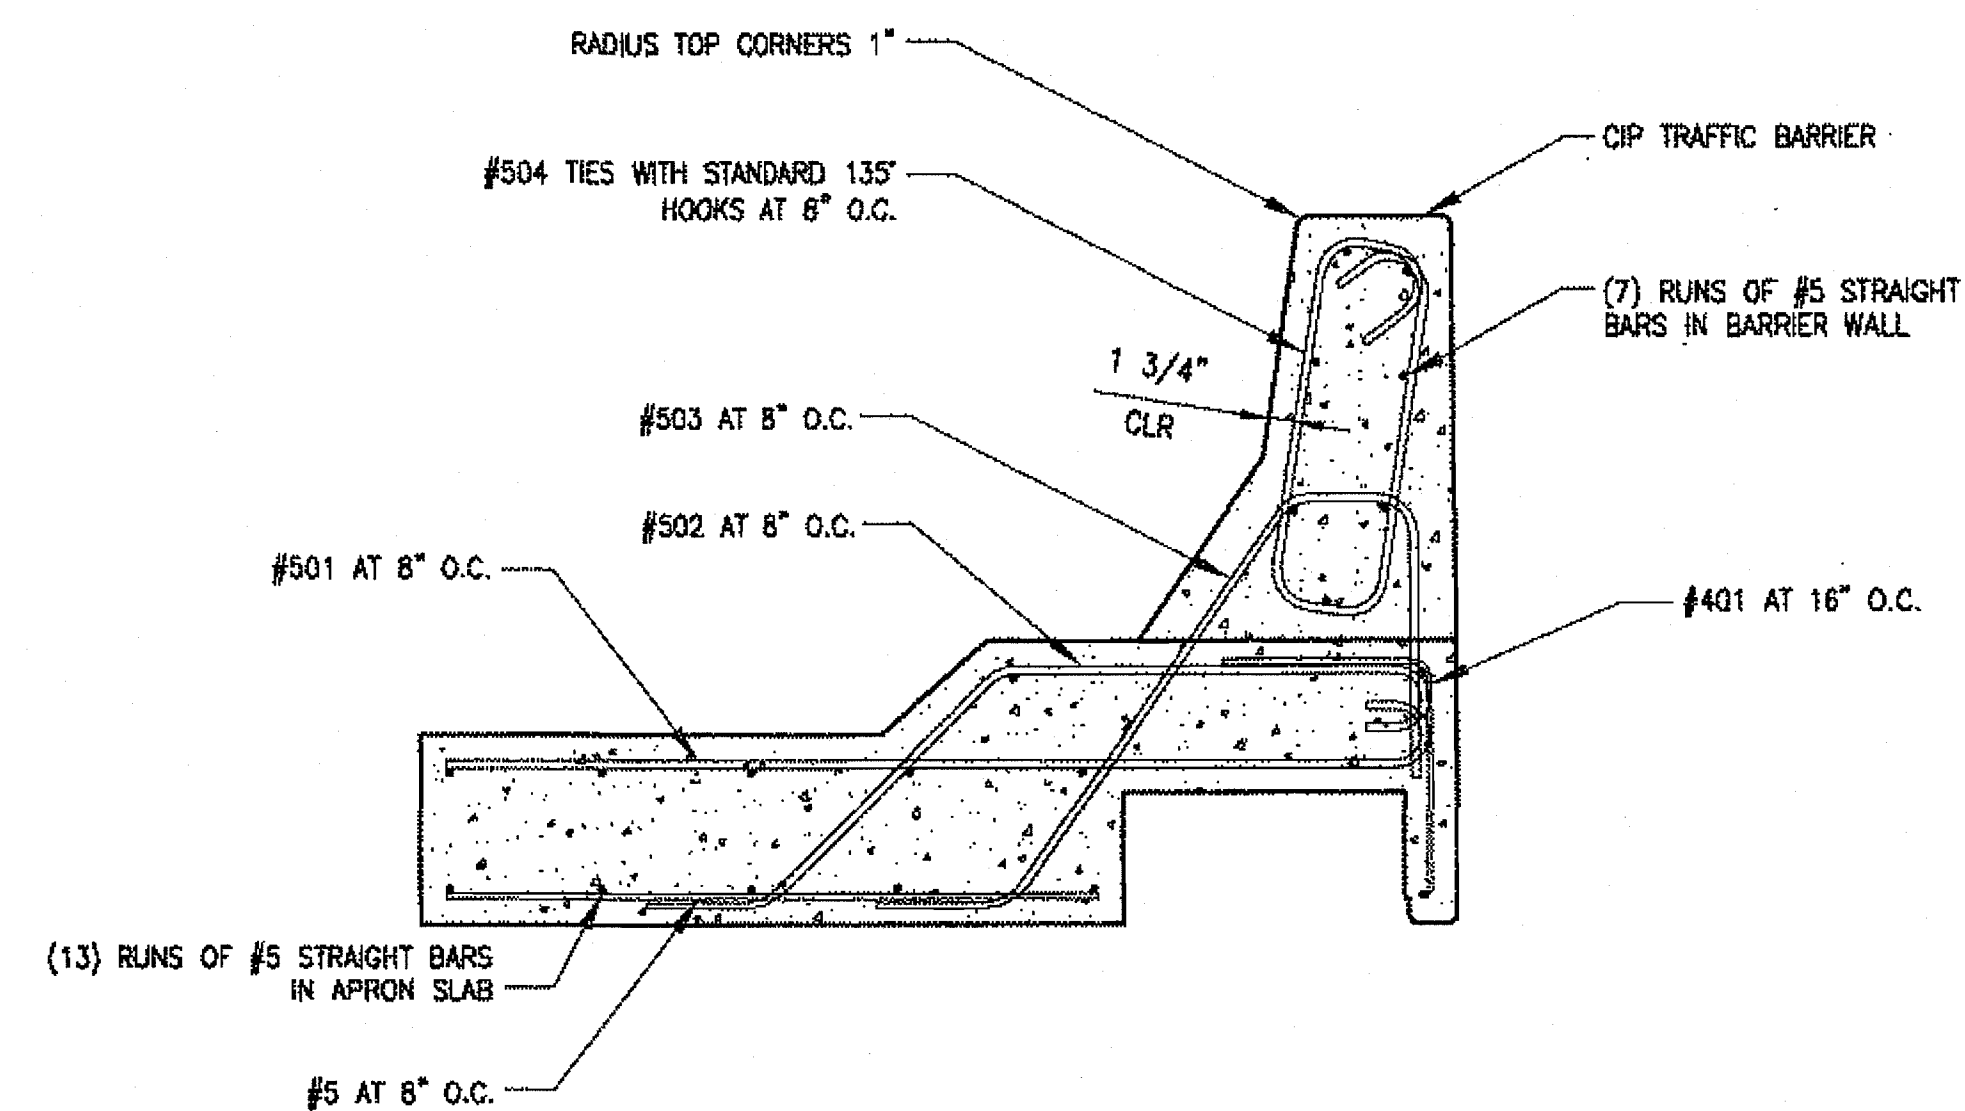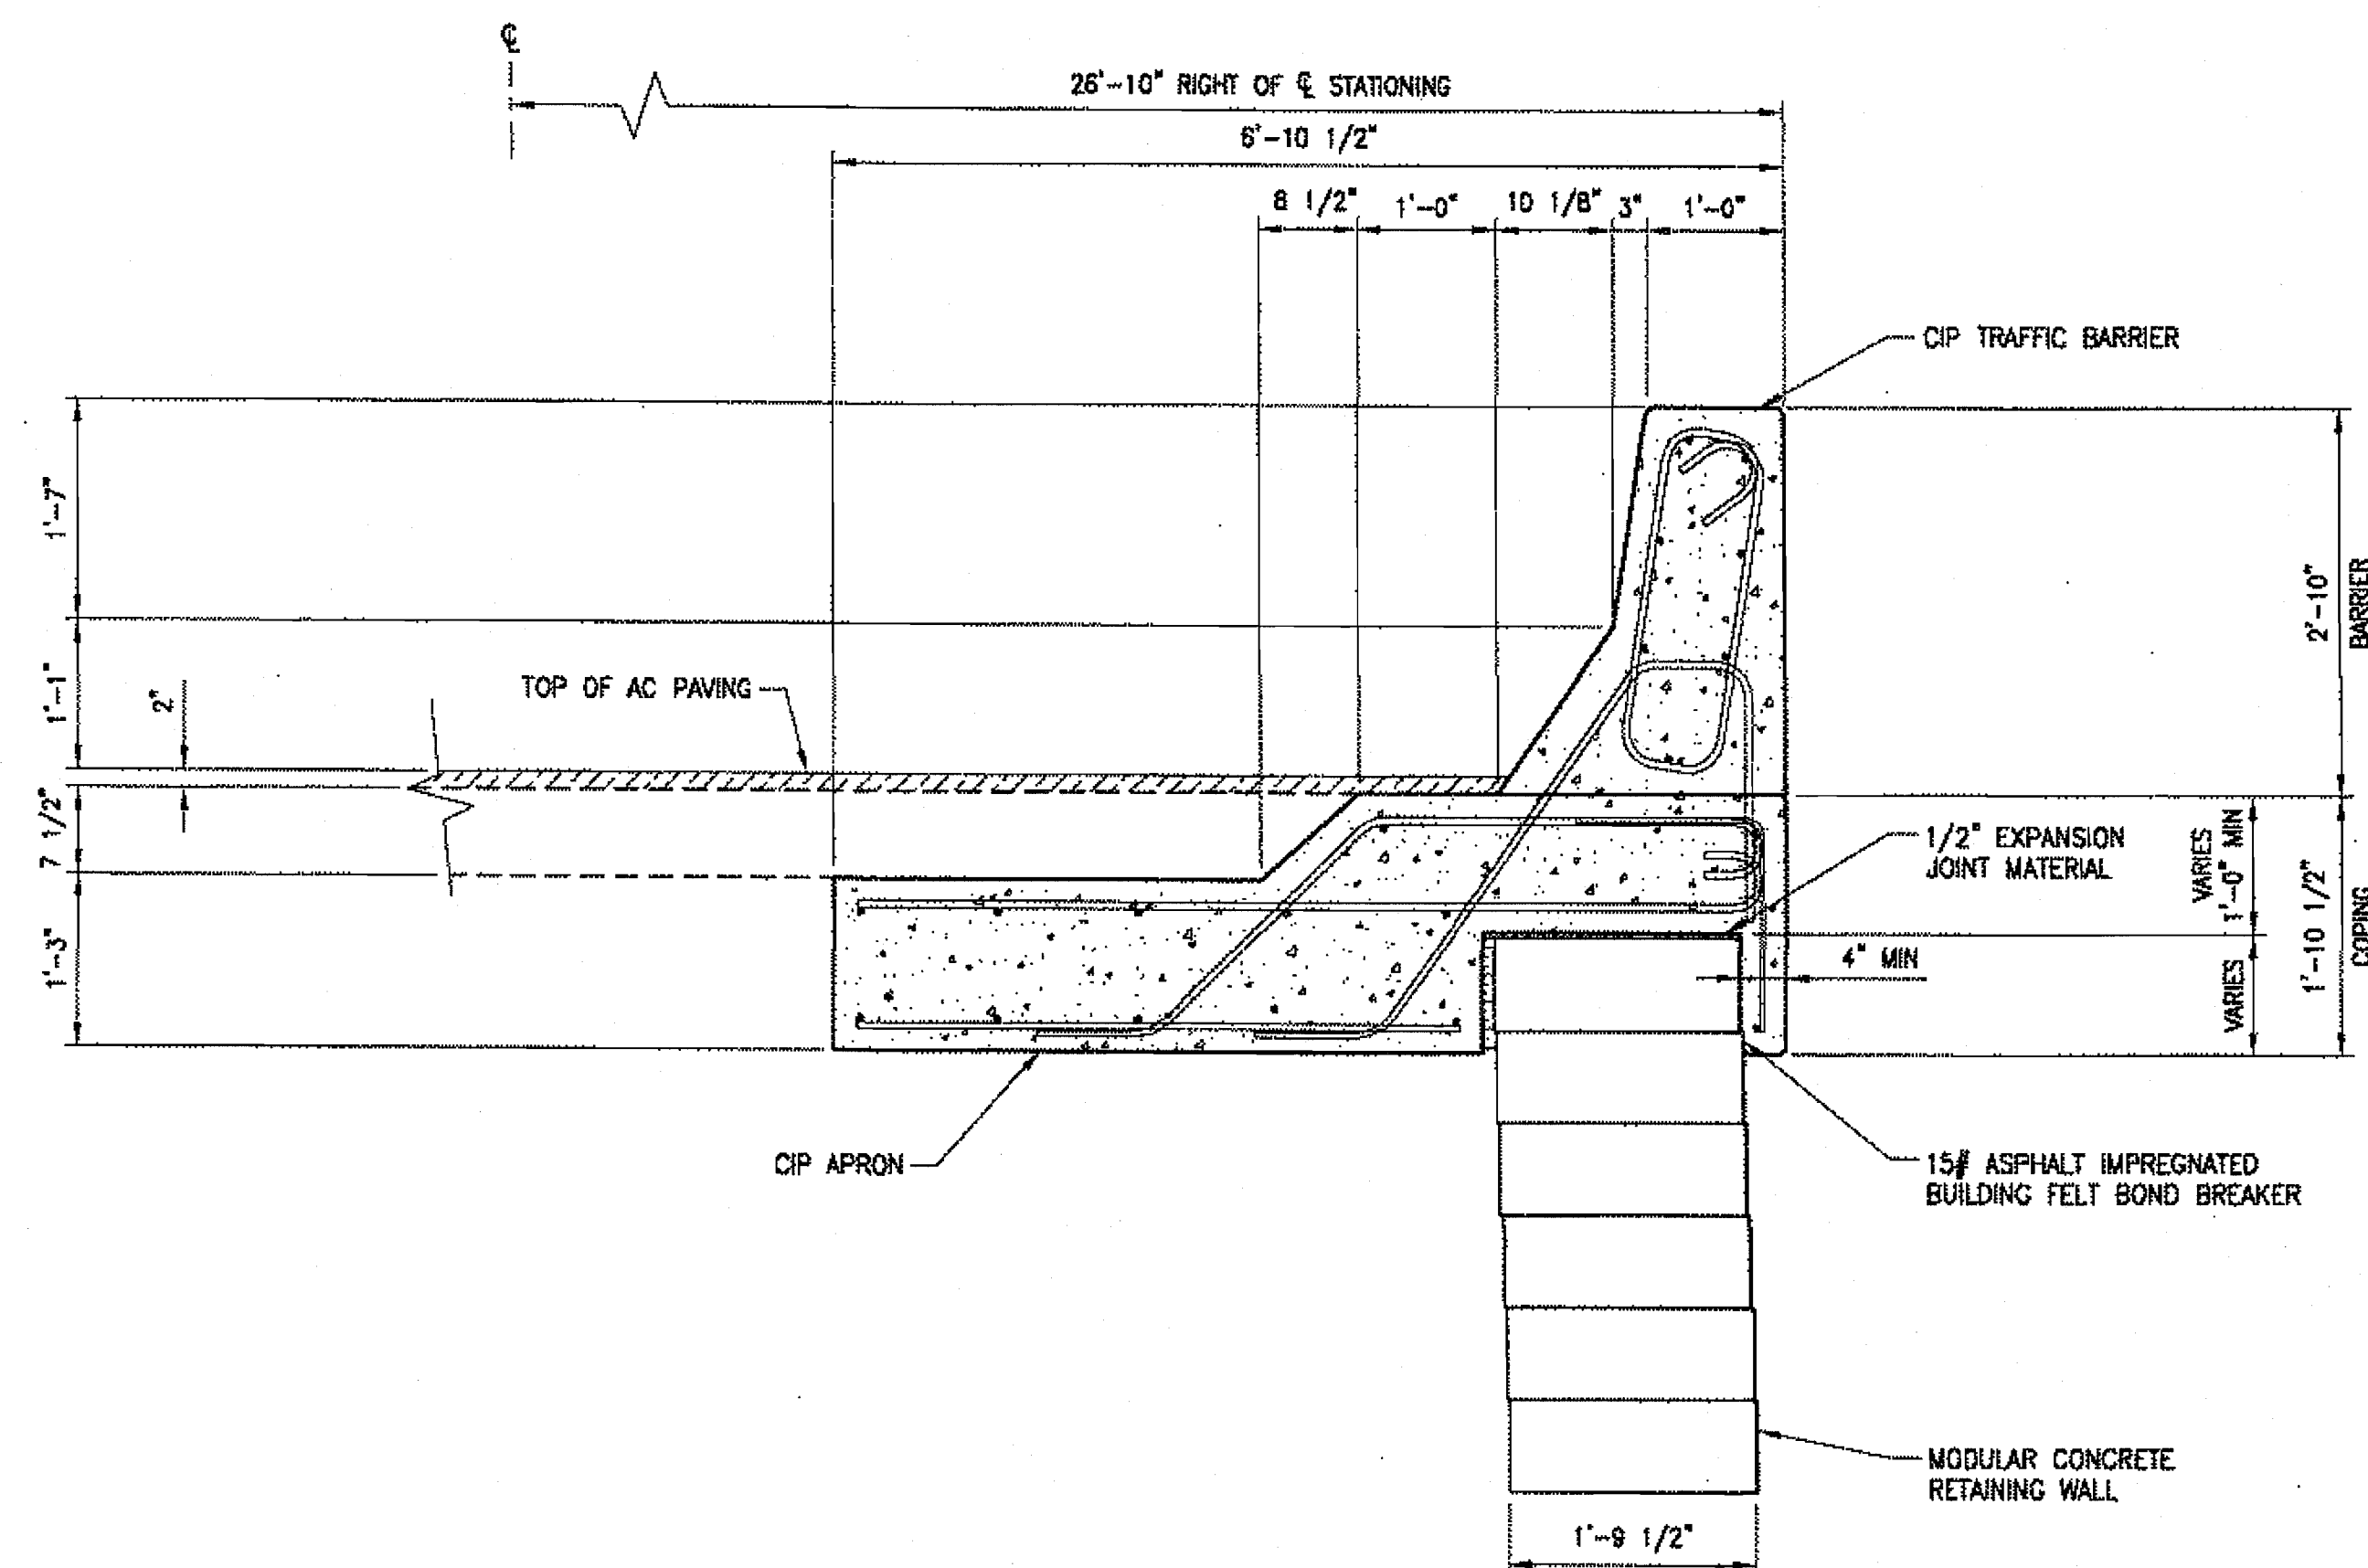[illegible]

NOTES:

BAR "TYPES" REFER TO CONCRETE REINFORCING STEEL INSTITUTE DETAIL REFERENCE TYPICAL BAR BEND DIAGRAMS.

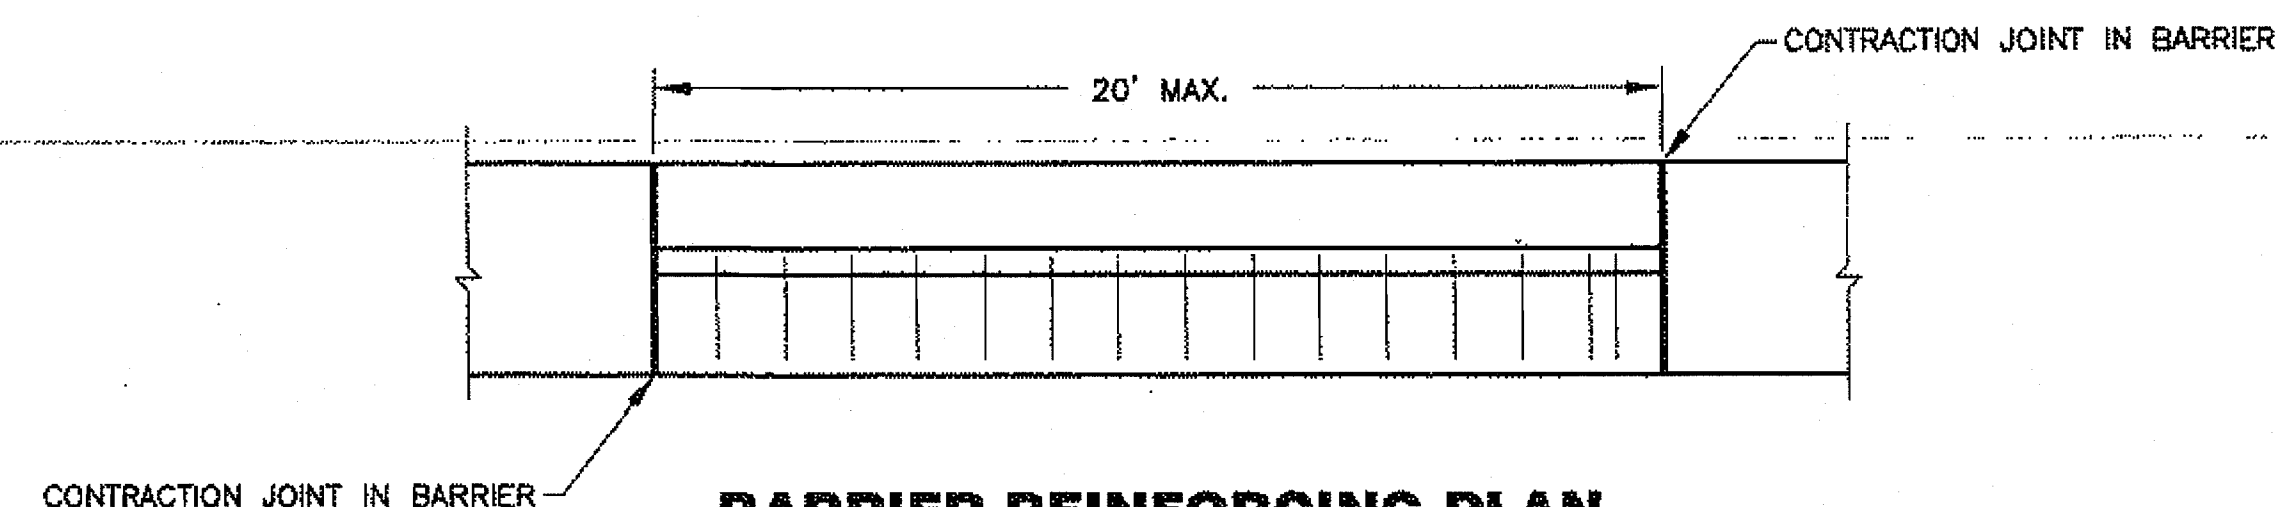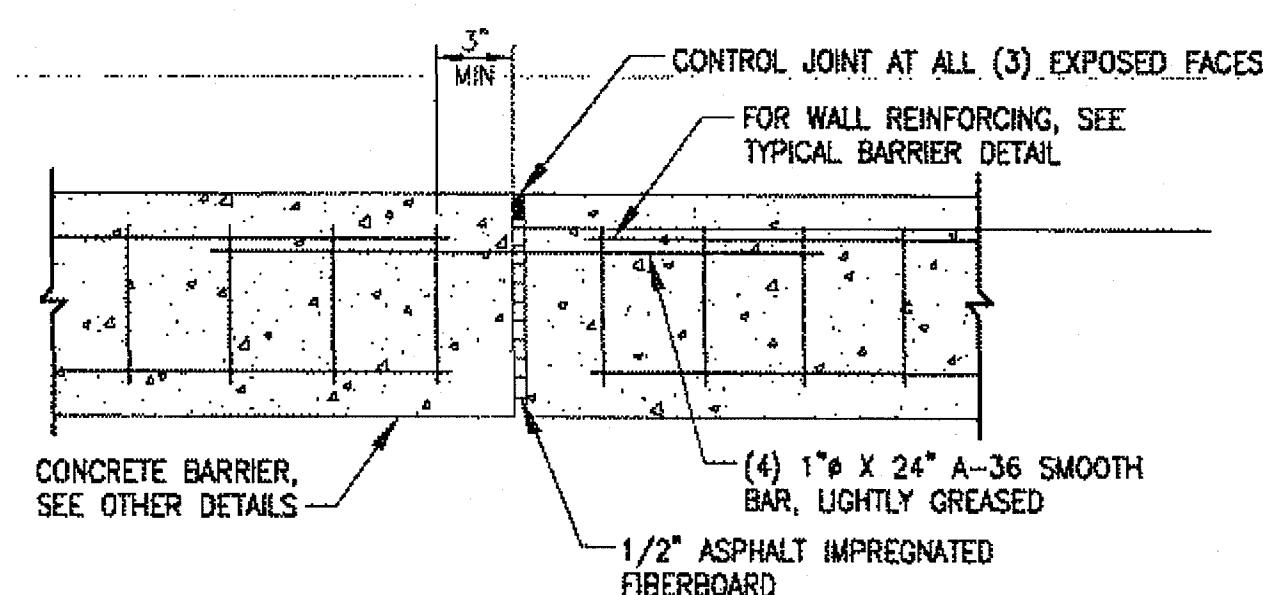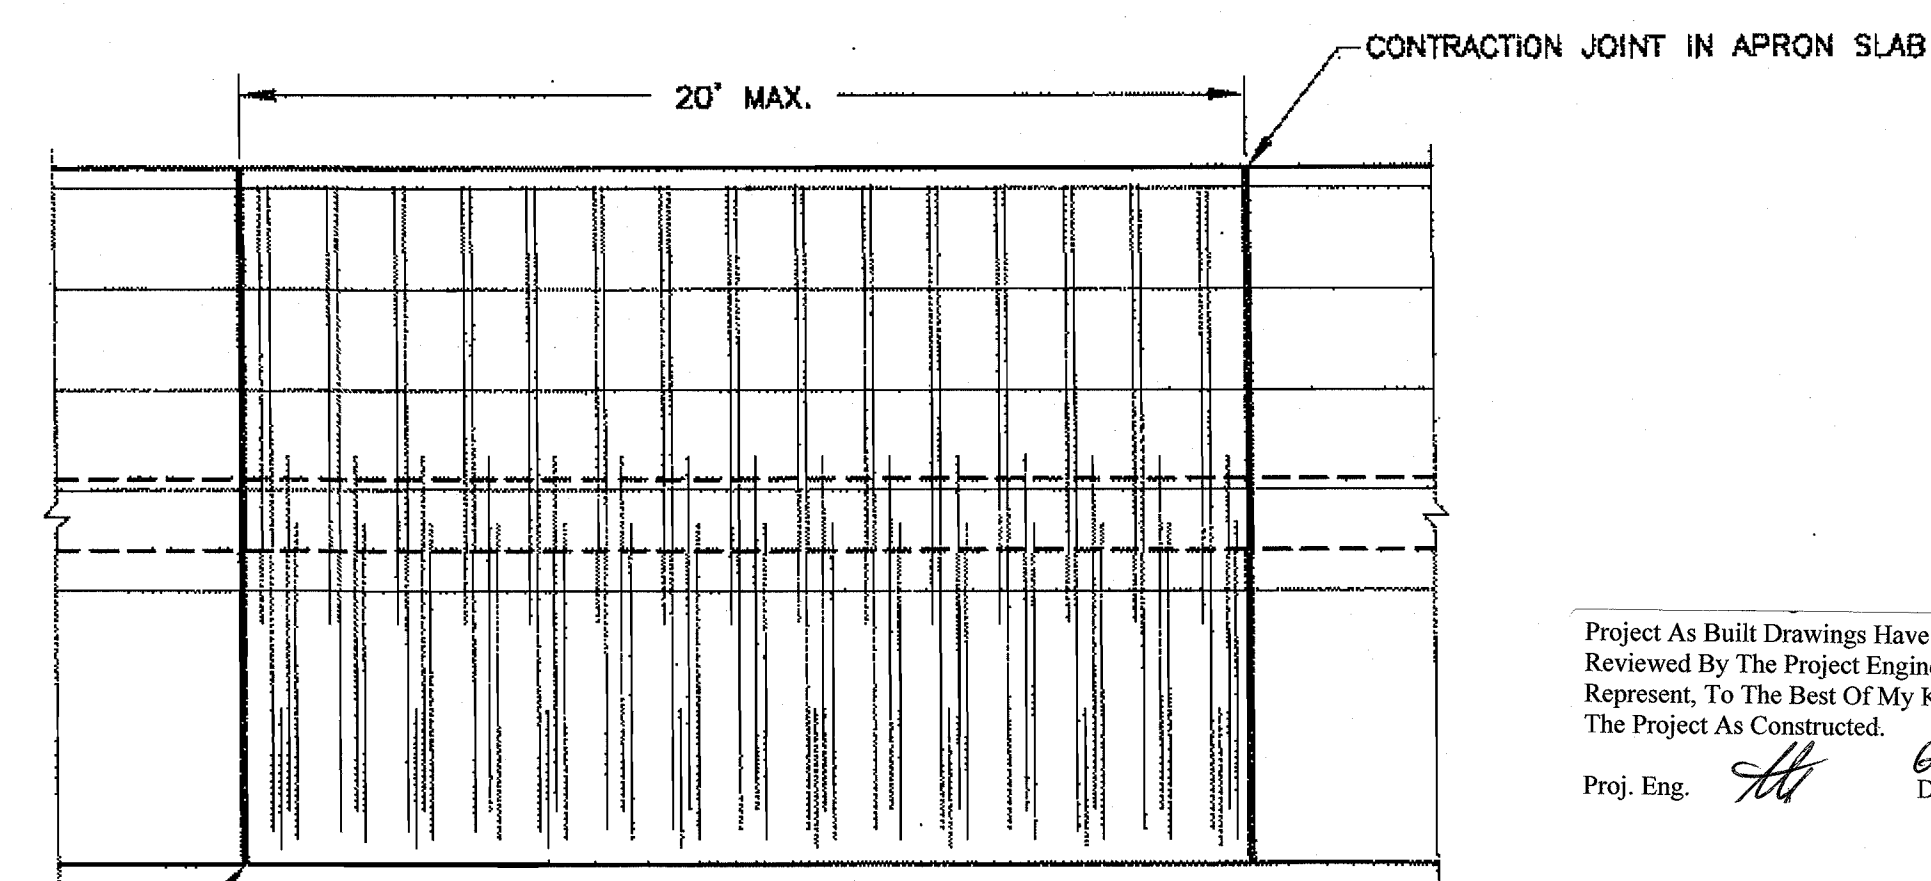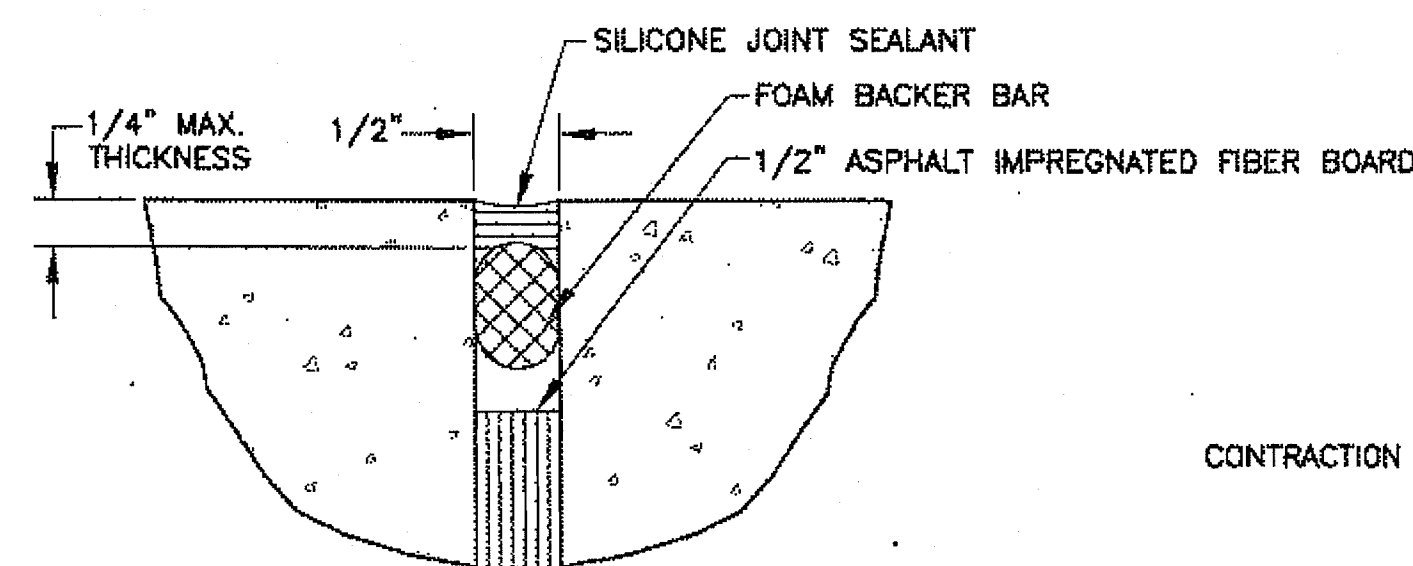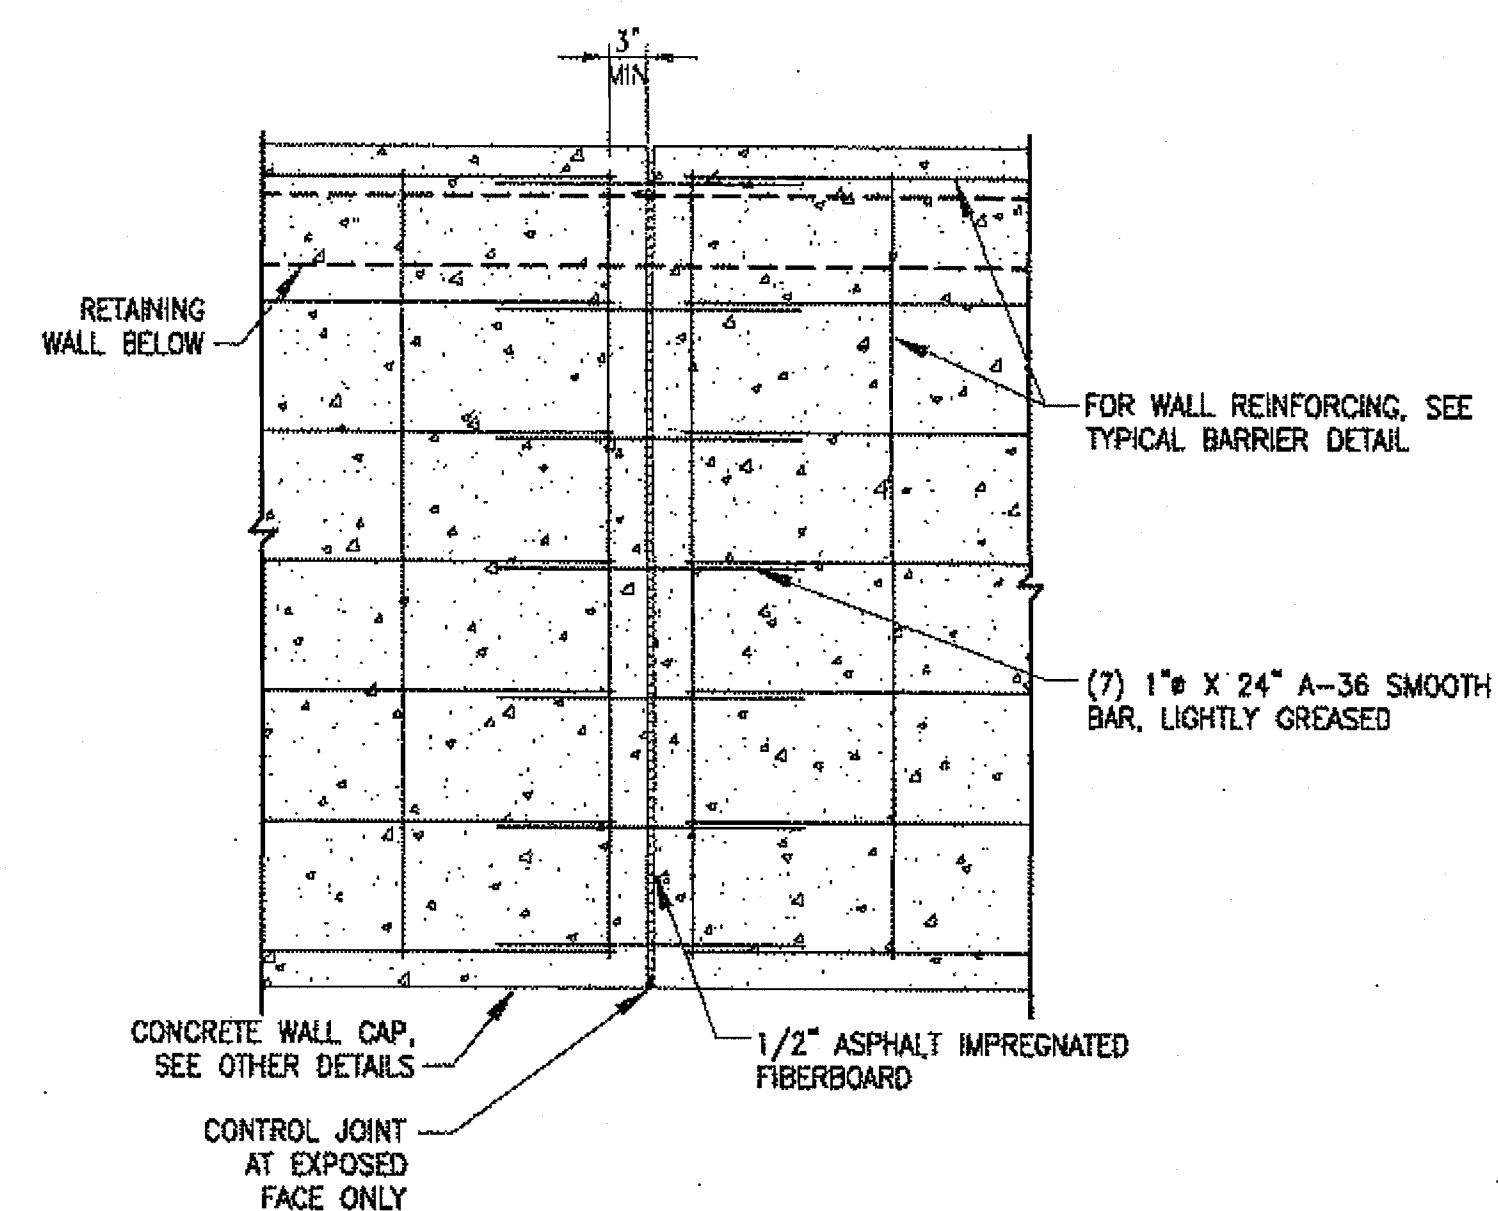

Project As Built Drawings Have Been
Reviewed By The Project Engineer &
Represent, To The Best Of My Knowledge,
The Project As Constructed.


Proj. Eng.  6-24-15
Date

Proj. Eng.

6-24-1
Date

PREPARED BY: USKH

CHECKED BY: BH

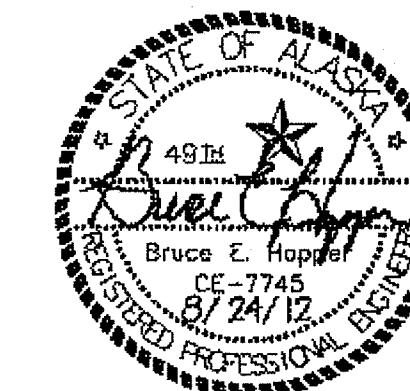

DESIGNED BY: NCI

DRAWN BY: WJP

STATE OF ALASKA
DEPARTMENT OF TRANSPORTATION
& PUBLIC FACILITIES
SOUTHEAST REGION

RETAINING WALL DETAILS

PROJECT DESIGNATION
68216\MSG-STP-0933(21)

STATE	YEAR
ALASKA	2012

SHEET NUMBER	TOTAL SHEETS
H8	109

DO NOT SCALE FROM THESE DRAWINGS USE DIMENSIONS

Traffic Control Notes:

- 1. A MINIMUM OF ONE LANE SHALL BE MAINTAINED AT ALL TIMES, THROUGH ALL WORK AREAS.
- 2. TWO LANES SHALL BE MAINTAINED AT ALL TIMES IN NON-WORK AREAS AND DURING NON-WORK HOURS.
- 3. TEMPORARY DRIVING LANES SHALL HAVE A MINIMUM WIDTH OF 10'-0".
- 4. WORK ZONE DOUBLE TRAFFIC FINES SIGNS SHALL BE USED AS DIRECTED BY THE ENGINEER AND PER STANDARD DRAWING C-04.12.
- 5. WARNING LIGHTS SHALL BE USED ON ALL CHANNELIZING DEVICES PLACED ALONG OR AROUND ROADWAY HAZARDS.
- 6. IT IS THE INTENT OF THIS TRAFFIC CONTROL PLAN (TCP) TO ILLUSTRATE SOME, NOT ALL, OF THE TRAFFIC CONTROL SETUPS WHICH WILL BE REQUIRED ON THIS PROJECT. PLANS FOR CONFIGURATIONS NOT COVERED BY THE TCP SHALL BE CREATED BY THE CONTRACTOR AND SUBMITTED TO THE ENGINEER FOR APPROVAL. WHERE APPROPRIATE, THEY SHALL INCORPORATE APPLICABLE PORTIONS OF DETAILS ON THESE SHEETS.
- 7. THE LENGTH OF WORK AREA SHALL BE MINIMIZED TO AVOID EXCESSIVE TRAFFIC DELAYS AS DIRECTED BY THE ENGINEER.
- 8. TRAFFIC DELAYS SHALL NOT EXCEED 15 MINUTES.
- 9. PRIOR TO BLASTING, THE BLASTER IN CHARGE SHALL DETERMINE WHETHER ROAD USERS IN THE BLASTING ZONE WILL BE ENDANGERED BY THE BLASTING OPERATION. IF THERE IS DANGER, ROAD USERS SHALL NOT BE PERMITTED TO PASS THROUGH THE BLASTING ZONE DURING BLASTING OPERATIONS AND FLAGGERS WITH THE APPROPRIATE SIGNAGE WILL BE REQUIRED.
- 10. MAX. CONE OR DRUM SPACING SHALL NOT EXCEED 35' ON TAPERS OR 70' ON TANGENTS.
- 11. TEMPORARY SIGNAL CONTROLS WILL BE COVERED UP OR REMOVED WHEN THEY ARE NOT IN USE.
- 12. TEMPORARY SIGNAL CONTROLS ARE REQUIRED WHEN SINGLE LANE CLOSURE IS USED FOR MORE THAN 24 HOURS.

Legend

- SIGN
- CONE
- DRUM
- CONCRETE BARRIER
- WATER FILLED BARRIER
- TYPE III BARRICADE
- FLAGGING STATION
- BLASTING CAP
- TEMPORARY SIGNAL
- HIGH LEVEL WARNING DEVICE

MIN. BUFFER	
S	LENGTH
20	115
25	155
30	200
35	250
40	305
45	360
50	425
55	495
60	570
65	645
70	730
75	820





FORMULAS FOR L (TAPER LENGTH)

40 MPH OR LESS $L = \frac{WS^2}{60}$

45 MPH OR GREATER $L = WS$

WHERE W = WIDTH OF OFFSET

S = POSTED SPEED LIMIT

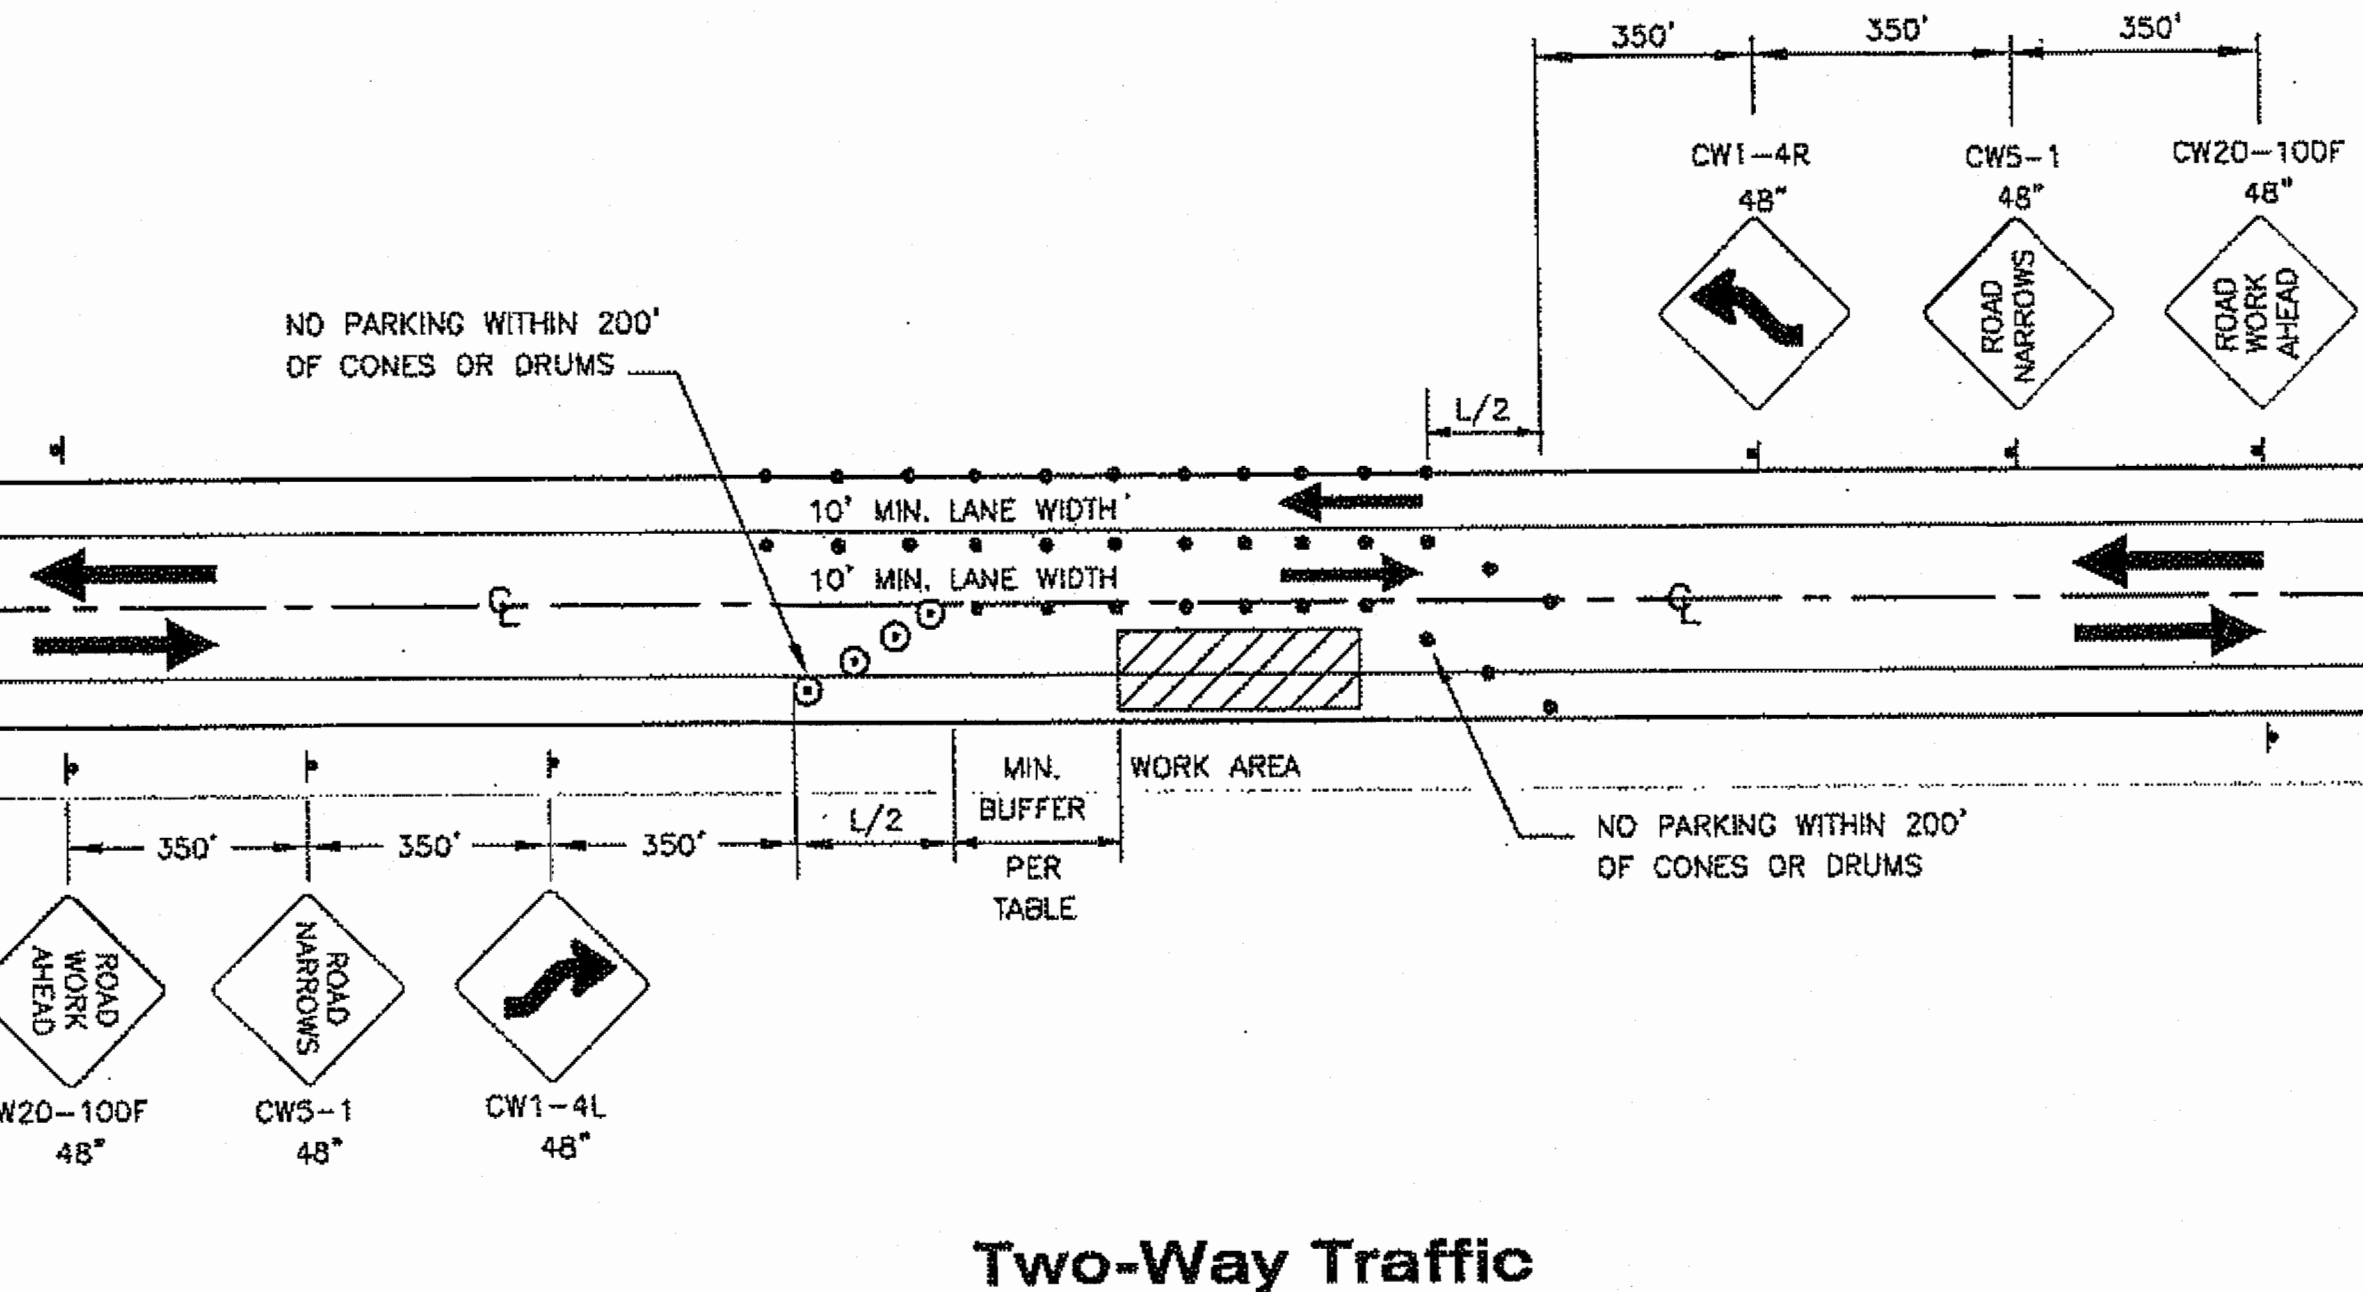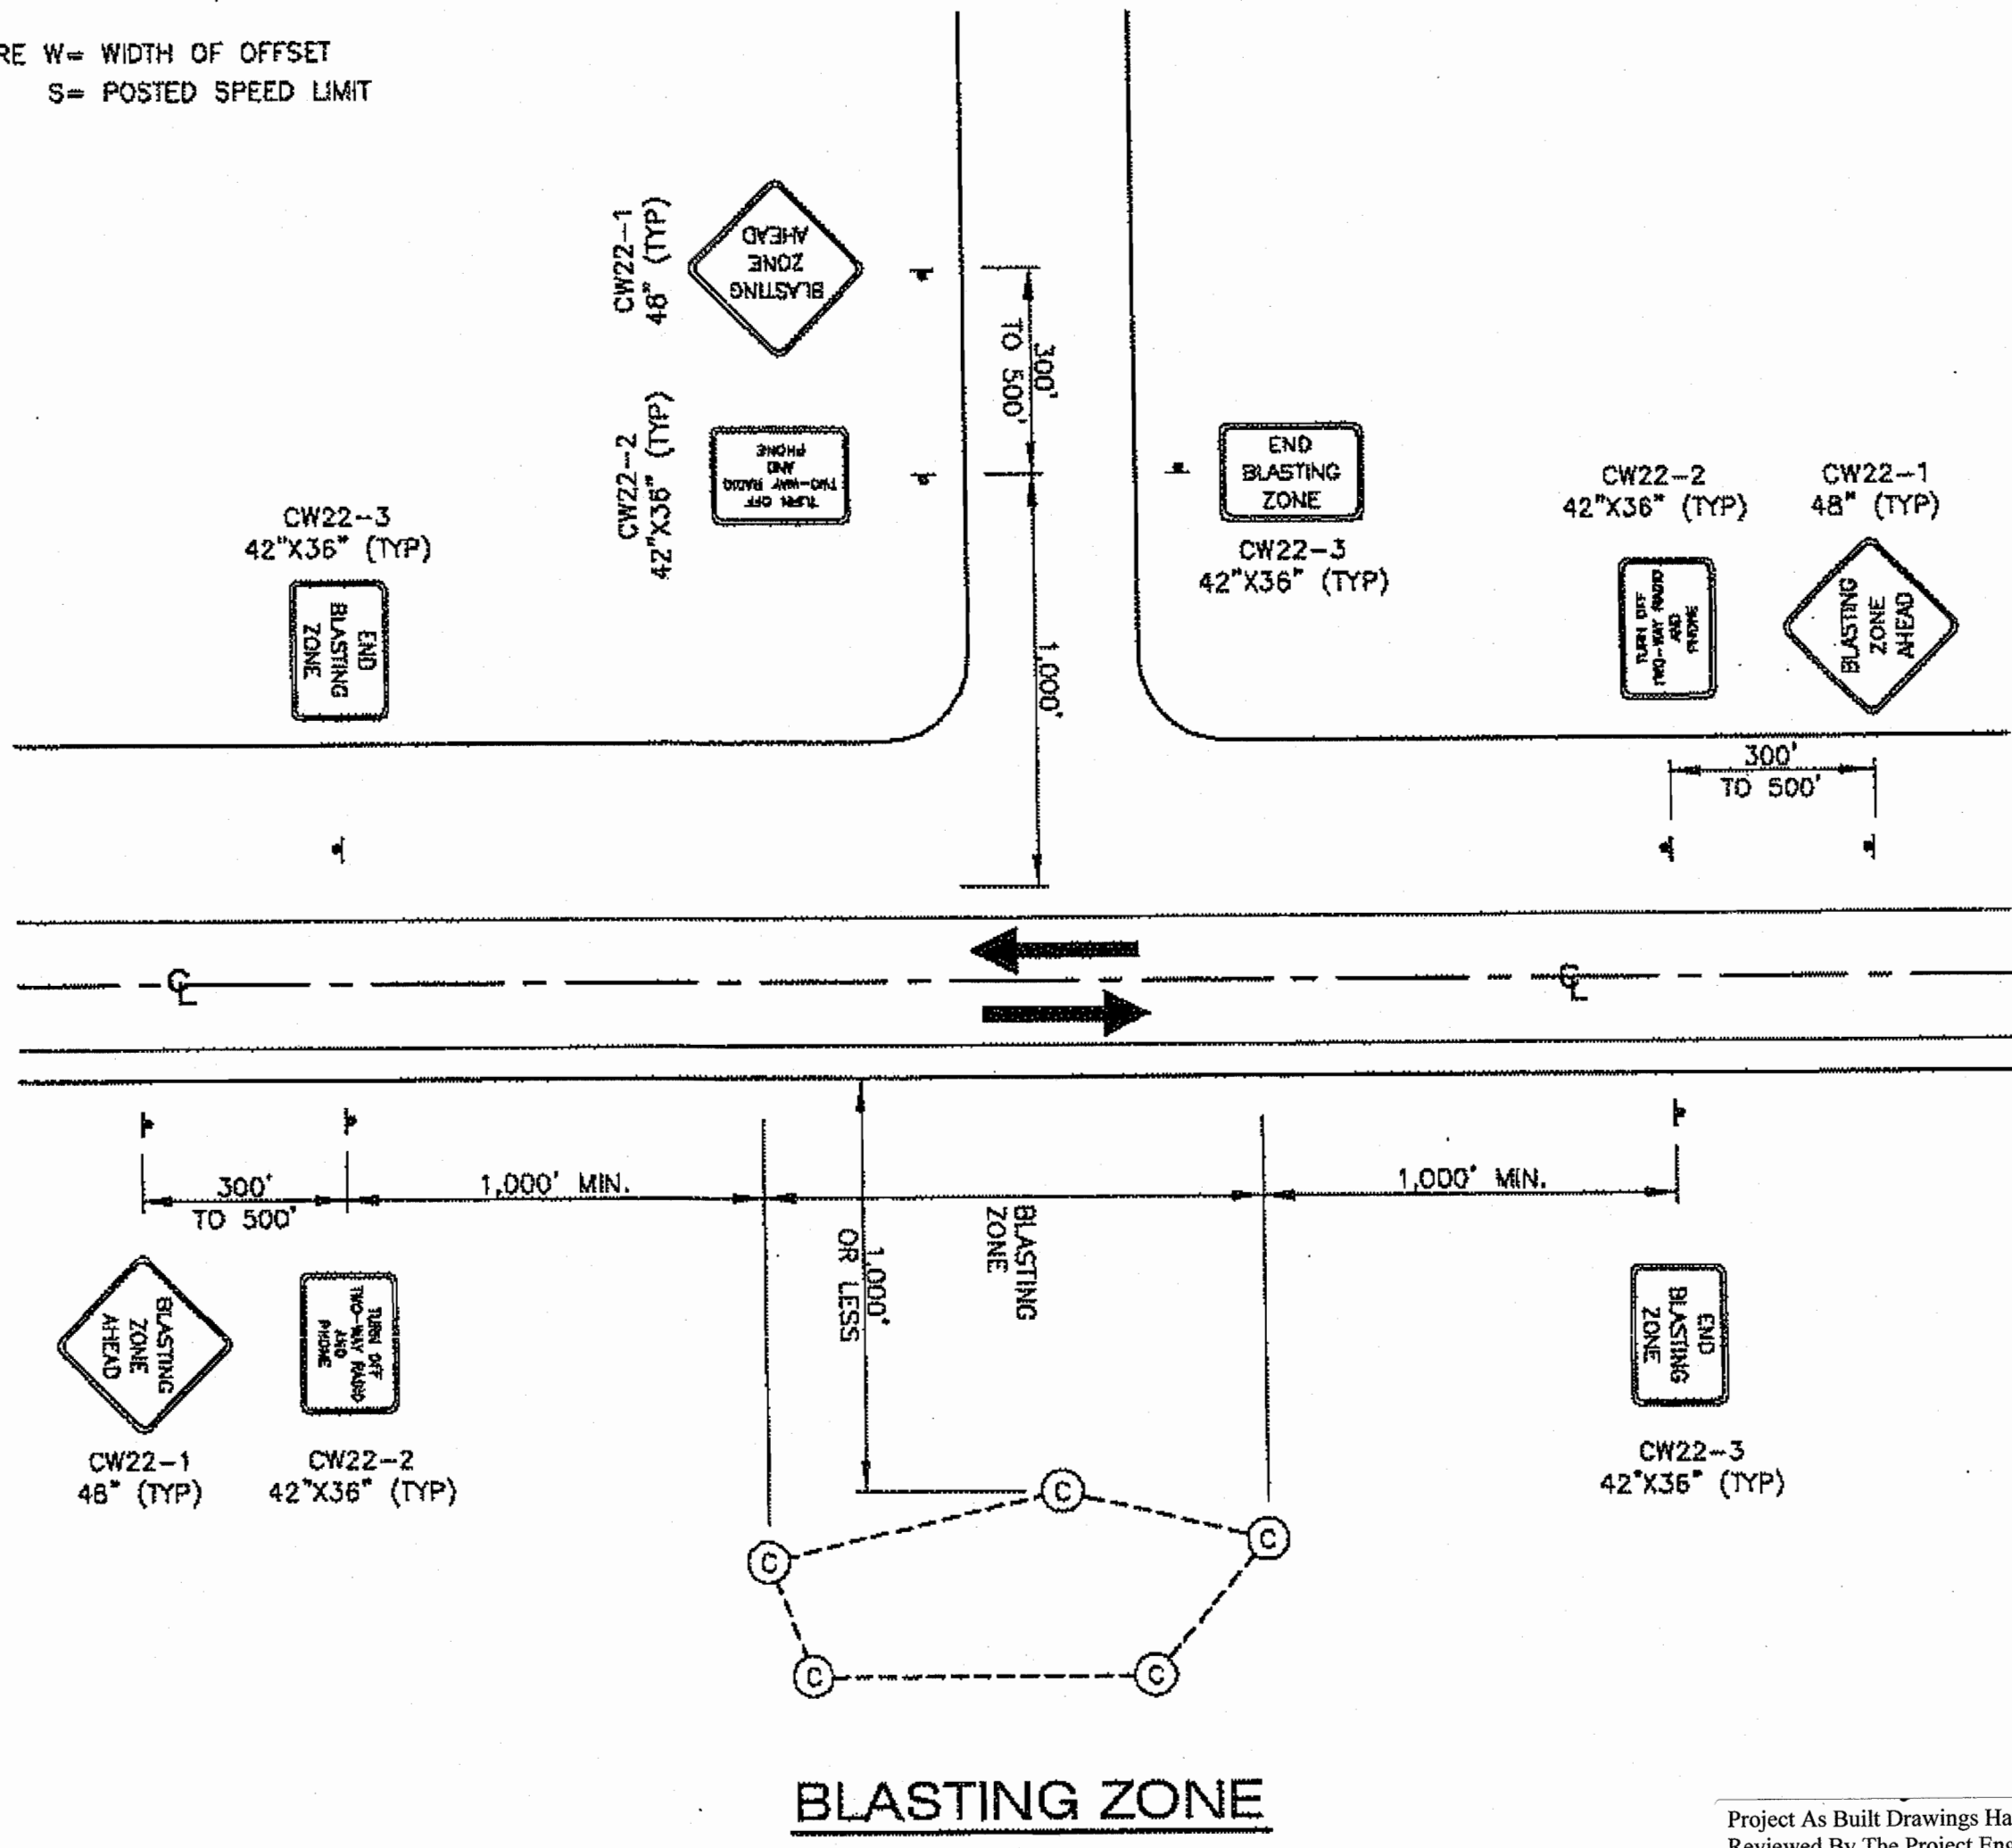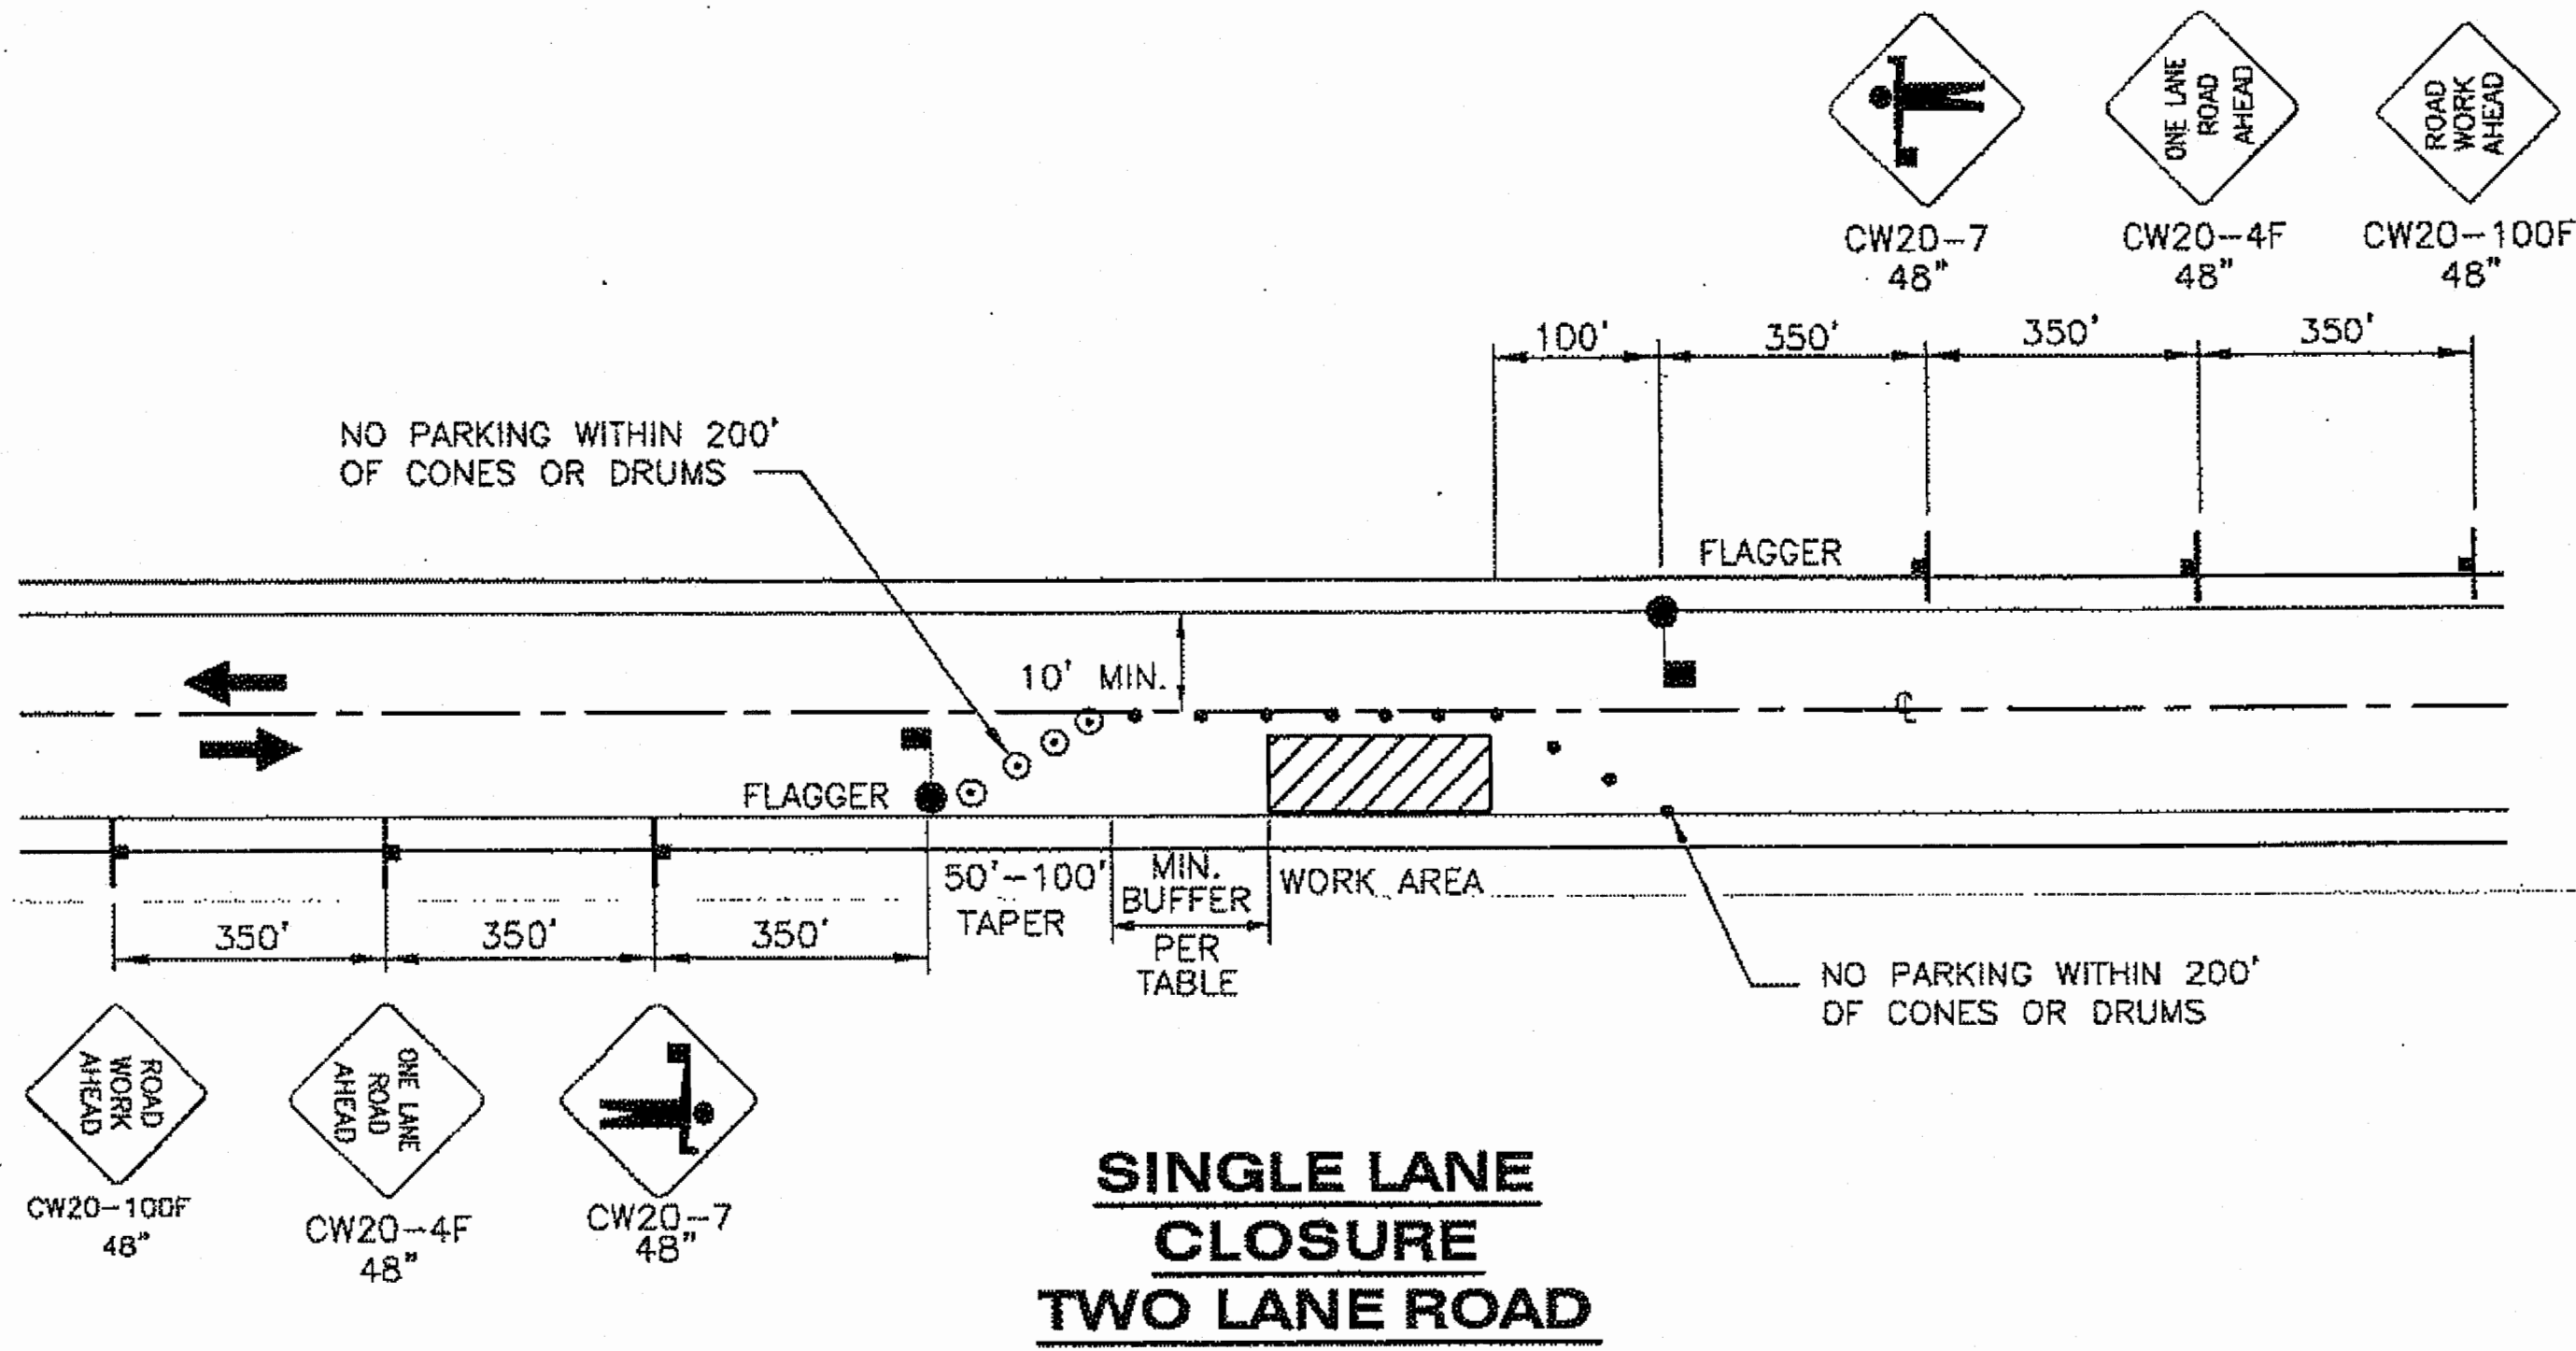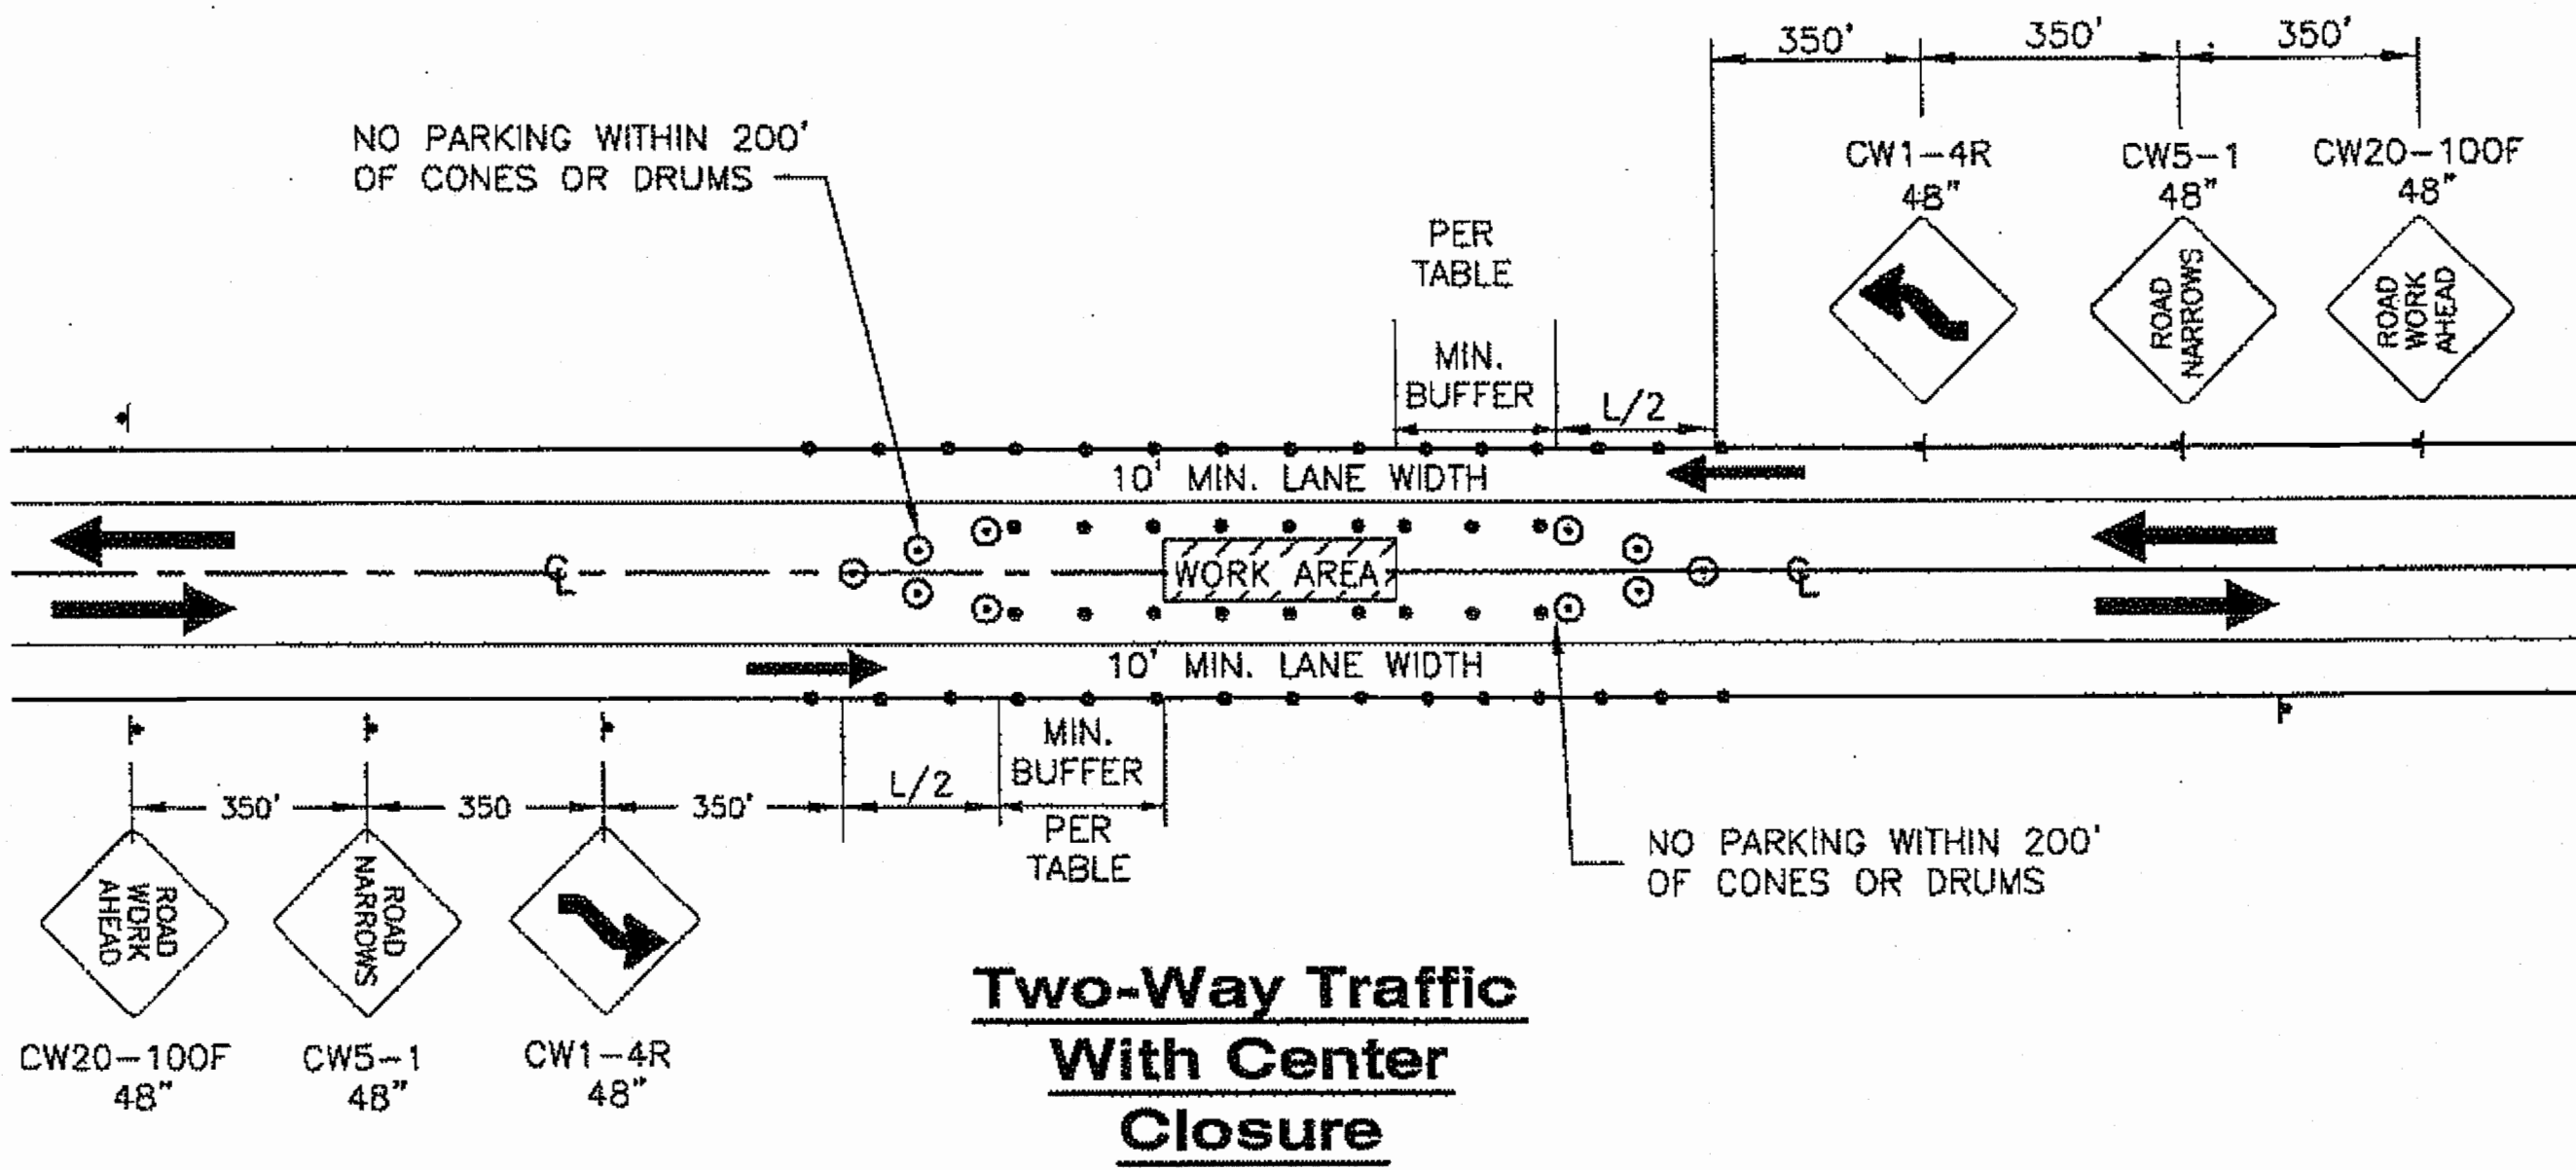

DO NOT SCALE FROM THESE DRAWINGS USE DIMENSIONS

PATH: \\NWFILE2\JOBS\1153805\DWG\SIG\SHEETS\K01.DWG
Friday, August 17, 2012 7:19:43 PM
TAB: K01

ADDENDUM NUMBER

ATTACHMENT NUMBER

RECORD OF REVISIONS

No.	DATE	DESCRIPTION

SAWMILL CREEK ROAD UPGRADE
PHASE III - WHALE PARK TO SAWMILL CREEK BRIDGE
68216MSG-STP-0933(21)
SITKA TELECOMMUNICATIONS CONDUIT
RSA NO. 69615

TRAFFIC CONTROL PLAN

Project As Built Drawings Have Been Reviewed By The Project Engineer & Represent, To The Best Of My Knowledge, The Project As Constructed.
Proj. Eng. *[Signature]* Date 6-24-15

PREPARED BY: USKH
CHECKED BY: NCL

DESIGNED BY: NCL
DRAWN BY: VWP


STATE OF ALASKA
DEPARTMENT OF TRANSPORTATION & PUBLIC FACILITIES
SOUTHEAST REGION

TRAFFIC CONTROL PLAN

PROJECT DESIGNATION
68216MSG-STP-0933(21)


STATE	YEAR
ALASKA	2012

SHEET NUMBER	TOTAL SHEETS
K1	109

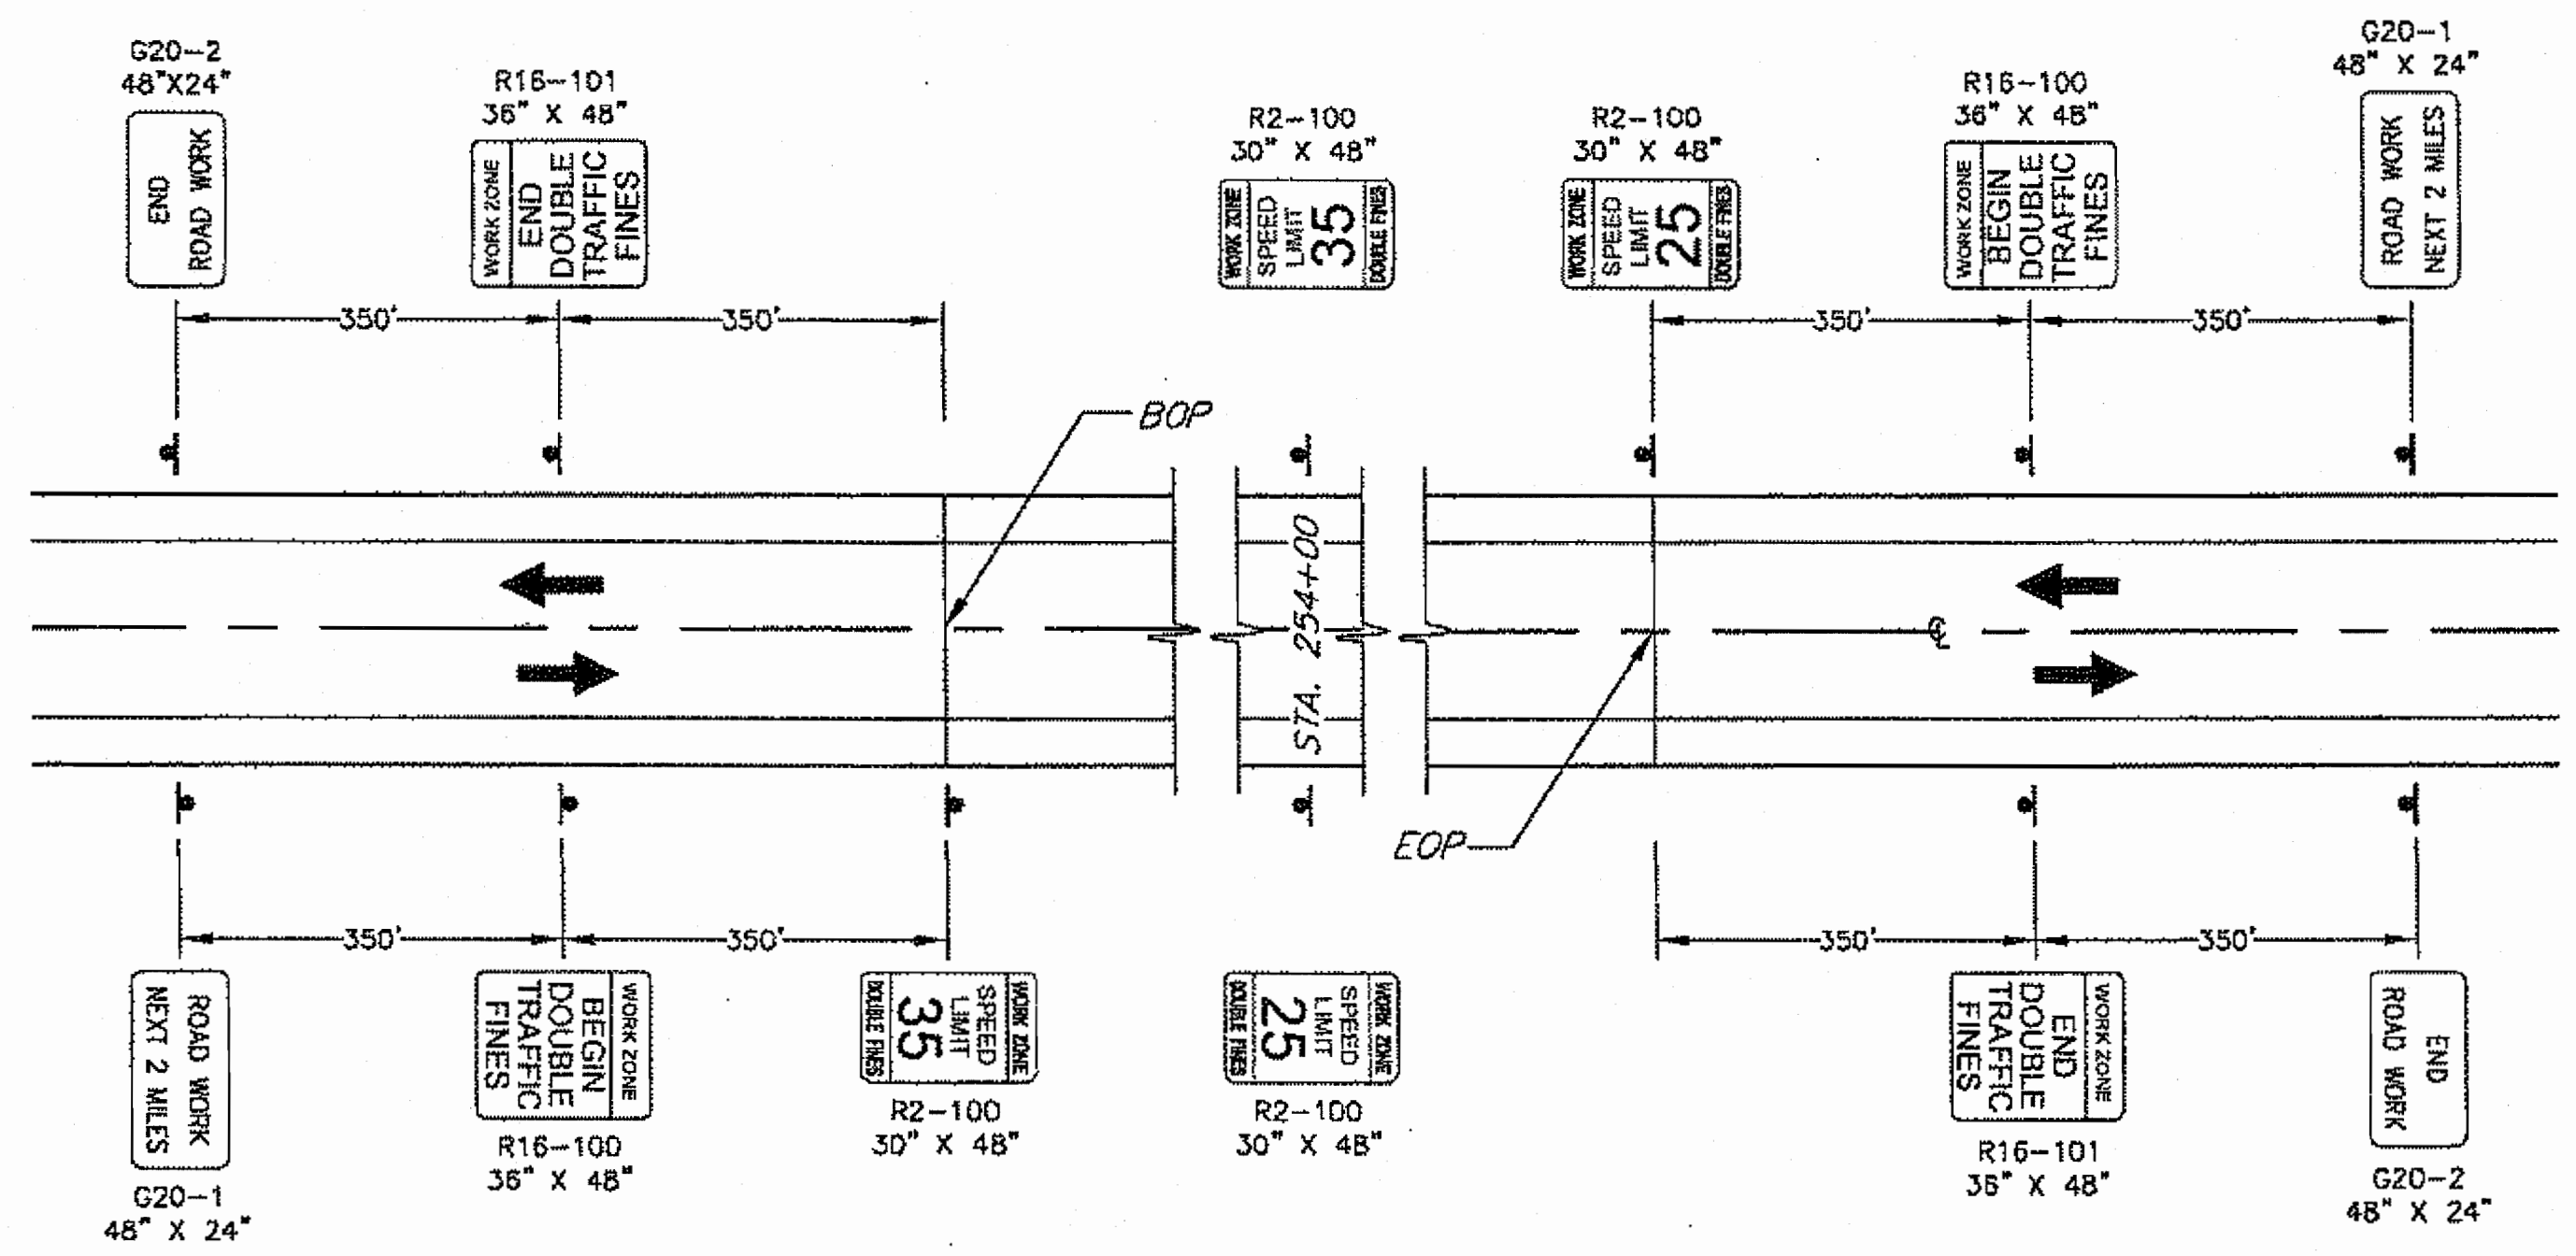

PERMANENT CONSTRUCTION SIGNING

- USE AT:
 1. BOP / BEFORE WHALE PARK
 2. EOP / PAST SAWMILL CREEK BRIDGE

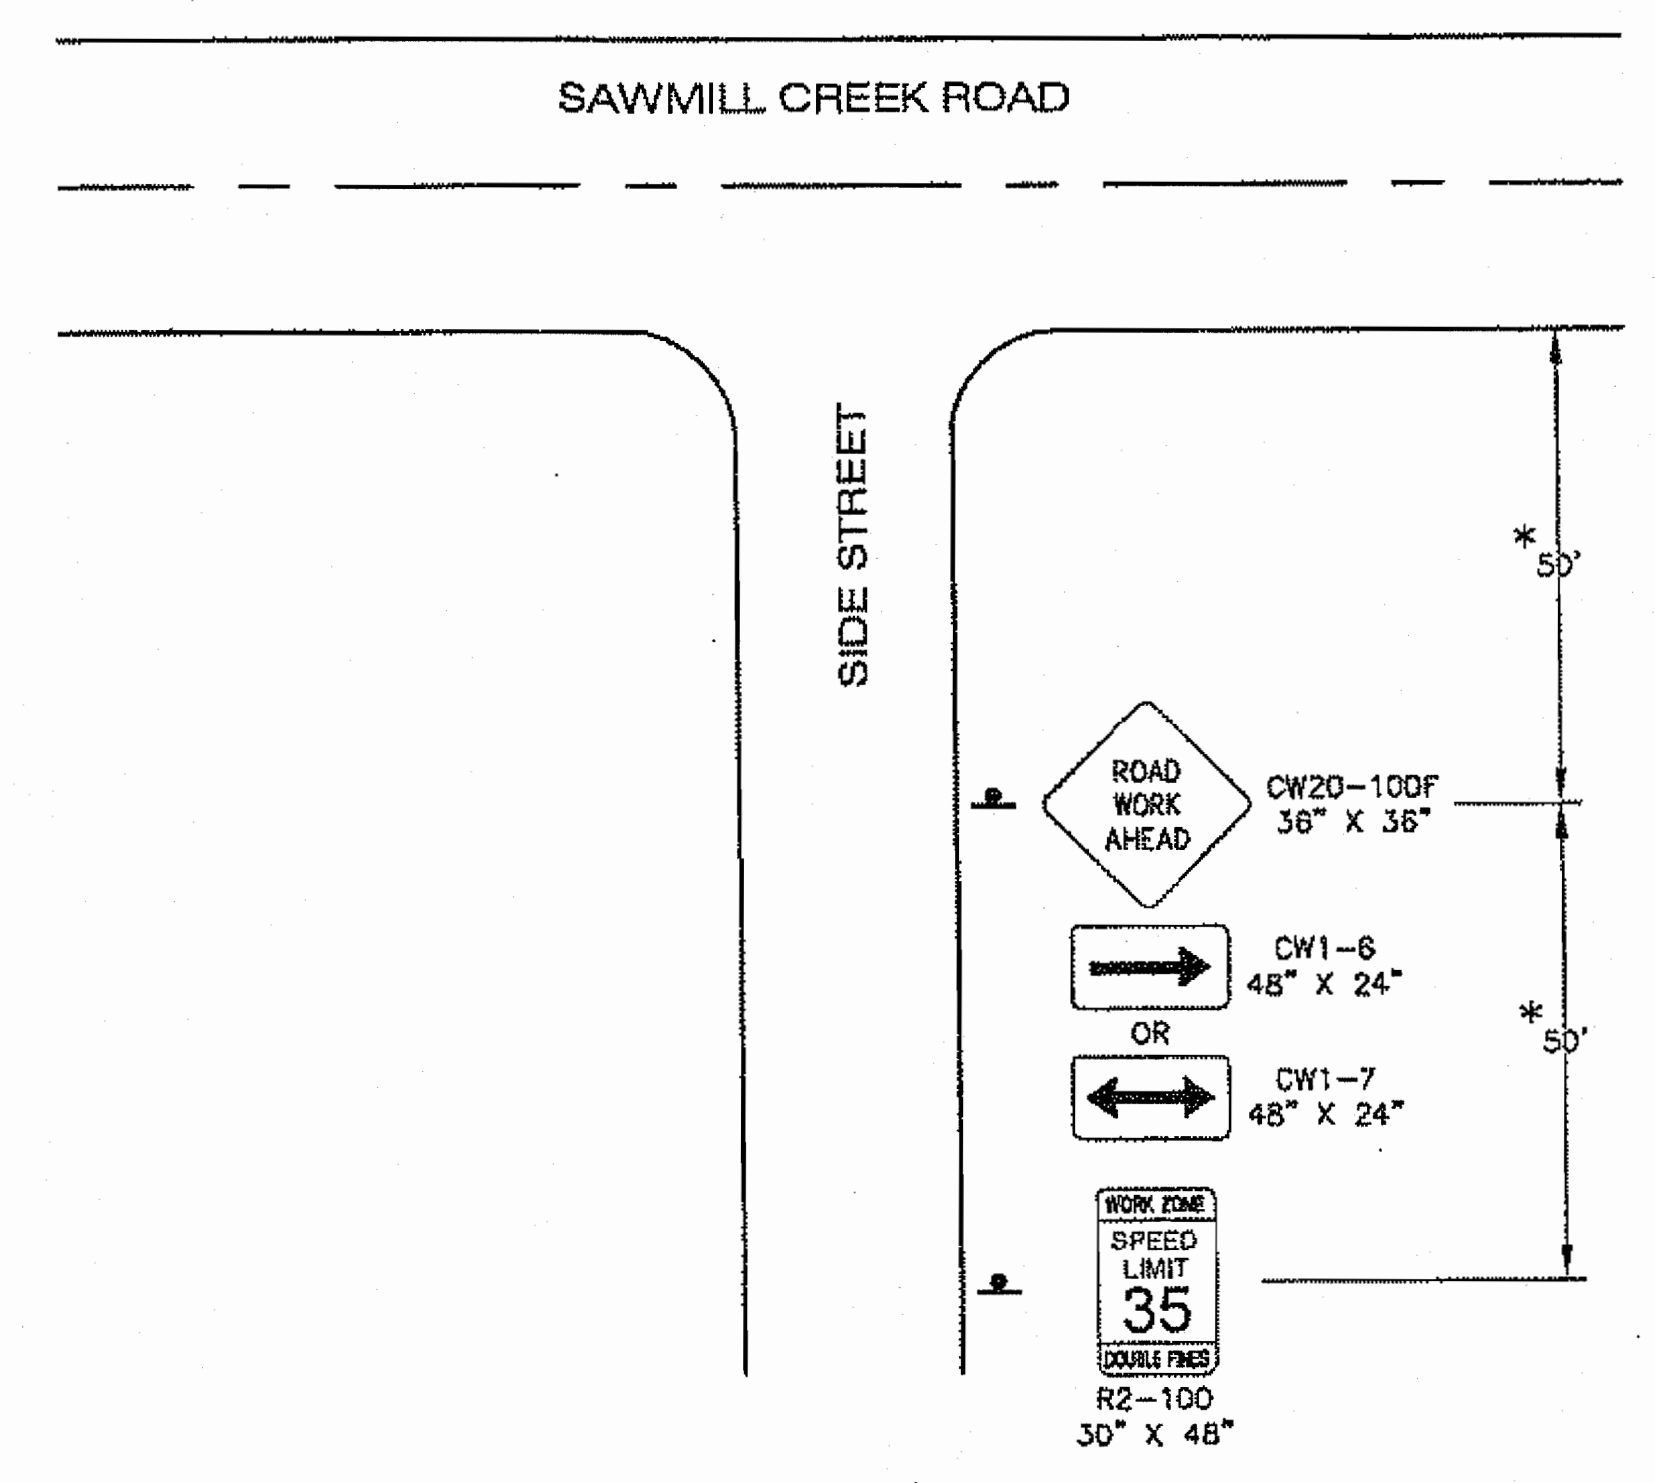

**PERMANENT CONSTRUCTION SIGNING
SIDE STREET APPROACHES**

* OR AS DIRECTED BY THE ENGINEER

Project As Built Drawings Have Been Reviewed By The Project Engineer & Represent, To The Best Of My Knowledge, The Project As Constructed.
 Proj. Eng. *[Signature]* Date 6-24-15

PATH: I:\JNU\FILE2\JOBS\1163806\DWG\BIC\SHETS\K02.DWG		
Friday, August 17, 2012 7:19:47 PM		
TAB: K02		
ADDENDUM NUMBER		
ATTACHMENT NUMBER		
RECORD OF REVISIONS		
No.	DATE	DESCRIPTION


SAWMILL CREEK ROAD UPGRADE
 PHASE III - WHALE PARK TO SAWMILL CREEK BRIDGE
 68216\MSG-STP-0933(21)
 SITKA TELECOMMUNICATIONS CONDUIT
 RSA NO. 69615

TRAFFIC CONTROL PLAN


PREPARED BY: USKH
CHECKED BY: NCL
DESIGNED BY: NCL
DRAWN BY: WJP

STATE OF ALASKA DEPARTMENT OF TRANSPORTATION & PUBLIC FACILITIES SOUTHEAST REGION	
TRAFFIC CONTROL PLAN	
PROJECT DESIGNATION 68216\MSG-STP-0933(21)	
STATE	YEAR
ALASKA	2012
SHEET NUMBER	TOTAL SHEETS
K2	109

DO NOT SCALE FROM THESE DRAWINGS USE DIMENSIONS

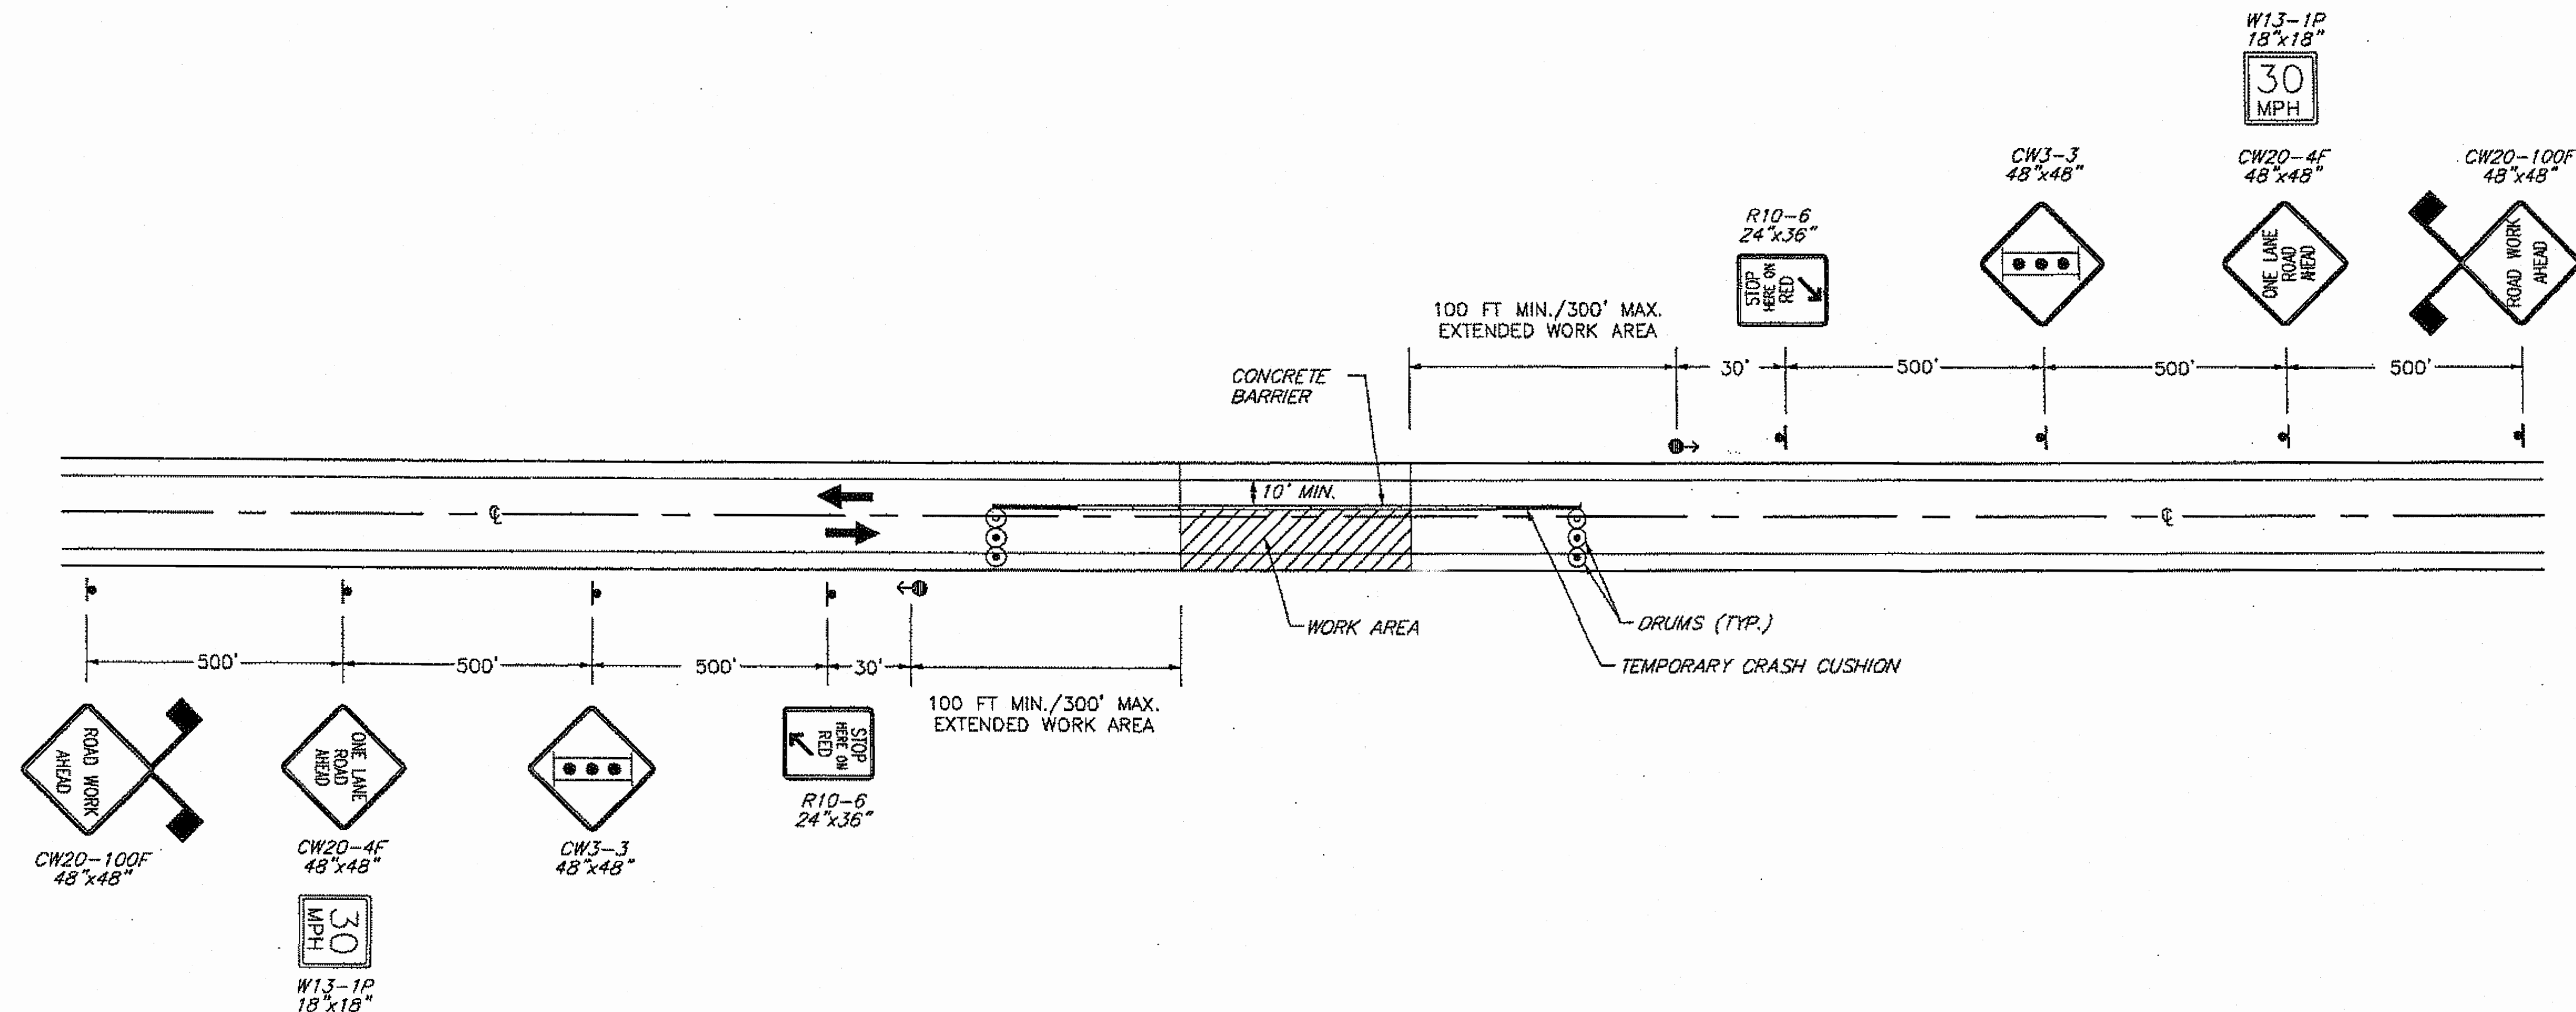

**TWO LANE ROADWAY - SINGLE LANE CLOSURE
SIGNAL CONTROL**

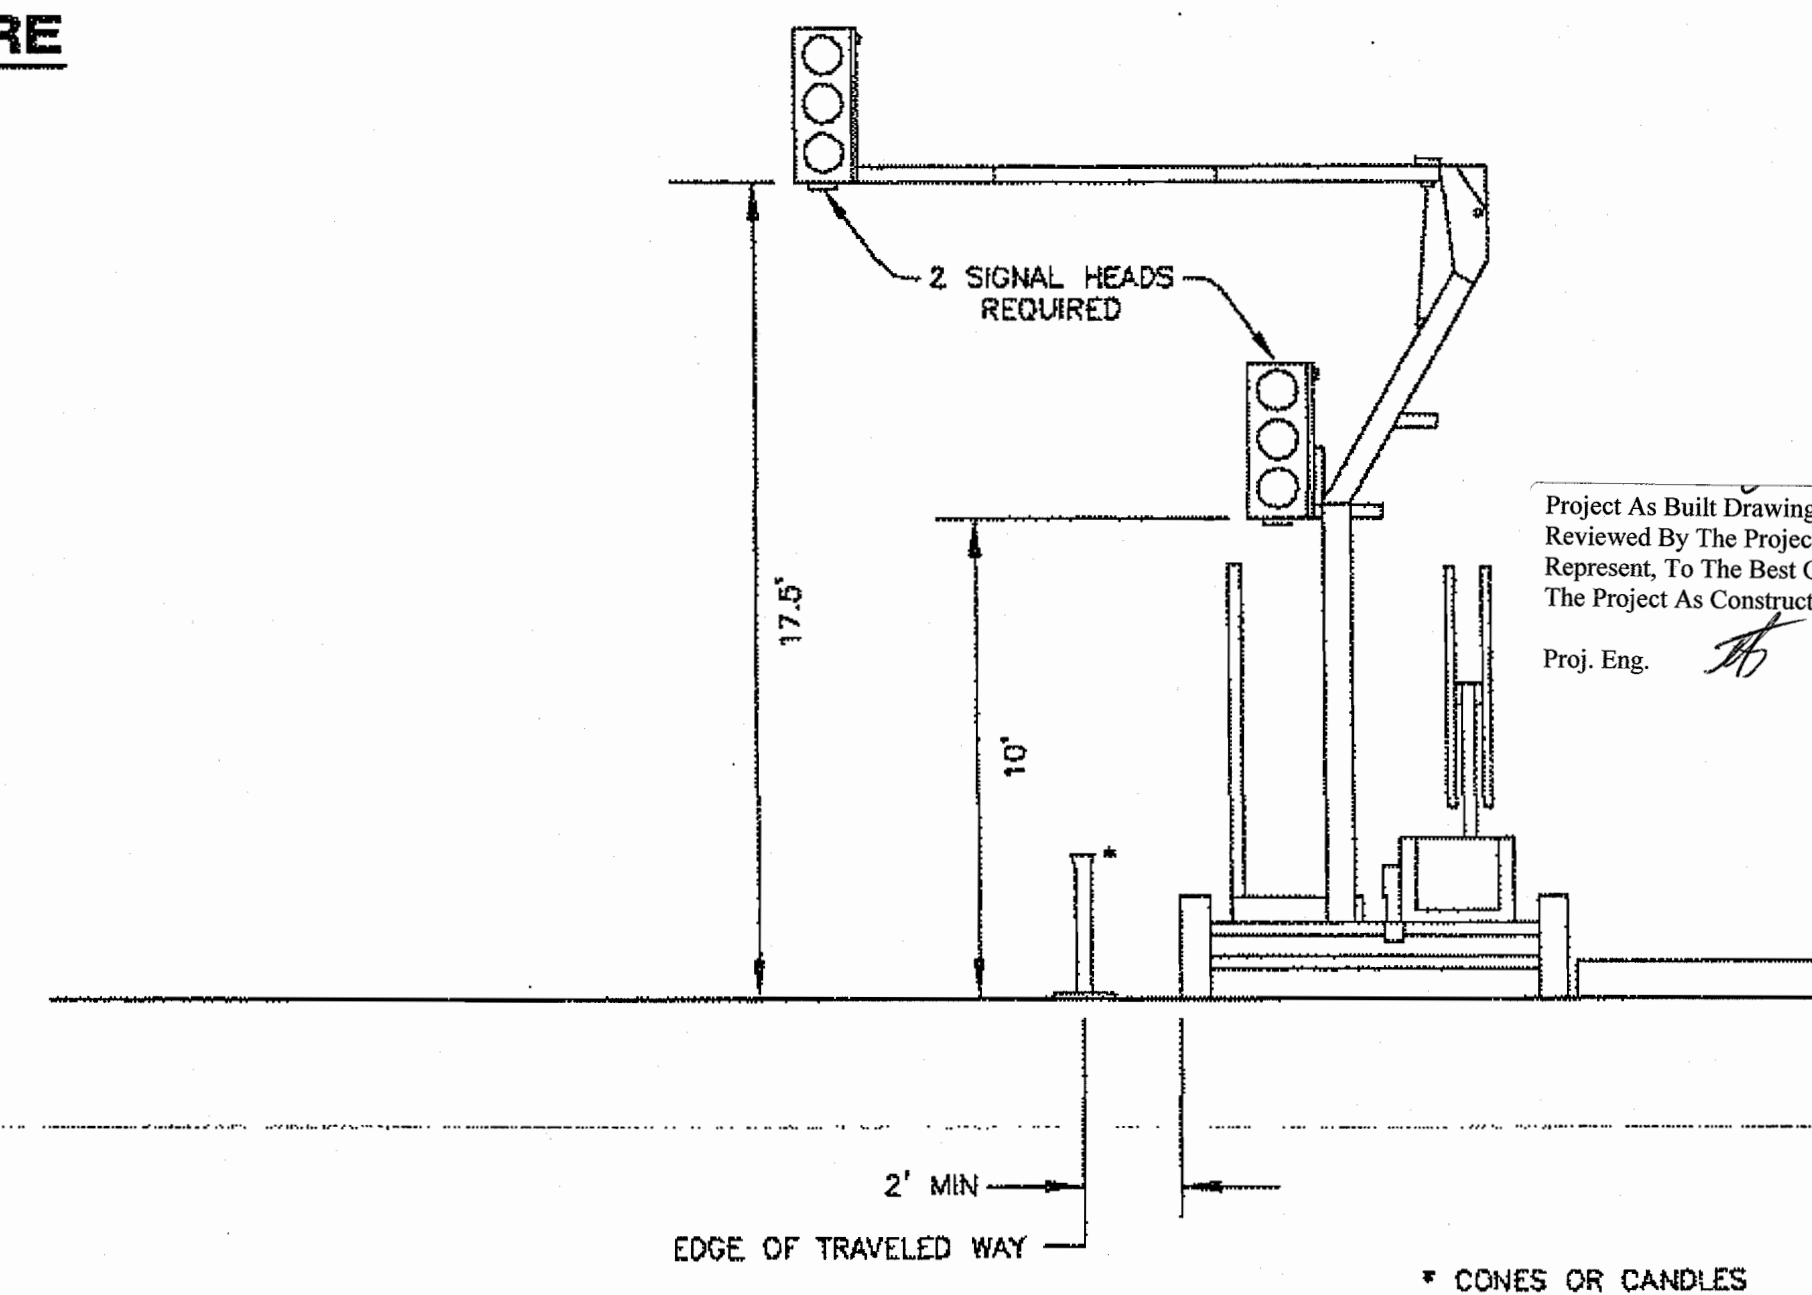


TYPICAL TEMPORARY SIGNAL SETUP

DO NOT SCALE FROM THESE DRAWINGS USE DIMENSIONS

PATH: \\UNUFILE\J\JOBS\1153805\DWGS\C\ISHEETS\K03.DWG		
Friday, August 17, 2012 7:19:51 PM		
TAB: K03		
ADDENDUM NUMBER		
ATTACHMENT NUMBER		
RECORD OF REVISIONS		
No.	DATE	DESCRIPTION
SAWMILL CREEK ROAD UPGRADE PHASE III - WHALE PARK TO SAWMILL CREEK BRIDGE 68216MSG-STP-0933(21) SITKA TELECOMMUNICATIONS CONDUIT RSA NO. 69615		
TRAFFIC CONTROL PLAN		
PREPARED BY: USKH		
CHECKED BY: NCL		
DESIGNED BY: NCL		
DRAWN BY: WJP		
STATE OF ALASKA DEPARTMENT OF TRANSPORTATION & PUBLIC FACILITIES SOUTHEAST REGION		
TRAFFIC CONTROL PLAN		
PROJECT DESIGNATION		
68216MSG-STP-0933(21)		
STATE	YEAR	
ALASKA	2012	
SHEET NUMBER	TOTAL SHEETS	
K3	109	

LEGEND

- CUT LIMITS
- FILL LIMITS
- FLOW DIRECTION
- DITCHLINE FLOW DIRECTION
- EXISTING DRAINAGE
- WATERS OF THE U.S.
- SB --- TEMPORARY SEDIMENT BARRIER
- FR --- FIBER ROLLS
- DD --- SLOPE DRAIN
- VBS --- VEGETATIVE BUFFER STRIP
- ||||| GRAVEL FILTER BERM
- ◇ AREA OF DISTURBANCE
- HTL --- HIGH TIDE LINE = 12.7'
- PROPERTY LINE
- CULVERT BYPASS
- CATCH BASIN INSERT
- ◇ TEMPORARY ROCK FILTER DAM
- ◇ TEMPORARY CHECK DAM
- TEMPORARY MULCHING (BFM)
- EAGLE NEST

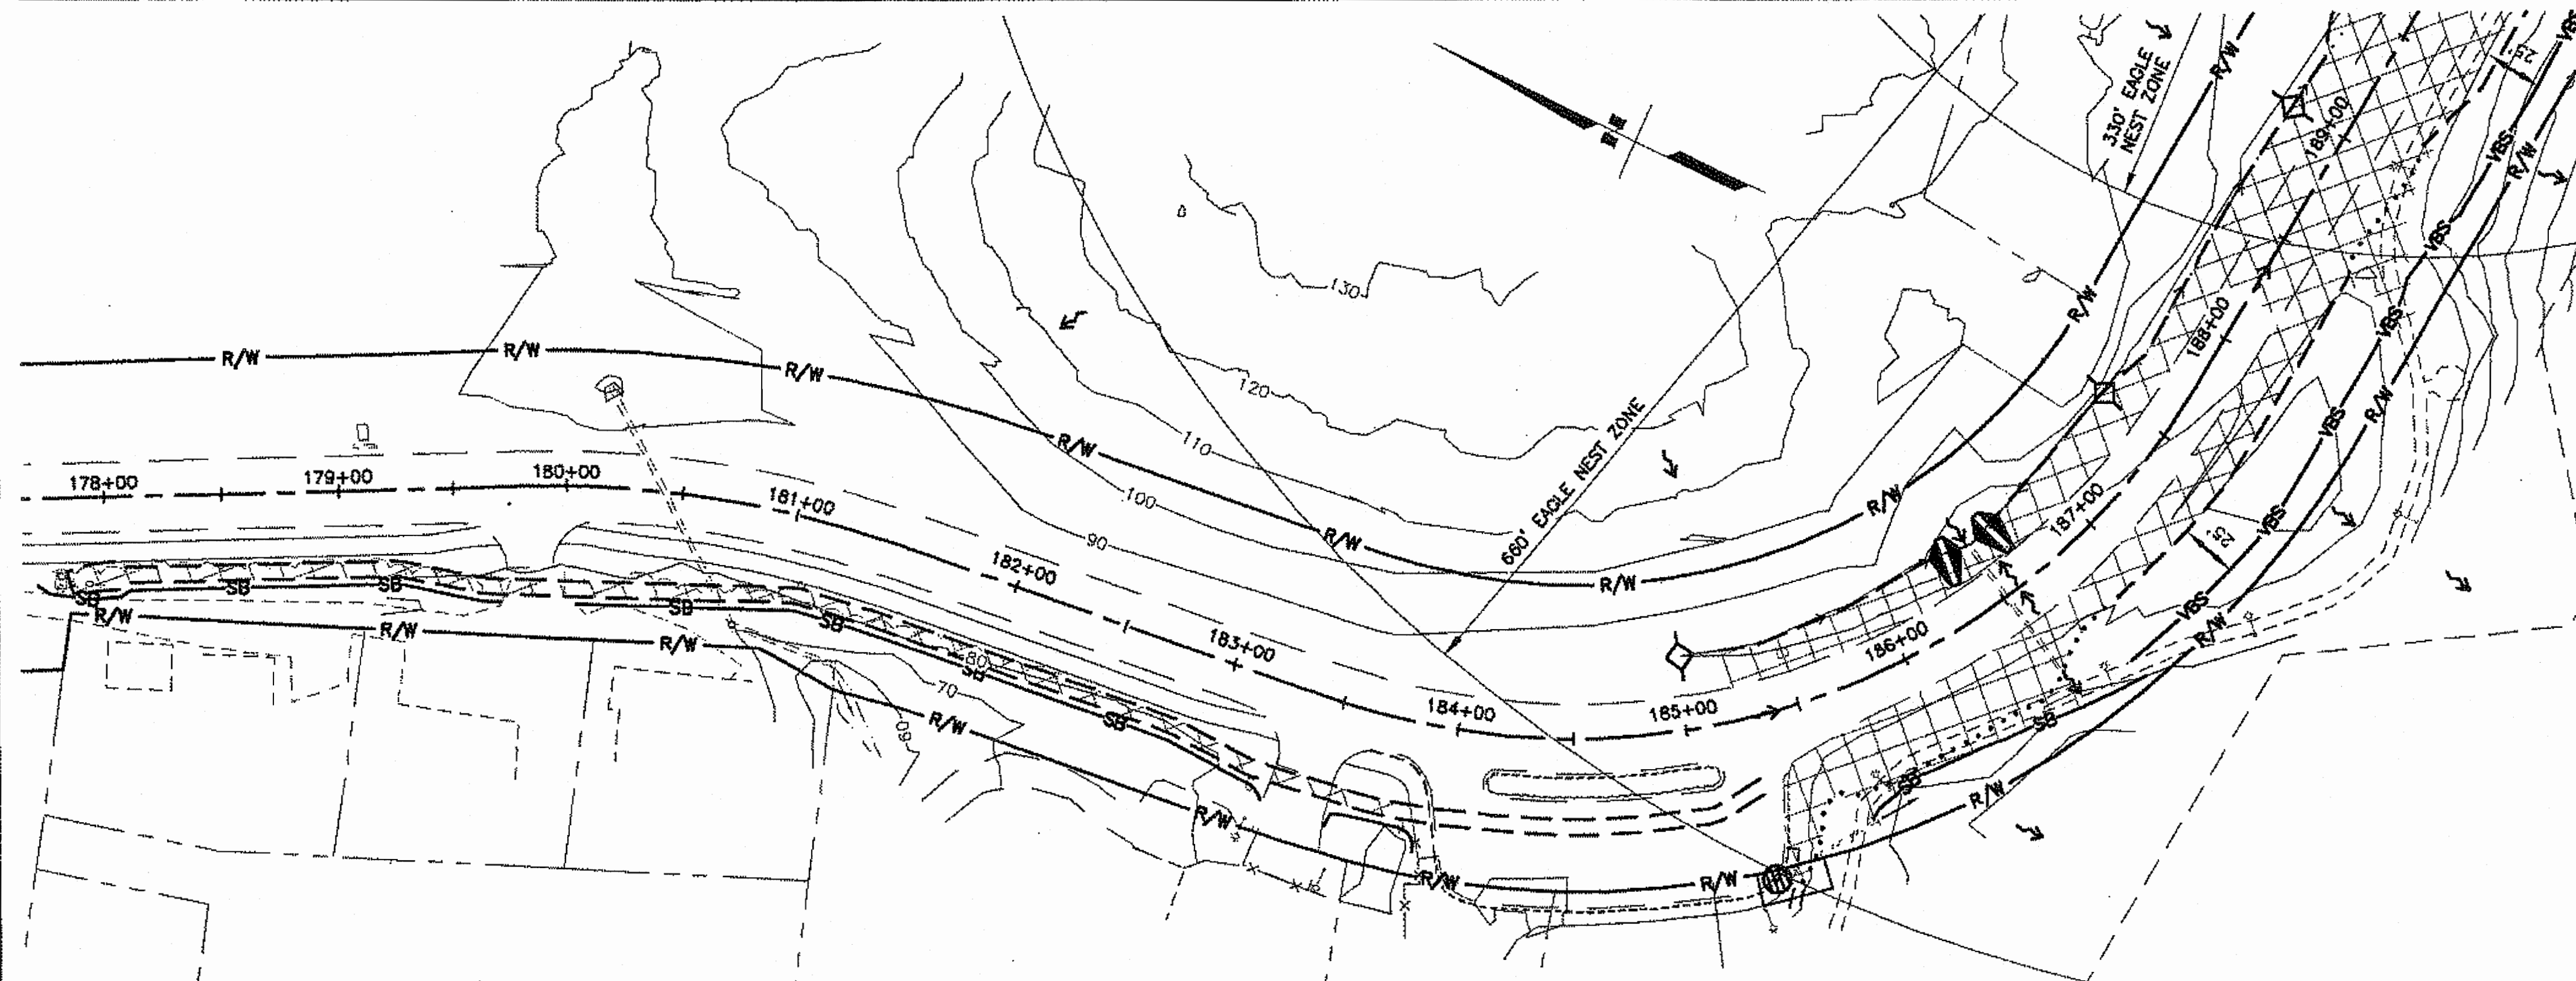


EROSION AND SEDIMENT CONTROL PLAN:

GENERAL: THE INTENT OF THE ESCP IS TO KEEP SEDIMENT FROM ENTERING ANY OF THE WATERS SURROUNDING THE PROJECT.

- MOST OF THE DRAINAGE FROM THE PROJECT ENTERS SILVER BAY. APPROXIMATELY THE LAST 100 FEET OF THE PROJECT DRAINS INTO THE TIDALLY INFLUENCED SECTION OF SAWMILL CREEK. SAWMILL CREEK CROSSES THE PROJECT AT APPROXIMATELY STATION 279+00.
- SITKA, ALASKA (SOURCE: NOAA)

TIDAL DATA	
RAIN FALL: 84"/YEAR	ELW = +14.6'
SNOW FALL: 39"/YEAR	MLLW = 0.0'
	ELW = -4.0'
- REFER TO ESCP REPORT FOR EROSION CONTROL BEST MANAGEMENT PRACTICES (BMP'S).
- INSTALL BMP'S PRIOR TO EARTH DISTURBING ACTIVITIES.
- IF INSPECTION REVEALS EROSION CONTROL MEASURES ARE INSUFFICIENT, THE CONTRACTOR SHALL IMMEDIATELY IMPLEMENT CORRECTIVE ACTION. THIS MAY INCLUDE: CHANGING CONSTRUCTION METHODS, INSTALLING ADDITIONAL EROSION CONTROL BMP'S, PHASING WORK, AND OTHER CORRECTIVE MEASURES.
- STABILIZE DISTURBED GROUND AS SOON AS POSSIBLE. UNSTABILIZED SURFACES MUST BE TEMPORARILY STABILIZED WITH BONDED FIBER MATRIX, SEEDING, MATTING, OR OTHER EFFECTIVE MEASURES. THE CONTRACTOR IS RESPONSIBLE FOR MAINTAINING EROSION AND SEDIMENT CONTROL UNTIL PROJECT WORK AREAS ARE PAVED AND SEEDING AREAS HAVE ACHIEVED 70% VEGETATIVE COVER.
- PROVIDE TEMPORARY SEDIMENT BARRIER AS SHOWN ON PLANS, AND AS NECESSARY, TO PREVENT MIGRATION OF SEDIMENT USING SILT FENCE, FIBER ROLLS, OR GRAVEL FILTER BERM.

Project As Built Drawings Have Been Reviewed By The Project Engineer & Represent, To The Best Of My Knowledge, The Project As Constructed.
 Proj. Eng. 6-24-15
 Date

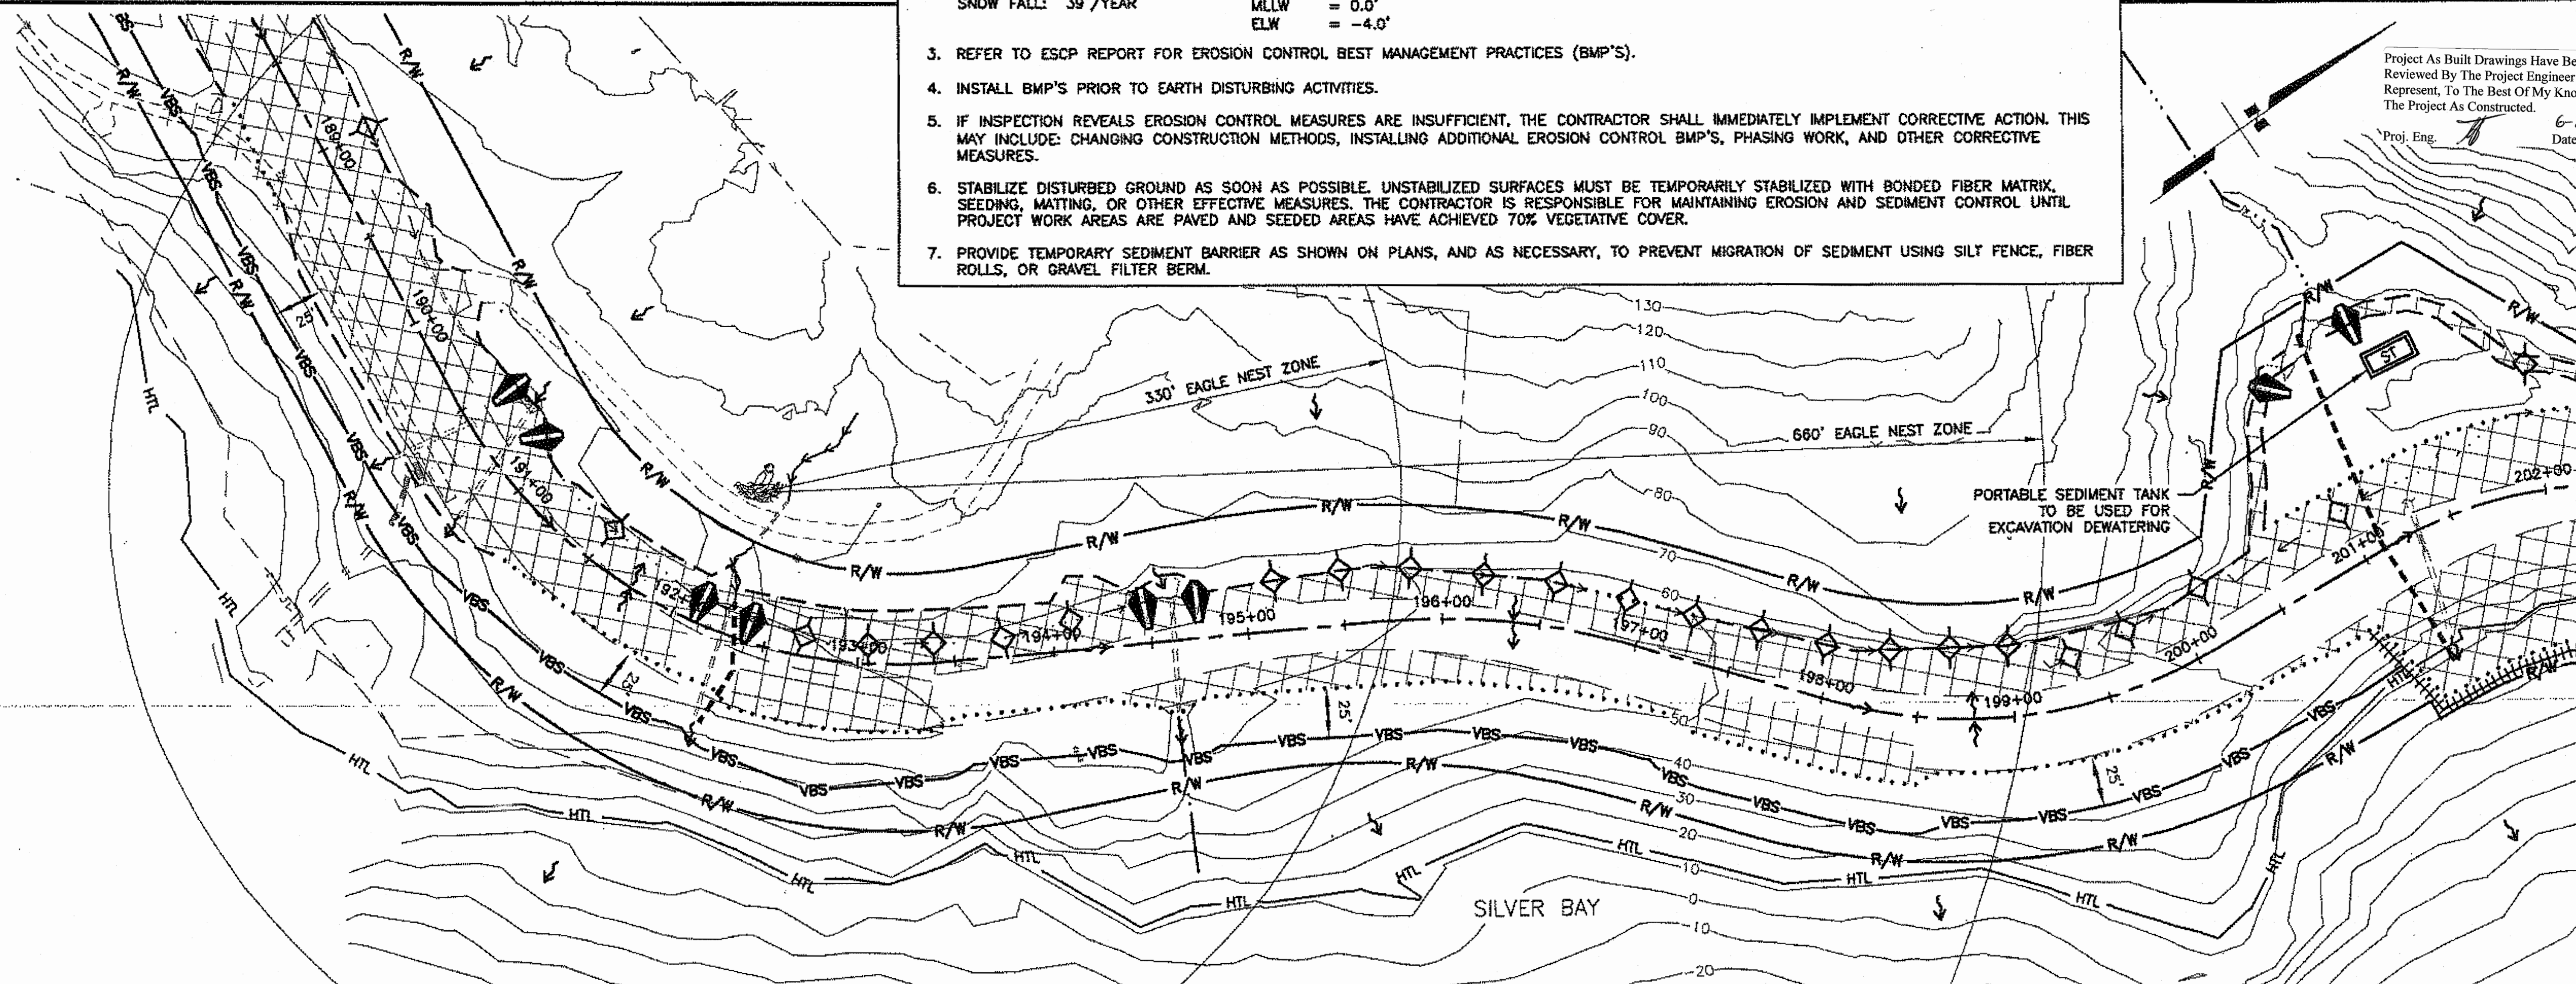

DO NOT SCALE FROM THESE DRAWINGS USE DIMENSIONS

PATH: I:\115380\DWGS\CSHETS\01-P04.DWG

Tuesday, August 21, 2012 11:54:22 AM
 TAB: P01

ADDENDUM NUMBER

ATTACHMENT NUMBER

RECORD OF REVISIONS

No.	DATE	DESCRIPTION

SAWMILL CREEK ROAD UPGRADE
 PHASE III - WHALE PARK TO SAWMILL CREEK BRIDGE
 68216\MSG-STP-0933(21)
 SITKA TELECOMMUNICATIONS CONDUIT
 RSA NO. 69615

EROSION SEDIMENT CONTROL PLAN (ESCP)

PREPARED BY: USKH

CHECKED BY: RP

DESIGNED BY: NCL

DRAWN BY: WJP

STATE OF ALASKA
 DEPARTMENT OF TRANSPORTATION
 & PUBLIC FACILITIES
 SOUTHEAST REGION

ESCP EARTHWORK
 PHASE BMP'S



STA. 178+00 TO
 STA. 202+00

PROJECT DESIGNATION

68216\MSG-STP-0933(21)

STATE	YEAR
ALASKA	2012

SHEET NUMBER	TOTAL SHEETS
P1	109

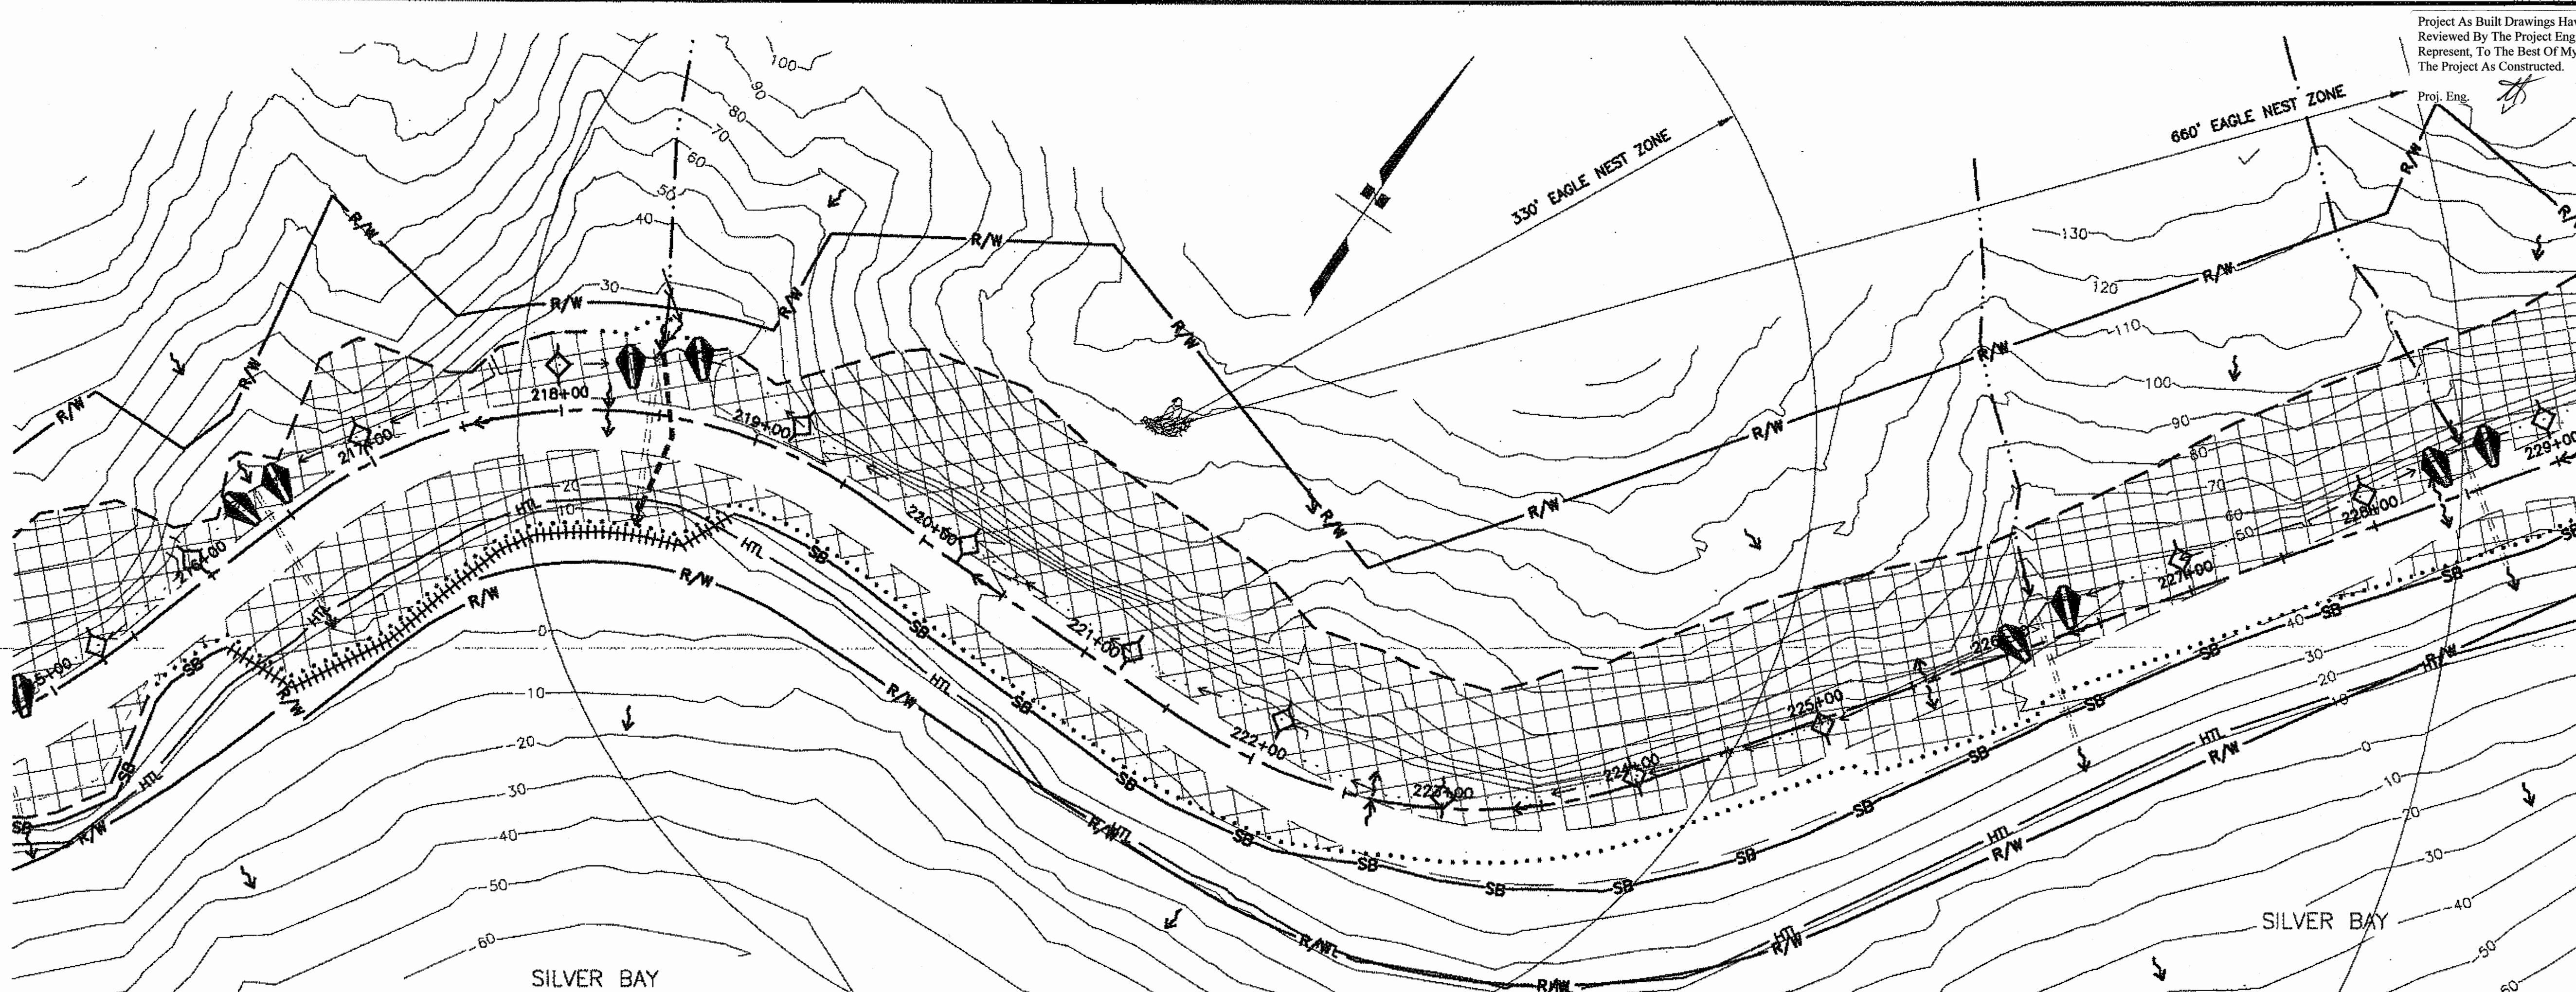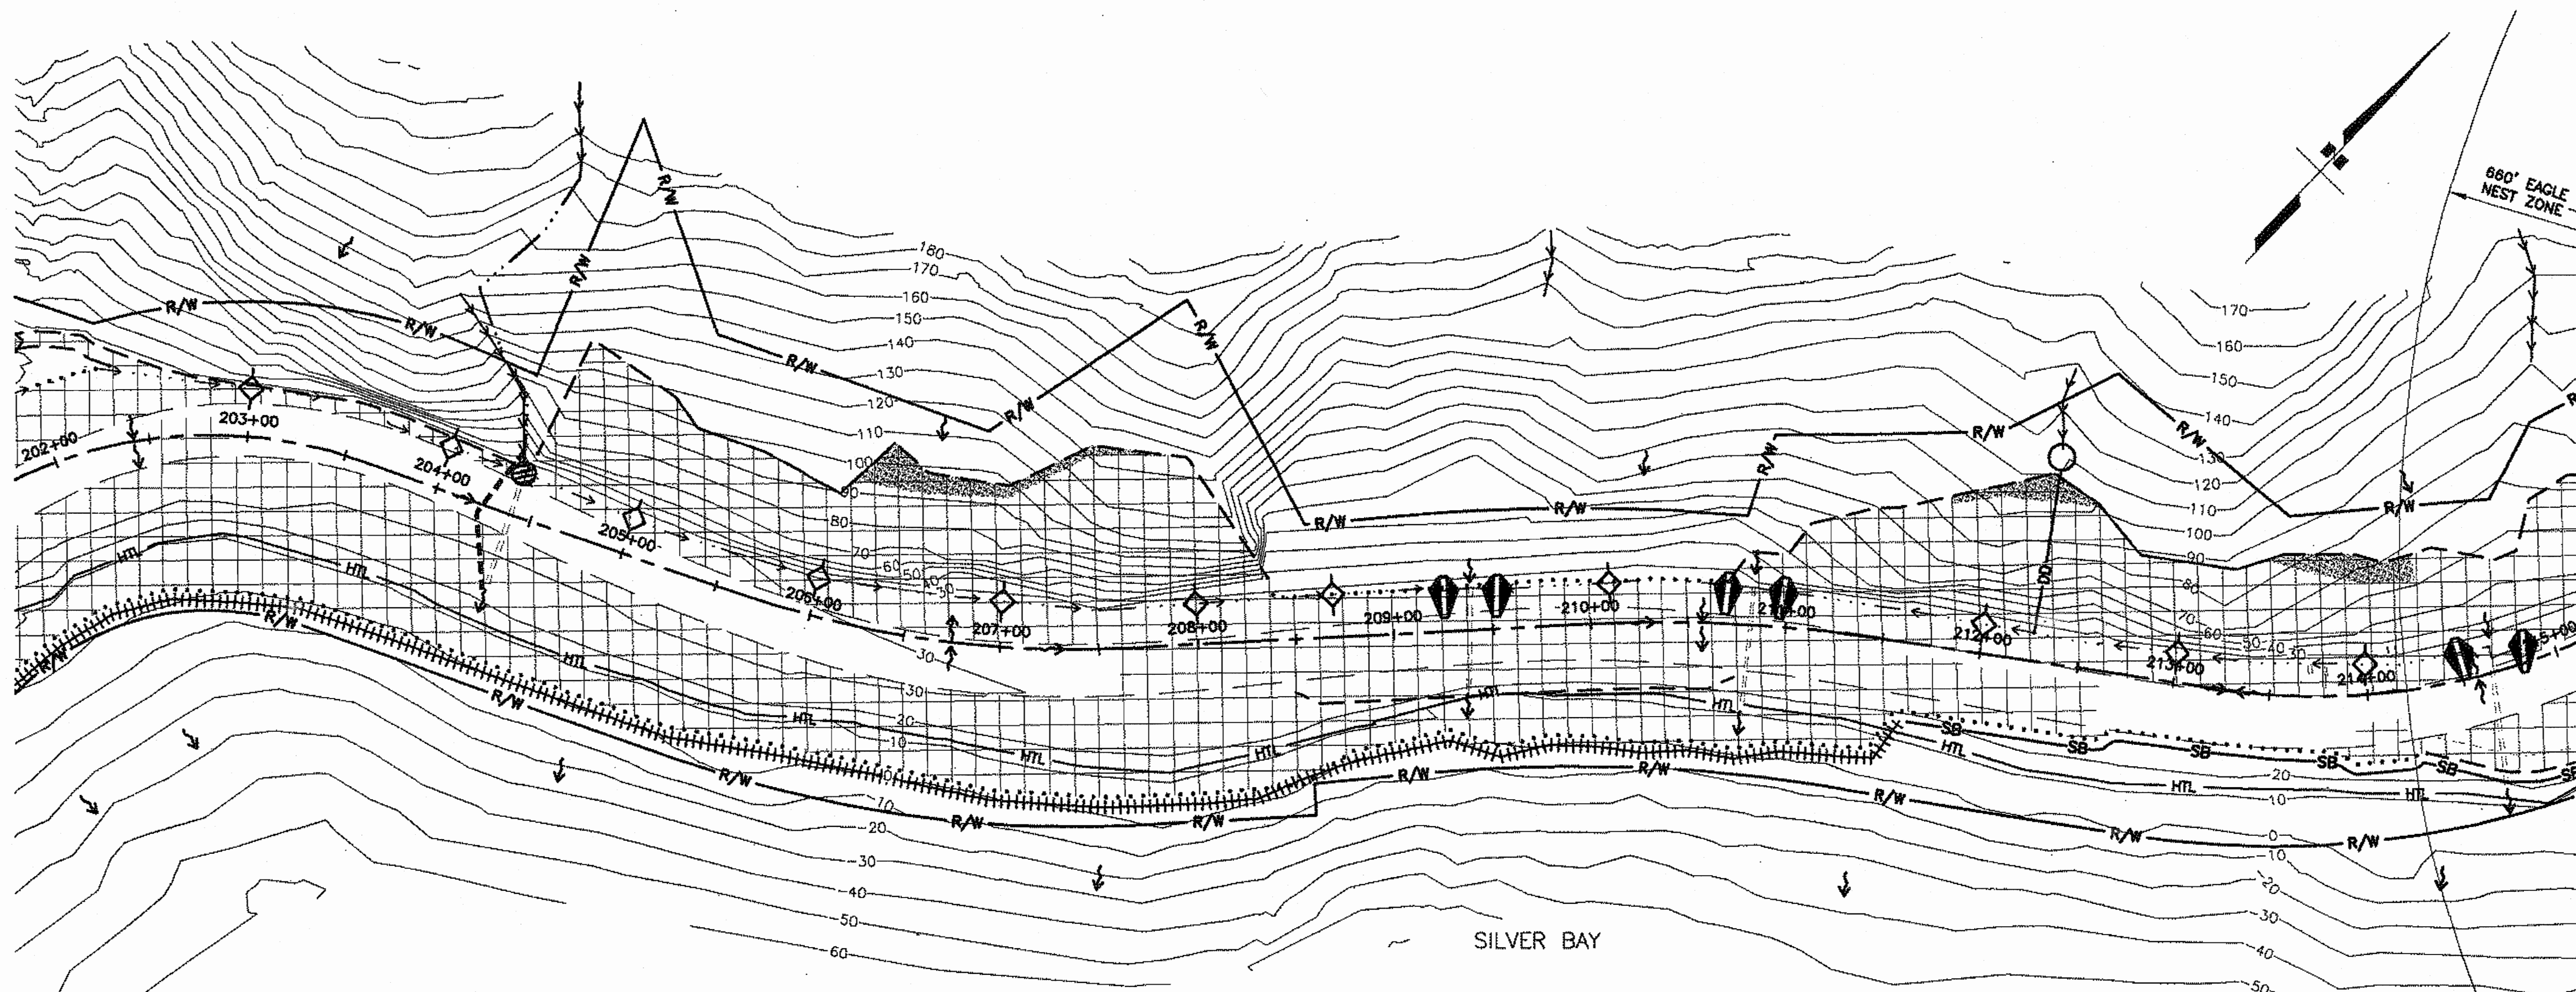

DO NOT SCALE FROM THESE DRAWINGS USE DIMENSIONS



PATH:
I:\1152805\DWGS\CS\SHEETS\001-P04.DWG
Thursday, August 30, 2012 8:06:43 AM
TAB: P02

ADDENDUM NUMBER		
ATTACHMENT NUMBER		
RECORD OF REVISIONS		
No.	DATE	DESCRIPTION

SAWMILL CREEK ROAD UPGRADE
PHASE III - WHALE PARK TO SAWMILL CREEK BRIDGE
68216MSG-STP-0933(21)
SITKA TELECOMMUNICATIONS CONDUIT
RSA NO. 69615

EROSION AND SEDIMENT CONTROL PLAN (ESCP)

PREPARED BY: USKH	
CHECKED BY: RP	
DESIGNED BY: NCL	
DRAWN BY: WJP	
STATE OF ALASKA DEPARTMENT OF TRANSPORTATION & PUBLIC FACILITIES SOUTHEAST REGION	
ESCP EARTHWORK PHASE BMPS	
STA. 202+00 TO STA. 229+00	
PROJECT DESIGNATION 68216MSG-STP-0933(21)	
STATE	YEAR
ALASKA	2012
SHEET NUMBER	TOTAL SHEETS
P2	109

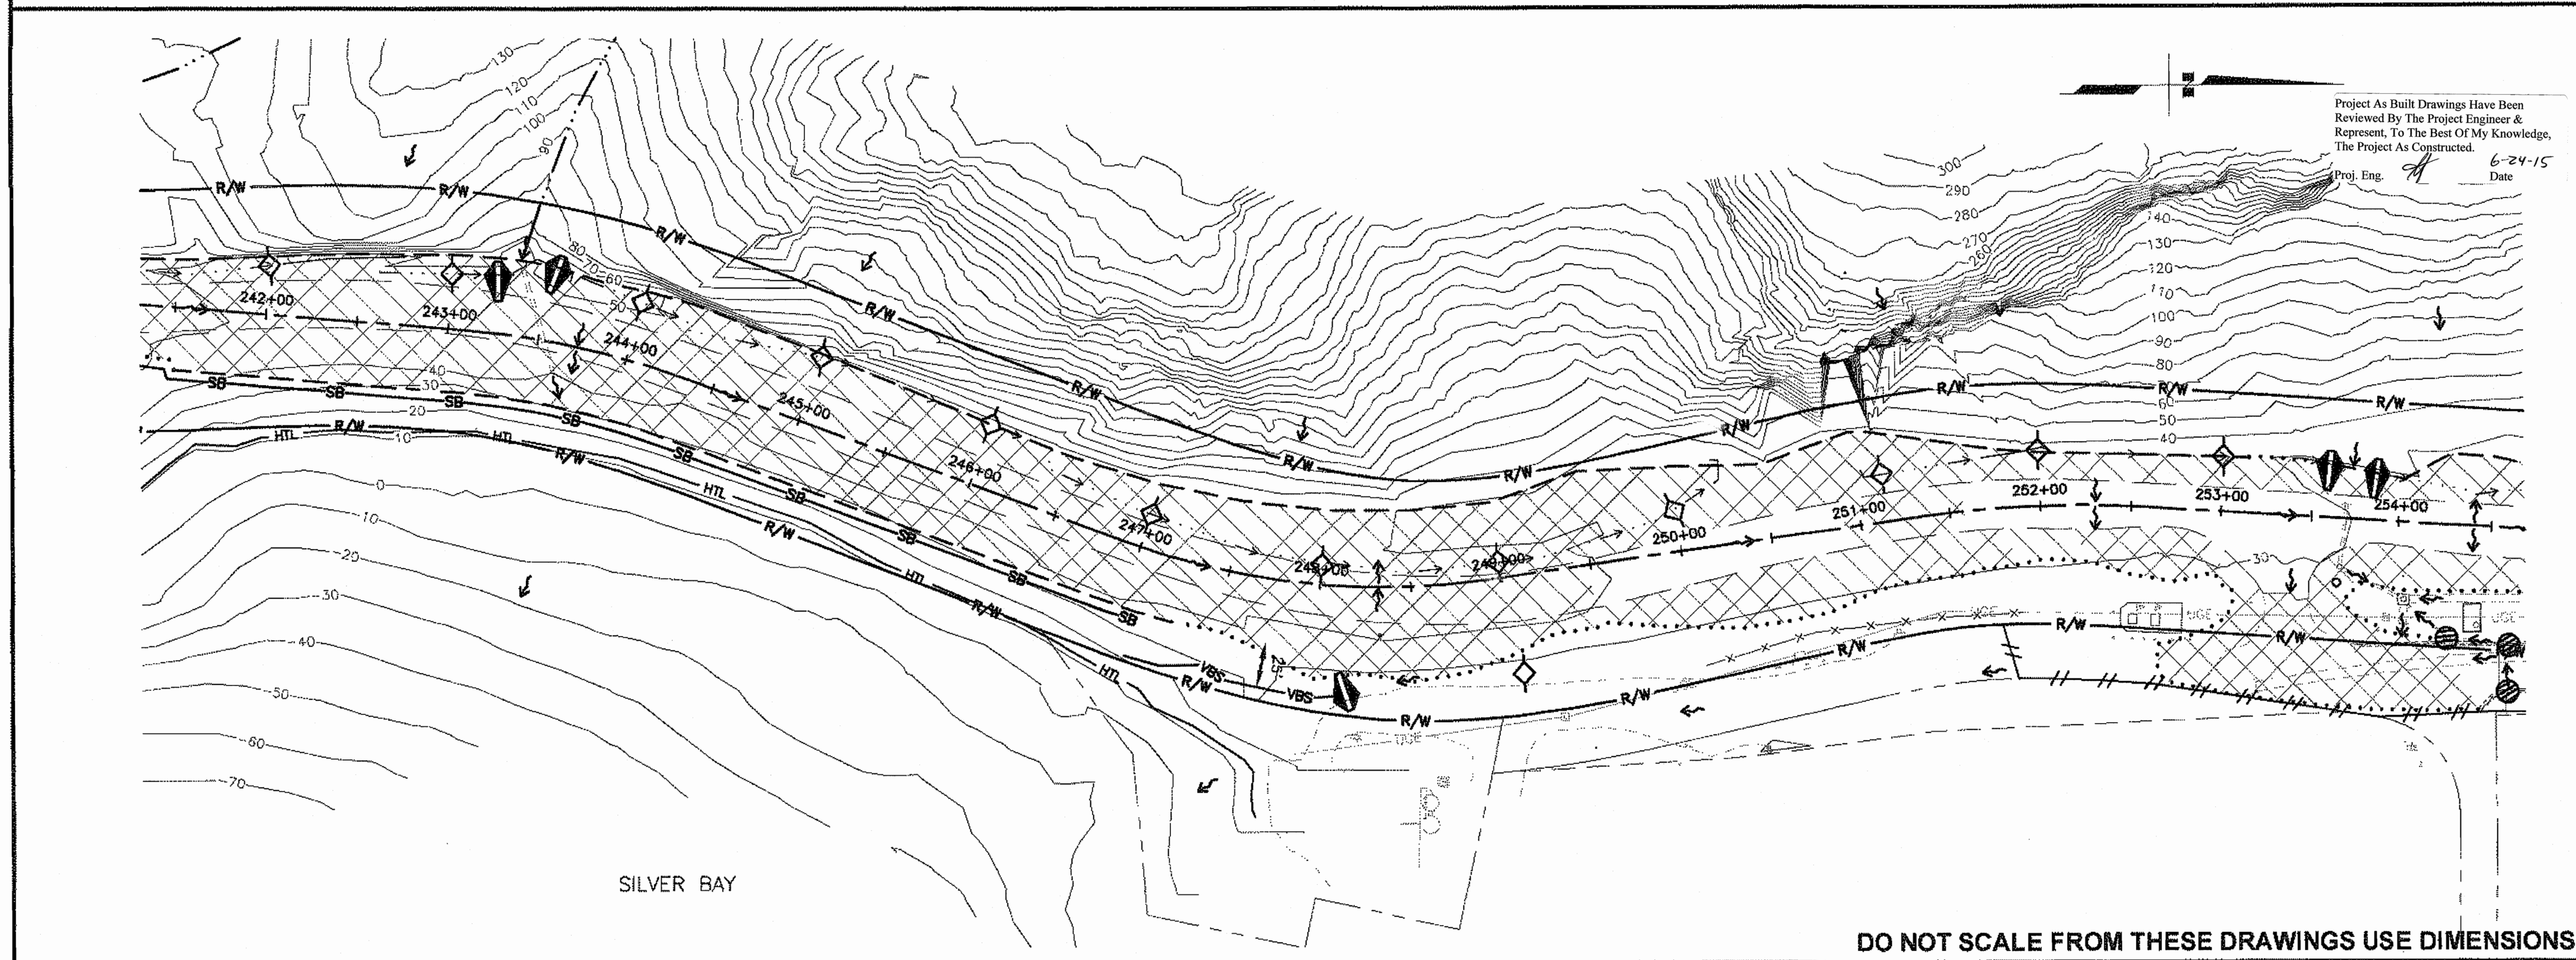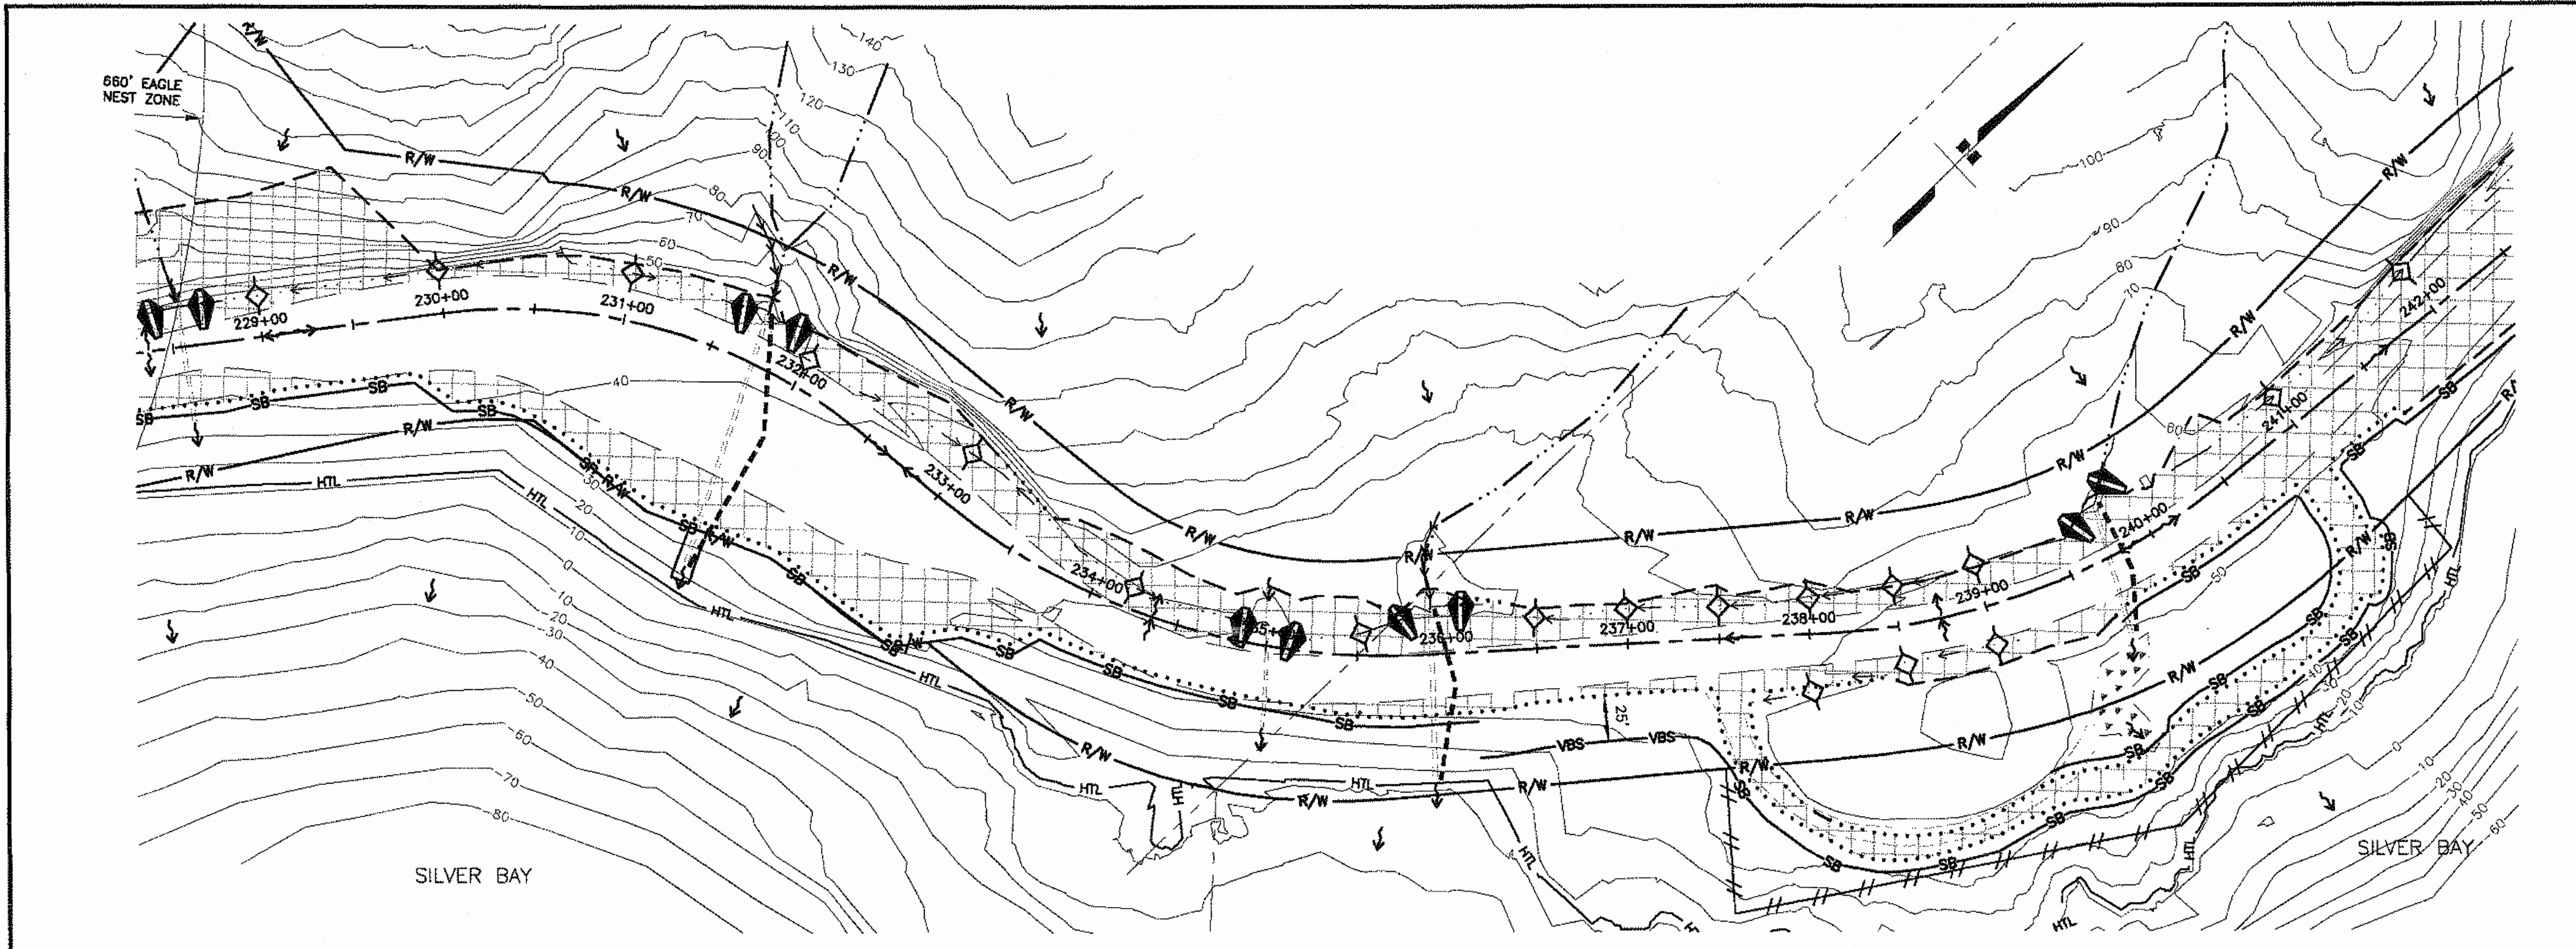

DO NOT SCALE FROM THESE DRAWINGS USE DIMENSIONS

PATH: \\UNUFILE2\JOBS\1153805\DWG\SC\SHETS\SP01-P04

Monday, August 27, 2012 9:49:32 AM
TAB: P03

ADDENDUM NUMBER		
ATTACHMENT NUMBER		
RECORD OF REVISIONS		
No.	DATE	DESCRIPTION

SAWMILL CREEK ROAD UPGRADE
PHASE III - WHALE PARK TO SAWMILL CREEK BRIDGE
68216\MSG-STP-0933(21)
SITKA TELECOMMUNICATIONS CONDUIT
RSA NO. 69615

EROSION AND SEDIMENT CONTROL PLAN (ESCP)

Project As Built Drawings Have Been Reviewed By The Project Engineer & Represent, To The Best Of My Knowledge, The Project As Constructed.
Proj. Eng. *[Signature]* Date 6-24-15

PREPARED BY: USKH
CHECKED BY: RP

DESIGNED BY: NCL
DRAWN BY: WJP



STATE OF ALASKA
DEPARTMENT OF TRANSPORTATION & PUBLIC FACILITIES
SOUTHEAST REGION

**ESCP EARTHWORK
PHASE BMPS**

**STA. 229+00 TO
STA. 254+00**

PROJECT DESIGNATION
68216\MSG-STP-0933(21)


STATE	YEAR
ALASKA	2012
SHEET NUMBER	TOTAL SHEETS
P3	109

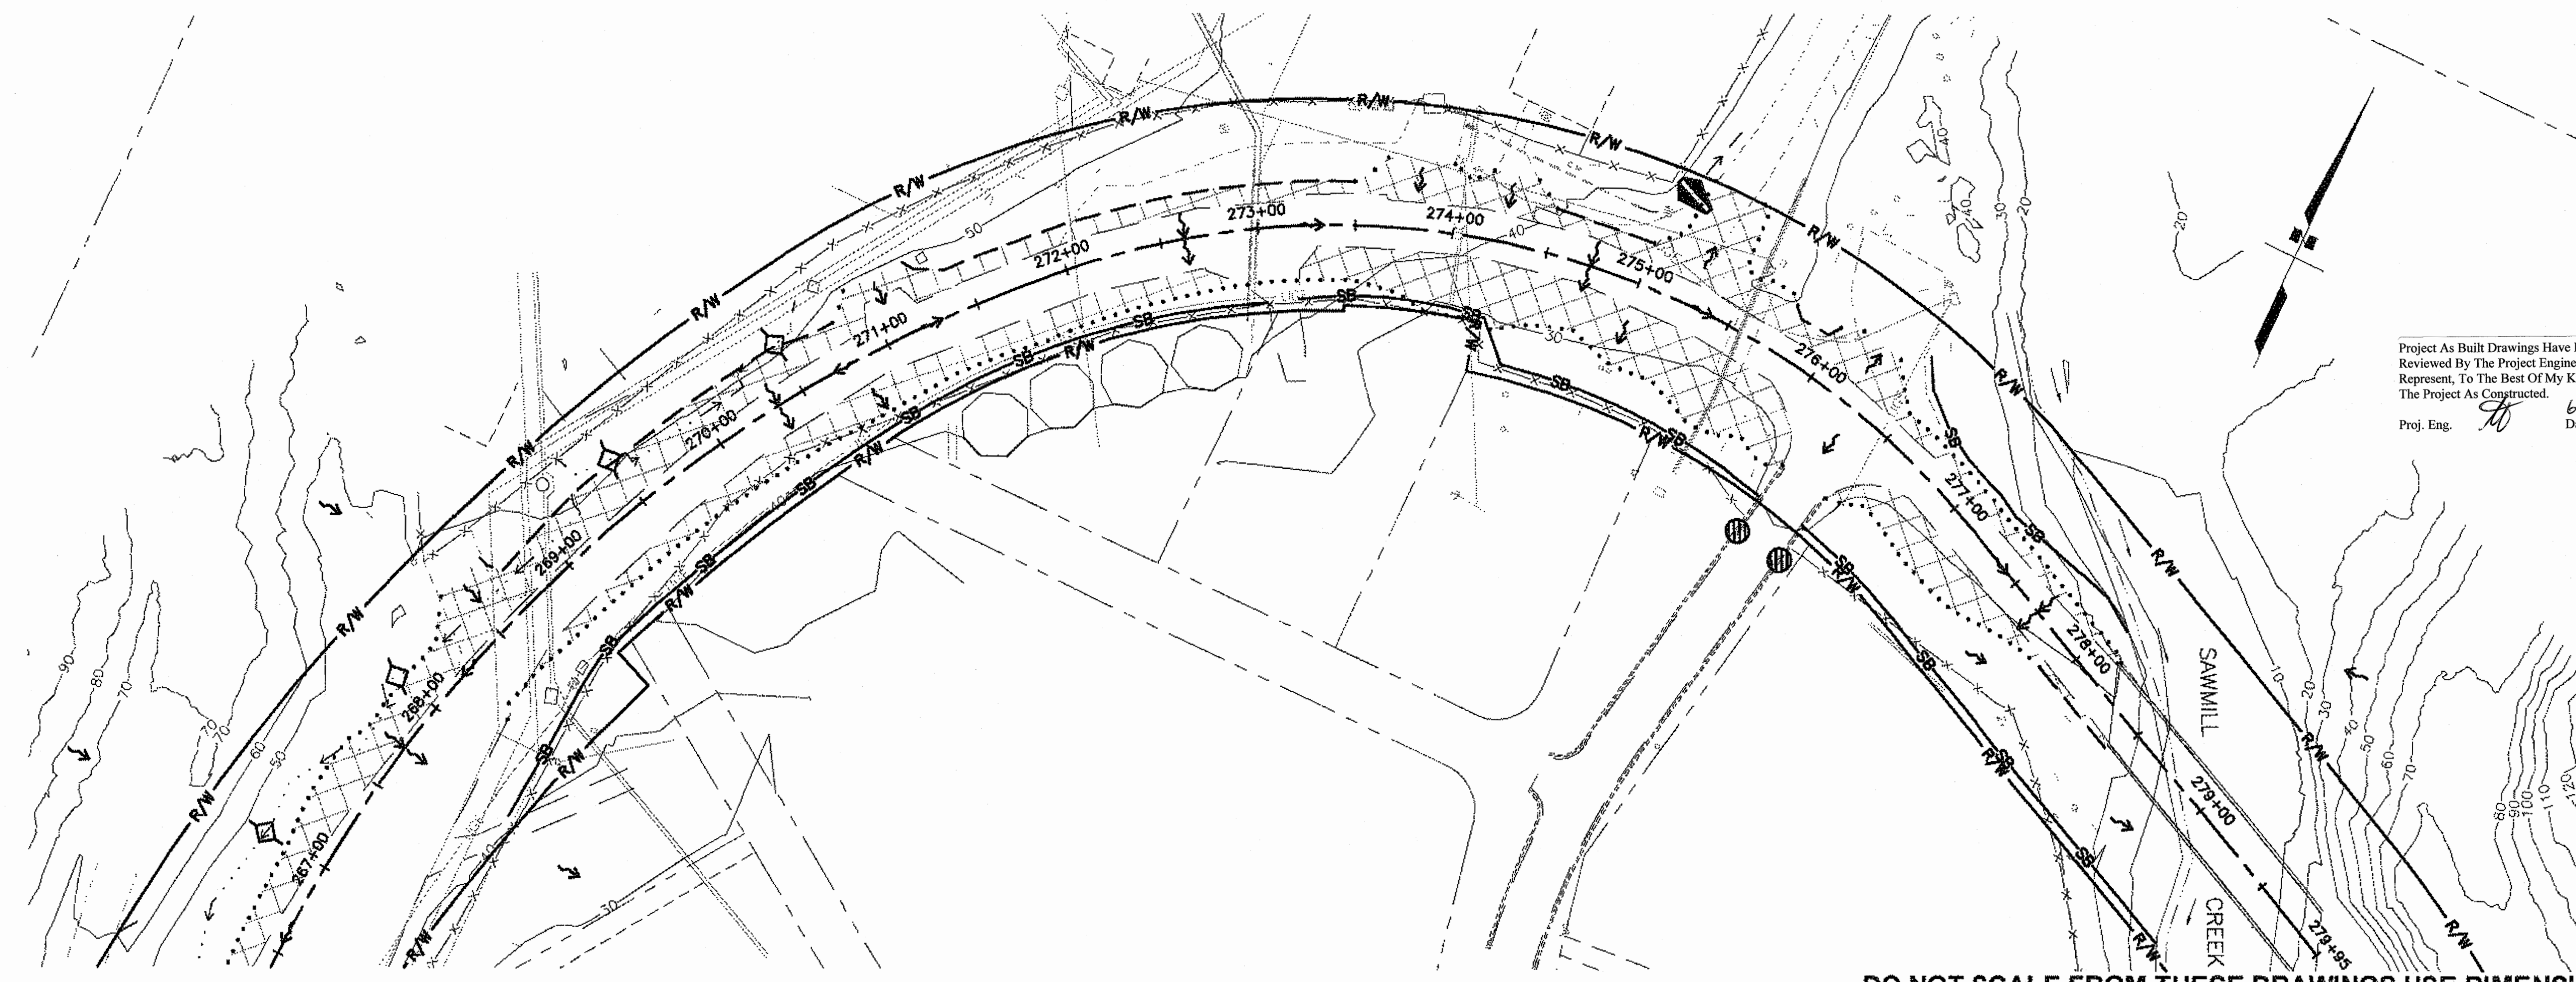
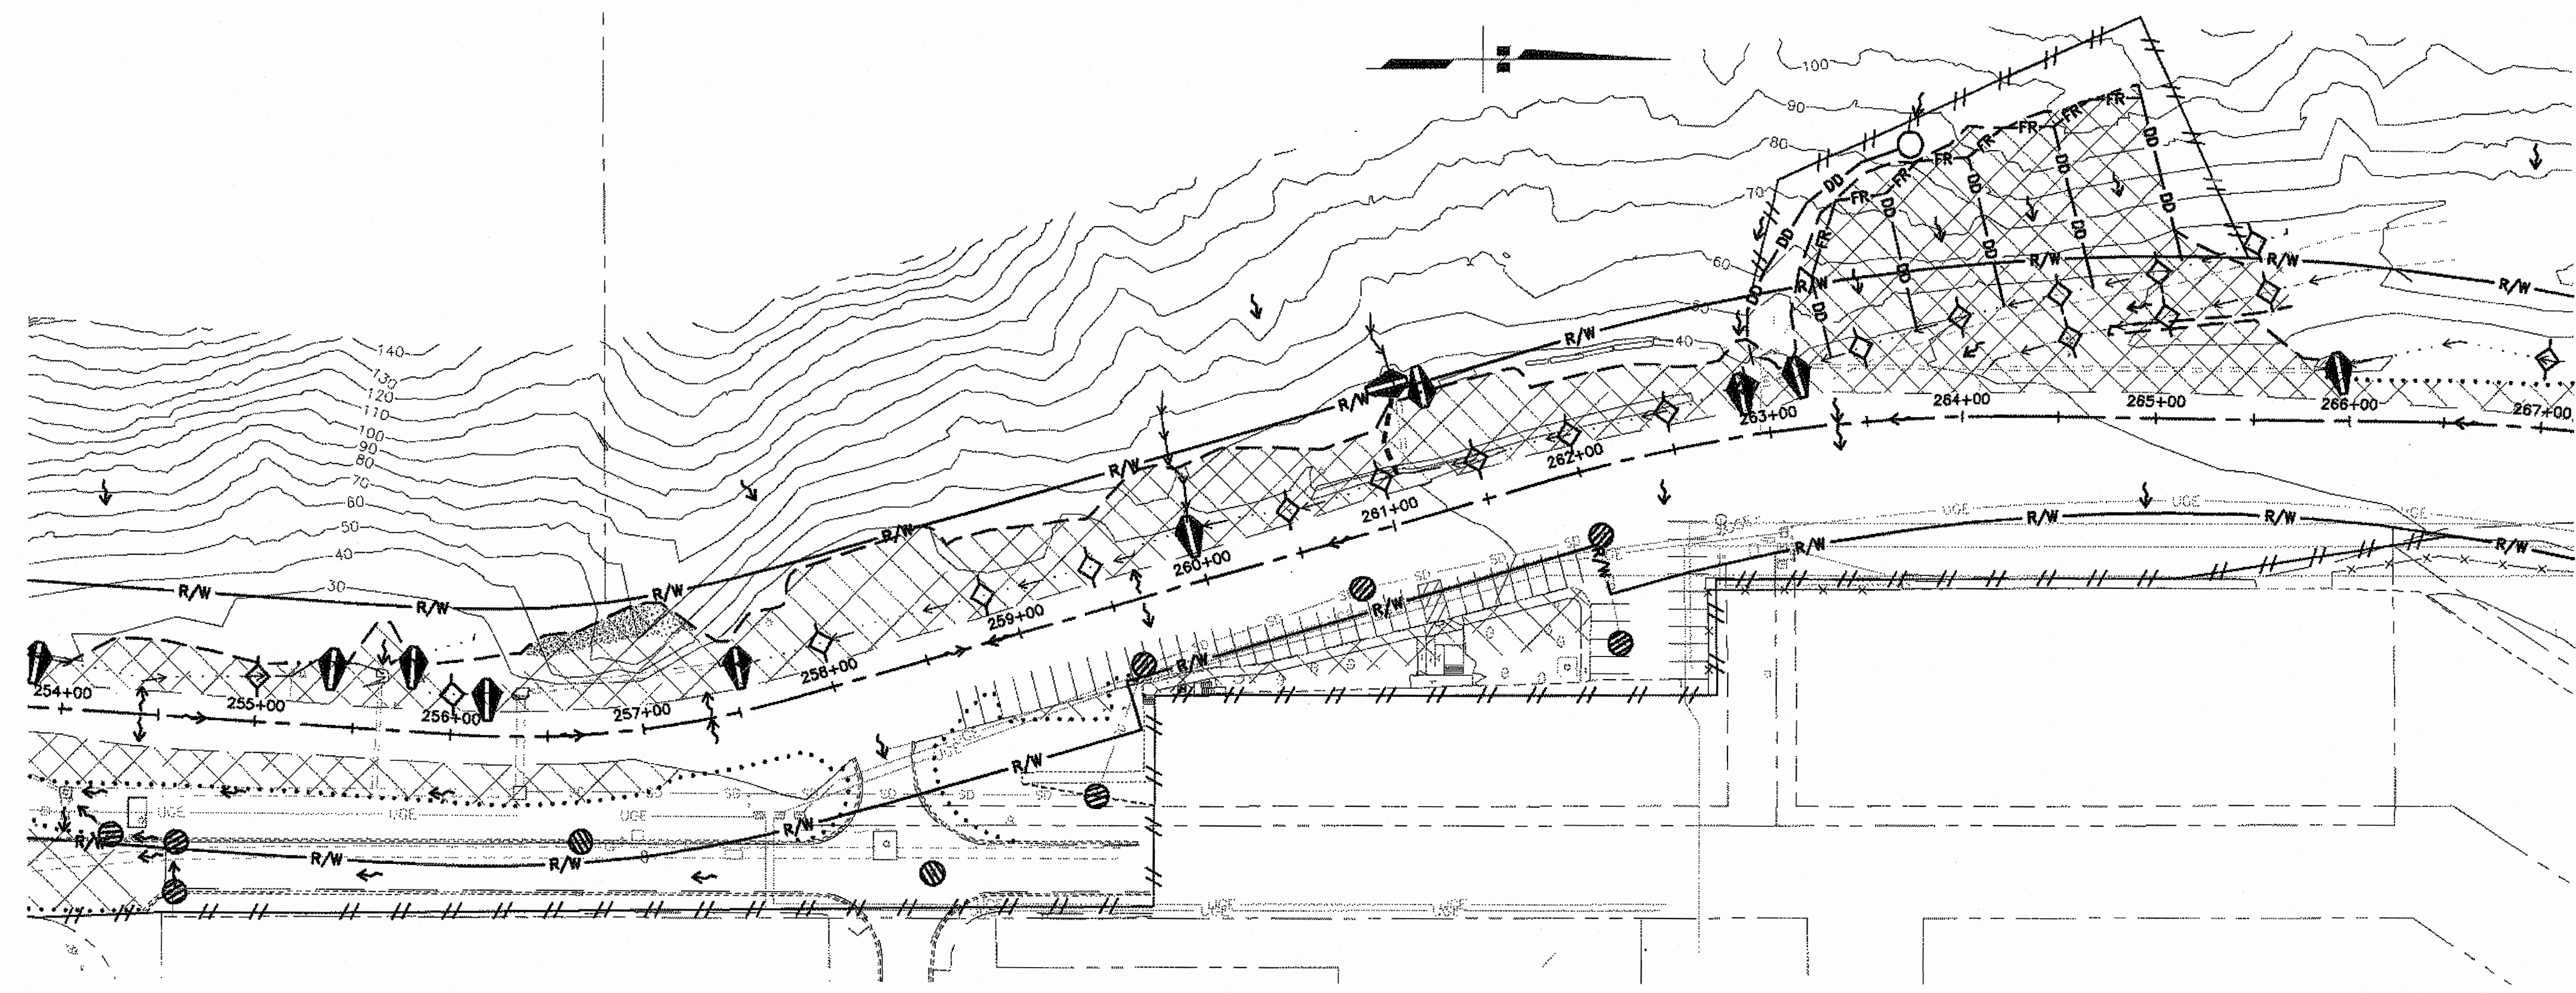


DO NOT SCALE FROM THESE DRAWINGS USE DIMENSIONS

PATH: \\NWJFILEZ\JOBS\1153805\DWG\SC\SHETS\IP01-P04 Monday, August 27, 2012 9:49:35 AM TAB: P04		
ADDENDUM NUMBER		
ATTACHMENT NUMBER		
RECORD OF REVISIONS		
No.	DATE	DESCRIPTION
SAWMILL CREEK ROAD UPGRADE PHASE III - WHALE PARK TO SAWMILL CREEK BRIDGE 68216MSG-STP-0933(21) SITKA TELECOMMUNICATIONS CONDUIT RSA NO. 69615		
EROSION AND SEDIMENT CONTROL PLAN (ESCP)		
PREPARED BY: USKH		
CHECKED BY: RP		
DESIGNED BY: NCL DRAWN BY: WJP		
STATE OF ALASKA DEPARTMENT OF TRANSPORTATION & PUBLIC FACILITIES SOUTHEAST REGION		
ESCP EARTHWORK PHASE BMPS		
STA. 254+00 TO EOP		
PROJECT DESIGNATION		
68216MSG-STP-0933(21)		
STATE	YEAR	
ALASKA	2012	
SHEET NUMBER	TOTAL SHEETS	
P4	109	

LEGEND

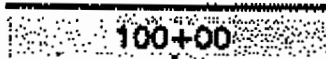-  = PAVED SURFACE
-  = BONDED FIBER MATRIX (BFM), SEEDING & MATTING
-  = BONDED FIBER MATRIX (BFM) & SEEDING
-  = RIPRAP SLOPE REHABILITATION
-  = GRAVEL SURFACING
-  = ROCK SURFACE
-  = OVERBURDEN ARMOR ROCK
-  = RIPRAP CULVERT SPILLWAY PROTECTION OR DITCH LINING
-  = FLOW DIRECTION
-  = DITCHLINE FLOW DIRECTION
-  = TEMPORARY ROCK FILTER DAM
-  = TEMPORARY CHECK DAM

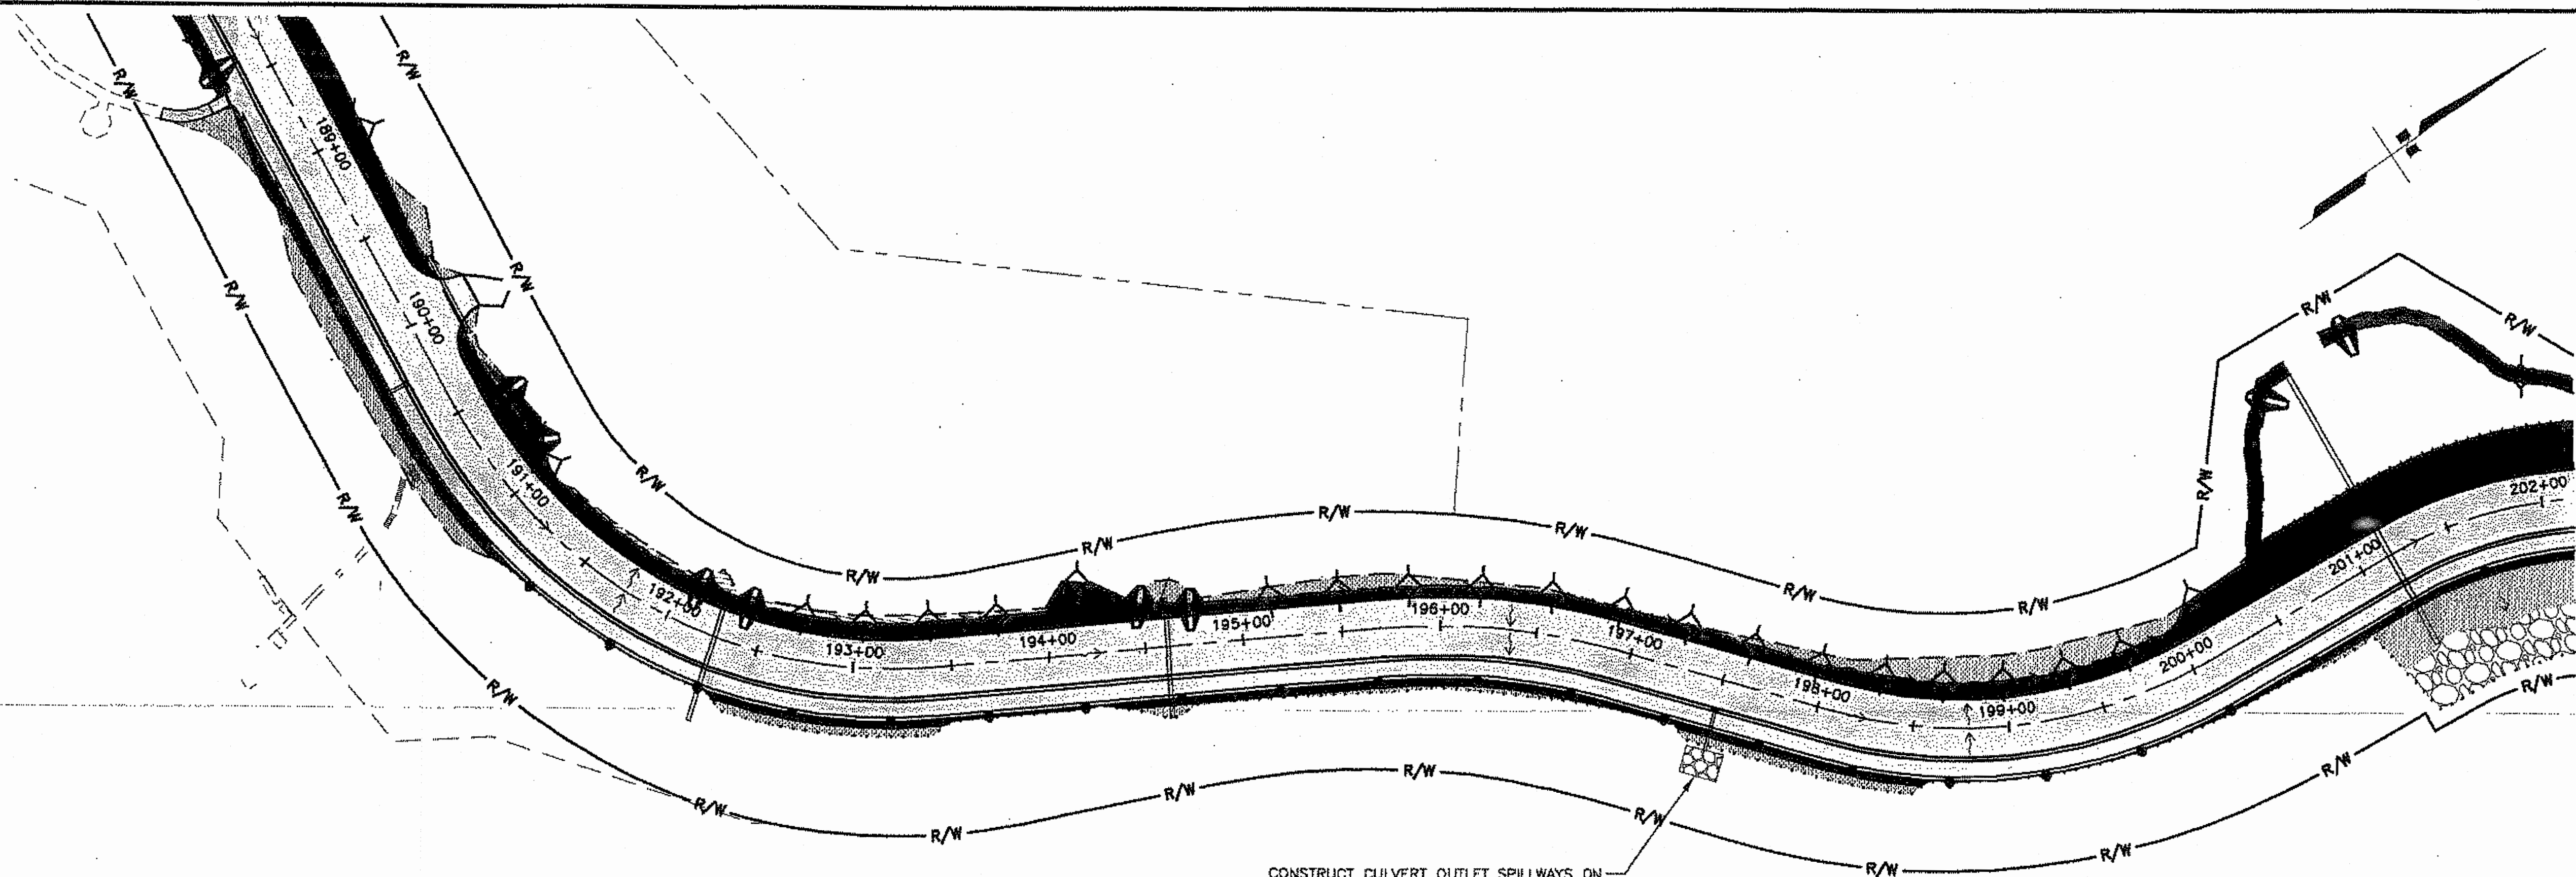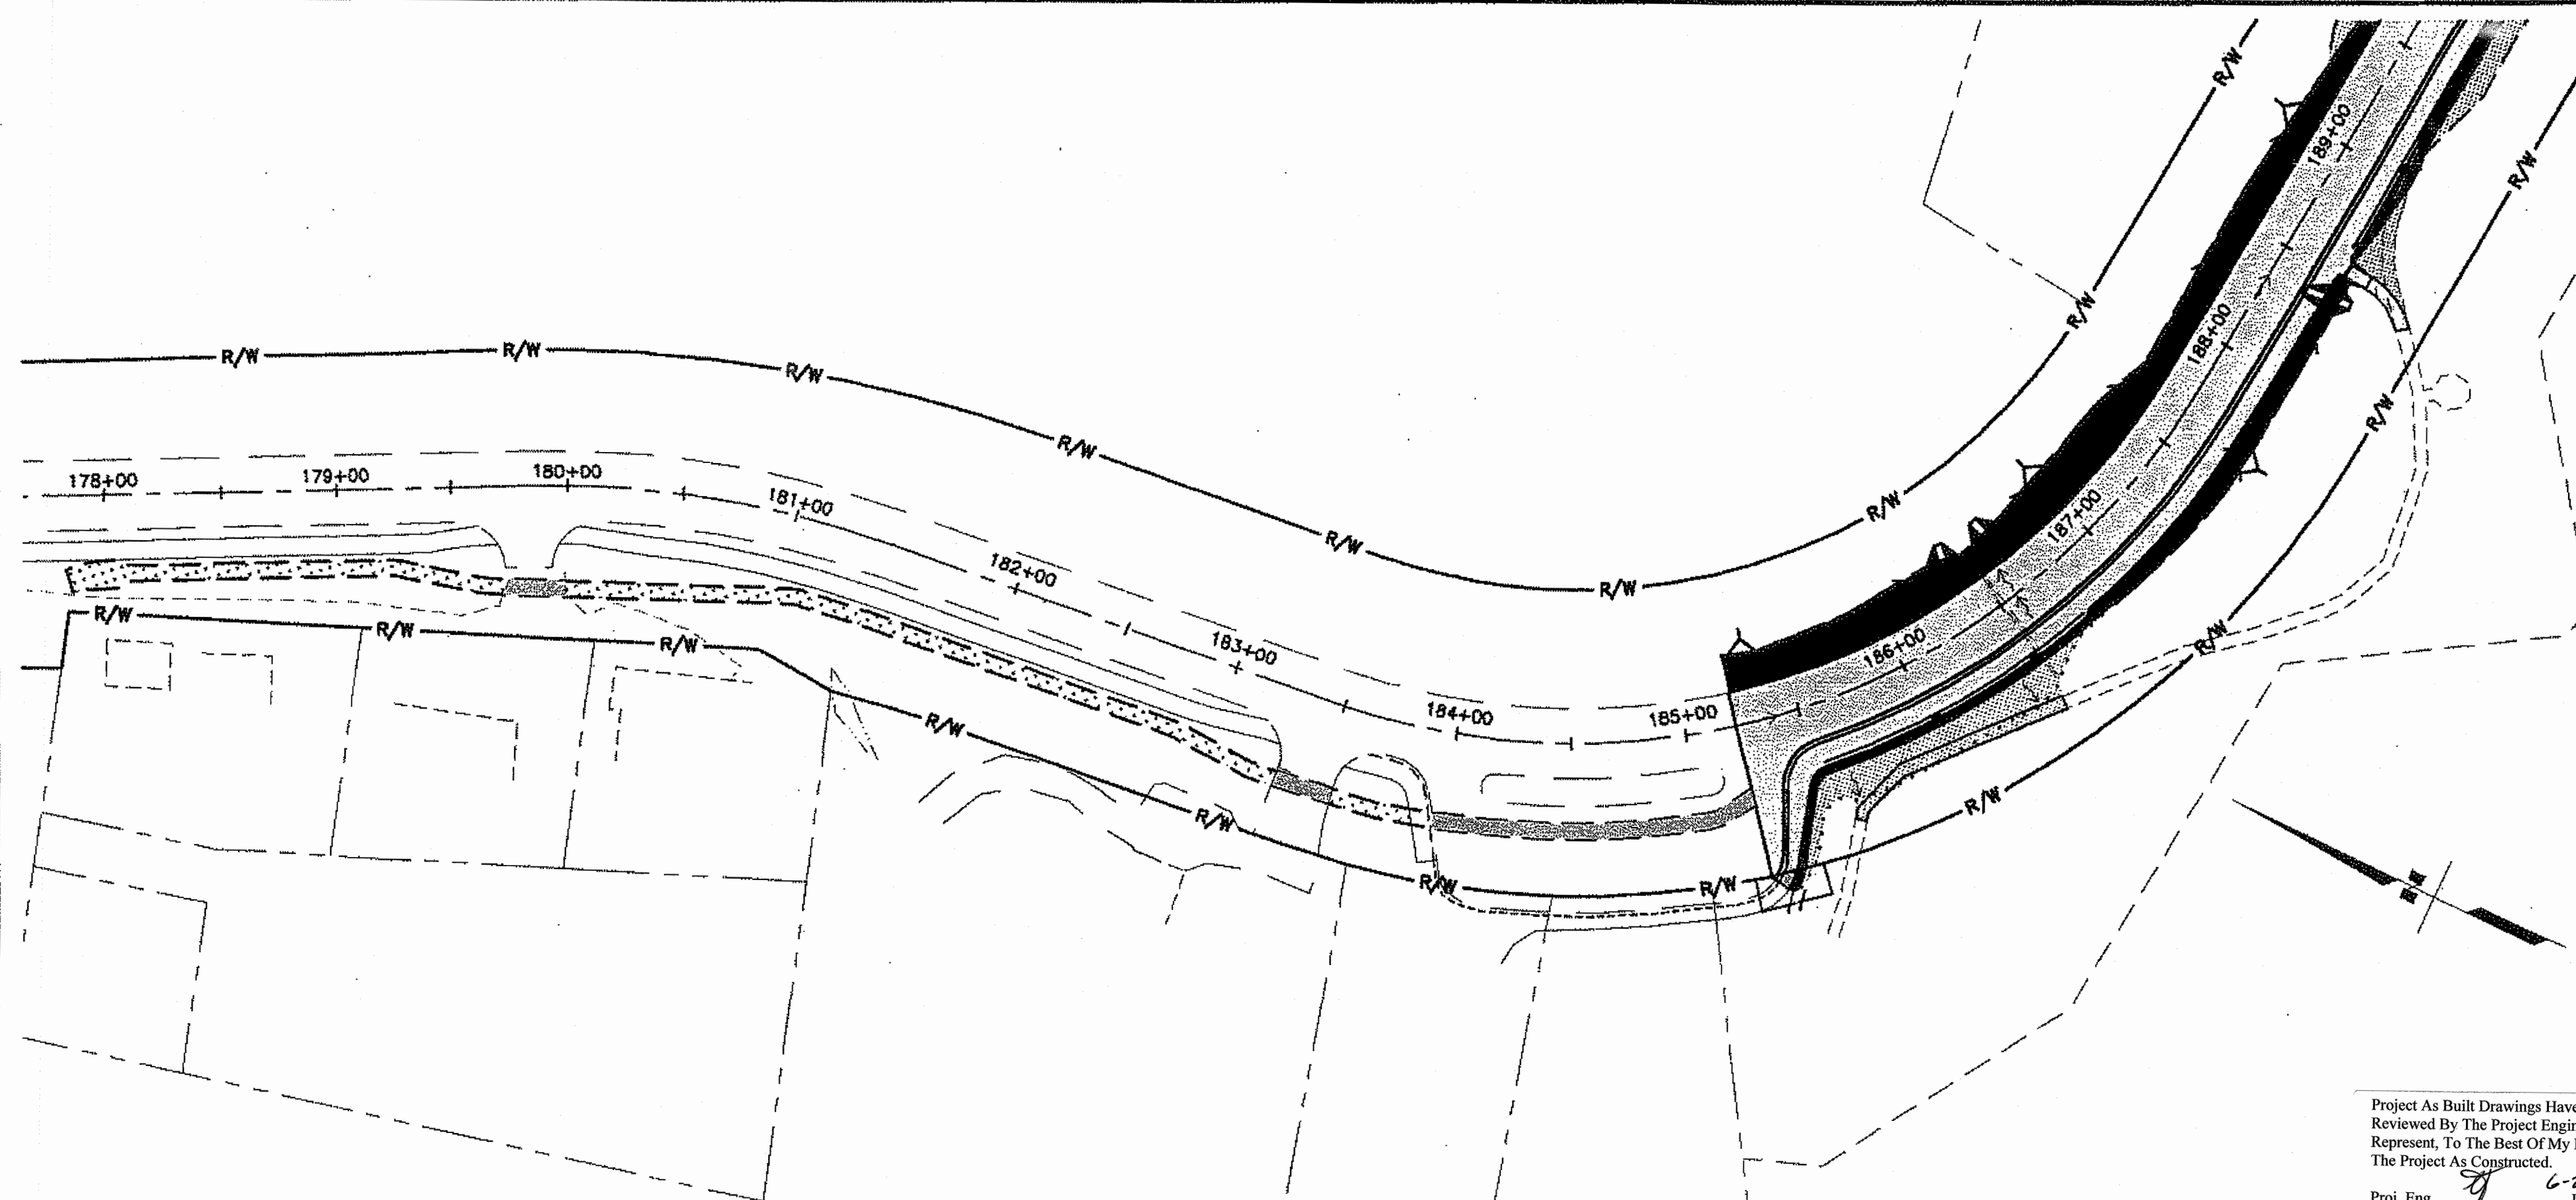

DO NOT SCALE FROM THESE DRAWINGS USE DIMENSIONS

PATH: I:\1153805\DWGS\CS\SHEETS\SP05-P08.DWG
Tuesday, August 21, 2012 12:03:55 PM
TAB: P05

ADDENDUM NUMBER

ATTACHMENT NUMBER

RECORD OF REVISIONS

No.	DATE	DESCRIPTION

SAWMILL CREEK ROAD UPGRADE
PHASE III - WHALE PARK TO SAWMILL CREEK BRIDGE
68216MSG-STP-0933(21)
SITKA TELECOMMUNICATIONS CONDUIT
RSA NO. 69615

EROSION AND SEDIMENT CONTROL PLAN (ESCP)

PREPARED BY: USKH

CHECKED BY: RP

DESIGNED BY: NCL

DRAWN BY: WJP



STATE OF ALASKA
DEPARTMENT OF TRANSPORTATION
& PUBLIC FACILITIES
SOUTHEAST REGION

ESCP SOIL
STABILIZATION
PHASE

STA. 178+00 TO
STA. 202+00

PROJECT DESIGNATION
68216MSG-STP-0933(21)



STATE	YEAR
ALASKA	2012
SHEET NUMBER	TOTAL SHEETS
P5	109

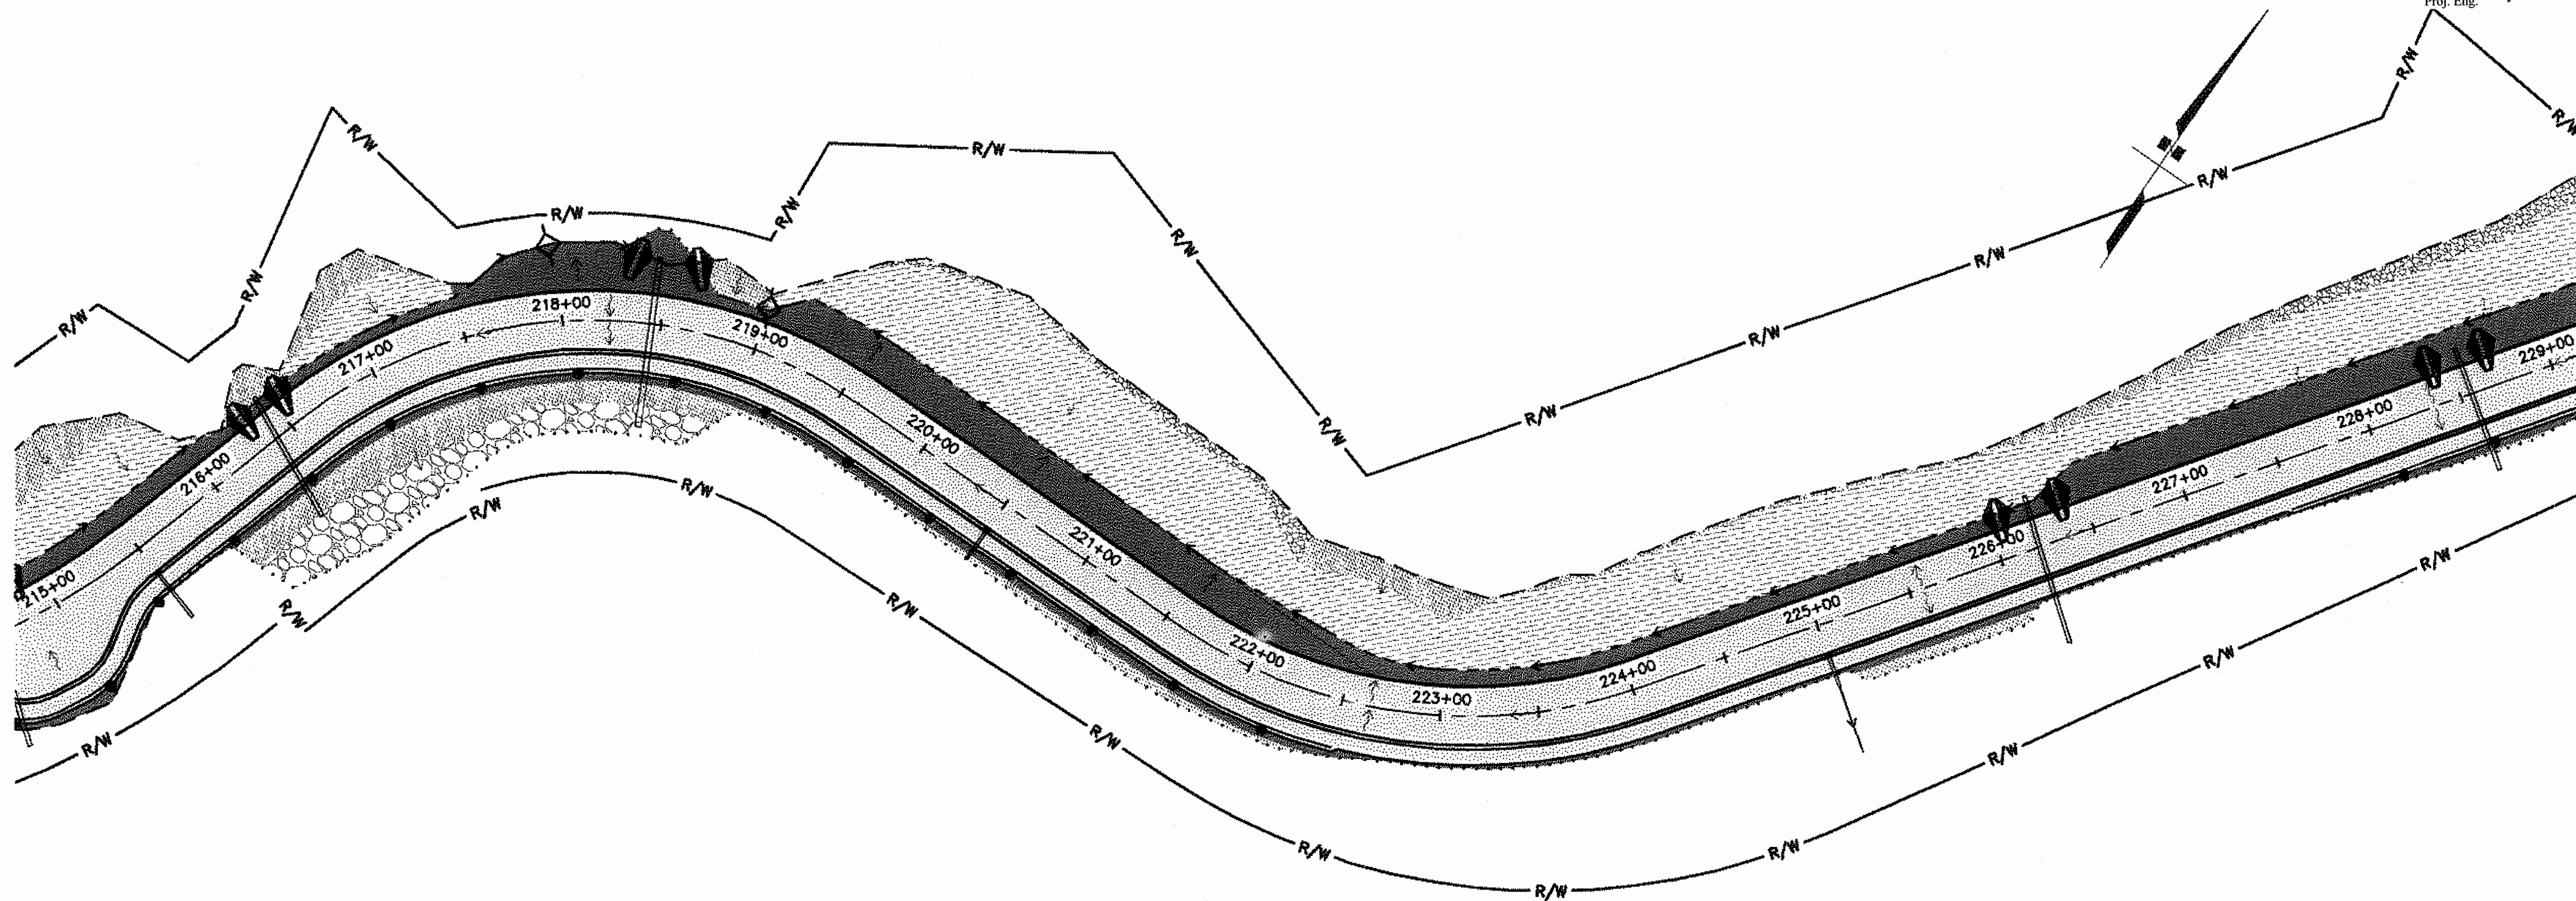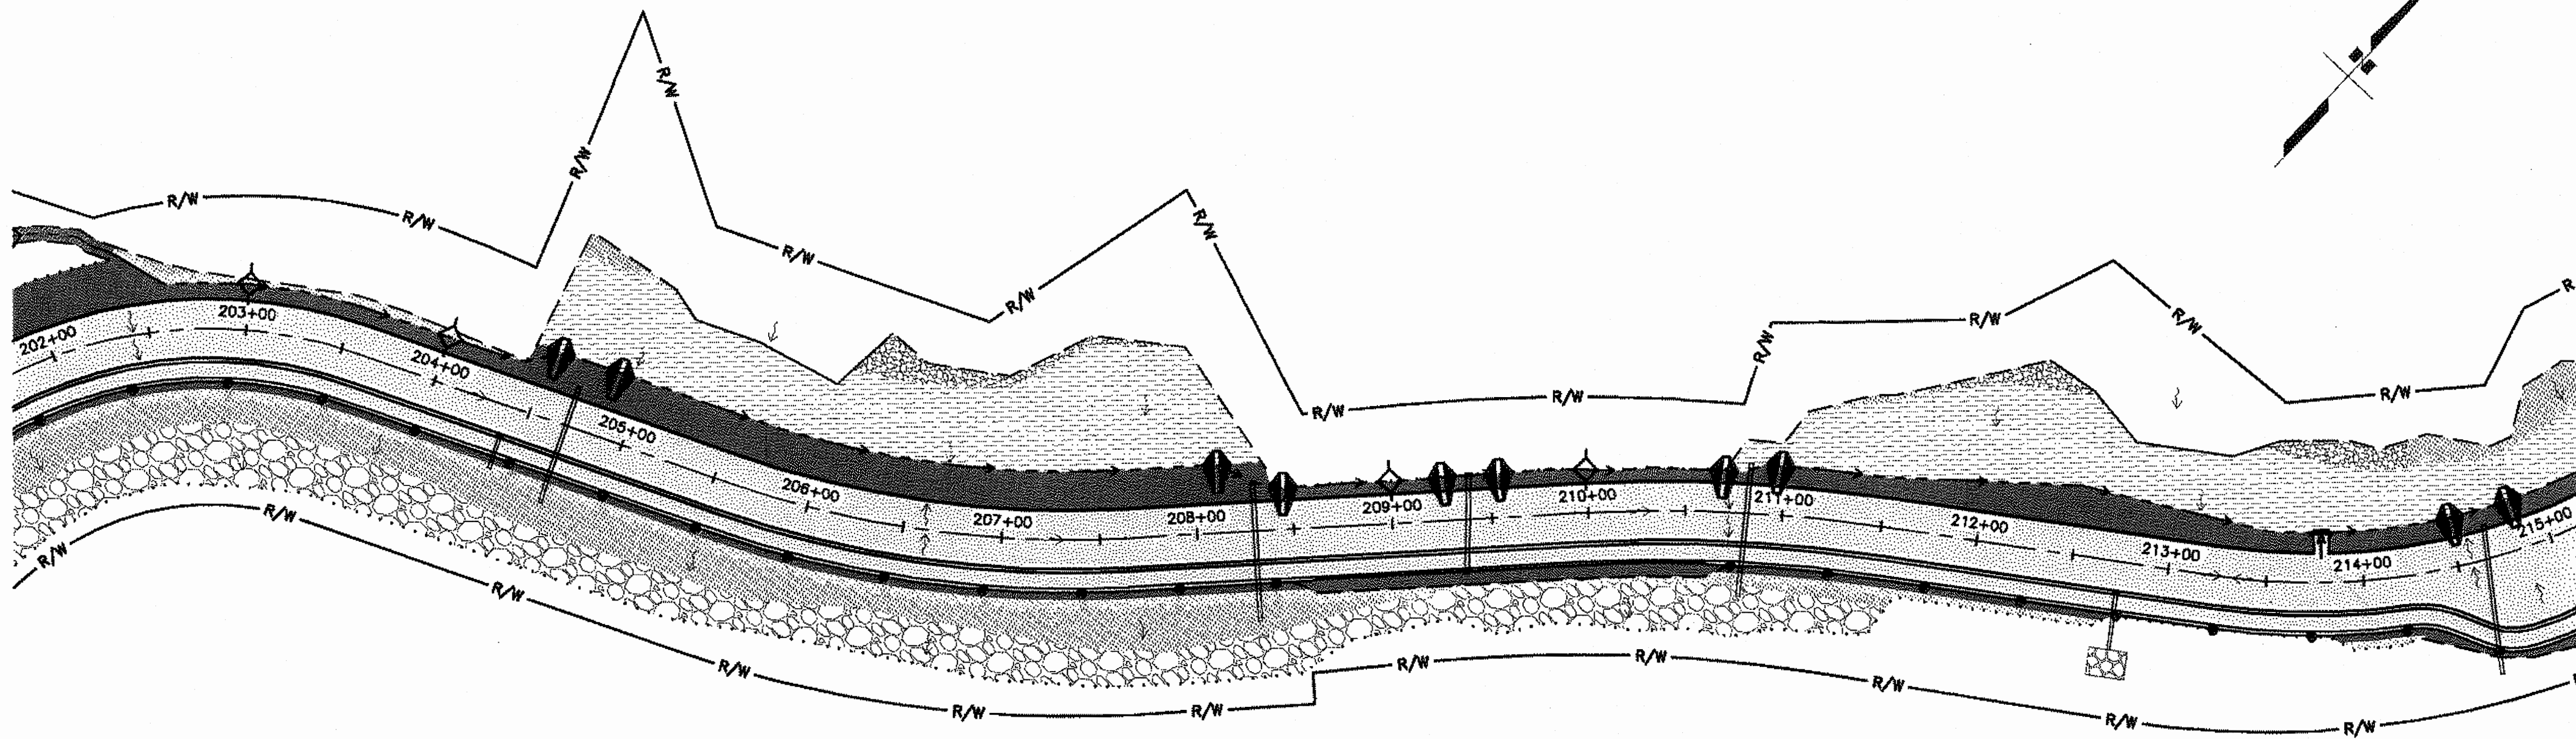

Project As Built Drawings Have Been
Reviewed By The Project Engineer &
Represent, To The Best Of My Knowledge,
The Project As Constructed.
Proj. Eng. *[Signature]* 6-29-15
Date

DO NOT SCALE FROM THESE DRAWINGS USE DIMENSIONS



PATH: \\UNUFILE2\JOBS\1153805\DWG\SC\SCHEETS\PO5-PO6		
Monday, August 27, 2012 9:50:20 AM TAB: P06		
ADDENDUM NUMBER		
ATTACHMENT NUMBER		
RECORD OF REVISIONS		
No.	DATE	DESCRIPTION
SAWMILL CREEK ROAD UPGRADE PHASE III - WHALE PARK TO SAWMILL CREEK BRIDGE 68216MSG-STP-0933(21) SITKA TELECOMMUNICATIONS CONDUIT RSA NO. 69615		
EROSION AND SEDIMENT CONTROL PLAN (ESCP)		
PREPARED BY: USKH		
CHECKED BY: RP		
DESIGNED BY: NCL		
DRAWN BY: WJP		
STATE OF ALASKA DEPARTMENT OF TRANSPORTATION & PUBLIC FACILITIES SOUTHEAST REGION		
ESCP SOIL STABILIZATION PHASE STA. 202+00 TO STA. 229+00		
PROJECT DESIGNATION 68216MSG-STP-0933(21)		
STATE	YEAR	
ALASKA	2012	
SHEET NUMBER	TOTAL SHEETS	
P6	109	

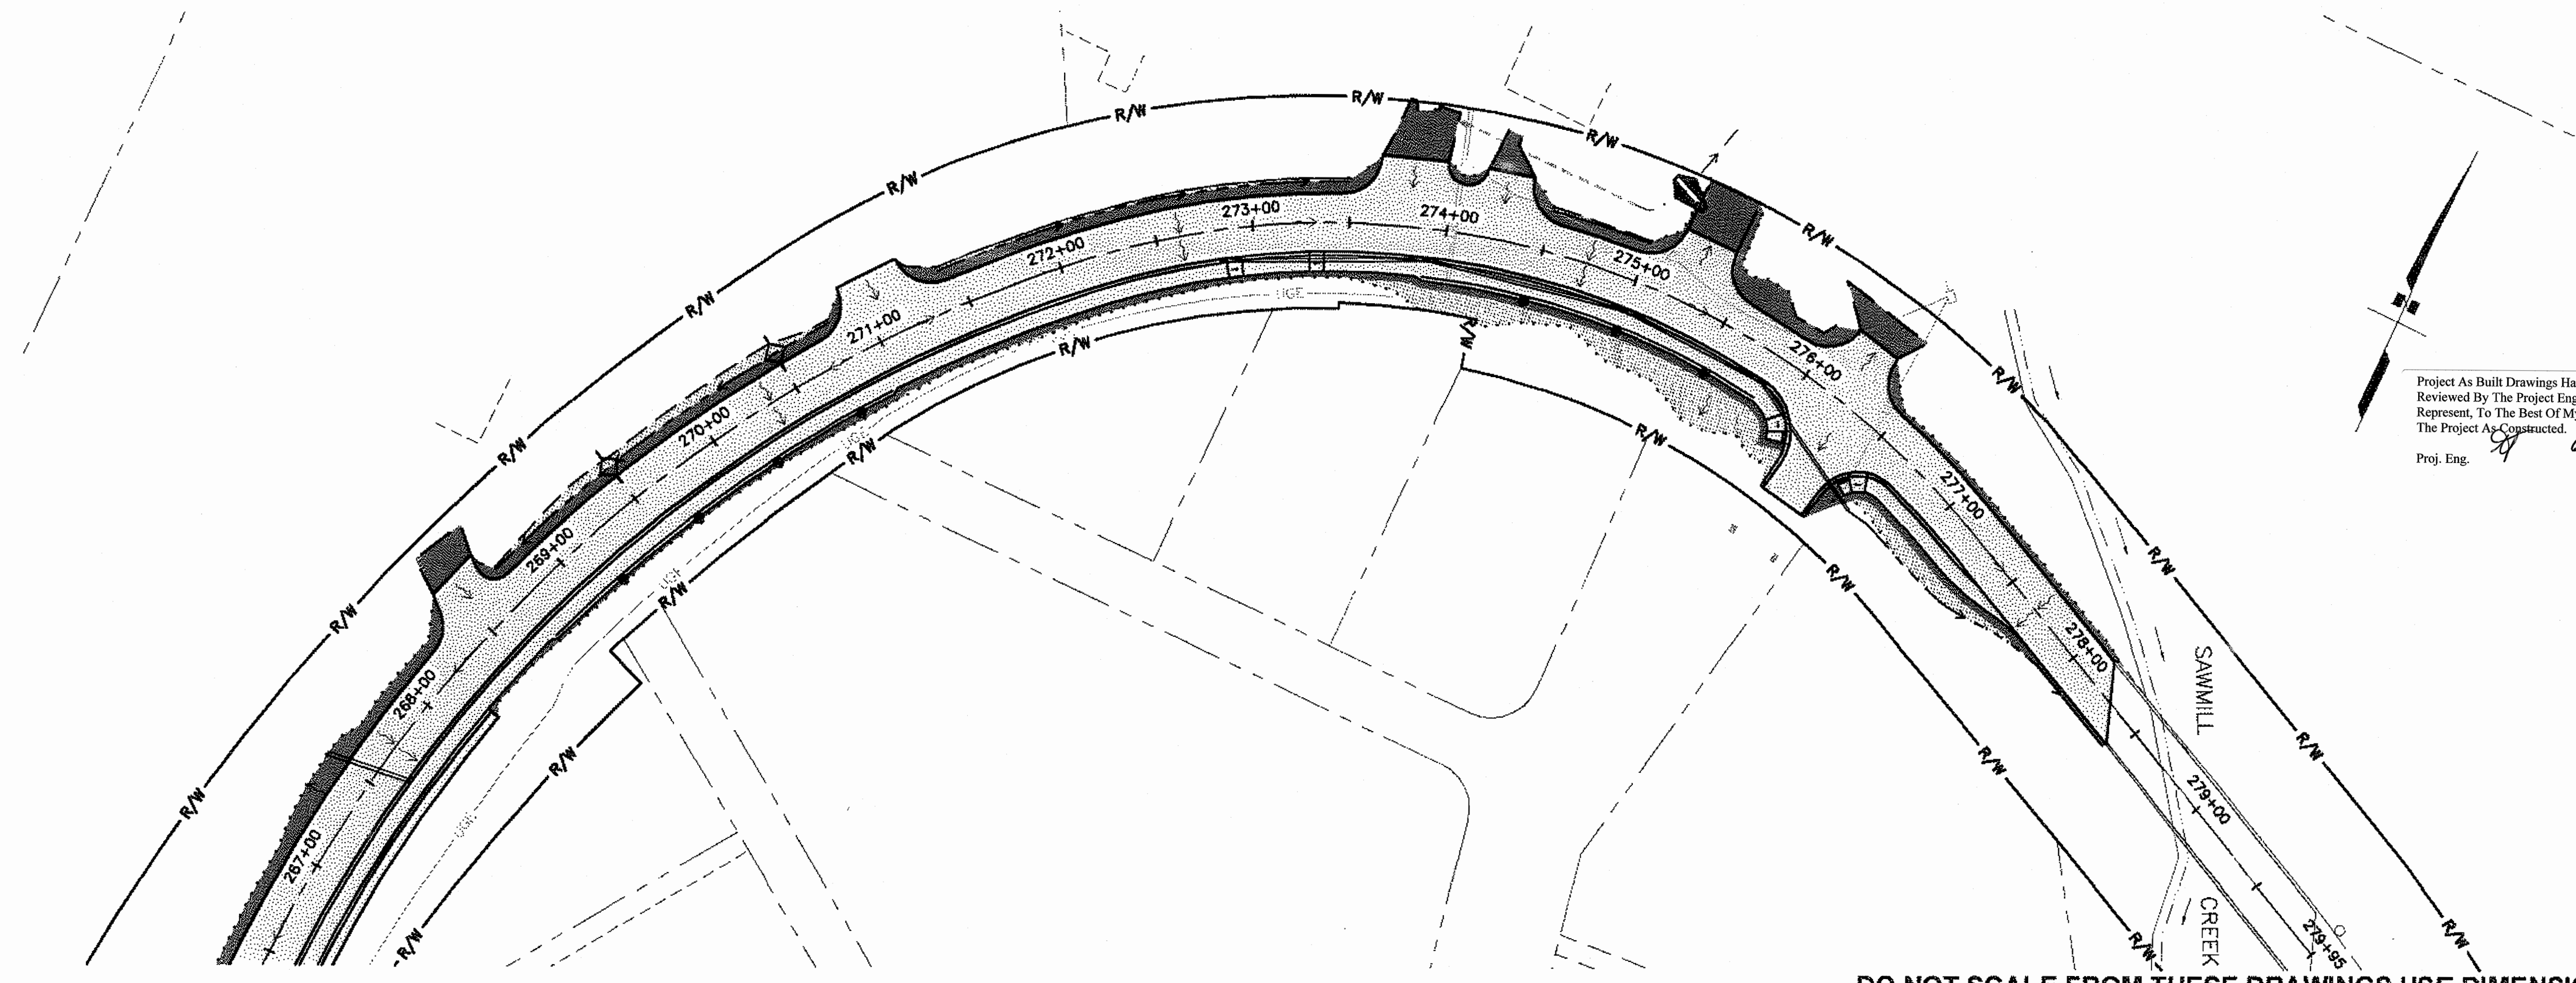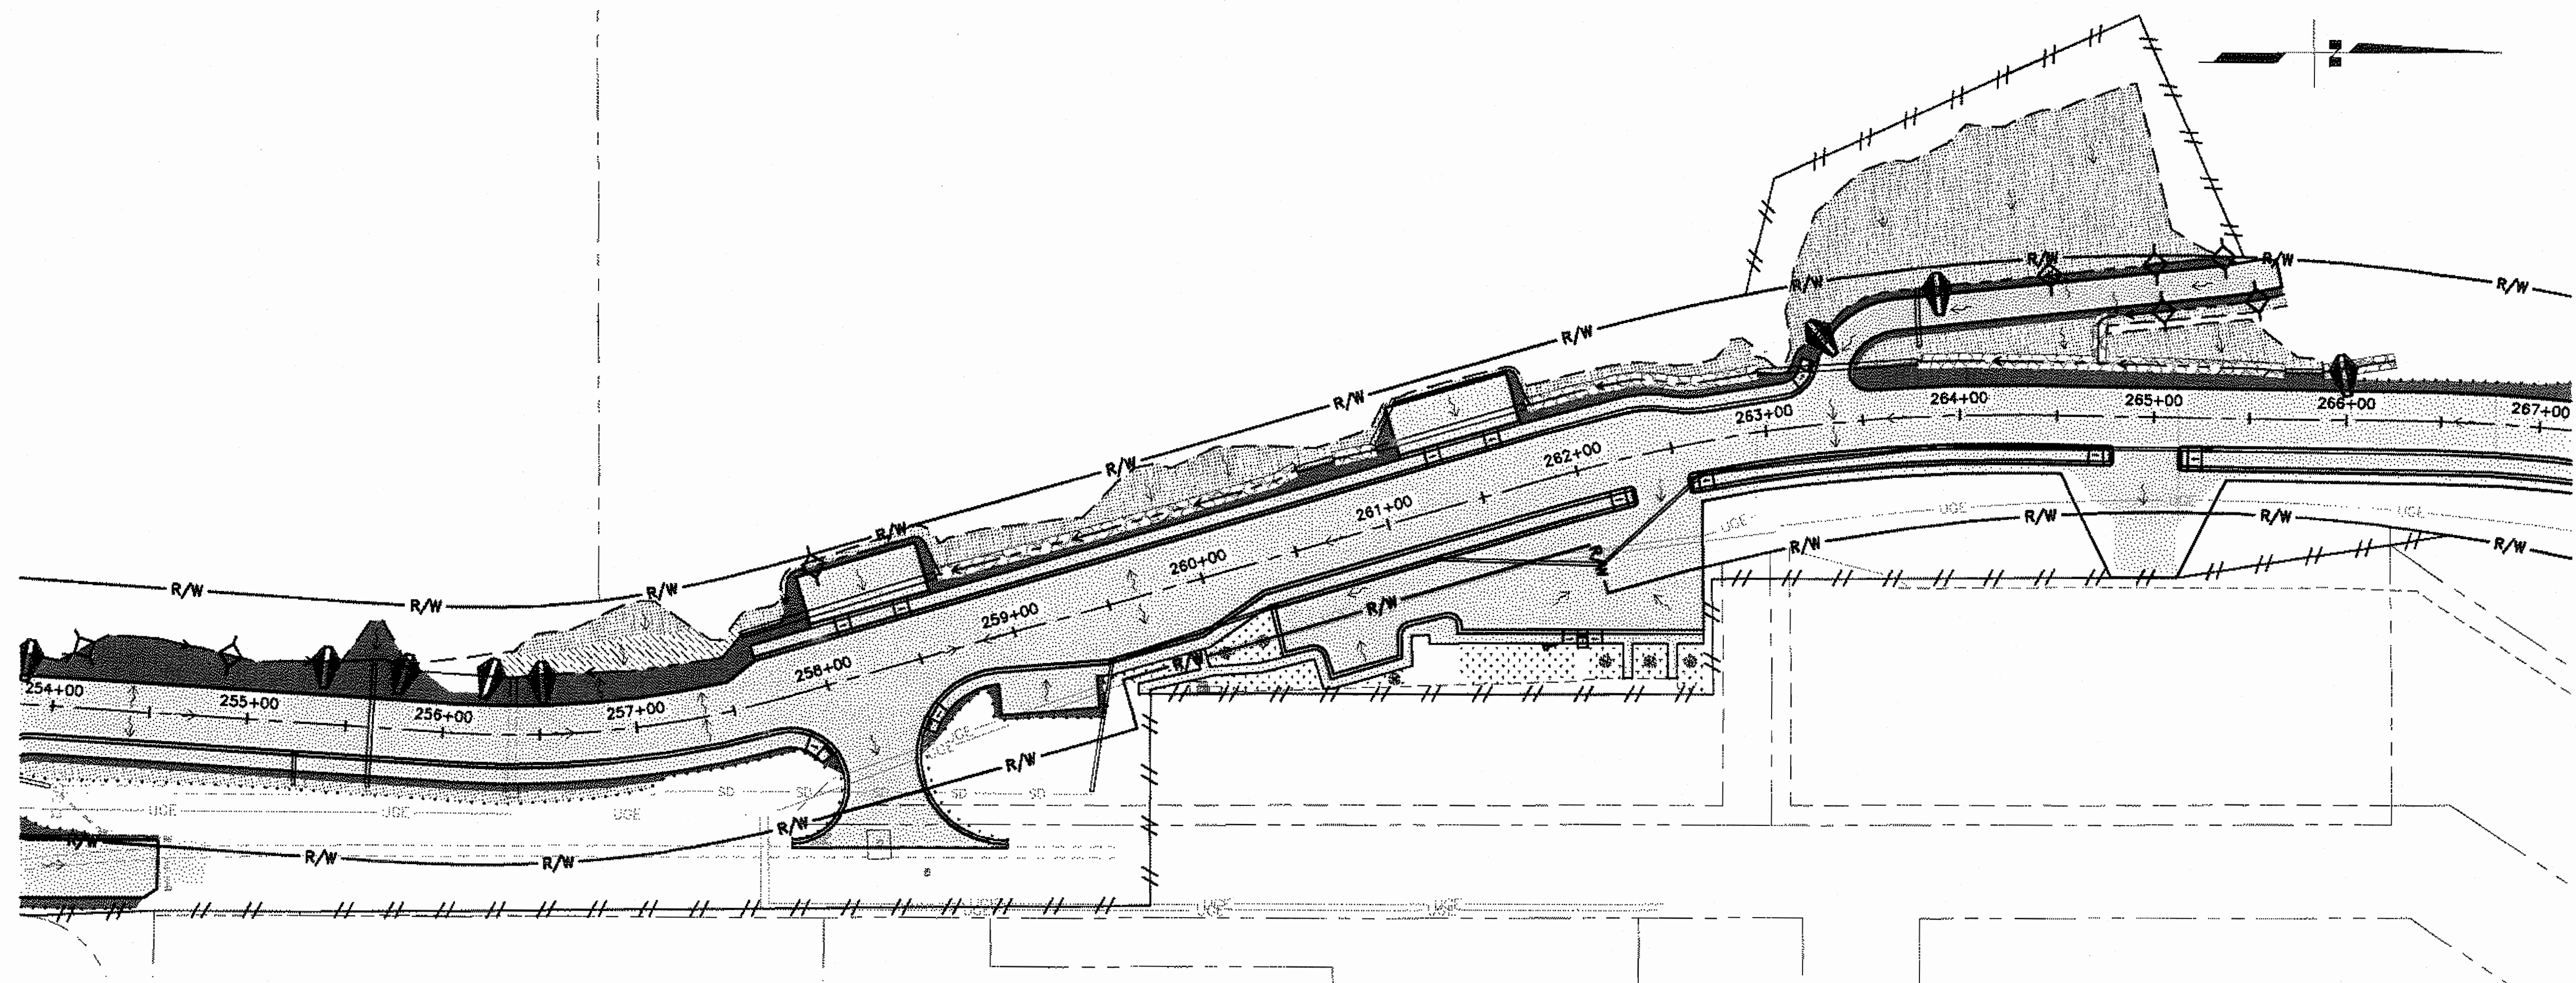

DO NOT SCALE FROM THESE DRAWINGS USE DIMENSIONS

PATH: \\N\FILE2\JOBS\1153805\DWG\SC\SHETS\IP05-P08 Monday, August 27, 2012 9:50:24 AM TAB: P08		
ADDENDUM NUMBER		
ATTACHMENT NUMBER		
RECORD OF REVISIONS		
No.	DATE	DESCRIPTION
SAWMILL CREEK ROAD UPGRADE PHASE III - WHALE PARK TO SAWMILL CREEK BRIDGE 68216\MSG-STP-0933(21) SITKA TELECOMMUNICATIONS CONDUIT RSA NO. 68615		
PREPARED BY: USKH CHECKED BY: RP		
DESIGNED BY: NCL DRAWN BY: WJP		
STATE OF ALASKA DEPARTMENT OF TRANSPORTATION & PUBLIC FACILITIES SOUTHEAST REGION		
ESCP SOIL STABILIZATION PHASE STA. 254+00 TO EOP		
PROJECT DESIGNATION 68216\MSG-STP-0933(21)		
STATE	YEAR	
ALASKA	2012	
SHEET NUMBER	TOTAL SHEETS	
P8	109	

EROSION AND SEDIMENT CONTROL PLAN (ESCP)

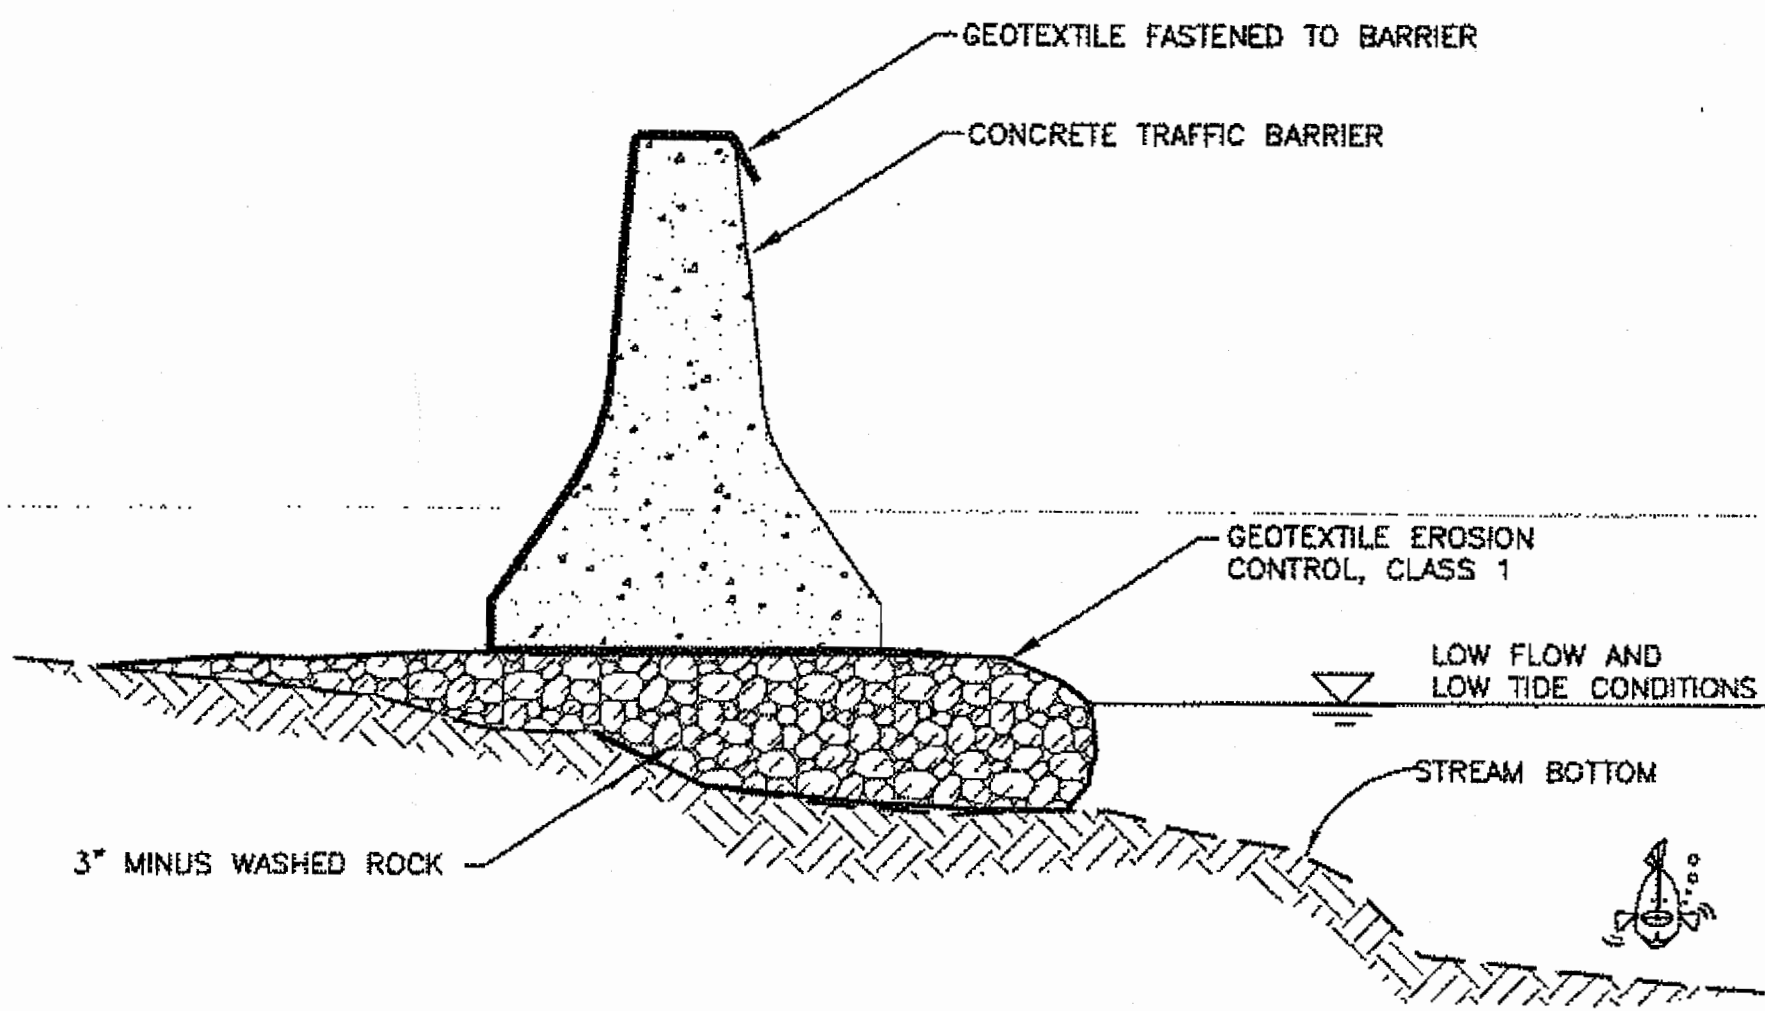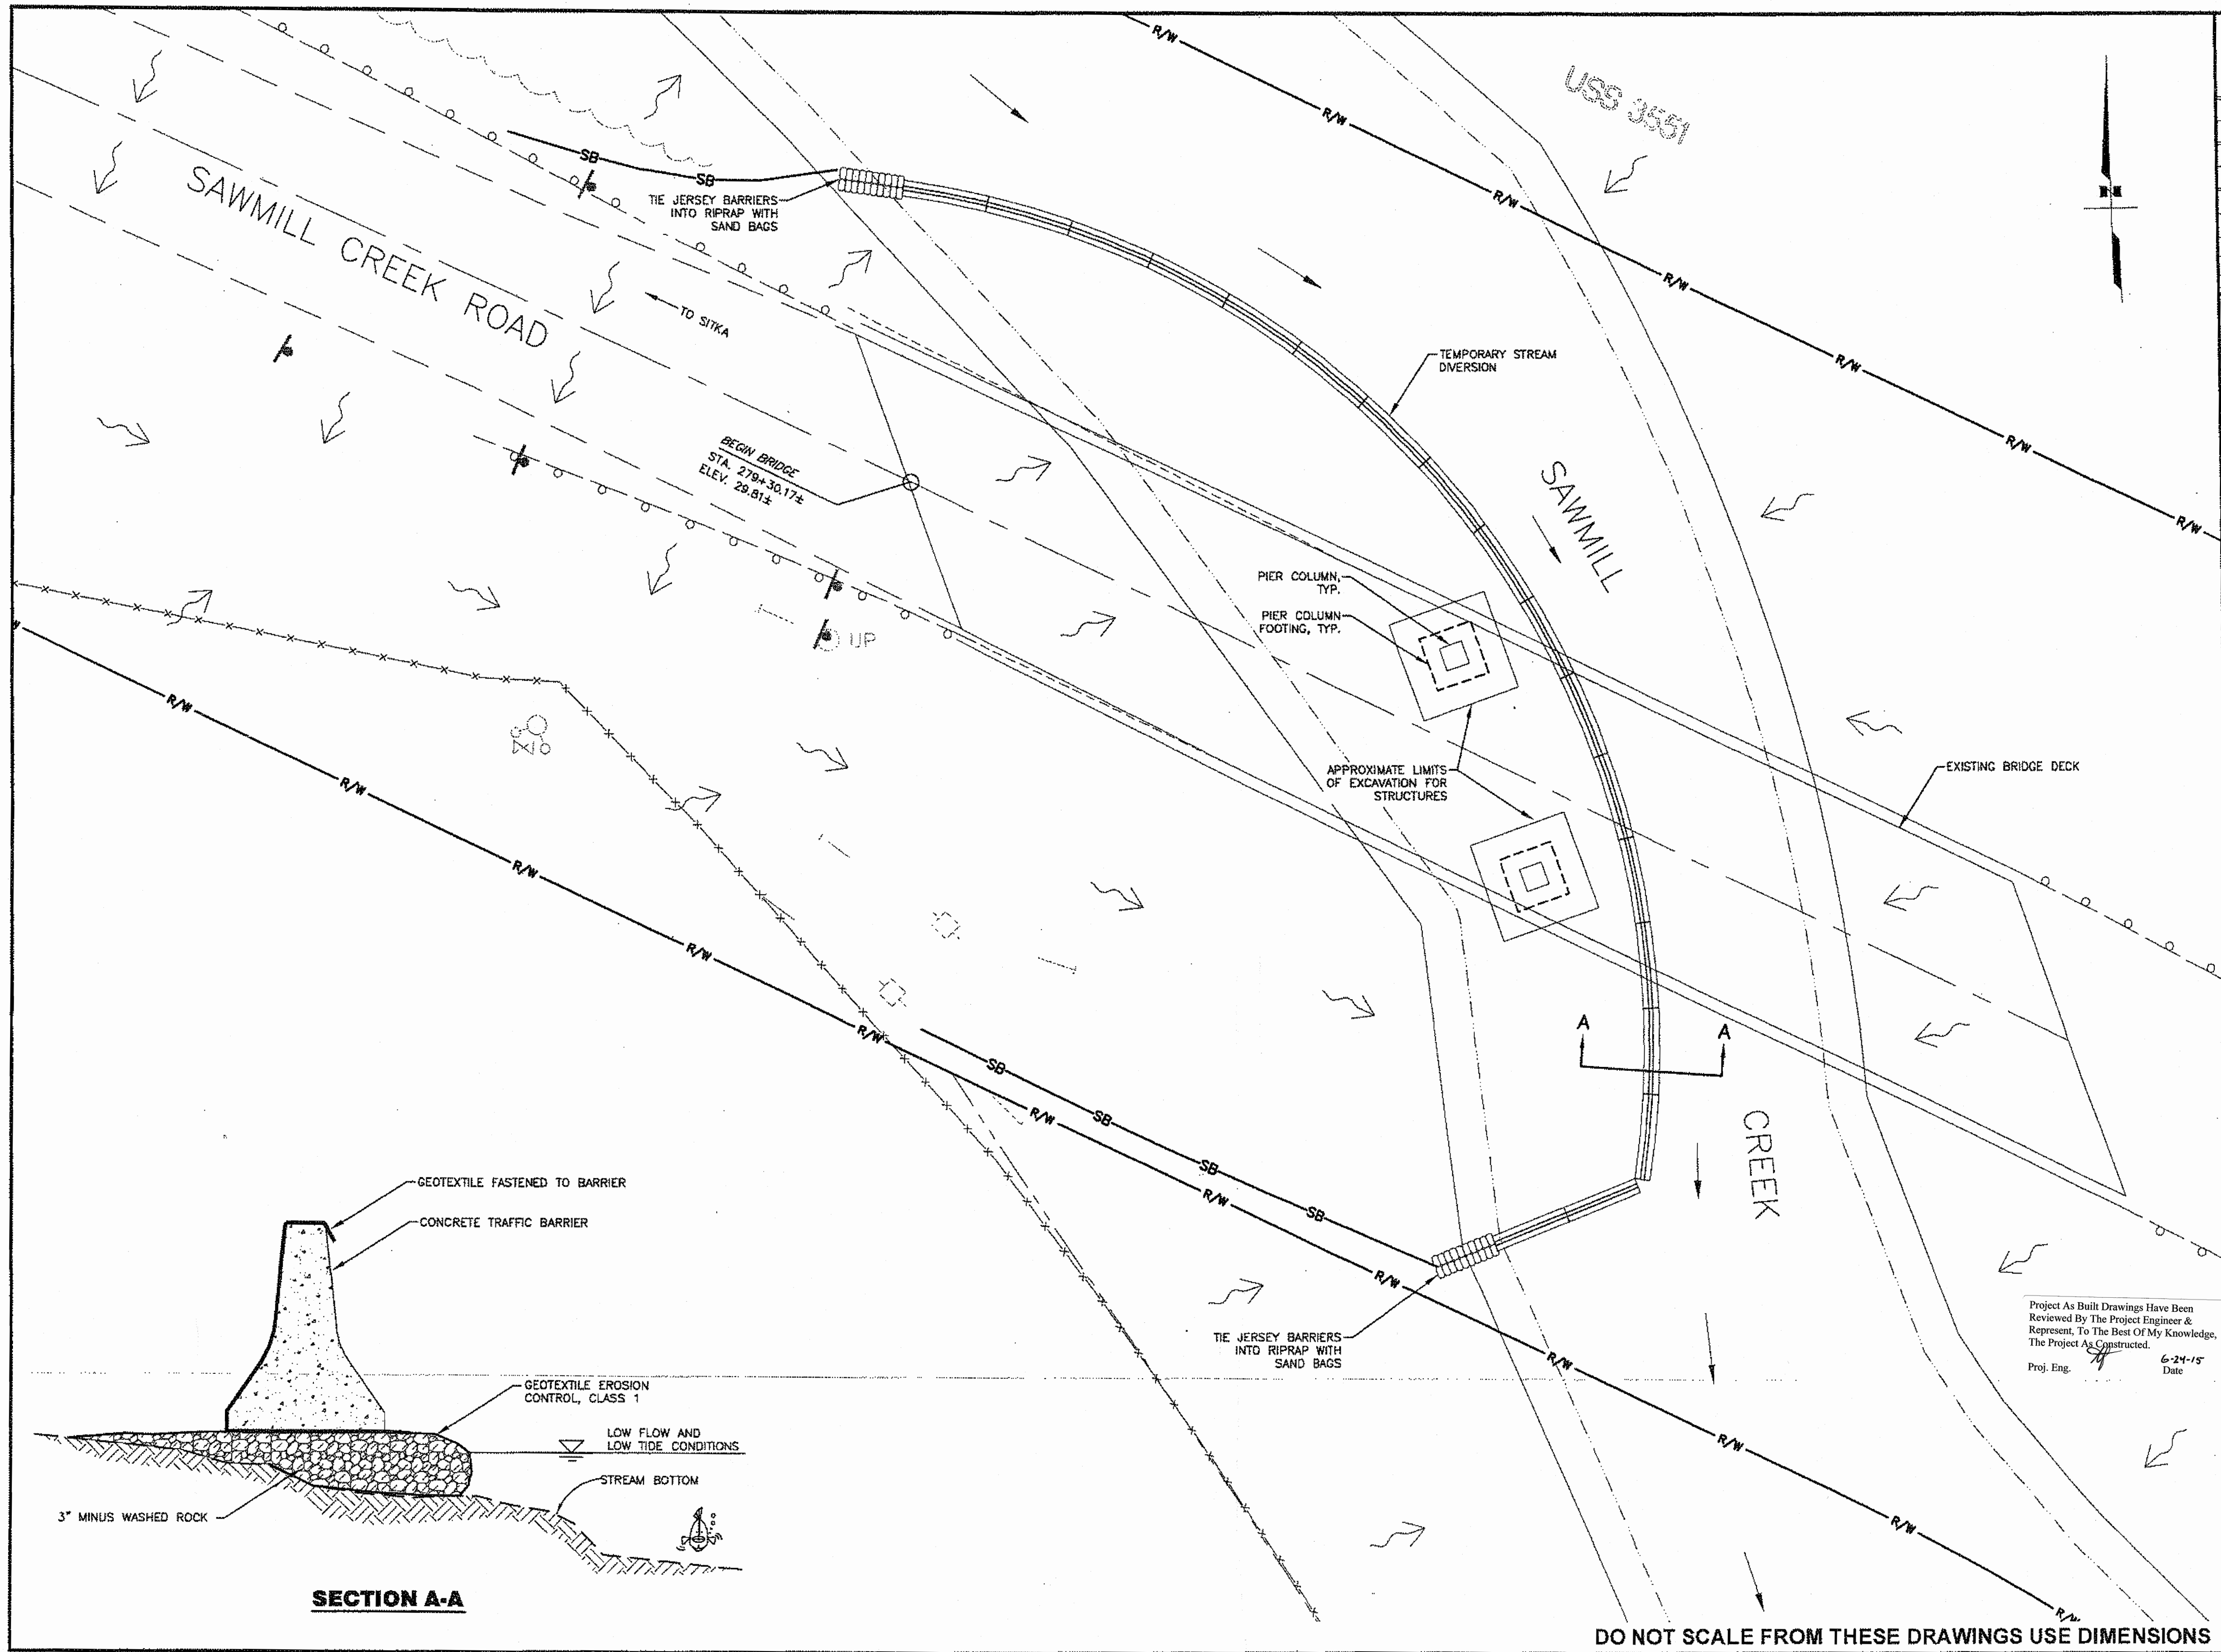


SECTION A-A

DO NOT SCALE FROM THESE DRAWINGS USE DIMENSIONS


PATH: I:\11538051\DWG\SCHEETS\SP08.DWG		
Thursday, August 23, 2012 2:51:36 PM		
TAB: P08		
ADDENDUM NUMBER		
ATTACHMENT NUMBER		
RECORD OF REVISIONS		
No.	DATE	DESCRIPTION
SAWMILL CREEK ROAD UPGRADE PHASE III - WHALE PARK TO SAWMILL CREEK BRIDGE 68216MSG-STP-0933(21) SITKA TELECOMMUNICATIONS CONDUIT RSA NO. 69615		
EROSION SEDIMENT CONTROL PLAN (ESCP)		
PREPARED BY: USKH		
CHECKED BY: RP		
DESIGNED BY: NCL		
DRAWN BY: WJP		
STATE OF ALASKA DEPARTMENT OF TRANSPORTATION & PUBLIC FACILITIES SOUTHEAST REGION		
ESCP BRIDGE REPAIR BMPS		
PROJECT DESIGNATION 68216MSG-STP-0933(21)		
STATE	YEAR	
ALASKA	2012	
SHEET NUMBER	TOTAL SHEETS	
P9	109	

BEGIN PAVING
WHALE PARK
STA. 185+22

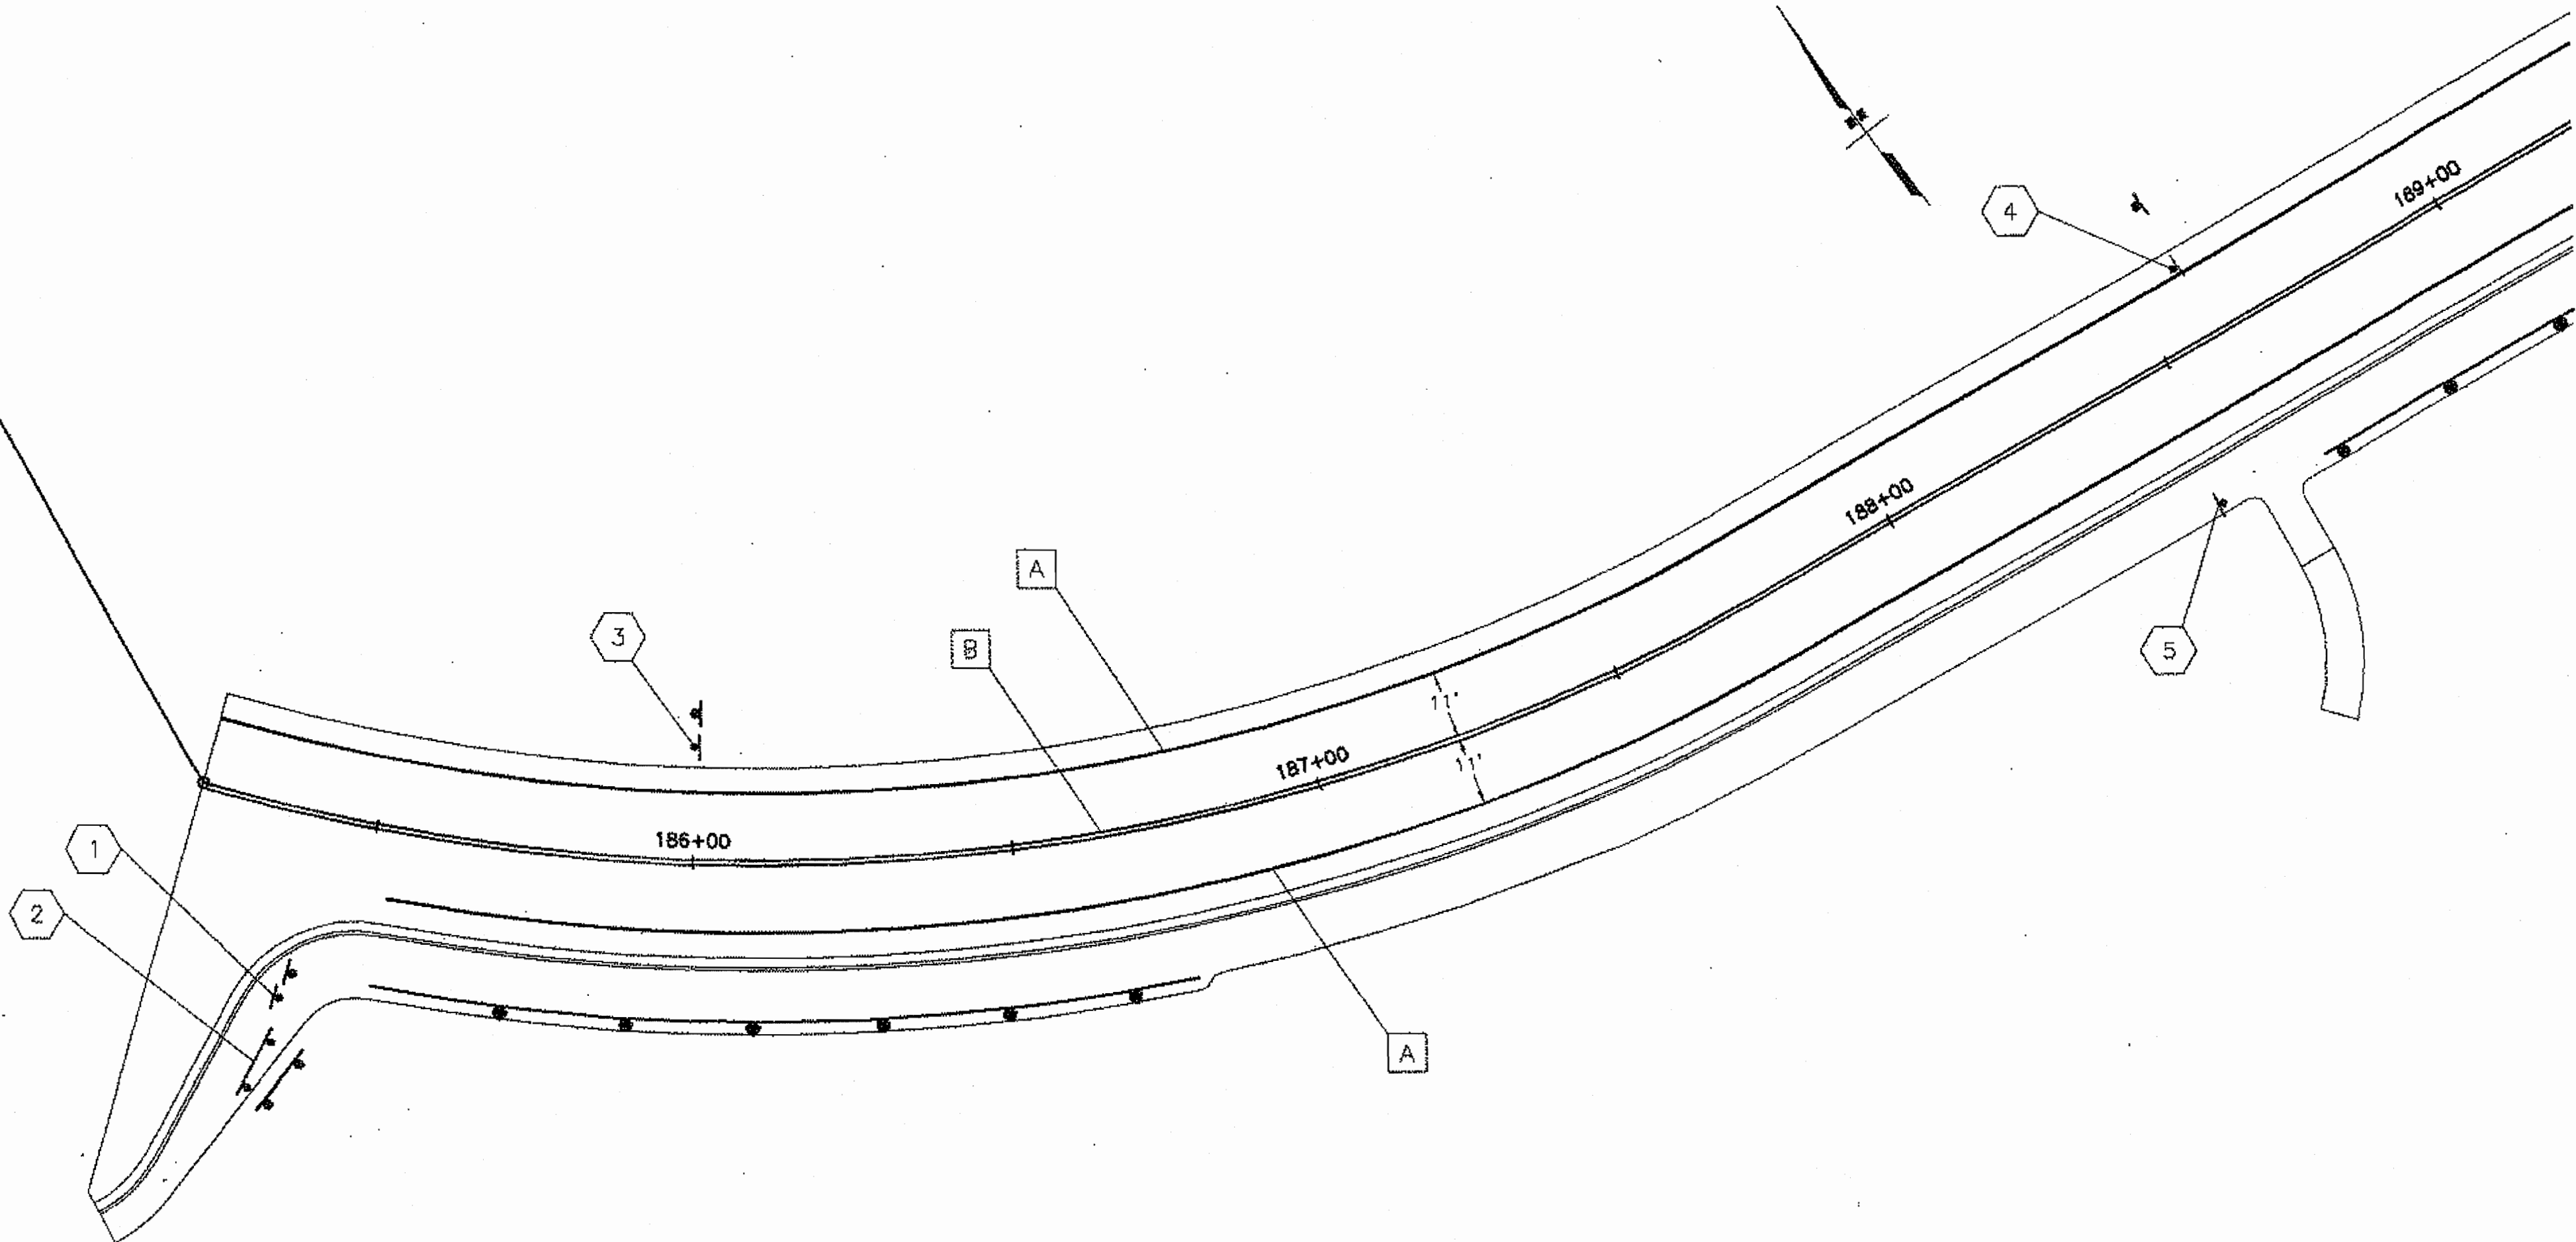

DO NOT SCALE FROM THESE DRAWINGS USE DIMENSIONS

STRIPING TABLE			
SYMBOL	DESCRIPTION	WIDTH	PATTERN
A	SOLID WHITE	4"	
B	SOLID DOUBLE YELLOW	13"	
10	SIGNS PER TABLE SHEET S-11		

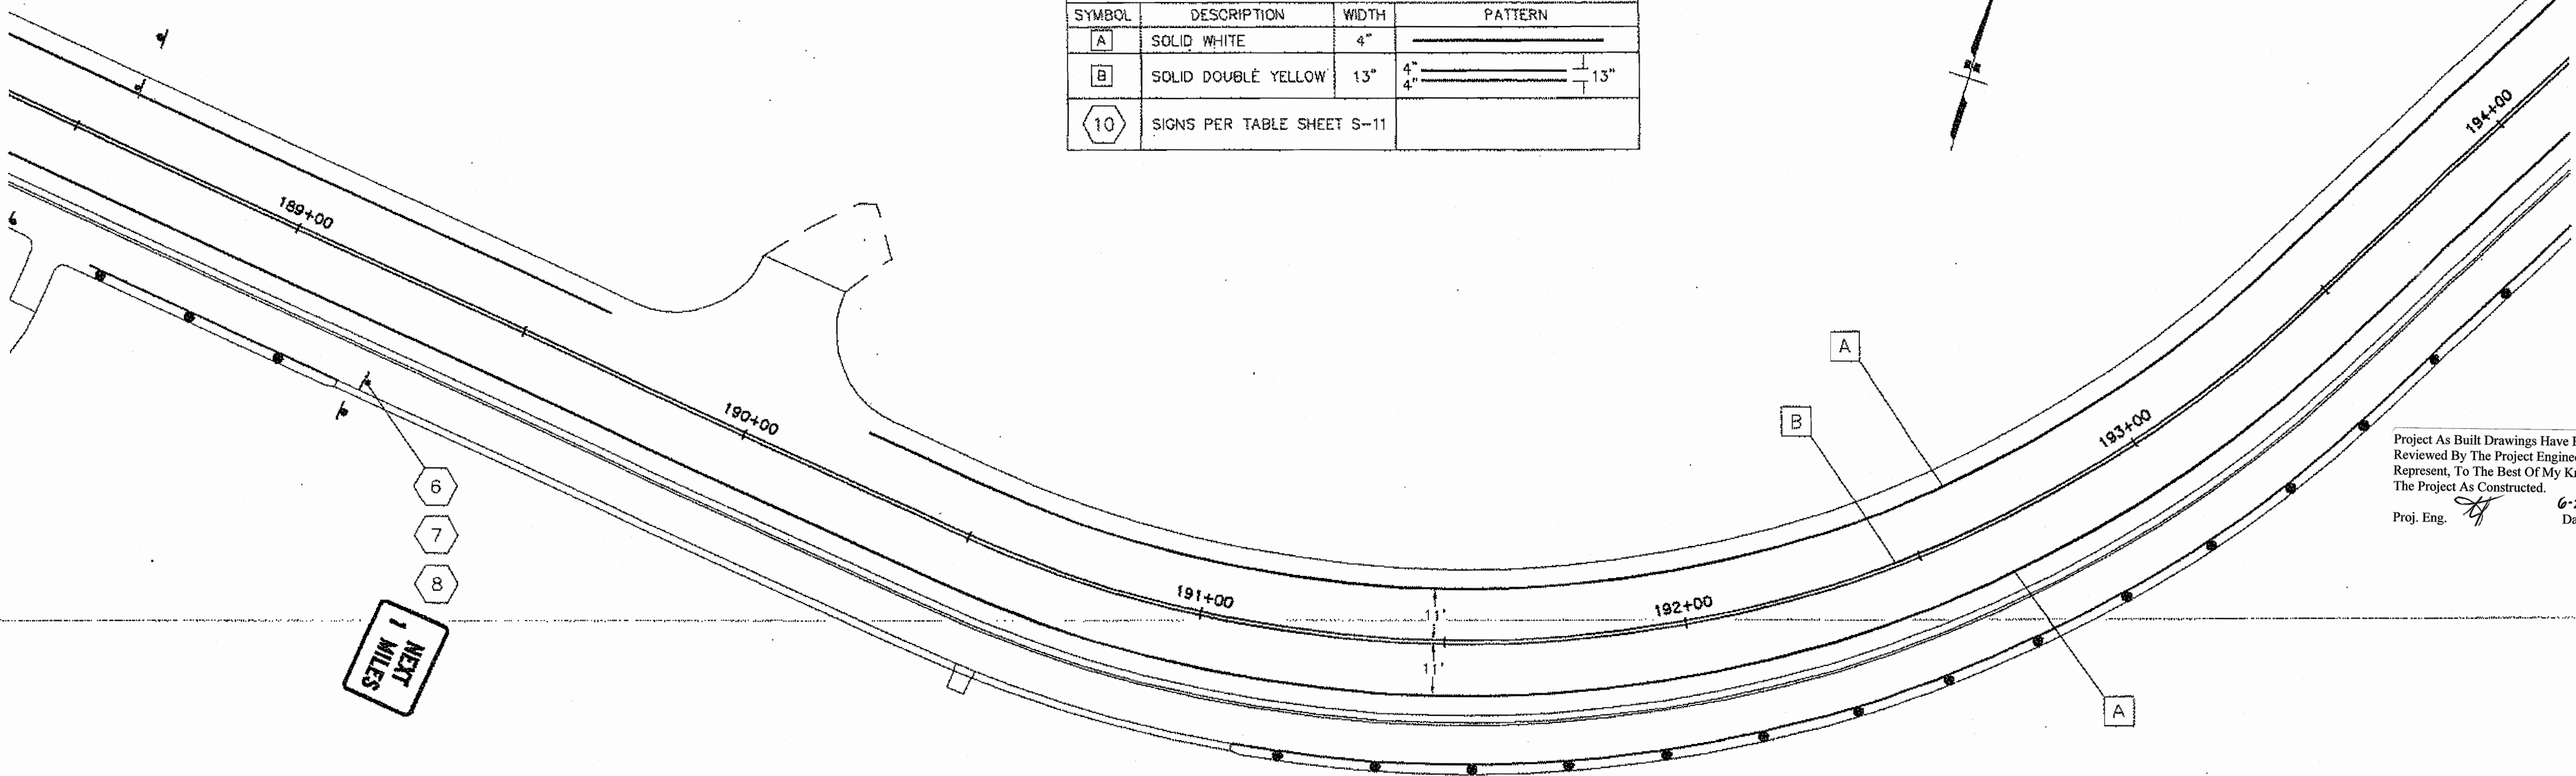

Project As Built Drawings Have Been
Reviewed By The Project Engineer &
Represent, To The Best Of My Knowledge,
The Project As Constructed.
Proj. Eng. Date 6-24-15

PATH:
\\NWFILE2\JOBS\1153805\DWG\SS\SSHEETS\S01-S100
Friday, August 17, 2012 7:22:15 PM
TAB: S01

ADDENDUM NUMBER

ATTACHMENT NUMBER

RECORD OF REVISIONS

No.	DATE	DESCRIPTION

SAWMILL CREEK ROAD UPGRADE
PHASE III - WHALE PARK TO SAWMILL CREEK BRIDGE
68216MSG-STP-0933(21)
SITKA TELECOMMUNICATIONS CONDUIT
RSA NO. 69615

SIGNING & STRIPING PLANS & SUMMARIES

PREPARED BY: USKH

CHECKED BY: KM

DESIGNED BY: NCL

DRAWN BY: WJP


STATE OF ALASKA
DEPARTMENT OF TRANSPORTATION
& PUBLIC FACILITIES
SOUTHEAST REGION

SIGNING & STRIPING
PLANS & SUMMARIES
BOP TO
STA. 193+50

PROJECT DESIGNATION


68216MSG-STP-0933(21)

STATE	YEAR
ALASKA	2012
SHEET NUMBER	TOTAL SHEETS
S1	109

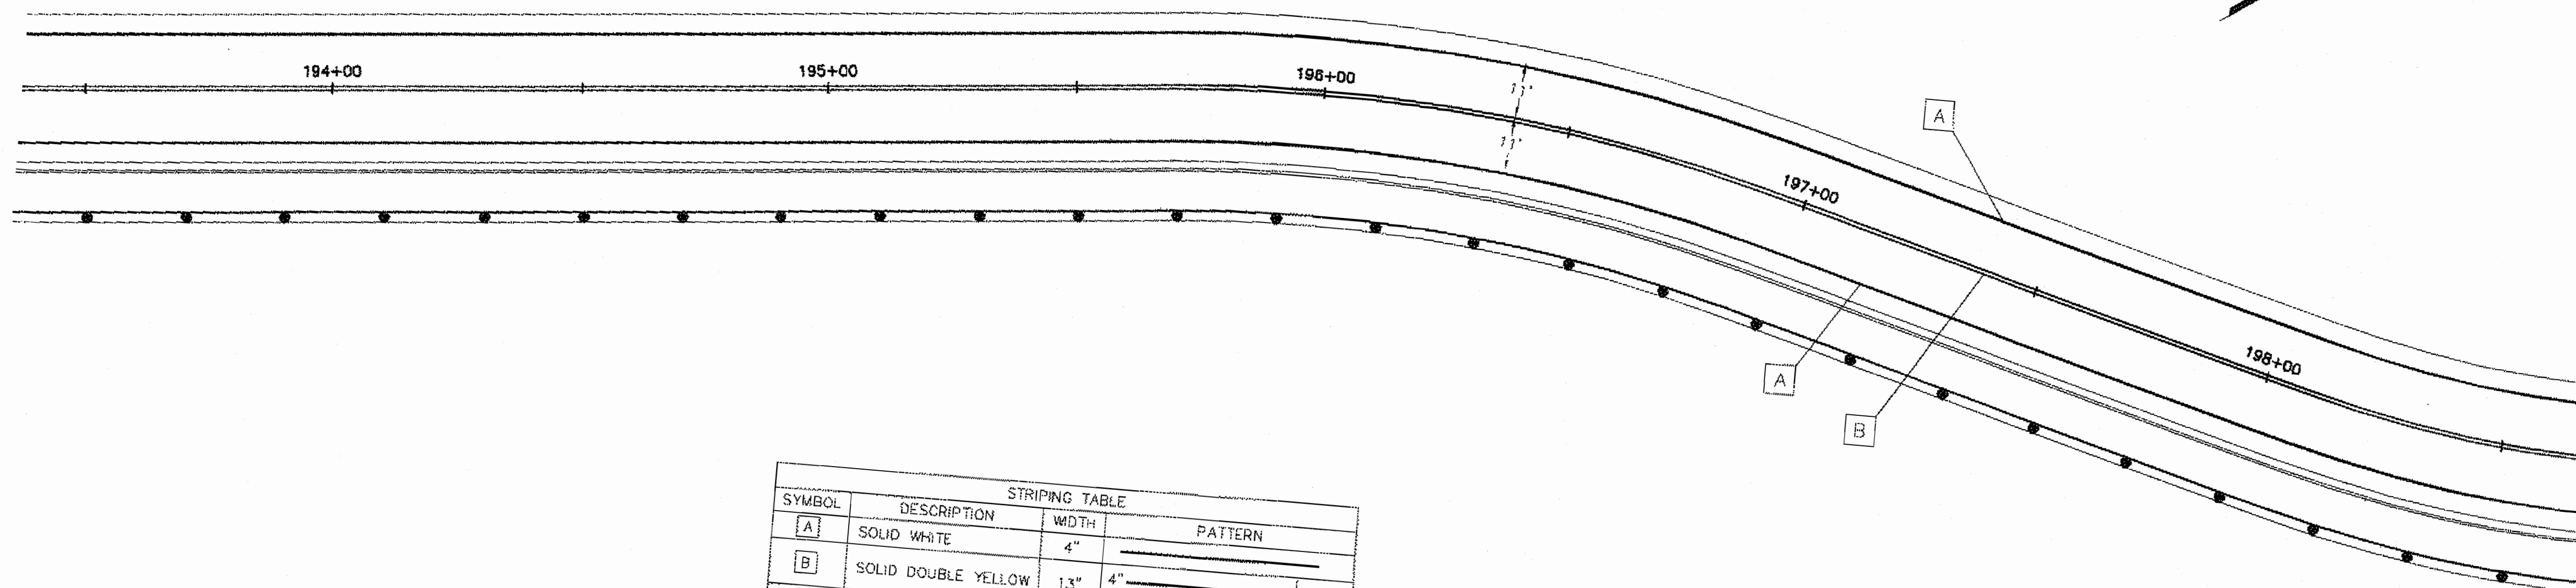

STRIPING TABLE			
SYMBOL	DESCRIPTION	WIDTH	PATTERN
[A]	SOLID WHITE	4"	
[B]	SOLID DOUBLE YELLOW	13"	4" 4" 1.3"
(10)	SIGNS PER TABLE SHEET S-11		

DO NOT SCALE FROM THESE DRAWINGS USE DIMENSIONS

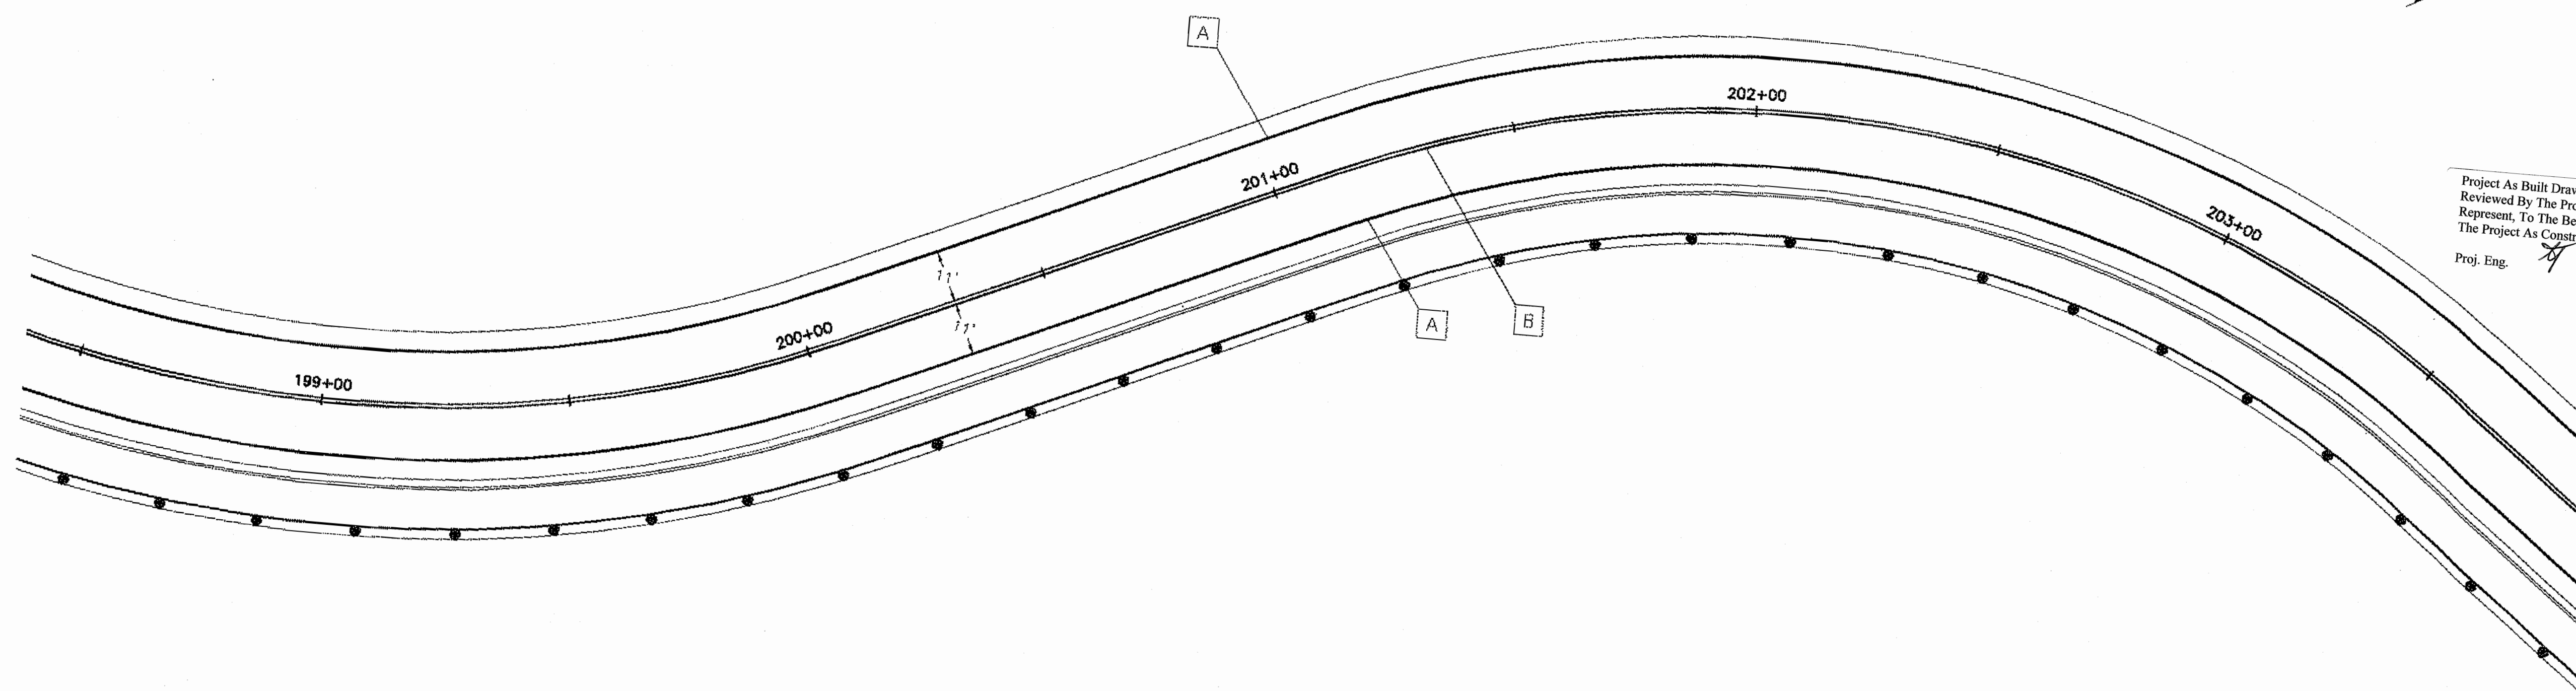

Project As Built Drawings Have Been
Reviewed By The Project Engineer &
Represent, To The Best Of My Knowledge,
The Project As Constructed.
Proj. Eng. *[Signature]* Date 6-24-15

PATH:
I:\UNFILE2\JOBS\1153805\DWGS\IC\SHEETS\S01-S10

TAB: S02

ADDENDUM NUMBER

ATTACHMENT NUMBER

RECORD OF REVISIONS


No.	DATE	DESCRIPTION

SAWMILL CREEK ROAD UPGRADE
PHASE III - WHALE PARK TO SAWMILL CREEK BRIDGE
68216MSG-STP-0933(21)
SITKA TELECOMMUNICATIONS CONDUIT
RSA NO. 69615

SIGNING & STRIPING PLANS & SUMMARIES

PREPARED BY: USKH

CHECKED BY: KM

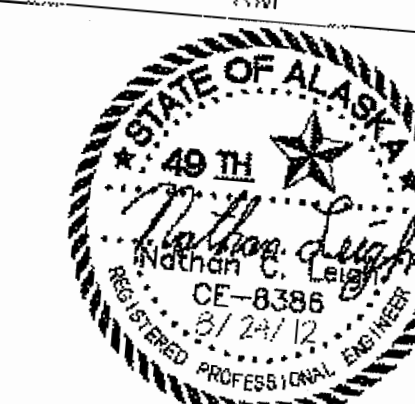

DESIGNED BY: NCL

DRAWN BY: WJP

STATE OF ALASKA
DEPARTMENT OF TRANSPORTATION
& PUBLIC FACILITIES
SOUTHEAST REGION


**SIGNING & STRIPING
PLANS & SUMMARIES**


STA. 193+50 TO
STA. 203+50

PROJECT DESIGNATION


68216MSG-STP-0933(21)

STATE	YEAR
ALASKA	2012
SHEET NUMBER	TOTAL SHEETS
S2	109

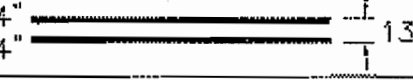STRIPING TABLE			
SYMBOL	DESCRIPTION	WIDTH	PATTERN
[A]	SOLID WHITE	4"	
[B]	SOLID DOUBLE YELLOW	13"	
[10]	SIGNS PER TABLE SHEET 5-11		

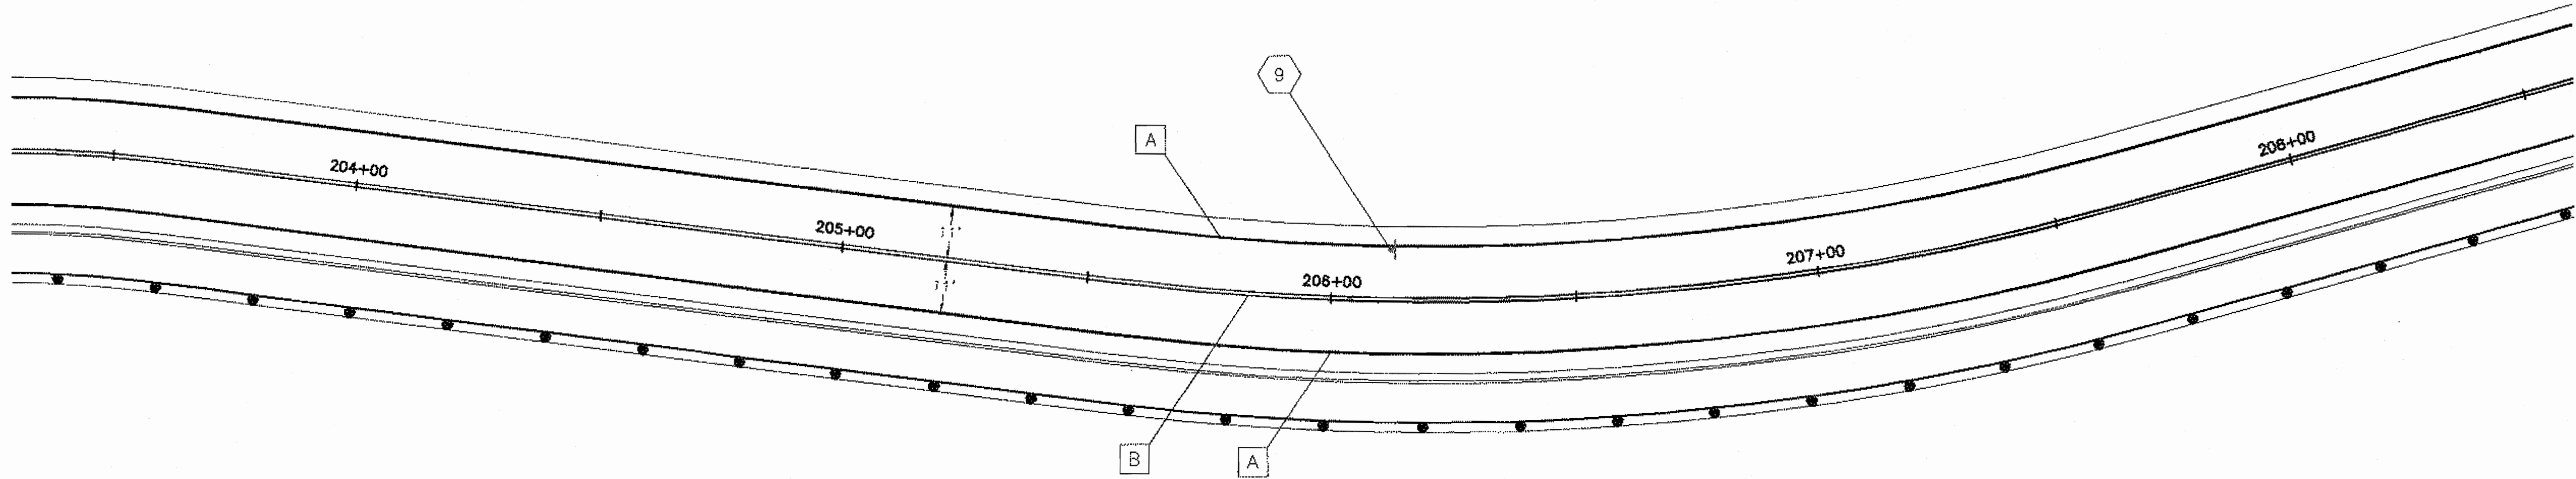


DO NOT SCALE FROM THESE DRAWINGS USE DIMENSIONS

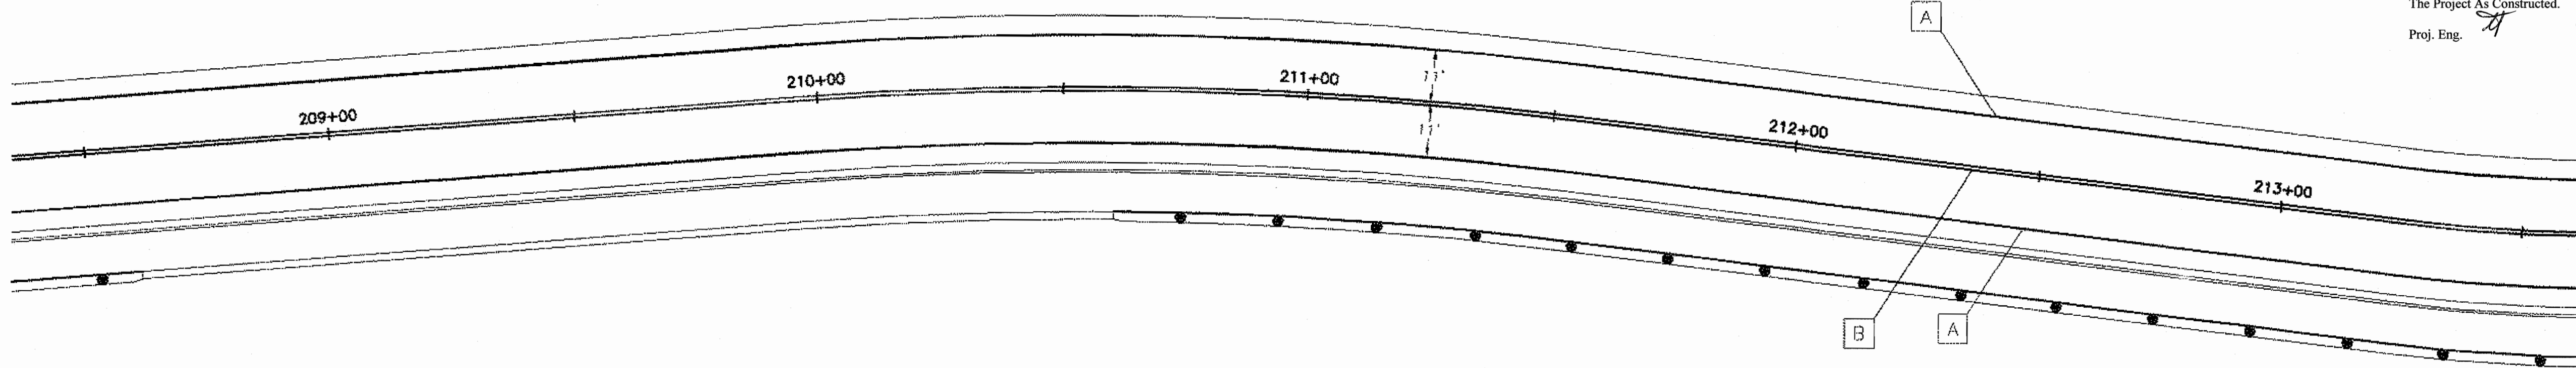


Project As Built Drawings Have Been Reviewed By The Project Engineer & Represent, To The Best Of My Knowledge, The Project As Constructed.
 Proj. Eng. *[Signature]* Date 6-24-15

PATH: \\NUNFILE2\JOBS\1153805\DWG\CS\SHEETS\501-S10		
TAB: S03		
ADDENDUM NUMBER		
ATTACHMENT NUMBER		
RECORD OF REVISIONS		
No.	DATE	DESCRIPTION
SAWMILL CREEK ROAD UPGRADE PHASE III - WHALE PARK TO SAWMILL CREEK BRIDGE 68216MSG-STP-0933(21) SITKA TELECOMMUNICATIONS CONDUIT RSA NO. 69615		
SIGNING & STRIPING PLANS & SUMMARIES		
PREPARED BY: USKH		
CHECKED BY: KM		
		
DESIGNED BY: NCL		
DRAWN BY: WJP		
STATE OF ALASKA DEPARTMENT OF TRANSPORTATION & PUBLIC FACILITIES SOUTHEAST REGION		
SIGNING & STRIPING PLANS & SUMMARIES		
STA. 203+50 TO STA. 213+50		
PROJECT DESIGNATION		
68216MSG-STP-0933(21)		
STATE	YEAR	
ALASKA	2012	
SHEET NUMBER	TOTAL SHEETS	
S3	109	

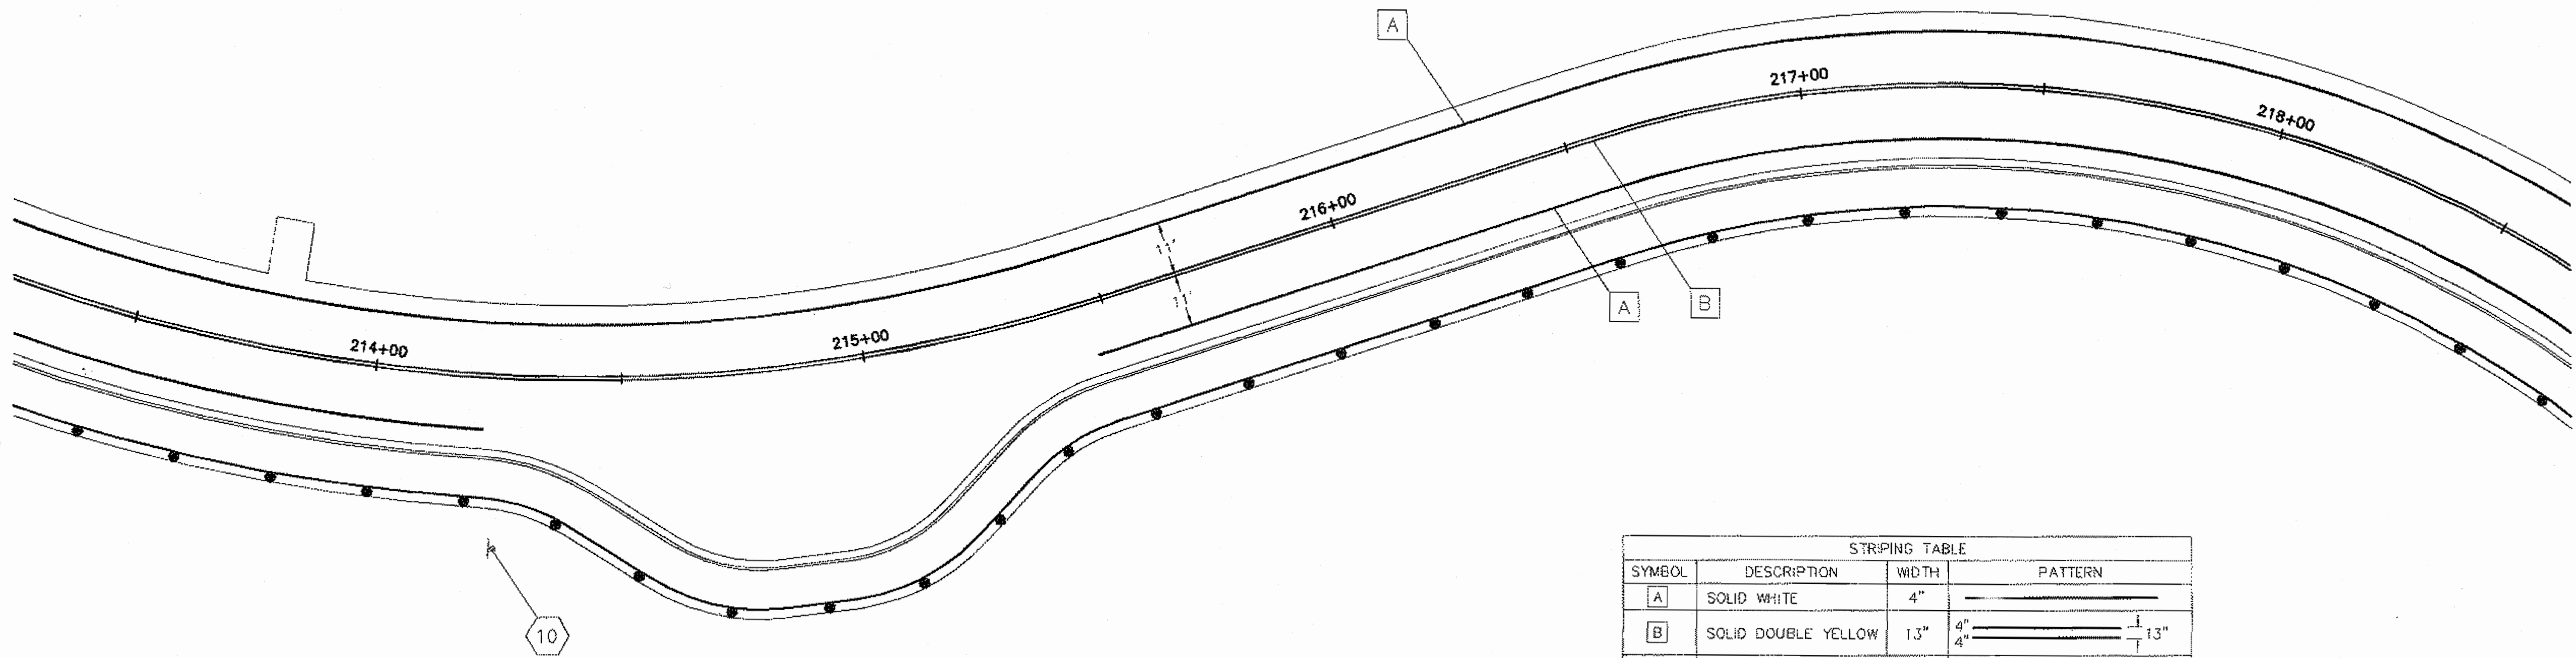

STRIPING TABLE			
SYMBOL	DESCRIPTION	WIDTH	PATTERN
A	SOLID WHITE	4"	
B	SOLID DOUBLE YELLOW	13"	
10	SIGNS PER TABLE SHEET S-11		

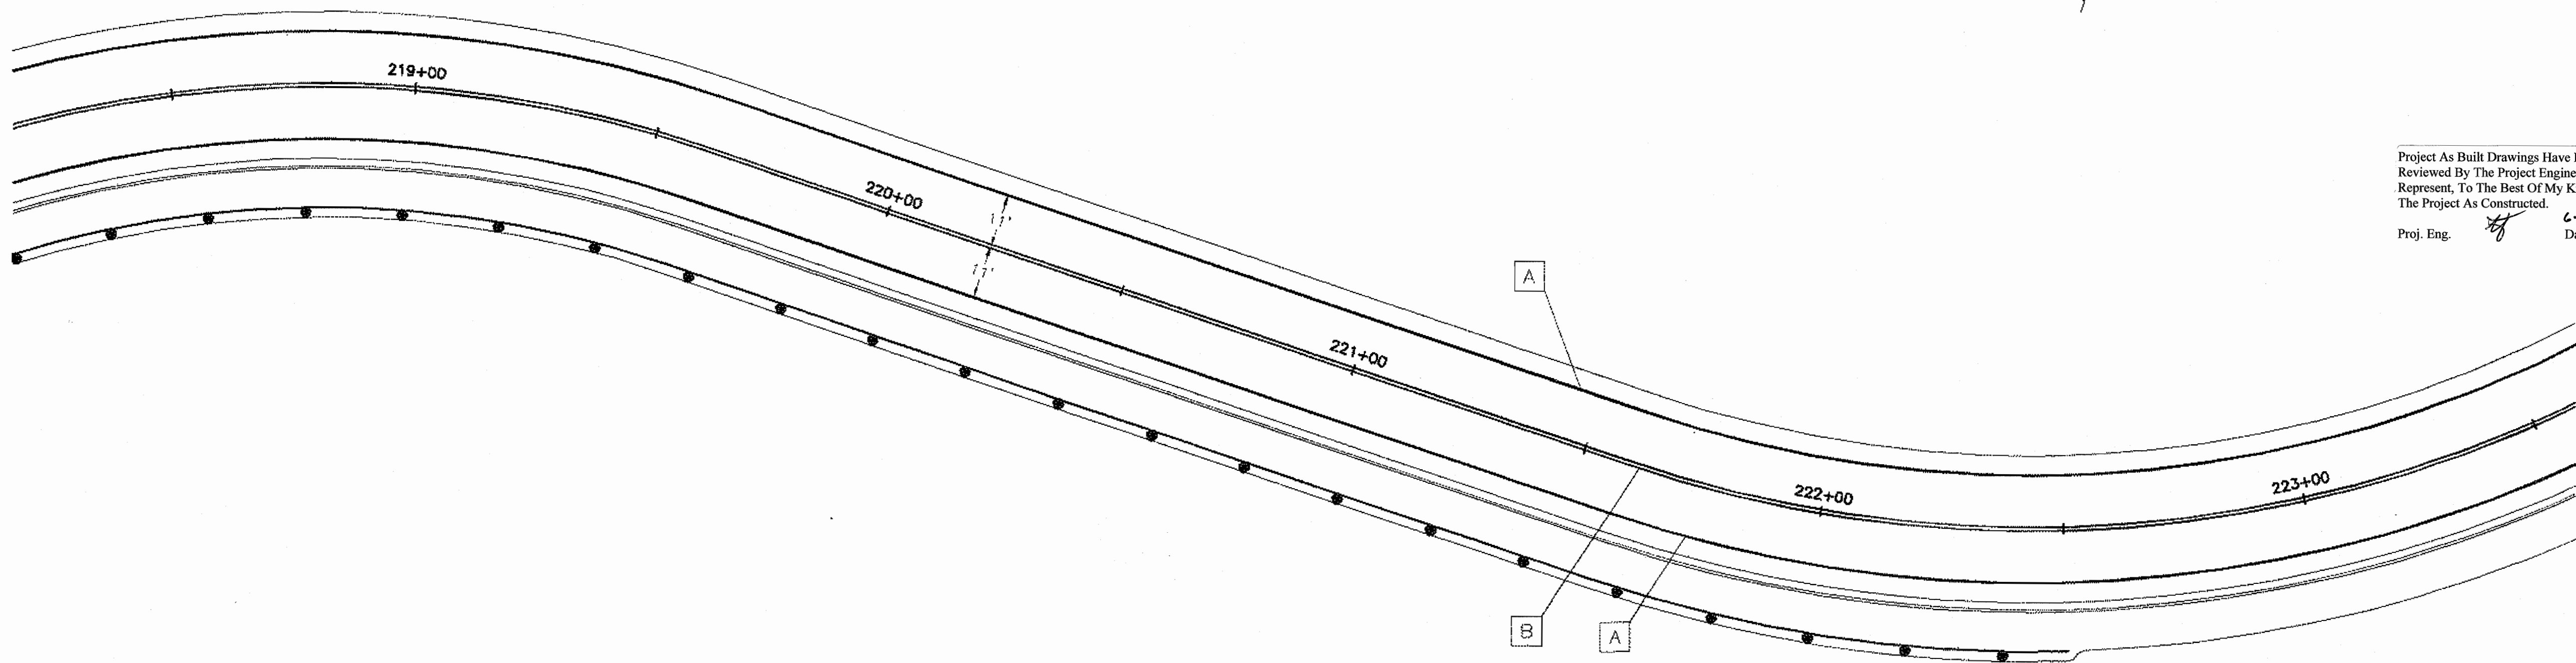

DO NOT SCALE FROM THESE DRAWINGS USE DIMENSIONS

Project As Built Drawings Have Been
Reviewed By The Project Engineer &
Represent, To The Best Of My Knowledge,
The Project As Constructed.
Proj. Eng. *[Signature]* 6-24-15 Date

PATH:
\\JUNIFILE2\JOBS\1153805\DWG\SC\1\SHEETS\S01-S10

TAB: S04

ADDENDUM NUMBER

ATTACHMENT NUMBER

RECORD OF REVISIONS


No.	DATE	DESCRIPTION

SAWMILL CREEK ROAD UPGRADE
PHASE III - WHALE PARK TO SAWMILL CREEK BRIDGE
68216MSG-STP-0933(21)
SITKA TELECOMMUNICATIONS CONDUIT
RSA NO. 69615

SIGNING & STRIPING PLANS & SUMMARIES

PREPARED BY: USKH

CHECKED BY: KM

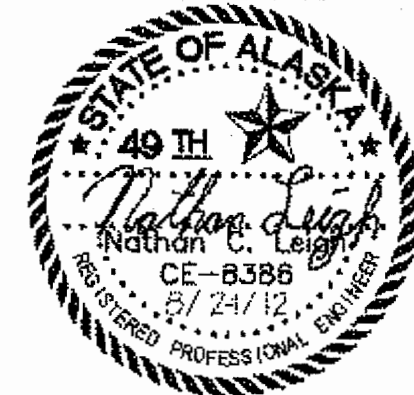

DESIGNED BY: NCL

DRAWN BY: WJP


STATE OF ALASKA
DEPARTMENT OF TRANSPORTATION
& PUBLIC FACILITIES
SOUTHEAST REGION


**SIGNING & STRIPING
PLANS & SUMMARIES**

**STA. 213+50 TO
STA. 223+50**


PROJECT DESIGNATION
68216MSG-STP-0933(21)

STATE	YEAR
ALASKA	2012
SHEET NUMBER	TOTAL SHEETS
S4	109

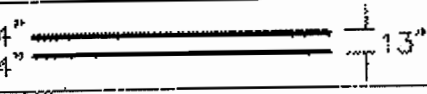
STRIPING TABLE			
SYMBOL	DESCRIPTION	WIDTH	PATTERN
[A]	SOLID WHITE	4"	
[B]	SOLID DOUBLE YELLOW	13"	
[10]	SIGNS PER TABLE SHEET S-11		

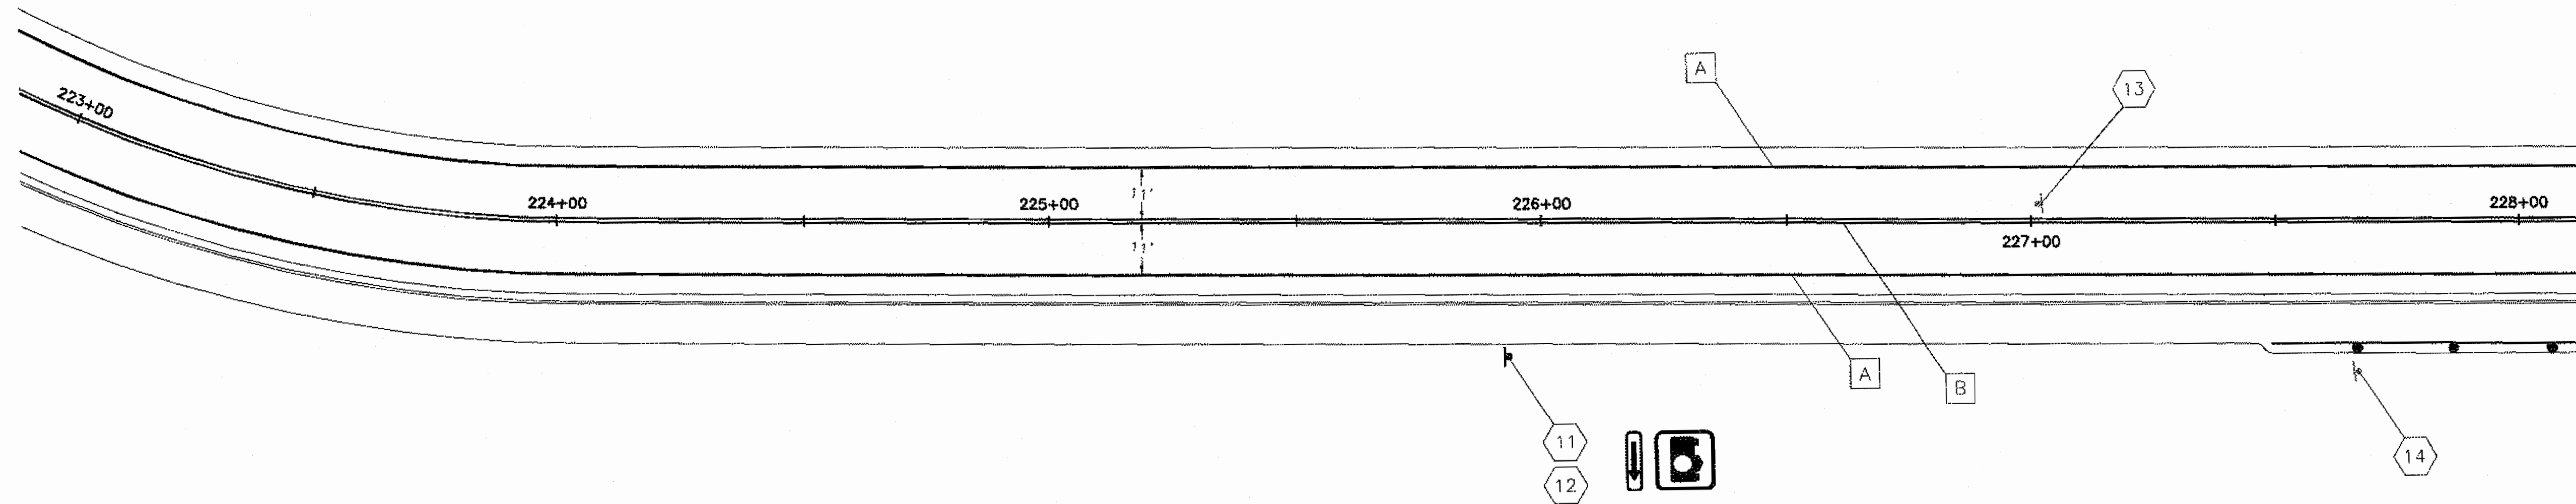


DO NOT SCALE FROM THESE DRAWINGS USE DIMENSIONS

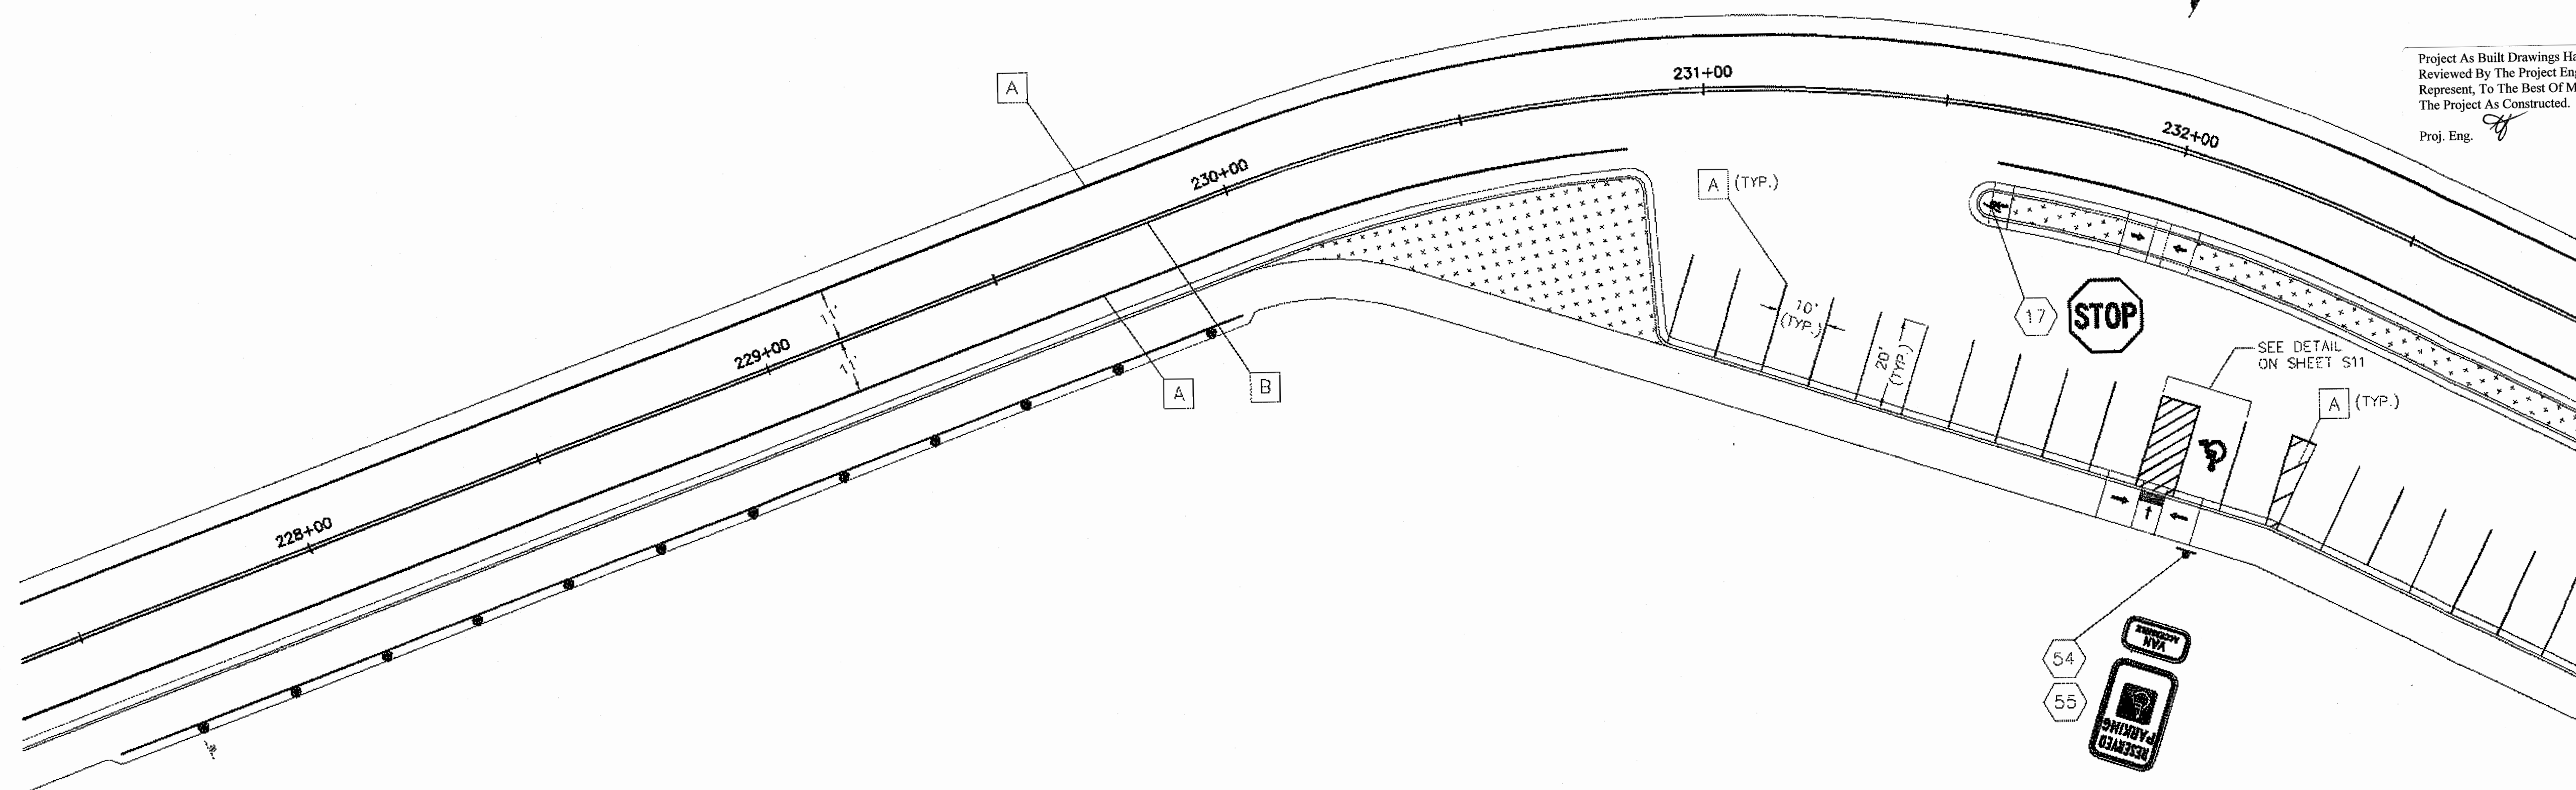


Project As Built Drawings Have Been Reviewed By The Project Engineer & Represent, To The Best Of My Knowledge, The Project As Constructed.
 Proj. Eng. *[Signature]* 6-24-15
 Date

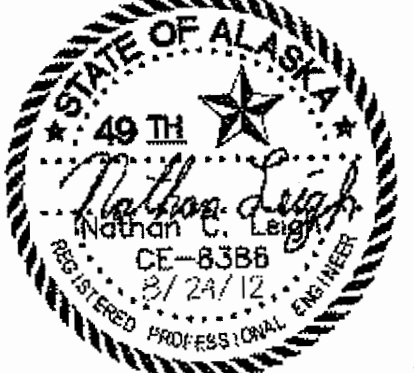PATH: \\JNFILE2\JOBS\1153805\DWG\CS\1153805\S01-S10	
TAB: S05	
ADDENDUM NUMBER	
ATTACHMENT NUMBER	
RECORD OF REVISIONS	
No.	DATE DESCRIPTION
SAWMILL CREEK ROAD UPGRADE PHASE III - WHALE PARK TO SAWMILL CREEK BRIDGE 68216MSG-STP-0933(21) SITKA TELECOMMUNICATIONS CONDUIT RSA NO. 69615	
PREPARED BY: USKH CHECKED BY: KM	
	
DESIGNED BY: NCL DRAWN BY: WJP STATE OF ALASKA DEPARTMENT OF TRANSPORTATION & PUBLIC FACILITIES SOUTHEAST REGION	
SIGNING & STRIPING PLANS & SUMMARIES STA. 223+50 TO STA. 232+50	
PROJECT DESIGNATION	
68216\MSG-STP-0933(21)	
STATE	YEAR
ALASKA	2012
SHEET NUMBER	TOTAL SHEETS
S5	109

SIGNING & STRIPING PLANS & SUMMARIES

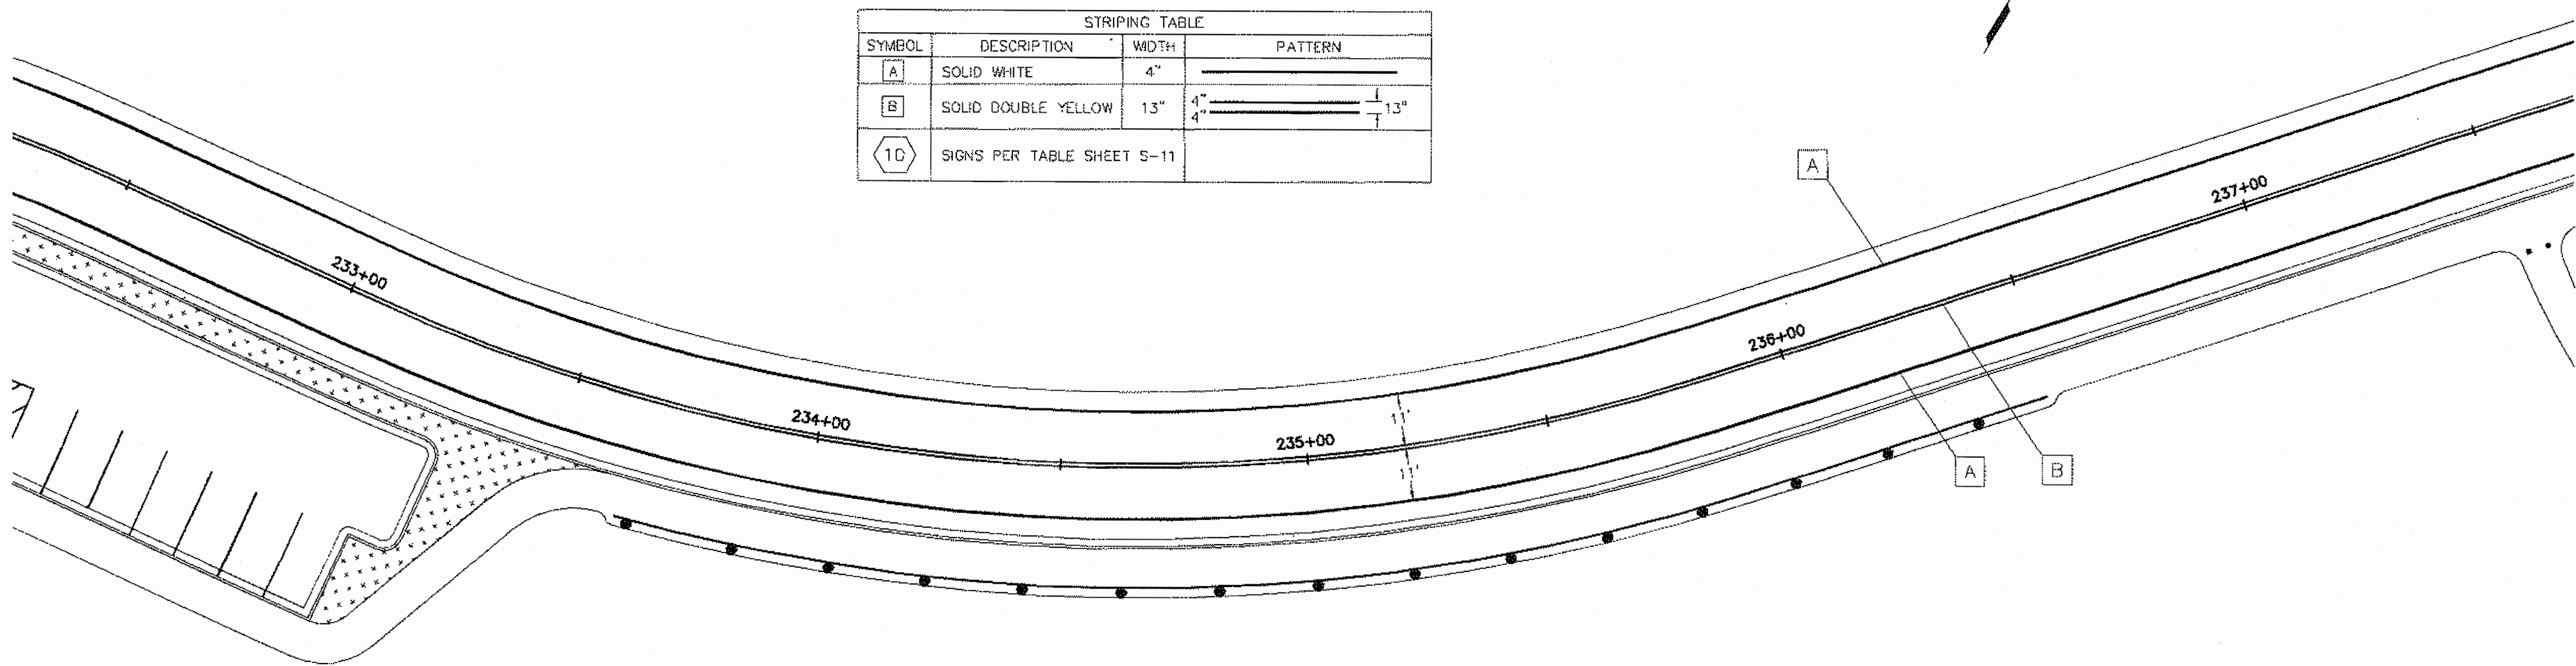

STRIPING TABLE			
SYMBOL	DESCRIPTION	WIDTH	PATTERN
A	SOLID WHITE	4"	
B	SOLID DOUBLE YELLOW	13"	
10	SIGNS PER TABLE SHEET S-11		

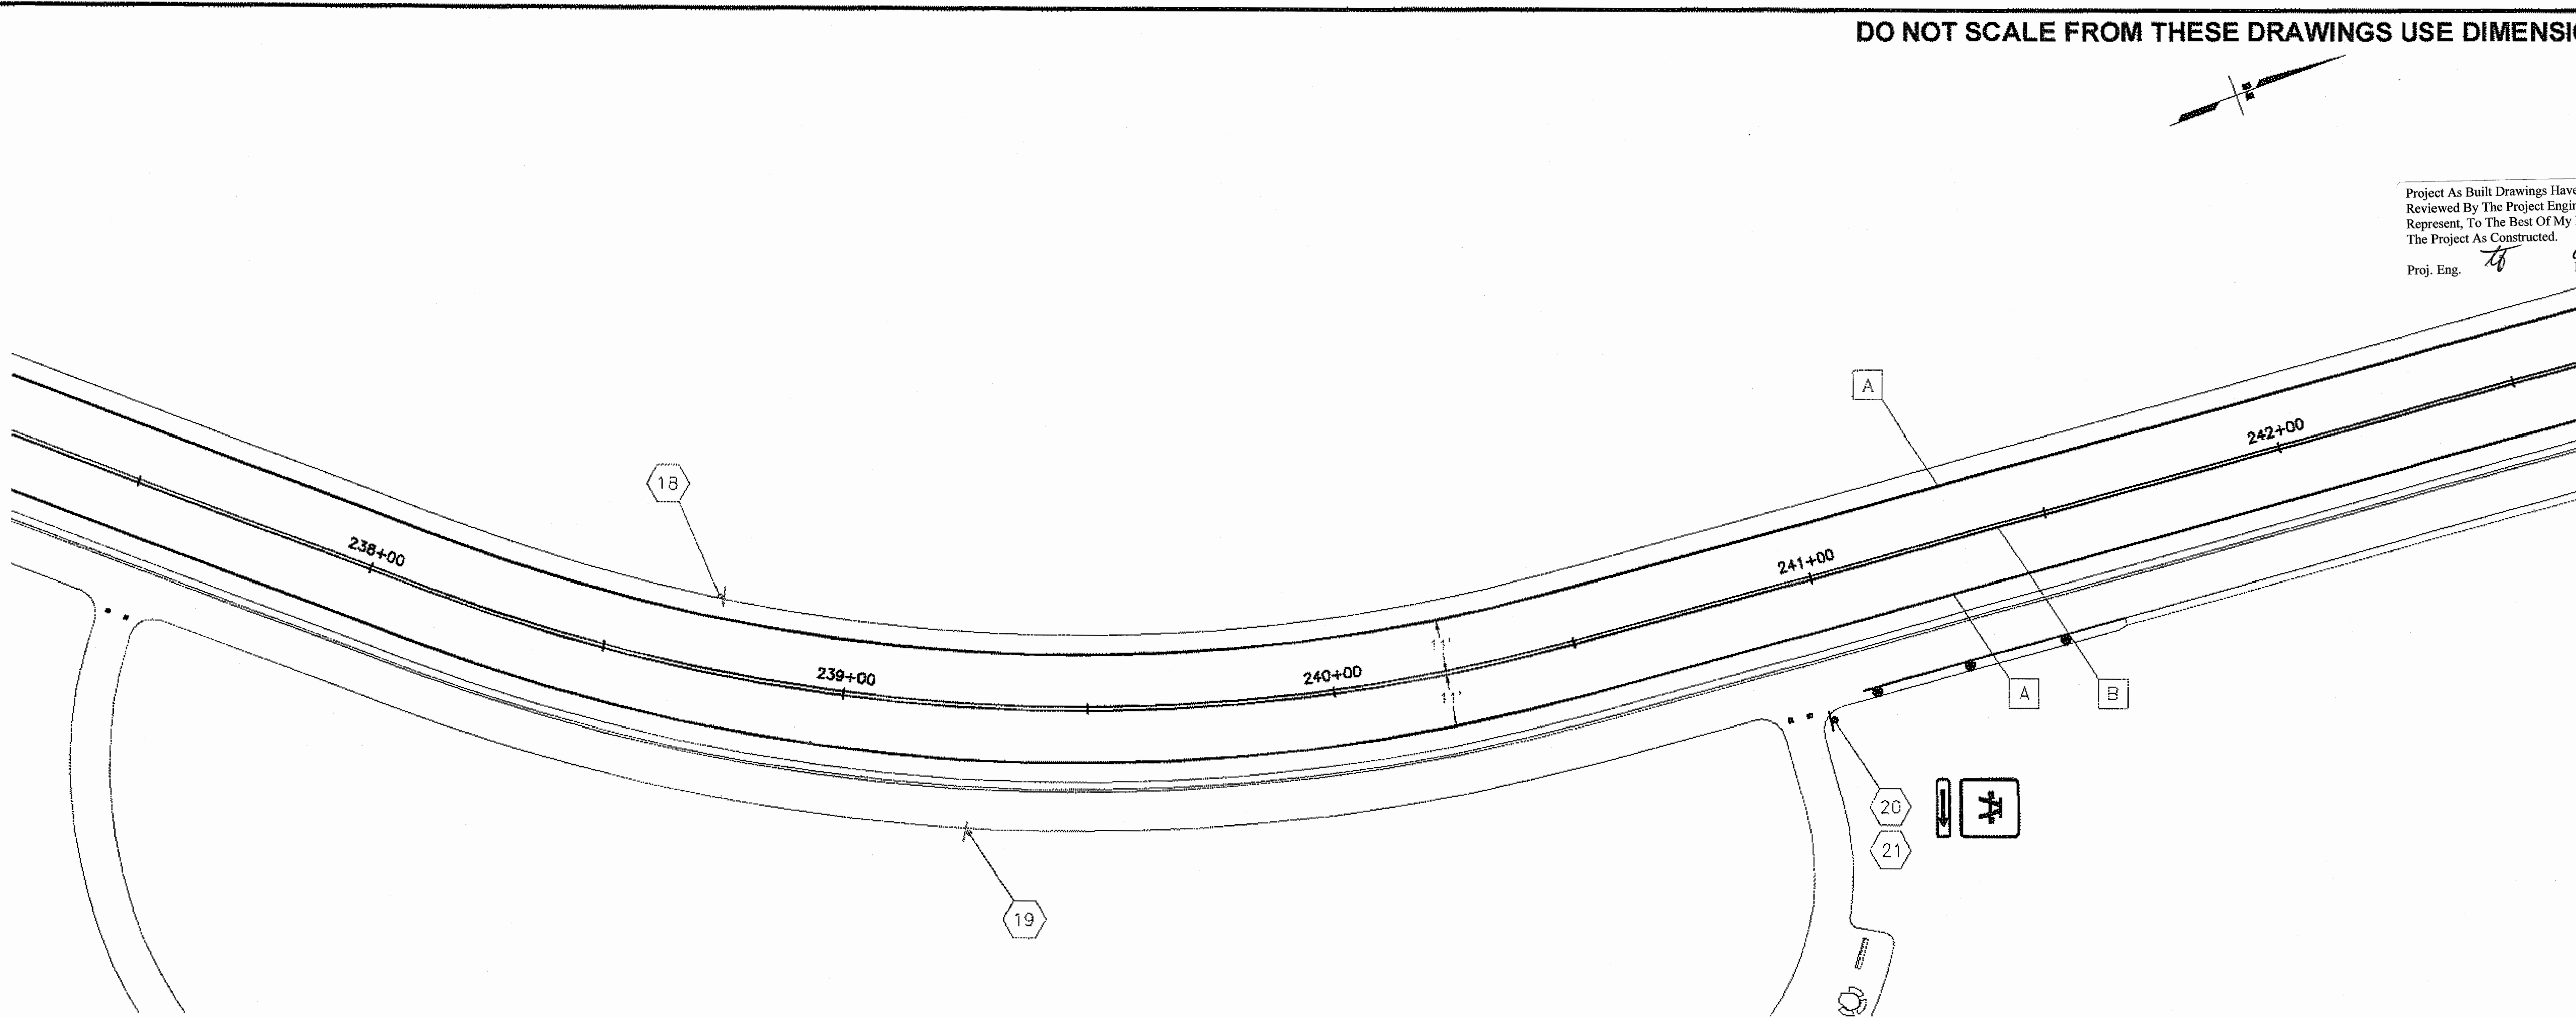

DO NOT SCALE FROM THESE DRAWINGS USE DIMENSIONS

Project As Built Drawings Have Been Reviewed By The Project Engineer & Represent, To The Best Of My Knowledge, The Project As Constructed.
 Proj. Eng. *[Signature]* Date 6-24-15

PATH: \\UNFILE\Z\JOBS\1153805\DWG\SIG\SHEETS\S01-S10		
TAB: S06		
ADDENDUM NUMBER		
ATTACHMENT NUMBER		
RECORD OF REVISIONS		
No.	DATE	DESCRIPTION

SAWMILL CREEK ROAD UPGRADE
 PHASE III - WHALE PARK TO SAWMILL CREEK BRIDGE
 68216MSG-STP-0933(21)
 SITKA TELECOMMUNICATIONS CONDUIT
 RSA NO. 69615

PREPARED BY: USKH
 CHECKED BY: KM

DESIGNED BY: NCL
 DRAWN BY: WJP


STATE OF ALASKA
 DEPARTMENT OF TRANSPORTATION
 & PUBLIC FACILITIES
 SOUTHEAST REGION


SIGNING & STRIPING PLANS & SUMMARIES

STA. 232+50 TO
 STA. 242+50


PROJECT DESIGNATION
 68216MSG-STP-0933(21)

STATE	YEAR
ALASKA	2012
SHEET NUMBER	TOTAL SHEETS
S6	109

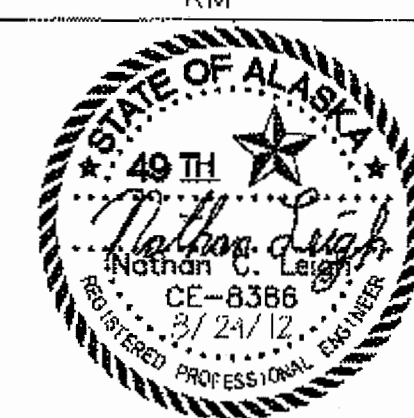

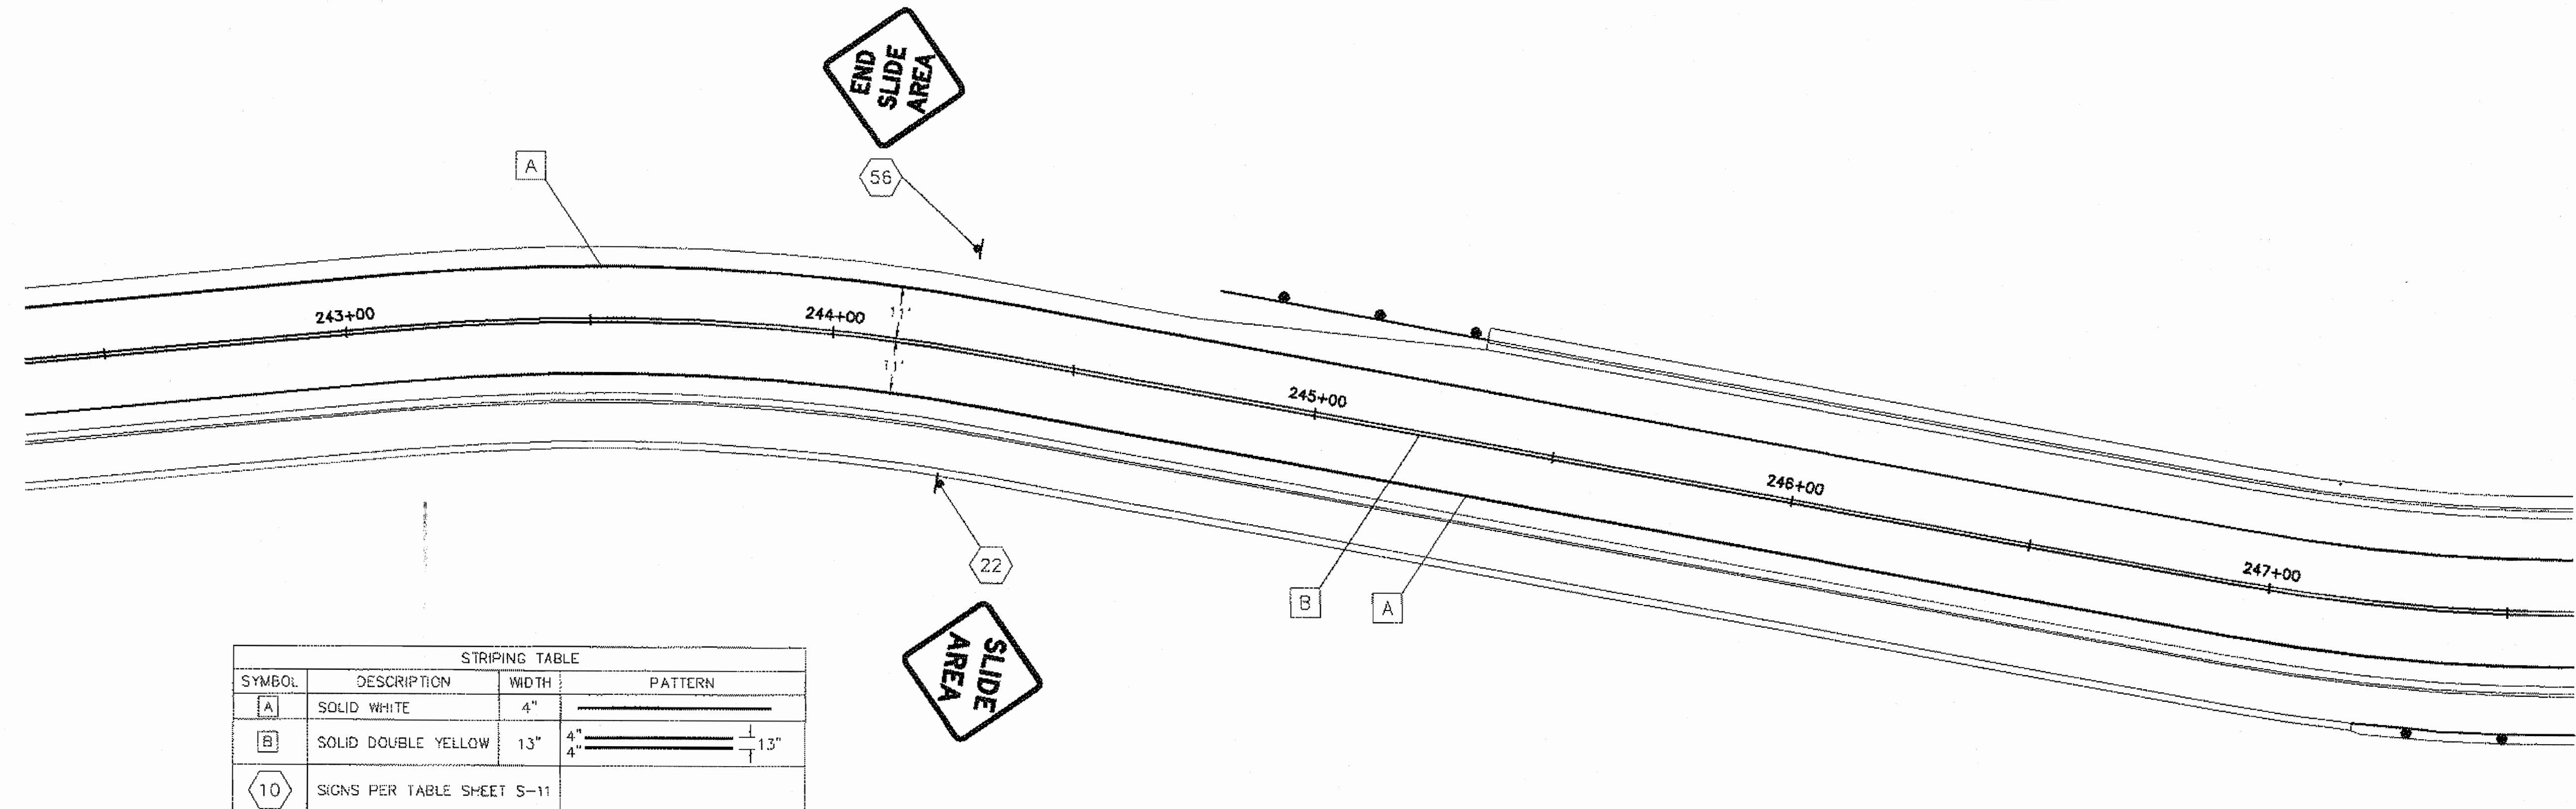

STRIPING TABLE			
SYMBOL	DESCRIPTION	WIDTH	PATTERN
[A]	SOLID WHITE	4"	
[B]	SOLID DOUBLE YELLOW	13"	
[10]	SIGNS PER TABLE SHEET S-11		

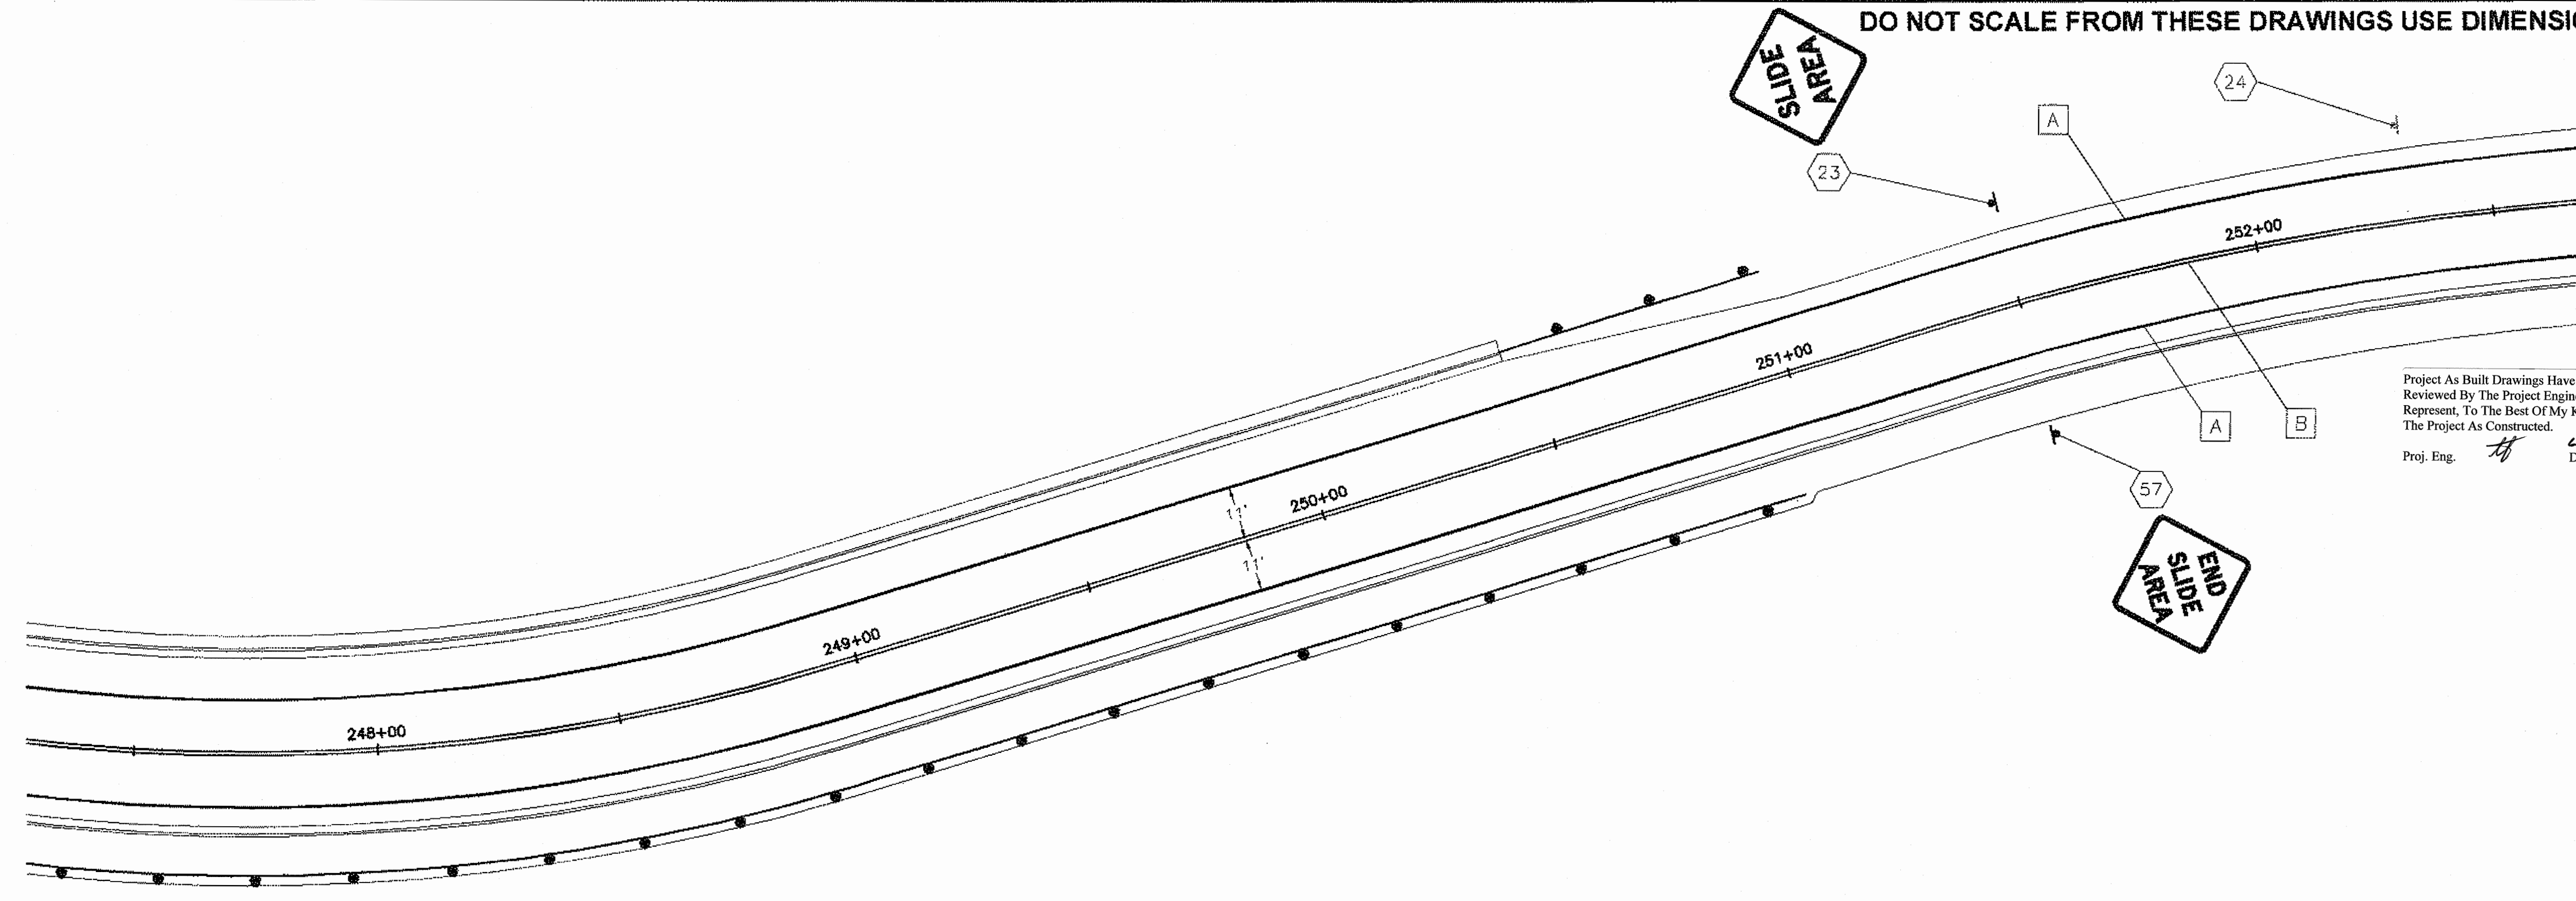

Project As Built Drawings Have Been Reviewed By The Project Engineer & Represent, To The Best Of My Knowledge, The Project As Constructed.
 Proj. Eng. *[Signature]* 2-24-15 Date

PATH:
 I:\UNFILE2\JOBS\1153805\DWG\SIG\SHEETS\S01-S10

TAB: S07

ADDENDUM NUMBER

ATTACHMENT NUMBER

RECORD OF REVISIONS

No.	DATE	DESCRIPTION

SAWMILL CREEK ROAD UPGRADE
 PHASE III - WHALE PARK TO SAWMILL CREEK BRIDGE
 68216MSG-STP-0933(21)
 SITKA TELECOMMUNICATIONS CONDUIT
 RSA NO. 69615

SIGNING & STRIPING PLANS & SUMMARIES

PREPARED BY: USKH

CHECKED BY: KM

DESIGNED BY: NCL

DRAWN BY: WJP

STATE OF ALASKA
 DEPARTMENT OF TRANSPORTATION
 & PUBLIC FACILITIES
 SOUTHEAST REGION

SIGNING & STRIPING
 PLANS & SUMMARIES

STA. 242+50 TO
 STA. 252+50

PROJECT DESIGNATION
 68216MSG-STP-0933(21)

STATE	YEAR
ALASKA	2012

SHEET NUMBER	TOTAL SHEETS
S7	109

No.	DATE	DESCRIPTION

SAWMILL CREEK ROAD UPGRADE
PHASE III - WHALE PARK TO SAWMILL CREEK BRIDGE
68216\MSG-STP-0933(21)
SITKA TELECOMMUNICATIONS CONDUIT
RSA NO. 68615

SIGNING & STRIPING PLANS & SUMMARIES


Project As Built Drawings Have Been
Reviewed By The Project Engineer &
Represent, To The Best Of My Knowledge,
The Project As Constructed.
Proj. Eng. *[Signature]* Date 6-29-15

STRIPING TABLE			
SYMBOL	DESCRIPTION	WIDTH	PATTERN
[A]	SOLID WHITE	4"	
[B]	SOLID DOUBLE YELLOW	13"	
[10]	SIGNS PER TABLE SHEET S-11		

DO NOT SCALE FROM THESE DRAWINGS USE DIMENSIONS

PREPARED BY: USKH

CHECKED BY: KM

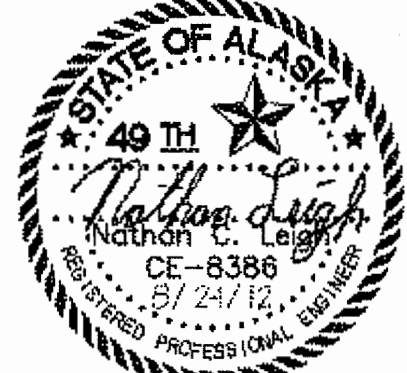

DESIGNED BY: NCL

DRAWN BY: WJP

STATE OF ALASKA
DEPARTMENT OF TRANSPORTATION
& PUBLIC FACILITIES
SOUTHEAST REGION


SIGNING & STRIPING
PLANS & SUMMARIES

STA. 252+50 TO
STA. 262+50


PROJECT DESIGNATION

68216\MSG-STP-0933(21)

STATE	YEAR
ALASKA	2012
SHEET NUMBER	TOTAL SHEETS
S8	109

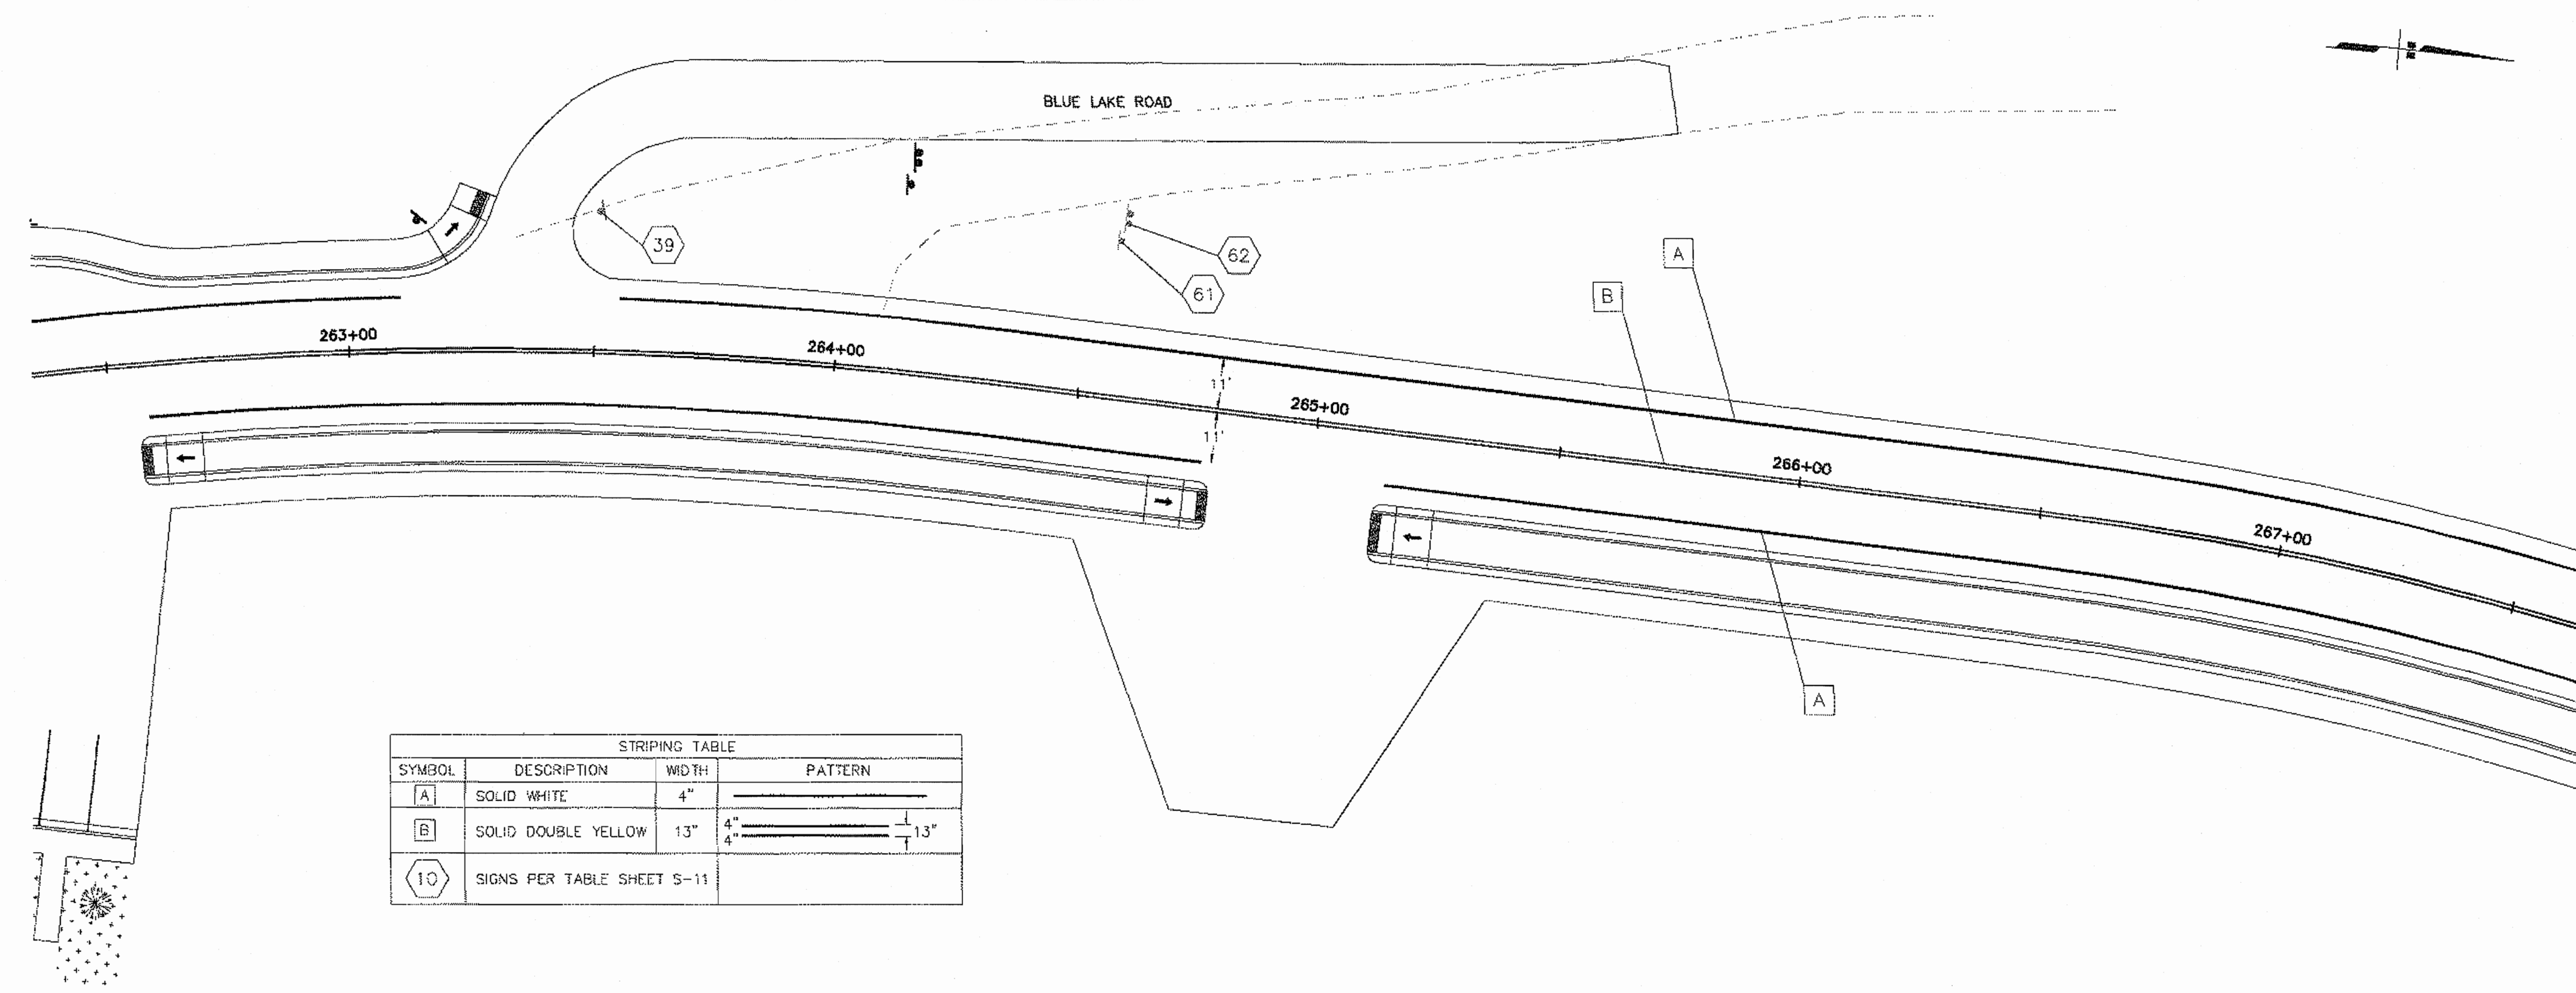

STRIPING TABLE			
SYMBOL	DESCRIPTION	WIDTH	PATTERN
[A]	SOLID WHITE	4"	
[B]	SOLID DOUBLE YELLOW	13"	
[10]	SIGNS PER TABLE SHEET S-11		

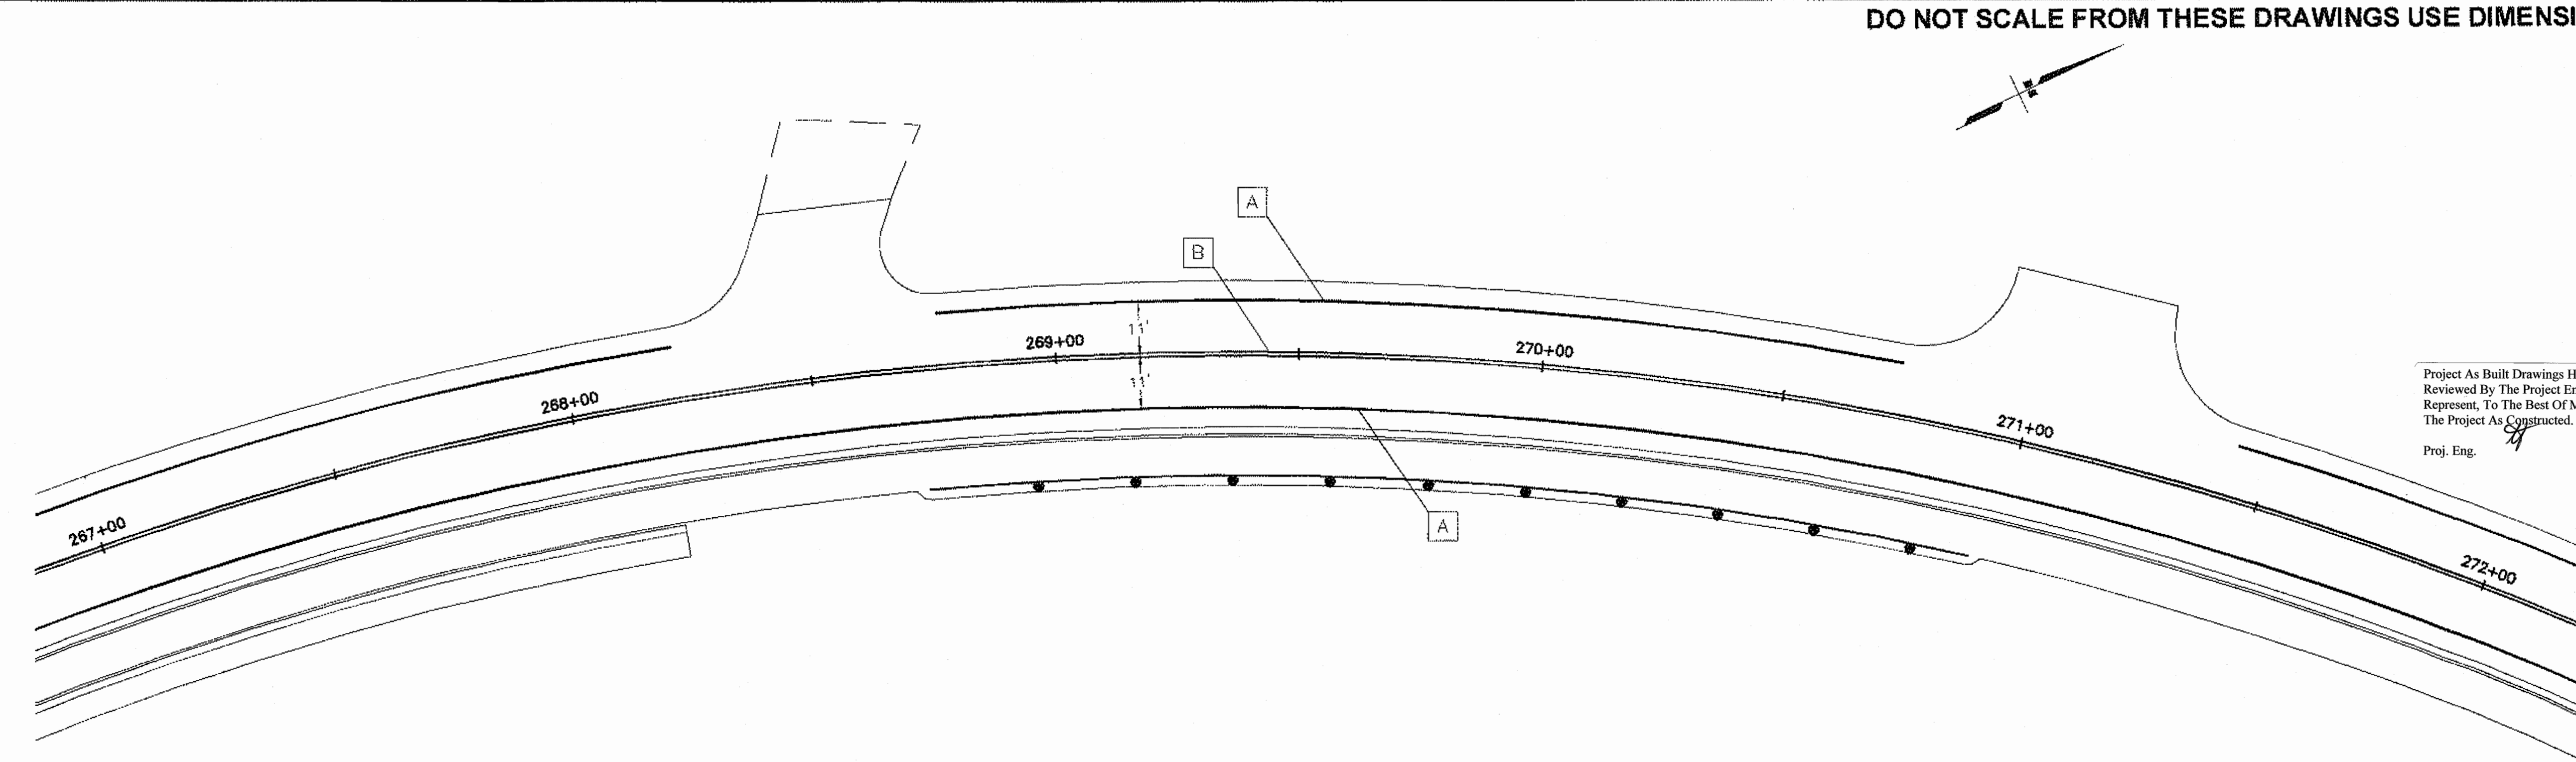

DO NOT SCALE FROM THESE DRAWINGS USE DIMENSIONS

Project As Built Drawings Have Been Reviewed By The Project Engineer & Represent, To The Best Of My Knowledge, The Project As Constructed.
 Proj. Eng. *[Signature]* Date 6-24-15

PATH:
W:\N\FILE2\JOBS\1153805\DWGS\CS\SHEETS\S01-S10

TAB: S09

ADDENDUM NUMBER

ATTACHMENT NUMBER

RECORD OF REVISIONS

No.	DATE	DESCRIPTION

SAWMILL CREEK ROAD UPGRADE
 PHASE III - WHALE PARK TO SAWMILL CREEK BRIDGE
 68216\MSG-STP-0933(21)
 SITKA TELECOMMUNICATIONS CONDUIT
 RSA NO. 69615

SIGNING & STRIPING PLANS & SUMMARIES

PREPARED BY: USKH

CHECKED BY: KM

DESIGNED BY: NCL

DRAWN BY: WJP

STATE OF ALASKA
 DEPARTMENT OF TRANSPORTATION
 & PUBLIC FACILITIES
 SOUTHEAST REGION


**SIGNING & STRIPING
 PLANS & SUMMARIES**

**STA. 262+50 TO
 STA. 272+00**


PROJECT DESIGNATION
68216\MSG-STP-0933(21)

STATE	YEAR
ALASKA	2012

SHEET NUMBER	TOTAL SHEETS
S9	109

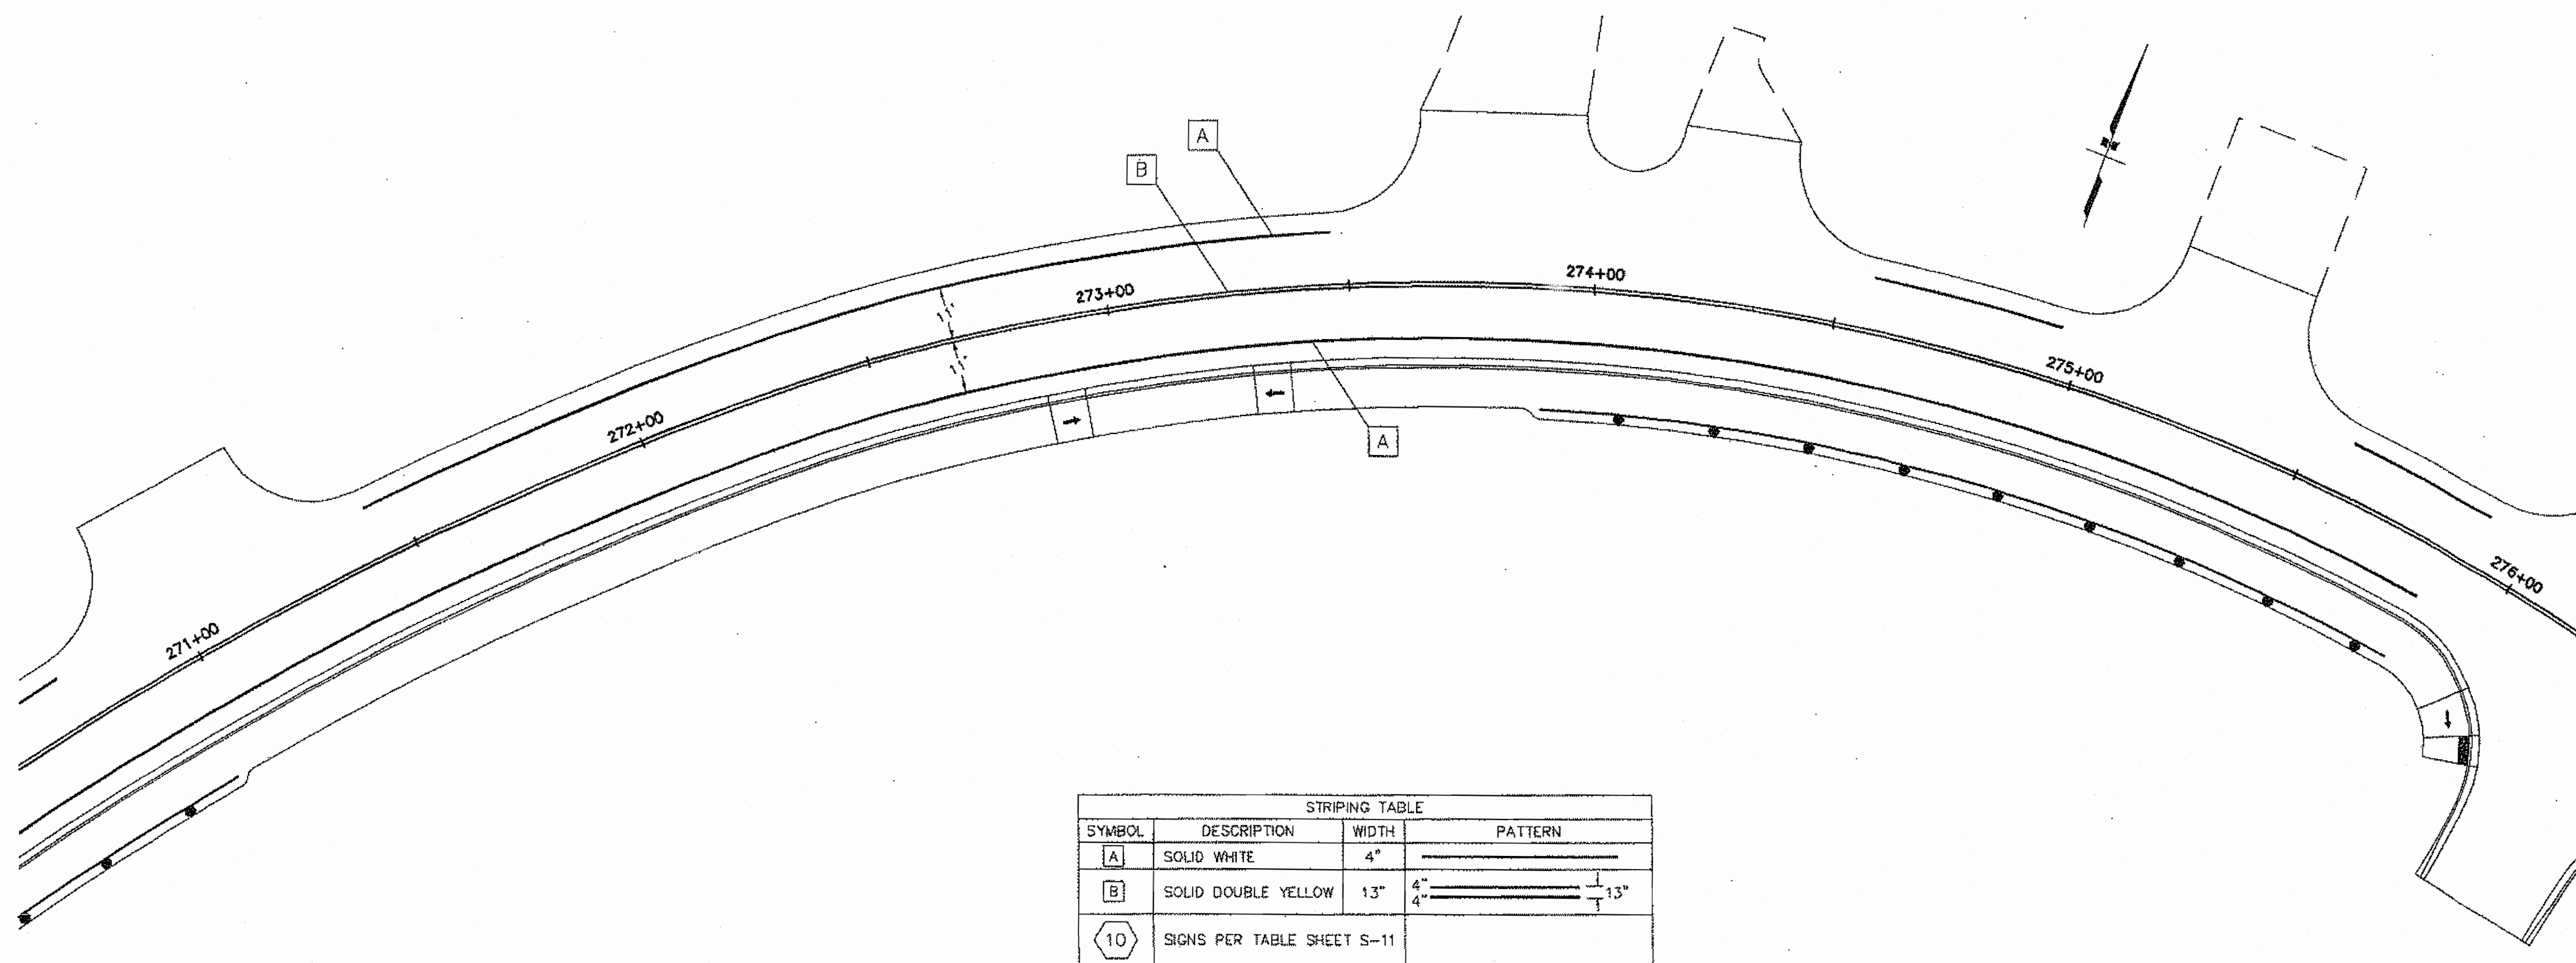

STRIPING TABLE			
SYMBOL	DESCRIPTION	WIDTH	PATTERN
[A]	SOLID WHITE	4"	
[B]	SOLID DOUBLE YELLOW	13"	
[10]	SIGNS PER TABLE SHEET S-11		

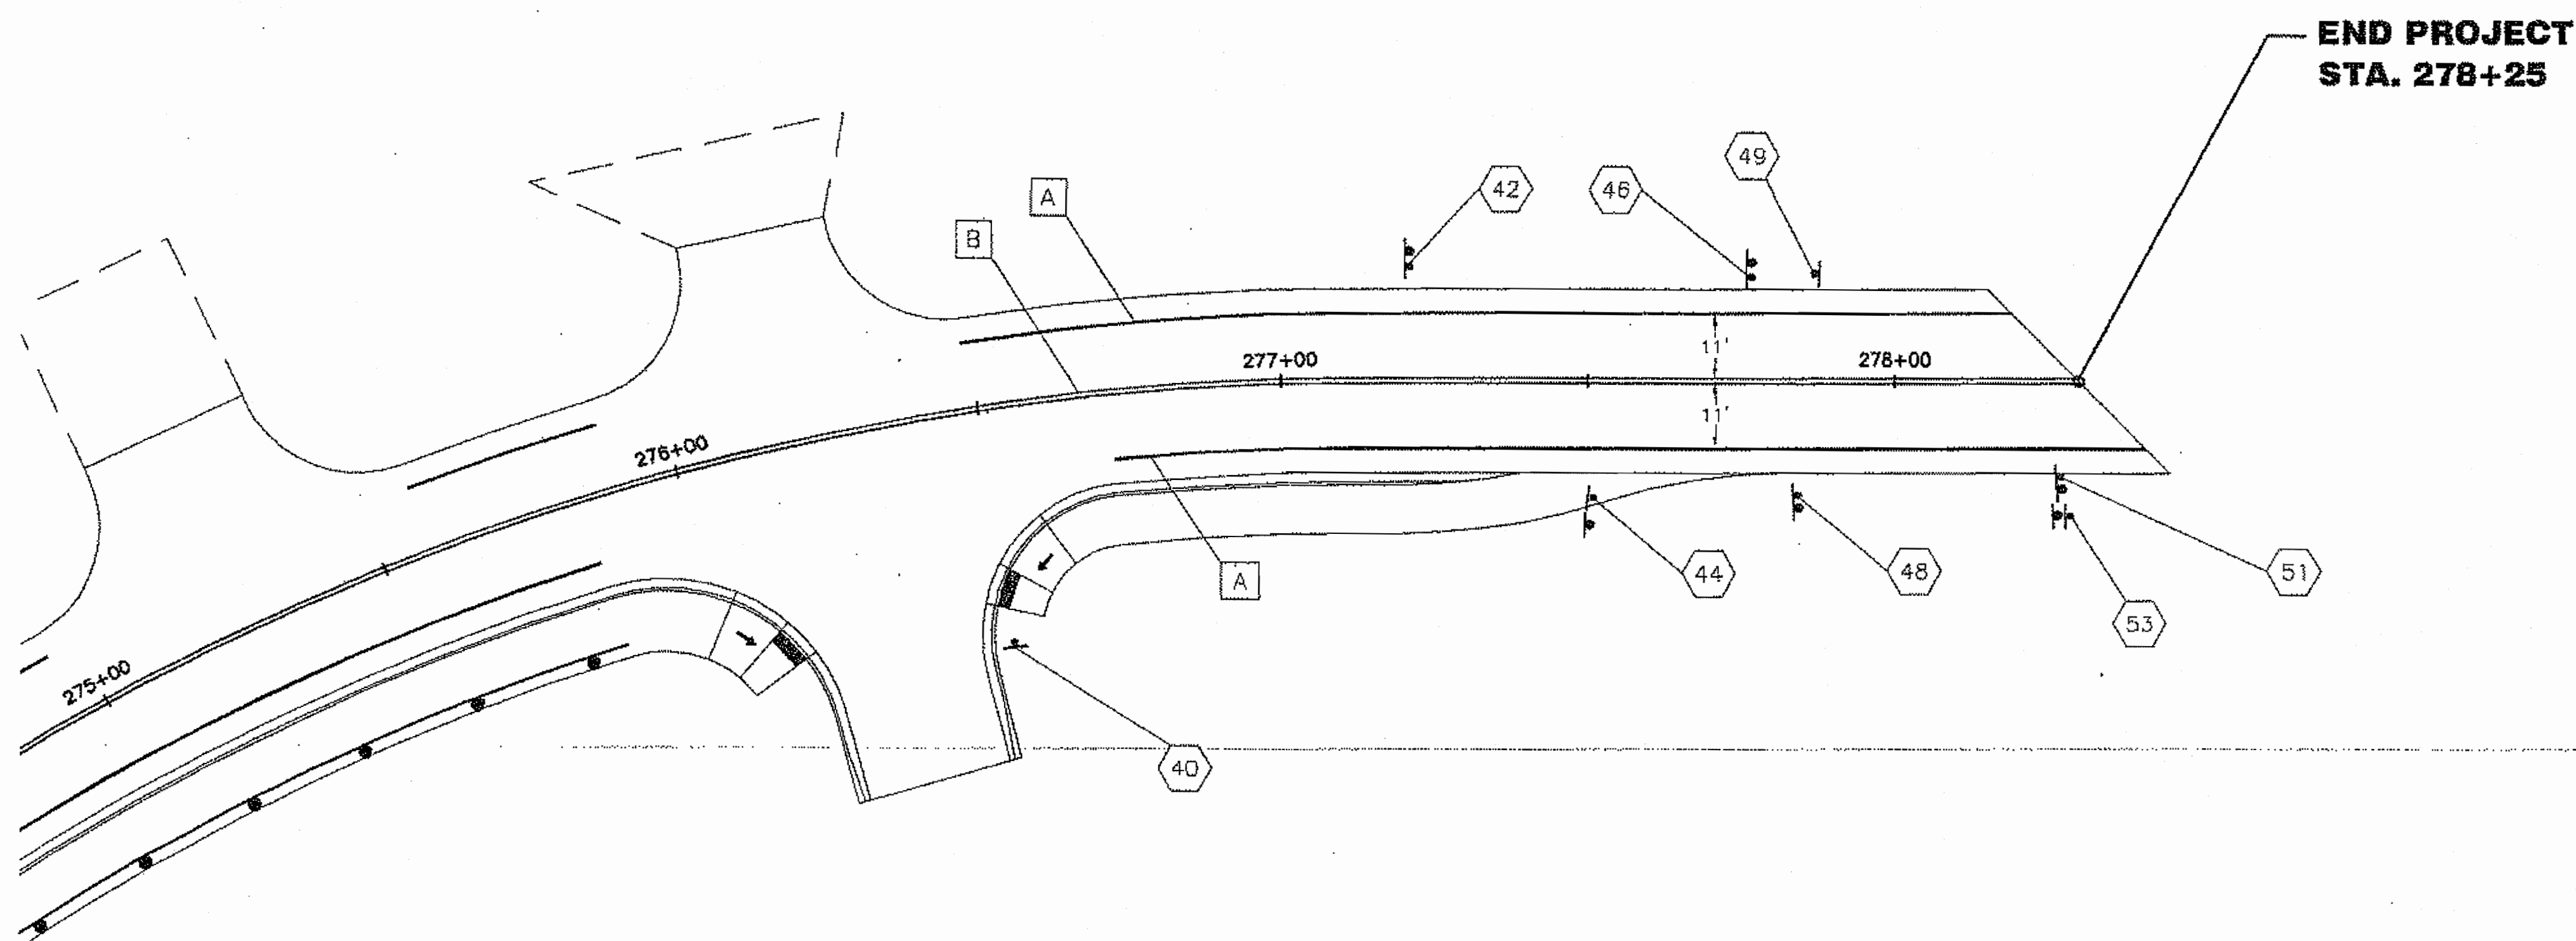

DO NOT SCALE FROM THESE DRAWINGS USE DIMENSIONS

END PROJECT
STA. 278+25


Project As Built Drawings Have Been
Reviewed By The Project Engineer &
Represent, To The Best Of My Knowledge,
The Project As Constructed.
Proj. Eng. *[Signature]* 6-24-15 Date

PATH: \\NUNUFILEZ\JOBS\1153805\DWGS\CISHEETS\S01-S10 Friday, August 17, 2012 7:22:31 PM TAB: S10		
ADDENDUM NUMBER		
ATTACHMENT NUMBER		
RECORD OF REVISIONS		
No.	DATE	DESCRIPTION
SAWMILL CREEK ROAD UPGRADE PHASE III - WHALE PARK TO SAWMILL CREEK BRIDGE 68216\MSG-STP-0933(21) SITKA TELECOMMUNICATIONS CONDUIT RSA NO. 69615		
SIGNING & STRIPING PLANS & SUMMARIES		
PREPARED BY: USKH		
CHECKED BY: KM		
DESIGNED BY: NCL		
DRAWN BY: WJP		
STATE OF ALASKA DEPARTMENT OF TRANSPORTATION & PUBLIC FACILITIES SOUTHEAST REGION		
SIGNING & STRIPING PLANS & SUMMARIES		
STA. 272+00 TO EOP		
PROJECT DESIGNATION		
68216\MSG-STP-0933(21)		
STATE	YEAR	
ALASKA	2012	
SHEET NUMBER	TOTAL SHEETS	
S10	109	


SIGN SUMMARY													
SIGN NO.	STATION	OFFSET		CODE NO. ASSDS	LEGEND	SIZE (INCHES)		AREA SQ. FT 615(1)	RELOCATE 615(2)	SALVAGE 615(6)	SIGN FACES (SEE NOTE 1)	POST TYPE	REMARKS
		LT	RT			W	H						
1	185+41		X	EXISTING	STOP				X		NB		RELOCATE 3' BEHIND CURB
2	185+39		X	EXISTING	WHALE PARK				X		NB		RELOCATE BEHIND SW
3	186+00	X		EXISTING	WHALE PARK				X		WB		RELOCATE AS NEEDED
4	188+58	X		EXISTING	ADOPT A HIGHWAY				X		WB		RELOCATE AS NEEDED
5	188+46		X	EXISTING	ADOPT A HIGHWAY					X	EB		
6	189+28		X	EXISTING	WINDING ROAD				X		EB		RELOCATE AS NEEDED
7	189+26		X	EXISTING	25 M.P.H.					X	EB		REMOVE FROM POST
8	189+26		X	W7-3A	NEXT 1 MILE	28	18	3.50			EB		REPLACE EXISTING W13-1 WITH W13-1A
9	206+12	X		EXISTING	WINDING ROAD					X	WB		
10	214+25		X	EXISTING	WINDING ROAD					X	EB		
11	225+93		X	D9-102	CAMERA SYMBOL	24	24	4.00			EB	2 1/2" PST	
12	225+93		X	D9-301	ARROW PLAQUE	24	6	1.00			EB		
13	227+01	X		EXISTING	WINDING ROAD					X	WB		
14	227+67		X	EXISTING	WINDING ROAD					X	EB		
													NOT USED
													NOT USED
17	231+63		X	R1-1	STOP	30	30	6.25			NB	2 1/2" PST	
18	238+71	X		EXISTING	WINDING ROAD					X	WB		
19	239+27		X	EXISTING	SPEED LIMIT 35					X	EB		
20	240+97		X	D7-RM-120	PICNIC SYMBOL	24	24	4.00			EB	2 1/2" PST	
21	240+97		X	D9-301	ARROW PLAQUE	24	6	1.00			EB		
22	246+45		X	W16-100	SLIDE AREA	36	36	9.00			EB	2 1/2" PST	ATTACH POLE TO BACK OF RETAINING WALL
23	251+05	X		W16-100	SLIDE AREA	36	36	9.00			WB	2 1/2" PST	
24	252+32	X		EXISTING	SLIDE AREA					X	WB		
25	253+76		X	R1-1	STOP	30	30	6.25			NB	2 1/2" PST	
26	254+36	X		EXISTING	SPEED LIMIT 35					X	WB		
27	254+41	X		R2-1	SPEED LIMIT 35	30	36	7.50			WB	2 1/2" PST	
28	254+66		X	EXISTING	SPEED LIMIT 25					X	EB		
29	254+66		X	R2-1	SPEED LIMIT 25	30	36	7.50			EB	2 1/2" PST	
30	257+58	X		R7P-101L	NO PARKING ANY TIME <---	12	18	1.50			NB	2 1/2" PST	
31	258+55		X	R1-1	STOP	30	30	6.25			NB	2 1/2" PST	
32	258+72		X	D7-2	SAWMILL CREEK CAMPGROUND	155	36	38.75			EB	2 3/4" TS	2 POSTS, SEE DETAIL ON SHEET S11
33	259+01	X		EXISTING	FINE FOR LITTERING \$1000					X	WB		
34	259+05	X		R16-106	FINE FOR LITTERING \$1000	42	42	12.25			WB	4"x6" W	(MAY SUBSTITUTE 3" TS)
35	260+41	X		EXISTING	NO PARKING ON PAVEMENT...					X	WB		
35	261+67		X	R7-8	ADA RESERVED PARKING	12	18	1.50			SB	2 1/2" PST	BEHIND SIDEWALK AT ADA PARKING SPACE
36	261+85		X	R7-8	ADA RESERVED PARKING	12	18	1.50			SB	2 1/2" PST	BEHIND SIDEWALK AT ADA PARKING SPACE
37	261+85		X	R7-8A	VAN ACCESSIBLE	12	6	0.50			EB		BENEATH #36
38	262+38	X		R7P-101R	NO PARKING ANY TIME ---->	12	18	1.50			NB	2 1/2" PST	
39	263+51	X		EXISTING	STOP				X		WB		RELOCATE TO STA. 263+14, BEHIND SIDEWALK
40	276+50		X	EXISTING	STOP				X		NB		RELOCATE AS NEEDED
42	277+21	X		EXISTING	OBJECT MARKER				X		EB		RELOCATE AS NEEDED
44	277+51		X	EXISTING	PAVEMENT ENDS				X		EB		RELOCATE AS NEEDED
46	277+77	X		EXISTING	OBJECT MARKER				X		EB		RELOCATE AS NEEDED
48	277+84		X	EXISTING	OBJECT MARKER				X		EB		RELOCATE AS NEEDED
49	277+87	X		EXISTING	ADOPT A HIGHWAY					X	WB		
51	278+27		X	EXISTING	OBJECT MARKER				X		EB		RELOCATE AS NEEDED
53	278+28		X	EXISTING	SAWMILL CREEK				X		EB		RELOCATE AS NEEDED
54	232+32	X		R7-8	ADA RESERVED PARKING	12	18	1.50			SB	2 1/2" PST	BEHIND SIDEWALK AT ADA PARKING SPACE
55	232+32		X	R7-8A	VAN ACCESSIBLE	12	6	0.50			EB		BENEATH #54
56	244+26	X		W16-101	END SLIDE AREA	36	36	9.00			WB	2 1/2" PST	
57	251+50		X	W16-102	END SLIDE AREA	36	36	9.00			EB	3 1/2" PST	
58	261+50		X	R7-8	ADA RESERVED PARKING	12	18	1.50			SB	4 1/2" PST	
59	185+41		X	EXISTING	ONE WAY				X		EB		BENEATH #1
60	185+41		X	EXISTING	ONE WAY				X		WB		BENEATH #1
61	264+55		X	EXISTING	RECREATIONAL SIGN				X		EB	2 1/2" PST	RELOCATE TO STA. 264+12, 3' FROM EDGE OF ROAD
62	264+56		X	EXISTING	RECREATIONAL SIGNS				X		EB		RELOCATE TO STA. 264+13, 3' FROM EDGE OF ROAD

SIGNING NOTES:

- FOR THE PURPOSE OF THIS TABLE, SAWMILL CREEK RD IS CONSIDERED AS RUNNING EAST AND WEST. TRAFFIC TRAVELING TOWARDS DOWNTOWN SITKA IS CONSIDERED WESTBOUND (WB). TRAFFIC TRAVELING TOWARDS BLUE LAKE IS CONSIDERED EASTBOUND (EB). TRAFFIC ENTERING FROM THE LEFT OR RIGHT IS CONSIDERED SOUTHBOUND (SB) OR NORTHBOUND (NB) RESPECTIVELY. SIGN LOCATIONS ARE APPROXIMATE ONLY AND SUBJECT TO MINOR REVISIONS BY THE ENGINEER.
- EXISTING SIGNS SHALL BE SALVAGED OR REMOVED AND DISPOSED OF AS DIRECTED.

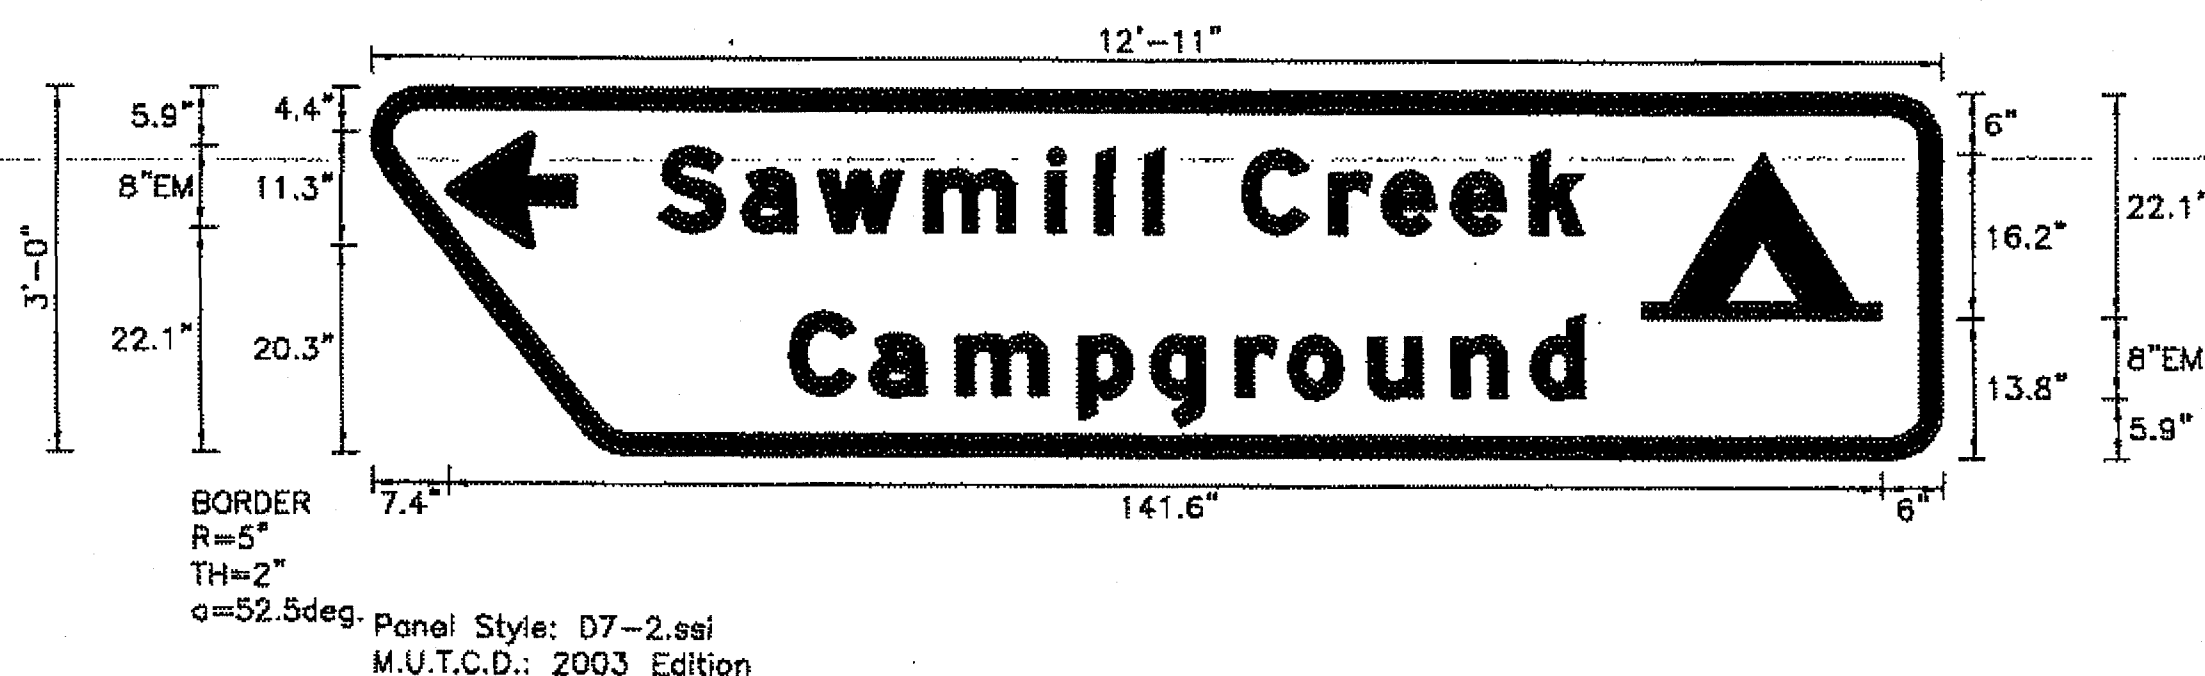


SAWMILL CAMPGROUND SIGN DETAIL

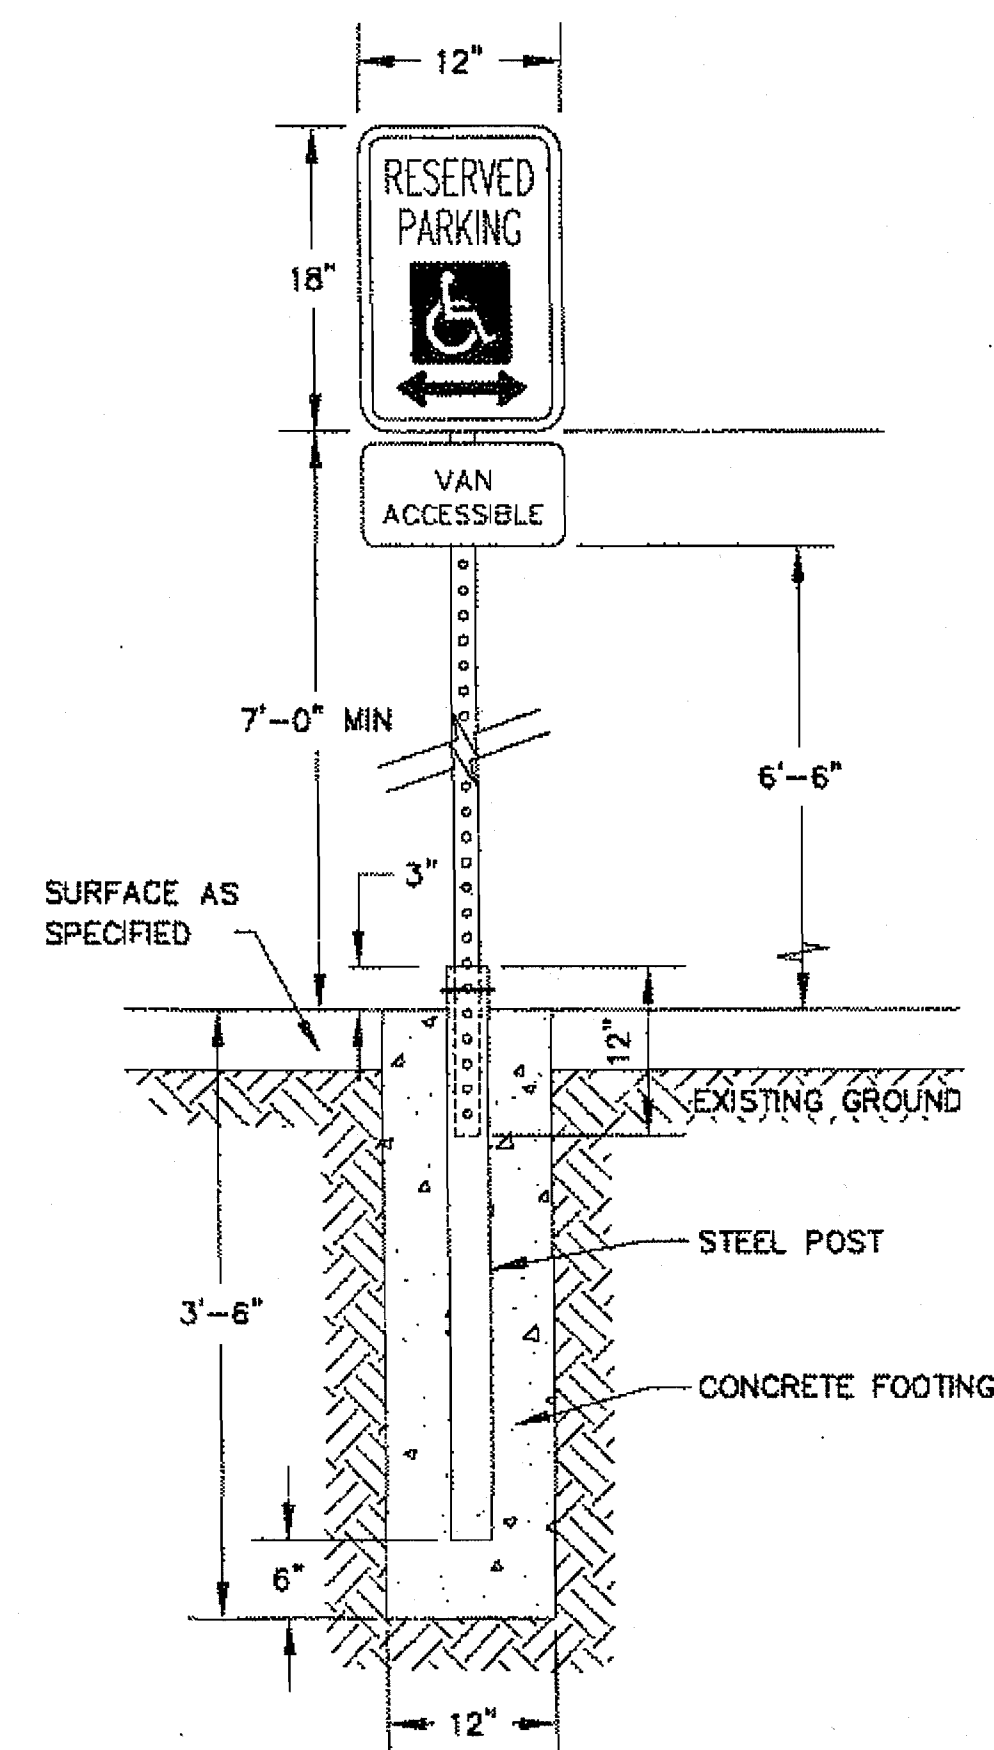

ACCESSIBLE PARKING SIGN DETAIL

NOTES:

- INSTALL SIGN CENTERED AT THE FRONT OF THE 8 FOOT WIDE ACCESS AISLE
- SEE SIGN SUMMARY FOR SPECIFIC SIGNAGE

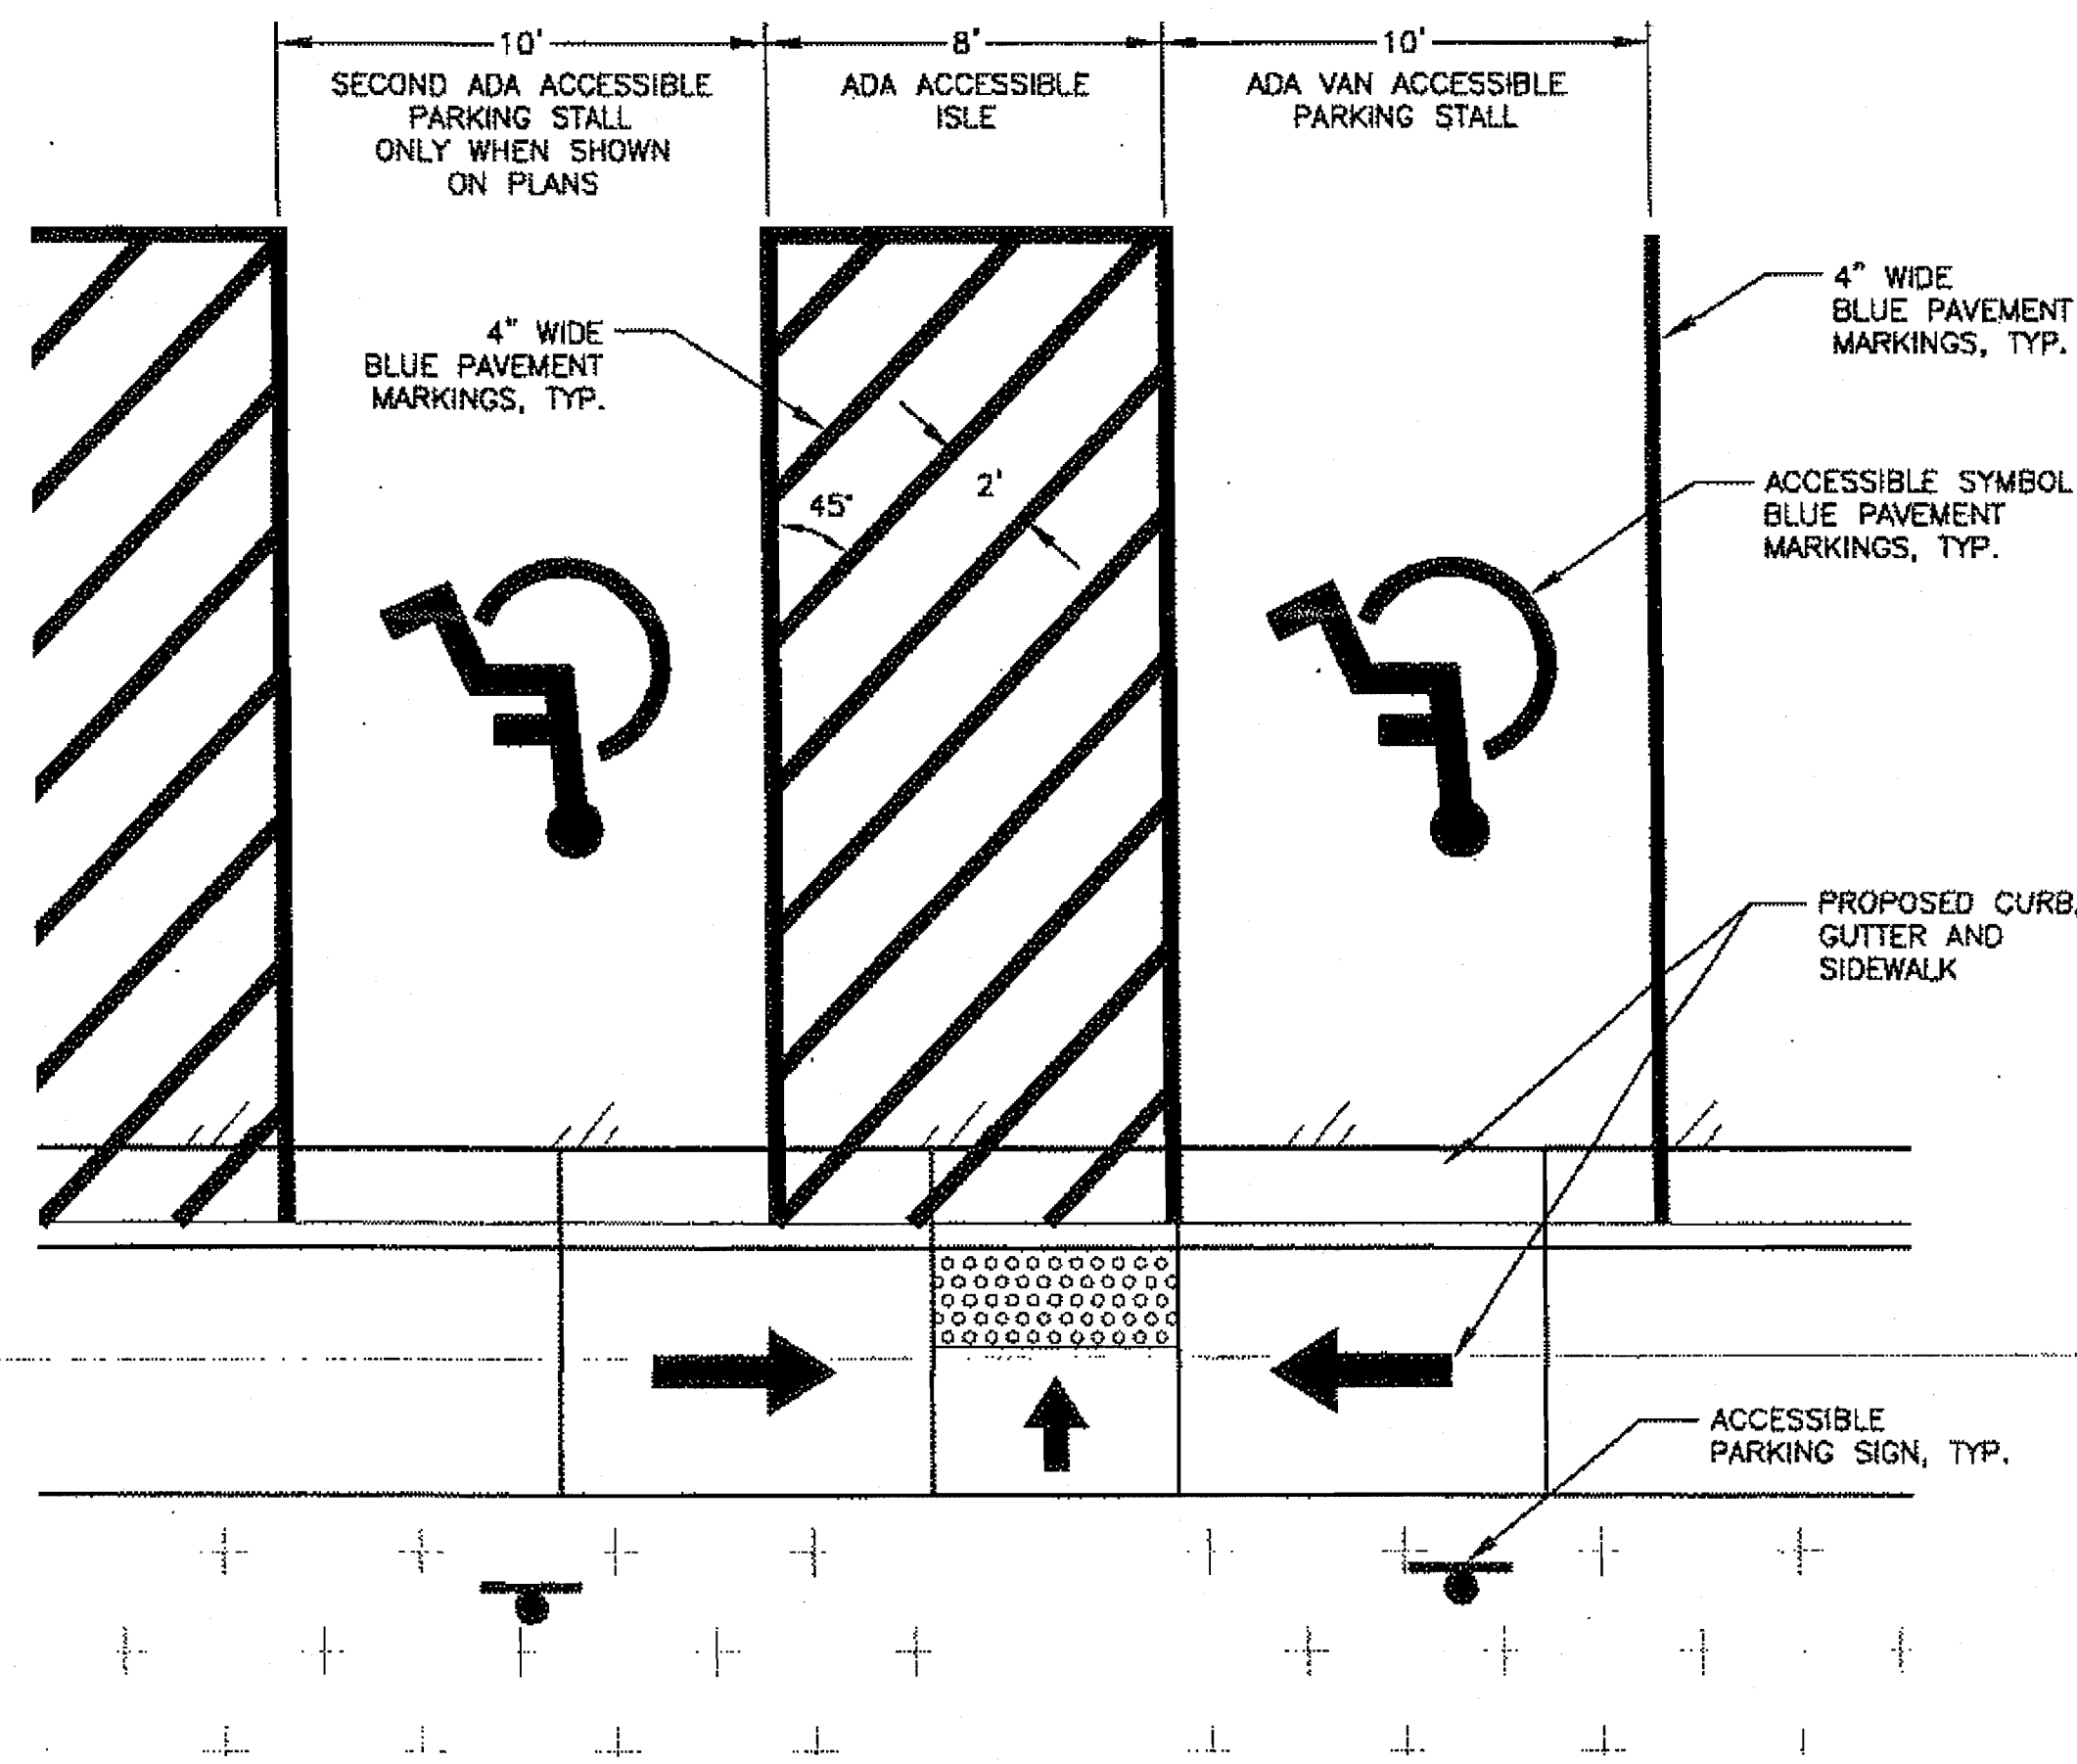

ACCESSIBLE PARKING STALL DETAIL

DO NOT SCALE FROM THESE DRAWINGS USE DIMENSIONS

PATH:
I:\115380\SDWGS\IC\SHEETS\S11.DWG

TAB: S11


ADDENDUM NUMBER		
ATTACHMENT NUMBER		
RECORD OF REVISIONS		
No.	DATE	DESCRIPTION

SAWMILL CREEK ROAD UPGRADE
PHASE III - WHALE PARK TO SAWMILL CREEK BRIDGE
68216MSG-STP-0933(21)
SITKA TELECOMMUNICATIONS CONDUIT
RSA NO. 69615

SIGNING & STRIPING PLANS & SUMMARIES

PREPARED BY: USKH

CHECKED BY: NCL

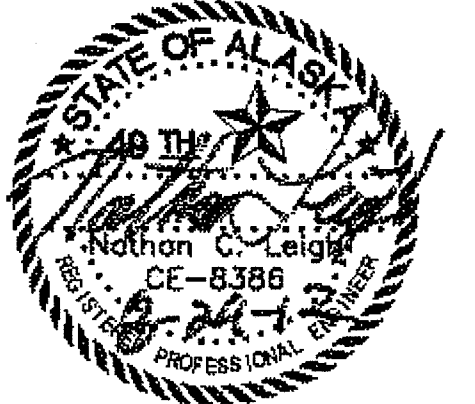

DESIGNED BY: NCL

DRAWN BY: VJJP

STATE OF ALASKA
DEPARTMENT OF TRANSPORTATION
& PUBLIC FACILITIES
SOUTHEAST REGION

SIGNING & STRIPING PLANS & SUMMARIES

PROJECT DESIGNATION	
68216MSG-STP-0933(21)	
STATE	YEAR
ALASKA	2012
SHEET NUMBER	TOTAL SHEETS
S11	109


STATE	PROJECT DESIGNATION	YEAR	DATE	REVISION
ALASKA	08216	2012		

BEGIN BRIDGE
Sta. 279+30.17±
Elev. 29.81±
See Note 1



END BRIDGE
Sta. 280+93.11±
Elev. 27.85±

BRIDGE PROFILE GRADE


No Scale

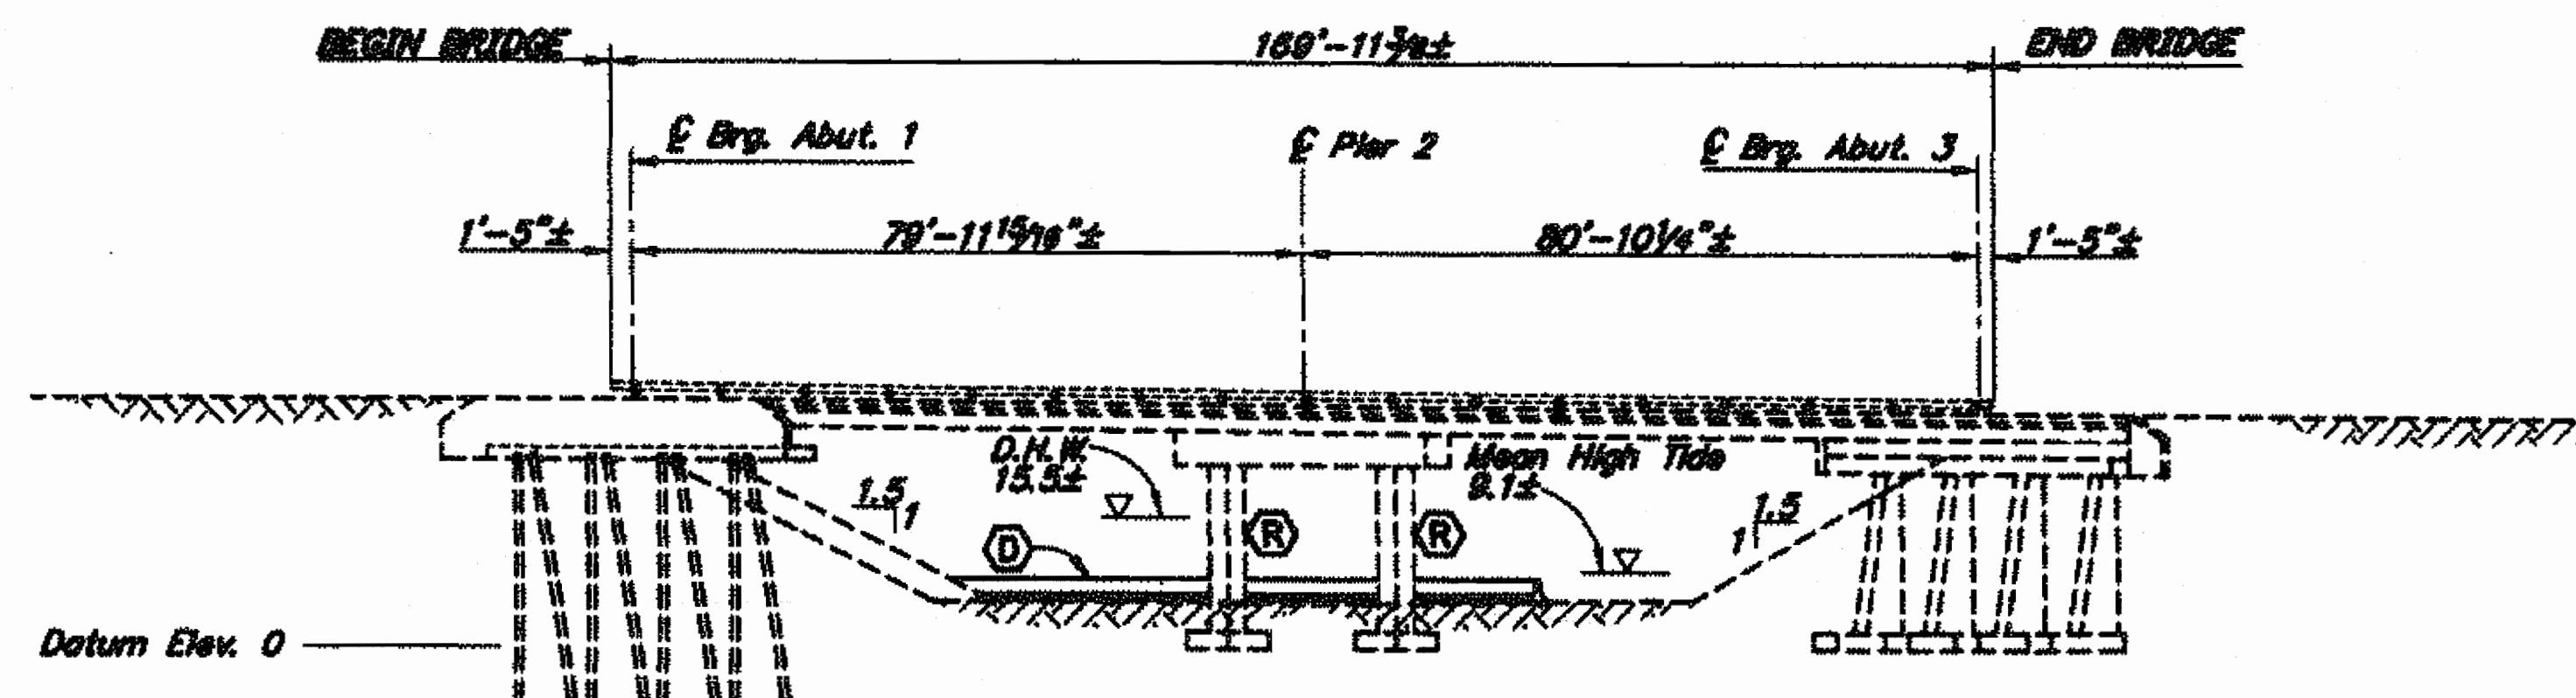

ELEVATION

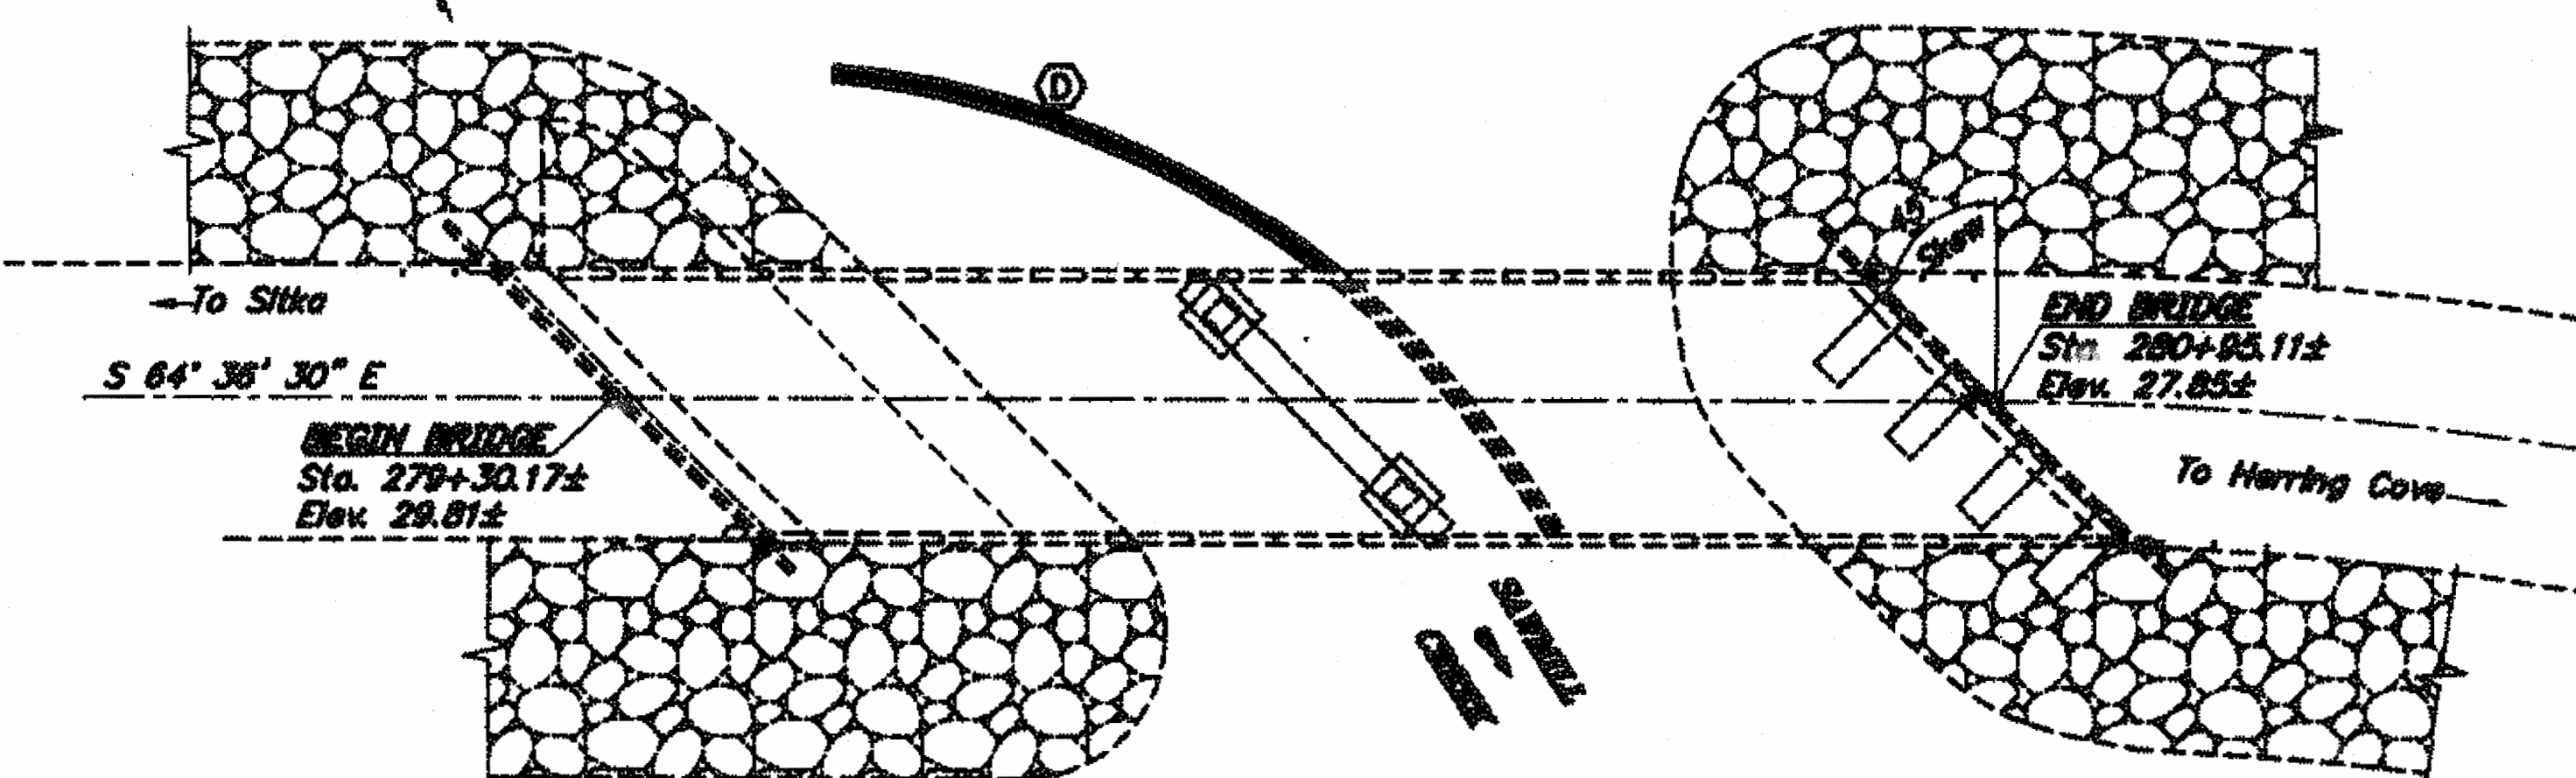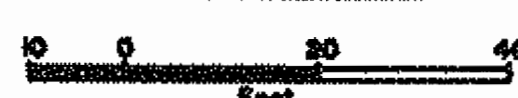

PLAN

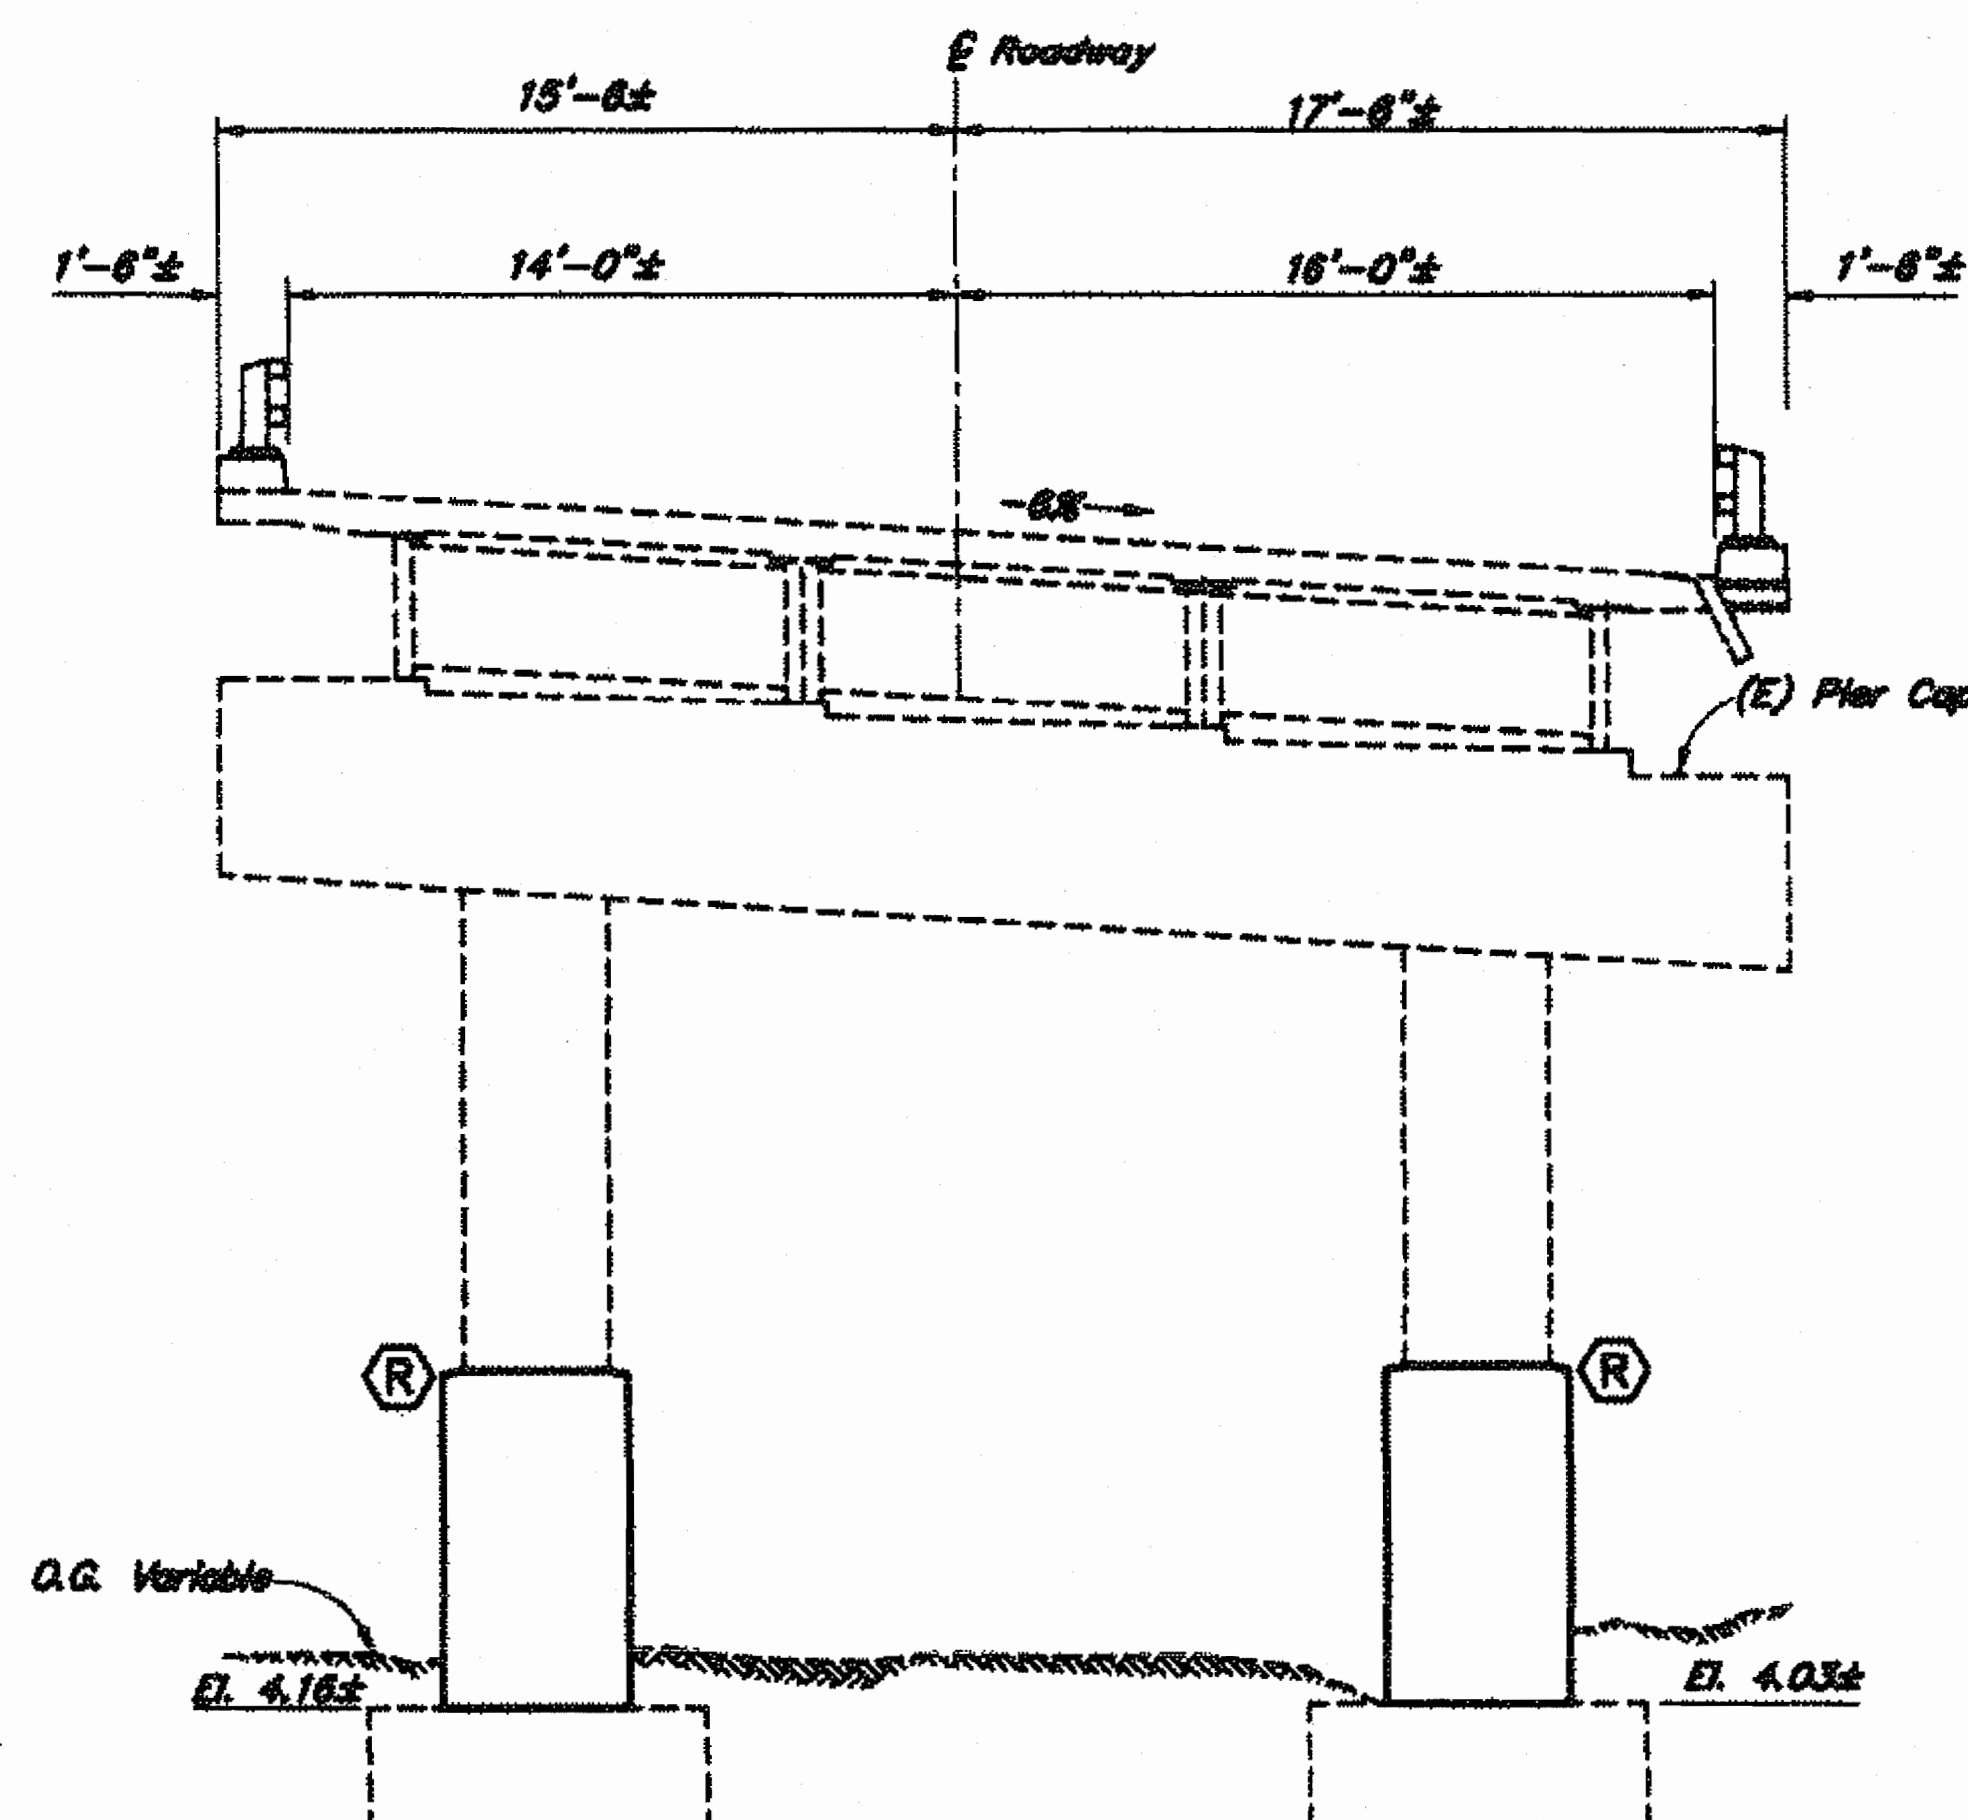

TYPICAL SECTION



BRIDGE BASIS OF ESTIMATE

ITEM NO.	ITEM	PAY UNIT	ESTIMATING UNIT	SUBST.	SUPERST.	TOTAL
203(1)	Excavation for Structures	LS	CY	25.0	-	25.0
501(9)	Drill & Bond Dowels	EA	EA	180	-	180
501(10)	Class R Concrete	LS	CY	3.7	-	3.7
503(2)	Epoxy-Coated Reinforcing Steel	LS	LBS	322	-	322
841(8)	Temporary Creek Diversion	LS	LS	All Req'd	-	All Req'd

Item numbers are for reference only. Quantities shown are not necessarily the pay quantities nor the total quantity of the particular item.

Project As Built Drawings Have Been Reviewed By The Project Engineer & Represent, To The Best Of My Knowledge, The Project As Constructed.

Proj. Eng. *[Signature]* 6-24-15
Date

NOTE

1. Stationing is As-Built stationing & unrelated to project stationing.

LEGEND	
(E)	Temporary Creek Diversion
(R)	Repair Concrete Columns

BRIDGE DRAWING INDEX


TITLE	DWG. NO.
GENERAL LAYOUT	1
PIER REPAIR	2
MISCELLANEOUS DETAILS	3

LEGEND

- (E) = Existing
± = Existing
--- = Existing
--- = Proposed

DESIGNED BY: Keith C. Carlson	CHECKED BY: Leslie Daugherty	LAYOUT BY: Keith C. Carlson	CHECKED BY: Leslie Daugherty
DRAWN BY: G. Anderson	CHECKED BY: Keith C. Carlson	SPECIFICATIONS BY: Keith C. Carlson	P & E COMPARED BY: Keith C. Carlson
QUANTITIES BY: Keith C. Carlson	CHECKED BY: Leslie Daugherty	APPROVAL RECOMMENDED BY: Richard Pratt	

STATE OF ALASKA
DEPARTMENT OF TRANSPORTATION
AND PUBLIC FACILITIES
BRIDGE SECTION

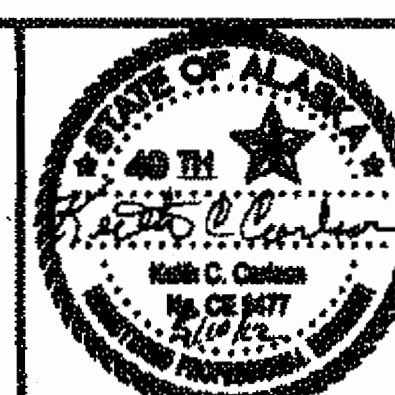

SAWMILL CREEK BRIDGE
PIER COLUMN REPAIRS
SAWMILL CREEK ROAD
GENERAL LAYOUT



BRIDGE NO. 432
DWG. NO. 1

STATE	PROJECT DESIGNATION	YEAR	SHEET NO.	TOTAL SHEETS
ALASKA	68216	2012		

REINFORCING STEEL SCHEDULE				
MARK	SIZE	NO.	LENGTH	TYPE
A301	3	80	1'-7 1/2"	Bent
A302	3	20	8'-6"	Bent
A303	3	16	6'-8 1/2"	-

BENDING DIAGRAM	
A301	A302

a - Epoxy Coat

GENERAL NOTES

- DESIGN:.....AASHTO LRFD Bridge Design Specifications, 4th Edition, 2012, with latest Interim Specifications
- REINFORCEMENT:.....ASTM A708, $F_y = 60,000$ psi
Space reinforcement evenly unless otherwise noted.
- CONCRETE:.....Class R Concrete with AASHTO M43 Gradation No. 7 or No. 8 aggregate, $f_c = 4,000$ psi.
- EXISTING MATERIALS:.....Concrete: $f_c = 3,300 \pm$ psi
Max. Aggregate Size: $1 1/2 \pm$ "
Reinforcing: $f_y = 40,000 \pm$ psi
Min. Cover: $2 \pm$ "


NOTES:

1. Remove loose and deteriorated concrete. Roughen sound concrete to $1/8$ " minimum amplitude. Remove existing concrete to provide a gradually varied repair depth. Avoid large repair depth changes over short distance.
2. Remove loose or deteriorated concrete from exposed reinforcing bar circumference for a minimum clear distance of $3/4$ ". Do not remove sound concrete from exposed reinforcing bars. Do not damage existing reinforcing.
3. Abrasive blast clean exposed reinforcing bars and sound concrete surfaces prior to placement of repair concrete.
4. Drill and bond A301 dowels per adhesive manufacturer's directions with embedment depth not less than $4 1/2$ inches.
5. All existing reinforcing to remain in place. Notify the Engineer of any damaged, deteriorated or missing reinforcing steel.

LEGEND

- (E) = Existing
± = Existing
--- = Existing
--- = Proposed







Project As Built Drawings Have Been Reviewed By The Project Engineer & Represent, To The Best Of My Knowledge, The Project As Constructed.
Proj. Eng. 6-24-15
Date

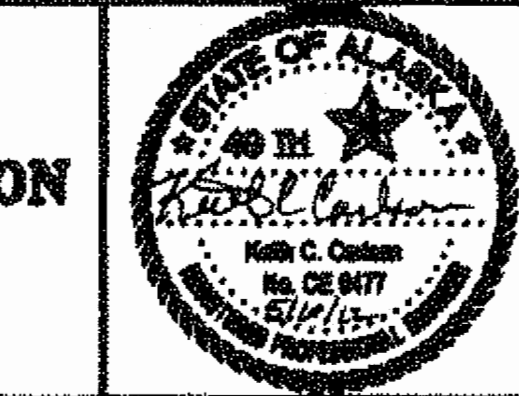

STATE OF ALASKA
DEPARTMENT OF TRANSPORTATION
AND PUBLIC FACILITIES
BRIDGE SECTION


SAWMILL CREEK BRIDGE
PIER COLUMN REPAIRS
SAWMILL CREEK ROAD
PIER REPAIR

BRIDGE NO. 432
DWG. NO. 2

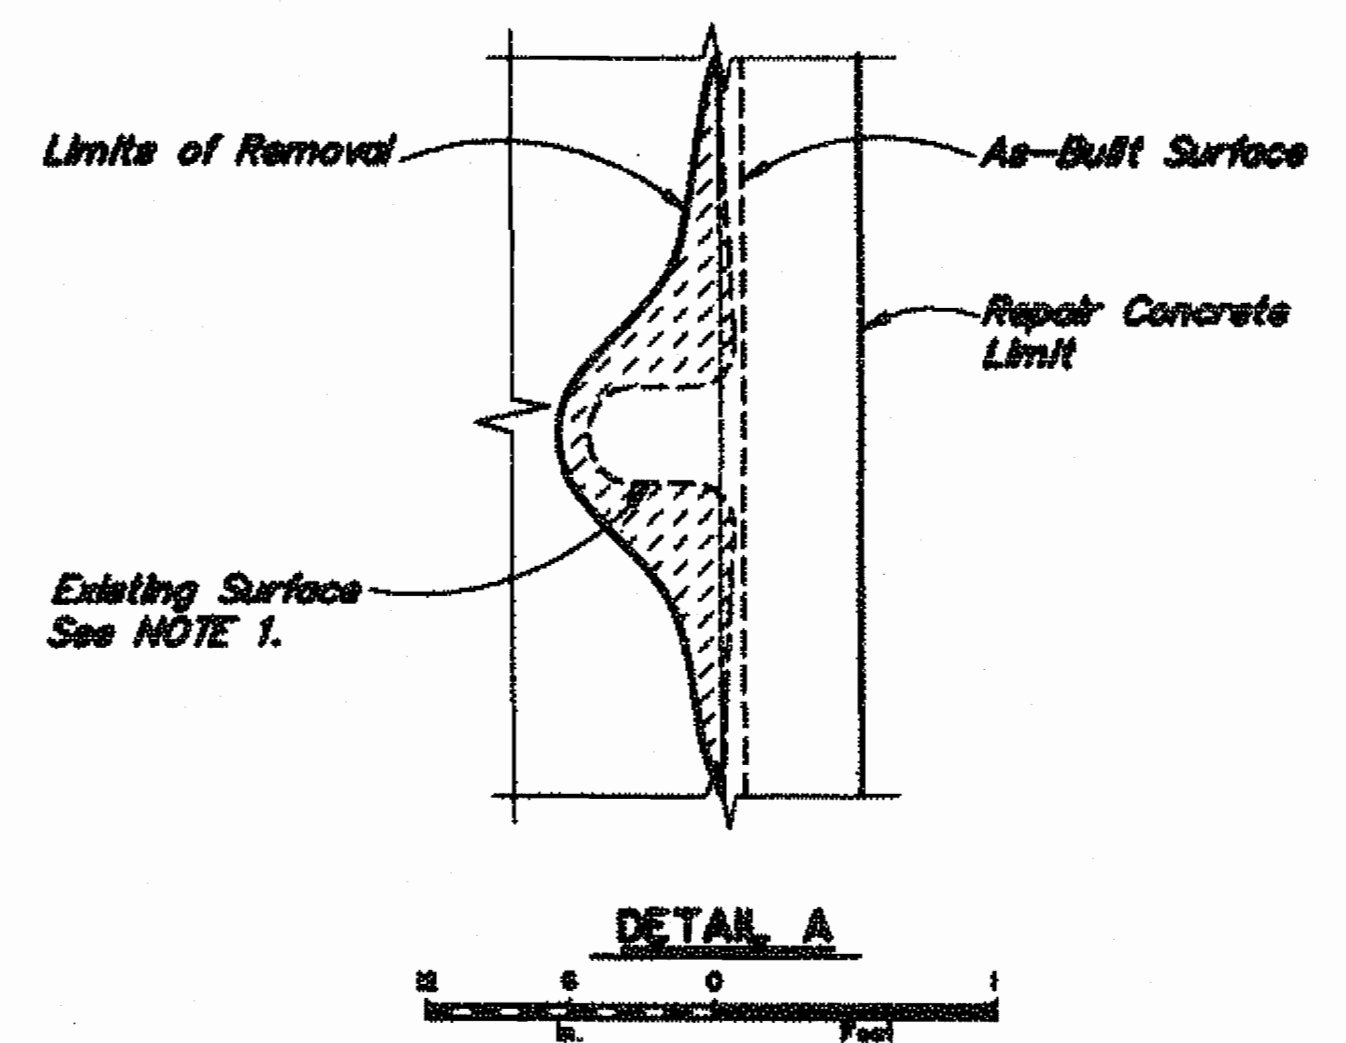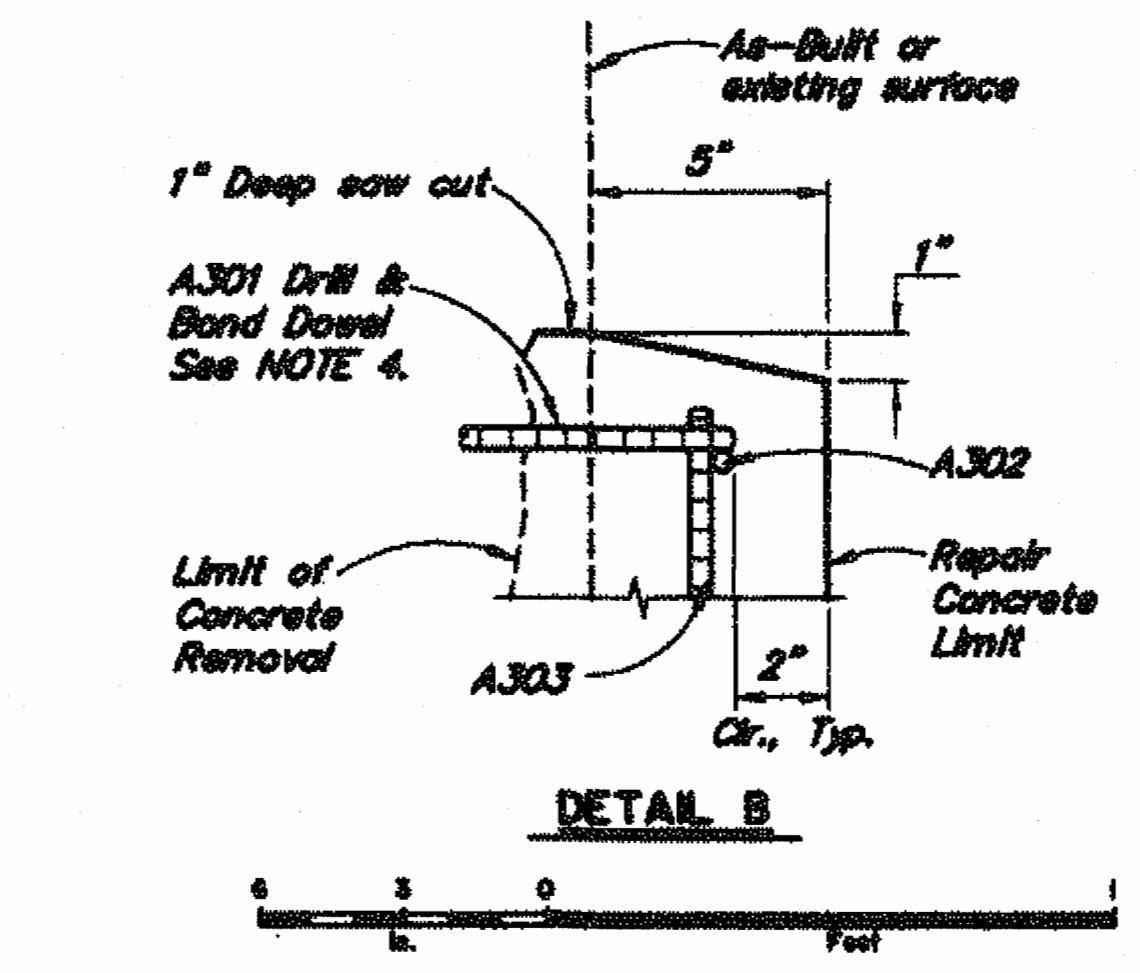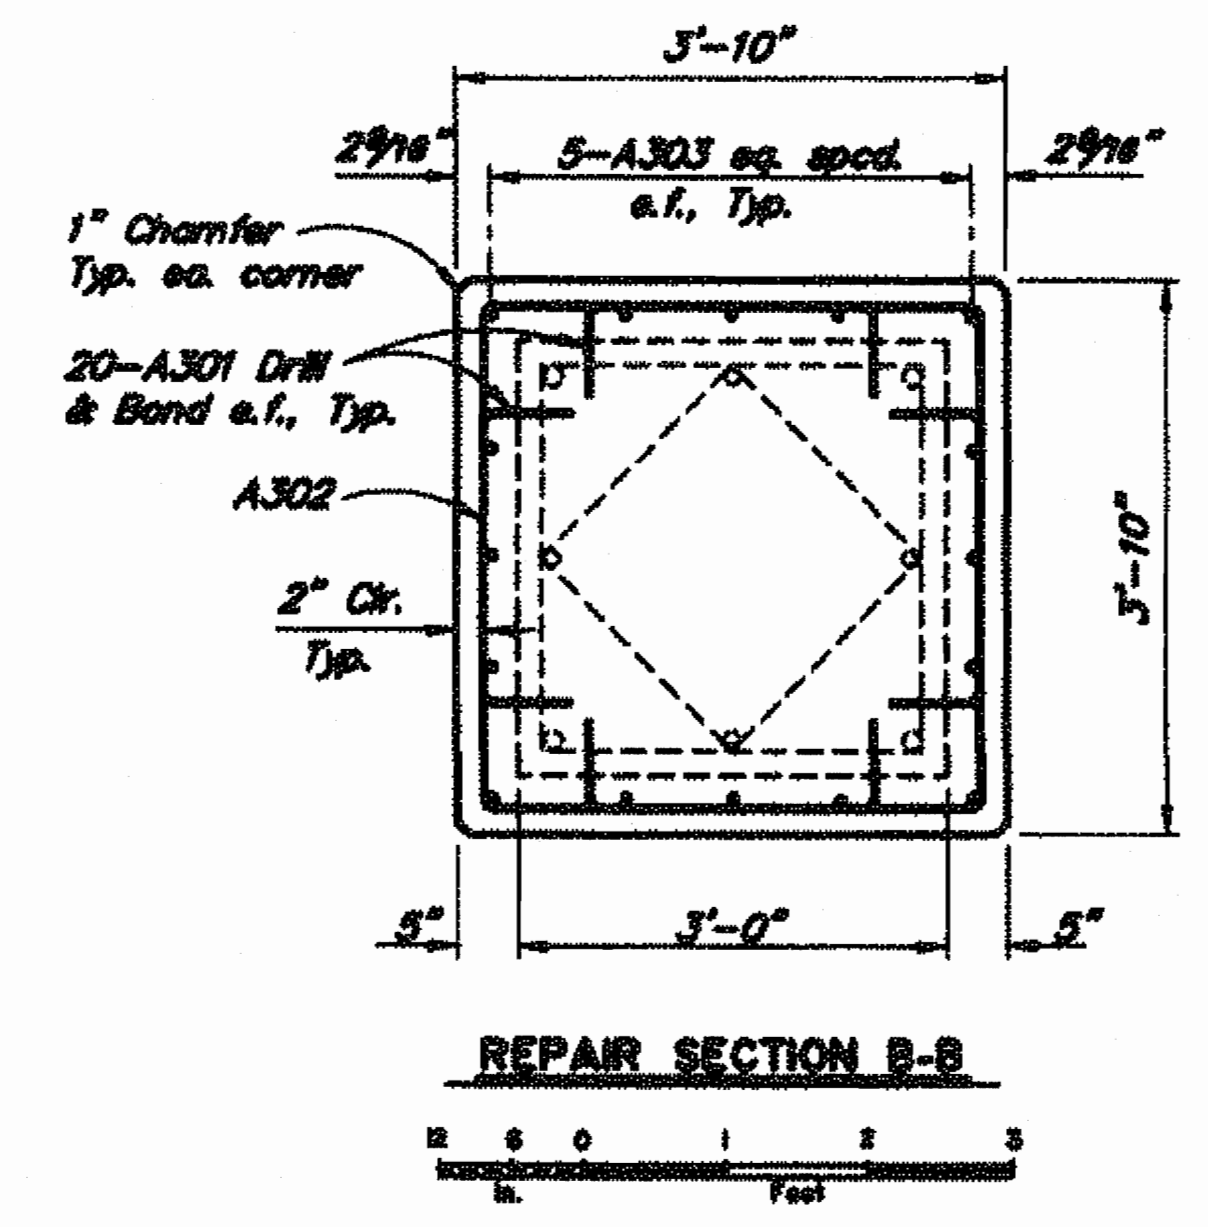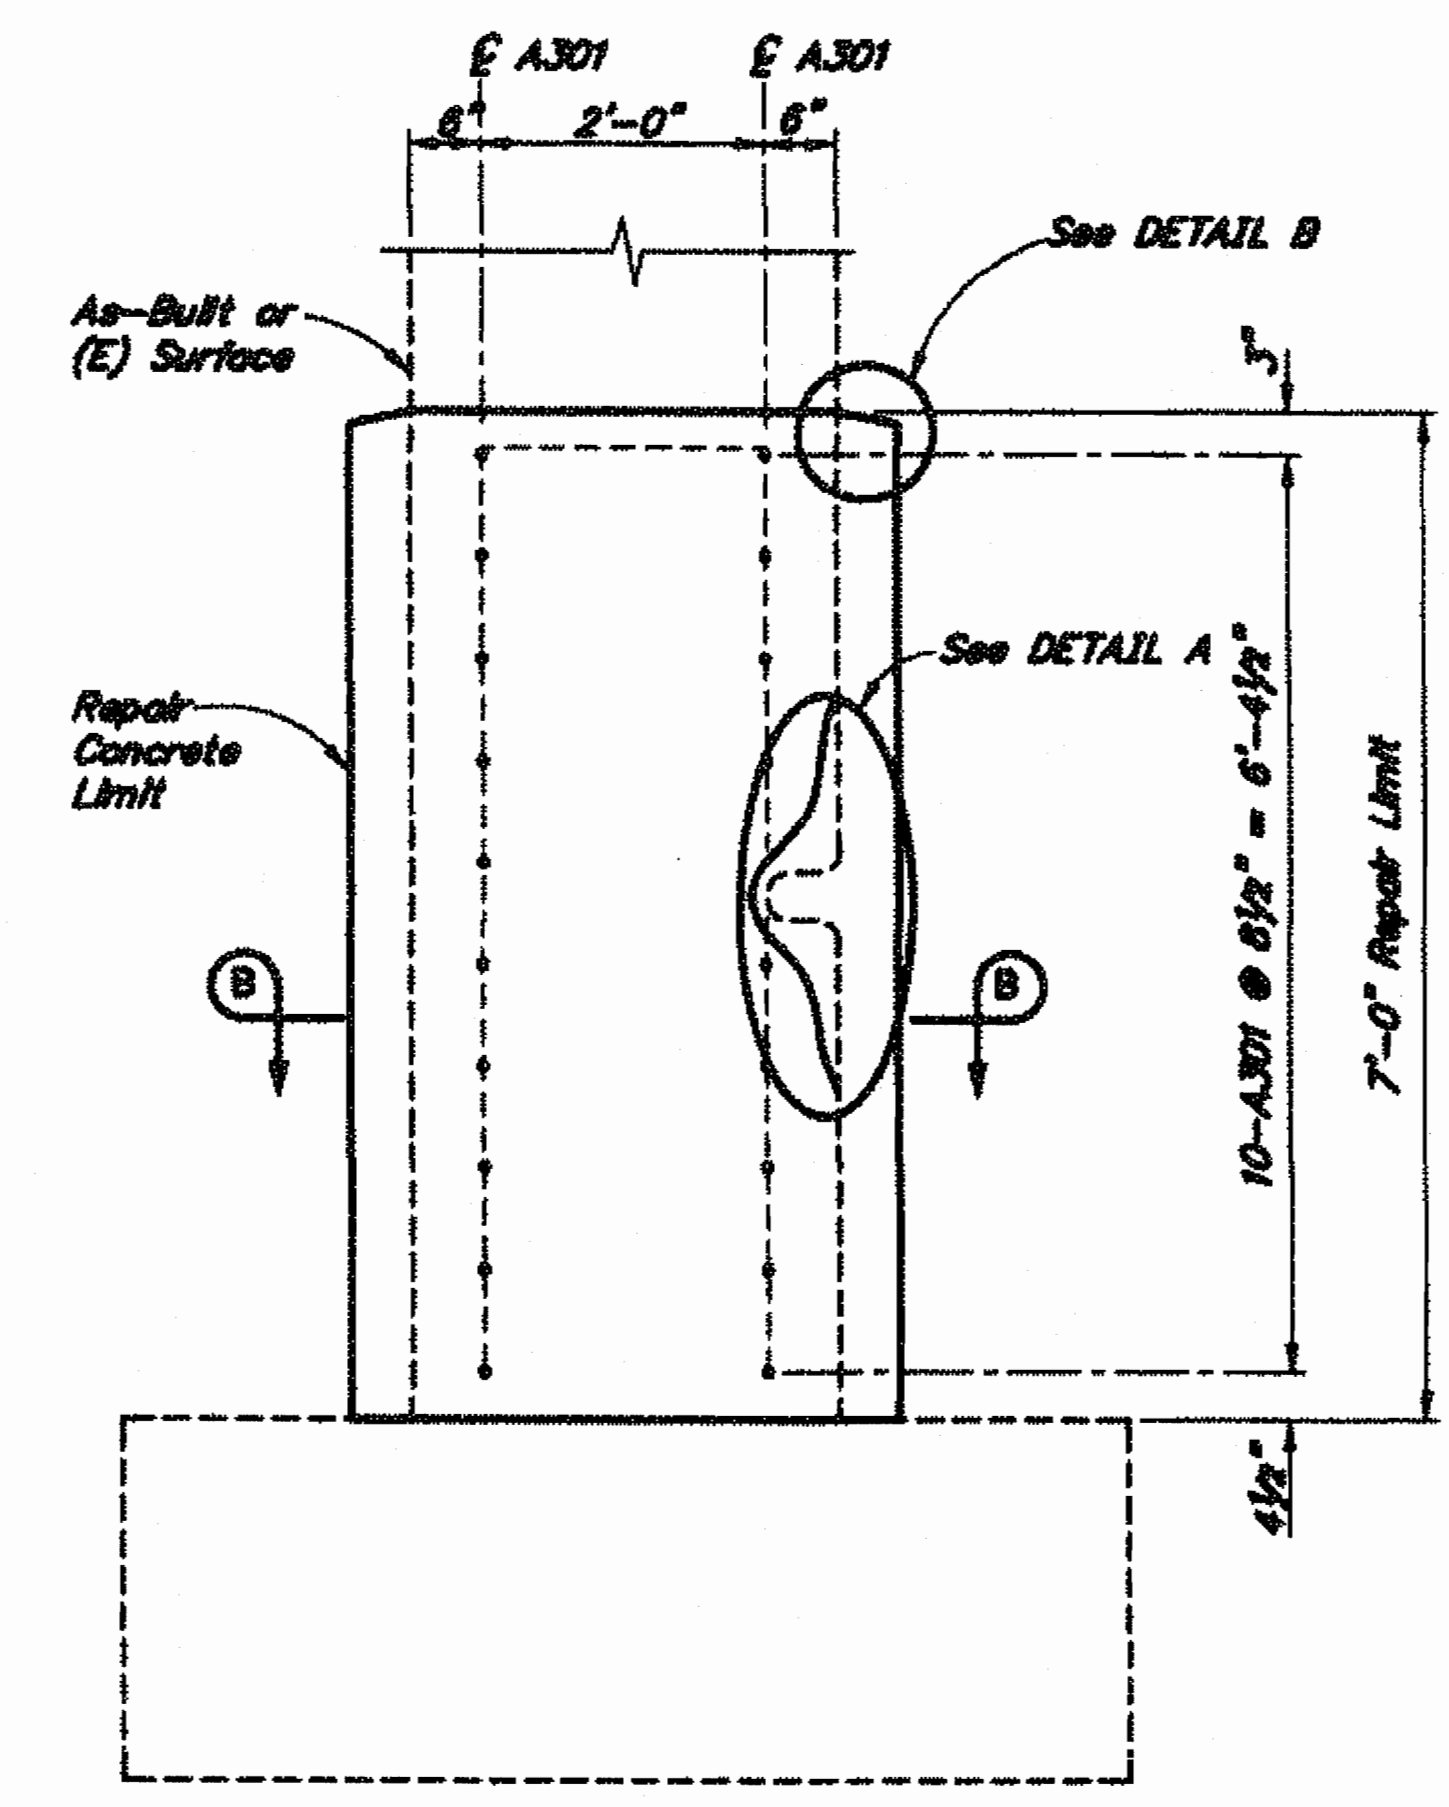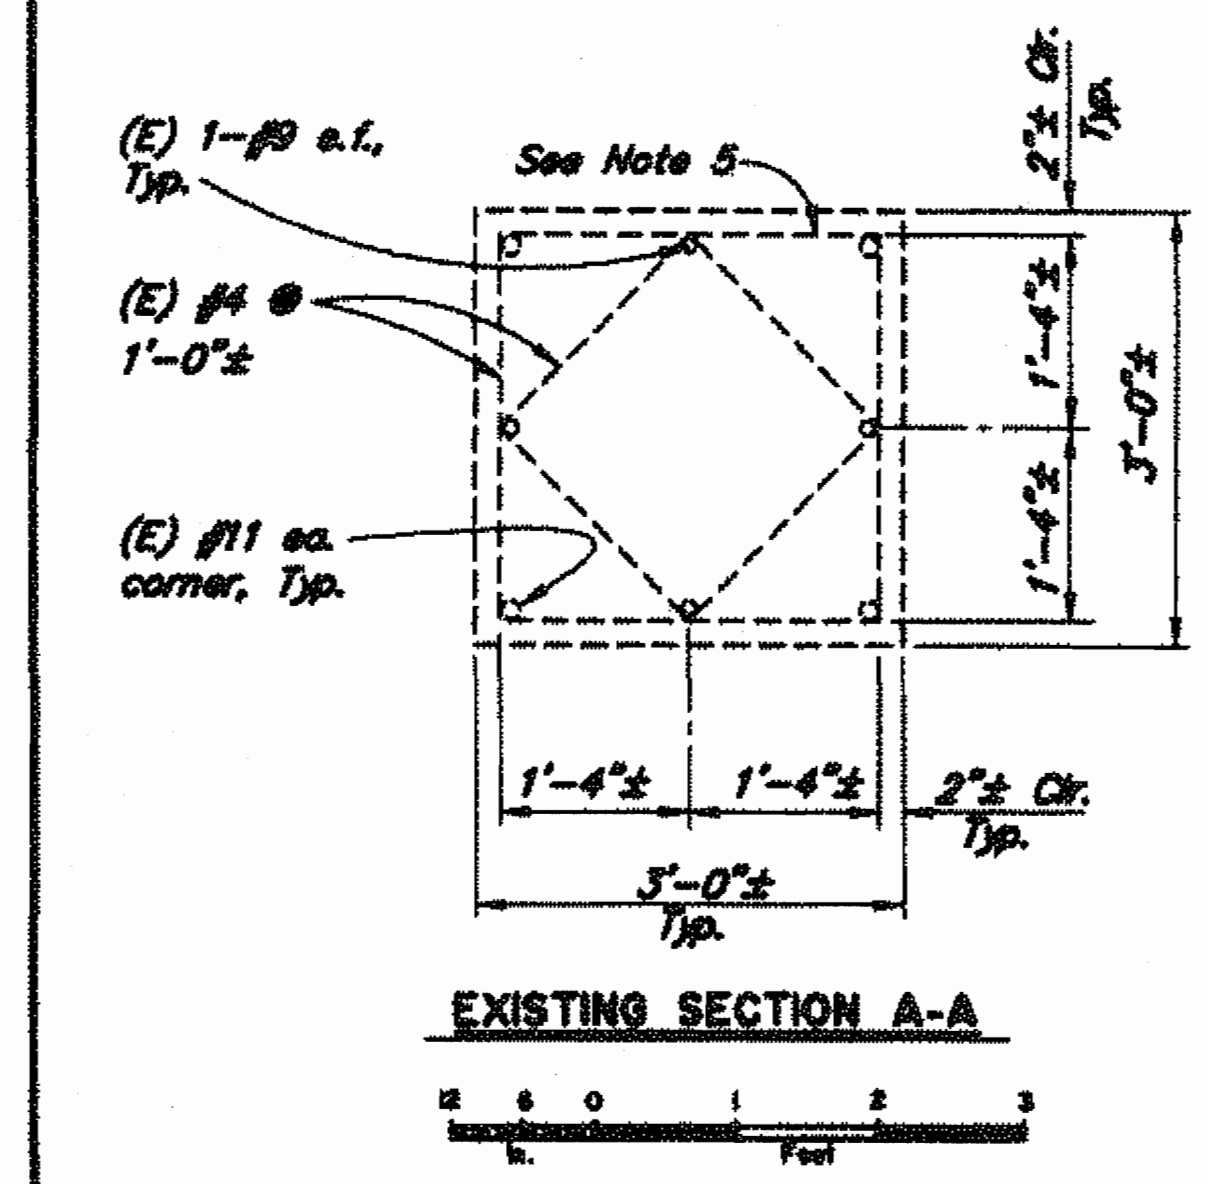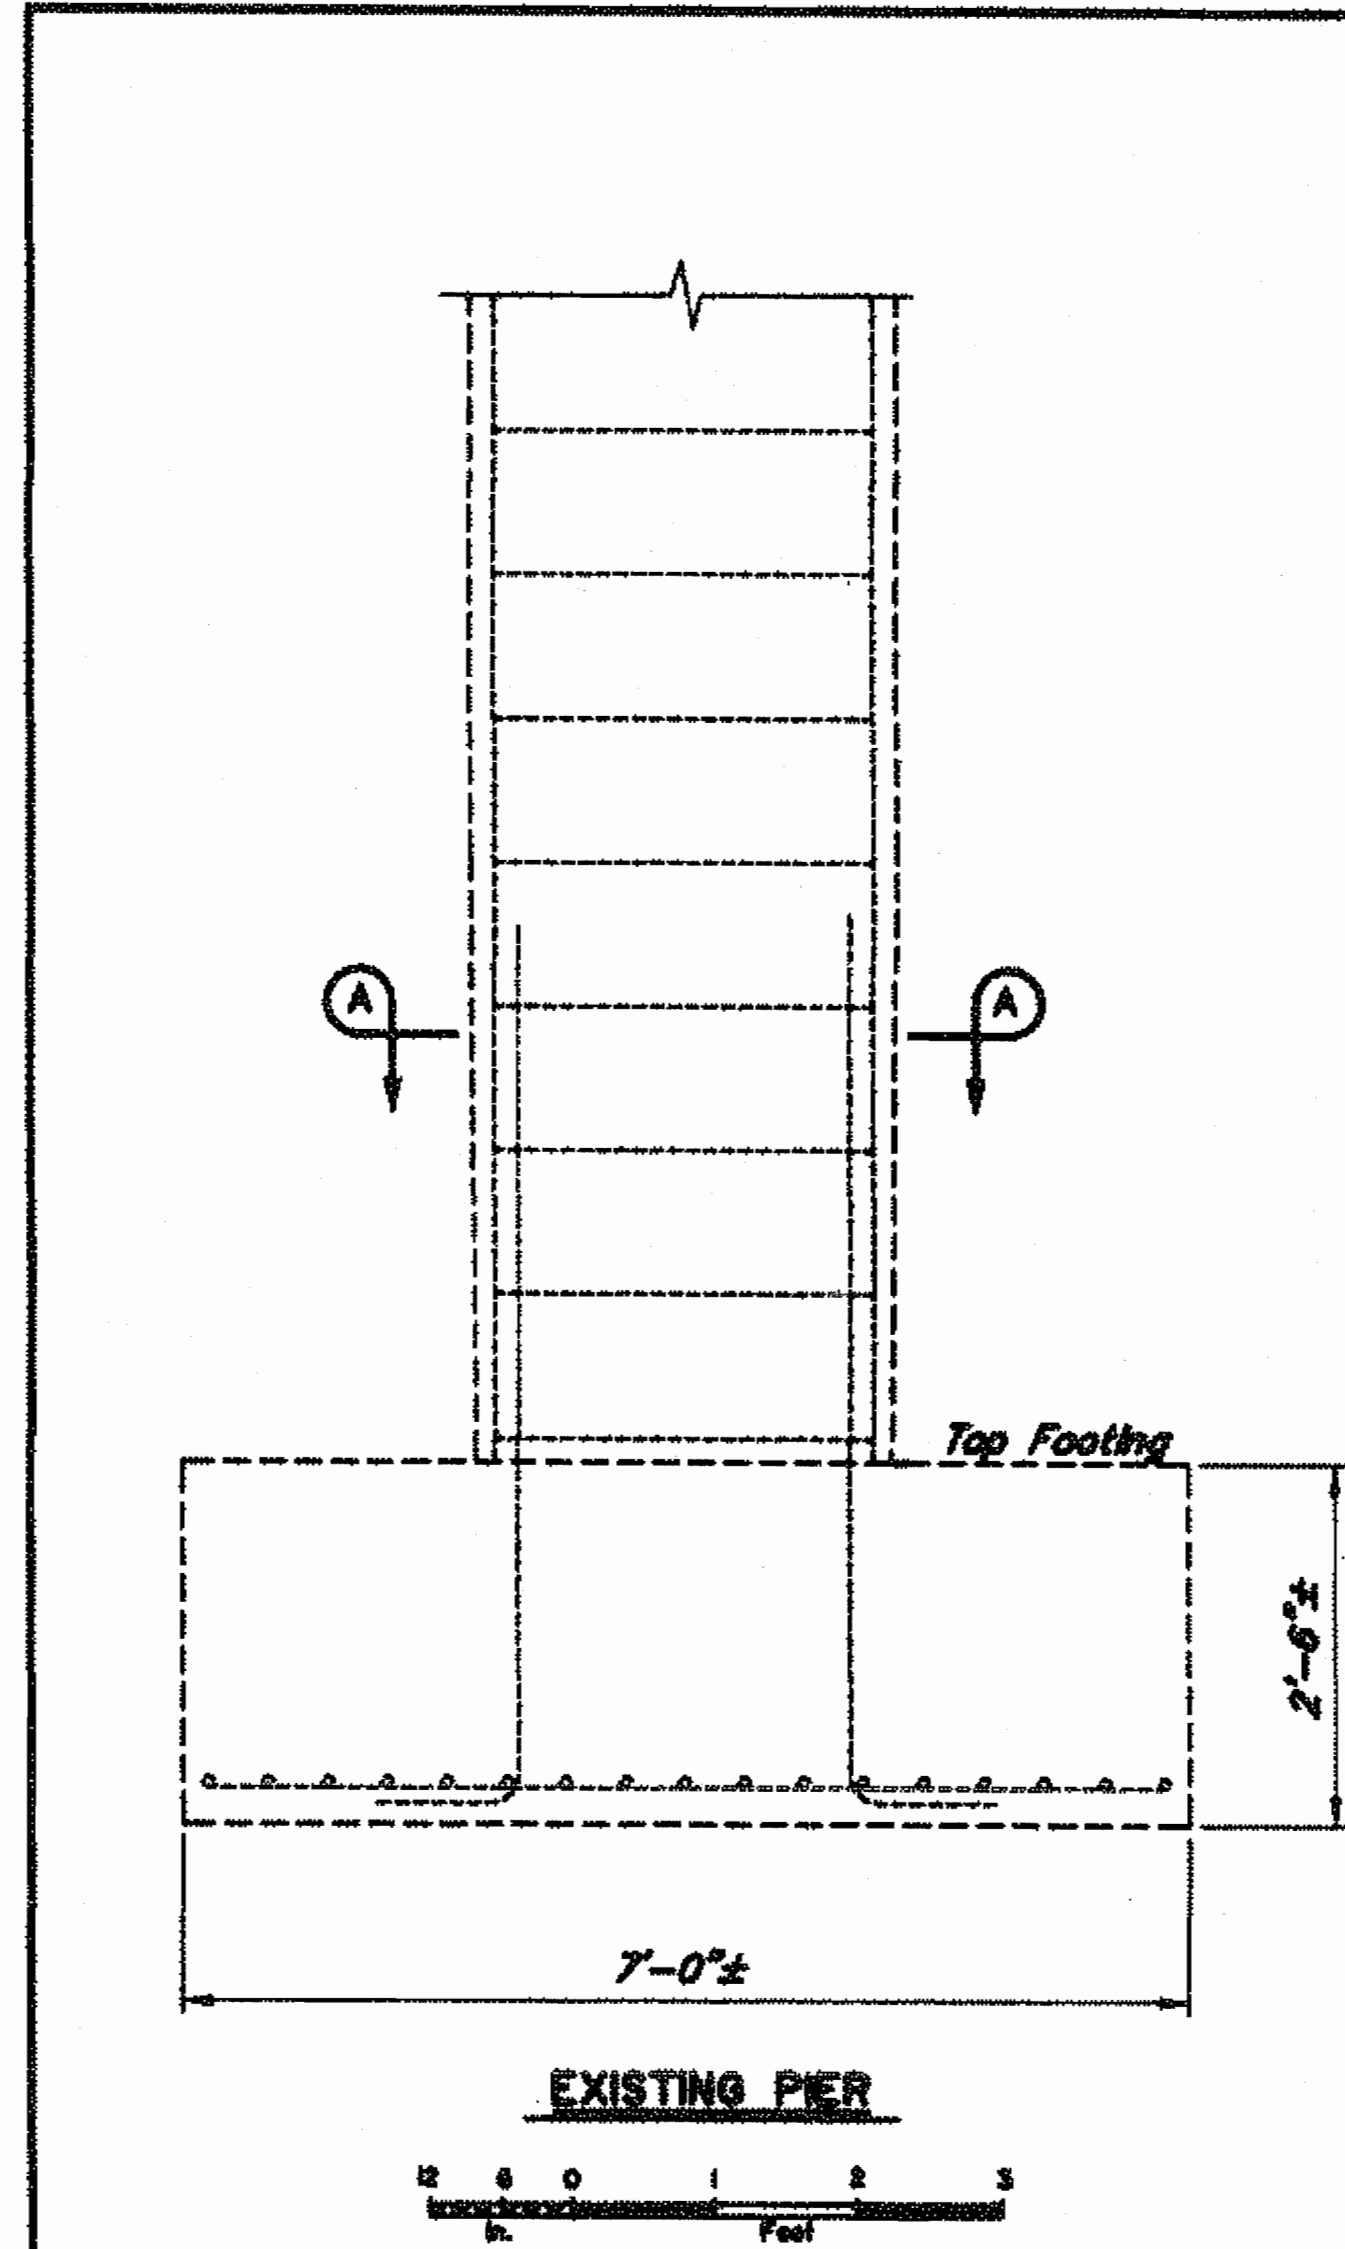


DESIGNED BY: Keith C. Carlson	CHECKED: Leslie Daugherty
DRAWN BY: C. Anderson	CHECKED: Keith C. Carlson
QUANTITIES BY: Keith C. Carlson	CHECKED: Leslie Daugherty


STATE	PROJECT DESIGNATION	YEAR	SHEET NO.	TOTAL SHEETS
ALASKA	08216	2012		

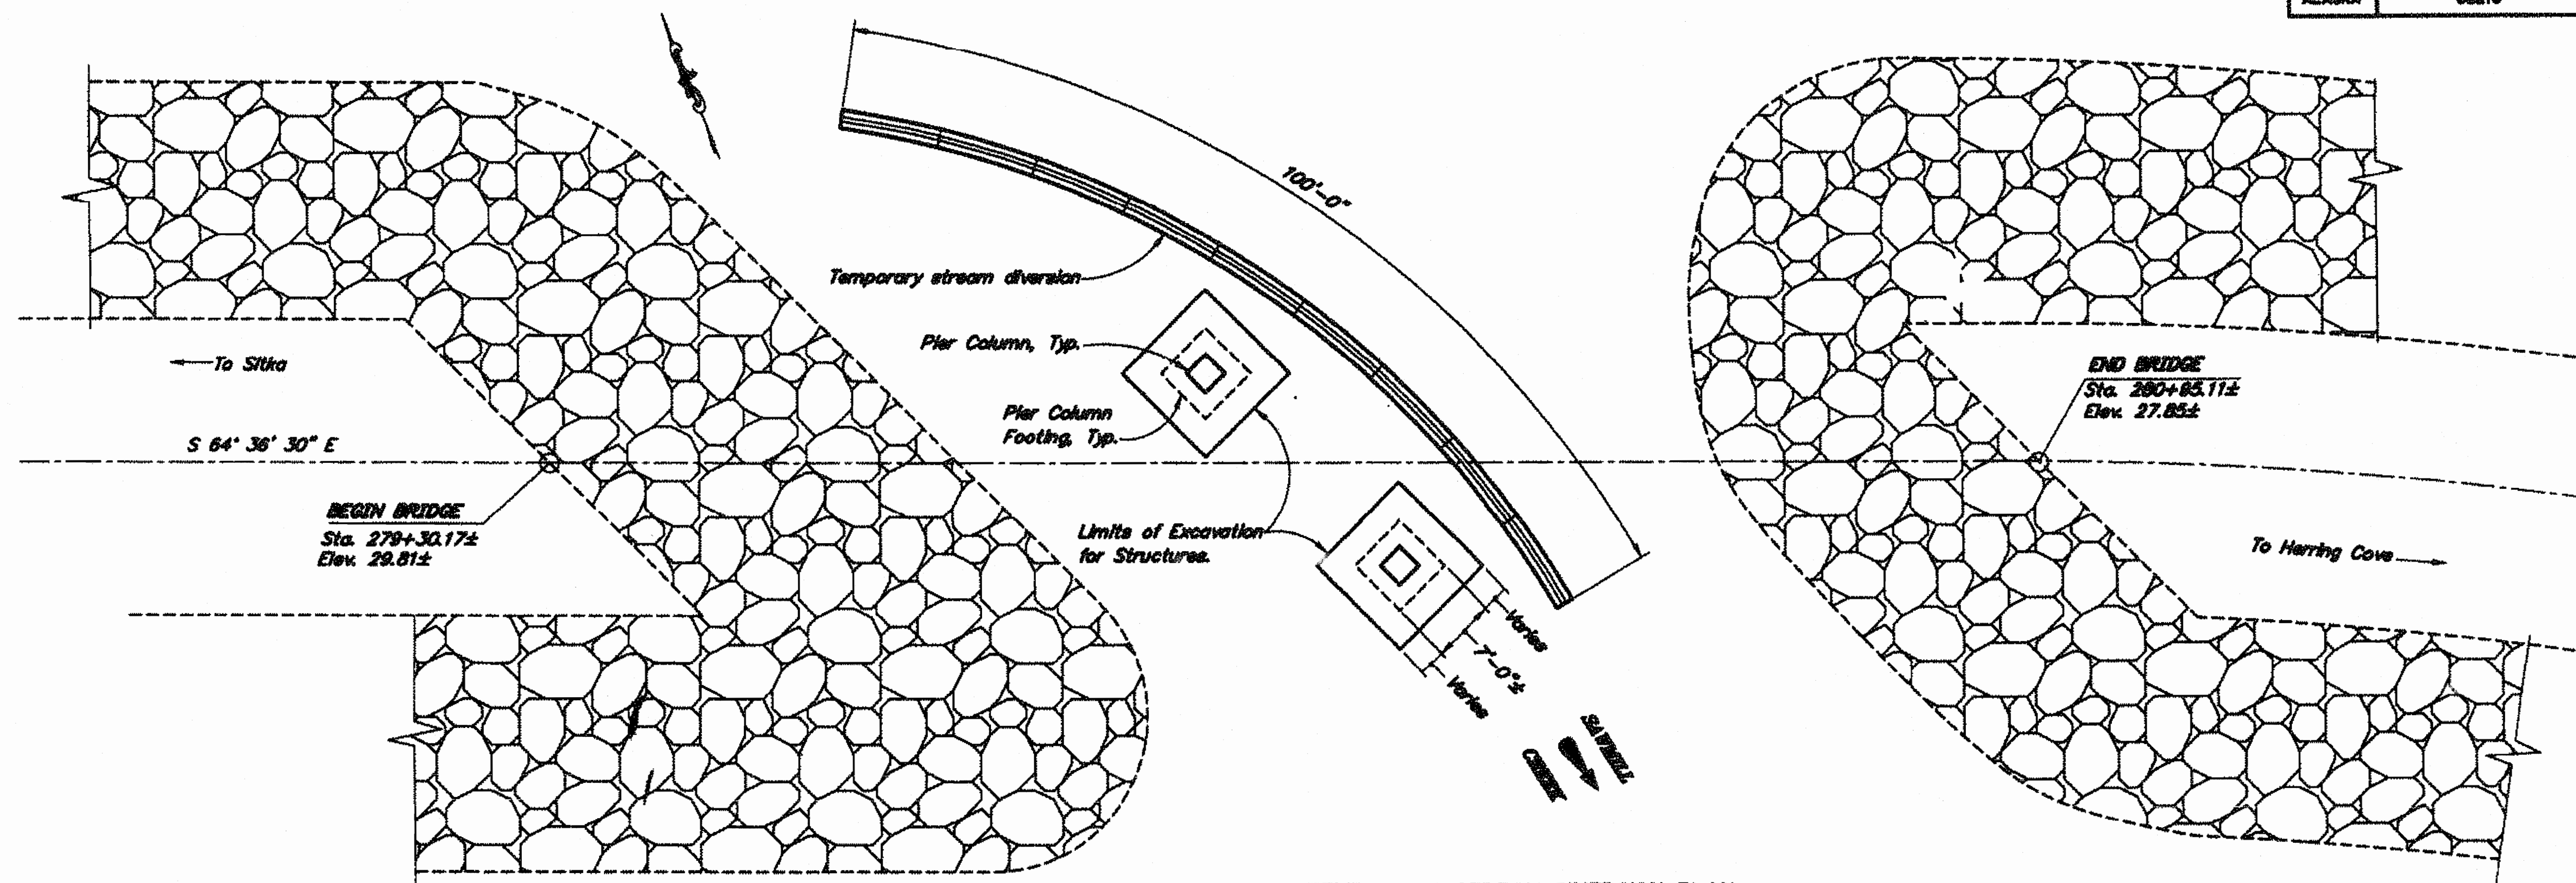

TEMPORARY STREAM DIVERSION PLAN

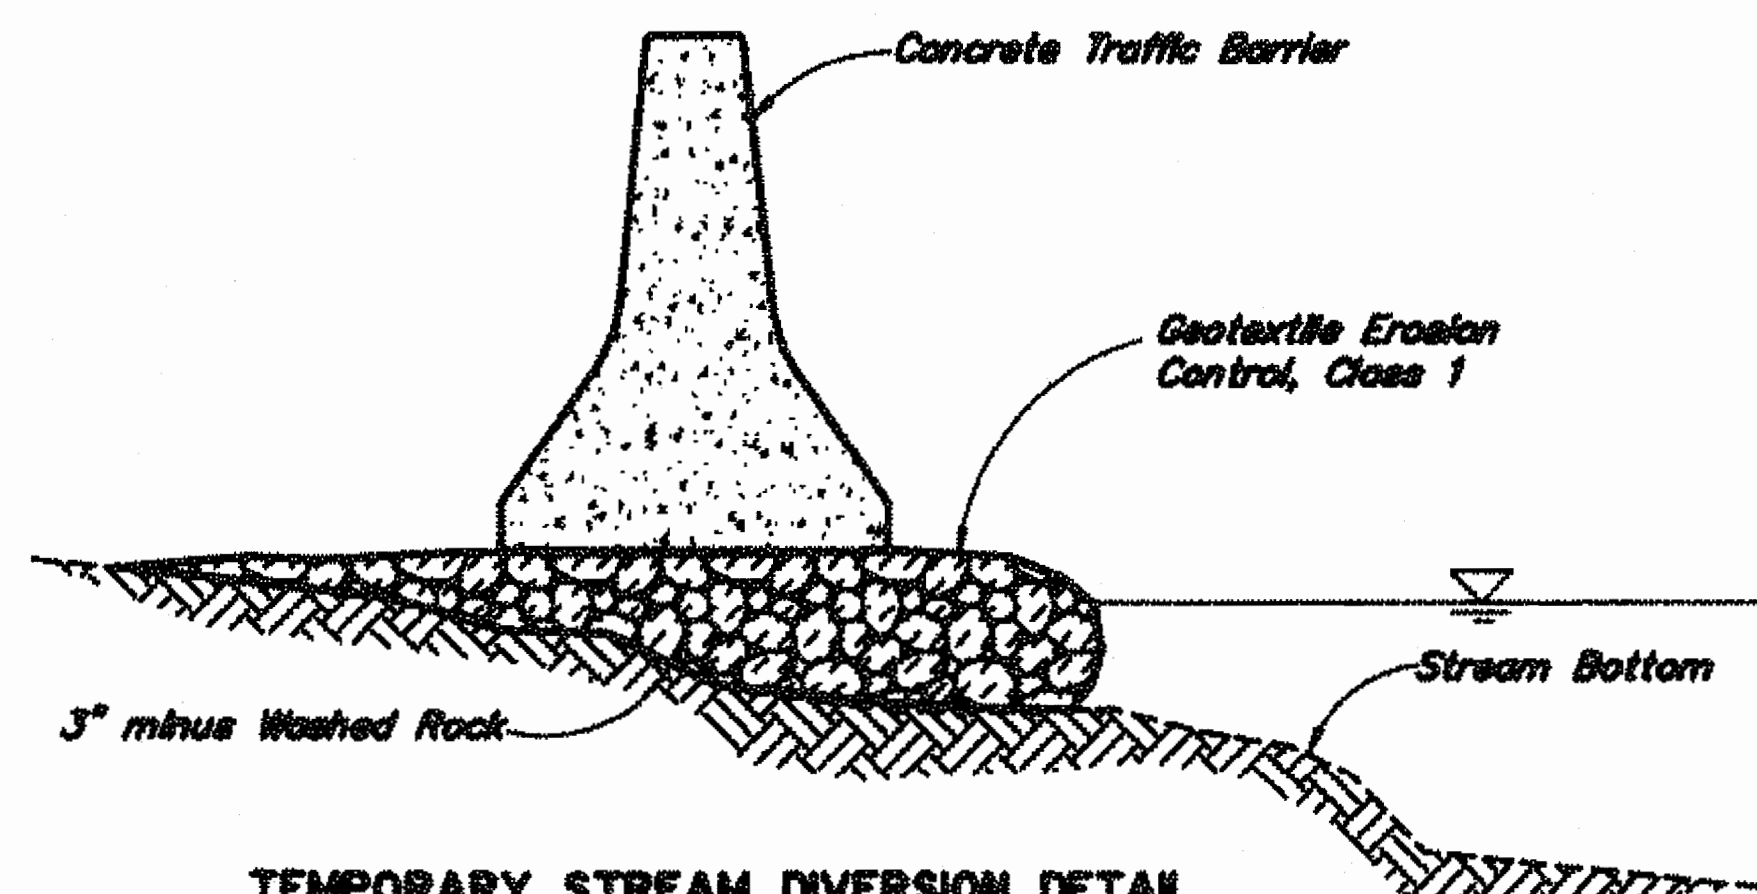

TEMPORARY STREAM DIVERSION DETAIL

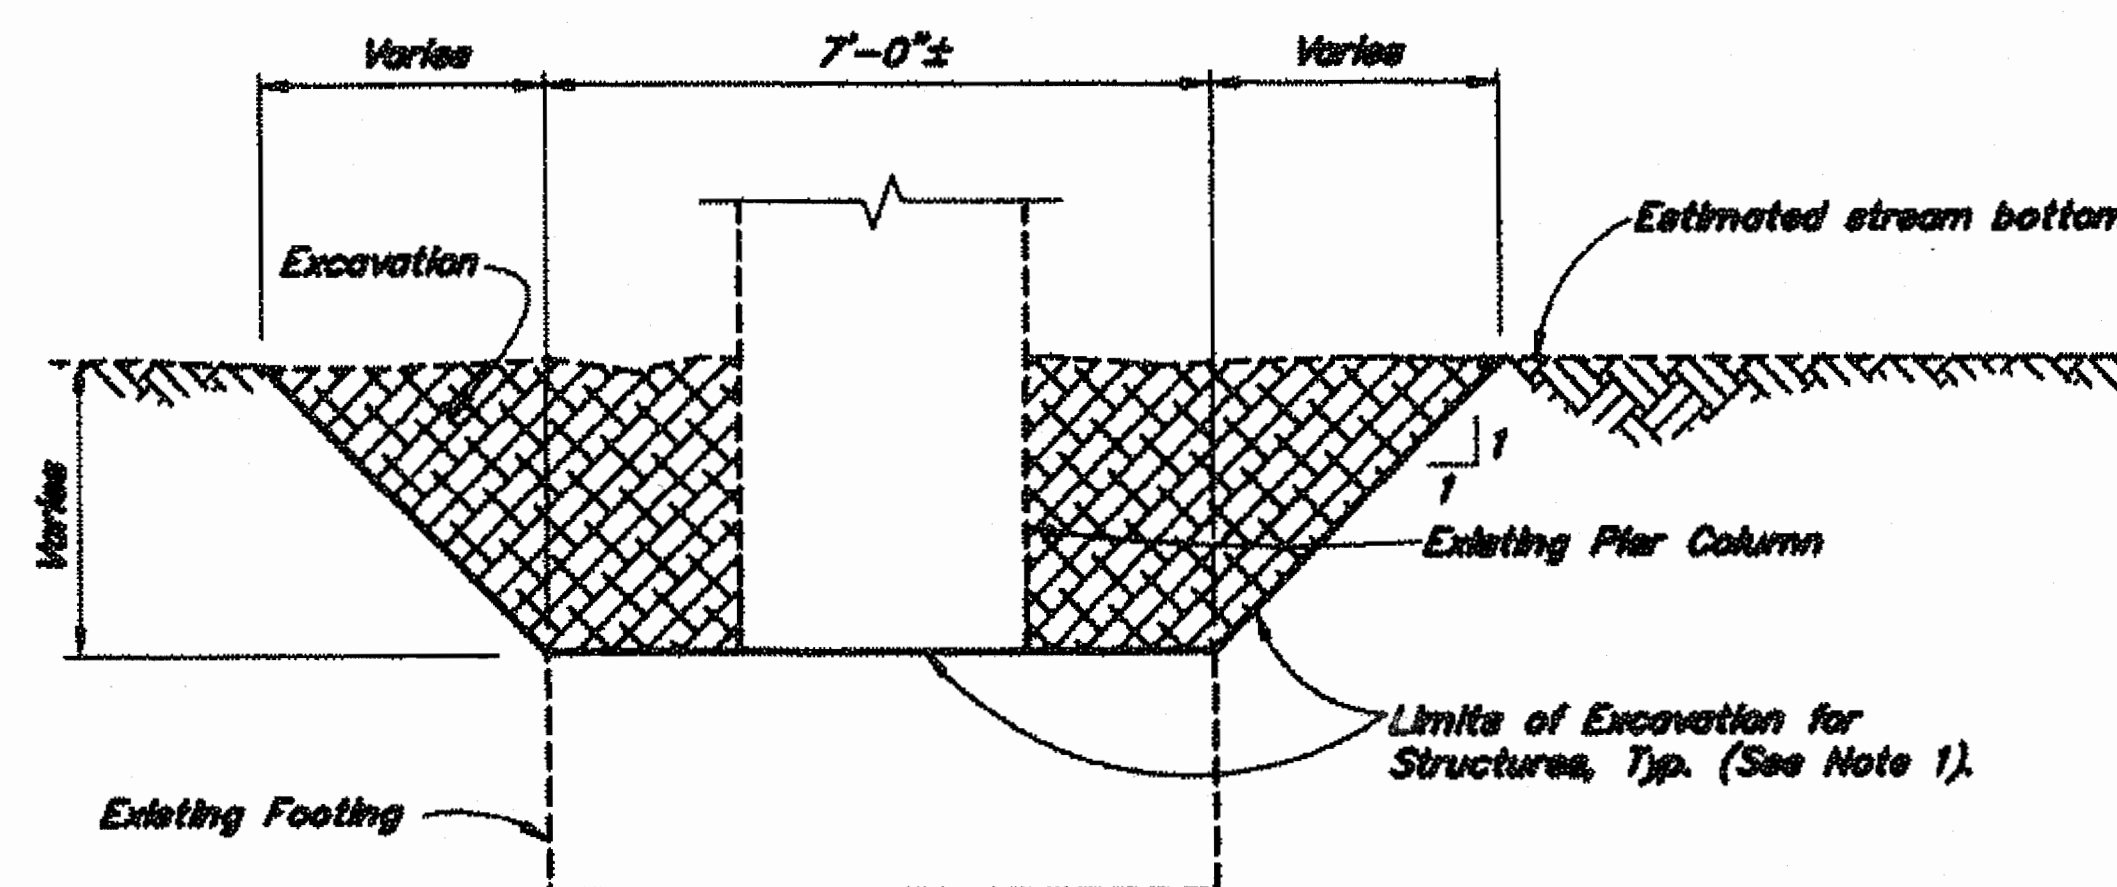

LIMITS OF EXCAVATION FOR STRUCTURES DETAIL

NOTE:
1. Excavate to top of footing. Do not damage any portion of structure during excavation and backfill operations.

LEGEND
(E) = Existing
± = Existing
--- = Existing
— = Proposed

Project As Built Drawings Have Been Reviewed By The Project Engineer & Represent, To The Best Of My Knowledge, The Project As Constructed.
Proj. Eng. *[Signature]* Date 6-24-15


DESIGNED BY: <i>Keith C. Carlson</i>	CHECKED: <i>Leslie Dougherty</i>
DRAWN BY: <i>Cathy Anderson</i>	CHECKED: <i>Keith C. Carlson</i>
QUANTITIES BY: <i>Keith C. Carlson</i>	CHECKED: <i>Leslie Dougherty</i>

STATE OF ALASKA
DEPARTMENT OF TRANSPORTATION
AND PUBLIC FACILITIES
BRIDGE SECTION



SAWMILL CREEK BRIDGE
PIER COLUMN REPAIRS
SAWMILL CREEK ROAD
MISCELLANEOUS DETAILS

BRIDGE NO. 432
DWG. NO. 3

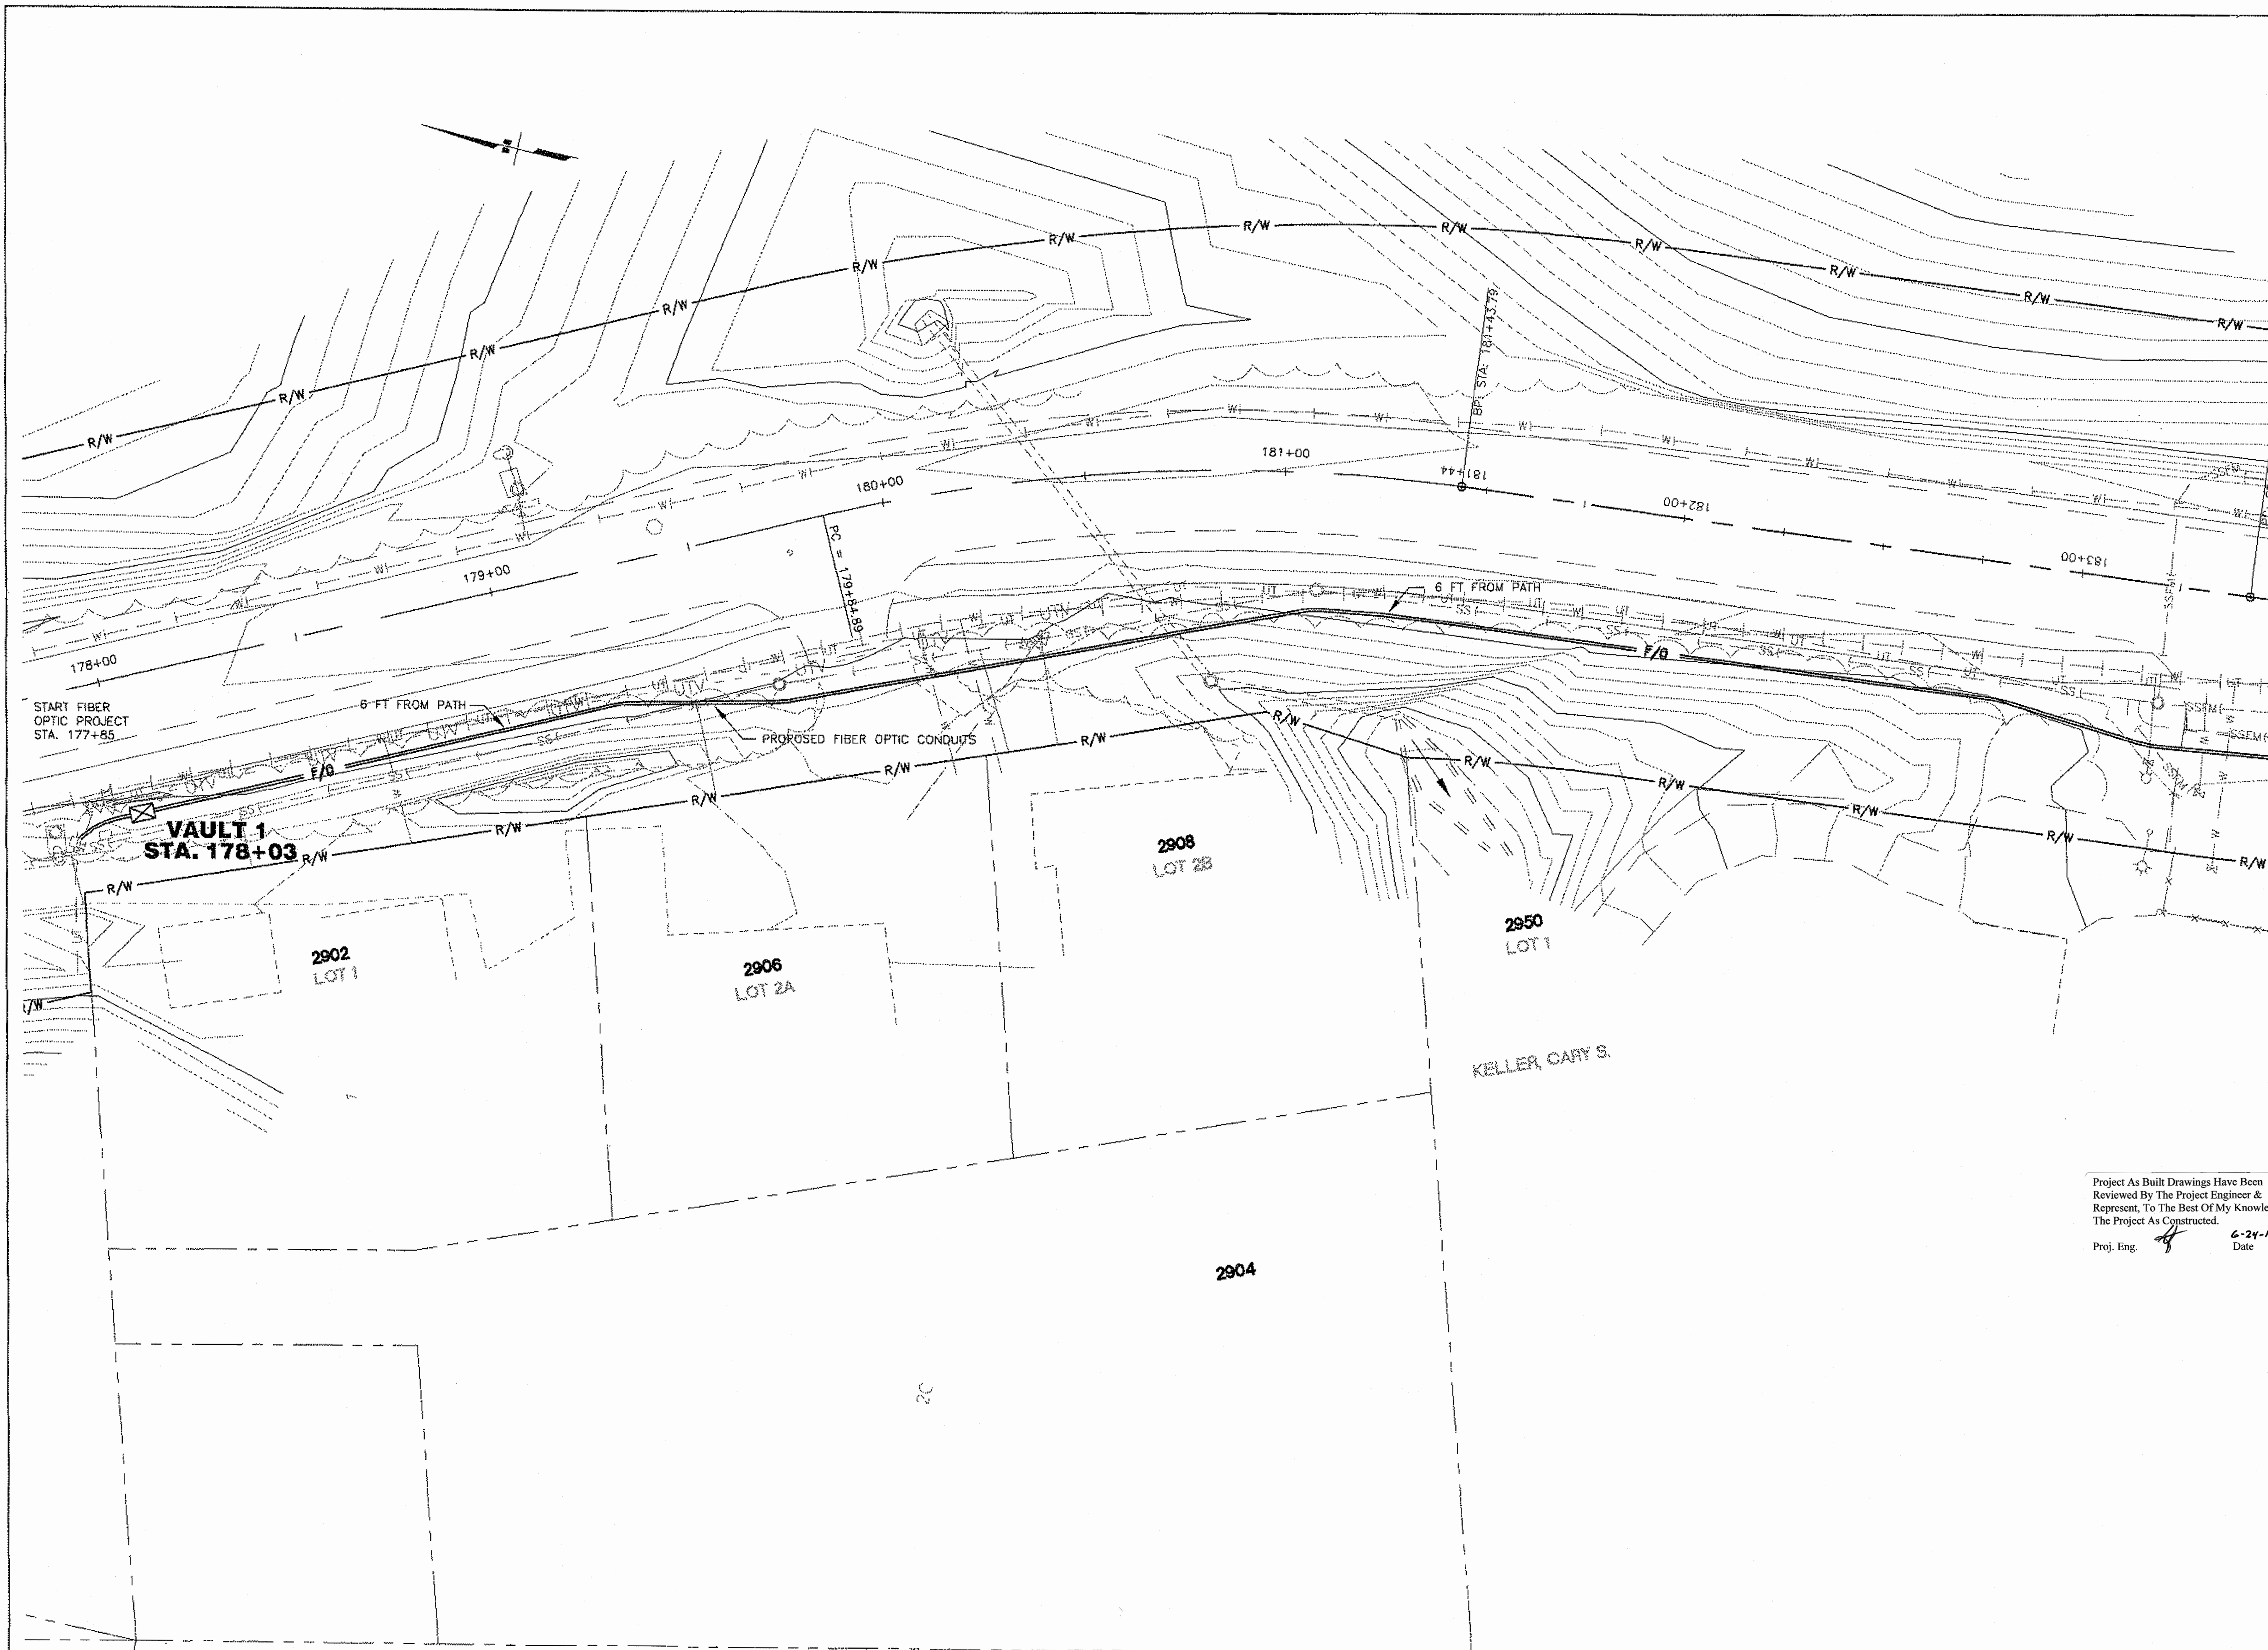


PATH:		
PLOT: PSPACE 1=1(F) OR MSPACE 1=1(F) TAB: D4		
ADDENDUM NUMBER		
ATTACHMENT NUMBER		
RECORD OF REVISIONS		
No.	DATE	DESCRIPTION

SAWMILL CREEK ROAD UPGRADE
PHASE III- WHALE PARK TO SAWMILL CREEK BRIDGE
68216MGS-STP-0933(21)
SITKA TELECOMMUNICATIONS CONDUIT
RSA NO. 69615

ELECTRIC UTILITY PLAN

DESIGNED BY: M. CARSON

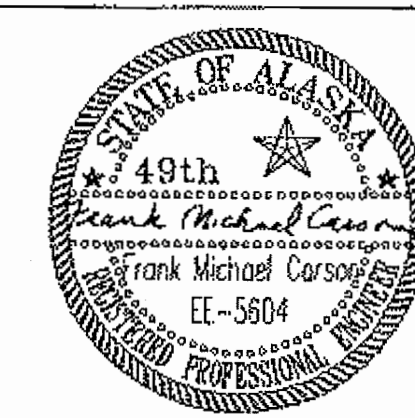

CHECKED BY: R. DRYDEN

DRAWN BY: M. CARSON

STATE OF ALASKA
DEPARTMENT OF TRANSPORTATION
& PUBLIC FACILITIES
SOUTHEAST REGION DESIGN
& ENGINEERING SERVICES DIVISION

**ELECTRIC
UTILITY PLAN
STA. 177+80 TO
STA. BOP**


PROJECT DESIGNATION NUMBER

68216MGS-STP-0933(21)

STATE	YEAR
ALASKA	2012
SHEET NUMBER	TOTAL SHEETS

U00 **109**

DO NOT SCALE FROM THESE DRAWINGS, USE DIMENSIONS

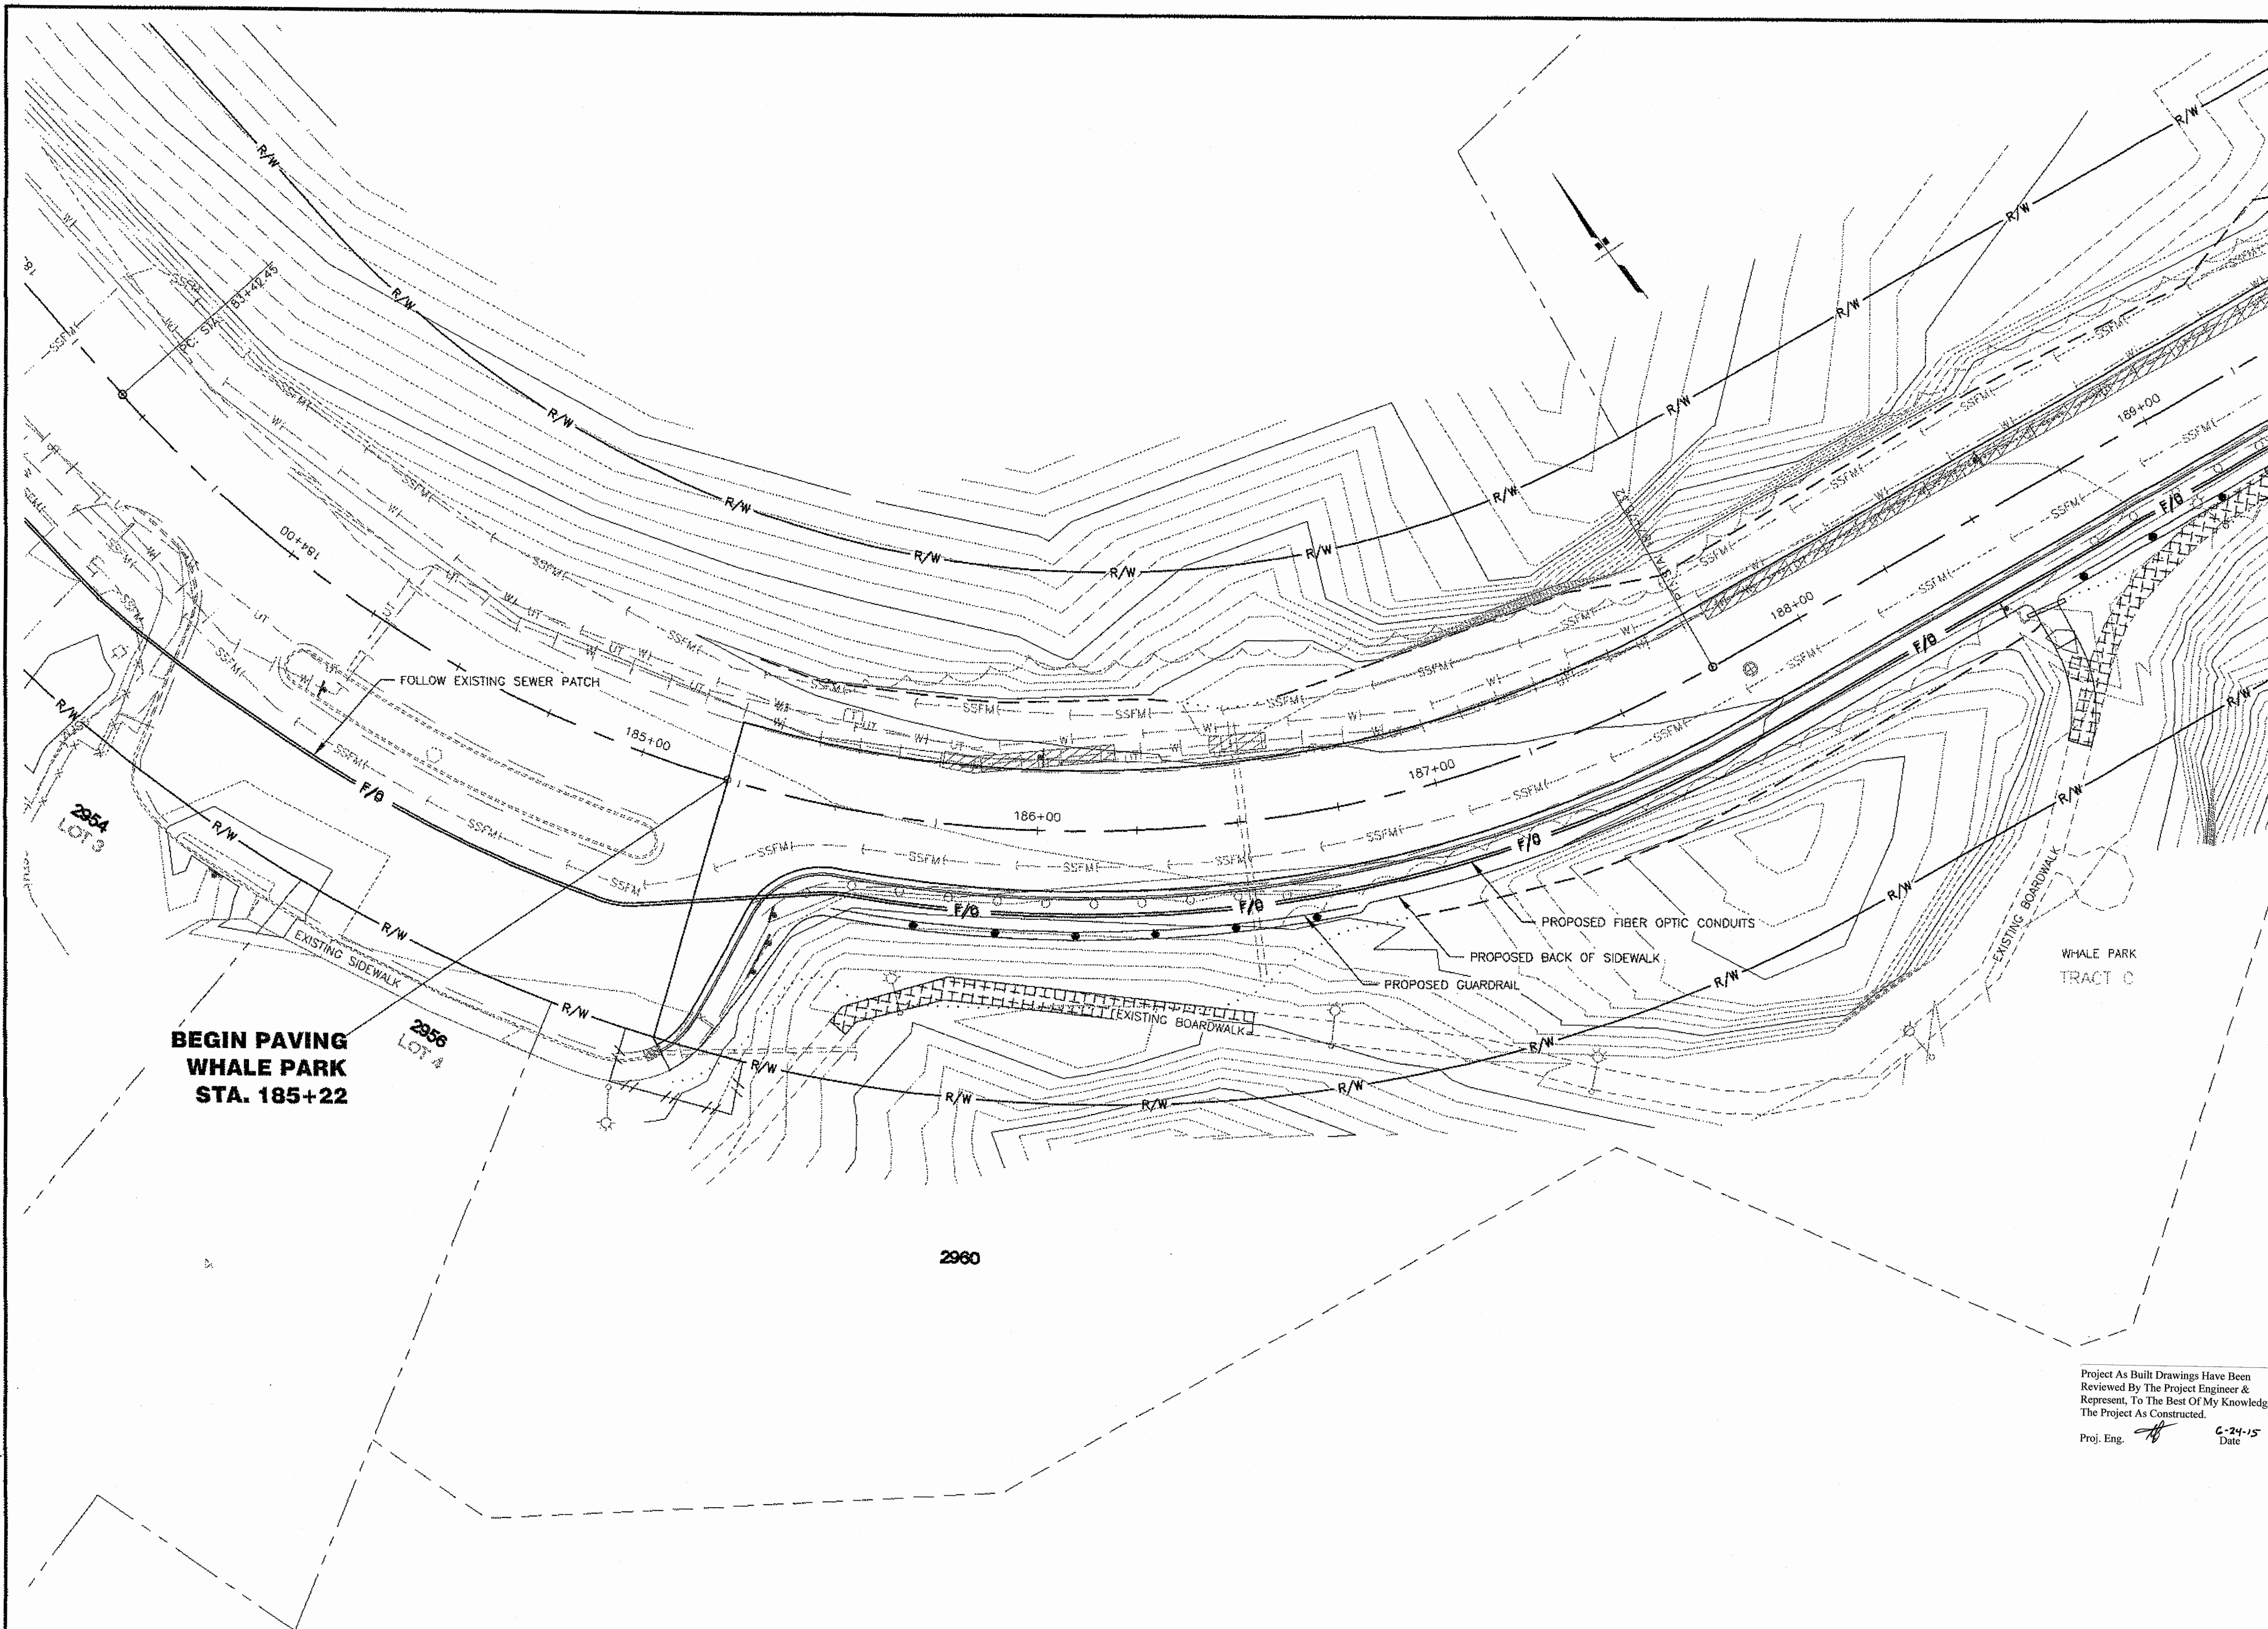

PATH:

PLOT:
PSPACE 1=1(F) OR MSPACE 1=1(F)
TAB: D4

ADDENDUM NUMBER		
1		
ATTACHMENT NUMBER		
4		
RECORD OF REVISIONS		
No.	DATE	DESCRIPTION

SAWMILL CREEK ROAD UPGRADE
PHASE III- WHALE PARK TO SAWMILL CREEK BRIDGE
68216MGS-STP-0933(21)
SITKA TELECOMMUNICATIONS CONDUIT
RSA NO. 69615

ELECTRIC UTILITY PLAN

DESIGNED BY: M. CARSON



CHECKED BY: R. DRYDEN
DRAWN BY: M. CARSON

STATE OF ALASKA
DEPARTMENT OF TRANSPORTATION
& PUBLIC FACILITIES
SOUTHEAST REGION DESIGN
& ENGINEERING SERVICES DIVISION


**ELECTRIC
UTILITY PLAN
BOP TO
STA. 188+50**

PROJECT DESIGNATION NUMBER
68216MGS-STP-0933(21)

STATE	YEAR
ALASKA	2012
SHEET NUMBER	TOTAL SHEETS
U01	109

Project As Built Drawings Have Been
Reviewed By The Project Engineer &
Represent, To The Best Of My Knowledge,
The Project As Constructed.
Proj. Eng. *[Signature]* Date 6-24-15


DO NOT SCALE FROM THESE DRAWINGS, USE DIMENSIONS

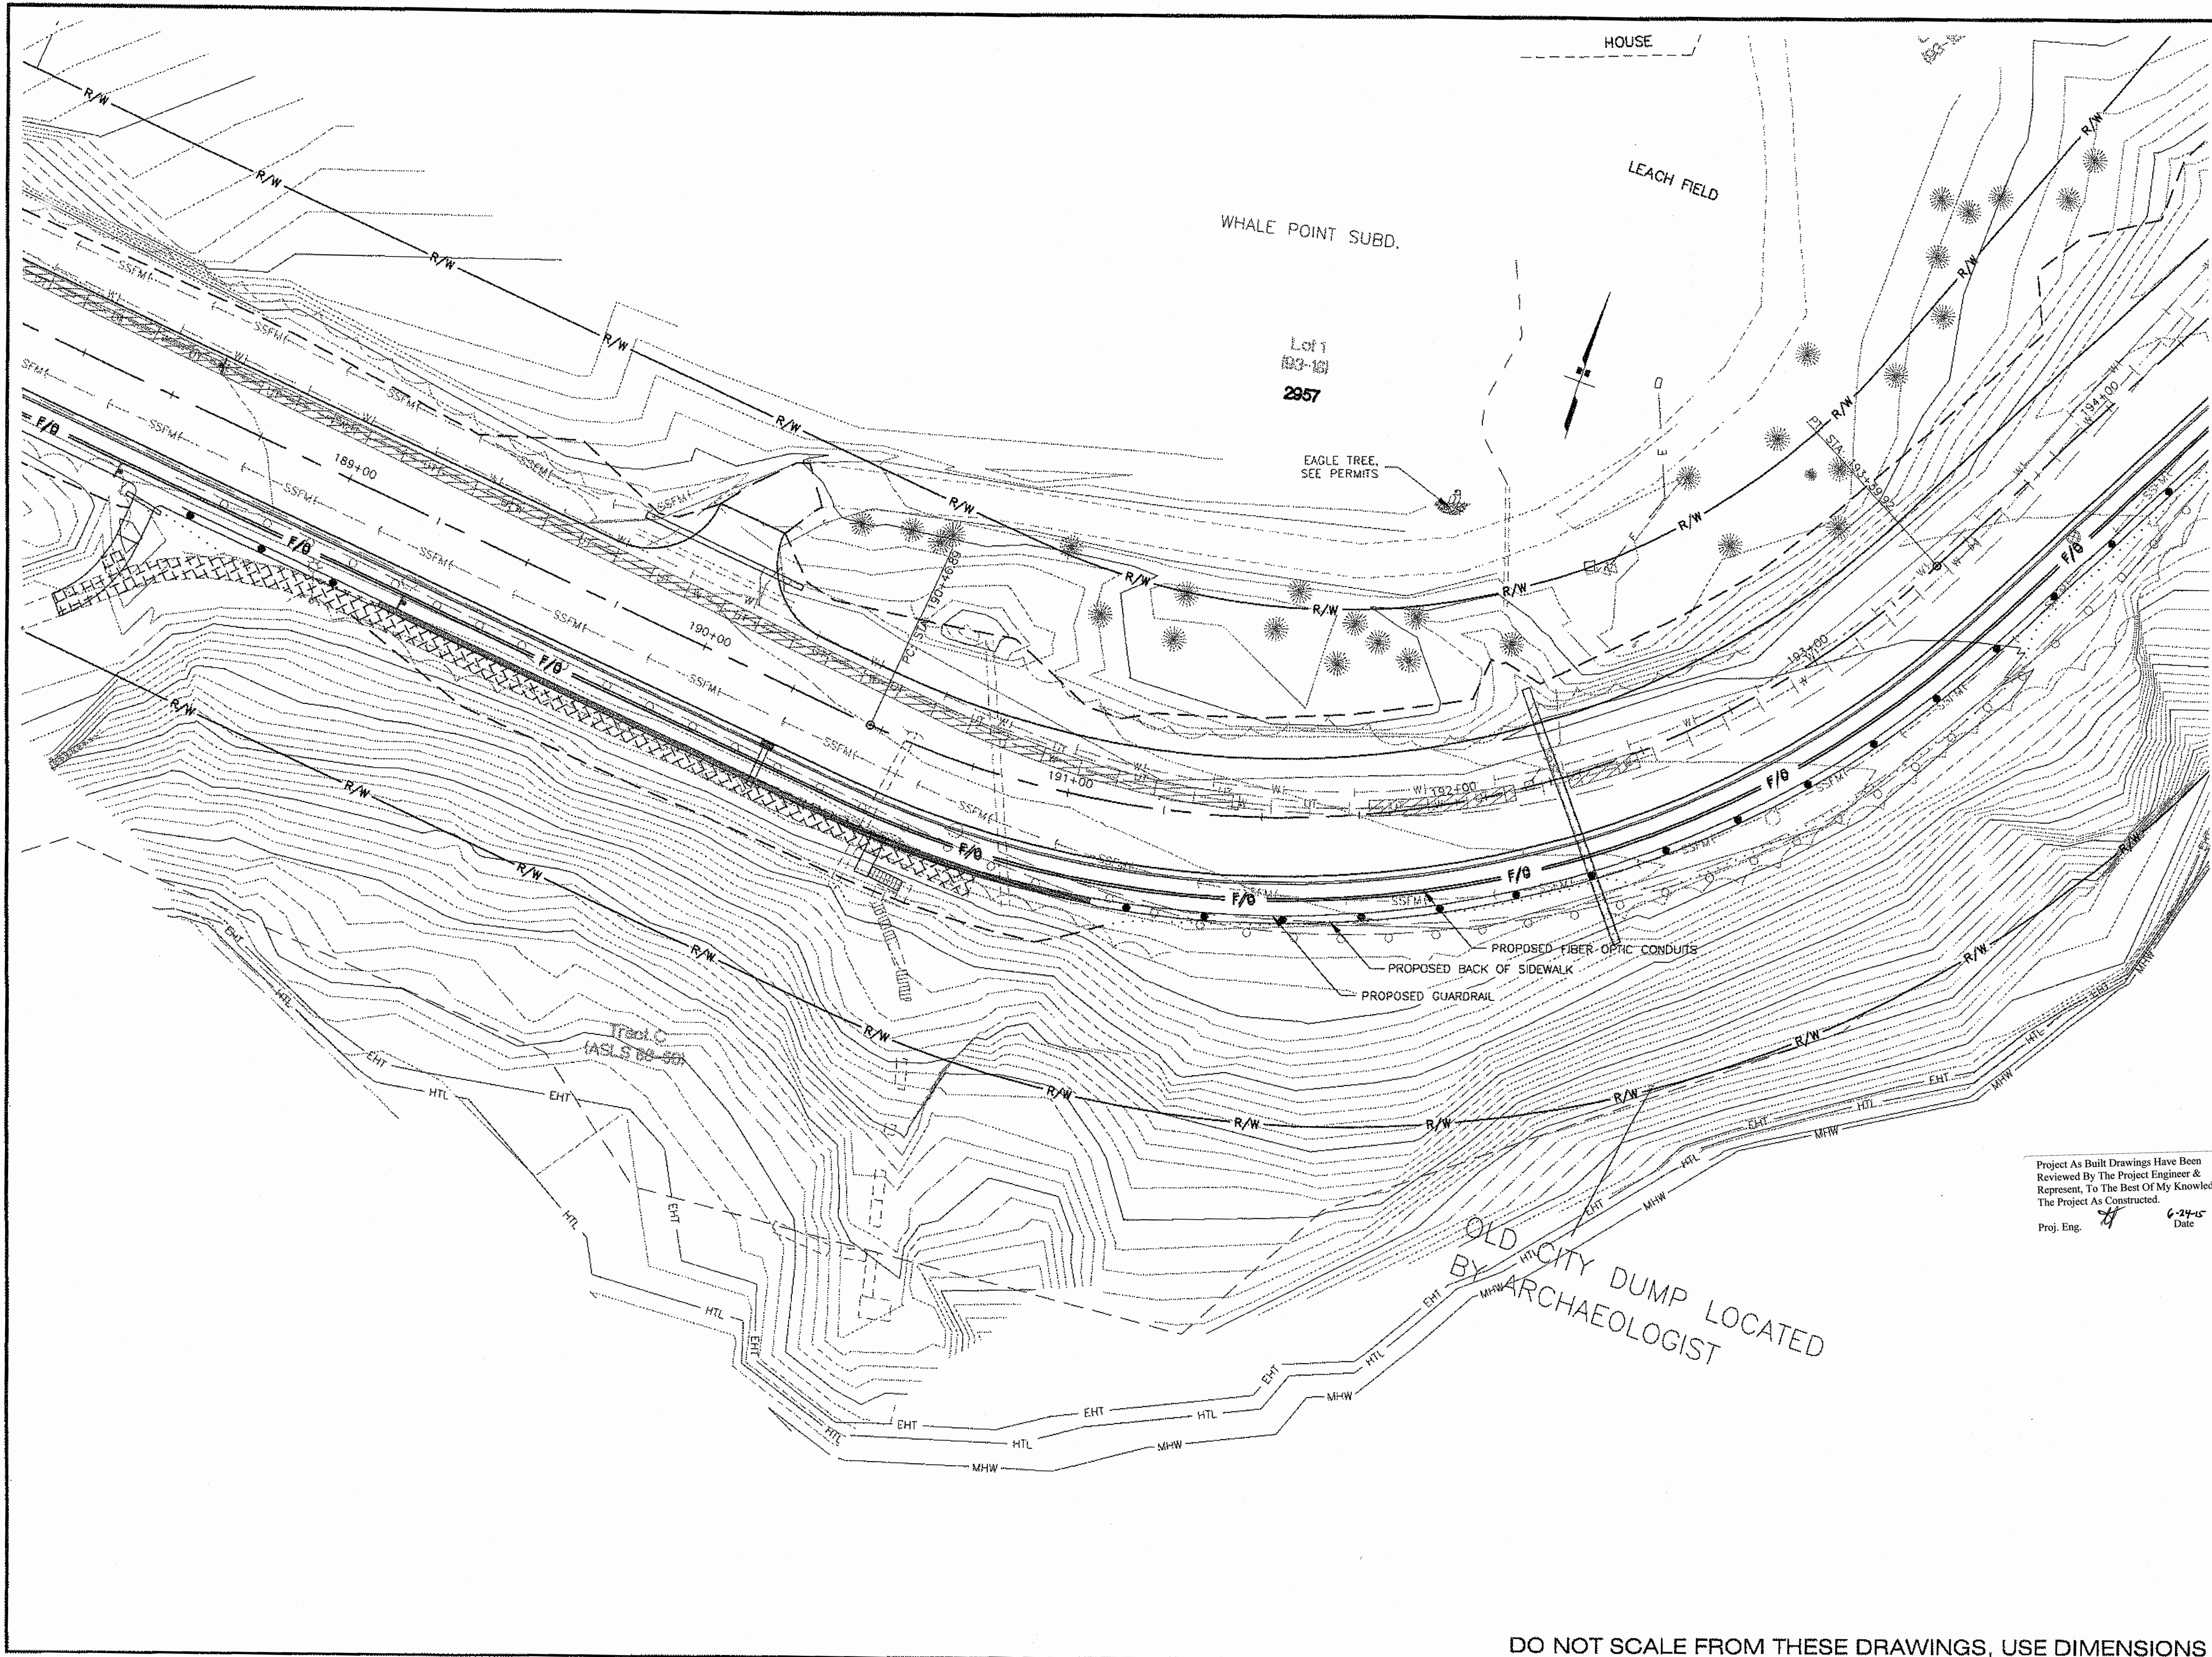

Project As Built Drawings Have Been Reviewed By The Project Engineer & Represent, To The Best Of My Knowledge, The Project As Constructed.
Proj. Eng. *[Signature]* 6-24-15 Date

DO NOT SCALE FROM THESE DRAWINGS, USE DIMENSIONS

PATH:		
PLOT: PSPACE 1=1(F) OR MSPACE 1=1(F) TAB: 04		
ADDENDUM NUMBER 1		
ATTACHMENT NUMBER 4		
RECORD OF REVISIONS		
No.	DATE	DESCRIPTION
SAWMILL CREEK ROAD UPGRADE PHASE III- WHALE PARK TO SAWMILL CREEK BRIDGE 68216MGS-STP-0933(21) SITKA TELECOMMUNICATIONS CONDUIT RSA NO. 69615		
ELECTRIC UTILITY PLAN		
DESIGNED BY: M. CARSON		
 10/3/12		
CHECKED BY: R. DRYDEN		
DRAWN BY: M. CARSON		
STATE OF ALASKA DEPARTMENT OF TRANSPORTATION & PUBLIC FACILITIES SOUTHEAST REGION DESIGN & ENGINEERING SERVICES DIVISION		
ELECTRIC UTILITY PLAN STA. 188+50 TO STA. 193+50		
PROJECT DESIGNATION NUMBER 68216MGS-STP-0933(21)		
STATE	YEAR	
ALASKA	2012	
SHEET NUMBER	TOTAL SHEETS	
U02	109	

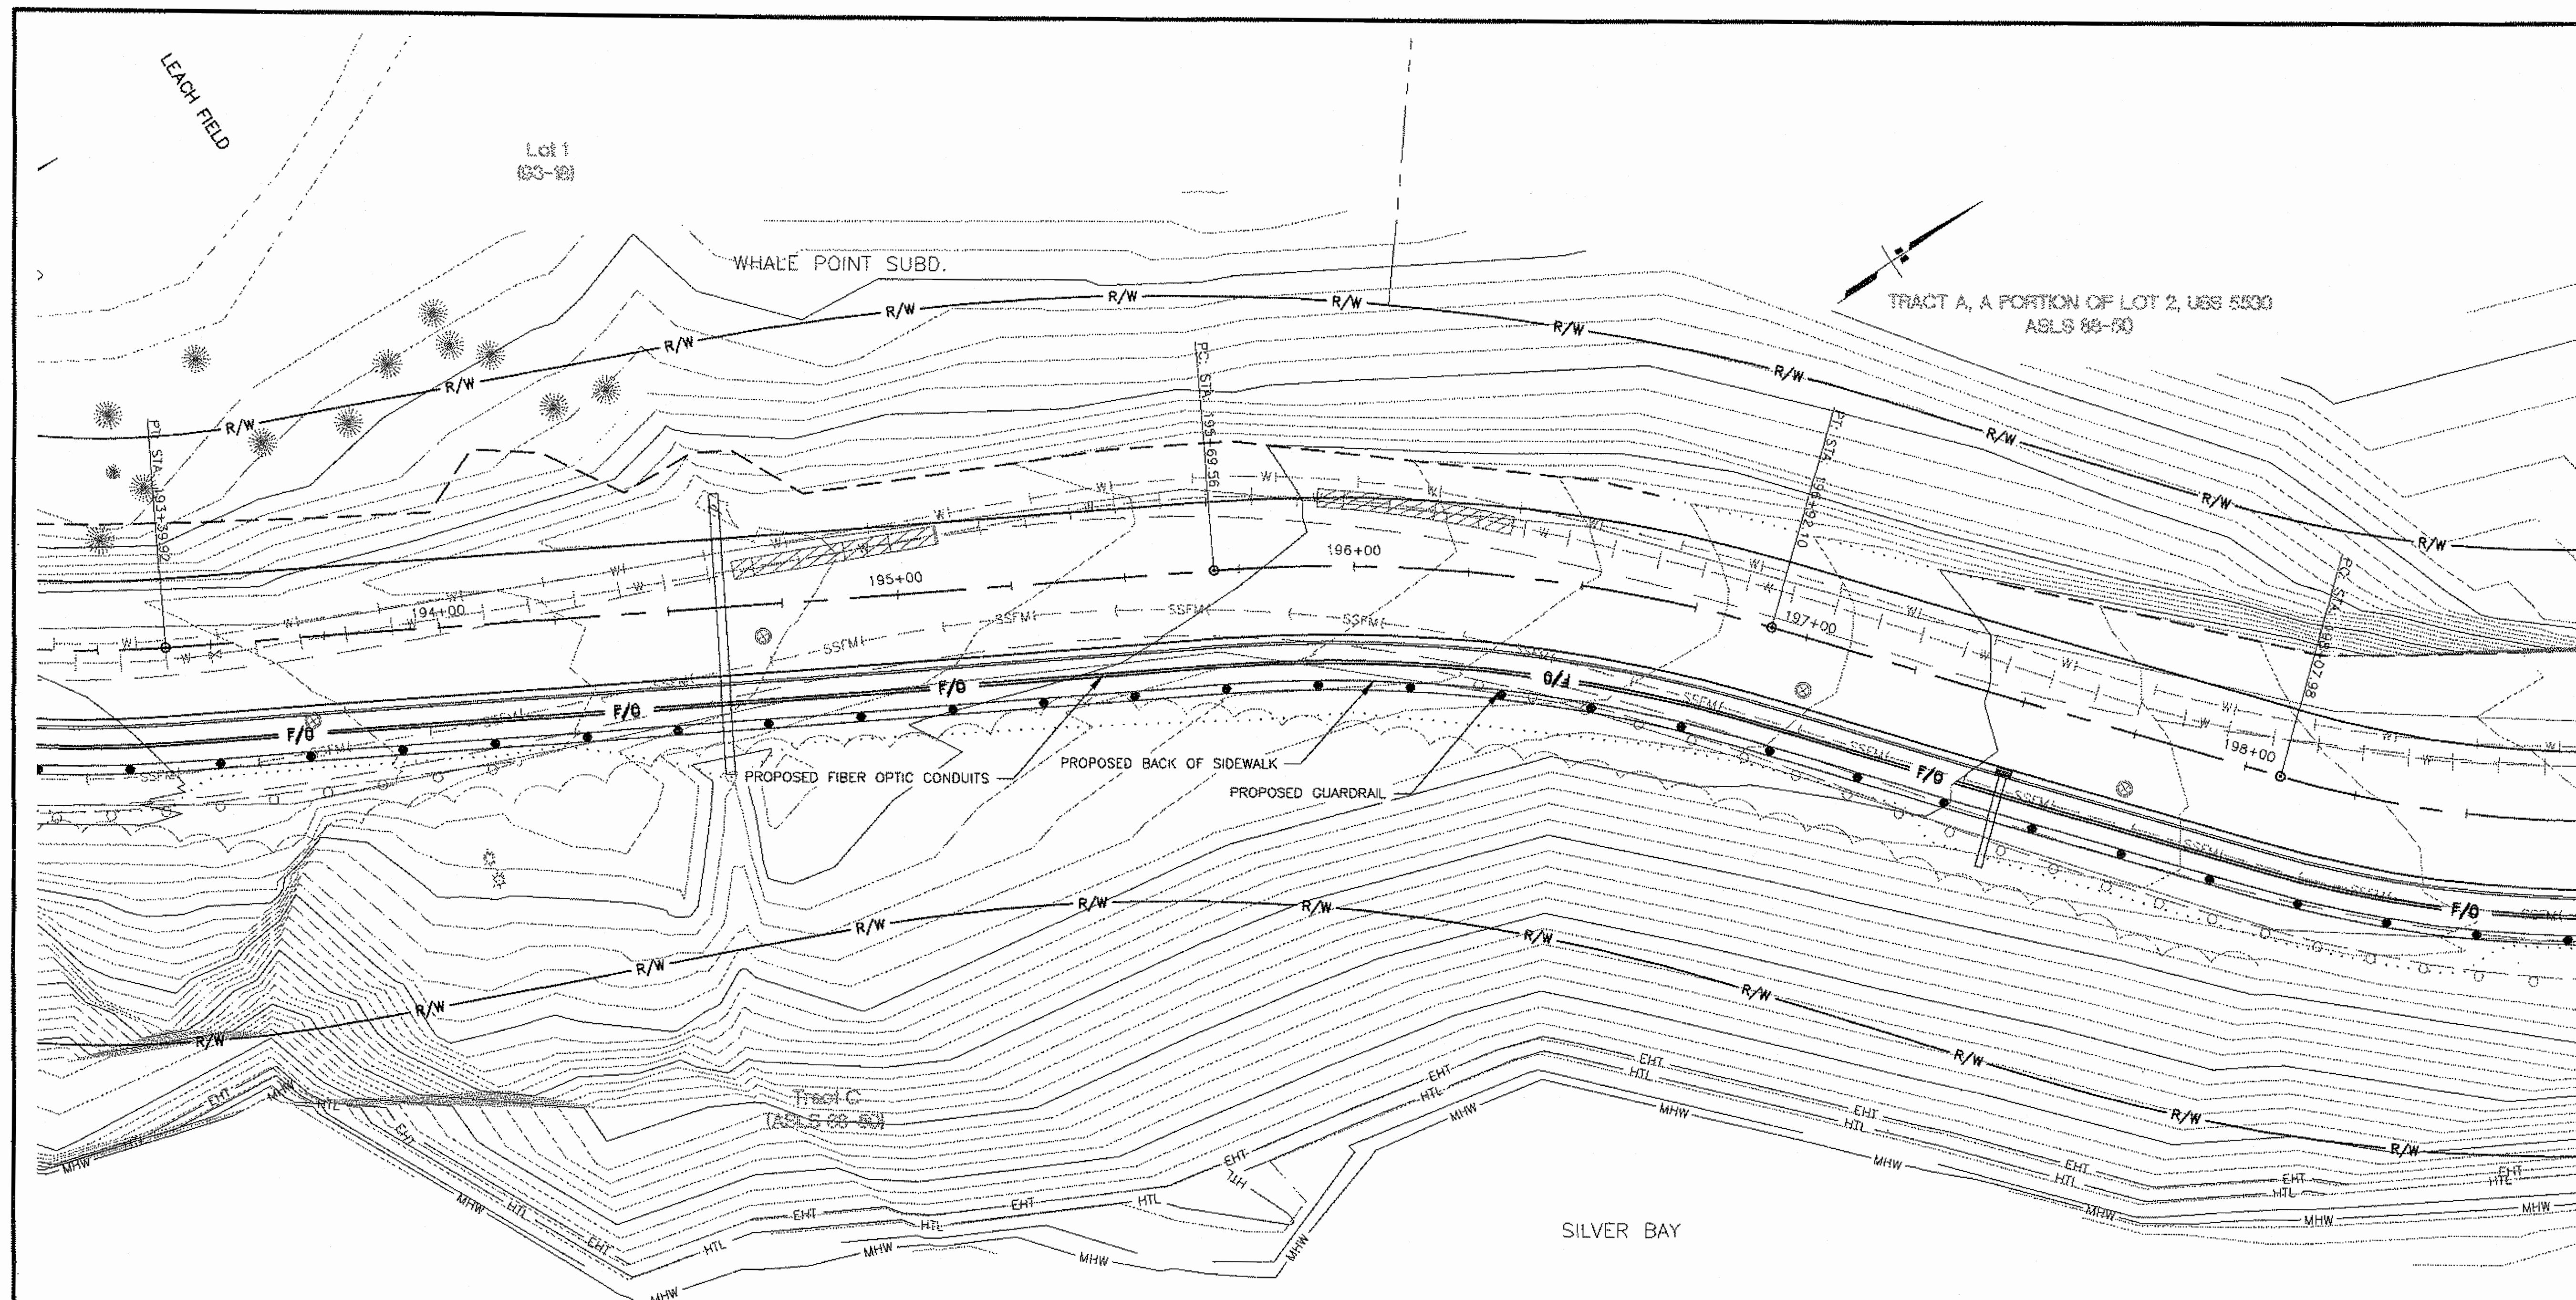

Project As Built Drawings Have Been Reviewed By The Project Engineer & Represent, To The Best Of My Knowledge, The Project As Constructed.
 Proj. Eng. *[Signature]* 6-24-15 Date

PATH:		
PLOT: PSPACE 1=1(F) OR MSPACE 1=1(F) TAB: D4		
ADDENDUM NUMBER		
ATTACHMENT NUMBER		
4		
RECORD OF REVISIONS		
No.	DATE	DESCRIPTION

SAWMILL CREEK ROAD UPGRADE
 PHASE III- WHALE PARK TO SAWMILL CREEK BRIDGE
 68216/MGS-STP-0933(21)
 SITKA TELECOMMUNICATIONS CONDUIT
 RSA NO. 69615

ELECTRIC UTILITY PLAN

DESIGNED BY: M. CARSON



10/3/12

CHECKED BY: R. DRYDEN
 DRAWN BY: M. CARSON


STATE OF ALASKA
 DEPARTMENT OF TRANSPORTATION
 & PUBLIC FACILITIES
 SOUTHEAST REGION DESIGN
 & ENGINEERING SERVICES DIVISION

ELECTRIC
 UTILITY PLAN
 STA. 193+50 TO
 STA. 198+50

PROJECT DESIGNATION NUMBER
 68216/MGS-STP-0933(21)

STATE	YEAR
ALASKA	2012
SHEET NUMBER	TOTAL SHEETS
U03	109

DO NOT SCALE FROM THESE DRAWINGS, USE DIMENSIONS

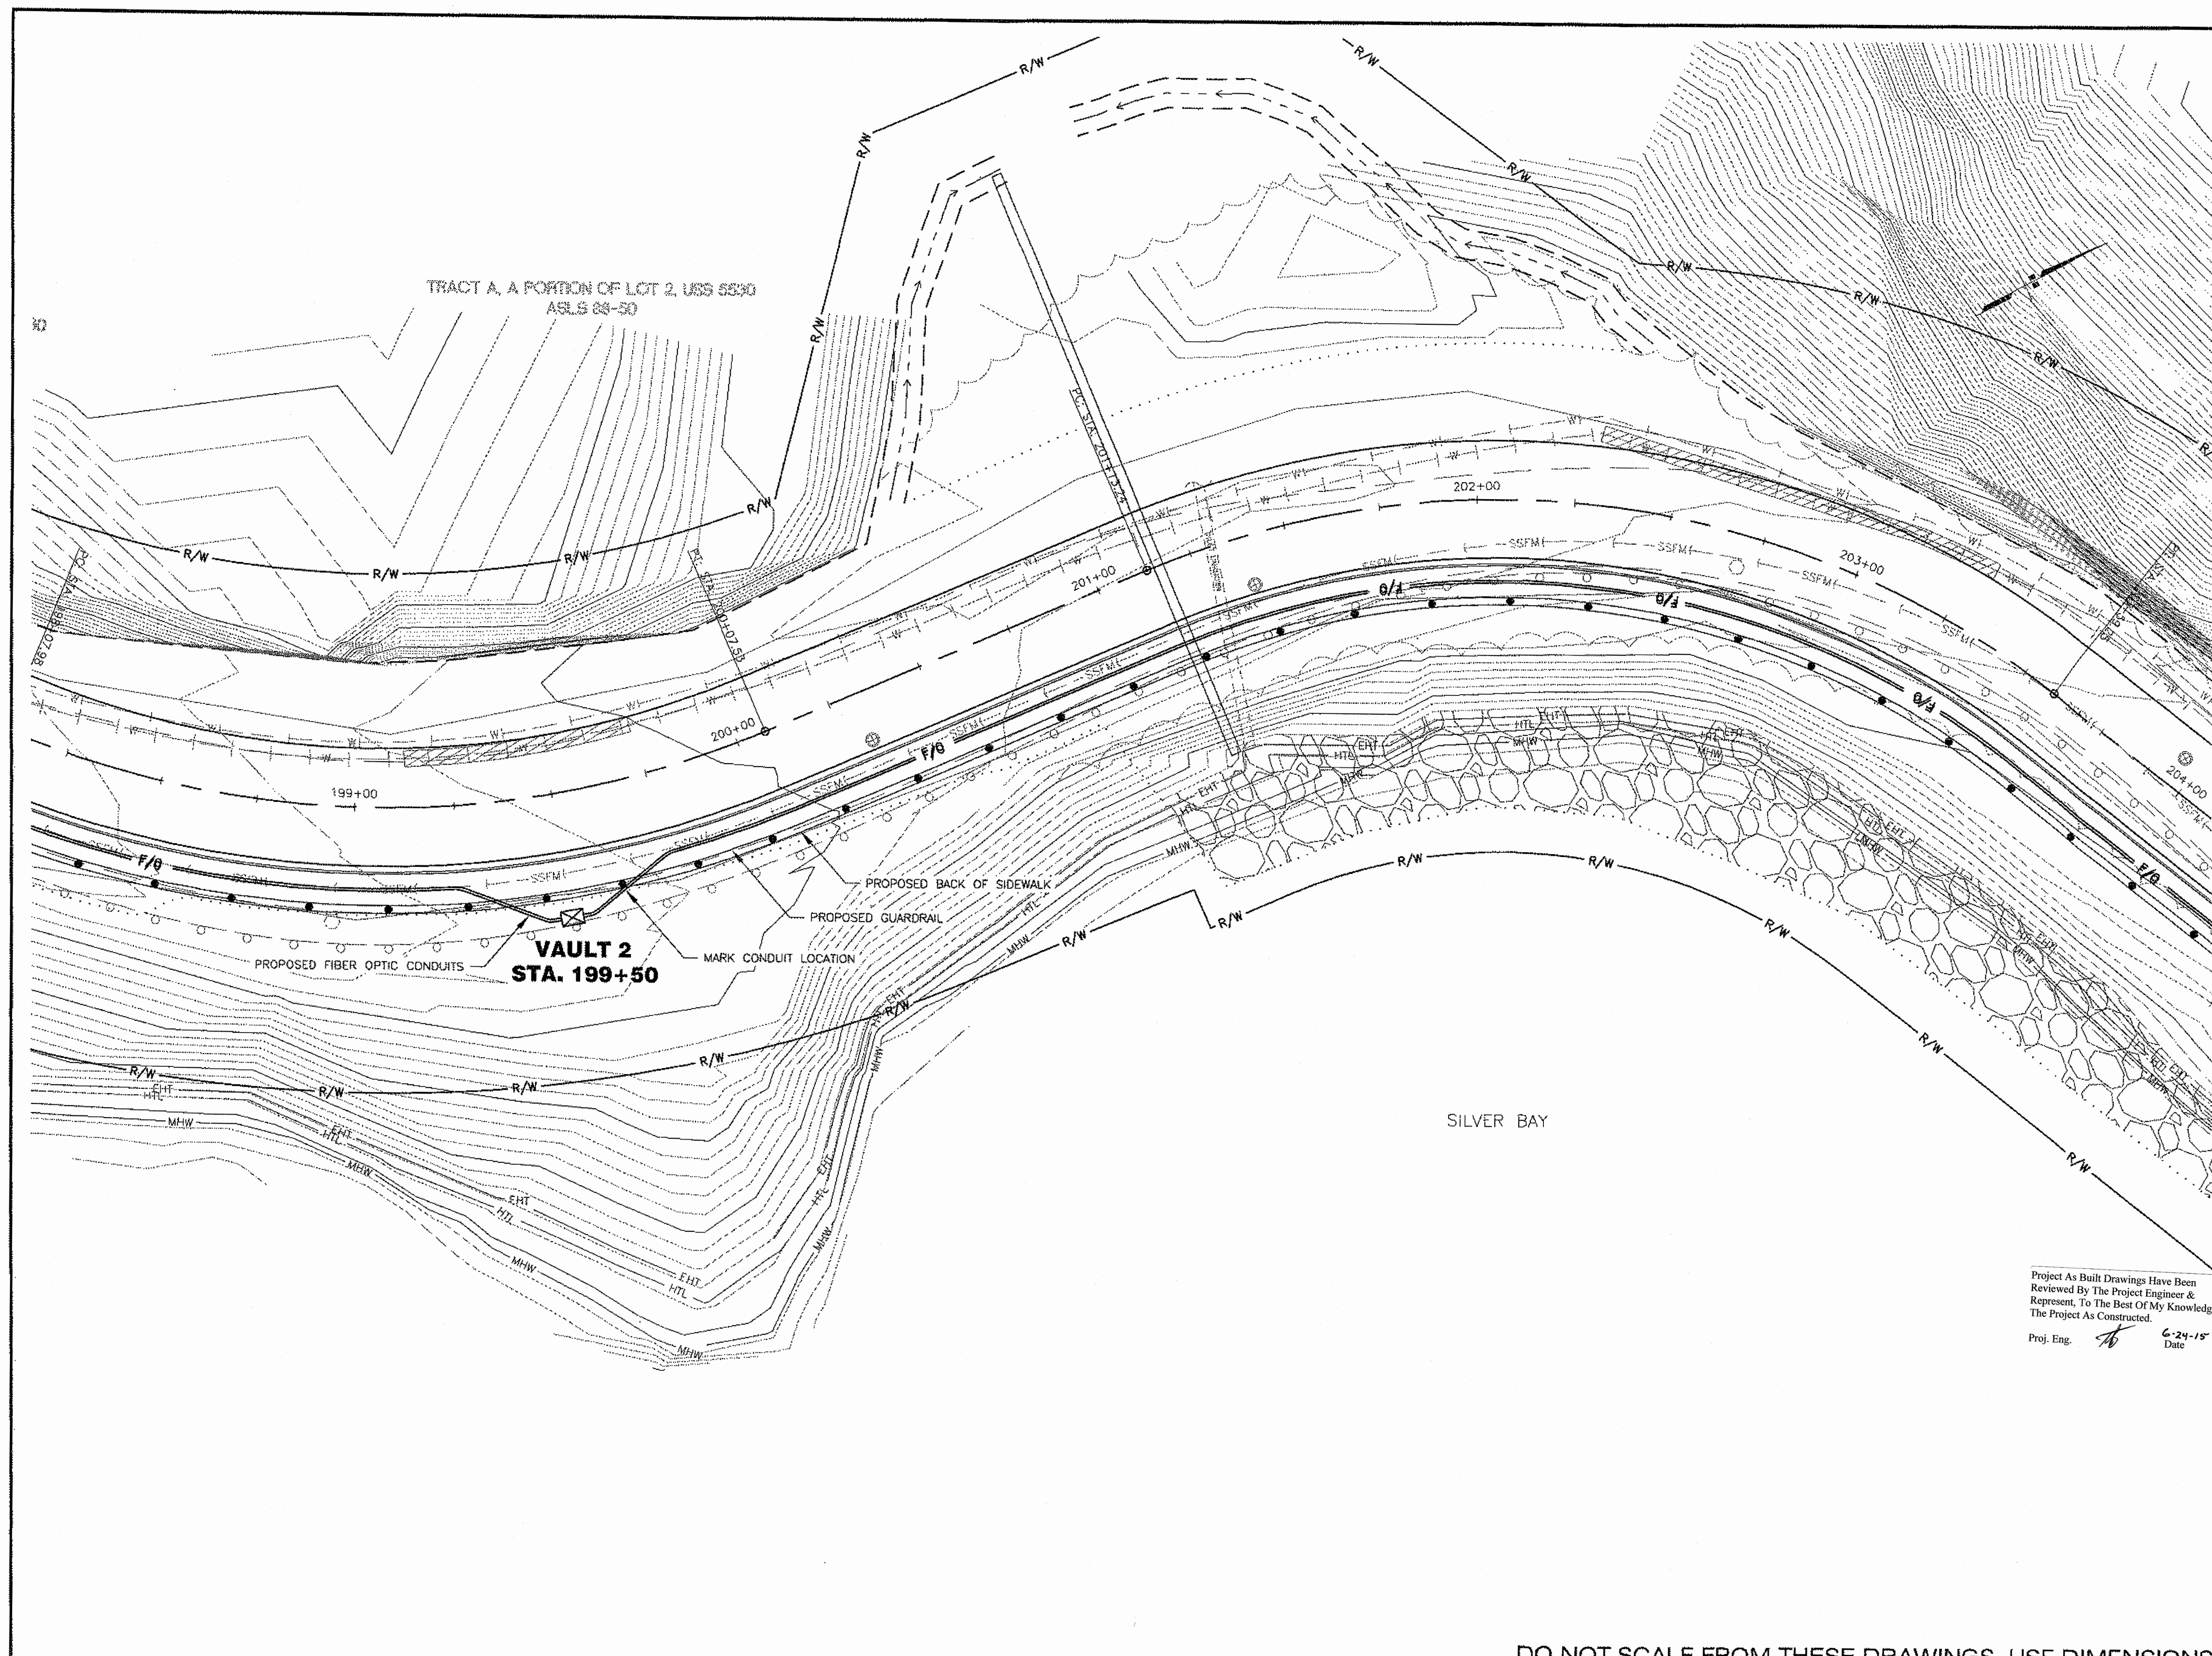

PATH:

PLOT:
PSPACE 1=1(F) OR MSPACE 1=1(F)
TAB: D4

ADDENDUM NUMBER
1

ATTACHMENT NUMBER
4

RECORD OF REVISIONS

No.	DATE	DESCRIPTION

SAWMILL CREEK ROAD UPGRADE
PHASE III- WHALE PARK TO SAWMILL CREEK BRIDGE
68216MGS-STP-0933(21)
SITKA TELECOMMUNICATIONS CONDUIT
RSA NO. 69615

ELECTRIC UTILITY PLAN

DESIGNED BY: M. CARSON

 10/3/12

CHECKED BY: R. GRYDEN

DRAWN BY: M. CARSON

STATE OF ALASKA
DEPARTMENT OF TRANSPORTATION
& PUBLIC FACILITIES
SOUTHEAST REGION DESIGN
& ENGINEERING SERVICES DIVISION


**ELECTRIC
UTILITY PLAN
STA. 198+50 TO
STA. 203+50**

PROJECT DESIGNATION NUMBER
68216MGS-STP-0933(21)

STATE	YEAR
ALASKA	2012

SHEET NUMBER	TOTAL SHEETS
U04	109


DO NOT SCALE FROM THESE DRAWINGS, USE DIMENSIONS

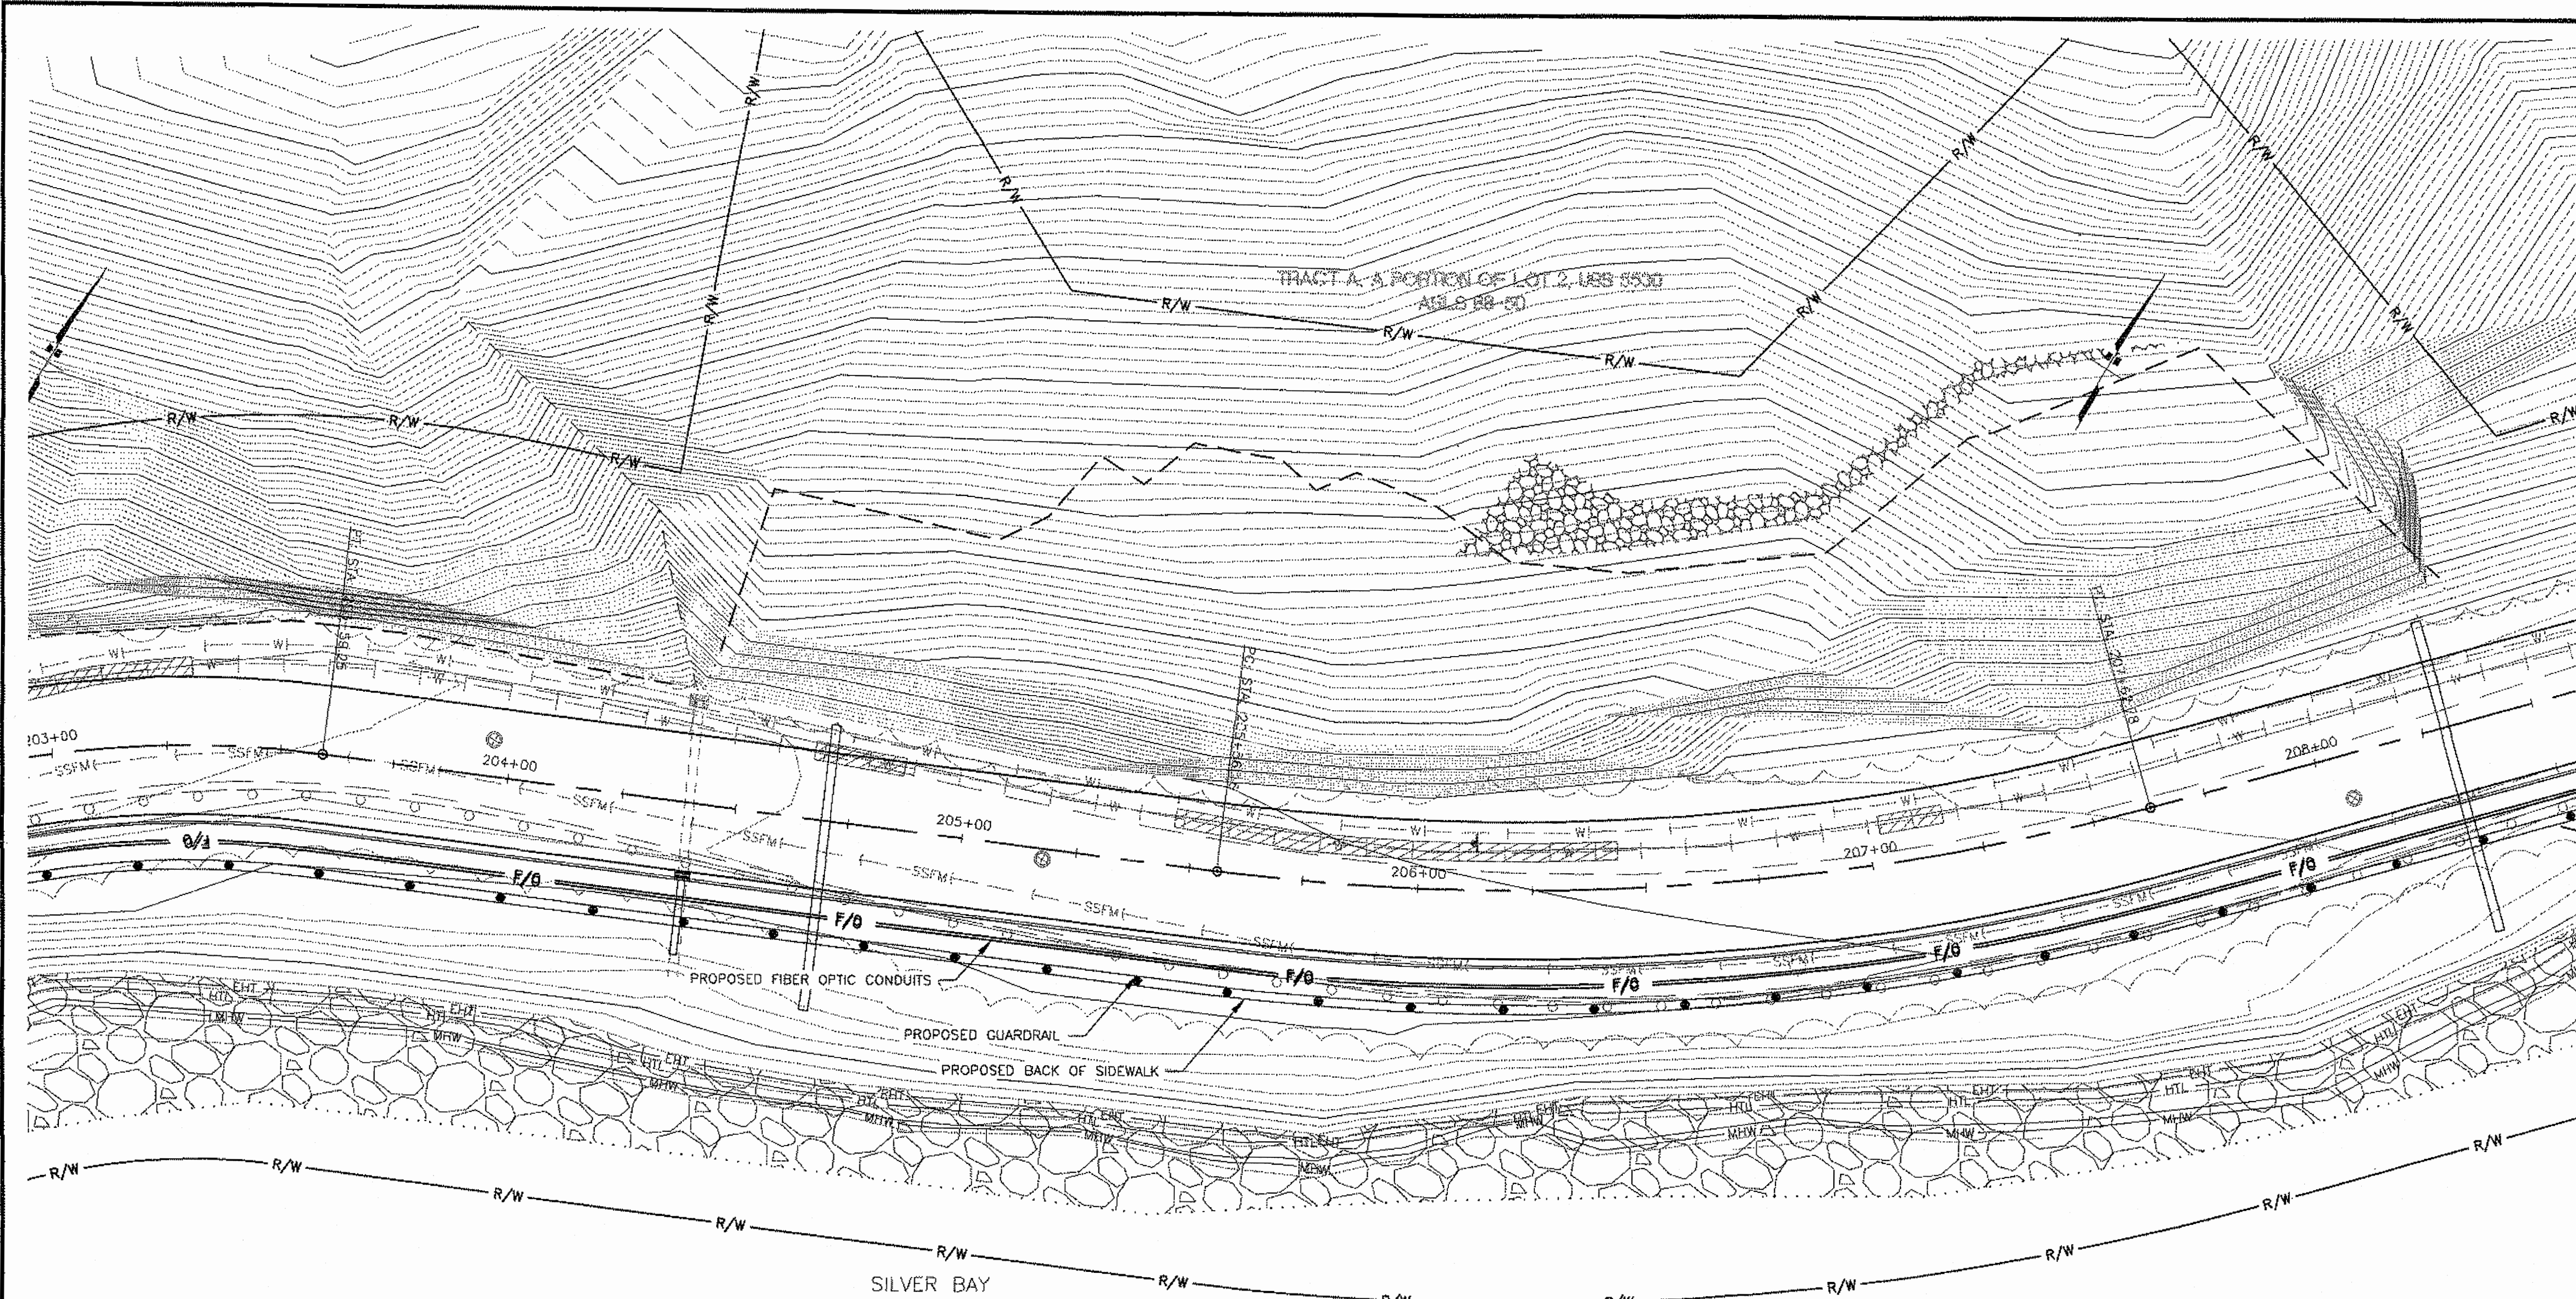

Project As Built Drawings Have Been Reviewed By The Project Engineer & Represent, To The Best Of My Knowledge, The Project As Constructed.
Proj. Eng. *[Signature]* 6-24-15 Date

PATH:		
PLOT: PSPACE 1=1(F) OR MSPACE 1=1(F) TAB: D4		
ADDENDUM NUMBER 1		
ATTACHMENT NUMBER 4		
RECORD OF REVISIONS		
No.	DATE	DESCRIPTION
SAWMILL CREEK ROAD UPGRADE PHASE III- WHALE PARK TO SAWMILL CREEK BRIDGE 68216MGS-STP-0933(21) SITKA TELECOMMUNICATIONS CONDUIT RSA NO. 69615		
ELECTRIC UTILITY PLAN		
DESIGNED BY: M. CARSON		
 10/3/12		
CHECKED BY: R. GRYDEN		
DRAWN BY: M. CARSON		
STATE OF ALASKA DEPARTMENT OF TRANSPORTATION & PUBLIC FACILITIES SOUTHEAST REGION DESIGN & ENGINEERING SERVICES DIVISION		
ELECTRIC UTILITY PLAN STA. 203+50 TO STA. 208+50		
PROJECT DESIGNATION NUMBER 68216MGS-STP-0933(21)		
STATE ALASKA	YEAR 2012	
SHEET NUMBER U05	TOTAL SHEETS 109	

DO NOT SCALE FROM THESE DRAWINGS, USE DIMENSIONS

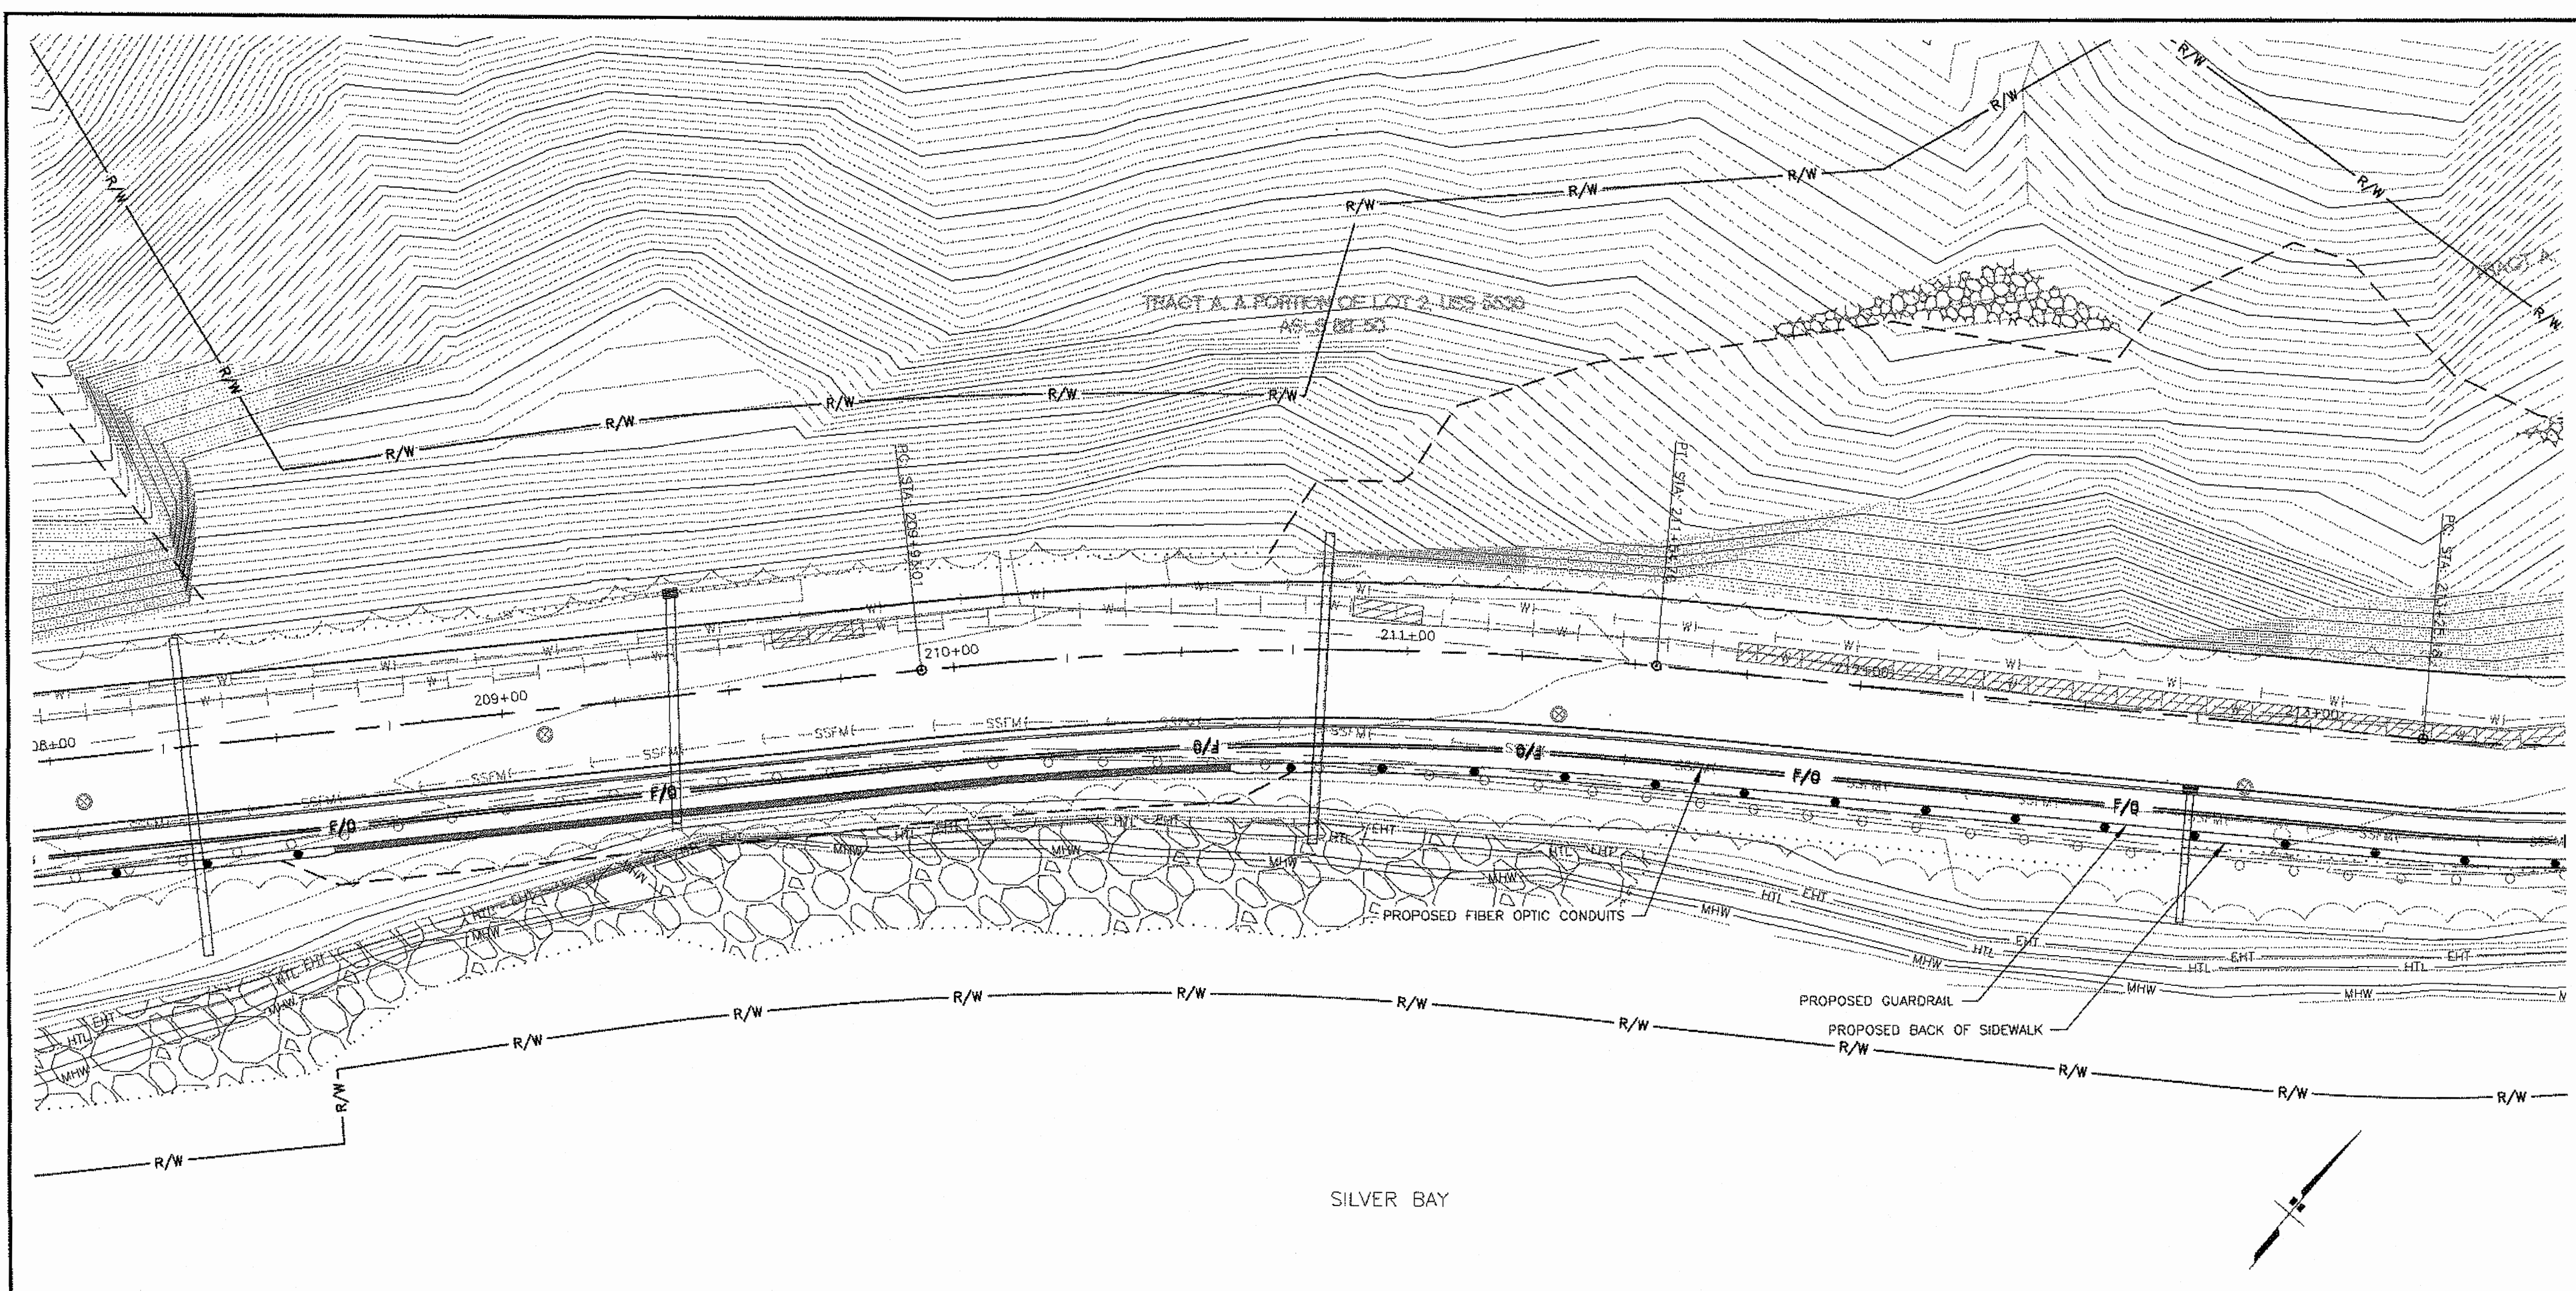

Project As Built Drawings Have Been
Reviewed By The Project Engineer &
Represent, To The Best Of My Knowledge,
The Project As Constructed.
Proj. Eng. *[Signature]* 6-24-12
Date

PATH:

PLOT:
PSPACE 1=1(F) OR MSPACE 1=1(F)
TAB: D4

ADDENDUM NUMBER
1

ATTACHMENT NUMBER
4

RECORD OF REVISIONS

No.	DATE	DESCRIPTION

SAWMILL CREEK ROAD UPGRADE
PHASE III- WHALE PARK TO SAWMILL CREEK BRIDGE
68216MGS-STP-0933(21)
SITKA TELECOMMUNICATIONS CONDUIT
RSA NO. 69615

ELECTRIC UTILITY PLAN

DESIGNED BY: M. CARSON

STATE OF ALASKA
49th
Frank Michael Carson
Professional Engineer
EE-5664

10/3/12

CHECKED BY: R. DRYDEN
DRAWN BY: M. CARSON


STATE OF ALASKA
DEPARTMENT OF TRANSPORTATION
& PUBLIC FACILITIES
SOUTHEAST REGION DESIGN
& ENGINEERING SERVICES DIVISION

**ELECTRIC
UTILITY PLAN
STA. 208+50 TO
STA. 213+50**

PROJECT DESIGNATION NUMBER
68216MGS-STP-0933(21)

STATE	YEAR
ALASKA	2012
SHEET NUMBER	TOTAL SHEETS
U06	109

DO NOT SCALE FROM THESE DRAWINGS, USE DIMENSIONS

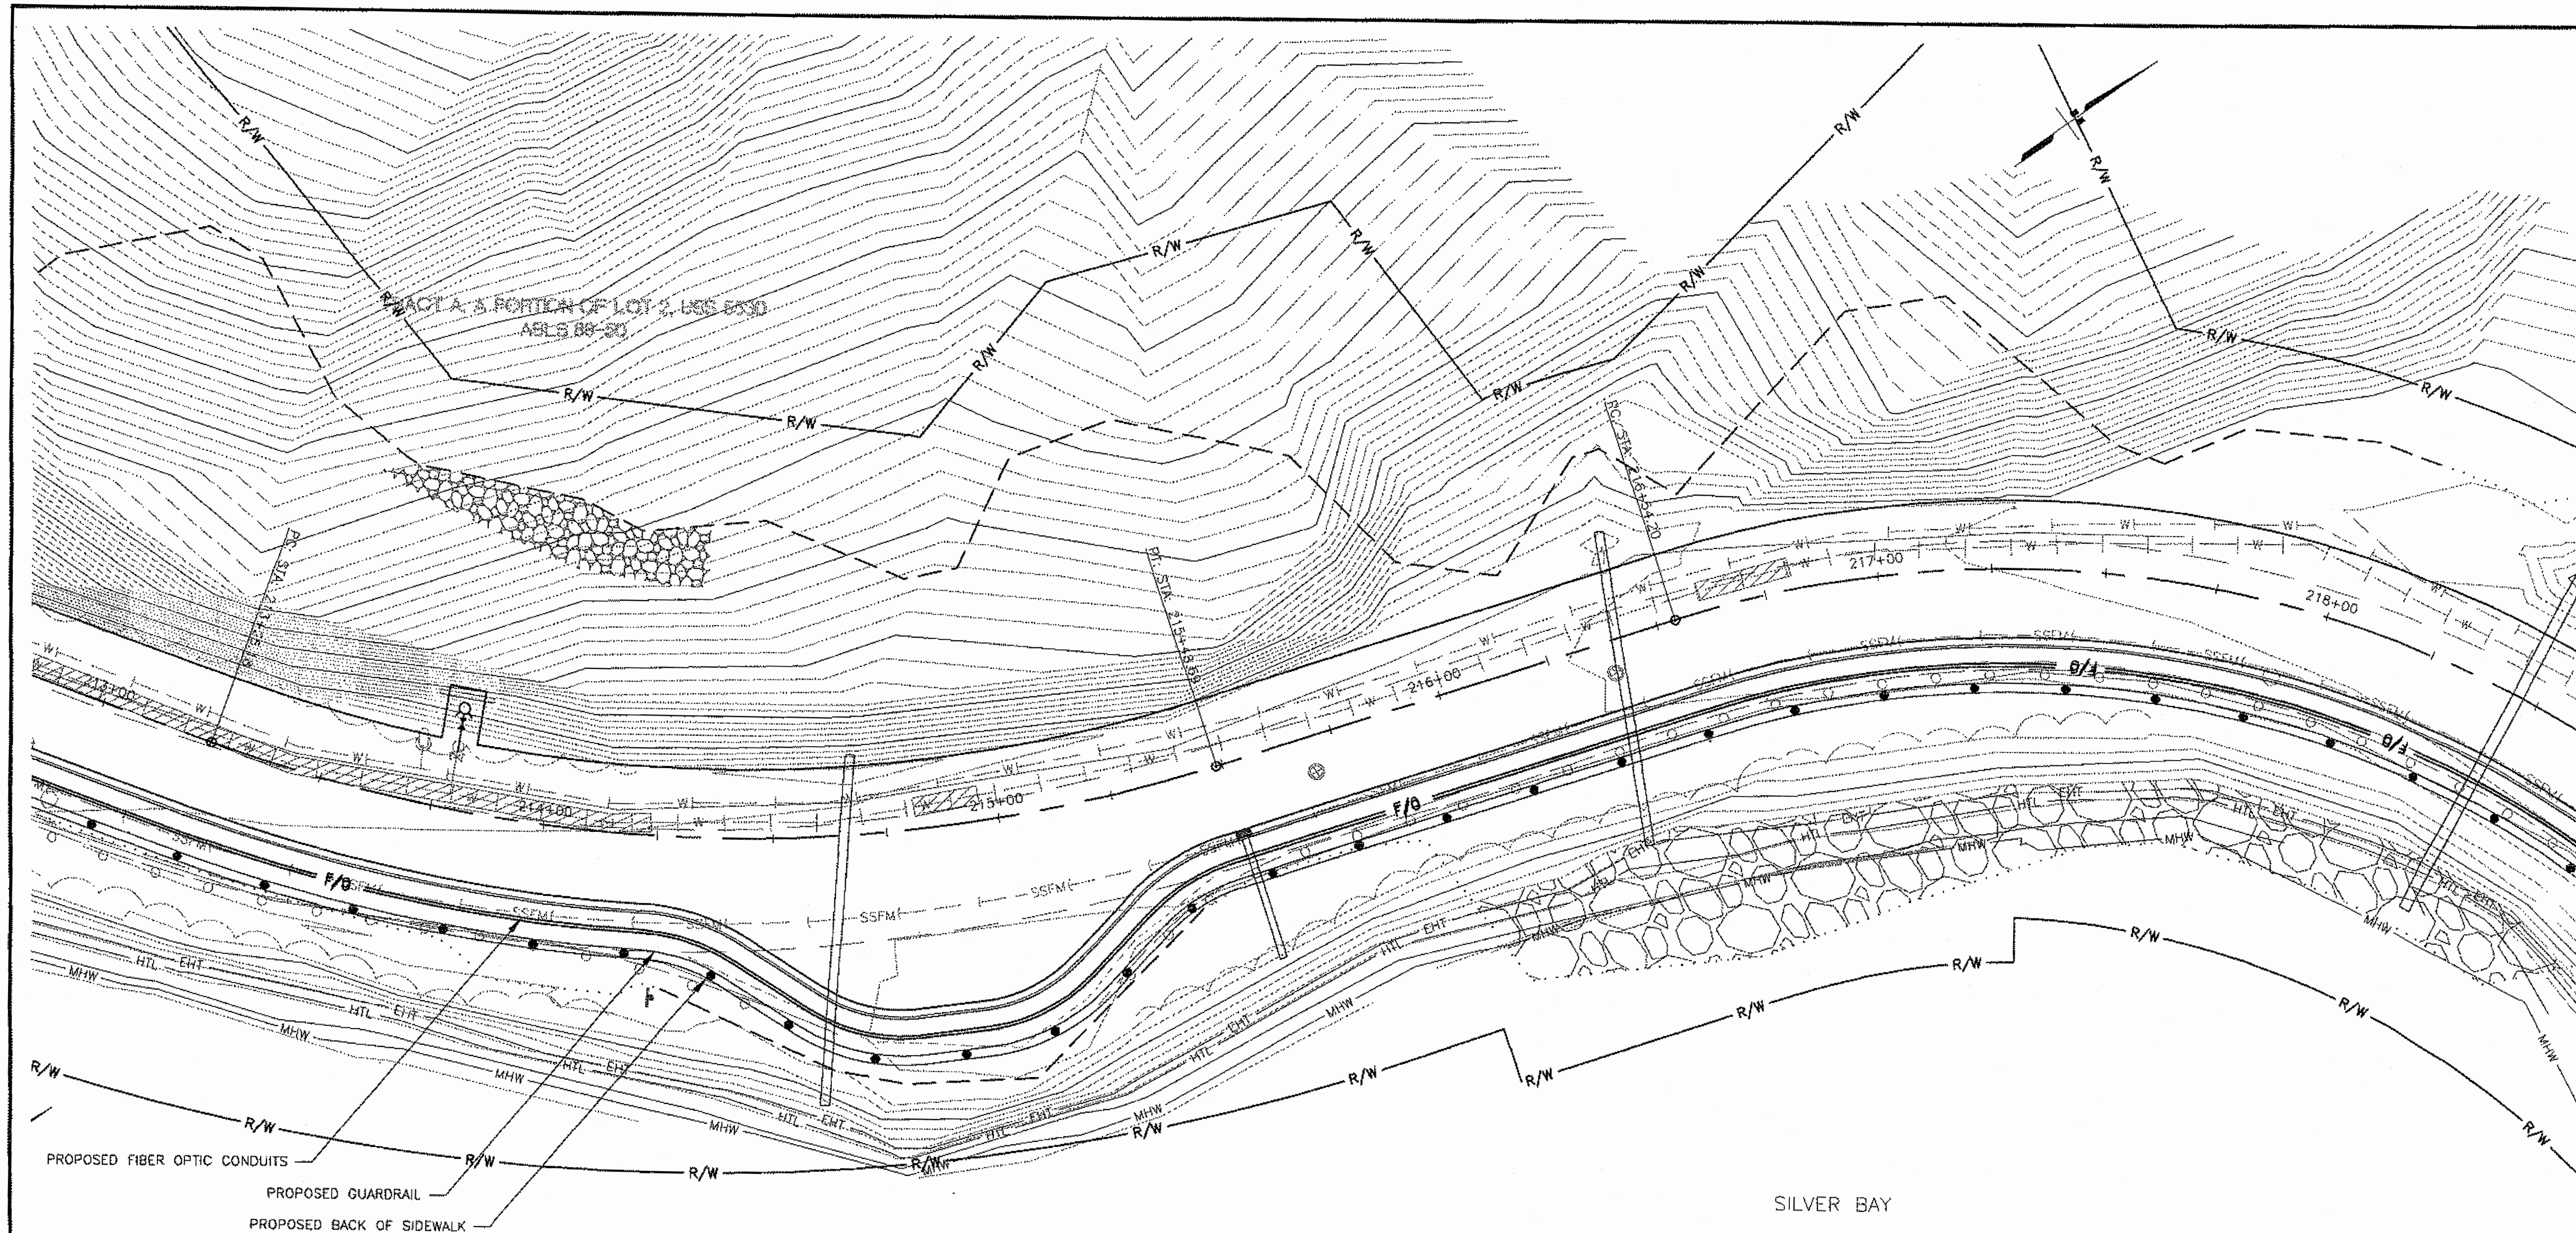

PATH:

PLOT:
PSPACE 1=1(F) OR MSPACE 1=1(F)
TAB: D4

ADDENDUM NUMBER
1

ATTACHMENT NUMBER
4

RECORD OF REVISIONS

No.	DATE	DESCRIPTION

SAWMILL CREEK ROAD UPGRADE
PHASE III- WHALE PARK TO SAWMILL CREEK BRIDGE
68216MGS-STP-0933(21)
SITKA TELECOMMUNICATIONS CONDUIT
RSA NO. 69615

ELECTRIC UTILITY PLAN

Project As Built Drawings Have Been
Reviewed By The Project Engineer &
Represent, To The Best Of My Knowledge,
The Project As Constructed.

Proj. Eng. *[Signature]* 6-24-12
Date

DESIGNED BY: M. CARSON

CHECKED BY: R. DRYDEN

DRAWN BY: M. CARSON

10/3/12

STATE OF ALASKA
DEPARTMENT OF TRANSPORTATION
& PUBLIC FACILITIES
SOUTHEAST REGION DESIGN
& ENGINEERING SERVICES DIVISION


**ELECTRIC
UTILITY PLAN
STA. 213+50 TO
STA. 218+50**

PROJECT DESIGNATION NUMBER
68216MGS-STP-0933(21)

STATE	YEAR
ALASKA	2012

SHEET NUMBER	TOTAL SHEETS
U07	109

DO NOT SCALE FROM THESE DRAWINGS, USE DIMENSIONS

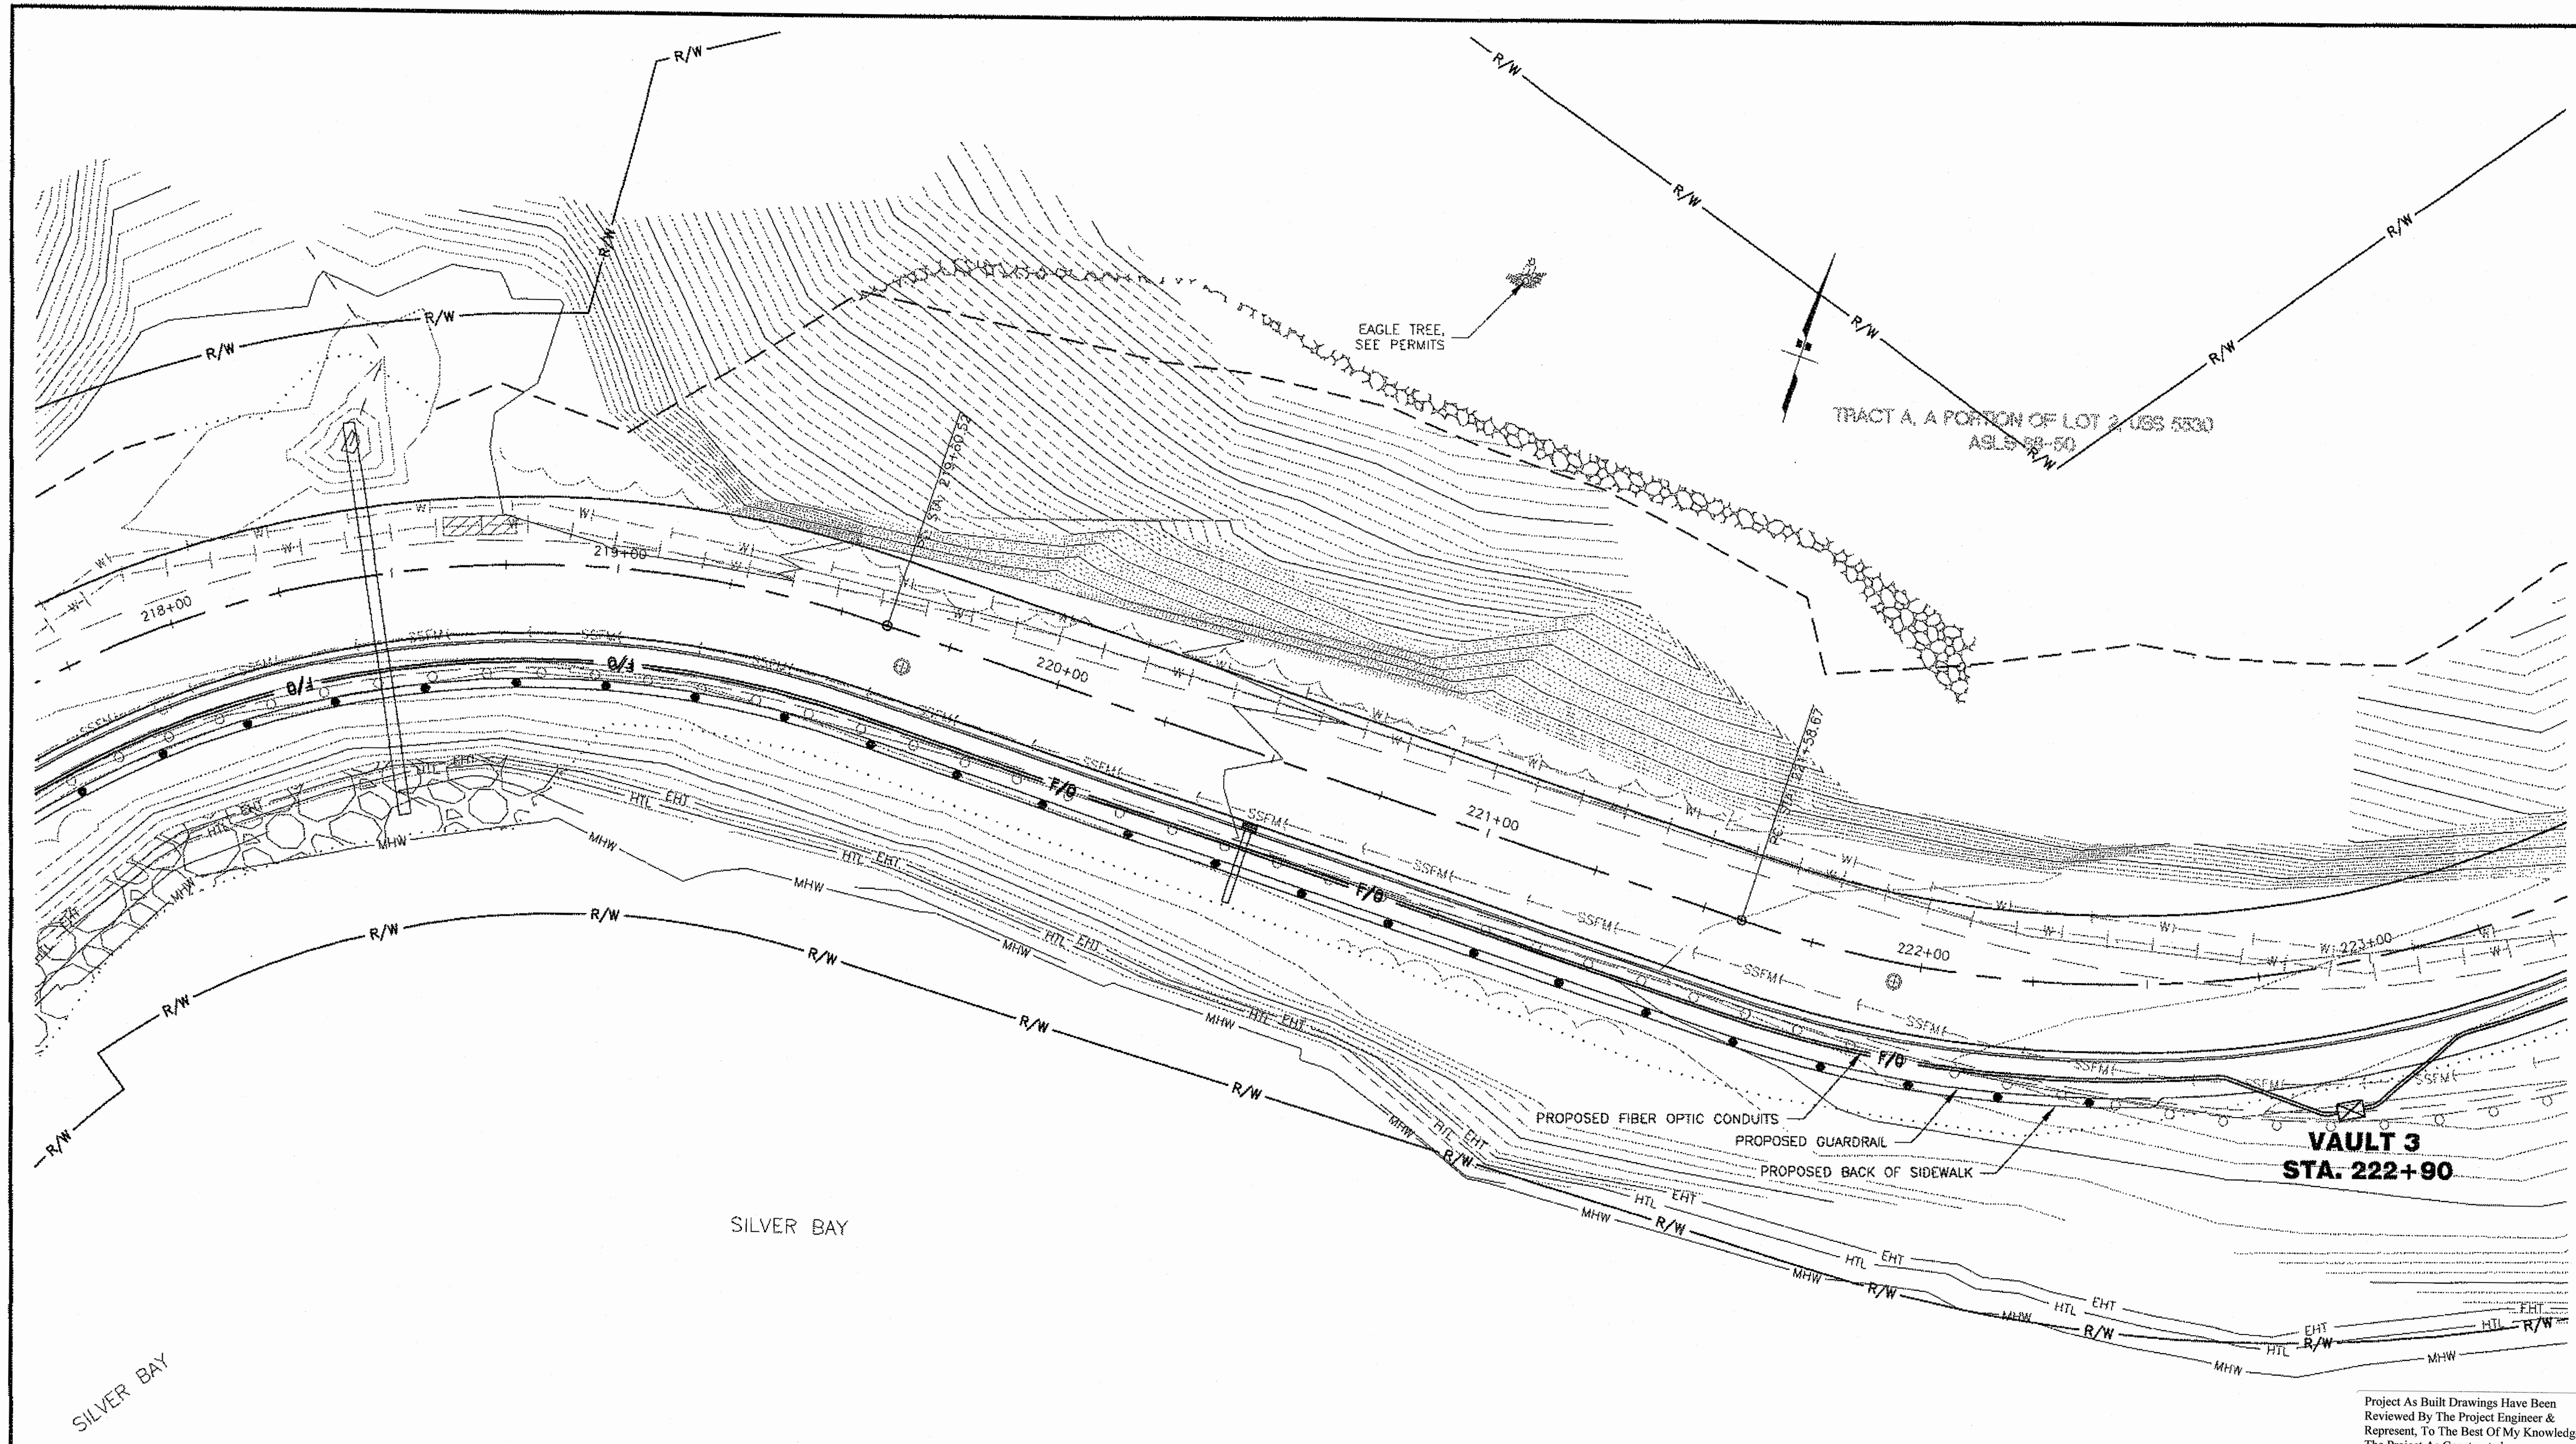

Project As Built Drawings Have Been
Reviewed By The Project Engineer &
Represent, To The Best Of My Knowledge,
The Project As Constructed.
Proj. Eng. *[Signature]* 6-24-15
Date

PATH:		
PLOT: PSPACE 1=1(F) OR MSPACE 1=1(F) TAB: D4		
ADDENDUM NUMBER		
ATTACHMENT NUMBER		
4		
RECORD OF REVISIONS		
No.	DATE	DESCRIPTION

SAWMILL CREEK ROAD UPGRADE
PHASE III- WHALE PARK TO SAWMILL CREEK BRIDGE
68216MGS-STP-0933(21)
SITKA TELECOMMUNICATIONS CONDUIT
RSA NO. 69615
ELECTRIC UTILITY PLAN

DESIGNED BY: M. CARSON



10/3/12

CHECKED BY: R. DRYDEN
DRAWN BY: M. CARSON


STATE OF ALASKA
DEPARTMENT OF TRANSPORTATION
& PUBLIC FACILITIES
SOUTHEAST REGION DESIGN
& ENGINEERING SERVICES DIVISION

**ELECTRIC
UTILITY PLAN
STA. 218+50 TO
STA. 223+50**

PROJECT DESIGNATION NUMBER
68216MGS-STP-0933(21)

STATE	YEAR
ALASKA	2012
SHEET NUMBER	TOTAL SHEETS
U08	109

DO NOT SCALE FROM THESE DRAWINGS, USE DIMENSIONS

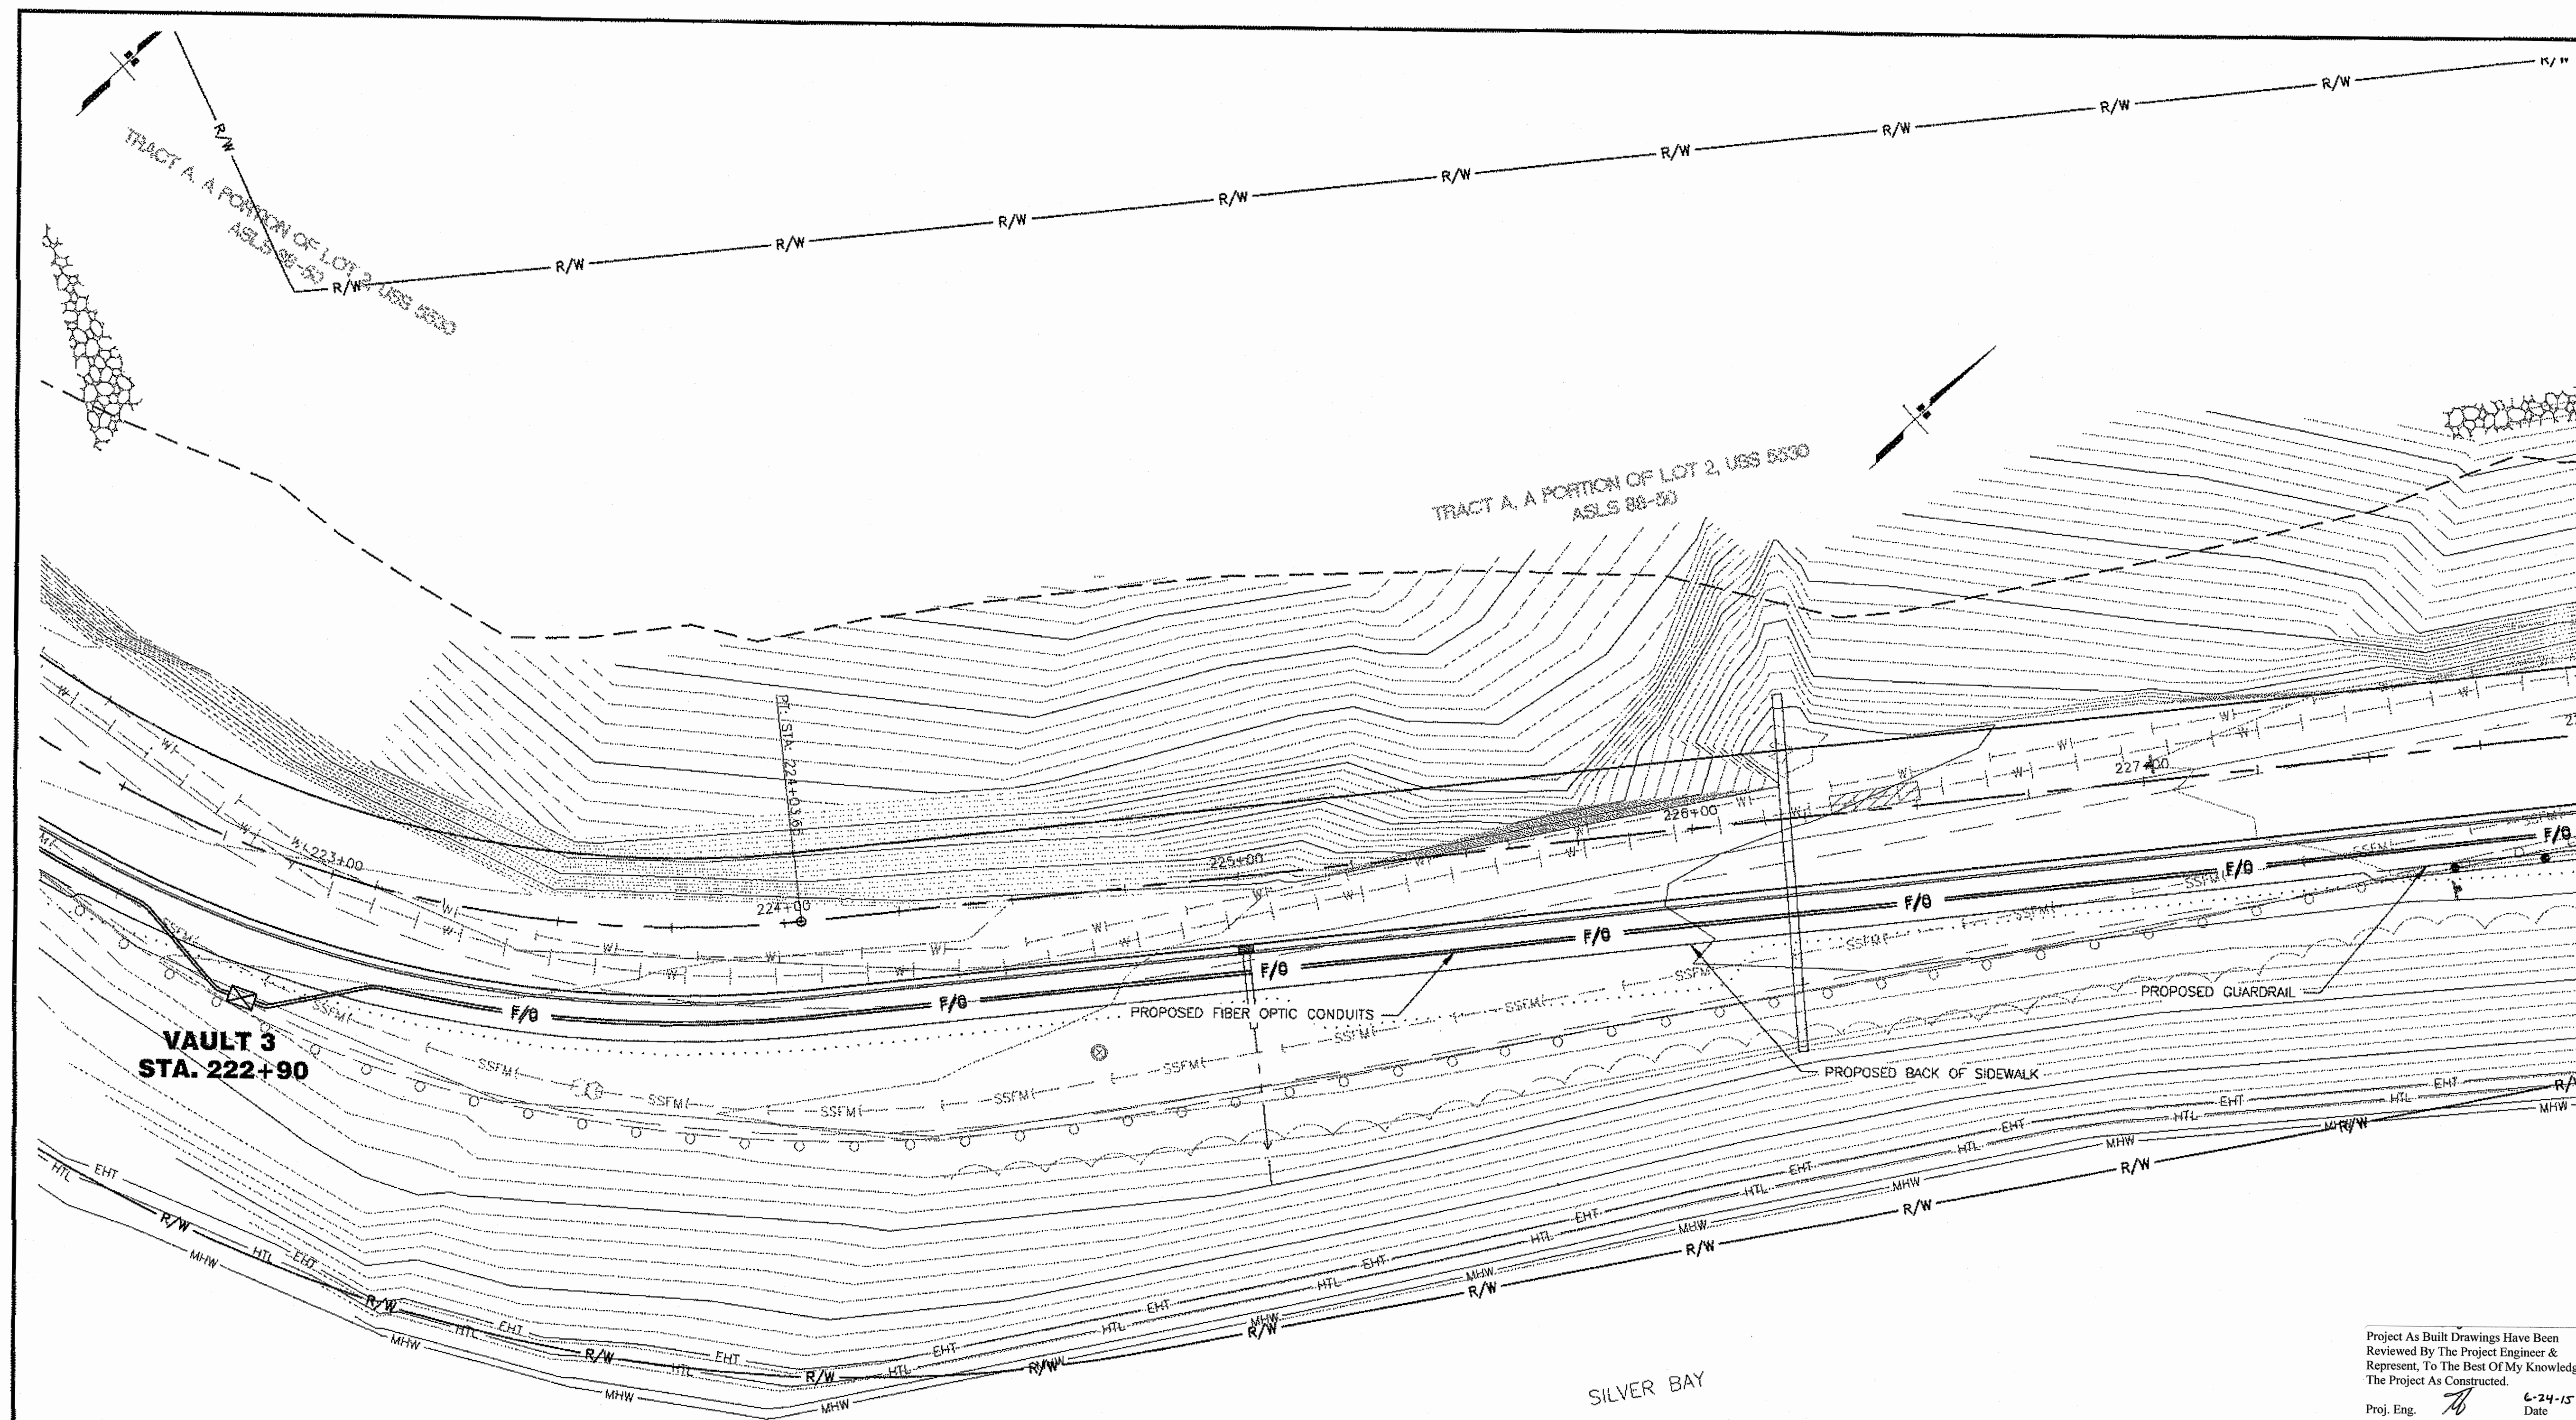

Project As Built Drawings Have Been
Reviewed By The Project Engineer &
Represent, To The Best Of My Knowledge,
The Project As Constructed.
Proj. Eng. *[Signature]* Date 6-24-15

PATH:		
PLOT: PSPACE 1=1(F) OR MSPACE 1=1(F) TAB: D4		
ADDENDUM NUMBER		
ATTACHMENT NUMBER		
RECORD OF REVISIONS		
No.	DATE	DESCRIPTION

SAWMILL CREEK ROAD UPGRADE
PHASE III- WHALE PARK TO SAWMILL CREEK BRIDGE
68216MGS-STP-0933(21)
SITKA TELECOMMUNICATIONS CONDUIT
RSA NO. 69615

ELECTRIC UTILITY PLAN

DESIGNED BY: M. CARSON



10/3/12


CHECKED BY: R. DRYDEN
DRAWN BY: M. CARSON

STATE OF ALASKA
DEPARTMENT OF TRANSPORTATION
& PUBLIC FACILITIES
SOUTHEAST REGION DESIGN
& ENGINEERING SERVICES DIVISION

ELECTRIC
UTILITY PLAN
STA. 223+50 TO
STA. 228+00

PROJECT DESIGNATION NUMBER	
68216MGS-STP-0933(21)	
STATE	YEAR
ALASKA	2012
SHEET NUMBER	TOTAL SHEETS
U09	109

DO NOT SCALE FROM THESE DRAWINGS, USE DIMENSIONS

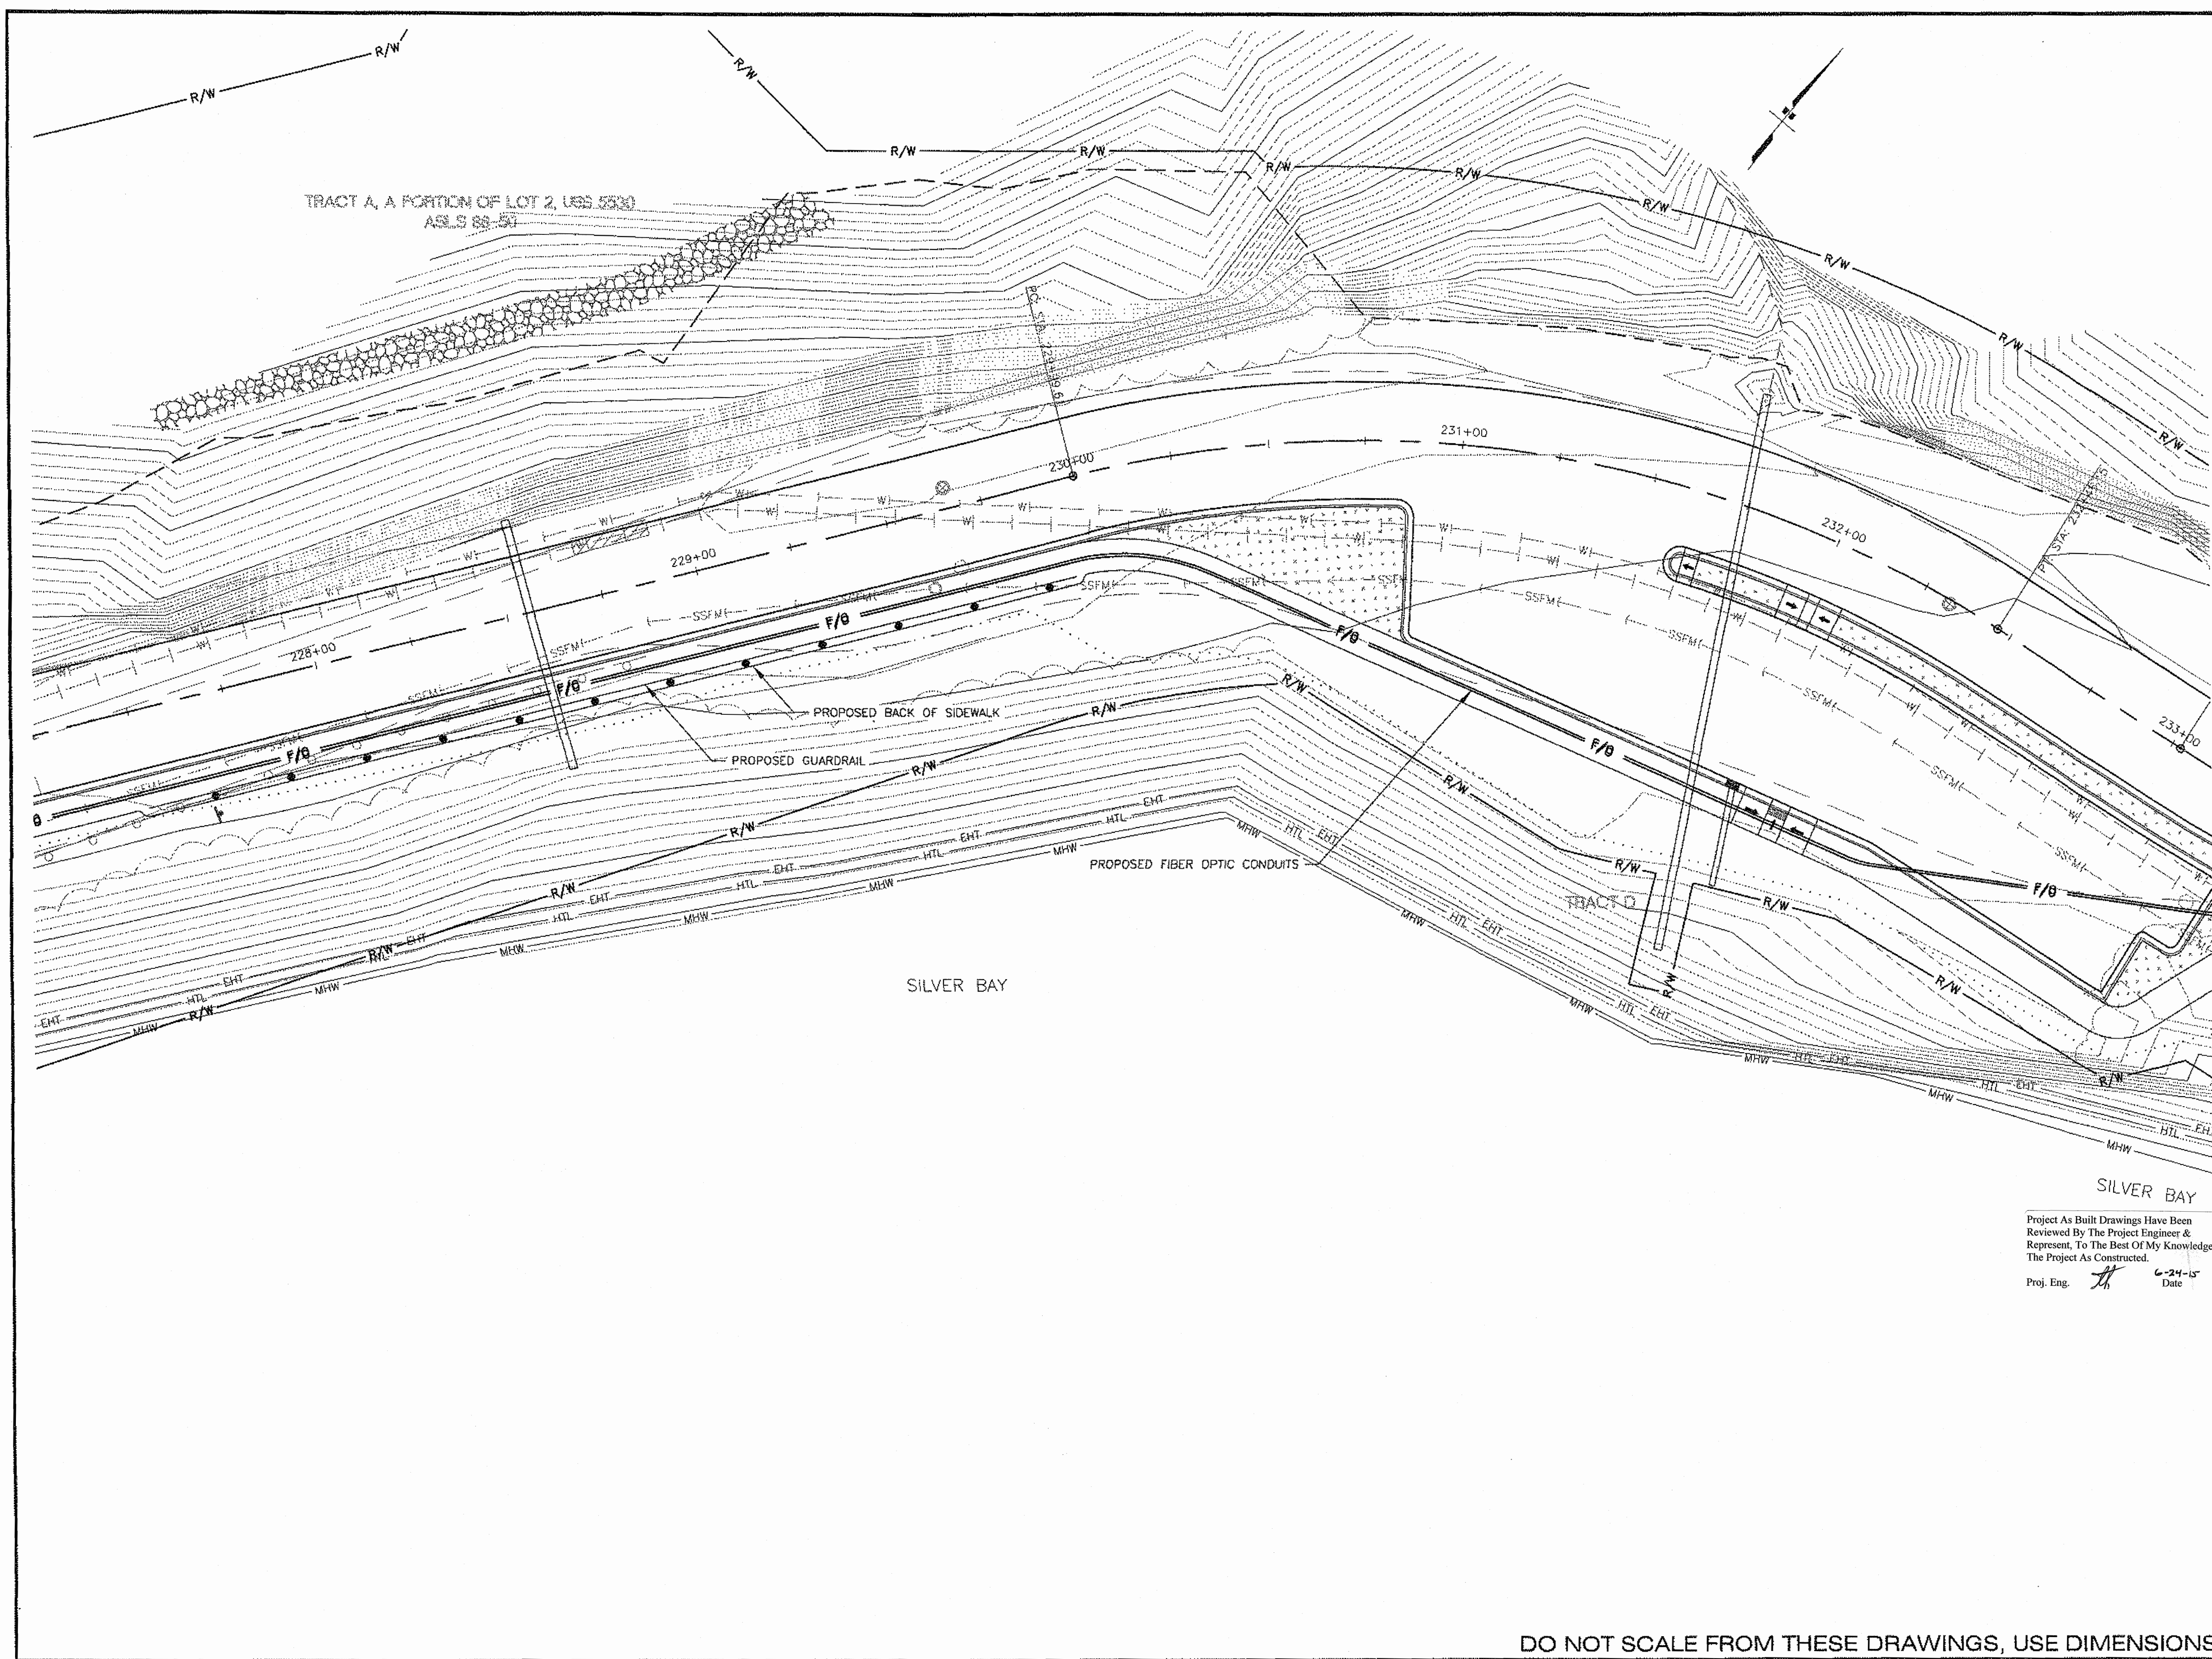

Project As Built Drawings Have Been Reviewed By The Project Engineer & Represent, To The Best Of My Knowledge, The Project As Constructed.
Proj. Eng. *[Signature]* 6-24-15 Date

PATH:


PLOT:
PSPACE 1=1(F) OR MSPACE 1=1(F)
TAB: D4

ADDENDUM NUMBER		
1		
ATTACHMENT NUMBER		
4		
RECORD OF REVISIONS		
No.	DATE	DESCRIPTION

SAWMILL CREEK ROAD UPGRADE
PHASE III- WHALE PARK TO SAWMILL CREEK BRIDGE
68216MGS-STP-0933(21)
SITKA TELECOMMUNICATIONS CONDUIT
RSA NO. 69615

ELECTRIC UTILITY PLAN

DESIGNED BY: M. CARSON

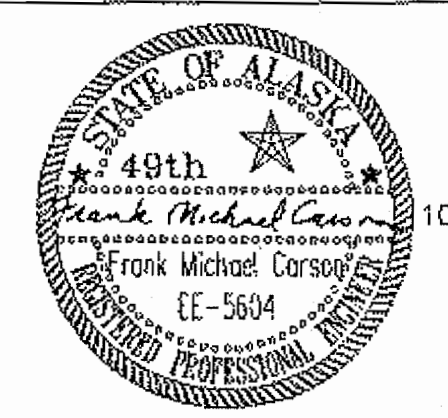

10/3/12

CHECKED BY: R. DRYDEN

DRAWN BY: M. CARSON

STATE OF ALASKA
DEPARTMENT OF TRANSPORTATION
& PUBLIC FACILITIES
SOUTHEAST REGION DESIGN
& ENGINEERING SERVICES DIVISION


ELECTRIC
UTILITY PLAN
STA. 228+00 TO
STA. 233+00

PROJECT DESIGNATION NUMBER

68216MGS-STP-0933(21)

STATE	YEAR
ALASKA	2012
SHEET NUMBER	TOTAL SHEETS
U10	109

DO NOT SCALE FROM THESE DRAWINGS, USE DIMENSIONS

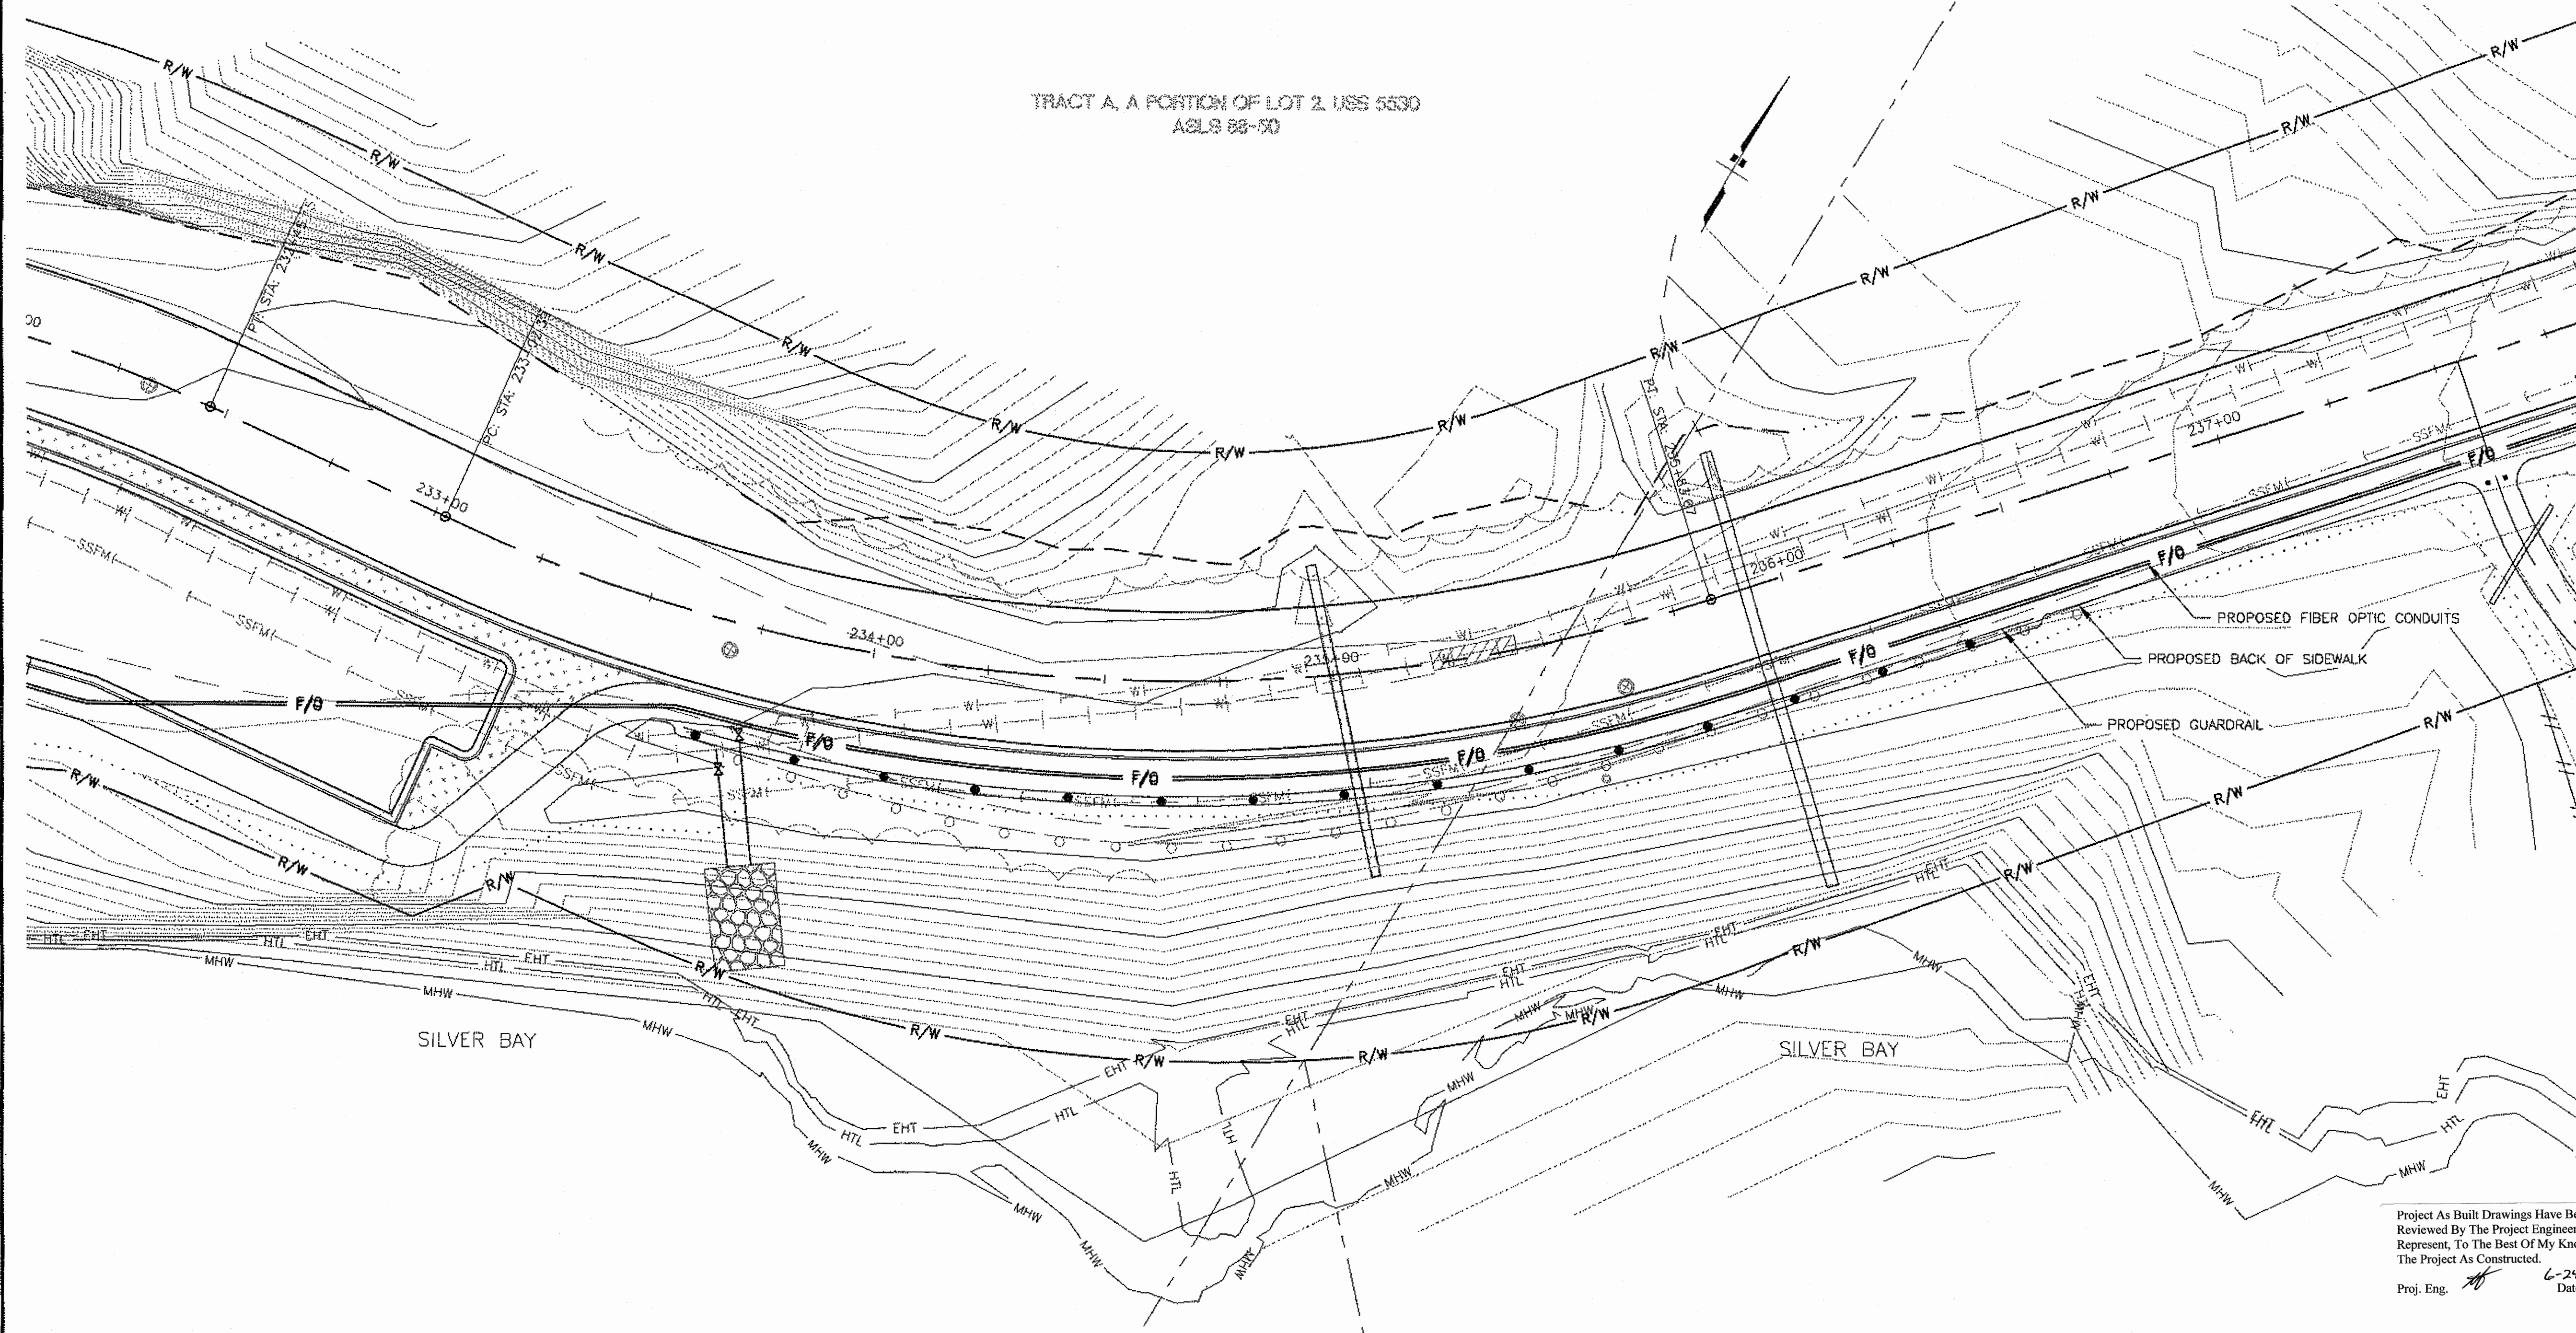

TRACT A, A PORTION OF LOT 2, USS 5530
AELS 55-50

SILVER BAY

SILVER BAY

Project As Built Drawings Have Been
Reviewed By The Project Engineer &
Represent To The Best Of My Knowledge
The Project As Constructed.
Proj. Eng. *[Signature]* 6-24-15 Date

PATH:		
PLOT: PSPACE 1=1(F) OR MSPACE 1=1(F) TAB: D4		
ADDENDUM NUMBER		
ATTACHMENT NUMBER		
4		
RECORD OF REVISIONS		
No.	DATE	DESCRIPTION

SAWMILL CREEK ROAD UPGRADE
PHASE III- WHALE PARK TO SAWMILL CREEK BRIDGE
68216MGS-STP-0933(21)
SITKA TELECOMMUNICATIONS CONDUIT
RSA NO. 69615

ELECTRIC UTILITY PLAN

DESIGNED BY: M. CARSON



CHECKED BY: R. DRYDEN

DRAWN BY: M. CARSON

STATE OF ALASKA
DEPARTMENT OF TRANSPORTATION
& PUBLIC FACILITIES
SOUTHEAST REGION DESIGN
& ENGINEERING SERVICES DIVISION


**ELECTRIC
UTILITY PLAN**
STA. 233+00 TO
STA. 238+00

PROJECT DESIGNATION NUMBER

68216MGS-STP-0933(21)

STATE	YEAR
ALASKA	2012
SHEET NUMBER	TOTAL SHEETS
U11	109

DO NOT SCALE FROM THESE DRAWINGS, USE DIMENSIONS

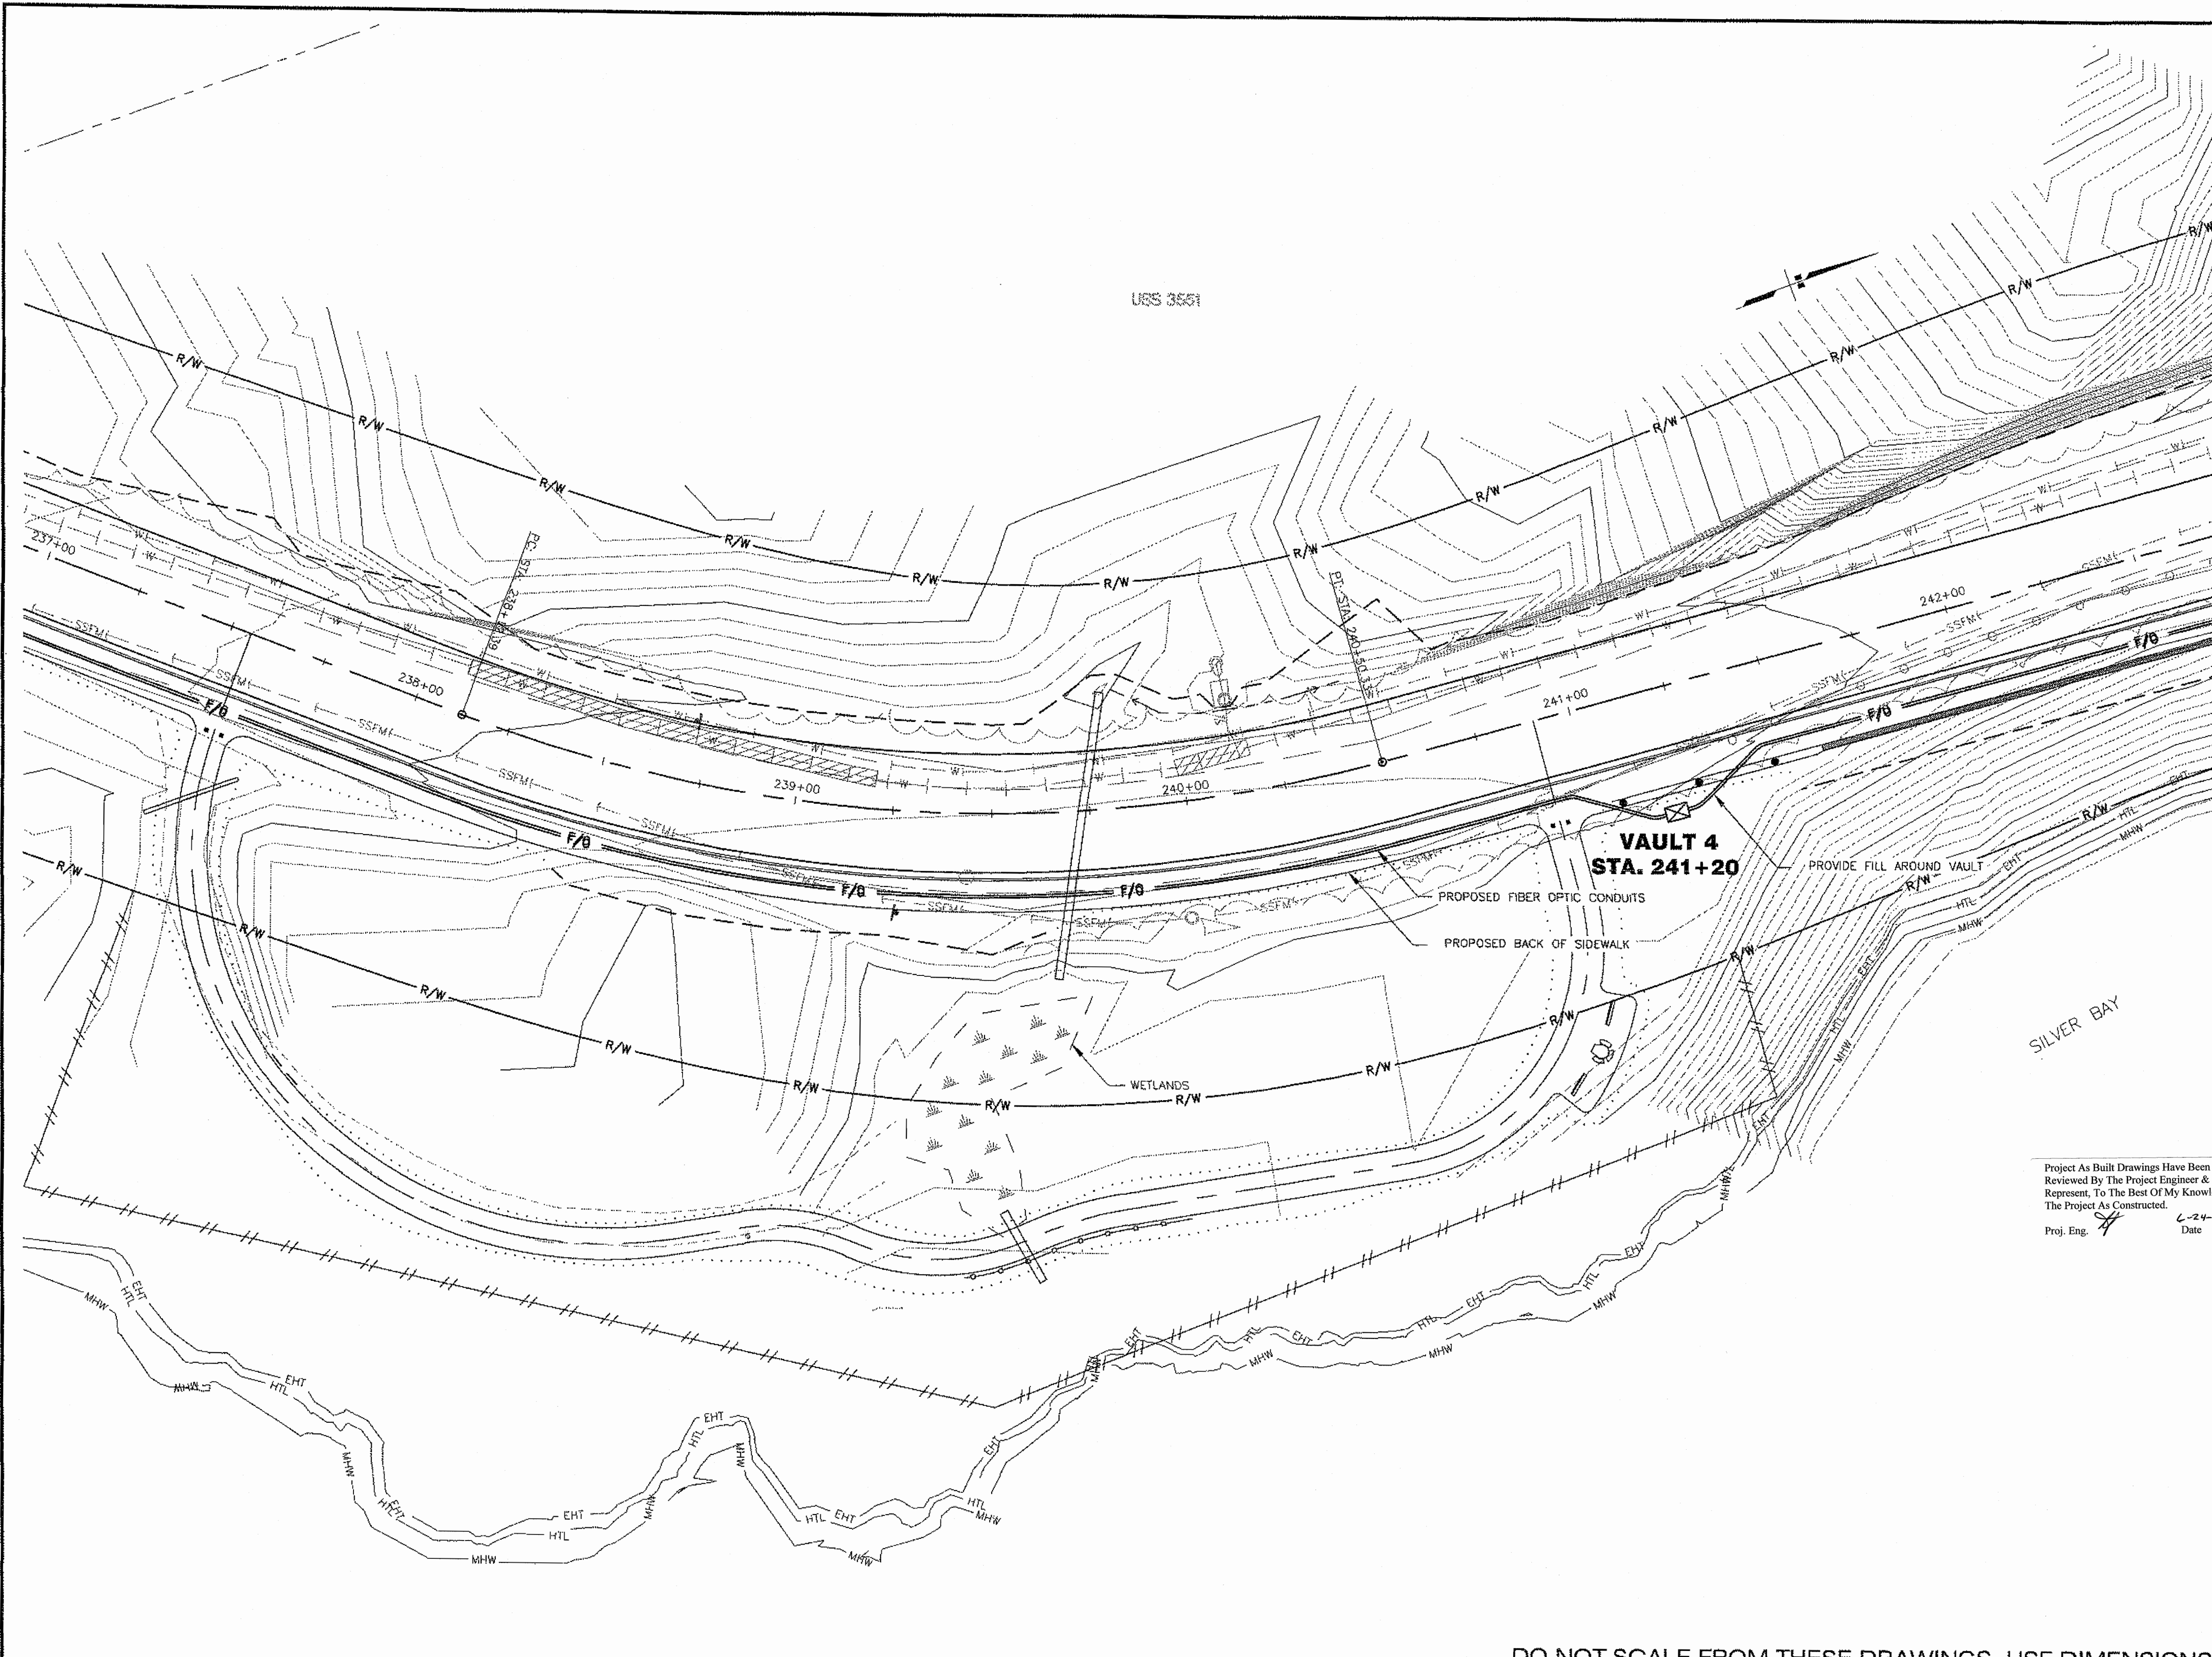

PATH:		
PLOT: PSPACE 1=1(F) OR MSPACE 1=1(F) TAB: D4		
ADDENDUM NUMBER 1		
ATTACHMENT NUMBER 4		
RECORD OF REVISIONS		
No.	DATE	DESCRIPTION

SAWMILL CREEK ROAD UPGRADE
PHASE III- WHALE PARK TO SAWMILL CREEK BRIDGE
68216MGS-STP-0933(21)
SITKA TELECOMMUNICATIONS CONDUIT
RSA NO. 69615

ELECTRIC UTILITY PLAN

DESIGNED BY: M. CARSON

Project As Built Drawings Have Been Reviewed By The Project Engineer & Represent, To The Best Of My Knowledge, The Project As Constructed.
Proj. Eng. *[Signature]* Date 6-24-15

10/3/12

CHECKED BY: R. DRYDEN
DRAWN BY: M. CARSON


STATE OF ALASKA
DEPARTMENT OF TRANSPORTATION & PUBLIC FACILITIES
SOUTHEAST REGION DESIGN & ENGINEERING SERVICES DIVISION

**ELECTRIC UTILITY PLAN
STA. 238+00 TO
STA. 243+00**

PROJECT DESIGNATION NUMBER
68216MGS-STP-0933(21)

STATE	YEAR
ALASKA	2012
SHEET NUMBER	TOTAL SHEETS
U12	109

DO NOT SCALE FROM THESE DRAWINGS, USE DIMENSIONS

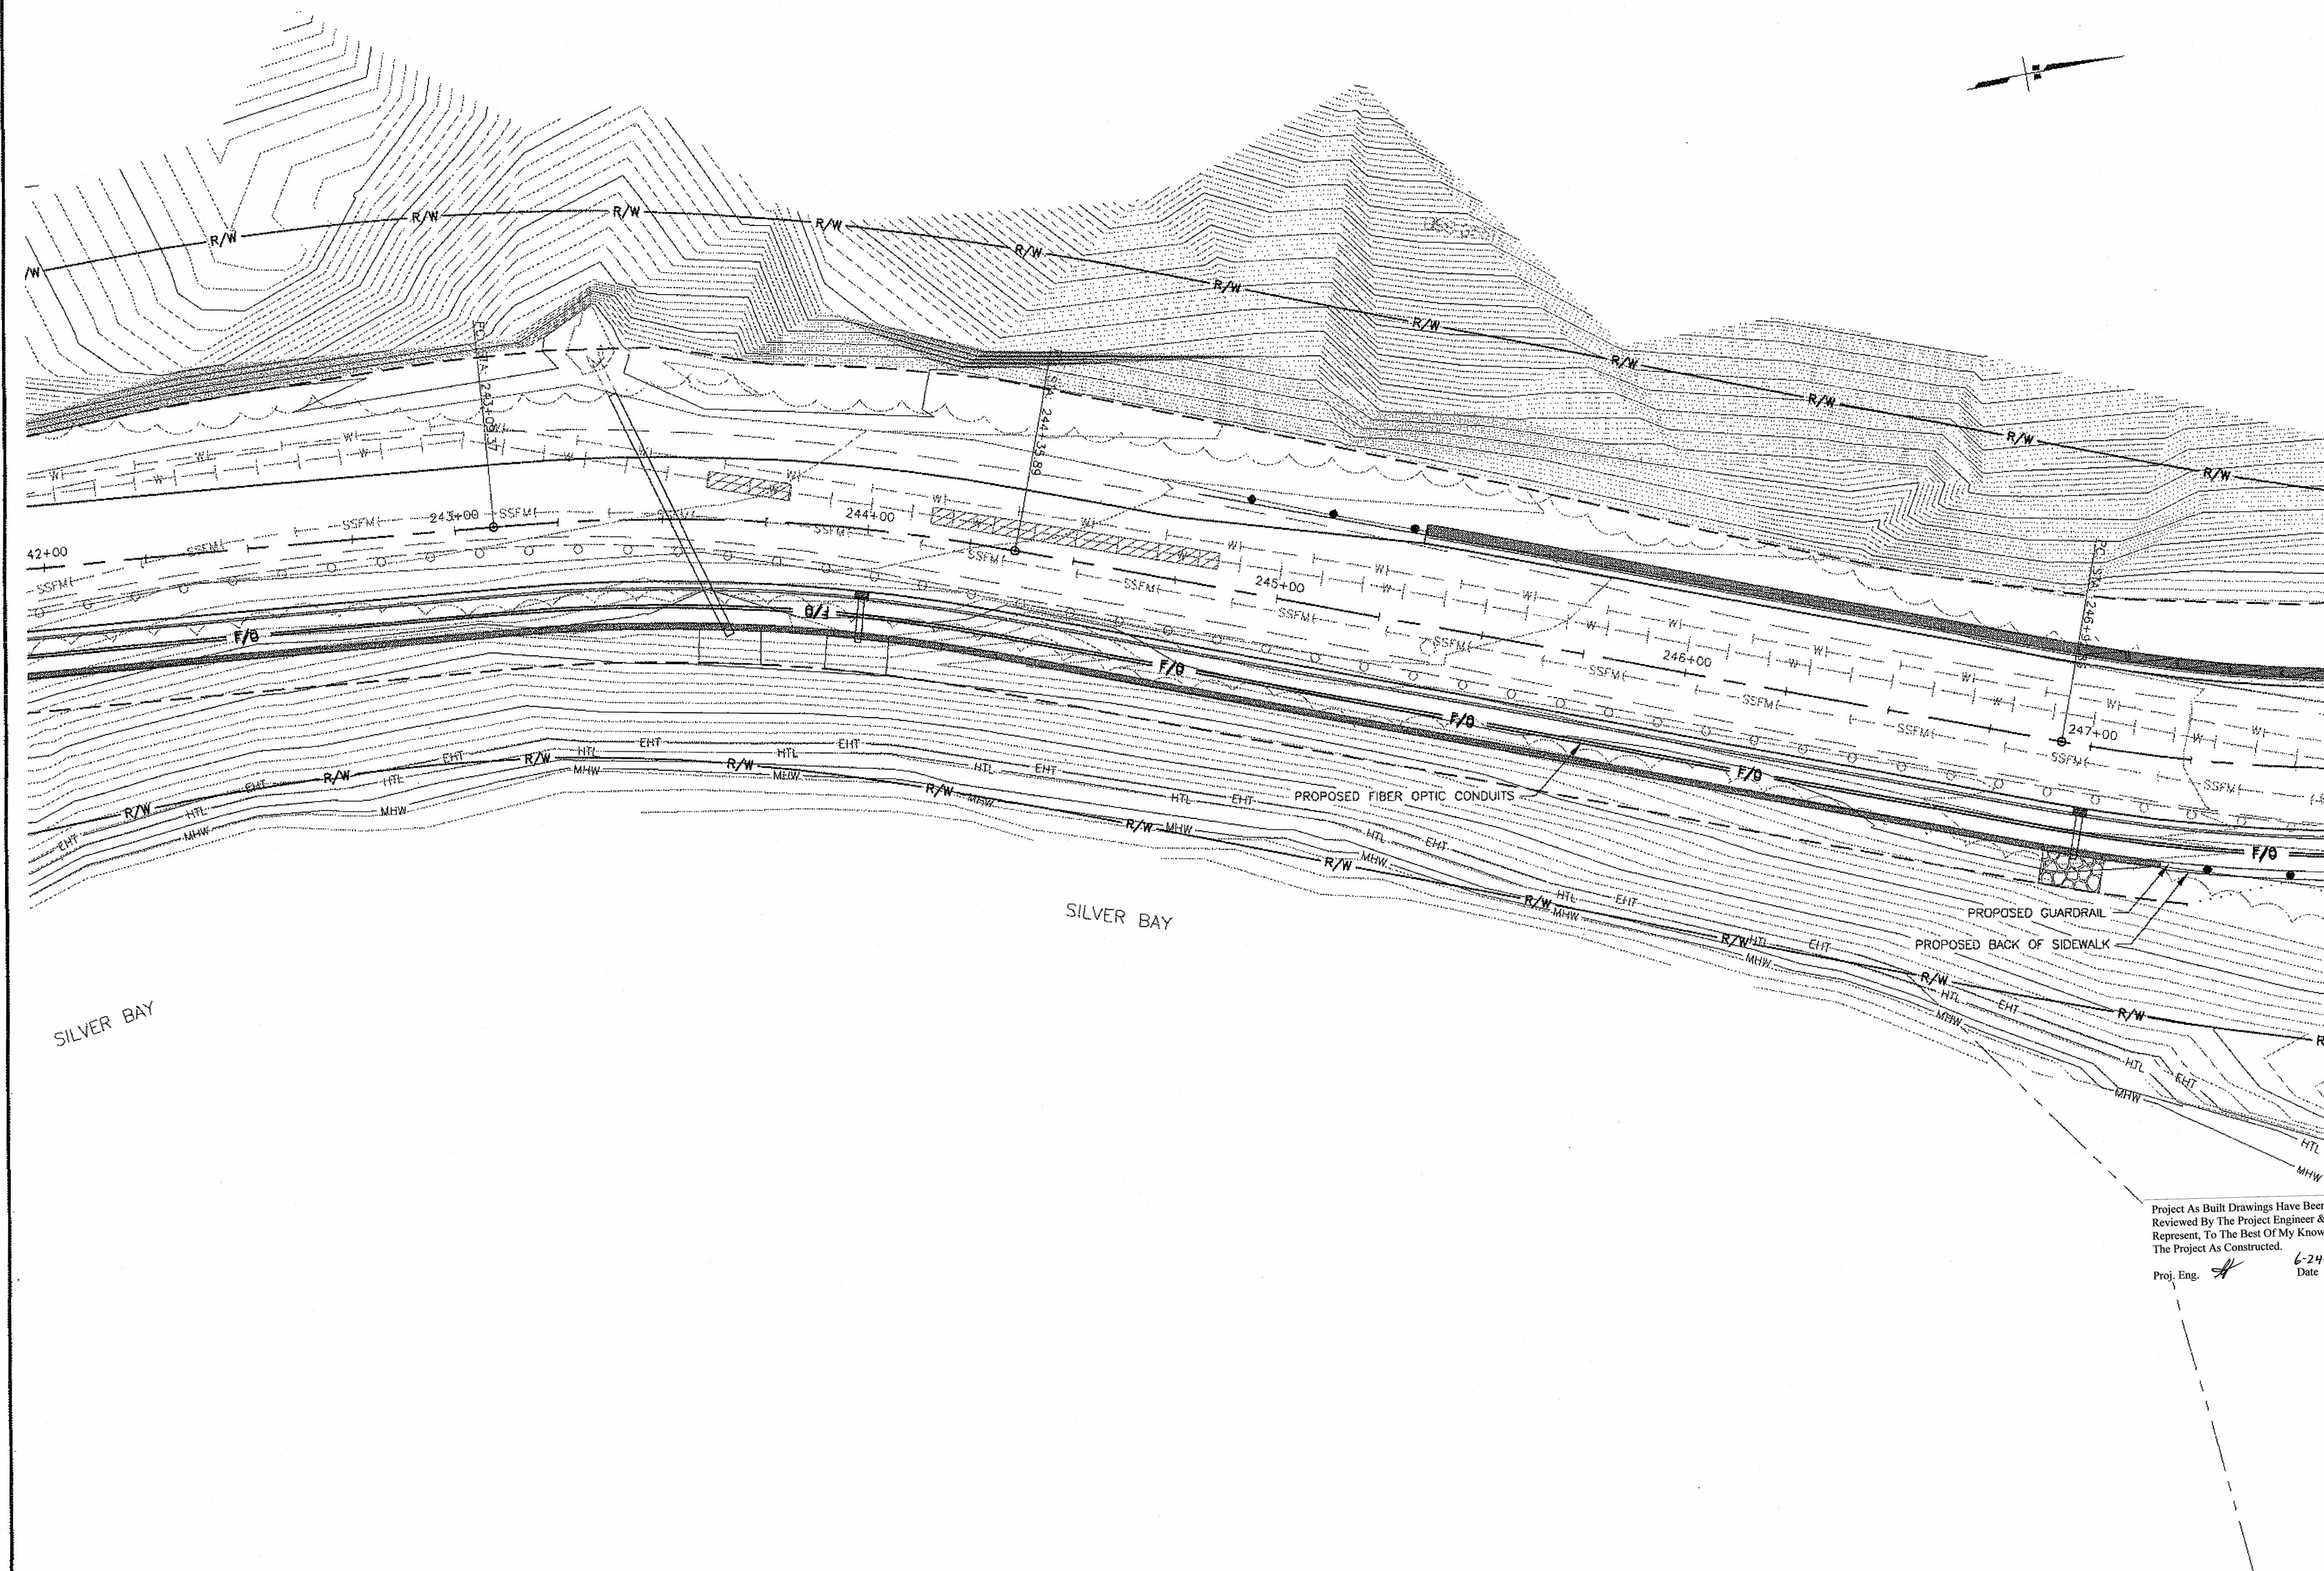


Project As Built Drawings Have Been
Reviewed By The Project Engineer &
Represent, To The Best Of My Knowledge,
The Project As Constructed.
Proj. Eng. *[Signature]* Date 6-24-15

PATH:		
PLOT: PSPACE 1=1(F) OR MSPACE 1=1(F) TAB: D4		
ADDENDUM NUMBER		
ATTACHMENT NUMBER		
RECORD OF REVISIONS		
No.	DATE	DESCRIPTION

SAWMILL CREEK ROAD UPGRADE
PHASE III- WHALE PARK TO SAWMILL CREEK BRIDGE
68216MGS-STP-0933(21)
SITKA TELECOMMUNICATIONS CONDUIT
RSA NO. 69615

ELECTRIC UTILITY PLAN

DESIGNED BY: M. CARSON

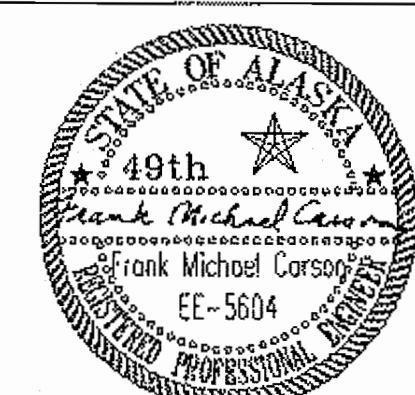

CHECKED BY: R. DRYDEN

DRAWN BY: M. CARSON

STATE OF ALASKA
DEPARTMENT OF TRANSPORTATION
& PUBLIC FACILITIES
SOUTHEAST REGION DESIGN
& ENGINEERING SERVICES DIVISION


ELECTRIC
UTILITY PLAN
STA. 243+00 TO
STA. 248+00

PROJECT DESIGNATION NUMBER

68216MGS-STP-0933(21)

STATE	YEAR
ALASKA	2012
SHEET NUMBER	TOTAL SHEETS
U13	109

DO NOT SCALE FROM THESE DRAWINGS, USE DIMENSIONS

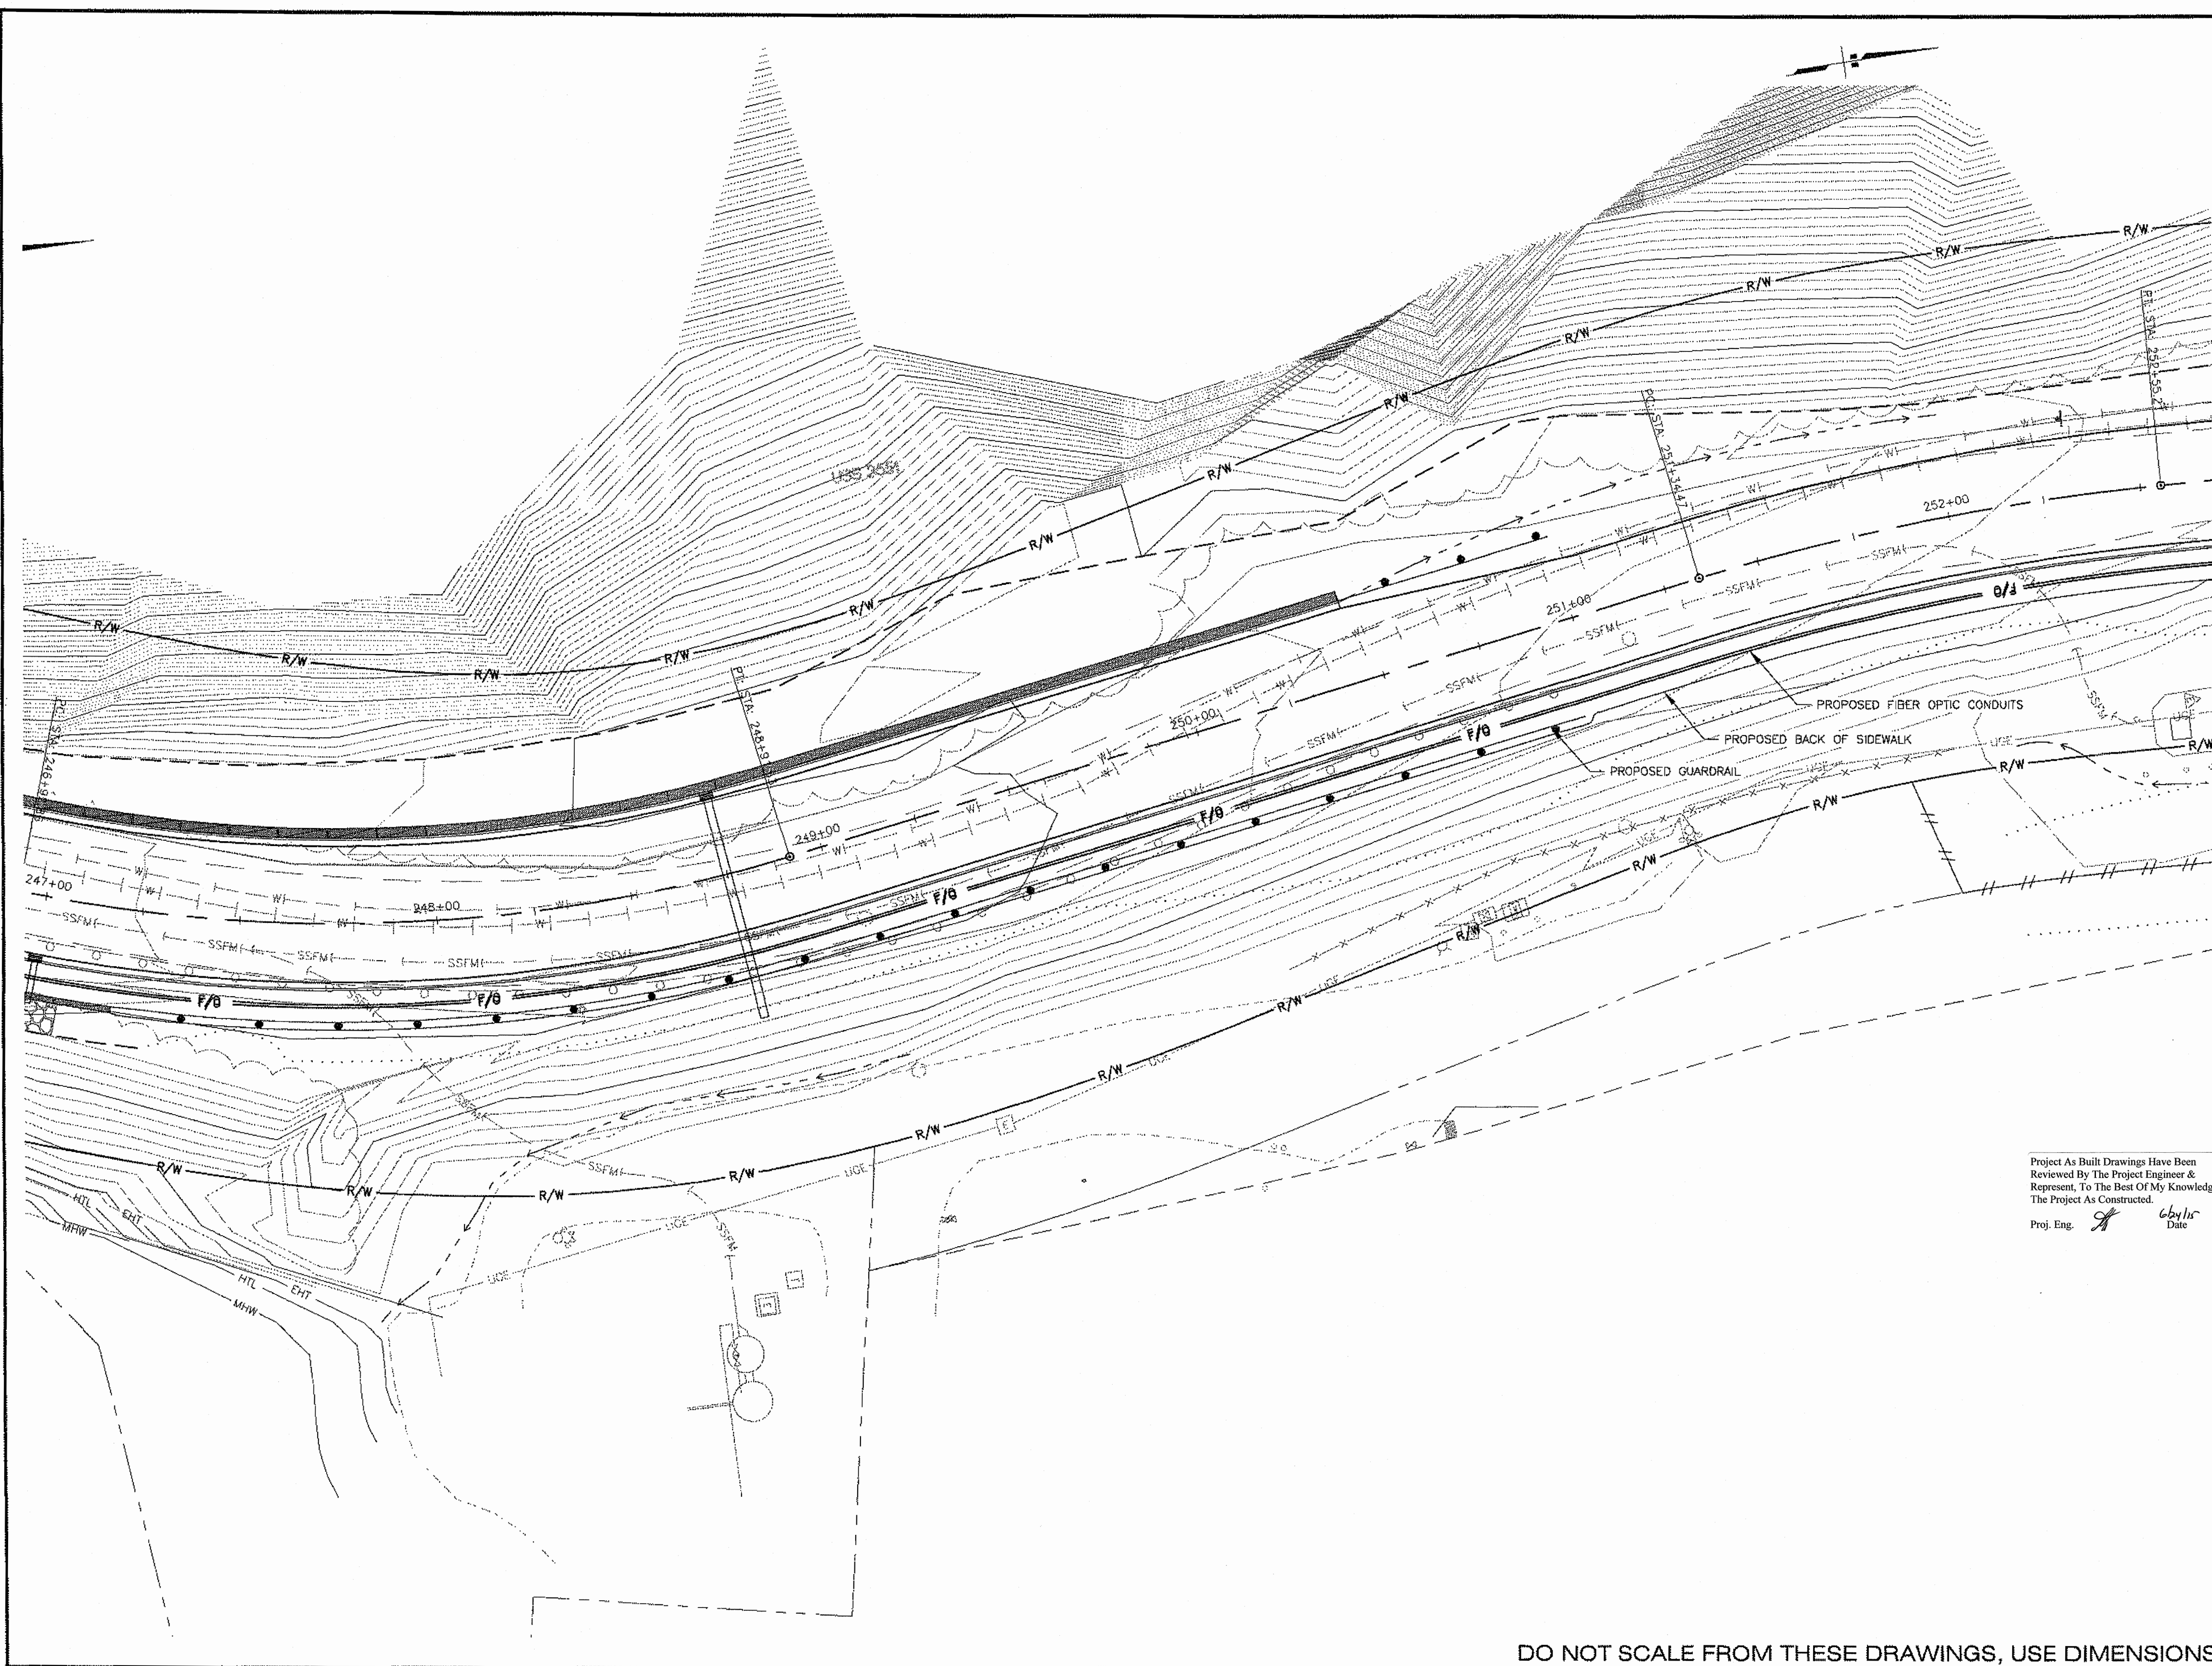

PATH:

PLOT:

PSPACE 1=1(F) OR MSPACE 1=1(F)

TAB: D4

ADDENDUM NUMBER

1

ATTACHMENT NUMBER

4

RECORD OF REVISIONS

No.	DATE	DESCRIPTION

SAWMILL CREEK ROAD UPGRADE
PHASE III- WHALE PARK TO SAWMILL CREEK BRIDGE
68216MGS-STP-0933(21)
SITKA TELECOMMUNICATIONS CONDUIT
RSA NO. 69615

ELECTRIC UTILITY PLAN

DESIGNED BY: M. CARSON

STATE OF ALASKA

49th

Frank Michael Carson

Professional Engineer

EE-5604

10/3/12

CHECKED BY: R. DRYDEN

DRAWN BY: M. CARSON

STATE OF ALASKA
DEPARTMENT OF TRANSPORTATION
& PUBLIC FACILITIES
SOUTHEAST REGION DESIGN
& ENGINEERING SERVICES DIVISION

ELECTRIC
UTILITY PLAN
STA. 248+00 TO
STA. 253+00


PROJECT DESIGNATION NUMBER

68216MGS-STP-0933(21)

STATE	YEAR
ALASKA	2012

SHEET NUMBER	TOTAL SHEETS
U14	109

DO NOT SCALE FROM THESE DRAWINGS, USE DIMENSIONS

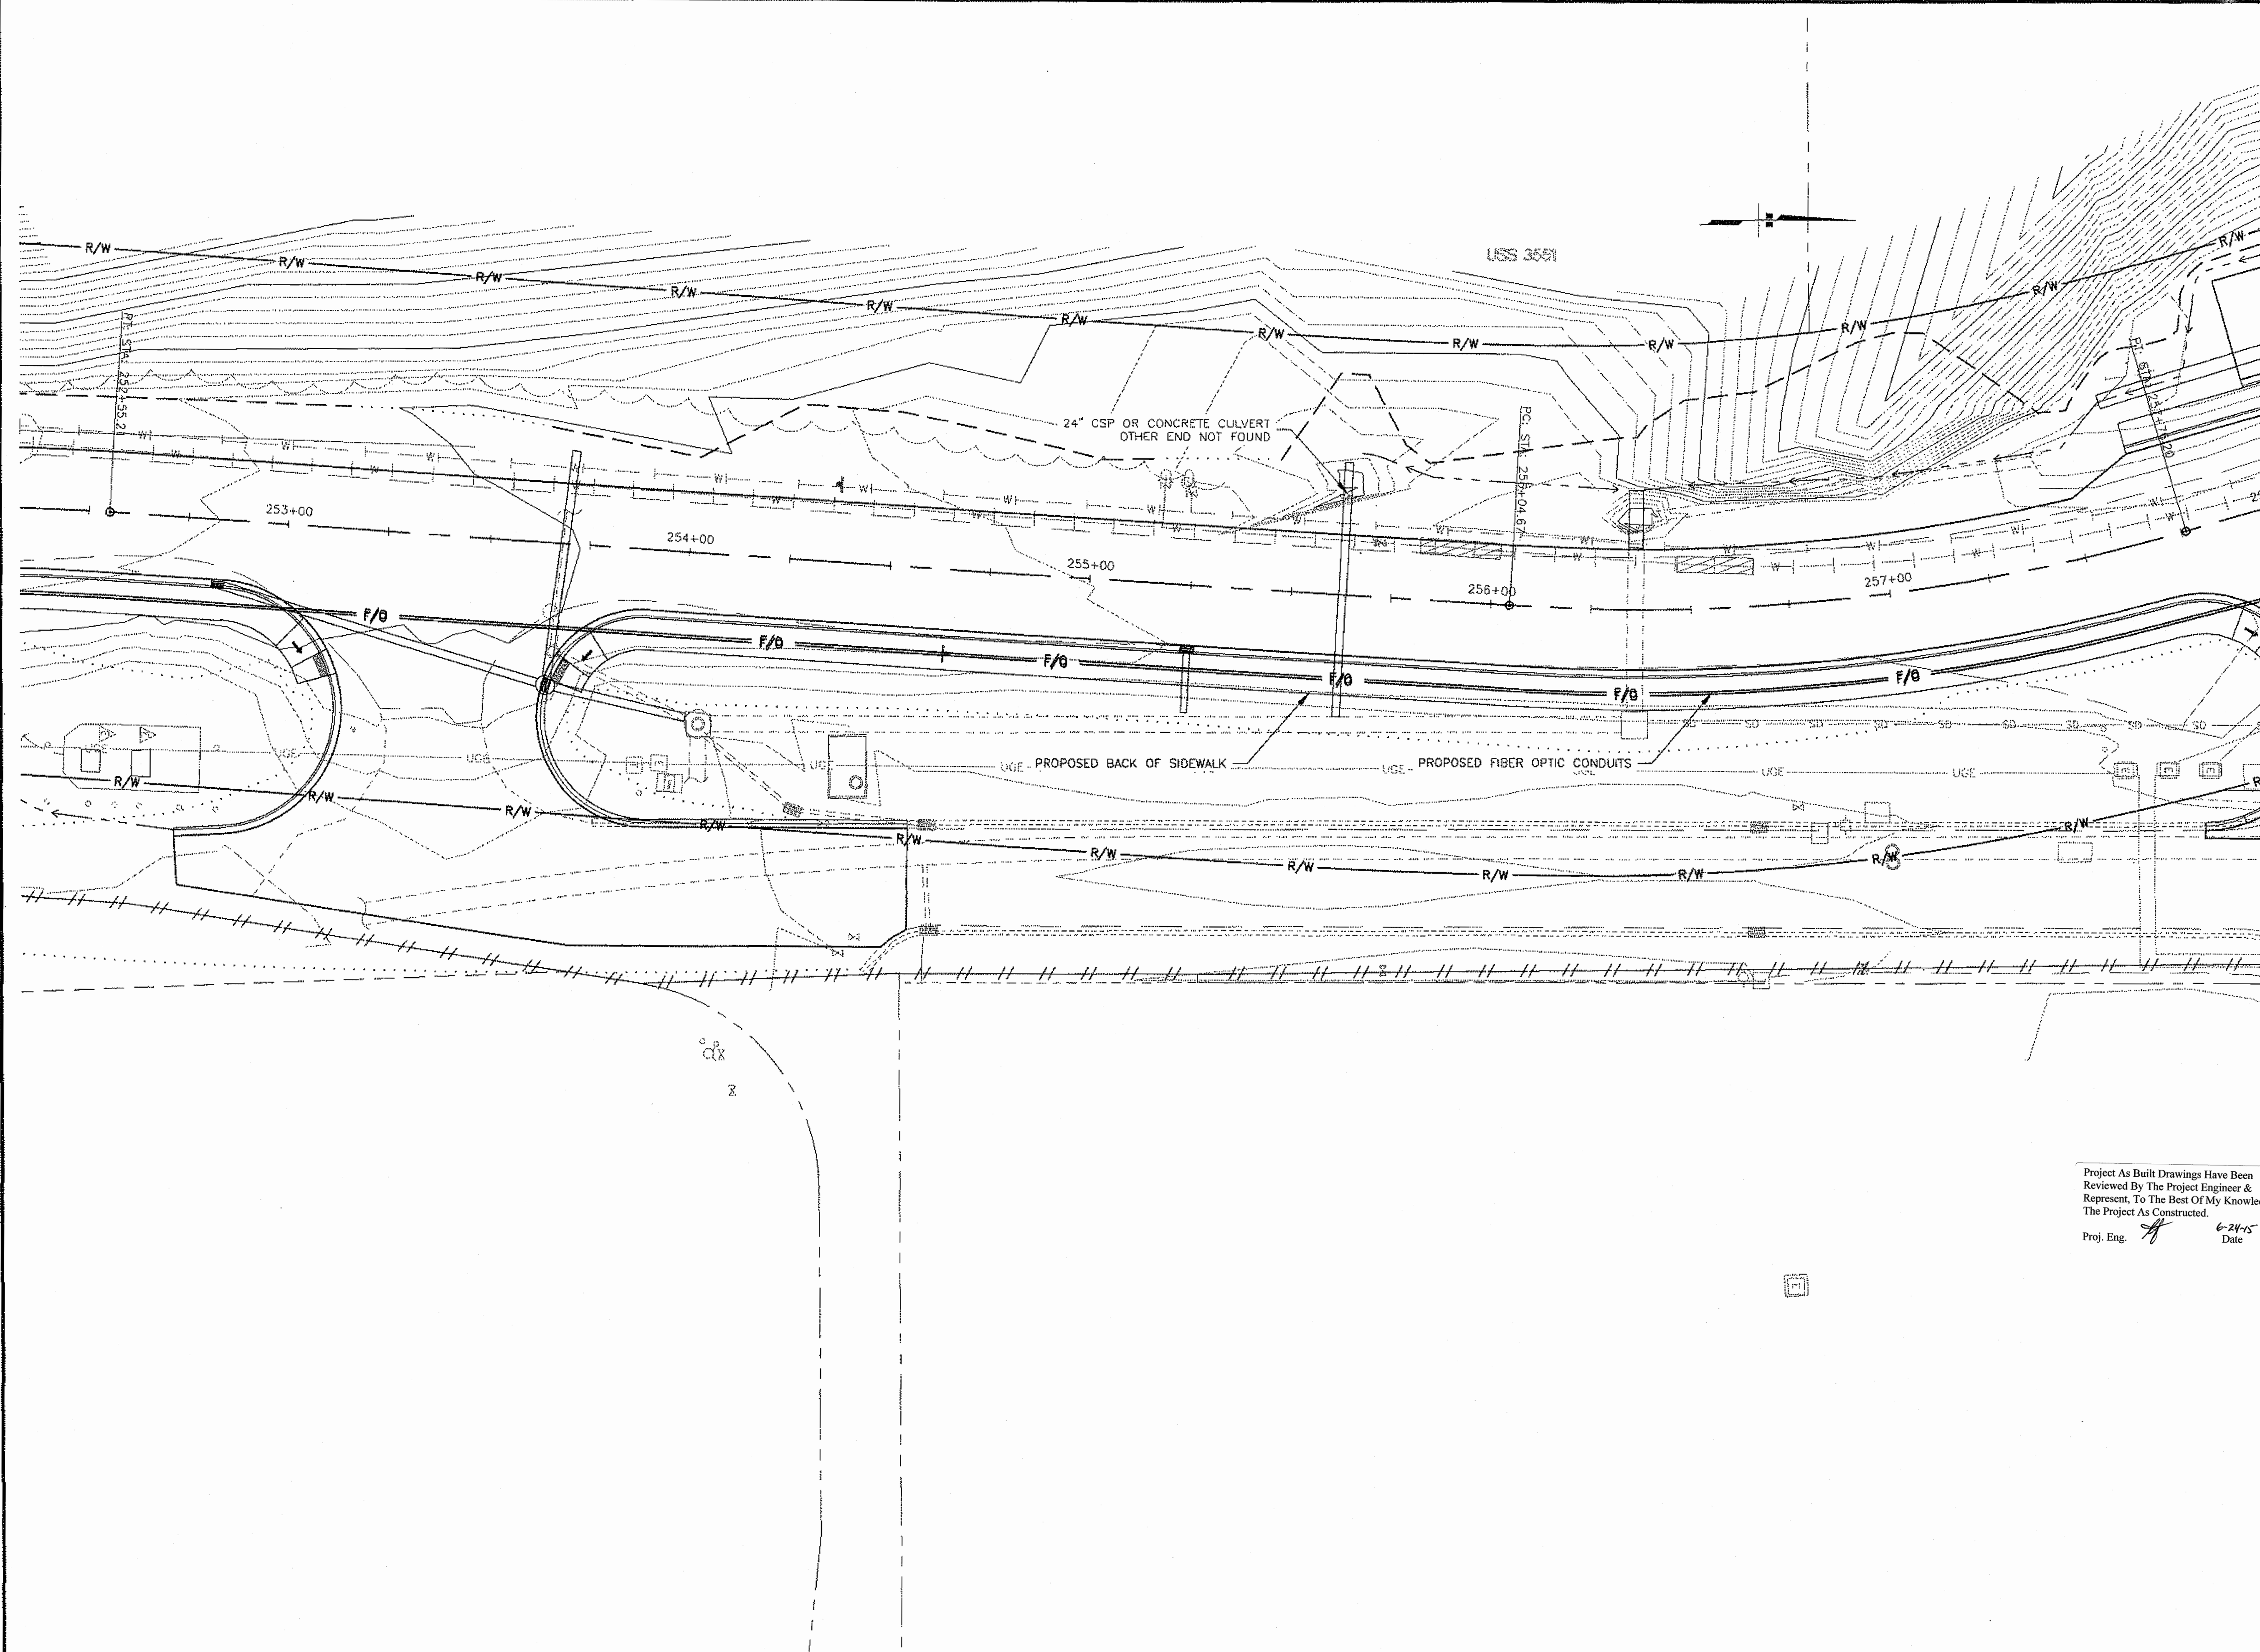

PATH:		
PLOT: PSPACE 1=1(F) OR MSPACE 1=1(F) TAB: 04		
ADDENDUM NUMBER		
ATTACHMENT NUMBER		
RECORD OF REVISIONS		
No.	DATE	DESCRIPTION

SAWMILL CREEK ROAD UPGRADE
 PHASE III- WHALE PARK TO SAWMILL CREEK BRIDGE
 68216MGS-STP-0933(21)
 SITKA TELECOMMUNICATIONS CONDUIT
 RSA NO. 69615

ELECTRIC UTILITY PLAN

Project As Built Drawings Have Been Reviewed By The Project Engineer & Represent, To The Best Of My Knowledge, The Project As Constructed.
 Proj. Eng. *[Signature]* 6-24-15 Date


DESIGNED BY: M. CARSON



10/3/12

CHECKED BY: R. DRYDEN	
DRAWN BY: M. CARSON	
STATE OF ALASKA DEPARTMENT OF TRANSPORTATION & PUBLIC FACILITIES SOUTHEAST REGION DESIGN & ENGINEERING SERVICES DIVISION	
ELECTRIC UTILITY PLAN	
STA. 253+00 TO STA. 258+00	
PROJECT DESIGNATION NUMBER 68216MGS-STP-0933(21)	
STATE	YEAR
ALASKA	2012
SHEET NUMBER	TOTAL SHEETS
U15	109

DO NOT SCALE FROM THESE DRAWINGS, USE DIMENSIONS

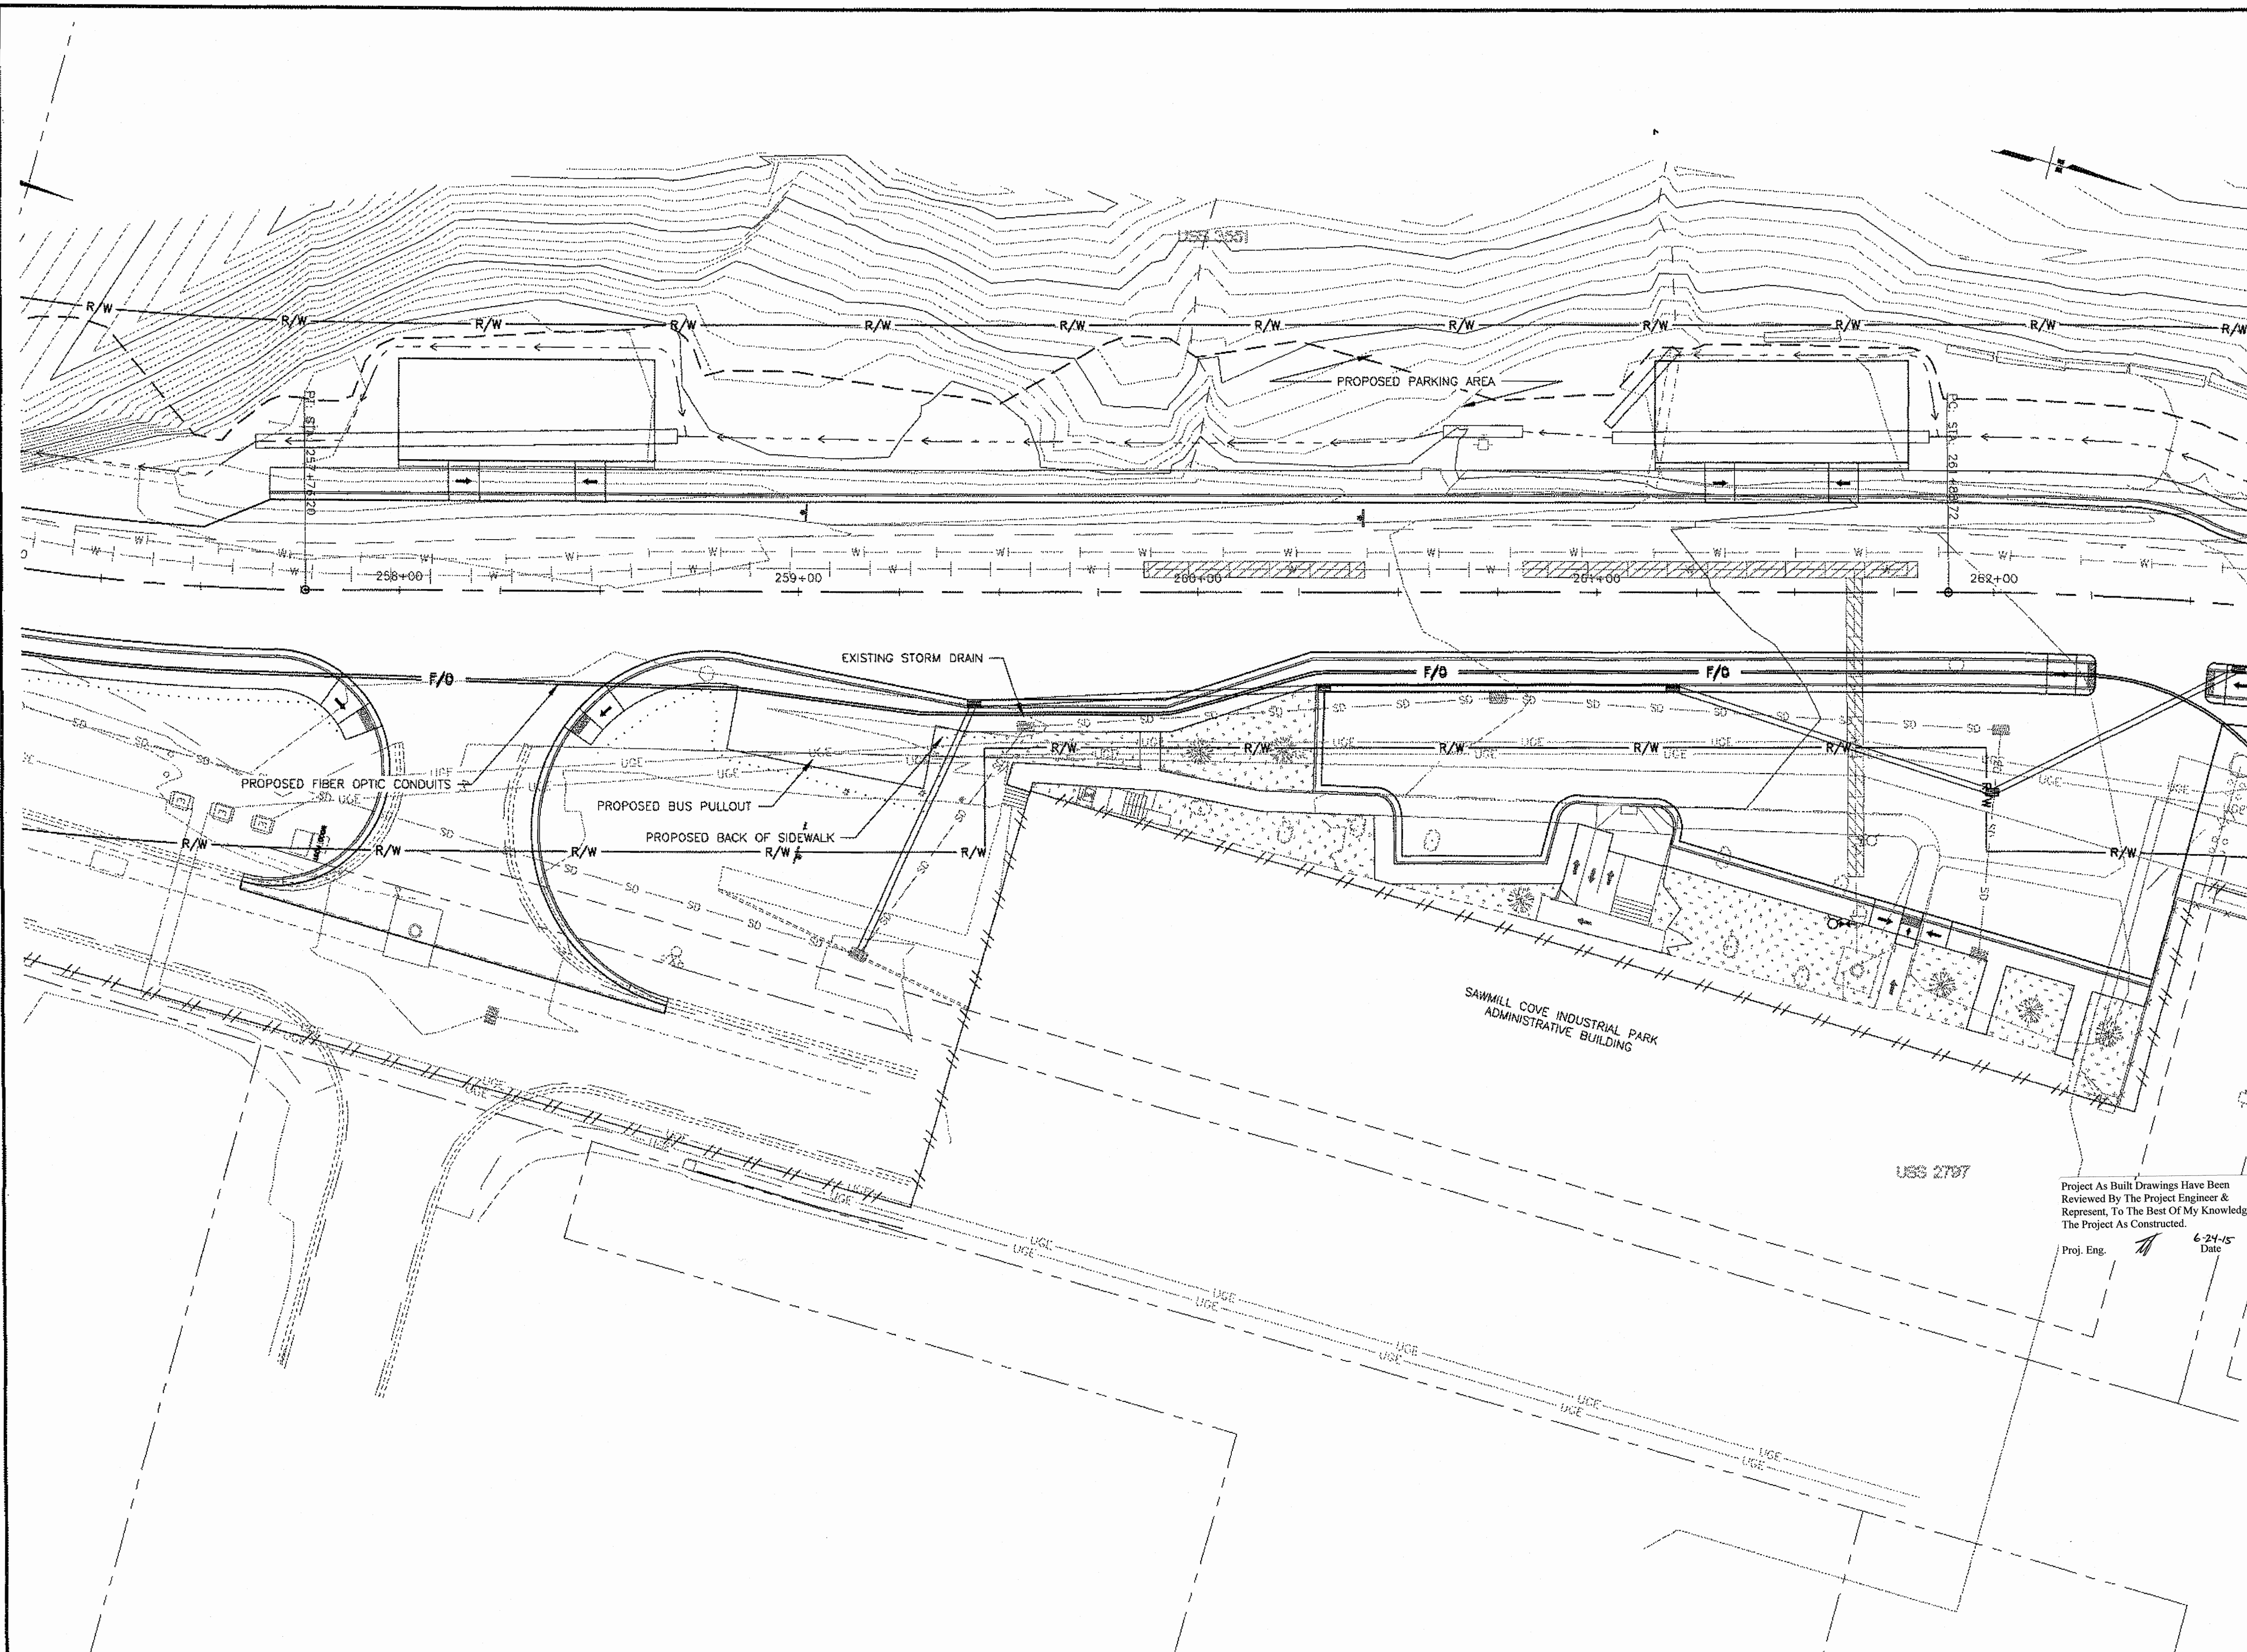

DO NOT SCALE FROM THESE DRAWINGS, USE DIMENSIONS

PATH:

PLOT:
PSPACE 1=1(F) OR MSPACE 1=1(F)
TAB: 04

ADDENDUM NUMBER
1

ATTACHMENT NUMBER
4

RECORD OF REVISIONS

No.	DATE	DESCRIPTION

SAWMILL CREEK ROAD UPGRADE
PHASE III- WHALE PARK TO SAWMILL CREEK BRIDGE
68216MGS-STP-0933(21)
SITKA TELECOMMUNICATIONS CONDUIT
RSA NO. 69615

ELECTRIC UTILITY PLAN

DESIGNED BY: M. CARSON

STATE OF ALASKA
49th
Frank Michael Carson
Professional Engineer
EE-5604

10/3/12

CHECKED BY: R. DRYDEN

DRAWN BY: M. CARSON

STATE OF ALASKA
DEPARTMENT OF TRANSPORTATION
& PUBLIC FACILITIES
SOUTHEAST REGION DESIGN
& ENGINEERING SERVICES DIVISION

ELECTRIC
UTILITY PLAN
STA. 258+00 TO
STA. 263+00

PROJECT DESIGNATION NUMBER
68216MGS-STP-0933(21)

STATE	YEAR
ALASKA	2012

SHEET NUMBER	TOTAL SHEETS
U16	109



PATH:		
PLOT: PSPACE 1=1(F) OR MSPACE 1=1(F) TAB: D4		
ADDENDUM NUMBER		
ATTACHMENT NUMBER		
RECORD OF REVISIONS		
No.	DATE	DESCRIPTION

SAWMILL CREEK ROAD UPGRADE
PHASE III- WHALE PARK TO SAWMILL CREEK BRIDGE
68216MGS-STP-0933(21)
SITKA TELECOMMUNICATIONS CONDUIT
RSA NO. 69615

ELECTRIC UTILITY PLAN

DESIGNED BY: M. CARSON



Project As Built Drawings Have Been Reviewed By The Project Engineer & Represent, To The Best Of My Knowledge, The Project As Constructed.
Proj. Eng. *[Signature]* 6-24-15
Date

CHECKED BY: R. DRYDEN
DRAWN BY: M. CARSON


STATE OF ALASKA
DEPARTMENT OF TRANSPORTATION & PUBLIC FACILITIES
SOUTHEAST REGION DESIGN & ENGINEERING SERVICES DIVISION

ELECTRIC
UTILITY PLAN
STA. 263+00 TO
STA. 268+00

PROJECT DESIGNATION NUMBER
68216MGS-STP-0933(21)

STATE	YEAR
ALASKA	2012
SHEET NUMBER	TOTAL SHEETS
U17	109

DO NOT SCALE FROM THESE DRAWINGS, USE DIMENSIONS

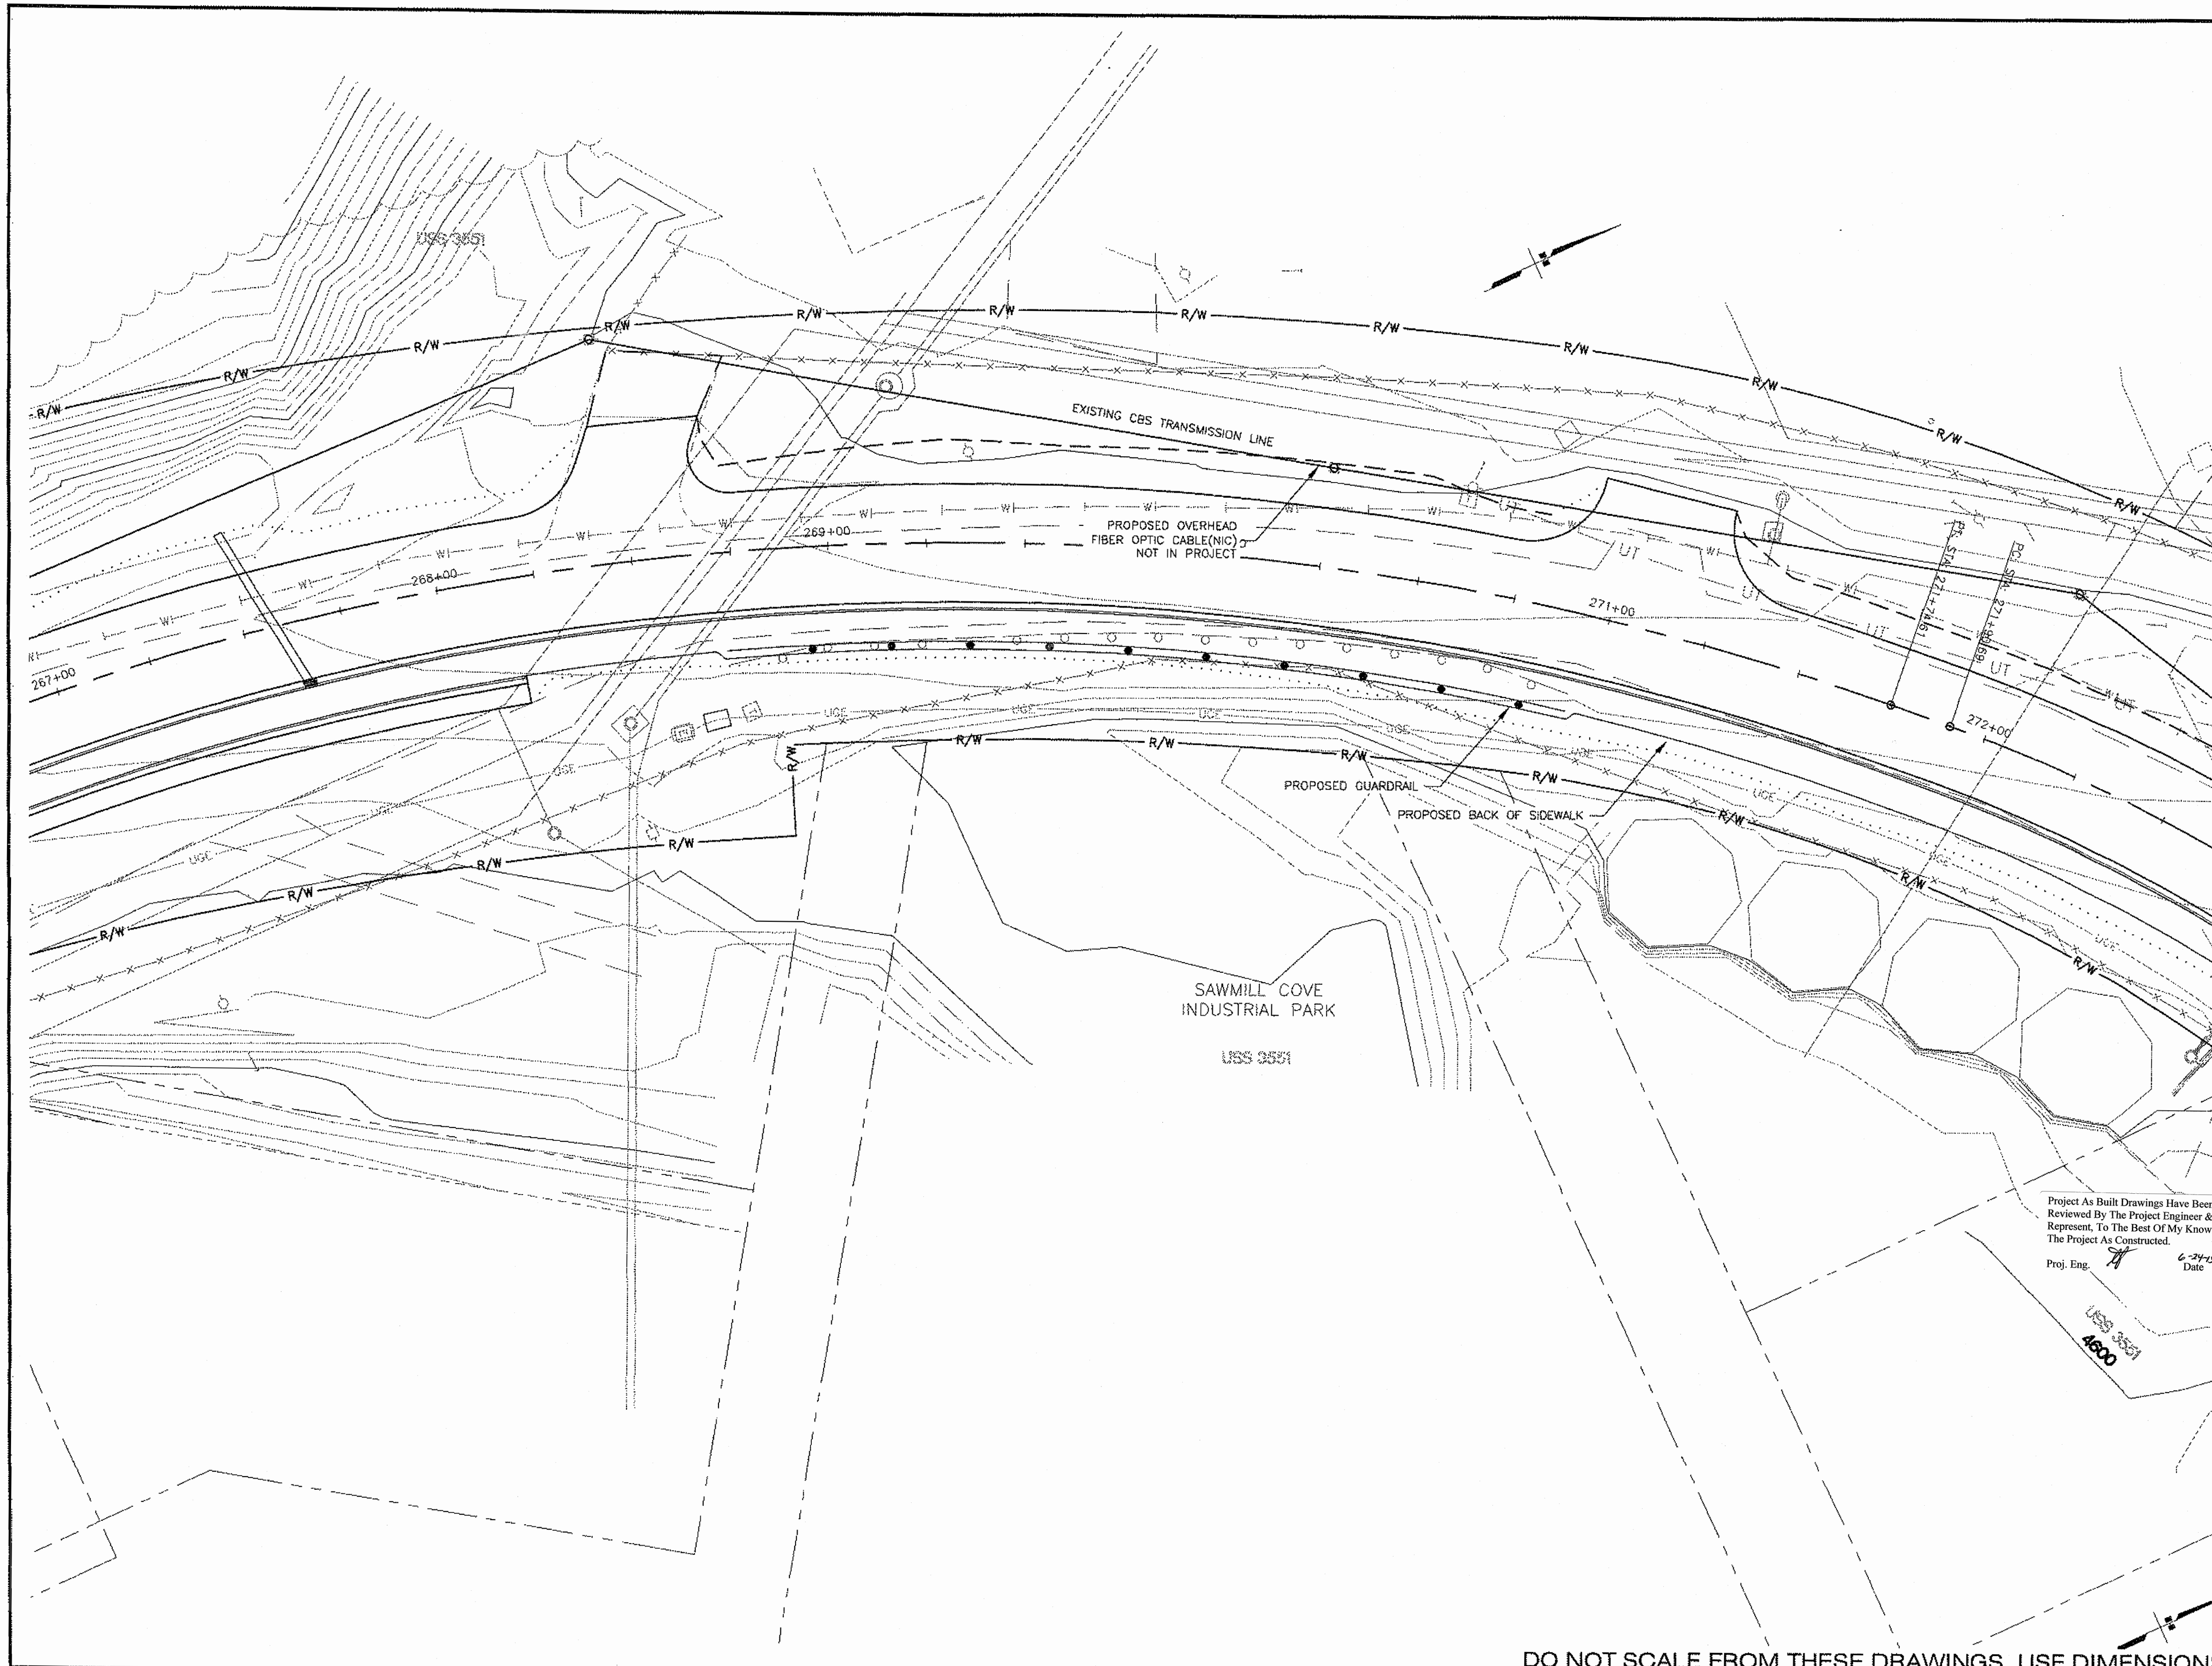

PATH:		
PLOT: PSPACE 1=1(F) OR MSPACE 1=1(F) TAB: D4		
ADDENDUM NUMBER		
ATTACHMENT NUMBER		
RECORD OF REVISIONS		
No.	DATE	DESCRIPTION

SAWMILL CREEK ROAD UPGRADE
PHASE III- WHALE PARK TO SAWMILL CREEK BRIDGE
68216MGS-STP-0933(21)
SITKA TELECOMMUNICATIONS CONDUIT
RSA NO. 69615

ELECTRIC UTILITY PLAN

DESIGNED BY: M. CARSON



Project As Built Drawings Have Been
Reviewed By The Project Engineer &
Represent, To The Best Of My Knowledge,
The Project As Constructed.
Proj. Eng. *[Signature]* 6-24-15
Date

CHECKED BY: R. DRYDEN

DRAWN BY: M. CARSON

STATE OF ALASKA
DEPARTMENT OF TRANSPORTATION
& PUBLIC FACILITIES
SOUTHEAST REGION DESIGN
& ENGINEERING SERVICES DIVISION

ELECTRIC
UTILITY PLAN
STA. 268+00 TO
STA. 273+00

PROJECT DESIGNATION NUMBER
68216MGS-STP-0933(21)

STATE	YEAR
ALASKA	2012
SHEET NUMBER	TOTAL SHEETS
U18	109




SAWMILL COVE
INDUSTRIAL PARK
USS 3551


Project As Built Drawings Have Been
Reviewed By The Project Engineer &
Represent, To The Best Of My Knowledge,
The Project As Constructed.
Proj. Eng. *[Signature]* 6-24-15
Date

DO NOT SCALE FROM THESE DRAWINGS, USE DIMENSIONS


PATH:		
PLOT: PSPACE 1=1(F) OR MSPACE 1=1(F) TAB: D4		
ADDENDUM NUMBER 1		
ATTACHMENT NUMBER 4		
RECORD OF REVISIONS		
No.	DATE	DESCRIPTION
SAWMILL CREEK ROAD UPGRADE PHASE III- WHALE PARK TO SAWMILL CREEK BRIDGE 68216MGS-STP-0933(21) SITKA TELECOMMUNICATIONS CONDUIT RSA NO. 69615		
ELECTRIC UTILITY PLAN		
DESIGNED BY: M. CARSON		
 10/3/12		
CHECKED BY: R. DRYDEN		
DRAWN BY: M. CARSON		
STATE OF ALASKA DEPARTMENT OF TRANSPORTATION & PUBLIC FACILITIES SOUTHEAST REGION DESIGN & ENGINEERING SERVICES DIVISION		
ELECTRIC UTILITY PLAN STA. 273+00 TO STA. 276+50		
PROJECT DESIGNATION NUMBER 68216MGS-STP-0933(21)		
STATE	YEAR	
ALASKA	2012	
SHEET NUMBER	TOTAL SHEETS	
U19	109	

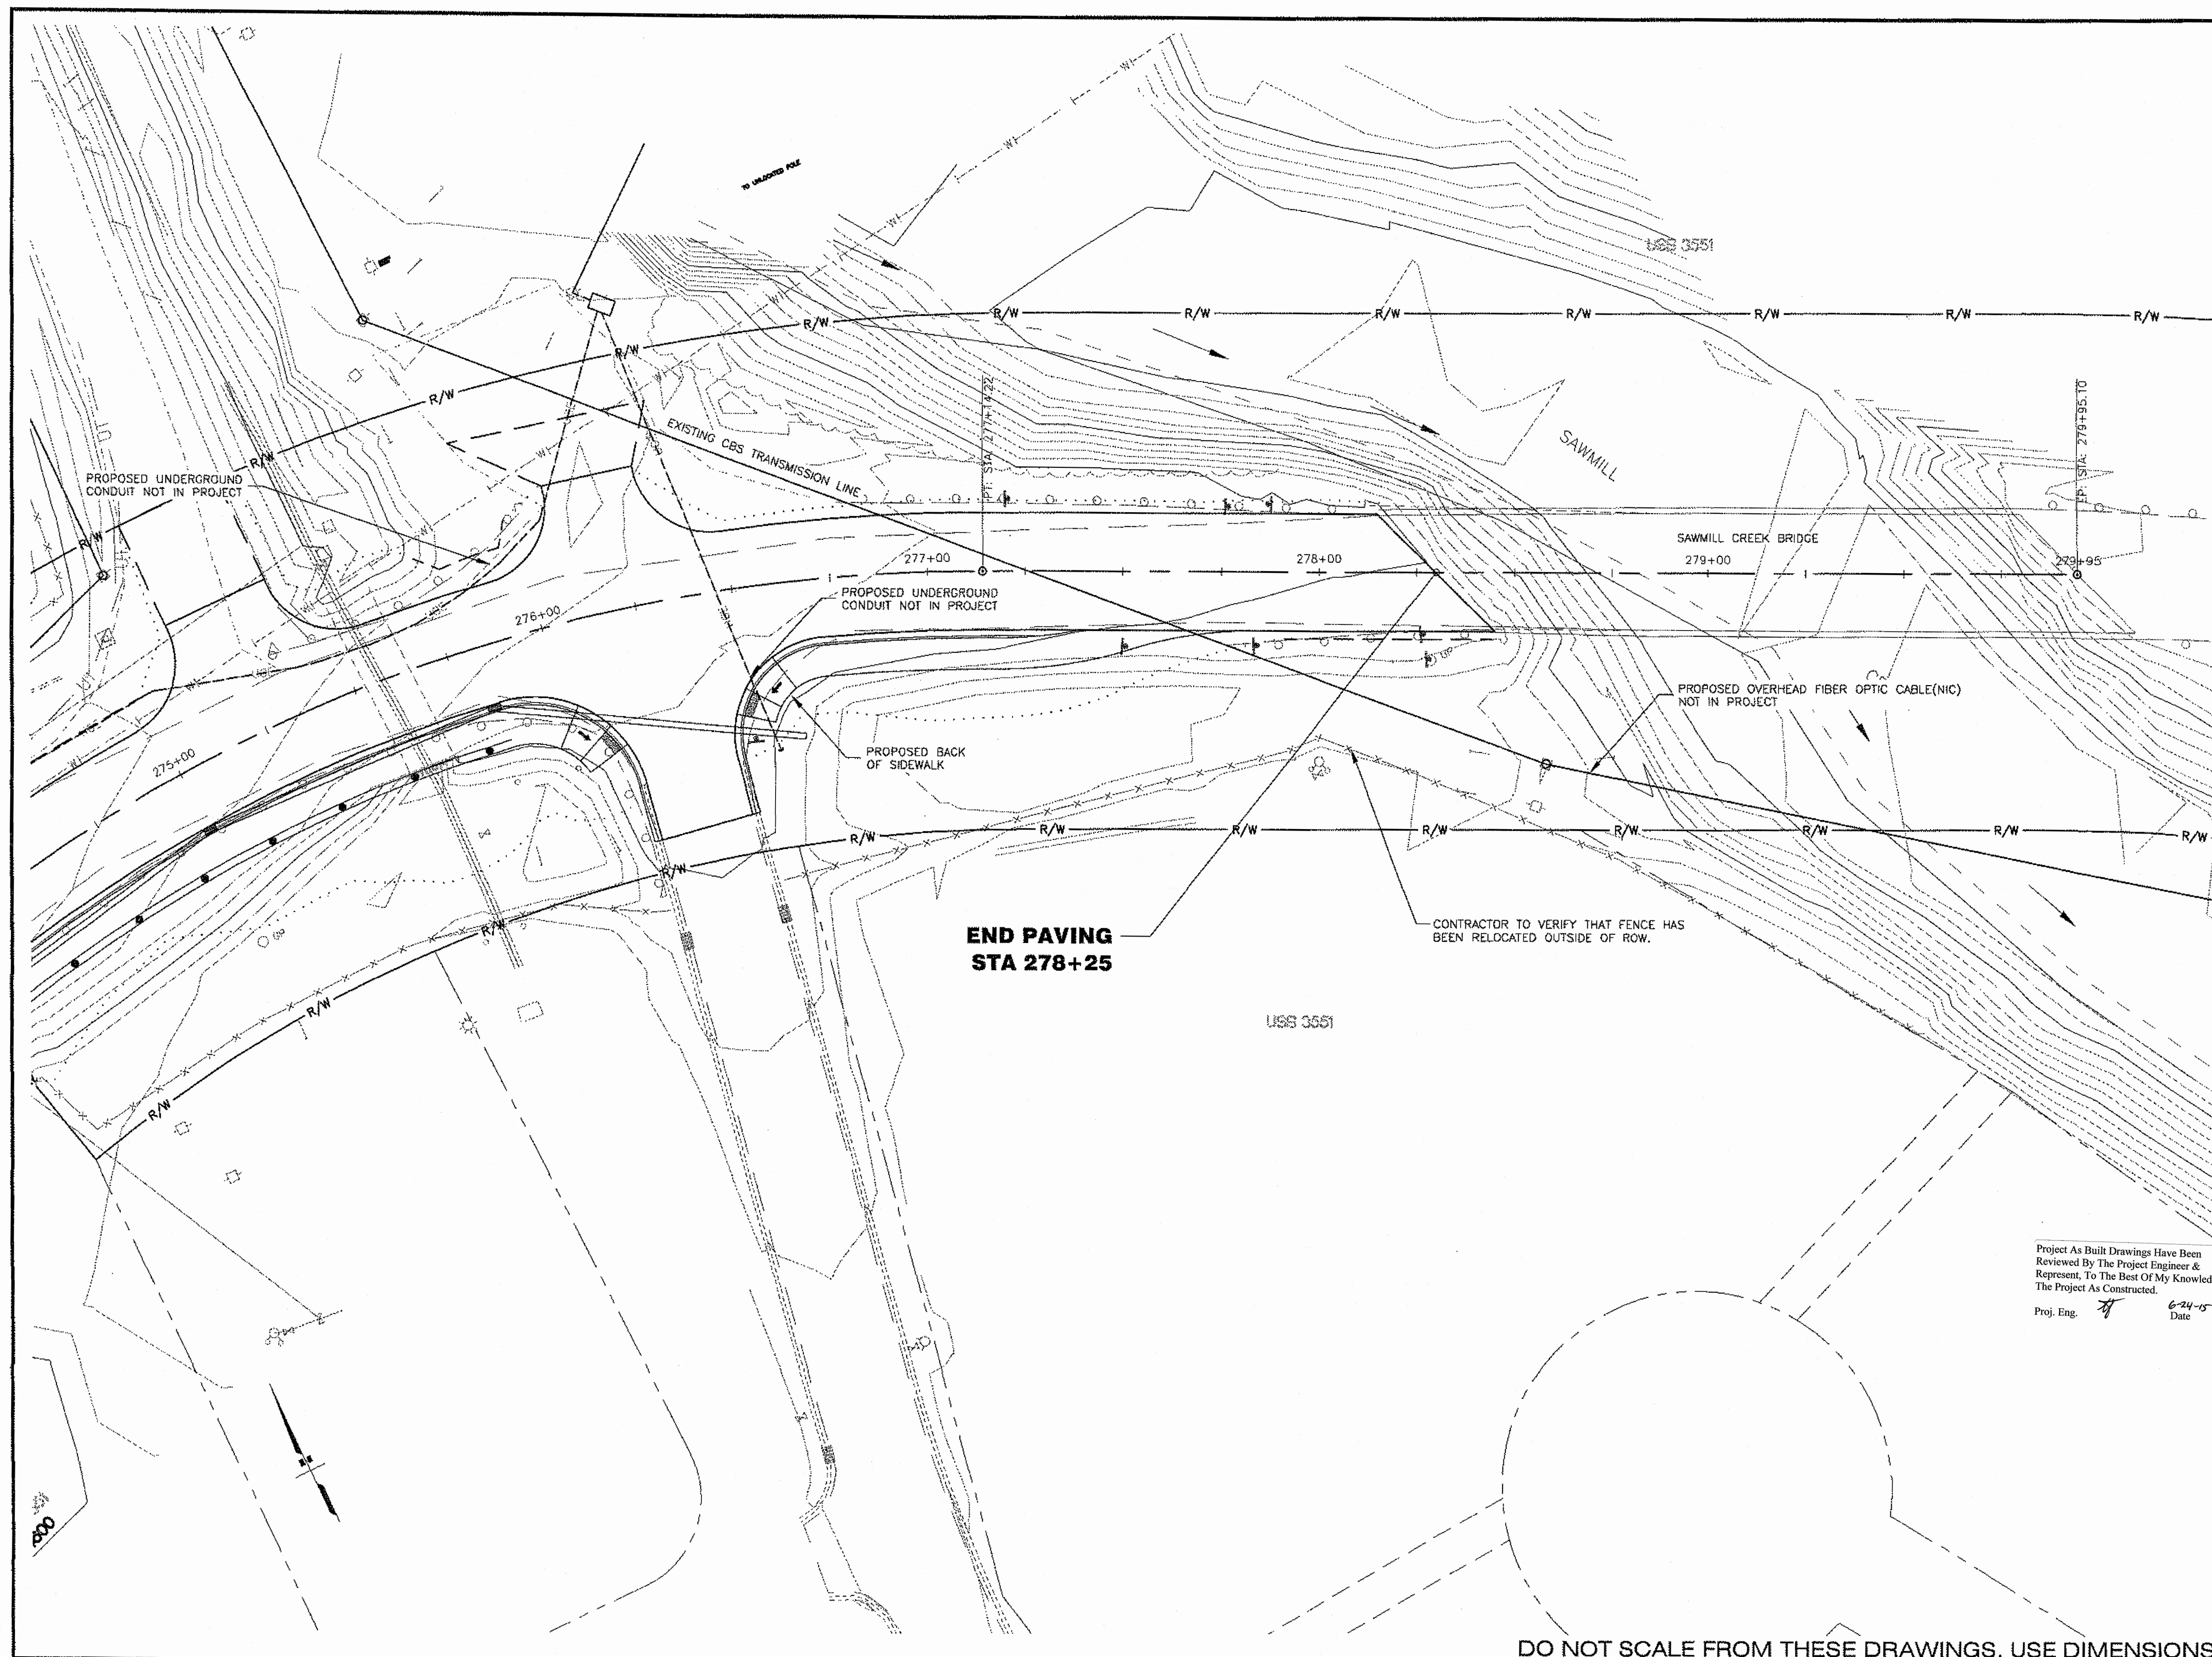



PATH:		
PLOT: PSPACE 1=1(F) OR MSPACE 1=1(F) TAB: D4		
ADDENDUM NUMBER		
ATTACHMENT NUMBER		
RECORD OF REVISIONS		
No.	DATE	DESCRIPTION
SAWMILL CREEK ROAD UPGRADE PHASE III- WHALE PARK TO SAWMILL CREEK BRIDGE 68216MGS-STP-0933(21) SITKA TELECOMMUNICATIONS CONDUIT RSA NO. 69615		
ELECTRIC UTILITY PLAN		
DESIGNED BY: M. CARSON		
		
CHECKED BY: R. DRYDEN		
DRAWN BY: M. CARSON		
STATE OF ALASKA DEPARTMENT OF TRANSPORTATION & PUBLIC FACILITIES SOUTHEAST REGION DESIGN & ENGINEERING SERVICES DIVISION		
ELECTRIC UTILITY PLAN STA. 276+50 TO STA. EOP		
PROJECT DESIGNATION NUMBER 68216MGS-STP-0933(21)		
STATE	YEAR	
ALASKA	2012	
SHEET NUMBER	TOTAL SHEETS	
U20	109	

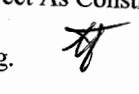Project As Built Drawings Have Been
Reviewed By The Project Engineer &
Represent, To The Best Of My Knowledge,
The Project As Constructed.
Proj. Eng.  Date 6-24-15


DO NOT SCALE FROM THESE DRAWINGS, USE DIMENSIONS

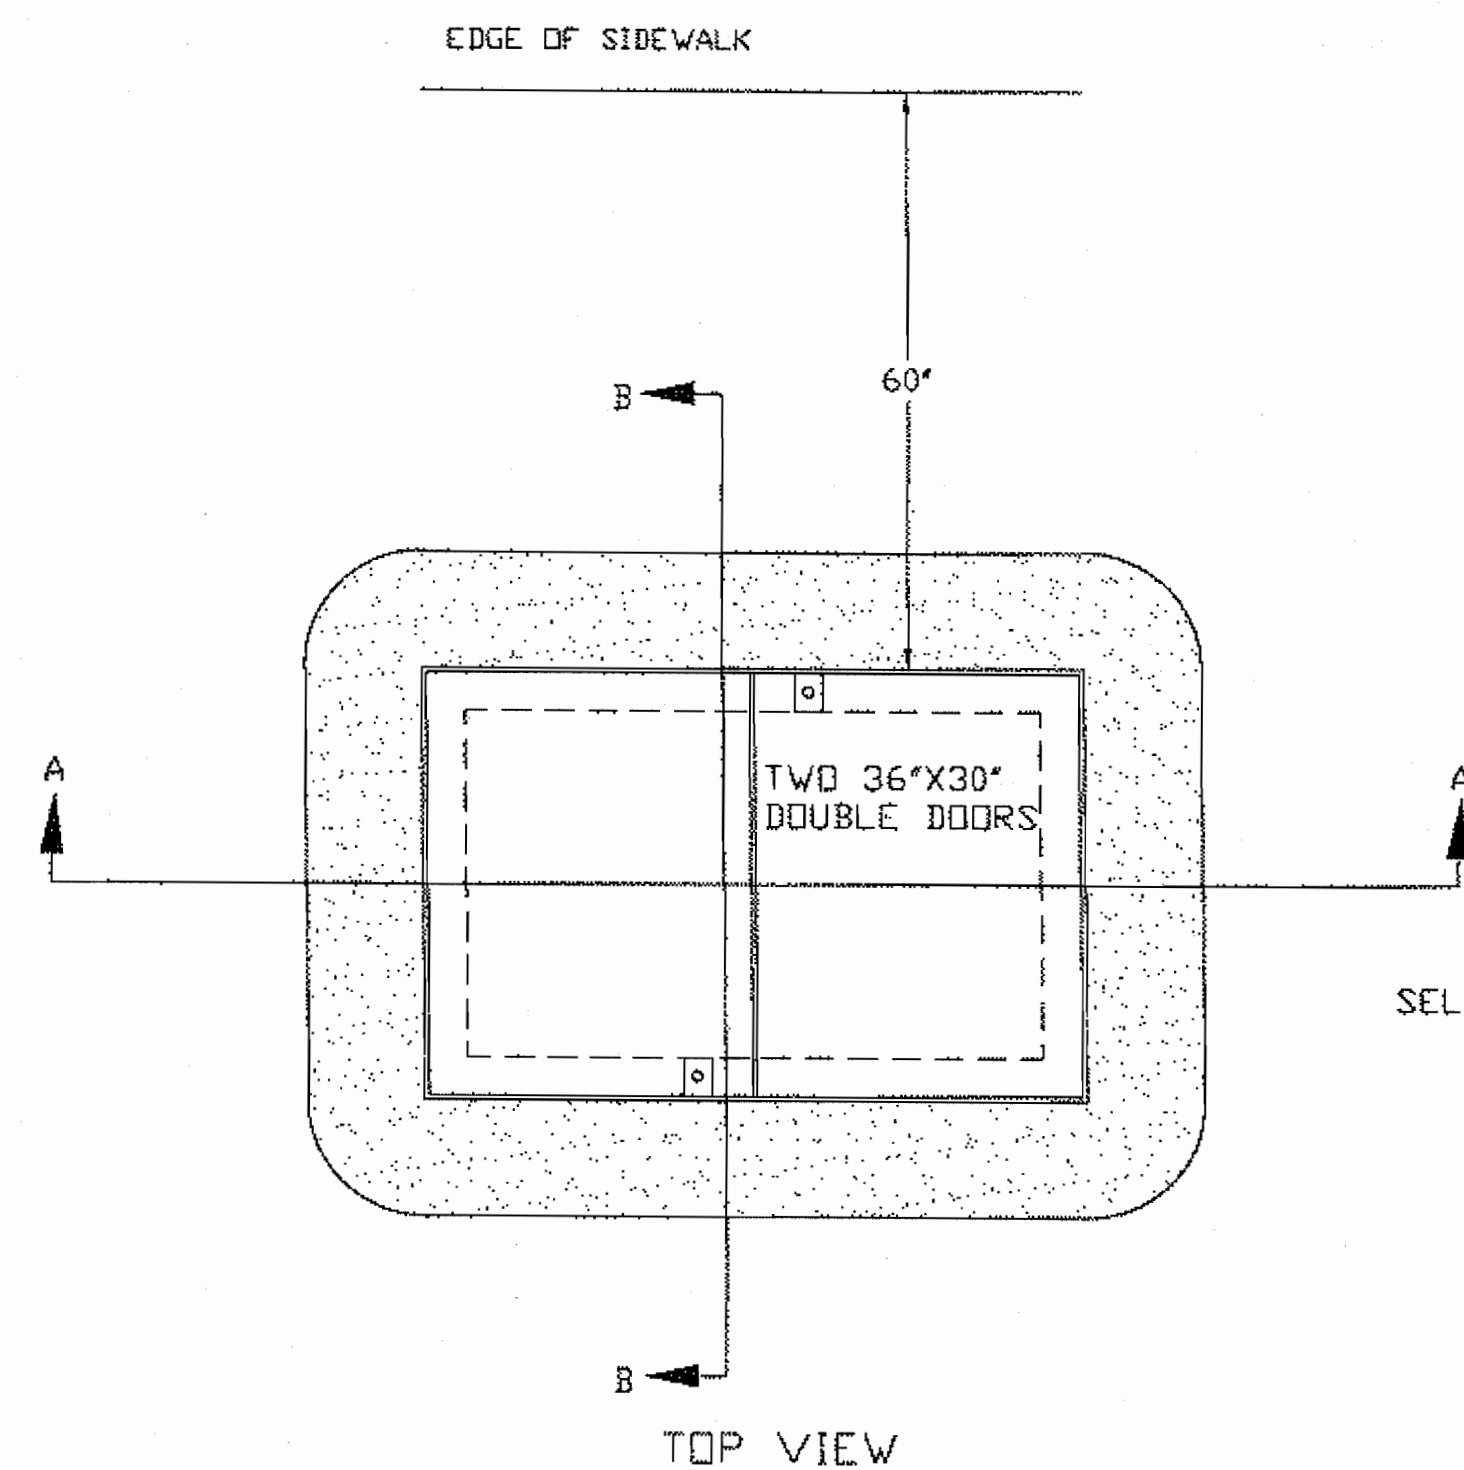


TRENCH CROSS-SECTION DETAILS

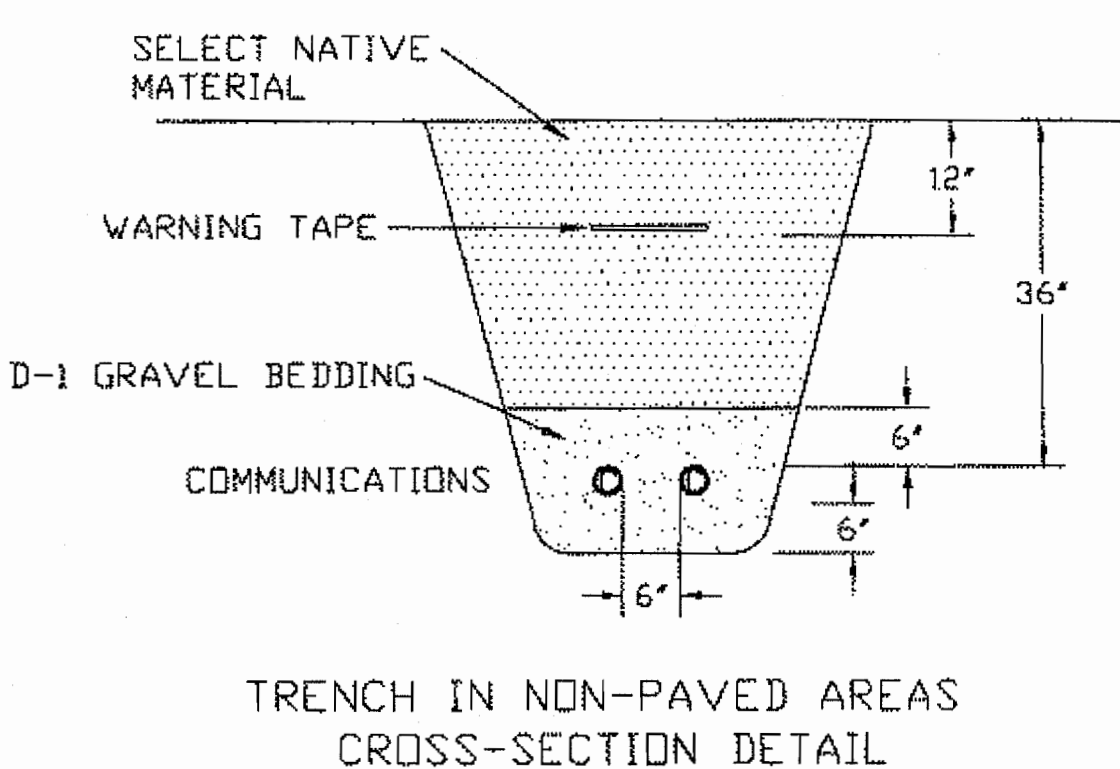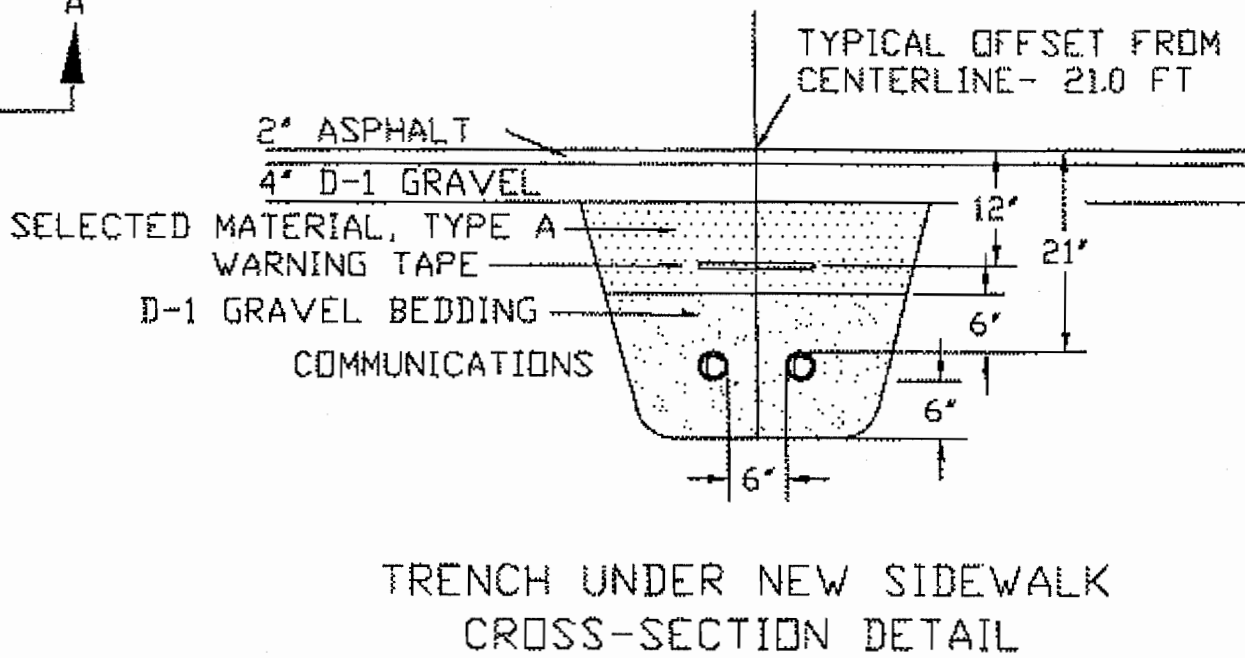

COMMUNICATIONS VAULT/CONDUIT SUMMARY									
FACILITY LOCATION				CONDUIT				TRENCH	
NUMBER	STATION	OFFSET	TYPE	NUMBER	SIZE	SCHED.	MAT'L.	LENGTH	LENGTH
POLE	177+85.2	37.21 RT	RISERS	2	2"	40	HDPE	60'	---
VLT 1	178+03.0	34.00 RT	VAULT	2	2"	40	HDPE	40'	15'
VLT 2	199+50.0	31.87 RT	VAULT	2	2"	40	HDPE	4420'	2205'
VLT 3	222+90.0	31.88 RT	VAULT	2	2"	40	HDPE	4700'	2345'
VLT 4	241+20.0	31.87 RT	VAULT	2	2"	40	HDPE	3700'	1850'
VLT 5	262+87.0	48.14 RT	VAULT	2	2"	40	HDPE	4370'	2180'
XING	263+00.3	---	CROSSING	2	2"	40	HDPE	200'	95'
POLE	263+13.0	40.61 LT	RISERS	2	2"	40	HDPE	60'	---

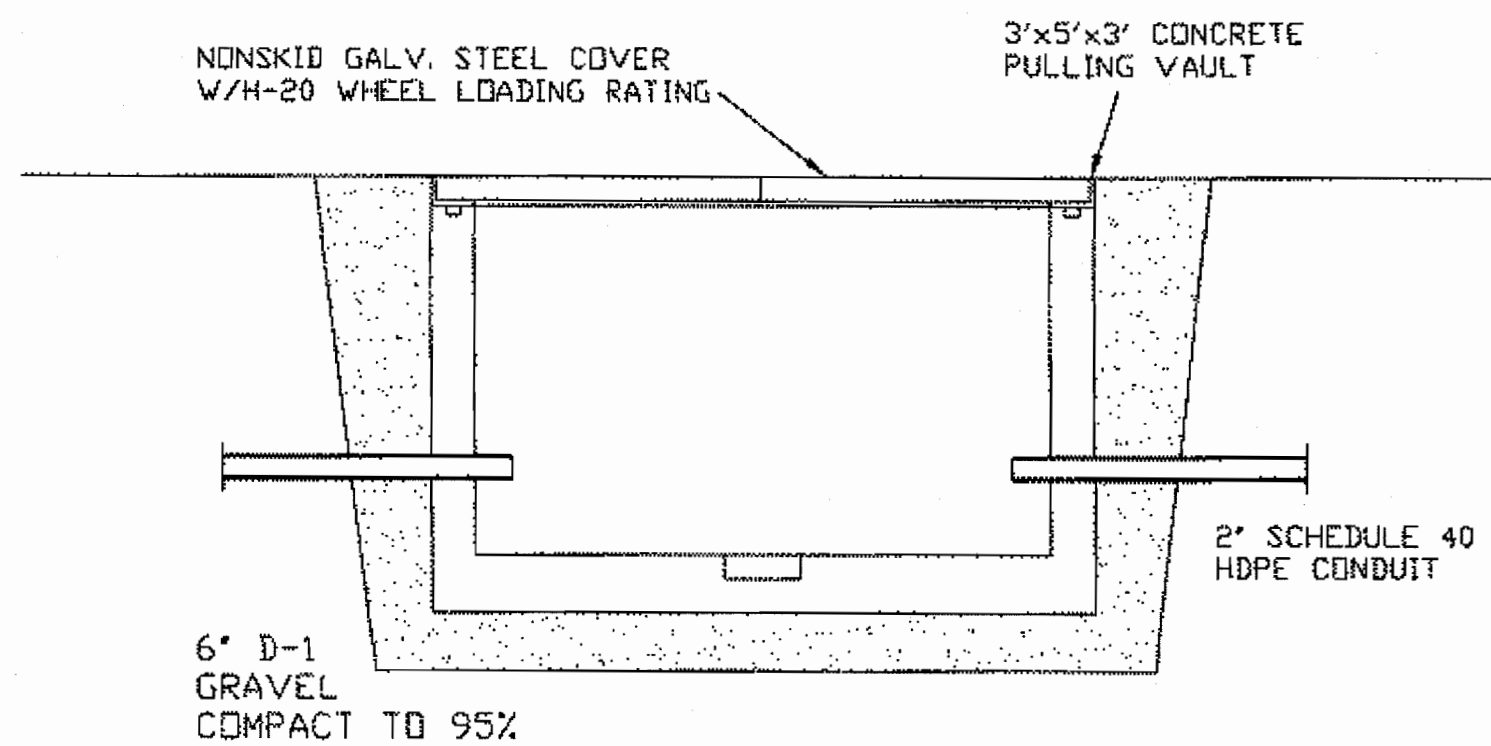

CABLE PULLING VAULT DETAIL

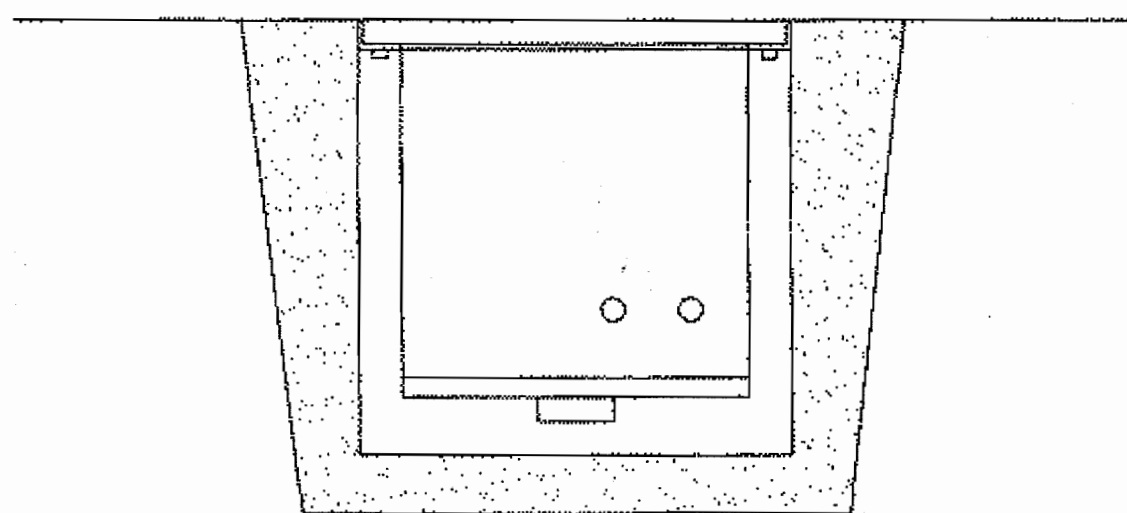

- NOTES:
1. CONTRACTOR SHALL INSTALL ADOT "AGGREGATE BASE COURSE, GRADING D-1" WHERE SPECIFIED. D-1 GRAVEL UNDER THE VAULTS AND FOR CONDUIT BEDDING AS SHOWN ON THESE DETAILS. VAULTS SHALL BE 5' BEHIND THE SIDEWALK; FINISHED ELEVATIONS SHALL BE THE SAME AS THE SIDEWALK. FILL SHALL BE COMPACTED TO 95%. VAULTS SHALL NOT BE PLACED IN LOW AREAS WHERE STORM WATER CAN ACCUMULATE.
 2. COMMUNICATIONS CONDUITS SHALL BE INSTALLED AT LEAST 21" BELOW FINISHED GRADE UNDER THE NEW SIDEWALK AND AT LEAST 36" BELOW FINISHED GRADE ALONG THE ROW WHERE THERE IS NO SIDEWALK. MEASUREMENTS SHALL BE TO THE TOP OF THE CONDUITS. CONDUITS FOR THE ONE ROAD CROSSING SHALL BE INSTALLED AT LEAST 48" BELOW FINISHED GRADE. COMMUNICATIONS CONDUITS SHALL BE CONTINUOUS 2" SCHEDULE 40 HDPE COILED ON REELS. CONDUIT BEDDING AND BACKFILL WHERE SPECIFIED SHALL BE ADOT "AGGREGATE BASE COURSE, GRADING D-1" GRAVEL COMPACTED TO 95%.
 3. CONSTRUCTION SHALL CONFORM TO THE NESC, ACS STANDARDS AND CITY AND BOROUGH OF SITKA'S REQUIREMENTS FOR UNDERGROUND SYSTEMS.
 4. ALL METALLIC EQUIPMENT REQUIRED TO BE GROUNDED SHALL BE GROUNDED TO A VAULT GROUND ROD AT EACH VAULT.
 5. THE CONTRACTOR SHALL MARK THE LOCATION OF THE CONDUITS WHERE THEY CROSS UNDER THE GUARD RAIL TO FACILITATE INSTALLATION OF POSTS.
 6. INSTALLATION OF UNDERGROUND OR OVERHEAD FIBER OPTIC CABLES IS NOT INCLUDED IN THE SCOPE OF THIS CONTRACT. THE CONTRACTOR SHALL TEMPORARILY PLUG CONDUITS TO PREVENT DIRT ACCUMULATION AND INSTALL PULLING LINES FOR FUTURE USE.

Project As Built Drawings Have Been Reviewed By The Project Engineer & Represent, To The Best Of My Knowledge, The Project As Constructed.

Proj. Eng. *[Signature]* 6-24-15 Date

DO NOT SCALE FROM THESE DRAWINGS USE DIMENSIONS

CHECKED BY: R. DRYDEN		STATE OF ALASKA DEPARTMENT OF TRANSPORTATION & PUBLIC FACILITIES SOUTHEAST REGION	
		SITKA, ALASKA SAWMILL CREEK ROAD PH. III WHALE PARK TO SAWMILL CREEK BRIDGE	
DESIGNED BY: M. CARSON DRAWN BY: M. CARSON		ELECTRIC UTILITY DETAILS	
PATH: C:\USERS\MIKE\DOCUMENTS\ISCR3\FIBER\CABLE\1153805-UTILITY DETAILS.DWG		PROJECT DESIGNATION FIBER OPTIC 69615	
TAB: DETAILS Wednesday, October 03, 2012 3:11:42 PM MIKE		YEAR 2012	SHEET NO. U21
REVISIONS NO. DATE DESCRIPTION		TOTAL SHEETS 109	