


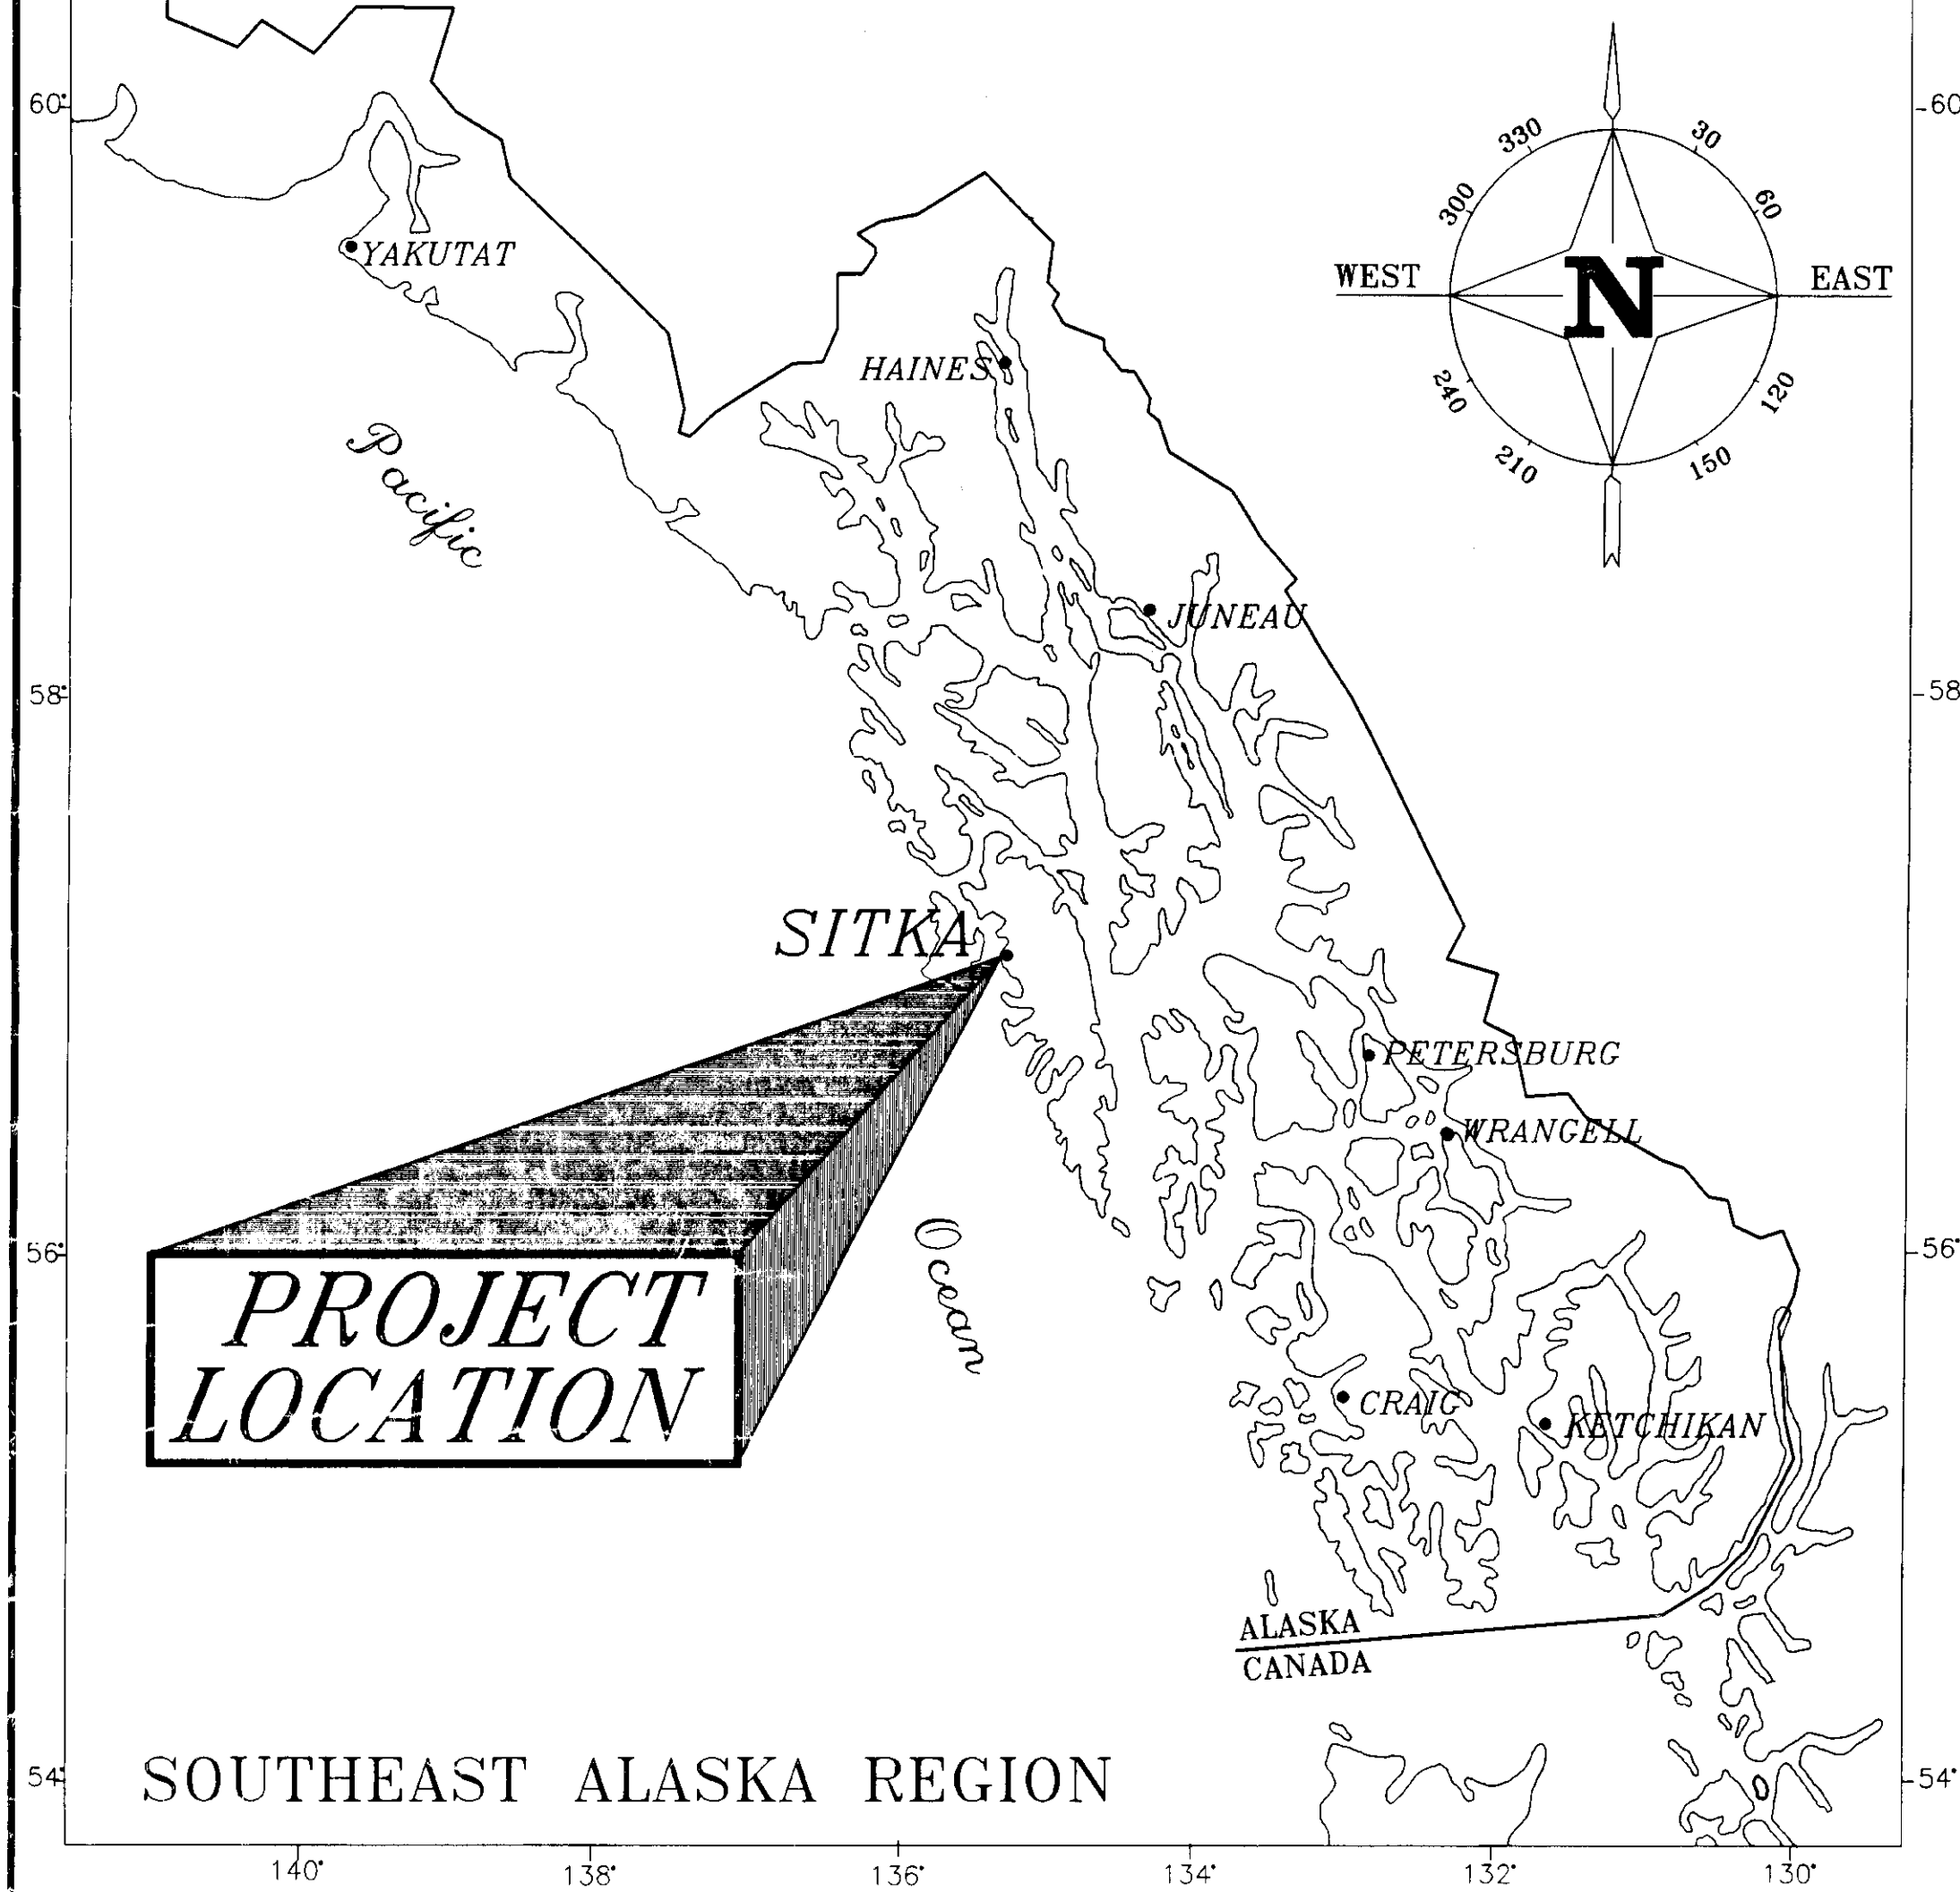

STATE OF ALASKA
DEPARTMENT OF TRANSPORTATION
AND
PUBLIC FACILITIES
SOUTHEAST REGION
DESIGN AND CONSTRUCTION DIVISION

SITKA

AIRPORT ACCESS ROAD

PROJECT NO. F-M-0935(8), 69272

SHEET NO.	DESCRIPTION
1	TITLE SHEET
2-4	TYPICAL SECTIONS
5	ESTIMATE OF QUANTITIES
6-7	MISCELLANEOUS SUMMARIES
8-11	PLAN & PROFILE SHEETS
12	APPROACH PLAN
13-14	APPROACH PROFILES
15-18	DRAINAGE PROFILE
19-20	TRAFFIC CONTROL PLAN
21	STRIPING, SIGNING & ILLUMINATION
22	ILLUMINATION DETAILS
23	RECESSED PAVEMENT MARKER & DETAILS
24-25	SIDEWALK DETAILS
26	MANHOLE DETAILS
27	MANHOLE RECONSTRUCTION/ADJUSTMENT
28	CULVERT GRATE DETAILS


DESIGN DESIGNATION

STA. "O" 41+00 TO STA. "O" 59+50

ADT (1994)	=	3,110
ADT (2014)	=	3,980
DHV (12%)	=	475
%T	=	4%
DESIGN SPEED	=	35 MPH
DESIGN LANE EAL	=	275,700

PROJECT SUMMARY

WIDTH OF PAVEMENT	=	36.0'
LENGTH OF PAVEMENT	=	1,850' (0.35 MILES)
LENGTH OF PROJECT	=	1,850' (0.35 MILES)

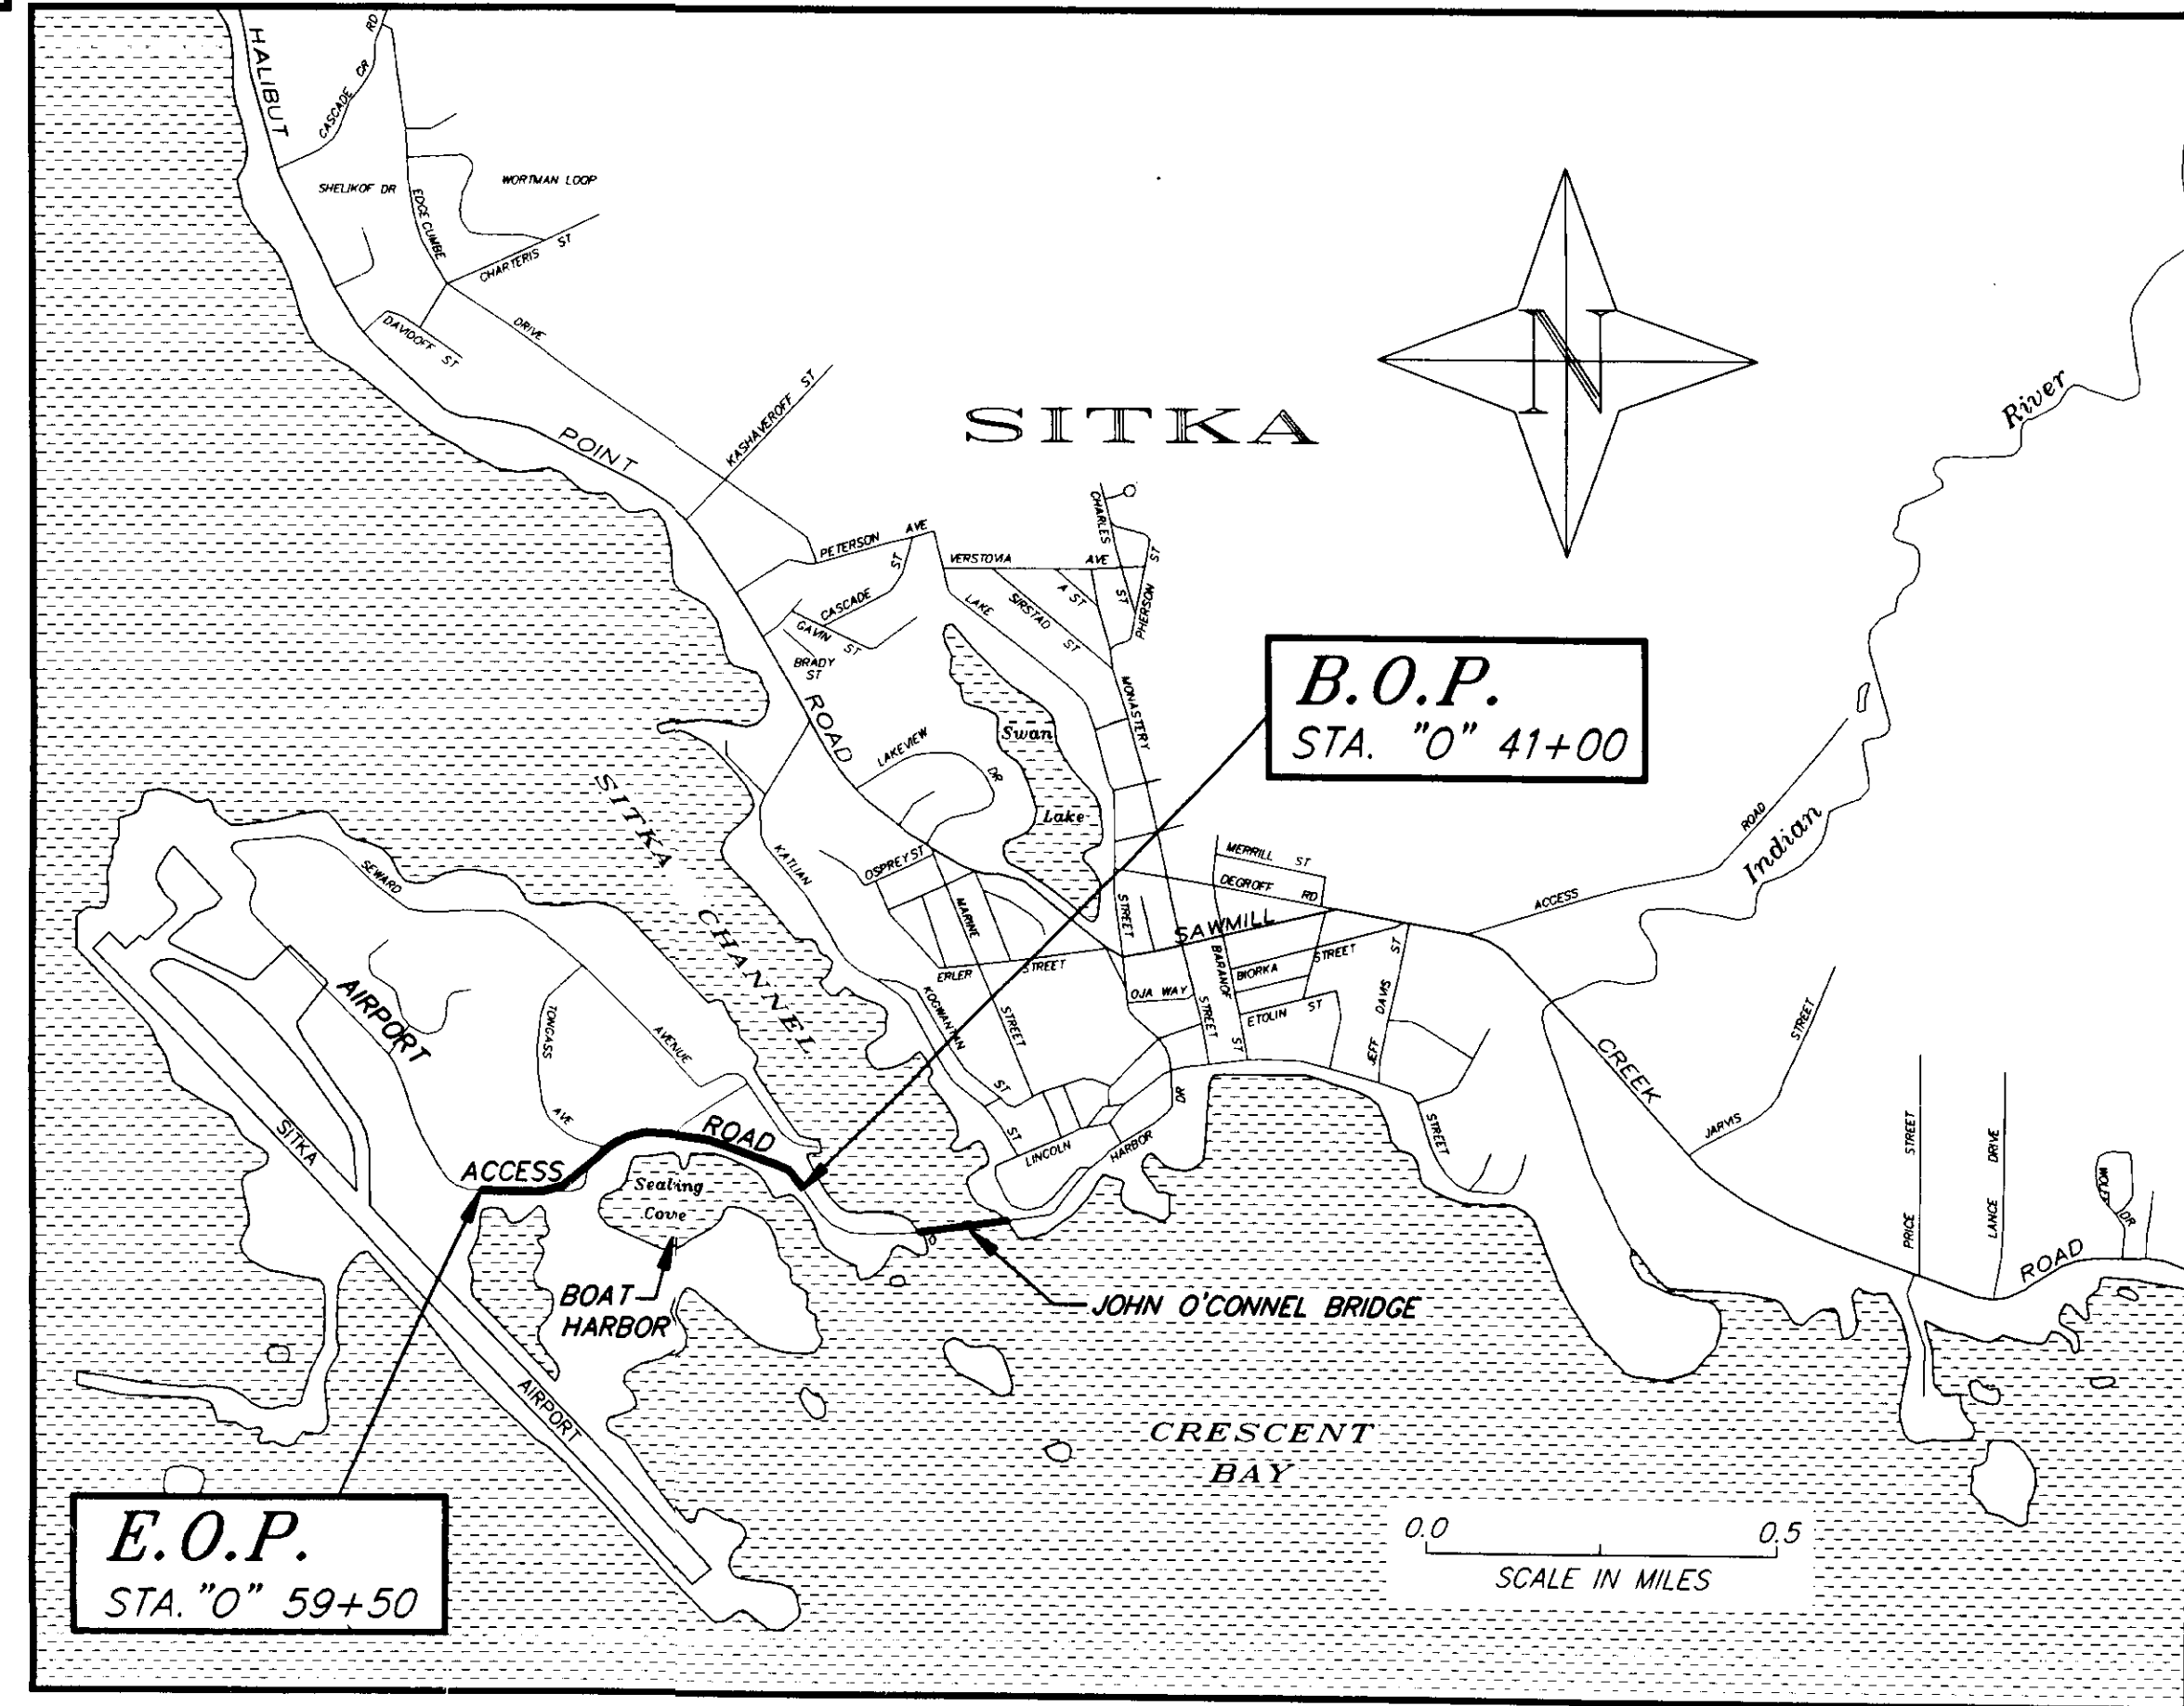

VICINITY MAP

The following Standard Drawings apply to this project :

A-1, C-01.03, C-02.01, C-03.01, D-01.02, D-04.10, D-20.02, D-23.00, D-26.01, D-27.01, E-00.00, E-09.00, G-04.05W, G-14.04W, G-18.00W, I-20.11, I-81.00, L-03.02, L-10.02, L-23.01, L-30.02, S-00.00, S-05.00, S-20.00, S-30.01, T-20.00, T-21.01

"As-Built" Plans

Contractor: Fosco Inc./A.C.I.
Project Engr: Tom Metlicka
Begin Construction: 3-15-94
End Construction: 8-10-94

