




STATE OF ALASKA
DEPARTMENT OF TRANSPORTATION
AND
PUBLIC FACILITIES
SOUTHEASTERN REGION
DESIGN AND CONSTRUCTION DIVISION

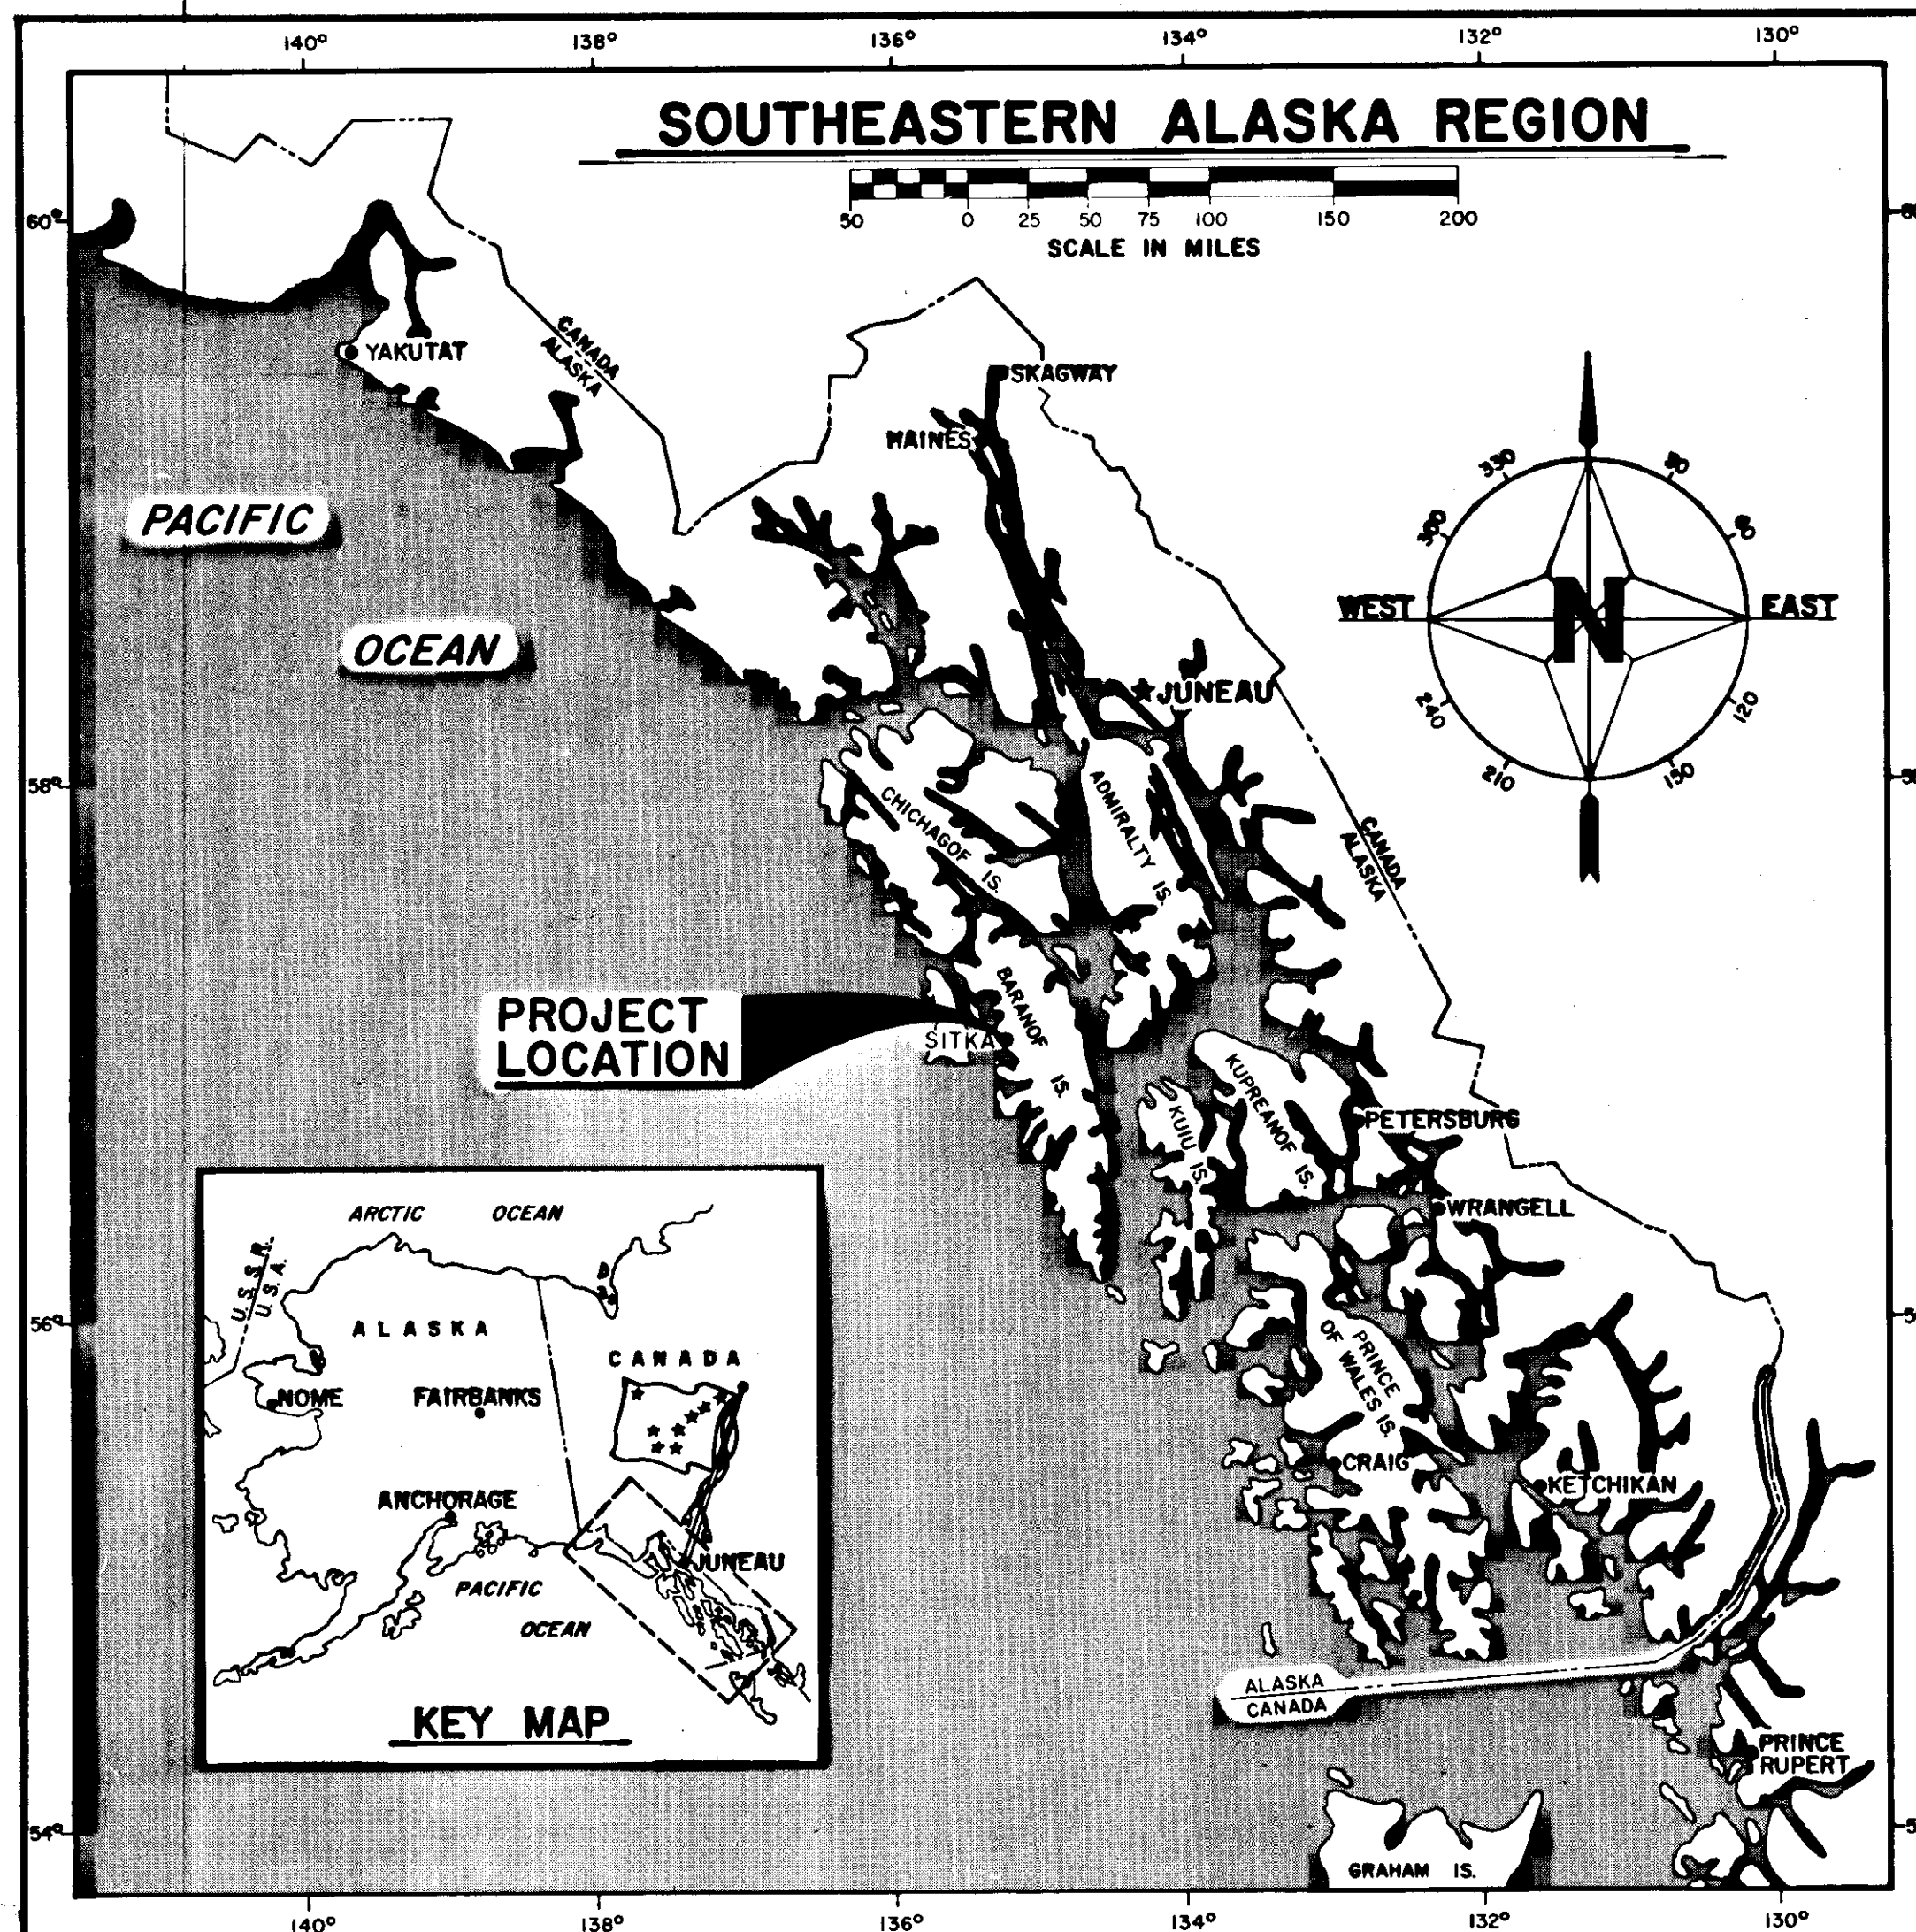

KATLIAN AVENUE
/ HALIBUT PT RD
SIGNAL

HES-099-3 (2)


70313

INDEX OF SHEETS	
SHEET NO.	DESCRIPTION
1	TITLE SHEET
2	ESTIMATE AND OVERHEAD UTILITIES
3	SUMMARY TABLES
4	TRAFFIC SIGNAL PLAN
5	SIGNING, STRIPING & ILLUMINATION
6	DETAILS
7-10	TRAFFIC CONTROL PLAN

THE FOLLOWING STANDARD DRAWINGS APPLY TO THIS PROJECT:
A-1, C-01.03, C-02.01, C-03.01, I-20.10, L-03.01, L-20.01, L-23.00, S-00.00, S-05.00, S-20.00, S-30.01, T-20.00, T-21.01, T-30.00, T-31.00, T-32.00, T-33.01, T-34.00, T-52.01 & U-03.00

DESIGN DESIGNATION		
HALIBUT POINT ROAD	KATLIAN AVENUE	
A.D.T. 1990 10,500	2,850	
A.D.T. 2010 14,200	3,500	
D.H.V. (12%) 1,700	420	
% T. 10%	10%	
T.I. N/A	N/A	

PROJECT SUMMARY		
LENGTH OF PROJECT	588'(0.111MI.)	
LENGTH OF PAVING	N/A	
LENGTH OF GRADING	N/A	

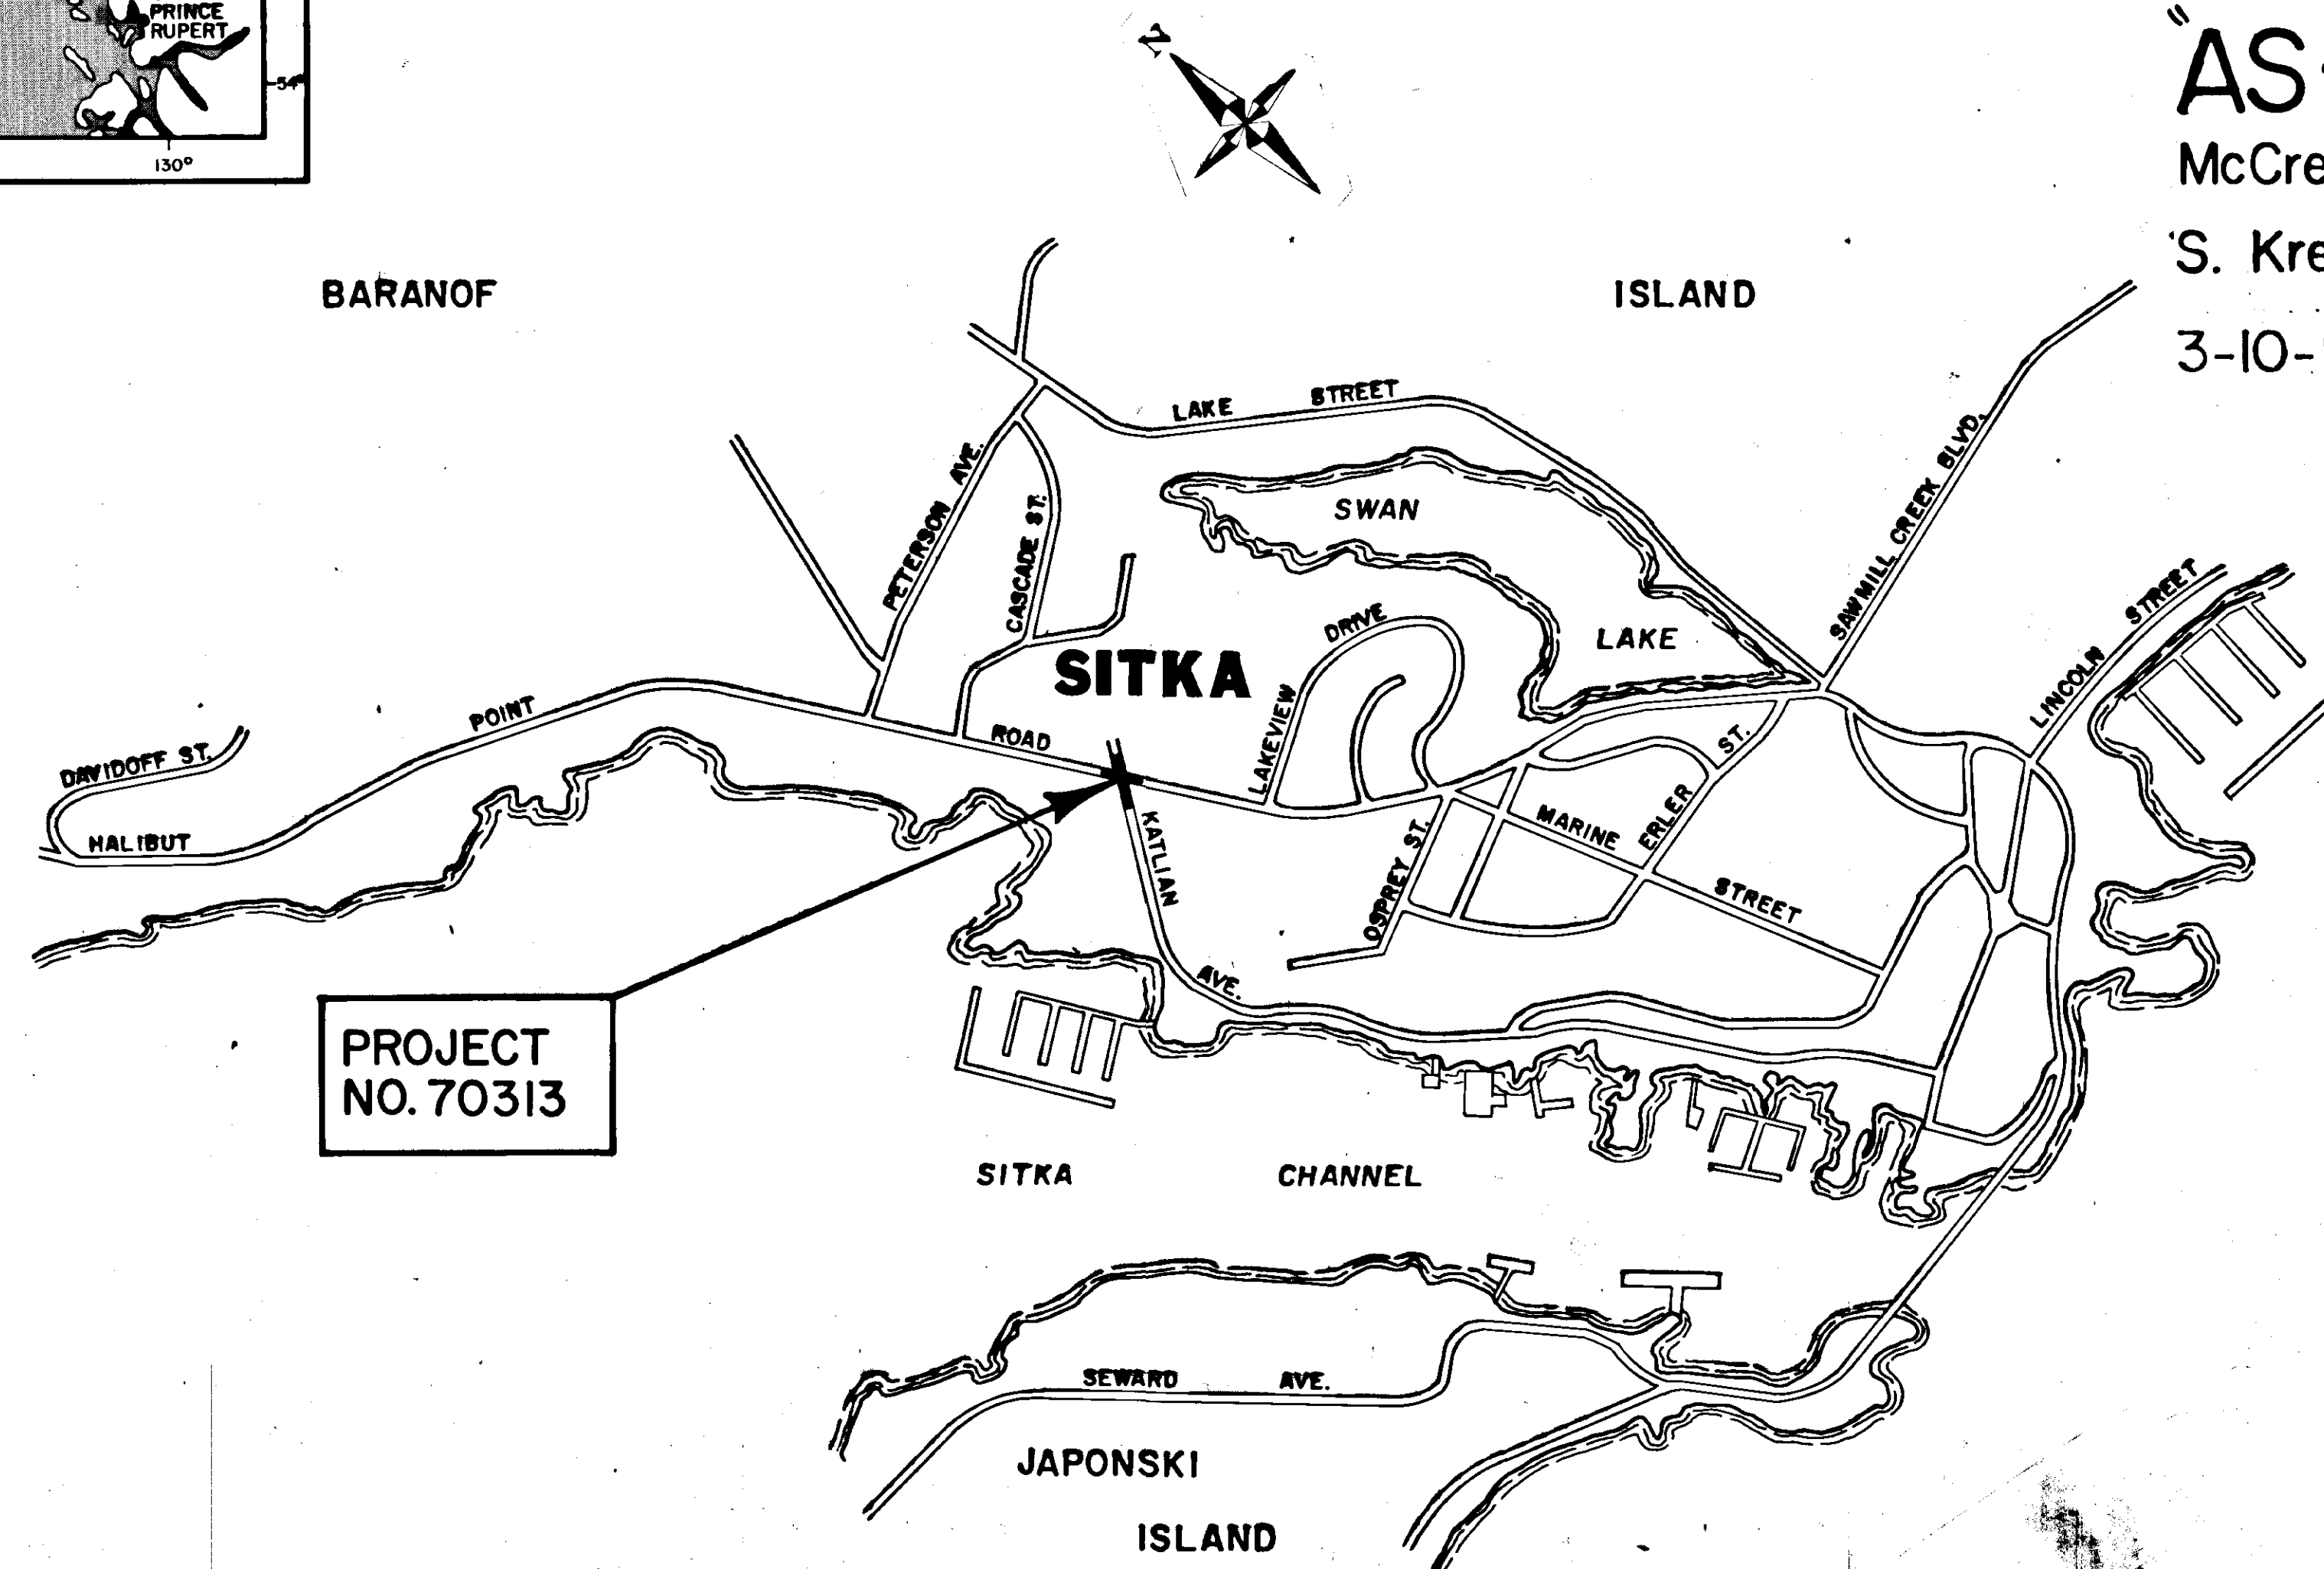

"AS-BUILT" PLANS

McCrehin General Contracting

S. Kreuzenstein, Proj. Engr.

3-10-91 to 6-12-91

STATE OF ALASKA
DEPARTMENT OF TRANSPORTATION
AND
PUBLIC FACILITIES
SOUTHEASTERN REGION DESIGN SECTION

APPROVED

E. V. Hamell
S.E. Region Design Chief

Date 9-12-90

APPROVED


E. V. Hamell
Director, S.E. Region Design & Construction

Date 9-13-90

PROJECT NUMBER: HES-099-3 (2) 70313	ENGINEER'S STAMP
DATE: 5/90	
SHEET 1 OF 10	

ESTIMATE OF QUANTITIES


ITEM NO.	ITEM	UNIT	TOTAL
120(1)	DBE ADJUSTMENT	C.S.	ALL REQ'D
201(4B)	HAND CLEARING	L.S.	ALL REQ'D
505(5)	STRUCTURAL STEEL PILES, FURNISHED	L.F.	136-93
505(6)	STRUCTURAL STEEL PILES, DRIVEN	EACH	8
603(22)	Remove and Replace C.M.P. C.O. No. 1	L.S.	All Req'd
615(1)	STANDARD SIGN C.O. No. 1	S.F.	106.5 82.25
640(1)	MOBILIZATION & DEMOBILIZATION	L.S.	ALL REQ'D
641(1)	TEMPORARY EROSION AND POLLUTION CONTROL	C.S.	ALL REQ'D
642(1)	CONSTRUCTION SURVEYING	L.S.	ALL REQ'D
643(2)	TRAFFIC MAINTENANCE	L.S.	ALL REQ'D
643(4)	CONSTRUCTION SIGN	EACH/DAY	450 609
643(5)	TYPE I I BARRICADE	EACH/DAY	100 177
643(7)	TRAFFIC CONE	EACH/DAY	500 1267
643(8)	DRUM	EACH/DAY	130 319
643(15)	FLAGGING	HOUR	360 2195
660(1)	TRAFFIC SIGNAL SYSTEM COMPLETE	L.S.	ALL REQ'D
660(3)	HIGHWAY LIGHTING SYSTEM	L.S.	ALL REQ'D
660(11)	TRAFFIC SIGNAL TRAINING	L.S.	ALL REQ'D
661(3)	LOAD CENTER, TYPE 3	EACH	1
670(1)	PAINTED TRAFFIC MARKINGS	L.S.	ALL REQ'D

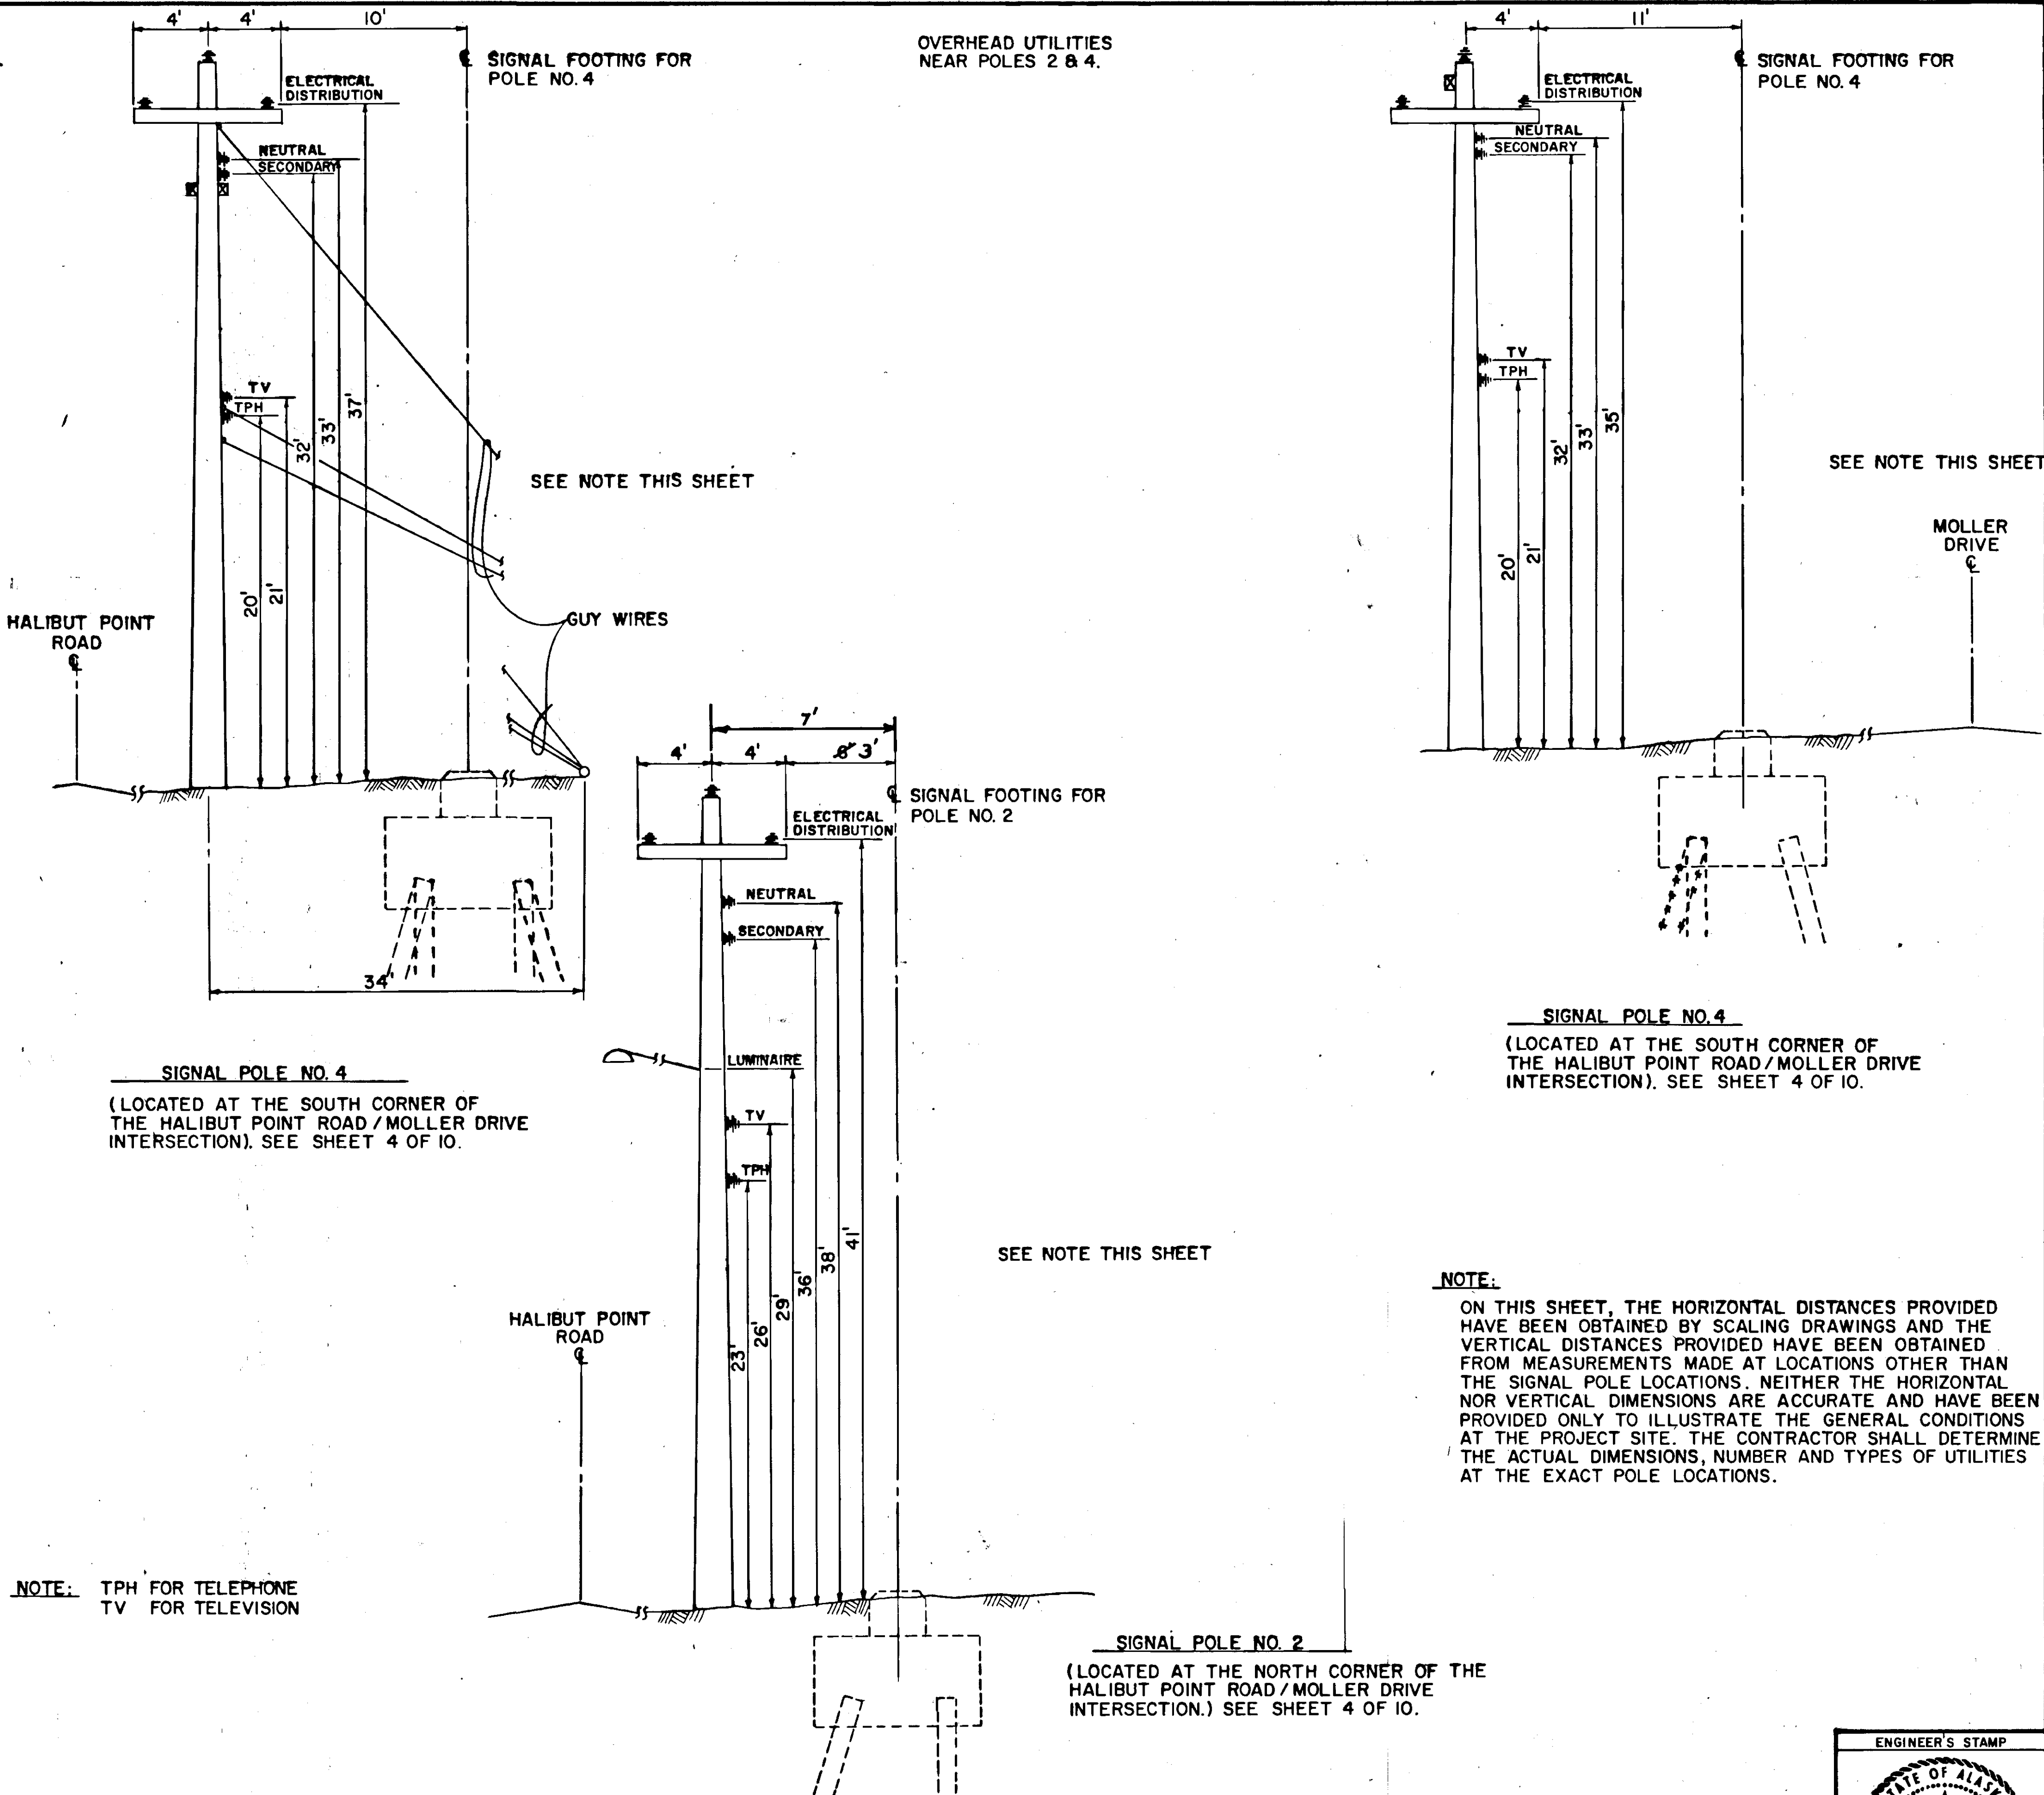

SIGNAL POLE NO. 4
(LOCATED AT THE SOUTH CORNER OF THE HALIBUT POINT ROAD/MOLLER DRIVE INTERSECTION). SEE SHEET 4 OF 10.

SIGNAL POLE NO. 2
(LOCATED AT THE NORTH CORNER OF THE HALIBUT POINT ROAD/MOLLER DRIVE INTERSECTION.) SEE SHEET 4 OF 10.

NOTE:
ON THIS SHEET, THE HORIZONTAL DISTANCES PROVIDED HAVE BEEN OBTAINED BY SCALING DRAWINGS AND THE VERTICAL DISTANCES PROVIDED HAVE BEEN OBTAINED FROM MEASUREMENTS MADE AT LOCATIONS OTHER THAN THE SIGNAL POLE LOCATIONS. NEITHER THE HORIZONTAL NOR VERTICAL DIMENSIONS ARE ACCURATE AND HAVE BEEN PROVIDED ONLY TO ILLUSTRATE THE GENERAL CONDITIONS AT THE PROJECT SITE. THE CONTRACTOR SHALL DETERMINE THE ACTUAL DIMENSIONS, NUMBER AND TYPES OF UTILITIES AT THE EXACT POLE LOCATIONS.

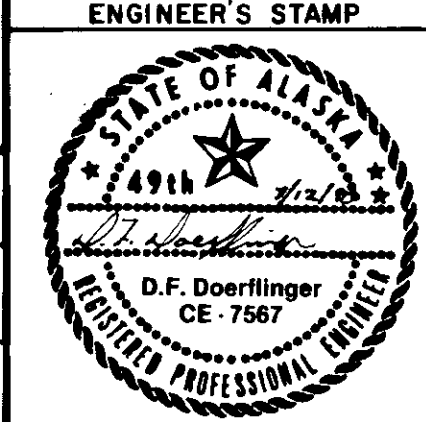

SIGNAL HEAD SUMMARY						
SIGNAL HEAD NUMBER	PHASE	POLE NUMBER	INDICATED	LENS SIZE	MOUNTING TYPE	REMARKS
1	6	1	R-Y-G	12"	S-1	
2	6	1	PED.SYMBL.	NEON	SW-2	
3	4	1	PED.SYMBL.	NEON	SW-2	
4	6	1	R-Y-G	12"	PLUMBIZER	
5	8	4	PED.SYMBL.	NEON	SW-1	
6	8	4	R-Y-G	12"	S-1	
7	8	4	R-Y-G	12"	PLUMBIZER	
8	2	2	R-Y-G	12"	S-1	
9	2	2	R-Y-G	12"	PLUMBIZER	
10	4	3	R-Y-G	12"	S-1	
11	2	3	PED.SYMBL.	NEON	SW-1	
12	4	3	R-Y-G	12"	PLUMBIZER	

J-BOX AND CABINET BASE SUMMARY					
NUMBER	"A" LINE STATION	OFFSET RT. LT.	TYPE	REMARKS	
1	7+31-21	25'	1		
2	8+52	20'	1		
3	9+52	26'	1	REMOVE EXISTING	
3	9+52	26'	2		
4	9+79	45'	1	EXISTING	
5	9+96	52'	1	REMOVE EXISTING	
5	9+96	52'	2		
6	10+46	48'	1	REMOVE EXISTING	
6	10+46	48'	2		
7	12+88		30'	1	
8	11+32		29'	1	
9	10+56		32'	1	
10	10+34		39'	1	
11	10+06		60'	2	In Sidewalk
12	9+35		71'	1	
13	9+35		62'	2	
14	9+28		39'	1	REMOVE EXISTING
14	9+28		39'	2	
	9+80	52'			INSTALL TYPE P-I CABINET
15	9+80	50'		3	INSTALL IN FRONT OF CABINET

DETECTOR SUMMARY						
NUMBER	"A" LINE STATION	OFFSET LT. RT.	TYPE	PHASE	REMARKS	
1	7+00		9'	6'X6' LOOP	2	3 TURNS
2	8+52		9'	6'X6' LOOP	2	3 TURNS
3	9+35	1'		6'X35' QUADRAPOLE	2	2-4-2 TURNS
4	9+37		9'	6'X25' LOOP	2	3 TURNS, DC-EC
5	9+90		55'	PED. PUSH BUTTON	4	INSTALL R10-4B(R)SIGN
6	10+22		51'	6'X35' LOOP	4	3 TURNS
7	10+47	2'		6'X35' QUADRAPOLE	6	2-4-2 TURNS
8	10+42	12'		6'X25' LOOP	6	3 TURNS, DC-EC
9	11+33	12'		6'X6' LOOP	6	3 TURNS
10	12+88	6'		6'X6' LOOP	6	3 TURNS
12	9+69	64'		6'X35' LOOP	8	3 TURNS
13	9+58	44' 64'		6'X35' LOOP	8	3 TURNS
14	9+31	46'		PED. PUSH BUTTON	8	INSTALL R10-4B(L)SIGN
15	9+31	46'		PED. PUSH BUTTON	2	INSTALL R10-4B(R)SIGN
16	10+22	50'		PED. PUSH BUTTON	6	INSTALL R10-4B(L)SIGN

DETECTOR SUMMARY NOTES

1. ALL DETECTOR AMPLIFIERS SHALL HAVE THE DELAY/EXTENSION OPTIONAL FEATURE.
2. DC-EC=DELAY CALL-EXTEND CALL.

SIGNAL POLE SUMMARY								
NUMBER	"A" LINE STATION	OFFSET LT. RT.	TYPE	SIGNAL MAST ARM			FOUNDATION	ILLUMINATION MAST ARM
				K	M	N		REMARKS
1	9+31	42'	COMBINATION IN PLACE	40	10	30	IN PLACE	IN PLACE
2	10+54		38' STANDARD	40	10	30	PILING, SEE SHT. 6	
3	10+23	50'	COMBINATION	28	NA	28	SPREAD FOOTING	15'
4	9+90		45' COMBINATION	15	NA	15	PILING, SEE SHT. 6	6'

SIGNAL POLE SUMMARY NOTES:

1. ALL POLES SHALL HAVE R9-4 DECAL PLACED 5' ABOVE GROUND LEVEL OF POLE, FACING THE CROSSING.
2. THE CONTRACTOR SHALL SUPPLY ALL ANCHOR BOLTS WITH NUTS AND WASHERS, FOR POLES 2,3, AND 4.
3. PILE-SUPPORTED FOOTINGS FOR POLES NO. TWO AND FOUR, SHALL BE CONSTRUCTED AS SHOWN ON SHEET SIX.

GENERAL NOTES


1. SIGNAL HARDWARE SHALL BE MOUNTED AS PER STANDARD DRAWING T-30.00 & T-52.01.
2. THE CONTRACTOR SHALL LOCATE ALL EXISTING UNDERGROUND UTILITIES PIPES, AND CULVERTS.
3. CONDUIT LOCATIONS AS SHOWN ON THE SIGNALIZATION PLAN ARE SCHEMATIC ONLY AND SHALL BE ADJUSTED AS NECESSARY TO SUIT FIELD CONDITIONS.
4. J-BOX LOCATIONS SHALL BE ADJUSTED AS NECESSARY TO SUIT FIELD CONDITIONS.
5. "C"=CONDUCTOR, "RMC"= RIGID METAL CONDUIT.
6. QUANTITY OF HAND CLEARING TO BE ACCOMPLISHED ON THIS PROJECT IS ESTIMATED TO BE APPROXIMATELY 2000 S.F.

BY:	DATE:	DESCRIPTION OF CHANGE:
RECORD OF REVISIONS		

STATE OF ALASKA
DEPARTMENT OF TRANSPORTATION
AND PUBLIC FACILITIES
SOUTHEAST REGION DESIGN & CONSTRUCTION




KATLIAN AVENUE/HALIBUT POINT ROAD SIGNAL
PROJECT NO. HES-099-3(2), 70313
SUMMARY TABLES

DESIGNED BY: R. PURVIS/W. TOWNSEND	SCALE NONE
DRAWN BY: AUTOCADD/CSA	DATE: 5/90
CHECKED BY: J. AHLGREN	SHEET 3 OF 10

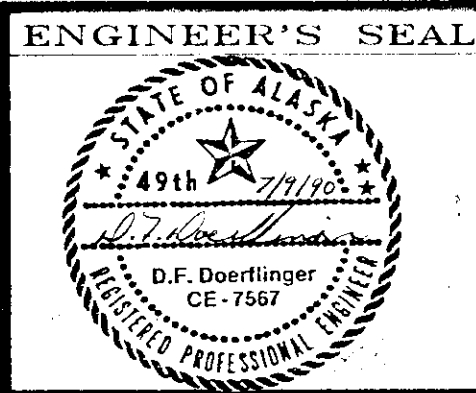

BASIS OF HORIZONTAL CONTROL
 The Basis of Horizontal Control is the centerline bearing between Halibut Point Road Monuments "L" 46+85.21 P.T. and the Katlian Avenue Intersection Monument given as N. 33°15'30"W.
 (NOTE: "L" 46+85.21 P.T. = "A" 4+83.77 P.O.T.)

* EXISTING CONDUIT LOCATIONS FOR CABLES			
QUANTITY	SIZE	FROM	TO
2	2"	"A" 10+6.60 LT.	"A" 9+40.62' LT.
1	3"		
1	2 1/2"	"A" 9+22.37' LT.	"A" 9+54.23' RT.
1	2"		
2	2"	"A" 9+97.49' RT.	"A" 10+45.46' RT.

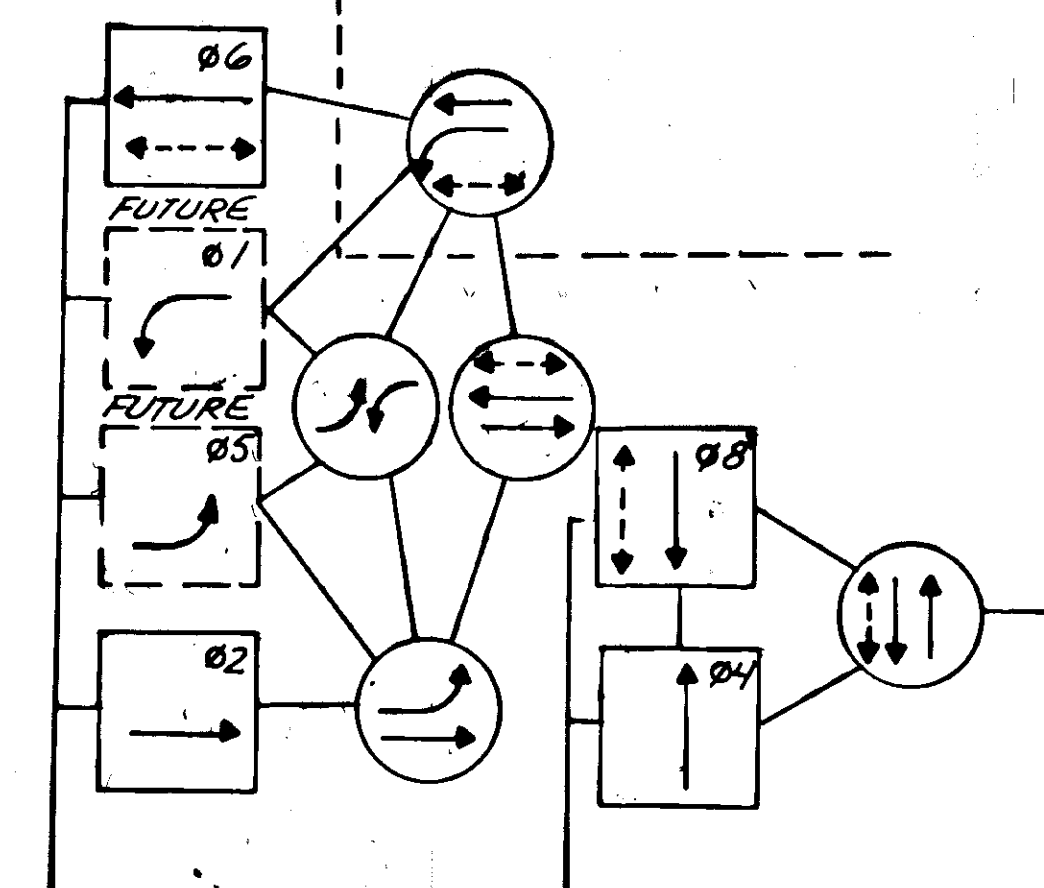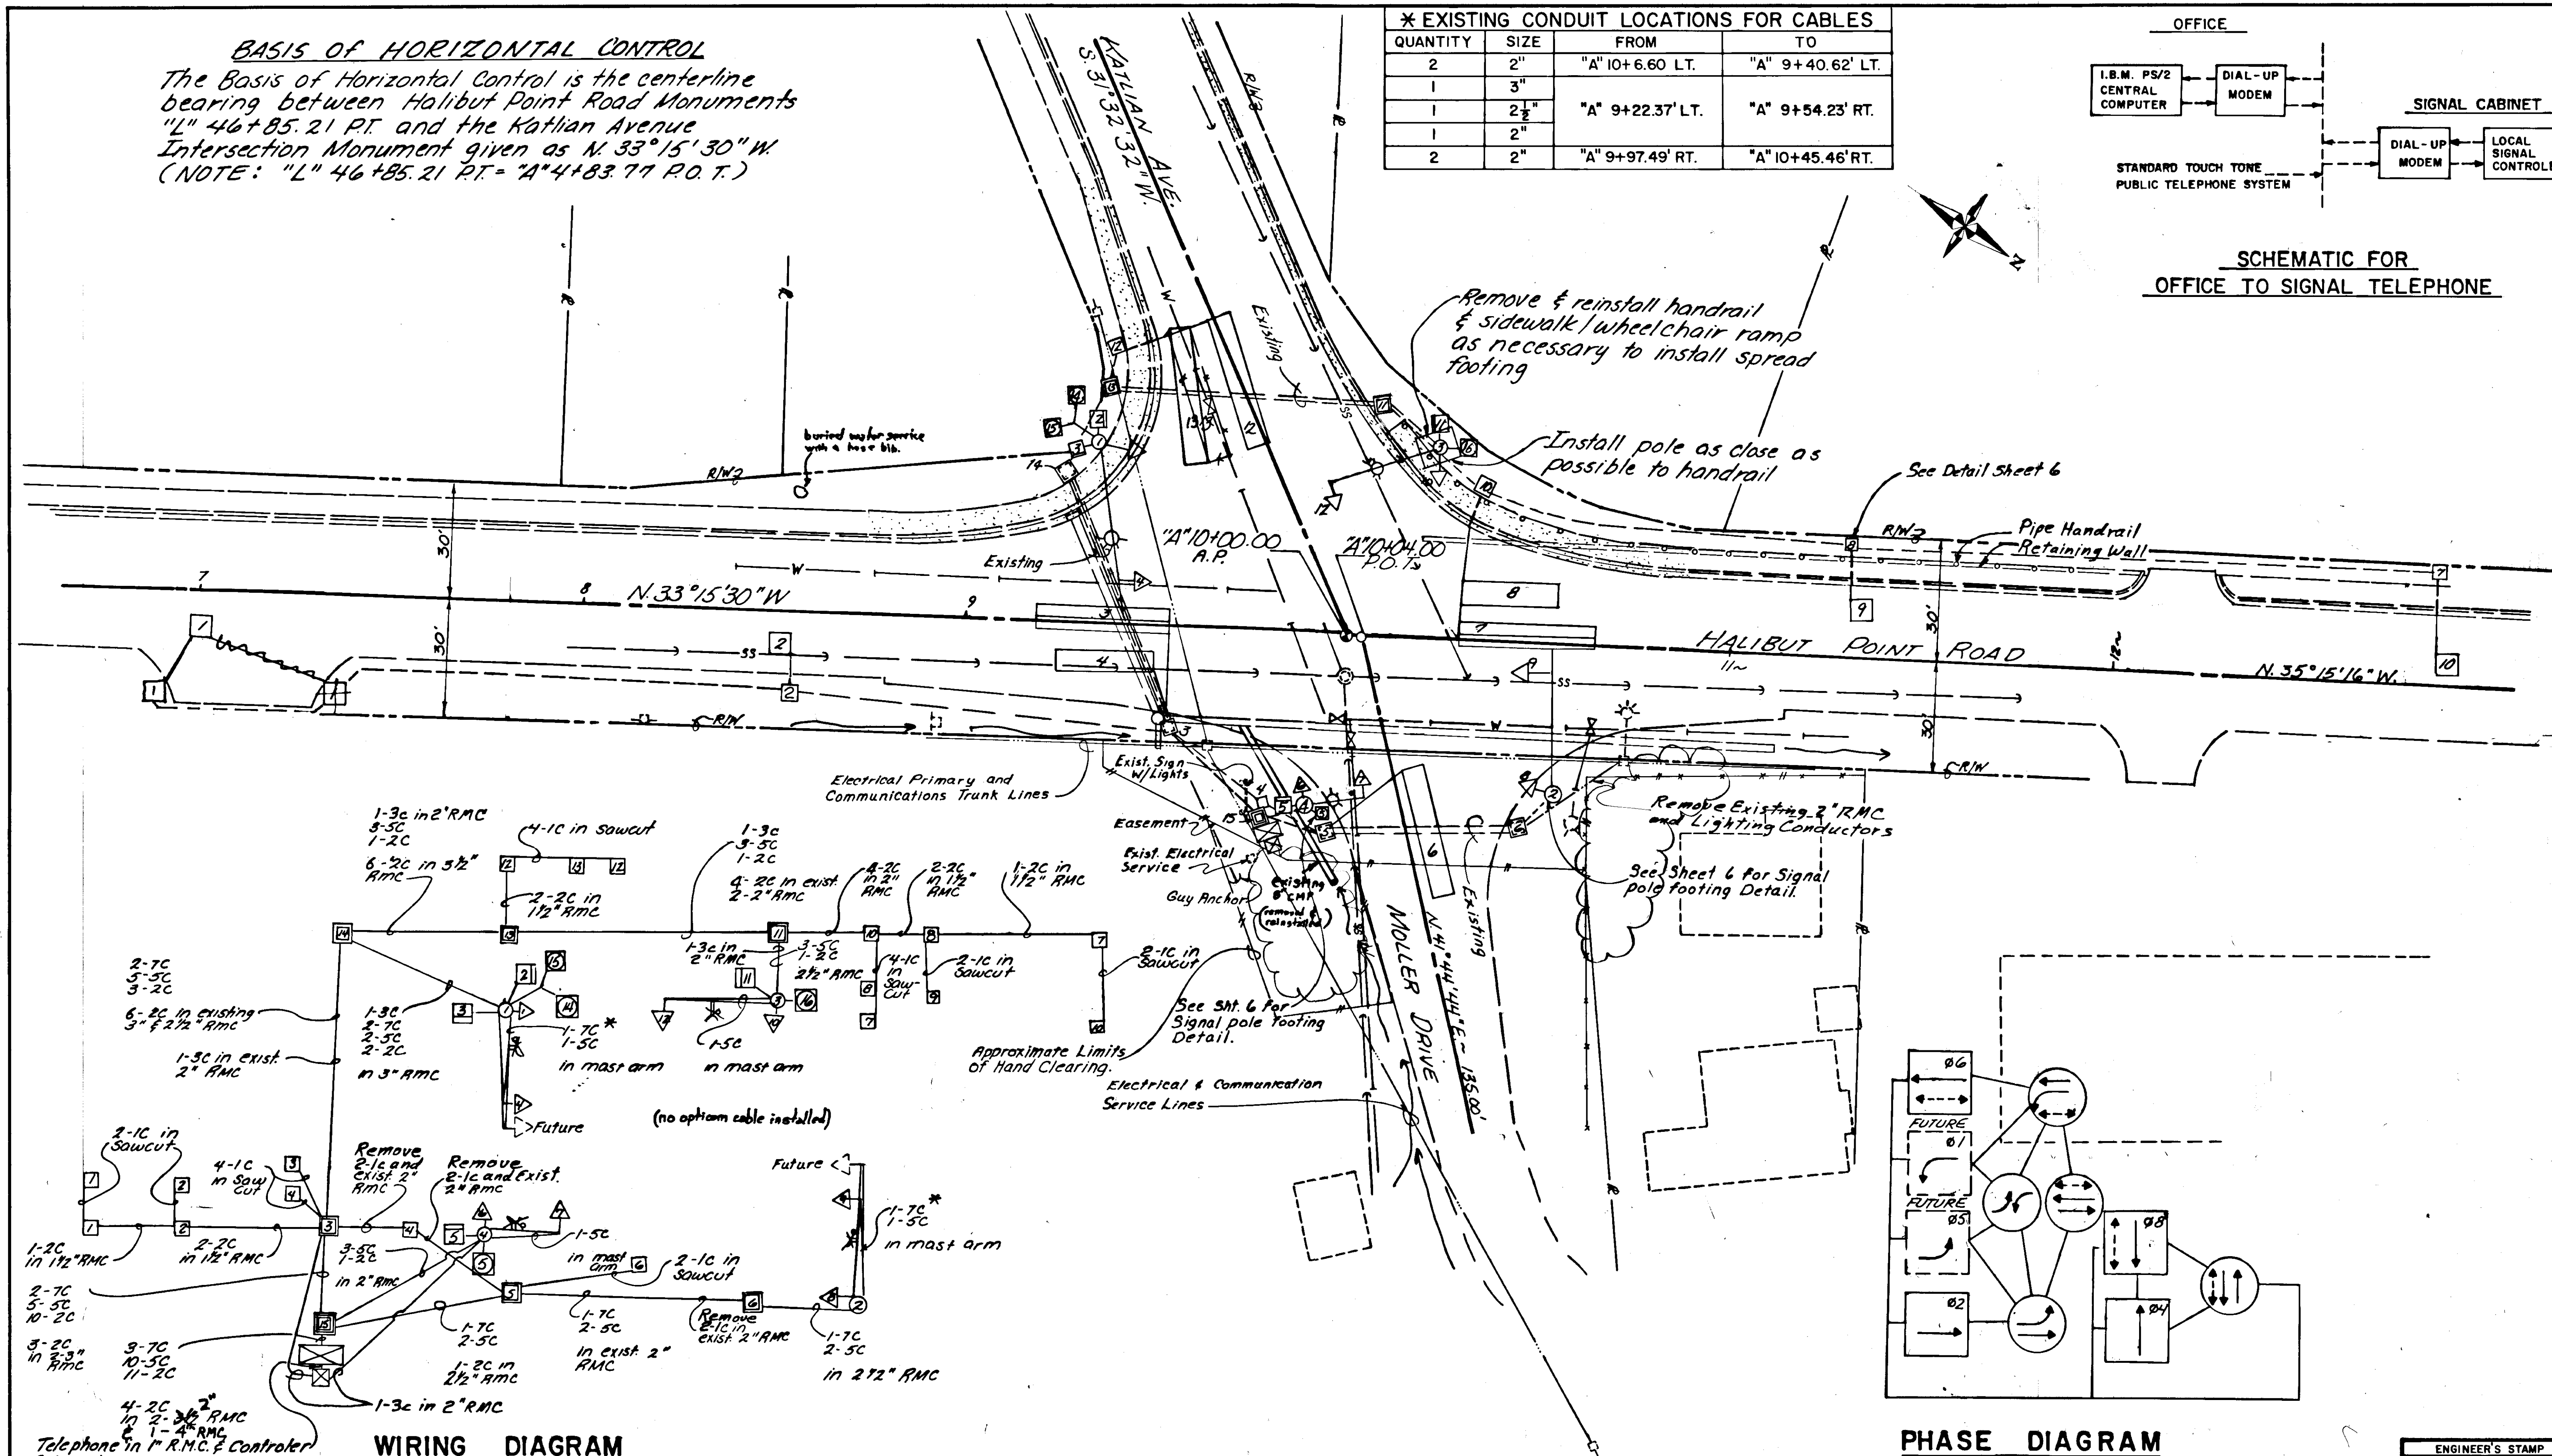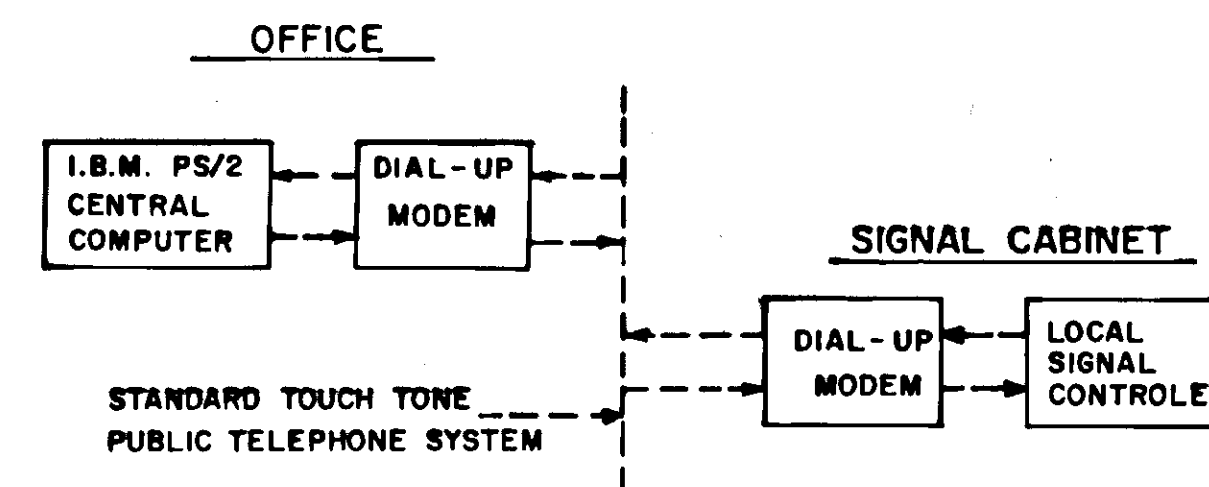

PHASE DIAGRAM

WIRING DIAGRAM


* For Future Signal Head

STATE OF ALASKA
 DEPARTMENT OF TRANSPORTATION
 & PUBLIC FACILITIES
 SOUTHEAST REGION DESIGN & CONSTRUCTION

KATLIAN AVENUE / HALIBUT POINT ROAD SIGNAL
 HES-099-3(2) 70313
 TRAFFIC SIGNAL PLAN

APPROVED BY: _____
 DESIGN GROUP CHIEF DATE _____
 RECOMMENDED BY: _____
 DESIGN ENGINEER, GROUP DATE _____
 PREPARED BY: _____
 PROJECT MANAGER LEAD DESIGNER

DESIGNED BY: J.E.A.
 DRAWN BY: B.A.
 CHECKED BY: R.P.
 SCALE: NONE
 DATE: 5/90
 SHEET 4 OF 10

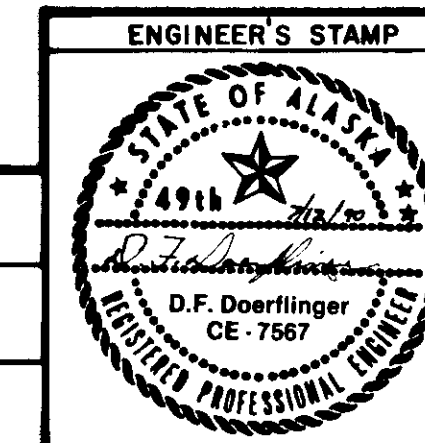



BY	DATE	DESCRIPTION OF CHANGE

SIGN SCHEDULE													
NO.	STATION	OFFSET LT. RT.	CODE	LEGEND	SIZE	THICK- NESS	SQ.FT.	NO. OF POSTS	SIZE	TYPE	FAC- ING	REMARKS	
1	"A" 9+33	55'		STOP (EXISTING)							WB	REMOVE STOP SIGN REINSTALL	
2	"A" 10+45	45'		STOP (EXISTING)							EB	STREET NAME SIGN & POST	
3	"A" 10+48	33'	D3-1B	← KATLIAN AVE	20"X18"		15.0				NB	REMOVE STOP SIGN REINSTALL	
4	"A" 9+36	38'	D3-1B	KATLIAN AVE →	20"X18"		15.0				SB	STREET NAME SIGN & POST	
5	"A" 10+48	15'	R10-12	LEFT TURN YIELD ON GREEN	30"X36"	3/16"	6.25	7.5			NB	MOUNT ON MAST ARM	
6	"A" 9+42	4'	R10-12	LEFT TURN YIELD ON GREEN	30"X36"	3/16"	6.25	7.5			SB	MOUNT ON MAST ARM	
7	"A" 9+98	42'	R3-B SL/R	← R3-B SL/R	36"X30"		7.5				EB	MOUNT ON MAST ARM	REMOVE C.O.1
8	"A" 9+90	42'	D3-1B	HALIBUT POINT RD.	126"X18"		16.125	15.75			EB	MOUNT ON MAST ARM	REMOVE C.O.1
9	"A" 10+45	50'	D3-1B	HALIBUT POINT RD.	126"X18"		16.125	15.75			WB	MOUNT ON MAST ARM	
10	"A" 10+48	15'	R10-13	← YIELD ON GREEN	30"X36"		7.5				NB	"	C.O.1
11	"A" 9+42	4'	R10-13	← YIELD ON GREEN	30"X36"		7.5				SB	"	C.O.1
12	"K" 1+50	32'	R3-B SL/R	← R3-B SL/R	30"X36"		7.5				EB	Post Mount	C.O.1

STRIPING LEGEND
W: WHITE

LOAD CENTER TABLE		
MAIN CIRCUIT BREAKER RATING	2 POLE	100 AMPS
LIGHTING CIRCUIT BREAKER RATING	2 POLE	20 AMPS
TRAFFIC SIGNAL CIRCUIT BREAKER RATING	1 POLE	50 AMPS

NOTE: INSTALL UNDERGROUND PRESSURE-TREATED SERVICE POLE AND LOAD CENTER TO THE AT "A" 9+83, 55 FEET RIGHT, WITH WEATHERHEAD FOR OVERHEAD SERVICE. CO, 52 Mounted on signal Cabinet.

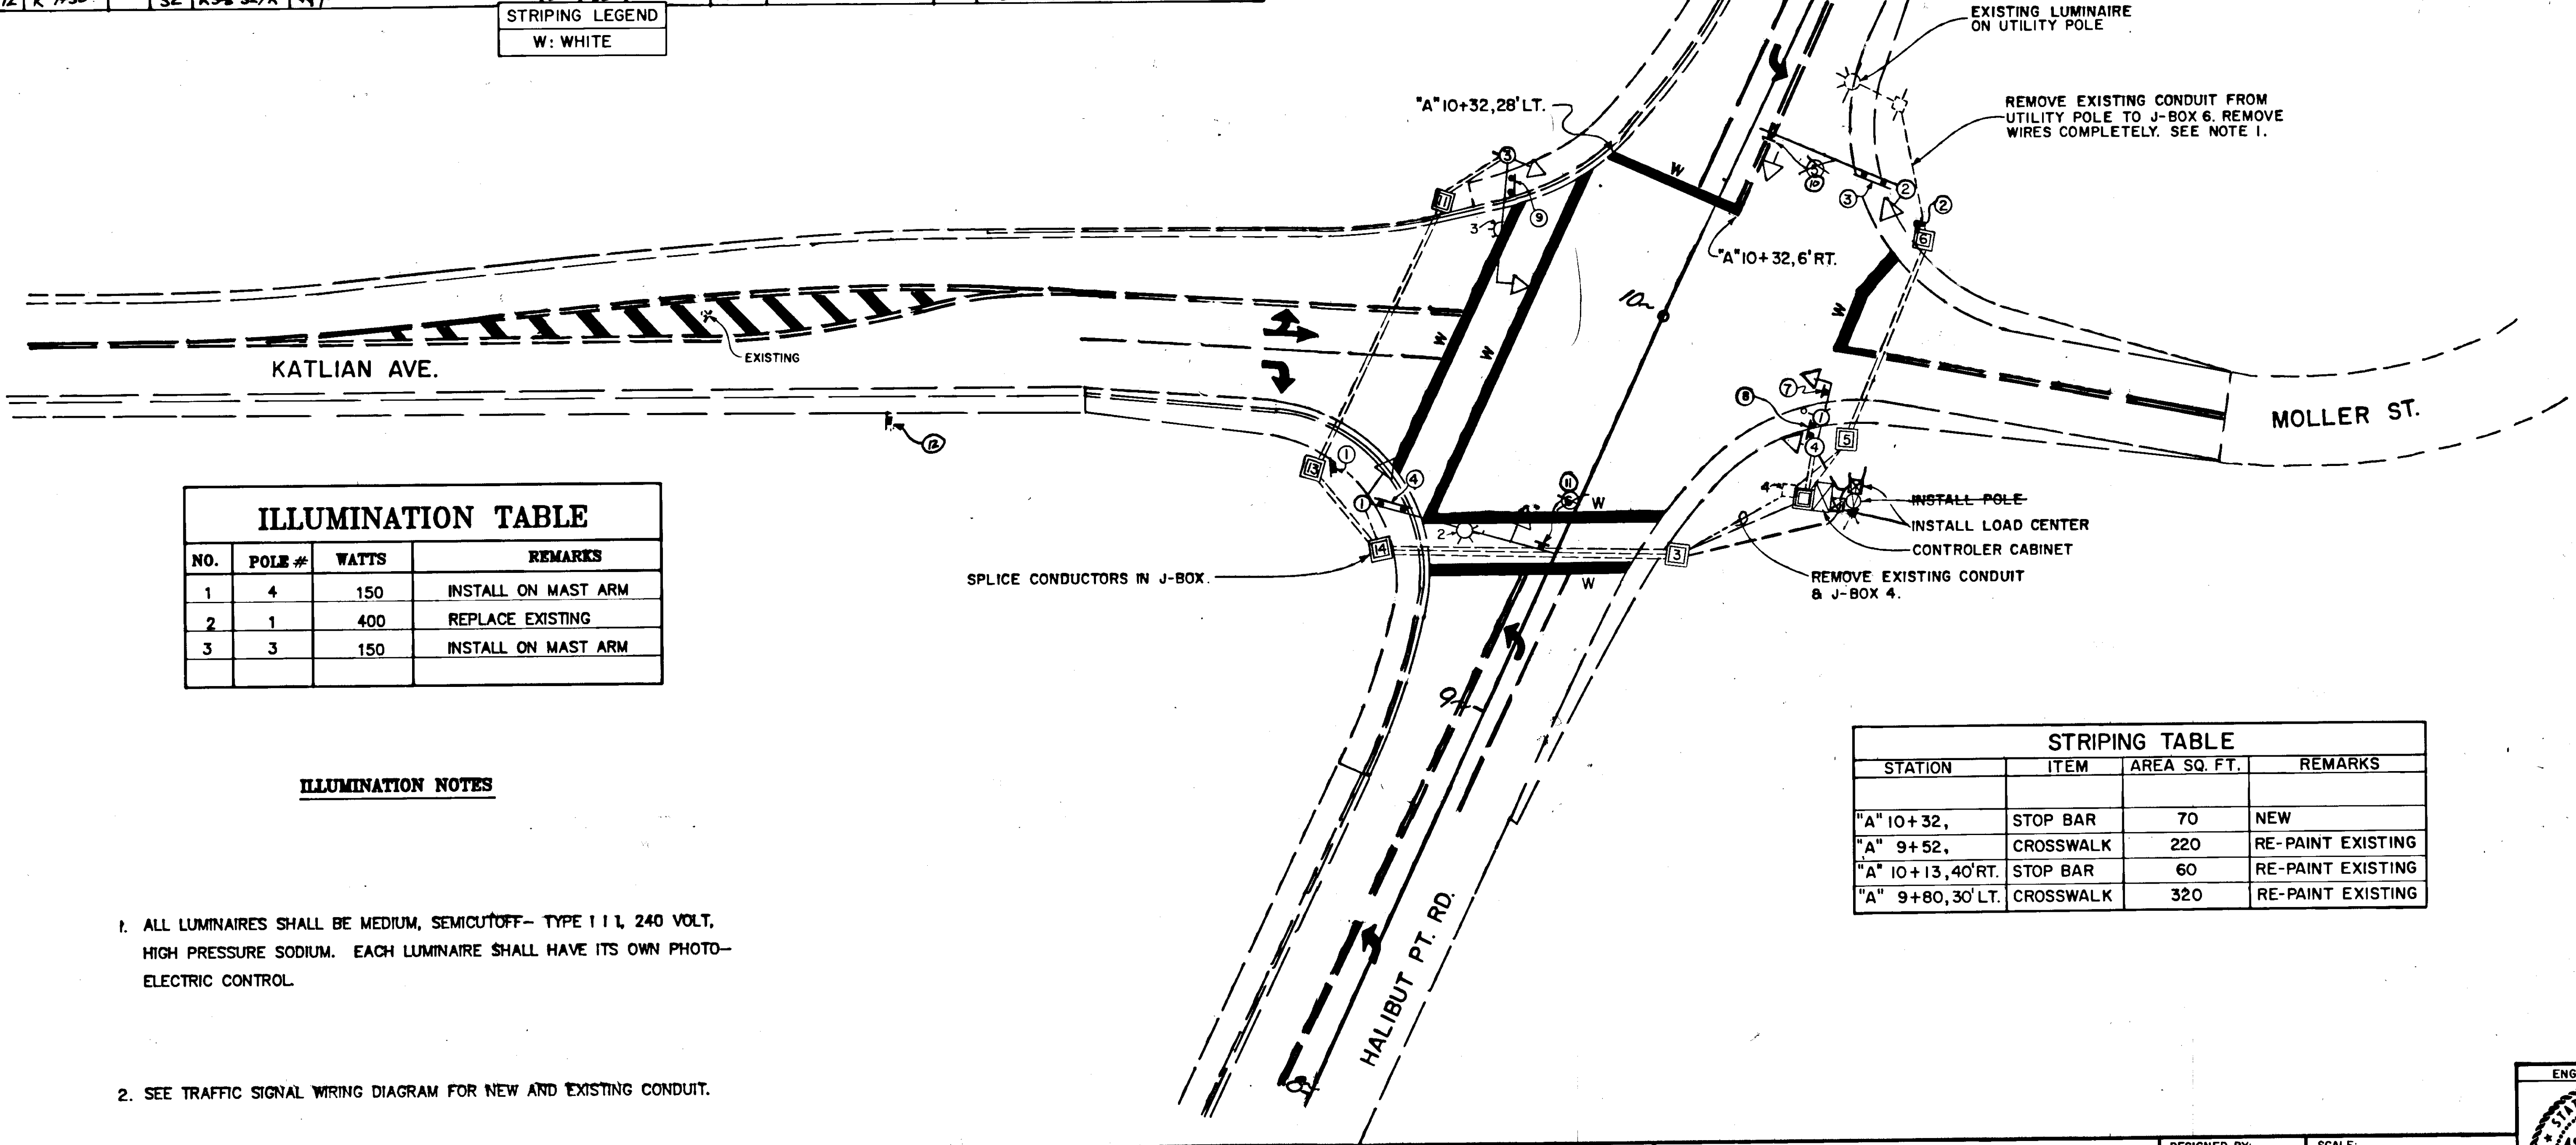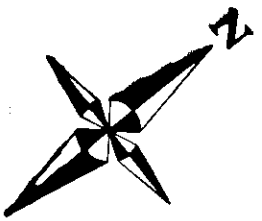

ILLUMINATION TABLE			
NO.	POLE #	WATTS	REMARKS
1	4	150	INSTALL ON MAST ARM
2	1	400	REPLACE EXISTING
3	3	150	INSTALL ON MAST ARM

ILLUMINATION NOTES


1. ALL LUMINAIRES SHALL BE MEDIUM, SEMICUTOFF- TYPE 111, 240 VOLT, HIGH PRESSURE SODIUM. EACH LUMINAIRE SHALL HAVE ITS OWN PHOTO-ELECTRIC CONTROL.
2. SEE TRAFFIC SIGNAL WIRING DIAGRAM FOR NEW AND EXISTING CONDUIT.

STRIPING TABLE			
STATION	ITEM	AREA SQ. FT.	REMARKS
"A" 10+32,	STOP BAR	70	NEW
"A" 9+52,	CROSSWALK	220	RE-PAINT EXISTING
"A" 10+13, 40' RT.	STOP BAR	60	RE-PAINT EXISTING
"A" 9+80, 30' LT.	CROSSWALK	320	RE-PAINT EXISTING

STATE OF ALASKA DEPARTMENT OF TRANSPORTATION & PUBLIC FACILITIES SOUTHEAST REGION DESIGN & CONSTRUCTION		
BY	DATE	DESCRIPTION OF CHANGE
RECORD OF REVISIONS		

KATLIAN AVENUE HALIBUT POINT ROAD SIGNAL
HES-099-3(2) 70313
STRIPING, SIGNING & ILLUMINATION

APPROVED BY: _____ DESIGN GROUP CHIEF	DESIGNED BY: J.E.A.	SCALE: NONE
RECOMMENDED BY: _____ DESIGN ENGINEER, GROUP	DRAWN BY: B.A.	DATE: 5/90
PREPARED BY: _____ PROJECT MANAGER	CHECKED BY: R.P.	SHEET 5 OF 10
LEAD DESIGNER		

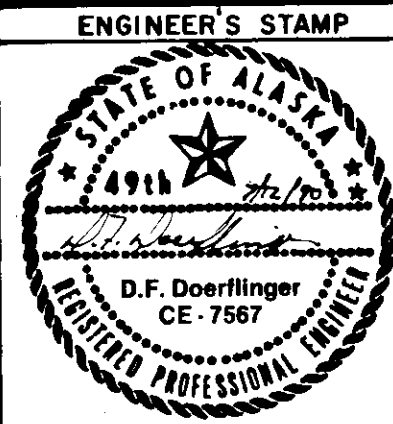

GENERAL NOTES

SPECIFICATIONS:

- DESIGN: AASHTO STANDARD SPECIFICATIONS FOR HIGHWAY BRIDGES, 1989 EDITION, WITH THE LATEST INTERIM SPECIFICATIONS.
- AASHTO STANDARD SPECIFICATIONS FOR STRUCTURAL SUPPORTS FOR HIGHWAY SIGNS, LUMINAIRES AND TRAFFIC SIGNALS.
- CONSTRUCTION: STATE OF ALASKA STANDARD SPECIFICATIONS FOR HIGHWAY CONSTRUCTION, 1988, WITH STANDARD MODIFICATIONS AND THE SPECIAL PROVISIONS.



DESIGN UNIT STRESSES:

- CAST-IN-PLACE CONCRETE: $f'_c = 3,000$ psi
 $f_c = 1,200$ psi
- REINFORCING STEEL: $f_y = 60,000$ psi

STRUCTURAL MATERIALS:

- CONCRETE: ALL CAST-IN-PLACE CONCRETE SHALL BE CLASS A.
- REINFORCING STEEL: ALL REINFORCING STEEL SHALL CONFORM TO ASTM 615, GRADE 60.
- PILING: HP 10 X 57, A36 STEEL WITH TIP REINFORCEMENT. DESIGN LOADING = 20 TONS.
- ANCHOR BOLTS: ANCHOR BOLTS, NUTS AND WASHERS SHALL CONFORM TO ASTM A449. THEY SHALL BE GALVANIZED IN ACCORDANCE WITH ASTM A153.



NOTE: SEE STD. DWG. T-52.01 FOR ADDITIONAL DETAILS NOT SHOWN ON THIS DRAWING.

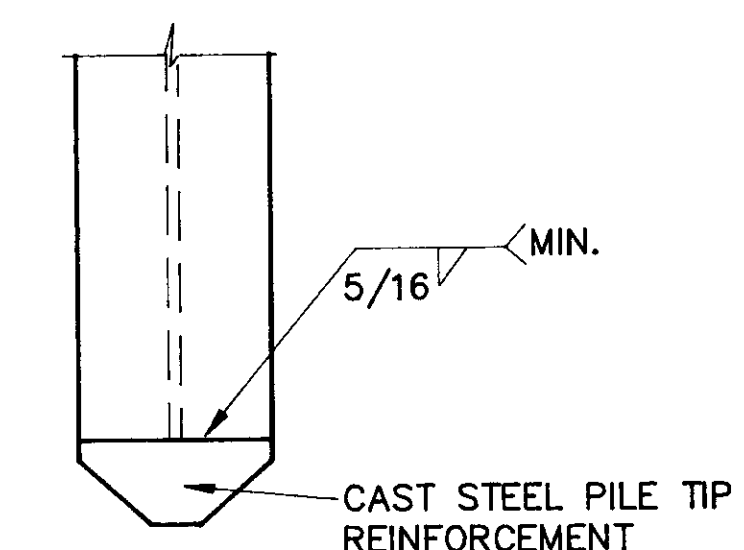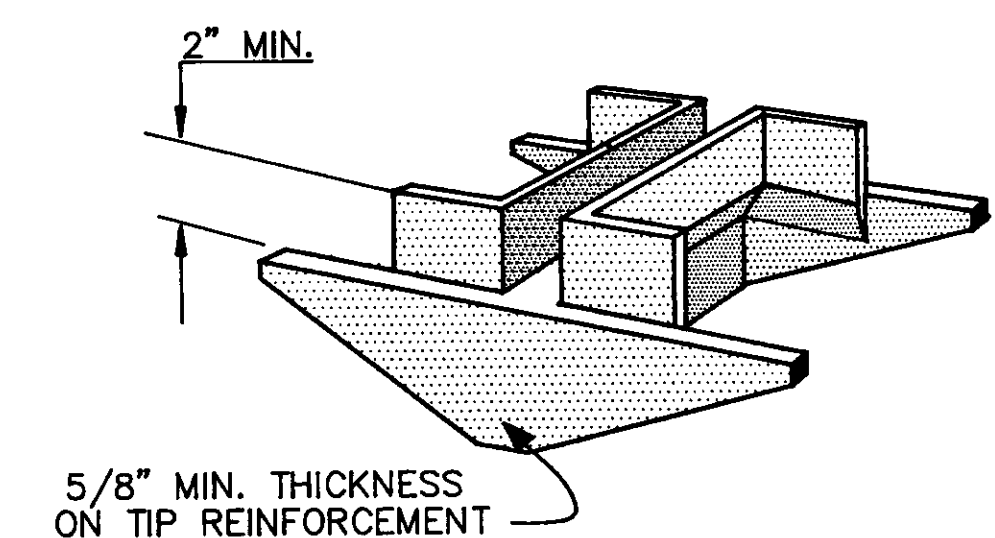


PILE TIP REINFORCEMENT

NOTE: DO NOT SCALE FROM THESE PLANS-USE DIMENSIONS


DESIGNED BY: W. TOWNSEND/R. PURVIS	SCALE NONE
DRAWN BY: AUTOCADD/CSA	DATE: 5/90
CHECKED BY: J. AHLGREN	SHEET 6 OF 10

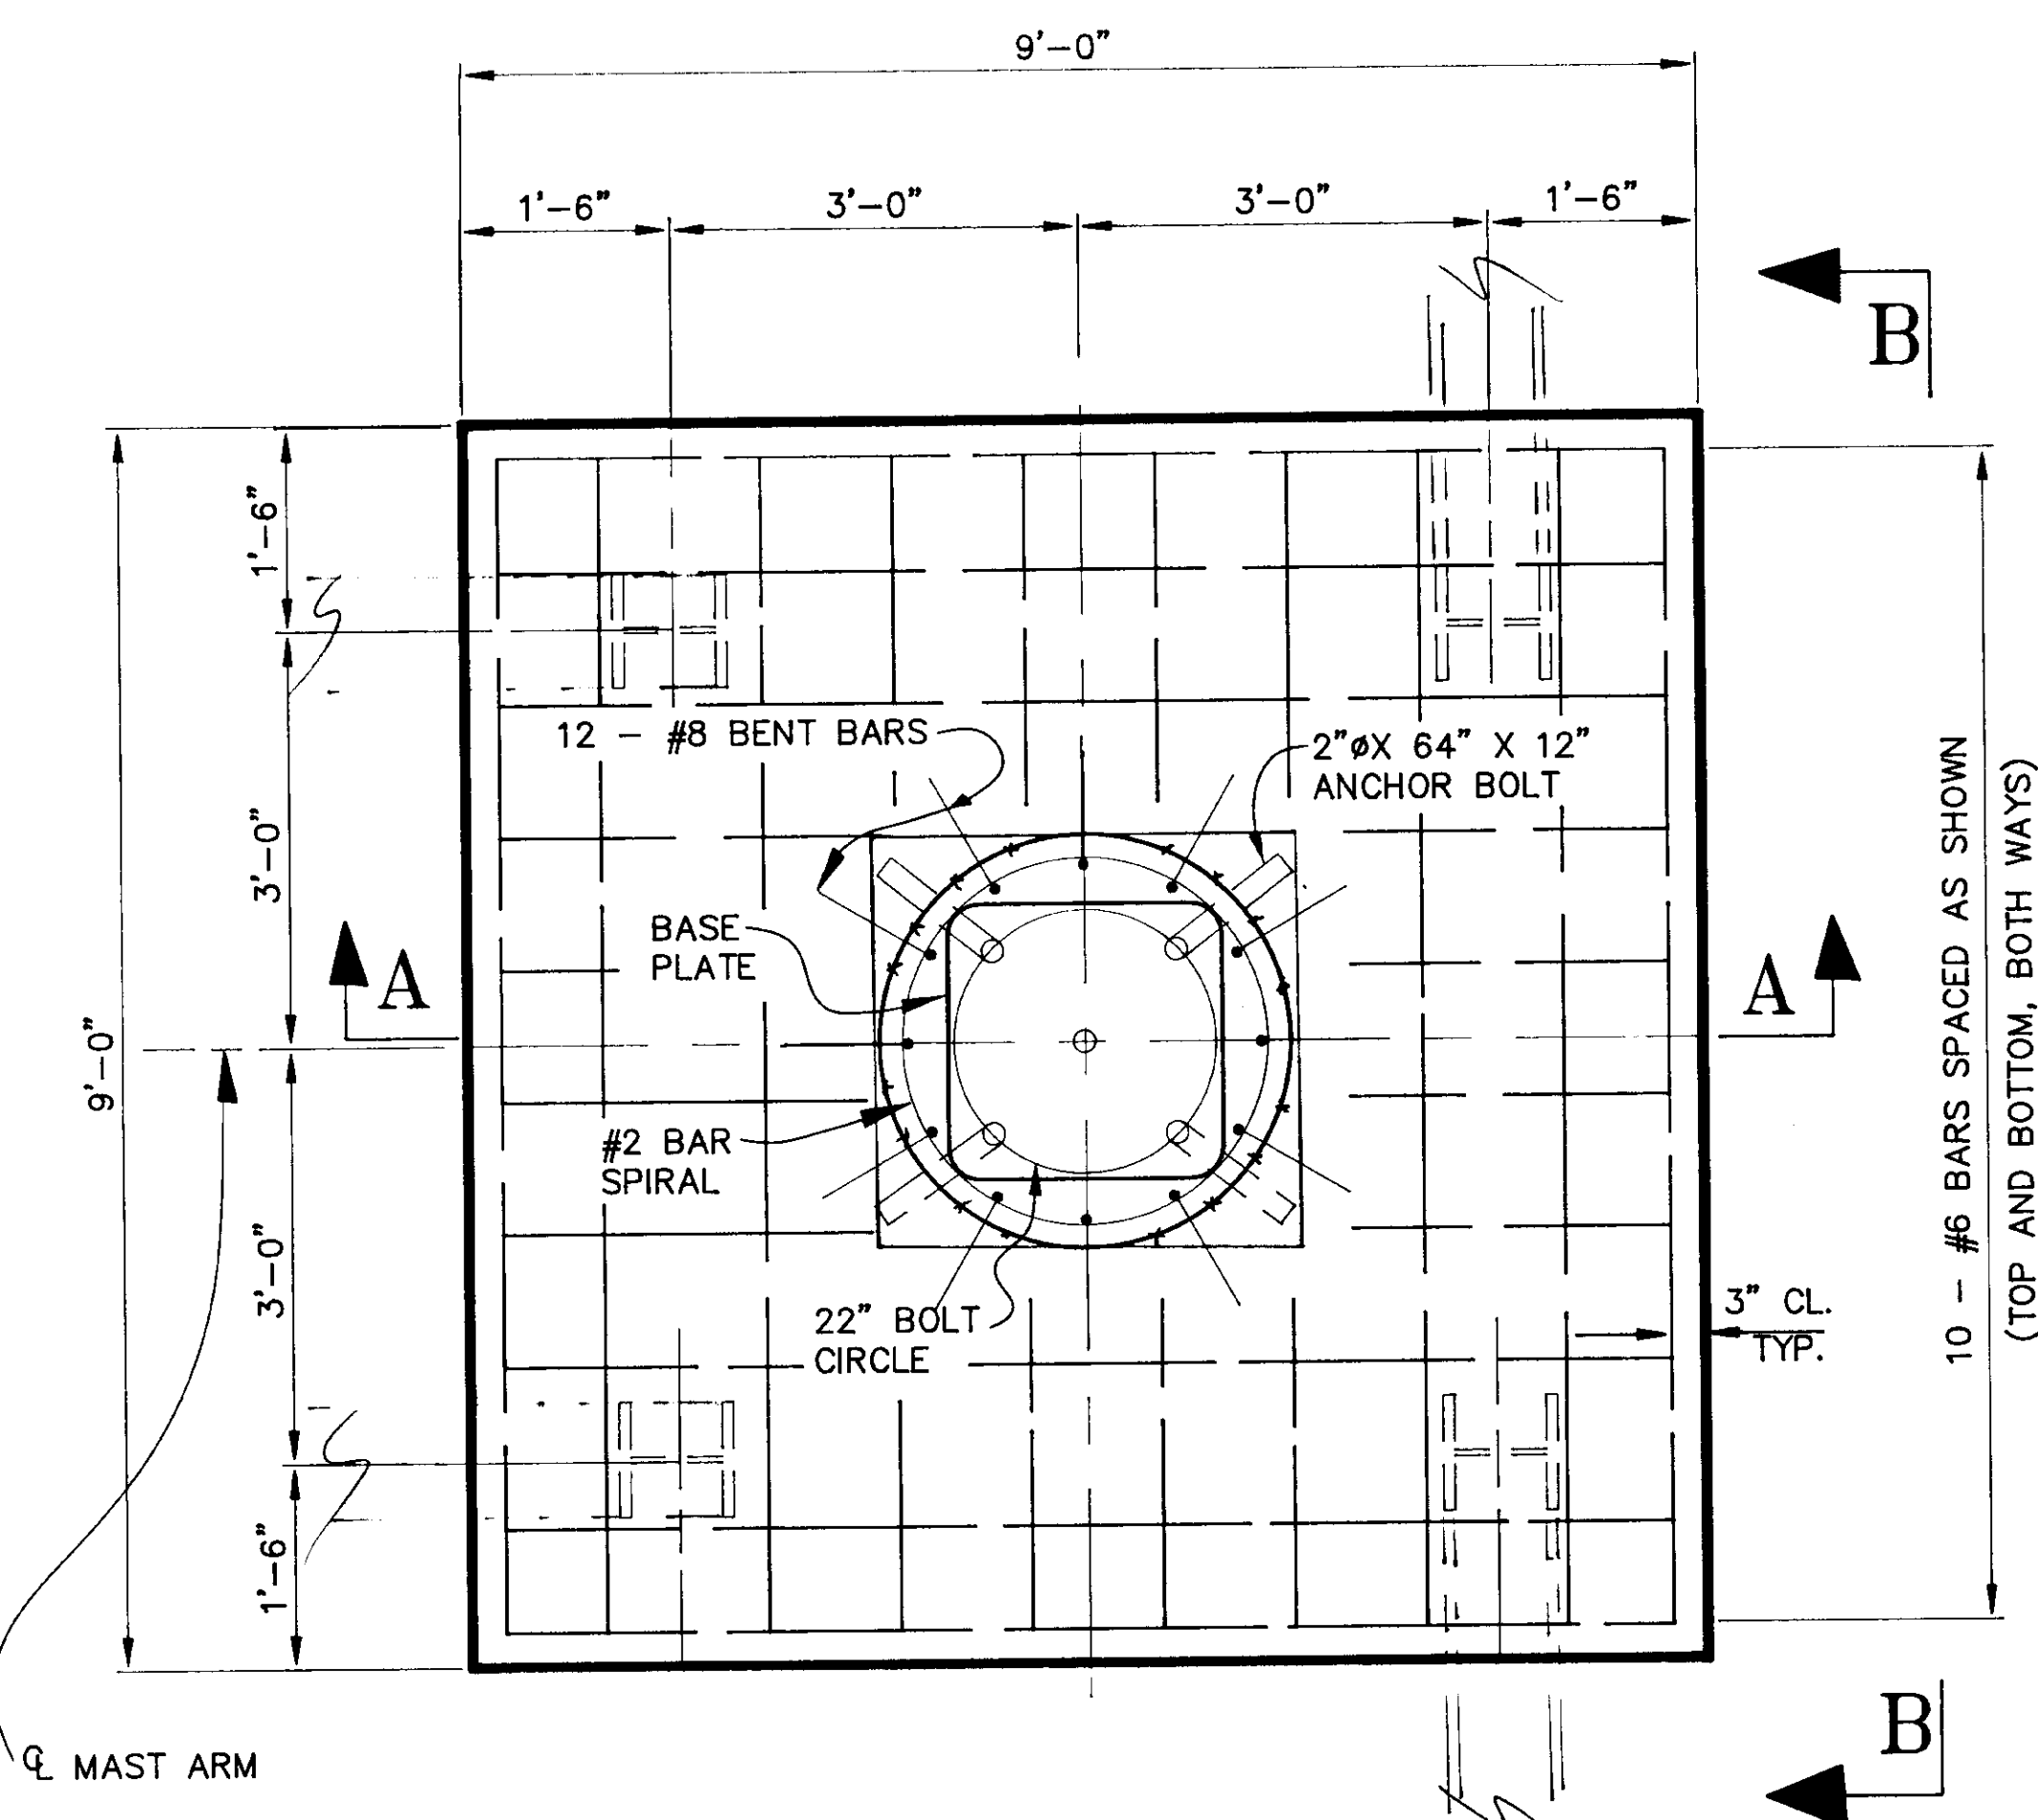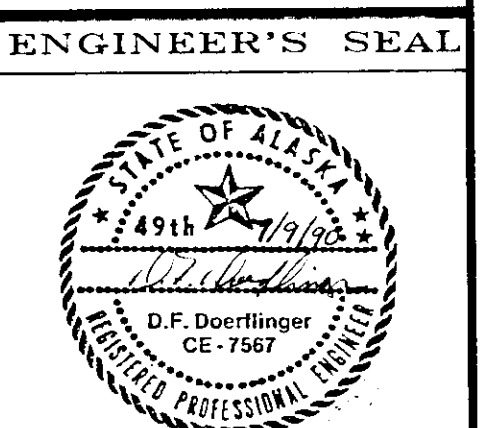

SIGNAL POLE #2 AND #4 FOOTING
(PILE SUPPORTED)

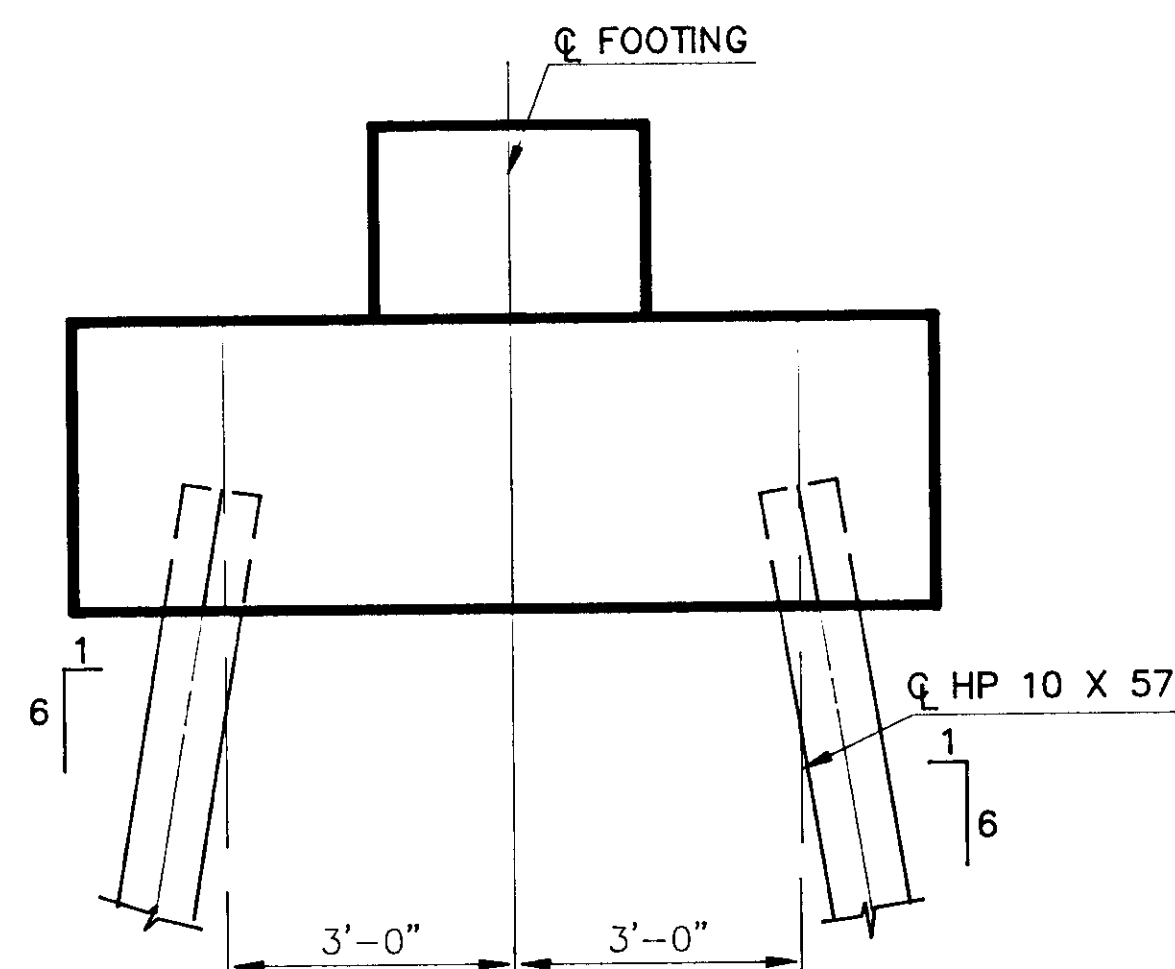


VIEW B-B

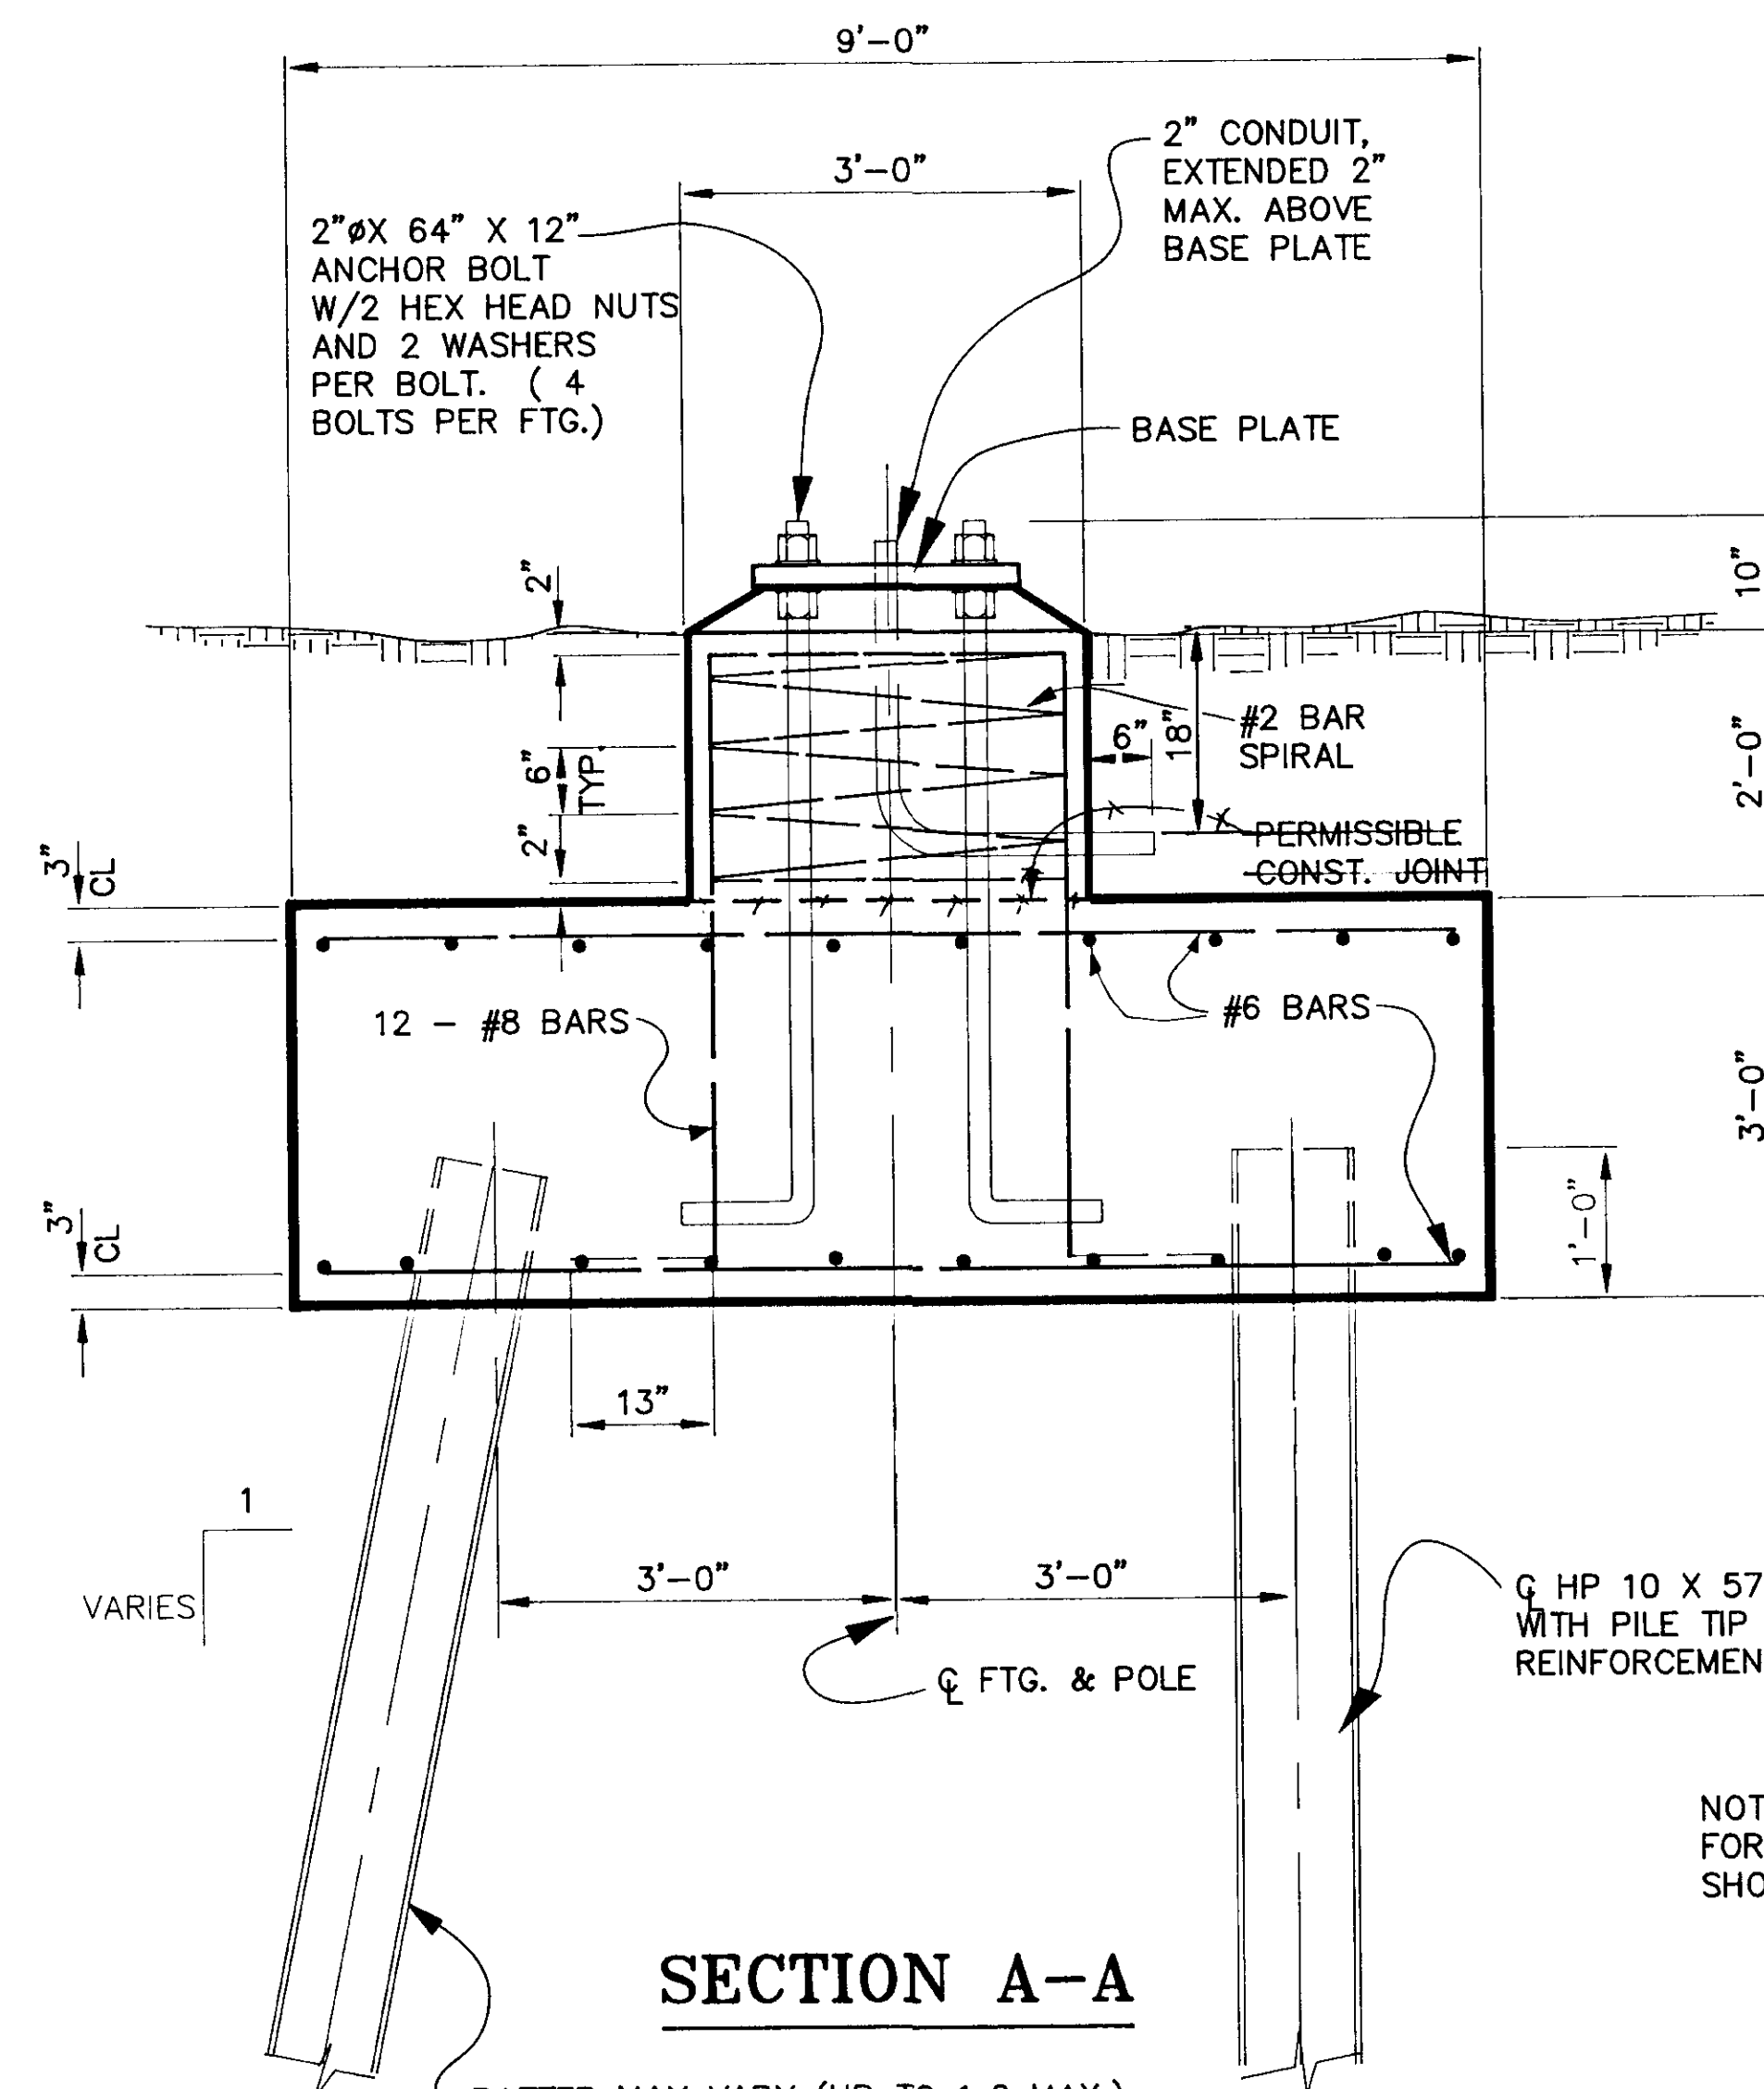

SECTION A-A

BATTER MAY VARY (UP TO 1:6 MAX.) TO PROVIDE CLEARANCE BETWEEN AN OVERHEAD POWERLINE AND THE PILE DRIVER.

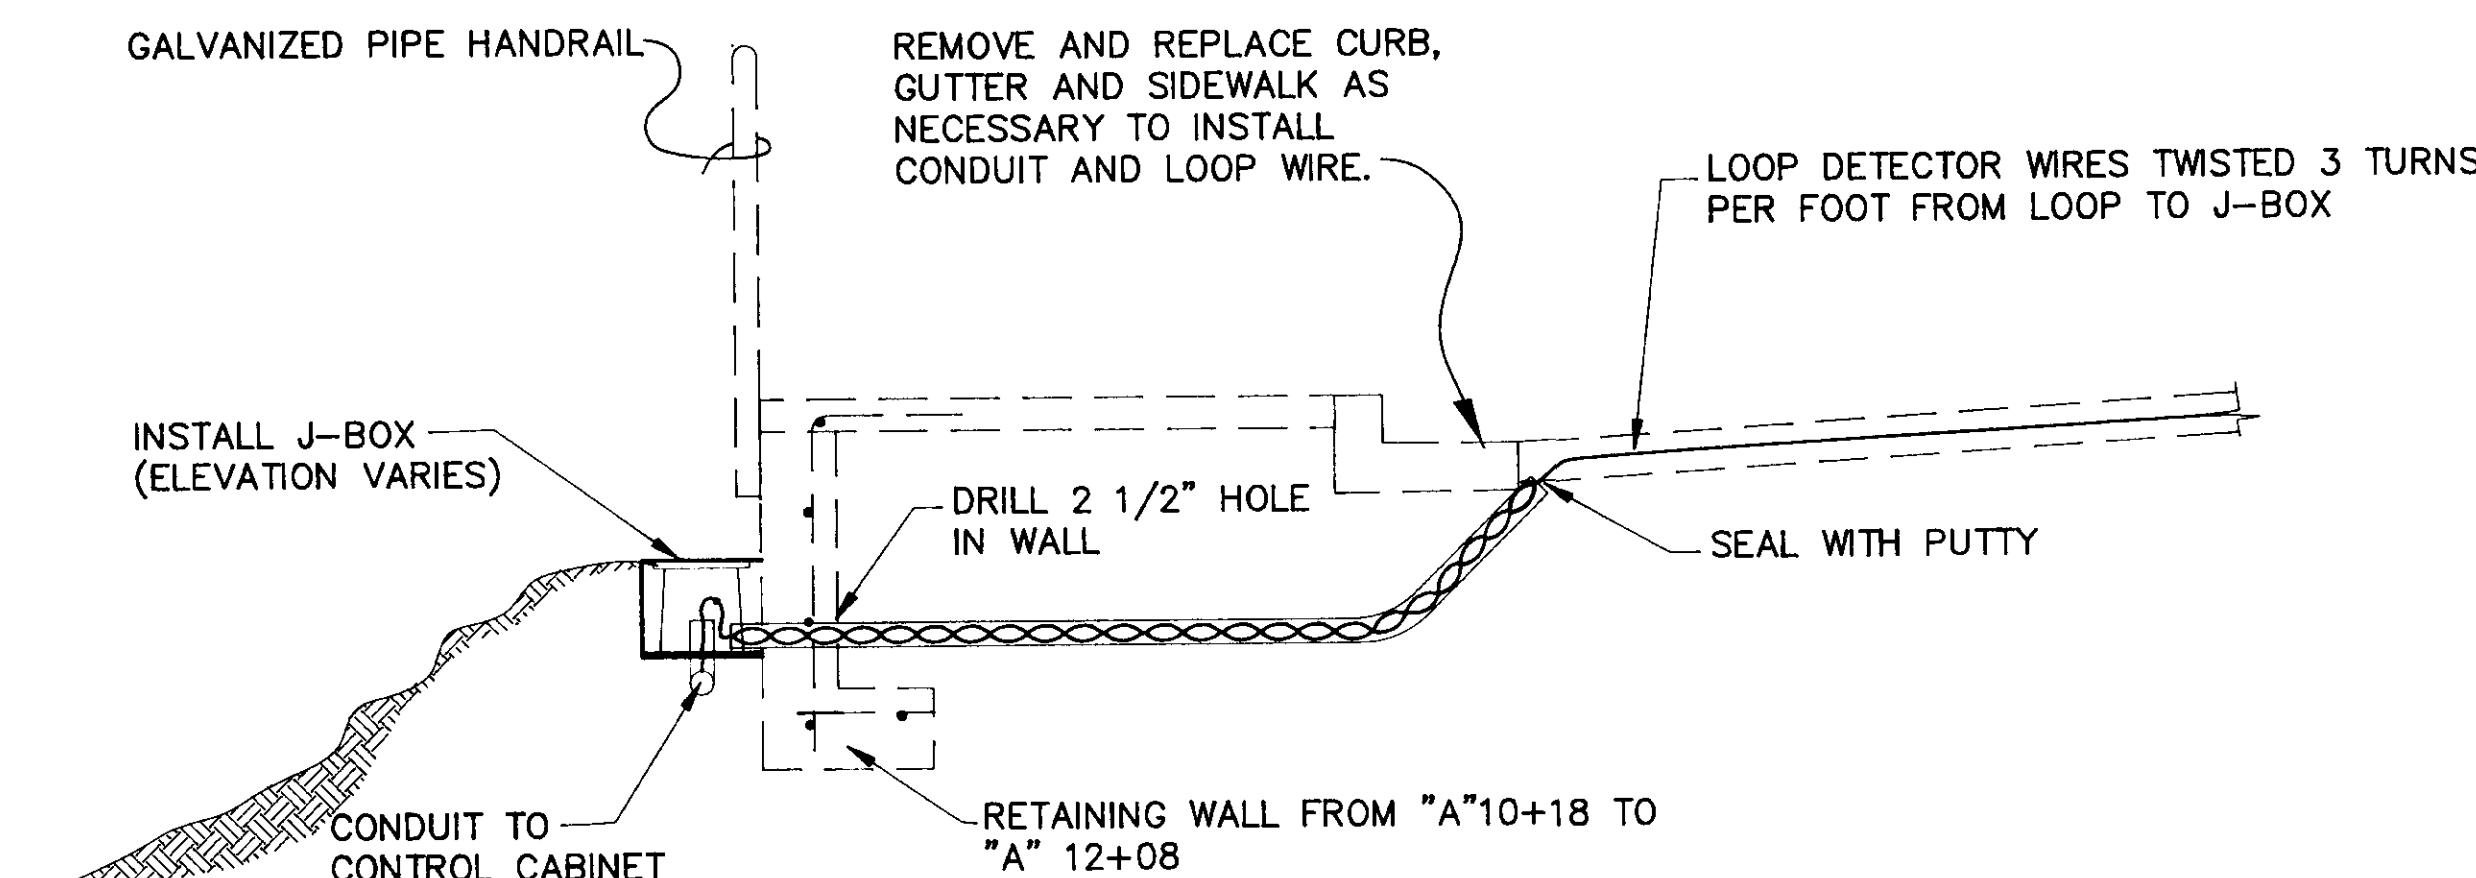




TYPICAL J-BOX INSTALLATION BEHIND SIDEWALK

NO.	DATE	DESCRIPTION OF CHANGE

STATE OF ALASKA
DEPARTMENT OF TRANSPORTATION
AND PUBLIC FACILITIES
SOUTHEAST REGION DESIGN & CONSTRUCTION

KATLIAN AVENUE/HALIBUT POINT ROAD SIGNAL
PROJECT NO. HES-099-3(2), 70313
SIGNAL POLE DETAILS

- TRAFFIC CONTROL PLAN**
1. LENGTH OF TAPERS (L) SHALL EQUAL $\frac{WS^2}{60}$
S= SPEED, W=WIDTH OF OFFSET.
 2. TWO LANE, TWO-WAY TRAFFIC SHALL BE MAINTAINED FROM 12:00 NOON TO 7:00 P.M. MONDAY THRU FRIDAY.
 3. MINIMUM LANE WIDTH SHALL BE 10 FEET.
 4. A PEDESTRIAN WALKWAY SHALL BE PROVIDED AT ALL TIMES AROUND WORK AREAS.
 5. DETAILED TRAFFIC CONTROL PLANS SHALL BE SUBMITTED FOR ALL SET-UPS DIFFERENT THAN TYPICALS SHOWN IN PLANS.
 6. SHEET NO. 10 IS INCLUDED FOR USE IN DEVELOPING ALTERNATE T.C.P.'S.

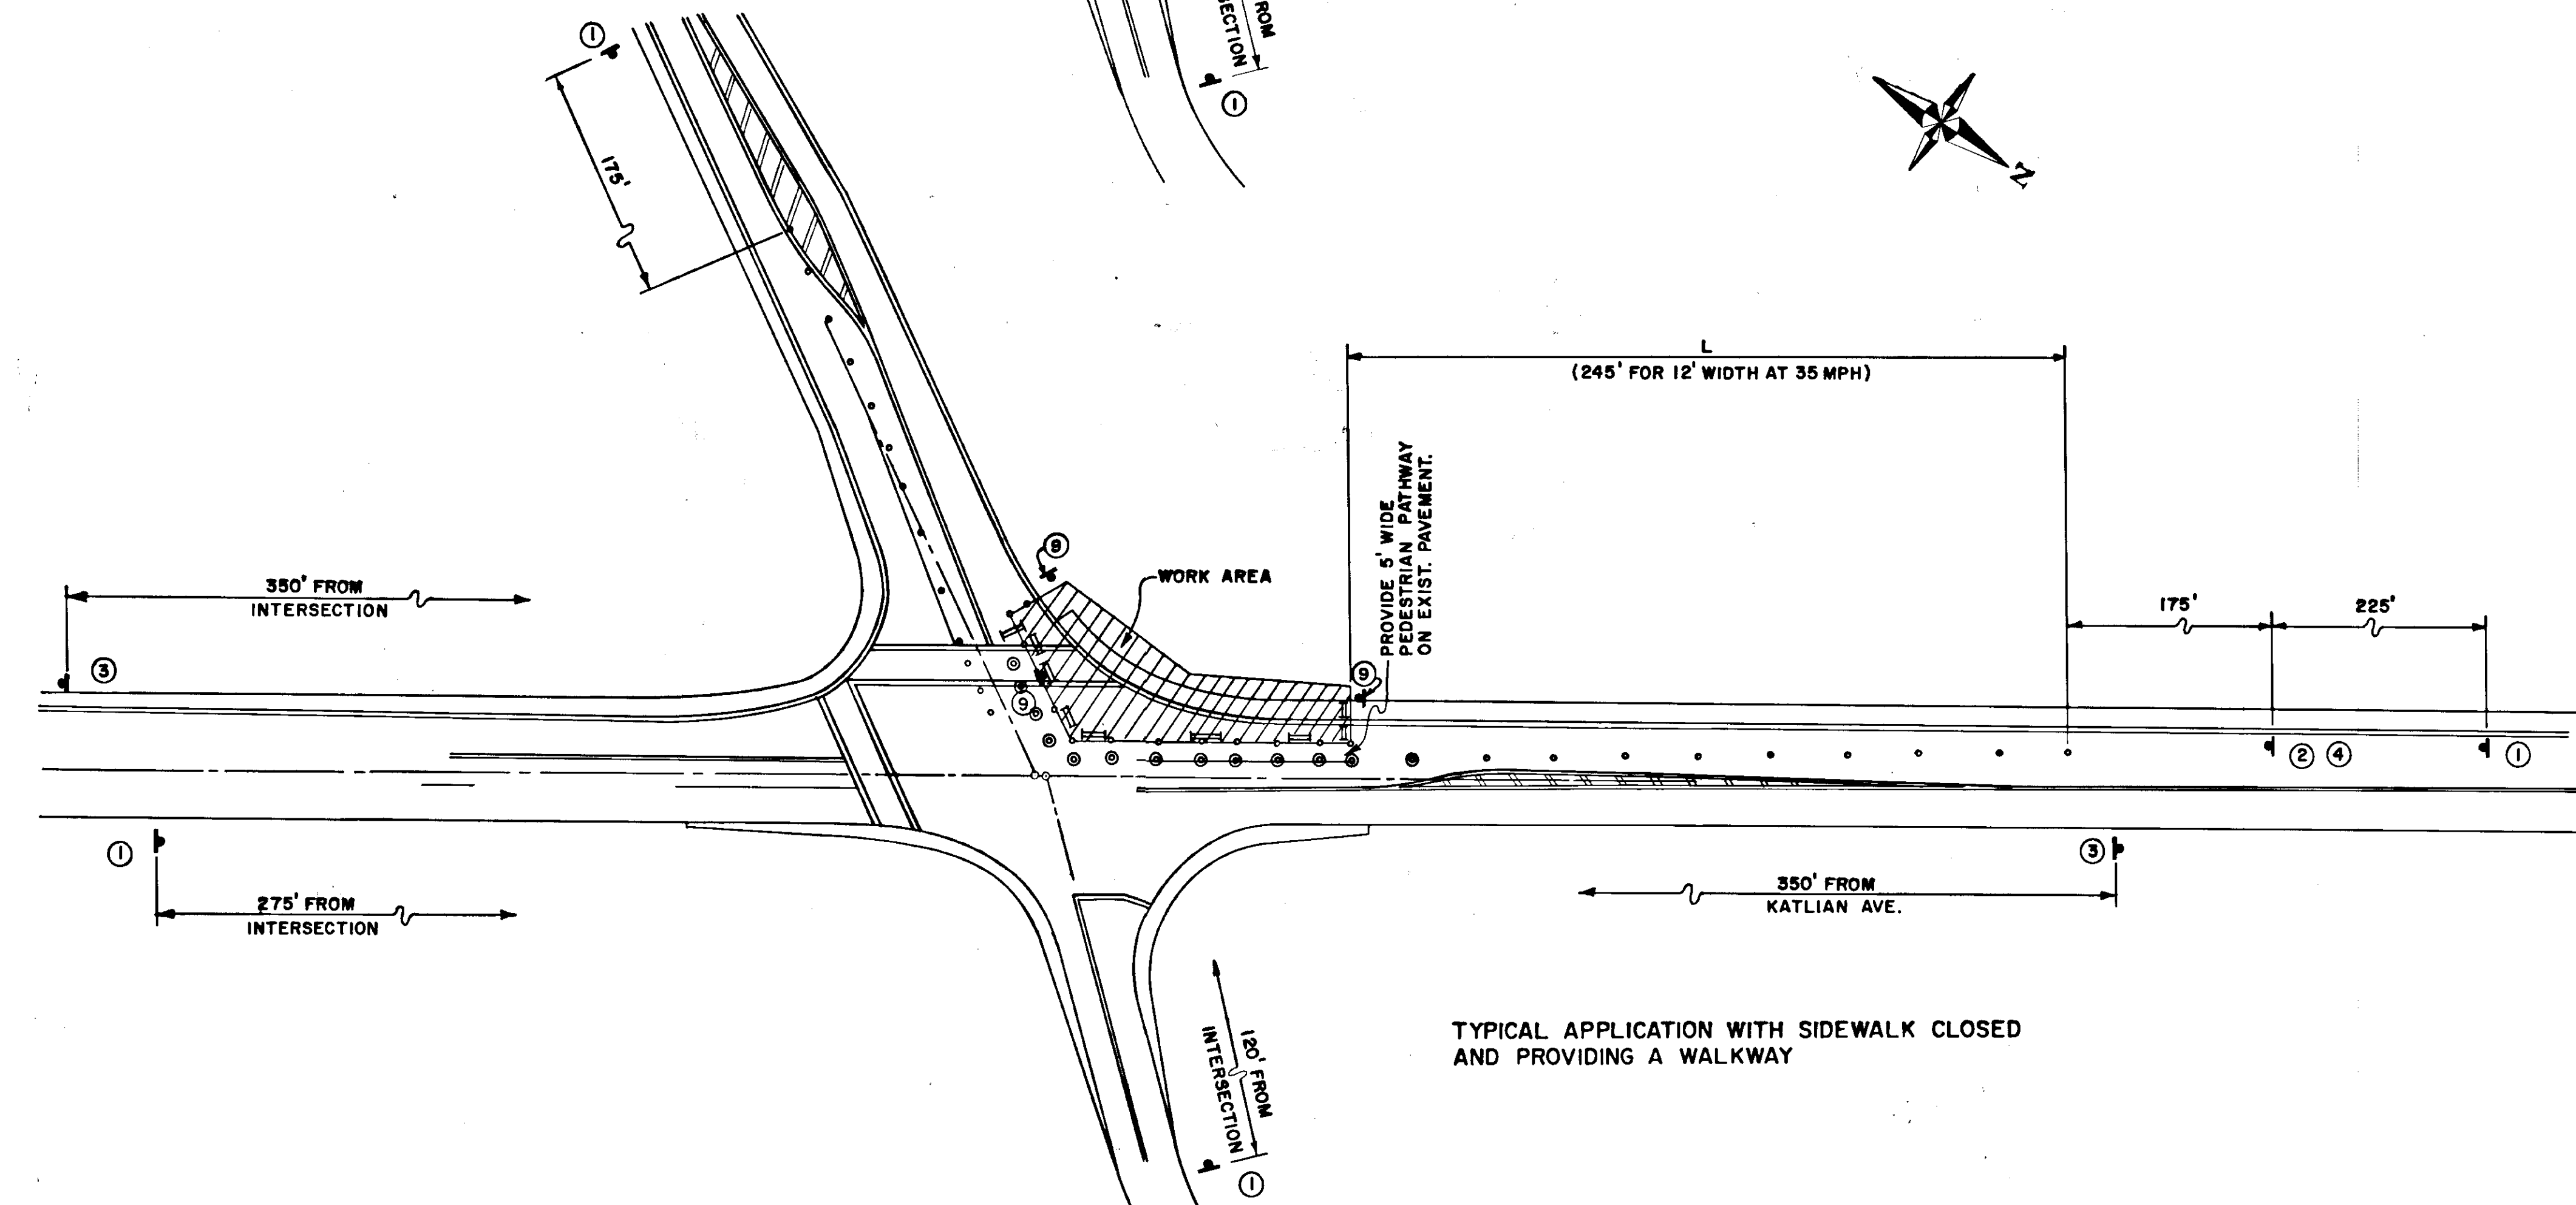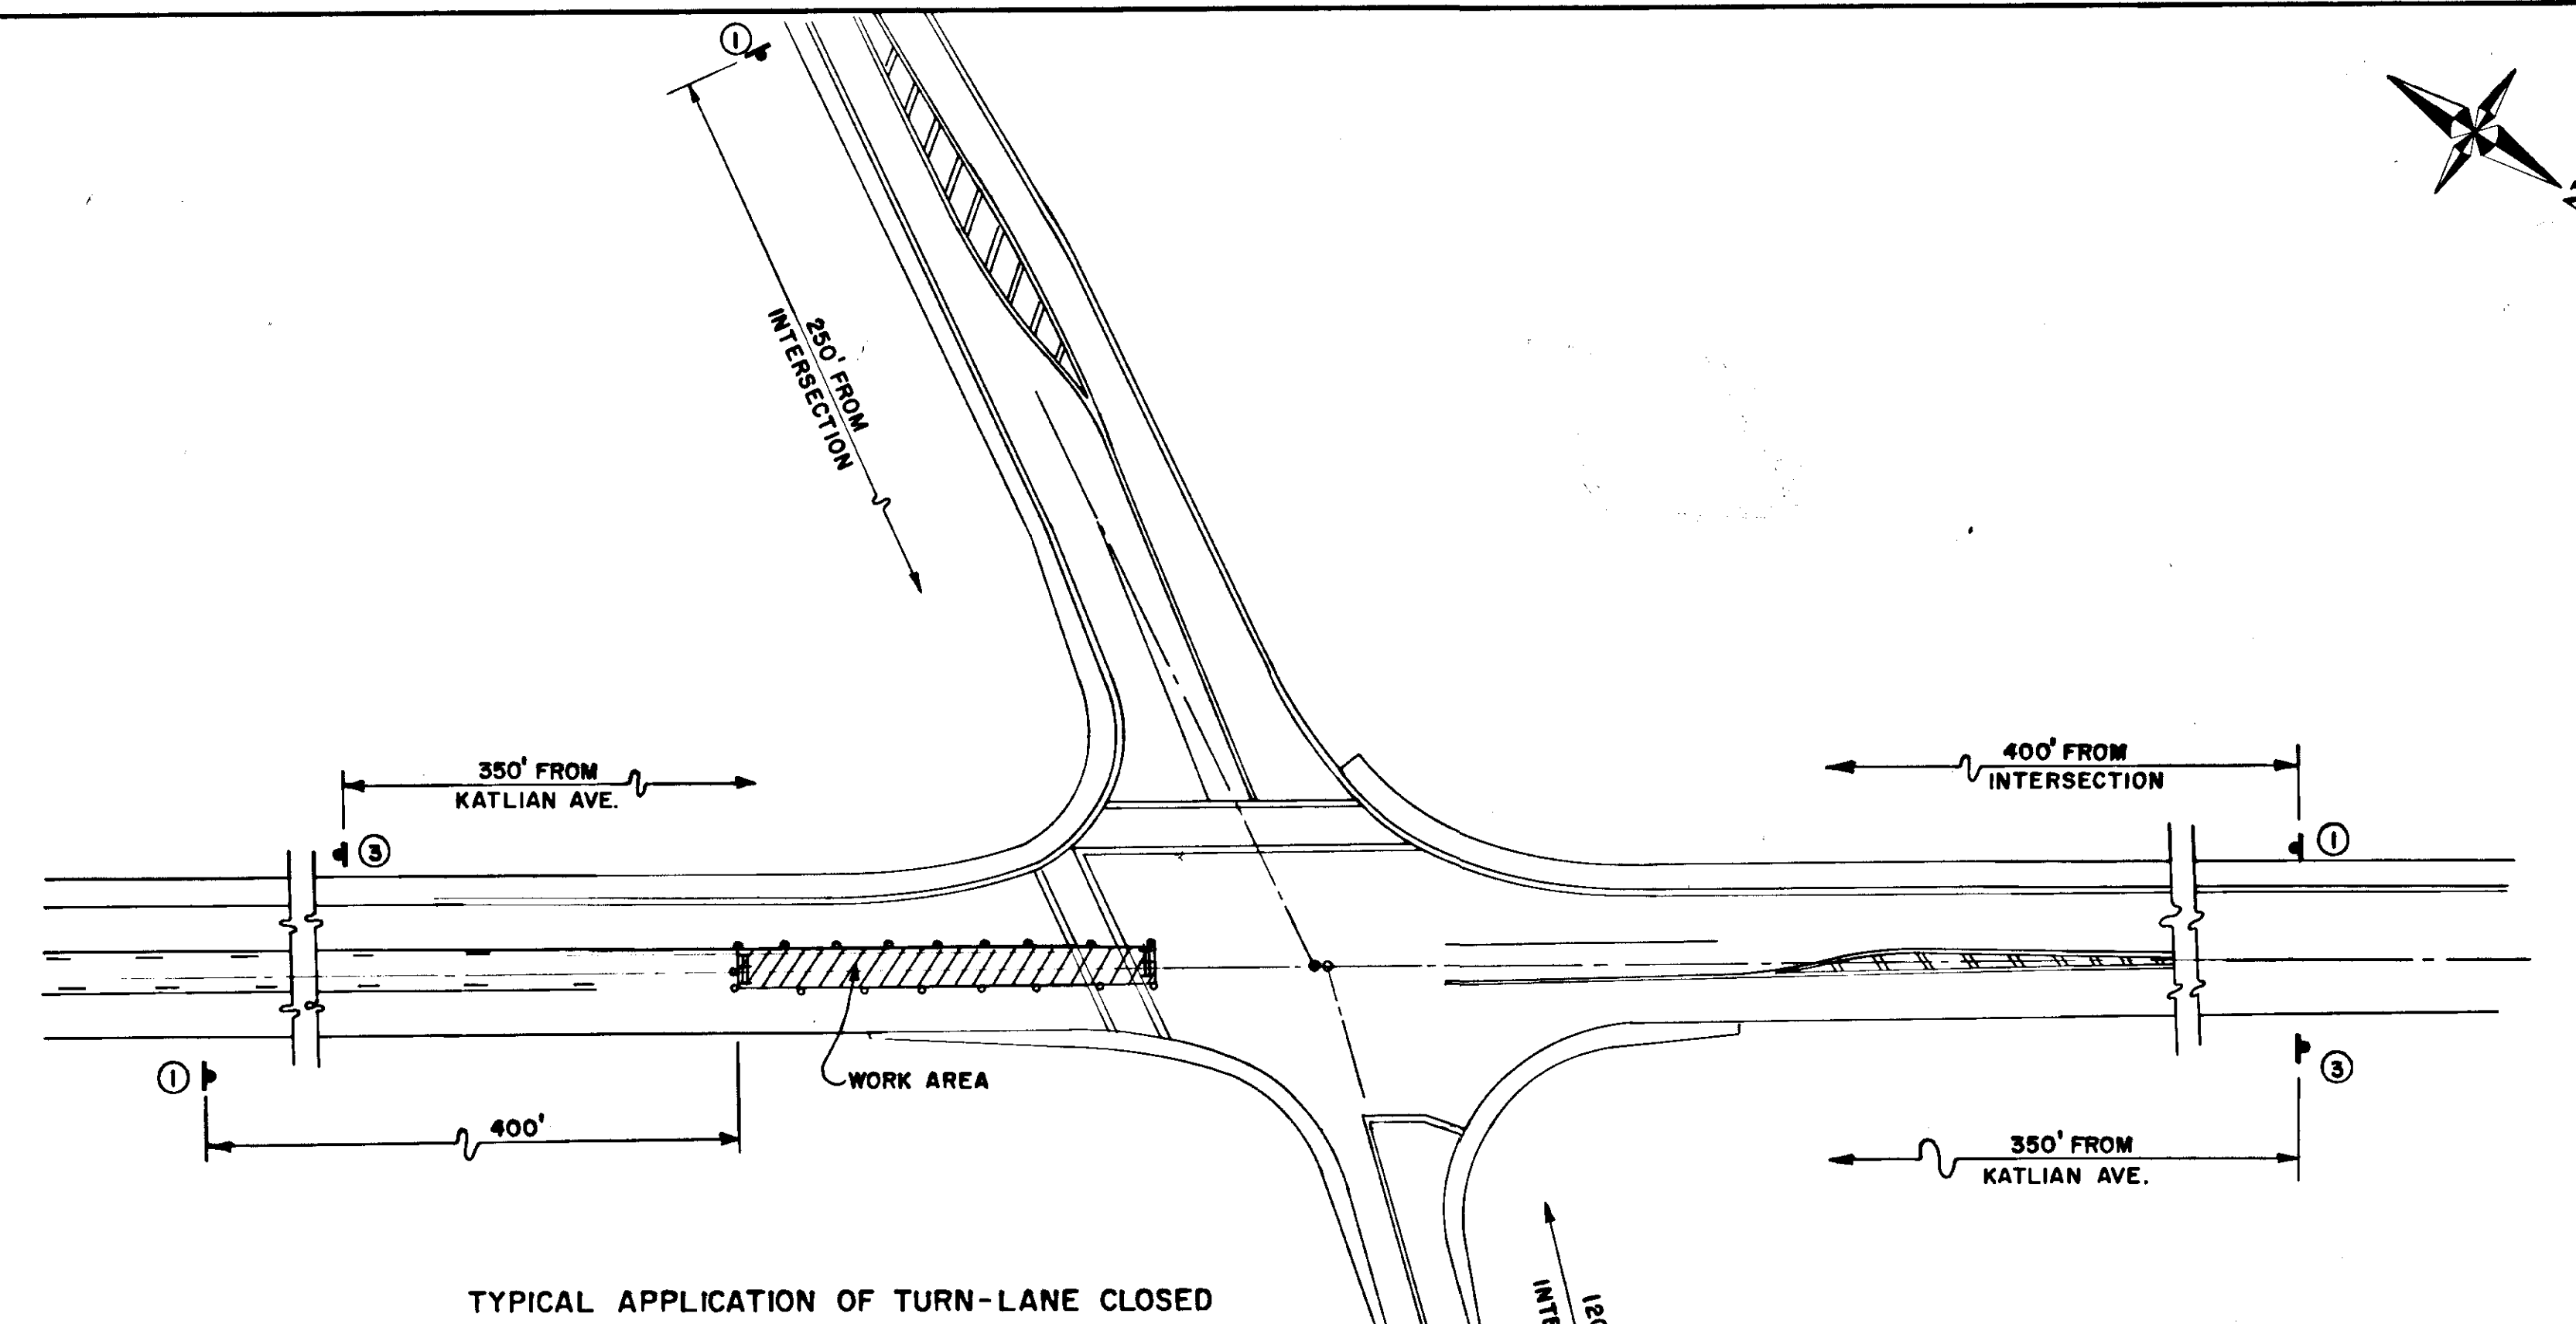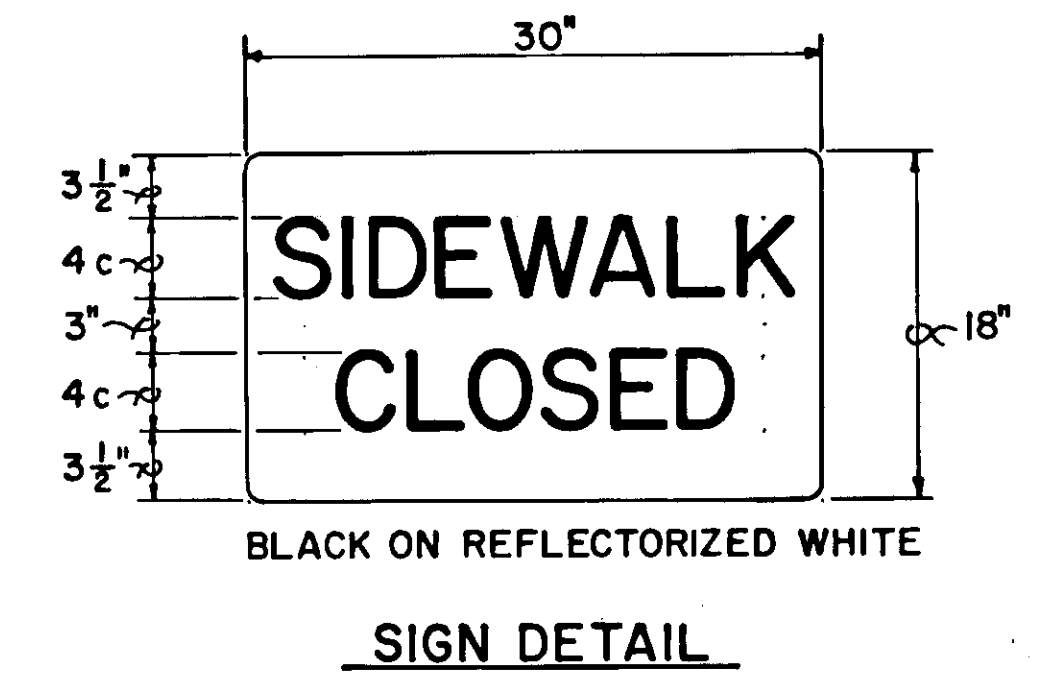


- LEGEND**
- FLAGPERSON
 - II TYPE II BARRICADES
 - CHANNELIZING DEVICE OR TRAFFIC CONE.
 - DRUMS
 - ① ROAD CONSTRUCTION AHEAD
 - ②
 - ③ END CONSTRUCTION
 - ④ 20 M.P.H.
 - ⑤ FLAGPERSON SYMBOL
 - ⑥
 - ⑦ NO PARKING
 - ⑧ ONE LANE ROAD AHEAD
 - ⑨ SIDEWALK CLOSED (SEE DETAIL THIS SHEET)


STATE OF ALASKA
DEPARTMENT OF TRANSPORTATION
& PUBLIC FACILITIES
SOUTHEAST REGION DESIGN & CONSTRUCTION

KATLIAN AVENUE / HALIBUT POINT ROAD SIGNAL
HES-099-3(2) 70313
TRAFFIC CONTROL PLAN


APPROVED BY:	DESIGNED BY:	SCALE:
RECOMMENDED BY:	J.E.A.	NONE
PREPARED BY:	DRAWN BY:	DATE:
PROJECT MANAGER	B.A.	5/90
LEAD DESIGNER	CHECKED BY:	SHEET 7 OF 10
	R.P.	

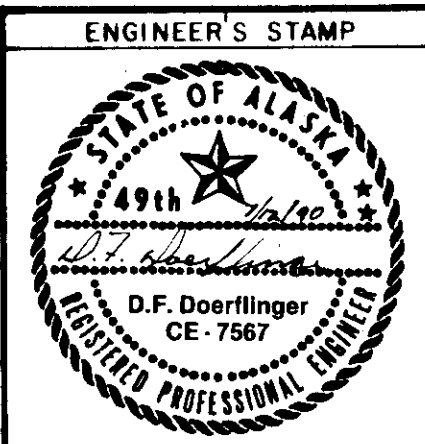

BY	DATE	DESCRIPTION OF CHANGE

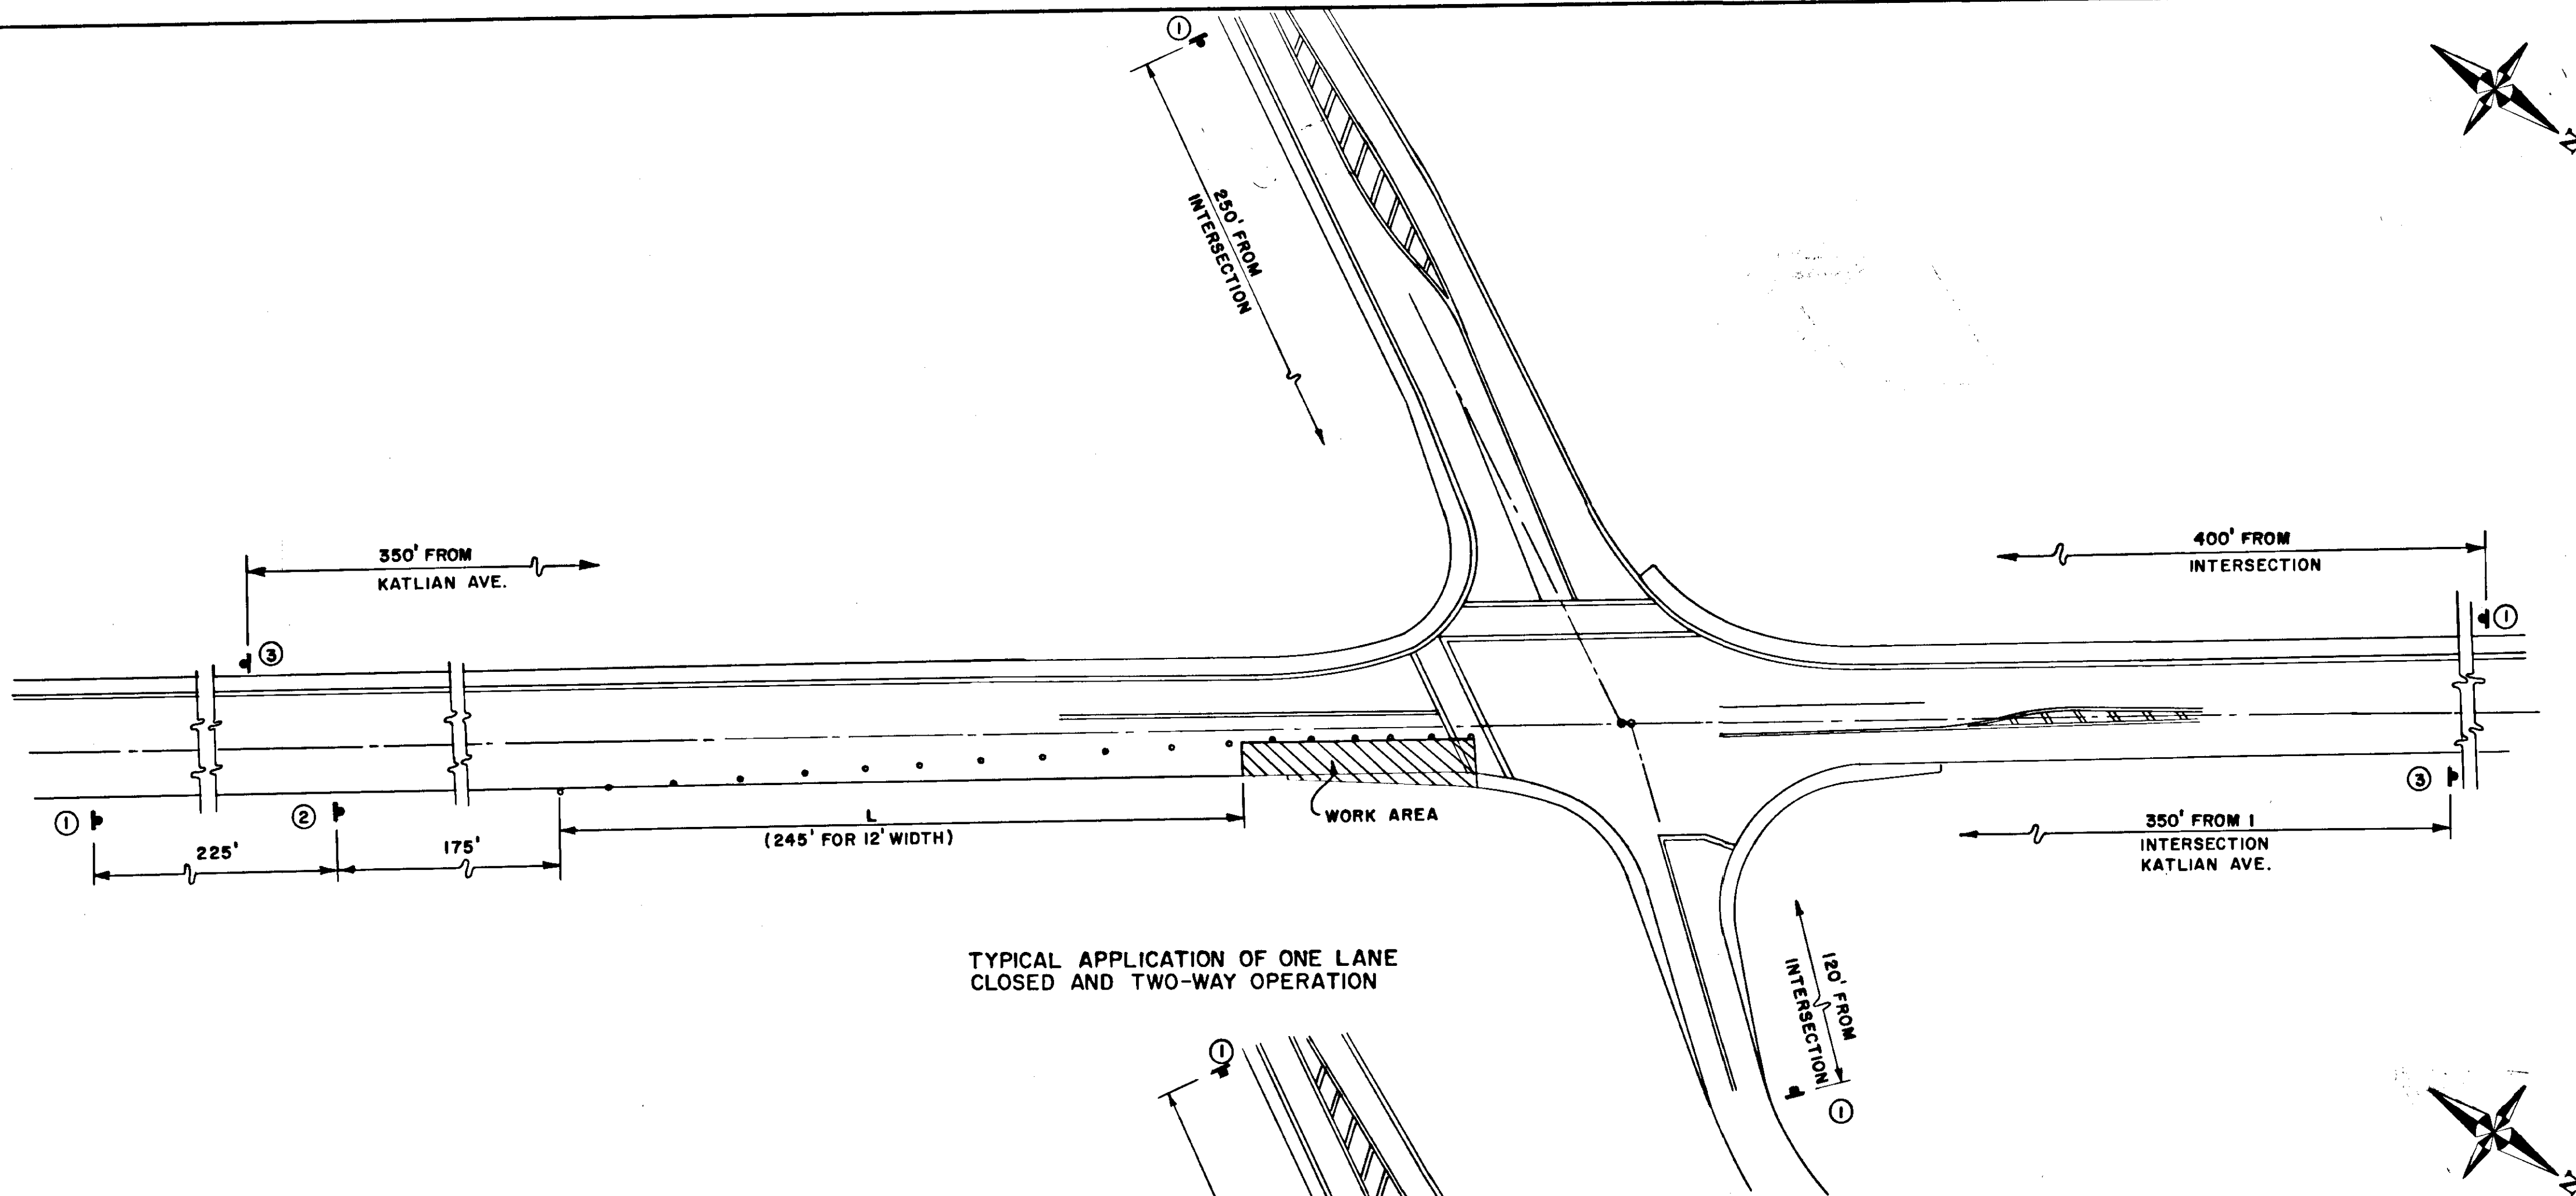


- LEGEND**
- FLAGPERSON
 - II TYPE II BARRICADES
 - CHANNELIZING DEVICE OR TRAFFIC CONE
 - ① ROAD CONSTRUCTION AHEAD
 - ② END CONSTRUCTION
 - ③ 20 M.P.H.
 - ④ FLAGPERSON SYMBOL
 - ⑤ NO PARKING
 - ⑥ ONE LANE ROAD AHEAD

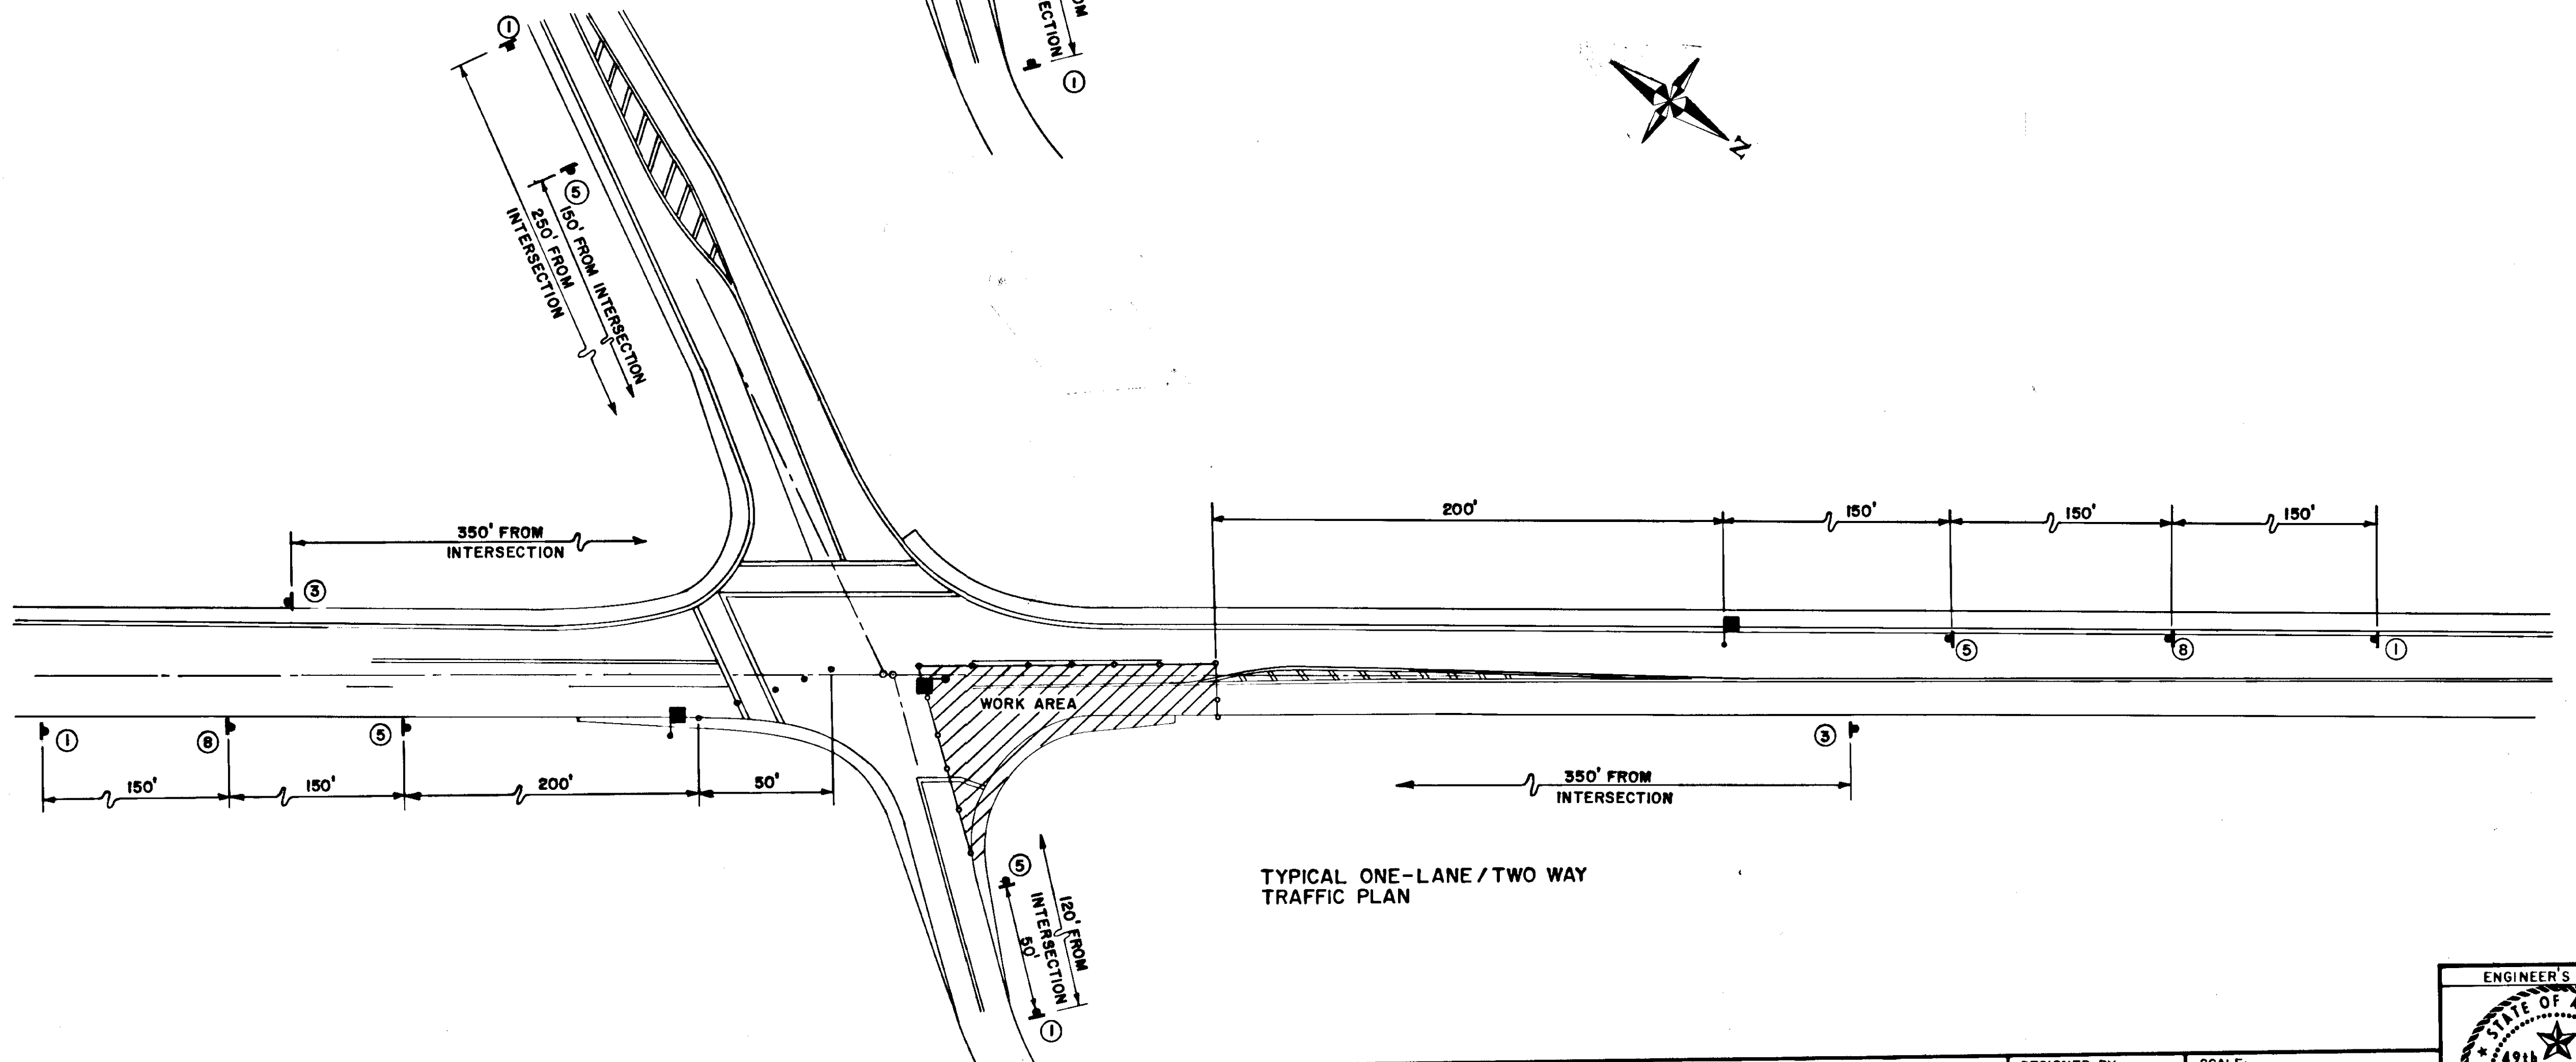

STATE OF ALASKA
DEPARTMENT OF TRANSPORTATION
& PUBLIC FACILITIES
SOUTHEAST REGION DESIGN & CONSTRUCTION


KATLIAN AVENUE / HALIBUT POINT ROAD SIGNAL
HES-099-3(2) 70313
TRAFFIC CONTROL PLAN

APPROVED BY:	DESIGNED BY:	SCALE:
RECOMMENDED BY:	J.E.A.	NONE
DESIGN GROUP CHIEF	DRAWN BY:	DATE:
DATE	B.A.	5/90
DESIGN ENGINEER, GROUP	CHECKED BY:	SHEET 8 OF 10
DATE	R.P.	
PROJECT MANAGER	LEAD DESIGNER	

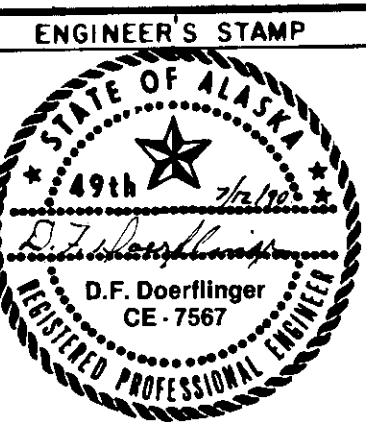

RECORD OF REVISIONS

BY	DATE	DESCRIPTION OF CHANGE

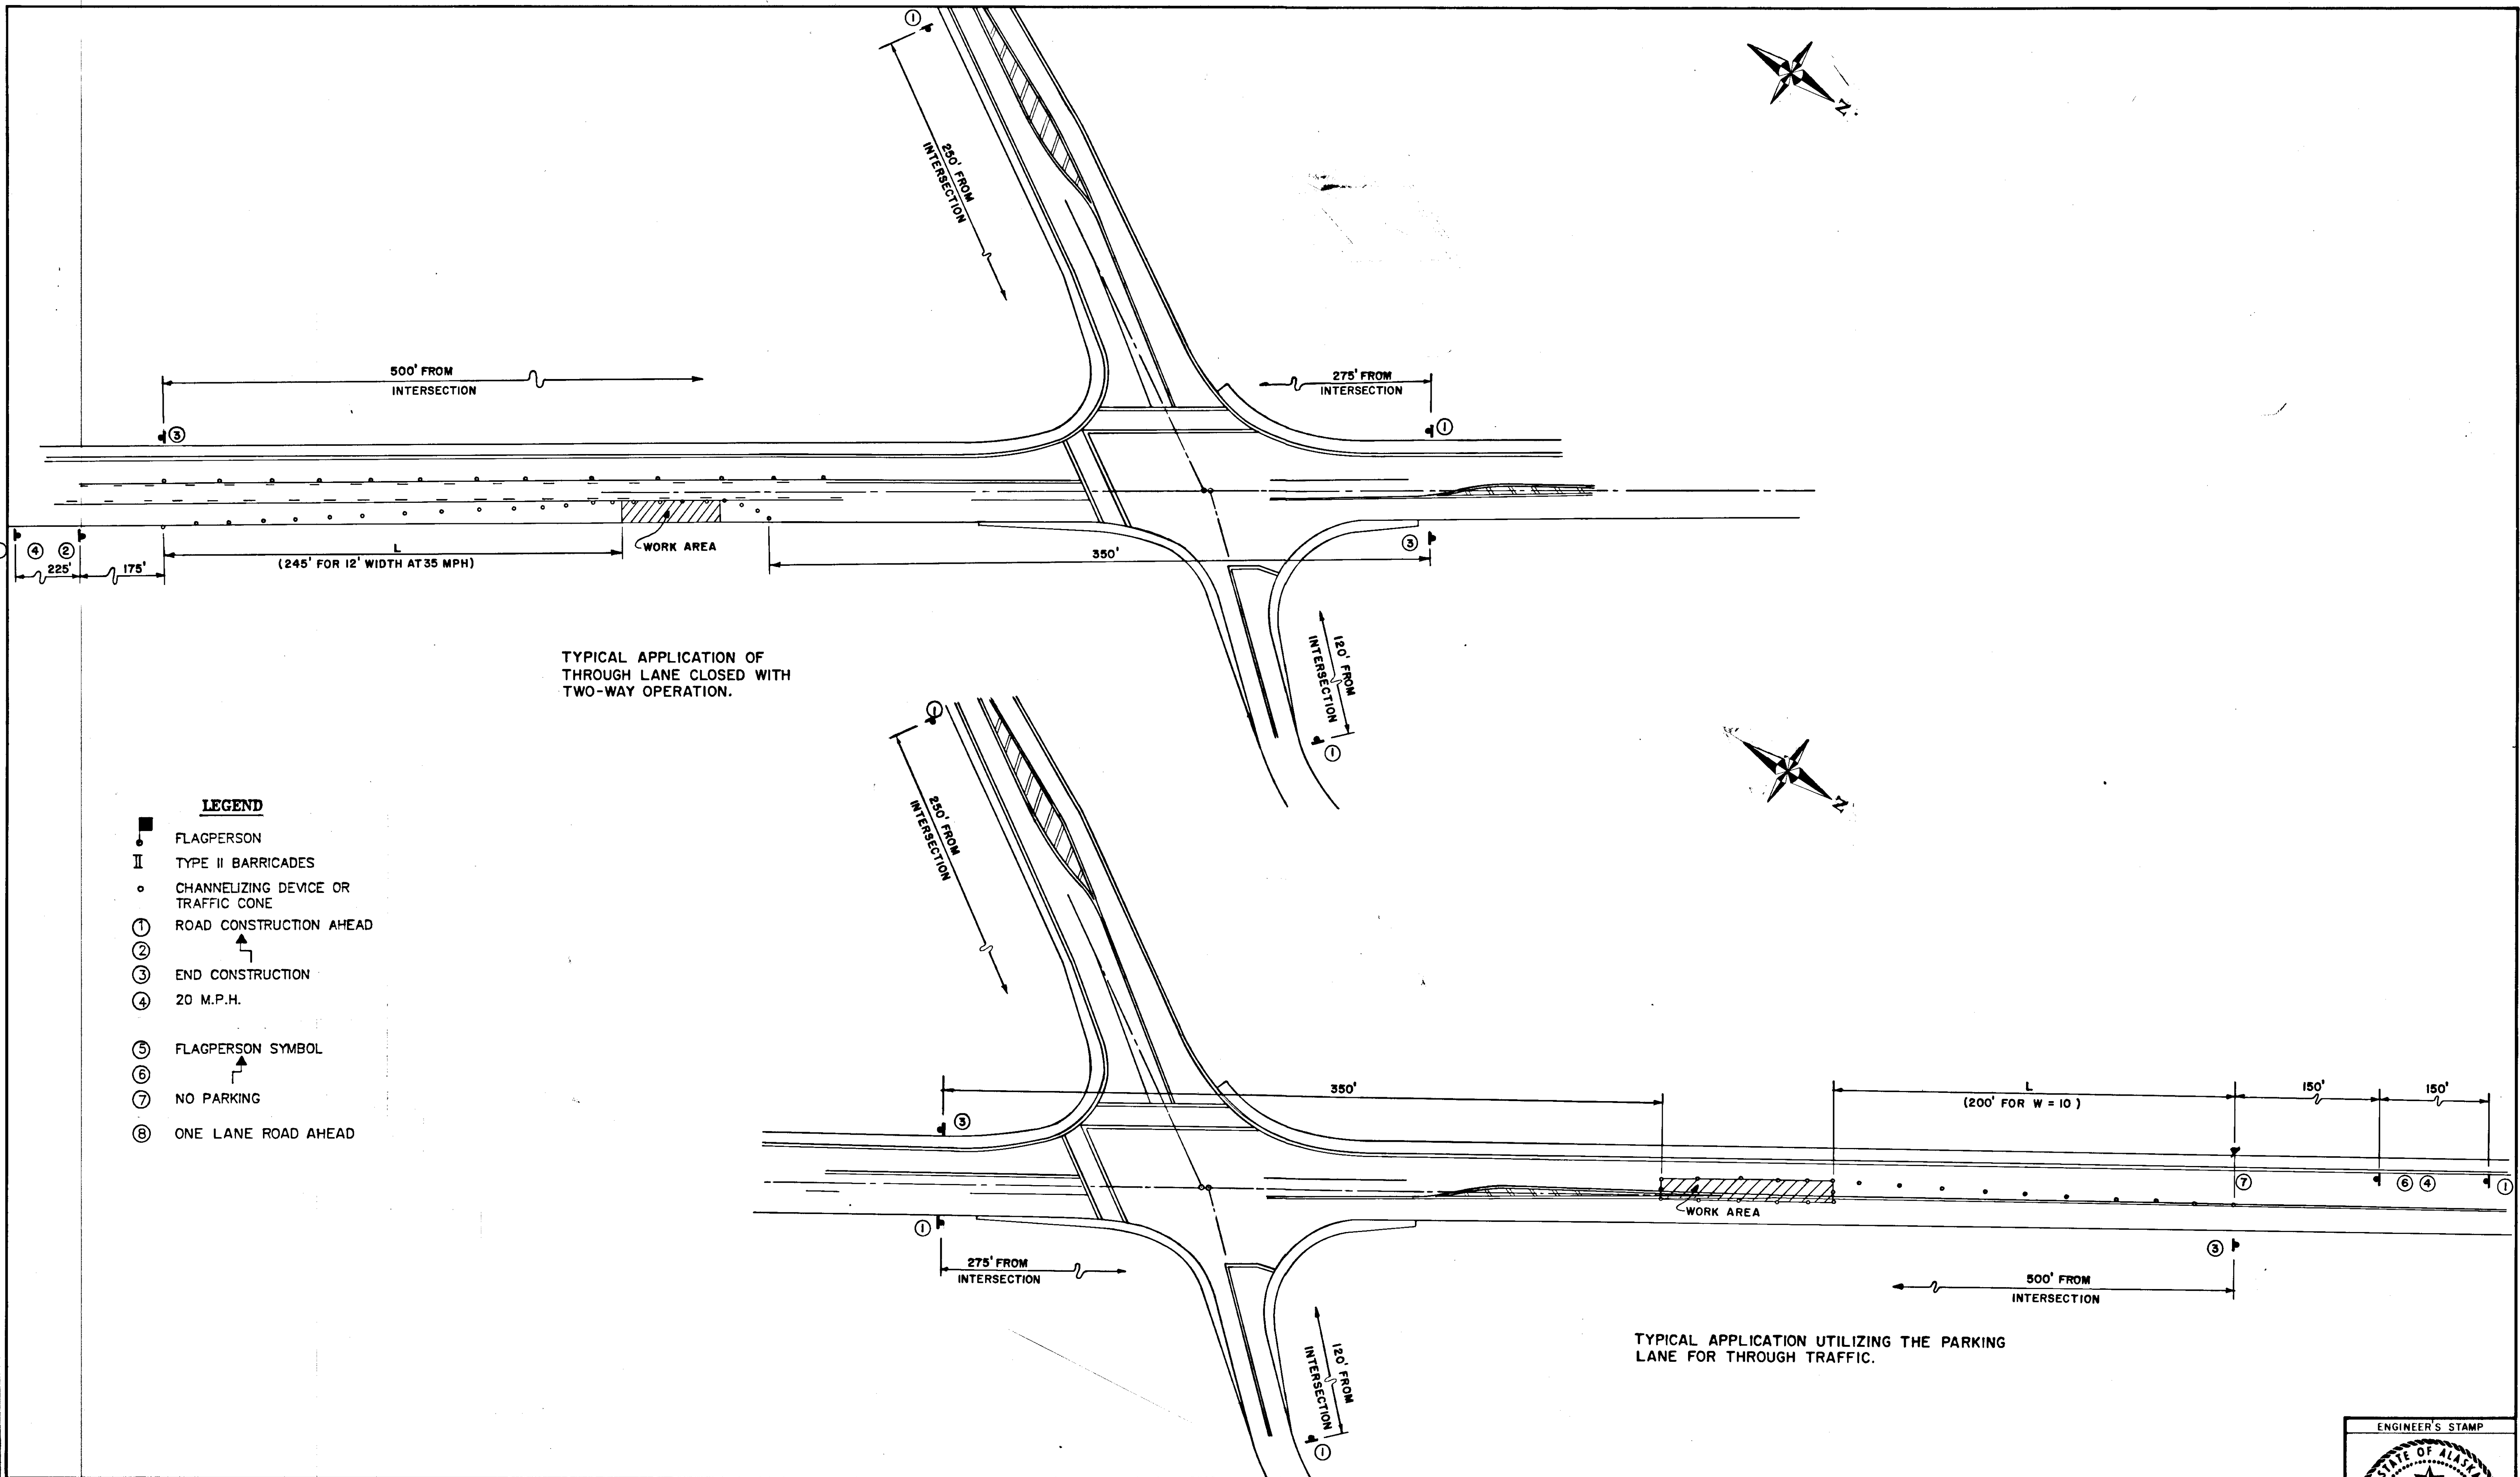

LEGEND

- FLAGPERSON
- II TYPE II BARRICADES
- CHANNELIZING DEVICE OR TRAFFIC CONE
- ① ROAD CONSTRUCTION AHEAD
- ② ↑
- ③ END CONSTRUCTION
- ④ 20 M.P.H.
- ⑤ FLAGPERSON SYMBOL
- ⑥ ↑
- ⑦ NO PARKING
- ⑧ ONE LANE ROAD AHEAD


BY	DATE	DESCRIPTION OF CHANGE
RECORD OF REVISIONS		


STATE OF ALASKA
DEPARTMENT OF TRANSPORTATION
& PUBLIC FACILITIES
SOUTHEAST REGION DESIGN & CONSTRUCTION

KATLIAN AVENUE / HALIBUT POINT ROAD SIGNAL
HES-099-3(2) 70313
TRAFFIC CONTROL PLAN

APPROVED BY:	DESIGNED BY:	SCALE:
DESIGN GROUP CHIEF	J.E.A.	NONE
RECOMMENDED BY:	DRAWN BY:	DATE:
DESIGN ENGINEER, GROUP	B.A.	5/90
PREPARED BY:	CHECKED BY:	SHEET 9 OF 10
PROJECT MANAGER	R.P.	
LEAD DESIGNER		

APPROVED BY:	DESIGNED BY:	SCALE:
DESIGN GROUP CHIEF	J.E.A.	NONE
RECOMMENDED BY:	DRAWN BY:	DATE:
DESIGN ENGINEER, GROUP	B.A.	5/90
PREPARED BY:	CHECKED BY:	SHEET 9 OF 10
PROJECT MANAGER	R.P.	
LEAD DESIGNER		

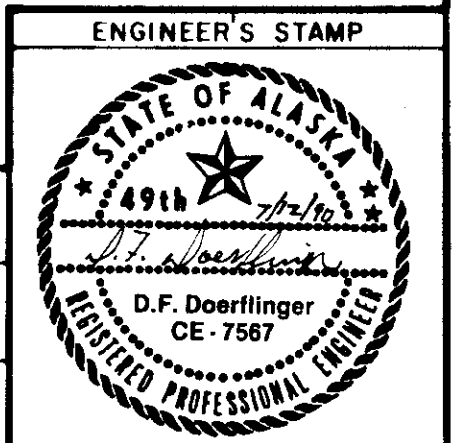

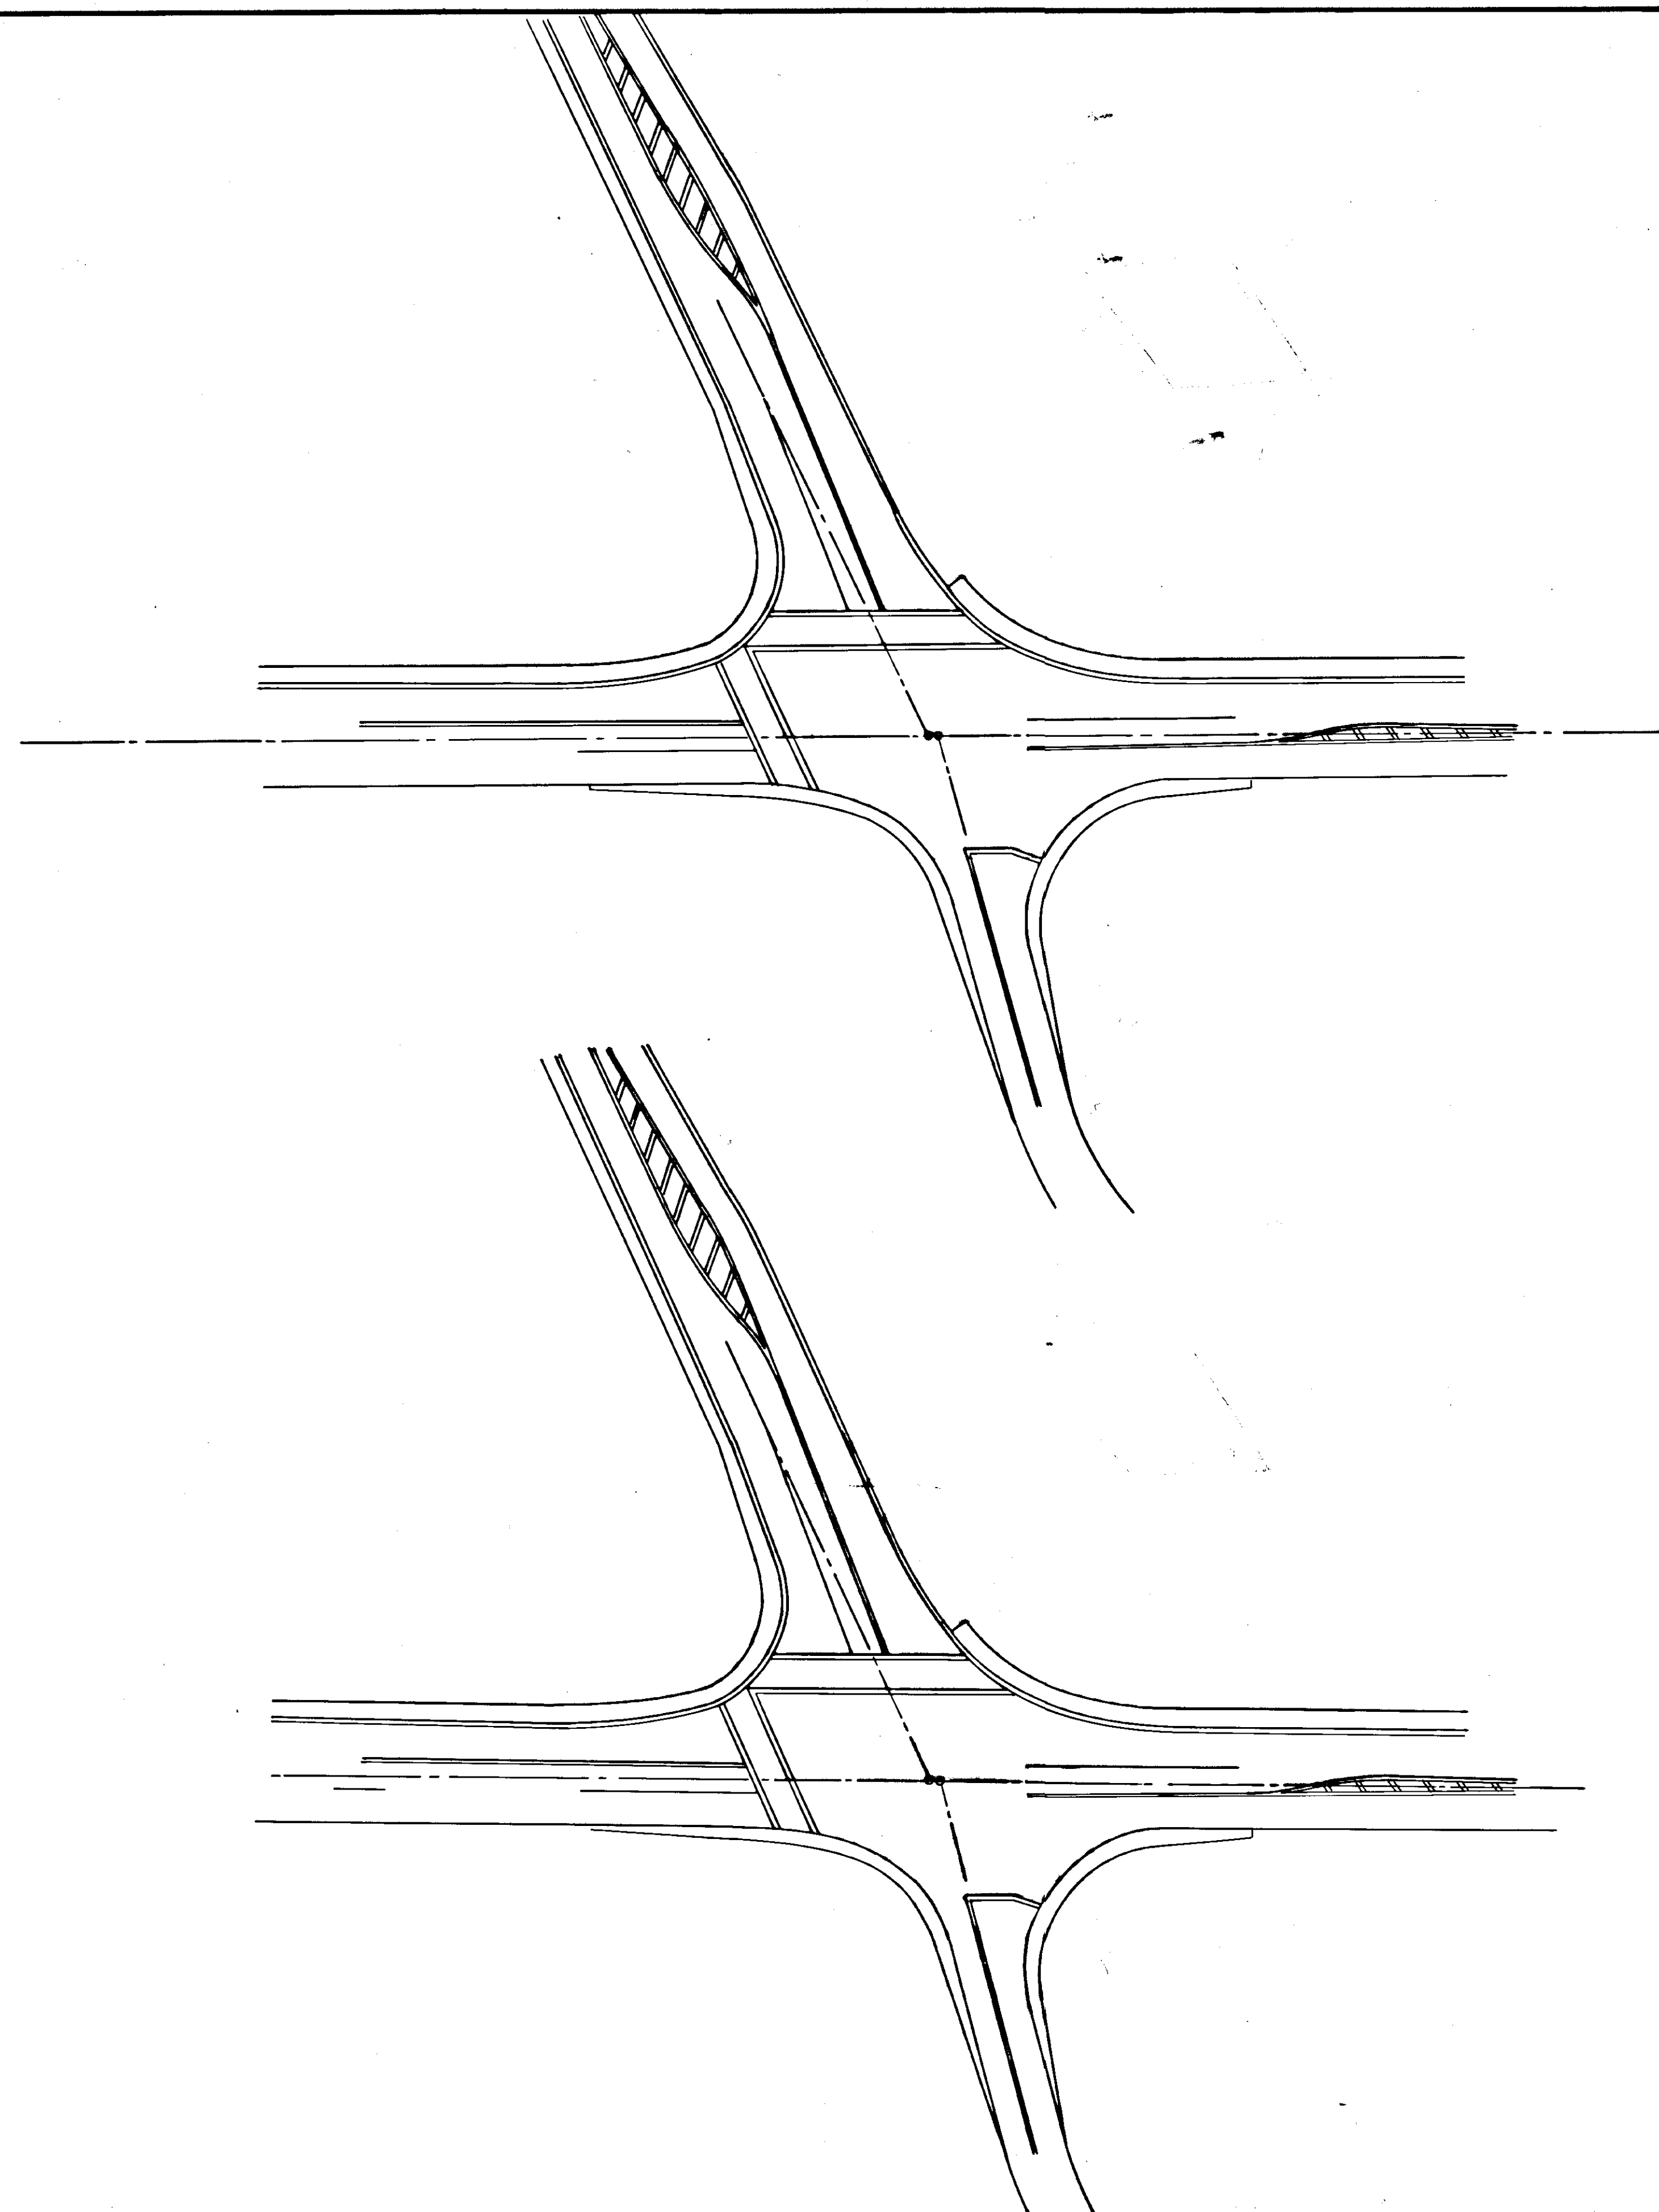

KATLIAN AVENUE / HALIBUT POINT ROAD SIGNAL
HES-099-3(2) 70313
TRAFFIC CONTROL PLAN

NOTE: THIS SHEET INTENDED FOR ALTERNATE T.C.P. PLANS BY THE CONTRACTOR.

APPROVED BY: _____ DESIGN GROUP CHIEF _____ DATE	DESIGNED BY: J.E.A.	SCALE: NONE
RECOMMENDED BY: _____ DESIGN ENGINEER, GROUP "A" _____ DATE	DRAWN BY: B.A.	DATE: 5/90
PREPARED BY: _____ PROJECT MANAGER _____ LEAD DESIGNER	CHECKED BY: R.P.	SHEET 10 OF 10