


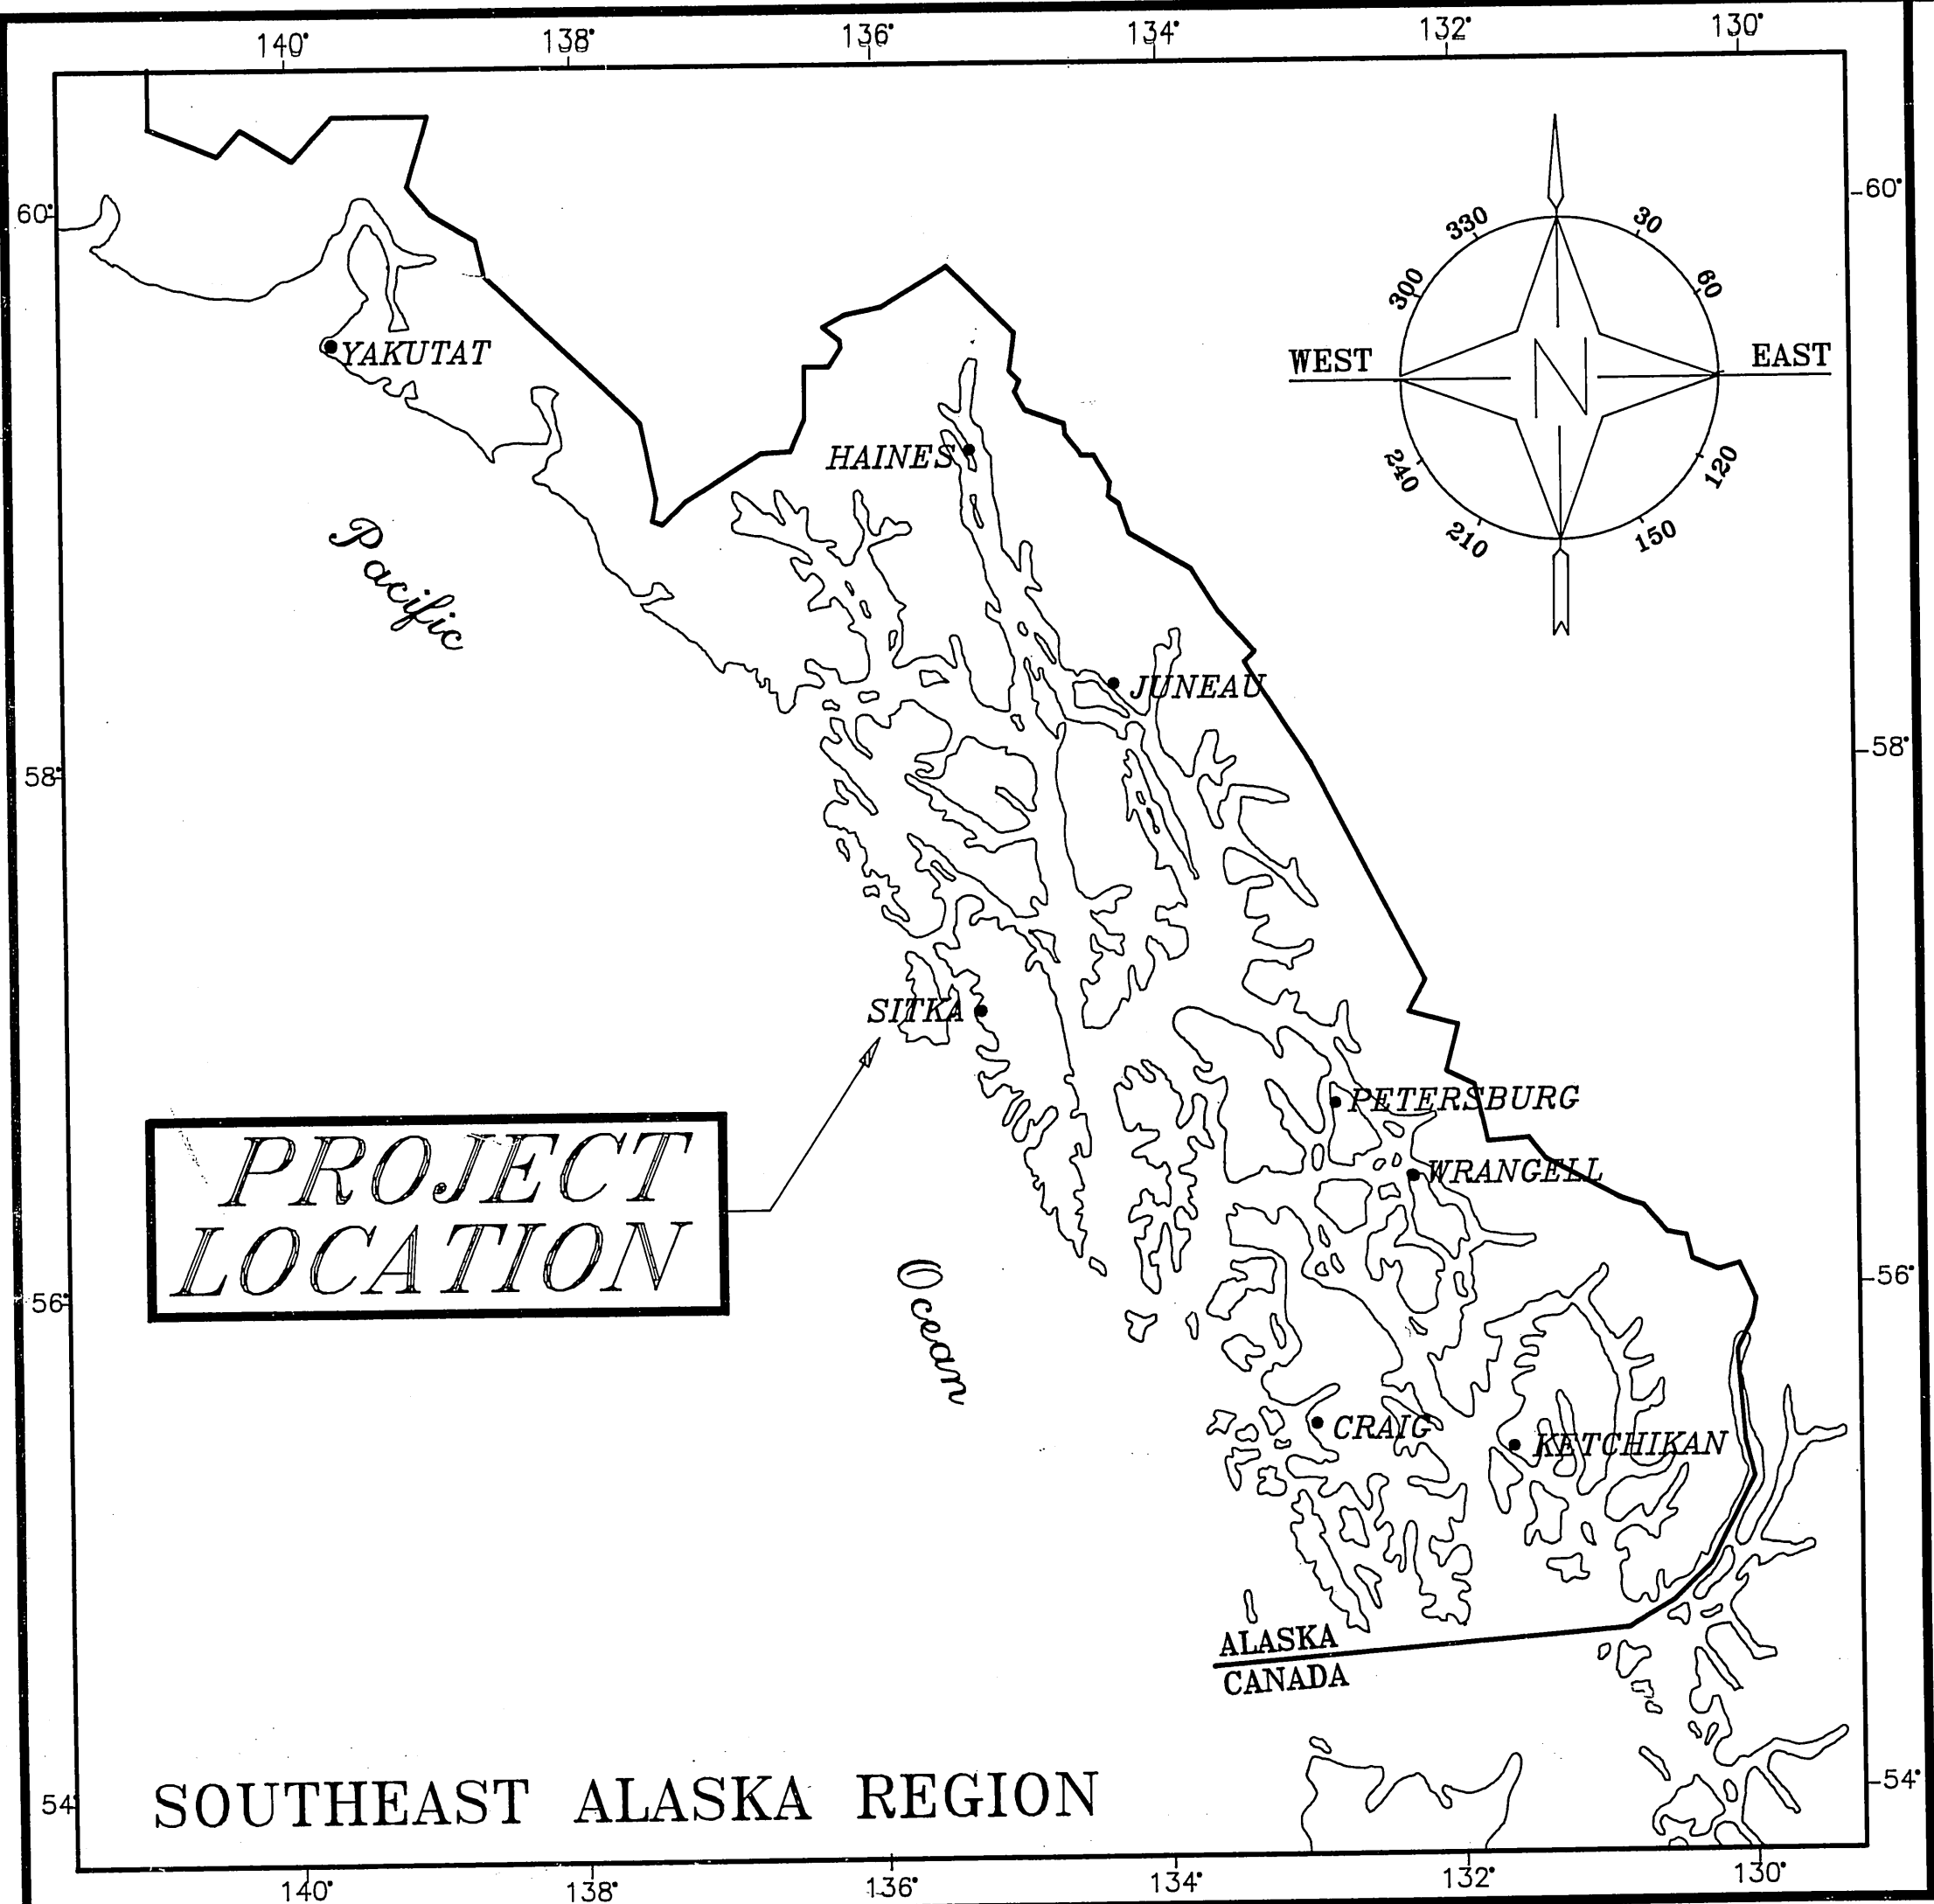

STATE OF ALASKA
DEPARTMENT OF TRANSPORTATION
AND
PUBLIC FACILITIES
SOUTHEAST REGION
DESIGN AND CONSTRUCTION DIVISION

*SITKA AIRPORT
ELECTRICAL
AND LIGHTING
IMPROVEMENTS*

A.I.P. 3-02-0268-03

PROJECT NO. 71457

INDEX OF SHEETS	
SHEET NO.	DESCRIPTION
1	TITLE SHEET
2	ESTIMATE OF QUANTITIES
3	ELEC. - SITE PLAN
4	ELEC. - EXISTING PARTIAL SITE PLAN
5	ELEC. - EXISTING CABLING SCHEDULE
6	ELEC. - NEW PARTIAL SITE PLAN
7	ELEC. - NEW CABLING SCHEDULE
8	ELEC. - HANDHOLES, LIGHTS, & SIGNS DETAILS
9	ELEC. - BEACON, WINDSOCK, & OBSTRUCTION LIGHTING DETAILS
10	ELEC. - EXISTING & NEW SYSTEM SINGLE LINE DIAGRAM
11	ELEC. - MAINT. BUILDING EXISTING & NEW SINGLE LINE DIAGRAMS
12	ELEC. - SINGLE LINE DIAGRAMS, FLOOR PLANS
13	ELEC. - CONTROL BUILDING FLOOR PLAN & EQUIPMENT SCHEDULE
14	ELEC. - GENSET & ANTENNA BRACKET DETAILS
15	ELEC. - BUILDING ALARM PANEL SCHEMATICS & DETAILS
16	ELEC. - LIGHTING CONTROLS & BUILDING ALARMS SCHEMATICS
17	ARCH. - NEW GENERATOR CONTROL BUILDING - PLANS
18	ARCH. - NEW GENERATOR CONTROL BUILDING - NOTES
19	CIVIL - VAULT DRAINAGE PLAN, CONTROL BLDG., ROTATING BEACON SITE PLAN
20	CIVIL - MISC. DETAILS


"As-Built"

Project Engineer: Tom Matlicka
Contractor: Gilco Construction Inc.
Begin Date: July 29, 1994
End Date: July 21, 1995




STATE OF ALASKA
DEPARTMENT OF TRANSPORTATION
AND
PUBLIC FACILITIES
SOUTHEAST REGION DESIGN SECTION

APPROVED
Regional Preconstruction Engineer Date 6/1/94

APPROVED
Director, S.E. Region Design & Construction Date 6/1/94

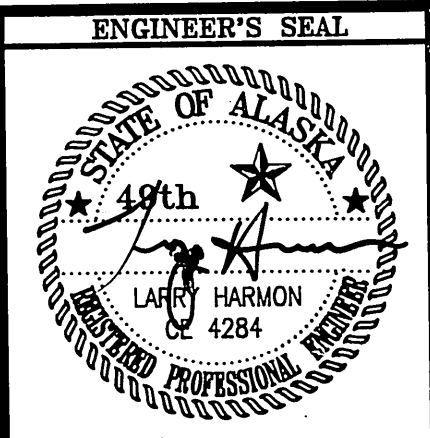

PROJECT NUMBER:
71457
DATE:
MAY, 1994
SHEET 1 OF 20

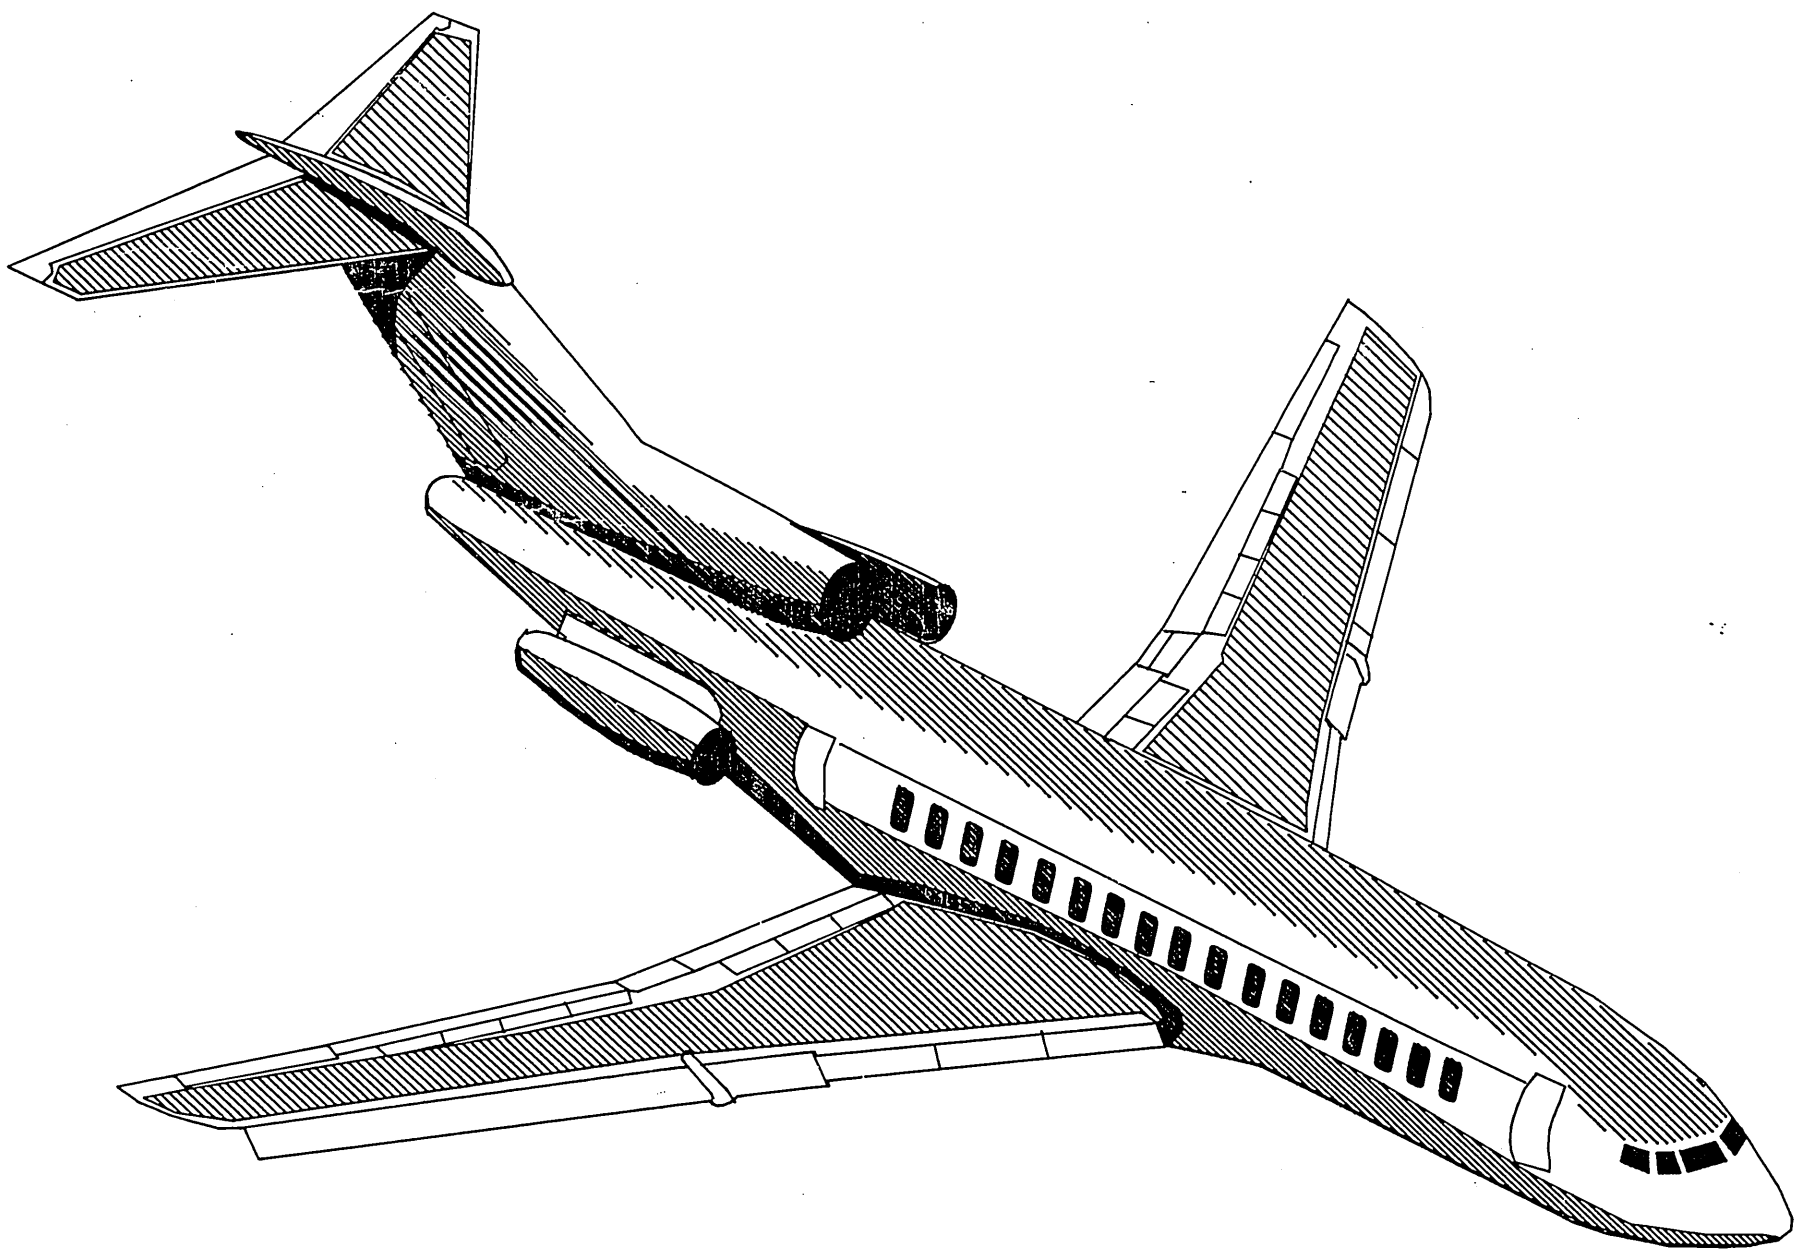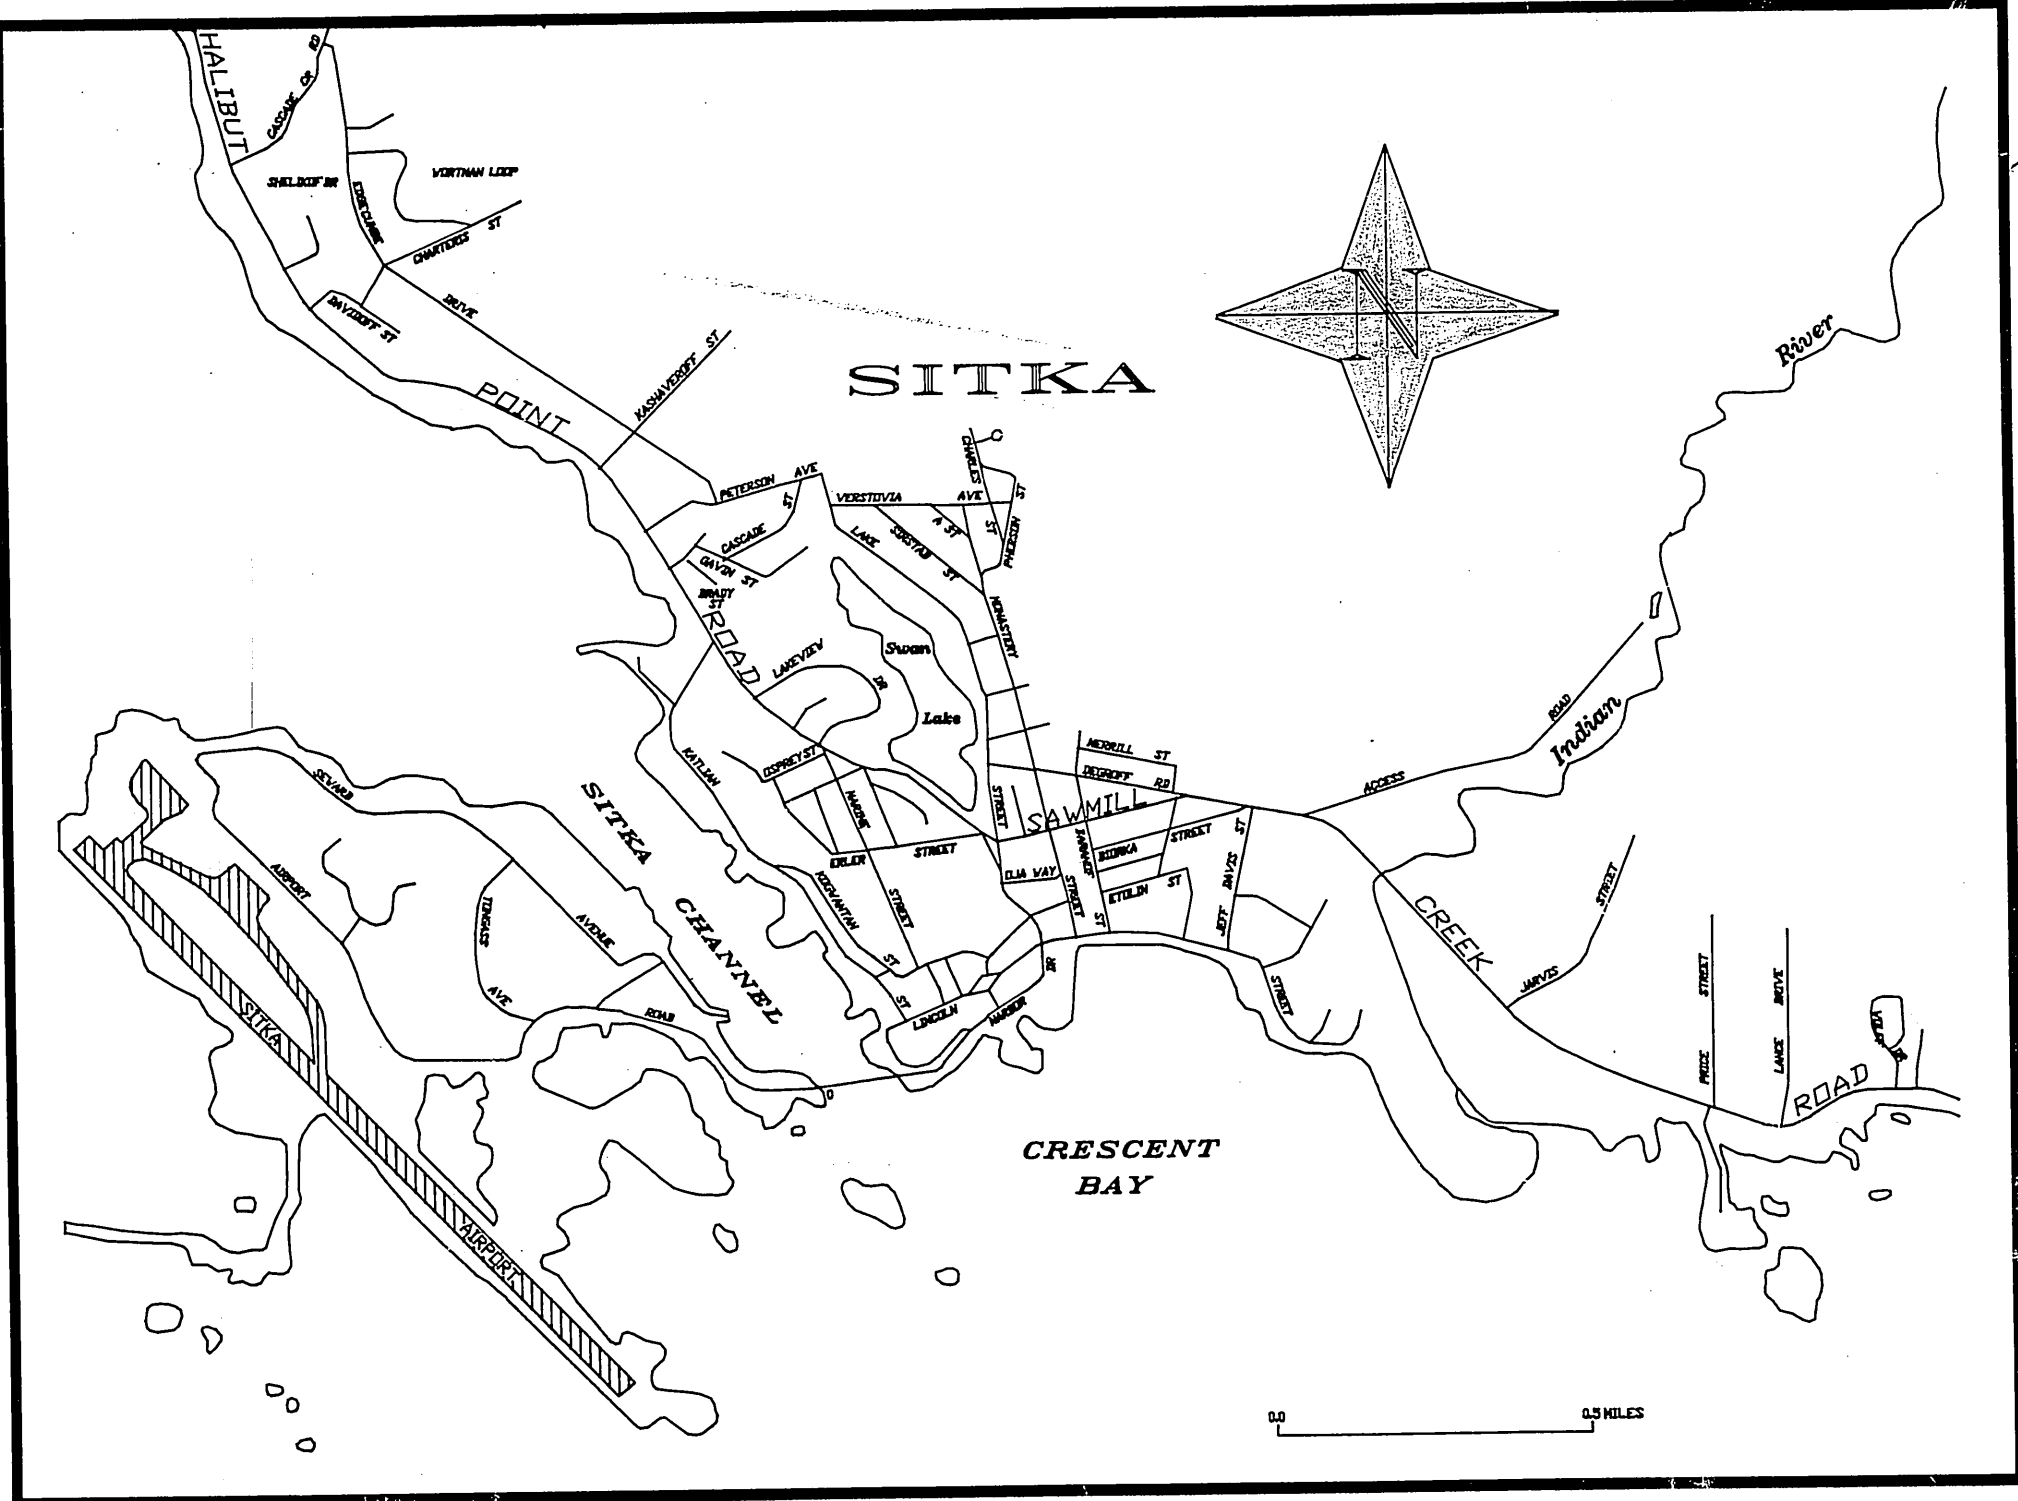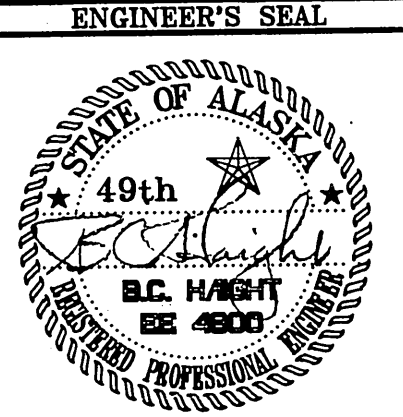

ESTIMATE OF QUANTITIES				
Item No.	BASE BID OR ALT.	Description	Unit	Quantity
1000-a	BASE BID	New spare regulator, L-829	EACH	1
1000-c	BASE BID	Airport Lighting Control Panel, L-821	EACH	2
1000-d	BASE BID	Runway Marker Light, L-862	EACH	53 65
* 1000-d	Alt #1	Runway Marker Light, L-862	EACH	12
1000-e	BASE BID	Threshold Marker Light, L-862E	EACH	8 16
* 1000-e	Alt #1	Threshold Marker Light, L-862E	EACH	8
1000-f	BASE BID	Taxiway Marker Light, L-861T	EACH	7 13
* 1000-f	Alt #1	Taxiway Marker Light, L-861T	EACH	6
1000-g	BASE BID	Furnish No. 6 Cable, L-824 C.O. #1	LF	4,900*
* 1000-g	Alt #1	Furnish No. 6 Cable, L-824	LF	3,100
1000-h	BASE BID	Installation of No. 6 Cable, L-824 C.O. #1	LF	24,900 18,964.19
* 1000-h	Alt #1	Installation of No. 6 Cable, L-824	LF	3,100
1000-i	BASE BID	1-1/2" or 1-1/4" HDPE conduit C.O. #1	LF	1,300 367
1000-j	BASE BID	2" HDPE conduit along taxiway C.O. #1	LF	1,300 521
1000-k	BASE BID	2" HDPE conduit along runway C.O. #1	LF	15,800 16,359
* 1000-k	Alt #1	2" HDPE conduit along runway	LF	3,100
1000-l	BASE BID	Lighting Control Cable C.O. #1	LF	3,200 5,462
1000-m	BASE BID	#8 XHHW Ground Conductor C.O. #1	LF	17,600 15,502.66
* 1000-m	Alt #1	#8 XHHW Ground Conductor	LF	3,100
1000-n	BASE BID	3" HDPE conduit C.O. #1	LF	500 409
1000-o	BASE BID	Removal of Taxiway Light and Base C.O. #1	EACH	7 6
* 1000-o	Alt #1	Removal of Taxiway Light and Base	EACH	6
1000-r	BASE BID	Lighting Regulator Monitor, L-827	EACH	1
* 1000-u	Alt #2	Lighted Holding Position Sign	EACH	3
* 1000-v	Alt #2	Lighted Taxiway Location Sign	EACH	3
* 1000-w	Alt #2	Lighted Runway Exit Sign	EACH	3
1000-x	BASE BID	Obstruction lights for mausoleum	LS	All Req'd.
1000-y	BASE BID	Illuminated Windcone Assembly	EACH	1
1000-z	BASE BID	Receiver-Controller, Type I, L-824	EACH	1
1000-aa	BASE BID	Relocated and Upgraded Runway Distance Sign	EACH	5
1000-bb	BASE BID	Relocated Lighting Regulator	EACH	2
* 1000-cc	BASE BID	Removal of existing cable	LS	All Req'd.
1000-cc	Alt #1	Removal of existing cable	LS	All Req'd.
1000-dd	BASE BID	Type 1 Handhole C.O. #1	EACH	2 3
1000-ee	BASE BID	Type 3 Handhole C.O. #1	EACH	4 5
1000-ff	BASE BID	Removal of existing Handhole C.O. #1	EACH	11 8
1000-gg	BASE BID	Series Plug Cutouts	EACH	2
1020	BASE BID	Reconditioned Beacon and Refurbished Pole	LS	All Req'd.
1100	BASE BID	Electrical Systems	LS	All Req'd.

* 20,000 FEET OF NO. 6, L-824 CABLE WILL BE FURNISHED BY THE SITKA AIRPORT MANAGER.

ESTIMATE OF QUANTITIES (Cont.)				
Item No.	BASE BID OR ALT.	Description	Unit	Quantity
100	BASE BID	Mobilization and Demobilization	LS	All Req'd.
120(1)	BASE BID	DBE Adjustment C.O. #1	CS	All Req'd.
121	BASE BID	Construction Surveying by the Contractor	LS	All Req'd.
131	BASE BID	Engineer's Field Office C.O. #1	LS	All Req'd.
250-a	BASE BID	Excavation and Disposal of Existing Pavement C.O. #1	SY	420 356.42
* 250-a	Alt #1	Excavation and Disposal of Existing Pavement	SY	100
400-a	BASE BID	12" Dia. Corrugated Metal Pipe	LF	40
400-b	BASE BID	4" Dia. Ductile Iron Pipe, Class 50 C.O. #1	LF	400 419
560-a	BASE BID	Rip-Rap, Class II	LS	All Req'd.
560-b	BASE BID	Rip-Rap, Class IV	LS	All Req'd.
660	BASE BID	Asphalt Concrete Pavement C.O. #1	SY	420 345.12
* 660	Alt #1	Asphalt Concrete Pavement	SY	100
2000	BASE BID	Construct New Control Building	LS	All Req'd.

* QUANTITIES FOR ALT #1 & #2 INCLUDED IN BASE BIDS

NOTE:

- THE ITEM NOS. LISTED IN THIS TABLE ARE THE SAME ITEM NOS. FOUND IN THE METHOD OF MEASUREMENT PARTS OF THE SPECIFICATIONS. FOR EXAMPLE, ITEM NO. 1000-a REPRESENTS THE WORK COVERED BY ITEM 1000-a IN PART 1000.7 "METHOD OF MEASUREMENT" OF SECTION 1000 OF THE SPECIFICATIONS.
- IT SHOULD BE NOTED THAT SECTION 1100 OF THE SPECIFICATIONS COVERS MANY OF THE SAME TYPES OF WORK THAT ARE COVERED IN SECTION 1000, SUCH AS INSTALLATION OF CONDUIT AND HANDHOLES. HOWEVER, THE SECTION 1100 WORK IS FOR ELECTRICAL SYSTEMS (PRIMARY POWER, EQUIP. POWER, ETC.) DIFFERENT FROM THE SECTION 1000 WORK (RUNWAY LIGHTING, TAXIWAY LIGHTING, ETC.). MAINTAIN SEPARATION OF MATERIALS AND LABOR TO THE SPECIFIC BID ITEMS AS SPECIFIED BY THESE SECTIONS.

NEW ITEMS ESTABLISHED BY CHANGE ORDER NUMBER 1				
ITEM No.	CHANGE ORDER	DESCRIPTION	UNIT	QUANTITY
440 c	1	24" Corrugated Metal Pipe	L.S.	All Req'd
660 a	1	Additional Asphalt Paving (Minor)	TON	102.4
660 b	1	Additional Asphalt Paving (Major)	TON	152.83
1000 e	1	Handhole Cable Tray	EACH	15
1100 a	1	Relocate Auto Transfer Switch	L.S.	All Req'd
1100 b	1	Electric Equipment Connections & Modifications	L.S.	All Req'd
1100 c	1	I.M.C. Conduit Circuit	L.S.	All Req'd

BY:	DATE:	DESCRIPTION OF CHANGE:



STATE OF ALASKA
DEPARTMENT OF TRANSPORTATION
AND PUBLIC FACILITIES
SOUTHEAST REGION DESIGN & CONSTRUCTION


SITKA AIRPORT ELECTRICAL AND LIGHTING IMPROVEMENTS
SITKA ALASKA
ESTIMATE OF QUANTITIES



CITY AND BOROUGH OF SITKA
PUBLIC SERVICES
304 Lake Street, Sitka, Alaska 99835
TEL (907) 747-5500 FAX (907) 747-3158

DESIGNED BY: MGM	DATE: MAY 1994	PROJECT No. 71457
DRAWN BY: JLC	SHEET 2 of 20	
CHECKED BY: BCH		

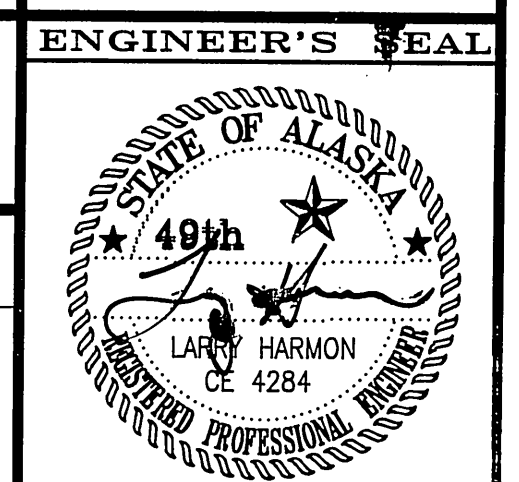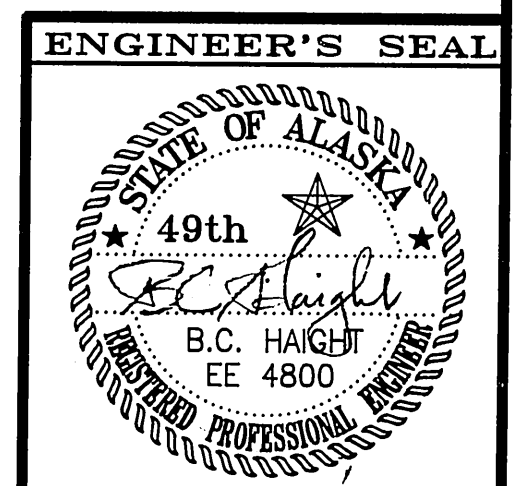

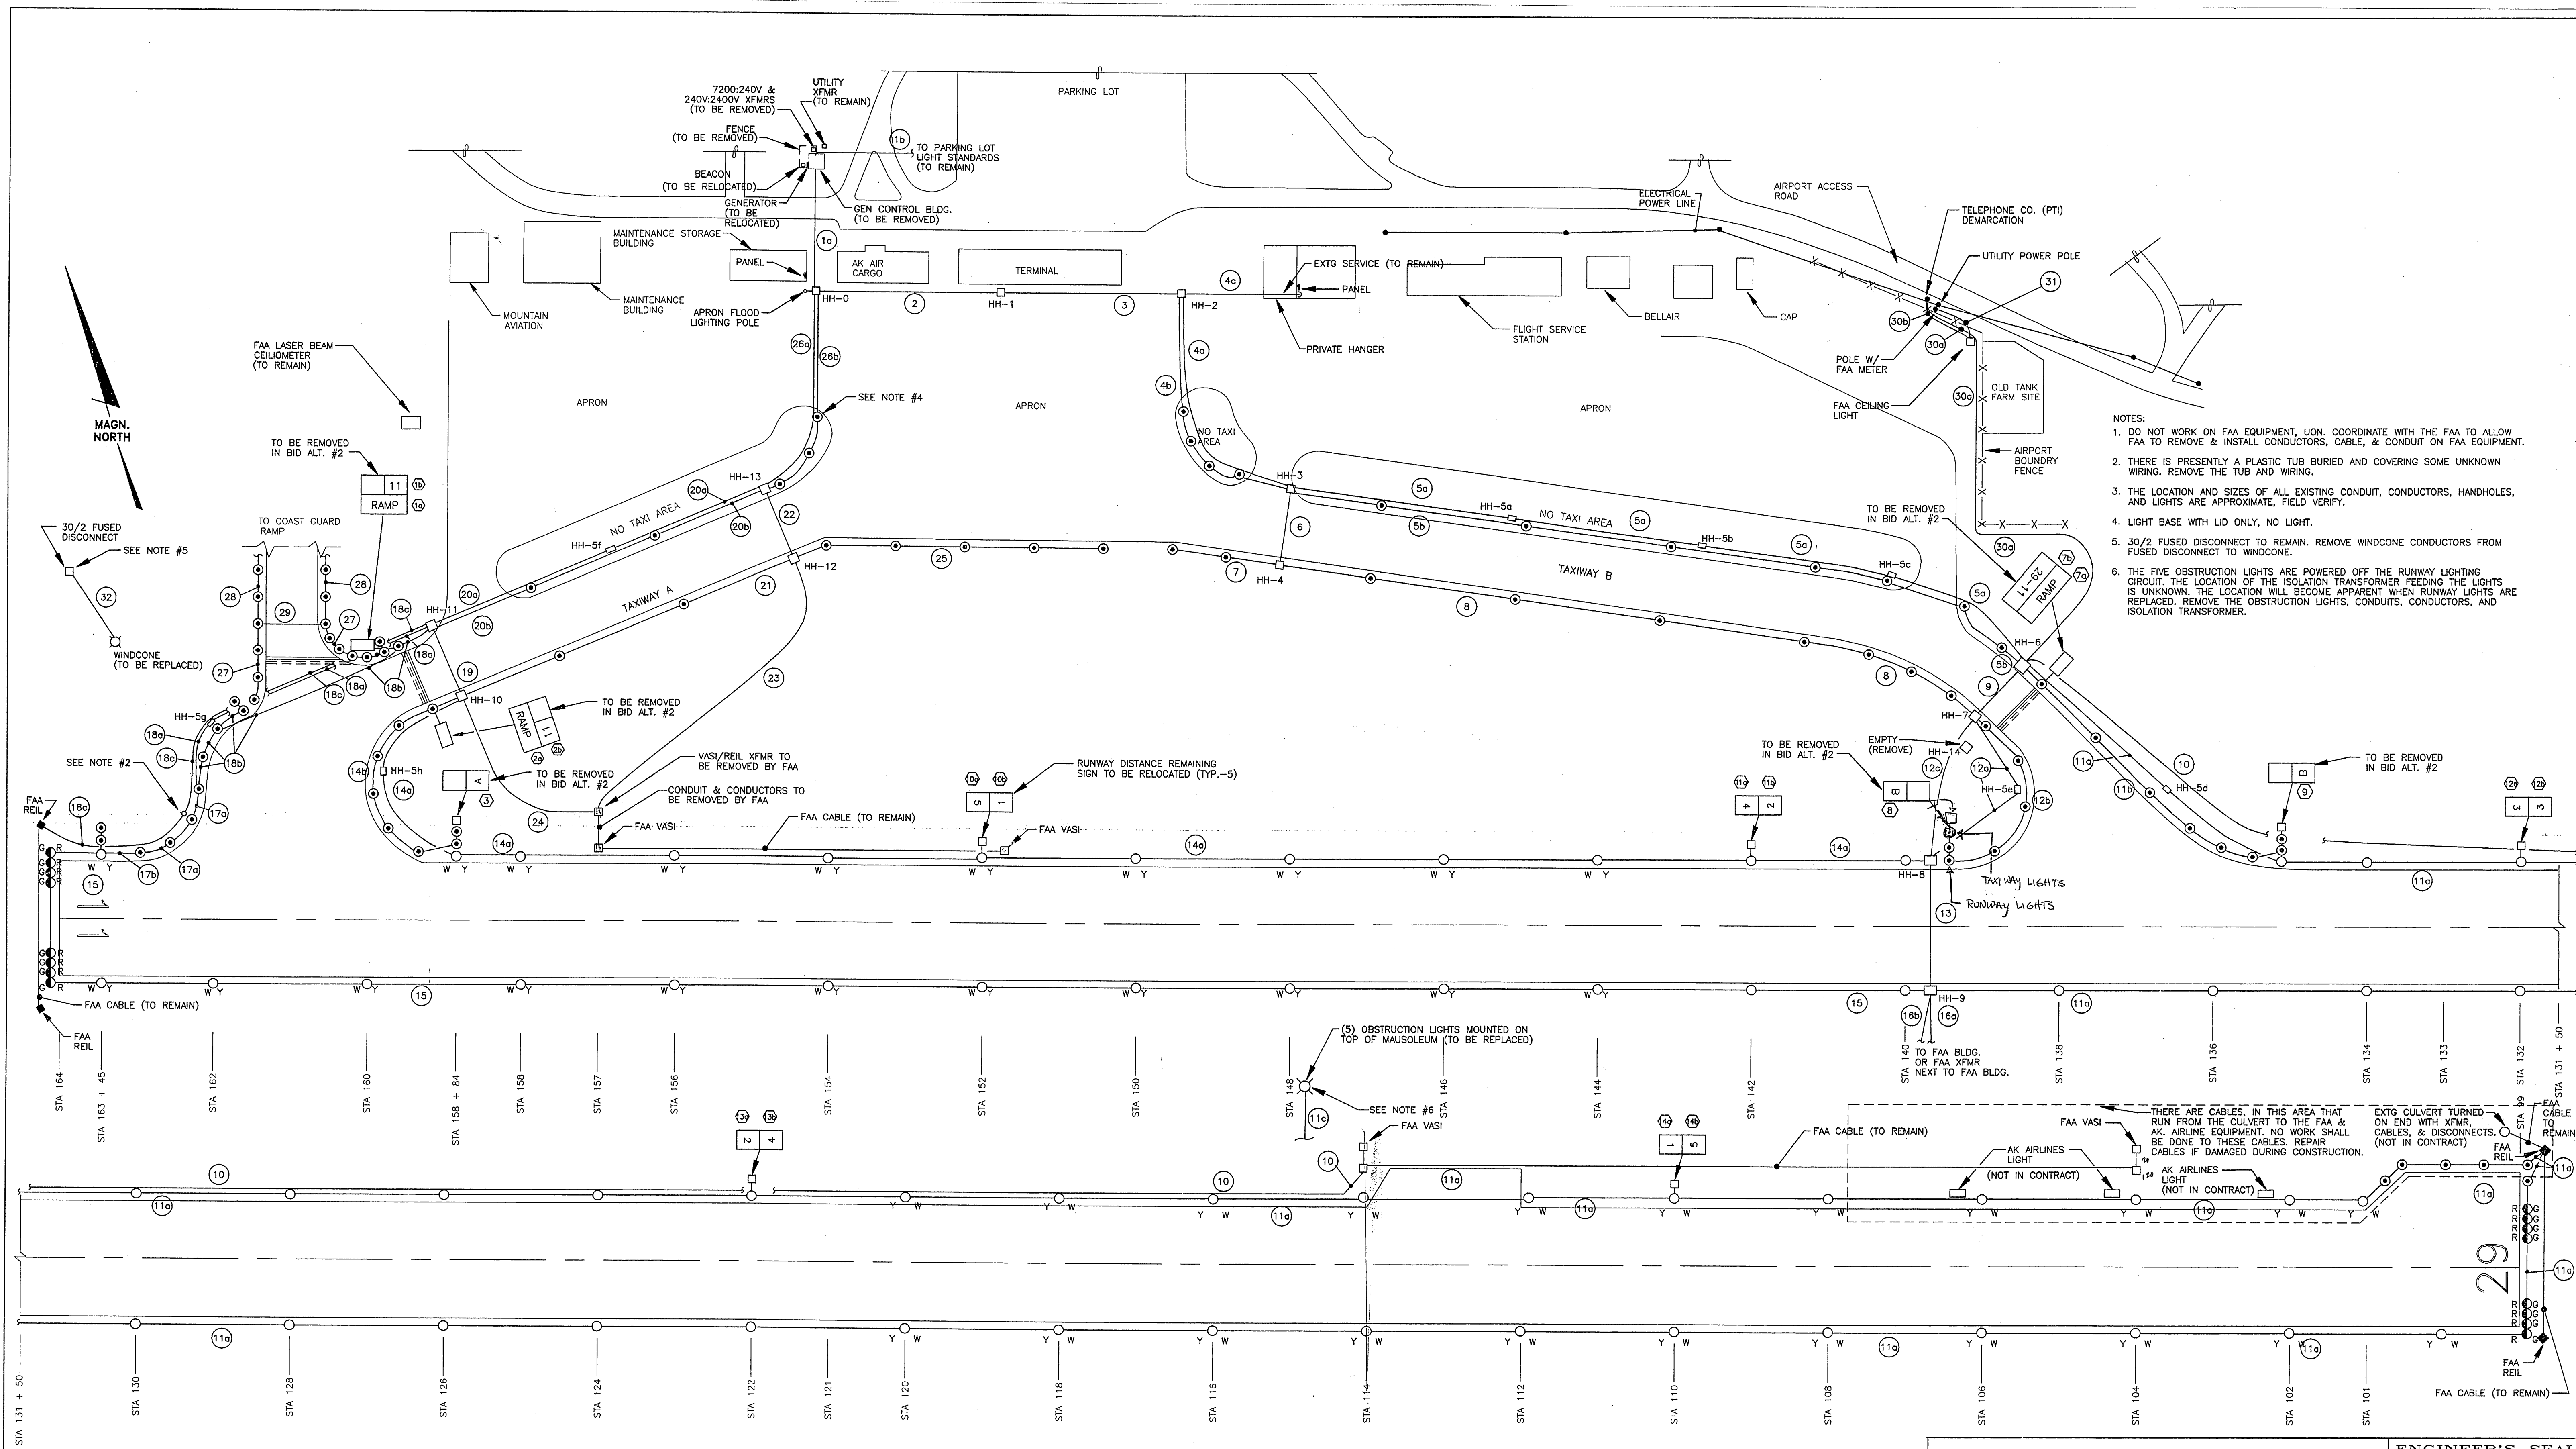

- NOTES:
1. DO NOT WORK ON FAA EQUIPMENT, UNLESS COORDINATE WITH THE FAA TO ALLOW FAA TO REMOVE & INSTALL CONDUCTORS, CABLE, & CONDUIT ON FAA EQUIPMENT.
 2. THERE IS PRESENTLY A PLASTIC TUB BURIED AND COVERING SOME UNKNOWN WIRING. REMOVE THE TUB AND WIRING.
 3. THE LOCATION AND SIZES OF ALL EXISTING CONDUIT, CONDUCTORS, HANDHOLES, AND LIGHTS ARE APPROXIMATE, FIELD VERIFY.
 4. LIGHT BASE WITH LID ONLY, NO LIGHT.
 5. 30/2 FUSED DISCONNECT TO REMAIN. REMOVE WINDCONE CONDUCTORS FROM FUSED DISCONNECT TO WINDCONE.
 6. THE FIVE OBSTRUCTION LIGHTS ARE POWERED OFF THE RUNWAY LIGHTING CIRCUIT. THE LOCATION OF THE ISOLATION TRANSFORMER FEEDING THE LIGHTS IS UNKNOWN. THE LOCATION WILL BECOME APPARENT WHEN RUNWAY LIGHTS ARE REPLACED. REMOVE THE OBSTRUCTION LIGHTS, CONDUITS, CONDUCTORS, AND ISOLATION TRANSFORMER.

EXISTING PARTIAL SITE PLAN


BY:	DATE:	DESCRIPTION OF CHANGE:

STATE OF ALASKA
DEPARTMENT OF TRANSPORTATION
AND PUBLIC FACILITIES
SOUTHEAST REGION DESIGN & CONSTRUCTION

SITKA AIRPORT ELECTRICAL AND LIGHTING IMPROVEMENTS
SITKA ALASKA
EXISTING PARTIAL SITE PLAN

HAIGHT & McLAUGHLIN, INC.
CONSULTING ENGINEERS
418 Harris Street, Juneau, Alaska 99801 (907) 586-9788

DESIGNED BY: MGM	DATE: MAY 1994	PROJECT No. 71457
DRAWN BY: JLC	E-2	
CHECKED BY: BCH	SHEET 4 OF 20	

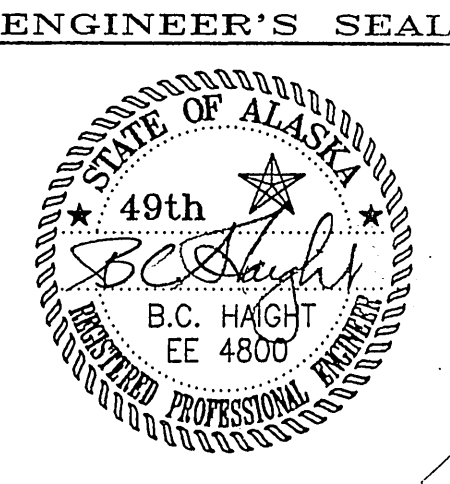

EXISTING SIGN SUMMARY											
SIGN NO.	LEGEND	LETTER SIZE & COLOR	BACKGROUND COLOR	LEGEND DIRECTION	STATION	R/W & OFFSET	REMARKS	TYPE	SIZE	NO. OF MODULES	
1a	RAMP	12" BLACK	YELLOW	S	C.G. TWY	20' FROM EXTG TWY SHOULDER	LOCATED PARALLEL TO TWY HOLDLINE	DESTINATION	1	2	
1b	11	12" WHITE	RED	N	C.G. TWY	20' FROM EXTG TWY SHOULDER	LOCATED PARALLEL TO TWY HOLDLINE	HOLDING POSITION	1	2	
2a	RAMP	12" BLACK	YELLOW	S.W.	TWY	20' FROM EXTG TWY SHOULDER	LOCATED PARALLEL TO TWY HOLDLINE	DESTINATION	1	2	
2b	11	12" WHITE	RED	N.E.	158 + 84	20' FROM EXTG TWY SHOULDER	LOCATED PARALLEL TO TWY HOLDLINE	HOLDING POSITION	1	2	
3	A	12" BLACK	YELLOW	E	TWY	95' RT		R/W EXIT	1	1	
7a	RAMP	12" BLACK	YELLOW	S.W.	TWY	20' FROM EXTG TWY SHOULDER	LOCATED PARALLEL TO TWY HOLDLINE	DESTINATION	1	2	
7b	11-29	12" WHITE	RED	N.E.	TWY	20' FROM EXTG TWY SHOULDER	LOCATED PARALLEL TO TWY HOLDLINE	HOLDING POSITION	1	2	
8	B	12" BLACK	YELLOW	W	139 + 40	95' RT		R/W EXIT	1	1	
9	B	12" BLACK	YELLOW	E	135 + 12	95' RT		R/W EXIT	1	1	
10a	5	25" WHITE	BLACK	W	152	99" RT		R/W DIST. REMAINING	5	1	
10b	1	25" WHITE	BLACK	E	152	99" RT		R/W DIST. REMAINING	5	1	
11a	4	25" WHITE	BLACK	W	142	99" RT		R/W DIST. REMAINING	5	1	
11b	2	25" WHITE	BLACK	E	142	99" RT		R/W DIST. REMAINING	5	1	
12a	3	25" WHITE	BLACK	W	132	99" RT		R/W DIST. REMAINING	5	1	
12b	3	25" WHITE	BLACK	E	132	99" RT		R/W DIST. REMAINING	5	1	
13a	2	25" WHITE	BLACK	W	122	99" RT		R/W DIST. REMAINING	5	1	
13b	4	25" WHITE	BLACK	E	122	99" RT		R/W DIST. REMAINING	5	1	
14a	1	25" WHITE	BLACK	W	110	99" RT		R/W DIST. REMAINING	5	1	
14b	5	25" WHITE	BLACK	E	110	99" RT		R/W DIST. REMAINING	5	1	

- NOTES:
- ALL EXISTING SIGNS ARE MADE BY ADB, ALNACO.
 - SIGN #'S 1-9 SHALL BE REMOVED IN BID ALTERNATE #2.
 - RELOCATE SIGN #'s 10-14 PER SHEETS E-4 & E-5.
 - WHEN REMOVING A SIGN, REMOVE CONDUIT & CABLES TO THE EXISTING LIGHT BASE WHICH FEEDS POWER TO THE SIGN, PLUG CONDUIT HUB IN REMAINING LIGHT BASE.

EXISTING CABLING SCHEDULE									
NOTE: THE LOCATION, AND SIZES OF CONDUIT & CONDUCTORS SHOWN IS APPROXIMATE, FIELD VERIFY.									
NO.	RACEWAY	CONDUCTOR	PURPOSE	INSTRUCTIONS	NO.	RACEWAY	CONDUCTOR	PURPOSE	INSTRUCTIONS
1a	(1) 3"	2 NO. 6, 5 KV 4 NO. 6, 5 KV 4 NO. 6, 5 KV 2 NO. 8, 5 KV 2 NO. 8, 5 KV	APRON FLOOD LIGHTS RWY LTS - A & B TWY LTS - A & B FAA POWER (2400V) FAA POWER (480V) SPARE	REMOVE CABLES AND REROUTE CONDUIT AS SHOWN ON SHEETS E4 & E5. REMOVE CABLES. REMOVE CABLES AND REROUTE CONDUIT AS SHOWN ON SHEETS E4 & E5. REMOVE CABLES. REMOVE CABLES. REROUTE CONDUITS AS SHOWN ON SHEETS E4 & E5. PLUG CONDUIT.	15	(1) 1-1/4"	1 NO. 6, 5 KV	RWY LTS - A	REMOVE CABLE. REMOVE CONDUIT FROM EACH LIGHT BASE BACK 2'. ABANDON REMAINDER OF CONDUIT IN PLACE.
1b	(1) 3/4"	2 NO. 8	PARKING LOT LIGHTING	REPLACE CONDUCTORS & REROUTE CONDUIT AS SHOWN ON SHEETS E4 & E5.	16a	(1) 1-1/2" (1) 1-1/2"	2 NO. 8, 5 KV 11 PR. TELE CABLE	FAA POWER (2400V) FAA CONTROL	REMOVE CABLES FROM HH-9 TO FAA XFMR. ABANDON CONDUIT IN PLACE. REMOVE LAST 75' ON N. END. REMOVE THE XFMR. REMOVE CABLE FROM HH-9 TO FAA BLPG. ABANDON CONDUIT IN PLACE. REMOVE LAST 75' ON N. END
2	(1) 3" (1) 3" (1) 2" (1) 2"	2 NO. 6, 5 KV 2 NO. 6, 5 KV 2 NO. 8, 5 KV 3 NO. 6	RWY LTS - B TWY LTS - B FAA POWER (2400V) EMPTY TENANT SERVICE	ABANDON CABLES AND CONDUIT IN PLACE. PLUG CONDUIT. ABANDON CABLES AND CONDUIT IN PLACE. PLUG CONDUIT. ABANDON CABLES. ABANDON CONDUIT IN PLACE. PLUG CONDUIT. TO REMAIN. PLUG CONDUIT.	16b	(1) 1-1/2"	25 PR. TELE CABLE	FAA CONTROL	CABLE AND CONDUIT ON GROUND. REMOVE CABLE AND CONDUIT.
3	(1) 3" (1) 3" (1) 2" (1) 2"	2 NO. 6, 5 KV 2 NO. 6, 5 KV 2 NO. 8, 5 KV 3 NO. 6	RWY LTS - B TWY LTS - B FAA POWER (2400V) EMPTY TENANT SERVICE	ABANDON CABLES AND CONDUIT IN PLACE. PLUG CONDUIT. ABANDON CABLES AND CONDUIT IN PLACE. PLUG CONDUIT. ABANDON CABLES. ABANDON CONDUIT IN PLACE. PLUG CONDUIT. TO REMAIN	17a	(1) 2"	1 NO. 6, 5 KV 2 NO. 6, 5 KV	RWY LTS - A TWY LTS - A	REMOVE CABLE. CABLE & CONDUIT TO REMAIN.
4a	(1) 1-1/2"	2 NO. 6, 5 KV	RWY LTS - B	REMOVE CABLES AND ABANDON CONDUIT IN PLACE. PLUG CONDUIT.	17b	(1) 2"C	1 NO. 6, 5 KV 2 NO. 6, 5 KV	RWY LTS - A TWY LTS - A	REMOVE W. END OF CONDUIT FROM RWY. LT. BASE . REROUTE AS SHOWN ON SHEETS E4 & E5. REMOVE CABLE.
4b	(1) 2"	2 NO. 6, 5 KV 2 NO. 8, 5 KV 3 NO. 6	TWY LTS - B FAA POWER (2400V) TENANT SERVICE	REMOVE CABLES AND ABANDON CONDUIT IN PLACE. PLUG CONDUIT. REMOVE CABLES. PLUG CONDUIT AT HH-2.	18a	(1) 1-1/4"	1 NO. 6, 5 KV	RWY LTS - A	REMOVE CABLE. REMOVE CONDUIT, BOTH SIDES, WITHIN 5' OF TAXIWAY CROSSING. RETAIN CONDUIT WHERE UNDER TAXIWAY. RECONNECT BOTH REMAINING ENDS AS SHOWN ON SHEETS E4 & E5.
5a	(1) 1-1/2"	2 NO. 6, 5 KV	RWY LTS - B	ABANDON CABLE AND CONDUIT. REMOVE CABLES BETWEEN HH-3 AND HH-5a. PLUG CONDUIT AT EVERY HAND HOLE. REMOVE S.E. END FROM HH-6 BACK 10'.	18b	(1) 1-1/2"	2 NO. 6, 5 KV	TWY LTS - A	REMOVE N.E. END FROM HH-11. REROUTE AS SHOWN ON SHEETS E4 & E5.
5b	(1) 1-1/4"	1 NO. 6, 5 KV	TWY LTS - B	REMOVE S.E. END FROM HH-6. REROUTE AS SHOWN ON SHEETS E4 & E5.	18c	(1) 1-1/2"	3 NO. 8, 600V	FAA POWER (480V)	REMOVE CABLE. REMOVE CONDUIT, BOTH SIDES, WITHIN 5' OF TAXIWAY CROSSING. RETAIN CONDUIT WHERE UNDER TAXIWAY. RECONNECT BOTH REMAINING ENDS AS SHOWN ON SHEETS E4 & E5.
6	(1) 3" (1) 3" (1) 3"	1 NO. 6, 5 KV 2 NO. 8, 5 KV FAA POWER (2400V)	TWY LTS - B EMPTY FAA POWER (2400V)	ABANDON CONDUIT IN PLACE. PLUG CONDUIT. ABANDON CABLES AND CONDUIT IN PLACE. PLUG CONDUIT.	19	(1) 3" (1) 3" (1) 3" (1) 3"	1 NO. 6, 5 KV 3 NO. 8, 600V 1 NO. 6, 5 KV	TWY LTS - A FAA POWER (480V) EMPTY RWY LTS - A	REMOVE CABLES. REUSE EXISTING CONDUIT AS SHOWN ON SHEETS E4 & E5. REMOVE CABLES. REUSE EXISTING CONDUIT AS SHOWN ON SHEETS E4 & E5. REUSE EXISTING CONDUIT AS SHOWN ON SHEETS E4 & E5. REMOVE CABLES. REUSE EXISTING CONDUIT AS SHOWN ON SHEETS E4 & E5.
7	(1) 1-1/2"	2 NO. 6, 5 KV	TWY LTS - B		20a	(1) 1-1/2"	2 NO. 6, 5 KV	RWY LTS - A	REMOVE CABLES. ABANDON CONDUIT IN PLACE. PLUG CONDUIT. REMOVE S.W. END FROM HH-11 BACK TO ASPHALT.
8	(1) 2"	1 NO. 6, 5 KV 2 NO. 8, 5 KV	TWY LTS - B FAA POWER (2400V)	REMOVE S.E. END FROM HH-7. REROUTE AS SHOWN ON SHEETS E4 & E5. REMOVE AS NECESSARY, ABANDON REMAINDER OF CABLES IN PLACE.	20b	(1) 1-1/4"	1 NO. 6, 5 KV	TWY LTS - A	REMOVE S.W. END FROM HH-11. REROUTE AS SHOWN ON SHEETS E4 & E5.
9	(1) 3" (1) 3" (1) 3" (1) 3"	25 PR. TELE CABLE 2/C NO. 8, 5 CABLE 1 NO. 6, 5 KV 1 NO. 6, 5 KV	FAA CONTROL FAA POWER (2400V) RWY LTS - B TWY LTS - B	REMOVE CABLE. REUSE EXTG CONDUIT AS SHOWN ON SHEETS E4 & E5. REMOVE CABLE. REUSE EXTG CONDUIT AS SHOWN ON SHEETS E4 & E5. REMOVE CABLE. REUSE EXTG CONDUIT AS SHOWN ON SHEETS E4 & E5. REMOVE CABLE. REUSE EXTG CONDUIT AS SHOWN ON SHEETS E4 & E5.	21	(1) 1-1/4"	1 NO. 6, 5 KV	TWY LTS - A	REMOVE S.W. END FROM HH-10. REROUTE AS SHOWN ON SHEETS E4 & E5.
10	----	2/C NO. 8, 5 CABLE	FAA POWER (2400V)	REMOVE DIRECT BURY CABLE.	22	(1) 3" (1) 3" (1) 3"	1 NO. 6, 5 KV 2 NO. 8, 5 KV	TWY LTS - A EMPTY FAA POWER (480V)	ABANDON CONDUIT IN PLACE. PLUG CONDUIT. ABANDON CABLES AND CONDUIT IN PLACE. PLUG CONDUIT.
11a	(1) 1-1/4"	1 NO. 6, 5 KV	RWY LTS - B	REMOVE CABLE. REMOVE CONDUIT FROM EACH LIGHT BASE BACK 2'. REMOVE CONDUIT BETWEEN HH-6 & HH-5d, AND BETWEEN HH-5d & THE FIRST RWY. LIGHT. ABANDON REMAINDER OF CONDUIT IN PLACE.	23	(1) 1-1/2"	2 NO. 8, 5 KV	FAA POWER (480V)	ABANDON CABLES AND CONDUIT IN PLACE. PLUG CONDUIT.
11b	(1) 1-1/2"	2 NO. 6, 5 KV	TWY LTS - B	REMOVE N.W. END FROM HH-6. REROUTE AS SHOWN ON SHEETS E4 & E5.	24	(1) 1-1/2"	3 NO. 8, 600V	FAA POWER (480V)	REMOVE CABLE AND CONDUIT.
11c	(1) 1-1/2"	2 NO. 10	OBSTRUCTION LIGHTS	REMOVE CONDUIT & CONDUCTORS.	25	(1) 1-1/2"	2 NO. 6, 5 KV	TWY LTS - A	
12a	(1) 1-1/4"	1 NO. 6, 5 KV	RWY LTS - B	REMOVE CABLE AND CONDUIT.	26a	(1) 1-1/2" (1) 1-1/2" (1) 1-1/2"	2 NO. 6, 5 KV 2 NO. 8, 5 KV	RWY LTS - A FAA POWER (480V) EMPTY	REMOVE CABLES. ABANDON CONDUIT IN PLACE. PLUG CONDUIT. REMOVE CABLES. ABANDON CONDUIT IN PLACE. PLUG CONDUIT. ABANDON CONDUIT IN PLACE. PLUG CONDUIT.
12b	(1) 2"	2 NO. 6, 5 KV	TWY LTS - B	REMOVE N.W. END FROM HH-7. REROUTE AS SHOWN ON SHEETS E4 & E5.	26b	(1) 1-1/2"	2 NO. 6, 5 KV	TWY LTS - B	REMOVE CABLES FROM HH-0 TO THE FIRST TWY. LIGHT. SPLICE THE CABLES TO THE TRANSFORMER AT THIS LIGHT FORMING A LOOP WITH THE CABLES. PLUG CONDUIT AT HH-0.
12c	(1) 1-1/2" (1) 2-1/2"	25 PR. TELE CABLE 2 NO. 8, 5 KV	FAA CONTROL FAA POWER (2400V)	REMOVE CABLE AND CONDUIT. REMOVE CABLE AND CONDUIT.	27	(1) 2"	2 NO. 6 OR 8, 5 KV	COAST GUARD TWY LTS	
13	(1) 3" (1) 3" (1) 3" (1) 3" (1) 3"	25 PR. TELE CABLE 1 NO. 6, 5 KV ----- 2 NO. 8, 5 KV 1 NO. 6, 5 KV	FAA CONTROLS RWY LTS - A EMPTY FAA POWER (2400V) RWY LTS - B	REMOVE CABLE. REUSE EXTG CONDUIT AS SHOWN ON SHEETS E4 & E5. REMOVE CABLE. REUSE EXTG CONDUIT AS SHOWN ON SHEETS E4 & E5. REUSE EXTG CONDUITS AS SHOWN ON SHEETS E4 & E5. REMOVE CABLES. REUSE EXTG CONDUIT AS SHOWN ON SHEETS E4 & E5. REMOVE CABLE. REUSE EXTG CONDUIT AS SHOWN ON SHEETS E4 & E5.	28	(1) 2"	1 NO. 6 OR 8, 5 KV	COAST GUARD TWY LTS	
14a	(1) 1-1/4"	1 NO. 6, 5 KV	RWY LTS - A	REMOVE CABLE. REMOVE CONDUIT FROM EACH LIGHT BASE BACK 2'. REMOVE CONDUIT BETWEEN HH-10 & HH-5h & BETWEEN HH-5h & THE FIRST RWY LIGHT. ABANDON REMAINDER OF CONDUIT IN PLACE.	29	(1) 2"	1 NO. 6 OR 8, 5 KV	COAST GUARD TWY LTS	
14b	(1) 1-1/2"	2 NO. 6, 5 KV	TWY LTS - A	REMOVE N. END FROM HH-10. REROUTE AS SHOWN ON SHEETS E4 & E5.	30a	(1) 1-1/2"	25 PR. TELE CABLE	FAA CONTROL	CONDUIT & CABLE ON GROUND. REMOVE CONDUIT AND CABLE FROM TELEPHONE DEMARCATION TO HH-6.
					30b	(1) 3/4"	TELE CABLE	CEILING LIGHT CONTROL	REMOVE AND REPLACE CONDUIT & CONDUCTORS AS SHOWN ON SHEETS E4 & E5.
					31	(1) 3/4"	3 NO. 10 & 1 NO. 12 GND	CEILING LIGHT POWER	REMOVE AND REPLACE CONDUIT & CONDUCTORS AS SHOWN ON SHEETS E4 & E5.
					32	NO CONDUIT	2 NO. 12 TYPE NM	WINDCONE	REMOVE CONDUCTORS FROM WINDCONE TO 30/2 FUSE DISCONNECT.

- NOTES:
- USE WATERTIGHT SEALING MATERIAL FOR PLUGGING CONDUITS. PLUG CONDUITS AT BOTH ENDS UNLESS OTHERWISE NOTED.
 - WHEN REMOVING CONDUIT FROM AN EXISTING LIGHT BASE TO REMAIN, PLUG CONDUIT HUB IN LIGHT BASE.
 - WHEN REMOVING CABLE AND CONDUIT TO FAA EQUIP. ALLOW FAA TO DISCONNECT CABLE AND CONDUIT PRIOR TO REMOVAL.


BY:	DATE:	DESCRIPTION OF CHANGE:
RECORD OF REVISIONS		


STATE OF ALASKA
DEPARTMENT OF TRANSPORTATION
AND PUBLIC FACILITIES
SOUTHEAST REGION DESIGN & CONSTRUCTION

SITKA AIRPORT ELECTRICAL AND LIGHTING IMPROVEMENTS
SITKA ALASKA
EXISTING CABLING SCHEDULE


HAIGHT & McLAUGHLIN, INC. CONSULTING ENGINEERS 418 Harris Street, Juneau, Alaska 99801 (907) 586-9788		
DESIGNED BY: MGM	DATE: MAY 1994	PROJECT No. 71457
DRAWN BY: JLC	E-3	
CHECKED BY: BCH	SHEET 5 OF 20	

ENGINEER'S SEAL

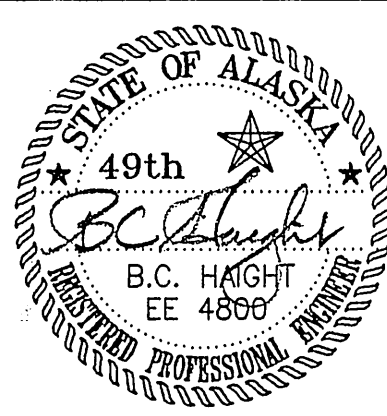

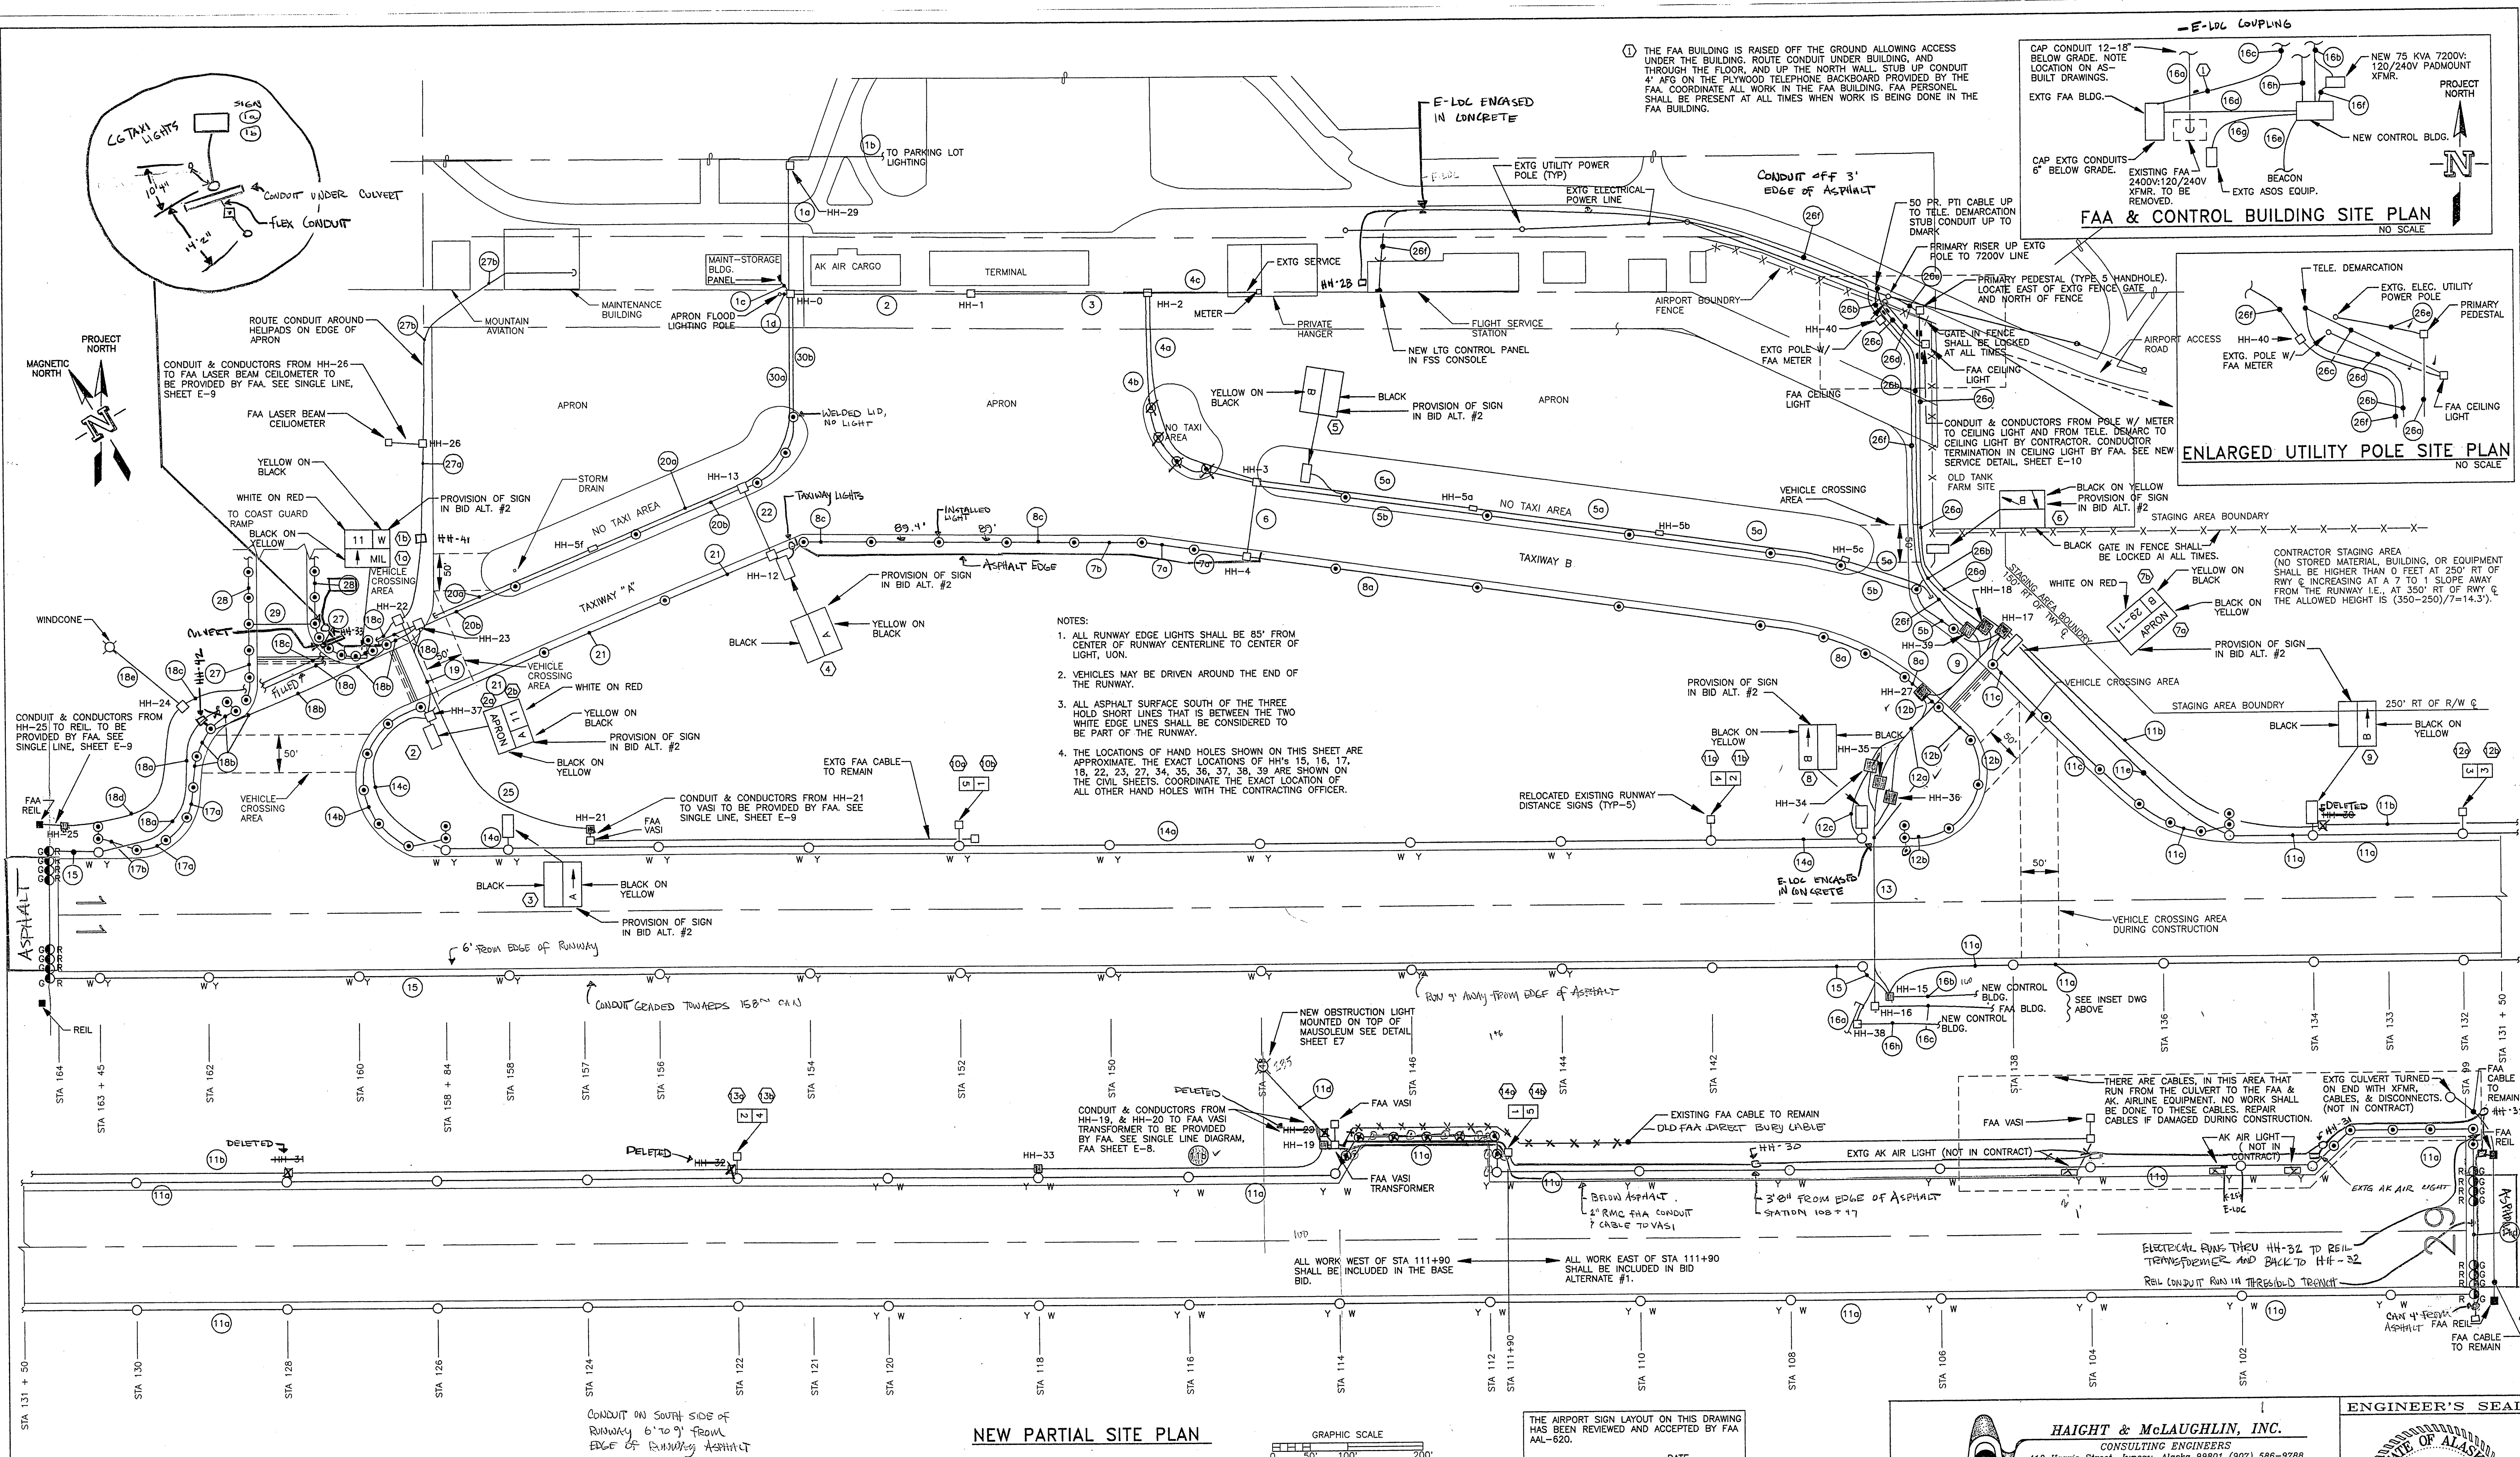

NEW PARTIAL SITE PLAN

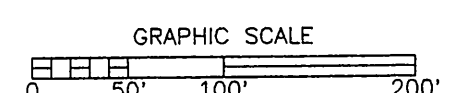

THE AIRPORT SIGN LAYOUT ON THIS DRAWING HAS BEEN REVIEWED AND ACCEPTED BY FAA AL-920. DATE _____

HAIGHT & McLAUGHLIN, INC.
CONSULTING ENGINEERS
418 Harris Street, Juneau, Alaska 99801 (907) 586-9788

DESIGNED BY: MGM	DATE: MAY 1994	PROJECT No. 71457
DRAWN BY: JLC	E-4	
CHECKED BY: BCH		
		SHEET 6 OF 20


BY:	DATE:	DESCRIPTION OF CHANGE:

STATE OF ALASKA
DEPARTMENT OF TRANSPORTATION
AND PUBLIC FACILITIES
SOUTHEAST REGION DESIGN & CONSTRUCTION

SITKA AIRPORT ELECTRICAL AND LIGHTING IMPROVEMENTS
SITKA ALASKA
NEW PARTIAL SITE PLAN

NEW CABLING SCHEDULE

(E) = EXISTING, (N) = NEW									
NO.	RACEWAY	CONDUCTOR	PURPOSE	INSTRUCTIONS	NO.	RACEWAY	CONDUCTOR	PURPOSE	INSTRUCTIONS
10	3" C (E)	2 NO. 4 & 1 NO. 10 GND, 600V(N)	PARKING LOT LIGHTS	REMOVED STUBBED UP PORTION OF CONDUIT ON N. END. EXTEND CONDUIT AT HORIZONTAL BURIAL DEPTH INTO NEW HAND HOLE #29 (REPEAT FOR ALL FOUR, 3 INCH CONDUITS).	14b	2" C (E)	2 NO. 6, 5KV (E)	TWY. LTS.	REROUTE N. END TO THE HH-37. PROVIDE NEW CABLE BETWEEN HH-37 AND THE FIRST TWY. LIGHT.
11	(3) 3" C (E)		SPARE		15	(2) 1 1/2" C (E)		ABANDONED	
12	3/4" C (E)	2 NO. 4 & 1 NO. 10 GND, 600V(N)	PARKING LOT LIGHTS	REPLACE CONDUCTORS TO FIRST LIGHT STANDARD (SEE SHEET E-9) & REROUTE END OF CONDUIT INTO HH-29 AS SHOWN.	16a	4" C (N)	1 NO. 2, 15KV (N) 2 NO. 6, 5KV (N) 2 NO. 6, 5KV (N) 1 NO. 2, 15KV (N)	UTIL. PRI. (7200V) TWY. LTS. RWY. LTS. EQUIP. POWER (2400V) SPARE	CONNECT S. END OF CONDUIT TO THE 75 KVA, 7200V/120/240V PADMOUNT XFMR. CONNECT S. END OF CONDUIT TO THE TWY. LIGHTING REGULATOR IN NEW CONTROL BLDG. CONNECT S. END OF CONDUIT TO THE RWY. LIGHTING REGULATOR IN NEW CONTROL BLDG. CONNECT S. END OF CONDUIT TO THE 10 KVA 240/240V XFMR. IN NEW CONTROL BLDG. STUB S. END OF CONDUIT UP ON THE INTERIOR SIDE OF SOUTH WALL ADJACENT TO TWY. LIGHTING REGULATOR. SEE FLOOR PLAN SHEET E-11.
13	2" C (N)	2 NO. 4, 2 NO. 10, & 1 NO. 10 GND, 600V(N)	PARKING LOT LIGHTS	CONNECT N.W. END TO EXTG. PANEL IN MAINT. STORAGE BLDG. CONNECT S.E. END TO HH-0. SLOPE CONDUIT DOWN AT 0.5% TO HH-0.	16b	4" C (N)	(1) 50 PR. TELE. CABLE (N)	FAA CONTROL	STUB S. END OF CONDUIT UP ON THE TELE. TERMINAL BOARD (TTB) IN THE FAA BLDG. STUB S. END OF CONDUIT UP ON THE TTB IN THE FAA BUILDING.
14	2" C (N)		APRON FLOOD LIGHTS	STUB N.W. END 2' BELOW EXTG. PANEL IN MAINT. STOR. BLDG. CONNECT S.E. END TO HH-0. PLUG CONDUIT.	16c	2" C (N)	(1) 6 PR. TELE. CABLE (N)	CONTROL BLDG. TELE.	STUB W. END UP ON THE TTB IN THE FAA BLDG. STUB THE E. END UP ON THE TTB IN THE NEW CONTROL BUILDING.
14a	1" C (E)	2 NO. 10, & 1 NO. 10 GND, 600V(N)	APRON FLOOD LIGHTS	PULL NEW CONDUCTORS, CONNECT TO EXTG CONDUCTORS IN POLE.	16d	2" C (N)	3 NO. 1/0, 600V (N)	FAA BLDG. POWER (240V)	CONNECT THE W. END OF CONDUIT TO THE 200 AMP FUSE DISCONNECT INSIDE THE FAA BUILDING. CONNECT THE E. END TO THE 100 AMP ATS. IN THE NEW CONTROL BUILDING.
2 & 3	3" C (E)	2 NO. 6, 5KV (E)	ABANDONED		16e	1" C (N)	3 NO. 10, 600V (N)	BEACON	STUB S. END OF CONDUIT UP INTO THE BEACON POLE. CONNECT N. END OF CONDUIT TO THE LIGHTING CONTROL PANEL.
4	3" C (E)	2 NO. 6, 5KV (E)	ABANDONED		16f	3" C (N)	2 NO. 500 MCM, & 1 NO. 1/0 NEUT., 600V (N)	NEW CONTROL BLDG. SERVICE POWER	CONNECT N. END OF CONDUIT TO PAD MOUNT TRANSFORMER. CONNECT S. END OF CONDUIT TO TERMINAL BUS ENCLOSURE ON THE SIDE OF THE NEW CONTROL BUILDING.
5	2" C (E)	3 NO. 6, 600V (E)	SPARE		16g	1" C (N)	2 NO. 10, 600V (N)	ASOS SERVICE	CONNECT S.W. END TO ASOS EQUIP. WIREWAY. PULL CONDUCTORS TO WIREWAY AND LEAVE FOR CONNECTION TO EXTG. DISCONNECT BY THE FAA. CONNECT N.E. END TO 30/2 C/B IN NEW CONTROL BLDG (SEE SHEET E-8).
5a	1 1/2" C (E)	2 NO. 6, 5KV (E)	ABANDONED		16h	2" C (N)	(2) 20 NO. 18, 600V (N)	LIGHTING CONTROL	CONNECT S. END OF CONDUIT TO THE LIGHTING CONTROL PANEL IN THE NEW CONTROL BLDG.
5b	1 1/4" C (E)	1 NO. 6, 5KV (E)	TWY. LTS.	REROUTE S.E. END OF CONDUIT TO HH-17. REPLACE CABLE WITH NEW FROM HH-17 TO FIRST TWY. LIGHT.	17a	2" C (E)	2 NO. 6, 5KV (E)	TWY. LTS.	REROUTE W. END OF CONDUIT TO TWY. LIGHT BASE ADJACENT RWY. LIGHT BASE. REMOVE EXTG. CONDUIT BETWEEN RWY LIGHT BASE AND ADJACENT TWY LIGHT BASE AS SHOWN.
5c	1 1/2" C (E)	1 NO. 6, 5KV (E)	TWY. LTS.	SPICE THE CABLE IN RUN #6 TO THE CABLE IN RUN #5b.	17b	2" C (E)	2 NO. 6, 5KV (N)	TWY. LTS.	THE EXISTING PORTION OF THIS CONDUIT LIES UNDER THE COAST GUARD TAXIWAY. CONNECT NEW 1 1/4" C TO THE N. END OF THE EXTG. CONDUIT AND ROUTE TO HH-23. CONNECT NEW CONDUIT TO THE S. END AND ROUTE TO THE RWY. LIGHT AS SHOWN ON SHEET E-4.
6	3" C (E)	1 NO. 6, 5KV (E)	TWY. LTS.		18	1 1/2" C (N&E)	1 NO. 6, 5KV (N)	RWY. LTS.	REROUTE N. END OF THIS CONDUIT TO HH-23. PROVIDE NEW CABLE FROM HH-23 TO FIRST TWY. LIGHT.
7	3" C (E)	2 NO. 8, 5KV (E)	ABANDONED		18a	1 1/2" C (N&E)	2 NO. 6, 5KV (E)	TWY. LTS.	THE EXTG. PORTION OF THIS CONDUIT RUN IS UNDER THE COAST GUARD TAXIWAY. EXTEND THE N. END TO HH-22. EXTEND THE S. END TO HH-24.
8	1 1/2" C (E)	2 NO. 6, 5KV (E)	TWY. LTS.	CONNECT CABLE AND ISOLATING TRANSFORMER IN WEST MOST TWY. LIGHT BASE TO ONE EACH OF THE TWO CABLES IN CONDUIT RUN #7b. REPLACE WEST MOST LIGHT BASE WITH A NEW BASE EQUIPPED WITH (2) 1 1/2" C HUBS.	18b	1 1/2" C (E)	2 NO. 6, 5KV (E)	EQUIP. POWER (240V)	EXTEND THE N. END OF CONDUIT TO HH-22. CONNECT THE S. END TO THE NEW 3" C IN RUN #25.
9	1 1/2" C (E)	2 NO. 6, 5KV (E)	TWY. LTS.	CONNECT W. END OF CONDUIT TO WEST MOST TWY. LIGHT BASE IN CONDUIT RUN 7a. CONNECT THE TWO CABLES TO ONE EACH OF THE CABLES AND ISOLATING TRANSFORMERS IN THESE TWO LIGHT BASES.	18c	1 1/2" C (N&E)	2 NO. 6, 1 NO. 10 GND., 600V (N)	EQUIP. POWER (240V)	EXTEND THE N. END OF CONDUIT TO HH-23. EXTEND THE S. END TO HH-37.
10a	2" C (E)	1 NO. 6, 5KV (E)	TWY. LTS.	REROUTE S.E. END OF CONDUIT TO HH-27. PROVIDE NEW CABLE BETWEEN THE LAST TWY. LIGHT & HH-27.	18d	2" C (N)	2 NO. 6, 1 NO. 10 GND., 600V (N)	EQUIP. POWER (240V)	EXTEND THE N. END OF CONDUIT TO HH-22. EXTEND THE S. END TO HH-37.
10b	1 1/2" C (E)	2 NO. 6, 5KV (E)	TWY. LTS.	REPLACE EAST MOST TWY. LIGHT BASE WITH A NEW BASE WITH (2) 1 1/2" C HUBS. CONNECT CABLE AND ISOLATING TRANSFORMER IN EAST MOST BASE TO ONE EACH OF THE NEW CABLES IN CONDUIT RUN #7b.	19	3" C (E)	2 NO. 6, 1 NO. 10 GND., 600V (N)	EQUIP. POWER (240V)	EXTEND THE N. END OF CONDUIT TO HH-22. EXTEND THE S. END 5' AND CAP UNDERGROUND.
11a	3" C (E)	1 NO. 2, 15KV (N)	UTILITY PRIMARY (7200V)		20	3" C (E)	1 NO. 6, 5KV (N)	SPARE	EXTEND THE N. END OF CONDUIT TO HH-22. EXTEND THE S. END 5' AND CAP UNDERGROUND.
11b	3" C (E)	1 NO. 2, 15KV (N)	EQUIP. POWER (2400V)		20a	1 1/2" C (E)	1 NO. 6, 5KV (E)	ABANDONED	EXTEND THE N. END OF CONDUIT TO HH-23. EXTEND THE S. END 5' AND CAP UNDERGROUND.
11c	3" C (E)	(2) 20 NO. 18, 600V (N)	LTG. CONTROLS		20b	1 1/4" C (E)	1 NO. 6, 5KV (E)	TWY. LTS.	REROUTE S. END INTO HH-37. PROVIDE NEW CABLE BETWEEN HH-37 AND FIRST TWY. LIGHT.
11d	3" C (E)	(1) 50 PR. TELE. CABLE (N)	FAA CONTROL		21	1 1/4" C (E)	1 NO. 6, 5KV (E)	TWY. LTS.	REROUTE S. END INTO HH-37. PROVIDE NEW CABLE BETWEEN HH-37 AND FIRST TWY. LIGHT.
11e	3" C (E)	1 NO. 6, 5KV (N)	RWY. LTS.		22	3" C (E)	1 NO. 6, 5KV (E)	TWY. LTS.	SPICE THE CABLE IN RUN #22 TO THE CABLE IN RUN #20b.
11f	3" C (E)	1 NO. 6, 5KV (N)	RWY. LTS.		23	3" C (E)	2 NO. 8, 5KV (E)	ABANDONED	
11g	2" C (N)	1 NO. 2, 15KV (N)	EQUIP. POWER (2400V)		24	3" C (E)	2 NO. 8, 5KV (E)	ABANDONED	
11h	2" C (N)	2 NO. 6, 5KV (E)	TWY. LTS.		25	3" C (N)	2 NO. 6, 1 NO. 10 GND., 600V (N)	EQUIP. POWER (240V)	CONNECT N.W. END OF CONDUIT TO THE EXTG. 3" C IN RUN #19. CONNECT THE S.E. END TO HH-21.
11i	2" C (N)	2 NO. 6, 5KV (E)	TWY. LTS.		26a	4" C (N)	1 NO. 2, 15KV (N)	UTIL. PRI. (7200V)	CONNECT N. END TO THE TELE. DEMARCATION.
11j	1" C (N)	2 NO. 10, 600V (N)	OBSTRUCTION LTS. (120V)		26b	4" C (N)	(1) 50 PR. TELE. CABLE (N)	FAA CONTROL	CONNECT N. END TO THE TELE. DEMARCATION.
11k	3" C (N)	1 NO. 2, 15KV (N)	UTIL. PRI. (7200V)		26c	4" C (N)	(1) 50 PR. TELE. CABLE (N)	CEILING LIGHT CONTROL	CONNECT W. END TO TELE. DEMARCATION. CONNECT E. END TO CEILING LIGHT AROUND EXTG. FOUNDATION.
11l	3" C (N)	1 NO. 2, 15KV (N)	EQUIP. POWER (2400V)		26d	3/4" C (N)	4 PR. TELE. CABLE (N) (PROVIDED BY CONTRACTOR)	CEILING LIGHT POWER	CONNECT W. END TO NEW METER. CONNECT E. END TO CEILING LIGHT AROUND EXTG. FOUNDATION.
11m	3" C (N)	(2) 20 NO. 18, 600V (N)	LTG. CONTROLS		26e	3/4" C (N)	2 NO. 10, 1 NO. 12 GND., 600V (N)	UTILITY PRIMARY (7200V)	ROUTE W. END UP POLE AND CONNECT CABLE TO PRIMARY LINE PER SITKA ELECTRIC DEPARTMENT'S REQUIREMENTS.
11n	3" C (N)	(1) 50 PR. TELE. CABLE (N)	FAA CONTROL		26f	2" C (N)	1 NO. 2, 15KV (N)	LIGHTING CONTROLS	ROUTE N.W. END UP THE SIDE OF THE FAA FSS BLDG. ROUTE THROUGH BUILDING TO NEW LIGHTING CONTROL PANEL IN THE EXTG. CONSOLE IN THE FSS. INSTALL HH-40 NEAR MIDPOINT OF RUN WHERE SHOWN.
12	3" C (N)	2 NO. 6, 5KV (N)	TWY. LTS.		27	2" C (E)	2 NO. 8, 5KV (E)	COAST GUARD TWY. LTS.	
12a	3" C (N)	2 NO. 6, 5KV (N)	RWY. LTS.		28	2" C (E)	1 NO. 8, 5KV (E)	COAST GUARD TWY. LTS.	
12b	2" C (E)	2 NO. 6, 5KV (E)	TWY. LTS.		29	1 1/2" C (E)	(3) 1 1/2" C (E)	ABANDONED	
12c	2" C (N)	1 NO. 6, 5KV (N)	RWY. LTS.		30	1 1/2" C (E)	2 NO. 6, 5KV (E)	TWY. LTS.	
13	3" C (E)	1 NO. 2, 15KV (N)	UTIL. PRI. (7200V)		31	1 1/2" C (E)	2 NO. 6, 5KV (E)	TWY. LTS.	
13a	3" C (E)	1 NO. 2, 15KV (N)	EQUIP. POWER (2400V)		32	3" C (E)	2 NO. 8, 5KV (E)	ABANDONED	
13b	3" C (E)	2 NO. 6, 5KV (N)	TWY. LTS.		33	3" C (E)	2 NO. 8, 5KV (E)	ABANDONED	
13c	3" C (E)	(2) 20 NO. 18, 600V (N)	LTG. CONTROL		34	3" C (E)	2 NO. 8, 5KV (E)	ABANDONED	
13d	3" C (E)	(1) 50 PR. TELE. CABLE (N)	FAA CONTROL		35	3" C (E)	2 NO. 8, 5KV (E)	ABANDONED	
13e	3" C (E)	2 NO. 6, 5KV (N)	TWY. LTS.		36	3" C (E)	2 NO. 8, 5KV (E)	ABANDONED	
13f	3" C (E)	2 NO. 6, 5KV (N)	RWY. LTS.		37	3" C (E)	2 NO. 8, 5KV (E)	ABANDONED	
13g	3" C (E)	2 NO. 6, 5KV (N)	RWY. LTS.		38	3" C (E)	2 NO. 8, 5KV (E)	ABANDONED	
13h	3" C (E)	2 NO. 6, 5KV (N)	RWY. LTS.		39	3" C (E)	2 NO. 8, 5KV (E)	ABANDONED	
13i	3" C (E)	2 NO. 6, 5KV (N)	RWY. LTS.		40	3" C (E)	2 NO. 8, 5KV (E)	ABANDONED	
13j	3" C (E)	2 NO. 6, 5KV (N)	RWY. LTS.		41	3" C (E)	2 NO. 8, 5KV (E)	ABANDONED	
13k	3" C (E)	2 NO. 6, 5KV (N)	RWY. LTS.		42	3" C (E)	2 NO. 8, 5KV (E)	ABANDONED	
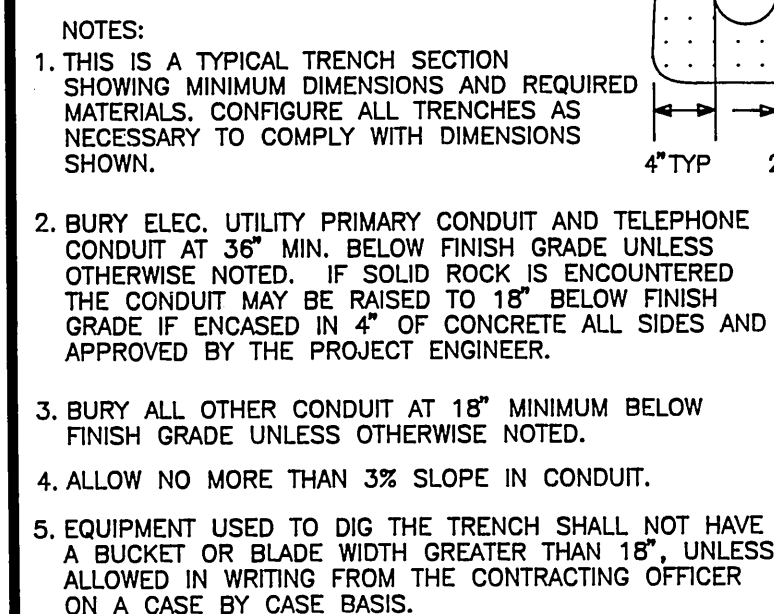


NO SCALE







- NOTES:
1. REMOVE THE EXISTING LIGHT BASES AND THE EXISTING CABLES.
 2. WHERE THE EXISTING CONDUIT IS LESS THAN 2' FROM EDGE OF PAVEMENT, CUT THE CONDUIT BACK 2' FROM THE NEW LIGHT BASE LOCATION AND ABANDON THE REMAINDER OF THE CONDUIT IN PLACE, UNLESS OTHERWISE NOTED.
 3. REMOVE THE EXISTING CONDUIT WHERE IT IS LOCATED 2' OR MORE FROM THE EDGE OF THE PAVEMENT.
 4. INSTALL THE NEW RUNWAY LIGHT BASES 85' FROM THE CENTER LINE OF THE RUNWAY TO THE CENTER OF THE LIGHT LENS WHEN INSTALLED ON THE BASE. INSTALL THE NEW RUNWAY LIGHT BASES 10' FROM THE OUTSIDE EDGE OF THE EDGE LINE TO THE CENTER OF THE LIGHT LENS WHEN INSTALLED ON THE BASE.
 5. INSTALL THE NEW CONDUIT THE FOLLOWING DISTANCE FROM THE EDGE OF THE PAVEMENT TO THE CENTER OF THE CONDUIT:

<u>DISTANCE, UNON</u>	<u>PAVEMENT SURFACE</u>
4'	RUNWAY
 6. BACKFILL BY HAND WHERE MATERIAL SLUFFS OUT FROM UNDER THE RUNWAY OR TAXIWAY COMPACT TO THE SATISFACTION OF THE CONTRACTING OFFICER.

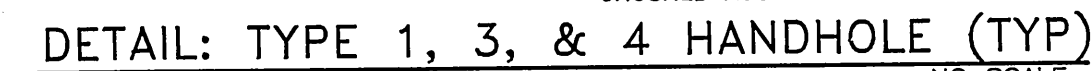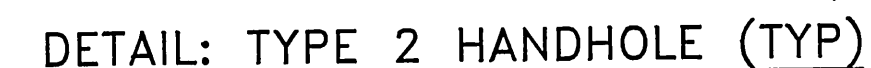


- NOTE:
1. TYPE 1 HANDHOLE SHALL BE 48" WIDE X 48" LONG X 48" DEEP OUTSIDE DIMENSIONS. UTILVAULT 444--LA OR APPROVED EQUAL.
 2. TYPE 3 AND 4 HANDHOLES SHALL BE 48" WIDE X 48" LONG X 36" DEEP OUTSIDE DIMENSIONS. UTILVAULT 443--LA OR APPROVED EQUAL.
 3. THE COVERS FOR HAND HOLES CONTAINING POWER CABLES SHALL BE LABELED "ELECTRICAL". THE COVERS FOR HAND HOLES CONTAINING TELEPHONE CABLES SHALL BE LABELED "TELEPHONE".

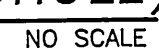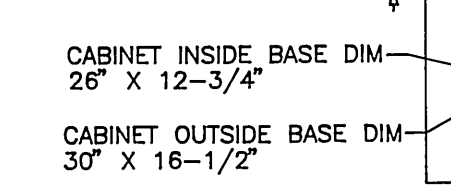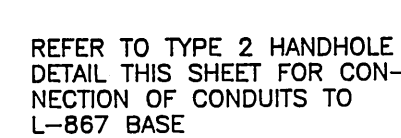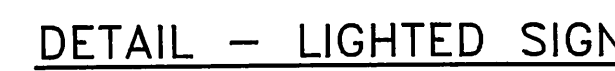

STATE OF ALASKA
DEPARTMENT OF TRANSPORTATION
AND PUBLIC FACILITIES
SOUTHEAST REGION DESIGN & CONSTRUCTION

SITKA AIRPORT ELECTRICAL AND LIGHTING IMPROVEMENTS
SITKA ALASKA
HANDHOLES, LIGHTS & SIGNS DETAILS




DESIGNED BY:	MGM	DATE:	MAY, 1994	PROJECT No.	71457
DRAWN BY:	JLC			E-6	SHEET 8 of 20
CHECKED BY:	BCH				

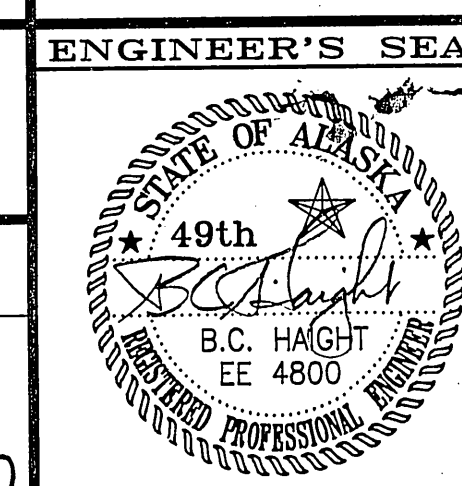

erial lighting assembly consists of a group of 1-watt PAR floodlights mounted at 90° intervals on a common support structure. The assembly is mounted on any part of the upper surface of the extended wind cone. The internally lighted wind cone consists of two 150W PAR floodlights which are mounted inside the wind cone. A 69W/120VAC is supplied with the lighted wind cone.


Mode of Operation

Operation of the wind cone is entirely dependent on the direction and relative velocity of the surface movement of the wind through the open throat of the wind cone. The internally lighted wind cone is designed to illuminate the tail of the wind cone and into the sock causes the tail to inflate and the wind direction. The tail of the inflated sock shows true wind direction and wind velocities as low as knots through a full 360° circle.

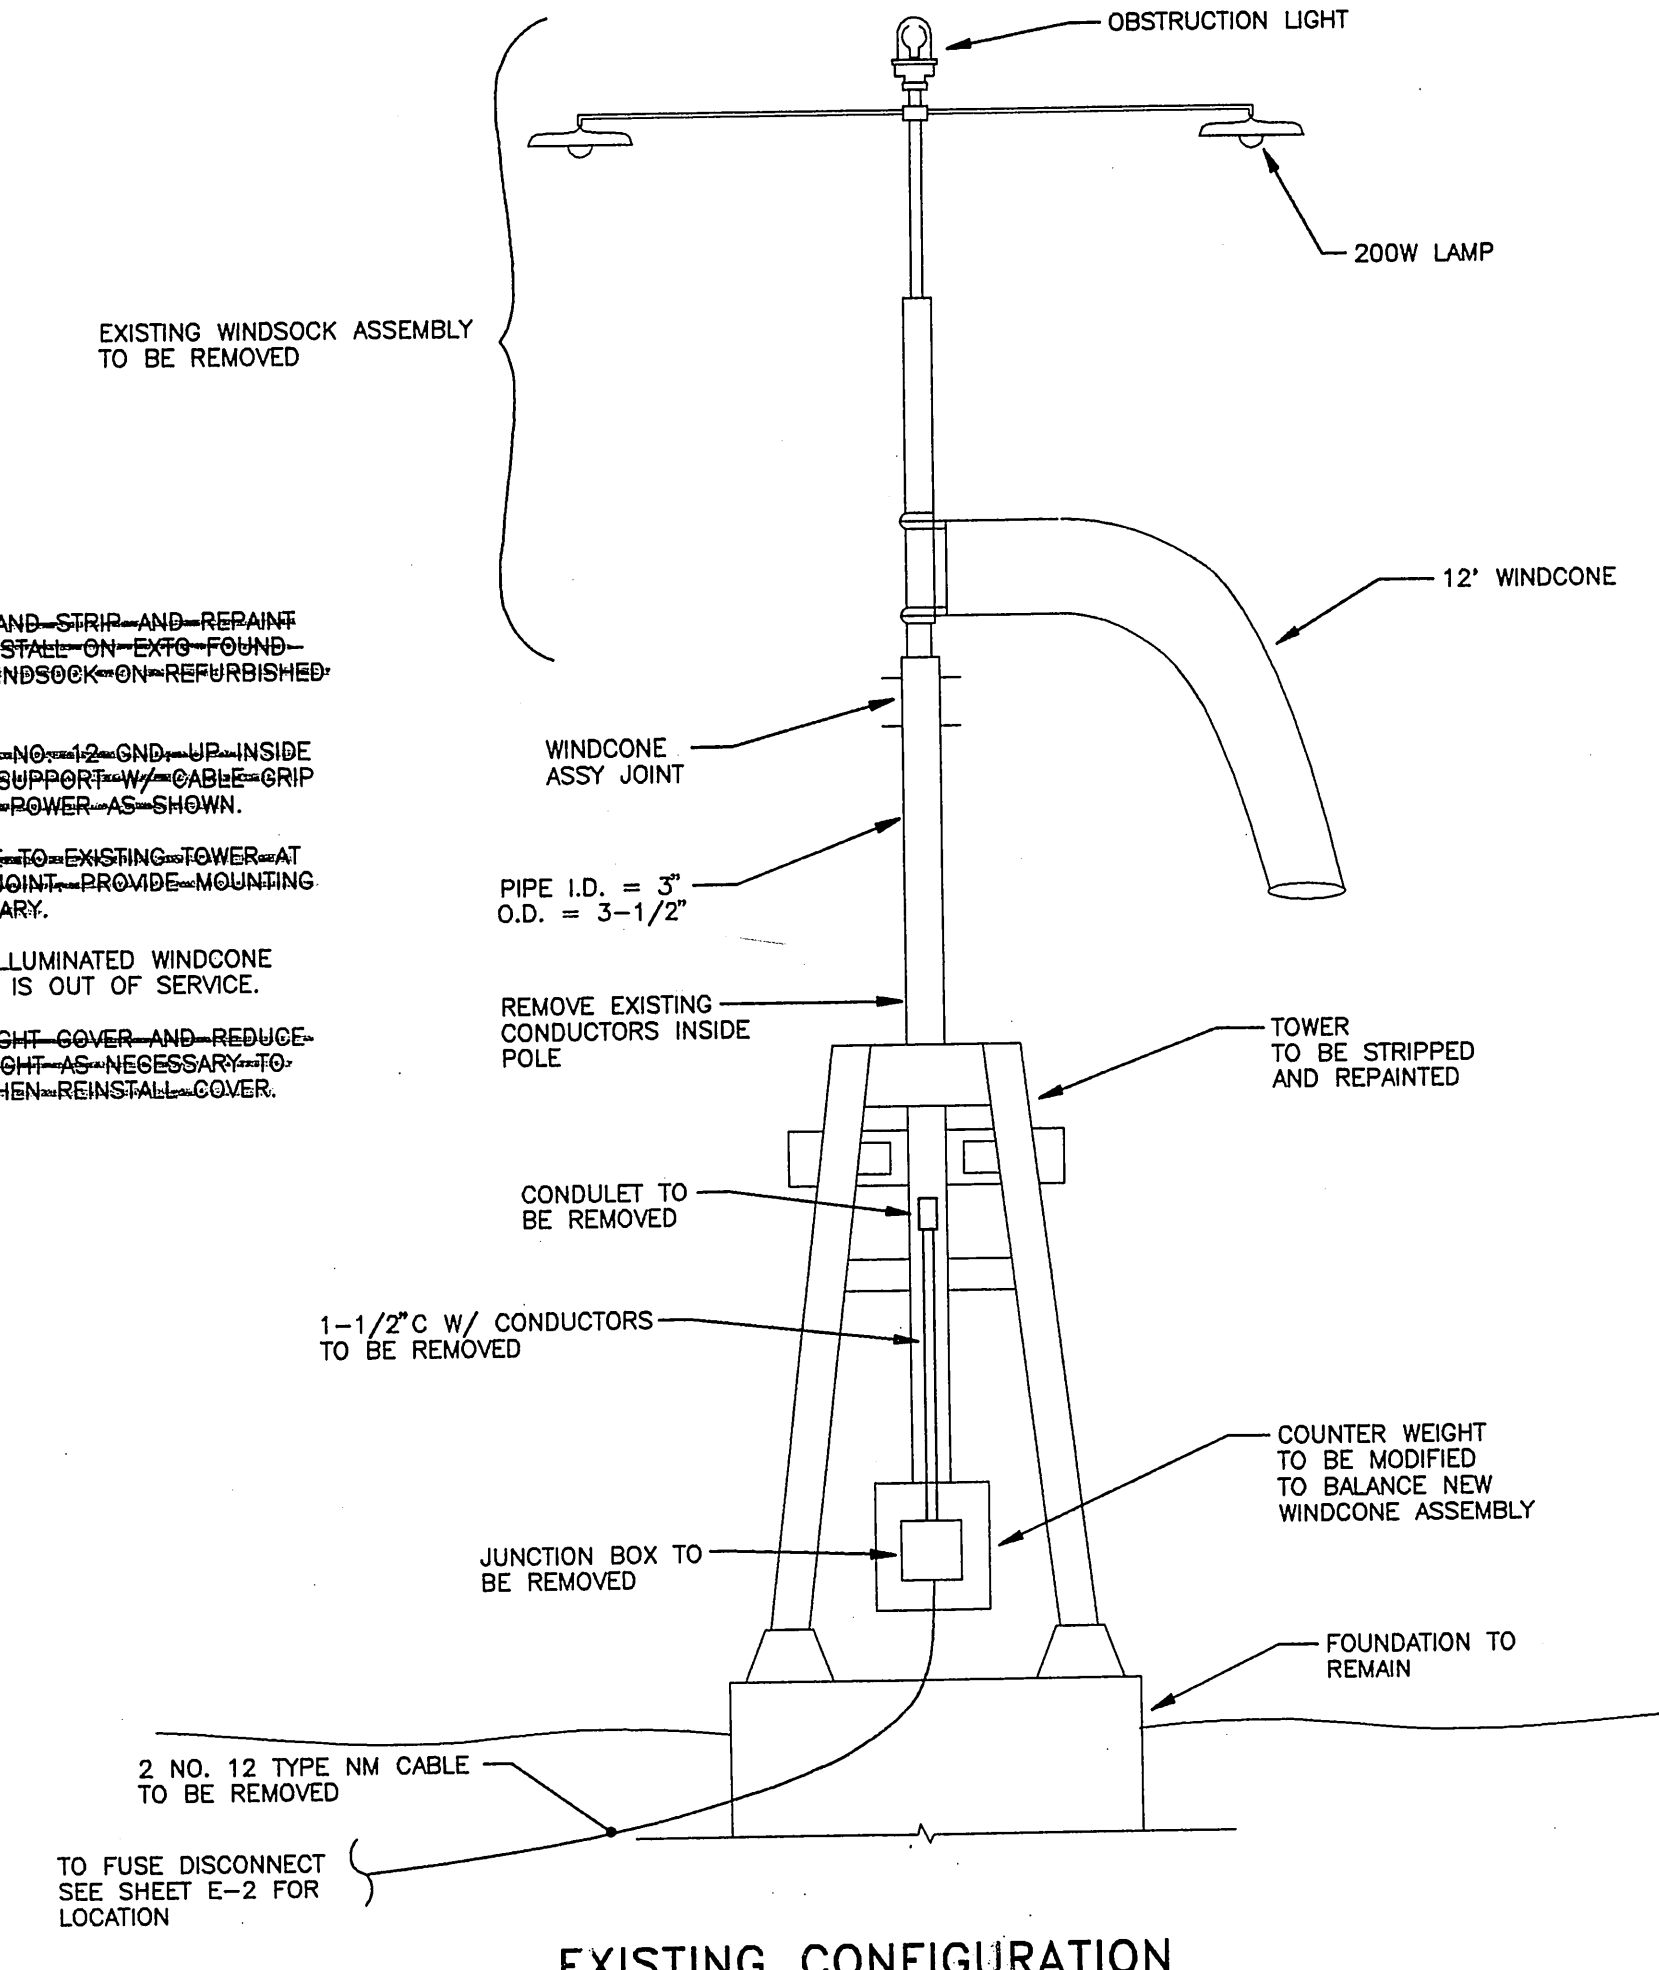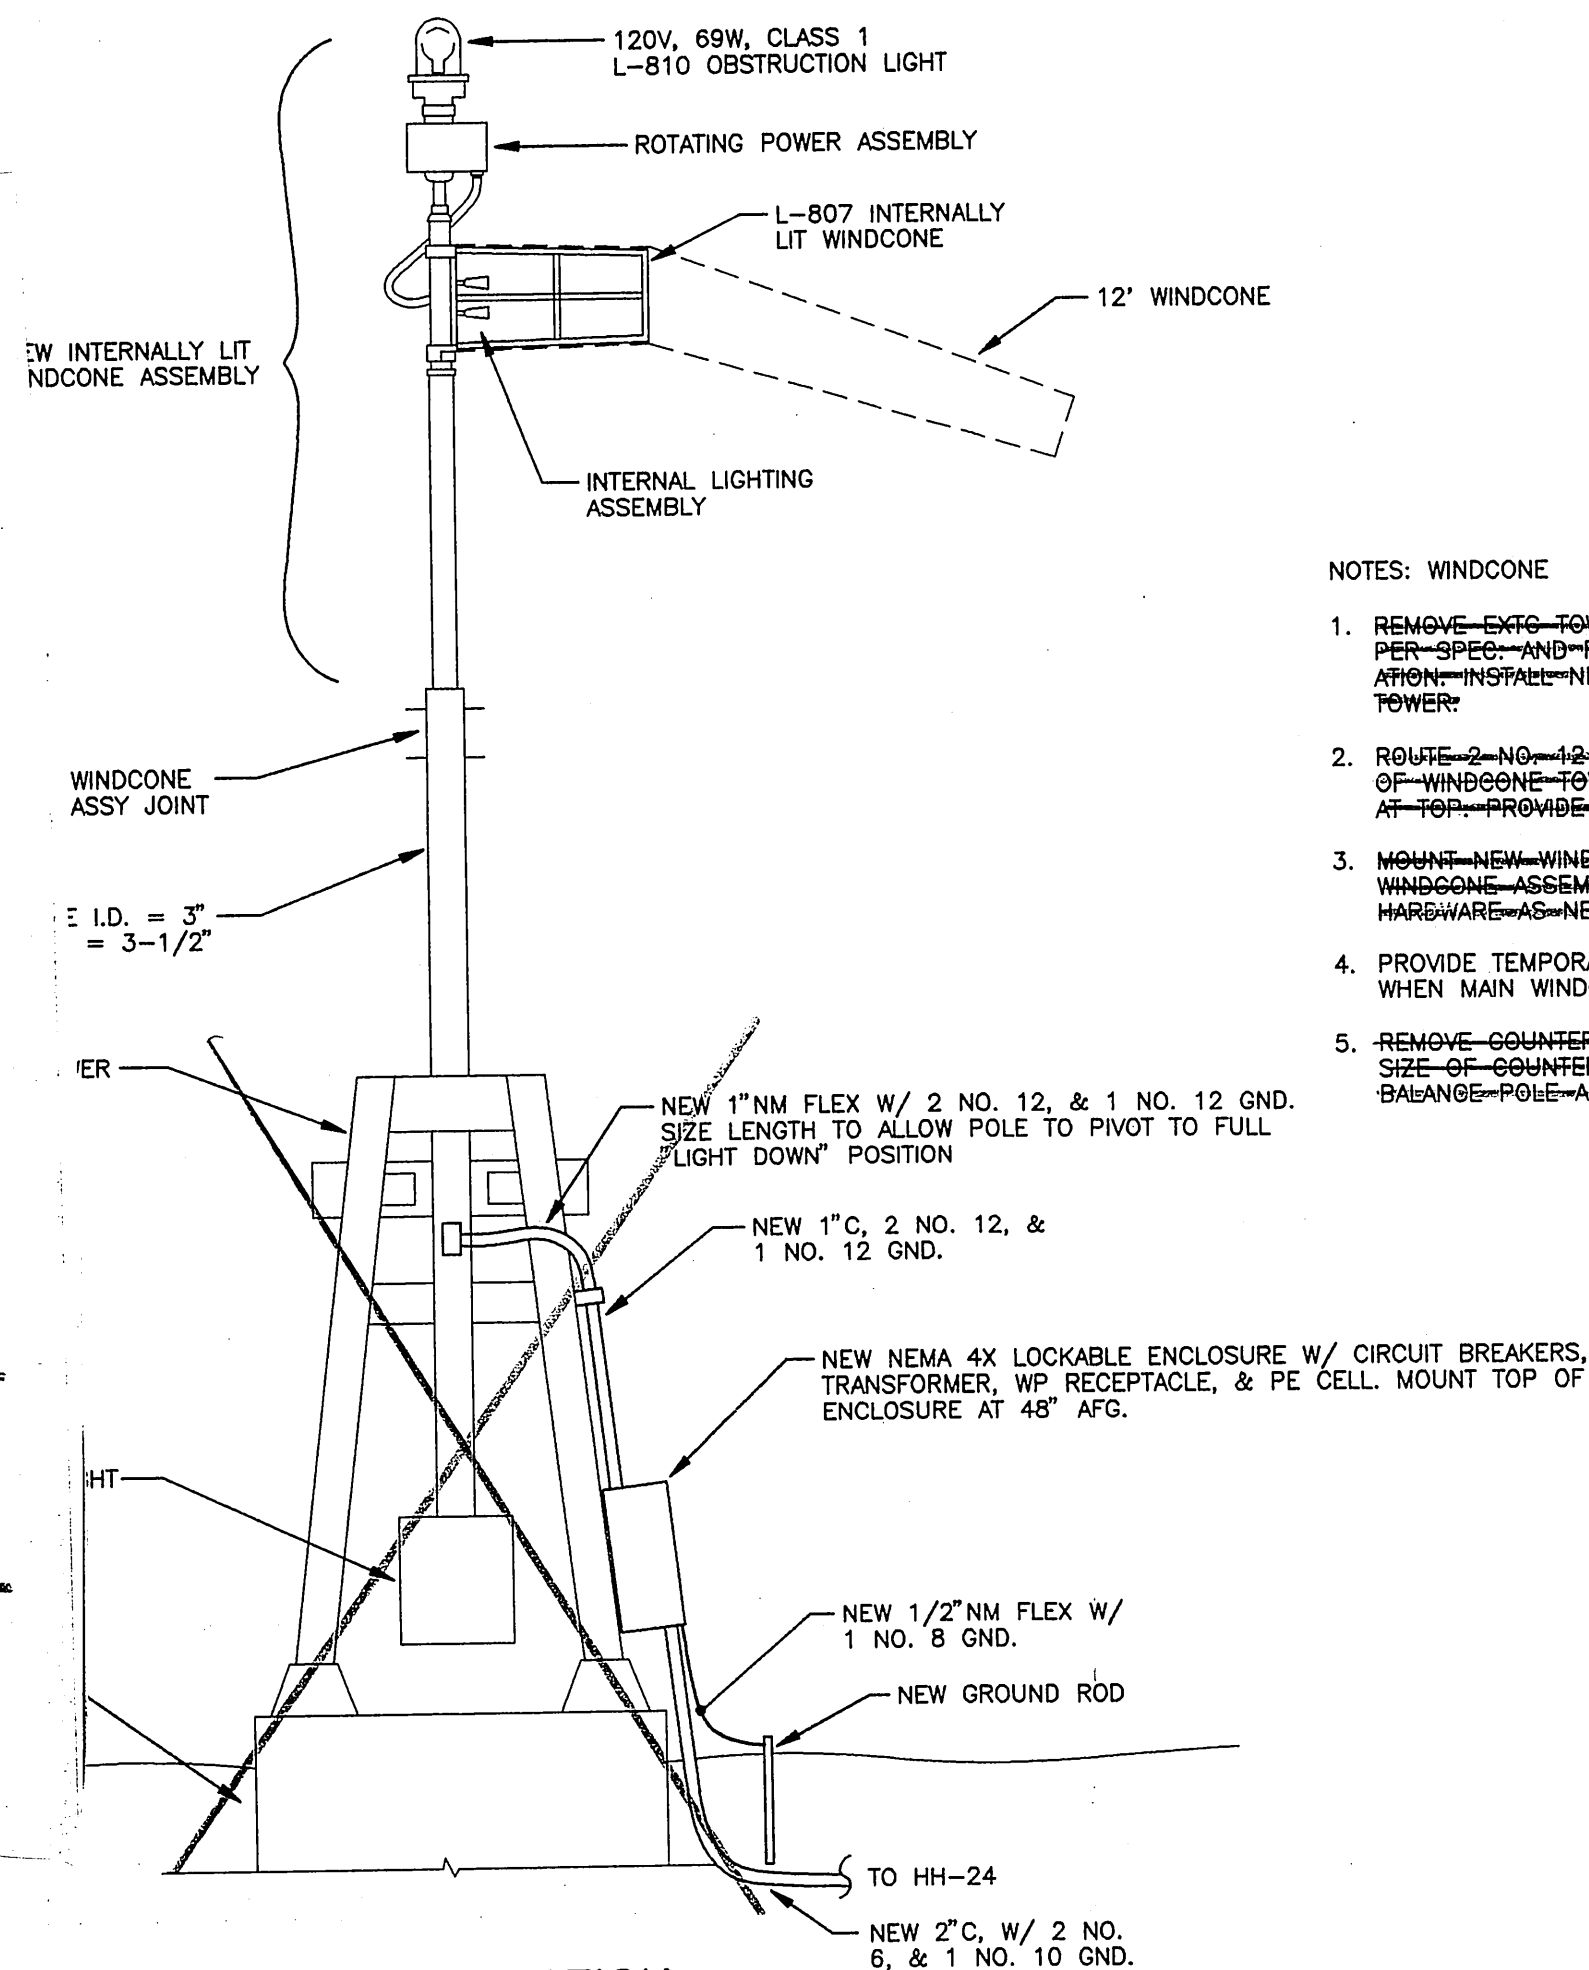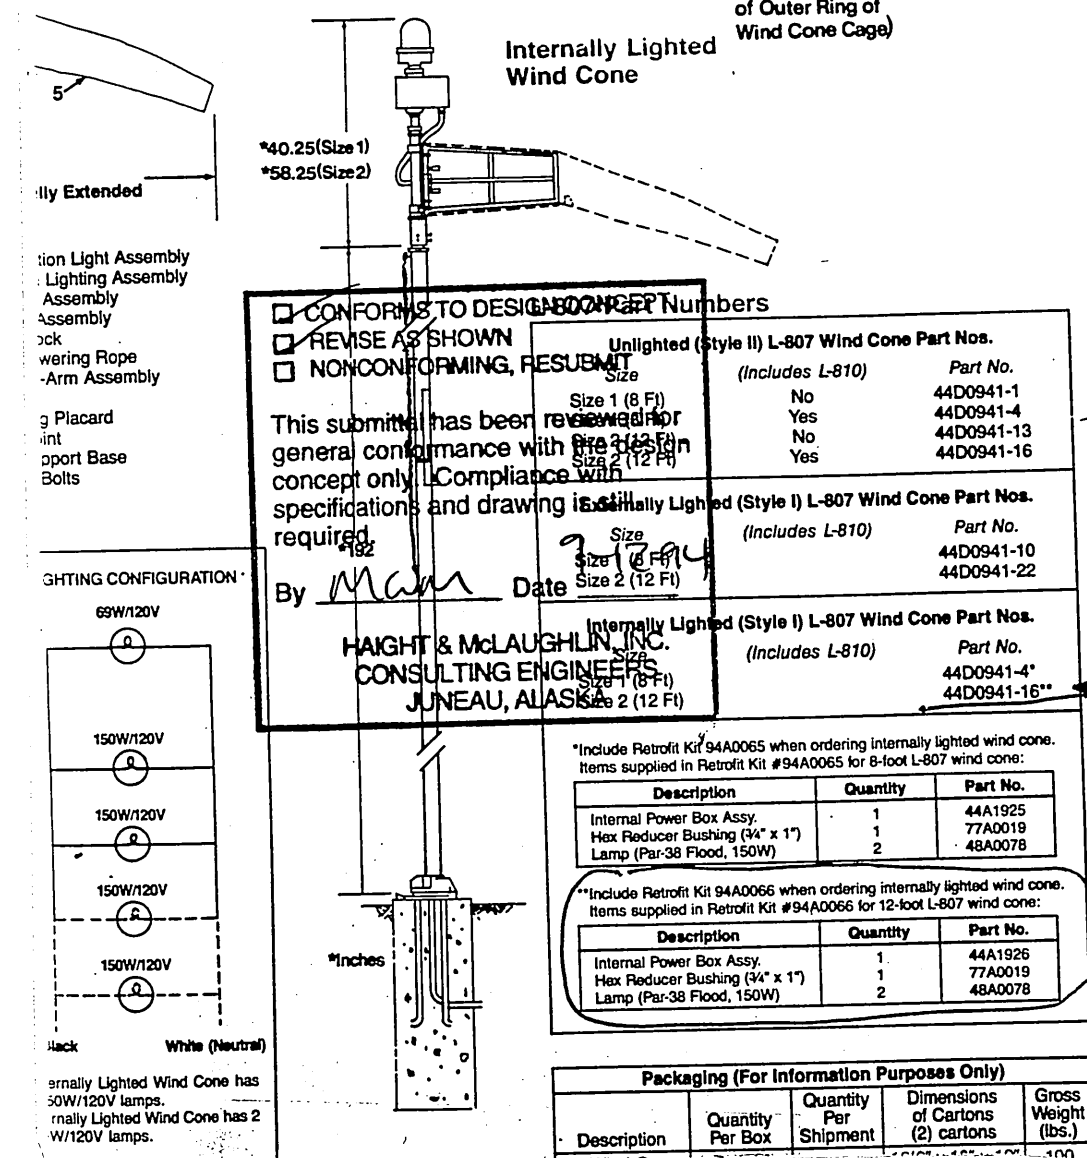


NOTES: BEACON

1. REMOVE AND REPLACE BEACON WITH A RECONDITIONED DCB-36 BEACON WITH A STATIONARY LAMP AND BELT DRIVE (REFER TO SPECIFICATIONS). REPLACE ALL MOUNTING HARDWARE.
2. REMOVE BEACON POLE, STRIP AND REPAINT, AND REMOUNT ON NEW FOUNDATION (SEE STRUCTURAL) WHERE SHOWN ON CIVIL DRAWINGS.
3. REMOVE EXISTING POWER PANEL INCLUDING MOUNTING TABS, CONDUIT, & WIRING. GRIND ANY REMAINING MOUNTING HARDWARE FLUSH WITH RAIL.
4. REMOVE LIGHT SHIELD AND ALL MOUNTING HARDWARE.
5. REMOVE AND REPLACE BOTH OBSTRUCTION LIGHTS ALONG WITH THE SUPPORTING CONDUIT, AND WIRING. USE GRS CONDUIT AND LIQUID TIGHT NON-METALLIC FLEX CONDUIT.
6. REPLACE THE WIRING INSIDE THE POLE WITH 4 NO. 10. SUPPORT THE CONDUCTORS WITH CABLE GRIPS AT EACH ACCESS PLATE ON THE POLE. ROUTE THE CONDUCTORS IN GRS, & NM LIQUID TIGHT FLEX FROM THE TOWER TO THE BEACON BASE.
7. STUB THE CONDUIT FROM THE GENERATOR BUILDING THROUGH THE FOUNDATION UP INTO THE POLE. ROUTE THE 3 NO. 10 CONDUCTORS INTO THE DISCONNECT ENCLOSURE. TERMINATE THE UNGROUNDED CONDUCTORS TO THE DISCONNECTS.
8. INSTALL TWO NEW GROUND RODS. CONNECT ONE TO A NO. 10 CONDUCTOR, AND ROUTE TO THE DISCONNECT ENCLOSURE. REPLACE THE EXISTING LIGHTING CABLE MOUNTED ON THE OUTSIDE OF THE POLE WITH A NEW NO. 1/0 INSULATED COPPER CONDUCTOR. CONNECT THIS CONDUCTOR TO THE OTHER NEW GROUND ROD. REMOVE THE EXISTING LIGHTNING RODS, CLEAN ALL CORROSION AND OXIDATION OFF THE RODS AND REMOUNT THE RODS. CONNECT THE RODS TO THE NEW LIGHTNING CABLE.
9. ROUTE 4 NO. 10 FROM THE DISCONNECT ENCLOSURE TO THE BEACON. TERMINATE 2 NO. 10 TO THE DISCONNECTS. SPLICE 1 NO. 10 TO THE NO. 10 NEUTRAL FROM THE CONTROL BUILDING. SPLICE 1 NO. 10 TO THE NO. 10 FROM THE GROUND ROD.

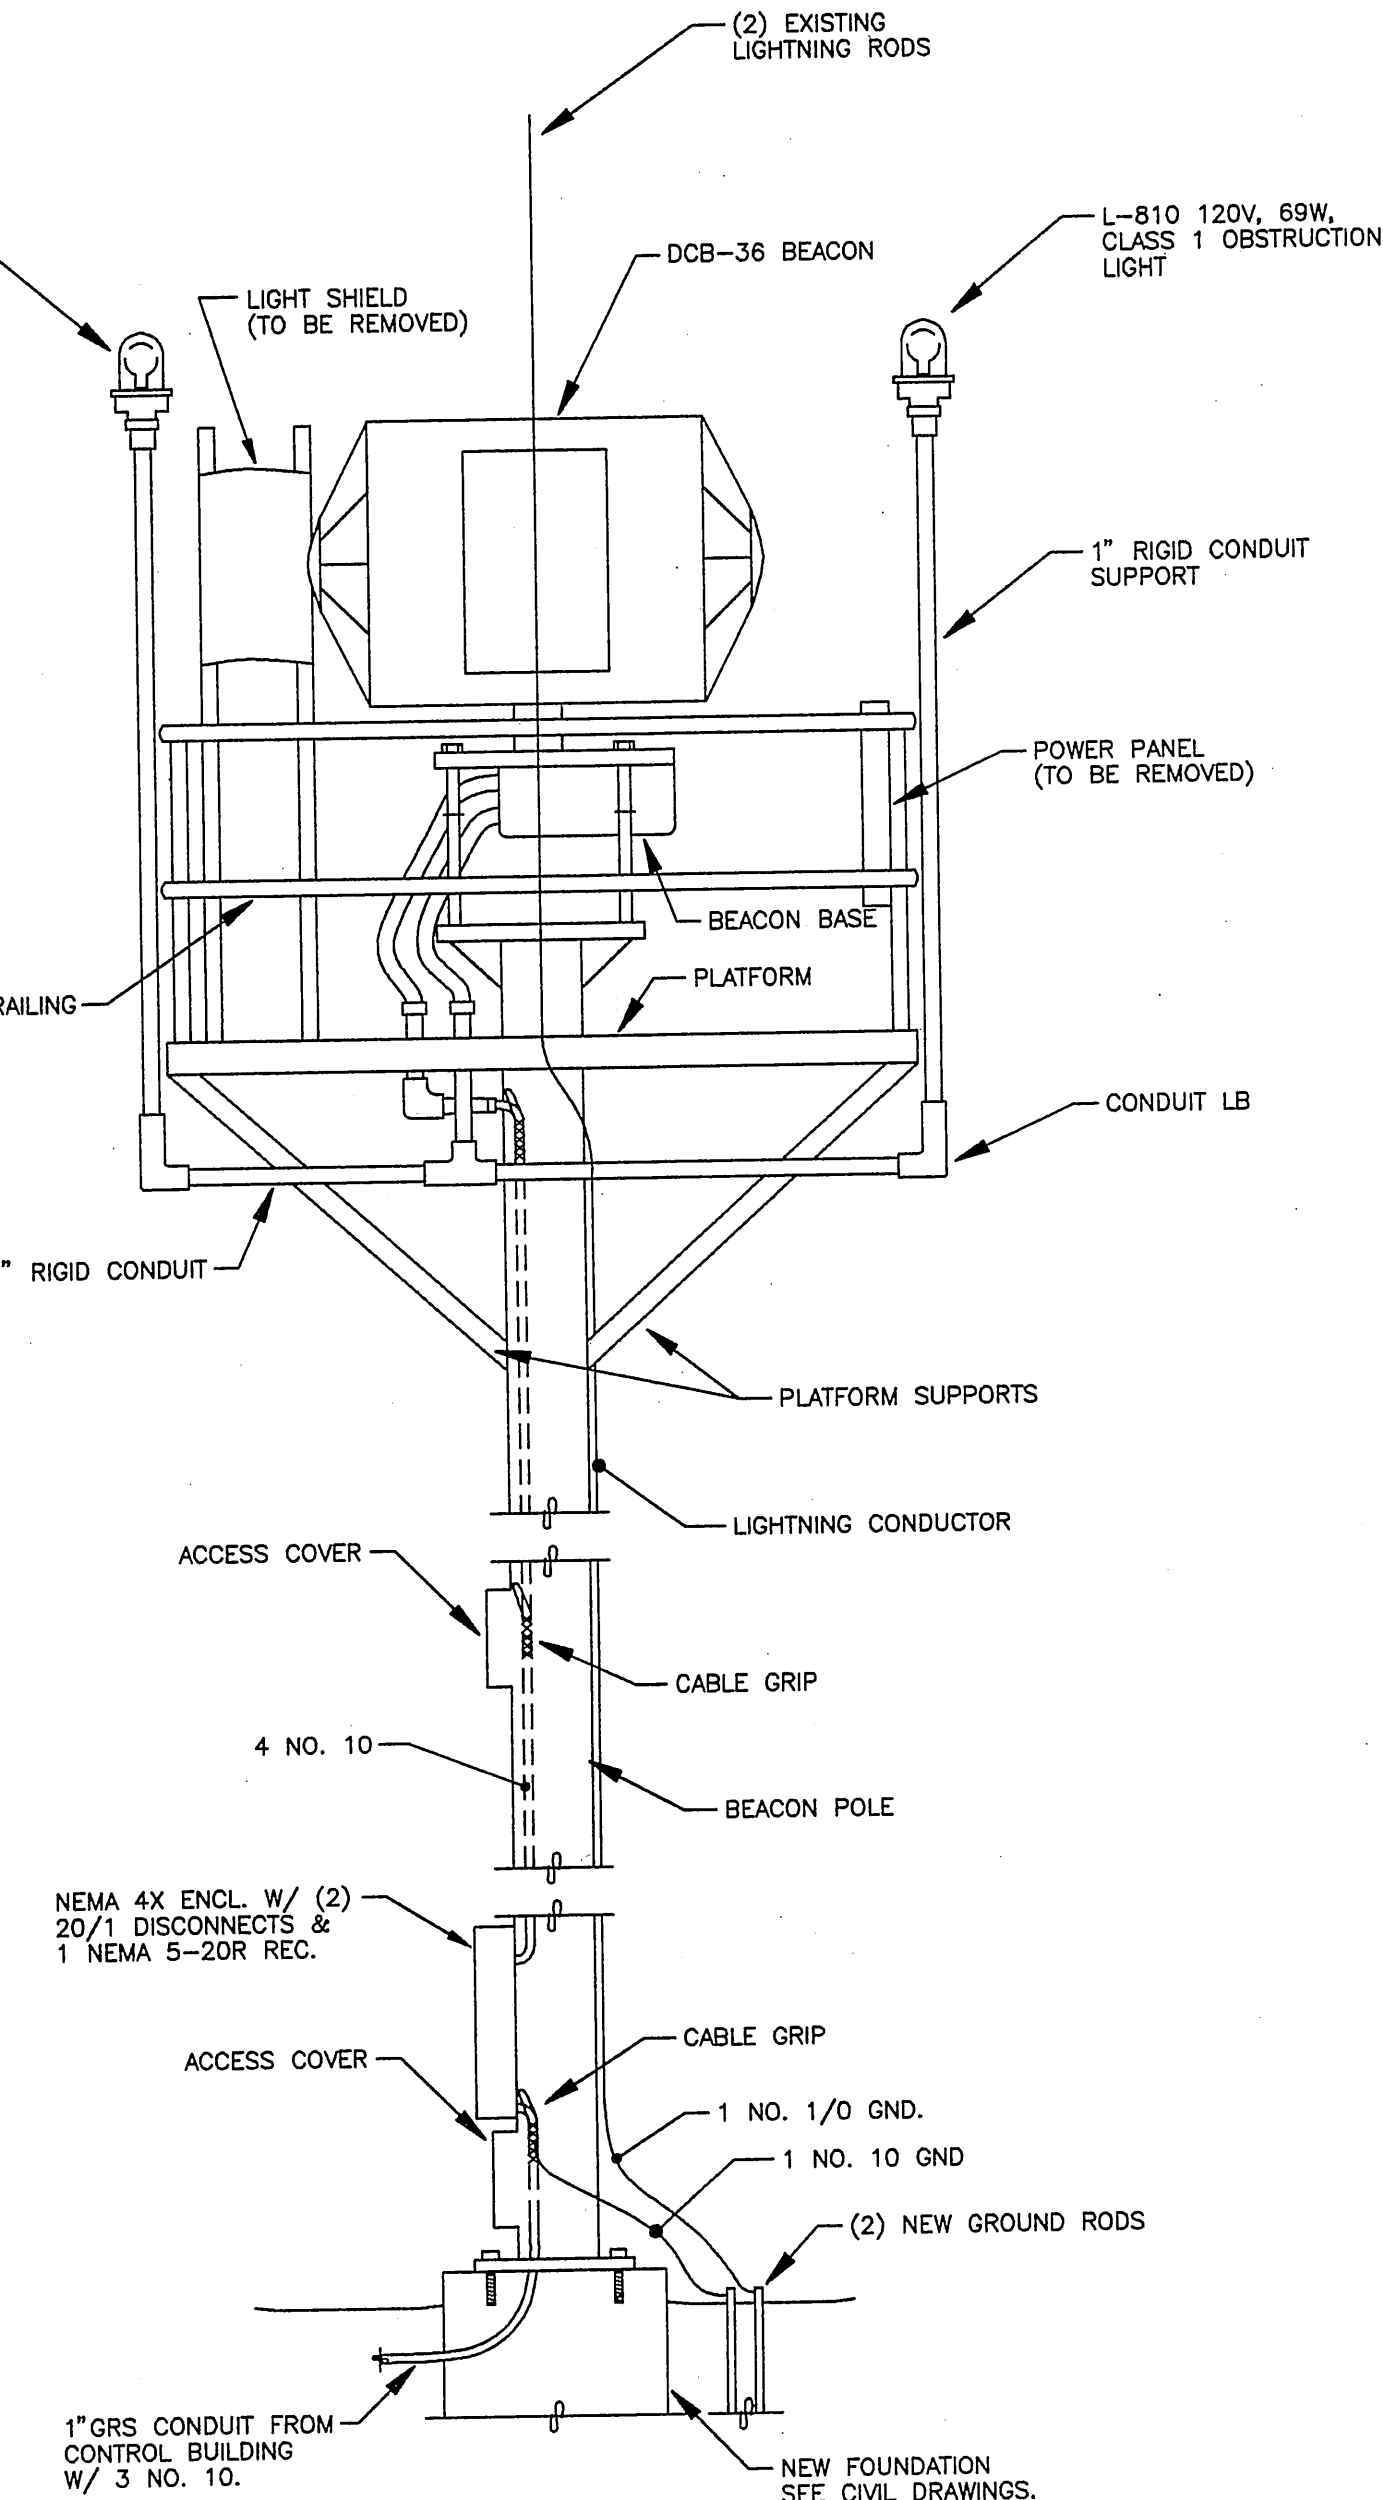

MAUSOLEUM OBSTRUCTION LIGHTS

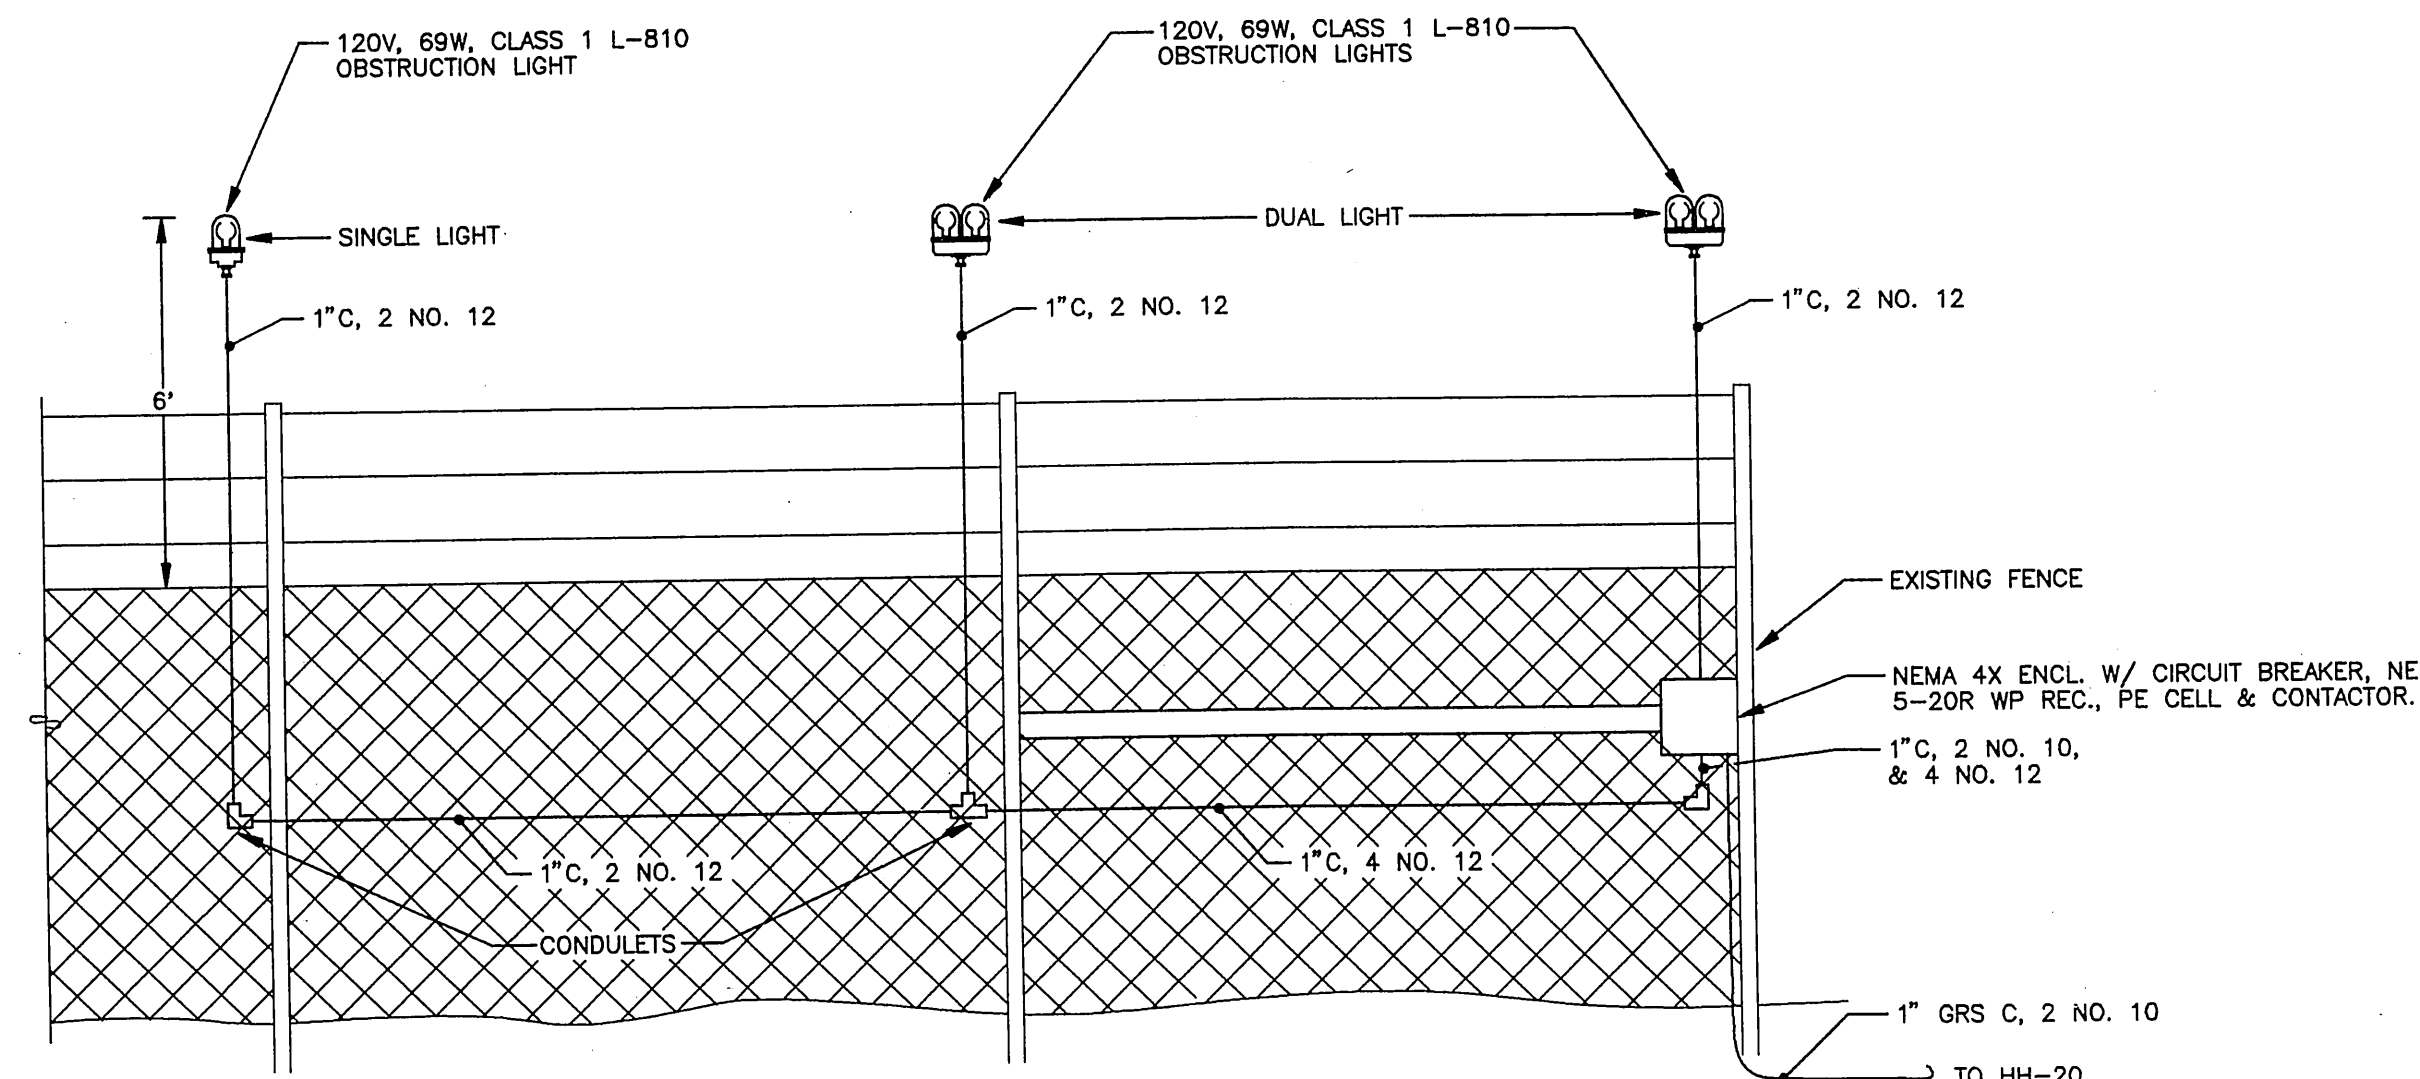

NOTES: OBSTRUCTION LIGHTS


1. REPLACE THE OBSTRUCTION LIGHTS, CONDUIT & CONDUCTORS WITH NEW AS SHOWN.
2. SECURE THE CONDUIT TO THE FENCE AT EVERY SUPPORT.
3. BURY THE 1" GRS CONDUIT FROM HH-20 TO NEMA 4X ENCLOSURE AT 6" BELOW GRADE OR AT 4" BELOW GRADE UNDER 4" OF CONCRETE EXTENDING 6" ON EACH SIDE OF CONDUIT. CONDUIT SHALL BE BURIED PER TRENCH DETAIL ON SHEET E6, WHERE INSTALLED OVER SOLID ROCK, COVER WITH 2" OF CONCRETE EXTENDING DOWN TO ROCK.


BY:	DATE:	DESCRIPTION OF CHANGE:

STATE OF ALASKA
DEPARTMENT OF TRANSPORTATION
AND PUBLIC FACILITIES
SOUTHEAST REGION DESIGN & CONSTRUCTION


SITKA AIRPORT ELECTRICAL AND LIGHTING IMPROVEMENTS
SITKA ALASKA
BEACON, WINDSOCK, & OBSTRUCTION LTG. DETAILS

DESIGNED BY:	MGM	DATE:	MAY 1994	PROJECT NO.	71457
DRAWN BY:	JLC				E-7
CHECKED BY:	BCH				SHEET 9 OF 20

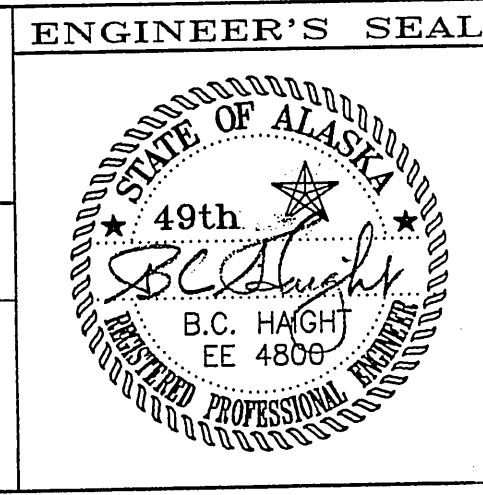


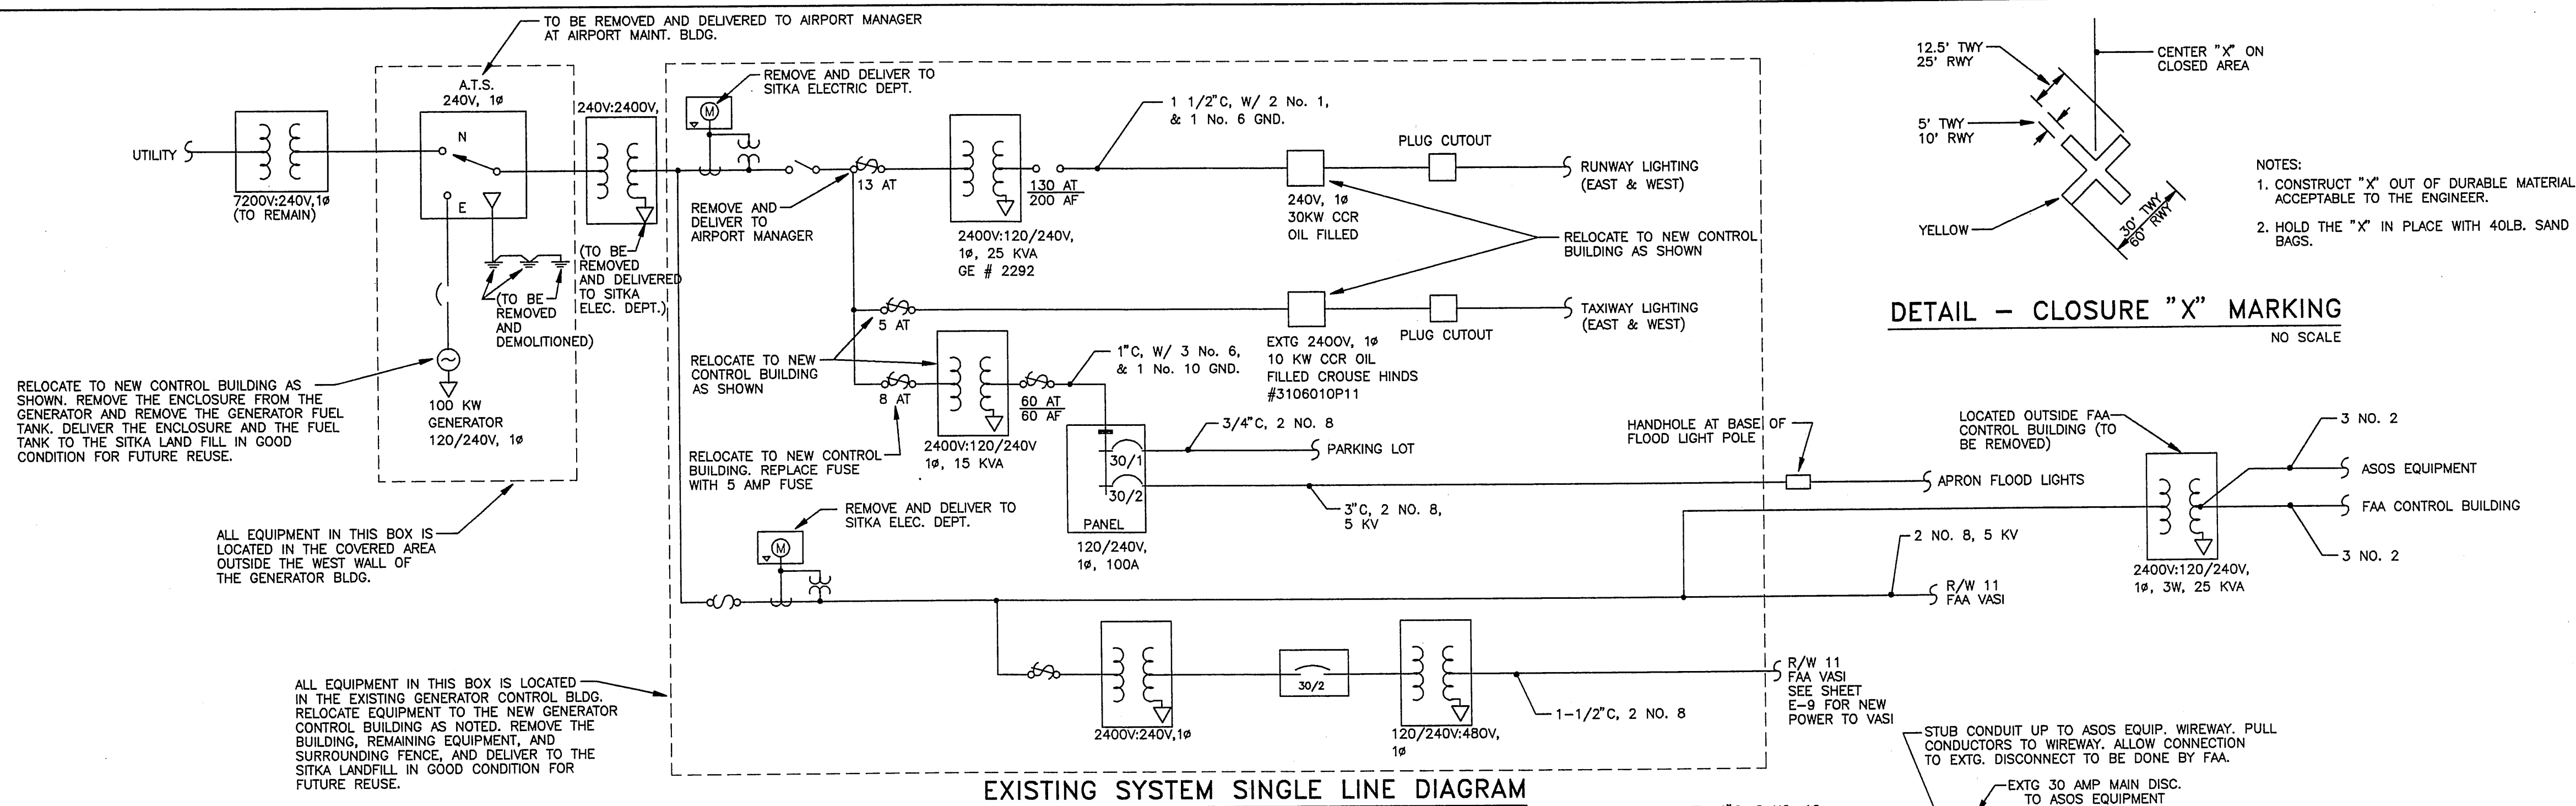


DETAIL - CLOSURE "X" MARKING
NO SCALE

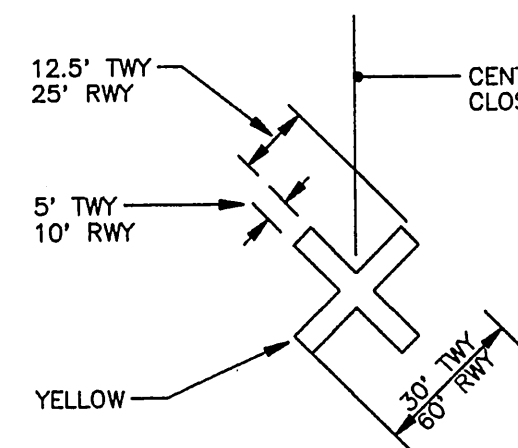


- NOTES:
1. CONSTRUCT "X" OUT OF DURABLE MATERIAL ACCEPTABLE TO THE ENGINEER.
 2. HOLD THE "X" IN PLACE WITH 40LB. SAND BAGS.

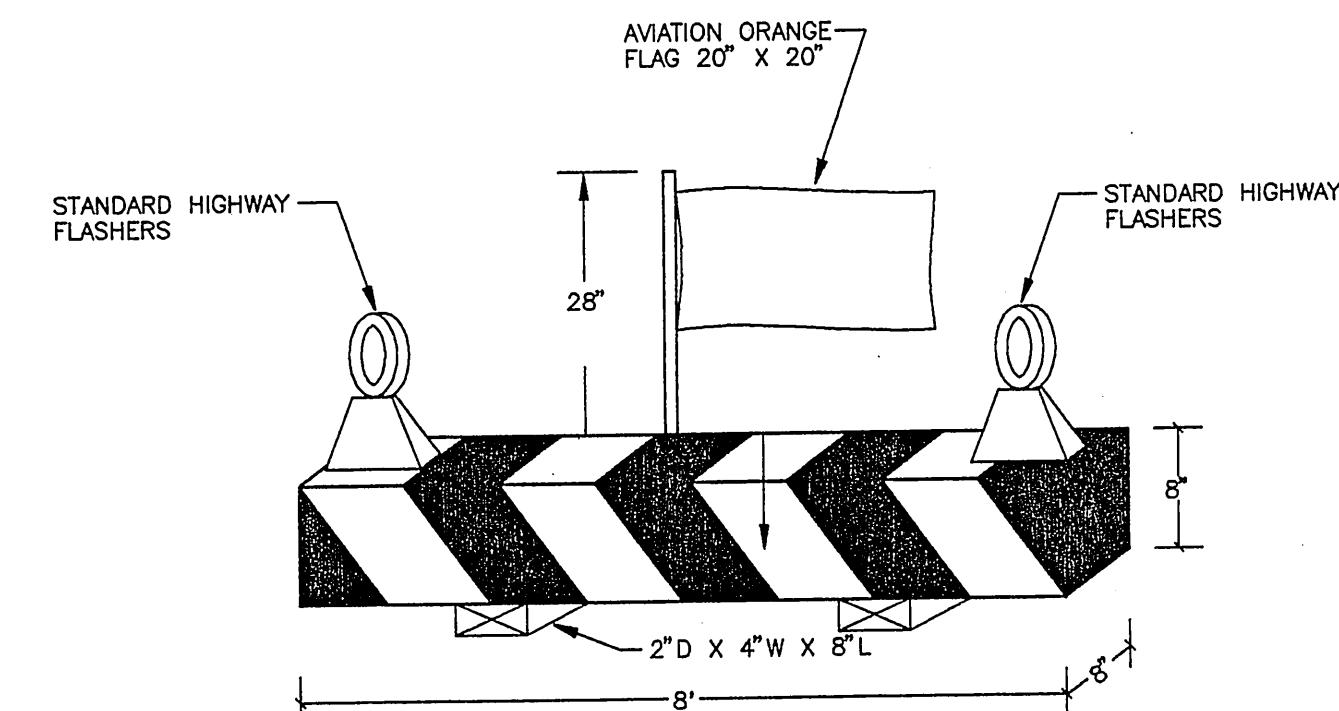

CONSTRUCTION BARRICADE
NO SCALE

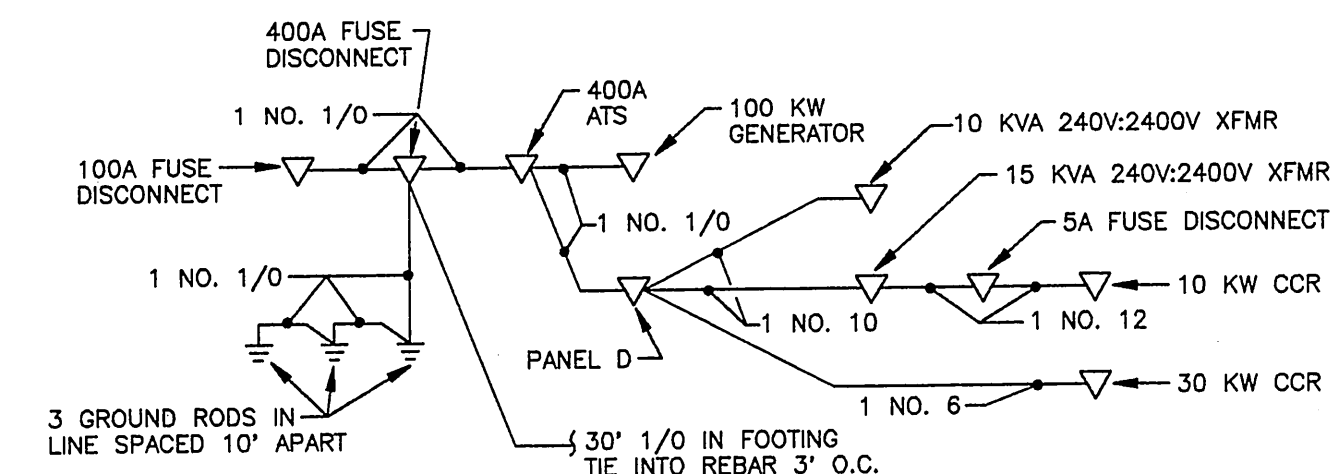

NEW SYSTEM GROUNDING SCHEMATIC
NO SCALE

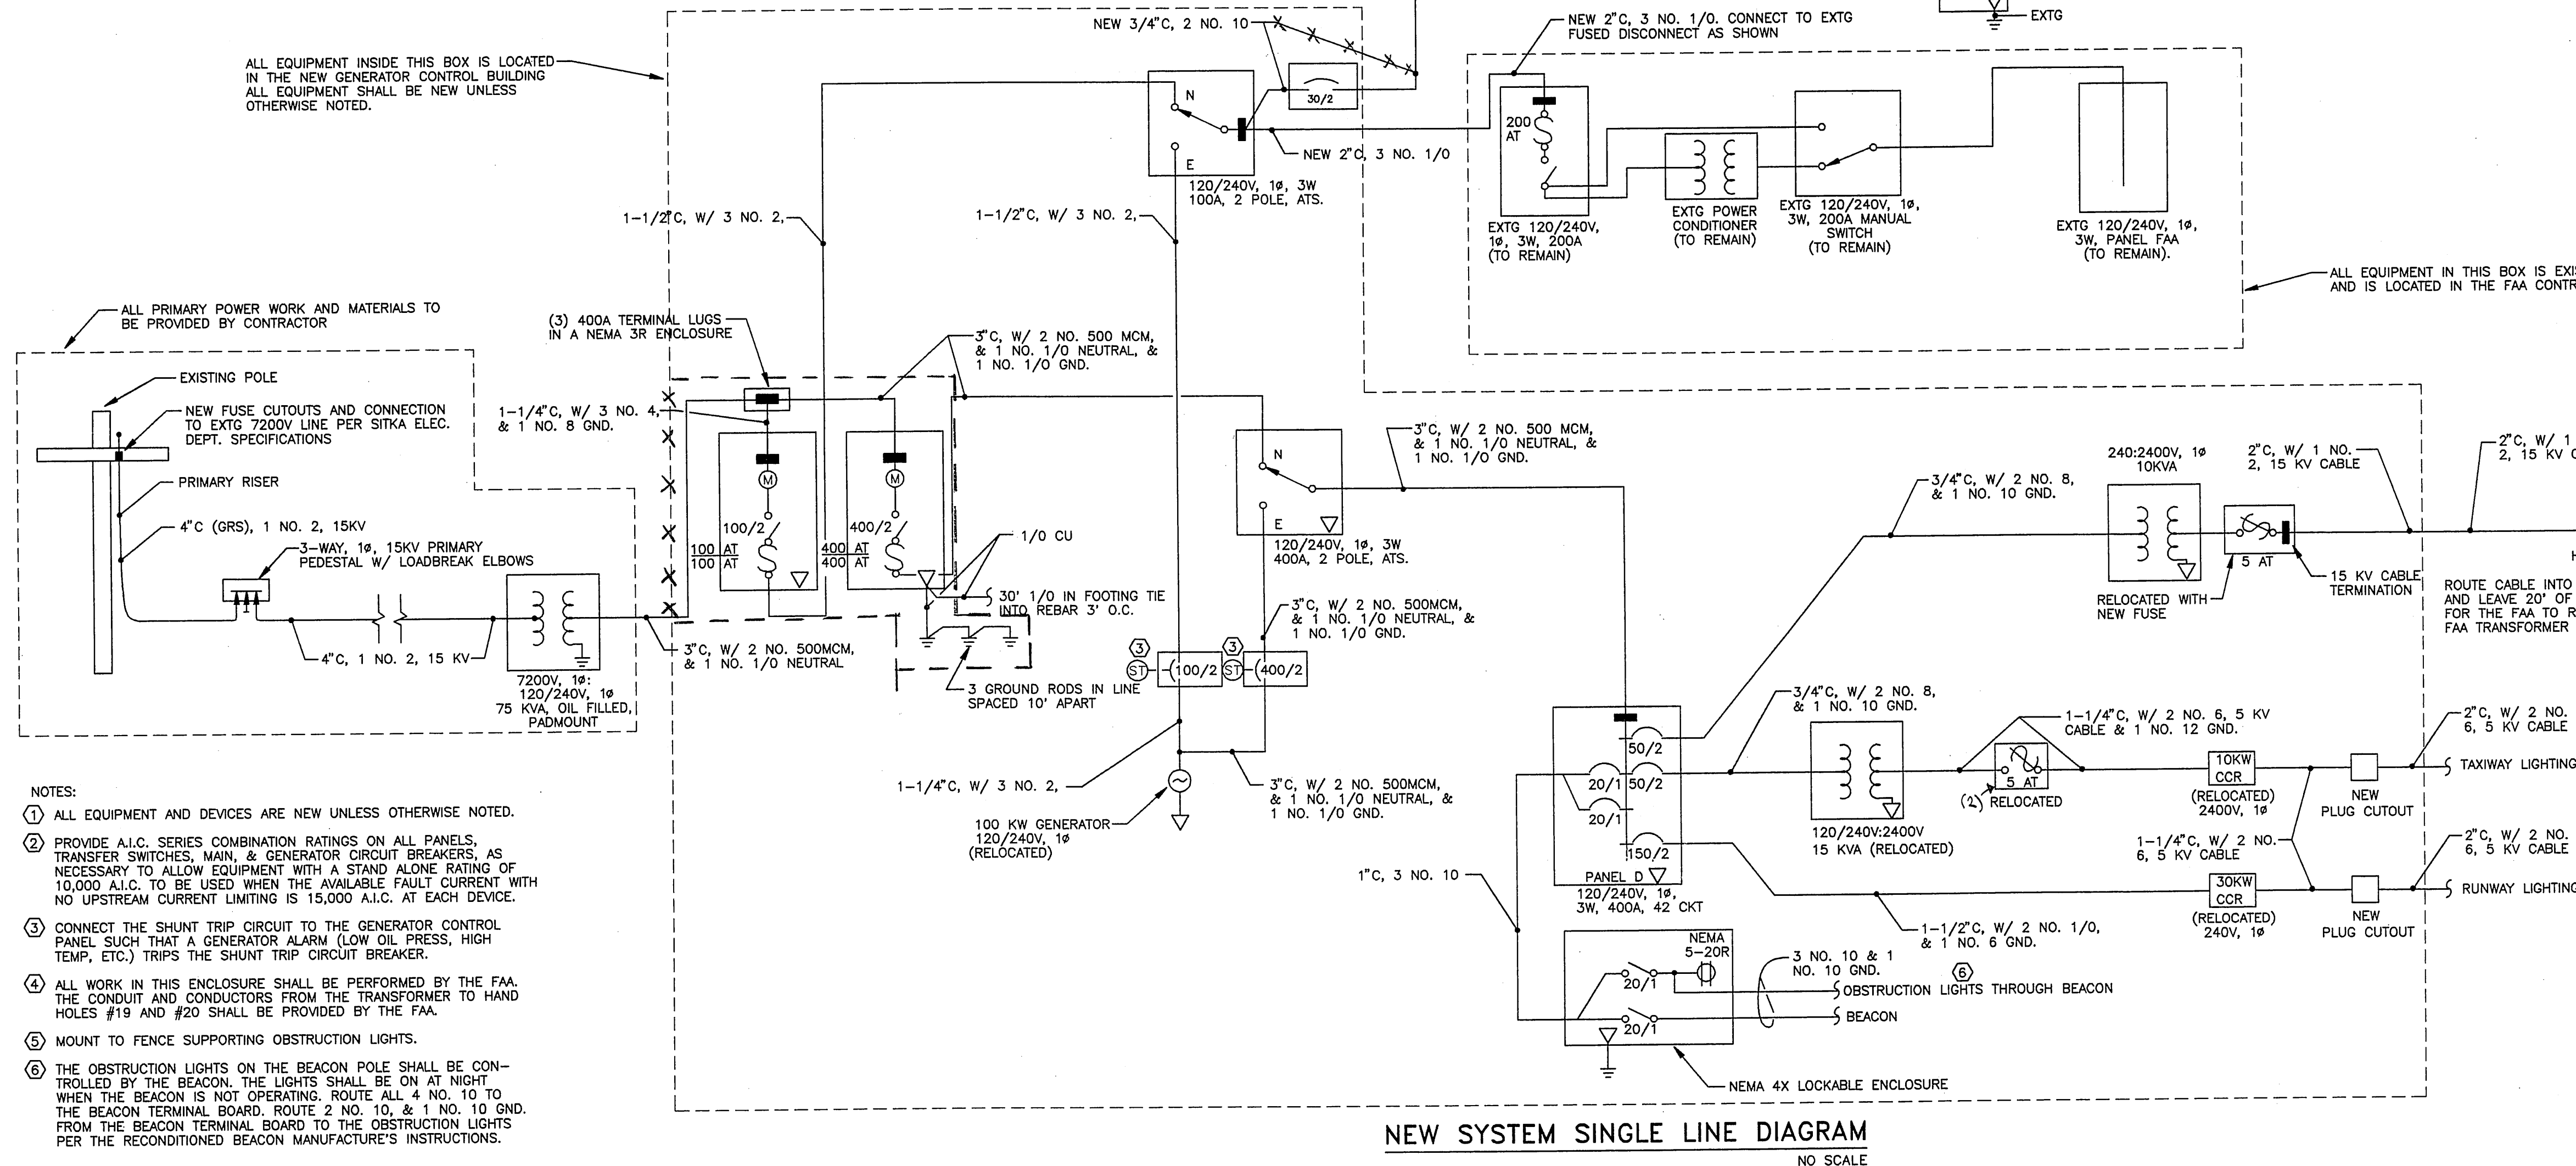

NEW SYSTEM SINGLE LINE DIAGRAM
NO SCALE



- NOTES:
1. ALL EQUIPMENT AND DEVICES ARE NEW UNLESS OTHERWISE NOTED.
 2. PROVIDE A.I.C. SERIES COMBINATION RATINGS ON ALL PANELS, TRANSFER SWITCHES, MAIN, & GENERATOR CIRCUIT BREAKERS, AS NECESSARY TO ALLOW EQUIPMENT WITH A STAND ALONE RATING OF 10,000 A.I.C. TO BE USED WHEN THE AVAILABLE FAULT CURRENT WITH NO UPSTREAM CURRENT LIMITING IS 15,000 A.I.C. AT EACH DEVICE.
 3. CONNECT THE SHUNT TRIP CIRCUIT TO THE GENERATOR CONTROL PANEL SUCH THAT A GENERATOR ALARM (LOW OIL PRESS, HIGH TEMP, ETC.) TRIPS THE SHUNT TRIP CIRCUIT BREAKER.
 4. ALL WORK IN THIS ENCLOSURE SHALL BE PERFORMED BY THE FAA. THE CONDUIT AND CONDUCTORS FROM THE TRANSFORMER TO HAND HOLES #19 AND #20 SHALL BE PROVIDED BY THE FAA.
 5. MOUNT TO FENCE SUPPORTING OBSTRUCTION LIGHTS.
 6. THE OBSTRUCTION LIGHTS ON THE BEACON POLE SHALL BE CONTROLLED BY THE BEACON. THE LIGHTS SHALL BE ON AT NIGHT WHEN THE BEACON IS NOT OPERATING. ROUTE ALL 4 NO. 10 TO THE BEACON TERMINAL BOARD. ROUTE 2 NO. 10, & 1 NO. 10 GND. FROM THE BEACON TERMINAL BOARD TO THE OBSTRUCTION LIGHTS PER THE RECONDITIONED BEACON MANUFACTURE'S INSTRUCTIONS.

BY:	DATE:	DESCRIPTION OF CHANGE:


STATE OF ALASKA
DEPARTMENT OF TRANSPORTATION
AND PUBLIC FACILITIES
SOUTHEAST REGION DESIGN & CONSTRUCTION

SITKA AIRPORT ELECTRICAL AND LIGHTING IMPROVEMENTS
SITKA ALASKA
EXTG & NEW SYSTEM SINGLE LINE DIAGRAMS


HAIGHT & McLAUGHLIN, INC. CONSULTING ENGINEERS 418 Harris Street, Juneau, Alaska 99801 (907) 586-9788			ENGINEER'S SEAL
DESIGNED BY:	DATE:	PROJECT No.	
MGM	MAY 1994	71457	
DRAWN BY:	JLC	E-8	
CHECKED BY:	BCH	SHEET 10 OF 20	

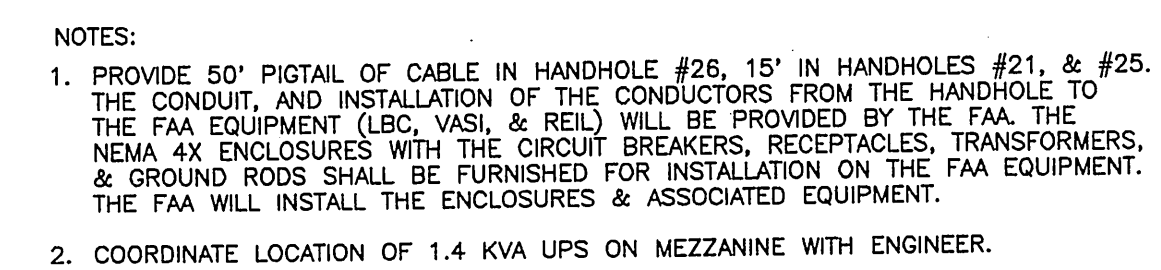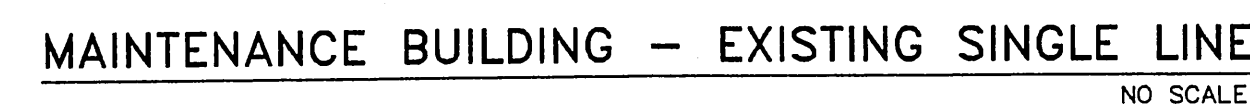

 HAIGHT & McLAUGHLIN, INC. CONSULTING ENGINEERS 418 Harris Street, Juneau, Alaska 98801 (907) 586-9788			ENGINEER'S SEAL 	
DESIGNED BY:	MGM	DATE:	PROJECT No. 71457	
DRAWN BY:	JLC	E-9		
CHECKED BY:	BCH			
			SHEET 11 of 20	

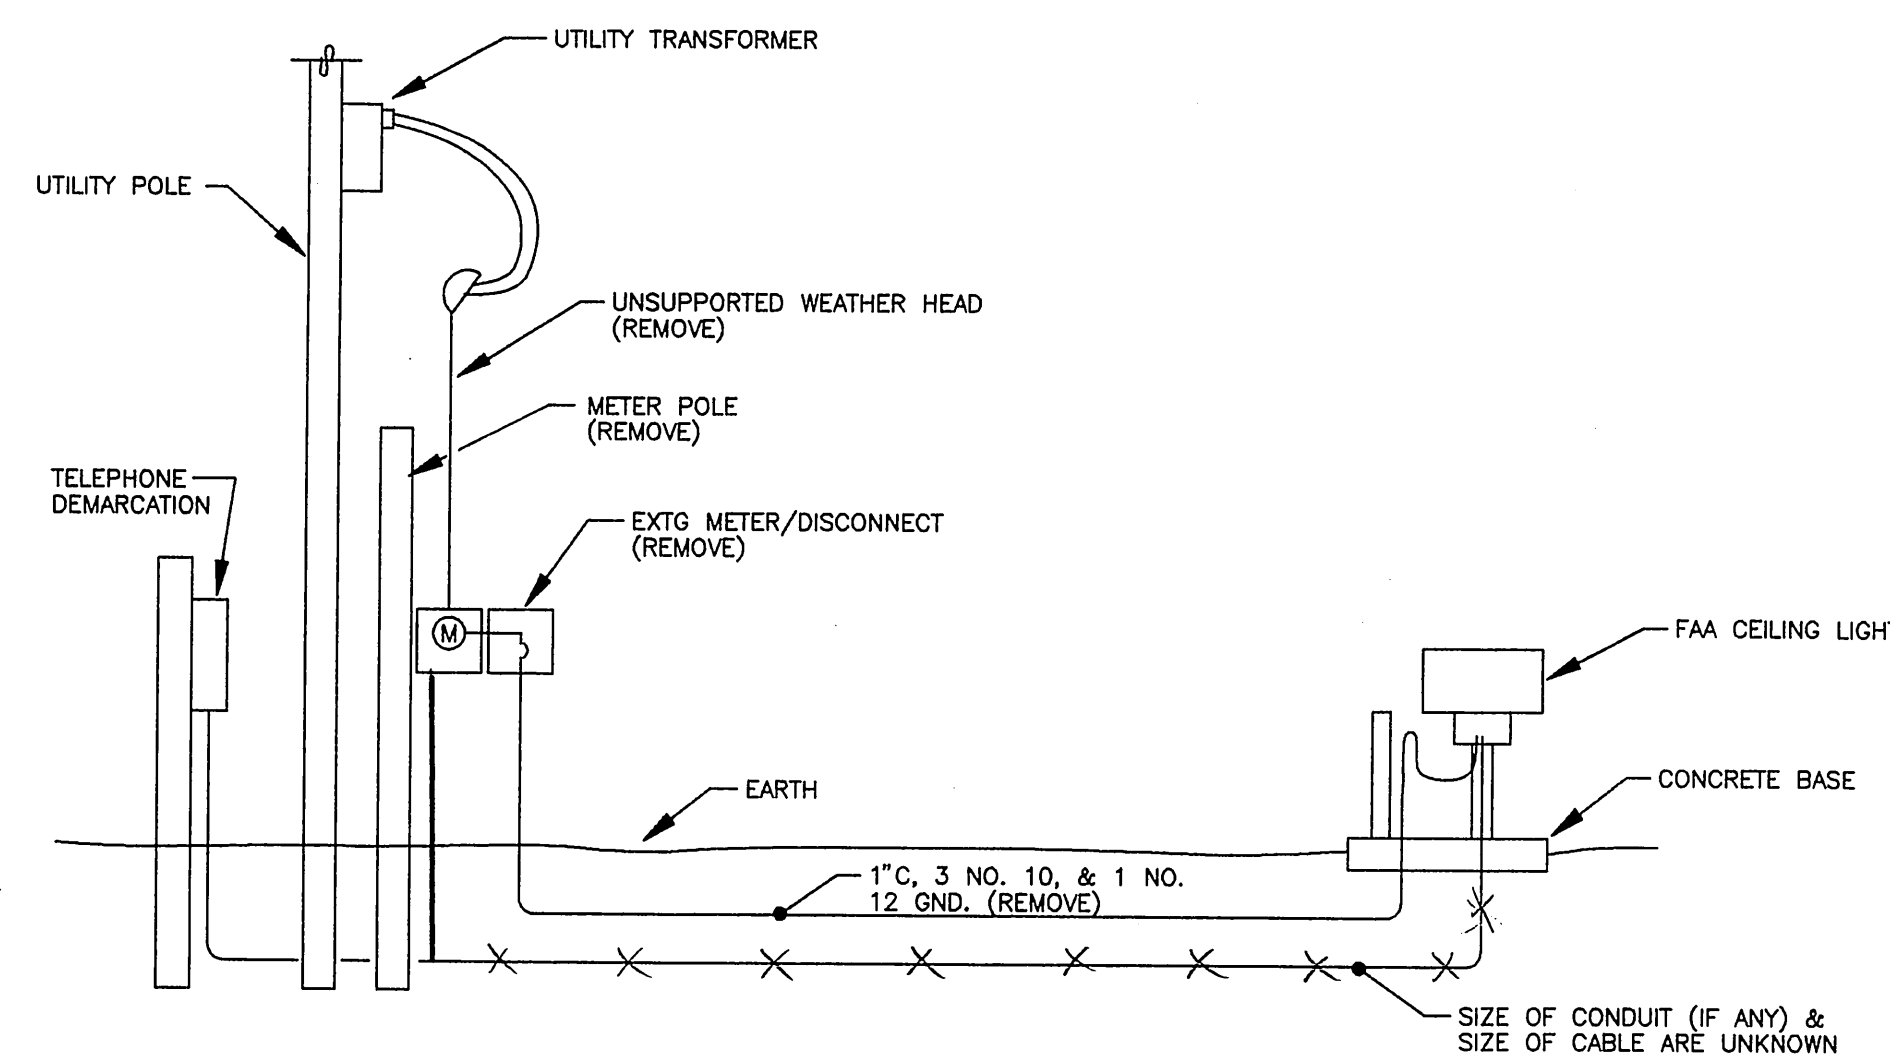


CEILING LIGHT - EXISTING SERVICE
NO SCALE

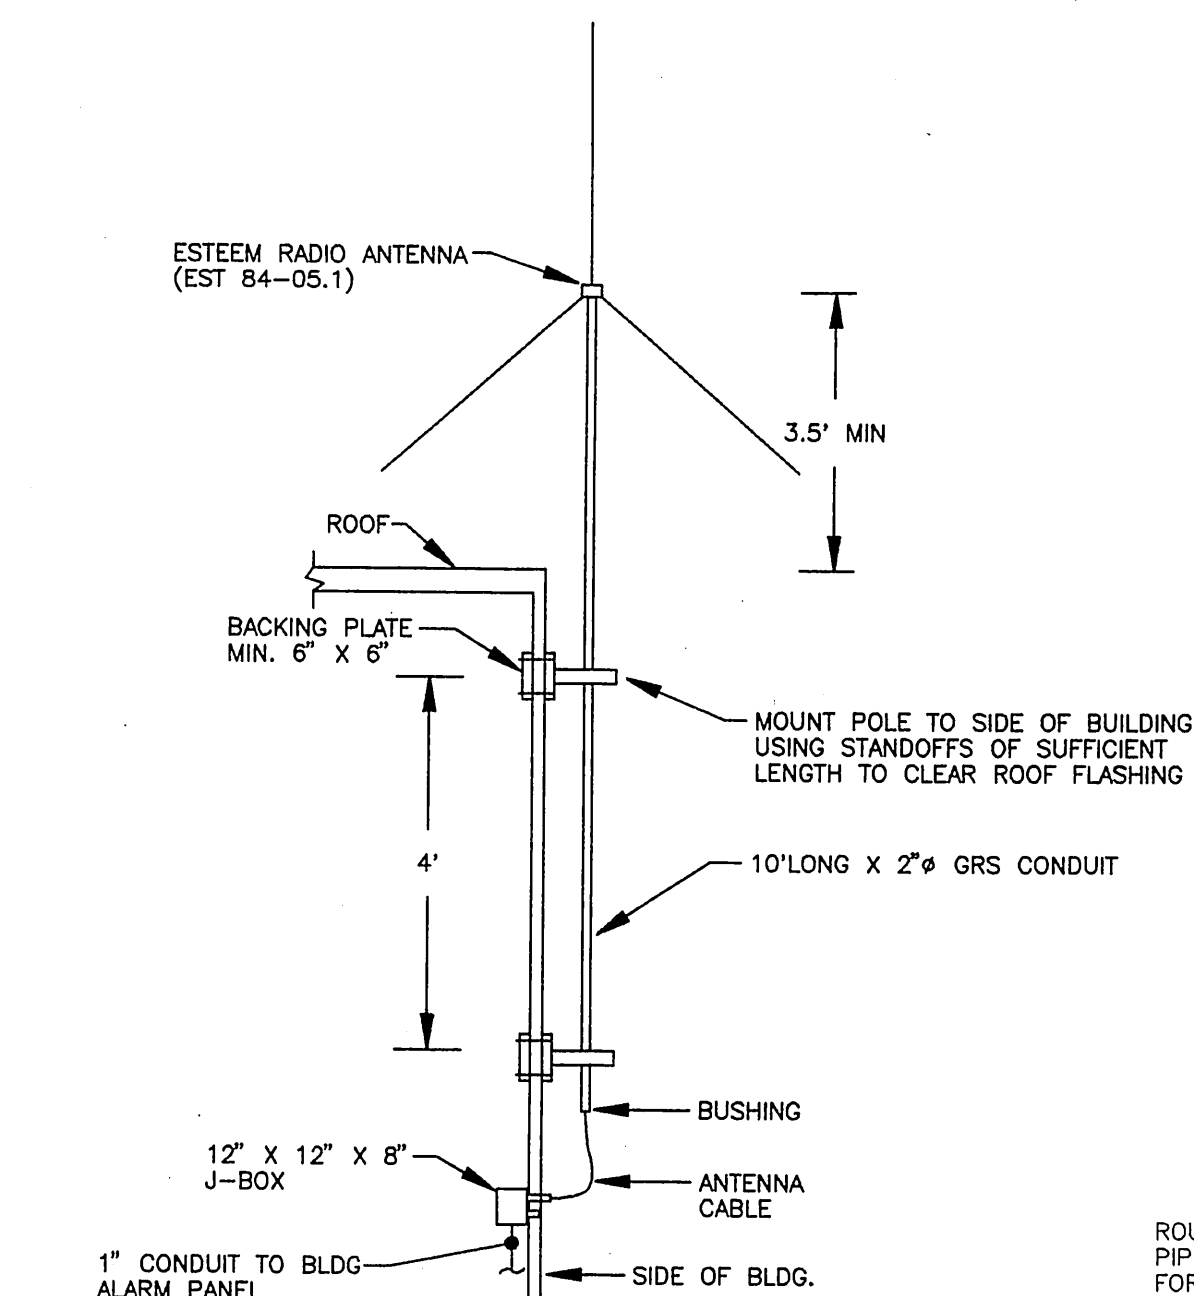


MAINTENANCE BUILDING ANTENNA BRACKET
NO SCALE

NOTE:
ALL MOUNTING HARDWARE SHALL BE GRS. THE STANDOFFS SHALL BE
MADE OF C CHANNEL 0.2" THICK, WELDED TO 4 BOLT MOUNTING PLATE.
PROVIDE BACKING PLATE & 1/4" MIN. BOLTS.

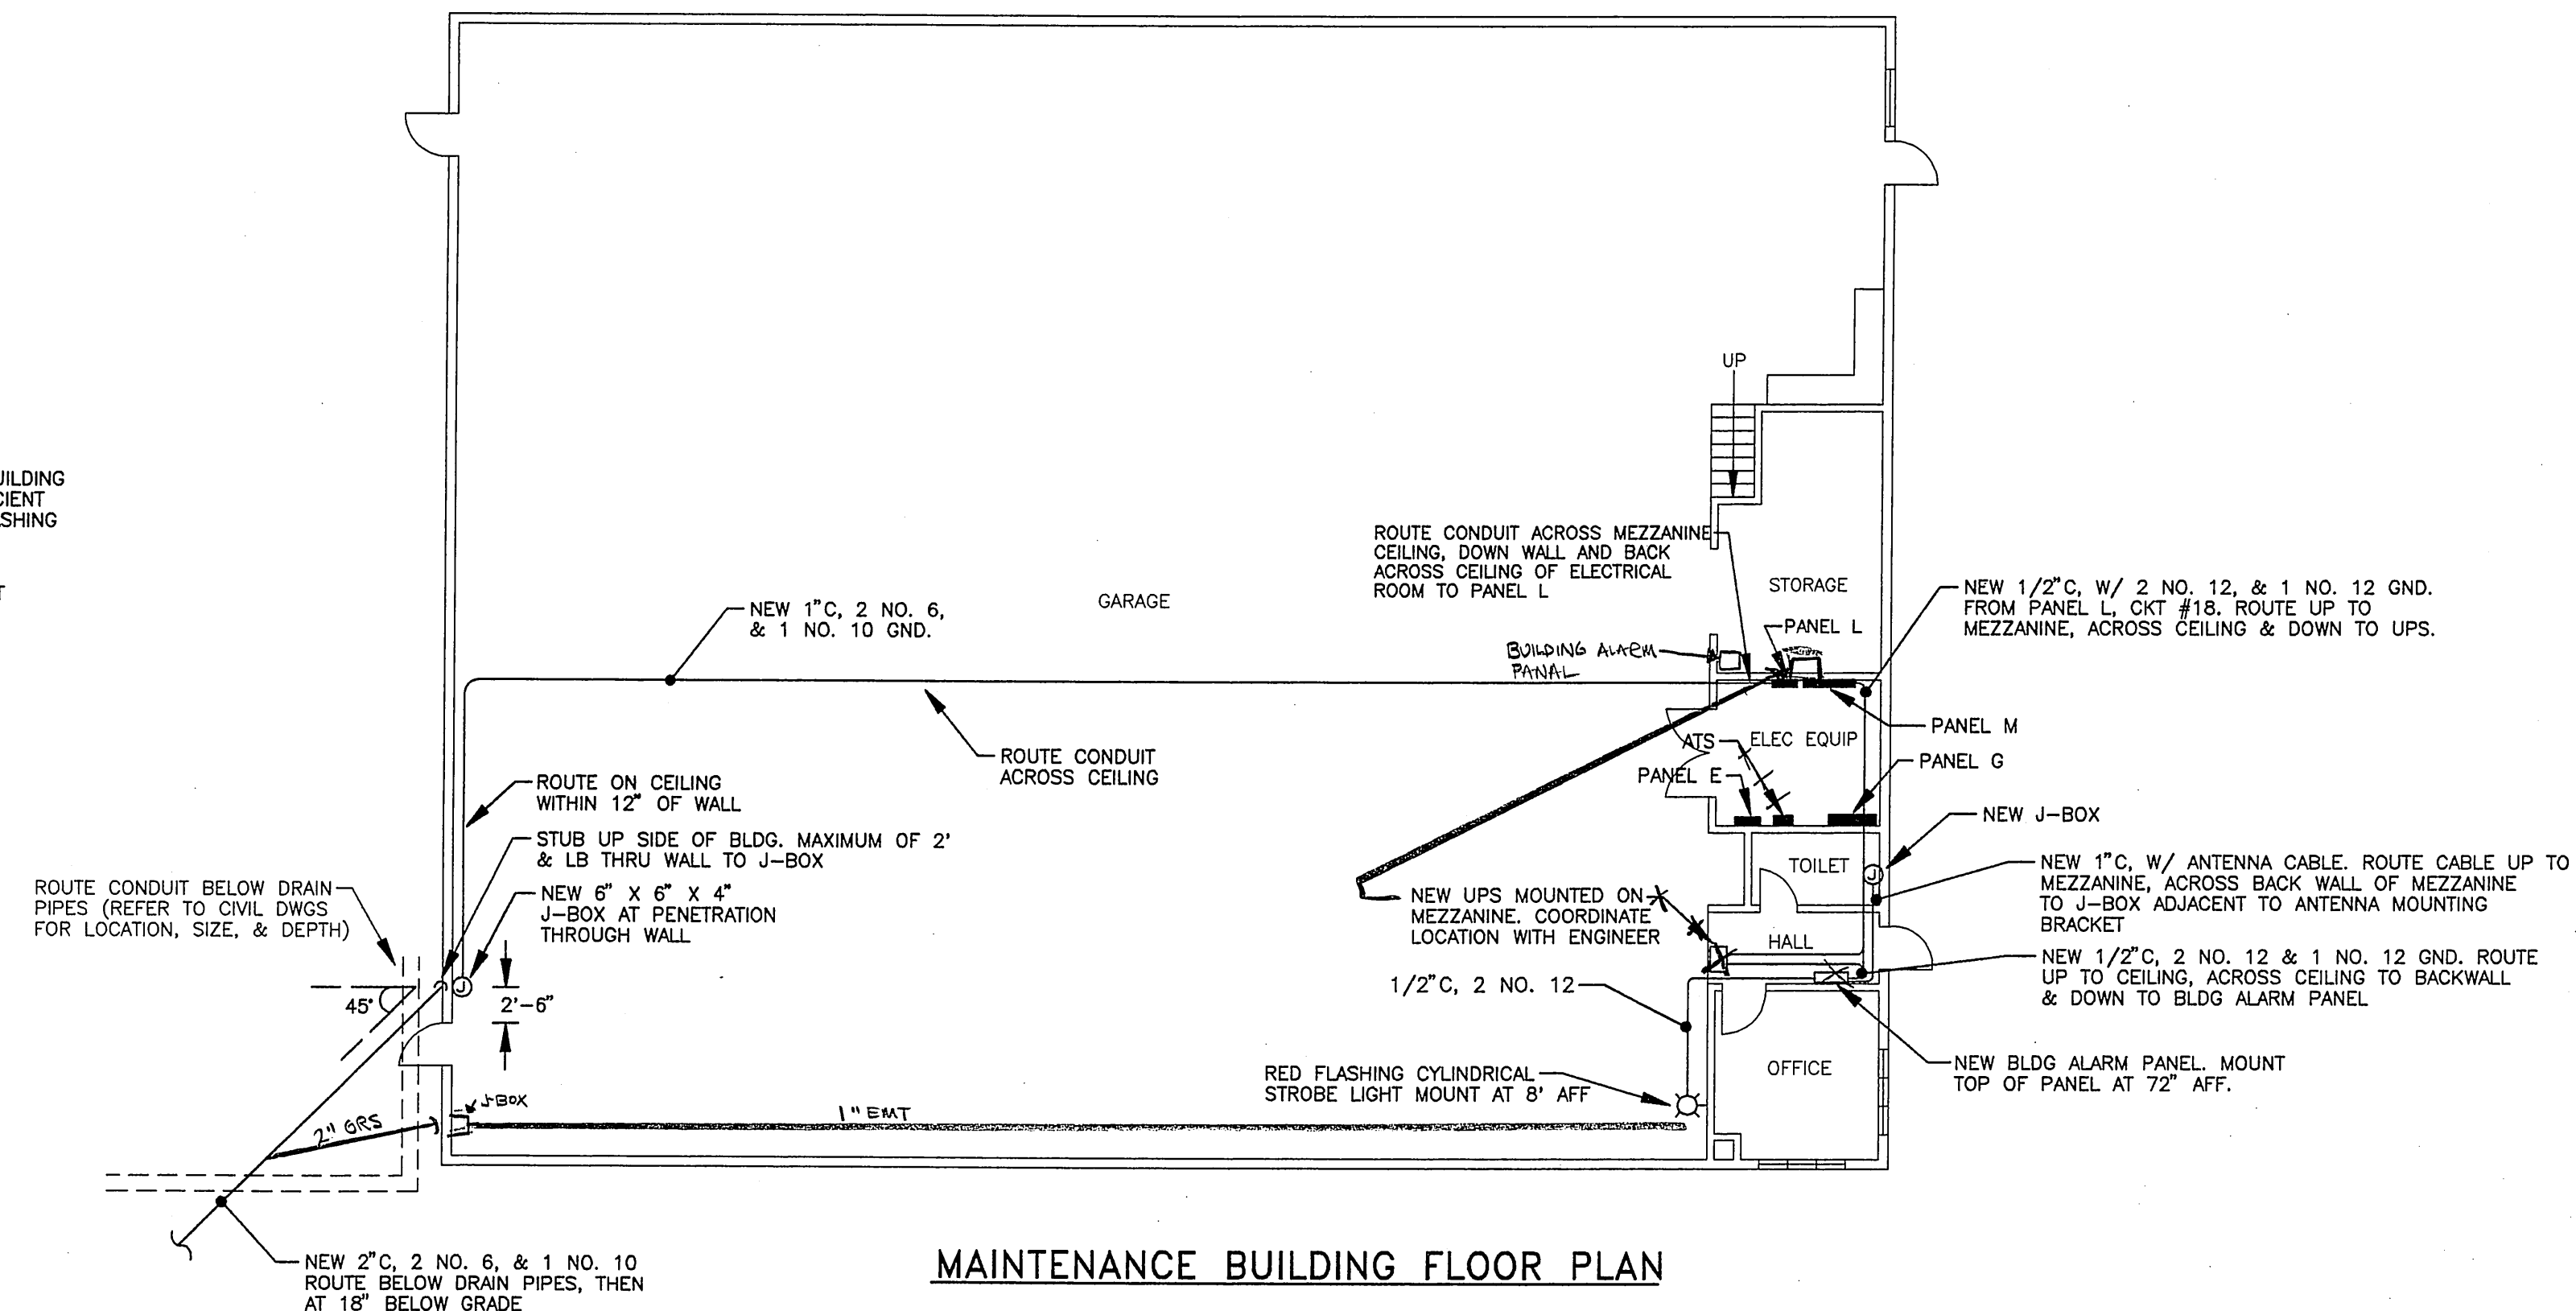

MAINTENANCE BUILDING FLOOR PLAN

0 10' 20' 30'
GRAPHIC SCALE

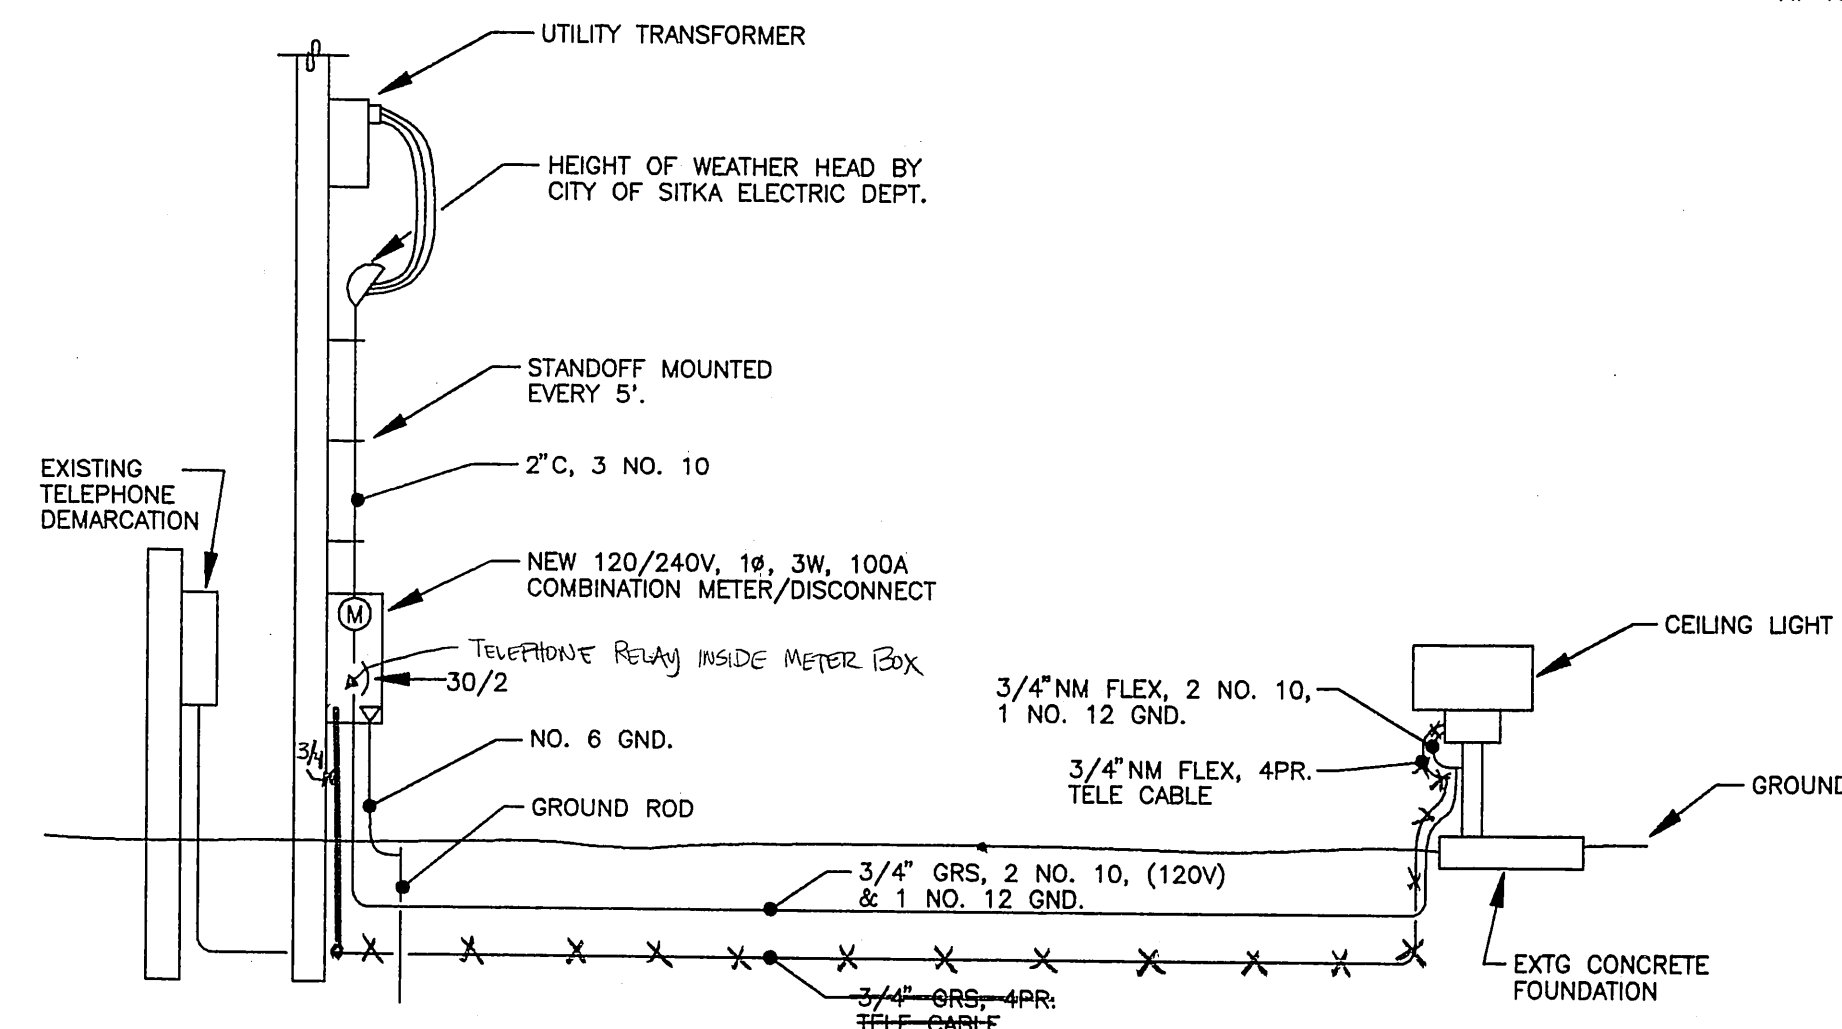

FAA CEILING LIGHT - NEW SERVICE
NO SCALE


NOTE:
1. PROVIDE 120V SERVICE TO CEILING LIGHT.
USE ONE POLE OF 30/2 CIRCUIT BREAKER.
2. INSTALL CONDUIT AS SHOWN. PROVIDE POWER CONDUCTORS
AND TELE. CABLE AS SHOWN. DO NOT TERMINATE POWER
CONDUCTORS & TELE. CABLE IN CEILING LIGHT.
TERMINATIONS SHALL BE PERFORMED BY FAA.

BY:	DATE:	DESCRIPTION OF CHANGE:
RECORD OF REVISIONS		

STATE OF ALASKA
DEPARTMENT OF TRANSPORTATION
AND PUBLIC FACILITIES
SOUTHEAST REGION DESIGN & CONSTRUCTION

SITKA AIRPORT ELECTRICAL AND LIGHTING IMPROVEMENTS
SITKA ALASKA
SINGLE LINE DIAGRAMS, FLOOR PLANS

 HAIGHT & McLAUGHLIN, INC. CONSULTING ENGINEERS 418 Harris Street, Juneau, Alaska 99801 (907) 586-9788			ENGINEER'S SEAL
DESIGNED BY: MGM	DATE: MAY 1994	PROJECT No. 71457	
DRAWN BY: JLC	CHECKED BY: JLC	E-10	

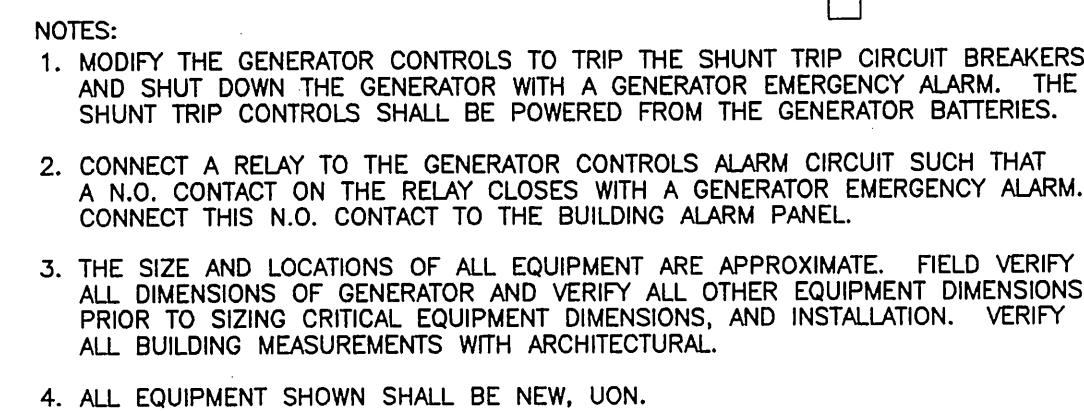

0' 1' 2' 3' 4'

GRAPHIC SCALE

PANEL D			SIZE		VOLTS/PHASE		MAIN		LOCATION		MOUNT	
CIRCUIT NO	WIRE NO / SIZE	DESCRIPTION	BREAKER AMP / POLE	400 AMP				120/240V, 1ø		LUGS ONLY	ELECTRICAL ROOM	SURFACE
				CKT	AØ	BØ	CKT	KVA	BREAKER AMP / POLE			
1	3/12	GENERATOR CONTROLS	20/1	0.2	1.2		1.0	20/1		LIGHTING		2/12
3		GENERATOR WATER HEATER	↓	1.8		2.6	0.8			RECEPTACLES GENERATOR ROOM		
5	3/12	UNIT HEATER GEN ROOM	20/2	1.7	2.5		0.8			RECEPTACLES ELECTRICAL ROOM		
7	---	---	---	1.7		3.4	1.7	20/2		UNIT HEATER ELEC. ROOM		3/12
9	2/12	BATTERY CHARGER	20/1	1.0	2.7		1.7	---		---		---
11	3/12	FUEL TANK CONTROLS	20/1	0.3		0.5	0.2	20/1		FACP, DIGITAL COMMUNICATOR		2/12
13	---	FUEL TANK PUMP	20/1	1.0	1.3		0.3			BUILDING ALARM PANEL / UPS		2/12
15						0.2	0.2			LIGHTING CONTROL PANEL		2/12
17					0.3		0.3			PILOT CONTROLLED LIGHTING		
19										SPARE		
21										SPARE		
23						11.7	11.7	150/2		RUNWAY LIGHTING		2/1/0
25					11.7		11.7			CURRENT REGULATOR		---
27						3.2	3.2	50/2		TAXIWAY LIGHTING		2/8
29					3.2		3.2	---		CURRENT REGULATOR		---
31						1.0	1.0	20/1		BEACON		4/12
33					0.2		0.2	20/1		BEACON OBS. LIGHTS		---
35						0.2	0.2	20/1		CONTROL OBS. LIGHTS		---
37					0.2		0.2	20/1		TELE. TERM. BOARD		2/12
39										SPARE		
41										↓		
TOTAL CONNECTED LOAD = 46.1 KVA / 192 AMPS					23.3	22.8						

STATE OF ALASKA
DEPARTMENT OF TRANSPORTATION
AND PUBLIC FACILITIES
SOUTHEAST REGION DESIGN & CONSTRUCTION

EQUIPMENT SCHEDULE

- 46 10 KVA 240V:2400V DRY TRANSFORMER. MOUNT TOP AT 84" AFF.
- 47 FUSED DISCONNECT 5 AMP, 2400V. RELOCATED FROM EXISTING CONTROL BUILDING. MOUNT 6" BELOW 10 KVA TRANSFORMER.
- 48 NOT USED.
- 49 WALL MOUNT TOUCH TONE TELEPHONE WITH JACK. PROVIDE ATT COMMERCIAL/BUSINESS GRADE OR EQUAL. MOUNT AT 60" AFF.
- 50 BLDG. ALARM PANEL ANTENNA (EST 84-05.1) MOUNTED ON 12' LONG X 2" GR5 POLE. MOUNT 3' ABOVE ROOF. SEE ANTENNA BRACKET DETAILS SHEET E12.
- 51 L-810 OBSTRUCTION LIGHT, 120V, 69W, CLASS 1 MOUNTED ON 16' LONG X 2" GR5 POLE. MOUNT WITHIN 6" OF TOP OF HIGHEST ANTENNA. SEE ANTENNA BRACKET DETAILS SHEET E12.
- 52 RADIO CONTROLLER ANTENNA MOUNTED ON 12' LONG X 2" GR5 POLE. MOUNT 3' ABOVE ROOF. SEE ANTENNA BRACKET DETAILS SHEET E12.
- 53 UNISTRUT ANTENNA BRACKET. BRACKET SHALL BE MADE OF HOT DIPPED GALVANIZED MATERIALS. SEE ANTENNA BRACKET DETAILS SHEET E12.
- 54 L-810 OBSTRUCTION LIGHT, 120V, 69W, CLASS 1 MOUNTED ON 12' LONG X 1" GR5 POLE MOUNTED TO FACIA.
- 55 GRADE 7" FROM HAND HOLE 15 NEXT TO RUNWAY. STUB UP 12" AND CAP.




- NOTES: ENERGIZE 2 TELEPHONE LINES
TO THE BUILDING.




NOTE:
CONNECT TWO PAIR OF THE 6 PAIR TELEPHONE CABLE TO
TWO TELEPHONE LINES IN THE MAINTENANCE BUILDING. COIL
THE OTHER 4 PAIR AS SPARES.


 HAIGHT & McLAUGHLIN, INC. CONSULTING ENGINEERS 418 Harris Street, Juneau, Alaska 99801 (907) 586-9788			ENGINEER'S SEAL 			
DESIGNED BY:	MGM	DATE:		MAY 1994	PROJECT No.	71457
DRAWN BY:	JLC	E-11		SHEET 13 OF 20		
CHECKED BY:	BCH					

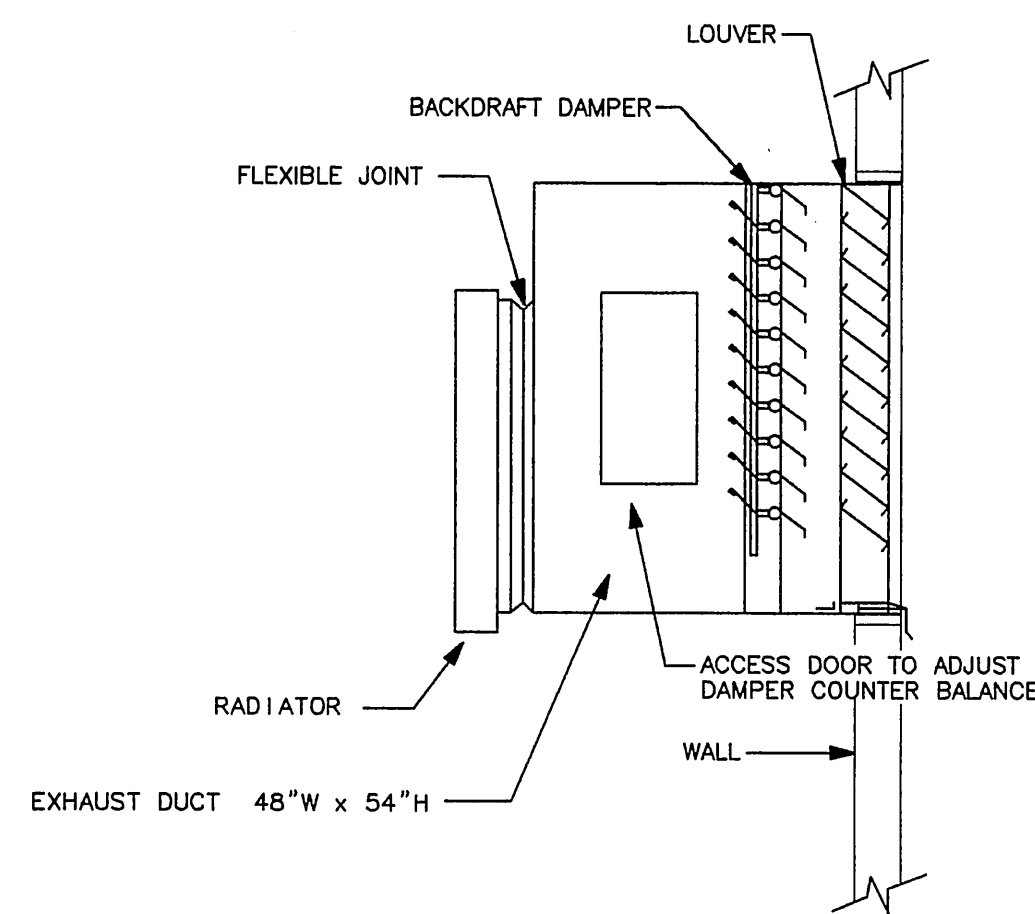


DETAIL - EXHAUST LOUVER
NO SCALE

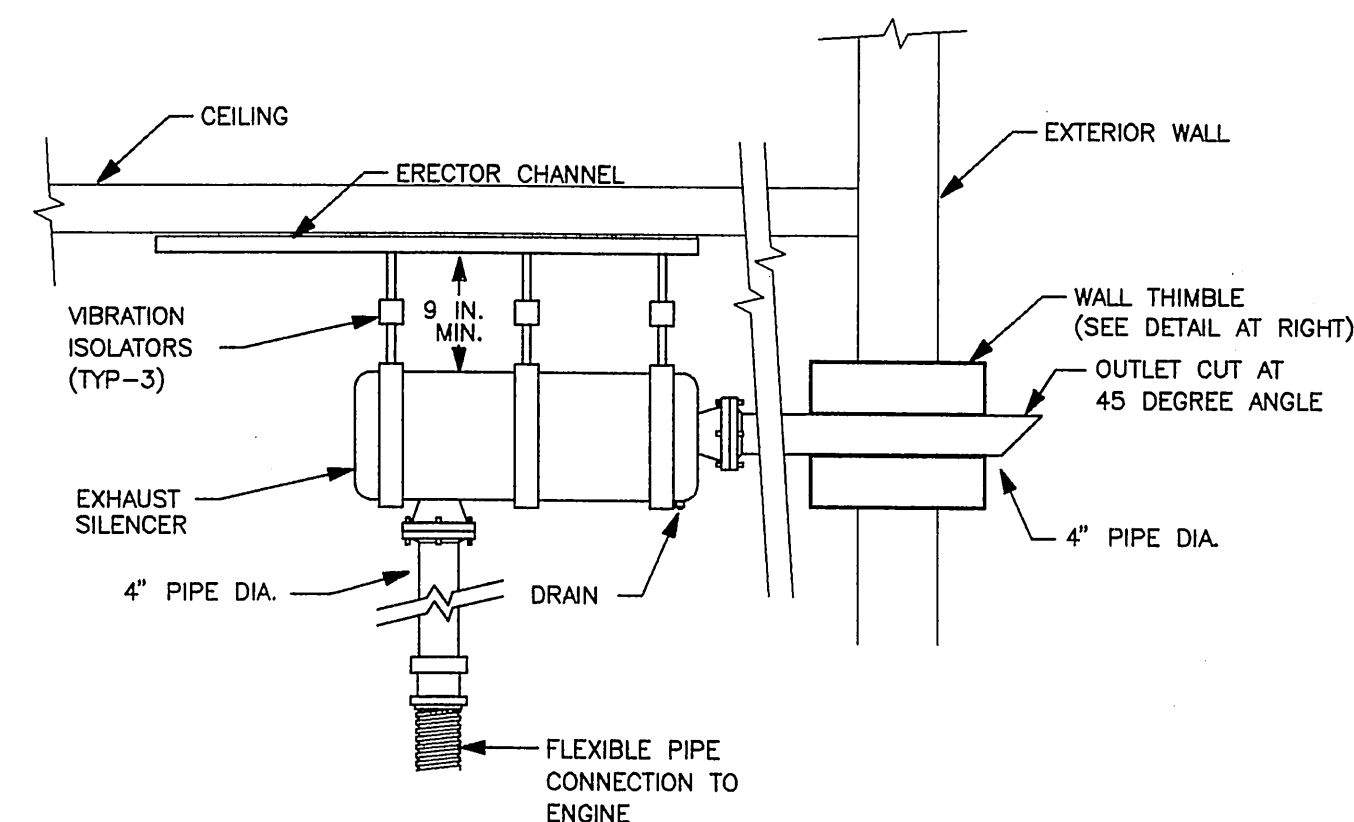

DETAIL - GENSET MUFFLER
NO SCALE

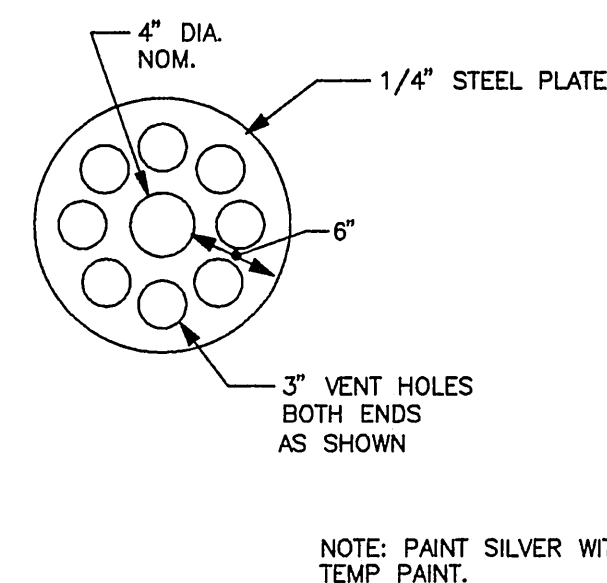


FRONT

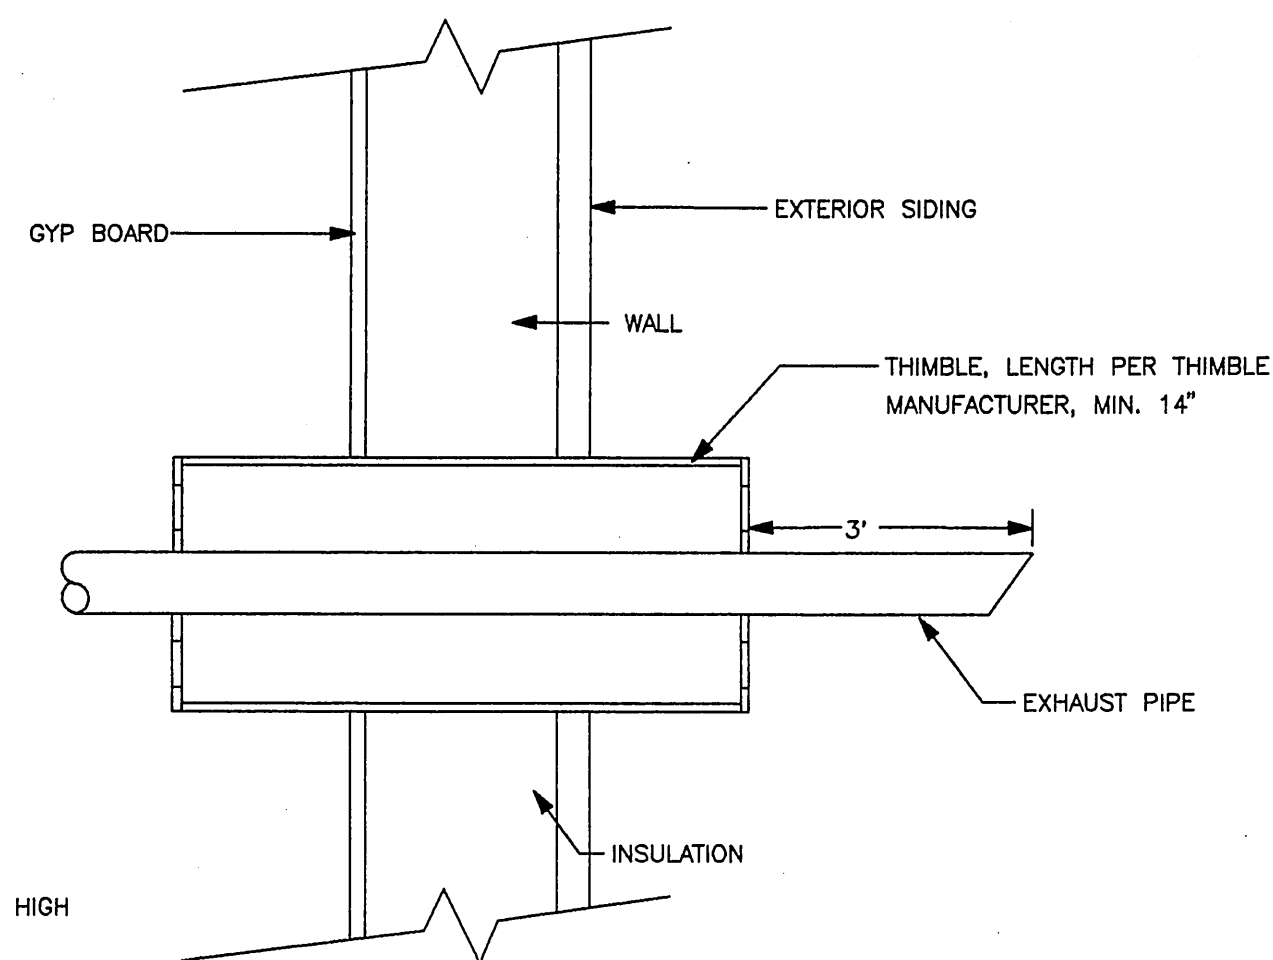


SIDE


DETAIL - EXHAUST THIMBLE
NO SCALE

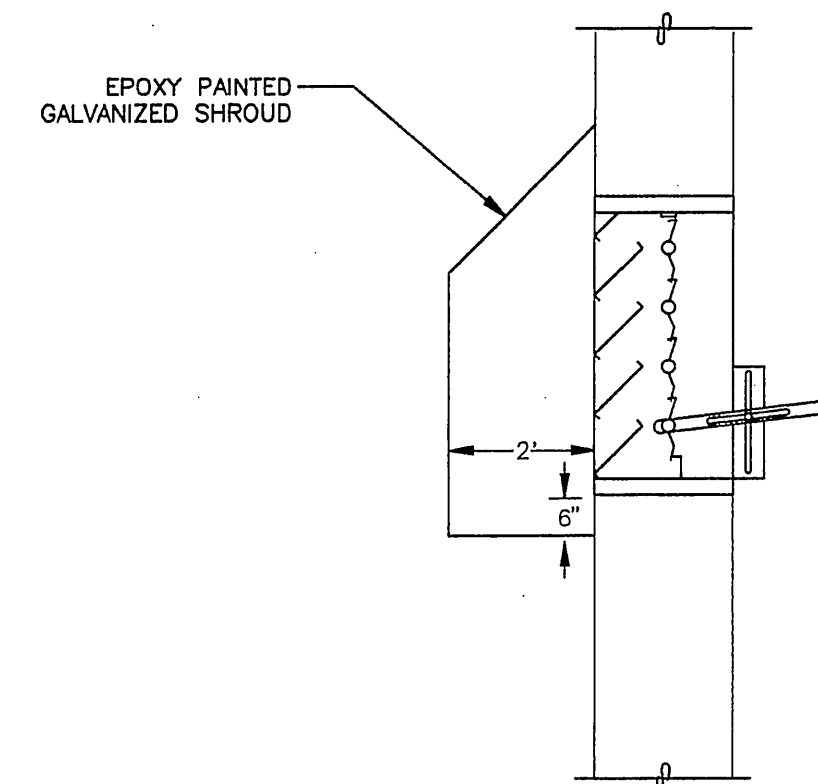


DETAIL - INTAKE LOUVER SHROUD
NO SCALE

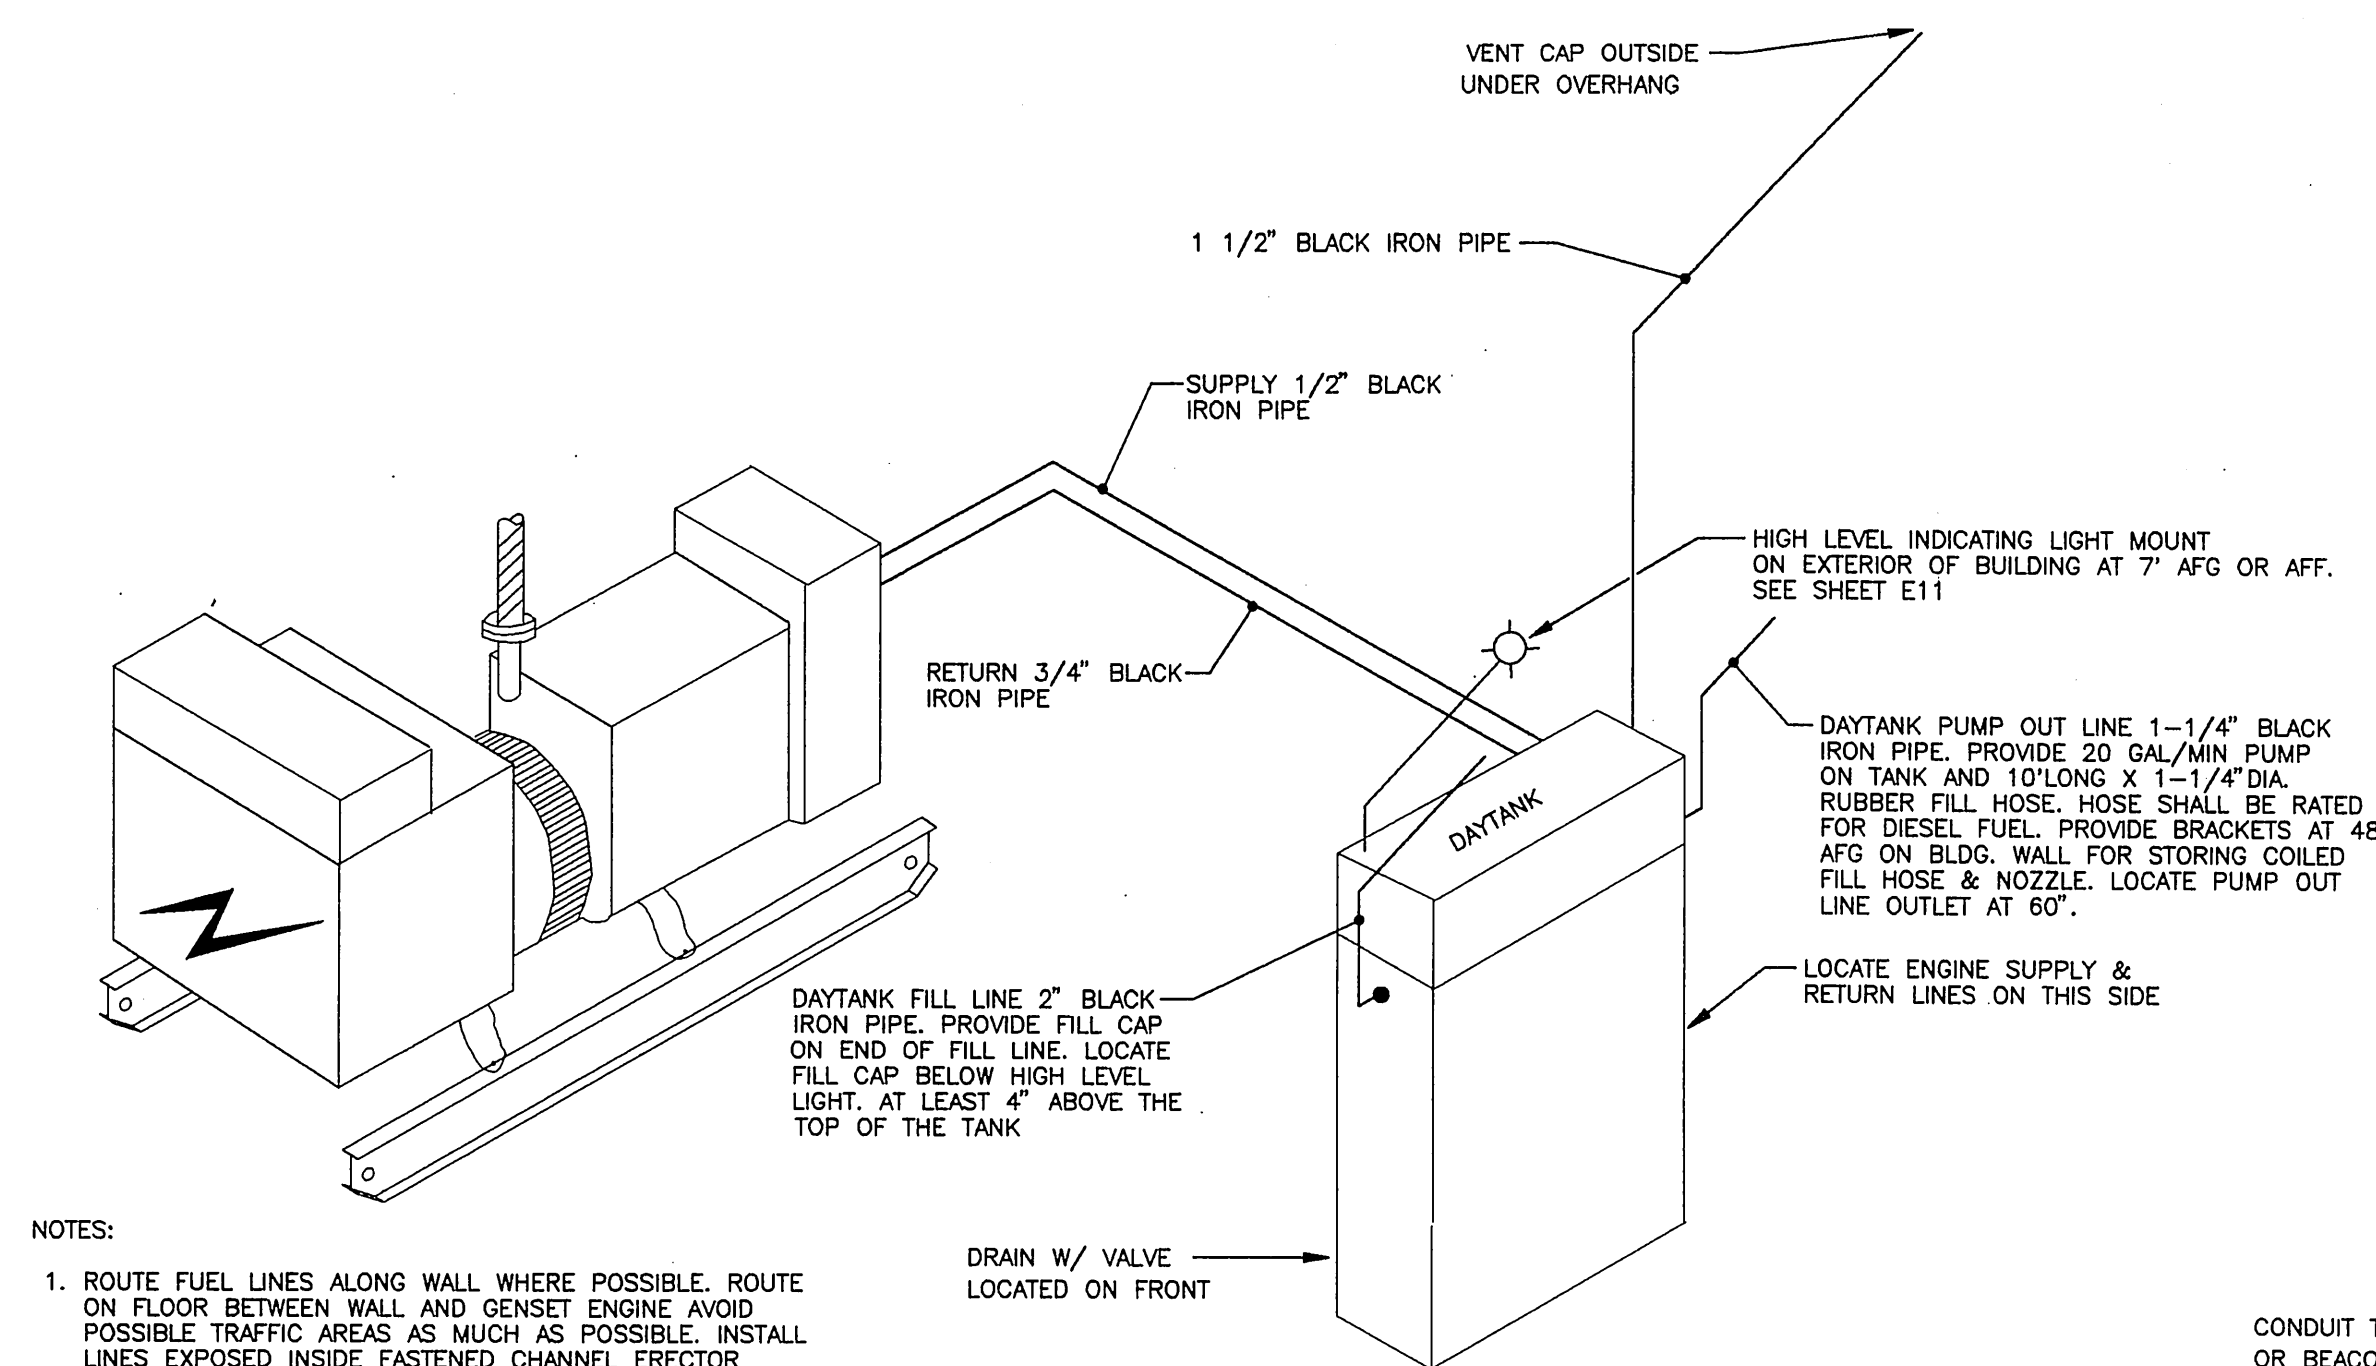

DETAIL - FUEL SYSTEM
NO SCALE

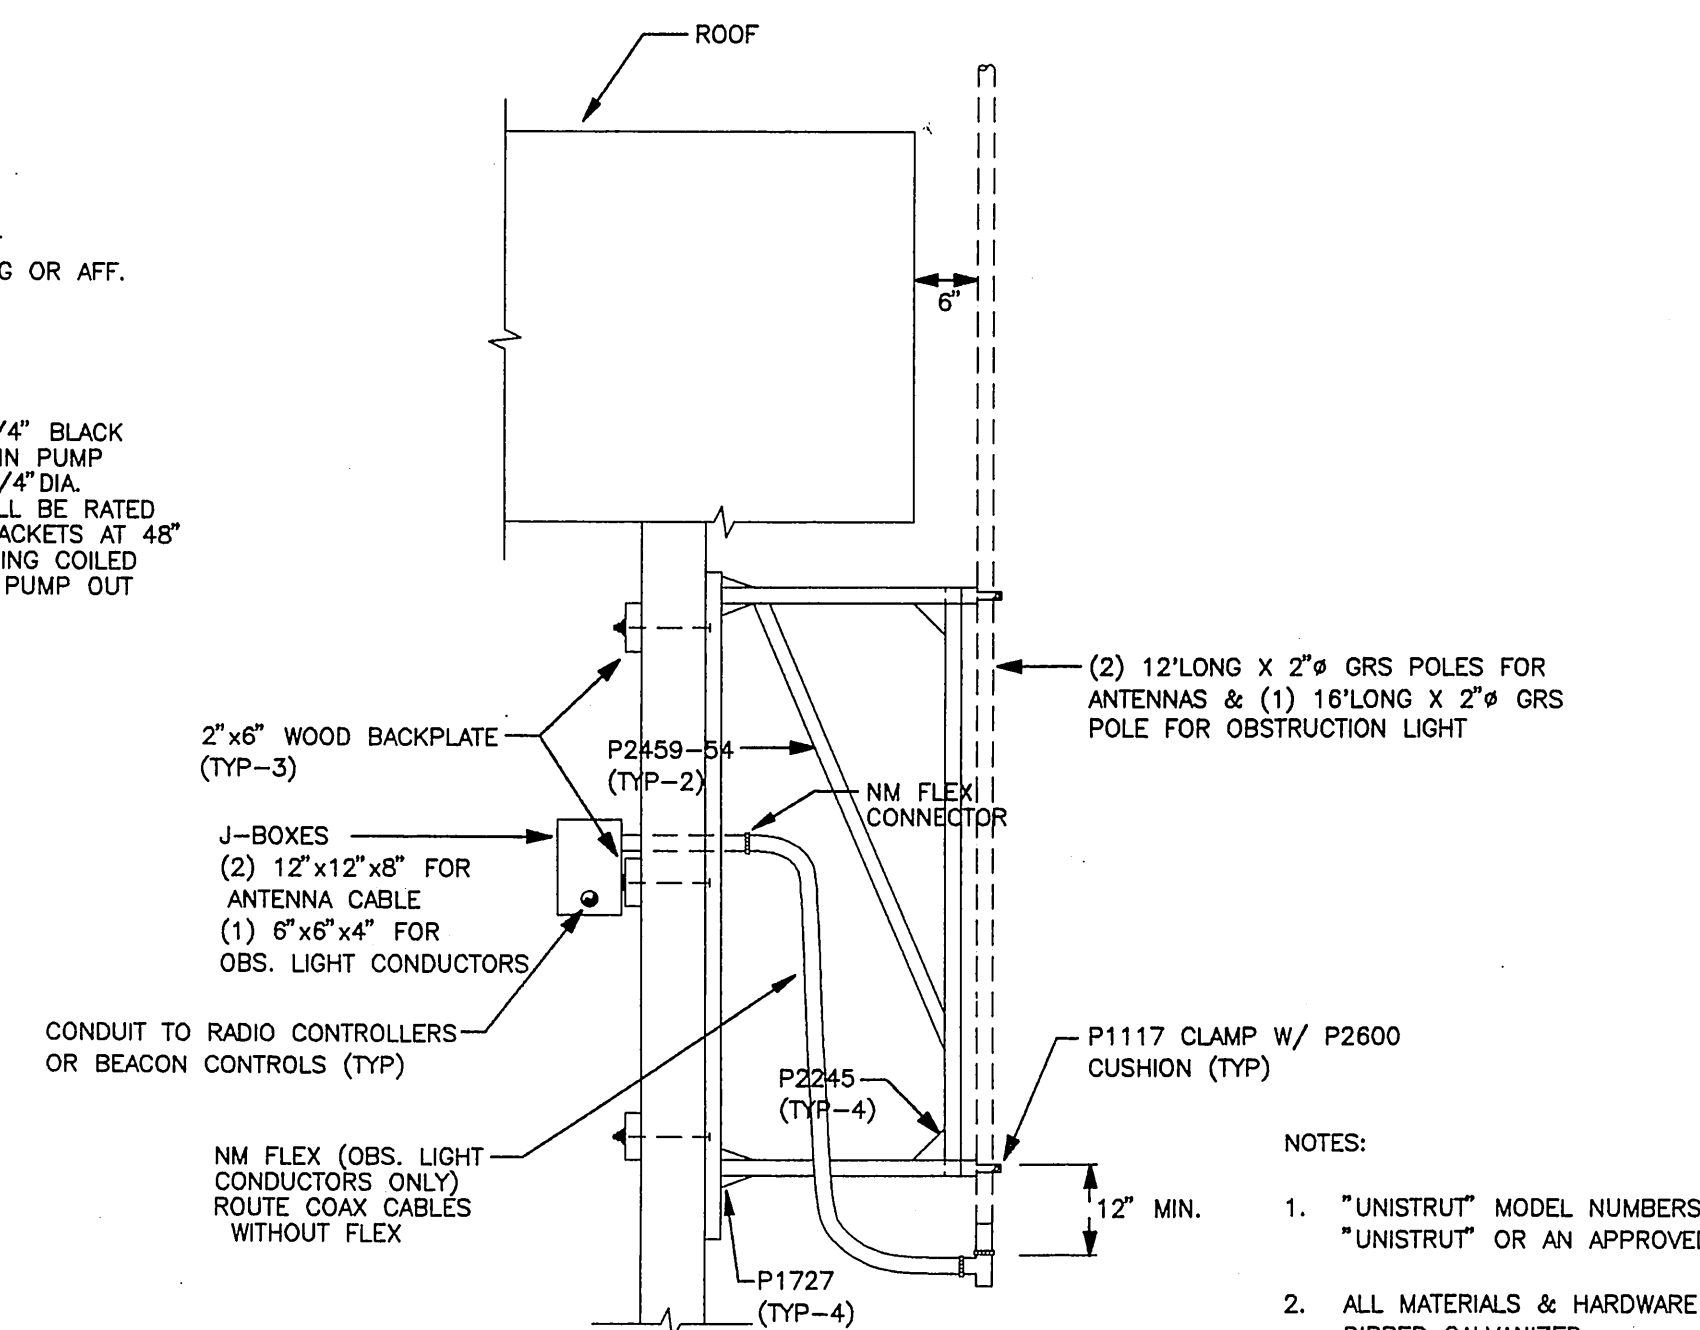

SIDE VIEW - NEW CONTROL BLDG. ANTENNA BRACKET
NO SCALE

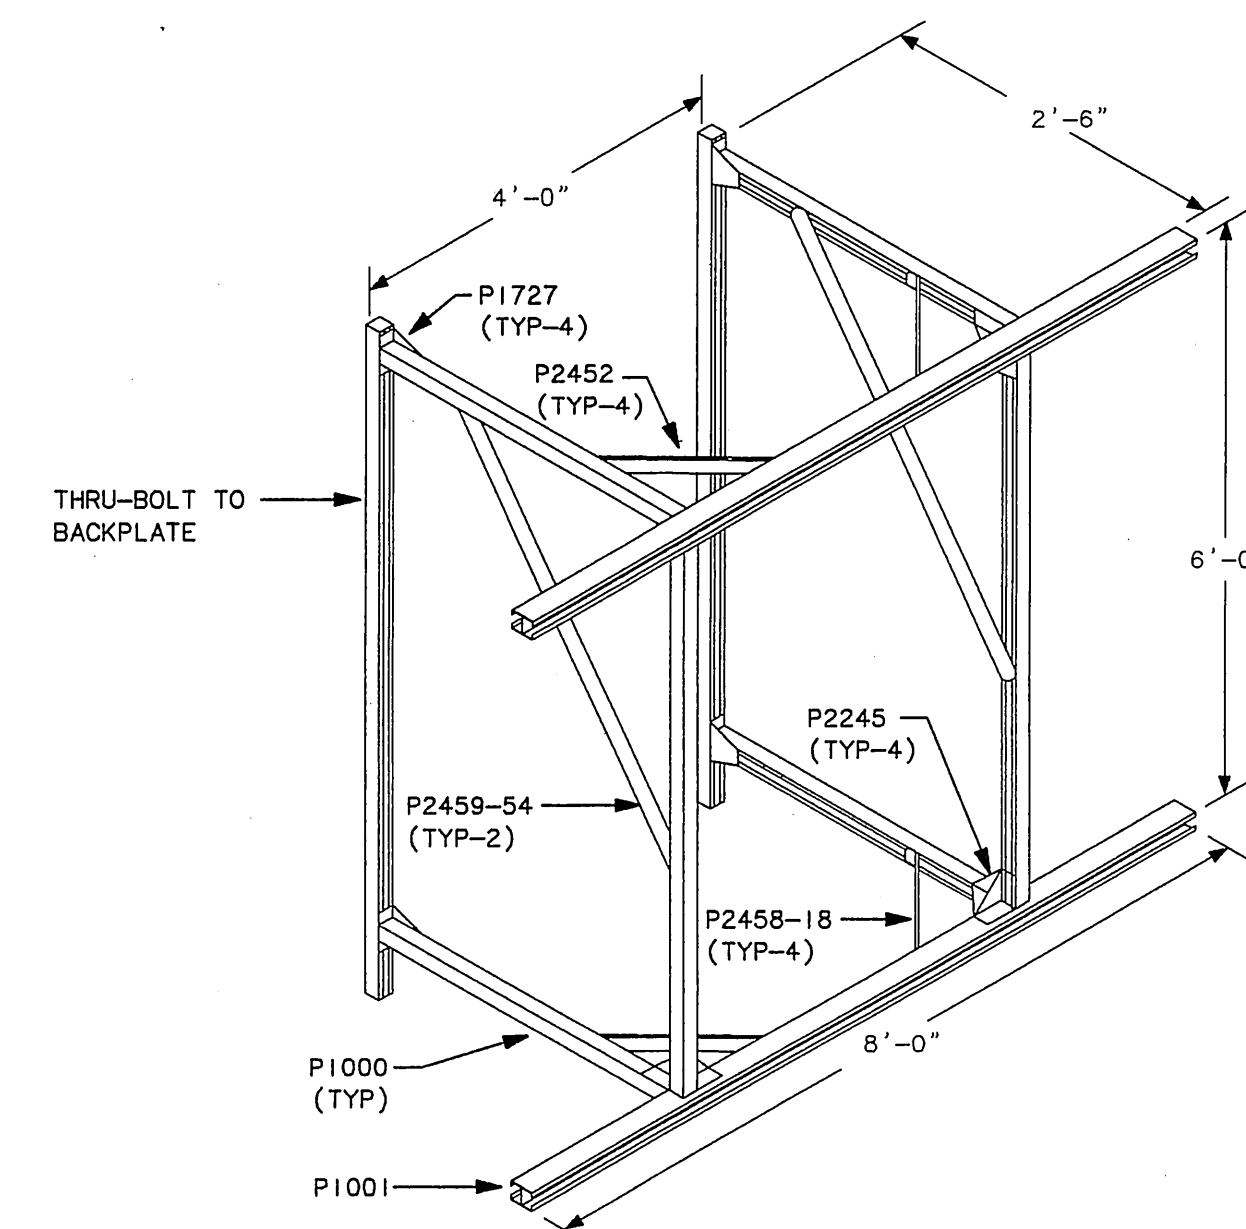


ISOMETRIC - NEW CONTROL BLDG. ANTENNA BRACKET
NO SCALE

BY:	DATE:	DESCRIPTION OF CHANGE:

STATE OF ALASKA
DEPARTMENT OF TRANSPORTATION
AND PUBLIC FACILITIES
SOUTHEAST REGION DESIGN & CONSTRUCTION

SITKA AIRPORT ELECTRICAL AND LIGHTING IMPROVEMENTS
SITKA ALASKA
GENSET & ANTENNA BRACKET DETAILS

 HAIGHT & McLAUGHLIN, INC. CONSULTING ENGINEERS 418 Harris Street, Juneau, Alaska 99801 (907) 586-9788			ENGINEER'S SEAL
DESIGNED BY: MGM	DATE: MAY 1994	PROJECT No. 71457	
DRAWN BY: JLC		E-12	
CHECKED BY: BCH		SHEET 14 of 20	

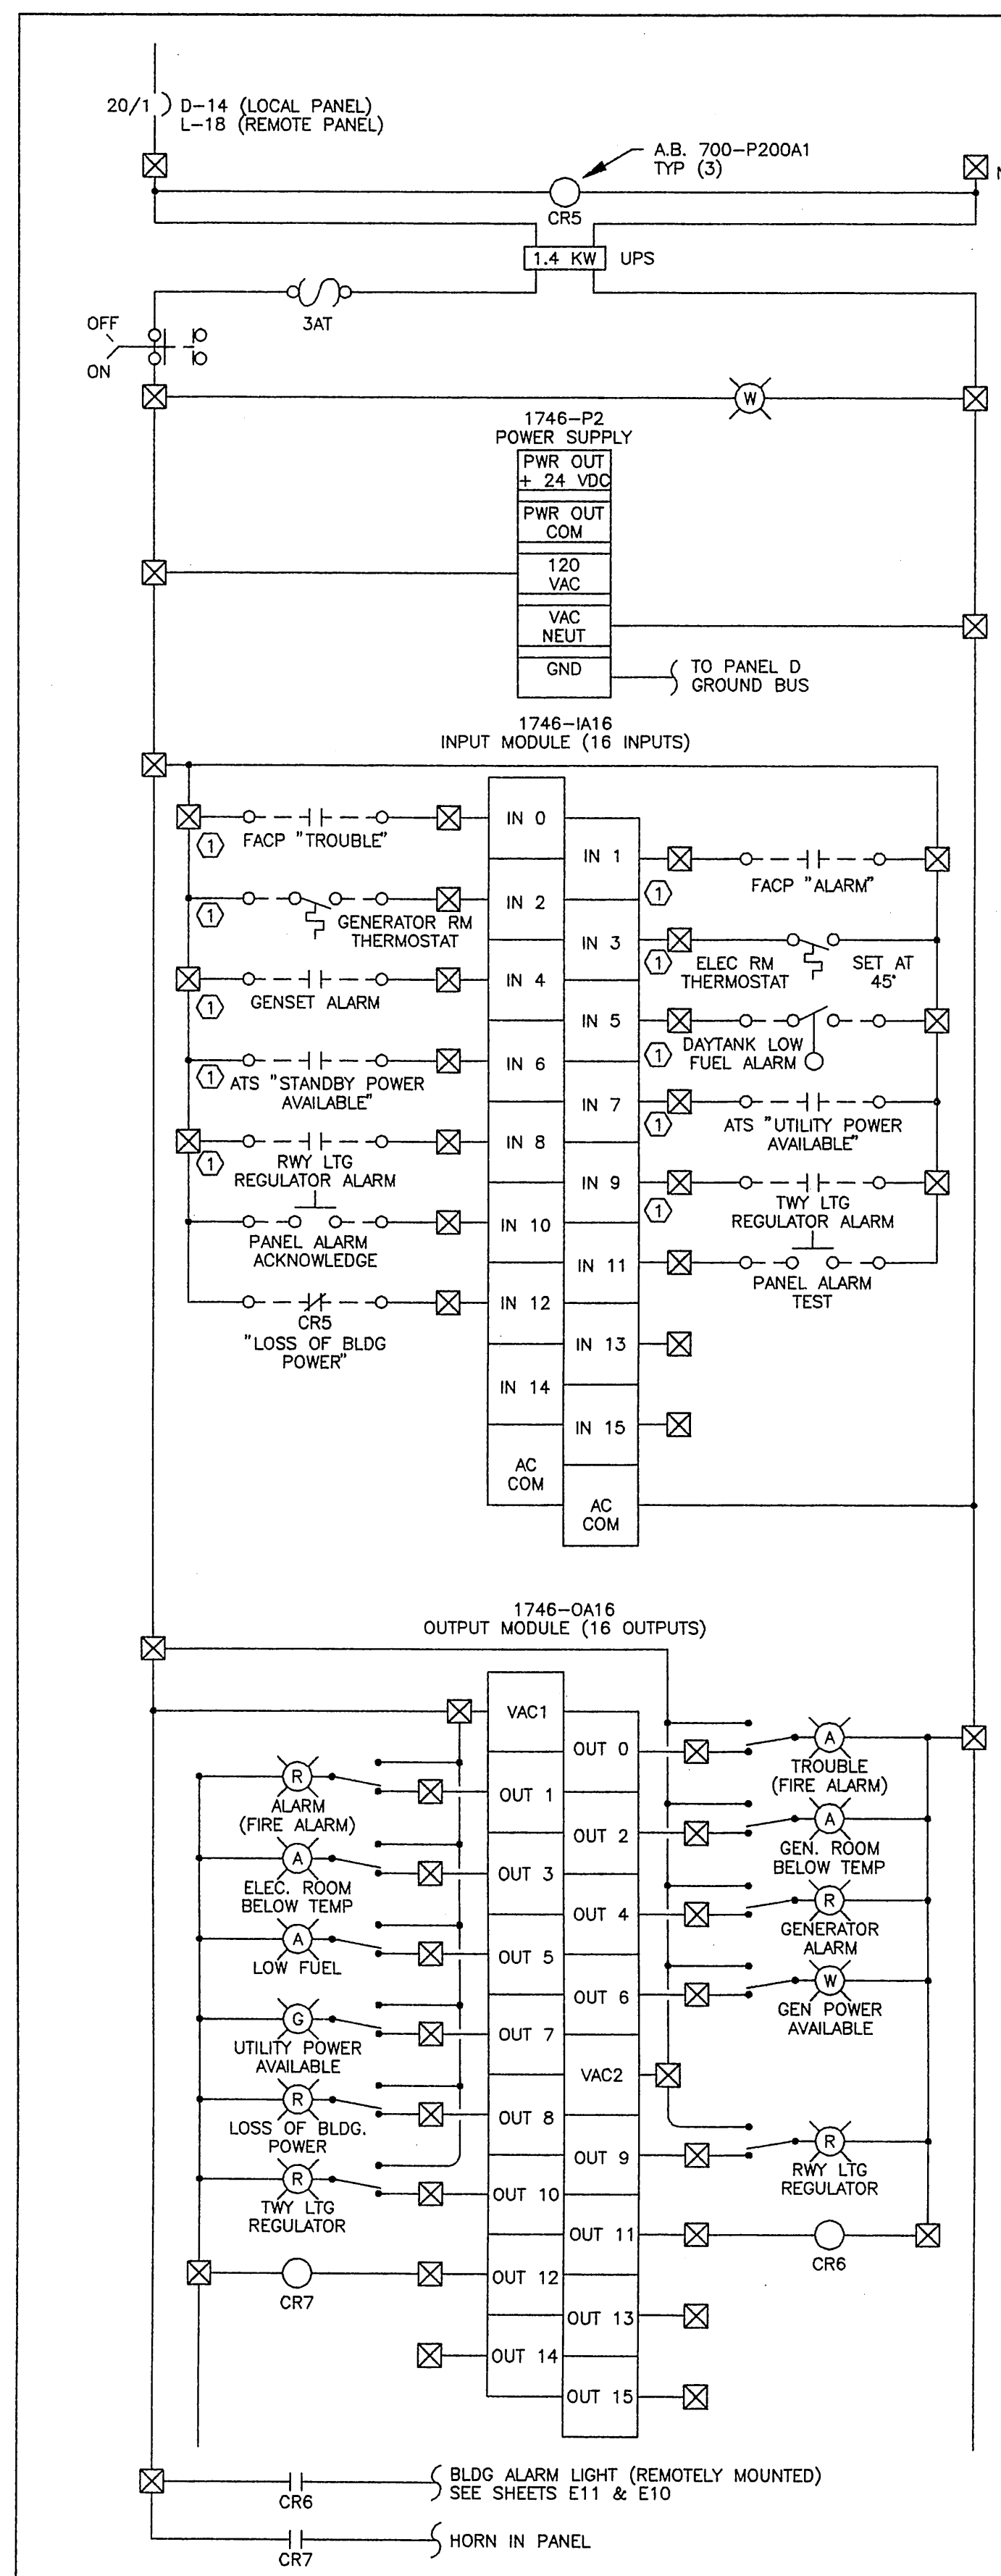


WIRING SCHEMATIC - LOCAL & REMOTE BUILDING ALARM PANEL
NO SCALE


BY:	DATE:	DESCRIPTION OF CHANGE:

STATE OF ALASKA
DEPARTMENT OF TRANSPORTATION
AND PUBLIC FACILITIES
SOUTHEAST REGION DESIGN & CONSTRUCTION

SITKA AIRPORT ELECTRICAL AND LIGHTING IMPROVEMENTS
SITKA ALASKA
BUILDING ALARM PANEL SCHEMATICS & DETAILS

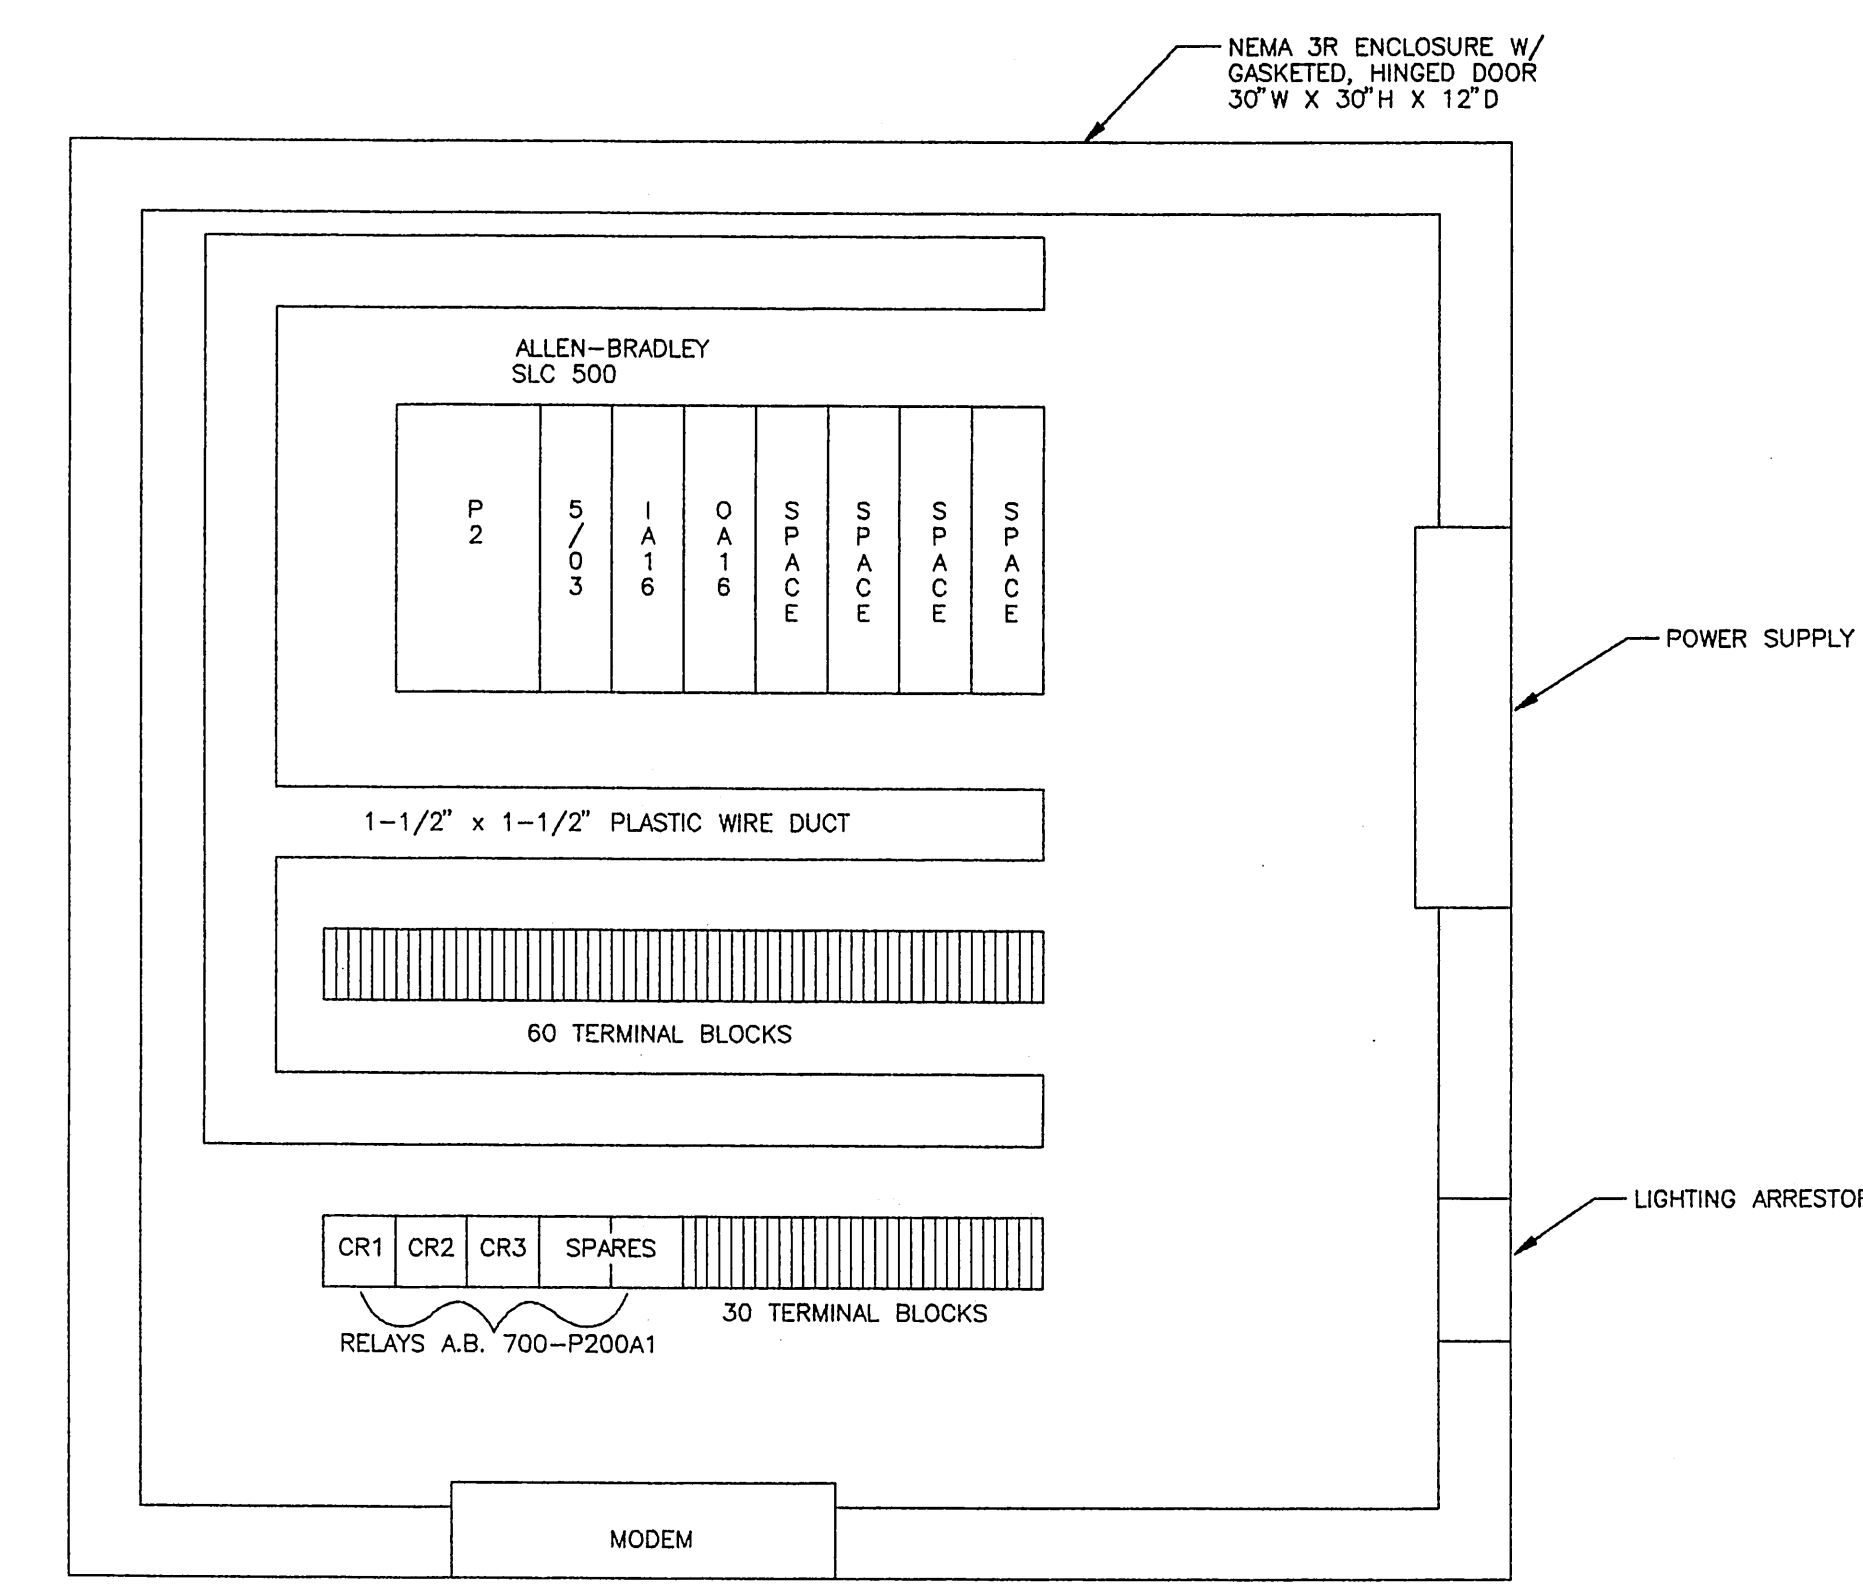


DETAIL - REMOTE & LOCAL BUILDING ALARM PANEL INTERIOR
SCALE: 3" = 1'-0"

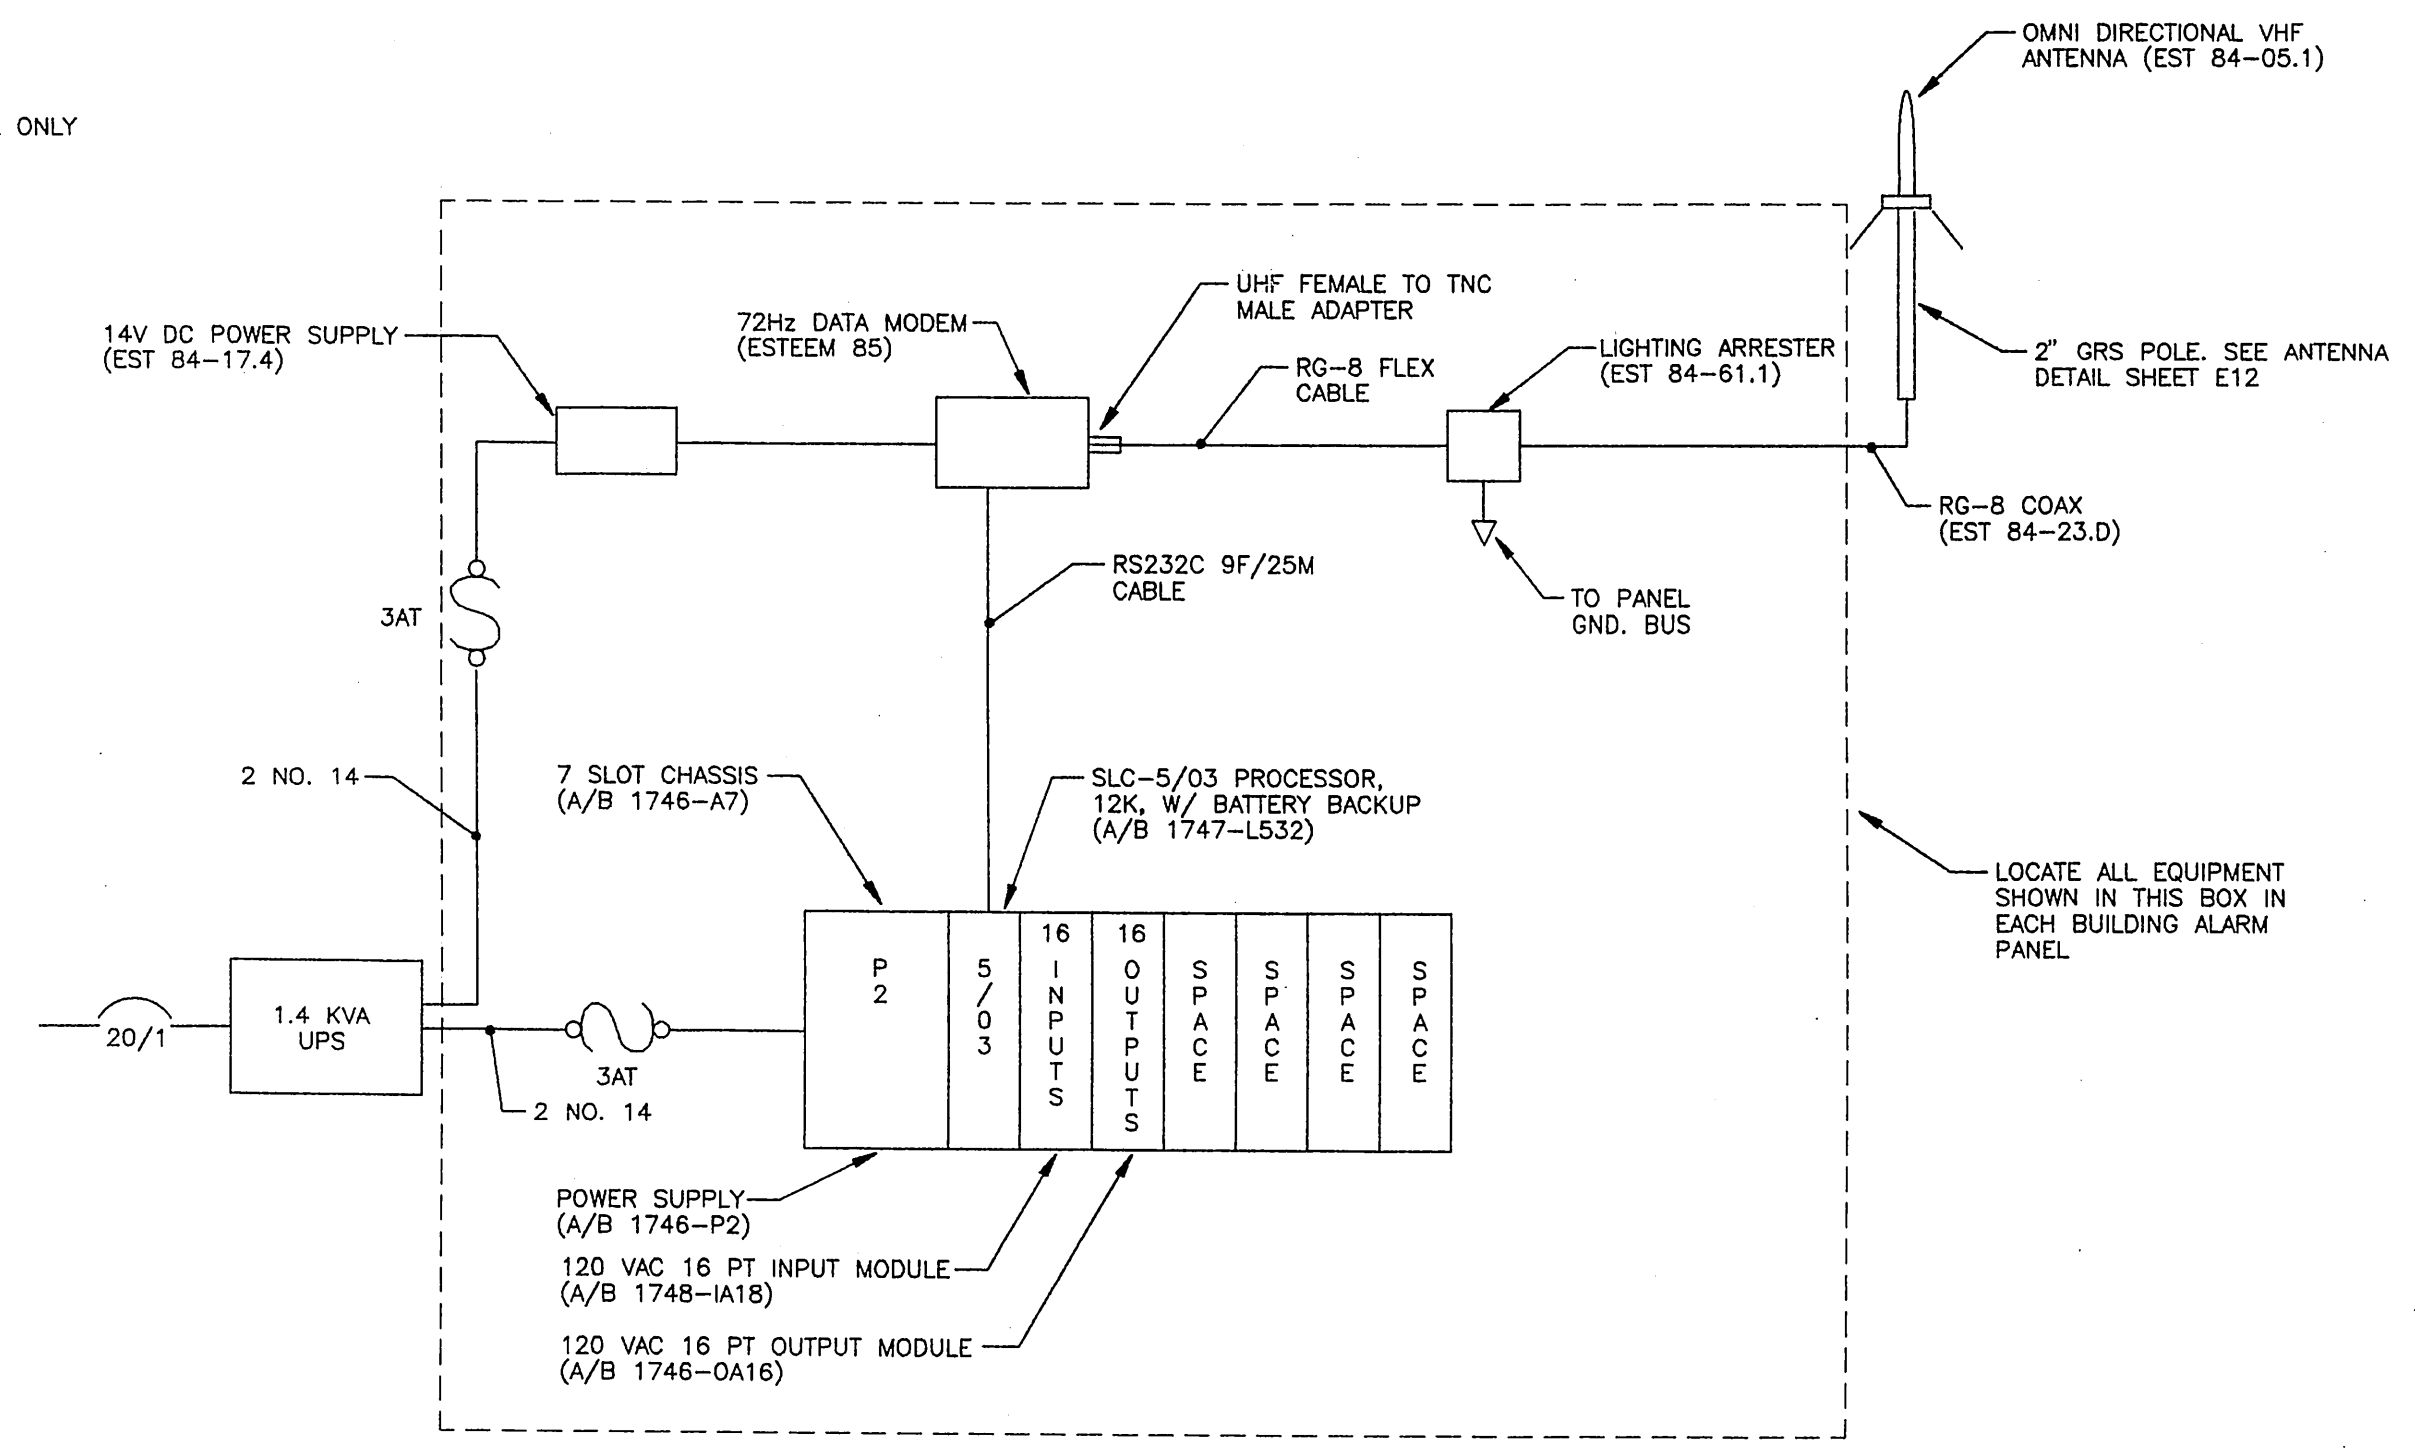

REMOTE & LOCAL BUILDING ALARM PANEL & UPS HARDWARE SCHEMATIC
NO SCALE

NOTE:
1. PROVIDE AN ALLEN BRADLEY (A/B) SLC-5 PLC AND ELECTRONIC SYSTEMS TECHNOLOGY RADIOS OR APPROVED EQUAL.

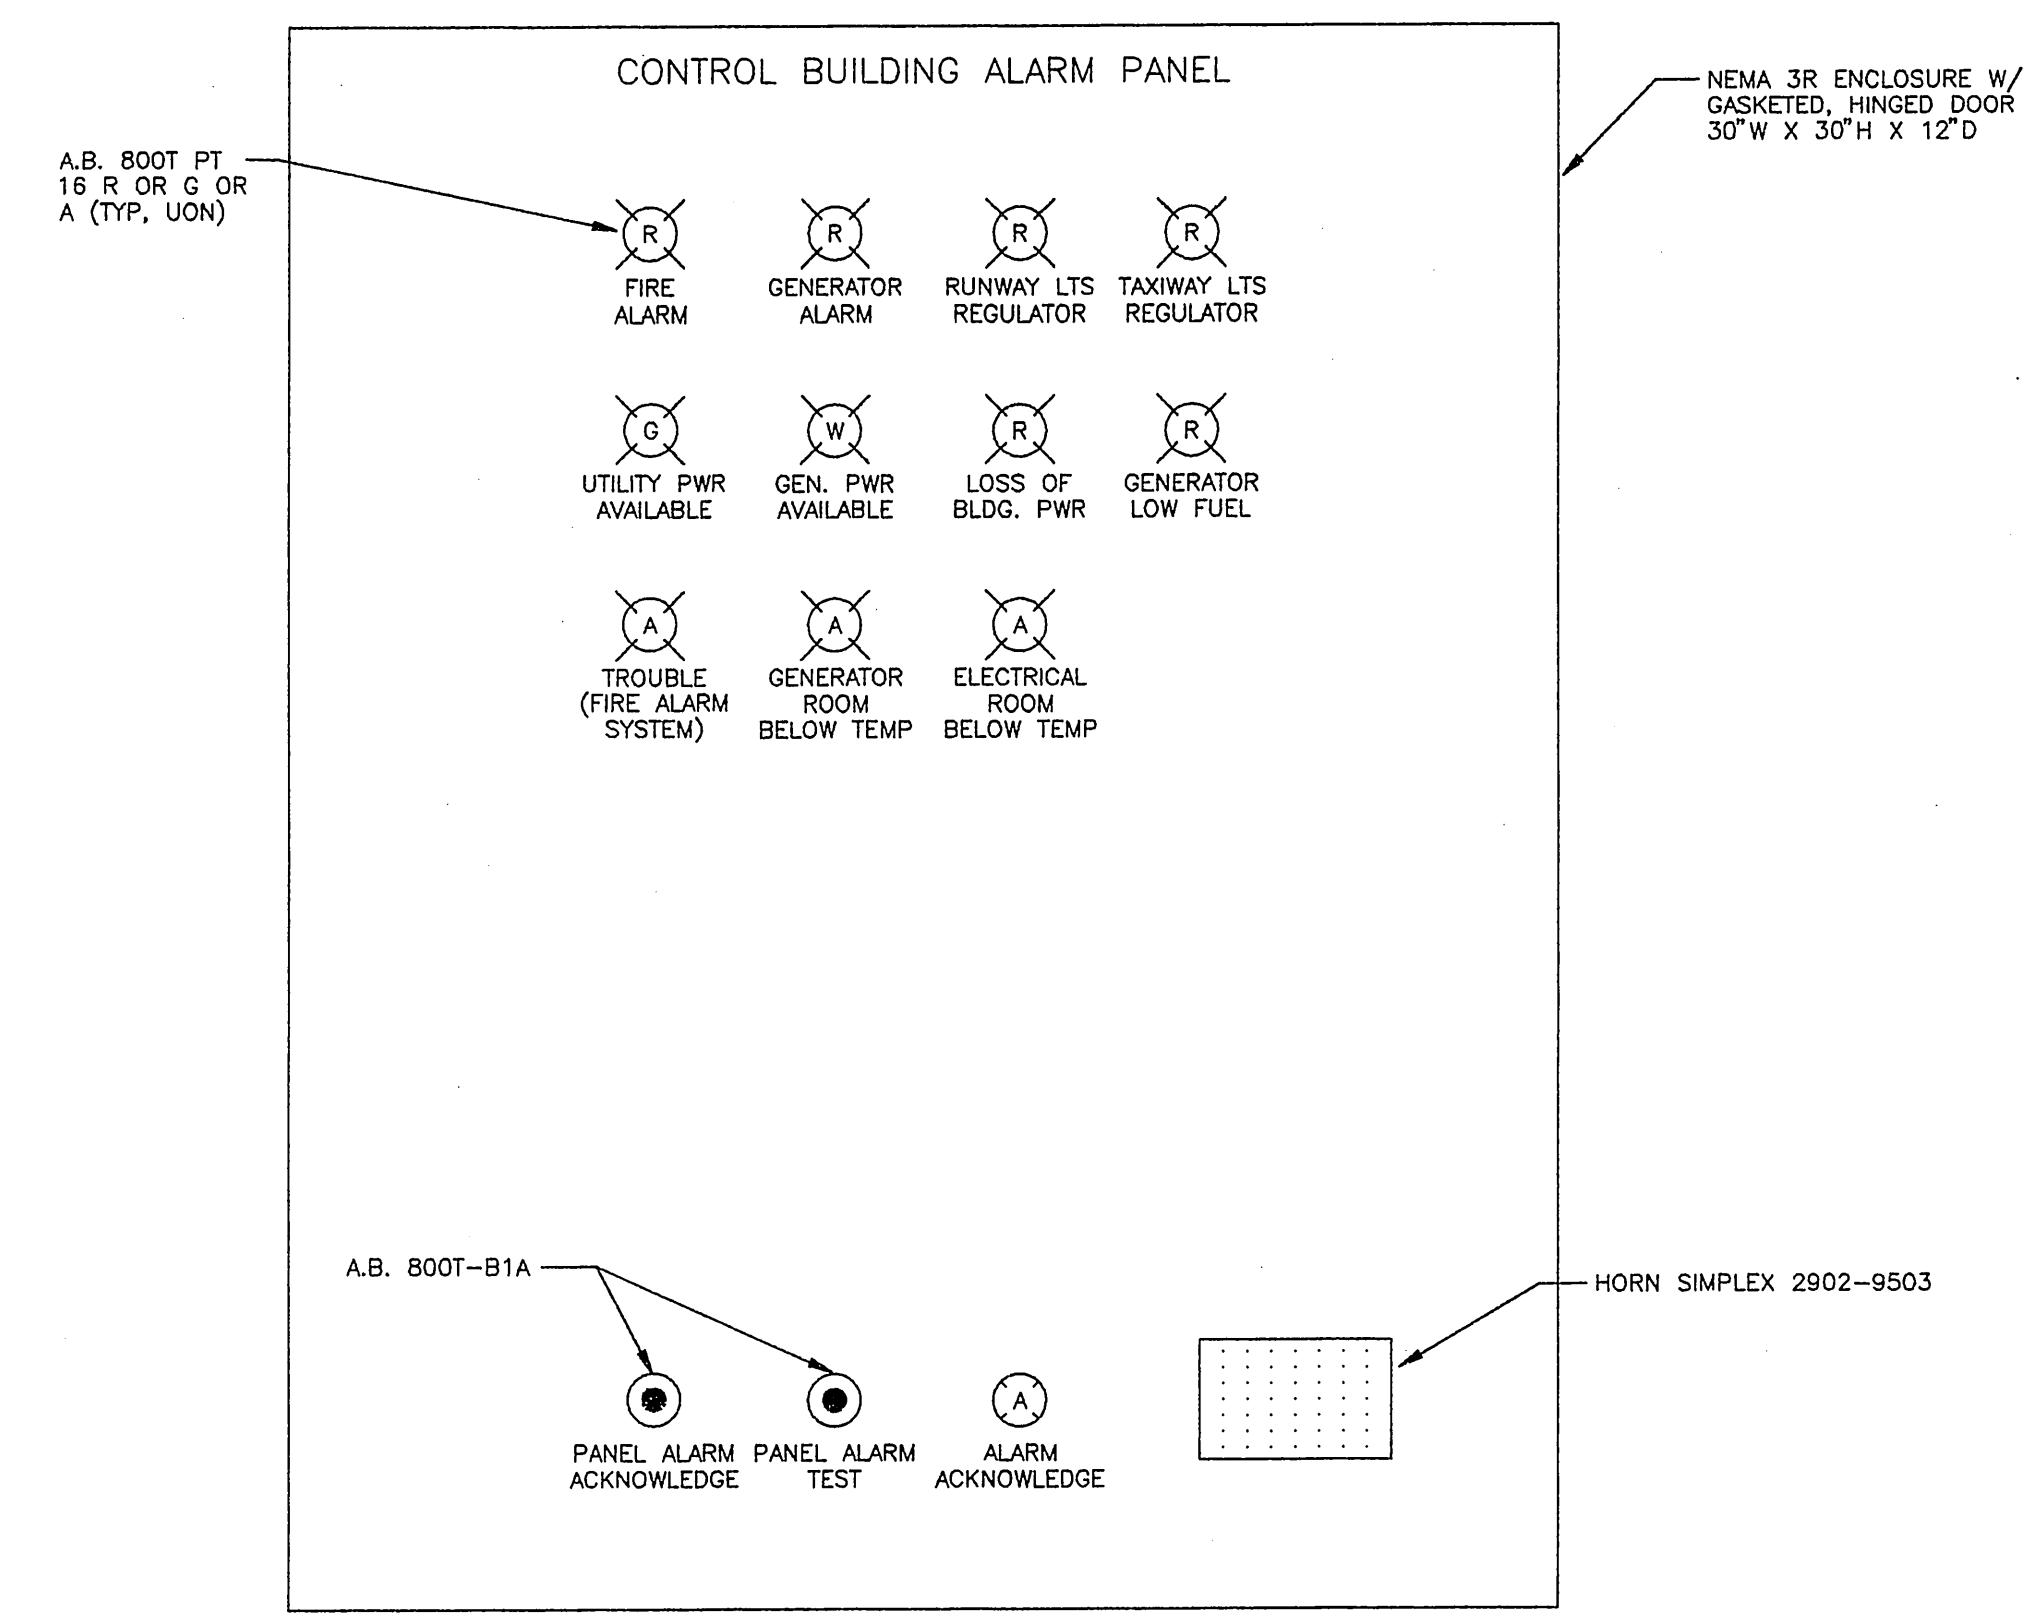

DETAIL - REMOTE & LOCAL BUILDING ALARM PANEL DOOR
SCALE: 3" = 1'-0"

BUILDING ALARM PANEL LOGIC

IF ANY OF THE NORMALLY OPEN DRY CONTACT INPUTS CLOSE, OR NORMALLY CLOSED CONTACTS OPEN, THEN ILLUMINATE THE CORRESPONDING LIGHT IN BOTH ALARM PANELS, (AS SHOWN IN TABLE BELOW), SOUND THE HORN IN BOTH ALARM PANELS, AND ILLUMINATE THE BUILDING ALARM LIGHT FOR EACH PANEL.

DRY CONTACT	PANEL LIGHT
FACP "TROUBLE"	TROUBLE (FIRE ALARM SYSTEM)
FACP "ALARM"	FIRE ALARM
GENERATOR RM. THERMOSTAT	GENERATOR RM. BELOW TEMP
ELEC. RM. THERMOSTAT	ELEC. RM. BELOW TEMP
GENSET ALARM	GENERATOR ALARM
DAYTANK LOW FUEL ALARM	GENERATOR LOW FUEL
ATS "STANDBY POWER AVAILABLE"	GEN. POWER AVAILABLE
ATS "UTILITY POWER AVAILABLE"	UTILITY POWER AVAILABLE
	(DO NOT SOUND THE HORN OR ILLUMINATE THE BLDG ALARM LIGHT FOR THE PANEL IN THIS CASE)
RUNWAY LTG. REGULATOR ALARM	RUNWAY LTG. REGULATOR
TAXIWAY LTG. REGULATOR ALARM	TAXIWAY LTG. REGULATOR
LOSS OF BLDG. POWER	LOSS OF BLDG. POWER

ONCE ANY OF THE NORMALLY OPEN DRY CONTACT INPUTS CLOSE OR NORMALLY CLOSED CONTACTS OPEN, THE CORRESPONDING PANEL LIGHTS AND BUILDING ALARM LIGHTS SHALL STAY ILLUMINATED UNTIL THE INPUT CONTACTS RETURN TO THEIR NORMAL CONDITION AND THE ALARM ACKNOWLEDGE BUTTON IS PRESSED AT EITHER PANEL. PRESSING THE ALARM ACKNOWLEDGE BUTTON SHALL SILENCE THE HORN.

PRESSING THE PANEL ALARM TEST BUTTON SHALL SOUND THE HORN IN THE SAME PANEL & ILLUMINATE THE BUILDING ALARM LIGHT FOR THAT PANEL AS LONG AS THE BUTTON IS HELD IN.

IMPLEMENT THIS LOGIC WITH THE EQUIPMENT SHOWN IN THE BUILDING ALARM PANEL DETAILS AND SCHEMATICS SHOWN ON THIS SHEET.

PROVIDE ALL NECESSARY SOFTWARE, & PROGRAMMING NECESSARY TO PROVIDE FULLY OPERATIONAL CONTROL PANELS WITH THE FUNCTIONS DESCRIBED ABOVE.

HAIGHT & McLAUGHLIN, INC.
CONSULTING ENGINEERS
418 Harris Street, Juneau, Alaska 99801 (907) 586-9788

DESIGNED BY: MGM DATE: MAY 1994 PROJECT No. 71457

DRAWN BY: JLC

CHECKED BY: BCH

BY: DATE: DESCRIPTION OF CHANGE:



PROJECT No. 71457

E-13


SHEET 15 OF 20

ENGINEER'S SEAL


49th B.C. HAIGHT EE 4800

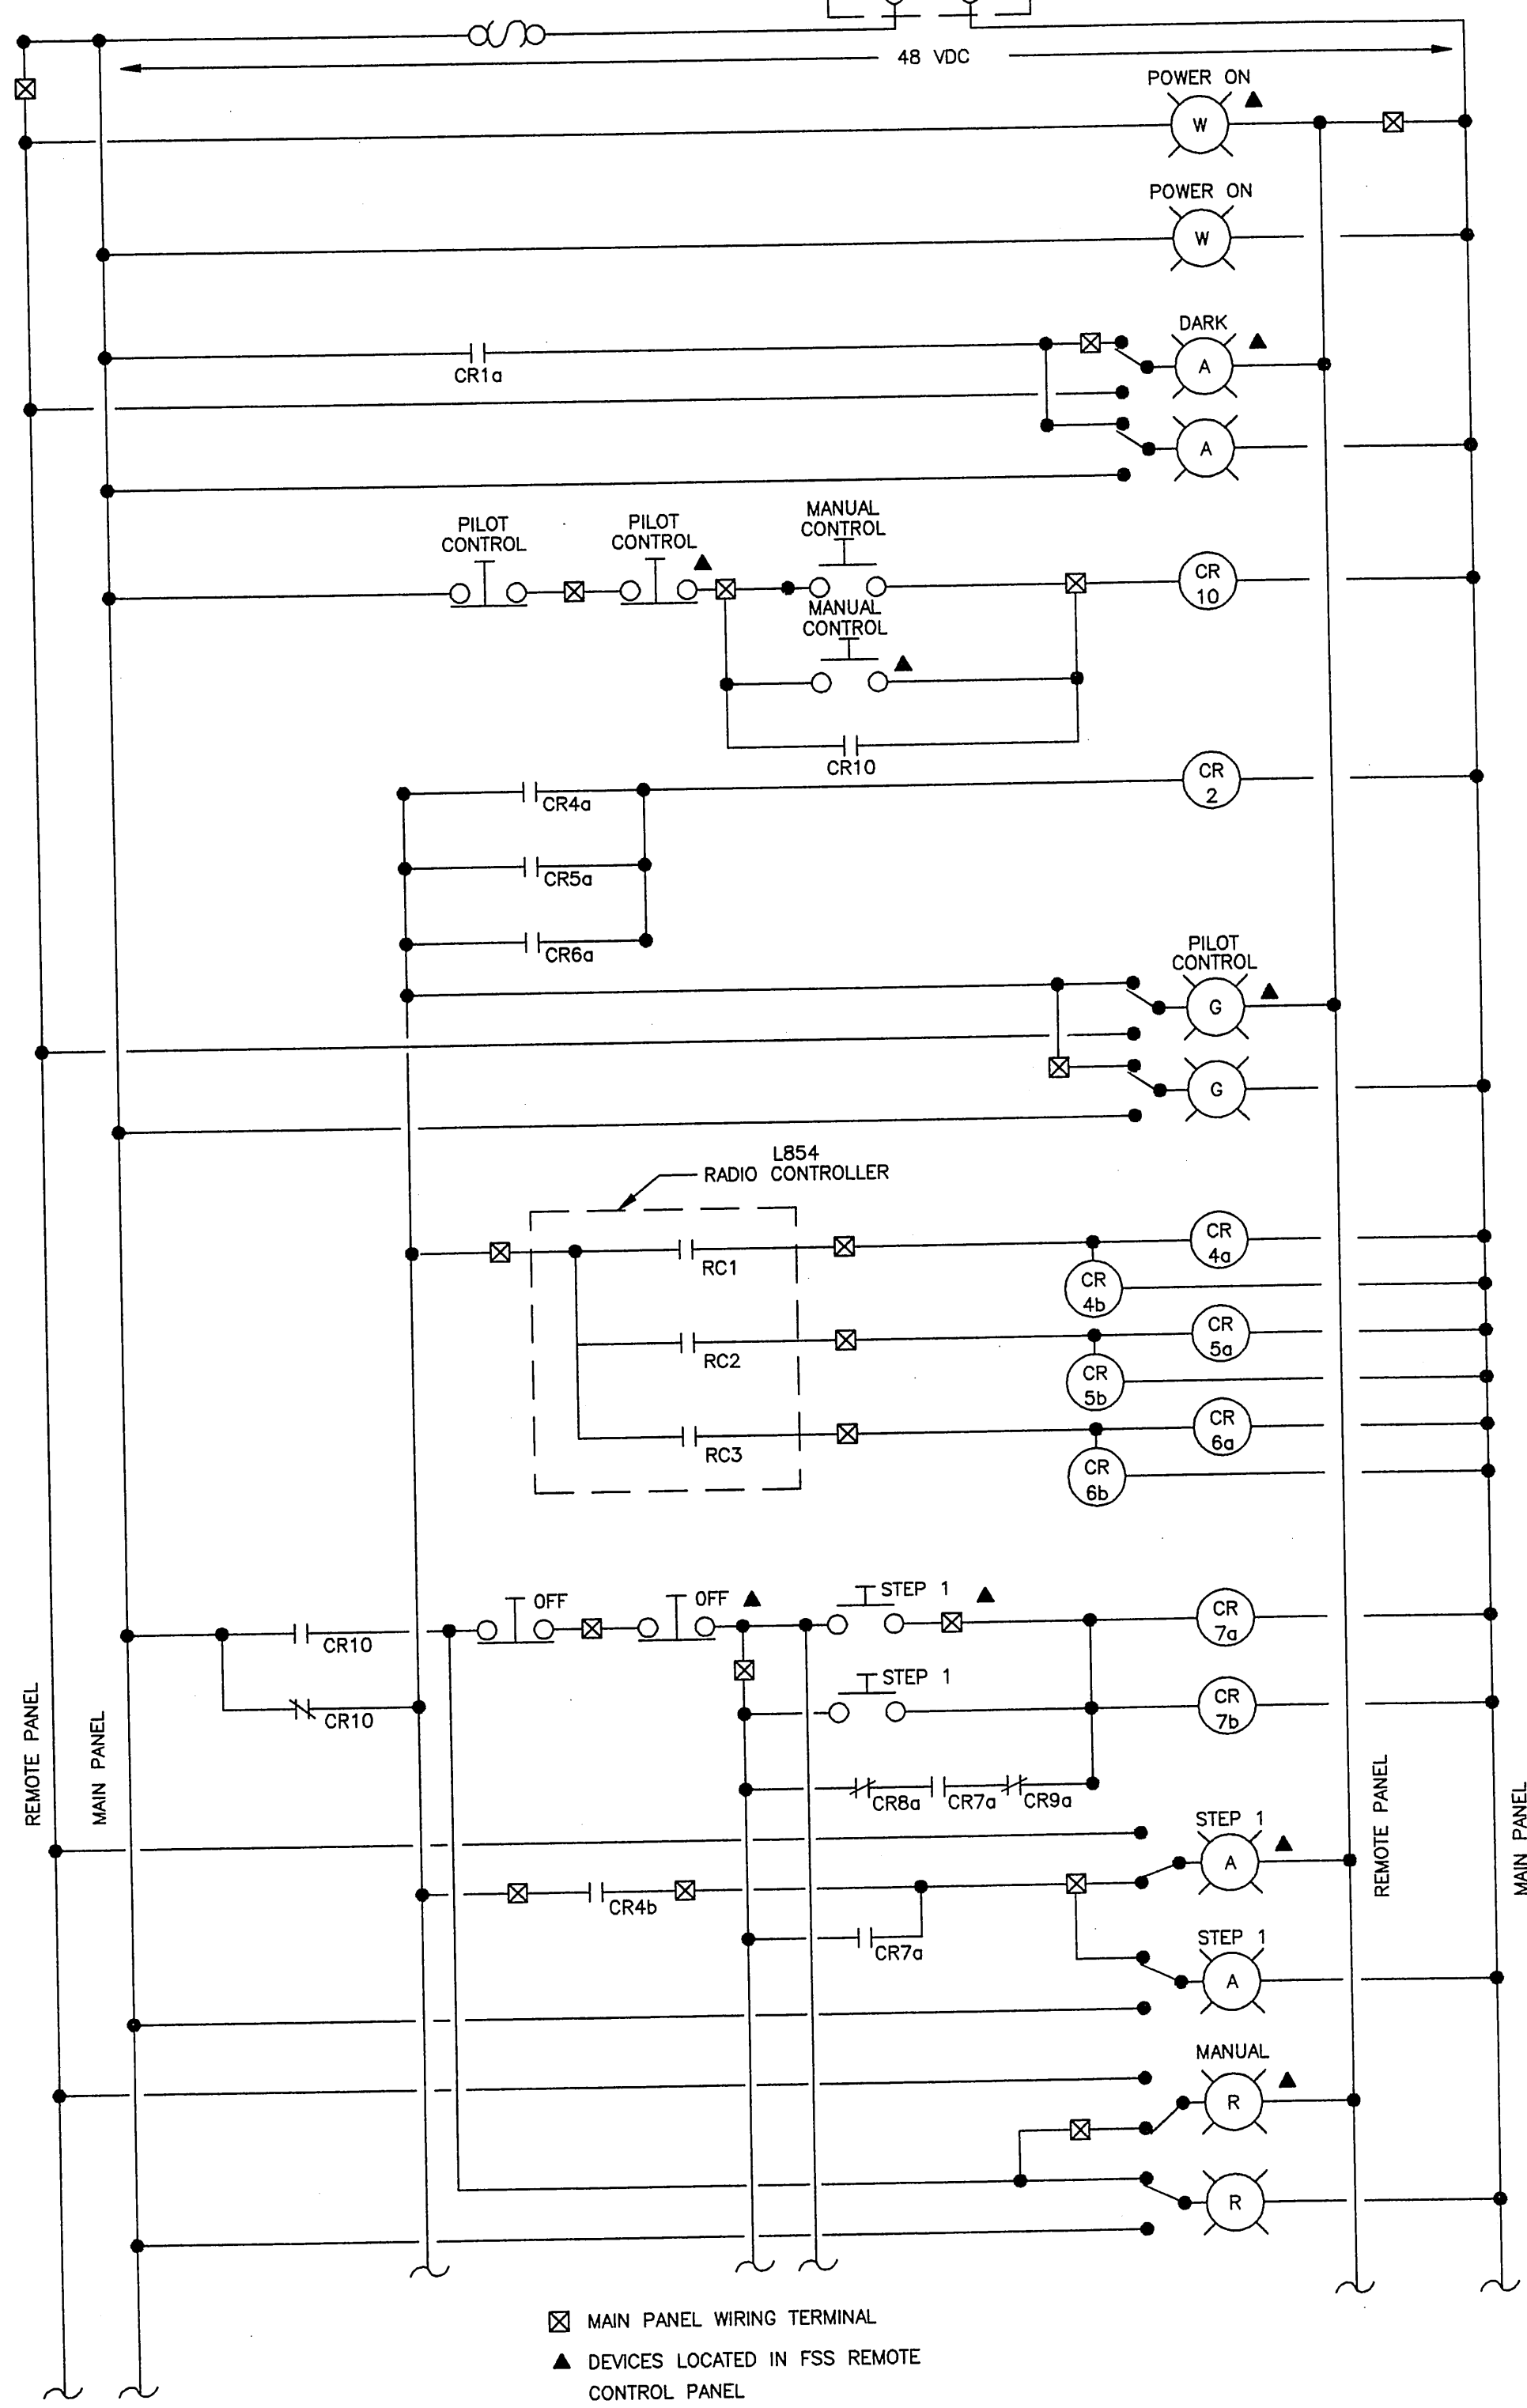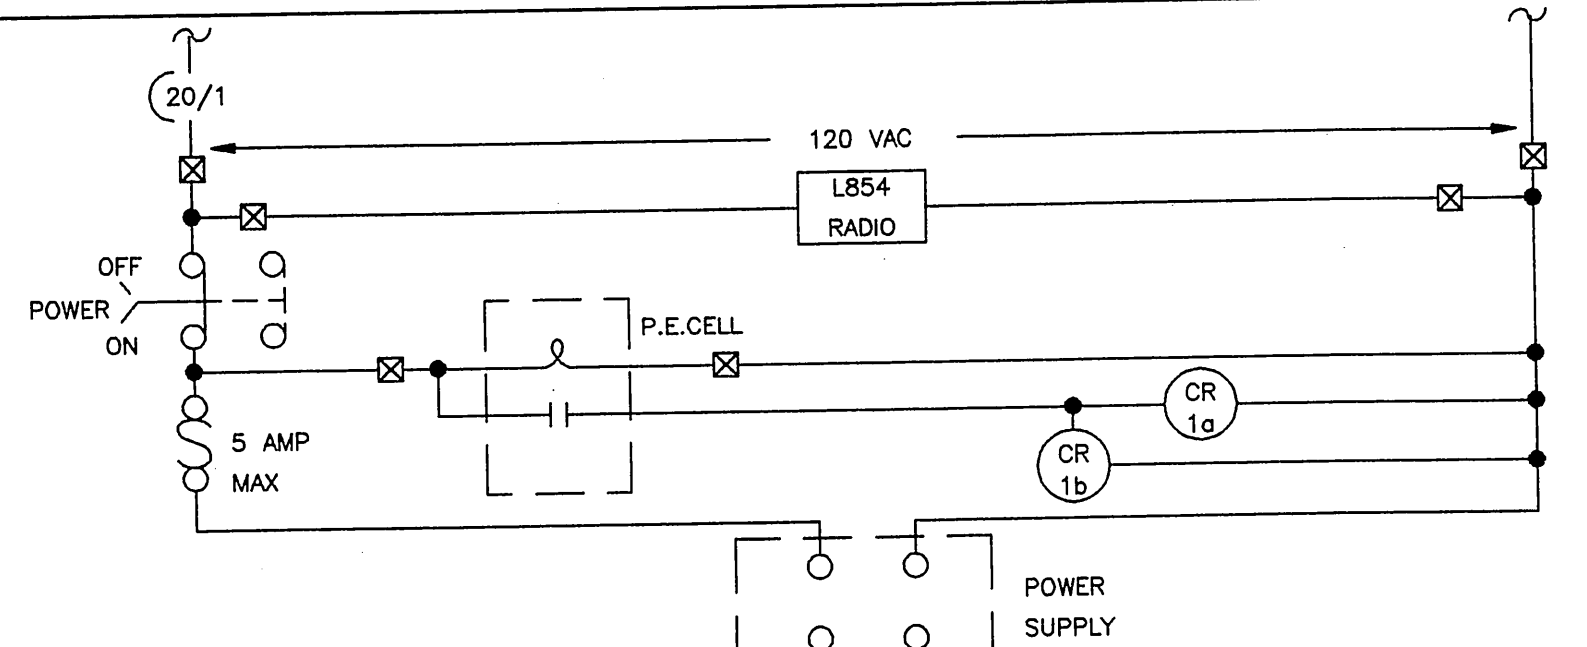


☒ MAIN PANEL WIRING TERMINAL
 ▲ DEVICES LOCATED IN FSS REMOTE CONTROL PANEL

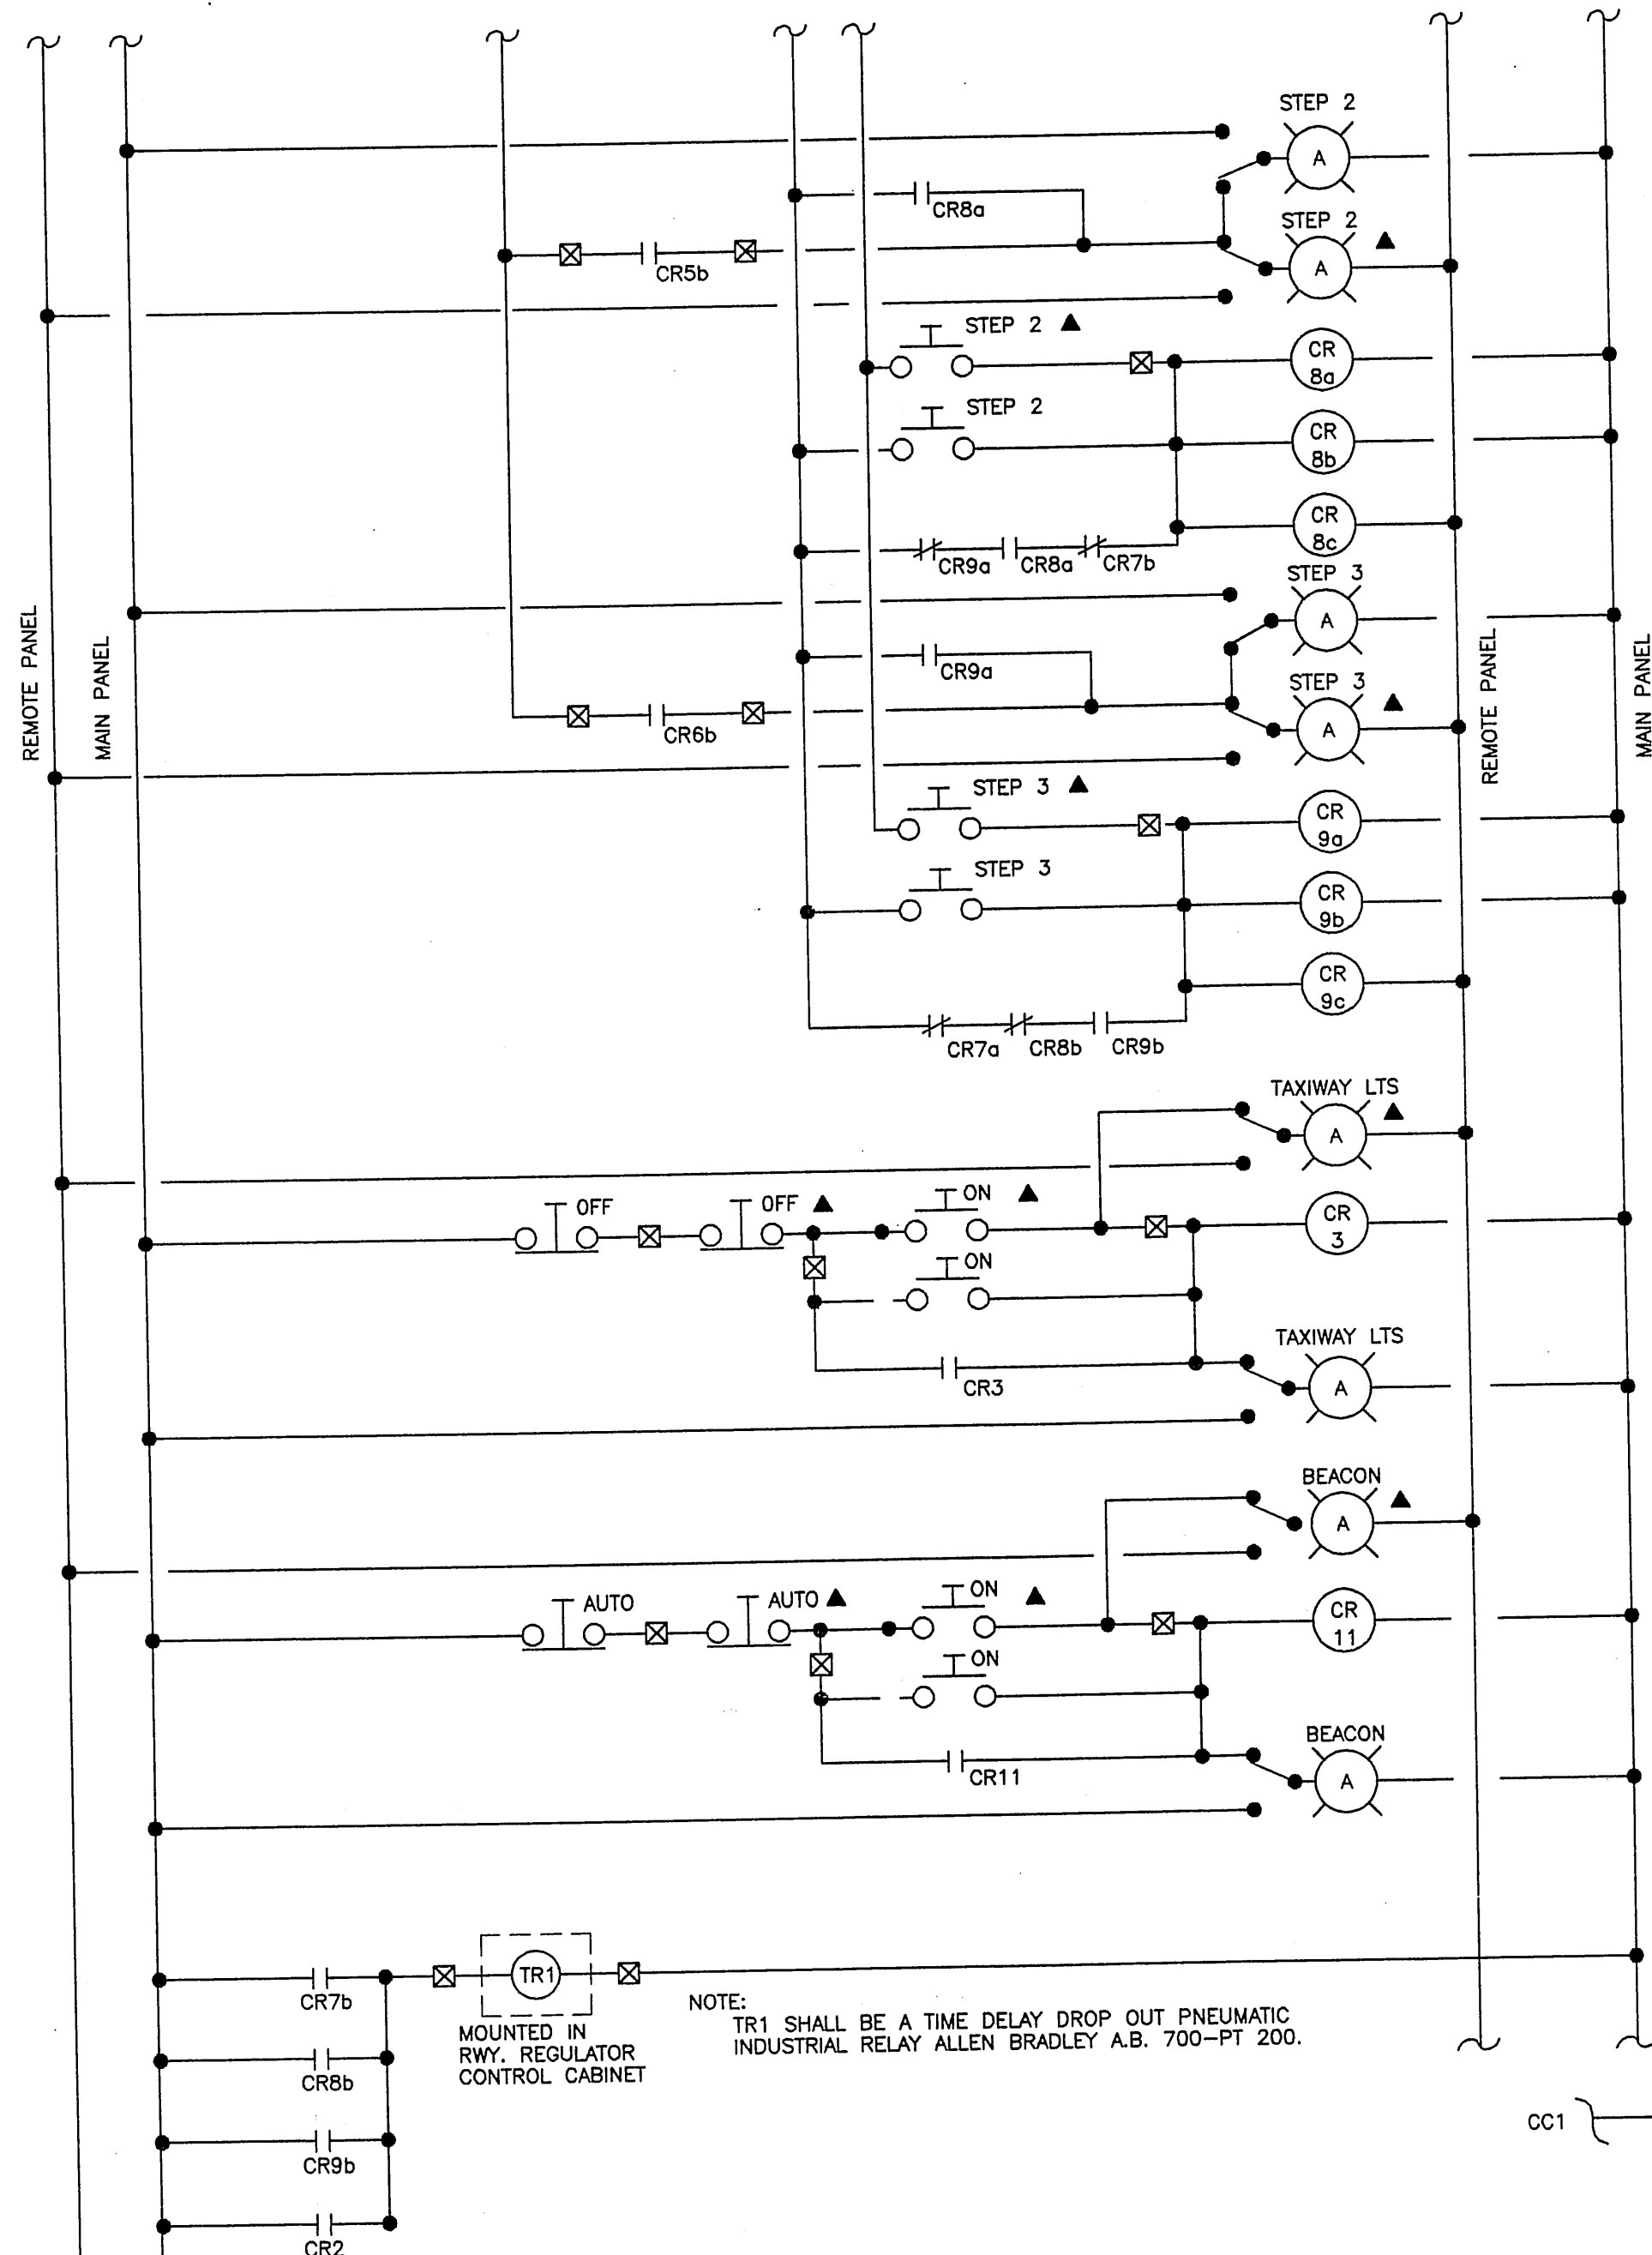


NOTE: TR1 SHALL BE A TIME DELAY DROP OUT PNEUMATIC INDUSTRIAL RELAY ALLEN BRADLEY A.B. 700-PT 200.
 MOUNTED IN R.W.Y. REGULATOR CONTROL CABINET

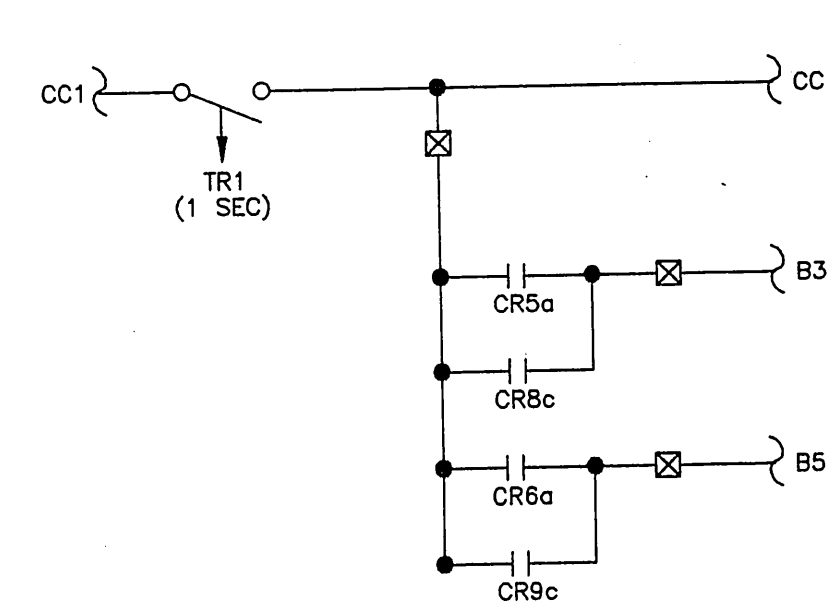

RUNWAY REGULATOR (30 KW)

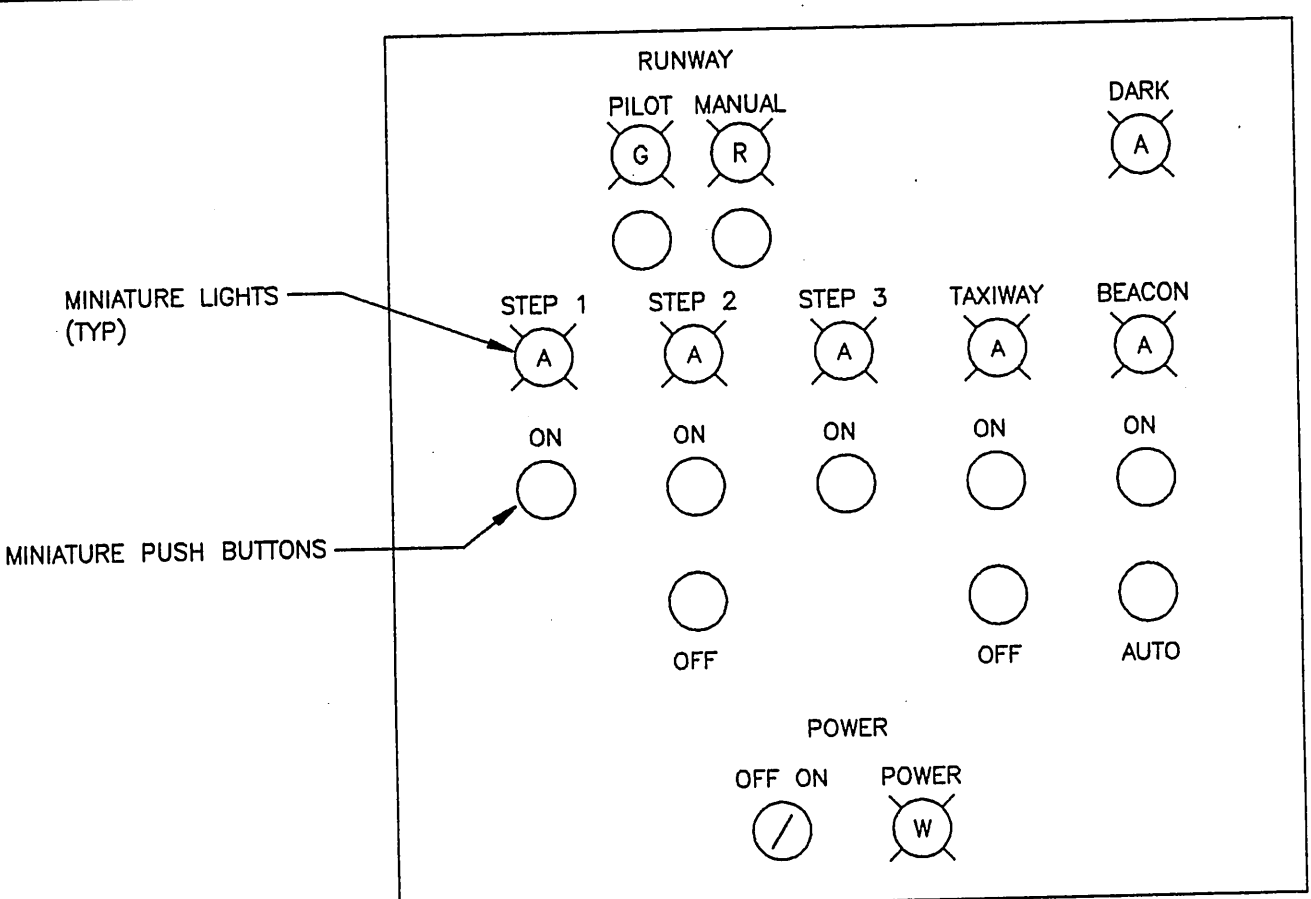


FRONT VIEW - MAIN LIGHTING CONTROL PANEL
(LOCATION IN CONTROL BUILDING)

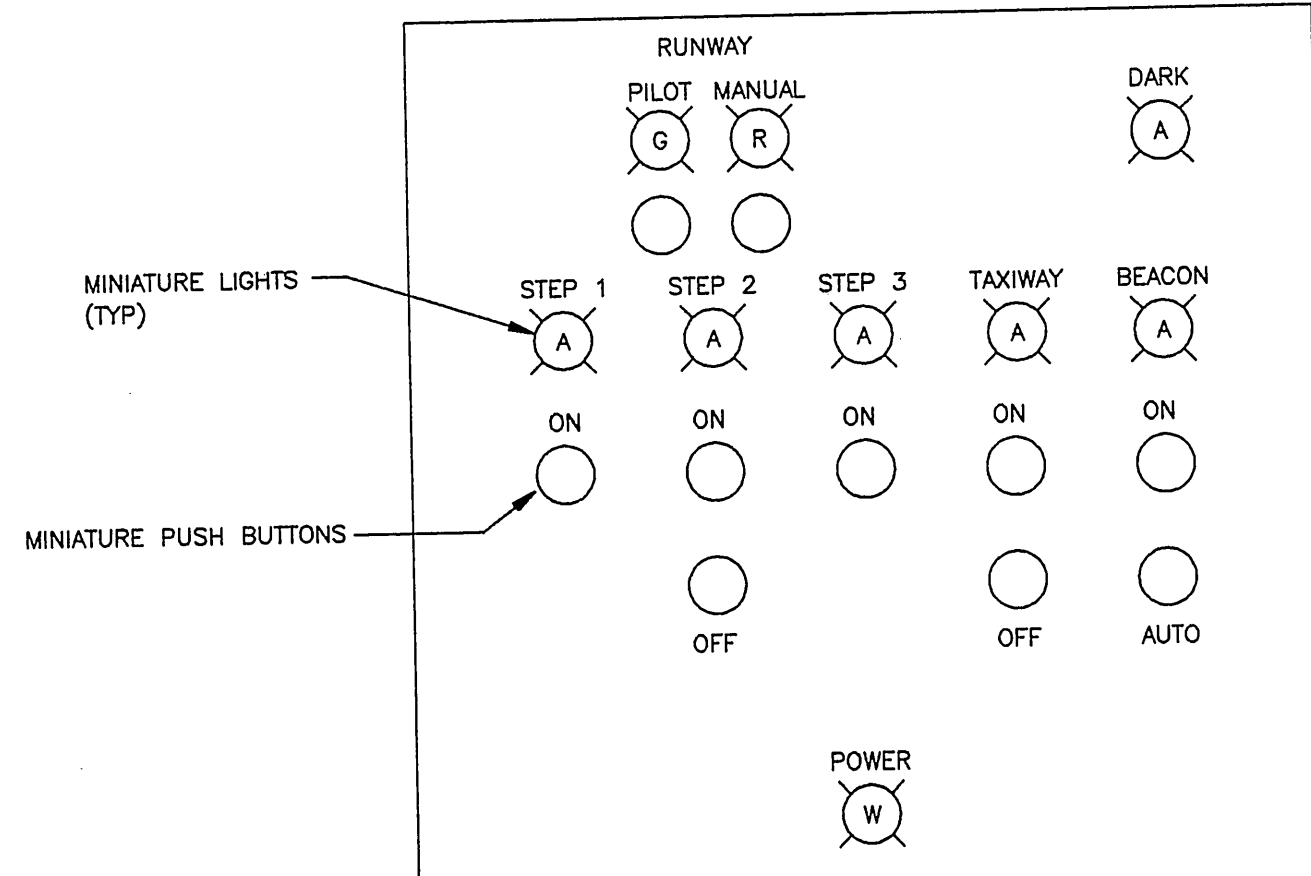


NOTES:
 1. REMOVE EXISTING RUNWAY LIGHTING CONTROL PANEL. MODIFY CONSOLE AS NECESSARY TO FLUSH MOUNT NEW PANEL.


FRONT VIEW - REMOTE LIGHTING CONTROL PANEL
(LOCATION IN FSS CONTROL CONSOLE)

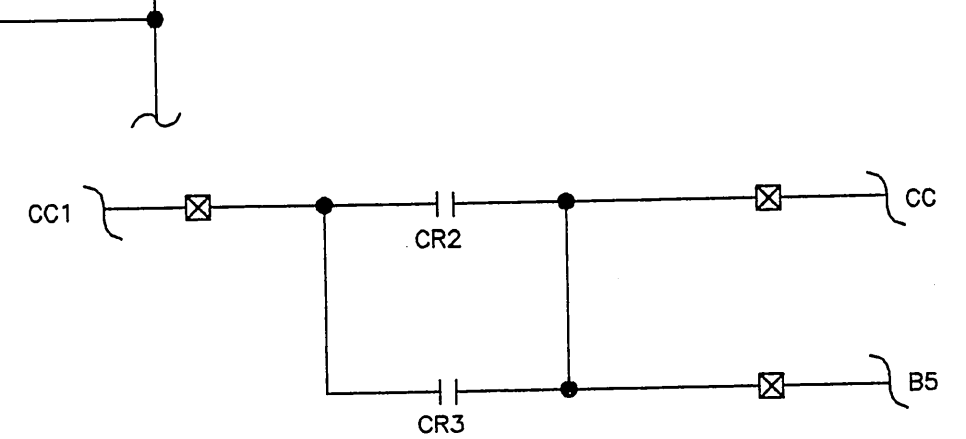

TAXIWAY REGULATOR

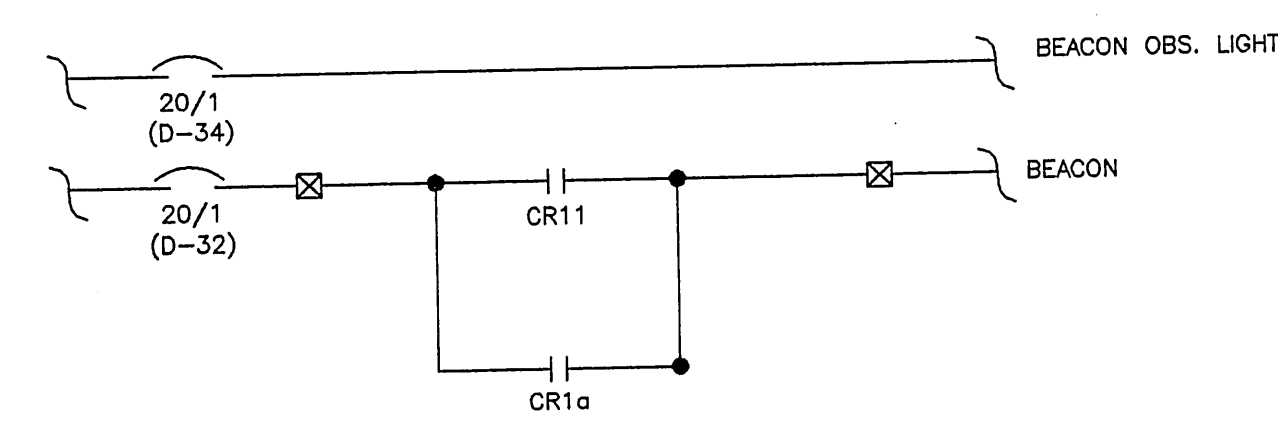

BEACON

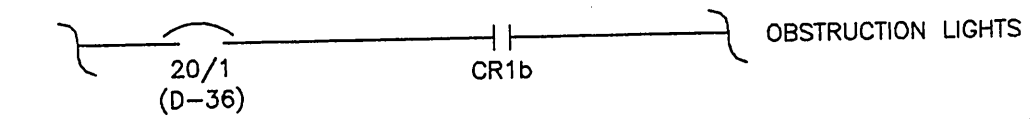


CONTROL BUILDING OBS. LIGHTS CONTROLS


BY:	DATE:	DESCRIPTION OF CHANGE:

STATE OF ALASKA
 DEPARTMENT OF TRANSPORTATION
 AND PUBLIC FACILITIES
 SOUTHEAST REGION DESIGN & CONSTRUCTION

SITKA AIRPORT ELECTRICAL AND LIGHTING IMPROVEMENTS
 SITKA ALASKA
 LIGHTING CONTROLS & BUILDING ALARMS SCHEM.


DESIGNED BY:	MGM	DATE:	MAY 1994	PROJECT No.	71457
DRAWN BY:	JLC				
CHECKED BY:	BCH				
				E-14	SHEET 16 OF 20

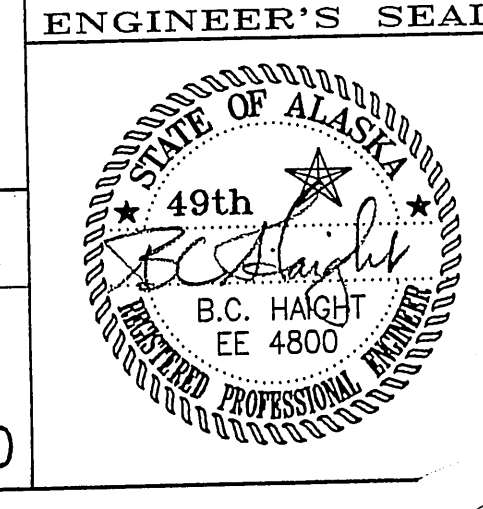

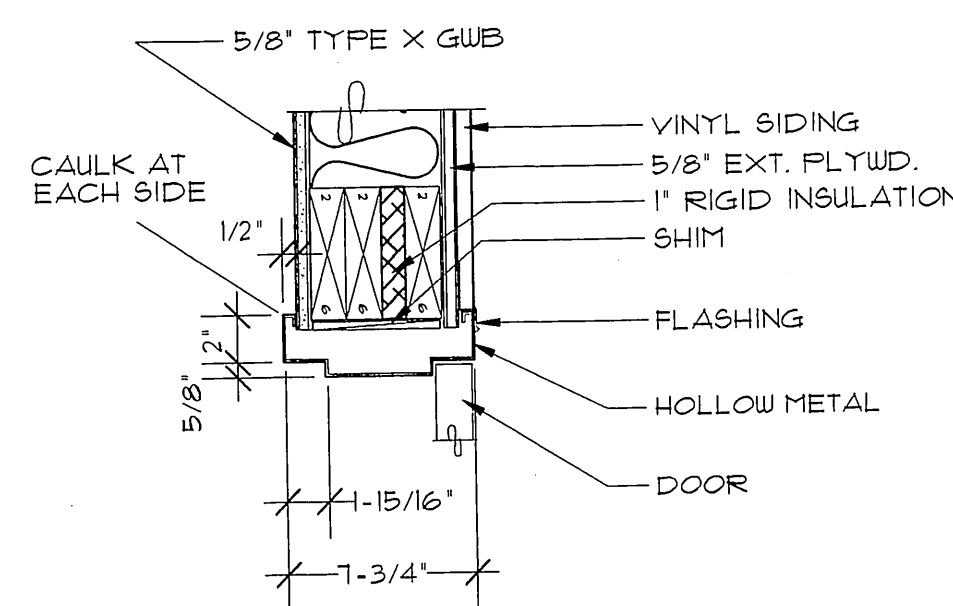


Door Head/Jamb
SCALE 1-1/2" = 1'-0"


NOTE: ELECTRICAL LAYOUT ON
SHEET E-11 (13 OF 20).

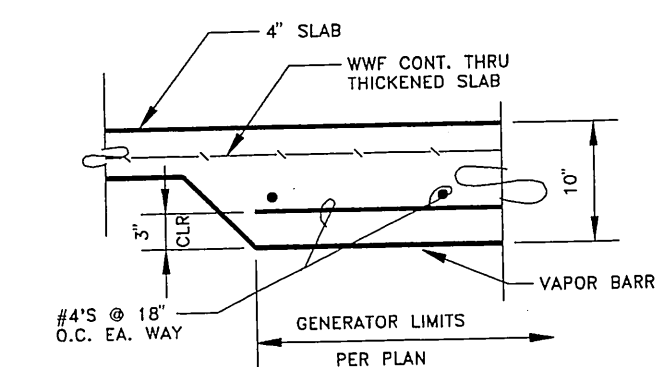


Thickened Slab Detail
SCALE 3/4" = 1'-0"

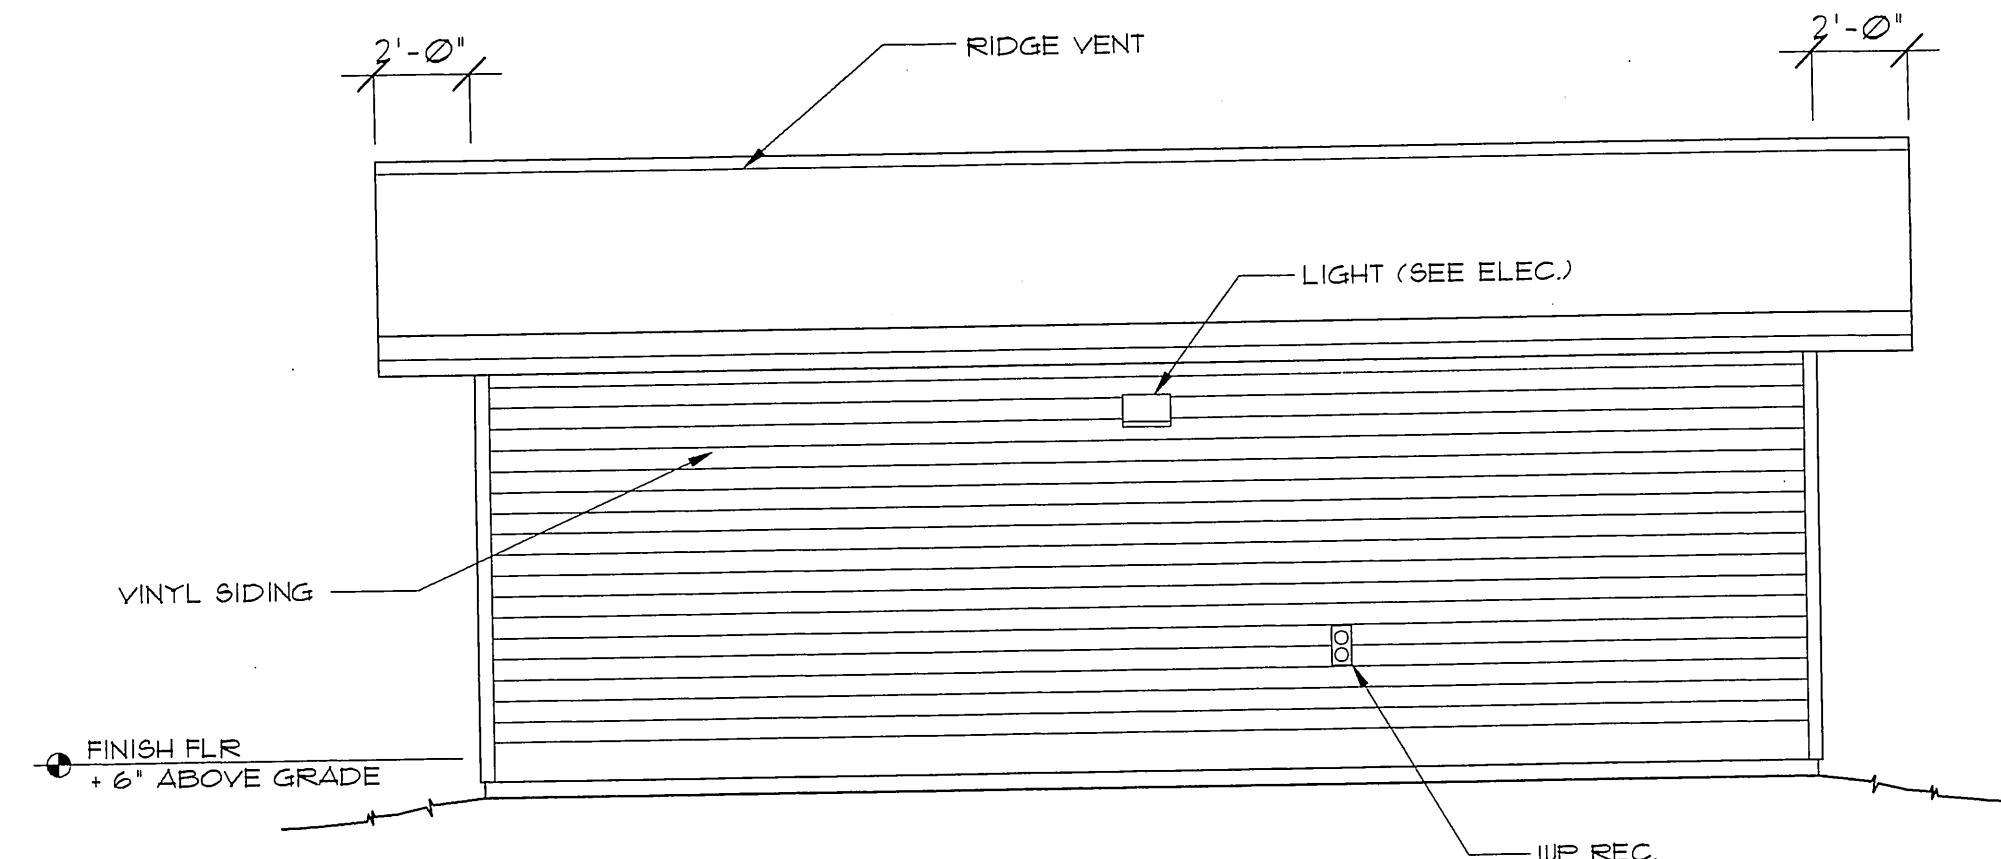

South Elevation
SCALE 1/4" = 1'-0"

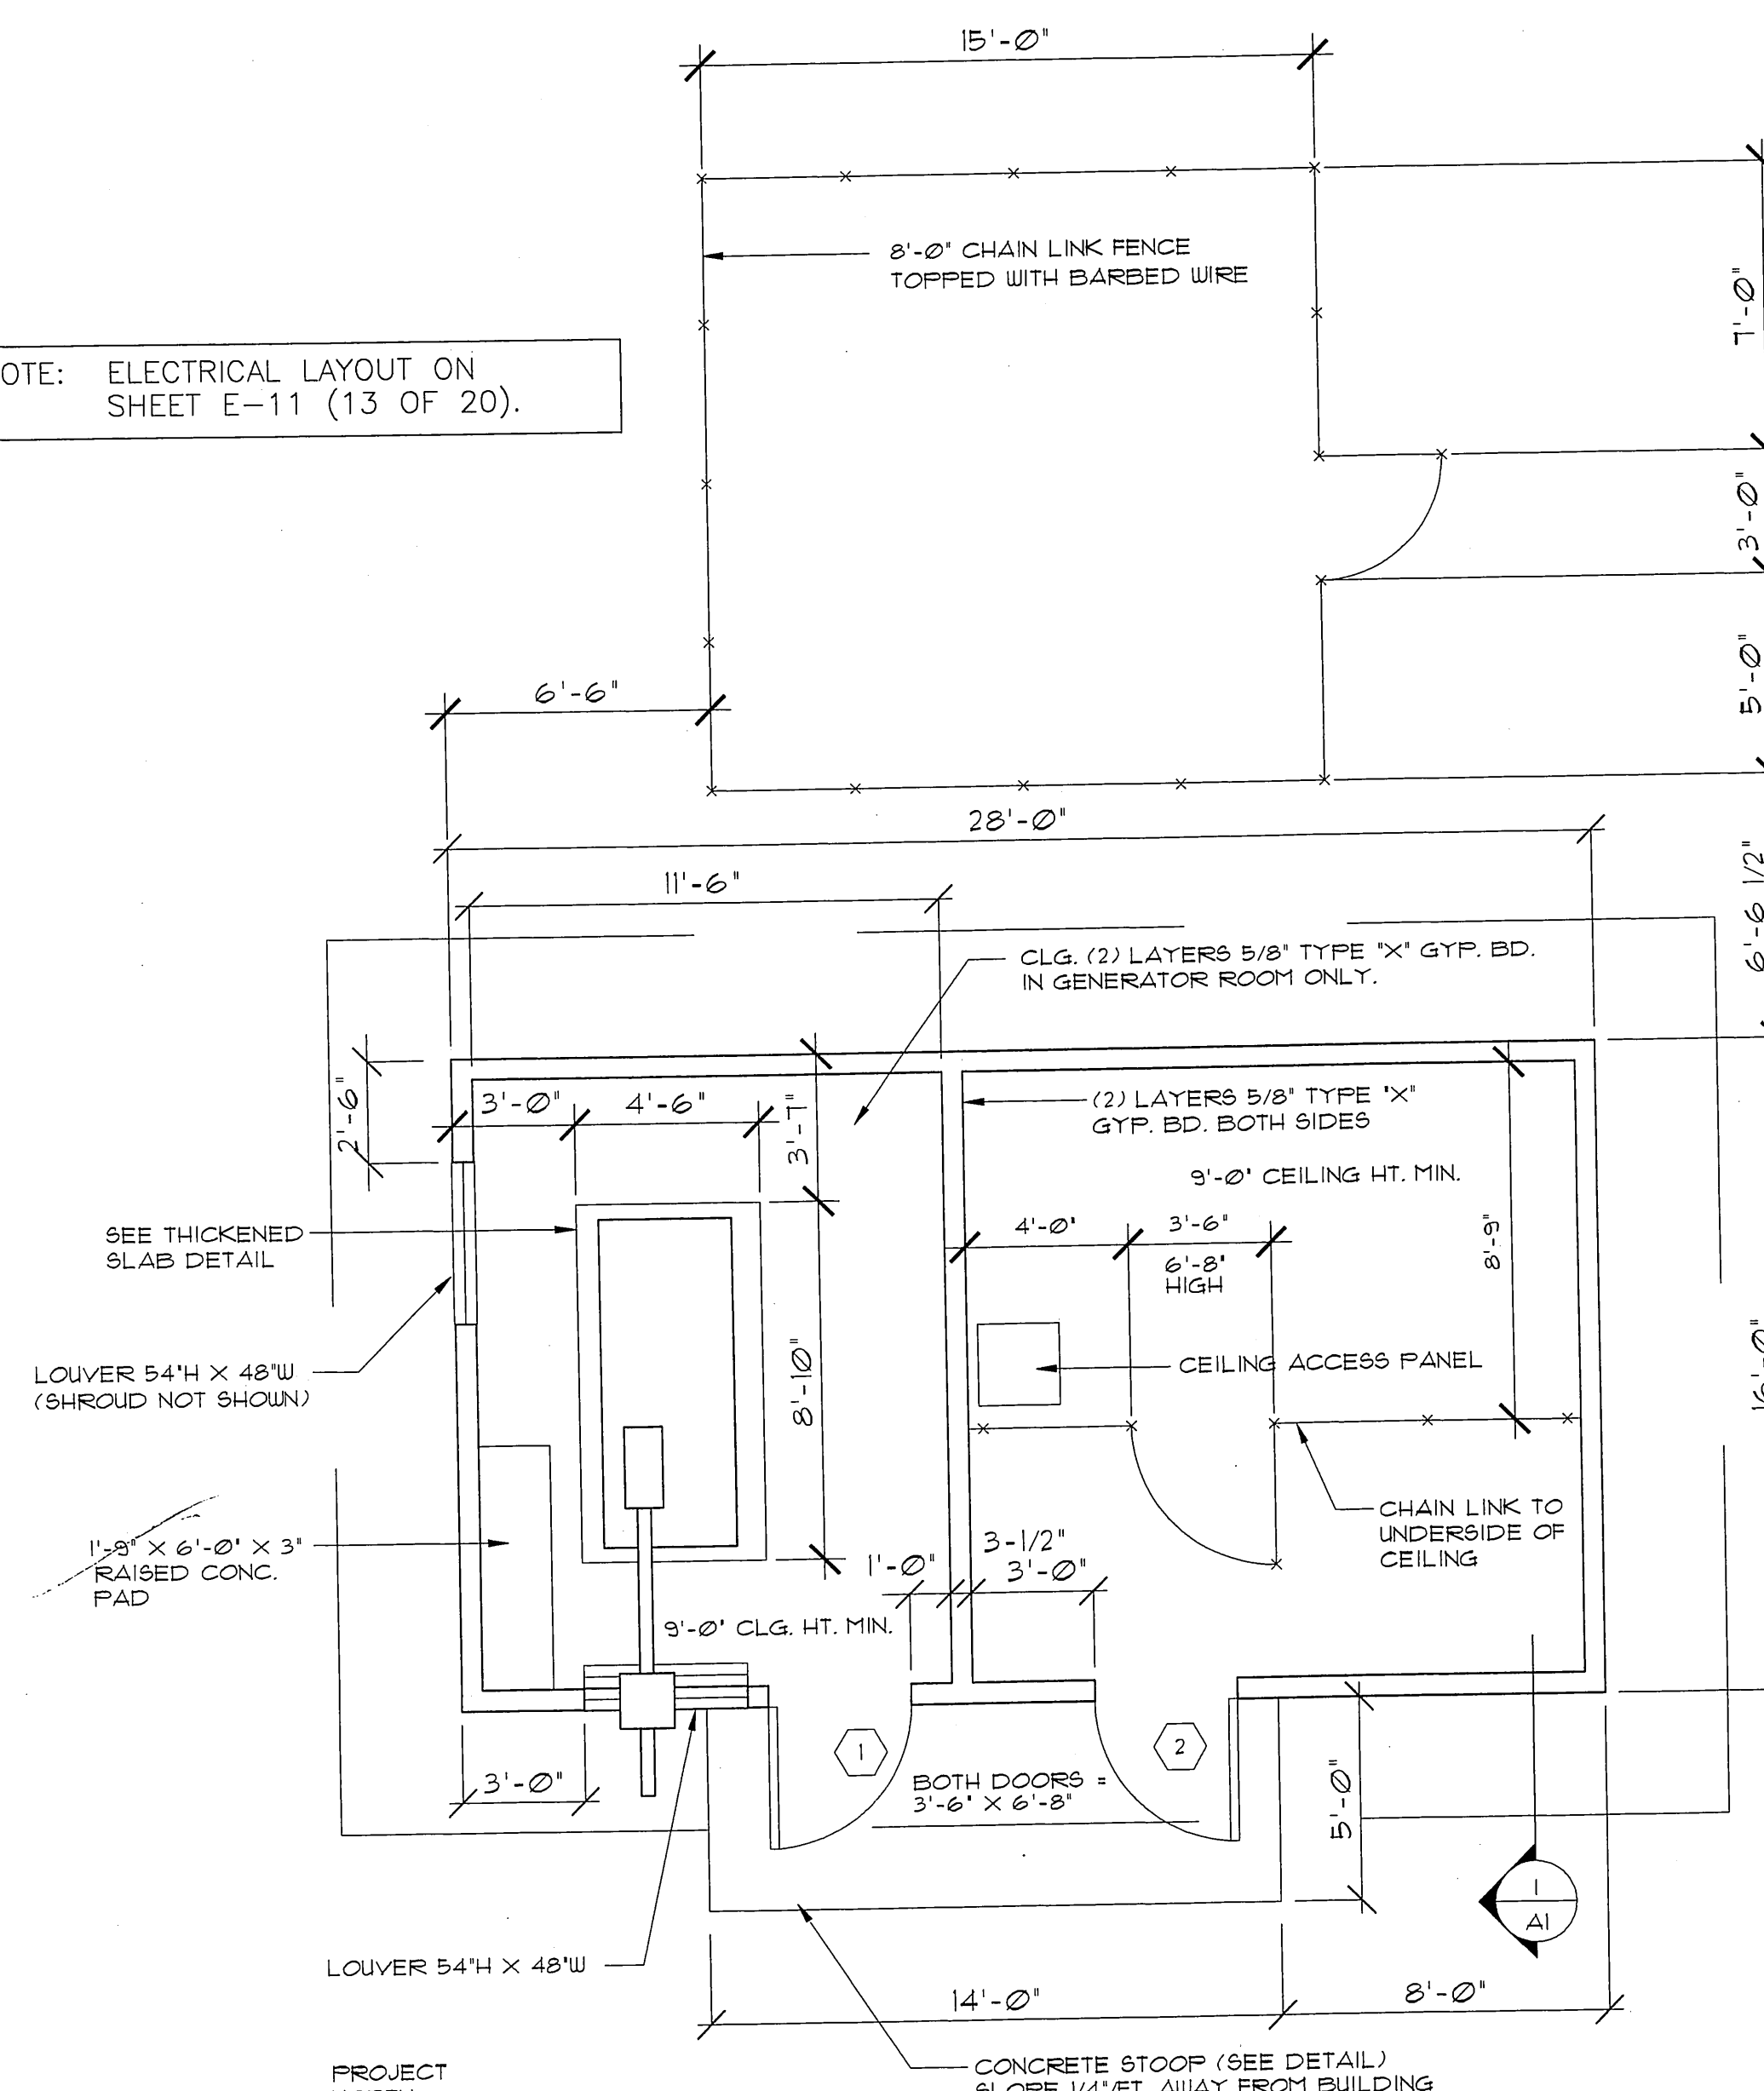


Control Building Plan
SCALE 1/4" = 1'-0"

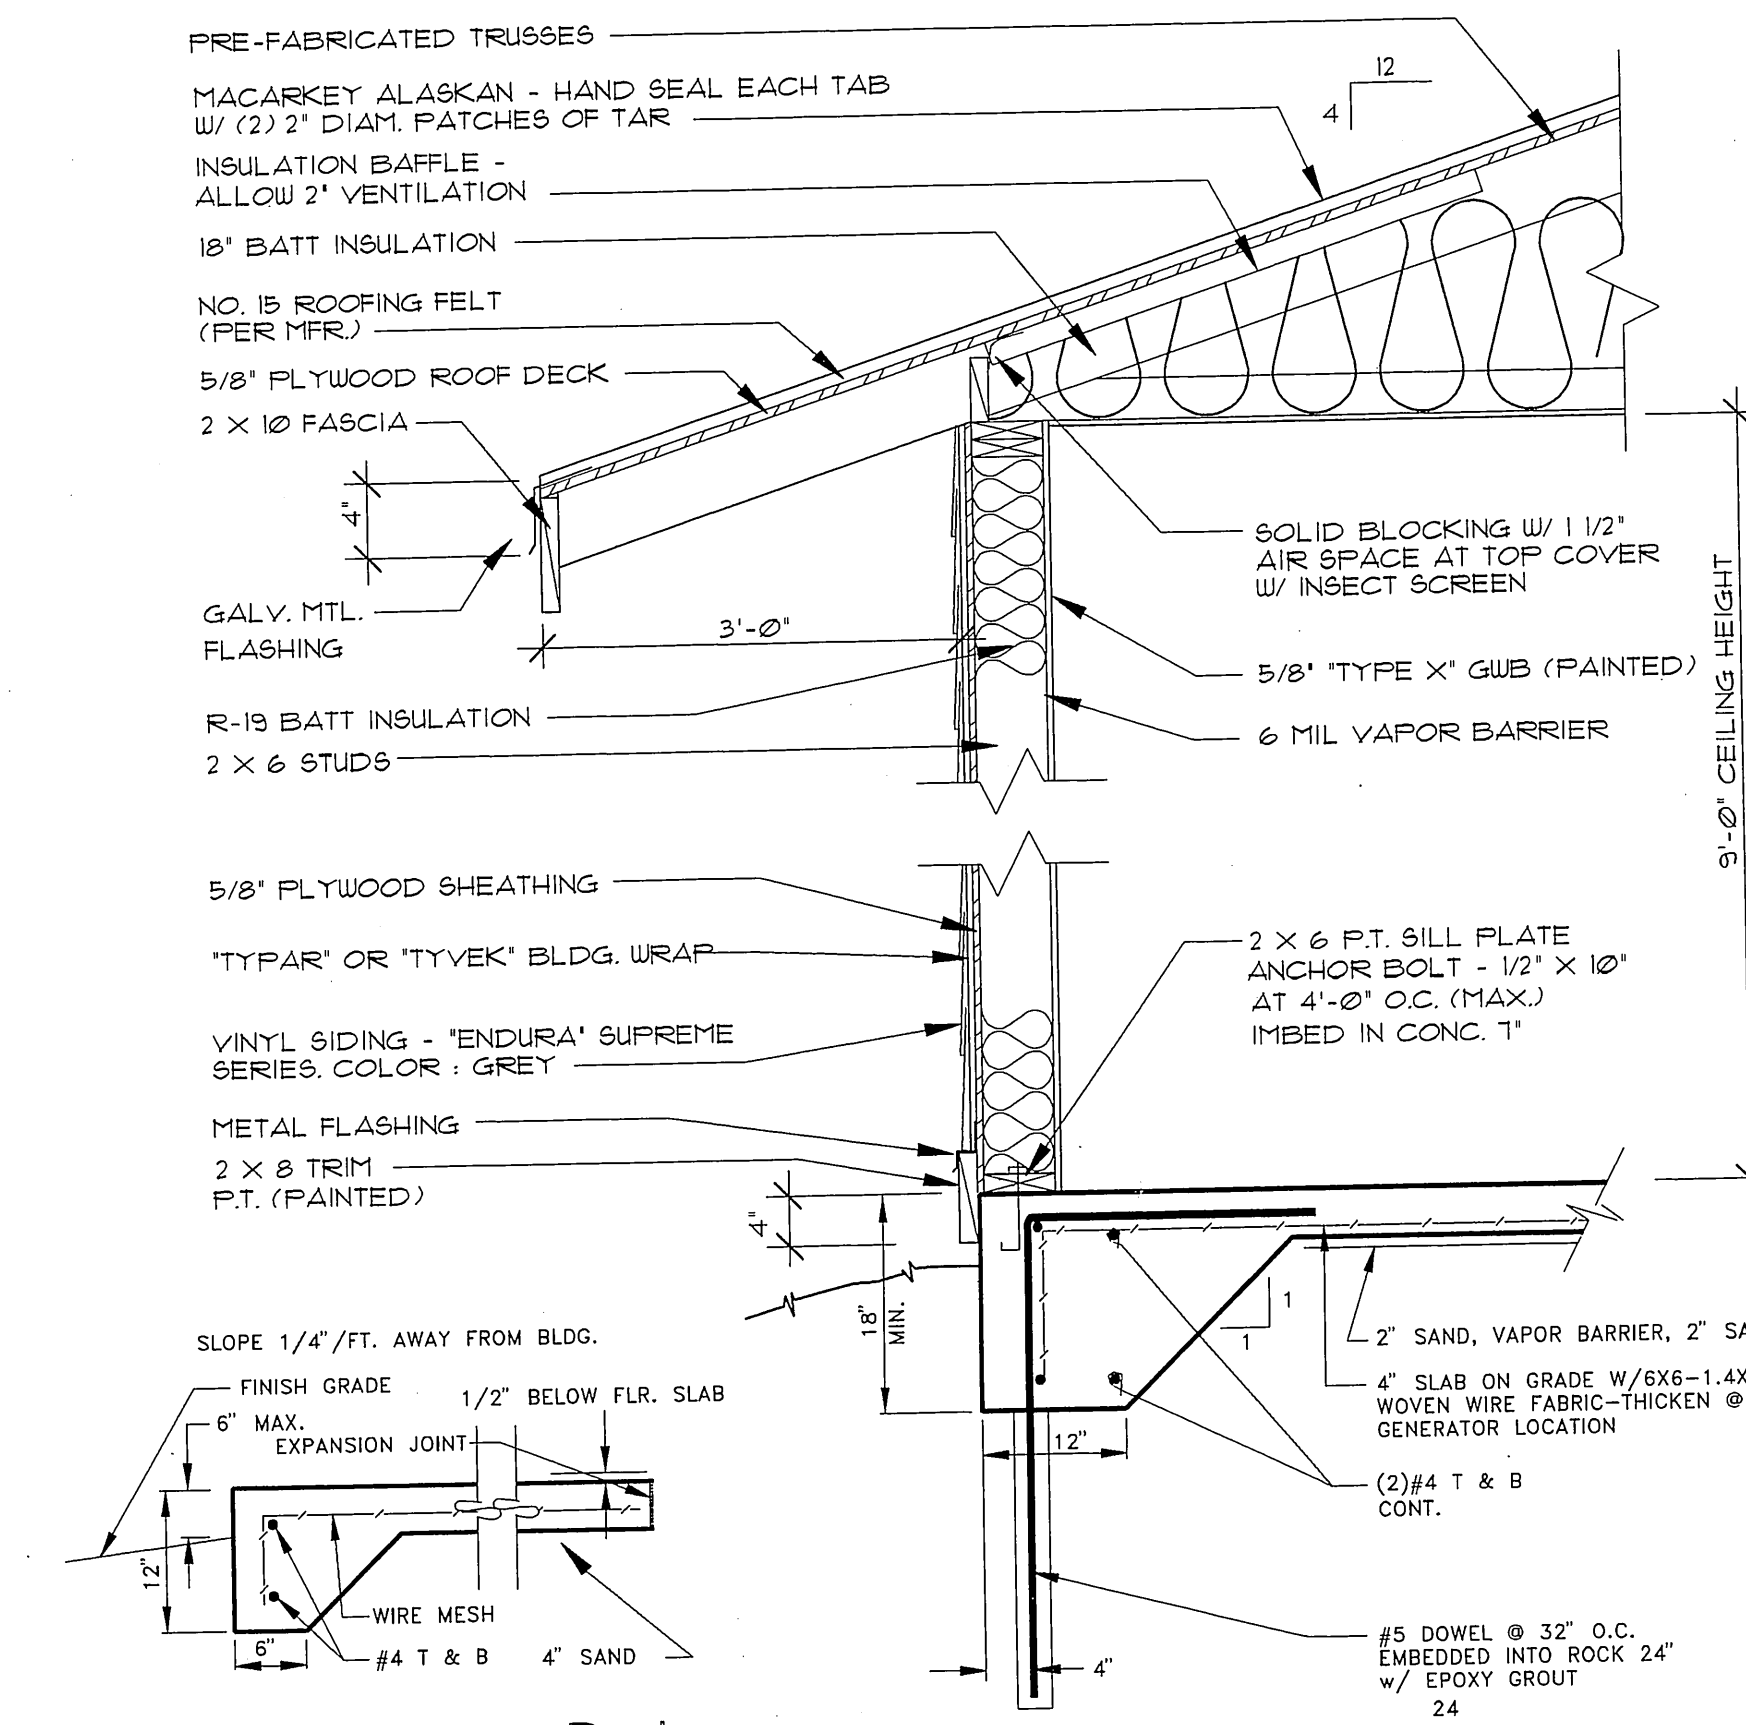


Conc. Stoop Det.
SCALE 3/4" = 1'-0"


Section
SCALE 3/4" = 1'-0"

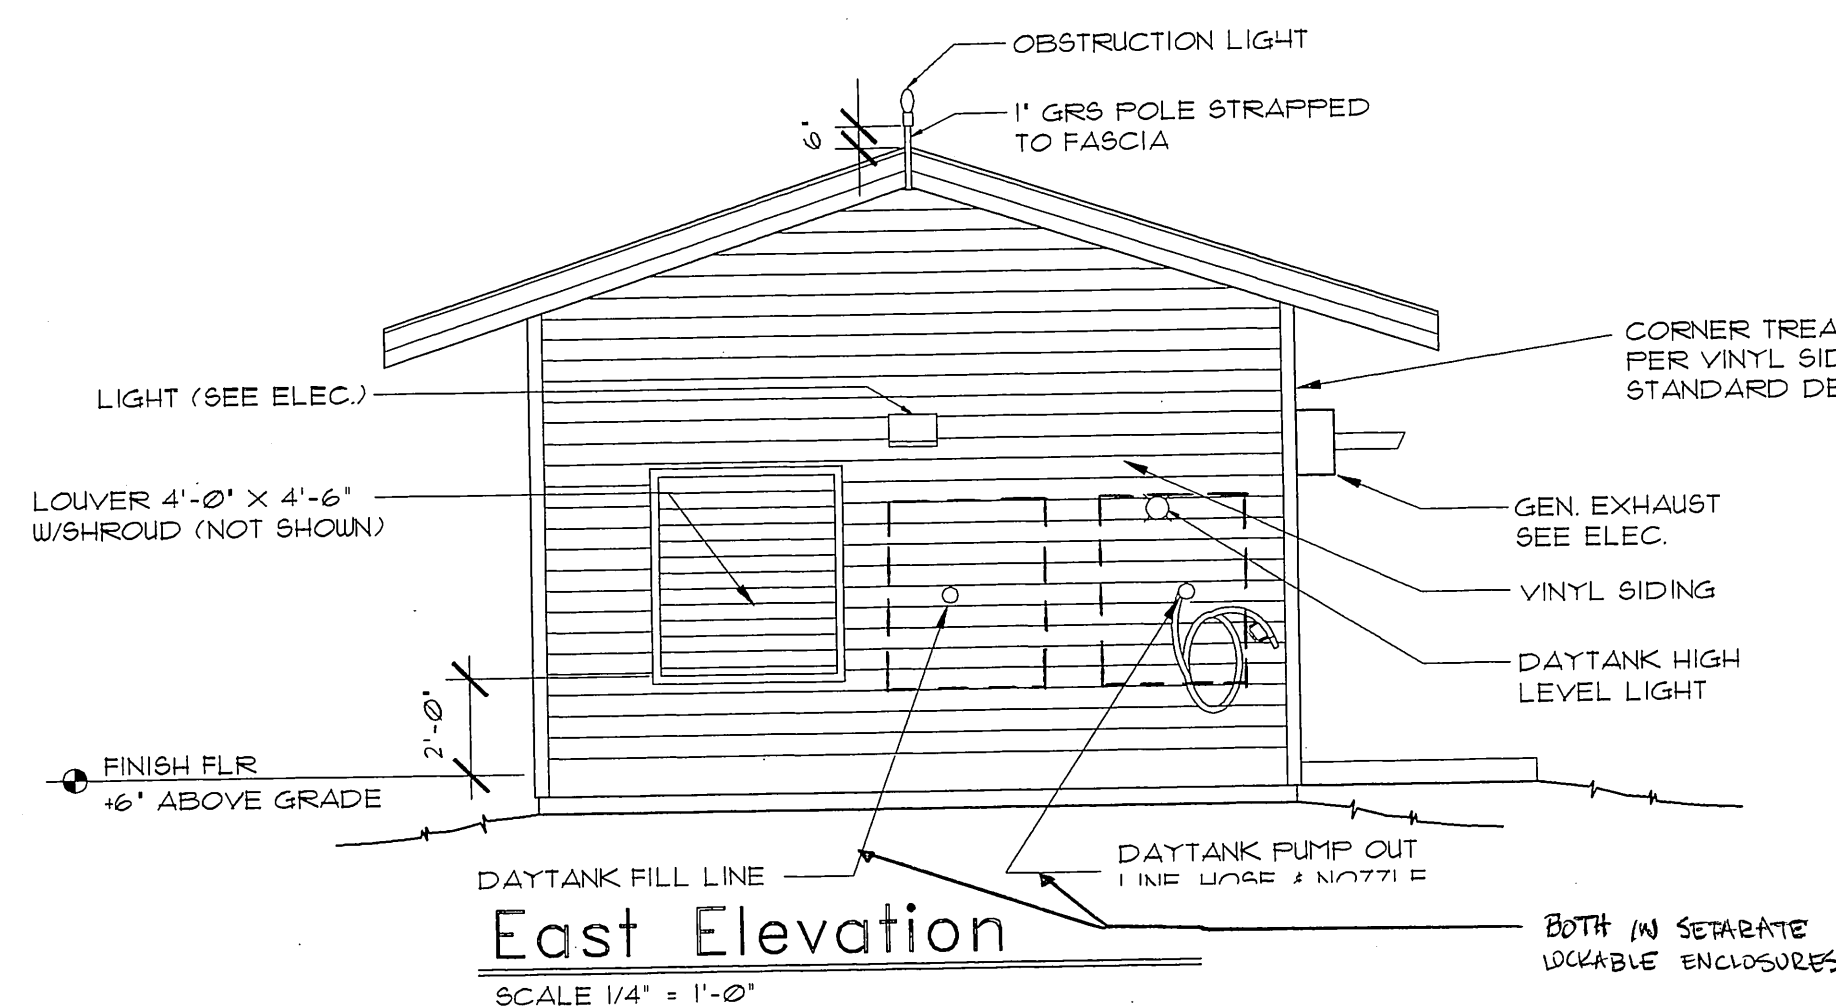

East Elevation
SCALE 1/4" = 1'-0"

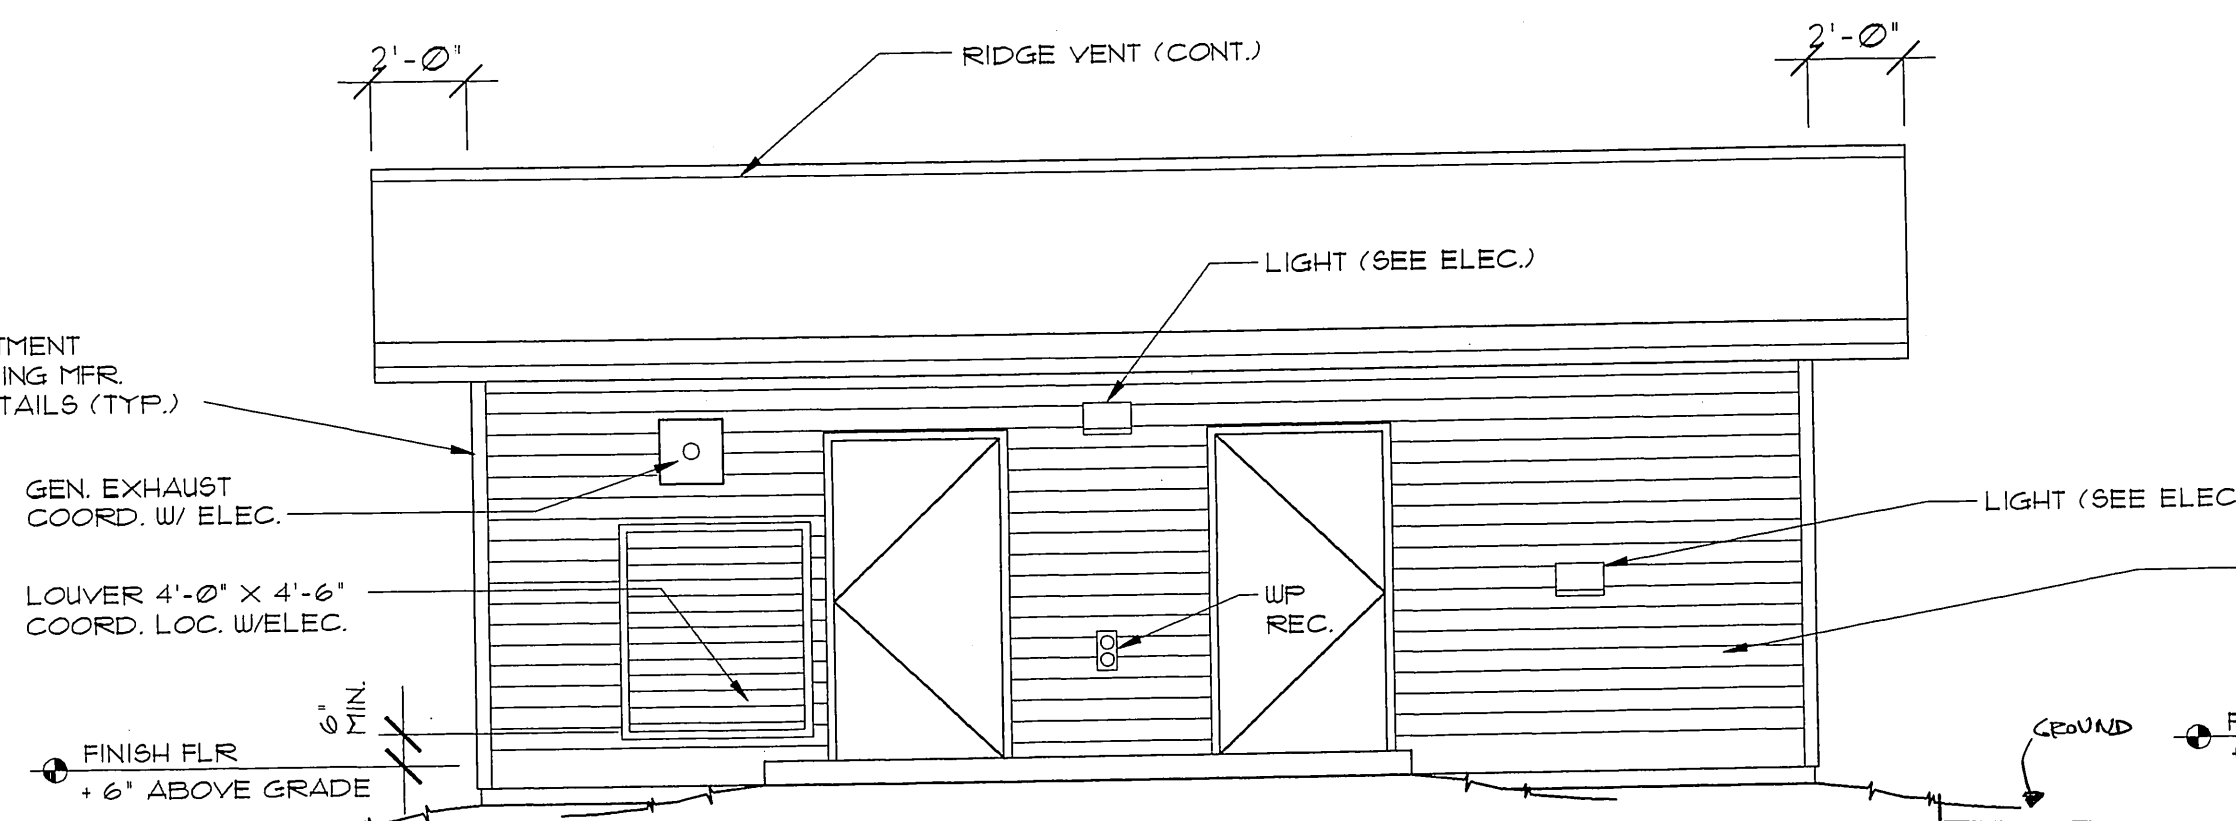

North Elevation
SCALE 1/4" = 1'-0"

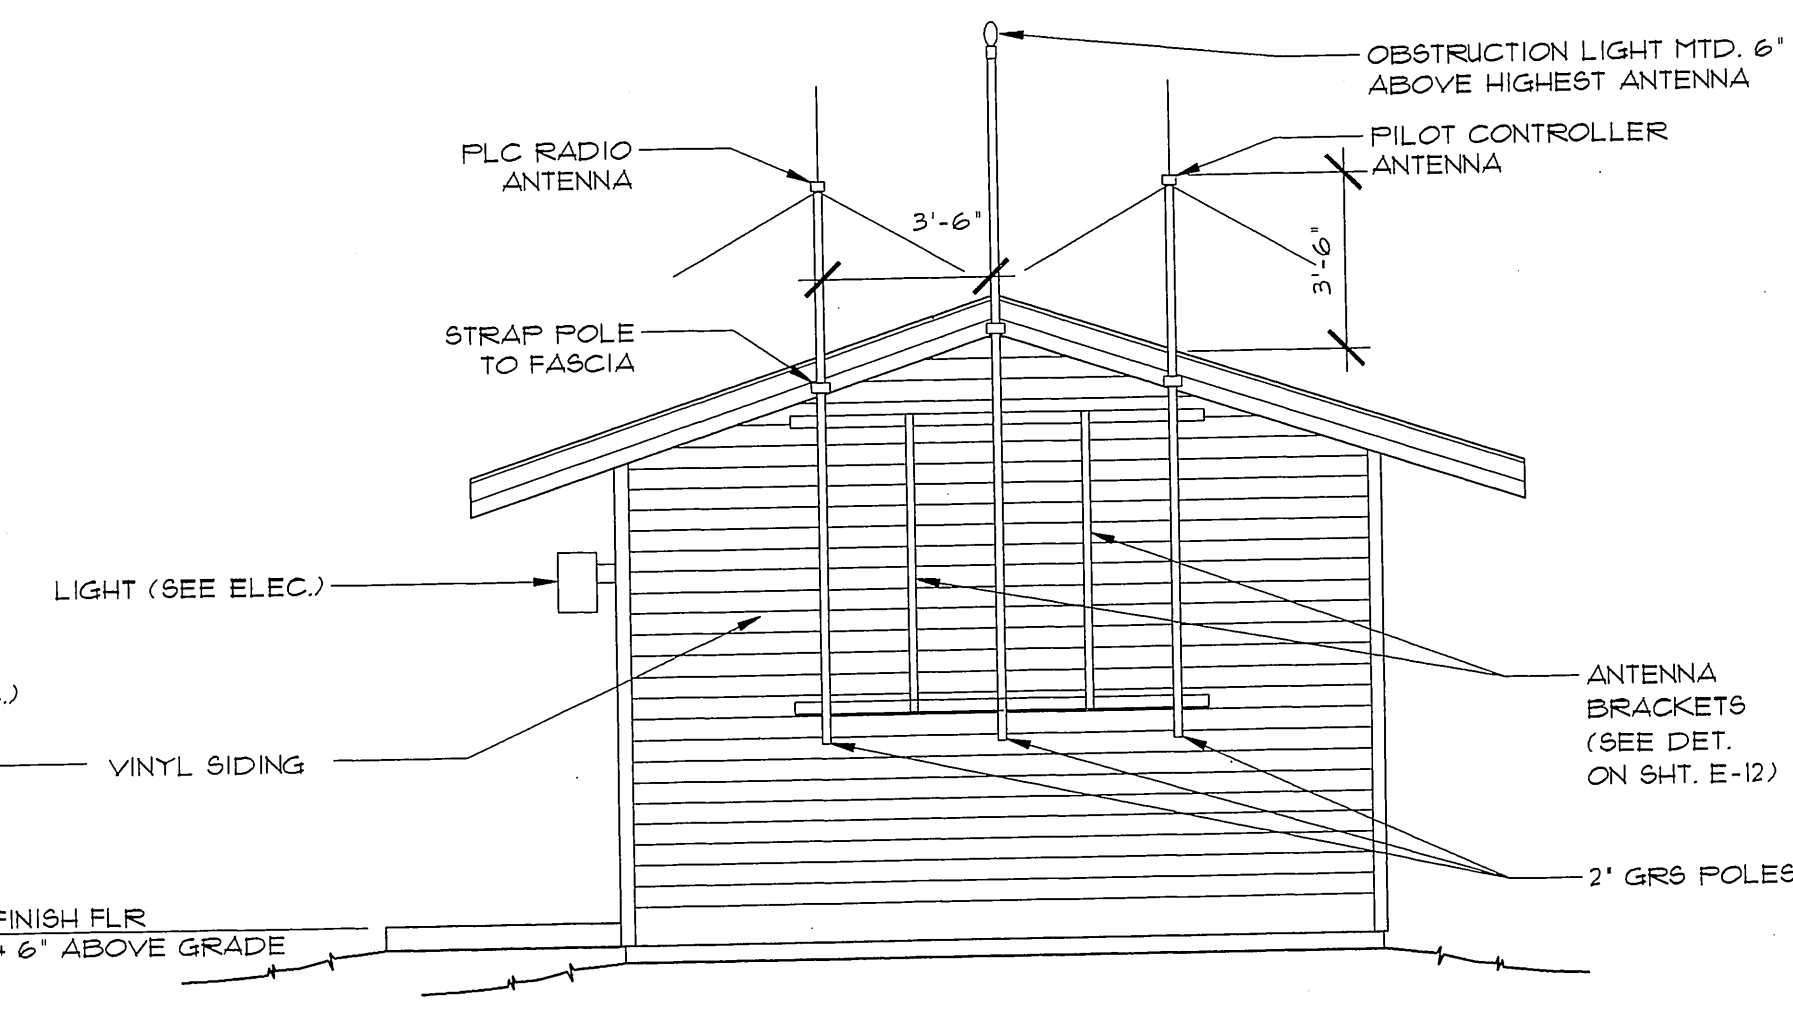

West Elevation
SCALE 1/4" = 1'-0"

NOTE: THIS DRAWING IS FULL SIZE
WHEN PRINTED AT 24" X 36".


BY:	DATE:	DESCRIPTION OF CHANGE:

STATE OF ALASKA
DEPARTMENT OF TRANSPORTATION
AND PUBLIC FACILITIES
SOUTHEAST REGION DESIGN & CONSTRUCTION

SITKA AIRPORT RUNWAY/TAXIWAY LIGHTING SYSTEM RENOVATION
SITKA ALASKA
NEW GENERATOR CONTROL BUILDING - PLANS

DESIGNED BY:	AER	PROJECT No.	71457
DRAWN BY:	AJC/AER (D:\PROJECTS\93019\A1.DWG)	DATE:	MAY 27, 1994
CHECKED BY:	AER	SHEET	17 OF 20

A. E. ROGERS
ARCHITECTS
P.O. Box 34401, Juneau, Alaska 99803
(907) 785-7559

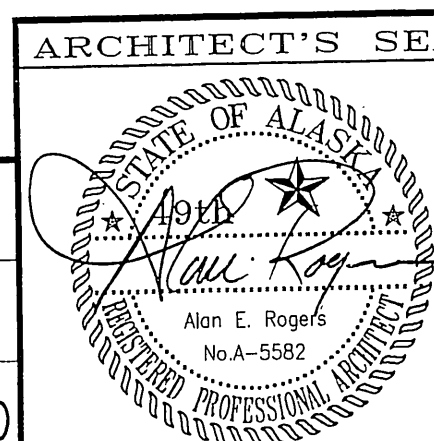

GENERAL NOTES

1. ALL CONSTRUCTION TO BE PER 1991 U.B.C. AND ALL APPLICABLE MECHANICAL, ELECTRIC, FIRE CODES (AS AMENDED BY THE CITY AND BOROUGH OF SITKA) AND THE SITKA ZONING/LAND USE REQUIREMENTS. THE CONSTRUCTION WILL BE IN ACCORDANCE WITH THE ADAAG (AMERICANS WITH DISABILITIES ACT - ACCESSIBILITY GUIDELINES).
2. ALL WALLS (EXTERIOR) ARE 2 X 6 (INTERIOR) 2 X 4 CONSTRUCTION UNLESS OTHERWISE NOTED. DIMENSIONS ARE TO THE FACE OF STUD UNLESS OTHERWISE INDICATED.
3. CONTRACTOR TO VERIFY ALL EXISTING CONDITIONS AND DIMENSIONS BEFORE BEGINNING WORK AND TO NOTIFY THE ARCHITECT AS TO ANY DISCREPANCIES.
4. ALL LUMBER EXPOSED TO MOISTURE AND IN DIRECT CONTACT WITH MASONRY SHALL BE PRESSURE TREATED.
5. CONTRACTOR TO USE ACCEPTED INDUSTRY STANDARDS AND TO FOLLOW MANUFACTURERS' RECOMMENDED METHODS AND INSTALLATION INSTRUCTIONS.
4. DISPOSAL OF DEMOLITION MATERIAL (NOT TO BE SALVAGED) IS THE RESPONSIBILITY OF THE CONTRACTOR. BURNING ON THE PROJECT SITE IS NOT ALLOWED.
5. THESE PLANS ARE NOT VALID UNLESS APPROVED BY THE STATE FIRE MARSHAL'S OFFICE.

STRUCTURAL NOTES

1. SOILS DESIGN INFORMATION:
- A. SOIL DESIGN PRESSURE: 4,000 PSF PER CLASS I BEDROCK, UBC TABLE NO. 23-B.
- B. BOTTOM OF FOOTING SHALL BE AT LEAST 12 INCHES BELOW LOWEST ADJACENT FINISH GRADE.
2. PRIOR TO PLACING FORMS OR REINFORCED STEEL, DOT/FF STAFF SHALL VERIFY THAT SITE PREPARATION COMPLIES WITH THE ASSUMPTIONS MADE ABOVE.
3. BAR REINFORCEMENT SHALL CONFORM TO GRADE 60 OF ASTM A615, INCLUDING SUPPLEMENT S1.
4. LAPs AT BAR SPLICES AND CONCRETE CONSTRUCTION SHALL BE CLASS A OR IN ACCORDANCE WITH CHAPTER 12 OF ASI 318-83 (REVISED 1986), UNLESS OTHERWISE NOTED.
5. ALL REINFORCING STEEL SHALL BE SECURELY TIGHTENED IN POSITION PRIOR TO PLACING CONCRETE OR GROUT.
6. WELDED WIRE FABRIC SHALL CONFORM TO ASTM A185.
7. LAPs OF WELDED WIRE FABRIC AT SPLICES SHALL BE IN CONFORMANCE WITH ASI 318-83 (REVISED 1986), BUT NOT LESS THAN 14 INCHES.
8. REINFORCED CONCRETE SHALL CONFORM TO THE FOLLOWING:
- A. THE MINIMUM 28 DAY COMPRESSIVE STRENGTH SHALL BE 3,000 PSI.
- B. THE MINIMUM CEMENT CONTENT SHALL BE 6 SACKS PER CUBIC YARD OF CONCRETE.
- C. SLABS AND OTHER FLAT WORK SHALL BE AIR ENTRAINED, HAVE A MAXIMUM SLUMP OF 3 INCHES AND A MAXIMUM WATER CEMENT RATIO OF 0.35.
9. PORTLAND CEMENT SHALL CONFORM TO ASTM C150, TYPE I OR II.
10. AGGREGATES FOR NORMAL WEIGHT CONCRETE SHALL CONFORM TO ASTM C33.
11. CONCRETE WORK SHALL CONFORM TO ALL REQUIREMENTS OF ASI 301, 'SPECIFICATIONS FOR STRUCTURAL CONCRETE FOR BUILDING', EXCEPT AS MODIFIED BY THESE NOTES.
12. ADMIXTURES MAY BE USED WITH PRIOR APPROVAL OF THE ENGINEER OR ARCHITECT. ADMIXTURE SHALL COMPLY WITH ASTM A494. ADMIXTURES USED TO INCREASE THE WORKABILITY OF THE CONCRETE SHALL NOT BE CONSIDERED TO REDUCE THE SPECIFIED MINIMUM CEMENT CONTENT. ADMIXTURES CONTAINING CHLORIDES SHALL NOT BE USED.
13. READY MIXED CONCRETE SHALL BE MIXED AND DELIVERED IN ACCORDANCE WITH ASTM C94.

14. MINIMUM CONCRETE COVER FOR REINFORCING STEEL SHALL BE AS FOLLOWS, UNLESS OTHERWISE NOTED:

LOCATION	MIN. COVER, INCHES
CAST AGAINST AND PERMANENTLY EXPOSED TO EARTH	3
FORM SURFACE EXPOSED TO EARTH OR WEATHER	1-1/2
CONCRETE SURFACES NOT EXPOSED TO EARTH OR WEATHER	3/4

15. LOCAL DESIGN CRITERIA:

BASIC WIND SPEED = 100 MPH
SEISMIC ZONE = 3
SNOW LOAD = 40 PSF
FROST DEPTH = 18 INCHES

CODE ANALYSIS (1991 UBC)

OCCUPANCY: B-4 (SWITCHGEAR & GENERATOR)
CONSTRUCTION TYPE: V-N
EXTERIOR WALLS: 1 HOUR LESS THAN 5'-0"
OPENINGS IN WALLS: NOT PERMITTED LESS THAN 5'-0"
ALLOWABLE AREA: 12,000 SF.
ACTUAL AREA: 448 SF.
MAXIMUM HEIGHT: 40 FEET
ACTUAL HEIGHT: 13'-0" +/-
MAXIMUM STORIES: 2
ACTUAL STORIES: 1
B-4 ROOF FRAMING: UBC SEC 1022(b), SPECIAL PROVISIONS, FIRE PROTECTION OF THE UNDERSIDE OF THE ROOF FRAMING MAY BE OMITTED.

OCCUPANT LOAD: (PER UBC TABLE 33-A), MECHANICAL EQUIPMENT ROOM, OCCUPANT LOAD FACTOR 1/300 SF. = 2 OCCUPANTS
H.C. ACCESSIBILITY: NO, (PER UBC TABLE 33-A)
EXITS REQUIRED: 1
SPRINKLER REQUIRED: REQUIRED UNLESS APPROVAL FOR DELETION BY THE SITKA BUILDING OFFICIAL PER UBC SEC. 3804(b), PERMISSIBLE SPRINKLER OMISSIONS.

SPECIFICATIONS

1. EXTERIOR METAL DOORS: INSULATED, ANSI/SDI-100, GRADE III EXTRA HEAVY DUTY, MODEL 4, MINIMUM 16 GA. GALVANIZED STEEL FACES IN COMPLIANCE WITH SDI-112.

2. HOLLOW METAL FRAMES: ANSI/SDI-100, MITERED OR COPED CORNERS, WELDED CONSTRUCTION, EXTERIOR FRAMES = 16 GA. GALVANIZED STEEL.

3. DOOR HARDWARE: (PER DOOR)

(3) BUTTS, 'HAGER' BB1193
(1) LOCKSET, 'BEST', 93K1AB16D, 626 FINISH
(1) CLOSER, 'LON', 4115H-CUSH WEATHERSTRIPPING

4. ROOFING: APPLY AN ADDITIONAL ^{GRADE 16 3 WATER SHIELD} ROOFING FELT CEMENTED OVER ROOF TO PREVENT ICE DAMMING. APPLY AT LOWER 5'-0' OF ROOF. 4-1/2' EXPOSURE OVERALL.

5. PAINTING:

EXTERIOR WOOD TRIM (SOLID COLOR LATEX EMULSION BASE STAIN) = 'GLIDDEN' Y-9400 ENDURANCE LATEX STAIN.

INTERIOR WALLS: PRIMER = 'GLIDDEN' 5019 PVA PRIMER. LATEX-BASED FLAT PAINT = 'GLIDDEN' 3400 SPRED SATIN LATEX WALL PAINT.

GALVANIZED METAL = SEE ELECTRICAL SPECIFICATIONS.

6. GALVANIZED STEEL FENCING AND GATES:

COMPLY WITH ASTM F 513 AND THE CHAIN LINK FENCE MANUFACTURERS INSTITUTE (CLFMI) PRODUCT MANUAL. FURNISH ONE-PIECE FABRIC WIDTHS, 2 INCH MESH, 3-GAGE (0.148 INCH DIAMETER) WIRE (INCL. ZINC COATING), GALV. STEEL FINISH = ASTM A 382, CLASS 2, WITH MINIMUM 2.0 OZ. ZINC PER SQ. FT. OF UNCOATED WIRE SURFACE. FRAMEWORK = TYPE I PIPE, STRENGTH REQUIREMENTS FOR POSTS AND RAILS CONFORMING TO ASTM F 669. TYPE I PIPE, HOT-DIPPED GALV. STEEL PIPE CONFORMING TO ASTM F 1083, FLAIN ENDS, STANDARD WEIGHT (SCHEDULE 40). END, CORNER AND FULL POSTS = 2.875 INCH OD TYPE I OR II STEEL PIPE, 2.5 INCH SQUARE STEEL TUBING WEIGHING 5.10 LBS PER LIN. FT. LINE OR INTERMEDIATE POSTS = 2.375 INCH OD TYPE I OR II STEEL PIPE, 2.25 INCH BY 1.70 INCH C SECTION WEIGHING 2.7 LBS PER LIN. FT. SWING GATES = COMPLY WITH ASTM F 900. PERIMETER FRAMES OF MIN. 1.50 INCH OD TYPE I OR II STEEL PIPE OR 2.0 INCH SQUARE STEEL TUBING, NON-LIFT-OFF TYPE HINGES, OFFSET TO PERMIT 180 DEGREE GATE OPENING, LOCKING LATCHSET KEYED TO NEW BLDG. MASTER SYSTEM ('BEST'). BARBED WIRE (EXTERIOR FENCING) = TWO STRANDS, 12-1/2 GA. STEEL WIRE WITH 14 GA. 4-POINT BARBS SPACED NOT MORE THAN 5 INCHES O.C. METALLIC COATED FINISH TO MATCH FABRIC. SUPPORTING ARMS (SINGLE 45 DEGREE ARM) CONFORMING TO ASTM F 626, ATTACHING 3 ROWS OF BARBED WIRE TO EACH ARM. ARMS MUST BE CAPABLE OF WITHSTANDING 250 LBS DOWNWARD PULL AT OUTERMOST END.

EXCAVATION: DRILL OR HAND-EXCAVATE (USING POST-HOLE DIGGER) HOLES FOR POSTS TO MIN. DIAMETERS RECOMMENDED BY FENCE MFR. BUT NOT LESS THAN 4 TIMES LARGEST CROSS-SECTION OF POST. EXCAVATE HOLE DEPTHS APPROXIMATELY 3 INCHES LOWER THAN POST BOTTOM, WITH BOTTOM OF POSTS SET NOT LESS THAN 36 INCHES BELOW FINISH GRADE SURFACE. PROTECT PORTION OF POSTS ABOVE GROUND FROM CONCRETE SPLATTER. PLACE CONCRETE AROUND POSTS AND VIBRATE OR TAMP FOR CONSOLIDATION. CHECK EACH POST FOR VERTICAL AND TOP ALIGNMENT, AND HOLD IN POSITION DURING PLACEMENT AND FINISHING OPERATIONS. EXTEND CONCRETE FOOTING 2 INCHES ABOVE GRADE AND TROUPEL TO A CROWN TO SHED WATER.

NOTE: PRODUCT NAMES ARE FOR PERFORMANCE STANDARDS ONLY AND ARE NOT MEANT TO BE PROPRIETARY. SUBMIT THE SPECIFIED PRODUCT OR AN APPROVED EQUAL.

BY:	DATE:	DESCRIPTION OF CHANGE:
RECORD OF REVISIONS		

STATE OF ALASKA
DEPARTMENT OF TRANSPORTATION
AND PUBLIC FACILITIES
SOUTHEAST REGION DESIGN & CONSTRUCTION

SITKA AIRPORT RUNWAY/TAXIWAY LIGHTING SYSTEM RENOVATION
SITKA ALASKA
NEW GENERATOR CONTROL BUILDING - NOTES

DESIGNED BY: AER	PROJECT No. 71457
DRAWN BY: AER (D:\PROJECTS\93019\A2.DWG)	DATE: MAY 27, 1994
CHECKED BY: AER	SHEET 18 OF 20

A. E. ROGERS
ARCHITECTS
P.O. Box 34401, Juneau, Alaska 99803
(907) 769-7559



