
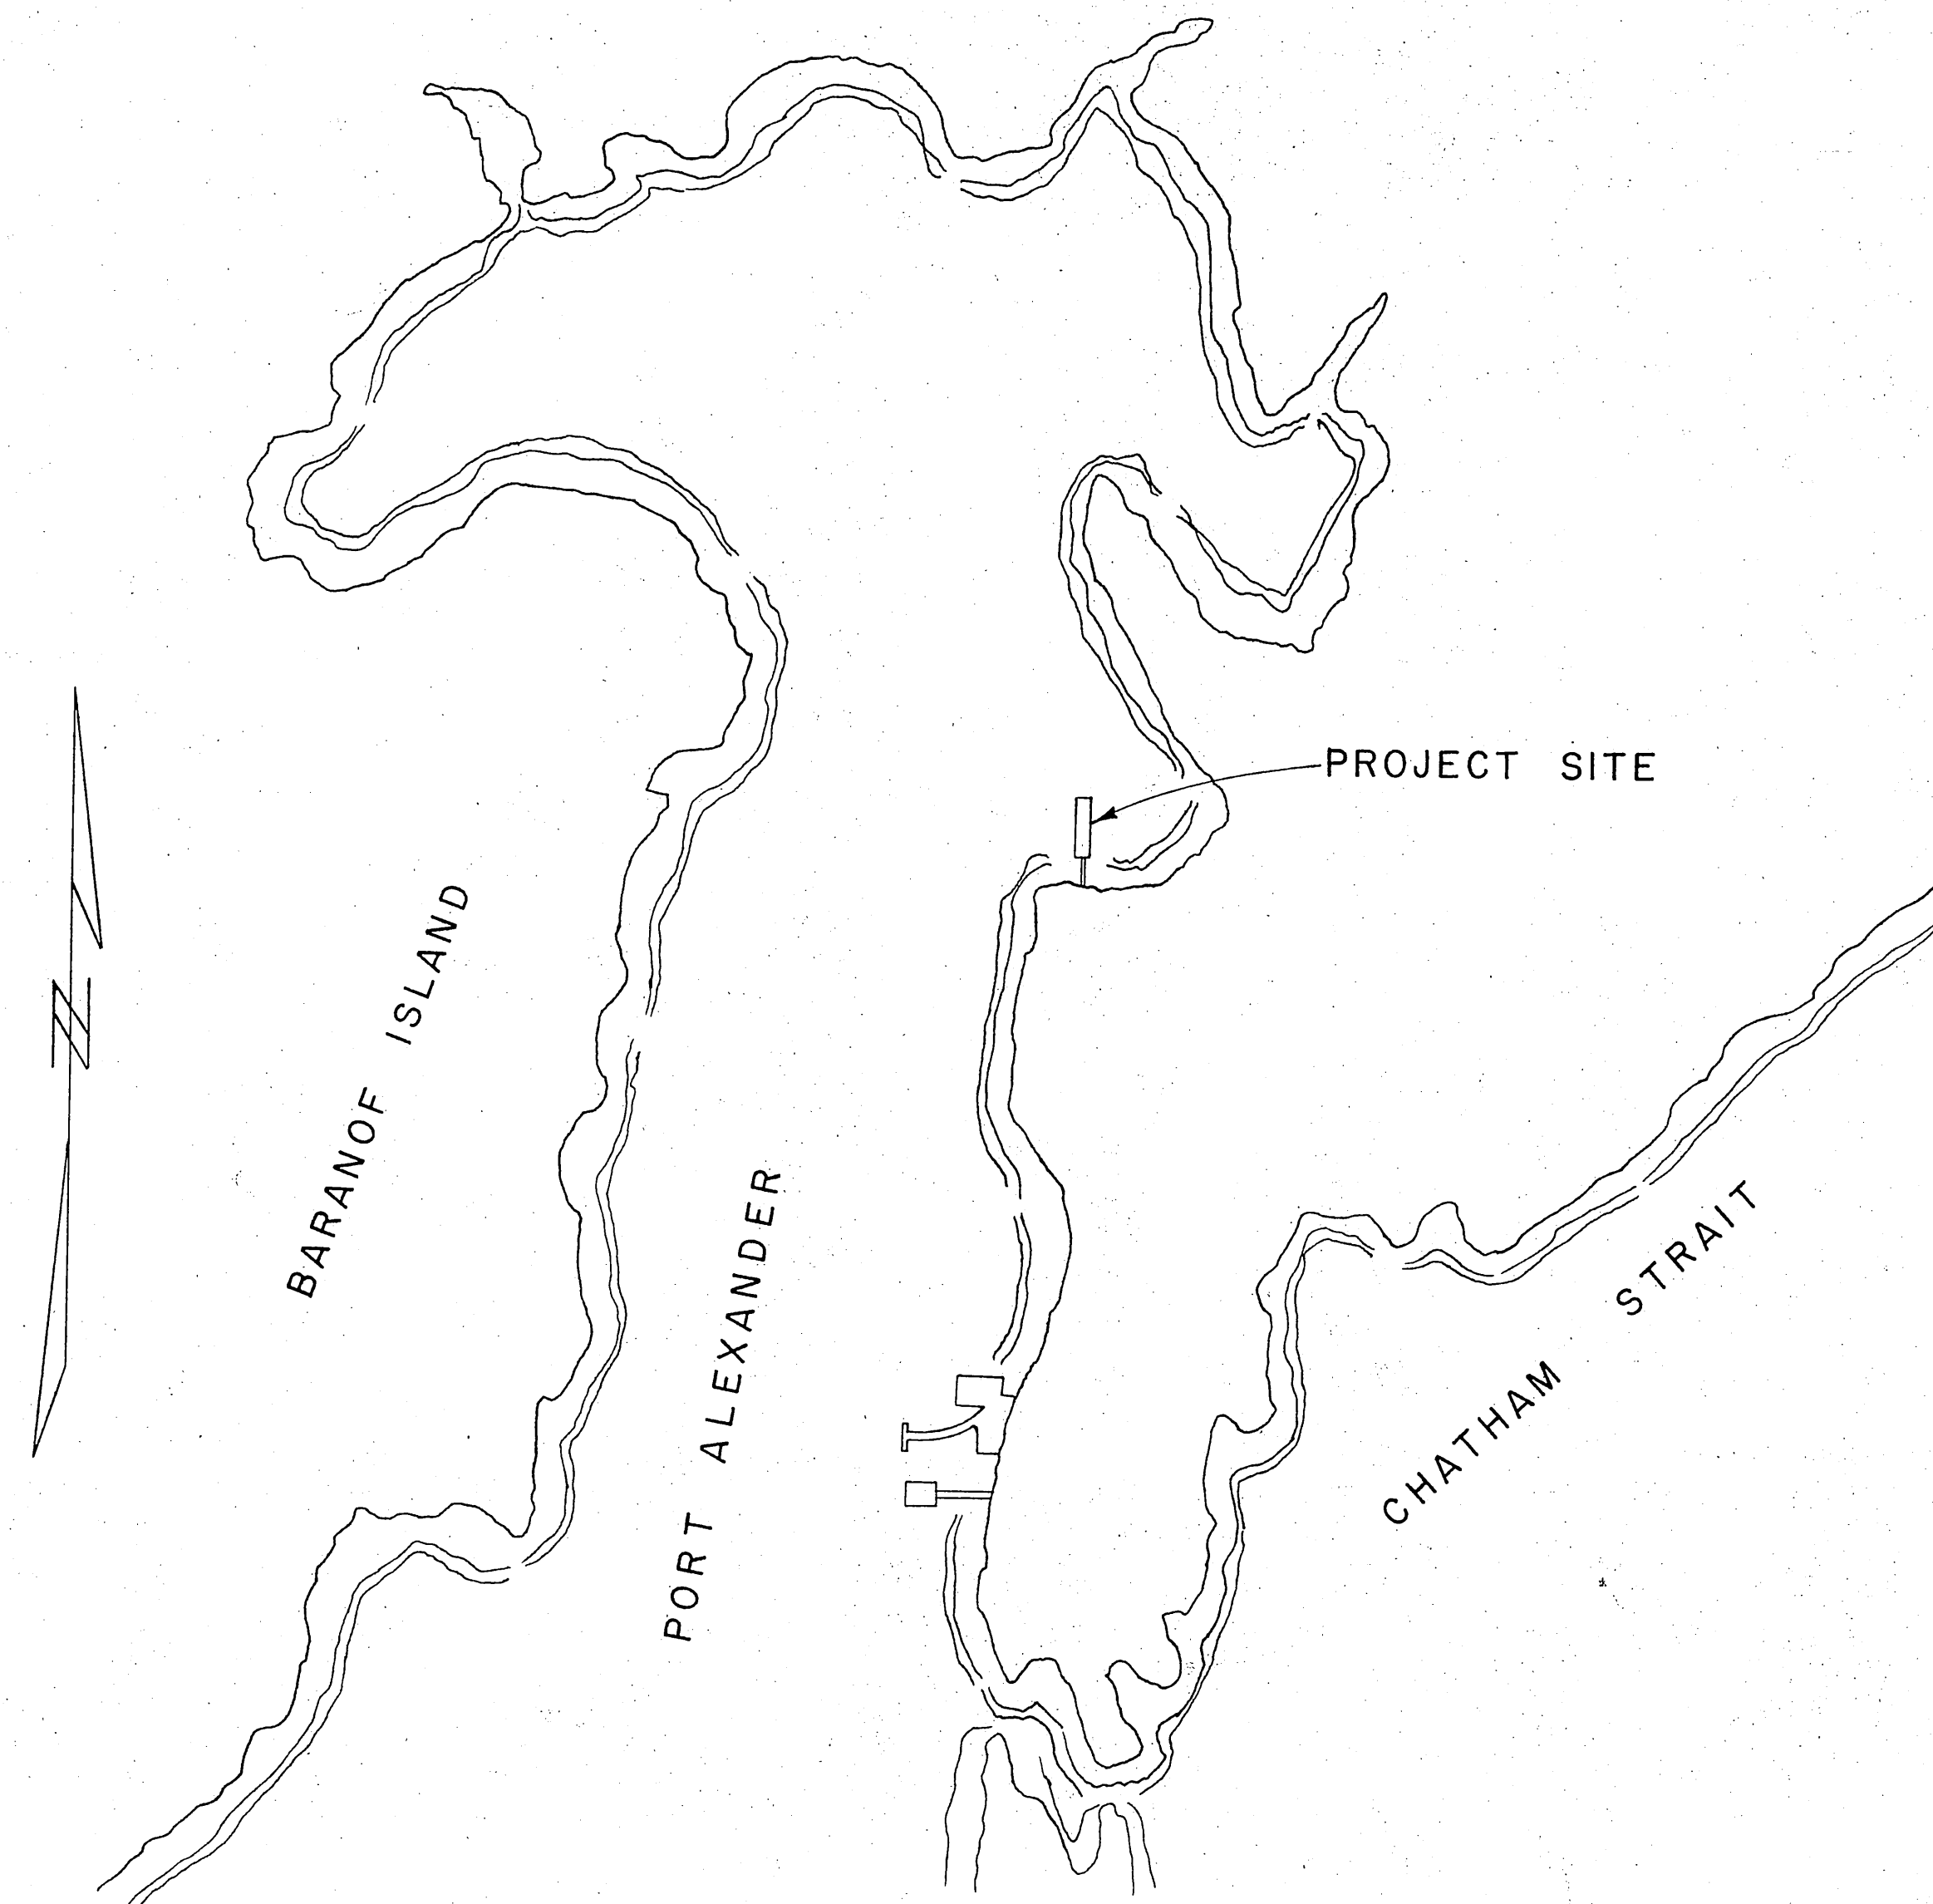


TERRITORY OF ALASKA

OFFICE OF THE HIGHWAY ENGINEER

PORT ALEXANDER FLOAT

PROJECT 1-56-W2

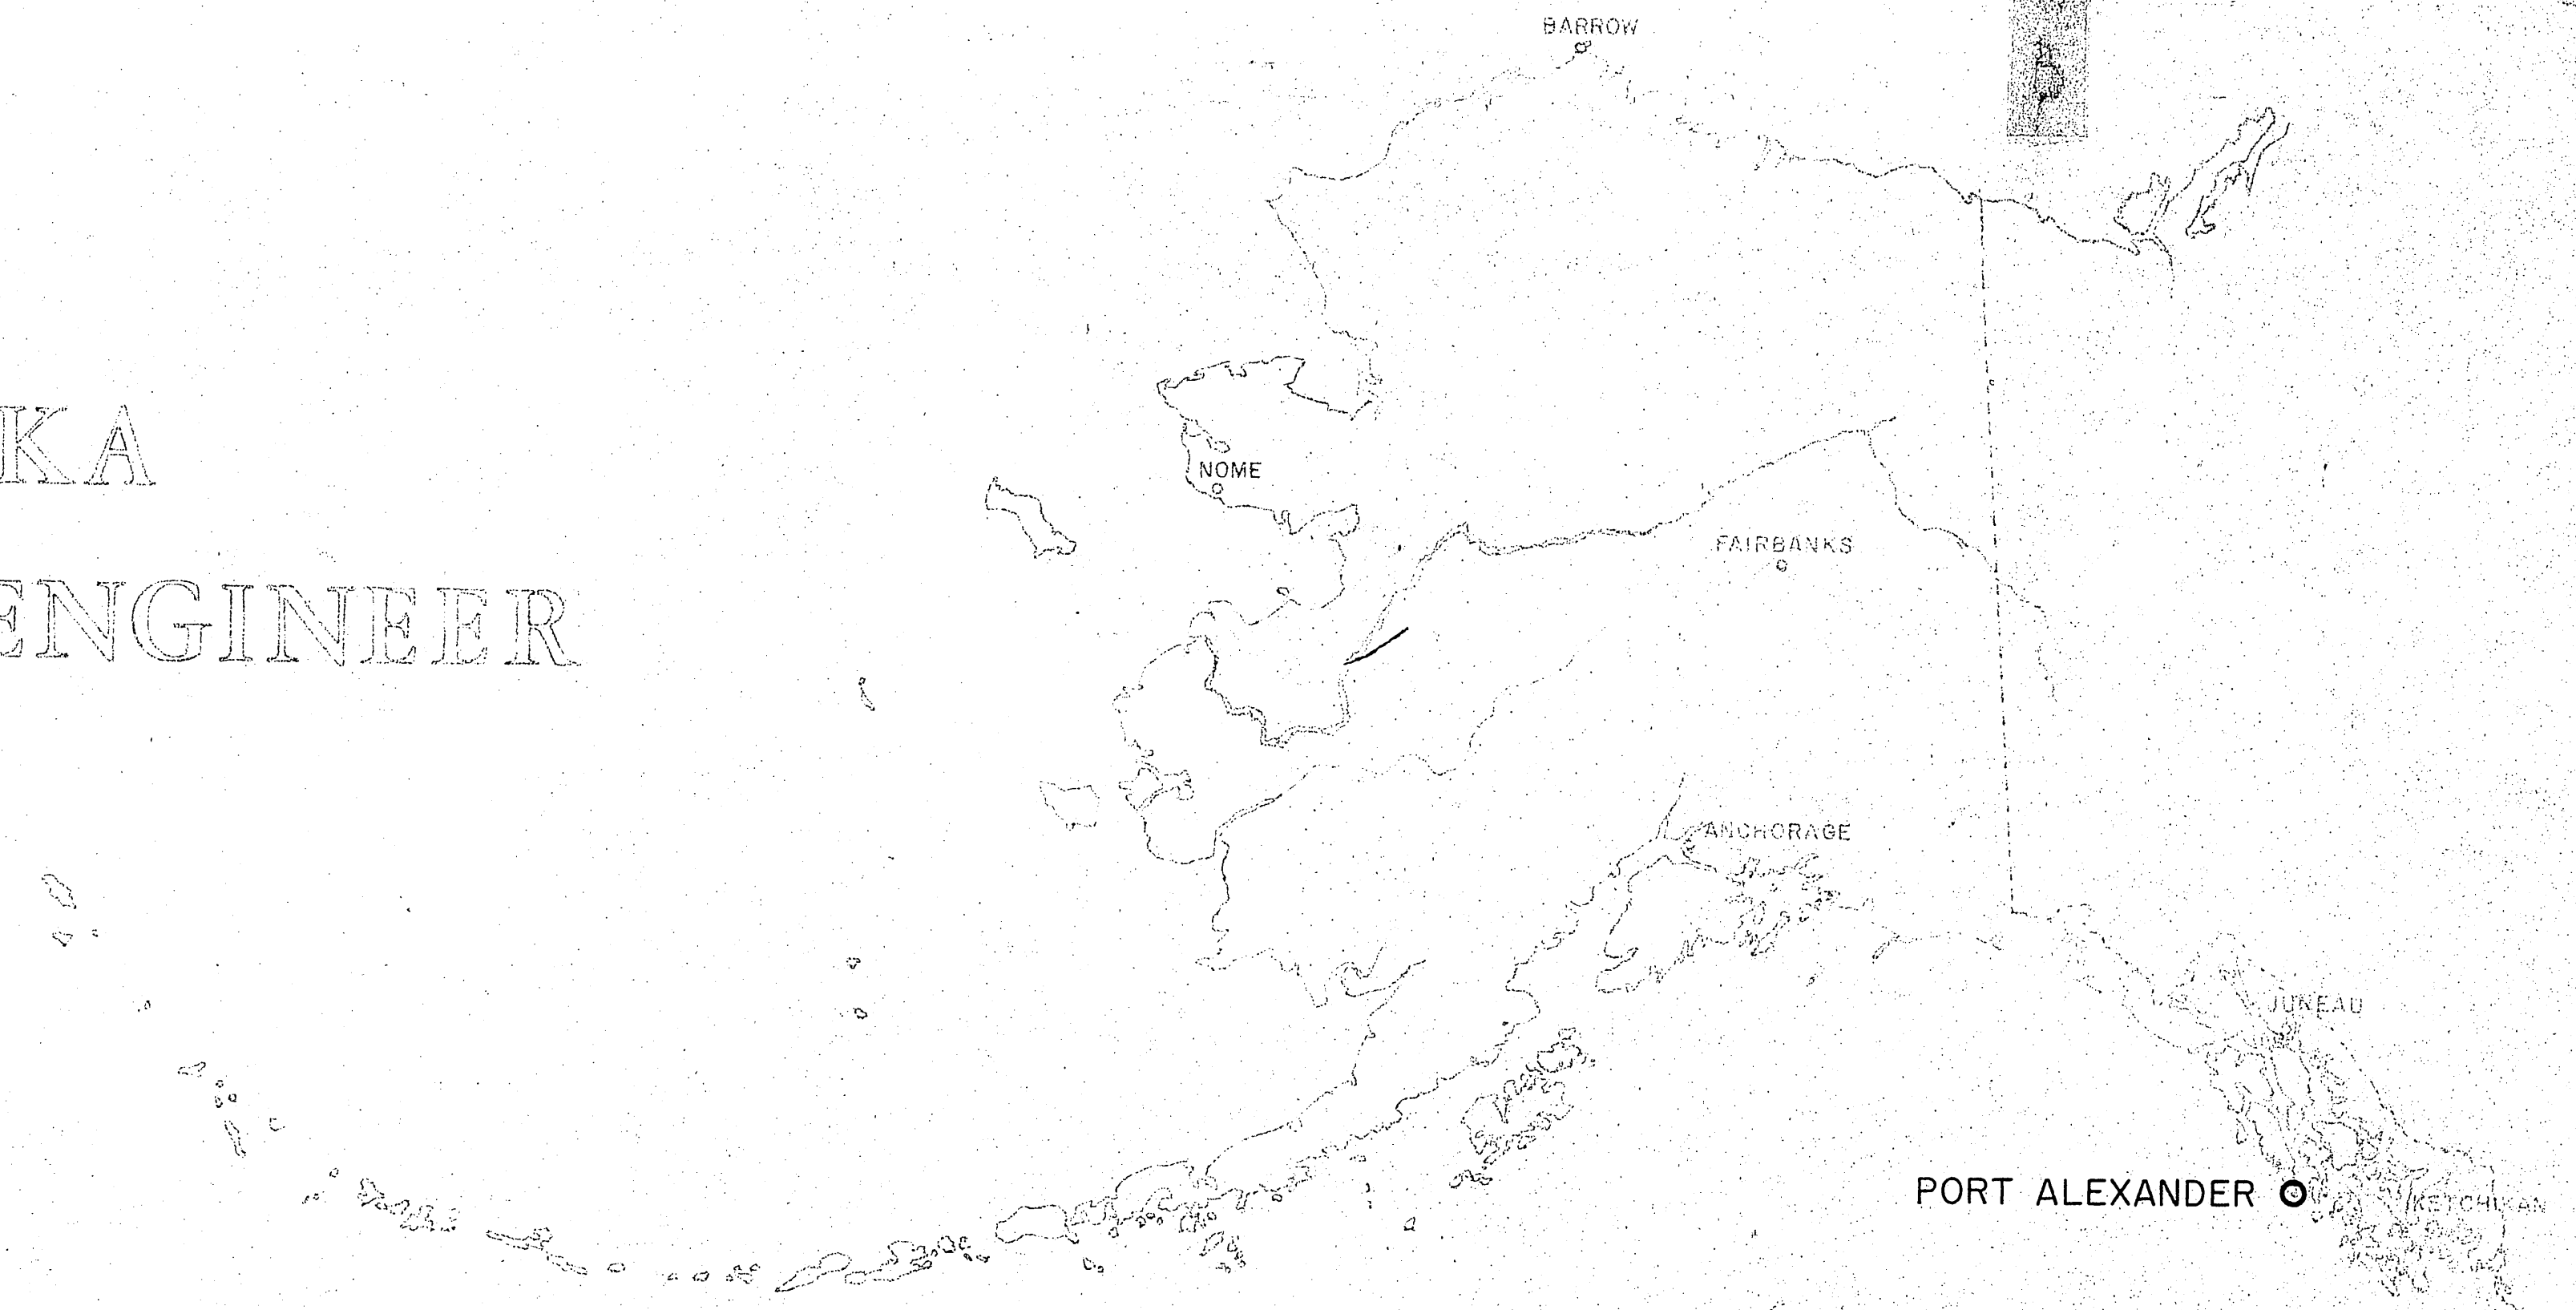

WORK SUMMARY

PRESENT PROJECT:

Catwalk and float to be constructed as shown, sheet Nos. 2 & 3, except for method of mooring in place. Delete all piling and overhead bracing. Substitute 4 anchors and lines, 2 at each extreme end of float. Anchors shall be trap anchors of 2000 lb. minimum weight, or the equivalent of such anchors, to be placed as directed. Each line shall be approximately 500 ft. in length and shall consist of 1 1/4 in. or larger galv. cable with 1/2 in. galv. chain at each end, attached by means of a chain shackle, cable thimble, and 3 cable clamps. Chain at the anchor end shall be 15 ft. in length and securely shackled to the anchor. Chain at the float end shall be 15 ft. long in addition to sufficient chain to make 2 complete turns around the log, and shall be fastened to the log with 6 or more 3/8 in. by 7 in. galv. staples, or with 2 - 3/4 in. by 24 in. drift pins with approved clinch ring heads. Lines shall pass under the float and attach to the outside float log on the opposite side. All fittings shall be galvanized.

FUTURE WORK: (Proposed for September, 1956)

Lines and anchors to be removed and salvaged. Mooring piles and bracing to be furnished and placed as shown on these plans.




NOTE: Exact location and orientation of units to be determined by the engineer.

STANDARD SYMBOLS

TREE	
POWER POLE	
TELEPHONE POLE	
FENCE	
SECTION LINE	
RIGHT OF WAY LINE	


INDEX TO SHEETS

TITLE SHEET	1
PLAN — PROFILE	
TYPICAL SECTIONS and DETAILS	2-3

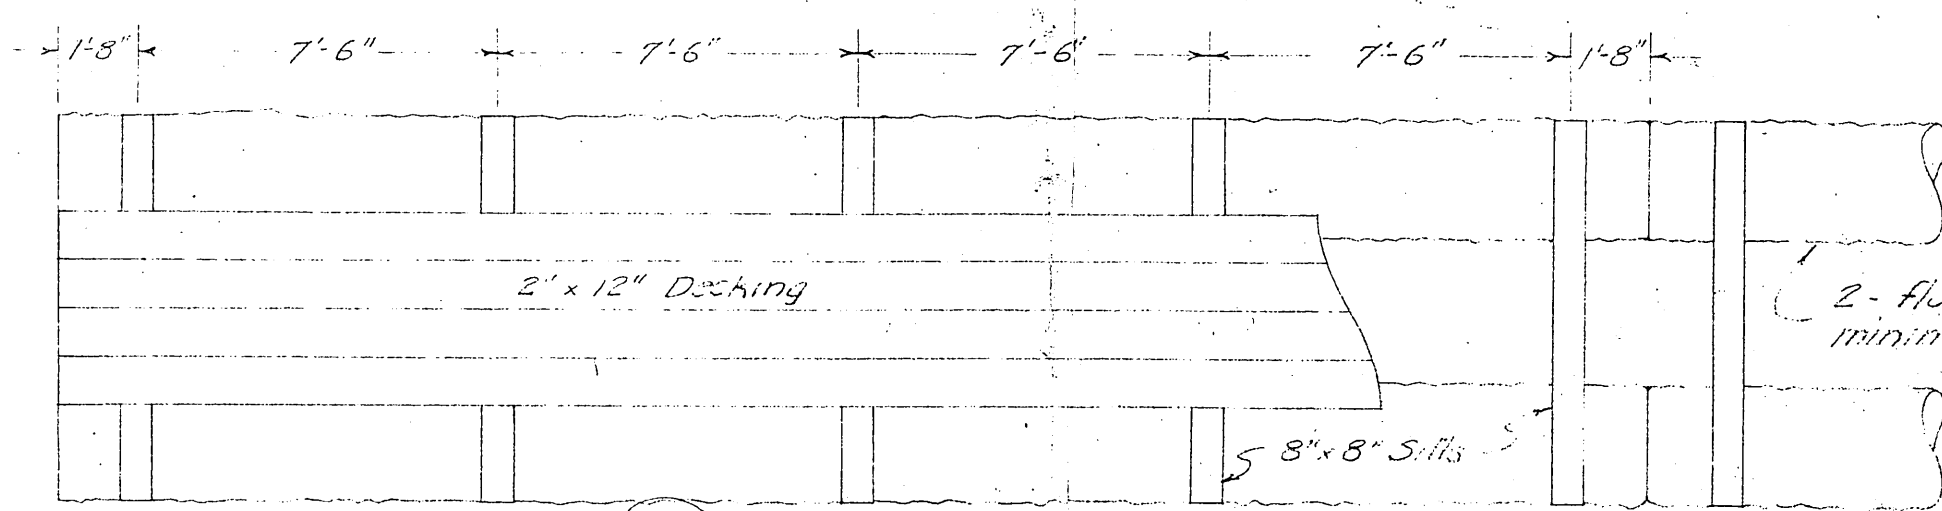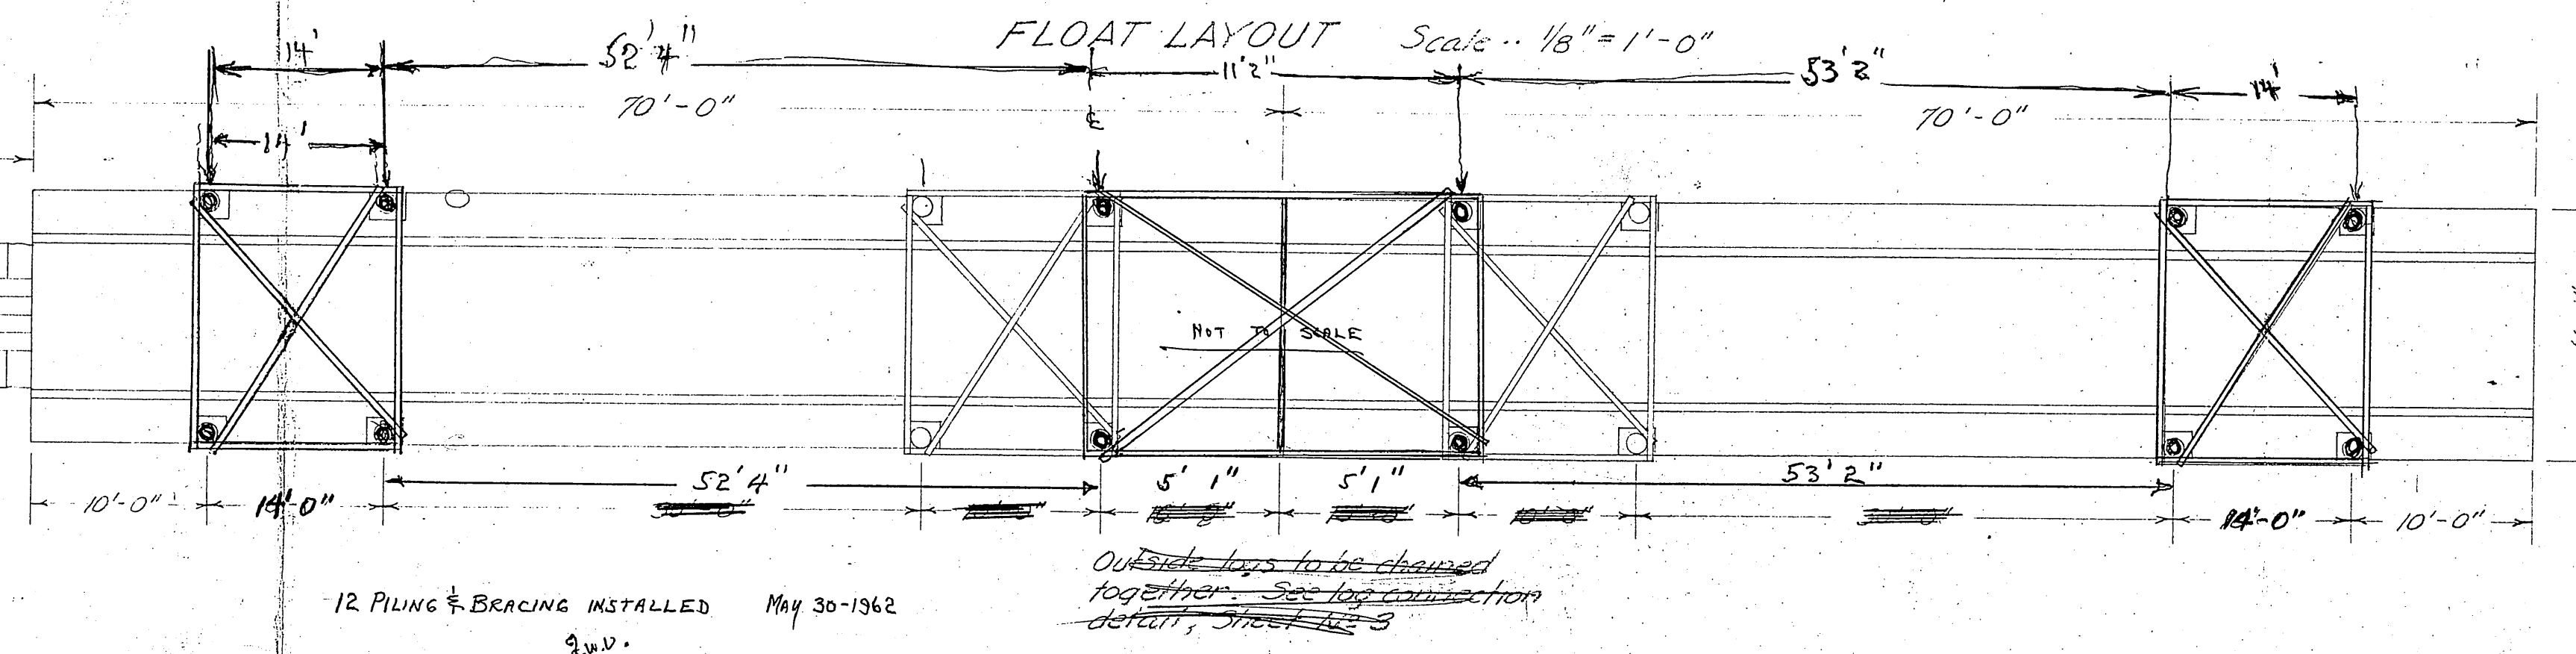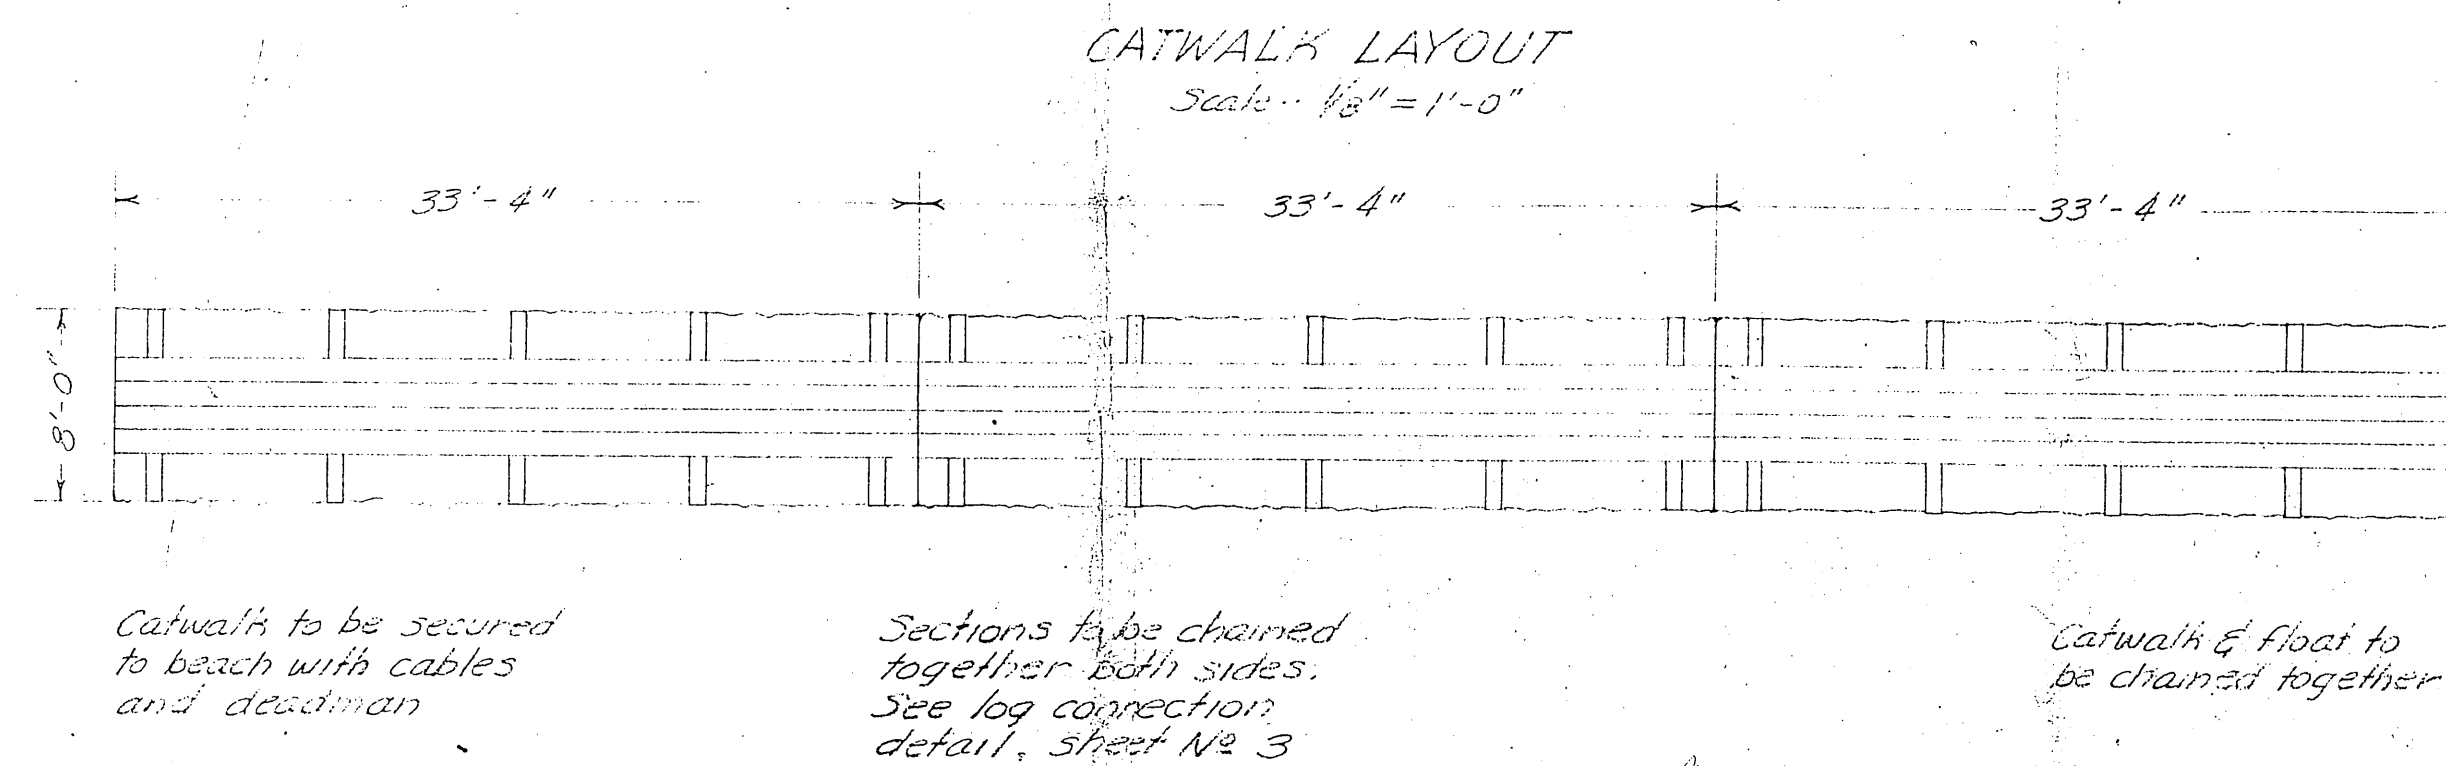


Sawed timbers shall be treated with "Cuprinol" or equal.

PLAN VIEW

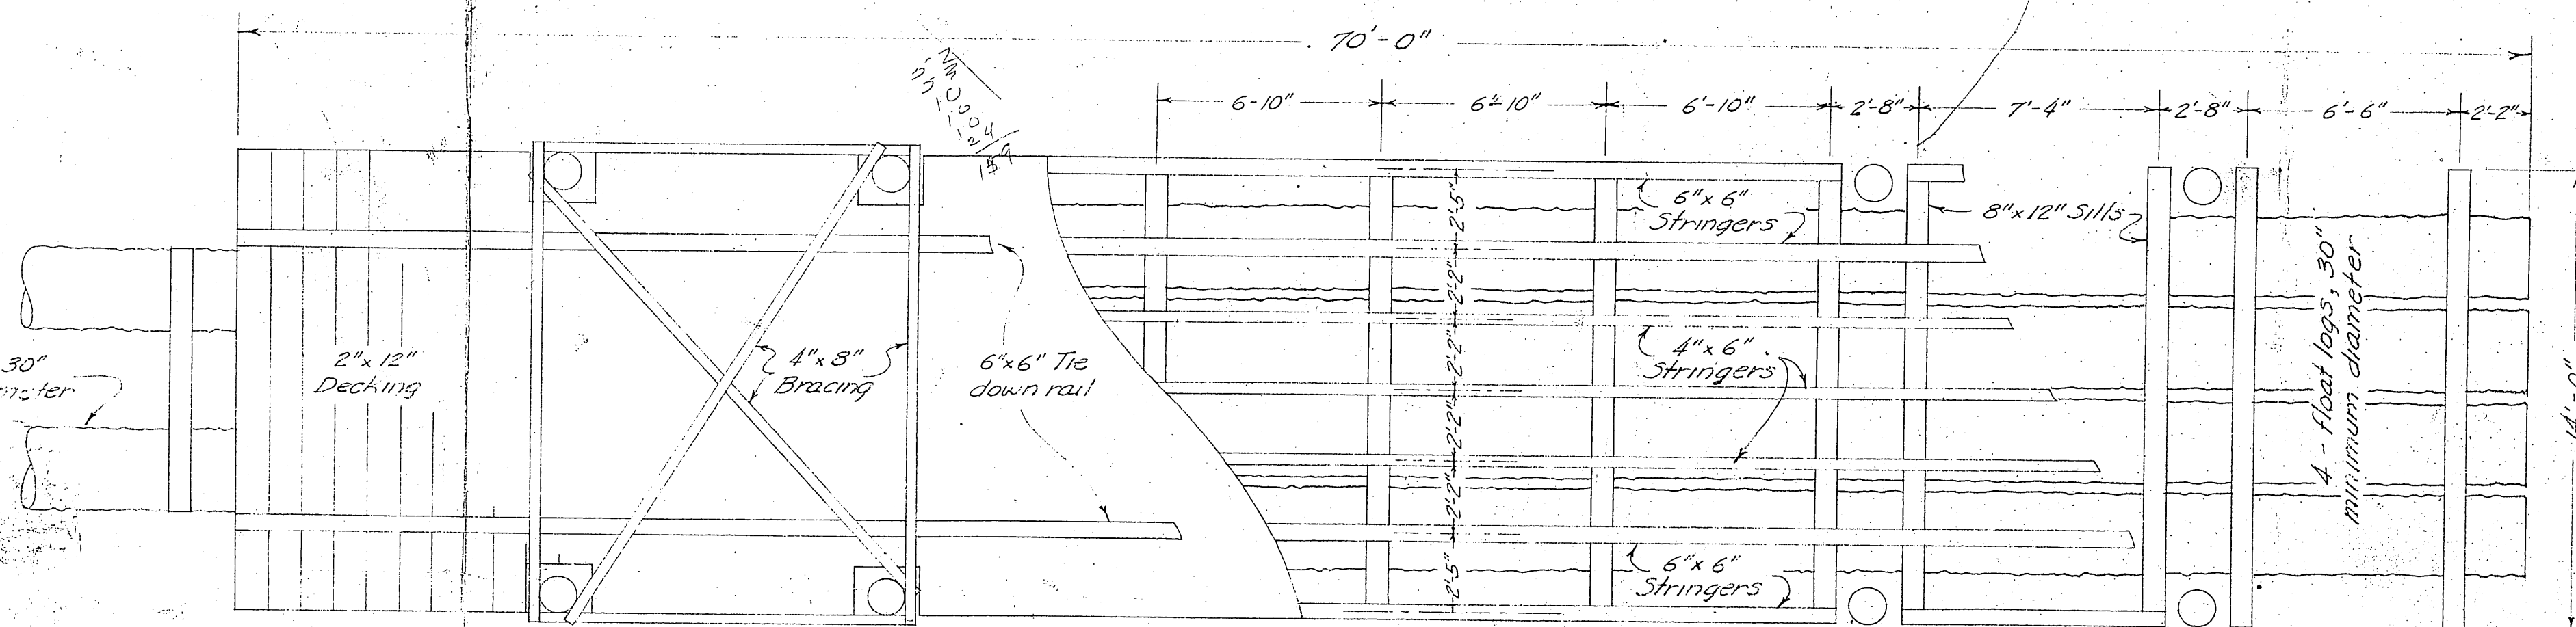

PLAN VIEW

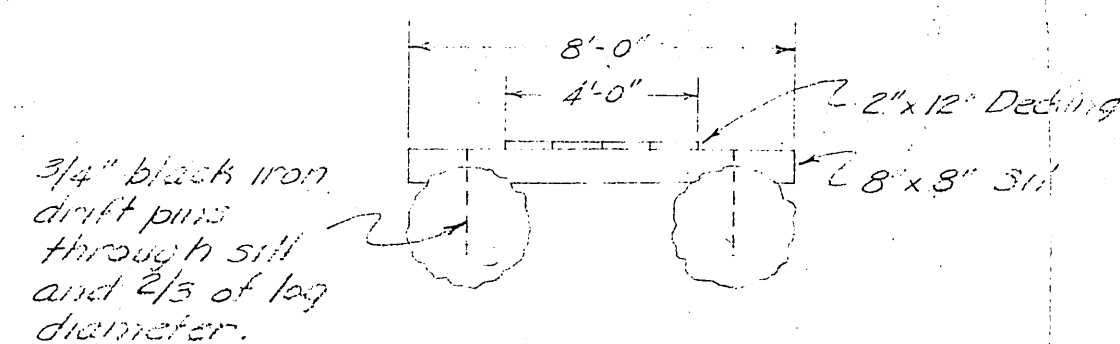

END ELEVATION

CATWALK DETAIL

Scale: 1/4" = 1'-0"

All decking to be fastened with 2" x 40 d. galv. spikes per plank at each stringer.

INNER HARBOR


TOP TIES ON PILING

- 6 - 4" x 8" x 16' - 10" CREO.
- 6 - 4" x 8" x 18' - 10" CREO.
- 6 - 8" x 6" x 26' - 10" LAMINATED

To 4" x 6" x 26"

ALL BOLTS GALVANIZED
PILING - CLASS "B" 12" CREO.

FOR PILING PENETRATION SEE PILING RECORD SHEETS

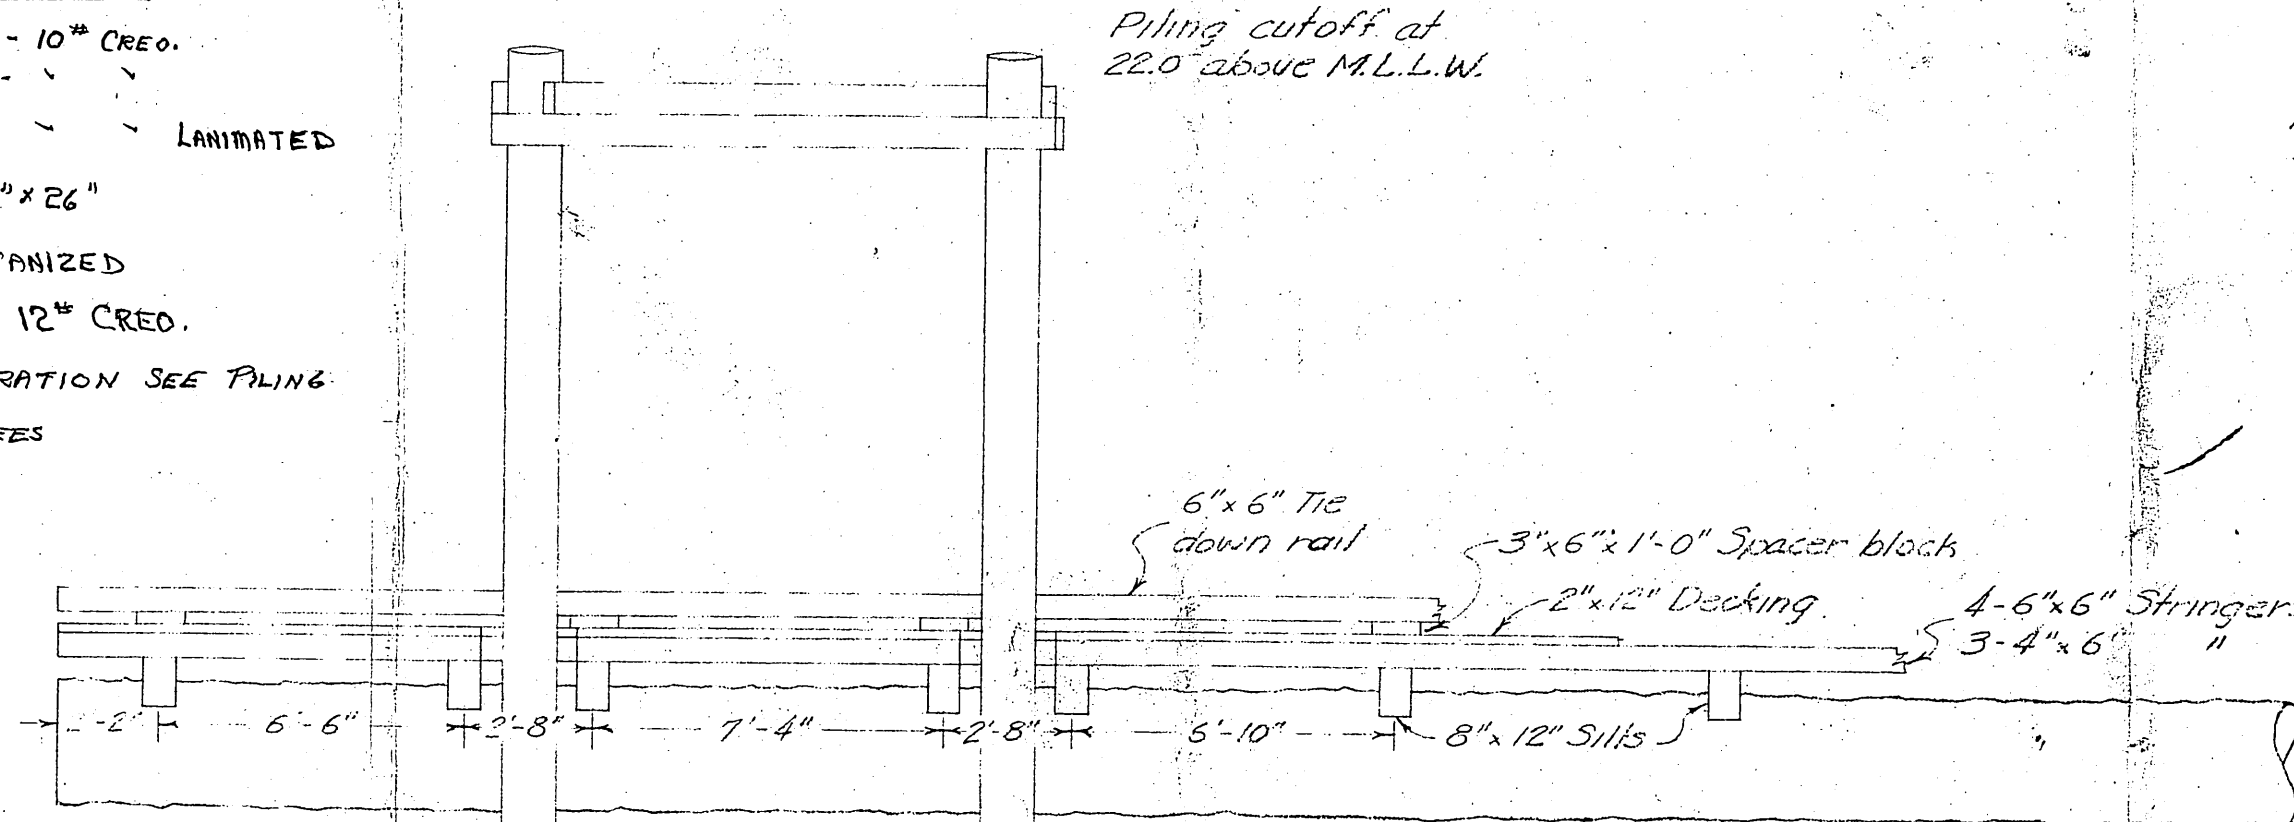


SIDE ELEVATION

Note: Piling to be class "B", creosote pressure treated to 12 lb. retention. All sawed timbers shall be treated with "Cuprinol" or equal.


FLOAT DETAIL

Scale: 1/4" = 1'-0"

Note: Present project does not include mooring piles and bracing. See WORK SUMMARY, sheet No 1.

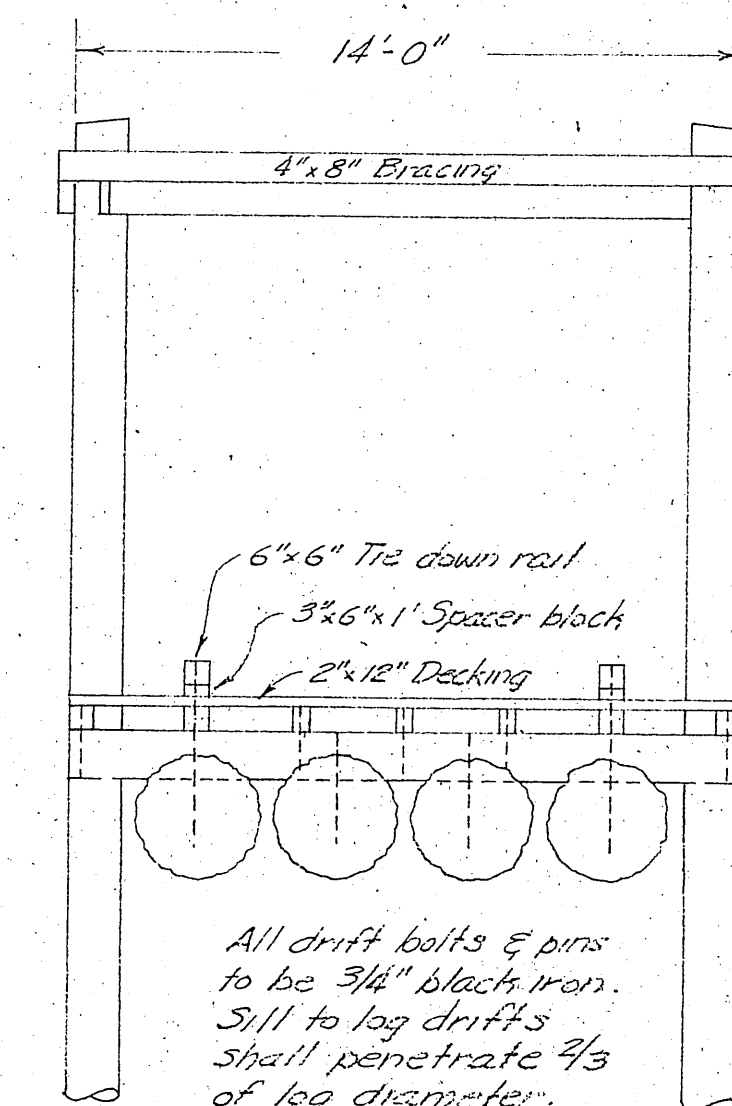

END ELEVATION

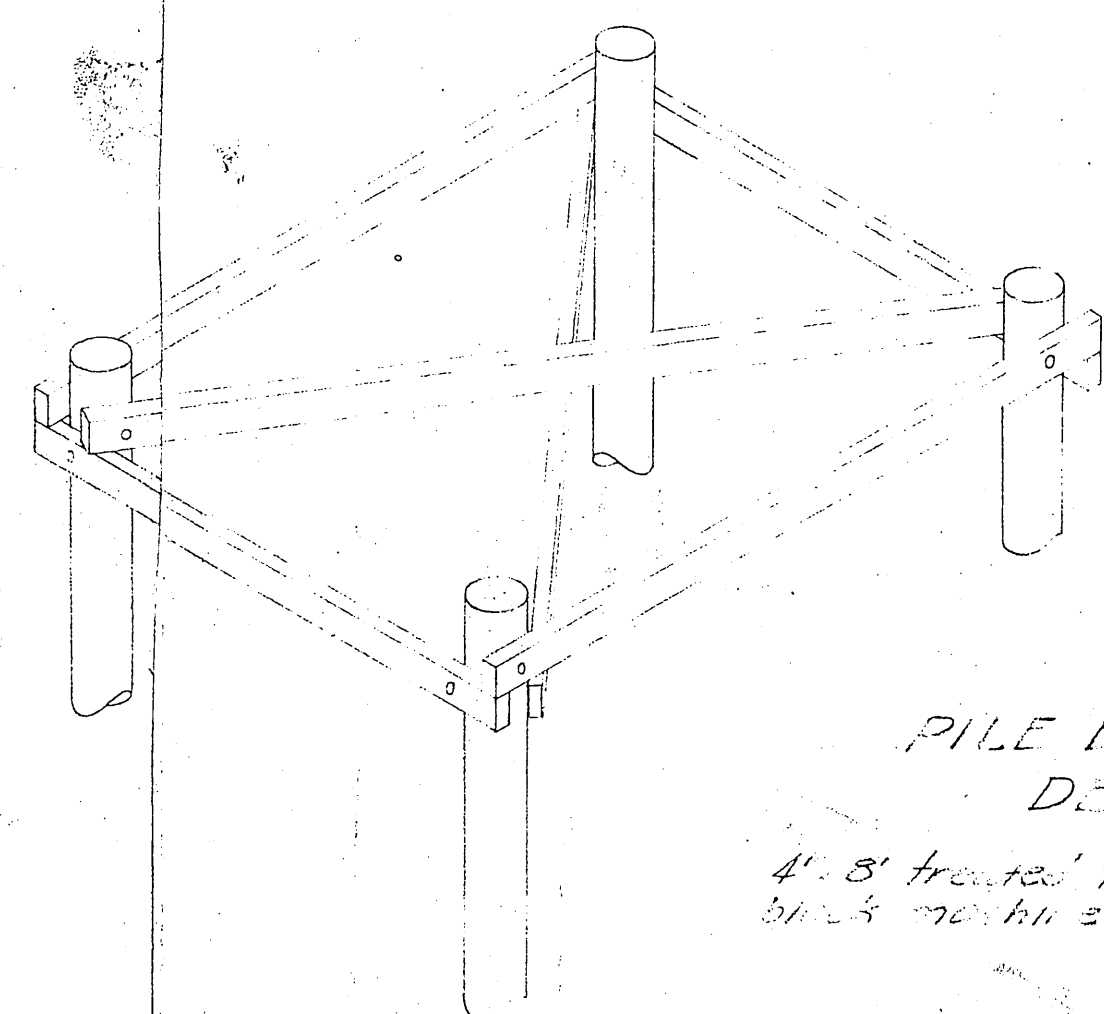


PILE BRACING DETAIL

TERRITORY OF ALASKA
OFFICE OF THE HIGHWAY ENGINEER
Construction Plans
**CATWALK & FLOAT,
PORT ALEXANDER**


SCALE AS SHOWN
DATE 3-5-56
FILE NO. L-56-W2
APPROVED *James Reed*
TERRITORIAL HWY. ENGINEER
SURVEYED BY *AMP* DRAWN BY *AMP* CHECKED BY *AMP*

SHEET No 2 of 3 SHEETS


AS BUILT
PORT ALEXANDER
JULY 1, 1962

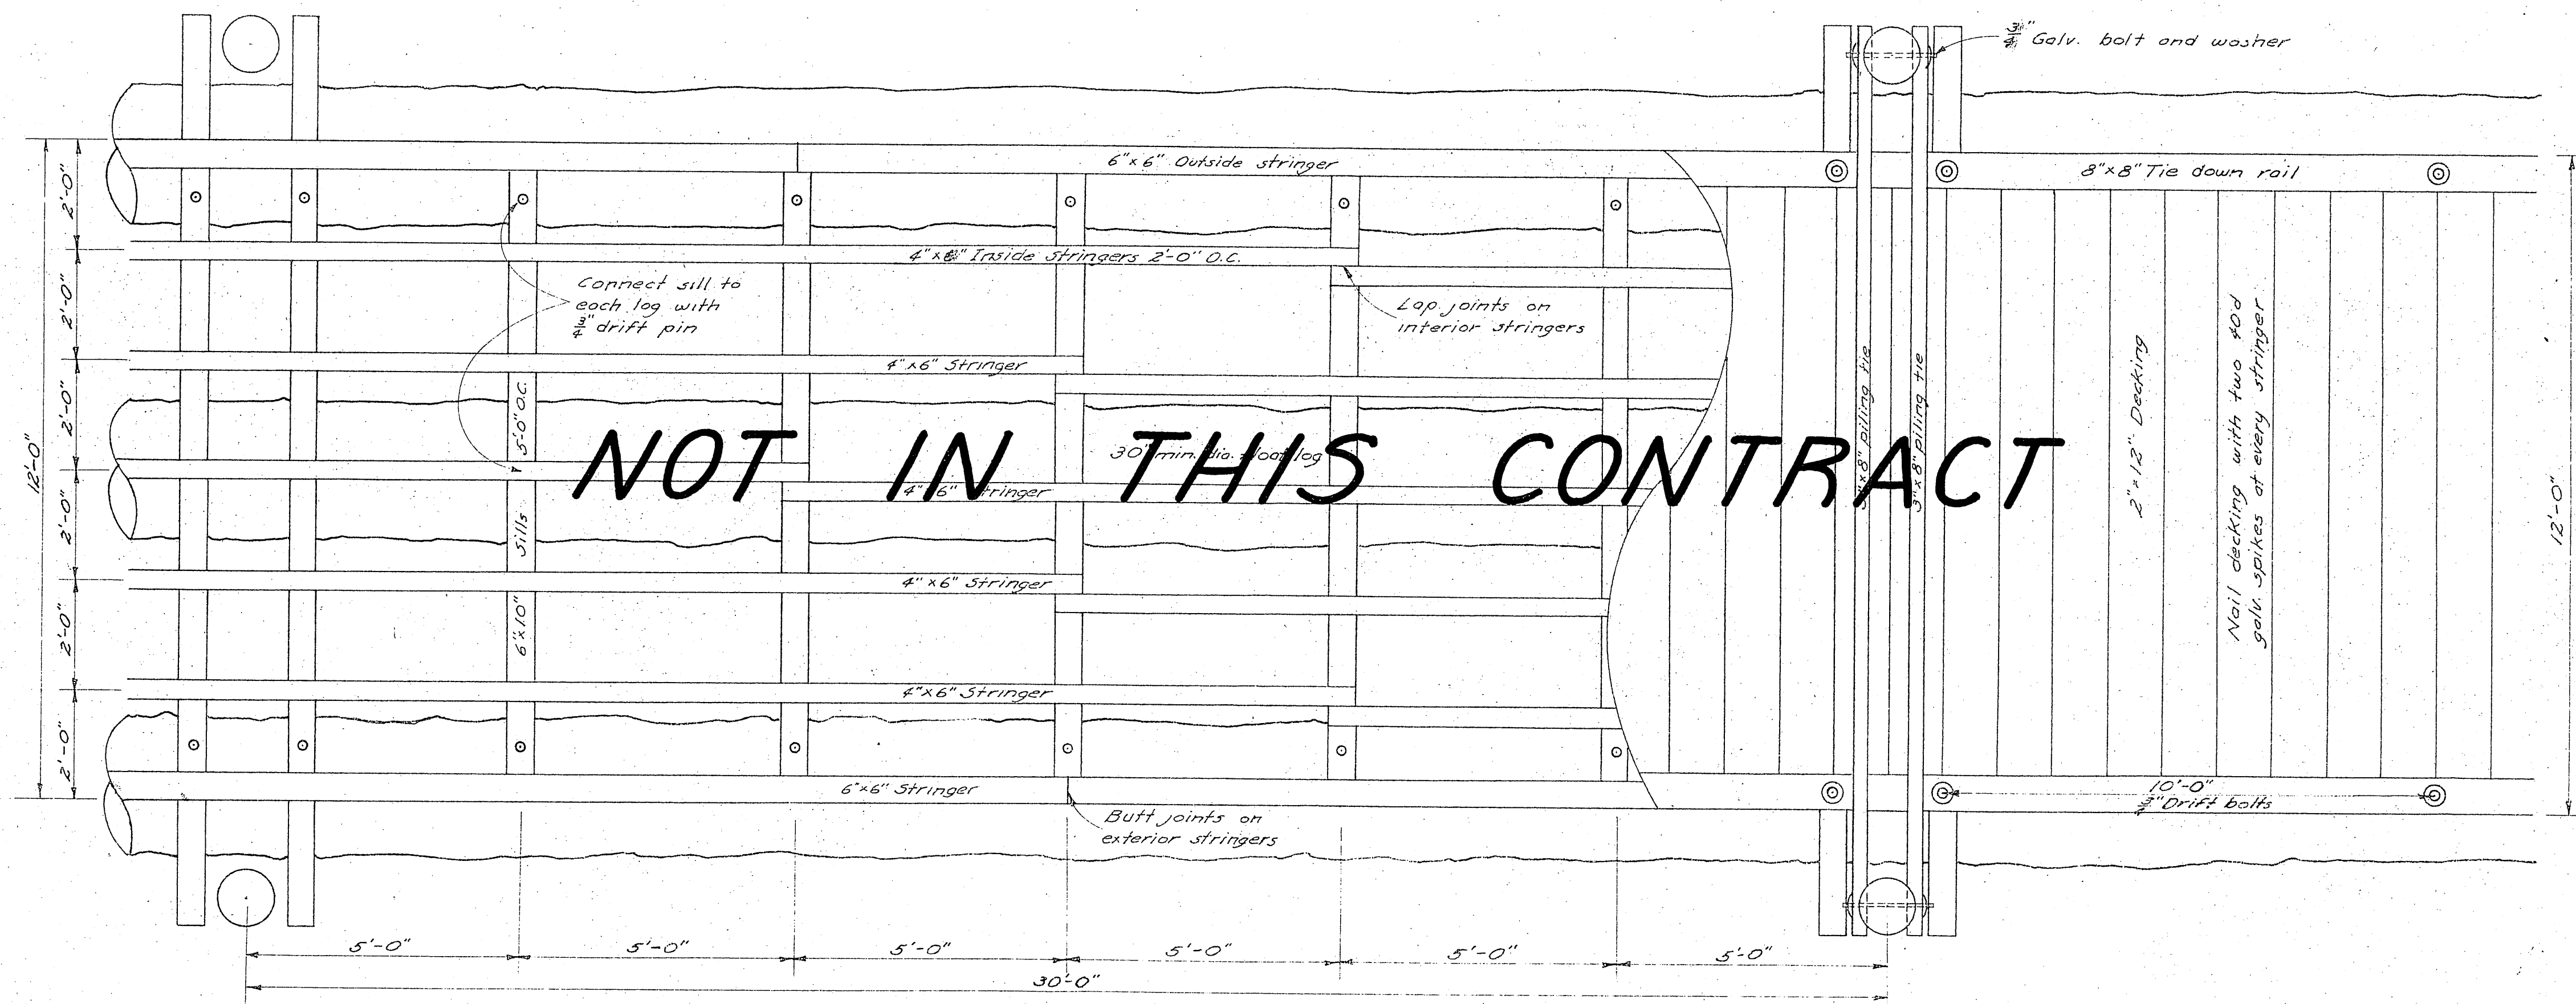


PLAN VIEW
Scale $\frac{1}{2}$ " = 1'-0"

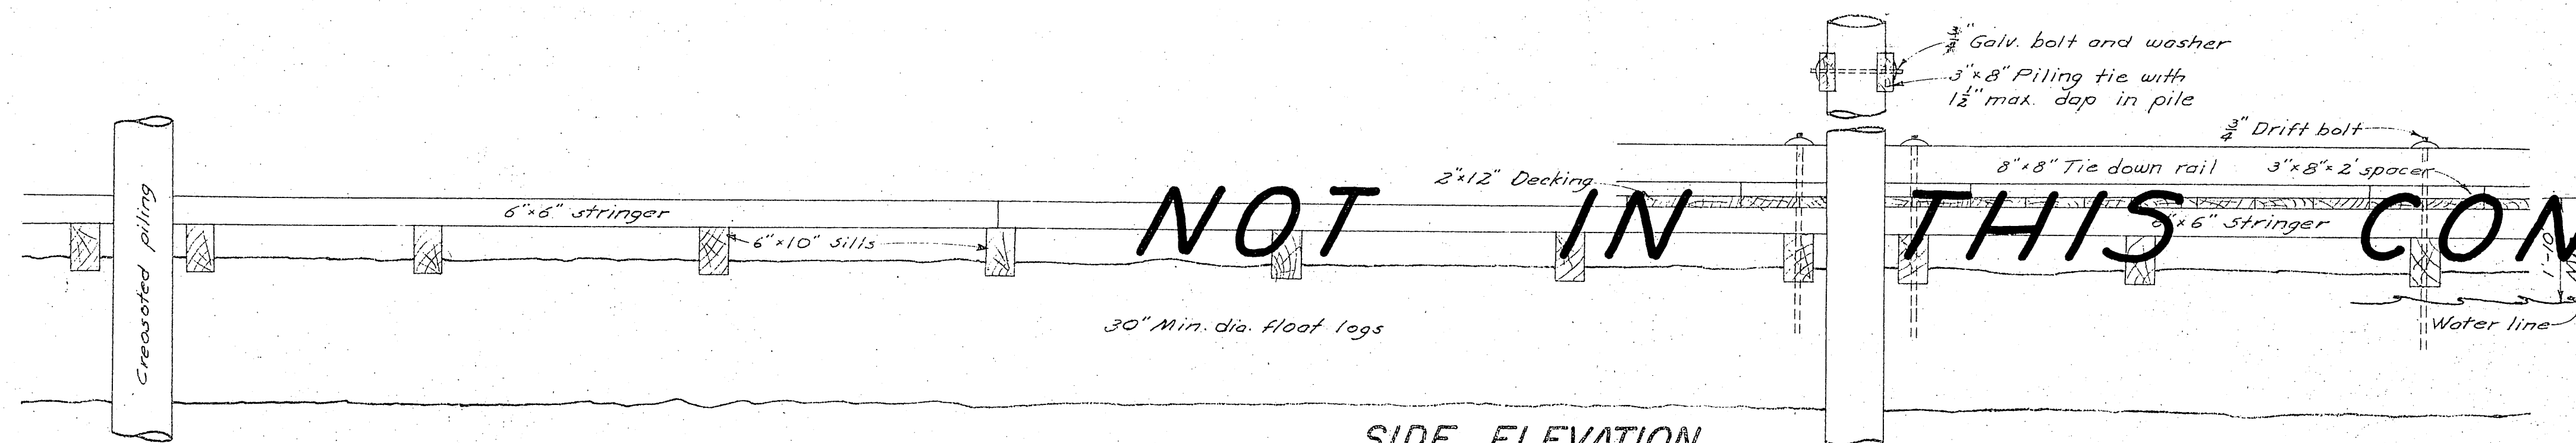

SIDE ELEVATION
Scale $\frac{1}{2}$ " = 1'-0"

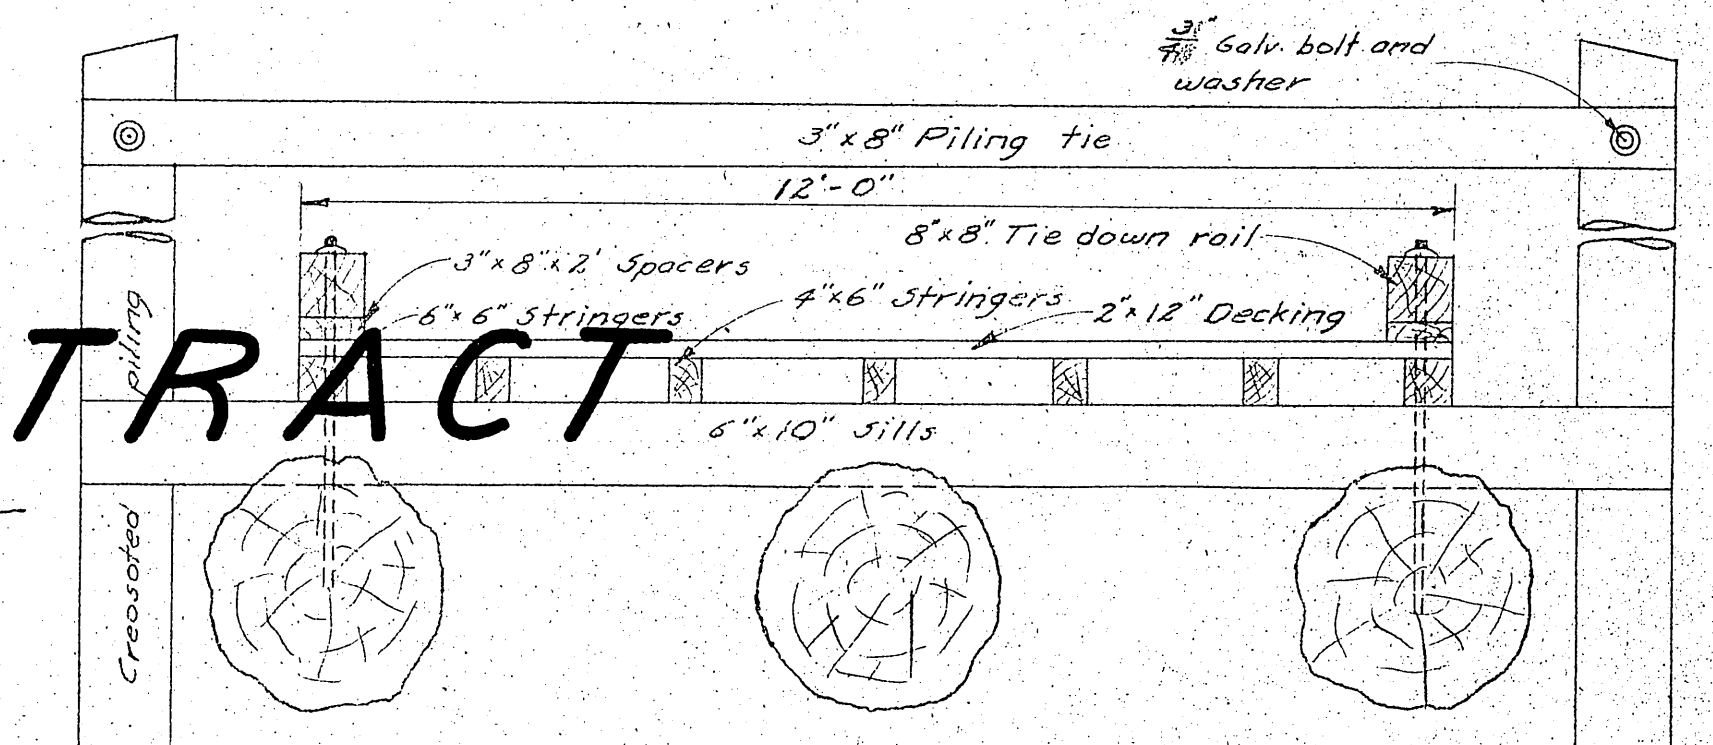


END ELEVATION
Scale $\frac{1}{2}$ " = 1'-0"

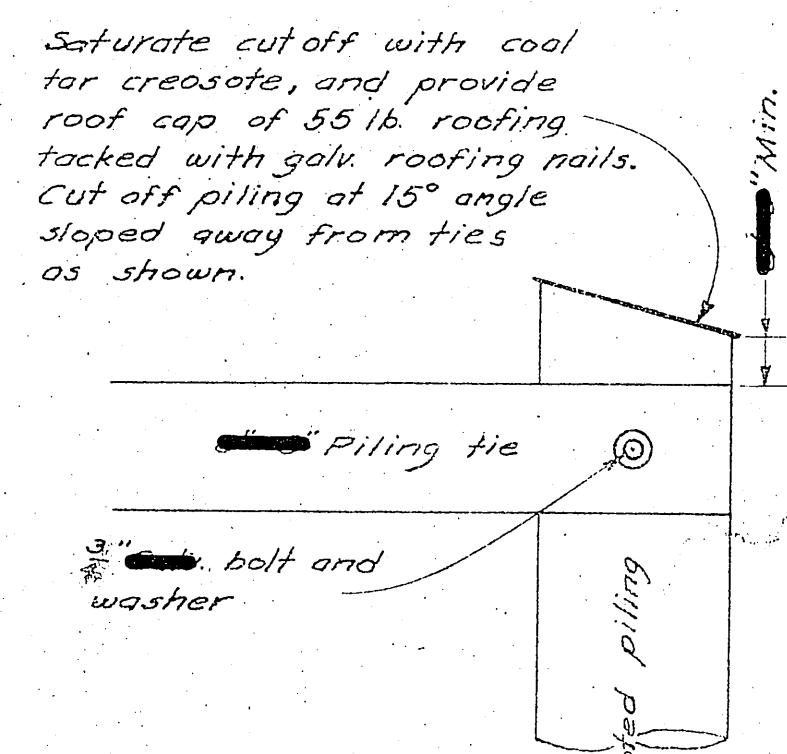


PILING TOP DETAIL
Scale 1" = 1'-0"


Roofing cap shall be pulled down over sides of pile before tacking.

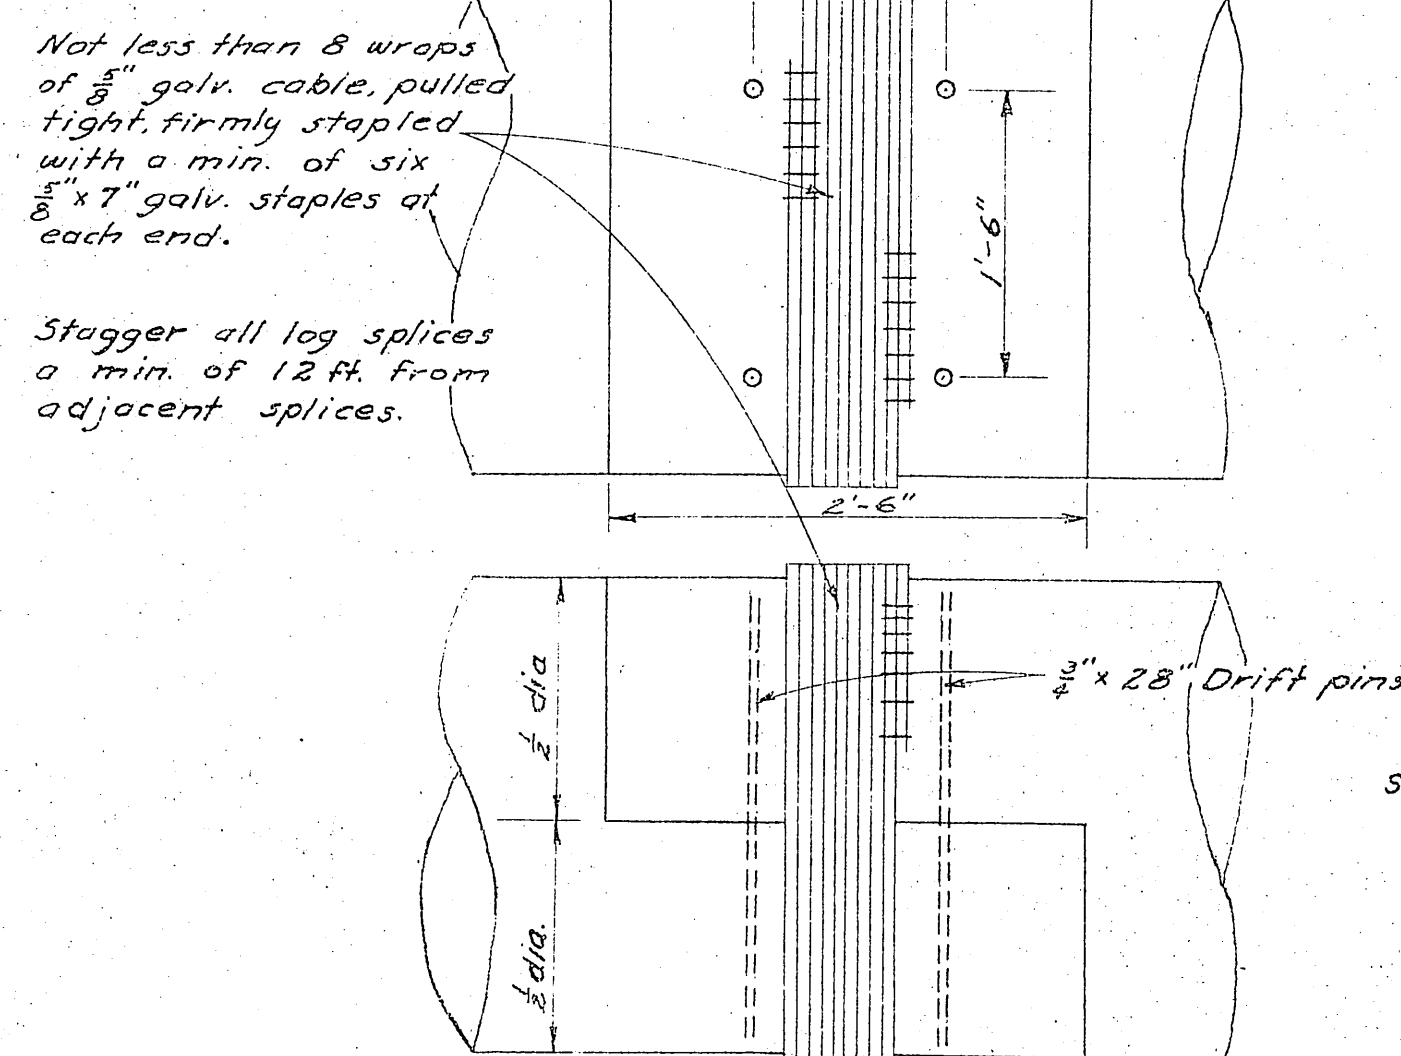


LOG SPLICE DETAIL
Scale 1" = 1'-0"

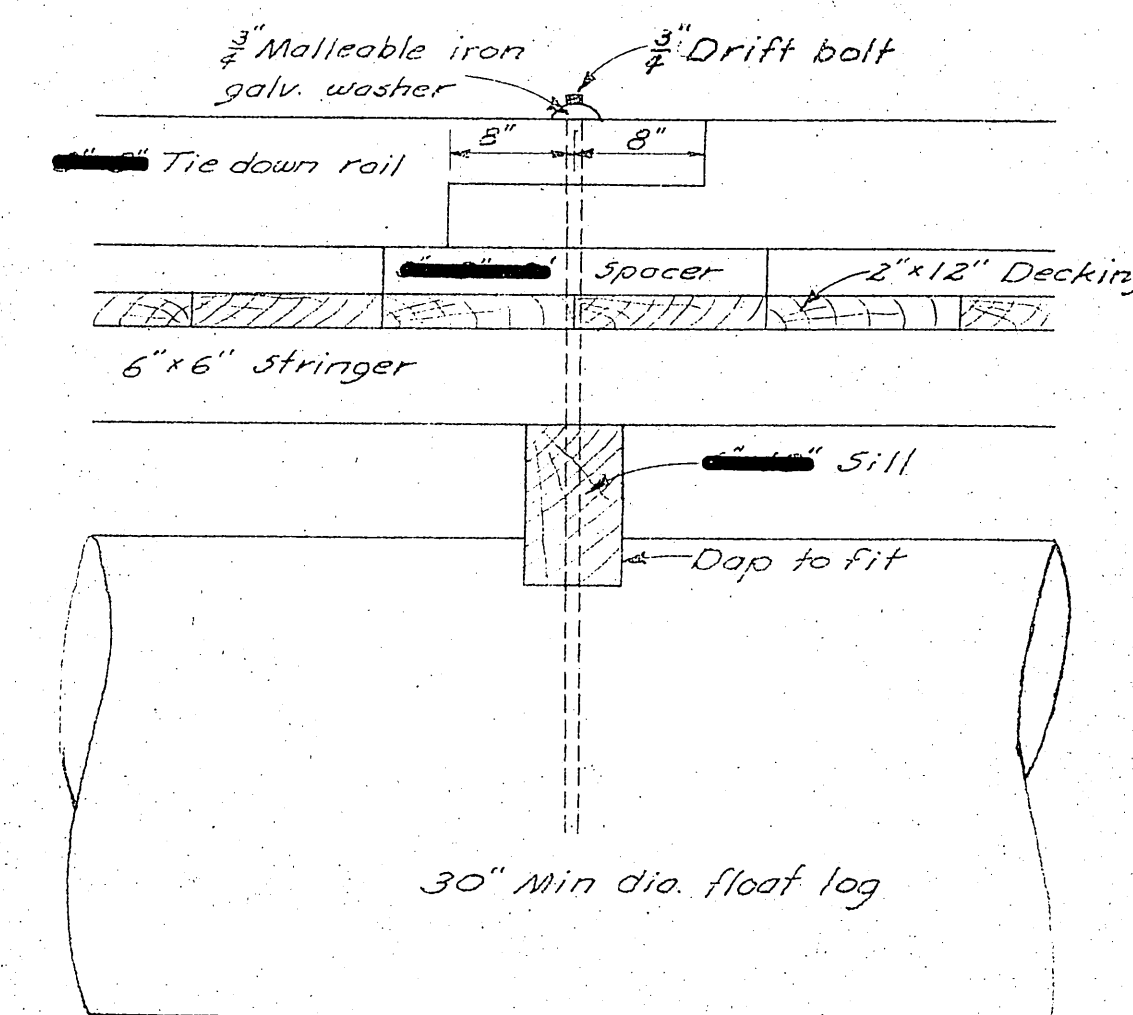

TIE DOWN RAIL SPLICE DETAIL

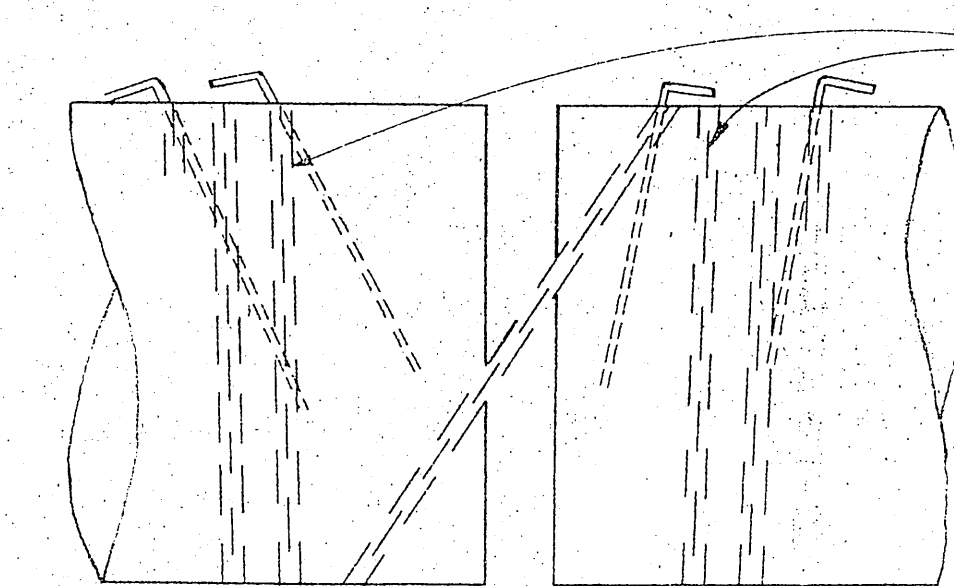

LOG CONNECTION DETAIL
Scale 1" = 1'-0"

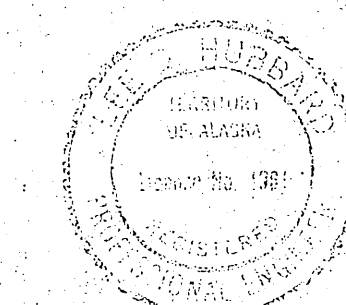

NO.	DATE	REVISION	BY
TERRITORY OF ALASKA			
OFFICE OF THE HIGHWAY ENGINEER			
DETAIL			
TYPICAL FLOAT			
SCALE <u>as shown</u>	APPROVED <i>Jim Reed</i>		
DATE <u>17 FEB 56</u>			
FILE NO. <u>0-56-WD2</u>	TERRITORIAL HWY. ENGINEER		
SURVEYED BY	DRAWN BY DMC	CHECKED BY	