


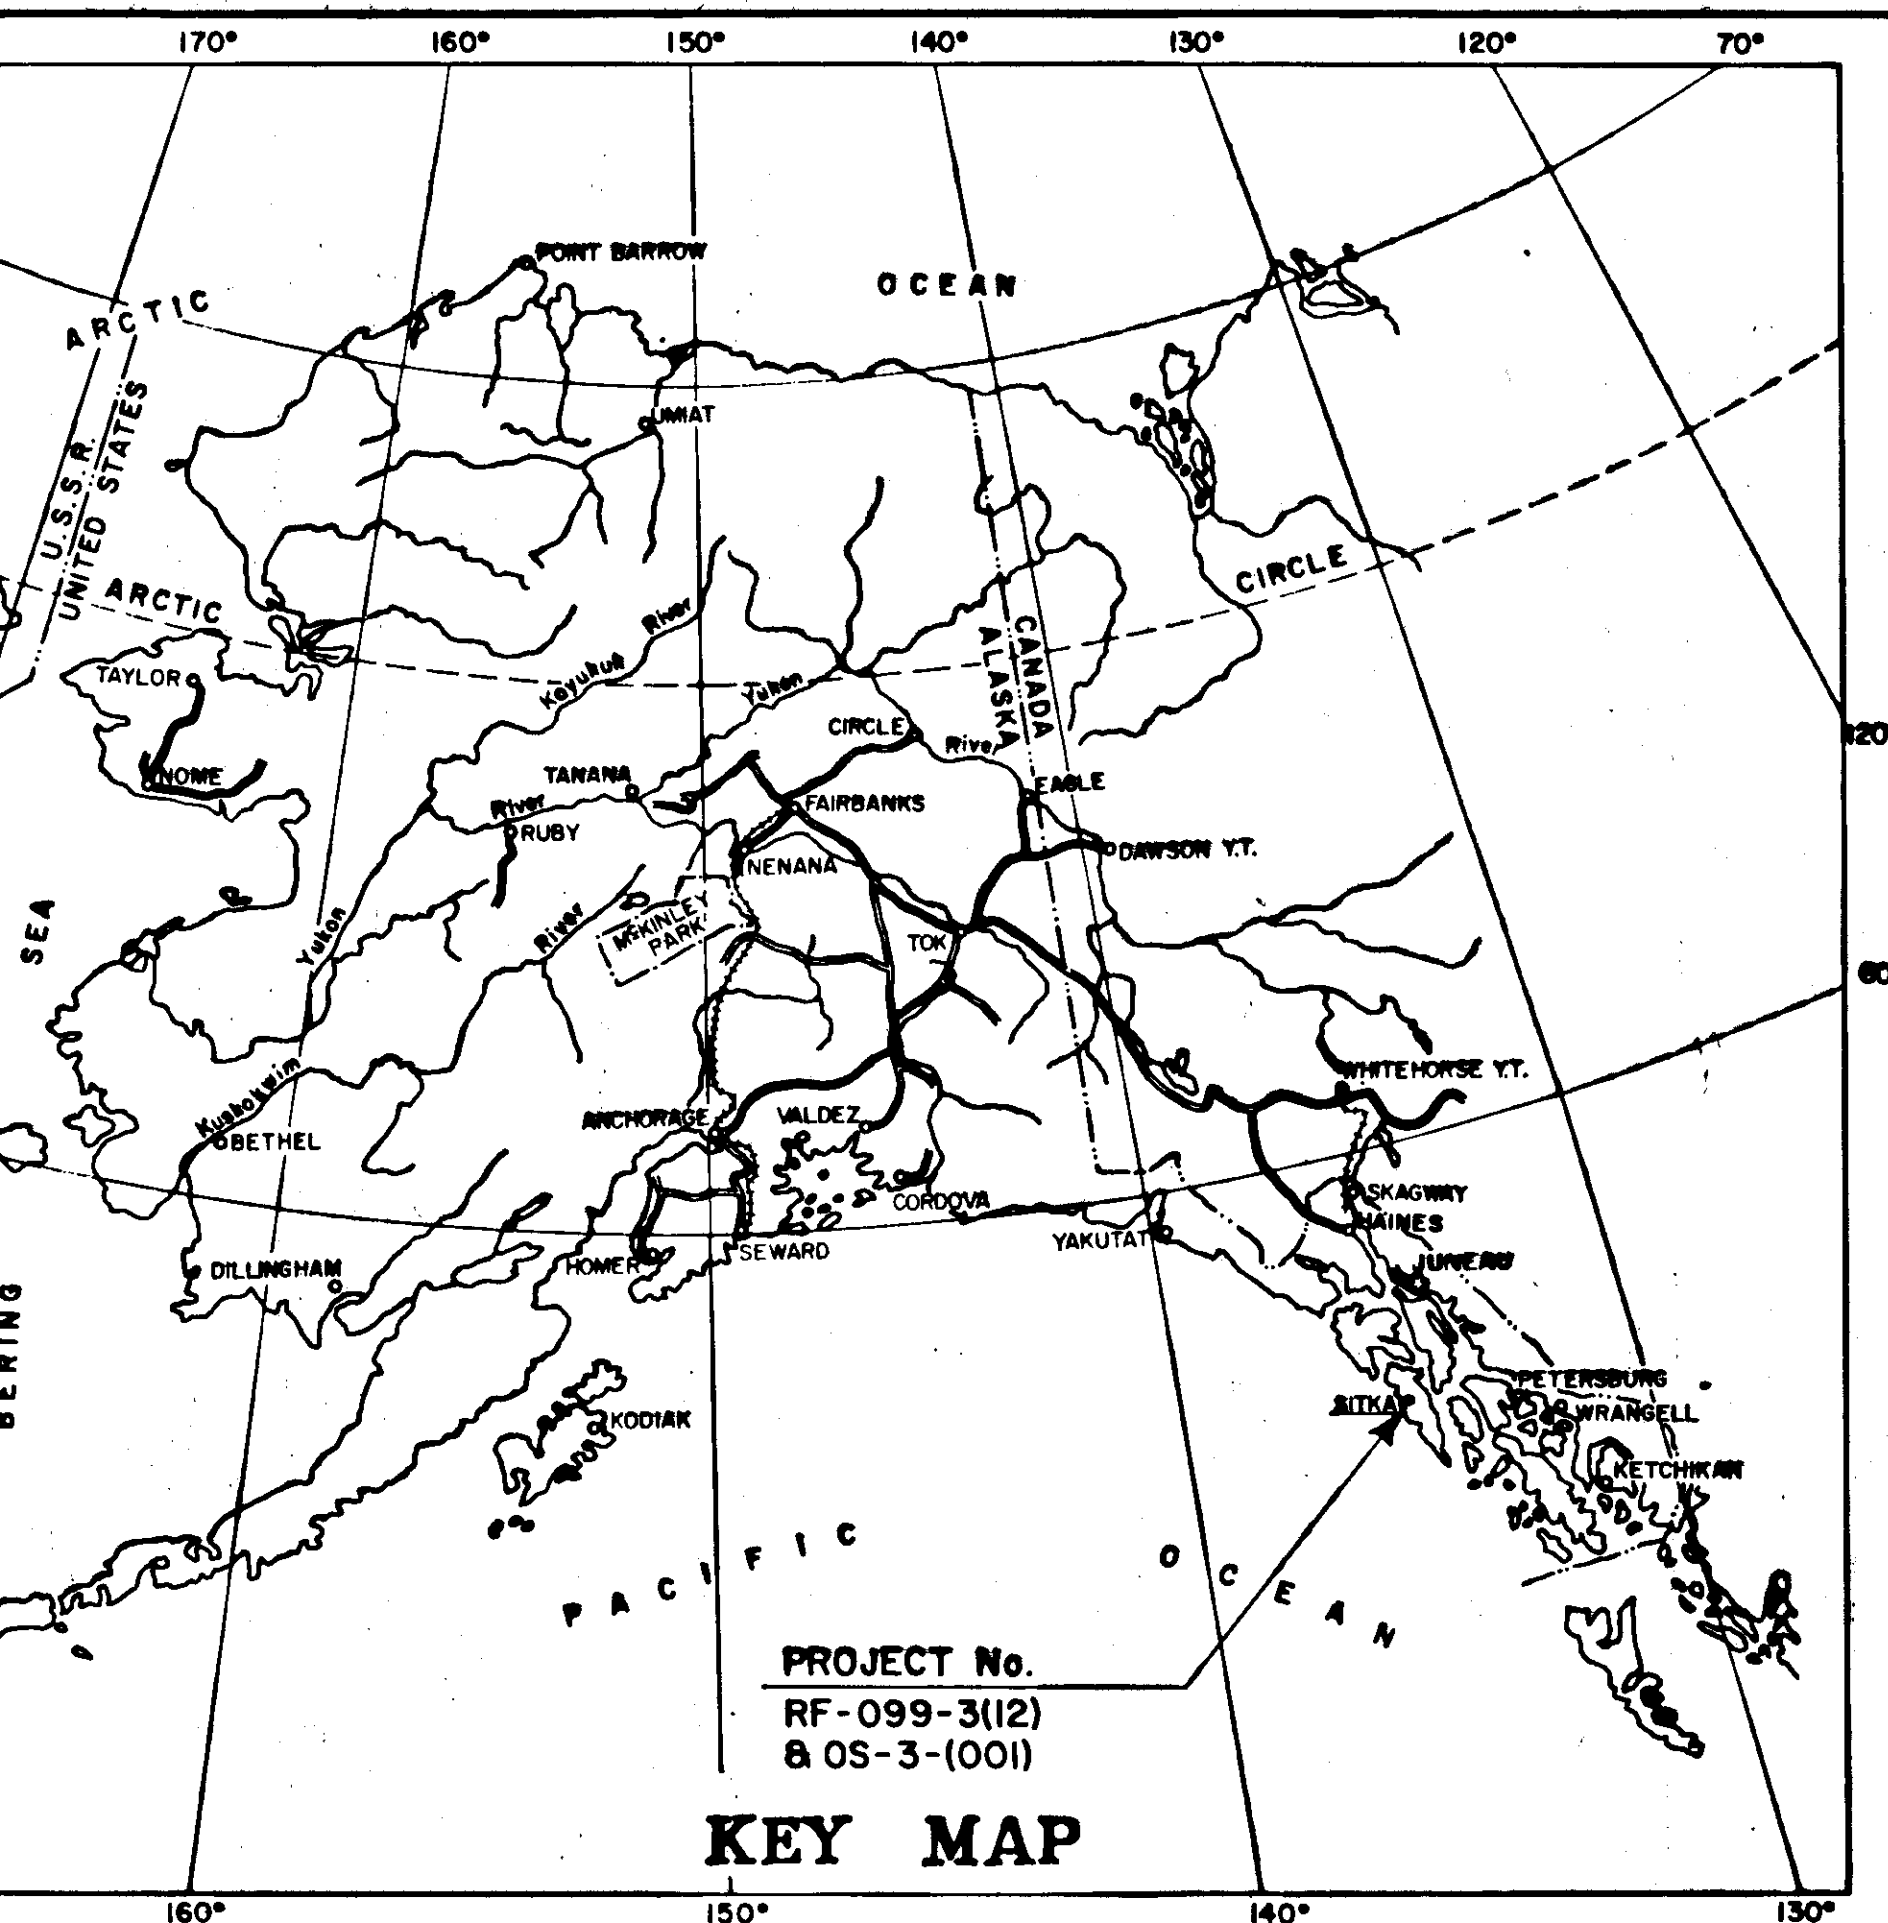

STATE OF ALASKA DEPARTMENT OF HIGHWAYS

PLAN AND PROFILE PROPOSED HIGHWAY PROJECT RF-099-3(12) HALIBUT POINT BLVD.,

OS-3(001) BRADY ST., GAVAN ST. & CASCADE ST. GRADING, DRAINAGE, PAVING & UTILITIES

STATE	PROJECT	SHEET NO.	TOTAL SHEETS
ALASKA	RF-099-3(12) OS-3-(001)	1	28

INDEX OF SHEETS

SHEET NO.	DESCRIPTION
1	Title Sheet
2	Typical Section
3	Estimate of Quantities
4 & 5	Summary Tables
6	Water Line Details
7-21	Plan & Profile Sheets
22-28	Off-System Road Plans

The following standard drawings apply to this project: A-1, C-00.01, C-10.00, C-11.01, D-02.01, D-20.10, D-23.01, D-24.11, D-26.00, G-04.31, G-10.11, I-20.01, I-80.00, M-16.03, U-03.00


RF-099-3(12) PROJECT SUMMARY

WIDTH of SUBGRADE	= 30.5'
WIDTH of PAVEMENT	= 30.5'
LENGTH of GRADING	= 1345.00' = 0.255 Mi.
LENGTH of PAVING	= 1414.58' = 1.404 Mi.
LENGTH of PROJECT	= 1414.58' = 1.404 Mi.

OS-3(001) PROJECT SUMMARY

WIDTH of SUBGRADE	= 54'
WIDTH of PAVEMENT	= 38'
LENGTH of GRADING	= 1512.57' = 0.287 mi.
LENGTH of PAVING	= 1512.57' = 0.287 mi.
LENGTH of PROJECT	= 1512.57' = 0.287 mi.

DESIGN	DESIGNATION
ADT (1974)	= 5700
ADT (1995)	= 8000
DHV (12%)	= 960
D	= 40-60
T	= 4%
V	= 25mph

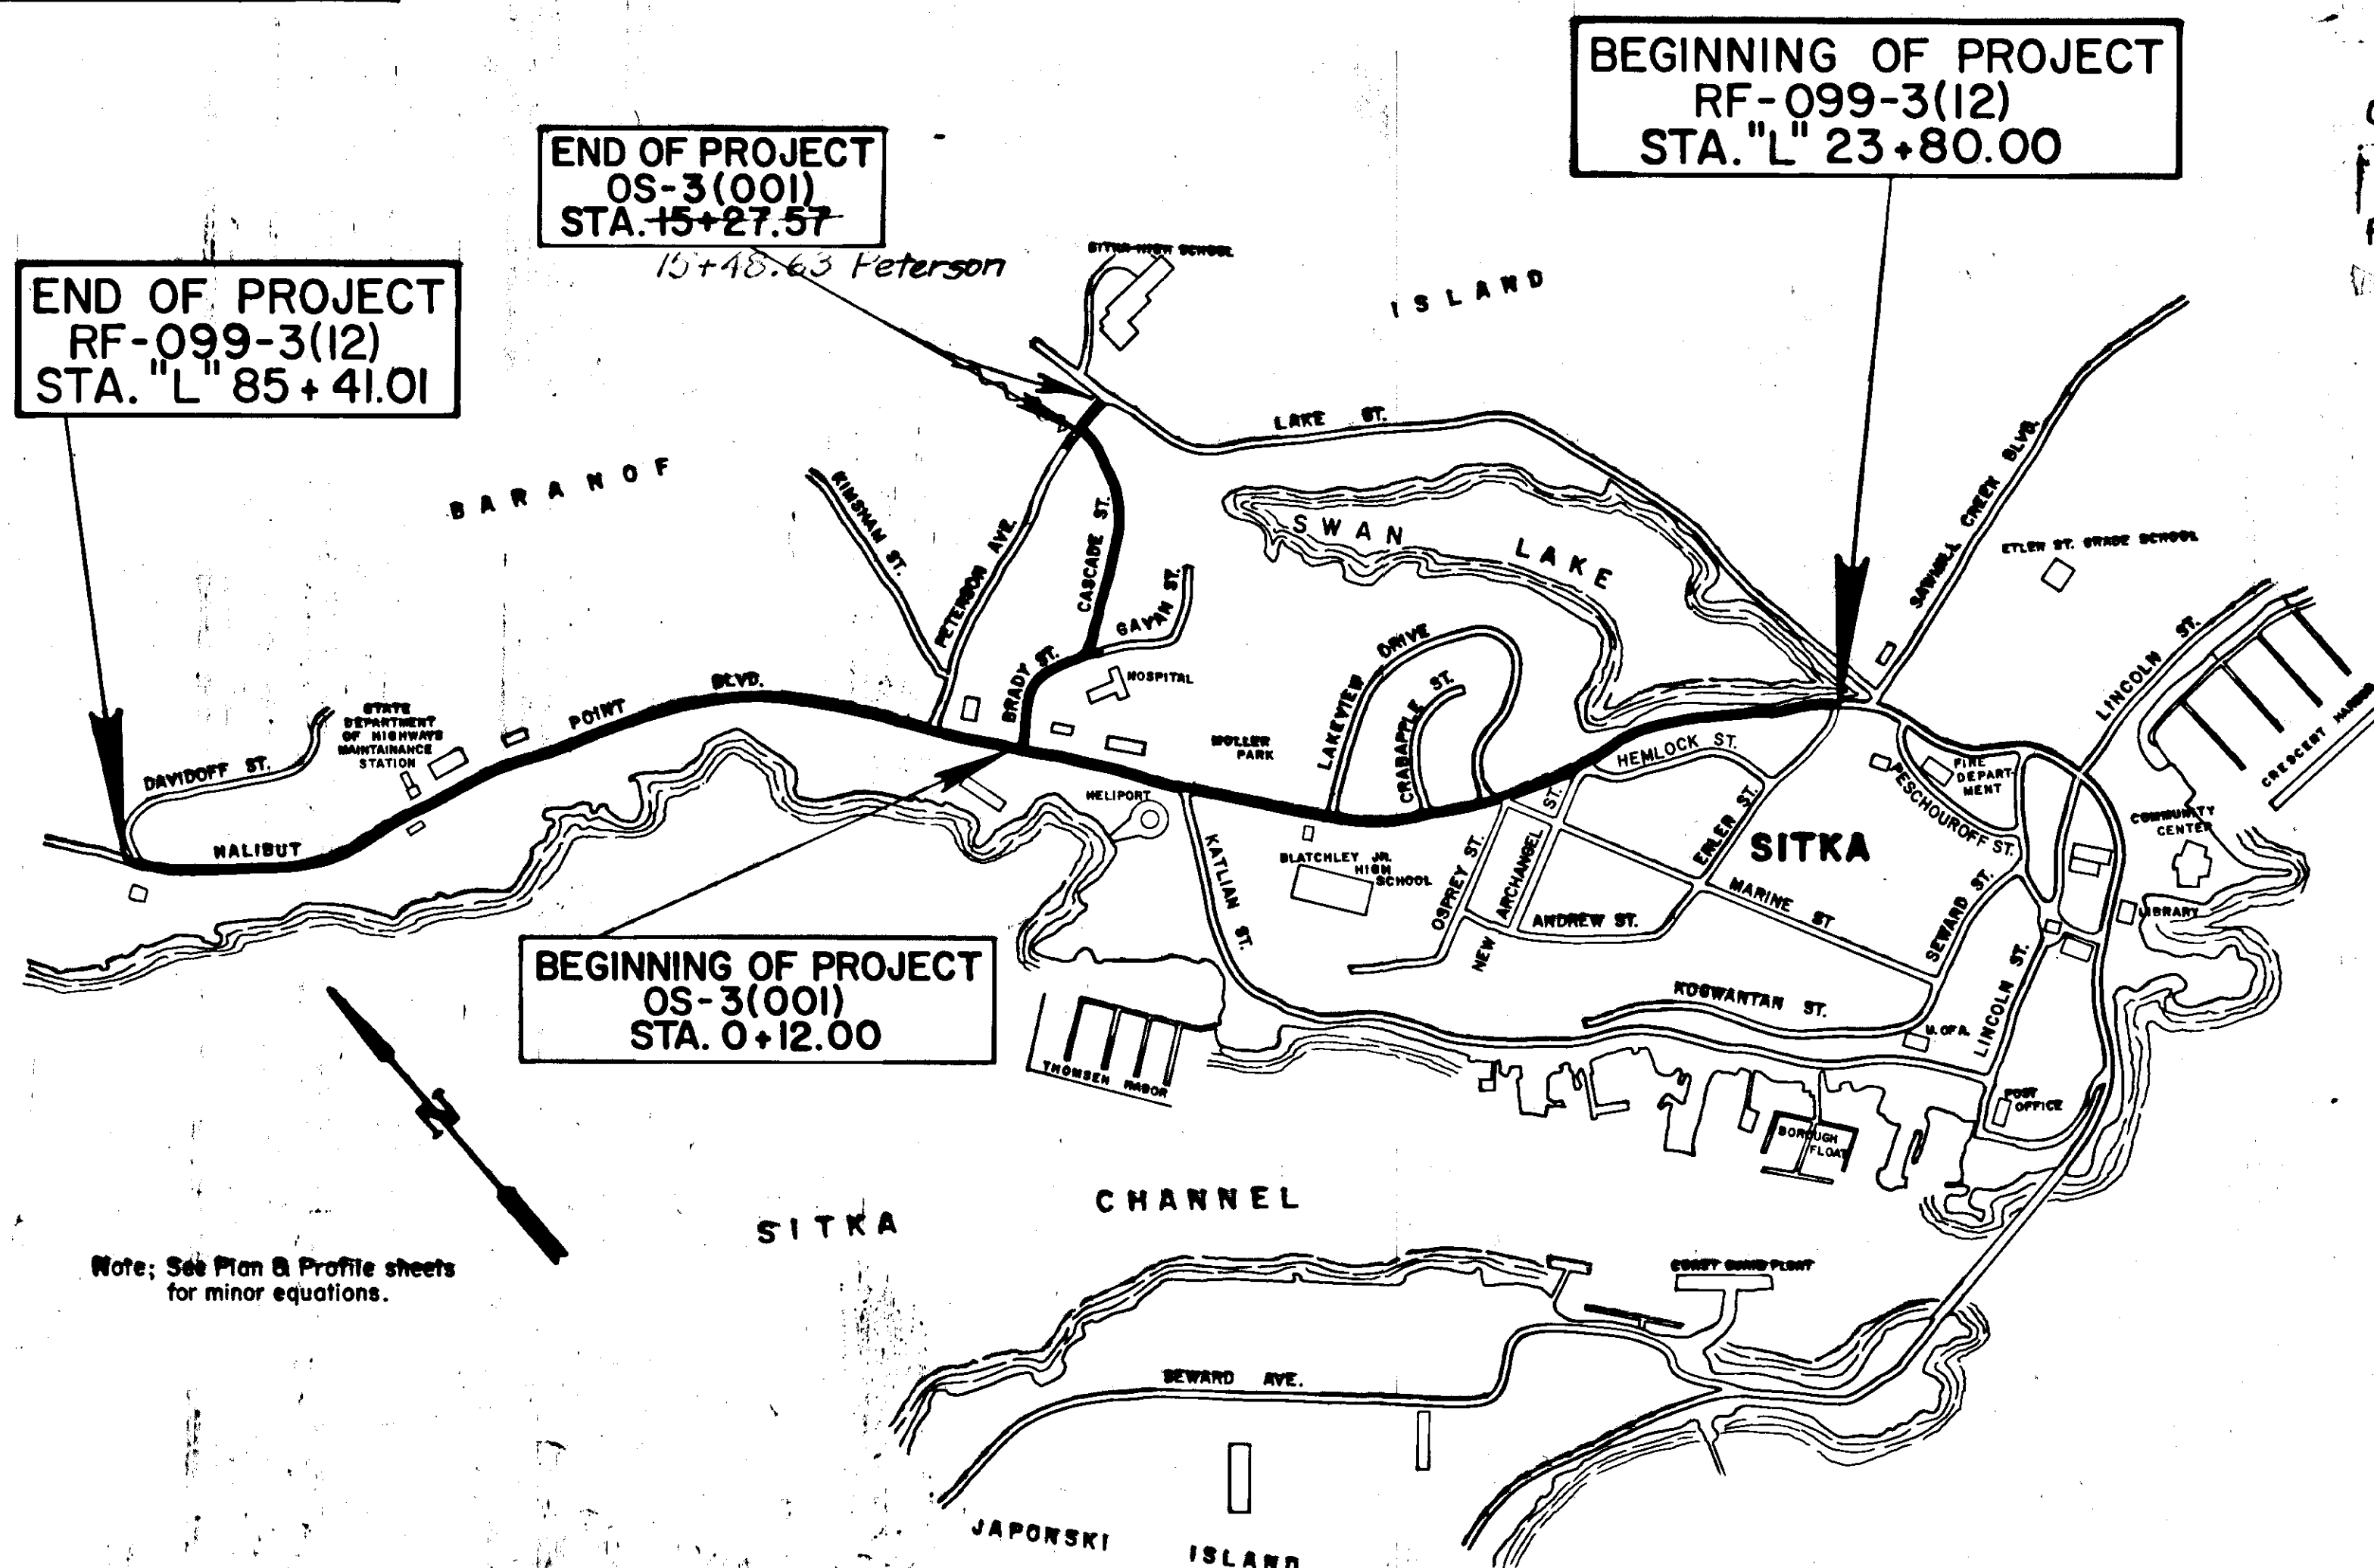

Note: See Plan & Profile sheets for minor equations.

AS BUILT

CONTRACTOR: CONSTRUCTORS - PAMCO
PROJECT ENGINEER: JOHN EDWARDS
Notice to Proceed: October 29, 1976
Actual Completion Date: December 3, 1976

STATE OF ALASKA
DEPARTMENT OF HIGHWAYS


APPROVED
Harold E. Wild
SOUTHEASTERN DISTRICT
HIGHWAY ENGINEER
Date 12/5/76

STATE OF ALASKA
DEPARTMENT OF HIGHWAYS

APPROVED
W. J. Chitt
COMMISSIONER OF HIGHWAYS
Date 1/13/75

TYPICAL SECTION OF IMPROVEMENT


STATE	PROJECT DESIGNATION	YEAR	SHEET NO.	TOTAL SHEETS
ALASKA	RF-099-3(12)	1975	2	28

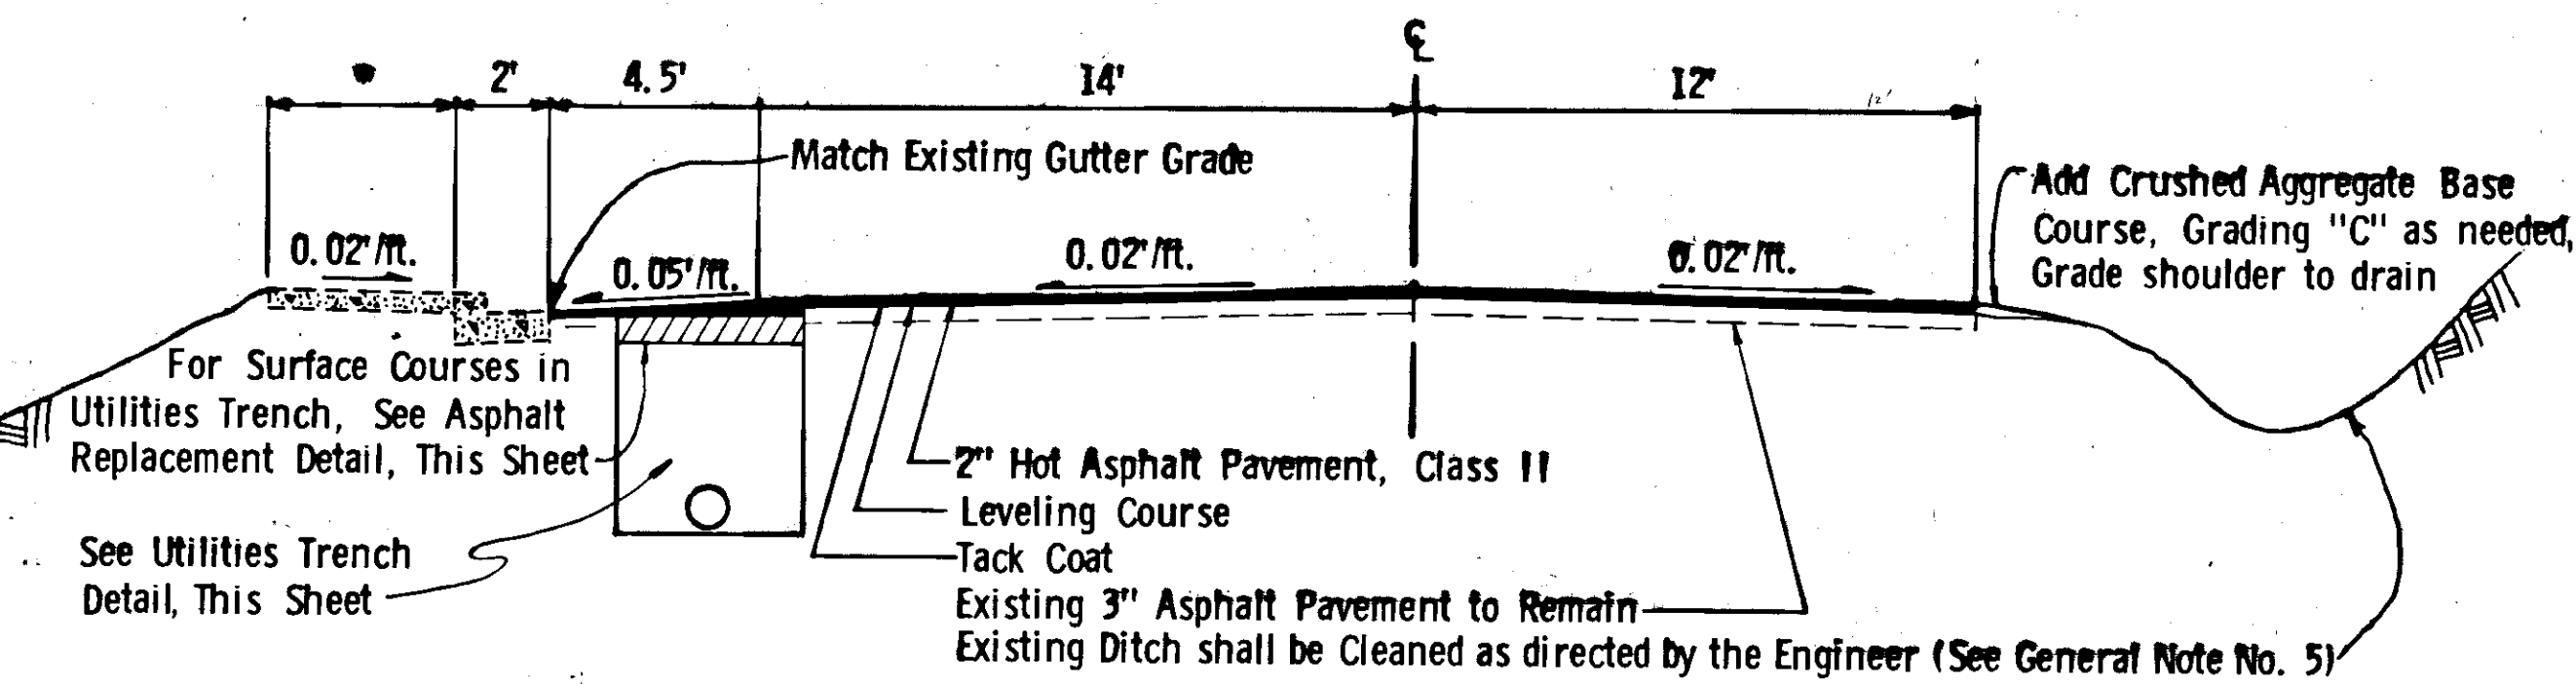

TYPICAL SECTION "A"

See Table "A" for Areas of Installation

- "L" 23+80 B. O. P. to "L" 59+77 - Existing 6' Sidewalk, "L" 59+77 to "L" 85+41.01 E. O. P. - Existing 4' Sidewalk, Existing Curb, Gutter and Sidewalk See Plan and Profile Sheets and Sidewalk Removal and Replacement Detail for Areas of Removal and Replacement.

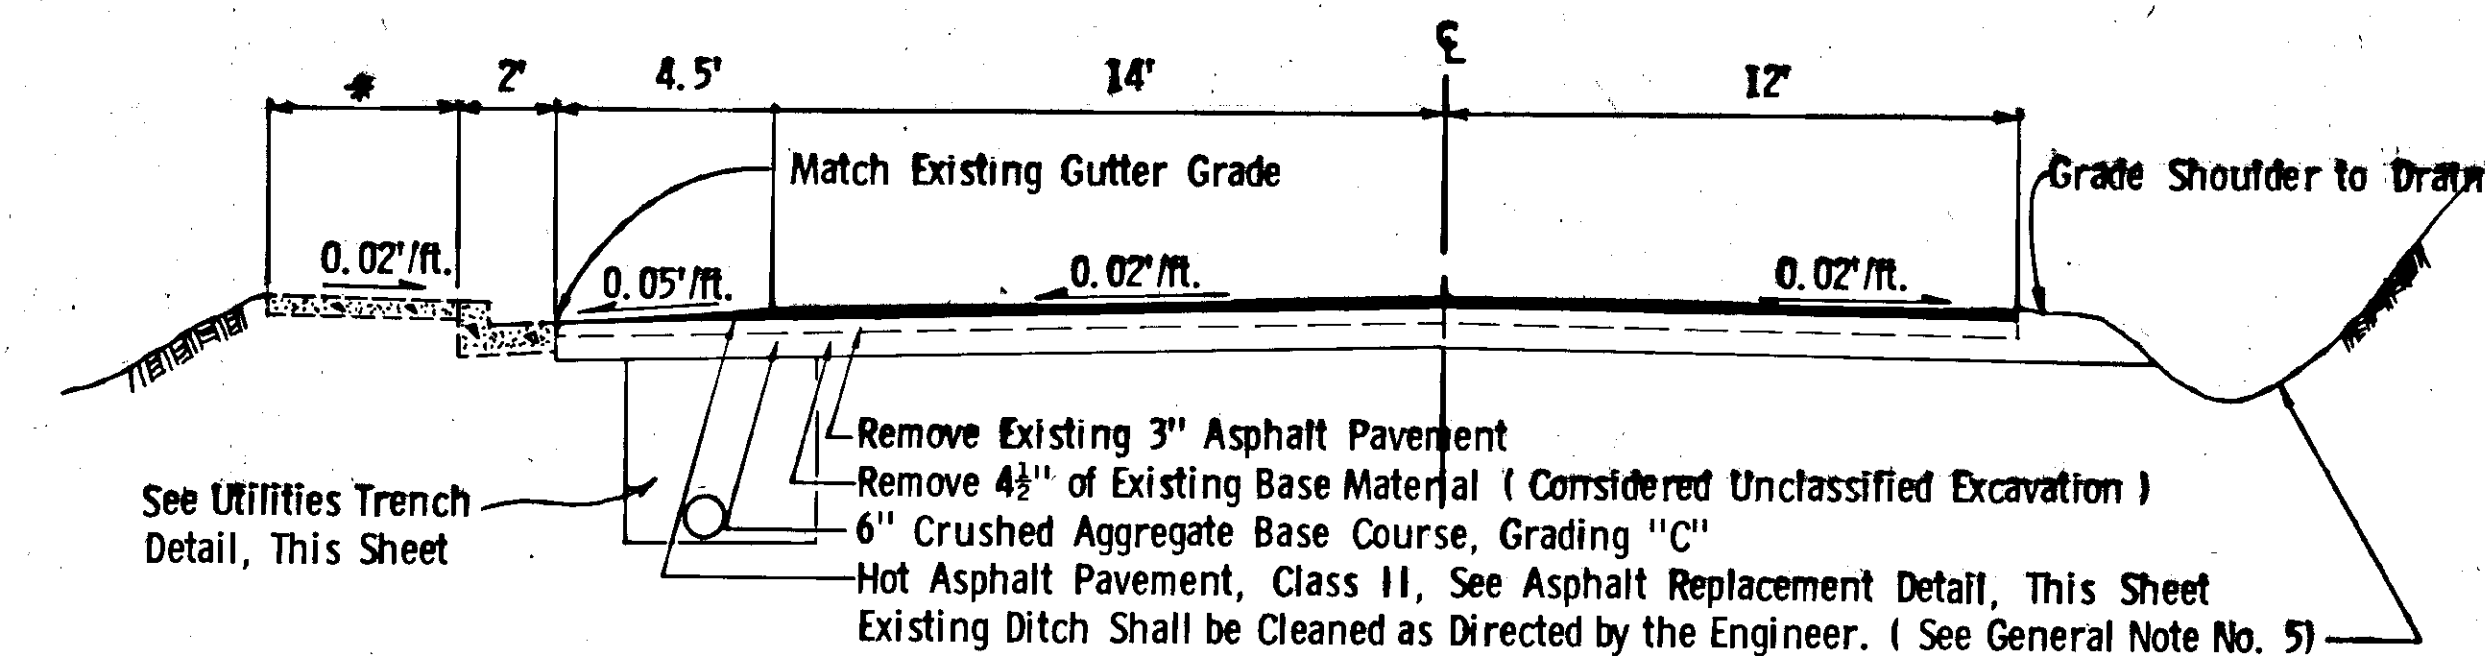

TYPICAL SECTION "B"


See Table "B" for Areas of Installation

BASIS OF ESTIMATE


Item	Estimating Factor
301(1)	1.96 Tons per Cu. Yd.
203(6B)	1.87 Tons per Cu. Yd.
401(1)	112 lbs. per sq. Yd. inch depth
401(2)	7.4% of Item 401(1)
402(2)	0.1 gal. / Sq. Yd. , 253 gal. / Ton

GENERAL NOTES:

1. Alignment shown on these plans is subject to minor revisions.
2. Storm inlets and culvert location are subject to minor revisions.
3. Location of utilities as shown are approximate.
4. Superelevation shall be revolved about the inside shoulder, or as directed by the engineer. See Standard Drawing I-80.00.
5. After the existing ditch has been cleaned, extra material may be needed to restore the flowline of the ditch. This material may be obtained from unclassified excavation. The flowline of the ditch shall be as directed by the engineer. This work shall be considered incidental to pay item 203(3) "Unclassified Excavation" and no separate payment shall be made therefore.
6. Existing wood stave water mains and existing sewer mains noted as (to be abandoned), shall be abandoned in place except where new construction requires their removal.
7. Valve boxes on abandoned water mains shall be removed to a depth of 24" below finished grade. This work shall be considered incidental to pay item #203(3) "Unclassified Excavation" and no separate payment shall be made therefore.
8. Removal of existing asphalt pavement in the utility trench shall be a neat line as directed by the engineer. All trench excavation shall be wasted unless otherwise directed by the engineer.
9. Those existing approaches requiring regrading behind curb cuts shall be regraded with Crushed Aggregate Base Course, Grading "C" as directed by the engineer. This work shall be considered incidental to pay item #203(3) "Unclassified Excavation" and no separate payment shall be made therefore.

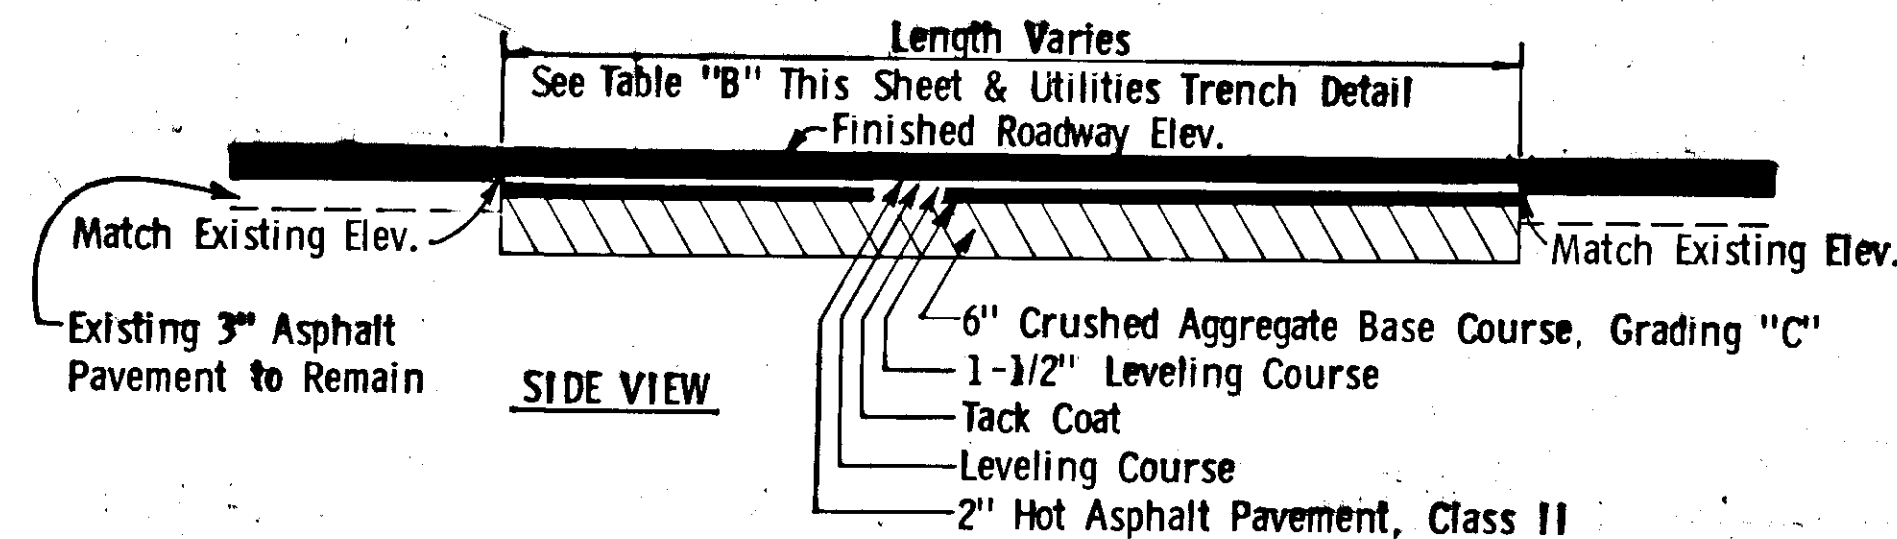


ASPHALT REPLACEMENT DETAIL

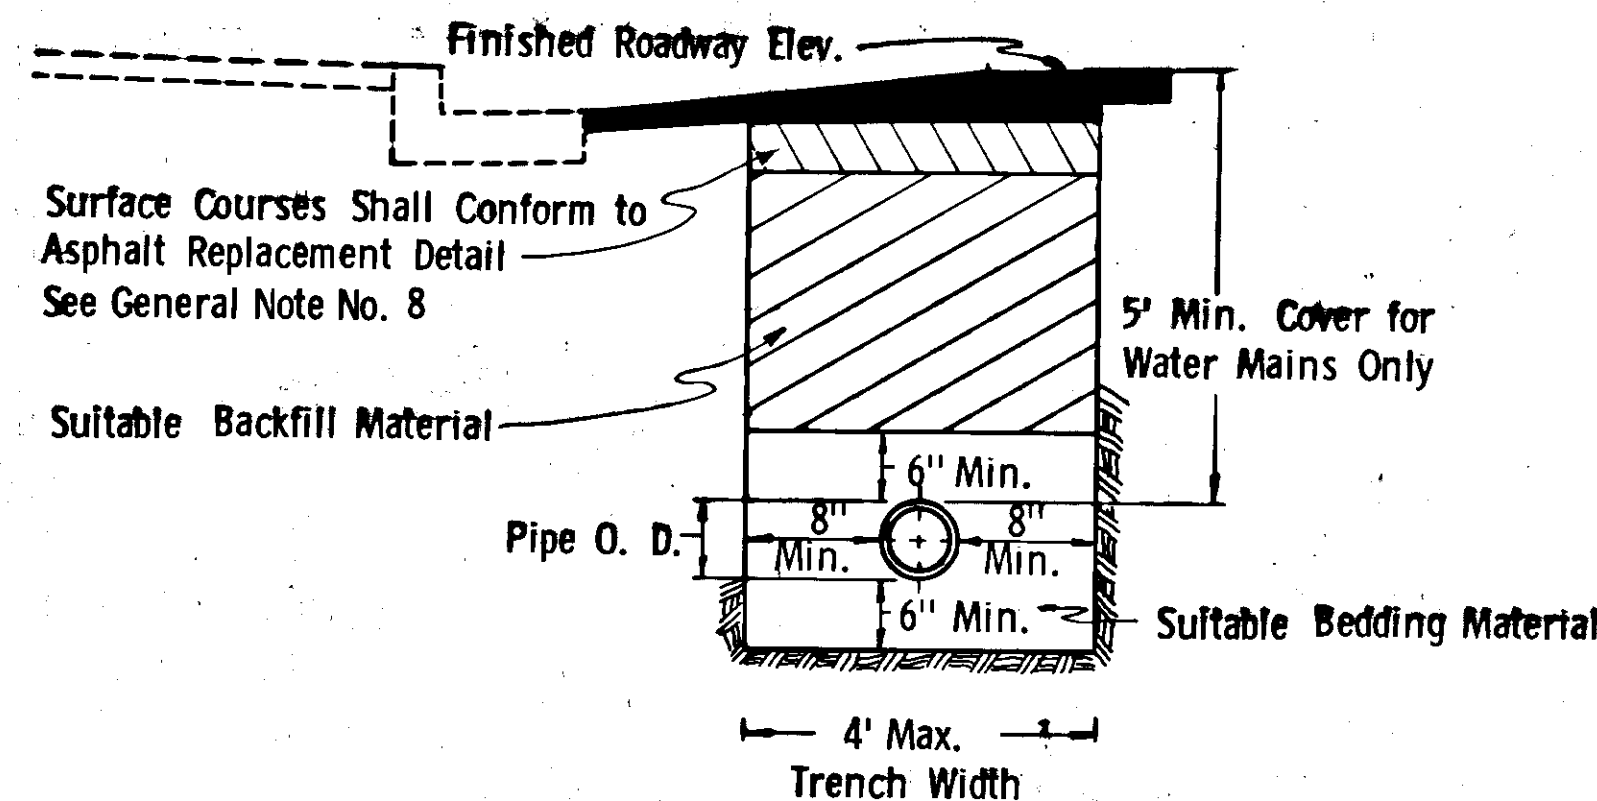

UTILITIES TRENCH DETAIL

For Water Mains, Sewer Conduits for Water Main Crossings and Sewer Services

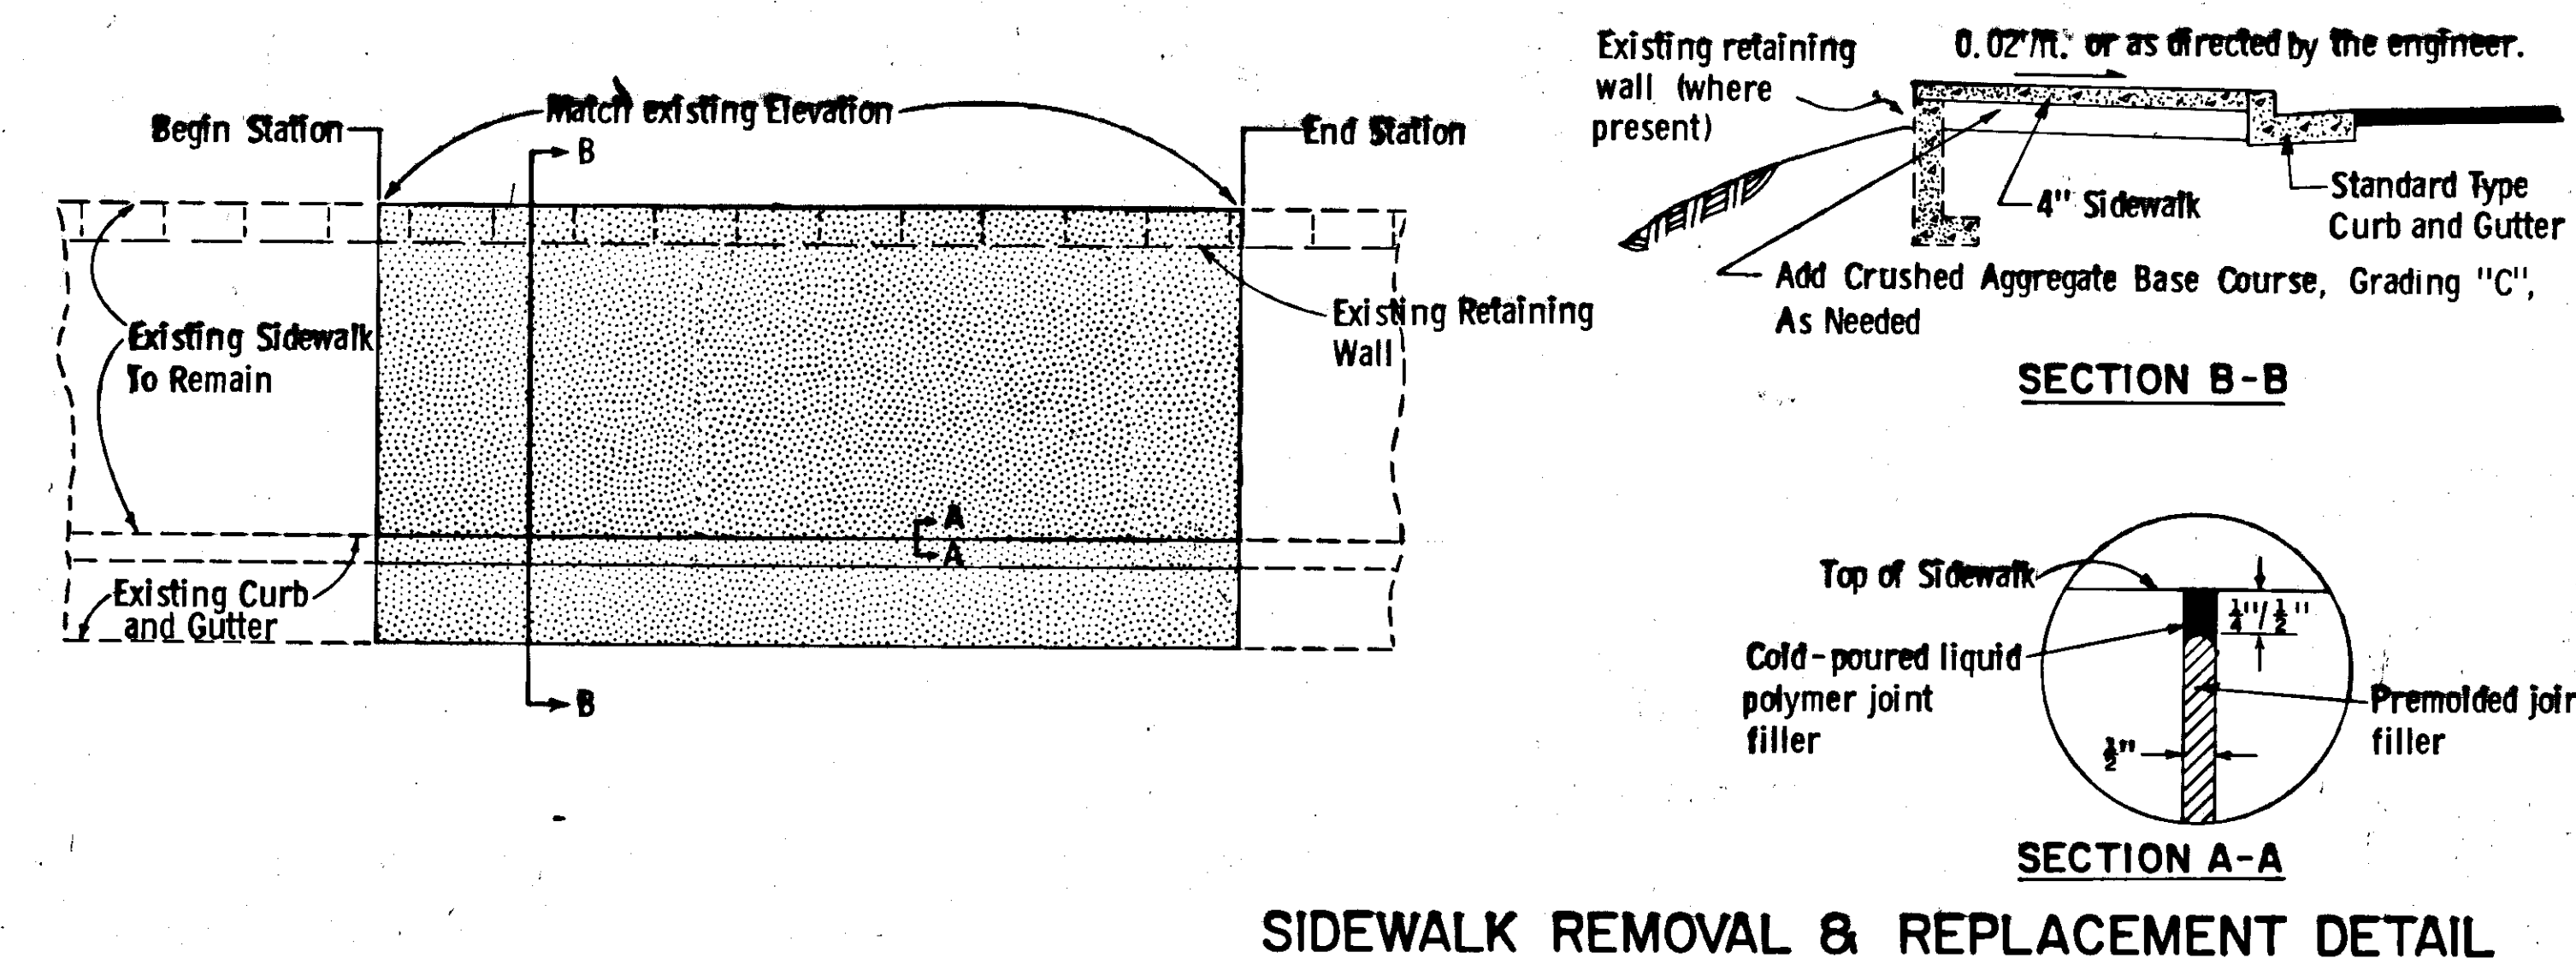

SIDEWALK REMOVAL & REPLACEMENT DETAIL

Notes:

1. Indicates removal and replacement of curb, gutter and/or sidewalk. See Plan and Profile sheets for begin and end stations. Curb, gutter and sidewalk removal shall begin and end at the nearest dummy and/or expansion joint, or as direct by the engineer.
2. Existing retaining walls in areas of sidewalk removal shall not be disturbed.
3. See sheet # 4 for curb cut replacement details.
4. Premolded expansion joint filler and liquid polymer joint sealer (see specification), shall be considered incidental to pay item #608 (1) "Concrete Sidewalk" and no separate payment shall be made therefore.
5. Existing expansion joints destroyed during sidewalk removal operation shall be replaced as detailed.
6. In areas where the existing sidewalk and curb & gutter are to remain in place, the existing cold-poured liquid polymer joint filler between them shall be removed and replaced. This work shall be considered incidental to pay item 608 (1) "Concrete Sidewalk" and no separate payment shall be made therefore.

TABLE "A"	
STATION	
From	To
"L" 23+80 B.O.P.	"L" 38+00 37+97
"L" 43+00	"L" 58+00 52+70
"L" 60+00 02	"L" 63+50 72+80
"L" 64+25	"L" 72+80
"L" 75+25	"L" 80+60 80
"L" 80+90 81+10	"L" 81+75 85+00
"L" 82+75	"L" 85+00
"L" 85+75 77	"L" 88+30 7
"L" 89+50	"L" 85+41 E.O.P.

TABLE "B"	
STATION	
From	To
"L" 23+80 B.O.P.	"L" 38+00 37+97
"L" 43+00	"L" 58+00 52+70
"L" 60+00 02	"L" 63+50 72+80
"L" 64+25	"L" 72+80
"L" 75+25	"L" 80+60 80
"L" 81+75	"L" 85+00
"L" 85+75 77	"L" 88+30
"L" 89+50	"L" 85+41 E.O.P.

ESTIMATE OF QUANTITIES

STATE	PROJECT DESIGNATION	YEAR	SHEET NO.	TOTAL SHEETS
ALASKA	RF-099-3(12) OS-3-(001)	1975	3	28

ITEM No	ITEM	UNIT	SHEET NUMBERS																			RF-099-3(12)										05-3(001) TOTAL	GRAND TOTAL
			7	8	9	10	11	12	13	14	15	16	17	18	19	20	21	Trooper Acadamy	TOTAL	24	25	26	27										
110(1)	Mobilization	Lump Sum																															
111(1)	Temporary Erosion & Pollution Control	Cont. Sum																			All Req'd						All Req'd	All Req'd					
112(1)	Training Program IAW FHWA Order Interim 7-2(2)	Cont. Sum																			All Req'd						All Req'd	All Req'd					
113(1)	Flagging	Man Hours																			All Req'd						All Req'd	All Req'd					
114(1)	Construction Engineering by the Contractor	Lump Sum																			604 1806						256477	860					
202(2)	Removal of Pavement	Sq. Yd.			684	1,017			678	254	746	186	593	407							All Req'd						All Req'd	All Req'd					
202(3)	Removal of Sidewalk	Sq. Yd.	44	115	7	43	235	23	39	40	38	97	38	102	47						4,565 6709	144	550				5,259 6	5,259 6					
202(4)	Removal and Disposal of Culvert Pipe	Linear Ft.	40						56												868 1073						868 1	868 1					
202(8)	Removal of Curb and Gutter	Linear Ft.	57	167		50	333		134	115	130	314	119	265	203						96 30						96 2	96 2					
203(3)	Unclassified Excavation	Cu. Yd.			98	146			97	36	107	27	85	58							1,887 2793						1,887 2	1,887 2					
203(6B)	Selected Material	Ton																			654 563	5,695	4,310				10,659	10,659					
301(1)	Crushed Aggregate Base Course, Grading "C"	Ton	74	101	365	453	162	163	408	238	439	220	436	232	104	96	31	301			7,891	6,442					14,333	14,333					
401(1)	Hot Asphalt Pavement	Ton	205	291	398	340	316	342	374	341	400	336	412	320	252	16	7	341.86			17,779	1,774	1,068				2,842	6,364 6					
401(2)	AR-10 Asphalt Cement AC-5	Ton	15.2	21.5	29.5	25.2	23.4	25.3	27.7	25.2	29.6	24.9	30.5	23.7	18.6	1.2	0.5	19.05			4,350 6240.86	729	470				5,549 75	5,549 75					
402(2)	CRS-1 Cationic Emulsified Asphalt for Tack Coat CSS-1	Ton	0.60	0.80	0.90	0.70	0.80	0.90	0.80	0.80	0.80	0.80	0.80	0.80	0.70	0.10	0.04				322 360.05	54	34.8				410.8 4	410.8 4					
603(22C)	12" Pipe Conduit	Linear Ft.																			10.34 12.90						10.34 13	10.34 13					
603(22E)	18" Pipe Conduit	Linear Ft.																			85	250	122				372 5	372 5					
603(22G)	24" Pipe Conduit	Linear Ft.			30	66			156		42										294 292	532	76				902 9	902 9					
604(1)	Storm Sewer Manhole	Each																			320 326						320 3	320 3					
604(3)	Reconstruct Manhole	Each																			3	3					3 4	6 7					
604(4)	Adjust Existing Manhole	Each	1	1	2	2	1		3	1			1								0	1	2				3 2	3 2					
604(5)	Inlet, Type A	Each																			12	2	1				15	15					
604(8)	Adjust Existing Cleanout	Each																			3 4	6	4				13 1	13 1					
605(2)	8" Perforated Corrugated Aluminum Pipe for Underdrains	Linear Ft.	44	524					236												2						2	2					
605(5)	Porous Backfill Material	Cu. Yd.	8	102					38												804 812						804 8	804 8					
606(2)	Beam Type Guardrail, Type I Post	Linear Ft.		62.5																	148 153						148 1	148 1					
606(4)	Removal and Disposal of Guardrail	Linear Ft.		62.5																	62.5						62.5	62.5					
607(4)	Removal and Reconstruction of Fence	Linear Ft.																			62.5						62.5	62.5					
608(1A)	Concrete Sidewalk, 4" Depth	Sq. Yd.	34	115	7	43	155	23	15	23	10	23	24	29								40	60				100 128	100 128					
608(1B)	Concrete Sidewalk, 6" Depth	Sq. Yd.	10				80		45	30	50	122	24	100	90						501 808.4	964	699				2,164 2	2,164 2					
609(1)	Curb, Type 5 (Asphalt)	Linear Ft.		271																	551 529						551 5	551 5					
609(2A)	Curb and Gutter, Type 1, (Standard)	Linear Ft.	57	167		50	333		134	115	130	314	119	265	203						271 288						271 2	271 2					
609(2B)	Curb and Gutter, Type 1, (Rolled)	Linear Ft.																			1,887 2833						1,887 2	1,887 2					
611(1)	Riprap, Class I	Cu. Yd.		4	17				19													1,782	1,317				3,099 3	3,099 3					
614(1)	Monuments	Each																			40 371						40 371	40 371					
614(2)	Monument Cases	Each																			9	4	1				5 7	5 7					
614(3)	Adjust Existing Monuments and Cases	Each		2	3	1	1	1	1	1	1	1	1	2	2						9	4	1				5 7	5 7					
625(1)	Pipe Handrail	Linear Ft.						181				226		72							17 14						17 14	17 14					
626(1A)	6" Cast Iron Sewer Conduit	Linear Ft.	86	160	20	74	64	68		20											479 541						479 5	479 5					
626(1B)	8" Cast Iron Sewer Conduit	Linear Ft.			20																492 352.3						36	492 3					
626(1C)	10" Cast Iron Sewer Conduit	Linear Ft.			20	20	20	45													20 411						43	20 8					
626(1D)	14" Cast Iron Sewer Conduit	Linear Ft.									20										105 20							105 2	105 2				
628(2A)	3" Ductile Iron Water Conduit, Class AWWA C-151	Linear Ft.		14																	20 0						20 0	20 0					
628(2B)	4" Ductile Iron Water Conduit, Class AWWA C-151	Linear Ft.				84	14						56				50				120 127.2							120 12	120 12				
628(2C)	6" Ductile Iron Water Conduit, Class AWWA C-151	Linear Ft.			60		98	58							35						133 176.5							133 17	133 17				
628(2D)	8" Ductile Iron Water Conduit, Class AWWA C-151	Linear Ft.			605	604	145	56	64	594	594	600	600	608	558	600	218				282 298												
628(4)	Install Valve Box	Each	1	1	3	2	5	2			1		2		3		1				6,848 6744						812	652	8,312 8	8,312 8			
628(6)	Fire Hydrant Installation	Each				1				1		1	1		1						21 24	6					6 7	2 7	2 7				
628(7)	Fire Hydrant Relocation	Each																			5 7		</										

WATER SERVICE CONNECTIONS				
STATION	SIZE	OFF-SET LT.	OFF-SET RT.	REMARKS
"L" 26+72 66.7	1"	21.5'		Reconnect existing service. See Sheet No. 6 for Details
"L" 27+87 86	1"	21.5'		
"L" 35+71 70	1"		25'	
"L" 36+67 66	1"		25'	
"L" 39+09 00	1"	21.5'		
"L" 42+24 49	1"	21.5'		
"L" 43+32 9	1"		25'	
"L" 43+98 99.2	1"		25'	
"L" 48+94	2"		25'	Reconnect existing service. See Sheet No. 6 for Details
"L" 54+20 26.5	2"	21.5'		Cap future Service
"L" 62+50	1"	21.5'		Reconnect existing service. See sheet no. 6 for Details
"L" 62+84	1"	21.5'		
"L" 63+81 85	1"	21.5'		
"L" 64+75 76.5	1"		40'	
"L" 66+64 61.9	1"		40'	
"L" 67+49 76	1"	21.5'		
"L" 68+04	1"	21.5'		
"L" 68+15 16	1"	21.5'		
"L" 68+62 63.2	1"		40'	
"L" 69+25 27	1"	21.5'		
"L" 69+67	1"		40'	
"L" 70+52 55.1	1"		40'	
"L" 71+20	1"		40'	
"L" 72+39 48.8	1"		40'	
"L" 73+09	1"	21.5'		
"L" 73+26 28.5	1"		40'	
"L" 73+94 64	1"		40'	
"L" 74+57 54	1"		40'	
"L" 74+85 83	1"	21.5'		
"L" 75+25 19.5	1"	21.5'		
"L" 75+40 37.6	1"		40'	
"L" 75+63 64	1"	21.5'		
"L" 76+25	1"	21.5'		
"L" 76+32 03	1"		40'	
"L" 76+67 66	1"	21.5'		
"L" 77+43	1"	21.5'		
"L" 78+57 48	1"	21.5'		
"L" 79+42 39	1"	21.5'		
"L" 79+85	1"	21.5'		
"L" 80+69 65	1"	21.5'		
"L" 83+18 05	2"		25'	
"L" 83+52 51	1"	21.5'		
"L" 84+76 73.2	2"		25'	
"L" 86+21 16	1"	21.5'		
"L" 87+26 21.5	1"	21.5'		
"L" 88+95 93.9	1"	21.5'		
"L" 87+93	1"		40	
"L" 90+72 63	1"	21.5'		
"L" 91+29 8	1"	21.5'		
"L" 92+40 08.5	1"	21.5'		
"L" 92+93	1"	21.5'		
"L" 93+16	1"	21.5'		
"L" 94+86.7	1"	21.5'		
"L" 94+88	1"	21.5'		
"L" 95+98 94.4	1"	21.5'		
"L" 96+84 86	1"	21.5'		Reconnect existing service. See sheet no. 6 for Details
EQUATION: Station "L" 97+32.1 Bk. = Station "L" 84+67.54 Ahd.				
"L" 86+39 27	1"		25'	Reconnect existing service. See sheet no. 6 for Details
"L" 86+90 76.5	1"		25'	
"L" 87+97	1"		25'	
"L" 88+23 17.5	1"		25'	
"L" 88+70 64	1" 2"		25'	
"L" 90+75 57.5	1"	25'		
"L" 91+78 75.7	1"		25'	
"L" 92+15 04	1"	25'		
"L" 92+95	1"	25'		
"L" 93+60 44	1"	25'		Reconnect existing service. See sheet No. 6 for Details
All service on Sheets 26 & 27	3/4"	22" Lt or Rt.		Reconnect existing service. See sheet No. 6 for details.

WATER MAIN INSTALLATION						
SIZE	TYPE	L.F.	WORK	STATION	OFFSET	REMARKS
8"	D.I.	2301 2260	Install	from "L" 23+88 to "L" 46+45	17' Lt. 15' Lt.	Connect to 16" C.I.W.M. Connect to 8" G.V.
3"	D.I.	14 20	Install	from "L" 32+73 to "L" 32+75	18' Lt. 38' Lt.	Connect to tee Connect to existing C.I.W.M.
6"	D.I.	60 56	Install	from "L" 39+40 55 to "L" 39+40 55	15' Lt. 48' Rt. 41'	Connect to tee Connect to existing 6" W.S.W.M.
4"	D.I.	16	Install	from "L" 41+86 88 to "L" 41+86 88	30' Lt. 15' Rt. Lt.	Cap future service Connect to cross
4"	D.I.	72 78.4	Install	from "L" 41+86 88 to "L" 41+78 88	15' Lt. 54' Rt.	Connect to cross Connect to existing 4" W.S.W.M.
4"	D.I.	14 16	Install	from "L" 45+27 26 to "L" 45+27 26	15' Lt. 29' Lt.	Connect to tee Connect to existing 4" C.I.W.M.
6"	D.I.	14 13.2	Install	from "L" 45+31 30 to "L" 45+31 30	15' Lt. 29' Lt. 28'	Connect to tee Connect to existing 6" C.I.W.M.
6"	D.I.	64	Install	from "L" 45+88 85 to "L" 45+85	13' Lt. 51' Rt.	Connect to tee Connect to existing 6" W.S.W.M.
6"	D.I.	20 21	Install	from "L" 49+28 26.6 to "L" 49+28 38	10' Lt. 30' Lt.	Connect to tee Cap future service
8"	D.I.	56 60.9	Install	from "L" 54+24.5 to "L" 54+24.5	26' Rt. 38' Lt. 34.9	Connect to tee Cap future service
6"	D.I.	58 57	Install	from "L" 55+77 to "L" 55+77	28' Rt. 38' Lt. 29'	Connect to tee Cap future service
8"	D.I.	4382.5 4 436	Install	from "L" 62+37 92 to "L" 94+13 14.5	10' Lt. 1' Lt.	Connect to existing 8" D.I.W.M. Connect to existing 8" G.V.
3"	D.I.	56 57.2	Install	from "L" 81+34 36 to "L" 81+34 36	15' Lt. 25' Rt.	Connect to tee Connect to existing 3" Galv. W.M.
6"	D.I.	66 62	Install	from "P" 85+21 24 to "P" 85+21 24	15' Lt. 51' Rt.	Connect to tee Connect to existing 6" W.S.W.M.
4"	D.I.	35 20	Install	from "P" 85+65 66 to "P" 85+65 66	15' Lt. 45' Lt.	Connect to tee Connect to existing 4" service
3"	D.I.	50	Install	from "P" 93+21 22.5 to "P" 93+21	15' Lt. 35' Rt.	Connect to tee Connect to existing 3" service
8"	D.I.	1460 1 464	Install	from 0+80 to 15+57 60	10' Rt. 15 10' Lt.	Connect to existing Connect to existing

WATER MAIN APPURTENANCES		
STATION	OFFSET	REMARKS
"L" 23+89 87	16' Rt	Install 8" G.V. & V.B.
"L" 31+00	15' Lt	Install C.A.R.V. See sheet for details
"L" 33+73 32+73	21.5' Lt.	Install 3" G.V. & V.B.
"L" 34+75 34+67	6' Lt.	Install 8" G.V. & V.B.
"L" 38+65 54	15' Lt.	Install 8" G.V. & V.B.
"L" 39+40 55.4	25' Rt.	Install 6" G.V. & V.B.
"L" 40+00 34	15' Lt.	Install C.A.R.V. See sheet for details.
"L" 41+86 88	28' Rt.	Install 4" G.V. & V.B.
"L" 41+86 88	21.5' Lt.	Install 4" G.V. & V.B.
"L" 44+63 68.5	*32' Lt.	Install 6" G.V. & V.B., F.H. & 6" D.I. as required
"L" 45+27 26	21.5' Lt.	Install 4" G.V. & V.B.
"L" 45+31 30	21.5' Lt.	Install 6" G.V. & V.B.
"L" 45+86 85	27' Rt.	Install 6" G.V. & V.B.
"L" 46+45 20	10' Lt.	Install 8" G.V. & V.B.
"L" 49+28 26.6	11' Lt.	Install 8" G.V. & V.B.
"L" 54+24	24' Rt.	Install 8" G.V. & V.B. ...
"L" 55+78 77	24' Rt.	Install 6" G.V. & V.B.
"L" 90+17	*30' Lt.	Install 6" G.V. & V.B., F.H. & 6" D.I. as required
"L" 66+30 22	*30' Lt.	Install 6" G.V. & V.B., F.H. & 6" D.I. as required
"L" 69+66.5	24' Rt.	Install 4" G.V. & V.B.
"L" 73+00 01	15' Lt.	Install 8" G.V. & V.B.
"L" 75+99 93	*26' Lt.	Install 6" G.V. & V.B., F.H. & 6" D.I. as required
"L" 77+50	15' Lt.	Install C.A.R.V. See sheet for details
"L" 90+00	15' Lt.	Install 8" G.V. & V.B.
"L" 81+34 36	30' Rt.	Install 3" G.V. & V.B.
"L" 83+00 02	15' Lt.	Install 8" G.V. & V.B.
"L" 84+87 83+23	34' Lt.	Install 6" G.V. & V.B., F.H. & 6" D.I. as required
"L" 87+00	15' Lt.	Install C.A.R.V. See sheet for details
"L" 94+00 93+22.5	15' Rt.	Install 8" G.V. & V.B. 3"
"L" 96+75	*45' Lt.	Install 6" G.V. & V.B., F.H. & 6" D.I. as required
"P" 85+21 24	16' Rt.	Install 6" G.V. & V.B.
"P" 85+65 63	35' Lt.	Install 4" G.V. & V.B.
"P" 93+21 85+66	25' Rt.	Install 3" G.V. & V.B. 4"

* Offset given is for F.H. Offset for G.V. & V.B. shall be 21.5'.
* "P" 90+20 45' Lt. Install 6" G.V. & V.B., F.H. & 6" D.I. as required

STATE	PROJECT DESIGNATION	YEAR	SHEET NO.	TOTAL SHEETS
ALASKA	RF-099-3(2) OS-3-(001)	1975	5	5

SUMMARY TABLES

ADJUST EXISTING VALVE BOXES			
STATION	OFFSET	STATION	OFFSET
"L" 34+93	10' Lt.		
"L" 34+96	15' Lt.		
"L" 51+81	9' Lt.		
"SR525" 0+74	17' Lt.		
"SR525" 0+74	5' Rt.		

SEWER MAIN APPURTENANCES		
STATION	OFFSET	REMARKS
"L" 26+00	9	Adjust M.H.
"L" 30+78	12' Rt.	
"L" 34+90	10' Rt.	
"L" 39+25	7' Rt.	
"L" 41+71	12' Rt.	
"L" 43+75	15' Rt.	
"L" 45+74	12.5' Rt.	
"L" 57+28	11' Rt.	
"L" 58+60	10' Rt.	
"L" 62+47	10' Rt.	
"L" 66+27 52+01	11' 20' Rt. Lt.	
"L" 85+00 55+08	11' 19' Rt. Lt.	Adjust M. H.

CAST IRON SEWER MAINS & SERVICES FOR WATER LINE CROSSINGS				
STATION to STATION	LENGTH L.F.	SIZE	OFFSET	RRMARKS
"L" 24+67 to "L" 24+84	30 28.6	6"	25' Lt.-1' Rt.	Reconnect existing service
"L" 26+81 to "L" 26+82 62	28 25	6"	25' Lt.-2' Rt. Lt.	
"L" 27+72 to "L" 27+72 0	28 18.6	6"	10' Lt.-3' Rt.	
"L" 28+77 to "L" 27+78 29+59	32 30.4	6"	28' Lt.-7' Rt.	
"L" 29+92 to "L" 27+92 0	34 28.6	6"	19' Lt.-9' Rt.	
"L" 30+71 to "L" 30+68	36.8	6"	25' Lt.-11' Rt.	
"L" 30+87 to "L" 30+82 79.4	36.8	6"	25' Lt.-8' Rt. 11'	
"L" 33+63 to "L" 33+65	22	6"	22' Lt.-0' Rt.	Reconnect existing service
"L" 35+02 to "L" 35+19 22	20 29.2	8"	0' Lt.-13' Rt. Lt.	
"L" 39+50 to "L" 39+50	20	6"	5' Lt.-25' Lt.	
"L" 39+30 to "L" 39+50	20	10"	7' Rt.-7' Rt.	
"L" 40+22 to "L" 40+22	20	6"	4' Lt.-30' Lt.	Cap future service
"L" 41+77 to "L" 41+97	20	10"	12' Rt. 14' Rt.	
"L" 42+81 to "L" 42+82 55	22 18.3	6"	8' Lt.-30' Lt.	
"L" 44+16 to "L" 44+17 12	26 18.6	6"	4' Lt.-38' Lt. 28'	Cap future service
"L" 45+47 to "L" 45+59	20	6"	22' Lt.-6' Lt.	
"L" 45+76 to "L" 45+97	20	10"	13' Rt.-14' Rt.	Connect to existing M.H.
"L" 49+28 to "L" 49+24	44 40.3	6"	30' Lt.-14' Rt. 10'	Connect to existing wye & cap, future service
"L" 52+64 to "L" 52+64	26	6"	10' Lt.-36' Lt.	Cap future service
"L" 54+13 to "L" 54+13	20	10"	15' Rt.-15' Rt.	
"L" 55+62 to "L" 55+92 88	25 20	10"	14' Rt.-14' Rt.	
"L" 55+87 to "L" 55+87	22 44.6	6"	30' Lt.-12' Rt. 14'	Cap future service
"L" 63+83 to "L" 63+85	20	6"	26' Lt.-6' Lt.	
"L" 72+81 to "L" 72+82	20	14"	5' Lt.-25' Lt.	
"L" 35+00	11.9	8"	6' to 12' Lt.	





WATER LINE DETAILS

NOTES

- See Standard Drawing U - 03.00 for location and size of thrust blocks.
- Service boxes installed on the left shall be set $\frac{1}{2}$ " below finished sidewalk elevation. Service boxes installed on the right shall be set flush with the existing ground or as directed by the engineer.
- Existing fire hydrants shall be removed and disposed of as directed by the engineer.
- Installation of new fire hydrants shall be in accordance with Standard Drawing U - 03.00. See Table of Water Main Appurtenances for locations of G.V., V.B. & F.H. Hydrants shall be Mueller A-24015 or equal.

ABBREVIATION TABLE


A.C.	Asbestos Cement
S.S.	Sanitary Sewer
M.H.	Man Hole
C.O.	Clean Out
W.M.	Water Main
L.F.	Linear Foot
C.I.	Cast Iron
D.I.	Ductile Iron
G.V.	Gate Valve
V.B.	Valve Box
F.H.	Fire Hydrant
C.A.R.V.	Captive Air Relief Valve

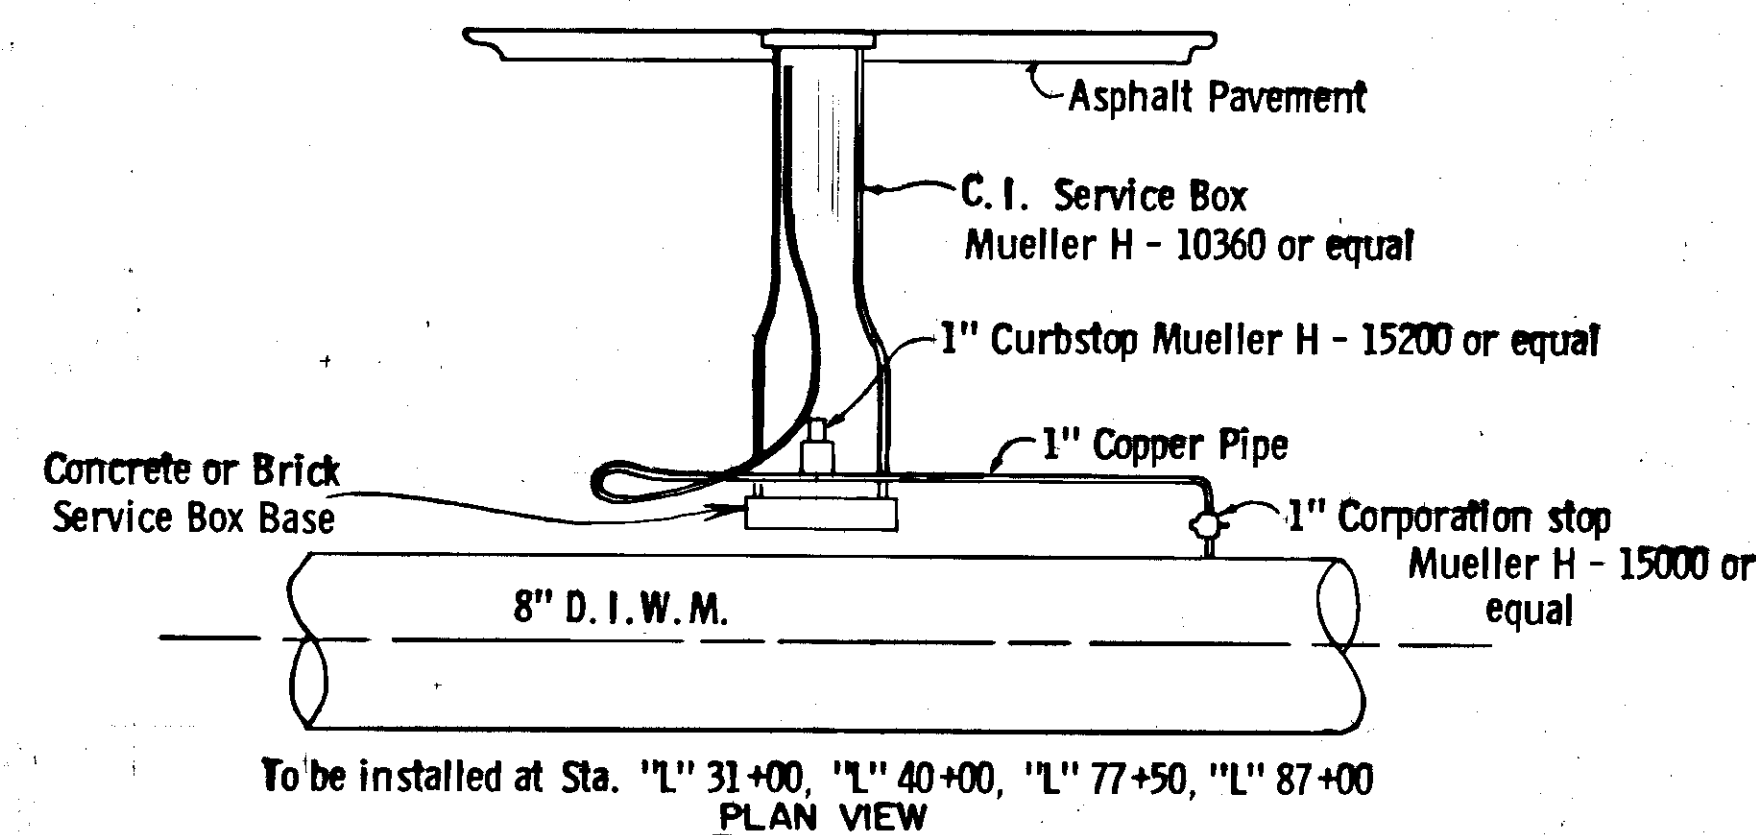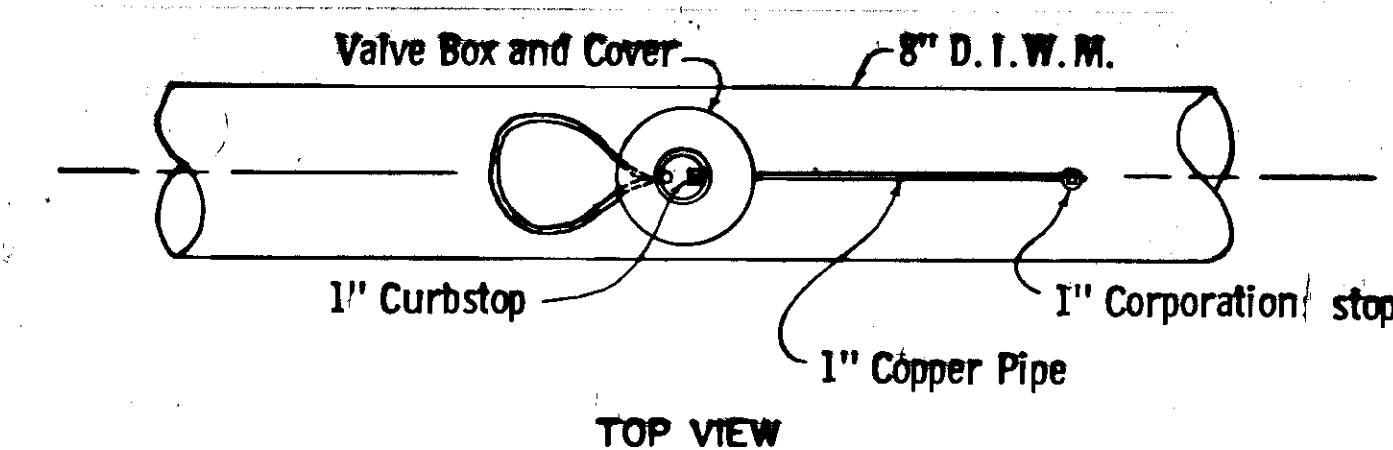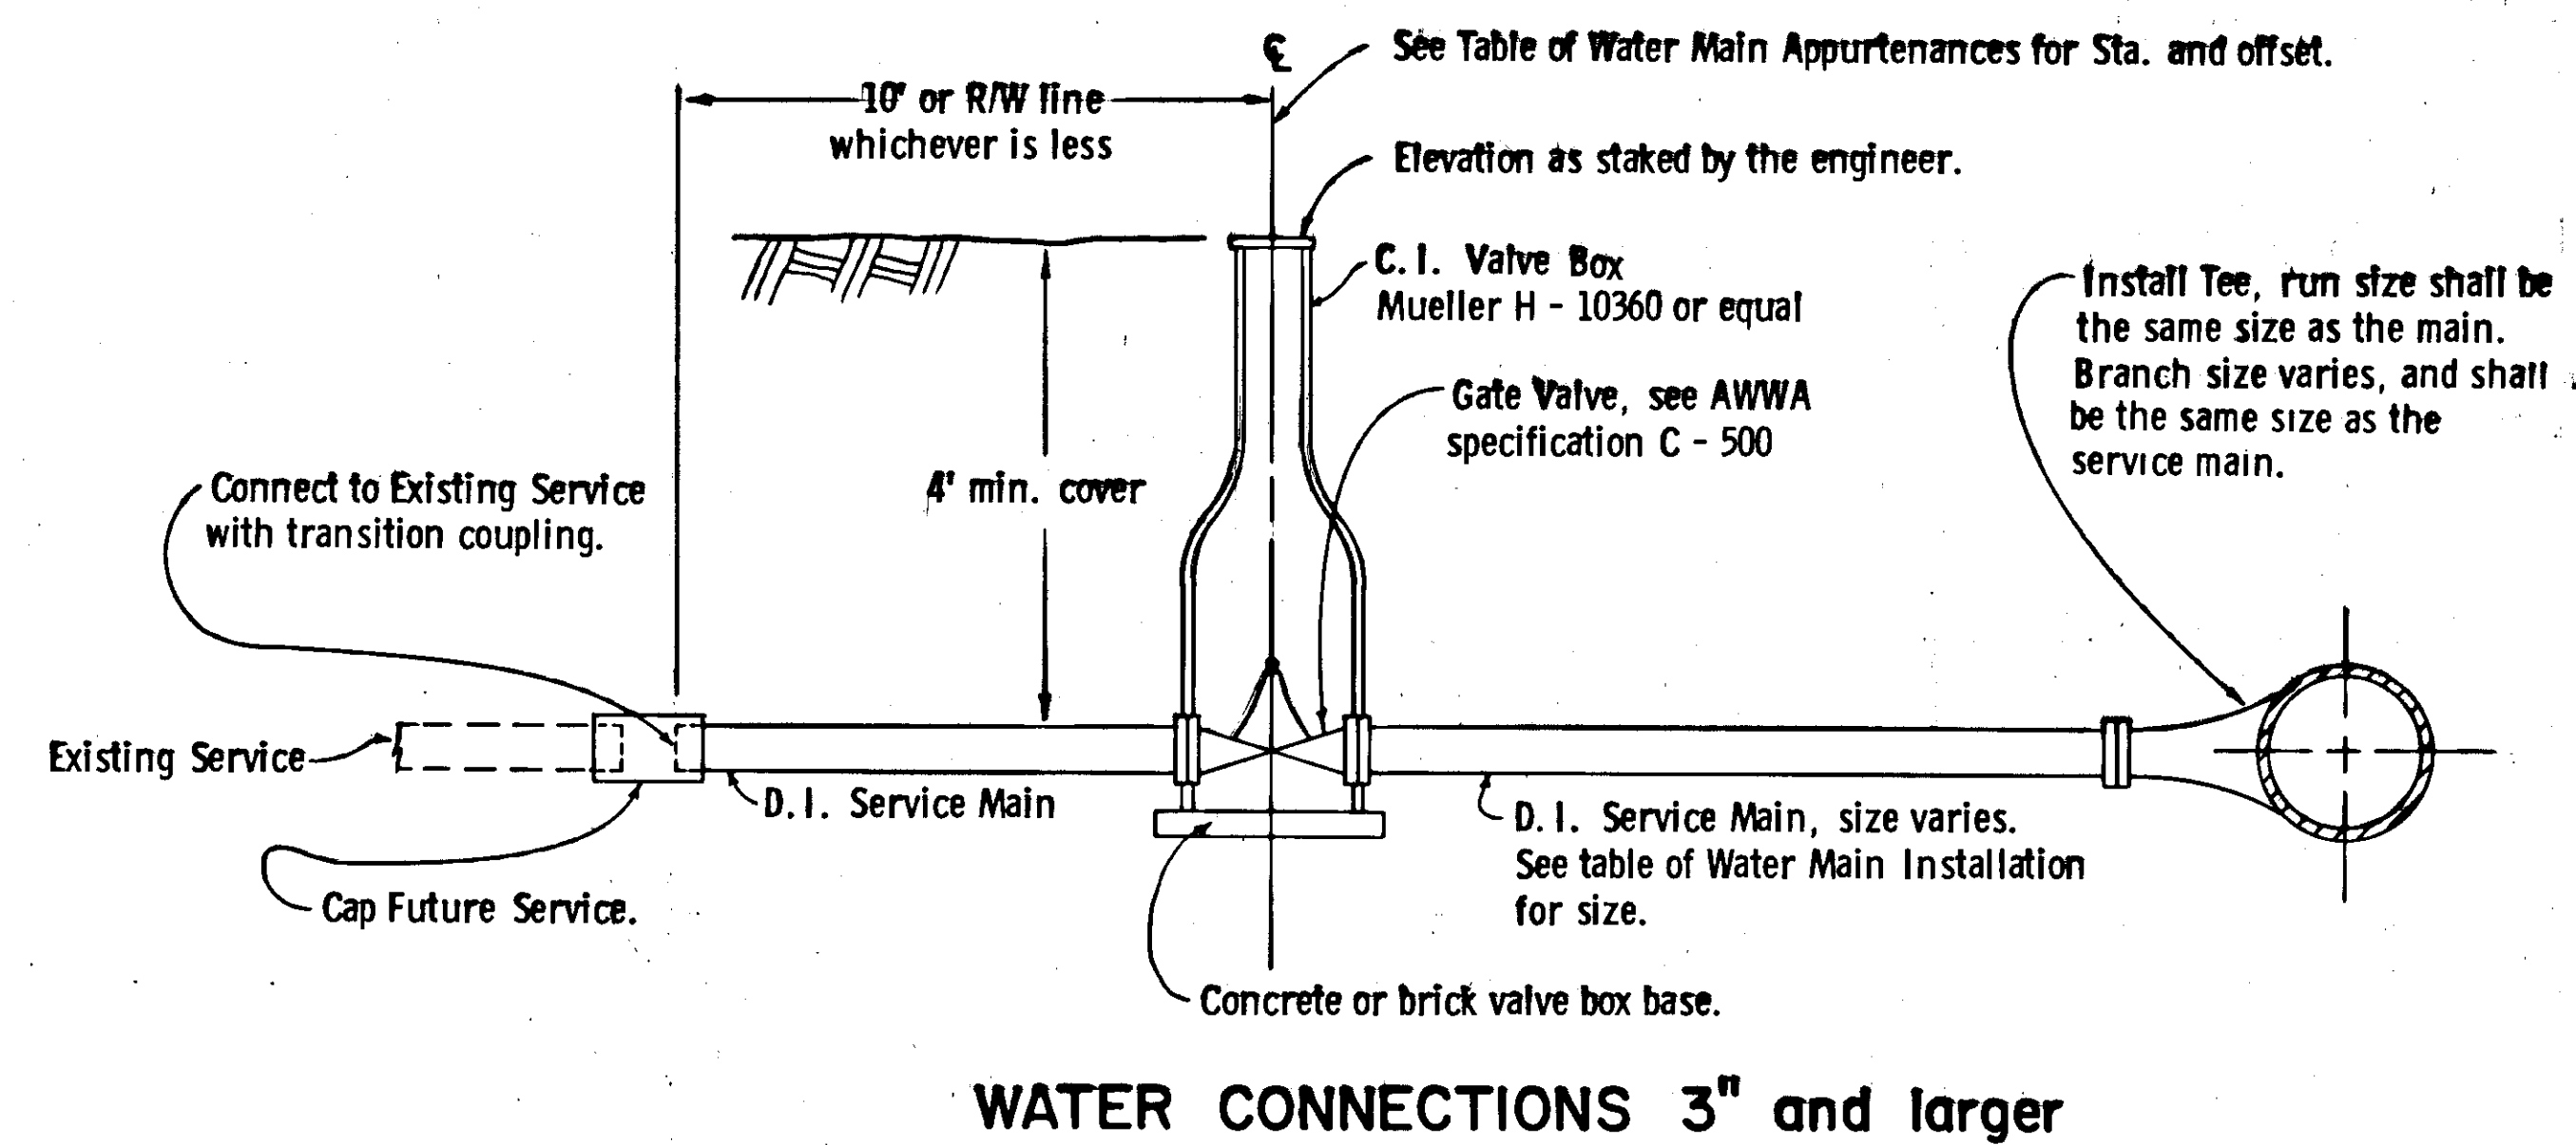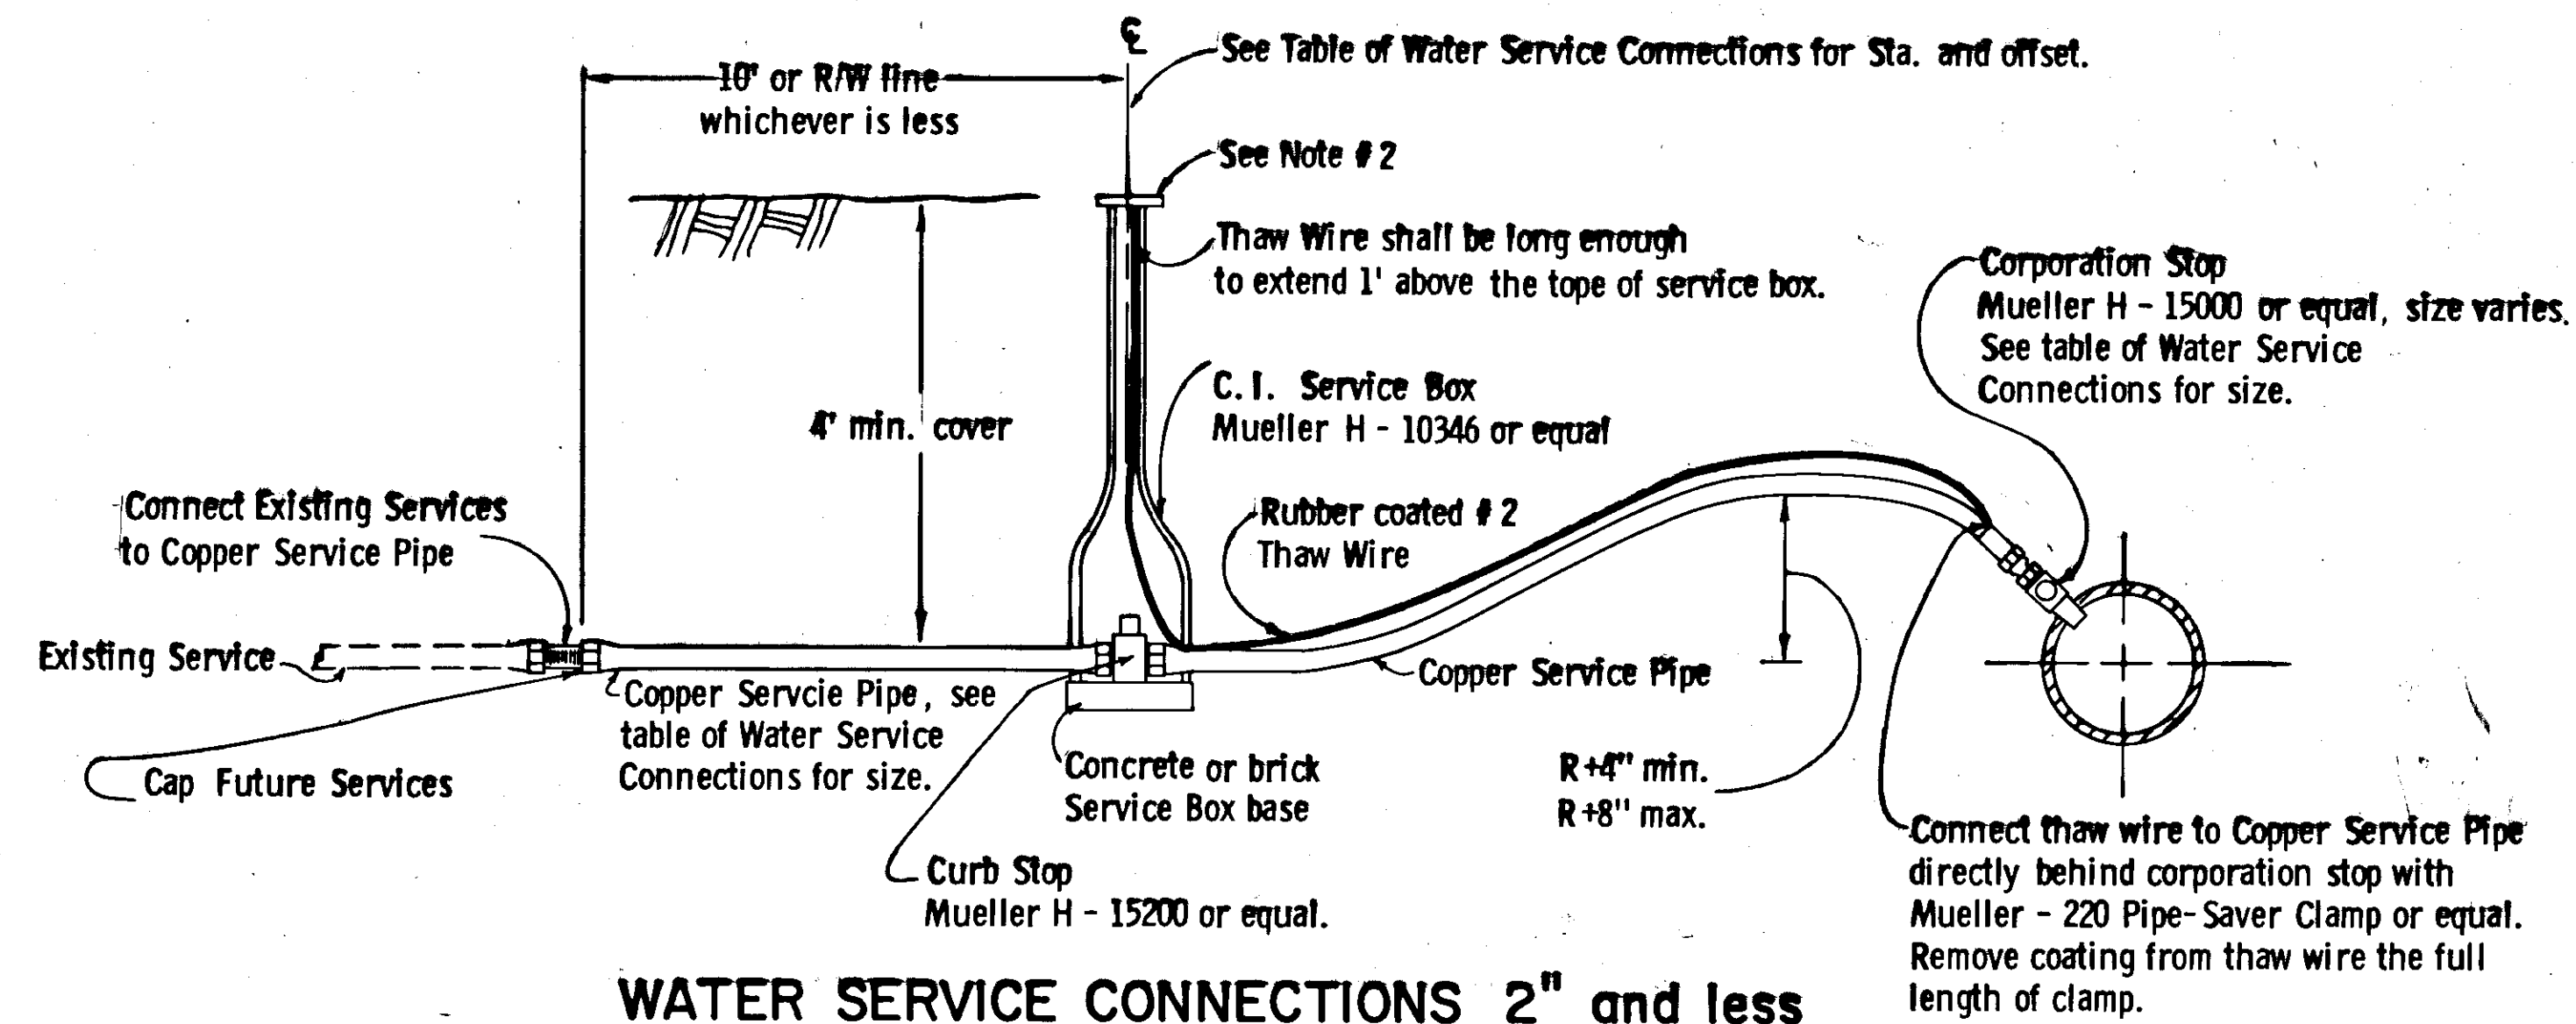

CAPTIVE AIR RELEASE VALVE DETAIL

"O"
 $\Delta = 41^\circ 48' 52''$
 $D = 28^\circ \text{ Lt.}$
 $T = 78.17'$
 $L = 149.34'$
 $R = 204.63'$
 $S = 0.02$

STATE	PROJECT DESIGNATION	YEAR	SHEET NO.	TOTAL SHEETS
ALASKA	RF-099-3(12)	1975	7	28

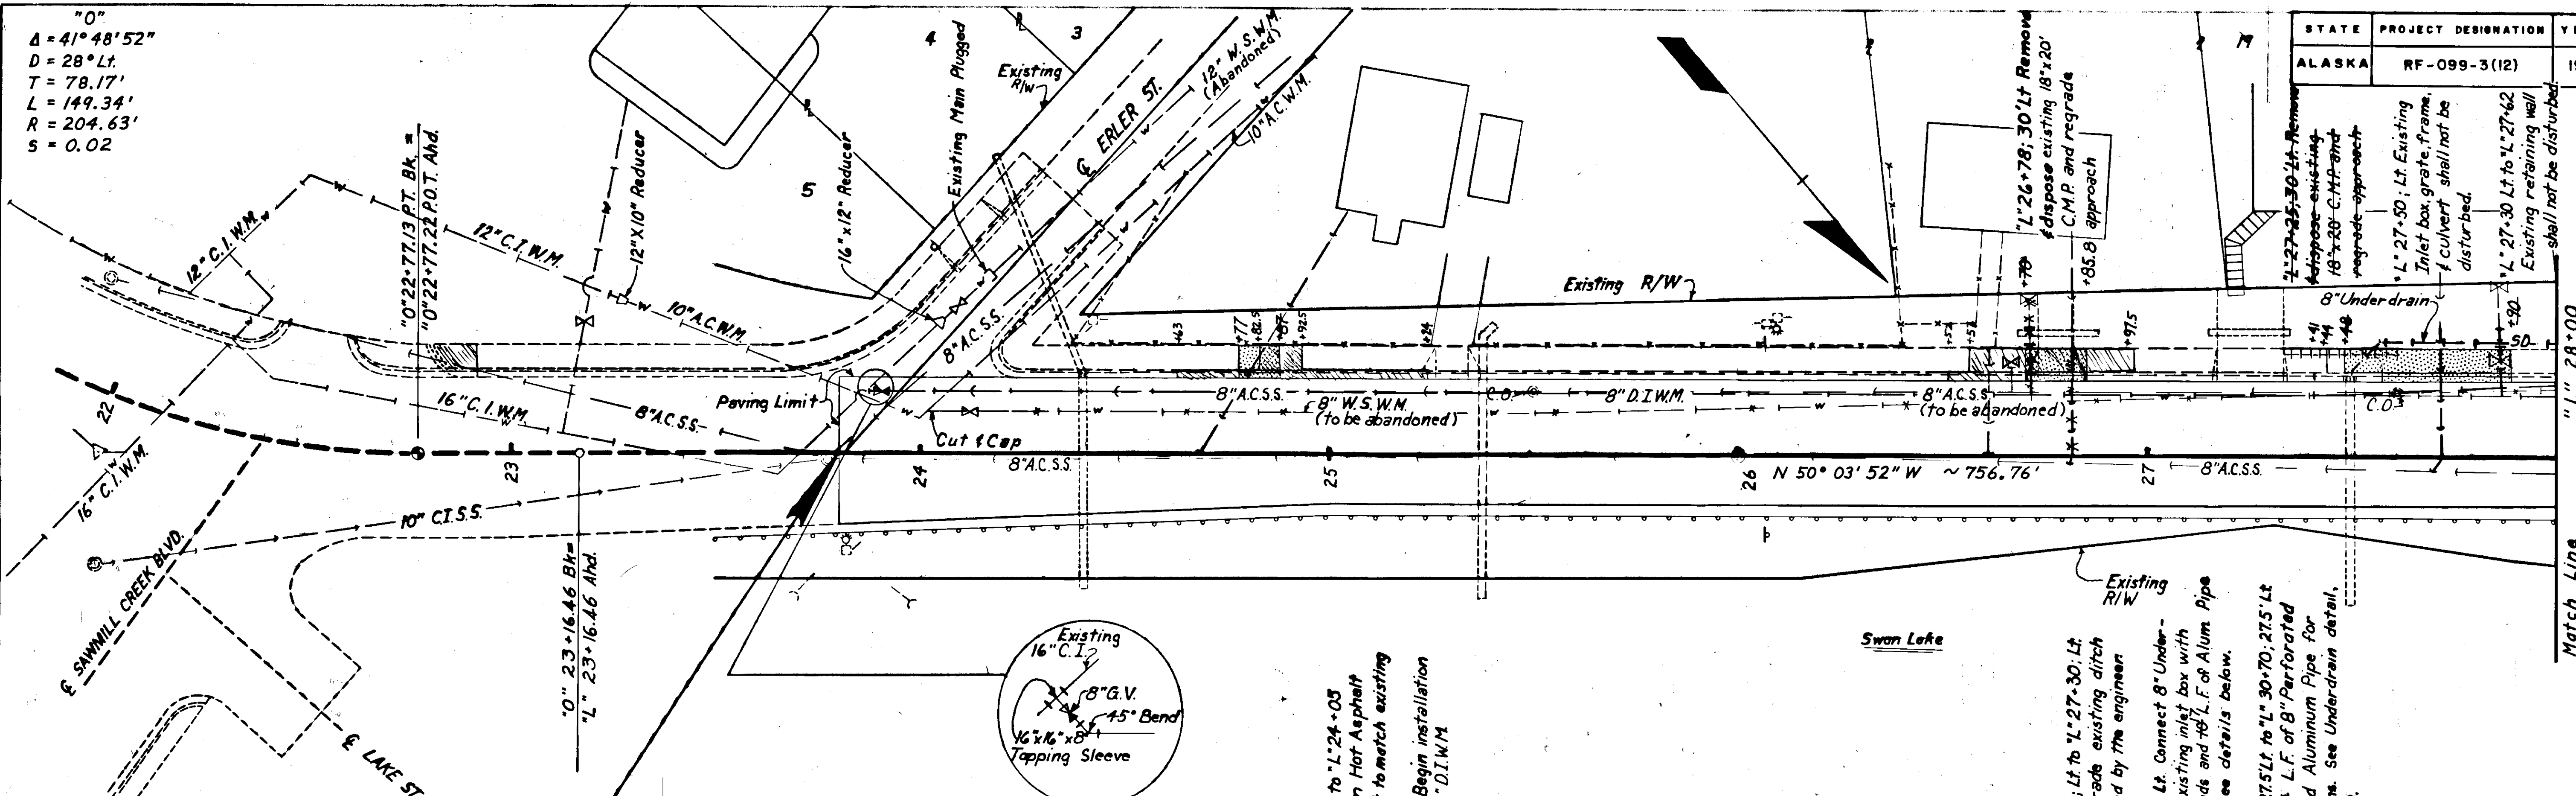

HORIZONTAL CONTROL:
Bearings for this project are based on U.S.C. & G.S. triangulation stations "GRIFF" for the B.O.P. and "CHAN" for the E.O.P.

VERTICAL CONTROL:
Vertical Control was derived from U.S.C. & G.S. Benchmark #8. A standard disk, stamped, "B 1924" set in a rock 30 ft. in dia., 300 ft. south of R.C.A. office. U.S.C. & G.S. Elev. 13.14

BEGINNING OF PROJECT
RF-099-3(12)
Sta. "L" 23 + 80.00


"L" 23 + 80 to "L" 24 + 03
Transition Hot Asphalt
Pavement to match existing

"L" 23 + 88 Begin installation
of New 8" D.I.W.M.



"L" 26 + 40; Lt. to "L" 27 + 30; Lt.
Fill & regrade existing ditch
as directed by the engineer

"L" 27 + 50; Lt. Connect 8" Under-
drain to existing inlet box with
2-45° bends and 167' L.F. of Alum. Pipe
conduit. See details below.



"L" 27 + 56; 27.5 Lt. to "L" 30 + 70; 27.5' Lt.
Install 3/4" L.F. of 8" Perforated
Corrugated Aluminum Pipe for
Underdrains. See Underdrain detail,
sheet no. 8.



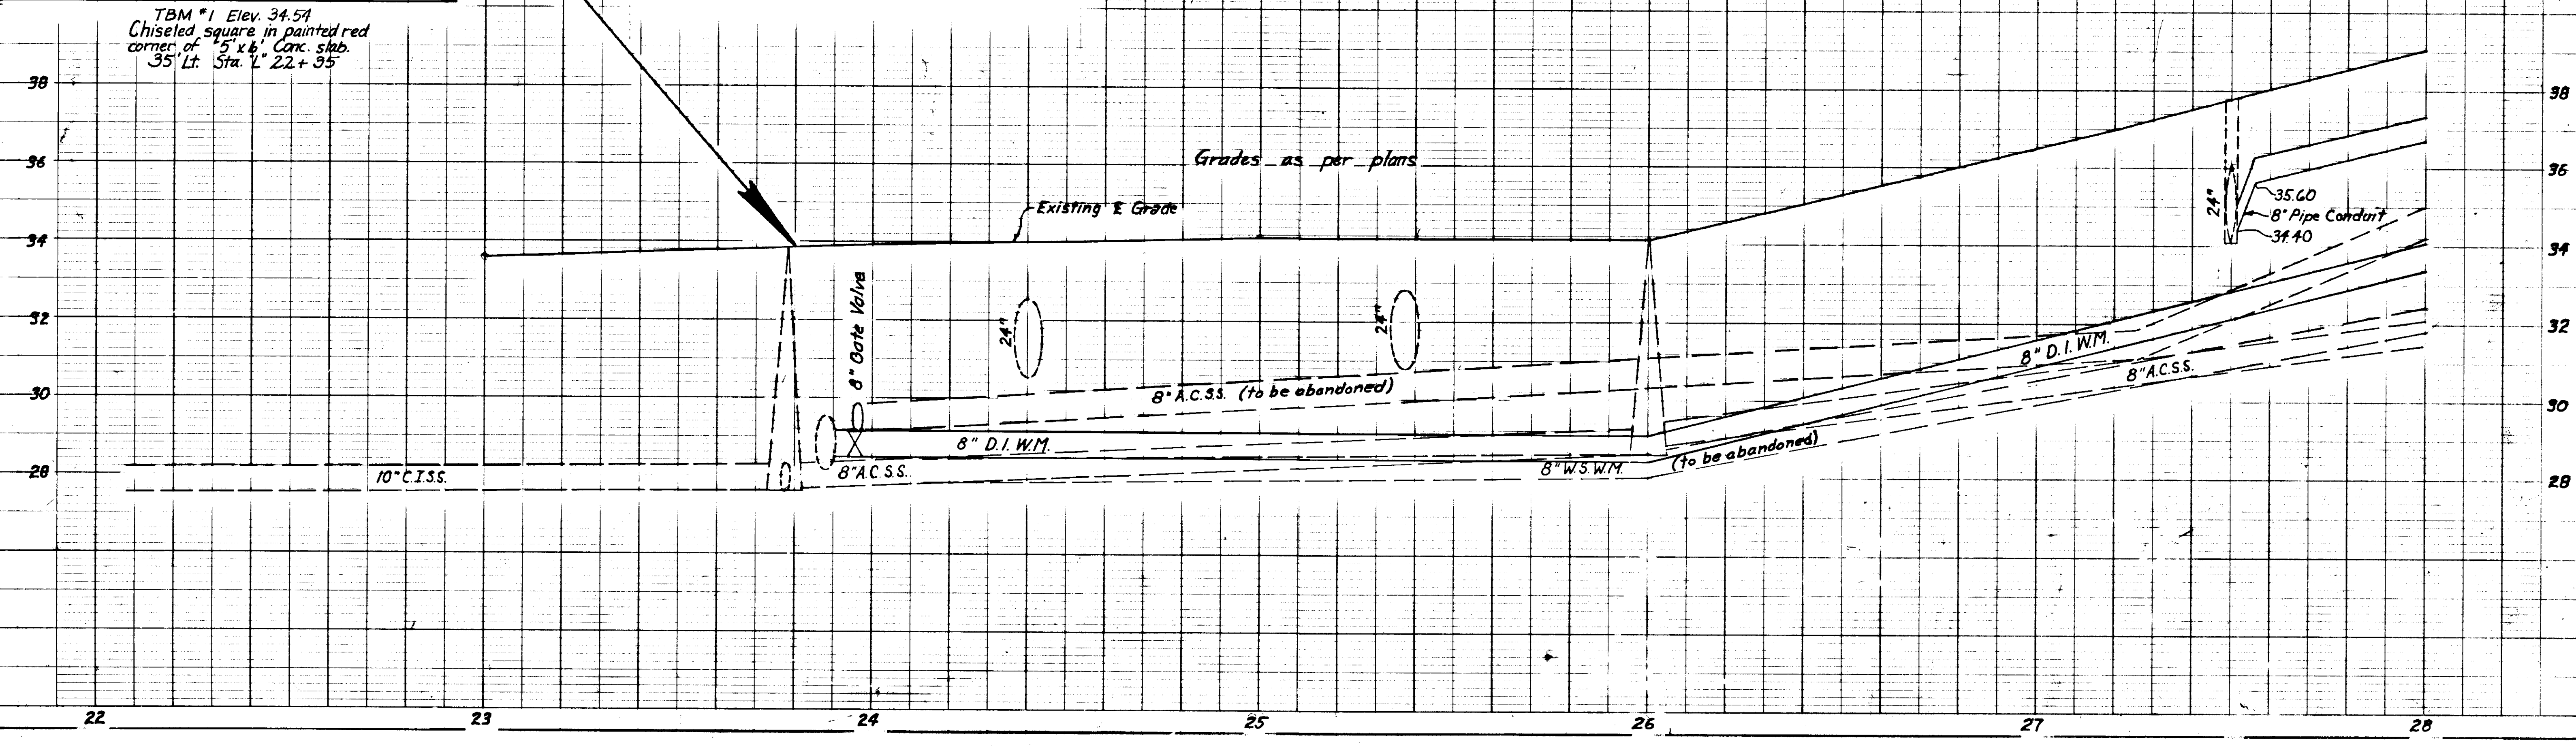


STATE	PROJECT DESIGNATION	YEAR	SHEET NO.	TOTAL SHEETS
ALASKA	RF-099-3 (12)	1975	8	28

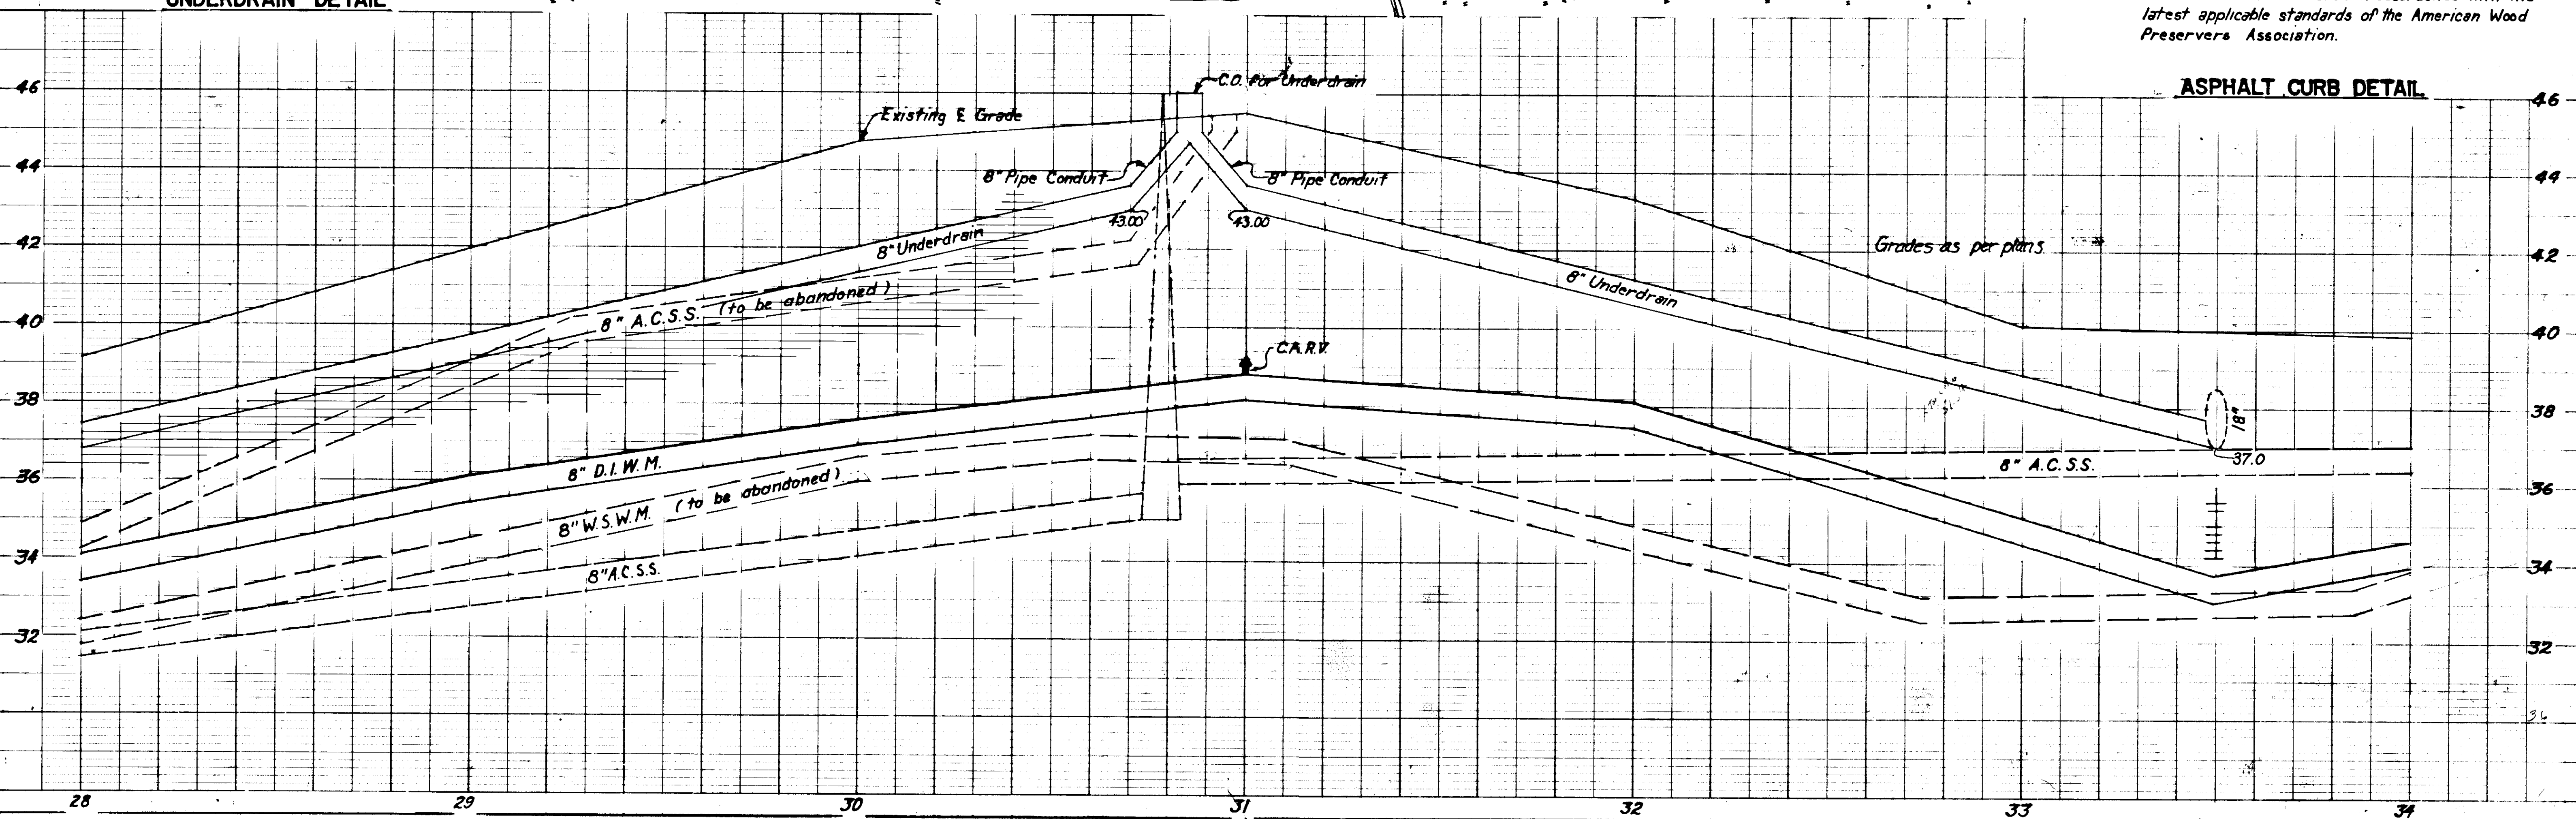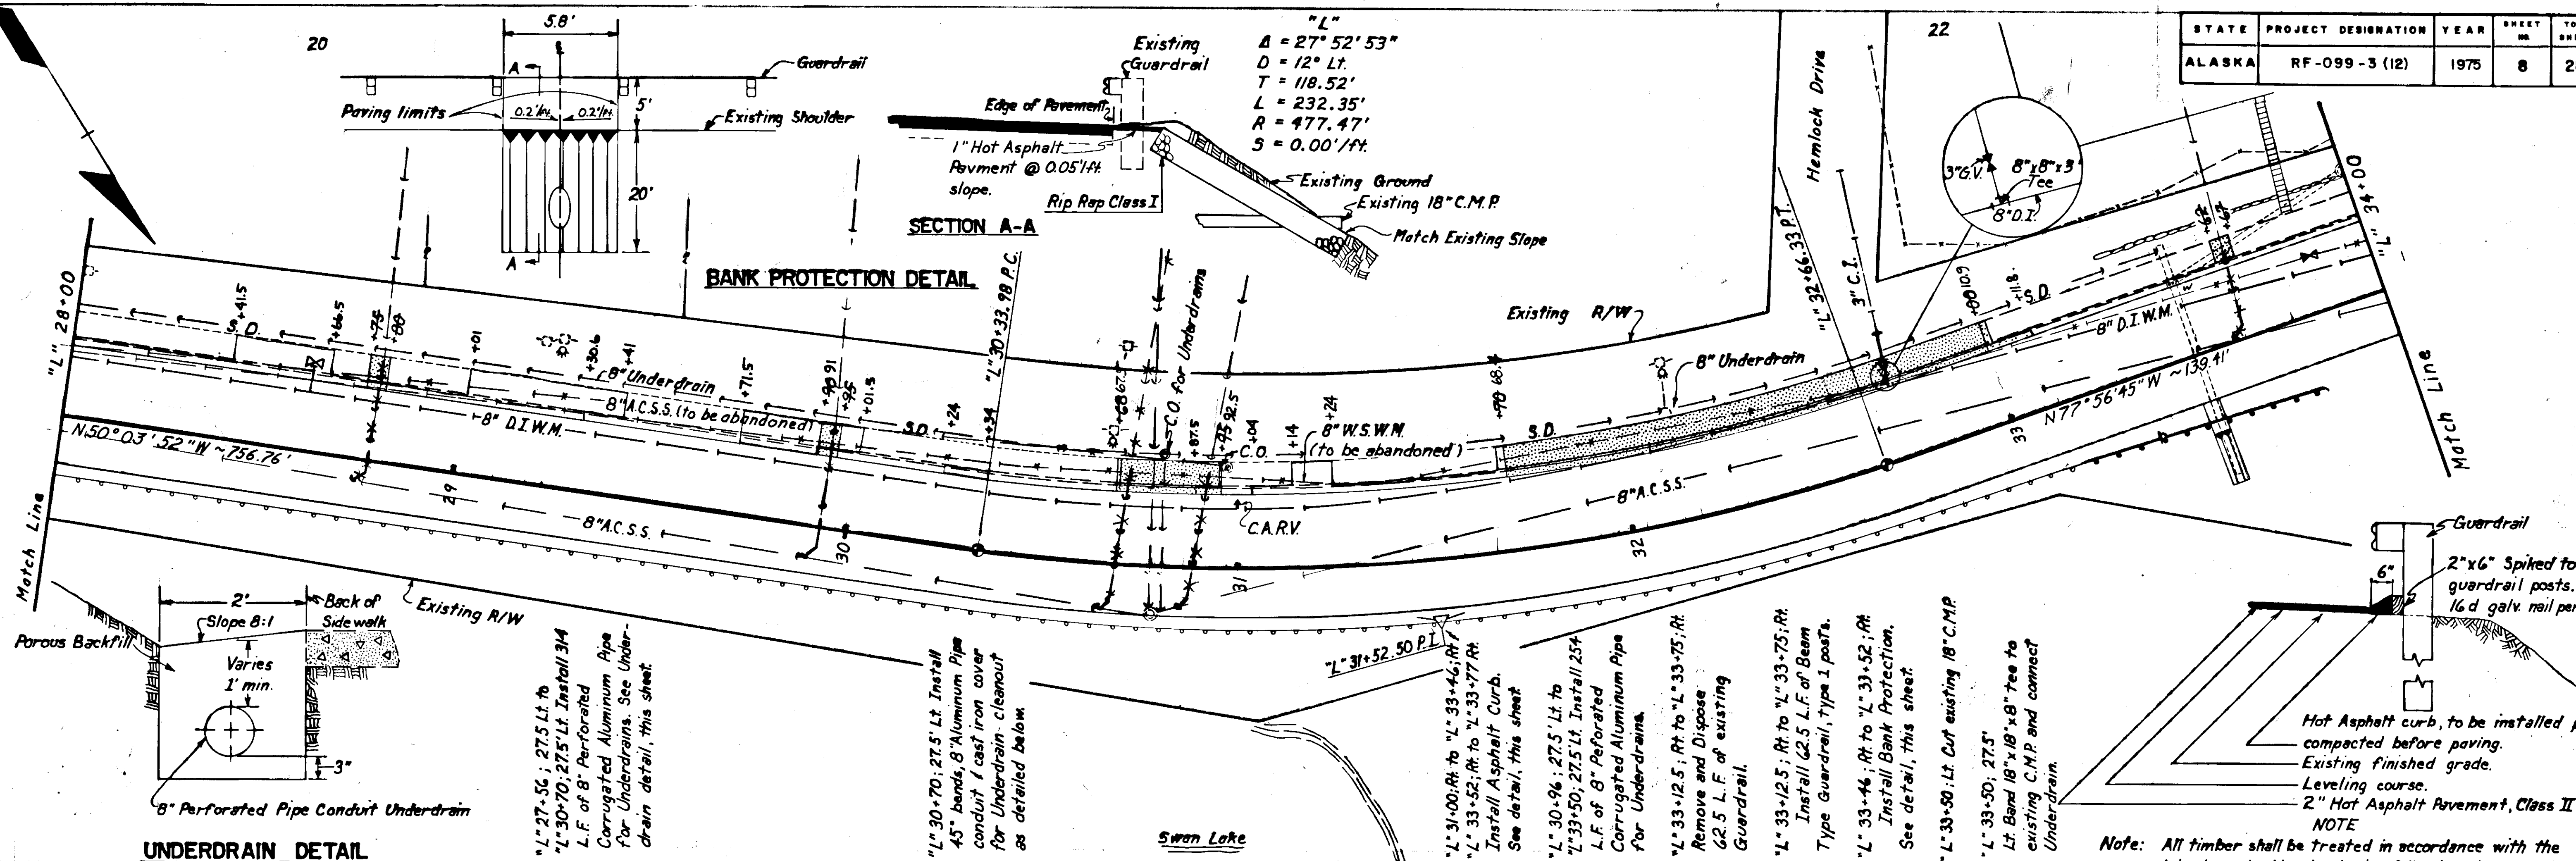

STATE	PROJECT DESIGNATION	YEAR	SHEET NO.	TOTAL SHEETS
ALASKA	RF-099-3(12)	1975	11	28

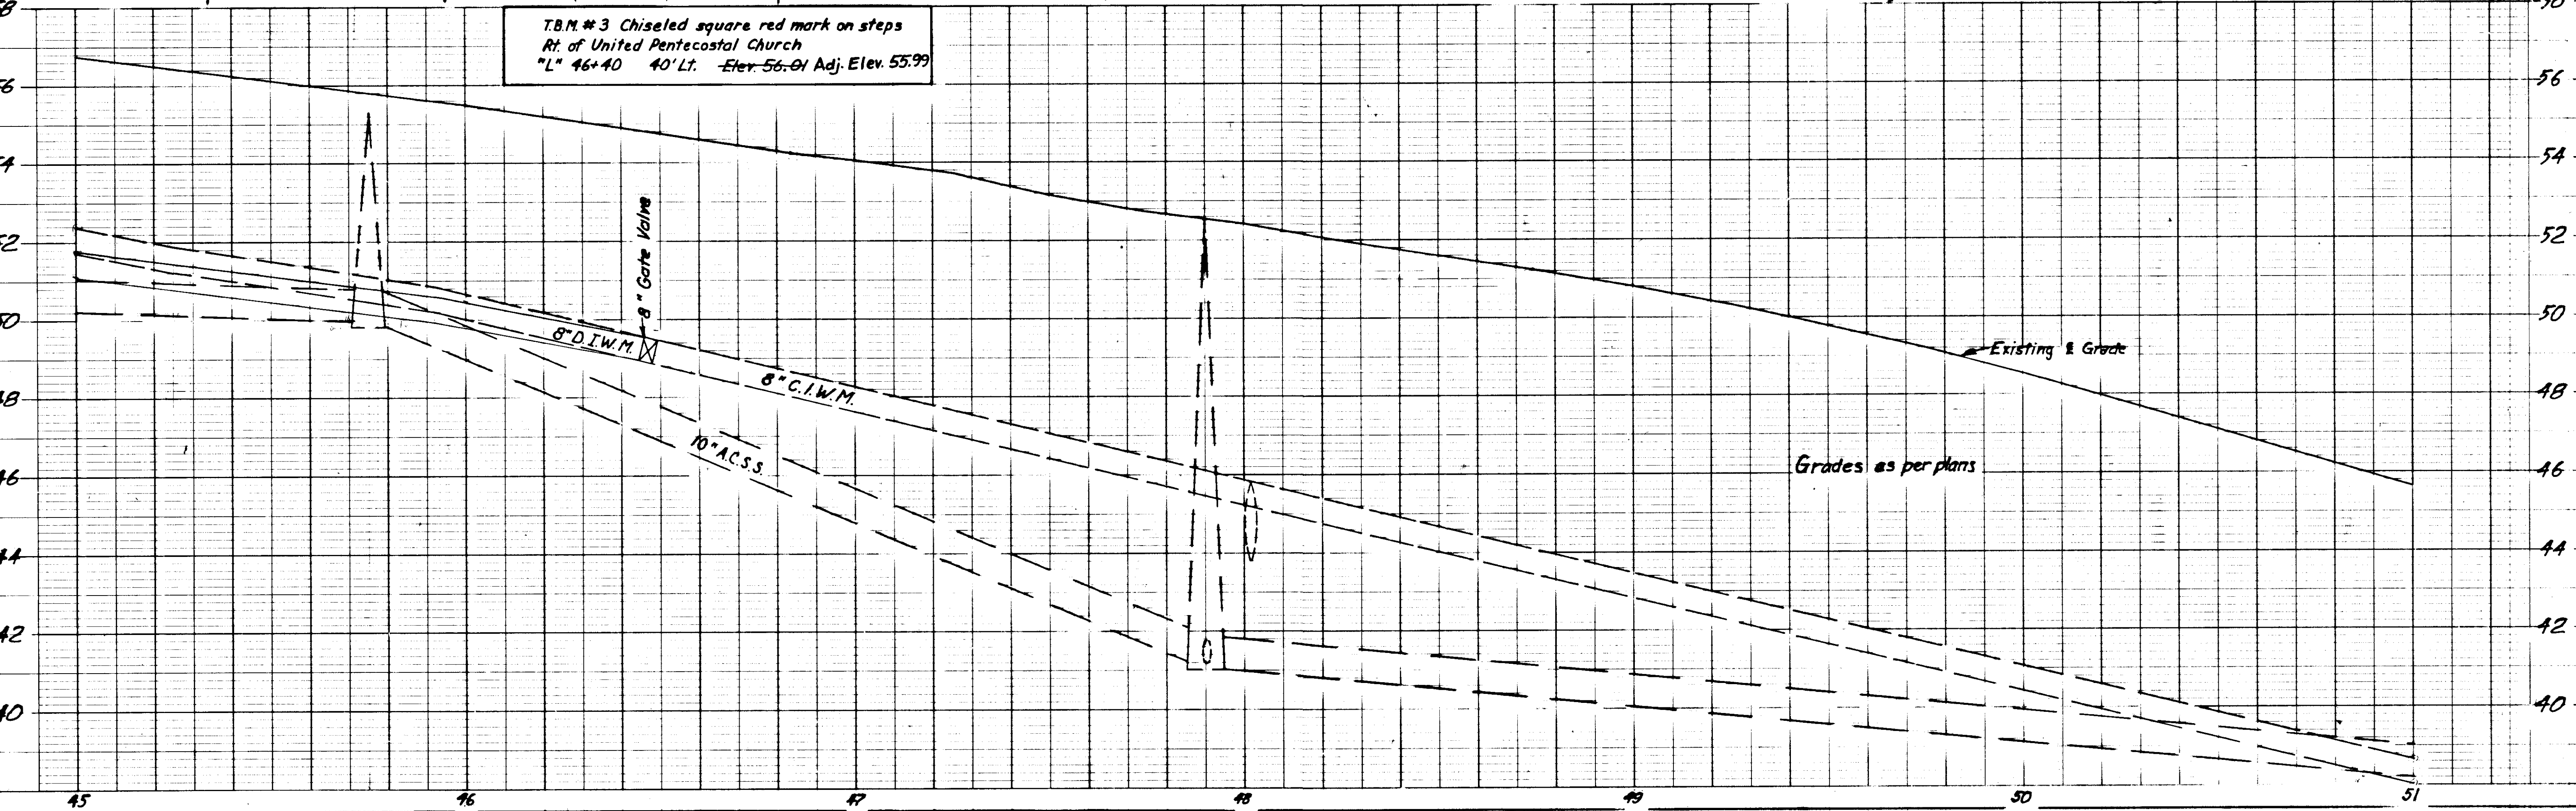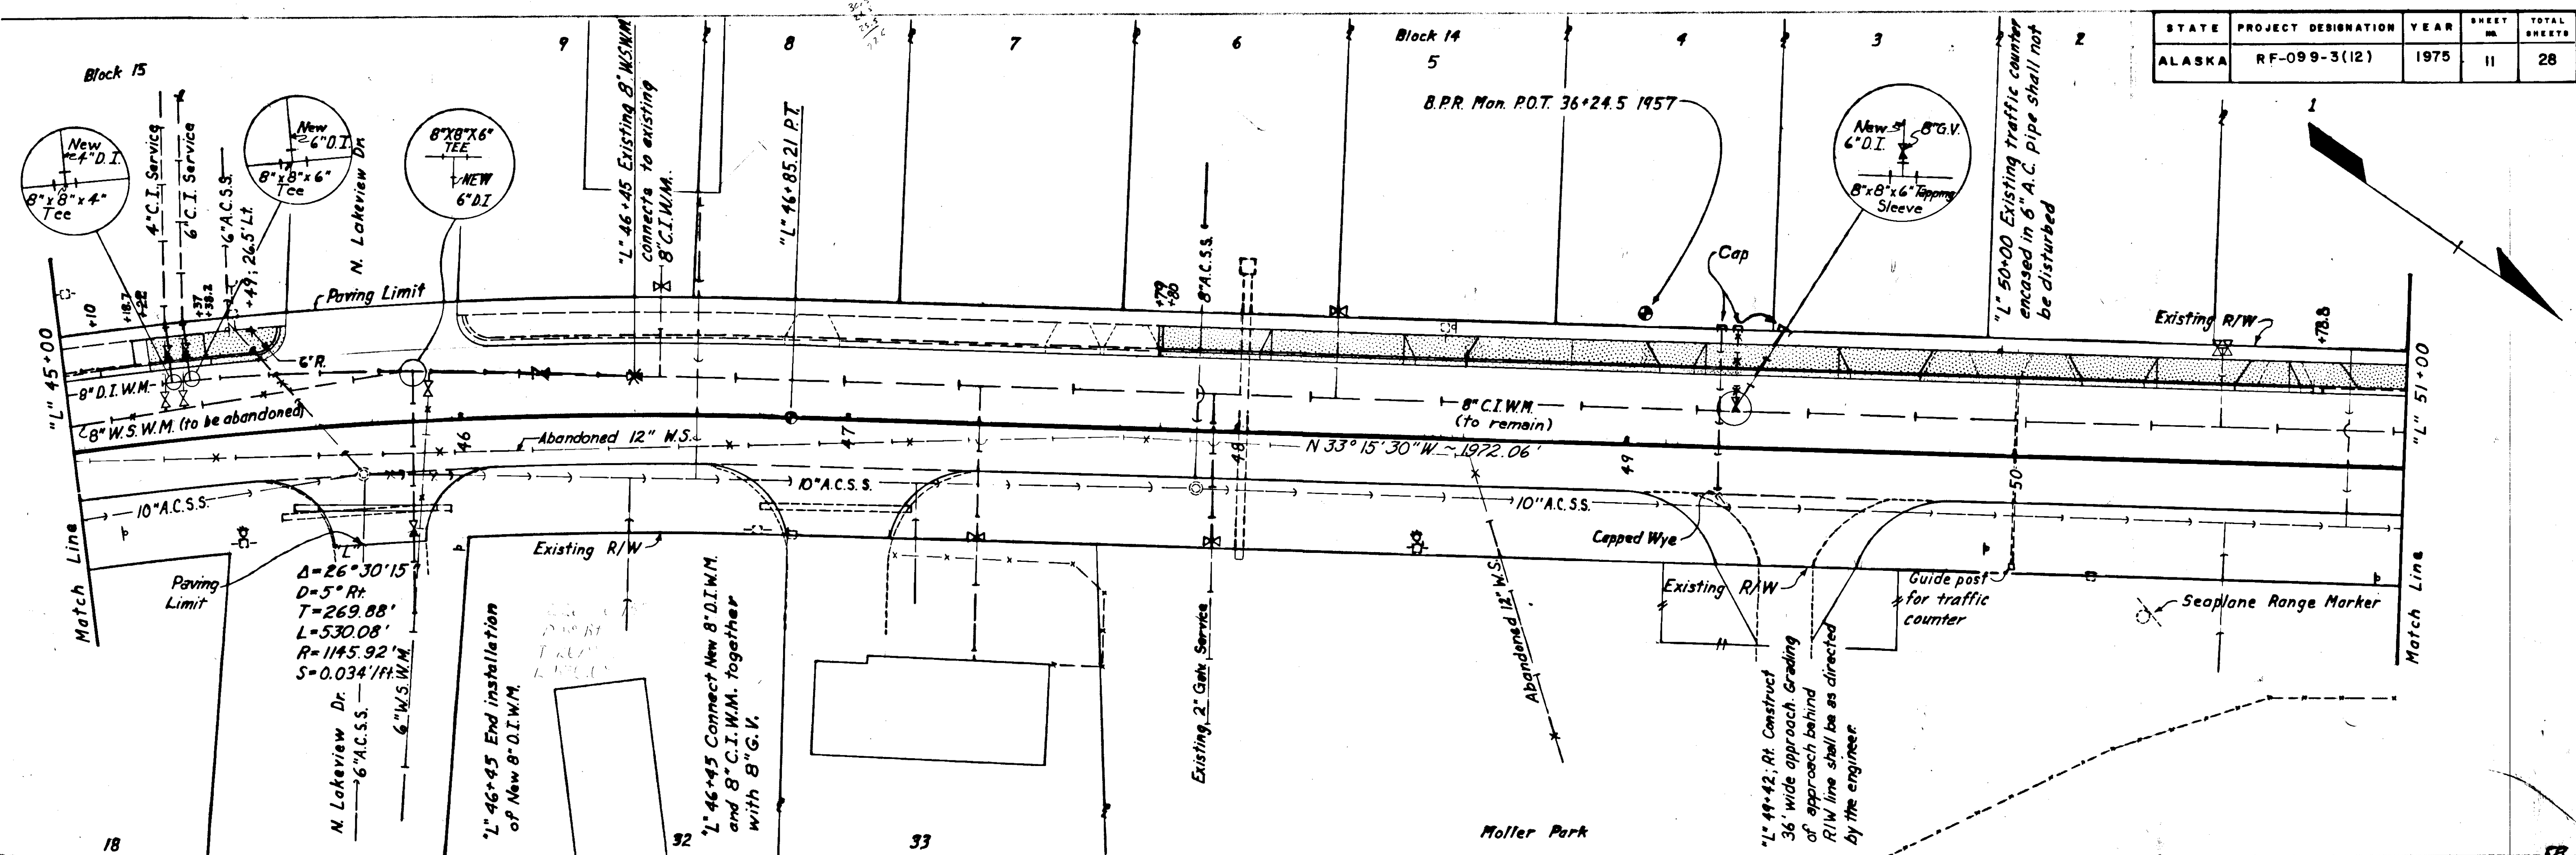

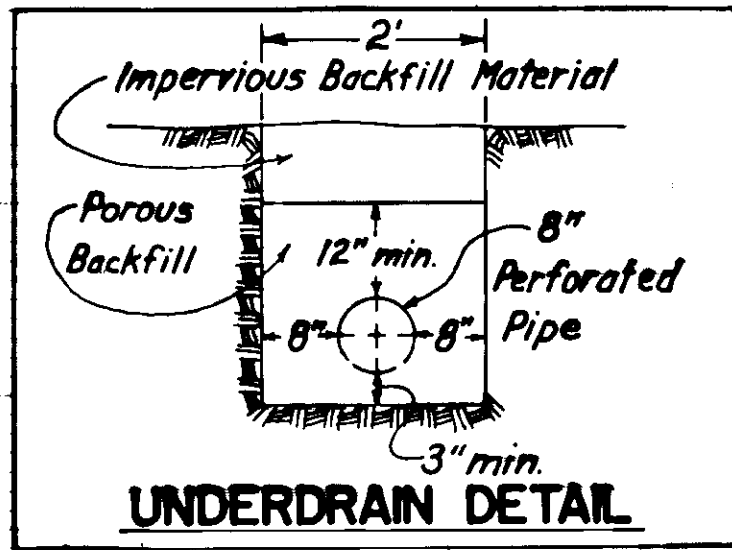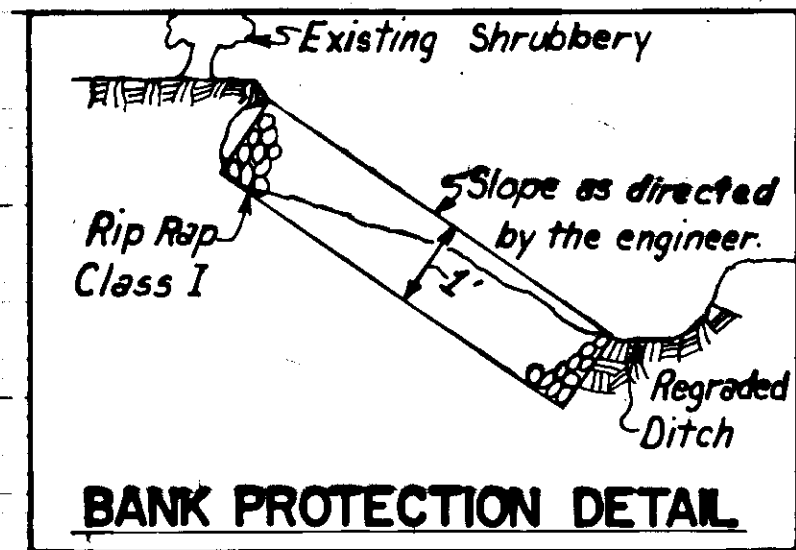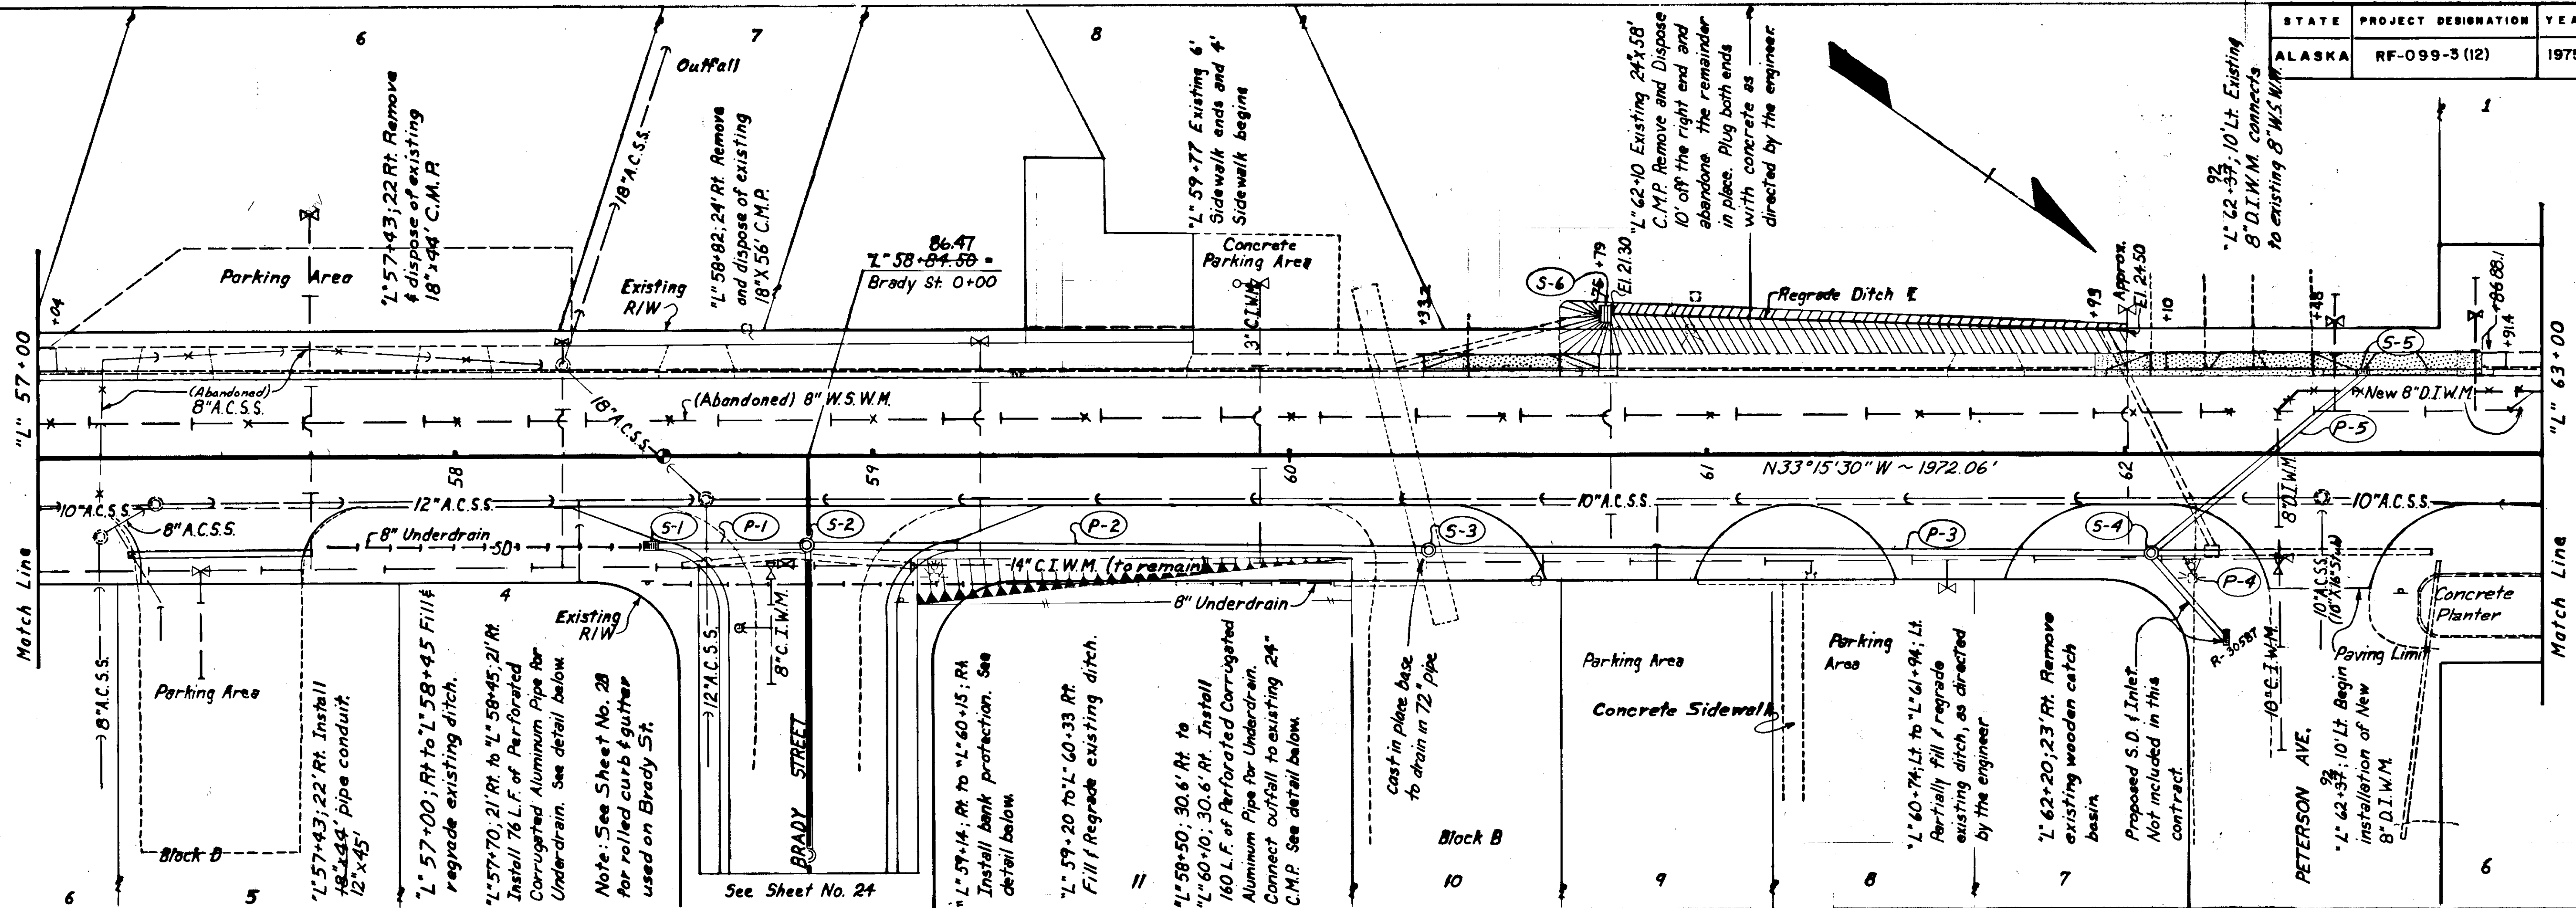


T.B.M. #4 Steel pipe with concrete nail.
"L" 59+30 30' Lt.
Elev. 24.82 Adj. Elev. 24.75


DRAINAGE STRUCTURE SUMMARY						
Inlet No.	Type	Location Station	Offset	Elev. Top of Curb	Inlet Elev.	Outlet Elev.
S-1	A	"L" 58+48 50	21' Rt.	21.47	17.60	18.43 11
S-2	M.H.	"L" 58+84 87	21' Rt.	21.90*	18.00	17.75 35
S-3	M.H.	"L" 60+33	21' Rt.	20.74*	16.25	15.90
S-4	M.H.	"L" 62+06	21' Rt.	24.80*	22.30 02	21.60 72
S-5	A	"L" 62+57	20' Lt. 21	27.48	—	24.40
S-6	Field Inlet	"L" 60+74	34' Lt.	21.30*	—	19.47 49

* Top of cover elev.
* Top of grate elev.


PIPE SUMMARY						
Pipe No.	Pipe Size	Pipe Lgth.	From		To	
			Inlet No.	Invert El.	Inlet No.	Invert El.
P-1	18"	32'	S-1	18.43 41	S-2	18.00 17.60
P-2	24"	148' 5"	S-2	17.75	S-3	16.25
P-3	24"	168'	S-4	21.60 80	S-3	16.25
P-4	18"	16' 15"	Band to existing Cul.		S-4	24.60 22.60
P-5	18"	64' 45"	S-5	24.40 32	S-4	22.30 02

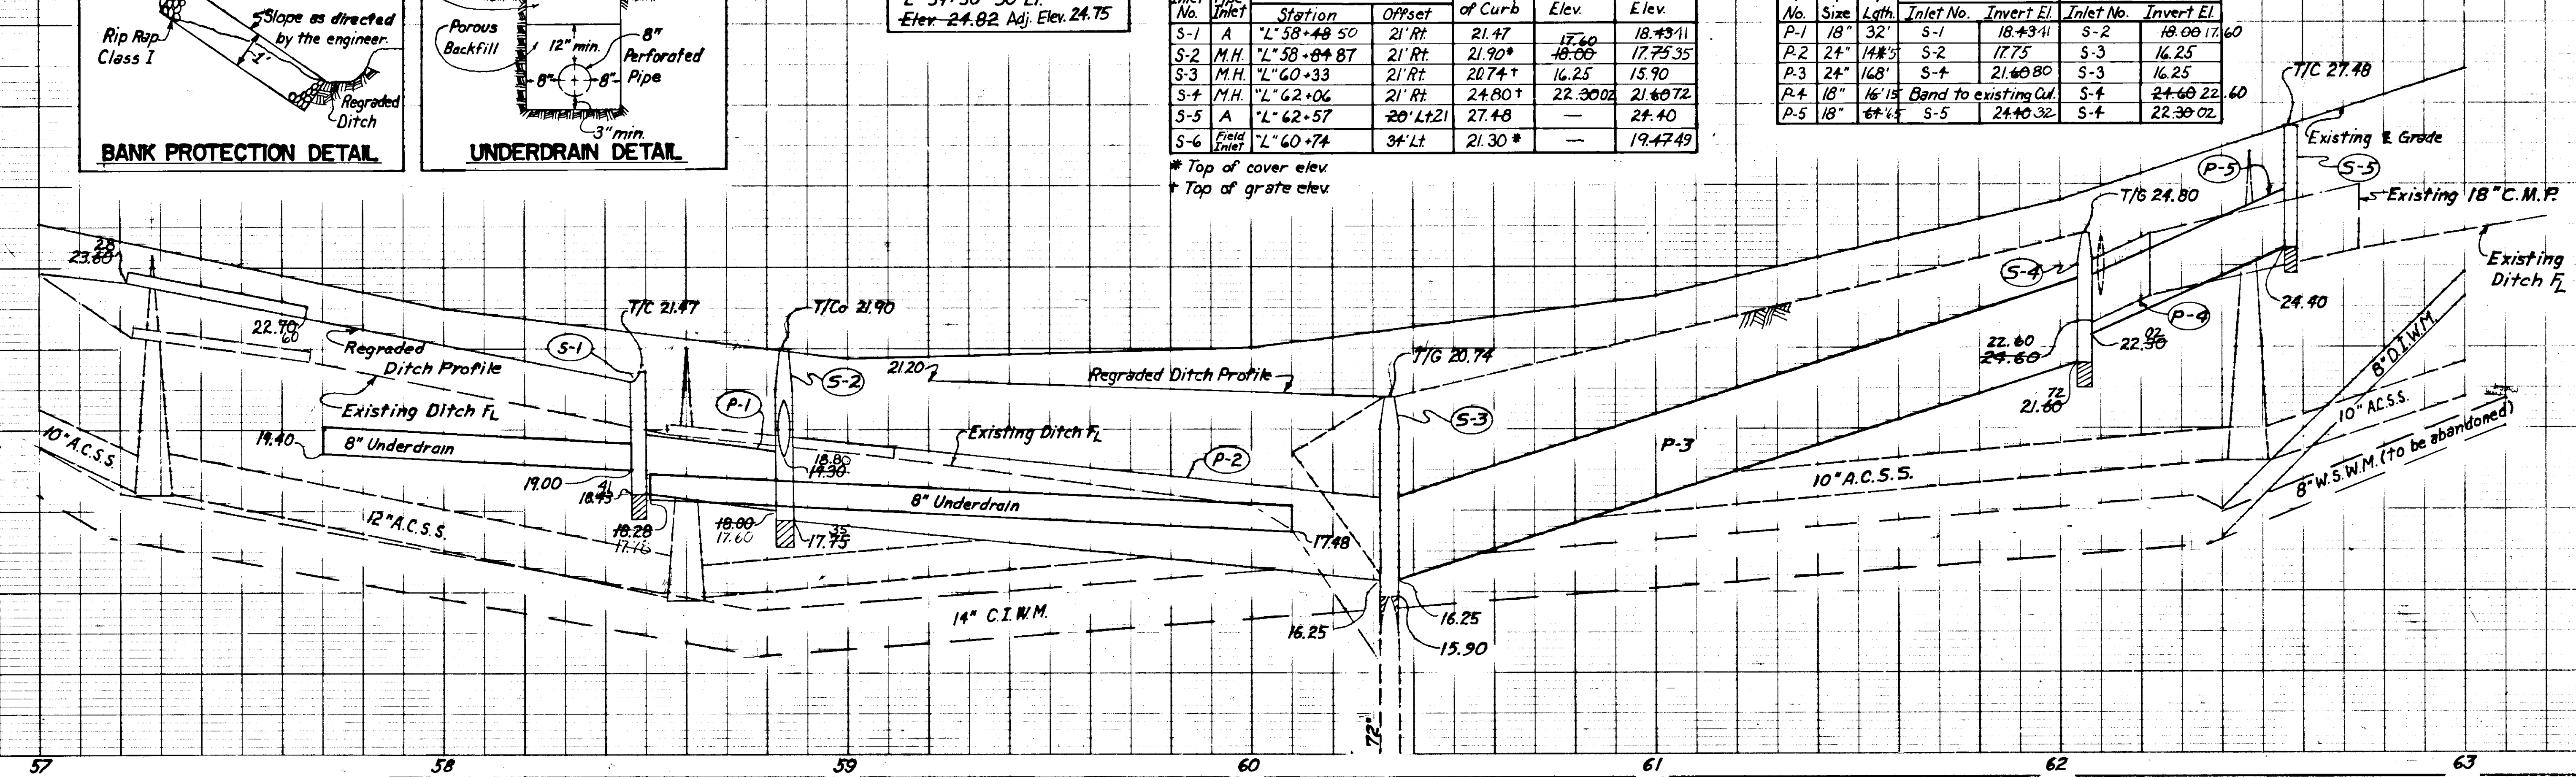



STATE	PROJECT DESIGNATION	YEAR	SHEET NO.	TOTAL SHEETS
ALASKA	RF-099-3(12)	1975	14	28

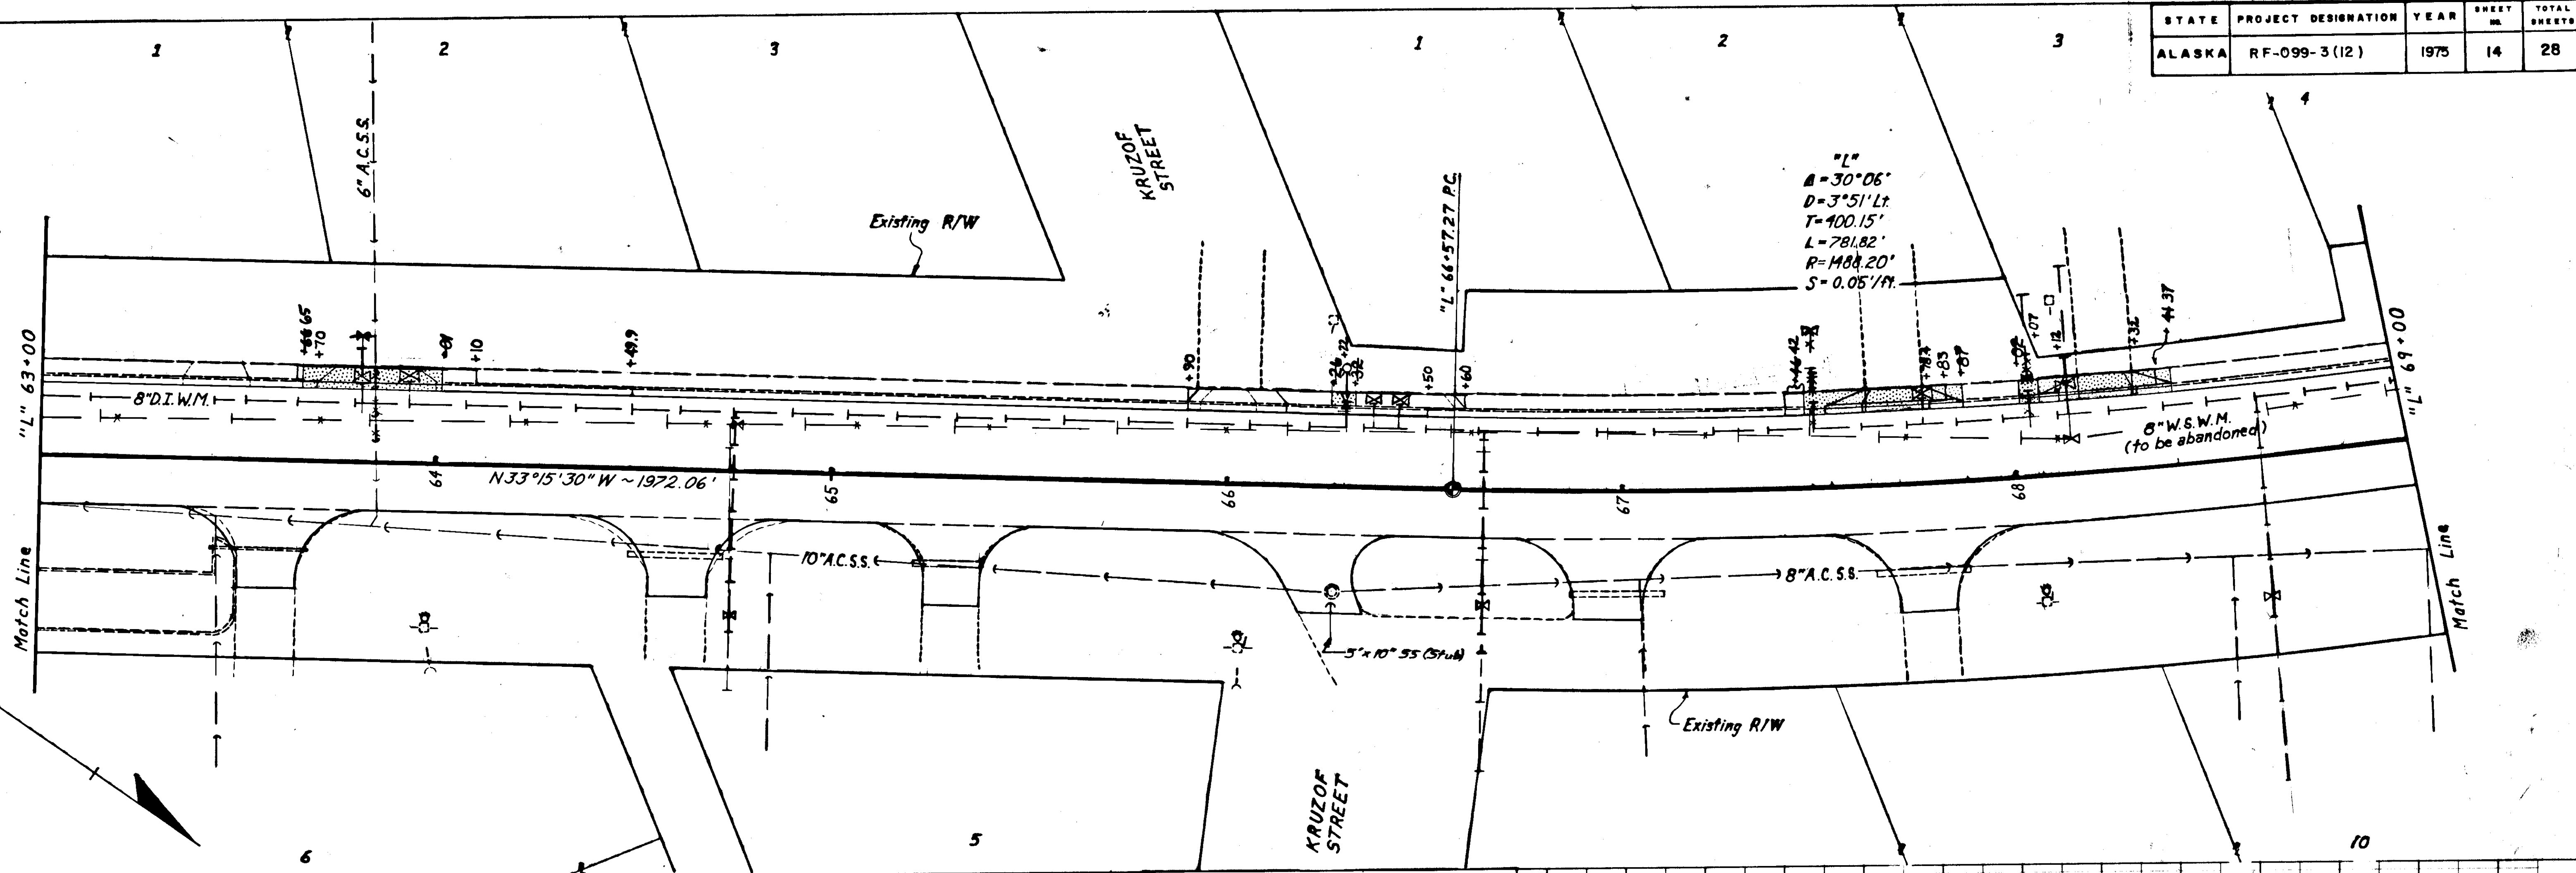


T.B.M. #5 PK. nail in top of cut off power pole. "L" 66+00 40' Rt. Elev. 39.69
Adj. Elev. 39.63

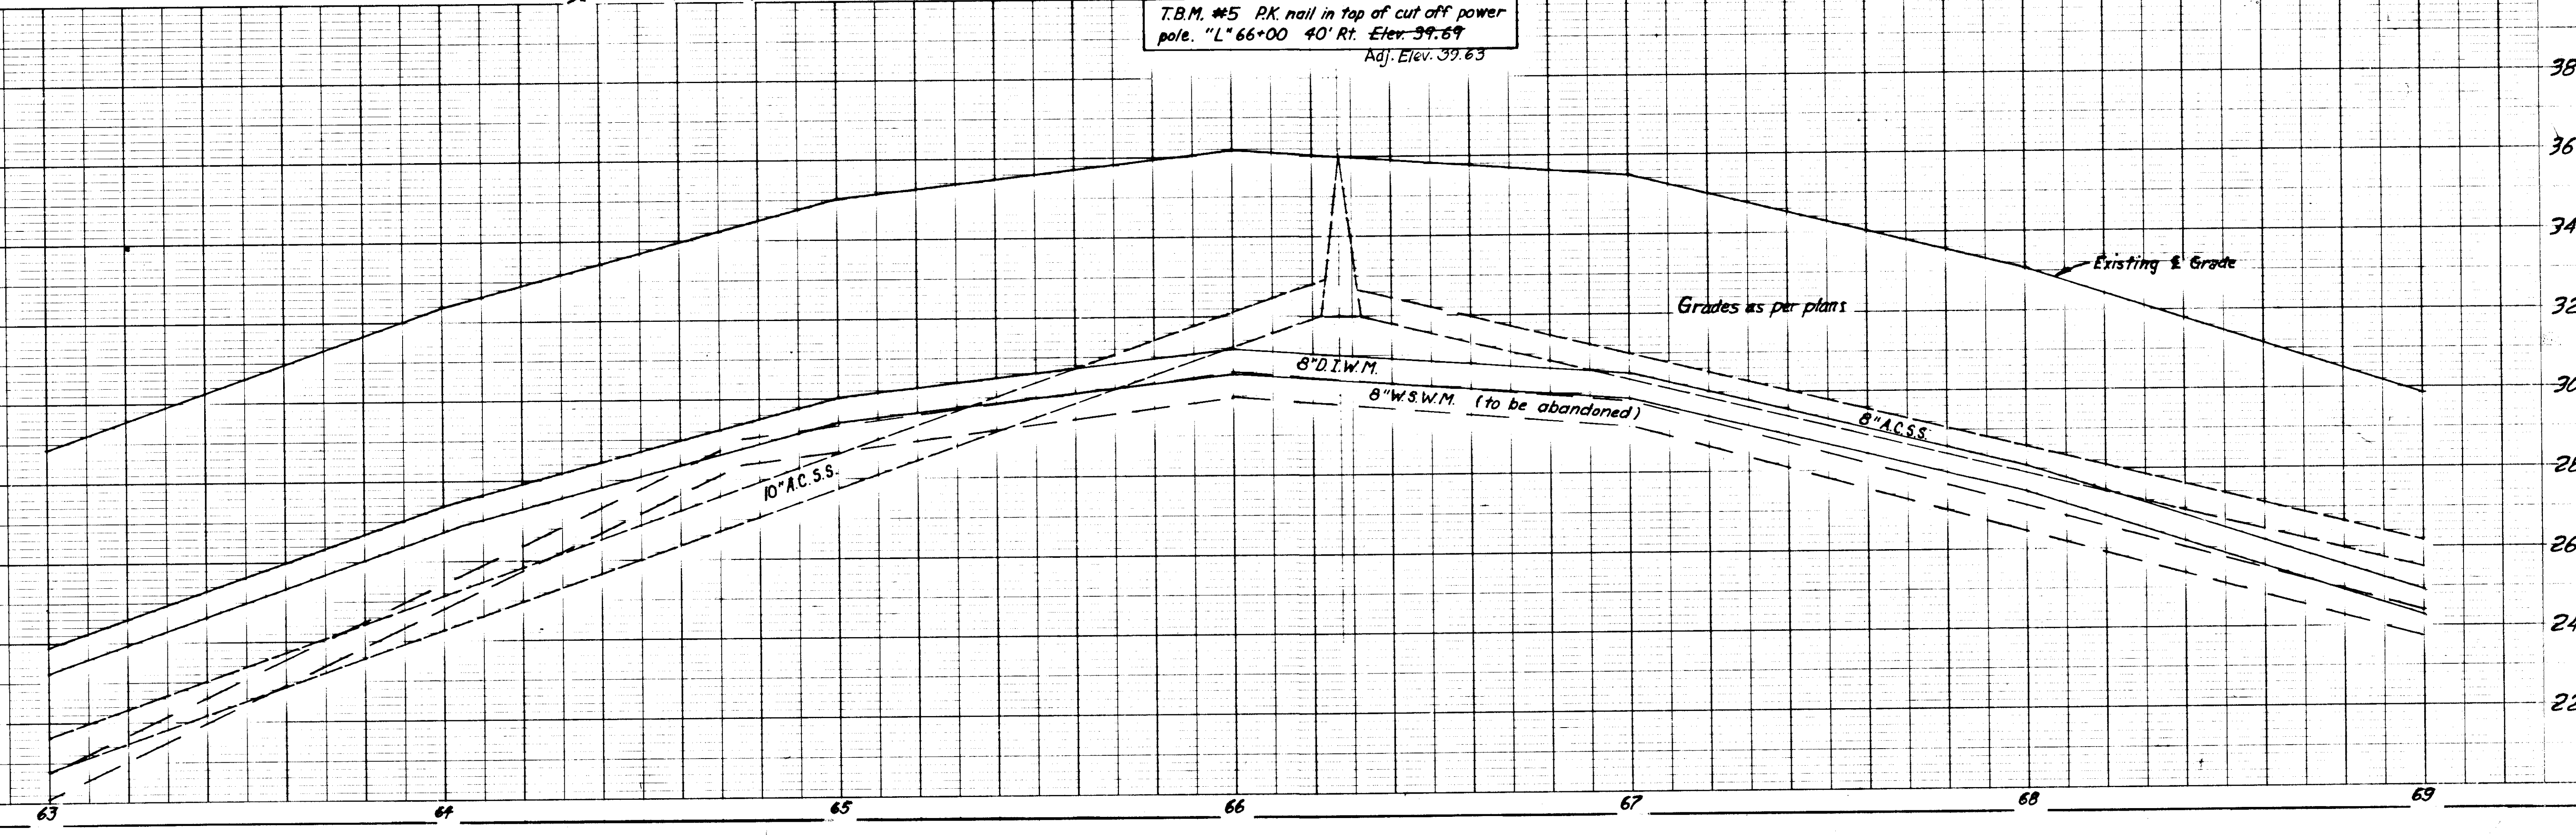


STATE	PROJECT DESIGNATION	YEAR	SHEET NO.	TOTAL SHEETS
ALASKA	RF-099-3(12)	1975	15	28

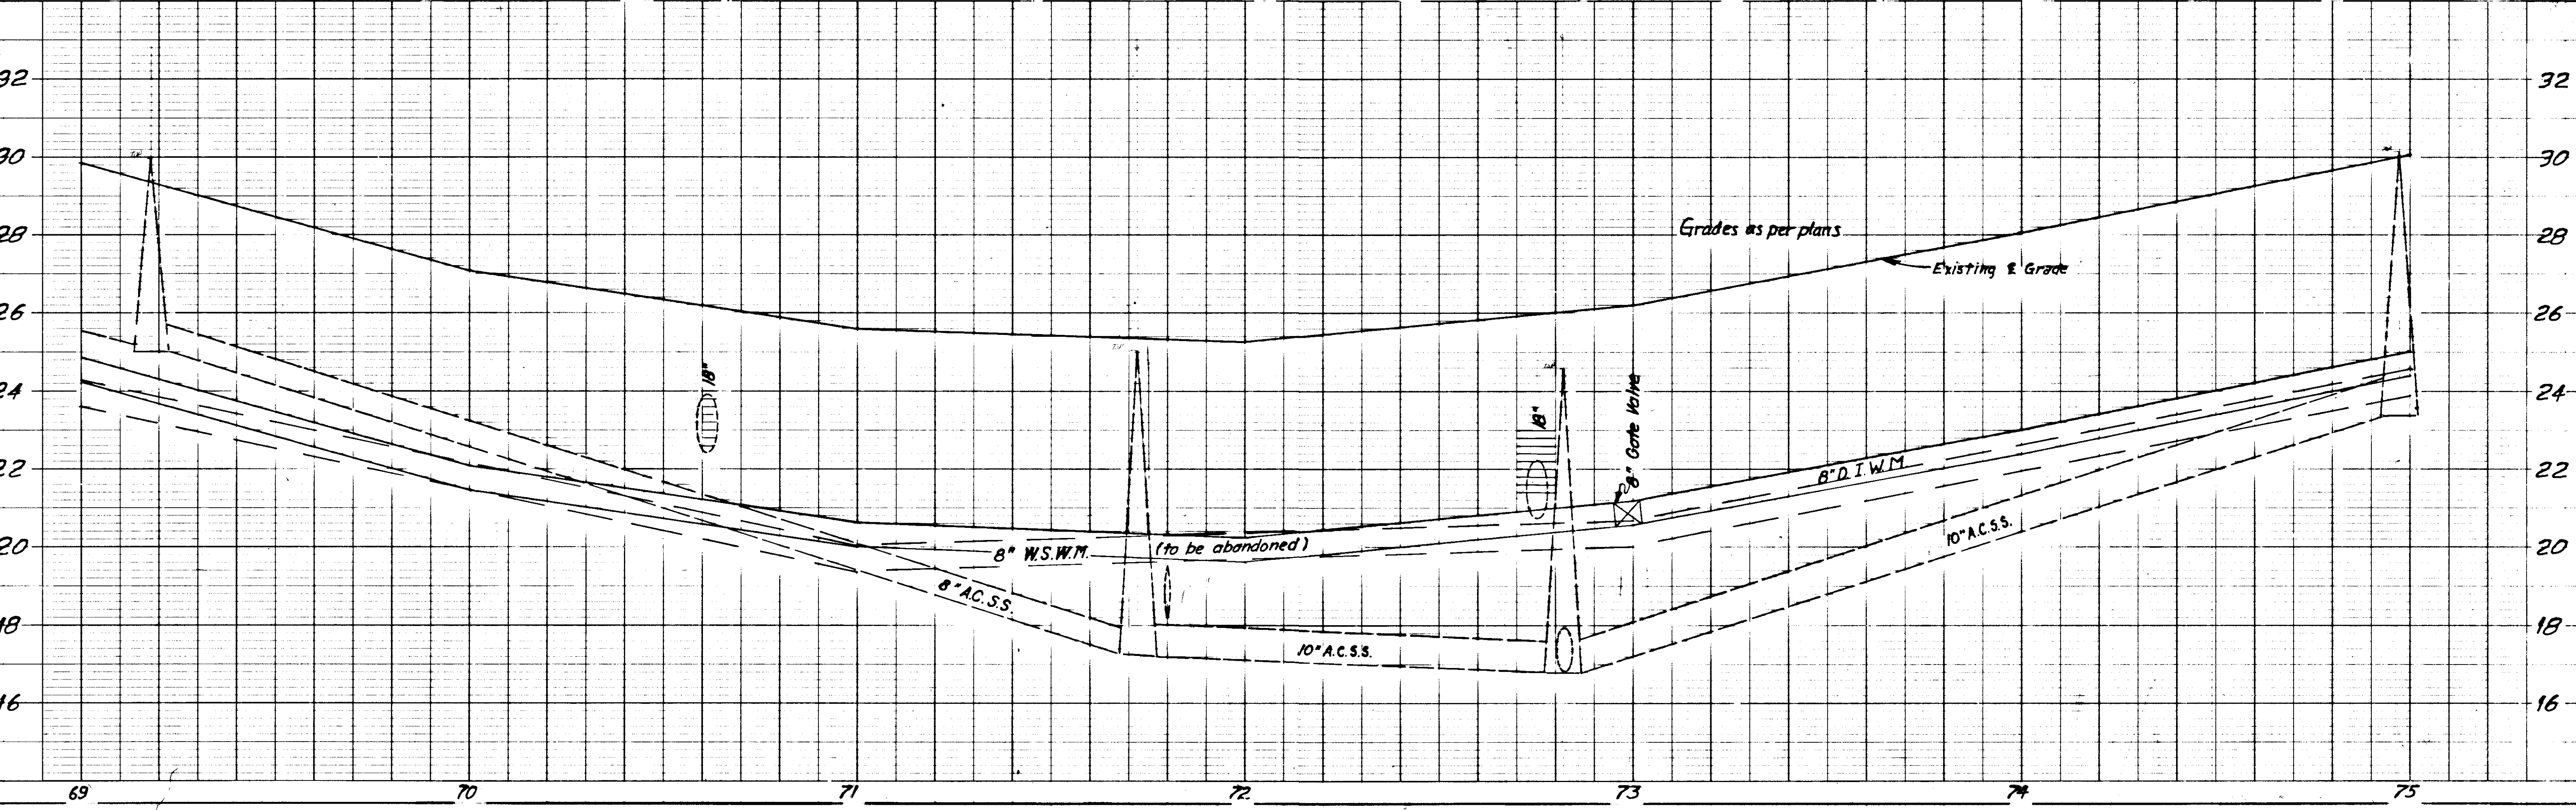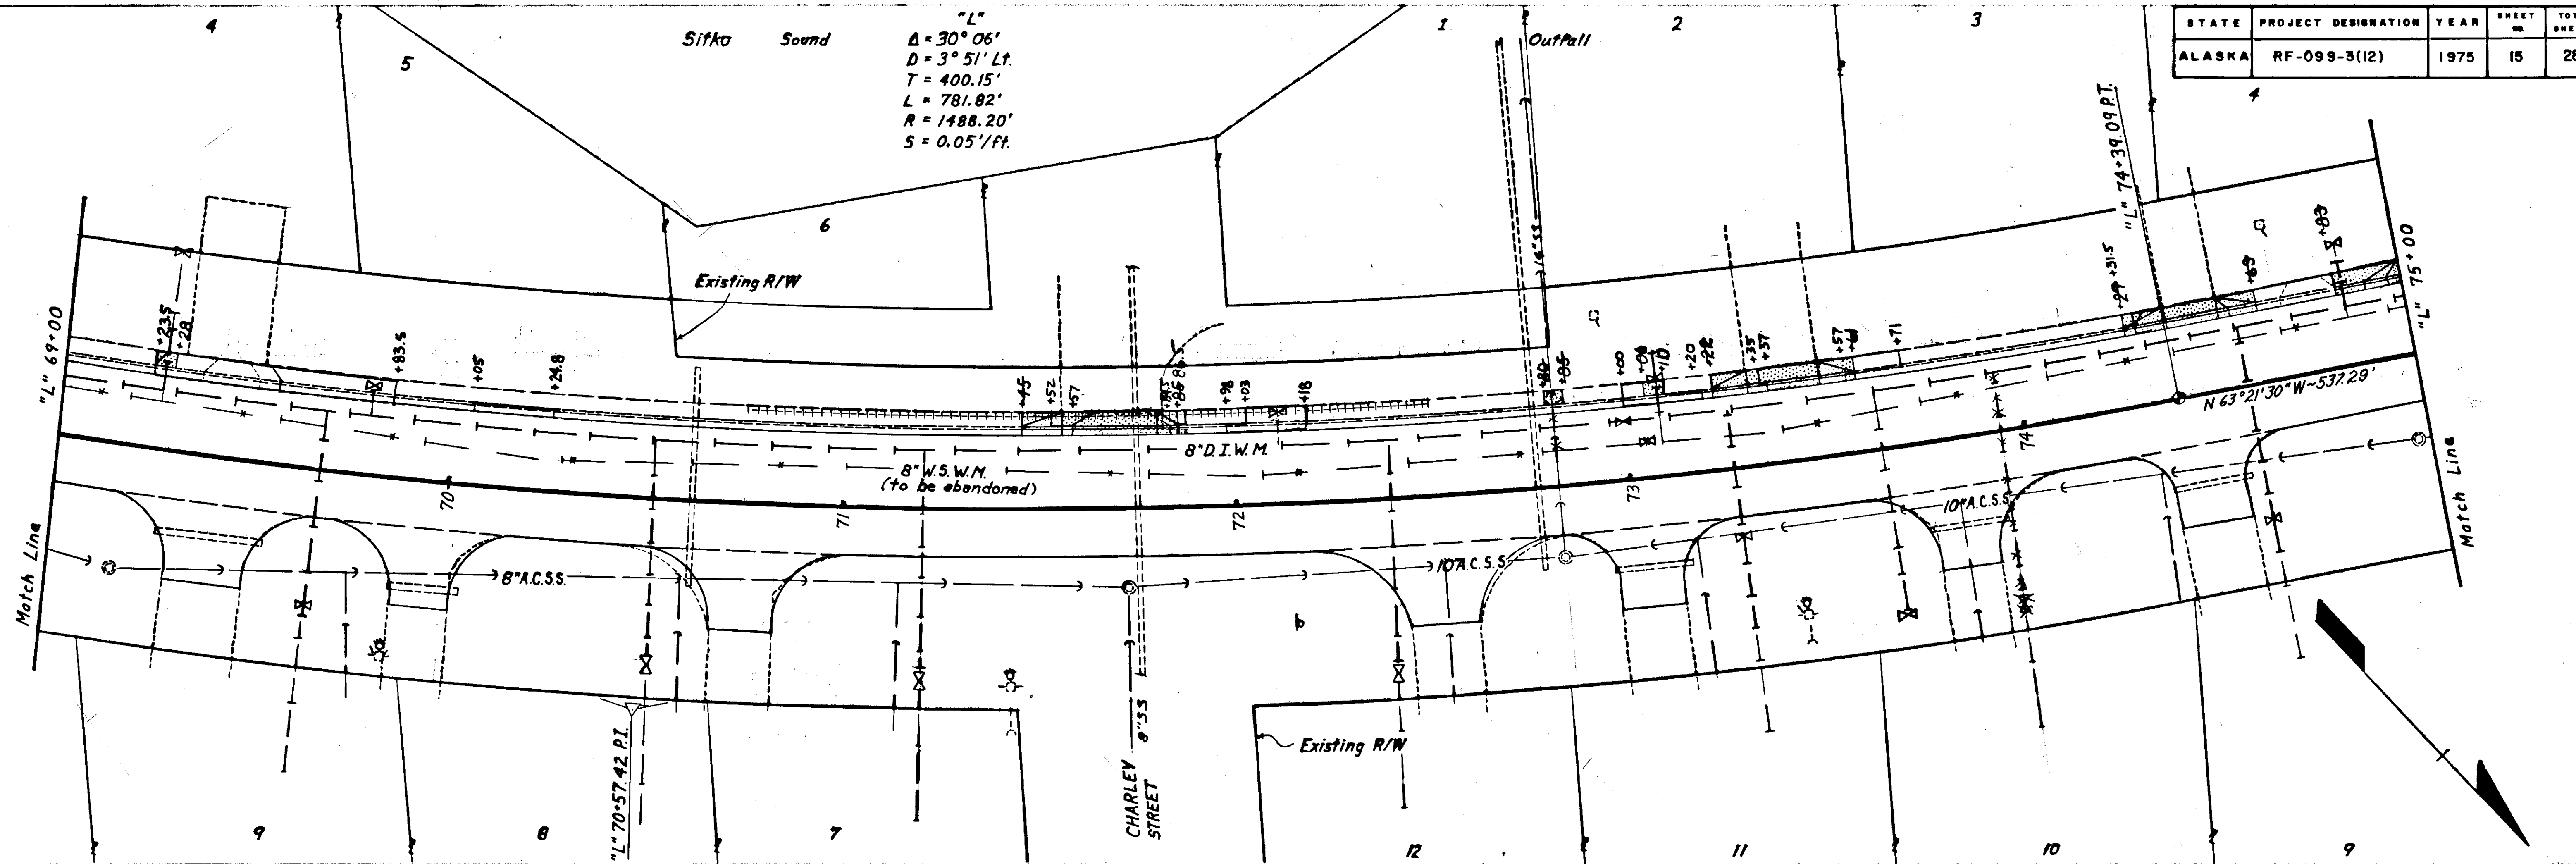



STATE	PROJECT DESIGNATION	YEAR	SHEET NO.	TOTAL SHEETS
ALASKA	RF-099-3(12)	1975	16	28

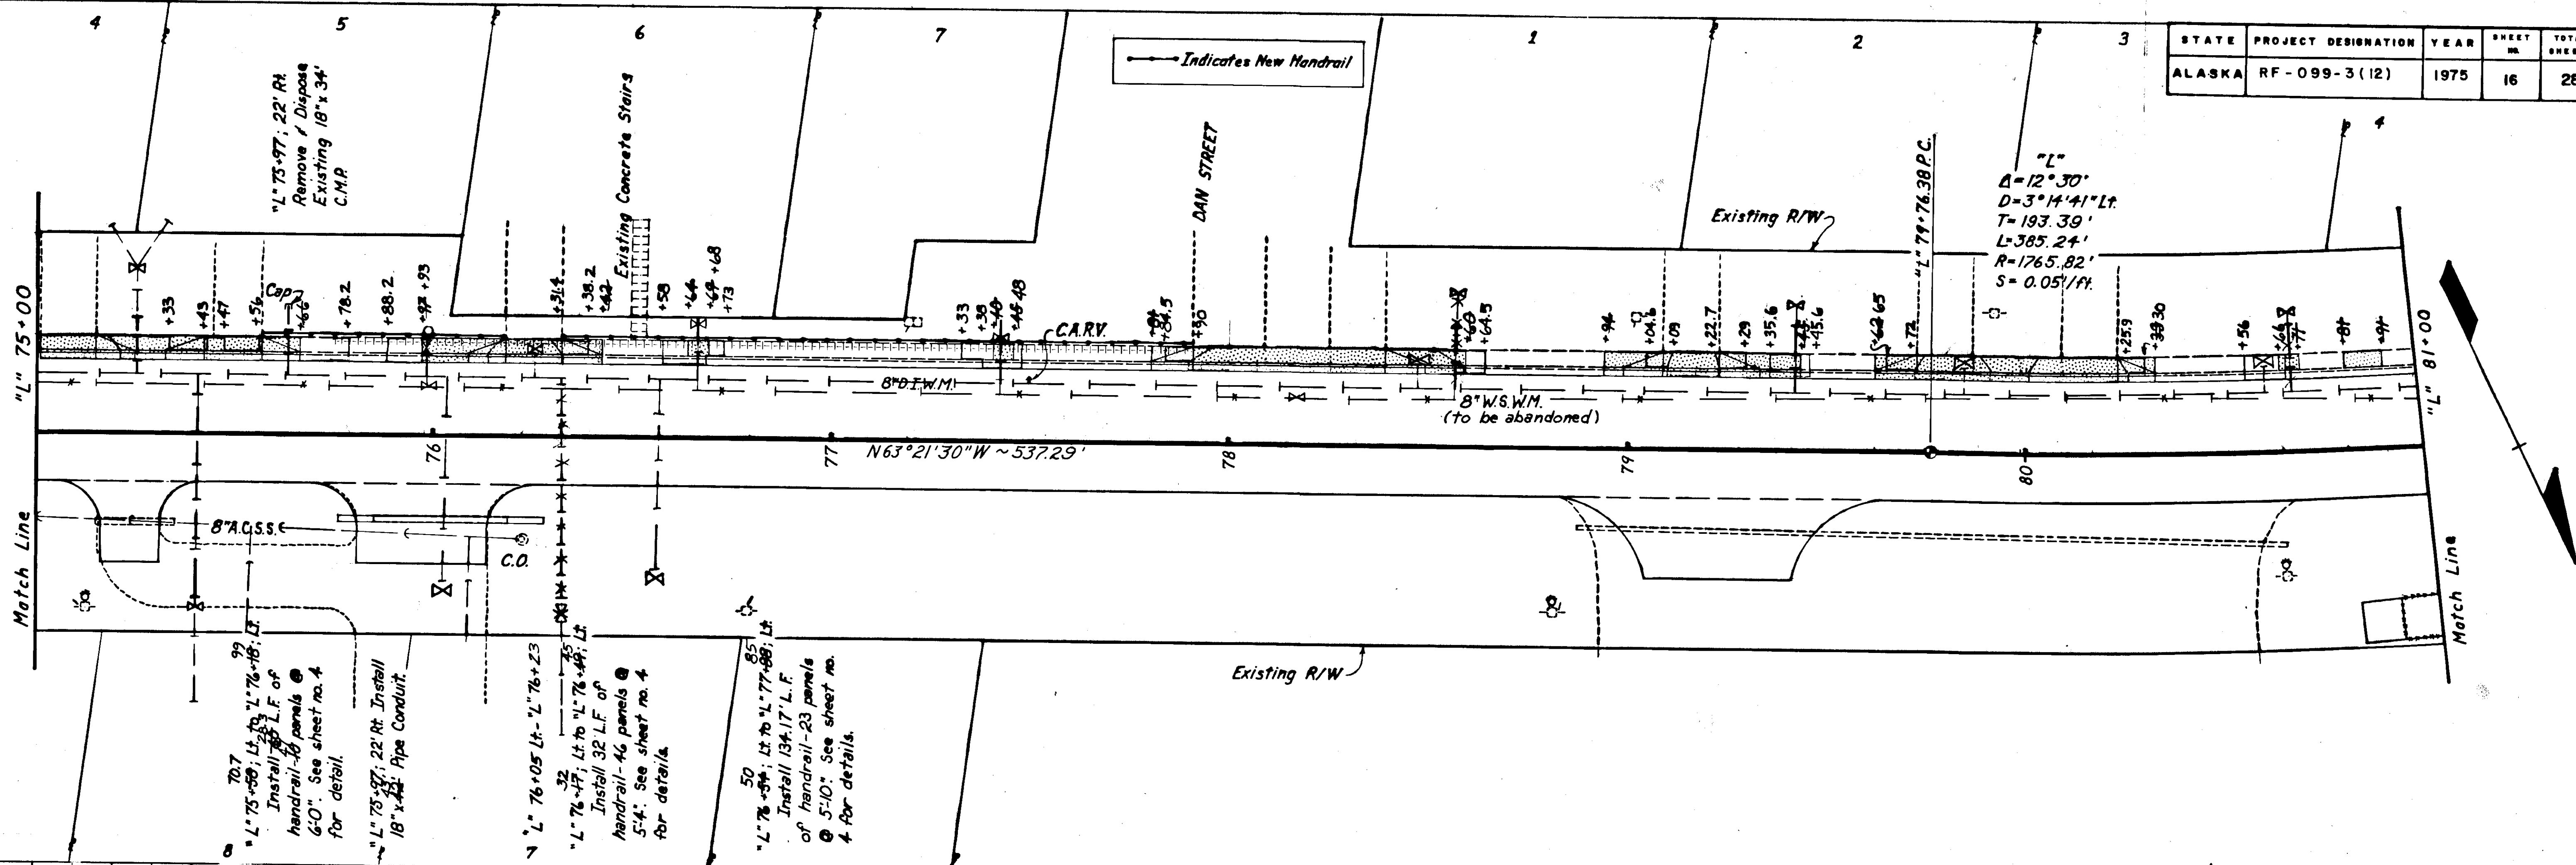



T.B.M. #6 Red mark on rock
 "L" 77+55 35' Rt. Elev. 35.02
 Adj. Elev. 34.96

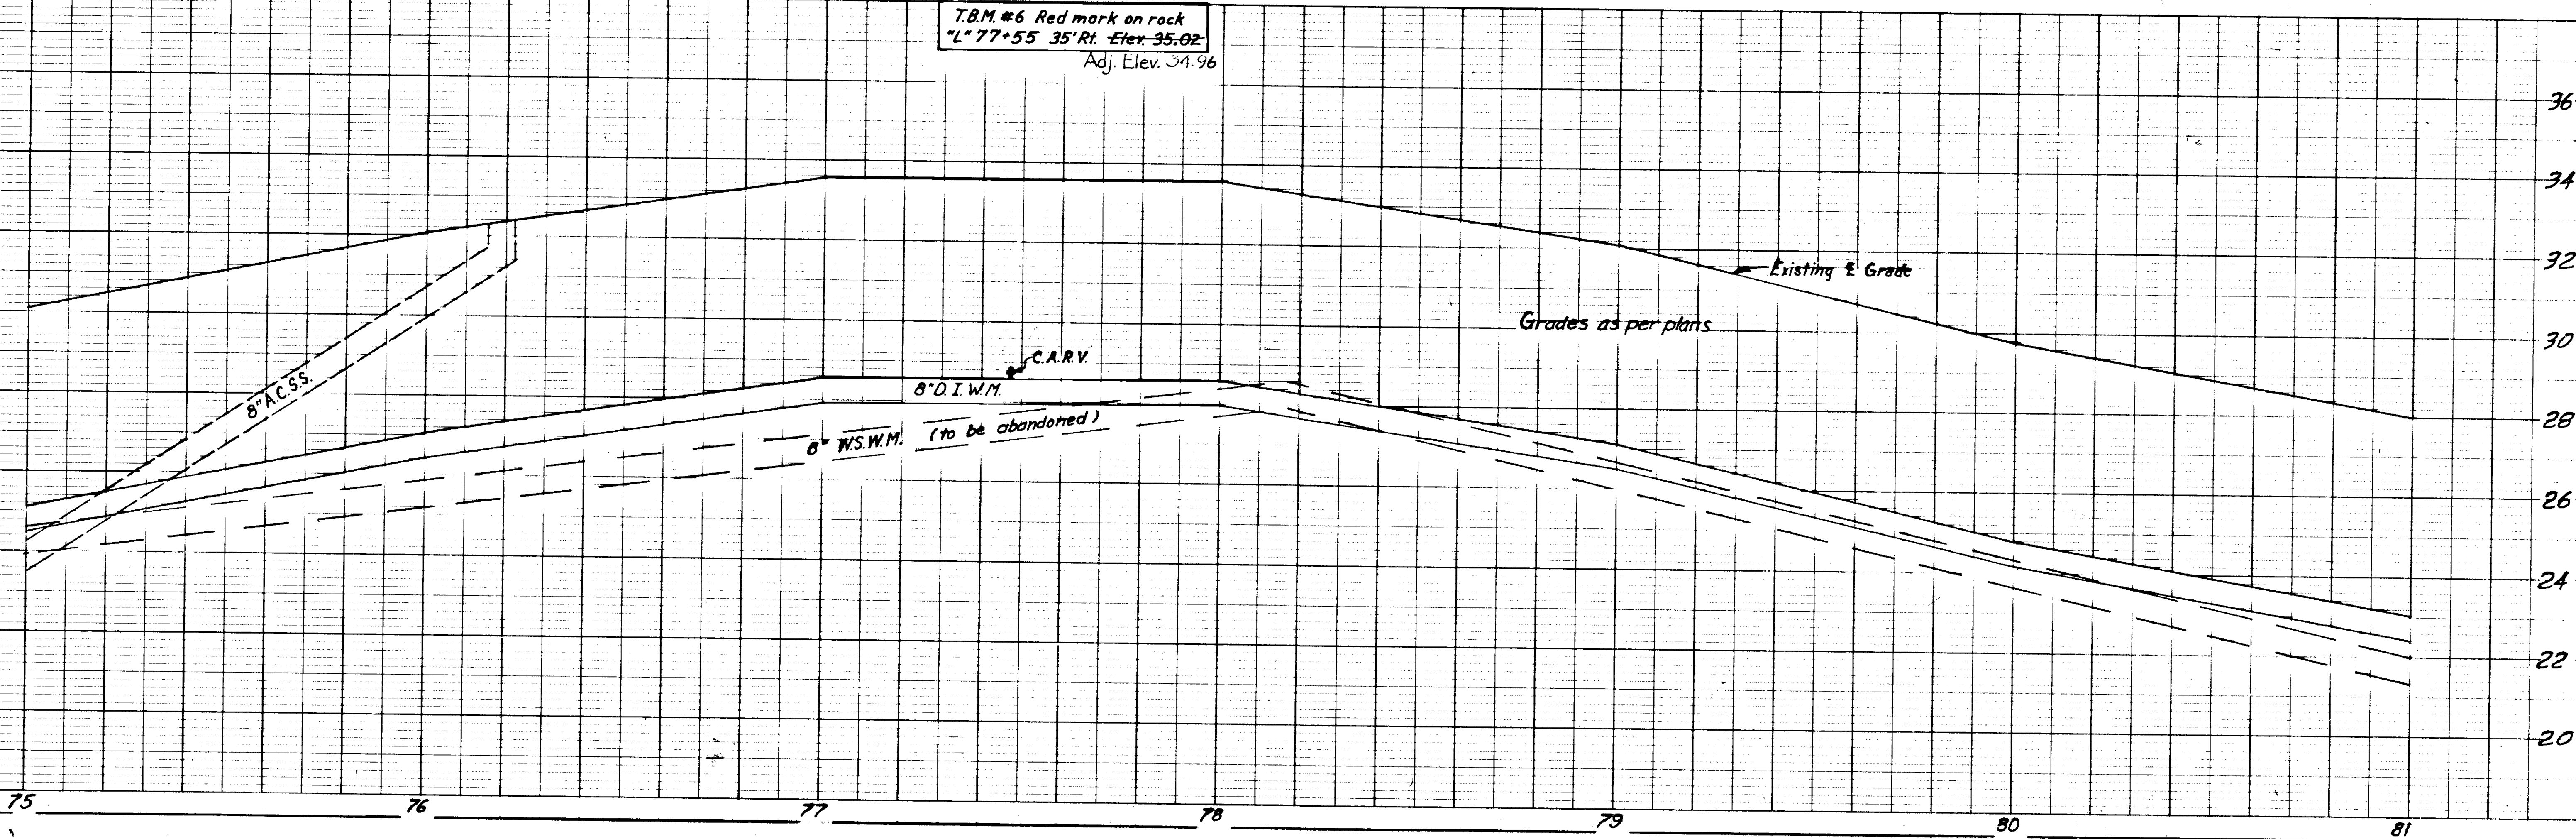


STATE	PROJECT DESIGNATION	YEAR	SHEET NO.	TOTAL SHEETS
ALASKA	RF-099-3(12)	1975	18	28

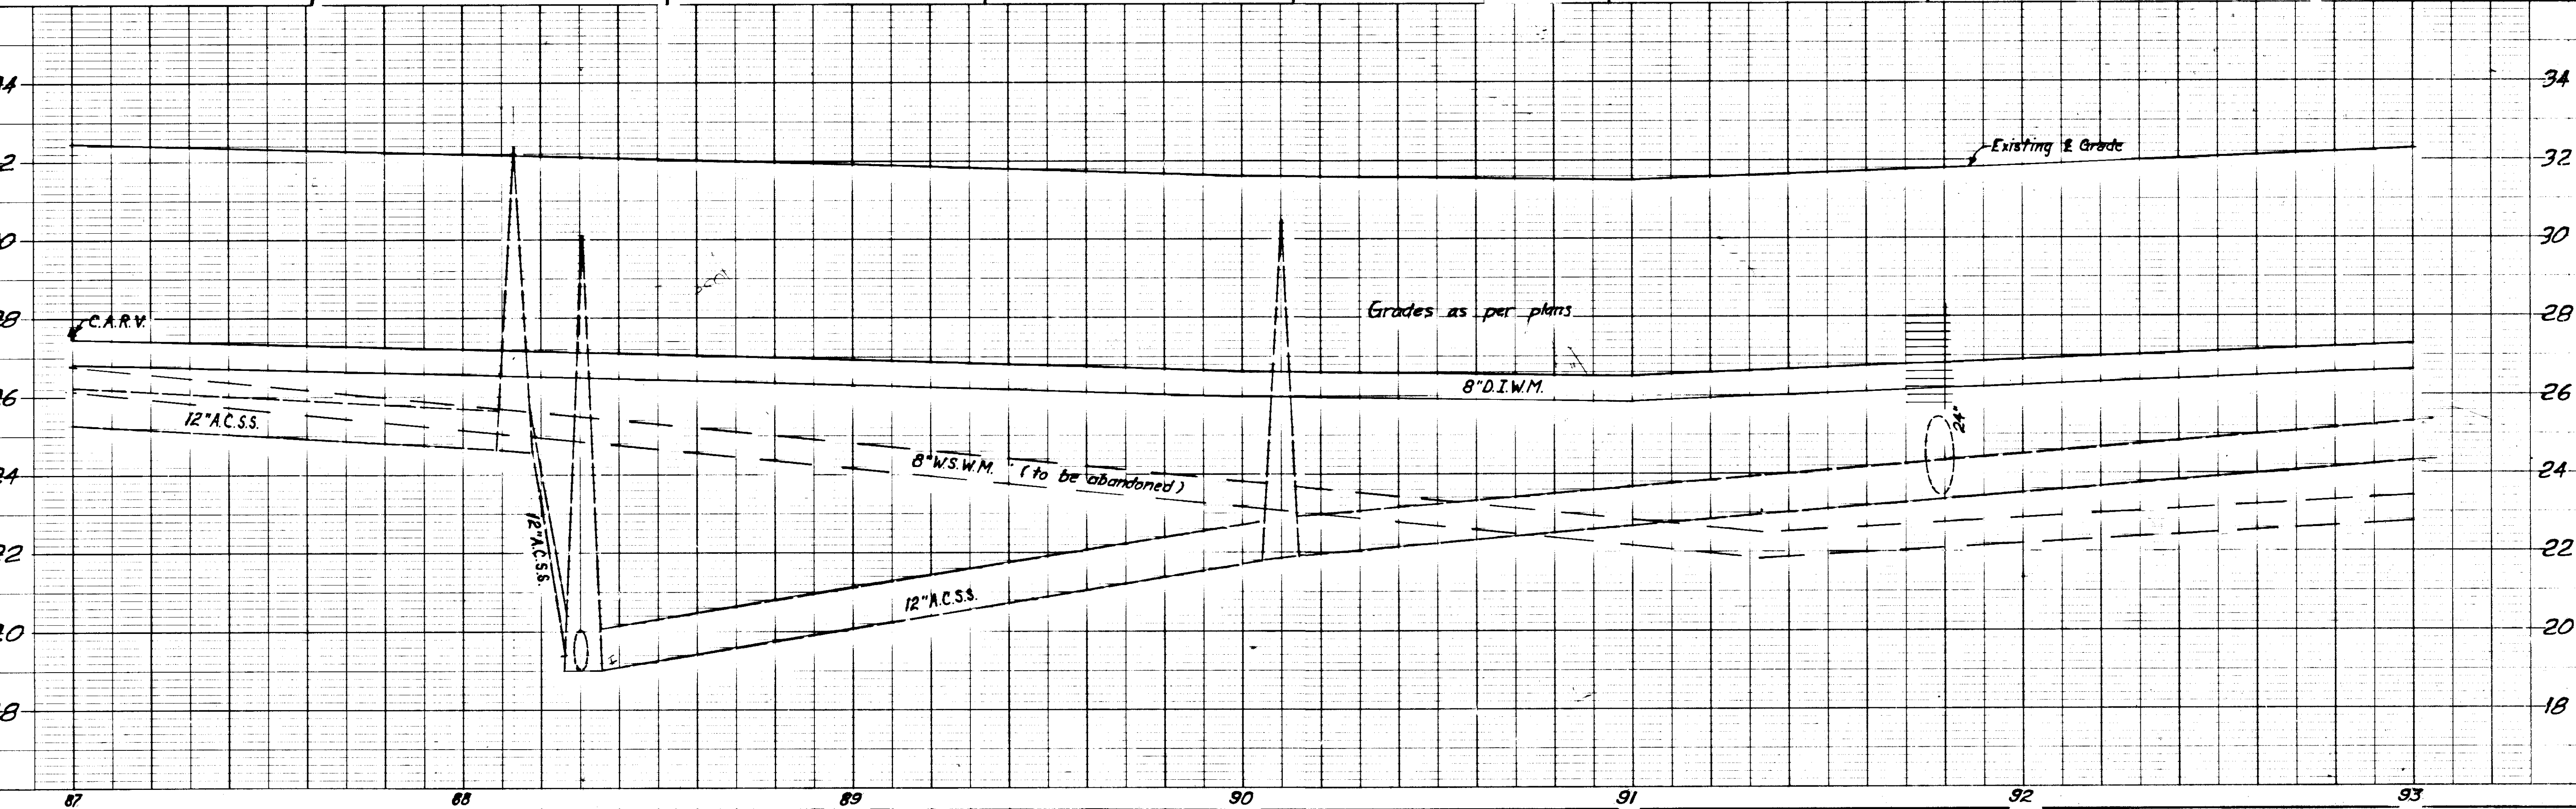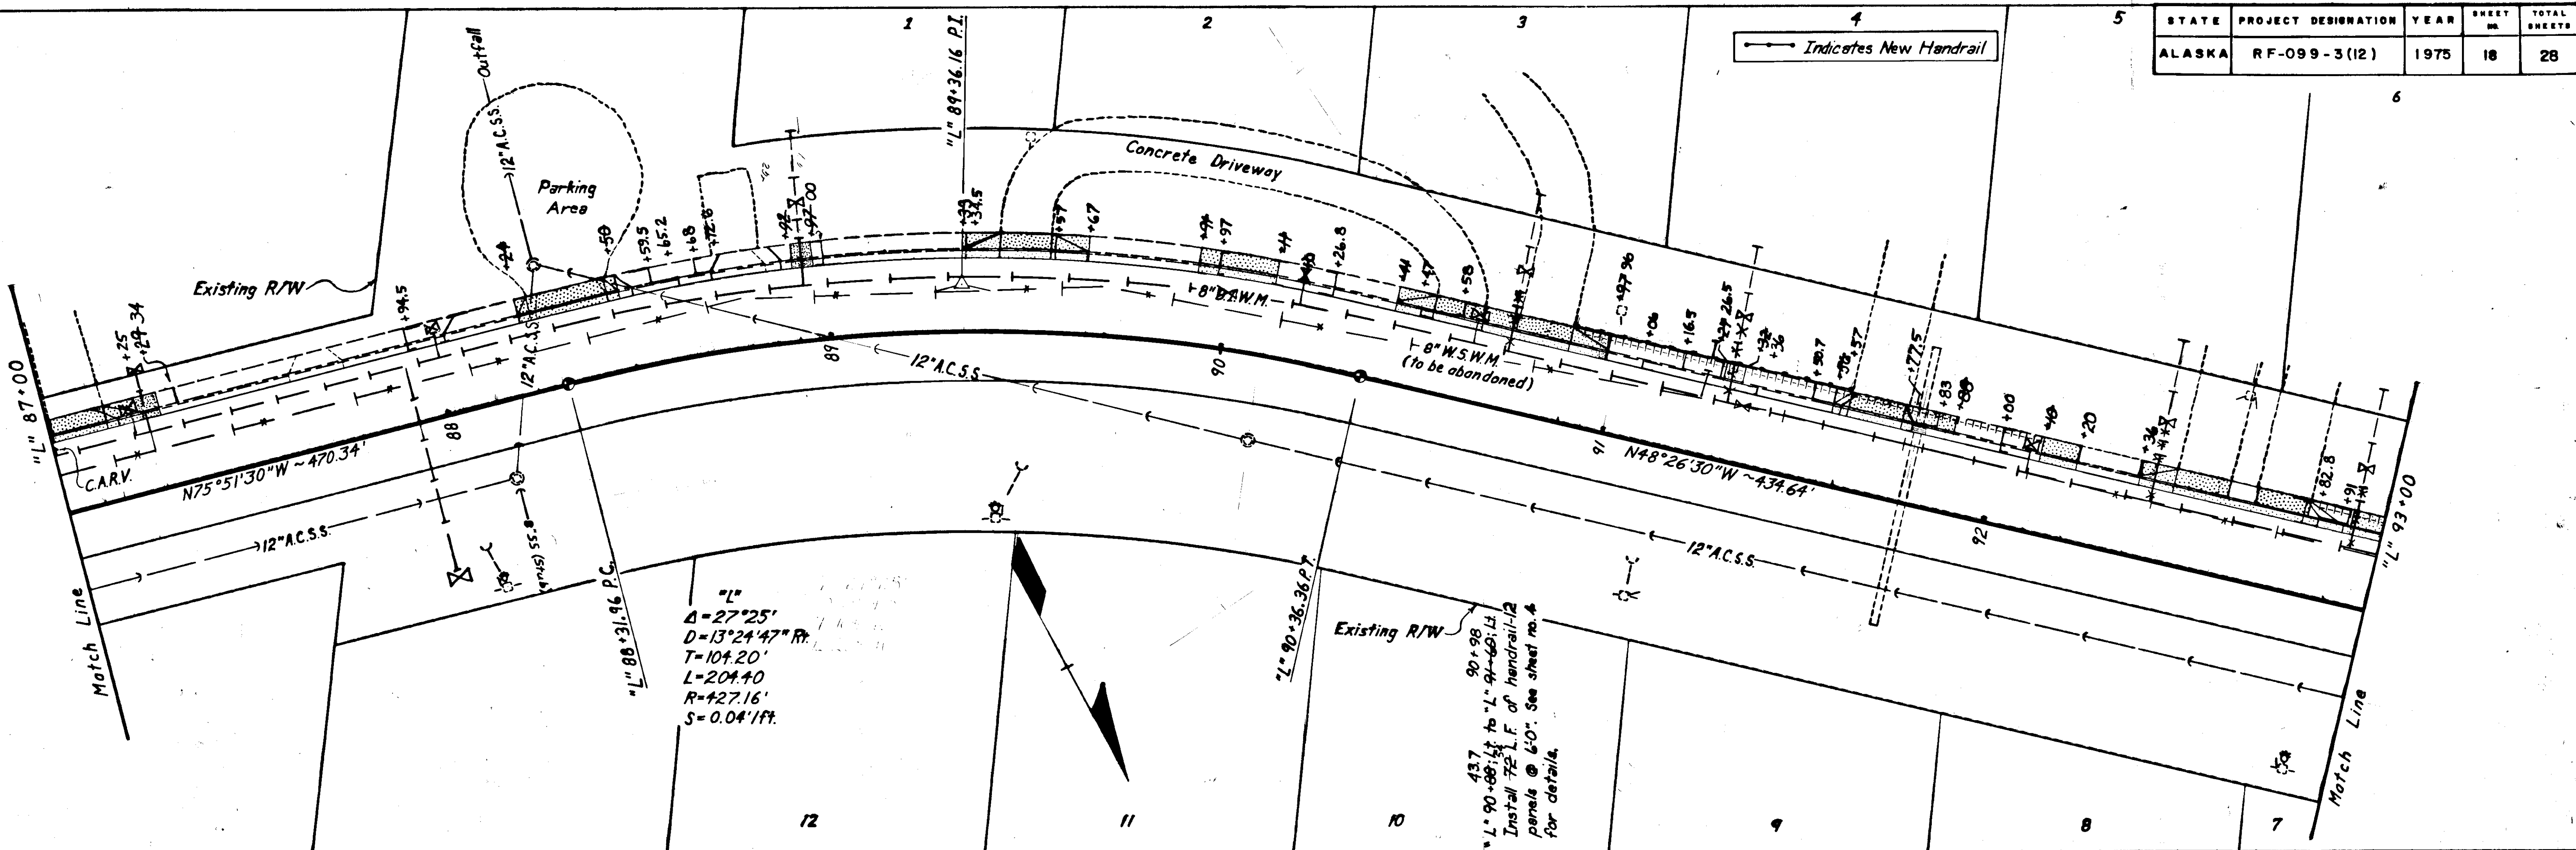


STATE	PROJECT DESIGNATION	YEAR	SHEET NO.	TOTAL SHEETS
ALASKA	RF-099-3(12)	1975	20	28

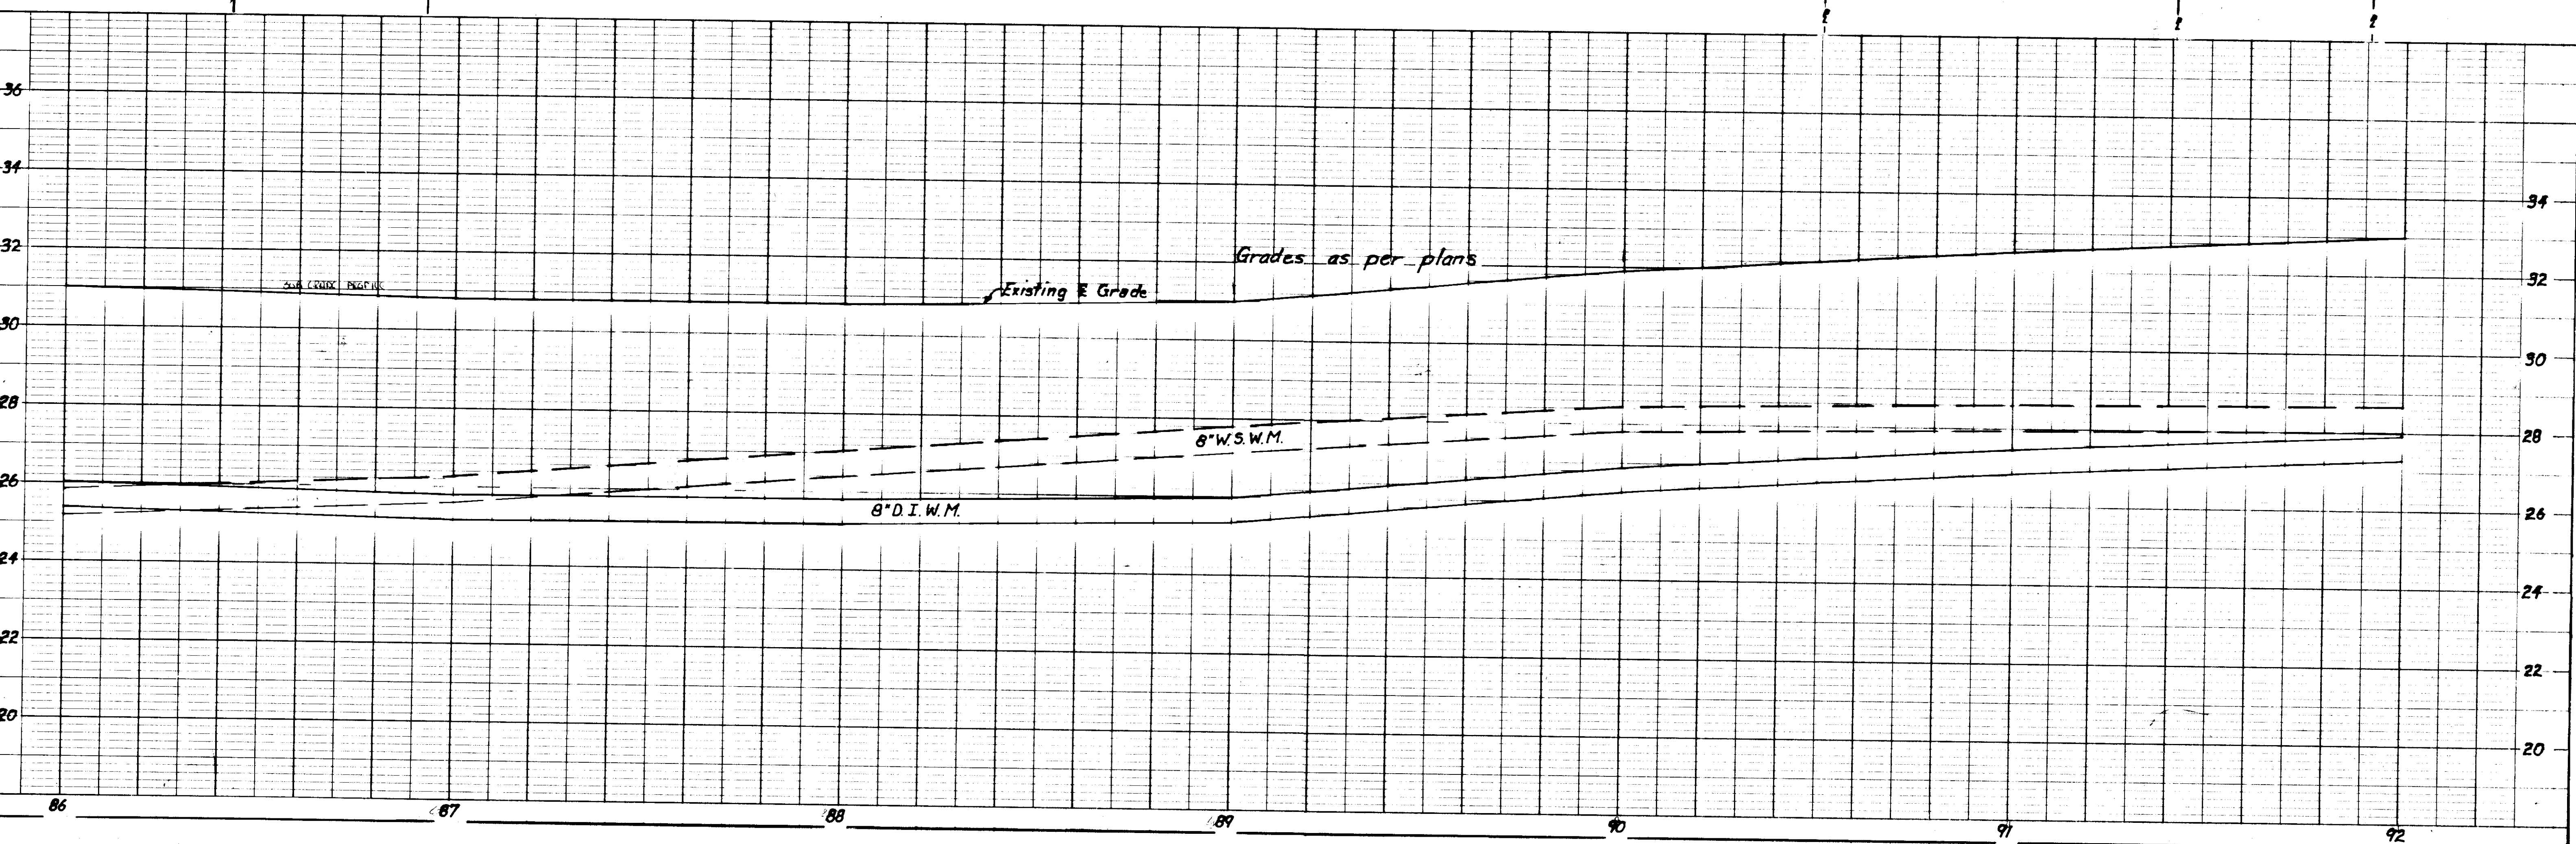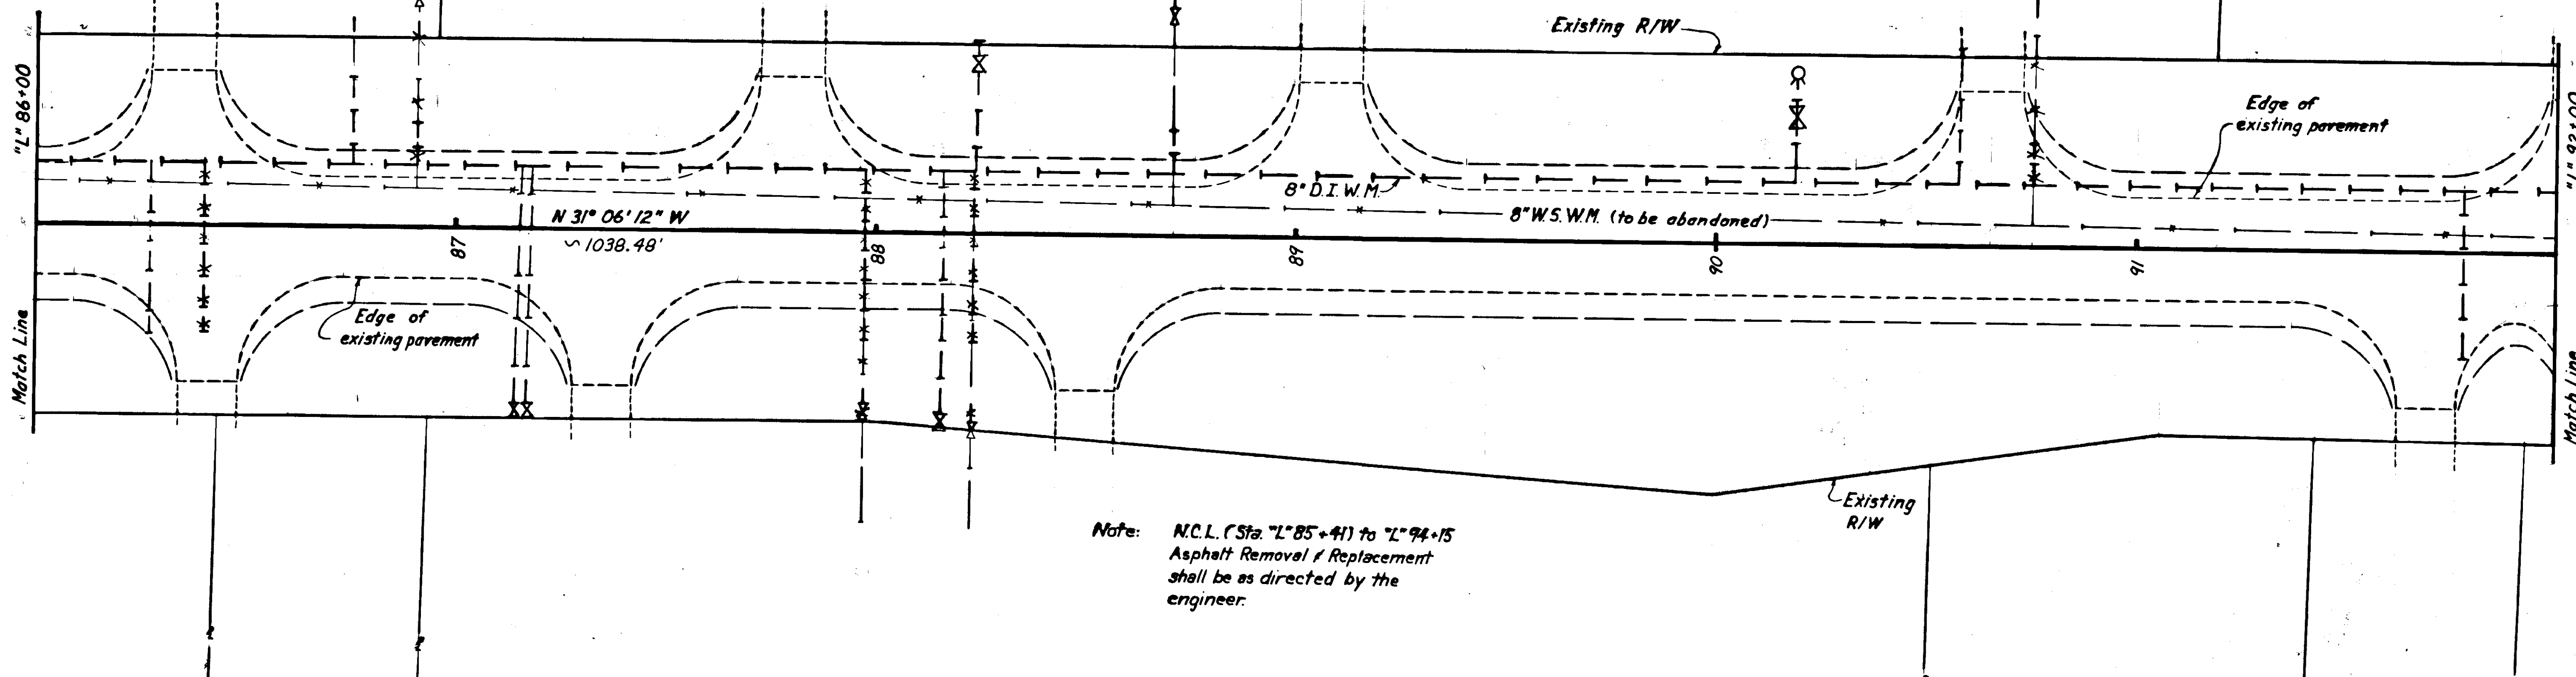

STATE	PROJECT DESIGNATION	YEAR	SHEET NO.	TOTAL SHEETS
ALASKA	RF-099-3(12)	1975	21	28

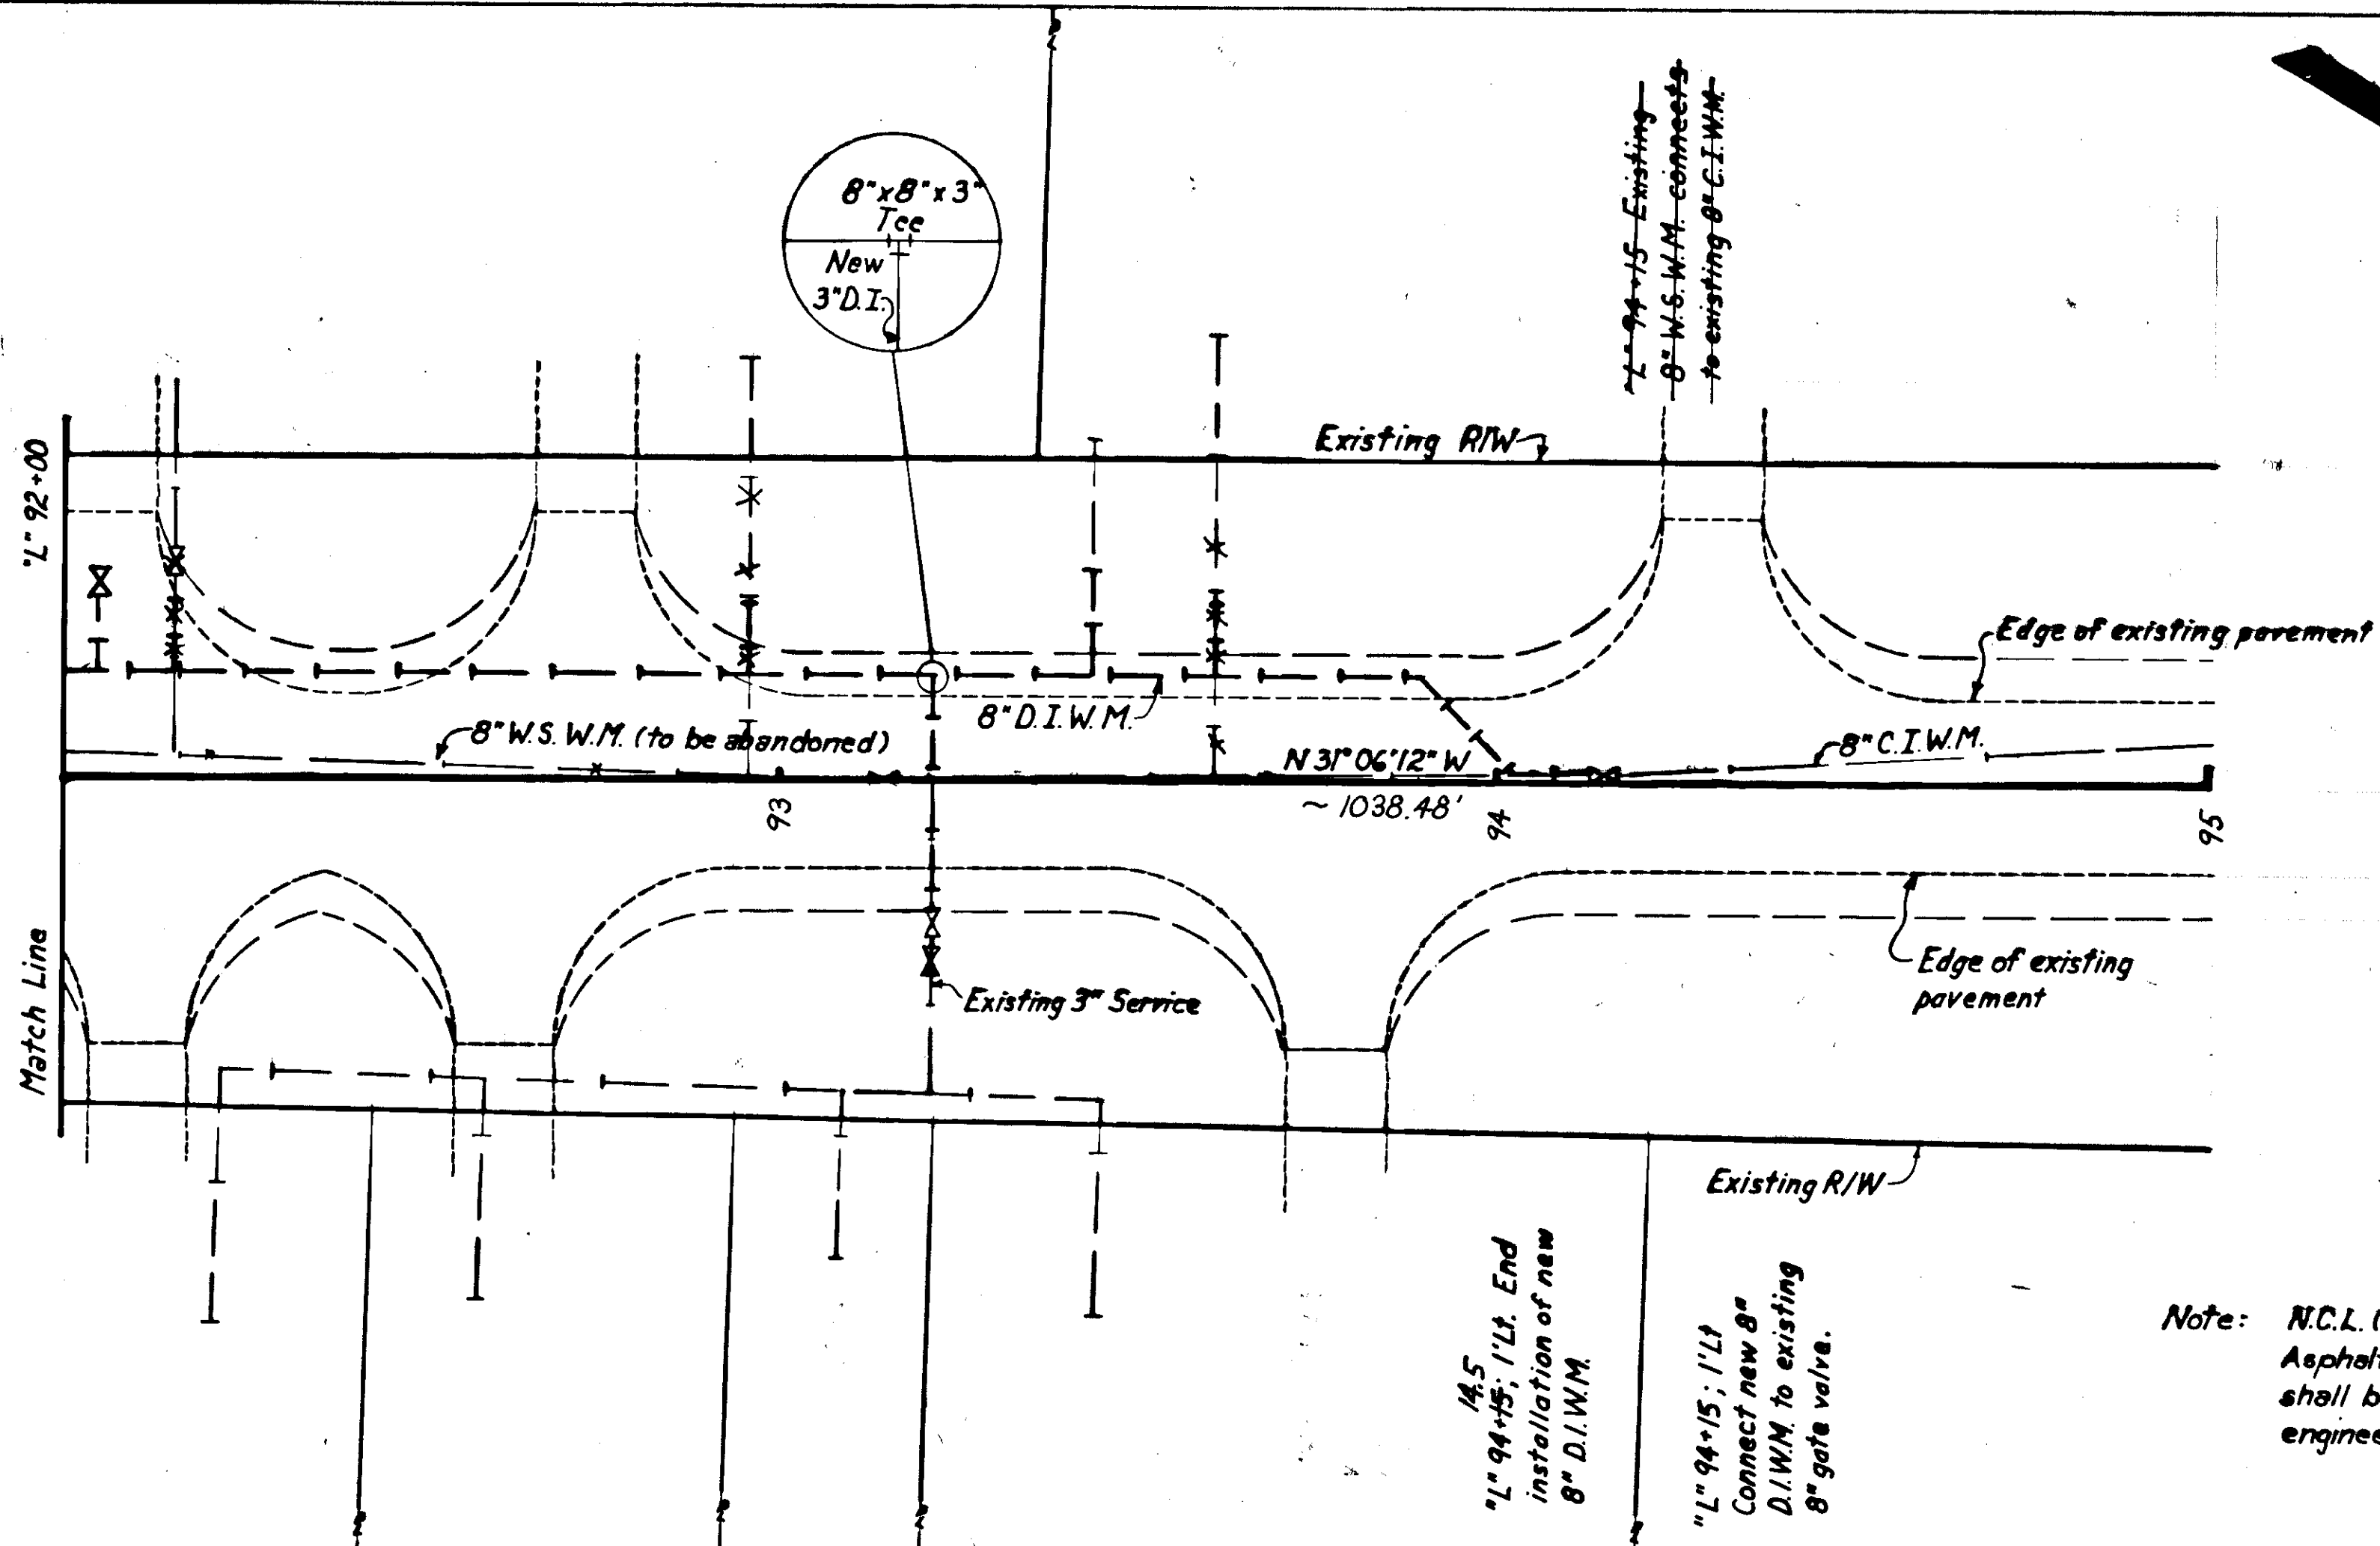


Note: N.C.L. (Sta. "L" 85+41) to "L" 94+15
 Asphalt Removal & Replacement
 shall be as directed by the
 engineer.

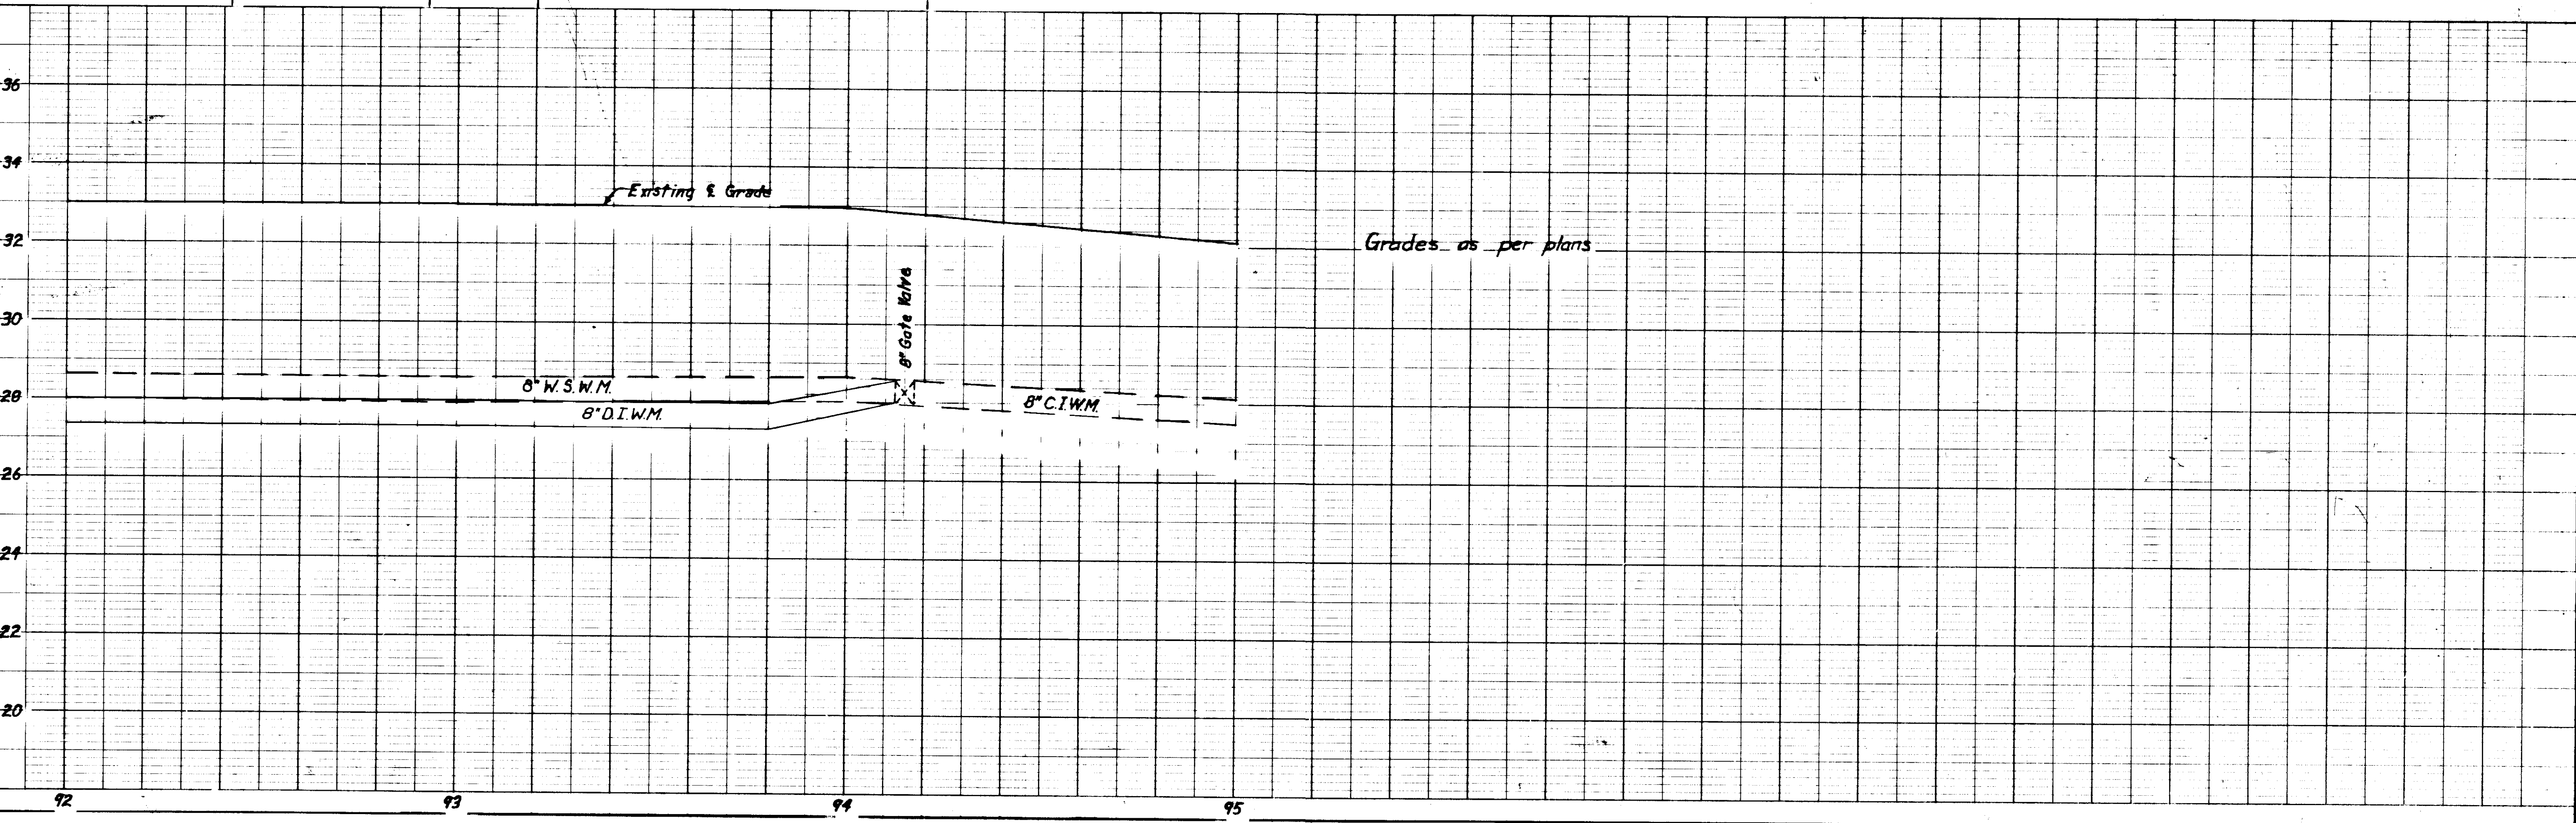


Grades as per plans


STATE	PROJECT DESIGNATION	YEAR	SHEET NO.	TOTAL SHEETS
ALASKA	OS-3-(001)	1975	23	28

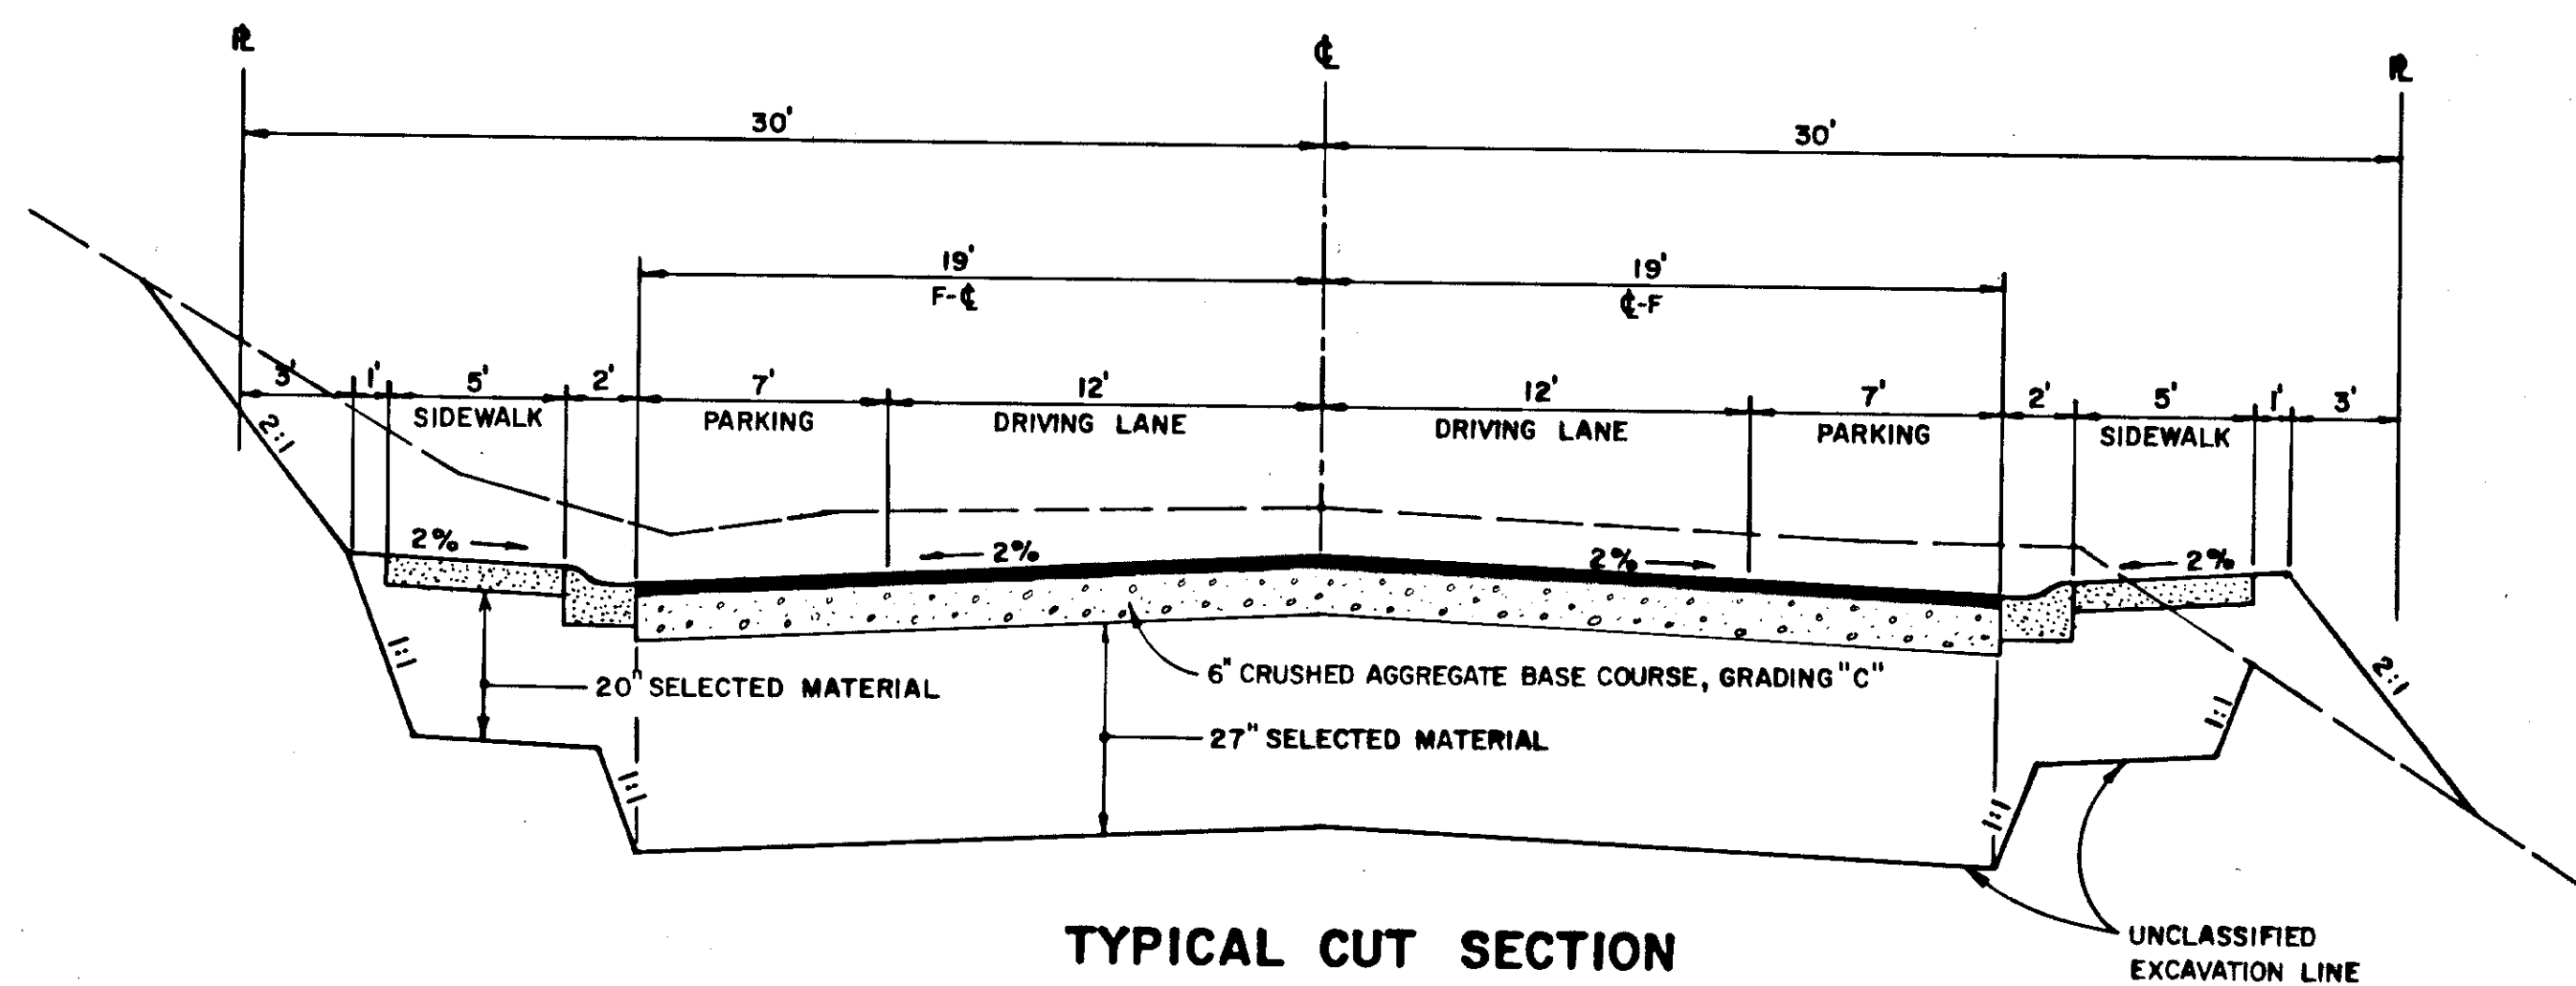

**TYPICAL CUT SECTION
BRADY, GAVAN AND CASCADE STREETS**

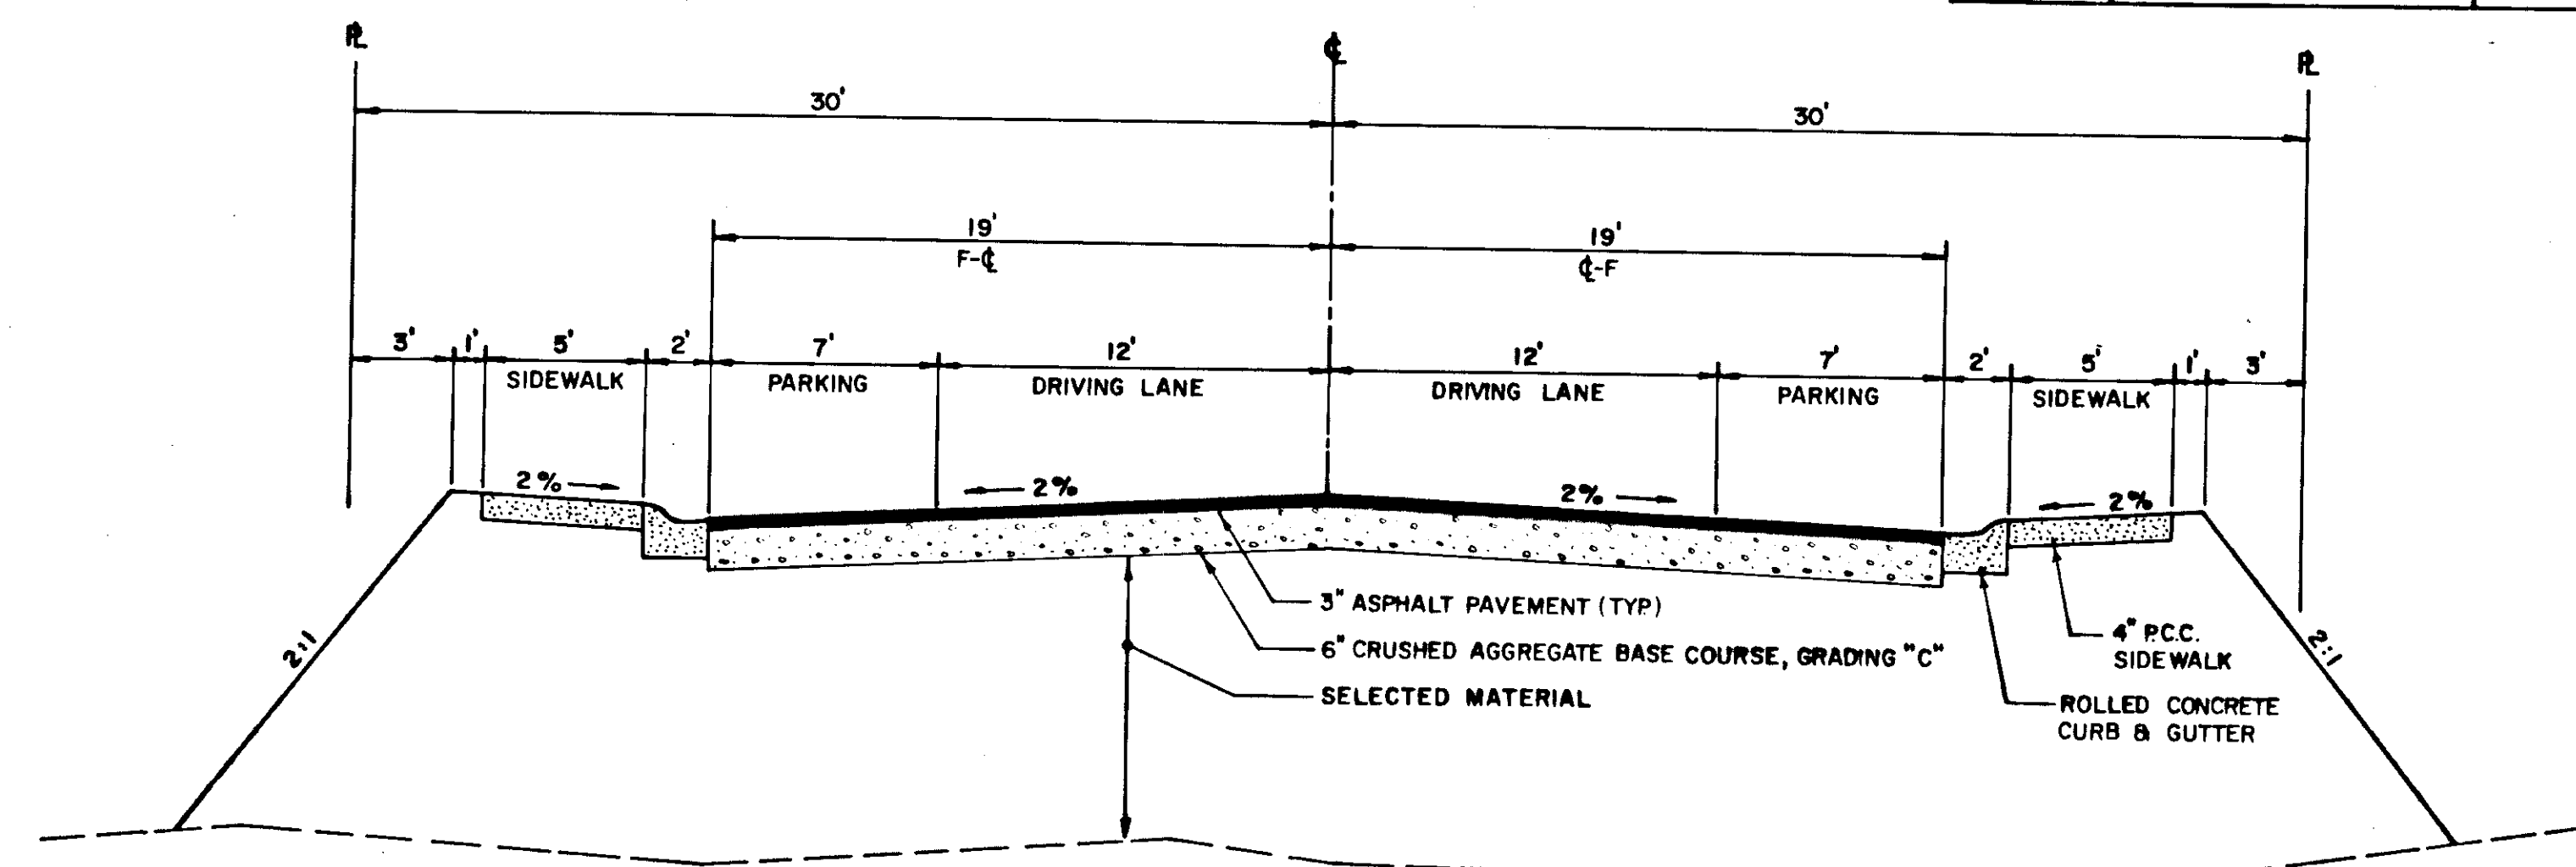

**TYPICAL FILL SECTION
BRADY, GAVAN AND CASCADE STREETS**

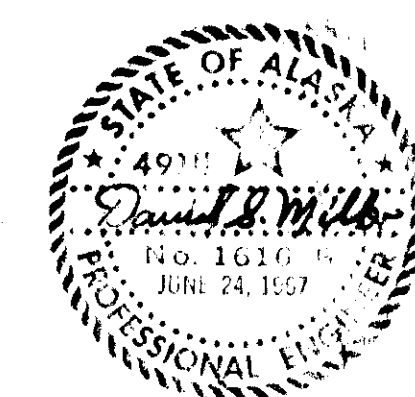


FIELD BOOKS		DESIGNED M.B.	
DESIGN A-283	A-284	DRAWN L.N.S.	
A-285	A-286	CHECKED R.L.C./M.B.	
STARTING		DATE	APPRO. DATE
AS BUILT			

**TRYCK
NYMAN**

**CITY AND BOROUGH OF SITKA
STREET IMPROVEMENTS**

SHEET
2 OF **18**



STATE	PROJECT DESIGNATION	YEAR	SHEET NO.	TOTAL SHEETS
ALASKA	OS-3-(001)	1975	24	28

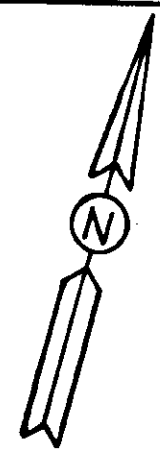

NOTES:

- (1) ADJUST SEWER MANHOLES, CLEANOUTS & WATER VALVES TO FINISH GRADE.
- (2) CRUSHED BASE THICKNESS VARIES. MATCH NEW & EXISTING GRADES AS SHOWN.
- (3) POWER POLE TO BE RELOCATED BY OTHERS.
- (4) REMOVE EXISTING CATCH BASIN.
- (5) REMOVE EXISTING CONC. DRIVEWAY AND RECONSTRUCT TO MATCH NEW SIDEWALK.
- (10) REMOVE & REPLACE FENCE TO PROPERTY LINE.
- (11) RELOCATE FIRE HYDRANT.

NOTE: BACK OF CURB RADIUS AT STREET INTERSECTIONS IS 15', EXCEPT AS NOTED.

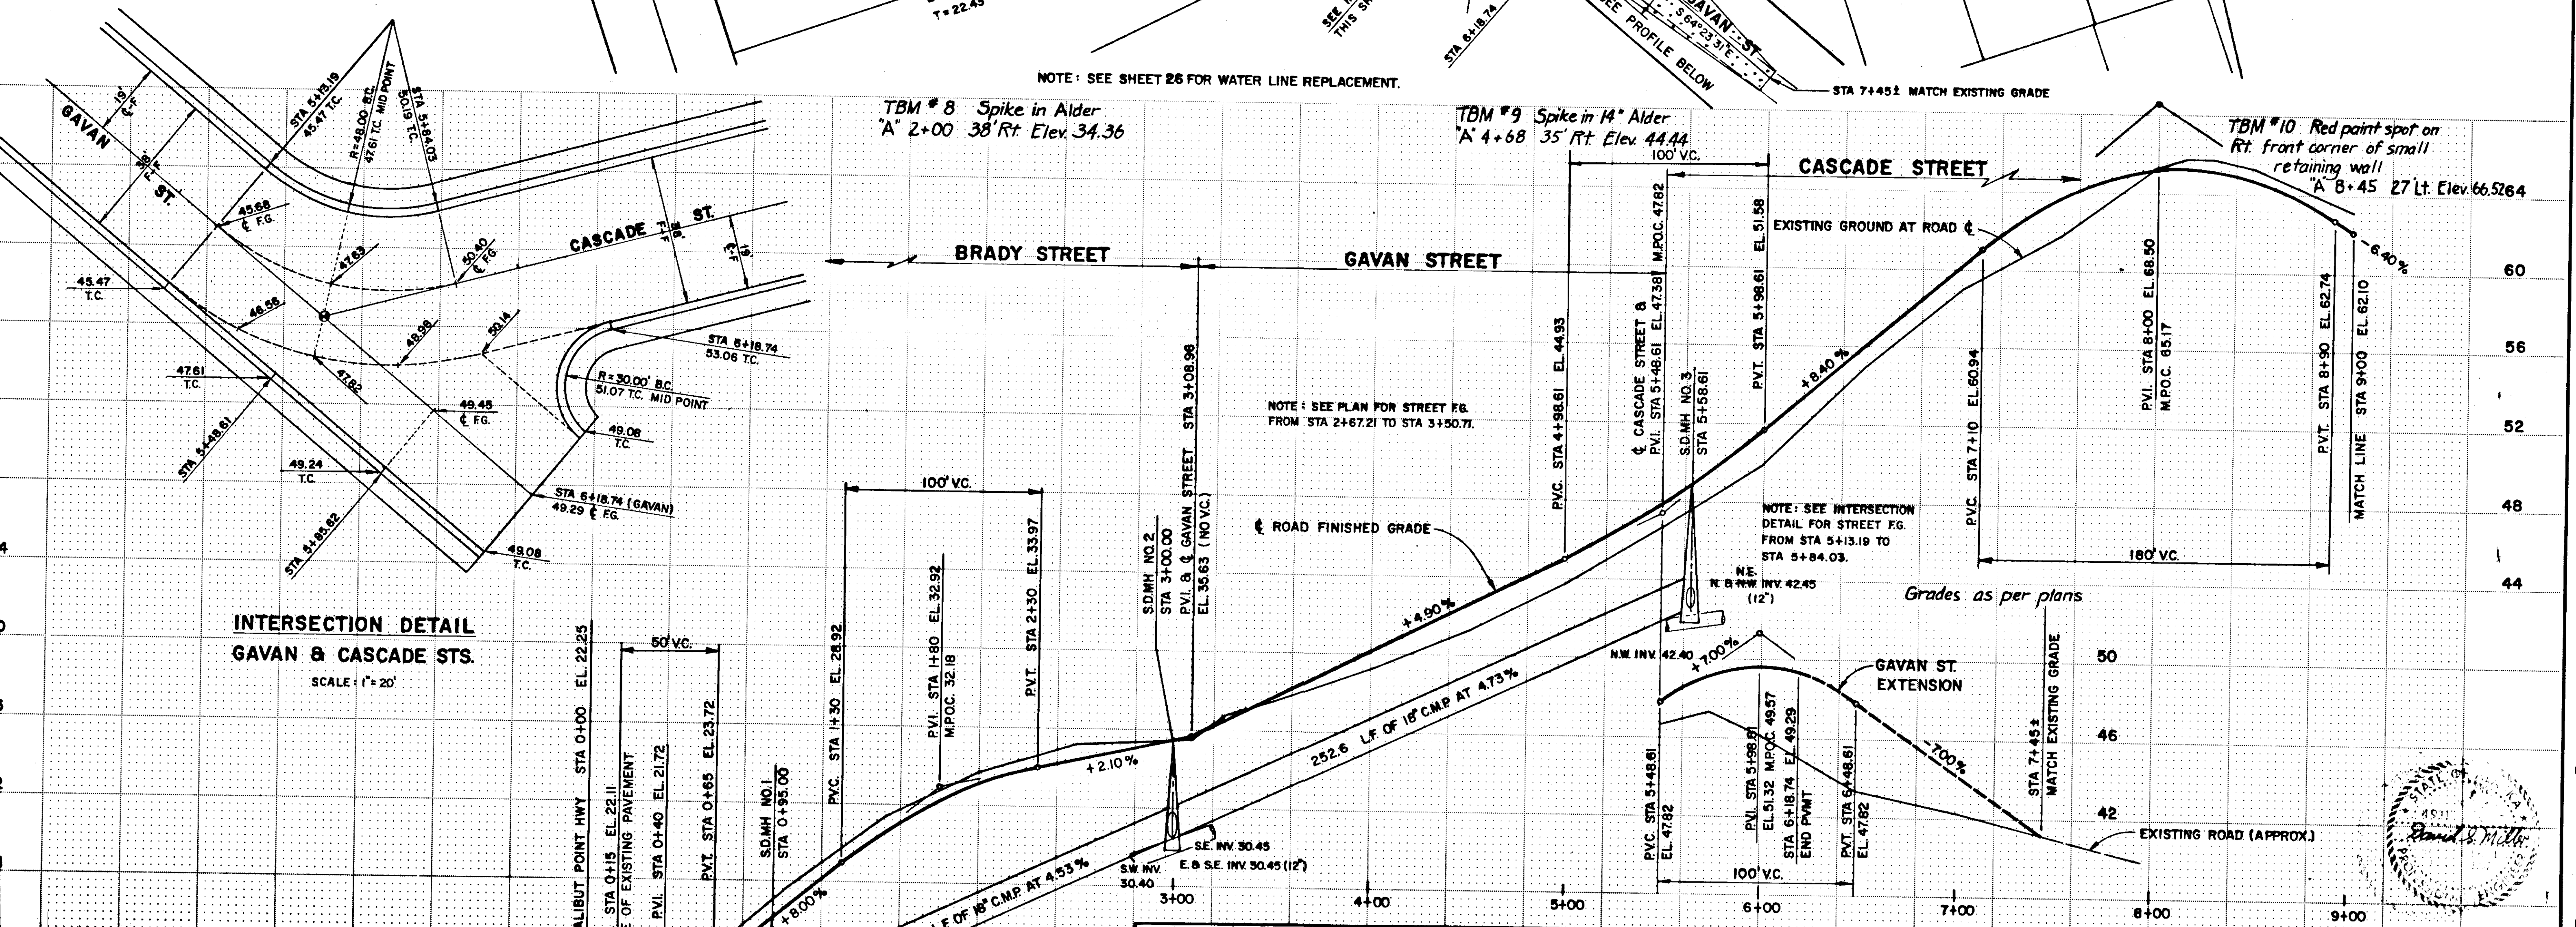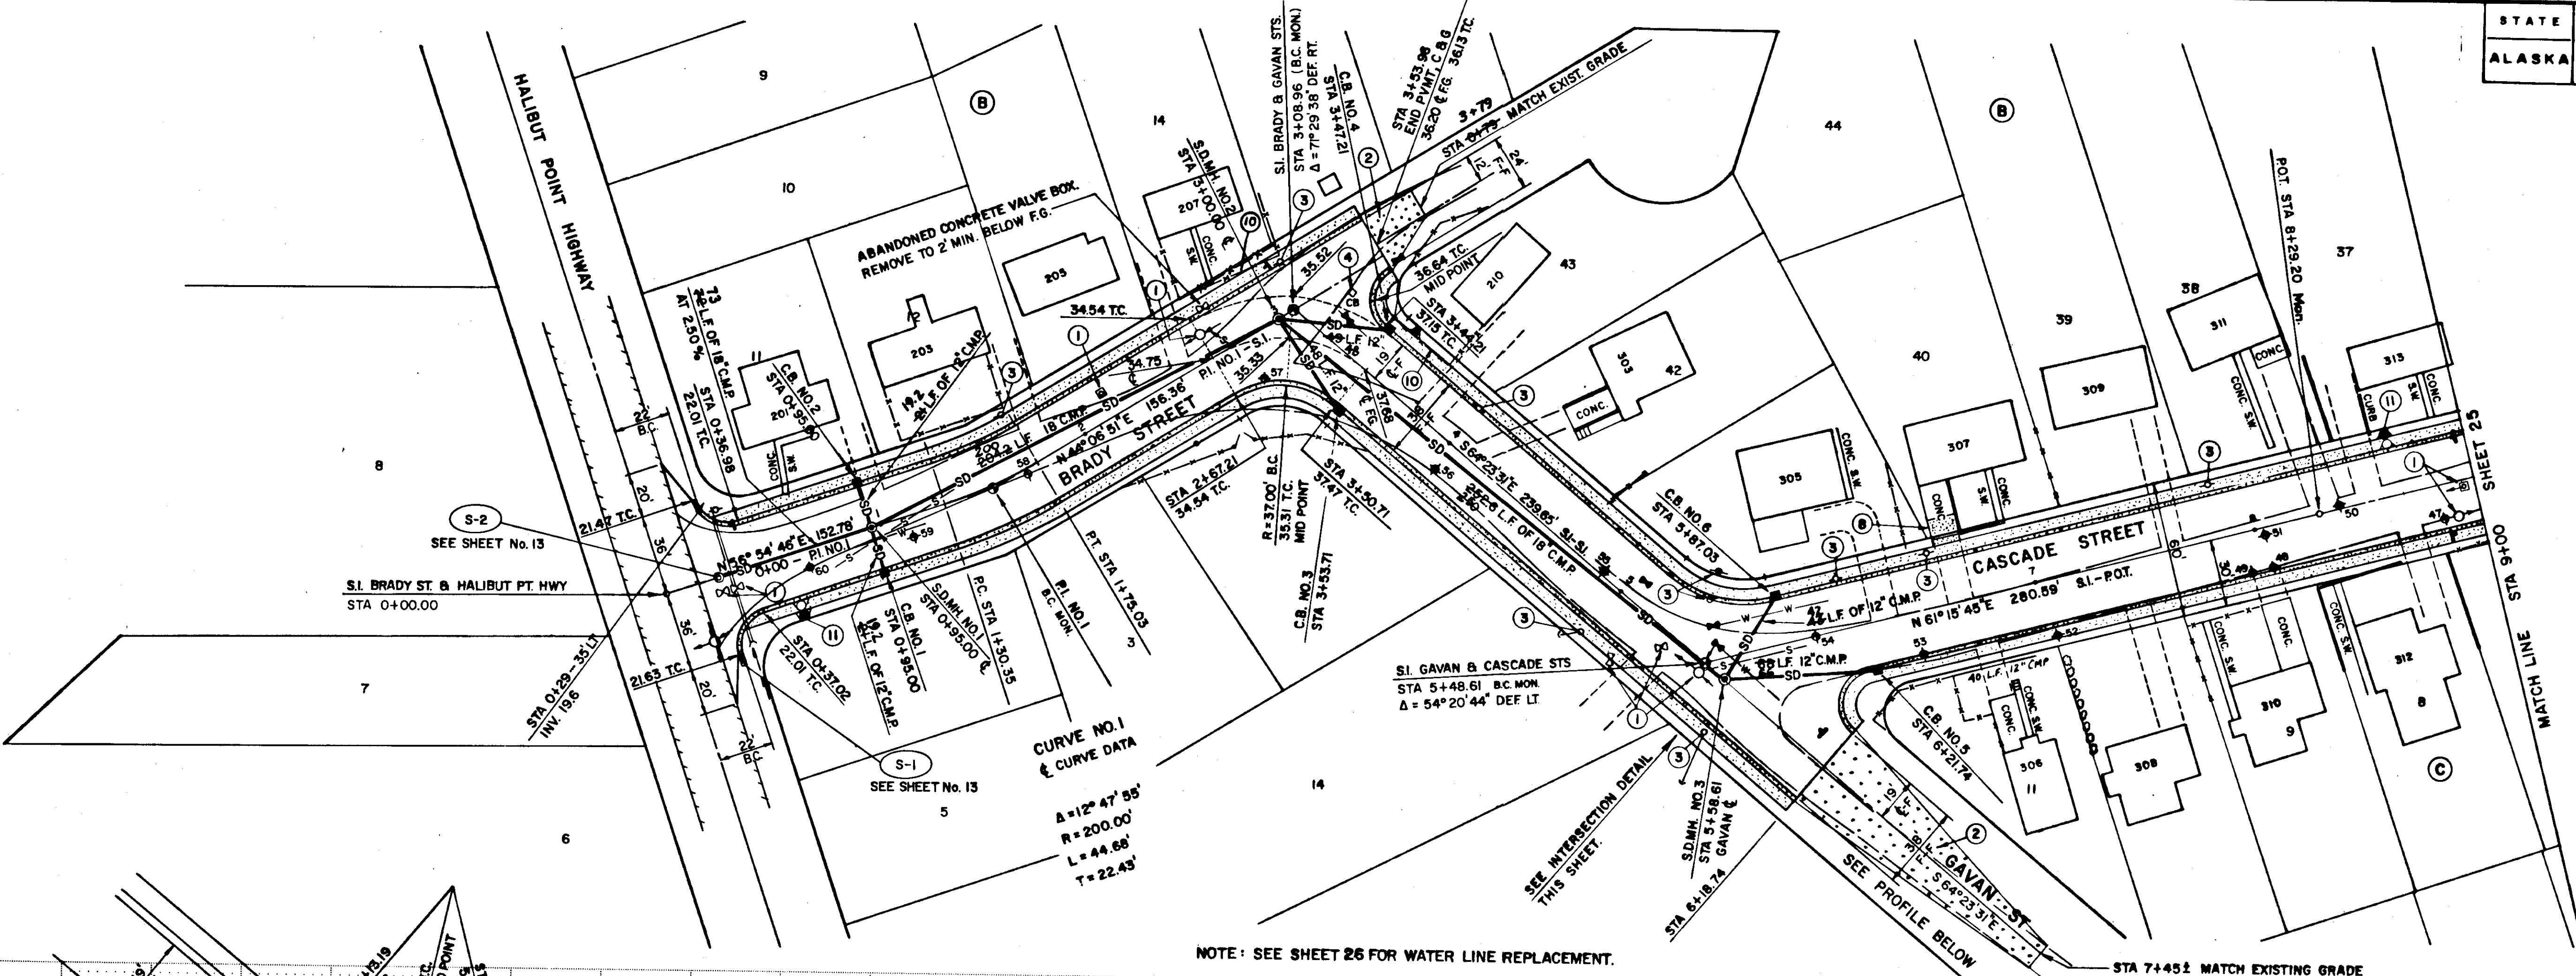

INTERSECTION DETAIL
GAVAN & CASCADE STS.

SCALE: 1" = 20'

DESIGNED	MB
DRAWN	L.N.S.
CHECKED	R.L.C.


TRYCK
NYMAN

CITY AND BOROUGH OF SITKA
STREET IMPROVEMENTS

STATE	PROJECT DESIGNATION	YEAR	SHEET NO.	TOTAL SHEETS
ALASKA	OS-3-(001)	1975	25	28

- NOTES:
- ① ADJUST SEWER MANHOLES TO FINISH GRADE.
 - ③ POWER POLE TO BE RELOCATED BY OTHERS.
 - ⑤ REMOVE EXISTING CULVERT.
 - ⑩ REMOVE & REPLACE FENCE TO PROPERTY LINE.
 - ⑪ RELOCATE FIRE HYDRANT



NOTE: BACK OF CURB RADIUS AT STREET INTERSECTIONS IS 15' THIS SHEET.

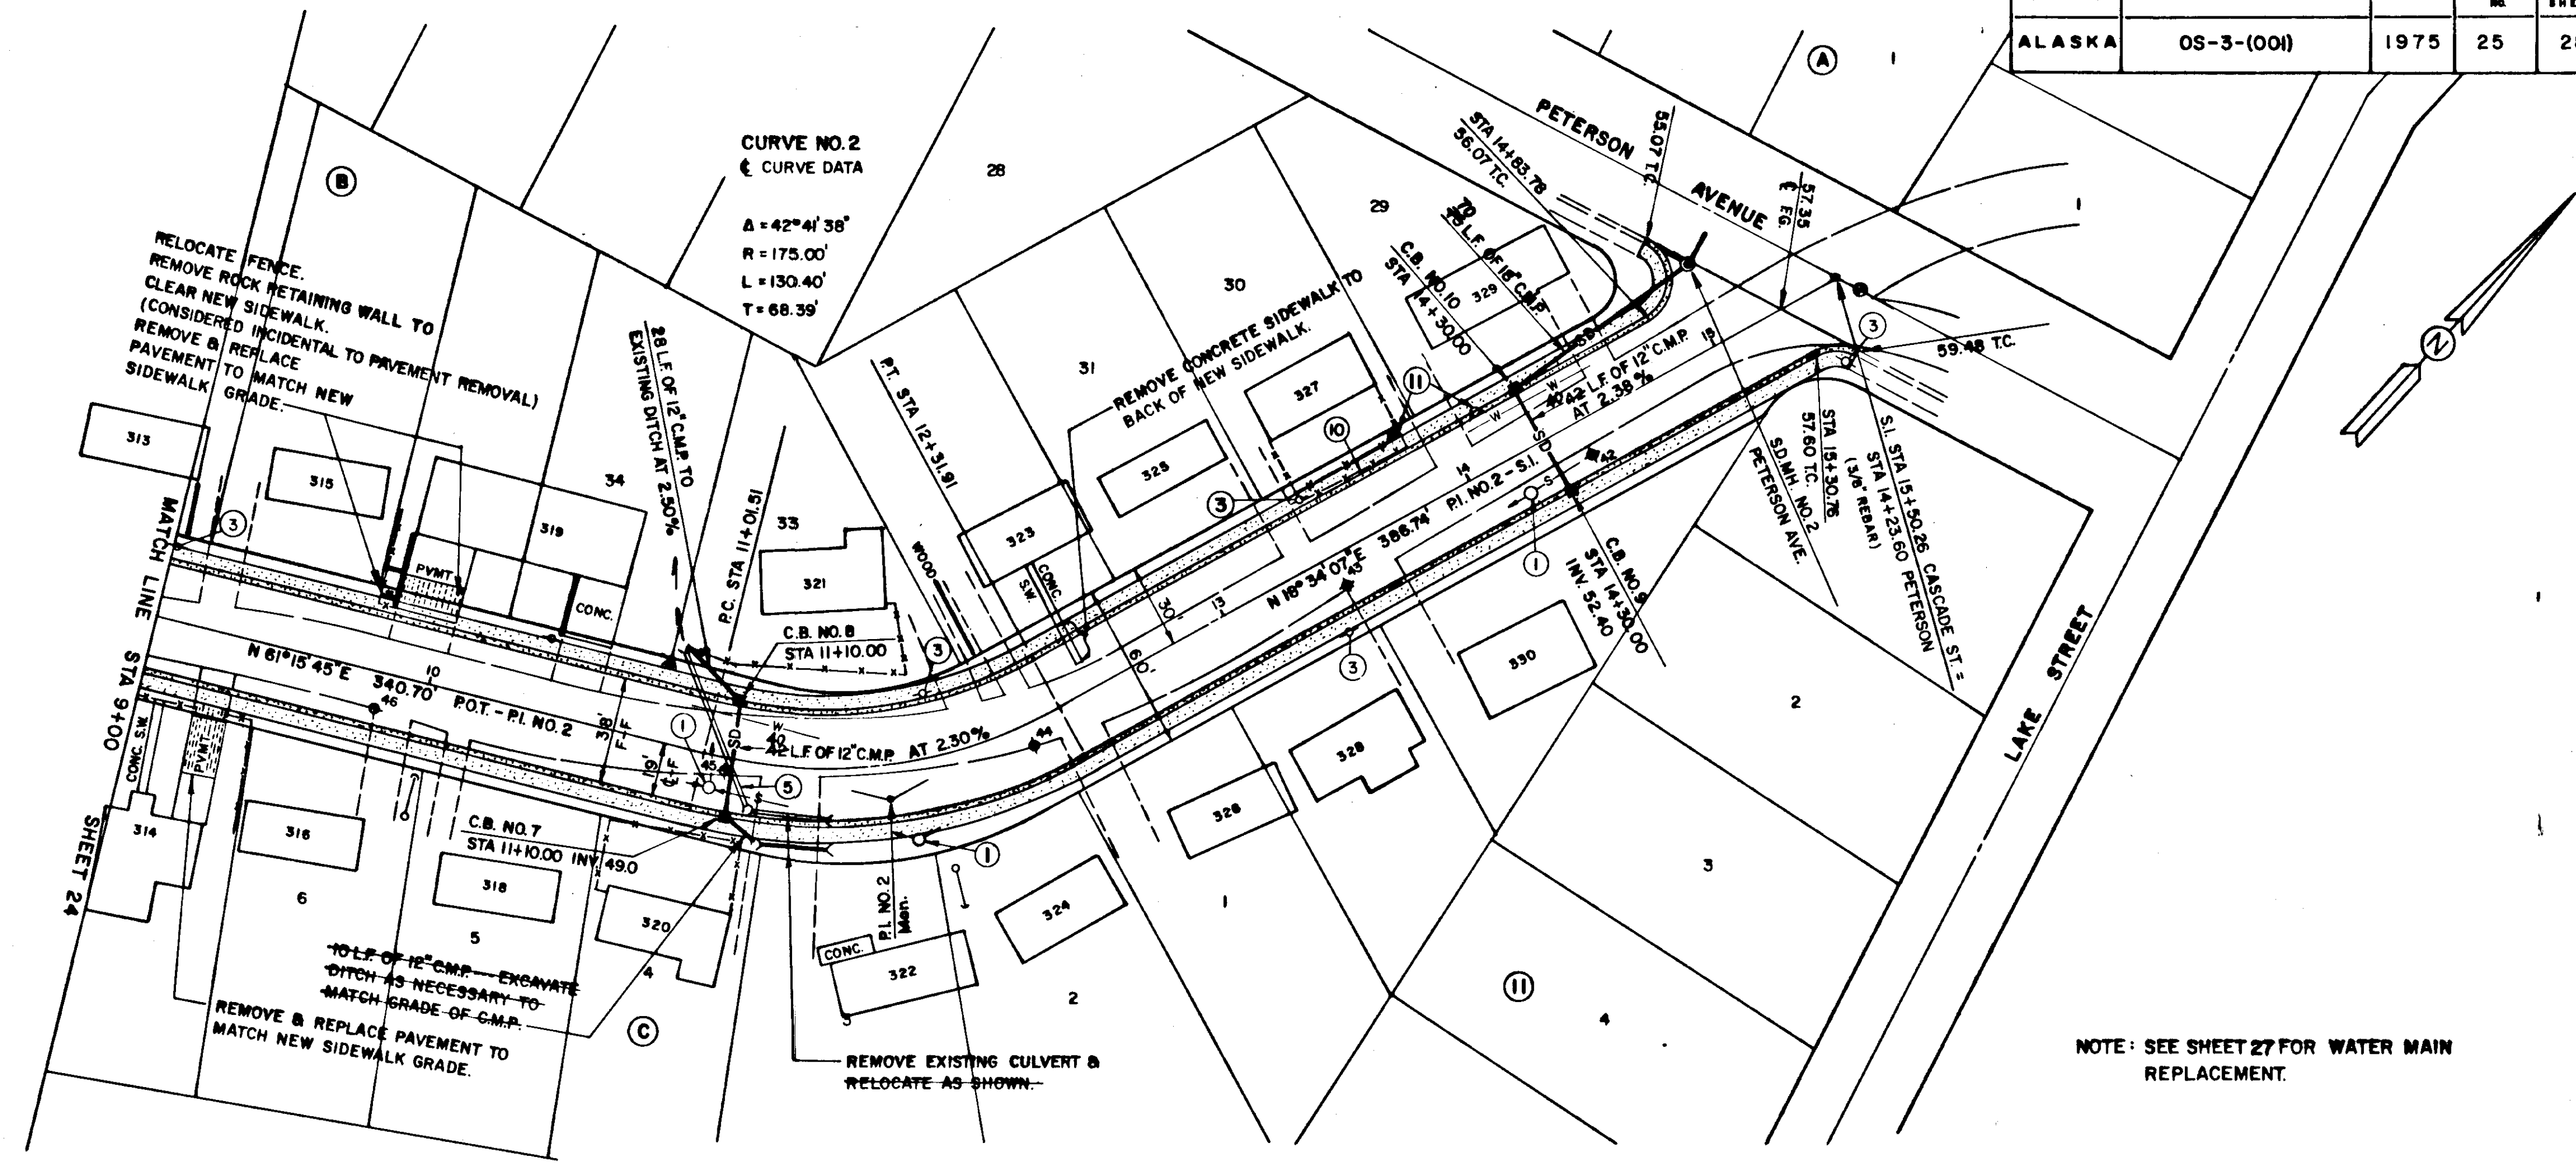


NOTE: SEE SHEET 27 FOR WATER MAIN REPLACEMENT.

TBM #11 Spike Power Pole
"A" 11+85 35' Rt. Elev. 54.56

TBM #12 Spike in Power Pole
"A" 14+80 85' Lt. Elev. 53.78

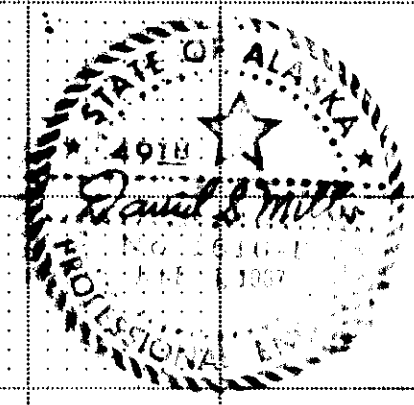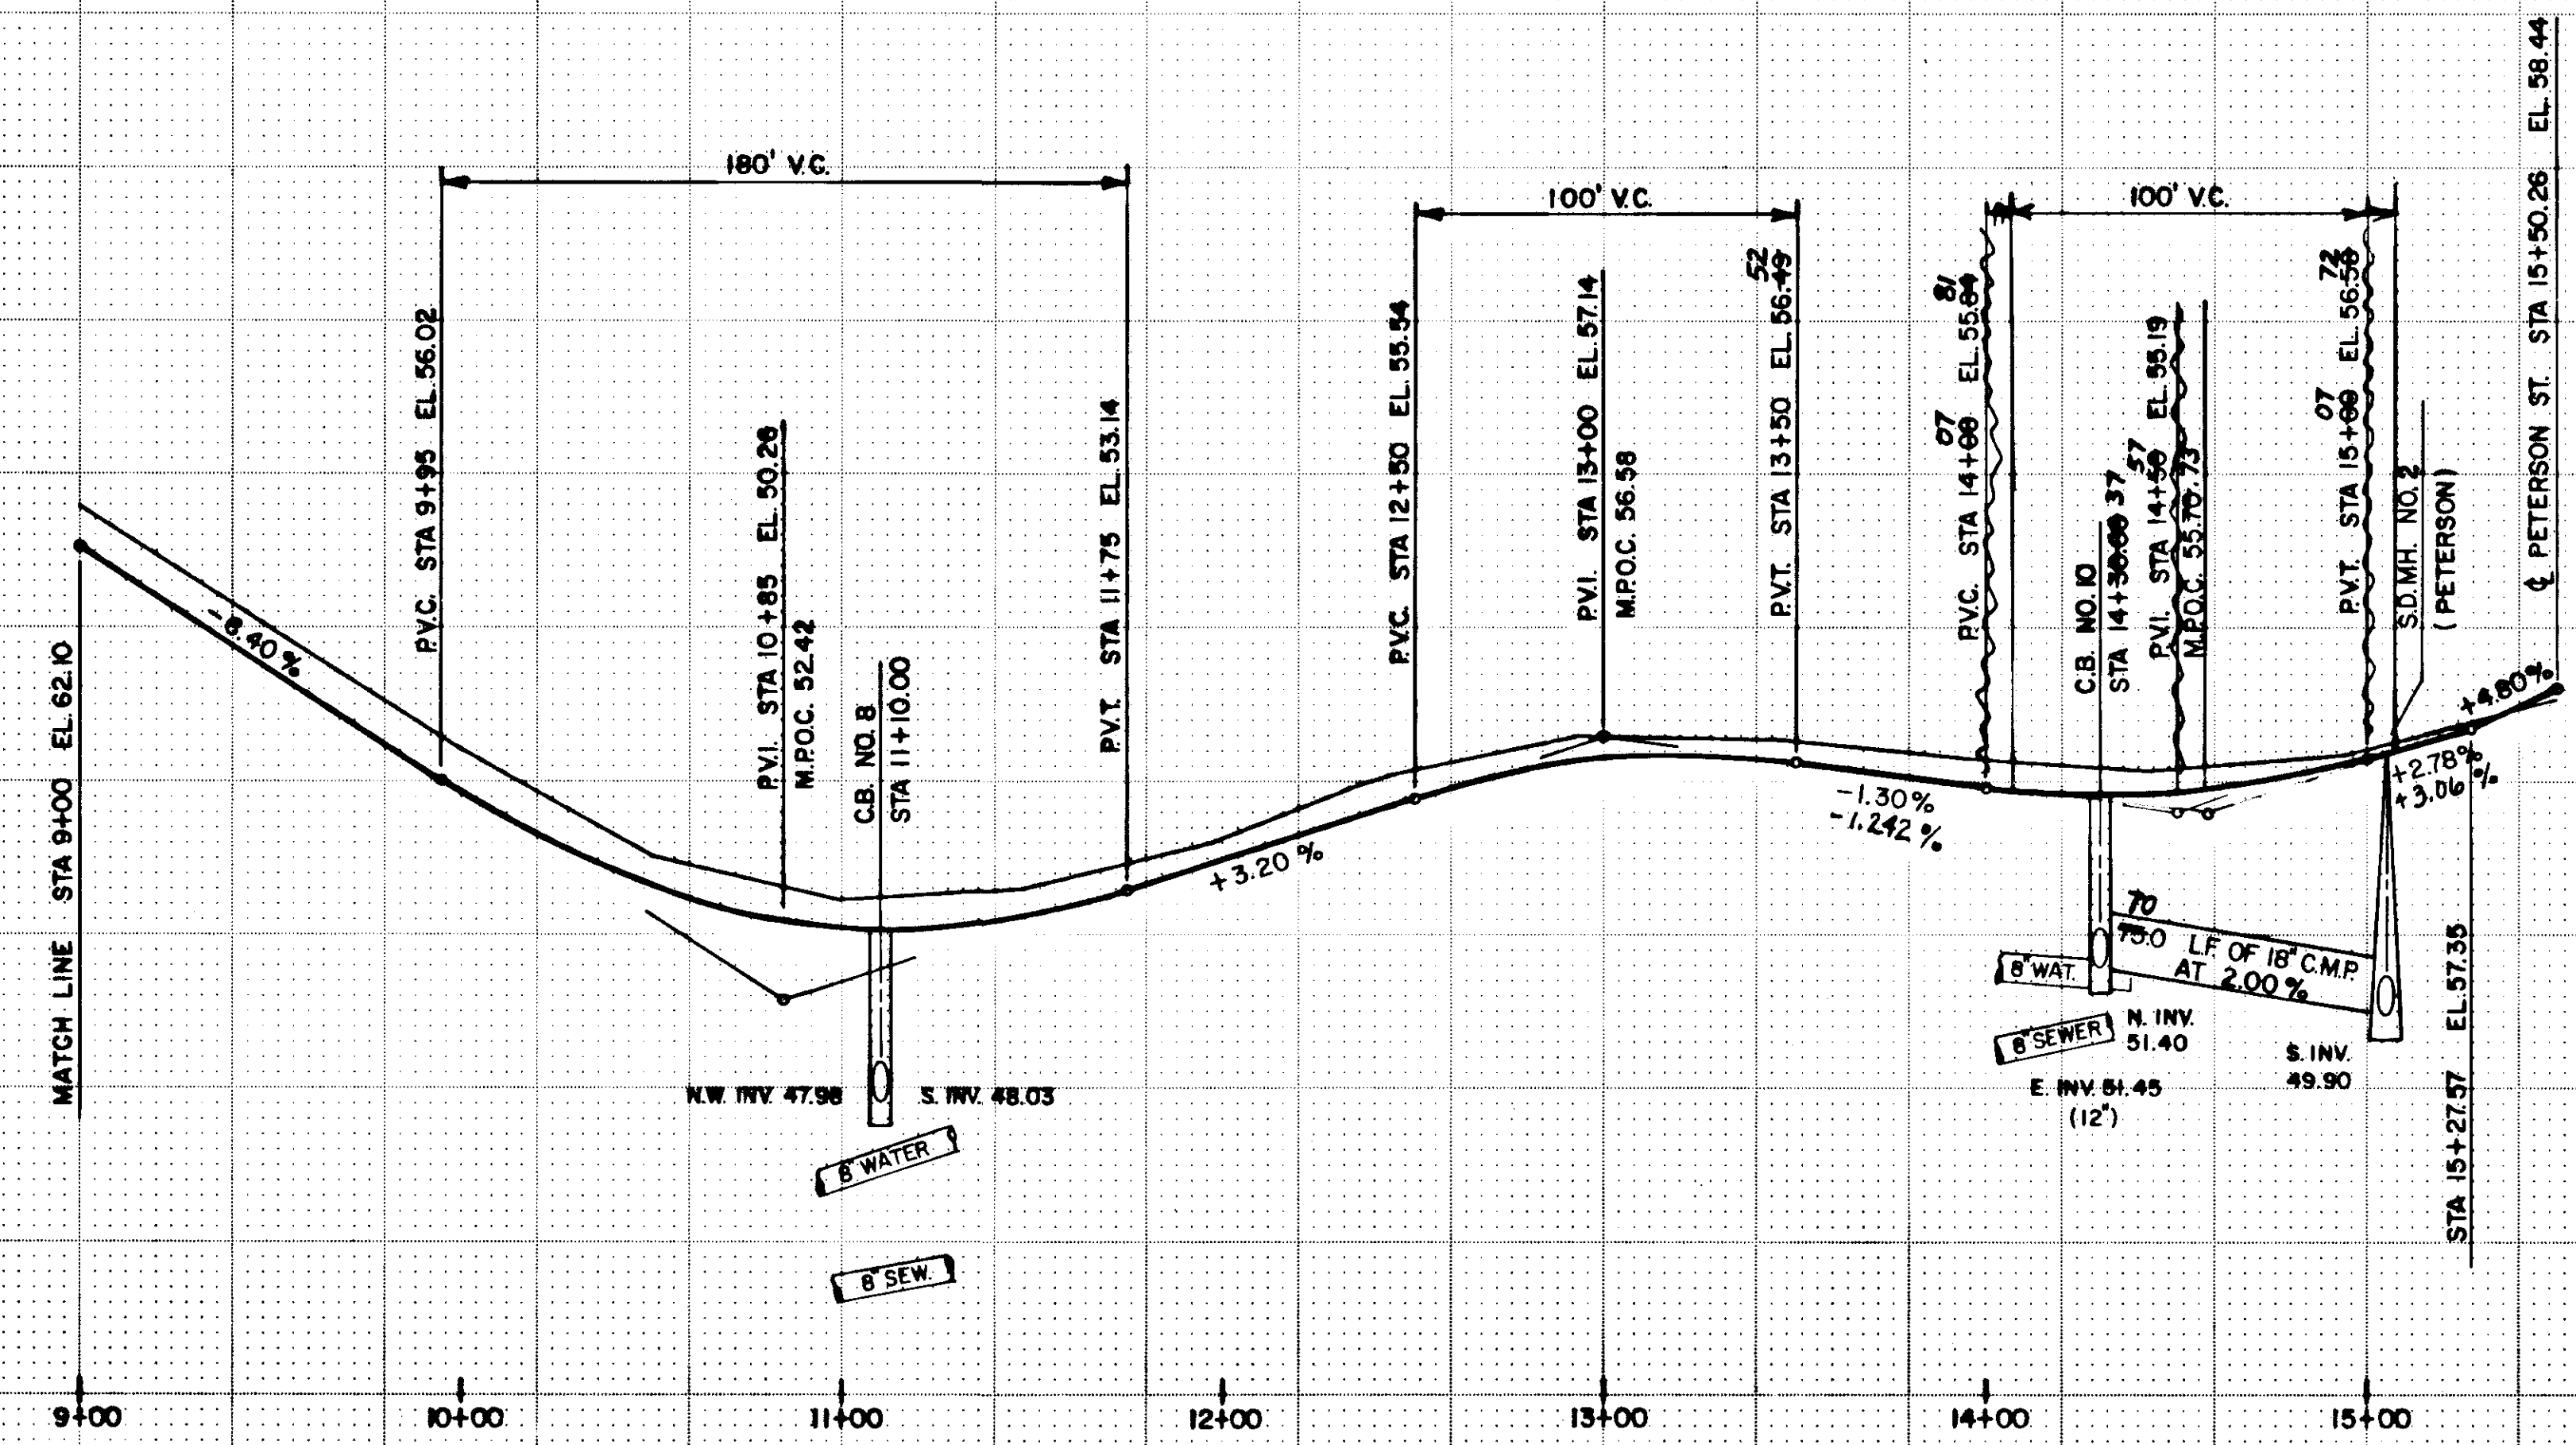

STATE	PROJECT DESIGNATION	YEAR	SHEET NO.	TOTAL SHEETS
ALASKA	OS-3-(001)	1975	26	28

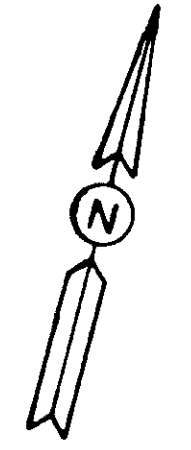



WATER LINE INSTALLATION



KEY

- RELOCATE EXISTING FIRE HYDRANT AS SHOWN
- NEW FIRE HYDRANT ASSEMBLY
- 6" GV & VB
- 8" GV & VB
- 11 1/4" BEND
- 22 1/2" BEND
- 90° BEND
- 8"x8" TEE
- 8"x8" WYE
- 8"x6" REDUCER
- 6" DI. TO 6" WSP FLANGE ADAPTER
- 20 LF OF SEWER ENCASEMENT SEE DETAIL ON SHEET 12
- 8"x8"x6" TEE


NOTES:

- WATER LINE AND STORM DRAIN LINE STATIONING IS BASED UPON STREET CENTERLINE STATIONING.
- 5' MINIMUM BURY ON ALL NEW WATER LINES NOT SHOWN IN PROFILE.
- CONNECT ALL EXISTING WATER SERVICES TO NEW WATER MAIN. SEE SHEET NO. 6.

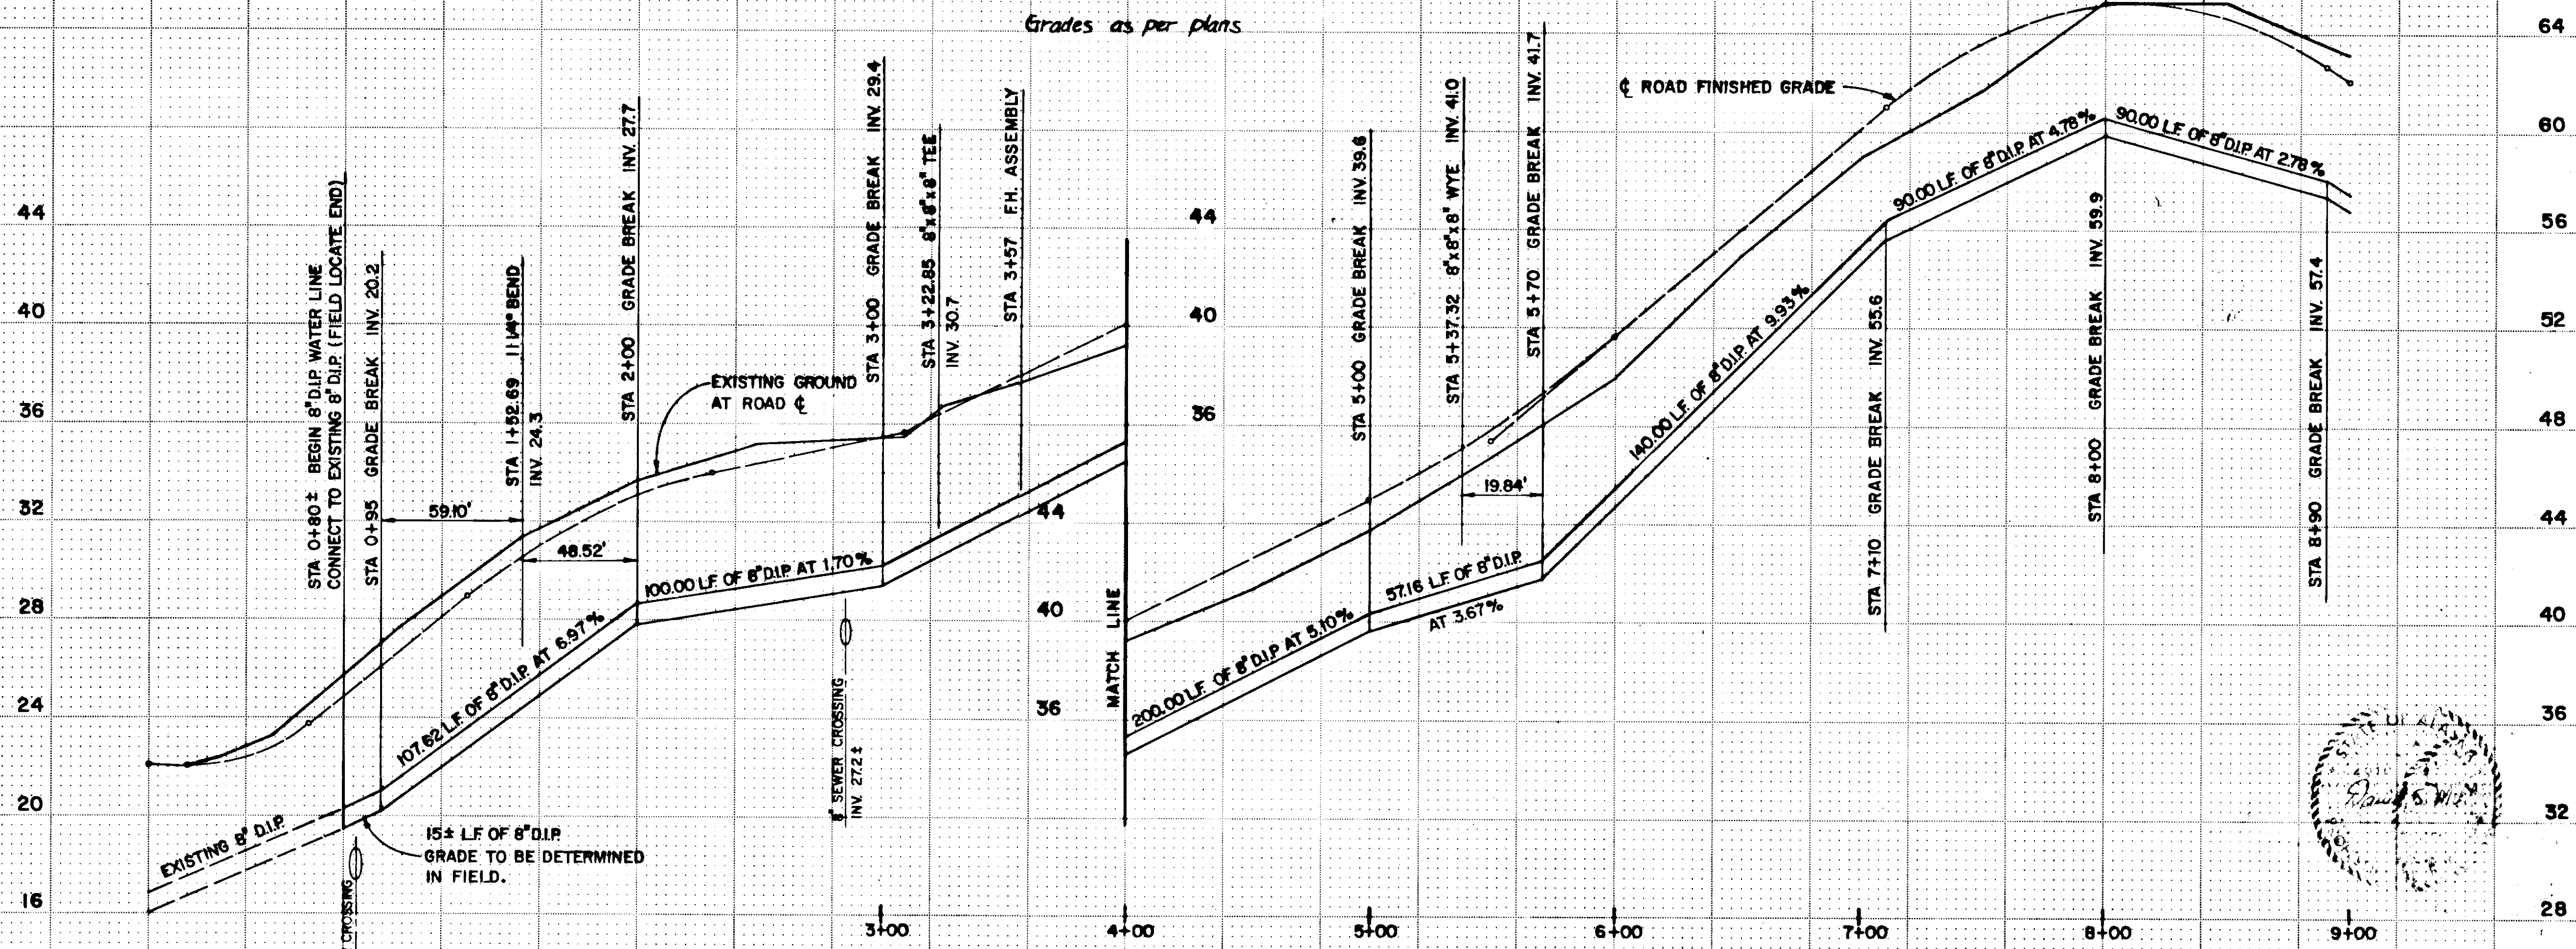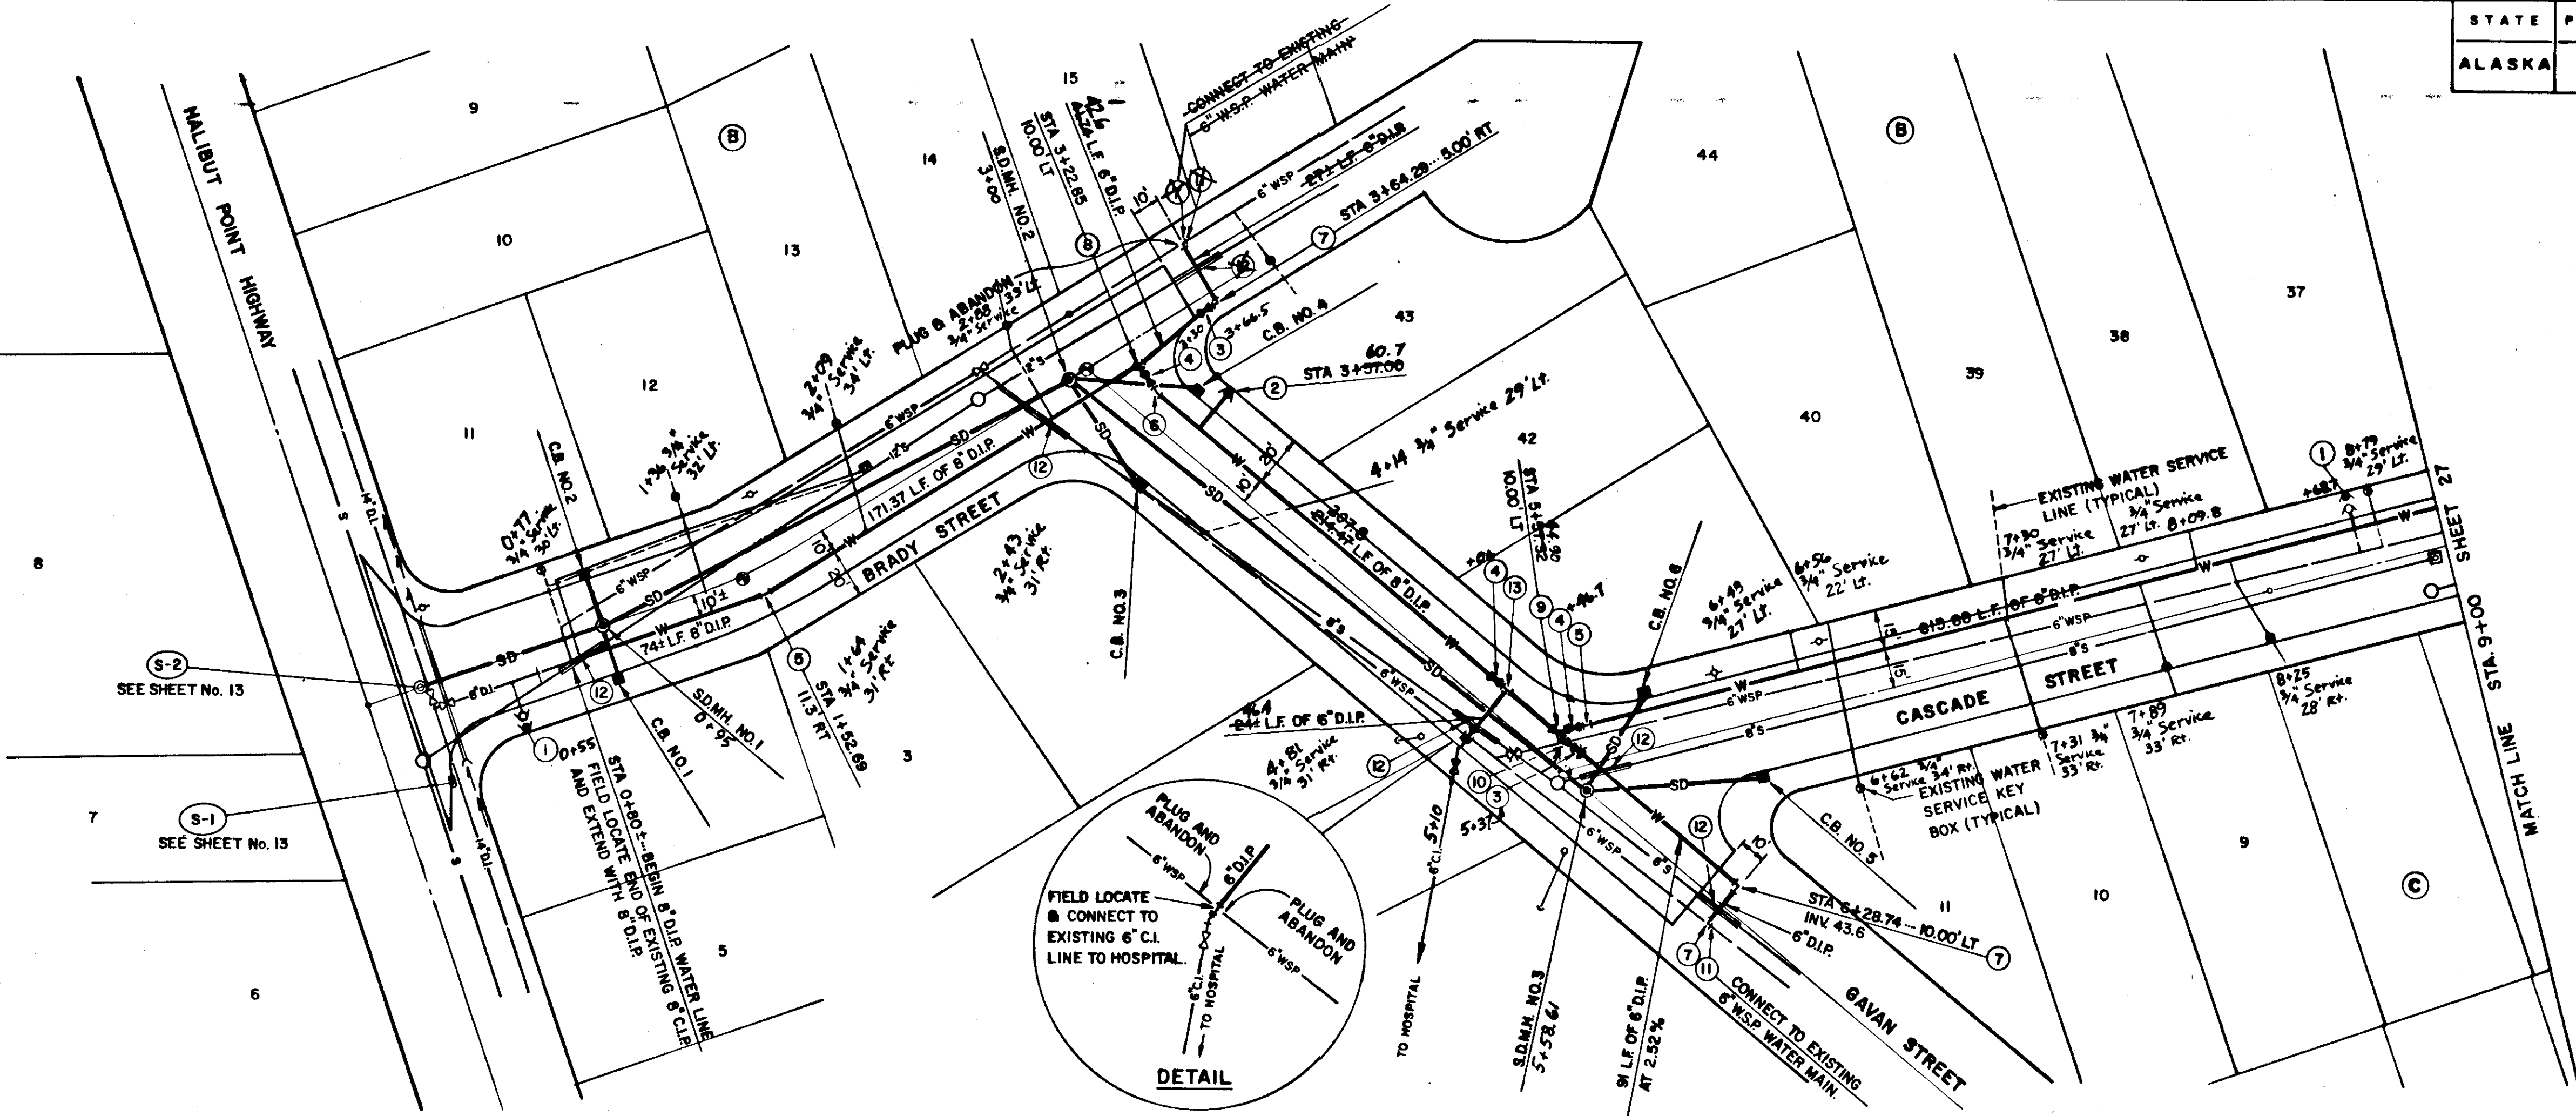

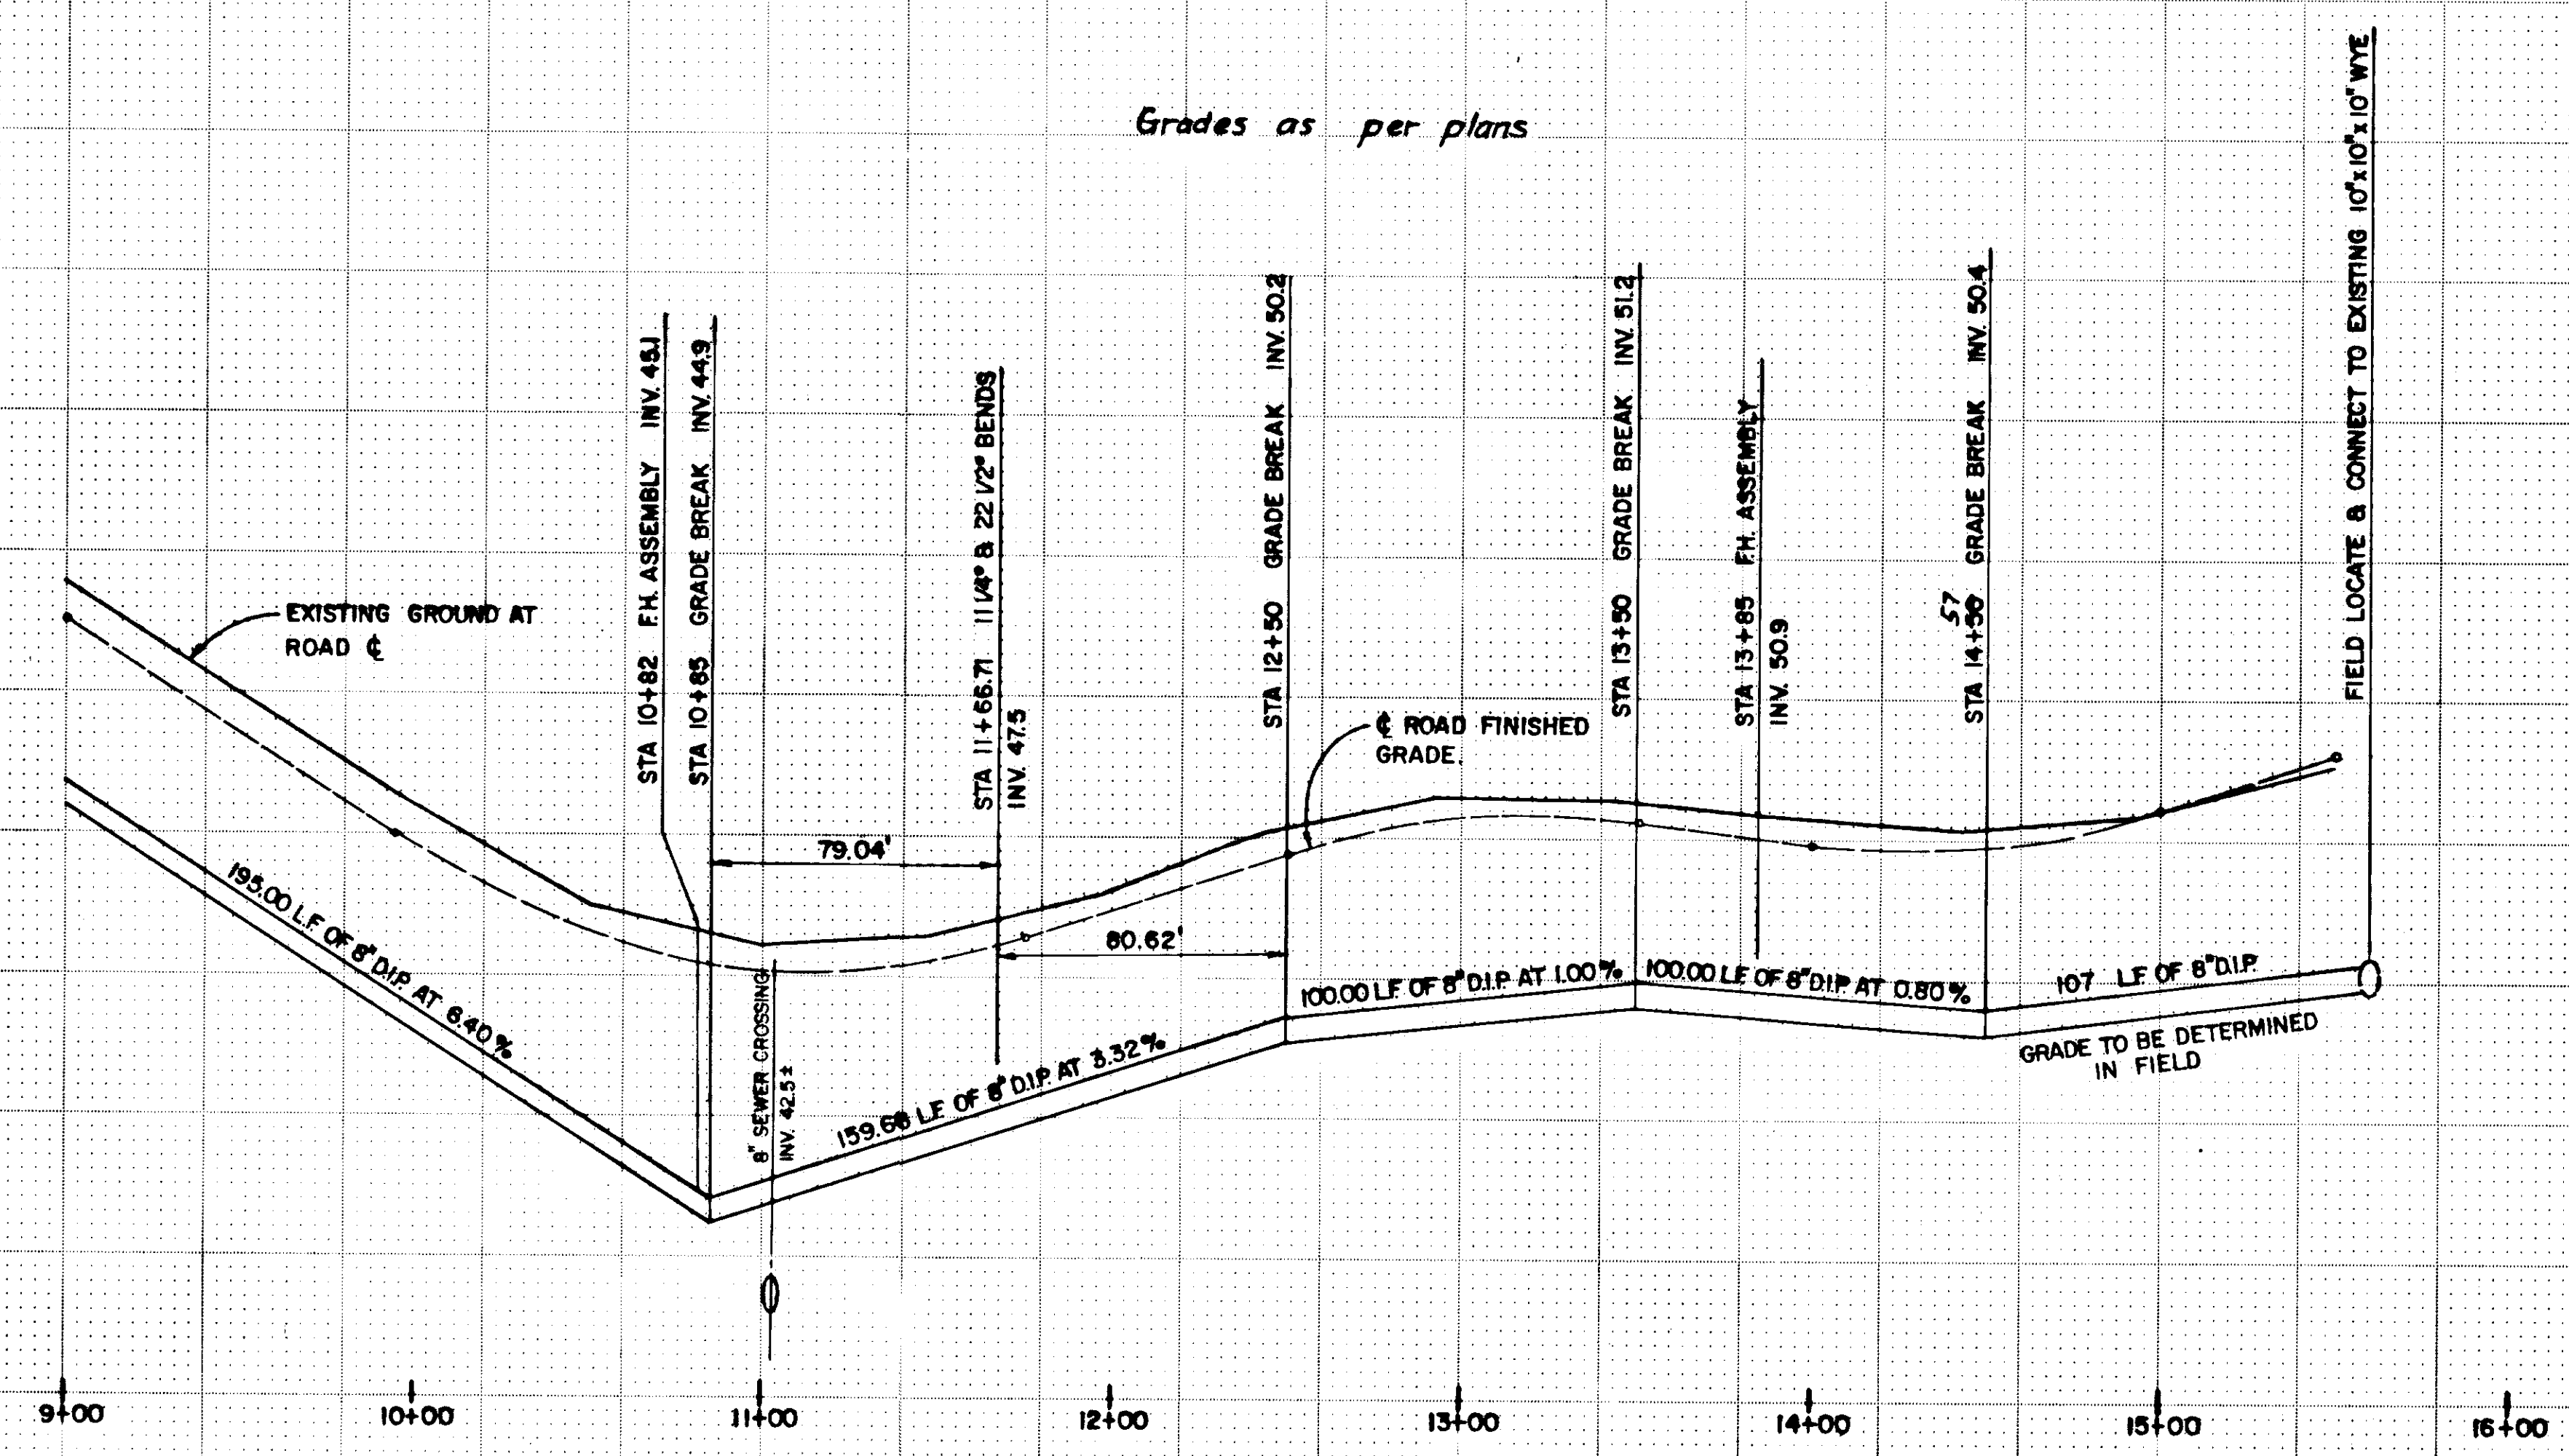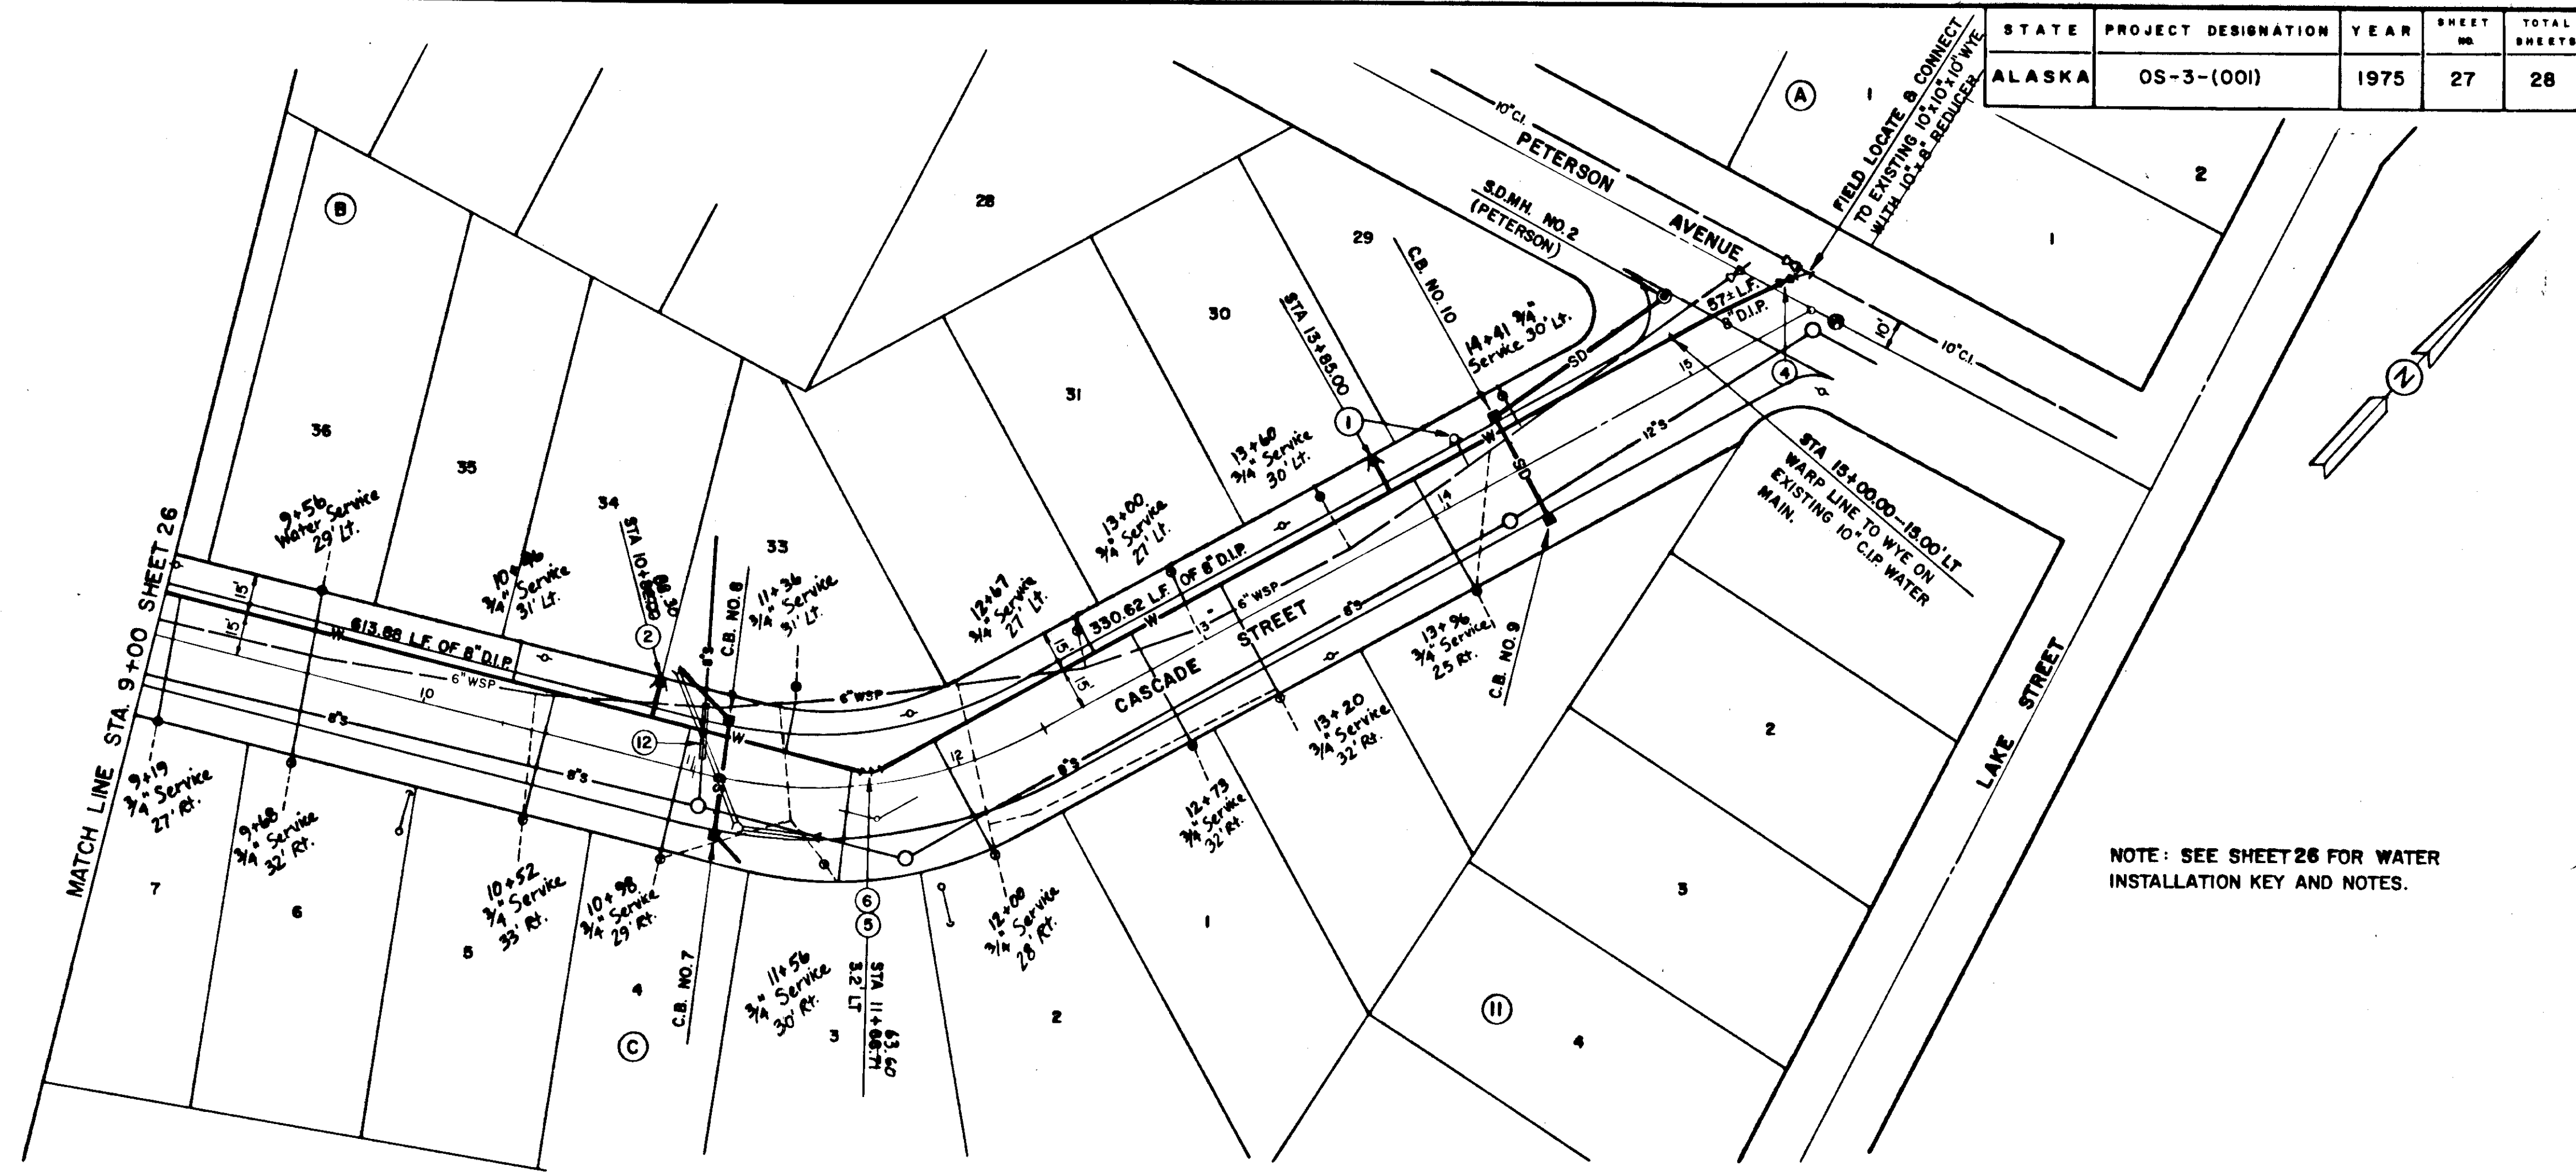


STATE	PROJECT DESIGNATION	YEAR	SHEET NO.	TOTAL SHEETS
ALASKA	OS-3-(001)	1975	28	28


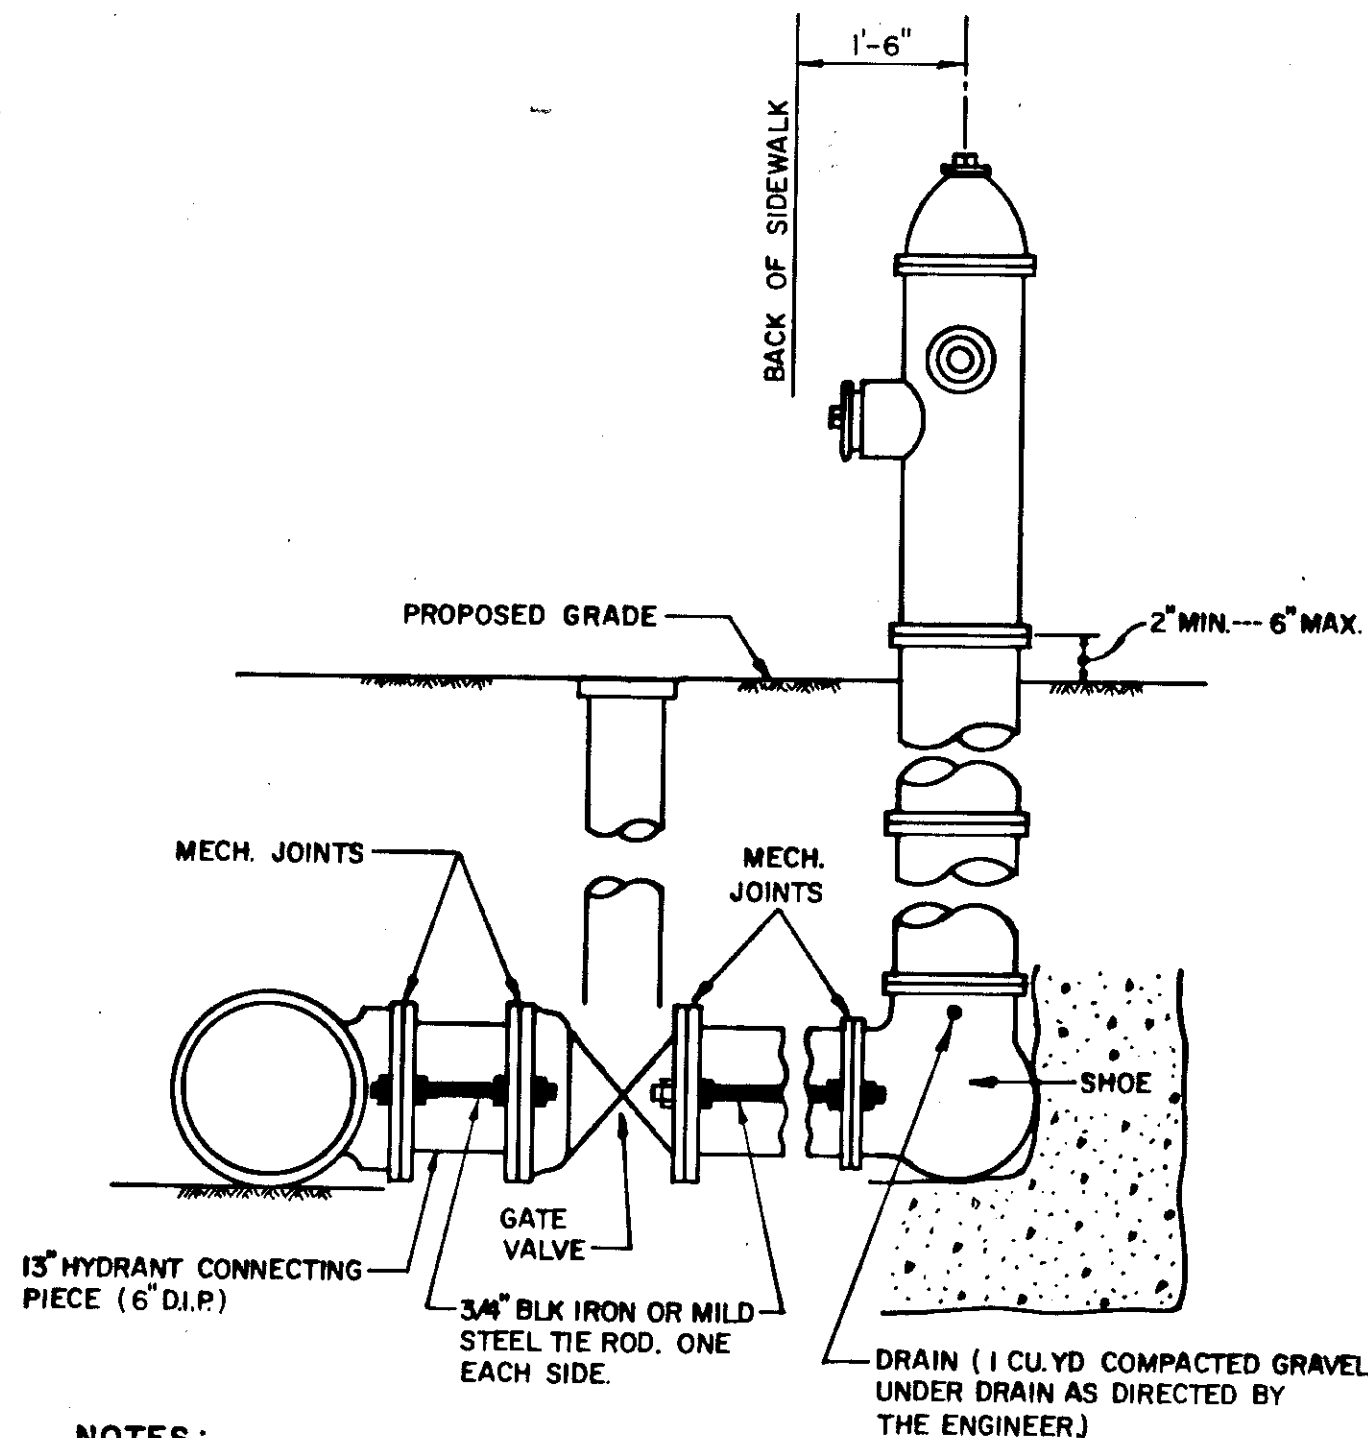


- NOTES:**
- HYDRANT BARREL MUST BE INSTALLED PLUMB AND THE LEG MUST BE INSTALLED LEVEL.
 - AUXILIARY GATE VALVE BOX TO BE INSTALLED ACCORDING TO DETAIL FOR TYPICAL VALVE BOX.
 - DRAIN PLUG TO BE REMOVED BY CONTRACTOR.

FIRE HYDRANT INSTALLATION

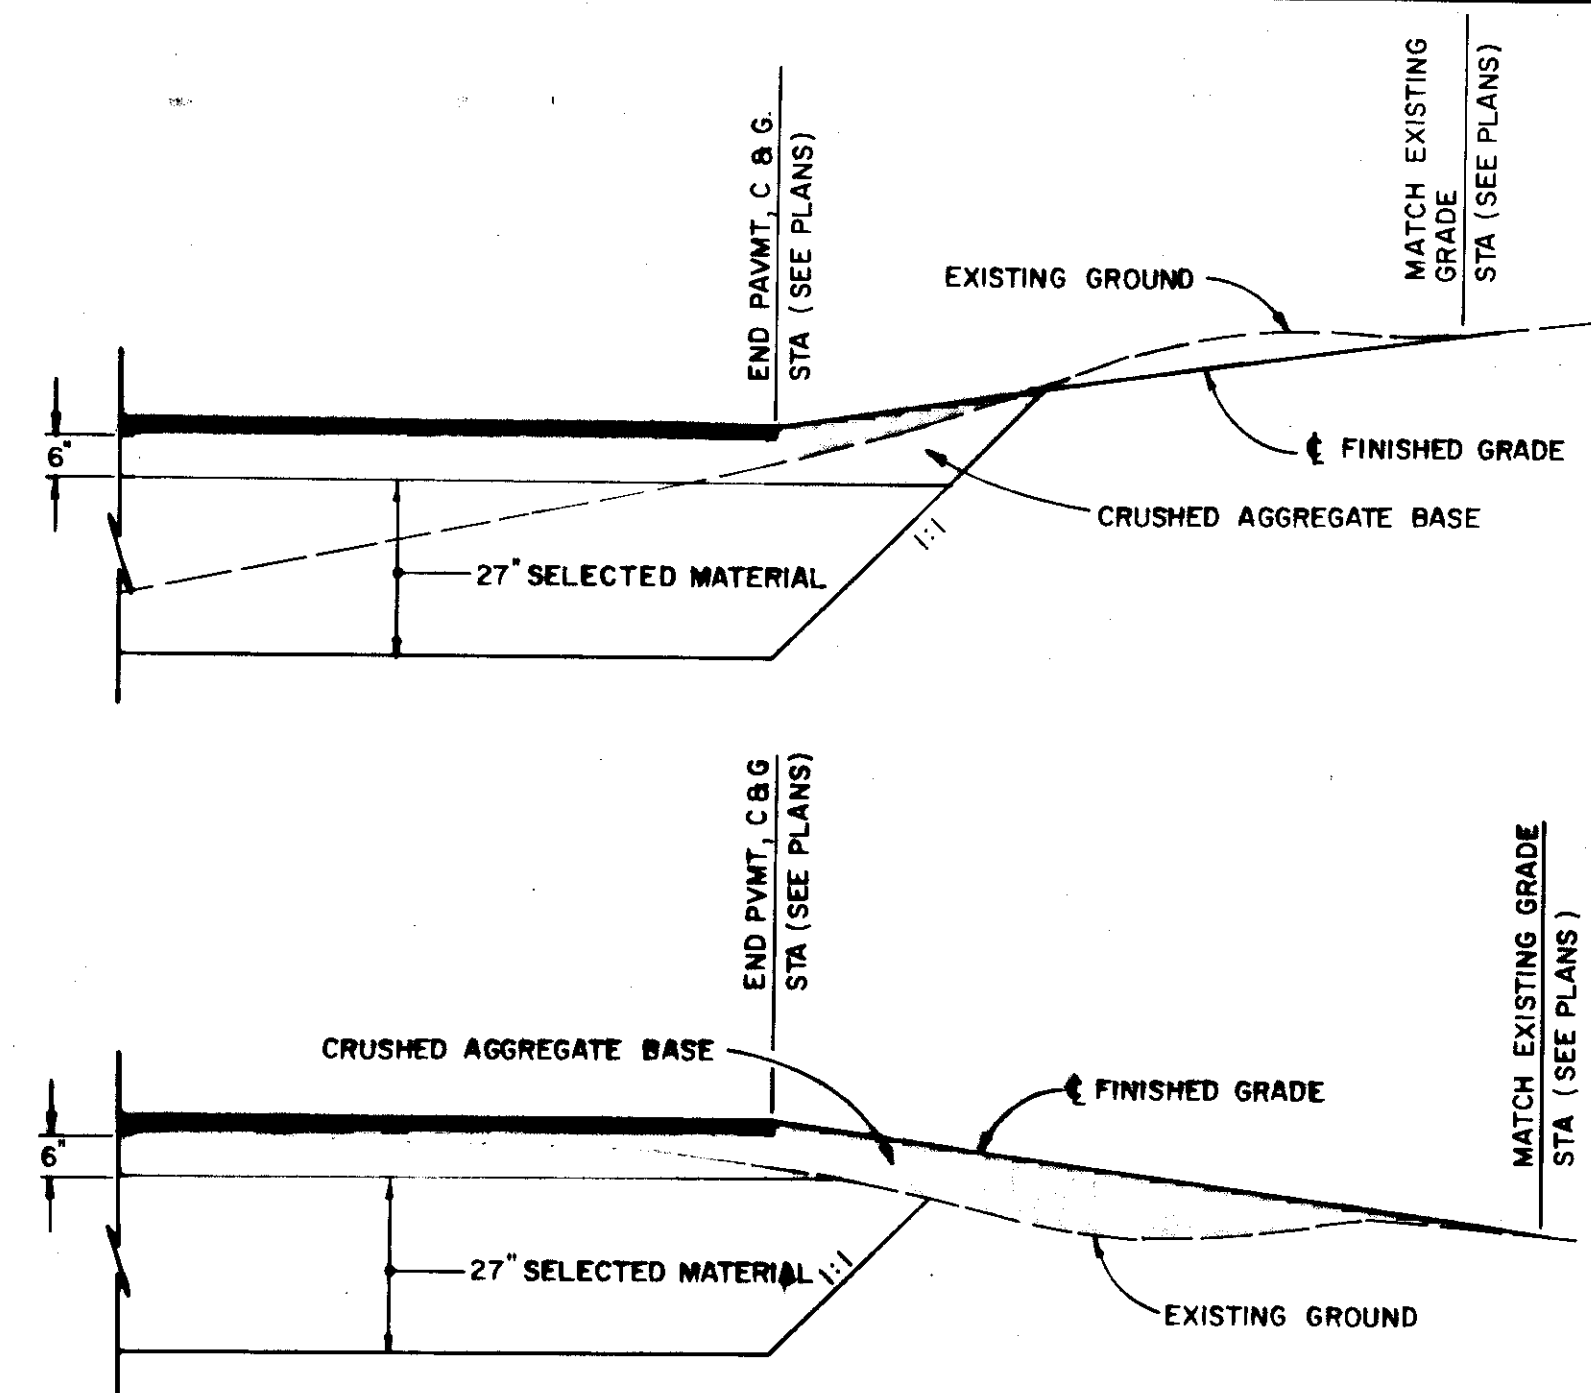


TRANSITION DETAIL -- END OF PAVEMENT TO EXISTING GRADE ON INTERSECTING STREETS

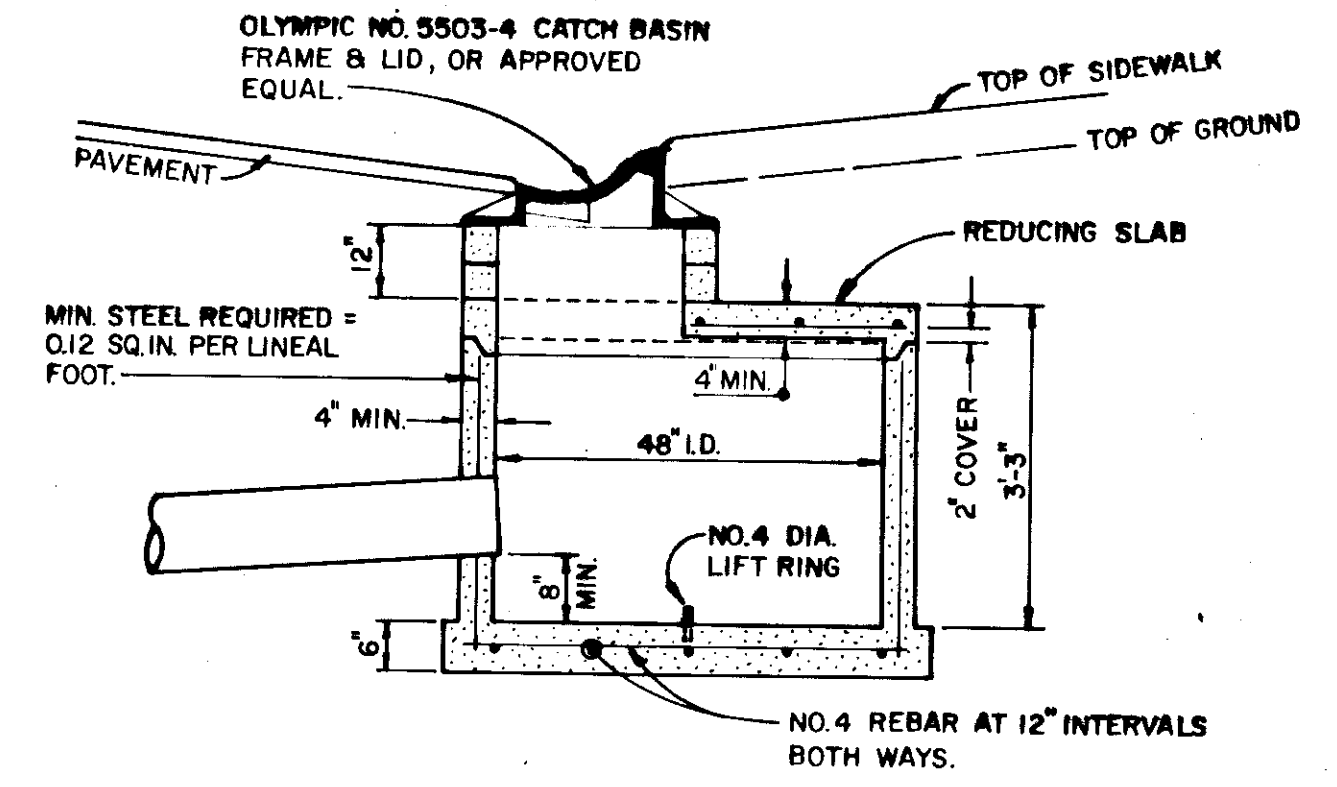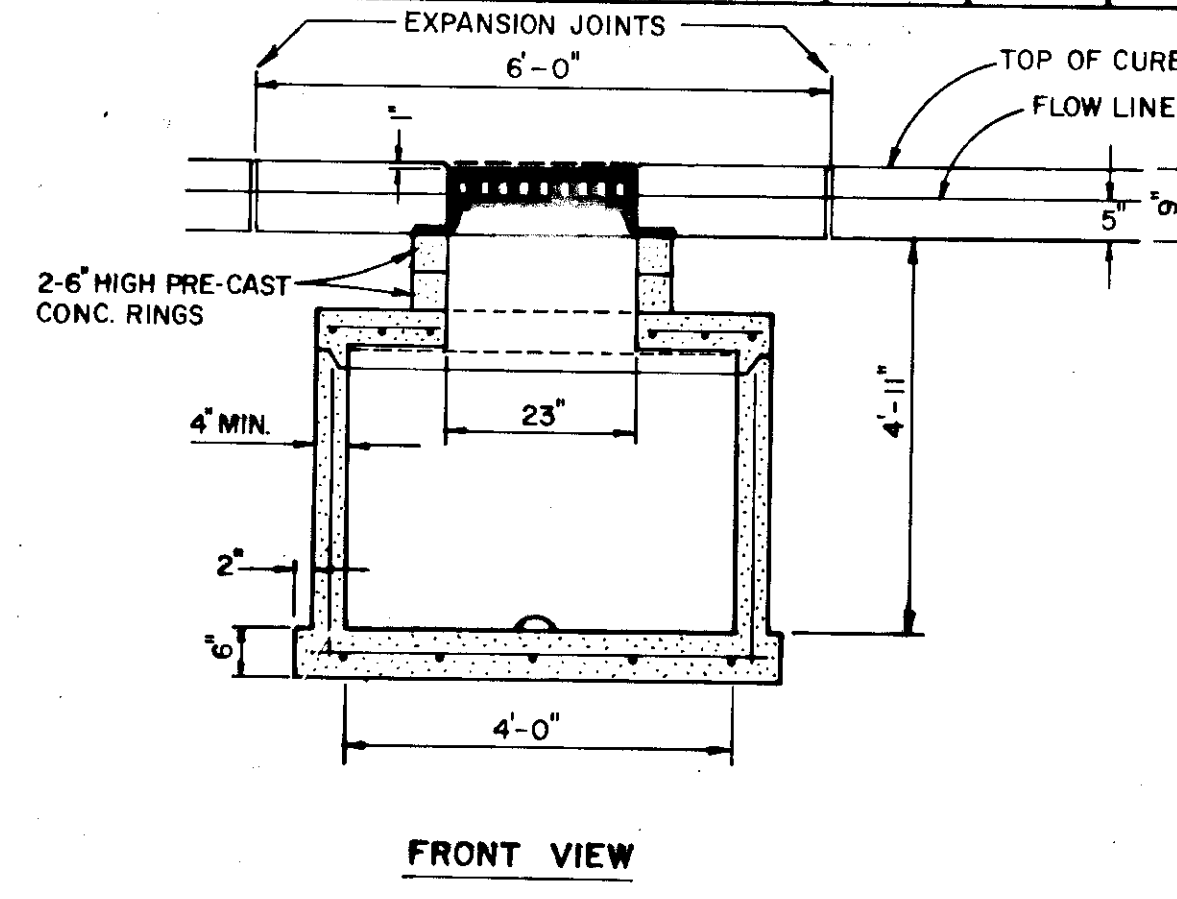


- NOTES:**
- AT CATCH BASIN, DELETE CONC. CURB & GUTTER, PAVE TO FACE OF CATCH BASIN INLET.
 - COMPRESSIVE STRENGTH OF CONCRETE SHALL BE MINIMUM 4,000 P.S.I. EXCEPT BASE SLAB WHICH MAY BE 3,000 P.S.I. BASE & BARREL SHALL BE CONNECTED BY CONTINUOUS STEEL.
 - CATCH BASIN RISERS & RINGS SHALL CONFORM TO A.S.T.M. C-478-69.

PRECAST CATCH BASIN

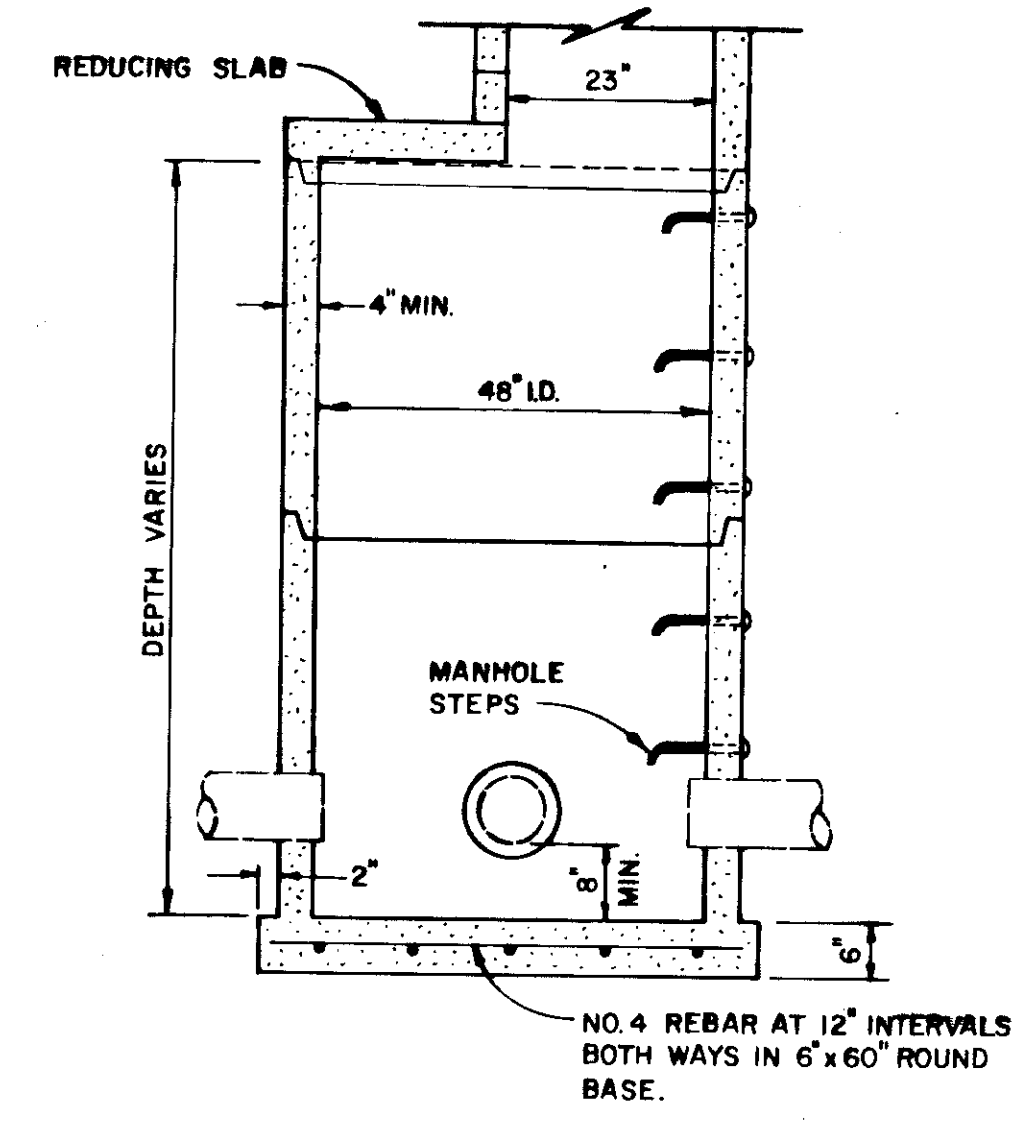


- MANHOLE STEPS TO BE CONSTRUCTED PER ALASKA DEPARTMENT OF HIGHWAYS STANDARD D-20.10

CATCH BASIN MANHOLE

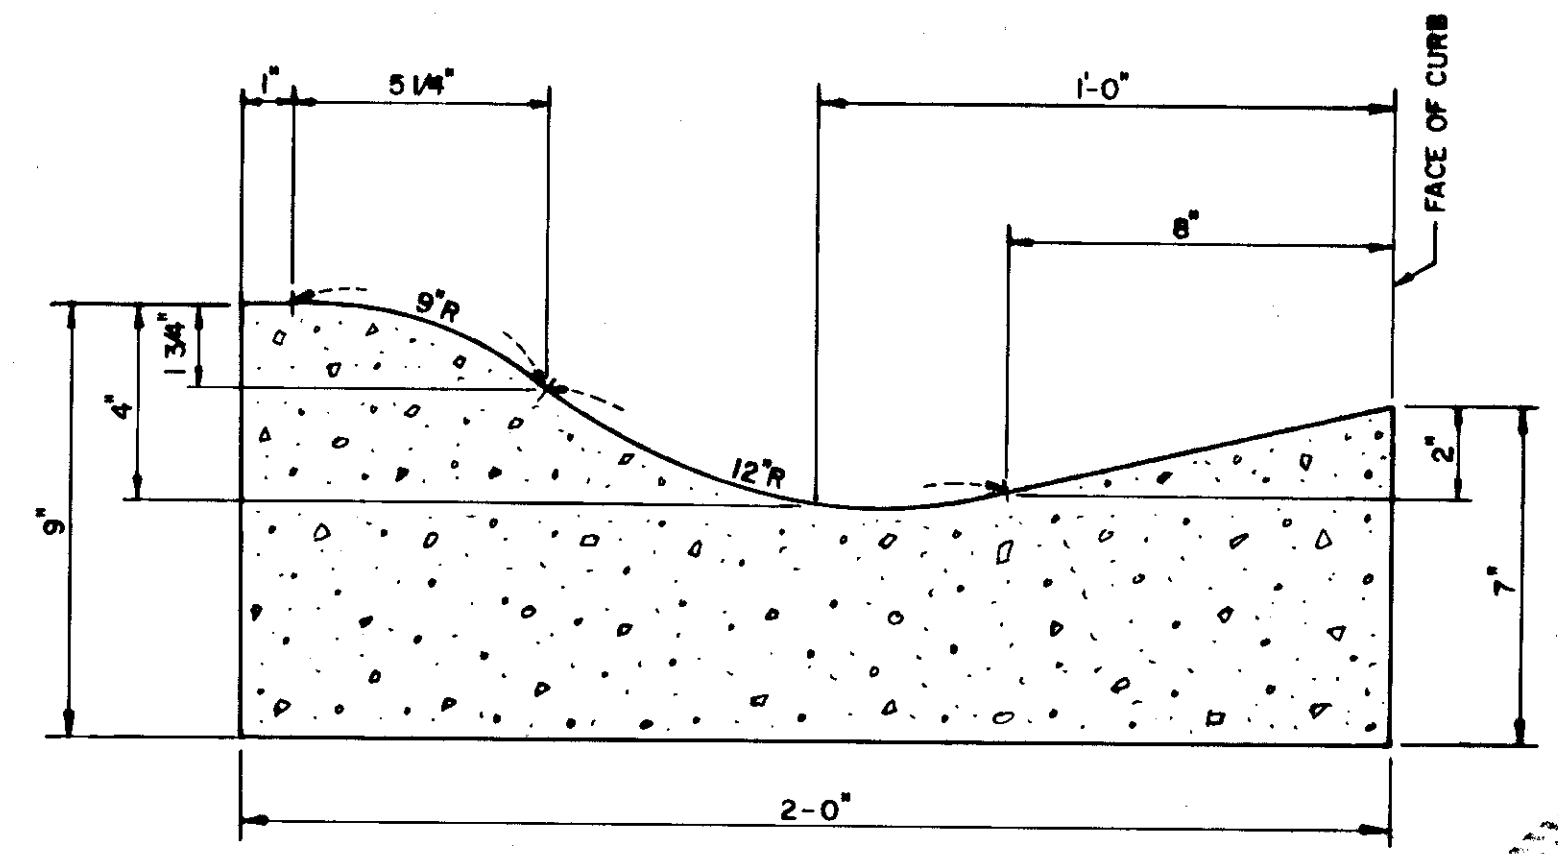


ROLLED CURB AND GUTTER

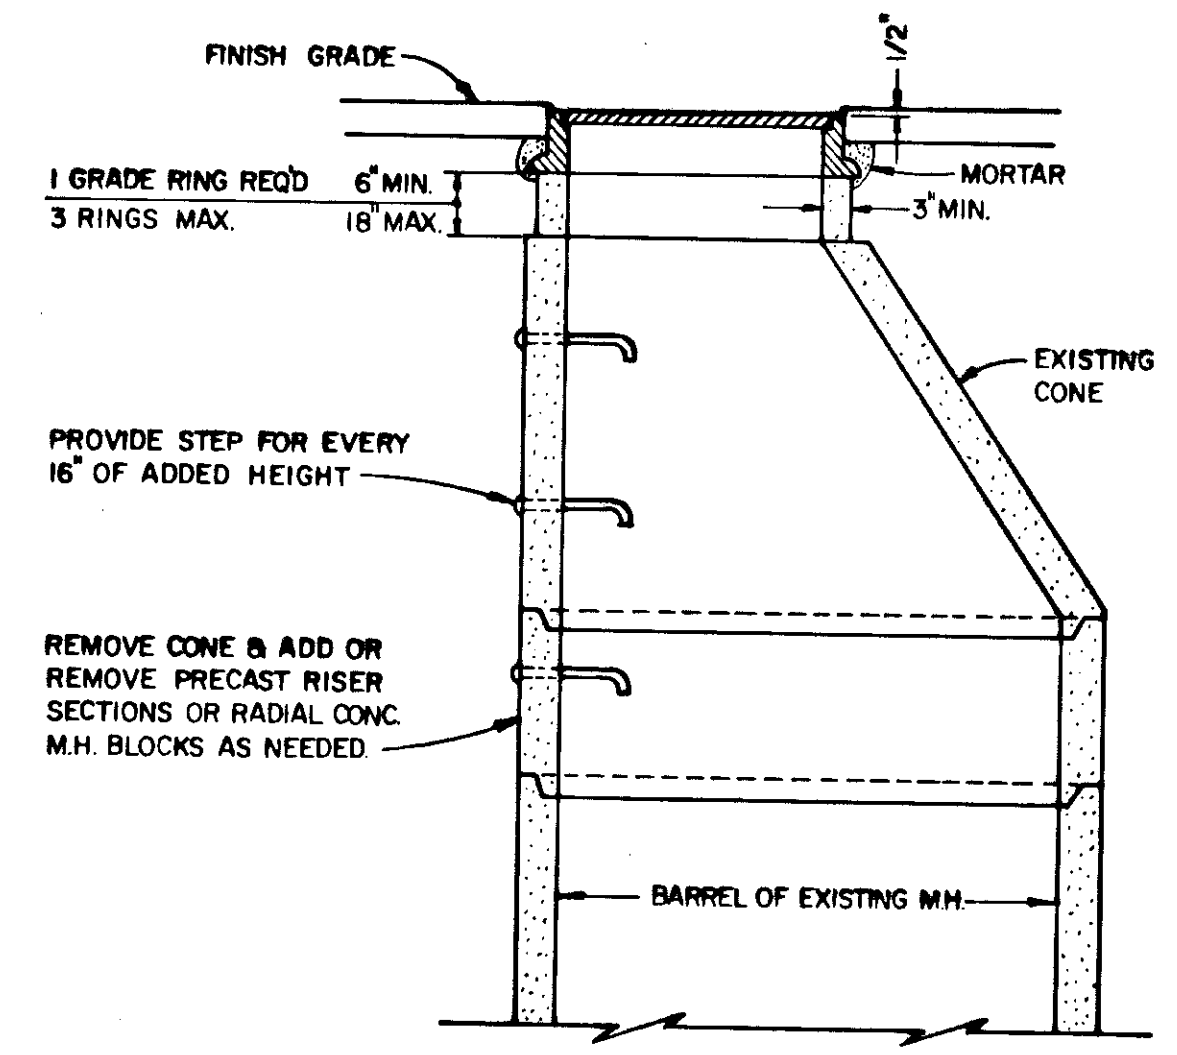

- NOTES:**
- RESET RING IN FULL BED OF MORTAR.
 - RESET CONE IN MASTIC GASKET.
 - REFER TO ASTM DESIGNATION C-478-69 FOR DESIGN AND STRENGTH REQUIREMENTS.

MANHOLE CONE ADJUSTMENT

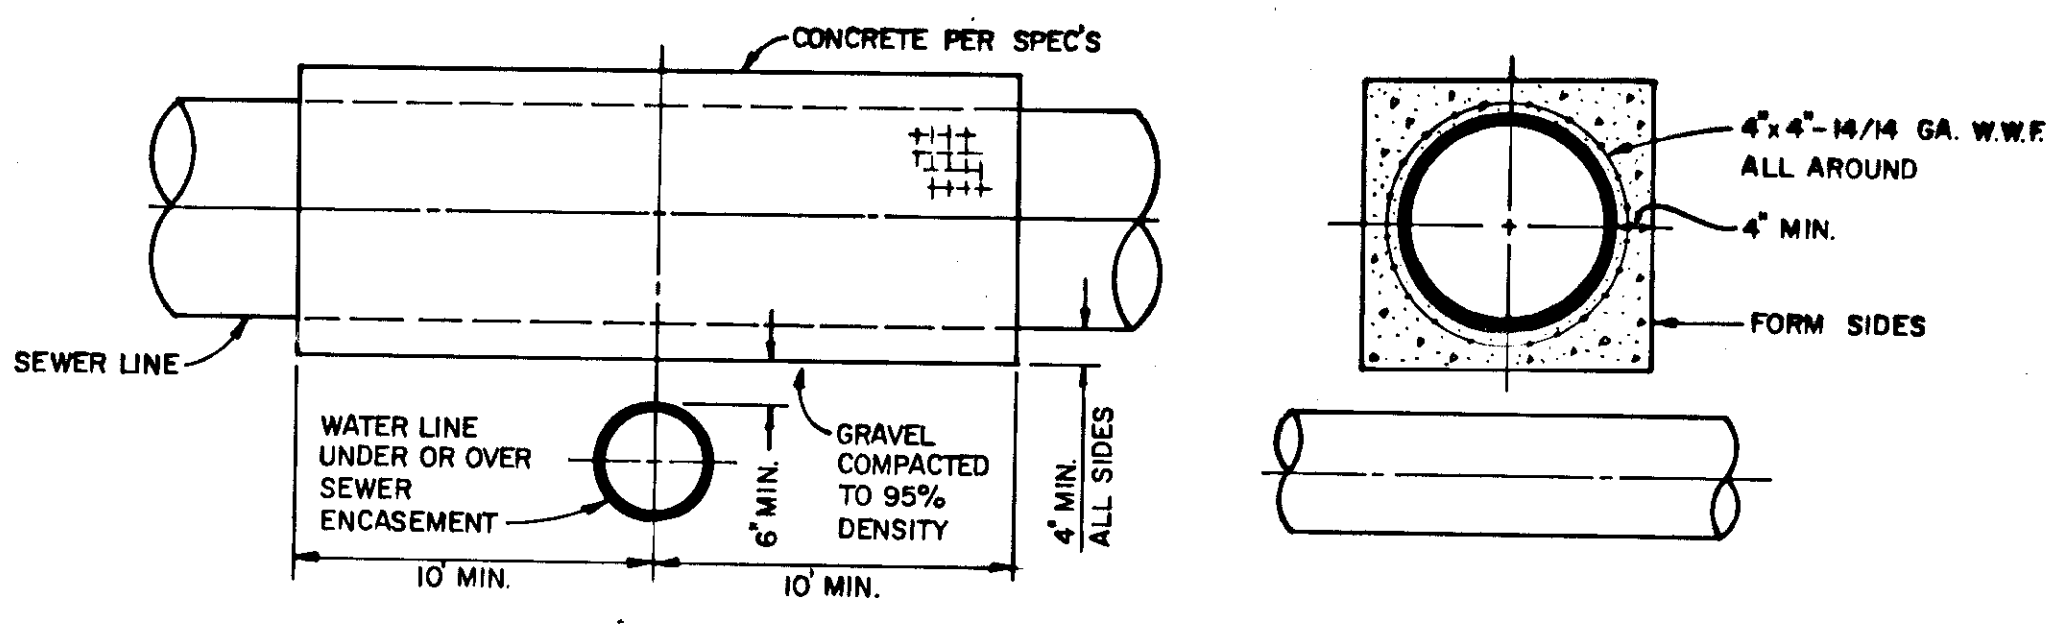

SEWER ENCASEMENT