


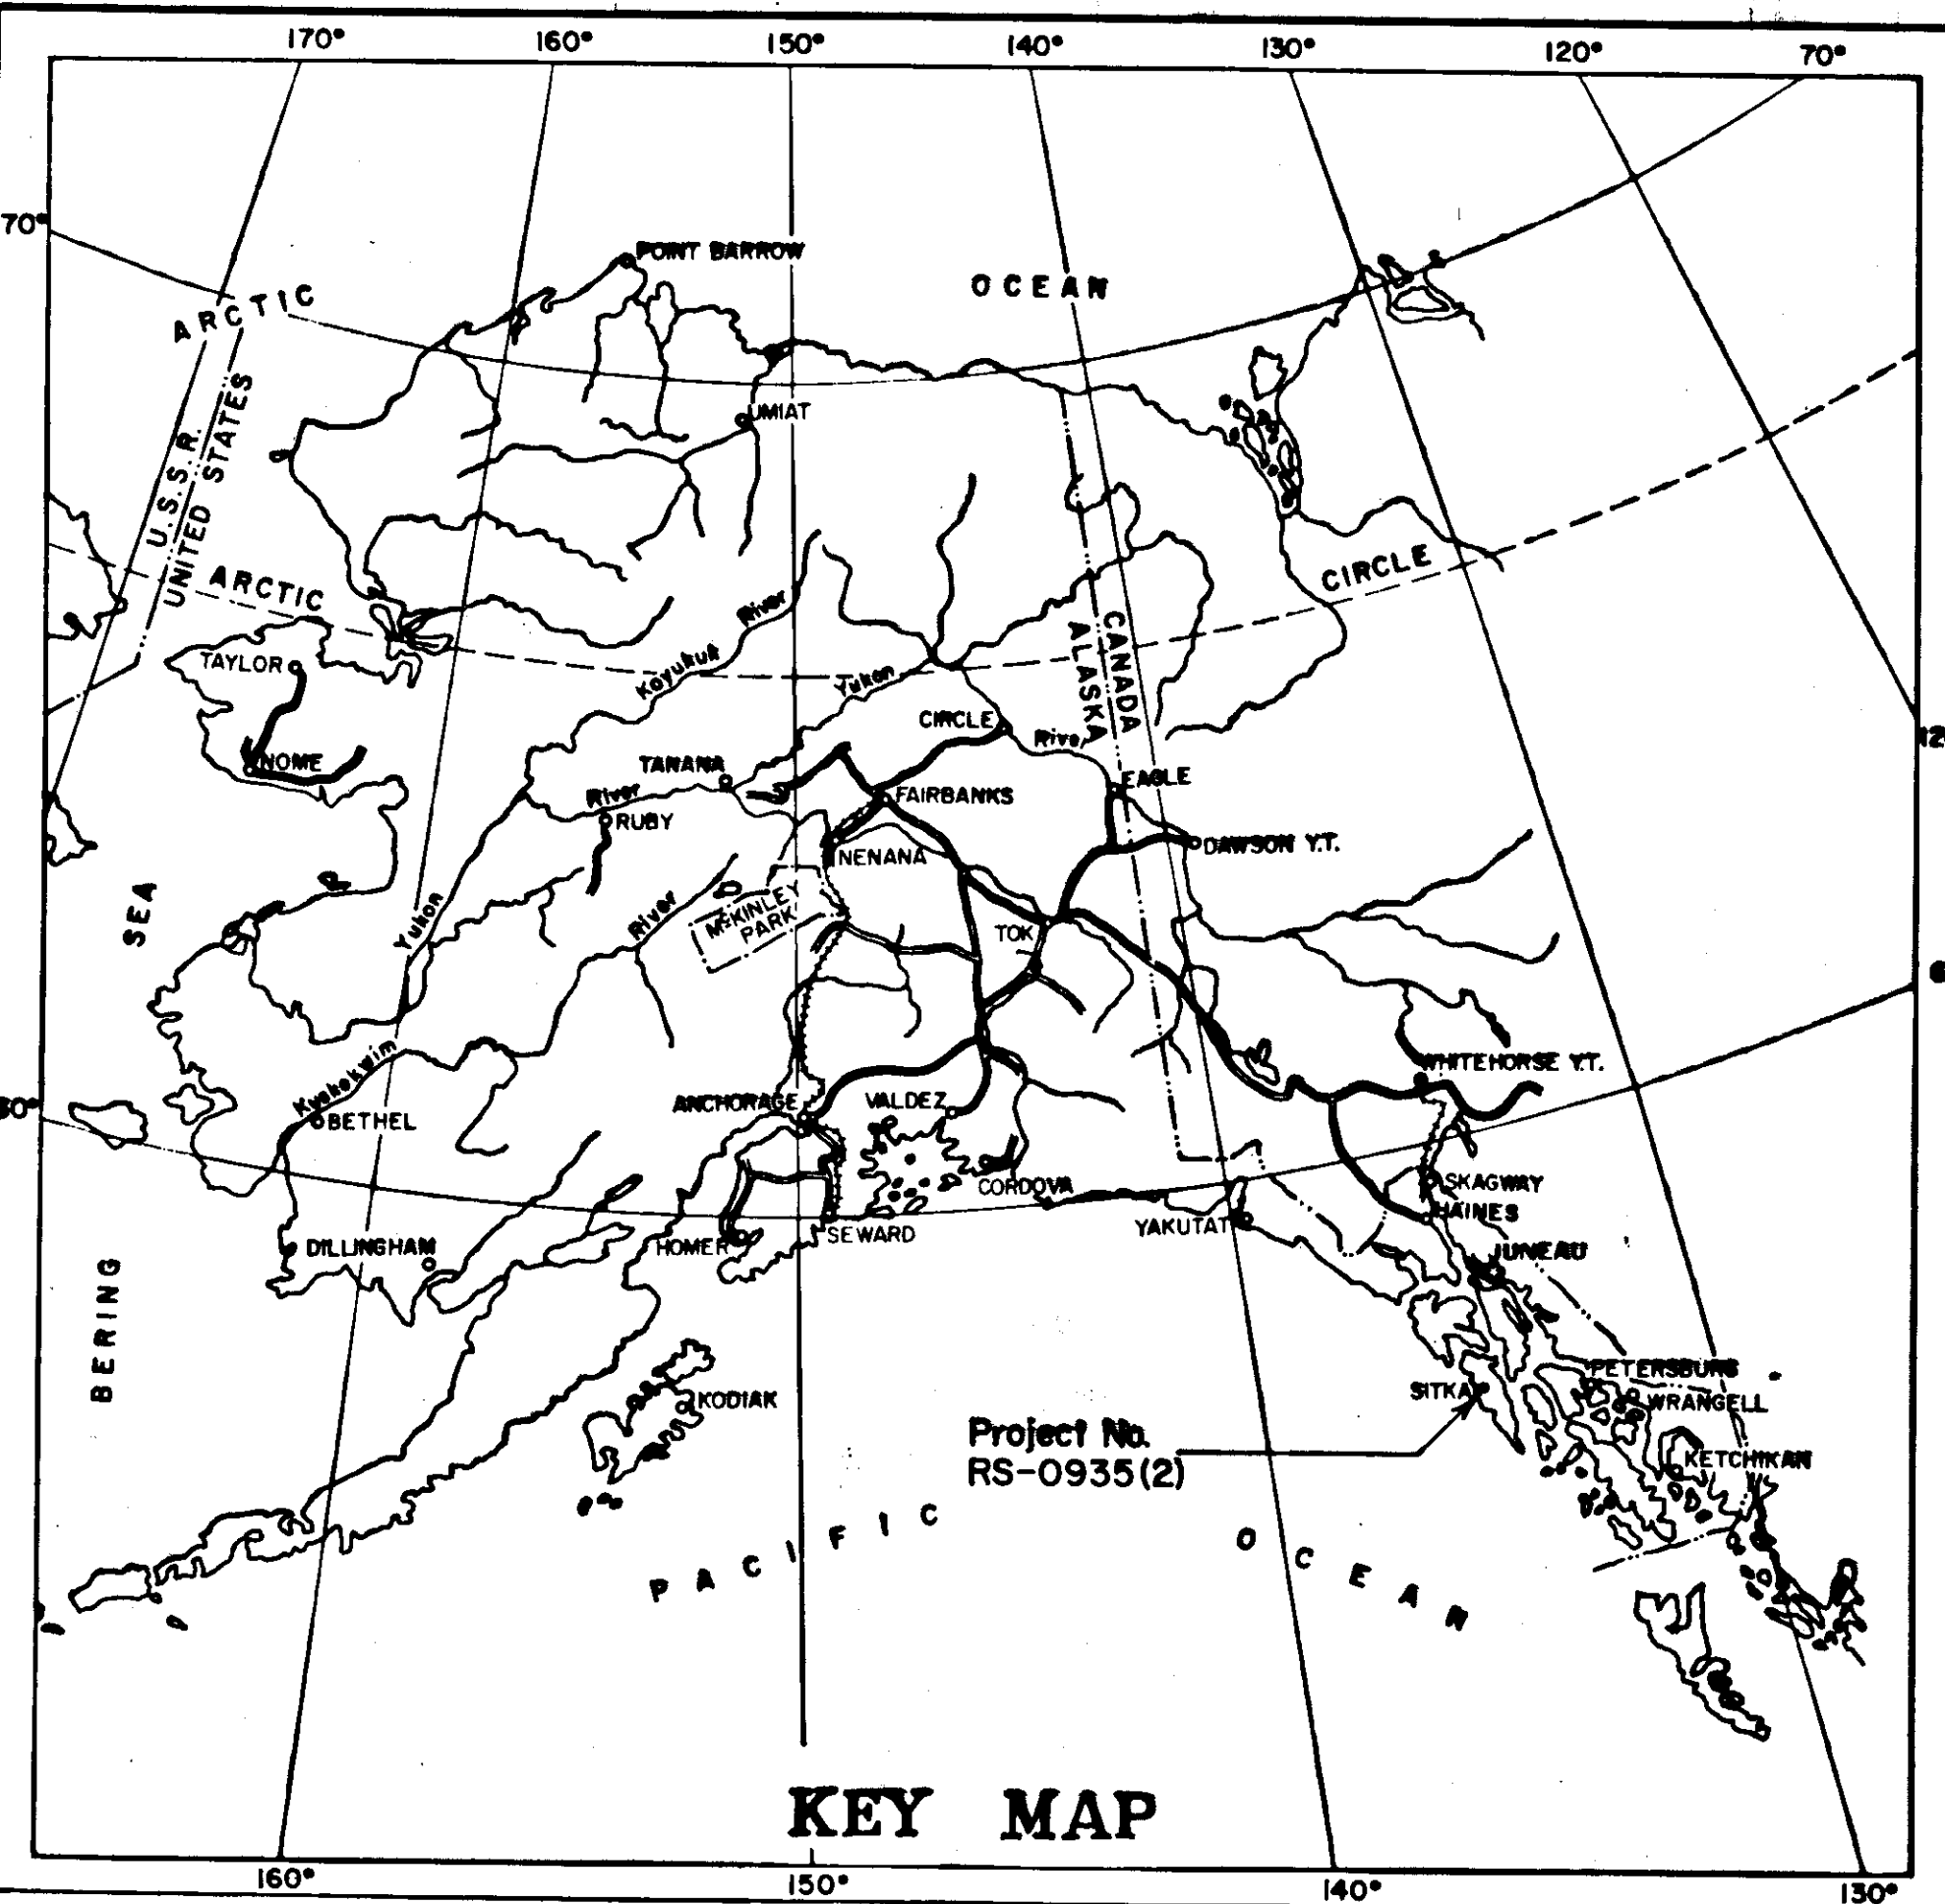

STATE OF ALASKA DEPARTMENT OF HIGHWAYS

PLAN AND PROFILE PROPOSED HIGHWAY PROJECT RS-0935(2) SITKA HALIBUT POINT ROAD CITY LIMITS TO FERRY TERMINAL PAVING AS BUILT

STATE	PROJECT	SHEET NO.
ALASKA	RS-0935 (2)	1

INDEX OF SHEETS


SHEET NO.	DESCRIPTION
1	TITLE SHEET
2	TYPICAL SECTION, ESTIMATE OF QUANTITIES, SUMMARY TABLES, AND DETAILS

The following standard drawings apply to this project: A-1, C-00.03, C-10.00, C-11.01, G-13.00, G-14.01, G-30.02, G-30.13 and M-16.03

DESIGN DESIGNATION

ADT (1977)	=	4050
ADT (1997)	=	8060
DHV (12%)	=	970
D	=	60/40
T	=	5%
V	=	50 M.P.H.

Contractor: AIC
Project Engr: F. DeLand
Work Started: 7-6-77
Work Completed: 9-1-77
Final Contract Amount: 799,483.40

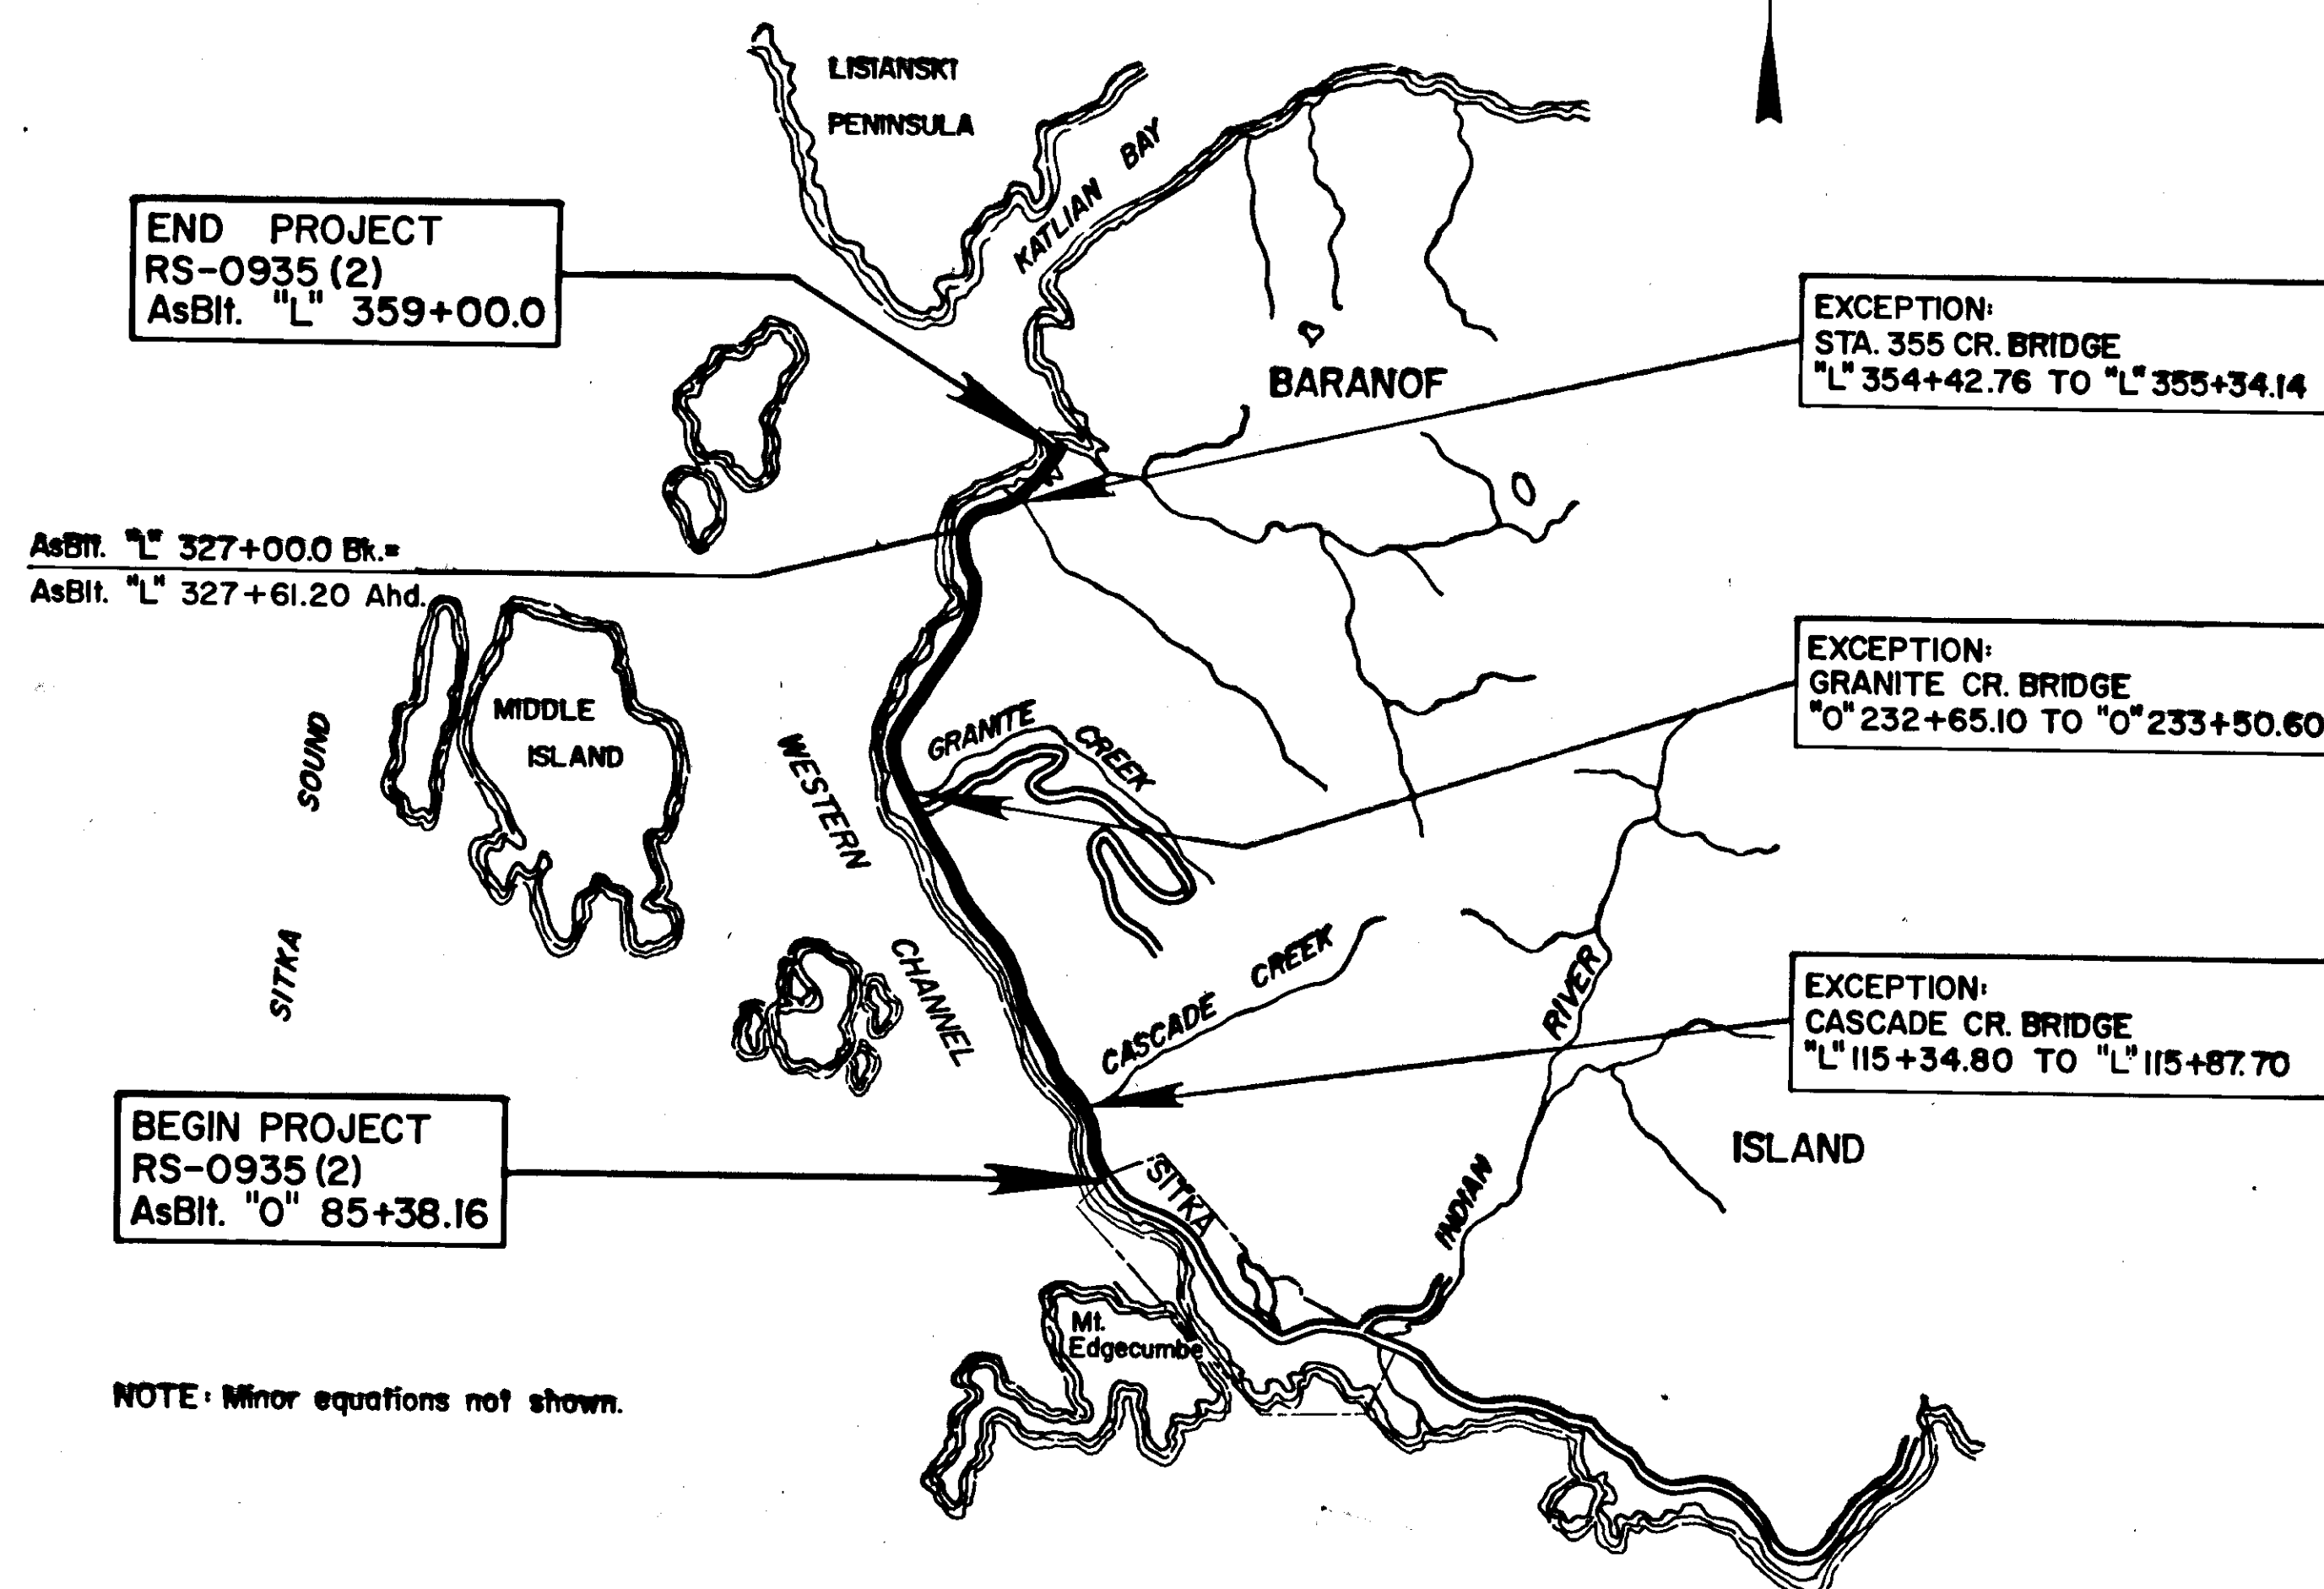

NOTE: Minor equations not shown.

PROJECT SUMMARY

WIDTH OF PAVEMENT	=	36'
LENGTH OF PAVING	=	27,049.31' = 5.123 mi.
LENGTH OF EXCEPTION	=	229.78' = 0.044 mi.
TOTAL LENGTH OF PROJECT	=	27,279.09' = 5.166 mi.

STATE OF ALASKA
DEPARTMENT OF HIGHWAYS

APPROVED
William K. Williams Date 4/18/77
SOUTHEAST DIVISION ENGINEER

STATE OF ALASKA
DEPARTMENT OF HIGHWAYS

APPROVED
F. DeLand Date 12/21/77
COMMISSIONER OF HIGHWAYS

GUARDRAIL INSTALLATION			
FROM		TO	
Station	Offset	Station	Offset
"O" 231 + 90.10	22'-3" Rt.	"O" 232 + 65.10	12' Lt.
"O" 232 + 15.10	20'-3" Lt.	"O" 232 + 65.10	12'
"O" 245 + 75	Lt.	"O" 246 + 75	Lt.
"O" 233 + 50.60	12' Lt.	"O" 234 + 25.60	22'-3" Lt.
"O" 233 + 50.60	12' Rt.	"O" 234 + 00.60	Rt. +
"O" 285 ~	Lt.	"O" 286 ~	Lt.
"L" 353 + 67.76	22'-3" Rt.	"L" 354 + 42.76	12' Rt.
"L" 353 + 92.76	20'-3" Lt.	"L" 354 + 42.76	12' Lt.
"O" 321 + 68	Lt.	"O" 322 + 68	Lt.
"L" 355 + 34.14	12' Rt.	"L" 355 + 84.14	20'-3" Rt.
"L" 355 + 34.14	12' Lt.	"L" 356 + 09.14	Lt. +

+ See Detail this sheet.

GUARDRAIL REMOVAL			
FROM		TO	
Station	Offset	Station	Offset
"O" 232 + 15.10	Lt.	"O" 232 + 65.10	Lt.
"O" 232 + 15.10	Rt.	"O" 232 + 65.10	Rt.
"O" 245 + 75	Lt.	"O" 246 ~	Lt.
"O" 233 + 50.60	Lt.	"O" 234 + 00.60	Lt.
"L" 353 + 80.26	Rt.	"L" 354 + 42.76	Rt.
"O" 285 ~	Lt.	"O" 285 + 25	Lt.
"L" 353 + 92.76	Lt.	"L" 354 + 42.76	Lt.
"L" 355 + 34.14	Lt.	"L" 355 + 84.14	Lt.
"O" 321 + 68	Lt.	"O" 321 + 93	Lt.
"L" 355 + 34.14	Rt.	"L" 355 + 84.14	Rt.


ESTIMATE OF QUANTITIES			
Item No.	Item	Unit	Quantity
1	Furnishing and Maintaining Engineering Facilities	L. S.	All Req'd
110 (1)	Mobilization	L. S.	All Req'd
111 (1)	Temporary Erosion and Pollution Control	C. S.	All Req'd
301 (1)	Crushed Aggregate Base Course	Ton	482
115 (1)	Traffic Maintenance	L. S.	All Req'd
401 (1)	Hot Asphalt Pavement	Ton	11,734
401 (2)	AC-5 Asphalt Cement	Ton	704.0
402 (2)	CSS-1 Emulsified Asphalt for Tack Coat	Ton	30.9
403 (1)	MC-30 Liquid Asphalt for Prime Coat	Ton	36.6
606 (1)	Beam Type Guard Rail, Type I Post	L.F.	500
606 (4)	Removal and Disposal of Guard Rail	L.F.	362.5
614 (3)	Adjust Existing Monuments and Cases	Each	19
401 (4)	Anti-Stripping Additive	C. S.	All Req'd

MONUMENT SUMMARY			
Stationing	Location	Point	Remarks
227+05.71	℄	PT	Adjust
235+12.65	"	PC	"
246+30.52	"	PC	"
251+94.82	"	PC	"
"O" 95+05.14	℄	P.C.	Adjust
"O" 99+41.98	"	P.T.	"
"O" 108+61.05	"	P.C.	"
"O" 113+45.93 Bk=	"	P.T.	"
"L" 113+42.19 Ahd.	"	P.O.T.	"
"O" 137+76.75	"	P.C.	"
"O" 148+89.95	"	P.C.	"
"O" 153+80.79	"	P.T.	"
"O" 159+93.75	"	P.C.	"
"O" 165+26.26	"	P.T.	"
"O" 175+75.09	"	P.C.	"
"O" 185+48.59	"	P.C.	"
"L" 202+68.03	"	P.T.	"
"O" 237+03.04	"	P.T.	"
"O" 261+96.00	7'6" Lt.	----	"
"O" 267+32.92	℄	P.C.	"
"O" 299+84.63	"	P.C.	"
"O" 314+51.05 Bk=	"	P.T.	"
"L" 314+92.86 Ahd.	"	P.O.T.	"
"L" 319+86.79	"	P.C.	"
"L" 324+66.47	"	P.T.	"
144+05.08	"	P.T.	"
160+80.91	"	P.T.	"
202+24	"	P.C.	PROPERTY CORNER
213+08.66	"	P.C.	"
217+23.74	"	P.T.	"
222+78.84	"	P.C.	"

GENERAL NOTES


- All stationing referred to on this project was derived from "As Built" Projects F-099-3 (2) and F-099-3 (6).
- The pavement transition at the existing bridges shall be accomplished by removing approximately 75' of the existing adjacent roadway pavement full depth to a neat line and replacing with new pavement as directed by the engineer. The removal of pavement shall be considered incidental to Item 401(1), Hot Asphalt Pavement.
- The pavement width shall be transitioned from 36' to 24' at the following locations:

Station	Width	to	Station	Width
"O" 231+90.10	36'	to	"O" 232+65.10	24'
"O" 233+50.60	24'	to	"O" 234+25.60	36'
"L" 353+67.76	36'	to	"O" 354+42+76	24'
"L" 355+34.14	24'	to	"O" 356+09.14	36'
- All approaches and intersections shall be paved as detailed on this sheet.
- Any excavation required shall be considered incidental to item 301(1), Crushed Aggregate Base Course.
- The pavement transition at the B.O.P. shall be in the form of a butt joint as detailed below. 25' of existing roadway pavement shall be removed and this removal of pavement shall be considered incidental to 401 (1) Hot Asphalt Pavement.

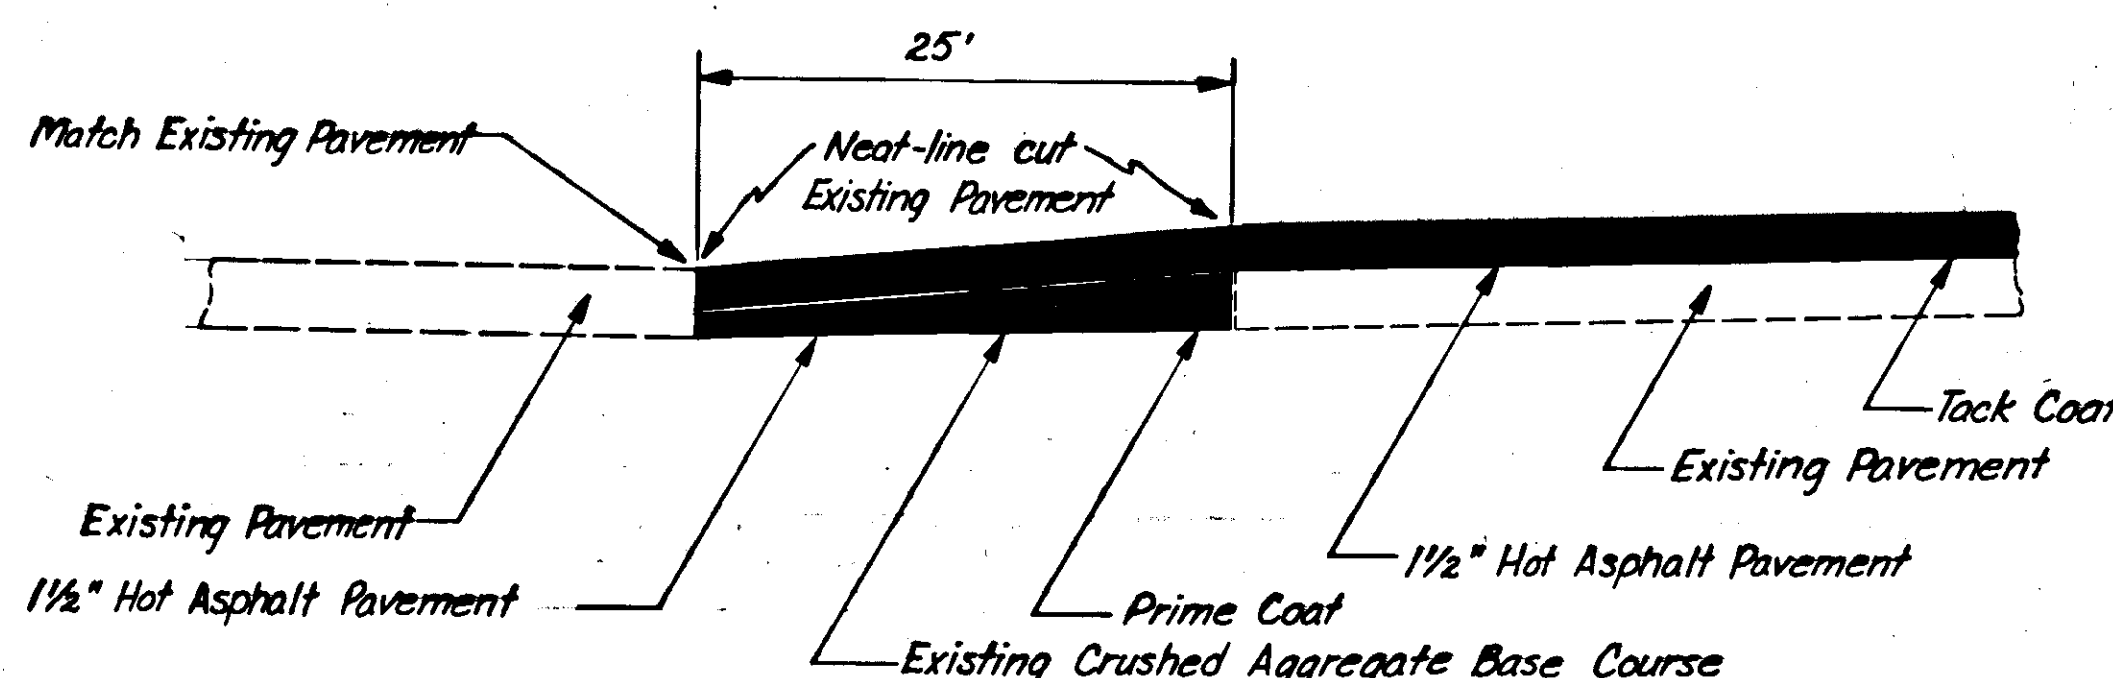


PAVEMENT TRANSITION DETAIL

BASIS OF ESTIMATE	
Item No.	Estimating Factor
301 (1)	1.96 Tons Per Cu. Yard
401 (1)	112lbs. per Sq. Yd. Inch Depth
401 (2)	6% of Item 401 (1)
402 (2)	0.10 gals. per Sq. Yd. / 253 gals. per Ton
403 (1)	0.25 gals. per Sq. Yd. / 256 gals per Ton

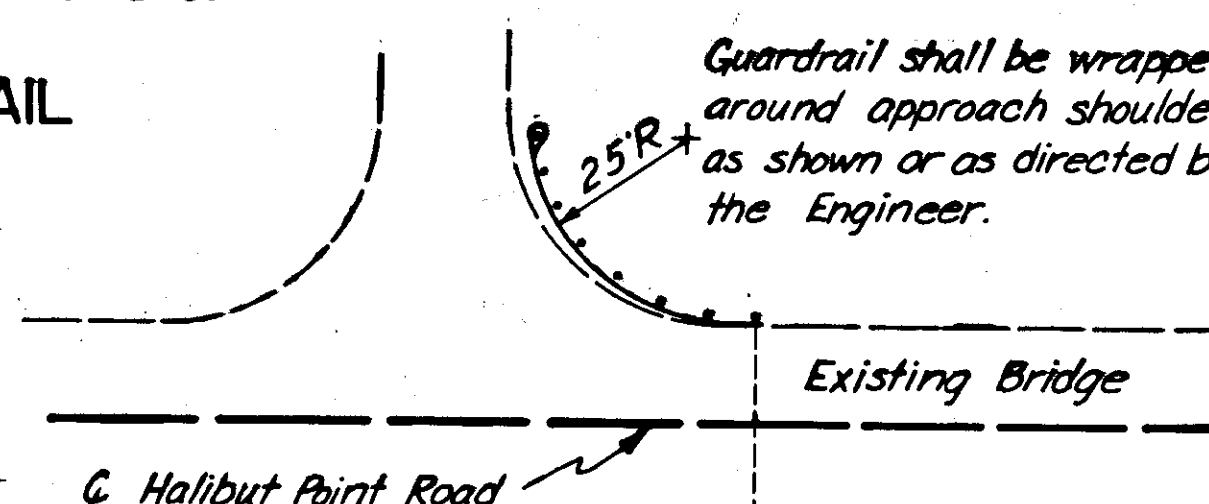


GUARDRAIL LOCATION DETAIL

Sta. "O" 233+50.60 Rt. to Sta. "O" 234+00.60 Rt.
and
Sta. "L" 355+34.14 Lt. to Sta. "O" 356+09.14 Lt.

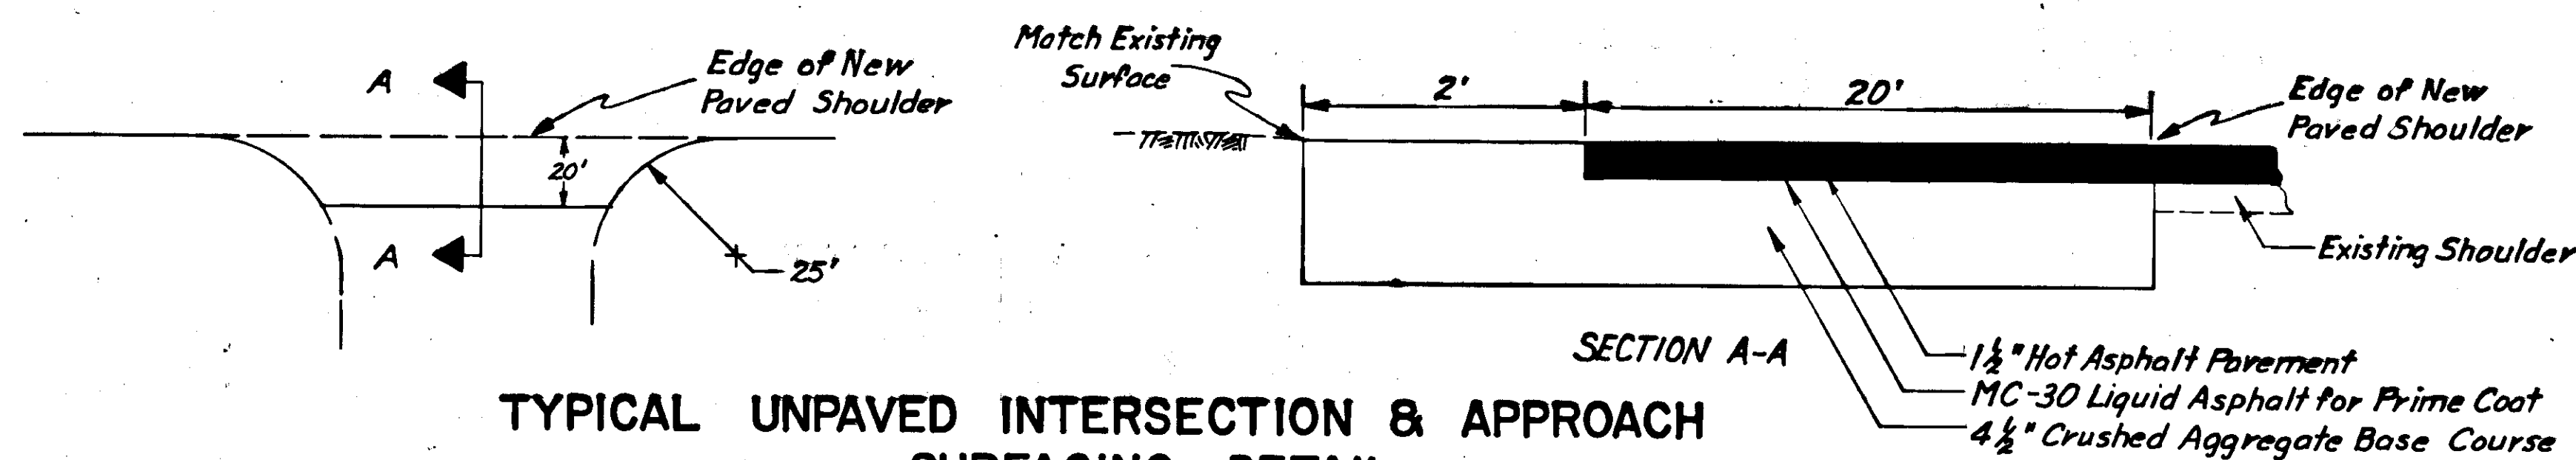

TYPICAL UNPAVED INTERSECTION & APPROACH SURFACING DETAIL

(See General Note #5)

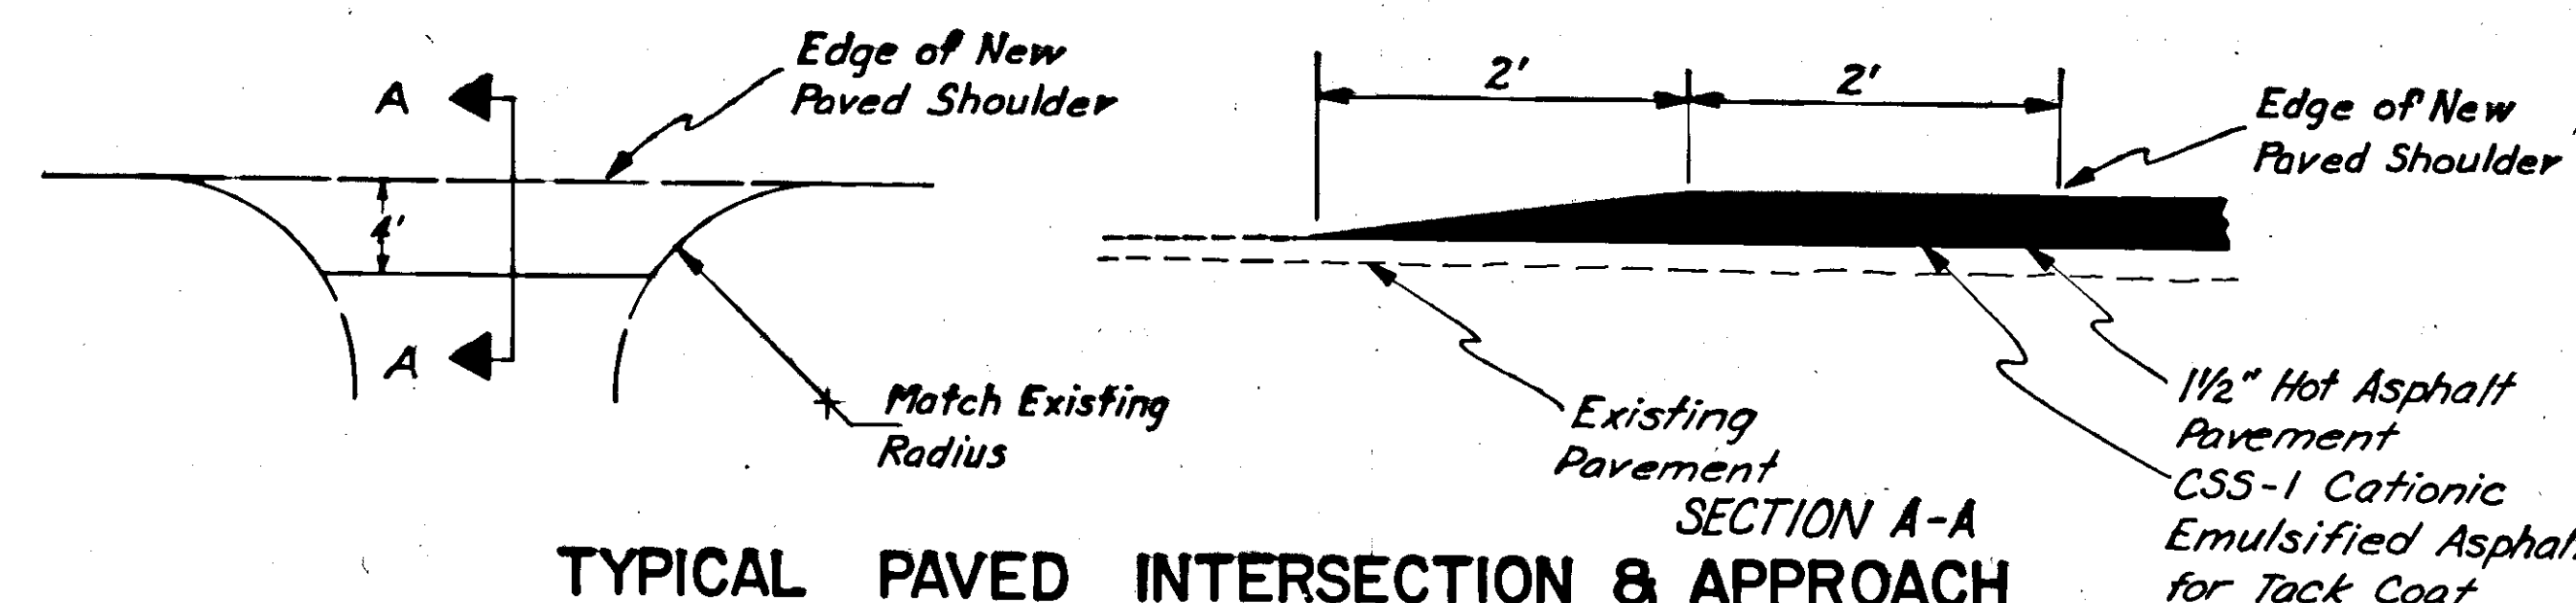

TYPICAL PAVED INTERSECTION & APPROACH SURFACING DETAIL