


FILE G:\SIT\SFH00064\PlanSet\SFH00064\_SIT\_A1.dwg  
 DATE 8/12/2019 14:44 LAYOUT A1  
 DESIGNED ###  
 CHECKED ###  
 DRAFTED ###

# STATE OF ALASKA

## DEPARTMENT OF TRANSPORTATION & PUBLIC FACILITIES

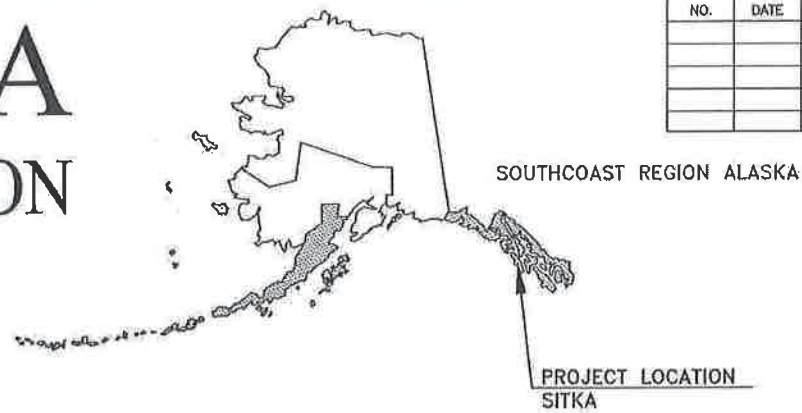

NO.	DATE	REVISIONS	STATE	PROJECT DESIGNATION	YEAR	SHEET NO.	TOTAL SHEETS
			ALASKA	0933046/SFH00064	2019	A1	7
CDS ROUTE: 295500					MILEPOINT: 0.44 TO 1.14		
LATITUDE: 57°03'60"N					LONGITUDE: 135°18'53"W		

### PROPOSED HIGHWAY PROJECT


## SITKA SAWMILL CREEK ROAD RESURFACE: JEFF DAVIS TO SMITH STREET PROJECT NO. NH-0933046/SFH00064

PAVING, SIGNING, STRIPING

DESIGN DESIGNATION - SFH00064	
PROJECT TYPE	PM
FUNCTIONAL CLASS	MAJOR COLLECTOR
ADT (2019)	8767
ADT (2024)	8877
DHV (2019)	930
DHV (2024)	940
PERCENT TRUCKS (T)	6.9%
DIRECTIONAL DISTRIBUTION (D)	52/48
DESIGN SPEED (V)	35 MPH
DESIGN VEHICLE	WB-50
DESIGN EAL'S	500,000

INDEX OF SHEETS	
SHEET NO.	DESCRIPTION
A1	TITLE SHEET
A2	LAYOUT & INDEX OF SHEETS
A3	LEGEND & SYMBOLS
A4-A7	SURVEY CONTROL
B1-B2	TYPICAL SECTIONS
C1	ESTIMATE OF QUANTITIES
D1	SUMMARY TABLES
E1-E3	MESCELLANEOUS DETAILS
F1-F5	PLAN & PROFILE
G1-G2	GRADING PLAN
H1-H5	SIGNING & STRIPING, ILLUMINATION
N1-N2	BRIDGE PLANS
Q1-Q4	EROSION & SEDIMENT CONTROL PLAN
T1-T3	TRAFFIC CONTROL
U1-U2	UTILITIES

PROJECT SUMMARY	
WIDTH OF PAVEMENT	30' TO 42'
LENGTH OF PAVING	0.64 MILE
LENGTH OF PROJECT	0.64 MILE

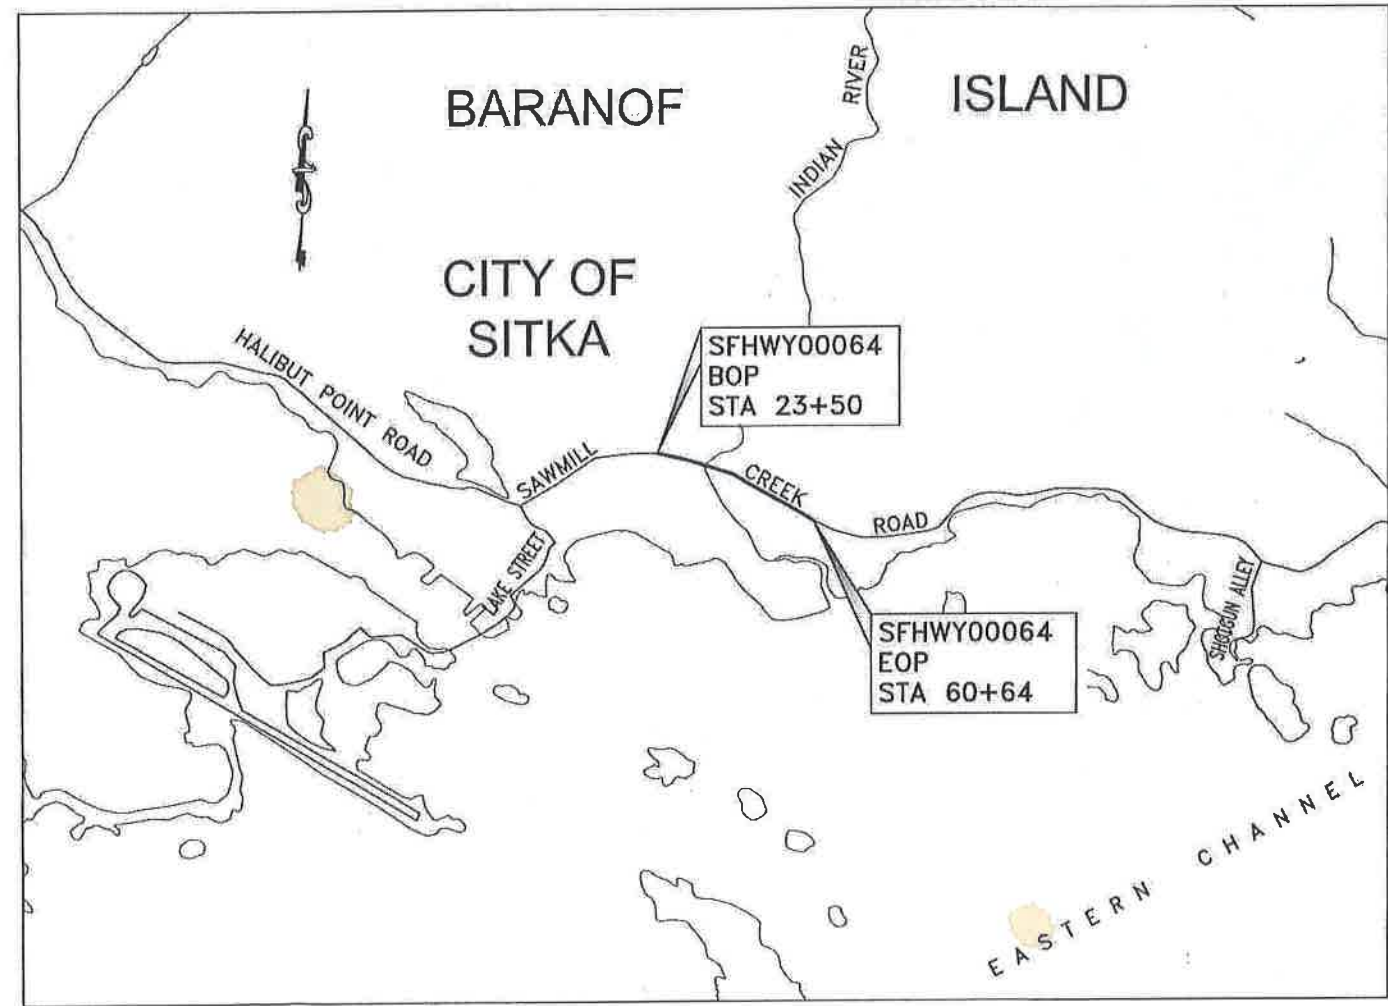

VICINITY MAP

The undersigned hereby certifies that this duplicated document is an exact and true copy of the original.

*Jessica Pukale*

March 20, 2020

AS-BUILTS

Contractor - SECON

Project Engineer - Valerie Bean

Begin Date - July 7, 2020

End Date - Sept 15, 2020

USE THESE PLANS IN CONJUNCTION WITH THE STATE OF ALASKA STANDARD SPECIFICATIONS FOR HIGHWAY CONSTRUCTION, 2017 EDITION AND THE PROJECT SPECIAL PROVISIONS.

STATE OF ALASKA  
DEPARTMENT OF TRANSPORTATION & PUBLIC FACILITIES  
6860 GLACIER HIGHWAY, JUNEAU, AK 99801  
(907) 465-1763

APPROVED: *[Signature]* 8/13/19  
L. PAT CARROLL, P.E.  
REGIONAL PRECONSTRUCTION ENGINEER  
DATE


CONCUR: *[Signature]* 13 Aug 2019  
D. LANCE MEARIG, P.E.  
DIRECTOR, SOUTHCOAST REGION  
DATE

FILE C:\SIT\SFH00064\PlanSet\SFH00064\_SIT\_A2.dwg  
 DATE 8/9/2019 15:39 LAYOUT A2 DESIGNED C.I. CHECKED BP DRAFTED JT, RG

NO.	DATE	REVISION	STATE	PROJECT DESIGNATION	YEAR	SHEET NO.	TOTAL SHEETS
			ALASKA	0933046/SFH00064	2019	A2	7


**GENERAL NOTES:**

1. MAKE ALL PAVEMENT CUTS CLEAN, VERTICAL, AND TRUE TO THE REMOVAL LIMITS SHOWN ON THE PLANS.

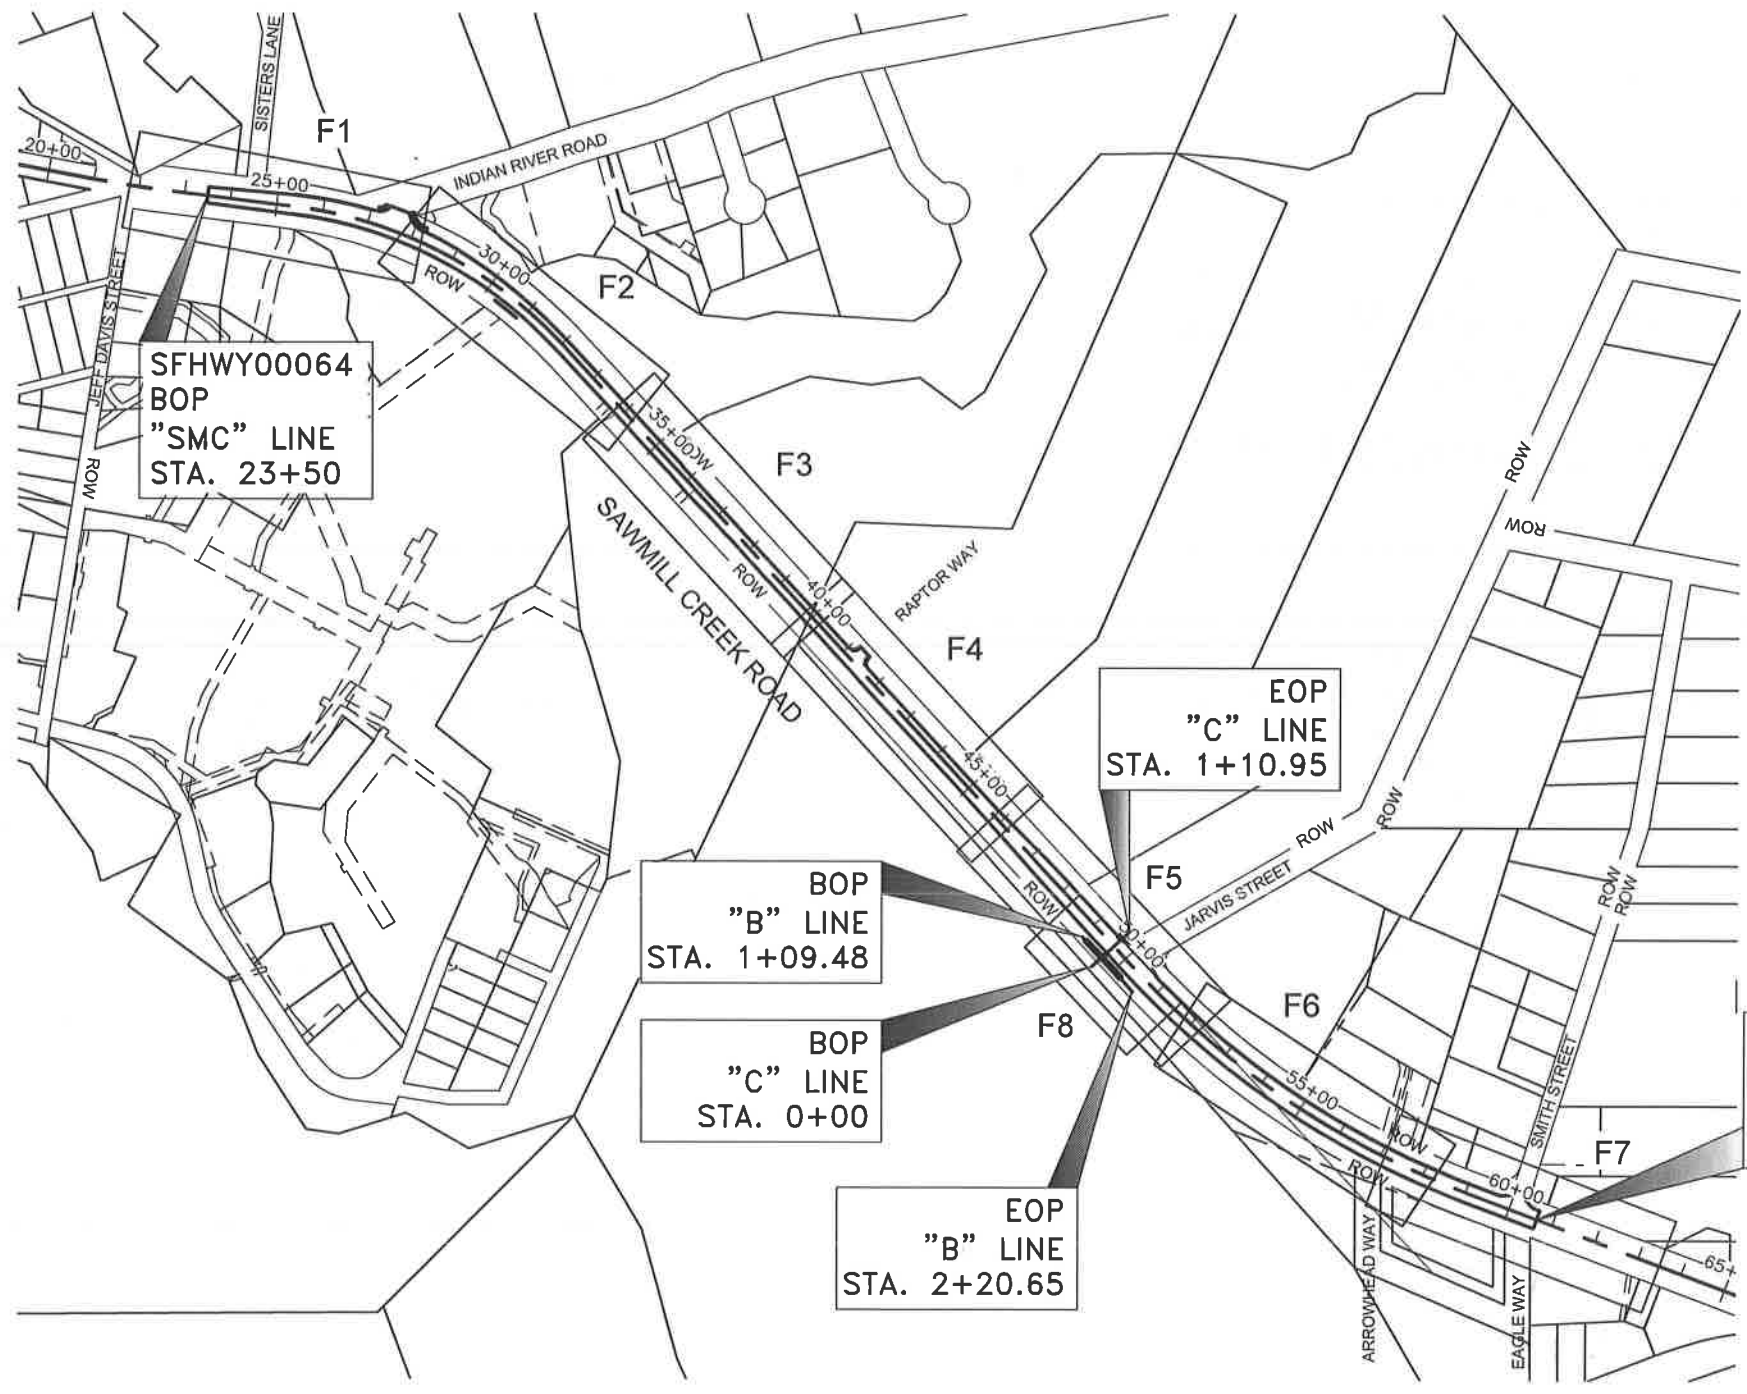

**THE FOLLOWING STANDARD PLANS APPLY TO THIS PROJECT:**

C-04.12	G-00.04	M-13.01	T-06.00
C-05.20	G-05.11S	M-16.01	T-20.04
	G-05.11W		T-21.03
D-22.01	G-20.12	S-00.11	T-22.04
D-24.00	G-31.01	S-01.01	T-23.00
D-26.04		S-05.01	
	I-21.11	S-20.10	
	I-81.00	S-23.00	
		S-30.04	
		S-31.01	

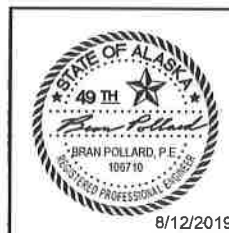

STATE OF ALASKA DEPARTMENT OF TRANSPORTATION  
 AND PUBLIC FACILITIES  
 6860 GLACIER HIGHWAY, JUNEAU, AK 99801  
 (907) 465-1763  
**SITKA SAWMILL CREEK  
 ROAD RESURFACE:  
 JEFF DAVIS TO SMITH STREET**  
 LAYOUT & INDEX OF SHEETS

8/12/2019

FILE Q:\SIT\SFHWY00064\PlanSet\SFHWY00064\_SIT\_A3.dwg  
 DATE 8/9/2019 15:39 LAYOUT A3  
 DESIGNED C.I.  
 CHECKED BP  
 DRAFTED JT, RG

NO.	DATE	REVISION	STATE	PROJECT DESIGNATION	YEAR	SHEET NO.	TOTAL SHEETS
			ALASKA	0933046/SFH00064	2019	A3	7

	RECOVERED	SET
BLM MONUMENT		
GLO MONUMENT		
USC&GS MONUMENT		
PRIMARY MONUMENT		
CENTERLINE MONUMENT IN CASING		
PRIMARY R.O.W. MONUMENT		
BEARING OBJECT		
MISCELLANEOUS MONUMENT		
LINE OF SIGHT MONUMENT		
CONCRETE R.O.W. MONUMENT		
BENCHMARK		
REBAR AND CAP		
REBAR		
IRON PIPE		
PK NAIL		
SPIKE		
HUB AND TACK		
CONSTRUCTION CENTERLINE		
MICELLANEOUS CENTERLINE		
STATION EQUATION		
PROJECT RIGHT-OF-WAY LINE		
EXISTING RIGHT-OF-WAY LINE		
EXISTING PROPERTY LINE		
CONTROLLED ACCESS LINE		
EXISTING EASEMENT LINE		
PROPOSED EASEMENT LINE		
PROPOSED CUT SLOPE LIMIT		
PROPOSED FILL SLOPE LIMIT		
SECTION LINE		
1/4 SECTION LINE		
1/16 SECTION LINE		
TOWNSHIP & RANGE LINE		
MEANDER LINE		

	EXISTING	PROPOSED
SANITARY SEWER (FLOW DIRECTION →)		
FUEL LINE		
GAS LINE		
WATER LINE		
METER, VALVE, FIRE HYDRANT		
EXISTING STORM DRAIN (FLOW DIRECTION →)		
PROPOSED STORM DRAIN		
FIBER OPTIC LINE		
DIRECT BURIAL TELEPHONE CABLE		
DIRECT BURIAL ELECTRIC CABLE		
ELECTRIC LINE (OVERHEAD)		
POWER POLE LINE		
JOINT USE POWER & TELEPHONE		
TELEPHONE POLE LINE		
POLE ANCHOR		
STUB POLE (POWER OR TELEPHONE)		
TELEPHONE DUCT		
TELEPHONE PEDESTAL		
BURIED CABLE MARKER		
PIPELINE MARKER OR VALVE		
CATCH BASIN OR DROP INLET		
MANHOLE		
SANITARY SEWER CLEAN OUT		
RIPRAP		
SPECIAL DITCH CENTERLINE		
HIGH TIDE LINE		

	EXISTING	PROPOSED
ROADWAY/PAVEMENT EDGE		
FENCE		
CURB AND GUTTER		
DETECTABLE WARNINGS		
GUARDRAIL		
CULVERT PIPE		
SIGN		
MAILBOX		
RAILROAD TRACKS		
RAILROAD DEVICES		
TREE LINE		
WATER BOUNDARY		
ORDINARY HIGH WATER LINE		
FLOW CENTERLINE		
FLOW DIRECTION		
WETLANDS		
EXISTING BUILDINGS		
POST OR BOLLARD		
WELL OR MONITORING WELL		
SEPTIC PIPE		
FUEL TANK FILL PIPE/VENT		
SATELLITE DISH		
TEST HOLE		
CONIFER TREE		
DECIDUOUS TREE		
GRAVE		
THERMOSIPHON		
PARKING METER		
VEHICLE PLUG-IN		
DELINEATOR/GUIDE MARKER		

	EXISTING	PROPOSED
JUNCTION BOX, TYPE IA		
JUNCTION BOX, TYPE II		
JUNCTION BOX, TYPE III		
SIGNAL FACE, VEHICULAR		
SIGNAL FACE, BACKPLATE		
SIGNAL FACE, LEFT TURN, BACKPLATE		
SIGNAL FACE, PEDESTRIAN		
LOOP DETECTOR		
VIDEO DETECTOR		
RADAR DETECTOR		
OPTICOM DETECTOR		
PEDESTRIAN PUSH BUTTON		
SIGNAL POST W/O MAST ARM		
SIGNAL POLE W/MAST ARM		
SIGNAL CONTROLLER		
LOAD CENTER		
LUMINAIRE		
RIGID METAL CONDUIT		

- H = HOUSE
- G = GARAGE
- M = MERCHANT/STORE
- B = BARN
- S = SHED
- P = PRIVY
- SS = SERVICE STATION
- W = WAREHOUSE

Record Drawings have been reviewed by the Project Engineer, and represent to the best of my knowledge, the project as constructed.  
 PE Date 10.25.20



STATE OF ALASKA DEPARTMENT OF TRANSPORTATION AND PUBLIC FACILITIES  
 6860 GLACIER HIGHWAY, JUNEAU, AK 99801  
 (907) 465-1763  
 SITKA SAWMILL CREEK ROAD RESURFACE:  
 JEFF DAVIS TO SMITH STREET  
 8/12/2019  
 LEGEND & SYMBOLS

DRAWING LOCATION: Q:\S1\68100\5\AC\BASEMAPS\68100\_SMC\_SC5.CWG  
 DATE: 8/7/2019 10:42  
 LAYOUT: A4  
 SCALE:  
 SHEETS:  
 DESIGNER: J. PAROL  
 CHECKER: J. PAROL  
 DRAFTER: J. PAROL

NO.	DATE	REVISION	STATE	PROJECT DESIGNATION	YEAR	SHEET NO.	TOTAL SHEETS
			ALASKA	Z68100\SFHWY00064	2019	A4	7

SEGMENT	STATION	NORTHING	EASTING	STATION	RADIUS	LENGTH	DELTA
C1	-0+00.00	302232.58	505819.76	1+36.84	1056.67	136.84	7°25'12"
L1	1+36.84	302275.31	505949.66	3+00.00			
L2	3+00.00	302310.55	506108.97	14+68.89			
L3	14+68.89	302590.16	507243.92	15+67.71			
C2	15+67.71	302615.49	507339.44	16+83.46	250.00	115.75	26°31'42"
L4	16+83.46	302618.68	507454.12	17+82.47			
L5	17+82.47	302598.65	507551.08	21+04.03			
C3	21+04.03	302540.14	507867.28	22+37.85	2245.00	133.82	3°24'55"
L6	22+37.85	302519.73	507999.51	25+36.23			
C4	25+36.23	302483.03	508295.62	32+11.12	960.00	674.89	40°16'47"
L7	32+11.12	302180.78	508883.56	50+13.69			
C5	50+13.69	300855.05	510104.91	59+15.46	1919.57	901.77	26°54'59"
L8	59+15.46	300356.85	510846.63	73+52.07			
C6	73+52.07	299855.38	512192.87	77+62.97	450.00	410.90	52°19'02"
L9	77+62.97	299894.98	512587.67	79+97.40			

COORDINATES LISTED ABOVE HOLD OVER DISTANCE AND BEARING

Point #	Northing	Easting	Elevation	Description
10	302789.08	505104.62	45.42	GPS_BC2"
41	302209.04	505884.62	34.53	ALCAP2" SET
50	302478.67	508560.37	60.54	ALCAP2" SMC-3
51	300835.42	510092.18	25.43	ALCAP2"
1500	300818.04	510096.21	23.65	ALCAP_FND_DOT/PF-SMC6
1501	300476.57	510495.08	27.64	ALCAP2" FND_DOT/PF-HP-19

**ALL SURVEY CONTROL MONUMENTS IN THIS TABLE ARE PROVIDED STRICTLY FOR SURVEY CONTROL. SHOULD ANY OF THEM BE DESTROYED DURING CONSTRUCTION THEY SHALL NOT BE REPLACED.**

**HORIZONTAL CONTROL**

BASIS OF HORIZONTAL CONTROL IS NGS STATION "BM-16", A "B" ORDER NGS STATION LOCATED ON THE PIONEERS HOME GROUNDS AND STAMPED "16 1941" NAD83 (1992)  
 N 57°02'59.71512"  
 W 135°20'20.43691"

"SIT C" IS A "FIRST" ORDER NGS STATION IS LOCATED AT THE LOCATED AT THE SITKA ROCKY GUTIERREZ AIRPORT ON JAPONSKI ISLAND AND STAMPED "SIT C 1999" AND WAS TIED FOR INCLUSION OF THE SITKA LOCAL GRID OF 2000 AS BELOW.  
 NAD83 (1992)  
 N 57°02'49.63882"  
 W 135°21'50.40083"

**DOT/PF SITKA 2000 LOCAL GRID**  
 TRANSLATION PARAMETERS ABOUT NGS STATION "SIT C"  
 SCALE FACTOR= 0.9999755100  
 CONVERGENCE ANGLE FROM GEODETIC NORTH= -1°25'39.4"


NAD83 AKSPC ZONE 1  
 NORTH = 1,908,220.83 FT US  
 EAST = 2,348,010.11 FT US

SITKA 2000 LOCAL GRID  
 NORTH = 300,000.00 FT US  
 EAST = 500,000.00 FT US

**VERTICAL CONTROL:**  
 MLLW BASED ON NOAA TIDAL BENCHMARK SERIES 9451600. NOS MONUMENT BM-16 IS 20.36' ABOVE MLLW ON THE 1960-1978 TIDAL EPOCH AS PUBLISHED 10/31/1984.

**MONUMENT NOTES:**

- IF ANY PAIR OF CONTROL POINTS DISAGREES FROM PUBLISHED VALUE BY MORE THAN 1:10,000 HORIZONTALLY OR VERTICALLY THEN A THIRD NETWORK POINT MUST BE TIED TO ASCERTAIN WHICH POINT IS IN ERROR OR HAS BEEN DISTURBED.
- WHETHER LISTED OR NOT, ALL PROPERTY MONUMENTS, OR PROPERTY MARKERS, CORNERS OR ACCESSORIES WHICH WILL BE DISTURBED OR BURIED SHALL BE REFERENCED PRIOR TO BEING DISTURBED, AND RE-ESTABLISHED IN THEIR ORIGINAL HORIZONTAL POSITION AND A RECORD OF MONUMENT FORM IN ACCORDANCE WITH (A.S.34.65.040) AND (A.S.19.10.260) SHALL BE SUBMITTED TO THE CONSTRUCTION ENGINEER FOR REVIEW PRIOR TO RECORDING. COORDINATE VALUES LISTED ARE FOR INFORMATIONAL PURPOSES AND SHOULD BE USED TO RESET MONUMENTS ONLY AS A LAST RESORT.
- RIGHT OF WAY LOCATION IS SHOWN FOR GRAPHICAL ORIENTATION PURPOSES ONLY. REFER TO ALASKA DOT&PF RIGHT OF WAY MAPS FOR RIGHT OF WAY INFORMATION.
- HORIZONTAL AND VERTICAL CONTROL MUST BE FIELD VERIFIED BY THE CONTRACTOR. DISCREPANCIES WILL BE REPORTED TO DOT&PF CONSTRUCTION PROJECT ENGINEER.

Record Drawings have been reviewed by the Project Engineer, and represent to the best of my knowledge, the project as constructed.  
 PE  Date 10.23.20

**PROJECT SPECIFIC BASIS OF HORIZONTAL CONTROL**


PROJECT BASIS OF BEARING IS N 88°12'43" E FROM DOT CONTROL POINT #1 TO DOT CONTROL POINT #2.

#1 : A NGS DISK LOCATED ON THE PIONEERS HOME GROUNDS AND STAMPED "16 1941"

SIT2000	N 301023.53'	E 504975.91'
AKSPC	N 1909120.06'	E 2353009.85'

#2 : 2" BRASS CAP LOCATED WEST OF NEW POWER PLANT AND STAMPED "SMC-2"

SIT2000	N 301181.00'	E 510020.19'
AKSPC	N 1909151.80'	E 2358056.36'

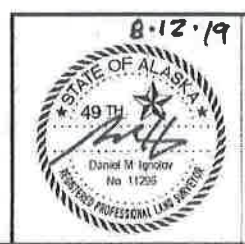

STATE OF ALASKA  
 DEPARTMENT OF TRANSPORTATION  
 AND PUBLIC FACILITIES  
 6800 Glacier Highway, Juneau, AK 99801  
 (907) 465-1763  
 SAWMILL CREEK ROAD RESURFACE & PEDESTRIAN IMPROVEMENTS  
 ROUNDABOUT TO SMITH STREET  
 PROJECT NO. NH-0933046/Z68100  
 PROJECT NO. NH-0933046/SFHWY00064  
 SURVEY CONTROL

DESIGNED: J. PARSONS  
 CHECKED: J. PARSONS  
 DRAFTER: J. PARSONS  
 XREFS  
 SCALE  
 LAYOUT: AS  
 DATE: TIME: 2/4/2020 10:18  
 DRAWING LOCATION: D:\S\1\B\00\5\A\3\BASEMAPS\68100\_SMC\_SCS\_020320.dwg

EXISTING PROPERTY MONUMENTS					
Point #	Northing	Easting	Description	Station	Offset
1419	302235.13	506314.07	ALCAP1.5" LS6304	4+81.09	122.27R
1424	300994.22	509908.94	ALCAP1.5" LS6304	47+78.55	49.83R
1425	300817.45	510071.74	ALCAP1.5" LS6304	50+18.74	49.88R
1427	300877.04	510181.02	BC3.25" BLM	50+50.44	70.54L
1429	302542.41	508235.70	ALCAP1.5" LS-6304	24+69.47	51.60L
1430	302507.52	508430.31	ALCAP1.5" LS-6304	26+60.85	49.39L
1432	302433.07	508296.32	ALCAP1.5" LS-6304	25+43.45	49.43R
1433	302465.56	508571.86	ALCAP1.5" 3337-S	28+00.90	55.00L
1434	302332.58	508796.76	ALCAP1.5" 3337-S	30+48.88	53.46L
1435	302027.84	508955.72	ALCAP3.25" LS-6304	33+72.49	50.55R
1436	302077.28	508910.28	BC3"-BPR-16+75.39	33+05.34	50.47R
1437	302268.00	508707.85	ALCAP1.5" LS-6304	30+16.19	51.46R
1438	301652.25	509437.69	BC3"-BPR-23+94.70	39+75.29	49.43L
1439	301899.47	509075.12	ALCAP1.5" LS-6304	35+47.80	49.72R
1440	301543.20	509386.04	BC3.25" DOI	40+20.50	62.45R
1441	301555.14	509391.73	ALCAP3.25" LS-6304	40+15.57	50.16R
1442	301992.61	509124.56	ALCAP1.5" LS13321	35+12.81	49.75L
1443	301303.28	509759.84	BC2.5" ROW-TR4A1-TR4A2-C10	44+50.22	49.91L
1444	300599.12	510478.90	SPINHOLE_REBAR-NO-CAP	54+71.15	48.78L
1445	300457.52	510732.37	ALCAP_LS3650	57+69.37	49.03L
1446	300414.68	510833.08	SPINHOLE_REBAR-NO-CAP	58+81.71	49.17L
1447	300375.05	510937.26	ALCAP_LS3650	59+94.04	48.69L
1448	300458.75	510964.12	ALCAP	59+89.99	136.50L
1449	300256.15	510969.48	ALCAP_LS6304	60+65.74	51.48R
1450	300374.63	510673.80	SPIKE_SQUARE-HEAD	57+51.44	50.86R
1451	302792.89	507974.21	BC_3" USACE_WC-3.0-N465040W	21+71.21	267.15L
1452	302653.79	508182.79	BC_3" COR-7 MARKINGS MISSING	24+03.27	155.63L
1453	302571.57	507952.40	REBAR_5/8	21+83.64	45.06L
1454	302699.77	507726.15	ALCAP_1.5" LS6304	19+36.22	131.34L
1455	302985.05	507835.00	ALCAP_2" LS6700	19+91.33	431.65L
1456	302759.23	508076.23	BC_3" WC-COR6-3.0-N465040W_USAC	22+84.55	247.17L
1457	302730.59	508041.20	ALCAP_3" LS6304	22+53.32	214.43L
1458	302830.14	508000.69	BC_3" WC-COR3-3.0-N465040E_USACE	21+94.97	307.90L
1459	303123.44	507796.07	IP_2"-CAP BROKEN-OFF	19+27.86	560.65L
1460	302768.28	508084.82	BC_2" J-1-1	22+91.97	257.20L
1461	302550.44	508170.16	BC_3" COR8_USACE	24+03.44	51.51L

EXISTING PROPERTY MONUMENTS					
Point #	Northing	Easting	Description	Station	Offset
1413	302333.33	506077.01	MAG_FND	2+73.71	29.19L
1414	302343.92	506119.70	ALCAP1.5" LS6304	3+18.40	29.87L
1415	302355.09	506164.90	ALCAP1.5" LS6304	3+64.96	29.90L
1416	302317.67	506239.42	ALCAP1.5" 3337S	4+28.37	24.26R
1417	302418.19	506420.99	ALCAP1.5" LS6304	6+28.72	29.88L
1418	302452.96	506562.26	ALCAP2" LS6304	7+74.19	29.83L
1420	302548.63	507176.45	ALCAP1.5" 3337-S	13+93.43	24.27R
1421	302514.69	507039.82	ALCAP1.5" 3337-S	12+52.65	24.52R
1422	302591.51	507125.23	ALCAP1.5" 3337-S	13+53.97	29.62L
1423	302666.04	507312.01	ALCAP1.5"	15+54.12	55.84L
1431	302450.29	508166.54	ALCAP1.5" LS-6304	24+12.16	48.32R
1432	302433.07	508296.32	ALCAP1.5" LS-6304	25+43.45	49.43R

ALL PROPERTY MONUMENTS IN THESE TABLES SHALL BE REFERENCED PRIOR TO DISTURBANCE FROM CONSTRUCTION AND RE-ESTABLISHED IN THEIR ORIGINAL HORIZONTAL POSITION AND A RECORD OF MONUMENT FORM IN ACCORDANCE WITH A.S.34.65.040 SHALL BE SUBMITTED TO DOT FOR REVIEW PRIOR TO RECORDING.

EXISTING CENTERLINE & SHOULDER MONUMENTS TO BE REFERENCED AND REPLACED ROUNDABOUT TO JEFF DAVIS						
Point #	Northing	Easting	Elevation	Description	Station	Offset
42	302303.19	506067.66	35.24	BC2.5" CASE	2+58.07	1.77L
43	302352.37	506267.44	36.56	BC2.5" CASE	4+63.87	2.72L
44	302354.44	506275.83	36.64	BC2.5" CASE	4+72.52	2.73L
45	302429.31	506579.43	38.61	BC3.25 CASE	7+85.21	2.76L
46	302619.79	507352.10	42.31	BC2.5" CASE	15+80.98	1.23L
47	302630.29	507394.90	42.71	BC2.5" CASE	16+24.12	6.57L
48	302622.30	507438.28	42.78	BC2.5" CASE	16+67.27	0.88L
49	302509.93	507986.62	55.49	BC_SH-MON	22+26.33	11.29R

EXISTING CENTERLINE & SHOULDER MONUMENTS TO BE REFERENCED AND REPLACED JEFF DAVIS TO SMITH STREET						
Point #	Northing	Easting	Elevation	Description	Station	Offset
53	300920.52	510070.46	24.32	BC2.5" SH_MON	49+42.20	19.02L
54	300511.84	510489.07	26.34	BC2.5" SH_MON	55+27.47	19.04R

EXISTING SHOULDER MONUMENTS						
Point #	Northing	Easting	Elevation	Description	Station	Offset
9	302336.83	505728.37	33.68	GPS_ALCAP3.5" CASE	N/A	N/A
40	302296.85	505835.04	34.45	ALCAP3.25" CASE	0+36.29	54.58L
55	299813.87	512349.51	25.37	BC2.5" SH_MON	75+12.10	13.20R
56	299949.11	512700.03	22.10	BC2.5" SH_MON	78+86.97	13.39R
1428	302232.58	505819.76	35.94	ALCAP3.25" INCASE	-0+00.00	0.00R


NO.	DATE	REVISION	STATE	PROJECT DESIGNATION	YEAR	SHEET NO.	TOTAL SHEETS
1	2/4/2020	ADDENDUM #3	ALASKA	Z68100/SFHWO0064	2019	A5	7

**MONUMENT NOTES:**  
 1. IF ANY PAIR OF CONTROL POINTS DISAGREES FROM PUBLISHED VALUE BY MORE THAN 1:10,000 HORIZONTALLY OR VERTICALLY THEN A THIRD NETWORK POINT MUST BE TIED TO ASCERTAIN WHICH POINT IS IN ERROR OR HAS BEEN DISTURBED.

2. WHETHER LISTED OR NOT, ALL PROPERTY MONUMENTS, OR PROPERTY MARKERS, CORNERS OR ACCESSORIES WHICH WILL BE DISTURBED OR BURIED SHALL BE REFERENCED PRIOR TO BEING DISTURBED, AND RE-ESTABLISHED IN THEIR ORIGINAL HORIZONTAL POSITION AND A RECORD OF MONUMENT FORM IN ACCORDANCE WITH (A.S.34.65.040) AND (A.S.19.10.260) SHALL BE SUBMITTED TO THE CONSTRUCTION ENGINEER FOR REVIEW PRIOR TO RECORDING. COORDINATE VALUES LISTED ARE FOR INFORMATIONAL PURPOSES AND SHOULD BE USED TO RESET MONUMENTS ONLY AS A LAST RESORT.

3. RIGHT OF WAY LOCATION IS SHOWN FOR GRAPHICAL ORIENTATION PURPOSES ONLY. REFER TO ALASKA DOT&PF RIGHT OF WAY MAPS FOR RIGHT OF WAY INFORMATION.

4. HORIZONTAL AND VERTICAL CONTROL MUST BE FIELD VERIFIED BY THE CONTRACTOR. DISCREPANCIES WILL BE REPORTED TO DOT&PF CONSTRUCTION PROJECT ENGINEER.

Record Drawings have been reviewed by the Project Engineer, and represent to the best of my knowledge, the project as constructed.  
 PE  Date 10.25.20


ALL CENTERLINE & SHOULDER MONUMENTS IN THIS TABLE SHALL BE REFERENCED PRIOR TO DISTURBANCE FROM CONSTRUCTION AND RE-ESTABLISHED IN THEIR ORIGINAL HORIZONTAL POSITION AND A RECORD OF MONUMENT FORM IN ACCORDANCE WITH A.S.34.65.040 SHALL BE SUBMITTED TO DOT FOR REVIEW PRIOR TO RECORDING.

REGISTRATION #  
 LS-15321  
 LS-13321




STATE OF ALASKA  
 DEPARTMENT OF TRANSPORTATION AND PUBLIC FACILITIES  
 6660 Glacier Highway Juneau, AK 99801  
 (907) 465-1763  
 SAWMILL CREEK ROAD RESURFACE & PEDESTRIAN IMPROVEMENTS ROUNDABOUT TO SMITH STREET  
 PROJECT NO. NH-0933046/Z68100  
 PROJECT NO. NH-0933046/SFHWO0064  
 SURVEY CONTROL

NO.	DATE	REVISION	STATE	PROJECT DESIGNATION	YEAR	SHEET NO.	TOTAL SHEETS
			ALASKA	Z68100/SFHWY00064	2019	A6	7

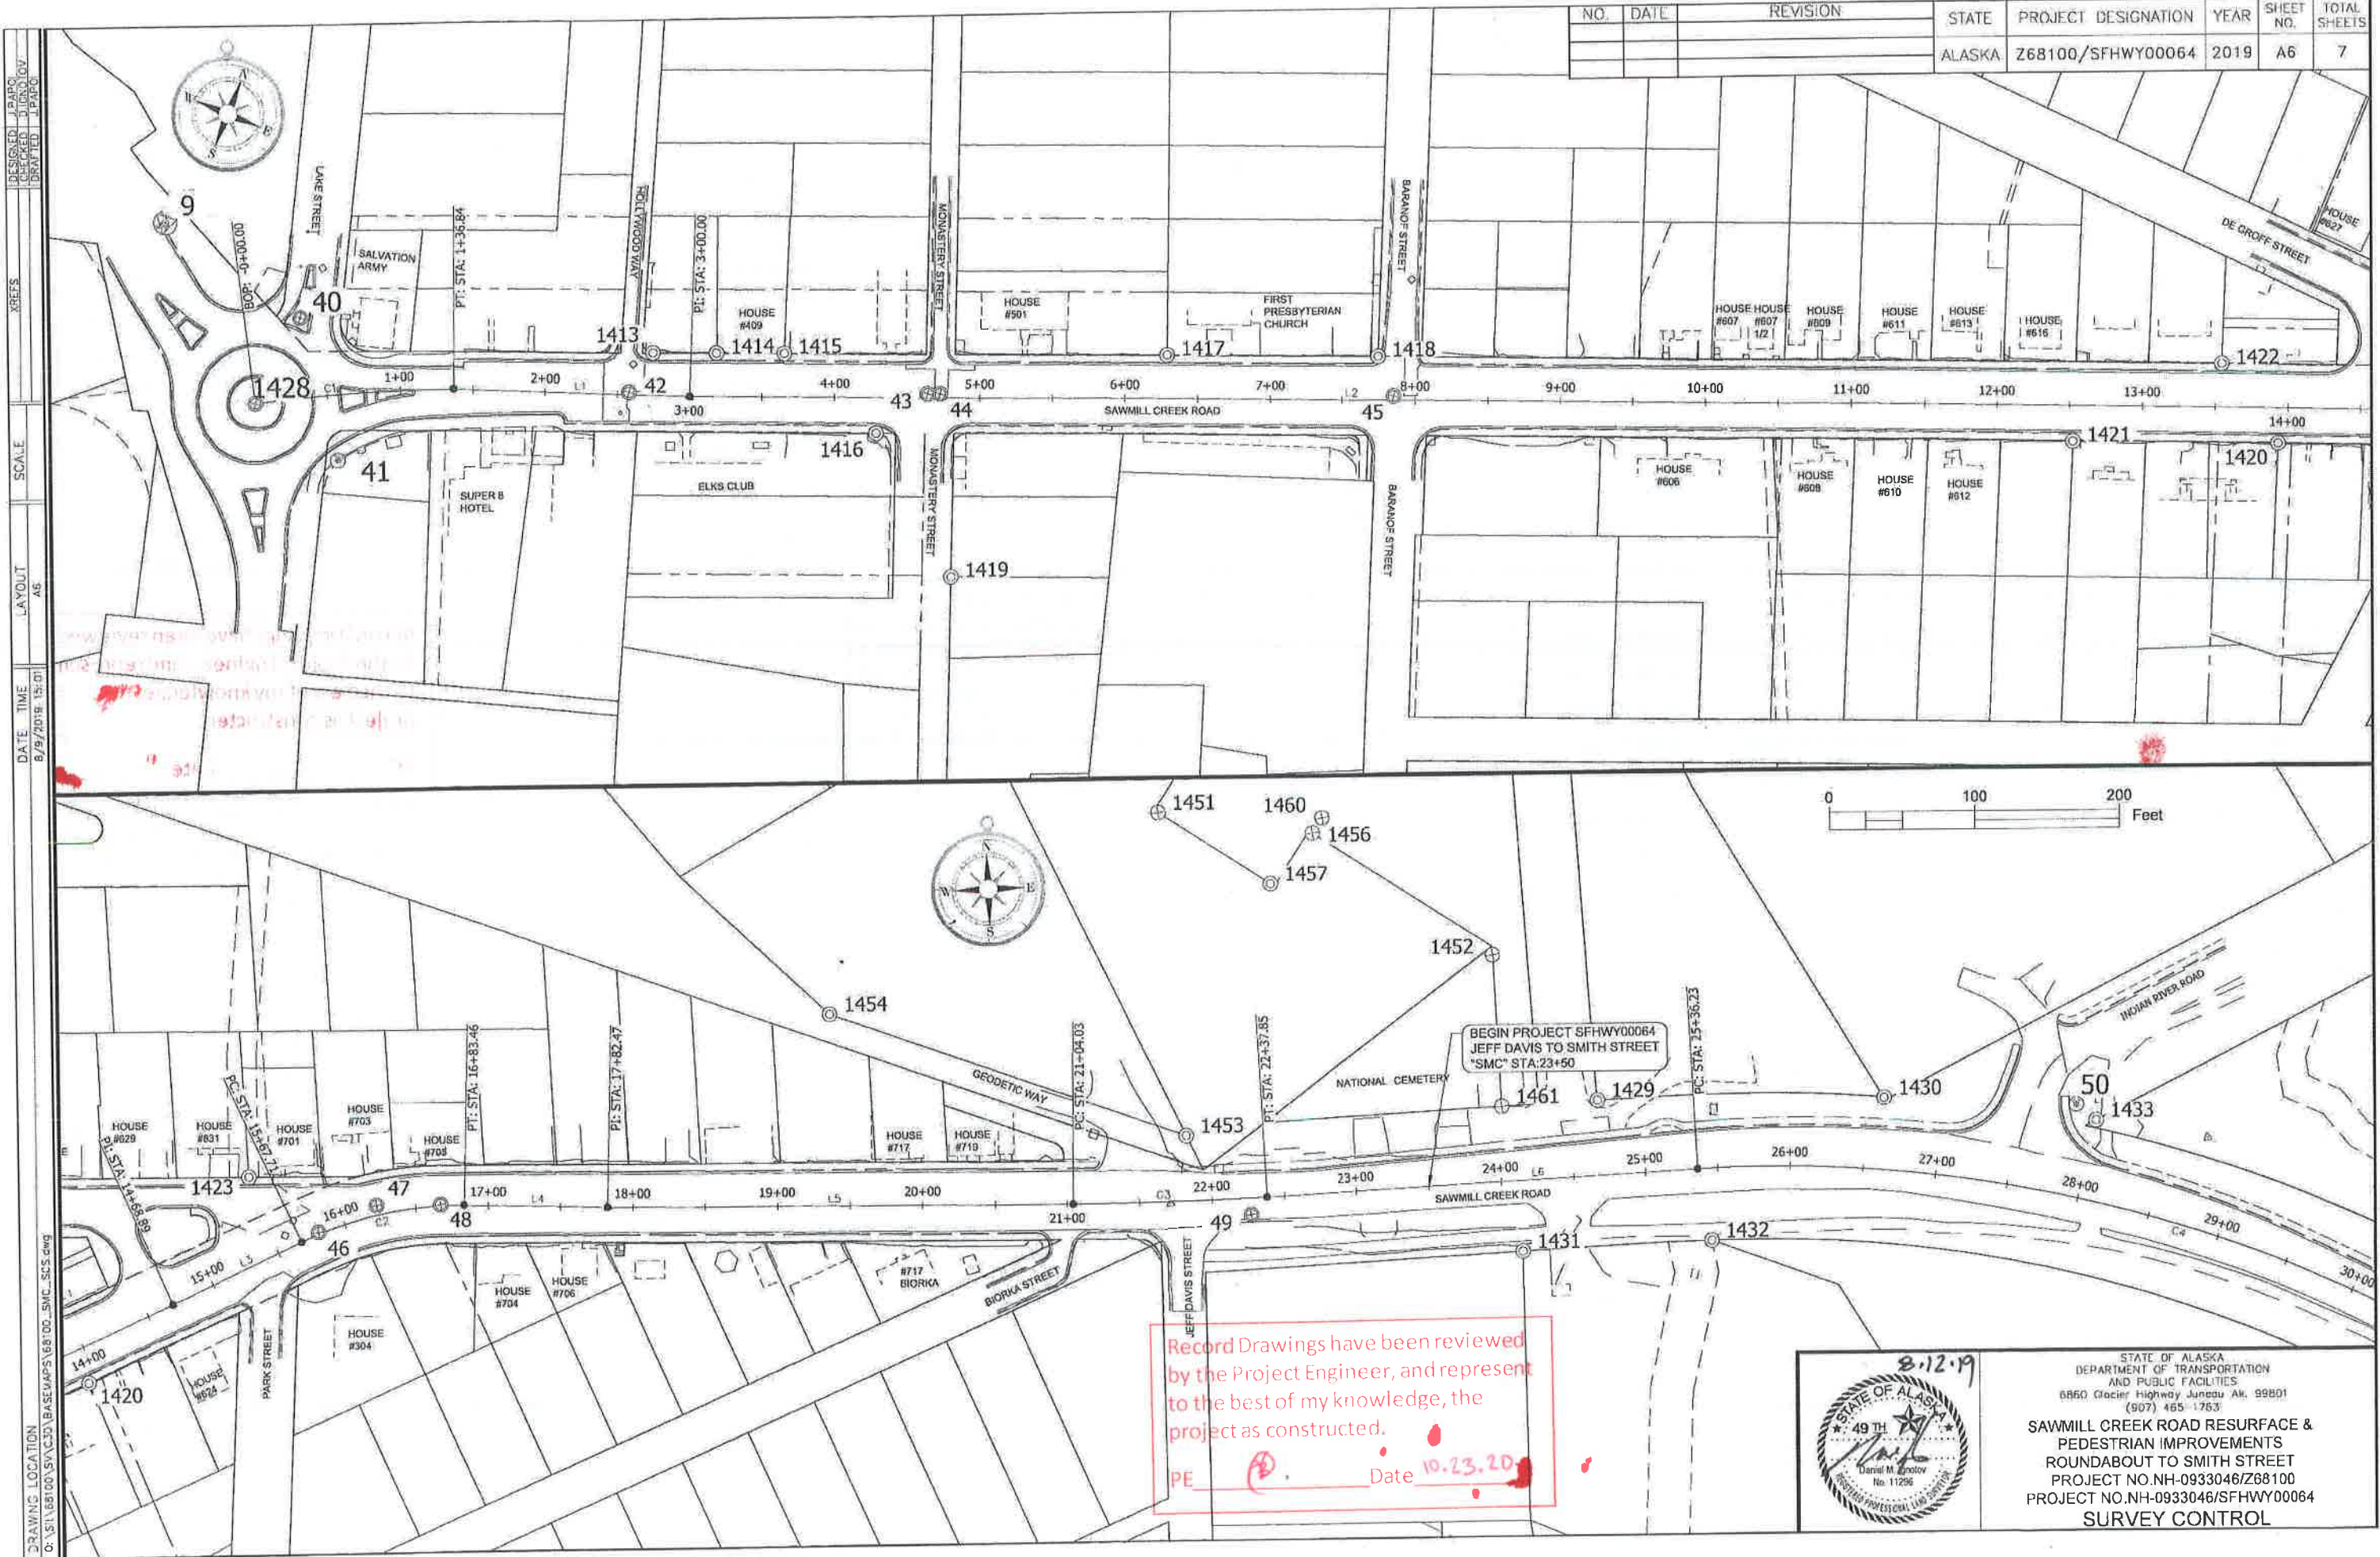

DESIGNED: J.P.A.P.O. CHECKED: J.L.B.L.O.V. DRAFTED: J.P.A.P.O.  
 XREFS: SCALE: LAYOUT: A6 DATE: TIME: 8/9/2019 15:01  
 DRAWING LOCATION: C:\S1\08100\SVAC30\BASEMAPS\68\00\_SMC\_SCS.cwg

Record Drawings have been reviewed by the Project Engineer, and represent to the best of my knowledge, the project as constructed.  
 PE Date 10.23.20

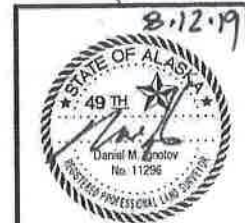

STATE OF ALASKA  
 DEPARTMENT OF TRANSPORTATION AND PUBLIC FACILITIES  
 6860 Glacier Highway Juneau AK, 99801  
 (907) 465-1763  
**SAWMILL CREEK ROAD RESURFACE & PEDESTRIAN IMPROVEMENTS  
 ROUNDABOUT TO SMITH STREET  
 PROJECT NO. NH-0933046/Z68100  
 PROJECT NO. NH-0933046/SFHWY00064  
 SURVEY CONTROL**

DESIGNED: J. P. PATO  
 CHECKED: D. L. CHODY  
 DRAFTED: J. P. PATO

XREFS:


SCALE:

LAYOUT: A7

DATE: TIME: 8/9/2019 15:01



DRAWING LOCATION: C:\ST1\68100\VA(CD)\BASE\MAPS\68100\_SMC\_SCS.dwg

NO.	DATE	REVISION	STATE	PROJECT DESIGNATION	YEAR	SHEET NO.	TOTAL SHEETS
			ALASKA	Z68100/SFHWHY00064	2019	A7	7

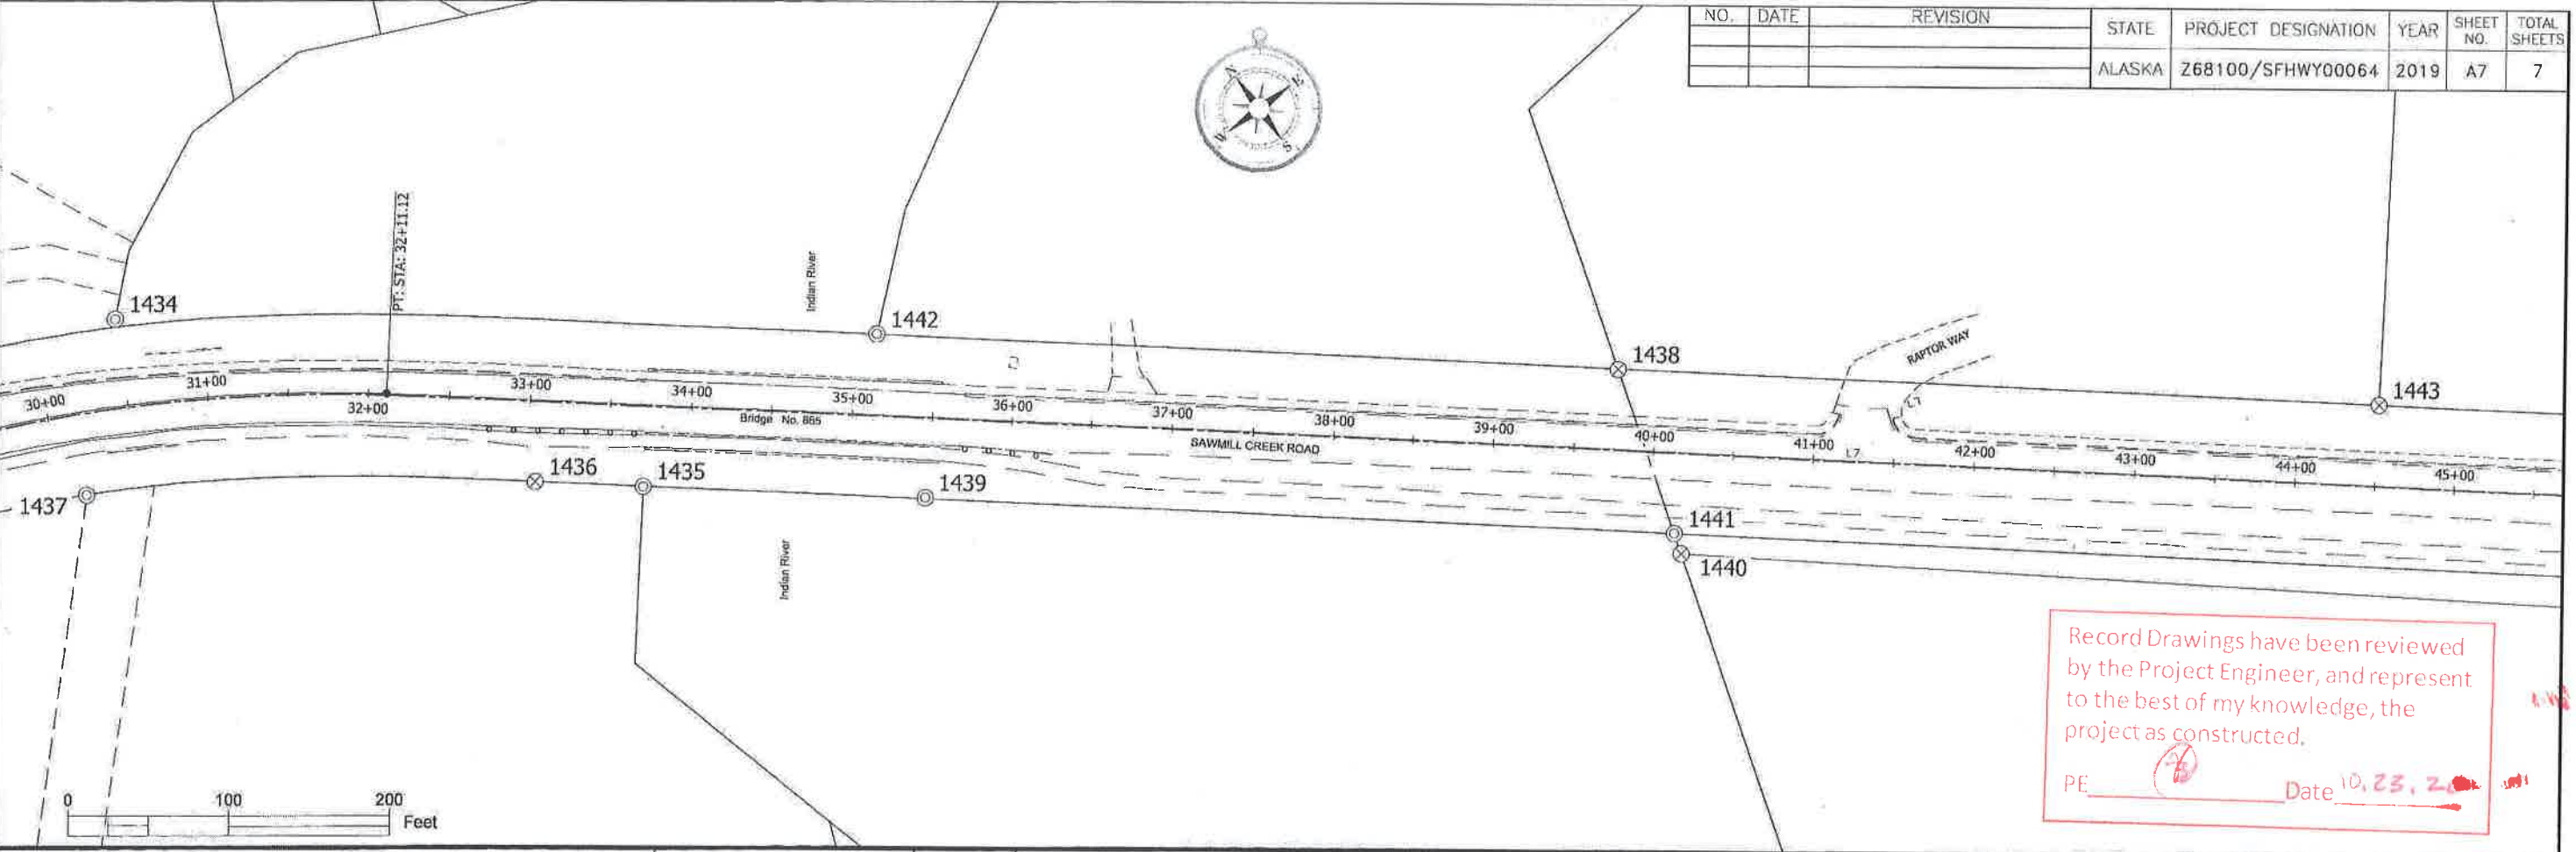

Record Drawings have been reviewed by the Project Engineer, and represent to the best of my knowledge, the project as constructed.

PE: *[Signature]* Date: 10.23.2019

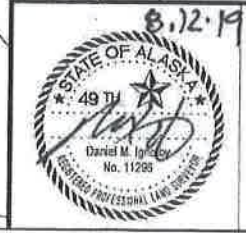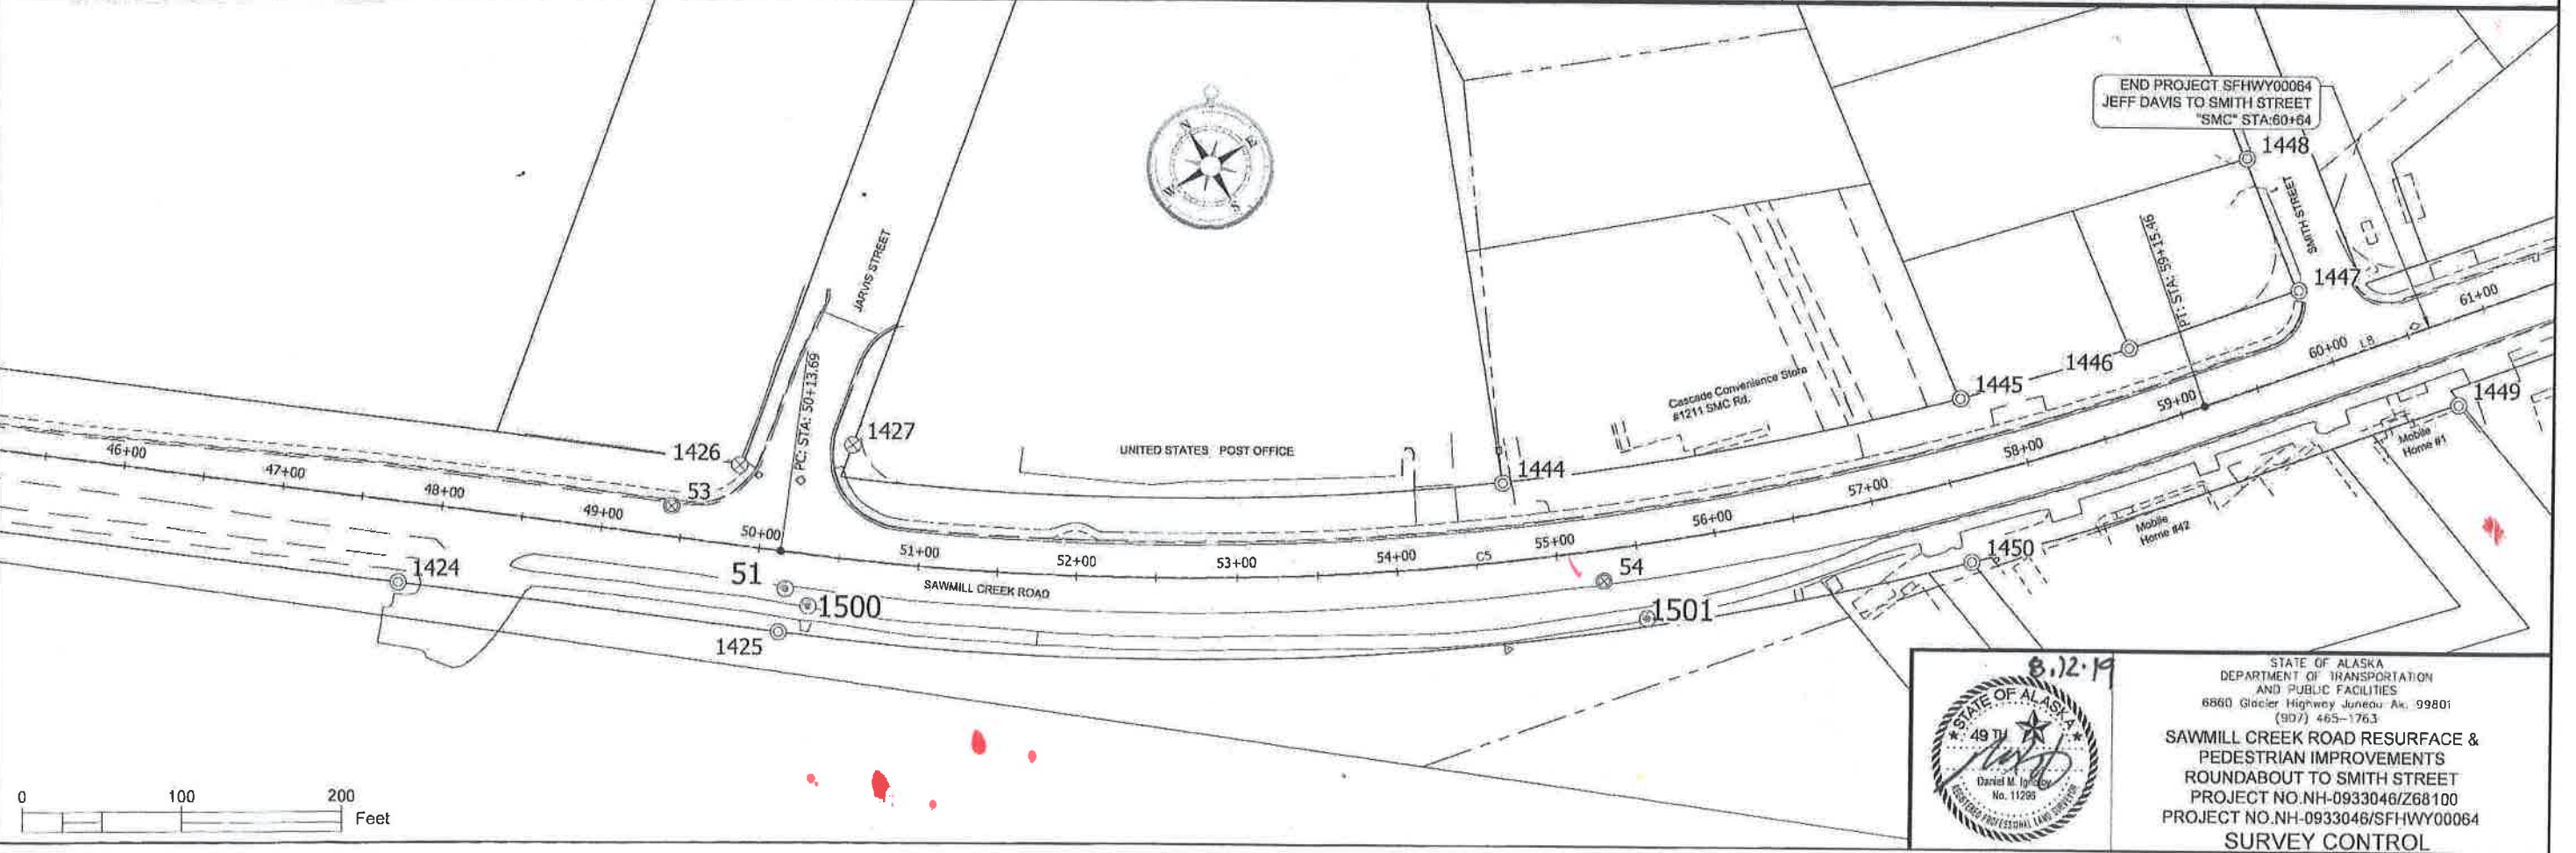


STATE OF ALASKA  
 DEPARTMENT OF TRANSPORTATION  
 AND PUBLIC FACILITIES  
 6860 Glacier Highway Juneau Ak. 99801  
 (907) 465-1763


SAWMILL CREEK ROAD RESURFACE &  
 PEDESTRIAN IMPROVEMENTS  
 ROUNDABOUT TO SMITH STREET  
 PROJECT NO. NH-0933046/Z68100  
 PROJECT NO. NH-0933046/SFHWHY00064  
 SURVEY CONTROL

NO.	DATE	REVISION	STATE	PROJECT DESIGNATION	YEAR	SHEET NO.	TOTAL SHEETS
			ALASKA	0933046/SFHWHY00064	2019	B1	2


- LEGEND**
- ① 2" HOT MIX ASPHALT, TYPE II; CLASS A, (PG 58-28)
  - ② 2" PAVEMENT COLD PLANING
  - ③ STE-1 ASPHALT FOR TACK COAT
  - ④ 2" ASPHALT SIDEWALK
  - ⑤ 4" AGGREGATE BASE COURSE, GRADING D-1
  - ⑥ 6" BORROW, SELECTED MATERIAL, TYPE A
  - ⑦ SEEDING ON DISTURBED SLOPES UNLESS OTHERWISE SPECIFIED.

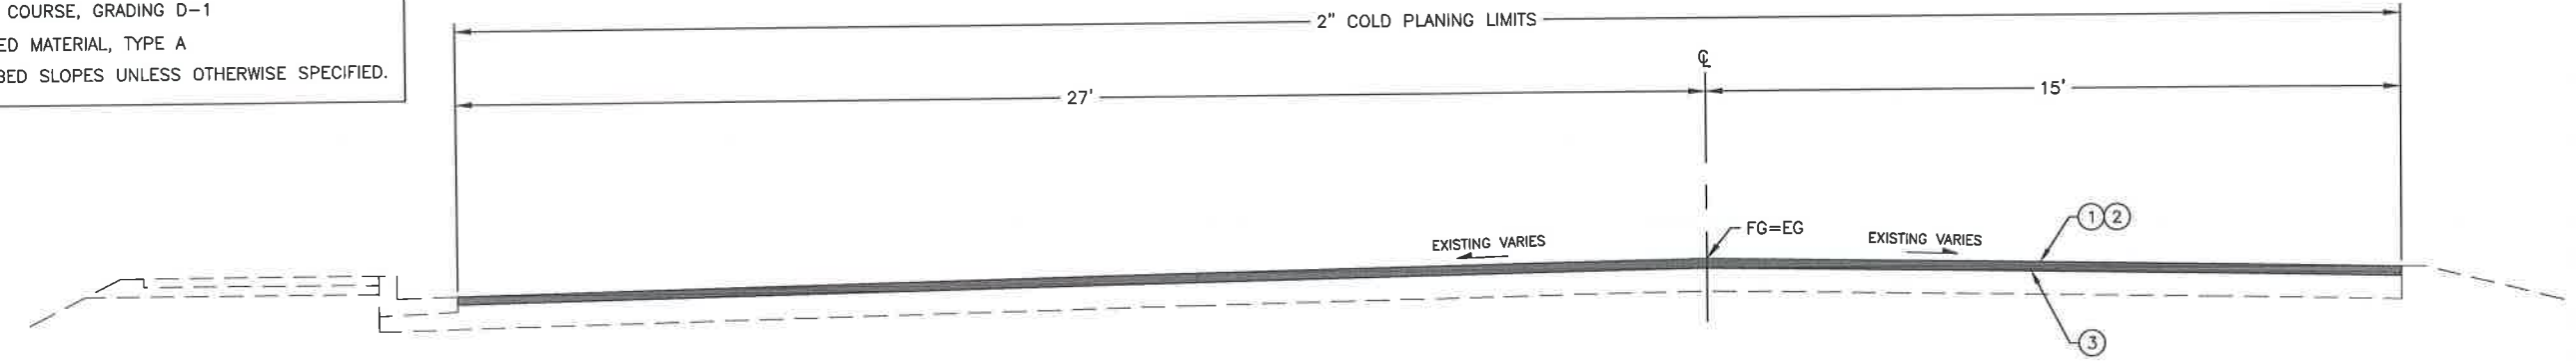


①  
B1  
**TYPICAL SECTION**  
"A" LINE STA. 25+00 TO 28+21

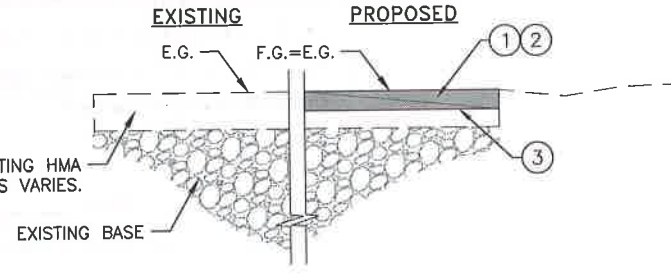

④  
B1  
**MILL AND PAVE**  
SCALE: N.T.S. STA. 23+50 TO EOP

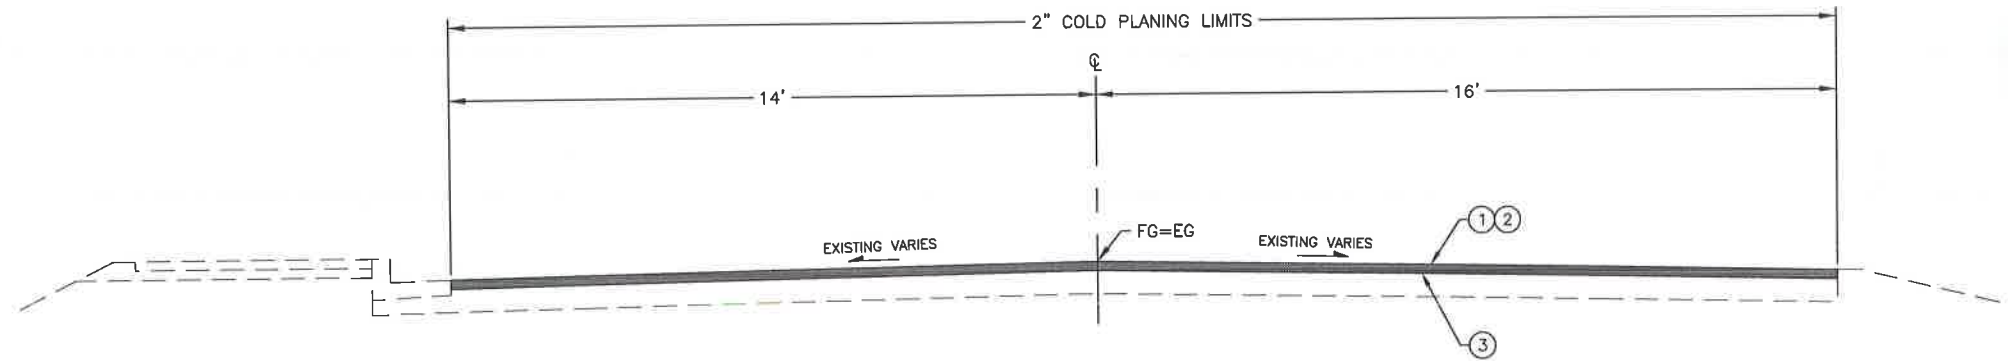


②  
B1  
**TYPICAL SECTION**  
"A" LINE STA. 31+00 TO 45+00

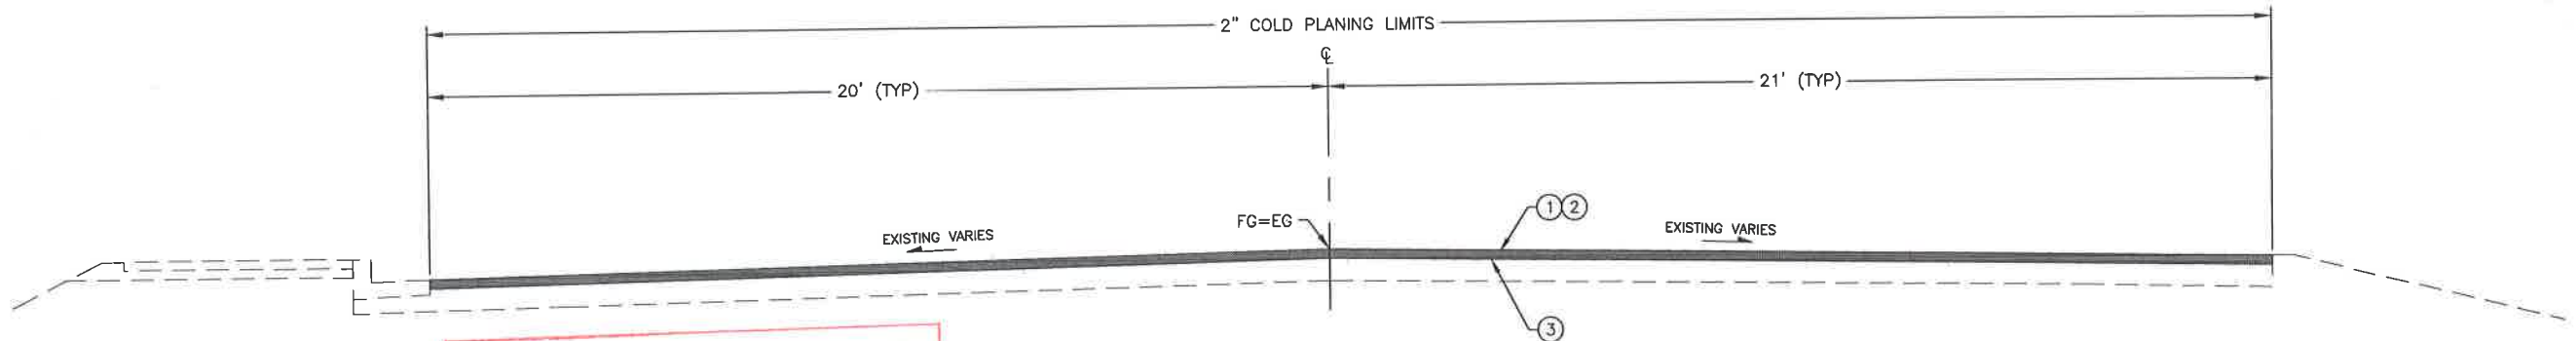

③  
B1  
**TYPICAL SECTION**  
"A" LINE STA. 48+68 TO EOP

- TYPICAL SECTION NOTES:**
- PAVEMENT COLD PLANING WIDTH VARIES:
- STA. 23+50 TO STA. 25+00 (34' TO 42')
  - STA. 28+21 TO STA. 31+00 (42' TO 30')
  - STA. 45+00 TO STA. 48+68 (30' TO 41')

Record Drawings have been reviewed by the Project Engineer, and represent to the best of my knowledge, the project as constructed.  
PE   P   Date   10.23.20  

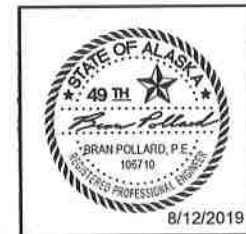

STATE OF ALASKA DEPARTMENT OF TRANSPORTATION AND PUBLIC FACILITIES  
6860 GLACIER HIGHWAY, JUNEAU, AK 99801  
(907) 465-1763

SITKA SAWMILL CREEK ROAD RESURFACE:  
JEFF DAVIS TO SMITH STREET

TYPICAL SECTIONS


FILE O:\SIT\SFHWHY00064\Planest\SFHWHY00064\_SIT\_B1.dwg DATE 8/9/2019 15:39 LAYOUT B1 DESIGNED C.L. CHECKED BP DRAFTED J.T. RG



FILE Q:\SIT\SFH\00064\Planset\SFH\00064\_SIT\_B1.dwg  
 DATE 8/9/2019 13:39 LAYOUT B2 DESIGNED C.I. CHECKED BP DRAFTED J.T. RG


NO.	DATE	REVISION	STATE	PROJECT DESIGNATION	YEAR	SHEET NO.	TOTAL SHEETS
			ALASKA	0933046/SFH\00064	2019	B2	2

- LEGEND**
- ① 2" HOT MIX ASPHALT, TYPE II; CLASS A, (PG 58-28)
  - ② 2" PAVEMENT COLD PLANING
  - ③ STE-1 ASPHALT FOR TACK COAT
  - ④ 2" ASPHALT SIDEWALK
  - ⑤ 4" AGGREGATE BASE COURSE, GRADING D-1
  - ⑥ 6" BORROW, SELECTED MATERIAL, TYPE A
  - ⑦ SEEDING ON DISTURBED SLOPES UNLESS OTHERWISE SPECIFIED.

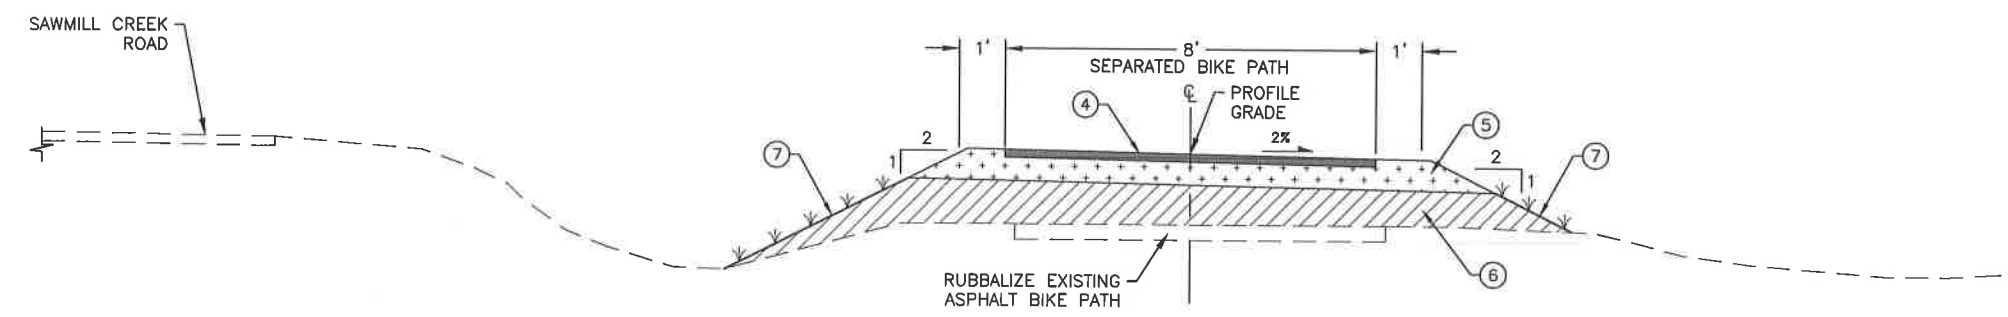

1  
B2  
**SEPARATED BIKE PATH TYPICAL SECTION**  
"B" LINE STA. 1+20 TO STA. 2+10

Record Drawings have been reviewed by the Project Engineer, and represent to the best of my knowledge, the project as constructed.  
 PE *[Signature]* Date 10.23.20

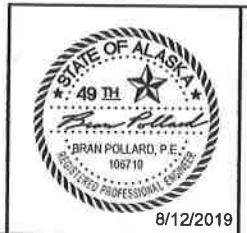


STATE OF ALASKA DEPARTMENT OF TRANSPORTATION AND PUBLIC FACILITIES  
 6860 GLACIER HIGHWAY, JUNEAU, AK 99801  
 (907) 465-1763  
**SITKA SAWMILL CREEK ROAD RESURFACE: JEFF DAVIS TO SMITH STREET**  
 TYPICAL SECTIONS


NO.	DATE	REVISION	STATE	PROJECT DESIGNATION	YEAR	SHEET NO.	TOTAL SHEETS
△	2/4/2020	ADDENDUM #3	ALASKA	0933046/SFHXY00064	2019	C1	1

FILE: Q:\SIT\SFHXY00064\PlanSet\SFHXY00064\_S1\_C1.dwg  
 DATE: 2/4/2020 9:07  
 LAYOUT: C1  
 DESIGNED: C.L.  
 CHECKED: BP  
 DRAFTED: JT, RG

ESTIMATE OF QUANTITIES				
ITEM No.	SSHC No.	PAY ITEM	PAY UNIT	QTY.
201.2002.0000	-	INVASIVE PLANTS SURVEY	LUMP SUM	ALL REQUIRED
201.2003.0000	-	INVASIVE PLANT SPECIES CONTROL, REMOVAL, AND DISPOSAL	CONTINGENT SUM	ALL REQUIRED
202.0002.0000	202(2)	REMOVAL PAVEMENT	SQUARE YARD	-10.5 706.43
202.0003.0000	202(3)	REMOVAL OF SIDEWALK	SQUARE YARD	-86.5 99.28
202.0004.0000	202(4)	REMOVAL OF CULVERT PIPE	LINEAR FOOT	-13 14
202.0009.0000	202(9)	REMOVAL OF CURB AND GUTTER	LINEAR FOOT	-174 182.30
203.2006.0000	203(6)	BORROW, SELECTED MATERIAL TYPE A	TON	-40 44.28
301.0001.00D1	301(1)	AGGREGATE BASE COURSE, GRADING D-1	TON	-70 145.01
401.0001.002A	401(1)	HMA, TYPE II; CLASS A	TON	-1,850 2117.38
401.0004.5828	401(4)	ASPHALT BINDER, GRADE PG 58-28	TON	-411 113.10
401.0008.002A	401(8)	HMA PRICE ADJUSTMENT, TYPE II, CLASS A	CONTINGENT SUM	ALL REQUIRED
401.0009.0000	401(9)	LONGITUDINAL JOINT DENSITY PRICE ADJUSTMENT	CONTINGENT SUM	ALL REQUIRED
401.0010.0002	401(10)	PAVEMENT SMOOTHNESS PRICE ADJUSTMENT, METHOD 2	CONTINGENT SUM	ALL REQUIRED
401.0015.0000	401(15)	ASPHALT MATERIAL PRICE ADJUSTMENT	CONTINGENT SUM	ALL REQUIRED
402.0001.STE1	402(1)	STE-1 ASPHALT FOR TACK COAT	TON	-6 5.80
410.2001.0000	408(1)	PAVEMENT COLD PLANING	SQUARE YARD	-15,704 15,797
604.0004.0000	604(4)	ADJUST EXISTING MANHOLE	EACH	5 2
604.0010.0000	-	RECONSTRUCT INLET	EACH	-1 1
604.0013.0000	604(13)	REPLACE INLET GRATE	EACH	1 175
608.0015.0000	608(15)	ADJUST EXISTING GUARDRAIL	LINEAR FOOT	-90 2
608.0016.0001	-	TRANSITON RAIL, MODIFICATION	EACH	-1 122.97
608.0001.0004	608(1a)	CONCRETE SIDEWALK, 4 INCHES THICK	SQUARE YARD	-28.5 124.05
608.0003.0000	608(3)	ASPHALT SIDEWALK	SQUARE YARD	-82
608.0006.0000	608(6)	CURB RAMP	EACH	10
609.0002.0001	609(2)	CURB AND GUTTER, TYPE 1	LINEAR FOOT	196.97
610.0002.0000	610(2)	DITCH LINING	TON	-5 13.39
615.0001.0000	615(1)	STANDARD SIGN	SQUARE YARD	-260.5
618.0004.0000	618(4)	SEEDING	SQUARE YARD	-78 0
619.2013.0000	619(3)	BONDED FIBER MATRIX (BFM)	POUND	-60 0
625.0001.0000	625(1)	PIPE HAND RAIL	LINEAR FOOT	60
627.0010.0000	627(10)	ADJUSTMENT OF VALVE BOX	EACH	-10 13
640.0001.0000	640(1)	MOBILIZATION AND DEMOBILIZATION	LUMP SUM	ALL REQUIRED
640.0004.0000	640(4)	WORKER MEALS AND LODGING, OR PER DIEM	LUMP SUM	ALL REQUIRED
641.0001.0000	641(1)	EROSION, SEDIMENT AND POLLUTION CONTROL ADMINISTRATION	LUMP SUM	ALL REQUIRED
641.0003.0000	641(3)	TEMPORARY EROSION, SEDIMENT AND POLLUTION CONTROL	LUMP SUM	ALL REQUIRED
641.0005.0000	641(5)	TEMPORARY EROSION, SEDIMENT AND POLLUTION CONTROL BY DIRECTIVE	CONTINGENT SUM	ALL REQUIRED
641.0006.0000	641(6)	WITHOLDING	CONTINGENT SUM	ALL REQUIRED
642.0001.0000	642(1)	CONSTRUCTION SURVEYING	LUMP SUM	ALL REQUIRED
642.0003.0000	642(3)	THREE PERSON SURVEY PARTY	HOUR	-40 3.58
642.0006.0000	642(6)	REPLACE EXISTING WITH PRIMARY MONUMENT	EACH	2
642.0010.0000	642(10)	MONUMENT CASE	EACH	2
643.0002.0000	643(2)	TRAFFIC MAINTENANCE	LUMP SUM	ALL REQUIRED
643.0003.0000	643(3)	PERMANENT CONSTRUCTION SIGNS	LUMP SUM	ALL REQUIRED
643.0023.0000	643(23)	TRAFFIC PRICE ADJUSTMENT	CONTINGENT SUM	ALL REQUIRED
643.0025.0000	643(25)	TRAFFIC CONTROL	CONTINGENT SUM	ALL REQUIRED
643.0032.0000	643(15)	FLAGGING	CONTINGENT SUM	ALL REQUIRED
643.2017.0000	-	PEDESTRIAN BARRIER	LUMP SUM	ALL REQUIRED
643.2024.0000	-	TEMPORARY RAMP	EACH	-2 6
644.0001.0000	644(1)	FIELD OFFICE	LUMP SUM	ALL REQUIRED
644.0002.0000	644(2)	FIELD LABORATORY	LUMP SUM	ALL REQUIRED
644.0006.0000	644(6)	VEHICLES	LUMP SUM	ALL REQUIRED
644.2004.0000	-	ENGINEERING COMMUNICATIONS	CONTINGENT SUM	ALL REQUIRED
660.0003.0000	660(3)	HIGHWAY LIGHTING SYSTEM COMPLETE, LED LUMINAIRES	LUMP SUM	ALL REQUIRED
660.0004.0000	660(4)	SIGN ILLUMINATION SYSTEM COMPLETE, LED ENHANCED BORDER	LUMP SUM	ALL REQUIRED
670.0001.0000	670(1)	PAINTED TRAFFIC MARKINGS	LUMP SUM	ALL REQUIRED
670.0008.0000	670(8)	RECESSED PAVEMENT MARKER	EACH	-81 96
670.0010.0000	670(9)	METHYL METHACRYLATE PAVEMENT MARKINGS	LUMP SUM	ALL REQUIRED
608.0007.0000	-	CONCRETE SPURWAYS CO 01	LUMP SUM	ALL REQUIRED
203.0019.0000	-	CURBING & GRUBBING (complete) CO 02	LUMP SUM	ALL REQUIRED
303.0003.0000	-	LINEAR GRADING (complete) CO 03	LUMP SUM	ALL REQUIRED

BASIS OF ESTIMATE				
ITEM NO.	SSHC No.	ITEM	ESTIMATING FACTOR	
203.0006.0000	203(6)	BORROW, SELECTED MATERIAL TYPE A	1.85 TONS/C.Y.	
301.0001.00D1	301(1)	AGGREGATE BASE COURSE, GRADING D-1	1.95 TONS/C.Y.	
401.0001.002A	401(1)	HMA, TYPE II; CLASS A	120 LBS./S.Y./IN.	
401.0004.5828	401(4)	ASPHALT BINDER, GRADE PG 58-28	6.0% OF ITEM 401(1)	
402.0001.STE1	402(1)	STE-1 ASPHALT FOR TACK COAT	0.10 GAL/S.Y. 243 GAL/TON	
610.0001.0000	610(1)	DITCH LINING	1.48 TONS/C.Y.	
618.0004.0000	618(4)	SEEDING	1.2 LB/ 1000 SF	
619.2013.0000	619(3)	HYDRAULIC GROWTH MEDIUM	3500 LB/ACRE	
619.2013.0000	619(3)	BONDED FIBER MATRIX (BFM)	4000 LB/ACRE	
670.0001.0000	670(1)	PAINTED TRAFFIC MARKINGS	SOLID, WHITE 4" = 6,970 L.F. SOLID, WHITE 8" = 248 L.F. SOLID, WHITE 24" STOP BARS = 49 L.F. SOLID DOUBLE, YELLOW 11" = 3,427 L.F. SOLID, YELLOW 4" = 1,948 SOLID, YELLOW 18" = 501 SKIP, YELLOW 4" = 500	
670.0010.0000	670(9)	METHYL METHACRYLATE PAVEMENT MARKINGS	SOLID, WHITE 24" LONGITUDINAL & PARALELL CROSSWALK BARS = 506 L.F.	

Record Drawings have been reviewed by the Project Engineer, and represent to the best of my knowledge, the project as constructed.  
 PE  Date 10.23.20

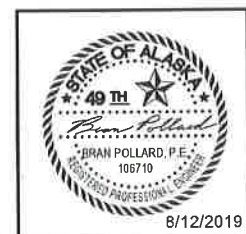

STATE OF ALASKA DEPARTMENT OF TRANSPORTATION AND PUBLIC FACILITIES  
 6860 GLACIER HIGHWAY, JUNEAU, AK 99801  
 (907) 465-1763  
 SITKA SAWMILL CREEK ROAD RESURFACE:  
 JEFF DAVIS TO SMITH STREET  
 ESTIMATE OF QUANTITIES

NO.	DATE	REVISION	STATE	PROJECT DESIGNATION	YEAR	SHEET NO.	TOTAL SHEETS
			ALASKA	0933046/SFHwy00064	2019	D1	1

202.0002.0000 REMOVAL OF PAVEMENT				
BEGIN STATION	END STATION	OFFSET	AREA (S.Y.)	REMARKS
28+04	28+20.6	LT	5.5	Sawcut and remove existing asphalt at seperated bikepath on Indian River Road. Grade to match back of pedestrian ramp.
28+06	28+15	RT	5.0	Sawcut and remove existing asphalt and replace with concrete landing.
TOTAL =			10.5	695.937 including bike path and RT 13.

608.0001.0004 CONCRETE SIDEWALK, 4 INCHES THICK				
BEGIN STATION	END STATION	OFFSET	AREA (S.Y.)	REMARKS
<del>27+94.5</del>	<del>28+03</del>	<del>LT</del>	<del>5.5</del>	<del>Indian River Road/SMC</del>
<del>28+06.0</del>	<del>28+15.2</del>	<del>RT</del>	<del>5.0</del>	<del>Seperated bikepath pedestrian landing</del>
<del>49+53.7</del>	<del>49+60</del>	<del>LT</del>	<del>3.5</del>	<del>Jarvis Street/SMC</del>
<del>49+58.7</del>	<del>49+67.7</del>	<del>RT</del>	<del>5.0</del>	<del>Seperated bikepath pedestrian landing</del>
<del>49+75.3</del>	<del>49+81</del>	<del>LT</del>	<del>4.5</del>	<del>Jarvis Street/SMC</del>
TOTAL =			23.5	122.87

202.0003.0000 REMOVAL OF SIDEWALK				
BEGIN STATION	END STATION	OFFSET	AREA (S.Y.)	REMARKS
27+15	27+29	LT	10.56	Indian River Road - Remove and replace existing pedestrian ramp and landing
27+81	27+21.5	LT	26.0	Indian River Road - Remove and replace existing pedestrian ramps and landings
49+53.8	49+90.7	LT	25.0	Jarvis Street - Remove and repalce existing pedestrian ramp and landing
50+40.6	50+55.4	LT	11.0	Jarvis Street - Remove and repalce existing pedestrian ramp and landing
59+87	59+93.7	LT	7.0	Smith Street - Remove and replace existing pedestrian ramp and landing
60+28	60+32.3	LT	7.0	Smith Street - Remove and replace existing pedestrian ramp and landing
TOTAL =			86.5	12.78 sq ft RAPTOR WAY

608.0001.0004  
 15.72 sq SMITH ST  
 28.92 sq JARVIS ST  
 18.39 sq RAPTOR WAY  
 47.83 sq INDIAN RIVER ROAD  
 122.87 sq

608.0006.0000 CURB RAMP			
STA.	OFFSET	TYPE OF RAMP	REMARKS
27+24.14	37.98' LT	Parallel	Indian River Road/SMC. Center of ramp at top back of curb
27+85.90	42.18' LT	Parallel	Indian River Road/SMC. Center of ramp at top back of curb
28+10.53	27.63' LT	Parallel	Indian River Road/SMC. Center of ramp at top back of curb
41+13.87	25.84' LT	Parallel	Raptor Way/SMC. Center of ramp at top back of curb
41+49.33	25.17' LT	Parallel	Raptor Way/SMC. Center of ramp at top back of curb
49+63.29	24.60' LT	Parallel	Jarvis Street/SMC. Center of ramp at top back of curb
49+86.55	41.12' LT	Parallel	Jarvis Street/SMC. Center of ramp at top back of curb
50+45.28	45.14' LT	Parallel	Jarvis Street/SMC. Center of ramp at top back of curb
59+92.86	39.29' LT	Parallel	Smith Street/SMC. Center of ramp at top back of curb
60+28.39	42.68' LT	Parallel	Smith Street/SMC. Center of ramp at top back of curb

202.0004.0000 REMOVAL OF CULVERT PIPE				
BEGIN STATION	END STATION	OFFSET	LENGTH (FT)	REMARKS
54+27	54+40	RT	13	Remove culvert & gravel path. Grade ditch to drain.

202.0009.0000 REMOVAL OF CURB AND GUTTER				
BEGIN STATION	END STATION	OFFSET	LENGTH (FT)	REMARKS
27+15.7	27+30.9	LT	20	Indian River Road - remove curb and gutter at pedestrian ramp and landing
27+81	28+21.5	LT	52	Indian River Road - remove curb and gutter at pedestrian ramp and landing
49+53.8	49+90.7	LT	50	Jarvis Street - remove curb and gutter at pedestrian ramp and landing
50+38.6	50+50	LT	22	Jarvis Street - remove curb and gutter at pedestrian ramp and landing
59+87.18	59+93.75	LT	13	Smith Street - remove curb and gutter at pedestrian ramp and landing
60+28	60+32.3	LT	4	Smith Street - remove curb and gutter at pedestrian ramp and landing
TOTAL =			171	25.9' RAPTOR WAY @ 41+52 LT

609.0002.0001 CURB AND GUTTER, TYPE 1				
BEGIN STATION	END STATION	OFFSET	LENGTH (FT)	REMARKS
27+15.7	27+30.9	LT	20	Indian River Road/SMC - curb and gutter at pedestrian ramp and landing
27+81	28+21.5	LT	52	Indian River Road/SMC - curb and gutter at pedestrian ramp and landing
41+09.5	41+16.4	LT	13	Raptor Way/SMC - curb and gutter at pedestrian ramp and landing
41+46.7	41+53.8	LT	12	Raptor Way/SMC - curb and gutter at pedestrian ramp and landing
49+53.8	49+90.7	LT	50	Jarvis Street/SMC - curb and gutter at pedestrian ramp and landing
50+38.6	50+50	LT	22	Jarvis Street/SMC - curb and gutter at pedestrian ramp and landing
59+87.18	59+93.75	LT	13	Smith Street/SMC - curb and gutter at pedestrian ramp and landing
60+28	60+32.3	LT	14	Smith Street/SMC - curb and gutter at pedestrian ramp and landing
TOTAL =			196.07	

604.0004.0000 ADJUST EXISTING MANHOLE		
STA.	OFFSET	REMARKS
25+36.80	17.81 LT	Sanitary Sewer Manhole
49+93.38	44.74 LT	Storm Drain Manhole
50+20.30	44.92 LT	Sanitary Sewer Manhole
60+18.06	36.22 LT	Sanitary Sewer Manhole
60+55.62	4.18 LT	Storm Drain Manhole

604.0010.0000 RECONSTRUCT INLET		
STA.	OFFSET	REMARKS
51+99	32' RT	
49+93	44' LT	

604.0013.0000 REPLACE INLET GRATE		
STA.	OFFSET	REMARKS
49+76.5	29.39 LT	STA & Offset at center of grate

606.0015.0000 ADJUST EXISTING GUARDRAIL				
STA. TO STA.	OFFSET	LENGTH	REMARKS	
32+64.5	33+54.372	90	Reset rail to meet NCHRP 350 Rail height of 28"	

606.0016.0001 TRANSITION RAIL, MODIFICATION		
STATION	OFFSET	REMARKS
35+67	RT	See N Sheets

625.0001.0000 PIPE HAND RAIL				
BEGIN STA	END STA	OFFSET	LENGTH (FT)	REMARKS
30+27	30+87	RT	60	

627.0010.0000 ADJUSTMENT OF VALVE BOX		
STA.	OFFSET	REMARKS
24+37.56	18.30 LT	Per CBS STD DWG 70-3
24+39.73	20.44 LT	Per CBS STD DWG 70-3
24+58.52	16.23 LT	Per CBS STD DWG 70-3
26+89.99	18.64 LT	Per CBS STD DWG 70-3
40+76.19	17.02 RT	Per CBS STD DWG 70-3
49+70.47	33.08 RT	Seperated Bike Path. Per CBS STD DWG 70-3
49+71.37	32.99 RT	Seperated Bike Path. Per CBS STD DWG 70-3
49+93.42	18.80 RT	Per CBS STD DWG 70-3
50+00.89	19.05 RT	Per CBS STD DWG 70-3
52+87.64	16.93 RT	Per CBS STD DWG 70-3

Record Drawings have been reviewed by the Project Engineer, and represent to the best of my knowledge, the project as constructed.  
 PE [Signature] Date 10.23.20



STATE OF ALASKA DEPARTMENT OF TRANSPORTATION AND PUBLIC FACILITIES  
 6860 GLACIER HIGHWAY, JUNEAU, AK 99801  
 (907) 465-1763  
 SITKA SAWMILL CREEK ROAD RESURFACE:  
 JEFF DAVIS TO SMITH STREET


8/12/2019

SUMMARIES

FILE O:\SITKASFHwy00064\Plan\set\SFHwy00064\_SIT\_D1.dwg  
 DATE 8/12/2019 10:50  
 LAYOUT D1  
 DESIGNED C.L.  
 CHECKED BP  
 DRAFTED J.T., RG


FILE G:\SIT\SFHWY00064\Plan\set\SFHWY00064\_SIT\_E1.dwg  
 DATE 8/9/2019 15:45 LAYOUT E1  
 DESIGNED C.L.  
 CHECKED BP  
 DRAFTED J.T. RG

NO.	DATE	REVISION	STATE	PROJECT DESIGNATION	YEAR	SHEET NO.	TOTAL SHEETS
			ALASKA	0933046/SFHwy00064	2019	E1	3

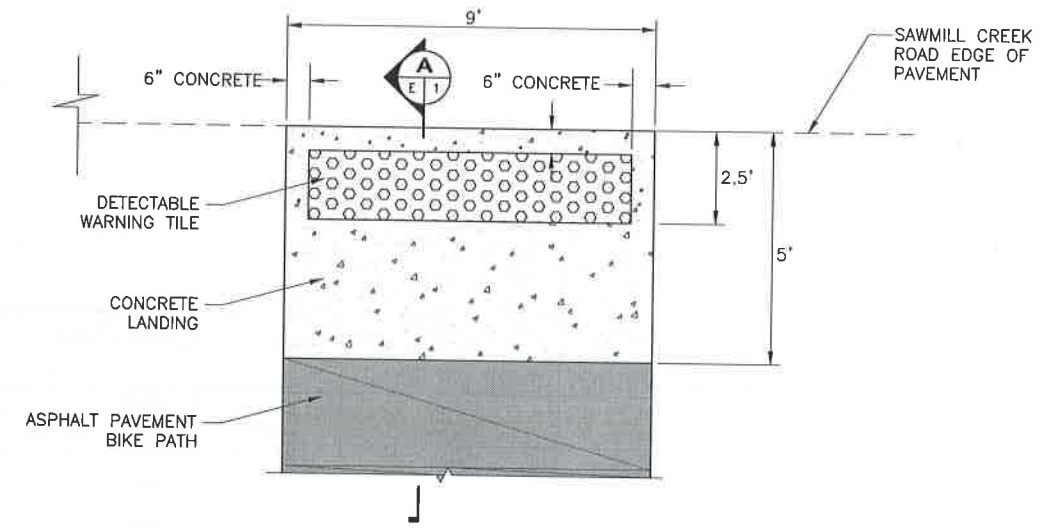


**PLAN VIEW**  
NTS

- LEGEND**
- ① 2" HOT MIX ASPHALT (HMA), TYPE II; CLASS A
  - ② STE-1 ASPHALT FOR TACK COAT
  - ③ 4" CONCRETE SIDEWALK
  - ④ 4" BED COURSE MATERIAL, GRADING D-1
  - ⑤ CURB & GUTTER, TYPE 1

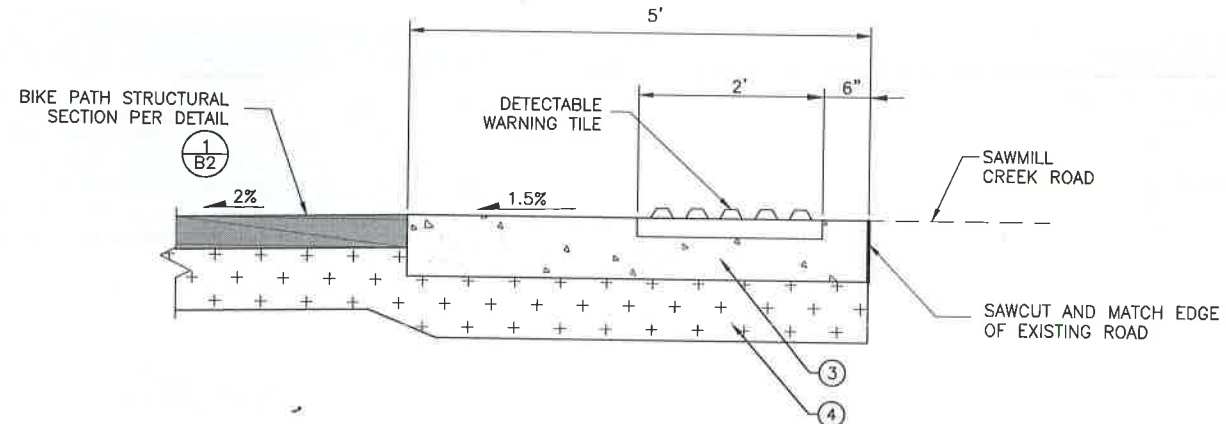


**SECTION A-A**  
NTS

**1 BIKE PATH PEDESTRIAN LANDING**  
SCALE: NOT TO SCALE

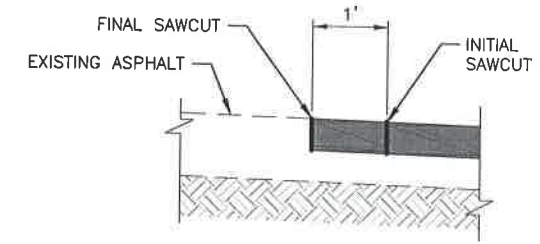


**2 SAWCUT**  
SCALE: NOT TO SCALE

- NOTES:**
- THIS DETAIL APPLIES TO ALL ASPHALT SAWCUTS.
  - INITIALLY SAWCUT EXISTING ASPHALT TO PROTECT FINAL CUT EDGE DURING ASPHALT REMOVAL & BASE COURSE PREPARATION.
  - FINAL SAWCUT WITHIN 24 HOURS PRIOR TO PAVING. PROTECT FINAL SAWCUT EDGE FROM DAMAGE.
  - INITIAL SAWCUT MAY BE ELIMINATED IF PAVING IS TO TAKE PLACE WITHIN 24 HRS AND SAWCUT EDGE IS PROTECTED FROM DAMAGE, PRIOR TO PAVING.
  - FINAL SAWCUT SHALL BE STRAIGHT & THE FULL DEPTH OF EXISTING ASPHALT.

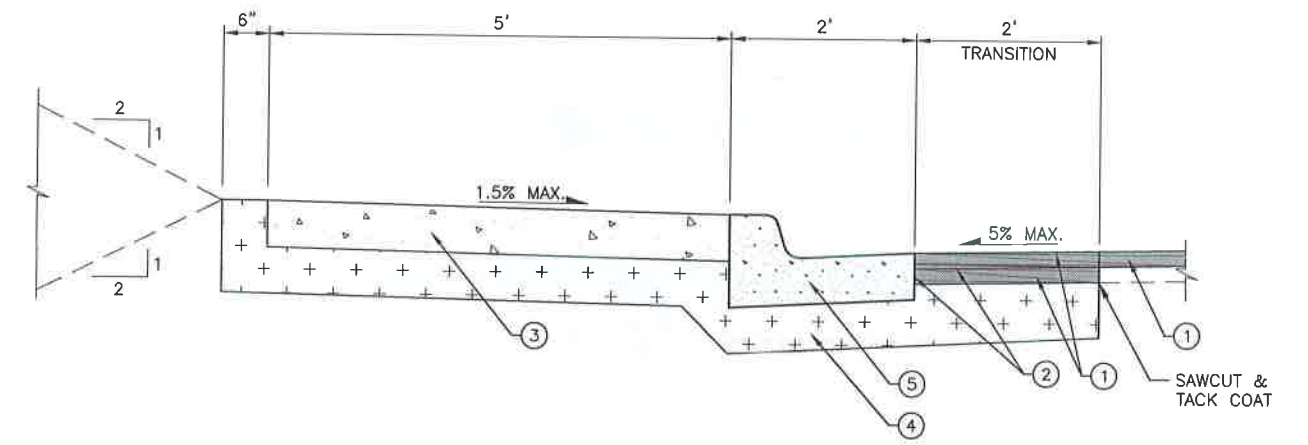


**3 CONCRETE SIDEWALK, 4" THICK**  
SCALE: NOT TO SCALE

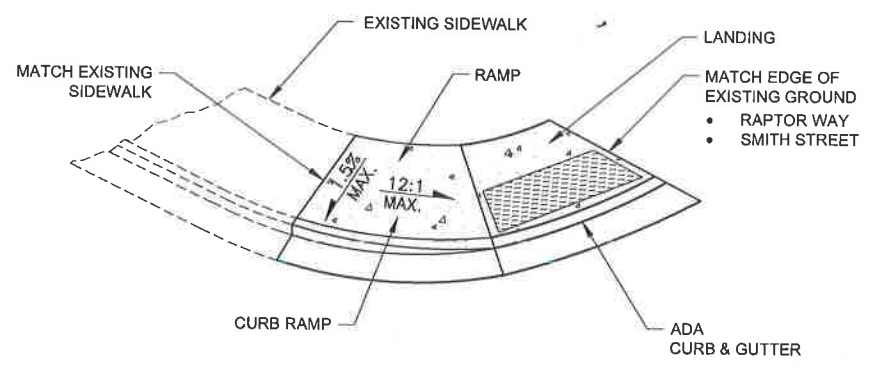


**4 PEDESTRIAN RAMPS-ONE WING**  
SCALE: NOT TO SCALE

Record Drawings have been reviewed by the Project Engineer, and represent to the best of my knowledge, the project as constructed.  
 PE Date 10.23.20

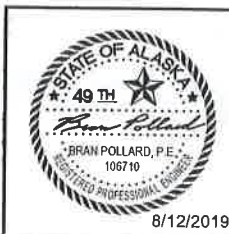


STATE OF ALASKA DEPARTMENT OF TRANSPORTATION AND PUBLIC FACILITIES  
 6860 GLACIER HIGHWAY, JUNEAU, AK 99801  
 (907) 465-1763  
**SITKA SAWMILL CREEK ROAD RESURFACE:**  
 JEFF DAVIS TO SMITH STREET  
 MISCELLANEOUS DETAILS

NO.	DATE	REVISION	STATE	PROJECT DESIGNATION	YEAR	SHEET NO.	TOTAL SHEETS
			ALASKA	0933046/SFHWO0064	2019	E2	3

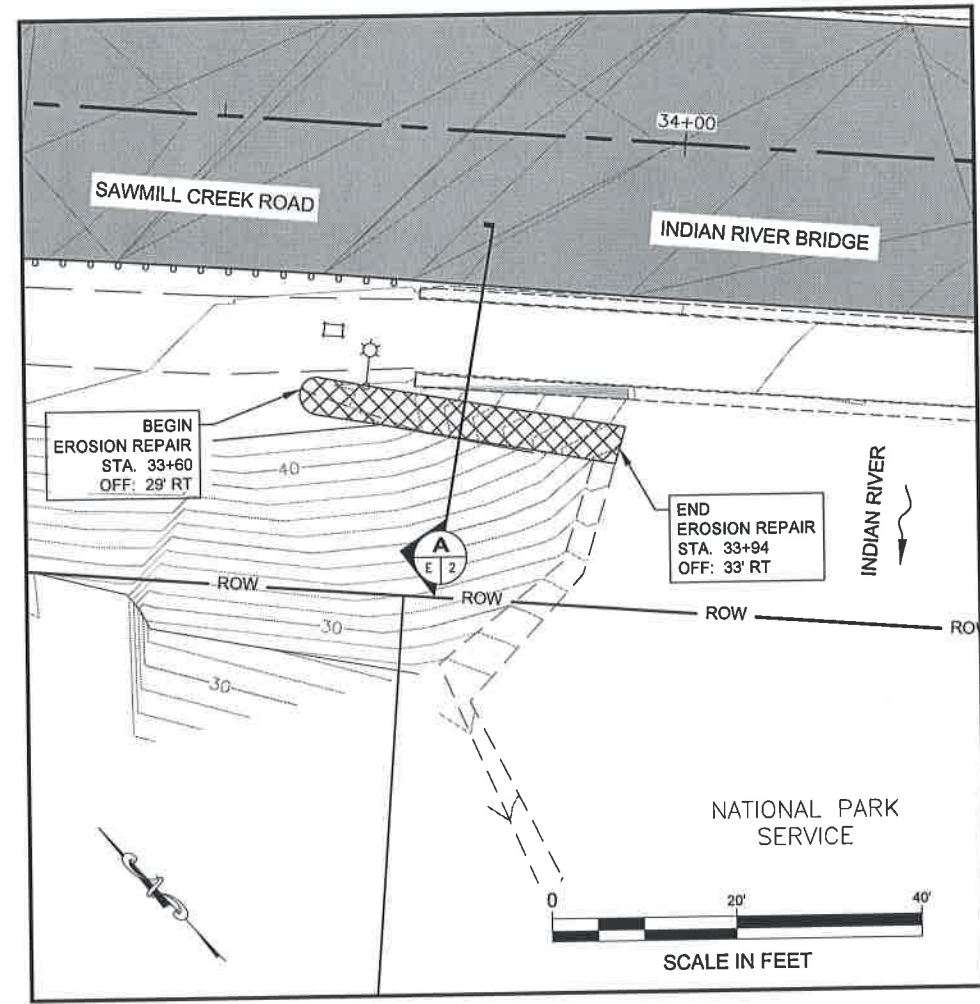


PLAN VIEW  
NTS

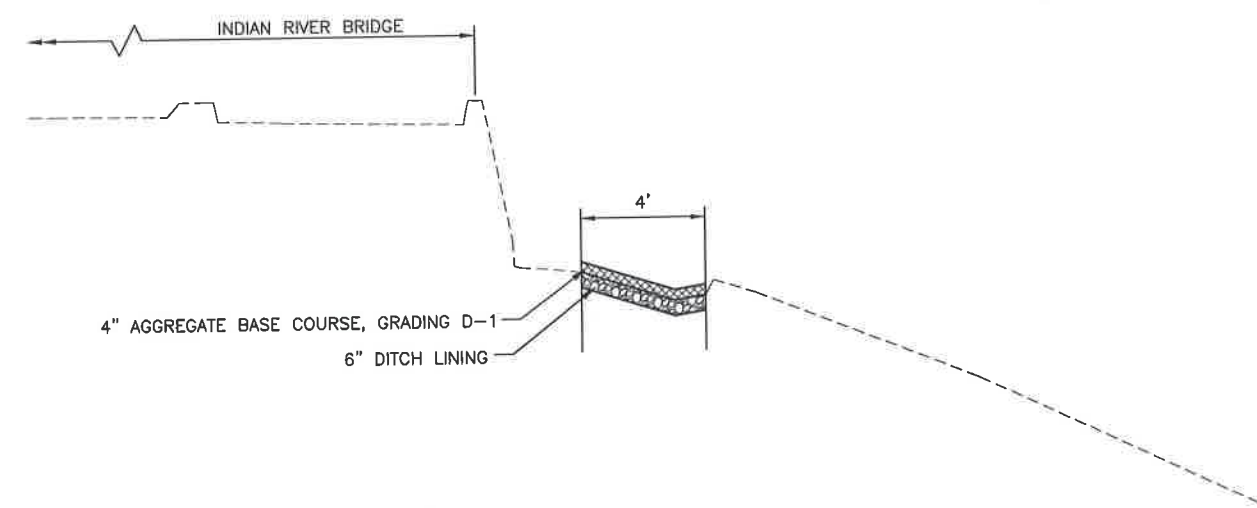

SECTION A-A  
NTS

1 EROSION REPAIR AT INDIAN RIVER BRIDGE  
E2 SCALE: NOT TO SCALE  
STA. 33+60 RT TO 33+94 RT

Record Drawings have been reviewed by the Project Engineer, and represent to the best of my knowledge, the project as constructed.  
PE *[Signature]* Date 10.23.20

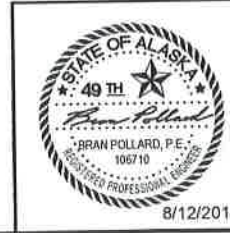


STATE OF ALASKA  
DEPARTMENT OF TRANSPORTATION  
AND PUBLIC FACILITIES  
SITKA SAWMILL CREEK  
ROAD RESURFACE:  
JEFF DAVIS TO SMITH STREET  
MISCELLANEOUS DETAILS


FILE C:\SIT\SFHWY00064\Plans\SFHWY00064\_SIT\_E2.dwg DATE 8/9/2019 15:47 LAYOUT E2 DESIGNED C.L. CHECKED BP DRAFTED JT, RG

FILE C:\SITKASFWHY00064\Plans\SFHWY00064\_SIT\_E2.dwg  
 DATE 8/9/2019 15:47 LAYOUT E3 DESIGNED C.I. CHECKED BP DRAFTED JT, RG


NO.	DATE	REVISION	STATE	PROJECT DESIGNATION	YEAR	SHEET NO.	TOTAL SHEETS
			ALASKA	0933046/SFWHY00064	2019	E3	3

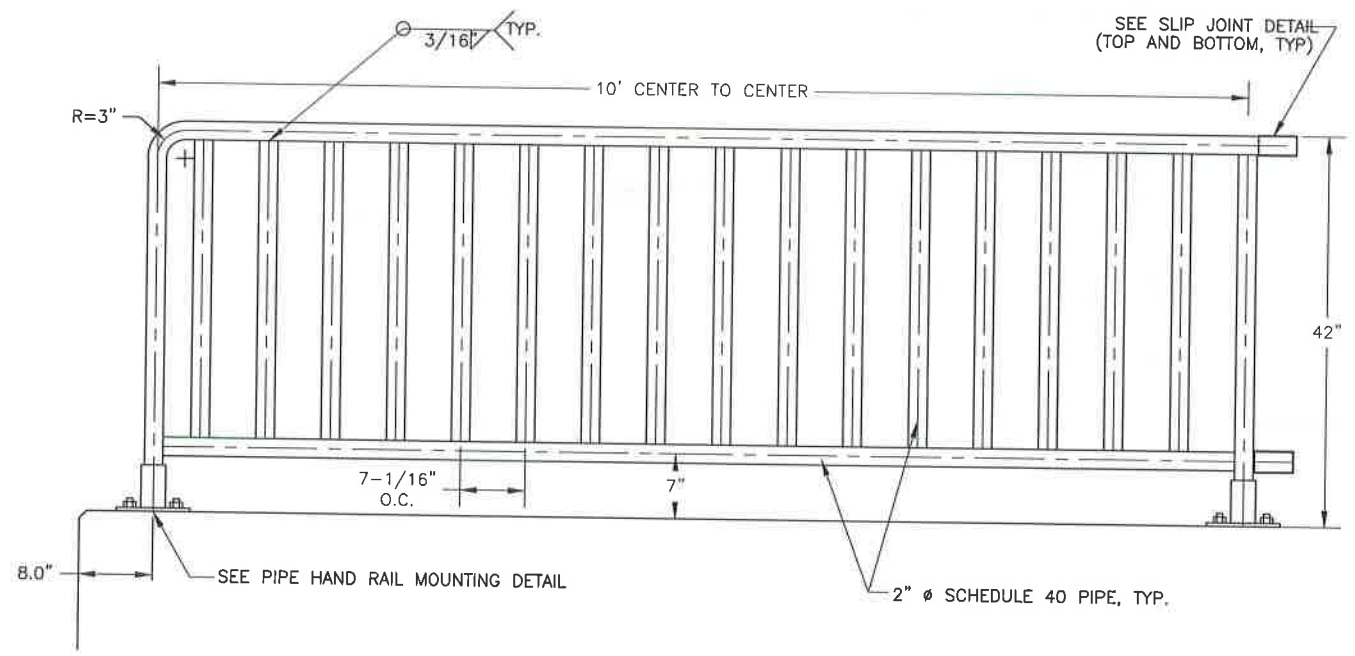


1 PIPE HAND RAIL, TYPE A ELEVATION VIEW  
E3 SCALE: NOT TO SCALE

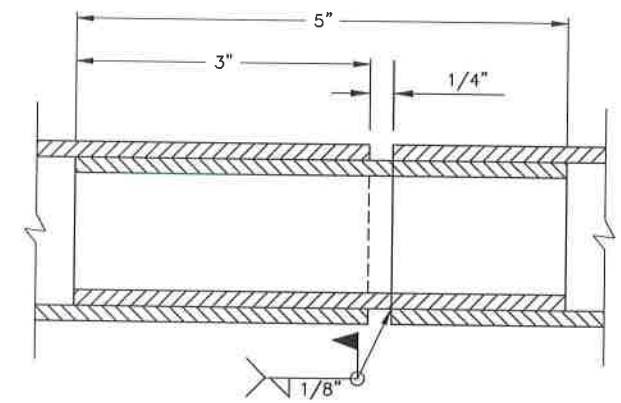

SLIP JOINT DETAIL  
NTS

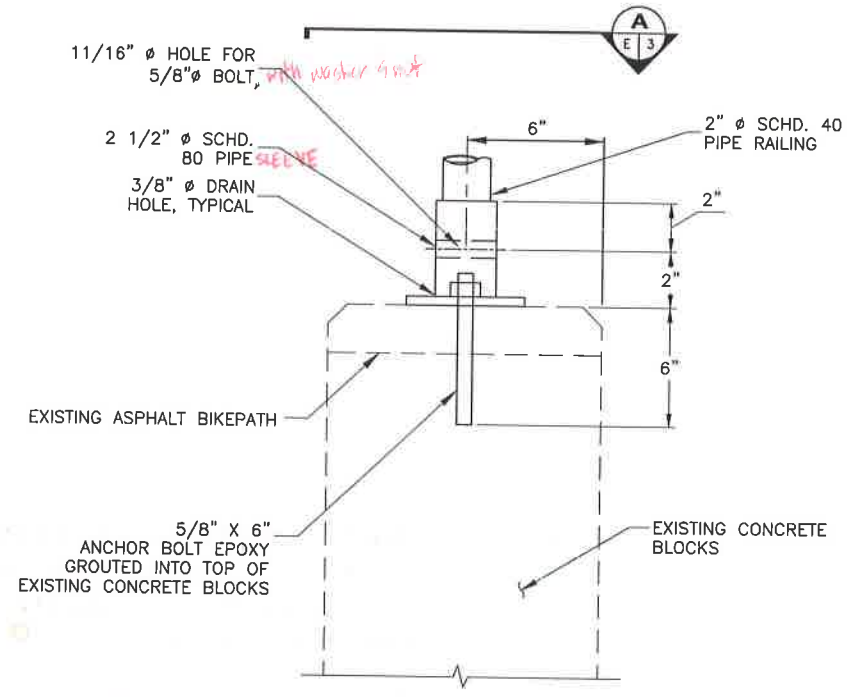

PIPE HAND RAIL, TYPE A MOUNTING DETAIL  
NTS

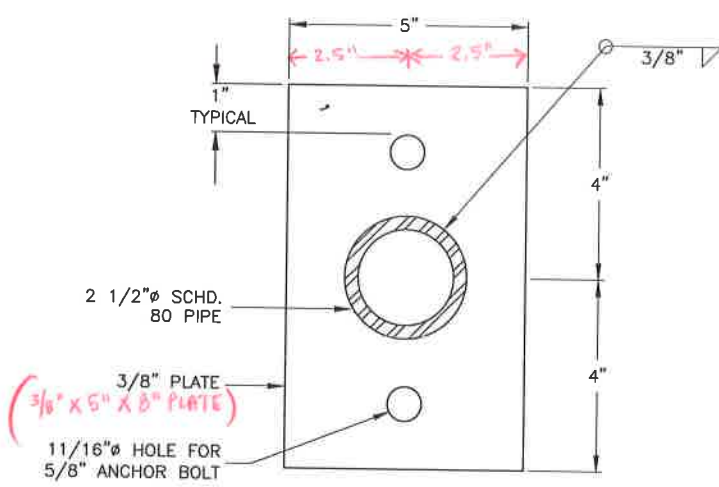


SECTION A-A  
NTS

**PIPE HANDRAIL NOTES:**

1. CONTRACTOR SHALL PROVIDE SHOP DRAWINGS OF ALL PIPE HAND RAIL PRIOR TO FABRICATION FOR THE ENGINEER'S REVIEW AND APPROVAL.
2. ASSURE VERTICAL RAILING IS PLUMB.
3. RAILING PANELS SHALL BE SPLICED USING SLIP JOINT TO PROVIDE CONTINUOUS RAILING. SEE DETAIL.
4. OVERALL LENGTH OF RAILING SEGMENT MAY BE LIMITED DUE TO CONFIGURATION OF WALL.
5. ALL RAILING MEMBERS AND ASSOCIATED HARDWARE SHALL BE GALVANIZED.
6. ALL VERTICAL MEMBERS SHALL BE SPACED TO MAINTAIN A UNIFORM GAP.
7. VERIFY ALL CONTROLLING DIMENSIONS IN THE FIELD BEFORE ORDERING OR FABRICATING ANY MATERIAL.



Record Drawings have been reviewed by the Project Engineer, and represent to the best of my knowledge, the project as constructed.  
 PE Date 10.23.20

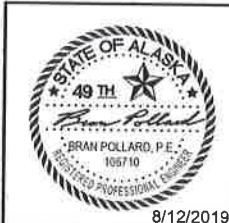

STATE OF ALASKA  
 DEPARTMENT OF TRANSPORTATION  
 AND PUBLIC FACILITIES  
 SITKA SAWMILL CREEK  
 ROAD RESURFACE:  
 JEFF DAVIS TO SMITH STREET  
 MISCELLANEOUS DETAILS

NO.	DATE	REVISION	STATE	PROJECT DESIGNATION	YEAR	SHEET NO.	TOTAL SHEETS
			ALASKA	0933046/SFHWY00064	2019	F1	5

FIRM STATE OF ALASKA DEPARTMENT OF TRANSPORTATION & PUBLIC FACILITIES  
 FILE O:\SIT\SFHWY00064\Project\SFHWY00064\_SIT\_F1.dwg  
 ADDRESS 6880 GLACIER HWY. JUNEAU, AK 99811  
 PHONE (907) 465-1763  
 DESIGNED C.I.  
 CHECKED BP  
 DRAFTED JT, RG  
 CERTIFICATE OF AUTH #  
 DATE 8/9/2019 16:07  
 LAYOUT F1

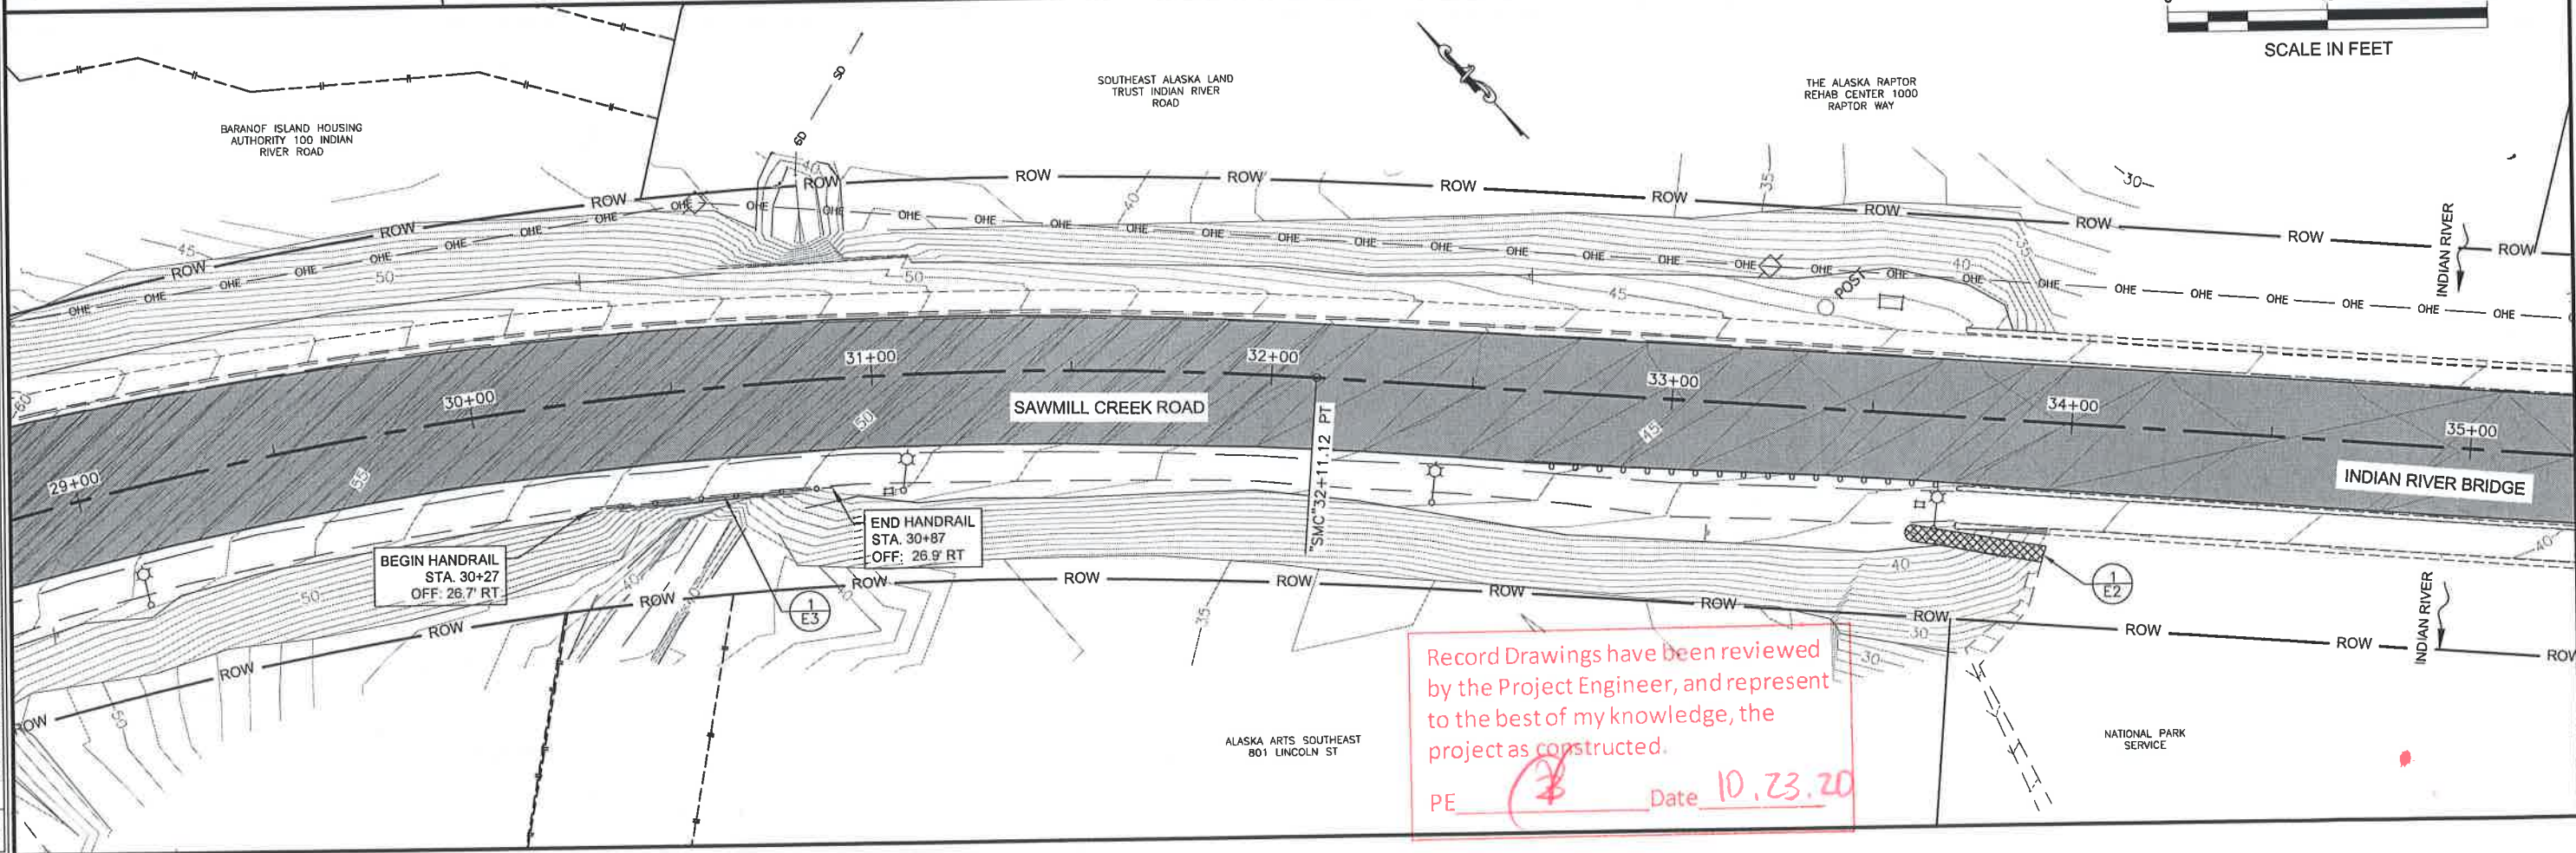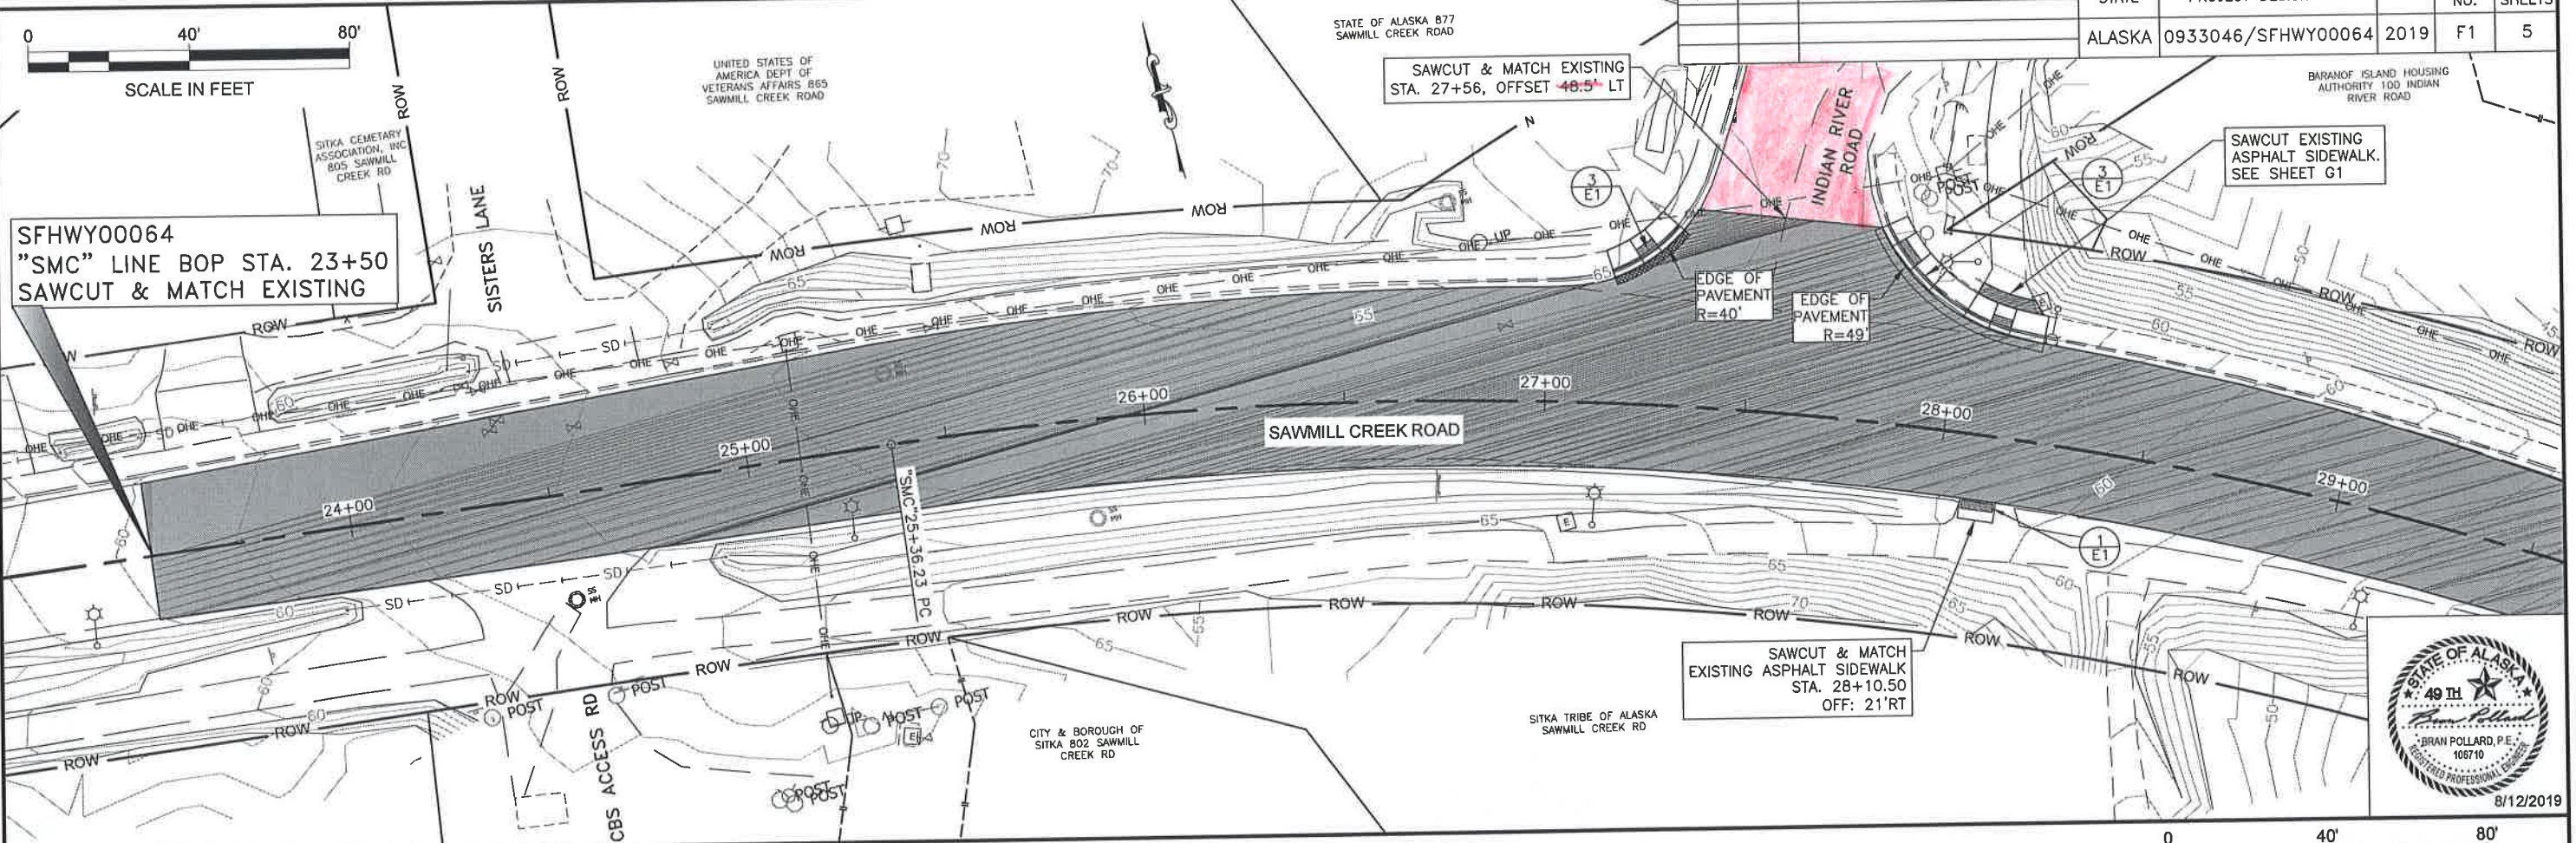


SFHWY00064  
"SMC" LINE BOP STA. 23+50  
SAWCUT & MATCH EXISTING

SAWCUT & MATCH  
EXISTING ASPHALT SIDEWALK  
STA. 28+10.50  
OFF: 21' RT

BEGIN HANDRAIL  
STA. 30+27  
OFF: 26.7' RT



END HANDRAIL  
STA. 30+87  
OFF: 26.9' RT

Record Drawings have been reviewed  
by the Project Engineer, and represent  
to the best of my knowledge, the  
project as constructed.  
PE *[Signature]* Date 10.23.20

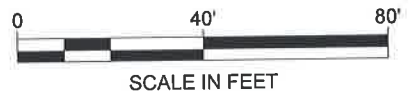

FIRM STATE OF ALASKA DEPARTMENT OF TRANSPORTATION & PUBLIC FACILITIES  
 FILE C:\SIT\SFHWY00064\Plan\set\SFHWY00064\_SIT\_F1.dwg  
 ADDRESS 6860 GLACIER HWY, JUNEAU, AK 99811  
 PHONE (907) 465-1783  
 DESIGNED C.I.  
 CHECKED BP  
 DRAFTED JT, RG  
 CERTIFICATE OF AUTH #  
 DATE 8/29/2019 16:07 LAYOUT F2



NO.	DATE	REVISION	STATE	PROJECT DESIGNATION	YEAR	SHEET NO.	TOTAL SHEETS
			ALASKA	0933046/SFHWY00064	2019	F2	5

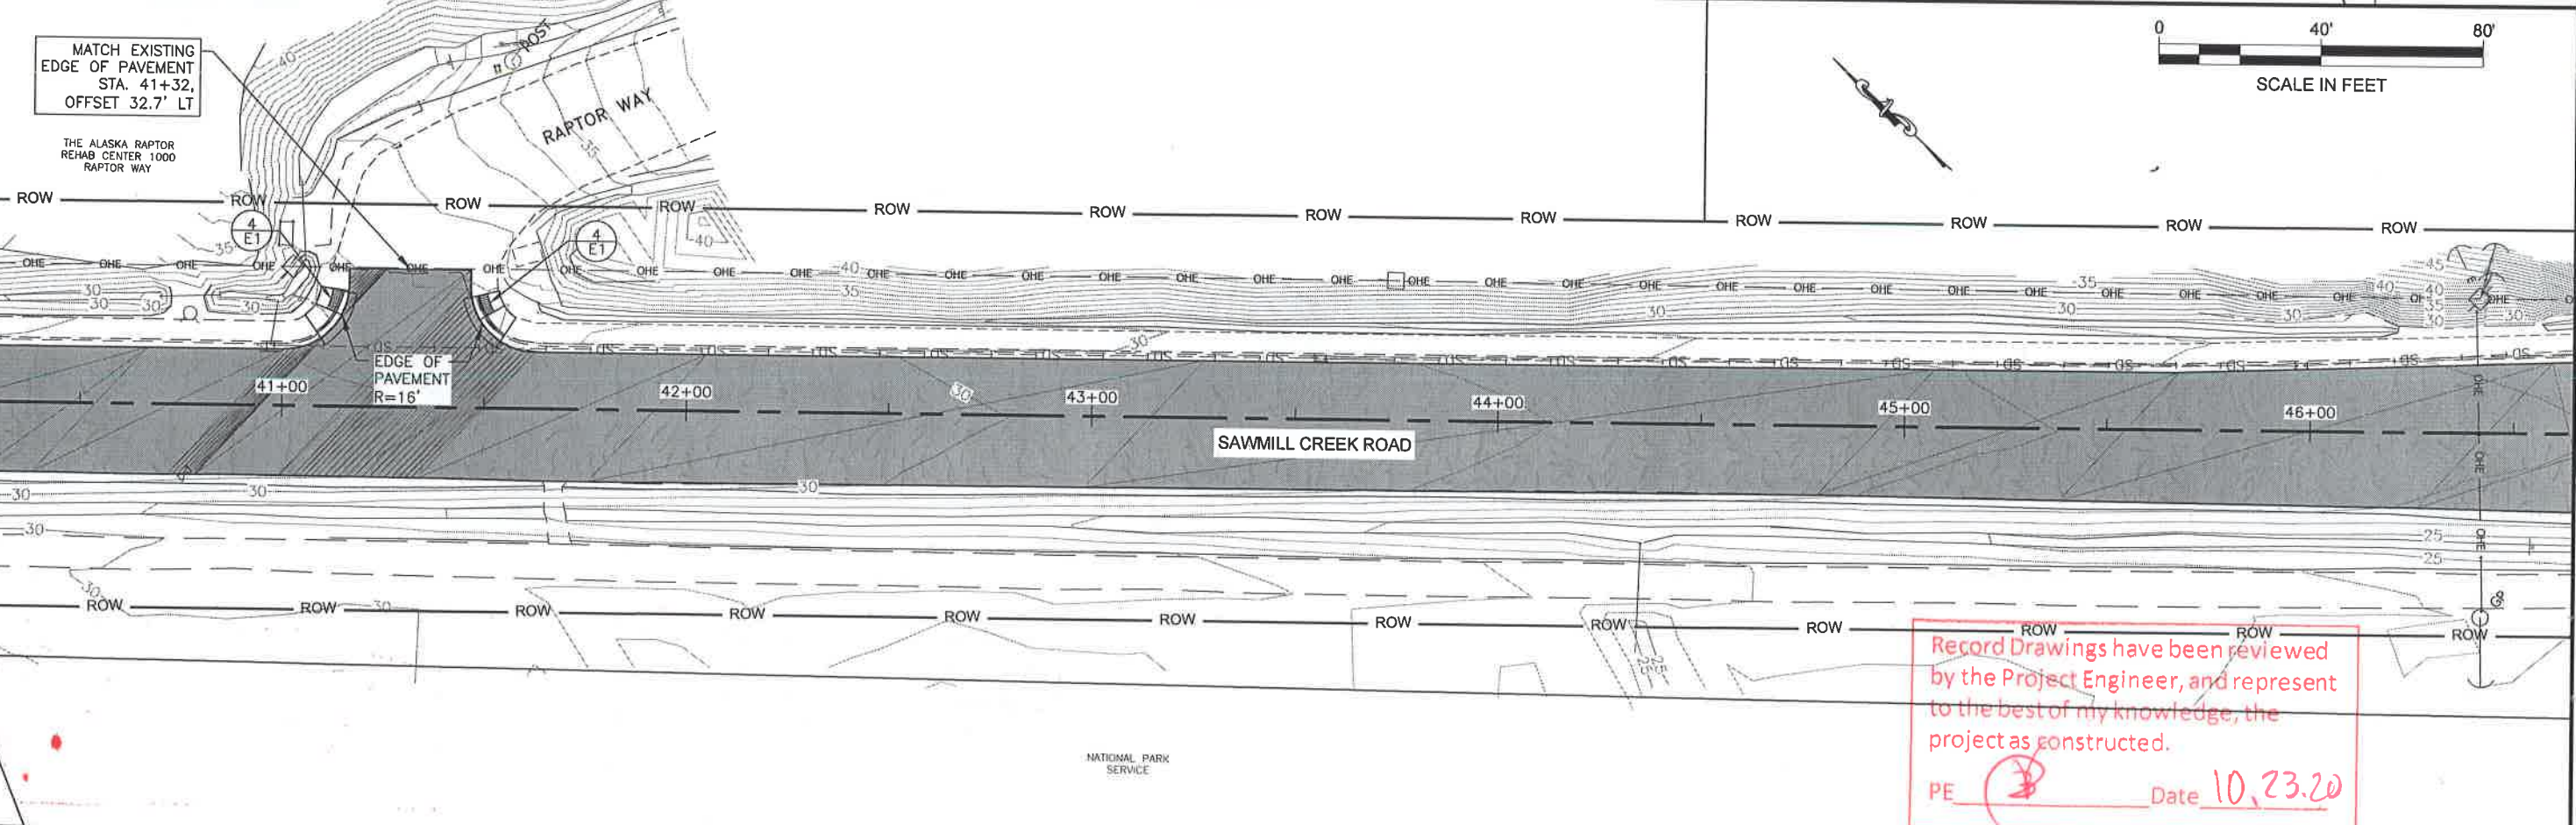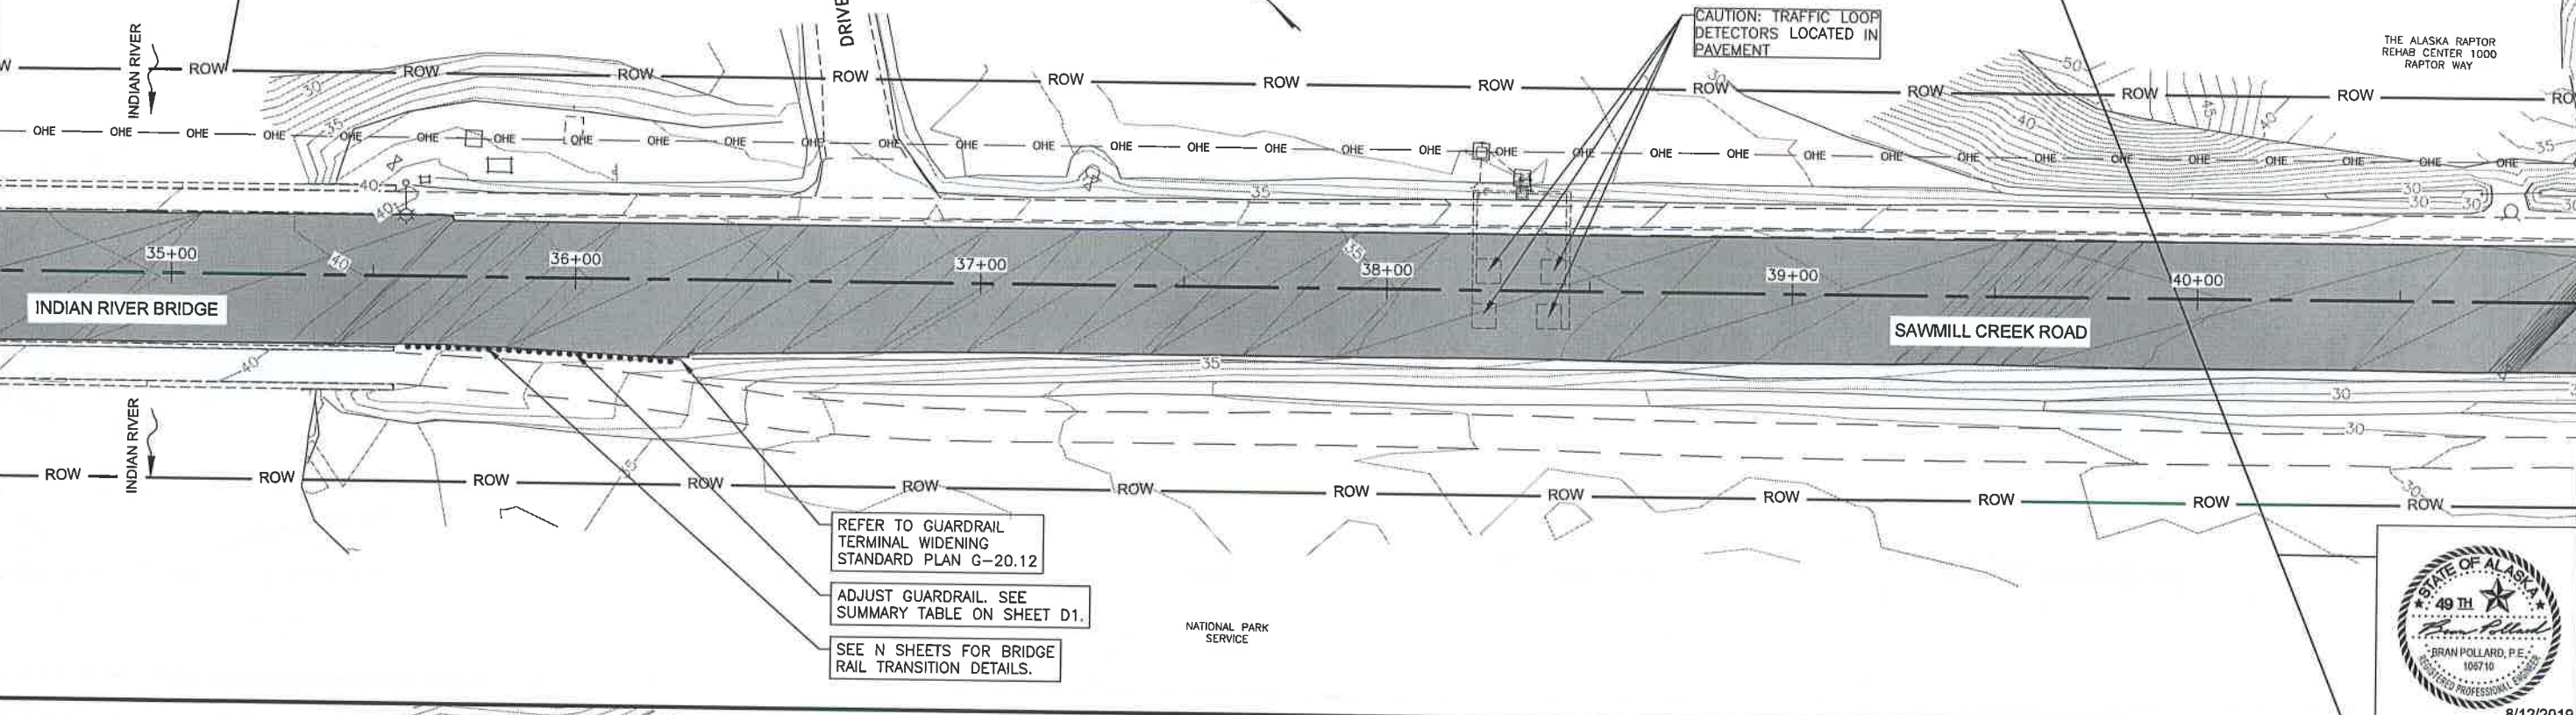


Record Drawings have been reviewed by the Project Engineer, and represent to the best of my knowledge, the project as constructed.  
 PE Date 10.23.20



NO.	DATE	REVISION	STATE	PROJECT DESIGNATION	YEAR	SHEET NO.	TOTAL SHEETS
			ALASKA	0933046/SFHWO0064	2019	F3	5

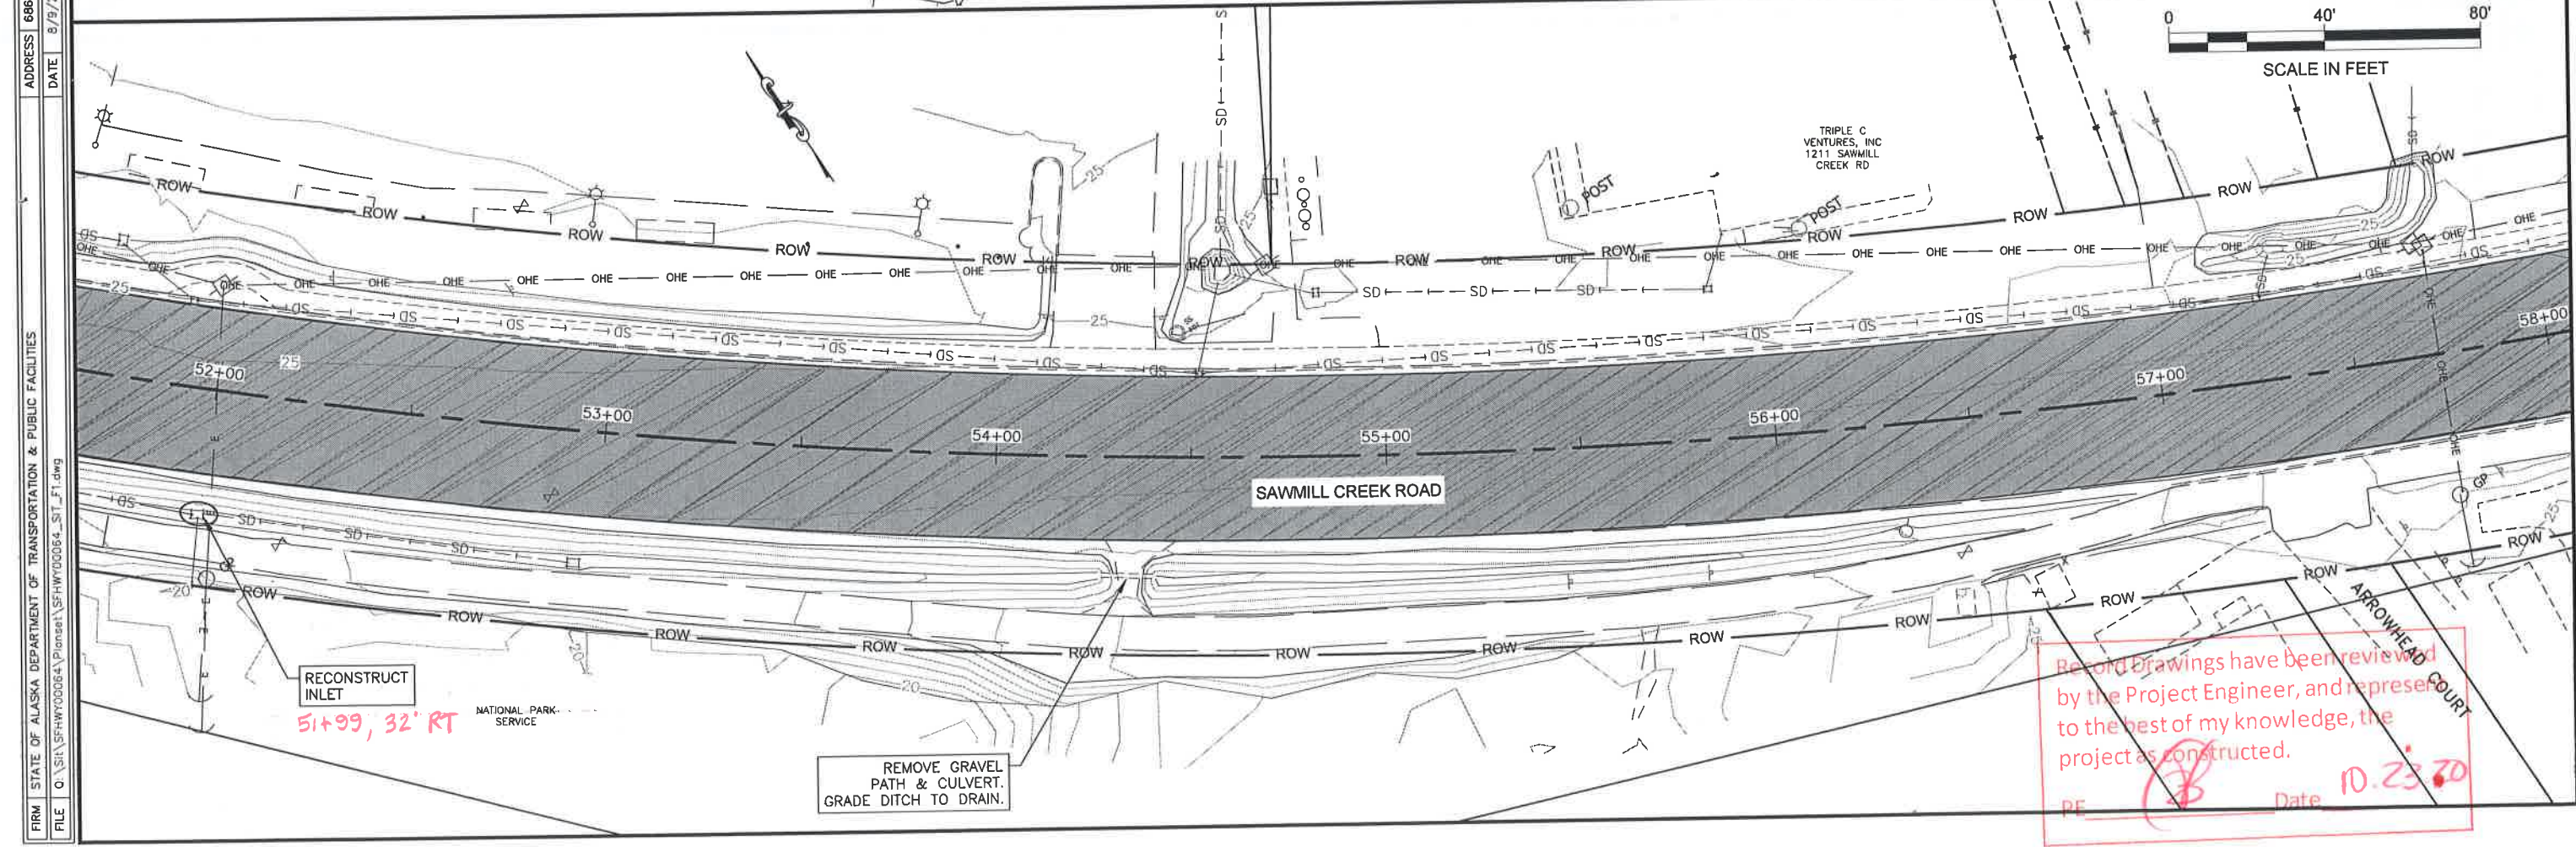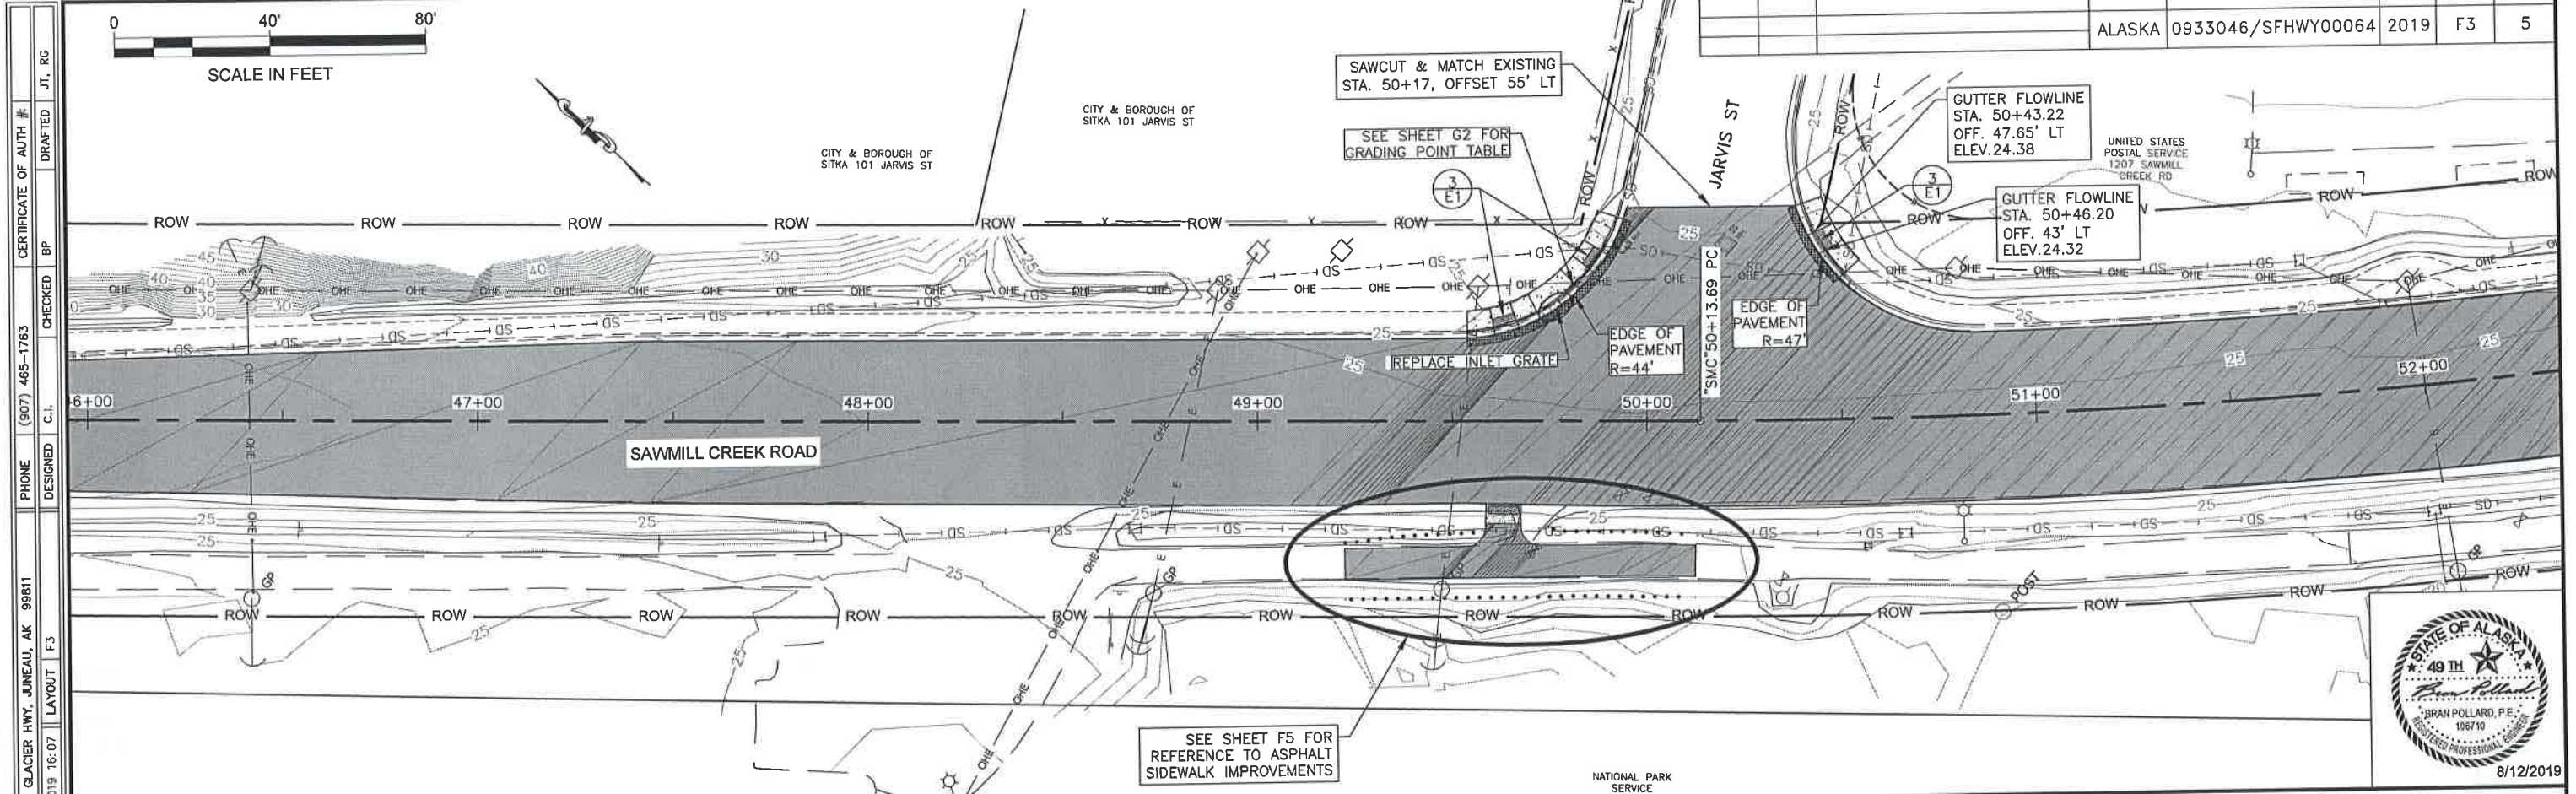


Revised Drawings have been reviewed by the Project Engineer, and represent to the best of my knowledge, the project as constructed.

PE  Date 10.23.20

FIRM STATE OF ALASKA DEPARTMENT OF TRANSPORTATION & PUBLIC FACILITIES  
 FILE O:\SIA\SFHWO0064\Planest\SFHW00064\_SIT\_F1.dwg  
 ADDRESS 6860 GLACIER HWY., JUNEAU, AK 99811  
 PHONE (907) 465-1763  
 CHECKED BP  
 DESIGNED C.I.  
 LAYOUT F3  
 DATE 8/9/2019 16:07  
 CERTIFICATE OF AUTH #  
 DRAFTED JT, RG

FIRM STATE OF ALASKA DEPARTMENT OF TRANSPORTATION & PUBLIC FACILITIES  
 FILE G:\SIT\SFH\00064\Plan\set\SFH\00064\_SIT\_F1.dwg  
 ADDRESS 6860 GLACIER HWY, JUNEAU, AK 99811  
 DATE 8/9/2019 16:07 LAYOUT F4  
 PHONE (907) 465-1763 DESIGNED C.I.  
 CHECKED BP  
 DRAFTED J.T. RG  
 CERTIFICATE OF AUTH #

NO.	DATE	REVISION	STATE	PROJECT DESIGNATION	YEAR	SHEET NO.	TOTAL SHEETS
			ALASKA	0933046/SFH\00064	2019	F4	5


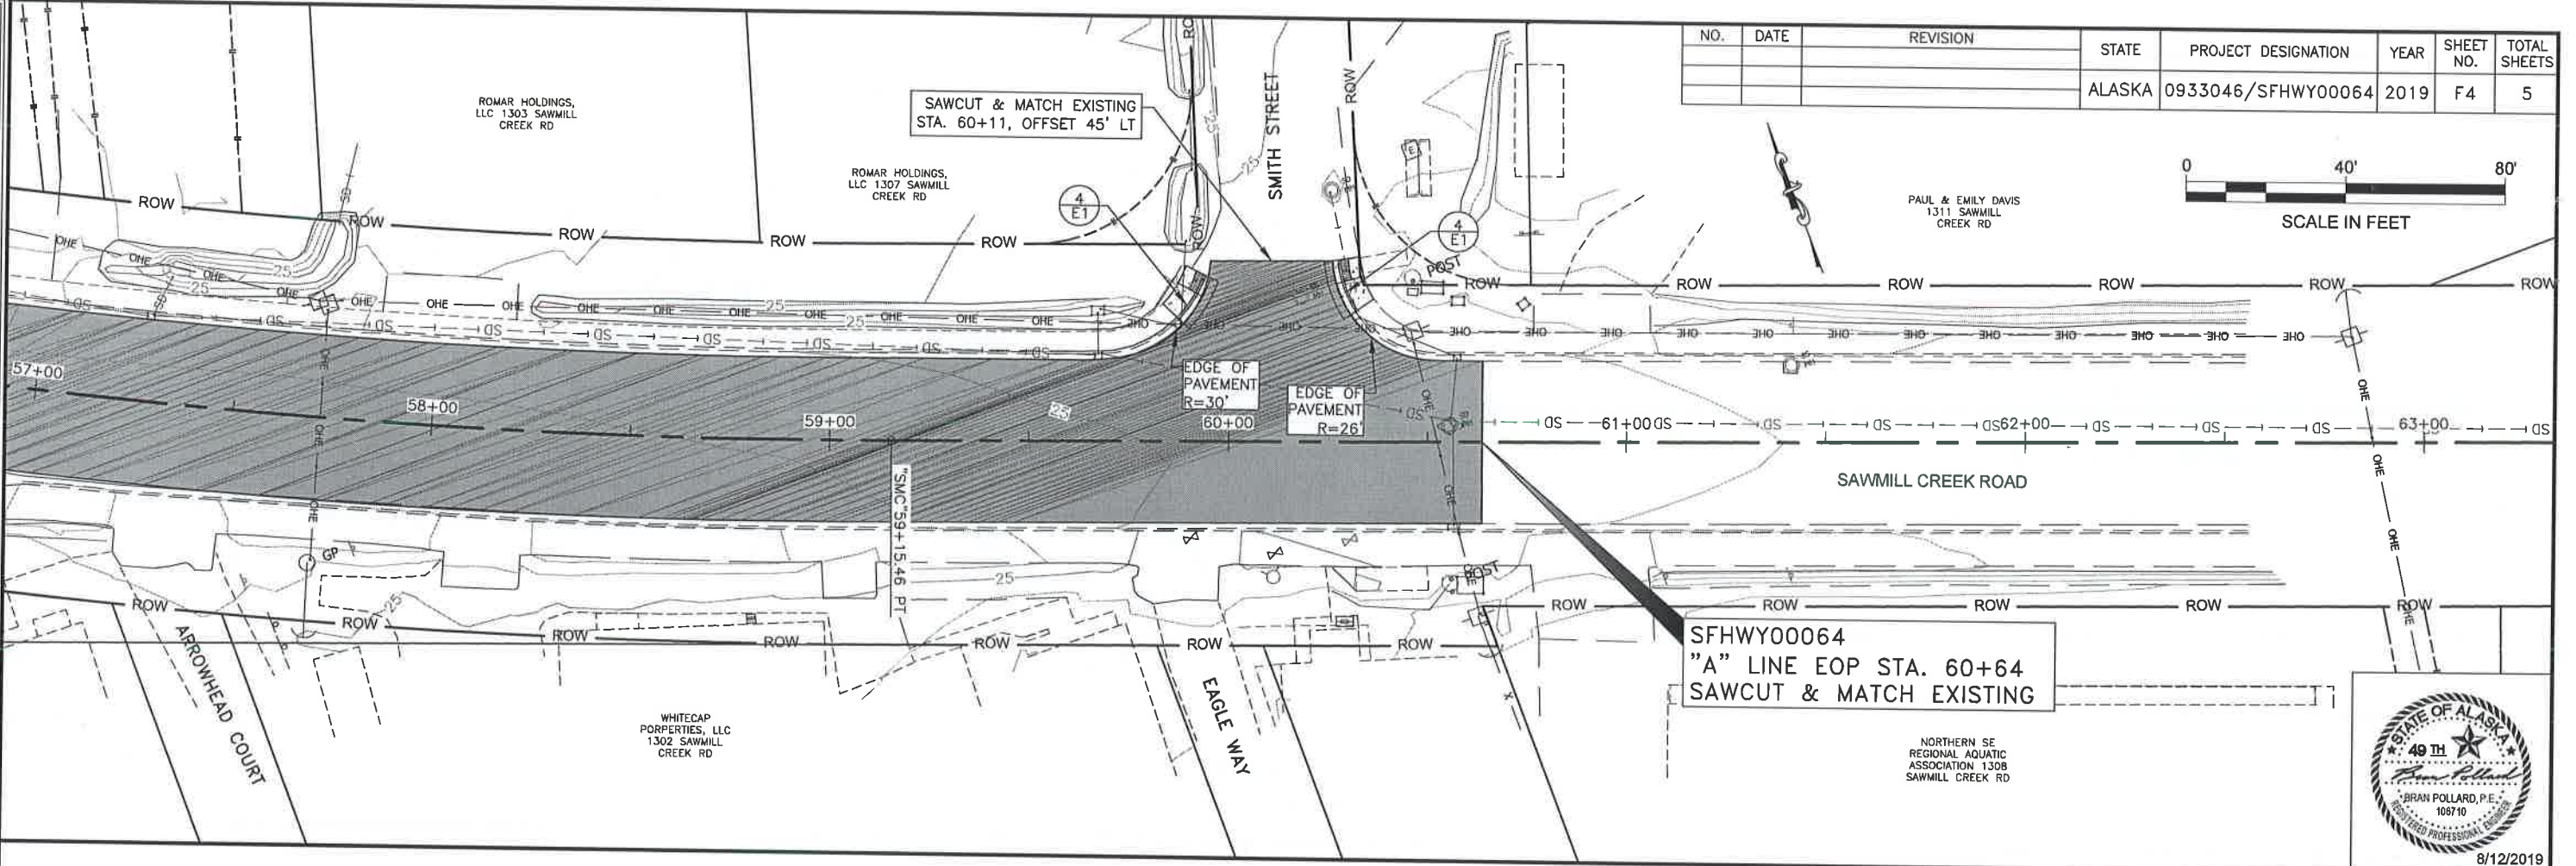


8/12/2019



Record Drawings have been reviewed  
 by the Project Engineer, and represent  
 to the best of my knowledge, the  
 project as constructed.  
 PE [Signature] Date 10 23.20

NO.	DATE	REVISION	STATE	PROJECT DESIGNATION	YEAR	SHEET NO.	TOTAL SHEETS
			ALASKA	0933046/SFHWY00064	2019	F5	5

FIRM STATE OF ALASKA DEPARTMENT OF TRANSPORTATION & PUBLIC FACILITIES  
 FILE O:\s\sfhw\00064\PlanSet\SFHWY00064\_SIT\_F1.dwg  
 ADDRESS 6860 GLACIER HWY, JUNEAU, AK 99811  
 DATE 8/9/2019 16:07 LAYOUT FS  
 PHONE (907) 465-1763  
 DESIGNED C.I.  
 CHECKED BP  
 DRAFTED JT, RG  
 CERTIFICATE OF AUTH. #

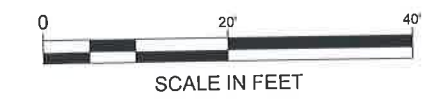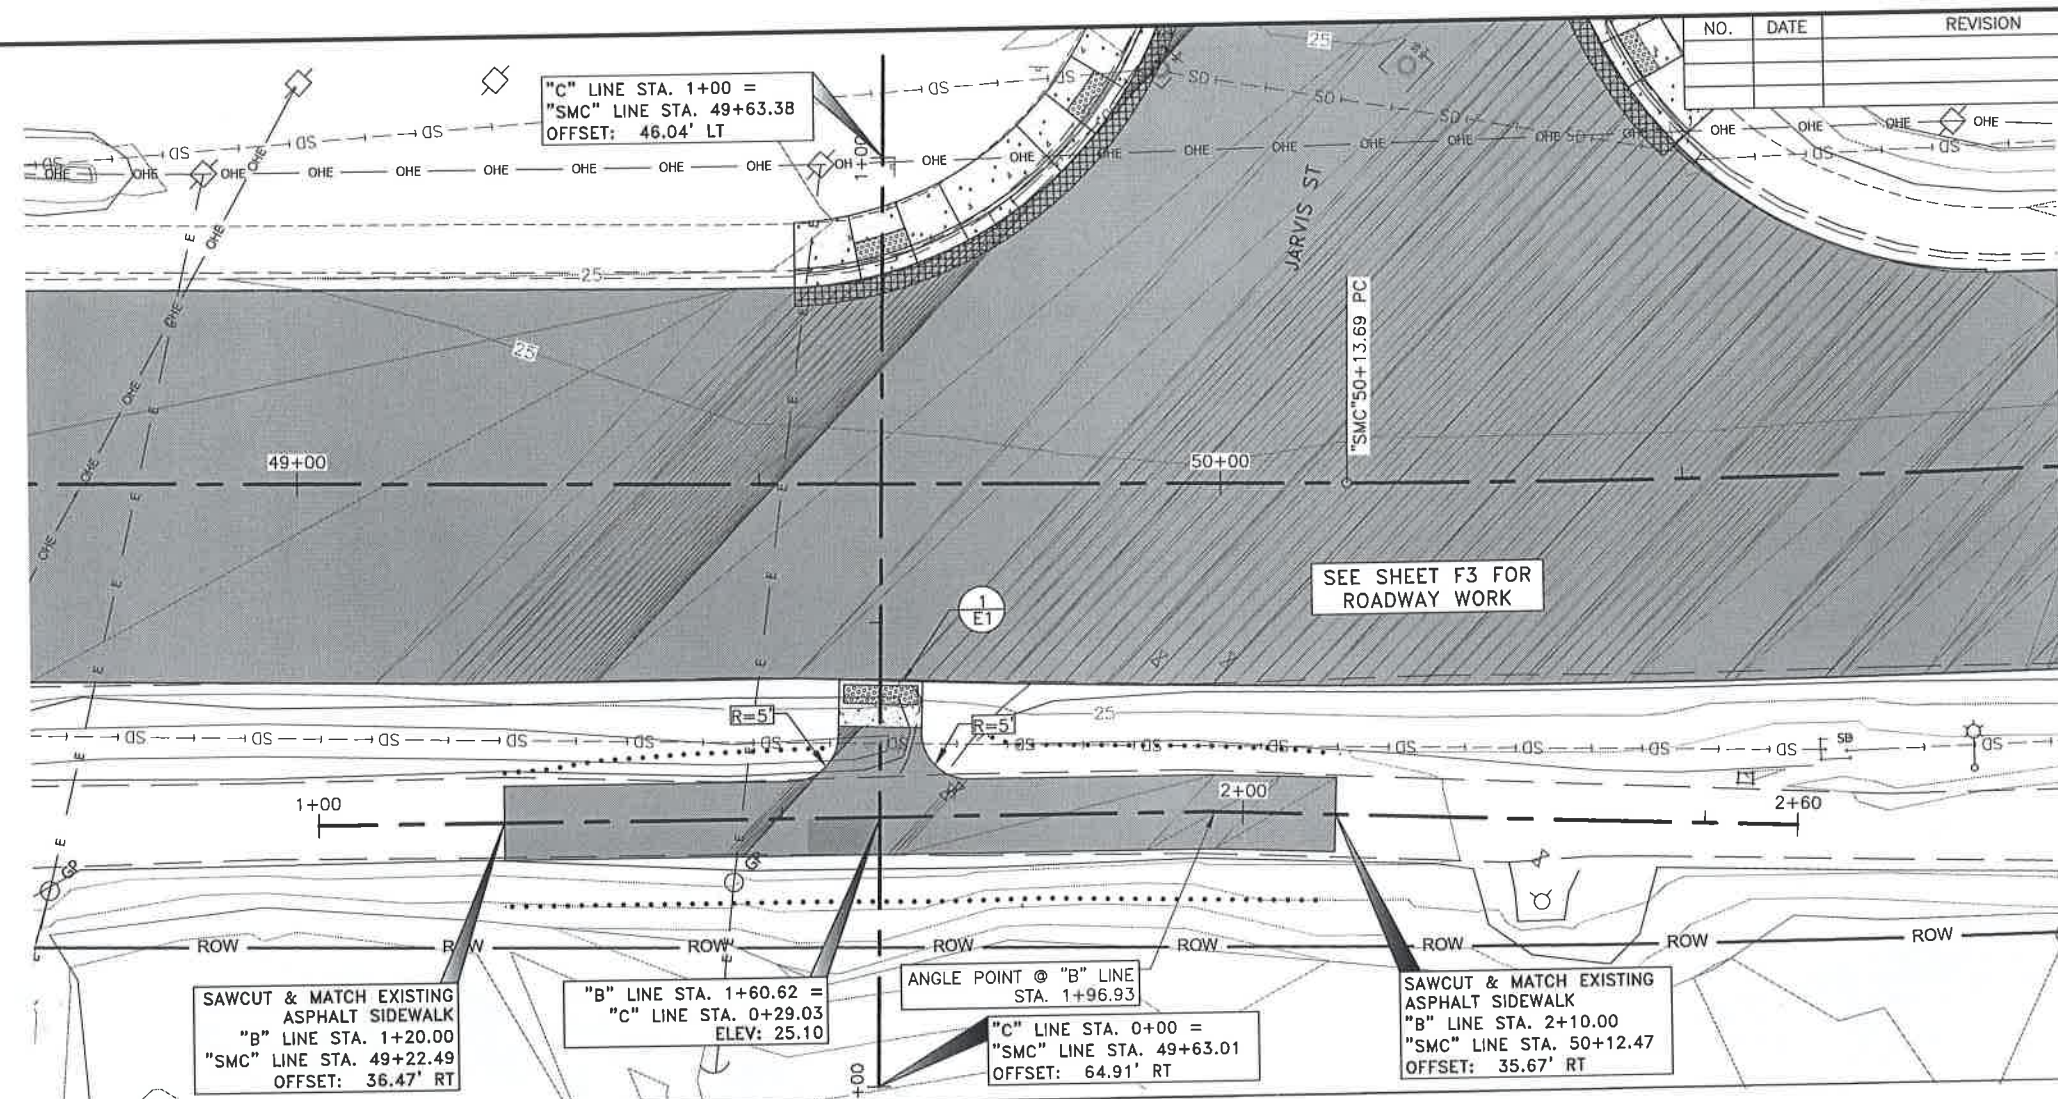


8/12/2019

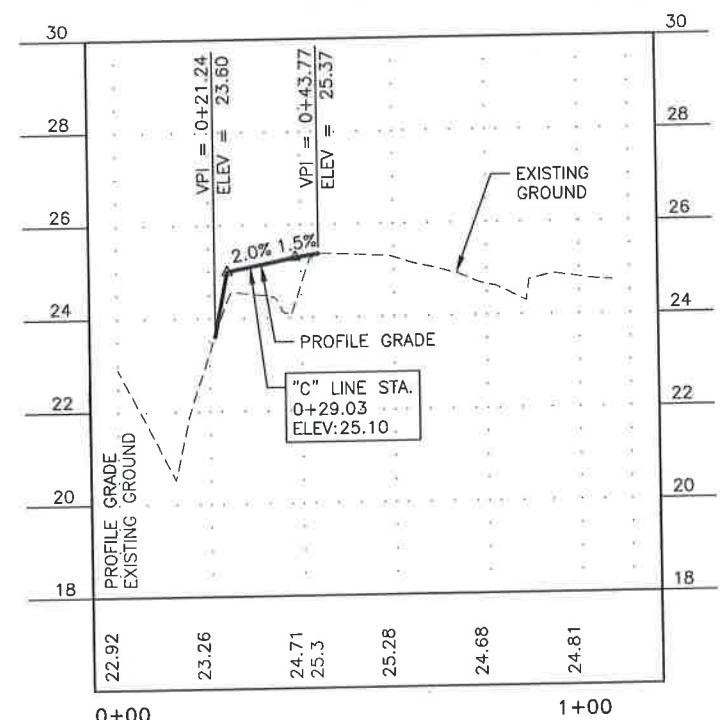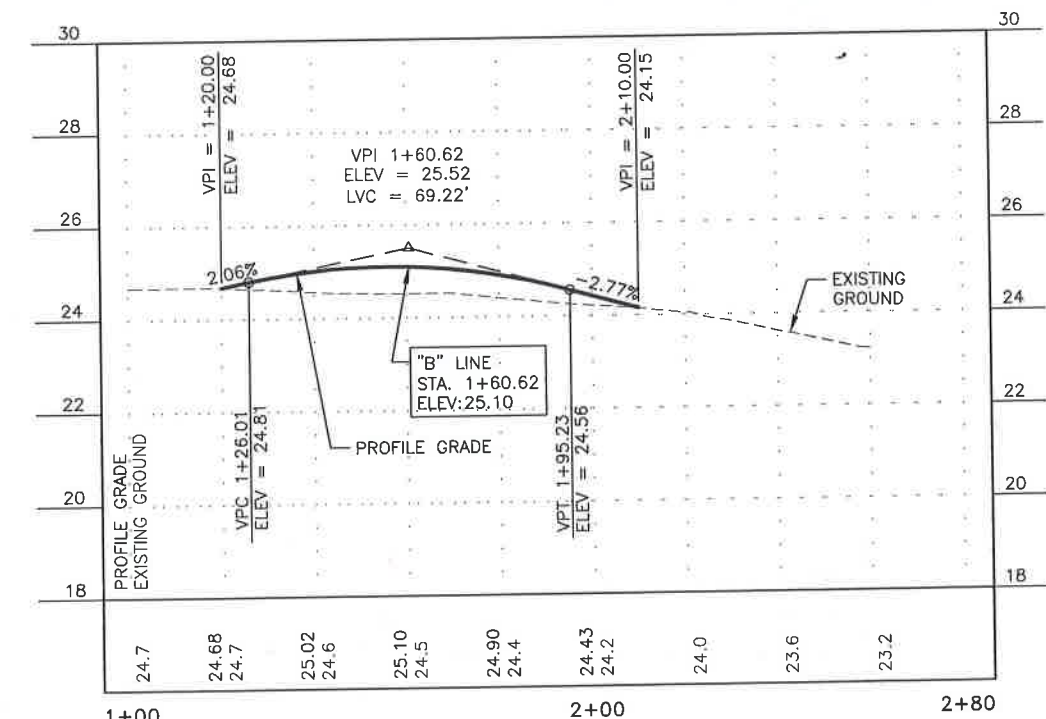

Record Drawings have been reviewed by the Project Engineer, and represent to the best of my knowledge, the project as constructed.  
 PE Date 10.23.20

FILE Q:\31\SFH\00064\Plans\SFH\00064\_S1\_G1.dwg  
 DATE 8/12/2019 14:05 LAYOUT G1  
 DESIGNED C.L.  
 CHECKED BP  
 DRAFTED JT, RC

NO.	DATE	REVISION	STATE	PROJECT DESIGNATION	YEAR	SHEET NO.	TOTAL SHEETS
			ALASKA	0933046/SFH\00064	2019	G1	2

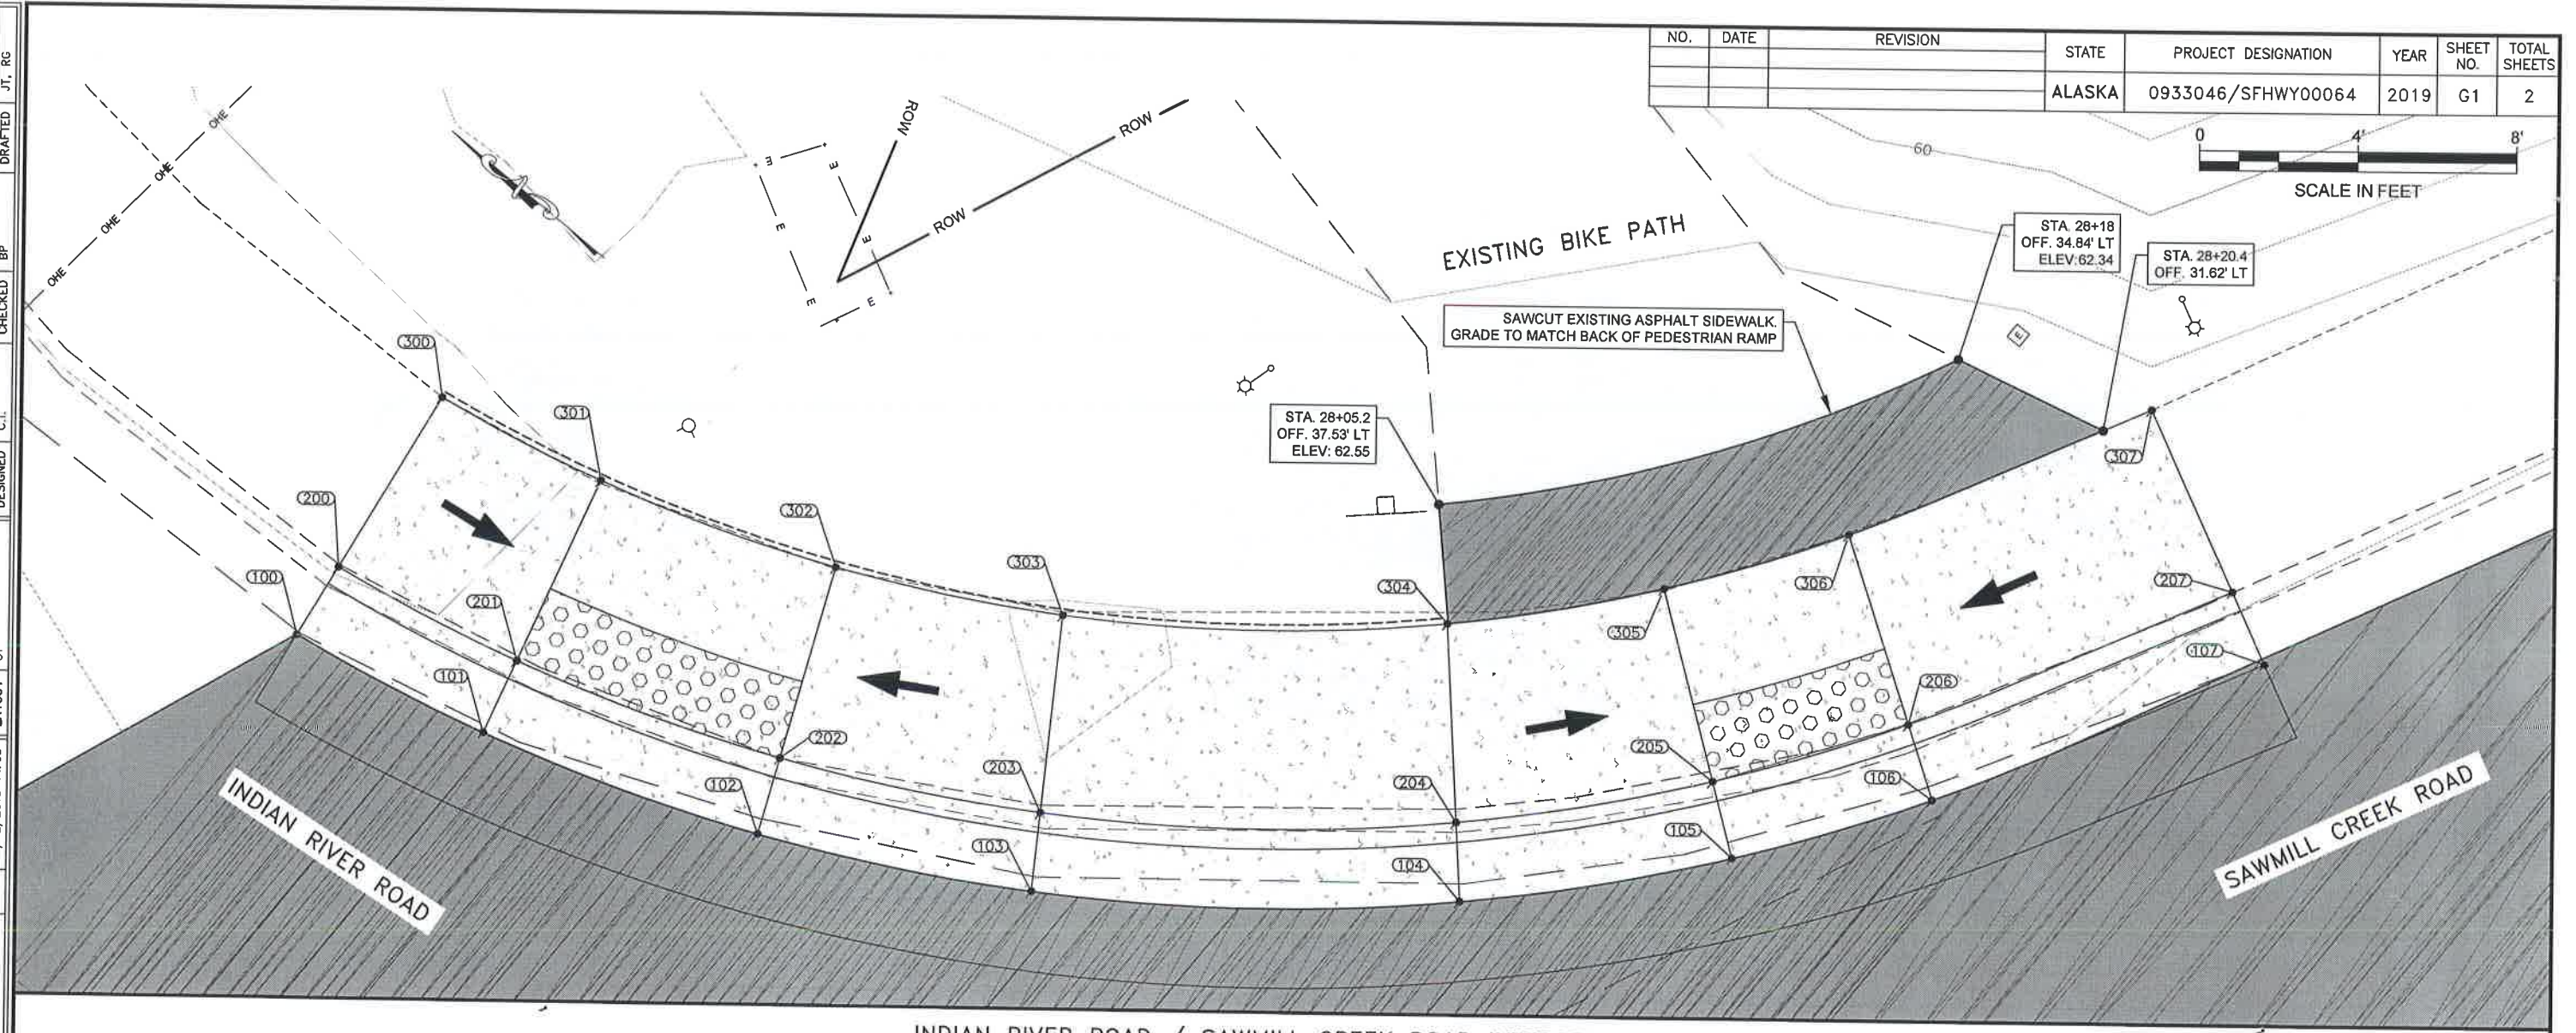


INDIAN RIVER ROAD / SAWMILL CREEK ROAD INTERSECTION

POINTS COORDINATE TABLE				
POINT	STATION	OFFSET	ELEVATION	DESCRIPTION
100	27+79.40	48.16L	62.77	EDGE OF PAVEMENT
101	27+82.22	43.74L	62.76	EDGE OF PAVEMENT
102	27+86.90	38.19L	62.67	EDGE OF PAVEMENT
103	27+92.12	33.67L	62.60	EDGE OF PAVEMENT
104	28+01.24	28.42L	62.42	EDGE OF PAVEMENT
105	28+07.66	26.24L	62.27	EDGE OF PAVEMENT
106	28+12.68	25.25L	62.11	EDGE OF PAVEMENT
107	28+21.49	24.54L	61.83	EDGE OF PAVEMENT

POINTS COORDINATE TABLE				
POINT	STATION	OFFSET	ELEVATION	DESCRIPTION
200	27+81.06	49.15L	63.06	TOP BACK OF CURB
201	27+83.76	44.92L	62.78	TOP BACK OF CURB
202	27+88.25	39.61L	62.67	TOP BACK OF CURB
203	27+93.20	35.31L	62.99	TOP BACK OF CURB
204	28+02.06	30.23L	62.72	TOP BACK OF CURB
205	28+08.09	28.18L	62.27	TOP BACK OF CURB
206	28+13.00	27.22L	62.11	TOP BACK OF CURB
207	28+21.57	26.54L	62.13	TOP BACK OF CURB

POINTS COORDINATE TABLE				
POINT	STATION	OFFSET	ELEVATION	DESCRIPTION
300	27+85.18	51.63L	63.27	BACK OF SIDEWALK
301	27+87.59	47.89L	62.86	BACK OF SIDEWALK
302	27+91.61	43.18L	62.76	BACK OF SIDEWALK
303	27+95.93	39.43L	63.07	BACK OF SIDEWALK
304	28+04.10	34.77L	62.78	BACK OF SIDEWALK
305	28+09.18	33.05L	62.31	BACK OF SIDEWALK
306	28+13.79	32.16L	62.23	BACK OF SIDEWALK
307	28+21.77	31.53L	62.57	BACK OF SIDEWALK

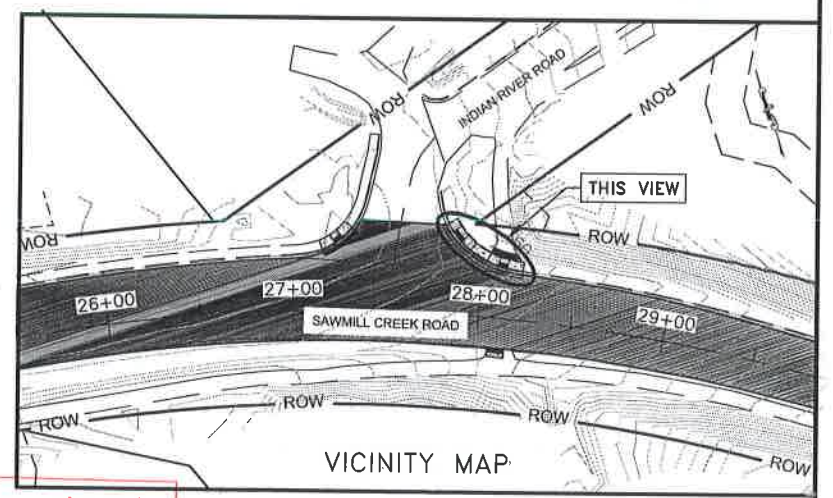

Record Drawings have been reviewed  
 by the Project Engineer, and represent  
 the best of my knowledge, the  
 project as constructed.  
 PE [Signature] Date 10.23.19




STATE OF ALASKA DEPARTMENT OF TRANSPORTATION  
 AND PUBLIC FACILITIES  
 6860 GLACIER HIGHWAY, JUNEAU, AK 99801  
 (907) 465-1763  
**SITKA SAWMILL CREEK  
 ROAD RESURFACE:  
 JEFF DAVIS TO SMITH STREET**  
 GRADING PLAN

8/12/2019

FILE: O:\SIT\SFHWY00064\Plan\set\SFHWY00064\_SIT\_G1.dwg  
 DATE: 8/12/2019 15:17 LAYOUT: G2 DESIGNED: C.L. CHECKED: B.P. DRAFTED: J.T. RG



NO.	DATE	REVISION	STATE	PROJECT DESIGNATION	YEAR	SHEET NO.	TOTAL SHEETS
			ALASKA	0933046/SFHWY00064	2019	G2	2

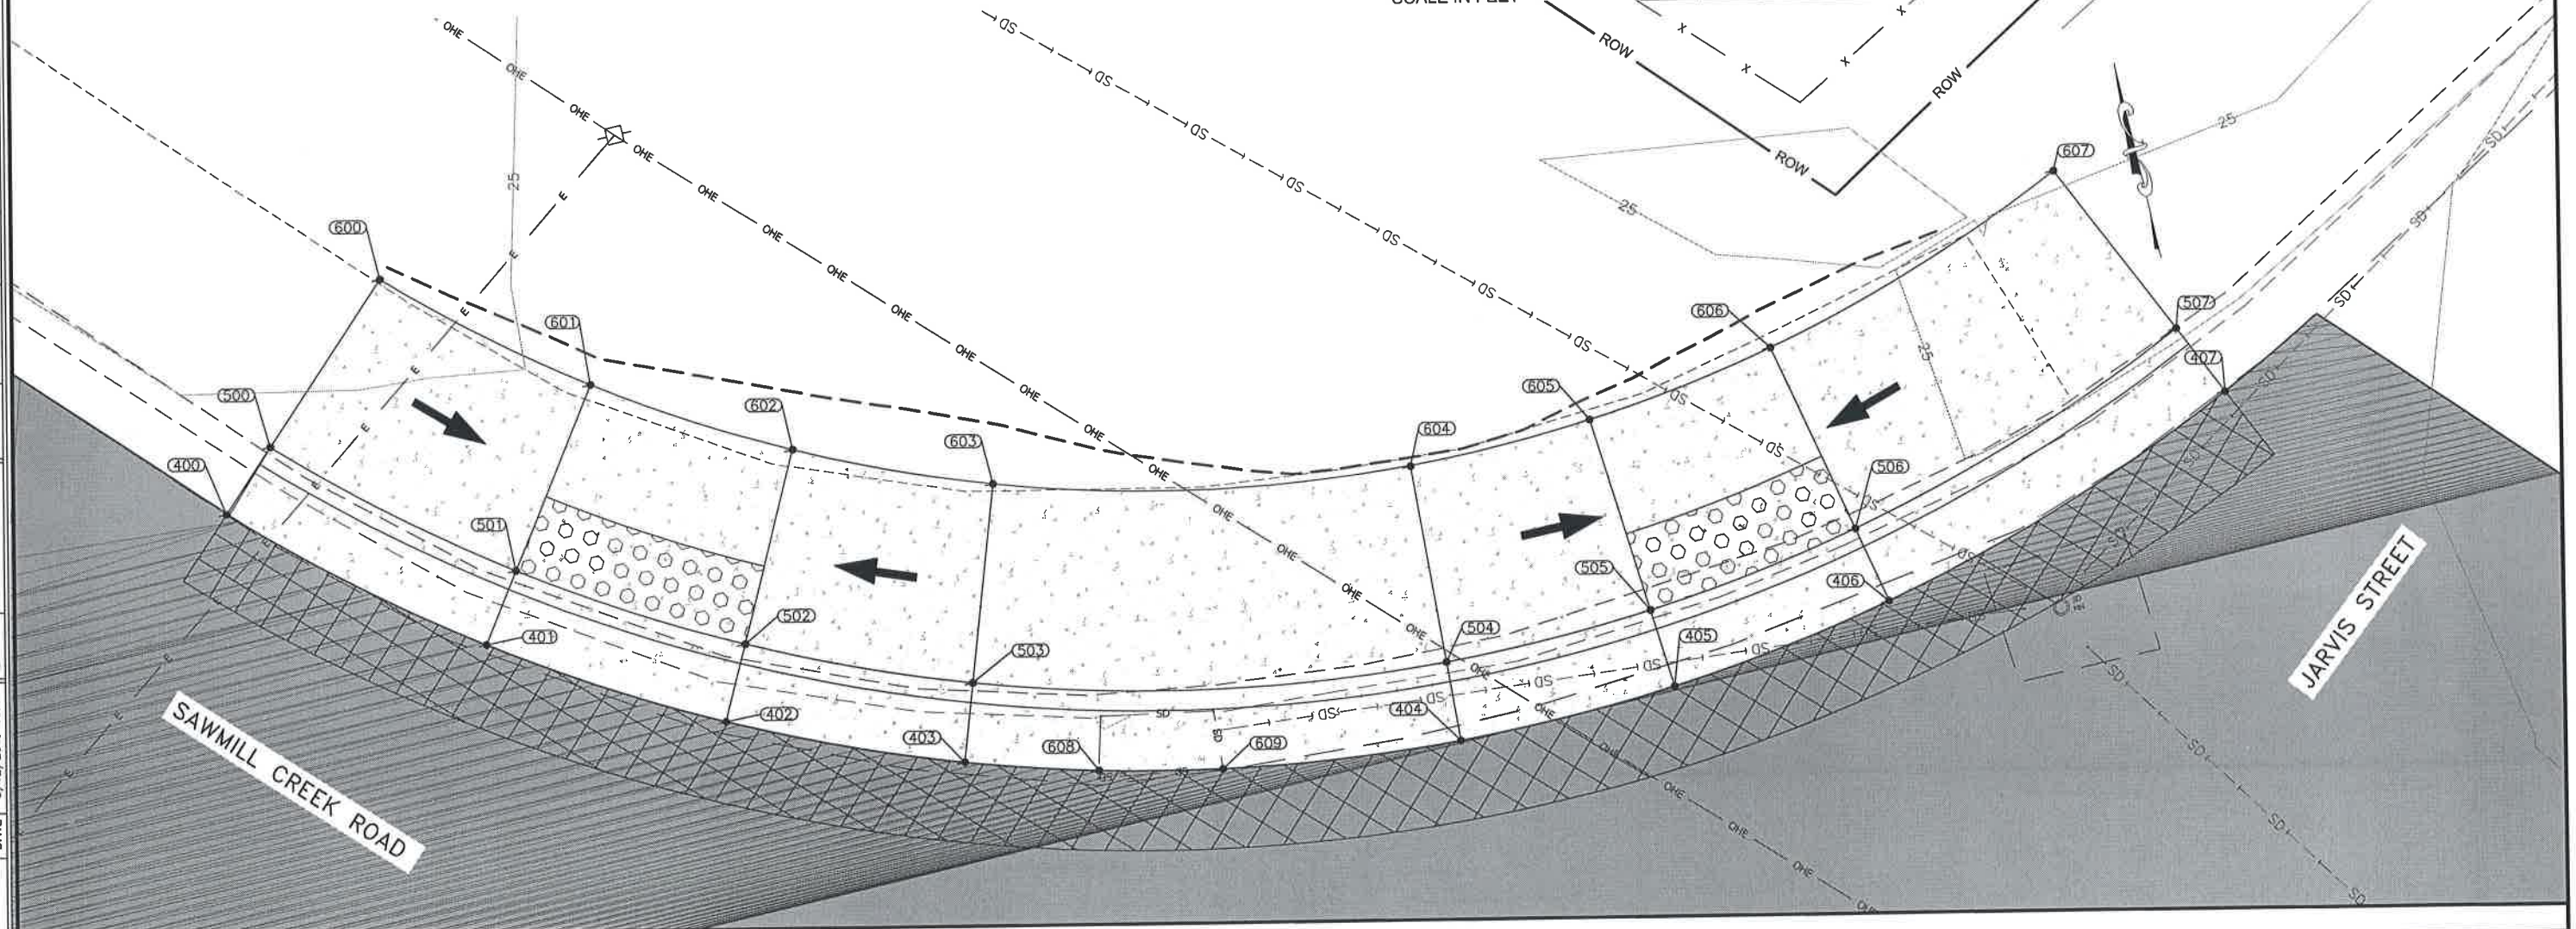


JARVIS STREET / SAWMILL CREEK ROAD INTERSECTION

POINTS COORDINATE TABLE				
POINT	STATION	OFFSET	ELEVATION	DESCRIPTION
400	49+53.83	21.08L	24.54	EDGE OF PAVEMENT
401	49+61.05	22.00L	24.42	EDGE OF PAVEMENT
402	49+67.13	23.74L	24.26	EDGE OF PAVEMENT
403	49+72.67	26.21L	24.12	EDGE OF PAVEMENT
404	49+82.75	33.56L	24.20	EDGE OF PAVEMENT
405	49+86.46	37.66L	24.30	EDGE OF PAVEMENT
406	49+89.77	42.41L	24.47	EDGE OF PAVEMENT
407	49+93.90	51.44L	24.81	EDGE OF PAVEMENT
500	49+53.81	23.09L	24.76	TOP BACK OF CURB
501	49+60.64	23.95L	24.22	TOP BACK OF CURB

POINTS COORDINATE TABLE				
POINT	STATION	OFFSET	ELEVATION	DESCRIPTION
502	49+66.44	25.62L	24.13	TOP BACK OF CURB
503	49+71.73	27.98L	24.34	TOP BACK OF CURB
504	49+81.36	35.00L	24.60	BACK OF SIDEWALK
505	49+84.90	38.90L	24.06	TOP BACK OF CURB
506	49+88.06	43.44L	24.15	TOP BACK OF CURB
507	49+92.00	52.06L	25.20	TOP BACK OF CURB
600	49+53.75	28.09L	24.82	BACK OF SIDEWALK
601	49+59.61	28.85L	24.29	BACK OF SIDEWALK
602	49+64.72	30.31L	24.20	BACK OF SIDEWALK
603	49+69.39	32.39L	24.42	BACK OF SIDEWALK

POINTS COORDINATE TABLE				
POINT	STATION	OFFSET	ELEVATION	DESCRIPTION
604	49+77.88	38.56L	24.67	BACK OF SIDEWALK
605	49+80.99	42.02L	24.14	BACK OF SIDEWALK
606	49+83.77	46.03L	24.49	BACK OF SIDEWALK
607	49+87.25	53.62L	25.27	BACK OF SIDEWALK
608	49+75.59	27.91L	24.09	INLET
609	49+78.16	29.67L	24.12	INLET

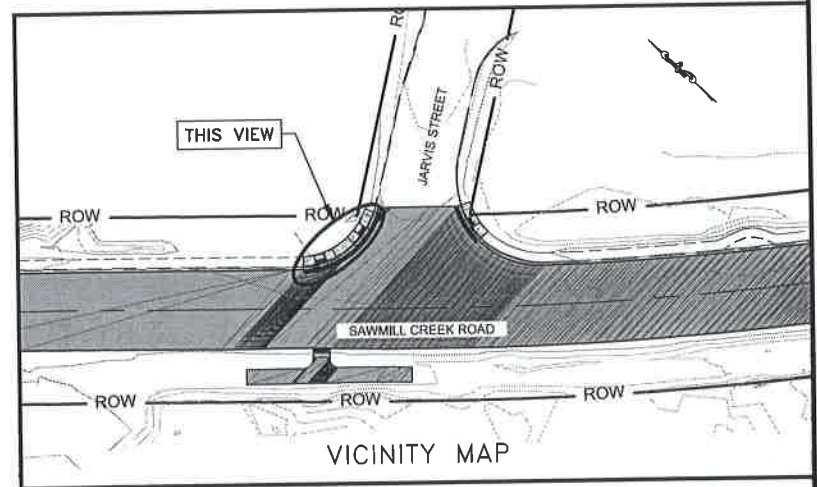


Record Drawings have been reviewed by the Project Engineer, and represent to the best of my knowledge, the project as constructed.  
 PE Date 10.23.20



STATE OF ALASKA DEPARTMENT OF TRANSPORTATION AND PUBLIC FACILITIES  
 6860 GLACIER HIGHWAY, JUNEAU, AK 99801  
 (907) 465-1763  
**SITKA SAWMILL CREEK ROAD RESURFACE: JEFF DAVIS TO SMITH STREET**  
 GRADING PLAN

FIRM STATE OF ALASKA DEPARTMENT OF TRANSPORTATION & PUBLIC FACILITIES  
 FILE O:\SIA\SFH\00064\Plans\Set\SFH\00064\_SIT\_H1.dwg  
 ADDRESS 6860 GLACIER HWY, JUNEAU, AK 99811  
 PHONE (907) 465-1763  
 DATE 8/12/2019 13:52 LAYOUT H1  
 CERTIFICATE OF AUTH # DRAFTED JT, RG  
 CHECKED BP  
 DESIGNED C.L.

NO.	DATE	REVISION	STATE	PROJECT DESIGNATION	YEAR	SHEET NO.	TOTAL SHEETS
			ALASKA	0933046/SFH\00064	2019	H1	5

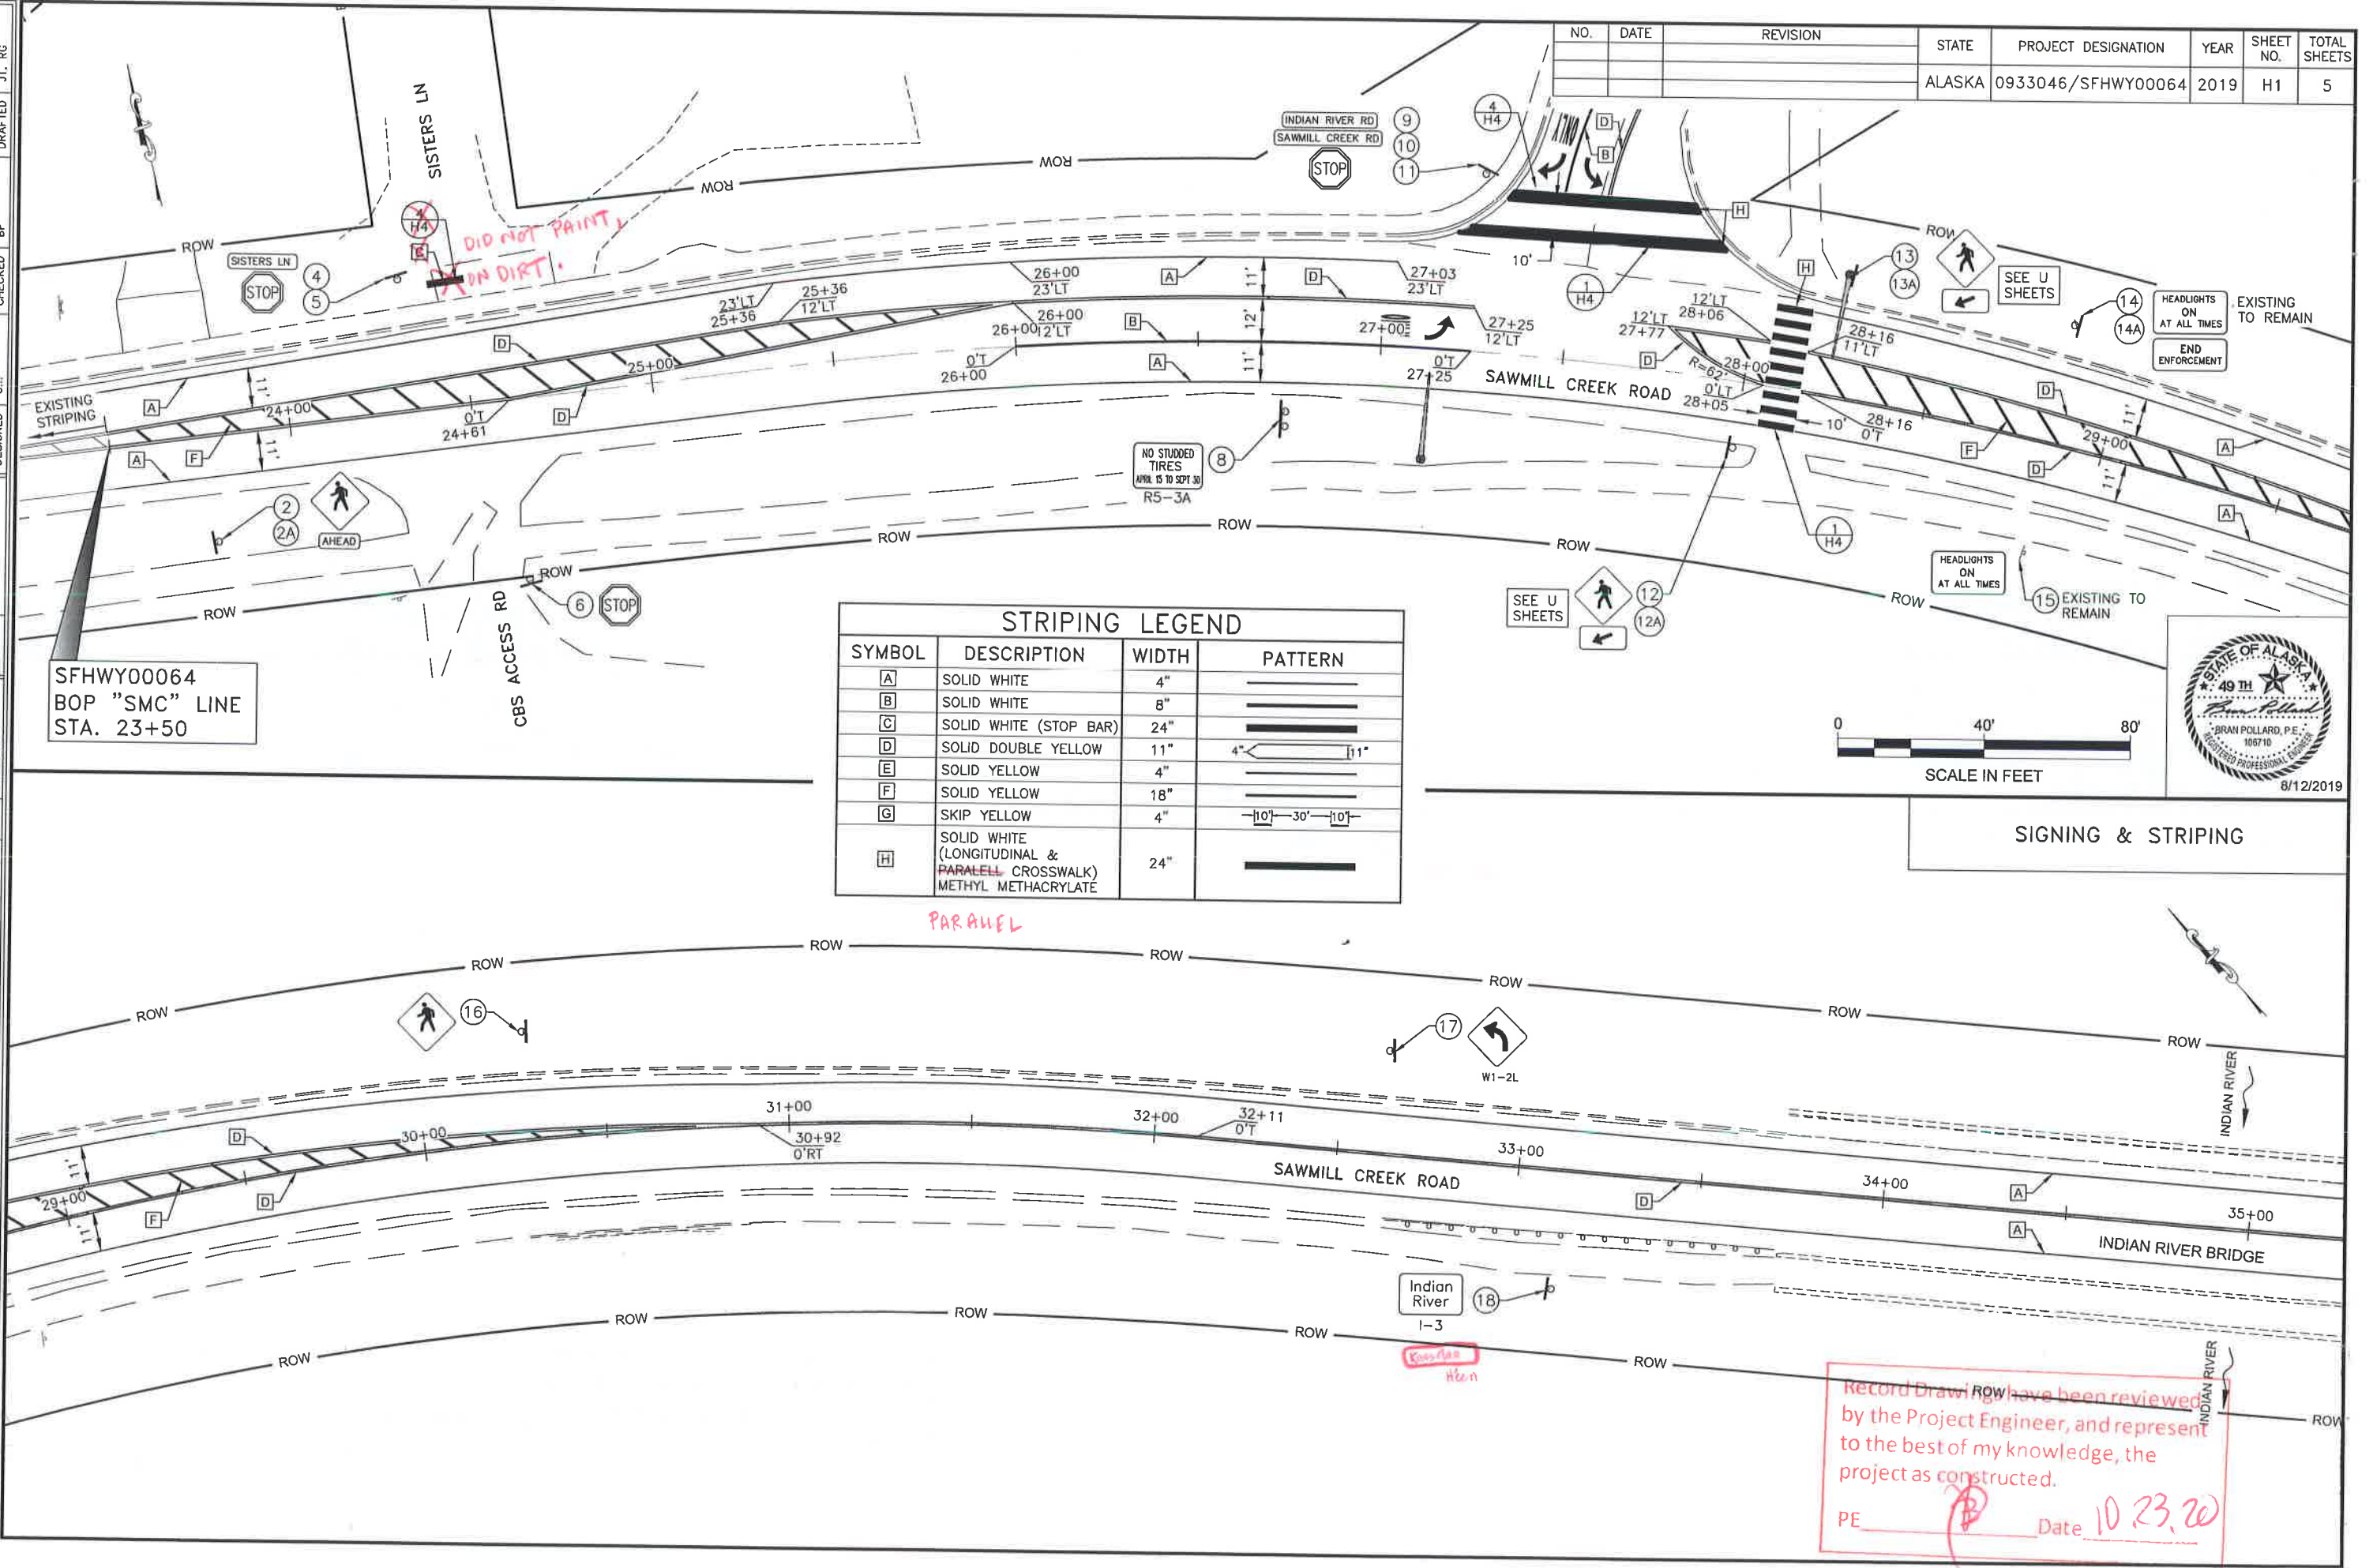

DID NOT PAINT  
ON DIRT!

SFH\00064  
BOP "SMC" LINE  
STA. 23+50

STRIPING LEGEND			
SYMBOL	DESCRIPTION	WIDTH	PATTERN
A	SOLID WHITE	4"	————
B	SOLID WHITE	8"	————
C	SOLID WHITE (STOP BAR)	24"	————
D	SOLID DOUBLE YELLOW	11"	4" ———— 11"
E	SOLID YELLOW	4"	————
F	SOLID YELLOW	18"	————
G	SKIP YELLOW	4"	- 10' —30' —10'
H	SOLID WHITE (LONGITUDINAL & PARALLEL CROSSWALK) METHYL METHACRYLATE	24"	————




SIGNING & STRIPING

PARALLEL

Record Drawing have been reviewed by the Project Engineer, and represent to the best of my knowledge, the project as constructed.  
 PE Date 10.23.20

NO.	DATE	REVISION	STATE	PROJECT DESIGNATION	YEAR	SHEET NO.	TOTAL SHEETS
			ALASKA	0933046/SFHwy00064	2019	H2	5

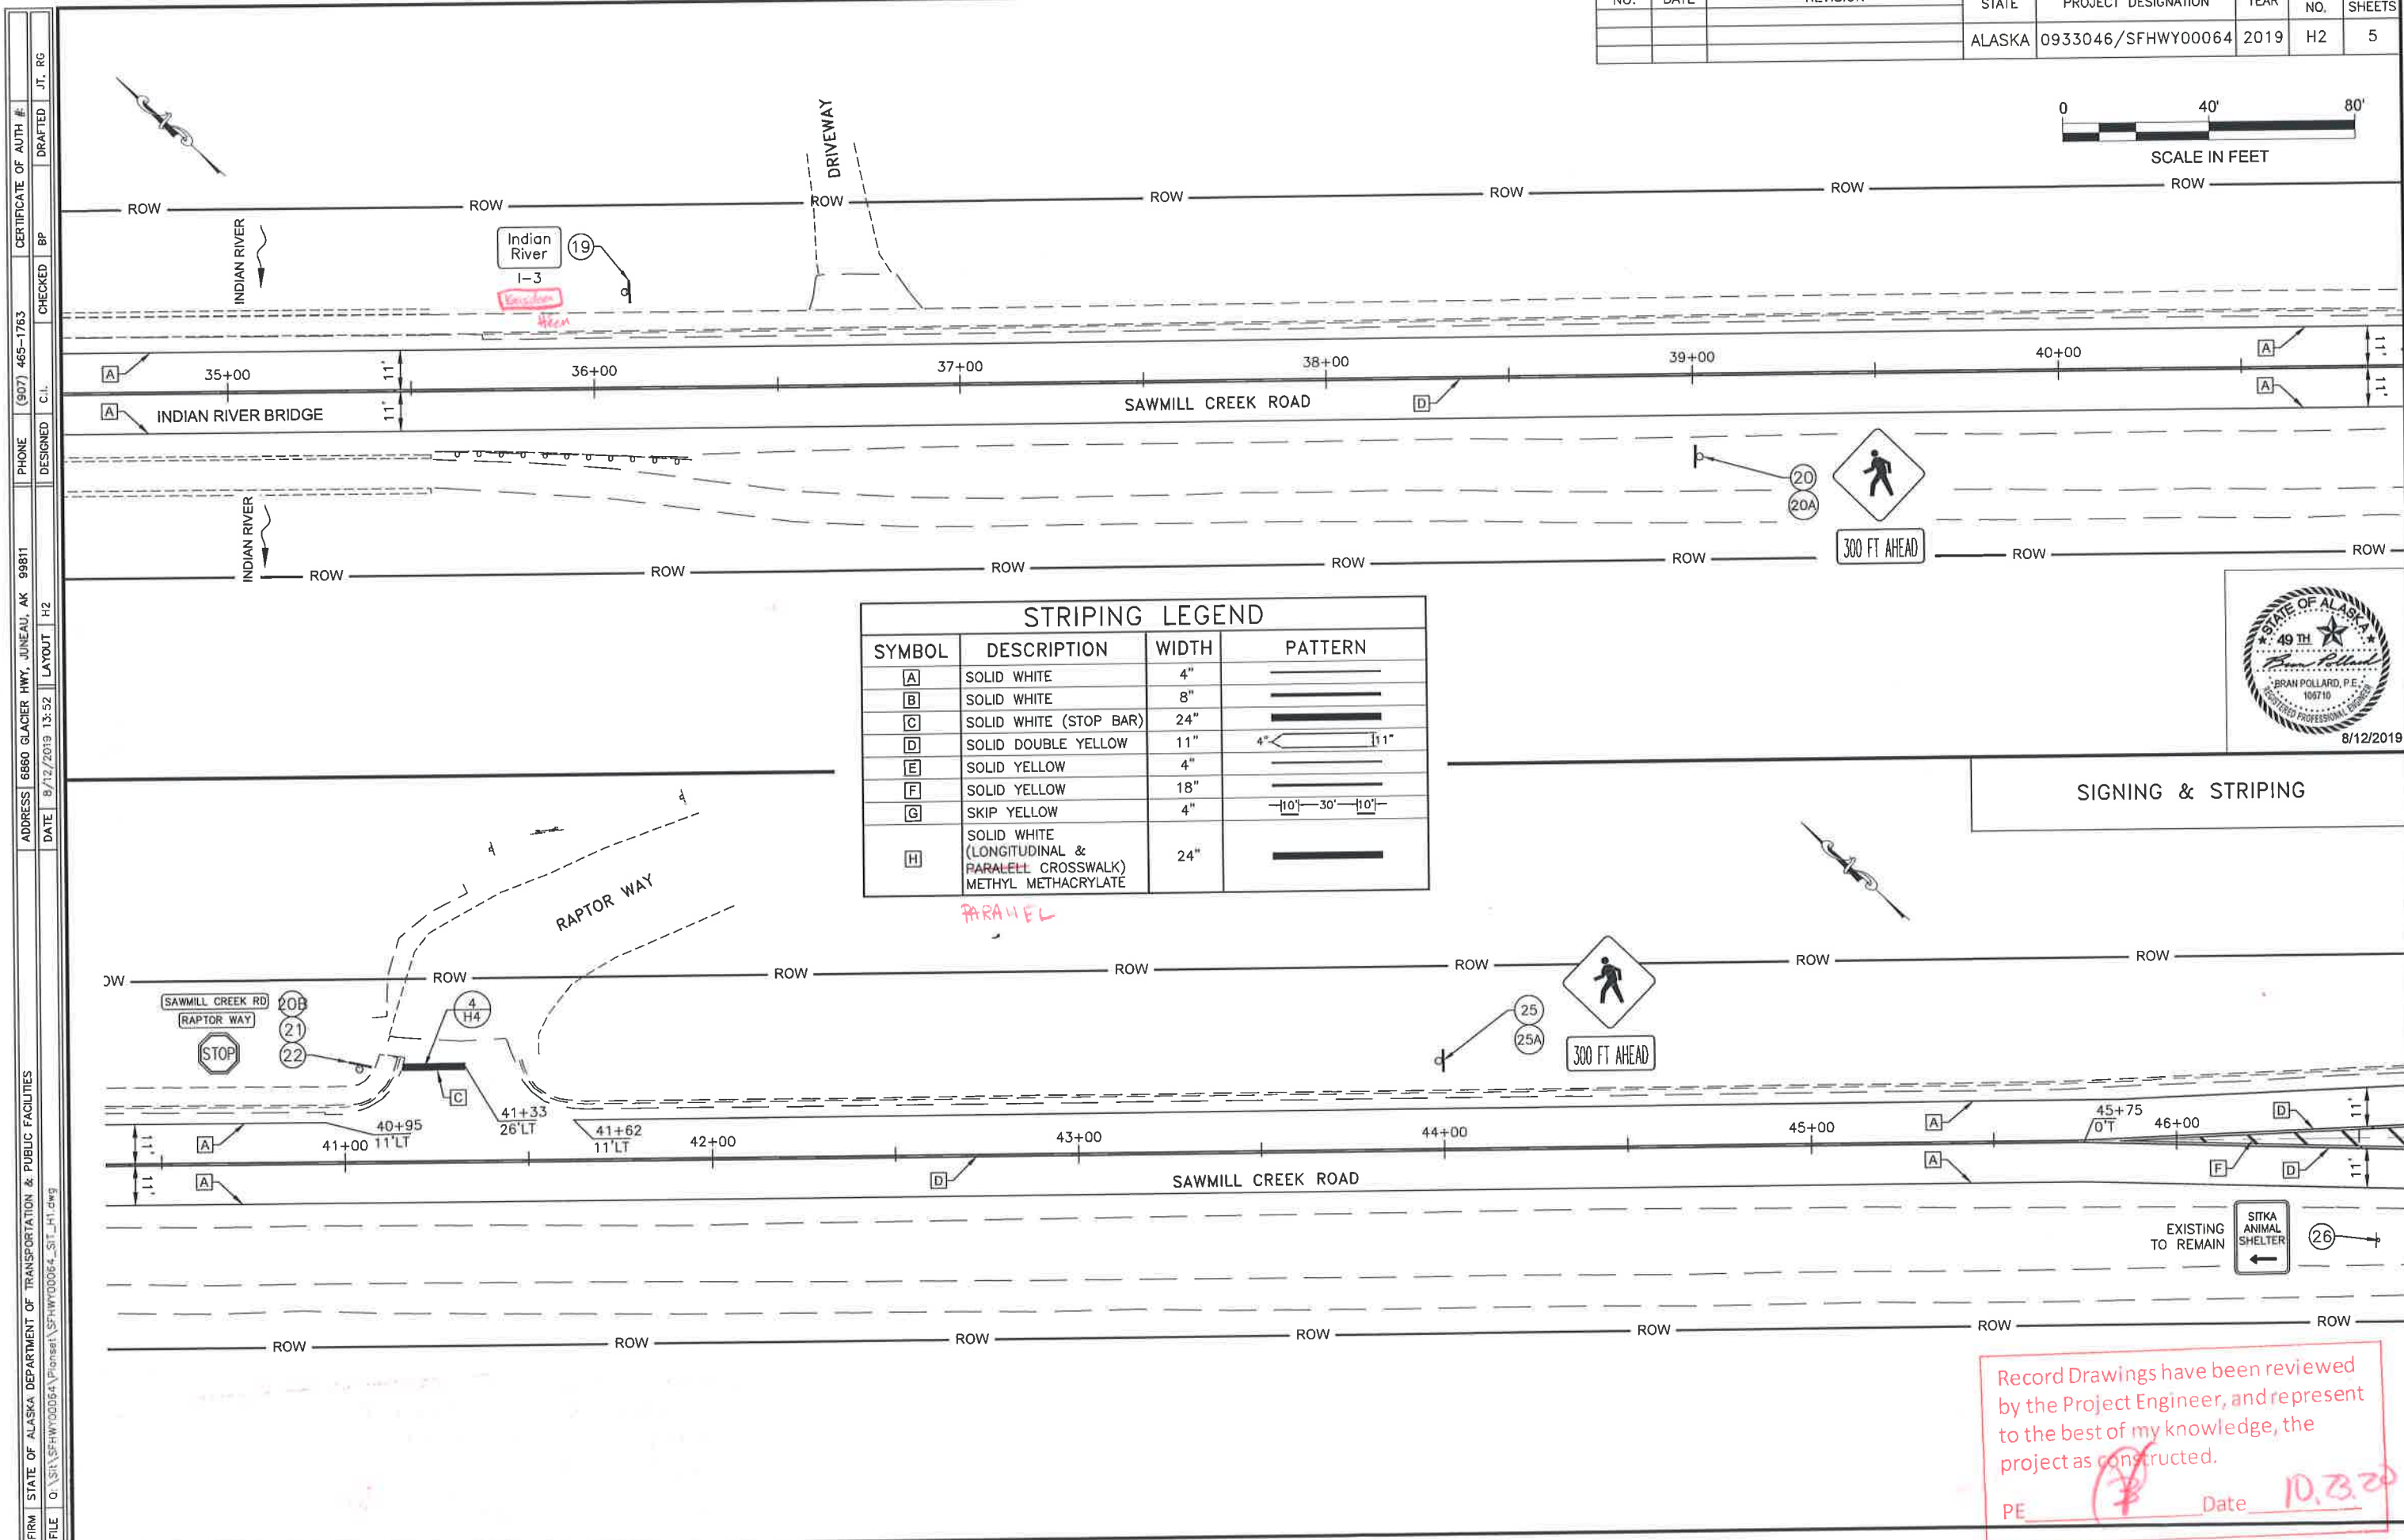

SYMBOL	DESCRIPTION	WIDTH	PATTERN
A	SOLID WHITE	4"	—————
B	SOLID WHITE	8"	—————
C	SOLID WHITE (STOP BAR)	24"	—————
D	SOLID DOUBLE YELLOW	11"	4" ← 11" →
E	SOLID YELLOW	4"	—————
F	SOLID YELLOW	18"	—————
G	SKIP YELLOW	4"	— 10' —30' — 10' —
H	SOLID WHITE (LONGITUDINAL & PARALLEL CROSSWALK) METHYL METHACRYLATE	24"	—————




SIGNING & STRIPING

FIRM STATE OF ALASKA DEPARTMENT OF TRANSPORTATION & PUBLIC FACILITIES  
 FILE O:\SIT\SFHwy00064\Planeset\SFHwy00064\_SIT\_H1.dwg  
 ADDRESS 6660 GLACIER HWY, JUNEAU, AK 99811  
 DATE 8/12/2019 13:52 LAYOUT H2  
 PHONE (907) 485-1763 DESIGNED C.L.  
 CHECKED B.P.  
 DRAFTED J.T. RG  
 CERTIFICATE OF AUTH #

Record Drawings have been reviewed by the Project Engineer, and represent to the best of my knowledge, the project as constructed.  
 PE Date 10.23.20

FIRM STATE OF ALASKA DEPARTMENT OF TRANSPORTATION & PUBLIC FACILITIES  
 FILE C:\S1\SFHWY00064\Plannet\SFHWY00064\_SIT\_H1.dwg  
 ADDRESS 8860 GLACIER HWY, JUNEAU, AK 99811  
 PHONE (907) 465-1763  
 DATE 8/12/2019 13:52 LAYOUT H3  
 CHECKED BP  
 DESIGNED C.I.  
 DRAFTED JT, RG  
 CERTIFICATE OF AUTH #


NO.	DATE	REVISION	STATE	PROJECT DESIGNATION	YEAR	SHEET NO.	TOTAL SHEETS
			ALASKA	0933046/SFHWY00064	2019	H3	5

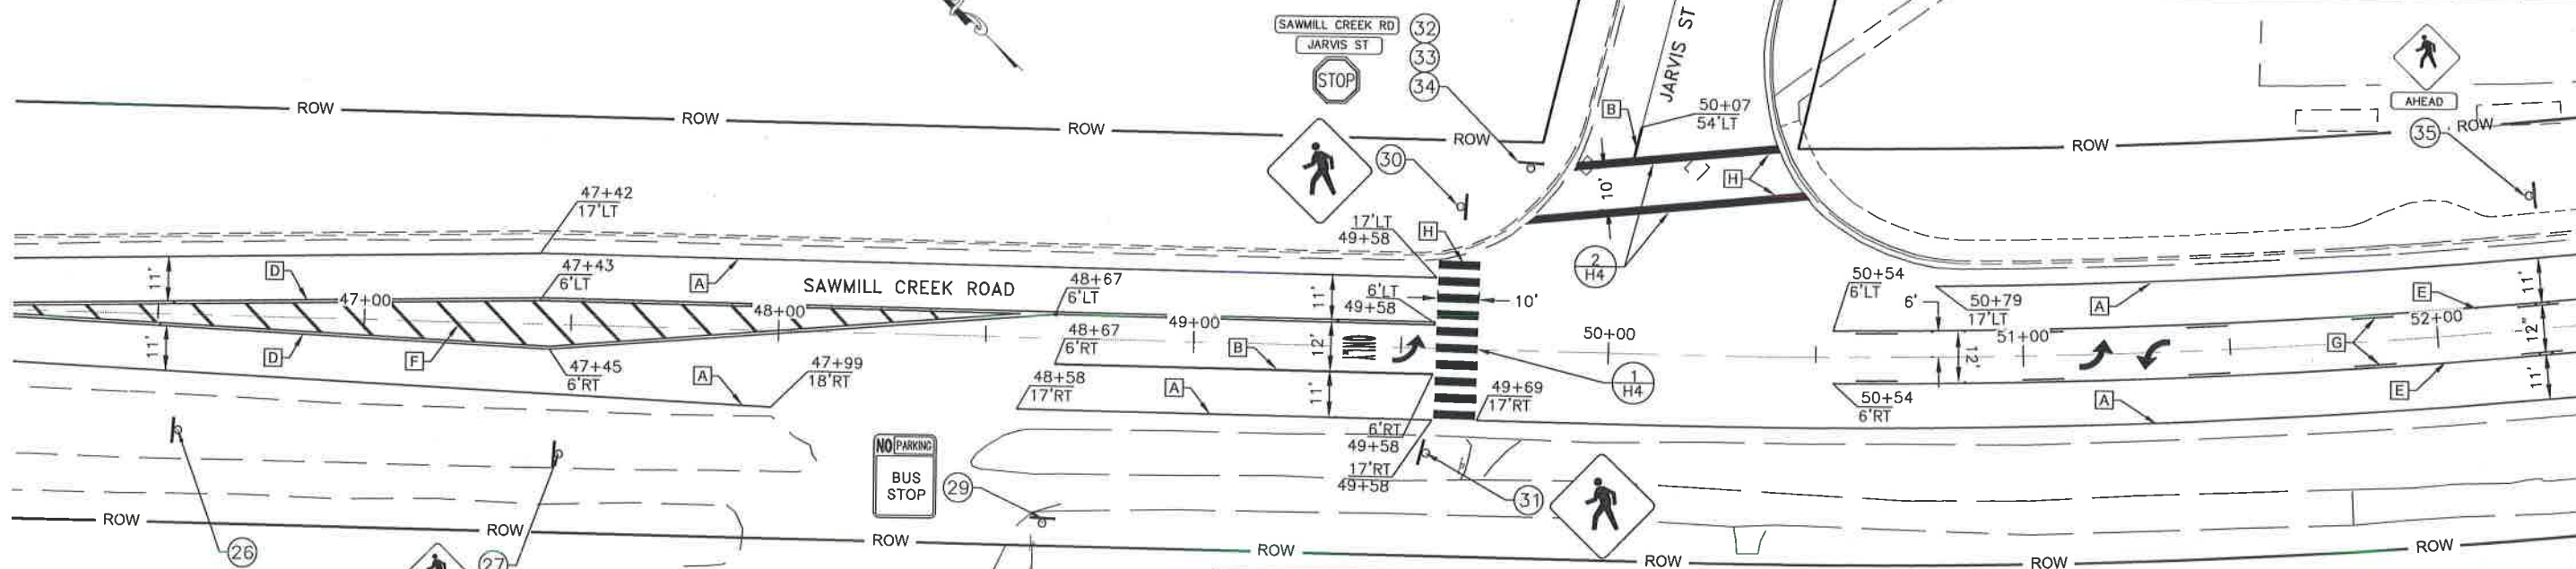

SYMBOL	DESCRIPTION	WIDTH	PATTERN
A	SOLID WHITE	4"	—————
B	SOLID WHITE	8"	—————
C	SOLID WHITE (STOP BAR)	24"	—————
D	SOLID DOUBLE YELLOW	11"	4" ← 11" →
E	SOLID YELLOW	4"	—————
F	SOLID YELLOW	18"	—————
G	SKIP YELLOW	4"	— 0' —30' — 0' —
H	SOLID WHITE (LONGITUDINAL & PARALLEL CROSSWALK) METHYL METHACRYLATE	24"	—————




SIGNING & STRIPING

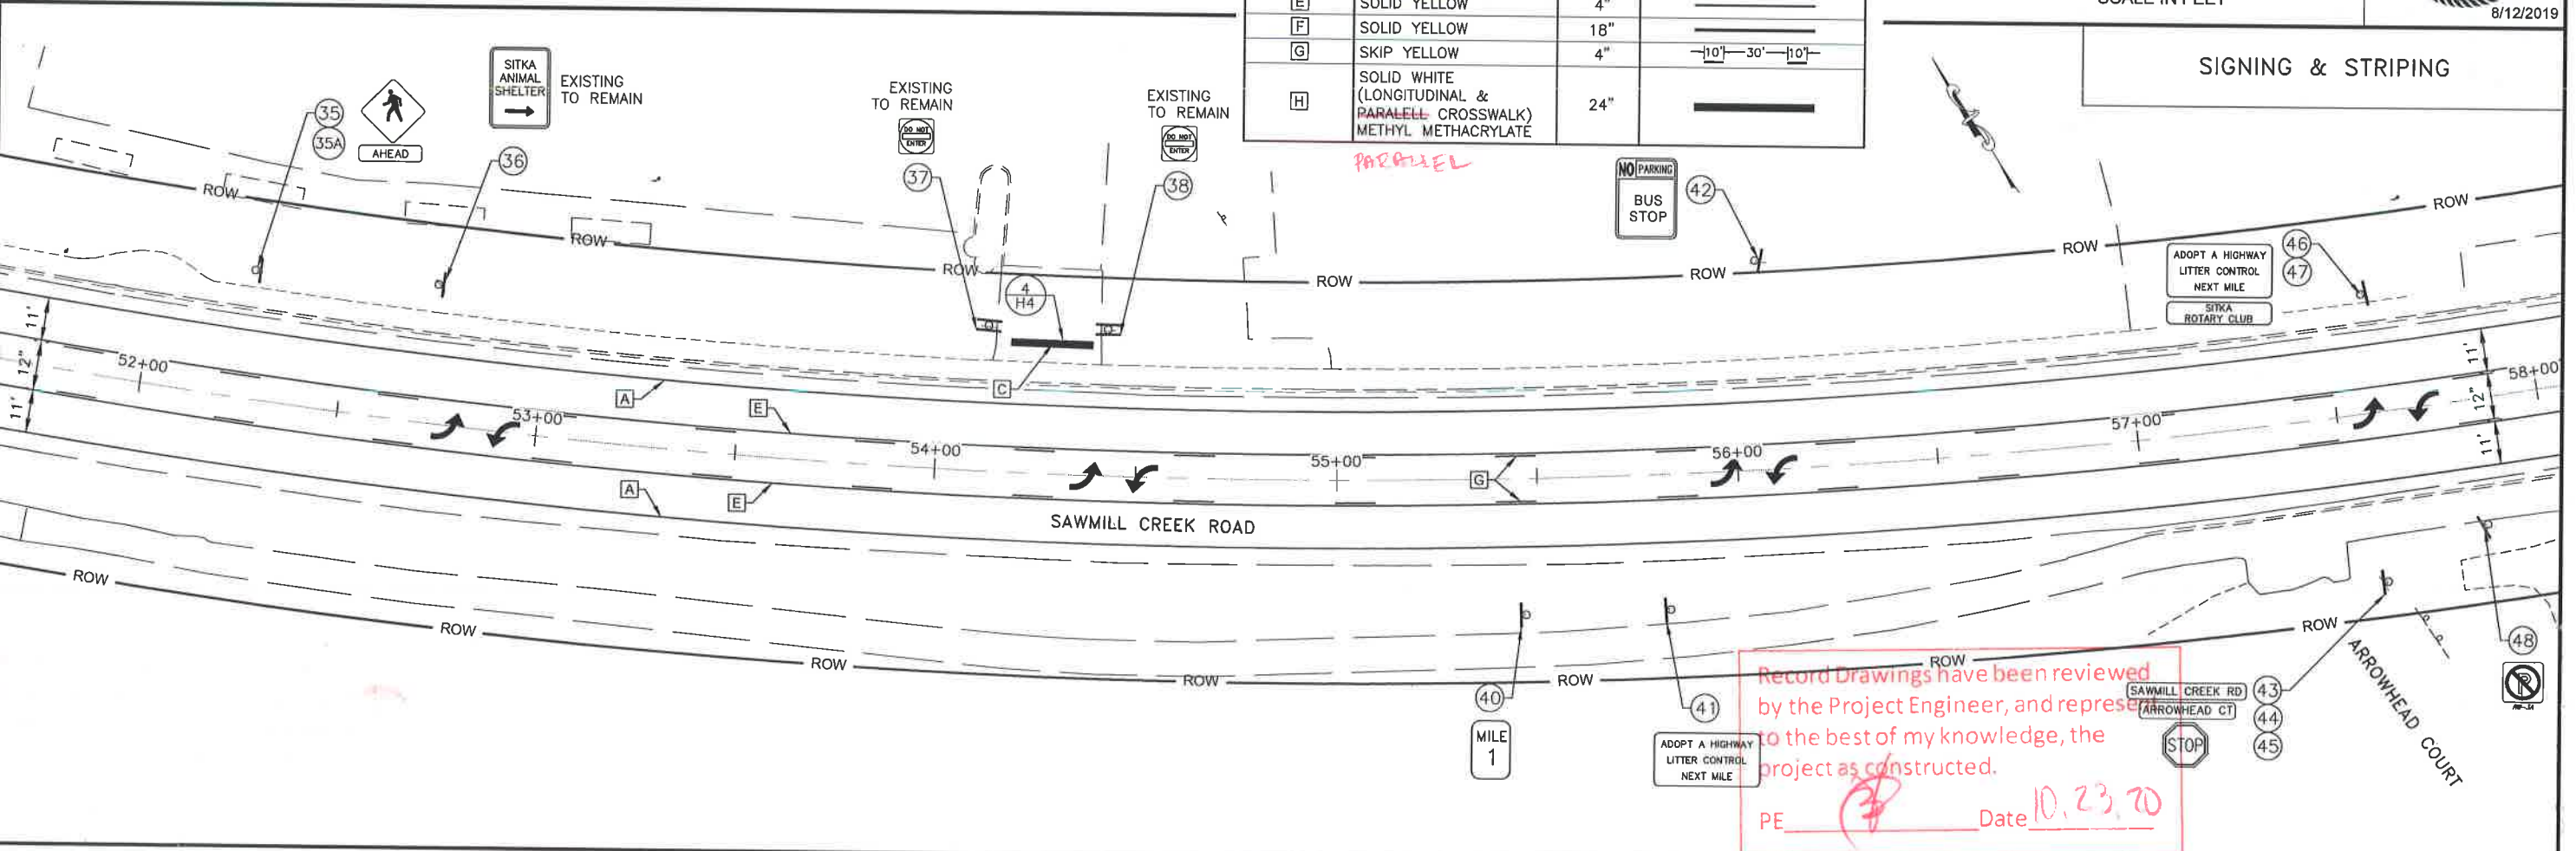

Record Drawings have been reviewed  
 by the Project Engineer, and represent  
 to the best of my knowledge, the  
 project as constructed.  
 PE *[Signature]* Date 10.23.20



NO.	DATE	REVISION	STATE	PROJECT DESIGNATION	YEAR	SHEET NO.	TOTAL SHEETS
			ALASKA	0933046/SFHWHY00064	2019	H4	5

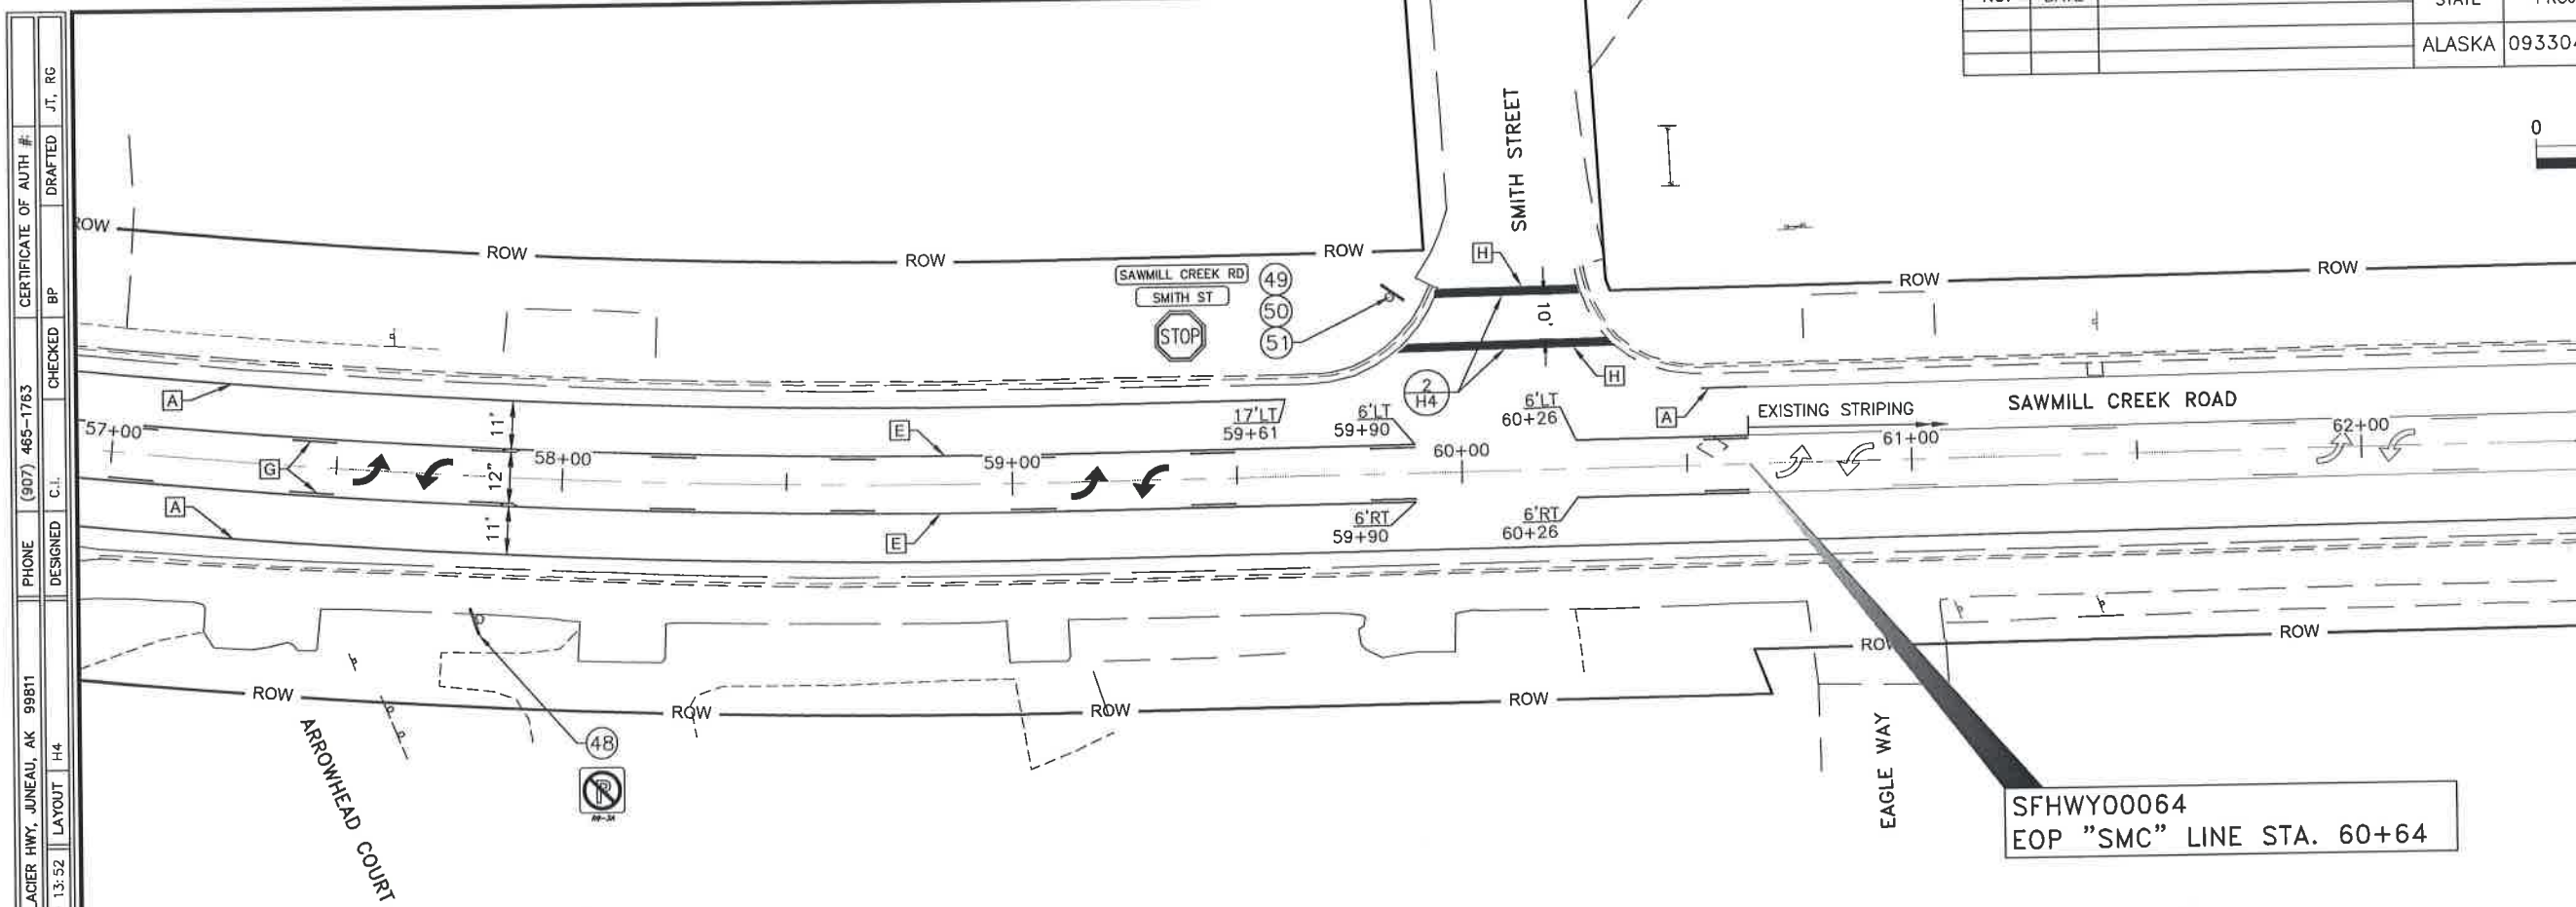

SFHWHY00064  
EOP "SMC" LINE STA. 60+64




PRM STATE OF ALASKA DEPARTMENT OF TRANSPORTATION & PUBLIC FACILITIES  
 FILE C:\SIT\SFHWHY00064\plans\sfhwh00064\_SIT\_H1.dwg  
 ADDRESS 6860 GLACIER HWY, JUNEAU, AK 99811  
 PHONE (907) 465-1763  
 DESIGNED C.I.  
 CHECKED BP  
 DRAFTED J.T. RC  
 CERTIFICATE OF AUTH #


**SIGNING & STRIPING**

Record Drawings have been reviewed by the Project Engineer, and represent to the best of my knowledge, the project as constructed.  
 PE Date 10.23.20


**1 LONGITUDINAL CROSSWALK DETAIL**  
SCALE: N.T.S.  
GAP MAY BE ADJUSTED TO 3' MAX SO MARKING IS OUTSIDE OF THE WHEEL PATH

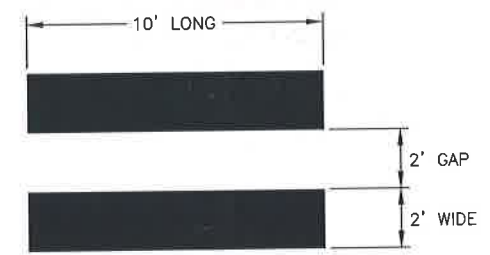


**3 STRIPING DETAIL**  
SCALE: NOT TO SCALE

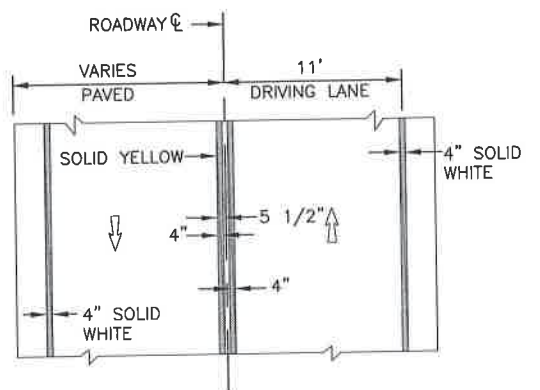

**2 PARALELL CROSSWALK DETAIL**  
SCALE: N.T.S.  
*PARALELL*

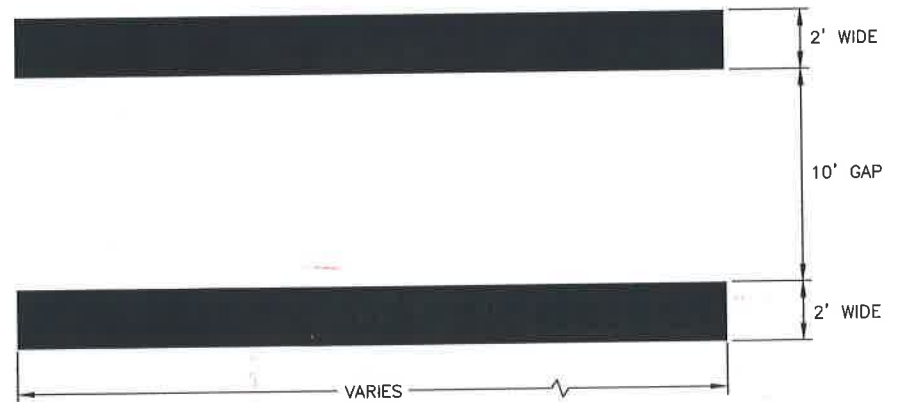

**4 STOP BAR DETAIL**  
SCALE: NOT TO SCALE

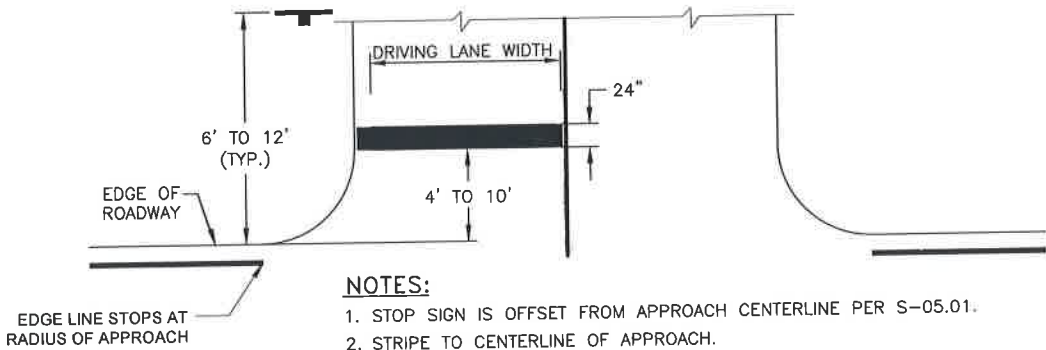

- NOTES:**
1. STOP SIGN IS OFFSET FROM APPROACH CENTERLINE PER S-05.01.
  2. STRIPE TO CENTERLINE OF APPROACH.

STRIPING LEGEND			
SYMBOL	DESCRIPTION	WIDTH	PATTERN
A	SOLID WHITE	4"	—————
B	SOLID WHITE	8"	—————
C	SOLID WHITE (STOP BAR)	24"	—————
D	SOLID DOUBLE YELLOW	11"	4" <— [11"] —>
E	SOLID YELLOW	4"	—————
F	SOLID YELLOW	18"	—————
G	SKIP YELLOW	4"	- 0' —30'— 0'
H	SOLID WHITE (LONGITUDINAL & PARALELL CROSSWALK) METHYL METHACRYLATE	24"	—————


- SIGNING AND STRIPING NOTES:**
1. IF THE NEW AND EXISTING PAVEMENT MARKINGS ARE NOT ALIGNED AT MATCH LINE, TRANSITION BETWEEN THE TWO USING A 100:1 TAPER ON THE NEW PAVEMENT.

FILE: Q:\SIT\SFHWD064\Planset\SFHWD064\_SIT\_H1.dwg  
 DATE: 8/12/2019 13:52 LAYOUT: HE DESIGNED: C.I. CHECKED: BP DRAFTED: JT, RG


NO.	DATE	REVISION	STATE	PROJECT DESIGNATION	YEAR	SHEET NO.	TOTAL SHEETS
			ALASKA	0933046/SFHWD00064	2019	H5	5

615.0001.0000 STANDARD SIGN										
NO.	STATION	OFFSET	DESCRIPTION	ASDS CODE	WIDTH (IN)	HEIGHT (IN)	AREA (SF)	POST	SIGN FACING	REMARKS
1										NOT USED
2	STA 23+76	RT	PEDESTRIAN TRAFFIC	W11-2	36	36	9.00	2.5 PST	N	
2A	STA 23+76	RT	AHEAD	W16-9P	30	18	3.75	2.5 PST	N	
3										NOT USED
4	STA 24+34	LT	SISTERS LN	D3-1	42	8	2.33		N	DOUBLE-SIDED LEGEND, 6" UC/4" LC C-FONT
5	STA 24+34	LT	STOP	R1-1	30	30	6.25	2.5 PST	N	MOUNT BELOW SIGN NO. 4
6	STA 24+61	RT	STOP	R1-1	30	30	6.25	2.5 PST	N	
7										NOT USED
8	STA 26+73	RT	NO STUDDED TIRES	R12-103	84	66	38.50	2.5 PST	W	3.5" x 3.5" T.S.
9	STA 27+26	LT	INDIAN RIVER RD	D3-1	54	12	4.50	2.5 PST	E	DOUBLE-SIDED LEGEND, 4" UC/3" LC B-FONT
10	STA 27+26	LT	SAWMILL CREEK RD	D3-1	48	8	2.67	2.5 PST	E	DOUBLE-SIDED LEGEND, 6" UC/4" LC C-FONT
11	STA 27+26	LT	STOP	R1-1	30	30	6.25	2.5 PST	E	MOUNT BELOW SIGN NO. 11
12	STA 28+00	RT	PEDESTRIAN CROSSING	W11-2	36	36	9.00	4.5 TUBE	W	SEE U SHEETS
12A	STA 28+00	RT	CROSSING ARROW	W16-7PR	24	12	2.00	4.5 TUBE	W	SEE U SHEETS
13	STA 28+24	LT	PEDESTRIAN CROSSING	W11-2	36	36	9.00		E	MOUNTED ON STREET LIGHT POLE. SEE U SHEETS
13A	STA 28+24	LT	CROSSING ARROW	W16-7PR	24	12	2.00		E	MOUNTED ON STREET LIGHT POLE. SEE U SHEETS
14	STA 28+85	LT	HEADLIGHTS ON AT ALL TIMES							EXISTING TO REMAIN
14A	STA 28+85	LT	END ENFORCEMENT							EXISTING TO REMAIN
15	STA 28+86	RT	HEADLIGHTS ON AT ALL TIMES							EXISTING TO REMAIN
16	STA 30+30	LT	PEDESTRIAN TRAFFIC	W11-2	36	36	9.00	2.5 PST	E	
17	STA 32+63	LT	LEFT CURVE AHEAD	W1-2L	30	30	6.25	2.5 PST	E	
18	STA 33+11	RT	INDIAN RIVER	I-3	30	18	3.75	2.5 PST	W	4" UC/3" LC Emod FONT
19	STA 36+09	LT	INDIAN RIVER	I-3	30	18	3.75	2.5 PST	E	
20	STA 39+00	RT	PEDESTRIAN CROSSING	W11-2	36	36	9.00		W	
20A	STA 39+00	RT	300 FT	W16-2aP	24	12	2.00		W	MOUNT BELOW SIGN NO. 20
20B	STA 41+04	LT	SAWMILL CREEK RD	D3-1	36	12	3.00		N	DOUBLE-SIDED LEGEND, 6" UC/4" LC C-FONT
21	STA 41+04	LT	RAPTOR WAY	D3-1	36	12	3.00		N	DOUBLE-SIDED LEGEND, 6" UC/4" LC C-FONT
22	STA 41+04	LT	STOP	R1-1	30	30	6.25	2.5 PST	N	MOUNT BELOW SIGN NO. 21
23										NOT USED
24										NOT USED
25	STA 44+00	LT	PEDESTRIAN CROSSING	W11-2	36	36	9.00	2.5 PST	W	
25A	STA 44+00	LT	300 FT	W16-2aP	24	12	2.00		W	MOUNT BELOW SIGN NO. 24
26	STA 46+55	RT	SITKA ANIMAL SHELTER							EXISTING TO REMAIN
27	STA 47+47	RT	PEDESTRIAN TRAFFIC	W11-2	36	36	9.00	2.5 PST	W	
28	STA 47+47	RT	AHEAD	W16-9P	30	18	3.75		W	
29	STA 48+65	RT	BUS STOP NO PARKING	R7P-107	12	18	1.50		N	
30	STA 49+64	LT	PEDESTRIAN TRAFFIC	W11-2	36	36	9.00	2.5 PST	E	
31	STA 49+65	RT	PEDESTRIAN TRAFFIC	W11-2	36	36	9.00	2.5 PST	W	
32	STA 49+80	LT	SAWMILL CREEK RD	D3-1	48	8	2.67		N	
33	STA 49+80	LT	JARVIS ST	D3-1	36	12	3.00		N	
34	STA 49+80	LT	STOP	R1-1	30	30	6.25	2.5 PST	N	
35	STA 52+26	LT	PEDESTRIAN TRAFFIC	W11-2	36	36	9.00	2.5 PST	E	
35A	STA 52+26	LT	AHEAD	W16-9P	30	18	3.75		E	
36	STA 52+72	LT	SITKA ANIMAL SHELTER							EXISTING TO REMAIN
37	STA 54+12	LT	DO NOT ENTER							EXISTING TO REMAIN
38	STA 54+42	LT	DO NOT ENTER							EXISTING TO REMAIN
39										NOT USED
40	STA 55+46	RT	MILE 1	D10-101	10	18	1.25	2.5 PST	E/W	TWO D10-101 SIGNS MOUNTED BACK TO BACK; LETTERS ALL 4" B-FONT; NUMBER 6" D-FONT
41	STA 55+81	RT	ADOPT A HIGHWAY	I-150	30	24	5.00		W	
42	STA 56+07	LT	BUS STOP NO PARKING	R7P-107	12	18	1.50		E	Both are paved into concrete pad, used existing.
43	STA 57+56	RT	SAWMILL CREEK RD	D3-1	48	8	2.67		W	4" UC/3" LC Emod FONT
44	STA 57+56	RT	ARROWHEAD RD	D3-1	48	12	4.00	2.5 PST	W	Double-sided legend x 2
45	STA 57+56	RT	STOP	R1-1	30	30	6.25	2.5 PST	W	
46	STA 57+61	LT	ADOPT A HIGHWAY	I-150	30	24	5.00		E	
47	STA 57+61	LT	SITKA ROTARY CLUB	I-165	36	12	3.00		E	
48	STA 57+82	RT	NO PARKING SYMBOL	R8-3A	24	24	4.00		W	
49	STA 59+85	LT	SAWMILL CREEK RD	D3-1	48	8	2.67		E	
50	STA 59+85	LT	SMITH ST	D3-1	42	12	3.50		E	
51	STA 59+85	LT	STOP	R1-1	30	30	6.25	2.5 PST	E	DOUBLE SIDED 4 1/2" C FONT
52	33+11	RT	Kaagriaan Heen						E	
53	36+09	LT	Kaagriaan Heen						W	
					total =		260.50			

Record Drawings have been reviewed by the Project Engineer, and represent to the best of my knowledge, the project as constructed.  
 PE [Signature] Date 10.23.20

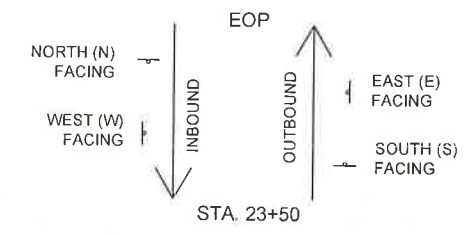

SIGN FACING NOTES: SIGN FACING IS RELATIVE TO THE DIAGRAM ABOVE. IT IS NOT RELATED TO CARDINAL DIRECTION.


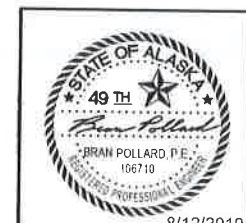


STATE OF ALASKA  
 DEPARTMENT OF TRANSPORTATION  
 AND PUBLIC FACILITIES  
**SIT SAWMILL CREEK-  
 RESURFACING & PEDESTRIAN  
 IMPROVEMENTS**


SIGNING & STRIPING

TOTAL =

STATE	PROJECT DESIGNATION	YEAR	SHEET NO.	TOTAL SHEETS
ALASKA	SFWY00064	2019	N1	N2

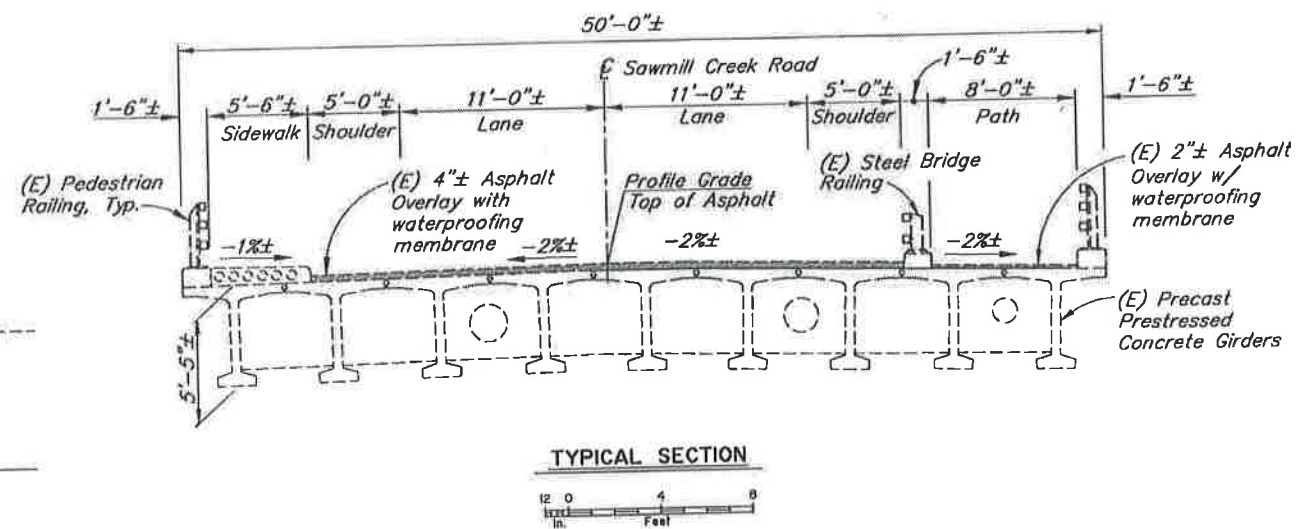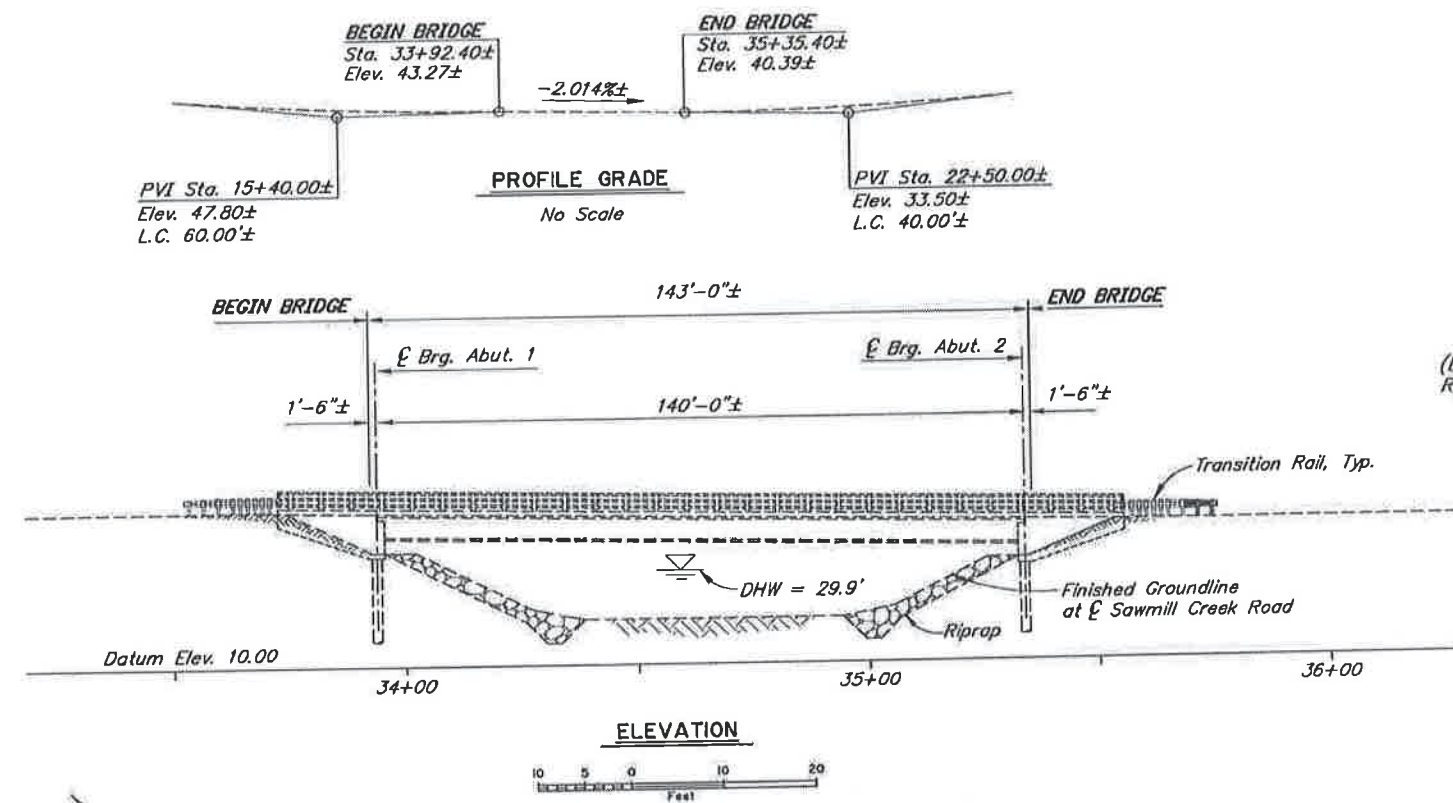

TYPICAL SECTION

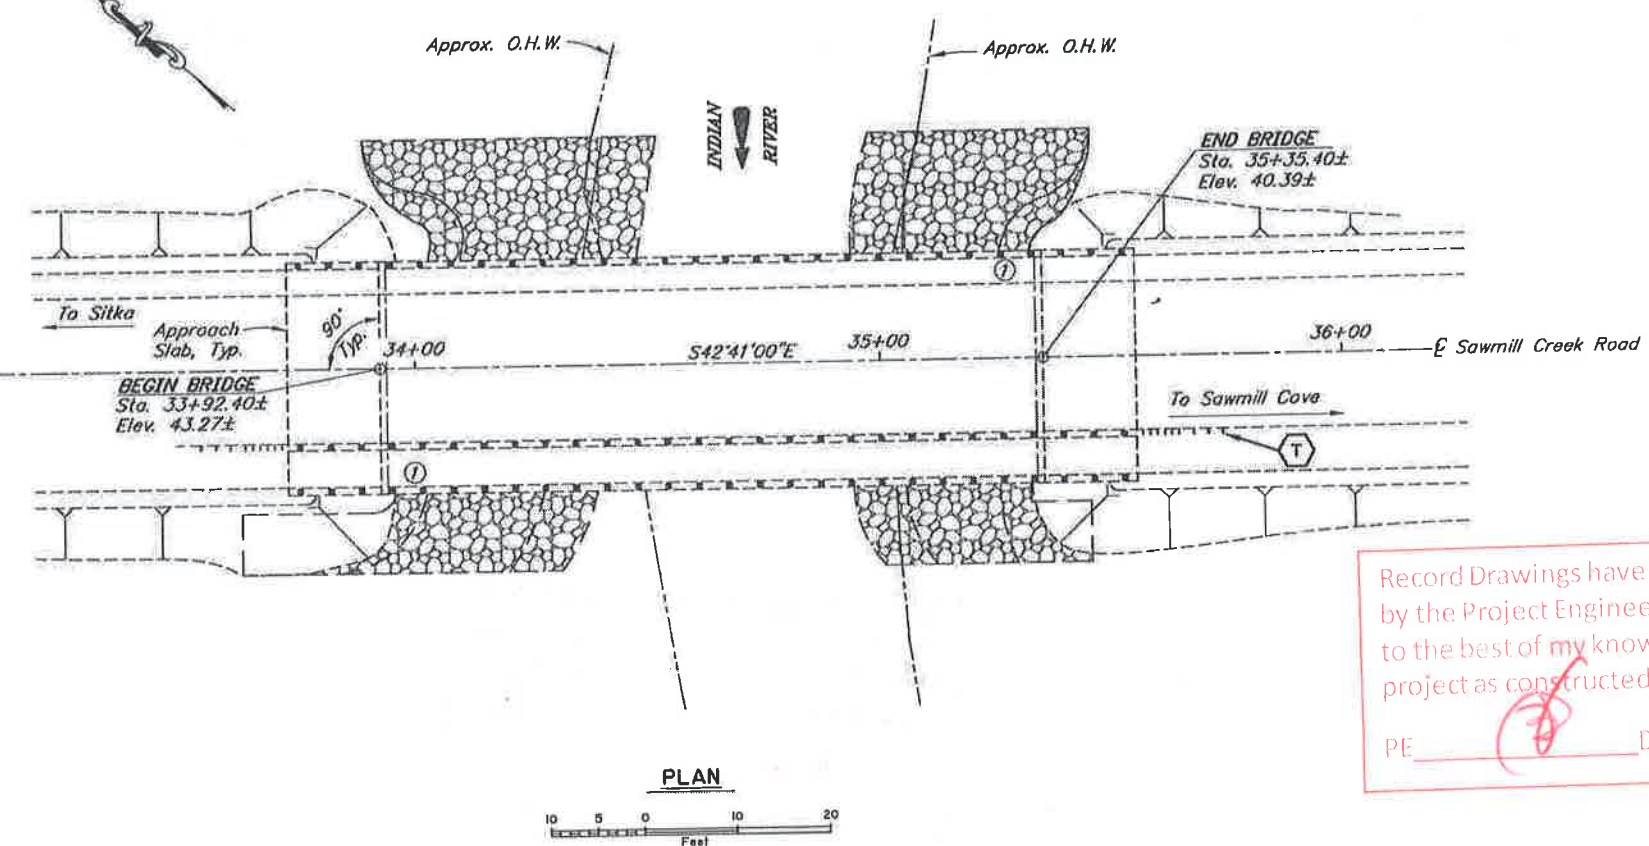

PLAN



ESTIMATE OF QUANTITIES				
ITEM NO.	ITEM	PAY UNIT	ESTIMATING UNIT	TOTAL QUANTITY
606.0016.0001	Transition Rail, Modification	EA	EA	1

Item numbers are for reference only. Quantities shown are not necessarily the pay quantities nor the total quantity of the particular item.

BRIDGE DRAWING INDEX	
TITLE	DWG. NO.
GENERAL LAYOUT	1
TRANSITION RAIL	2

LEGEND	
	Modify Transition Rail

**REHABILITATION**

NOTES:

- (E) = Existing
- = Existing
- = Proposed

Bridge stations and elevations are based on as-built drawings.

See Roadway sheets for project stationing, elevations, alignments, and proposed pavement typical sections.

Verify controlling field dimensions before ordering or fabricating any material.

Record Drawings have been reviewed by the Project Engineer, and represent to the best of my knowledge, the project as constructed.  
 PE Date 10.23.20

R:\cadd\665\665-GENERAL LAYOUT Wed, Jul/23/19 09:29am

DESIGNED BY: Leslie Dougherty	CHECKED: Sara Manning	LAYOUT BY: Leslie Dougherty	CHECKED BY: Sara Manning
DRAWN BY: Michael Foster	CHECKED: Leslie Dougherty	SPECIFICATIONS BY: Leslie Dougherty	P.S. & E COMPARED: Sara Manning
QUANTITIES BY: Leslie Dougherty	CHECKED: Sara Manning	APPROVAL RECOMMENDED BY: Sara Manning	Rich Pritchett



STATE OF ALASKA  
 DEPARTMENT OF TRANSPORTATION  
 AND PUBLIC FACILITIES  
 BRIDGE SECTION  
 3132 Channel Drive  
 Juneau, Alaska 99801  
 907-465-2975



INDIAN RIVER BRIDGE  
 SAWMILL CREEK ROAD  
 GENERAL LAYOUT

BRIDGE NO. 865  
 DWG. NO. 1

STATE	PROJECT DESIGNATION	YEAR	SHEET NO.	TOTAL SHEETS
ALASKA	SFWY00064	2019	N2	N2

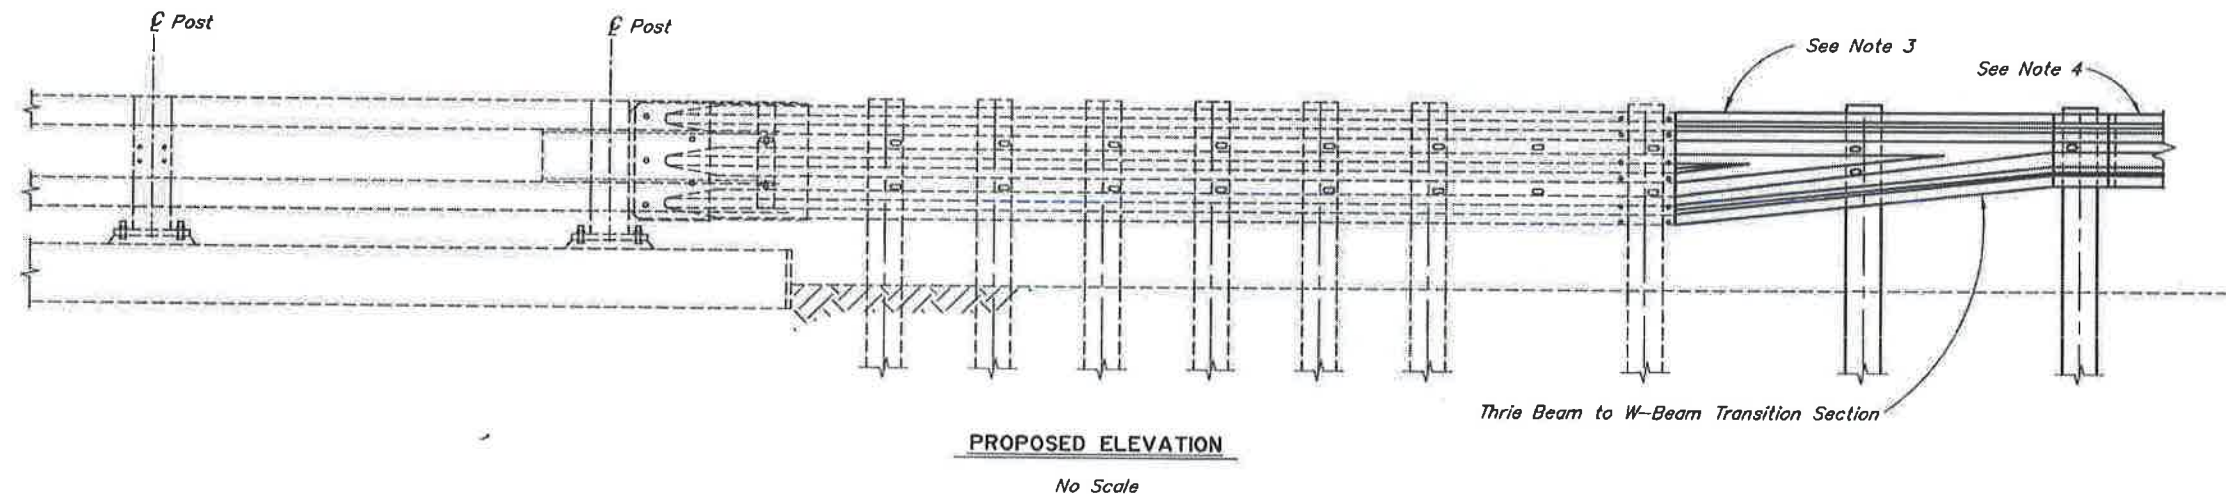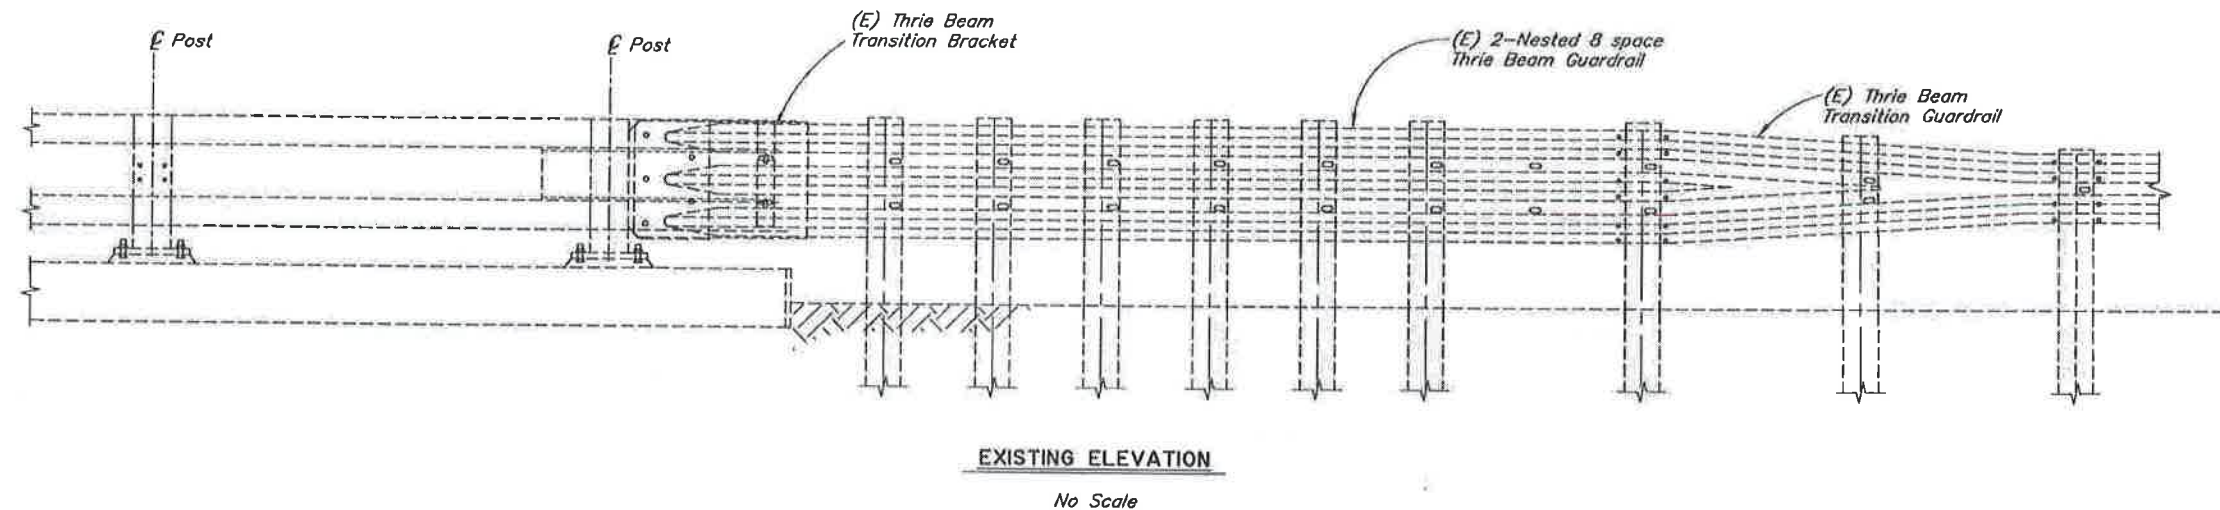

**NOTES:**

- (E) = Existing
- = Existing
- = Proposed

1. All guardrail and guardrail connection hardware to conform to AASHTO M 180. Use H.S. Bolts conforming to ASTM F1325, Grade A325. All other steel conforms to ASTM A709 Grade 36.
2. Conform to Alaska Standard Plans G-00.04 and G-05.11S for guardrail details not shown.
3. Lap approach guardrail to prevent snags from oncoming traffic.
4. Match height of existing or new rail elements and end treatments. See Roadway plans.
5. Verify controlling field dimensions before ordering or fabricating any material.


Record Drawings have been reviewed by the Project Engineer, and represent to the best of my knowledge, the project as constructed.  
PE Date 10.23.20

R:\road\865\865-RAIL REPLACEMENT Wed, Jul/31/19 09:29am

DESIGNED BY: <i>Leslie Daugherty</i>	CHECKED: <i>Sara Manning</i>
DRAWN BY: <i>Michael Foster</i>	CHECKED: <i>Leslie Daugherty</i>
QUANTITIES BY: <i>Leslie Daugherty</i>	CHECKED: <i>Sara Manning</i>

**REHABILITATION**

STATE OF ALASKA  
DEPARTMENT OF TRANSPORTATION  
AND PUBLIC FACILITIES  
BRIDGE SECTION  
3132 Channel Drive  
Juneau, Alaska 99801  
907-485-2975


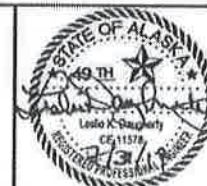


**INDIAN RIVER BRIDGE**  
SAWMILL CREEK ROAD  
TRANSITION RAIL





BRIDGE NO. 865  
DWG. NO. 2

NO.	DATE	REVISION	STATE	PROJECT DESIGNATION	YEAR	SHEET NO.	TOTAL SHEETS
			ALASKA	0933046/SFHXY00064	2019	Q1	4

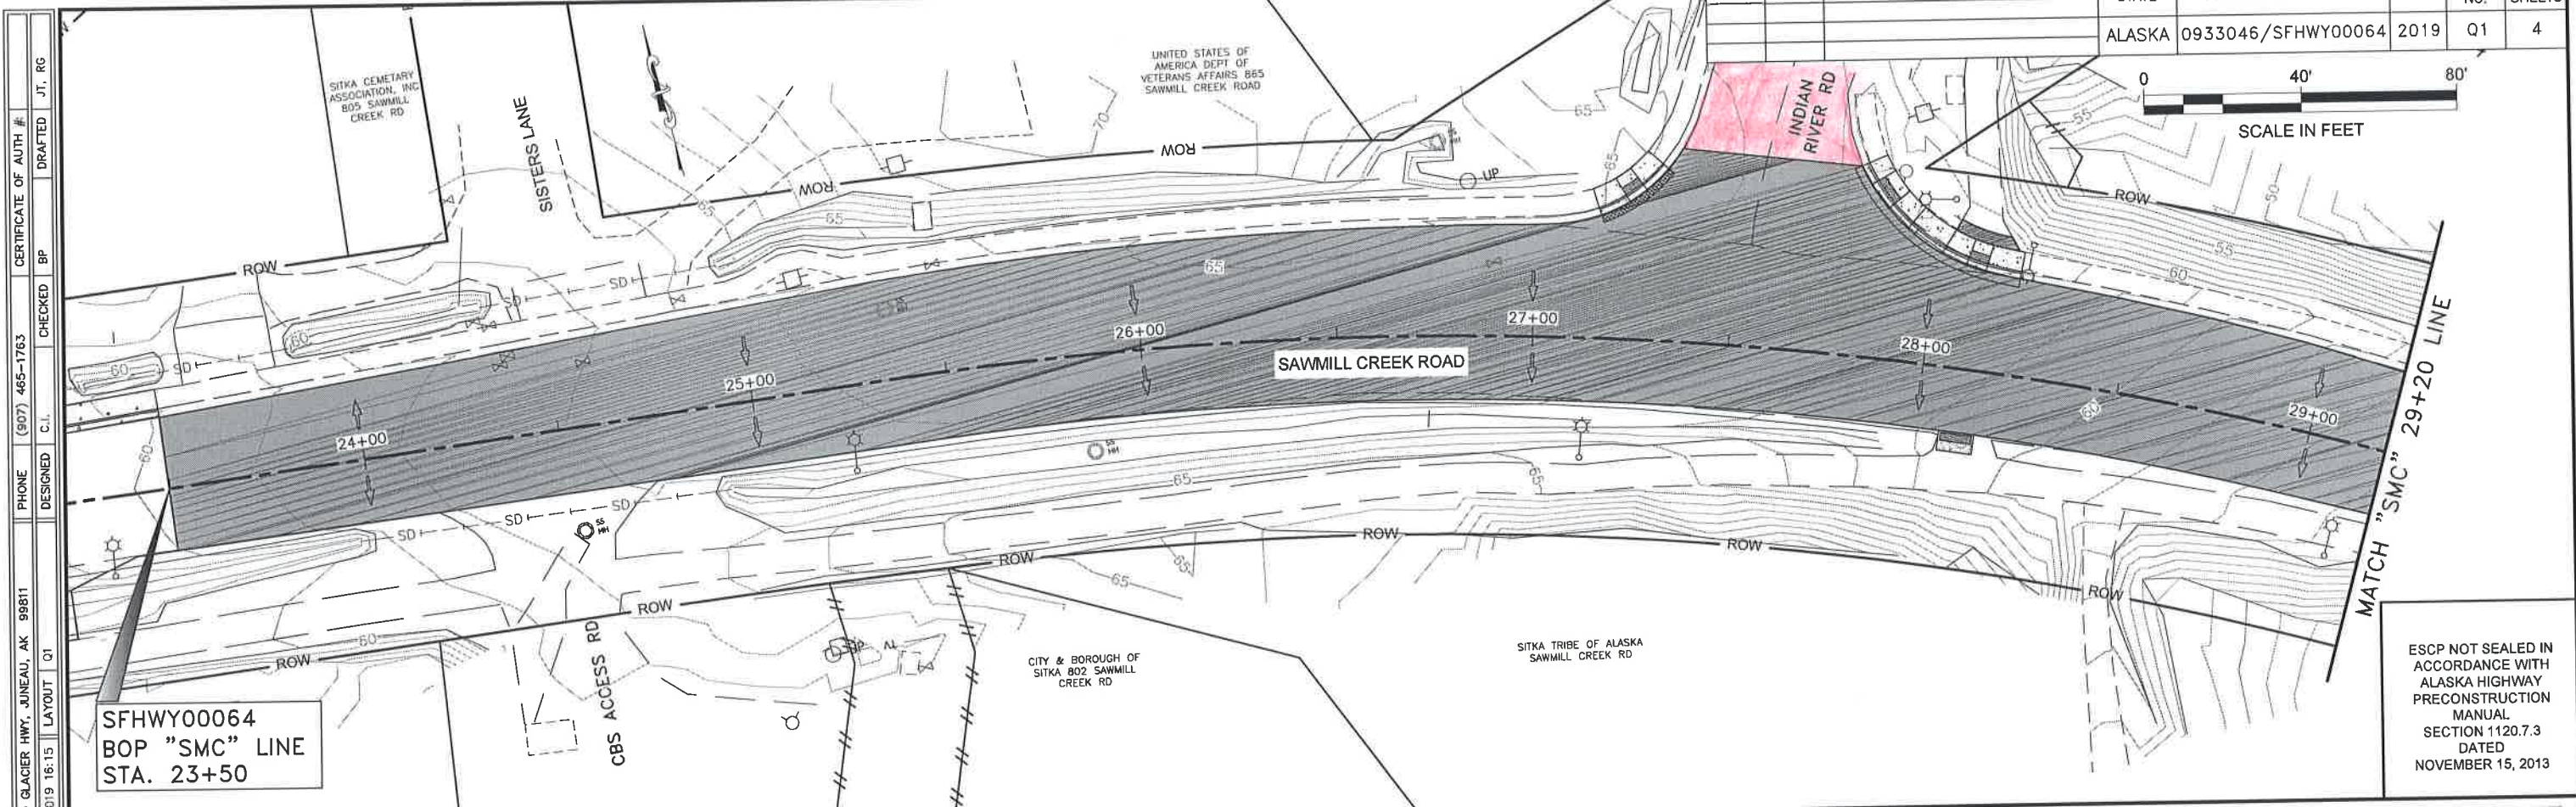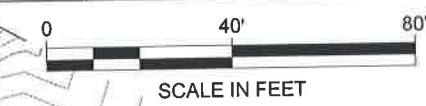

ESCP NOT SEALED IN ACCORDANCE WITH ALASKA HIGHWAY RECONSTRUCTION MANUAL SECTION 1120.7.3 DATED NOVEMBER 15, 2013

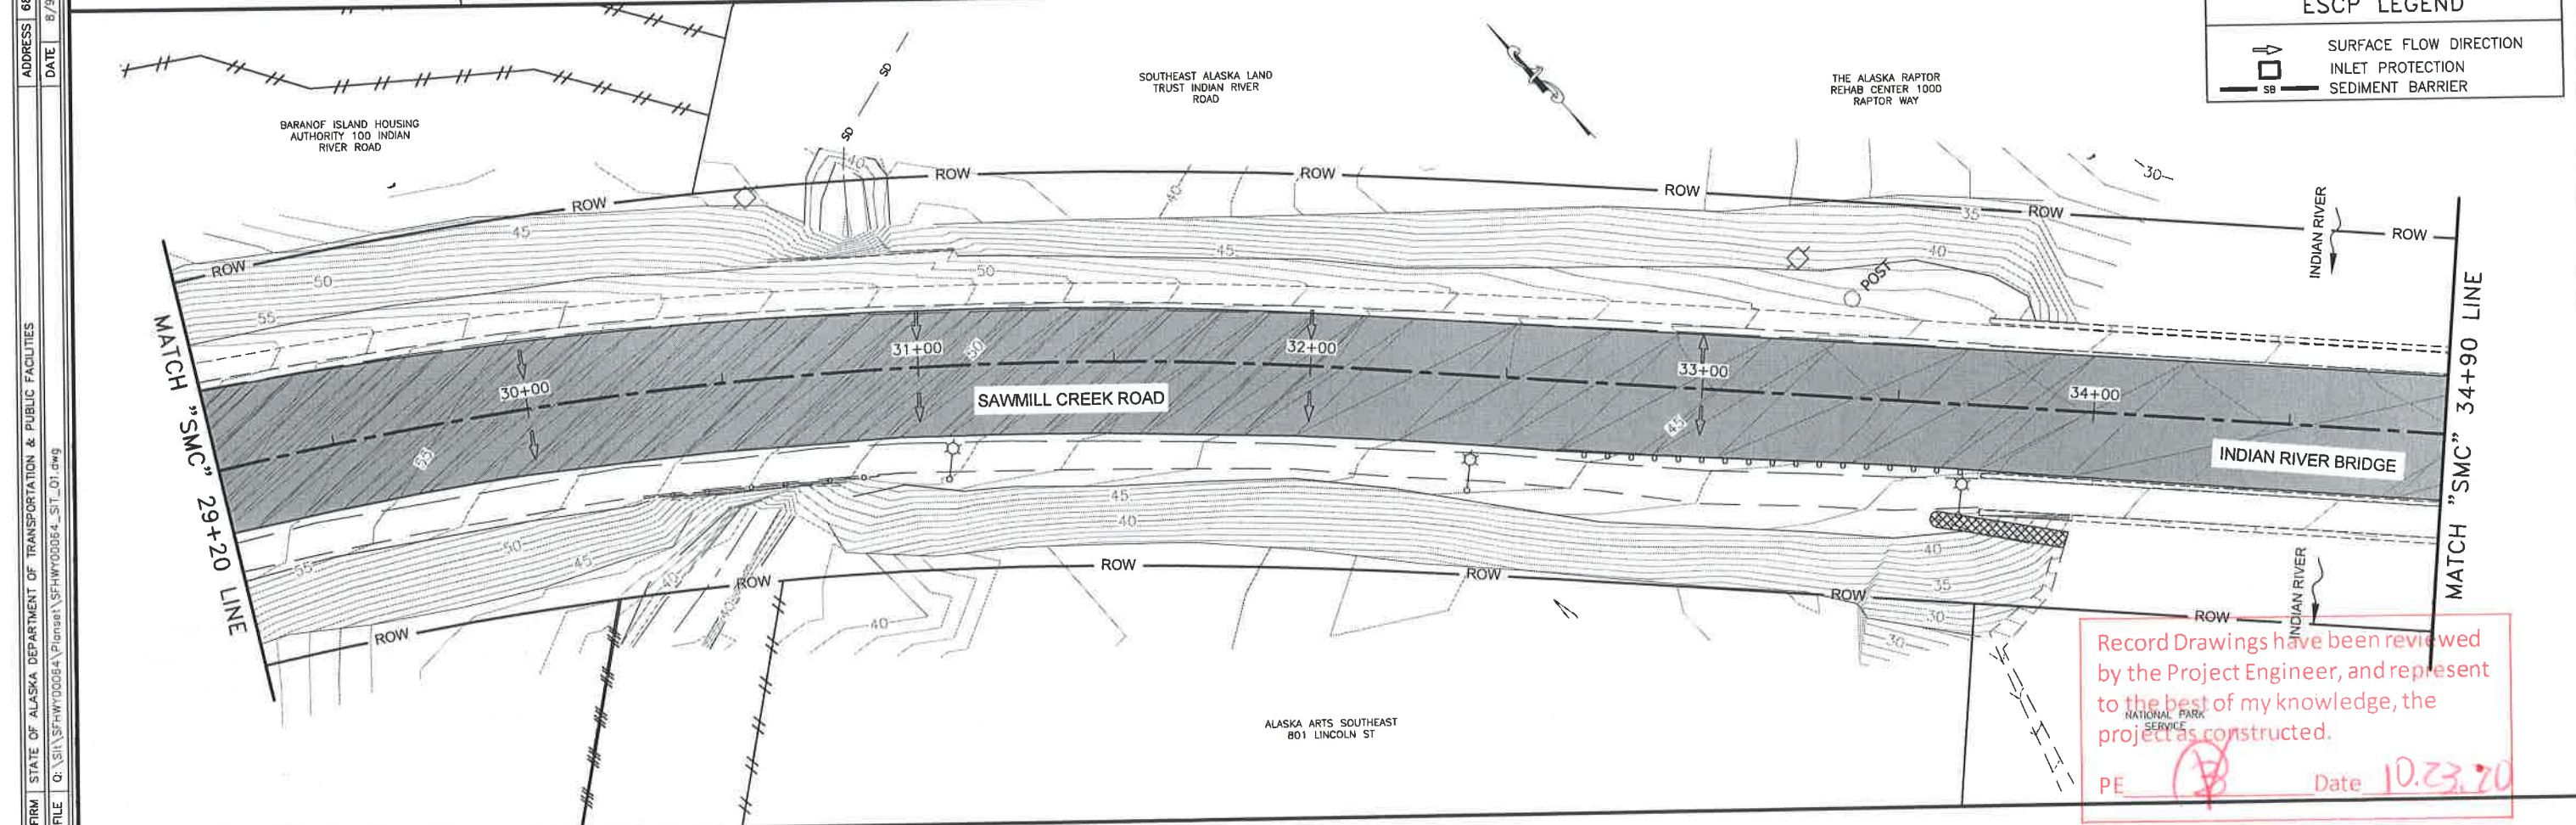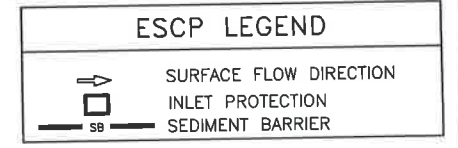

Record Drawings have been reviewed by the Project Engineer, and represent to the best of my knowledge, the project as constructed.

PE Date 10.23.20



FIRM STATE OF ALASKA DEPARTMENT OF TRANSPORTATION & PUBLIC FACILITIES  
 FILE O:\S11\SFHXY00064\Plans\SFHWY00064\_S11\_01.dwg  
 ADDRESS 6860 GLACIER HWY, JUNEAU, AK 99811  
 DATE 8/9/2019 16:15 LAYOUT 01  
 PHONE (907) 485-1763 DESIGNED C.L.  
 CERTIFICATE OF AUTH # 485-1763 CHECKED BP  
 DRAFTED JT. RG

FIRM STATE OF ALASKA DEPARTMENT OF TRANSPORTATION & PUBLIC FACILITIES  
 FILE D:\SIT\SFH\00064\Plan\set\SFH\00064\_SIT\_01.dwg  
 ADDRESS 6860 GLACIER HWY., JUNEAU, AK 99811  
 PHONE (907) 465-1763  
 CERTIFICATE OF AUTH #  
 DRAFTED JT, RG  
 CHECKED BP  
 DESIGNED C.L.  
 LAYOUT Q2  
 DATE 8/9/2019 16:15

**ESCP LEGEND**

- SURFACE FLOW DIRECTION
- INLET PROTECTION
- SEDIMENT BARRIER

NO.	DATE	REVISION	STATE	PROJECT DESIGNATION	YEAR	SHEET NO.	TOTAL SHEETS
			ALASKA	0933046/SFH\00064	2019	Q2	4

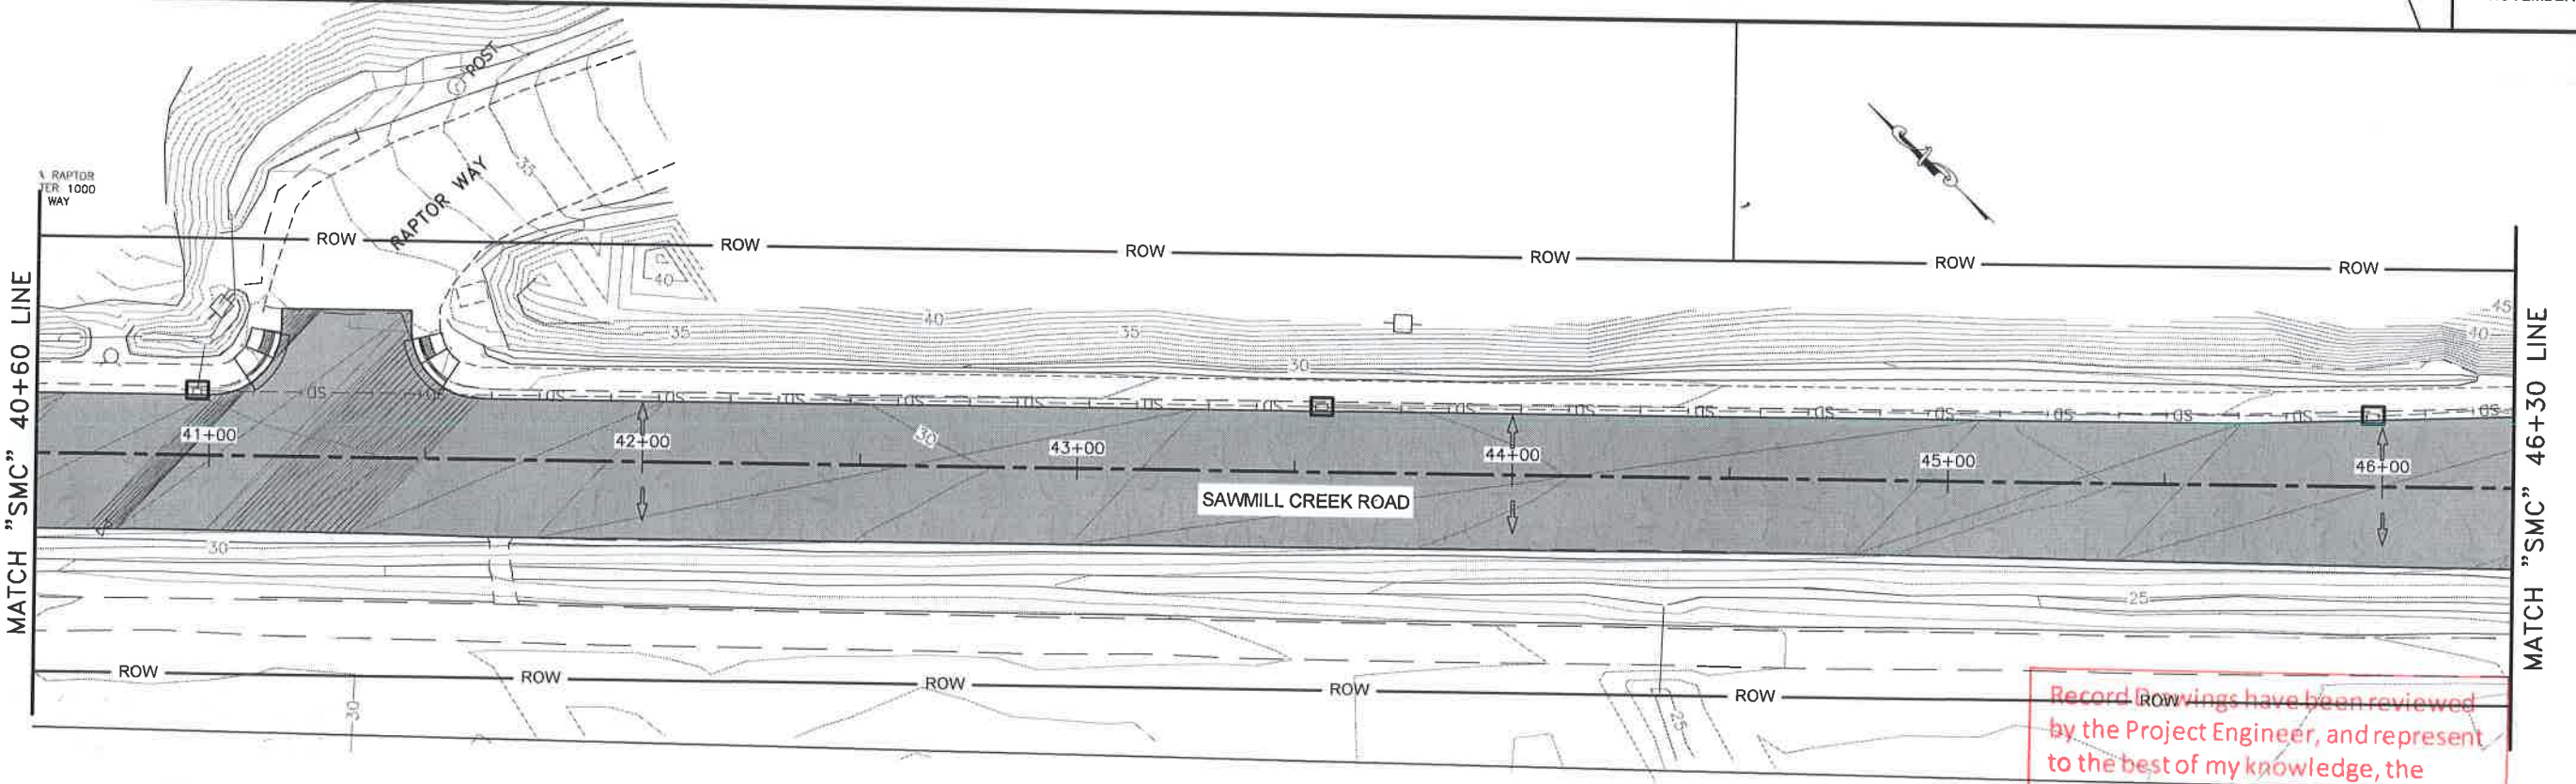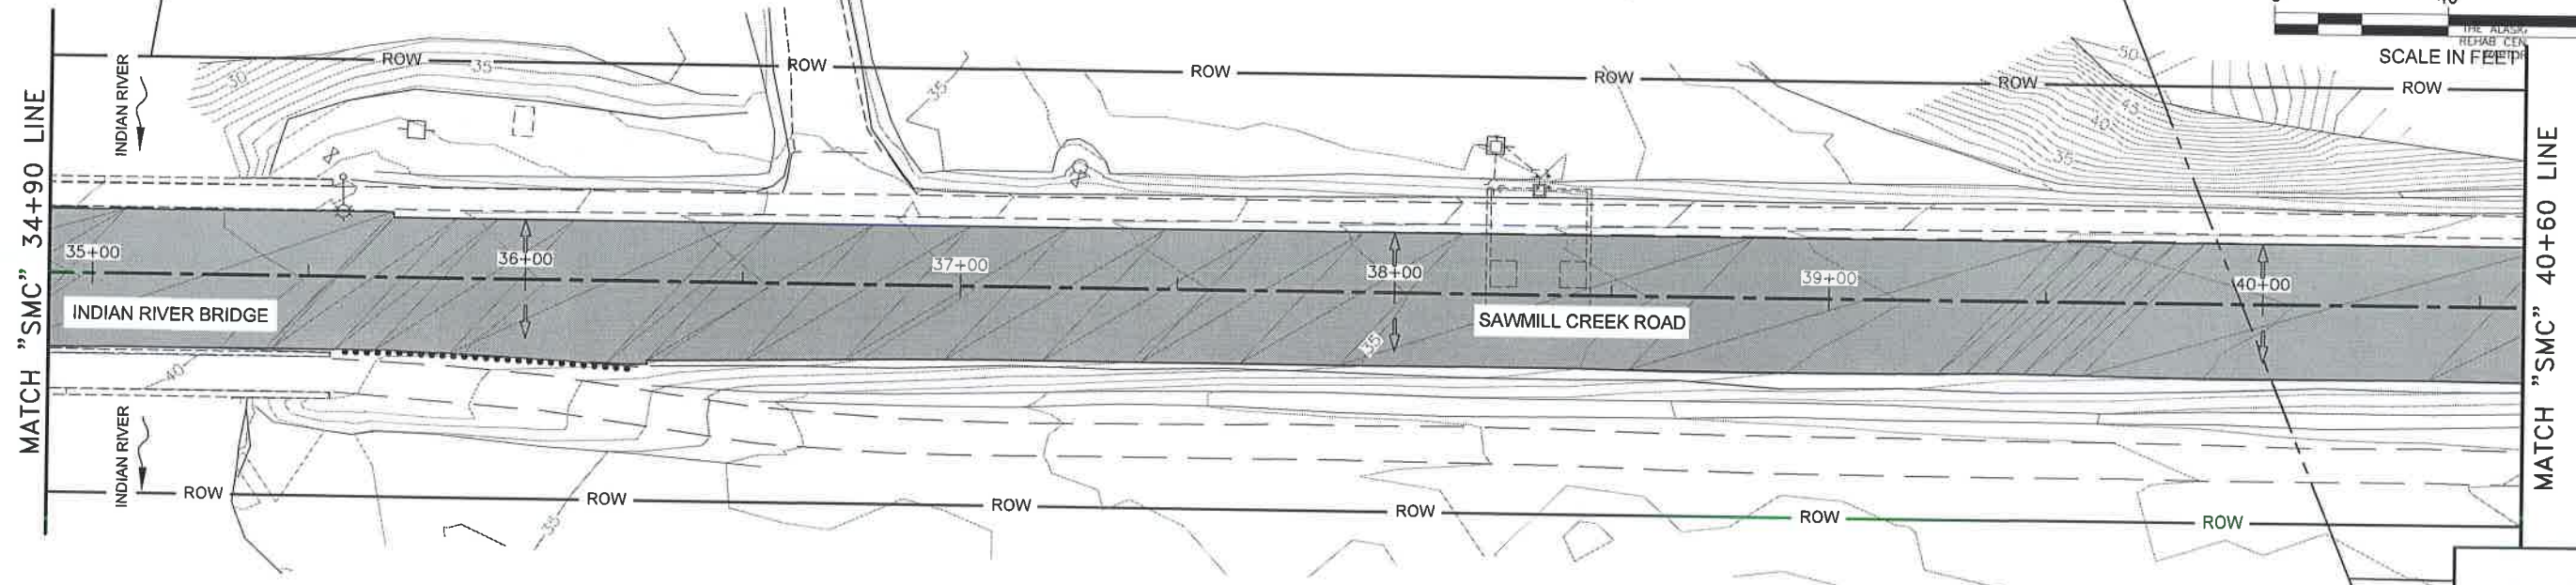

ESCP NOT SEALED IN ACCORDANCE WITH ALASKA HIGHWAY PRECONSTRUCTION MANUAL SECTION 1120.7.3 DATED NOVEMBER 15, 2013

Record Drawings have been reviewed by the Project Engineer, and represent to the best of my knowledge, the project as constructed.  
 PE Date 10.23.20


NATIONAL PARK SERVICE

FIRM STATE OF ALASKA DEPARTMENT OF TRANSPORTATION & PUBLIC FACILITIES  
 FILE C:\SIT\SFHWY00064\Planes\SFHWY00064\_SIT\_01.dwg  
 ADDRESS 6860 GLACIER HWY, JUNEAU, AK 99811  
 PHONE (907) 465-1763  
 DESIGNED C.L.  
 CHECKED B.P.  
 DRAFTED J.T. RG  
 CERTIFICATE OF AUTH #  
 DATE 8/9/2019 16:15 LAYOUT 03


NO.	DATE	REVISION	STATE	PROJECT DESIGNATION	YEAR	SHEET NO.	TOTAL SHEETS
			ALASKA	0933046/SFHwy00064	2019	Q3	4

**ESCP LEGEND**

- SURFACE FLOW DIRECTION
- INLET PROTECTION
- SEDIMENT BARRIER

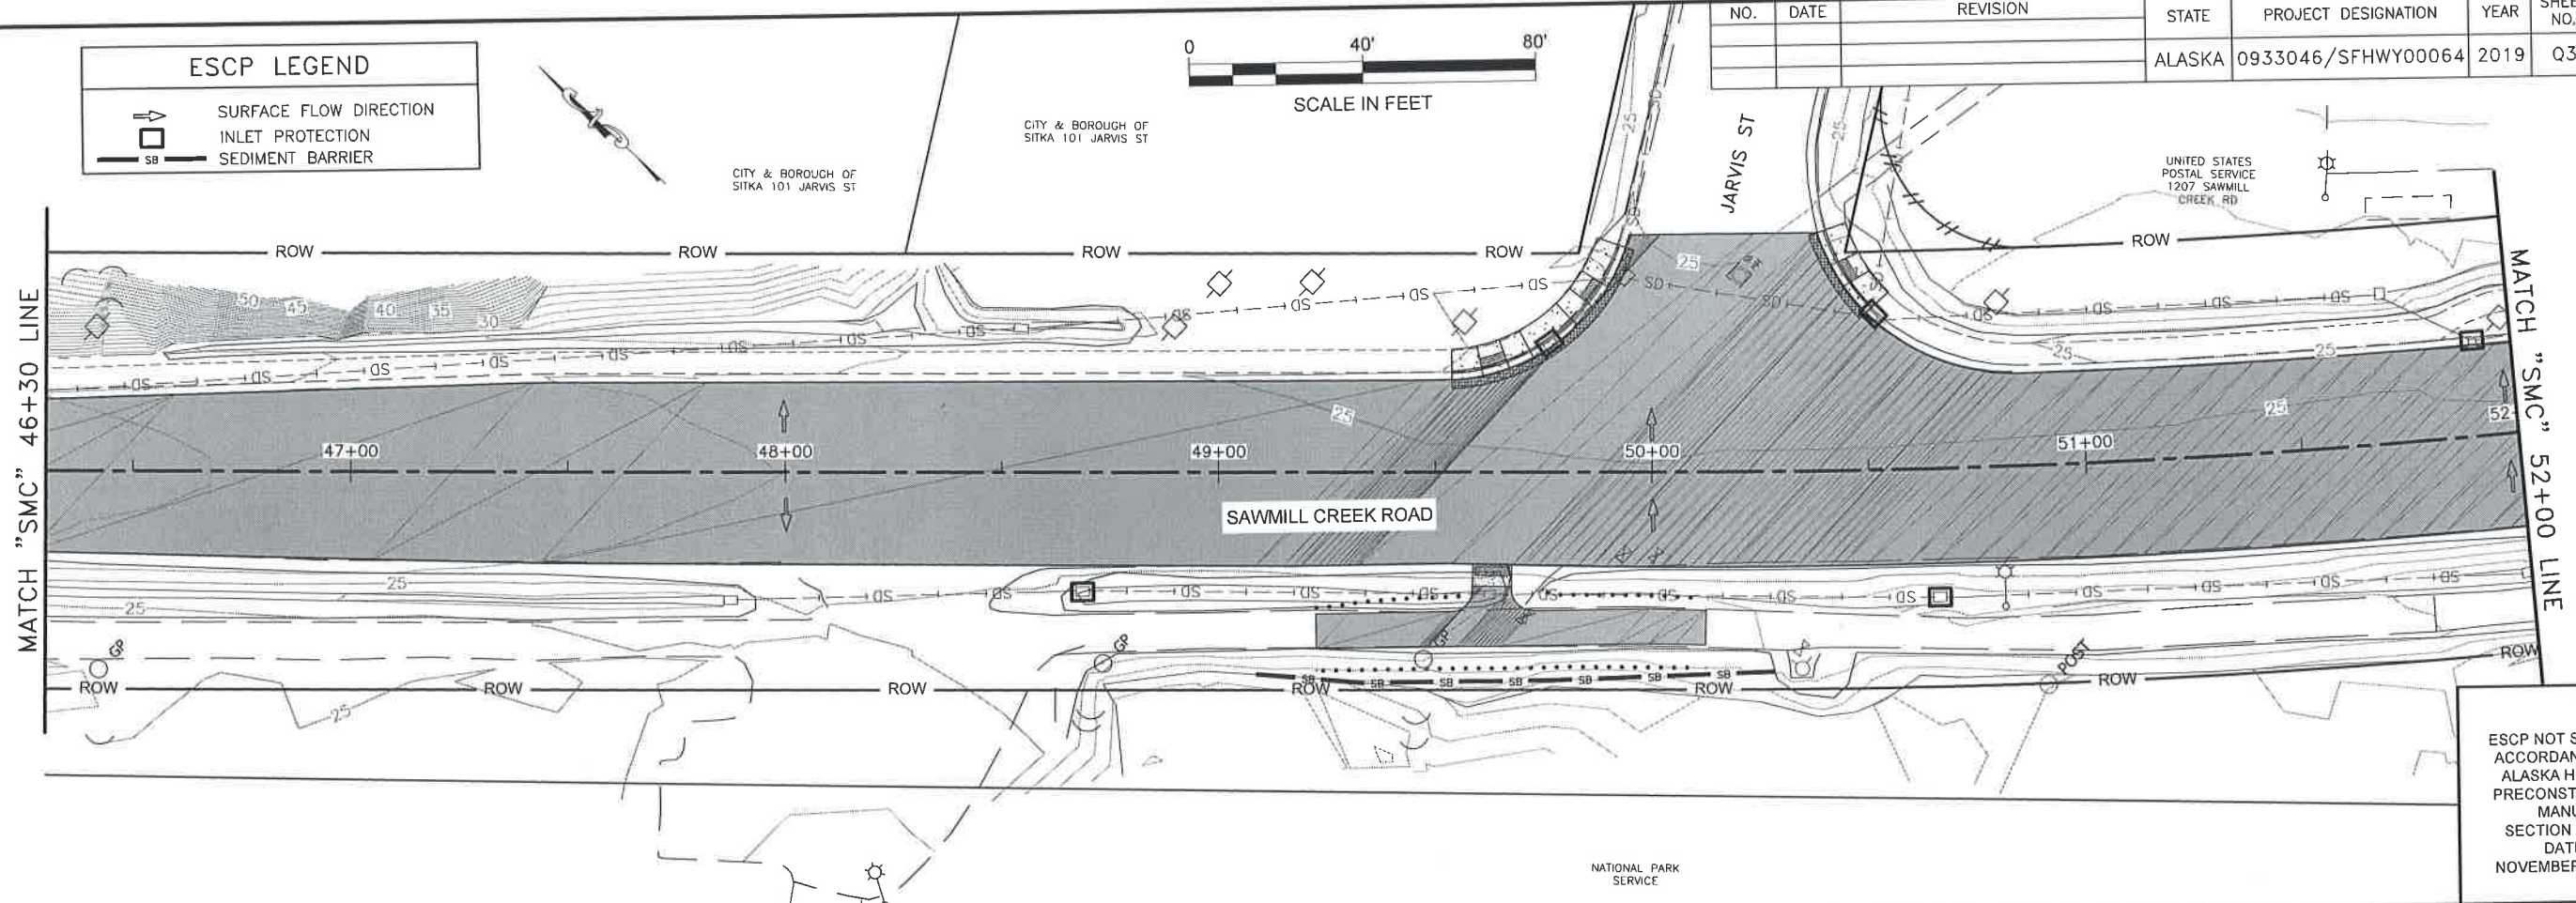


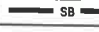

ESCP NOT SEALED IN ACCORDANCE WITH ALASKA HIGHWAY PRECONSTRUCTION MANUAL SECTION 1120.7.3 DATED NOVEMBER 15, 2013

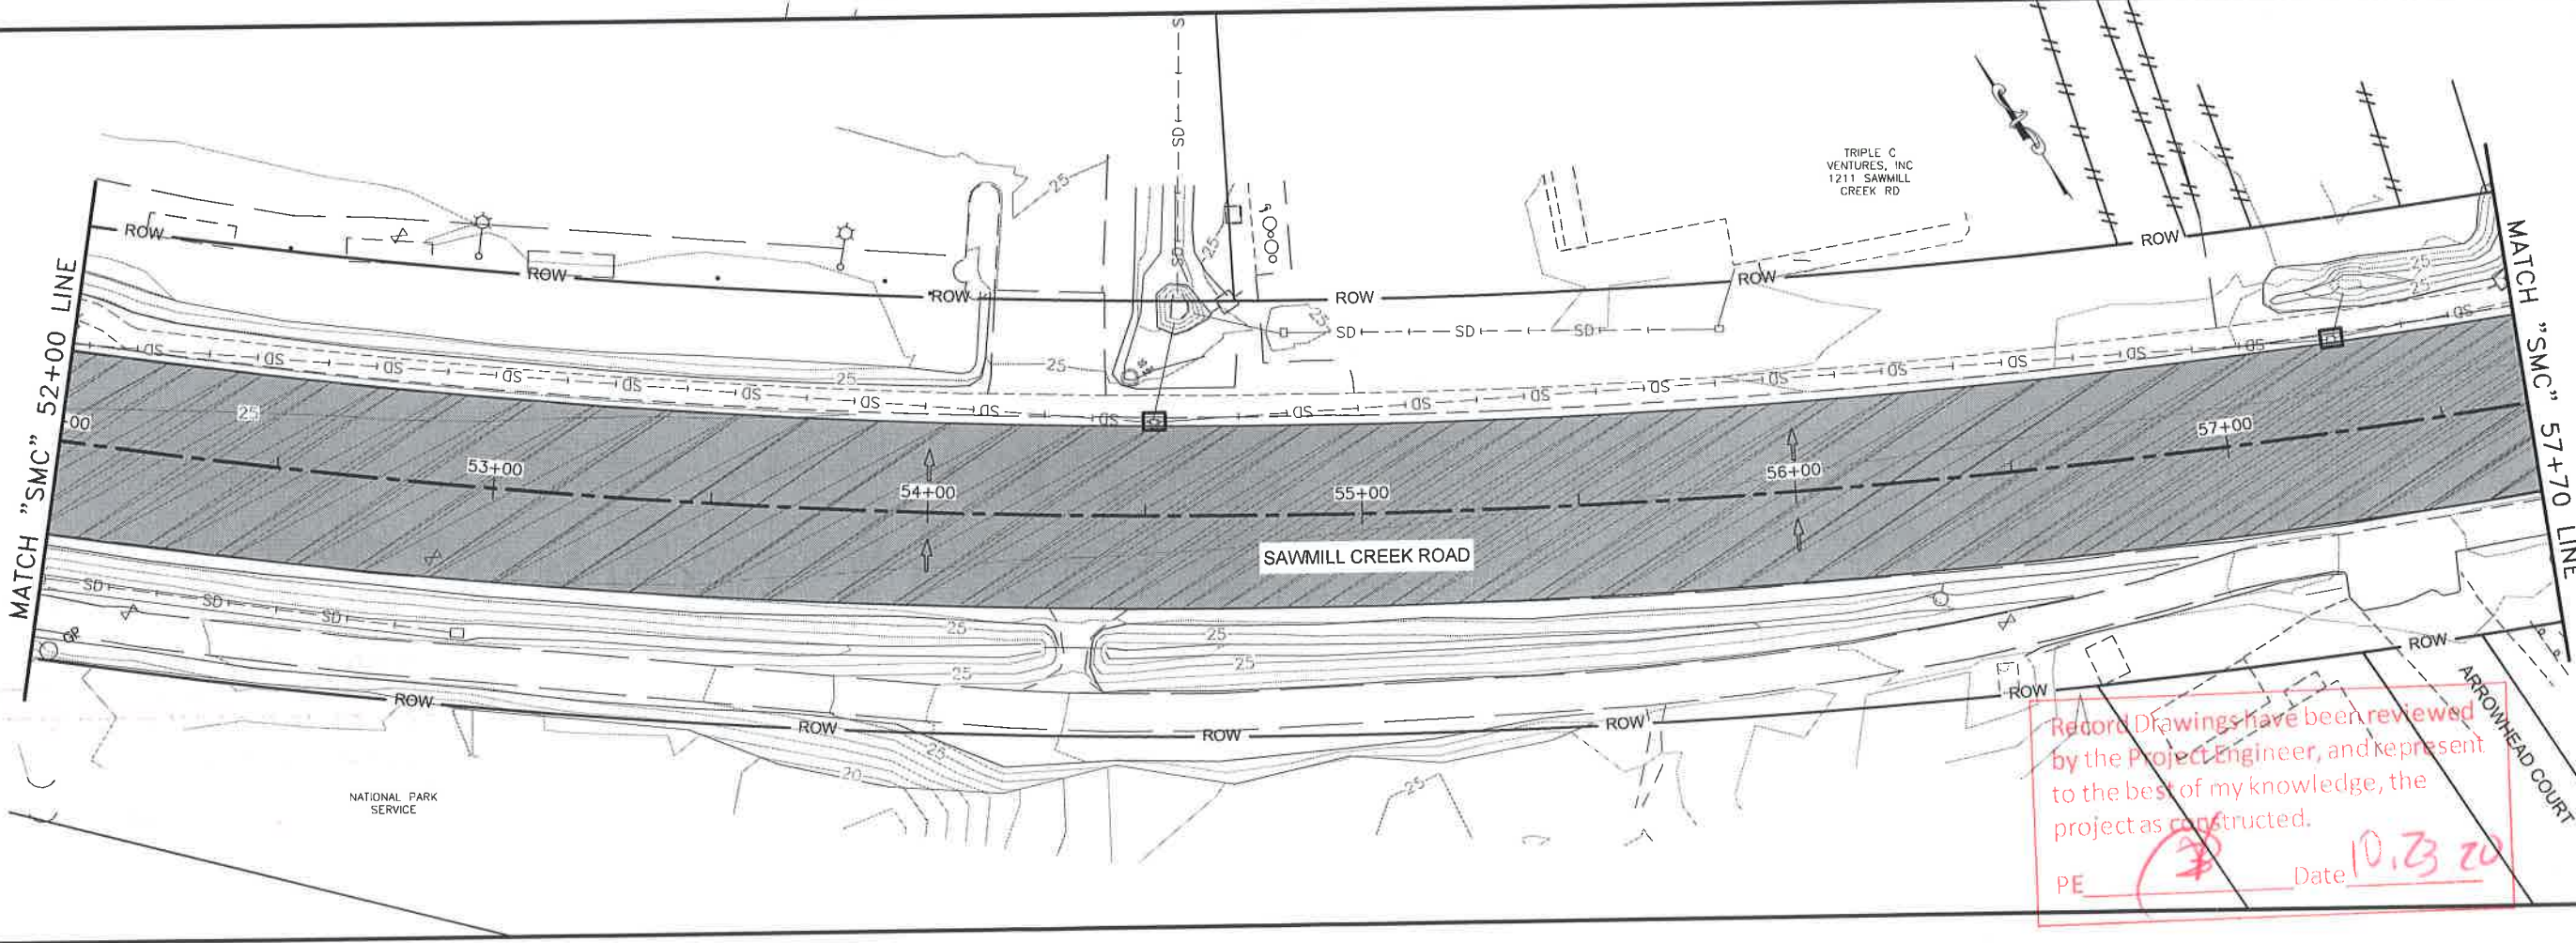


Record Drawings have been reviewed by the Project Engineer, and represent to the best of my knowledge, the project as constructed.  
 PE Date 10.23.20

FIRM STATE OF ALASKA DEPARTMENT OF TRANSPORTATION & PUBLIC FACILITIES  
 FILE D:\sit\SFH\000064\Plan\escp\SFH\WY00064\_01.dwg  
 ADDRESS 6860 GLACIER HWY, JUNEAU, AK 99811  
 DATE 8/9/2019 16:15 LAYOUT 04  
 PHONE (907) 465-1763 DESIGNED C.I.  
 CHECKED BP  
 DRAFTED JT, RG  
 CERTIFICATE OF AUTH #

**ESCP LEGEND**


 SURFACE FLOW DIRECTION  
 INLET PROTECTION  
 SEDIMENT BARRIER

NO.	DATE	REVISION	STATE	PROJECT DESIGNATION	YEAR	SHEET NO.	TOTAL SHEETS
			ALASKA	0933046/SFH\WY00064	2019	Q4	4

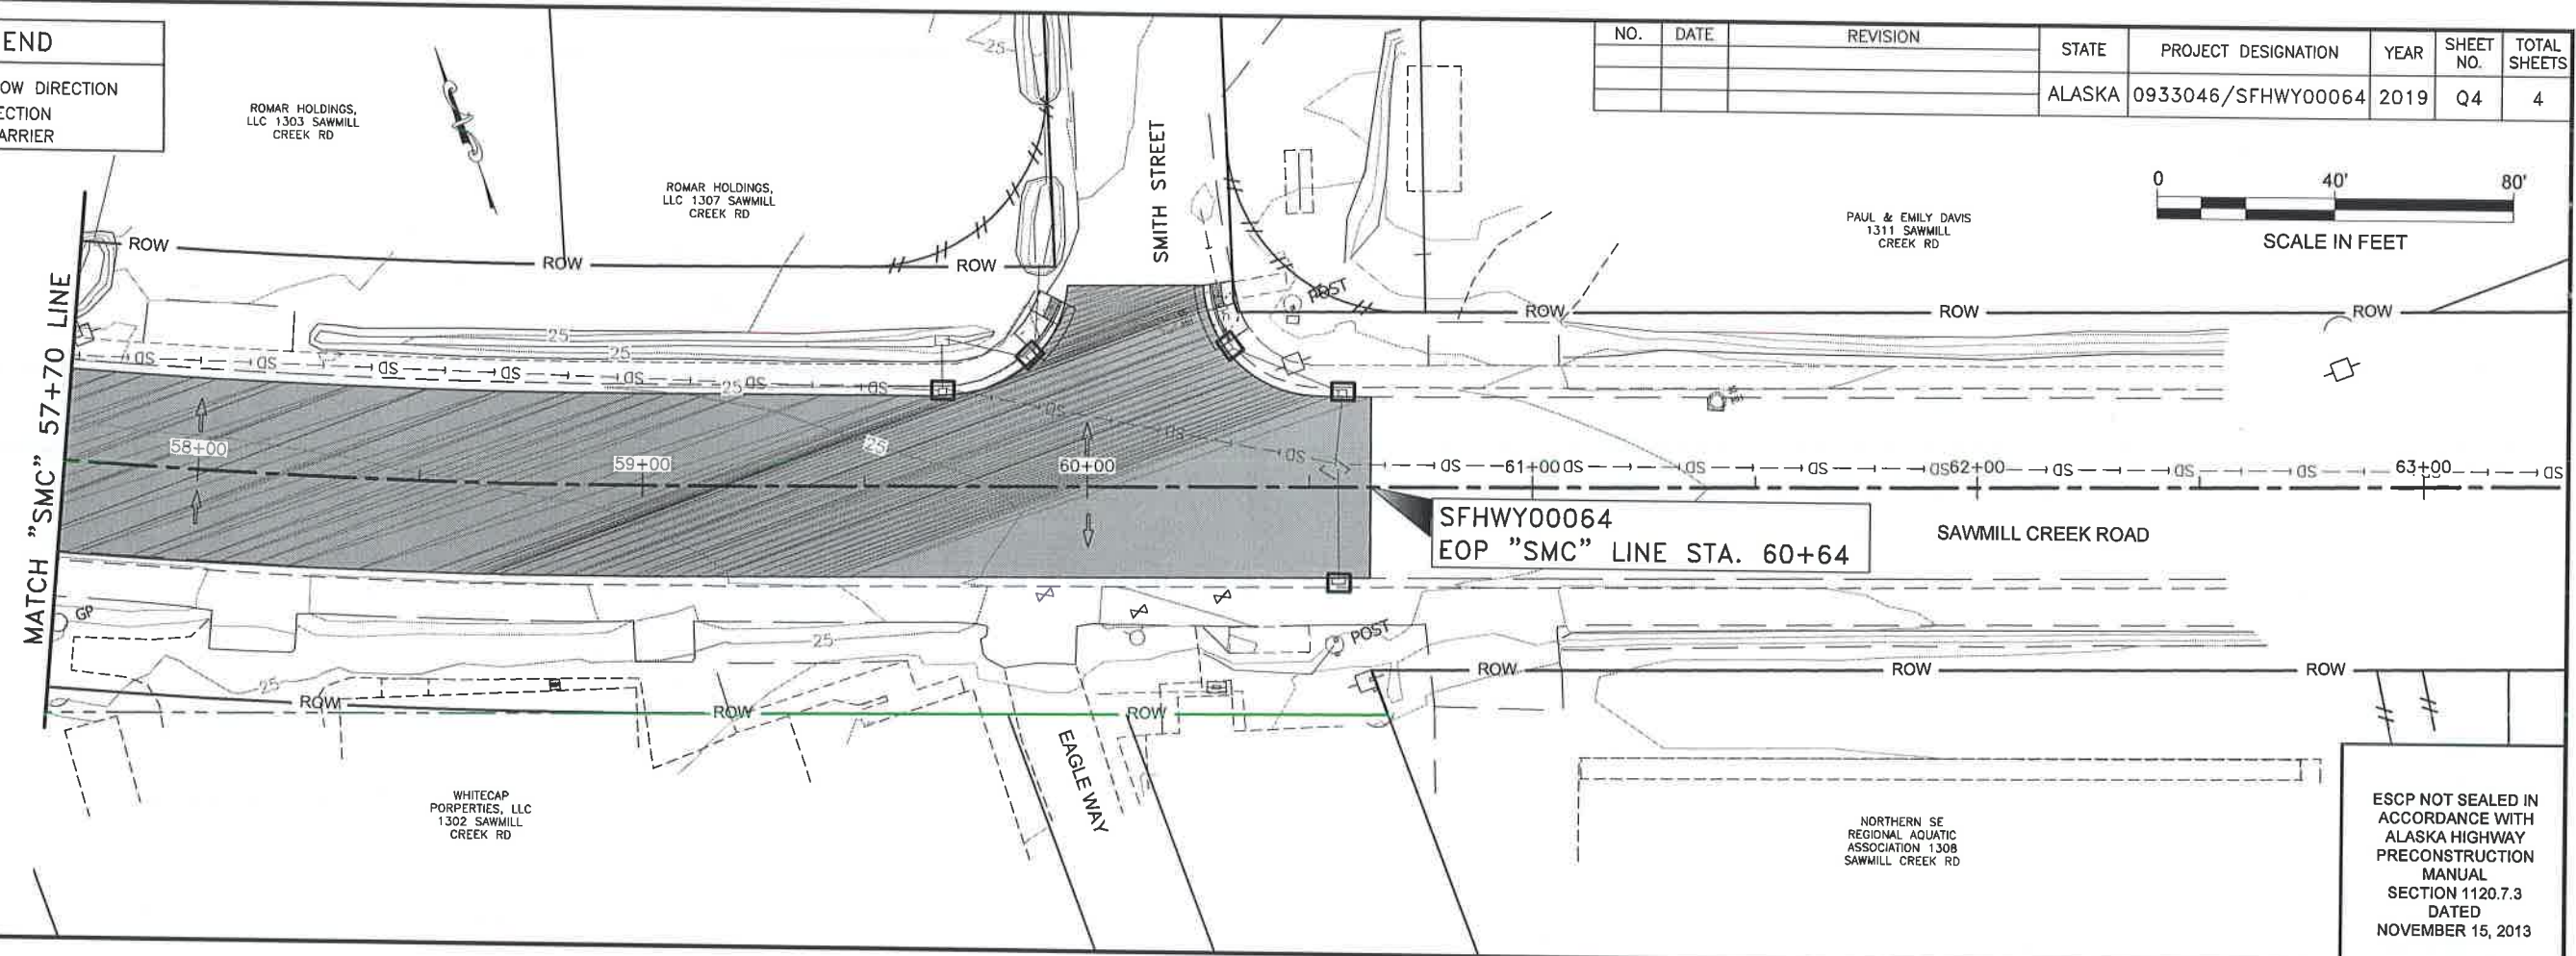

ESCP NOT SEALED IN ACCORDANCE WITH ALASKA HIGHWAY PRECONSTRUCTION MANUAL SECTION 1120.7.3 DATED NOVEMBER 15, 2013

Record Drawings have been reviewed by the Project Engineer, and represent to the best of my knowledge, the project as constructed.



PE  Date 10.23.20



FILE: 0:\SIT\SFH\00064\Planeset\SFH\00064\_SIT\_11.dwg DATE: 8/9/2019 16:16 LAYOUT: T1 DESIGNED: C.I. CHECKED: BP DRAFTED: J.T. RG



NO.	DATE	REVISION	STATE	PROJECT DESIGNATION	YEAR	SHEET NO.	TOTAL SHEETS
			ALASKA	0933046/SFH\00064	2019	T1	3

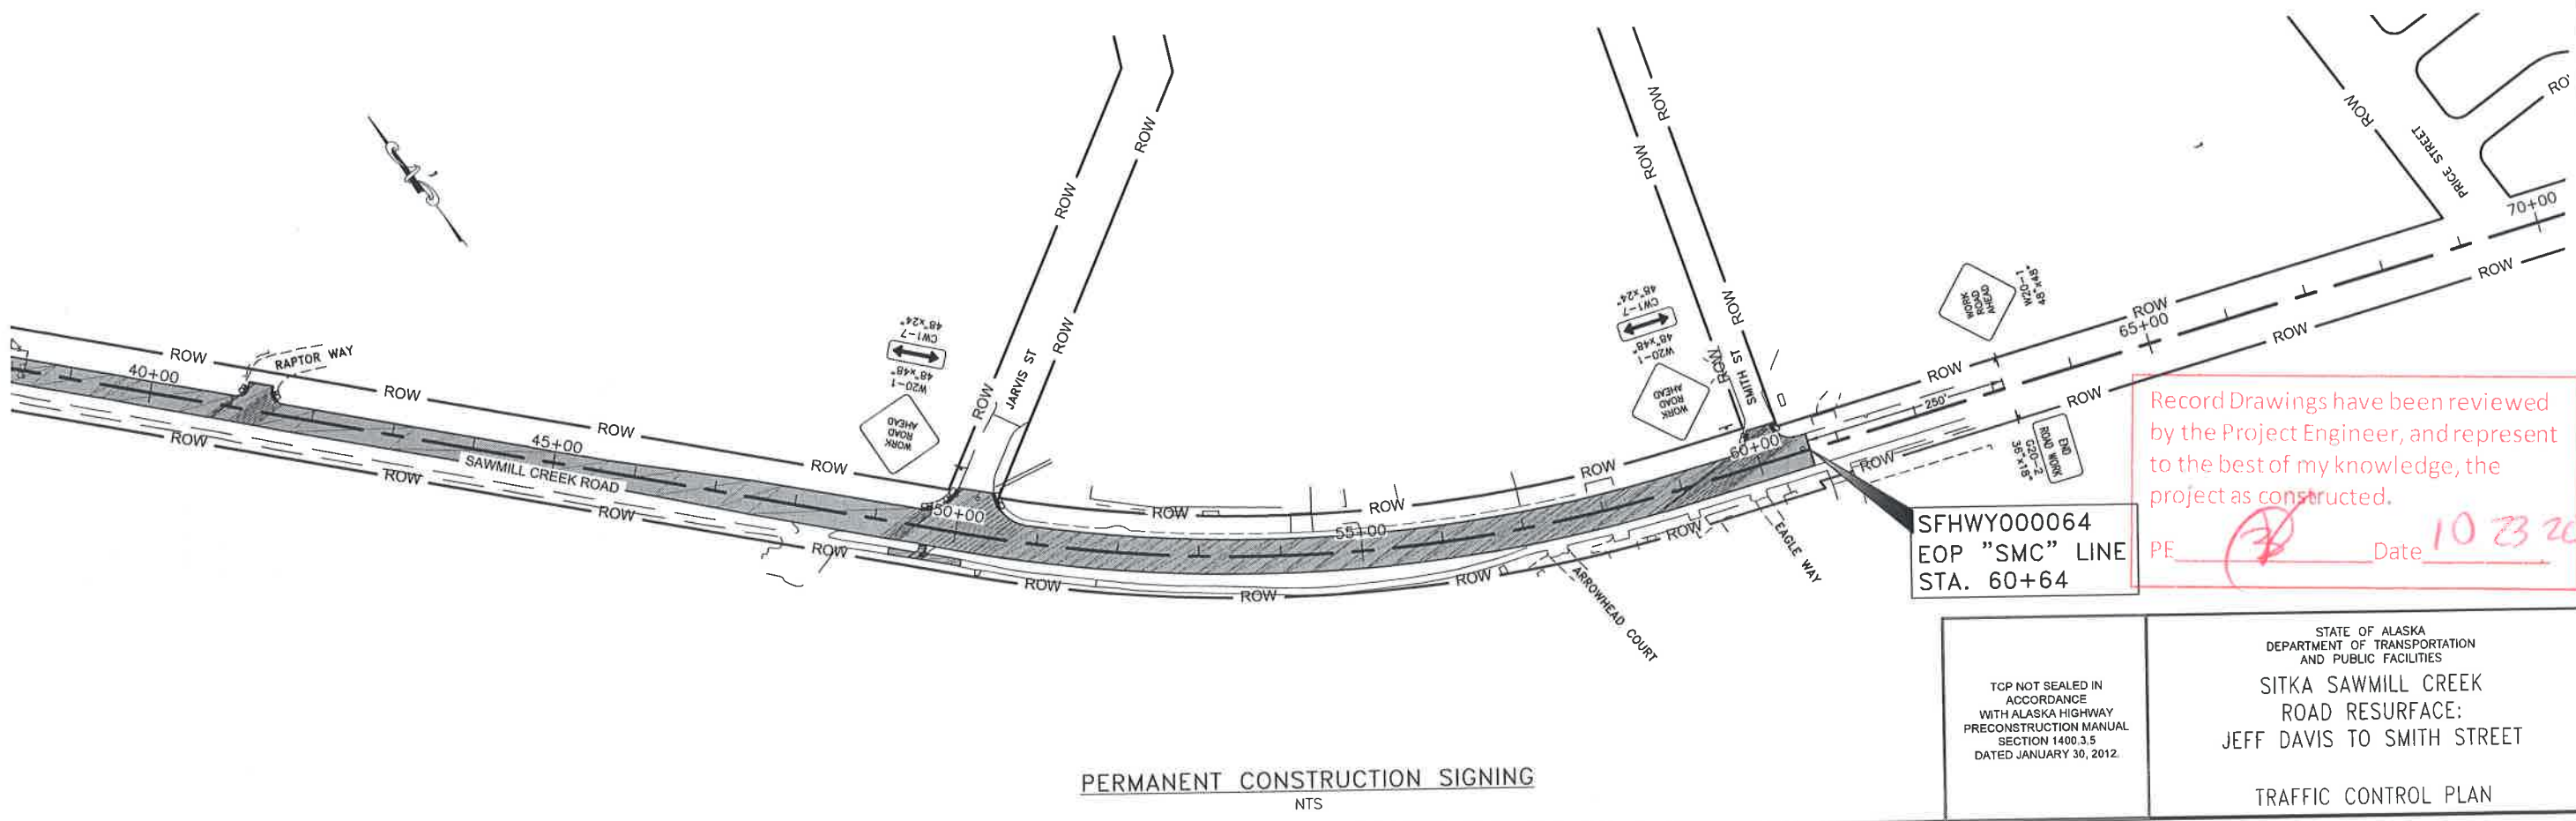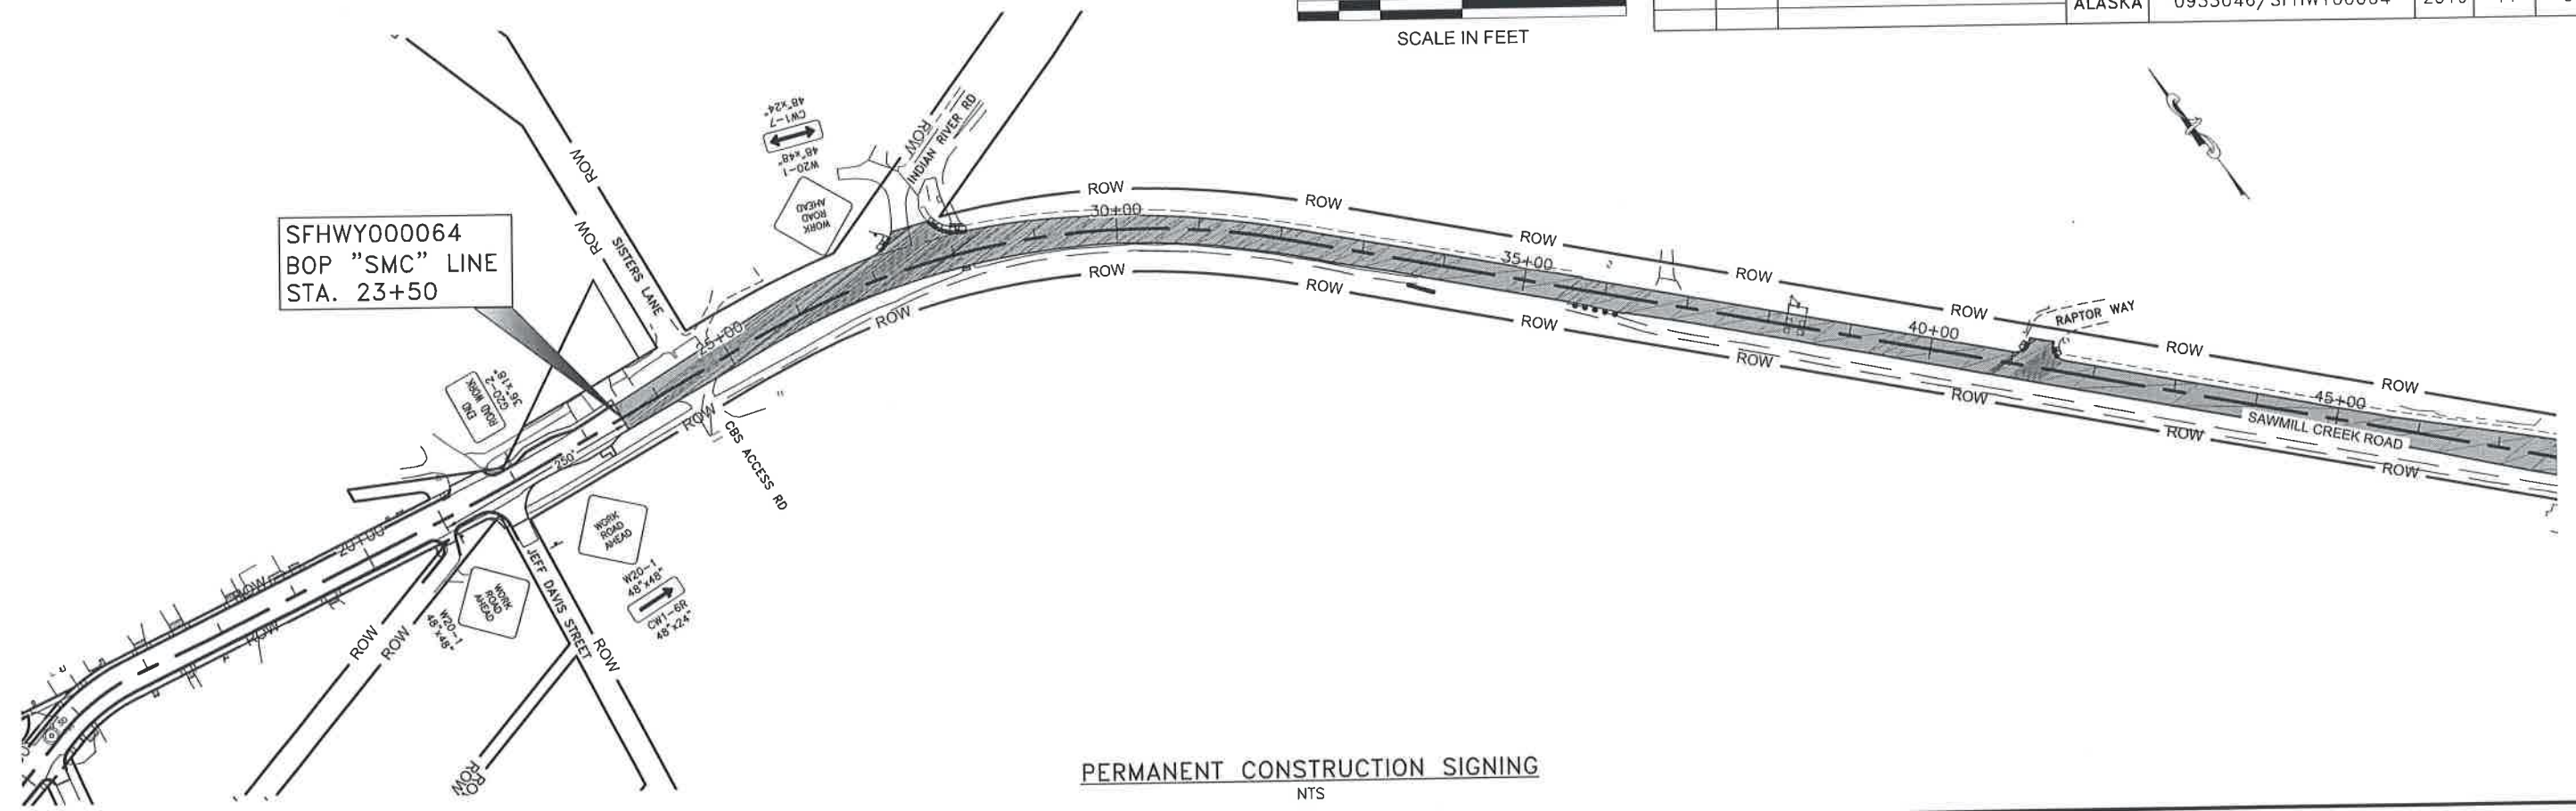


TCP NOT SEALED IN ACCORDANCE WITH ALASKA HIGHWAY PRECONSTRUCTION MANUAL SECTION 1400.3.5 DATED JANUARY 30, 2012.

STATE OF ALASKA  
DEPARTMENT OF TRANSPORTATION AND PUBLIC FACILITIES  
SITKA SAWMILL CREEK ROAD RESURFACE:  
JEFF DAVIS TO SMITH STREET  
TRAFFIC CONTROL PLAN

DATE 8/9/2019 16:17 LAYOUT T2 DESIGNED C.L. CHECKED BP DRAFTED J.T. RG  
 FILE D:\SIT\SFHWY00064\Plans\SFHWY00064\_SIT\_T2.dwg

NO.	DATE	REVISION	STATE	PROJECT DESIGNATION	YEAR	SHEET NO.	TOTAL SHEETS
			ALASKA	0933046/SFHWY00064	2019	T2	3

SPEED (MPH)	MIN MERGING TAPER LENGTH (L) IN FEET WIDTH OF OFFSET (W) IN FEET			MIN NUMBER OF DEVICES WIDTH OF OFFSET (W) IN FEET			MAX DEVICE SPACING IN FEET		BUFFER SPACE (FT)
	10'	11'	12'	10'	11'	12'	ALONG TAPER	ALONG TANGENT	
25 OR BELOW	105	115	125	6	6	6	25	50	155
30	150	165	180	6	7	7	30	60	200
35	205	225	245	7	8	8	35	70	250

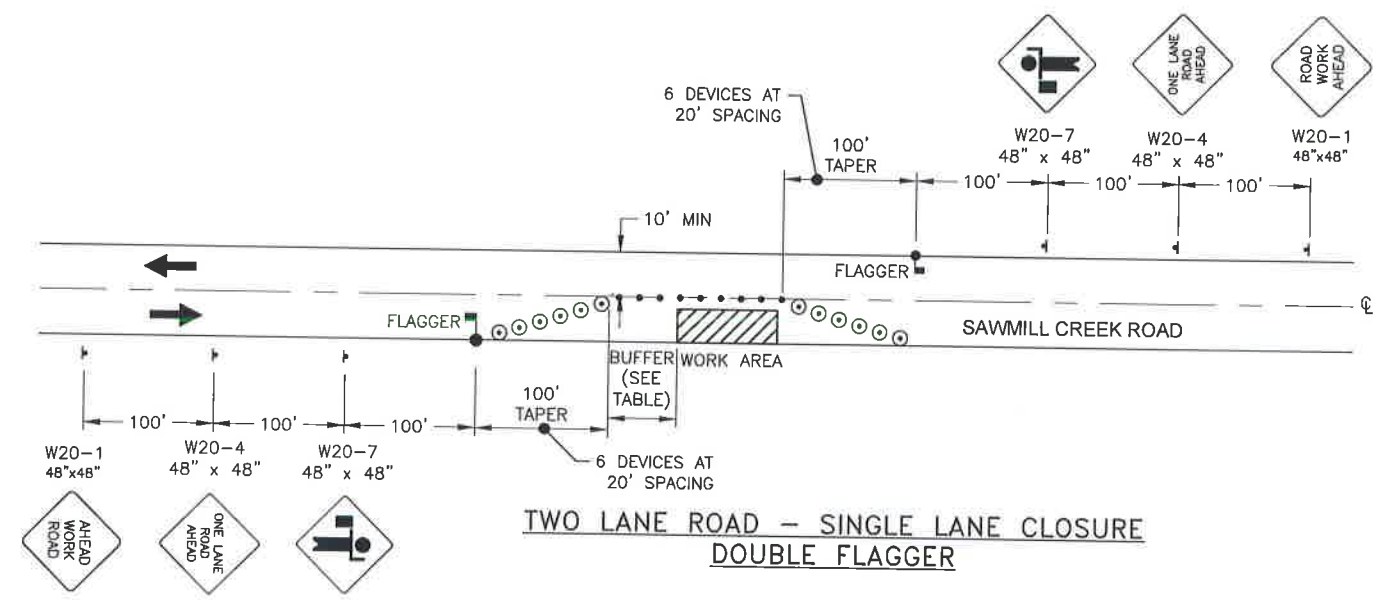

**TRAFFIC CONTROL NOTES**

1. A MINIMUM OF ONE LANE SHALL BE MAINTAINED AT ALL TIMES, THROUGH ALL WORK AREAS.
2. TWO LANES SHALL BE MAINTAINED AT ALL TIMES IN NON-WORK AREAS AND DURING NON-WORKING HOURS.
3. TEMPORARY DRIVING LANES SHALL HAVE A MINIMUM WIDTH OF 10'.
4. CONSTRUCTION SIGNS SHALL BE IN PLACE ONLY WHEN THE CONDITIONS THEY WARN ABOUT EXIST.
5. REFER TO 643-1.03 SUBMIT ALL TCPs, INCLUDING THE TCPs PROVIDED ON THE PLANS IF YOU INTEND TO USE THEM TO THE ENGINEER FOR APPROVAL.
6. TEMPORARY PAVEMENT MARKINGS WILL BE REQUIRED AS DESCRIBED IN SECTION 643-3.09 OF THE SPECIFICATIONS.
7. REFER TO 643-1.08 FOR CONSTRUCTION PHASING REQUIREMENTS.


Record Drawings have been reviewed by the Project Engineer, and represent to the best of my knowledge, the project as constructed.  
 PE Date 10.23.20

	.....	SIGN
	.....	CONE
	.....	DRUM
	.....	FLAGGING STATION

TCP NOT SEALED IN ACCORDANCE WITH ALASKA HIGHWAY PRECONSTRUCTION MANUAL SECTION 1400.3.5 DATED JANUARY 30, 2012

STATE OF ALASKA  
 DEPARTMENT OF TRANSPORTATION AND PUBLIC FACILITIES  
 SITKA SAWMILL CREEK  
 ROAD RESURFACE:  
 JEFF DAVIS TO SMITH STREET  
 TRAFFIC CONTROL PLAN

NO.	DATE	REVISION	STATE	PROJECT DESIGNATION	YEAR	SHEET NO.	TOTAL SHEETS
			ALASKA	0933046/SFHWHY00064	2019	T3	3

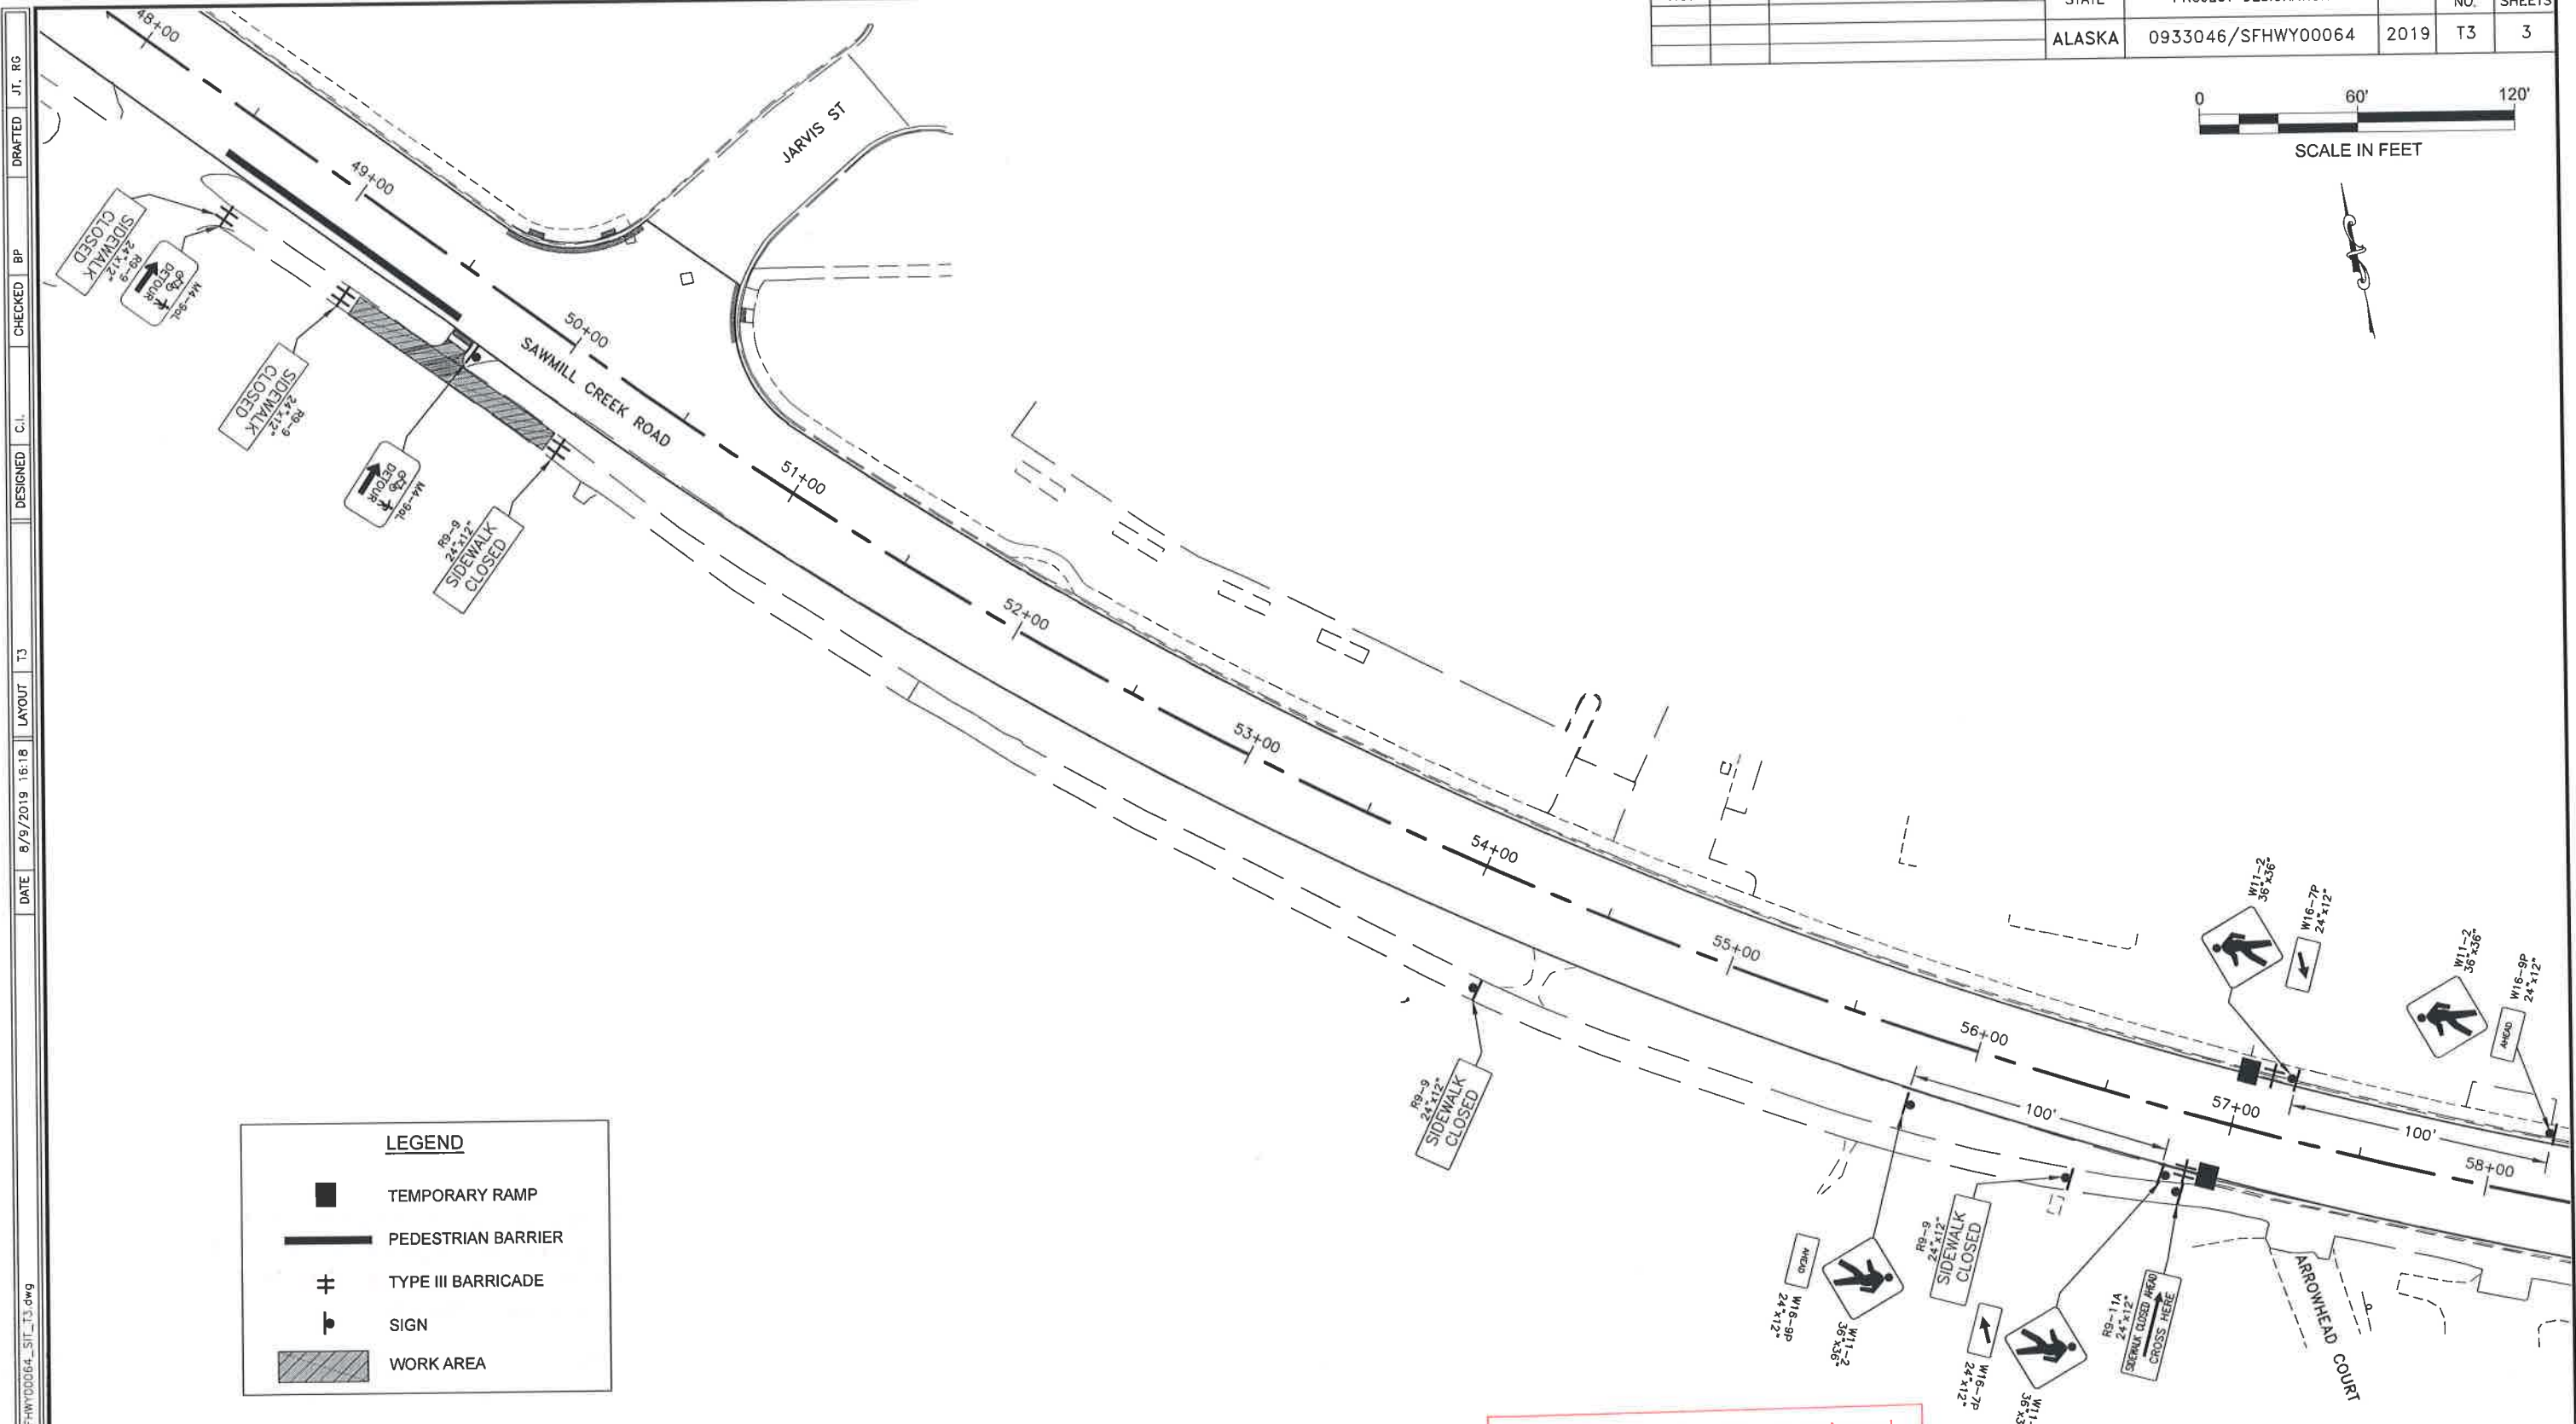

LEGEND	
	TEMPORARY RAMP
	PEDESTRIAN BARRIER
	TYPE III BARRICADE
	SIGN
	WORK AREA

**NOTES:**

1. PROVIDE PEDESTRIAN TRAFFIC CONTROL DEVICES WHEN SIDEWALKS OR PATHWAYS ARE CLOSED TO PEDESTRIANS AND WHERE REQUIRED BY THE PLANS OR SPECIFICATIONS.
2. AVOID ROUTING PEDESTRIANS ACROSS ROADS UNNECESSARILY. WHEN ROUTING PEDESTRIANS ACROSS THE ROAD, ROUTE TO THE BEST CROSSING POINT NEAR THE WORK AREA.
3. MAINTAIN A MINIMUM PEDESTRIAN FACILITY WIDTH OF 5 FEET OR THE WIDTH OF THE FACILITY THAT EXISTED BEFORE CONSTRUCTION, WHICHEVER IS LESS.

Record Drawings have been reviewed by the Project Engineer, and represent to the best of my knowledge, the project as constructed.  
 PE Date 10.23.20

<p>TCP NOT SEALED IN ACCORDANCE WITH ALASKA HIGHWAY PRECONSTRUCTION MANUAL SECTION 1400.3.5 DATED JANUARY 30, 2012.</p>	<p>STATE OF ALASKA          DEPARTMENT OF TRANSPORTATION AND PUBLIC FACILITIES  <b>SITKA SAWMILL CREEK ROAD RESURFACE:          JEFF DAVIS TO SMITH STREET</b>          TRAFFIC CONTROL PLAN</p>
---	--

FILE: O:\SIT\SFHWY00064\Plans\SFHWY00064\_SIT\_T3.dwg  
 DATE: 8/9/2019 16:18 LAYOUT: T3  
 DESIGNED: C.I.  
 CHECKED: B.P.  
 DRAFTED: J.T. RC

FILE: F:\Projects\134 State of Alaska DOT\PF\133 Sitka Sawmill Creek Rd\Drawings\Working\U1.dwg  
 DATE: 8/7/2019 2:58 PM LAYOUT: U1  
 DESIGNED: Q. JUDSON CHECKED: Q. JUDSON DRAFTED: P. LESLIE

LUMINAIRE SCHEDULE				
TYPE	DESCRIPTION	MANUFACTURER	LAMPS	REMARKS
A	ARM MOUNTED STREET LIGHT, DIE-CAST ALUMINUM HOUSING, TEMPERED GLASS LENS, TYPE III DISTRIBUTION, INTEGRAL ELECTRONIC DRIVER, 120-277V, 14,000 LUMENS, GRAY FINISH, 7 PIN PHOTOCELL	GE LIGHTING ERLH 2 14 C3 40 D GRAY	122W WHITE LED 4000K, CRI 70	MOUNT TO EXISTING ARM.
B	LED ENHANCED PEDESTRIAN CROSSING SIGN WITH PUSHBUTTON ACTIVATION, SOLAR PANEL AND BATTERY STORAGE	AEL ATB2 60BLEDE70 MVOLT R3 BL HK P7 SH  CARMANAH OR TADCO	130W WHITE LED 4000K, CRI 70  (8 EA) WHITE LED INTEGRAL TO PEDESTRIAN SIGN	SOLAR PANEL, CONTROL CABINET, SIGNS AND PUSHBUTTON TO BE INSTALLED. RADIO COMMUNICATION BETWEEN SIGNS ON EACH SIDE OF SAWMILL CREEK ROAD SO THAT SIGNS OPERATE TOGETHER. SOLAR PANELS TO FACE WEST.

**LEGEND**

**ABBREVIATIONS:**

- OHE OVERHEAD ELECTRICAL
- UGE UNDERGROUND ELECTRICAL
- UON UNLESS OTHERWISE NOTED
- PST PERFORATED STEEL TUBE
- PE PHOTOELECTRIC CELL

**SHEET NOTE SYMBOLS:**

- ⓔ EXISTING TO BE RETAINED
- Ⓝ NEW
- ⓧ REMOVE EXISTING

**SERVICE EQUIPMENT:**



- Ⓜ HANDHOLE
- UTILITY POLE

**LIGHTING:**

- EXTERIOR POLE MOUNTED LUMINAIRE
- ◇ PEDESTRIAN SIGN WITH LED FLASHING BEACON

**NOTES:**

- ALL ELECTRICAL COMPONENTS ARE EXISTING (TO REMAIN AND BE REUSED), UON.
- LUMINAIRE POLES, ARMS, AND CIRCUITRY SHALL REMAIN TO BE REUSED WITH NEW LUMINAIRES.
- NEW LED LUMINAIRES SHALL REPLACE EXISTING 250 WATT SODIUM FIXTURES. LIGHTING CONTROL CENTER AND METER WILL REMAIN TO MAINTAIN CURRENT SYSTEM FUNCTIONALITY.

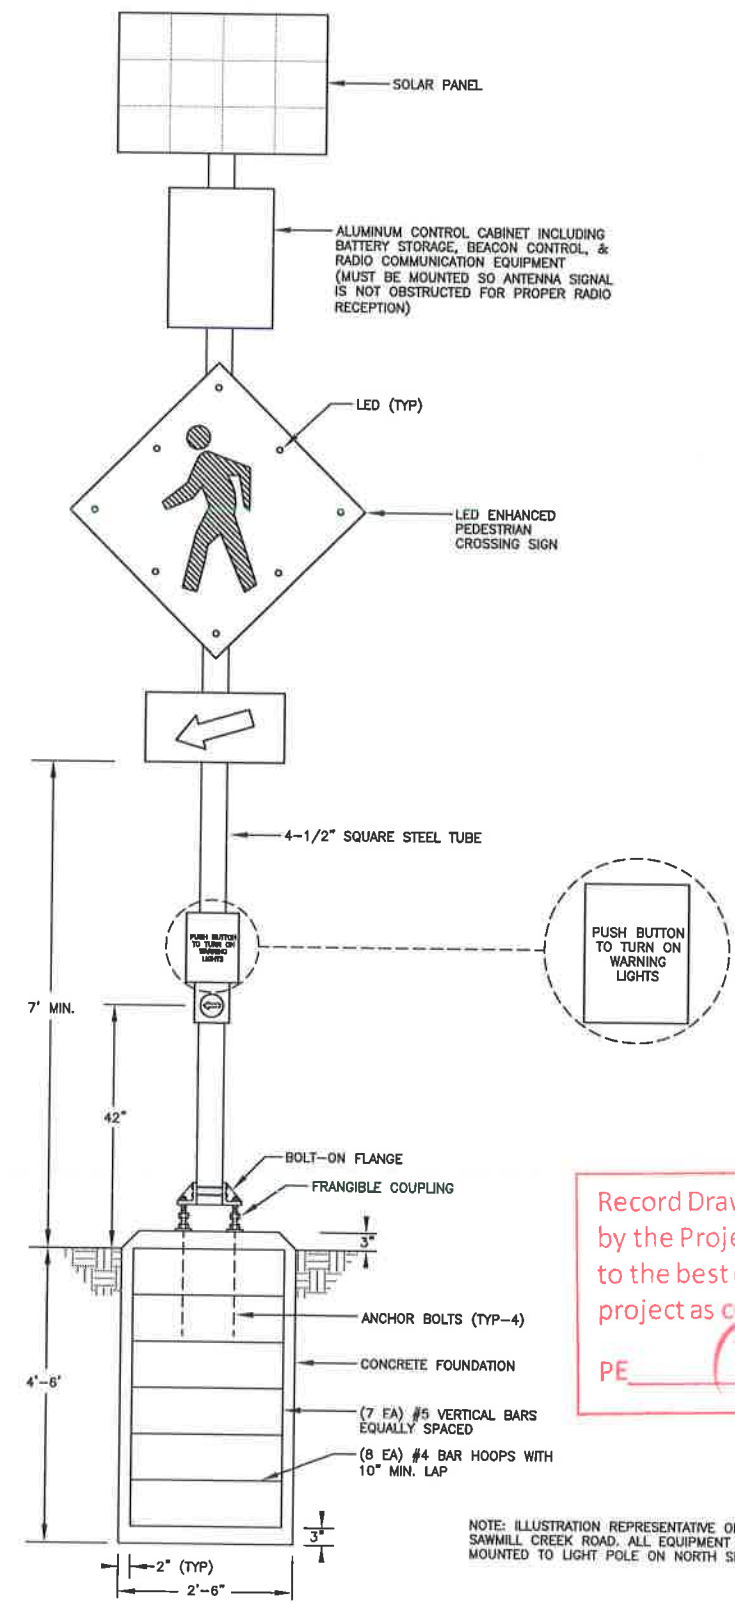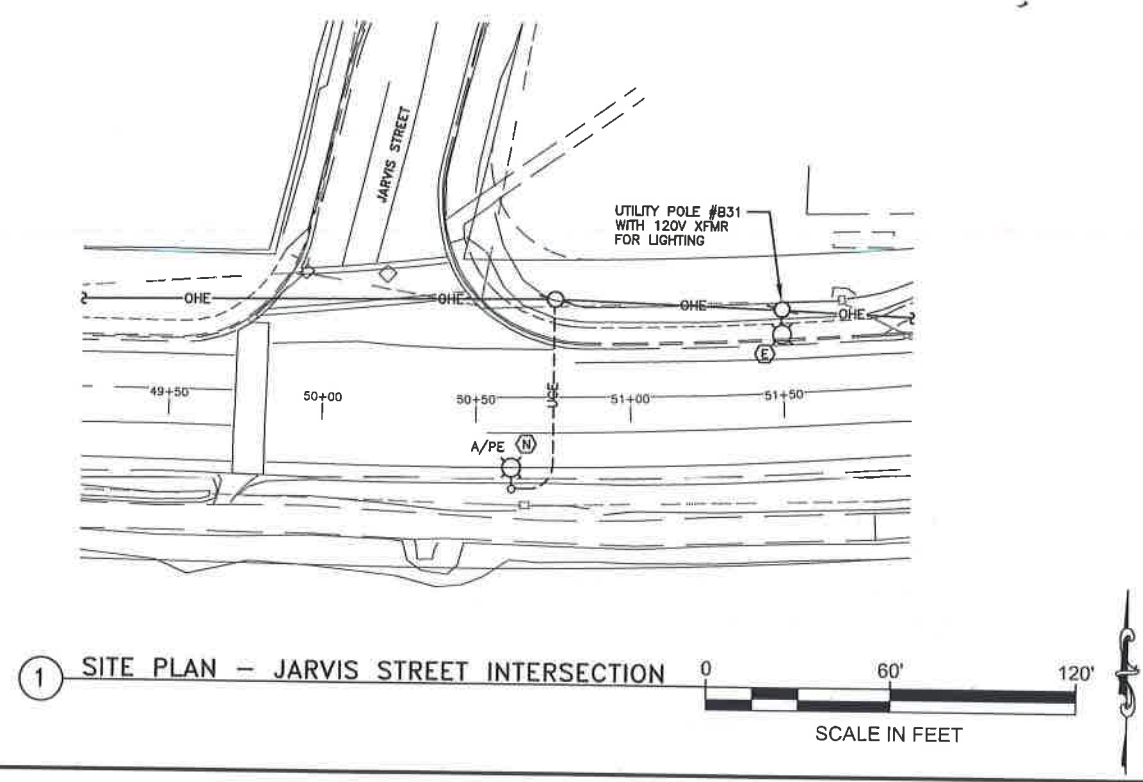


Record Drawings have been reviewed by the Project Engineer, and represent to the best of my knowledge, the project as constructed.  
 PE *[Signature]* Date 10.23.20

NOTE: ILLUSTRATION REPRESENTATIVE OF BEACON ON SOUTH SIDE OF SAWMILL CREEK ROAD. ALL EQUIPMENT ILLUSTRATED HERE SHALL BE MOUNTED TO LIGHT POLE ON NORTH SIDE OF SAWMILL CREEK ROAD.

SHEET NO.	TOTAL SHEETS
U1	U2
STATE	YEAR
ALASKA	2019
PROJECT DESIGNATION	
SFHWY00064/0933046	
REVISION	
NO.	DATE
PLANS DEVELOPED BY: HAIGHT & ASSOCIATES, INC. 526 MAIN STREET JUNEAU, AK 99801 (907) 586-9788 AECC670	
STATE OF ALASKA DEPARTMENT OF TRANSPORTATION AND PUBLIC FACILITIES SAWMILL CREEK ROAD RESURFACE: JEFF DAVIS TO SMITH STREET SITKA, AK LEGEND, LUMINAIRE SCHEDULE, SITE PLAN - JARVIS STREET INTERSECTION	


FILE F:\Projects\134 State of Alaska DOT\PF\133 Sitka Sawmill Creek Rd Drawings\Working\U2.dwg DATE 8/7/2019 2:59 PM LAYOUT U2 DESIGNED Q. JUDDSON CHECKED Q. JUDDSON DRAFTED P. LESLIE

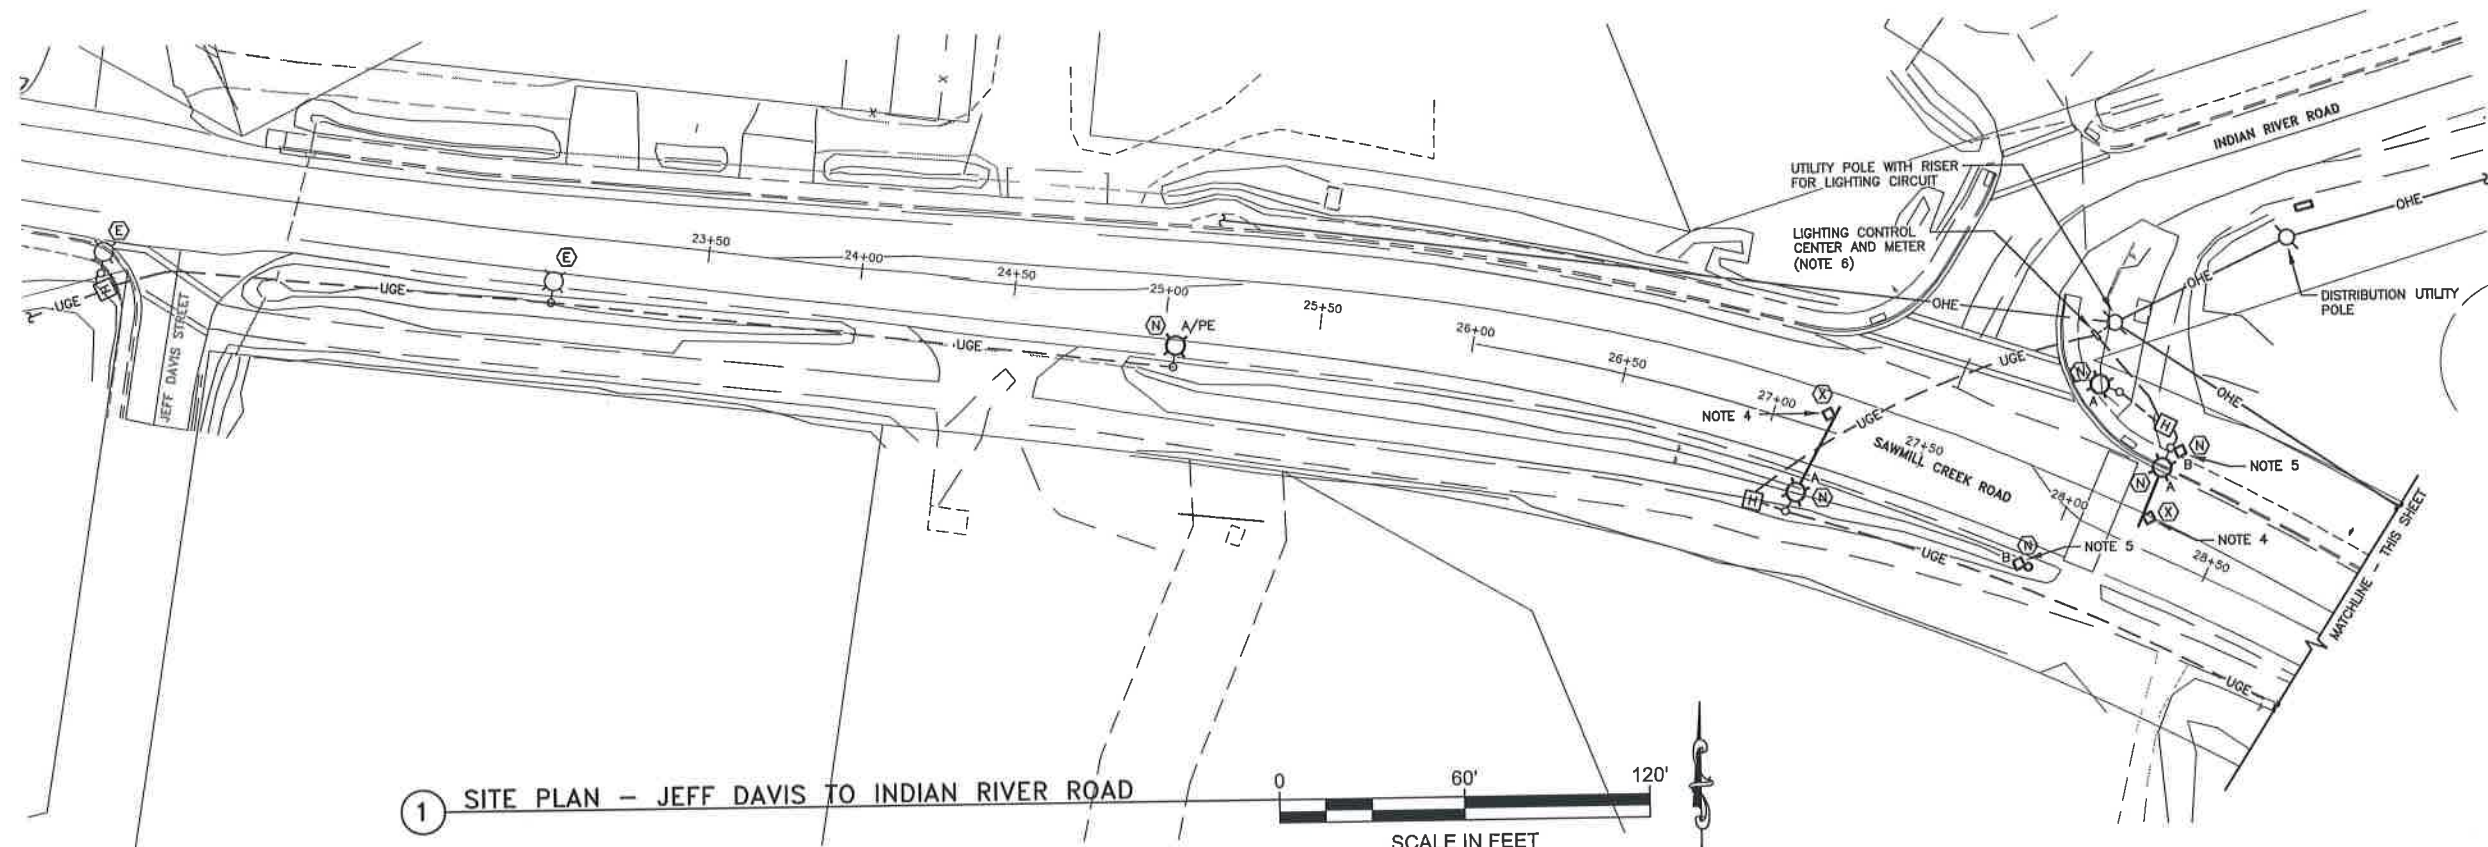

1 SITE PLAN - JEFF DAVIS TO INDIAN RIVER ROAD



- NOTES:
1. ALL ELECTRICAL COMPONENTS ARE EXISTING (TO REMAIN AND BE REUSED), UON.
  2. LUMINAIRE POLES, ARMS, AND CIRCUITRY SHALL REMAIN TO BE REUSED WITH NEW LUMINAIRES.
  3. NEW LED LUMINAIRES SHALL REPLACE EXISTING 250 WATT SODIUM FIXTURES. LIGHTING CONTROL CENTER AND METER WILL REMAIN TO MAINTAIN CURRENT SYSTEM FUNCTIONALITY.
  4. EXISTING ILLUMINATED PEDESTRIAN CROSSING SIGNS, CIRCUITRY, MAST ARMS, AND ALL OTHER EQUIPMENT ASSOCIATED WITH SIGNS OR ARMS SHALL BE DEMOLISHED AND REMOVED AND HOLES COVERED.
  5. NEW LED ENHANCED PEDESTRIAN CROSSING SIGNS, BATTERY, BATTERY STORAGE/CONTROL ENCLOSURE, SOLAR PANEL, AND PUSH BUTTON ACTIVATION SHALL BE INSTALLED. SEE DETAIL 2, SHEET U1. ALL MOUNTING HARDWARE SHALL BE PROVIDED BY CONTRACTOR.
  6. LIGHTING CONTROL CENTER UTILIZES PHOTOELECTRIC CELL TO POWER STREET LIGHTS WHEN AMBIENT LIGHT IS LOW.

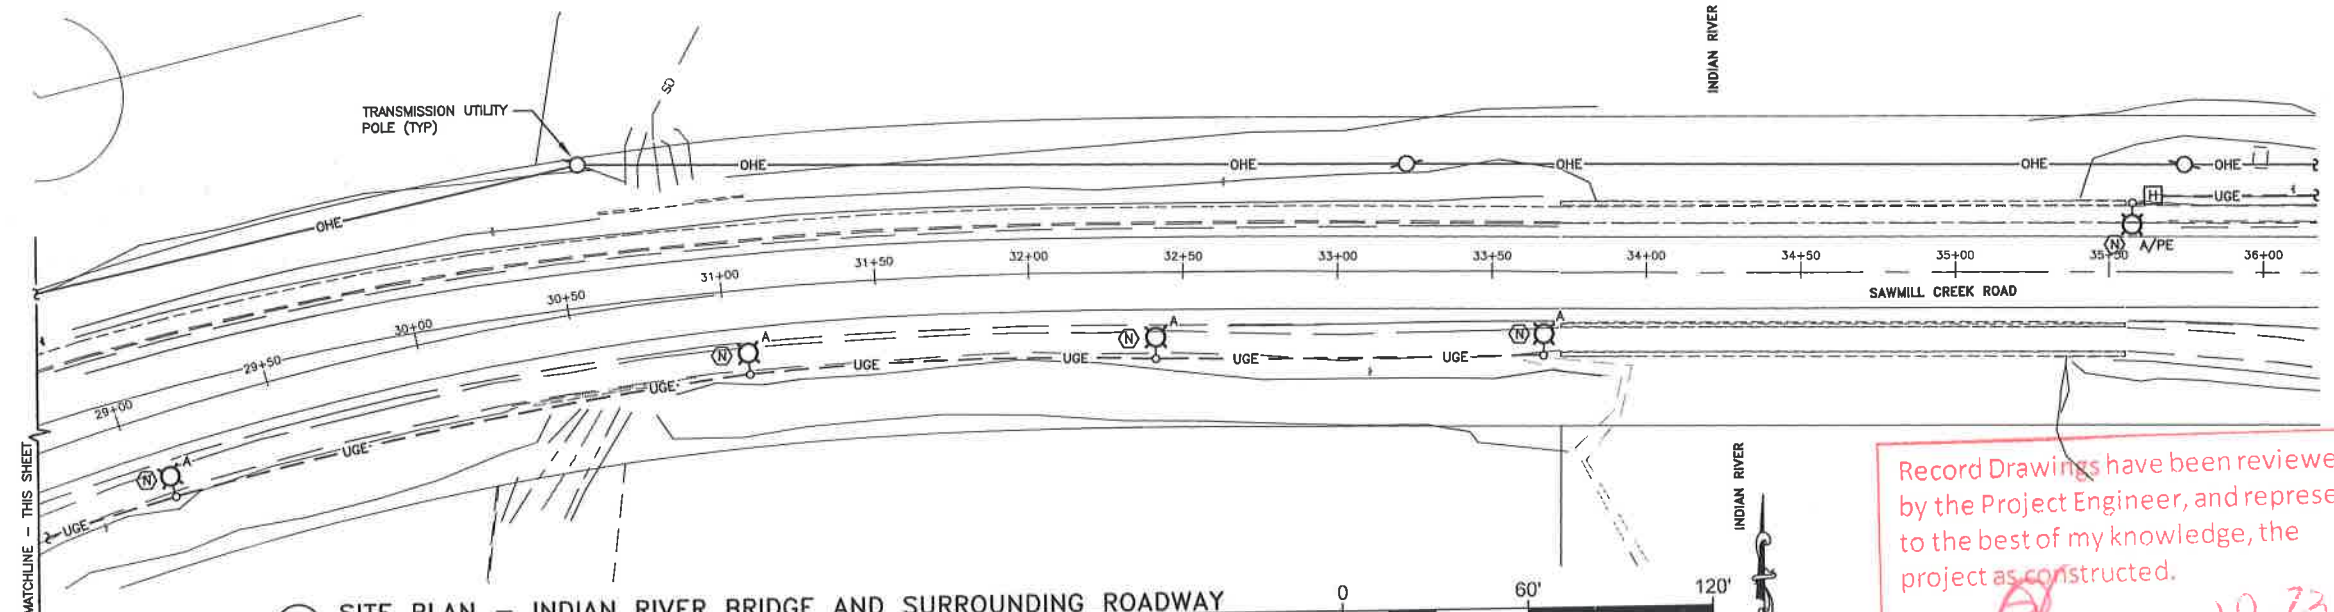

2 SITE PLAN - INDIAN RIVER BRIDGE AND SURROUNDING ROADWAY



Record Drawings have been reviewed by the Project Engineer, and represent to the best of my knowledge, the project as constructed.  
 PE [Signature] Date 10.23.20

SHEET NO.	TOTAL SHEETS
U2	U2
STATE	YEAR
ALASKA	2019
PROJECT DESIGNATION	
SFHWY00064/0933046	


REVISION	DATE	NO.

PLANS DEVELOPED BY:  
 HAIGHT & ASSOCIATES, INC.  
 526 MAIN STREET  
 JUNEAU, AK 99801  
 (907) 586-9788  
 AECC670



STATE OF ALASKA DEPARTMENT OF TRANSPORTATION AND PUBLIC FACILITIES  
 SAWMILL CREEK ROAD RESURFACE: JEFF DAVIS TO SMITH STREET SITKA, AK

SITE PLAN - JEFF DAVIS STREET TO INDIAN RIVER

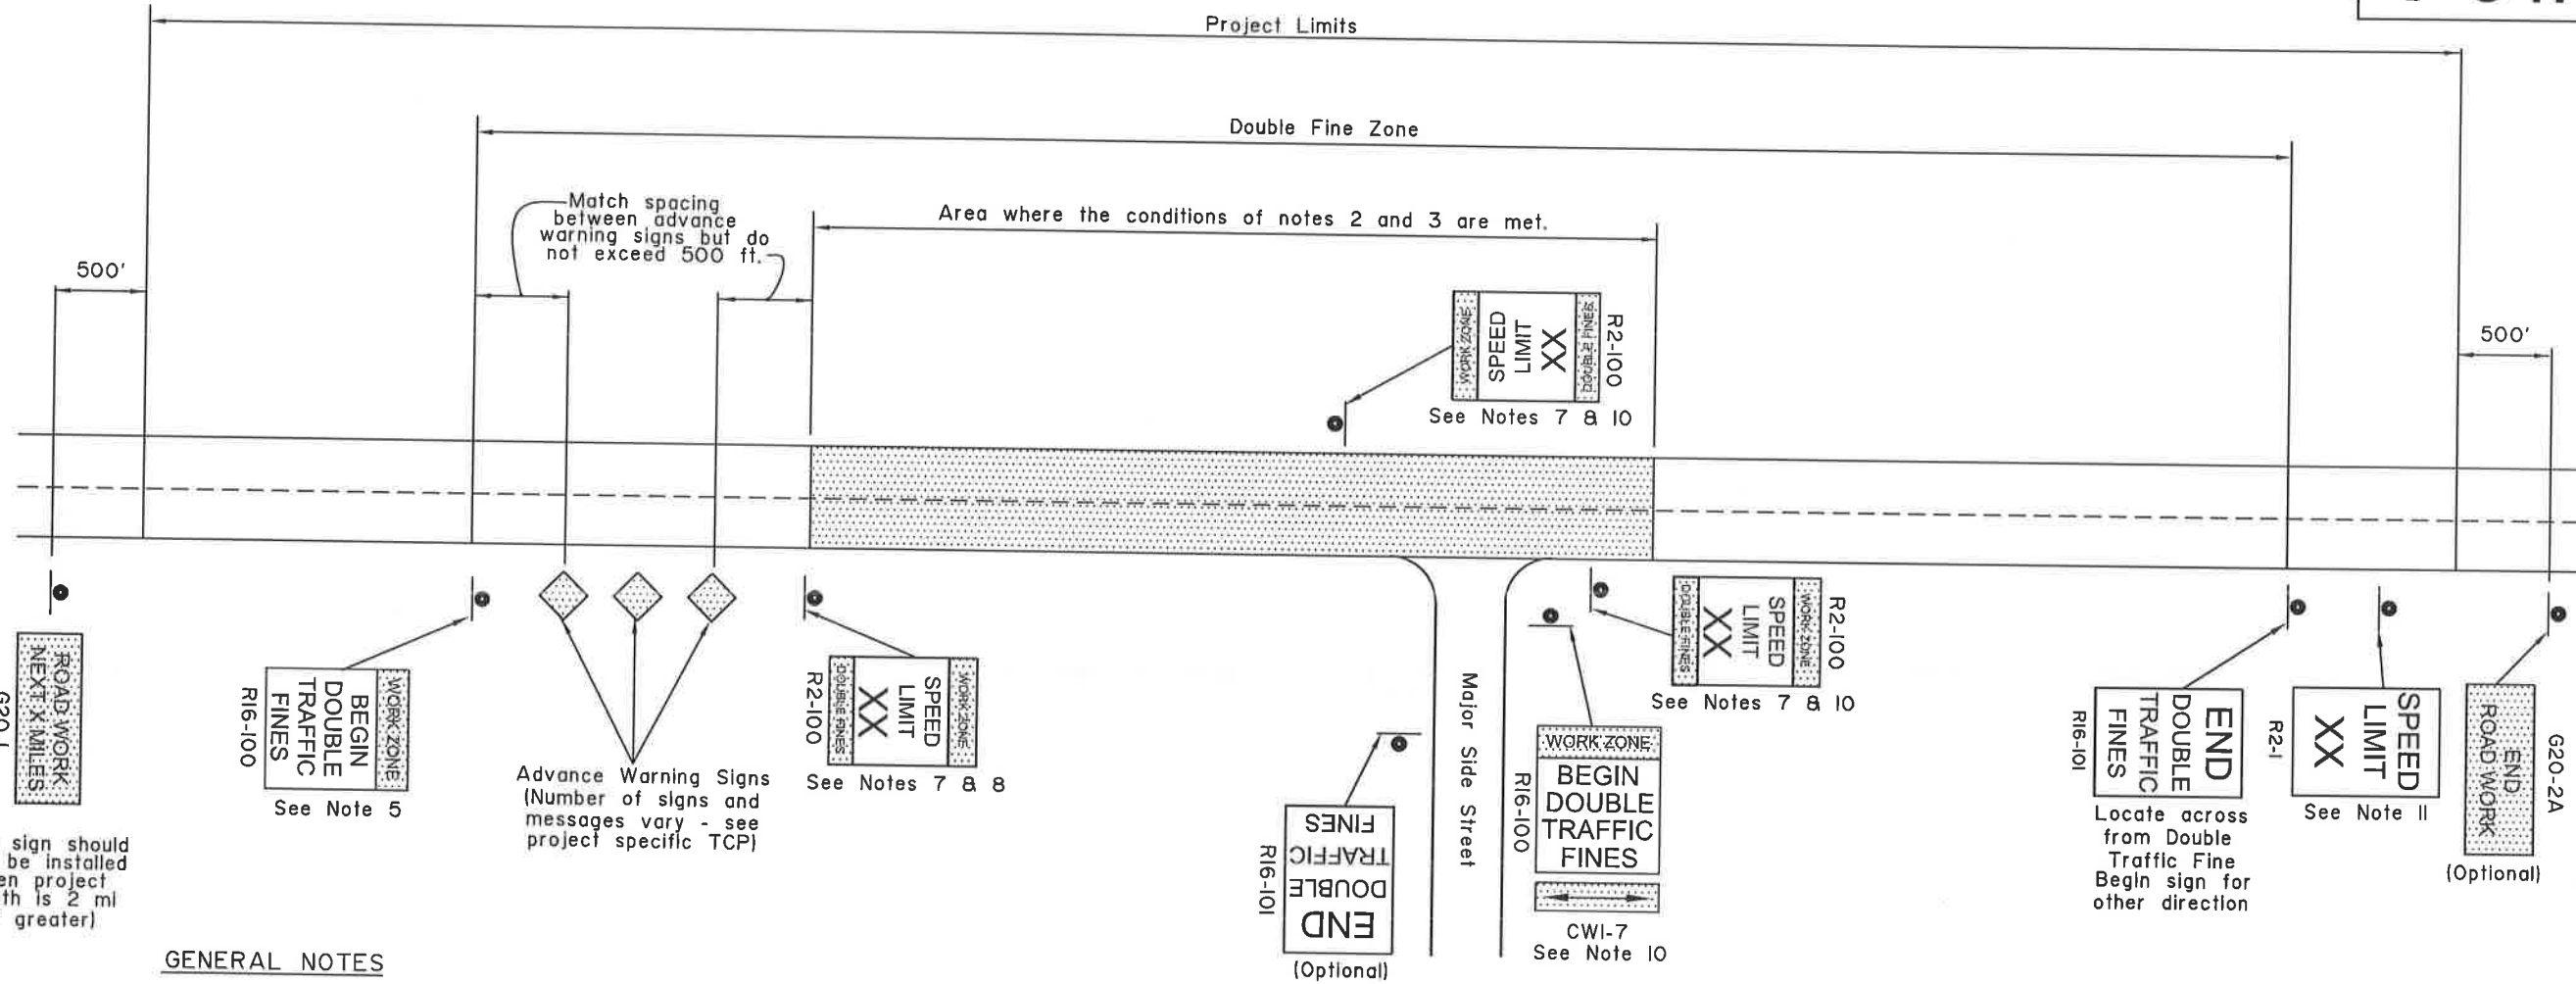

GENERAL NOTES

1. Signs are shown for one direction only (with one exception). Signs for the other direction mirror those shown.
2. Double fine signs shall be used only where one or more of the following conditions exist:
  - a. Active work areas (where road workers and/or machines are presently working on or adjacent to a road)
  - b. Detours on new temporary roads built for that purpose (this does not include detours on existing streets)
  - c. Sections of paved roads where pavement has been removed.
  - d. Roads being paved, where unmatched asphalt lifts result in a vertical lip between lanes.
3. Double fine signs shall be confined to the areas where the above conditions exist, with the following exceptions:
  - a. If the project is 2 miles or shorter in length, the entire project may be posted for double fines when the above conditions exist on any part of the project.
  - b. When the above conditions exist at multiple locations separated by less than 2 miles, the locations and the intervening segments may be posted as a single double fine zone.
4. Double fine signs shall be removed or covered when work activity ceases for more than two days and conditions b, c, or d of note 2 are not met.
5. The R16-100 "BEGIN" sign may be used in place of the first advance warning sign. However, when this is done, the appropriate advance warning sign must be reinstalled when the double fine sign is taken down or covered.
6. When a double fine zone is longer than 2 miles, work zone speed limit signs shall be posted at spacings not greater than 2 miles within the double fine zone.
7. "Work zone speed limit signs", as used here, refer either to 1) R2-100 signs or 2) standard R2-1 regulatory speed limit signs with CW20-102 "DOUBLE FINES" plates mounted below.
8. The limit shown on work zone speed limit signs shall be either the existing limit before construction or, if a work zone speed limit order has been approved in accordance with ADOT&PF Procedure 05.05.020 PDR, a reduced limit.
9. All existing regulatory speed limit signs within double fine zones shall either be replaced with R2-100 signs or supplemented with CW20-102 plates.
10. Signs shall be installed at major intersections within the double fine zone to warn entering drivers of double fines. This may be done with a R16-100 sign with a CWI-7 arrow panel on the side street or with two work zone speed limit signs on the main street on either side of the intersection. Use of R16-100 signs on side streets eliminates the need for "Road Work Ahead" signs on those streets. If the speed limit has been reduced, the two work zone speed limit signs are mandatory.
  - ii. At the end of each double fine zone, install an R2-1 sign showing the speed limit for the road beyond the double fine zone.

State of Alaska DOT&PF  
ALASKA STANDARD PLAN


LOCATION OF  
DOUBLE TRAFFIC  
FINE SIGNS

Adopted as an Alaska  
Standard Plan by: *Kenneth J. Fisher*  
Kenneth J. Fisher, P.E.  
Chief Engineer


Adoption Date: 02/08/2019

Last Code and Sids. Review  
By: Date:

Next Code and Standards Review date: 02/08/2029

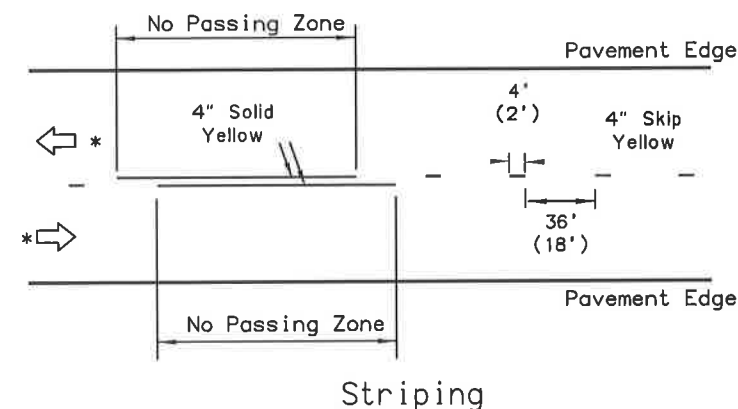


Striping

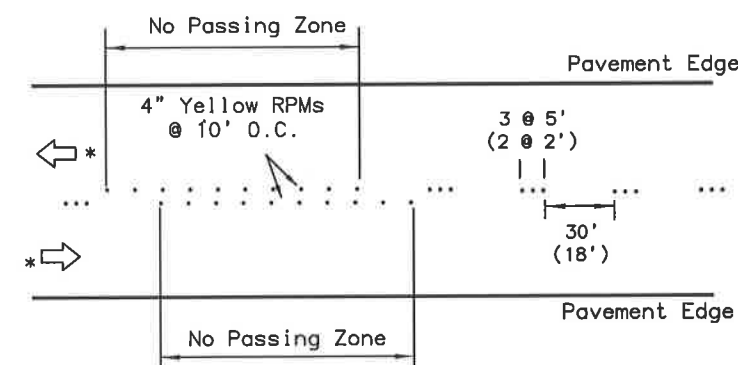

Temporary Raised Pavement Markers


**DETAIL A**

Two-lane road: No Passing Zones indicated with pavement markings.

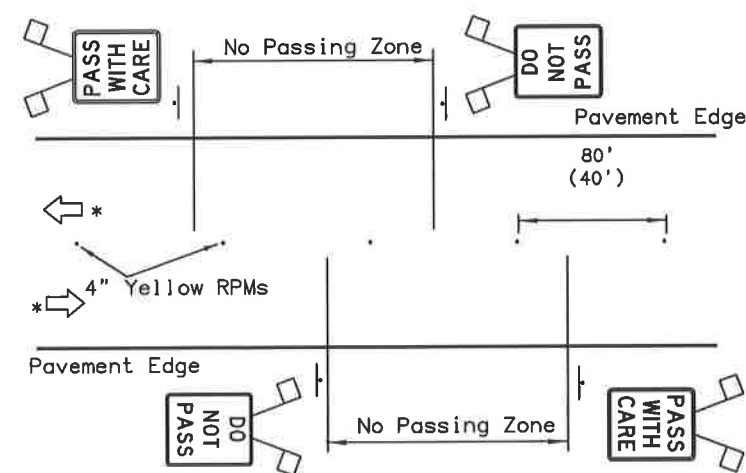


**DETAIL B**

Two-lane road: No Passing Zones indicated by signs only. Raised pavement markers for centerline delineation.

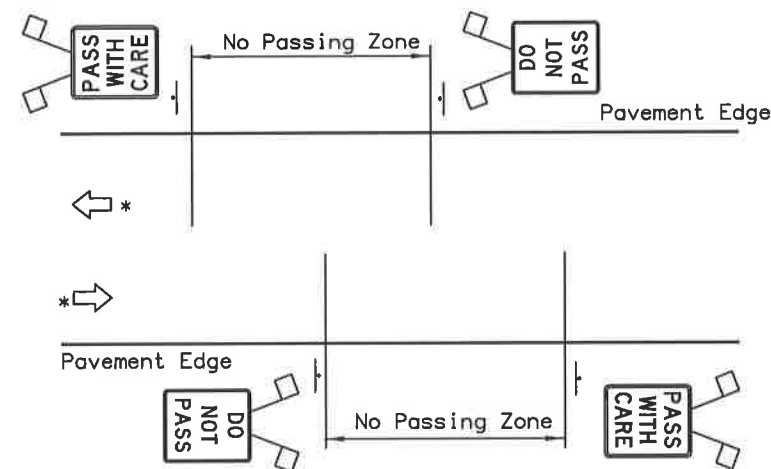


**DETAIL C**

Two-lane road: No Passing Zones indicated by signs only (see Note 2c). No centerline delineation.

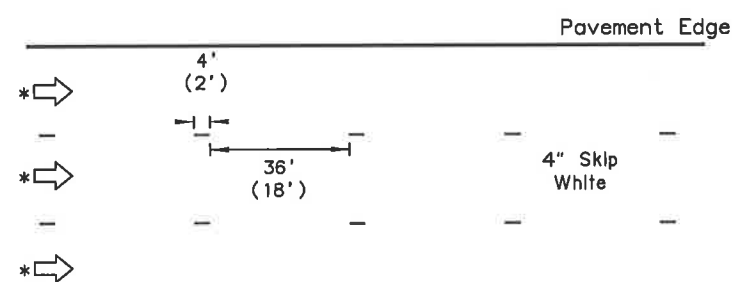

Striping

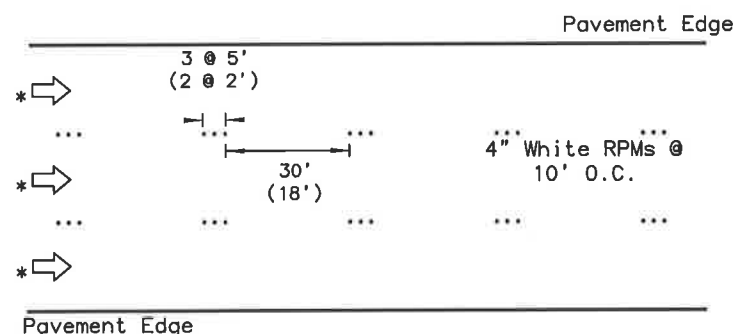

Temporary Raised Pavement Markers

**DETAIL D**

Multilane one-way road: Lane dividing lines

\* Direction of Travel

**GENERAL NOTES:**

1. Final pavement markings conforming to Part 3 of the Alaska Traffic Manual should be installed before paved roads are open to public travel. If that is not practical, install interim pavement markings as shown on this drawing. Maintain interim pavement markings until final pavement markings are installed.
2. No interim pavement markings are required:
  - a. on projects that will not have permanent markings when finished.
  - b. in work zones that are open to public travel for no more than one work shift during daytime or for no more than one hour at night.
  - c. where DO NOT PASS and PASS WITH CARE signs are installed on two lane roads as shown in Detail C, no pavement markings are required:
    - 1) for 3 days if seasonal ADT is above 2000, or
    - 2) for 1 month if seasonal ADT is below 2000.
3. Interim pavement markings should not be in place longer than 14 calendar days before being replaced with permanent markings conforming to Part 3 of the Alaska Traffic Manual unless the Engineer provides written approval.
4. Where R4-1 DO NOT PASS signs are used, install at the beginning of no passing zones and at no more than 1500' spacings within no passing zones.
5. Install high level warning devices on all DO NOT PASS and PASS WITH CARE signs.
6. Offset temporary markings 8"-12" from the future location of permanent markings if applied on the same lift of pavement.
7. Dimensions in parenthesis apply to curves with a radius of 1000 feet or less or where posted speed limit is 30 mph or less.


State of Alaska DOT&PF  
ALASKA STANDARD PLAN  
INTERIM  
PAVEMENT MARKINGS

Adopted as an Alaska Standard Plan by: *Kenneth J. Fisher*  
Kenneth J. Fisher, P.E.  
Chief Engineer


Adoption Date: 02/08/2019

Last Code and Stds. Review  
By: Date:

Next Code and Standards Review date: 02/08/2029

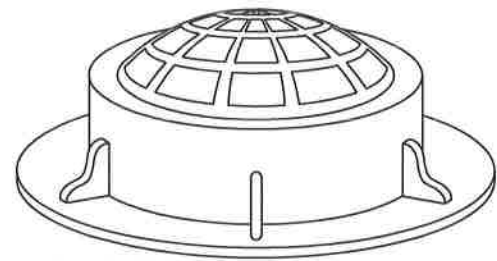


Surround field inlets with a 24" wide rock rubble collar 10" deep, 3" maximum size rock.

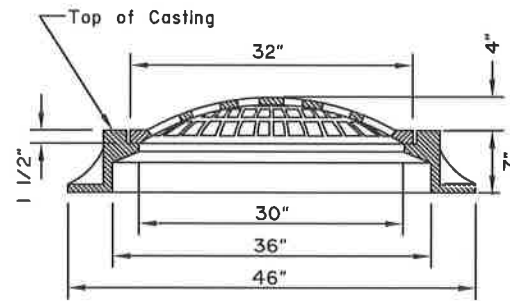

FIELD INLET FRAME & GRATE


To be supplied for storm drain manholes where field inlets are specified. Field inlet frame and grate shall have a Minimum total weight of 525 lb.

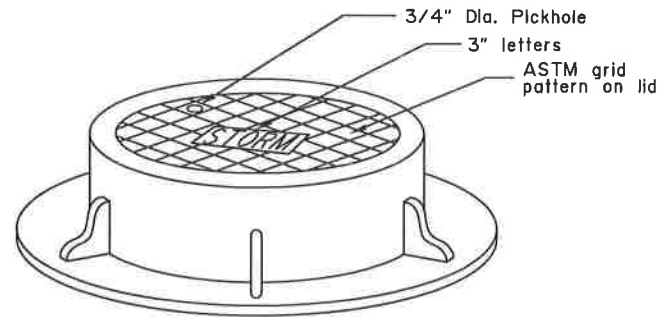

MANHOLE LID FRAME AND GRATE


NOTES:

- Details shown are to indicate general design only. Dimensions and design may vary among the manufacturers, except that inlet grate shall be within 1/4"± of dimensions shown on this drawing.
- Manhole lids shall be 32" in diameter and may be used with field inlet frames.
- Type A field inlet frame inside dimensions shall be 24" x 36". Lugs will not protrude outside the concrete surface of the inlet box.
- Grates shall be bicycle safe. Where high capacity grates are called for on the plans, they shall conform to Std. Dwg. D-25.
- Frame and grate casting types are identified by the following abbreviations:  
C.I. = Curb Inlet  
F.I. = Field Inlet  
M.H. = Manhole
- Flowline depression shall conform to Std. Dwg. D-23 for an on grade or sag point conditions.
- These are the default frames and grates to be used unless shown otherwise on the drainage plans or drainage structure summary.

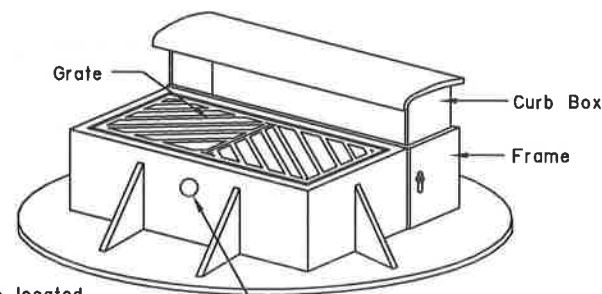


Pickhole located 3" from the top of frame

NOTE: Curb Box, Grate and frame shall have a minimum total weight of 725 lb.

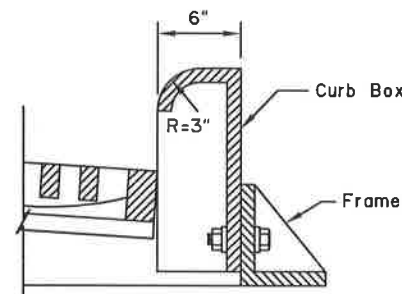

SIDE VIEW  
MOUNTABLE CURB AND GUTTER


REQUIRED FRAME AND GRATES (See Note 7)			
STRUCTURE	INLET TYPE	CURB TYPE	TYPE FRAME AND GRATE
INLET BOX, TYPE A	Curb	Mountable	Standard Curb Inlet
	Curb	Expressway	Mountable Curb Inlet
	Curb	Rolled Curb	Depressed Inlet
	Field	-----	Field Inlet
STORM DRAIN MANHOLES, TYPE I, II AND III	Curb	Mountable	Mountable Curb Inlet
	Curb	Expressway	Expressway Curb Inlet
	Curb	Rolled Curb	Depressed Inlet
	Field	-----	Field Inlet
	Manhole Lids	-----	Field Inlet Frame, Solid MH. Lid

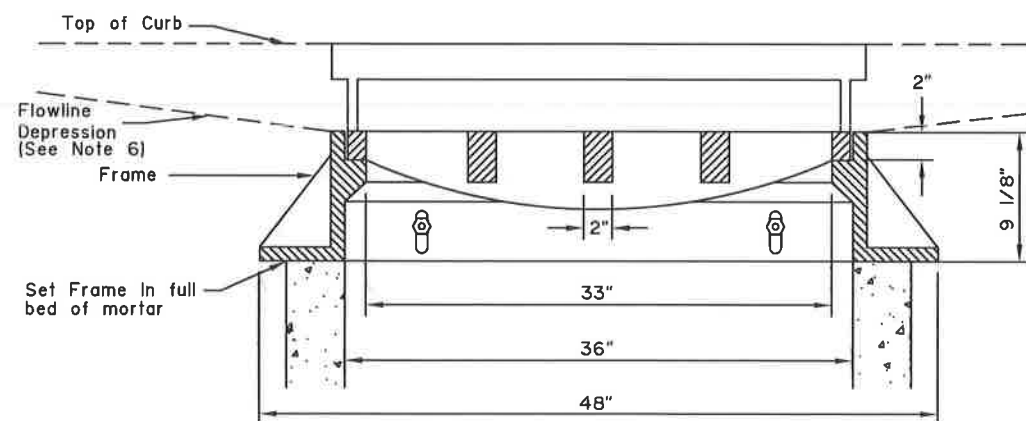

FRONT VIEW

CURB INLET FRAME AND GRATE

To be supplied for storm drain manholes Type I, Type II and Type III where curb inlets are specified.

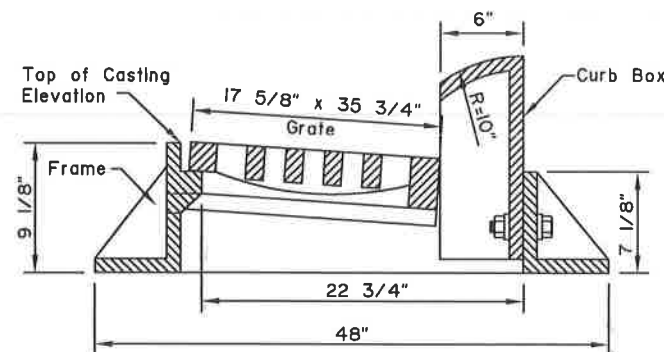

SIDE VIEW  
EXPRESSWAY CURB AND GUTTER

NOT TO SCALE

State of Alaska DOT&PF  
ALASKA STANDARD PLAN  
STORMDRAIN MANHOLE  
FRAME AND GRATE  
DETAILS

Adopted as an Alaska Standard Plan by: *Kenneth J. Fisher*  
Kenneth J. Fisher, P.E.  
Chief Engineer

Adoption Date: 02/08/2019











Last Code and Sds. Review  
By: Date:

Next Code and Standards Review date: 02/08/2029





GENERAL NOTES:

1. Details shown are to indicate general design only. Dimensions and design may vary among the manufacturers. Except inlet grate outside dimension shall be as shown on this drawing.
2. Minimum casting weight shall be 550lbs. for Curb Inlet Frame and Grate, 450lbs. for Gutter Inlet Frame and Grate, and 300lbs. for Field Inlet Frame and Grate.
3. Field Inlet Frame may be welded assembly of L 1 3/4"x1 3/4"x1/4" angle equivalent to ASTM A-36 steel.

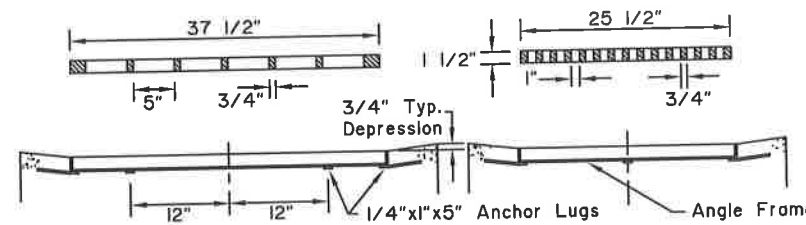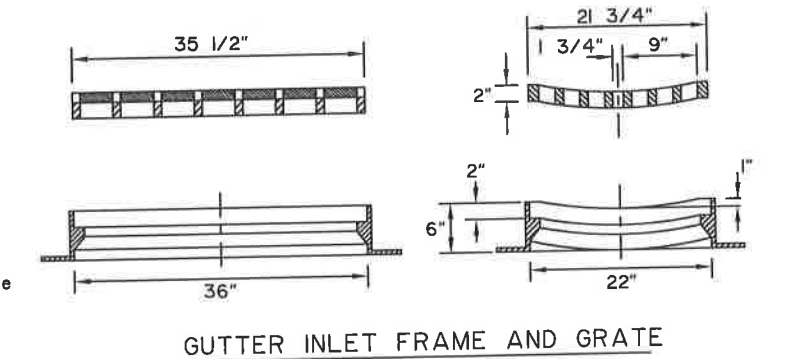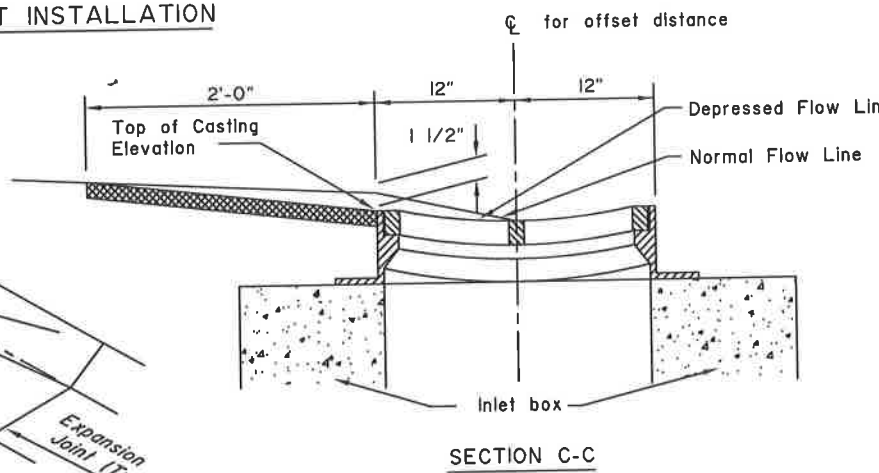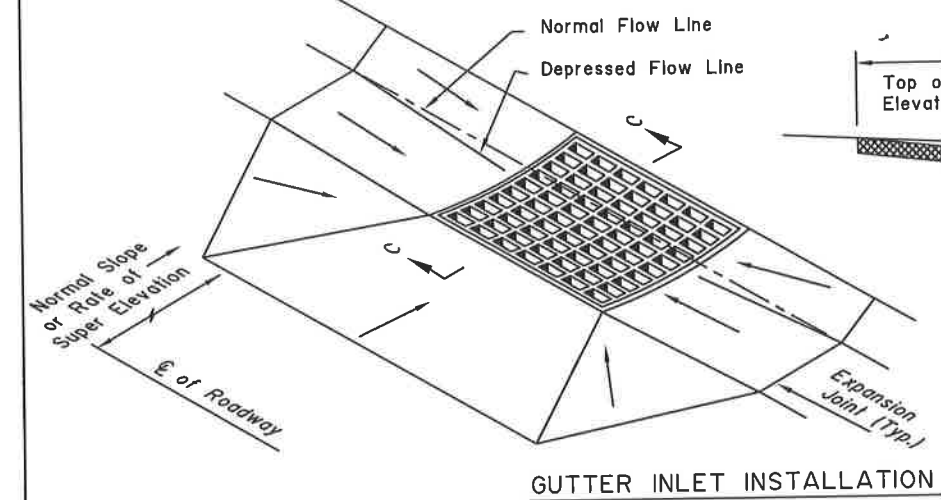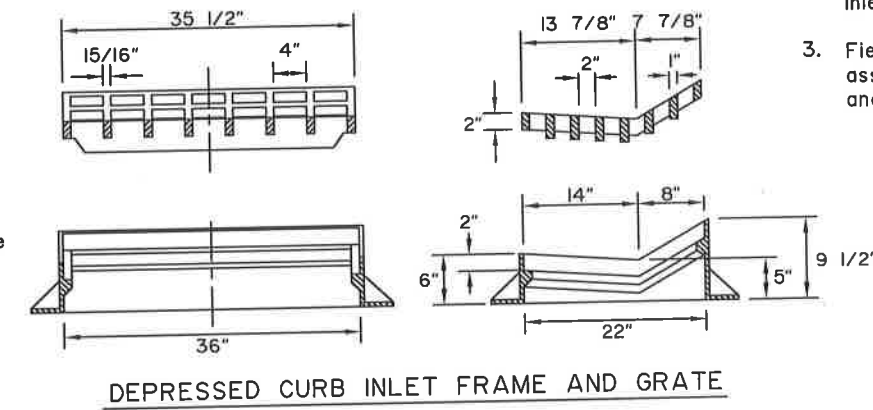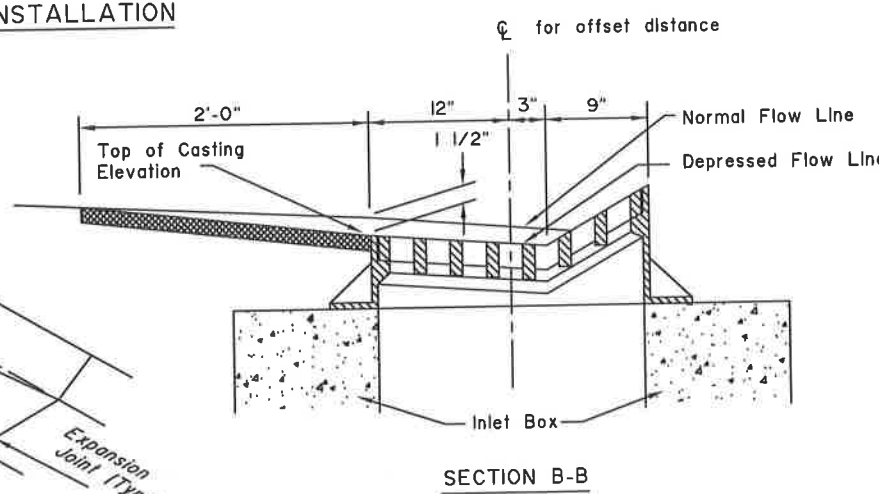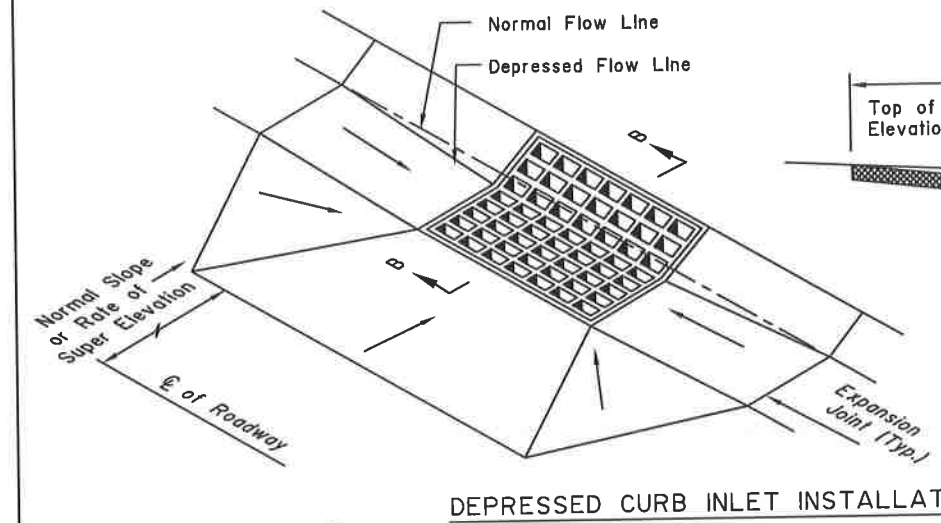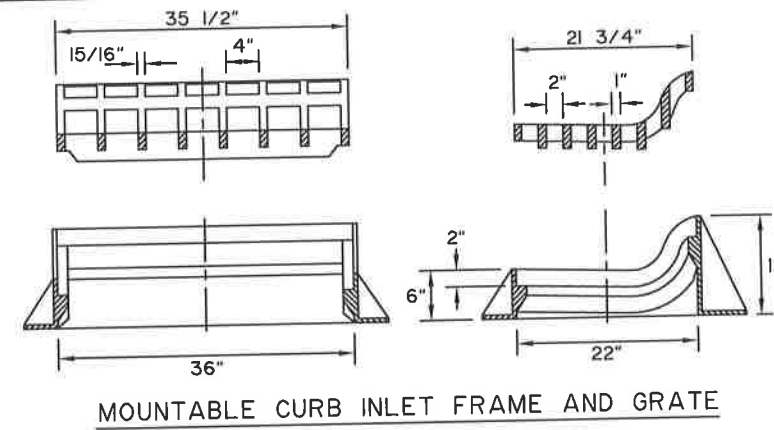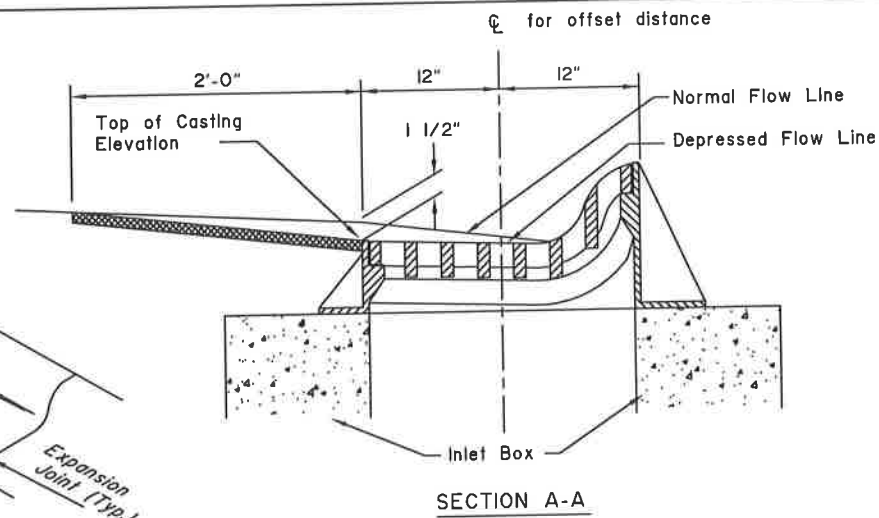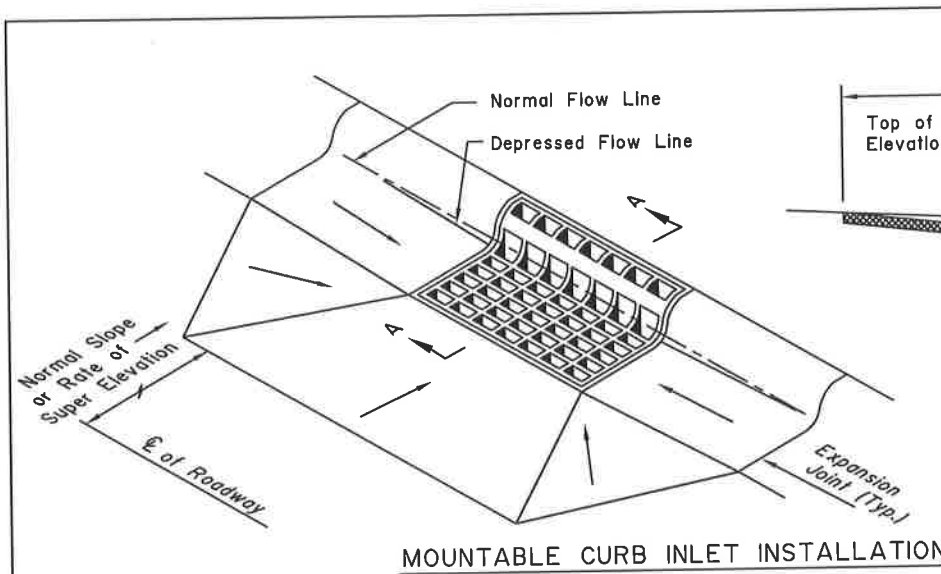

NOTE: All Angle Frame shall have Anchor Lugs

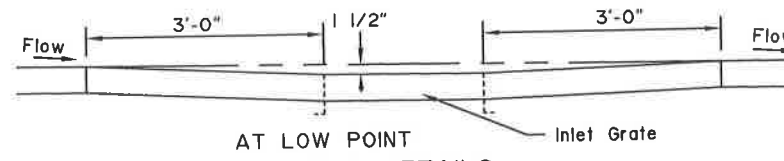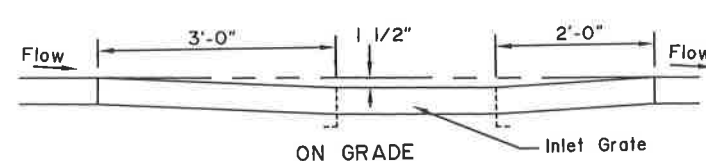

DEPRESSION IN FLOW LINE AT INLET CONSTRUCTION DETAILS








State of Alaska DOT&PF  
ALASKA STANDARD PLAN  
**INLET FRAMES  
AND GRATES**

Adopted as an Alaska  
Standard Plan by: *Kenneth J. Fisher*  
Kenneth J. Fisher, P.E.  
Chief Engineer

Adoption Date: 02/08/2019

Last Code and Sds. Review  
By: Date:

Next Code and Standards Review date: 02/08/2029

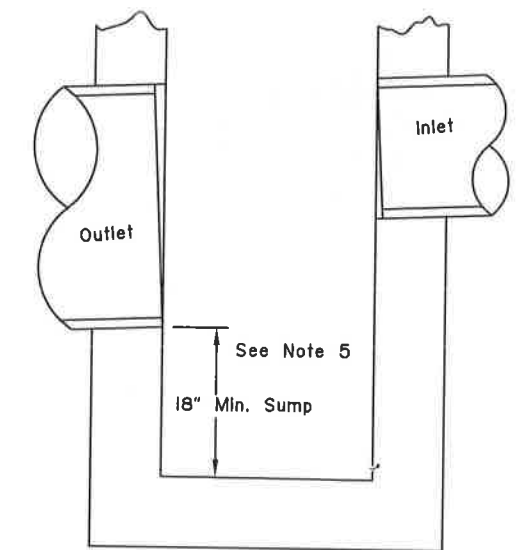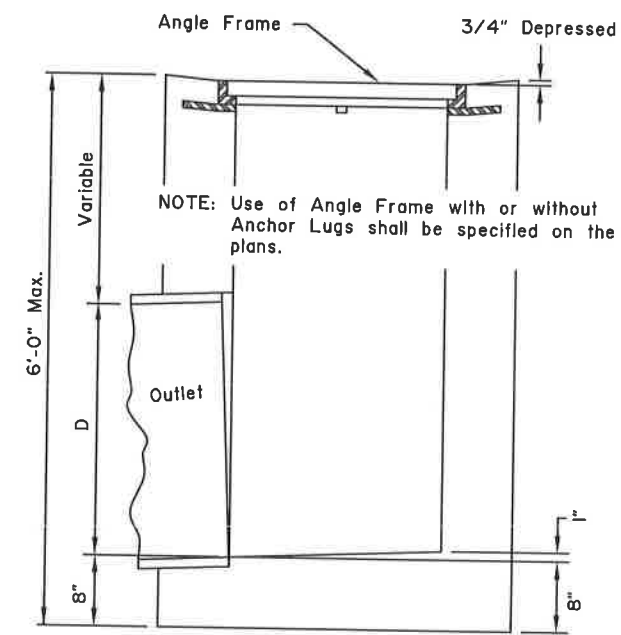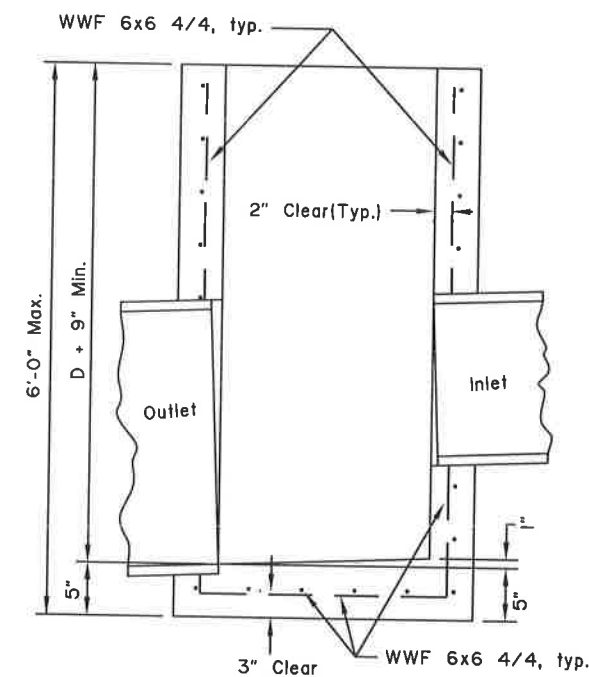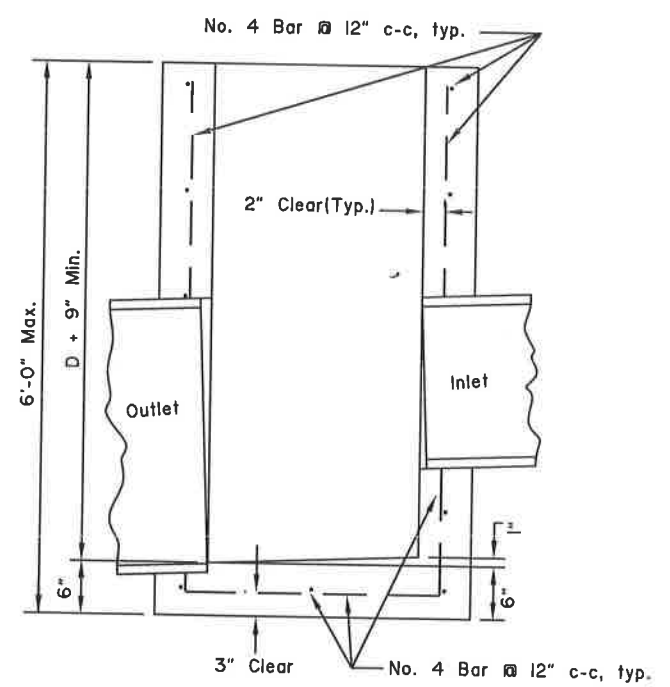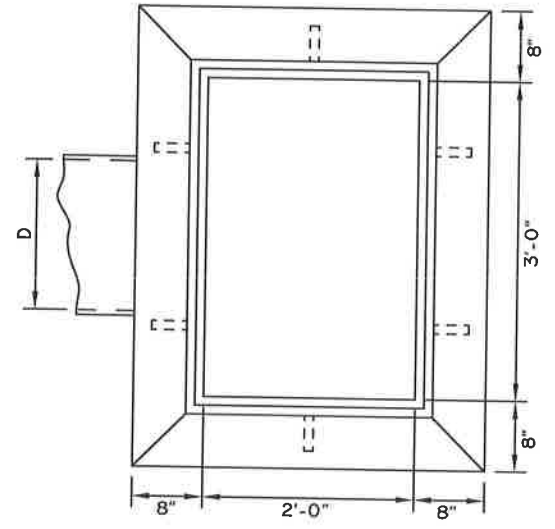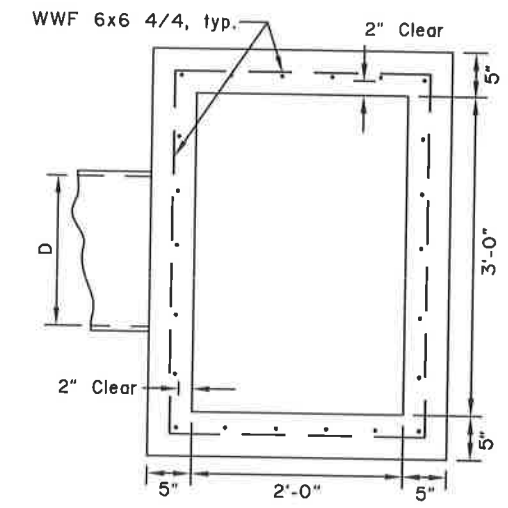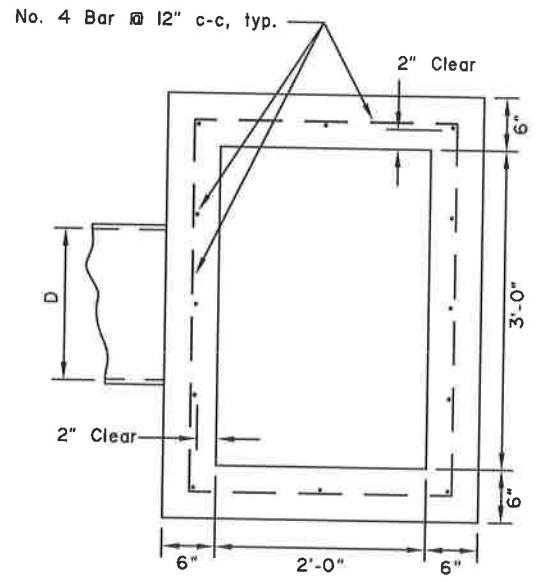

SUMP DETAIL

- GENERAL NOTES:**
1. Install inlet boxes parallel to the curb line.
  2. The plans will indicate which inlet boxes require a sump.
  3. Shape floors to drain.
  4. Use Grade 40 minimum reinforcing steel.
  5. The plans will indicate which inlet boxes require sumps.

REINFORCED  
CAST IN PLACE

PRECAST

FIELD INLET BOX  
CAST\* IN PLACE

TYPE "A" CONCRETE INLET BOXES

\* May be Precast or Reinforced Cast-In-Place Box.

State of Alaska DOT&PF  
ALASKA STANDARD PLAN  
TYPE "A"  
INLET BOX

Adopted as an Alaska Standard Plan by: *Kenneth J. Fisher*  
Kenneth J. Fisher, P.E.  
Chief Engineer


Adoption Date: 02/08/2019

Last Code and Stds. Review By: \_\_\_\_\_ Date: \_\_\_\_\_

Next Code and Standards Review date: 02/08/2029


NOT TO SCALE

D-26.04

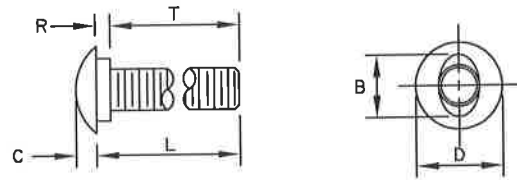


B	C	D	L (Length)	R	T (Thread Length)
15/16"	5/16"	1 5/16" or 1 7/16"	As Required	7/32"	As Required

5/8" BUTTONHEAD BOLT  
(FBB01-05)

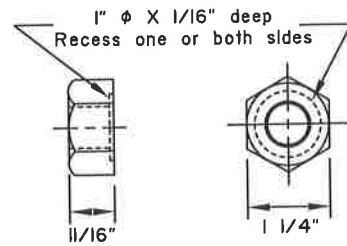


5/8" Dia. RECESSED HEX NUT  
(FBB01-05)

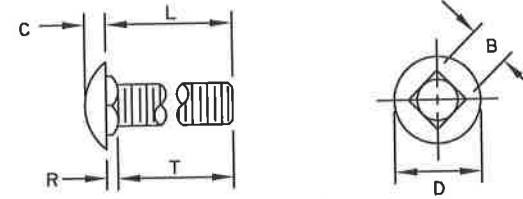

B	C	D	L (Length)	R	T (Thread Length)
5/8"	5/16"	1 5/16"	As Required	3/16"	As Required


5/8" Dia. CARRIAGE BOLT  
(FBC10-20)

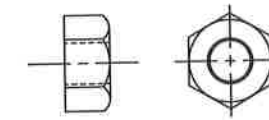

STANDARD HEX NUT


GENERAL NOTES:

- All covered hardware shall comply with the Task Force 13 (TF13) Guide to Standardized Roadside Safety Hardware online publication. Designators given when possible in parentheses.

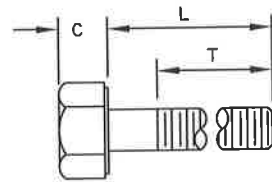


Bolt Size	C	D	L (Length)	T (Thread Length)
5/16"	—	—	1 1/2"	7/8"
5/16"	—	—	1"	1"
3/8"	—	—	7 1/2"	1 1/2"
1/2"	—	—	1 1/2"	1 1/2"
1/2"	—	—	1 1/4"	1 1/4"
5/8" H.S.	5/16"	7/8"	8"	1 1/2"
5/8"-H	—	—	1 1/2"	1 1/2"
3/4"	—	—	1 1/2"	1 1/2"
3/4"	—	—	As Required	2"
3/4" H.S.	15/32"	1 1/4"	2"	1 1/2"

STANDARD HEX BOLTS

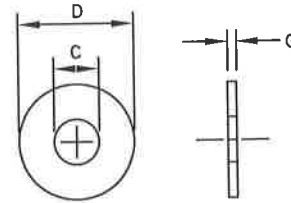


For Bolt $\phi$	C	D	G
3/8"	7/16"	1"	5/64"
1/2"	17/32"	1 1/16"	3/32"
1/2" H.S.	17/32"	1 1/16"	3/32"
5/8"	11/16"	1 3/4"	9/64"
3/4"	13/16"	1 15/32"	9/64"
3/4" H.S.	13/16"	2"	5/32"
1"	1 1/16"	2"	9/64"


STANDARD STEEL WASHERS

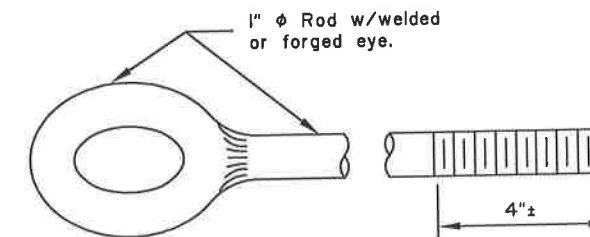


EYE BOLT

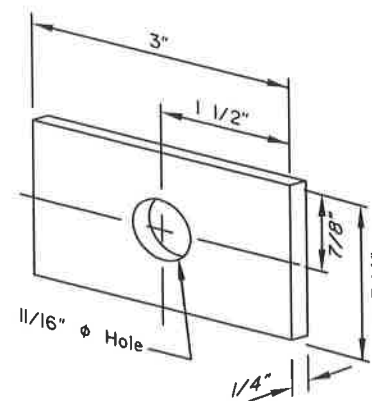

FLAT PLATE WASHER

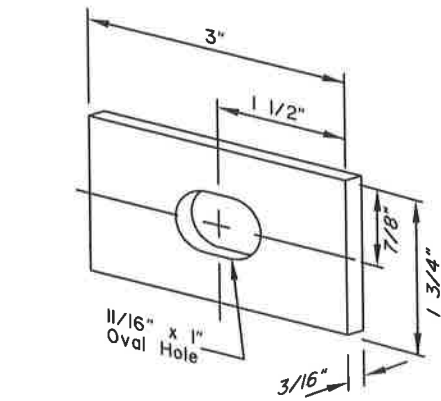

RECTANGULAR POST BOLT WASHER  
(FWR03)

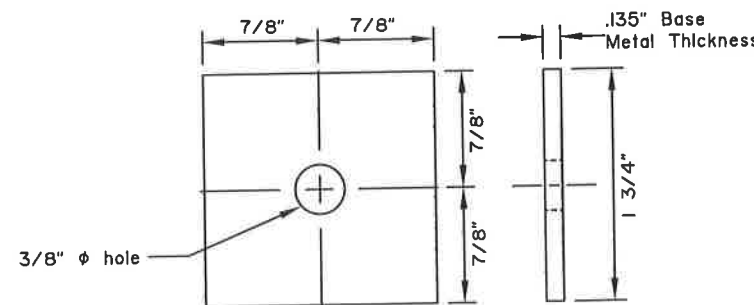

SQUARE STEEL WASHER  
(FWR01)

Note: drawing not to scale


State of Alaska DOT&PF  
ALASKA STANDARD PLAN  
STANDARD GUARDRAIL  
HARDWARE  
(NUTS, BOLTS, AND WASHERS)

Adopted as an Alaska Standard Plan by: *Kenneth J. Fisher*  
Kenneth J. Fisher, P.E.  
Chief Engineer


Adoption Date: 02/08/2019

Last Code and Stds. Review  
By: Date:

Next Code and Standards Review date: 02/08/2029

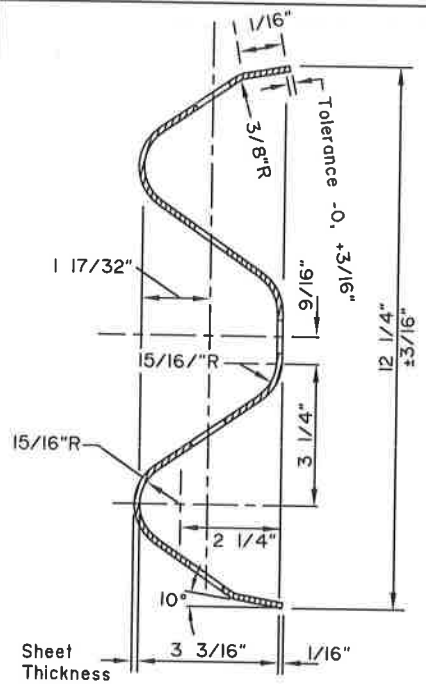


SECTION A-A  
(RWM02a-b)

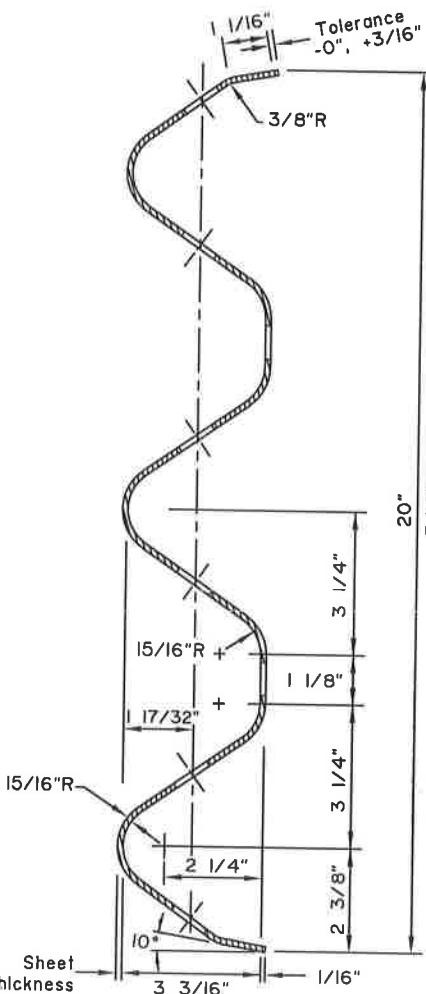


SECTION B-B




SECTION C-C  
(RTM01a-02b)

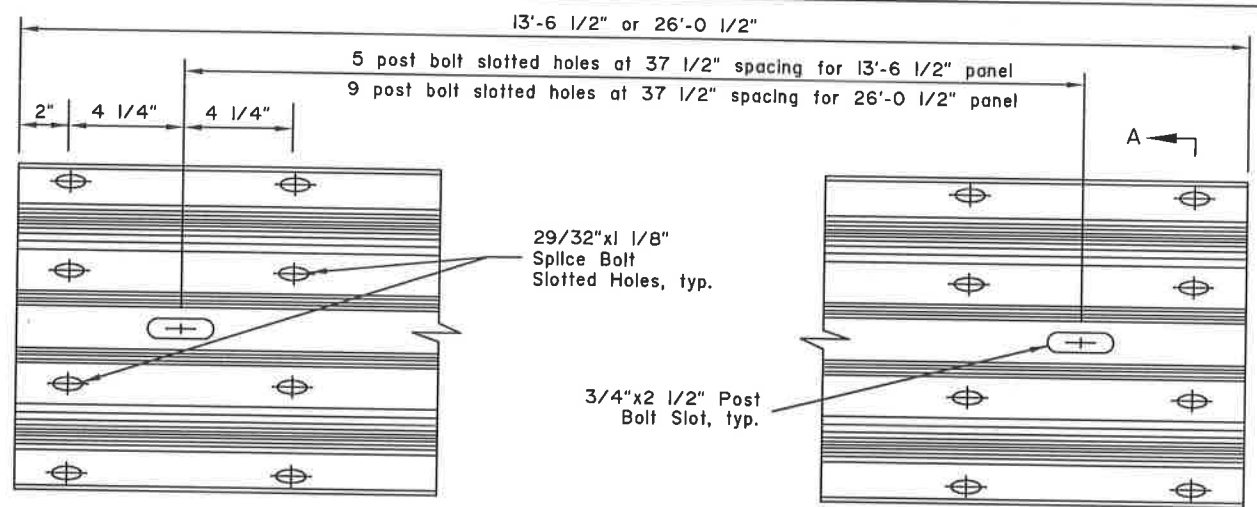


STANDARD W-BEAM PANEL (RWM04a-b)

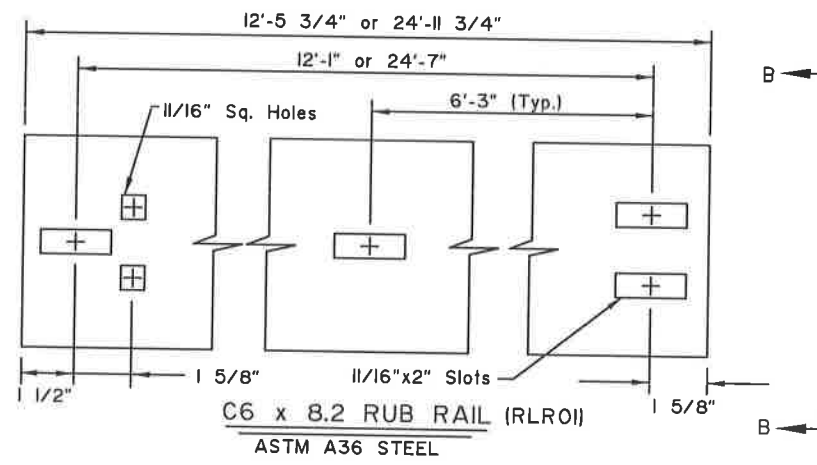


C6 x 8.2 RUB RAIL (RLR01)  
ASTM A36 STEEL

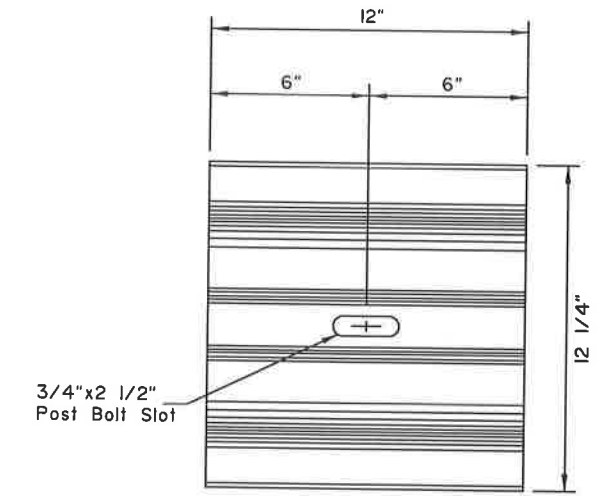


W-BEAM BACKUP PLATE  
(RWB01a-b)

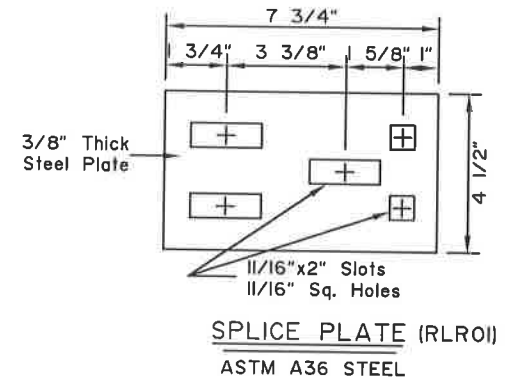

SPLICE PLATE (RLR01)  
ASTM A36 STEEL

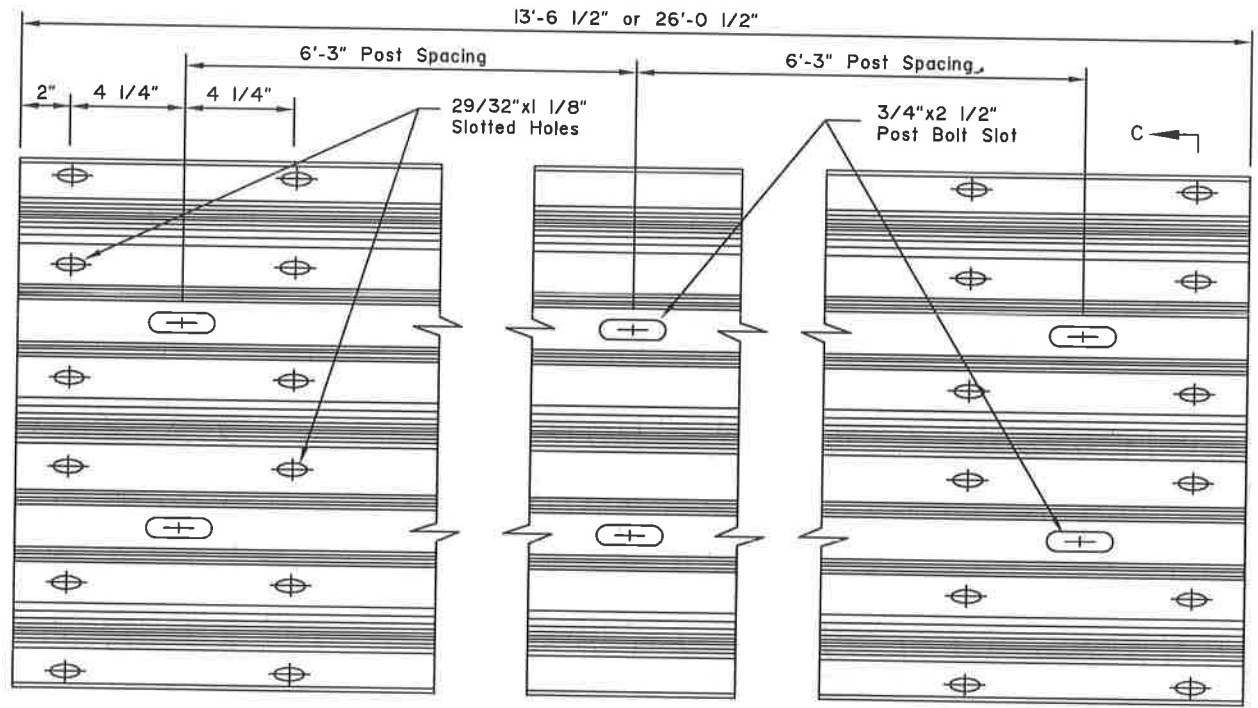

STANDARD THRIE BEAM PANEL (RTM01a-02b)

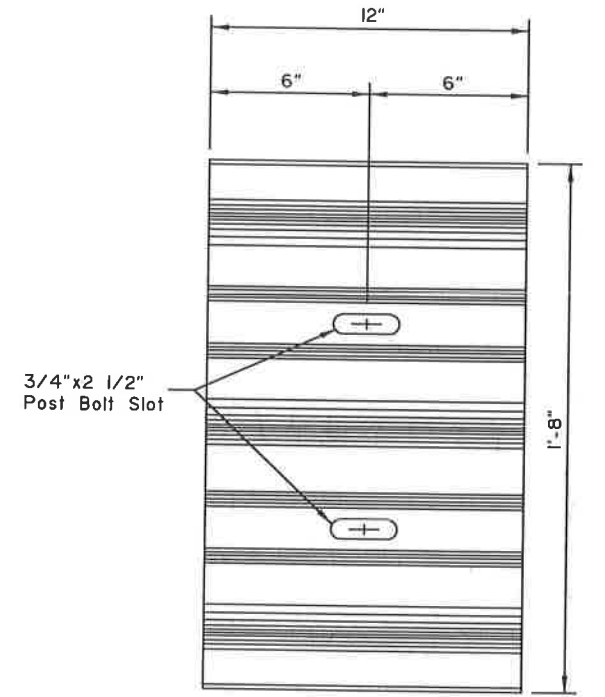

THRIE BEAM BACKUP PLATE  
(RTB01a-02b)

- GENERAL NOTES:**
1. All covered hardware shall comply with the Task Force 13 (TF13) Guide to Standardized Roadside Safety Hardware online publication. Designators given when possible in parentheses.
  2. Install back-up plates between blockouts and w-beam or thrie-beam rail at intermediate (non-splice) posts when steel blockouts are used but not with wood, rubber, plastic, or other approved blockouts.

State of Alaska DOT&PF  
ALASKA STANDARD PLAN  
STANDARD GUARDRAIL  
HARDWARE  
(RAIL AND SPLICES)


Adopted as an Alaska  
Standard Plan by: *Kenneth J. Fisher*  
Kenneth J. Fisher, P.E.  
Chief Engineer

Adoption Date: 02/08/2019


Last Code and Stds. Review  
By: Date:  
Next Code and Standards Review date: 02/08/2029

GENERAL NOTES:


1. W-Beam and Thrie Beam Terminal Connectors shall conform to AASHTO M 180, Class B, Type II.
2. W-Beam end sections shall conform to AASHTO M 180, Class A, Type II.
3. All covered hardware shall comply with the Task Force 13 (TF13) Guide to Standardized Roadside Safety Hardware online publication. Designators given when possible in parentheses.

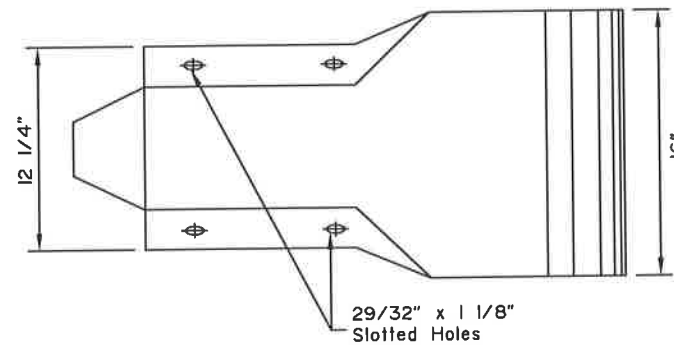

PROFILE

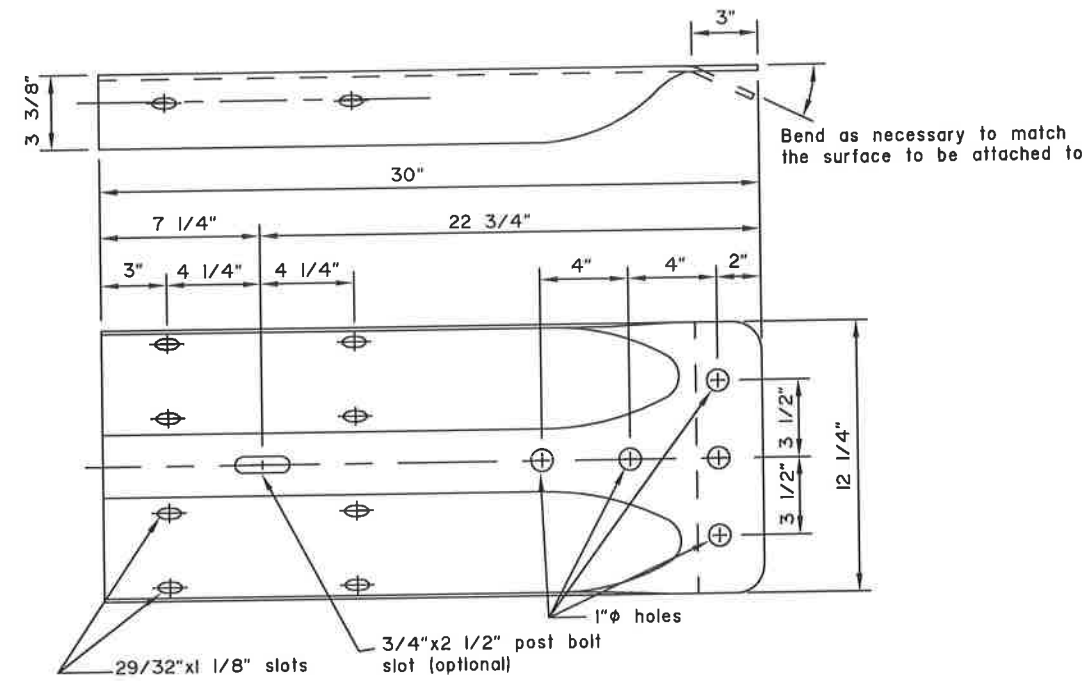


STANDARD W-BEAM TERMINAL CONNECTOR  
(RWE02)

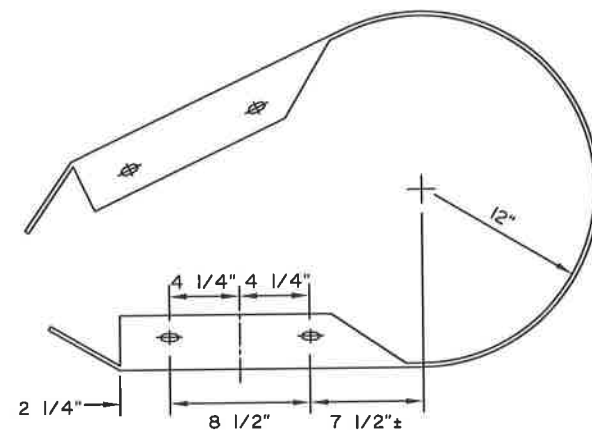

W-BEAM PLAN VIEW

\*Radius to be specified on the plans

STANDARD W-BEAM END SECTION  
(RWE06)

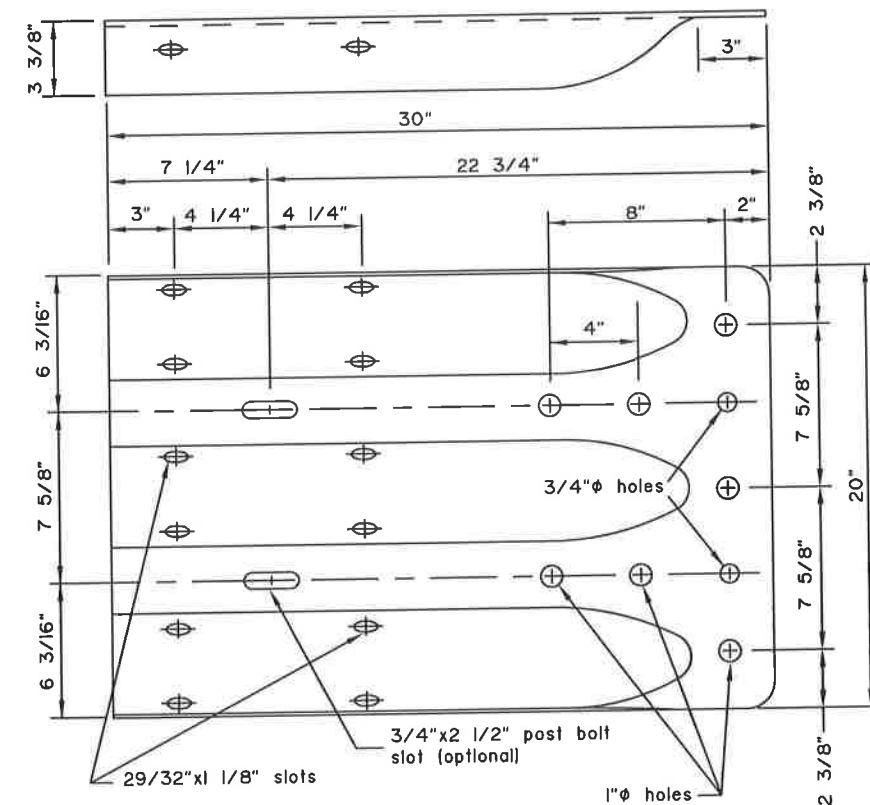

STANDARD THRIE BEAM TERMINAL CONNECTOR  
(RTE01b)

Note: Drawing not to scale


State of Alaska DOT&PF  
ALASKA STANDARD PLAN  
STANDARD GUARDRAIL  
HARDWARE  
(TERMINAL CONNECTORS)

Adopted as an Alaska  
Standard Plan by: *Kenneth J. Fisher*  
Kenneth J. Fisher, P.E.  
Chief Engineer


Adoption Date: 02/08/2019

Last Code and Stds. Review  
By: Date:


Next Code and Standards Review date: 02/08/2029

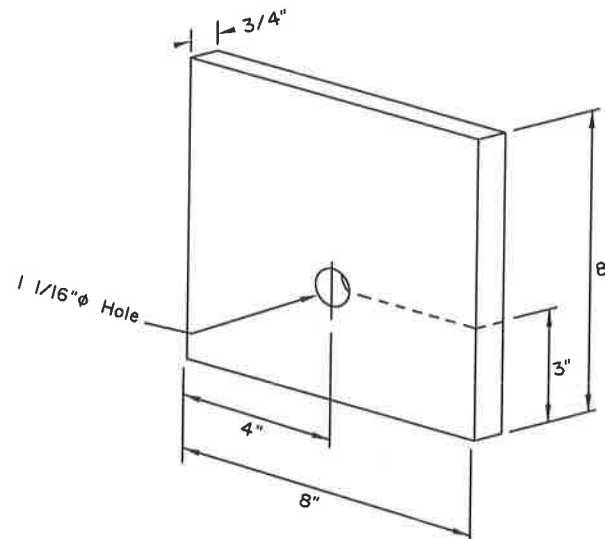


**BEARING PLATE for CRT TERMINAL ANCHOR**  
(FPBO1)

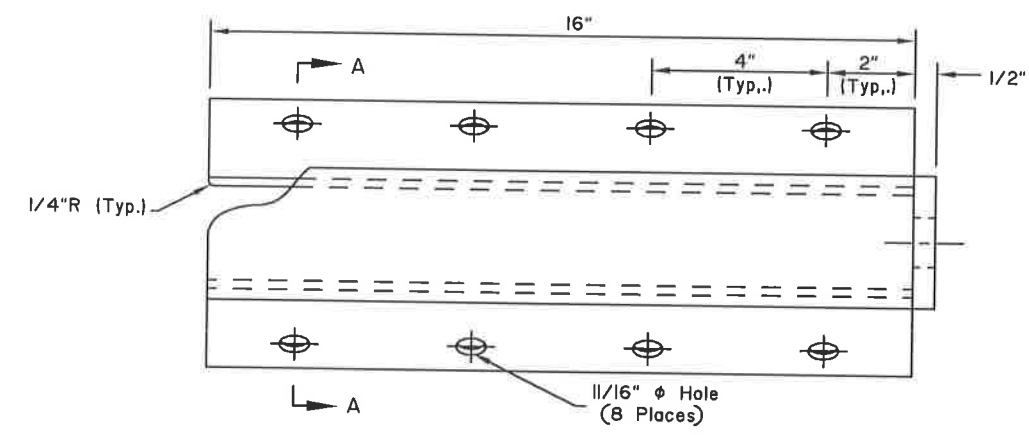


**CABLE ANCHOR PLATE**  
(FPAO1)

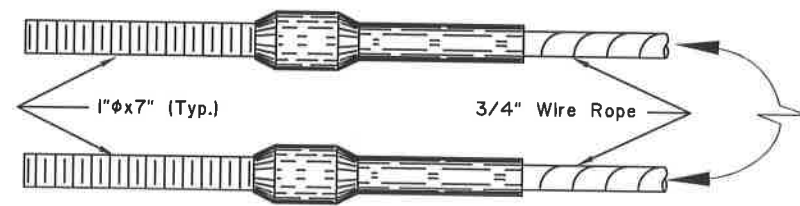

**SWAGED FITTING DETAIL**  
(FCAO1-02)

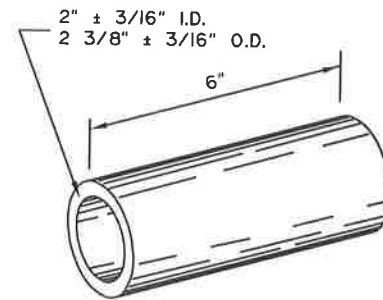

**SLEEVE DETAIL**  
(FMMO2)

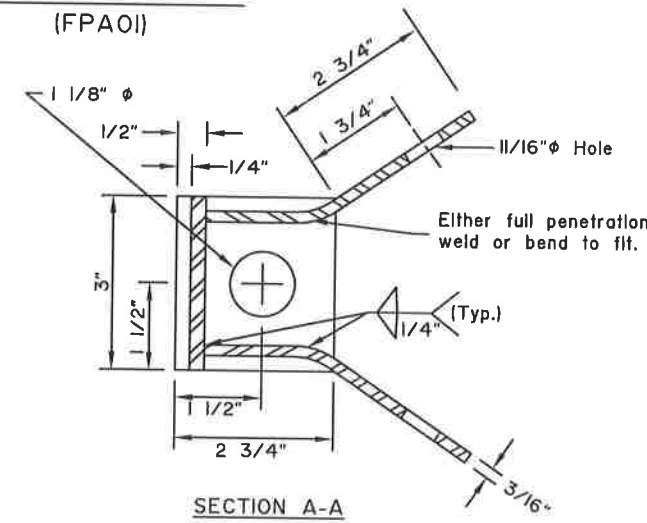


**SECTION A-A**

**CONTROLLED RELEASE TERMINAL HARDWARE DETAILS**


**GENERAL NOTES:**

1. Cable Anchor Plate may be formed in single unit or welded fabrication.
2. Anchor Cable Assembly must conform to AASHTO M 30 with Type II Wire Rope.
3. Provide Sleeve for Wood Posts meeting the requirements of ASTM A53 and made of 2-inch galvanized standard pipe. Sleeve shall be a tight, pressed fit in post.
4. Attach radius ID plates to all shop-bent guardrail sections. Bolt the ID plates to the back side of the guardrail panel with the lower splice bolt nearest the P.C. of the radius.
5. Show the Roll bend radius, in feet, as "XX" on the radius ID plate. Digits shall be etched or stamped and have a min. height of 1 1/2" and a max. width of 3/4". Galvanize the plate after the digits are marked.
6. All covered hardware shall comply with the Task Force 13 (TF13) Guide to Standardized Roadside Safety Hardware online publication. Designators given when possible in parentheses.


Note: Drawing not to scale

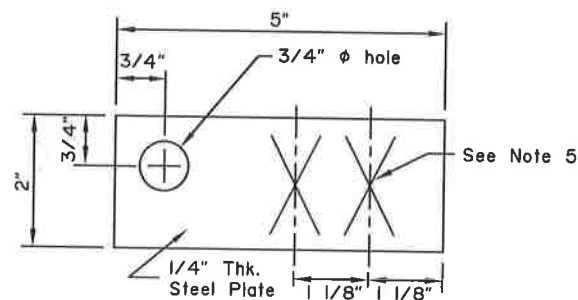

**RADIUS I.D. PLATE**

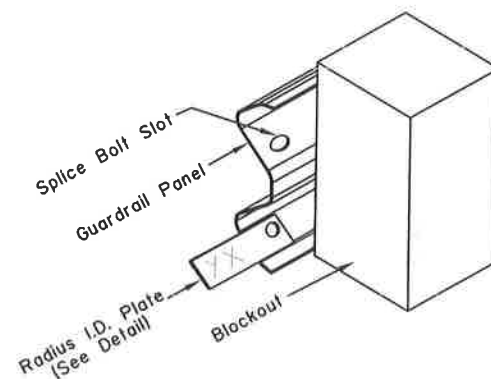

**RADIUS I.D. PLATE MOUNTING DETAIL**

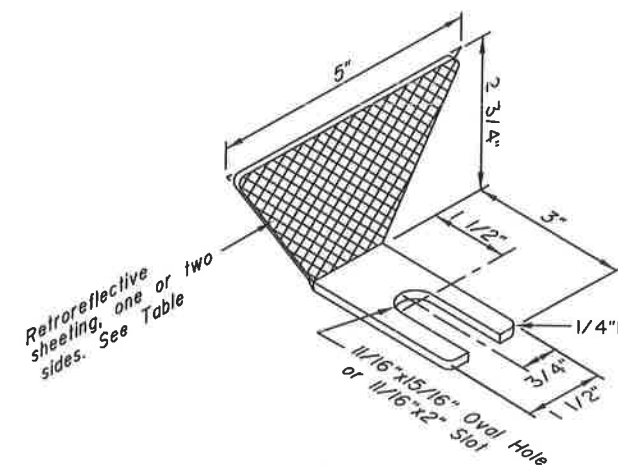

**GUARDRAIL REFLECTOR**

Guardrail Reflector Table		
Type	Color	Reflectorized
A	White	Front & Rear
B	White	Front
C	Yellow	Front
D	Yellow	Front & Rear


State of Alaska DOT&PF  
ALASKA STANDARD PLAN  
**STANDARD GUARDRAIL HARDWARE**  
(MISCELLANEOUS)

Adopted as an Alaska Standard Plan by: *Kenneth J. Fisher*  
Kenneth J. Fisher, P.E.  
Chief Engineer

Adoption Date: 02/08/2019

Last Code and Stds. Review  
By: Date:

Next Code and Standards Review date: 02/08/2029

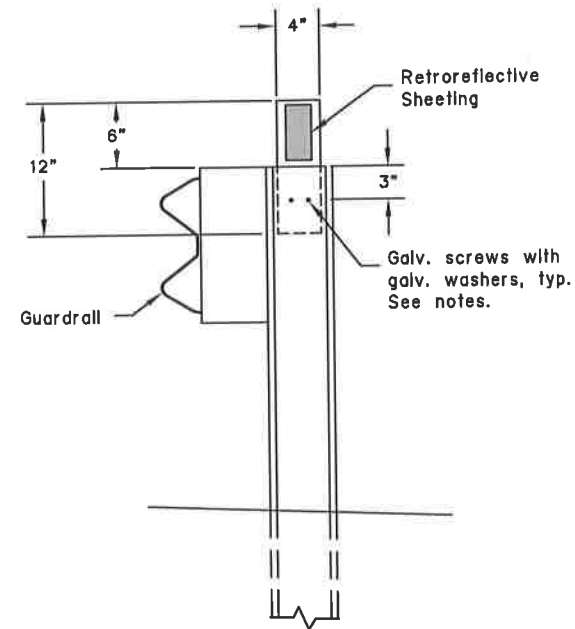

GUARDRAIL FLEXIBLE DELINEATOR DETAIL

(Steel post shown - similar for wood post)

CONSTRUCTION NOTES

1. Install guardrail flexible delineators where shown on the plans.
2. Install guardrail flexible delineators at 50 foot spacing, unless otherwise noted on the plans. Install not less than 2 delineators per guardrail run.
3. Use 3" x 5" white/yellow/red retroreflective sheeting as required per Standard Drawing T-05. Install retroreflective sheeting on both sides of delineator on two-way roads.
4. Attach 4" x 12" flexible delineators to the top of new guardrail posts, on the trailing side of the posts relative to the adjacent lane's direction of travel.
5. Predrill or preform 5/16" diameter mounting holes in steel posts by the manufacturer prior to galvanizing. Predrilling or preforming holes not required for wood posts.
6. Use 2 each 1/4" dia. x 1-1/2" long galvanized lag screws for attaching to wood posts and 2 each 1/4" dia. x 3/4" long galvanized self-drilling fasteners for steel posts. Install a galvanized washer between the fastener head and the flexible delineator.

Note: Drawing not to scale

State of Alaska DOT&PF  
ALASKA STANDARD PLAN  
STANDARD GUARDRAIL  
(FLEXIBLE DELINEATORS)


Adopted as an Alaska  
Standard Plan by: *Kenneth J. Fisher*  
Kenneth J. Fisher, P.E.  
Chief Engineer

Adoption Date: 02/08/2019


Last Code and Sids. Review  
By: \_\_\_\_\_  
Date: \_\_\_\_\_

Next Code and Standards Review date: 02/08/2029

G-00.04

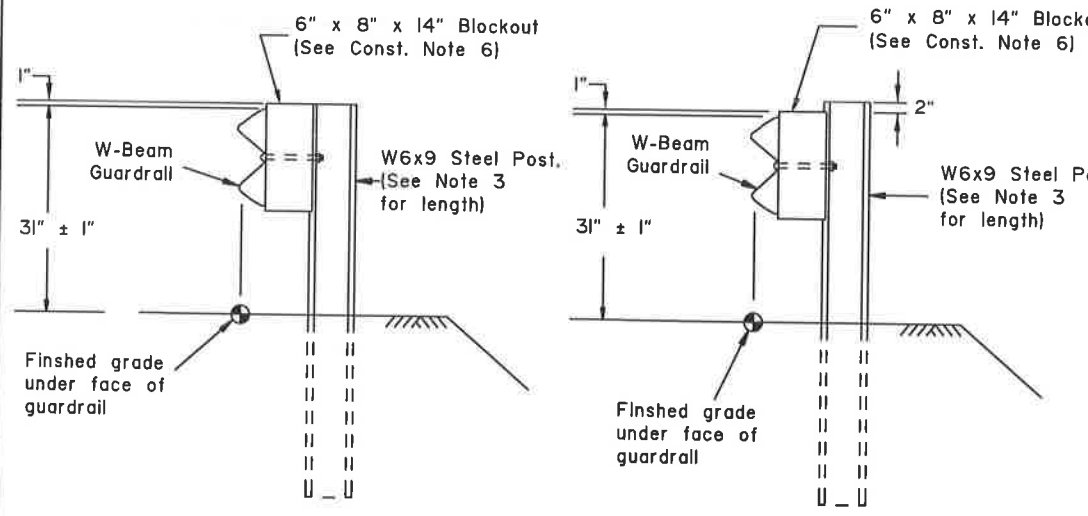







TYPE I POST INSTALLATION

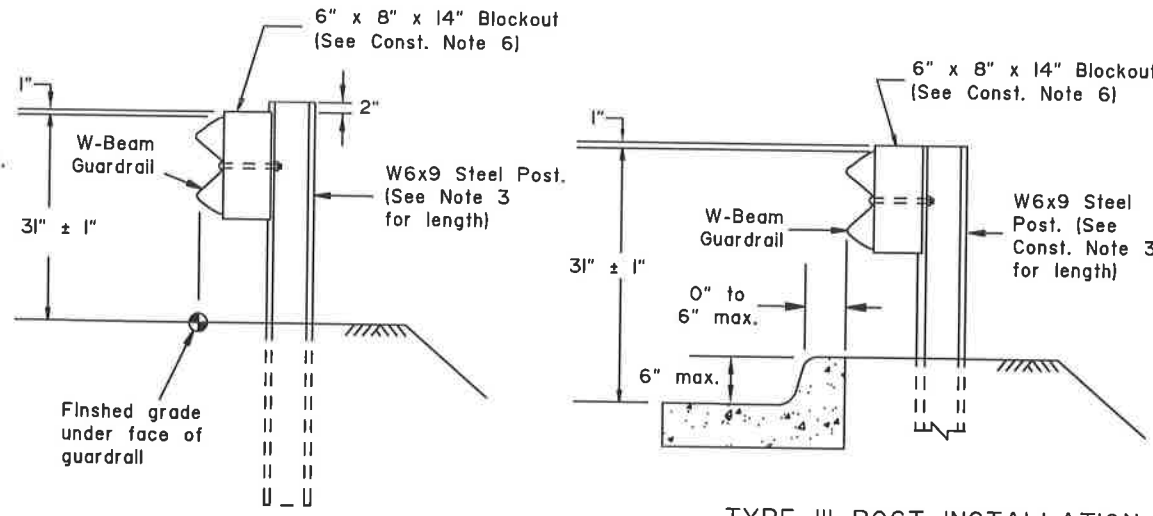

TYPE II POST INSTALLATION

TYPE III POST INSTALLATION

(Facilitates raising rail for future overlays.)

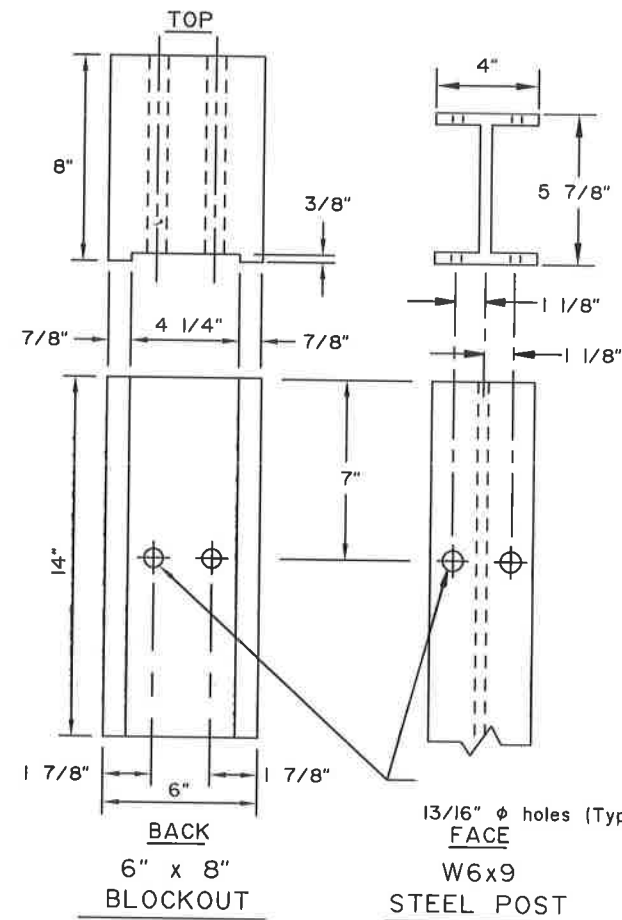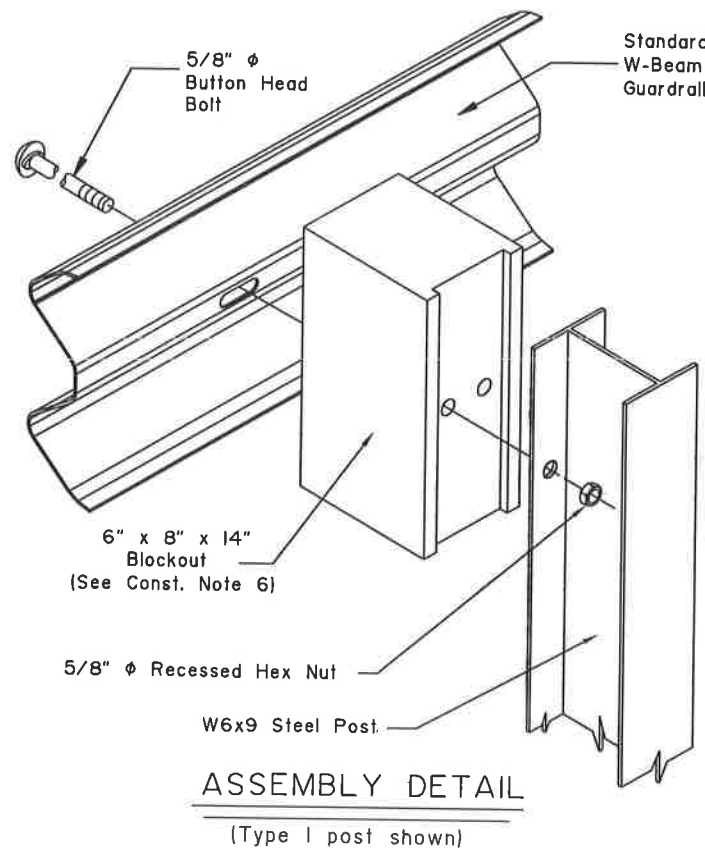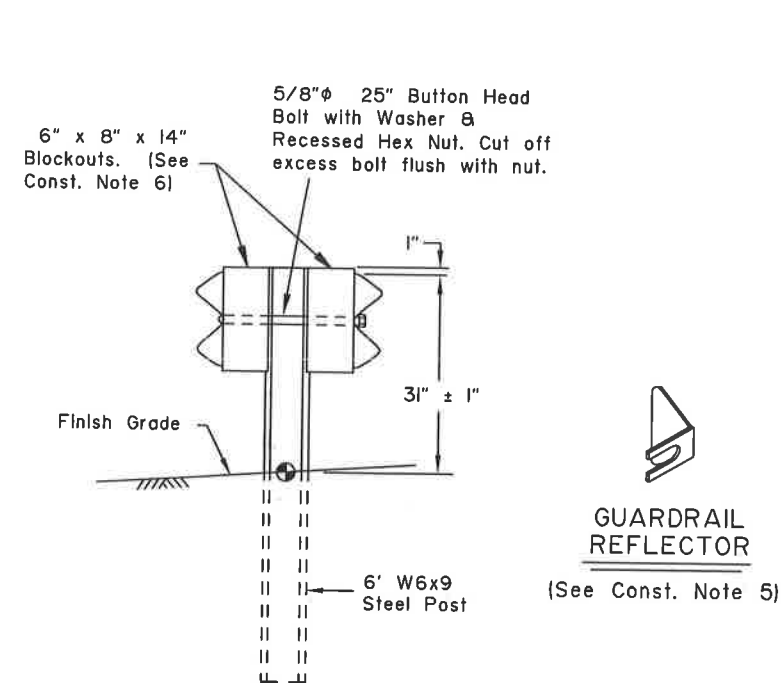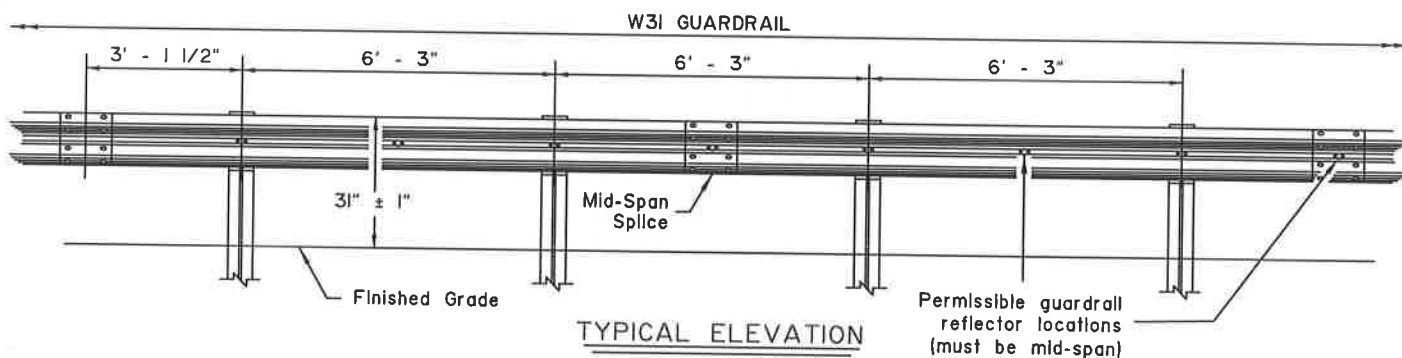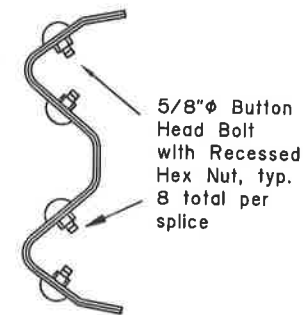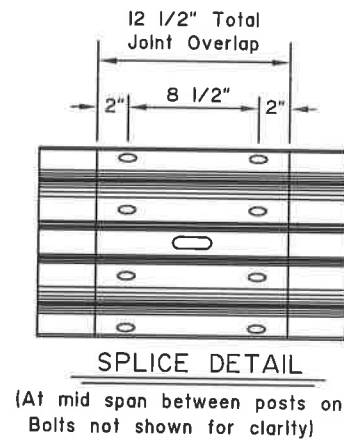

CONSTRUCTION NOTES:

1. Provide hardware compliant with the Task Force 13 (TF13) Guide to Standardized Roadside Safety Hardware.
2. See Standard Plan G-00 for hardware details not shown on this drawing.
3. See Standard Plan G-10 for post lengths corresponding to different combinations of slope and behind-post embankment width.
4. Typical post spacing is 6'-3" center to center.
5. Attach guardrail reflector to guardrail using a 5/8" button head bolt with 5/8" recessed head hex nut and steel washer at location shown in the Typical Elevation. Install reflectors every 25' on tangents and every 12.5' on curves starting 100' before the P.C. and ending 100' after the P.T.
6. Use wood or synthetic blockouts designed, tested, and passed per MASH for use with steel posts. Either bolt hole on the blockout may be used for attachment.
7. Use a 25 linear foot transition to match differing height of existing or new rail elements and end treatments - see Standard Plan G-11.
8. W6x8.5 steel post may be substituted for W6x9 steel post.
9. Install flexible delineators on guardrail posts when called for in the contract. See Standard Plan G-00 for guardrail flexible delineator details.

DESIGN NOTES:

1. No fixed objects allowed within 36" of the back side of guardrail post.
2. This barrier is acceptable under MASH Tests 3-10 and 3-11.

State of Alaska DOT&PF  
ALASKA STANDARD PLAN  
STEEL POST W31  
GUARDRAIL

Adopted as an Alaska Standard Plan by: *Carolyn Morehouse*


Carolyn Morehouse, P.E.  
Chief Engineer

Adoption Date: 05/15/2019


Last Code and Stds. Review  
By: LRG Date: 5/15/2019

Next Code and Standards Review date: 5/15/2029




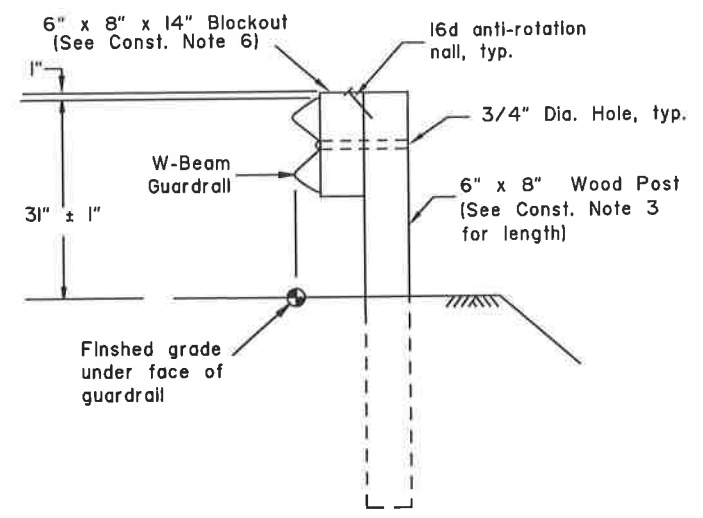


**TYPE I POST INSTALLATION**

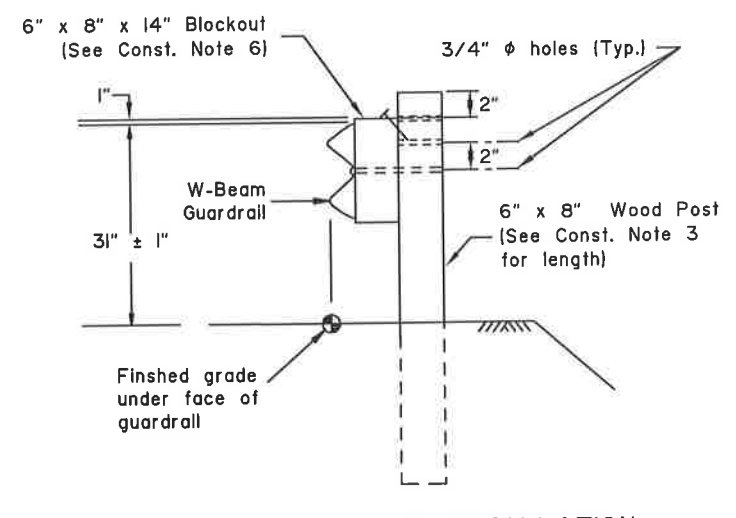


**TYPE II POST INSTALLATION**  
(Facilitates raising rail for future overlays.)

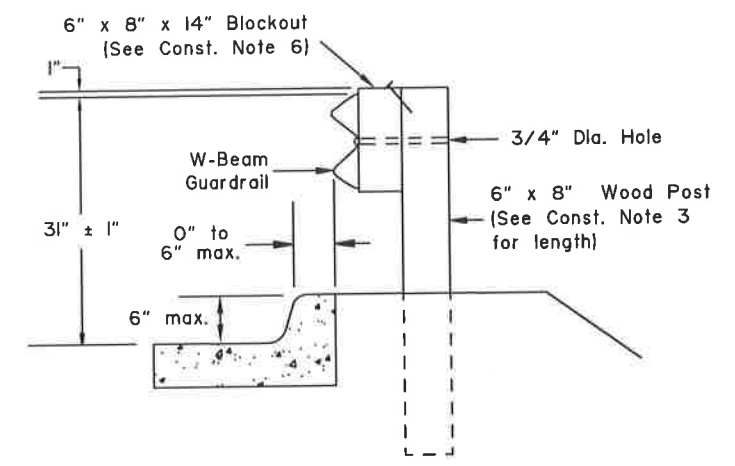


**TYPE III POST INSTALLATION**

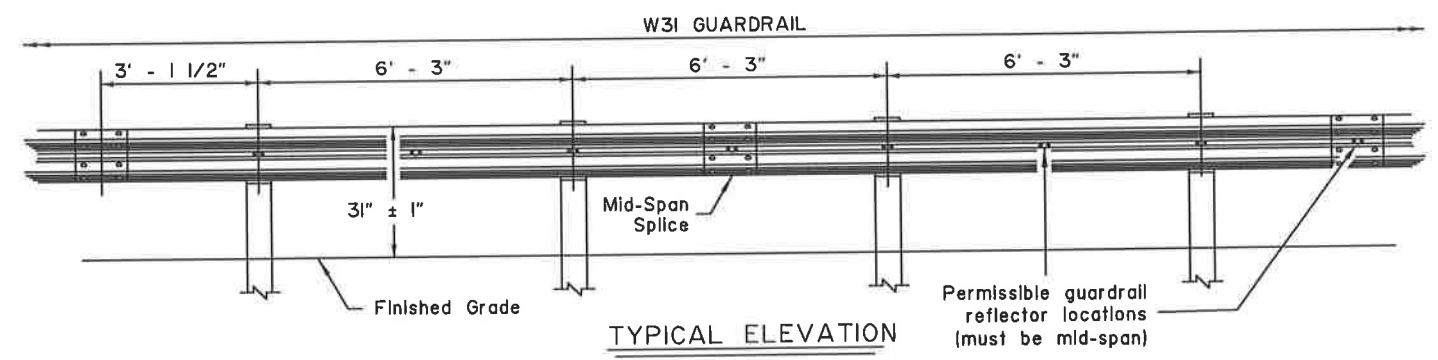

**TYPICAL ELEVATION**

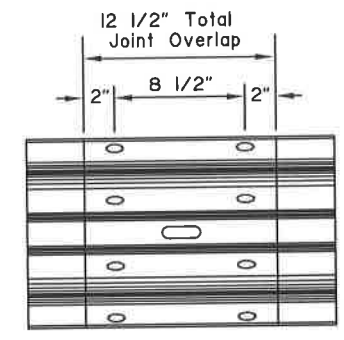

**SPLICE DETAIL**

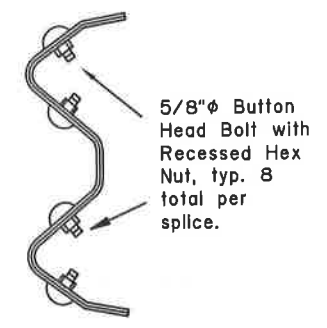


**SPLICE CROSS-SECTION**

(At mid-span between posts only. Bolts not shown for clarity.)

- CONSTRUCTION NOTES:**
1. Provide hardware compliant with the Task Force 13 (TF13) Guide to Standardized Roadside Safety Hardware.
  2. See Standard Plan G-00 for hardware details.
  3. See Standard Plan G-10 for post lengths corresponding to different combinations of slope and behind-post embankment width.
  4. Typical post spacing is 6'-3" center to center.
  5. Attach guardrail reflector using a 5/8" button head bolt with 5/8" recessed head hex nut and steel washer at the location shown on the Typical Elevation. Install reflectors every 25' on tangents and every 12.5' on curves starting 100' before the P.C. and ending 100' after the P.T.
  6. Use wood blockouts designed, tested, and passed per MASH to be used with wood posts.
  7. Use 25 linear foot transition panel to match differing height of existing or new rail elements and end treatments. See Standard Plan G-11.
  8. Install flexible delineators on guardrail posts when called for in the contract. See Standard Plan G-00 for guardrail flexible delineator details.

**DESIGN NOTES:**


1. No fixed objects allowed within 36" of the back side of guardrail post.
2. This barrier is acceptable under MASH tests 3-10 and 3-11.

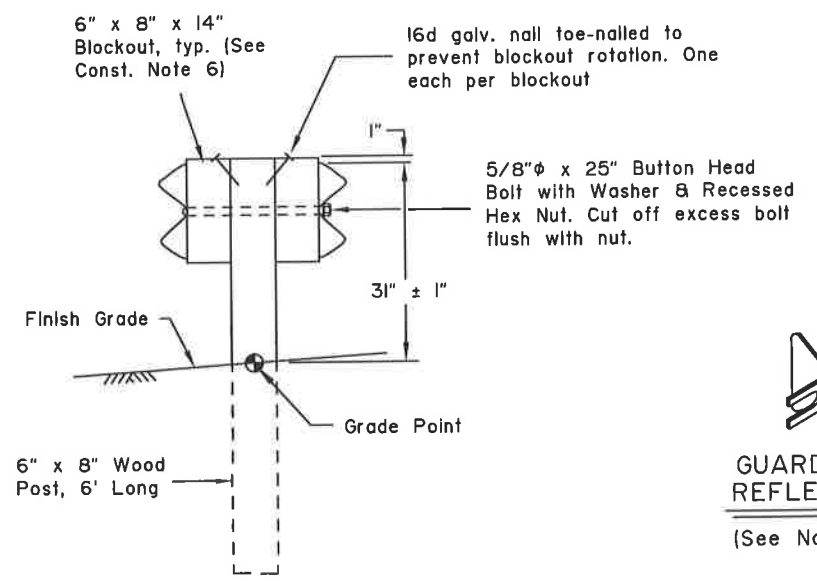

**TYPE IV DOUBLE SIDED INSTALLATION**



**GUARDRAIL REFLECTOR**  
(See Note 5)

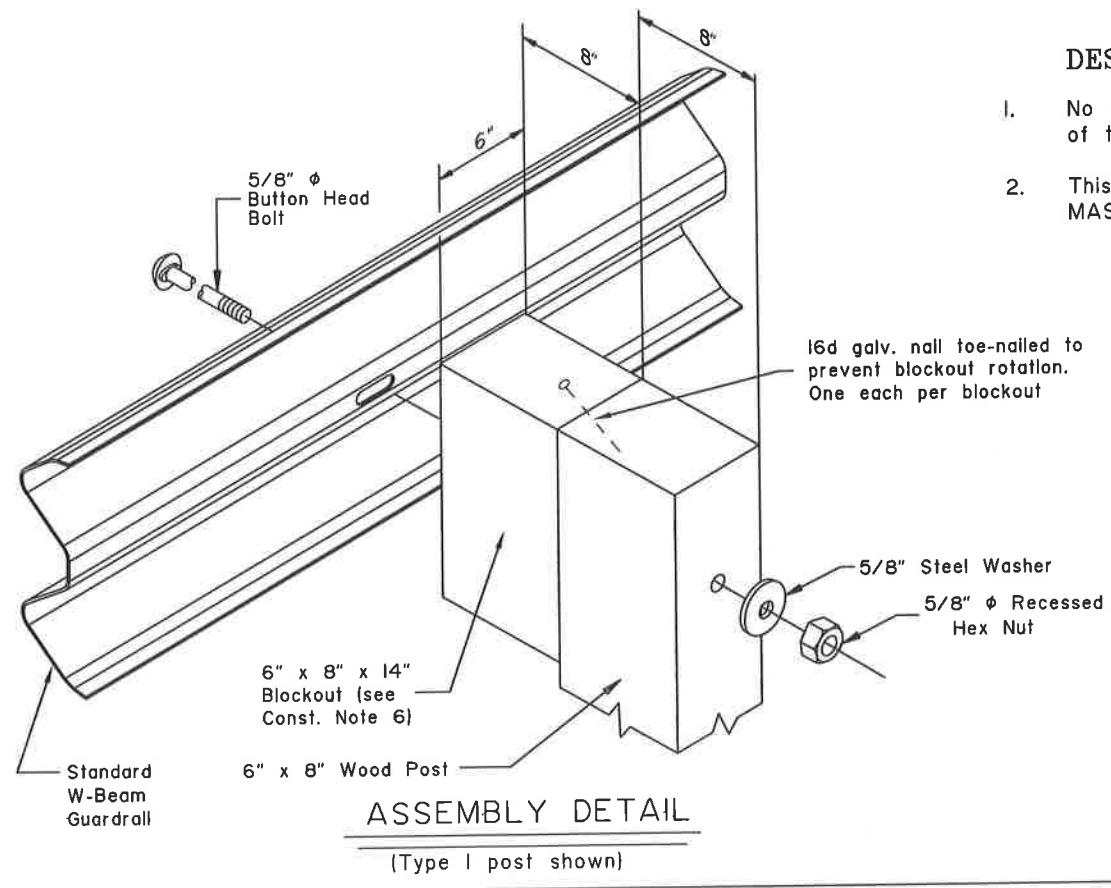


**ASSEMBLY DETAIL**  
(Type I post shown)

State of Alaska DOT&PF  
ALASKA STANDARD PLAN  
**STEEL POST W3  
GUARDRAIL**


Adopted as an Alaska Standard Plan by: *Carolyn Morehouse*  
Carolyn Morehouse, P.E.  
Chief Engineer

Adoption Date: 5/15/2019

Last Code and Stds. Review  
By: LRG Date: 5/15/2019  
Next Code and Standards Review date: 5/15/2029

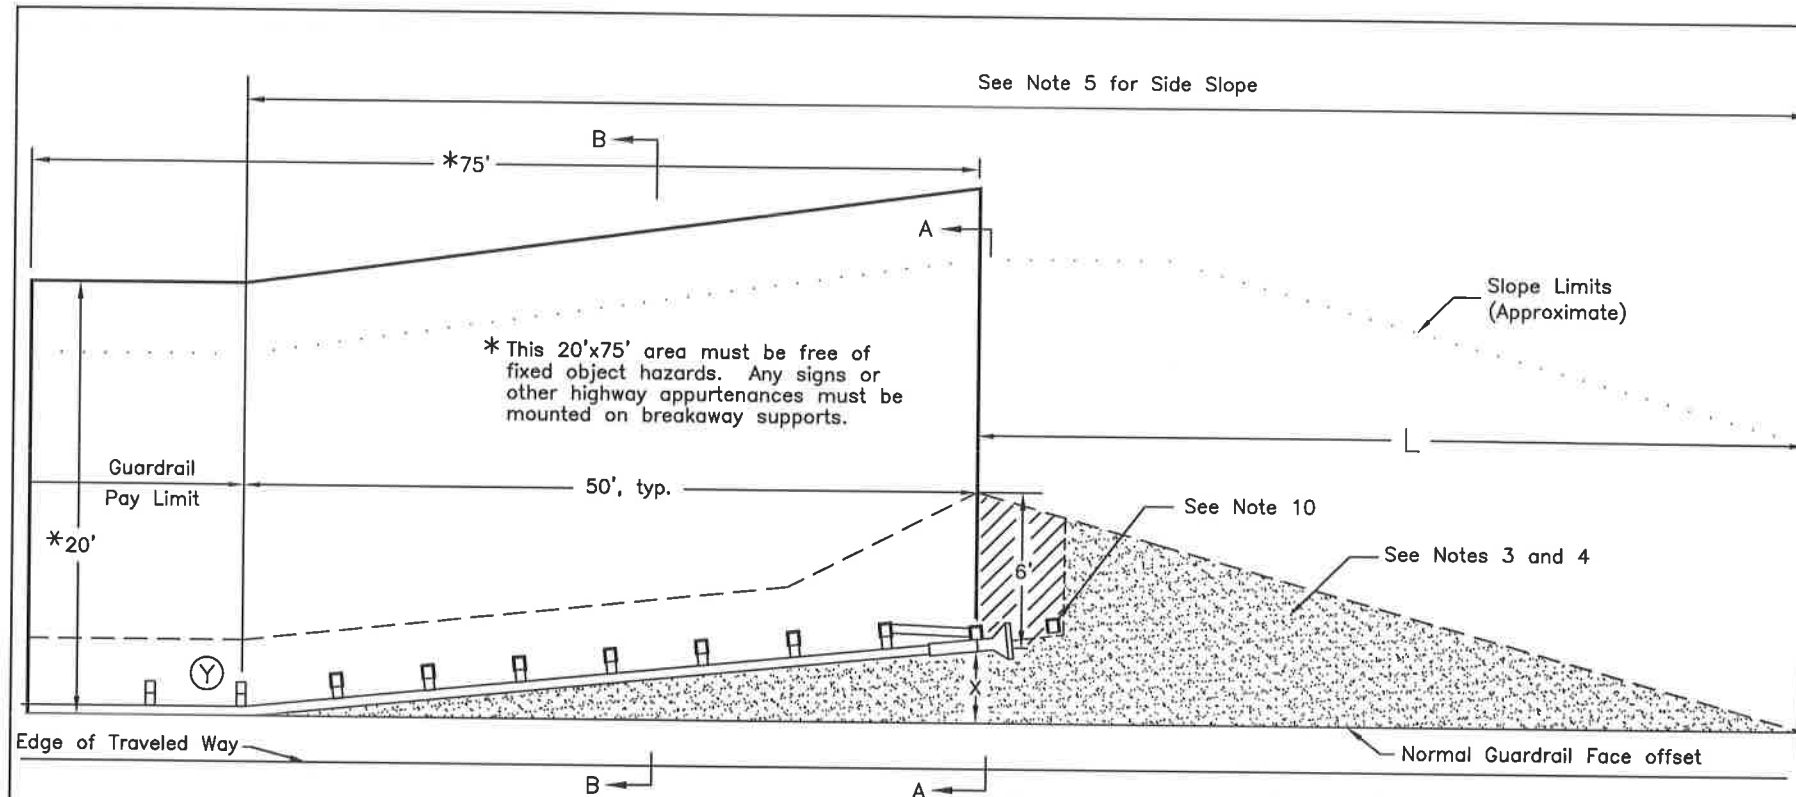


STANDARD GUARDRAIL TERMINAL WIDENING DETAIL

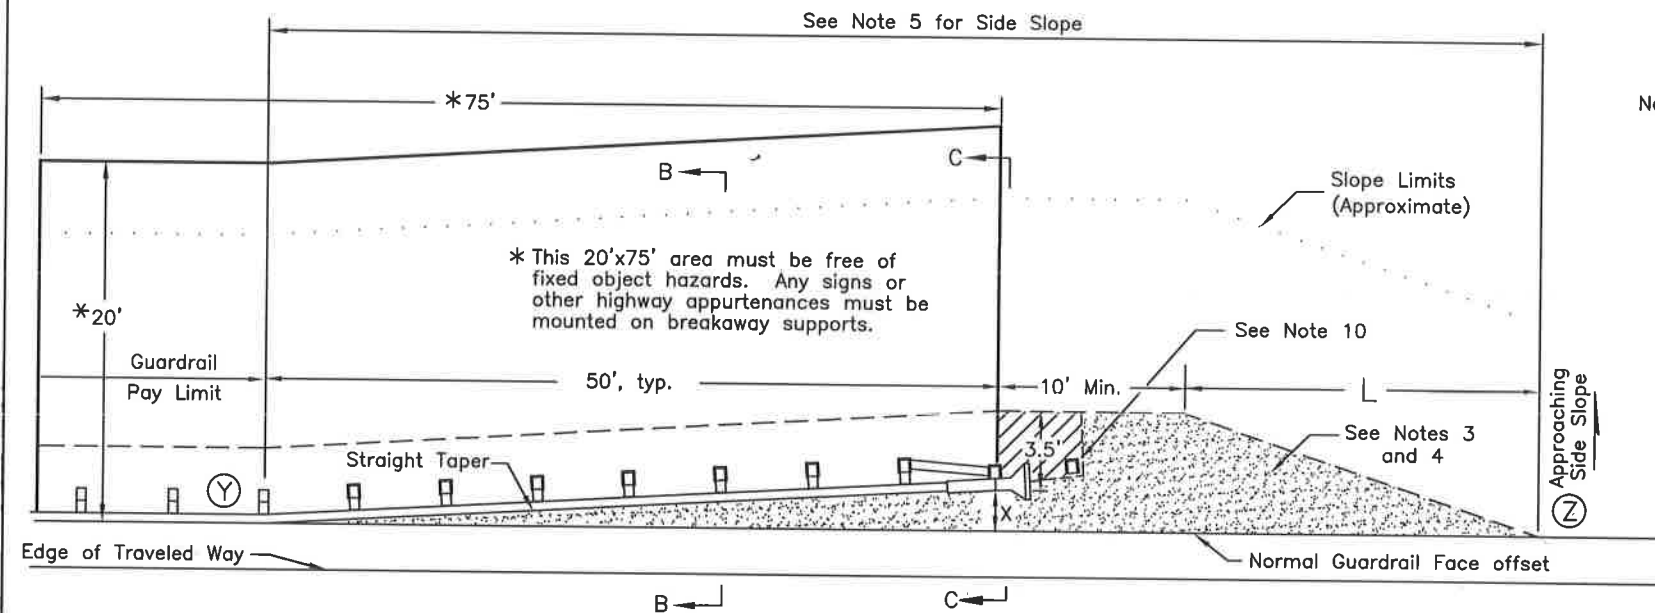


ALTERNATE GUARDRAIL TERMINAL WIDENING DETAIL

(USE ONLY WHEN LIMITED RIGHT-OF-WAY OR LIMITING SITE CONDITIONS MAKE THE STANDARD DETAIL INFEASIBLE)


X=End offset. See manufacturer's information for the range of acceptable end offsets for each MASH compliant terminal.

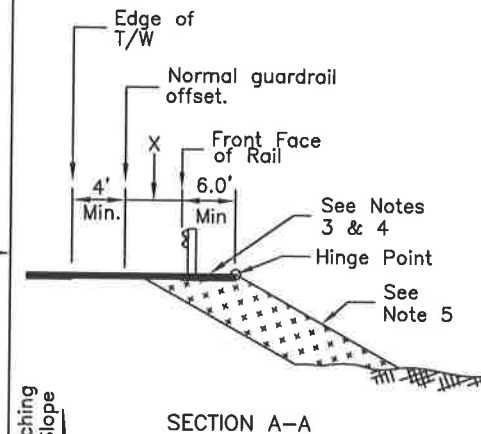

SECTION A-A

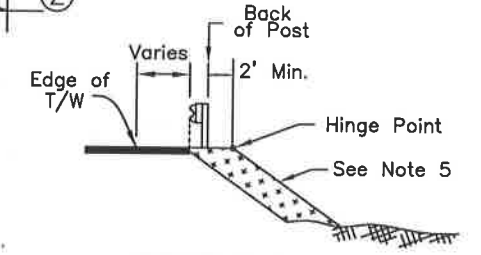

SECTION B-B  
(Applies to both details)

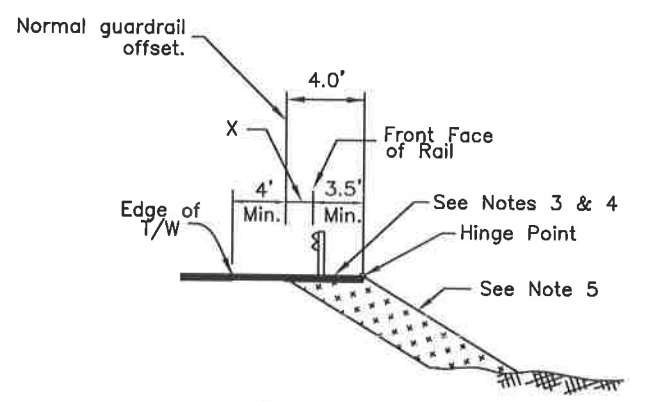

SECTION C-C

GENERAL NOTES

1. This Std. Dwg. applies to all MASH approved guardrail end terminals (GETs). The alternate detail may only be used with parallel or tangent GETs. The terminal details shown are for illustration only - see manufacturer's drawings for actual post, rail, strut, etc. configuration and layout.
2. Use this Std. Widening Detail for all GETs except when limited right-of-way or limiting site conditions make the use of the Std. Widening Detail infeasible. In that case, the alternate detail is permissible.
3. Construct the shaded areas to match the slope of the adjacent shoulder. The slope may be increased to 10:1 if identified in the plans or when approved by the engineer. Match the slope when the shoulder slopes toward the road as well as away from the road.
4. On paved roads, the shaded areas shall be paved. On gravel roads, surface the shaded areas with the same materials used to surface the travel lanes.
5. From point (Y) to point (Z) make the side slope match the approaching side slope except where it is flatter than 4:1. In that case, the slope may be steepened to 4:1.
6. Attach a flexible marker at the beginning of each GET.
7. The max. allowable height for foundation tubes or other steel components of terminal post breakaway systems is 4" above the surrounding grade.
8. The details on this sheet do not apply to W31 Downstream End Anchors (Std Dwg G-14).
9. The details on this sheet apply to GETs on both the approach and downstream ends on two-way undivided roads and to any downstream MASH compliant GETs.
10. Some MASH GET systems have an additional post/anchor at the approximate location shown. If this post/anchor is present do not pave the diagonally hatched area. If not present, pave the diagonally hatched area also.

Taper Lengths (L) for Common End Offsets (X)		
End Offset	Standard Detail	Alternate Detail
0'	24.0'	13.0'
1'	26.0'	17.0'
1.5'	28.0'	19.0'
2'	30.0'	21.0'
2.5'	32.0'	22.0'
4'	37.0'	28.0'

Interpolate if the end offset falls between table values

State of Alaska DOT&PF  
ALASKA STANDARD PLAN  
WIDENING FOR  
GUARDRAIL END TERMINALS

Adopted as an Alaska Standard Plan by: *Kenneth J. Fisher*  
Kenneth J. Fisher, P.E.  
Chief Engineer










Adoption Date: 02/08/2019

Last Code and Stds. Review By: \_\_\_\_\_ Date: \_\_\_\_\_

Next Code and Standards Review date: 02/08/2029

GENERAL NOTES

1. All guardrail and guardrail connection hardware to conform to AASHTO M-180. All H.S. Bolts conform to ASTM A325. All other steel to conform to ASTM A709 Grade 36.
2. Conform to G-00, G-04S, G-10 for all guardrail details not shown. No Back-up Plates required.
3. Lap approach guardrail to prevent snags from oncoming traffic.
4. Provide 4 1/2" horizontal slot in approach guardrail. Adjust guardrail bolts for sliding fit.
5. This design is approved for NCHRP 350, TL 4.

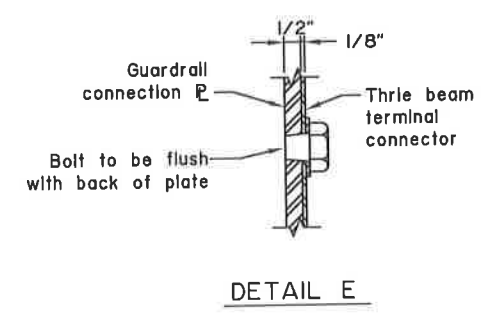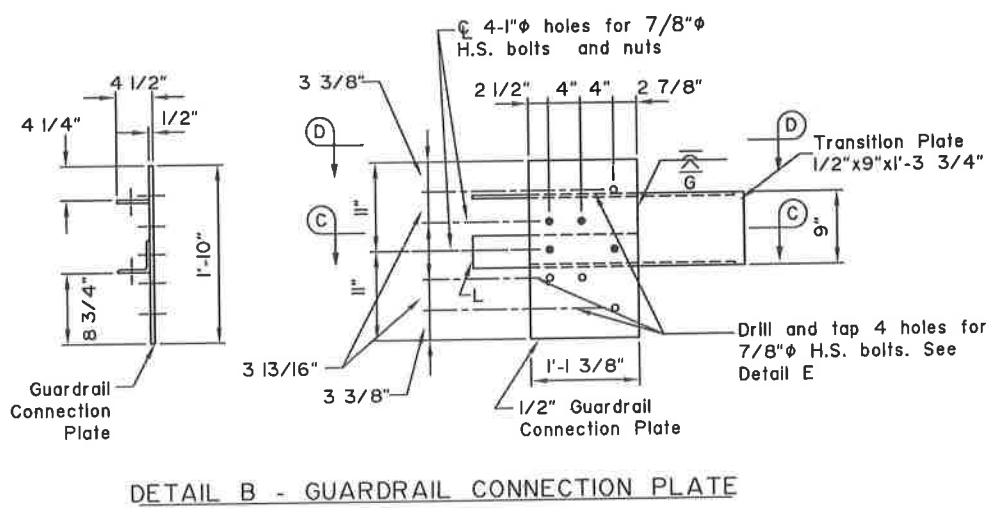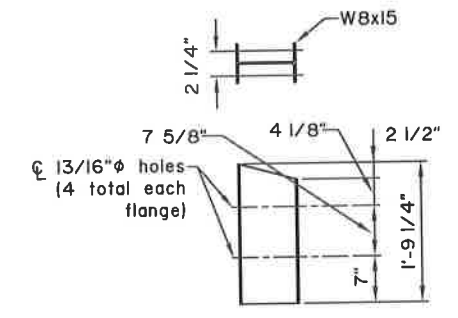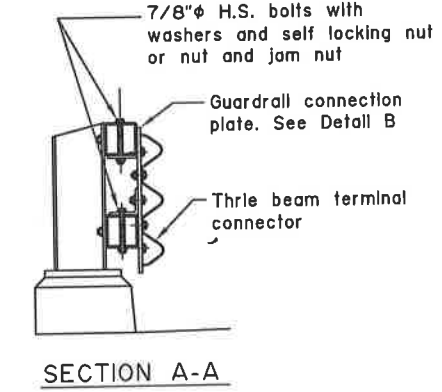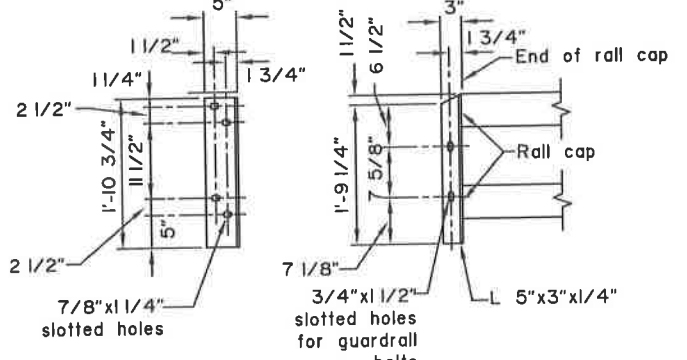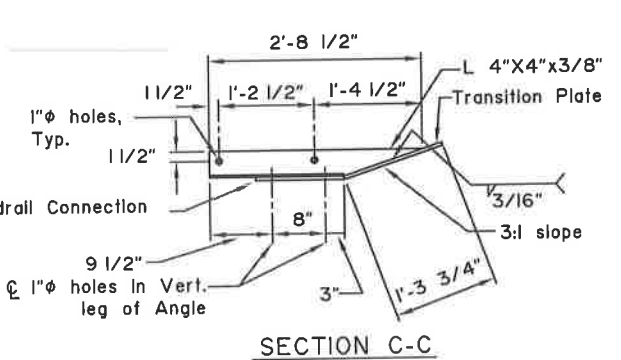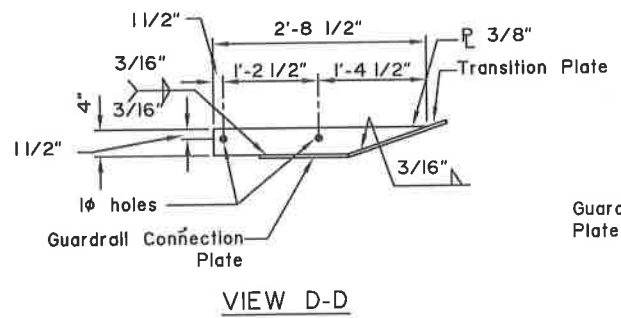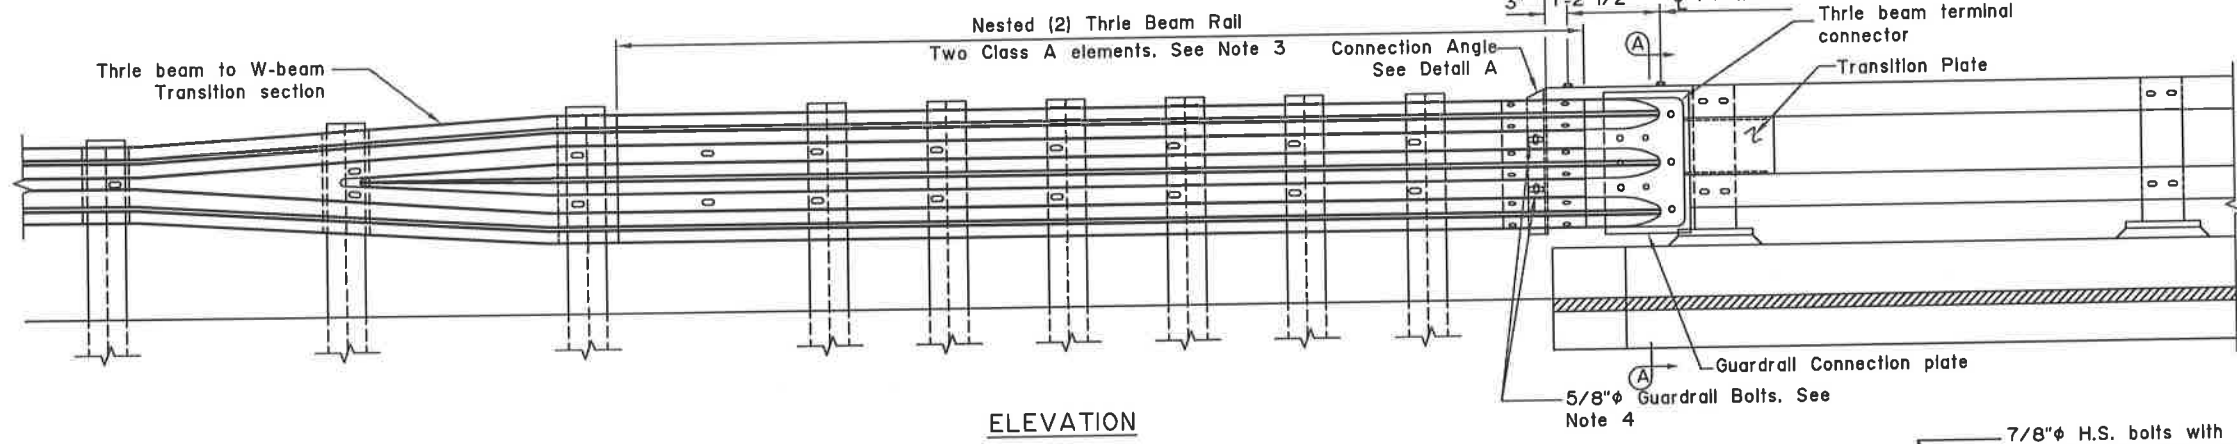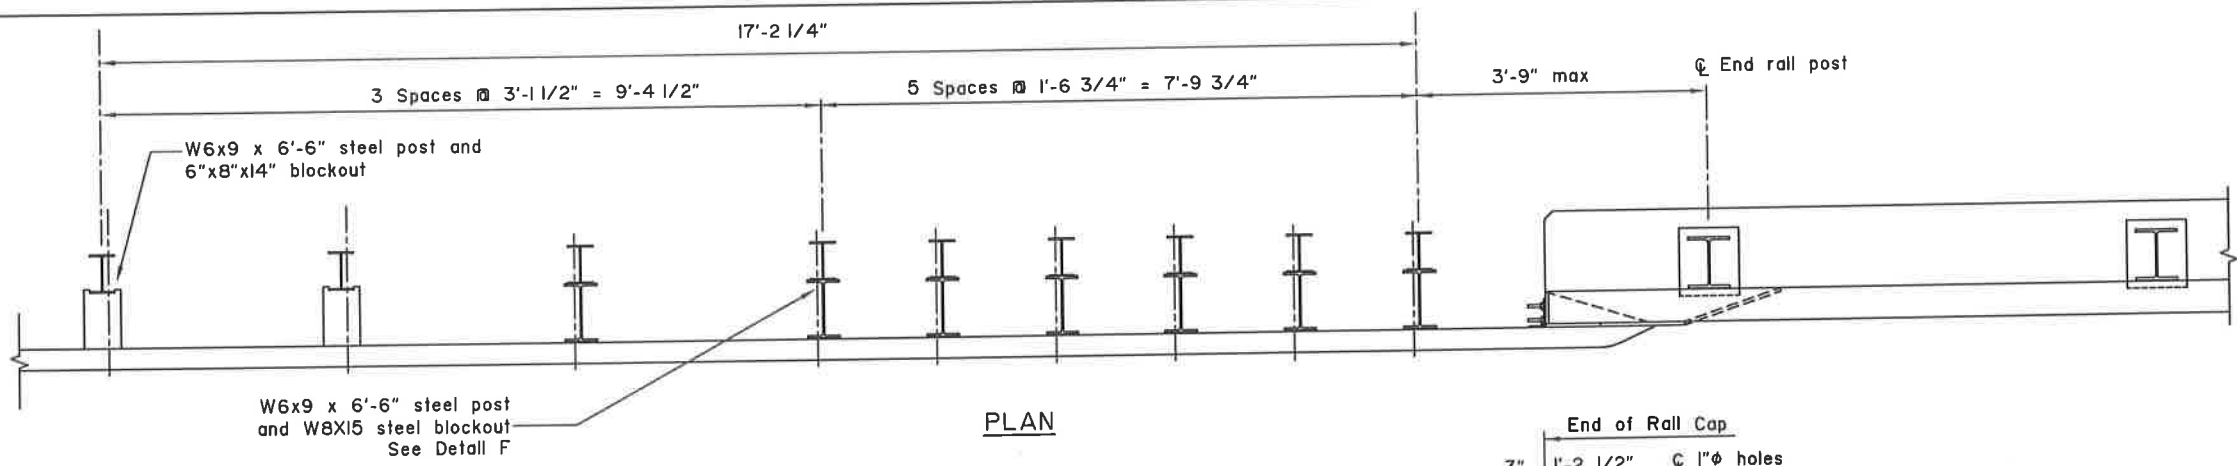

State of Alaska DOT&PF  
ALASKA STANDARD PLAN  
BRIDGE RAIL THRIE  
BEAM TRANSITION

Adopted as an Alaska Standard Plan by: *Kenneth J. Fisher*  
Kenneth J. Fisher, P.E.  
Chief Engineer

Adoption Date: 02/08/2019

Last Code and Sids. Review By: Date:

Next Code and Standards Review date: 02/08/2029

No Scale


G-31.01

CONSTRUCTION NOTES:


1. See plans for ramp type at specific locations. See striping plans for crosswalk layouts.
2. Construct ramp runs and landings of concrete, regardless of whether the sidewalk is asphalt or concrete.
3. When one parallel curb ramp will serve two directions, use the One Crossing Direction detail and refer to the striping plans for crosswalk layouts.
4. Ramp run lengths are shown for a flat sidewalk grade. For other sidewalk grades, increase or decrease ramp and flare lengths to maintain the slopes shown.
5. Construct ramp slopes at a nominal 7.7% grade, or flatter. Ramp slopes may be increased to a maximum of 8.3% when site conditions warrant it. Ramp lengths should be increased to keep grades under the 8.3% maximum, but are not required to exceed 15.0 feet. The resulting ramp grade at a 15.0 foot ramp length is acceptable even if it exceeds 8.3%.
6. Construct sidewalk cross slopes at 1.5% nominal (1.0% min. and 2.0% max).
7. Provide a coarse broomed finish running perpendicular to the curb on ramp runs and upper landings and parallel to the curb on lower landings.
8. Install 24" detectable warning tiles meeting Section 705.1 of the 2006 ADA Standards for Transportation Facilities for the full width of the ramp.
9. Maximum cross slope on lower landings is 2.0% as measured in any direction. Maximum cross slope on ramps is 2.0% measured perpendicular to the ramp run.
10. Provide 4" minimum thick concrete on ramps and landings.

DESIGN NOTES


1. Parallel curb ramps are typically used when the sidewalk is at least 4' wide but can not be constructed wide enough for perpendicular ramps.
2. When one curb ramp is installed in a curb radius to serve both directions of pedestrian traffic, construct it in accordance with the One Crossing Direction detail.
3. Locate lower landings within the inner edges of marked crosswalks or, if crosswalks are not marked, within the area a standard marked crosswalk would enclose. See Standard Drawing T-23 for standard crosswalk layout.
4. Avoid drainage grates within marked crosswalks or, if crosswalks aren't marked, within the area a standard marked crosswalk would enclose. If a drainage grate is located directly in the pedestrian accessible route (e.g. a wheel chair must pass over it), install a grate meeting the requirements of Section 302.3 of the 2006 ADA Standards.
5. These details are compliant with the 2006 ADA Standards for Transportation Facilities, except for the 15' maximum ramp length noted in Construction Note 5, which is from the Draft 2011 PROWAG.

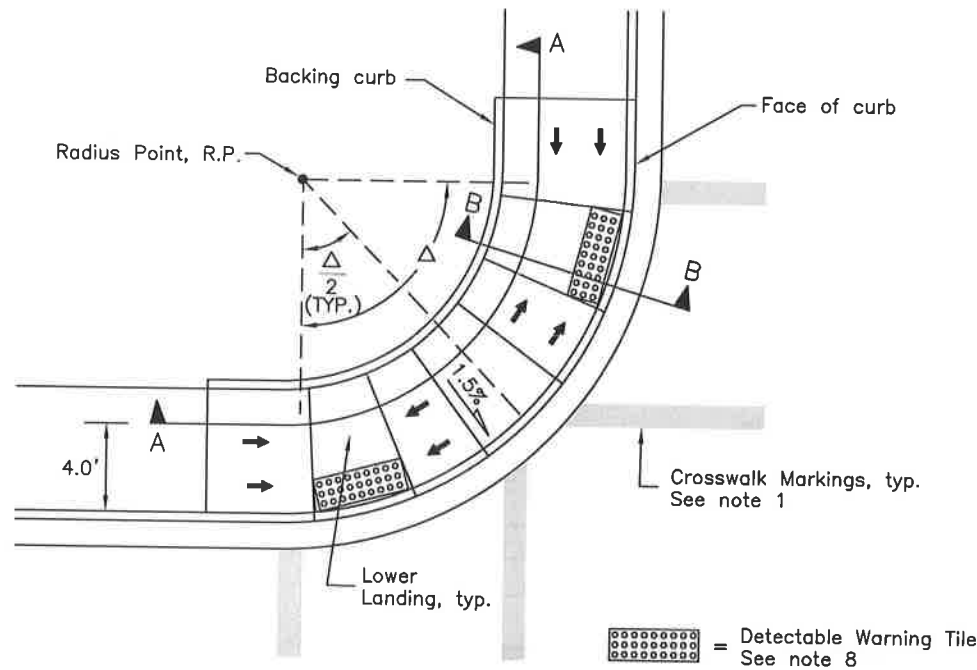


TWO CROSSING DIRECTIONS  
At corner

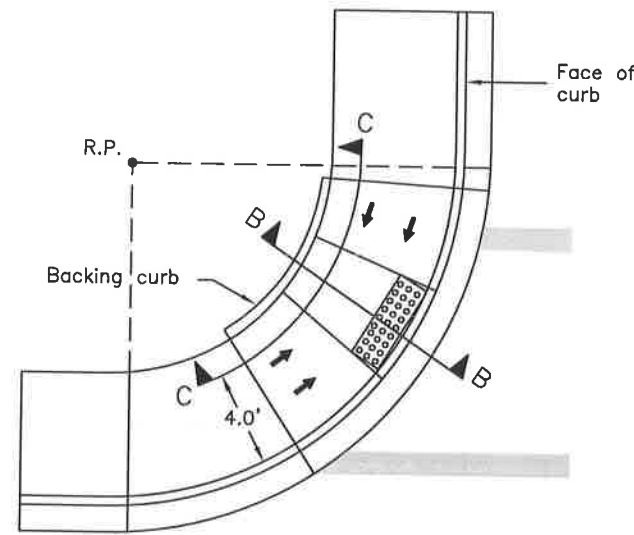

ONE CROSSING DIRECTION  
At corner - generic location shown

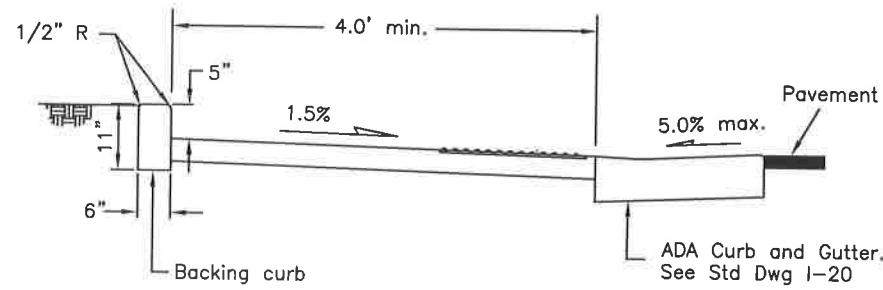


SECTION B-B

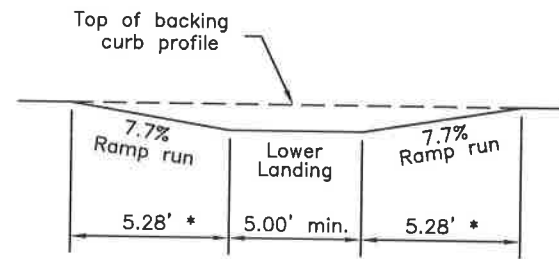


\* See Const. Note 5

PROFILE C-C

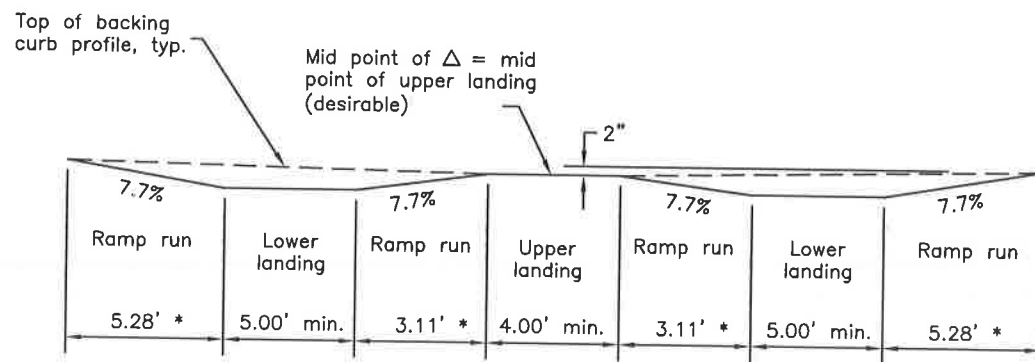

\* See Const. Note 5

PROFILE A-A

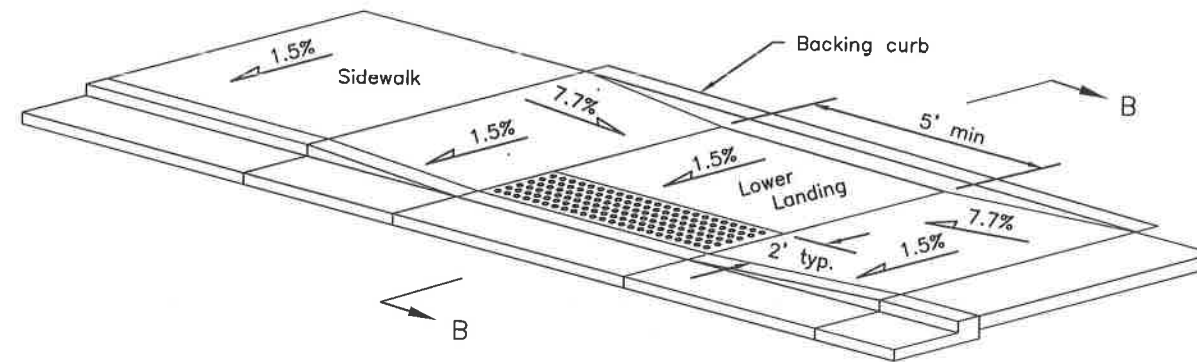

MID-BLOCK

Note: Drawing not to scale

State of Alaska DOT&PF  
ALASKA STANDARD PLAN

PARALLEL CURB RAMP

Adopted as an Alaska Standard Plan by: *Kenneth J. Fisher, P.E.*  
Kenneth J. Fisher, P.E.  
Chief Engineer


Adoption Date: 02/08/2019

Last Code and Stds. Review By: Date:


Next Code and Standards Review date: 02/08/2029

GENERAL NOTES:


1. Location of transition length relative to horizontal curves will be shown on the plans or as directed by the Engineer.
2. Widening for guardrail or curvature will not change the location of the axis of rotation.
3. Minimum vertical curve length in feet shall be the numerical value of the design speed in M.P.H.
4. Superelevation shall be built into the subgrade and carried through the shoulders.

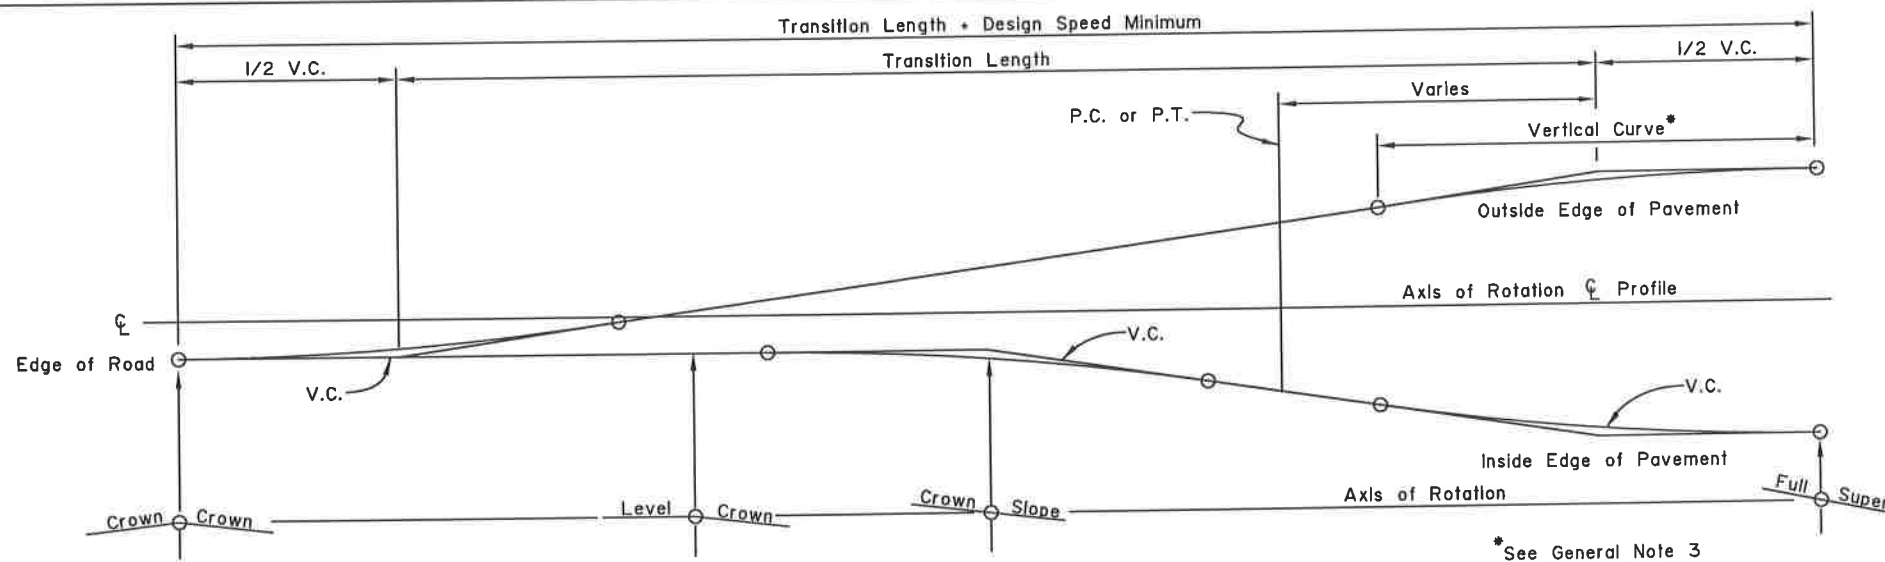

CASE I  
PAVEMENT REVOLVED ABOUT CENTERLINE

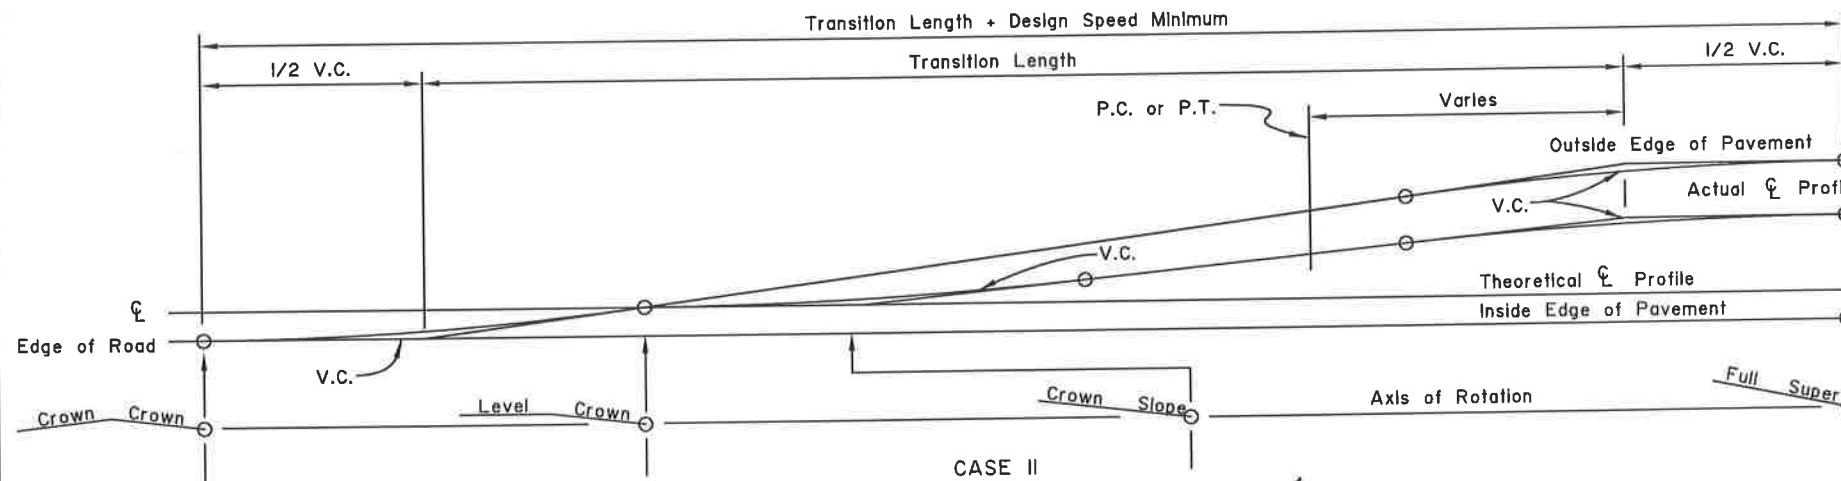

CASE II  
PAVEMENT REVOLVED ABOUT INSIDE EDGE  
TO BE USED WHERE DRAINAGE IS THE GOVERNING CONSIDERATION

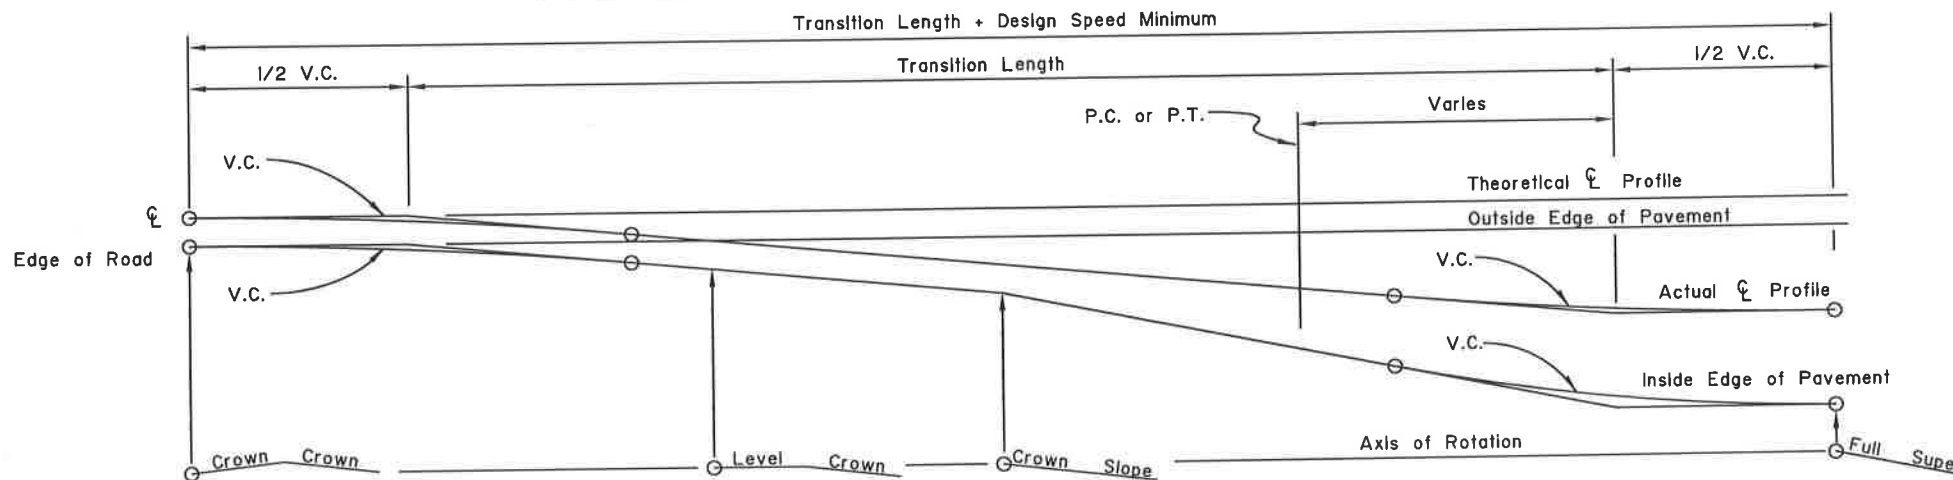

CASE III  
PAVEMENT REVOLVED ABOUT OUTSIDE EDGE TO BE  
USED WHERE OVERALL APPEARANCE IS THE MAIN CONTROL

State of Alaska DOT&PF  
ALASKA STANDARD PLAN


SUPERELEVATION TRANSITION

Adopted as an Alaska  
Standard Plan by: *Kenneth J. Fisher*  
Kenneth J. Fisher, P.E.  
Chief Engineer

Adoption Date: 02/08/2019


Last Code and Stds. Review  
By: Date:

Next Code and Standards Review date: 02/08/2029

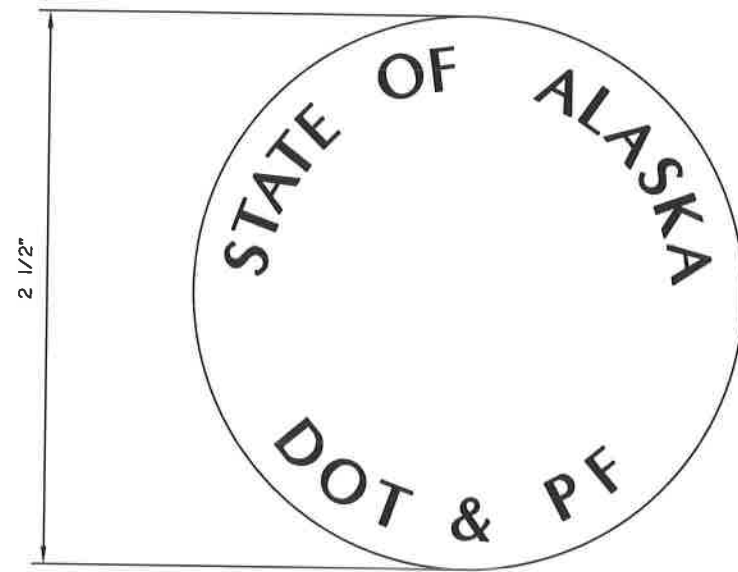

GENERAL NOTES:

1. For Structures under 200' total length: provide 1 monument.
2. For Structures 200' or over: provide 2 Monuments.
3. Monuments shall be located as directed by the Engineer.

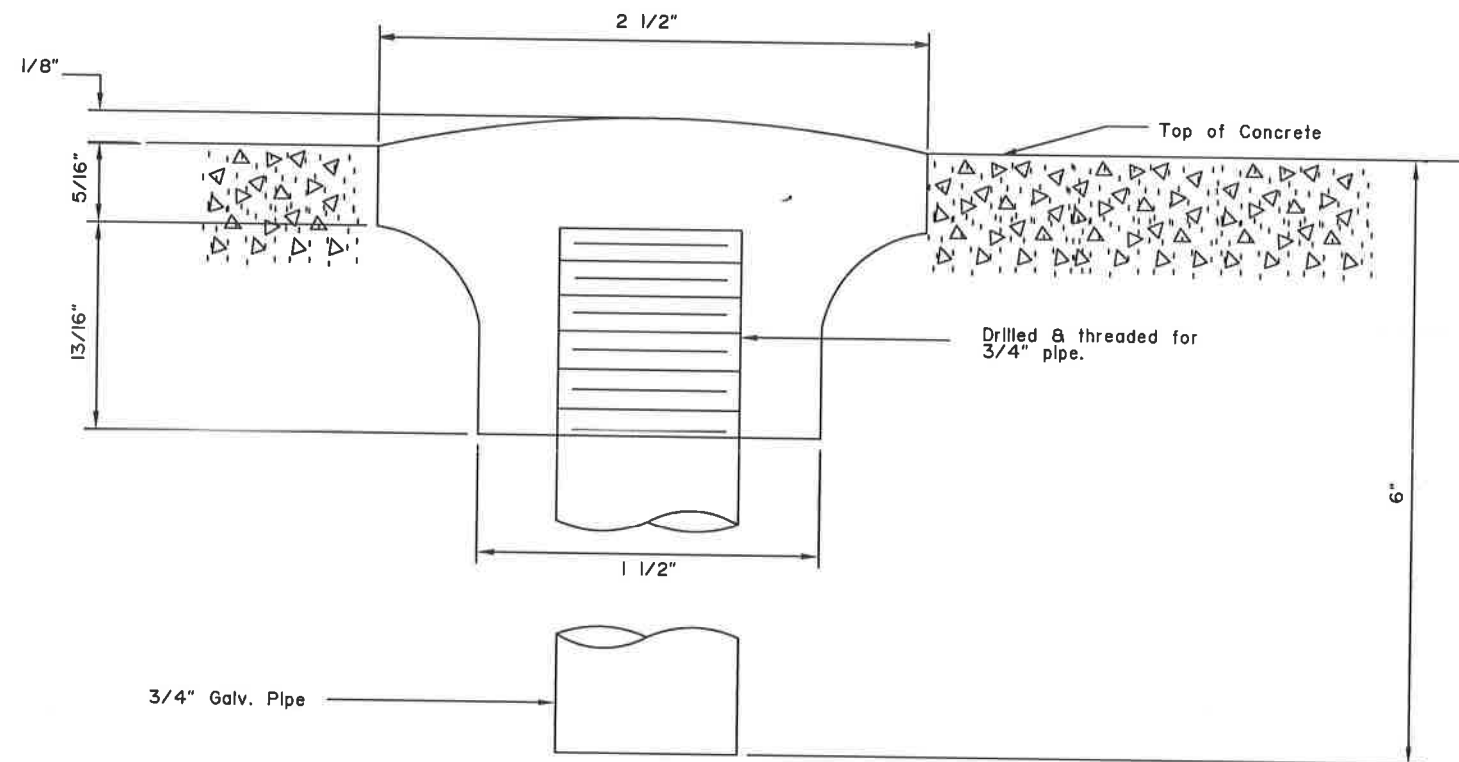

SURVEY MONUMENT

State of Alaska DOT&PF  
ALASKA STANDARD PLAN

SURVEY MONUMENT

Adopted as an Alaska  
Standard Plan by: *Kenneth J. Fisher*  
Kenneth J. Fisher, P.E.  
Chief Engineer


Adoption Date: 02/08/2019

Last Code and Stds. Review  
By: Date:


Next Code and Standards Review date: 02/08/2029

GENERAL NOTES:


1. Details shown are to indicate general design only. Dimensions and design may vary among the manufacturers.
2. Where monument cases are to be placed in paved area of a roadway or sidewalk, the top of the case and/or cover shall be the same elevation as the top of the finish surface with bolting type access cover.
3. Where monument cases are to be placed in a gravel surfaced roadway, the top of the case shall be placed 1'-0" below the top of the surface of the roadway.
4. In solid rock, drill a 2" Dia. hole a minimum of 1'-0" deep, fill with mortar and set cap. 3/4"x9" galvanized pipe, designated length when set in mortar.
5. The top of the monument cap shall be placed 1' above the bottom of the monument case.

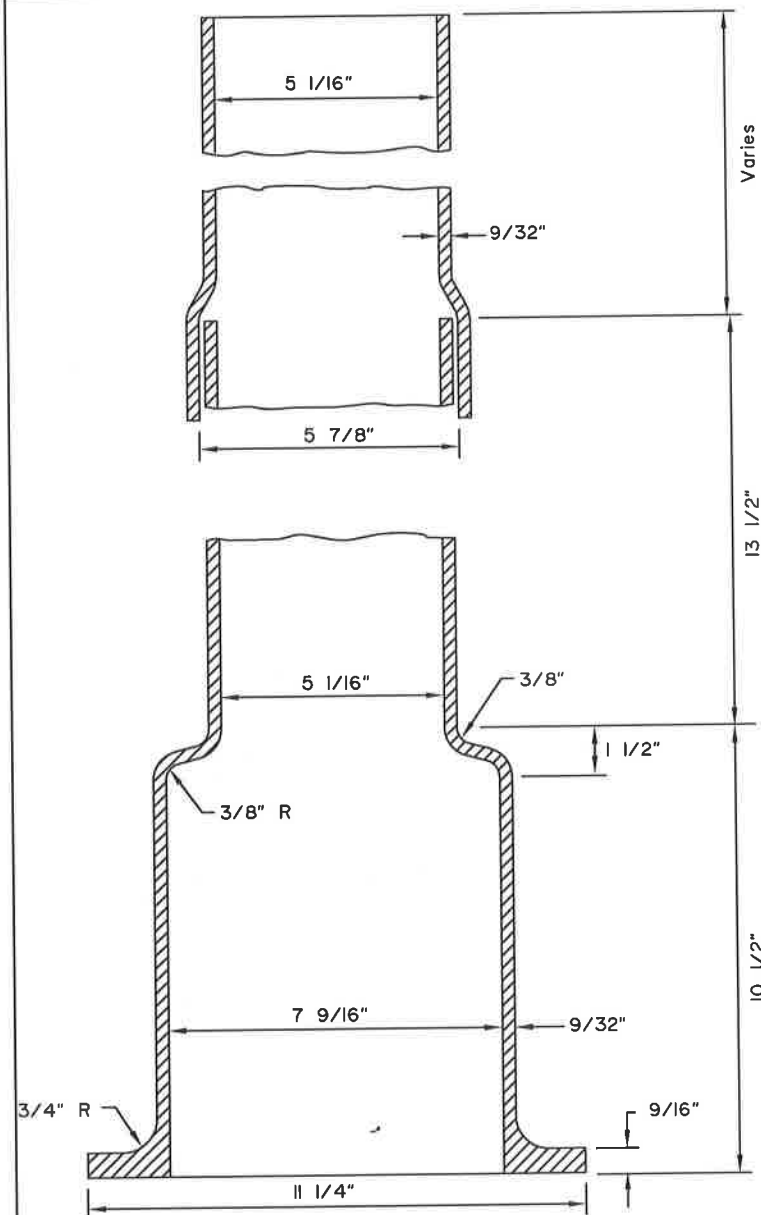


EXTENSION PIPES

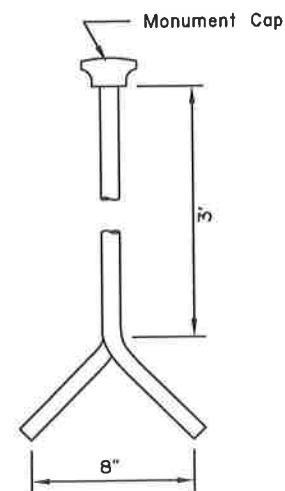


MONUMENT DETAIL

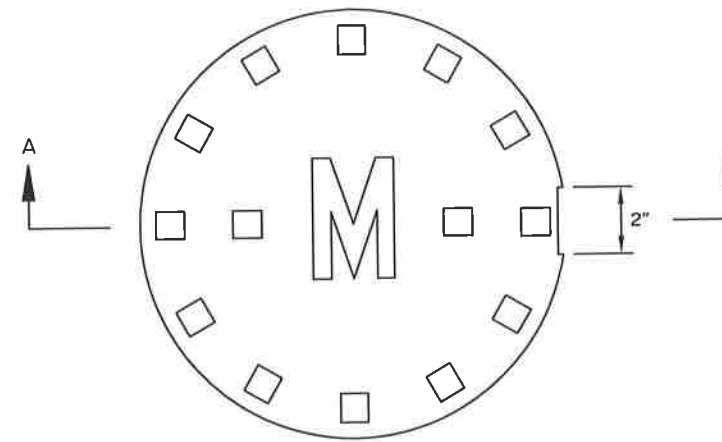


PLAN VIEW ACCESS COVER

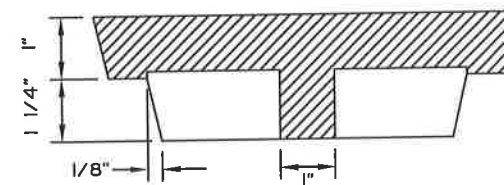

SECTION A-A

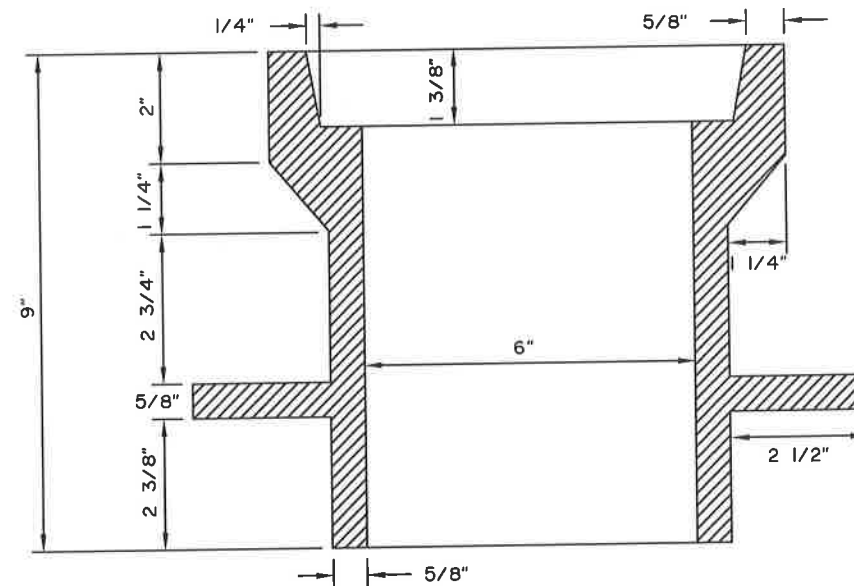

MONUMENT CASE

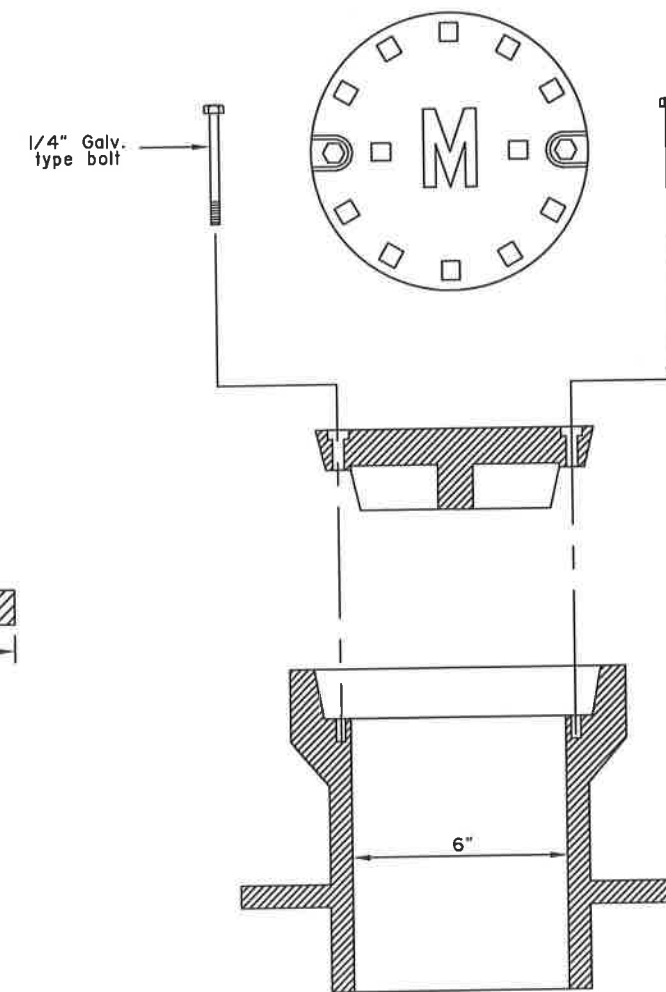

BOLTING MONUMENT CASE ASSEMBLY  
(See Note 2)


State of Alaska DOT&PF  
ALASKA STANDARD PLAN  
BRASS CAP MONUMENT  
AND MONUMENT CASE

Adopted as an Alaska  
Standard Plan by: *Kenneth J. Fisher*  
Kenneth J. Fisher, P.E.  
Chief Engineer

Adoption Date: 02/08/2019

Last Code and Stds. Review  
By: Date:

Next Code and Standards Review date: 02/08/2029

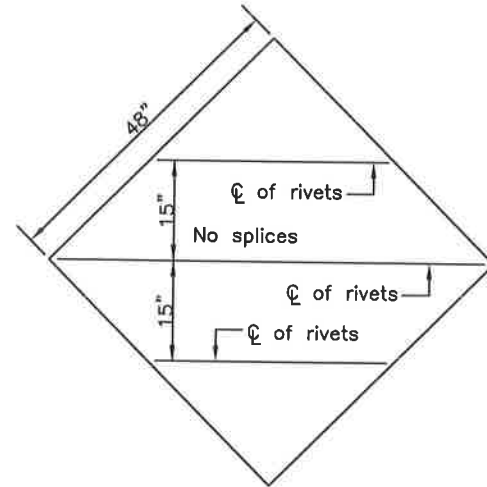


TUBE SIGN POST SPACING							
Sign Width (feet)	No. of Posts	Distance Between Posts	Sign Overhang	Post Type			Notes
				P.S.T.	Wood	Steel Tube W-Shape	
0.5 to 4.0	1	—	0.5W	X	X	X	See Note 2.
4.5 to 10.0	2	0.6W	0.2W	X	X	X	See Note 3.
10.5 to 11.0	2	6	Varies	X	X	X	See Note 3.
11.5 to 13.0	2	8	Varies			X	
13.5 to 20.0	2	0.6W	0.2W			X	
20.5 to 22.5	3	8	Varies			X	
23.0 to 29.5	3	0.35W	0.15W			X	
30.0 to 31.5	4	8	Varies			X	
32.0 to 40.0	4	0.25W	0.125W			X	

GENERAL NOTES

- See the standard specifications for the aluminum alloys that you may use for sign sheeting and wind framing members.
- Fabricate all signs from 0.125" thick aluminum sheeting.
- Sign fabricators may use alternates to the zee shaped framing member with approval of the engineer, if the frame manufacturer certifies their design equals or exceeds the strength of the zee shaped design.
- Install one piece wind framing members on all signs up to 23.5' wide. Use one splice in each wind frame on all signs wider than 23.5'. Locate splices at least 18" from all posts and panel edges. Stagger splices in adjacent framing members at least 8.0' apart.
- Attach wind framing members with rivets or with an engineer approved, double sided, high strength, adhesive tape. Clean and handle sheeting and framing members and apply tape in accordance with the tape manufacturer's written instructions. Install two rivets in both ends of each framing member.
- Use 3/16" diameter rivets conforming to aluminum alloy 6061-T6 for cold driven rivets, or aluminum alloy 6061-T43 for hot driven rivets.
- Sign fabricators may use sign panels extruded with integral framing with approval of the engineer, if the manufacturer certifies their design equals or exceeds the strength of the 0.125" thick panel with framing attached to it.
- Frame all signs taller than 8.0' with five wind framing members located  $(H-0.15)/4$  spaces. If needed, make a horizontal splice at the middle wind frame.
- Do not use round pipes for sign supports.

SIGN POST SPACING NOTES:


- Install sign support in accordance with the table above, unless otherwise required by plans or specifications.
- Exceptions:
  - Use one post for all E5-1 gore signs, regardless of width.
  - Use one 2.5" P.S.T. for all STOP signs, with or without street name signs.
- Supports placed within 7' of each other must be acceptable for that use. See Standard Drawing S-30 for the sizes of wood posts and P.S.T.s that may be used within 7'. See Manufacturer's documentation for breakaway couplings and tubes that may be used within 7'.
- See Standard Drawing S-31 for frangible couplings, hinges, and foundations for tube and W-shape sign supports.

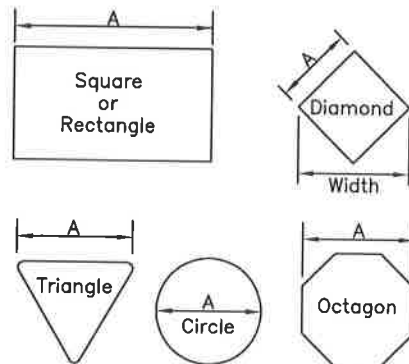


Maximum size unframed signs using 0.125" thick aluminum sheeting.	
Sign Shape	A
Squares, Shields, and Route Markers	48"
Rectangles	48"
Diamonds	48"
Triangles	48"
Rounds and Octagons	48"

Install wind framing on all signs that exceed the dimensions listed.


LIGHT SIGNS

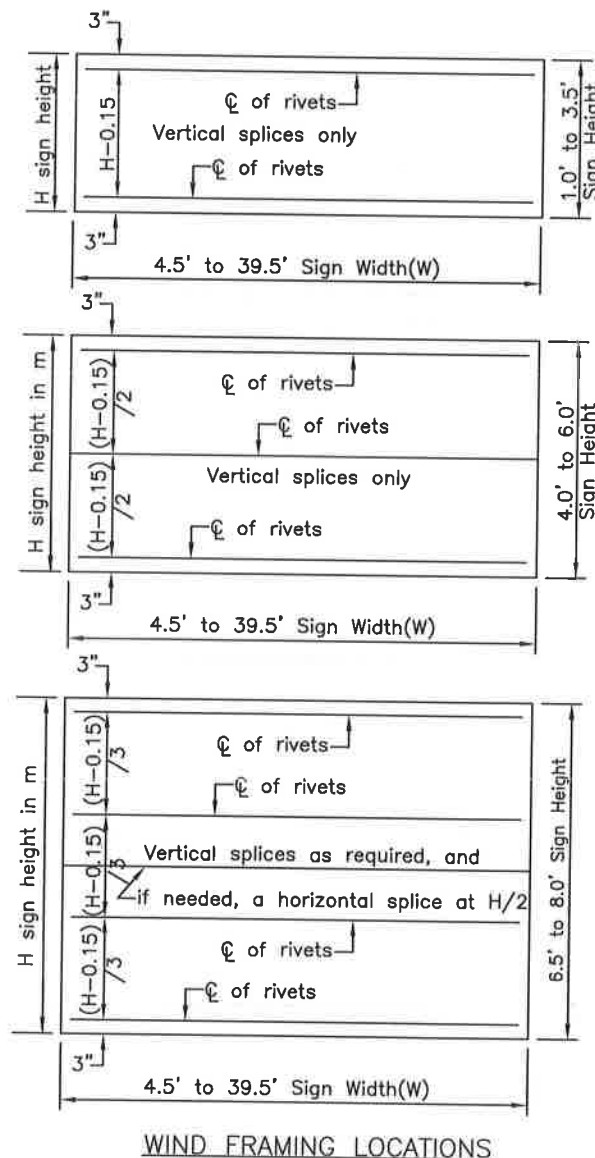

WIND FRAMING LOCATIONS

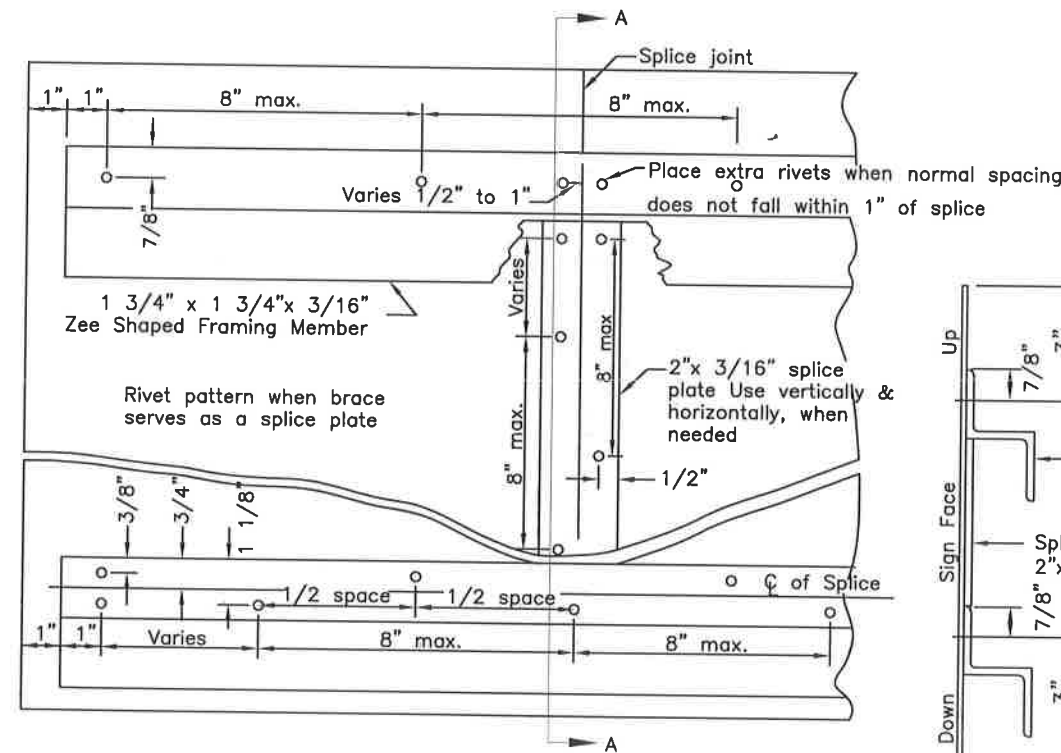

RIVET DETAIL FOR ZEE SHAPED WIND FRAMING & SPLICE PLATE

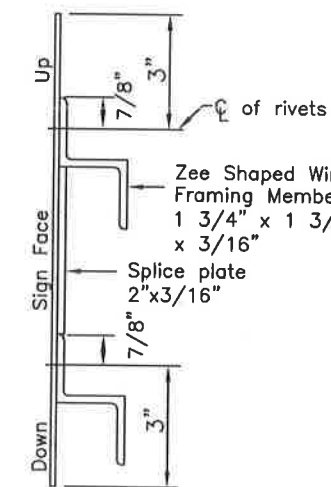

SECTION A-A

State of Alaska DOT&PF  
ALASKA STANDARD PLAN  
SIGN FRAMING AND  
POST SPACING


Adopted as an Alaska Standard Plan by: *Kenneth J. Fisher, P.E.*  
Kenneth J. Fisher, P.E.  
Chief Engineer

Adoption Date: 02/08/2019

Last Code and Stds. Review By: Date:


Next Code and Standards Review date: 02/08/2029



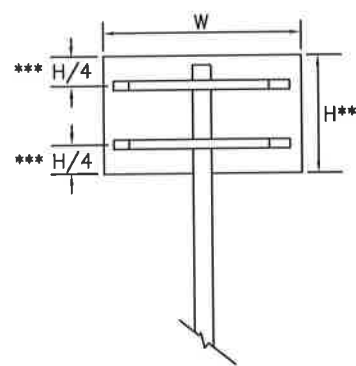


\*\*\* Use one brace when  $H \leq 18"$   
 Use two braces when  $18" < H < 48"$   
 Use three braces when  $H \geq 48"$   
 \*\* Position of brace may be varied to match  
 Pre-drilled mounting holes in panel


SIGN BRACING PLACEMENT

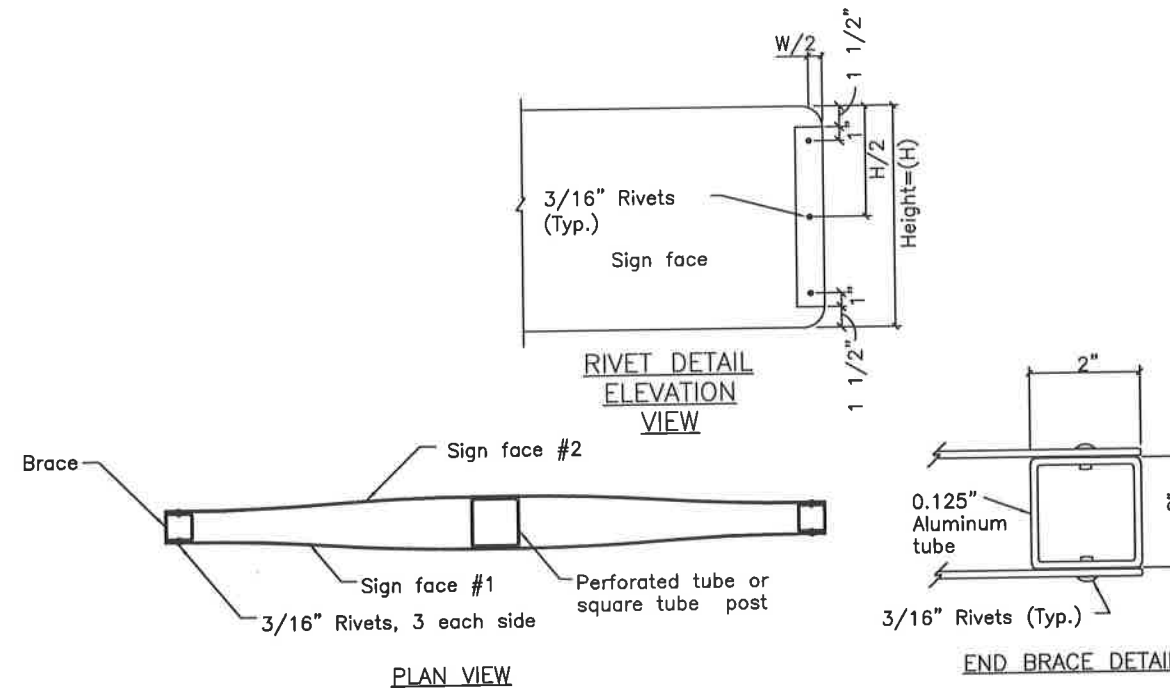

SMALL STREET NAME SIGN (D3-1, D3-1A, D3-1D) BRACING DETAILS

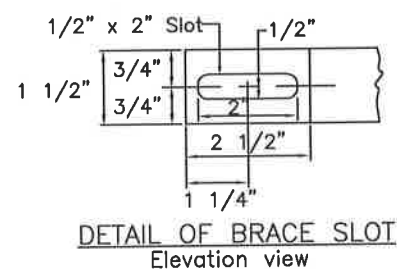

DETAIL OF BRACE SLOT  
Elevation view

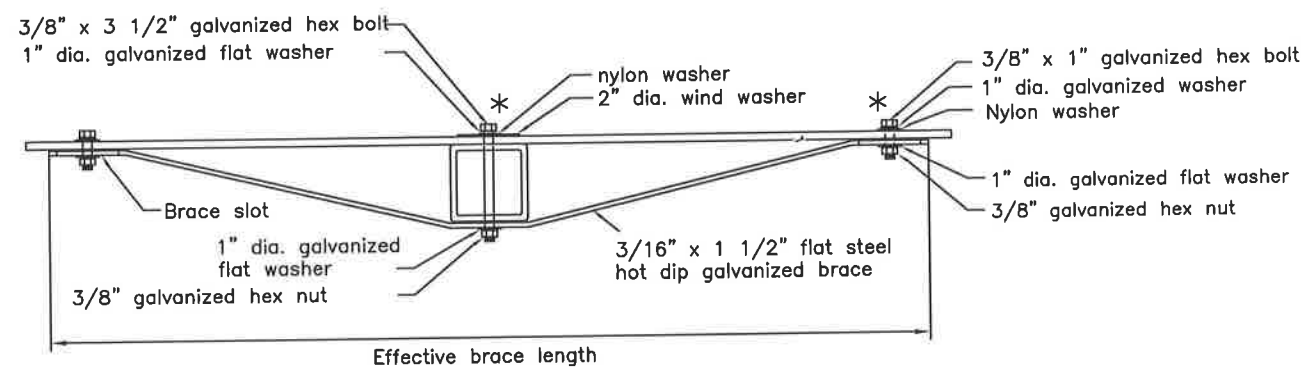

TUBE POST SIGN BRACING  
Plan view

\* Adjust location of bracing so that bolts and washers will miss the sign legend

Sign Width(W)	Effective Brace Length		
	Warning	Yield	Other
30"	36"	24"	24"
36"	42"	30"	30"
42"	48"	-	36"
48"	Two posts	36"	42"

< 30" No bracing required and use square tube

DRAWING NOT TO SCALE




State of Alaska DOT&PF  
 ALASKA STANDARD PLAN  
 BRACING FOR SIGNS  
 MOUNTED ON SINGLE POST

Adopted as an Alaska  
 Standard Plan by: *Kenneth J. Fisher*  
 Kenneth J. Fisher, P.E.  
 Chief Engineer

Adoption Date: 02/08/2019







Last Code and Stds. Review  
 By: Date:

Next Code and Standards Review date: 02/08/2029

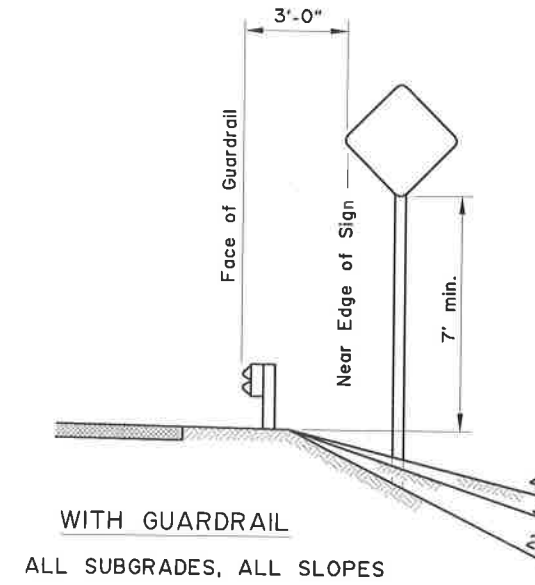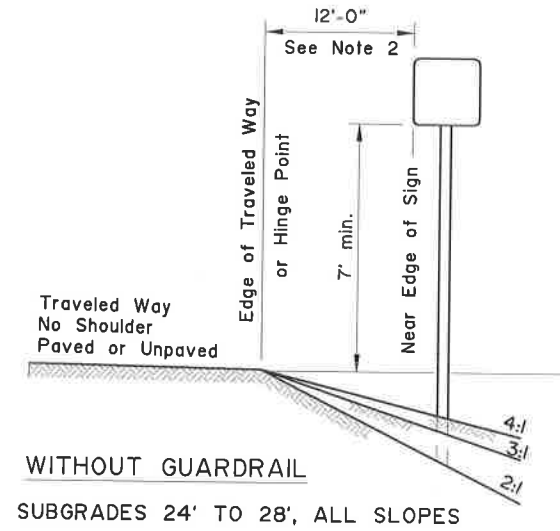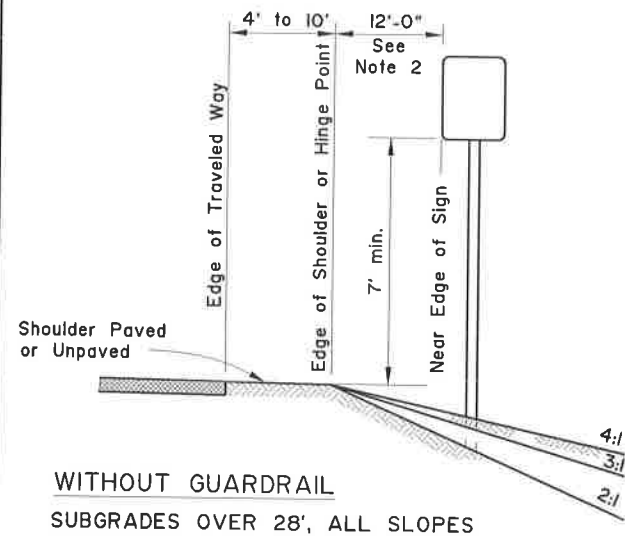

GENERAL NOTES

1. Unless shown otherwise on the plans, the standard sign offset is 12'. The minimum is 6'.
2. If signs extend over sidewalks, the minimum vertical clearance is 7'-0".
3. Add 6" to mounting height on unpaved roads.
4. If signs extend over bike paths, the minimum vertical clearance is 8' 0".
5. When signs are placed 30' or more from the edge of traveled way, mount them with the bottom of the sign at least 5' above the road surface at the near edge of the road.
6. When multiple hinged sign supports are used, mount hinges at least 7' above the ground.


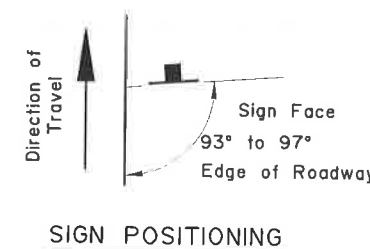
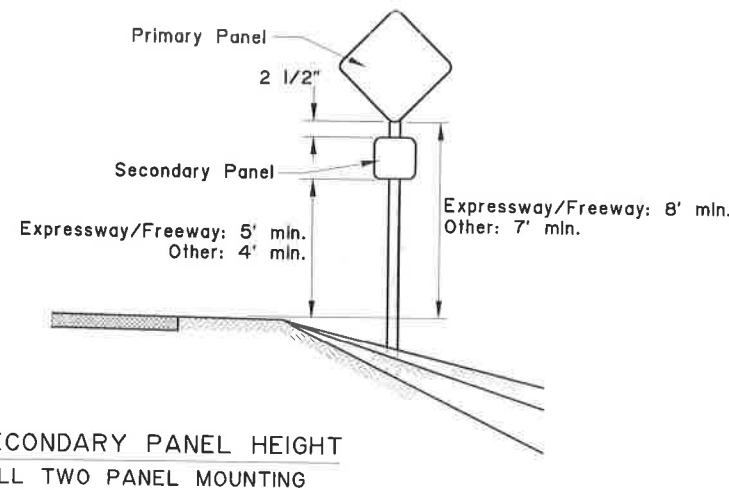
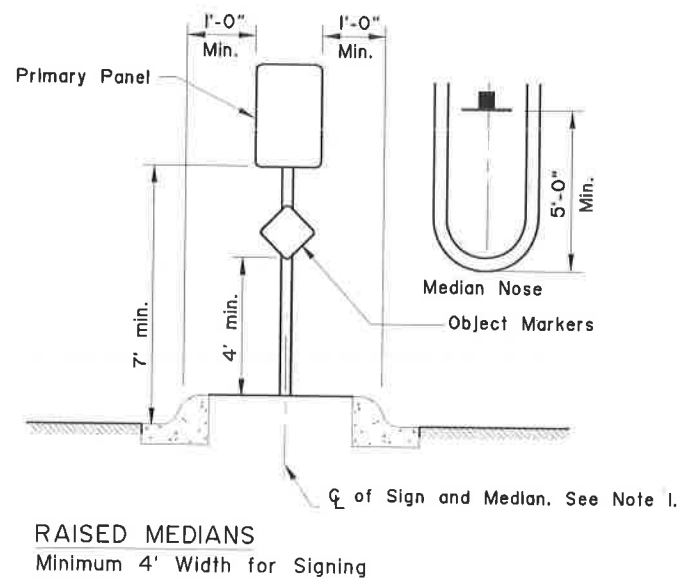
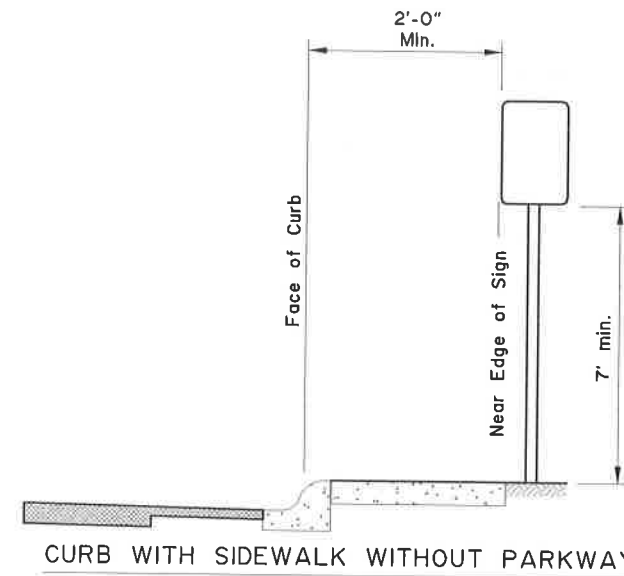
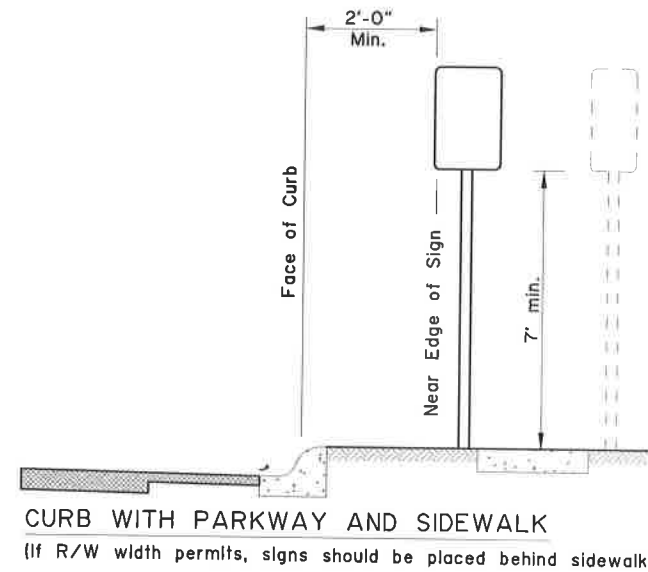
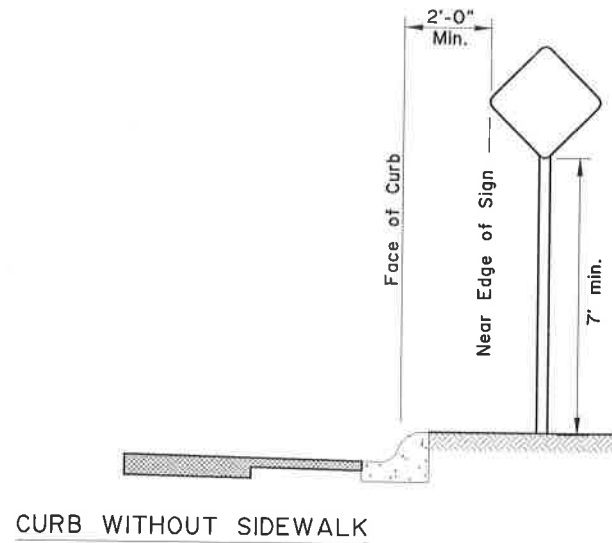


State of Alaska DOT&PF  
ALASKA STANDARD PLAN  
POST MOUNTED SIGN  
OFFSET AND HEIGHT

Adopted as an Alaska  
Standard Plan by: *Kenneth J. Fisher*  
Kenneth J. Fisher, P.E.  
Chief Engineer

Adoption Date: 02/08/2019

Last Code and Sids. Review  
By: Date:  
Next Code and Standards Review date: 02/08/2029

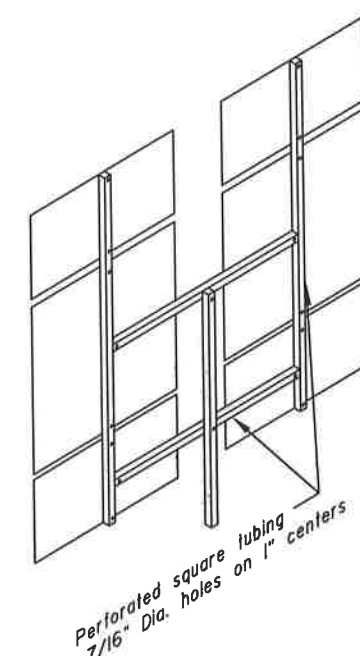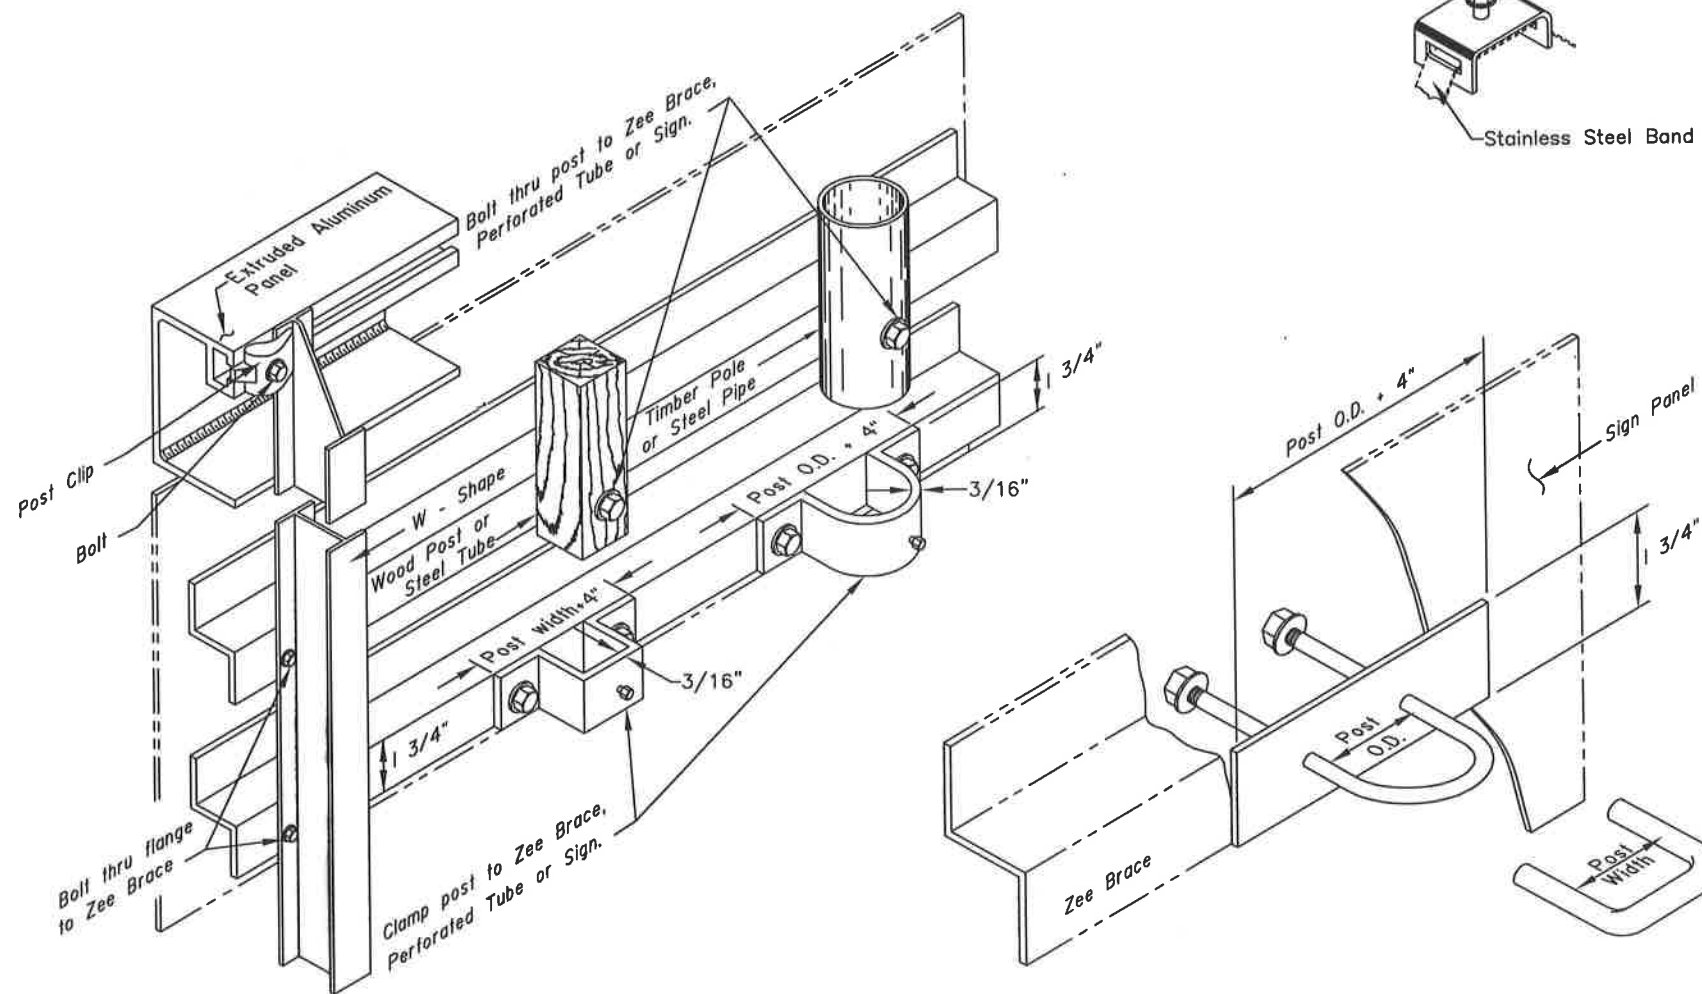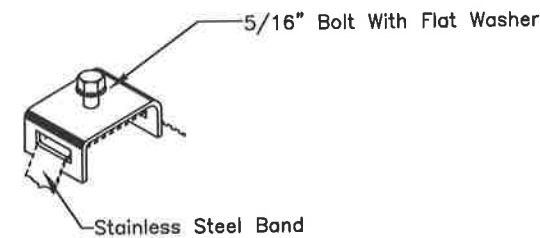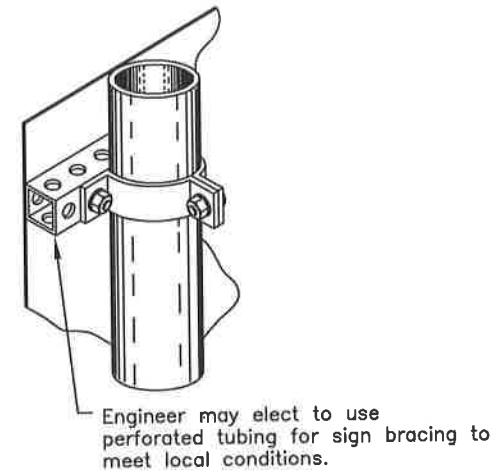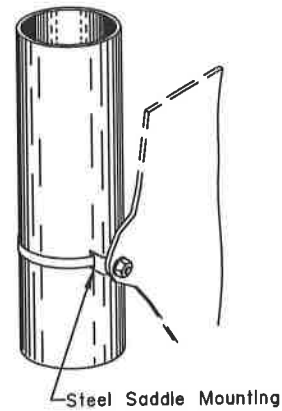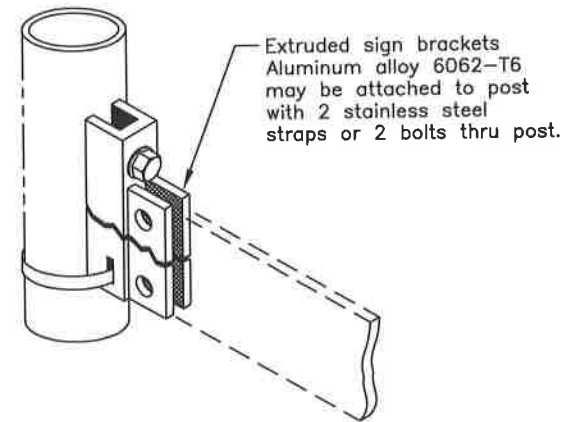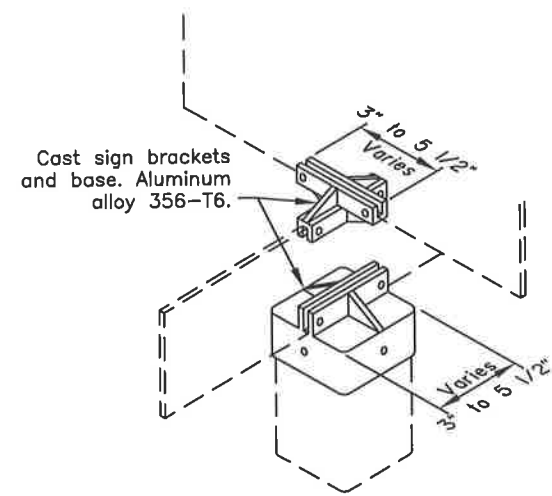

- GENERAL NOTES**
1. Details shown indicate general design only. Dimensions and design may vary among the manufacturers.
  2. Install weather tight caps on all pipe and tube post (except perforated tubing).
  3. Protect sign posts installed using driving methods with drive caps during installation.
  4. Bolt braces to posts at each point where they cross posts.
  5. Install signs with top of post, mounting brackets, etc. with a minimum of 3" below top of sign.
  6. Paint all sign mounting fasteners on sign face a color closely matching the sign face.
  7. Attach all signs, zeos and braces mounted to the posts with 5/16" bolts.
  8. Furnish all aluminum nuts, bolts and washers with anodized finish.

FASTENER SPECIFICATION TABLE				
FASTENERS		ALUMINUM	STEEL	STAINLESS STEEL
BOLTS	MACHINE CARRIAGE "U"	2024-T4	A-307	A-276
NUTS	REGULAR	6061-T6	A-307	A-276
	LOCK	2017-T4		
WASHERS		2024-T4	A-36	A-276
POST CLIP		356-T6		

State of Alaska DOT&PF  
ALASKA STANDARD PLAN  
SIGN TO SIGN POST CONNECTION


Adopted as an Alaska Standard Plan by: *Kenneth J. Fisher*  
Kenneth J. Fisher, P.E.  
Chief Engineer

Adoption Date: 02/08/2019

Last Code and Stds. Review By: Date:  
Next Code and Standards Review date: 02/08/2029

GENERAL NOTES


1. Use pole plate assemblies shown here to install signs on tapered mast arms and light poles. Install one pole plate per 10 square feet of sign panel. Use at least two plates for each installation.
  2. Fabricate each pole plate-to-perforated tube adapter (steel plate welded to pipe) using steel plate conforming to ASTM A36 and steel pipe conforming to ASTM A53. Paint these adapters in conformance with section 504 of the Standard Specifications for Highway Construction, latest edition.
  3. Paint the assemblies in accordance with AASHTO standard specification M69.
  4. Attach each pole plate with two bands of 3/4" wide by 0.020" thick stainless steel banding material. Double wrap each band and tighten it until the band stops moving through the buckle.
- Install bolts, nuts and washers conforming to
5. ASTM A325.

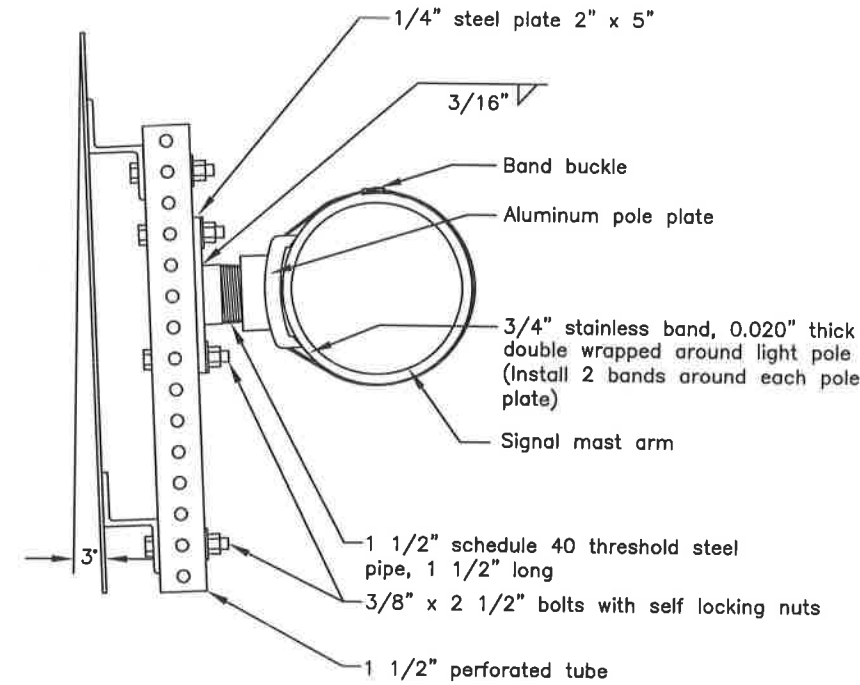


SIGNAL POLE MAST ARM SIGN MOUNTING  
(ELEVATION VIEW)

TABLE 1  
POLE PLATE SPACING

NO. OF POLE PLATES	OVERHANG	BETWEEN POLE PLATES	OVERHANG
2	0.2W	1 SPACE AT 0.6W	0.2W
3	0.15W	2 SPACES AT 0.35W	0.15W
4	0.125W	3 SPACES AT 0.25W	0.125W
5	0.2W	4 SPACES AT 0.6W	0.2W

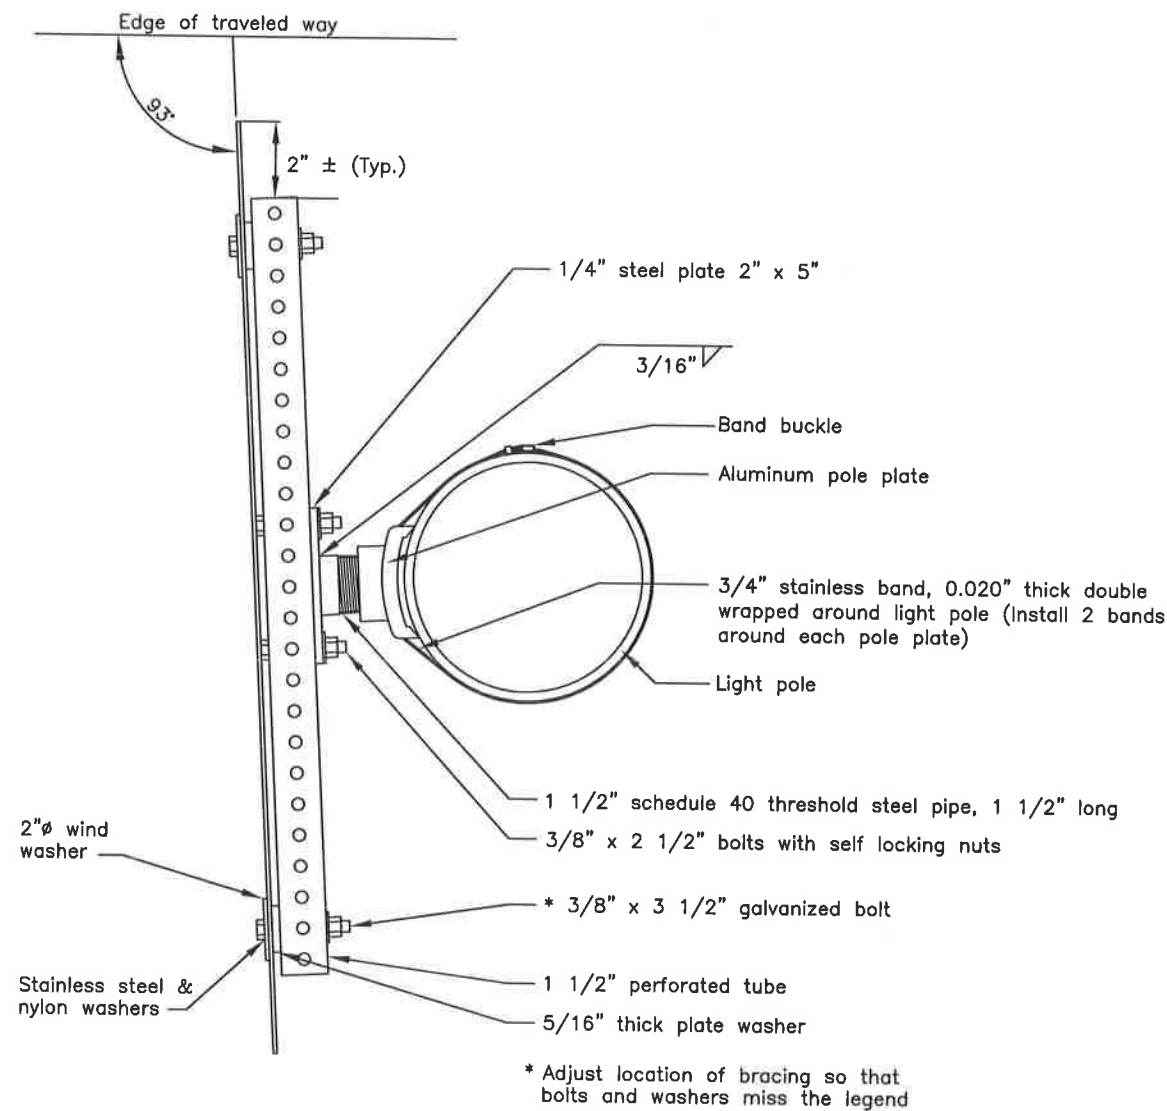

ELECTROLIER SIGN MOUNTING  
(PLAN VIEW)

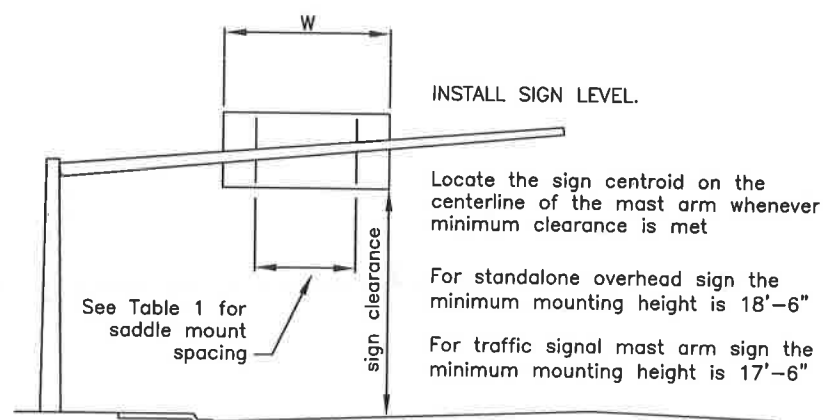


INSTALL SIGN LEVEL.

Locate the sign centroid on the centerline of the mast arm whenever minimum clearance is met

For standalone overhead sign the minimum mounting height is 18'-6"


For traffic signal mast arm sign the minimum mounting height is 17'-6"

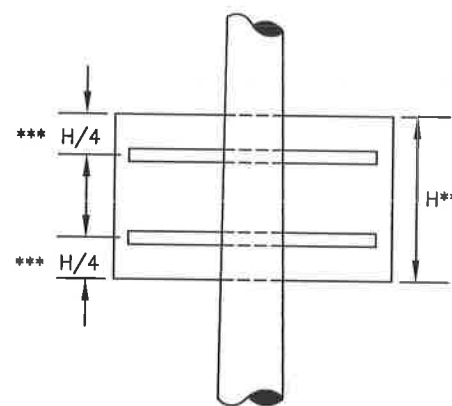

1 1/2" PT brace only when H ≤ 48"

\*\* Use two pole plates when H ≤ 48"  
use three pole plates when H > 48"

\*\*\* When sign panels features predrilled mounting holes, use them to attach the perforated tubes

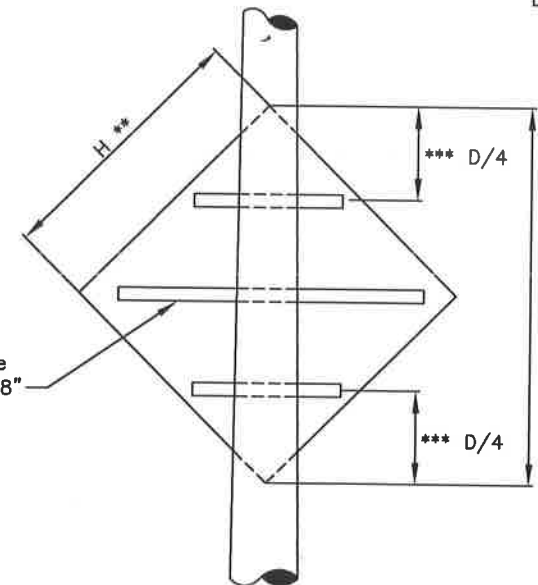

State of Alaska DOT&PF  
ALASKA STANDARD PLAN  
POLE AND MASTARM  
SIGN MOUNTING

Adopted as an Alaska Standard Plan by: *Kenneth J. Fisher*  
Kenneth J. Fisher, P.E.  
Chief Engineer




Adoption Date: 02/08/2019

Last Code and Sds. Review  
By: Date:

Next Code and Standards Review date: 02/08/2029

GENERAL NOTES:

1. Refer to Std Dwg S-00 for sign framing details.
2. See plans for type of post, size and embedment type.
3. To maintain crashworthiness, install no more than the number of P.S.T.s or wood posts specified in the tables within 7' of each other.
4. Do not install wood posts larger than 6"x8".
5. Do not use the supports on this drawing for multiple support signs if supports are separated by more than 7 feet.
6. Treat all field cuts and field drilled holes in wood posts in accordance with Section 730-2.04 of the Standard Specifications.

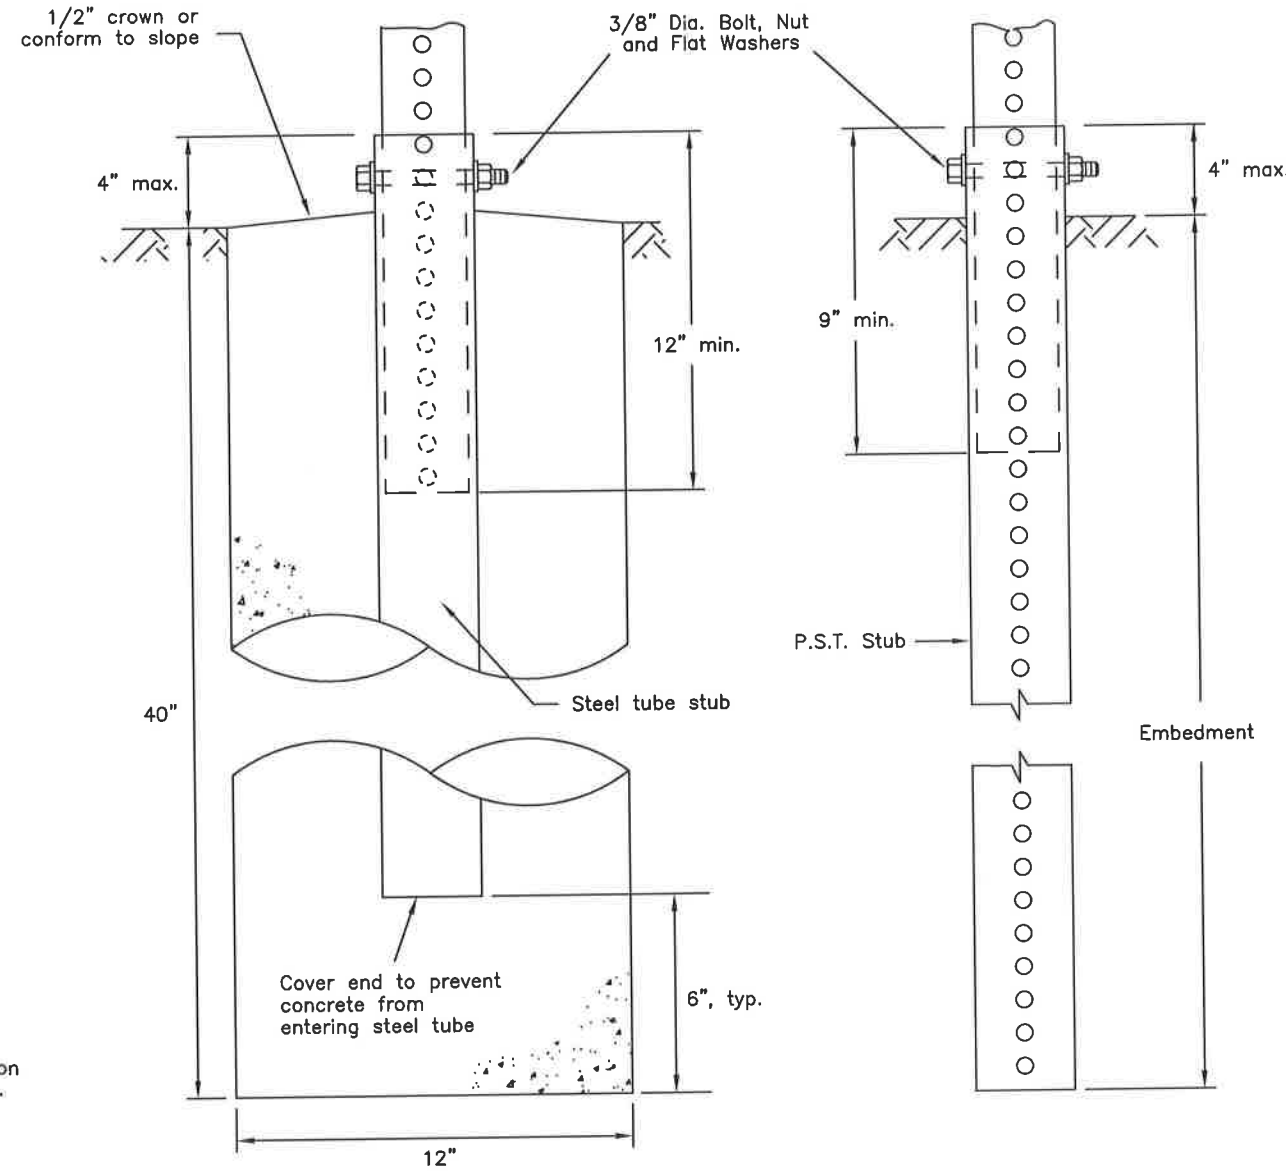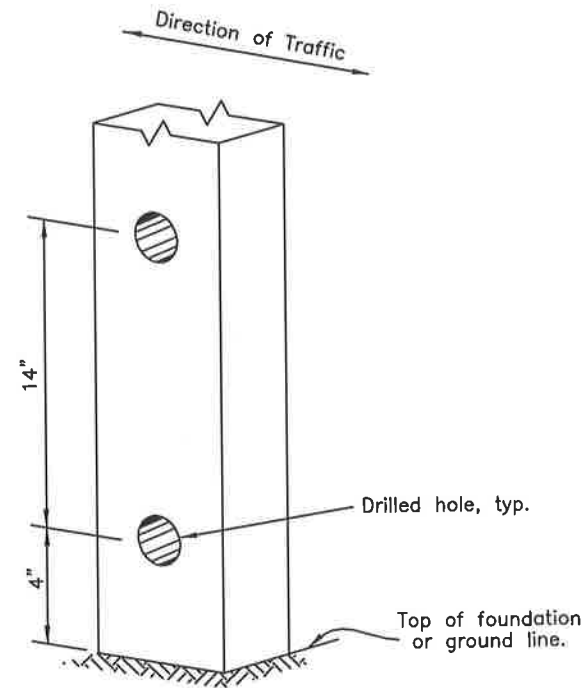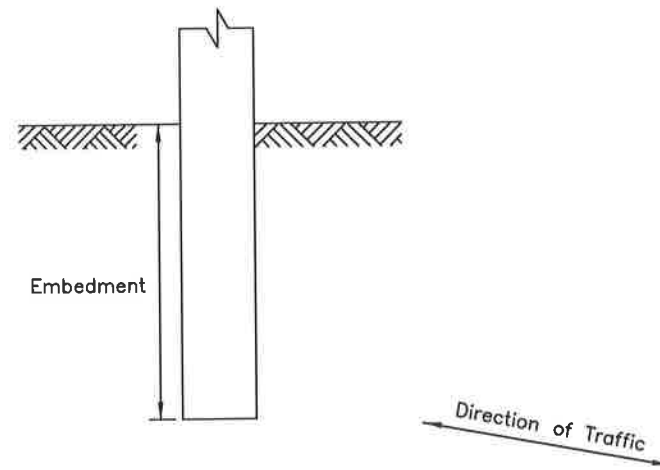

SLEEVE TYPE  
CONCRETE FOUNDATION

SLEEVE TYPE \*  
SOIL EMBEDMENT

WOOD SIGN POSTS			
SIZE	HOLE DIA.	EMBEDMENT*	NO. OF POSTS WITHIN 7 Ft. PATH
4"x4"	NONE	36"	2
4"x6"	1 1/2"	36"	2
6"x6"	1 1/2"	40"	1
6"x8"	3"	48"	1

\* Embedment depth applies in both strong and weak soil.

WOOD POSTS

PERFORATED STEEL TUBES (P.S.T.)		
POST SIZE	Embedment Depth	No. of P.S.T.s permitted within 7 ft path
1 1/2" x 1 1/2"	3'-0"	2
1 3/4" x 1 3/4"	3'-0"	2
2" x 2"	3'-6"	2
2 1/4" x 2 1/4"	4'-0"	1
2 1/2" x 2 1/2"	4'-6"	1

\* Use 3"x3"x3/16" Stub for 2 1/2"x2 1/2" PST Applications.

PERFORATED STEEL TUBE (PST) POSTS

State of Alaska DOT&PF  
ALASKA STANDARD PLAN  
LIGHT SIGN STRUCTURE  
POST EMBEDMENT



Adopted as an Alaska Standard Plan by: *Kenneth J. Fisher*  
Kenneth J. Fisher, P.E.  
Chief Engineer

Adoption Date: 02/06/2019

Last Code and Stds. Review  
By: Date:

Next Code and Standards Review date: 02/08/2029

**NOTE:**  
Install hinges when more than one post is used to support a sign. Do not install hinges on single post installations.

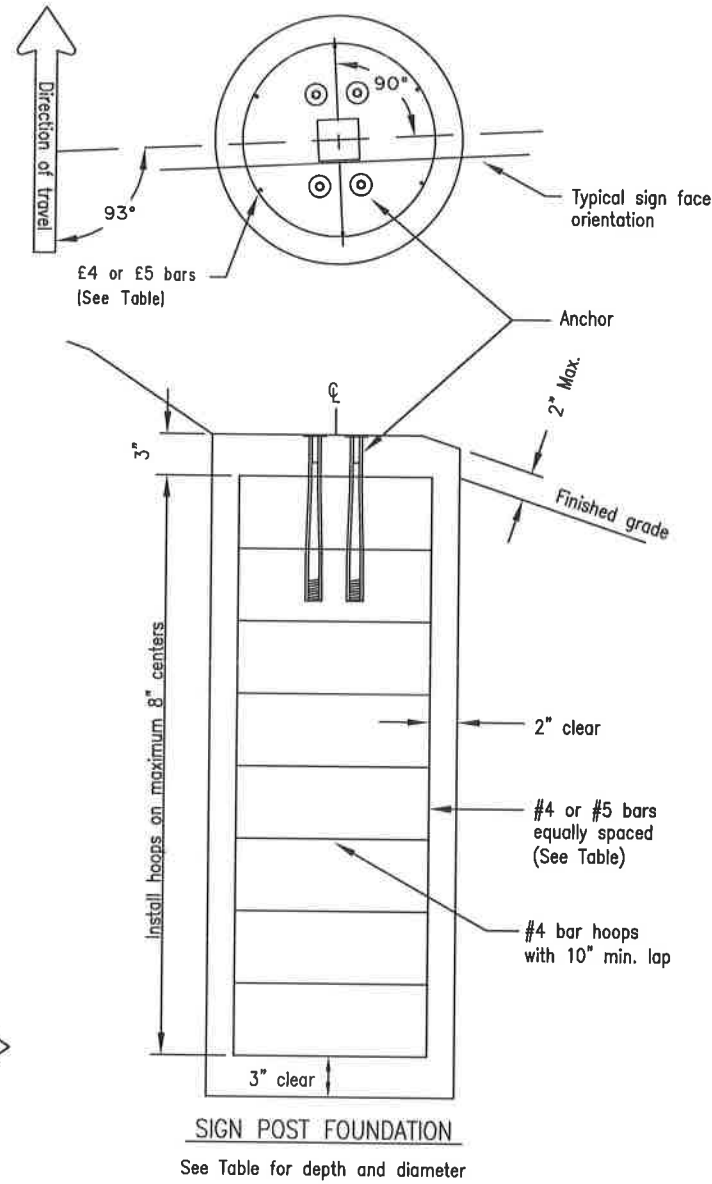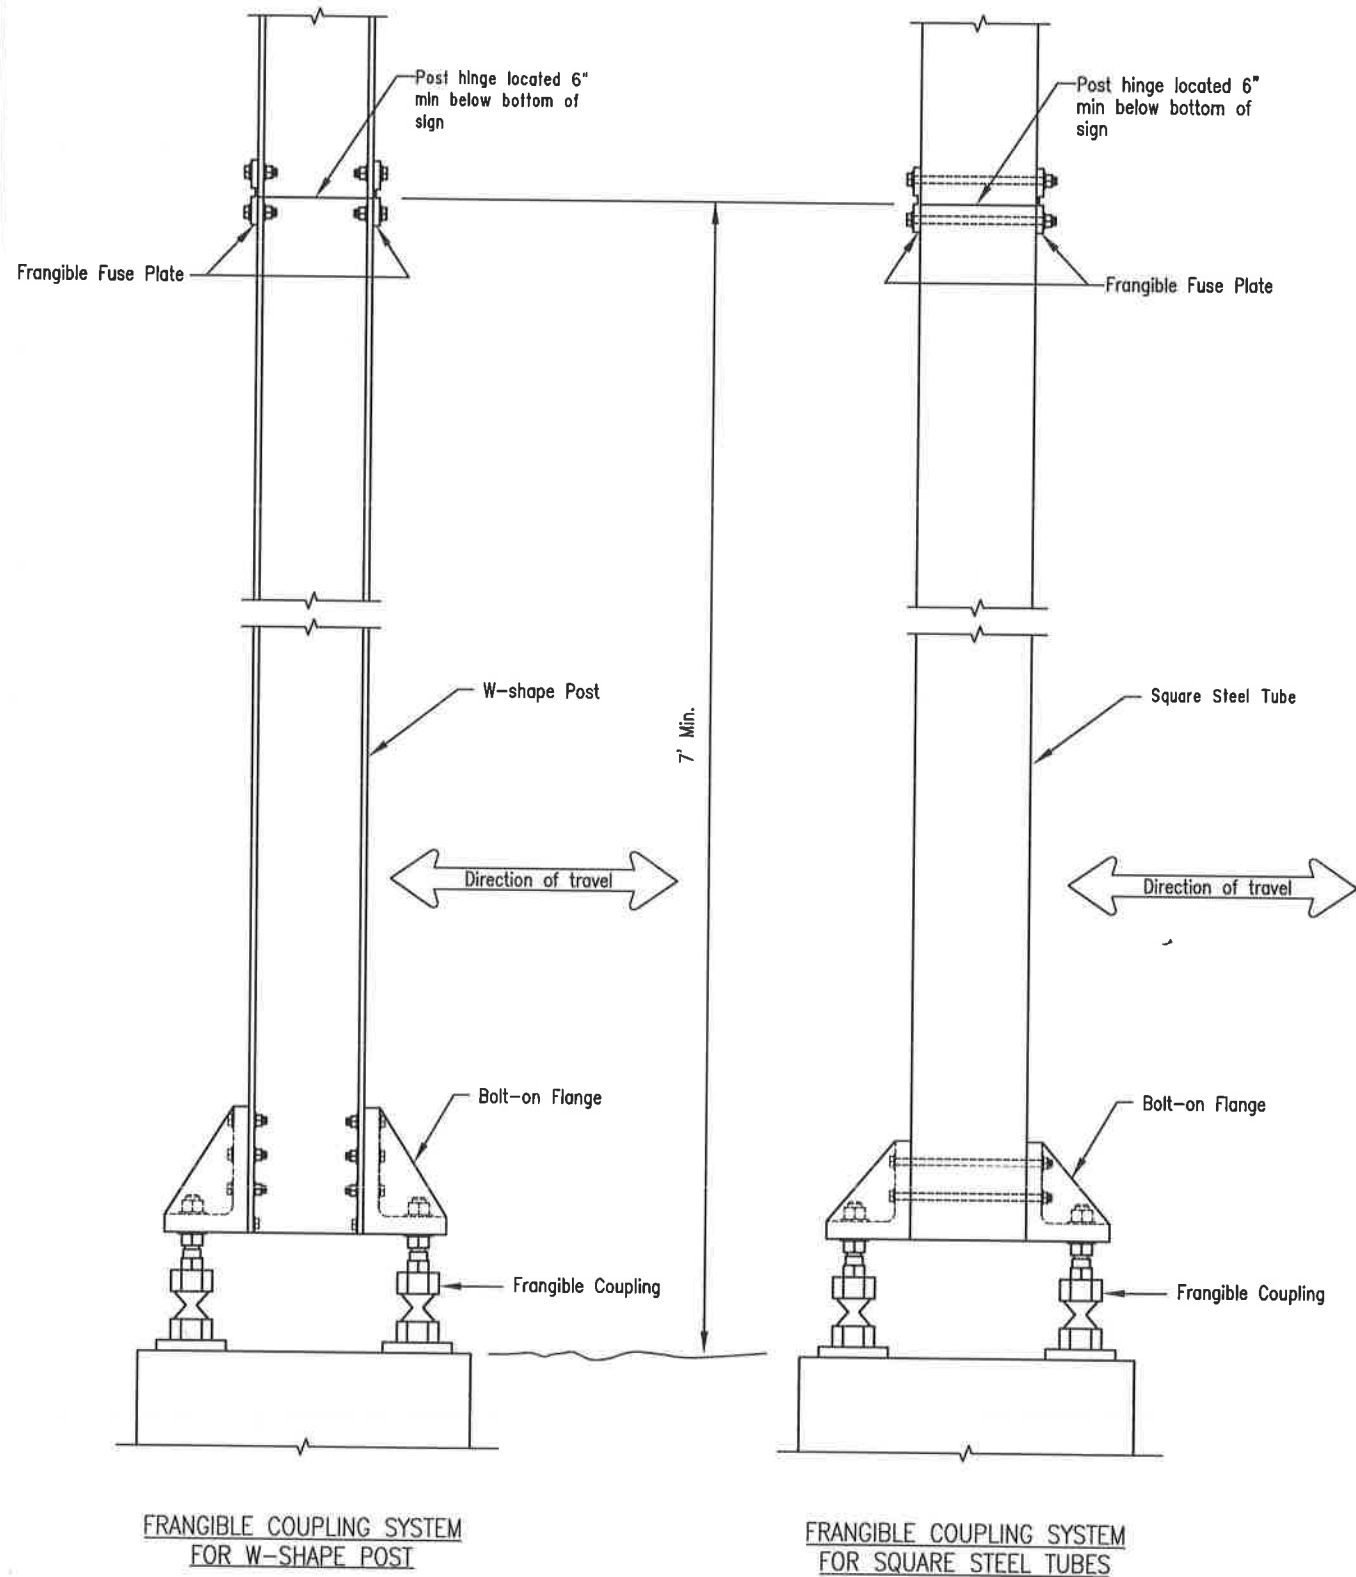

POST SIZE & TYPE	FOUNDATION *			REINFORCEMENT			
	DIA.	MIN. DEPTH	CY <sup>3</sup> CONC.	VERTICAL BARS QTY./SIZE	LGTH.	HOOPS QTY./SIZE	DIA.
2 1/2" TUBE	1'-6"	4'-0"	0.26	6 #4	3'-6"	7 #4	1'-2"
3" TUBE	1'-6"	4'-0"	0.26	6 #4	3'-6"	7 #4	1'-2"
3 1/2" TUBE	1'-6"	4'-6"	0.30	6 #4	4'-0"	8 #4	1'-2"
4" TUBE	2'-6"	4'-0"	0.72	7 #5	3'-6"	7 #4	2'-2"
4 1/2" TUBE	2'-6"	4'-6"	0.81	7 #5	4'-0"	8 #4	2'-2"
5" TUBE	2'-6"	5'-6"	1.00	7 #5	5'-0"	9 #4	2'-2"
W6 x 9	2'-6"	4'-0"	0.95	8 #5	3'-6"	7 #4	2'-2"
W6 x 12	2'-6"	4'-6"	1.07	8 #5	4'-0"	8 #4	2'-2"
W6 x 15	3'-0"	6'-6"	1.69	8 #5	6'-0"	11 #4	2'-8"
W6 x 30	3'-0"	7'-6"	1.95	8 #5	7'-0"	12 #4	2'-8"

FOUNDATION TABLE

\* Foundations sized for use where there are no loose, high moisture, or fine grained soils.

**GENERAL NOTES**

1. Furnish sign posts with NCHRP 350 or MASH compliant FHWA-approved frangible couplings designed to break away safely when struck from any direction. The frangible couplings shall not have specific installation torque requirements.
2. Furnish frangible coupling systems with bolt-on flanges.
3. Details on this sheet illustrate only the general components of a frangible coupling system, and are not intended to specify a particular product.
4. Install frangible fuse plates as specified by the manufacturer and hinged joints when multiple posts are used to support a sign. Do not use round pipes.
5. Install the components of the breakaway system, including hinges, in accordance with the written instructions of the system manufacturer.
6. Use Class A concrete conforming to section 501 of the Standard Specifications. Furnish ASTM A615 grade 60 steel bars for concrete reinforcement conforming to AASHTO M31.
7. Spiral reinforcing steel may be substituted for hoops in concrete foundation. Spiral option shall consist of #3 plain spiral with 6" pitch with three flat turns at the top and one flat turn at the bottom.
8. Install the concrete anchors using a rigid template. Locate the anchors on centers and within tolerances specified by the manufacturer.
9. Install the anchors in fresh concrete as recommended by the manufacturer. Adjust the template's final position until it is level. Remove and replace all foundations that need more than 2 shims under any 1 coupling or more than a total of 3 shims under any pair of couplings to plumb the post.
10. Drill the holes for attaching brackets before the sign posts are hot dip galvanized. Test fit templates in the holes to ensure the brackets can be installed square to the posts.

State of Alaska DOT&PF  
ALASKA STANDARD PLAN  
SIGN POST BASE AND  
FOUNDATION

Adopted as an Alaska Standard Plan by: *Kenneth J. Fisher, P.E.*  
Kenneth J. Fisher, P.E.  
Chief Engineer

Adoption Date: 02/08/2019


Last Code and Stds. Review  
By: Date:

Next Code and Standards Review date: 02/08/2029


GENERAL NOTES

1. Install recessed pavement markers spaced at 80' on tangent sections of roadway and on curves with a radius greater than 1,600'.
2. Install recessed pavement markers spaced at 40' on curves with a radius 1,600' or less.
3. Install recessed pavement markers between the lines on sections with double lines (either broken or solid.)
4. Increase the distance between yellow painted lines from the standard 3" up to a maximum of 5" to minimize paint overspray onto the marker.
5. Install recessed pavement markers on the centerline of the line, midpoint between stripe segments on sections with single broken lines.
6. Install reflectors of the same color as the pavement markings they supplement, except when red reflectors are specified on the departure side of markers on one-way roads to warn motorists they are going the wrong way.
7. Unless otherwise specified on one-way roads, reflectors are required only on the approaching traffic side of markers. In these cases, the 2'-6" taper may be omitted on the departure side.


Make groove deep enough to put the top of marker 1/16" below pavement surface.

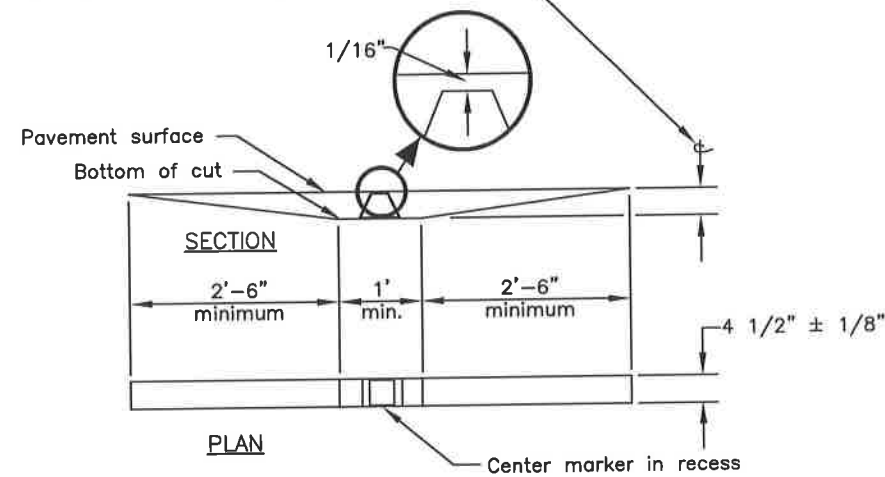


RECESSED PAVEMENT MARKER SLOT

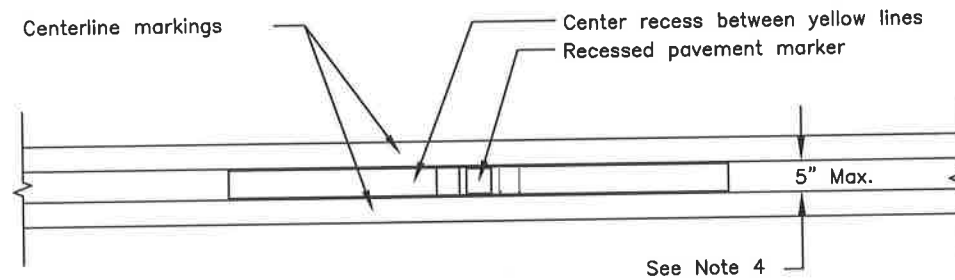

RECESSED PAVEMENT MARKERS WITH DOUBLE CENTERLINE INSTALLATION

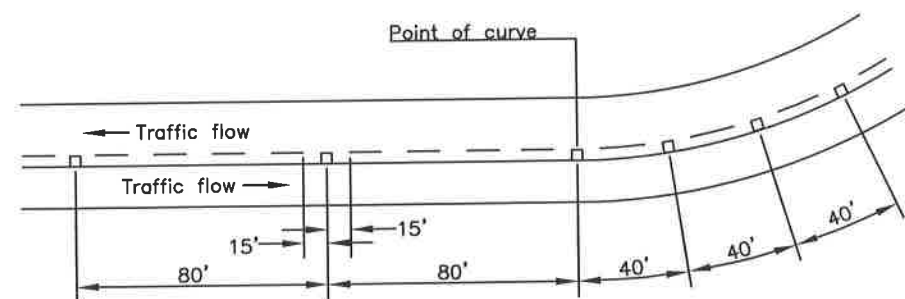

RECESSED PAVEMENT MARKERS ON CURVES WITH A RADIUS LESS THAN 1,600'

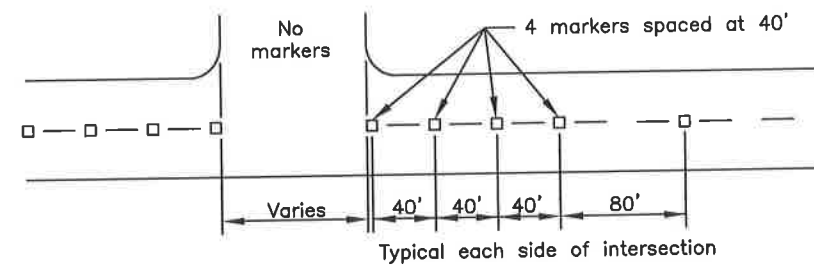

RECESSED PAVEMENT MARKERS AT INTERSECTION APPROACHES






State of Alaska DOT&PF  
ALASKA STANDARD PLAN  
RECESSED PAVEMENT MARKERS

Adopted as an Alaska Standard Plan by: *Kenneth J. Fisher*  
Kenneth J. Fisher, P.E.  
Chief Engineer

Adoption Date: 02/08/2019

Last Code and Stds. Review  
By: Date:

Next Code and Standards Review date: 02/08/2029

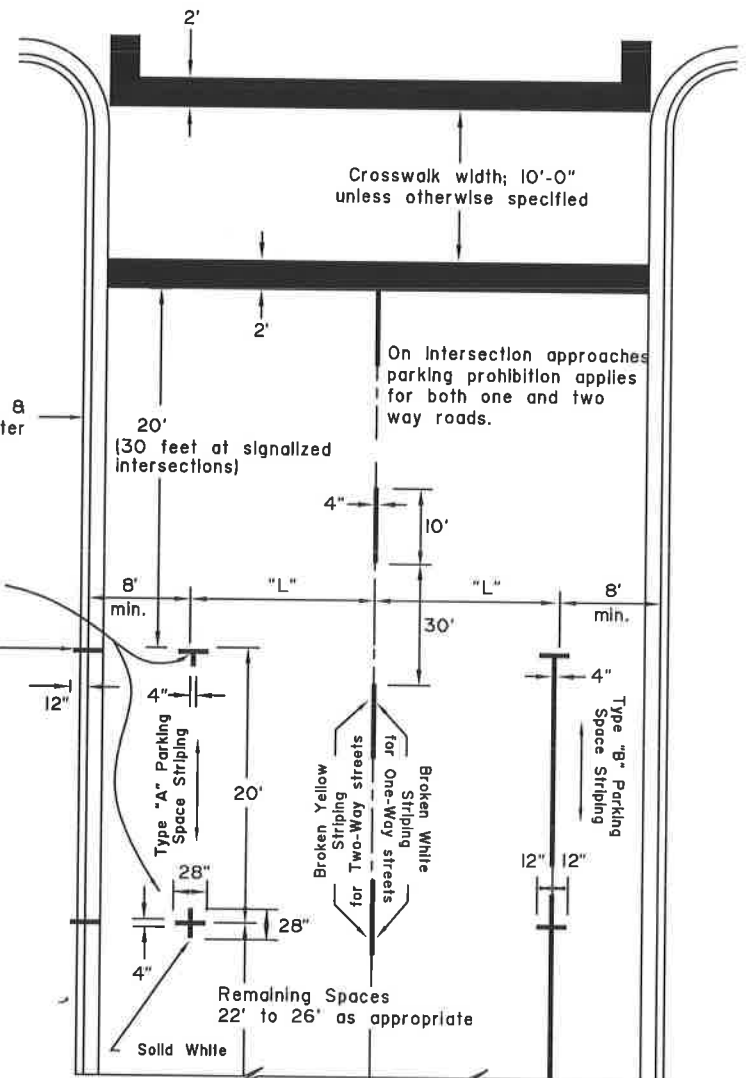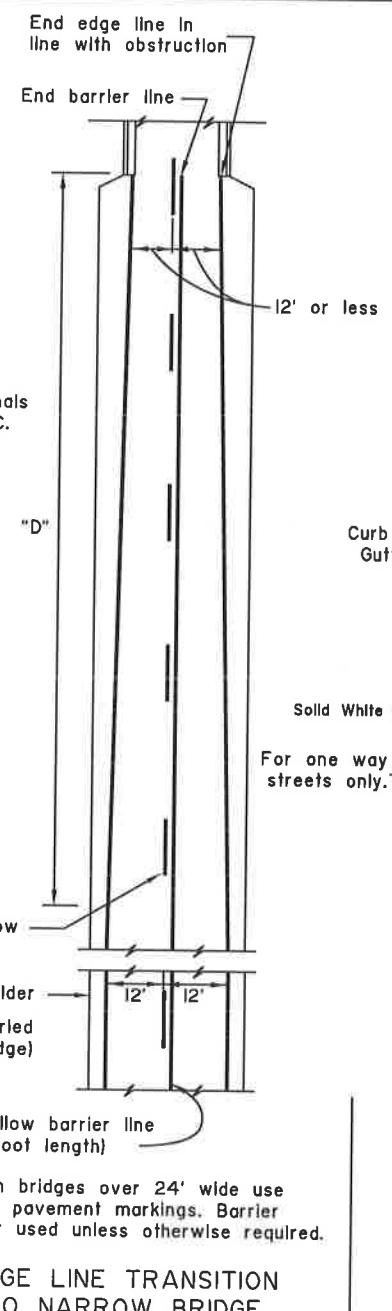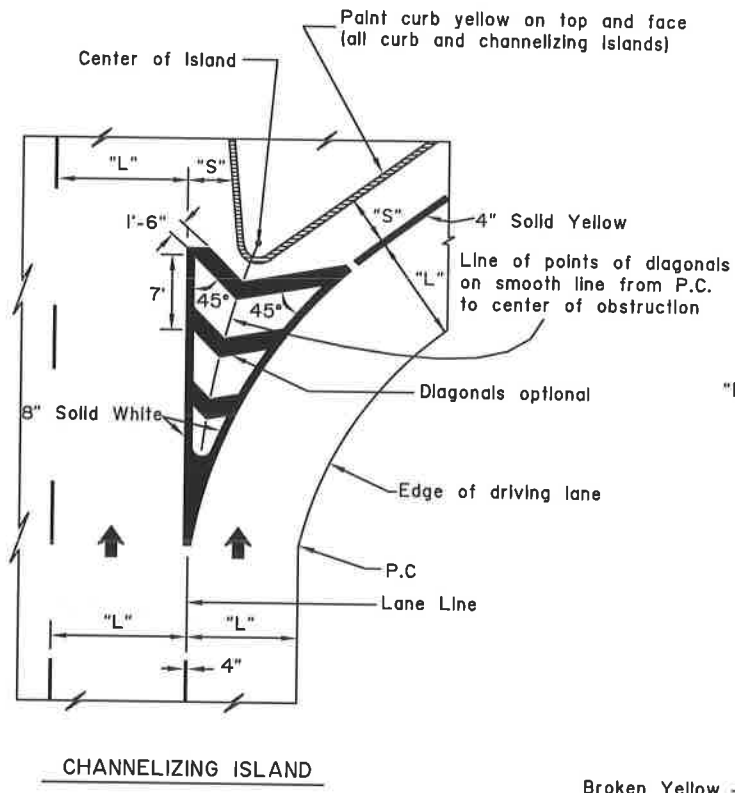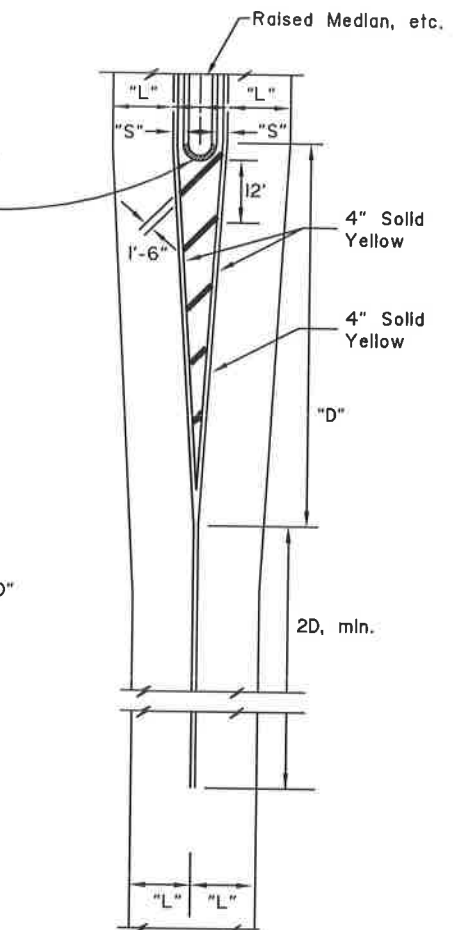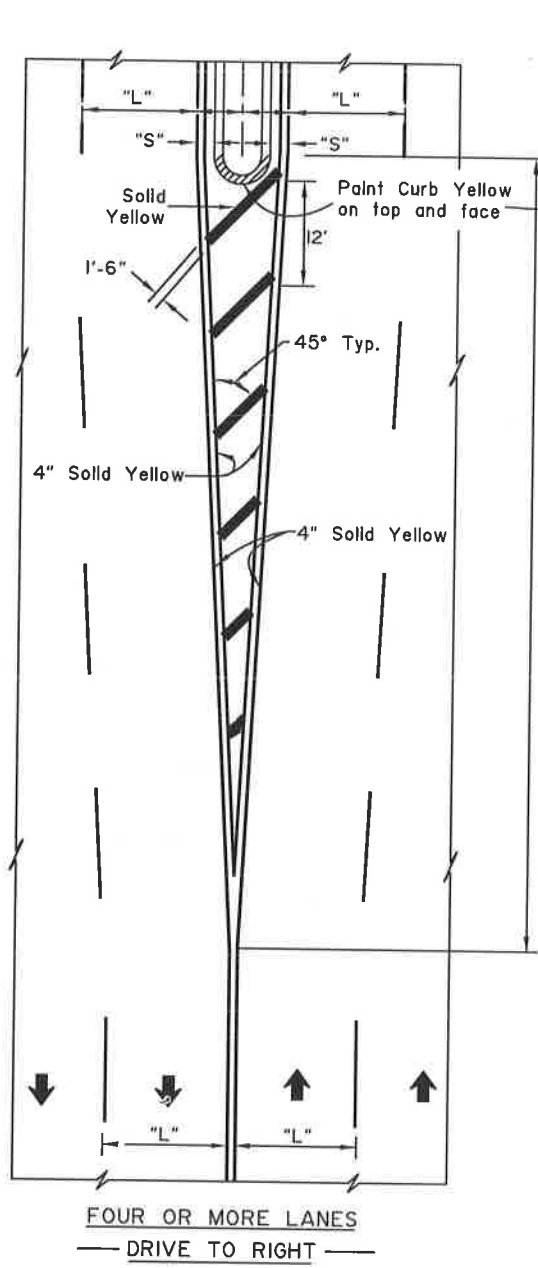

**TWO LANES DRIVE TO RIGHT**  
White longitudinal and diagonal markers identical to Four Lane Arrangement.

**NOTES:** "D" = Speed limit (mph) X "S" (offset width in feet) or as indicated on the plans. Minimum "D" = 100 feet urban, 200 feet rural.


4" Solid yellow barrier line (500 foot length)  
Note: On bridges over 24' wide use standard pavement markings. Barrier lines not used unless otherwise required.

**CENTERLINES FOR TWO LANE TWO WAY URBAN ROADS-PARKING LIMIT LINES**

**RAILROAD CROSSING NOTES:**

- All markings solid white unless indicated otherwise.
- On 4-lane roadways place railroad crossing approach markings in each lane of the approach.
- Locate Stop Bar 15' from railroad track or 8' from gate, if present.
- Place edge lines and lane lines on a uni-directional approach in a normal manner except that the lane line(s) shall be solid 4" white in lieu of broken for a distance of (D+60') in advance of the stop bands.

POSTED LIMIT	D
30 M.P.H.	225'
40	350'
50	475'
60	625'

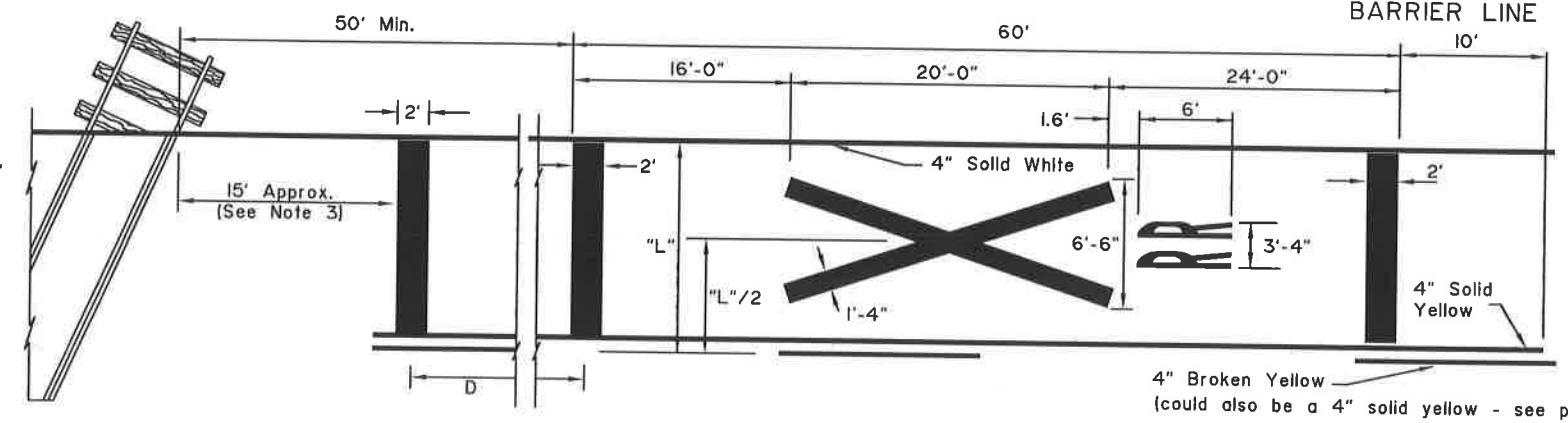

**APPROACH TO RAILROAD CROSSING ON 2 LANE 2 WAY HIGHWAY**

**GENERAL NOTES:**

- "S" = offset distance as shown on the plans, otherwise 1 to 2 feet.
- "L" = driving lane width.
- See the Alaska Traffic Manual for additional guidance and/or restrictions on the use of traffic control devices.

NOT TO SCALE


State of Alaska DOT&PF  
ALASKA STANDARD PLAN  
PAVEMENT MAKING APPLICATIONS

Adopted as an Alaska Standard Plan by: *Kenneth J. Fisher, P.E.*  
Kenneth J. Fisher, P.E.  
Chief Engineer


Adoption Date: 02/08/2019

Last Code and Stds. Review By: \_\_\_\_\_ Date: \_\_\_\_\_  
Next Code and Standards Review date: 02/08/2029




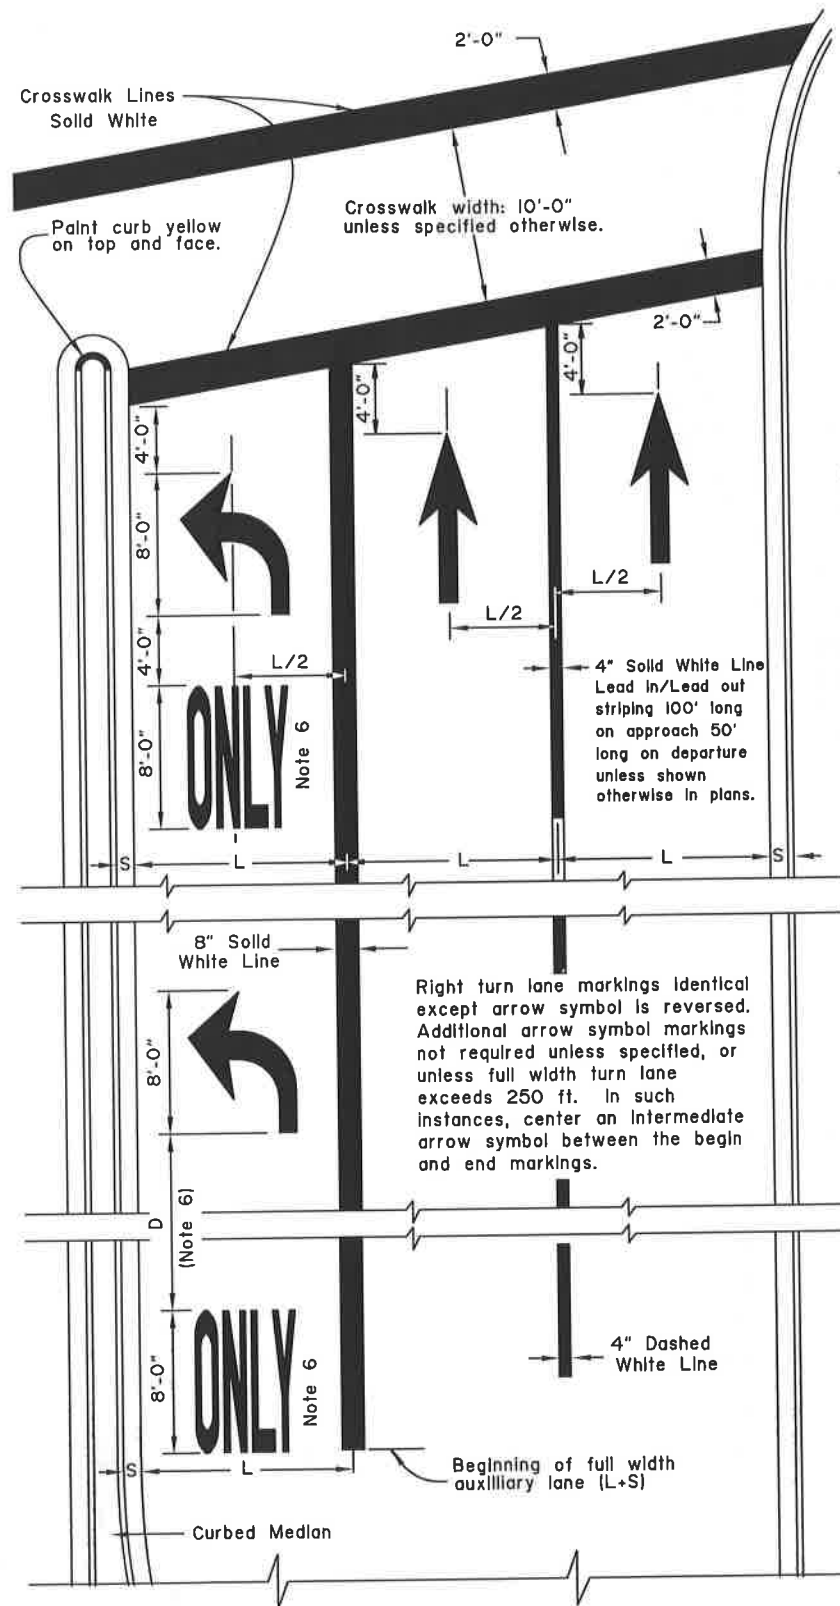


APPROACH TO INTERSECTION

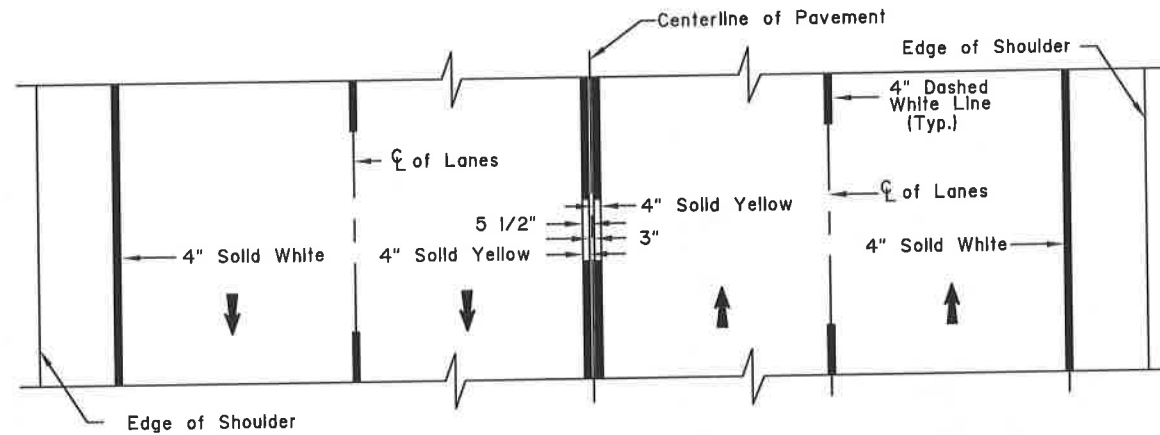


FOUR LANE TWO WAY

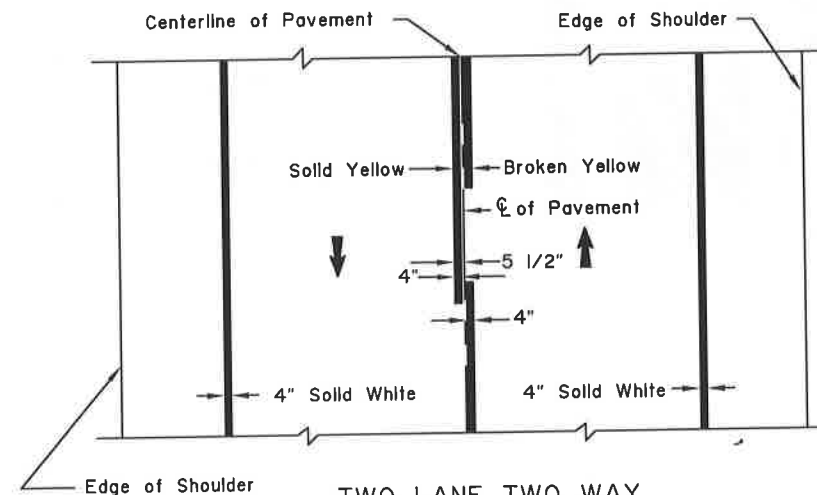


TWO LANE TWO WAY

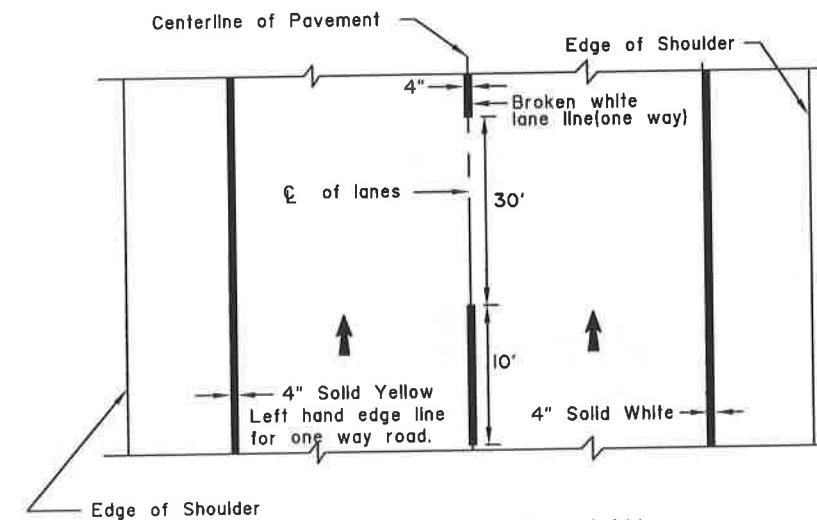

TWO LANE ONE WAY

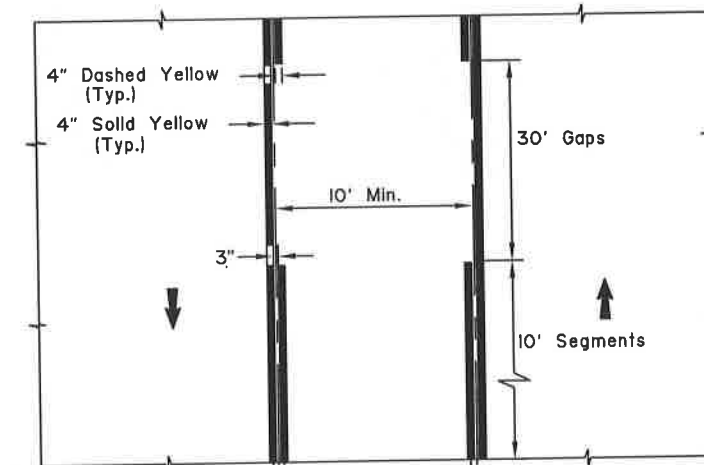

TWO-WAY LEFT TURN LANE

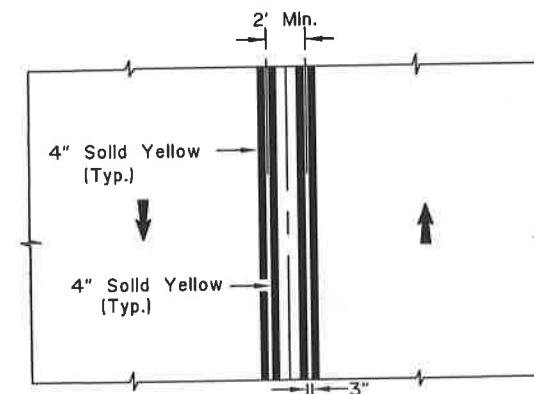

STRIPED MEDIAN

GENERAL NOTES:

1. All markings white unless indicated otherwise.
2. Lengths of stripe and gap for lane and center lines identical.
3. Lane lines for auxiliary lanes are unbroken solid lines.
4. "L" = driving lane width.
5. "S" = shy distance as shown on plans, otherwise 1 to 2 feet.
6. ONLY markings are required where through lanes change to turn lanes. In other cases, apply ONLY markings as indicated on plans.
7. See ALASKA TRAFFIC MANUAL for additional instruction on the use of TRAFFIC CONTROL DEVICES.
8. 6. Adjust distance D between ONLY and Turn Arrow based on SPEED vs. D table.

SPEED	D
25 or less	35'
30	45'
35	50'
40	60'
45	65'
50	75'
55 or more	80'

State of Alaska DOT&PF  
ALASKA STANDARD PLAN  
PAVEMENT MAKING  
APPLICATIONS

Adopted as an Alaska  
Standard Plan by: *Kenneth J. Fisher*  
Kenneth J. Fisher, P.E.  
Chief Engineer




Adoption Date: 02/08/2019

Last Code and Stds. Review  
By: Date:

Next Code and Standards Review date: 02/08/2029


GENERAL NOTES:

1. All symbols shown shall be white and reflectorized in accordance with the Special Provisions.
2. See the Alaska Sign Design Specifications (ASDS) for lettering and symbols for pavement marking details not provided on this drawing.

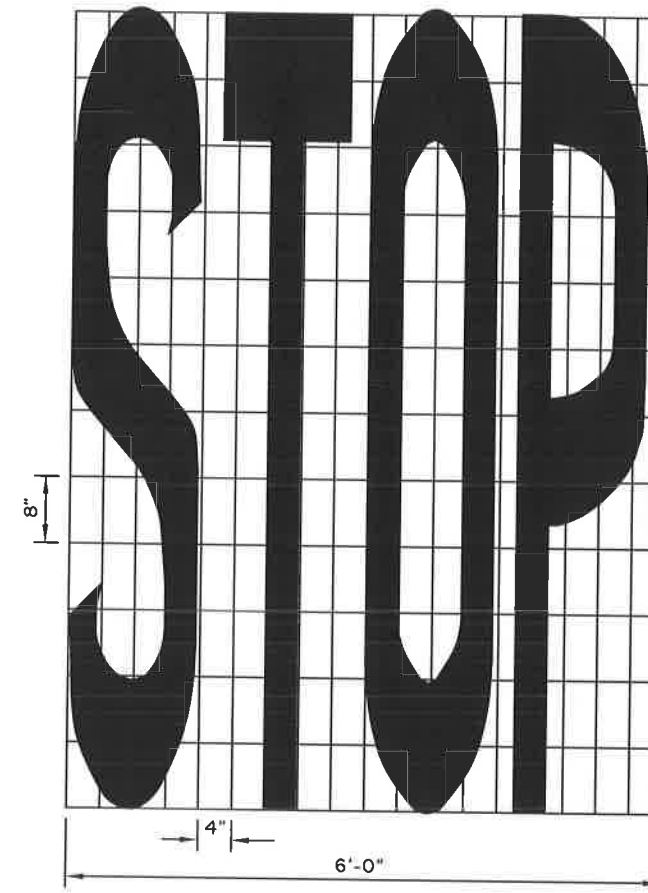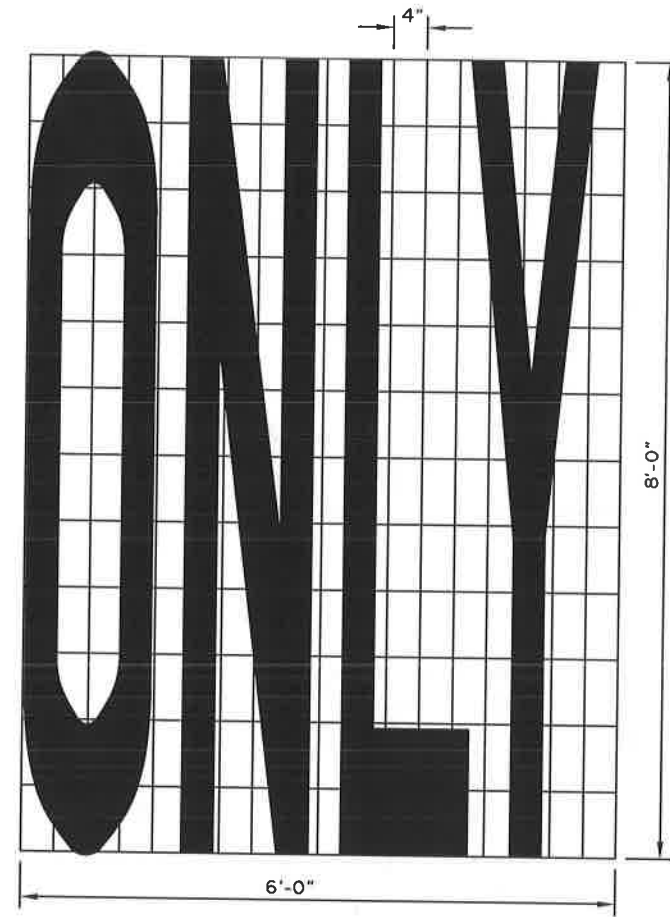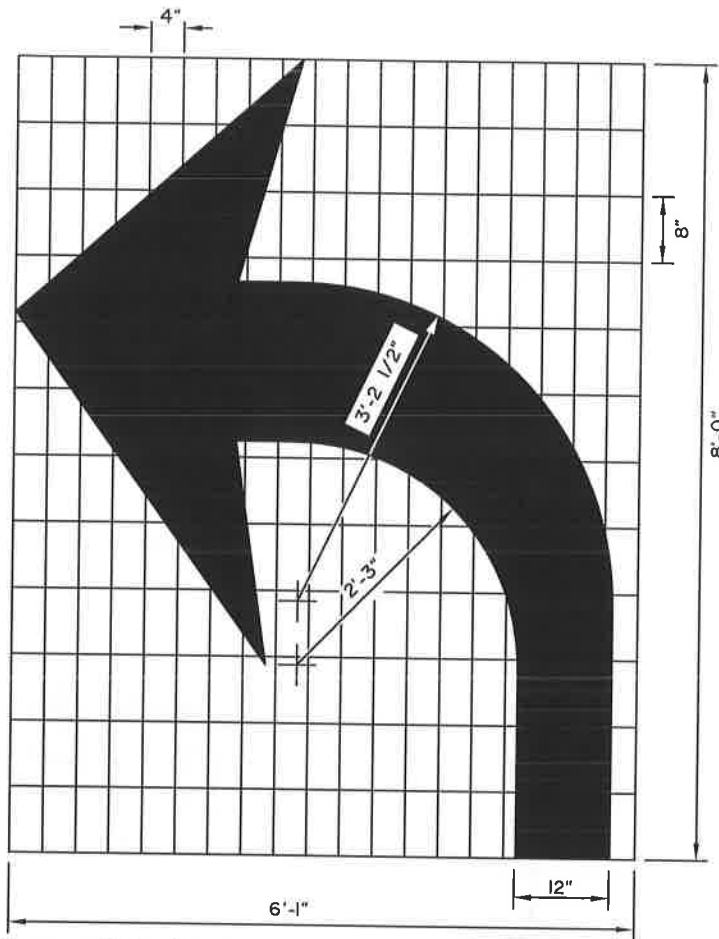


Right turn auxillary lane usage markings identical except arrow symbol is reversed.


LAYOUT TEMPLATES FOR STENCILS

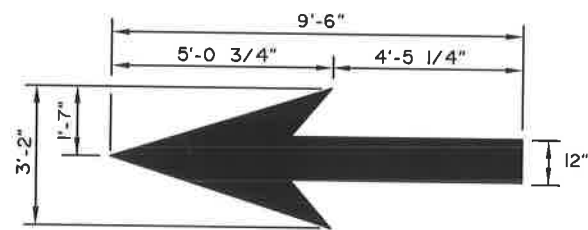


STRAIGHT AHEAD ARROW

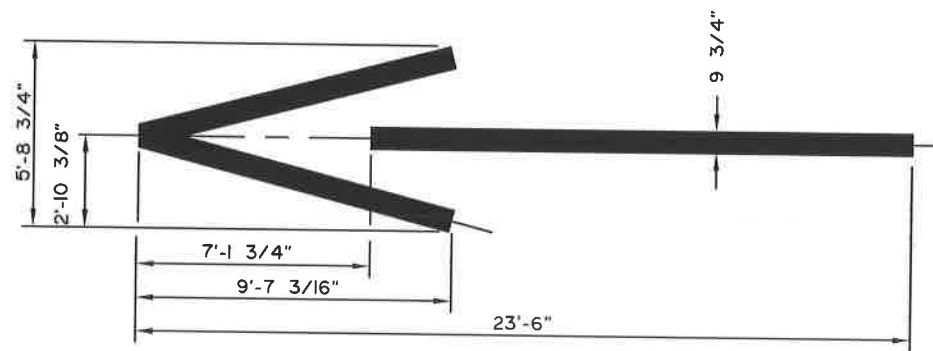

WRONG WAY ARROW

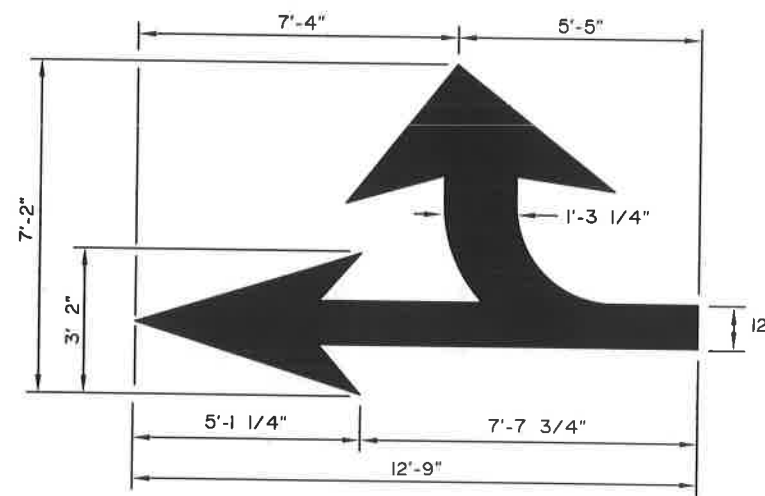

COMBINATION ARROW

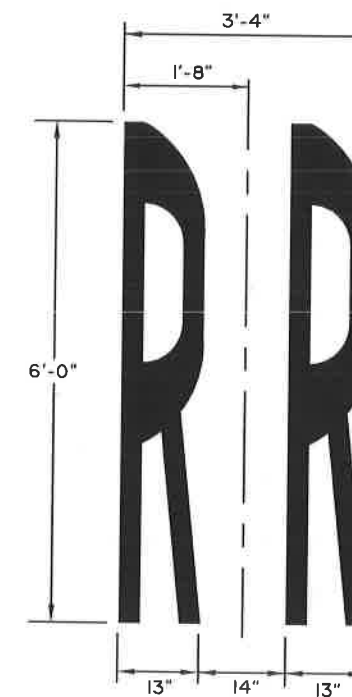

RAILROAD SYMBOL

State of Alaska DOT&PF  
ALASKA STANDARD PLAN


PAVEMENT MARKING  
SYMBOL DIMENSIONS

Adopted as an Alaska Standard Plan by: *Kenneth J. Fisher*  
Kenneth J. Fisher, P.E.  
Chief Engineer

Adoption Date: 02/08/2019

Last Code and Sds. Review  
By: Date:


Next Code and Standards Review date: 02/08/2029

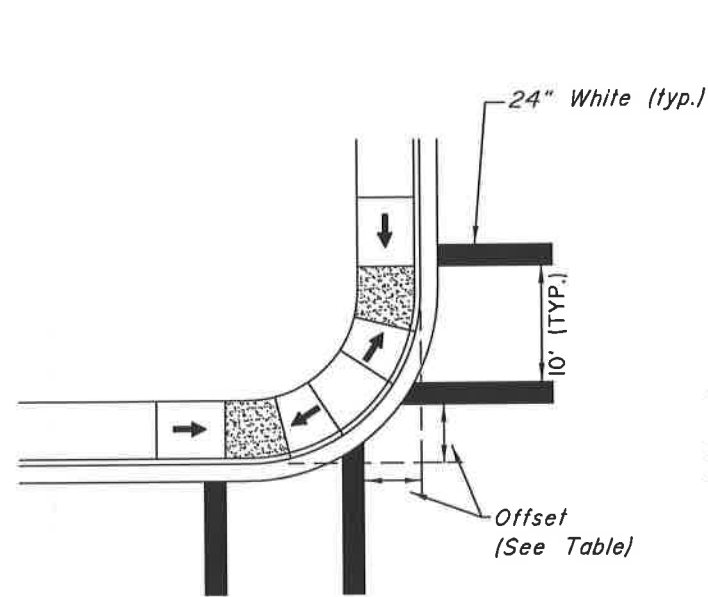

CASE 1


Dual Curb Ramps  
Radius  $\leq 25'$

CASE 1	
Crosswalk Offset From Face of Curb	
Radius (ft.)	Offset (ft.)
5	5
10	6
15	7
20	8
25	9

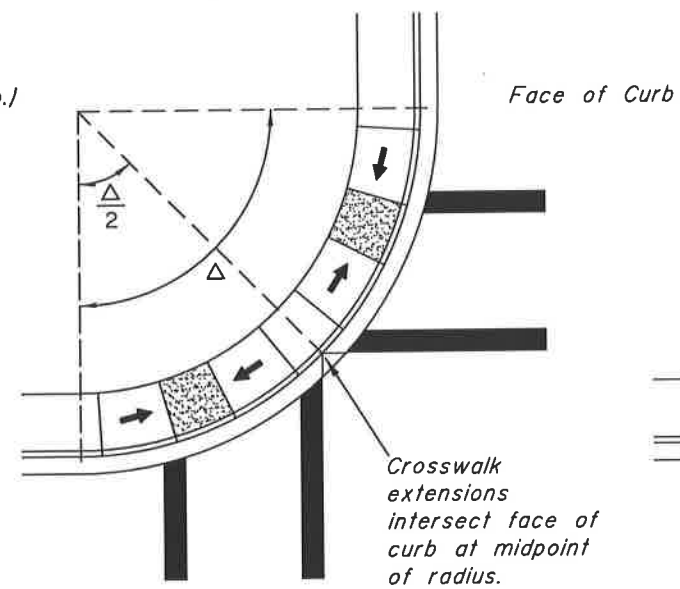

CASE 2

Dual Curb Ramps  
 $25' < \text{Radius} \leq 50'$

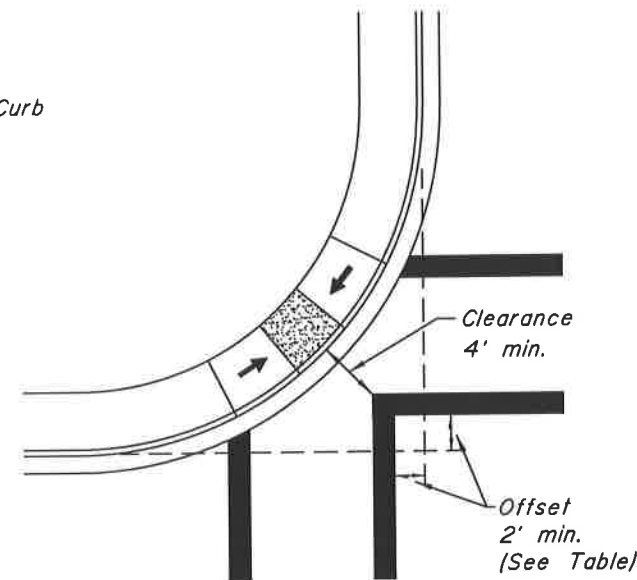

CASE 3

Single Central Curb Ramp  
 $25' \leq \text{Radius} \leq 50'$   
(Not Recommended)

CASE 3	
Crosswalk Offset From Face of Curb	
Radius (ft)	Offset (ft)
25	2
30	3
35	5
40	6
45	8
50	9

NOTES.

- The crosswalk locations shown assume a 90-degree intersection - adjust as necessary on skewed intersections to ensure that crosswalk landings (for parallel curb ramps) or ramp runs (for perpendicular curb ramps) fall within the inner edges of crosswalk stripes. If Case 3 (not recommended) is used, the layout should also be adjusted to provide at least the minimum clearance while maximizing the offset.
- Although border crosswalks are shown, these details apply to ladder crosswalks also. When used, the outside of 10' wide ladder crosswalks should coincide with the inside of border crosswalks as shown here.
- Border crosswalks should be used at traffic signals or on approaches controlled by stop signs. At other locations, ladder crosswalks should be used.
- If only one crosswalk connects with a curb radius, it should be located as if there were two connecting crosswalks.
- These details apply to parallel (shown) as well as perpendicular curb ramps.
- Case 3, the layout for a single central curb ramp, should be used only when installing two ramps is not feasible. It should not be used for radii under 25 feet. See plans for ramp layout at particular locations.
- Radius is measured to the face of curb.

State of Alaska DOT&PF  
ALASKA STANDARD PLAN  
CROSSWALK LOCATION  
AT INTERSECTIONS

Adopted as an Alaska  
Standard Plan by: *Kenneth J. Fisher*  
Kenneth J. Fisher, P.E.  
Chief Engineer

Adoption Date: 02/08/2019

Last Code and Stds. Review  
By: Date:

Next Code and Standards Review date: 02/08/2029

