



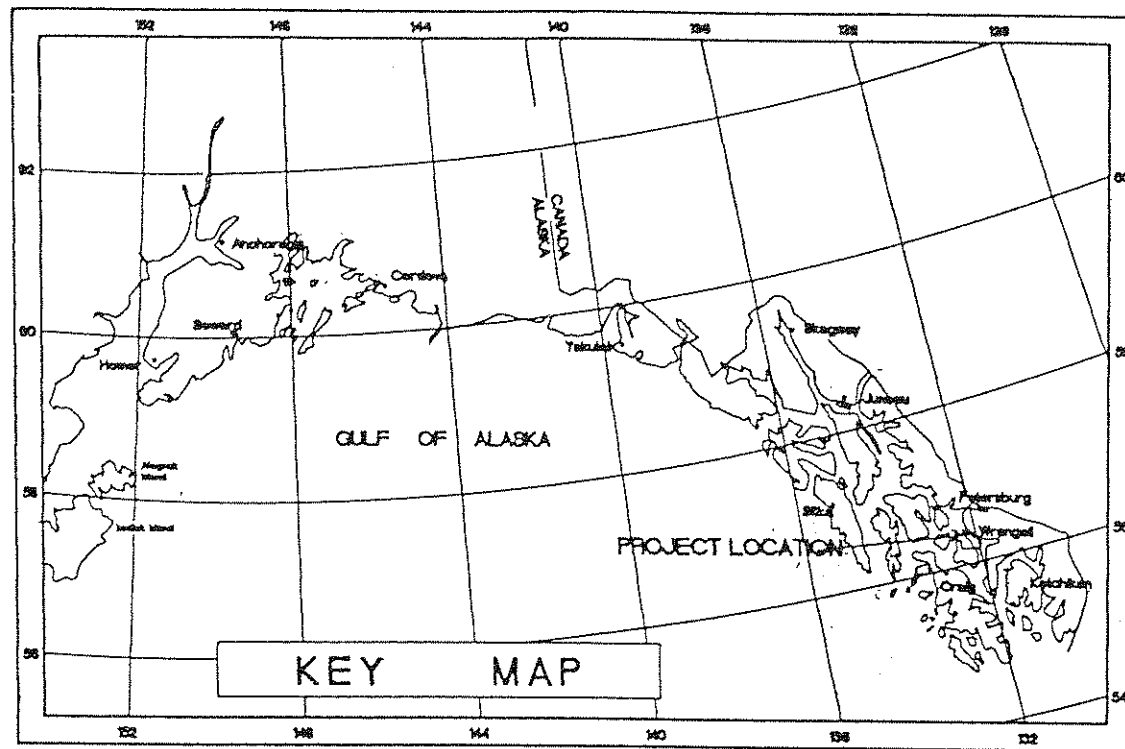

- LEGEND**
- Paved Highway
 - Gravel Surfaced Road
 - Project Location
 - Non Surfaced Road
 - Other Proposed Projects
 - Designated Material Source

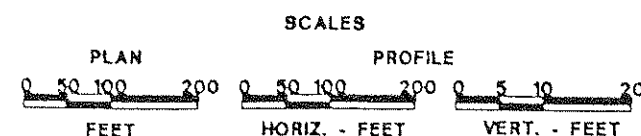


UNITED STATES DEPARTMENT OF AGRICULTURE
FOREST SERVICE - REGION 10

TONGASS NATIONAL FOREST STIKINE AREA WRANGELL RANGER DISTRICT

PLANS FOR PROPOSED FOREST DEVELOPMENT PROJECT


FOREST HIGHWAY 16 PHASE III ROAD RECONSTRUCTION

ROAD NUMBER	LENGTH	CLASSIFICATION	NAME	TYPE OF WORK
FH-16	3.04	DC34-300A	WRANGELL ROAD	RECONSTRUCTION

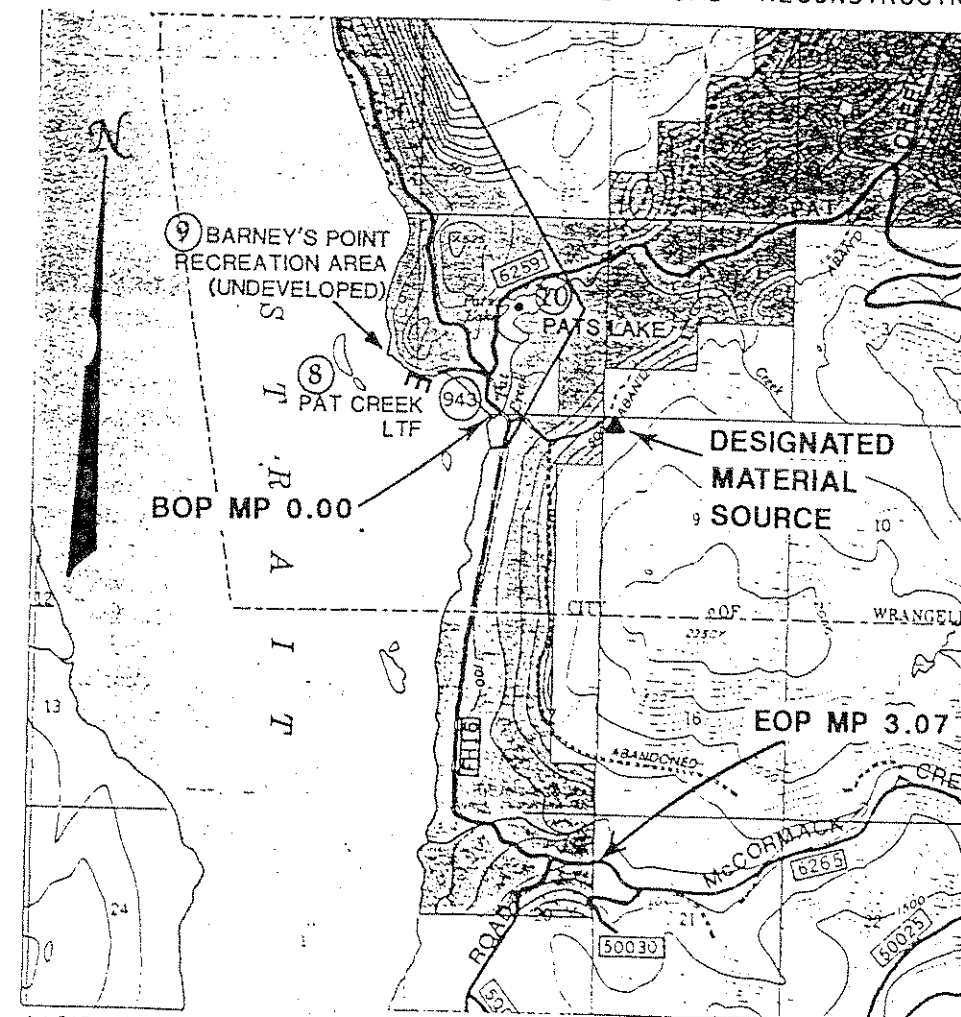

BASIS of SKETCH USGS QUADRANGLE PETERSEURG (B-2), ALASKA

VICINITY MAP

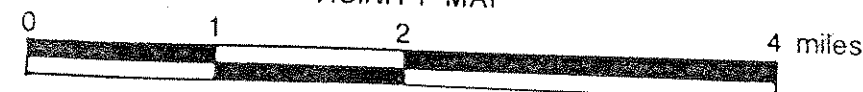

INDEX OF SHEETS

1a	TITLE SHEET
2a	SUMMARY OF EST. QUANTITIES
3a	SUMMARY OF DRAINAGE STRUCTURES
4a	TYPICAL ROAD CROSS SECTIONS
5a	TYPICAL EROSION BALE DETAILS
6a	TYPICAL CULVERT INSTALLATION
7a	CONSTRUCTION STAKING DETAILS
8a	QUARRY DEVELOPMENT & HAUL DIAG.
9a	PAT CREEK QUARRY CONTOUR MAP
10a	TRAFFIC CONTROL PLAN
11a	FH-16 PLAN & PROFILE
12a	FH-16 PLAN & PROFILE
13a	FH-16 SUBSURFACE TEST PIT DATA
14a	BUS TURNAROUND & SAND QUARRY RD.
15a	NEMO JCT. & SNOWPLOW TURNAROUND
16a	FH-16 TRAFFIC MARKINGS
17a	FH-16 TRAFFIC MARKINGS
18a	FH-16 AGGREGATE BASE COURSE, EATB, BST & SUPERELEVATION
19a	FH-16 AGGREGATE BASE COURSE, EATB, BST & SUPERELEVATION
20a	FH-16 SIGN DETAILS & PLACEMENT
21a	FH-16 SIGN DETAILS & PLACEMENT
22a	SIGN PLACEMENT SUMMARY
1b	BRIDGE GENERAL LAYOUT
2b	BRIDGE SITE PLAN
3b-5b	BRIDGE ABUTMENTS AND PIER DETAILS
6b	BRIDGE TYPICAL SECTION
7b-9b	BRIDGE GIRDERS AND DETAILS
10b	BRIDGE RAILING DETAILS
11b	BRIDGE APPROACH GUARDRAILS PLAN
12b-16b	STATE APPROACH GUARDRAILS TYPICAL DETAILS
17b-18b	FH-16 BRIDGE REMOVAL AND RELOCATION
19b-20b	USFS STANDARD APPROACH GUARDRAIL DETAILS

REVISION	DATE	APPROVED	DESCRIPTION
1			
2			
3			

DESIGNED BY: SCHWARTZ, RICHARD ELMORE	Dwg. No.	Sheet 1a
DRAWN BY: BARNETT, ELMORE		of 22a & 20b
REVIEWED BY: L.D.		
RECOMMENDED		
FOREST ENGINEER	1/27/97	DATE
RECOMMENDED		
DISTRICT RANGER	1/27/97	DATE
APPROVED		
FOREST SUPERVISOR	1/27/97	DATE
APPROVED		
DIRECTOR OF ENGINEERING & AVIATION MGMT., R10	3/27/97	DATE
APPROVED		
REGIONAL DIRECTOR, S.E. REGION ALASKA DOT & PF	4/7/97	DATE
APPROVED		
DIVISION ENGINEER, FHWA		DATE

SUMMARY OF ESTIMATED QUANTITIES

ITEM NUMBER	DESCRIPTION	METHOD OF MEASUREMENT	UNIT	FH16 PROJECT TOTALS	ITEM NUMBER	DESCRIPTION	METHOD OF MEASUREMENT	UNIT	FH16 PROJECT TOTALS
104(01)	TRAFFIC MAINTENANCE, TRAFFIC CONTROL DEVICES, SIGNING, MARKING, PILOT CARS, SWEEPERS AND WATERING	LSQ	LS	1	556(08)	TERMINAL SECTION, TYPE 2	AQ	EA	4
104(02)	FLAGGING	AQ	HR	832	601(01)	MOBILIZATION	LSQ	LS	1
121(01)	FIELD OFFICE & LABORATORY	LSQ	LS	1	603(01)18	18-INCH CORRUGATED METAL PIPE, 0.064-INCH THICKNESS FOR STEEL OR 0.060-INCH THICKNESS FOR ALUM., METHOD C, 2-2/3" X 1/2" CORRUGATIONS	AQ	LF	567
170(02)	ESTABLISH CENTERLINE, PRECISION A	AQ	MI	3.04	603(01)24	24-INCH CORRUGATED METAL PIPE, 0.064-INCH THICKNESS FOR STEEL OR 0.060-INCH THICKNESS FOR ALUM., METHOD C, 2-2/3" X 1/2" CORRUGATIONS	AQ	LF	472
170(03)	SLOPE STAKING, PRECISION A	AQ	MI	0.88	603(01)36*	36-INCH CORRUGATED METAL PIPE, 0.064-INCH THICKNESS FOR STEEL OR 0.060-INCH THICKNESS FOR ALUM., METHOD C, 2-2/3" X 1/2" CORRUGATIONS	AQ	LF	136
170(04)	FINISH STAKING, SUBGRADE, PRECISION A	AQ	MI	0.88	625(03)	SEEDING, HYDRAULIC METHOD, WITH MULCH	DQ	ACRE	5.2
170(05)	FINISH STAKING, BASE COURSE, PRECISION A	AQ	MI	3.04	633(02)	STEEL POSTS	AQ	EA	46
201(01)	CLEARING & GRUBBING, SLASH TREATMENT METHODS FOR TOPS AND LIMBS 1, LOGS 1, AND STUMPS 1, UTILIZATION OF TIMBER 2	DQ	ACRE	8.37	633(11)	REGULATORY SIGNS	AQ	EA	18
202(02)	REMOVAL OF CULVERTS	AQ	EA	12	633(12)	WARNING SIGNS & MARKERS	AQ	EA	24
202(05)	REMOVAL OF BRIDGE	LSQ	LS	1	633(13)	GENERAL INFORMATION SIGNS	AQ	EA	10
203(01)	EXCAVATION, PLACEMENT METHOD 1	DQ	CY	13,358	634(02)	TRAFFIC MARKINGS, SINGLE REFLECTORIZED, BROKEN, COLOR <u>YELLOW</u> , TYPE A	AQ	MI	0.74
203(10)	BORROW EXCAVATION, PLACEMENT METHOD 1	DQ	CY	57,368	634(04)a	TRAFFIC MARKINGS, SINGLE REFLECTORIZED, SOLID, COLOR <u>WHITE</u> , TYPE A	AQ	MI	6.14
204(05)	STRAW/HAY BALES	AQ	EA	290	634(04)b	TRAFFIC, MARKINGS, SINGLE REFLECTORIZED, SOLID, COLOR <u>YELLOW</u> , TYPE A	AQ	MI	0.71
204(07)	SILT FENCE	AQ	EA	24	634(06)	TRAFFIC MARKINGS, DOUBLE REFLECTORIZED, SOLID, COLOR <u>YELLOW</u> , TYPE A	AQ	MI	2.36
204(21)	SOIL EROSION AND POLLUTION CONTROL	AQ	CONTINGENT SUM	AS REQUIRED					
205A(02)	HAUL	DQ	CYM	173,825					
205B(01)	END HAUL	DQ	CY	5,220					
210(02)	OBLITERATION OF ABANDONED ROADWAYS	DQ	MI	0.4					
304(10)	CRUSHED AGGREGATE, TYPE BASE, GRADING P, COMPACTION E	DQ	CY	8,270					
304(21)	STOCKPILED AGGREGATE, TYPE <u>ROAD SALVAGED</u> , FH16 M.P. 2.3 - M.P. 3.1	AQ	CY	1,097					
304(23)	ROADWAY AGGREGATE REMOVAL FROM FH-16, HAUL & PLACEMENT ON FOR # 6259 PAT LAKE ROAD, COMPACTION G	DQ	CY	2,737					
306(01)	RECONDITIONING OF ROADBED, RD #6259	DQ	MI	1.6					
405(01)	EMULSIFIED ASPHALT TREATED BASE	AQ	SY	48,905					
405(03)	EMULSIFIED ASPHALT, GRADE CSS-1	AQ	GAL	78,248					
405(04)	CHOKE AGGREGATE, GRADING A	DQ	CY	227					
410(06)	POLYMER MODIFIED EMULSIFIED ASPHALT, RAPID SET, LOW TEMPERATURE	AQ	GAL	48,781					
410(09)	BITUMINOUS SURFACE TREATMENT, DOUBLE BST-2A	AQ	SY	48,781					
551(25)	STEEL H-PILES, FURNISHED AND INSTALLED	DQ	LF	475					
553(02)	PRESTRESSED CONCRETE STRUCTURE	LSQ	LS	1					
556(05)	BRIDGE RAILING	LSQ	LS	1					
556(06)	BRIDGE APPROACH RAILING, GALVANIZED 2 ELEMENT BEAM-TYPE, CLASS A, TYPE 2	AQ	LF	876					
556(07)	END ANCHORAGE, TYPE 2	AQ	EA	4					

* THE FOLLOWING ESTIMATED QUANTITIES ARE PROVIDED FOR INFORMATIONAL AND BIDDING PURPOSES ONLY. THEY ARE INCIDENTAL TO THE INDICATED PAY ITEM, AND WILL NOT BE MEASURED SEPARATELY FOR PAYMENT:

GRADING 10 AGGREGATE REQUIRED IN TABLE 410-1 (INCIDENTAL TO 410(09))
 GRADING 11 AGGREGATE REQUIRED IN TABLE 410-1 (INCIDENTAL TO 410(09))
 CLASS VII RIPRAP (INCIDENTAL TO 603(01)36)

1,074 TONS
586 TONS
5 C.Y.

DESIGNED BY: JS, SG & KE DATE 2/96
 DRAWN BY: BARNETT DATE 2/96
 CHECKED BY: SCHAEFER DATE 2/96
 REVIEWED BY: DUNHAM DATE 4/96



U.S. DEPARTMENT OF AGRICULTURE
FOREST SERVICE
R-10 ALASKA REGION

FOREST TONGASS / STIKINE AREA
DISTRICT WRANGELL RANGER DISTRICT
SHEET TITLE: SUMMARY SHEET 2a OF 22a

DRAINAGE SUMMARY

[illegible]

NOTE: SEE SCHEDULE OF ITEMS FOR CORRUGATED METAL PIPE THICKNESS AND CORRUGATIONS.


[illegible]

DESIGNED BY: JS, SG & KE DATE 2/96
DRAWN BY: BARNETT DATE 2/96
CHECKED BY: SCHAEFER DATE 2/96
REVIEWED BY: DUNHAM DATE 4/96






U.S. DEPARTMENT OF AGRICULTURE
FOREST SERVICE
R-10 ALASKA REGION

FOREST TONGASS / STIKINE AREA
DISTRICT WRANGELL RANGER DISTRICT
SHEET TITLE DRAINAGE SUMMARY SHEET 30 of 220

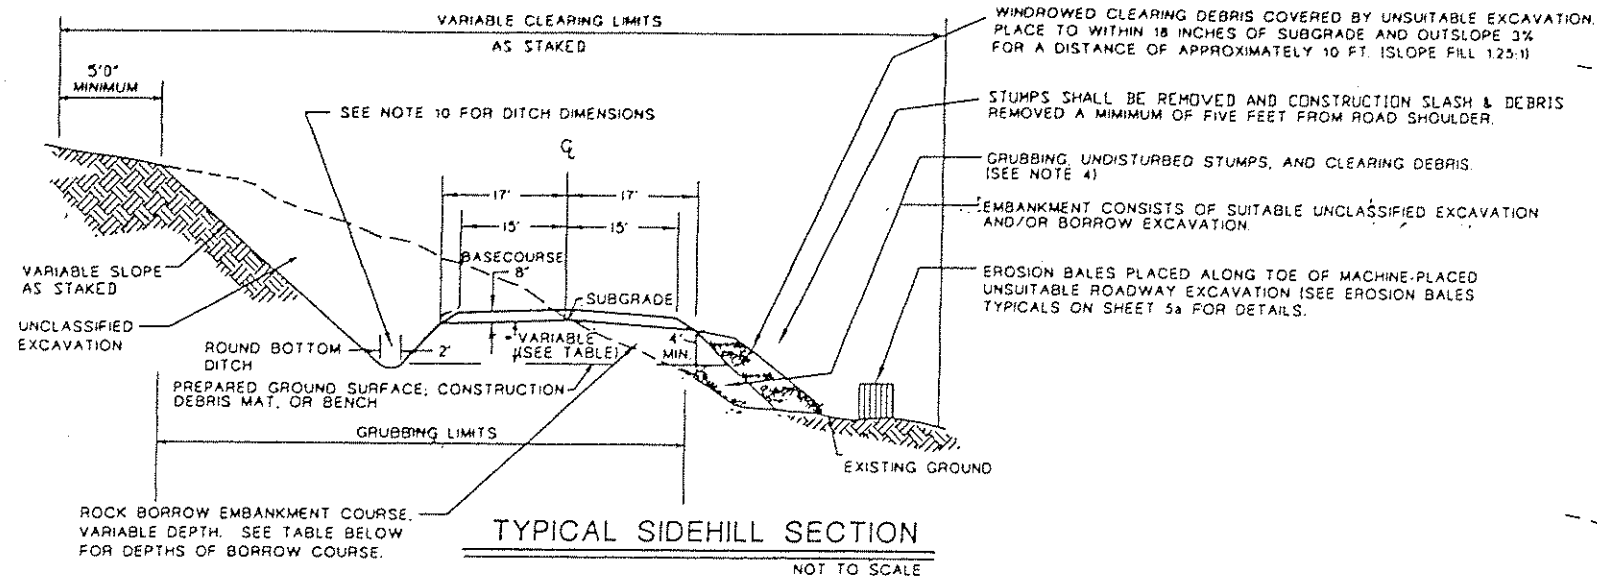

ROCK BORROW COURSE DEPTHS		
SECTION TYPE	UNDERLYING MATERIAL	MINIMUM DEPTH OF BORROW COURSE
EMBANKMENT (OVERLAY)	ALL MATERIALS	48 INCH
	COMMON MATERIAL	48 INCH
SIDEHILL AND THROUGH CUT	BEDROCK AND COMPETENT EXISTING ROADBED (AS STAKED ON GROUND)	24 INCH

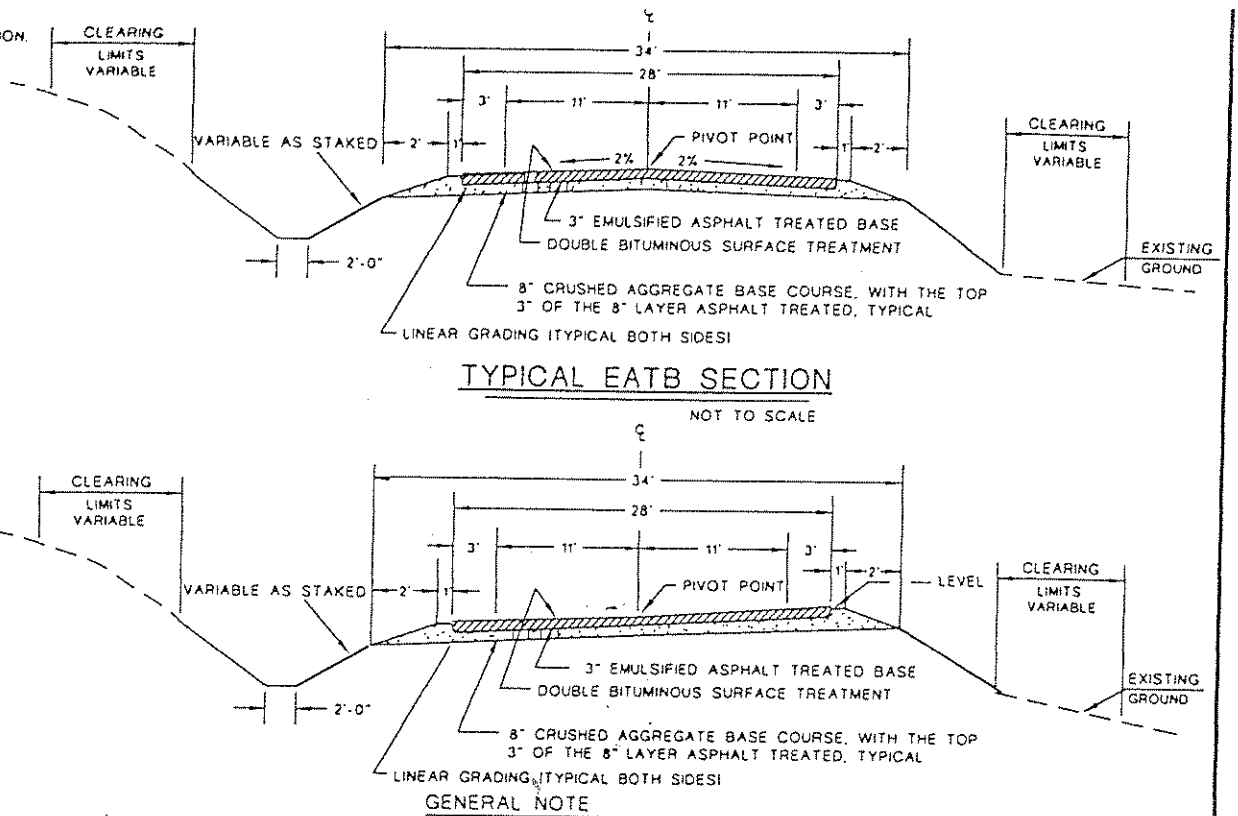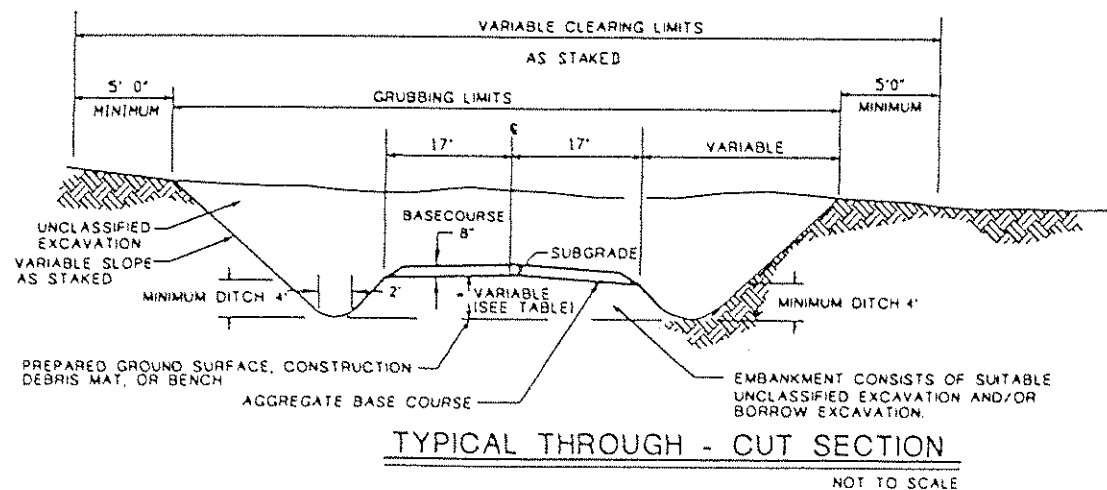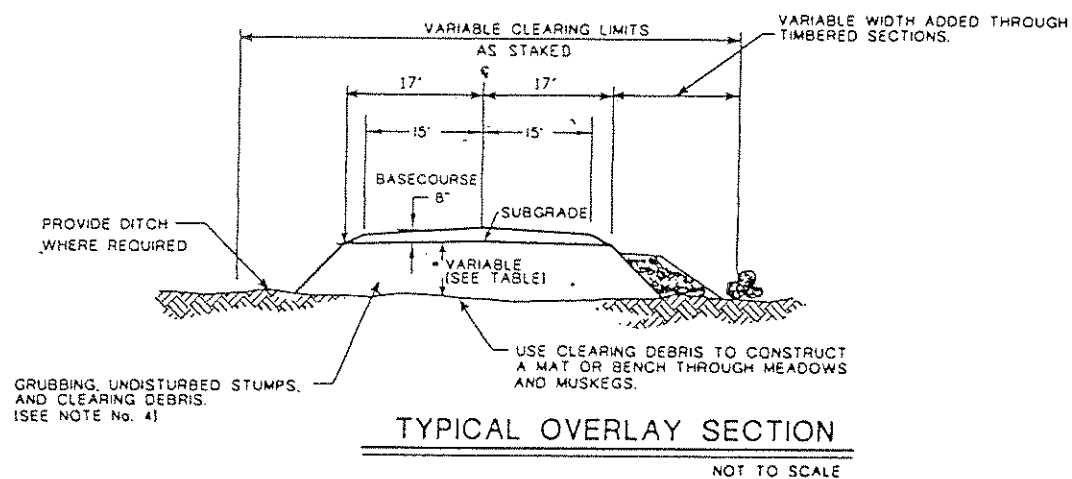

THE SUPERELEVATION SHALL BE ROTATED ABOUT THE CENTERLINE. THE RATE OF SUPERELEVATION AND SUPERELEVATION TRANSITION LENGTHS ARE SHOWN ON THE SUPERELEVATION DETAILS.

TYPICAL SUPERELEVATION SECTION

NOT TO SCALE

PAVEMENT COURSES LEGEND:

	DOUBLE BITUMINOUS SURFACE TREATMENT
	3" EMULSIFIED ASPHALT TREATED BASE
	8" CRUSHED AGGREGATE BASE COURSE, WITH THE TOP 3" OF THE 8" LAYER ASPHALT TREATED, TYPICAL

GENERAL NOTES:

- ROAD GRADES AND ALIGNMENT, AS SHOWN ON THE PLANS, ARE SUBJECT TO REVISION.
- PROFILE ELEVATIONS ARE SHOWN TO THE TOP OF THE SUBGRADE.
- THE TRAVELED WAY SHALL BE CROWNED 2%, EXCEPT IN SUPERELEVATION SECTIONS.
- UNDISTURBED STUMPS AND OTHER CLEARING DEBRIS IN EMBANKMENT AREAS MAY BE LEFT IN PLACE IF THEY DO NOT EXTEND CLOSER THAN 48 INCHES TO ANY SUBGRADE. (REFERENCE SPS 201)
- UNLESS OTHERWISE INDICATED OR STAKED, ALL CUT SLOPES SHALL BE 1:1 AND ALL FILL SLOPES SHALL BE 1 1/4:1.
- CLEARING LIMITS VARIABLE. (SEE STAKE NOTES)
- ALL BORROW EXCAVATION SHALL BE REDUCED IN SIZE TO A MAXIMUM DIMENSION OF 24 INCHES.
- | ROAD No. | FROM STA. TO STA. | LENGTH (MI) | DESIGN SPEED | TOLERANCE CLASS | SUBGRADE WIDTH |
|------------------|-----------------------|-------------|--------------|-----------------|----------------|
| FH - 16 | 15+25 - 175+73 | 3.04 | 30 MPH | B | 34 FEET |
| FOR 6267, MP 3.3 | STA. 0+00 - STA. 7+75 | 0.15 | 10 MPH | D | 20 FEET |
- SPECIFIED THICKNESS OF CRUSHED AGGREGATE BASE COURSE IS 8-INCHES (COMPACTED). THE TOP 3-INCHES OF THE CRUSHED AGGREGATE BASE COURSE SHALL BE ASPHALT TREATED AS SHOWN IN THE EATB TYPICAL SECTION DETAIL. AGGREGATE BASE COURSE WIDTH SHALL BE 30-FEET, WITH 3:1 FILL SLOPES.
- DITCHES IN NON-BEDROCK CUT SECTIONS SHALL BE 4 FEET DEEP WITH A 2 FOOT ROUNDED BOTTOM. DITCHES IN SECTIONS WHERE BEDROCK IS ENCOUNTERED SHALL BE A MINIMUM 2 FEET DEEP WITH A 4 FOOT ROUNDED BOTTOM.
- CLEARING DEBRIS TOO LARGE TO BE WINDROWED AND COVERED WITH SOIL SHALL BE REMOVED AND PLACED IN A DISPOSAL SITE DESIGNATED BY THE ENGINEER.
- SEE SECTION 304 FOR AGGREGATE BASE COURSE CONSTRUCTION TOLERANCES.


DESIGNED BY: SCHAEFER DATE: 2-12-96

DRAWN BY: BARNETT DATE: 2-12-96


REVIEWED BY: DUNHAM DATE: 4-12-96

U.S. DEPARTMENT OF AGRICULTURE
FOREST SERVICE
TONGASS N.F. STIKINE AREA


FOREST HIGHWAY 16 PHASE III
TYPICAL
ROAD CROSS SECTIONS
Dwg. No. _____ Sht. 4a of 22g

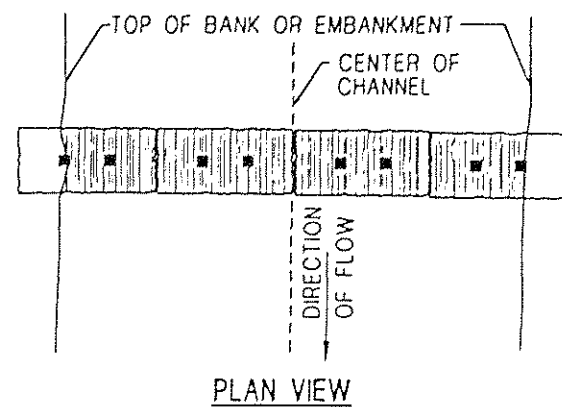


PLAN VIEW

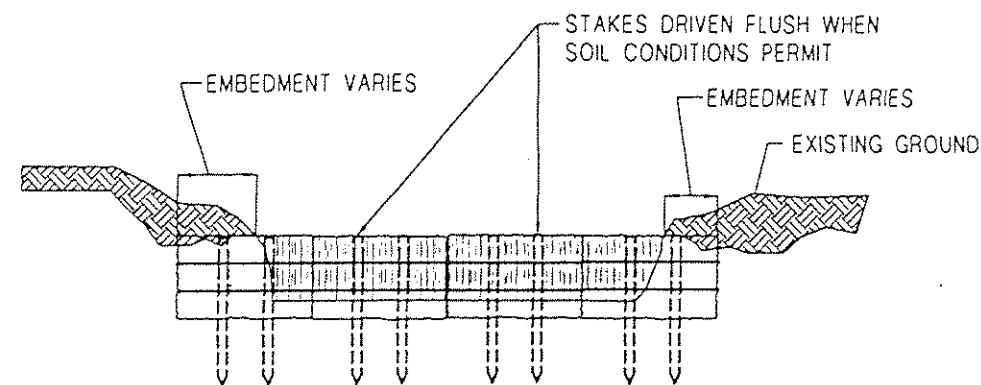

FRONT VIEW - EROSION CONTROL CHANNEL CHANGE

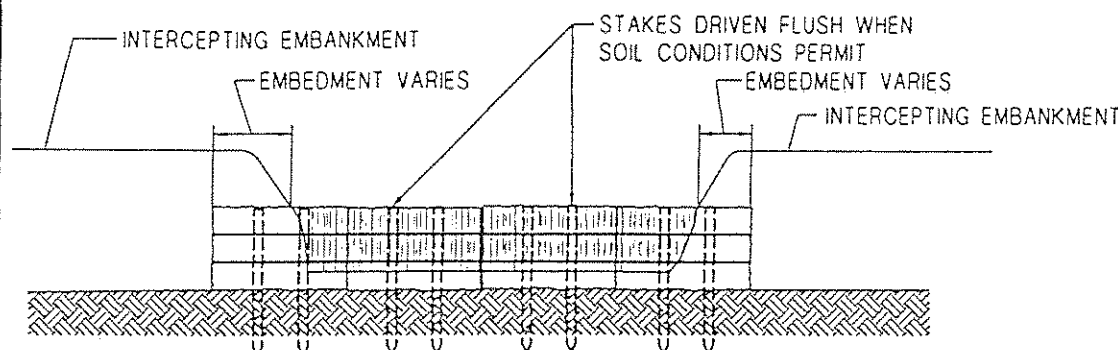

FRONT VIEW - EROSION CONTROL INTERCEPTING EMBANKMENT
EROSION CONTROL CHANNELS

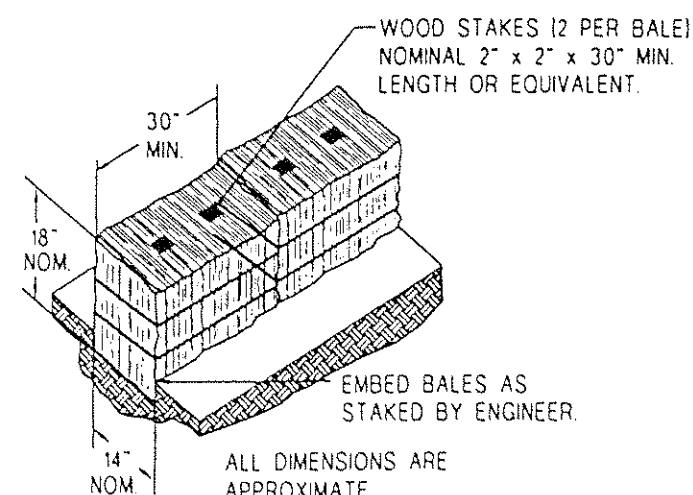


EROSION BALE INSTALLATION DETAIL

NOTES:


BALES SHALL BE PLACED END TO END OR OVERLAPPING AT RIGHT ANGLES TO THE DIRECTION OF FLOW AND FAR ENOUGH UP THE SIDES OF THE DITCH TO PREVENT ERODING AROUND THE ENDS.

BALES SHALL BE PLACED WITH THE TWINE OR TIE WIRES PARALLEL TO THE GROUND.

STAKES TO BE BATTERED IN OPPOSITE DIRECTIONS.

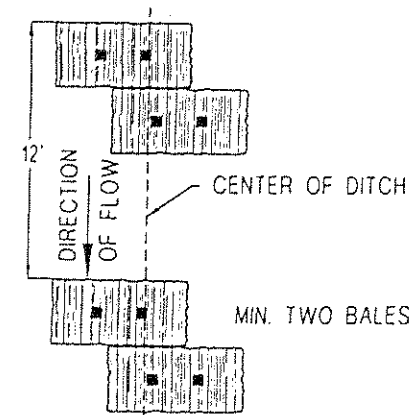


PLAN VIEW

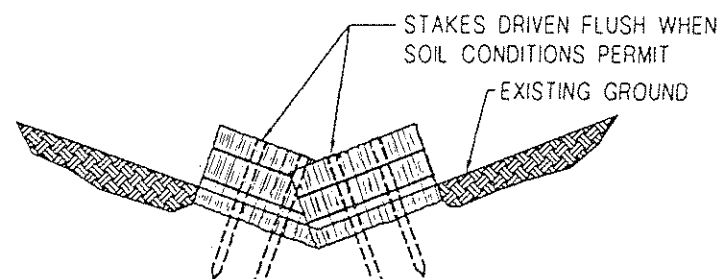


FRONT VIEW

DITCH CHECKS

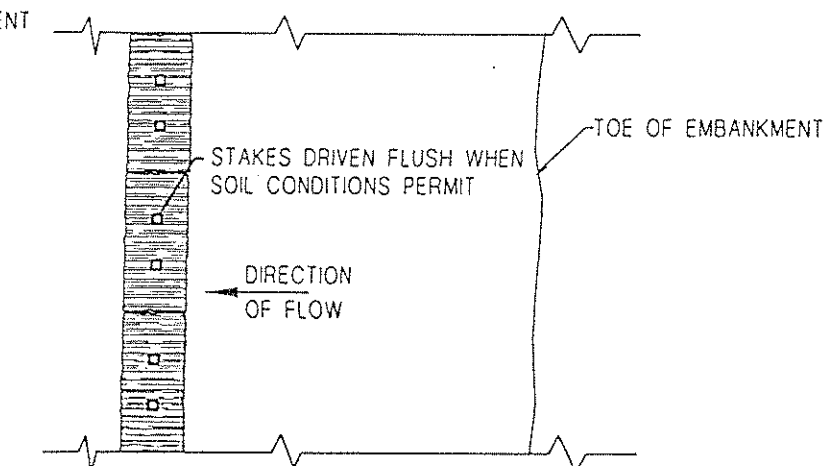


PLAN VIEW

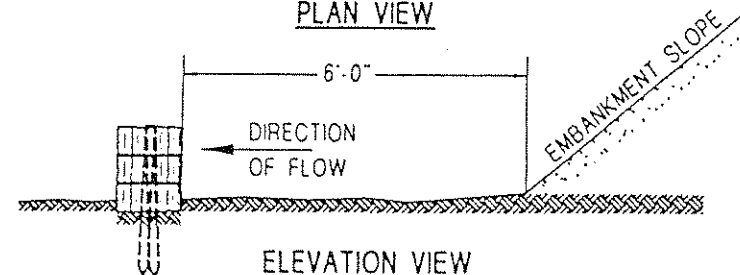


ELEVATION VIEW

BALES AT TOE OF SLOPE


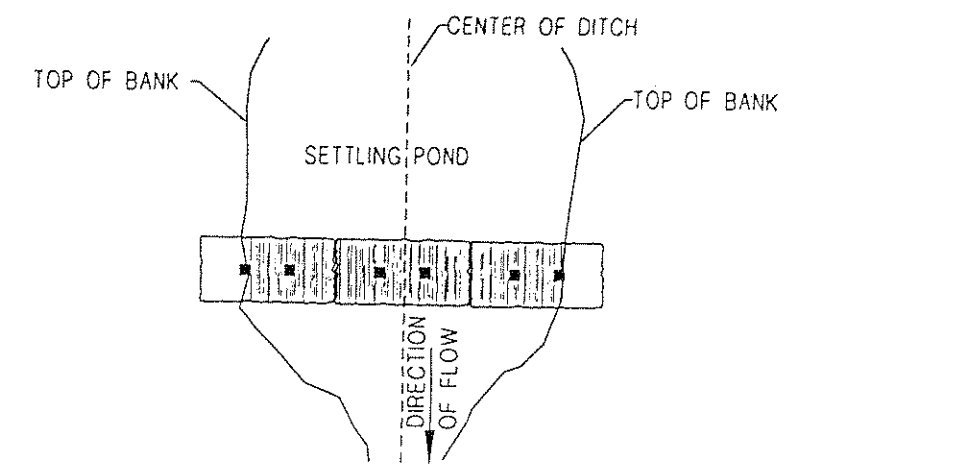


PLAN VIEW

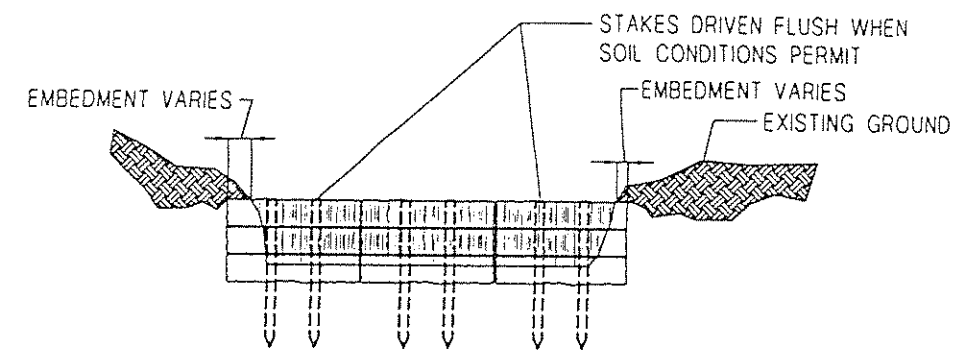

FRONT VIEW

SETTLING POND

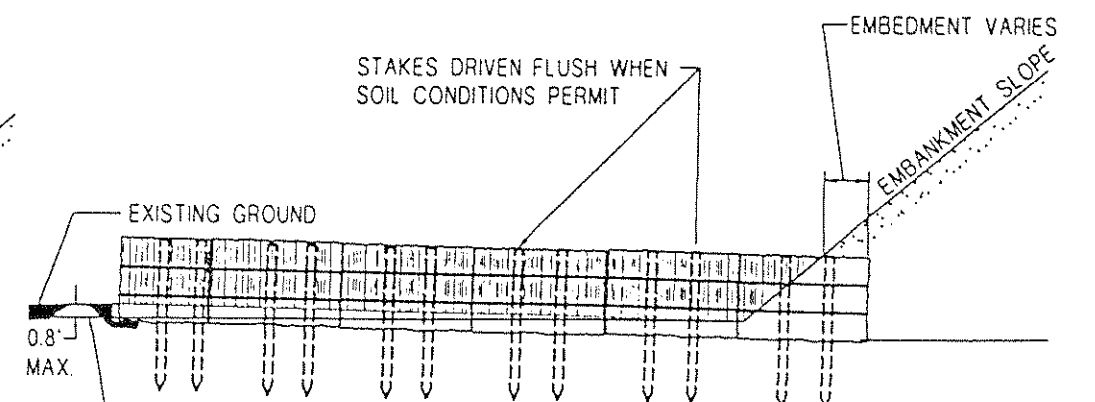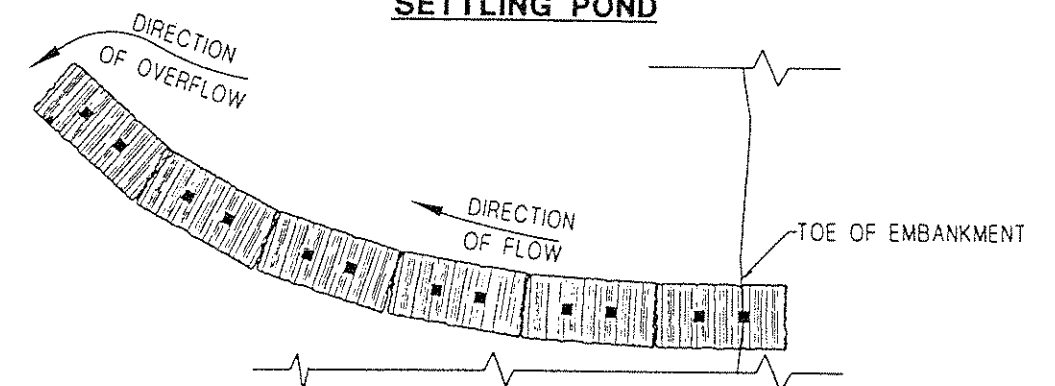

FRONT ELEVATION VIEW


EROSION BALES CHANNEL AT TOE OF SLOPE

DESIGNED BY: K. ELMORE DATE: 3/25/96
DRAWN BY: K. ELMORE DATE: 3/25/96
REVIEWED BY: L. DUNHAM DATE: 4/12/96


U.S. DEPARTMENT OF AGRICULTURE
FOREST SERVICE
TONGASS N.F. STIKINE AREA

EROSION CONTROL &
SETTLING POND
TYPICAL DETAILS
Dwg. No. EROSION Sht. 5a of 22a



TYPICAL CULVERT INSTALLATION

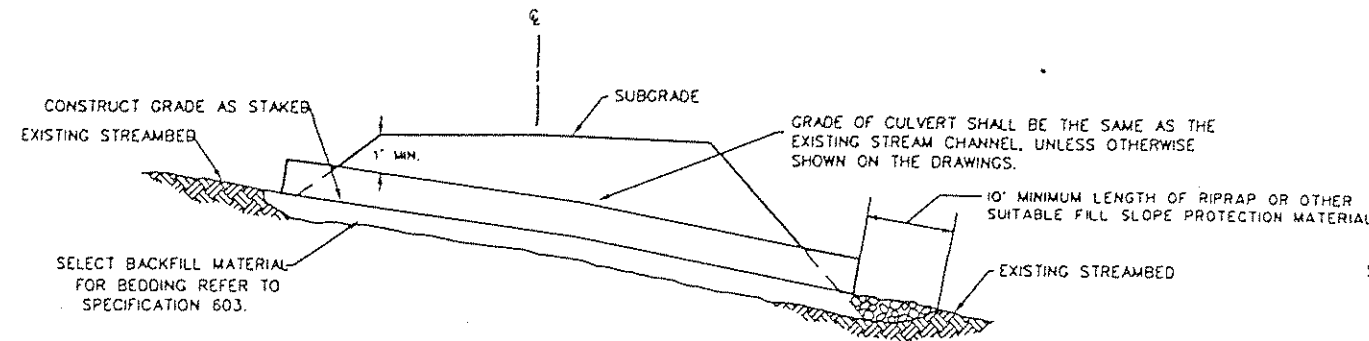


TYPICAL CULVERT INSTALLATION IN LIVE STREAMS
NO SCALE

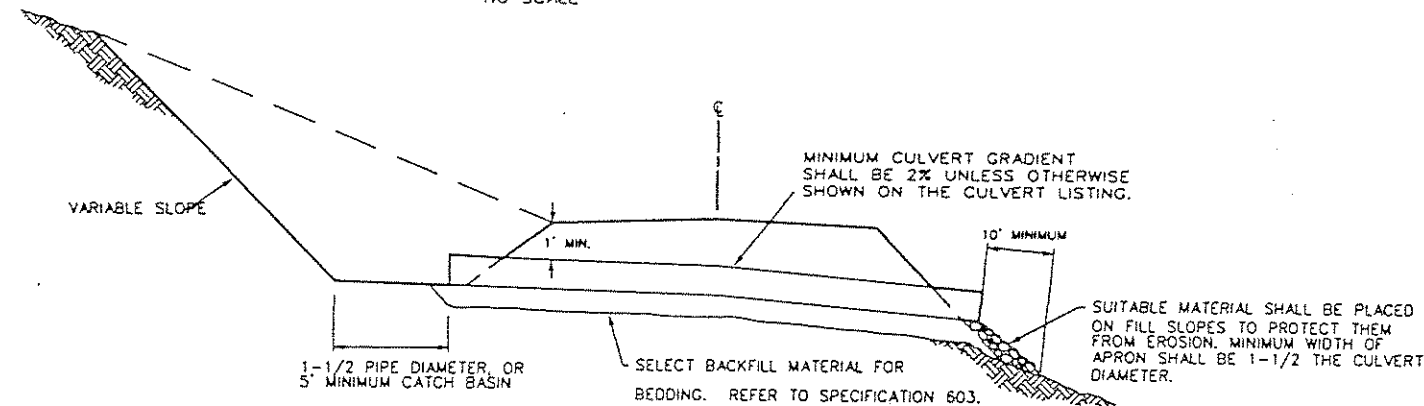


TYPICAL CULVERT INSTALLATION FOR DITCH RELIEF
NO SCALE

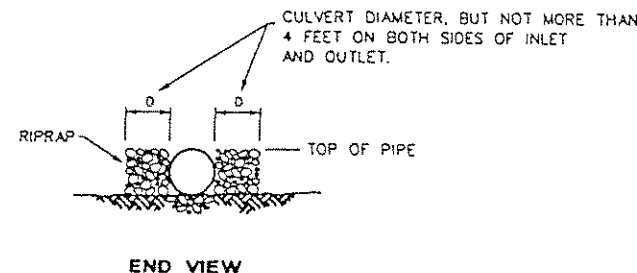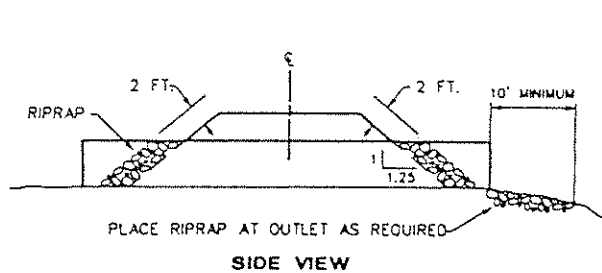


TYPICAL RIPRAP PLACEMENT
NO SCALE

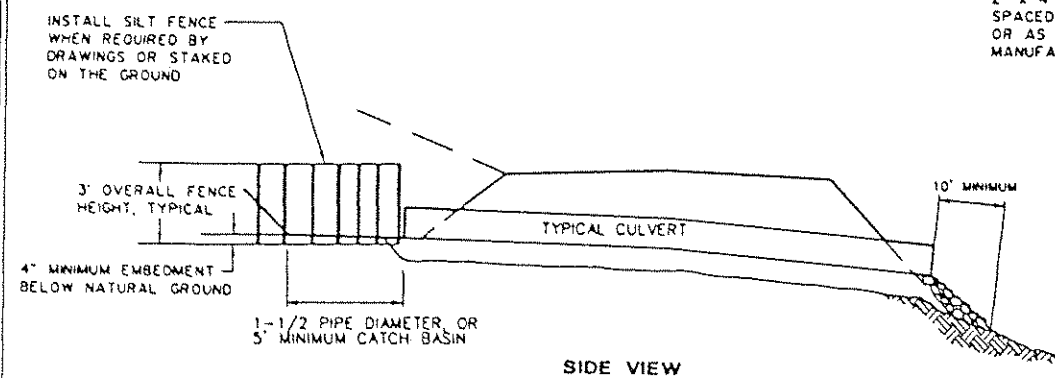

TYPICAL SILT FENCE PLACEMENT
NO SCALE

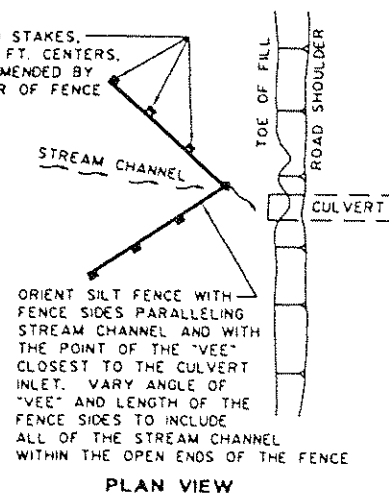


PLAN VIEW

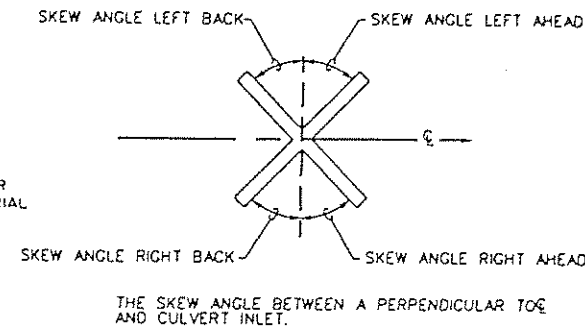

CULVERT SKEW DIAGRAM
NO SCALE


GENERAL NOTES

1. CULVERT LENGTHS, DIAMETERS, AND LOCATIONS, AS SHOWN ON THE PLANS, ARE APPROXIMATE AND ARE SUBJECT TO REVISION BY THE ENGINEER.
2. ONE FOOT OF CULVERT SHALL EXTEND BEYOND THE CATCH POINT ON BOTH INLET AND OUTLET END OF CMP.
3. CAMBER WILL DEPEND ON SITE CONDITIONS. MINIMUM CAMBER IS 1% OF CULVERT LENGTH BUT NOT LESS THAN 0.3 FT. AT CENTER.
4. CULVERTS AND PIPE ARCHES SHALL HAVE RIPRAP PLACED AT THE INLET AND OUTLET AS CALLED FOR ON THE SITE PLAN.
5. A "LIVE STREAM" IS DEFINED AS ANY STREAM REQUIRING A CULVERT WITH A DIAMETER OF 36" OR GREATER.

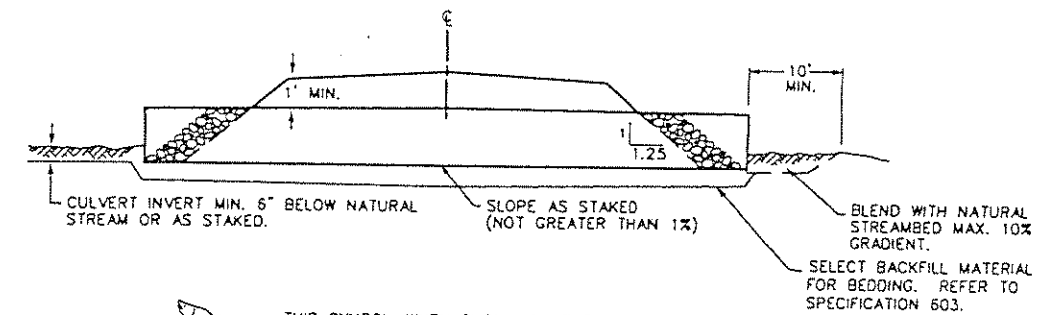

THIS SYMBOL, WHEN SHOWN ON THE PLAN AND PROFILE SHEETS, REPRESENTS A FISH CULVERT INSTALLATION.

TYPICAL FISH CULVERT PLACEMENT
NO SCALE

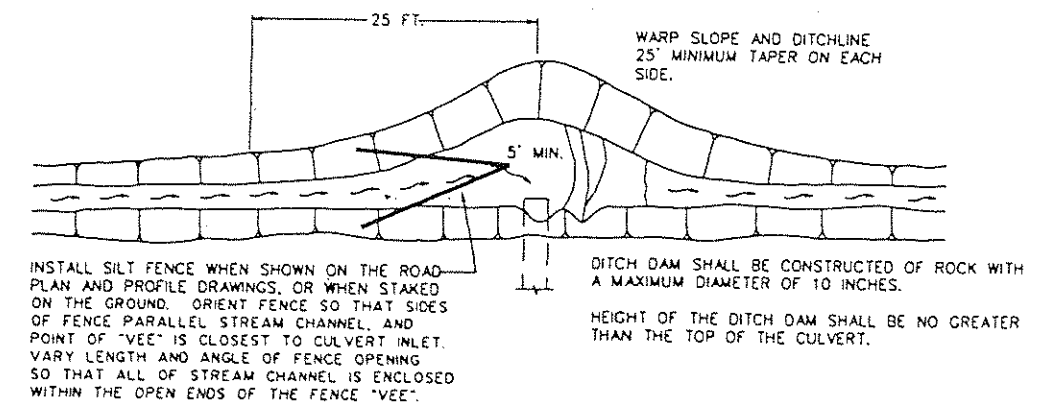

TYPICAL CATCH BASIN WITH DITCH DAM
NO SCALE

FOREST HIGHWAY 16 PHASE III


DESIGNED BY: JS, SG & KE DATE 2/96
DRAWN BY: BARNETT/ELMORE DATE 4/96
CHECKED BY: SCHAEFER DATE 2/96
REVIEWED BY: DUNHAM DATE 4/96





U.S. DEPARTMENT OF AGRICULTURE
FOREST SERVICE
R-10 ALASKA REGION

FOREST TONGASS / STIKTINE AREA
DISTRICT WRANGELL RANGER DISTRICT
SHEET TITLE CULVERT TYPICALS SHEET 60 OF 220

TYPICAL CONSTRUCTION STAKING DETAIL

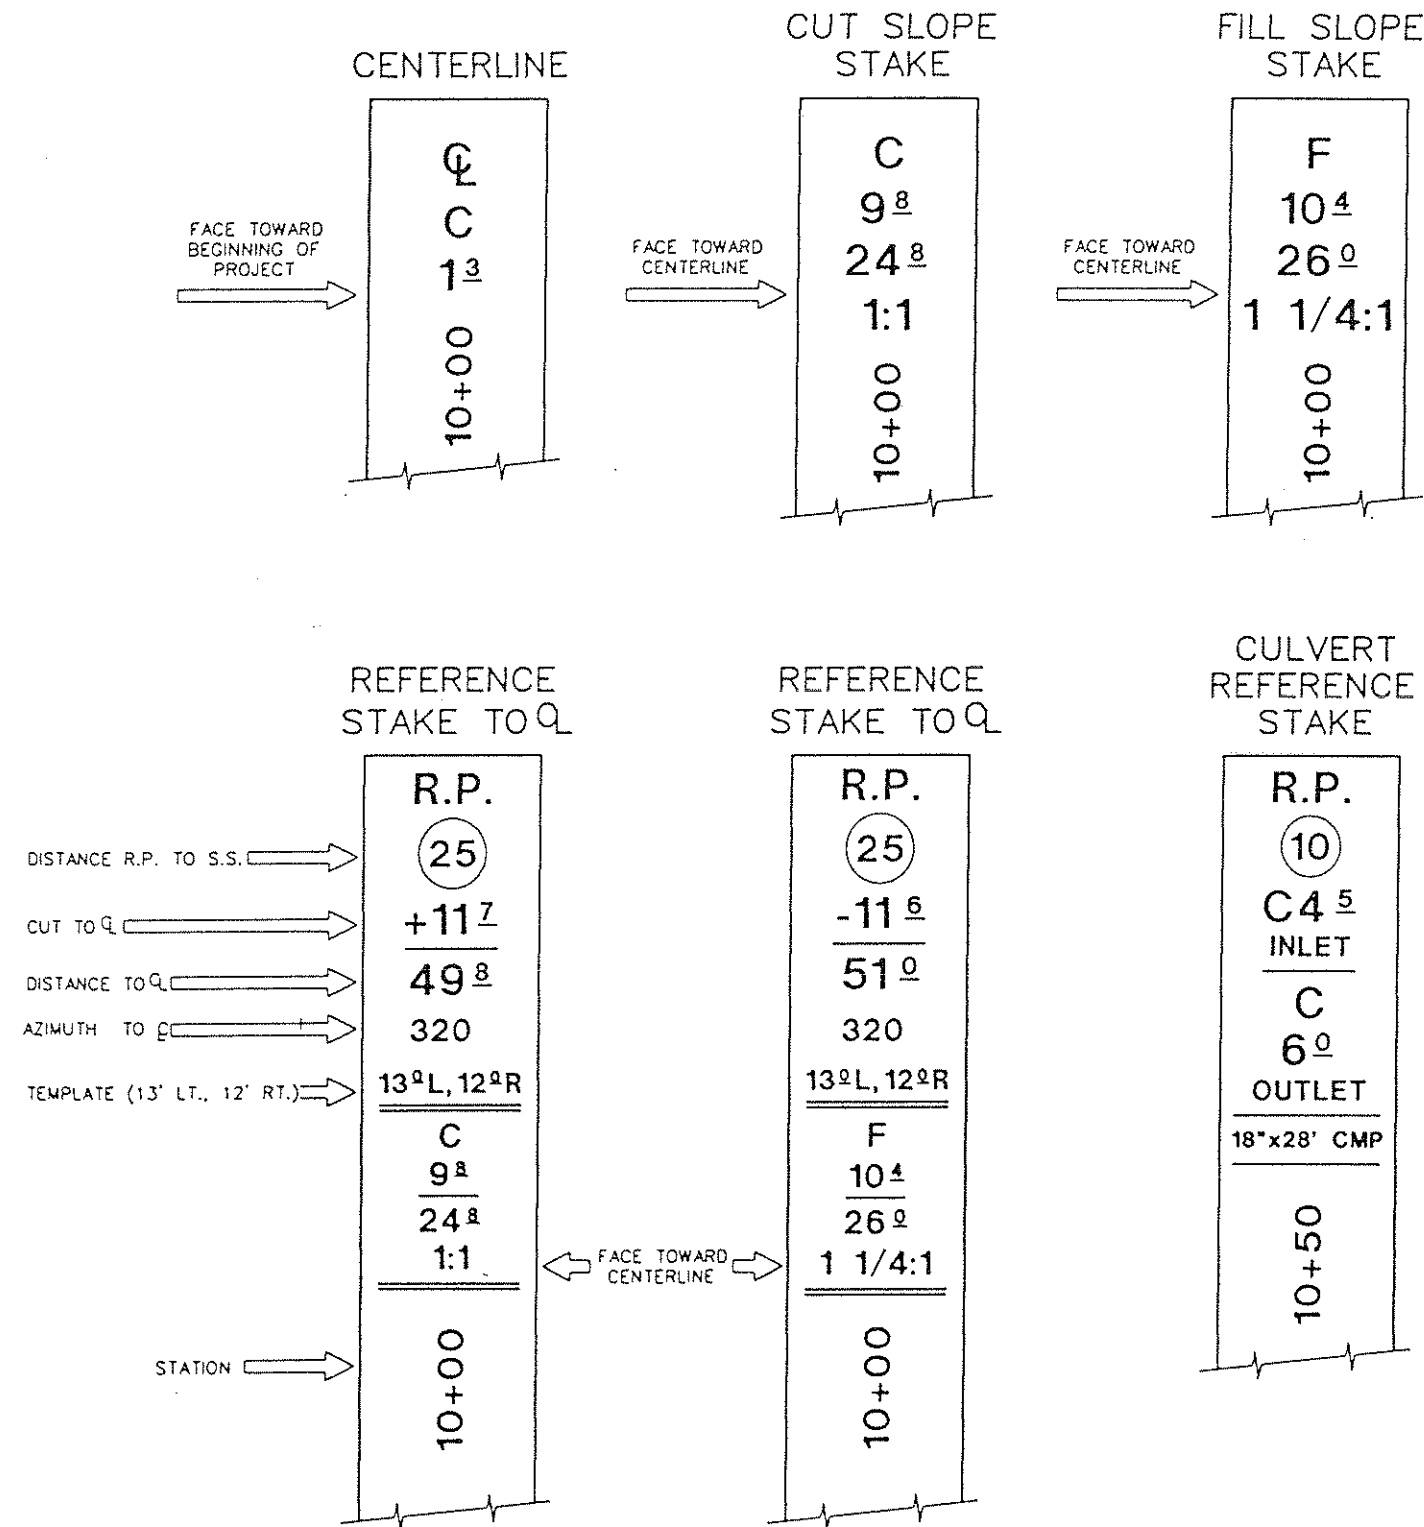

* LINE LATH IS AN UNMARKED LATH IN ALIGNMENT WITH CENTERLINE, S.S. AND R.P. STAKES

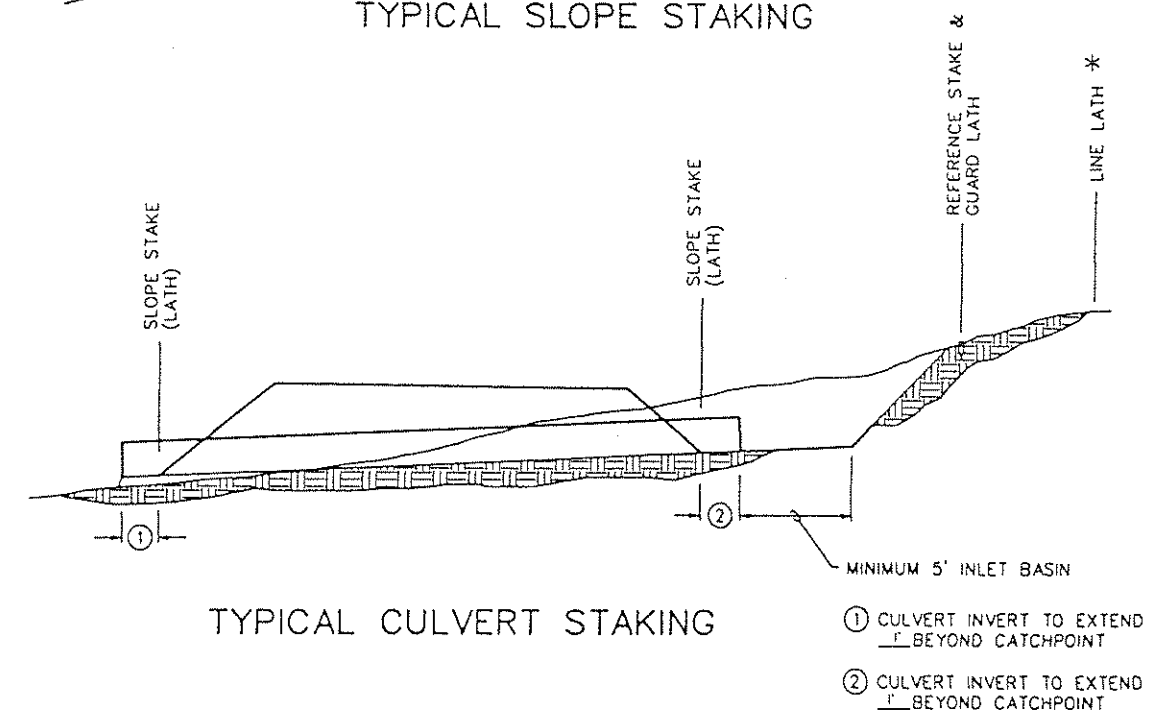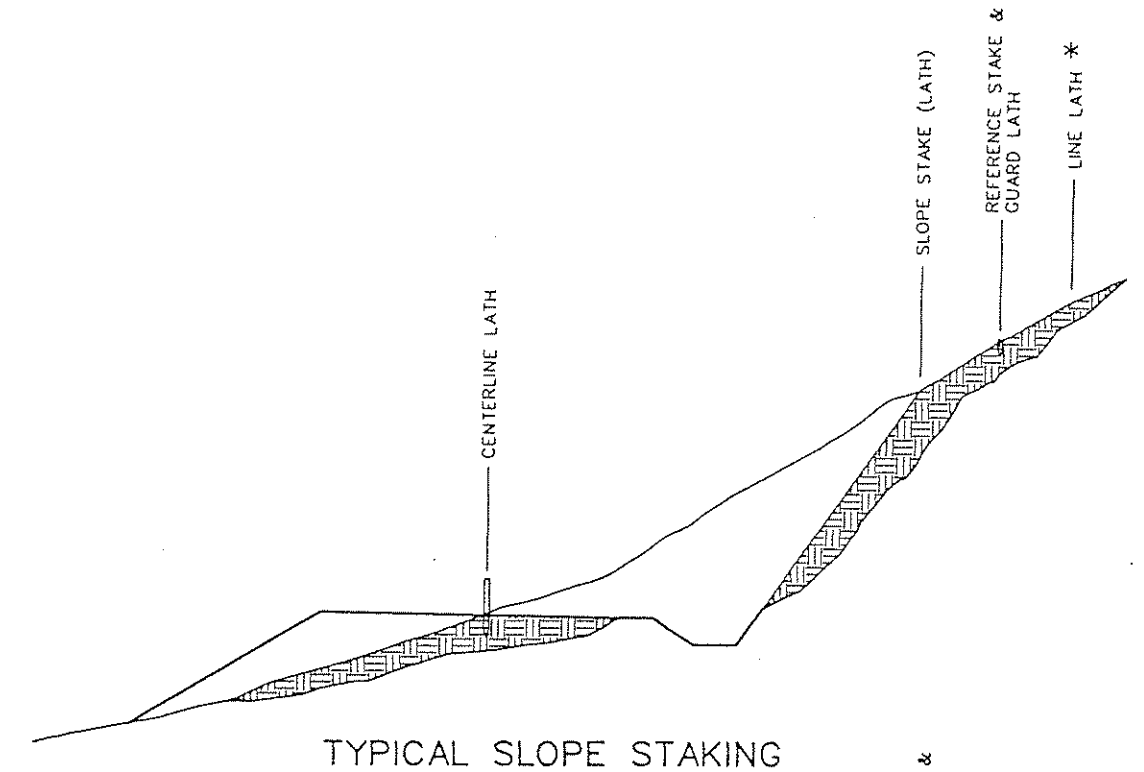

NOTE:
CLEARING LIMITS SHALL BE MARKED WITH FLORESCENT ORANGE FLAGGING.
REFERENCE STAKES, SLOPE STAKES, STRUCTURE STAKES, AND MISCELLANEOUS STAKES SHALL BE MARKED WITH FLORESCENT ORANGE PAINT.

DESIGNED BY: VS. SG. B. KE DATE 2/96
DRAWN BY: BARNETT DATE 2/96
CHECKED BY: SCHAEFER DATE 2/96
REVIEWED BY: DUNHAM DATE 4/96




U.S. DEPARTMENT OF AGRICULTURE
FOREST SERVICE
R-10 ALASKA REGION

FOREST TONGASS / STIKINE AREA
DISTRICT WRANGELL RANGER DISTRICT
SHEET TITLE STAKING DETAIL SHEET 7 of 22



PIT AND QUARRY DEVELOPMENT DETAILS

DESIGNATED MATERIAL SOURCE		
TYPE OF MATERIAL	LOCATION	CONSTRUCTION AREA
BORROW EXCAVATION	PAT QUARRY	FH16 WP. 2.24-WP. 3.07
AGGREGATE, GRADING P	PAT QUARRY	FH16 WP. 0.04-WO. 3.07
COVER AGGREGATE, GRADING 10	CONTRACTOR FURNISHED SOURCE	FH16 WP. 0.04-WP. 3.00
COVER AGGREGATE, GRADING 11	CONTRACTOR FURNISHED SOURCE	FH16 WP. 0.04-WP. 3.00
CHOKE AGGREGATE, GRADING A	PAT QUARRY	FH16 WP. 0.04-WP. 3.00
RIPRAP	PAT QUARRY	FH16 WP. 2.3
WOODFILL	SPUR ROAD AT WP 4.8, RD. #6267	RD #6267, WP. 5.4


DESIGNATED DISPOSAL SITE FOR UNSUITABLE ROADWAY EXCAVATION LOCATED AT WP 0.5, RD #6267.
PLACE UNSUITABLE EXCAVATION ON EXISTING ROAD FILL SLOPES AS STAKED ON THE GROUND OR
DESIGNATED BY THE ENGINEER.

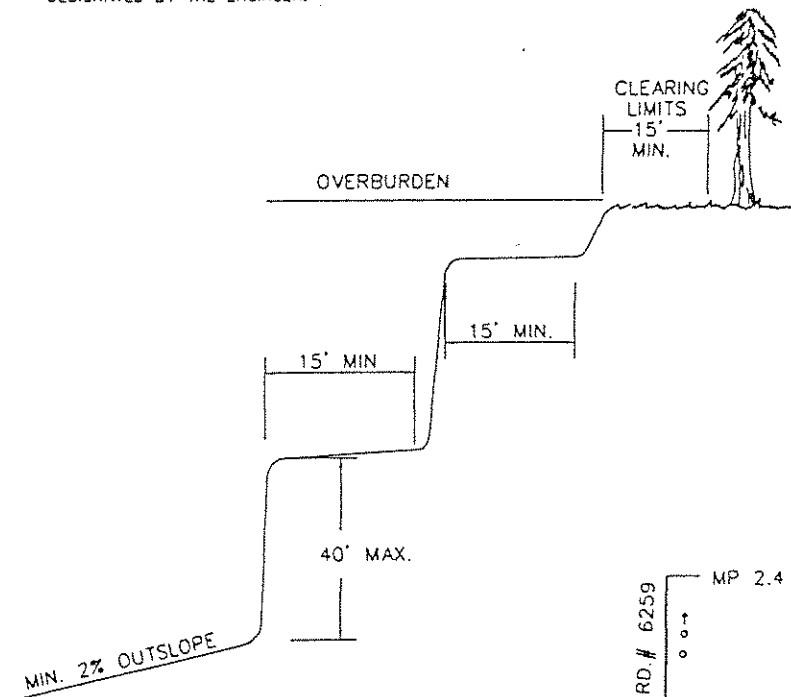


TYPICAL SECTION

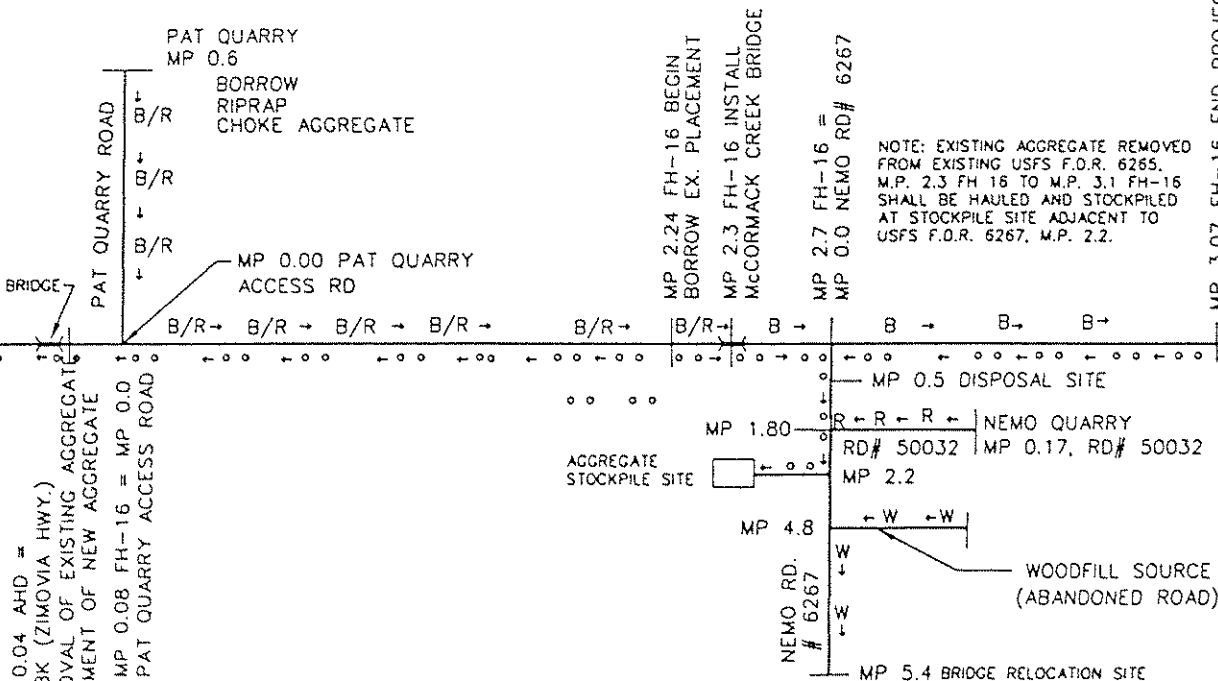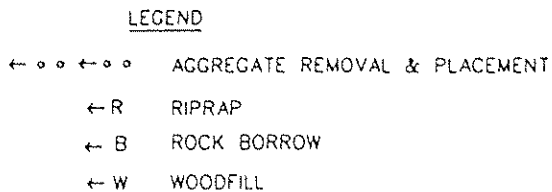

HAUL DIAGRAM

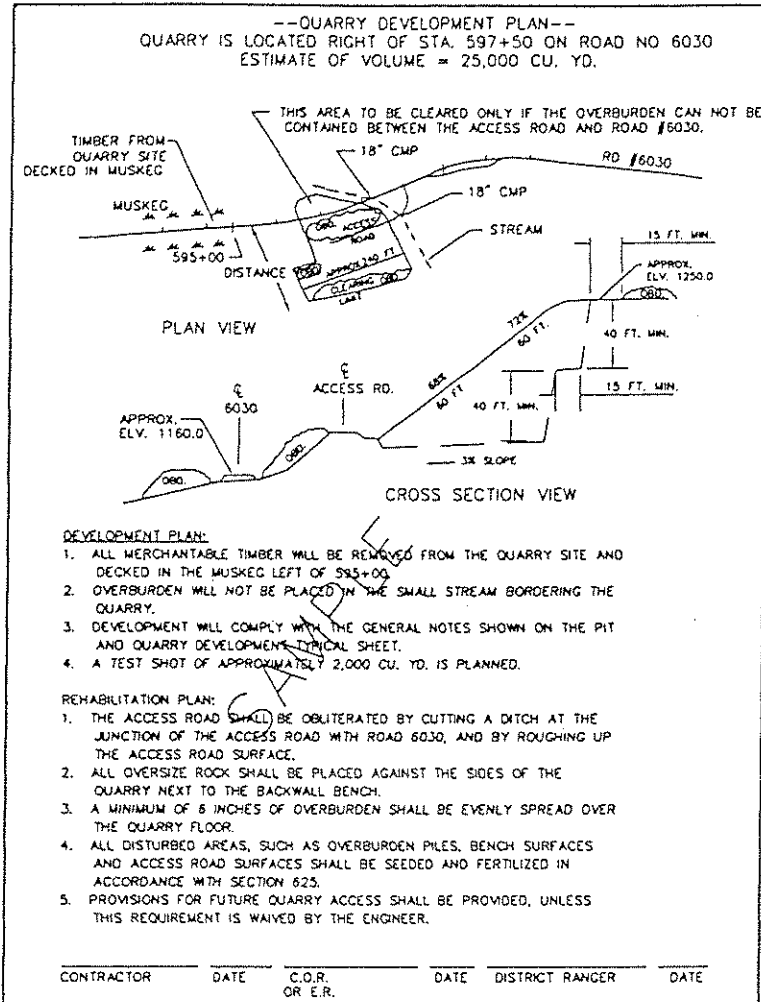

- 8-1/2" x
SHEET

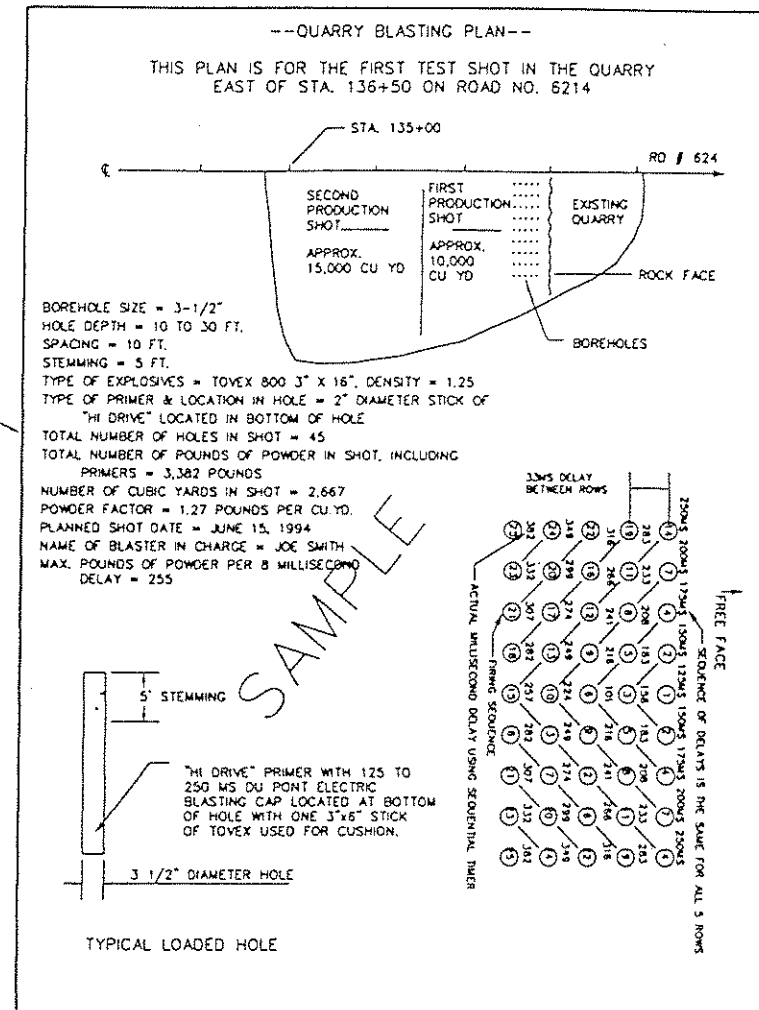

GENERAL NOTES:



1. ALL PITS AND QUARRIES SHALL BE APPROVED IN WRITING BY THE FOREST SERVICE PRIOR TO EXPLORATION, CLEARING OR DEVELOPMENT.
2. ALL OVERBURDEN SHALL BE REMOVED TO SOLID ROCK FOR MINIMUM DISTANCE OF 15 FT. FROM THE WORKING FACE.
3. THE CUTBANK OF THE OVERBURDEN SHALL BE SLOPED TO THE NATURAL ANGLE OF REPOSE, BUT SHALL IN NO CASE, BE STEEPER THAN 1:1.
4. WITHIN CLEARING LIMITS:
 - (a) MAXIMUM HEIGHT OF STUMPS SHALL BE IN ACCORDANCE WITH SPECIFICATION NO. 201.
 - (b) STABLE TREES UP TO 6 INCHES DBH NEED NOT BE CUT IF THEY WILL NOT INTERFERE WITH BACK SLOPE STABILITY.
5. ALL OVERBURDEN, CLEARING, MERCHANTABLE TIMBER, AND GRUBBING DEBRIS SHALL BE DISPOSED OF OR STOCKPILED FOR LATER USE AS SHOWN ON QUARRY DEVELOPMENT PLANS.
6. ALL DEAD TREES AND SNAGS WHICH ARE SUFFICIENTLY TALL TO REACH THE WORK AREA SHALL BE FELLED.
7. THE PIT OR QUARRY SHALL BE LEFT IN A NEAT, ORDERLY AND WELL-DRAINED CONDITION. ALL OVERHANGS AND LOOSE ROCK SHALL BE REMOVED. ROCK, LOOSENED BY BLASTING OPERATIONS, SHALL BE SCALED FROM FACES PRIOR TO LEAVING THE SITE.
8. AFTER EXCAVATION IS COMPLETE, THE AREA SHALL BE CLEANED UP AND LEFT AS SHOWN ON QUARRY DEVELOPMENT PLAN. ANY ACCESS ROAD WILL BE TREATED AS SHOWN ON THE DRAWINGS OR QUARRY DEVELOPMENT PLAN.
9. NO MORE THAN SIX BY VOLUME OF OVERSIZE MATERIAL SHALL REMAIN IN THE QUARRY. ALL OTHER MATERIAL SHALL BE BROKEN DOWN AND USED AS SPECIFIED IN SPECIFICATIONS 203, 304, AND 611.
10. TEST SHOTS OF FROM 1,500 TO 3,500 CUBIC YARDS MAY BE REQUIRED AT ALL QUARRY SITES AS SPECIFIED IN SPECIFICATION 611.
11. INSTALL AND MAINTAIN A "FOREST SERVICE" TYPE RAIN GAUGE.


DESIGNED BY: SCHAEFER DATE 2/96
DRAWN BY: BARNETT DATE 2/96
CHECKED BY: SCHAEFER DATE 2/96
REVIEWED BY: DUNHAM DATE 4/96



U.S. DEPARTMENT OF AGRICULTURE
FOREST SERVICE
R-10 ALASKA REGION


FOREST TONGASS / STIKINE AREA
DISTRICT WRANGELL
SHEET TITLE QUARRY DETAILS SHEET 80 OF

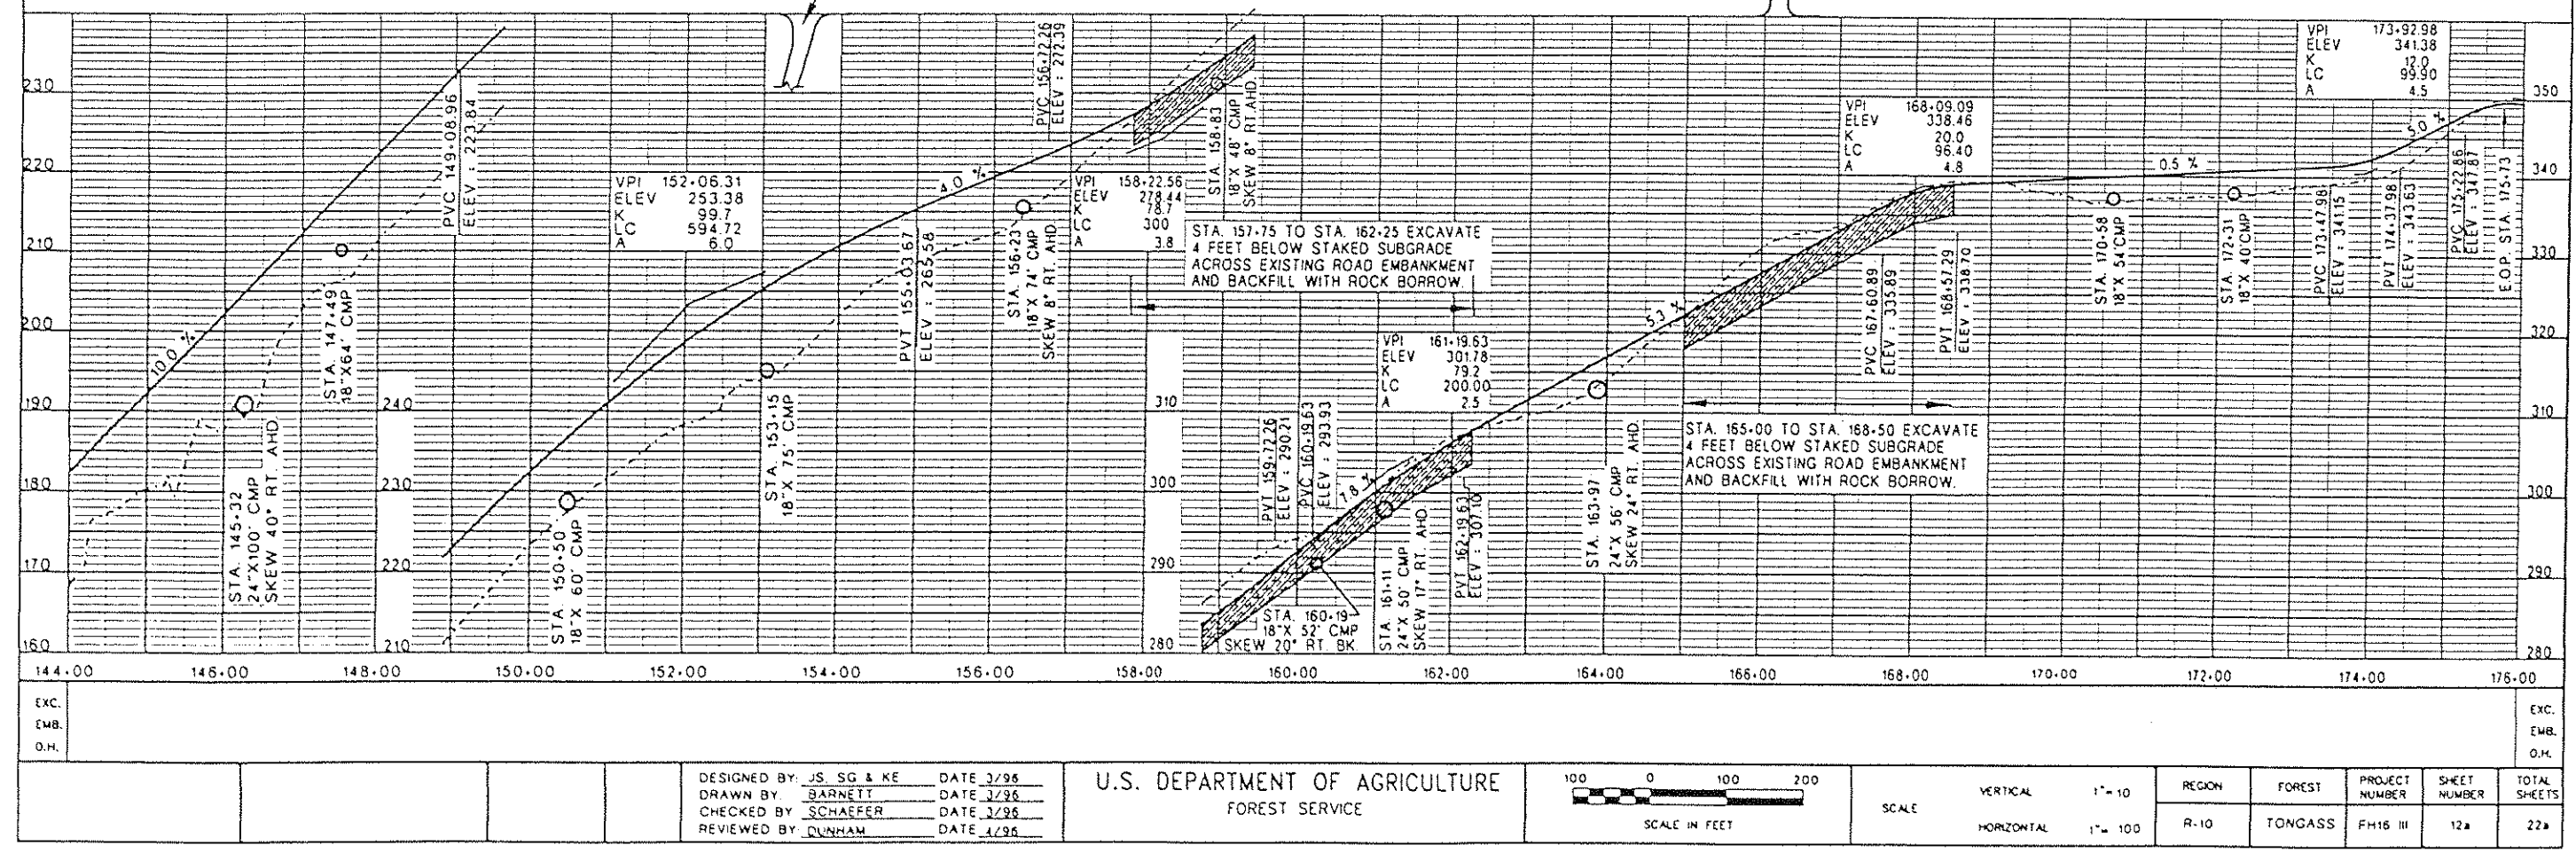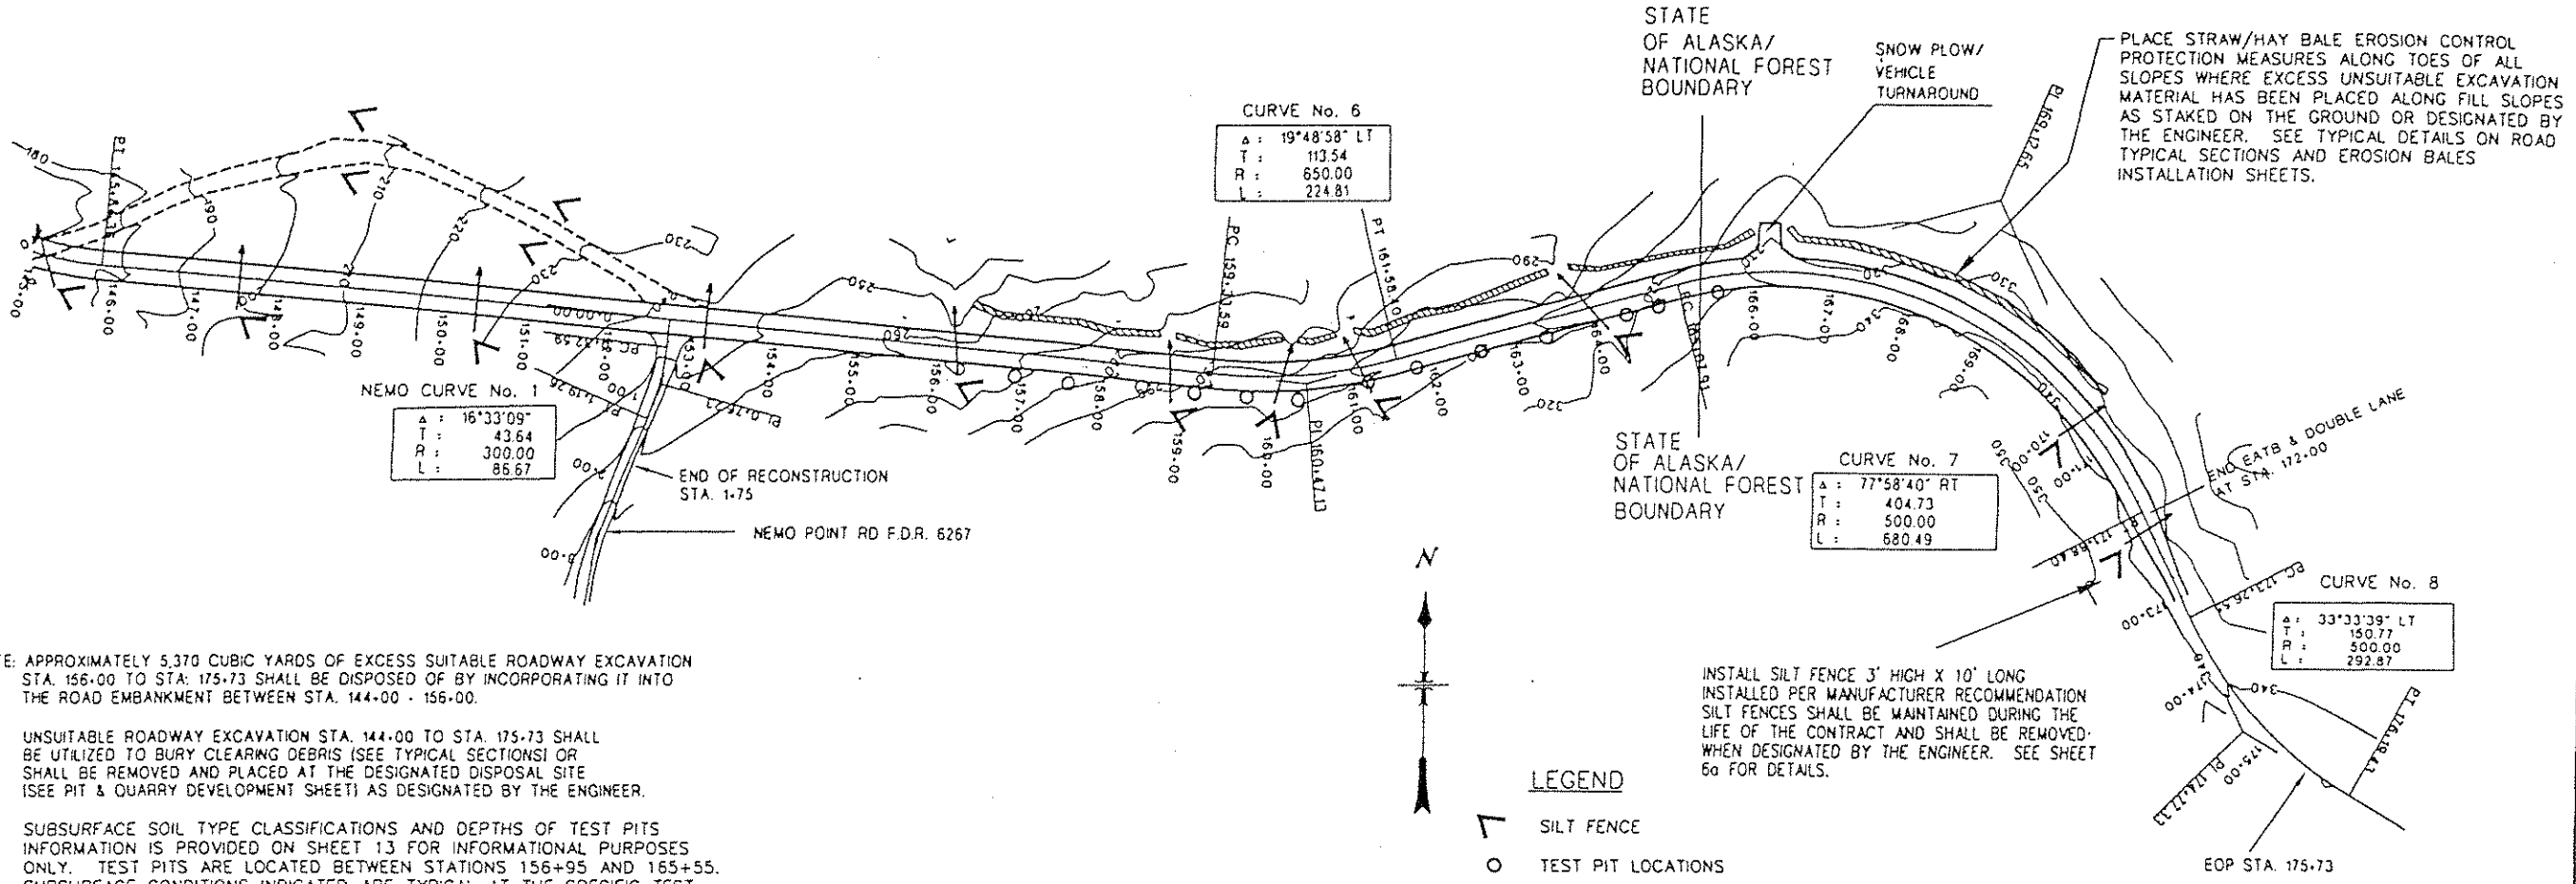

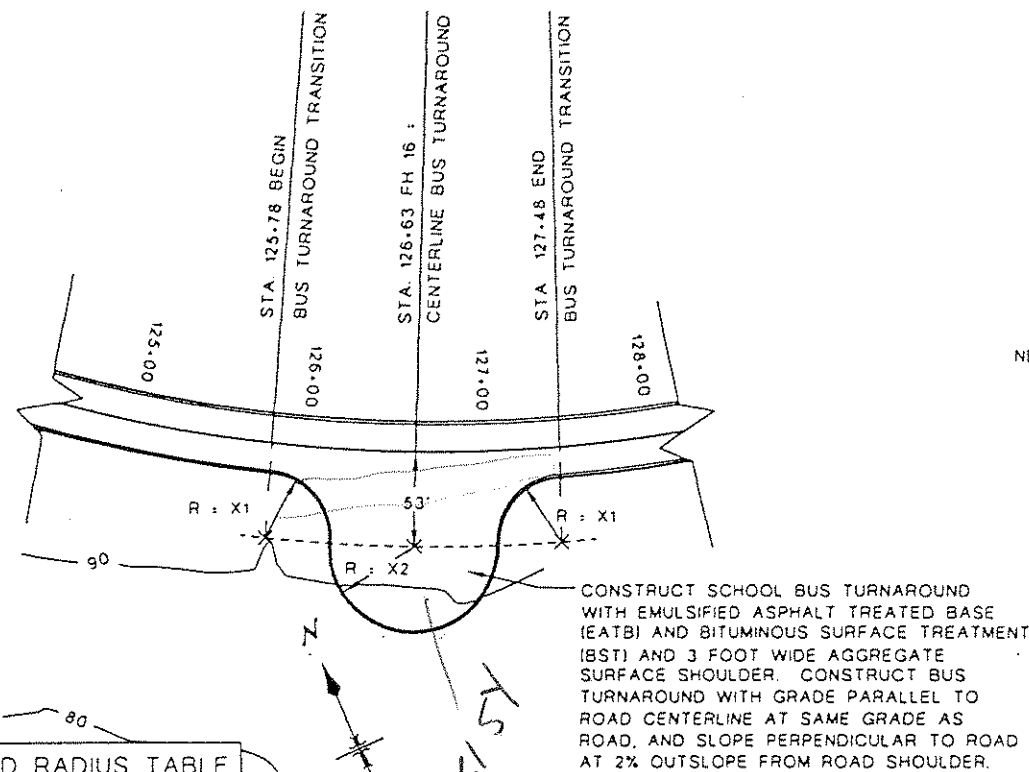



BUS TURNAROUND RADIUS TABLE		
RADIUS	EDGE OF BST	EDGE OF SHOULDER
R : X1	38'	35'
R : X2	47'	50'

SCHOOL BUS TURNAROUND
DETAIL



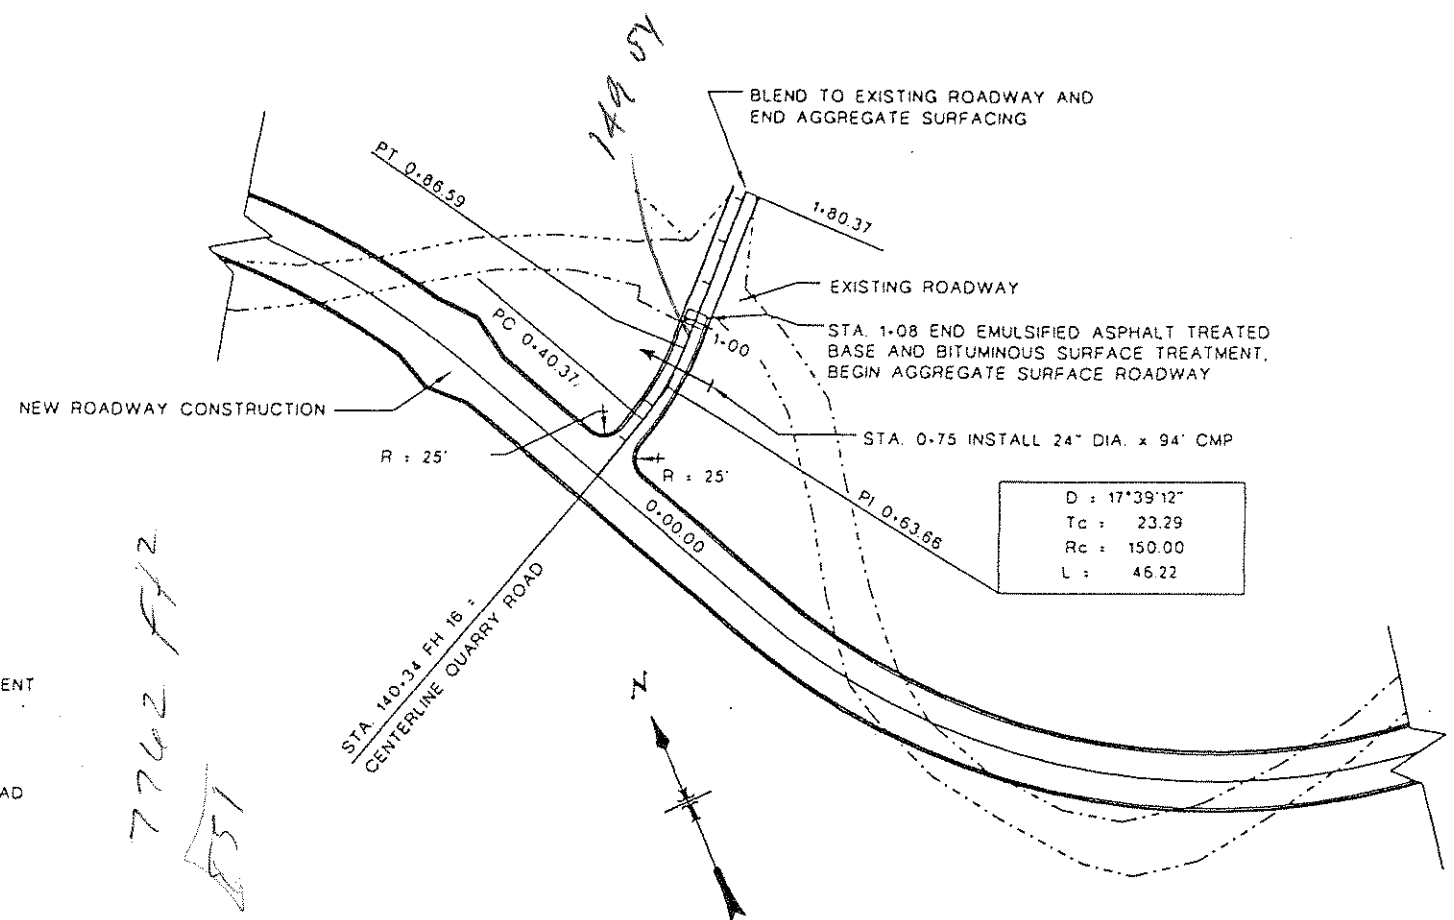


STATE SAND QUARRY ACCESS ROAD
DETAIL

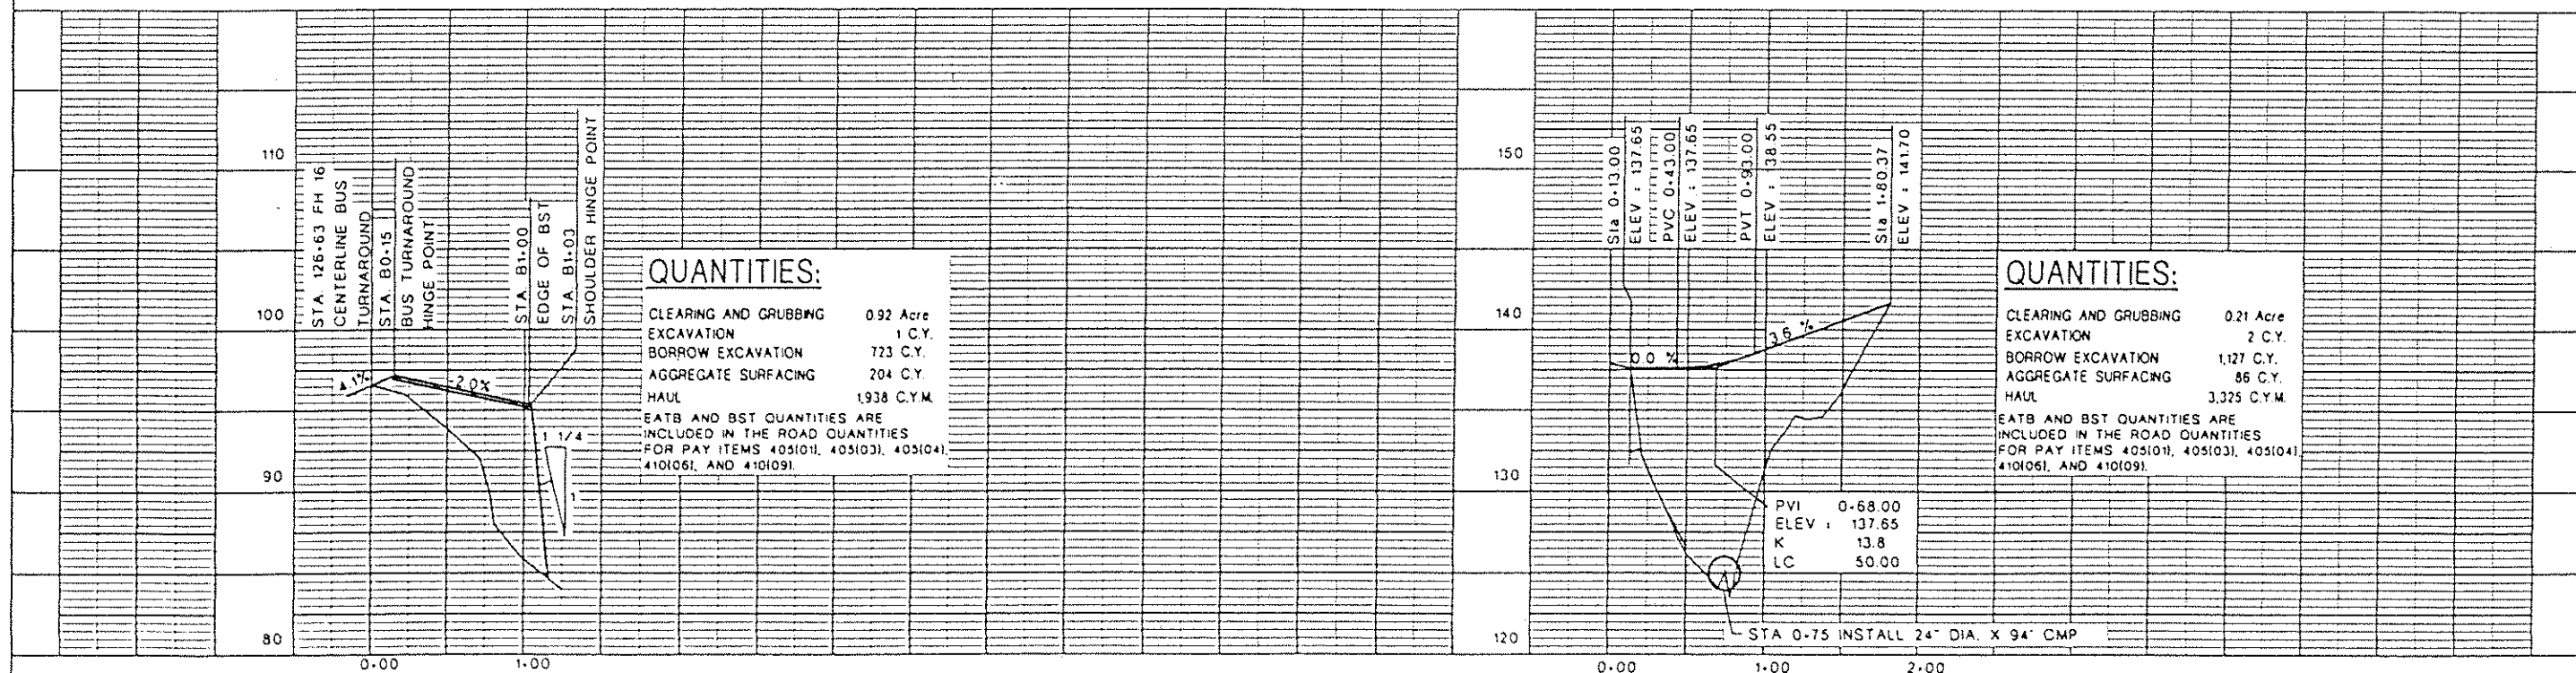

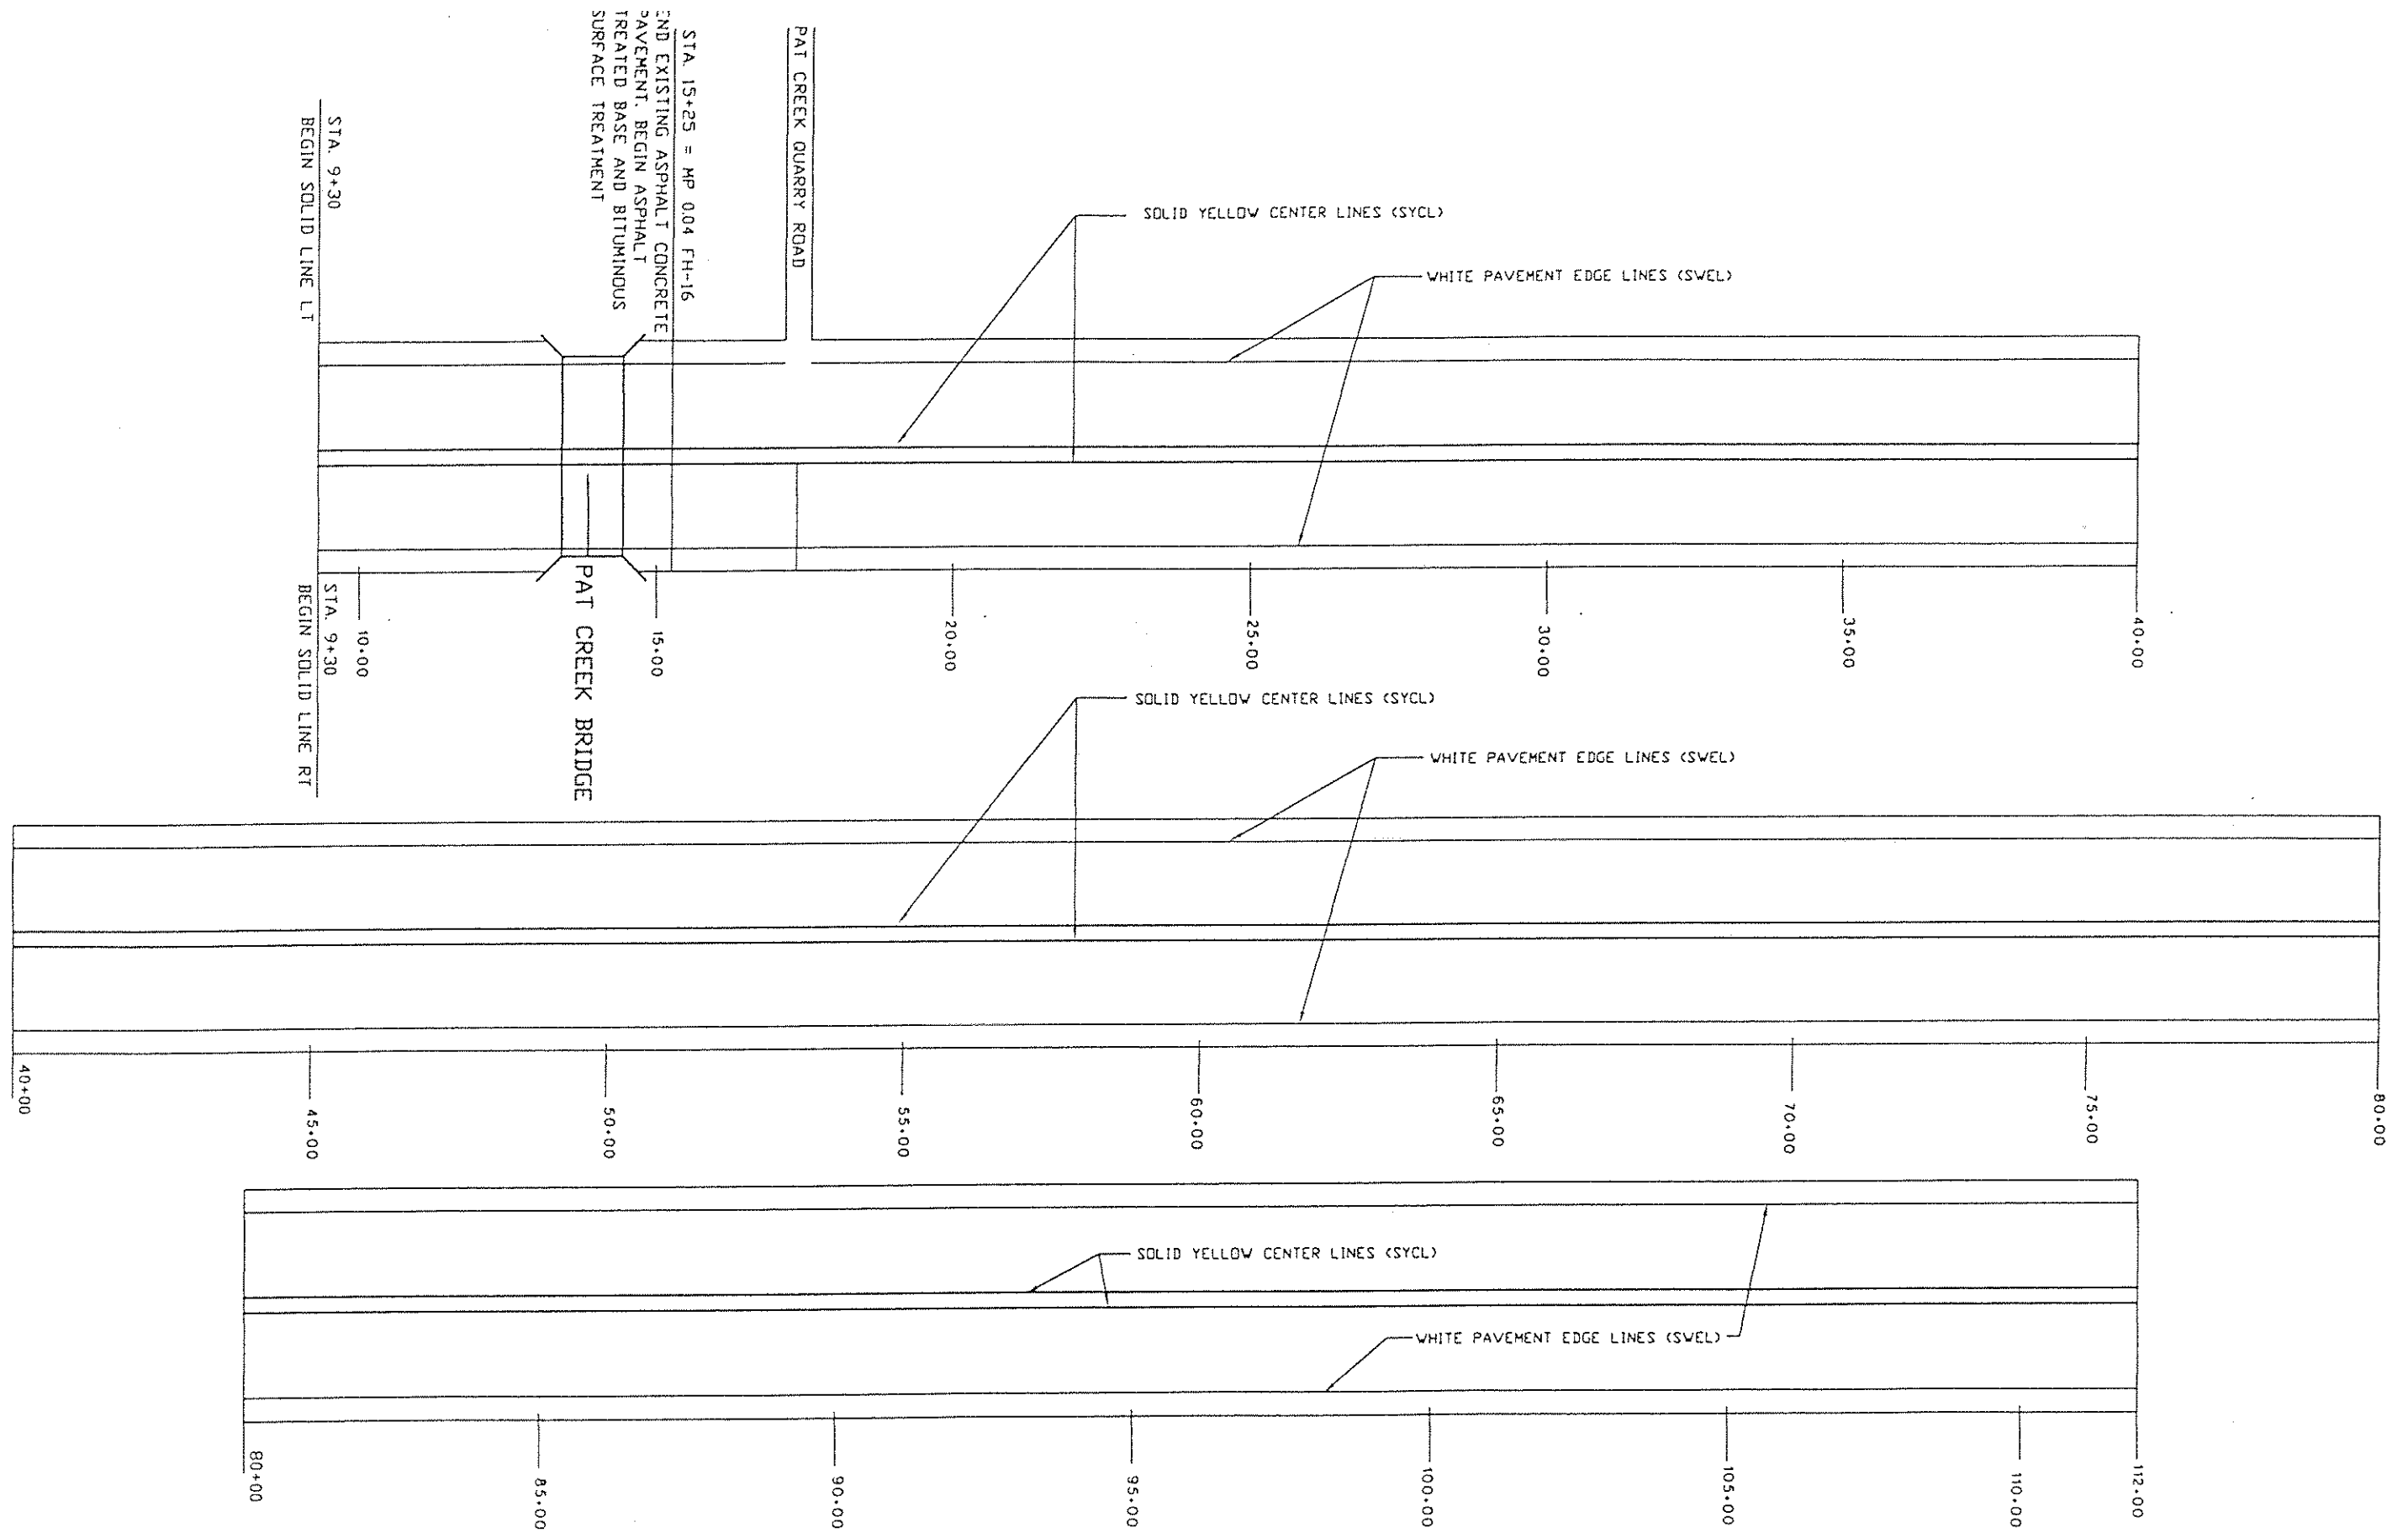

LEGEND

   SOLID YELLOW CENTER LINE (SYCL) 
 BROKEN YELLOW CENTER LINE (BYCL) 
 SOLID WHITE EDGE LINE (SWEL) 

ALL BROKEN LINE SEGMENTS SHALL BE 10 FOOT LONG WITH
 30 FOOT BLANK SEGMENTS, PER MUTCD SUBSECTION 3A-6, No. 4.

REVISION	DATE	DESCRIPTION	BY

Designed By: K. ELMORE Date 2/12/96
 Drawn By: K. ELMORE Date 2/12/96
 Checked by: L. DUNHAM Date 4/12/96




U.S. DEPARTMENT OF AGRICULTURE
 FOREST SERVICE
 REGION 10 STIKINE AREA


FOREST HIGHWAY 16
 PHASE III
 TRAFFIC MARKINGS

Drawing No. _____ Page 16a of 22a

Rock Pervis to contact
Mike Lutken
DOT-Traffic 405-1779

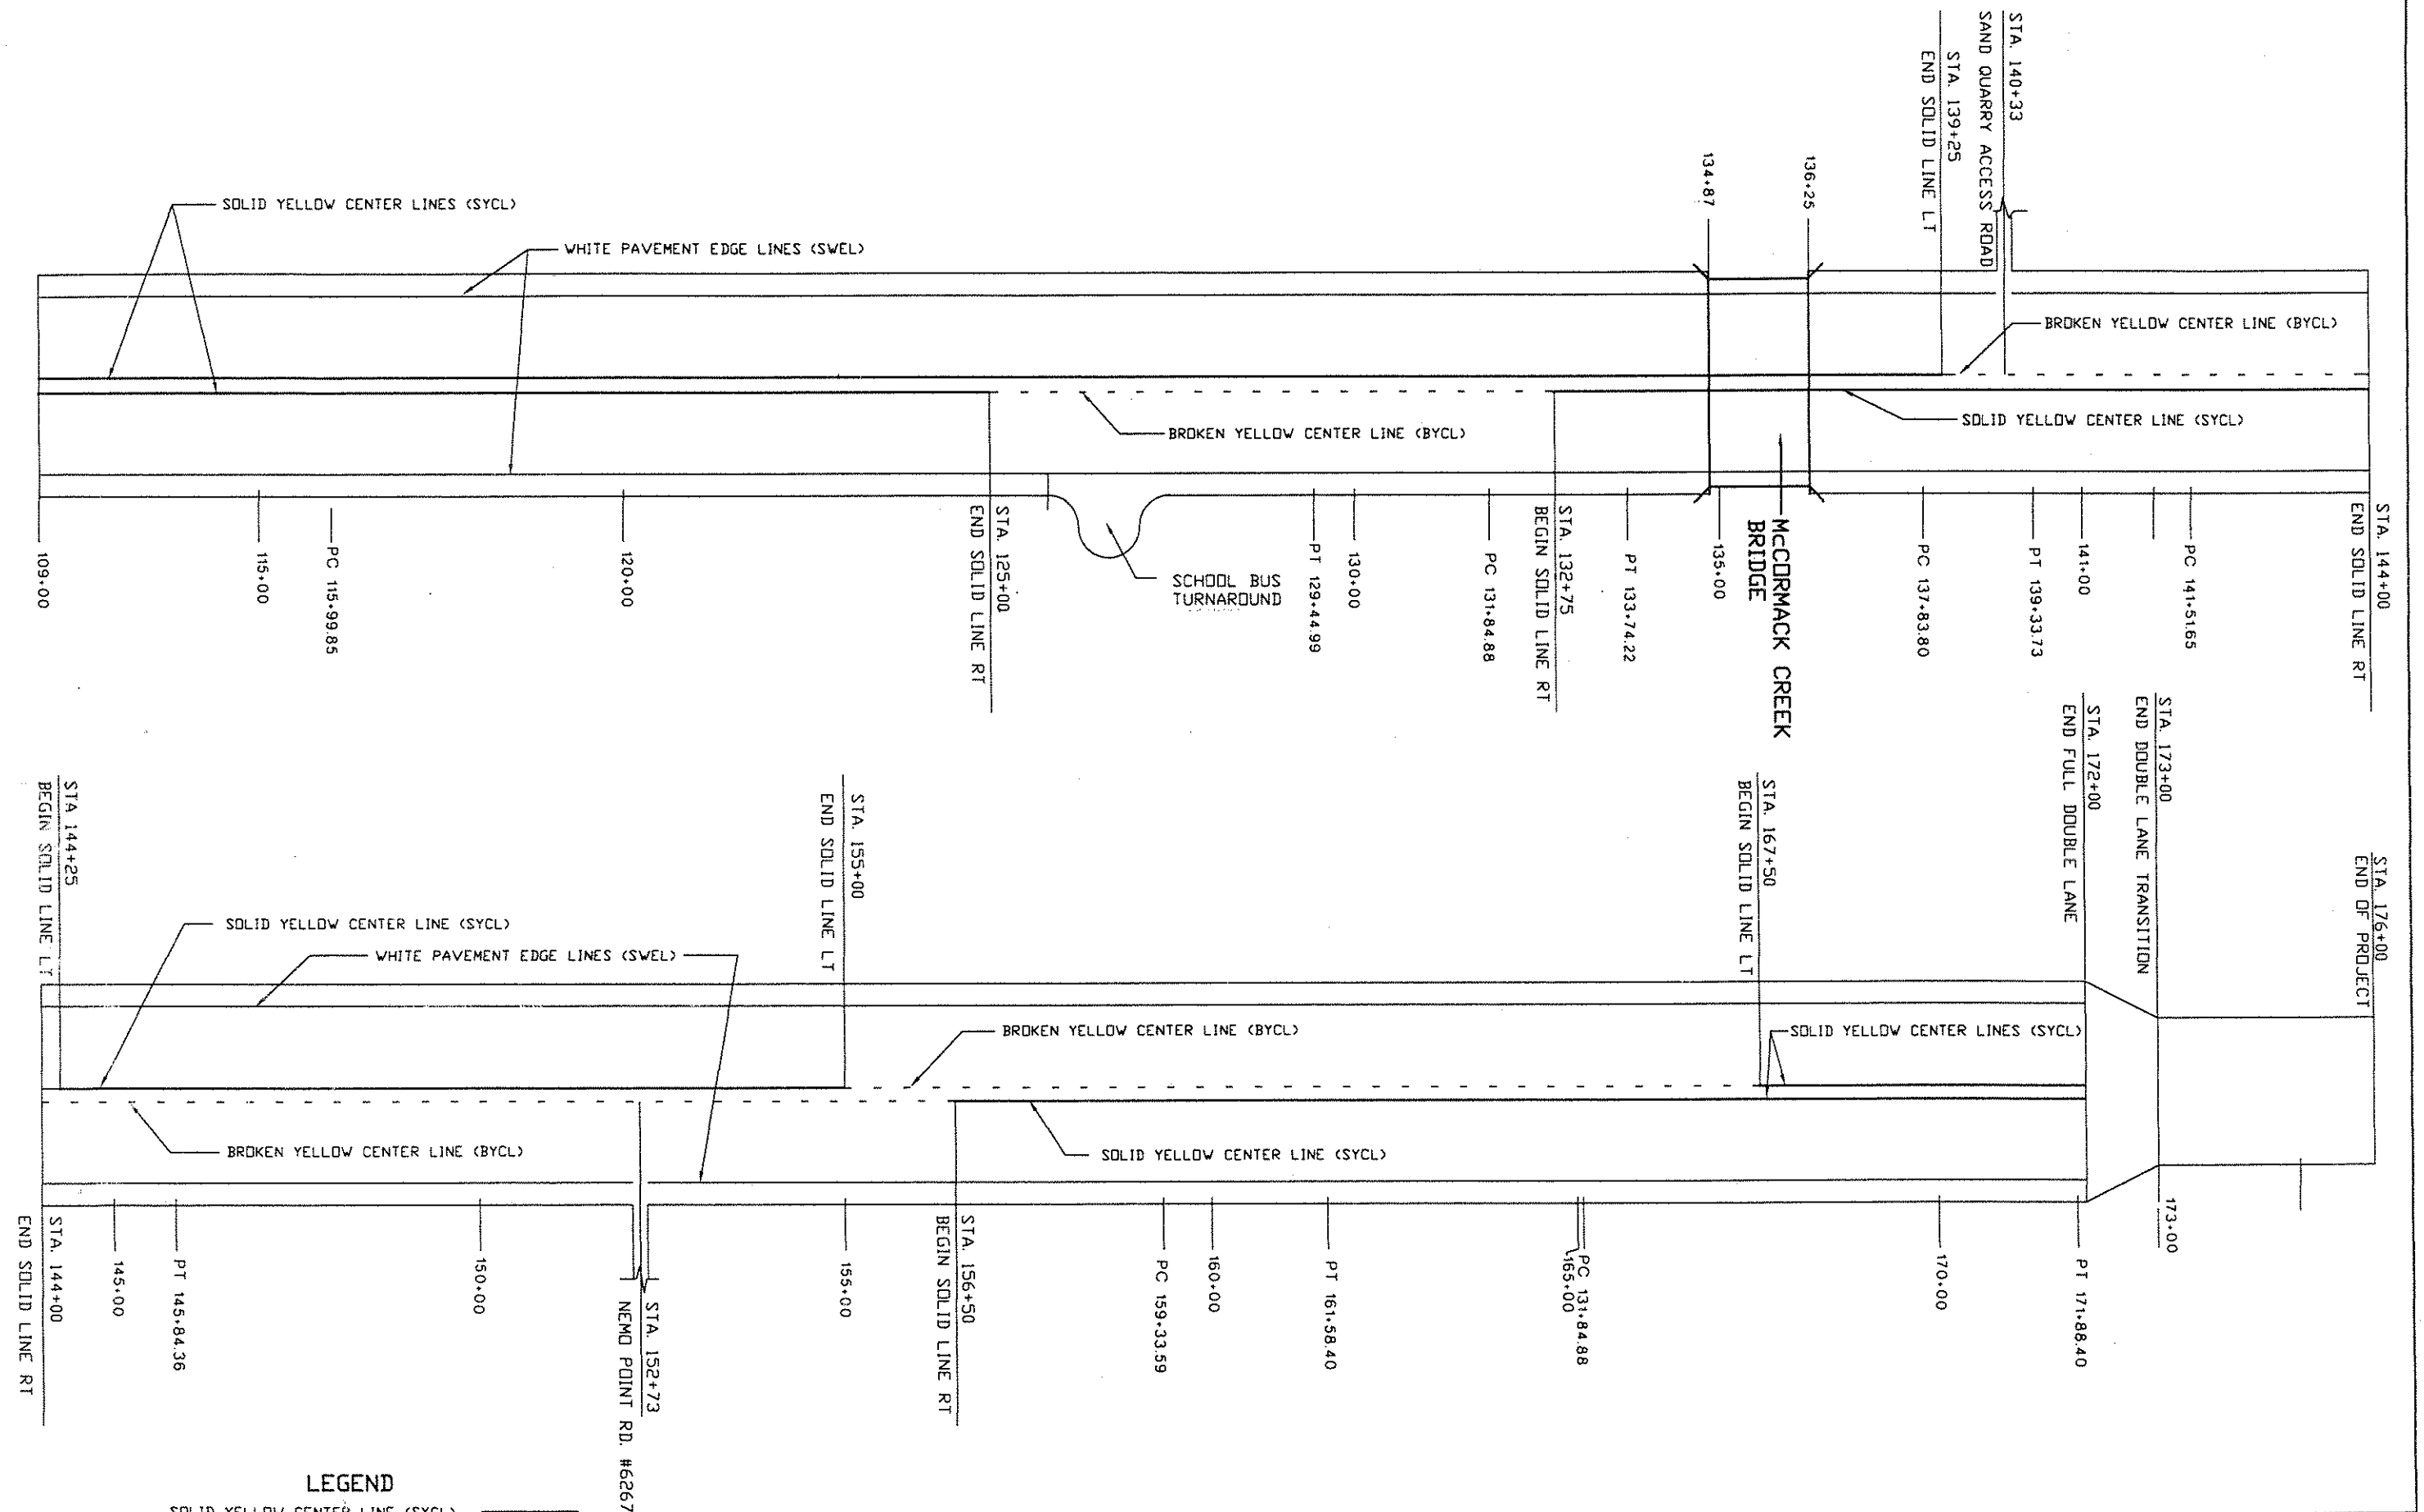


DESIGNED BY: K. ELMORE	DATE: 2/12/96		U.S. DEPARTMENT OF AGRICULTURE FOREST SERVICE REGION 10 STIKINE AREA	FOREST HIGHWAY 16	
DRAWN BY: K. ELMORE	DATE: 2/12/96			PHASE III	
CHECKED BY: L. DUNHAM	DATE: 4/12/96			TRAFFIC MARKINGS	
REVISION DATE	DESCRIPTION	BY	DRAWING NO.	PAGE 17a OF 22a	

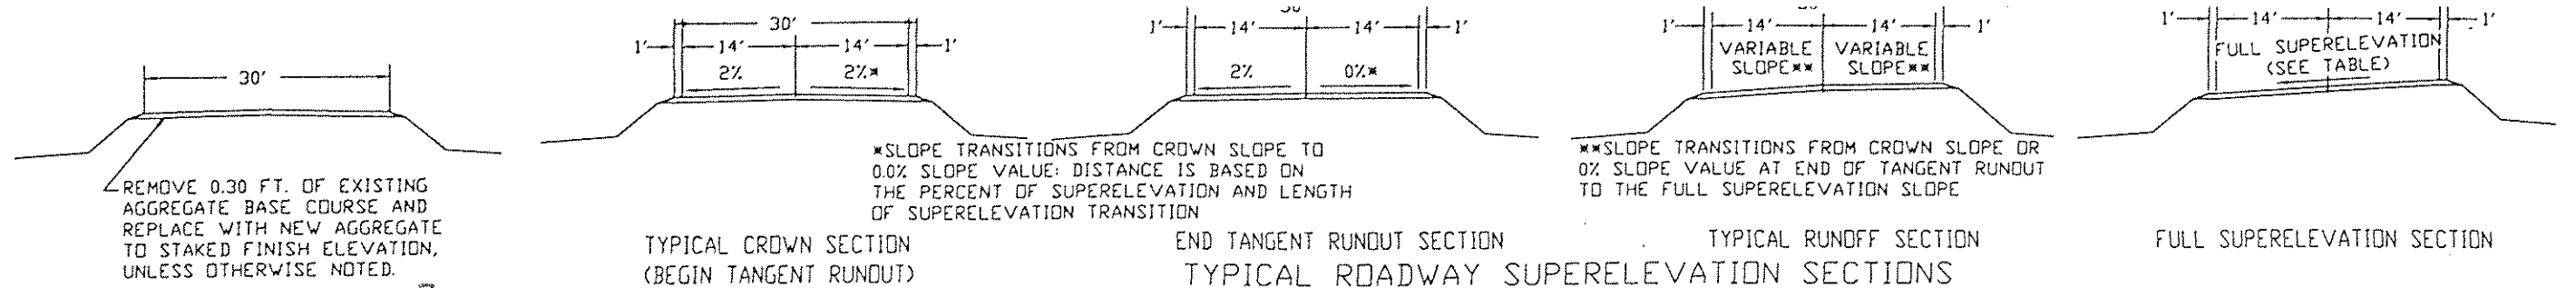

CROSS SECTION SHOWN ARE FOR A LEFT-HAND CURVE LOOKING FROM BEGINNING OF CURVE TOWARD END OF CURVE; CROSS SECTIONS FOR RIGHT-HAND CURVE ARE MIRROR IMAGE ABOUT ROAD CENTERLINE OF THE CROSS SECTIONS SHOWN. TRANSITIONS AT THE END OF EACH CURVE USE THE SAME CROSS SECTIONS AS THE BEGINNING OF THE CURVE, BUT IN REVERSE ORDER.

NO SCALE

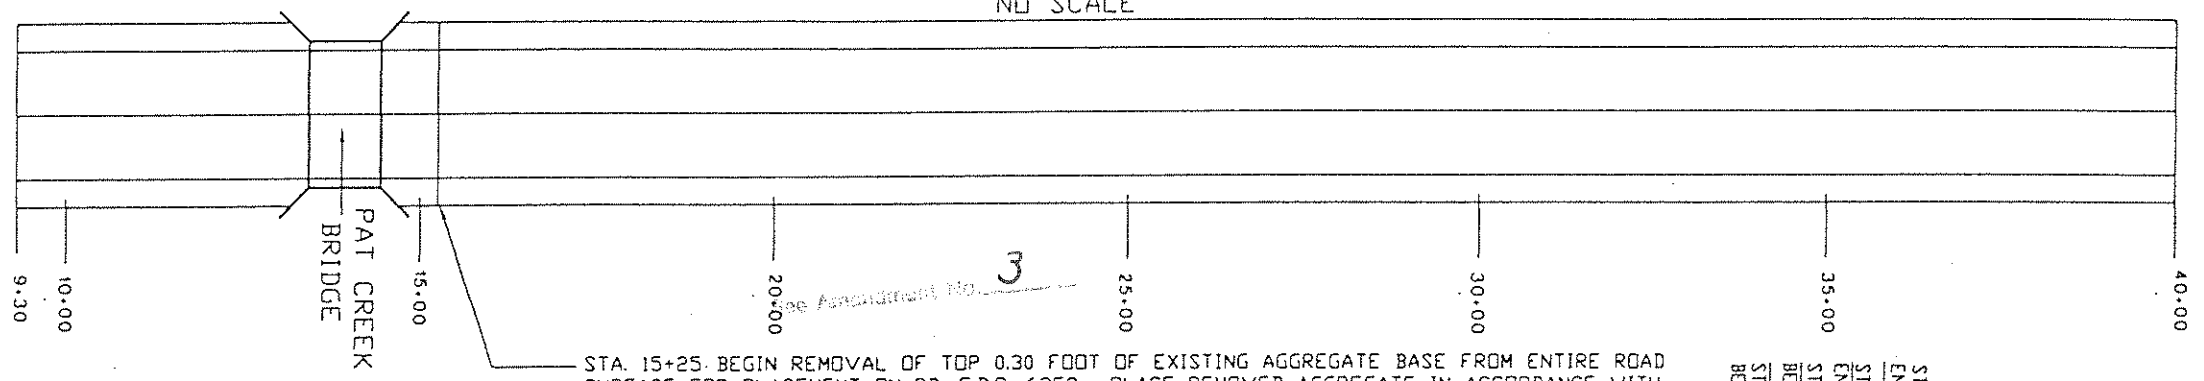

STA. 15+25. BEGIN REMOVAL OF TOP 0.30 FOOT OF EXISTING AGGREGATE BASE FROM ENTIRE ROAD SURFACE FOR PLACEMENT ON RD. F.D.R. 6259. PLACE REMOVED AGGREGATE IN ACCORDANCE WITH SECTION 304 ON PAT LAKE RD. F.D.R. 6259 FROM M.P. 0.6 TO M.P. 2.4 AT A COMPACTED DEPTH OF 0.5 FT.

PLACE A 0.30 FOOT THICK LIFT OF NEW AGGREGATE FROM STA. 15+25 TO 131+51, F.H. 16, FOLLOWING REMOVAL OF EXISTING AGGREGATE, FOR CONSTRUCTION OF EMULSIFIED ASPHALT TREATED BASE (EATB). CONSTRUCT EMULSIFIED ASPHALT TREATED BASE (EATB) 3 INCHES THICK FROM STA. 15+25 TO STA. 172+00, F.H. 16, AND PLACE DOUBLE BITUMINOUS SURFACE TREATMENT (BST). CONSTRUCT A 6 INCH THICK EATB FOR 20 FEET AHEAD OF EACH BRIDGE APPROACH AT MCCORMACK CREEK. EATB AND BST SHALL NOT BE PLACED ON THE MCCORMACK CREEK BRIDGE DECK.

COMPACTED AGGREGATE BASE COURSE AND EMULSIFIED ASPHALT TREATED BASE (EATB) SHALL MEET 95% OF MAXIMUM DENSITY ACHIEVED THROUGH CONTROL STRIP COMPACTION IN ACCORDANCE WITH SUBSECTION 212.03.

STA. 75+84
END SUPERELEVATION TRANSITION

STA. 75+39
END FULL SUPERELEVATION

STA. 74+66
BEGIN FULL SUPERELEVATION

STA. 74+21
BEGIN SUPERELEVATION TRANSITION


STA. 76+78
END SUPERELEVATION TRANSITION

STA. 76+31
END FULL SUPERELEVATION

STA. 73+27
BEGIN SUPERELEVATION TRANSITION


SUPERELEVATION DATA						
CURVE No.	% FULL SUPER.	RUNOFF LENGTHS		TANGENT RUNOUT LENGTHS		TRANSITION GRADIENT+
		LEFT LANE	RIGHT LANE	LEFT LANE	RIGHT LANE	
1	3.9% (0.039)	45'	92'	0	47'	0.005935
2	4.1% (0.041)	47'	92'	0	45'	0.006239
3	6.0% (0.060)	105'	70'	35'	0	0.008000
4	5.6% (0.056)	98'	63'	35'	0	0.008000
5	5.6% (0.056)	63'	98'	0	35'	0.008000
6	4.7% (0.047)	53'	92'	0	39'	0.007152
7	5.3% (0.053)	95'	59'	36'	0	0.007811

+TRANSITION GRADIENTS ARE BASED ON 11' LANE WIDTH + 3' PAVED SHOULDER WIDTH = 14' TOTAL WIDTH

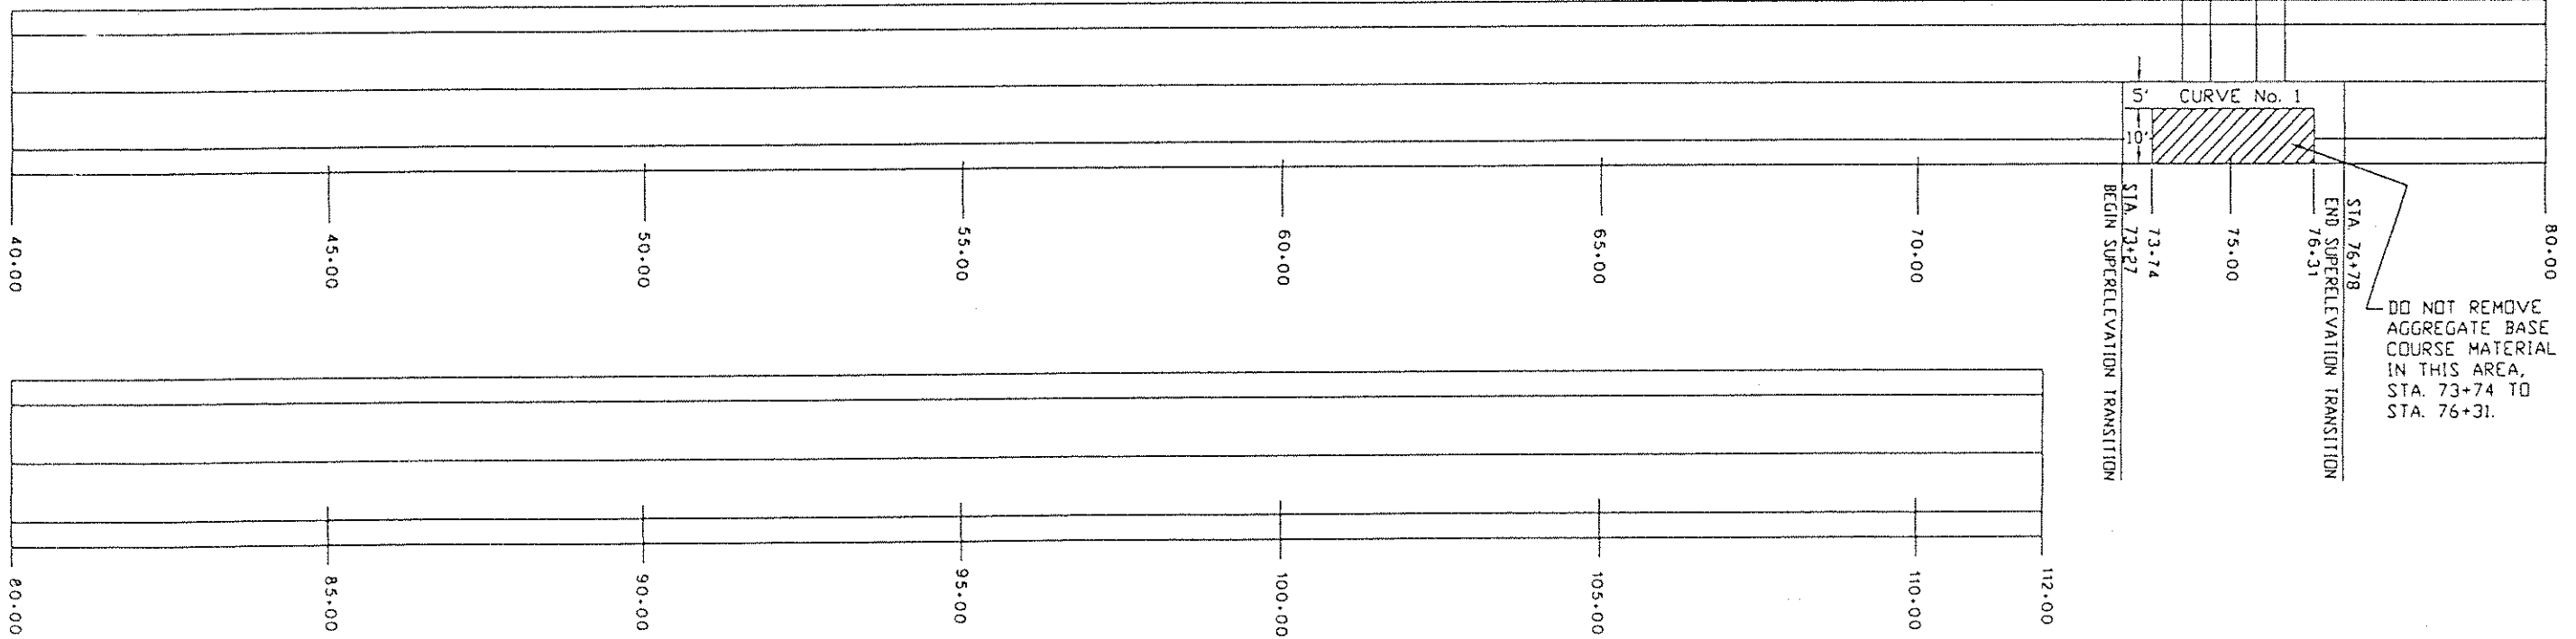

NOTE: SUPERELEVATED AND OTHER DESIGNATED SECTIONS WILL REQUIRE ADDITIONAL THICKNESS OF AGGREGATE AS STAKED.

DESIGNED BY: K. ELMORE	DATE: 2/12/96		FOREST HIGHWAY 16 PHASE III		
DRAWN BY: K. ELMORE	DATE: 2/12/96		AGGREGATE BASE, EATB, BST, & SUPERELEVATIONS		
CHECKED BY: L. DUNHAM	DATE: 4/12/96		Drawing No. _____ Page 18a of 22a		
REVISION DATE	DESCRIPTION	BY			

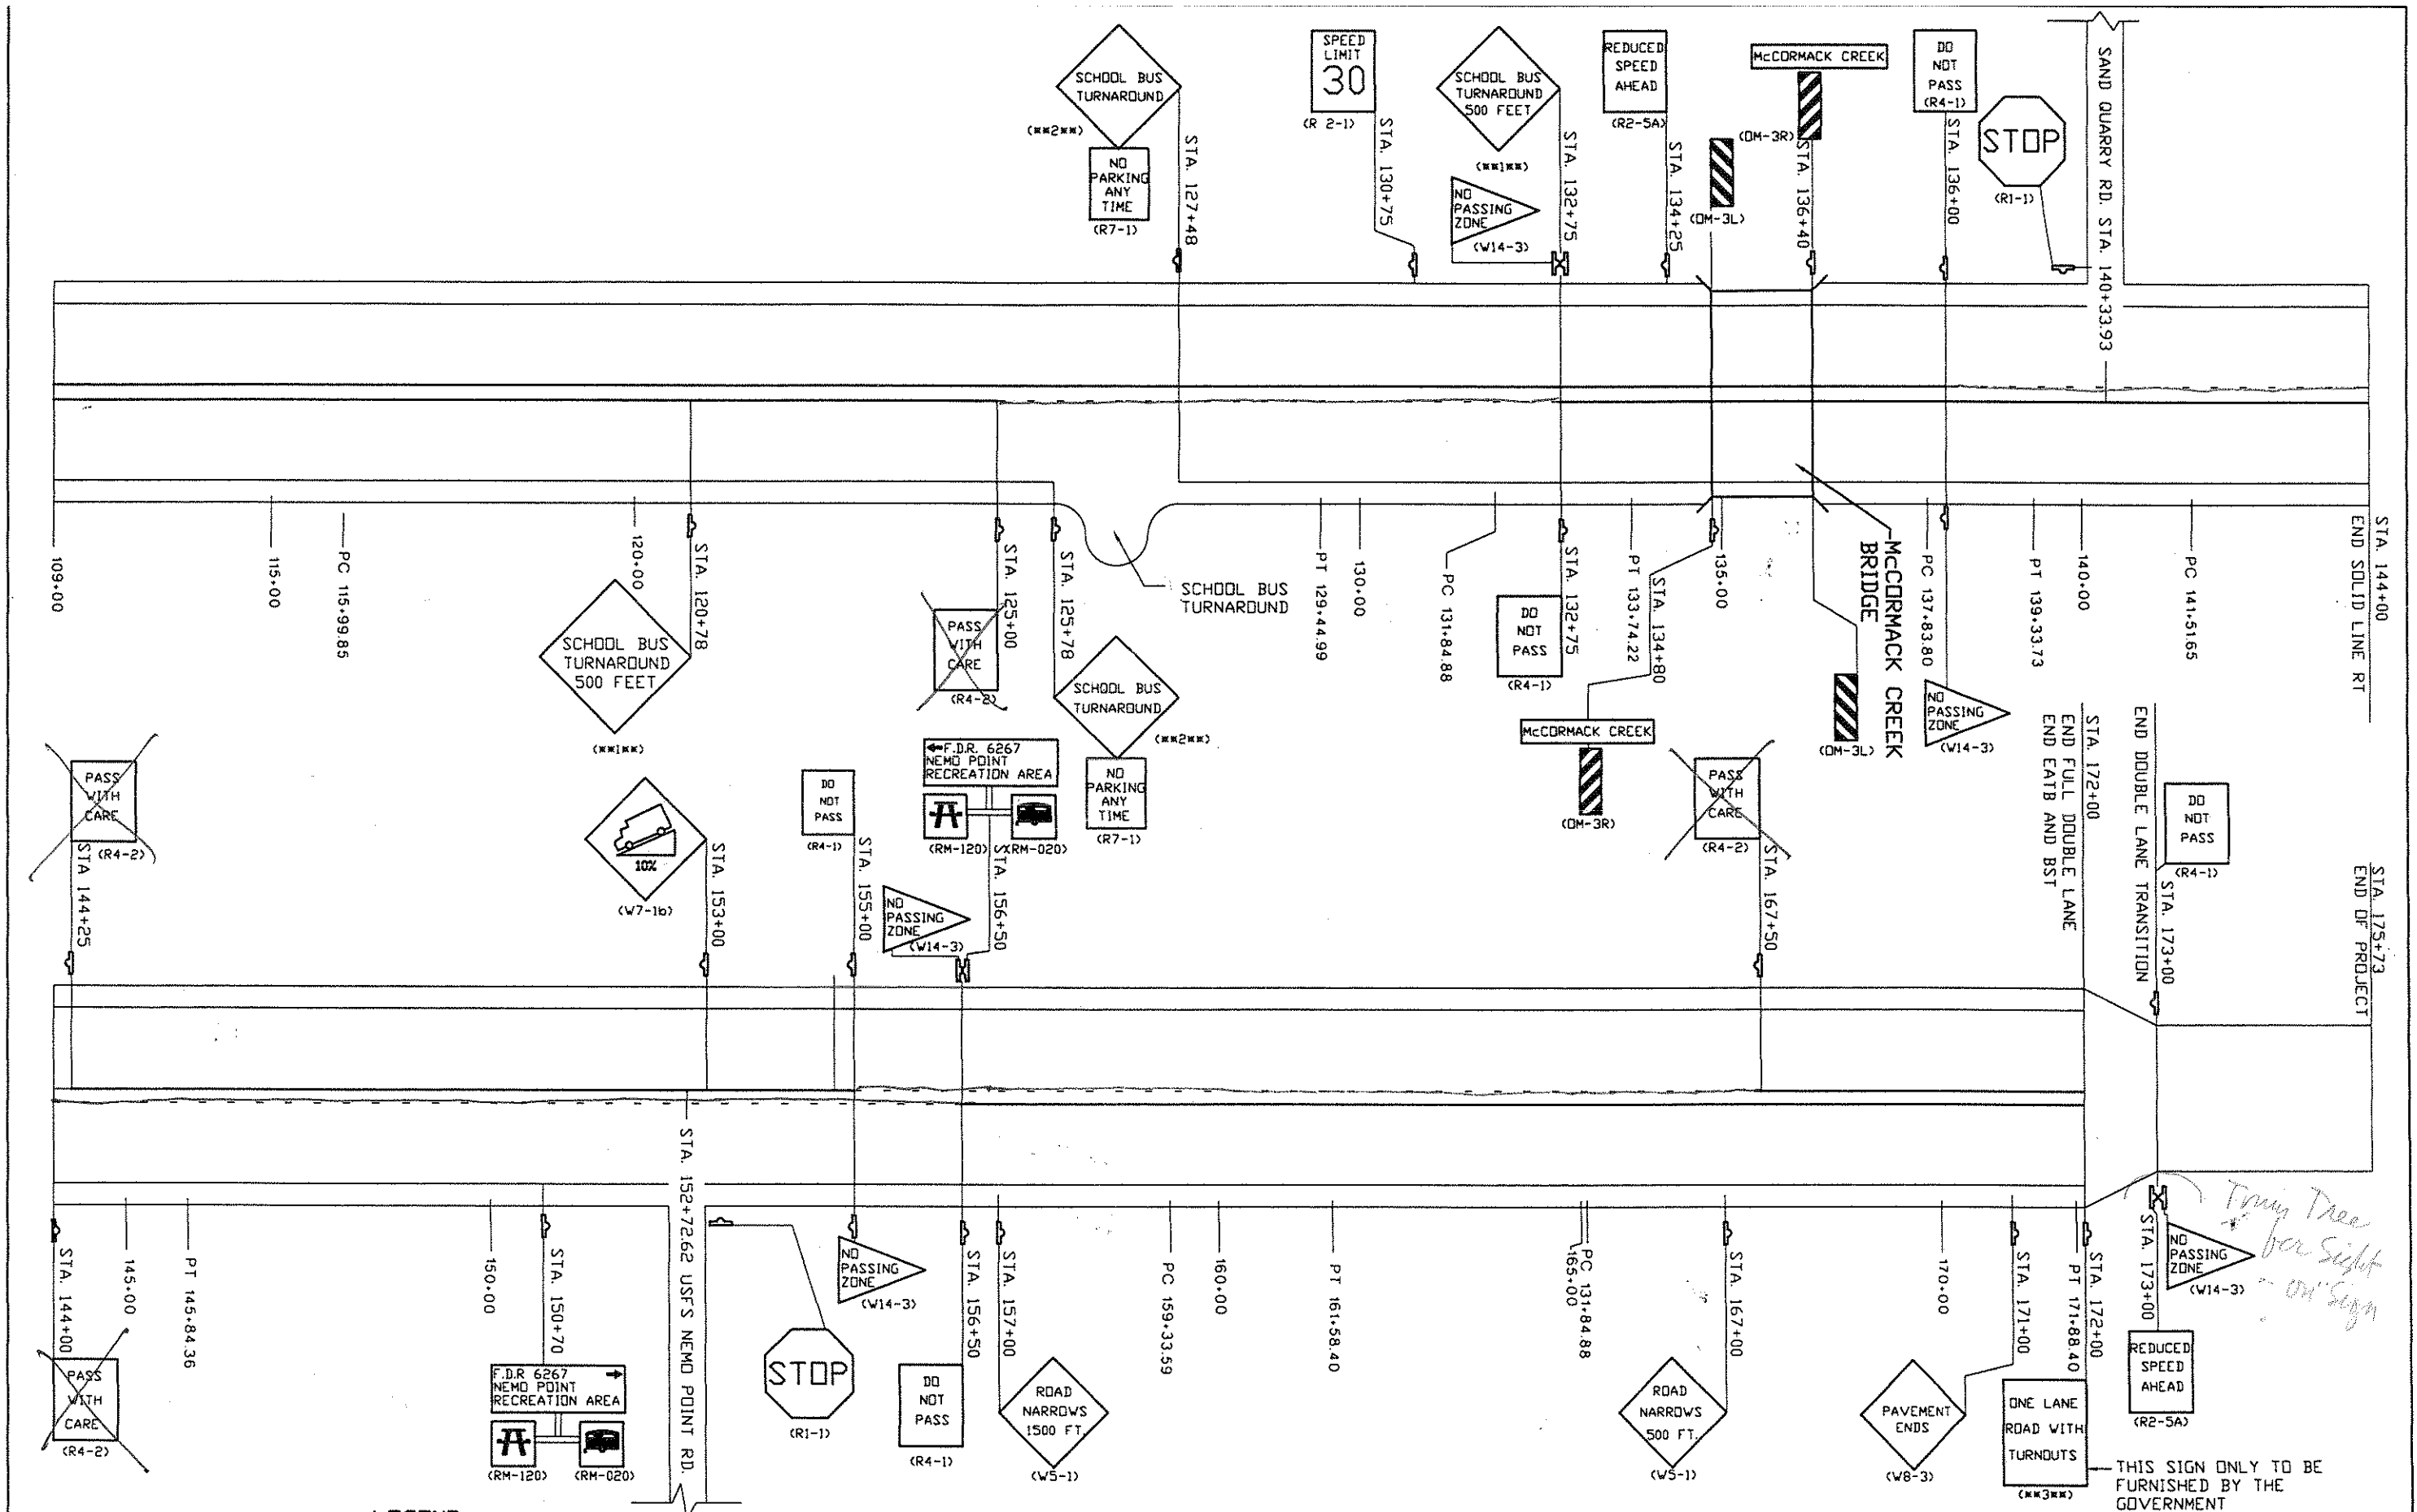

Trim Tree for Sight - on Sign

LEGEND

SOLID YELLOW CENTER LINE
 BROKEN YELLOW CENTER LINE
 SOLID WHITE EDGE LINE

SIGN LOCATION, WITH SIGN LEGIBLE FROM VIEWING SIDE
 MUTCD CODE FOR STANDARD SIGNS
 CODE FOR NON-STANDARD SIGNS

(R1-1)
 (**1**)

REVISION	DATE	DESCRIPTION	BY

Designed By: K. ELMORE Date 2/12/96
 Drawn By: K. ELMORE Date 2/12/96
 Checked by: L. DUNHAM Date 4/12/96







U.S. DEPARTMENT OF AGRICULTURE
 FOREST SERVICE
 REGION 10 STIKINE AREA

**FOREST HIGHWAY 16
 PHASE III
 SIGNS PLACEMENT**

SIGNING SUMMARY (INCHES)


SIGN No.	STATION	REF. C.L.	TYPE	LEGEND	POST SIZE	WIDTH (INCHES)	HEIGHT (INCHES)	SIGN COLOR	REMARKS
1	9+30	RT.	R4-1	DO NOT PASS	2.5	24	30	BLACK ON WHITE	
2	9+30	LT.	W14-3	NO PASSING ZONE	2.5	48	36	BLACK ON YELLOW	
3	12+40	RT.	W5-2A	NARROW BRIDGE SYMBOL	2.5	30	30	BLACK ON YELLOW	
4	13+40	RT.		DIRECTIONAL GUIDE SIGN - PAT CREEK	2.0	36 +/-	12 +/-	WHITE ON BROWN	MOUNT ABOVE SIGN #5
5	13+40	RT.	DM-3R			12	36	BLACK ON YELLOW	
6	13+40	LT.	DM-3L		2.0	12	36	BLACK ON YELLOW	
7	14+43	RT.	DM-3R		2.0	12	36	BLACK ON YELLOW	
8	14+43	LT.	DM-3R			12	36	BLACK ON YELLOW	
9	14+43	LT.		DIRECTIONAL GUIDE SIGN - PAT CREEK	2.0	36 +/-	12 +/-	WHITE ON BROWN	MOUNT ABOVE SIGN #8
10	15+43	LT.	W5-2A	NARROW BRIDGE SYMBOL	2.5	30	30	BLACK ON YELLOW	
11	15+50	RT.	R2-1	SPEED LIMIT 30	2.5	24	30	BLACK ON WHITE	
12	120+78	RT.	**1**	NON-STANDARD SIGN - SCHOOL BUS TURNAROUND 500 FEET	2.5	30	30	BLACK ON YELLOW	
13	125+00	RT.	R4-2	PASS WITH CARE	2.5	24	30	BLACK ON WHITE	
14	125+78	RT.	**2**	NON-STANDARD SIGN - SCHOOL BUS TURNAROUND	2.5	30	30	BLACK ON YELLOW	
15	125+78	RT.	R7-1	NO PARKING ANY TIME		12	18	RED ON WHITE	MOUNT BELOW SIGN #14
16	127+48	LT.	**2**	NON-STANDARD SIGN - SCHOOL BUS TURNAROUND	2.5	30	30	BLACK ON YELLOW	
17	127+48	LT.	R7-1	NO PARKING ANY TIME		12	18	RED ON WHITE	MOUNT BELOW SIGN #16
18	130+75	LT.	R2-1	SPEED LIMIT 30	2.5	24	30	BLACK ON WHITE	
19	132+75	LT.	**1**	NON-STANDARD SIGN - SCHOOL BUS TURNAROUND 500 FEET	2.5	30	30	BLACK ON YELLOW	
20	132+75	RT.	R4-1	DO NOT PASS	2.5	24	30	BLACK ON WHITE	
21	132+75	LT.	W14-3	NO PASSING ZONE	2.5	48	36	BLACK ON YELLOW	MOUNT BACK TO BACK WITH SIGN #19
22	134+25	LT.	R2-5A	REDUCED SPEED AHEAD	2.5	24	30	BLACK ON WHITE	
23	134+80	RT.		DIRECTIONAL GUIDE SIGN - MCCORMACK CREEK	2.0	36 +/-	12 +/-	WHITE ON BROWN	MOUNT ABOVE SIGN #24
24	134+80	RT.	DM-3R		2.0	12	36	BLACK ON YELLOW	
25	134+80	LT.	DM-3L		2.0	12	36	BLACK ON YELLOW	
26	136+40	RT.	DM-3L		2.0	12	36	BLACK ON YELLOW	
27	136+40	LT.	DM-3R		2.0	12	36	BLACK ON YELLOW	
28	136+40	LT.		DIRECTIONAL GUIDE SIGN - MCCORMACK CREEK	2.0	36 +/-	12 +/-	WHITE ON BROWN	MOUNT ABOVE SIGN #27
29	139+25	LT.	R4-1	DO NOT PASS	2.5	24	30	BLACK ON WHITE	
30	139+25	RT.	W14-3	NO PASSING ZONE	2.5	48	36	BLACK ON YELLOW	
31	144+00	RT.	R4-2	PASS WITH CARE	2.5	24	30	BLACK ON WHITE	
32	144+25	LT.	R4-2	PASS WITH CARE	2.5	24	30	BLACK ON WHITE	
33	150+70	RT.		F.D.R. 6267 WITH DIRECTION ARROW RT.	2.5	48 +/-	24 +/-	WHITE ON BROWN	
34	150+70	RT.	RM-120	PICNIC TABLE SYMBOL		18	18	WHITE ON BROWN	MOUNT BELOW SIGN #33
35	150+70	RT.	RM-020	CAMPING TRAILER SYMBOL		18	18	WHITE ON BROWN	MOUNT BELOW SIGN #33
36	153+00	LT.	W7-1B	STEEP GRADE AHEAD SYMBOL WITH 10% ADDED	2.5	30	30	BLACK ON YELLOW	
37	155+00	RT.	W14-3	NO PASSING ZONE	2.5	48	36	BLACK ON YELLOW	
38	155+00	LT.	R4-1	DO NOT PASS	2.5	24	30	BLACK ON WHITE	
39	156+50	LT.		F.D.R. 6267 WITH DIRECTION ARROW LT.	2.5	48 +/-	24 +/-	WHITE ON BROWN	
40	156+50	LT.	RM-120	PICNIC TABLE SYMBOL		18	18	WHITE ON BROWN	MOUNT BELOW SIGN #39
41	156+50	LT.	RM-020	CAMPING TRAILER SYMBOL		18	18	WHITE ON BROWN	MOUNT BELOW SIGN #39
42	156+50	RT.	R4-1	DO NOT PASS	2.5	24	30	BLACK ON WHITE	
43	156+50	LT.	W14-3	NO PASSING ZONE	2.5	48	36	BLACK ON YELLOW	MOUNT BACK TO BACK WITH SIGN #39
44	157+00	RT.	W5-1*	ROAD NARROWS 1500 FT.	2.5	36	36	BLACK ON YELLOW	
45	167+00	RT.	W5-1*	ROAD NARROWS 500 FT.	2.5	36	36	BLACK ON YELLOW	
46	167+50	LT.	R4-2	PASS WITH CARE	2.5	24	30	BLACK ON WHITE	
47	171+00	RT.	W8-3	PAVEMENT ENDS	2.5	30	30	BLACK ON YELLOW	
48	172+00	RT.		ONE LANE ROAD WITH TURNOUTS	2 @ 2.5			GOVERNMENT FURNISHED SIGN - SUPPLY 2 POSTS ONLY FOR THIS SIGN	
49	173+00	RT.	R2-5A	REDUCED SPEED AHEAD	2.5	24	30	BLACK ON WHITE	
50	173+00	RT.	W14-3	NO PASSING ZONE	2.5	48	36	BLACK ON YELLOW	MOUNT BACK TO BACK WITH SIGN #49
51	173+00	LT.	R4-1	DO NOT PASS	2.5	24	30	BLACK ON WHITE	
52	0+25	LT.	R1-1	STOP					
53	0+25	LT.	R1-1	STOP	2.5	30	30	WHITE ON RED	

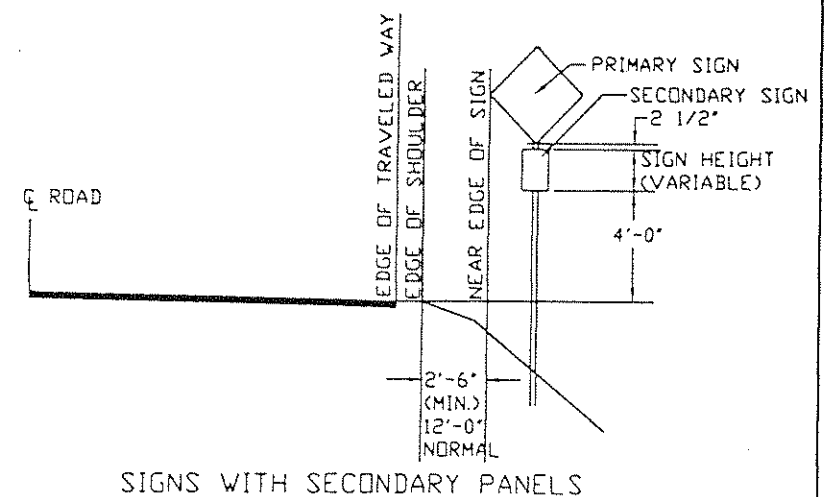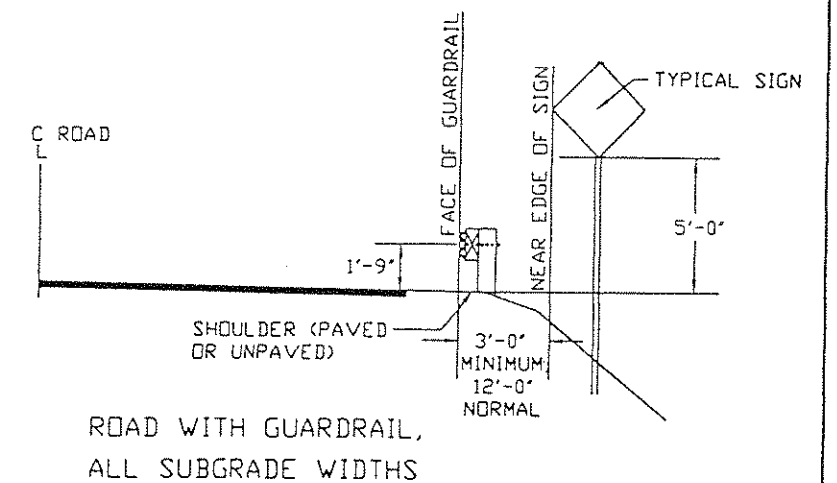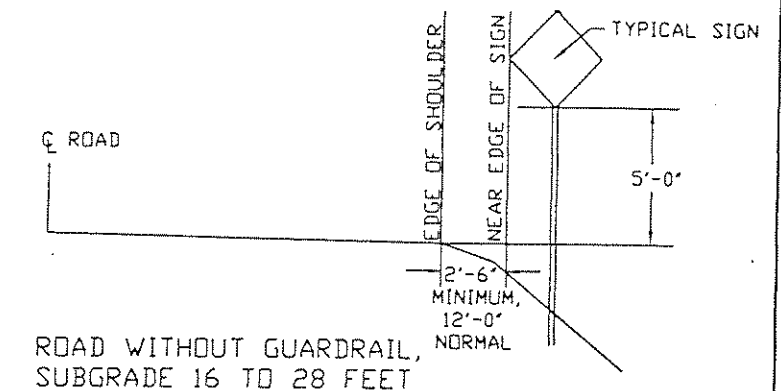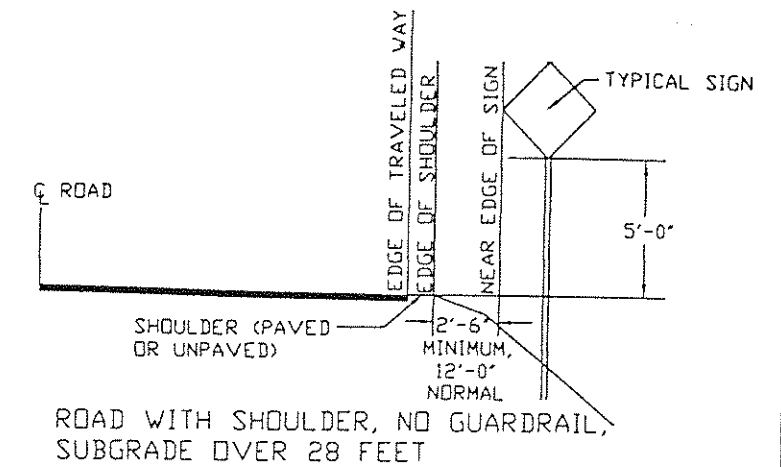


SIGNS GENERAL NOTES

- ALL SIGNS SHALL BE INSTALLED USING DIMENSIONS SHOWN ON THE DRAWINGS.
- ALL SIGN POSTS SHALL BE TELESCOPING PERFORATED GALVANIZED STEEL POSTS.
- STANDARD SIGN OFFSET IS 12 FT., UNLESS OTHERWISE SHOWN ON THE DRAWINGS. MINIMUM SIGN OFFSET IS 2 1/2 FT.

SIGN POSITIONING

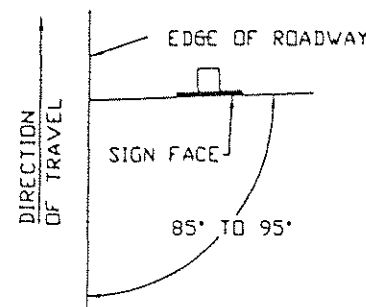

GENERAL INFORMATION SIGNS LAYOUT

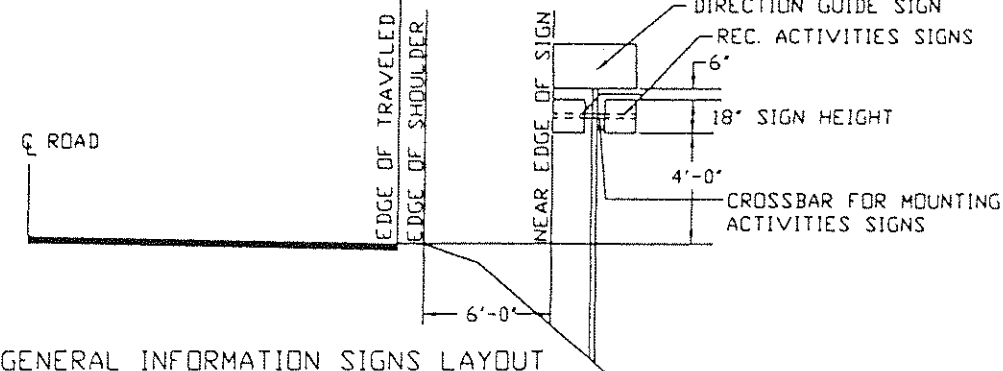

REVISION	DATE	DESCRIPTION	BY


Designed By: K. ELMORE Date: 2/29/96

Drawn By: K. ELMORE Date: 2/29/96



Checked by: L. DUNHAM Date: 4/12/96

U.S. DEPARTMENT OF AGRICULTURE
FOREST SERVICE
REGION 10 STIKINE AREAFOREST HIGHWAY 16
PHASE III
SIGN PLACEMENT SUMMARY


Drawing No. _____ Page 22a of 22a

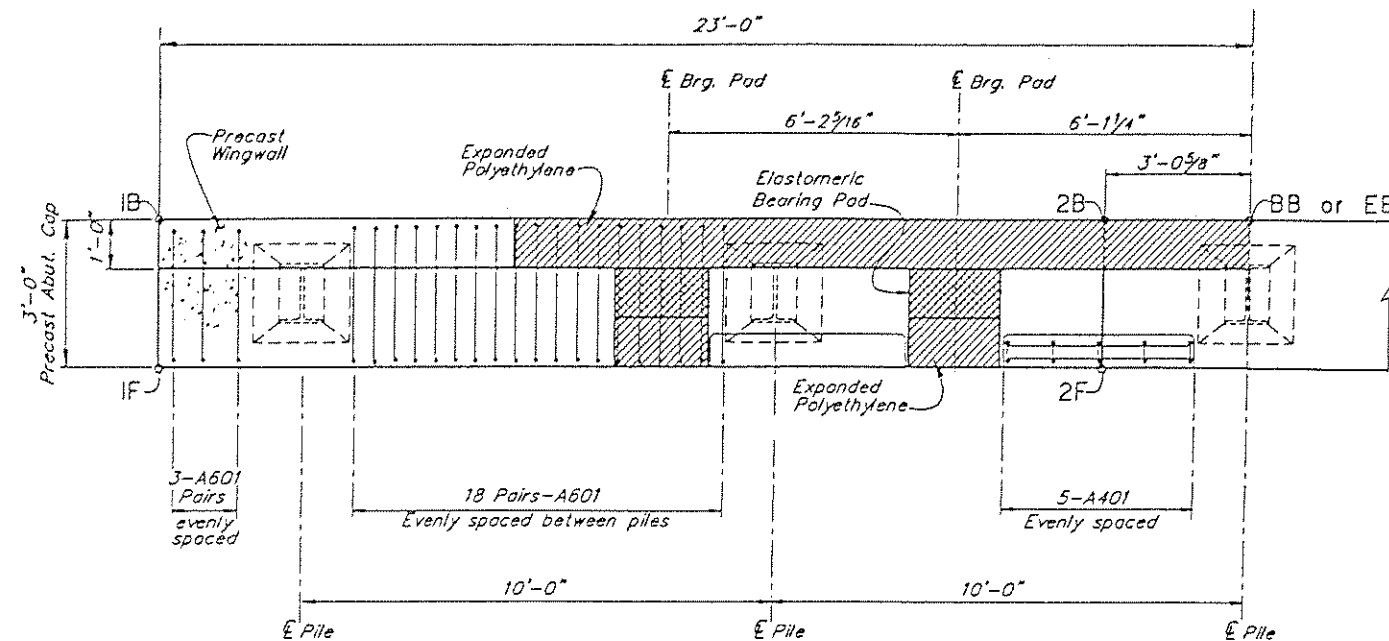

ABUTMENT PLAN

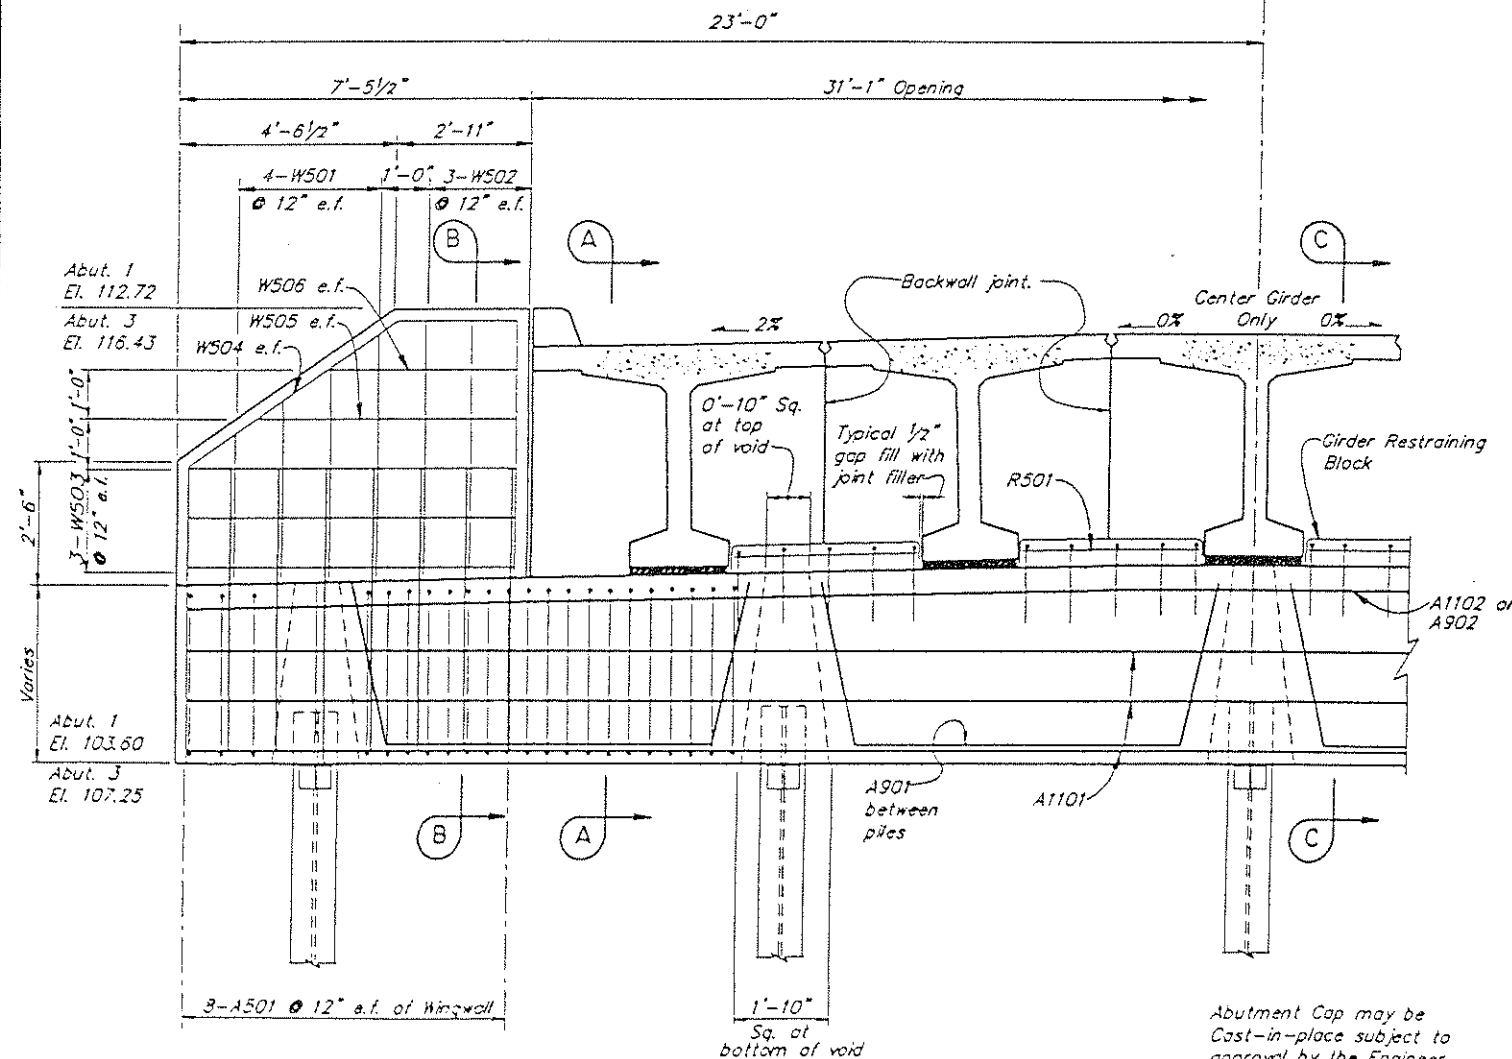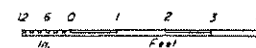

ABUTMENT ELEVATION

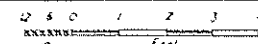


NOTE
Center 3' wide filter cloth over vertical joint on earth side of backwall full depth. (6 pieces each abutment).



Abutment Cap may be Cast-in-place subject to approval by the Engineer and at no additional cost to the owner.

TOP OF CAP ELEVATIONS


PT	ABUT. 1	ABUT. 3
1B	107.19	110.92
1F	107.27	110.84
2B	107.59	111.32
2F	107.67	111.24

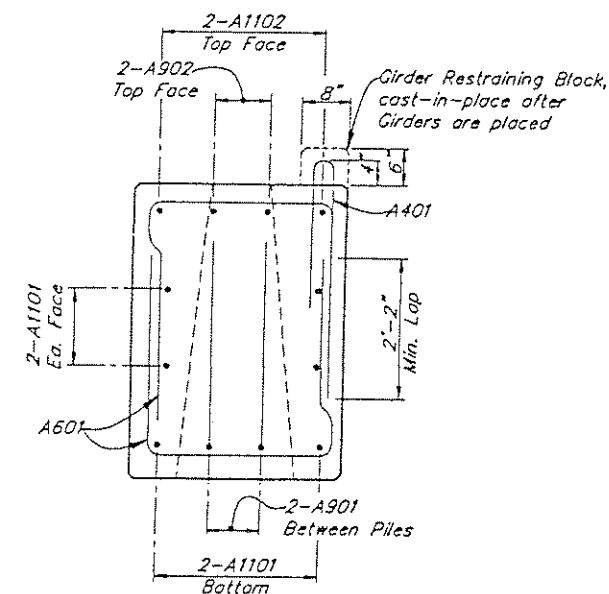

ABUTMENT SECTION C-C

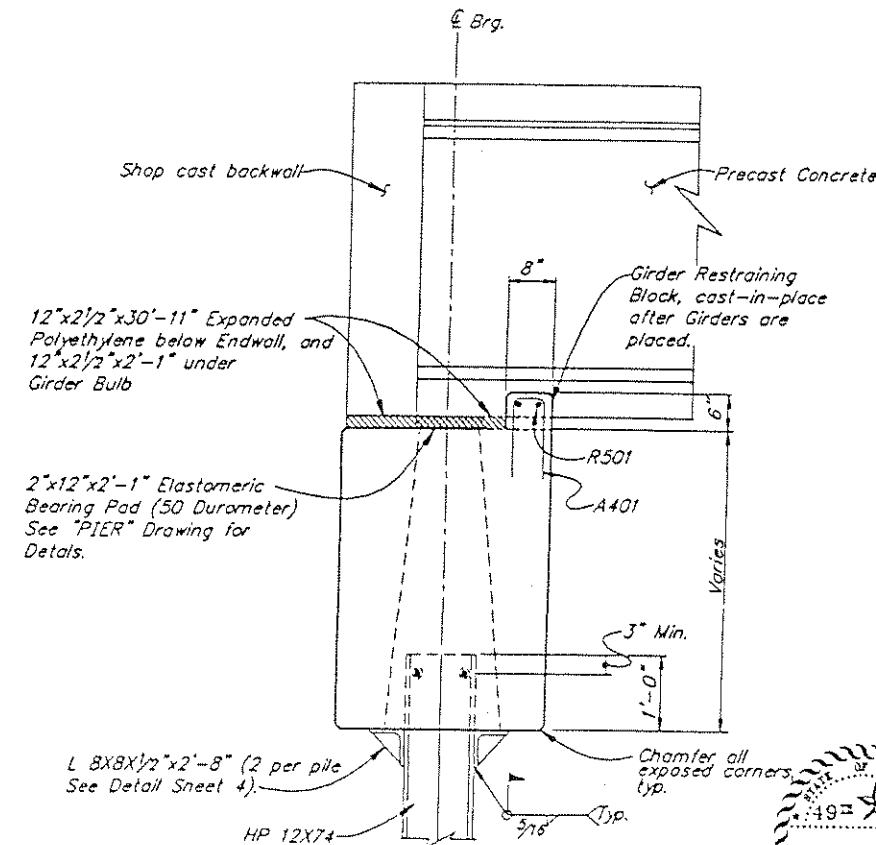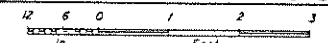



ABUTMENT SECTION A-A

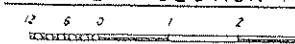


REINFORCING STEEL-ONE ABUTMENT

MARK	SIZE	NO.	LENGTH	TYPE
A401	4	20	5'-2"	Bent
A501	5	32	5'-10"	—
A601	6	156	8'-8"	Bent
A901	9	8	13'-8"	Bent
A902	9	2	45'-8"	Bent
A1101	11	6	45'-8"	—
A1102	11	2	45'-8"	Bent
R501	5	8	3'-8"	—
W501	5	16	Varies	—
W502	5	12	5'-2"	—
W503	5	12	7'-2"	—
W504	5	4	8'-0"	Bent
W505	5	4	5'-6"	—
W506	5	4	4'-0"	—

A Bars are in precast cap
R&W Bars are in C.I.P. concrete

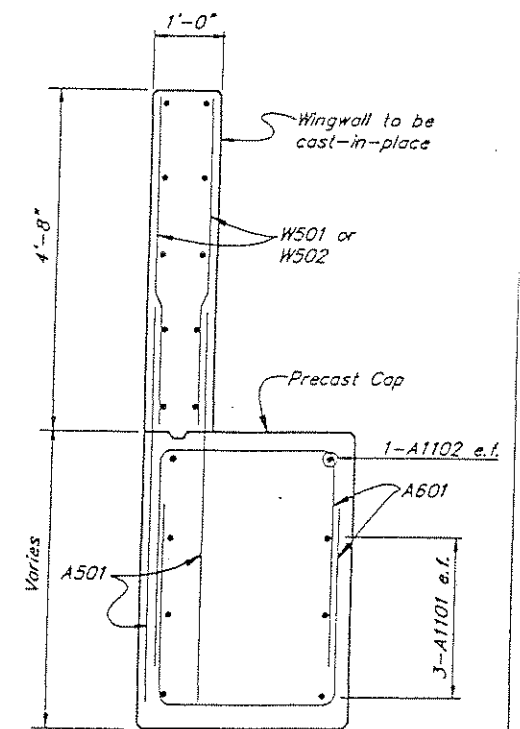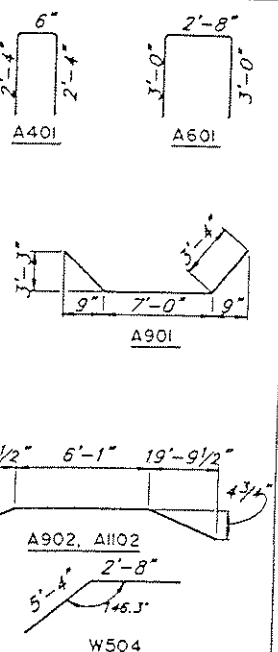

ABUTMENT SECTION B-B

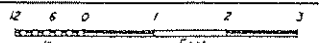




FOREST HIGHWAY 16
PHASE III
McCORMACK CREEK BRIDGE
ABUTMENTS

STATE OF ALASKA
DEPARTMENT of TRANSPORTATION
and PUBLIC FACILITIES
JUNEAU, ALASKA

DESIGNED BY: JRM
CHECKED BY: JRM
DATE: 12/1/74
SCALE: 1/4" = 1'-0"






PROJECT NO. 1082
SHEET NO. 3b

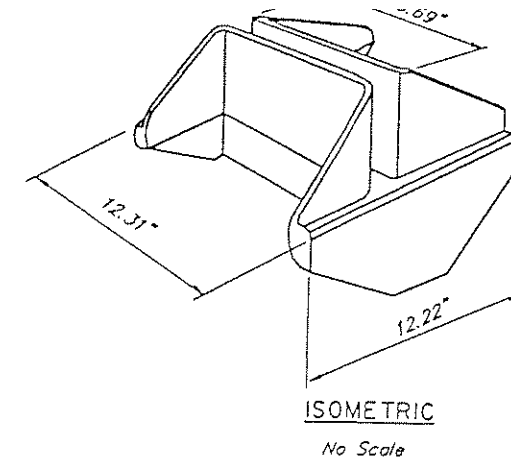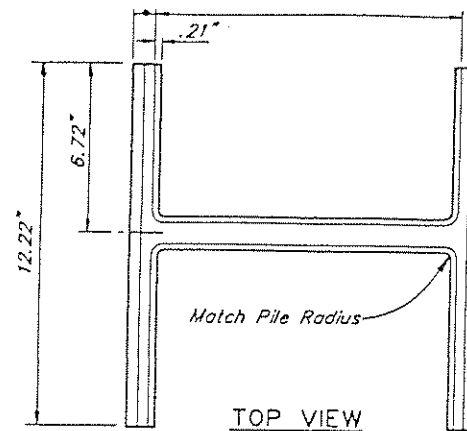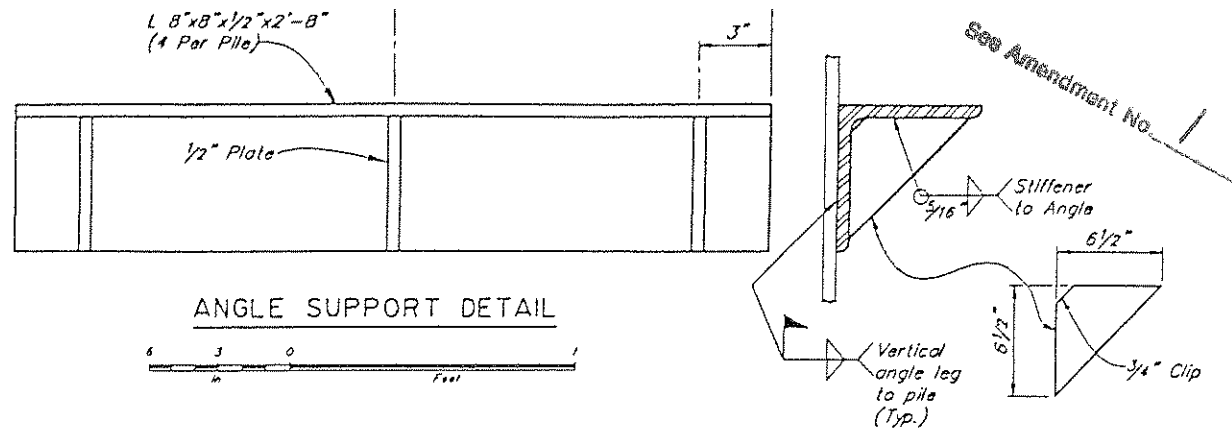


GIRDERS	± ELEVATIONS-TOP OF CAP		
	ABUT. 1	PIER 2	ABUT. 3
A	107.45	109.98	
B	107.57	110.11	
C	107.63	110.17	
D	407.57	110.11	
E	407.45	109.98	
F		110.01	111.10
G		110.14	111.22
H		110.20	111.28
I		110.14	111.22
J		110.01	111.10



± At E Bearings

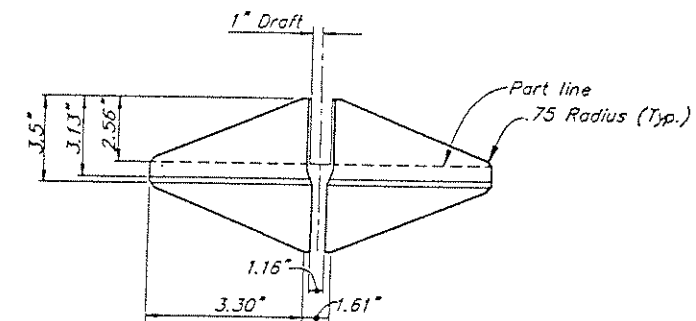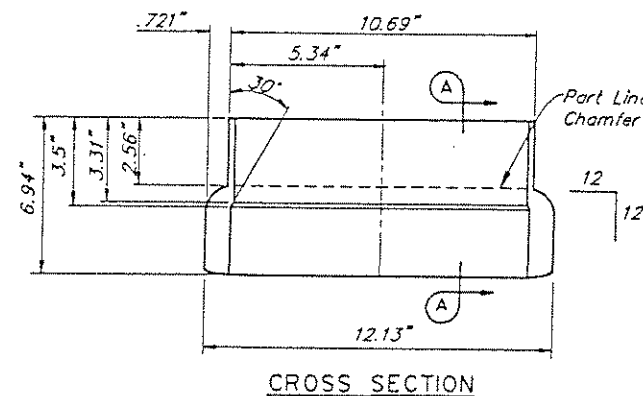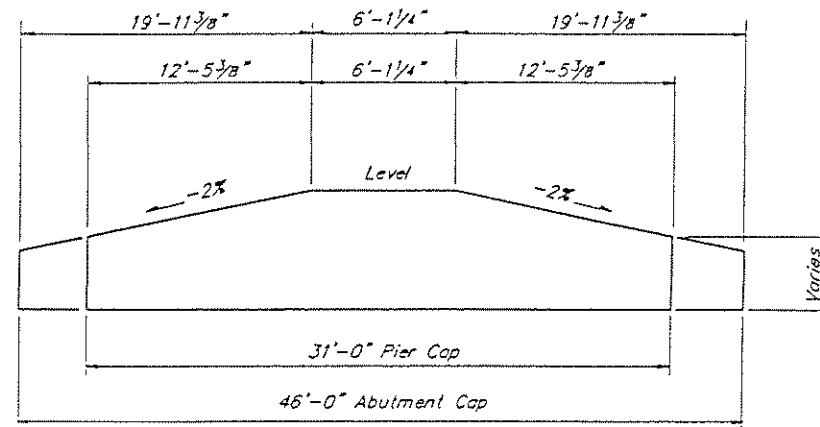


STEEL PILE SHOE DETAIL

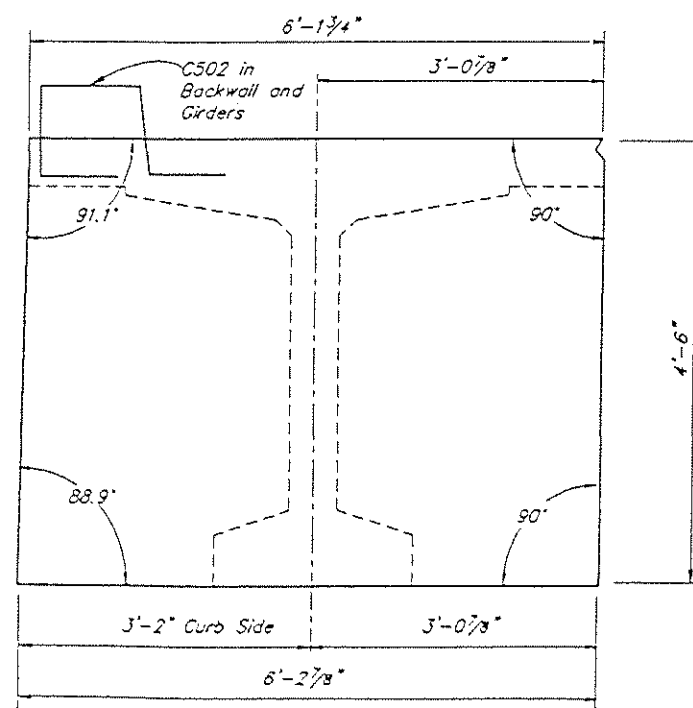


BACKWALL ELEVATION
GIRDERS A, E, F, & J

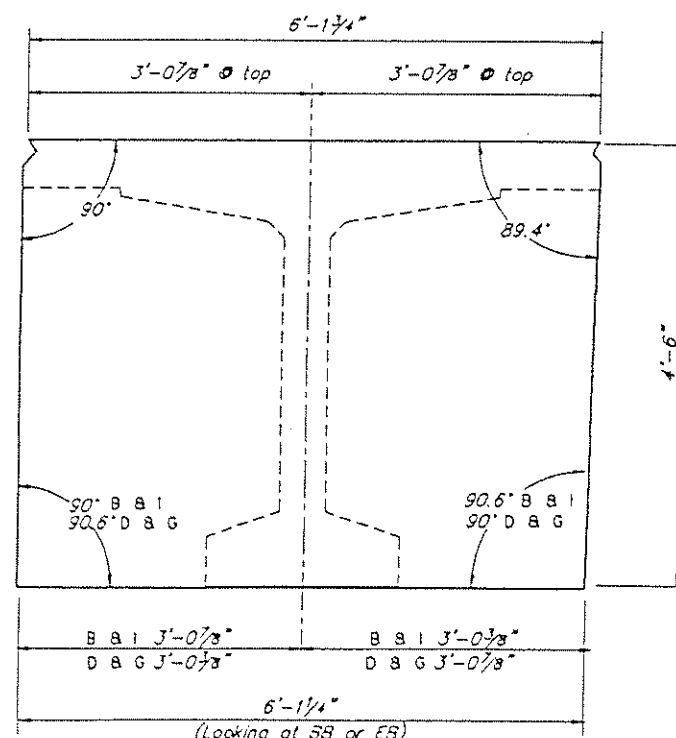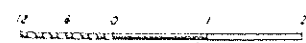

BACKWALL ELEVATION
GIRDERS B, D, G, & I

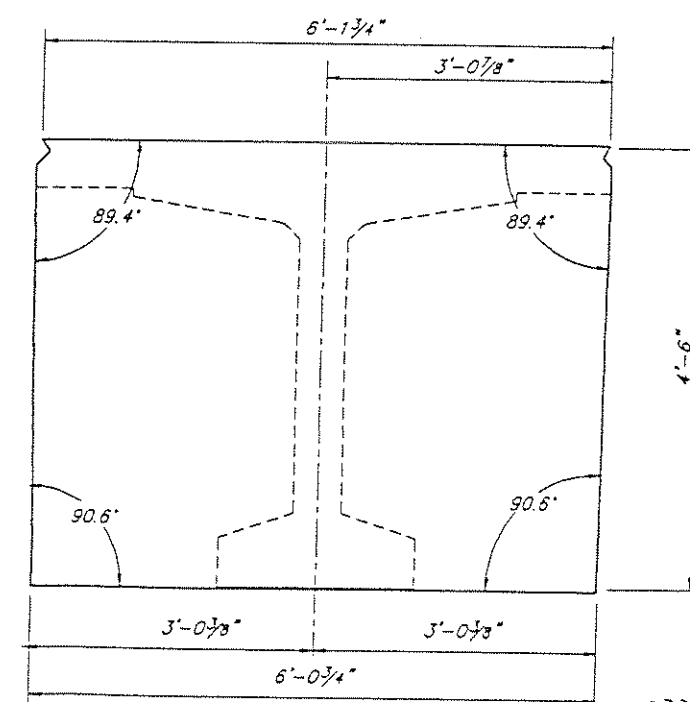

BACKWALL ELEVATION
GIRDERS C & H

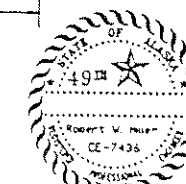


Designed by: RWM
Detail Check by: ESM
Design Check by: JLM
10/20/1994
2/3/1995
Print Scale = 1/8" = 1'-0"
Drawn by: RWM

FOREST HIGHWAY 16
PHASE III
McCORMACK CREEK BRIDGE
ABUTMENT AND PIER DETAILS

STATE OF ALASKA
DEPARTMENT of TRANSPORTATION
and PUBLIC FACILITIES
JUNEAU, ALASKA



BRIDGE NO. 1089
DRAW NO. 4b

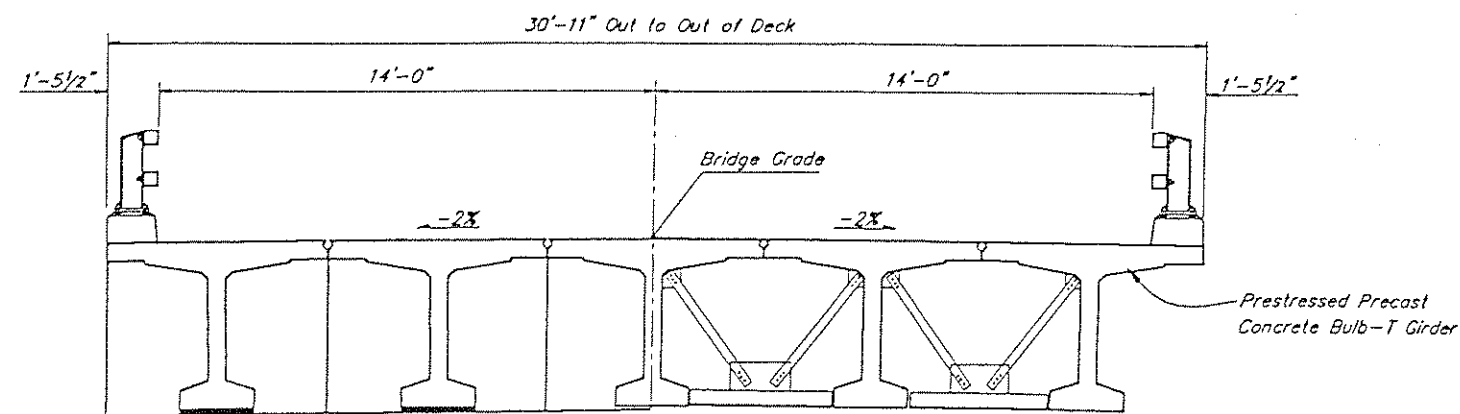

AT ABUTMENT


NEAR MIDSPAN

TYPICAL SECTION

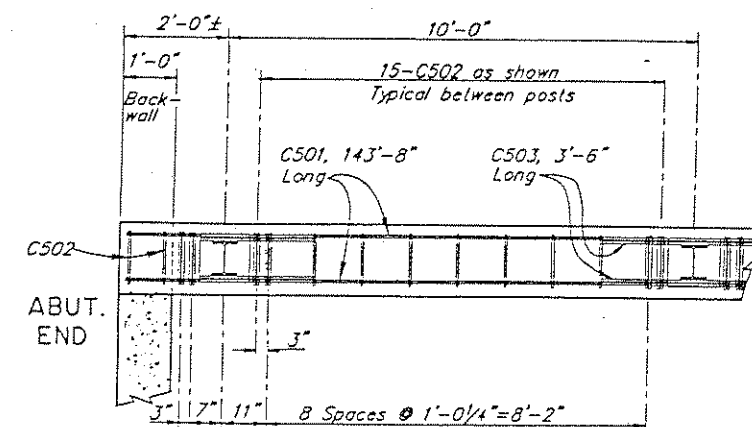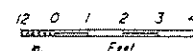

BRIDGE CURB REINFORCING


No Scale

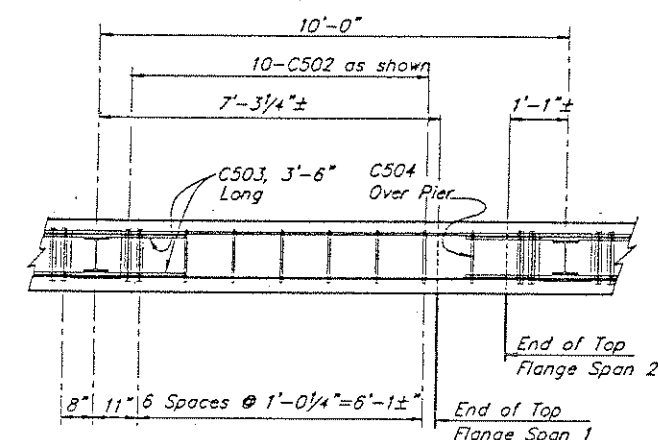

BRIDGE CURB REINFORCING OVER PIER

No Scale


CURB REINFORCING (BOTH SIDES)					
MARK	SIZE	NO.	LENGTH	TYPE	
C501	5	4	143'-8"		
C503	5	60	3'-6"		
C504	5	2	4'-7"	Bent	

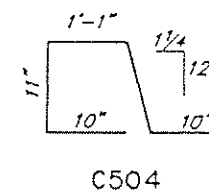


All curb bars are epoxy coated and are incidental to Metal Bridge Railing.

Minimum lap length is 2'-0" for C501 bars.

C502 bars are cast in Girders and Backwall. See "GIRDERS" drawings for Reinforcing Steel Schedule for C502 bars.

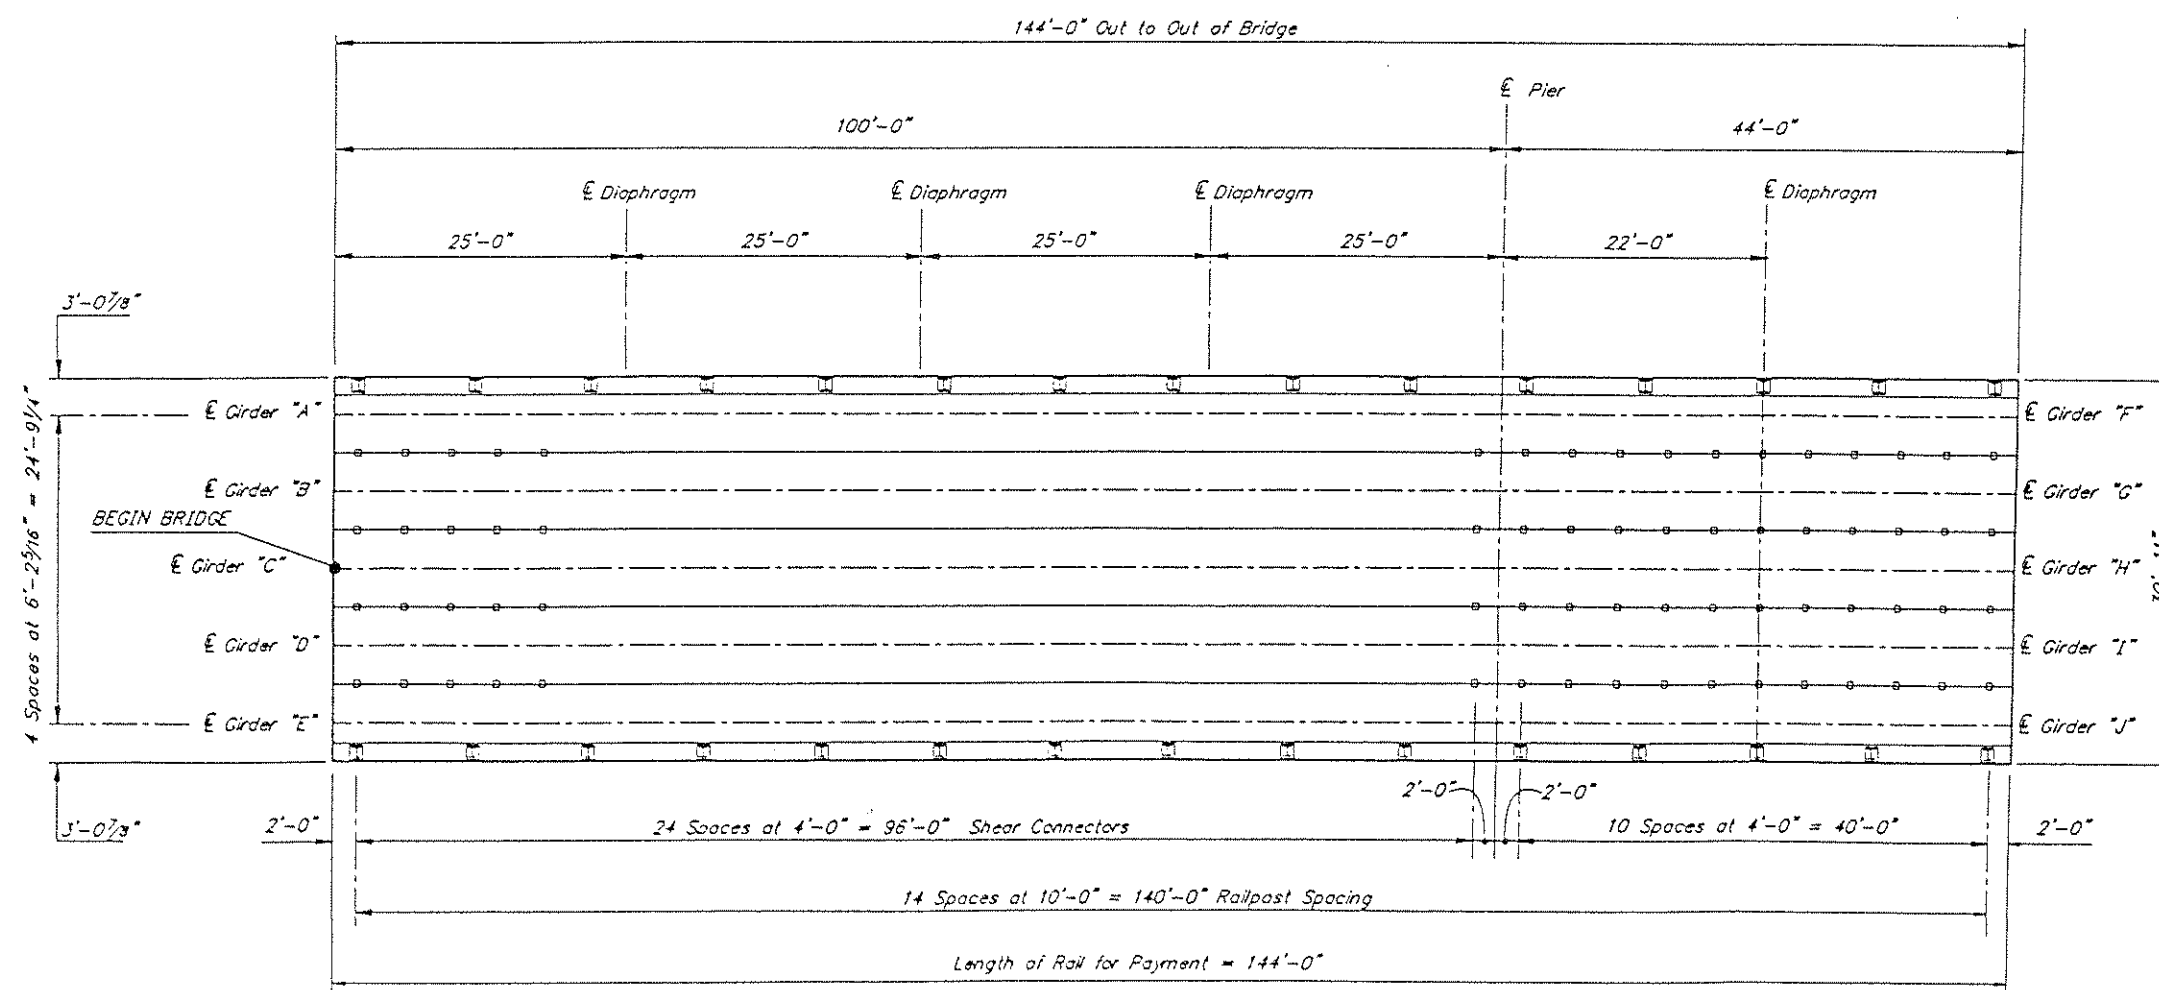

FRAMING PLAN

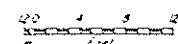

FOREST HIGHWAY 16
PHASE III
McCORMACK CREEK BRIDGE
TYPICAL SECTION


STATE OF ALASKA
DEPARTMENT OF TRANSPORTATION
and PUBLIC FACILITIES
JUNEAU, ALASKA



BRIDGE NO. 1089
RWS NO. 6b


Designed by: [Signature]
Checked by: [Signature]
Drawn by: [Signature]

Reviewed by: [Signature]
Date: 10/10/10
Scale: 1/2" = 1'-0"

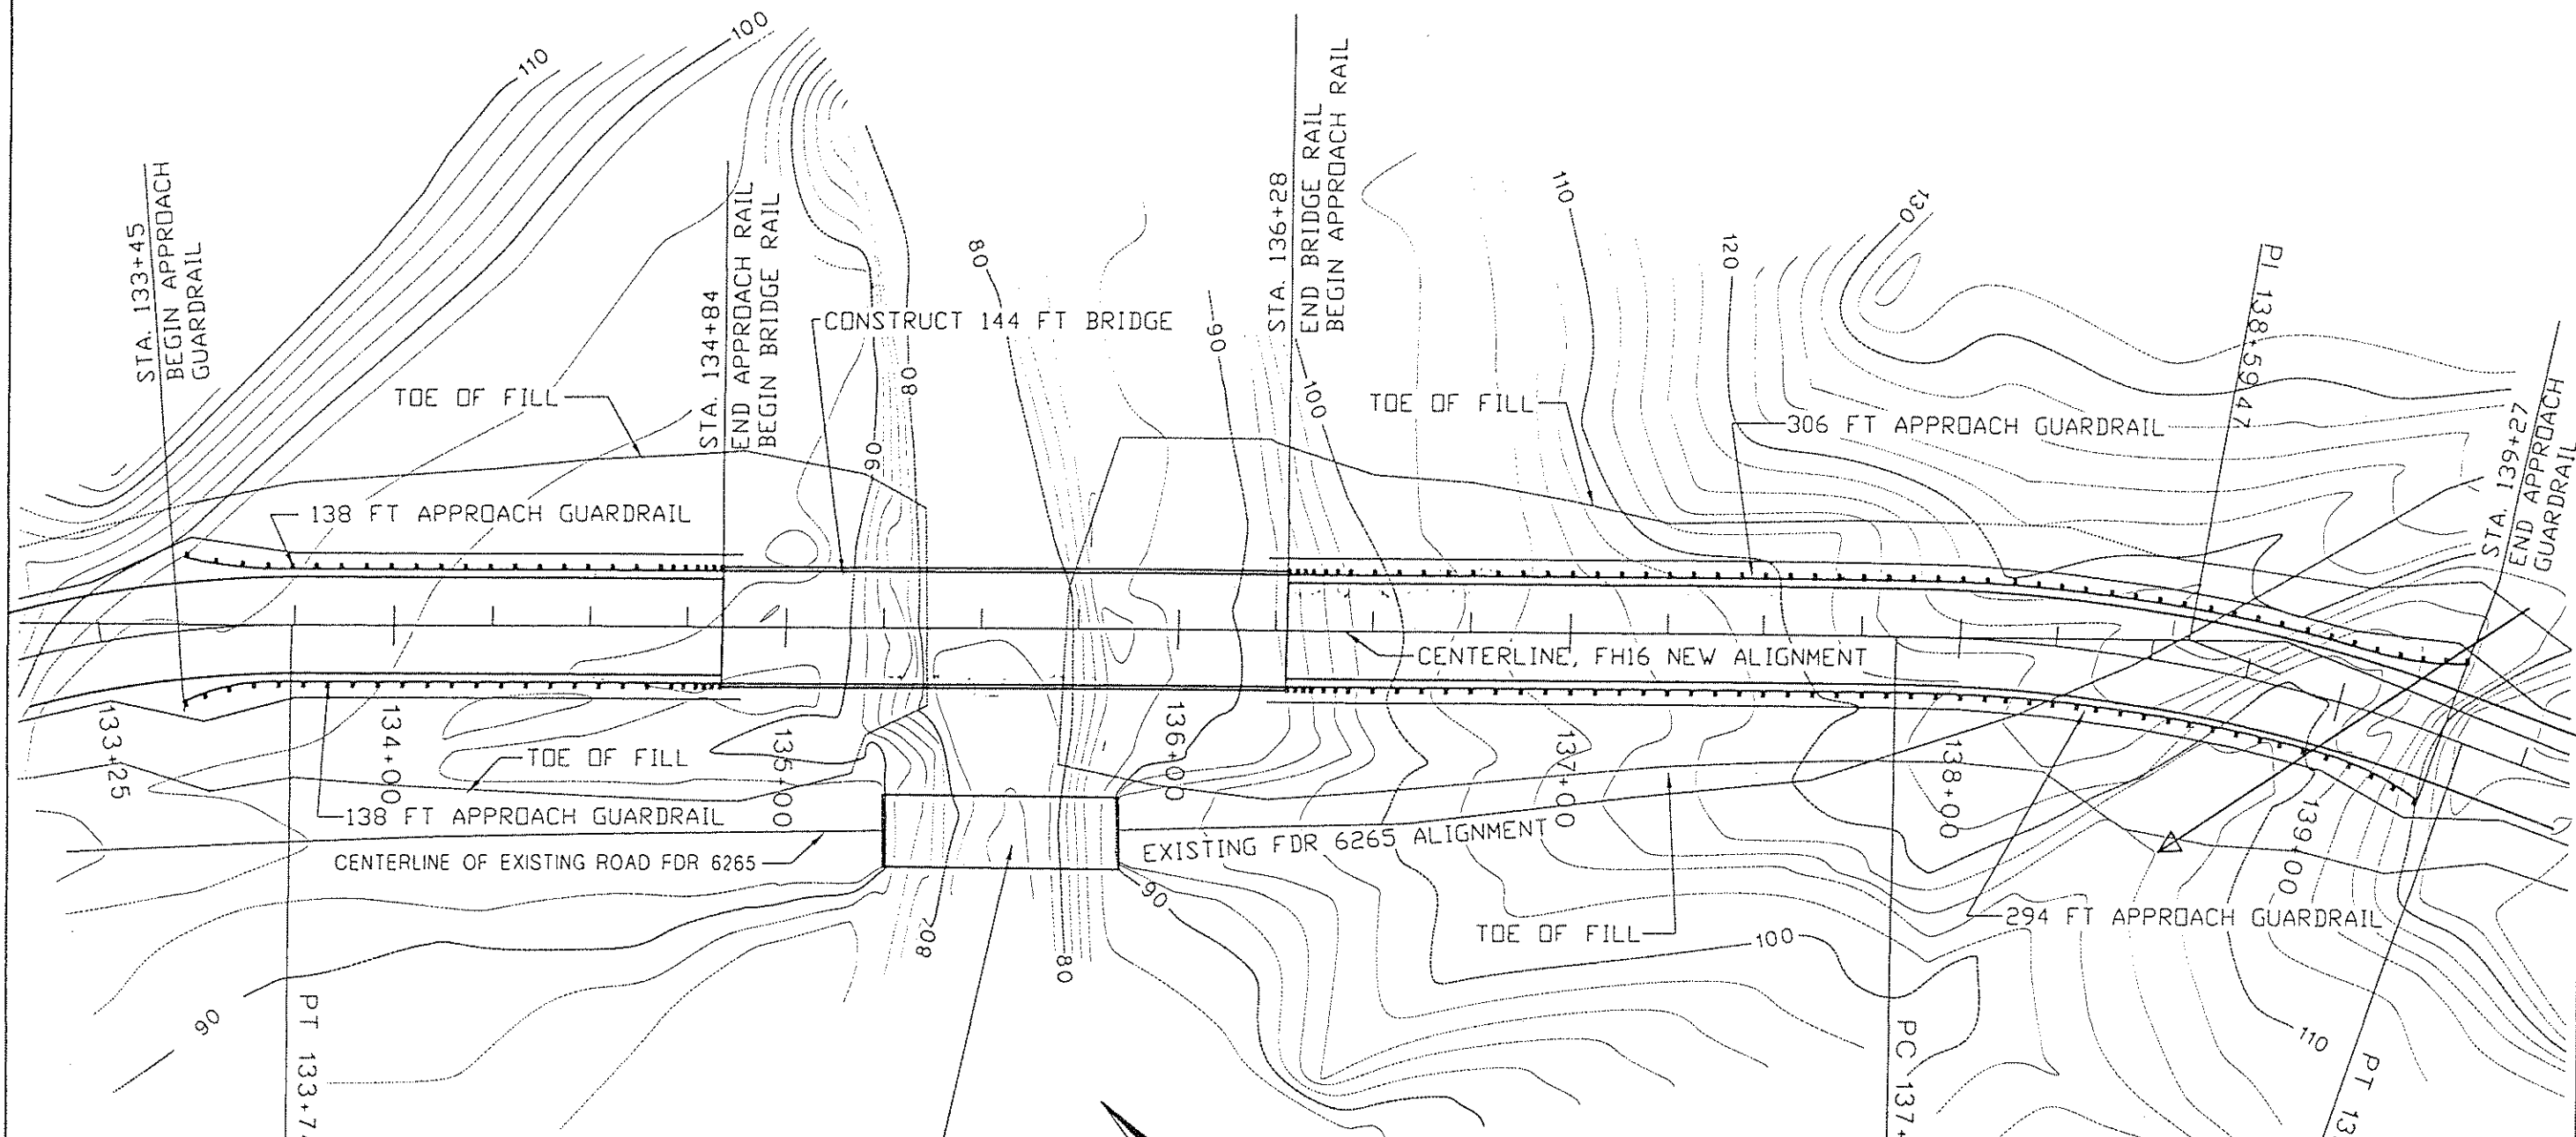

SALVAGE, REMOVE, AND TRANSPORT EXISTING TREATED TIMBER BRIDGE, AND REINSTALL BRIDGE AT M.P. 5.4, F.D.R. 6267. SEE DETAILS ON SHEETS 17b - 20b.
 UPON REMOVAL OF EXISTING TREATED TIMBER BRIDGE, REMOVE EXISTING ROAD APPROACH FILLS.
 UTILIZE SUITABLE MATERIAL SALVAGED FROM ROAD FILLS IN NEW ROAD CONSTRUCTION.

PLAN VIEW

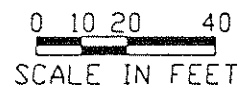


C: 19°05'19"
 Tc: 75.66
 Rc: 450.00
 A: 149.92


DESIGNED BY: K. ELMORE	DATE: 11/16/95		U.S. DEPARTMENT OF AGRICULTURE FOREST SERVICE REGION 10 STIKINE AREA	FOREST HIGHWAY 16	
DRAWN BY: K. ELMORE	DATE: 11/16/95			PHASE III	
CHECKED BY: B. BRUNETTE	DATE: 12/05/95			APPROACH GUARDRAILS	
REVISION DATE	DESCRIPTION	BY		Drawing No.	Page 11b of 20b

GENERAL NOTES:


- 1. See Standard Drawing 'G4S Breakaway Cable Terminal' for terminal details.
- 2. See Standard Drawing 'G4S Beam Guardrail' for W-beam and post installation details.
- 3. See Standard Drawing 'G9S Beam Guardrail' for Thrie Beam and post installation details.
- 4. All posts shall be W6x9 steel.

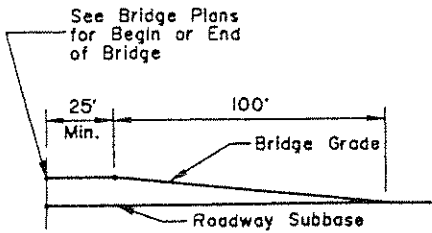

PROFILE - ROADWAY TO BRIDGE TRANSITION*
* To be used when surfacing is not part of roadway contract.

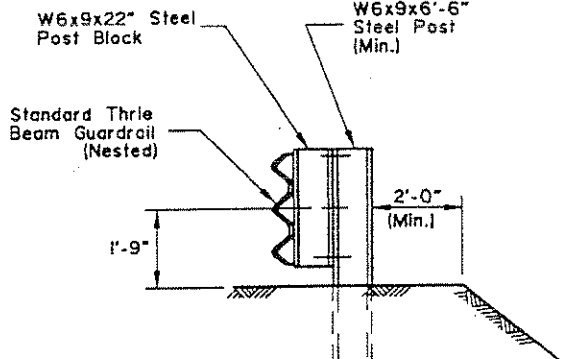

STEEL BLOCKING DETAIL

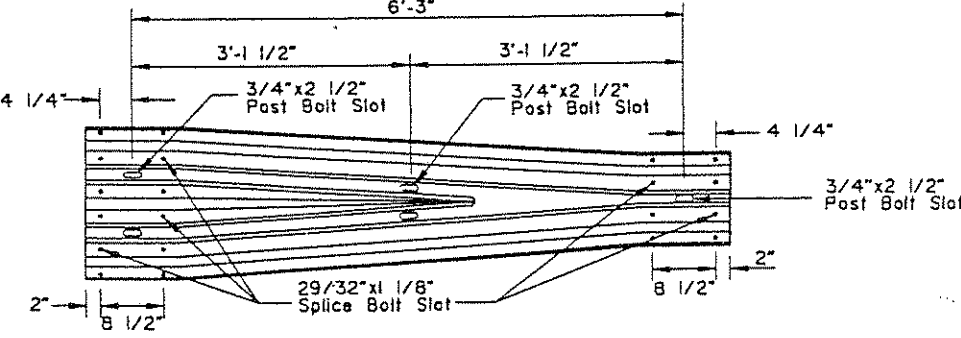


THRIE-BEAM TO W-BEAM TRANSITION SECTION

REVISIONS		
Date	Description	By
5/15/89	Post length--6'-6"	Gdo
1/1/96	Bridge Connect Note	Gdo


State of Alaska
Department of Transportation
& Public Facilities
**G9S THRIE BEAM
GUARDRAIL TERMINAL
TRANSITION AT BRIDGES**




Date 12/1/87

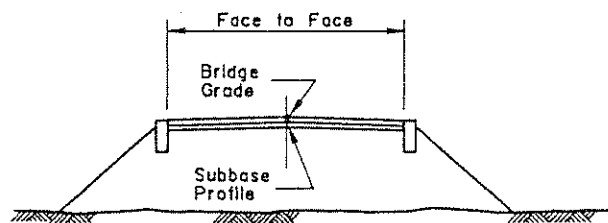


SECTION A-A
See Bridge Typical for Bridge Cross Slope

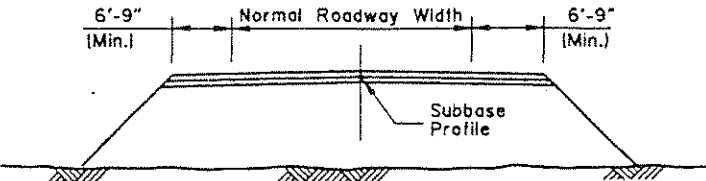

SECTION B-B

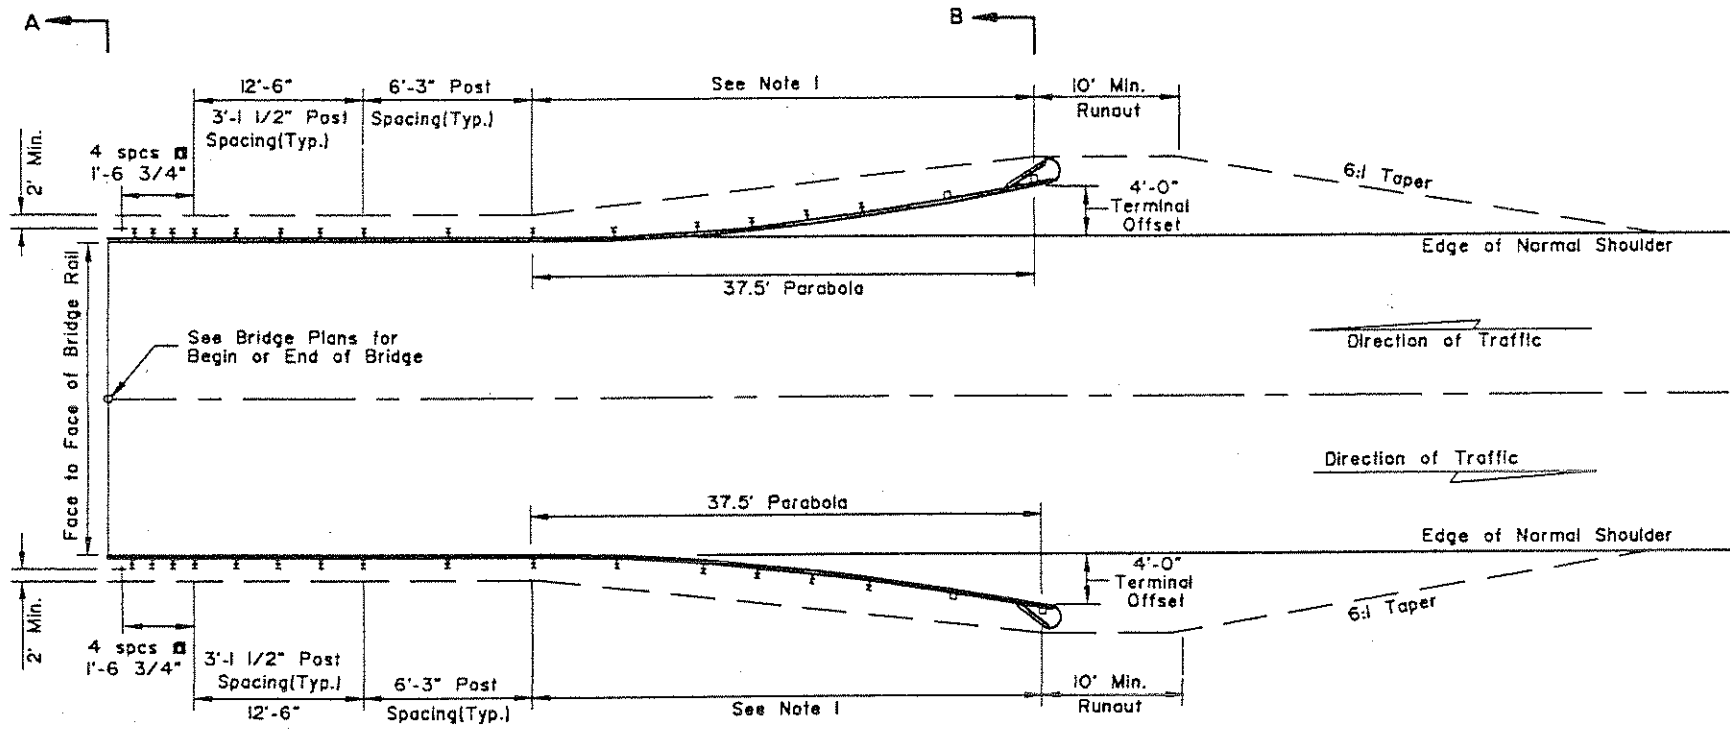

PLAN VIEW

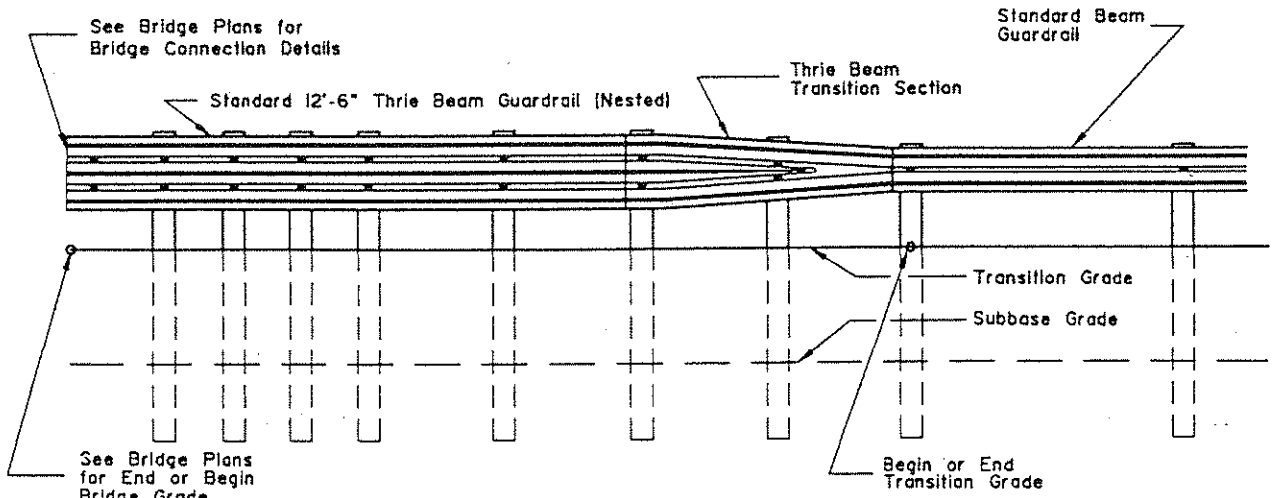

W-BEAM TO THRIE BEAM TRANSITION DETAIL

P STA.	OFFSET	△ ELEV.	L STA.
P 2255	0.81	-0.81	0+00
P 2250	-2.58	-3.57	0+23.97
P 2240	-5.57	-7.41	0+63.48
P 2230	-11.89	-5.49	1+03.43
P 2225	-17.42	-0.81	1+31.79
P 2220	-24.45	14.07	1+48.65
P 2205	-33.11	14.42	1+77.90
P 2195	-42.33	10.80	2+07.12
P 2190	-39.94	0.00	2+20.71
P 2185	-41.92	-8.07	2+62.87
P 2180	-44.62	-11.38	2+88.78


SURVEY DATA:

STA. 0+00 : "P" SEC. 2255
 STA. 2+88.78 : "P" SEC. 2180
 ELEV. 100.0 : ELEV. 651.52
 POINT 2 : P 2225


FROM	TO	AZIMUTH	H. DIST.	POINT	ELEVATION
TBM	PT. 1	218	59.50	TBM	117.10
RP 1	PT. 1	21	47.74	RP 1	84.22
RP 2	PT. 3	48	58.20	RP 2	83.96
RP 3	PT. 3	24	63.46	RP 3	82.92

ESTIMATED QUANTITIES:

STA. 0+56 TO STA. 2+16
 STRUCTURAL EX. : 220 C.Y. (SOLID)
 EXCAVATION : 262 C.Y. (PRISM)
 BORROW : 847 C.Y. (PRISM)
 CLASS VII RIPRAP : 140 C.Y. (PRISM)
 TOTAL PROJECT
 WOOD FILL : 1,321 C.Y. (PRISM)

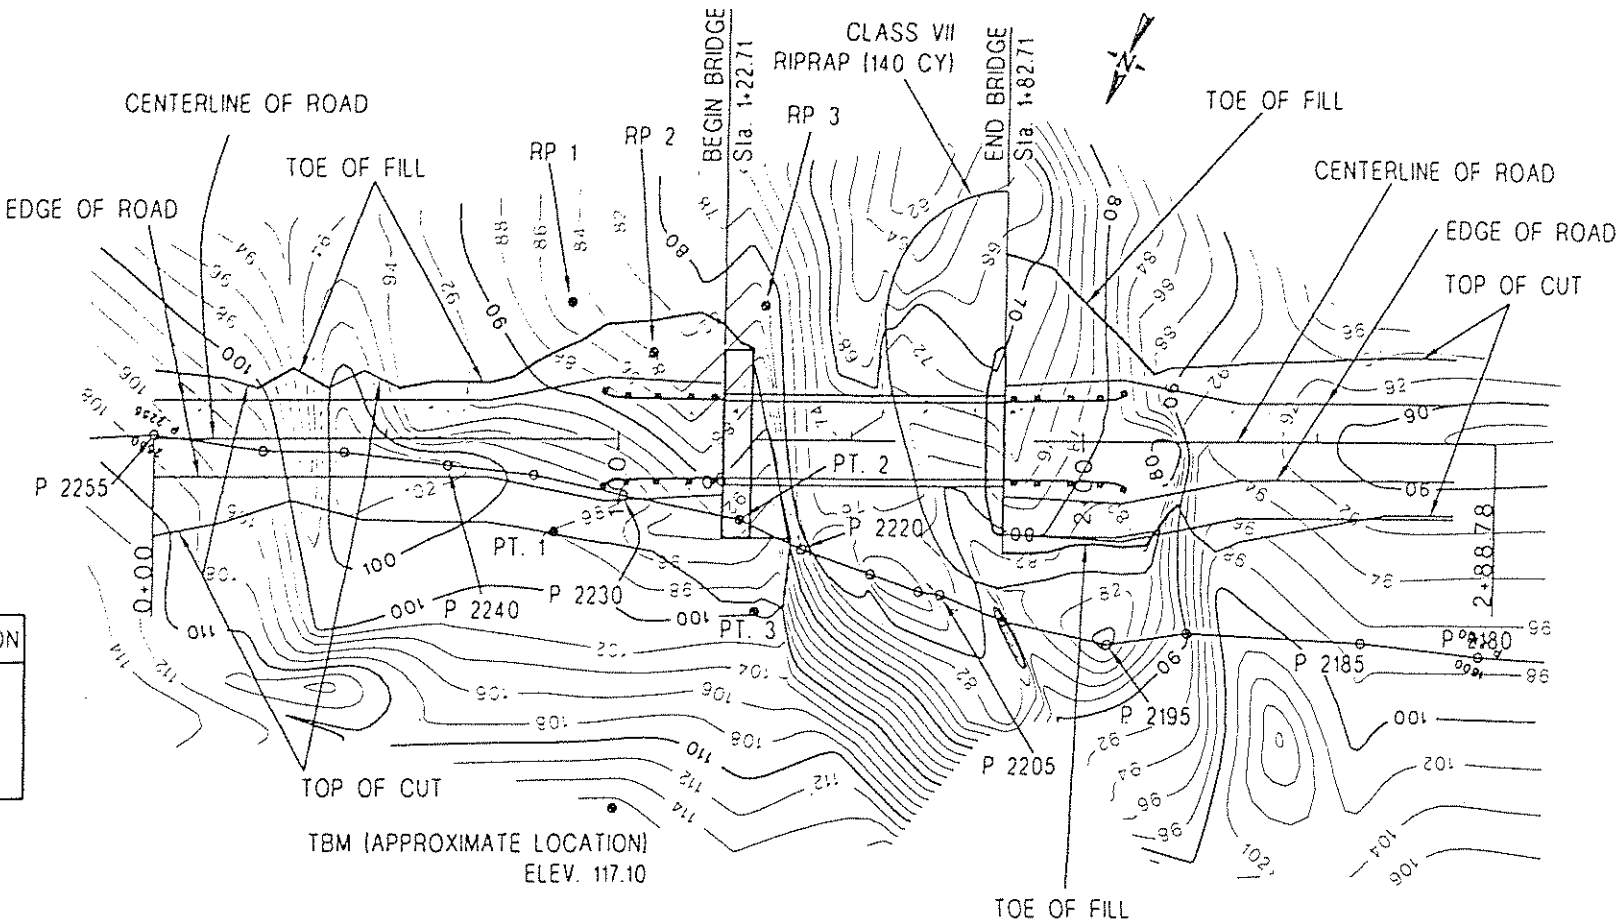

PLAN VIEW

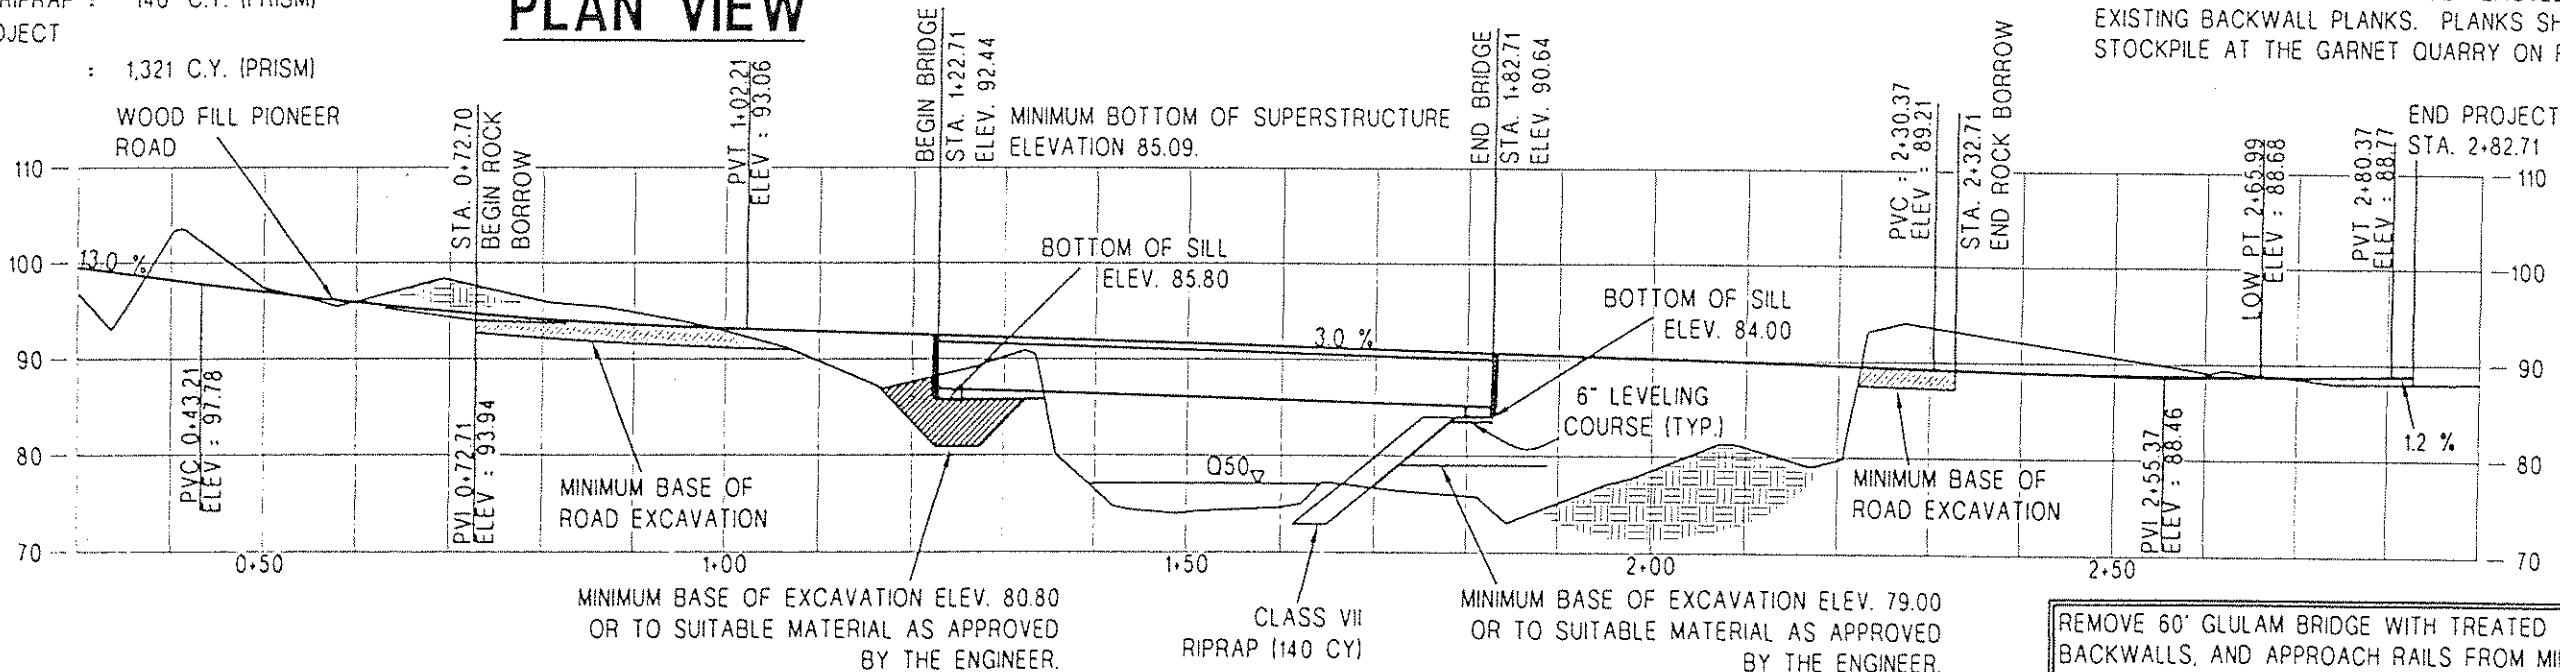

PROFILE ALONG CENTERLINE OF ROAD

BEGIN PIONEER ROAD CONSTRUCTION FROM THE END OF THE EXISTING AGGREGATE SURFACE ROAD AT MP 5.28 TO END OF PROJECT MP 5.42

Q50 : 308 CFS
 V50 : 11.8 FPS
 So : 10.9 %
 N : 0.055

REVISION	DATE	DESCRIPTION	BY

Designed By: T. Laurent Date 1/21/97
 Drawn By: T. Laurent Date 1/22/97
 Checked by: L. Dunham Date 1/23/97



U.S. DEPARTMENT OF AGRICULTURE
 FOREST SERVICE
 REGION 10 STIKINE AREA

FDR 6267 GNEISS CREEK
 HYDRO SITE PLAN & PROFILE
 MP 5.4 STA. 1+06

Drawing No. GNEISS Page 17b of 20b

NOTES:

EXCESS AND/OR UNSUITABLE MATERIAL EXCAVATED DURING BRIDGE CONSTRUCTION SHALL NOT BE PLACED ON THE SLOPES ADJACENT TO THE STREAM OR IN THE STREAM CHANNEL.

EXCAVATION SHALL BE APPROVED BY THE ENGINEER BEFORE BACKFILLING IN ACCORDANCE WITH SECTION 203, METHOD 4.

FURNISH AND INSTALL NEW APPROACH RAIL ENDS. NEW ENDS SHALL BE CLASS A TYPE 2, METHOD A END ANCHOR. METHOD 1 TERMINAL SECTION. BRIDGE AND APPROACH RAIL CONSTRUCTION IS INCIDENTAL TO BRIDGE CONSTRUCTION.

INSTALL TYPE THREE OBJECT MARKERS (TYPICAL ALL FOUR CORNERS.)

ALL ESTIMATED QUANTITIES SHOWN ON THIS DRAWING ARE INCLUDED IN THE WORK FOR PAY ITEM 202(05) AND WILL NOT BE MEASURED SEPERATELY FOR PAYMENT.

ACTUAL RIPRAP PLACEMENT WILL BE AS FIELD DETERMINED BY THE ENGINEER DURING CONSTRUCTION.

REPLACE NATIVE MATERIAL OVER BASE OF RIPRAP AFTER PLACEMENT OF RIPRAP.

BEDROCK MAY BE ENCOUNTERED AND BLASTING MAY REQUIRED.

EXISTING BACKWALL SHALL BE REMOVED WITH MINIMAL DAMAGE. FASTENERS SHALL BE REMOVED FROM THE EXISTING BACKWALL PLANKS. PLANKS SHALL BE PLACED IN STOCKPILE AT THE GARNET QUARRY ON FDR 6265 AT MP 5.6.


REMOVE 60' GLULAM BRIDGE WITH TREATED TIMBER SILLS, BACKWALLS, AND APPROACH RAILS FROM MILEPOST 2.32 ON FDR 6265. REINSTALL THE ENTIRE BRIDGE STRUCTURE BETWEEN STA. 0+06.07 AND 1+66.07 ON FDR 6267. FURNISH AND INSTALL NEW BACKWALLS. BACKWALLS SHALL BE FABRICATED IN ACCORDANCE WITH FOREST SERVICE SPECIFICATIONS 557. FURNISH AND INSTALL NEW APPROACH RAIL ENDS.

MATERIALS LIST FOR ONE BACKWALL


PLANK	TIMBER	
	SIZE	LENGTH
1A	6 x 12	14' 9-1/4"
1B	6 x 12	10' 9-1/4"
2A	6 x 12	12'
2B	6 x 12	16'
3A	6 x 12	17' 3-1/4"
3B	6 x 12	13' 3-1/4"
4A	6 x 12	14' 6-1/4"
4B	6 x 12	18' 6-1/4"
5A	6 x 12	19' 9-1/4"
5B	6 x 12	15' 9-1/4"
6A	6 x 12	19' 1/4" (2 REQ'D)
DIAGONAL BRACE	6 x 12	16' 0" (2 REQ'D)

HARDWARE


24 3/4" x 14" BOLTS
24 3/4" NUTS
48 3/4" MALLEABLE IRON WASHERS
MISCELLANEOUS 3/8" x 10" SPIKES
ALL HARDWARE IS GALVANIZED.

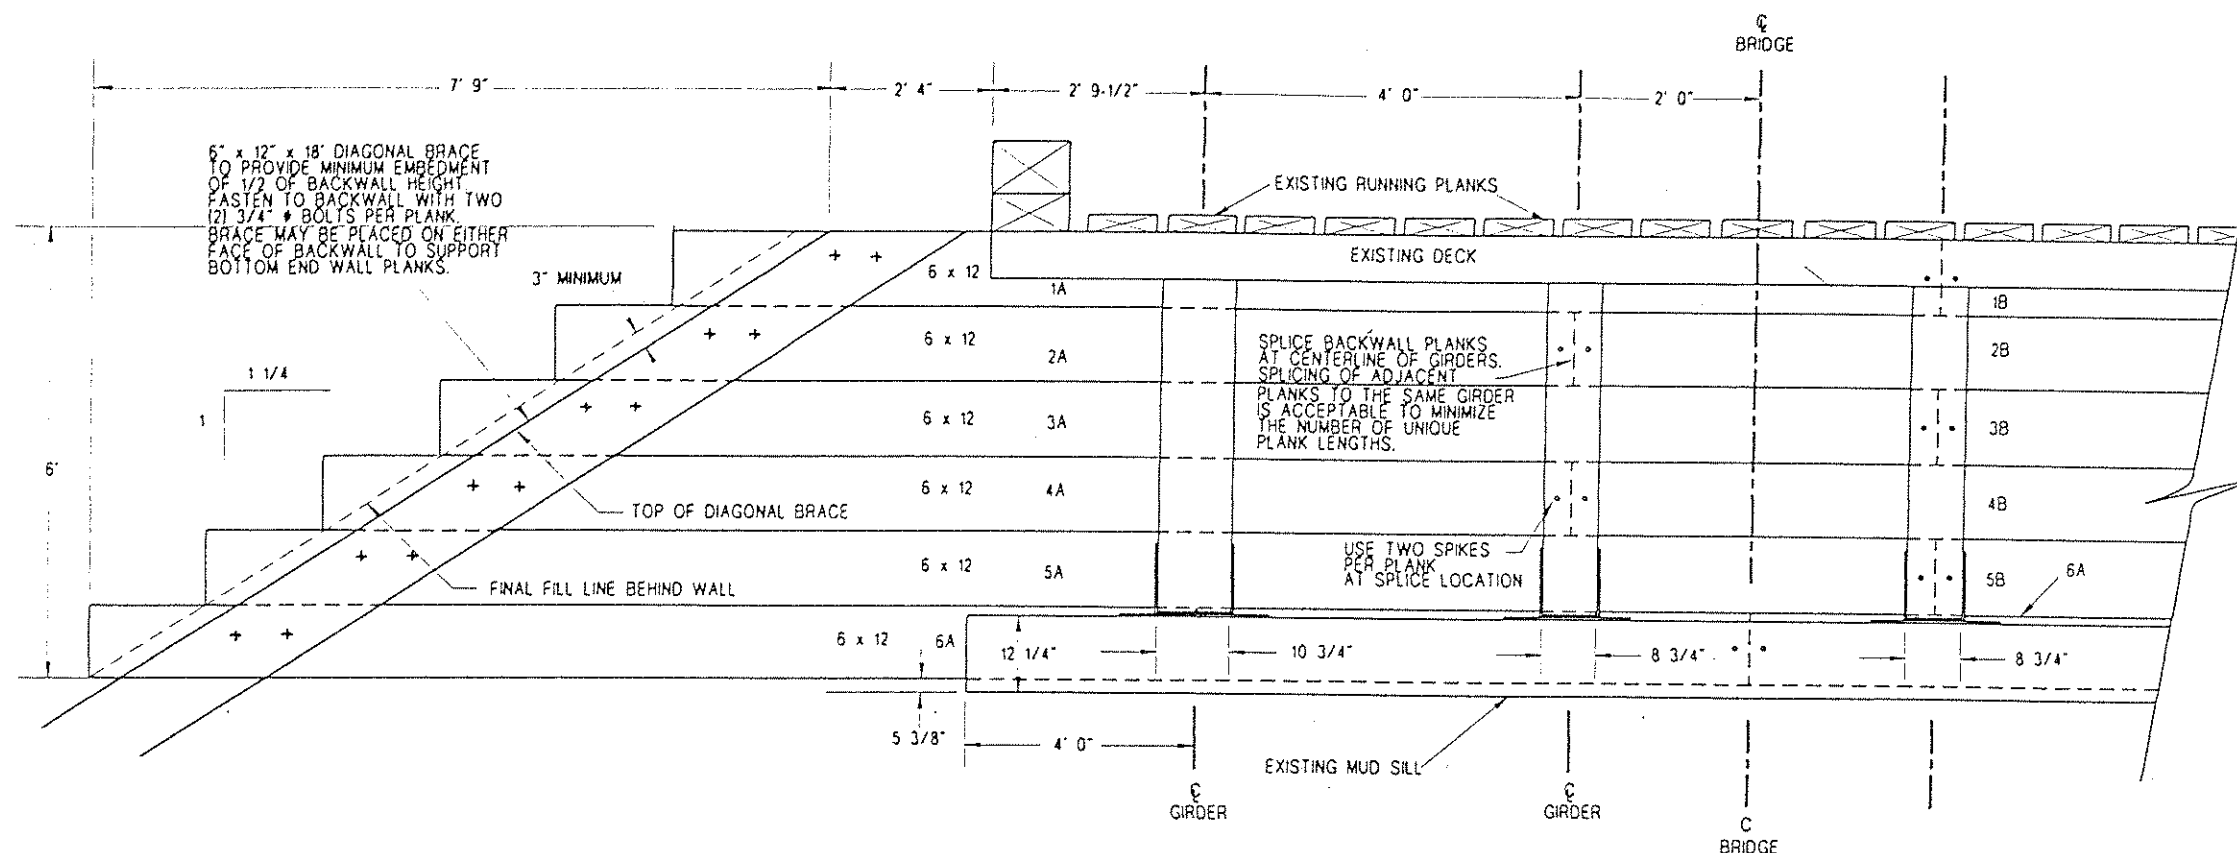


ABUTMENT ELEVATION
NOT TO SCALE

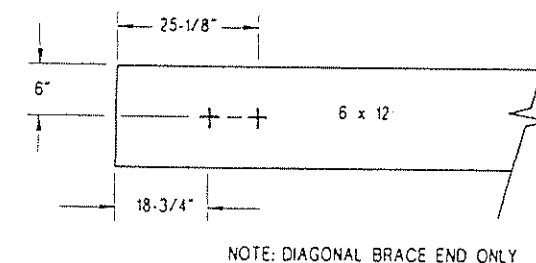

6 x 12 END DETAIL
NOT TO SCALE

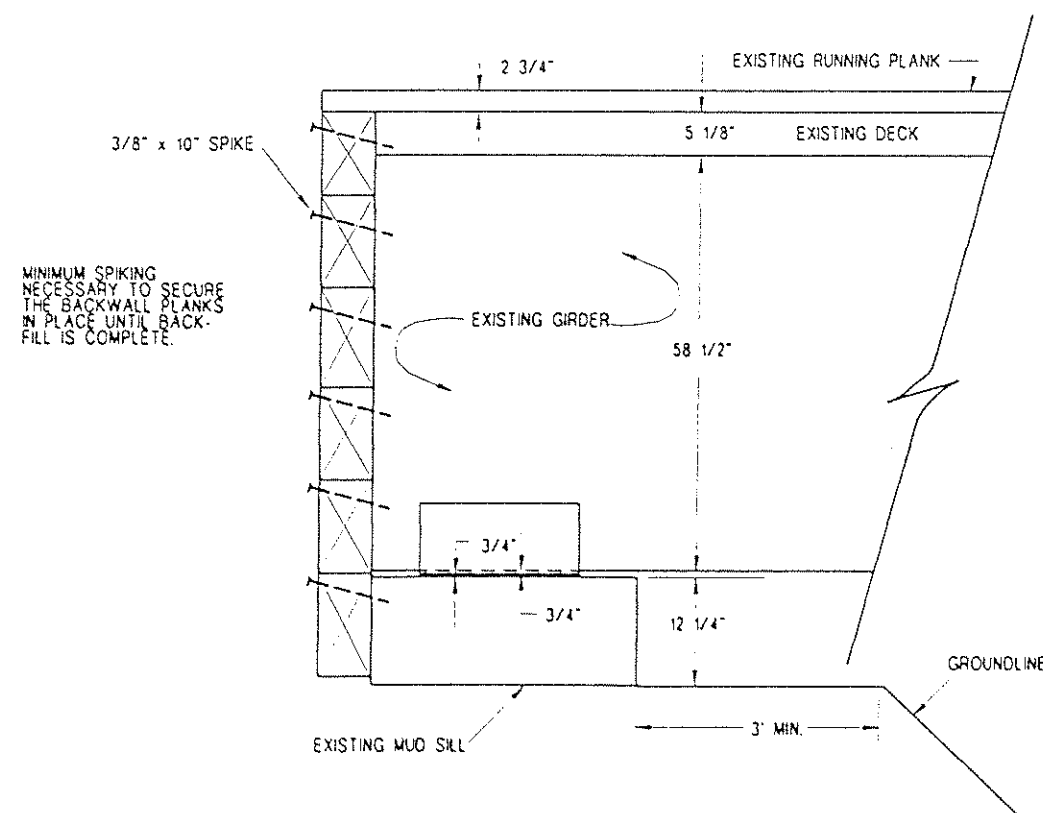


**PLANK PLACEMENT AT
BASE OF BACKWALL**
NOT TO SCALE

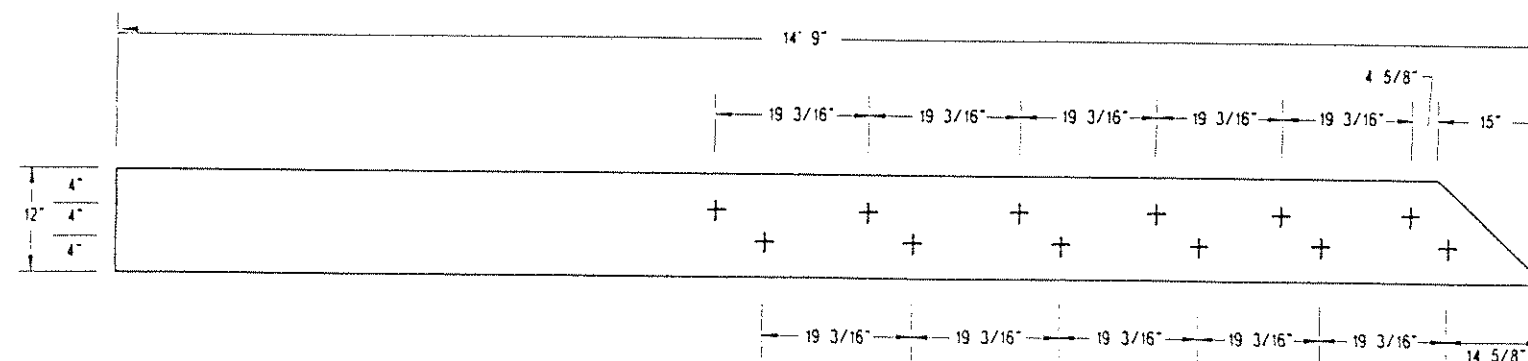


DIAGONAL BRACE
NOT TO SCALE

			Designed By: <u>T. Laurent</u>	Date: <u>1/23/96</u>		U.S. DEPARTMENT OF AGRICULTURE FOREST SERVICE REGION 10 STIKINE AREA	FDR 6267 GNEISS CREEK	
			Drawn By: <u>T. Laurent</u>	Date: <u>1/23/96</u>			BACKWALL LAYOUT	
			Checked by: <u>L. Dunham</u>	Date: <u>1/23/96</u>			MP 5.4	STA. 1+06
REVISION	DATE	DESCRIPTION	BY				Drawing No. <u>GNEISSRW</u>	Page 18b of 20b


SOUTHEAST GRAPHIC MEDIA - JUNEAU, ALASKA

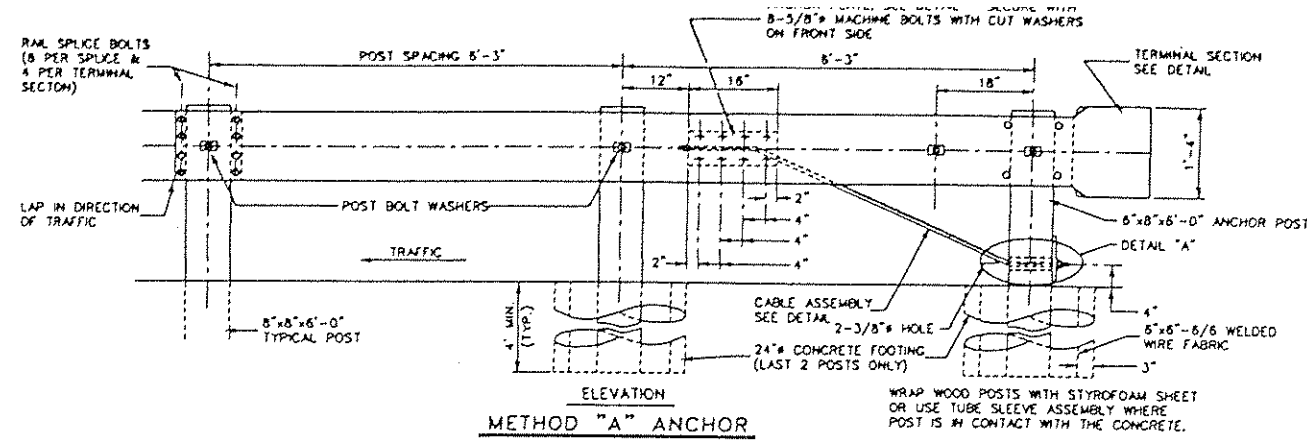


METHOD "A" ANCHOR

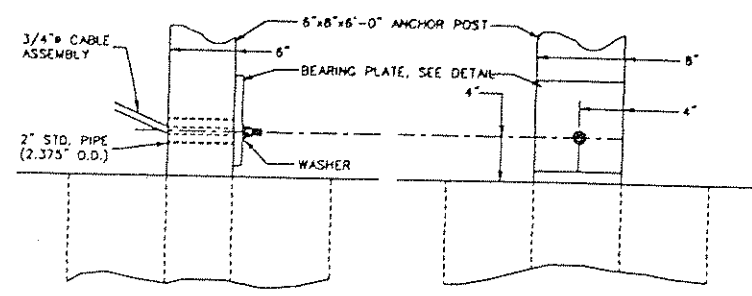


DETAIL "A"

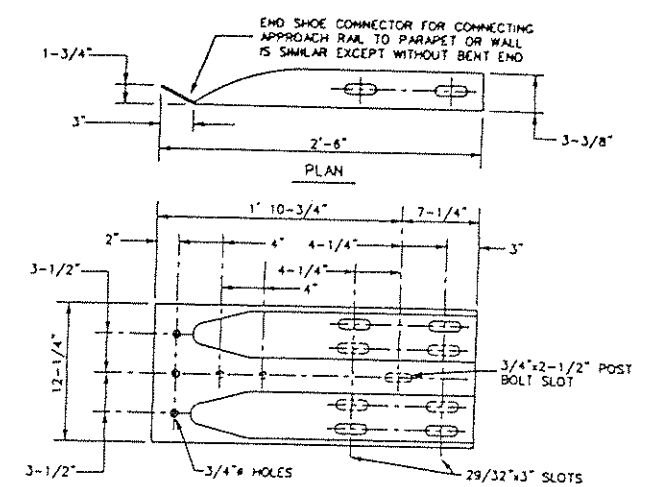


TERMINAL CONNECTOR

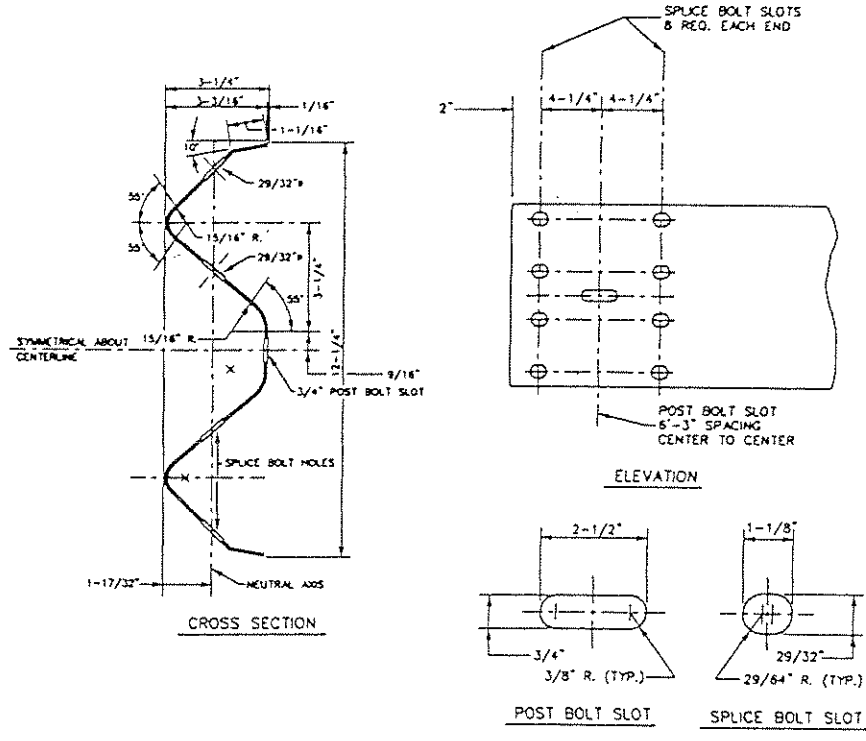


RAIL ELEMENT

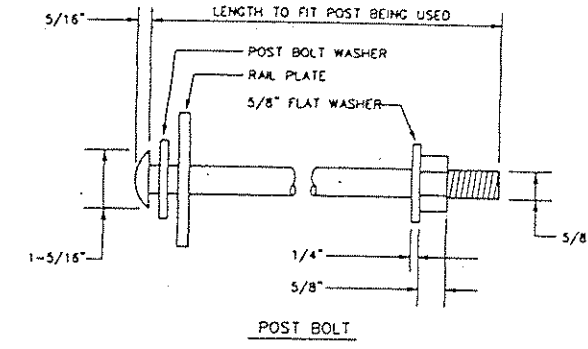


POST BOLT

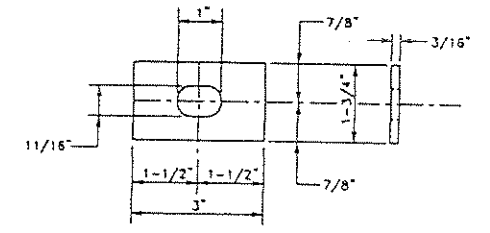

POST BOLT ASSEMBLY

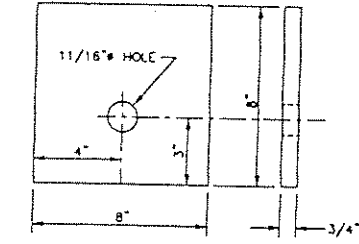


BEARING PLATE

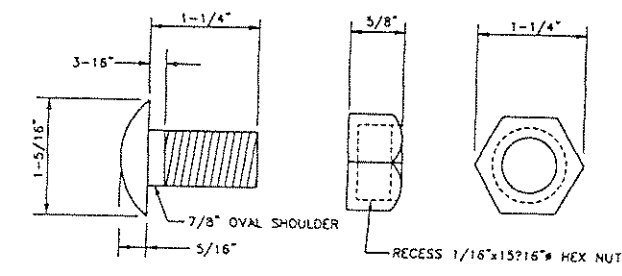


RAIL SPLICE BOLT


A SCREW HEAD RAIL SPLICE BOLT WITHOUT SHOULDER, BUT WITH THE SAME GENERAL DIMENSIONS MAY BE USED IN LIEU OF THE RAIL BOLT AS SHOWN.

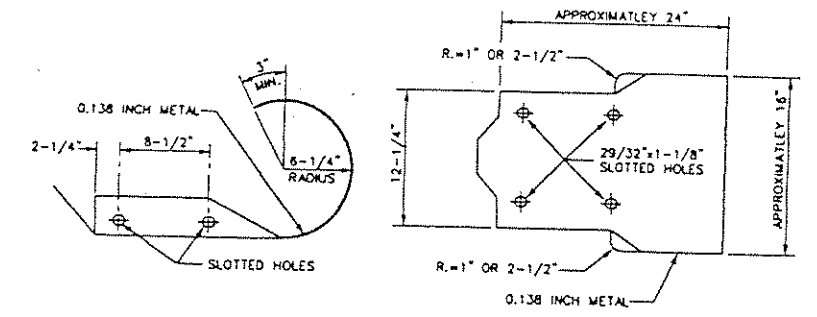


METHOD 2

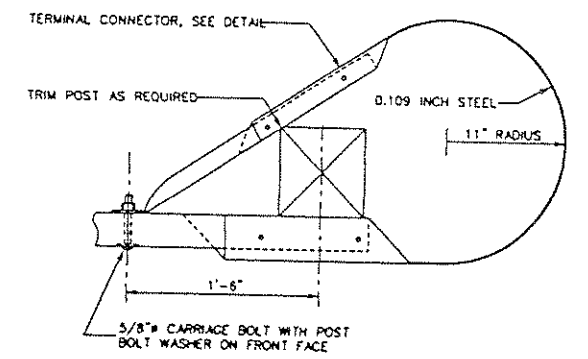


TERMINAL SECTION

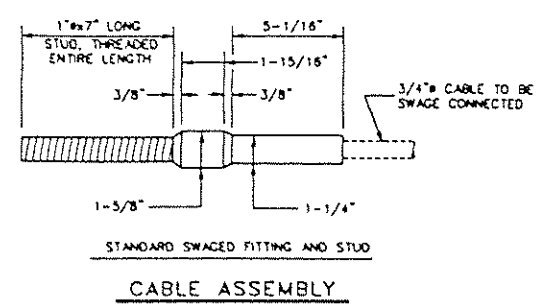


CABLE ASSEMBLY

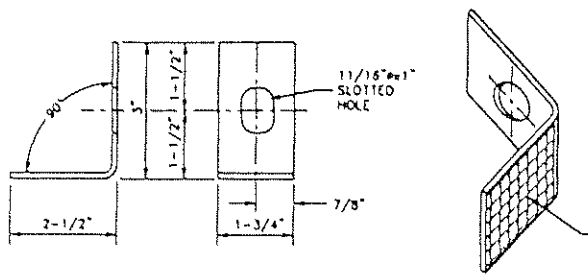

REFLECTORIZED WASHER DETAIL

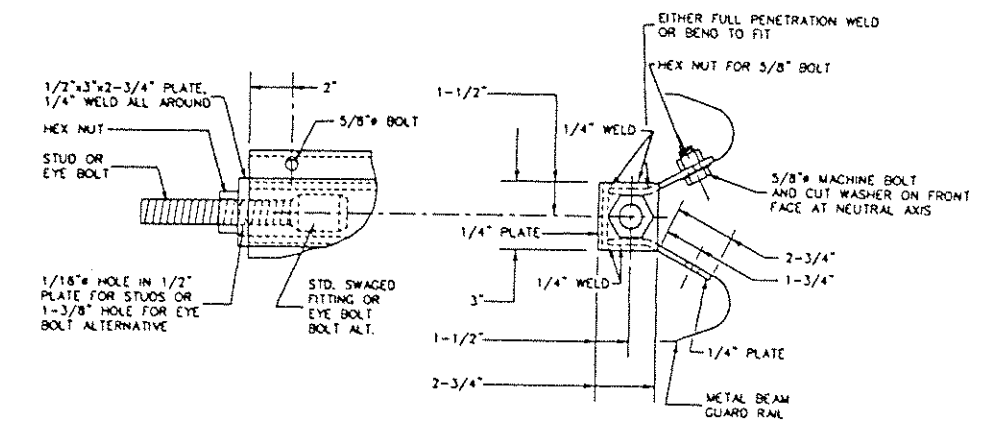

ANCHOR PLATE DETAILS

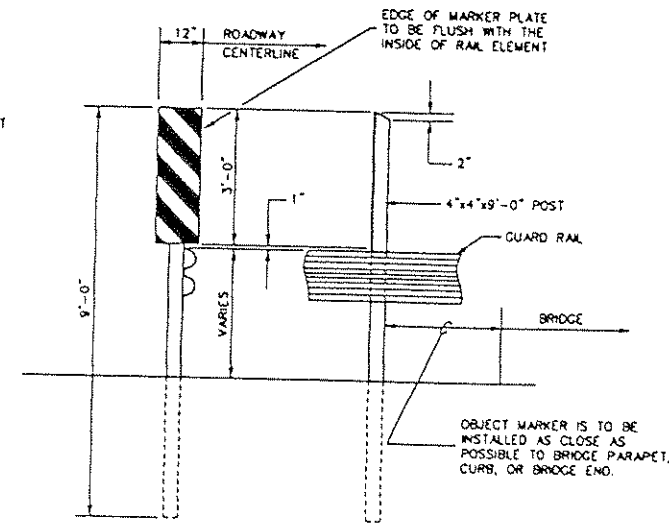

OBJECT MARKER

MANUAL ON UNIFORM TRAFFIC CONTROL DEVICES- TYPE 3 (M.U.T.C.D. TYPE 3)

REVISION	DATE	DESCRIPTION	BY

U.S. DEPARTMENT OF AGRICULTURE
FOREST SERVICE
REGION TEN

STANDARD BRIDGE
APPROACH GUARD RAIL

SERVICE LOAD-HS-20, U60 INFREQUENT LOAD U102, L90

DESIGNED _____ CHECKED _____

REVIEW & CHECK _____

APPROVED _____

Regional Structural Engineer Date _____

Director of Engineering Date _____

DRAWING No. SD 161-2 SHEET 20b of 20b