

STATE OF ALASKA
 DEPARTMENT OF TRANSPORTATION
 AND
 PUBLIC FACILITIES
 SOUTHEAST REGION
 DESIGN AND CONSTRUCTION DIVISION

**WRANGELL AIRPORT
 IMPROVEMENTS**

PROJECT NO. 70150
 AIP 3-02-0323-0797


**PAVING, GRADING, DRAINAGE,
 FENCING AND ELECTRICAL
 AS-BUILT PLANS**

Contractor: SOUTH COAST INC.
 Project Engineer: Allen Culbreath
 Begin Date: May 15, 1997
 End Date: October 31, 1997

RUNWAY 9-27

INDEX OF SHEETS

| SHEET NO. | DESCRIPTION |
|-----------|--|
| 1 | TITLE SHEET |
| 2 | ESTIMATE OF QUANTITIES |
| 3 | TYPICAL SECTIONS |
| 4 | MISCELLANEOUS CONSTRUCTION DETAILS |
| 5 | PLAN & PROFILE - "W" AND "X" LINES |
| 6 | PLAN & PROFILE - "G" AND "F" LINES |
| 7 | PLAN & PROFILE - EAST TAXIWAY |
| 8 | G/A SMALL AIRCRAFT PAVING PLAN |
| 9 | JET HARDSTAND PLAN AND DETAILS |
| 10 | MAIN AVIATION APRON BITUMINOUS OVERLAY |
| 11 | MAIN AVIATION APRON BITUMINOUS OVERLAY |
| 12 | FENCING |
| 13 | CANTILEVER SLIDE GATE DETAILS |
| 14 | STRIPING PLAN |
| 15 | SAFETY PLAN |
| E-1 | ELECTRICAL PLAN |
| E-2 | ELECTRICAL DETAILS |
| E-3 | ELECTRICAL DETAILS |
| E-4 | UNDERGROUND ELECTRICAL PLAN |

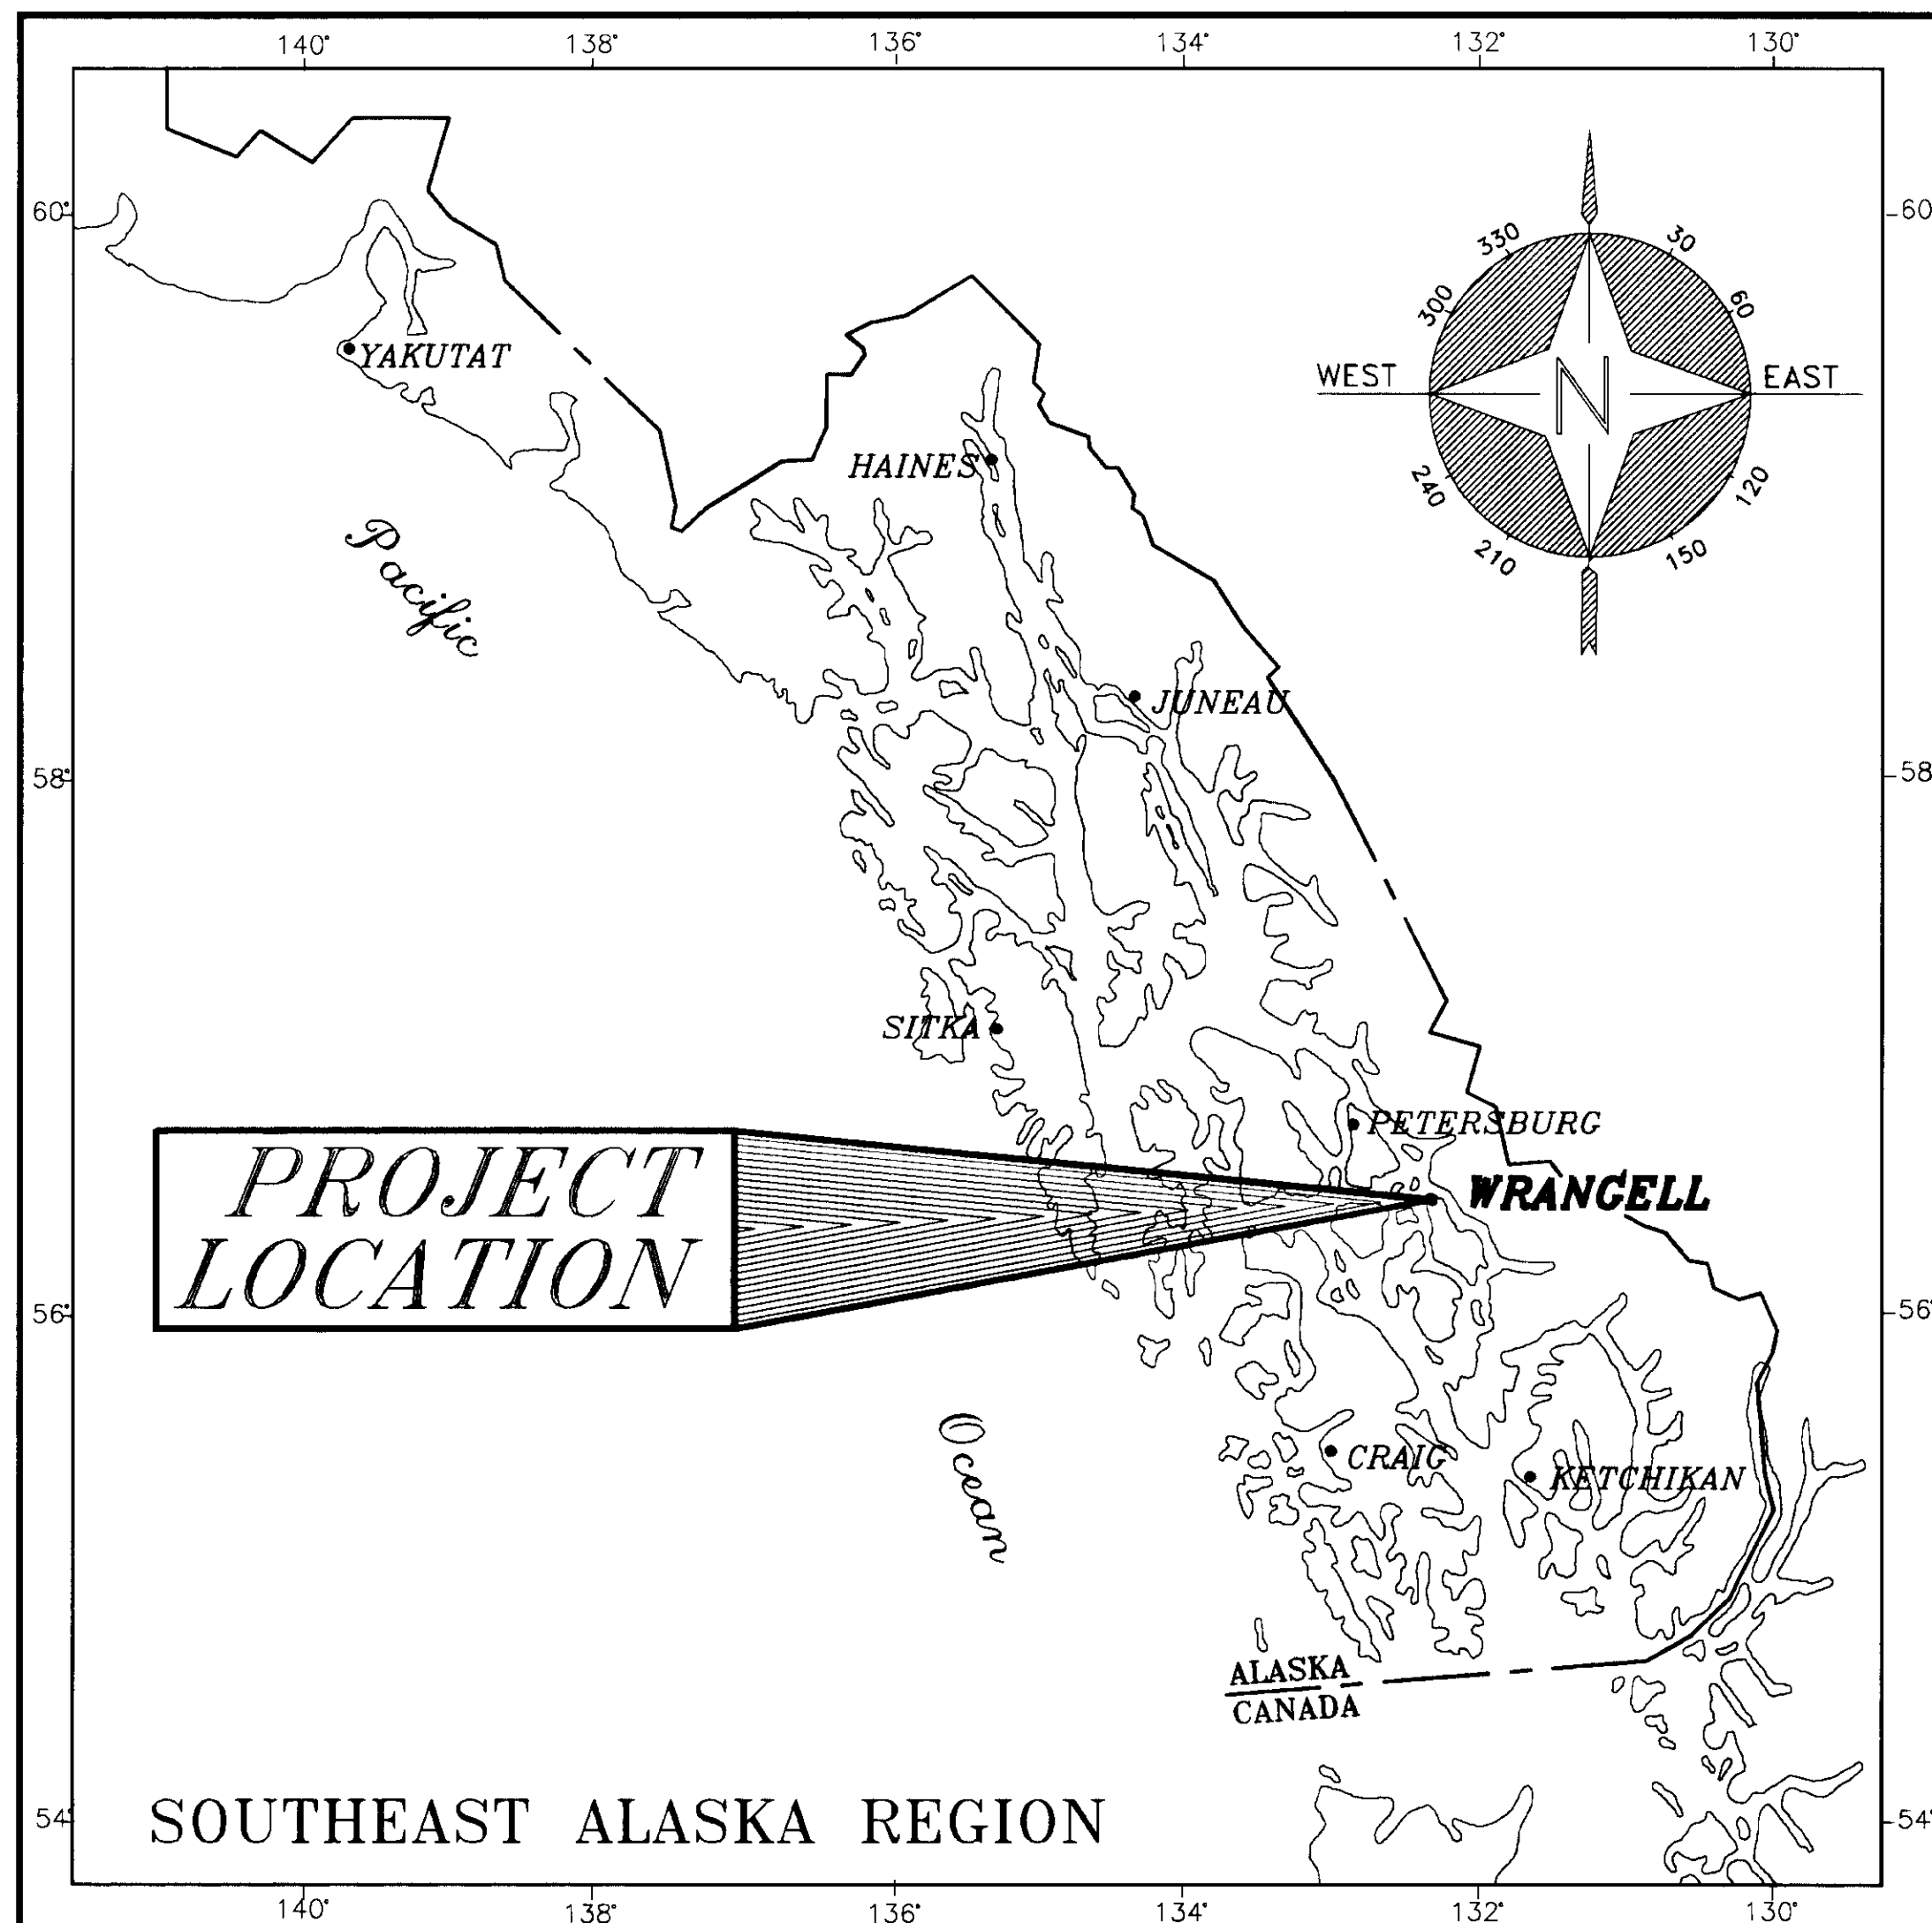


SURVEY CONTROL NOTES

HORIZONTAL:
 THE BASIS OF HORIZONTAL CONTROL IS THE LINE-OF-SIGHT BETWEEN EXISTING RUNWAY CENTERLINE MONUMENTS AT THE WEST END, R/W STA. 10+98.51, AND THE INTERSECTION OF TAXIWAY "A" AND THE RUNWAY, R/W STA. 22+00, HAVING A RECORD BEARING OF S. 58°41'18" E. AS REPORTED BY THE "WRANGELL AIRPORT PROPERTY PLAN" DATED 6-10-70.

VERTICAL:
 NO BENCH MARK INFORMATION WAS FURNISHED. A REVIEW OF VARIOUS AS-BUILT PLANS DATED 7-29-76 REFLECTED THAT THE RUNWAY CENTERLINE MONUMENT STA. 22+00 NOTED THE FOLLOWING INFORMATION:
 ELEVATION OF RECORD PER PLAN SHEET 5 OF 13 = 40.48'
 ELEVATION OF RECORD PER PLAN SHEET 7 OF 13 = 40.53'
 ASSUMED "MEAN" ELEVATION, THIS SURVEY = 40.50' (M.L.L.W.).

The following Standard Drawings apply to this project :

A-01.01, C-01.03, C-02.01, C-03.01, D-01.01, D-06.01, D-20.02, D-24.00, D-26.01, D-27.01, F-01.01, F-03.01 G-04.04W, G-14.04W, G-18.00W, I-20.10, S-00.00, S-05.00, S-30.01

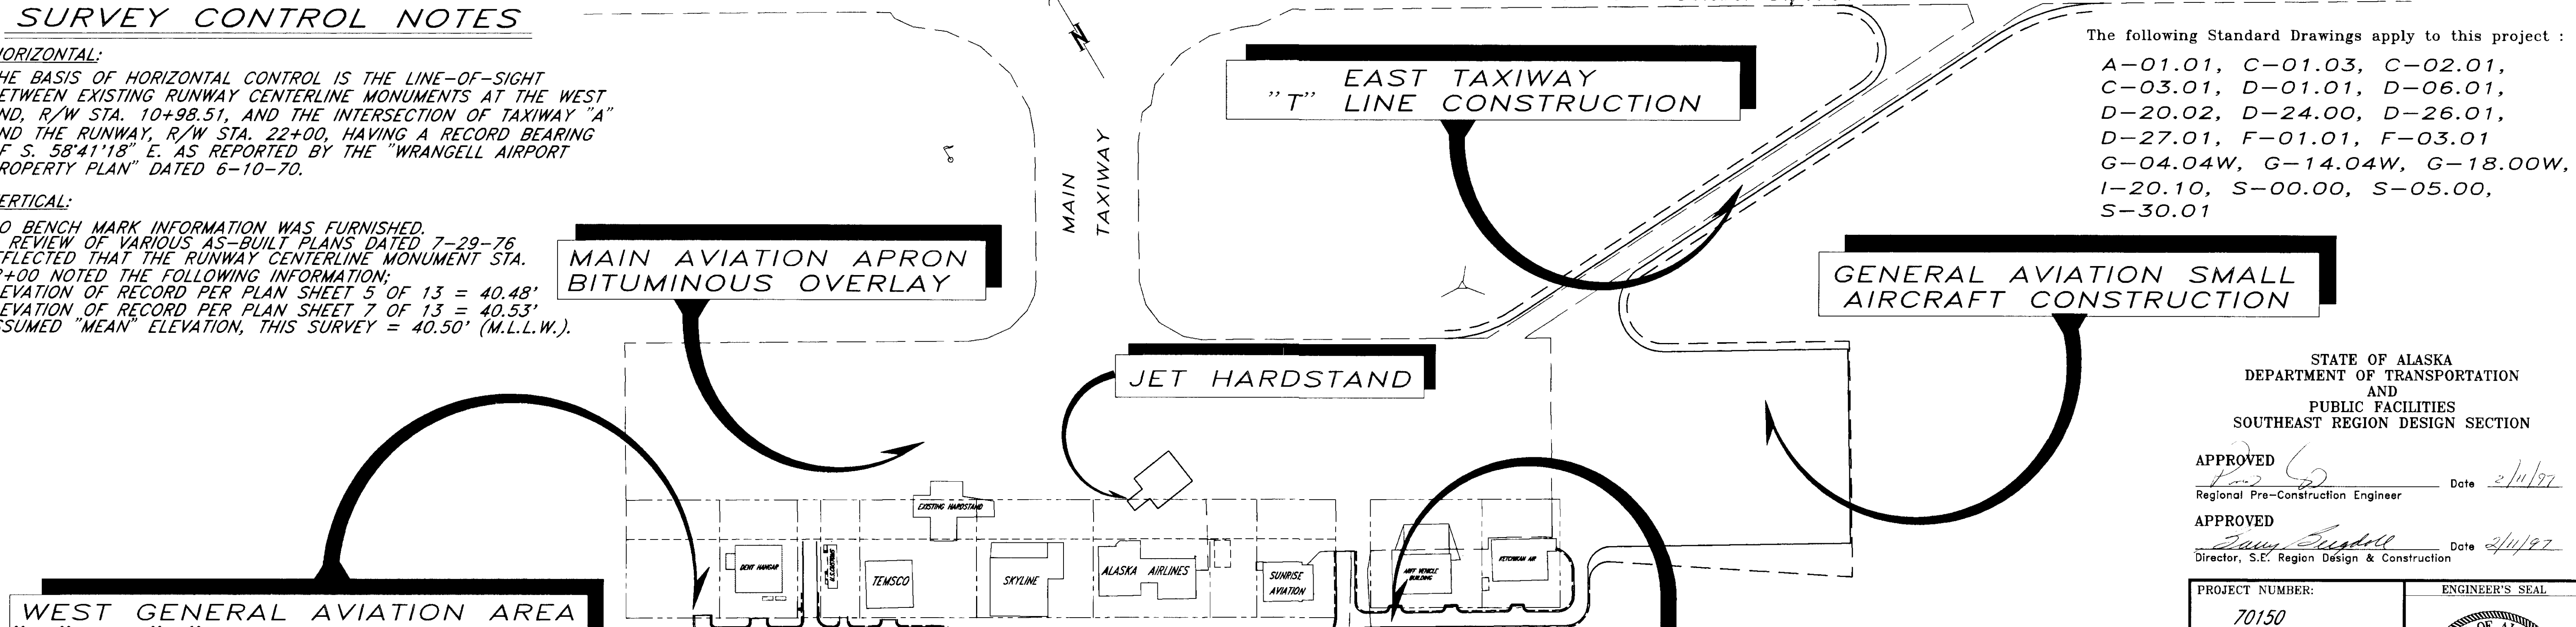

STATE OF ALASKA
 DEPARTMENT OF TRANSPORTATION
 AND
 PUBLIC FACILITIES
 SOUTHEAST REGION DESIGN SECTION

APPROVED *[Signature]* Date 2/11/97
 Regional Pre-Construction Engineer

APPROVED *[Signature]* Date 2/11/97
 Director, S.E. Region Design & Construction

PROJECT NUMBER: 70150
 ENGINEER'S SEAL

ESTIMATE OF QUANTITIES

| ITEM NO. | ITEM | UNIT | SHEET NUMBER | | | | | | | | | | TOTAL | | |
|----------|---|------|--------------|-----------|--------------|-----------|---------|---------|-----------|---------|------------|-----|-------|--|---------------|
| | | | 5 | 6 | 7 | 8 | 9 | 10 | 11 | 12 | E-1 | E-4 | | | |
| 100 | MOBILIZATION AND DEMOBILIZATION | L.S. | | | | | | | | | | | | | ALL REQUIRED |
| 111 | TEMP. EROSION AND POLLUTION CONTROL | C.S. | | | | | | | | | | | | | ALL REQUIRED |
| 120 | DBE ADJUSTMENT | C.S. | | | | | | | | | | | | | ALL REQUIRED |
| 121 | CONSTRUCTION SURVEYING BY THE CONTR. | L.S. | | | | | | | | | | | | | ALL REQUIRED |
| 125 | ENGINEERING TRANSPORTATION | L.S. | | | | | | | | | | | | | ALL REQUIRED |
| 130 | ENGINEERS FIELD OFFICE AND LABORATORY | L.S. | | | | | | | | | | | | | ALL REQUIRED |
| 200f | CLEARING AND GRUBBING | L.S. | | | | | | | | | | | | | ALL REQUIRED |
| 203a | W-BEAM GUARDRAIL | L.F. | 110 50 | 25 | | | | | | | | | | | 135 |
| 203b | REMOVAL AND DISPOSAL OF GUARDRAIL | L.F. | | 25 | | | | | | | | | | | 25 |
| 203c | END ANCHORAGES | EACH | 2 | 1 | | | | | | | | | | | 3 |
| 210a | REM. OF STRUCTURES AND OBSTRUCTIONS | L.S. | | | | | | | | | | | | | ALL REQUIRED |
| 210b | REMOVAL OF CULVERT PIPE | L.F. | 132 161 | 100 101 | 100 196 | | | | | | | | | | 420 458 |
| 250a | EXCAVATION & DISPOSAL OF PVMT. MAT'L. | S.Y. | 144 | | 2,450 | 270 | 1,833 | | | | | | | | 4,697 6035.61 |
| 280a | ADJUST EXIST. SEWER MANHOLE TO FINISH GRADE | EACH | 1 | 1 | | | | | | | | | | | 2 |
| 280b | ADJUST EXIST. SEWER CLEANOUT TO FINISH GRADE | EACH | 3 | 1 | | | | | | | | | | | 4 |
| 280c | ADJUST EXIST. VALVE BOX TO FINISH GRADE | EACH | 3 4 | 3 | | | | | | | | | | | 7 |
| 280d | LOWER EXIST. SEWER MANHOLE | EACH | 1 | | | | | | | | | | | | 1 |
| 285a | EXTEND EXIST. 6" D.I. WATER SERVICE | EACH | 2 3 | | | | | | | | | | | | 3 |
| 285b | EXTEND EXIST. 6" D.I. SEWER SERVICE | EACH | 2 | | | | | | | | | | | | 3 |
| 290 | TAPERED PAVEMENT MILLING | S.Y. | | | | | | 923 700 | 1,550 752 | | | | | | 3,250 1675 |
| 330a | UNCLASSIFIED EXCAVATION | C.Y. | 3385 080 | 1,650 731 | 3,893 285 55 | 2,068 270 | 292 316 | | | 2900 63 | | | | | 10,989 13050 |
| 330c | EMBANKMENT | C.Y. | 170 155 | 130 | 800 485 | 265 230 | | | | | | | | | 1,385 870 |
| 340 | DRIVEWAYS | EACH | 3 | 3 | | | | | | | | | | | 6 |
| 350 | ROCKERY WALL | S.F. | | 1,250 | | | | | | | | | | | 1,250 |
| 360 | ROCK FACING | S.F. | | | | 4,050 | | | | | | | | | 4,050 |
| 400a | 18" CORRUGATED METAL PIPE | L.F. | 234 228 | 84 76 | | | | | | | | | | | 312 |
| 400b | 28" X 20" CORRUGATED METAL PIPE ARCH | L.F. | | 28 | | | | | | | | | | | 28 |
| 400c | 42" X 29" CORRUGATED METAL PIPE ARCH | L.F. | | 62 108 | 248 251 | 350 290 | | | | | | | | | 660 649 |
| 400d | 57" X 38" CORRUGATED METAL PIPE ARCH | L.F. | 180 | | 196 | | | | | | | | | | 376 |
| 400e | END SECTION 18 INCH C.M.P. | EACH | 8 6 | 2 | | | | | | | | | | | 14 8 |
| 400f | END SECTION 28" X 20" C.M.P.A. | EACH | | 2 | | | | | | | | | | | 2 |
| 400g | END SECTION 42" X 29" C.M.P.A. | EACH | | 4 | 4 2 | 3 1 | | | | | | | | | 8 7 |
| 400h | END SECTION 57" X 38" C.M.P.A. | EACH | 4 | | | | | | | | | | | | 6 |
| 405a | INLET, TYPE A | EACH | 1 | 2 | | | | | | | | | | | 3 |
| 405b | INLET, TYPE B | EACH | 1 | 1 | | | | | | | | | | | 2 1 |
| 405c | INLET, TYPE C | EACH | | 1 | 1 | | | | | | | | | | 2 |
| 440a | CHAIN-LINK FENCE | L.F. | | | | | | | | | 603 676 5 | | | | 603 676 5 |
| 440b | DRIVE THRU GATE | EACH | | | | | | | | | 3 | | | | 3 |
| 440c | PEDESTRIAN GATE | EACH | | | | | | | | | 2 4 | | | | 2 4 |
| 440d | RELOCATE EXISTING CHAINLINK FENCE | L.F. | | | | | 600 400 | | | | | | | | 600 400 |
| 441 | GATE OPERATOR | EACH | | | | | | | | | 3 | | | | 3 |
| 500a | SUBBASE COURSE C.O. 1 | C.Y. | 560 | 565 | 2,820 | 4,120 | | | | | | | | | 8,065 12688 |
| 510a | CRUSHED AGGREGATE BASE COURSE | TON | 555 | 580 | 3,350 | 4,360 | 220 | | | | | | | | 9,065 10587 |
| 570a | TRAFFIC MAINTENANCE | L.S. | | | | | | | | | | | | | ALL REQUIRED |
| 570b | TRAFFIC CONTROL DEVICES | L.S. | | | | | | | | | | | | | ALL REQUIRED |
| 600a | BITUMINOUS PRIME COAT, CMS-2S | TON | 0.78 | 0.85 | 5.70 | 7.25 | 0.91 | | | | | | | | 15.49 |
| 610 | BITUMINOUS TACK COAT, STE-1 | TON | | | | | | | 6.85 | 6.10 | | | | | 12.95 |
| 660a | ASPHALT CONCRETE | TON | 155 | 170 | 940 | 1,900 | 270 | | 1,460 | 1,190 | | | | | 6,085 |
| 660c | ASPHALT CEMENT, P.B.A.-2 | TON | 9.30 | 10.20 | 56.4 | 114 | 16.20 | | 87.60 | 71.40 | | | | | 365.10 |
| 660e | ASPHALT PRICE ADJUSTMENT | C.S. | | | | | | | | | | | | | ALL REQUIRED |
| 700c | TAXIWAY AND APRON MARKING | L.S. | | | | | | | | | | | | | ALL REQUIRED |
| 805 | JET HARDSTAND | L.S. | | | | | | | | | | | | | ALL REQUIRED |
| 820a | TIE-DOWN ANCHORS | EACH | | | | | 75 | | | | | | | | 75 |
| 900d | SEEDING | L.S. | | | | | | | | | | | | | ALL REQUIRED |
| 920 | STANDARD SIGNS | EACH | 3 | 2 | 2 | 2 | | | | | | | | | 7 9 |
| 1000a | NEW REGULATOR, 7.5KW, L-828 | EACH | | | | | | | | | 1 | | | | 1 |
| 1000d | NEW HI. INT. RUNWAY, MARKER LT. L-862 | EACH | | | | | | | | | 1 | | | | 1 |
| 1000f | NEW TAXIWAY MARKER LIGHT L-861T | EACH | | | | | | | | | 32 | | | | 32 |
| 1000i | 2" RIGID STEEL CONDUIT | L.F. | | | | | | | | | 1,205 | | | | 1,205 |
| 1000k | 2" PVC CONDUIT | L.F. | | | | | | | | | 1,205 | | | | 1,205 |
| 1000l | UNDERGROUND CABLE #8 AWG, COPPER, 5KV TYPE "B", L-824 | L.F. | | | | | | | | | 4,440 3770 | | | | 4,440 3770 |
| 1000m | #6 THW GREEN COPPER GROUND | L.F. | | | | | | | | | 2,430 1995 | | | | 2,430 1995 |
| 1000n | REMOVE EXIST. #8 5KV CABLE | L.F. | | | | | | | | | 2,195 2192 | | | | 2,195 2192 |
| 1000o | REMOVE EXIST. RUNWAY/TAXIWAY LTS. | EACH | | | | | | | | | 4 | | | | 4 |
| 1000q | GROUND ROD | EACH | | | | | | | | | 2 | | | | 2 |
| 1000r | FLUSH BIDIRECTIONAL RUN. MARKER LT. L-850C | EACH | | | | | | | | | 1 | | | | 1 |
| 1000s | RETROREFLECTOR MARKER L853 | EACH | | | | | | | | | 2 | | | | 2 |
| 1000t | CLEAN AND TEST EXISTING SYSTEM | L.S. | | | | | | | | | | | | | ALL REQUIRED |
| 1002a | ELECT./TELEPHONE RELOCATION & PANEL B | L.S. | | | | | | | | | | | | | ALL REQUIRED |
| 1002b | FIXTURE TYPE A | EACH | | | | | | | | | 2 | | | | 2 |
| 1002c | FIXTURE TYPE B | EACH | | | | | | | | | 11 | | | | 11 |
| 1002d | HARDSTAND GROUND SYSTEM | L.S. | | | | | | | | | | | | | ALL REQUIRED |
| 1002e | ELECTRIC GATE POWER | EACH | | | | | | | | | 3 | | | | 3 |


| BASIS OF ESTIMATE | | |
|-------------------|-------------------------------|-------------------------------|
| ITEM No. | PAY ITEM | ESTIMATING FACTOR |
| 330c | EMBANKMENT | 1.86 TONS/C.Y. |
| 500a | SUBBASE COURSE | 1.96 TONS/C.Y. |
| 510a | CRUSHED AGGREGATE BASE COURSE | 1.96 TONS/C.Y. |
| 600a | BITUMINOUS PRIME COAT CMS-2S | 0.15 GAL/S.Y. AT 256 GAL/TON |
| 610 | BITUMINOUS TACK COAT, STE-1 | 0.10 GAL./S.Y. AT 240 GAL/TON |
| 660a | ASPHALT CONCRETE | 2.10 TONS/C.Y. |
| 660c | ASPHALT CEMENT, P.B.A.-2 | 6% OF ITEM 660a |

GENERAL NOTES


- GRADES AND ALIGNMENTS SHOWN ON THESE PLANS MAY BE SUBJECT TO MINOR REVISIONS AS APPROVED OR DIRECTED BY THE ENGINEER.
- PIPE CONDUIT LENGTHS AND LOCATIONS SHOWN ON THESE PLANS MAY BE SUBJECT TO MINOR FIELD REVISIONS AS APPROVED OR DIRECTED BY THE ENGINEER.
- STORM DRAINAGE STRUCTURE LOCATIONS SHOWN ON THESE PLANS MAY BE SUBJECT TO MINOR FIELD REVISIONS AS APPROVED OR DIRECTED BY THE ENGINEER.
- WASTE MATERIAL REMOVED FROM THE PROJECT SHALL BE DISPOSED OF BY THE CONTRACTOR AT DOT/PF APPROVED OFF-SITE DISPOSAL SITES.
- THE UNCLASSIFIED EXCAVATION VOLUME SHOWN INCLUDES ALL EXCAVATION, REGARDLESS OF THE MATERIAL ENCOUNTERED.
- IT IS ASSUMED THAT SOME OF THE UNCLASSIFIED EXCAVATION VOLUME MAY BE USABLE ON THE PROJECT AS EMBANKMENT MATERIAL PROVIDED IT MEETS THE PROJECT SPECIFICATIONS FOR EMBANKMENT.

ENGINEER'S SEAL

NOTE: DO NOT SCALE FROM THESE PLANS-USE DIMENSIONS

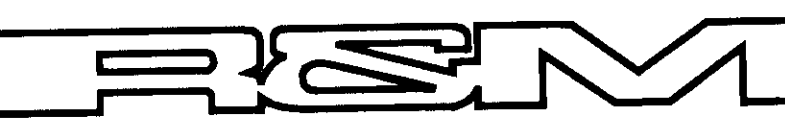


R & M ENGINEERING, INC.
ENGINEERS GEOLGISTS SURVEYORS
CLEARING LIMITS

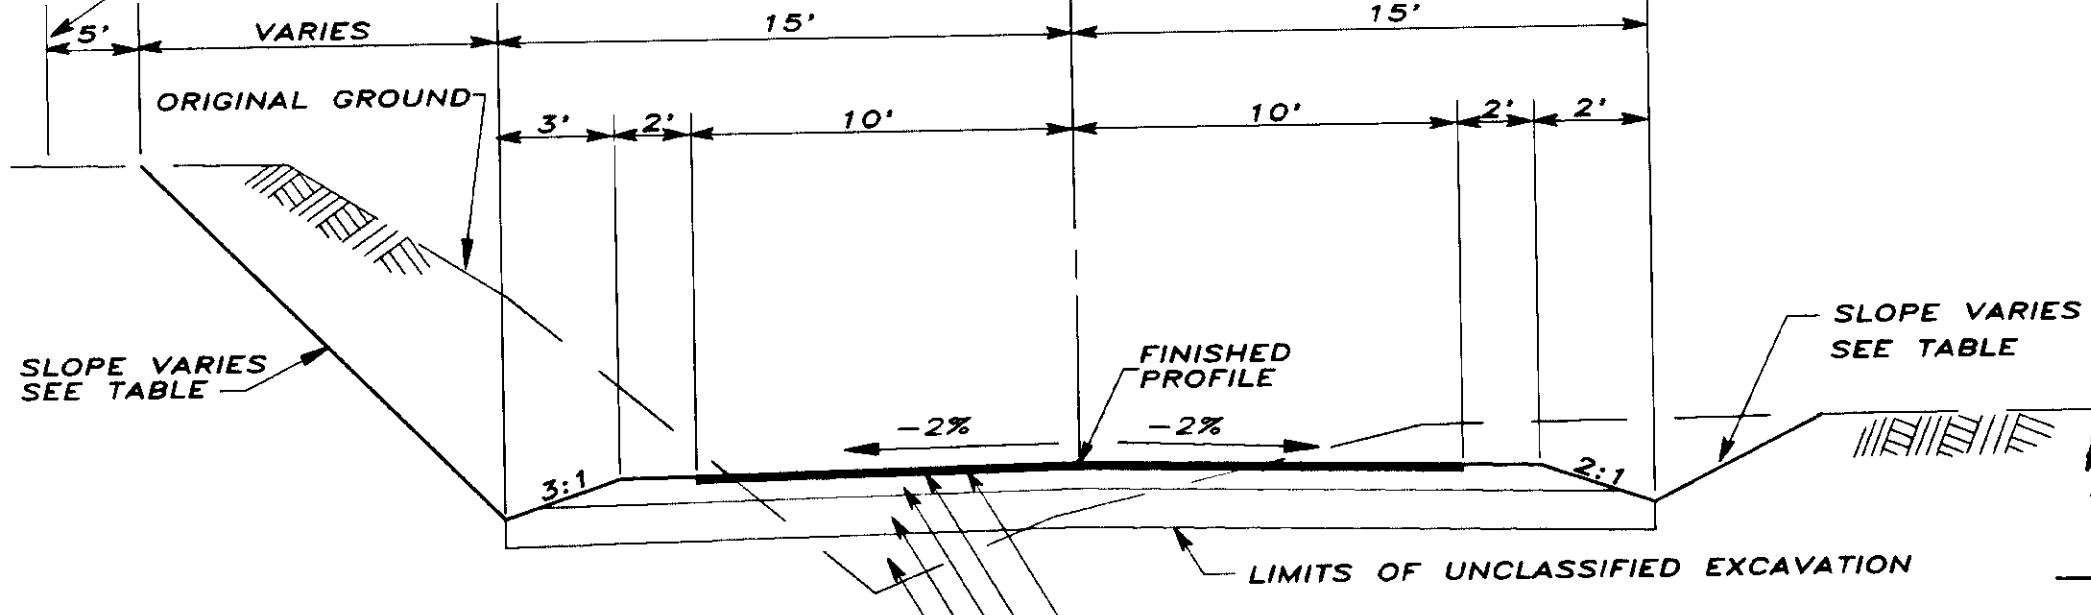


TYPICAL SECTION
"W" LINE
STA. "W" 10+50 TO STA. "W" 12+00


NOTE:
STA. "W" 10+14 TO
"W" 10+50 PAVED
WIDTHS VARY.

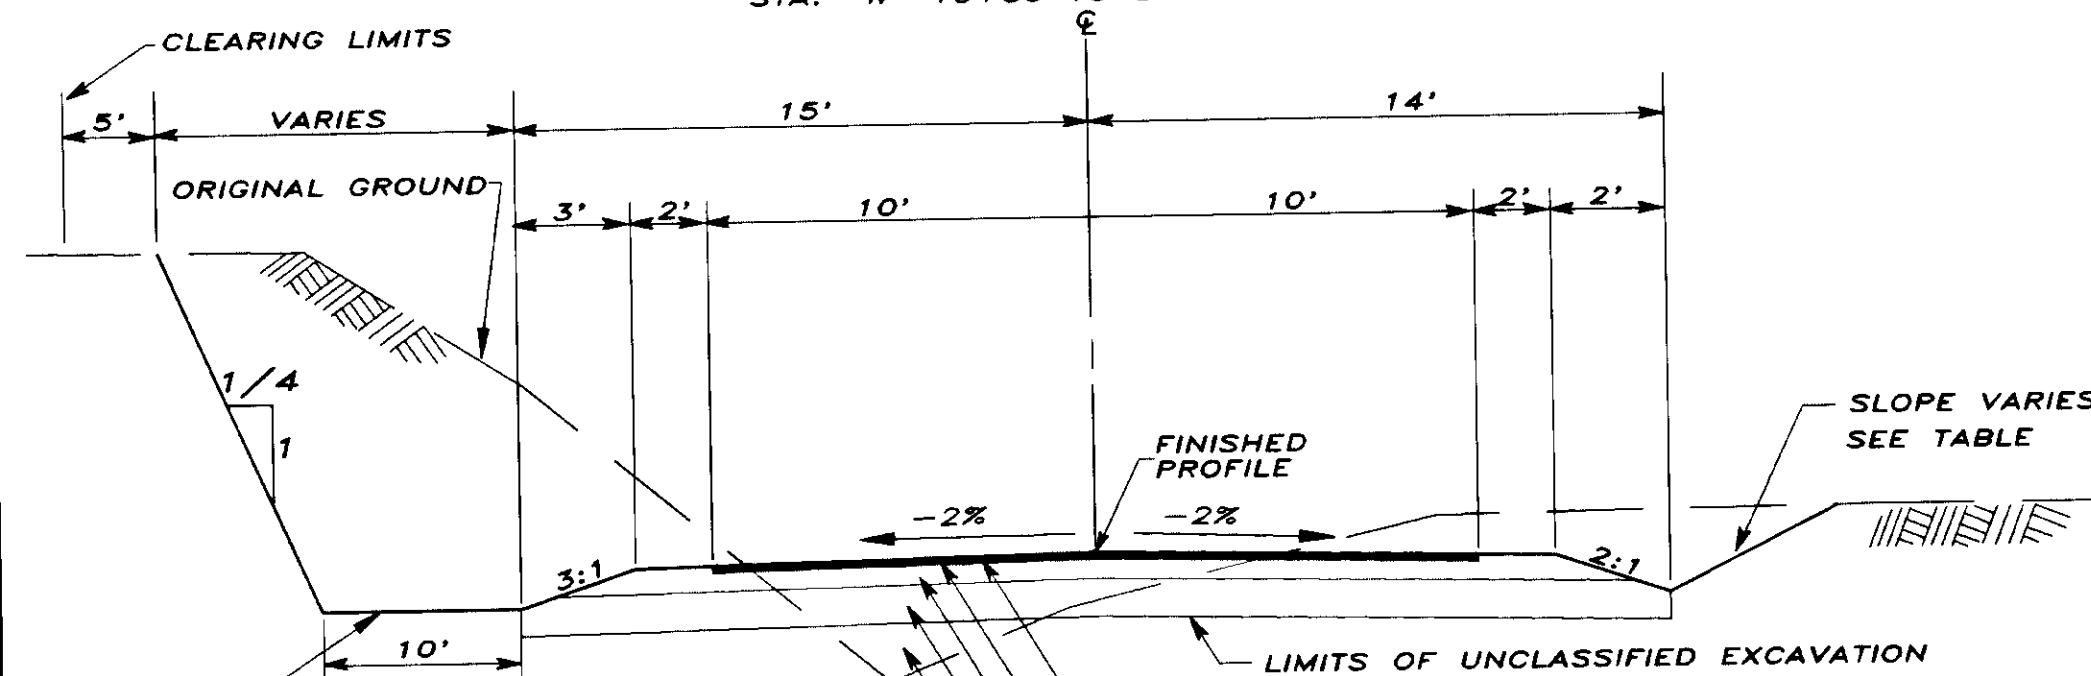

TYPICAL SECTION
"W" LINE
STA. "W" 12+00 TO STA. "W" 14+00

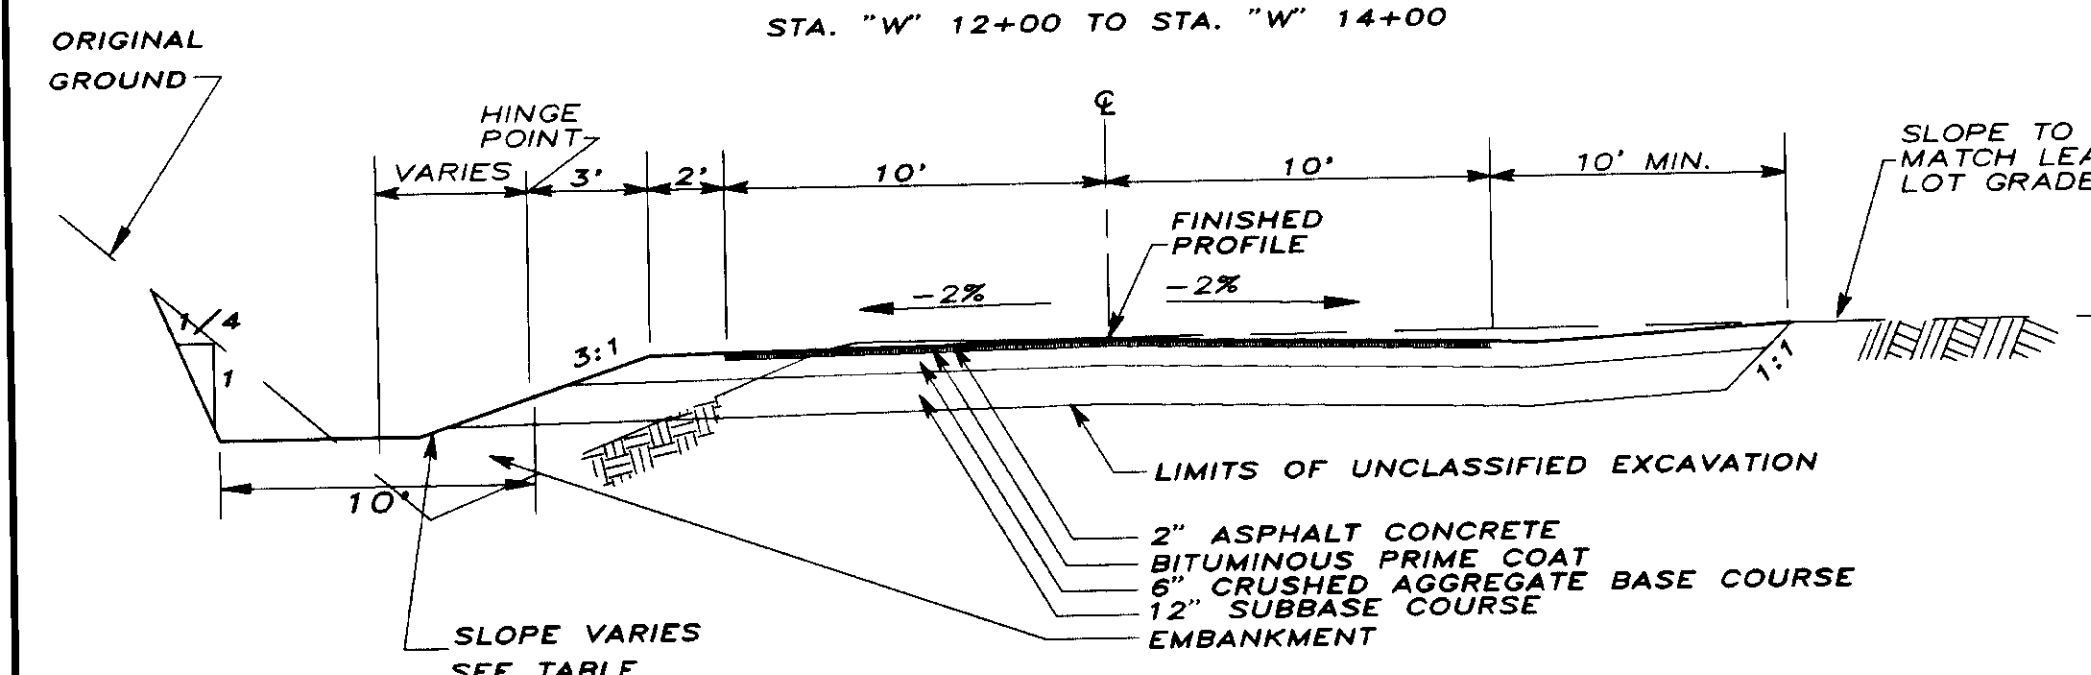


TYPICAL SECTION
"G" LINE
STA. "G" 20+00 TO STA. "G" 21+31.94

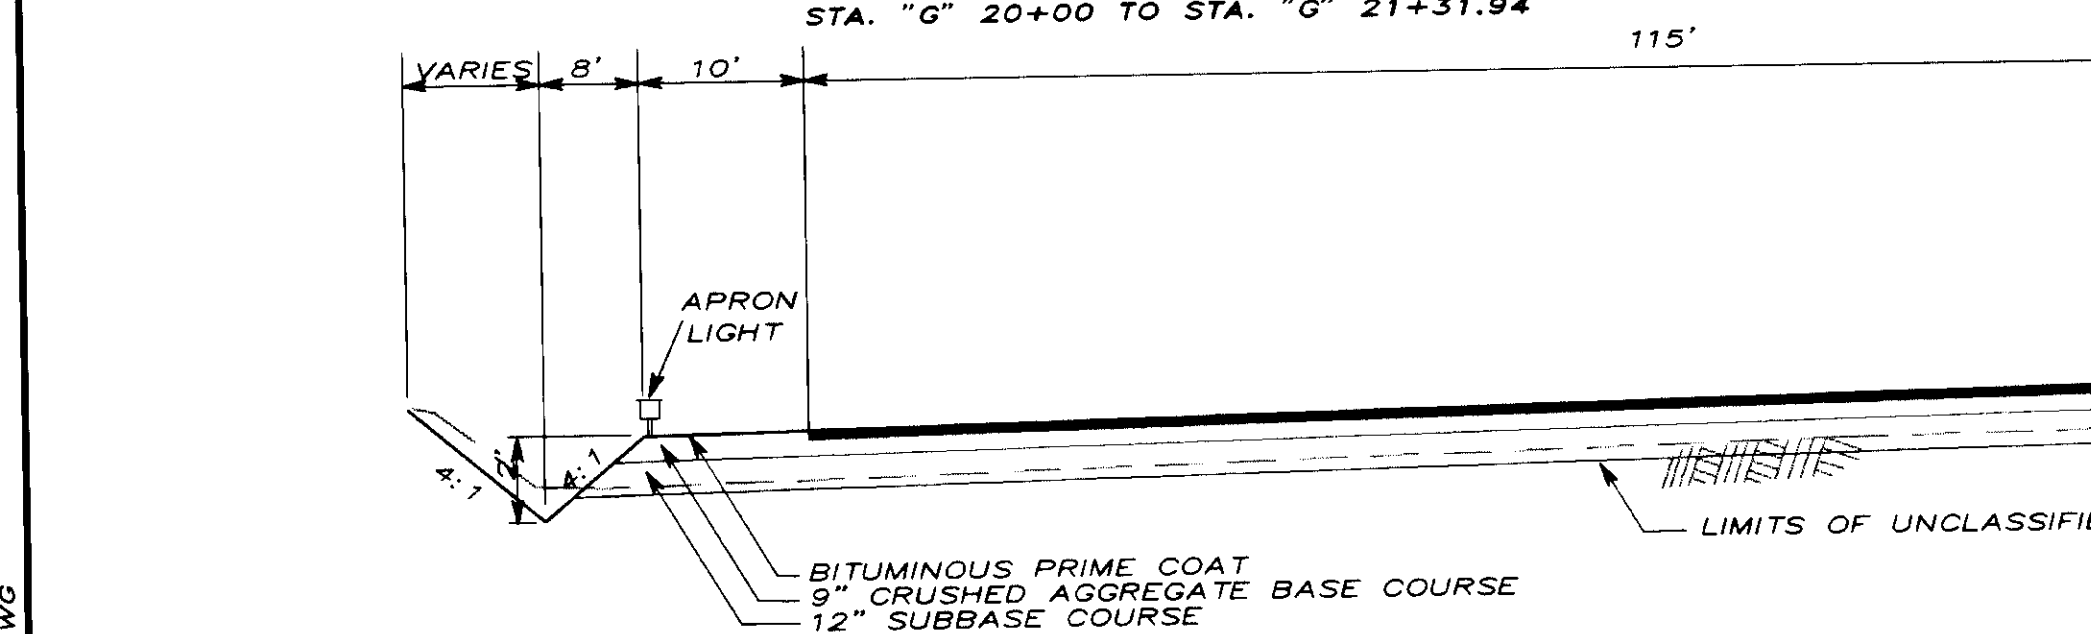


APRON TYPICAL SECTION
"A" LINE
STA. "A" 10+00 TO STA. "A" 13+92

NOTE: EMBANKMENT REQUIRED TO FILL EXISTING DITCH ADJACENT TO EAST END OF MAIN AVIATION APRON

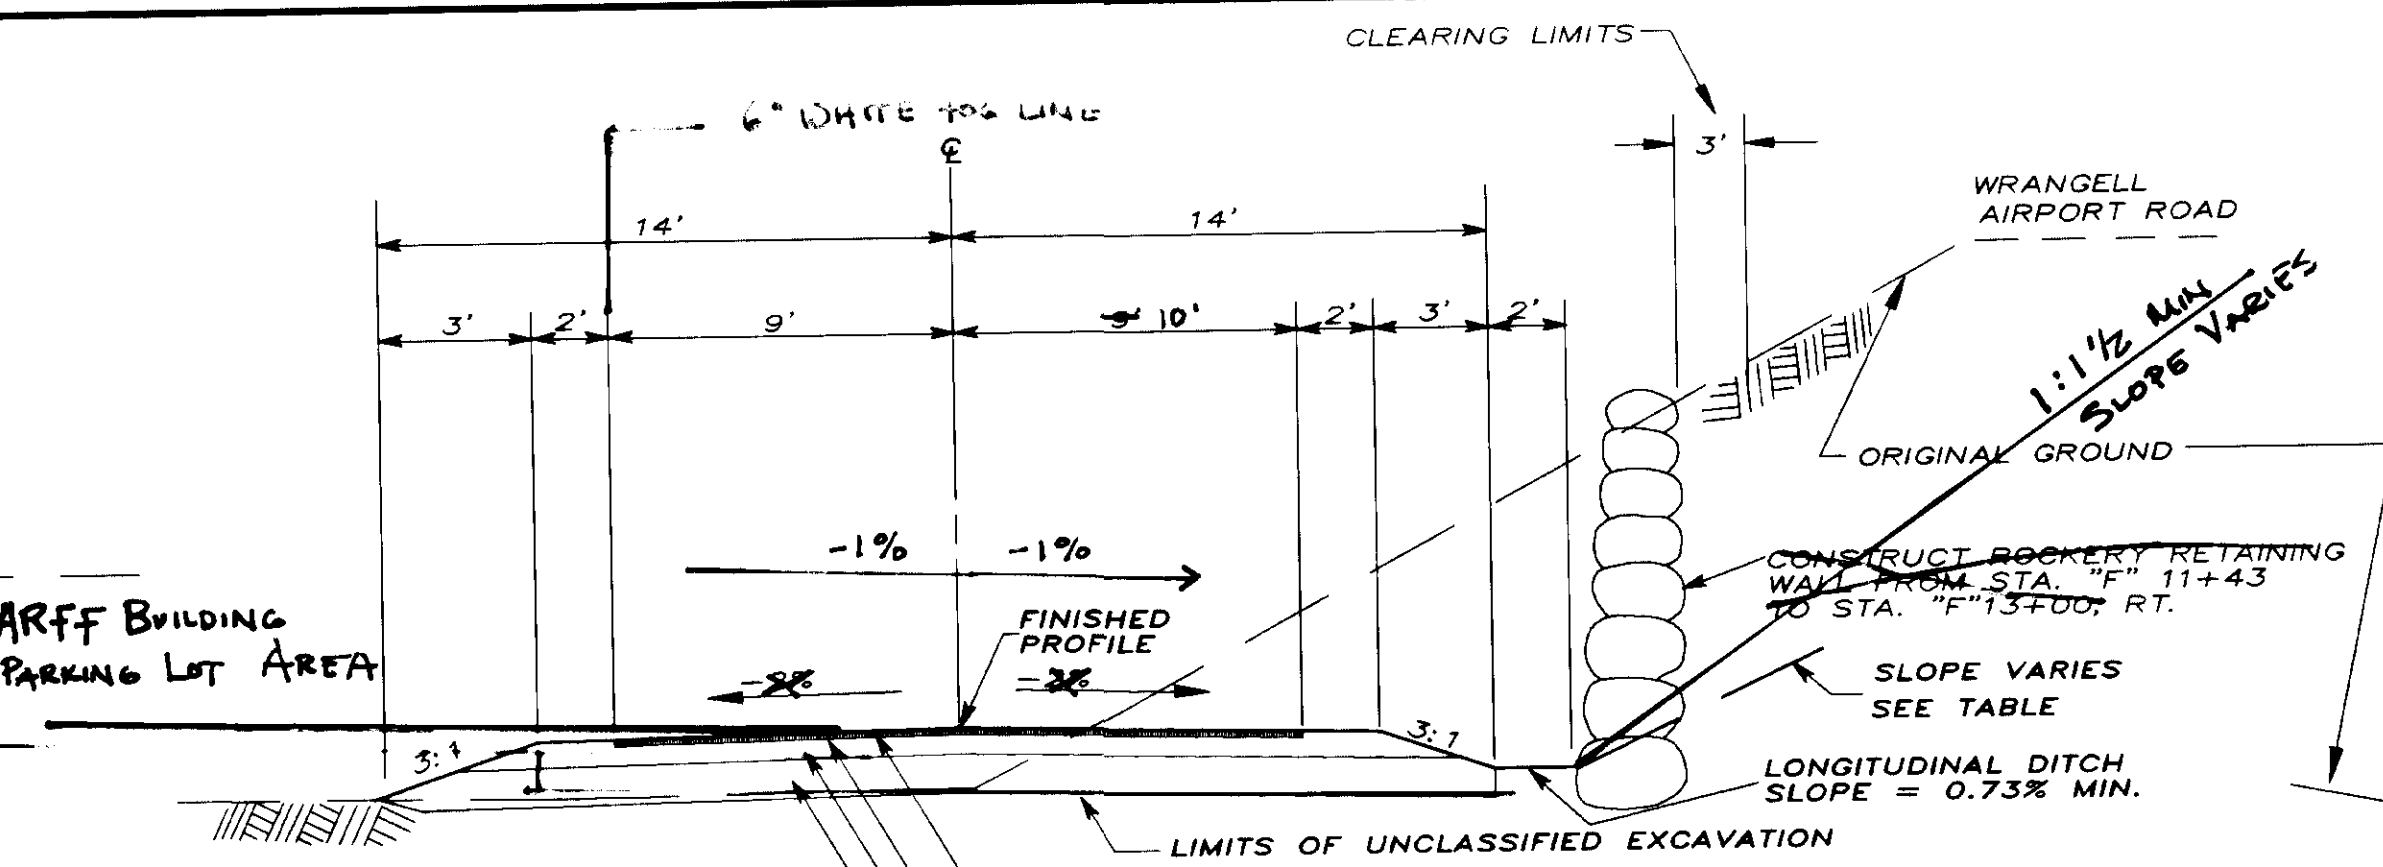


TYPICAL SECTION
"F" LINE
STA. "F" 10+00 TO STA. "F" 13+14

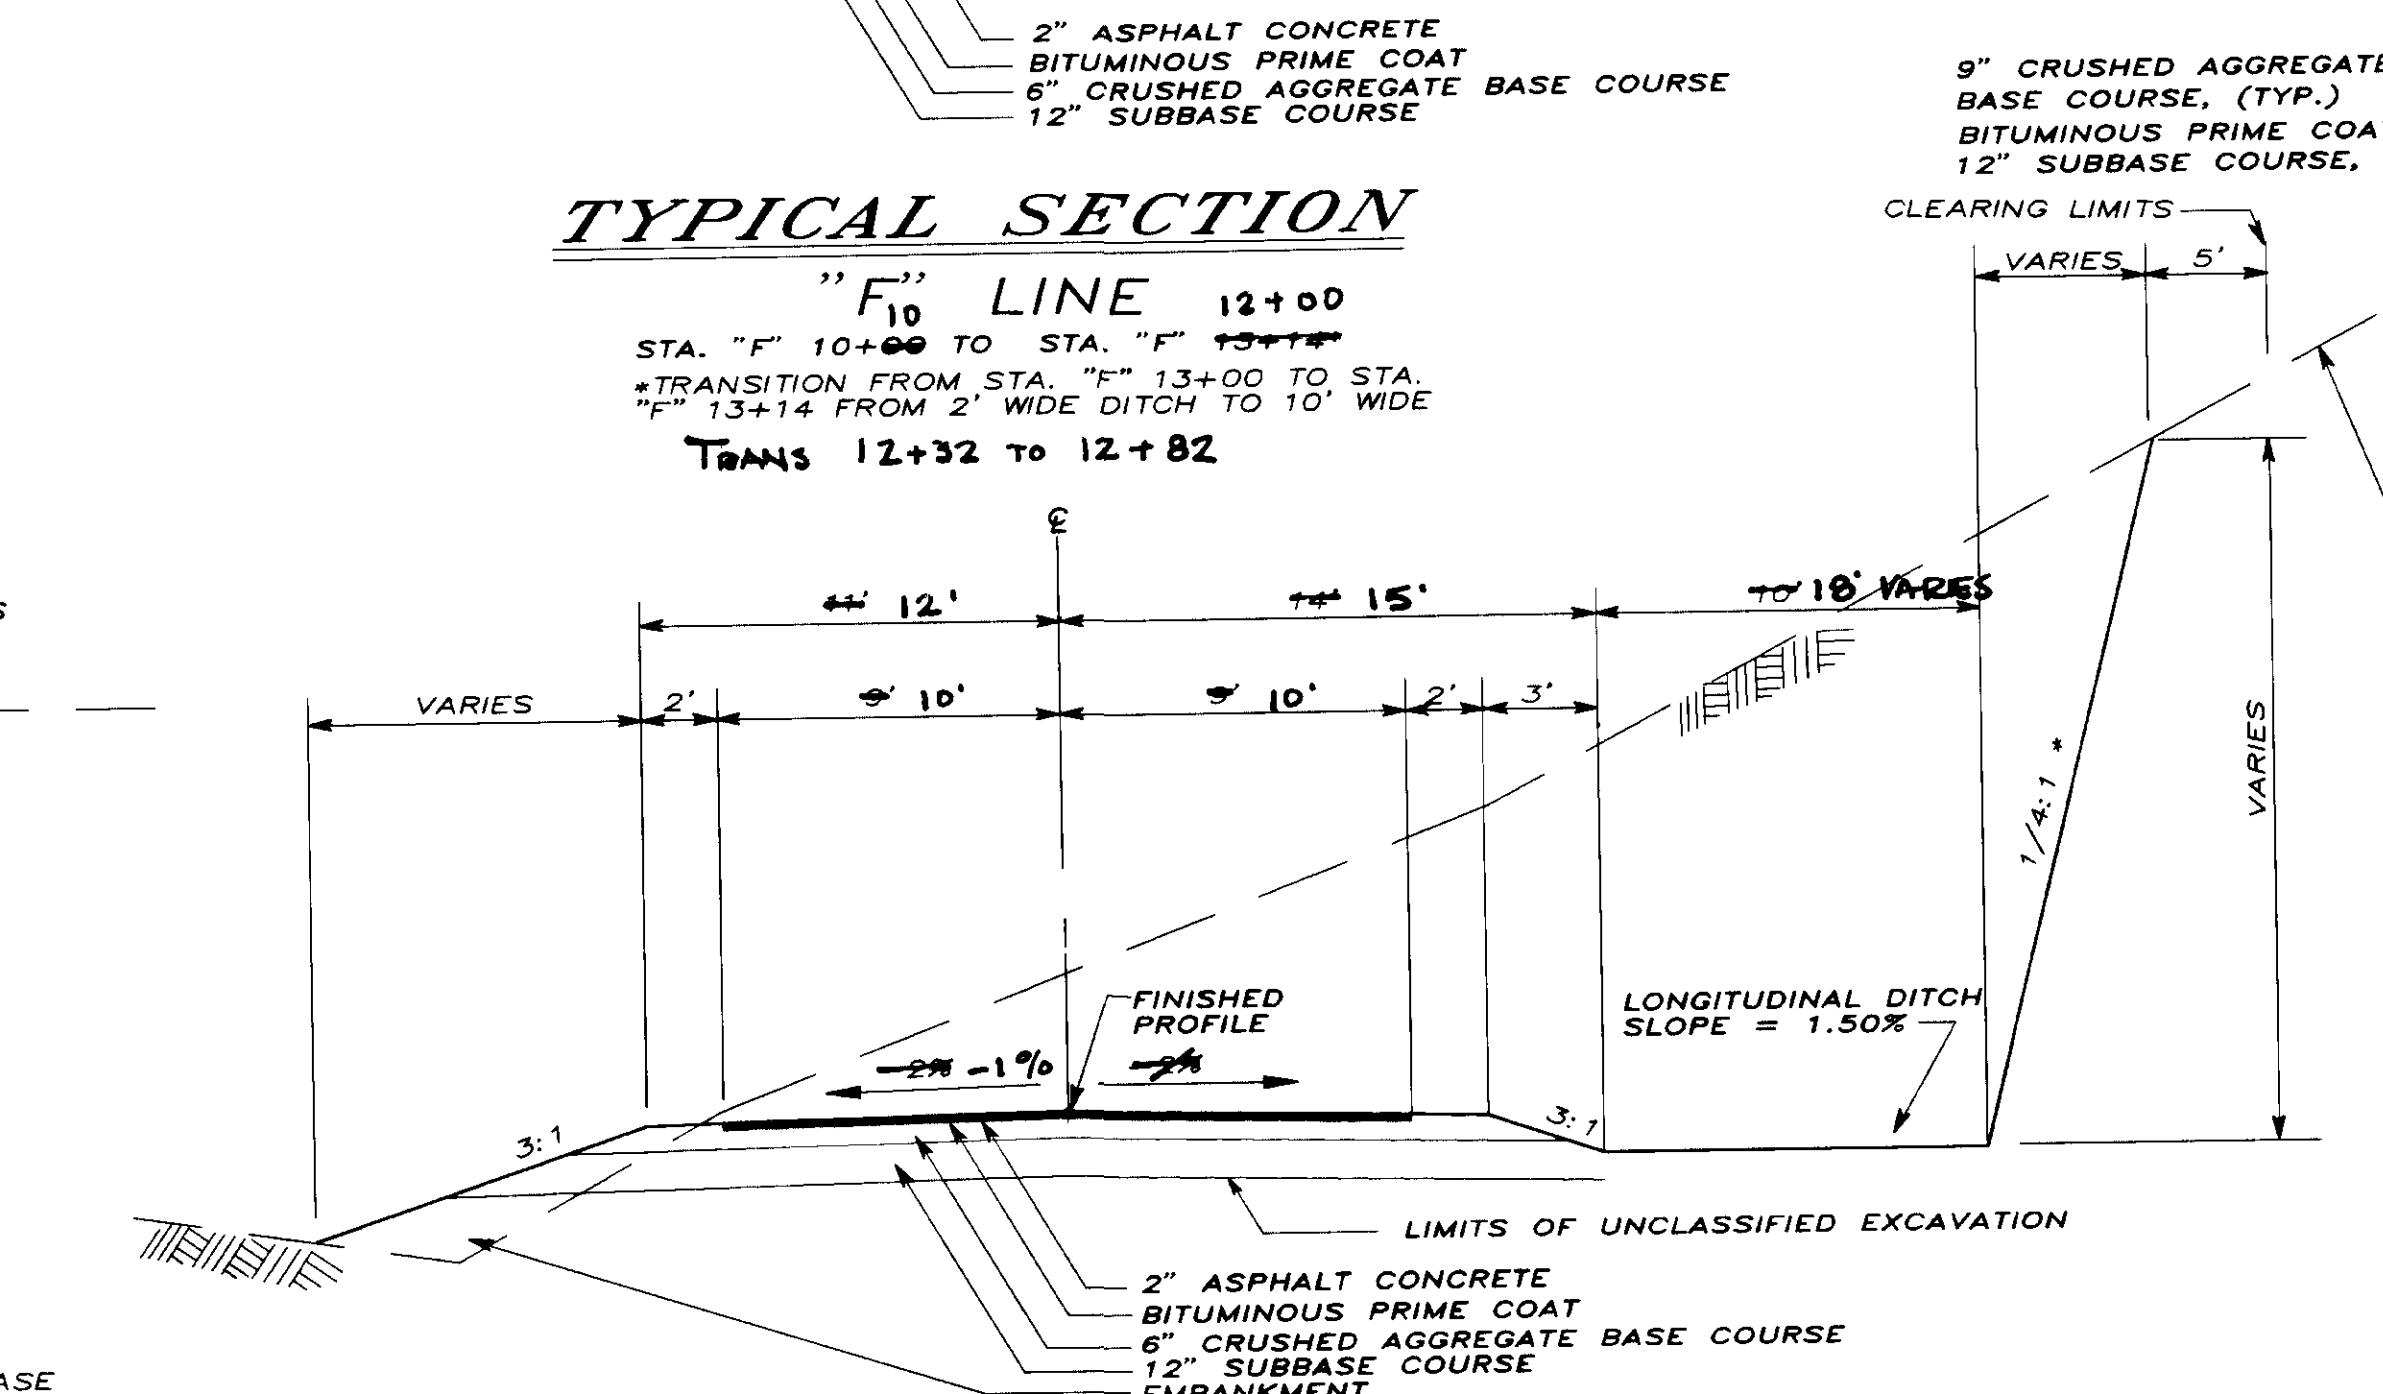


TYPICAL SECTION
"F" LINE
STA. "F" 13+14 TO STA. "F" 13+36.22


* BACKSLOPE MAY VARY TO MATCH EXIST. CUTSLOPES

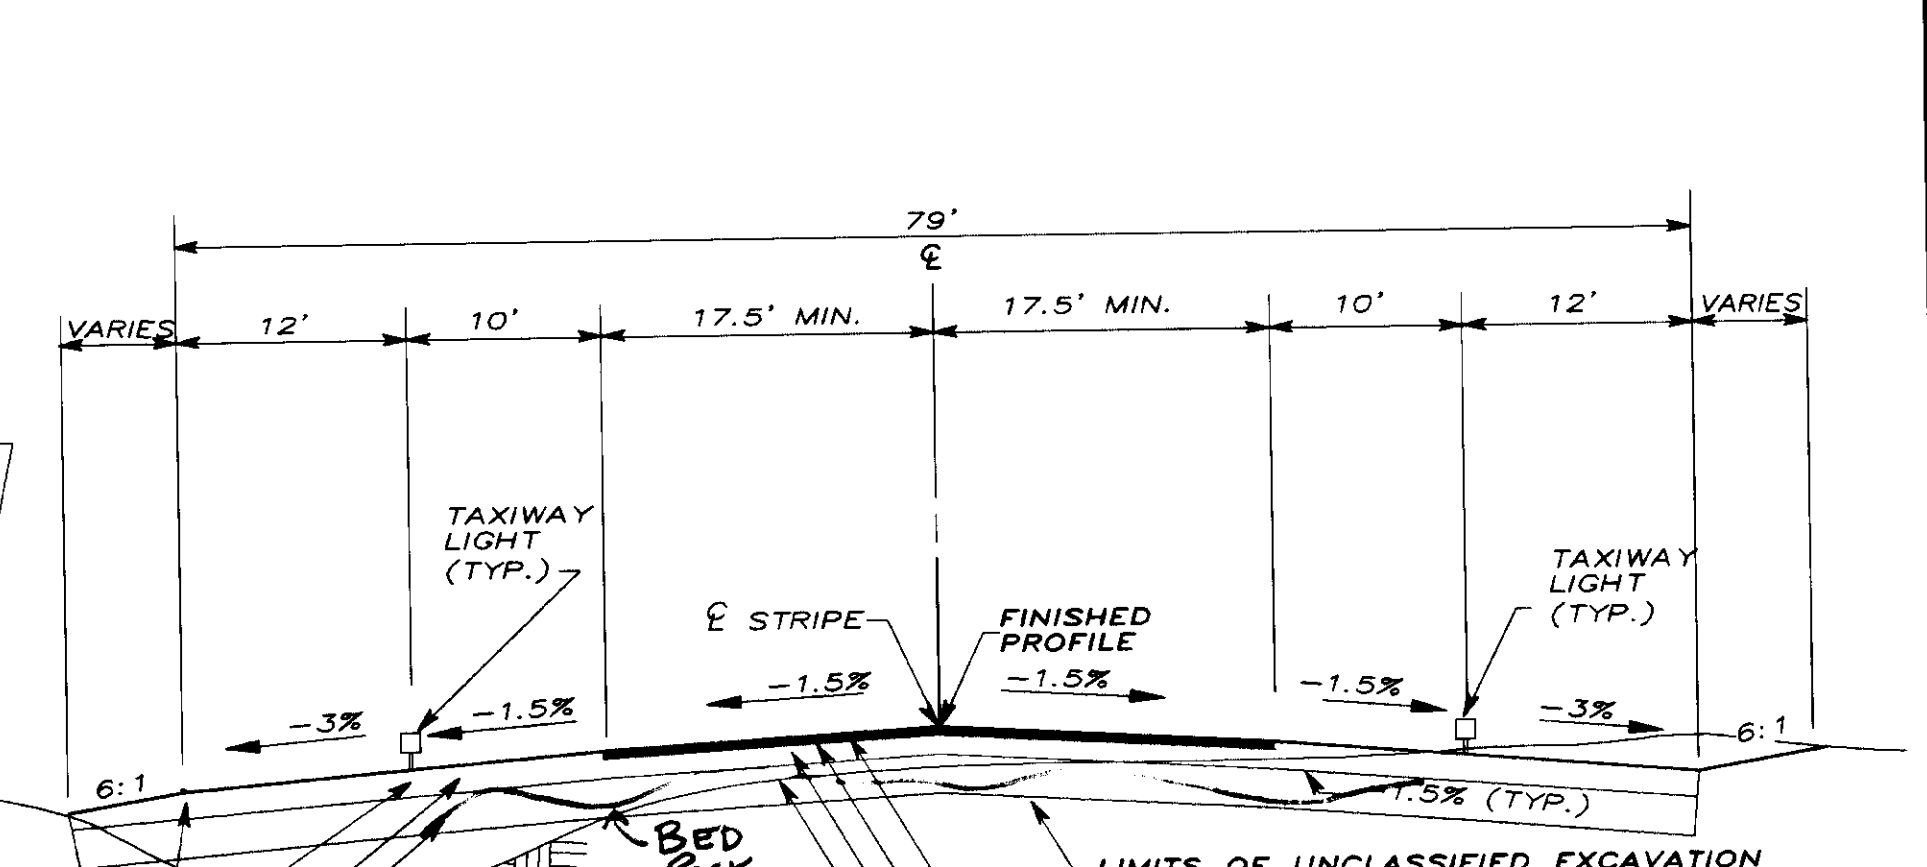

TAXIWAY TYPICAL SECTION
"T" LINE
STA. "T" 9+57.40 TO STA. "T" 17+84.60

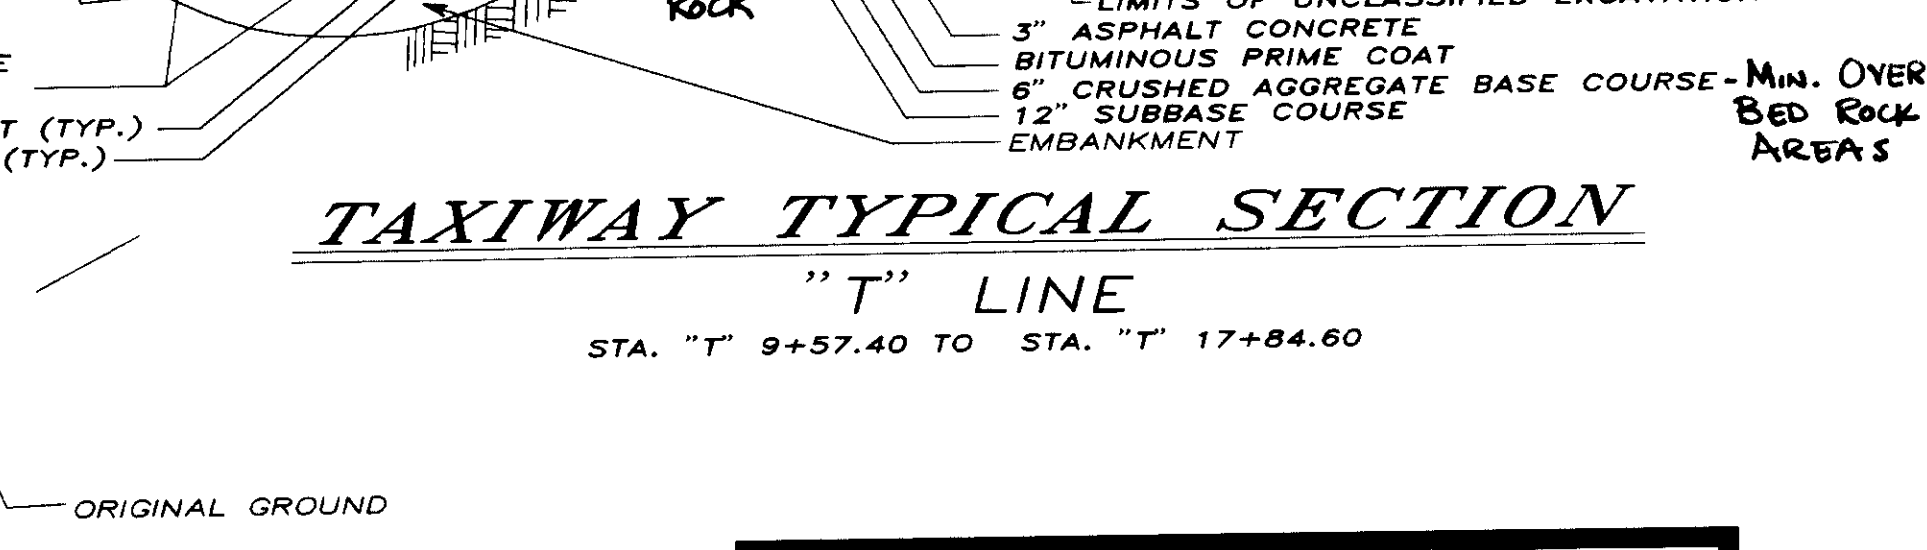

TYPICAL SECTION
"F" LINE
STA. "F" 13+14 TO STA. "F" 13+82

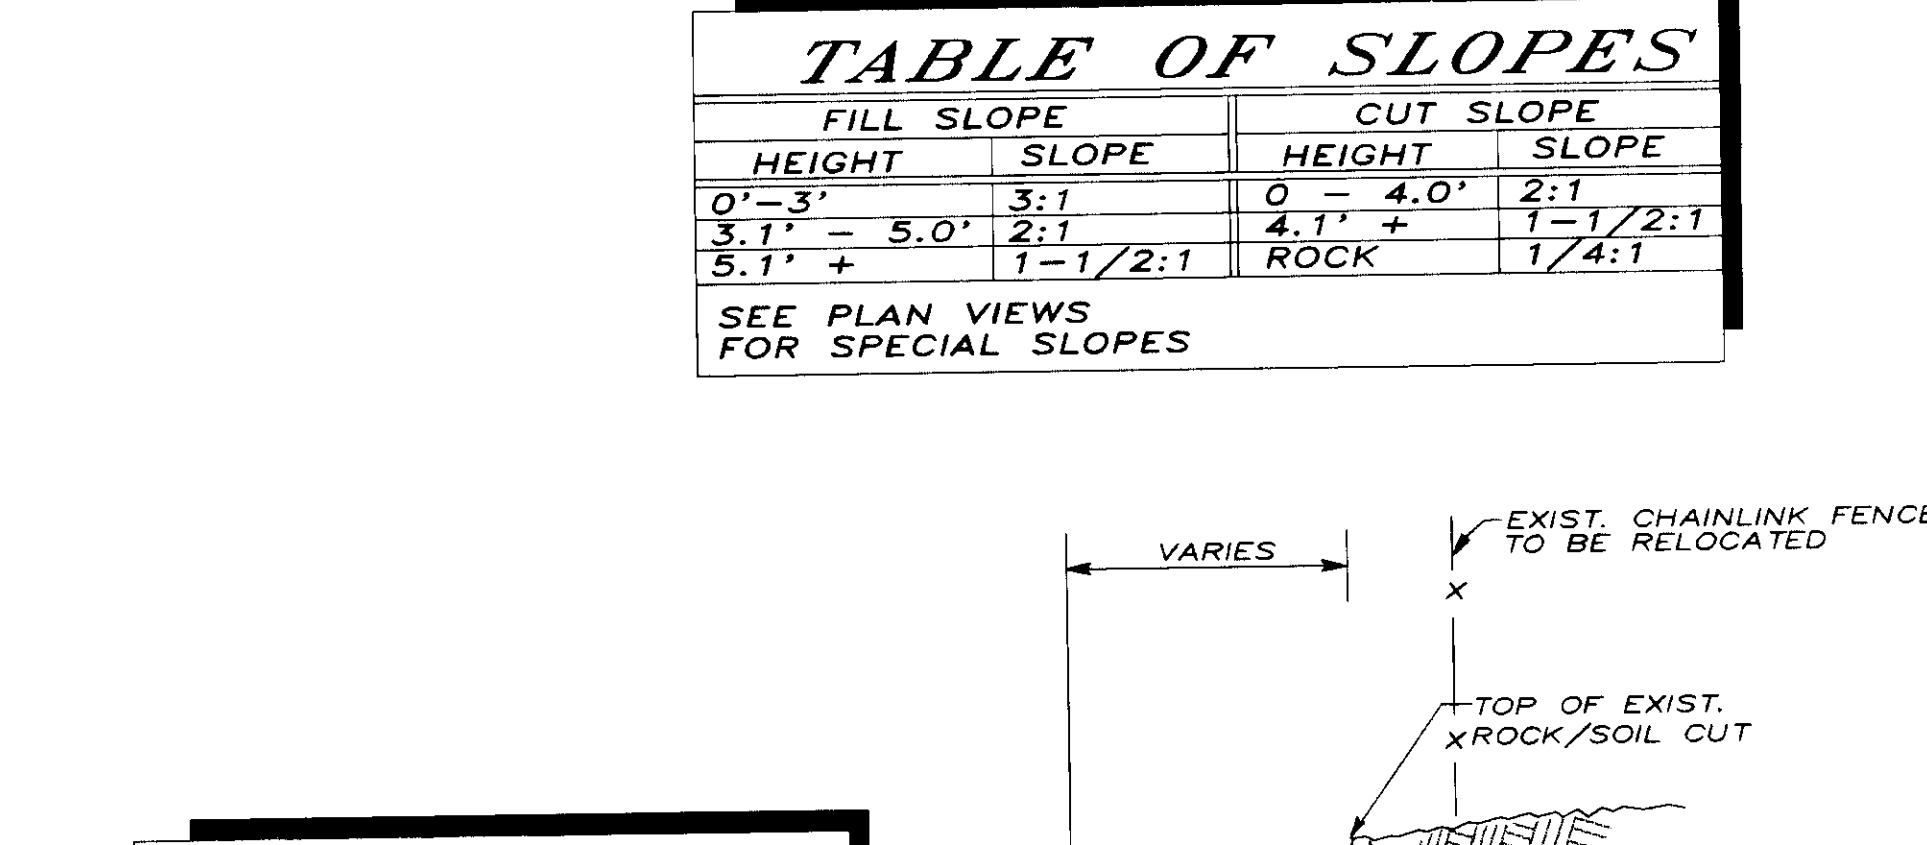

APRON TYPICAL SECTION
"A" LINE
STA. "A" 10+00 TO STA. "A" 11+00

* CROSS SLOPE VARIES FROM STA. "A" 10+00 TO STA. "A" 11+00

| FILL SLOPE | | CUT SLOPE | |
|-------------|---------|-----------|---------|
| HEIGHT | SLOPE | HEIGHT | SLOPE |
| 0' - 3' | 3:1 | 0 - 4.0' | 2:1 |
| 3.1' - 5.0' | 2:1 | 4.1' + | 1-1/2:1 |
| 5.1' + | 1-1/2:1 | ROCK | 1/4:1 |

SEE PLAN VIEWS FOR SPECIAL SLOPES


NOTE: ALL SLOPES THAT ARE NOT BEDROCK SHALL BE HYDROSEEDED.

NOTE: DO NOT SCALE FROM THESE PLANS-USE DIMENSIONS

ENGINEER'S SEAL




CALSDWG

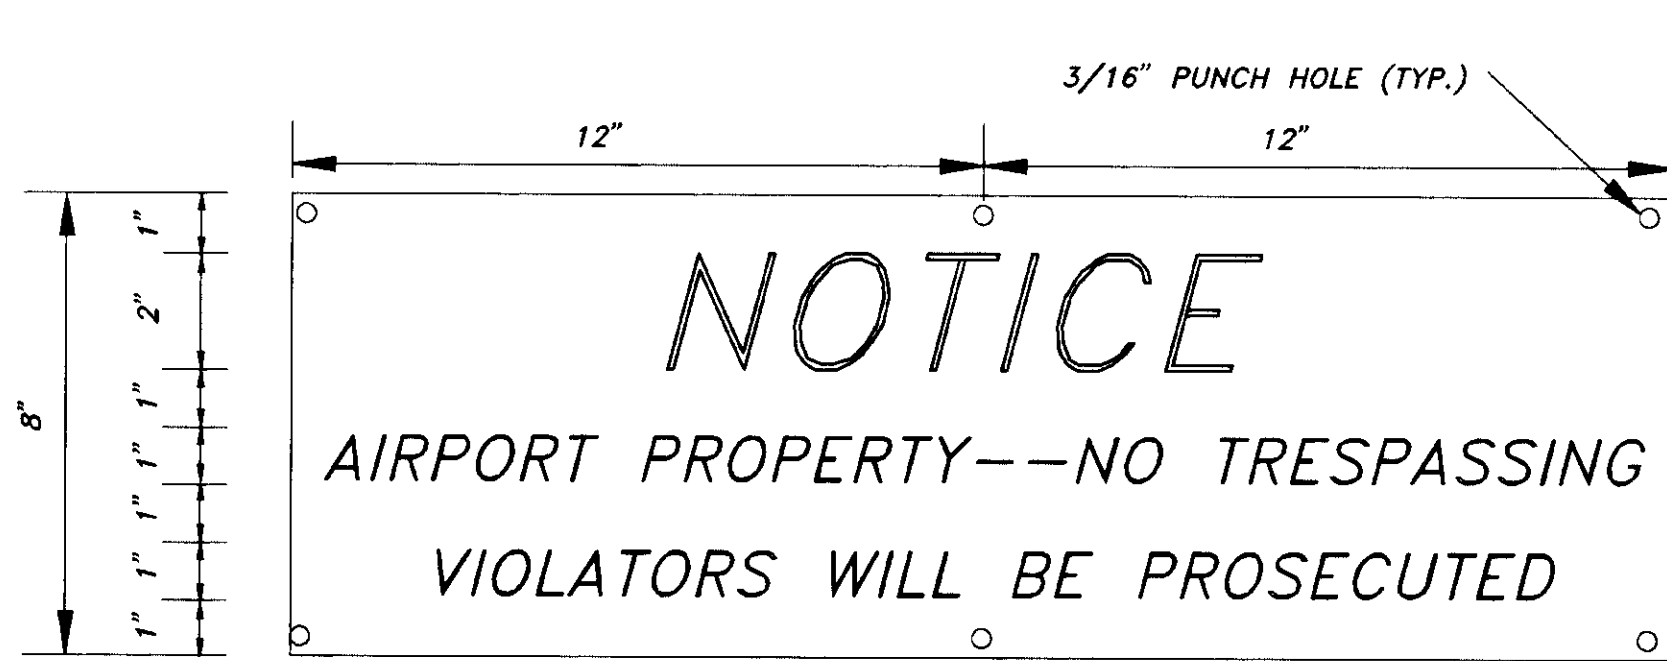

BOUNDARY SIGN PLATE DETAIL

N.T.S.


INSTALL AT 400' O.C. OF CHAINLINK FENCE- 8 TOTAL

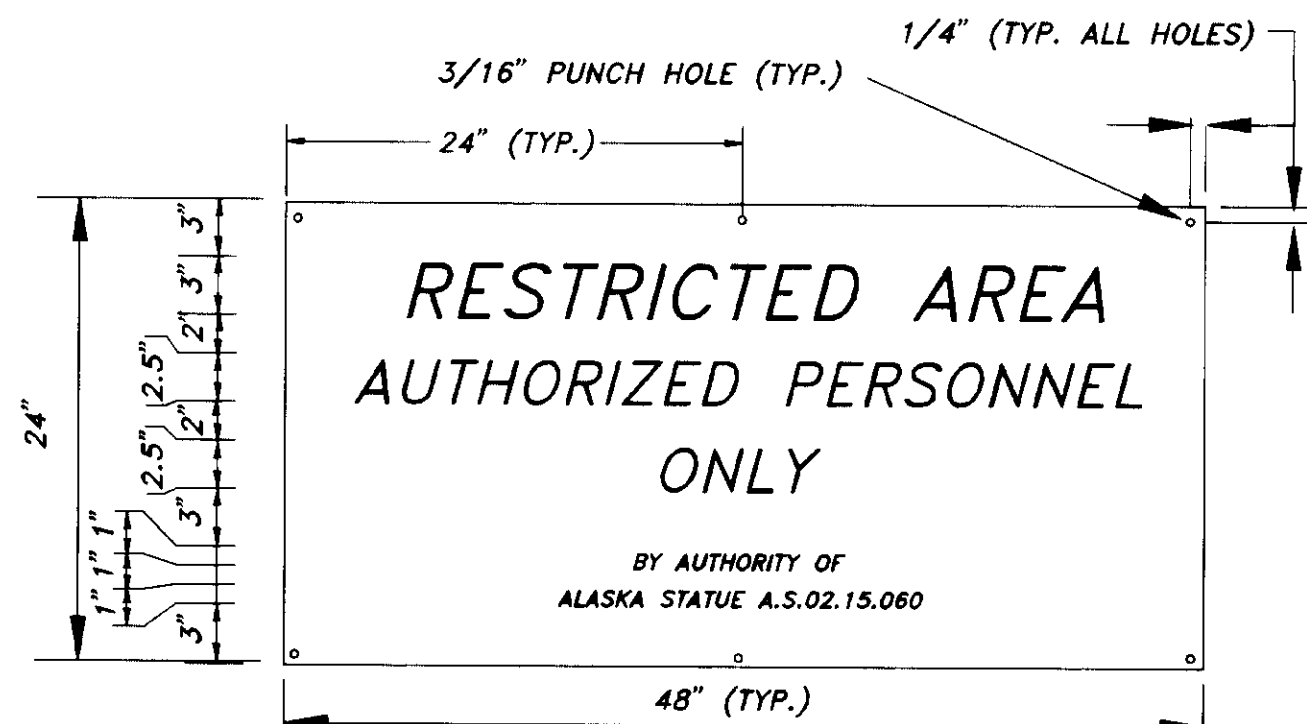

GATE SIGN-PERSONNEL

N.T.S.


INSTALL AT ALL MAN GATES- 2 TOTAL

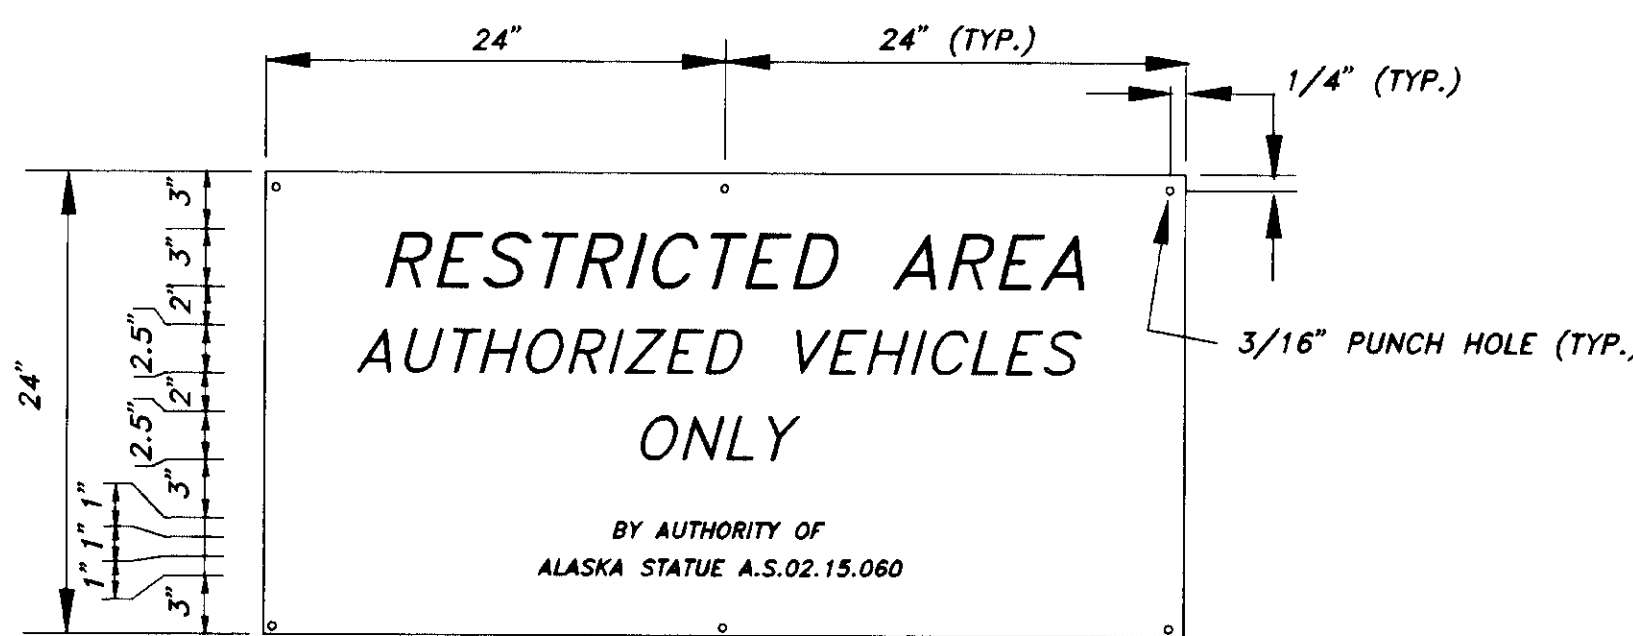

GATE SIGN-VEHICLES

N.T.S.

INSTALL AT DRIVE-THRU GATE 1, 2 & 3 - 3 TOTAL

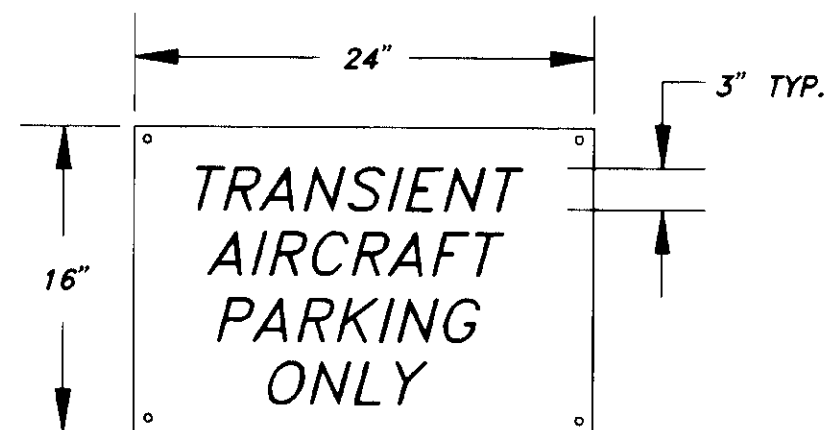

AIRCRAFT PARKING SIGN


N.T.S.

| SIGN NUMBER | STATION | OFFSET | CODE No. | LEGEND | SIZE INCHES | AREA SQ. FT. | FACING DIRECTION | Nb. OF POST | REMARKS |
|-------------|--------------------|--------------------|----------|---------------------------------|--------------|--------------|------------------|-------------|---------------|
| ① | "G" 20+23 | 25' LT. | R1-1 | STOP | 30 X 30 | 6.25 | NORTH BOUND | 1 | |
| ② | "F" 10+23 | 18' LT. | R1-2 | YIELD | 36 X 36 X 36 | 4.50 | WEST | 1 | |
| ③ | "W" 10+23 | 26' LT. | R1-1 | STOP | 30 X 30 | 6.25 | NORTH BOUND | 1 | |
| ④ | "W" 12+87 | 16' RT. | R1-2 | YIELD | 36 X 36 X 36 | 4.50 | SOUTH BOUND | 1 | |
| ⑤ | "W" 11+71 | 12' RT. | R1-2 | YIELD | 36 X 36 X 36 | 4.50 | SOUTH BOUND | 1 | |
| ⑥ | "A" 13+94 | 75' RT. | | TRANSIENT AIRCRAFT PARKING ONLY | 24 X 16 | 2.67 | | 1 | MOUNT ON POST |
| ⑦ | "A" 13+94 | 45' LT. | | TRANSIENT AIRCRAFT PARKING ONLY | 24 X 16 | 2.67 | | 1 | MOUNT ON POST |
| 819 | "T" 11+29 16+00 | 65' LT. 62' RT. | | CLOSED TO AIRCRAFT UNDER 12.5 | 48 X 24 | 8.00 | WEST EAST | 2 | MOUNT ON POST |

| STATION | OFFSET TO ϵ | | RADIUS | | WIDTH | REMARKS |
|--------------|----------------------|-------|--------|-------|-------|---------|
| | LEFT | RIGHT | LEFT | RIGHT | | |
| "W" 11+57.84 | | X | 10' | 10' | 18' | PAVED |
| "W" 12+22 | | X | 5' | 5' | 6' | GRAVEL |
| "W" 12+58.32 | | X | 15' | 25' | 18' | PAVED |
| "F" 10+64 | X | | 7.5' | 7.5' | 14' | PAVED |
| "F" 11+37 | X | | 7.5' | 7.5' | 14' | PAVED |
| "F" 12+22 | X | | 7.5' | 7.5' | 14' | PAVED |


SIGNING NOTES

- STATIONS AND OFFSETS AS GIVEN ARE APPROXIMATE ONLY AND ARE SUBJECT TO MINOR FIELD REVISIONS AS DIRECTED BY THE ENGINEER.
- ALL SIGNS SHALL BE CLASS "T". SIGNS WITH A WIDTH LESS THAN 34" SHALL BE ON 0.080" THICK SHEET ALUMINUM AND SHALL BE UNFRAMED. SIGNS WITH A WIDTH GREATER THAN 34" SHALL BE ON 0.125" THICK SHEET ALUMINUM AND SHALL BE FRAMED. SEE STANDARD DRAWING S-00.00 FOR DETAILS.
- ALL SIGN POSTS SHALL BE TELESCOPING, PERFORATED GALVANIZED SQUARE STEEL POSTS. THE 2" SIZE SHALL BE USED ABOVE GROUND 2 1/4" SIZE BELOW GROUND. SEE STANDARD DRAWING S-30.01 FOR DETAILS.
- CODE NUMBER GIVEN REFERS TO A STANDARD FROM THE ALASKA SIGN DESIGN SPECIFICATIONS.
- POST LENGTHS SHALL BE DETERMINED AS PER STANDARD DRAWING S-05.00.
- ALL FENCE AND GATE SIGNING SHALL BE RED REFLECTIVE SHEETING WITH WHITE LETTERING. THEY SHALL BE INSTALLED 4' ABOVE GROUND.
- SLIDE GATES SHALL HAVE SIGNS ATTACHED IN THE CENTER OF THE GATE. OTHER GATE SIGNS SHALL BE INSTALLED IMMEDIATELY ADJACENT TO THE GATE.
- SIGNS MAY BE ATTACHED TO THE FENCE WITH 9 GAUGE WIRE.
- "AUTHORIZED VEHICLE" SIGNS SHALL BE USED ON VEHICLE GATES FOR VEHICULAR ACCESS. "AUTHORIZED PERSONNEL" SIGNS SHALL BE USED ON MANGATES FOR PERSONNEL ACCESS. "AIRPORT PROPERTY-NO TRESPASSING" SIGNS SHALL BE INSTALLED ON ALL DRIVE-THRU GATES, AND ALONG RELOCATED CHAINLINK FENCE.

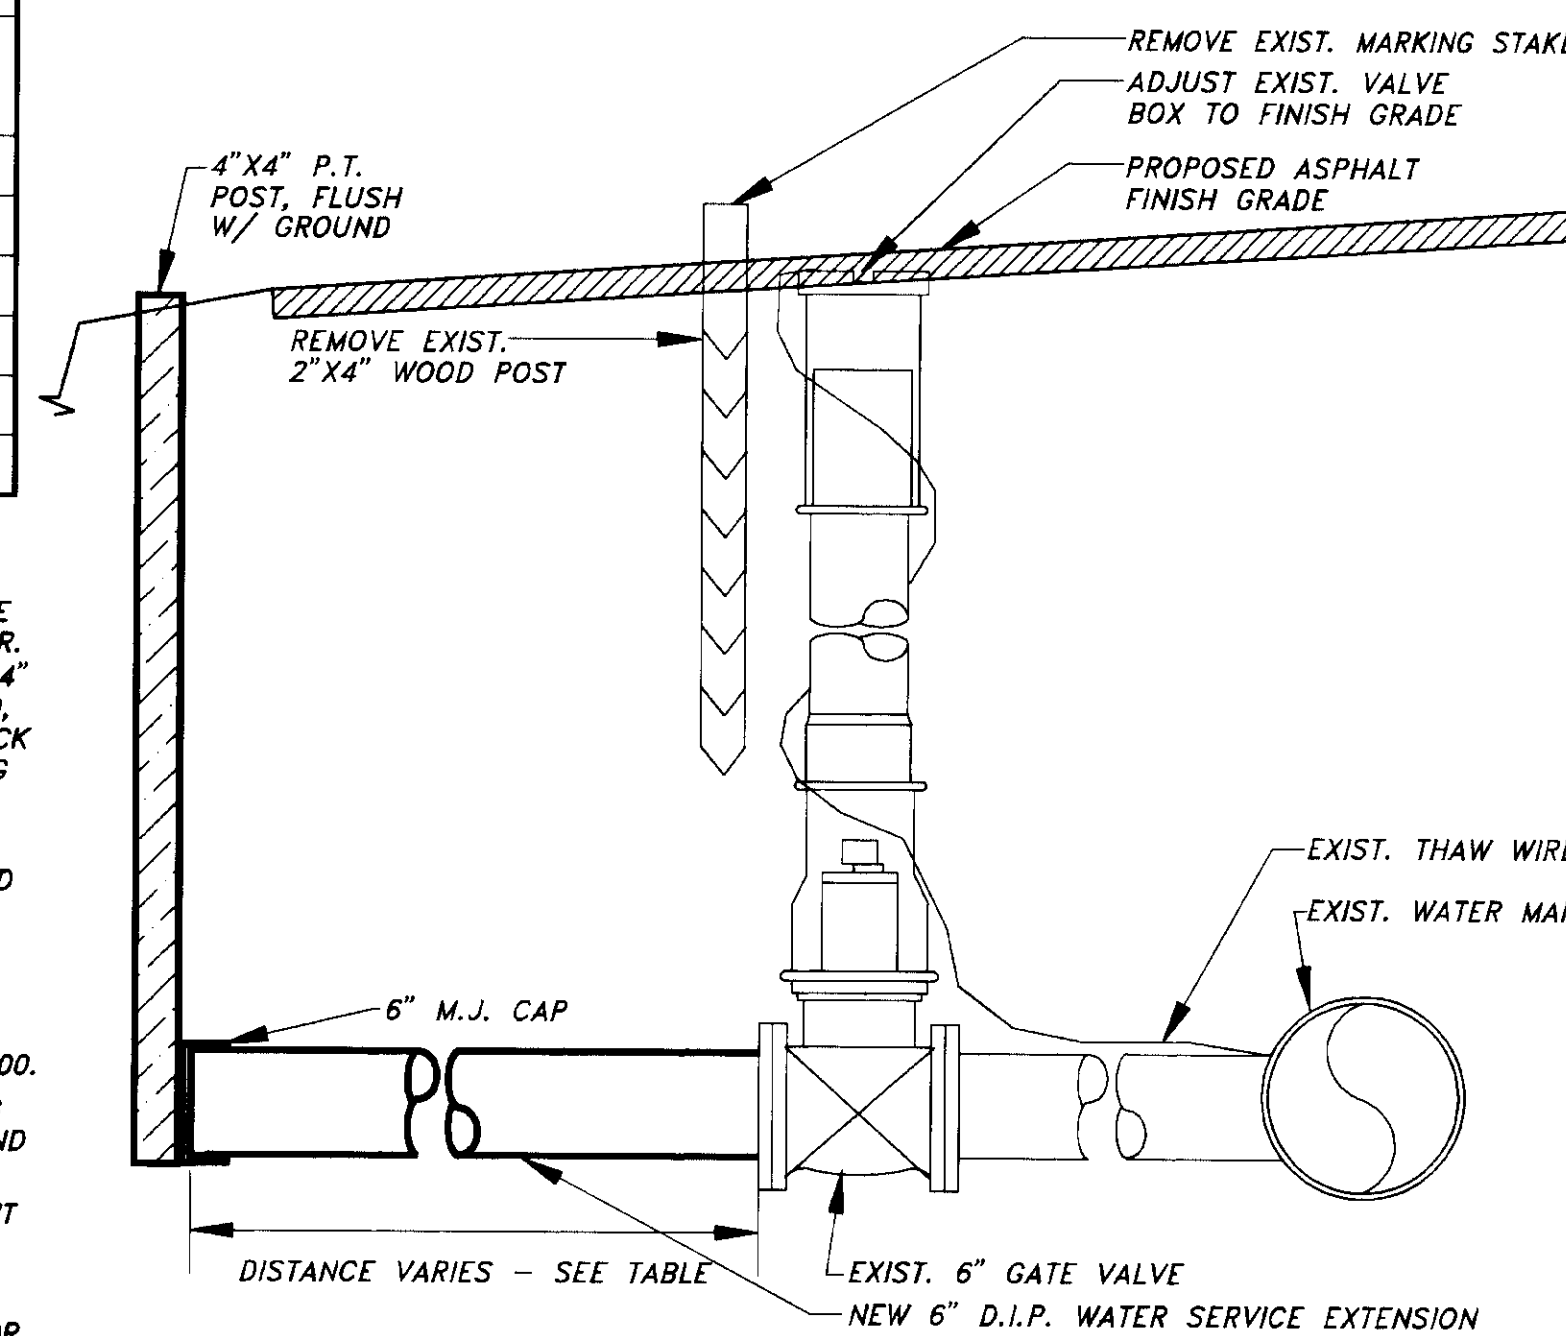


WATER SERVICE EXTENSION

N.T.S.

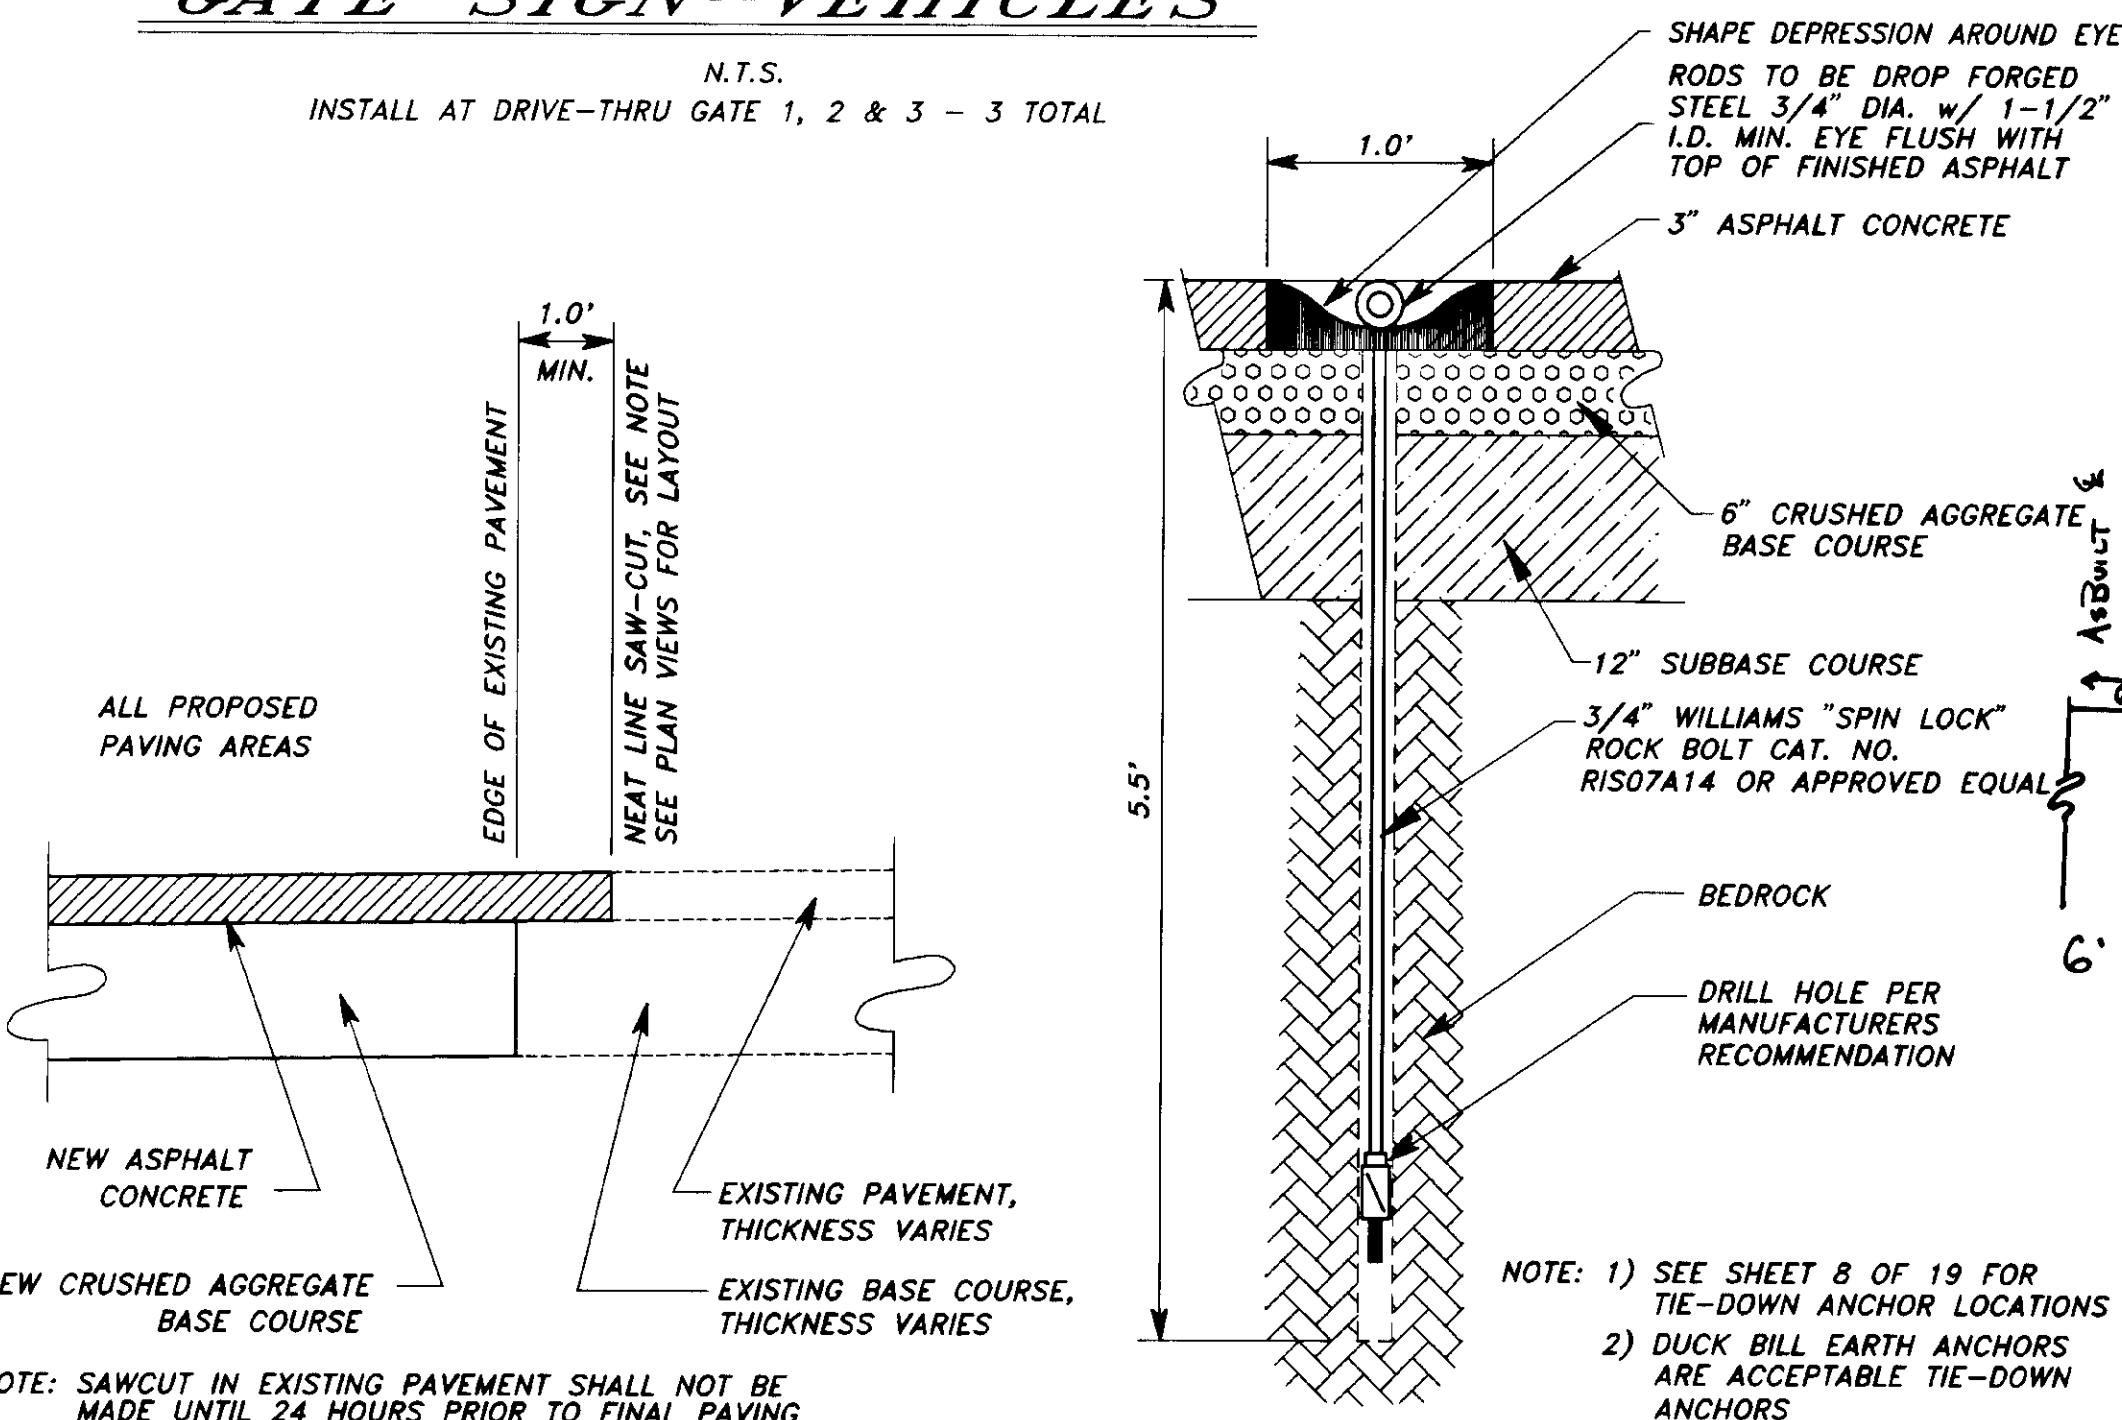

TIE-DOWN ANCHOR DETAIL


N.T.S.

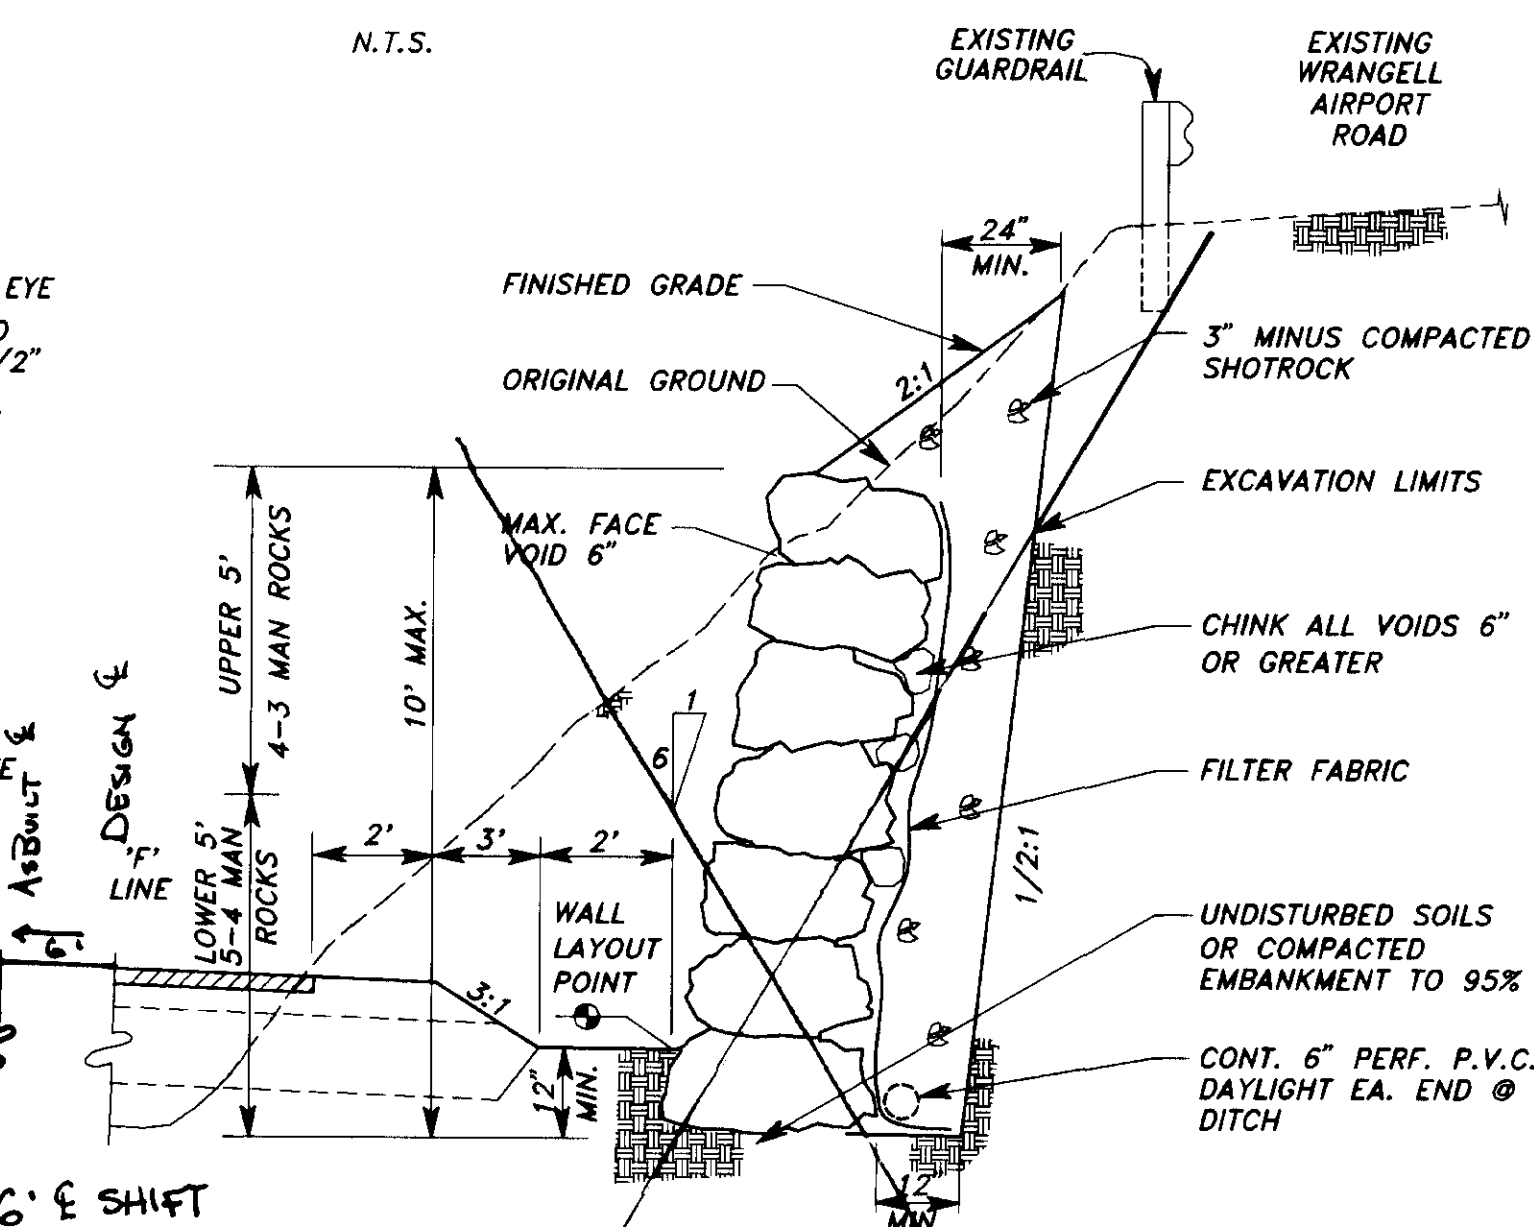

ROCKERY WALL DETAIL

N.T.S.

- ROCKERY WALL NOTES**
- THE LONG DIMENSION OF THE ROCKS SHALL EXTEND INTO THE EARTH TO PROVIDE MAXIMUM STABILITY.
 - THE ROCK SHALL BE PLACED SO AS TO LOCK INTO TWO ROCKS IN THE TIER.
 - 3 MAN ROCKS 800 POUNDS MIN., 1,500 POUNDS MAX., SIZED 18" TO 24"
4 MAN ROCKS 1,500 POUNDS MIN., 2,100 POUNDS MAX., SIZED 24" TO 32"
5 MAN ROCKS 2,100 POUNDS MIN., 3,000 POUNDS MAX., SIZED 30" TO 38"
 - ROCKERIES 7' AND LOWER SHALL BE CONSTRUCTED OF 4 MAN TO 3 MAN ROCKS FROM BOTTOM TO TOP.
ROCKERIES UP TO 10' SHALL BE CONSTRUCTED OF 5 MAN TO 4 MAN ROCKS FROM BOTTOM TO TOP.
 - SEE SPECIFICATIONS FOR THE FILTER FABRIC REQUIREMENTS.
 - SEE SHEET 6 OF 19 FOR WALL LAYOUT

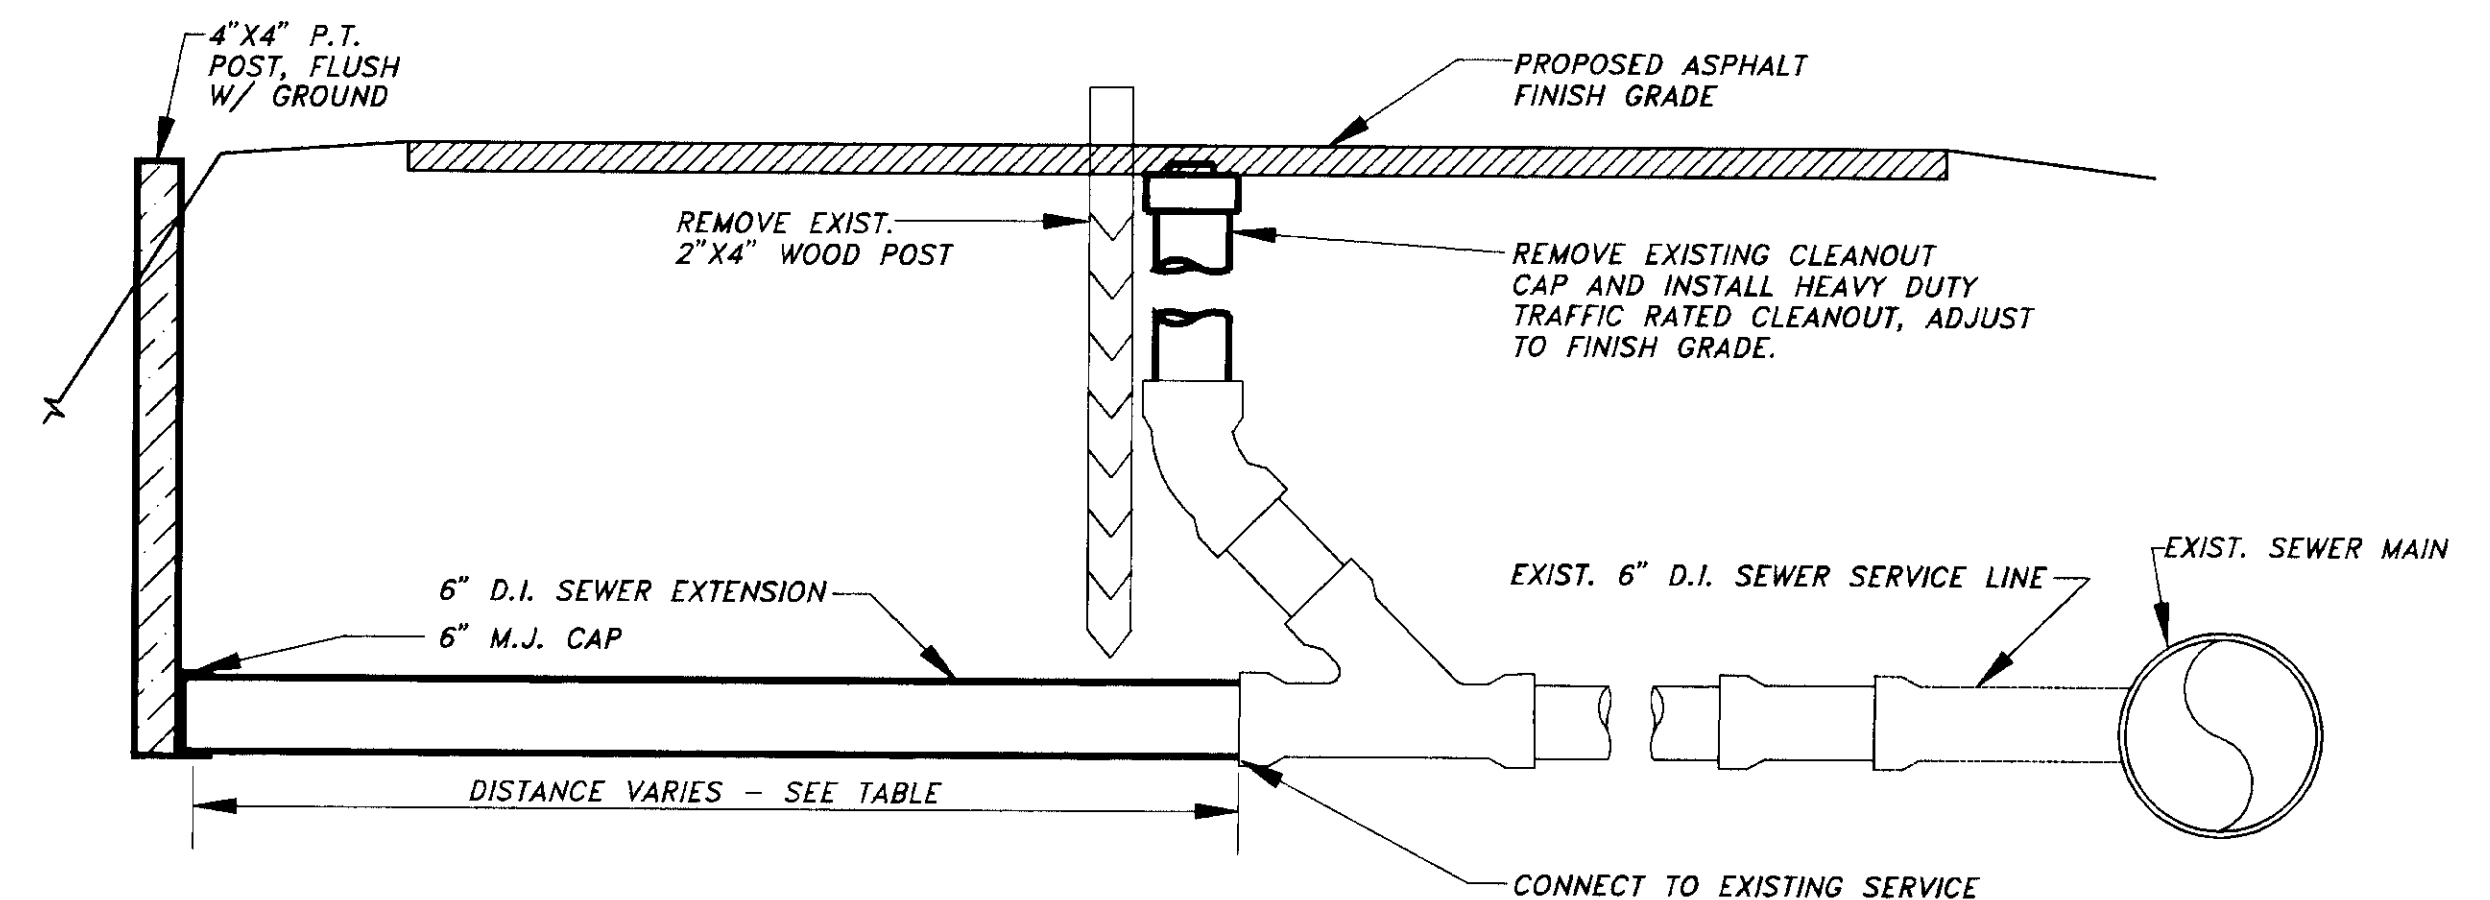

SANITARY SEWER SERVICE EXTENSION

N.T.S.

PAVEMENT MATCH JOINT DETAIL

N.T.S.

NOTE: DO NOT SCALE FROM THESE PLANS-USE DIMENSIONS



R & M ENGINEERING, INC.
ENGINEERS GEOLOGISTS SURVEYORS

NOTE: DITCH LINE INSULATED WITH 2" FOAM YANEX FROM STA. 12+80 TO 13+96 60" DI L DYER 10" WATER MAIN.

PROJECT DESIGNATION 70150/AIP 3-02-0323-0797
YEAR 1997

STRUCTURE ADJUSTMENT SUMMARY

| STATION | OFFSET | COMMENTS |
|-----------|--------|---|
| "W" 10+96 | 2'LT | CONNECT TO EXIST. VALVE AND EXTEND EXIST. 6" D.I. WATER SERVICE 12'28" CAP & MARK W/ P.T. 4X4 POST, ADJUST EXIST. VALVE BOX TO FINISH GRADE. |
| "W" 11+34 | 2'LT | EXTEND EXIST. 6" D.I. SEWER SERVICE 17', CAP & MARK W/P.T. 4"X4" POST. ADJUST EXISTING CLEANOUT TO FINISH GRADE. |
| "W" 12+40 | 2'LT | CONNECT TO EXIST. VALVE AND EXTEND EXIST. 6" D.I. WATER SERVICE 40'14" CAP & MARK W/ P.T. 4X4 POST, ADJUST EXIST. ADJUST EXISTING CLEANOUT TO FINISH GRADE. |
| "W" 12+53 | 3'LT | EXTEND EXIST. 6" D.I. SEWER SERVICE 10', CAP & MARK W/P.T. 4"X4" POST. ADJUST EXISTING VALVE BOX TO FINISH GRADE. |
| "W" 12+79 | 8'RT | ADJUST EXIST. M.H. TO FINISHED GRADE |
| "W" 13+93 | 15'LT | ADJUST EXIST. 6" D.I. SEWER CLEANOUT TO FINISH GRADE. |
| "W" 13+97 | 19'LT | ADJUST EXIST. WATER VALVE BOX TO MATCHED FINISHED SLOPE. |


PIPE CONDUIT SUMMARY

| PIPE | INLET STA. | INV. EL. | OUTLET STA. | INV. EL. | DIAMETER | LENGTH | % SLOPE | REMARKS |
|------|------------|----------|-------------|-----------------|----------------|--------|---------|----------------|
| P-1 | "W" 10+60 | 29.87 | "W" 12+00 | 21.5'LT, 29.67' | 57" X 38" CMPA | 160' | 0.33 | |
| P-2 | "W" 11+15 | 34.87 | "W" 11+73 | 8'LT, 30.58' | 18" CMP | 42' | 1.00 | CONNECT TO P-1 |
| P-3 | "W" 11+39 | 49.87 | "W" 11+73 | 18'RT, 31.98' | 18" CMP | 34' | 2.00 | |
| P-4 | "W" 12+04 | 49.87 | "W" 12+53 | 11'RT, 29.54' | 18" CMP | 52'40" | 4.00 | |
| P-5 | "W" 12+53 | 41.87 | "W" 12+81 | 11'RT, 29.20' | 18" CMP | 48'40" | 0.50 | |
| P-6 | "W" 13+06 | 18.87 | "W" 13+42 | 18'RT, 28.64' | 18" CMP | 36'40" | 1.00 | |
| P-7 | "W" 14+07 | 31.87 | "W" 14+07 | 18'LT, 27.92' | 18" CMP | 36' | 1.00 | |
| P-7A | "W" 14+00 | 25.87 | "W" 14+04.5 | 35'LT, 27.81' | 57" X 38" CMPA | 20' | 0.75 | |

STRUCTURE INSTALLATION SUMMARY

| STRUCTURE | LOCATION | TYPE | GRATE ELEV. |
|-----------|------------------------|------|-------------|
| S-1 | STA. "W" 11+15, 35'RT. | A | 33.40' |
| S-2 | STA. "W" 12+79, 22'RT. | B | 32.50' |

* ADJUST STORM DRAIN STRUCTURE AS NECESSARY TO AVOID CONFLICTING WITH EXISTING UTILITY POLE.
12+38

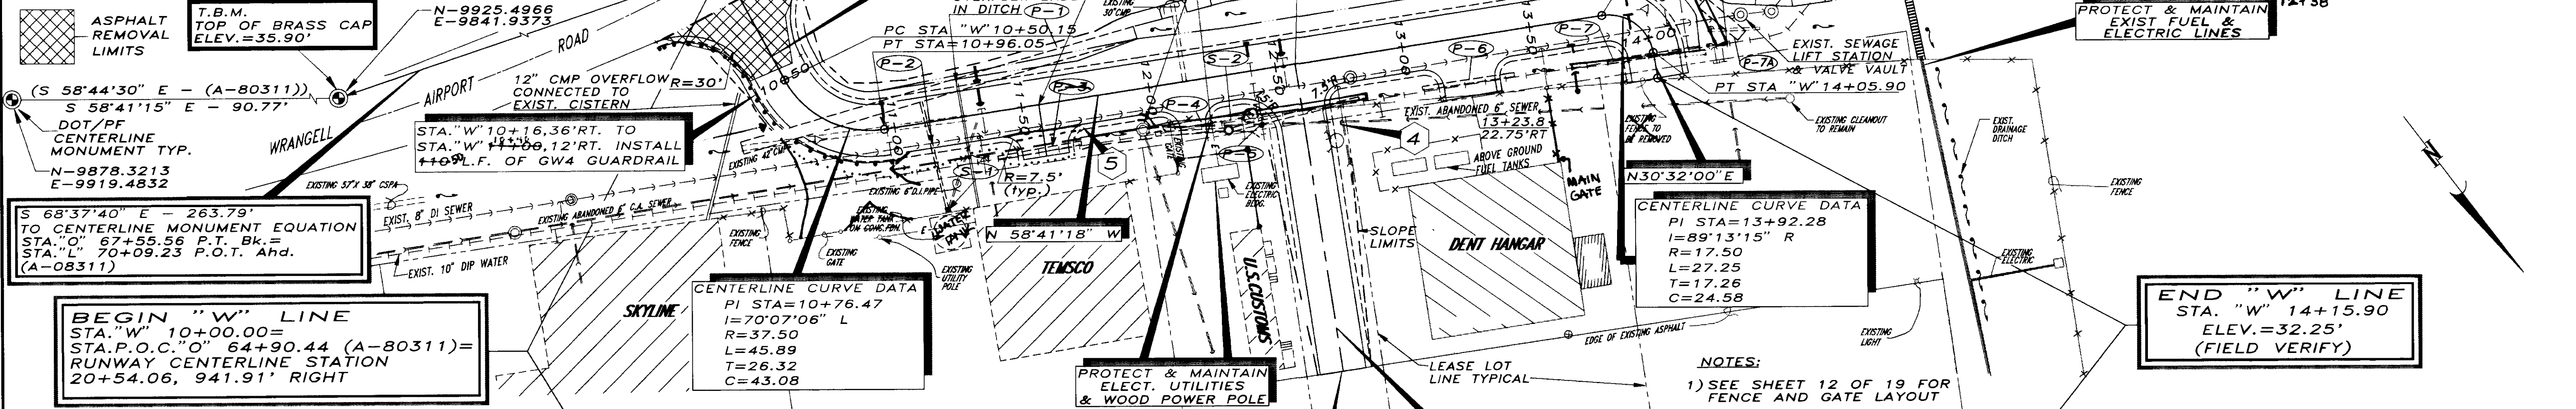


BEGIN "W" LINE
STA. "W" 10+00.00=
STA. P.O.C. "O" 64+90.44 (A-80311)=
RUNWAY CENTERLINE STATION
20+54.06, 941.91' RIGHT

CENTERLINE CURVE DATA
PI STA=10+76.47
I=70°07'06" L
R=37.50
L=45.89
T=26.32
C=43.08

CENTERLINE CURVE DATA
PI STA=13+92.28
I=89°13'15" R
R=17.50
L=27.25
T=17.26
C=24.58

END "W" LINE
STA. "W" 14+15.90
ELEV.=32.25'
(FIELD VERIFY)

END "X" LINE
SAW CUT & MATCH TO
PROPOSED 1-1/2" A.C. OVERLAY
ELEV.=33.72'(+)
(FIELD VERIFY)

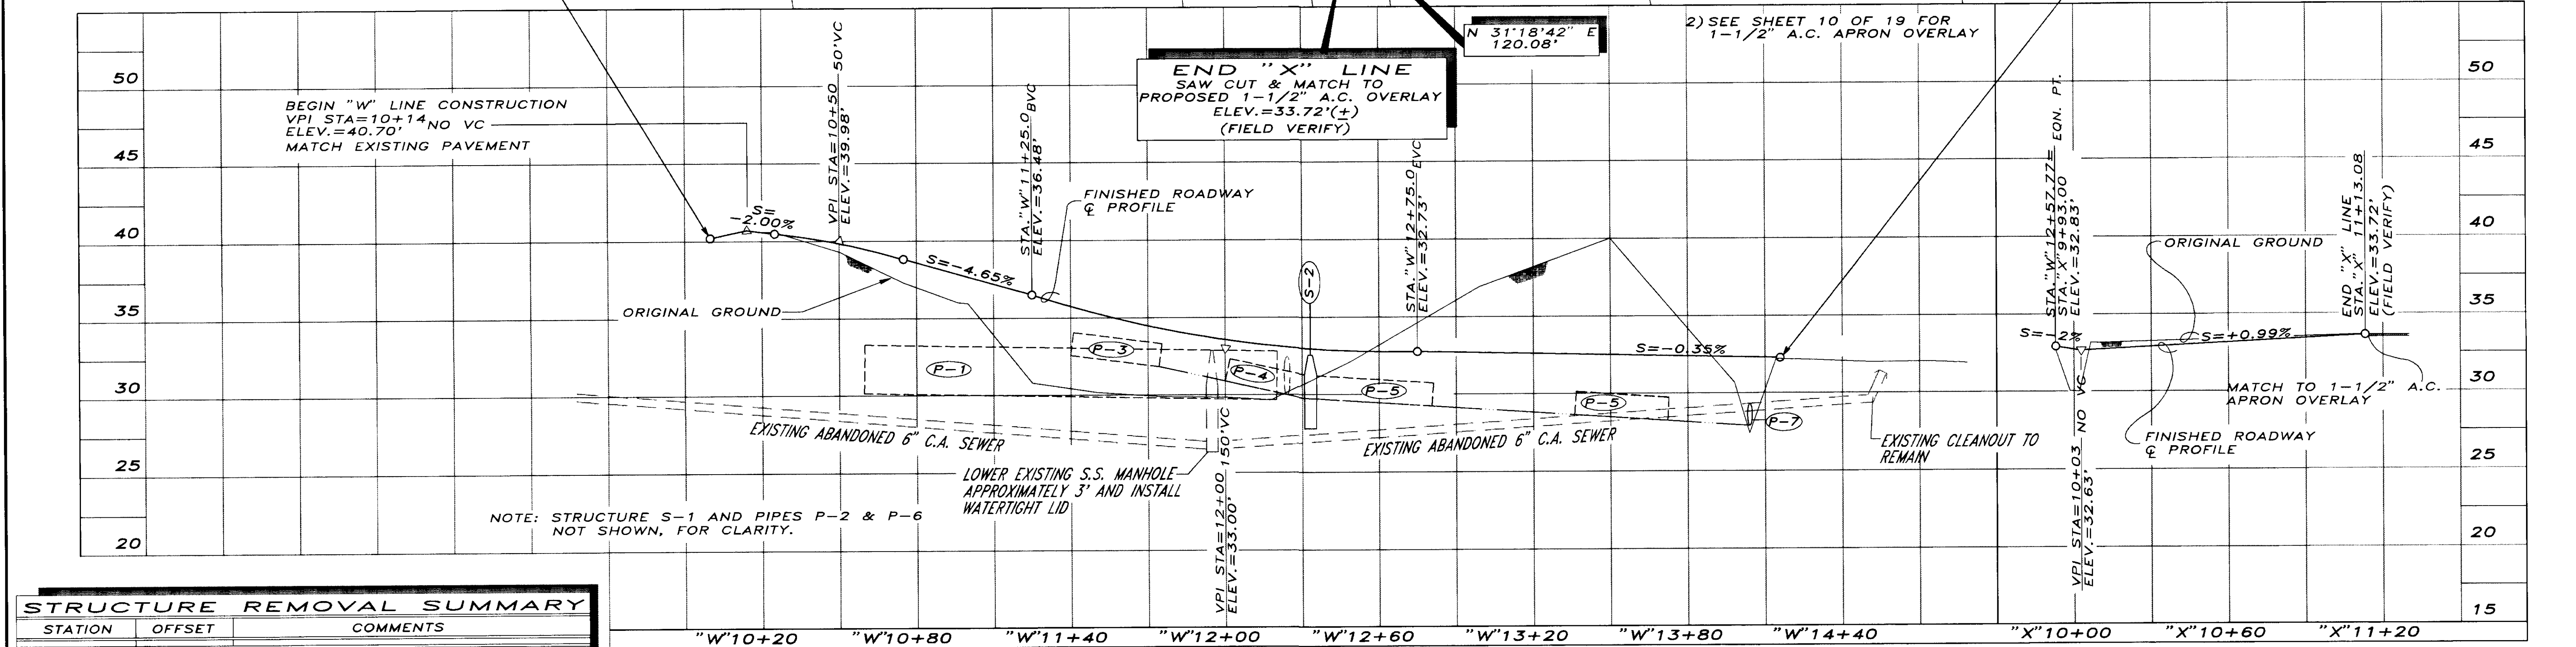


STRUCTURE REMOVAL SUMMARY


| STATION | OFFSET | COMMENTS |
|-----------|-----------------|--|
| "W" 11+00 | 0' | REMOVE & DISPOSE 42" CMP |
| "W" 11+18 | 34'RT. | REMOVE & DISPOSE 6" D.I. PIPE |
| "W" 12+15 | 0' TO 22'+/-LT. | REMOVE & DISPOSE 30" CMP - MITER TO MATCH FINISH SLOPE |
| "W" 14+03 | 30'LT | REMOVE & DISPOSE 24" X 20' CMP |

"W" LINE PROFILE

"X" LINE PROFILE

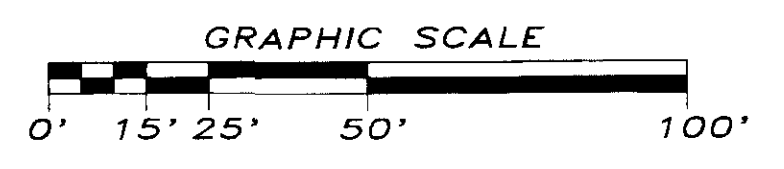


NOTE: DO NOT SCALE FROM THESE PLANS-USE DIMENSIONS

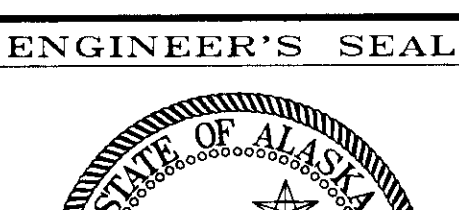



R & M ENGINEERING, INC.
ENGINEERS GEOLOGISTS SURVEYORS

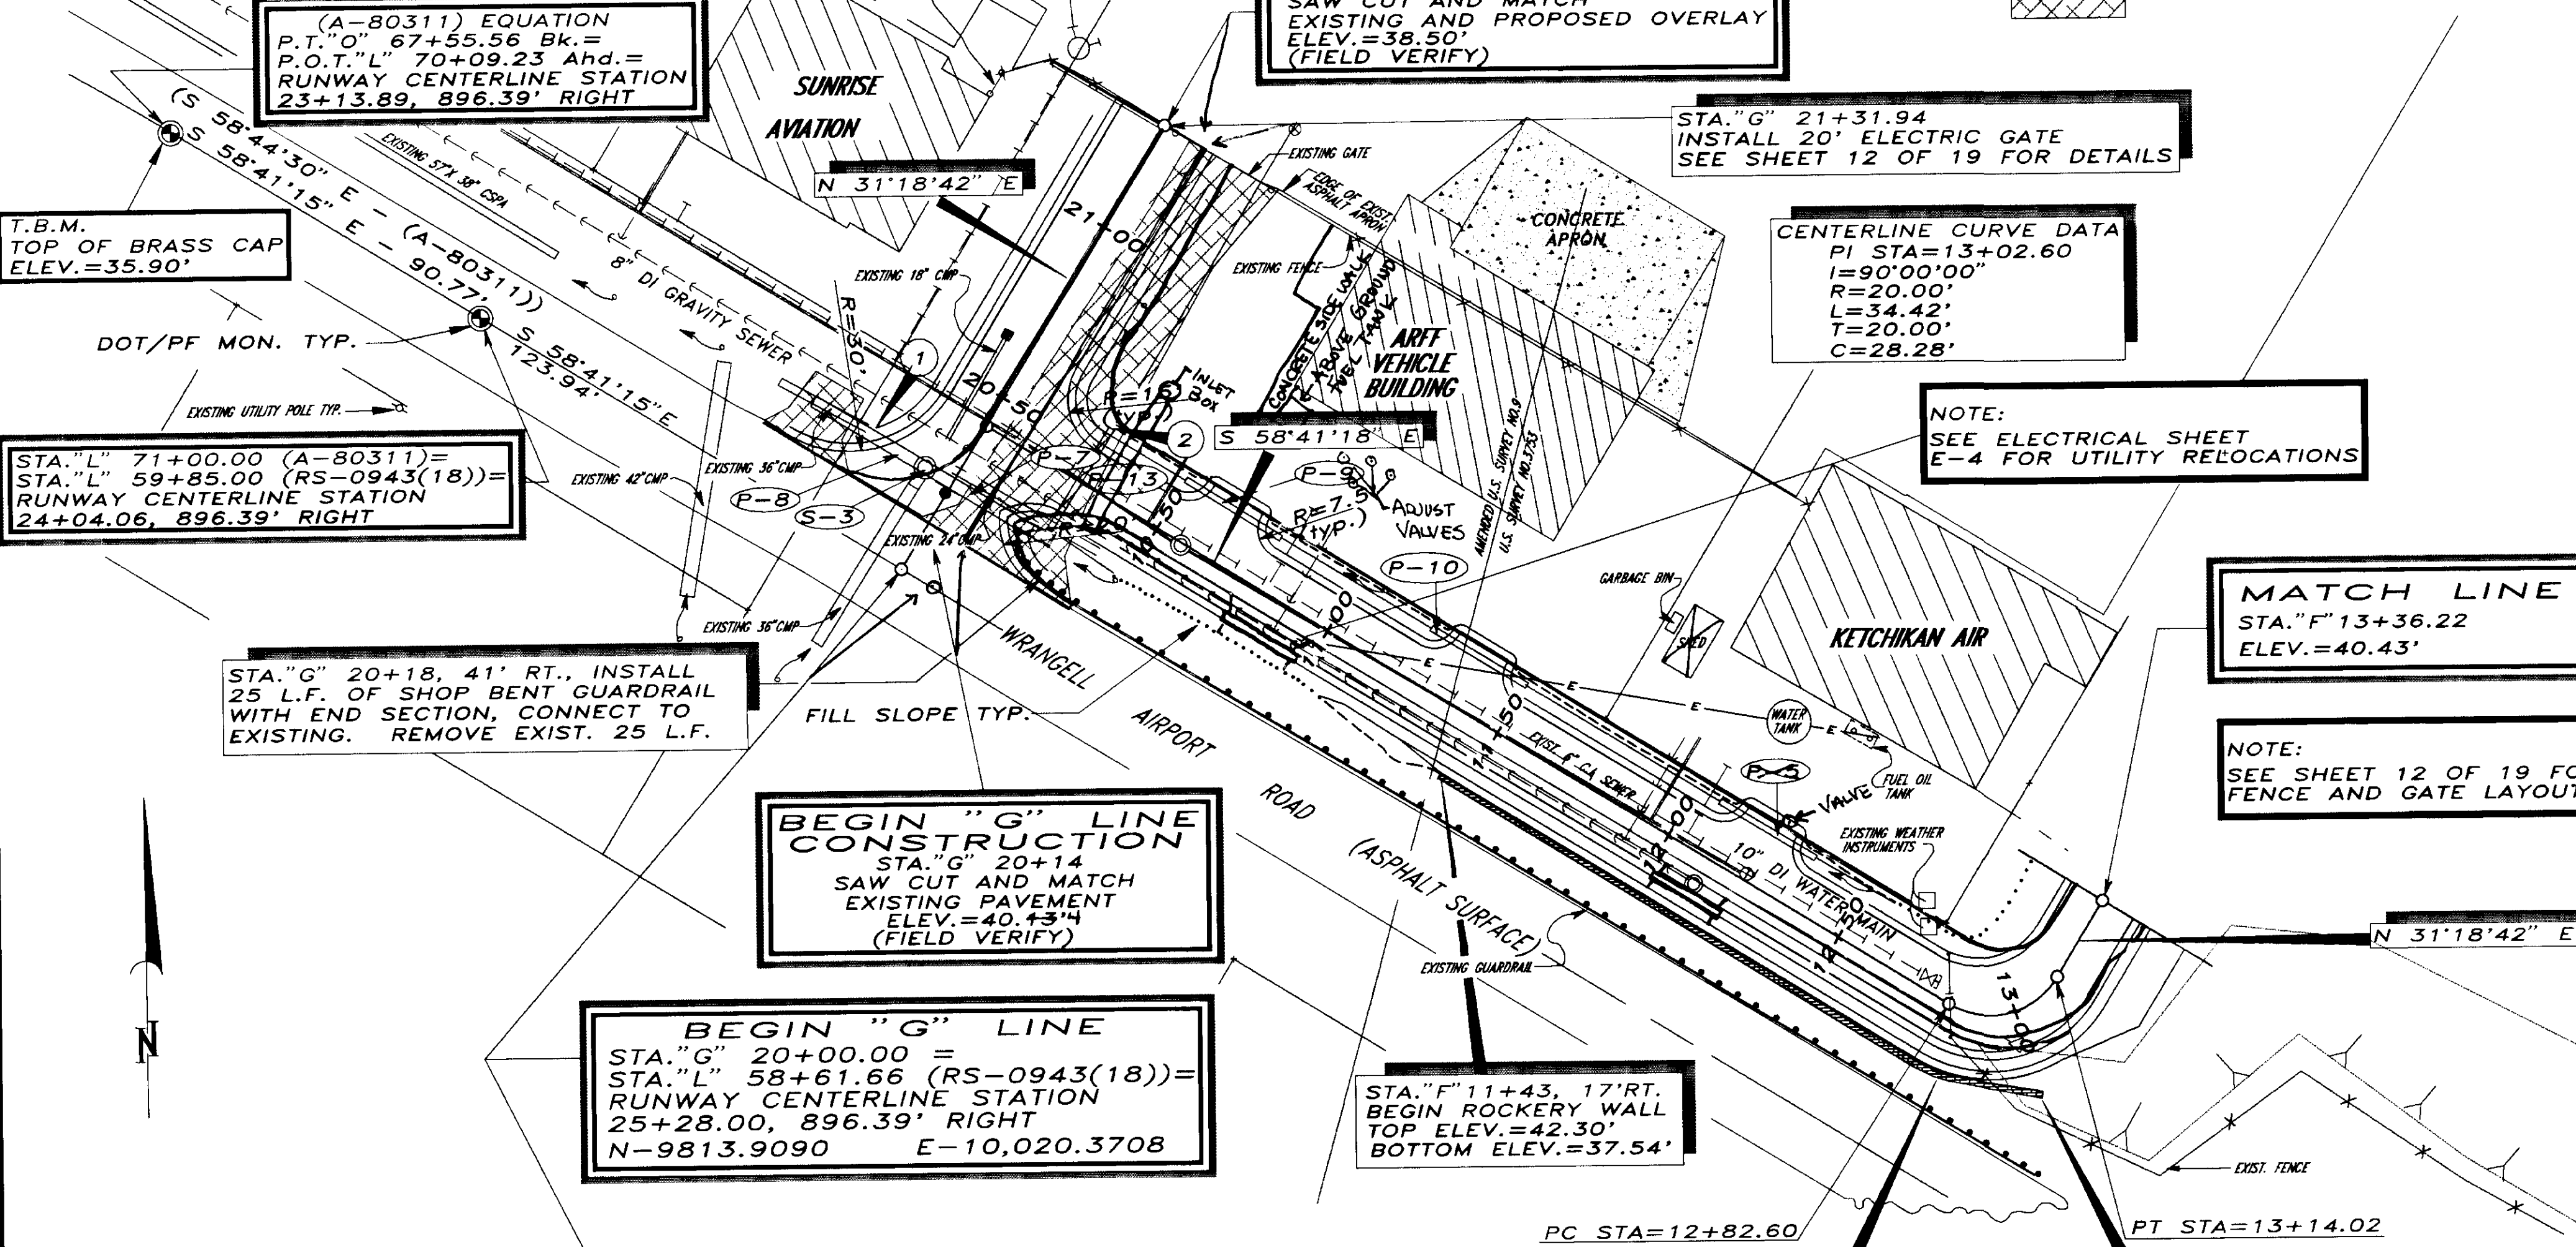

(A-80311) EQUATION
P.T. "O" 67+55.56 Bk.=
P.O.T."L" 70+09.23 Ahd.=
RUNWAY CENTERLINE STATION
23+13.89, 896.39' RIGHT

END "G" LINE
STA."G" 21+31.94
SAW CUT AND MATCH
EXISTING AND PROPOSED OVERLAY
ELEV.=38.50'
(FIELD VERIFY)

STA."G" 21+31.94
INSTALL 20' ELECTRIC GATE
SEE SHEET 12 OF 19 FOR DETAILS

CENTERLINE CURVE DATA
PI STA=13+02.60
I=90°00'00"
R=20.00'
L=34.42'
T=20.00'
C=28.28'

NOTE:
SEE ELECTRICAL SHEET
E-4 FOR UTILITY RELOCATIONS

MATCH LINE
STA."F" 13+36.22
ELEV.=40.43'

NOTE:
SEE SHEET 12 OF 19 FOR
FENCE AND GATE LAYOUT

T.B.M.
TOP OF BRASS CAP
ELEV.=35.90'

STA."L" 71+00.00 (A-80311)=
STA."L" 59+85.00 (RS-0943(18))=
RUNWAY CENTERLINE STATION
24+04.06, 896.39' RIGHT

STA."G" 20+18, 41' RT., INSTALL
25 L.F. OF SHOP BENT GUARDRAIL
WITH END SECTION, CONNECT TO
EXISTING. REMOVE EXIST. 25 L.F.

BEGIN "G" LINE
CONSTRUCTION
STA."G" 20+14
SAW CUT AND MATCH
EXISTING PAVEMENT
ELEV.=40.434
(FIELD VERIFY)

BEGIN "G" LINE
STA."G" 20+00.00 =
STA."L" 58+61.66 (RS-0943(18))=
RUNWAY CENTERLINE STATION
25+28.00, 896.39' RIGHT
N-9813.9090 E-10,020.3708

STA."F" 11+43, 17' RT.
BEGIN ROCKERY WALL
TOP ELEV.=42.30'
BOTTOM ELEV.=37.54'

PC STA=12+82.60

PT STA=13+14.02

PIPE CONDUIT SUMMARY

| PIPE | STATION | OFFSET | DIAMETER | LENGTH | % SLOPE | INLET EL | OUTLET EL | TYPE |
|------|--------------------|-----------|-----------|--------|---------|----------|-----------|------|
| P-7 | "G" 20+25 | 0' * | 42" X 29" | 32' | 1.69 | 35.90' | 35.36' | CMPA |
| P-8 | "G" 20+25 | 0' ** | 42" X 29" | 30' | 2.00 | 35.26' | 34.66' | CMPA |
| P-9 | "F" 10+64 | 14.0' | 18" | 28' | 0.73 | 36.60' | 36.40' | CMP |
| P-10 | "F" 11+36 | 14.0' | 18" | 28' | 0.73 | 37.32' | 37.12' | CMP |
| P-11 | "F" 12+21 | 14.0' | 18" | 28' | 0.73 | 37.94' | 37.74' | CMP |
| P-13 | "F" 10+26+4' LT/RT | 28" X 20" | 28' | 0.40 | 36.06' | 35.95' | CMPA | |

STRUCTURE REMOVAL SUMMARY


| STATION | OFFSET | COMMENTS |
|-----------|---------|--|
| "G" 20+25 | 36' LT. | OBLITERATE DRIVEWAY, REMOVE AND DISPOSE EXISTING 36" CMP |
| "G" 20+25 | 0' | OBLITERATE DRIVEWAY, REMOVE AND DISPOSE EXISTING 24" CMP |
| "G" 20+64 | 7' LT. | REMOVE AND DISPOSE EXISTING CATCH BASIN & 18" CMP |
| "G" 20+14 | | TO REMOVE AND DISPOSE EXISTING ASPHALT PAVEMENT |
| "G" 21+32 | | REMOVE AND RETURN EXISTING SWING GATE TO DOT/PF AIRPORT |
| "G" 20+30 | 0' | REMOVE AND REPOSITION EXISTING TIMBER WHEEL STOPS |
| "G" 20+26 | 0' | REMOVE EXISTING STOP SIGN |

STRUCTURE ADJUSTMENT SUMMARY

| STATION | OFFSET | COMMENTS |
|-----------|---------|--|
| "F" 12+12 | 7' RT. | ADJUST EXISTING MANHOLE TO FINISHED GRADE |
| "F" 12+68 | 15' LT. | RELOCATE EXISTING WEATHER INSTRUMENTS TO 25' LT. |
| "F" 12+75 | 3' LT. | ADJUST EXISTING WATER VALVE BOX TO FINISHED GRADE |
| "F" 10+75 | 32' Rt. | ADJUST EXISTING WATER VALVE BOX TO FINISHED GRADE |
| "F" 12+37 | 4' Rt. | VALVE BOX AT END OF MAIN ADJUST TO FINISH GRADE |
| "F" 12+25 | 11' Lt. | VALVE BOX FOR TAQUAN AIR BUILDING |
| "F" 10+92 | 35' Lt. | ADJUST EXISTING CLEANOUT (OIL SEPARATOR VALVE BOX FOR ARFF BUILDING) |
| "F" 10+85 | 35' Lt. | ADJUST EXISTING SEWER CLEAN OUT |


STRUCTURE INSTALLATION SUMMARY

| STRUCTURE | LOCATION | TYPE | LID | COMMENTS |
|-----------|-------------------|------|--------|---|
| S-3 | "G" 20+25, 8' LT. | B | 39.52' | INSTALL 36" CMP AS REQ'D TO CONNECT EXISTING 36" CMP TO S-3 |

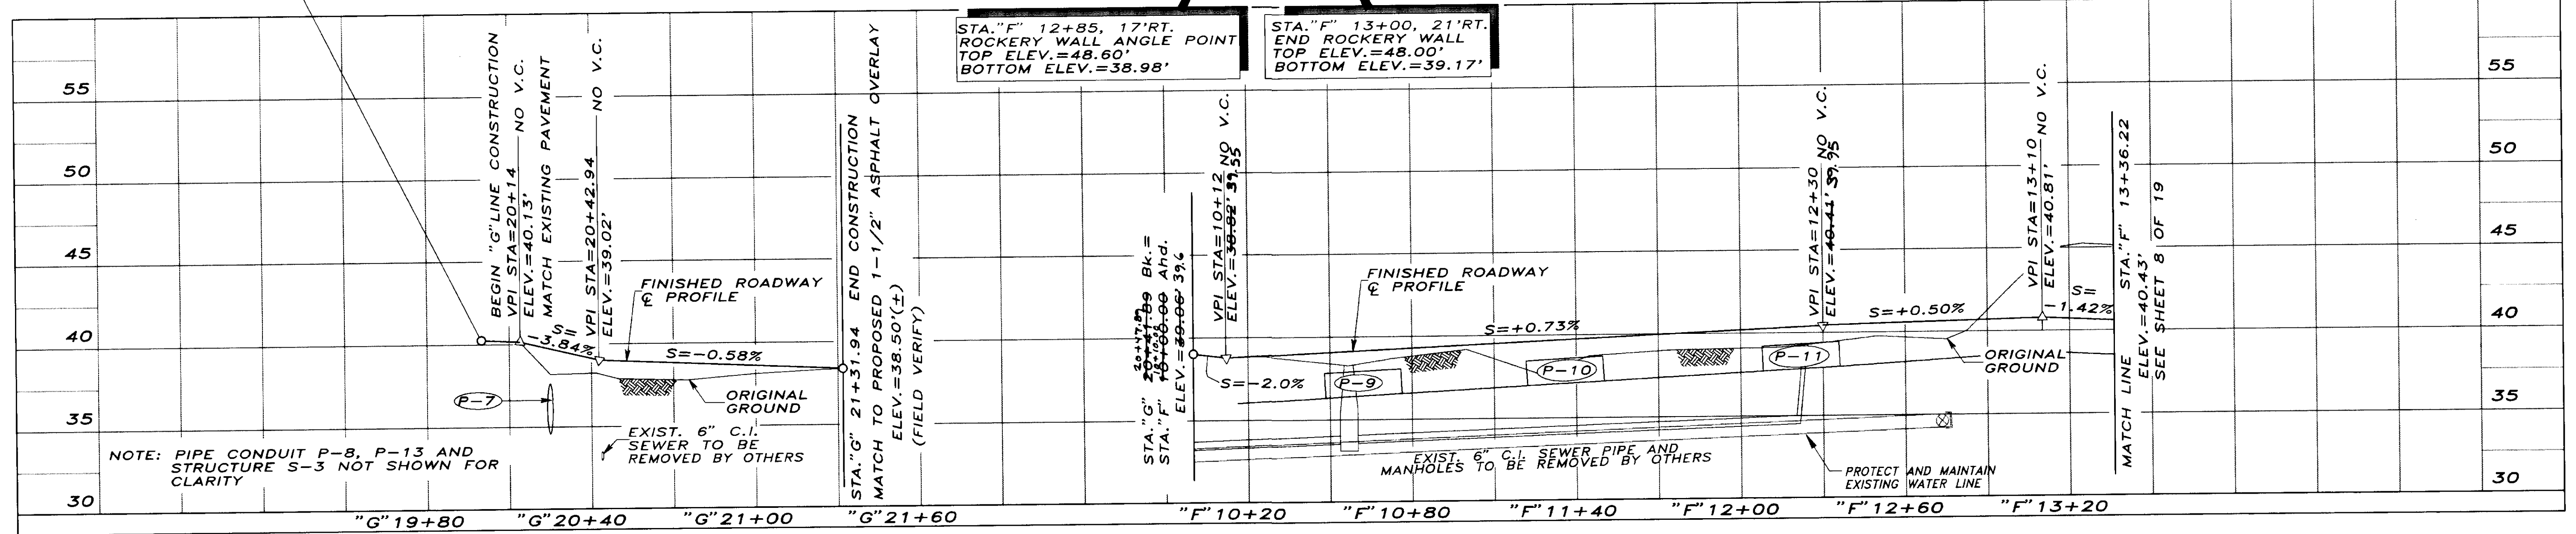

"G" LINE PROFILE

"F" LINE PROFILE

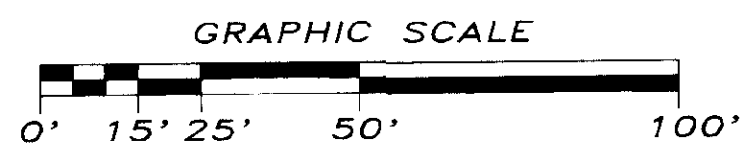

NOTE: DO NOT SCALE FROM THESE PLANS-USE DIMENSIONS

ENGINEER'S SEAL



| PIPE CONDUIT SUMMARY | | | | | | | |
|----------------------|--------------------|----------|----------------------|----------|----------------|----------|---------|
| PIPE | INLET STA. | INV. EL. | OUTLET STA. | INV. EL. | DIAM. | LENGTH | SLOPE % |
| P-14 | "T" 11+73, 72' RT. | 38.06' | "T" 10+53, 25' RT. | 34.76' | 42" X 29" CMPA | 124' | 1.00 |
| P-15 | "T" 10+53, 25' RT. | 34.62' | "T" 9+50, 46' LT. | 34.00' | 42" X 29" CMPA | 131'+24" | 0.50 |
| P-16 | "T" 16+45, 62' RT. | 39.40' | "T" 14+88, 53.5' LT. | 38.42' | 57" X 38" CMPA | 196' | 0.50 |

| STRUCTURE INSTALLATION SUMMARY | | | | |
|--------------------------------|-------------------------|------|-------------|-----------------------|
| STRUCTURE | LOCATION | TYPE | GRATE ELEV. | COMMENTS |
| S-4 | STA. "T" 10+53, 25' RT. | C | 38.54' | SEE DETAIL THIS SHEET |

PROTECT AND MAINTAIN EXIST. TAXIWAY SIGN

T.B.M. RUNWAY & MON.
STA. 22+00
ELEV.=40.50'


REMOVE EXIST. RUNWAY LIGHT, SEE ELECTRICAL SHEET E-1 & E-2

DELTA=152'28'27"
R=57.50'
L=153.01'
T=234.75'
CH=111.69'

PROTECT AND MAINTAIN EXIST. APRON LIGHT

GRADE EXISTING DITCH TO DRAIN

DELTA=33'12'36"
R=57.50'
L=33.33'
T=17.15'
CH=32.86'

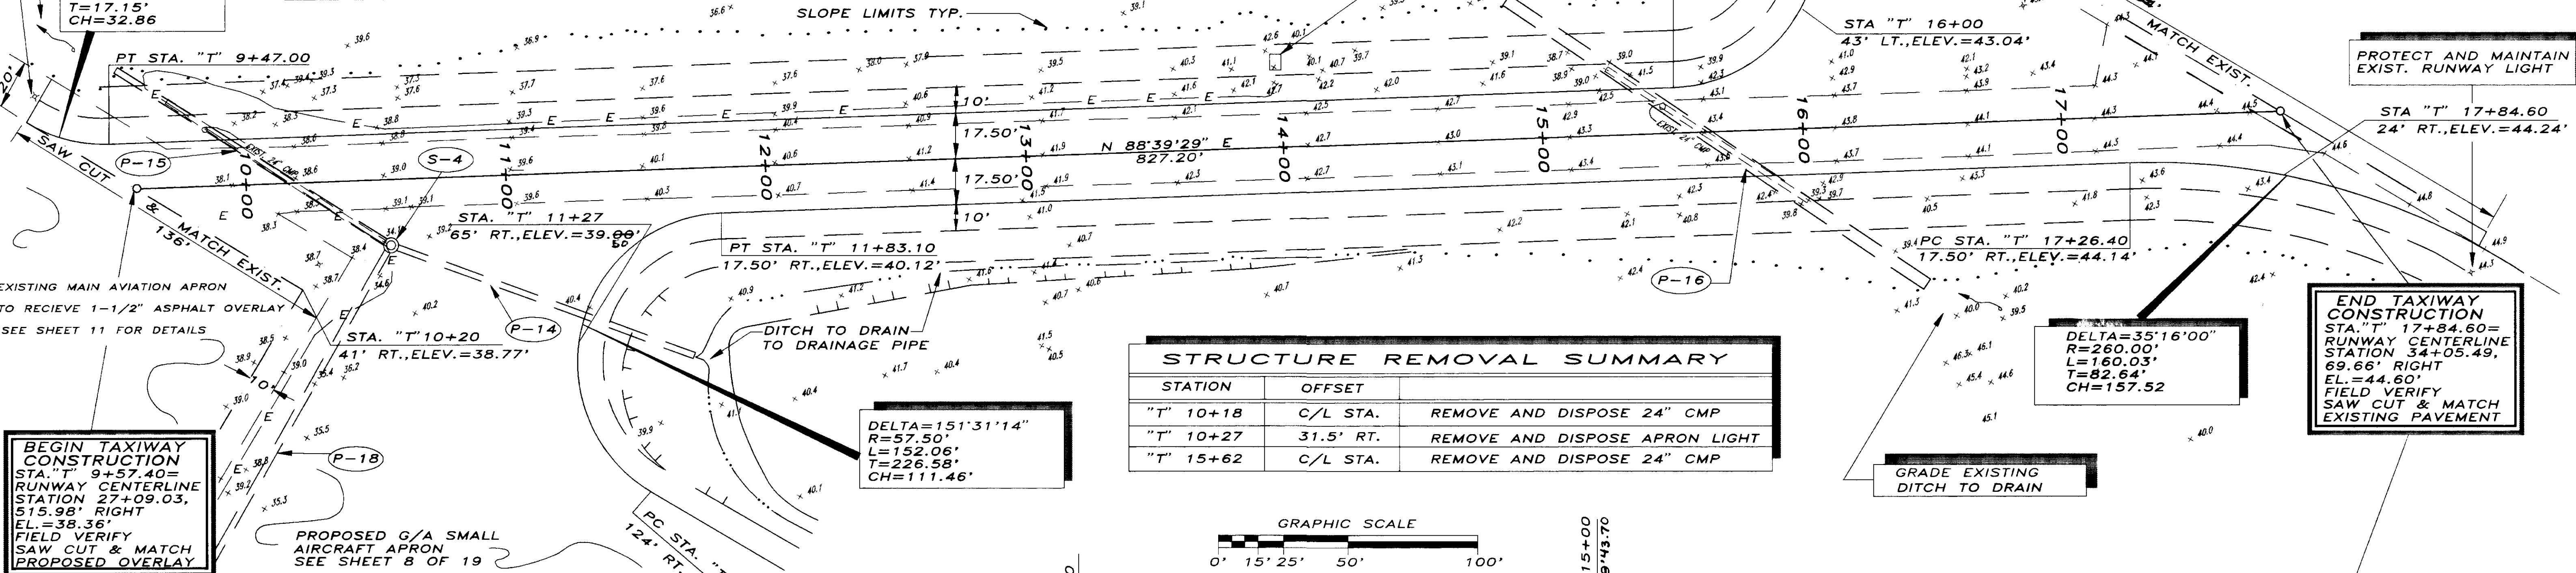



| STRUCTURE REMOVAL SUMMARY | | |
|---------------------------|-----------|--------------------------------|
| STATION | OFFSET | REMOVAL ACTION |
| "T" 10+18 | C/L STA. | REMOVE AND DISPOSE 24" CMP |
| "T" 10+27 | 31.5' RT. | REMOVE AND DISPOSE APRON LIGHT |
| "T" 15+62 | C/L STA. | REMOVE AND DISPOSE 24" CMP |

DELTA=151'31'14"
R=57.50'
L=152.06'
T=226.58'
CH=111.46'

DELTA=35'16'00"
R=260.00'
L=160.03'
T=82.64'
CH=157.52'

END TAXIWAY CONSTRUCTION
STA. "T" 17+84.60=
RUNWAY CENTERLINE
STATION 34+05.49,
69.66' RIGHT
EL.=44.60'
FIELD VERIFY
SAW CUT & MATCH
EXISTING PAVEMENT

BEGIN TAXIWAY CONSTRUCTION
STA. "T" 9+57.40=
RUNWAY CENTERLINE
STATION 27+09.03,
515.98' RIGHT
EL.=38.36'
FIELD VERIFY
SAW CUT & MATCH
PROPOSED OVERLAY

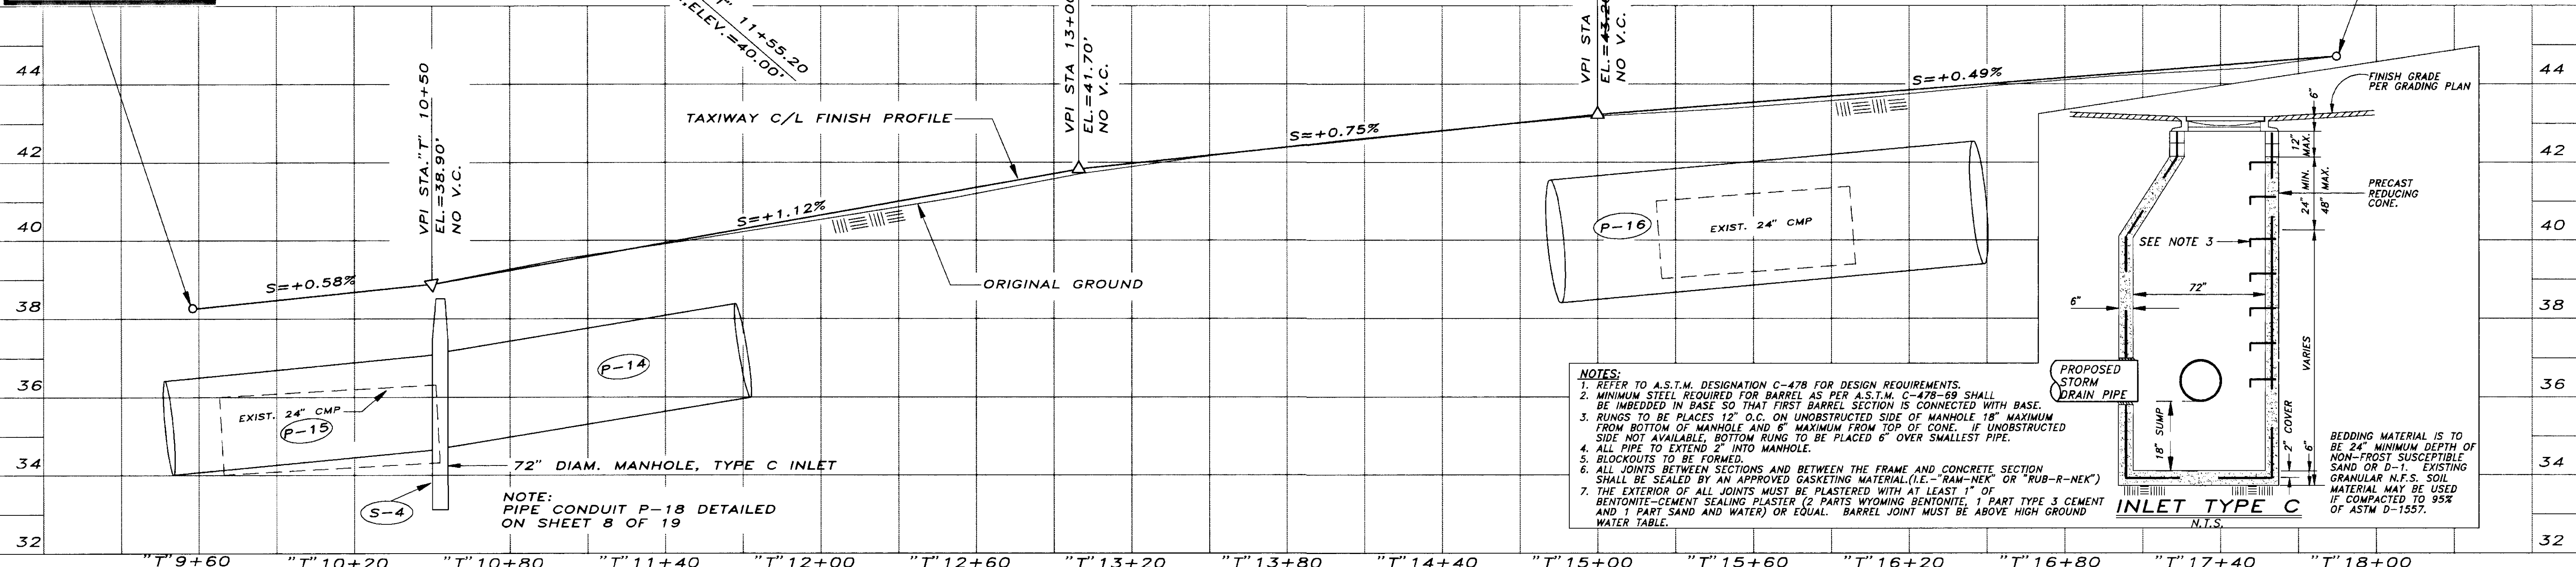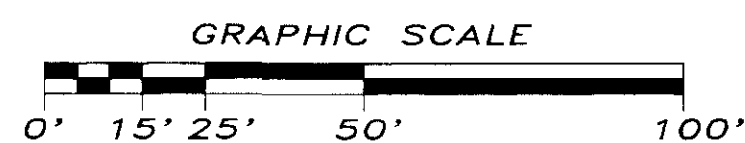

NOTES:
1. REFER TO A.S.T.M. DESIGNATION C-47B FOR DESIGN REQUIREMENTS.
2. MINIMUM STEEL REQUIRED FOR BARREL AS PER A.S.T.M. C-47B-69 SHALL BE IMBEDDED IN BASE SO THAT FIRST BARREL SECTION IS CONNECTED WITH BASE.
3. RINGS TO BE PLACED 12" O.C. ON UNOBSTRUCTED SIDE OF MANHOLE 18" MAXIMUM FROM BOTTOM OF MANHOLE AND 6" MAXIMUM FROM TOP OF CONE. IF UNOBSTRUCTED SIDE NOT AVAILABLE, BOTTOM RING TO BE PLACED 6" OVER SMALLEST PIPE.
4. ALL PIPE TO EXTEND 2" INTO MANHOLE.
5. BLOCKOUTS TO BE FORMED.
6. ALL JOINTS BETWEEN SECTIONS AND BETWEEN THE FRAME AND CONCRETE SECTION SHALL BE SEALED BY AN APPROVED GASKETING MATERIAL (I.E. "RAM-NEK" OR "RUB-R-NEK").
7. THE EXTERIOR OF ALL JOINTS MUST BE PLASTERED WITH AT LEAST 1" OF BENTONITE-CEMENT SEALING PLASTER (2 PARTS WYOMING BENTONITE, 1 PART TYPE 3 CEMENT AND 1 PART SAND AND WATER) OR EQUAL. BARREL JOINT MUST BE ABOVE HIGH GROUND WATER TABLE.

PIPE CONDUIT SUMMARY

| PIPE | INLET STA. | INV. ELEV. | OUTLET STA. | INV. ELEV. | DIAMETER | LENGTH | % SLOPE |
|------|--------------------|------------|--------------------|------------|----------------|--------|---------|
| P-17 | "A" 10+65, 173'LT. | 36.91' | "A" 10+25, 170'RT. | 36.71' | 42" X 29" CMPA | 40' | 0.50 |
| P-18 | "A" 10+22, 166'RT. | 36.27' | "A" 10+20, 144'LT. | 34.72' | 42" X 29" CMPA | 310' | 0.50 |

NOTE: CONSTRUCT ROCK INLET AT PIPE END SECTIONS ON STRUCTURE P-17 & P-18.

ROCK FACING SUMMARY

| FROM | TO | HEIGHT | S.F. |
|----------------|----------------|--------|---------|
| "A" 11+00, RT. | "A" 13+70, RT. | 15' | 4,050 - |

RELOCATE EXIST. CHAINLINK FENCE SEE PLAN VIEW THIS SHEET

REMOVE AND DISPOSE OF EXIST. EXPOSED SLOUGHING ORGANIC MATERIAL AS DIRECTED BY THE ENGINEER

EXISTING 1:1 TO 1 1/2:1 SLOPE

HAND CLEAR ALL TREES WITHIN 15' OF TOP OF BANK

GRASS COVERED SLOPE EXCEPT BED ROCK AREAS

18" - 24" DIMENSION ROCK WITH MIN. WEIGHT OF 1,000 LBS. SCALE ROCK SLOPES PRIOR TO ROCK PLACEMENT

EDGE OF PROPOSED APRON PAVING PROPOSED BUFFER ROCK-

10' MIN. 3' 4' 8'

12" MIN. KEY



FIRST TWO ROWS OF ROCKS SHALL BE DOUBLE ROCKED TO FORM ROCK FACING BUTTRESS

UNDISTURBED SOIL OR COMPACTED EMBANKMENT TO 95%

ROCK FACING DETAIL

N.T.S.

- NOTES:
1. REFERENCED ELEVATIONS GIVEN ON THIS SHEET ARE TO FINISH GRADE.
 2. ELEVATIONS WITH GRID TIES, ARE ORIGINAL GROUND ELEVATIONS.
 3. PIPE CONDUITS P-14, P-15 & STRUCTURE S-4 ARE DETAILED ON SHEET 7 OF 19.

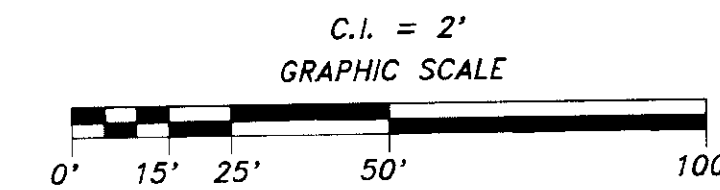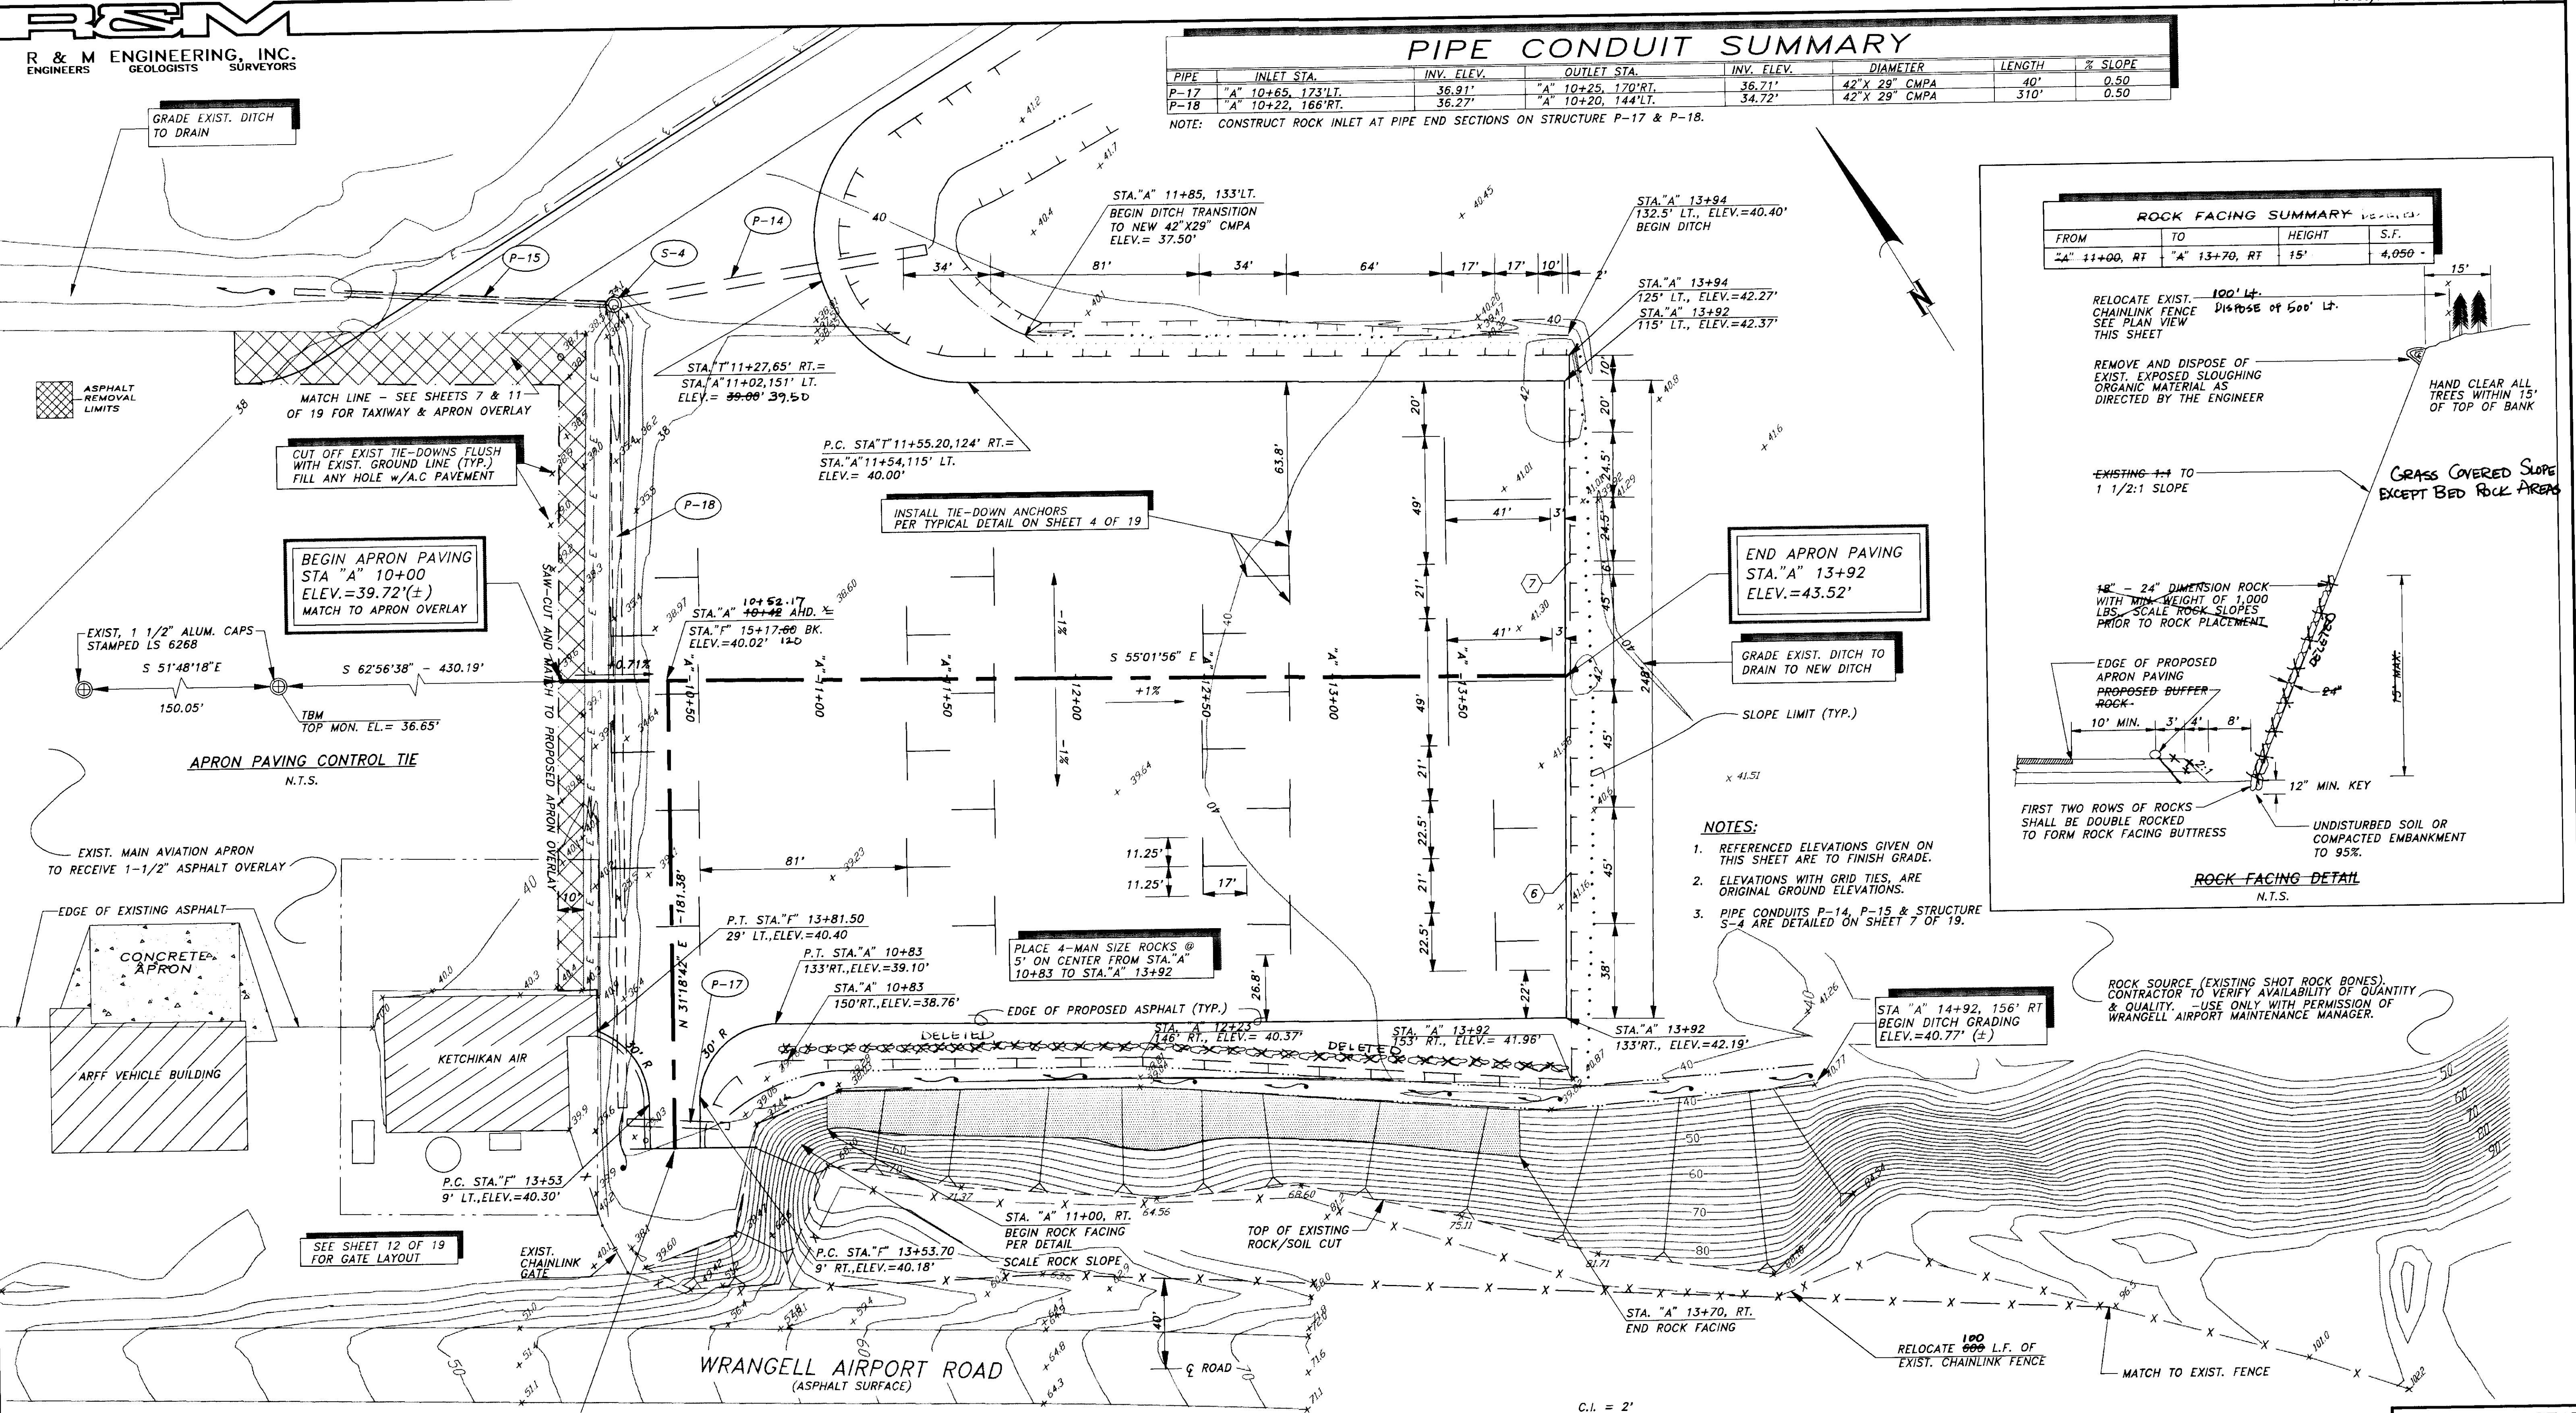



NOTE: DO NOT SCALE FROM THESE PLANS-USE DIMENSIONS

ENGINEER'S SEAL



10+98.51
 N 58°41'19" W
 BASIS OF BEARING
 22+00

RUNWAY CENTER LINE

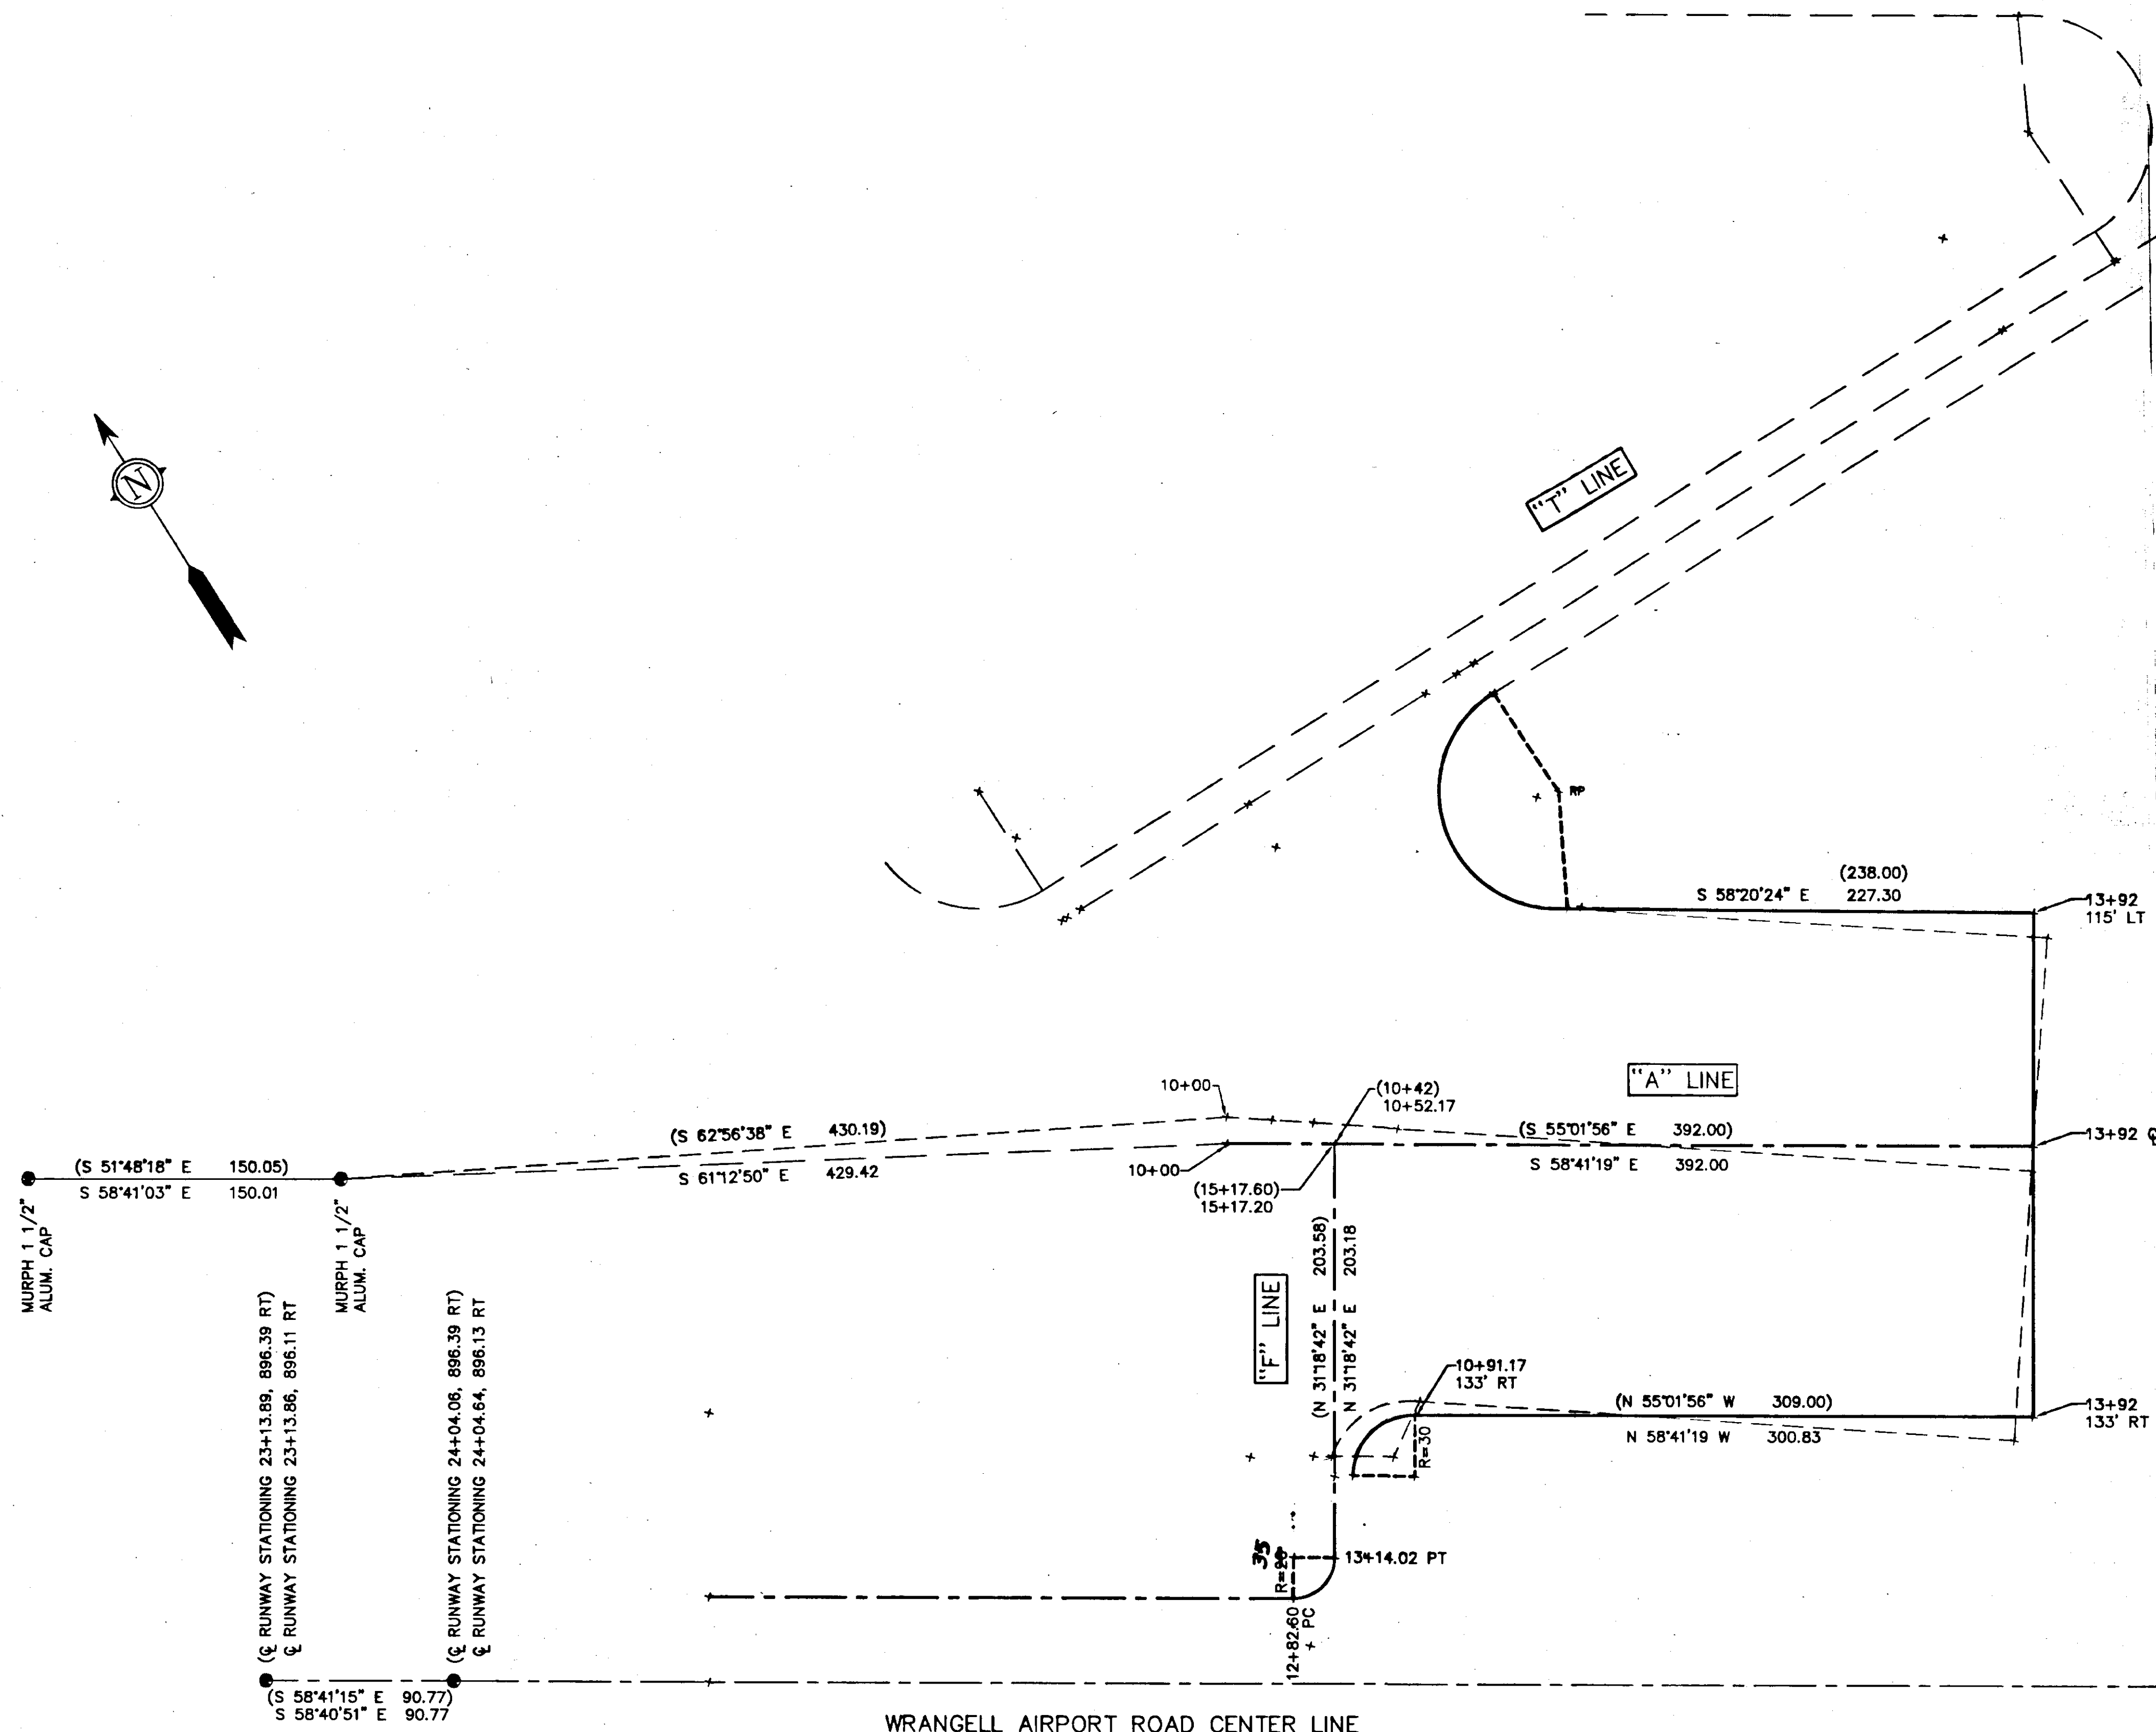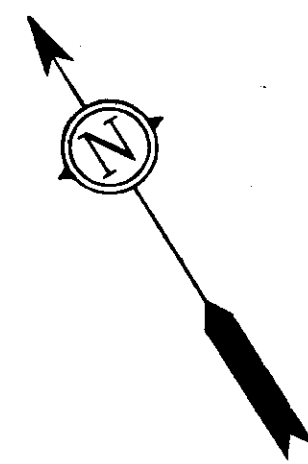

————— ADJUSTED APRON LAYOUT
 - - - - - ADJUSTED APRON LAYOUT CENTER LINE
 - - - - - APRON LAYOUT PER PLAN
 - - - - - TAXIWAY LAYOUT PER PLAN
 (S 55°01'56" E 92.00) PER PLAN INFORMATION
 S 55°01'56" E 92.00 MEASURED OR CALCULATED DATA


DESIGNED: GGS
 DRAWN: TJS
 CHECKED: GGS
 DATE OF SURVEY: 05/30/97



GREG SCHEFF & ASSOCIATES
 LAND SURVEYORS


BOX 1331 WRANGELL, ALASKA 99929

PROJECT: WRANGELL AIRPORT IMPROVEMENTS

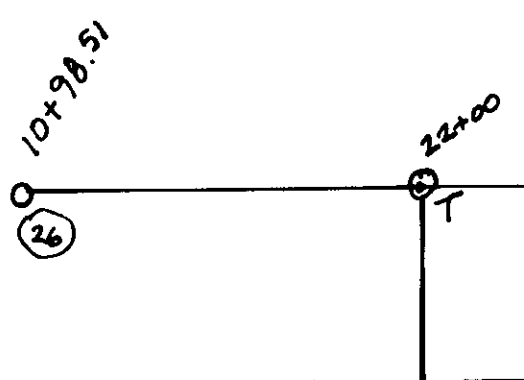


Runway
558-41-19E


R & M ENGINEERING, INC.
ENGINEERS GEOLOGISTS SURVEYORS

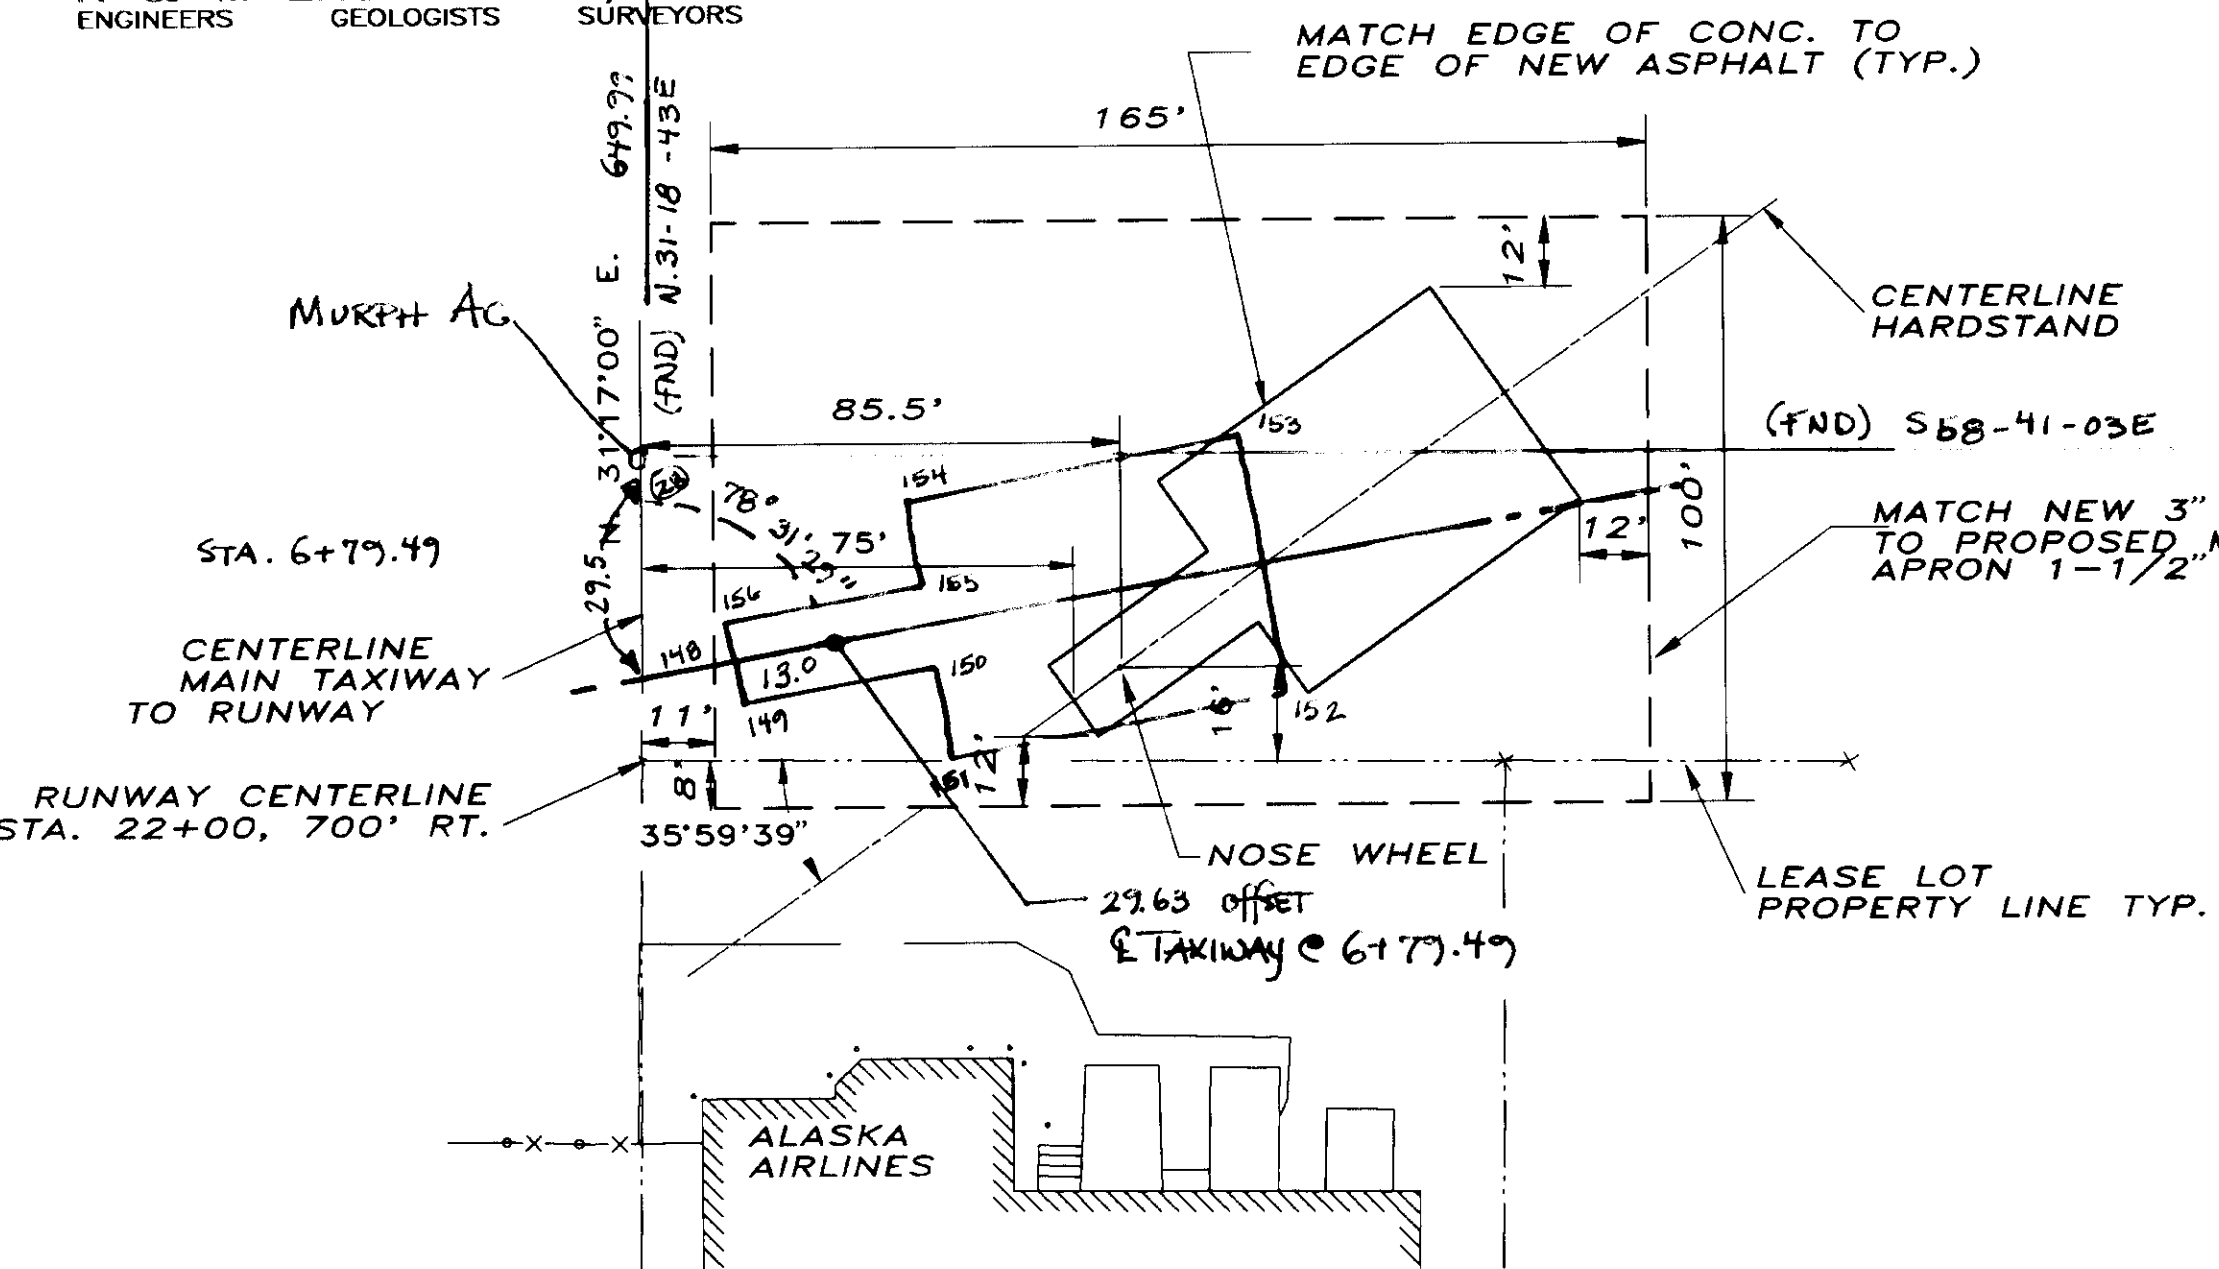


**LAYOUT DETAIL
CONCRETE JET HARDSTAND**
N.T.S.

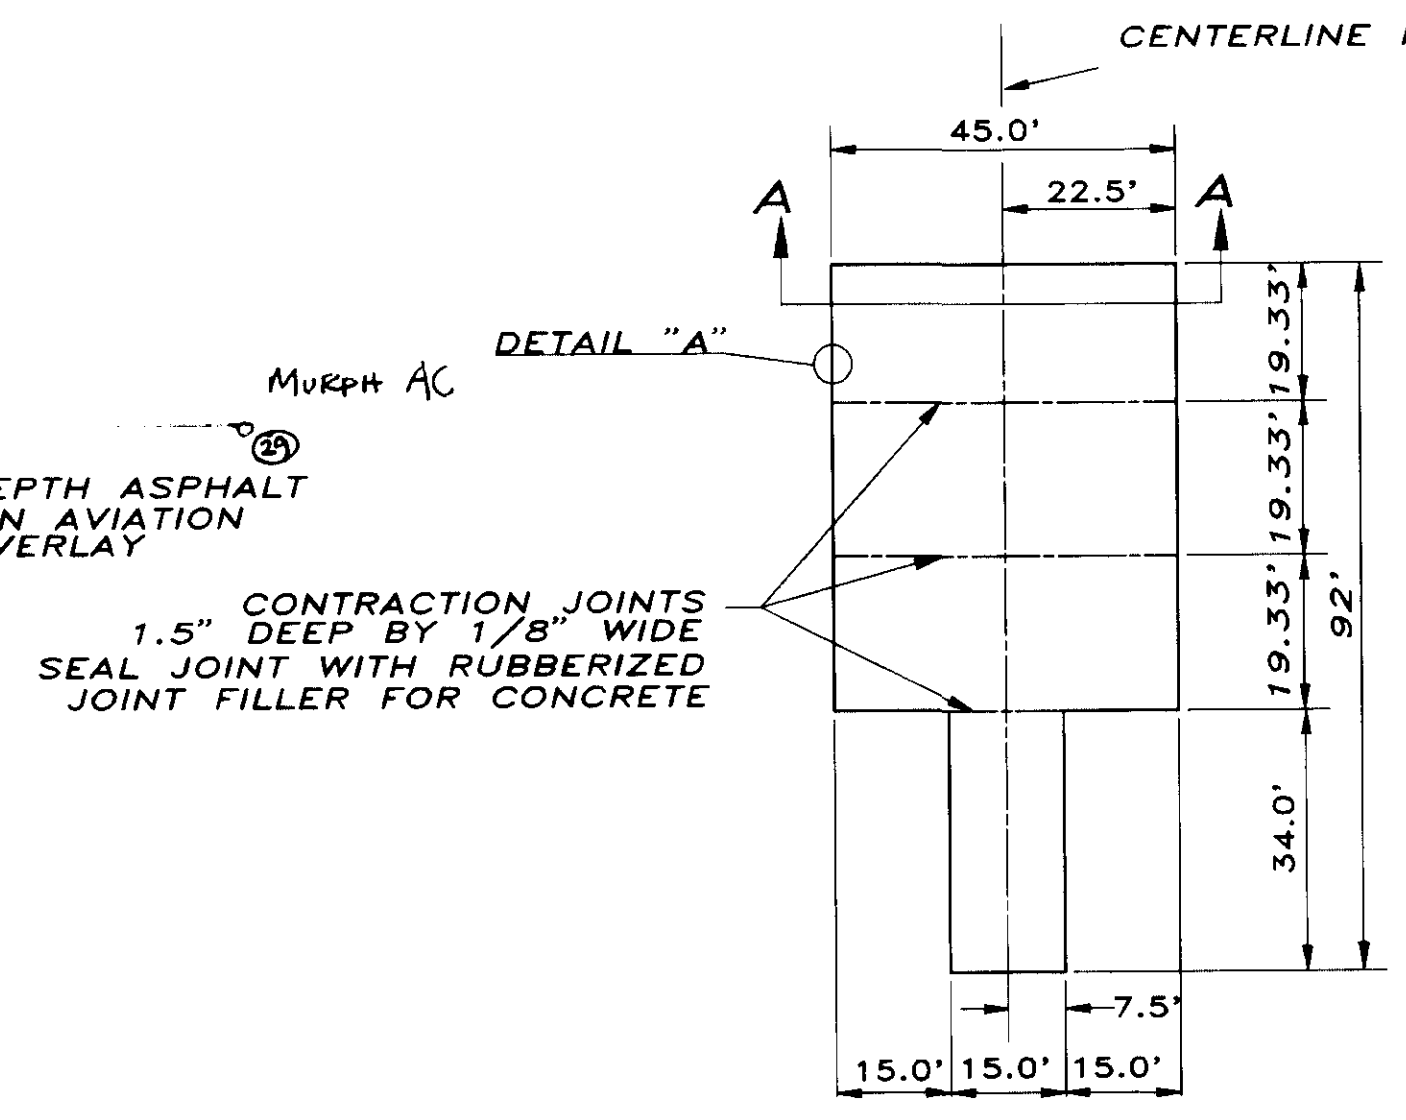



**PLAN VIEW
CONCRETE JET HARDSTAND**
N.T.S.

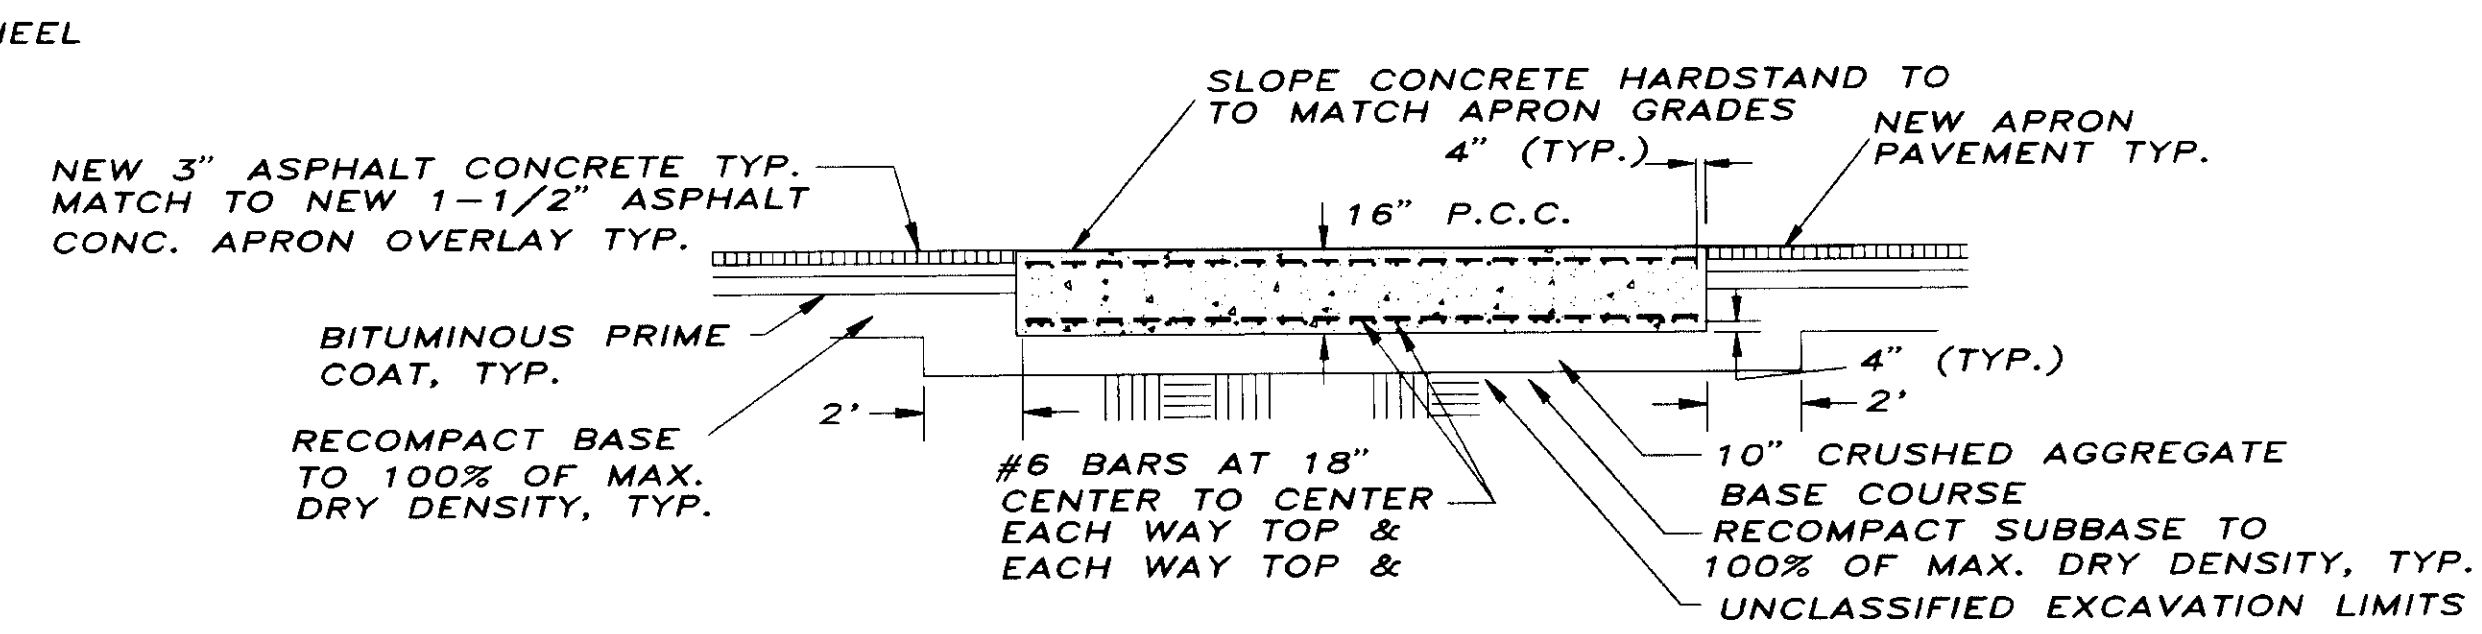

SECTION A-A
N.T.S.


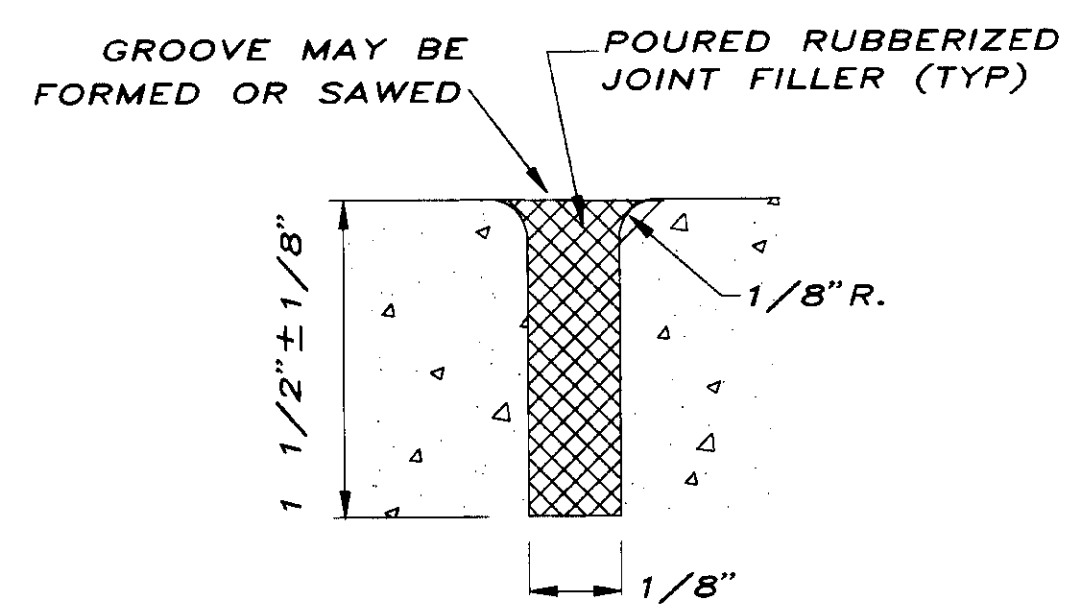


CONTRACTION JOINT DETAIL
N.T.S.

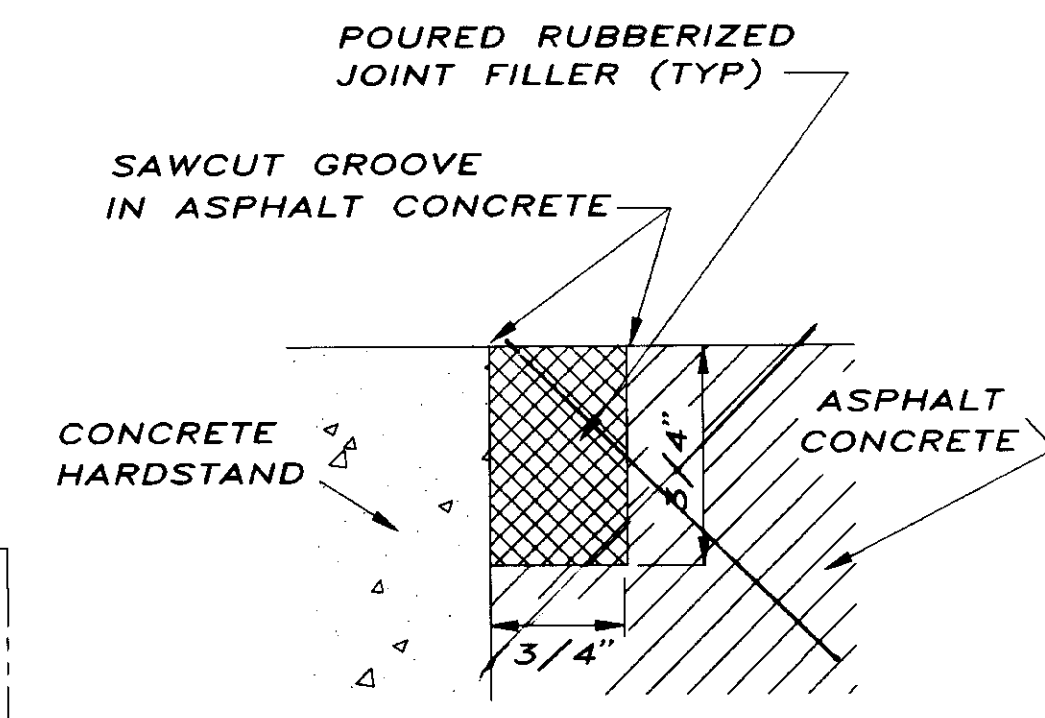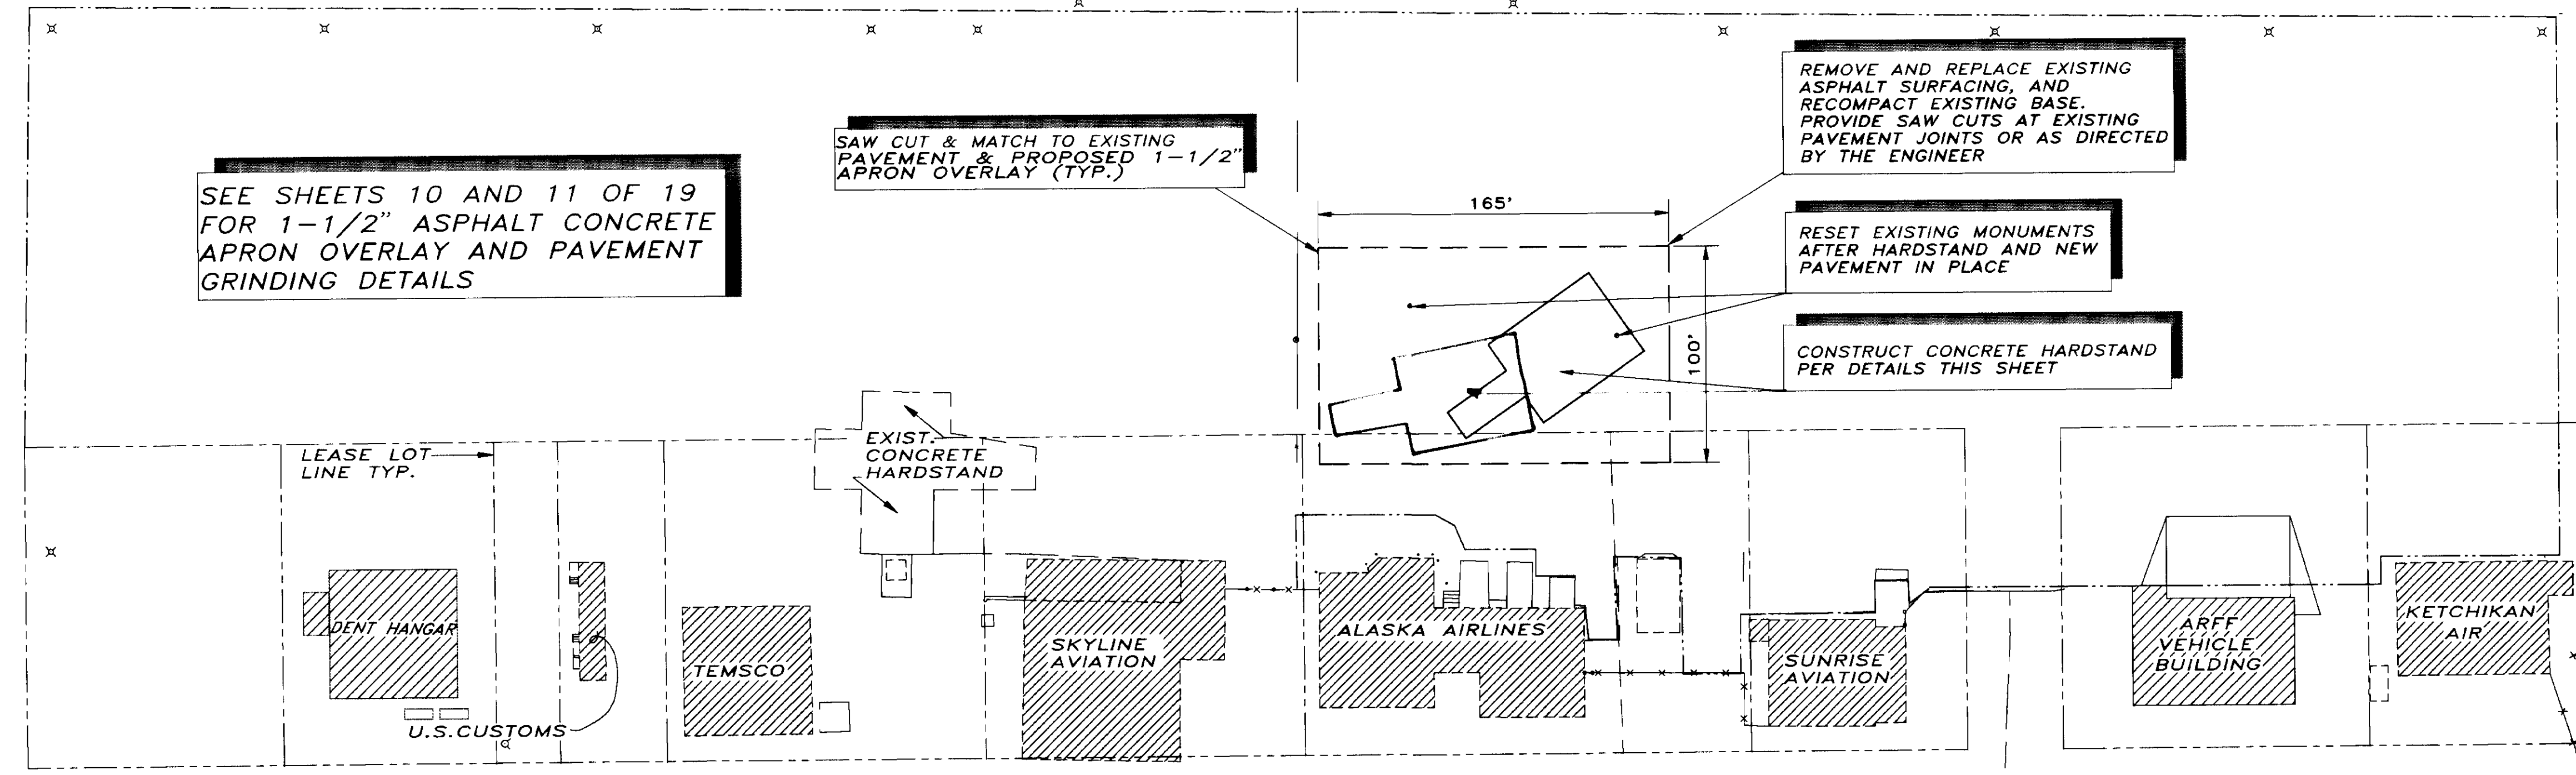



DETAIL "A"
N.T.S.

WRANGELL AIRPORT ROAD

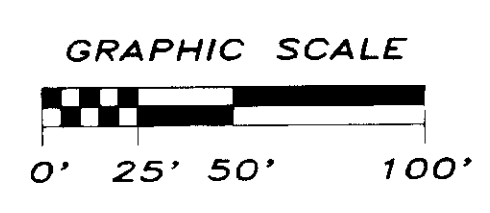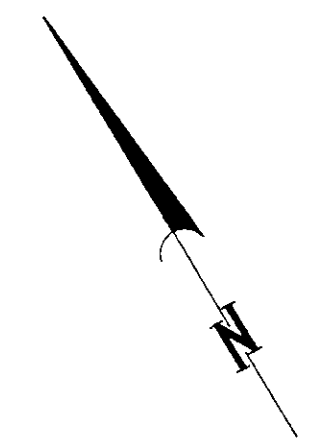


NOTE: DO NOT SCALE FROM THESE PLANS—USE DIMENSIONS

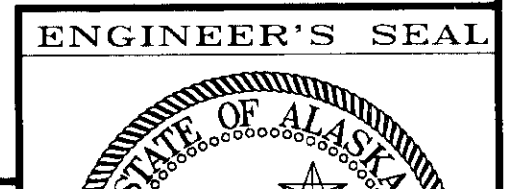

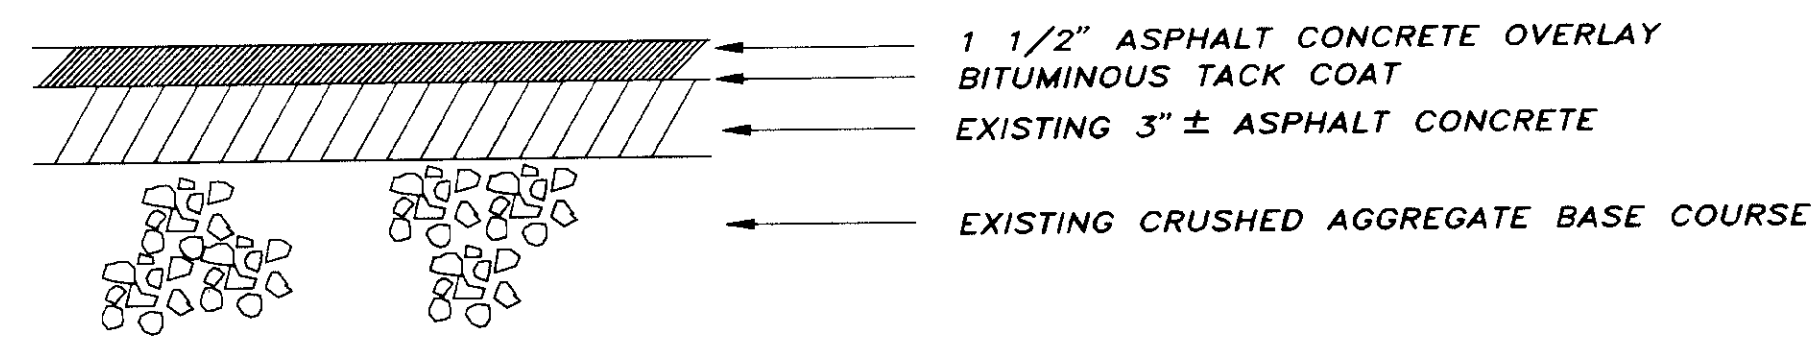


MAIN AVIATION APRON - OVERLAY SECTION

N.T.S.

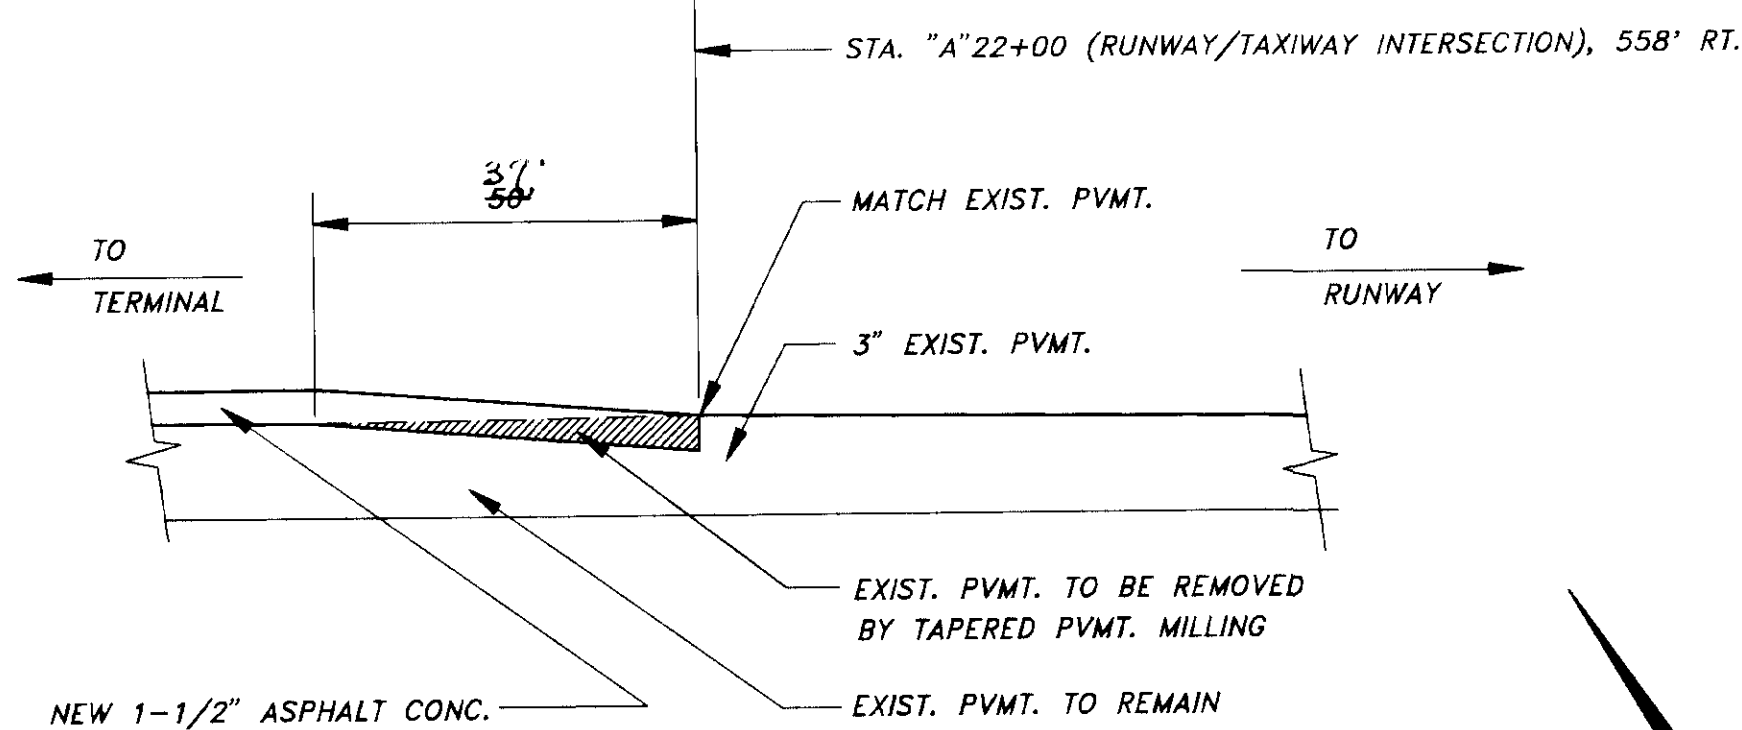


PAVEMENT TRANSITION DETAIL
MAIN APRON TO MATCH TAXIWAY

N.T.S.

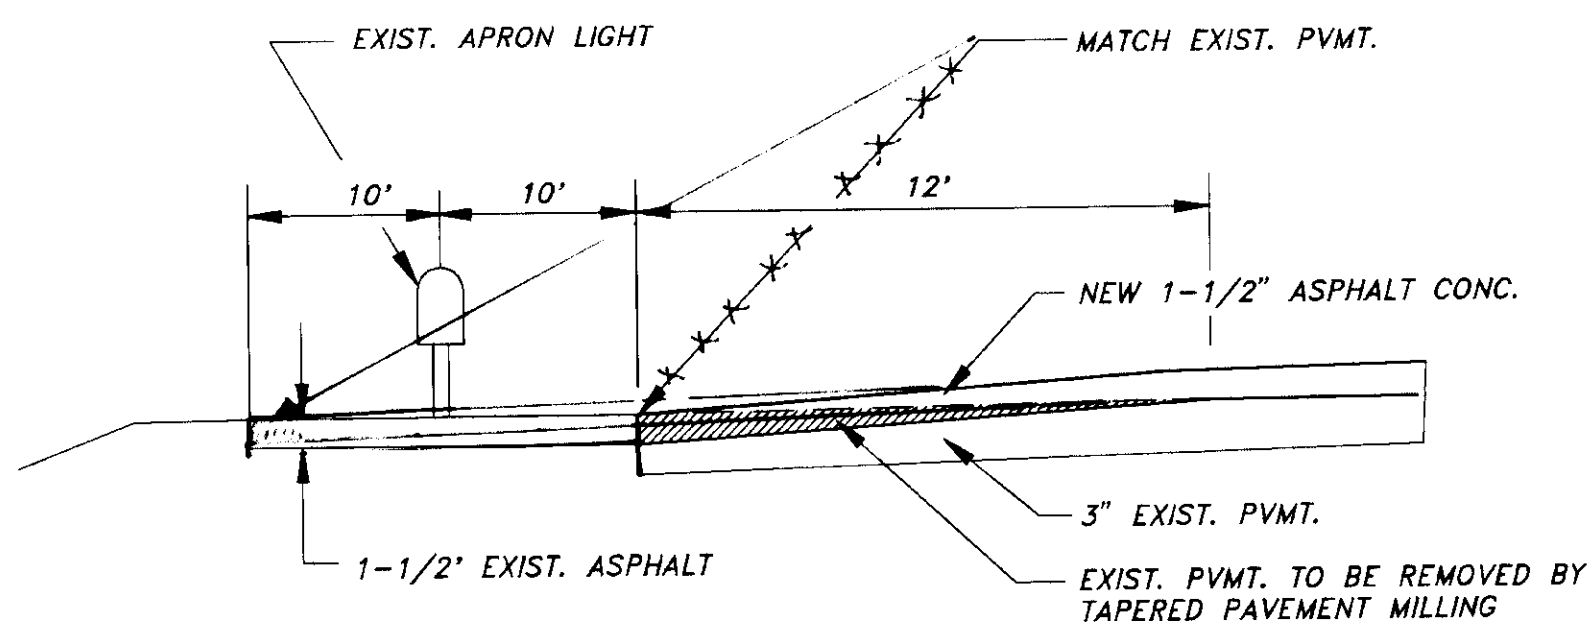

SECTION A-A

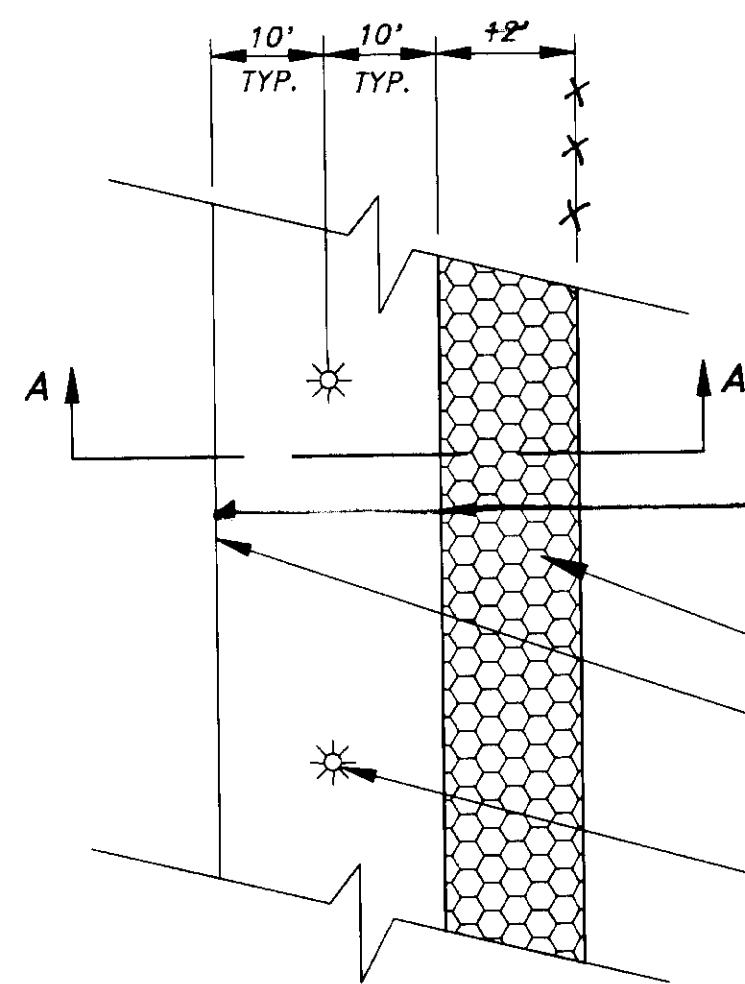

PLAN
TAPERED PAVEMENT MILLING DETAILS

N.T.S.

NOTES:

1. TAPERED PAVEMENT MILLING SHALL REMOVE A WEDGE OF PAVEMENT RANGING IN DEPTH OF 0" AT START (RUNWAY STA "A"22+00, 608' RT.) TO 1.5" (RUNWAY STA "A"22+00, 558' RT.)
2. ASPHALT MILLING MAY TAKE PLACE AT THE MAIN AVIATION AND TAXIWAY "A" PRIOR TO PAVING AS LONG AS TEMPORARY RAMP NOT EXCEEDING 1.5% IS CONSTRUCTED.
3. THE LIMITS OF BITUMINOUS OVERLAY ARE SUBJECT TO REVISIONS AS APPROVED BY THE ENGINEER.
4. THE EXISTING MAIN AVIATION APRON GRADE AND CROSS SLOPE SHALL BE USED AS CONTROL FOR THE NEW 1-1/2" ASPHALT PAVEMENT OVERLAY. THE CONTRACTOR SHALL BE RESPONSIBLE FOR DETERMINING THE EXISTING CROSS SLOPE GRADIENTS TO THE SATISFACTION OF THE ENGINEER.
5. BITUMINOUS OVERLAY OPERATIONS SHALL COMPLY WITH THE PROJECT OPERATIONS PLAN, SECTION 80-04, OF THE TECHNICAL SPECIFICATIONS.
6. SEE PLAN SHEETS 5, 12 AND 13 FOR "X" LINE ACCESS ROAD, FENCING AND GATE DETAILS.

PROTECT AND MAINTAIN EXIST LIGHTS DURING BITUMINOUS OVERLAY OPERATIONS. REMOVE ANY ASPHALT PLACED ON LIGHTS (TYP.)

LIMITS OF BITUMINOUS OVERLAY SHALL BE EDGE OF FULL STRENGTH PAVEMENT ON NORTH SIDE OF APRON AS SHOWN

12' WIDE TAPERED PAVEMENT MILLING PER DETAIL THIS SHEET.

RESET EXIST. MONUMENT AFTER OVERLAY OPERATIONS TYPICAL

LIMITS OF BITUMINOUS OVERLAY SHALL BE EDGE OF EXIST. ASPHALT PAVEMENT OF WEST AND SOUTH SIDES OF MAIN APRON AS SHOWN


PLACE ASPHALT CONCRETE OVERLAY OVER EXIST. CONCRETE HARDSTAND

12' WIDE TAPERED PAVEMENT MILLING PER DETAIL THIS SHEET.


DO NOT PAVE OVER EXIST. TIE-DOWN ANCHORS TYP.

SYMBOLS

- ☼ EXISTING APRON LIGHT
- EXISTING TIE-DOWN ANCHOR
- X-X- EXISTING CHAINLINK FENCE
- E-E- EXISTING UNDERGROUND ELECTRIC
- LEASE LOT PROPERTY LINE
- ▨ PROPOSED PAVEMENT MILLING LIMITS

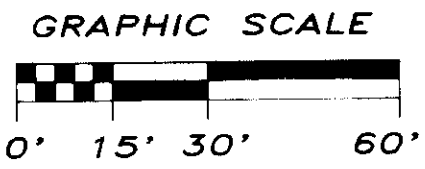

NOTE: DO NOT SCALE FROM THESE PLANS-USE DIMENSIONS



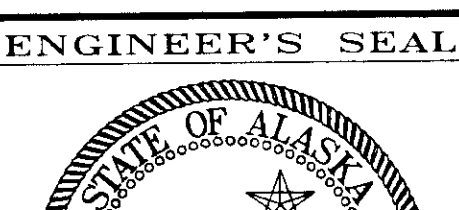


BITUMINOUS OVERLAY MATCH LINE
SEE SHEET 11 OF 19

30 SCALE

NOTES:

1. TAPERED PAVEMENT MILLING SHALL REMOVE A WEDGE OF PAVEMENT RANGING IN DEPTH OF 0" AT START (RUNWAY STA. "A" 22+00, 608'RT.) TO 1.5" (STA. "A" 22+00, 558'RT).
2. ASPHALT MILLING MAY TAKE PLACE AT THE MAIN AVIATION AND TAXIWAY "A" PRIOR TO PAVING AS LONG AS TEMPORARY RAMP NOT EXCEEDING 1.5% IS CONSTRUCTED.
3. THE LIMITS OF BITUMINOUS OVERLAY ARE SUBJECT TO REVISIONS AS APPROVED BY THE ENGINEER.
4. THE EXISTING MAIN AVIATION APRON GRADE AND CROSS SLOPE SHALL BE USED AS CONTROL FOR THE NEW 1-1/2" ASPHALT PAVEMENT OVERLAY. THE CONTRACTOR SHALL BE RESPONSIBLE FOR DETERMINING THE EXISTING CROSS SLOPE GRADIENTS TO THE SATISFACTION OF THE ENGINEER.
5. BITUMINOUS OVERLAY OPERATIONS SHALL COMPLY WITH THE PROJECT OPERATIONS PLAN, SECTION 80-04, OF THE TECHNICAL SPECIFICATIONS.
6. SEE PLAN SHEETS 6, 12 AND 13 FOR "F" AND "G" LINE ACCESS ROAD, FENCING AND GATE DETAILS.
7. SEE SHEET 10 OF 19 FOR CONSTRUCTION DETAILS FOR TAPERED PAVEMENT MILLING AND TRANSITION DETAILS.

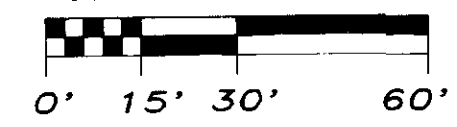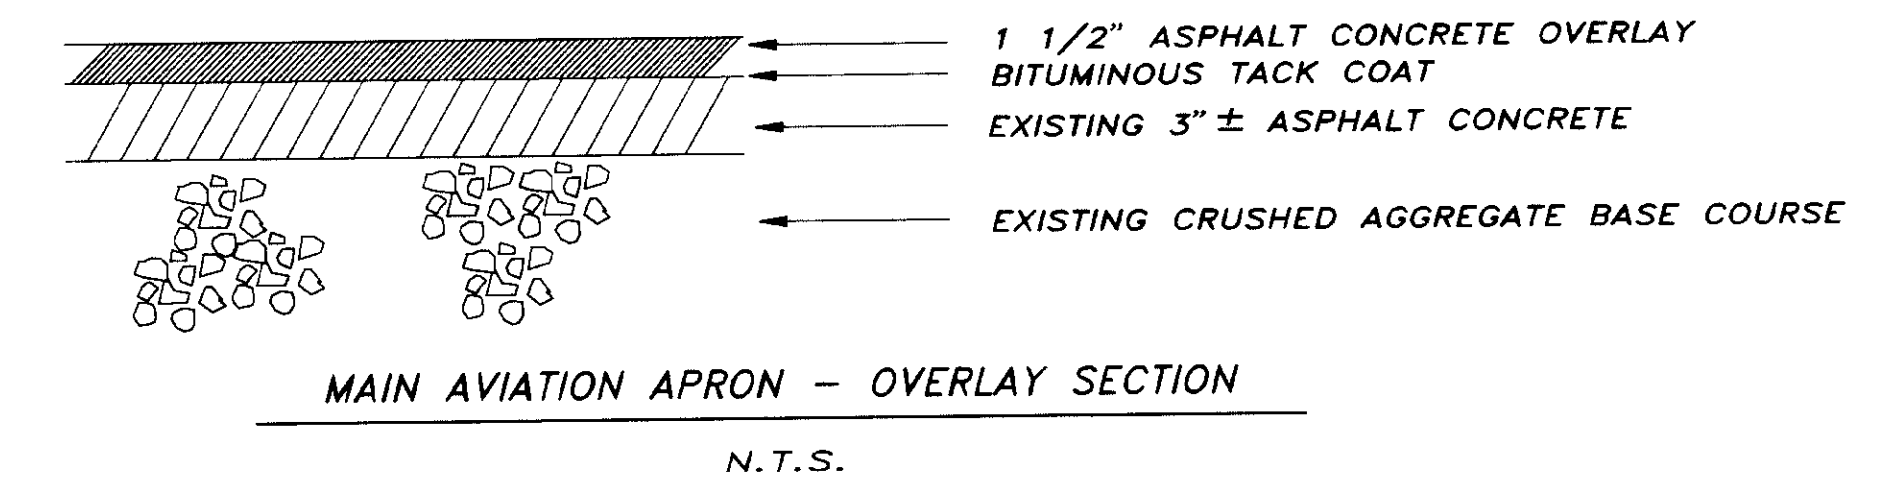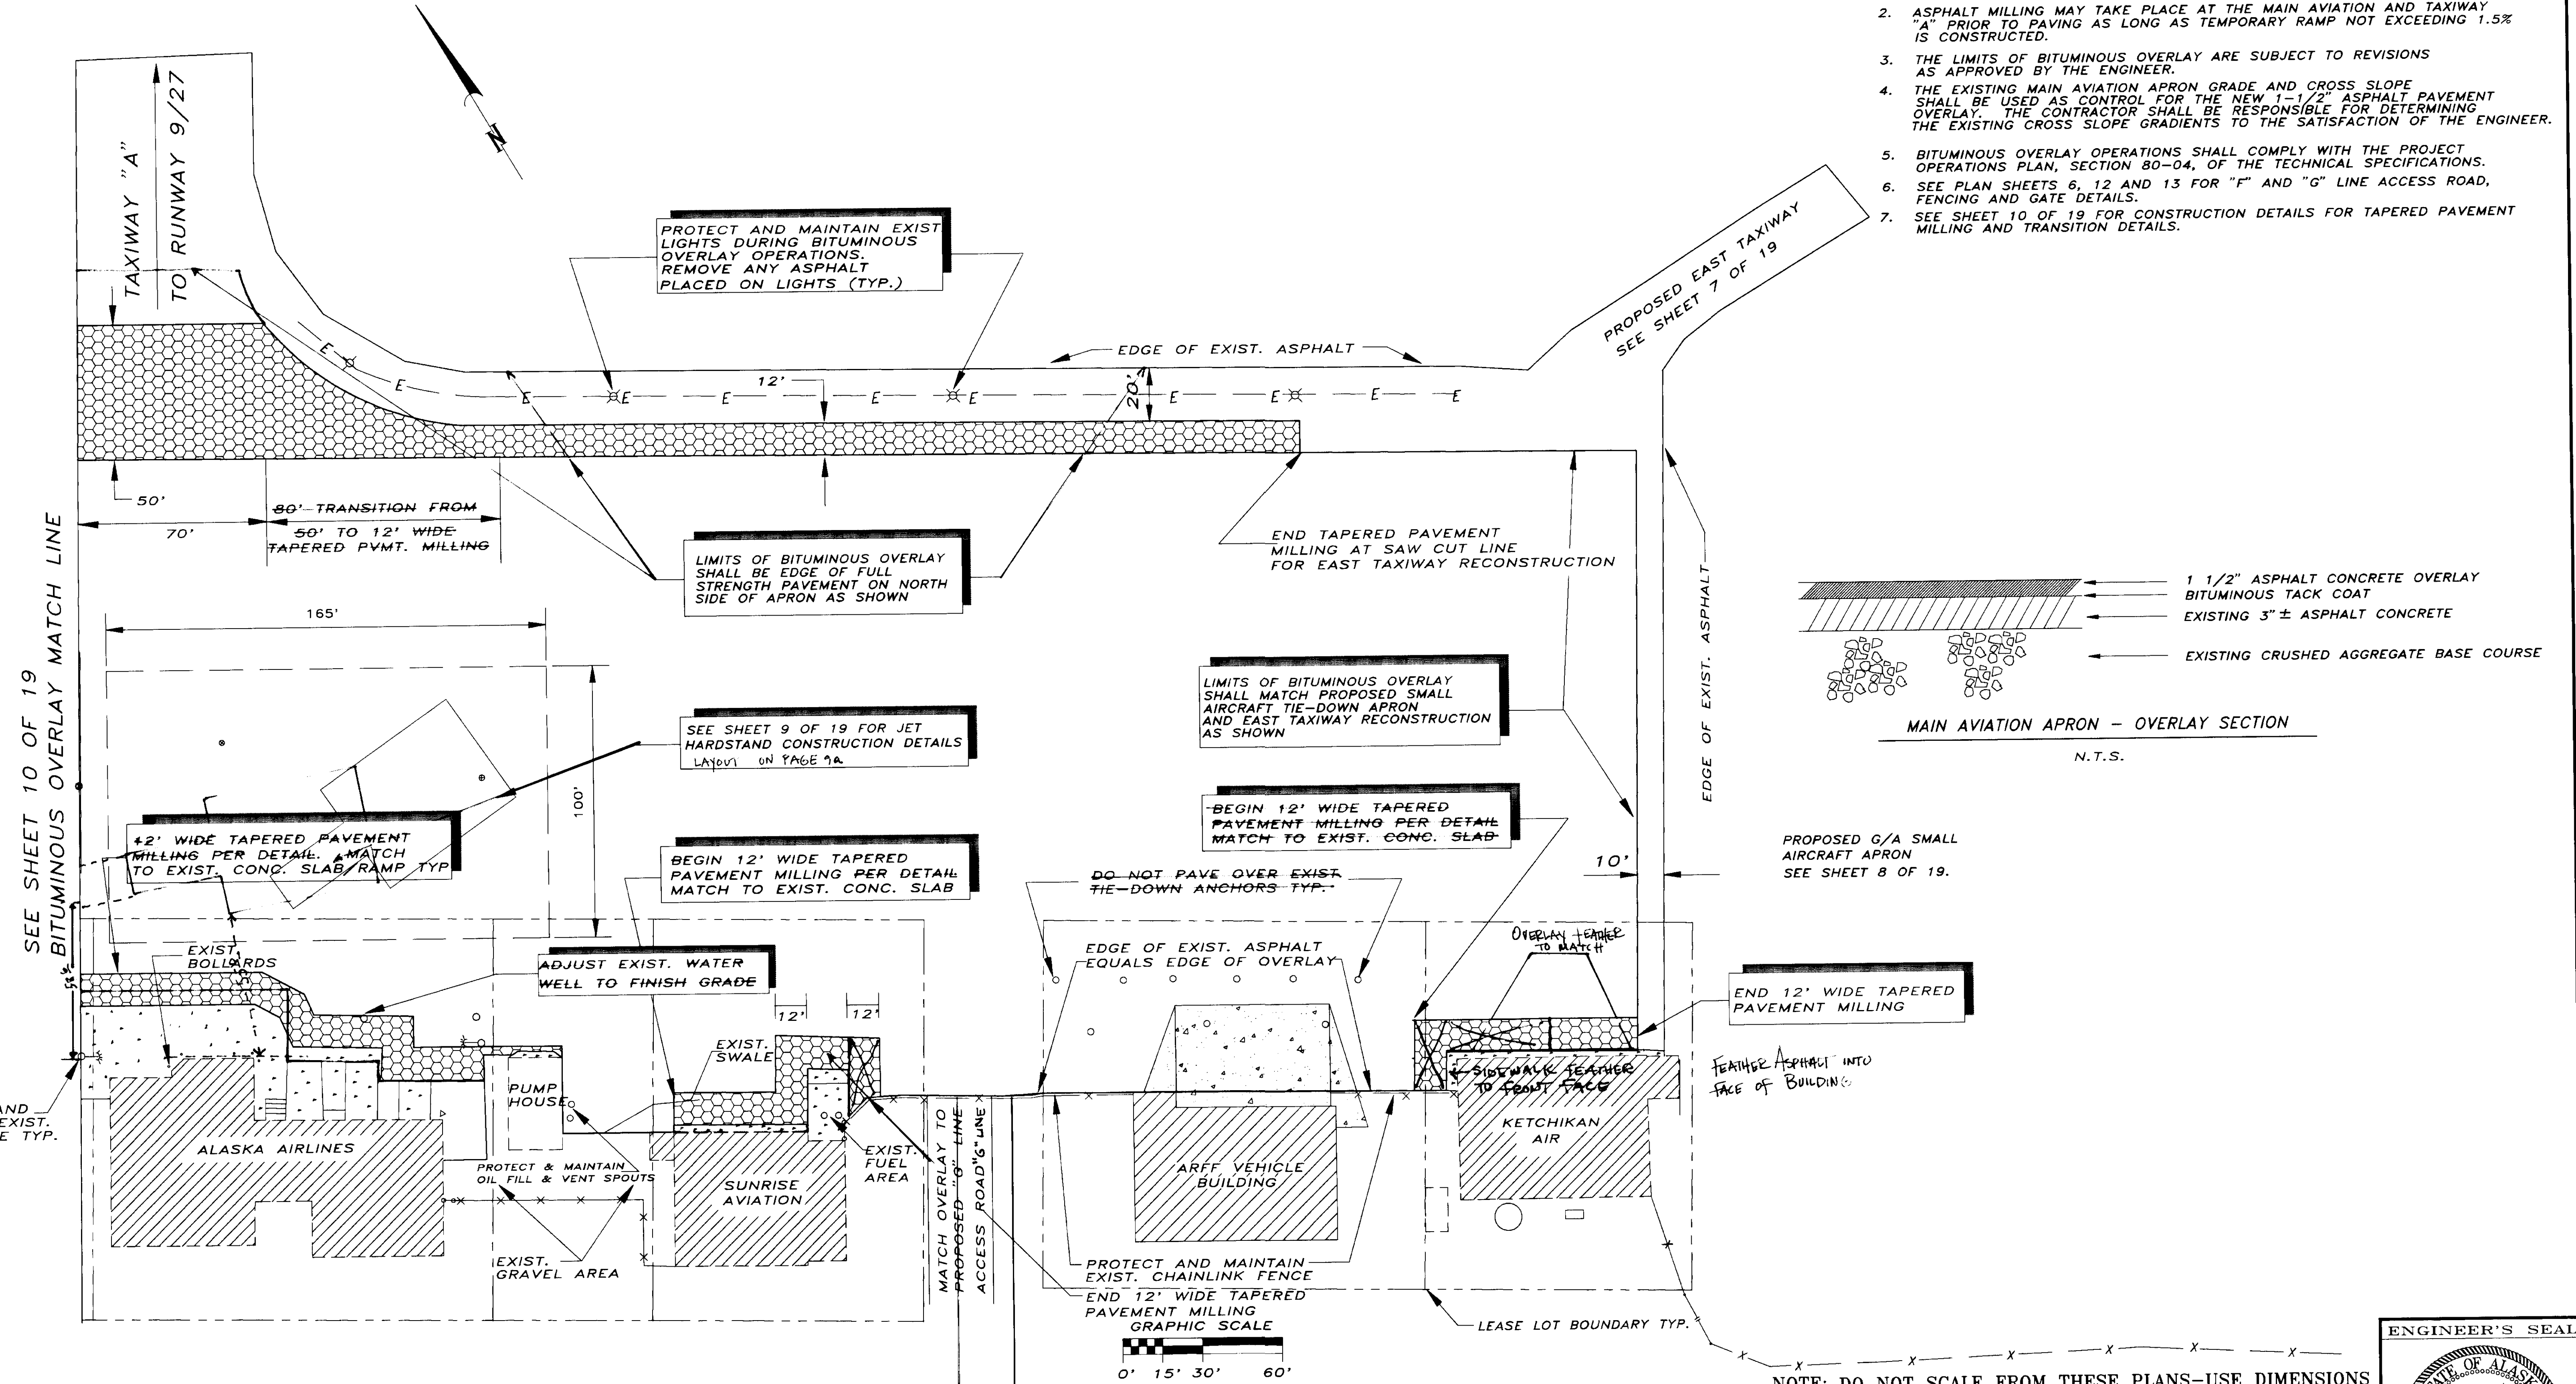


NOTE: DO NOT SCALE FROM THESE PLANS-USE DIMENSIONS

ENGINEER'S SEAL







R & M ENGINEERING, INC.
ENGINEERS GEOLOGISTS SURVEYORS

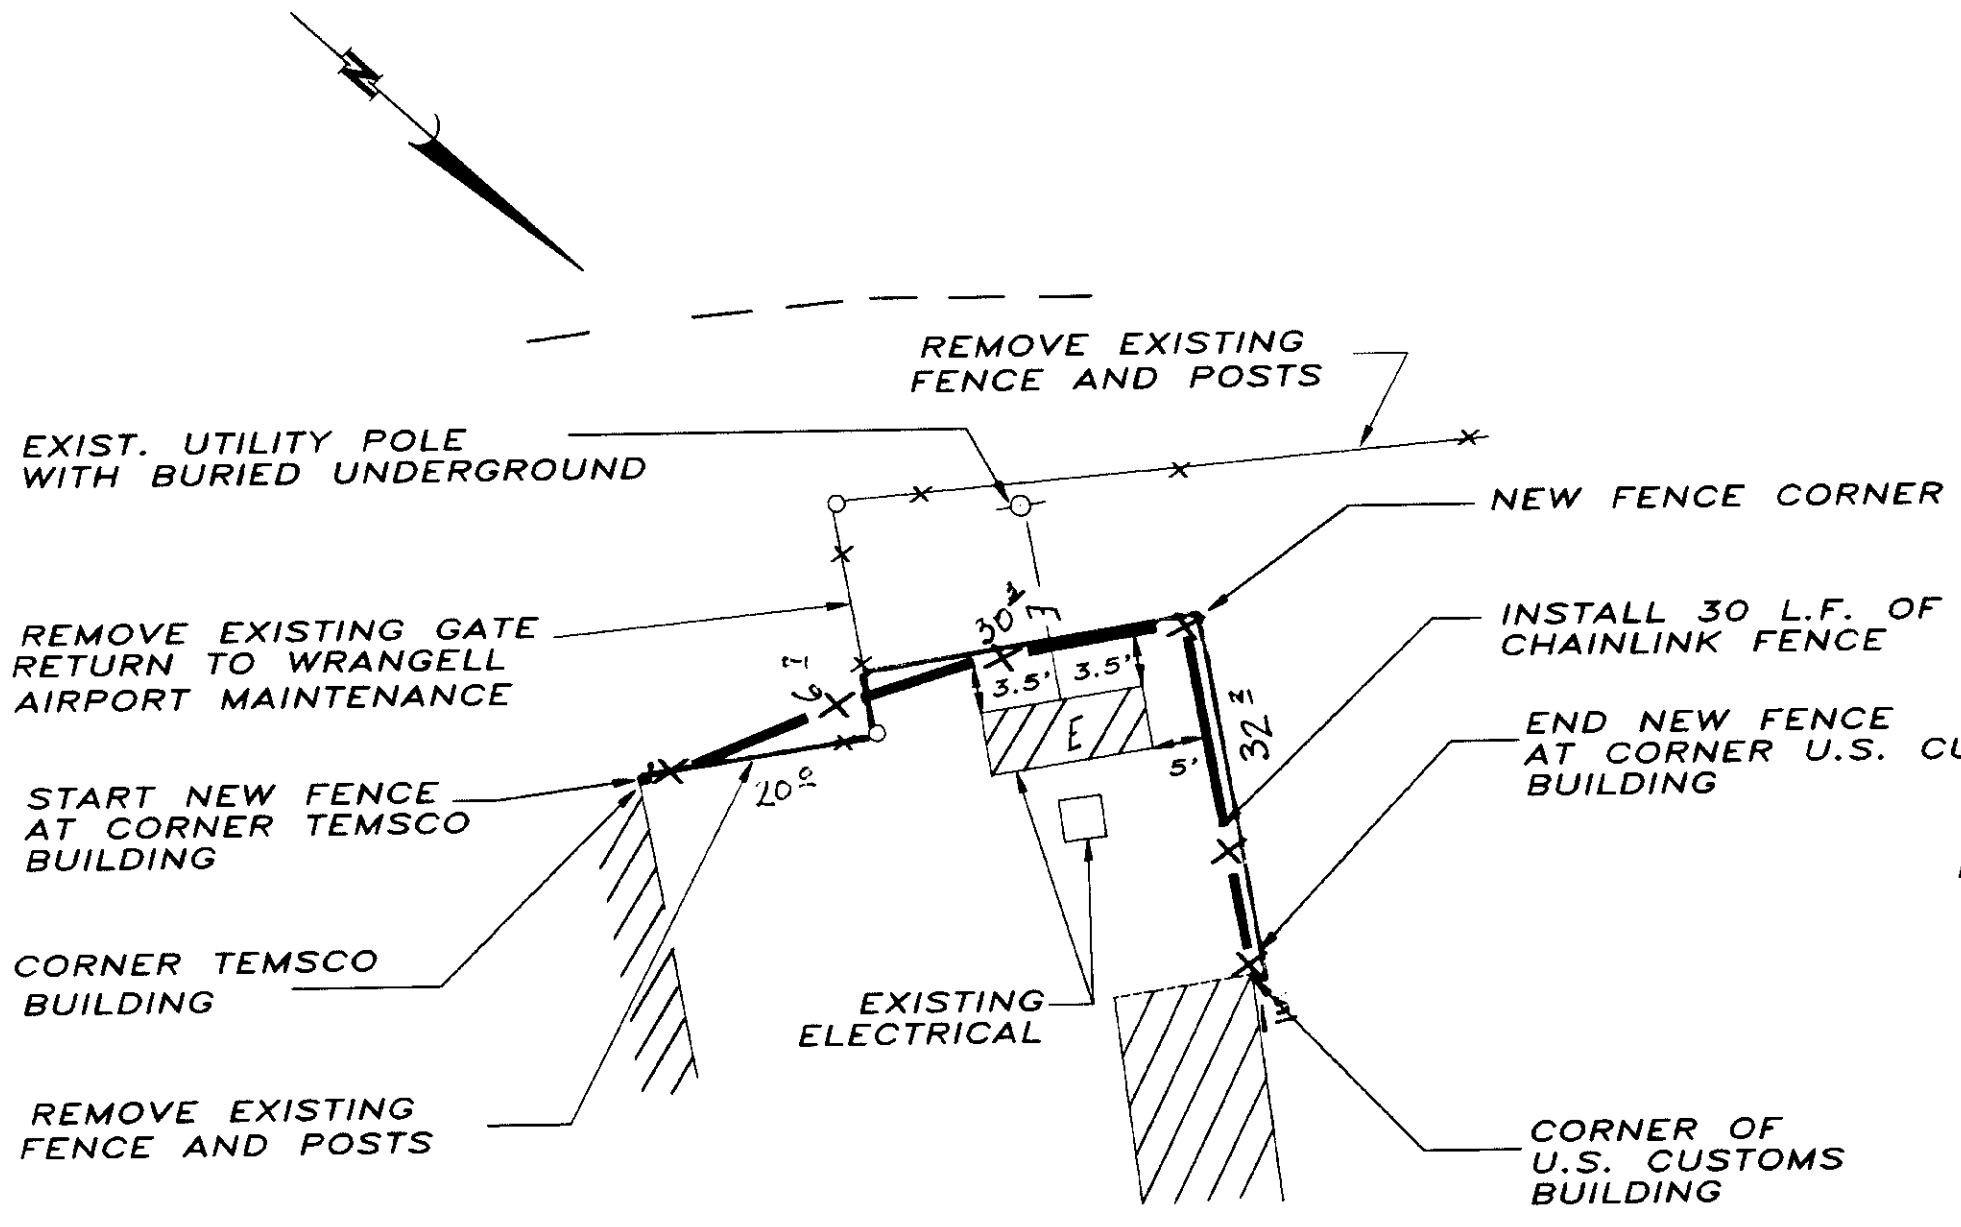


DETAIL A
N.T.S.

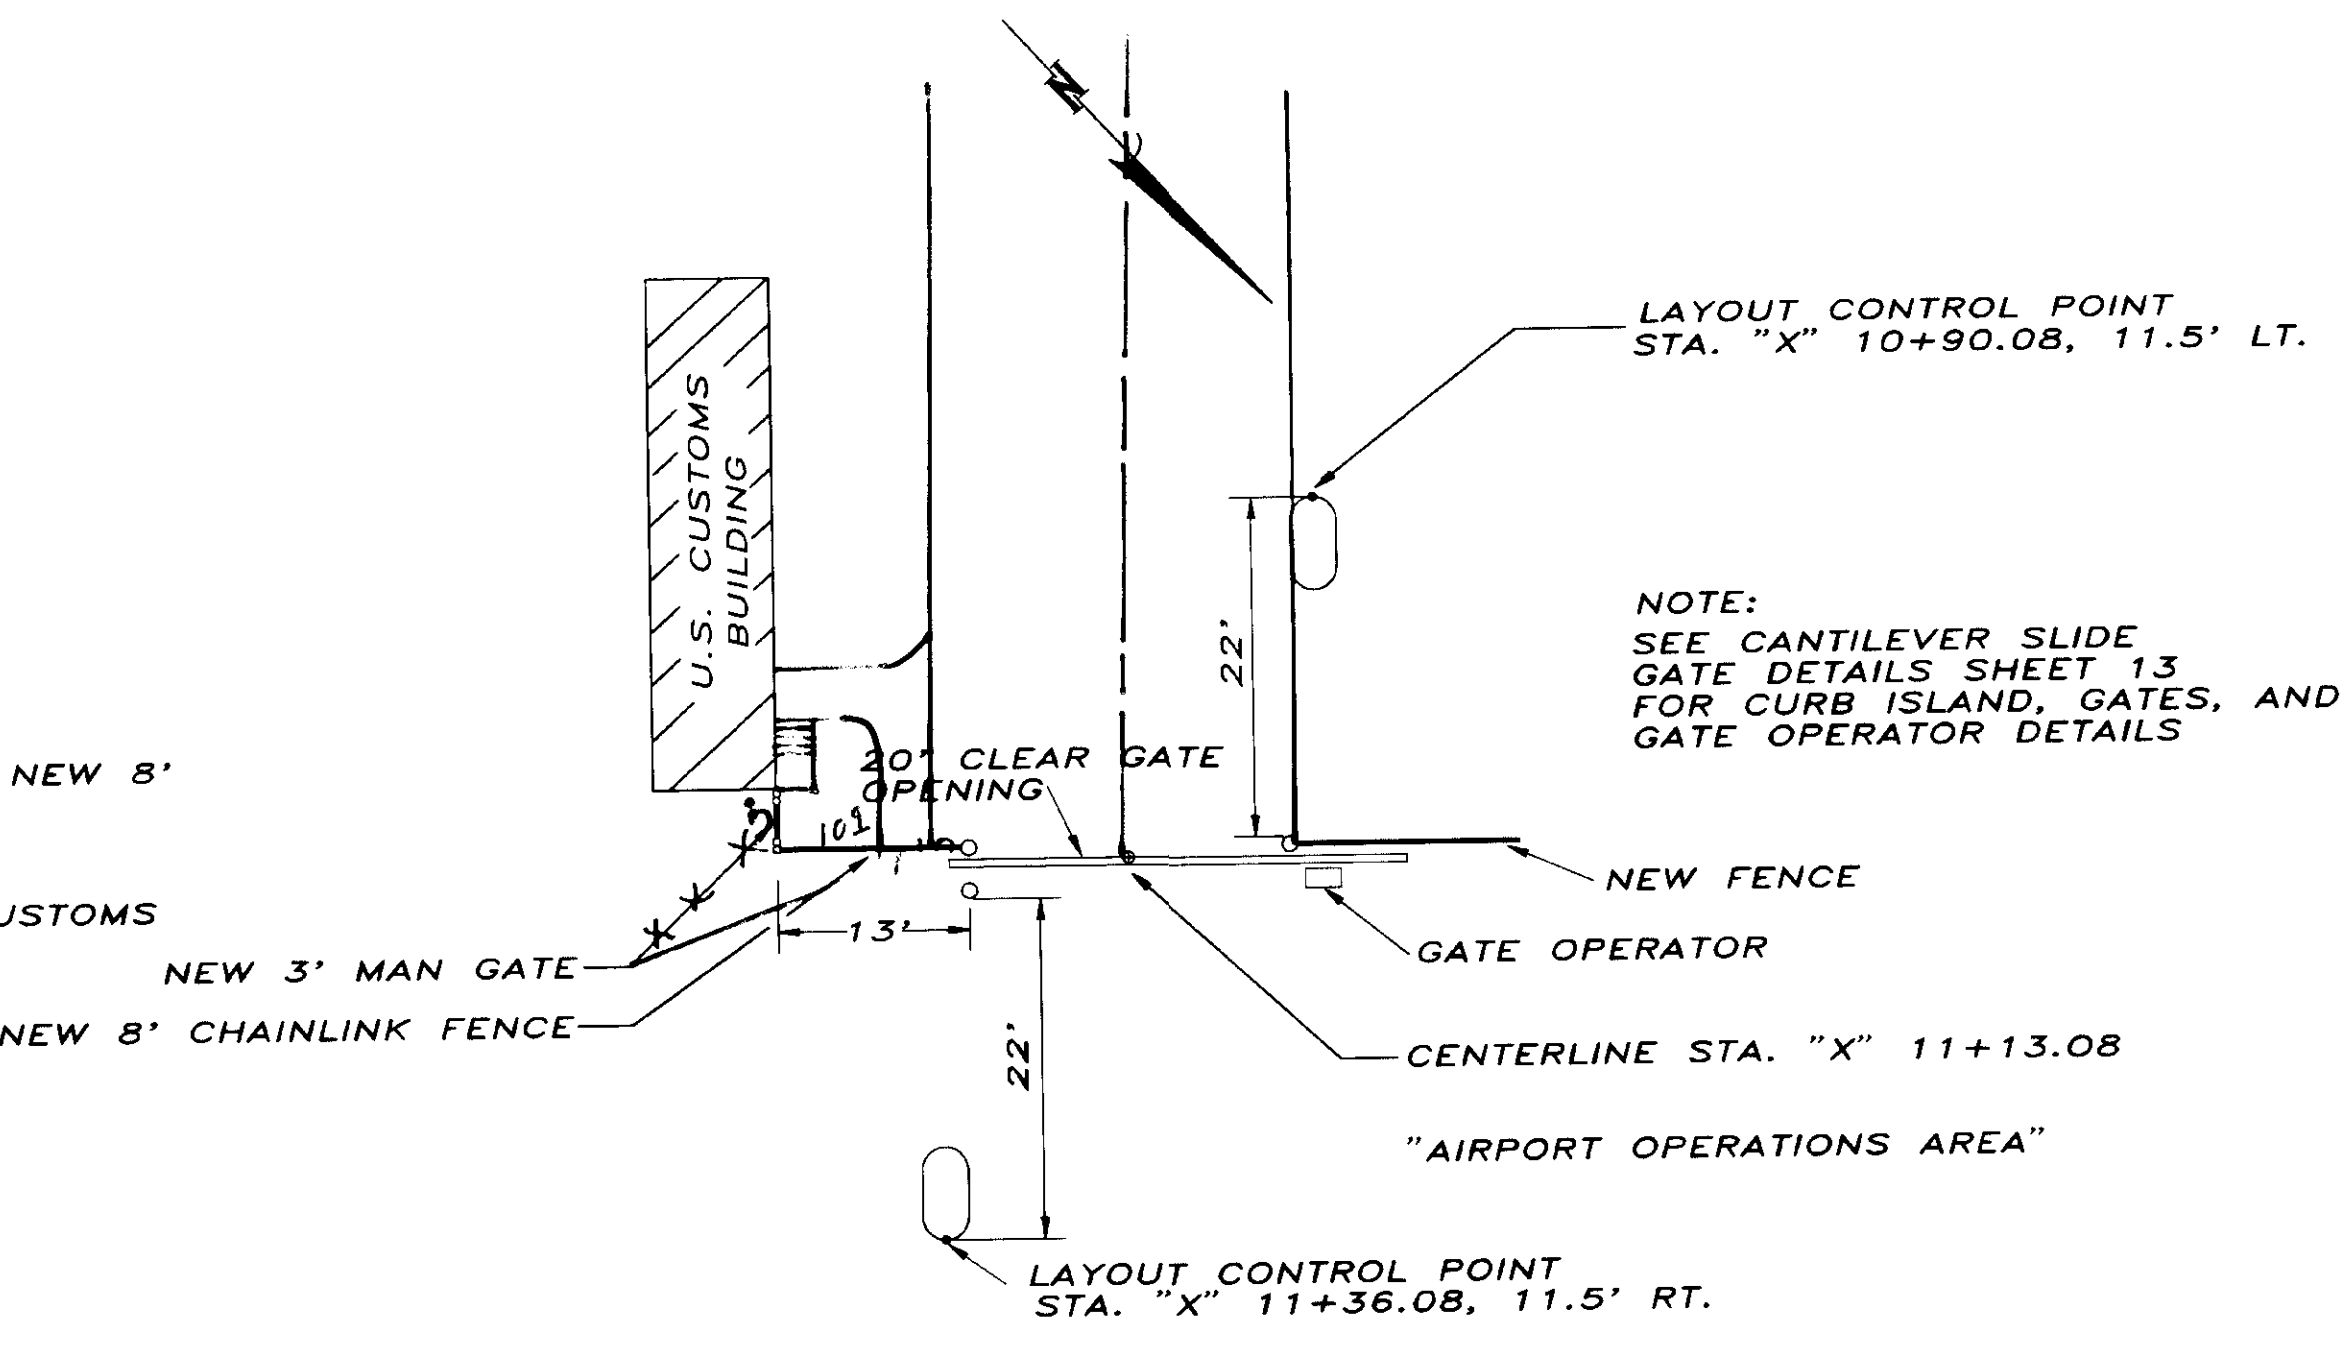


DETAIL B GATE 1
N.T.S.

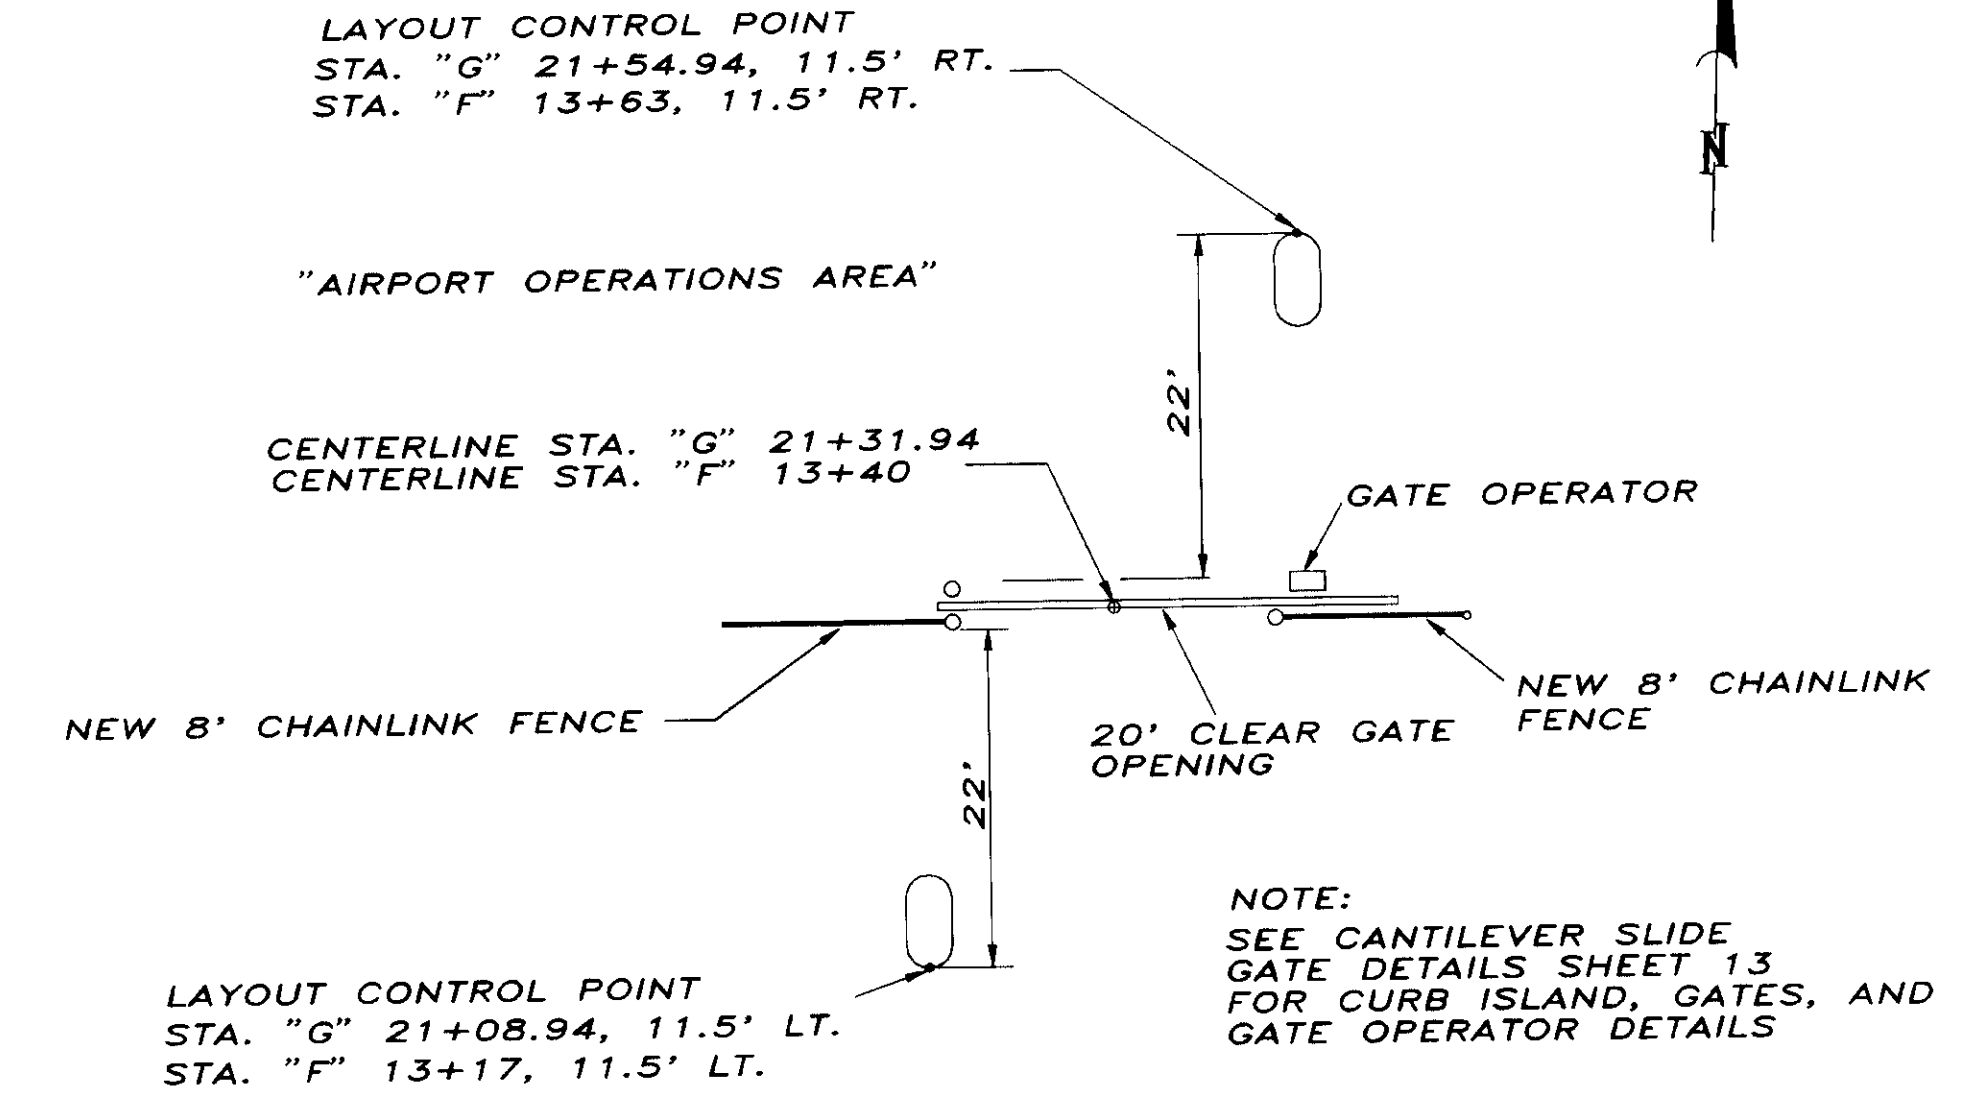

DETAIL C GATE 2 & 3
N.T.S.

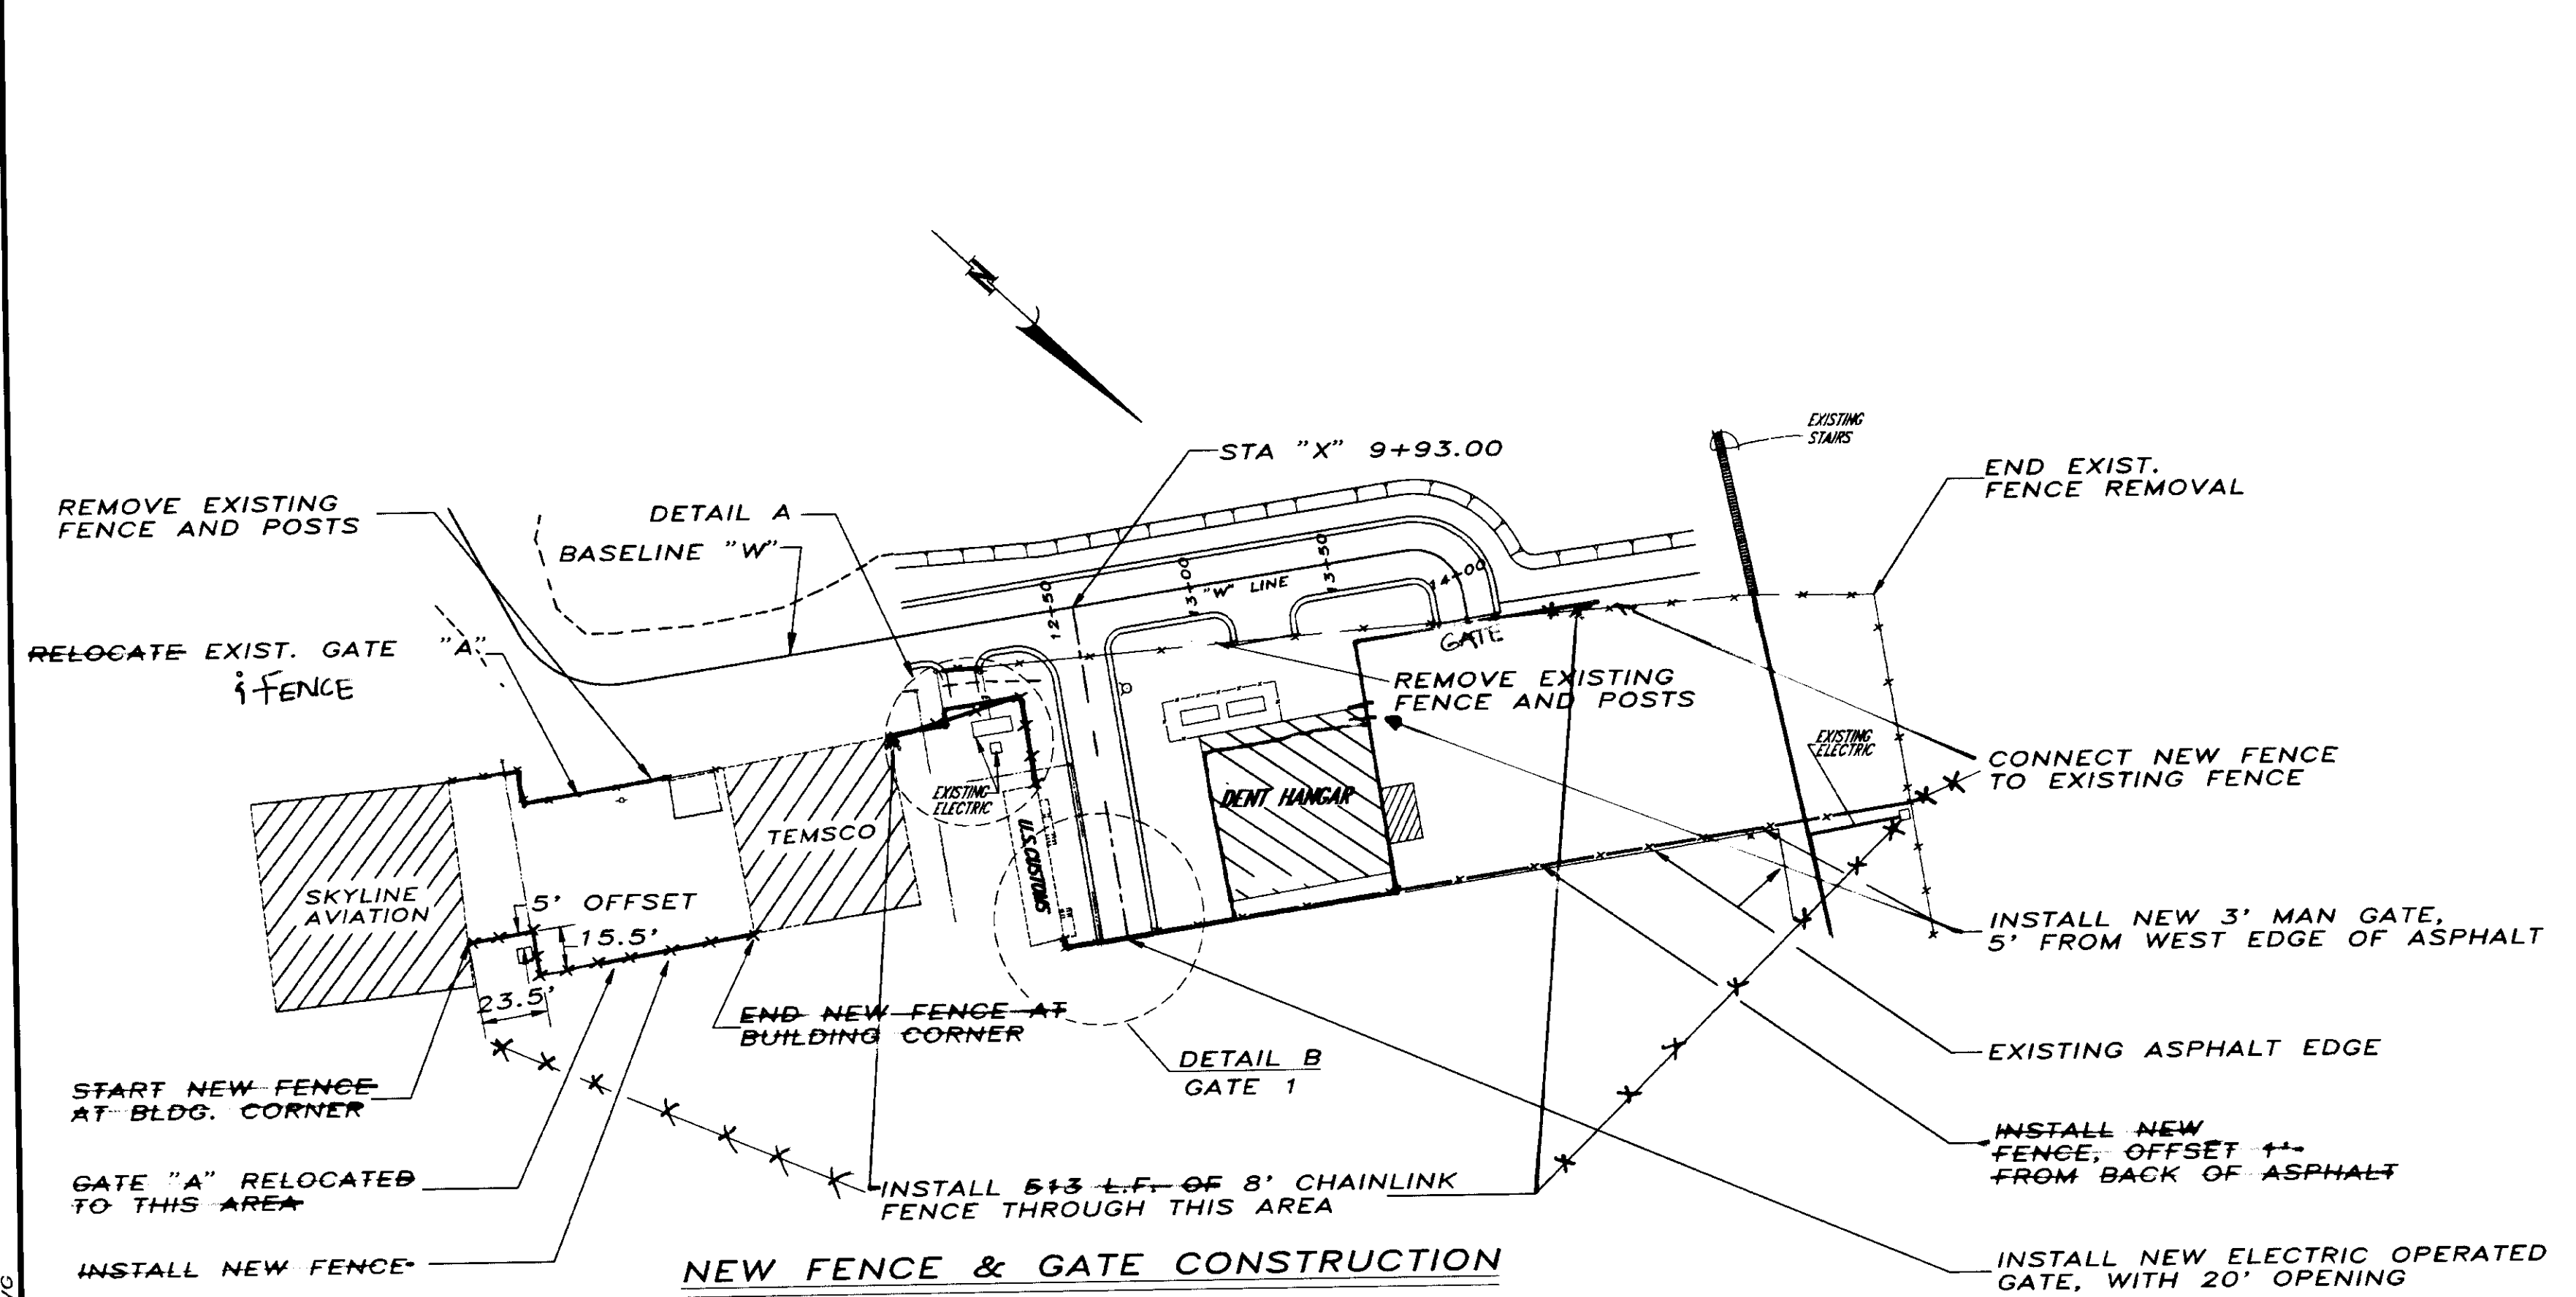

NEW FENCE & GATE CONSTRUCTION
WEST END
N.T.S.

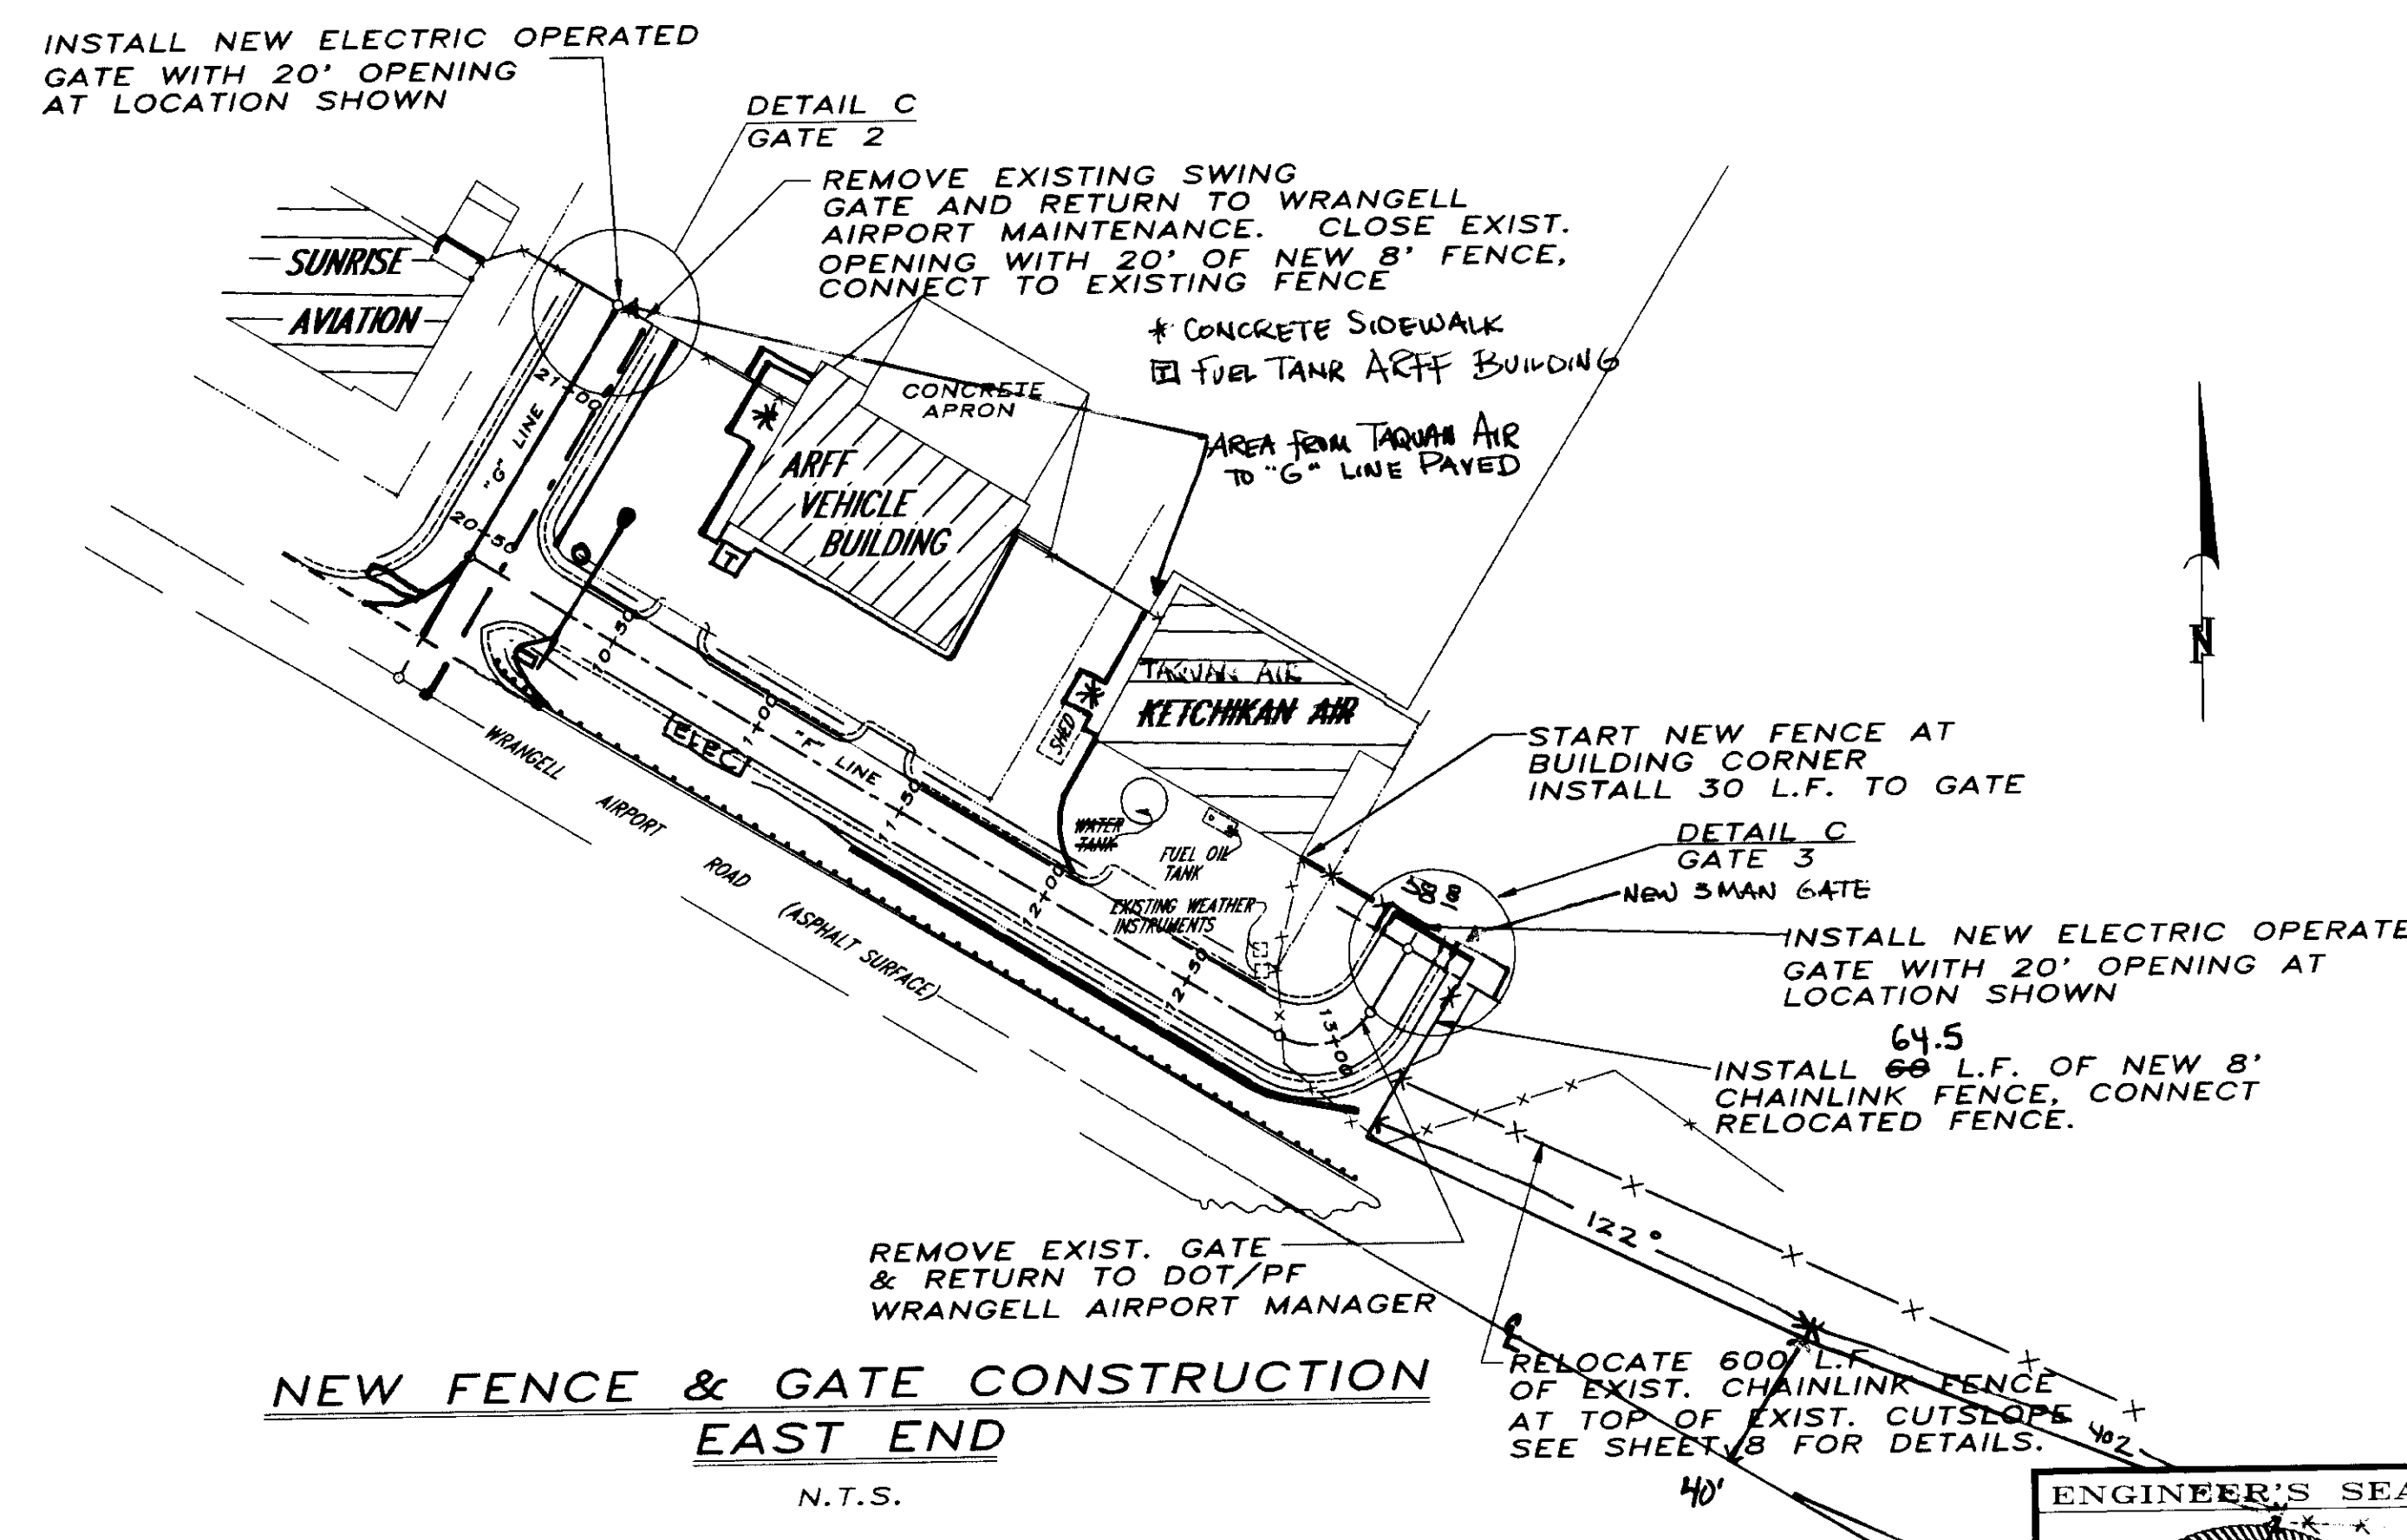

NEW FENCE & GATE CONSTRUCTION
EAST END
N.T.S.


NOTE: DO NOT SCALE FROM THESE PLANS-USE DIMENSIONS

ENGINEER'S SEAL




ISLAND CURB NOTES:

- 1) SAW-CUT AND MATCH EXIST. PAVEMENT WHERE PAVEMENT EXISTS AT GATES 1 AND 2 WITHIN THE AIRPORT OPERATIONS AREA.
- 2) PROVIDE WIDENED SHOULDER FOR ISLAND CURB LOCATIONS AS REQUIRED.
- 3) INSTALL #2 AWG BARE APPROX. 22 L.F. AT 24" DEPTH WITH #12 EACH WAY FOR EACH CARD READER.
- 4) SEE SHEET 12 OF 19 FOR GATE LOCATIONS.

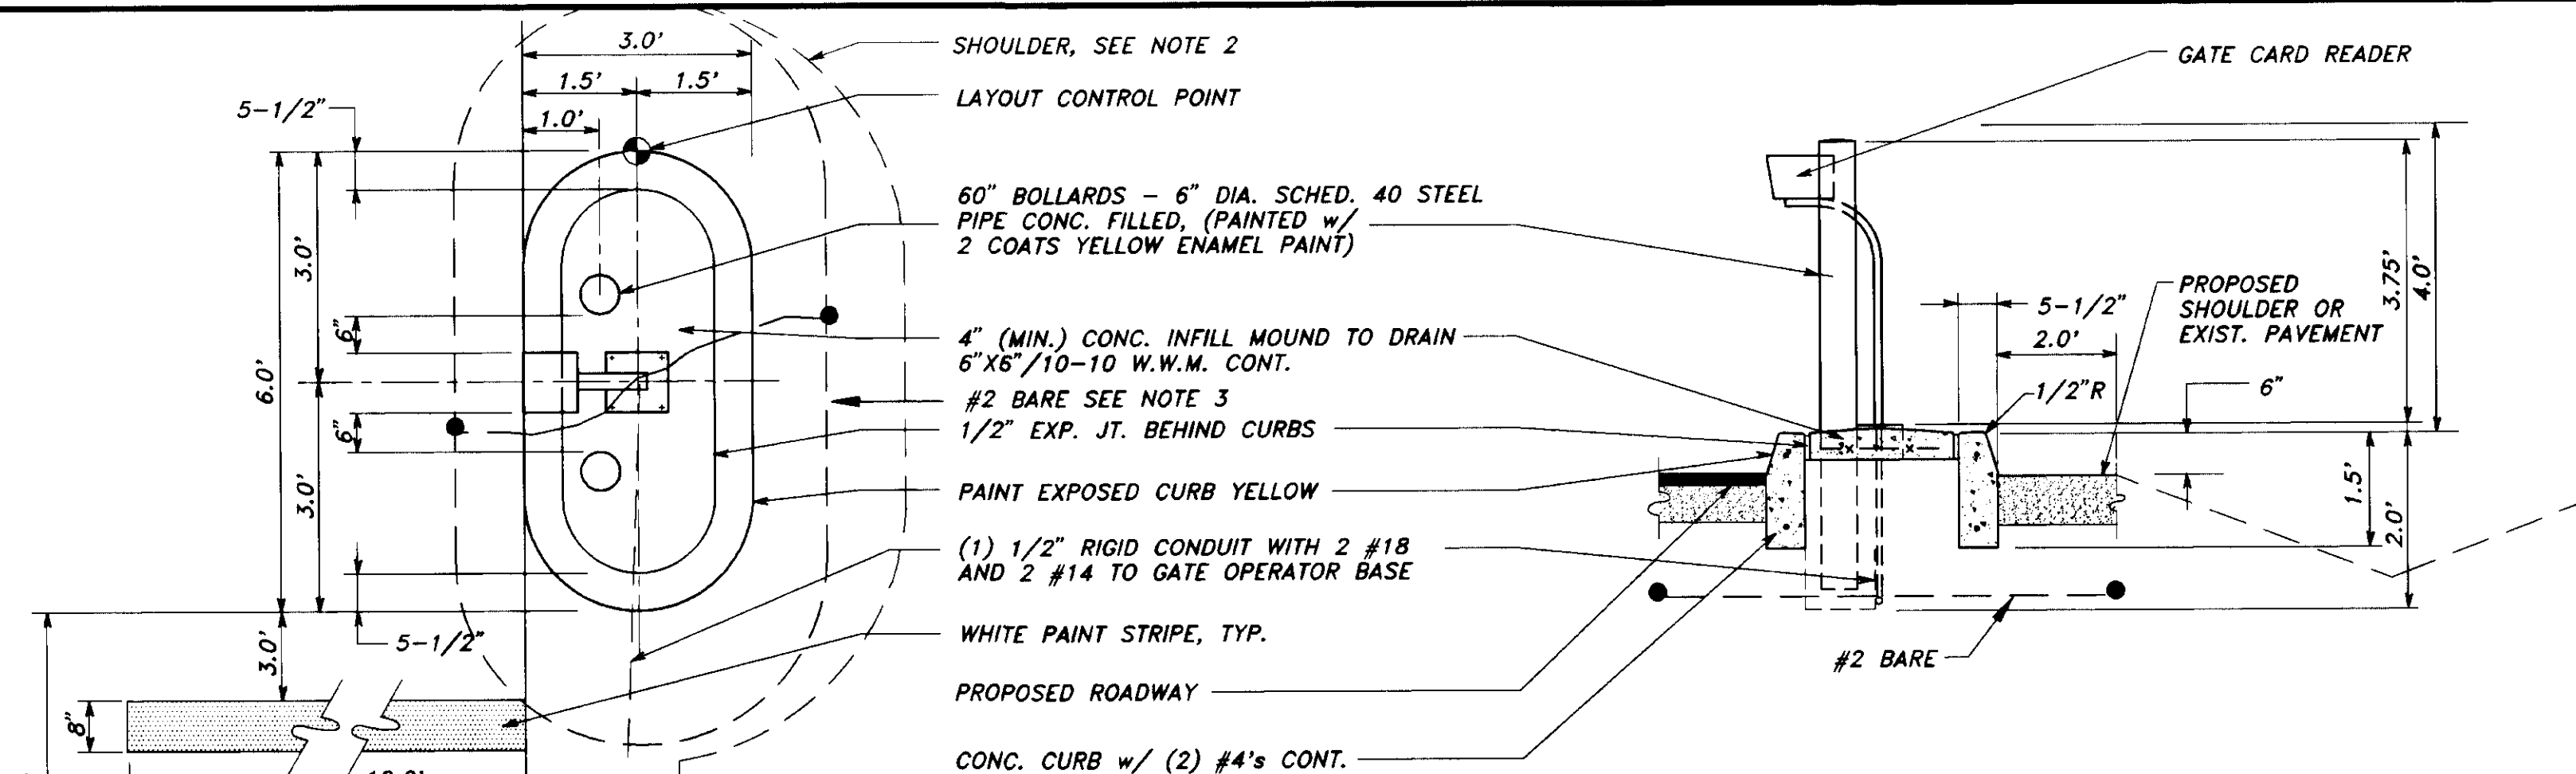



ISLAND CURB DETAIL

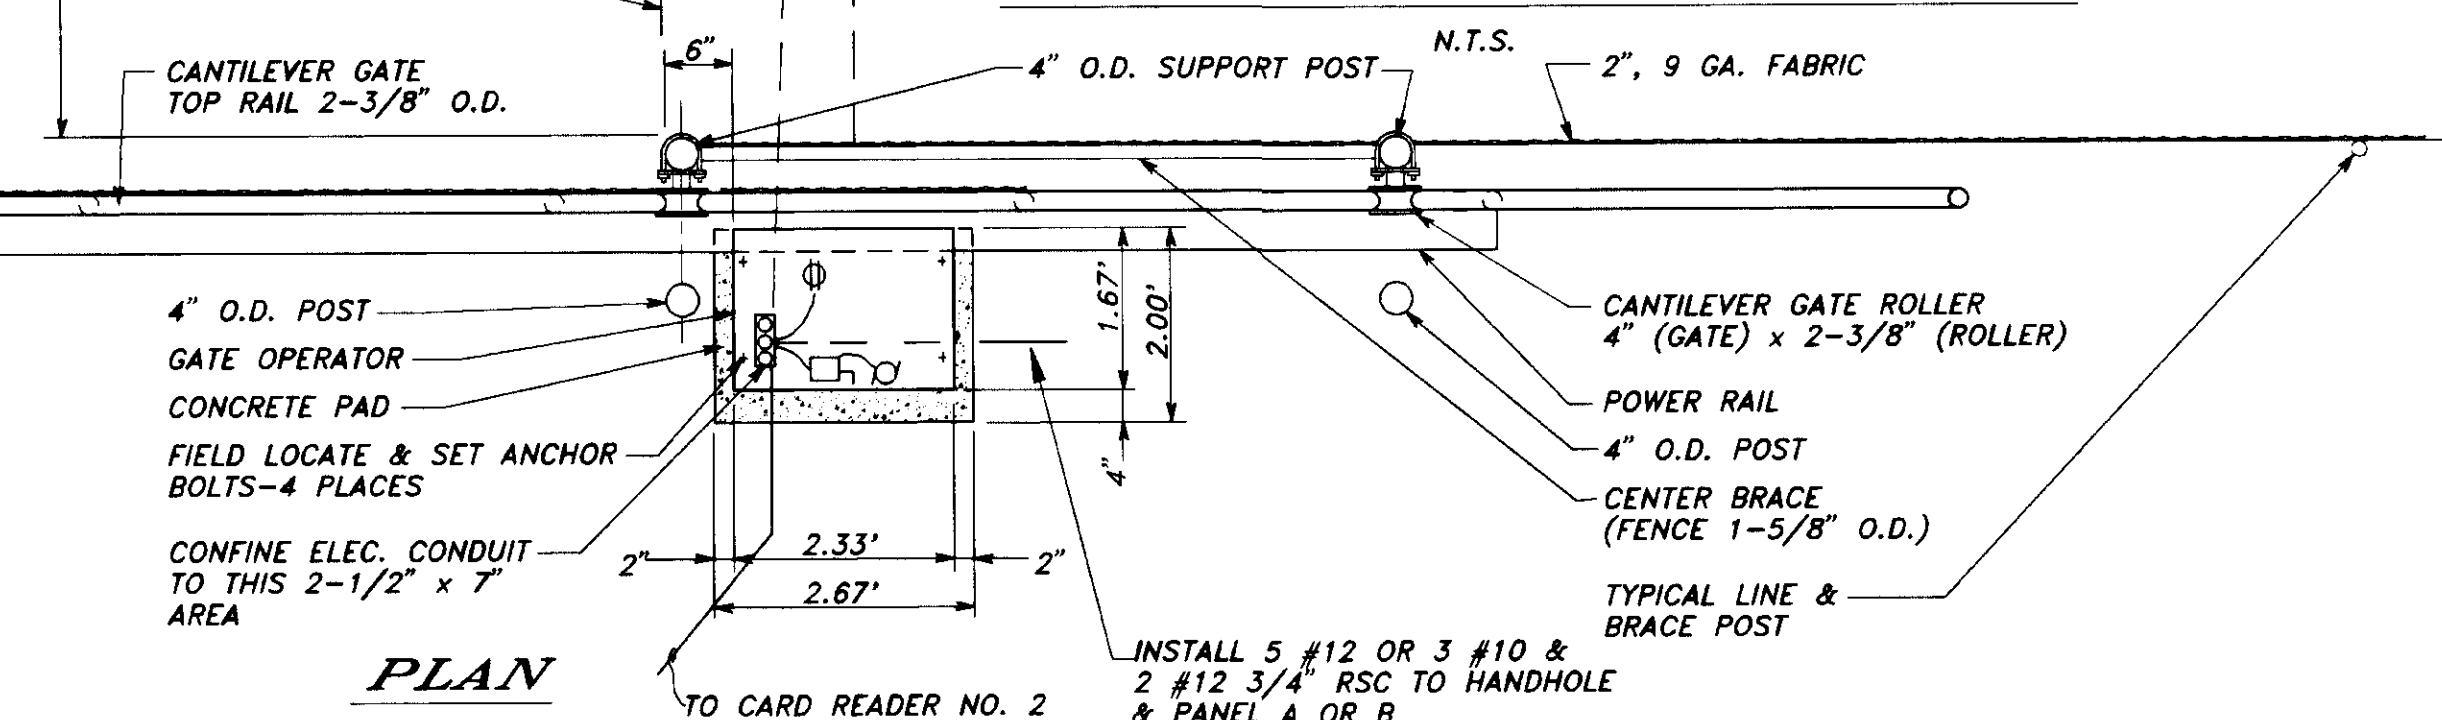


ISLAND CURB DETAIL PLAN

FENCING NOTES:

- 1) FENCE FABRIC SHALL BE 9 GA. WIRE WOVEN IN A 2" MESH. FENCING SHALL BE 8' TALL WITH BARBED WIRE ON TOP.
- 2) NOT ALL OF CHAINLINK FENCE AND MISC. FENCING HARDWARE IS SHOWN IN THIS DETAIL. REFER TO DOT/PF STANDARD DETAILS NO. F-01.01 FOR FURTHER DETAIL.

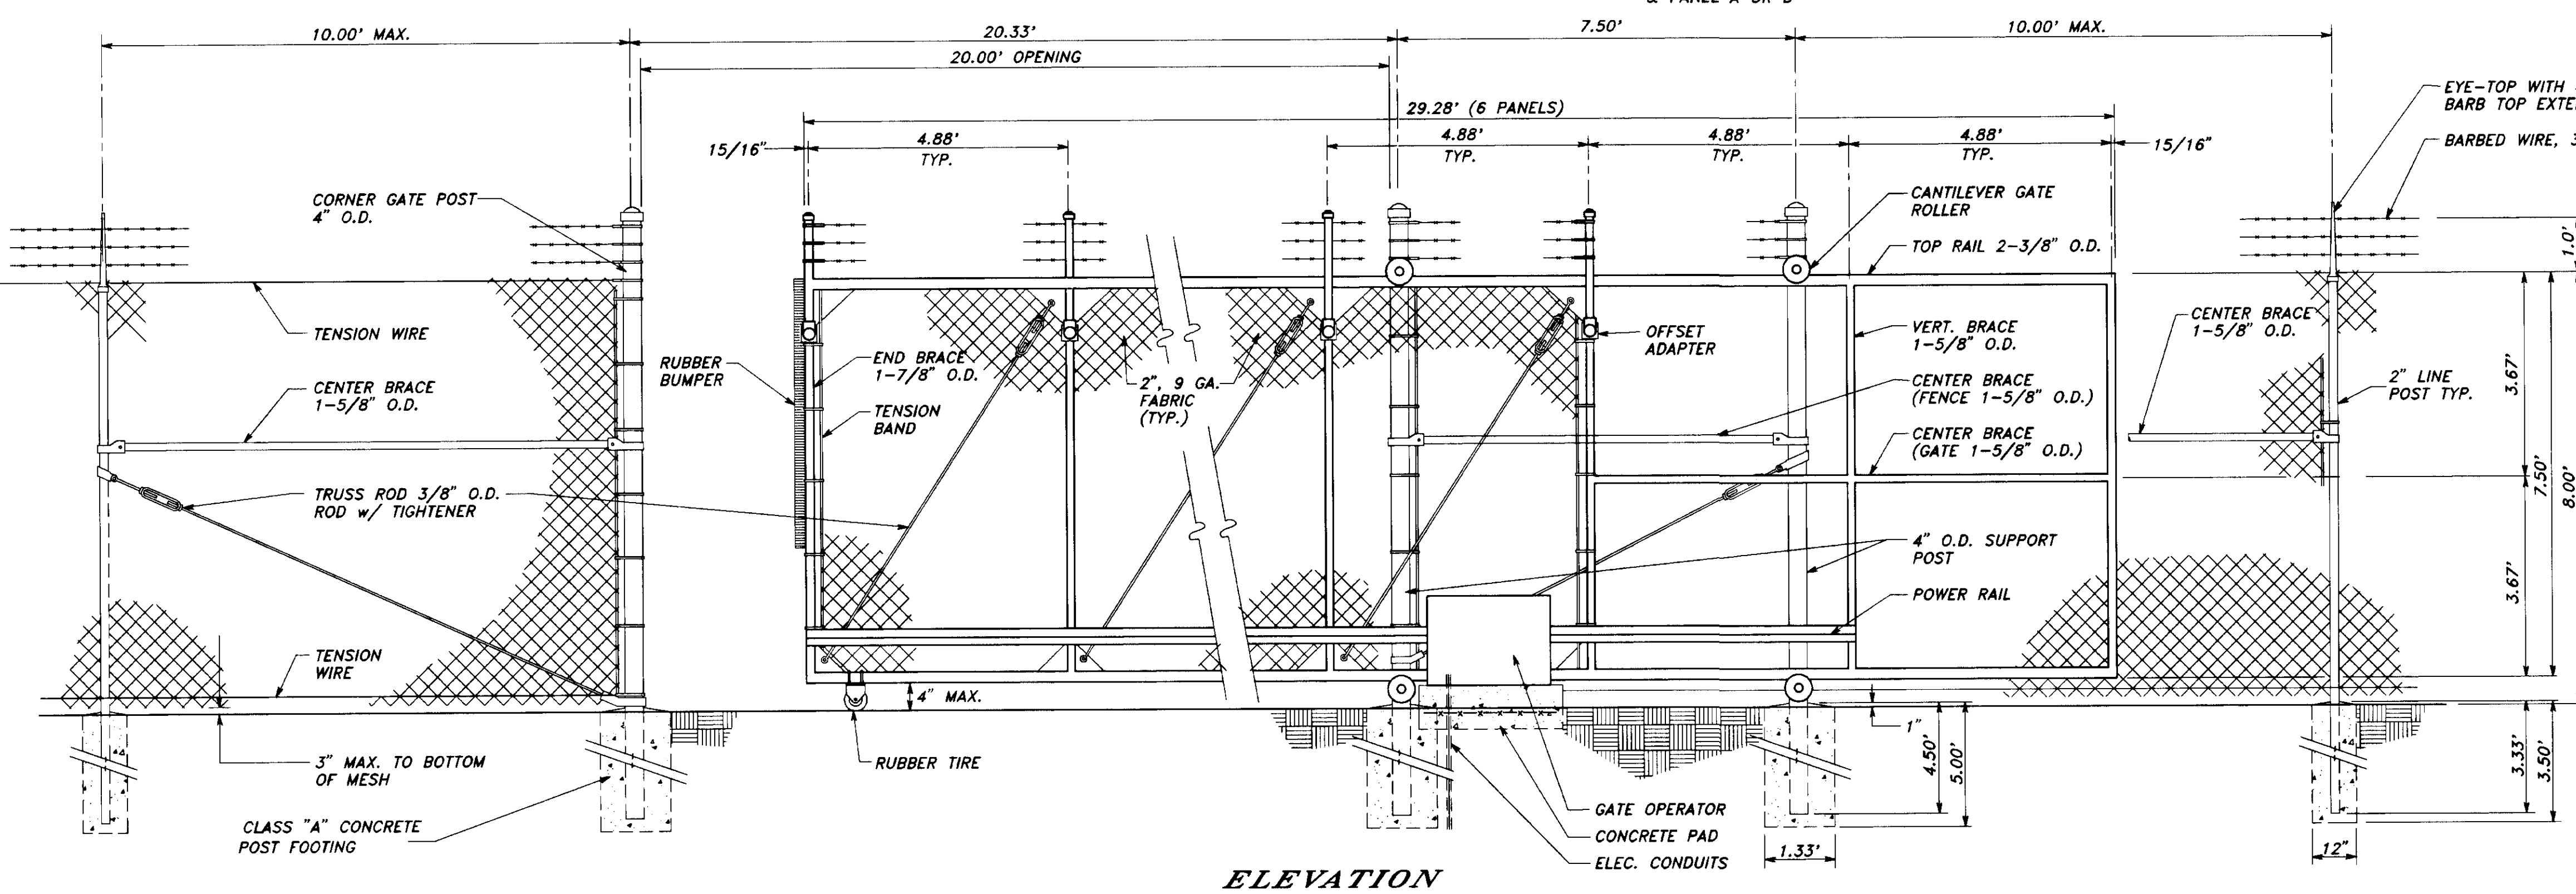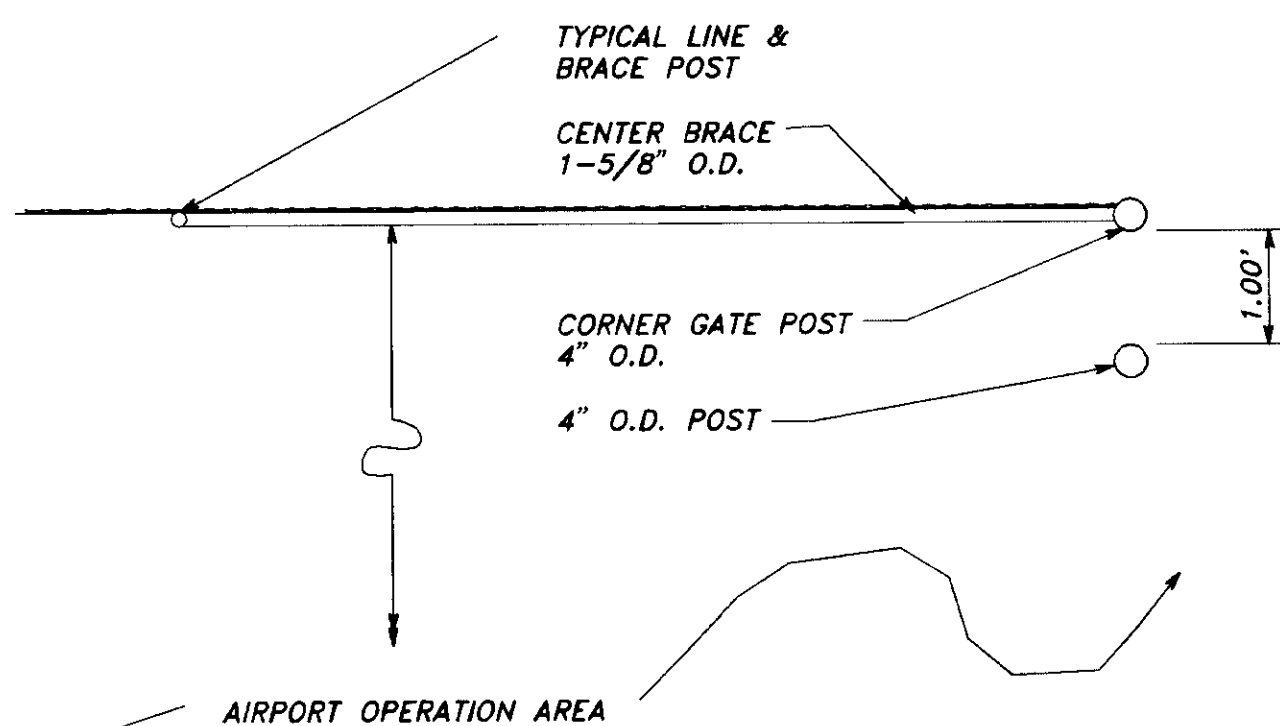

AUTOMATIC SLIDING GATE DETAILS ELEVATION

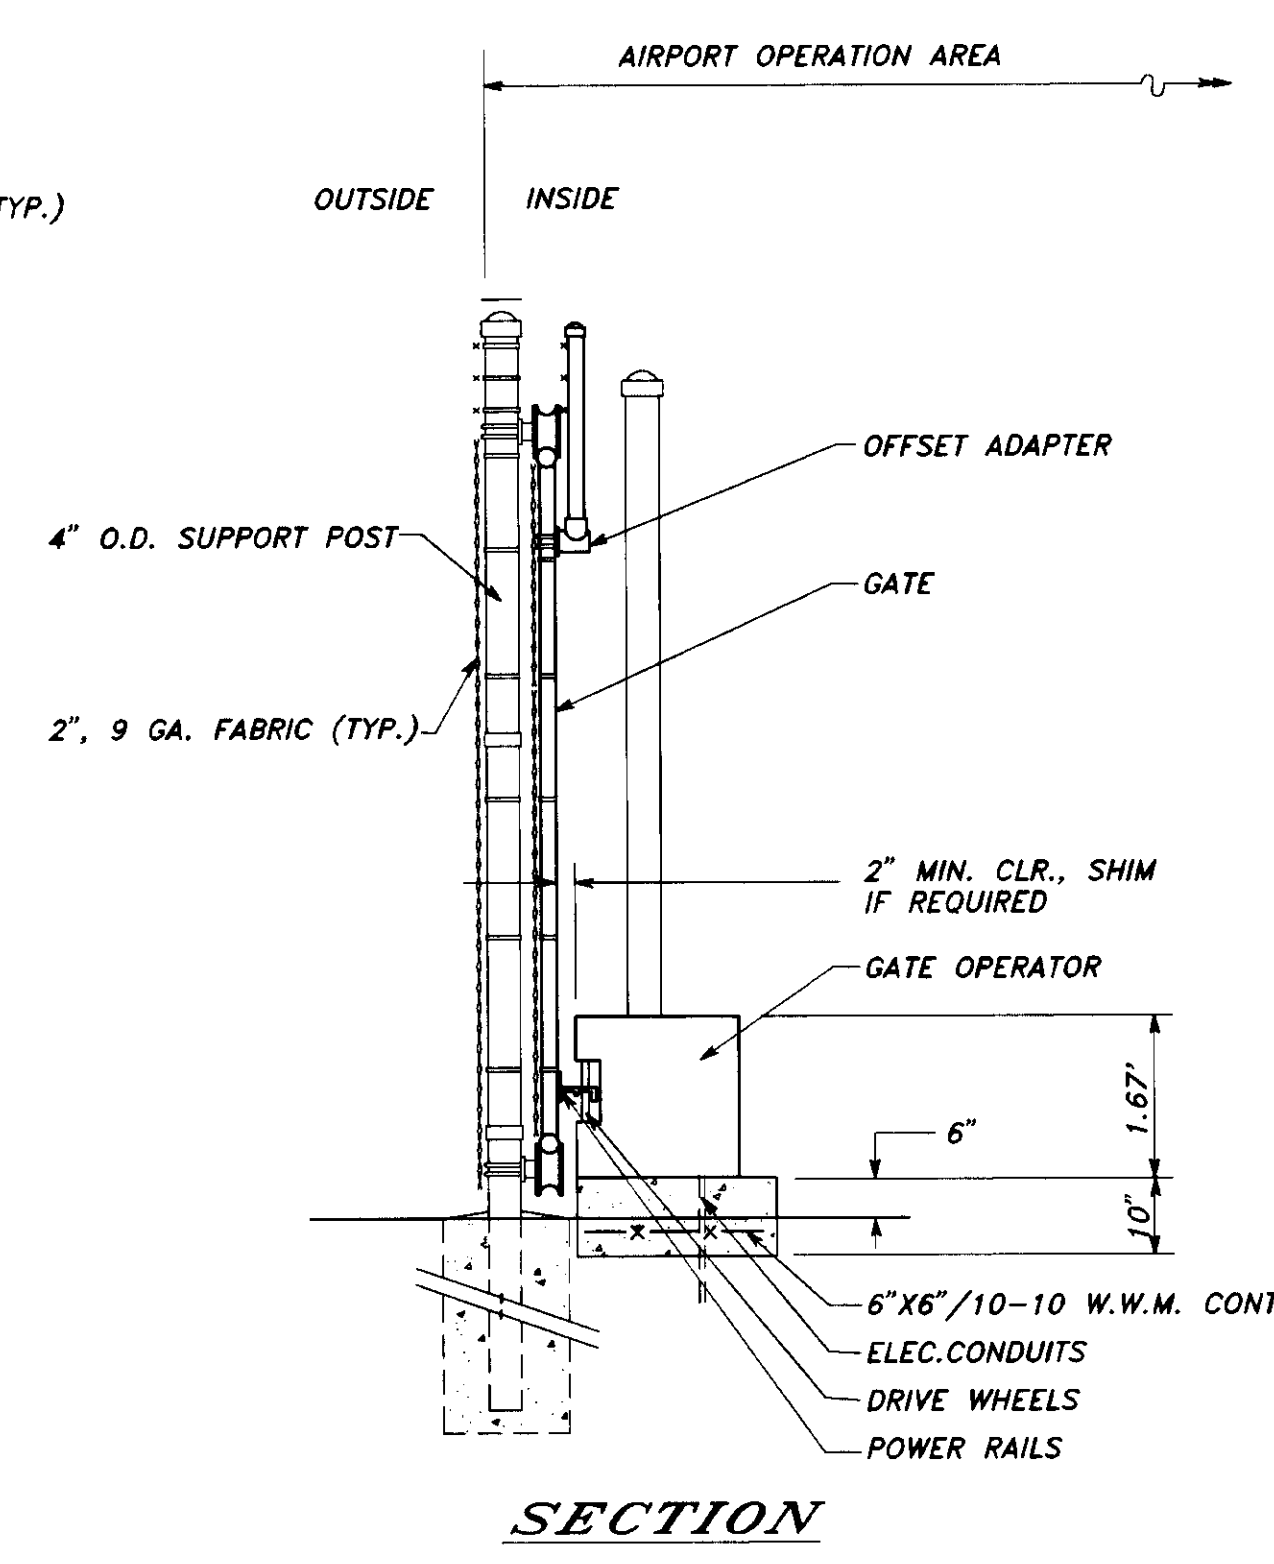



AUTOMATIC SLIDING GATE DETAILS SECTION

AUTOMATIC SLIDING GATE DETAILS


N.T.S.

NOTE: DO NOT SCALE FROM THESE PLANS-USE DIMENSIONS

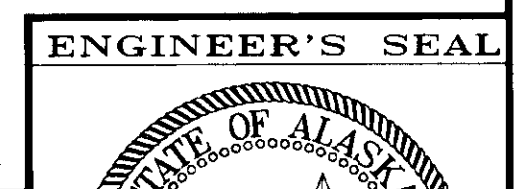

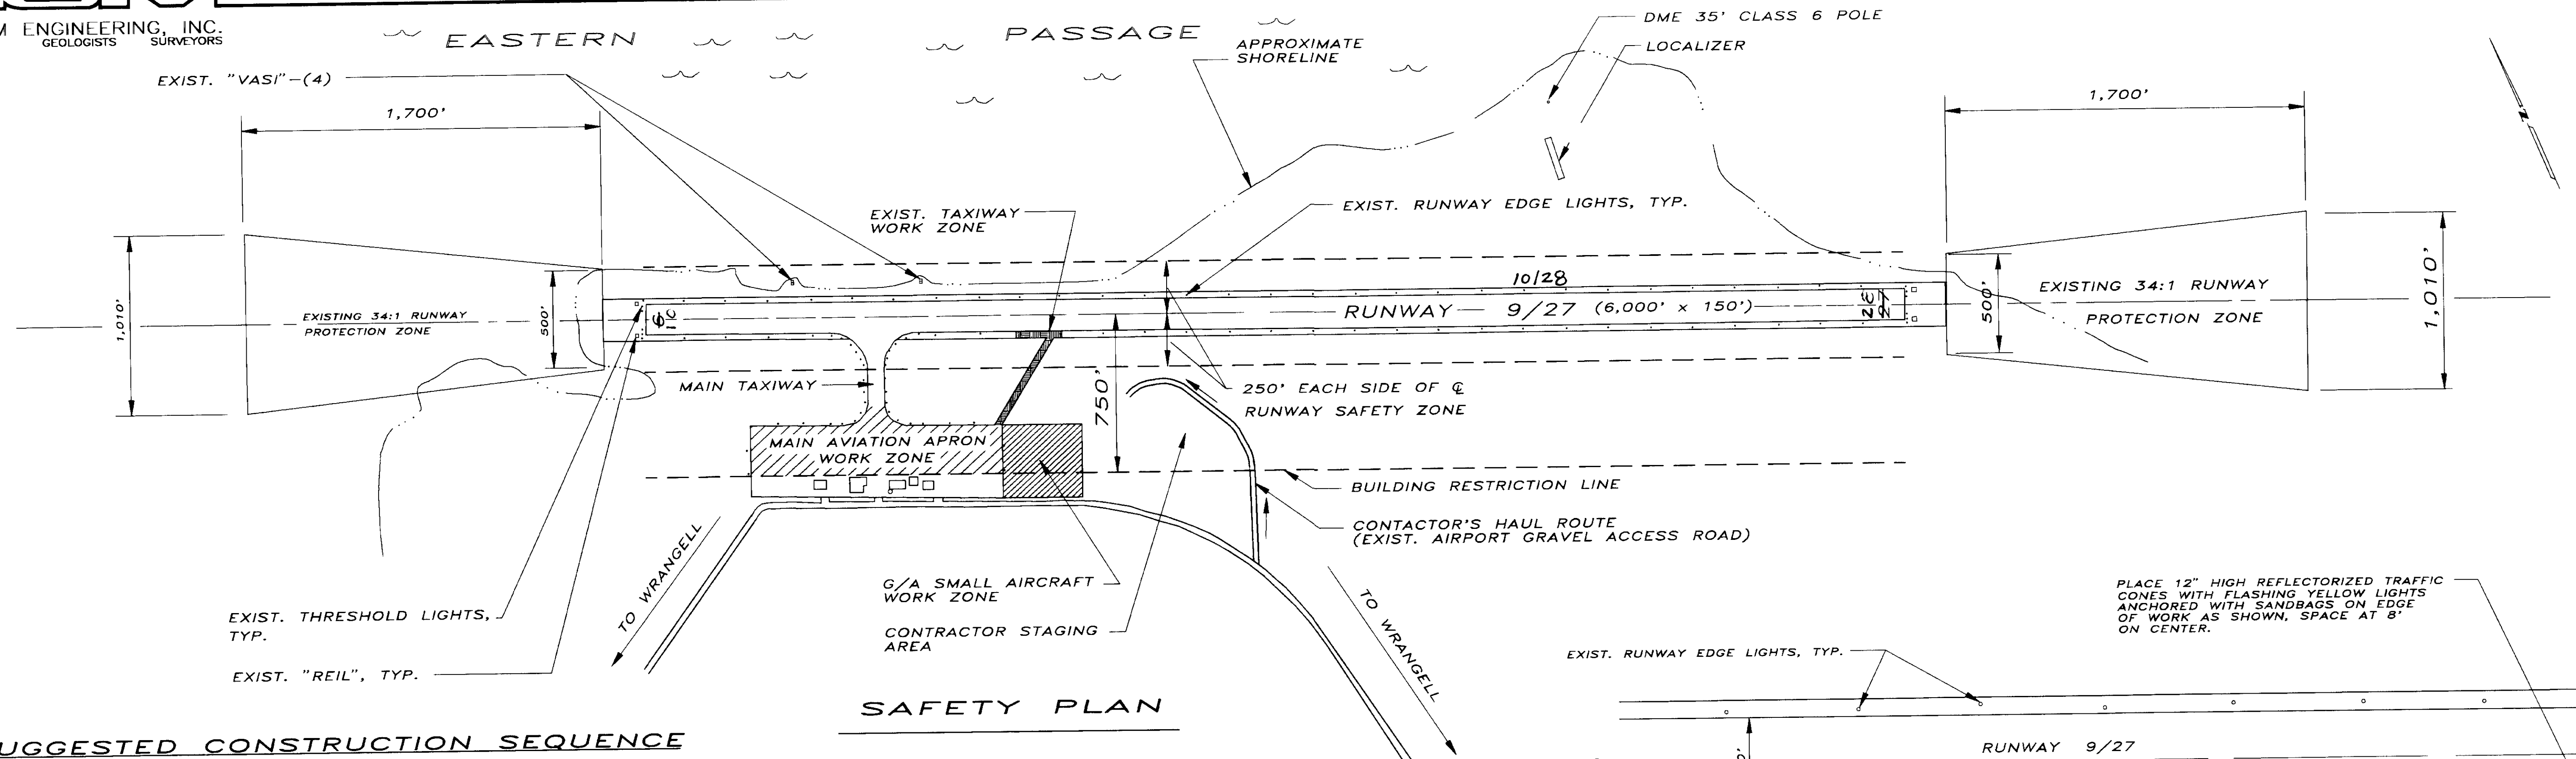

SAFETY PLAN

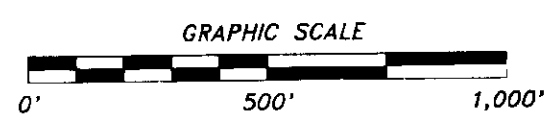


SUGGESTED CONSTRUCTION SEQUENCE

- COMPLETE PAVEMENT REMOVAL, EXCAVATION, EMBANKMENT, SUBBASE COURSE AND CRUSHED AGGREGATE BASE COURSE ON EAST TAXIWAY.
- COMPLETE SUBBASE COURSE AND CRUSHED AGGREGATE BASE COURSE ON SMALL AIRCRAFT TIE-DOWN FACILITY.
- COMPLETE PAVING ON EAST TAXIWAY AND SMALL AIRCRAFT TIE-DOWN FACILITY.
- COMPLETE JET HARDSTAND PAVEMENT REMOVAL, EXCAVATION, CRUSHED AGGREGATE BASE PLACEMENT AND CONCRETE PLACEMENT. PROVIDE TEMPORARY JET PARKING AREA ON WEST HALF OF MAIN AVIATION APRON. COMPLETE TAPERED PAVEMENT MILLING AND 1-1/2" ASPHALT CONCRETE OVERLAY ON EAST HALF OF MAIN AVIATION APRON.
- COMPLETE TAPERED PAVEMENT MILLING AND 1-1/2" ASPHALT CONCRETE OVERLAY ON WEST HALF OF MAIN APRON.
- COMPLETE STRIPING AND CLEAN-UP WORK.
- CHANGES TO THE CONSTRUCTION SEQUENCE PLAN MUST BE APPROVED IN WRITING BY THE AIRPORT MANAGER AND THE ENGINEER PRIOR TO COMMENCING WORK.


SAFETY PLAN NOTES

- NO WORK (PERSONNEL, EQUIPMENT, AND MATERIALS) SHALL BE ALLOWED WITHIN 250' OF RUNWAY 9-27 CENTERLINE 30 MINUTES BEFORE UNTIL 30 MINUTES AFTER JET OPERATIONS.
- SEE SECTION 80 OF THE PROJECT SPECIFICATIONS FOR SPECIAL LIMITATIONS AND OPERATIONAL SAFETY CONCERNS.
- TEMPORARY PAVEMENT TRANSITION SHALL BE CONSTRUCTED AT ALL VERTICAL DROPS OF 1-1/2" OR GREATER IN THICKNESS. PAVEMENT TRANSITIONS SHALL BE SIZED SUCH THAT THE GRADE OF THE TRANSITION DOES NOT EXCEED 1.5%.
- AT ALL EXCAVATIONS ADJACENT TO EXISTING RUNWAY, TAXIWAY OR APRON PAVEMENTS A 6:1 RAMP SHALL BE CONSTRUCTED FOR THE FULL WIDTH OF THE EXCAVATION.
- TEMPORARY "X" MARKINGS MAY BE CLOTH, WOOD OR PLASTIC SECURELY ANCHORED IN PLACE WITH YELLOW COLORED SANDBAGS.
- ONLY ONE HALF OF THE MAIN TAXIWAY MAY BE CLOSED AT ANY ONE TIME. THE CONTRACTOR SHALL PROVIDE JET AND GENERAL AVIATION ACCESS TO THE MAIN AVIATION APRON AT ALL TIMES.

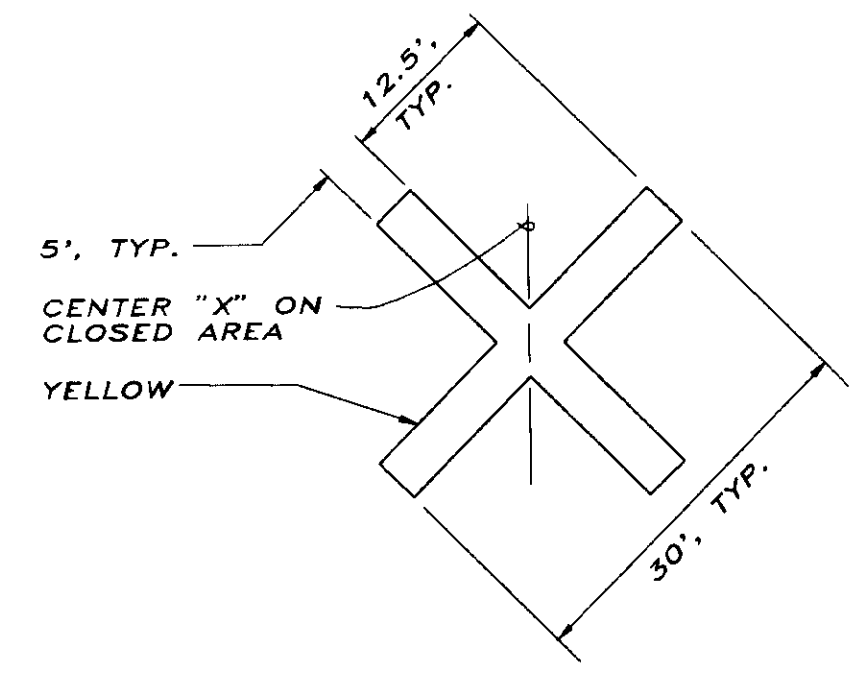

TEMPORARY MARKINGS

N.T.S.

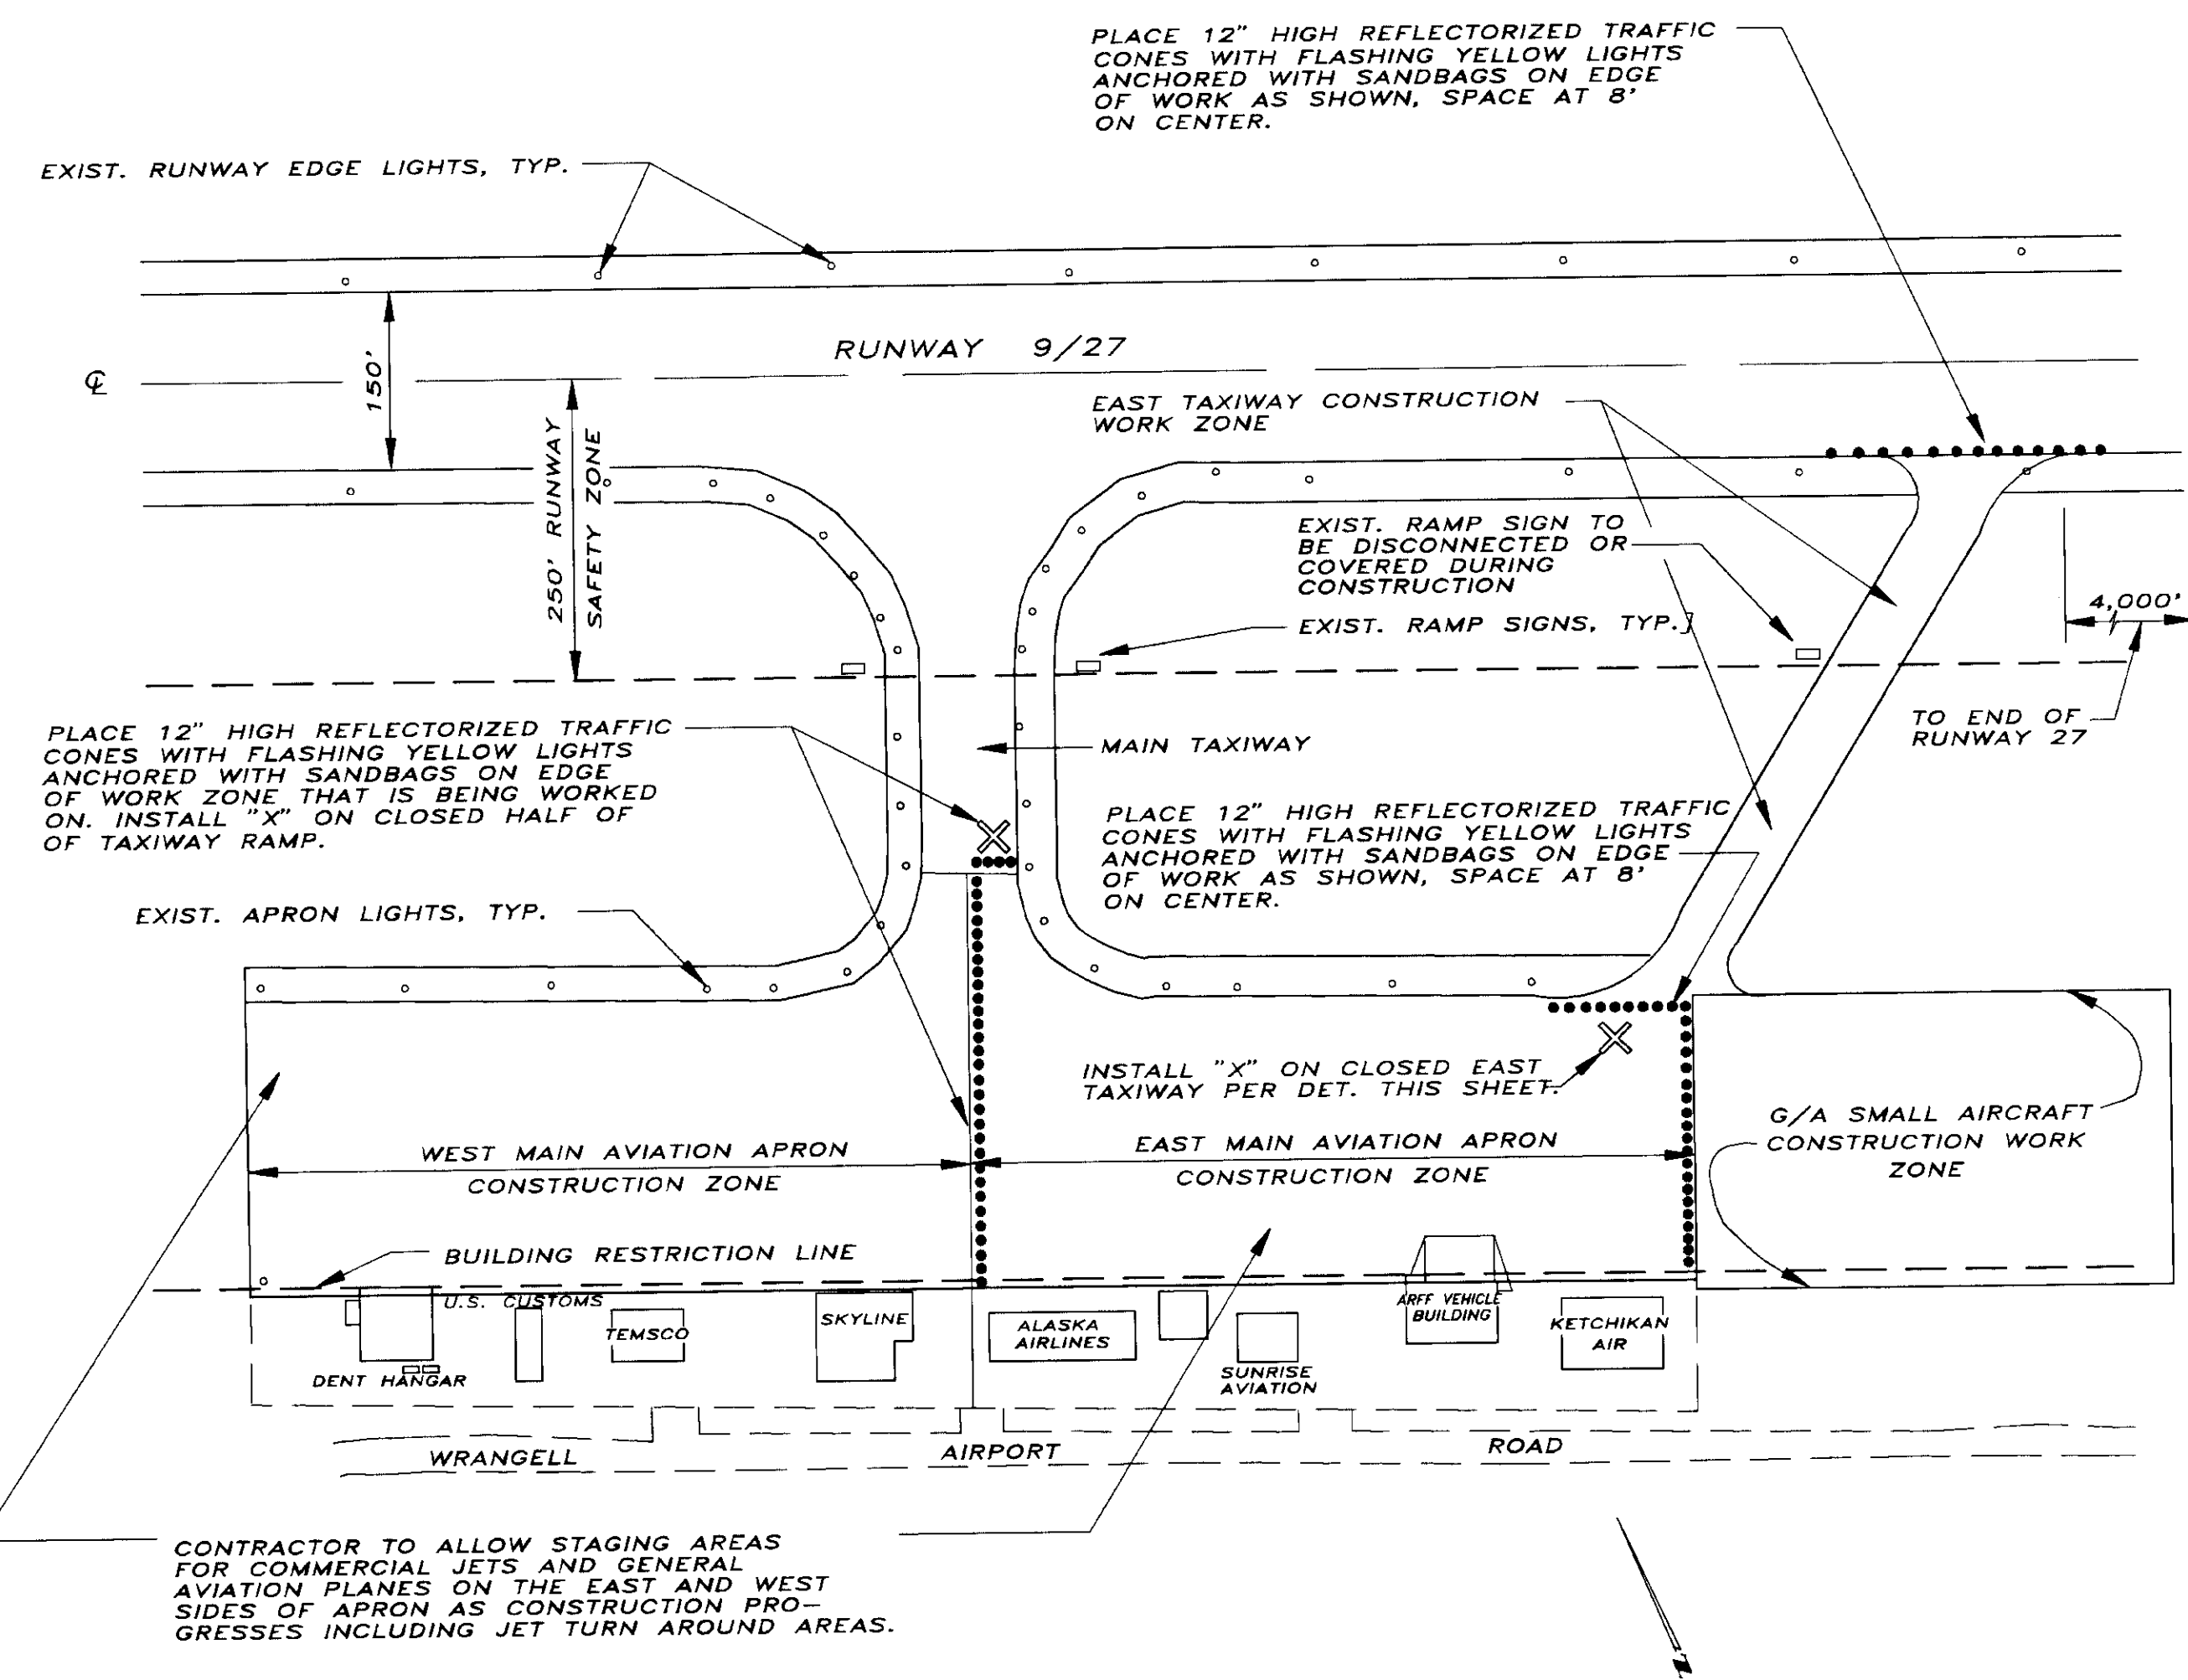

SAFETY PLAN

N.T.S.

NOTE: DO NOT SCALE FROM THESE PLANS-USE DIMENSIONS

ENGINEER'S SEAL



LEGEND

- ⊗ EXISTING RUNWAY/TAXIWAY LIGHTS
- NEW TAXIWAY LIGHT - BLUE
- NEW RUNWAY LIGHT - ELEVATED WHITE/YELLOW
- ⊙ NEW RUNWAY LIGHT - FLUSH WHITE/YELLOW
- JUNCTION
- SINGLE FIXTURE TYPE A
- DOUBLE FIXTURE TYPE B
- ① NOTE 1, SEE PLAN REFERENCES
- ⓔ EXISTING ITEM
- ⓧ REMOVE
- NEW CONDUIT AND WIRE - 2/C
- EXISTING CONDUIT AND WIRE
- EXISTING CONDUIT AND WIRE CONTINUES
- ☉ EXISTING FLOODLIGHT
- ▼ APRON REFLECTOR
- RSC RIGID STEEL CONDUIT
- ⊙ MOTOR - SIZE NOTED
- ⊙ EXISTING UTILITY POLE
- ⊙ DUPLEX OUTLET 5-15R
- DISCONNECT
- ⊞ TRANSFORMER
- ⊞ PRIMARY CUTOUT
- ▽ PRIMARY TERMINATOR
- ⋮ PRIMARY ARRESTOR

FIXTURE SCHEDULE

| TYPE | MFG. | W | REMARKS (SEE SHEET E-3) |
|------|-------------------------------------|----------|----------------------------|
| A | DEVINE PCR1628A-250HPS-DB-240-LEX | 1-250HPS | SEE DETAIL |
| | HUBBELL RCJ-0250S-IT8-1-240-RCS-SPC | 1-250HPS | SEE DETAIL AND MAA-10-1 |
| | McPHILBEN 17RA64-1D-240-VC | 1-250HPS | SEE DETAIL |
| B | DEVINE PCR1628B-400HPS-DB-240-LEX | 2-400HPS | SEE DETAIL |
| | HUBBELL RCJ-0400S-IT8-1-240-RCS-SPC | 2-400HPS | SEE DETAIL AND MAA-10-1(2) |
| | McPHILBEN 17RB66-2D-240-VC | 2-400HPS | SEE DETAIL |


TAXIWAY LIGHT LOCATIONS

| LIGHT # | STATION | OFFSET | LIGHT # | STATION | OFFSET |
|---------|-------------|-----------|---------|-------------|-----------|
| T-39 | "T"9+52.0 | 27.50'LT | T-55 | "T"17+77.92 | 32.80'RT |
| T-40 | "T"10+02.0 | 27.50'LT | T-56 | "T"17+31.40 | 27.50'RT |
| T-41 | "T"10+95.0 | 27.50'LT | T-57 | "T"16+81.40 | 27.50'RT |
| T-42 | "T"11+88.0 | 27.50'LT | T-58 | "T"16+18.70 | 27.50'RT |
| T-43 | "T"12+38.0 | 27.50'LT | T-59 | "T"15+56.0 | 27.50'RT |
| T-44 | "T"13+72.0 | 27.50'LT | T-60 | "T"15+06.0 | 27.50'RT |
| T-45 | "T"15+06.0 | 27.50'LT | T-61 | "T"13+72.0 | 27.50'RT |
| T-46 | "T"15+56.0 | 27.50'LT | T-62 | "T"12+38.0 | 27.50'RT |
| T-47 | "T"15+79.90 | 37.00'LT | T-63 | "T"11+88.0 | 27.50'RT |
| T-48 | "T"15+96.45 | 59.50'LT | T-64 | "T"11+53.53 | 38.00'RT |
| T-49 | "T"15+97.5 | 88.50'LT | T-65 | "T"11+39.68 | 61.75'RT |
| T-50 | "T"15+71.14 | 103.20'LT | T-66 | "T"11+41.36 | 93.00'RT |
| T-51 | "T"15+74.70 | 108.80'LT | T-67 | "T"11+58.30 | 114.50'RT |
| T-52 | "T"18+53.50 | 70.00'RT | T-68 | "T"12+00 | 142.00'RT |
| T-53 | "T"18+49.40 | 75.60'RT | T-69 | "T"12+76.23 | 190.50'RT |
| T-54 | "T"18+20.05 | 46.20'RT | T-70 | "T"13+51.92 | 238.50'RT |


NOTE - STATION AND OFFSETS GIVEN TO CENTER OF TAXIWAY OR APRON LIGHT, SEE SHEET 7 OF 19 FOR "T" BASELINE INFORMATION.

PLAN REFERENCES



- ① REMOVE EXISTING 2-1/C #8 5KV IN 2" PVC TO T-8.
- ② REMOVE ② 2-1/C #8 5KV FROM ② 2" PVC - ALSO REMOVE T-2, T-4 & T-6.
- ③ EXISTING 2" PVC WITH 12-2 UF AND 10/C-14 TO EXISTING WIND GAUGE. PROVIDE 3 RUNS OF 340 LF 2" RSC - REPLACEMENT OF CABLE WILL BE BY U.S. WEATHER BUREAU - NOTE EXISTING CONDUIT IS IN EXISTING CULVERT.
- ④ INSTALL NEW HIGH INTENSITY RUNWAY LIGHT TO MATCH ④ (C-H 44609A WHITE/YELLOW). INTERCEPT ④ 2" PVC CONDUIT AND INSTALL NEW L-867-12" BASE WITH NEW #8-5KV CABLE EACH WAY.
- ⑤ REMOVE ⑤ ELEVATED RUNWAY LIGHT AND INSTALL NEW FLUSH MOUNTED L-850C RUNWAY WHITE/YELLOW BIDIRECTION EDGE LIGHT WITH NEW L868-15" BASE.
- ⑥ REMOVE ⑥ 40' STEEL TOWER WITH 2-1000 MV AND CONCRETE BASE. INSTALL NEW FIXTURE TYPE "B".
- ⑦ ELECTRIC GATE 1H.P. 240V 1 ⌀ 5#12 OR 3#10 & 2#12-3/4 OR 2" RSC - SEE DETAIL SHEET 13 OF 19 FOR INSTALLATION AND CONTROLS.
- ⑧ CHANGE EXISTING SIGN CIRCUIT FROM RUNWAY TO NEW TAXIWAY CIRCUIT.

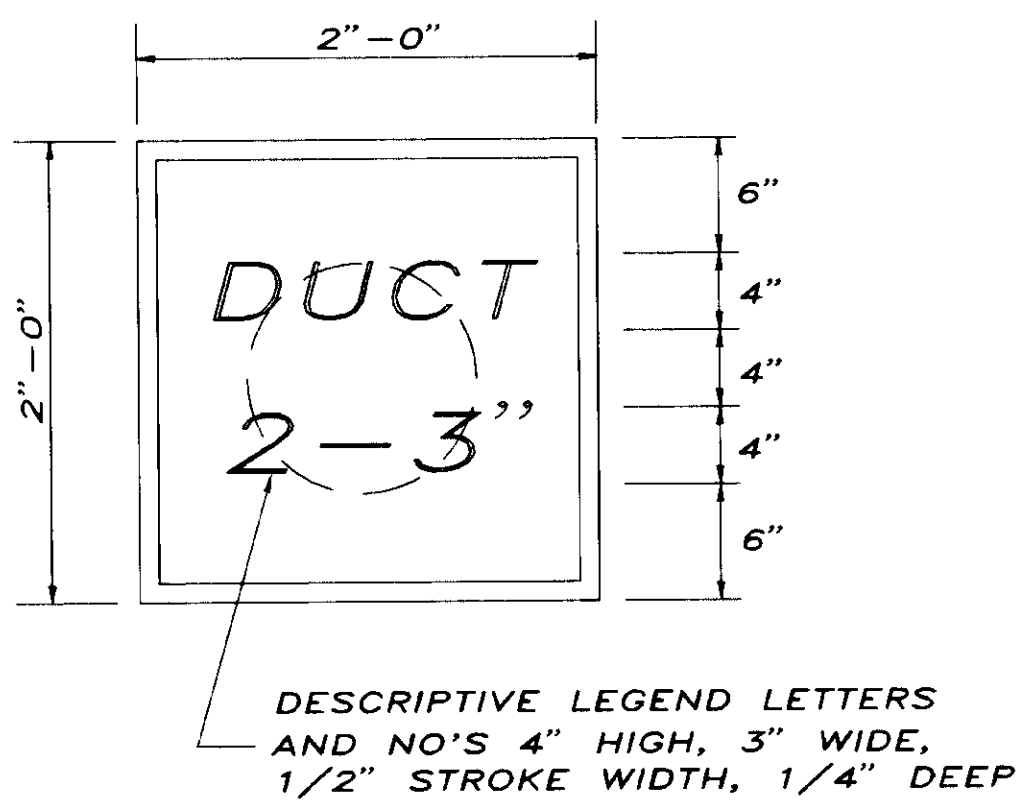

DUCT MARKER (TOP VIEW)
N.T.S.

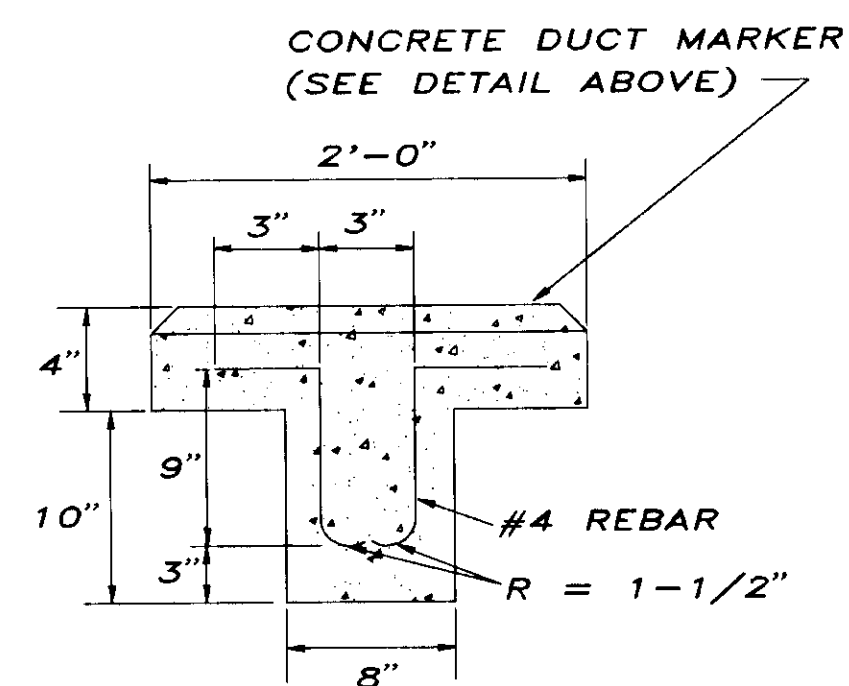


DUCT MARKER (ELEVATION)
N.T.S.

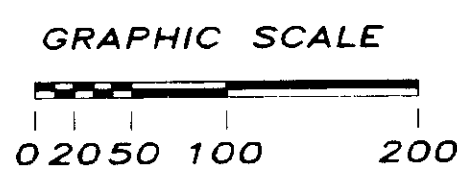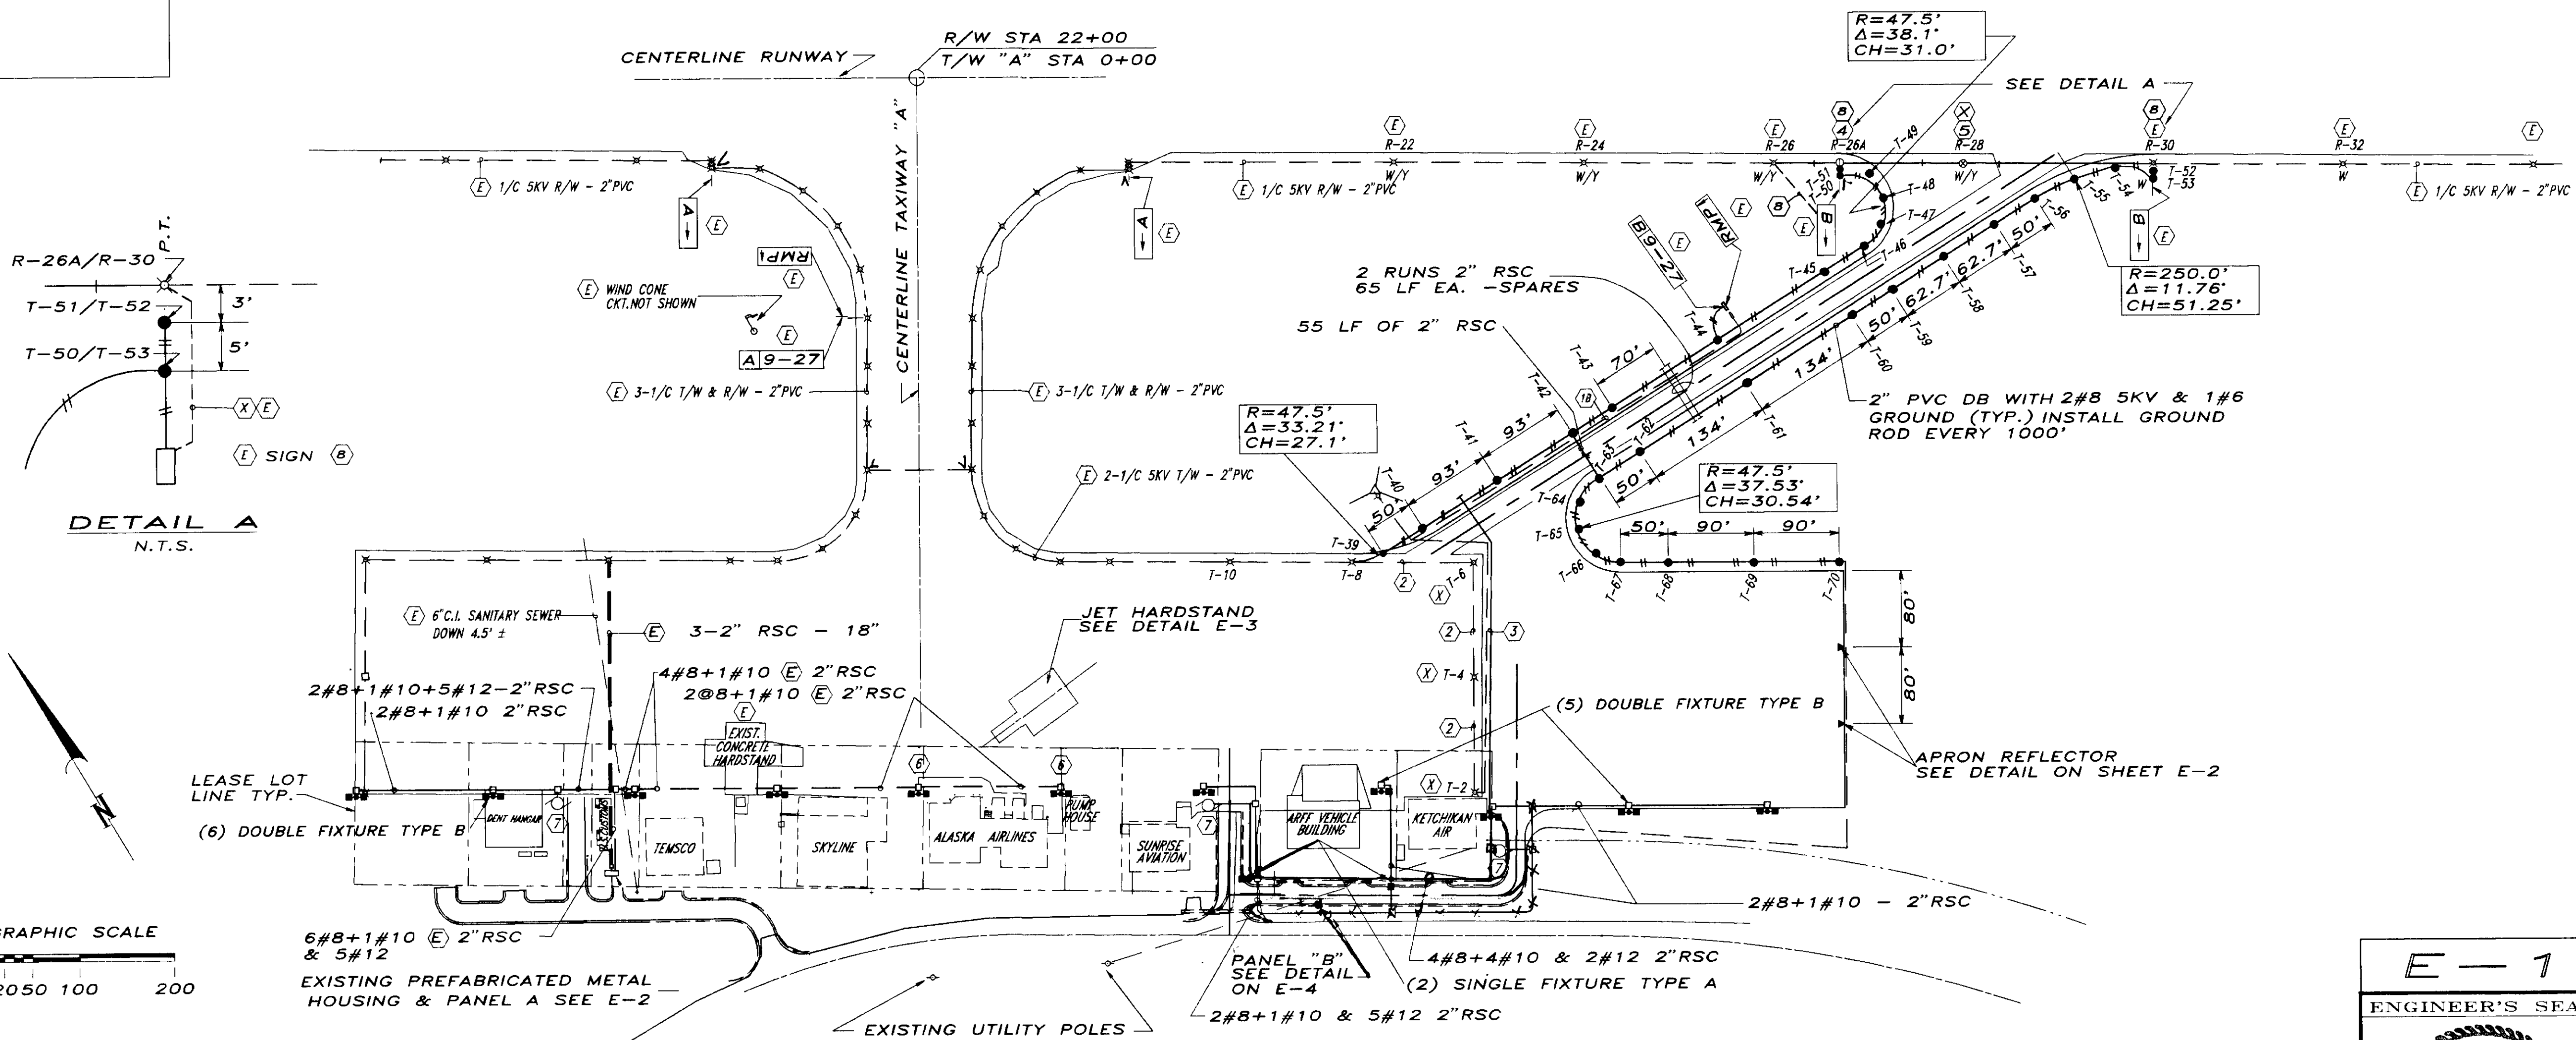


NOTE: DO NOT SCALE FROM THESE PLANS-USE DIMENSIONS

R & M ENGINEERING, INC.
ENGINEERS GEOLOGISTS SURVEYORS

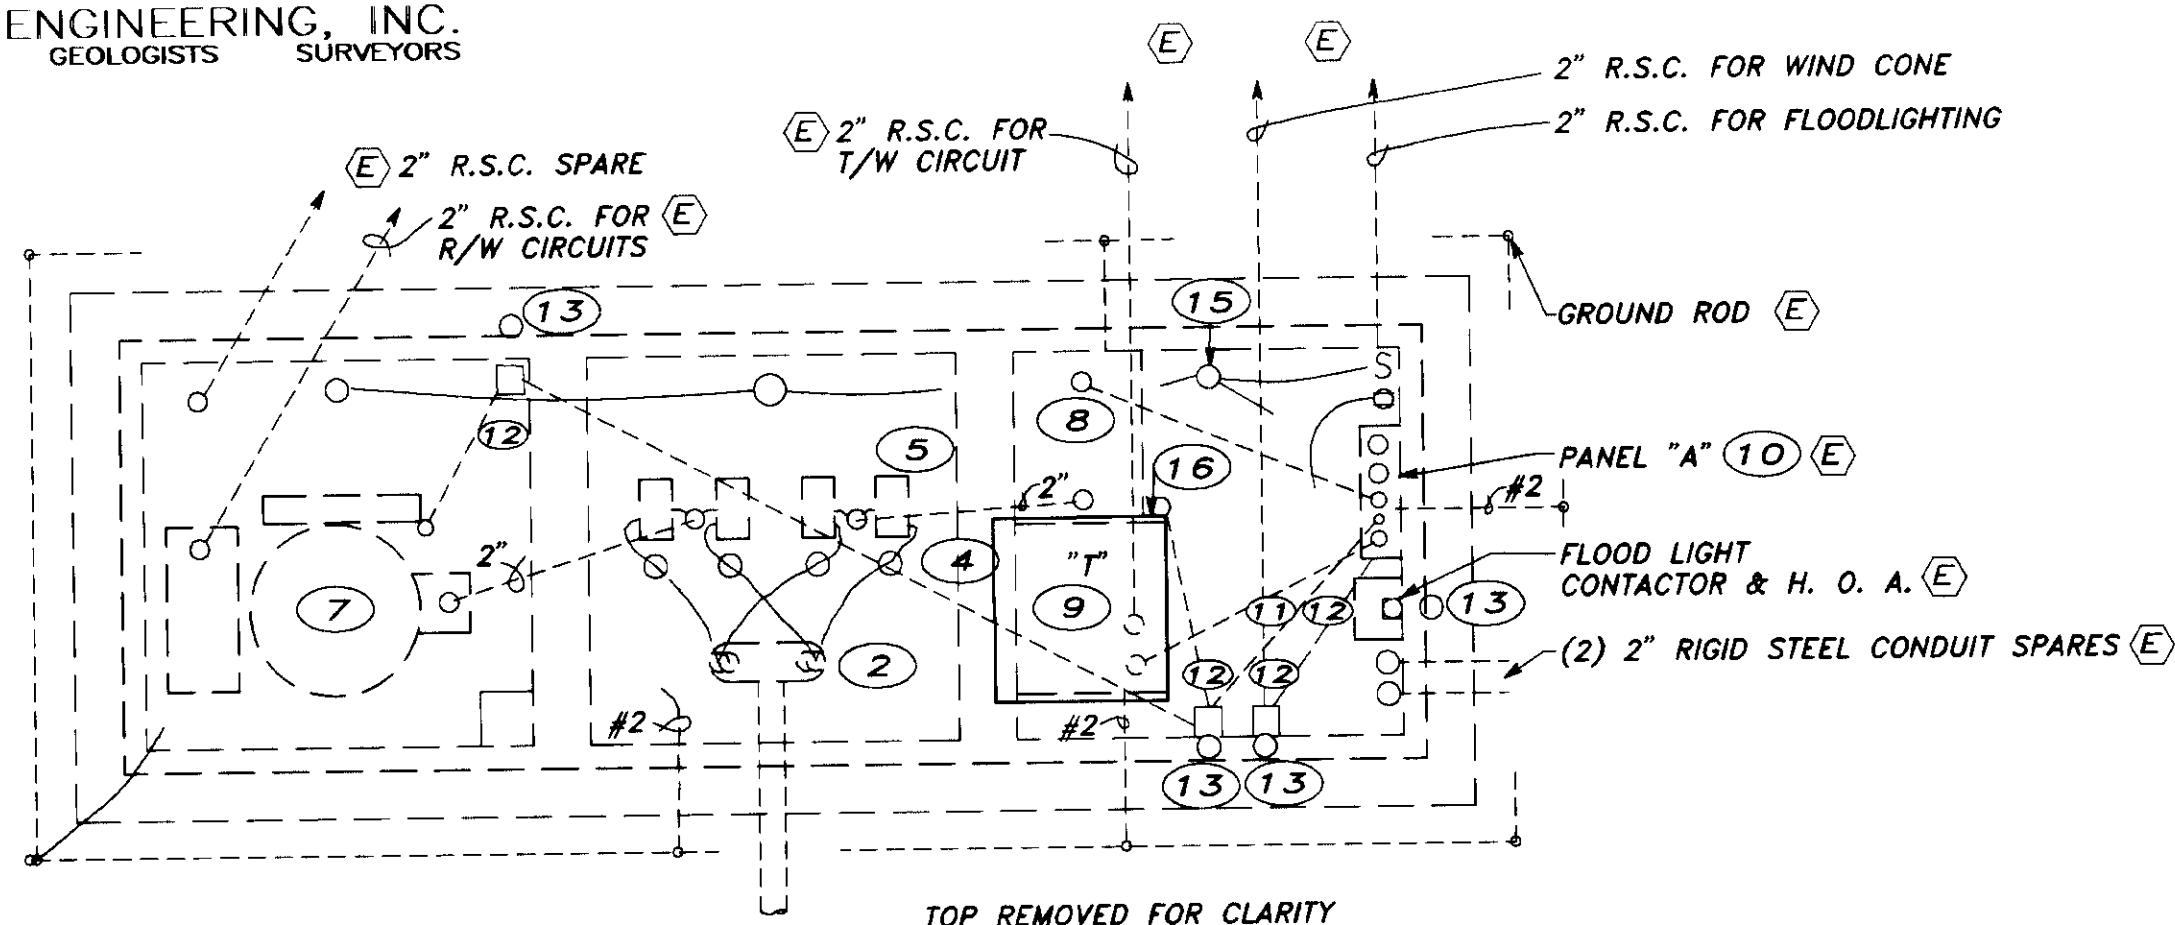

PLAN

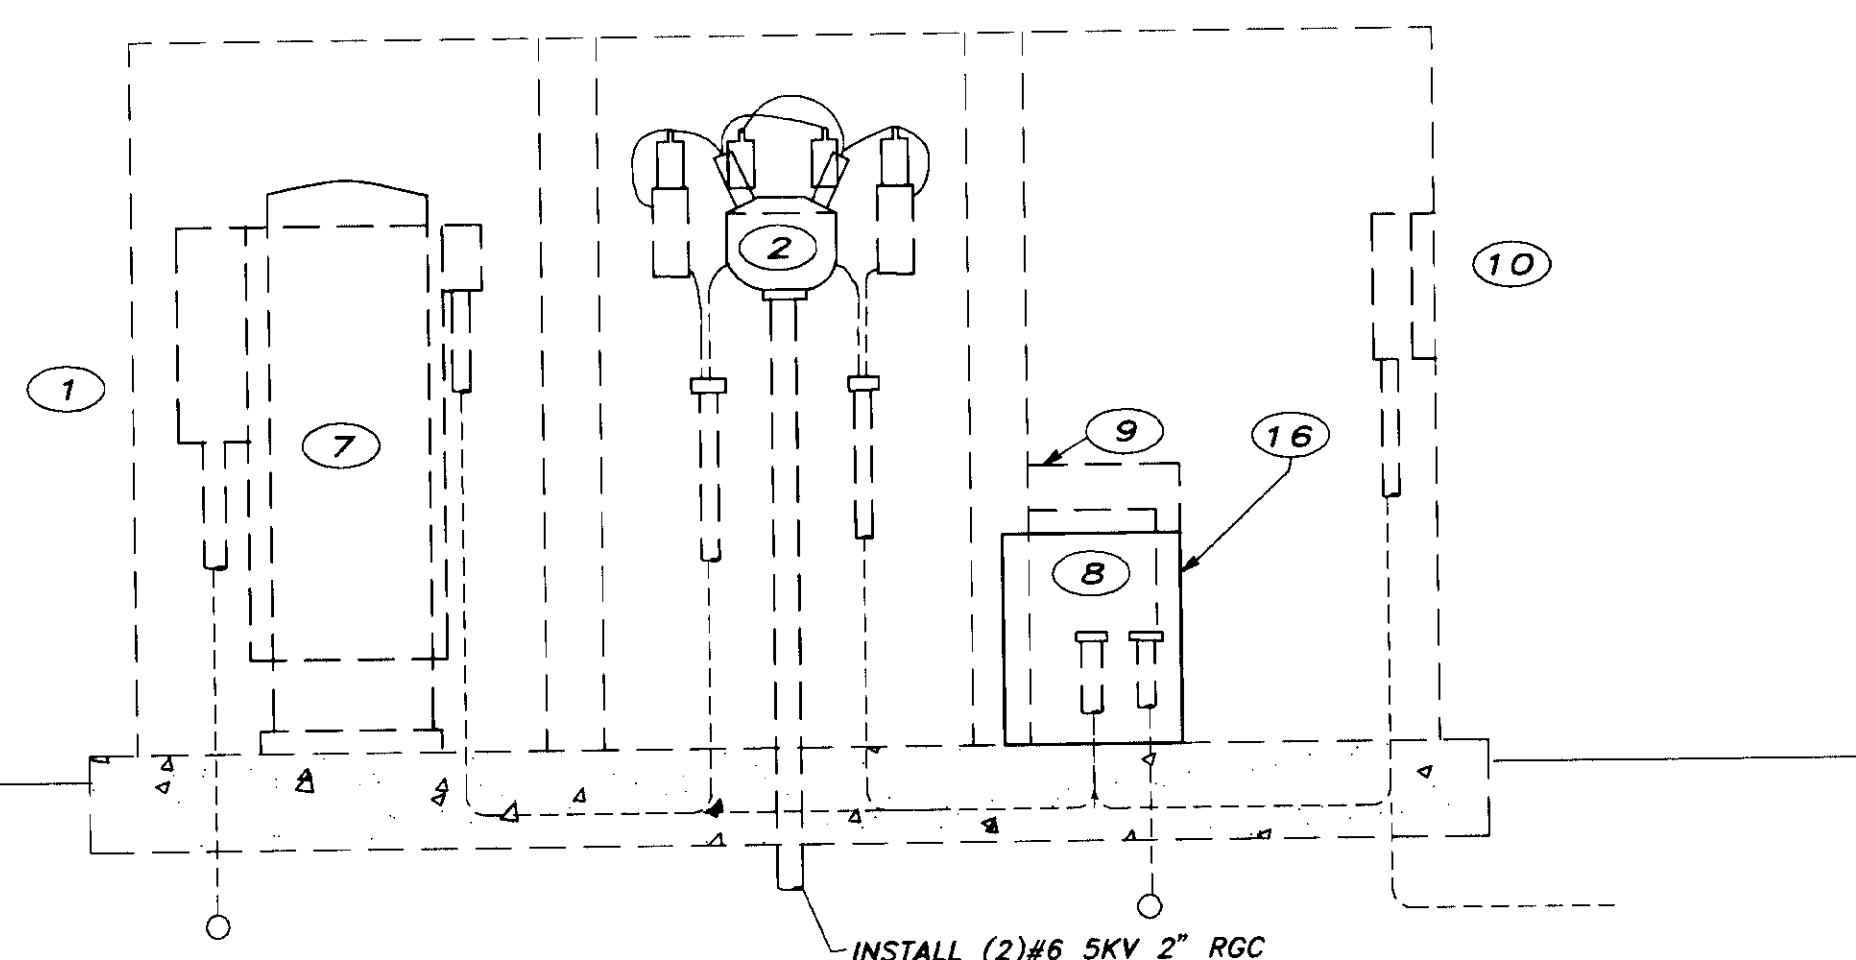


ELEVATION
PREFABRICATED METAL HOUSING

N.T.S.


| QUANTITIES | | | | |
|------------|------|----------------------|--|-----------|
| ITEM | QTY. | MFG OR EQUAL | DESCRIPTION | REMARKS |
| 1 | 1 | L/M DU13E43 | 55"Wx162"Lx91"H | (E) |
| 2 | 1 | G&W JT2404B | POTHEAD BKV | (E) |
| 3 | LOT | | #6-5KV 1/C | (E) |
| 4 | 4 | | INSULATOR 5KV | (E) |
| 5 | 4 | L/MFEIA3 | CUTOUT FUSED | (E) |
| 6 | | | | (E) |
| 7 | 1 | L828 | CONSTANT CURRENT 20KW | (E) |
| 8 | 1 | TIERNEY SAC12515Y13H | 25VA 2400-1Ø TO 120/240 1Ø WEATHER PROOF | (E) |
| 9 | | L813 (HD#D52620) | CONSTANT CURRENT 4KW | REMOVE |
| 10 | 1 | SQ D NQOB-100A | PNL A NEMA 3R | (E) |
| 11 | 1 | SQ D LG80 | 8P-20A NEMA 3R | (E) |
| 12 | 4 | SQ D KYC111 | H.O.A. NEMA 3R | (E) |
| 13 | 3 | TORK 2100 | PHOTO ELEC. - NORTH SIDE | (E) |
| 14 | LOT | L/M | MOUNTING RAILS & BOLTS | (E) |
| 15 | 3 | APP. VGAT1050G | 100W ABOVE DOOR | (E) |
| 16 | 1 | L828 | CONSTANT CURRENT 7.5KW | INSTALL * |

* C-H 26.1H X 21.0W X 23.0D MAINTAIN CLEARANCE TO PANEL A PER NEC

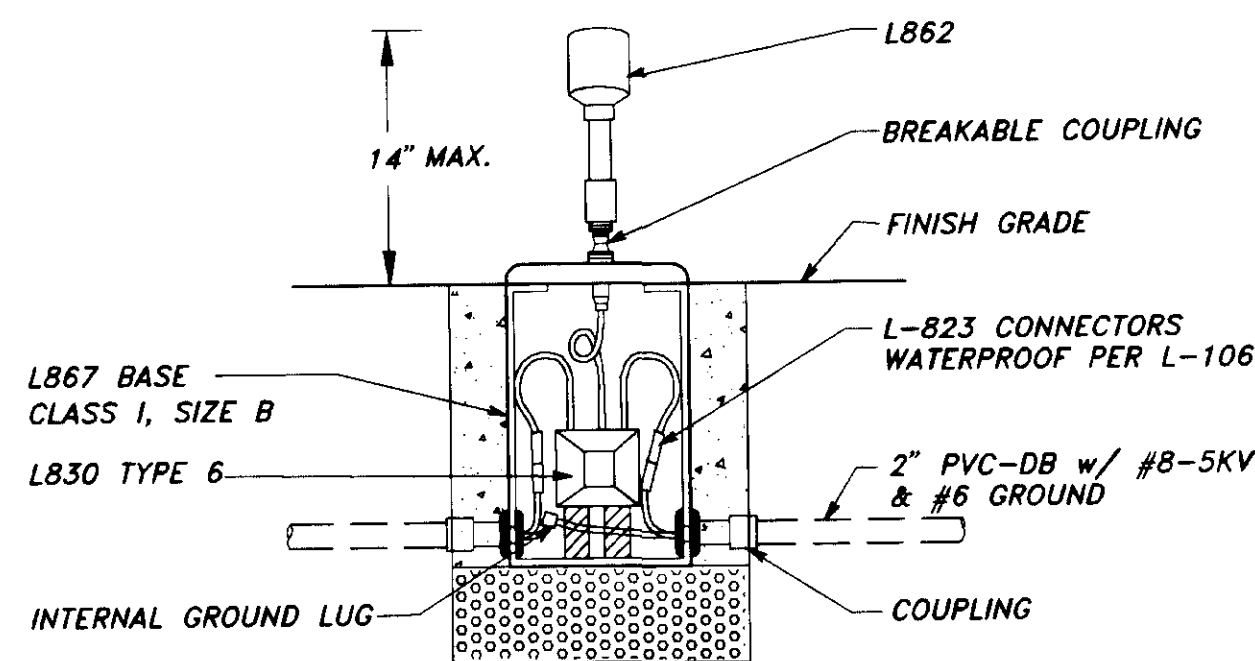


TYPICAL RUNWAY LIGHT INSTALLATION DETAIL

N.T.S.

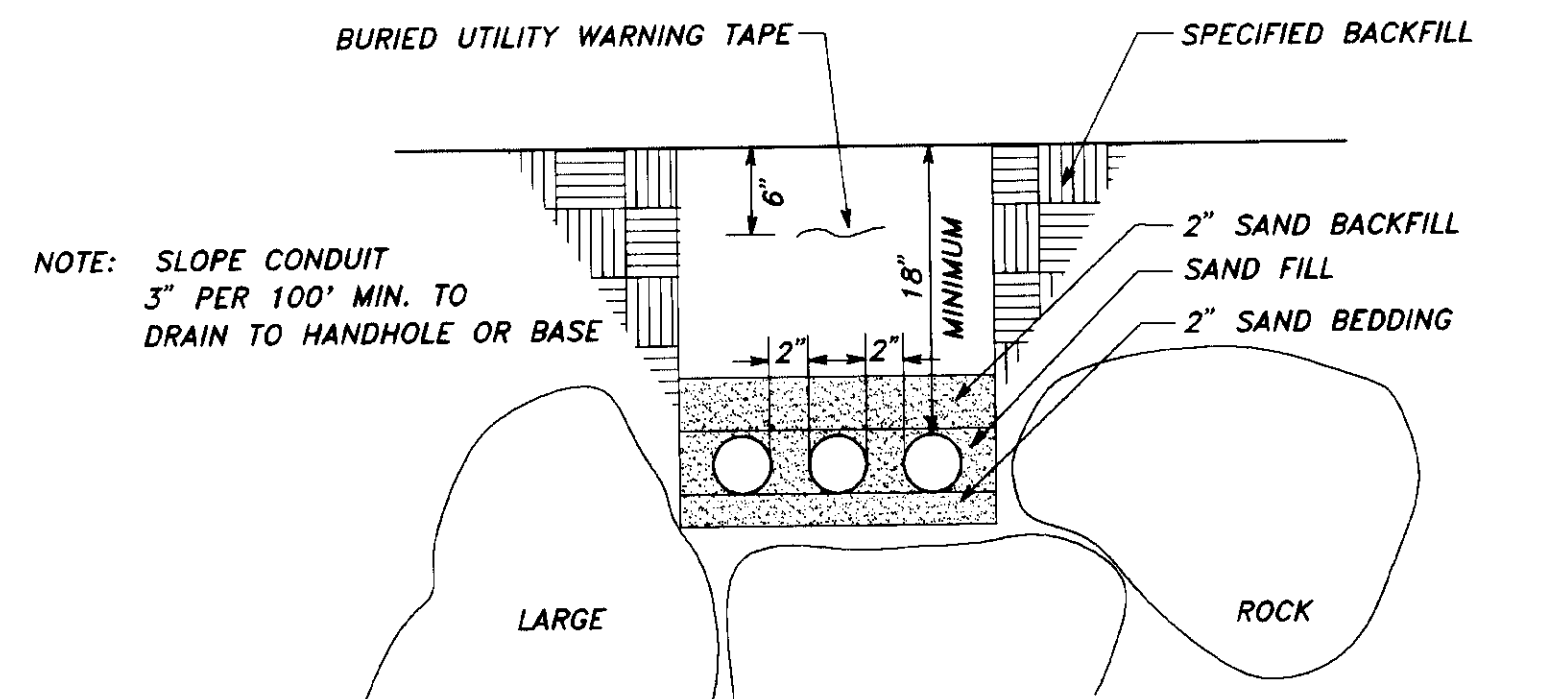


TYPICAL TRENCH DETAIL

N.T.S.

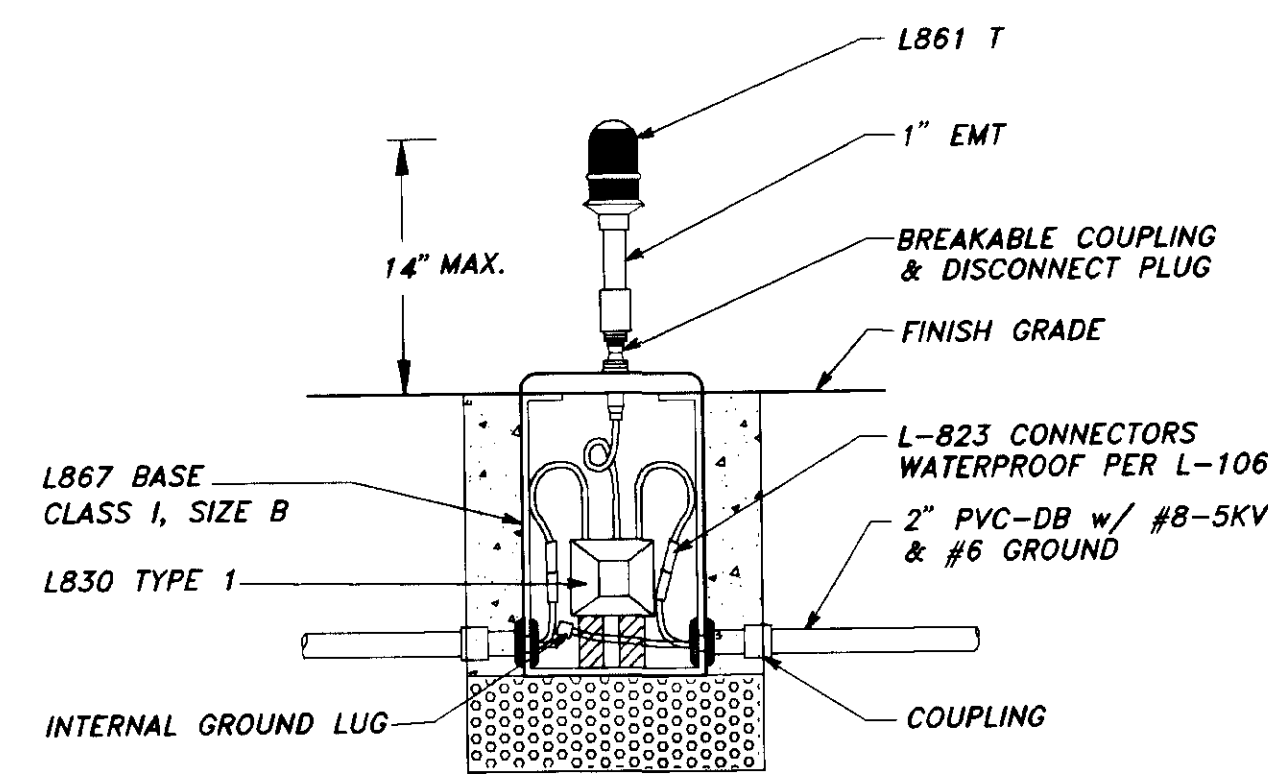


TAXIWAY LIGHT INSTALLATION DETAIL

N.T.S.

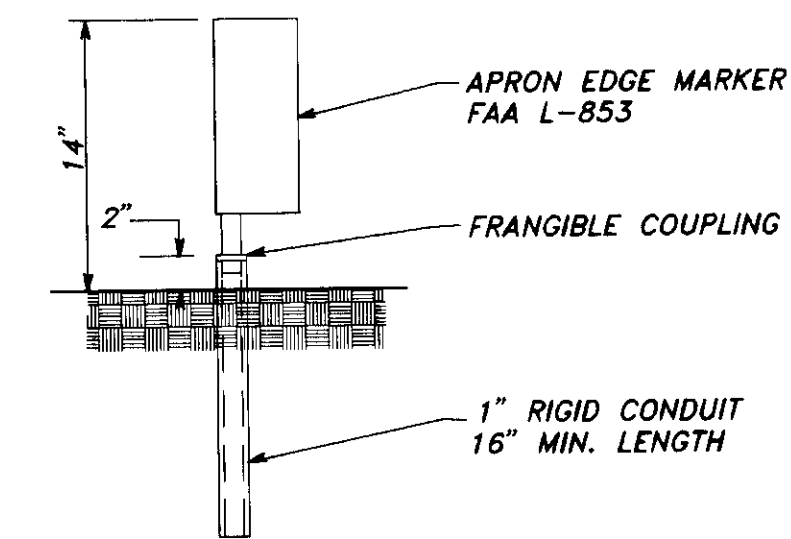


APRON REFLECTOR DETAIL

N.T.S.

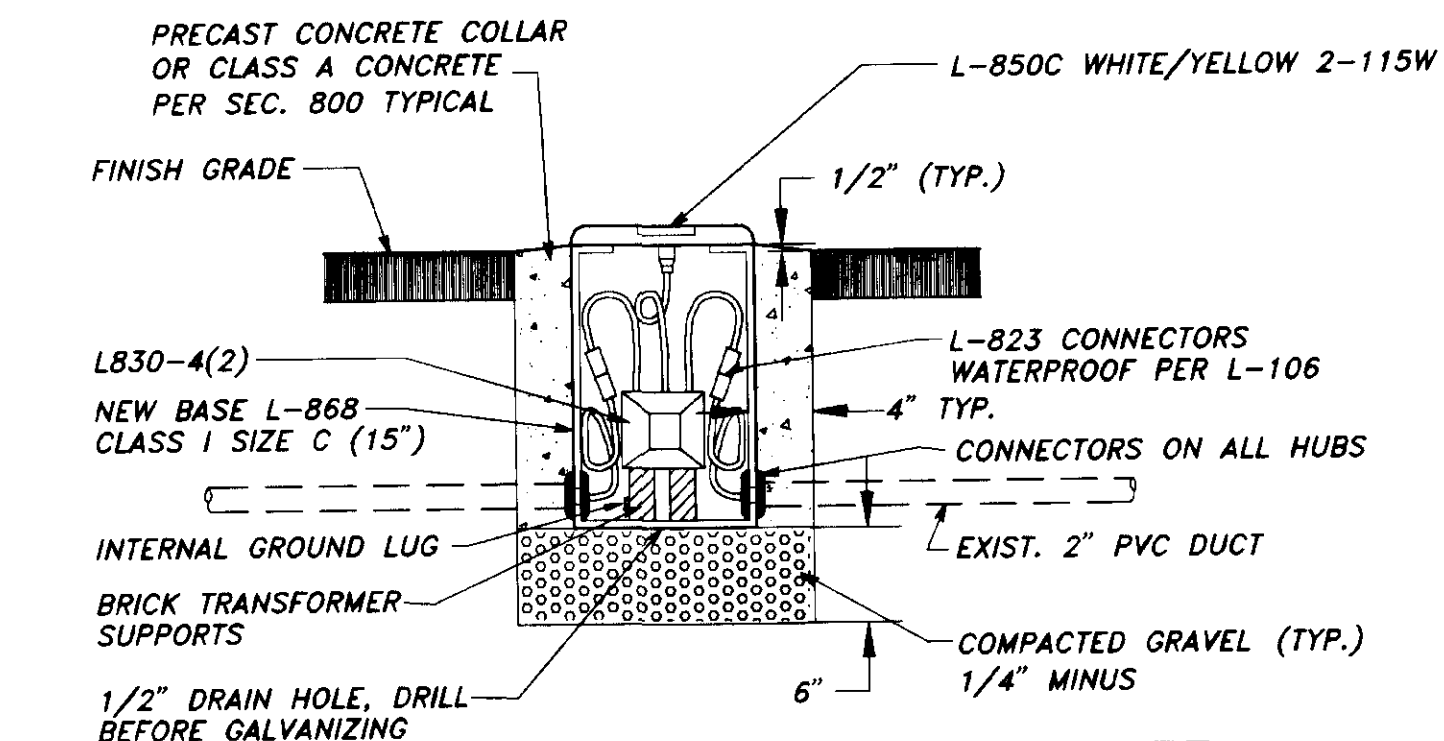

BASE MOUNTED HIGH INTENSITY RUNWAY LIGHT

N.T.S.

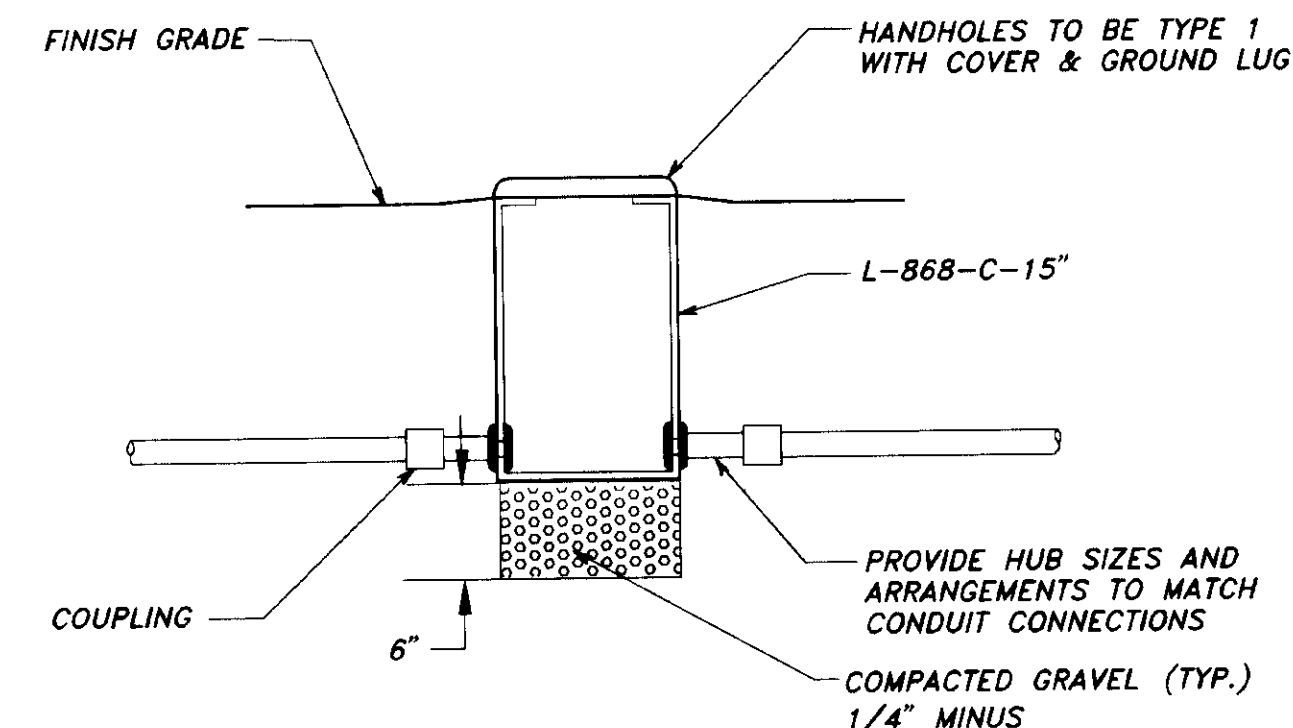



HANDHOLE DETAIL

N.T.S.

NOTE: DO NOT SCALE FROM THESE PLANS-USE DIMENSIONS


E-2
ENGINEER'S SEAL

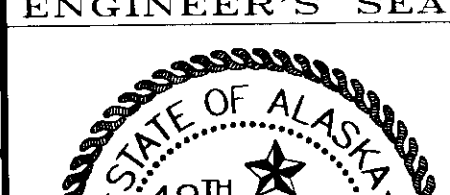

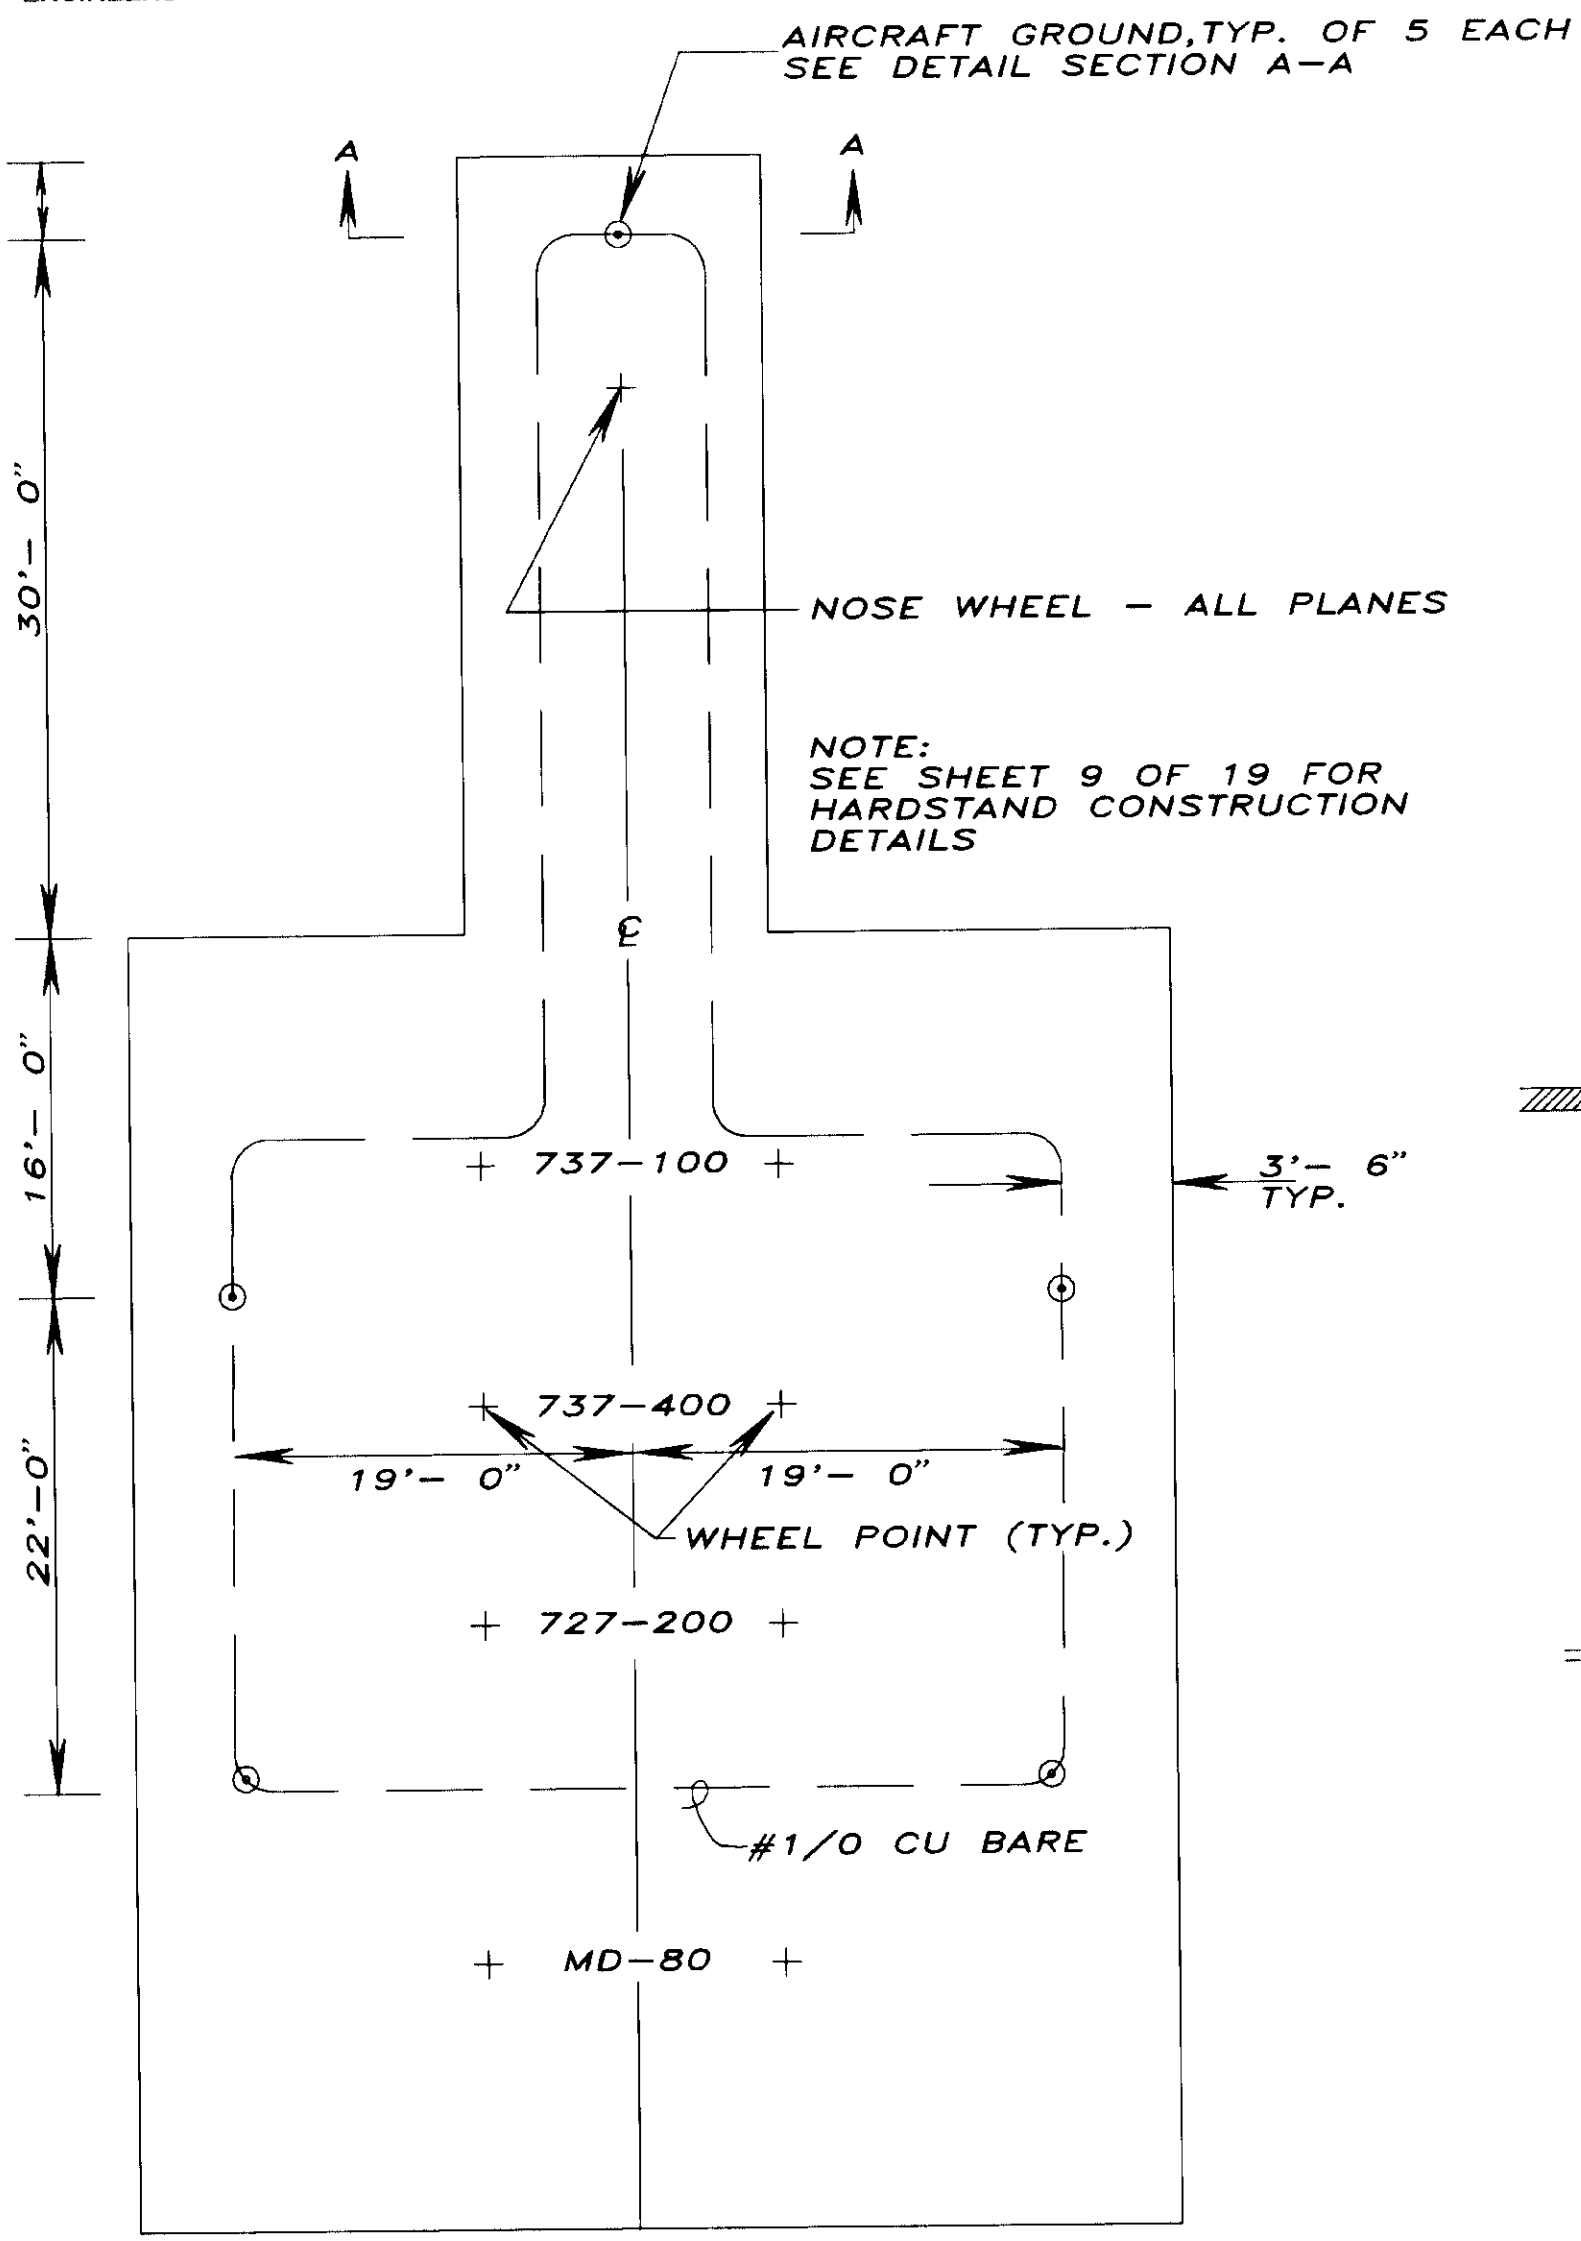


AIRCRAFT HARDSTAND GROUND PLAN

N.T.S.

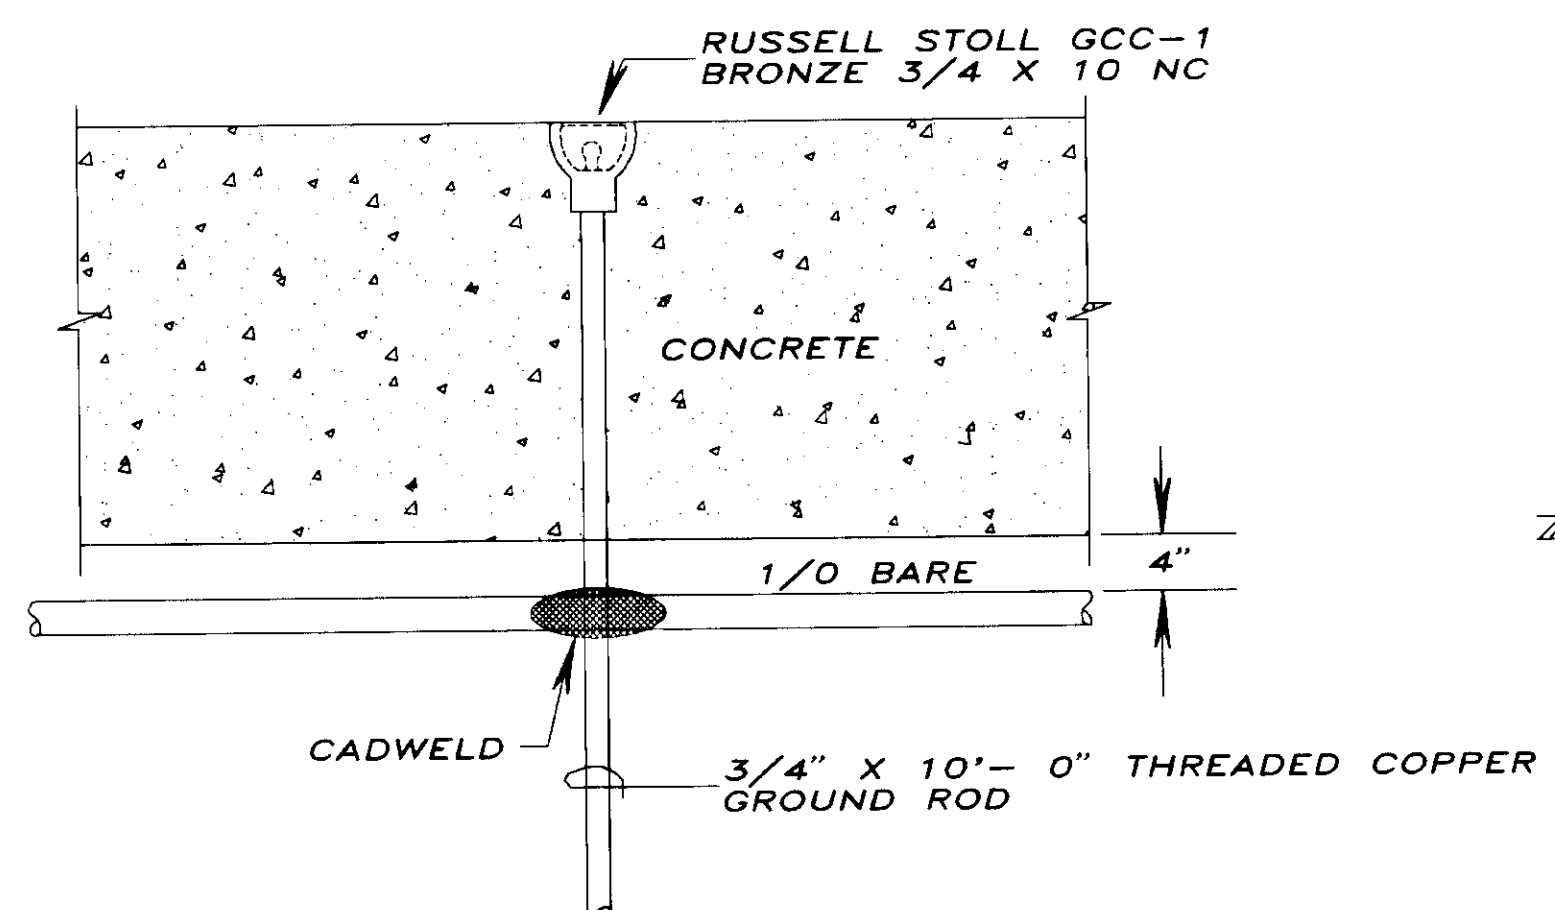


SECTION A-A

N.T.S.

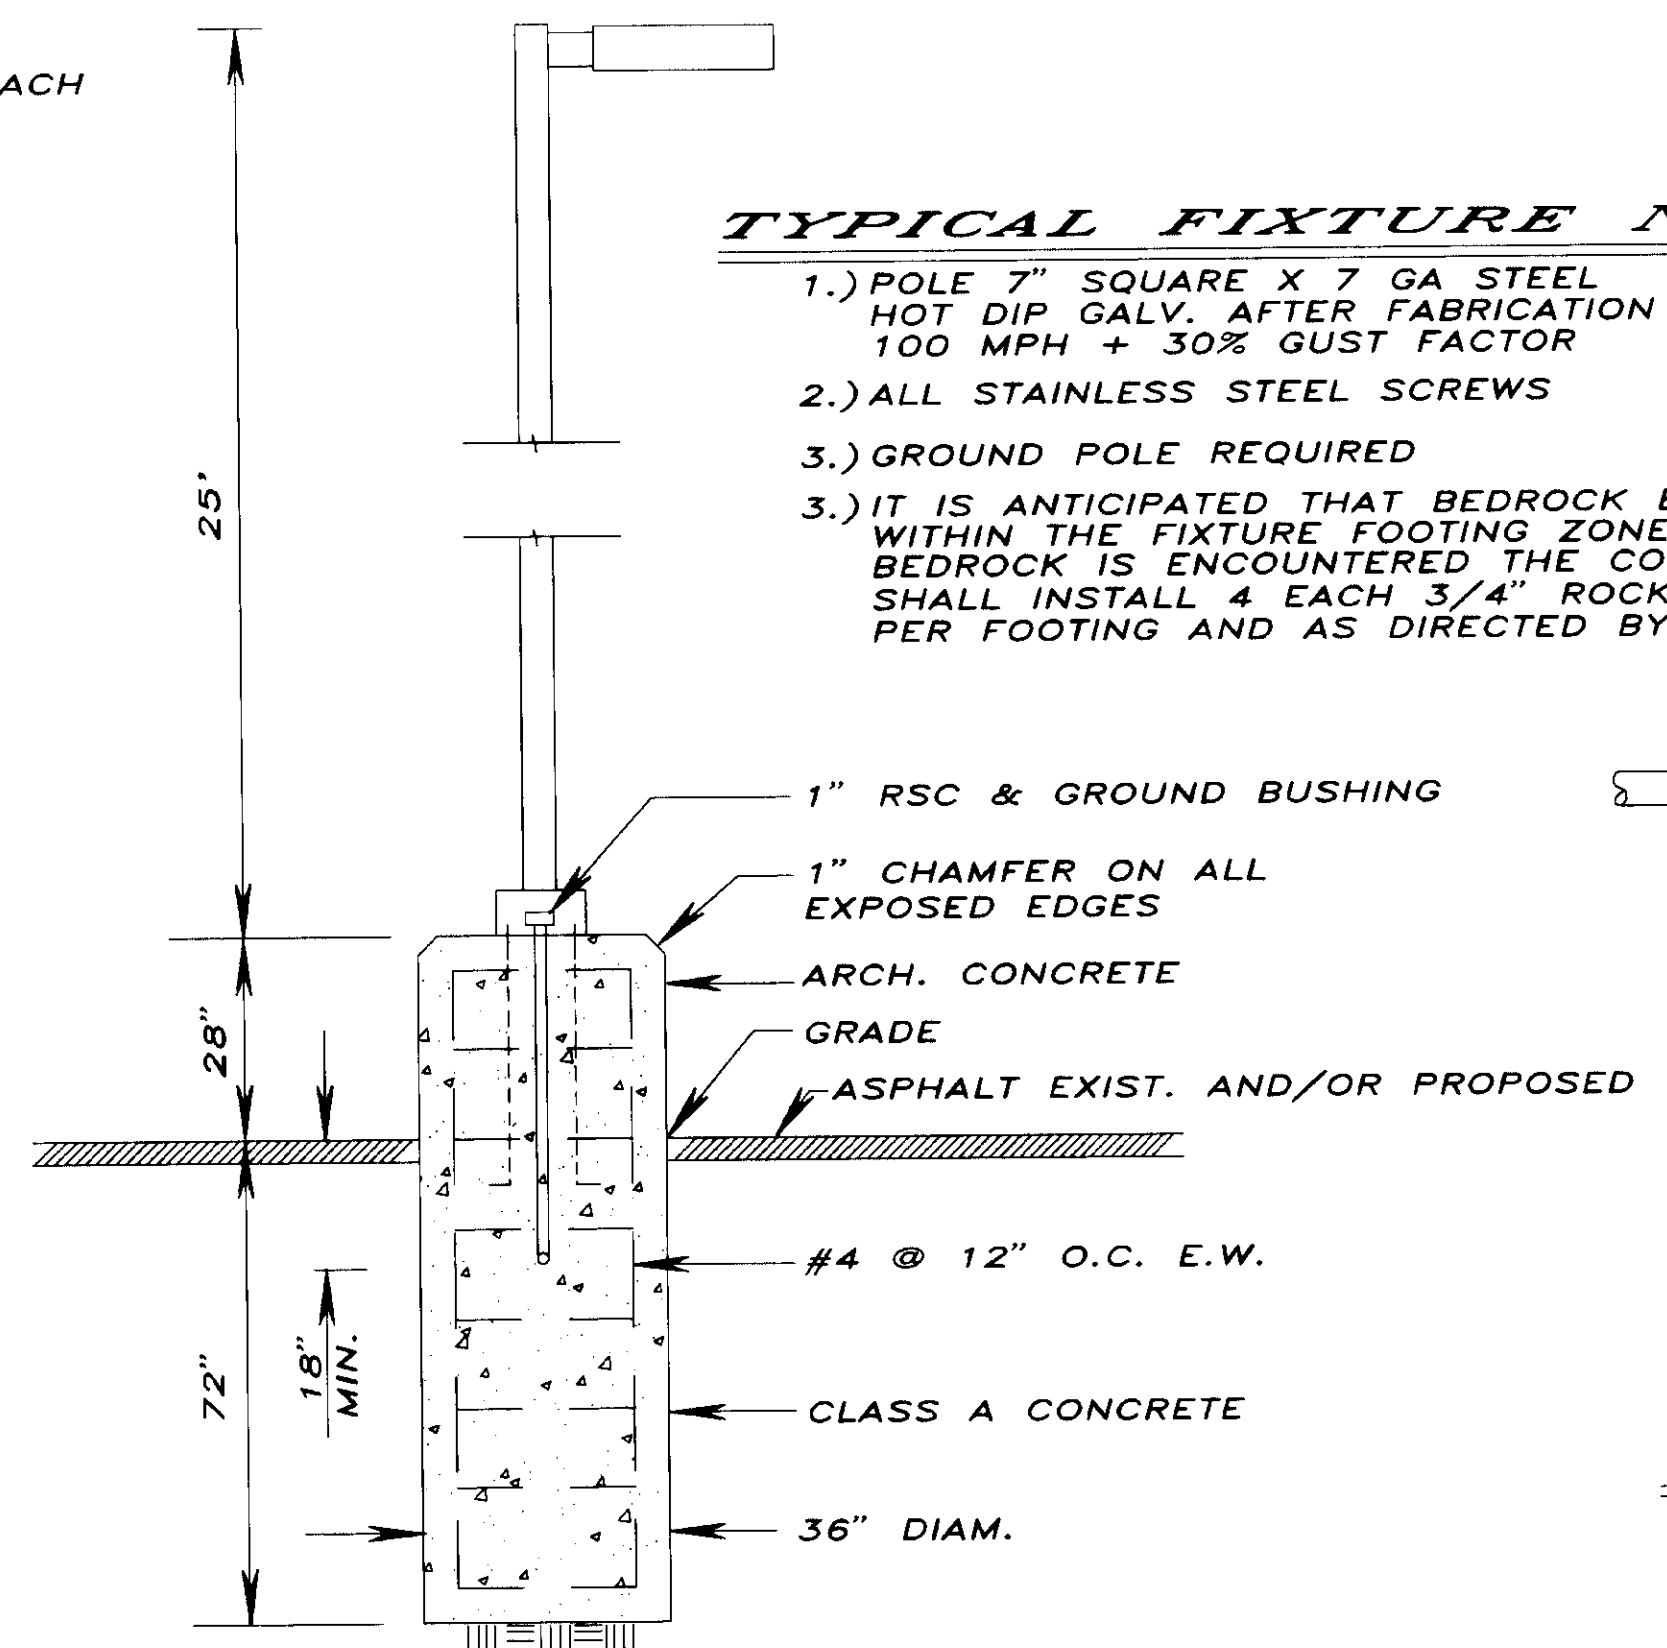

FIXTURE TYPE "A"

N.T.S.

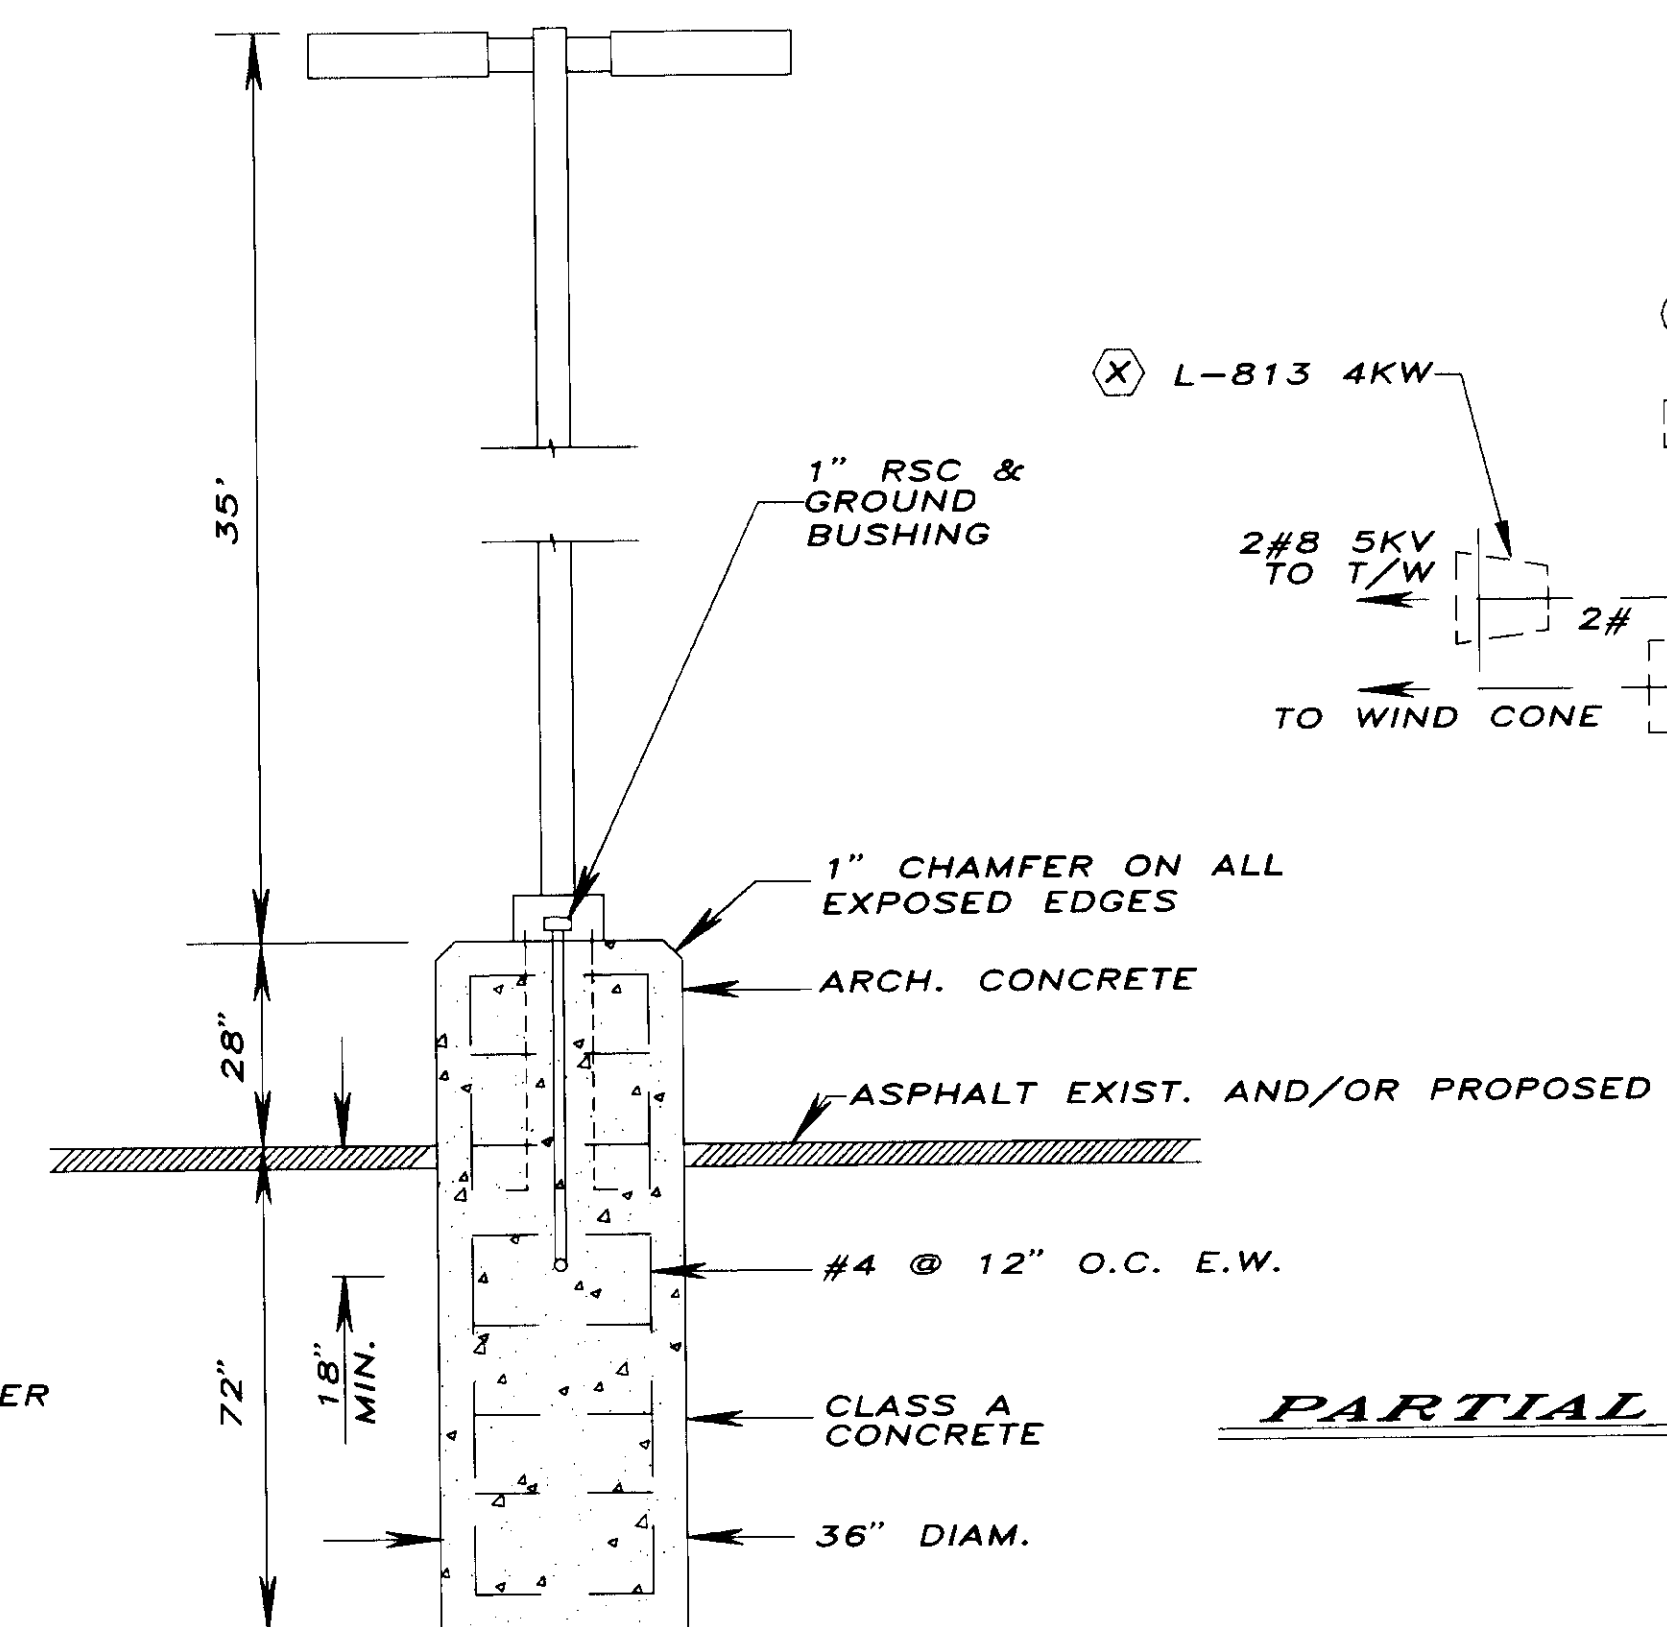


FIXTURE TYPE "B"

N.T.S.


TYPICAL FIXTURE NOTES:

- 1.) POLE 7" SQUARE X 7 GA STEEL HOT DIP GALV. AFTER FABRICATION 100 MPH + 30% GUST FACTOR
- 2.) ALL STAINLESS STEEL SCREWS
- 3.) GROUND POLE REQUIRED
- 3.) IT IS ANTICIPATED THAT BEDROCK EXISTS WITHIN THE FIXTURE FOOTING ZONE. IF BEDROCK IS ENCOUNTERED THE CONTRACTOR SHALL INSTALL 4 EACH 3/4" ROCK ANCHOR BOLTS PER FOOTING AND AS DIRECTED BY THE ENGINEER.

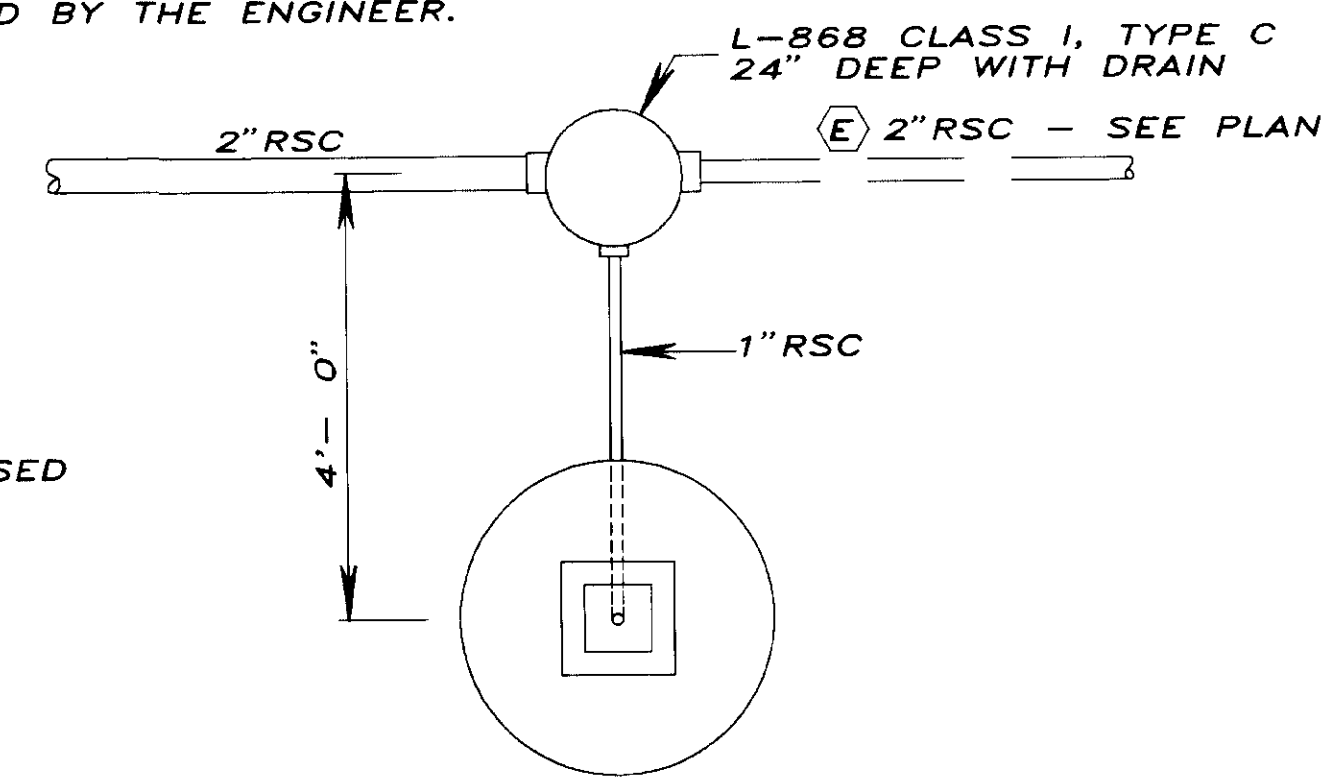


FIXTURE DETAIL PLAN

N.T.S.

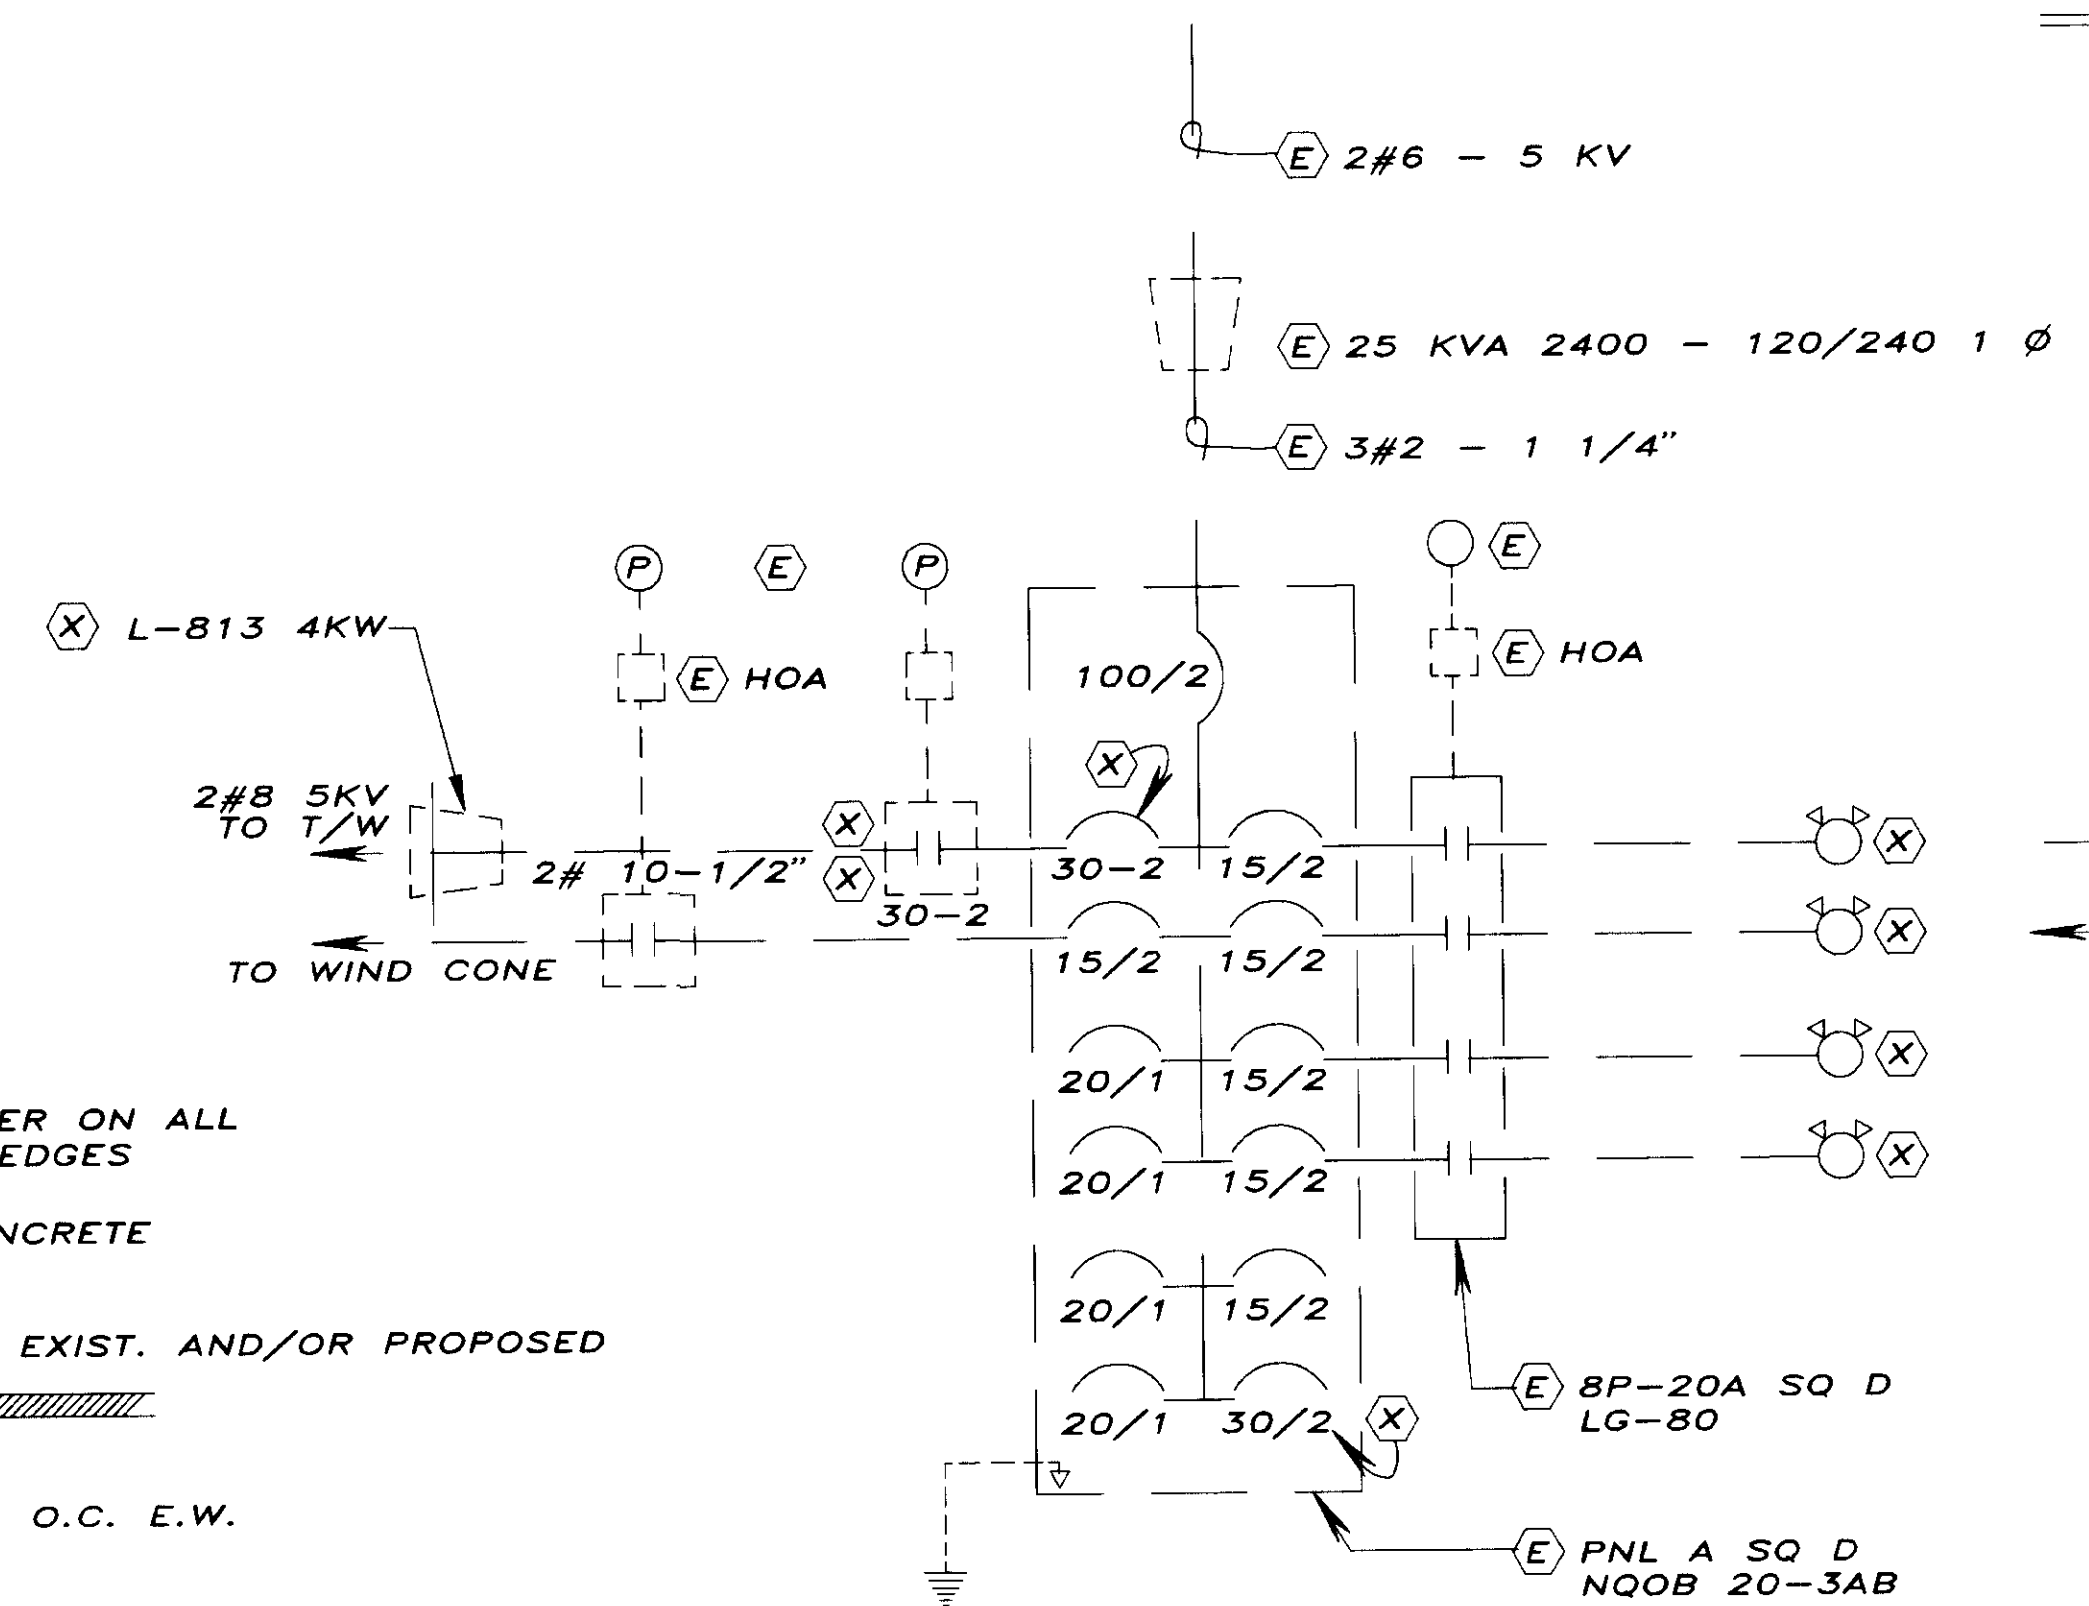


PARTIAL EXISTING ONE LINE DIAGRAM

N.T.S.

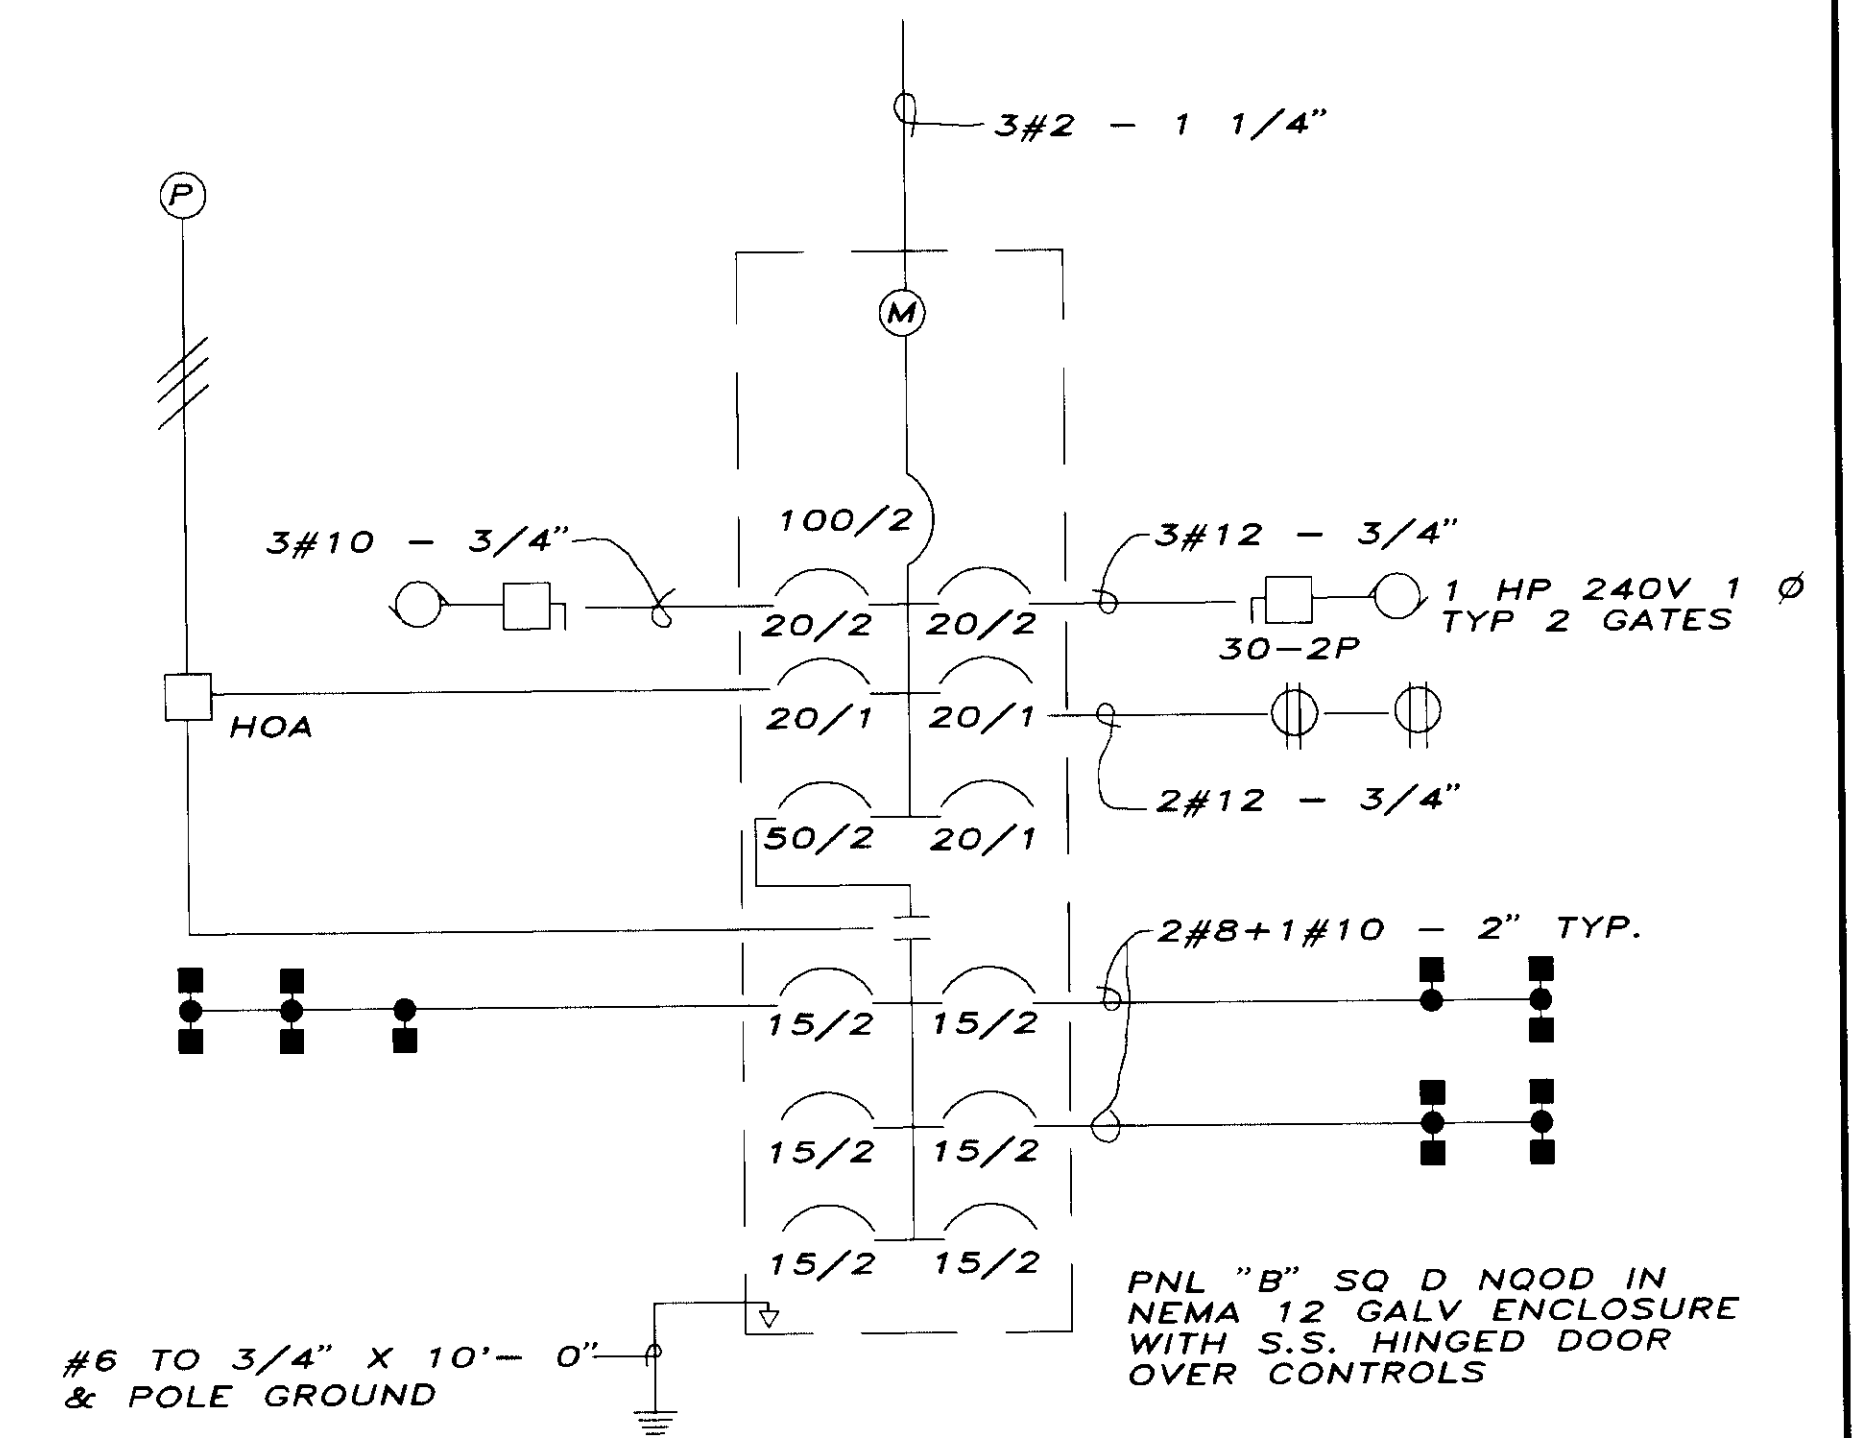

ONE LINE DIAGRAM PANEL "B"

N.T.S.

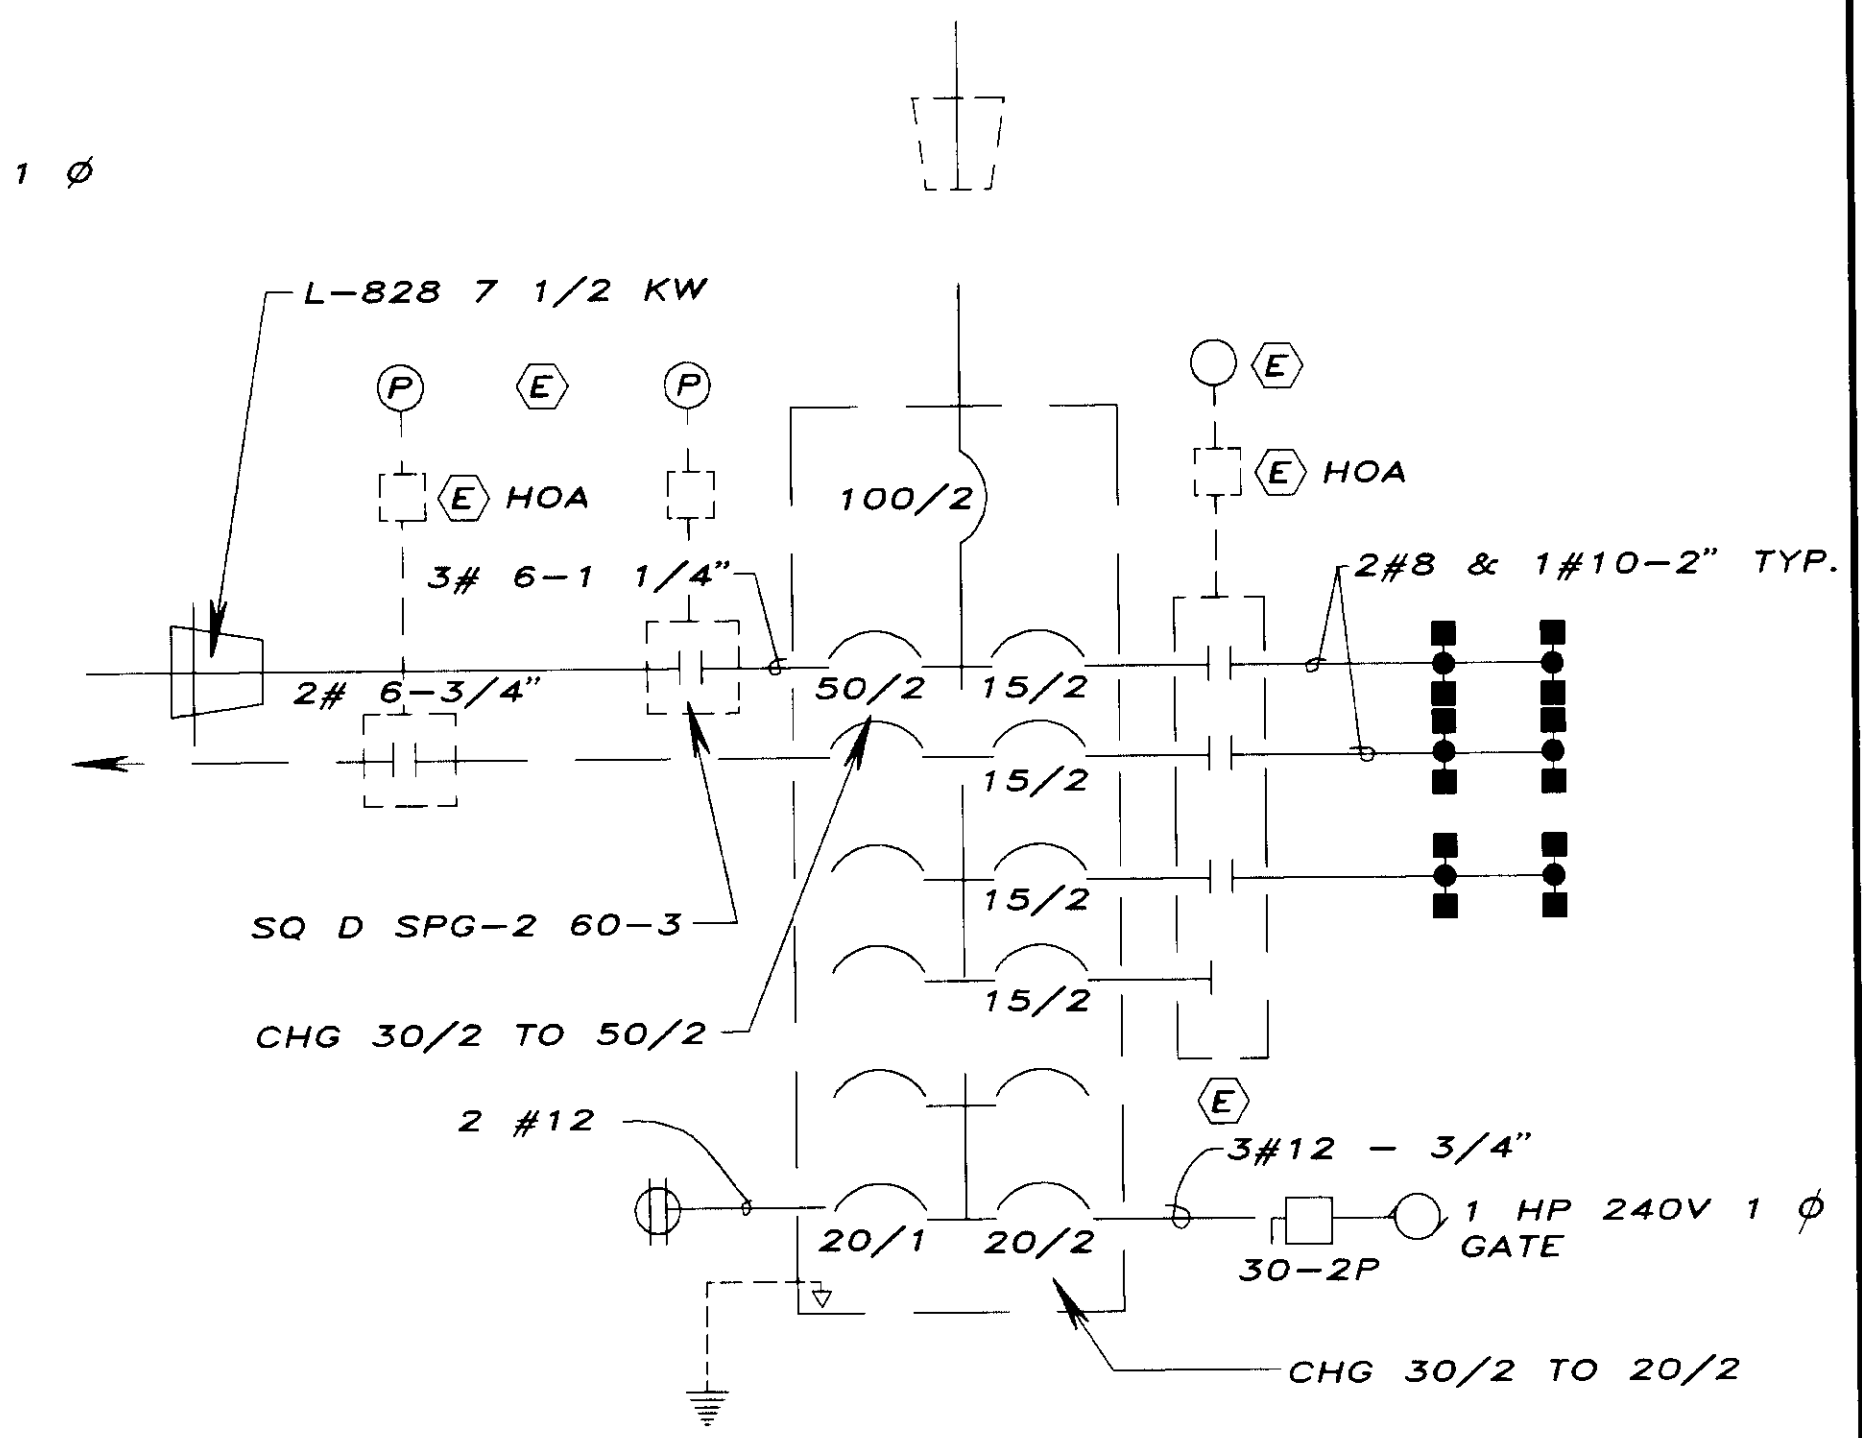


REVISED ONE LINE DIAGRAM

N.T.S.


NOTE: DO NOT SCALE FROM THESE PLANS-USE DIMENSIONS

E-3


ENGINEER'S SEAL

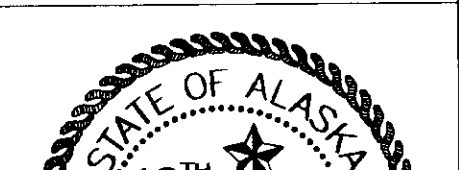


R & M ENGINEERING, INC.
ENGINEERS GEOLOGISTS SURVEYORS

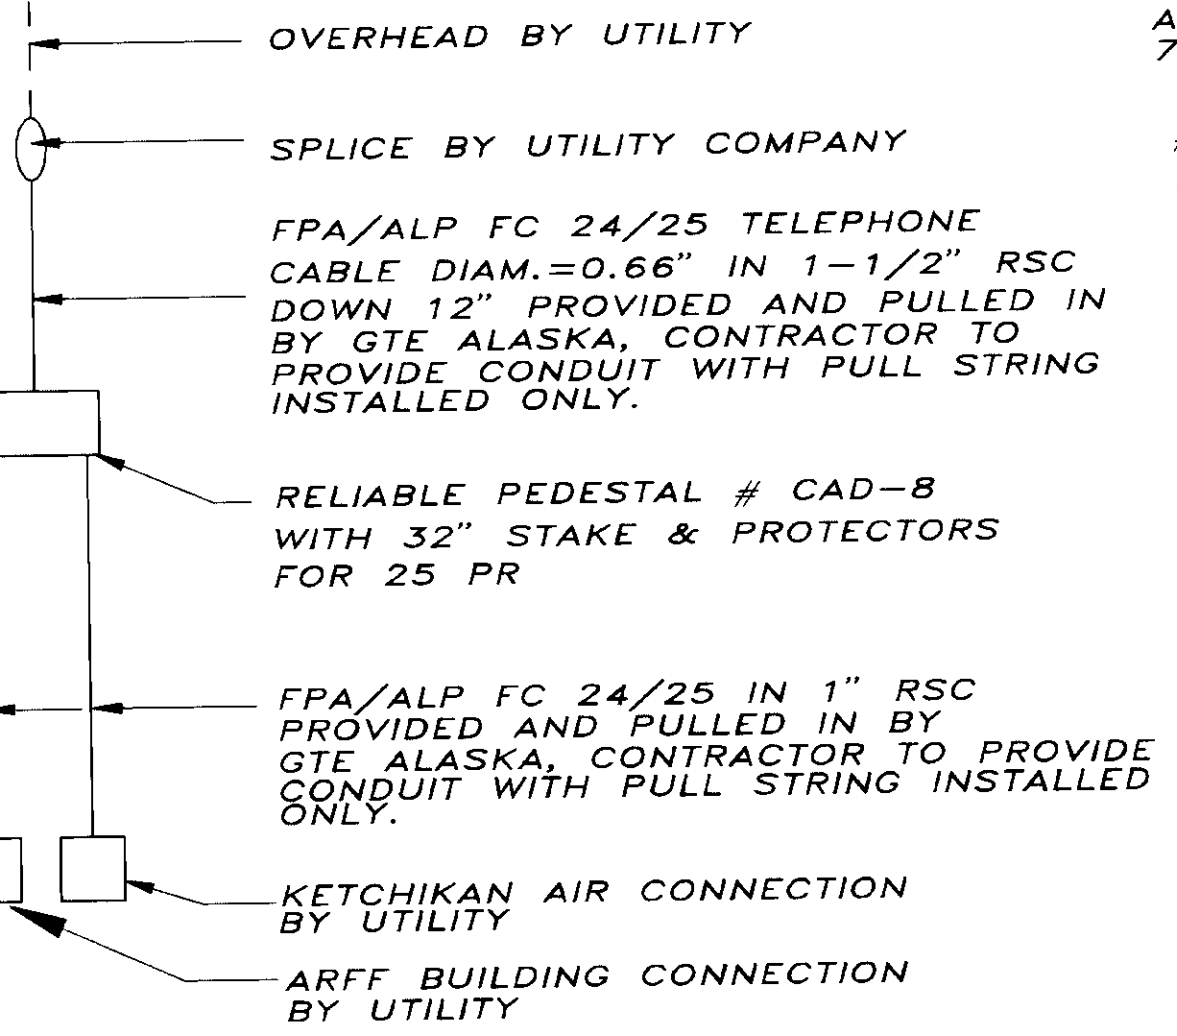


ONE LINE TELEPHONE DIAGRAM
N.T.S.

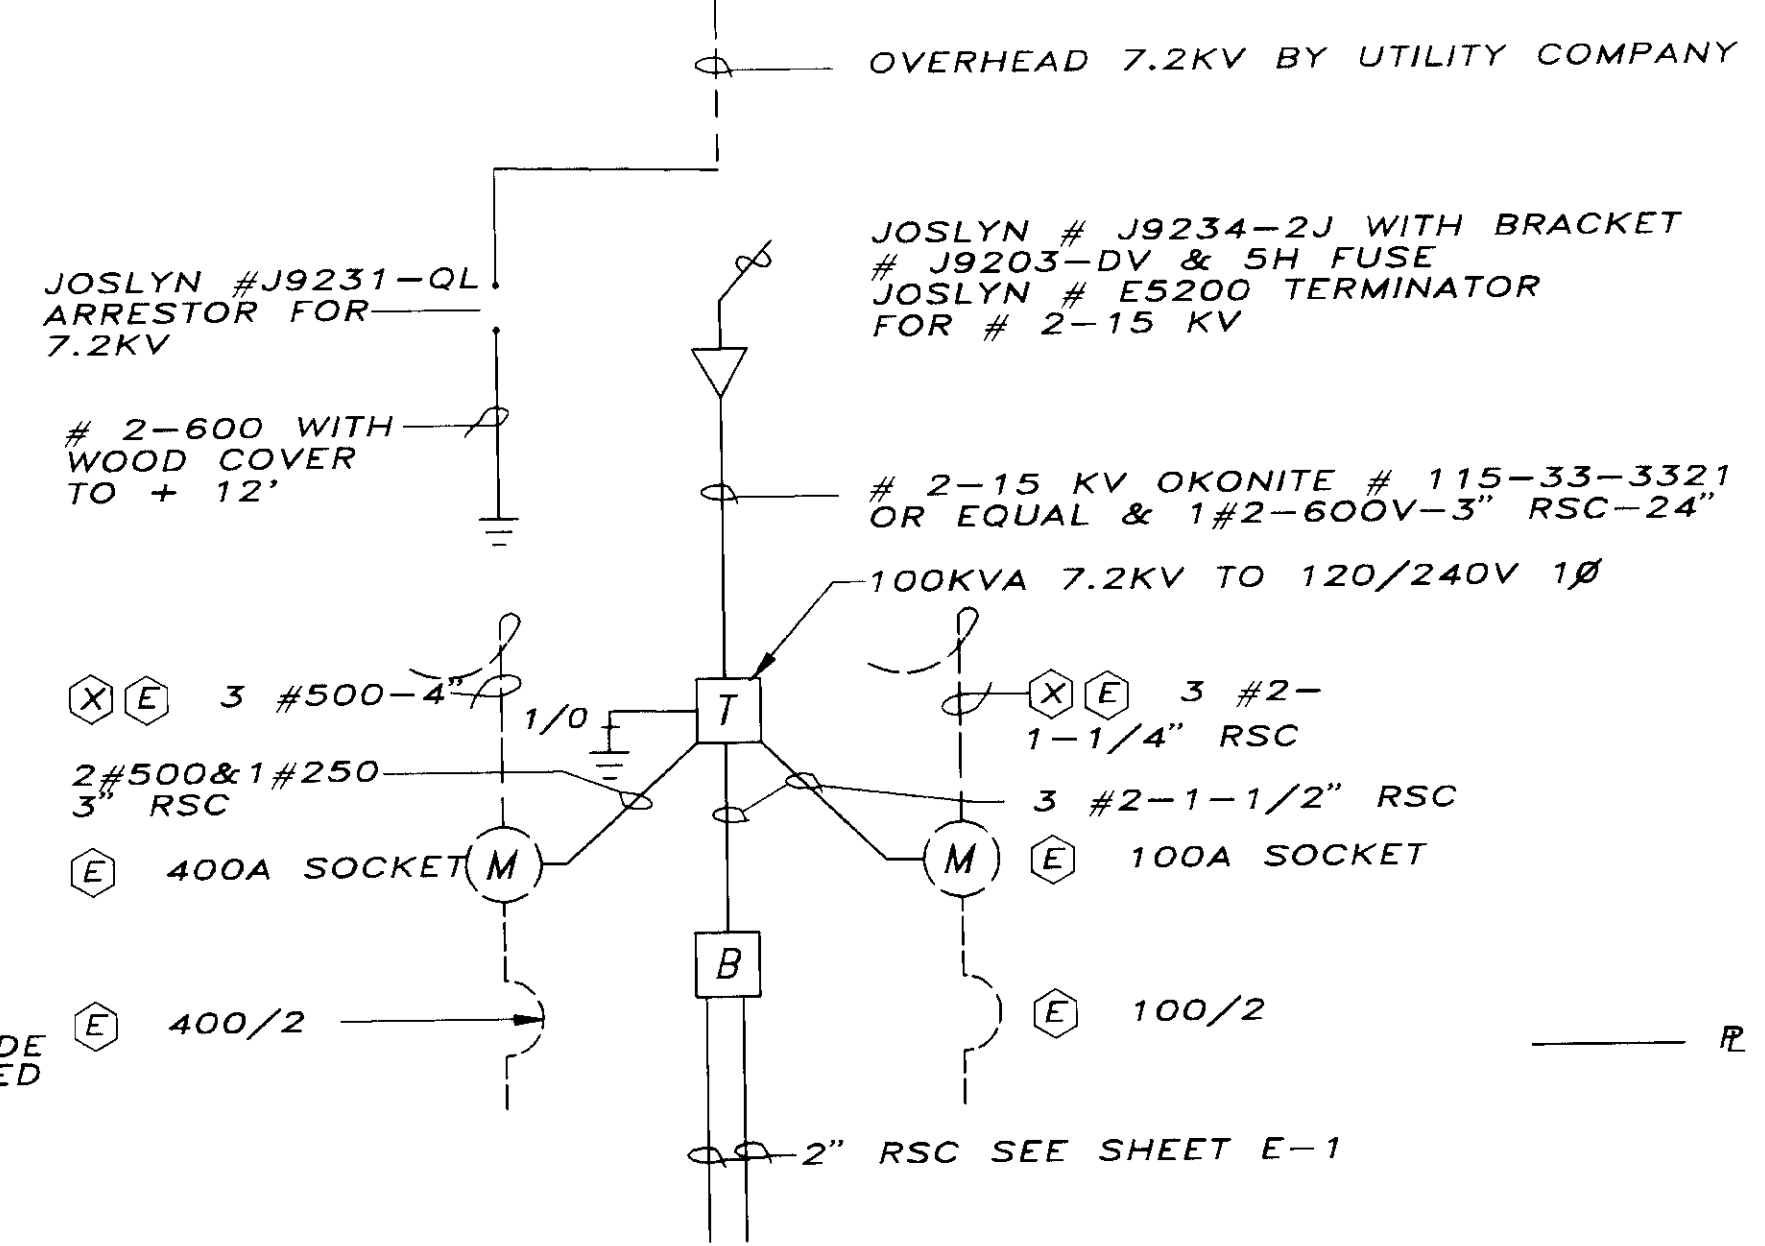

ONE LINE POWER DIAGRAM
N.T.S.

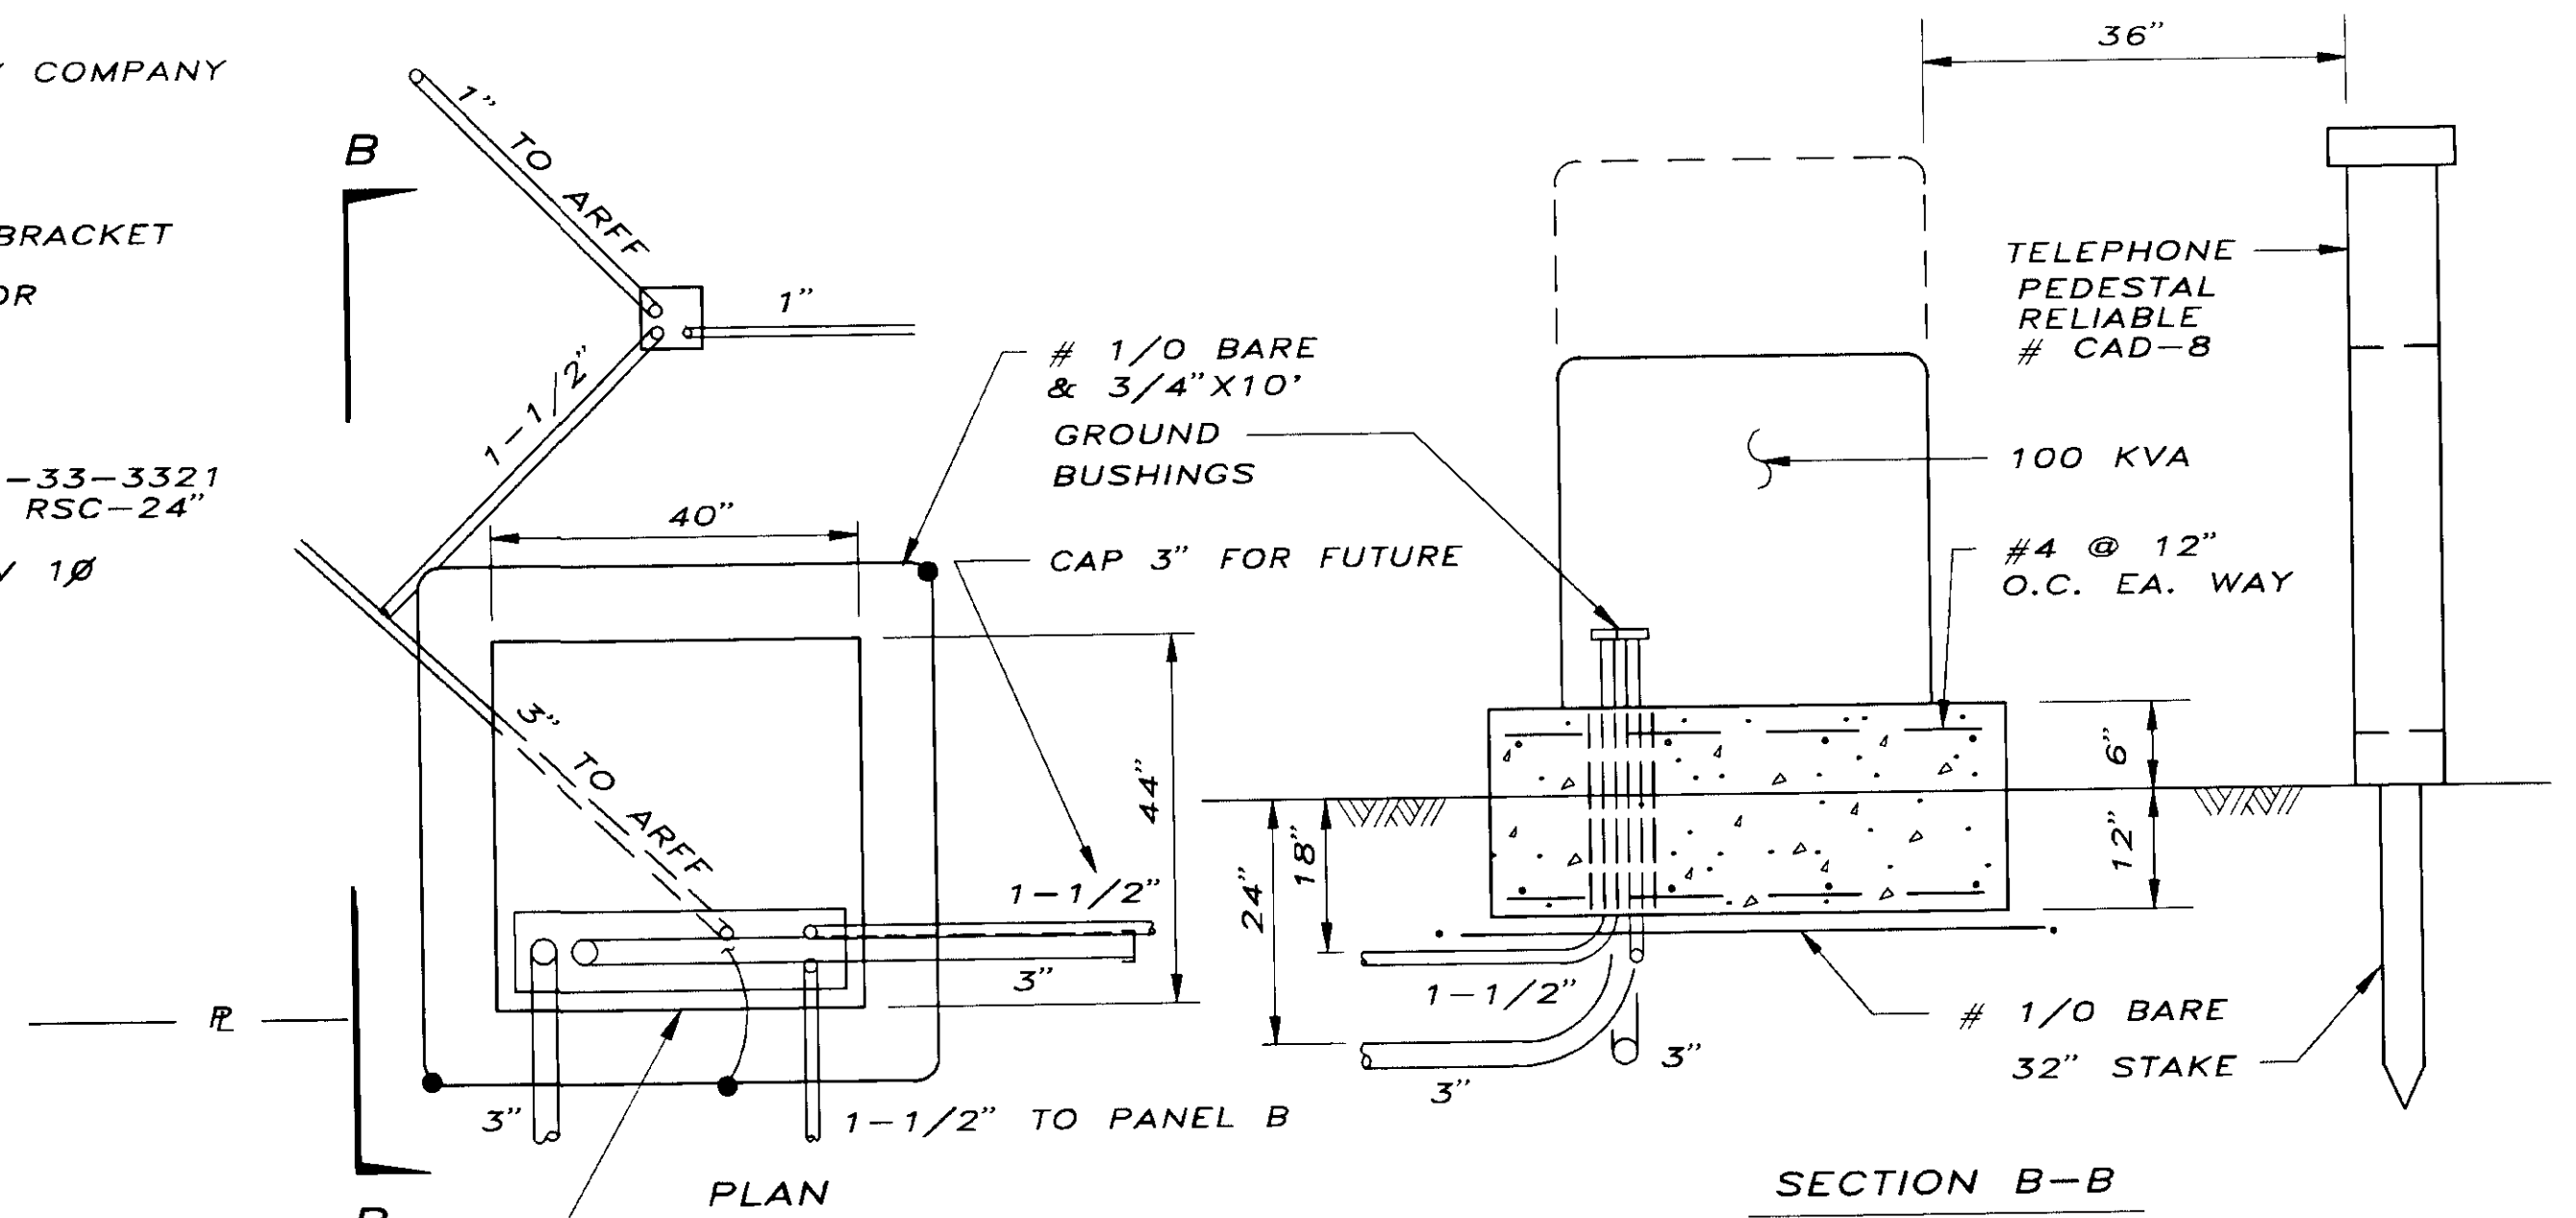


TRANSFORMER & PEDESTAL DETAIL
STA. "F"11+00, 17.5'LT
N.T.S.

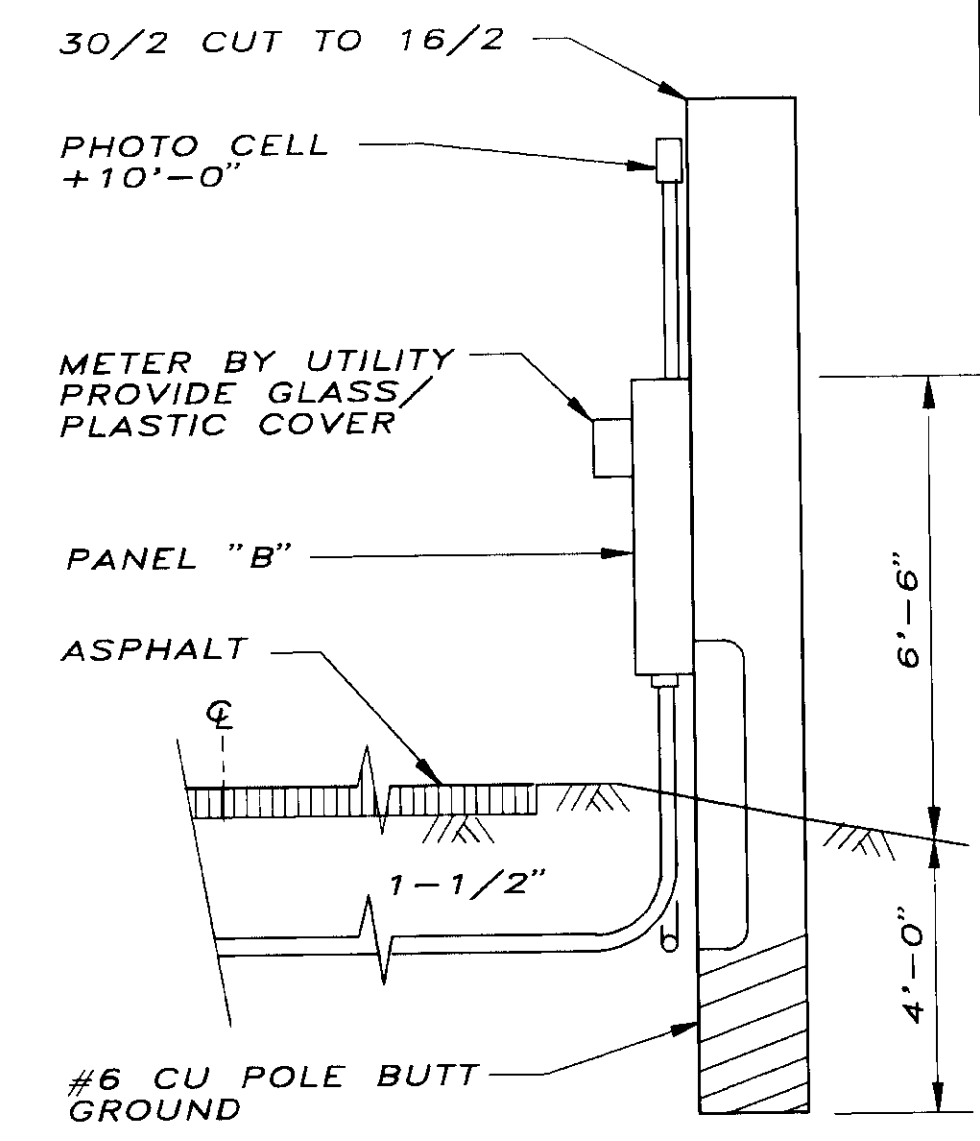

PANEL "B" DETAIL
STA. "F"11+00, 13'RT
N.T.S.

POWER AND TELEPHONE PLAN REFERENCE NOTES

- ① EXISTING OVERHEAD POWER & TELEPHONE REMAINS.
- ② EXISTING 30/2 REMOVED & REPLACED BY ELECTRIC UTILITY WITH 40/2 & 15KVA 7.2KV TO 120/240V 1Ø.
- ③ EXISTING SECONDARY OVERHEAD CHANGED TO 7.2KV PRIMARY BY ELECTRIC UTILITY. TELEPHONE REMAINS & RECONNECTED.
- ④ REMOVE EXISTING OVERHEAD ELECTRIC & TELEPHONE SERVICE & POLE.
- ⑤ CITY OF WRANGELL UTILITIES WILL PERFORM ITEMS NO. 2 AND 3 ABOVE AT THEIR OWN EXPENSE.
- ⑥ EXISTING ABOVE GROUND FUEL STORAGE TANK.
- ⑦ EXISTING BURIED WASTE OIL STORAGE TANK.
- ⓔ EXISTING
- ⓧ REMOVE

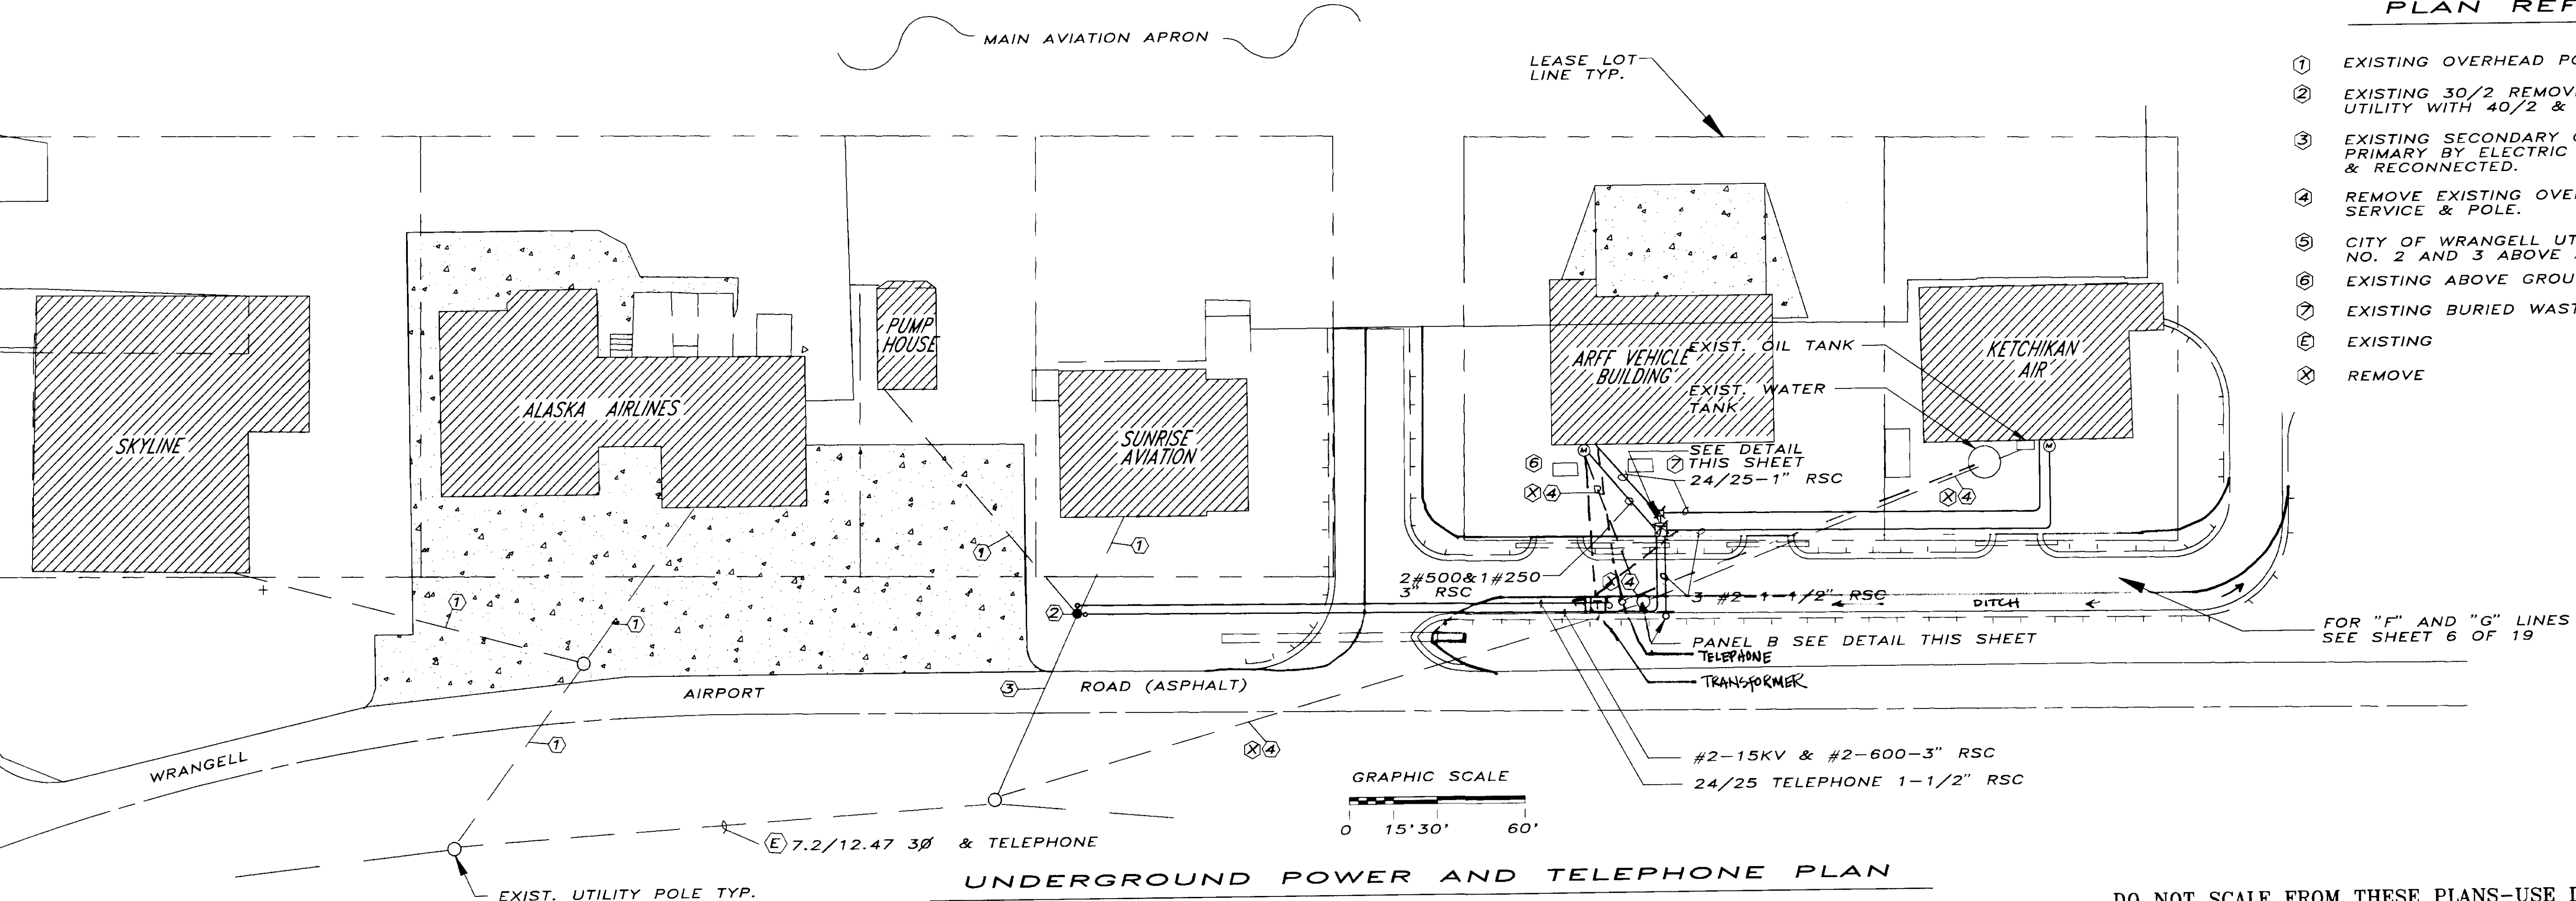

UNDERGROUND POWER AND TELEPHONE PLAN

E-4
ENGINEER'S SEAL

