



ALASKA HIGHWAY AND PUBLIC WORKS DEPARTMENT PUBLIC WORKS DIVISION

9/28
01/28

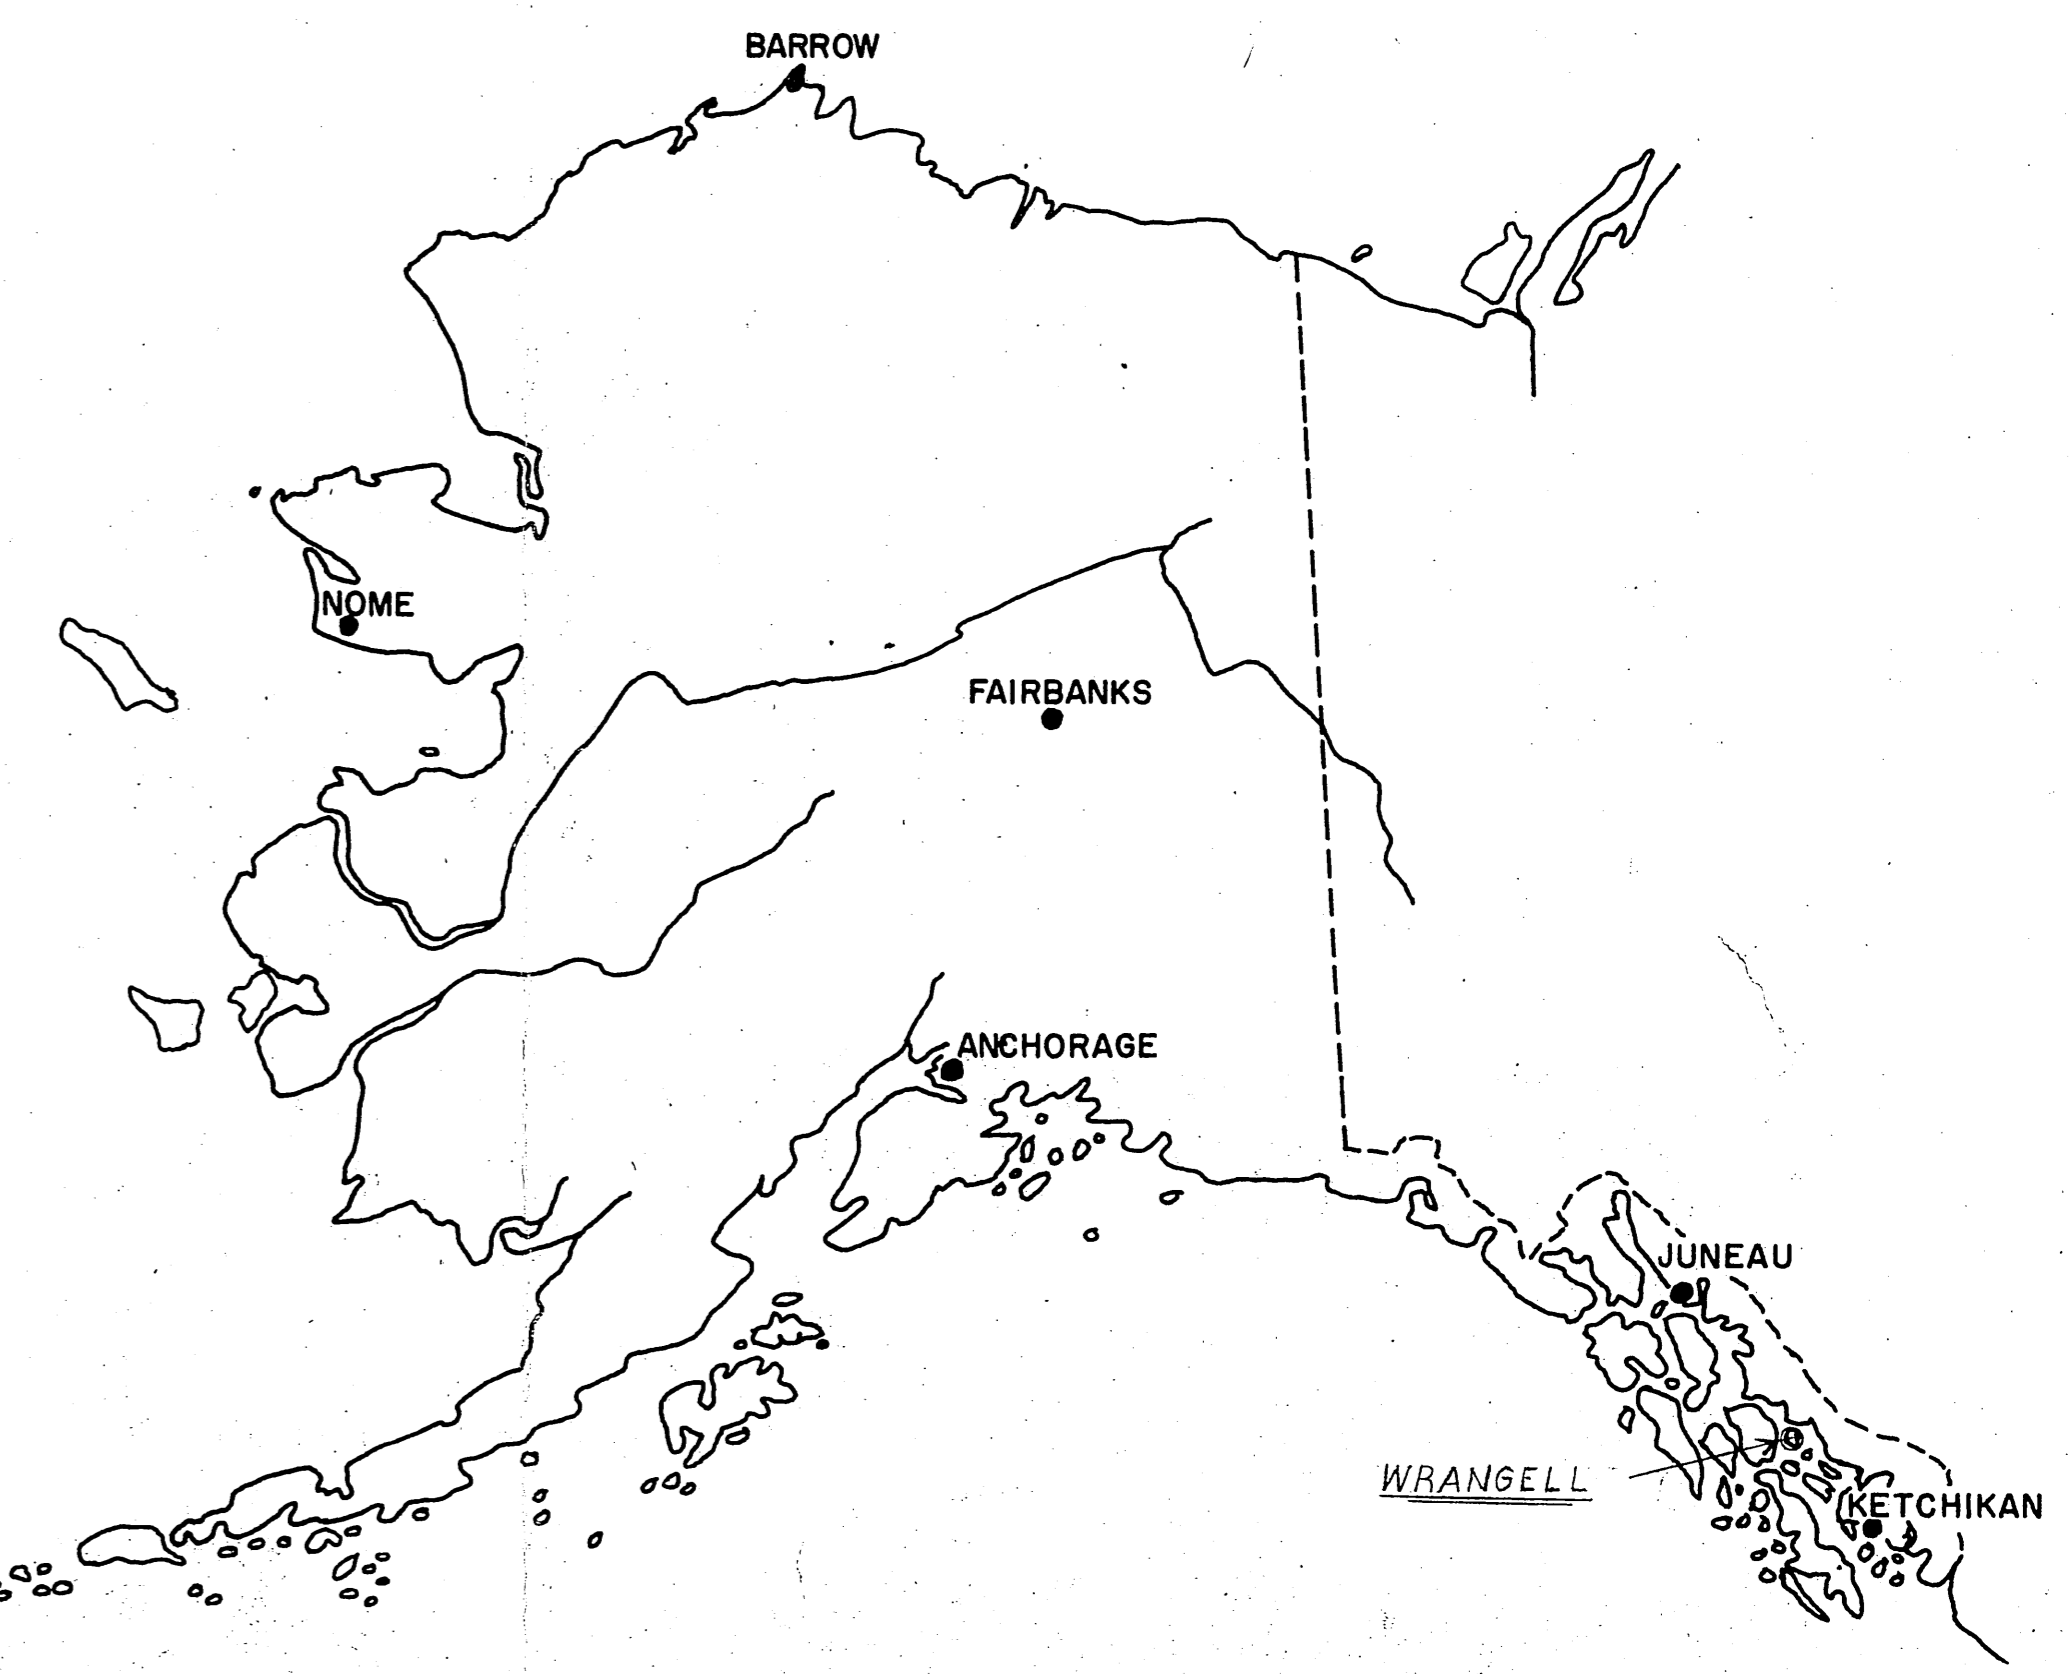

WRANGELL FLOATS
PROJECT NO. 9651-56

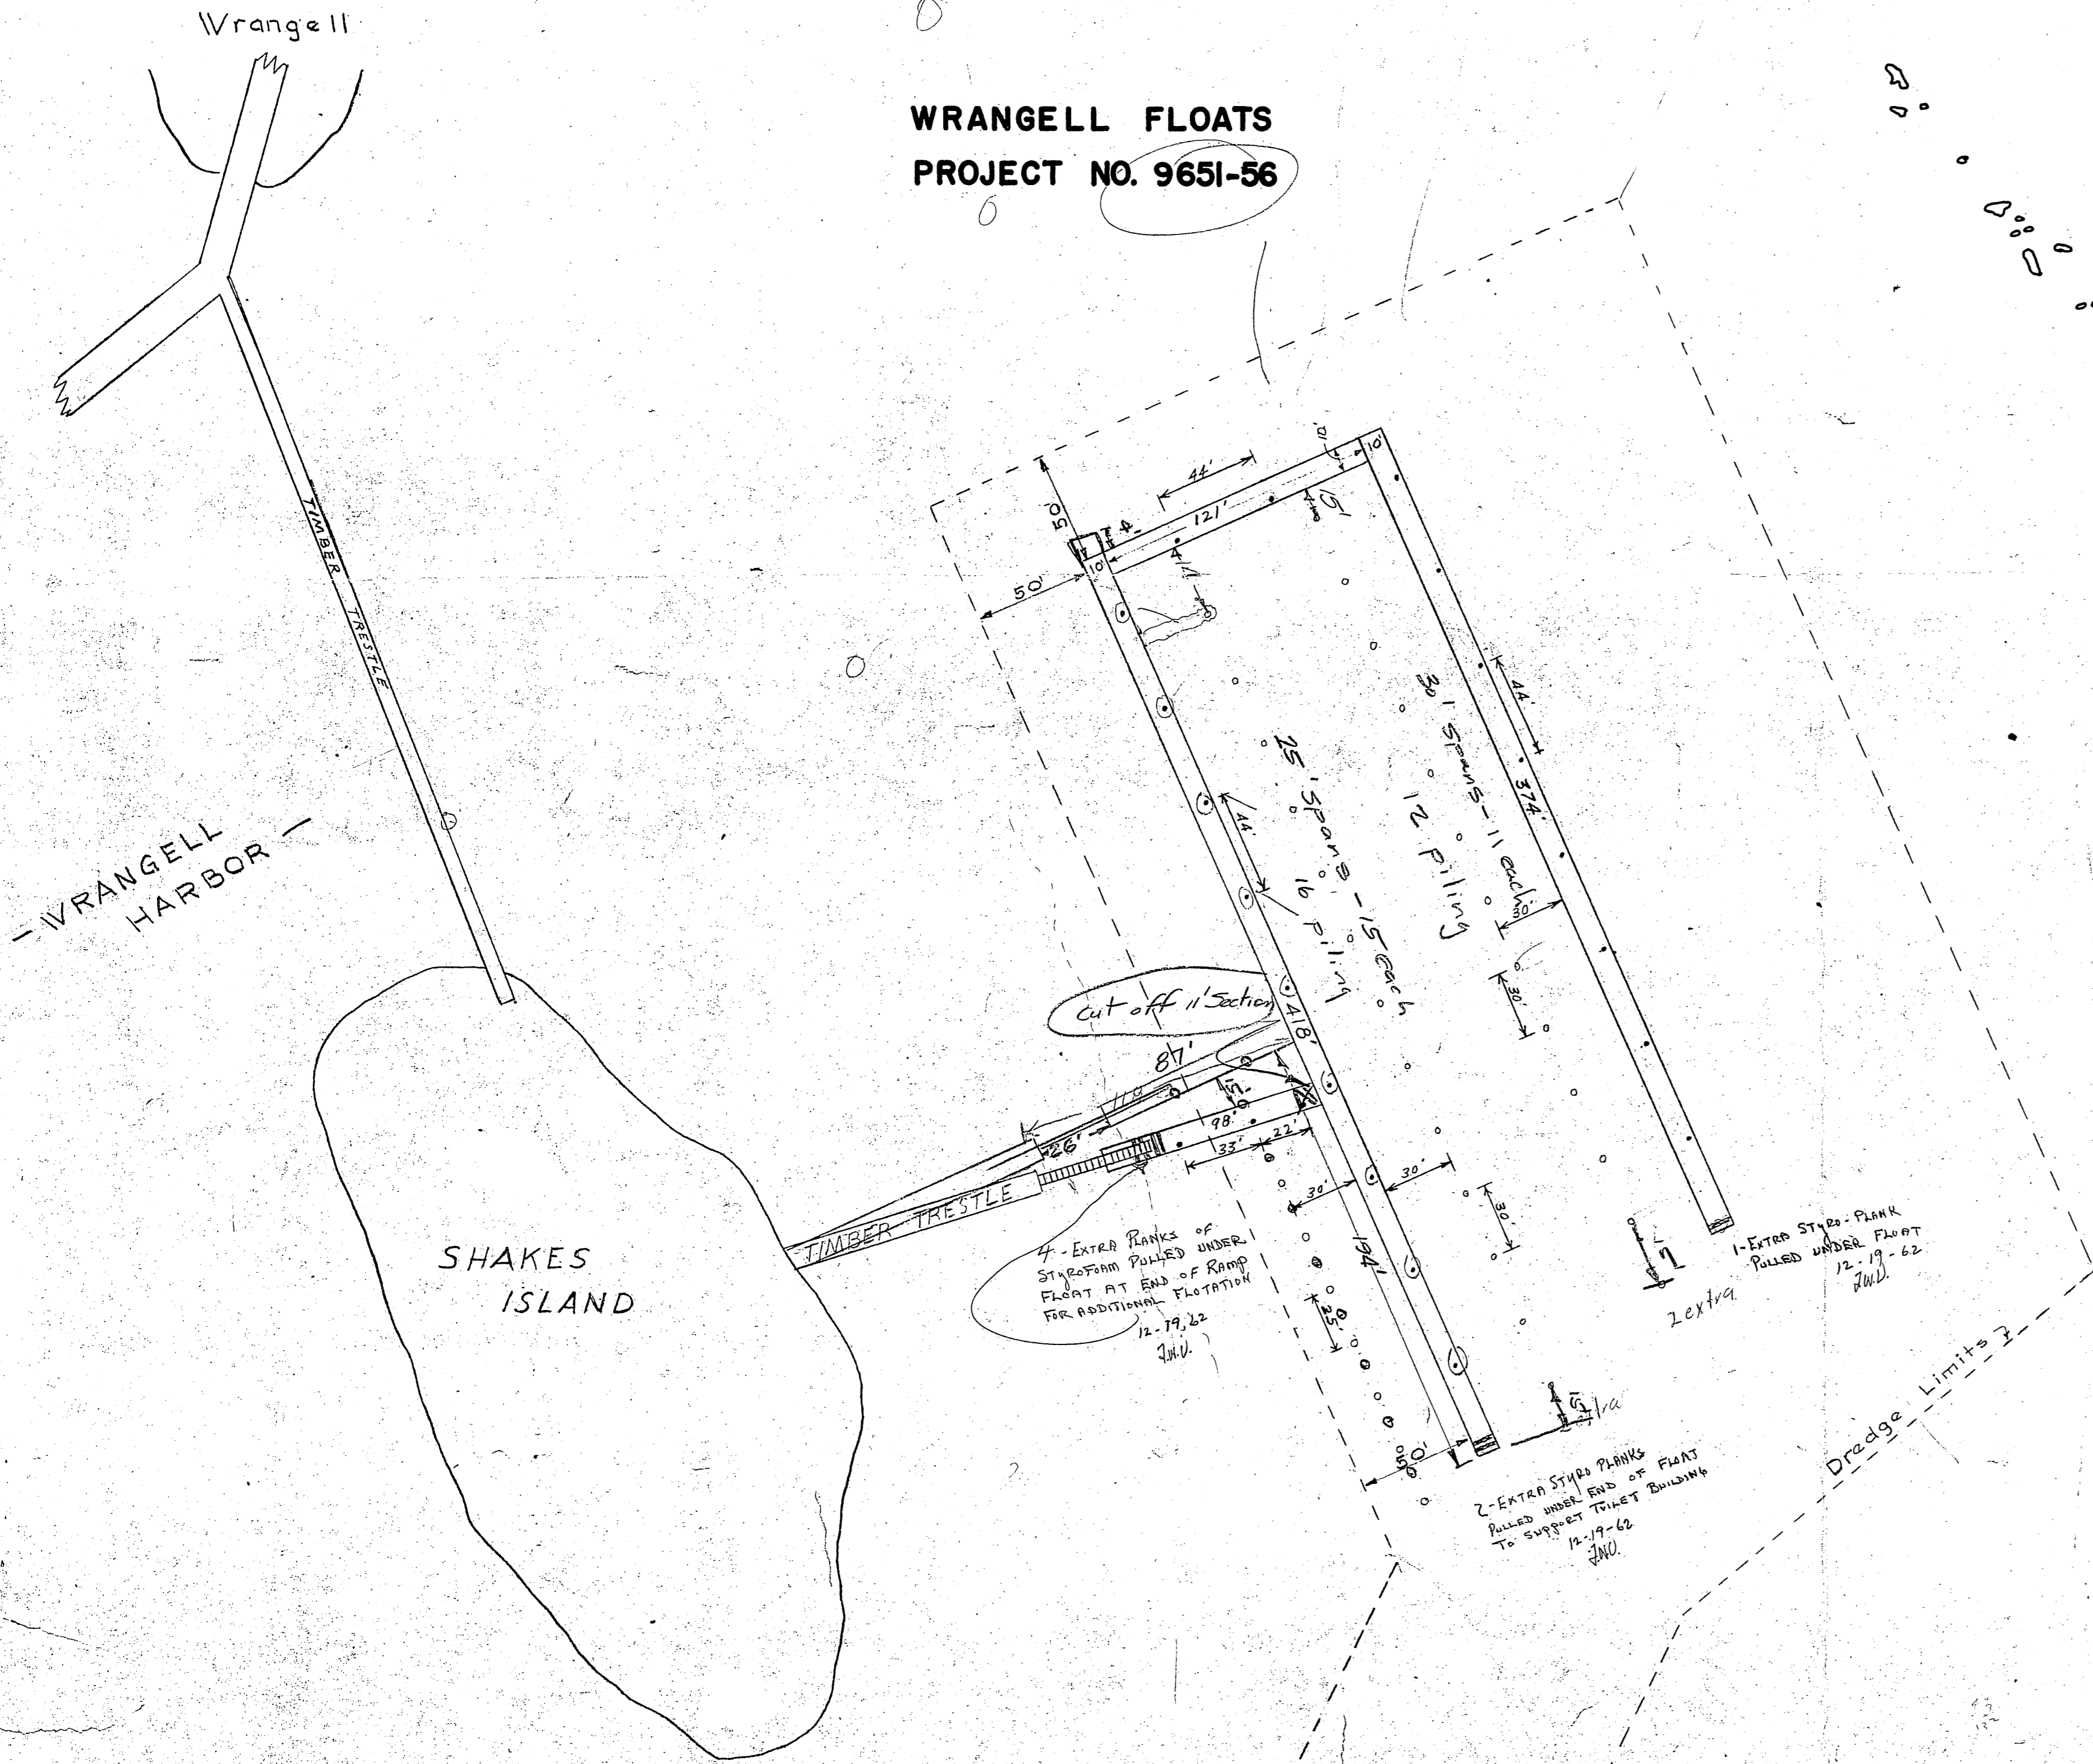

INDEX TO SHEETS

TITLE SHEET	---	1
FLOAT DETAIL	---	2
GANGWAY DETAIL	---	3