


WRANGELL BREAKWATER REPAIR

PROJECT NO. K30131

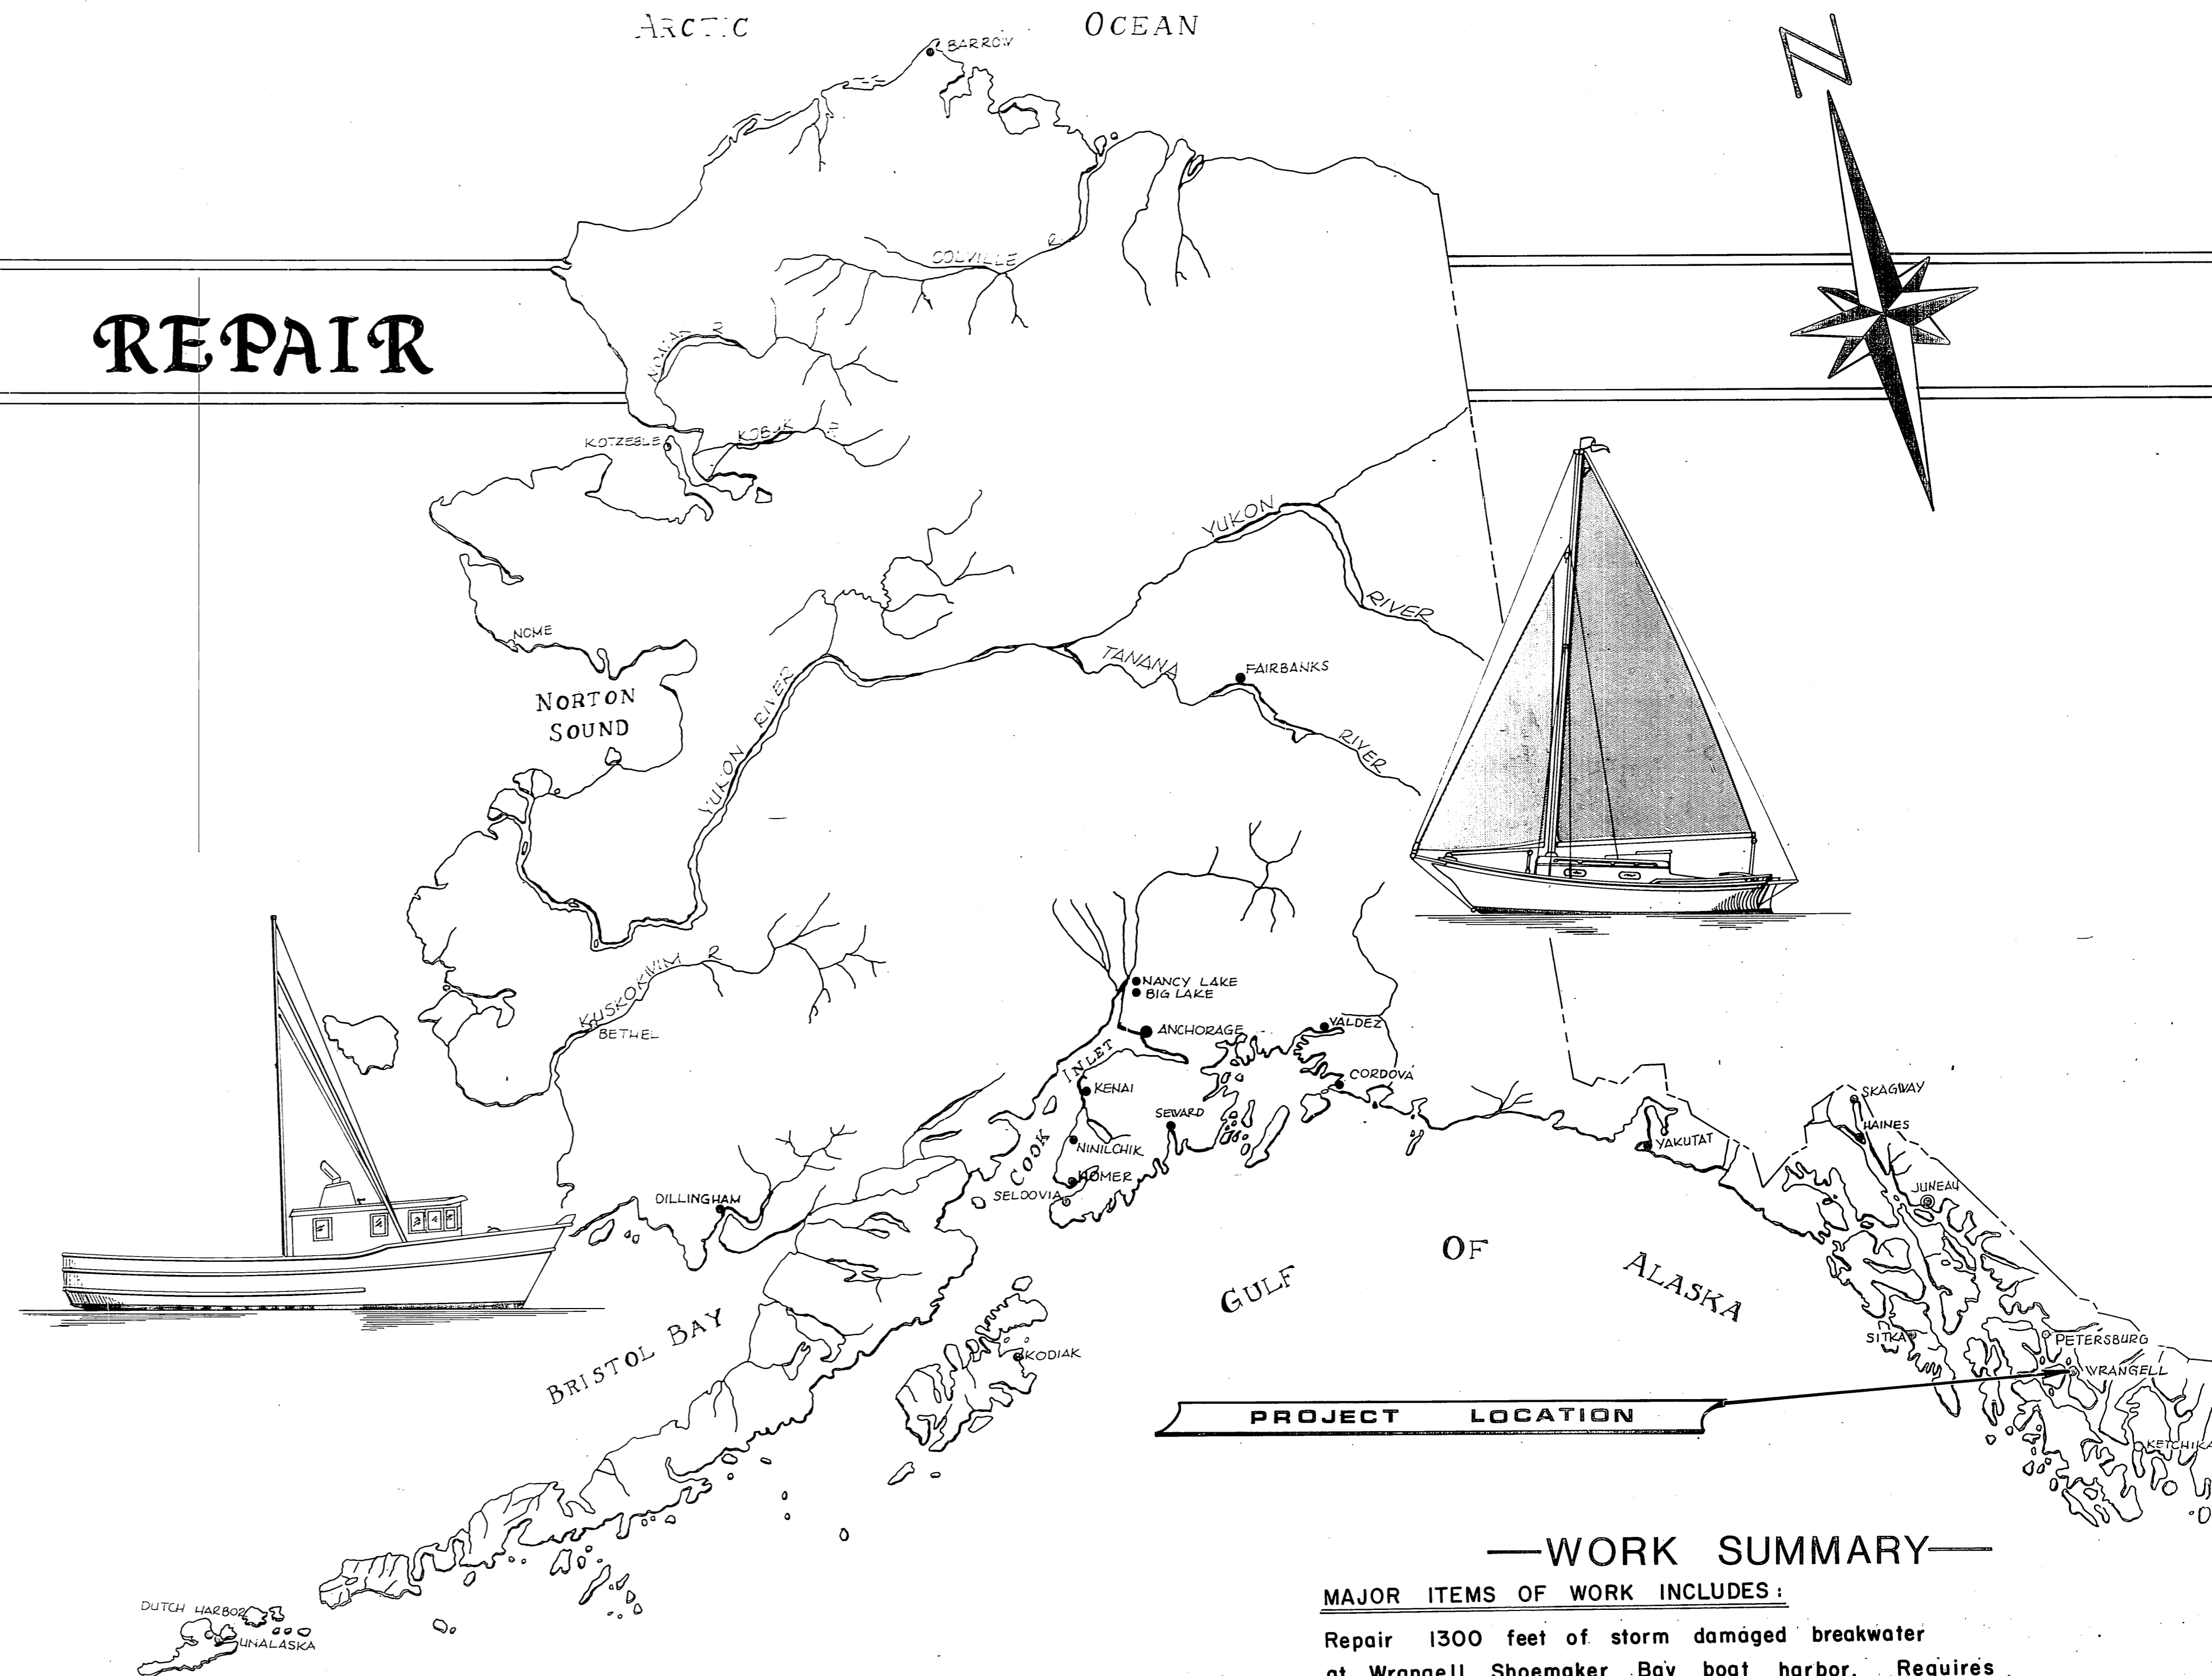

—WORK SUMMARY—

MAJOR ITEMS OF WORK INCLUDES:
 Repair 1300 feet of storm damaged breakwater at Wrangell Shoemaker Bay boat harbor. Requires approximately 500 c.u. yds. of 1100 lb. average size rock to be placed and regrading of rock slopes to original contours.

INDEX TO SHEETS

1.	Title Sheet	
2.	Breakwater Repair Details	

AS-BUILT
 Date: 8-20-82
 Division of Harbors, Design and Construction
 Supplement Agreement No. 1, Repair 10x4875' (Forest Service) Float, unbalanced flotation. Billets seven provided by State. (completed 11-9-82)

APPROVED
Charles M. [Signature] 3/9/82
 DIRECTOR, S.E. R.C. DATE
RECOMMEND FOR APPROVAL
[Signature] 3/7/82
 CHIEF, S.E. HARBOR, D.S.C. DATE
 SHEET 1 OF 2

STATE OF ALASKA

DEPARTMENT OF TRANSPORTATION & PUBLIC FACILITIES
 S.E. REGION
HARBOR DESIGN & CONSTRUCTION