


AS-BUILT PLANS

STATE OF ALASKA

DEPARTMENT OF HIGHWAYS

STATE	ROUTE DESIGNATION	YEAR	SHEET NO.	TOTAL SHEETS
ALASKA	F-095-4(1) & S-0943(7)	1967	1	34

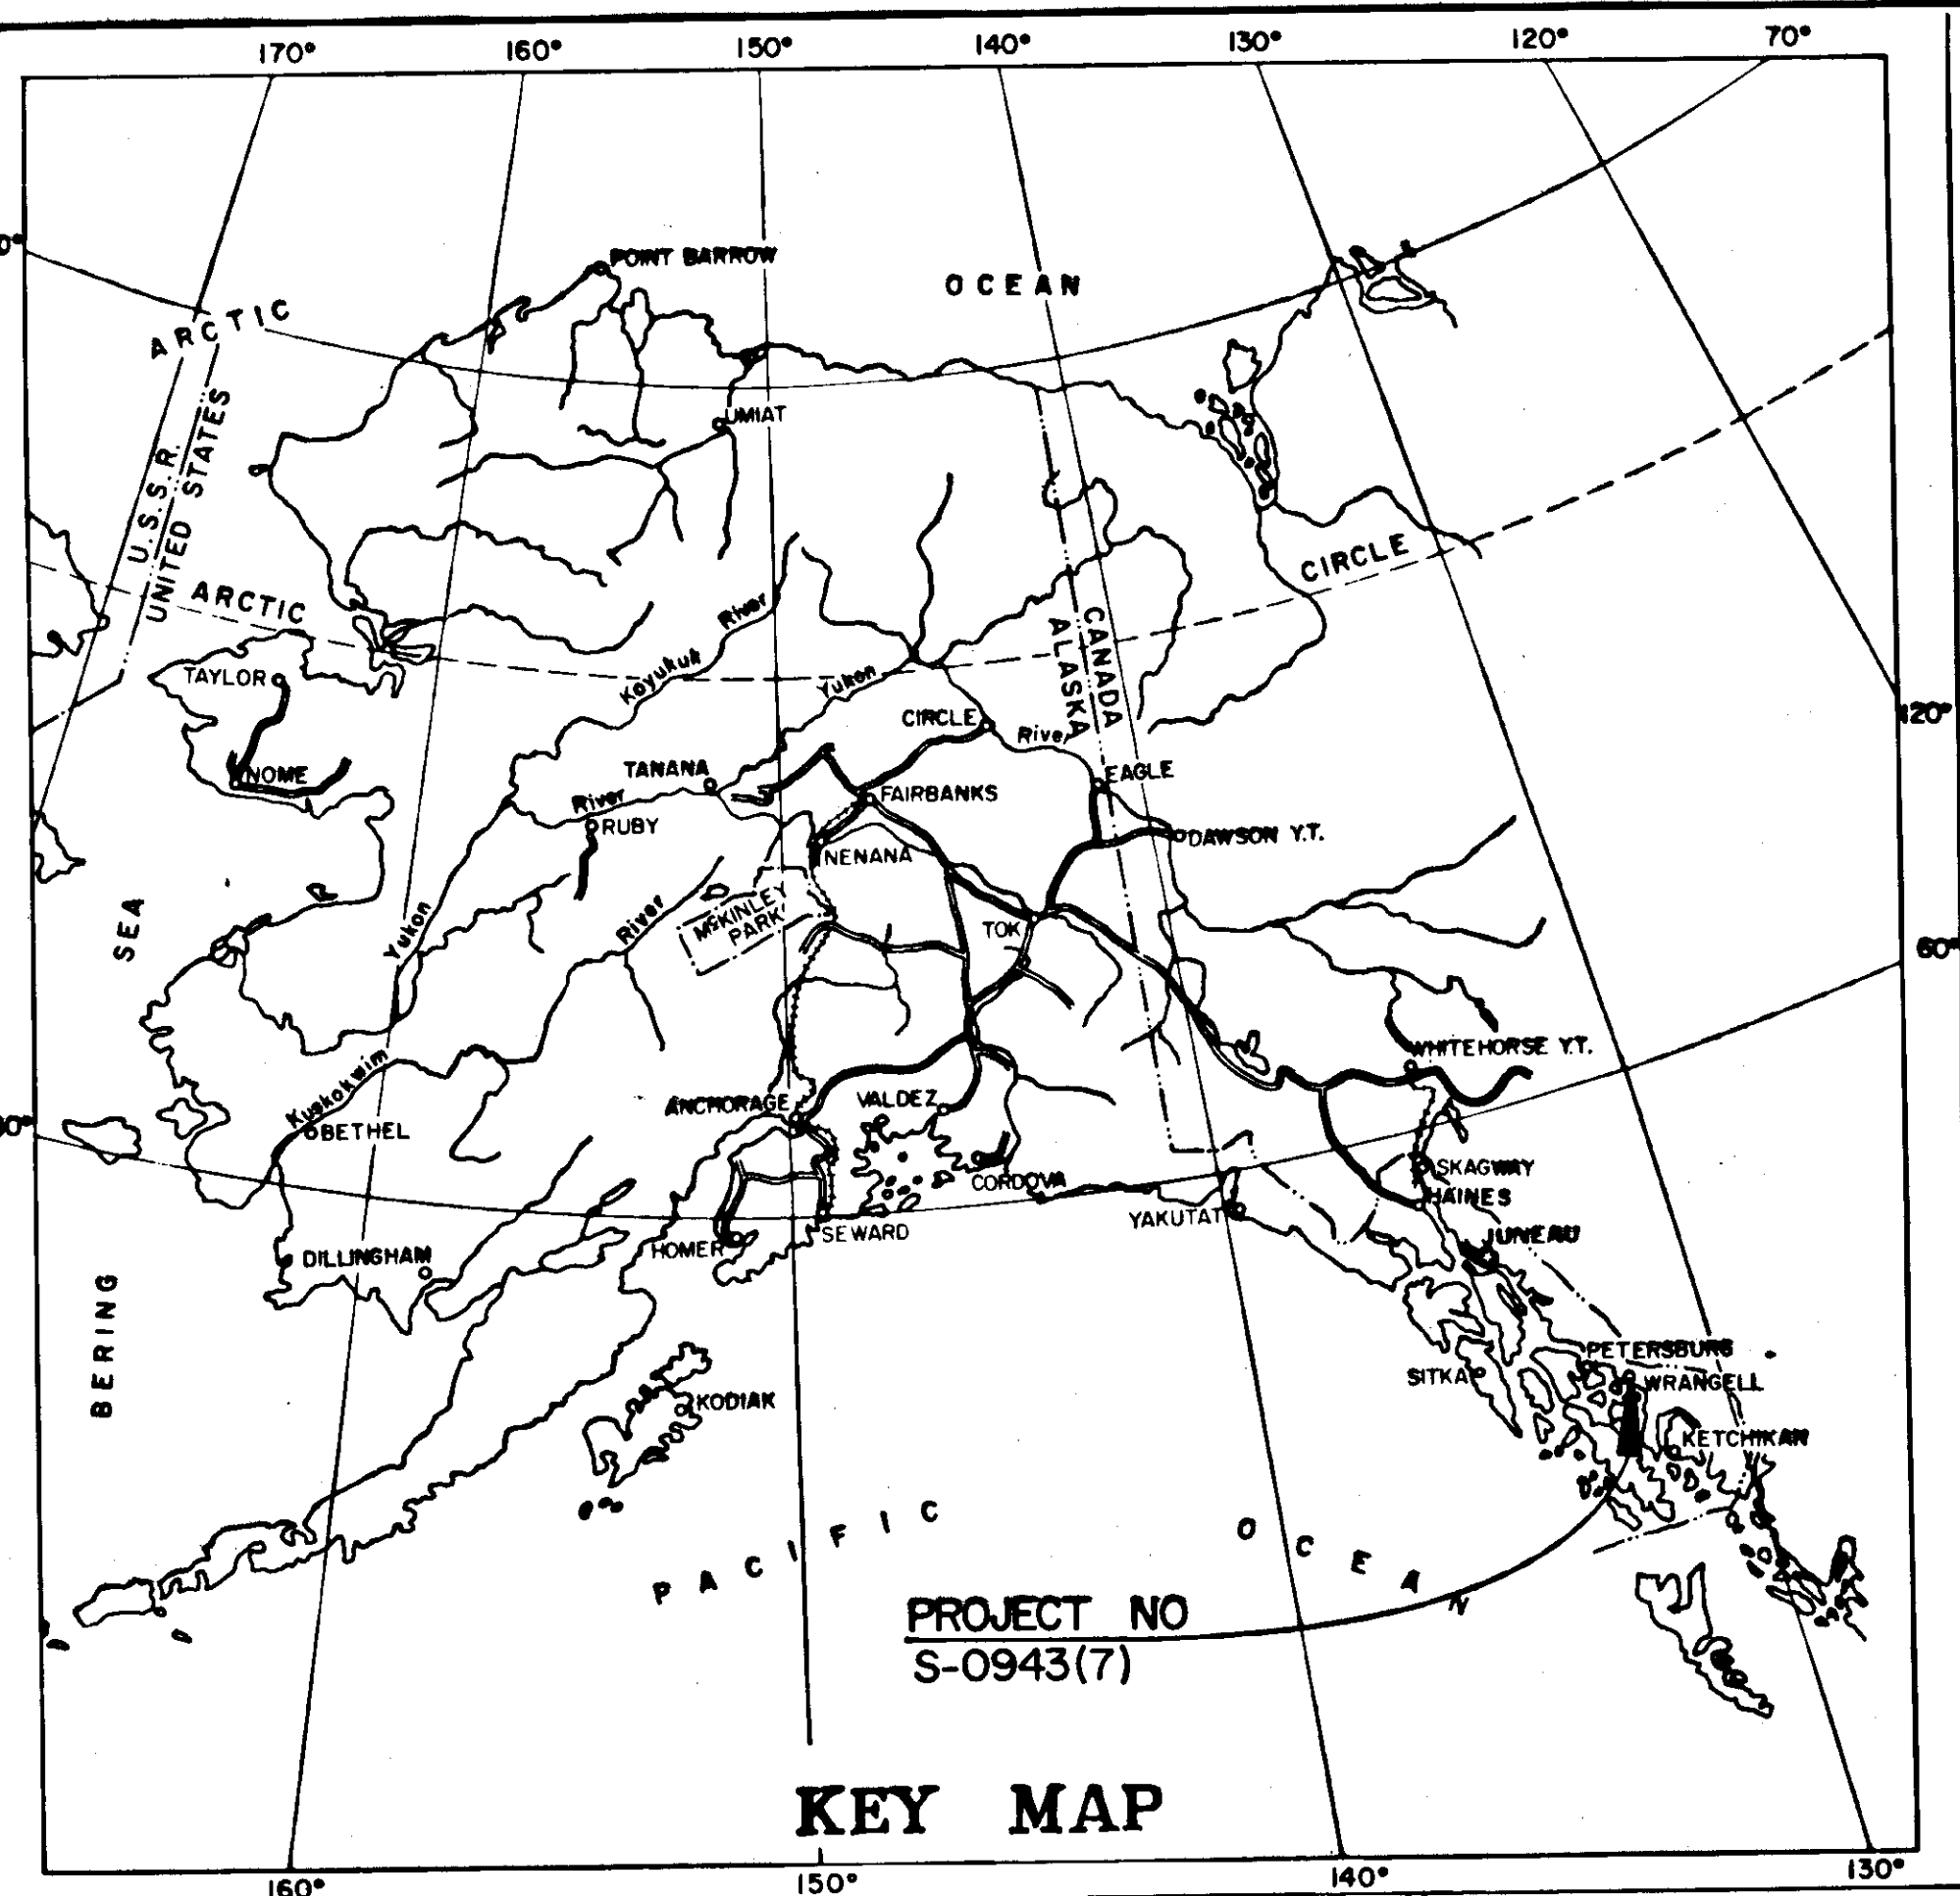

PLAN AND PROFILE

PROPOSED HIGHWAY PROJECT

F-095-4(1) & S-0943(7)

WRANGELL - CHURCH ST. TO FERRY TERMINAL

GRADING, DRAINAGE, & PAVING
 FERRY TERMINAL PAVING
 ZIMOVIA HIGHWAY PAVING

contractor: **GREEN CONST. CO.**
 proj. eng.: **T. VANDER WEYST**

BEGIN CONST: 4-16-68
End CONST: 10-21-68

INDEX OF SHEETS

SHEET NO.	DESCRIPTION
1	TITLE SHEET
2	Typical Section of Improvement
3	Estimate of Quantities
4	Summary Tables
5-9	Plan and Profile Sheets
10	Drainage Structure Details
11-13	Retaining Wall Details
14	Concrete Stairway Detail
15	Timber Stairway Detail
1	Misc. Detail
17-20	Intersection Details
20-21	Outfall Detail
22	Typical Section of Improvement F-095-4(1)
23	Plan and Profile F-095-4(1)
24	Zimovia Highway Paving Details
25	Summary of Standard Signs


THE FOLLOWING STANDARD DRAWINGS APPLY TO THIS PROJECT: D-1, D-3, D-4, M-1, R-1 (Mod.), R-4, T-16 (2 sheets), T-20
CHURCH ST. TO FERRY TERMINAL

DESIGN	DESIGNATION	PROJECT SUMMARY
ADT (1967)	= 500	WIDTH OF GRADING = 59.0'
ADT (1987)	= 1000	WIDTH OF PAVING = 39.0'
DHV	= 120	LENGTH OF GRADING = 2861.21' 0.542 Mi
D	= 45-55%	LENGTH OF PAVING = 2811.21' 0.532 Mi
T	= 5%	LENGTH OF PROJECT = 2861.21' 0.542 Mi

ZIMOVIA HIGHWAY PAVING

DESIGN	DESIGNATION	PROJECT SUMMARY
ADT (1967)	= 400	WIDTH OF GRADING = VARIES
ADT (1987)	= 1000	WIDTH OF PAVING = 24.0'
DHV	= 150	LENGTH OF GRADING = 32,134.08' 6.08 Mi
D	= 40-60%	LENGTH OF PAVING = 32,134.08' 6.08 Mi
T	= 5%	LENGTH OF PROJECT = 2,134.08' 6.08 Mi

- CONVENTIONAL SIGNS**
- MANHOLE (EXISTING)
 - INSTALL MANHOLE
 - ADJUST EXISTING MANHOLE
 - RECONSTRUCT EXISTING MANHOLE
 - PROPOSED CONSTRUCTION CENTERLINE
 - PRELIMINARY SURVEY LINE
 - TOWNSHIP LINE
 - SECTION LINE
 - PROPERTY LINE
 - RIGHT-OF-WAY LINE
 - EASEMENT LINE
 - CORPORATED OR CITY LIMITS
 - POWER LINE
 - TELEPHONE OR TELEGRAPH LINE
 - POLE ANCHOR
 - LIGHT POLE
 - WATER LINE
 - SEWER LINE
 - VALVE BOX
 - CATCH BASIN
 - DROP INLET
 - MANHOLE
 - CULVERT PROPOSED
 - CULVERT EXISTING
 - FIRE HYDRANT
 - TRAVELED WAY
 - SWAMP
 - FENCE
 - CURB CUT
 - LAND MONUMENT
 - RIGHT-OF-WAY MONUMENT
 - DIRECTION OF SIDE INTAKE
 - DROP INLET (WOOD)
 - PIPE OUTLET

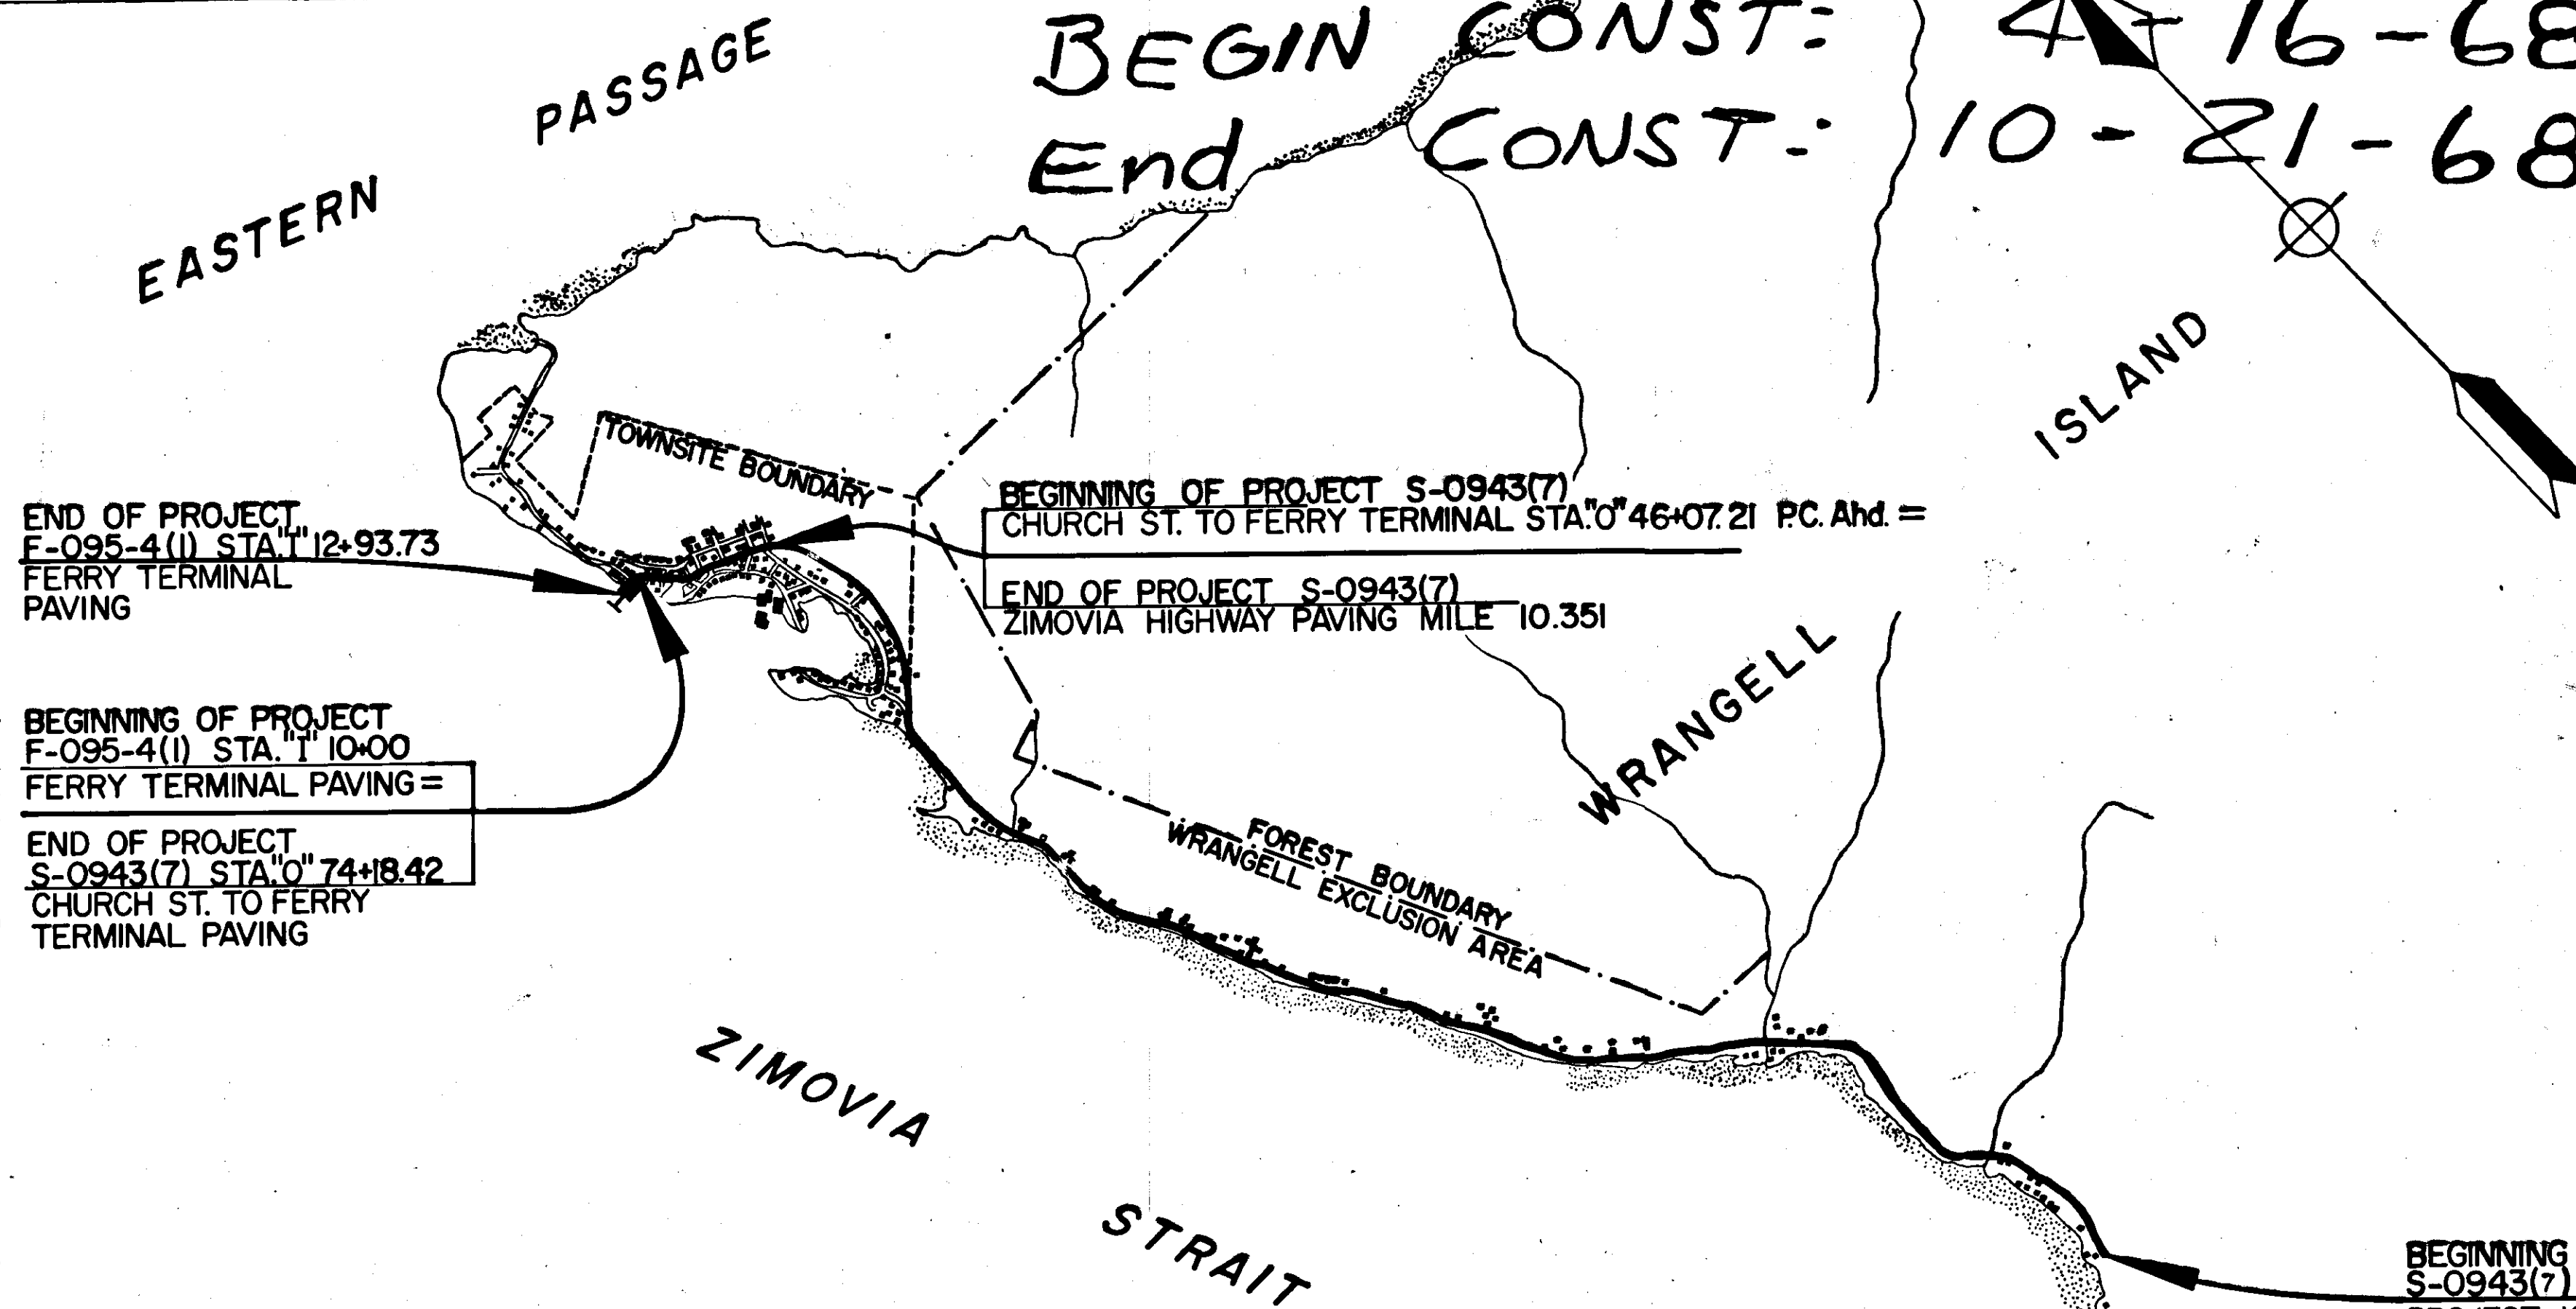

BEGINNING OF PROJECT
 S-0943(7) MILE 4.265
 PROJECT 16-A4, C4, D3, E2
 STA. 312-00.8


STATE OF ALASKA
 DEPARTMENT OF HIGHWAYS
 APPROVED
[Signature] Date 12/15/67
 COMMISSIONER OF HIGHWAYS

A5-BUILT

NOTE: Minor grading at the toe of fill slopes may be required to facilitate drainage.

NOTE: For detail of special drainage ditch in cut sections see detail on sheet No. 10

NOTE: Clearing and grubbing limits shall be 5' outside of slope limits or to the Right-of-Way or Easement Line, whichever is the lesser.

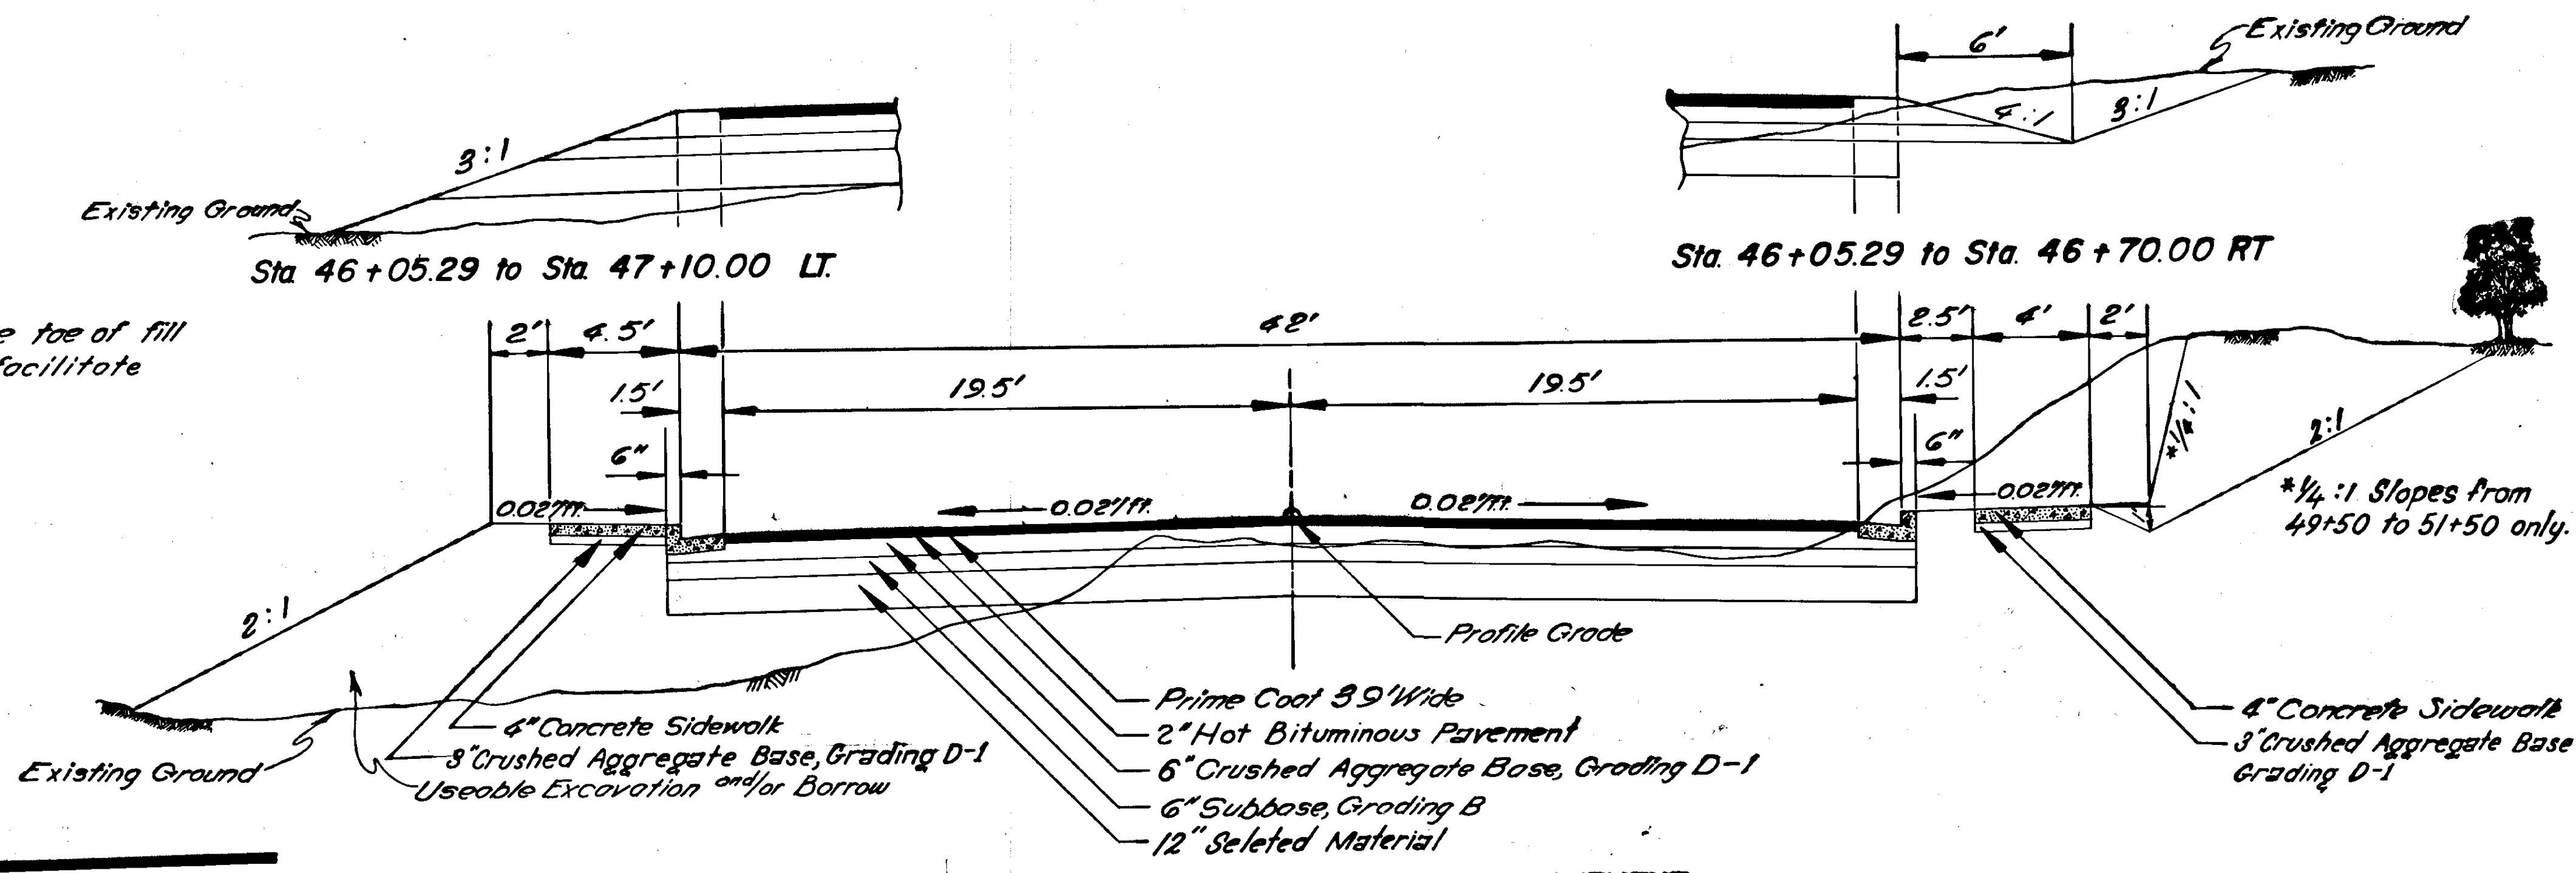


TYPICAL SECTION OF IMPROVEMENT STA. 47 + 10.00 TO STA. 74 + 18.42

BASIS OF ESTIMATE


Item	Estimating Factor
203(5)	1.86 Tons per cu. yd.
304(1)	1.95 Tons per cu. yd.
307(1)	1.87 Tons per cu. yd.
403(1)	149.33 Lbs. per cu. ft.
403(2)	6% of Item 403(1)
408(2)	7.8 Lbs. per gal. @ 60°F.

GENERAL NOTES


1. Culvert lengths and locations are approximate only and are subject to minor revisions.
2. Grades and alignment shown on these plans are subject to minor revisions.
3. Right-of-way encroachments--such as fences, abandoned foundations, and stairs, shall be removed by the contractor if inside the right-of-way at the time of construction. This work will be considered incidental to other items of work performed under this contract. This is not a pay item.
4. All waste and/or surplus material encountered on this project will be disposed of by the contractor at locations of his own choice and as approved by the engineer. There is no payment for haul or overhaul of unclassified excavation designated as waste and/or surplus material by the engineer.
5. All concrete shall be Class A, unless otherwise noted.
6. Where any portion of a new pipe is placed in an embankment section the excavation shall be performed after the embankment has been constructed to a height of twelve (12) inches above the top of the pipe and a distance of five (5) diameters on each side of the pipe. See detail sheet no. 16.
7. The contractor shall take adequate precautions to insure that application of prime coat will not discolor or damage private property or any highway appurtenance such as curb and gutter or other installation.
8. The removal and disposal of the wood stove water line from stations 0+65+93 to 0+74+06 will be considered incidental to item 640(2), six inch cast iron water main, class 150.
9. The removal and disposal of the existing wood inlet rt. of station 0+55+71 as well as the three existing wood drop inlets at the intersection of McKinnon street will be paid for under item no. 202(1) Removal of Structures and Obstructions.
10. At the option of the Contractor, corrugated galvanized metal pipe, corrugated Aluminum pipe or reinforced Concrete Pipe may be furnished for pay item 603(26), Pipe Conduit.
11. All buildings within the R/W will be removed by others prior to the beginning of construction.

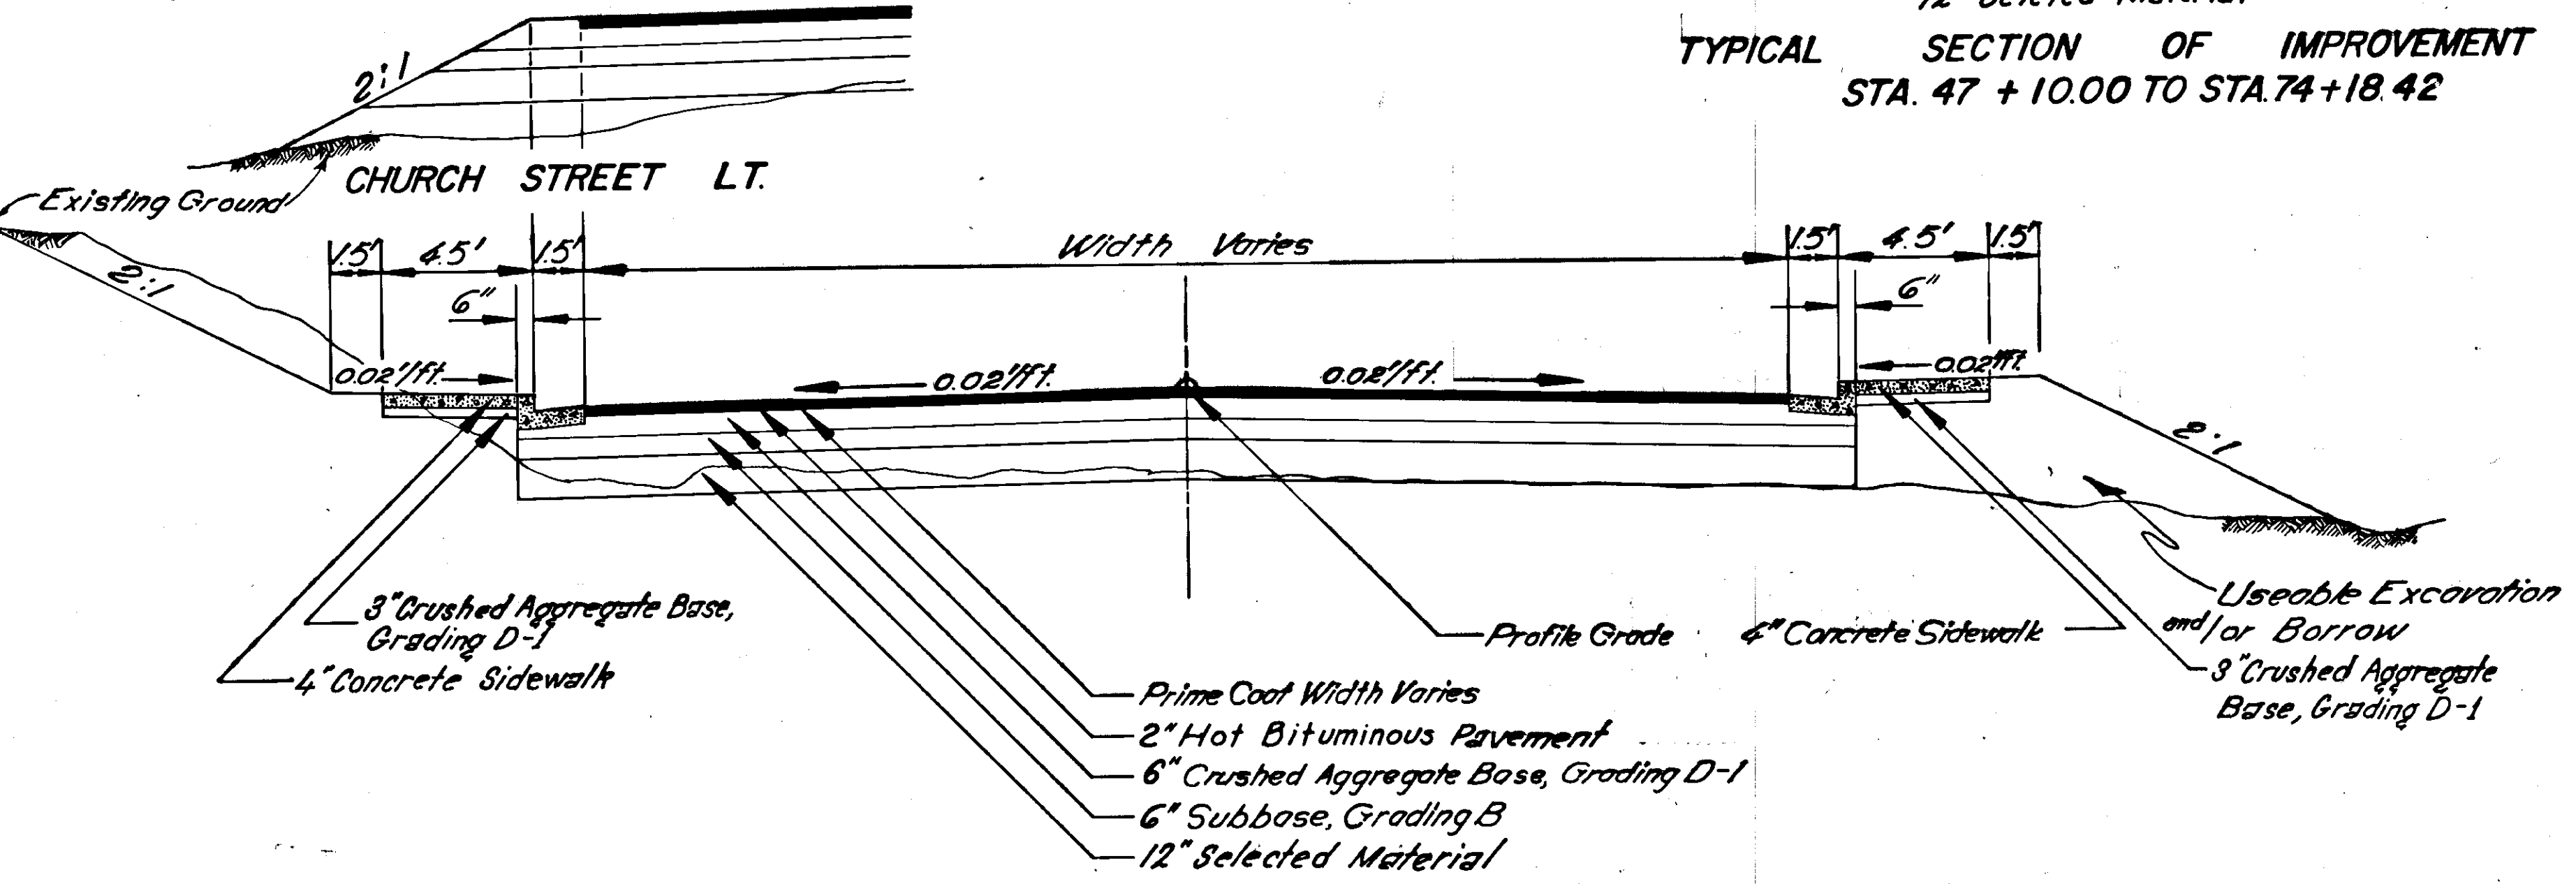

TYPICAL SECTION SIDE STREET PAVED APPROACH

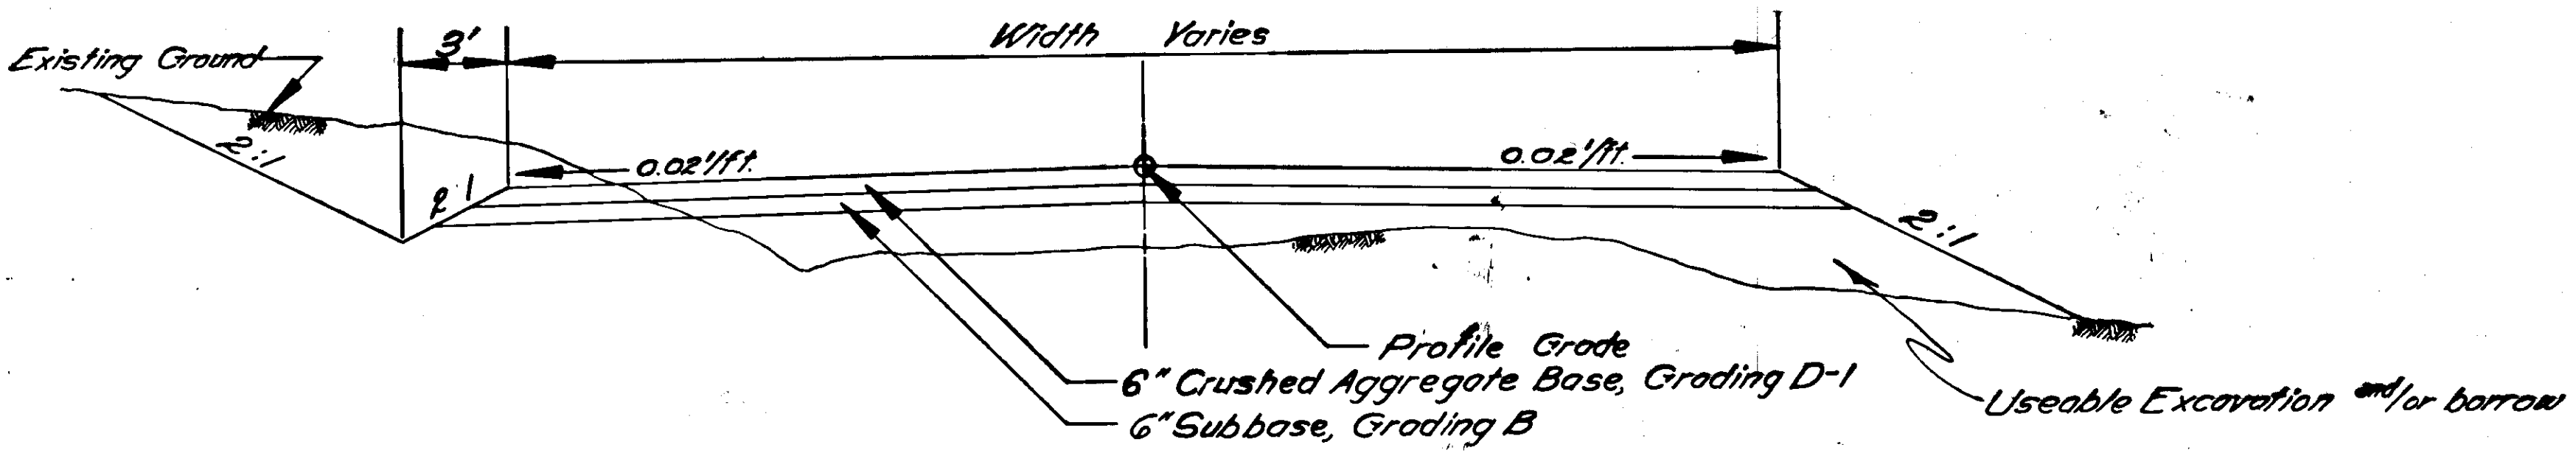

TYPICAL SECTION SIDE STREET (BEYOND PAVING LIMITS)

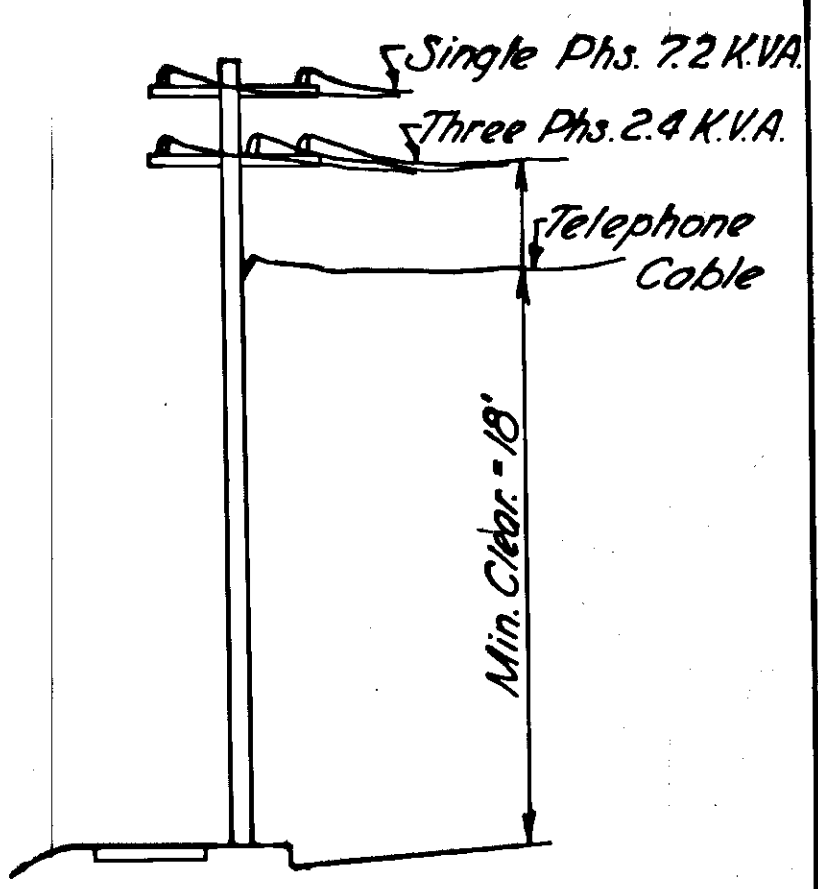

TYPICAL UTILITY INSTALLATION & CROSSING

ESTIMATE OF QUANTITIES

ITEM NO	ITEM	UNIT	SHEET						NUMBER		PROJECT S-0943(7)	PROJECT F-095-4(1)	Zimovia Highway Paving	24	CONTRACT TOTAL AS-BUILT
			5	6	7	8	9	20-21	22-23						
201(3)	Clearing and Grubbing	Lump Sum								All Required					All Required
202(1)	Removal of Structures and Obstructions	Lump Sum								All Required					All Required
202(4)	Removal and Disposal of Culvert Pipe	Lin. Ft.	146	48	0	65	96			355				146	501
203(3)	Unclassified Excavation	Cu. Yd.	2,568	3,369	2,422	2,069	1,365			11,793				18,350	30,143
203(5)	Borrow	Ton	539		491	4,285	1,298			6,613				2,995	6,613
206(1)	Structure Excavation	Cu. Yd.	187	71	469	282	140	1,717		2,866				129	2,995
207(1)	Class I, Excavation for Structures	Cu. Yd.	227	230	157	61	187	59		921				48,536	53,316
304(1)	Crushed Aggregate Base Course, Grading D-1	Ton	955	933	942	980	895			4,780			.05	6.09	6.14
306(1)	Reconditioning	Mile								4,441				35,833	40,274
307(1)	Subbase, Grading B	Ton	760	915	933	947	886			1,000				11,667	1,000
310(1)	Stockpiled Material, Grading A	Ton								1,423		300		9,944	700.0
403(1)	Hot Bituminous Pavement	Ton	239	293	298	309	284		300.0	18.0		18.0		596.7	122.1
403(2)	Asphalt Cement, 120-150 Penetration	Ton	14.3	17.6	17.9	18.5	17.0		18.0	85.3		2.9		104.4	
408(2)	M. C. 30 Liquid Asphalt for Prime Coat	Ton	2.5	3.0	3.1	3.2	3.0		2.9	14.8		2.9			
601(1)	Class "A" Concrete	Lump Sum								All Required					All Required
602(1)	Reinforcing Steel	Lump Sum								All Required					All Required
603(26A)	8" Pipe Conduit	Lin. Ft.			124	34	56			278					278
603(26C)	12" Pipe Conduit	Lin. Ft.	64							1,059					1,059
603(26E)	18" Pipe Conduit	Lin. Ft.	384	223	48	90	314			1,896				110	2,006
603(26G)	24" Pipe Conduit	Lin. Ft.	432		454	158		852		5					5
604(1)	Manholes	Each								10					10
604(2A)	Type "A" Inlet	Each	2	2	2		4			6					6
604(2B)	Type "B" Inlet	Each	2			1	1			14					14
604(2C)	Corrugated Metal Pipe Inlet Box	Each	4	2	4	3	1			3					3
604(5)	Adjustment of Existing Manholes	Each	1		1	1				10					10
604(4)	Reconstruct Existing Manhole	Each	2	1	1	3	3			84					84
605(1)	8" Perforated C. M. P. for Underdrains	Lin. Ft.	54		30					2,288					2,288
608(1)	4" Concrete Sidewalk	Sq. Yd.	390	509	478	487	424			144					144
608(4)	6" Concrete Sidewalk	Sq. Yd.	6	25	19	28	66			198		198			5,787
609(3)	Curb and Gutter, Type 2	Lin. Ft.	915	1,200	1,183	1,186	1,105			10					10
614(1)	Survey Monuments	Each	0	3	1	3	3			10					10
614(2)	Monument Cases	Each	0	3	1	3	3			10					10
614(3)	Adjust Existing Monument & Cases	Each	1	2	1	2	2		2	8		2		10	33
615(1)	Standard Signs	Each	7	3	5	10	7			32		1			33
635(2)	Treated Timber	M. B. M.	0.57	1.54	0.35	0.58	0.60			3.64					3.64
640(2)	6" Cast Iron Water Conduit	Lin. Ft.				280	618			898					898
640(7)	Fire Hydrant Relocation	Each	1	2	1	1	1			6					6
640(9)	Water Service Connection	Each	2	1	2	4	6			15					15
640(10)	6" Gate Valve & Service Box	Each				1	1			2					2
640(11)	Adjust or Relocate Water Valve Boxes	Each	2	5	5	8	4			24					24
641(1)	Hand Railing	Lin. Ft.	245.7	424.1	250.8	96.4	196.0			1213.0					1213.0
645(1)	Construct Sewer Laterals	Each	2		1					6					6
645(3)	Adjust or Relocate Sewer Laterals	Each	2			2	3			7					7
603(26I)	36" Pipe Conduit	Lin. Ft.												56	56
606(2)	Beam Type Guardrail, Type II Posts	Lin. Ft.												875	875

SUMMARY TABLES

AS-BUILT

STAIRWAYS

Station	Location	Type	Cu. Yd. Conc.	Re-Steel	Lin. Ft. Rail	M.B.M. Lumber
47+09.95	Lt.	Wood	0.151			0.250.121
48+35	Rt.	Wood	0.150			0.140.119
48+73	Lt.	Wood	0.150			0.180.114
A+B Lines						
B' 9+68	Rt.	Concrete	2.11	100	28'8"	
A' 10+70	Lt.	Concrete	1.87	161.9	24'2"	
51+00	Rt.	Wood	0.150			0.400.648
51+95.92	Lt.	Wood	0.150			0.290.015
52+76	Lt.	Concrete	1.54	148	17'2"	
53+45	Lt.	Concrete	1.05	90	12'6"	
54+17	Lt.	Wood	0.15	130		0.270
55+35	Lt.	Wood	0.150			0.290.045
55+65.67	Lt.	Wood	0.150			0.290.347
55+67	Rt.	Concrete	1.0	90	12'6"	DELETED
59+20.17	Lt.	Wood	0.150			0.170.155
60+10	Lt.	Wood	0.15	51		0.180
60+60	Lt.	Concrete	0.64	50.4		
61+80	Lt.	Concrete	0.64	50.35		
62+28	Lt.	Concrete	0.71	64.30		
E Line						
E' 10+25	Lt.	Concrete	0.63	50.25		
65+65	Rt.	Concrete	0.63	50.25		
66+80	Lt.	Wood	0.15			0.180
67+15	Lt.	Wood	0.15			0.220
67+40	Lt.	Wood	0.15			0.180
69+45.25	Lt.	Wood	0.15	3		0.220.127
70+15	Lt.	Concrete	0.6	50.2		
70+80	Lt.	Wood	0.15			0.300.045
Total			13.4	986	950'	3.640

* The excavation required to construct this stairway will be paid for under Item *207(1), Class I Excavation for structures.

ADJUST SEWER LATERALS

Station L/R	Station L/R	Station L/R
47+45 Rt.	65+55 Rt.	48+00 Lt.
49+25 Rt.	67+70 Lt.	48+89 Lt.
49+10 Rt.	68+75 Rt.	68+33 Lt.
58+70 Rt.	71+00 Rt.	68+89 Rt.
61+42 Rt.	71+25 Lt.	69+57 Lt.
63+00 Rt.	71+68 Rt.	70+28 Lt.
64+70 Rt.	72+25 Rt.	70+70 Lt.
64+95 Rt.	72+00 Rt.	
65+35 Rt.		

STAIRWAYS (WOOD)

Station L/R	Comp. Cu. Yd.	Min. Lumber
57+10 Lt.	0	0.336
59+25 Rt.	0	0.346
64+27 Lt.	0	0.249
71+80 Lt.	0	0.244
72+26 Lt.	0	0.409

ADJUST MANHOLE

Station	Finished Grade el.	Location
46+61	63.63	11' Rt.
60+54	60.27	8.5' Lt.
67+31	51.10	4' Lt.

RECONSTRUCT EXIST. MANHOLE

Station	Finished Grade el.	Location
47+34	61.70	1' Rt.
49+79	63+58	4.5' Rt.
55+65	62.46	23' Lt.
58+43	48.38	2' Lt.
62+95	39.04	8.5' Lt.
63+87.5	41.18	18' Lt.
68+19	50.20	9' Lt.
70+79	43.82	10' Lt.
73+23	34.21	14' Rt.
74+16.5	29.52	13' Rt.
Front St.		Rt.
46+61		Rt.
60+54		Rt.
67+31		Rt.

ADJUST MAIN VALVES

Station
47+26
47+45
49+63
58+60
56+15
60+40
63+12
58+69
66+00

ADJUST OR RELOCATE WATER VALVE BOXES

Station	Location	Station	Location	Station
48+18	9' Rt.	62+83	4' Lt.	70+70 Lt.
49+25	20' Lt.	62+84	4' Rt.	70+23 Lt.
52+01	28' Lt.	63+83.65	5' Lt.	52+02 Lt.
52+79	28' Lt.	65+58	11' Rt.	52+01 Lt.
53+20	24' Lt.	65+92	2' Rt.	54+35 Lt.
54+39	27' Lt.	66+00	20' Lt.	49+70 Rt.
55+53	18' Rt.	68+43	30' Lt.	56+75 Lt.
58+75	3' Rt.	68+49	11' Rt.	51+20 Lt.
60+28	2' Lt.	71+82	20' Lt.	
60+29	28' Lt.	71+87	15' Rt.	
61+42	1' Lt.	71+88	19' Rt.	
61+40.56	28' Lt.	73+00	16' Rt.	

* To be relocated to new main at same location and adjusted to grade.

CULVERT REMOVAL

Station	Location	Length	Station	Location	Length	
46+77	Rt.	24'	24+70	X-ing	54'	
47+30	X-ing	62'	34+20	X-ing	18'	
49+57	X-ing	30'	52+02	X-ing	30'	
49+86	X-ing	30'	52+01	X-ing	30'	
55+67	X-ing	48'	54+35	X-ing	30'	
McKinnon St. intersect						65'
69+90	Rt.	20'				
71+75	Rt.	20'				
72+35	Rt.	17'				
72+48	Rt.	22'				
72+90	Rt.	17'				
Total		355'				

PAY QUANTITIES FOR ITEM 601(1)

Class A Concrete	Cu. Yds.
Stairways	13.4
Retaining Walls	307.4
Total	320.8

INSTALL OR RELOCATE WATER SERVICE

Existing	New	Existing	Existing	Existing
68+44 Lt.	47+93 Rt.	47+51 Rt.	66+42 Lt.	72+90 Rt.
67+59 Lt.	50+30 Lt.	47+30 Rt.	66+42 Rt.	48+18 Lt.
68+03 Lt.	55+90 Lt.	48+18 Lt.	60+47 Lt.	48+55 Lt.
69+48 Lt.	58+40 Lt.	48+18 Rt.	67+61 Lt.	48+80 Lt.
71+84 Lt.	60+80 Rt.	48+82 Rt.	69+17 Rt.	47+28 Lt.
71+88 Rt.	62+70 Rt.	58+75 Rt.	68+49 Rt.	49+25 Lt.
71+90 Rt.	68+55 Lt.	61+42 Rt.	72+22 Lt.	63+75 Rt.
72+22 Lt.	73+20 Lt.	64+95 Rt.	65+00 Rt.	47+31 Rt.

REMOVAL OF STRUCTURES

Station	Location	Type
62+87	Lt. 6'	Catch Basin
63+07	Lt. 27'	Catch Basin *
63+16	Lt. 5'	Catch Basin
55+71	Rt. 29.5'	Wood Inlet

* Price paid for removal of this structure includes plugging this structure's outfall pipe in a secure manner as approved by the engineer.

RELOCATE FIRE HYDRANTS

Station	Lin. Ft.
50+00 Rt.	19
53+78 Rt.	25
55+82 Rt.	28
60+75 Rt.	25
62+75 Rt.	27
72+95 Rt.	10
Total	134'

INSTALL SEWER SERVICE


Station	Lin. Ft.
47+93 Rt.	37'
B' 10+77 Rt.	11'
60+80 Rt.	40'
62+70 Rt.	33'
68+55 Lt.	18'
73+20 Lt.	50'
Total	194'

MONUMENTS & CASES

Station	Location	Station	Location
47+47.05	Adjust	45+67	45'
50+76.12 PC	Install	36+07.48	
51+15.40	Adjust	32+99.26	
52+64.69 PT	Install	22+50.25	
53+23.28	Adjust	16+11.43	
56+02.11 PC	Install	9+66.42	
58+48.55	Adjust	7+41.21	
60+86.69 PT	Install	2+14.15	
63+26.68 PC	Install	0+09.13	
64+12.12	Adjust		
64+96.95 PT	Install		
67+04.84 PC	Install		
68+04.89	Adjust		
68+79.19 PT	Install		
72+75.92 PC	Install		
73+59.11 PT	Install		
73+44.32	Adjust		
74+76.73	Adjust		
Ferry Terminal	Adjust (2)		

CONSTRUCTION PLAN AS-BUILT

NOTE: For details of Intersections see Intersection sheets #17 to #20

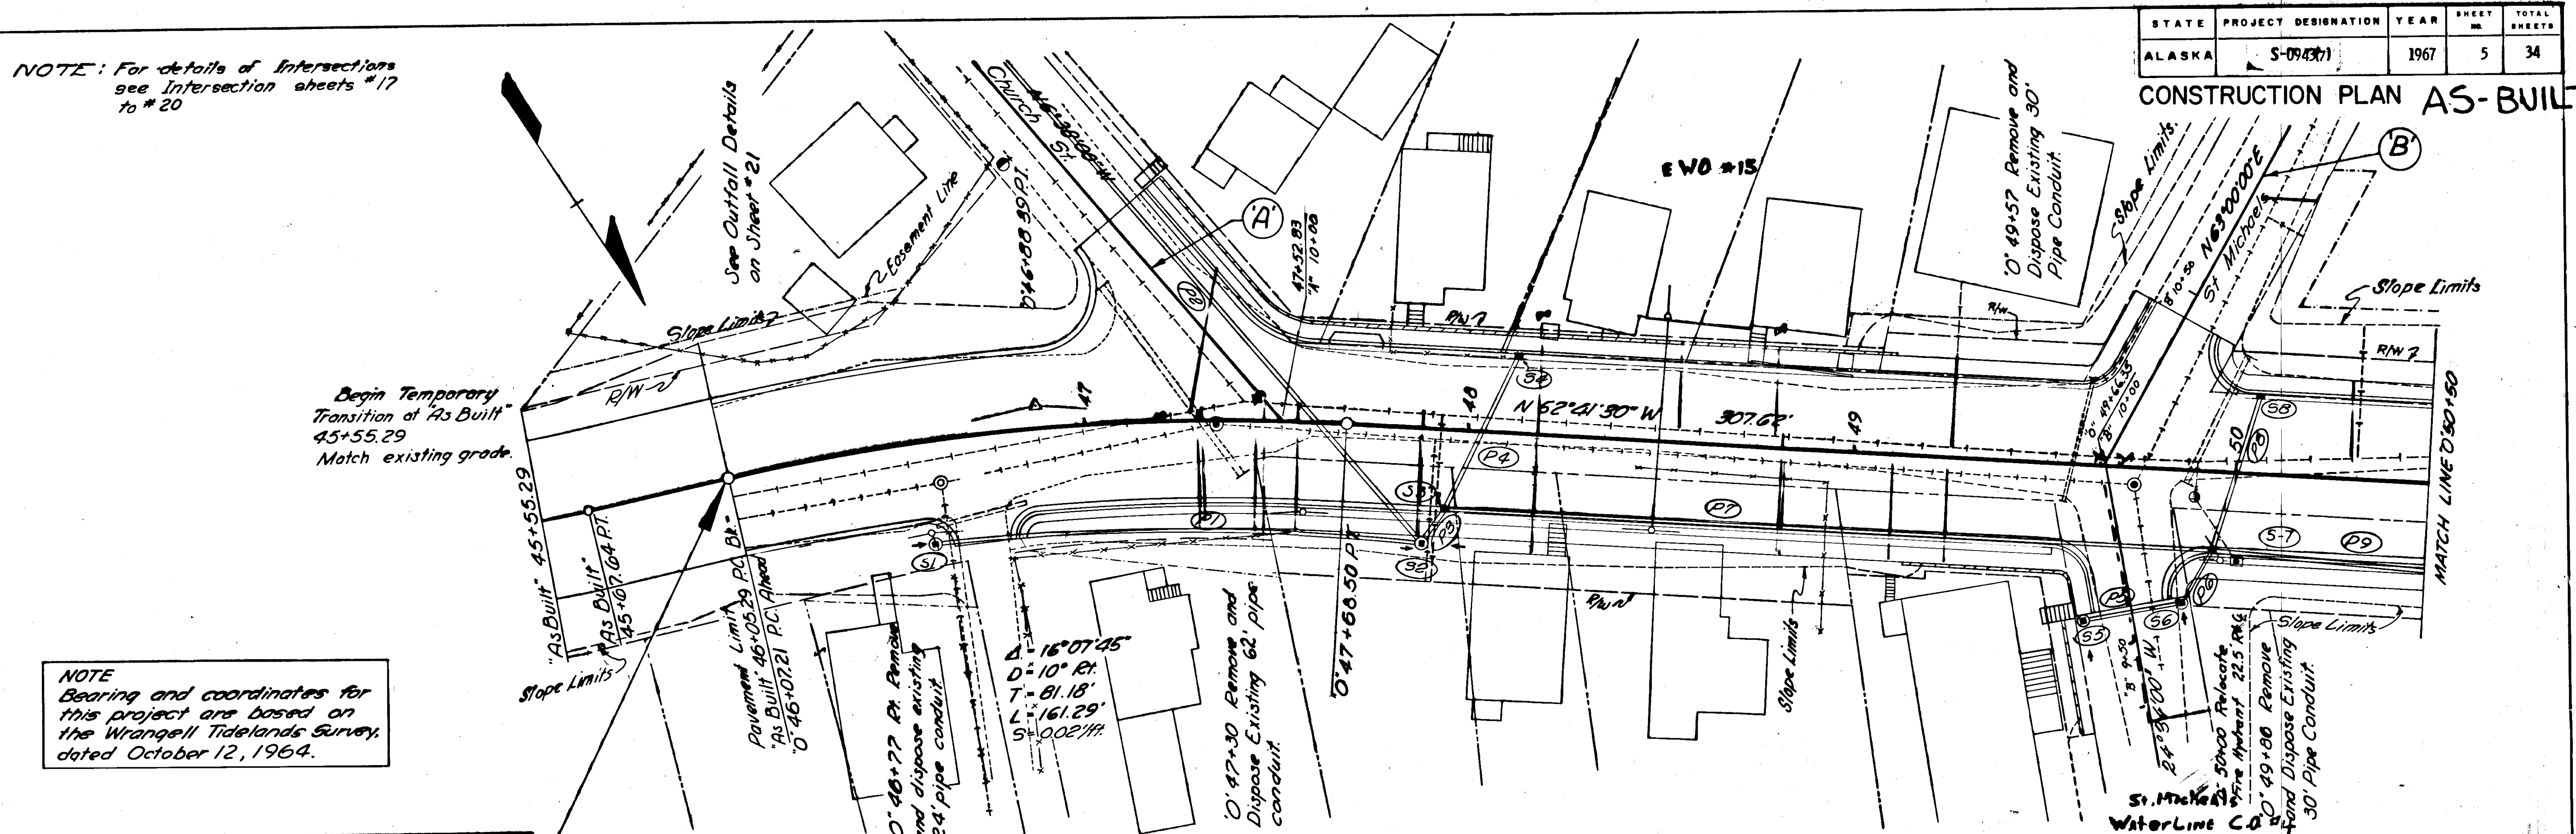

NOTE
Bearing and coordinates for this project are based on the Wrangell Tidelands Survey, dated October 12, 1964.

BEGINNING OF PROJECT S-0943(7)
STA. "AS BUILT" 46+05.29 P.C. BK. =
STA. "O" 46+07.21 P.C. AH.

TBM #1 Elev. 69.62
8" spike in power pole
35' Right @ Sta. 45+00


NOTE
The elevation of a standard benchmark disk, stamped "No. 6 1954" located on a rock outcrop 127.6 ft. from the Southwest corner of the Federal Building, is taken to be 59.10' as established by U.S.C. & G.S.

Embankment = (Excavation - Waste - Excess Excavation) x (Grading Factor) + (Subbase) x (0.538 c.y./ton) + (Crushed Aggregate) x (0.513 c.y./ton) = 8914 c.y.

STRUCT. No.	TYPE	LOCATION		REFERENCE ELEV.	INV. ELEV.
		STA.	OFFSET		
S-1	C.M.P. INLET	46+57	27' Rt.	62.83	60.83
*S-2	C.M.P. INLET	47+90	29.5' Rt.	60.63	54.10
S-3	B INLET	47+96	19.5' Rt.	61.06	56.31
S-4	A INLET	48+12	19.5' Lt.	60.78	58.53
**S-5	C.M.P. INLET	B' 9+61.5	13' Lt.	61.25	59.75
S-6	C.M.P. INLET	B' 9+61.5	13' Rt.	61.25	59.25
S-7	B INLET	49+94	19.5' Pt.	63.40	58.65
S-8	A INLET	50+05.5	19.5' Lt.	63.58	61.33


* Shape inlet ditches to allow for flow from uphill side if required.
** Inlet flow line of Underdrain = 61.86

PIPE No.	PIPE DIA.	DESIGN LENGTH	FROM		TO	
			STR. No.	INV. ELEV.	STR. No.	INV. ELEV.
P-1	18"	124'	S-1	60.83	S-2	57.14
P-2	24"	432'	S-2	54.10	S-29	41.72
P-3	18"	8'	S-3	56.26	S-2	55.70
P-4	18"	42'	S-4	58.53	S-3	57.31
P-5	12"	24'	S-5	59.75	S-6	59.45
P-6	18"	14'	S-6	59.25	S-7	58.75
P-7	18"	196'	S-7	58.75	S-3	57.41
P-8	12"	40'	S-8	61.33	S-7	58.75

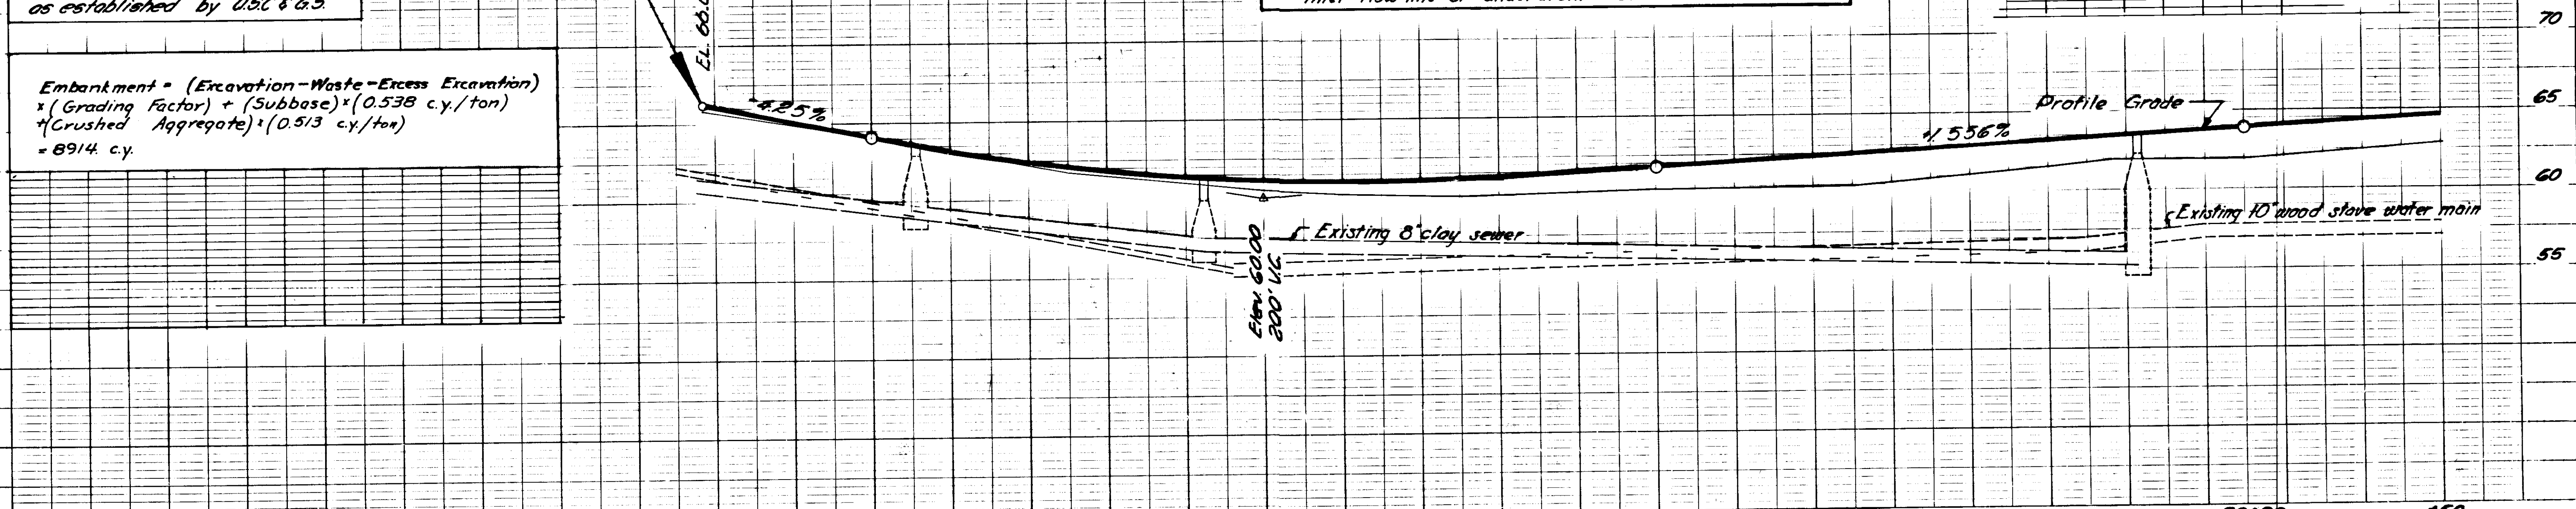

STATE	PROJECT DESIGNATION	YEAR	SHEET NO.	TOTAL SHEETS
ALASKA	S-094371	1967	6	34


CONSTRUCTION PLAN AS-BUILT

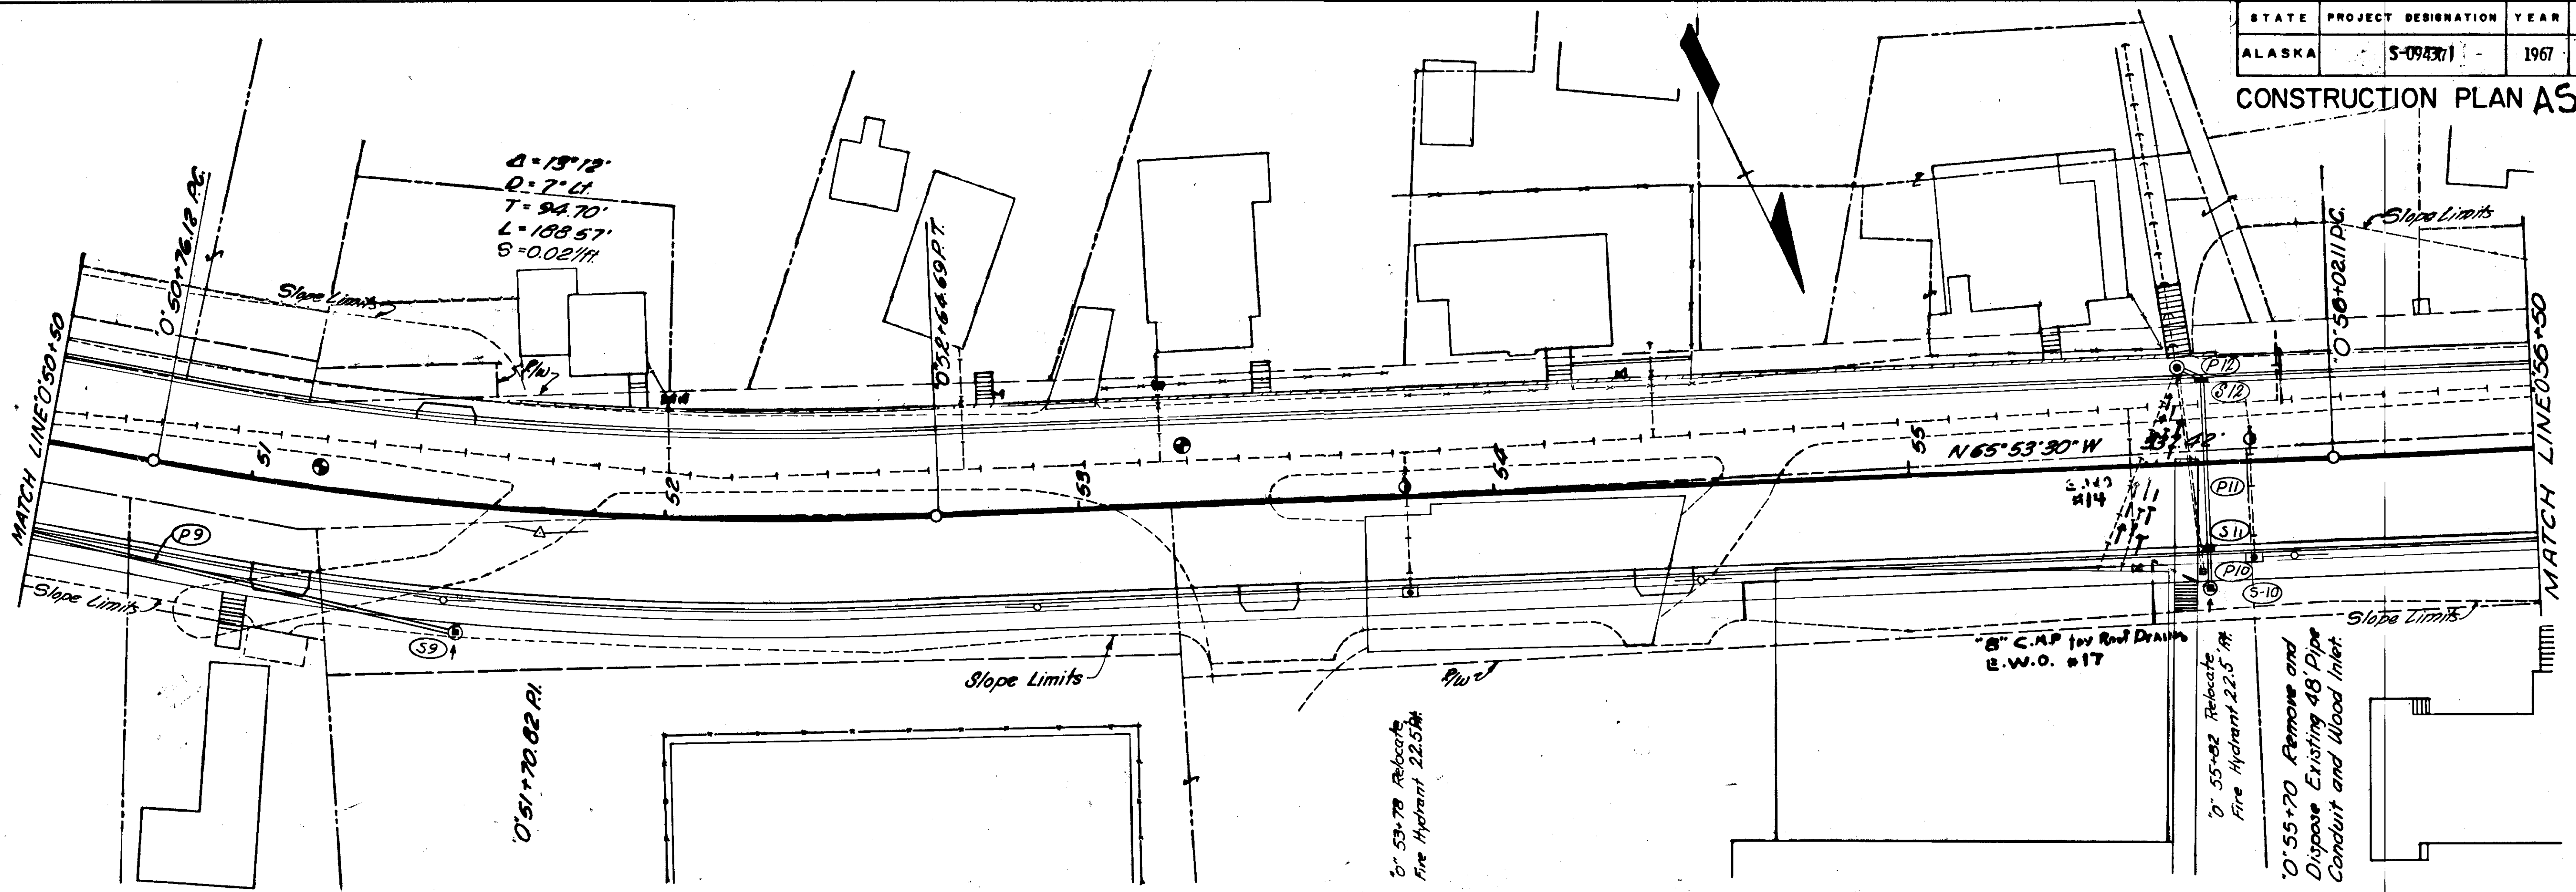


STRUCT No.	TYPE	LOCATION		REFERENCE ELEV.	INV. ELEV.
		STA.	OFFSET		
*S-9	C.M.P. INLET	51+52.5	29.5' Pt.	64.67	63.27
*S-10	C.M.P. INLET	55+71	29.5' Pt.	61.14	58.65
S-11	A Inlet	55+70	19.5' Pt.	61.61	57.81
S-12	A Inlet	55+70	19.5' Lt.	61.61	57.81

* Shape Inlet ditch to allow for flow from Side ditch, if required.

PIPE No.	PIPE DIA.	DESIGN LENGTH	FROM		TO	
			STR. NO.	INV. ELEV.	STR. NO.	INV. ELEV.
P-9	18"	168'	S-9	63.27	S-7	58.75
P-10	18"	8'	S-10	58.65	S-11	57.91
P-11	18"	40'	S-11	57.81	S-12	57.00
P-12	18"	7'	S-12	57.15	Exist. MH.	57.00

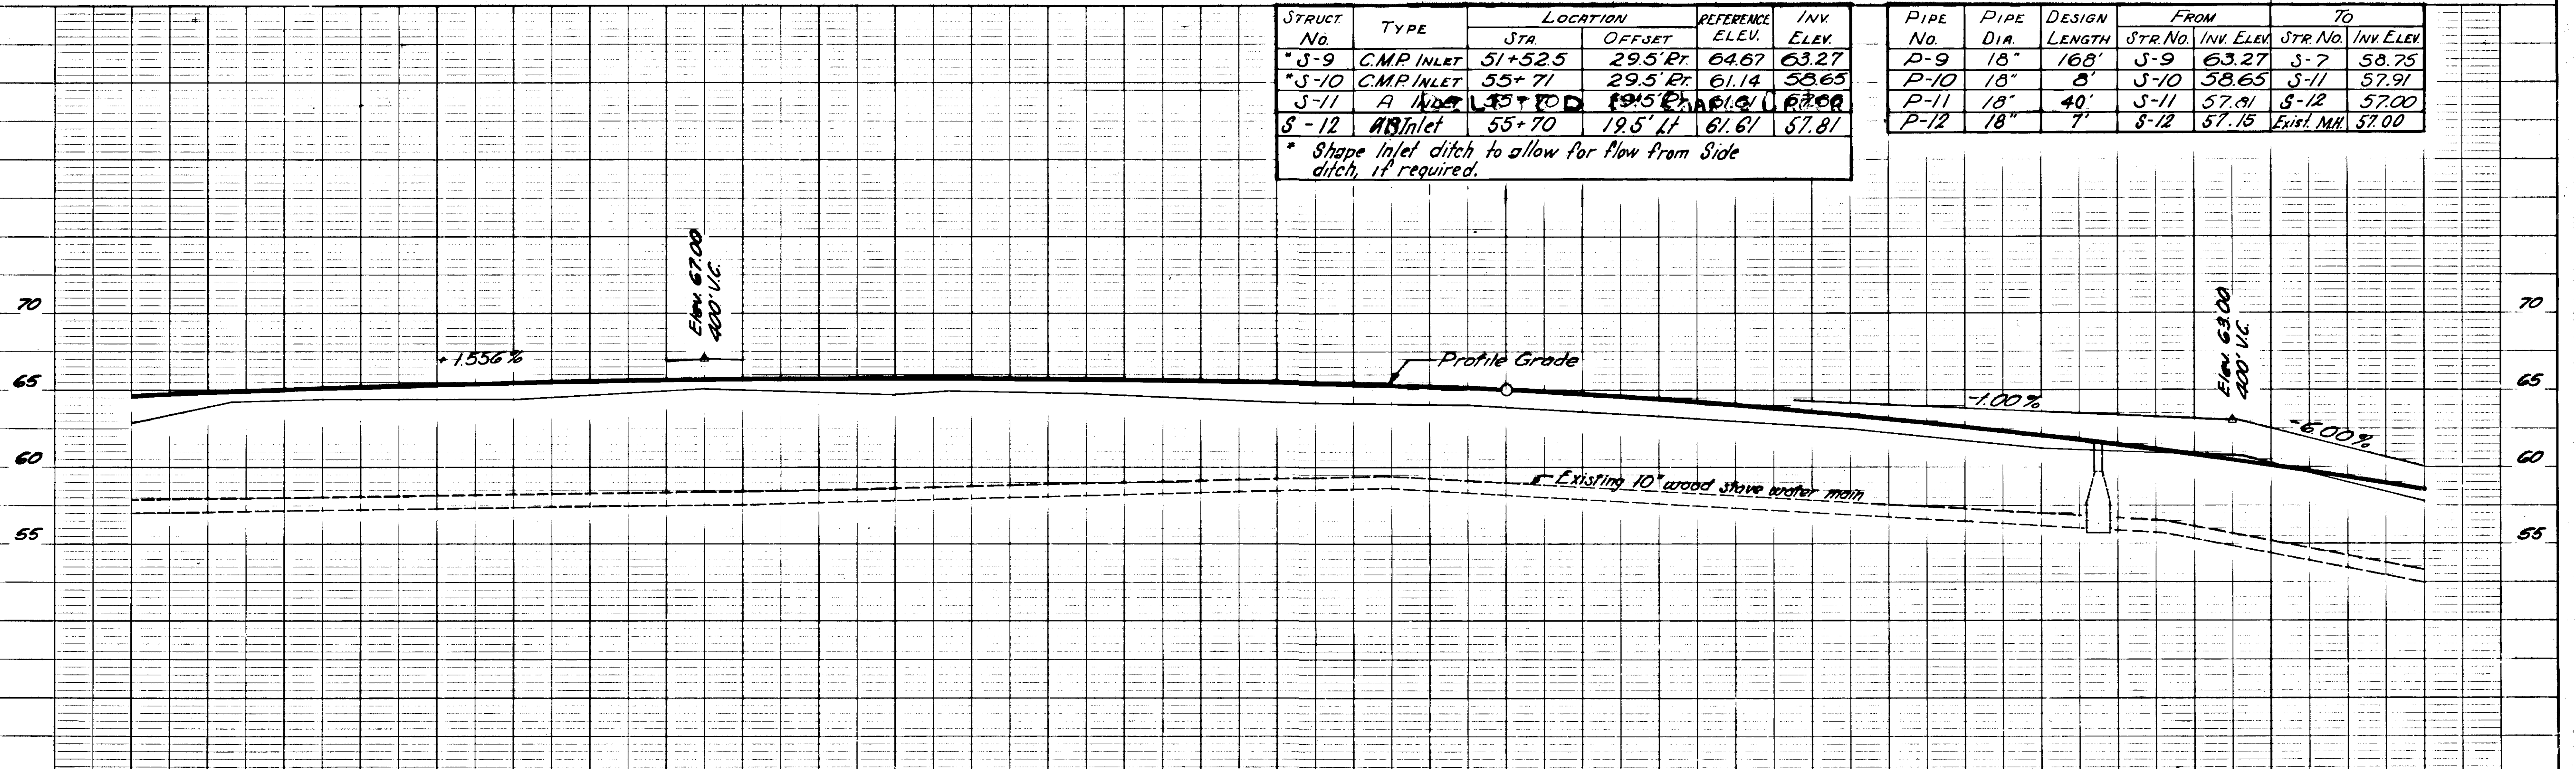

CONSTRUCTION PLAN AS-BUILT.

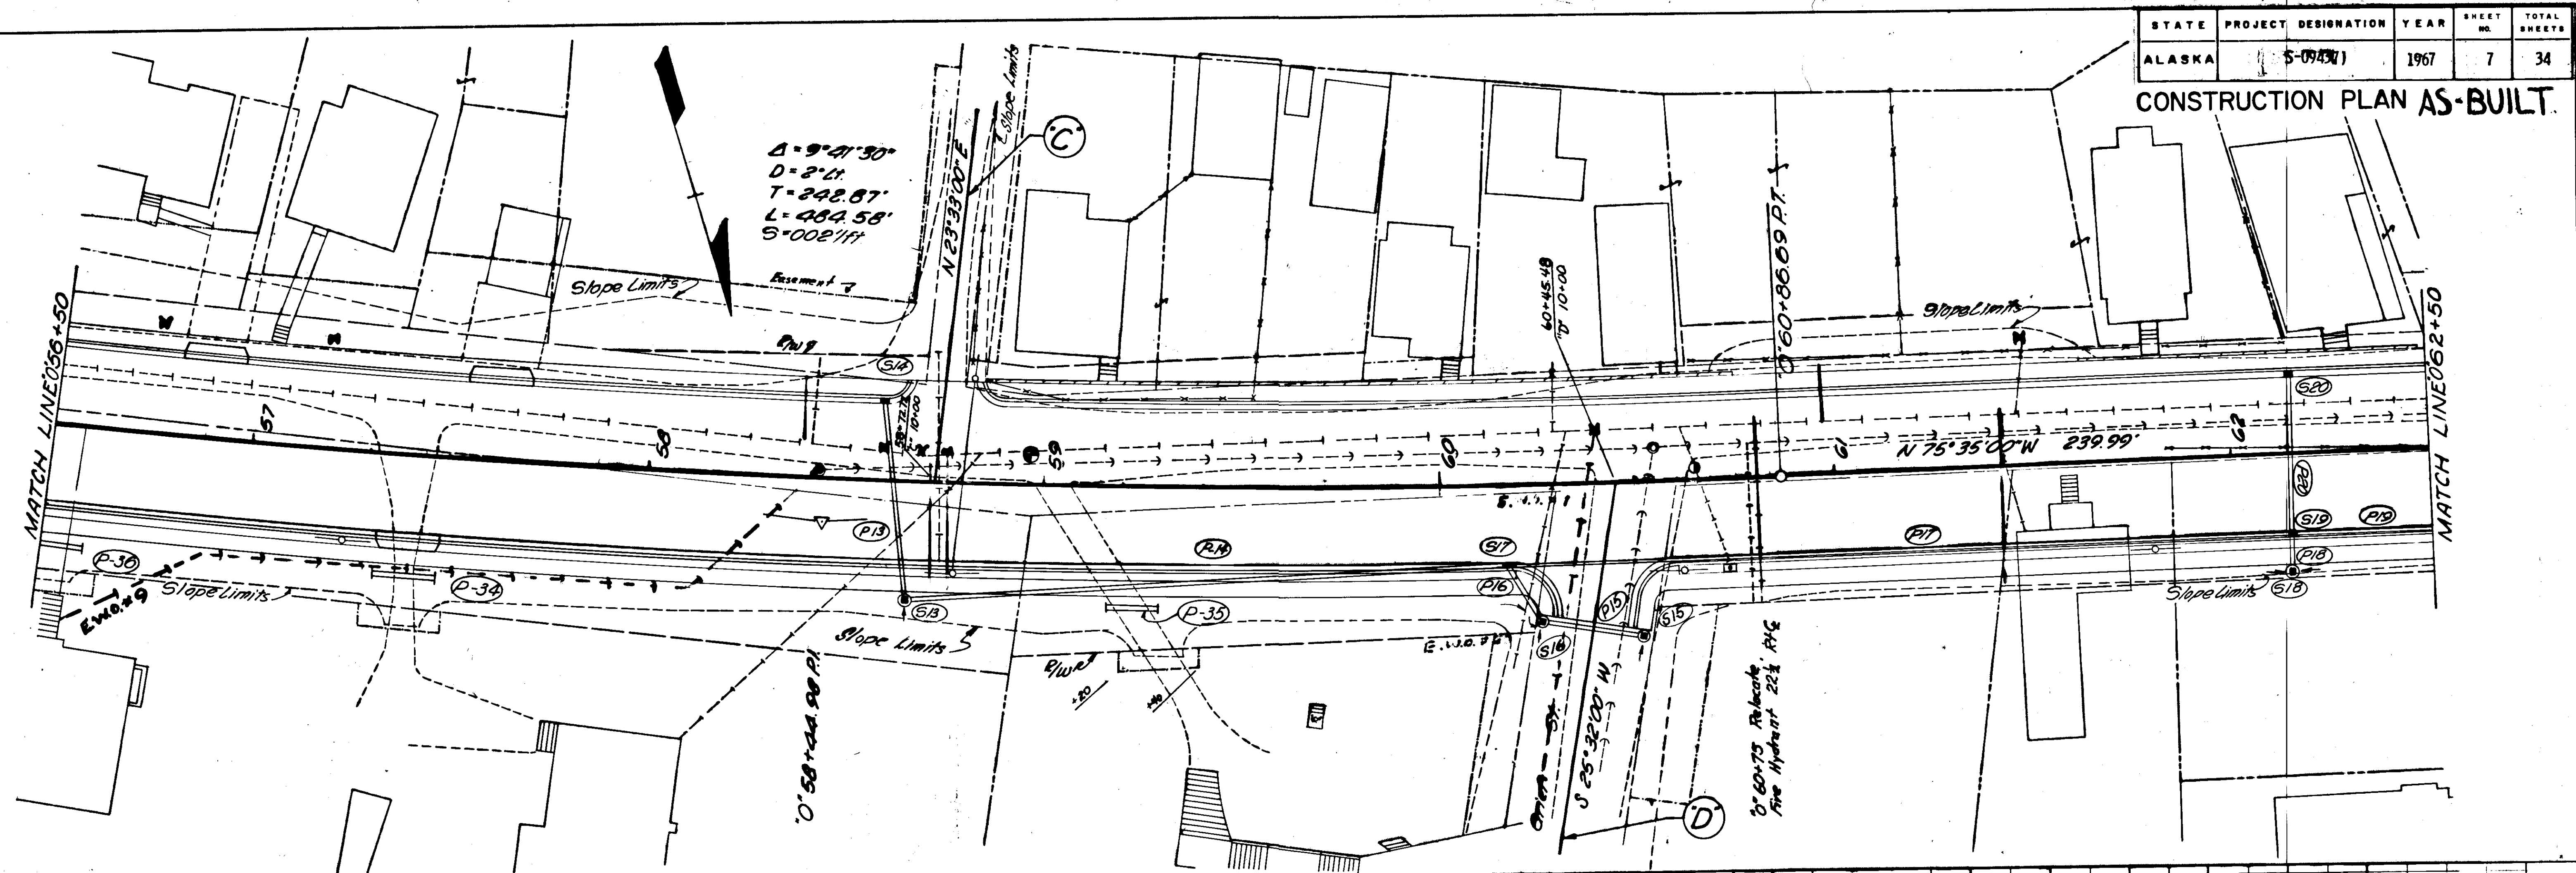


$\Delta = 9^{\circ} 41' 30''$
 $D = 2' 11''$
 $T = 242.87'$
 $L = 484.58'$
 $S = 002' 11''$



Struct. No.	Type	Location		Reference Inv. Elev.	
		Sta.	Offset	Elev.	Elev.
S-13	C.M.P. INLET	58+66	29.5' Rt.	47.29	43.29
S-14	A INLET	58+59	19.5' Lt.	47.32	45.07
S-15	C.M.P. INLET	D' 9+63	13' Lt.	40.64	39.14
S-16	C.M.P. INLET	D' 9+63	13' Rt.	40.64	38.64
S-17	B INLET	60+20	19.5' Rt.	40.70	35.95
S-18	C.M.P. INLET	62+13	29.5' Rt.	37.74	36.24
S-19	B INLET	62+13	19.5' Rt.	38.21	32.46
S-20	A INLET	62+13	19.5' Lt.	38.21	35.96

* Shape inlet ditch to allow flow from directly uphill if necessary.

Pipe No.	Pipe Dia.	Design Length	From		To	
			Str. No.	Inv. Elev.	Str. No.	Inv. Elev.
P-13	18"	48'	S-14	45.02	S-12	43.34
P-14	24"	150'	S-12	43.29	S-17	36.05
P-15	12"	24'	S-15	39.14	S-16	38.64
P-16	12"	14'	S-16	38.64	S-17	37.45
P-17	24"	196'	S-17	35.95	S-19	32.56
P-18	12"	8'	S-18	36.24	S-19	33.96
P-19	24"	108'	S-19	32.46	S-23	31.99
P-20	12"	38'	S-20	35.96	S-19	33.96
P-34	12"	16'	Side drain Pt. @ Sta. 57+40			
P-35	12"	12'	Side drain Pt. @ Sta. 59+20			
P-36	12"	12'	Side drain Pt. @ Sta. 56+55			

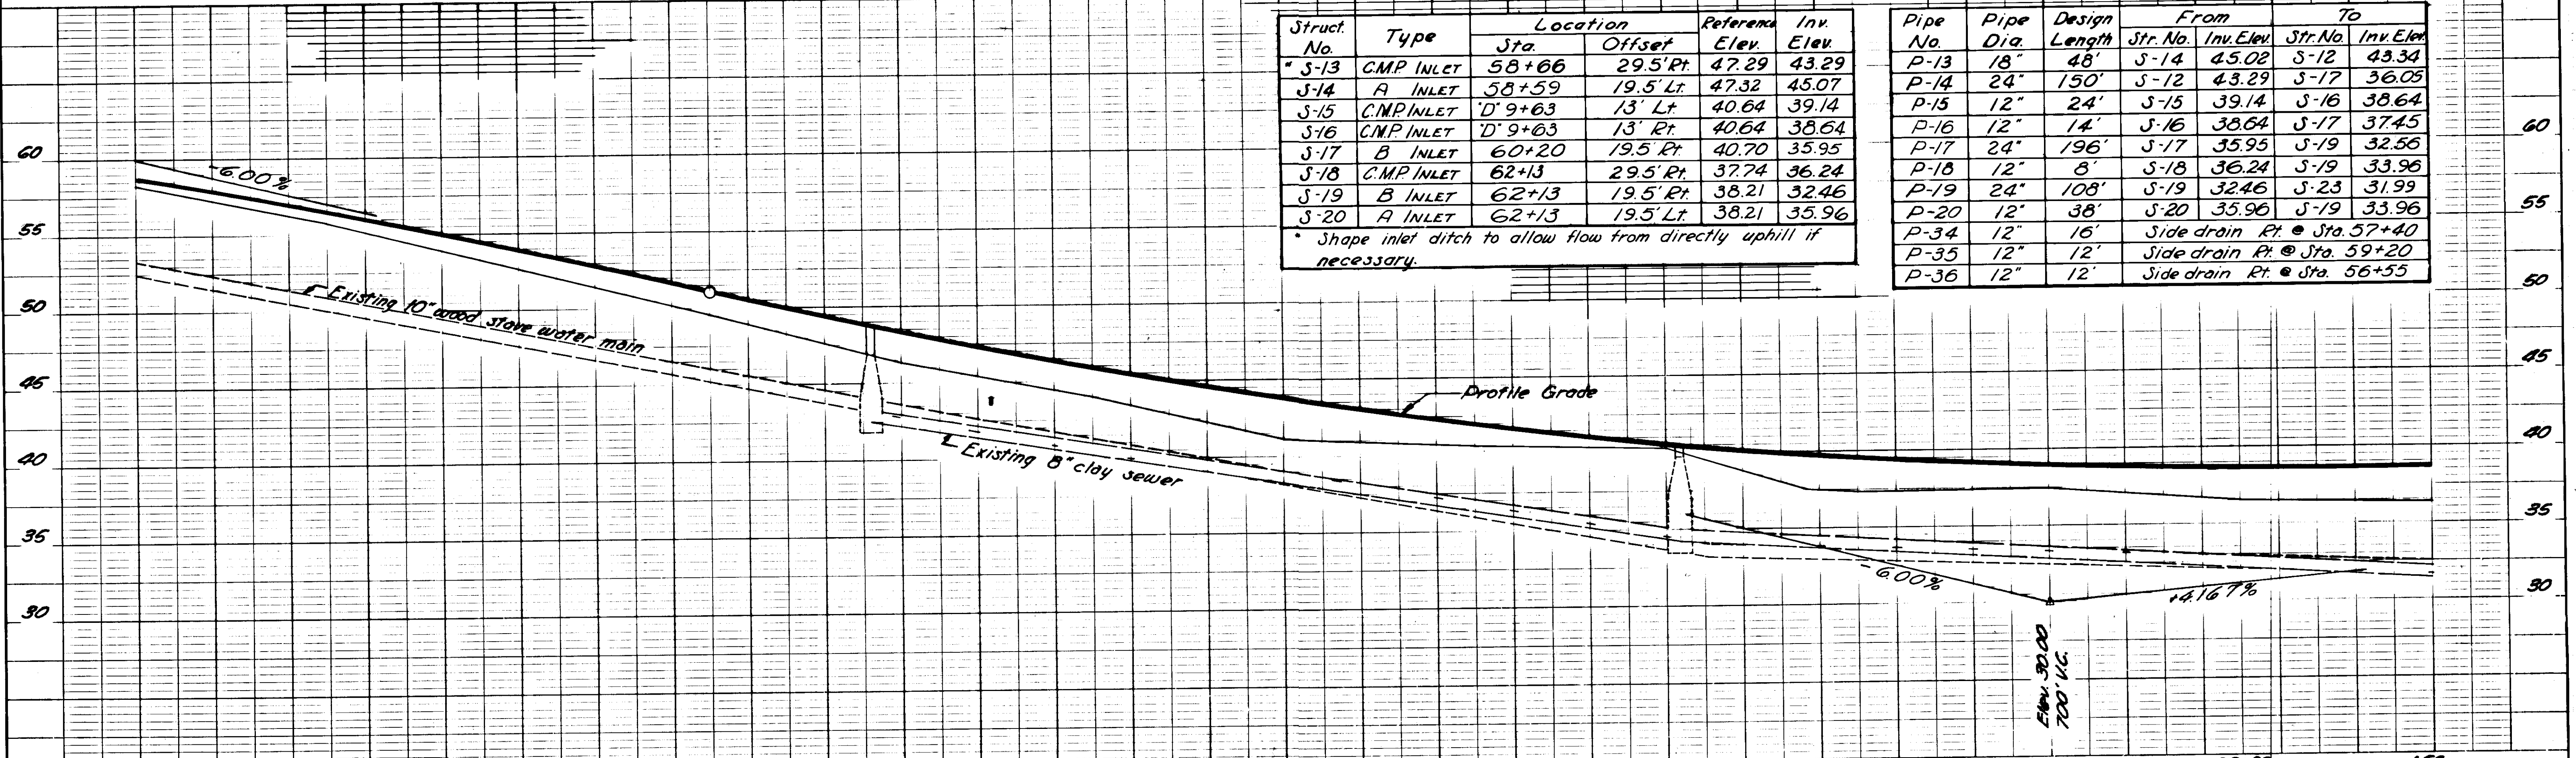

CONSTRUCTION PLAN AS-BUILT

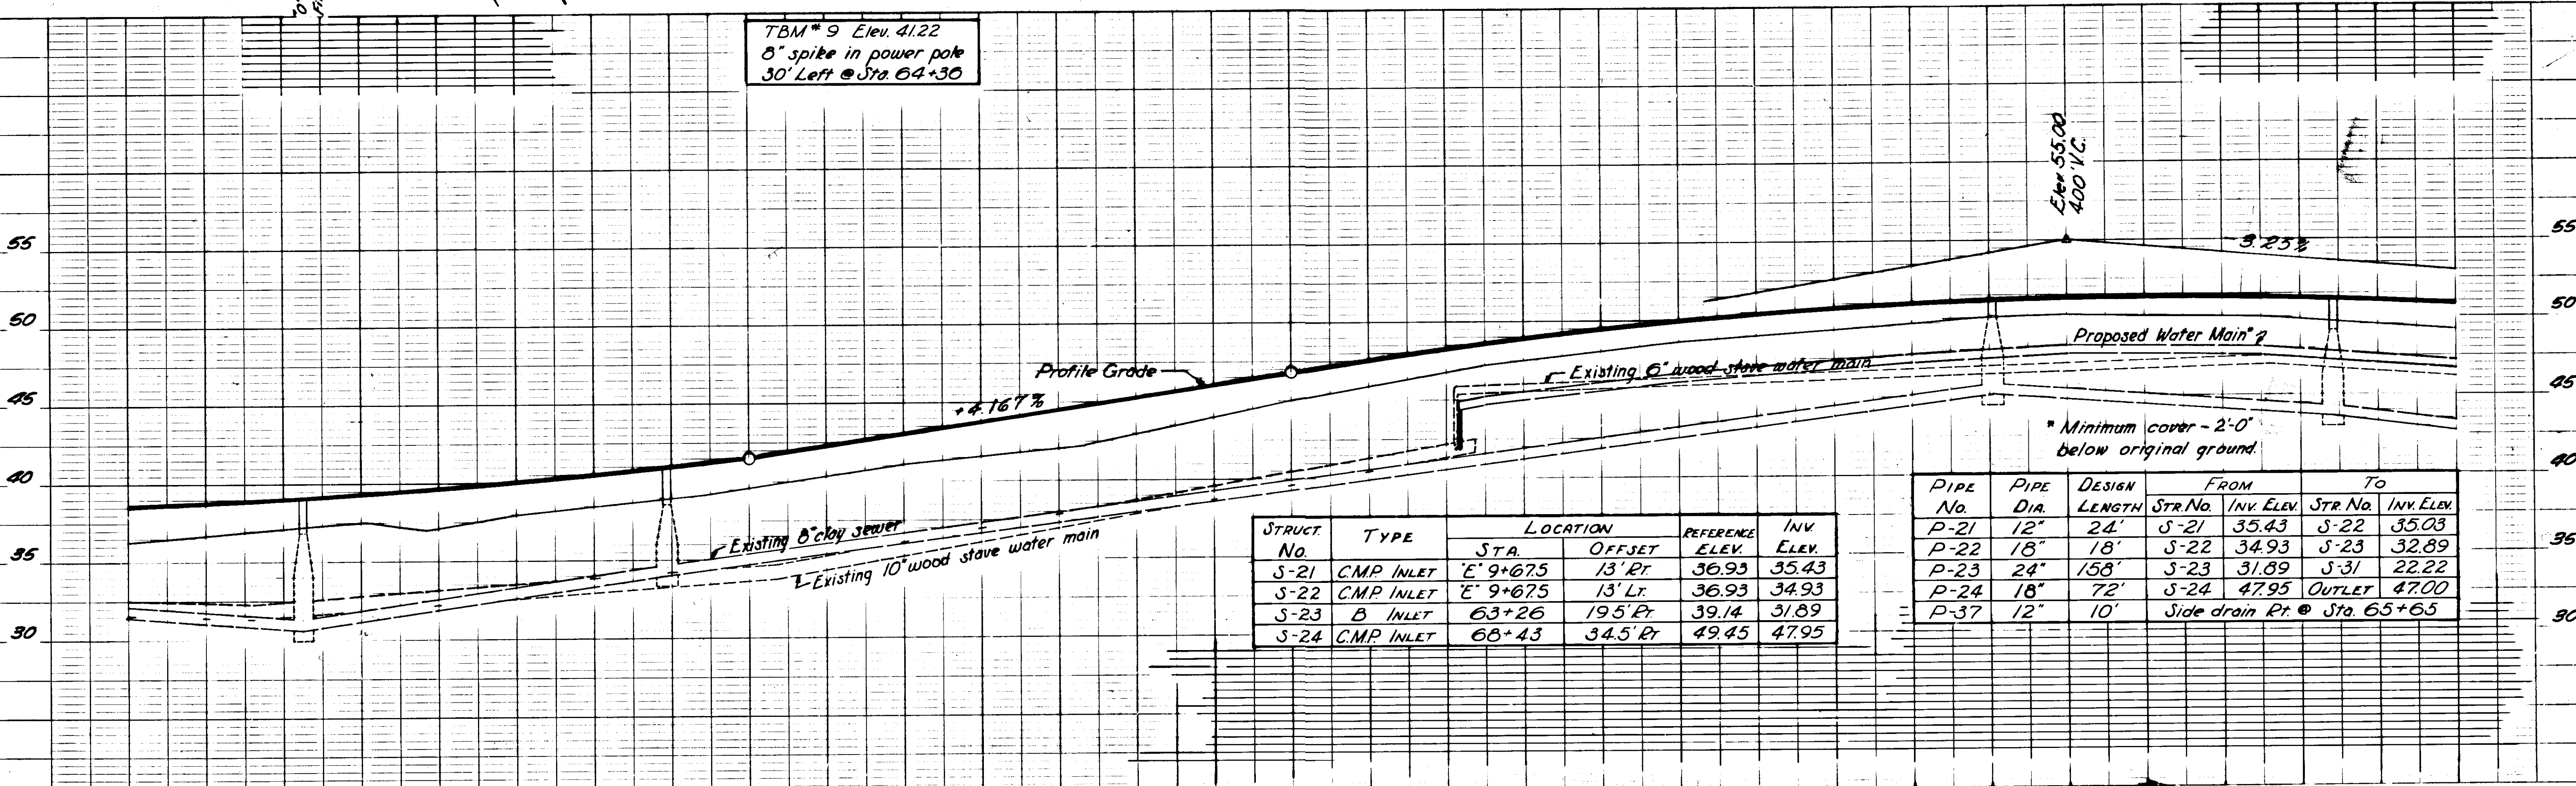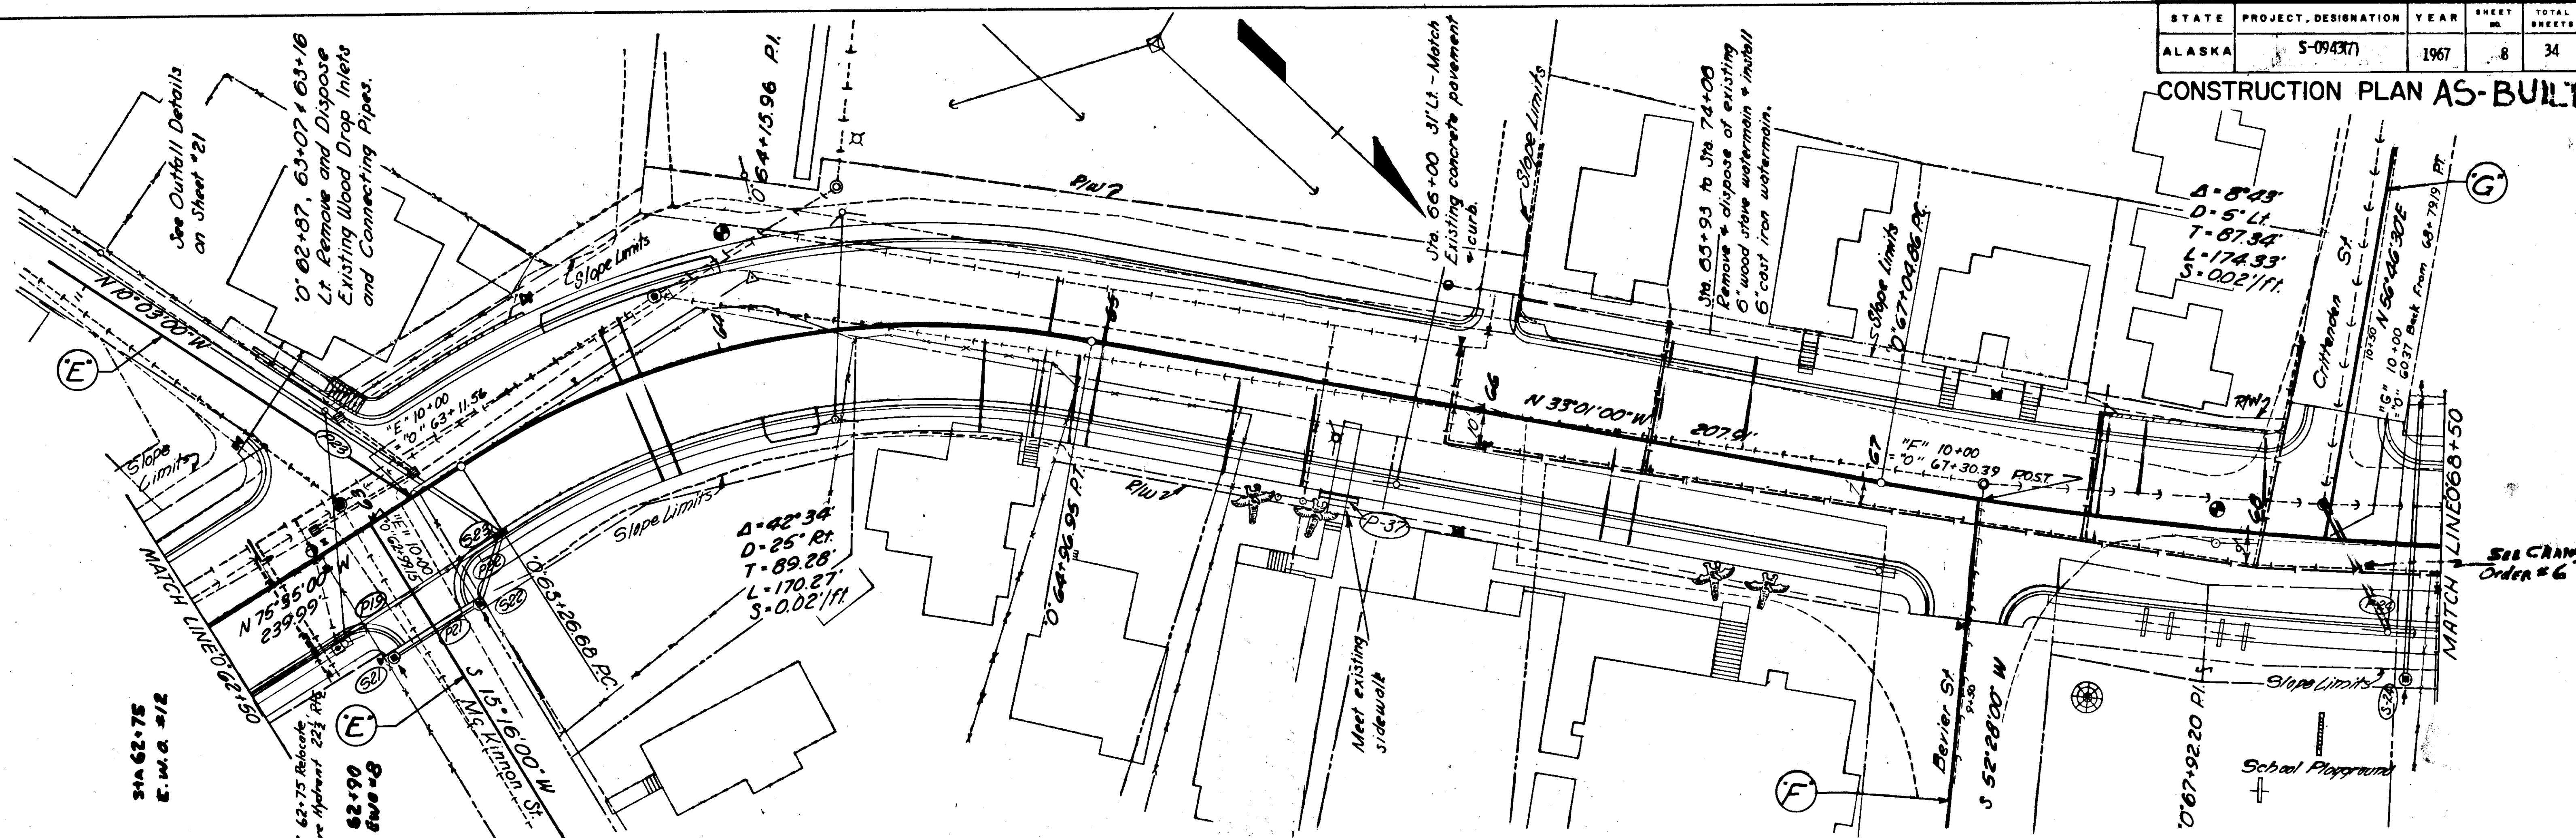


TBM # 9 Elev. 41.22
8" spike in power pole
30' Left @ Sta. 64+30

STRUCT. No.	TYPE	LOCATION		REFERENCE ELEV.	INV. ELEV.
		STA.	OFFSET		
S-21	CMP INLET	E' 9+67.5	13' RT	36.93	35.43
S-22	CMP INLET	E' 9+67.5	13' LT	36.93	34.93
S-23	B INLET	63+26	19.5' RT	39.14	31.89
S-24	CMP INLET	68+43	34.5' RT	49.45	47.95

* Minimum cover - 2'-0" below original ground.


PIPE No.	PIPE DIA.	DESIGN LENGTH	FROM		TO	
			STR. No.	INV. ELEV.	STR. No.	INV. ELEV.
P-21	12"	24'	S-21	35.43	S-22	35.03
P-22	18"	18'	S-22	34.93	S-23	32.89
P-23	24"	158'	S-23	31.89	S-31	22.22
P-24	18"	72'	S-24	47.95	OUTLET	47.00
P-37	12"	10'	Side drain Rt. @ Sta. 65+65			

CONSTRUCTION PLAN AS-BUILT

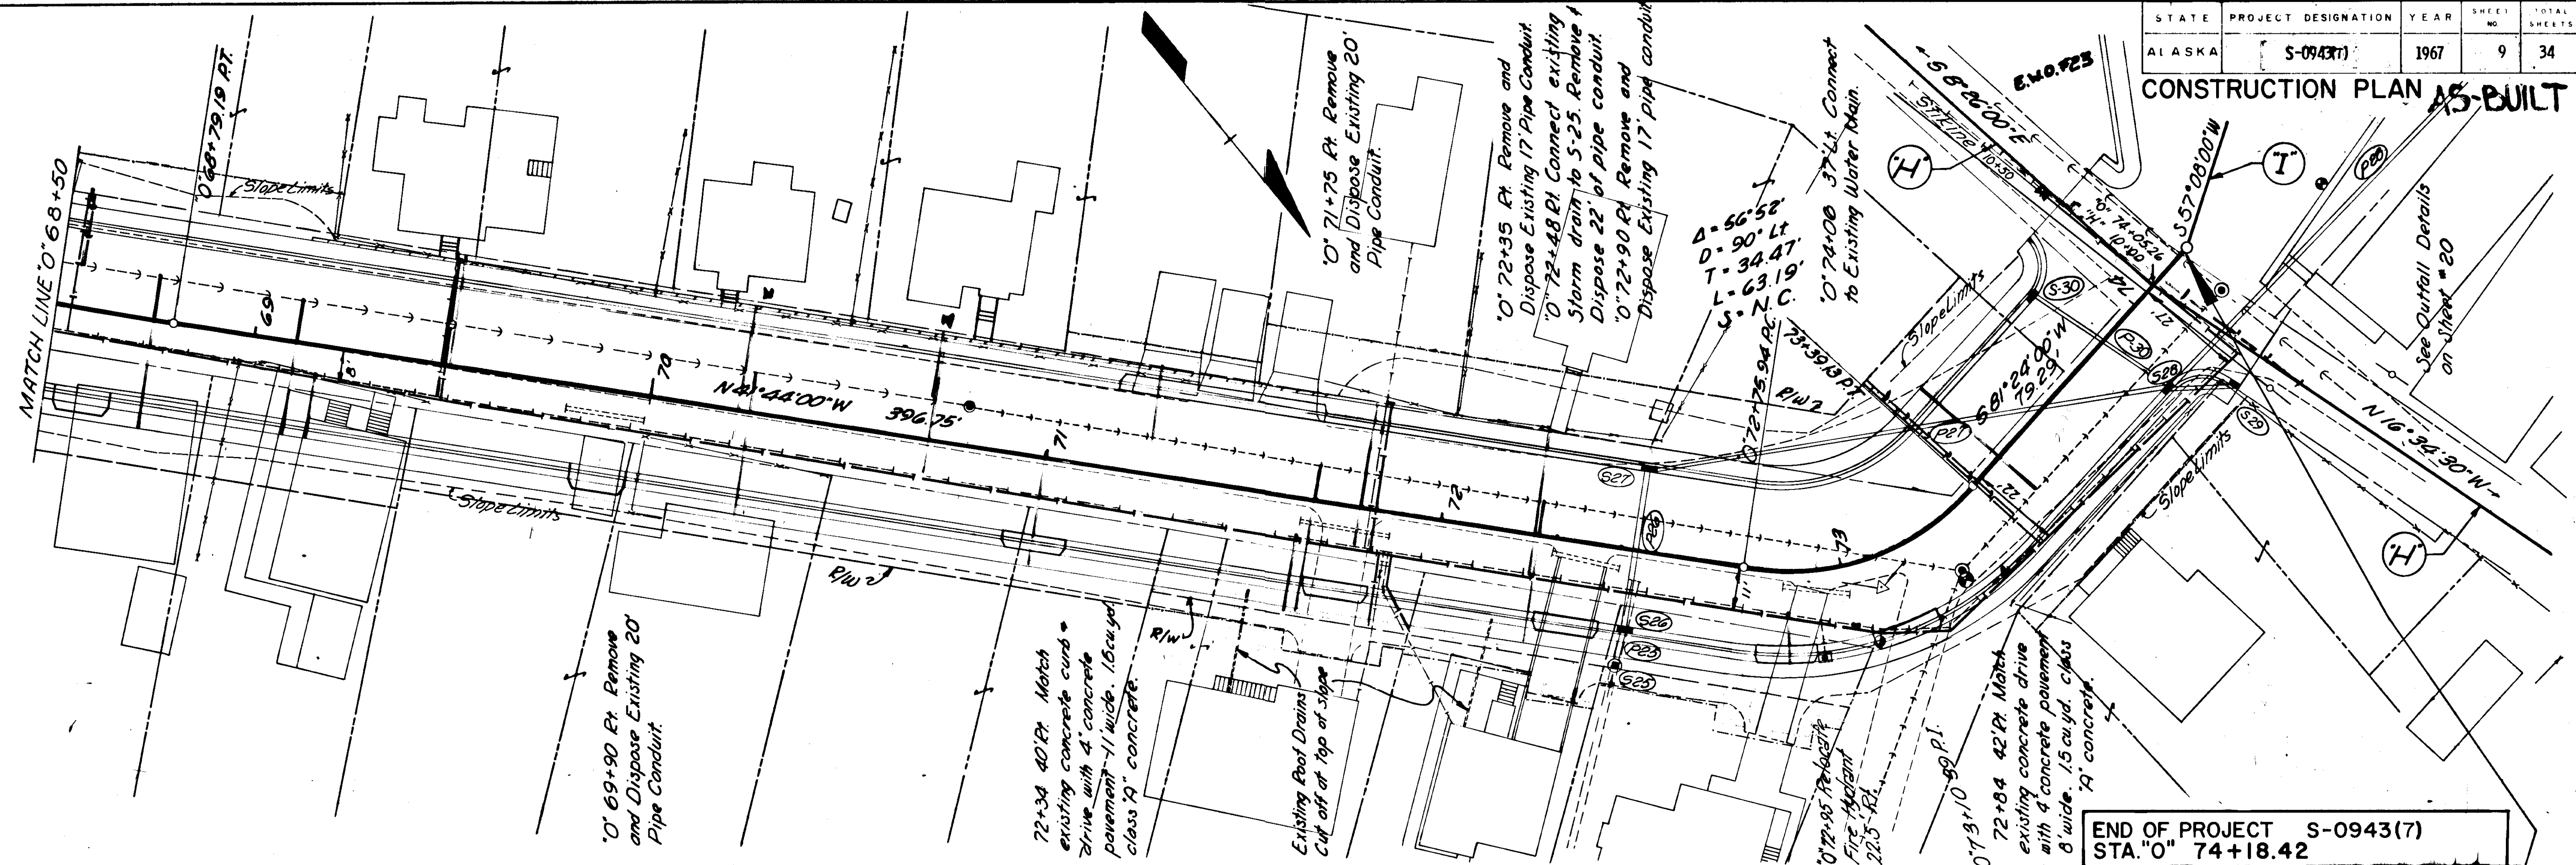


END OF PROJECT S-0943(7)
 STA. "O" 74+18.42
 BEGINNING OF PROJECT F-0954(1)
 STA. "I" 10+00


STRUCT. No.	TYPE	LOCATION		REFERENCE ELEV.	INV. ELEV.	PIPE No.	PIPE DIA.	DESIGN LENGTH	FROM		TO	
		STA.	OFFSET						STR. No.	INV. ELEV.	STR. No.	INV. ELEV.
S-25	C.M.P. Inlet	72+48	29.5 Rt.	36.41	34.41	P-25	18"	8'	S-25	34.41	S-26	34.18
S-26	A Inlet	72+49	19.5 Rt.	36.83	34.08	P-26	18"	40'	S-26	34.08	S-27	33.68
S-27	A Inlet	72+49	19.5 Lt.	36.83	33.58	P-27	18"	130'	S-27	33.58	S-28	25.75
S-28	B Inlet	73+90	19.5 Rt.	30.40	25.65	P-28	18"	136'	S-28	25.65	OUTFALL	18.50
S-29	A Inlet	74+02	28.5 Rt.	29.05	25.85	P-29	12"	16'	S-29	25.85	S-28	25.70
S-30	A Inlet	73+83	19.5 Lt.	30.78	28.75	P-30	12"	40'	S-30	28.75	S-28	25.70

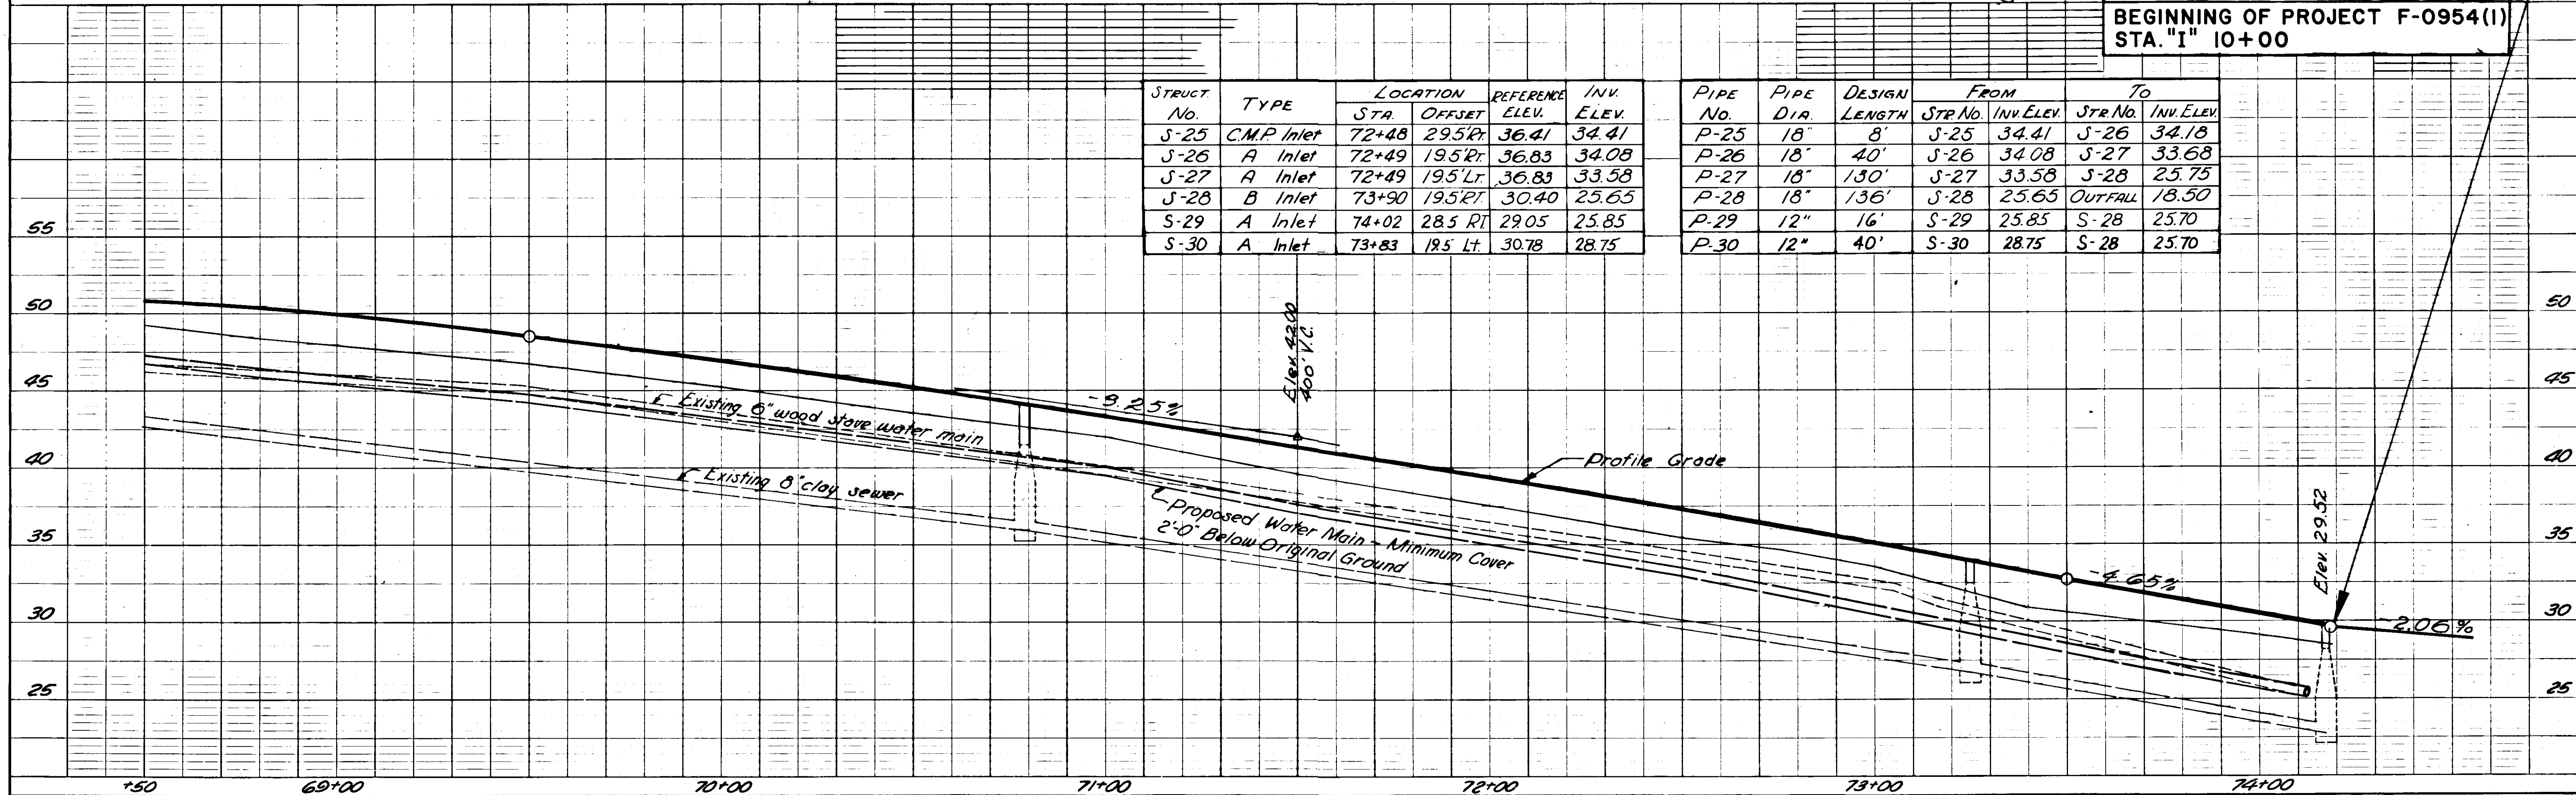


**DRAINAGE STRUCTURES
AS-BUILT**

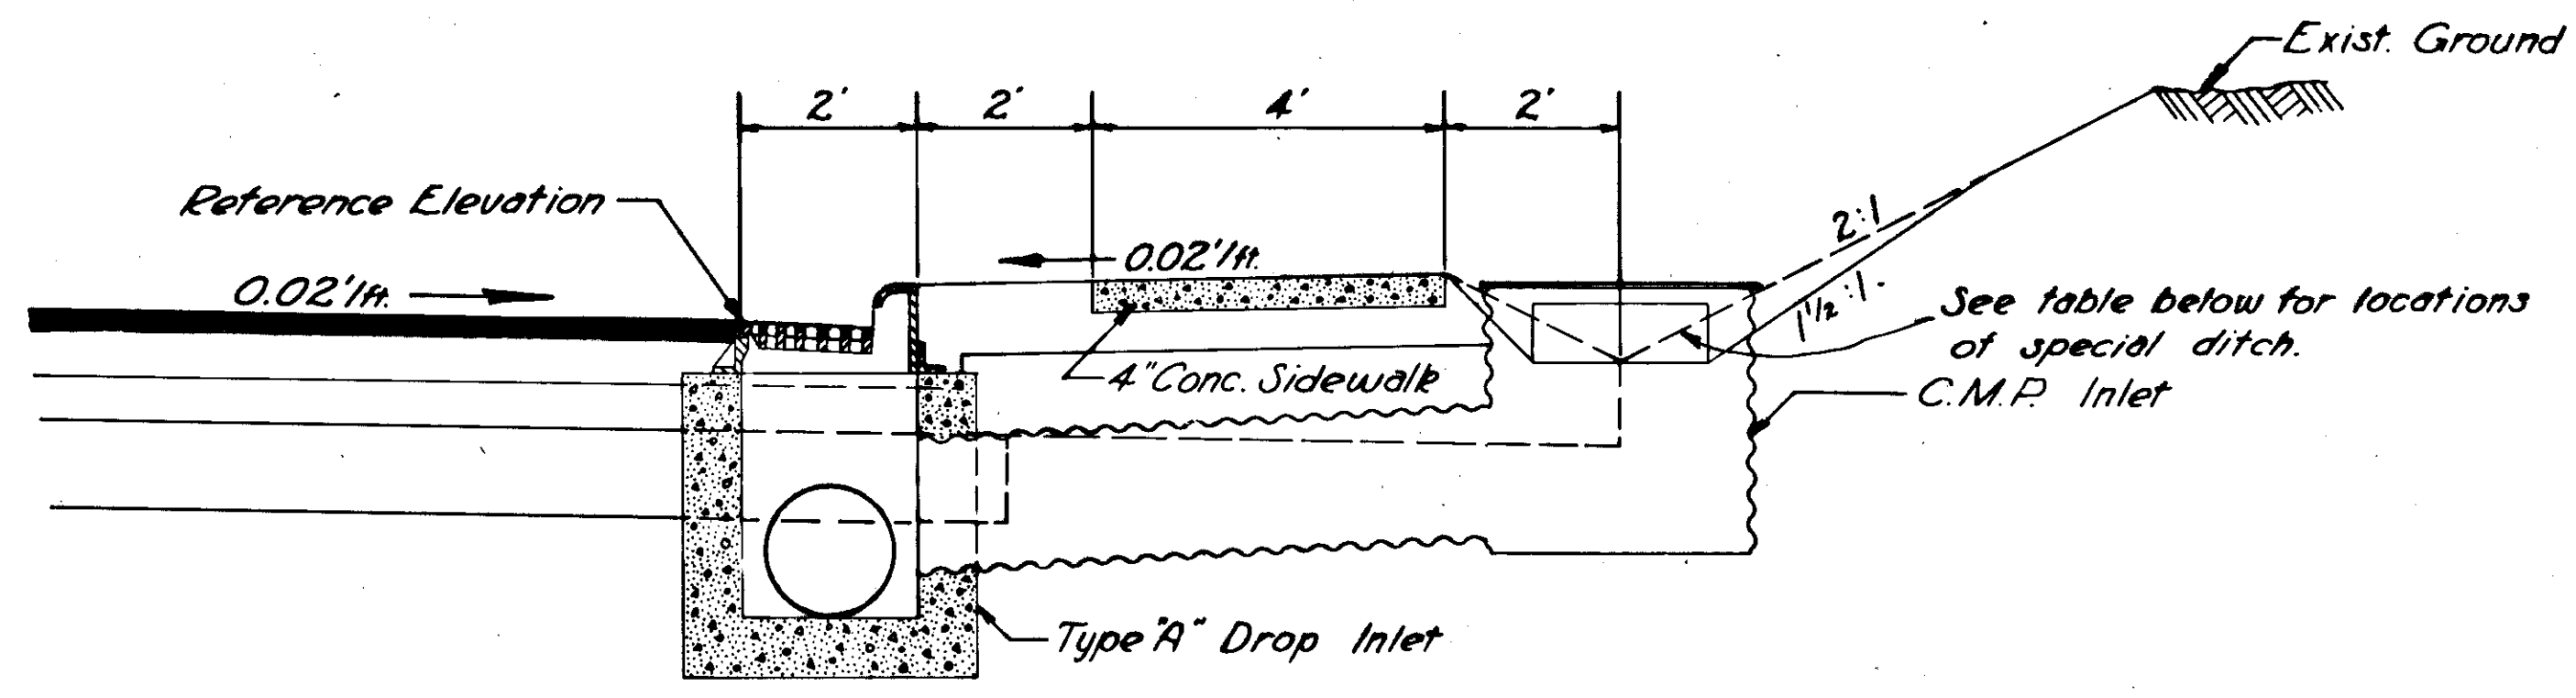

**TYPICAL STORM SEWER
INSTALLATION**

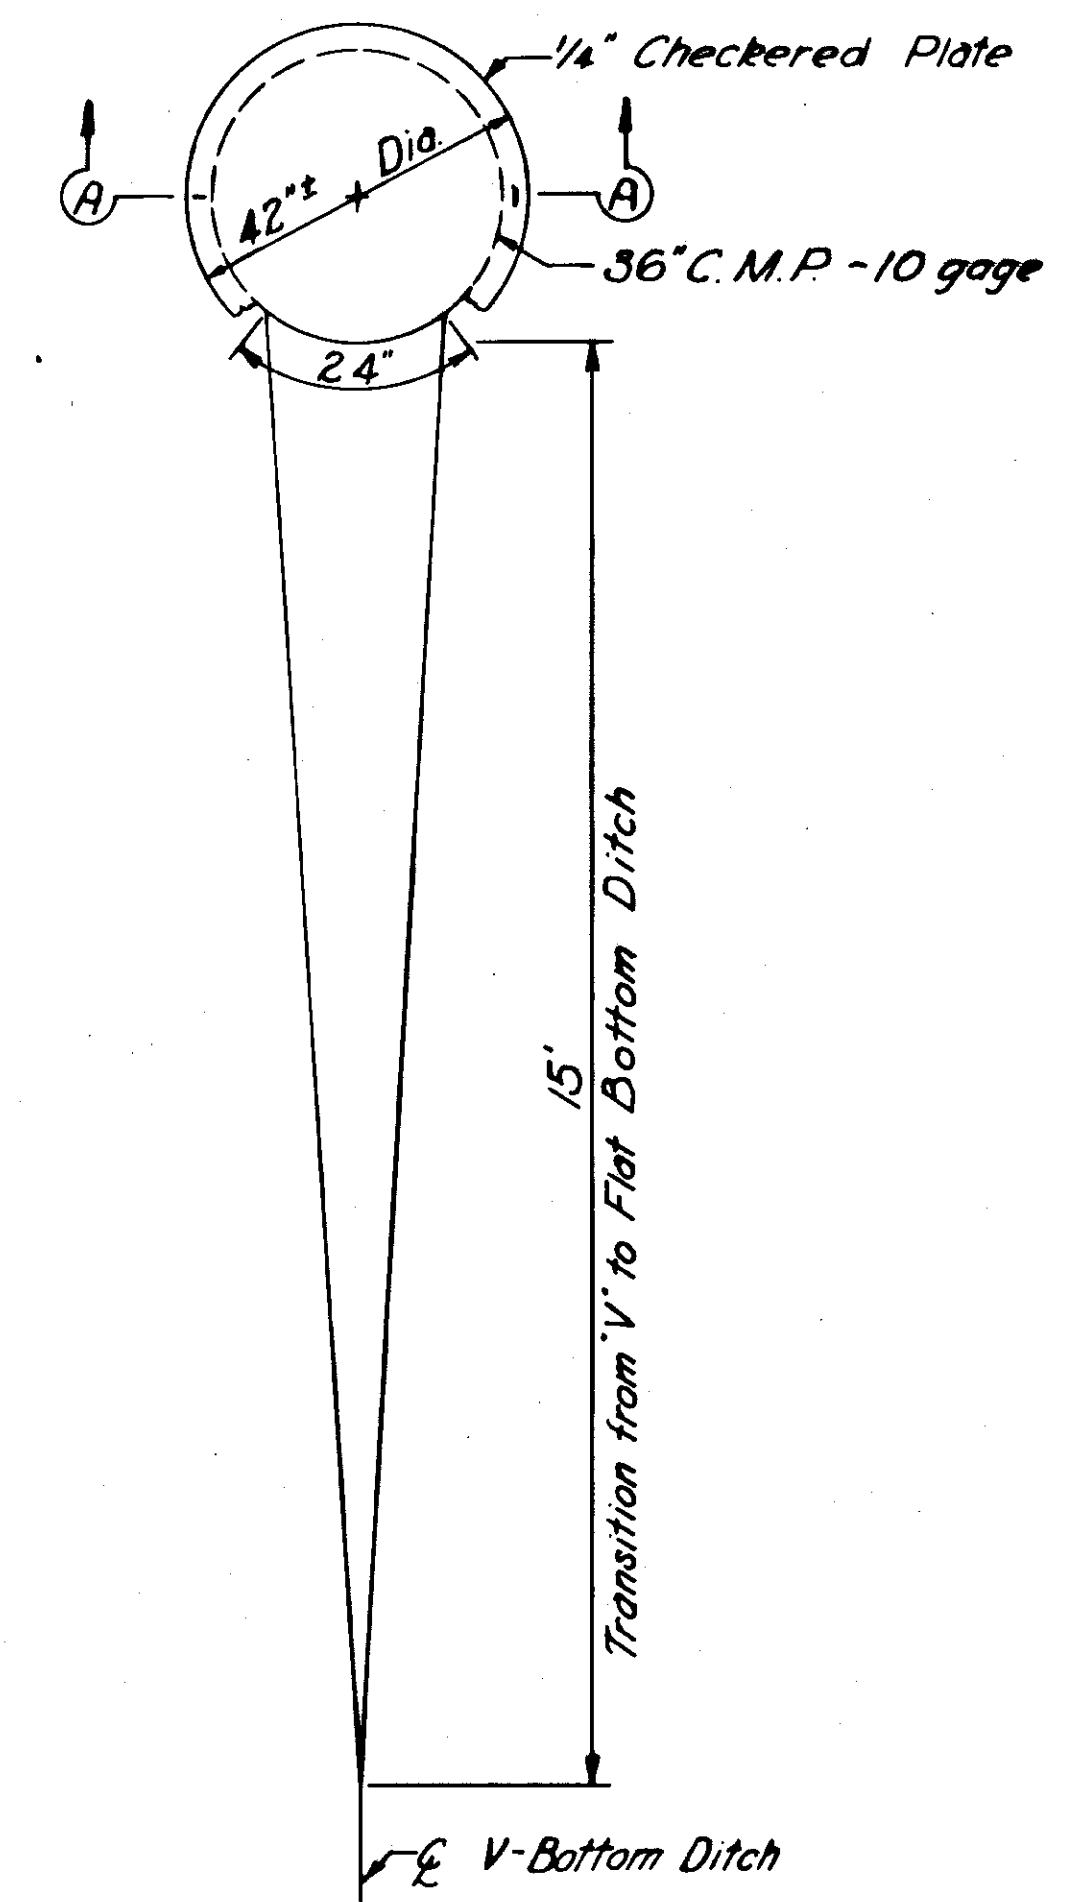


**TRANSITION FROM V-BOTTOM
DITCH TO FLAT BOTTOM DITCH**

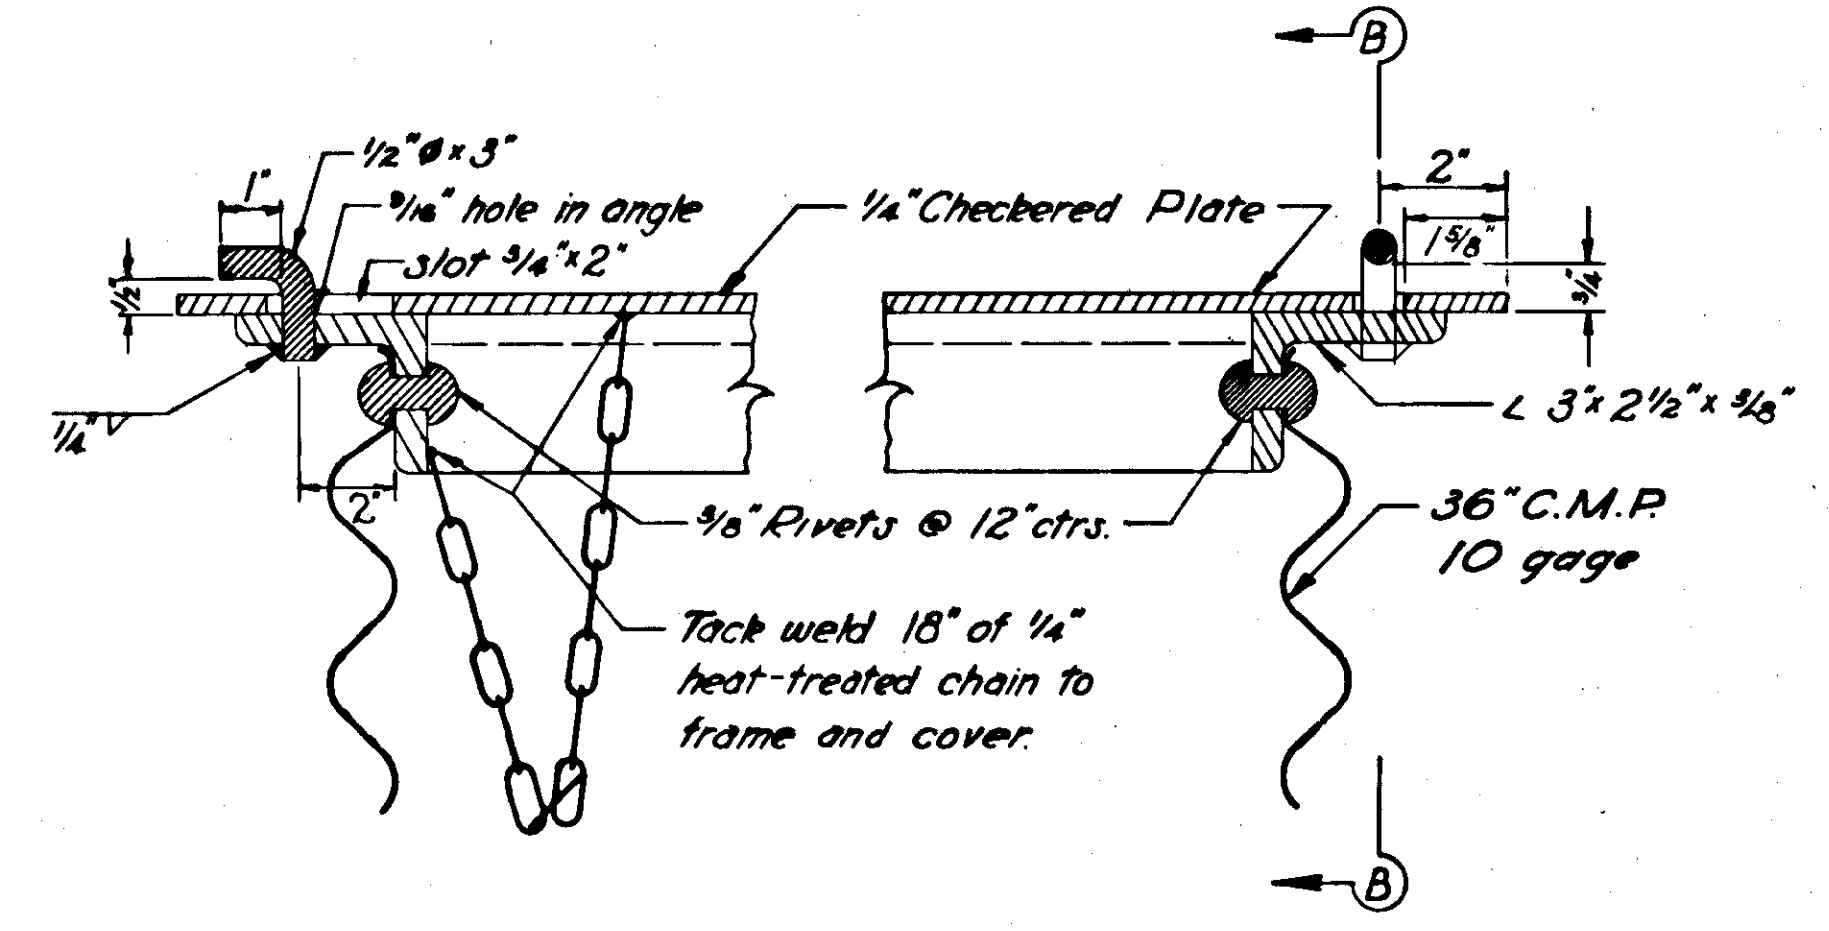


SECTION A-A

**SPECIAL DITCH AND C.M.P. INLET
LOCATIONS**

Drains to Inlet No.	From Sta.	To Sta.
S-2	47+85	49+10
S-9	51+45	52+40
S-12	56+00	58+70
S-16	58+70	60+20
S-18	60+65	62+80
S-22	63+10	67+00
S-24	67+50	68+50

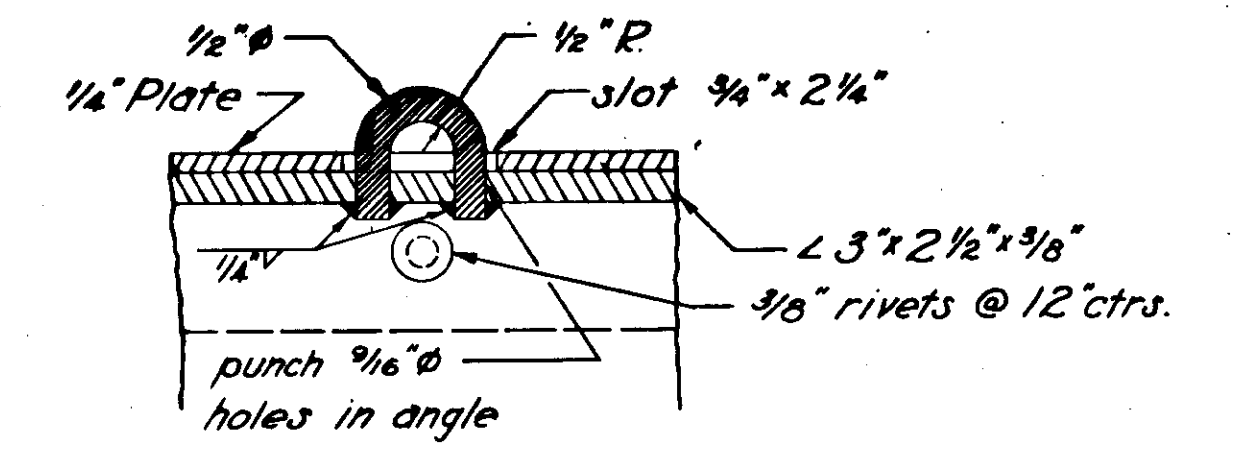


SECTION B-B

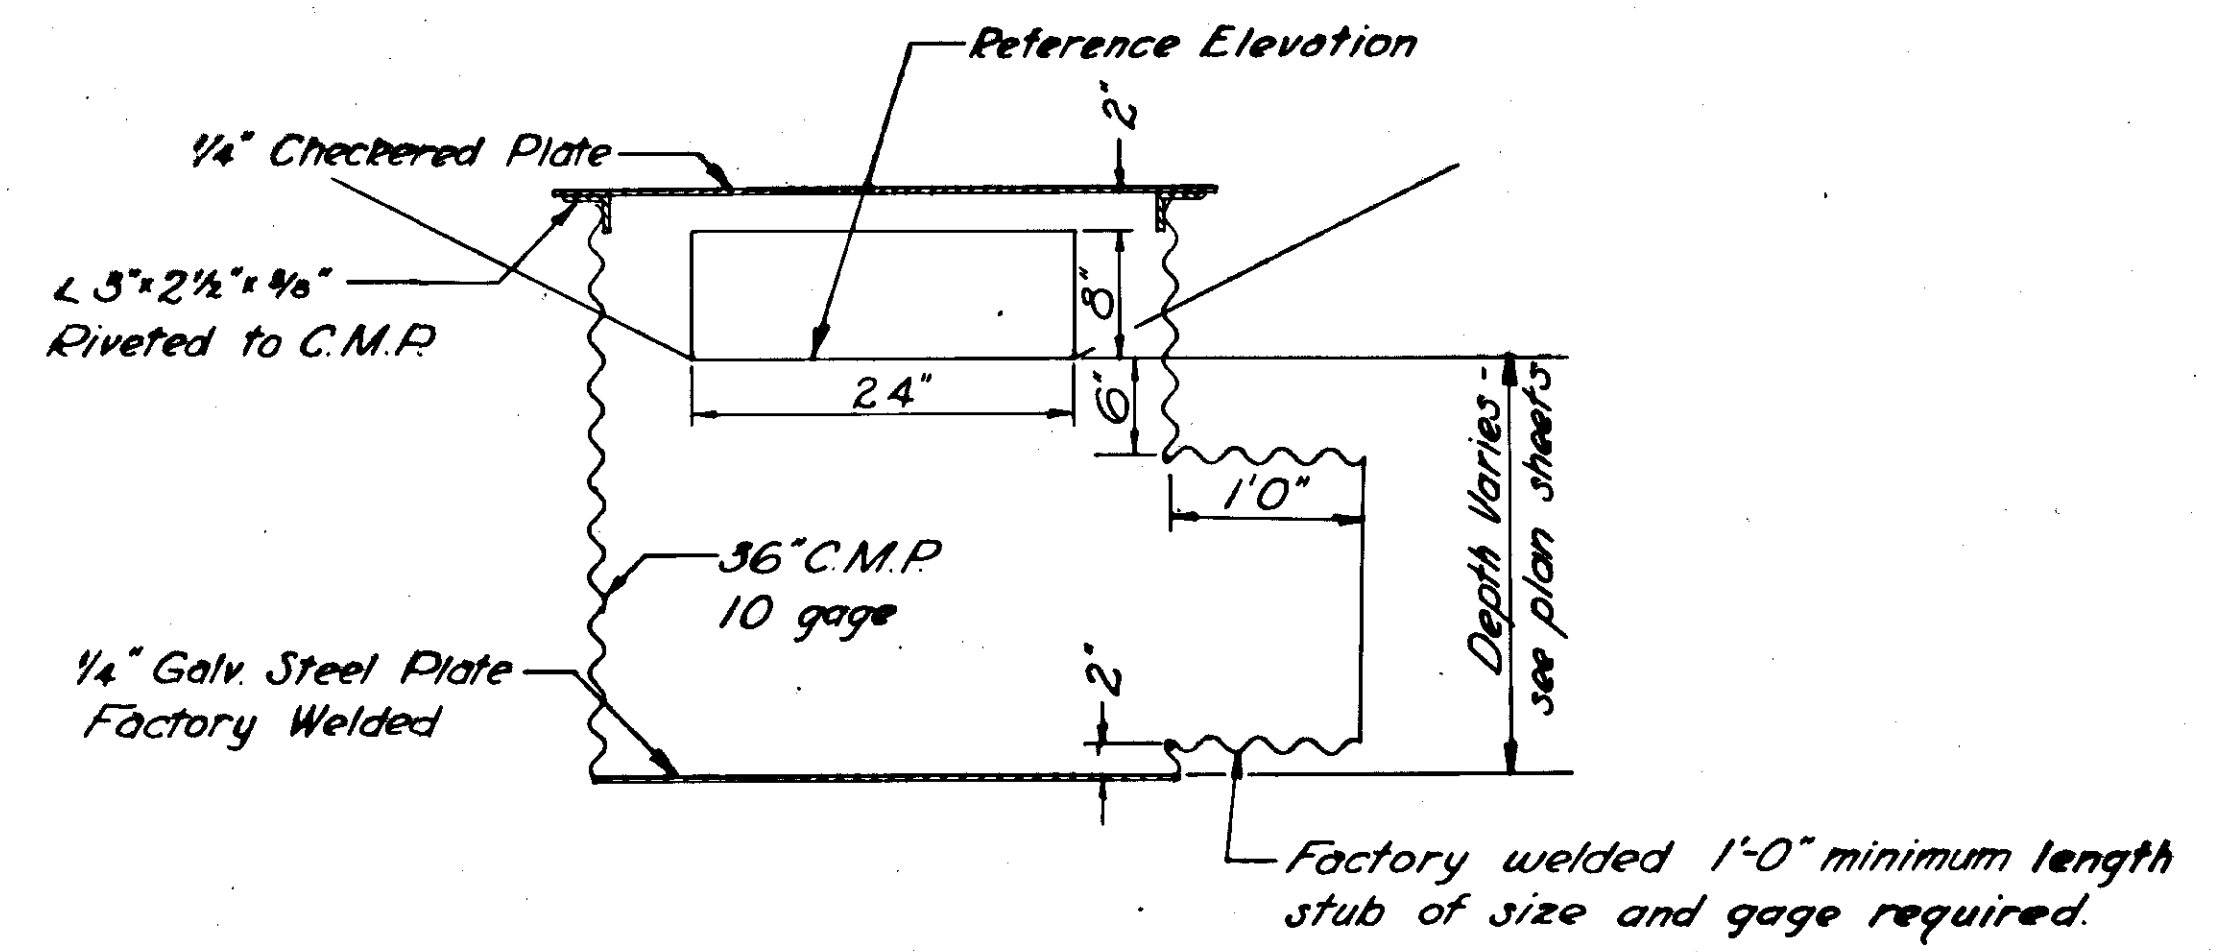

TYPICAL C. M. P. INLET

AS-BUILT

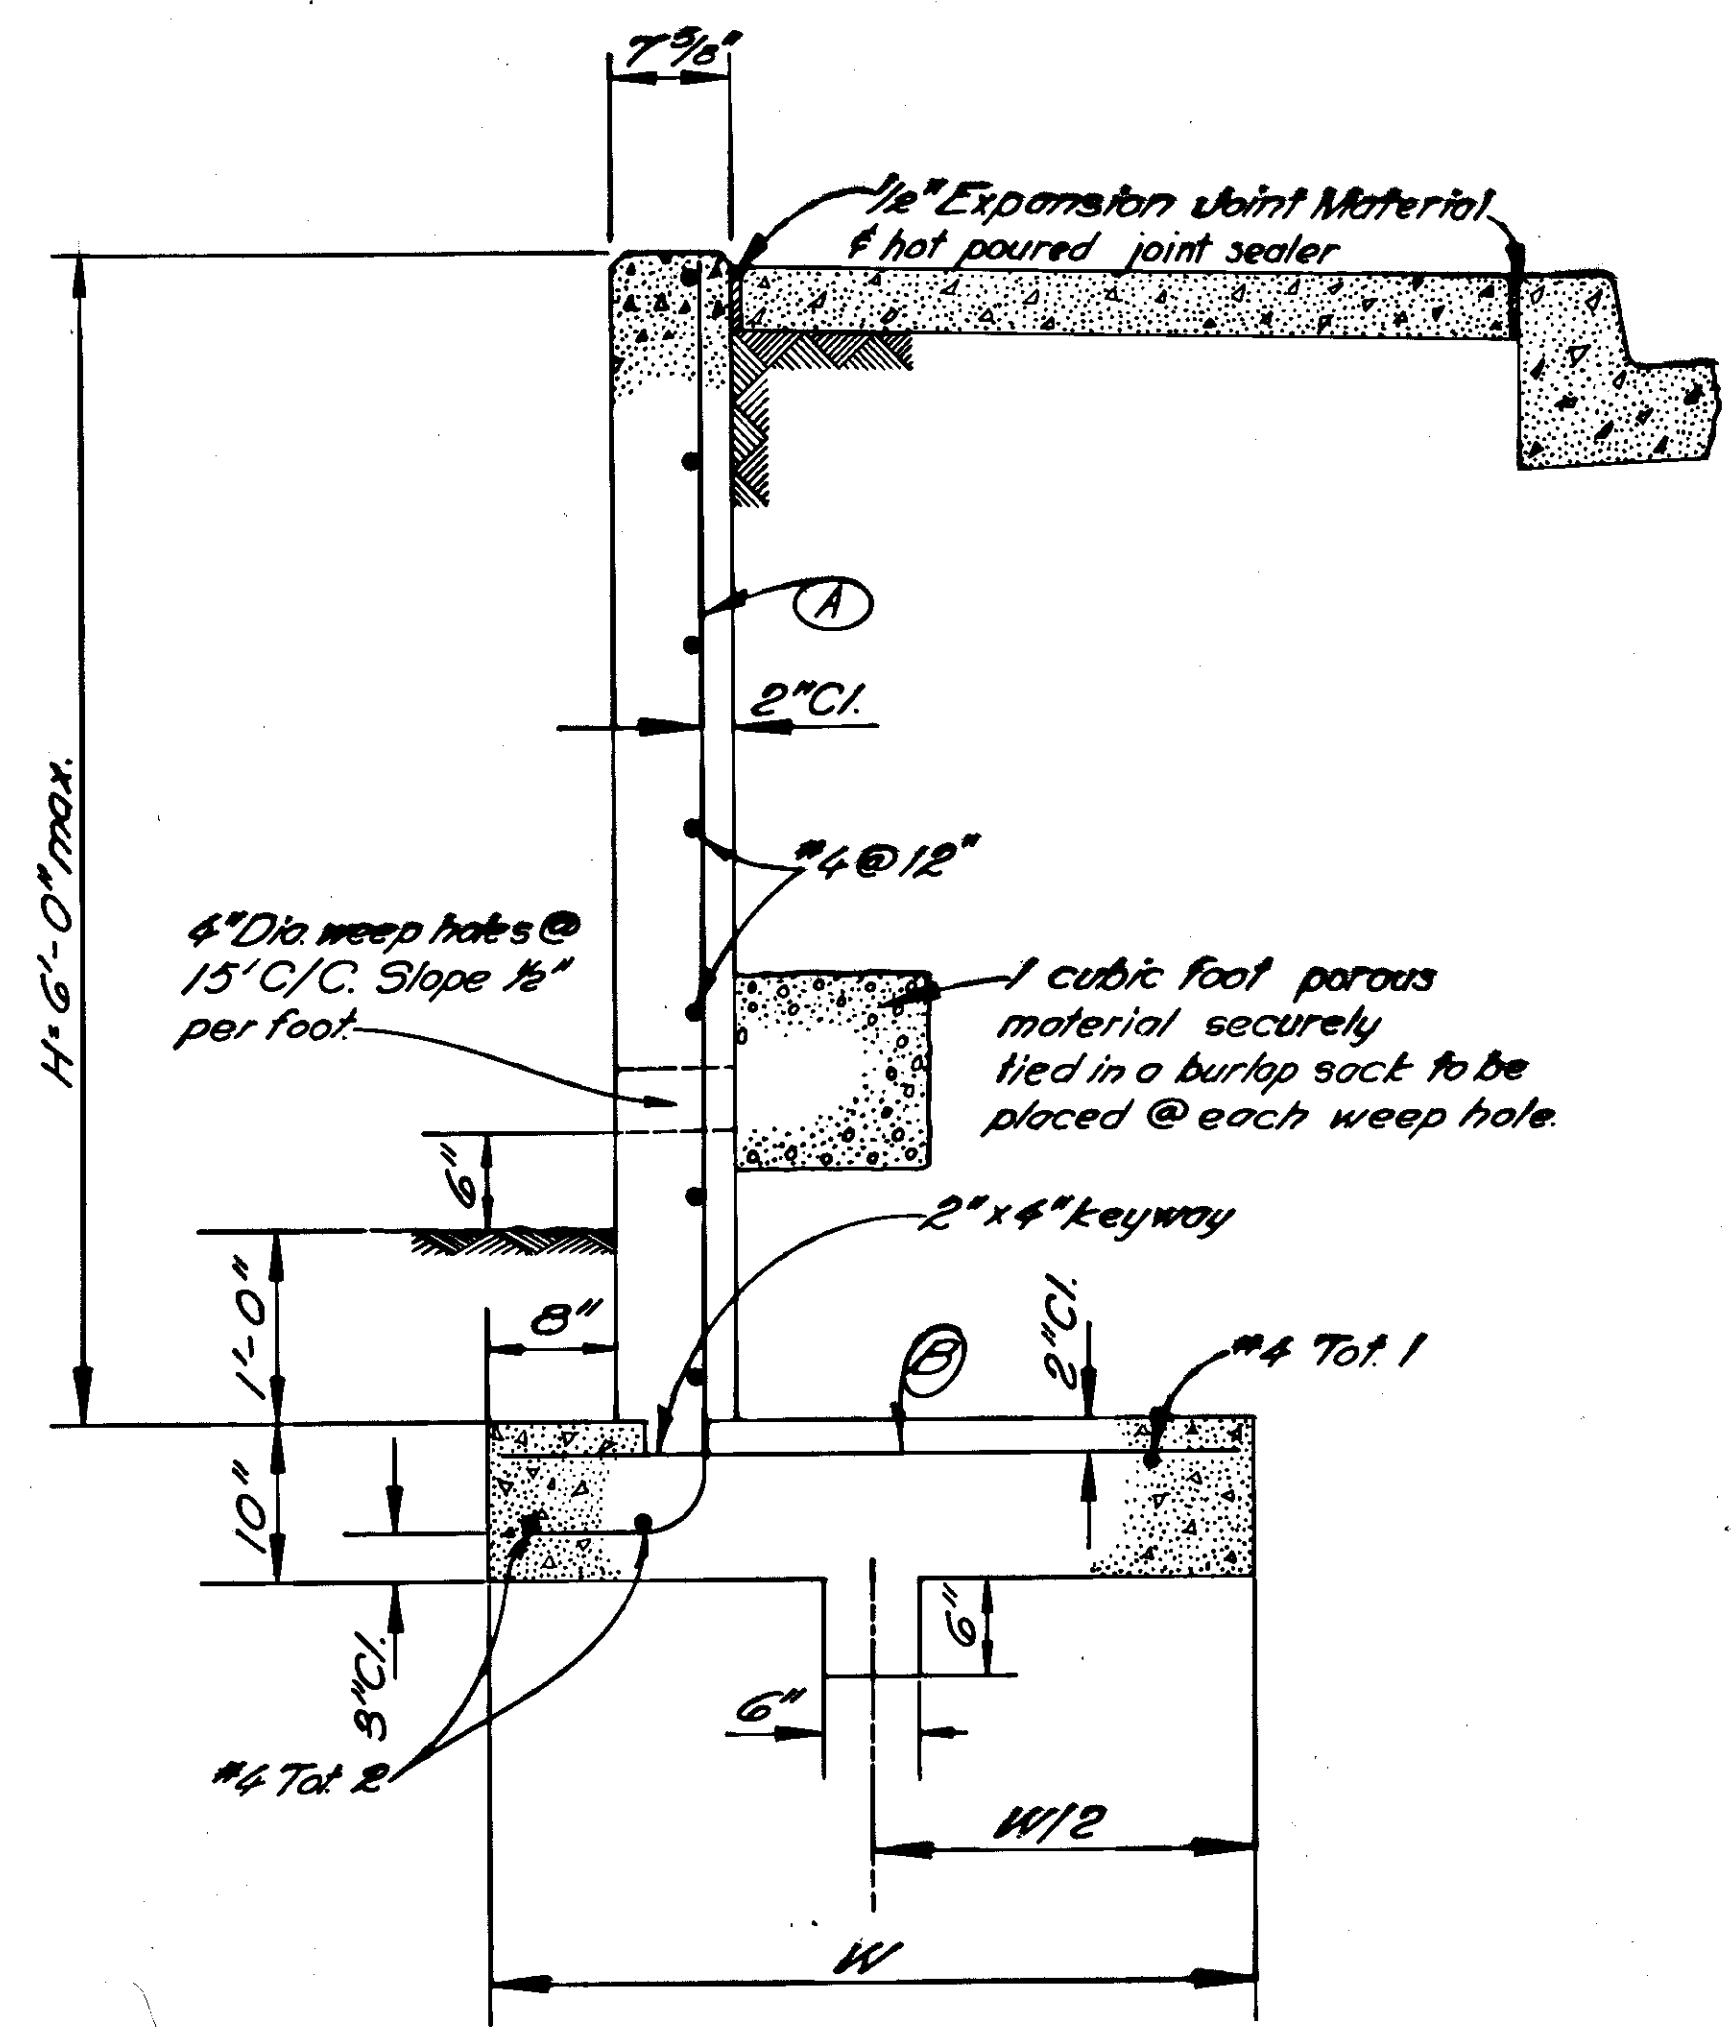


TYPICAL SECTION TYPE A
RETAINING WALL
WALL NOS 1, 4, 5, 6, 7, 8, & 9

Design	3'-4"	4'-0"	4'-8"	5'-4"	6'-0"
W	2'-8"	3'-0"	3'-4"	3'-8"	4'-0"
A	#4 @ 16"	#4 @ 12"	#4 @ 8"	#5 @ 10"	#5 @ 8"
B	#4 @ 16"	#4 @ 16"	#4 @ 8"	#4 @ 10"	#4 @ 8"

QUANTITIES



Wall No.	Concrete (Cu. Yds)	Steel (lbs)
1	41.5	2745
2	11.6	756
3	15.8	807
4	91.4	6498
5	41.5	2994
6	18.4	1228
7	19.2	1491
8	7.7	312
9	60.3	4269
Stairs	13.4	936

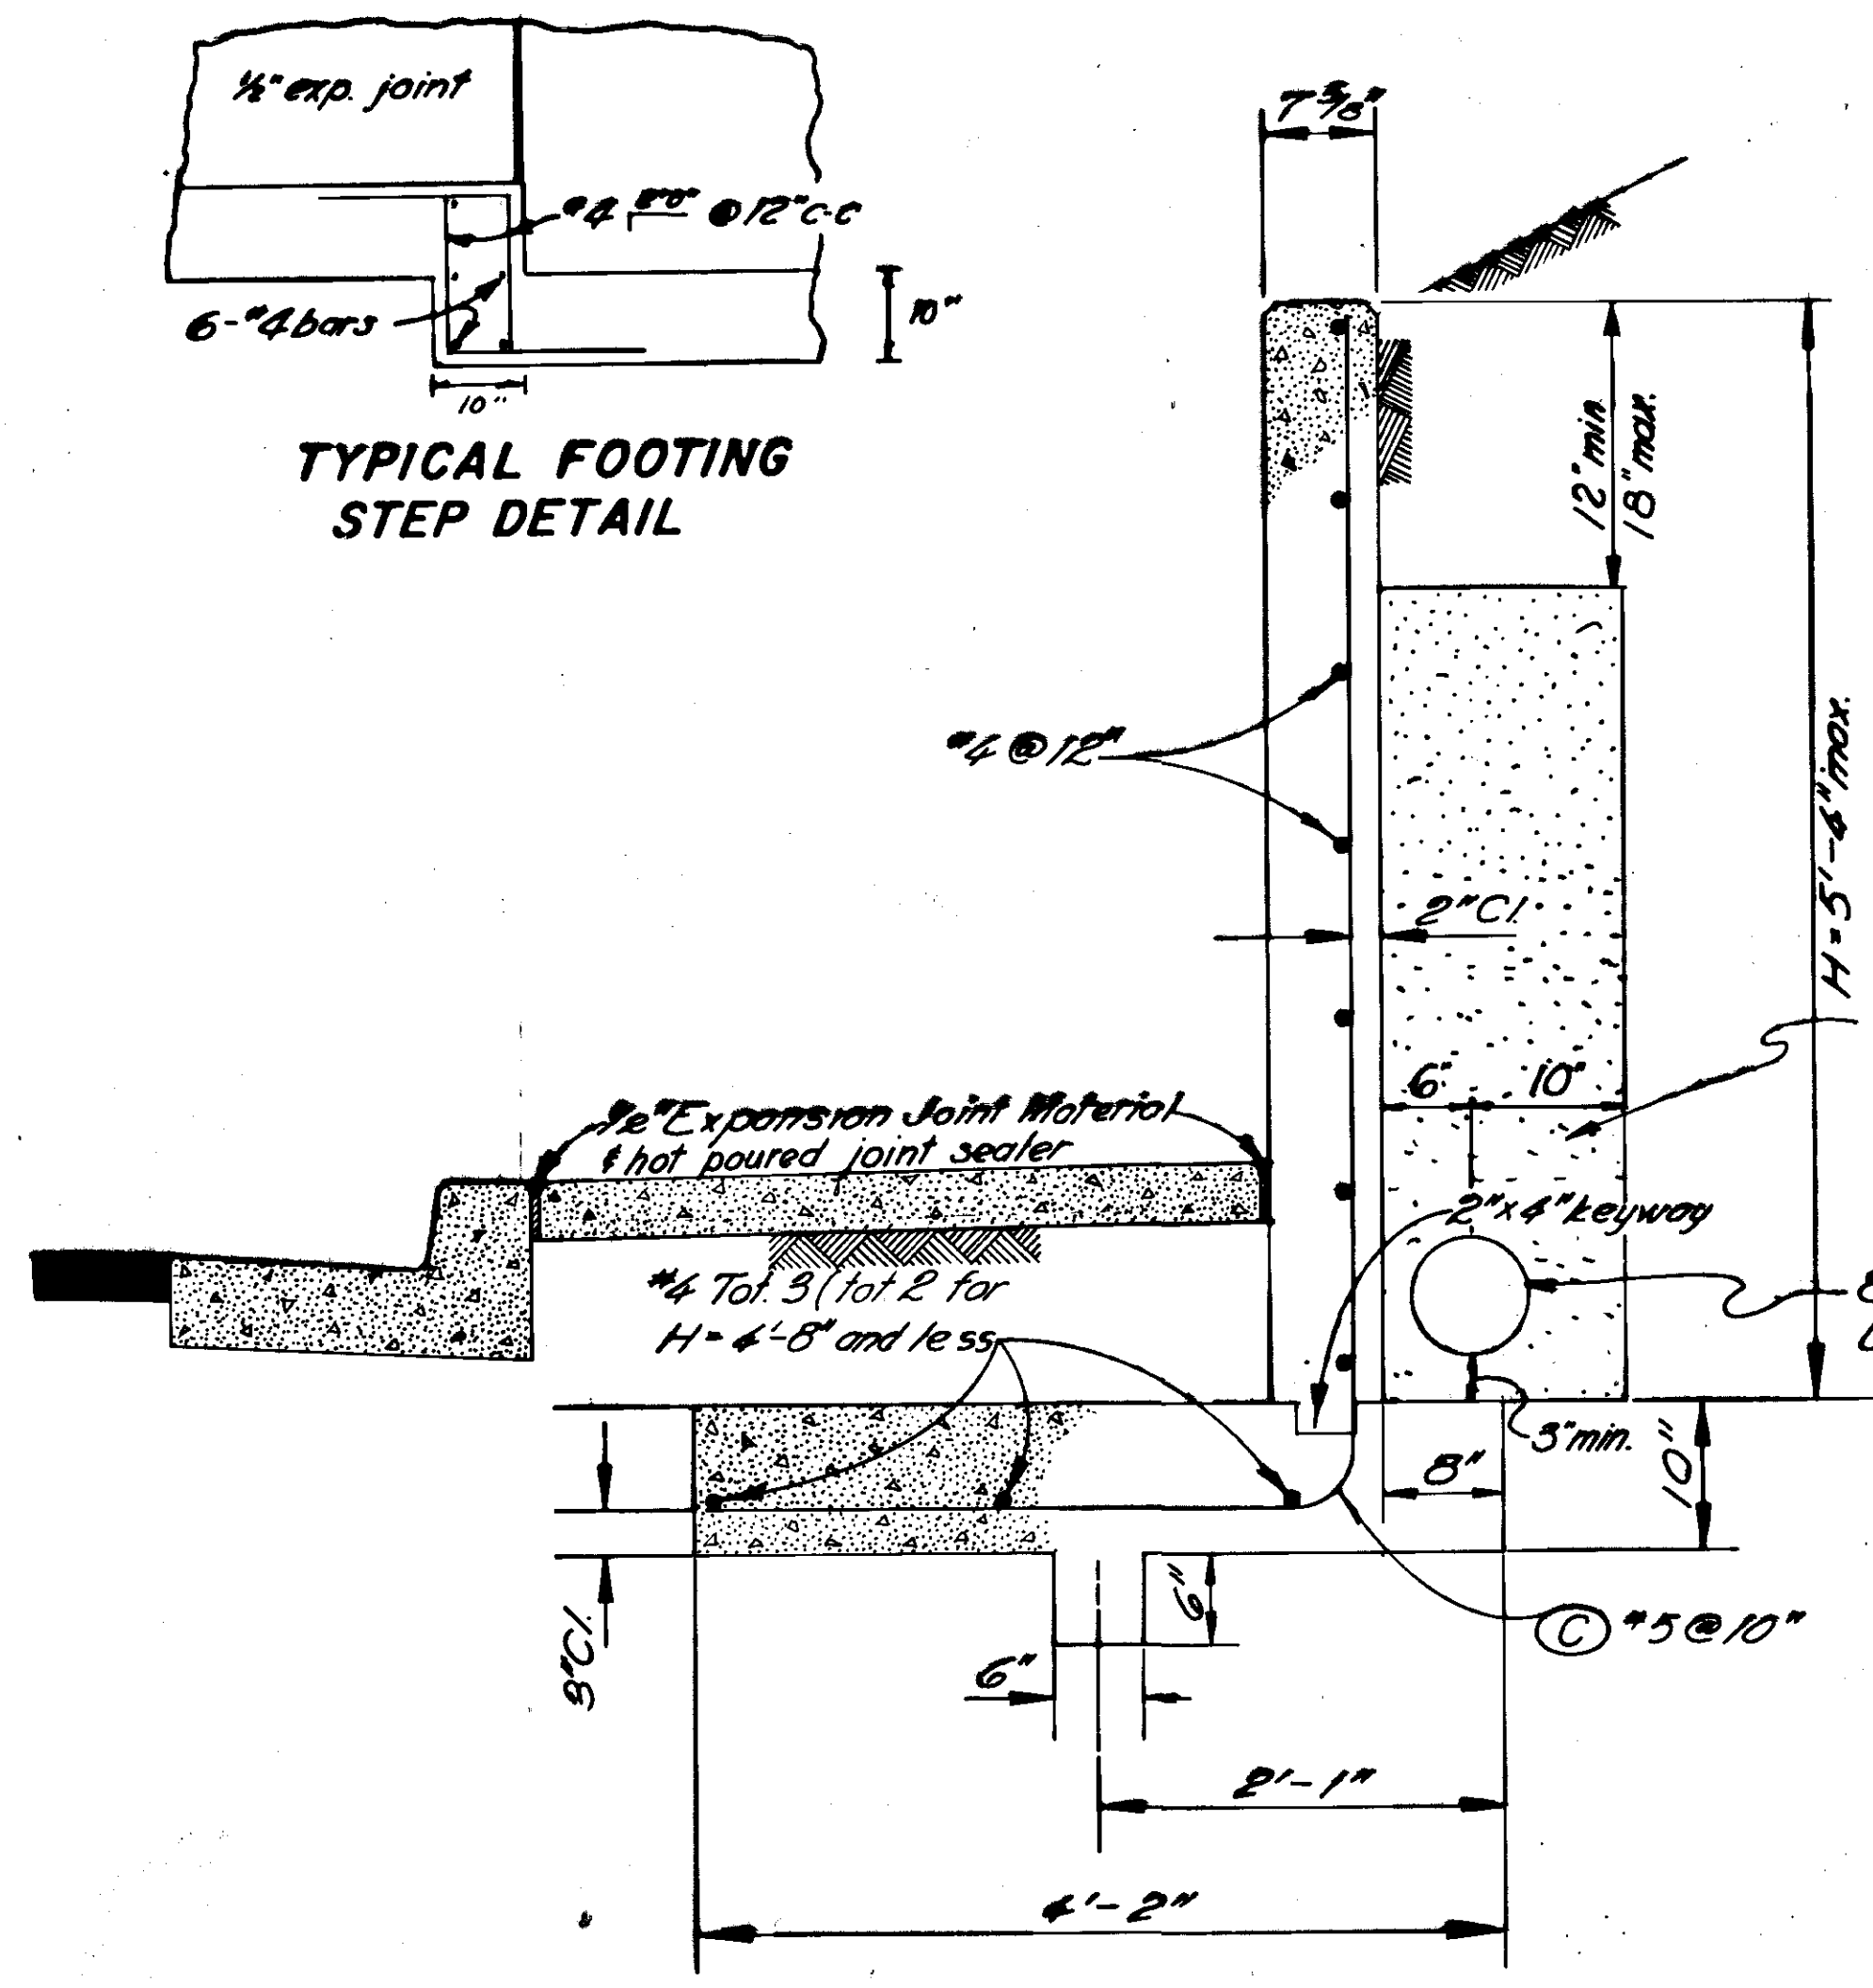

TYPICAL SECTION TYPE B
RETAINING WALL
WALL NO 2


GENERAL NOTES:

- Expansion joints shall have a maximum spacing of 90 feet.
- Contraction joints shall have a maximum spacing of 30 feet.
- Construction joints shall be at every footing step.
- All exposed joint corners shall have a 3/4" chamfer.
- All reinforcing bars shall have a 2 inch minimum clear distance to face of concrete except where shown.
- Porous material shall conform to the requirements established in the special provisions.
- Footing step detail to be used where ever there is a change in footing elevation.

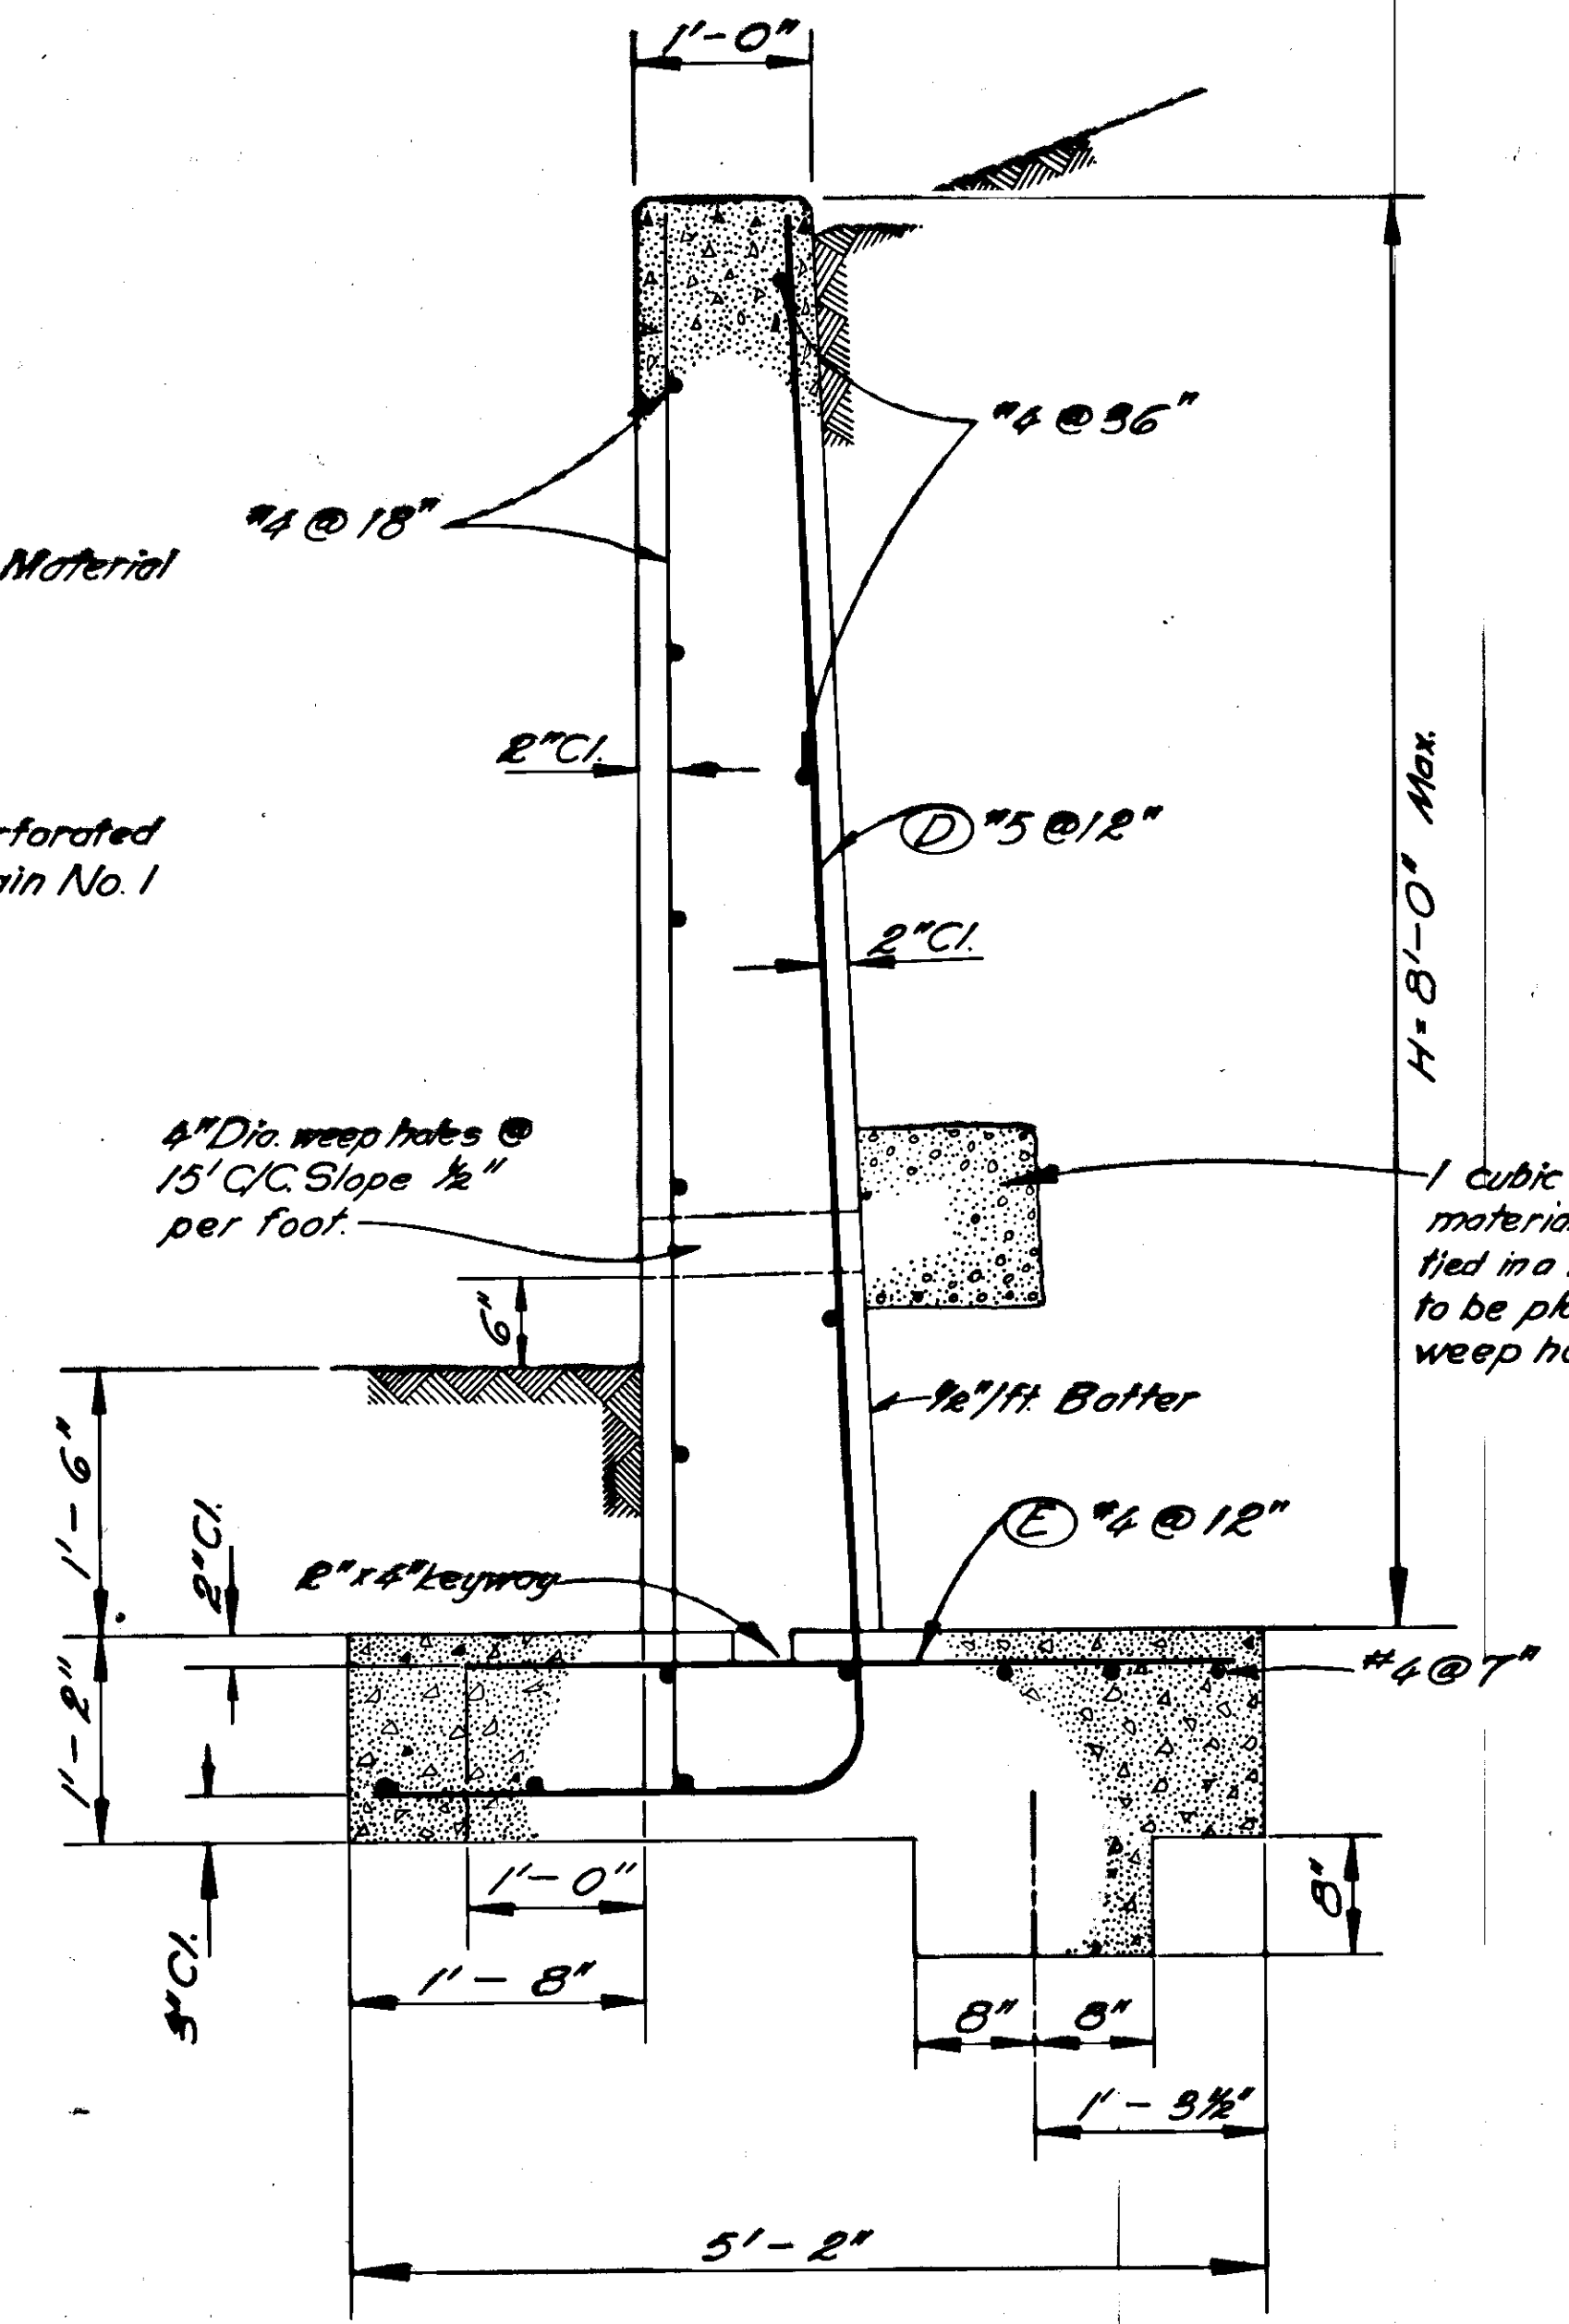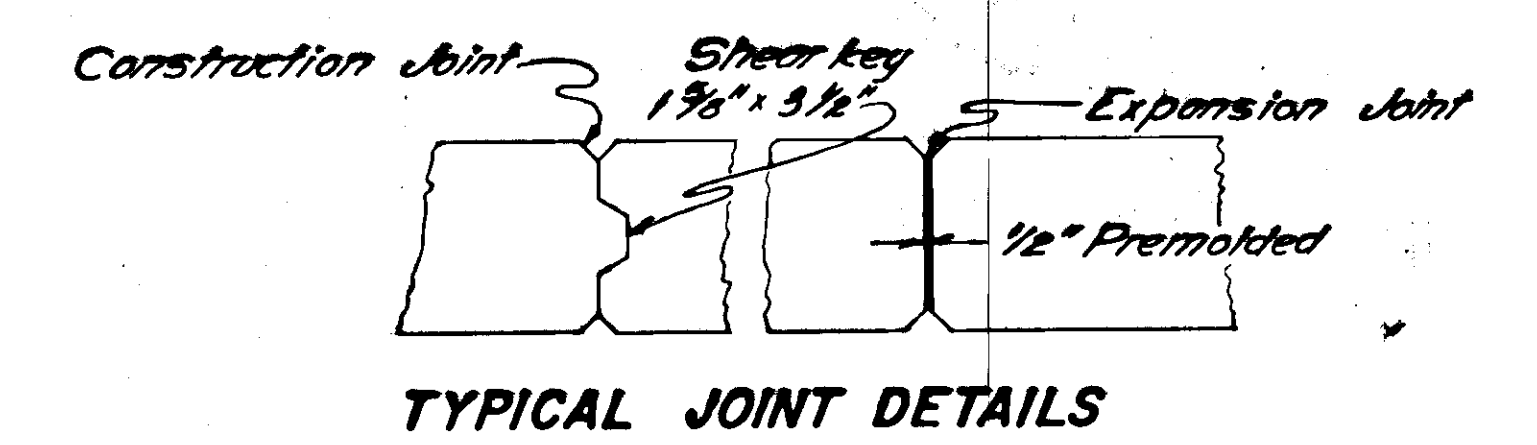


TYPICAL SECTION TYPE C
RETAINING WALL
WALL NO. 3


RETAINING WALLS
AS-BUILT

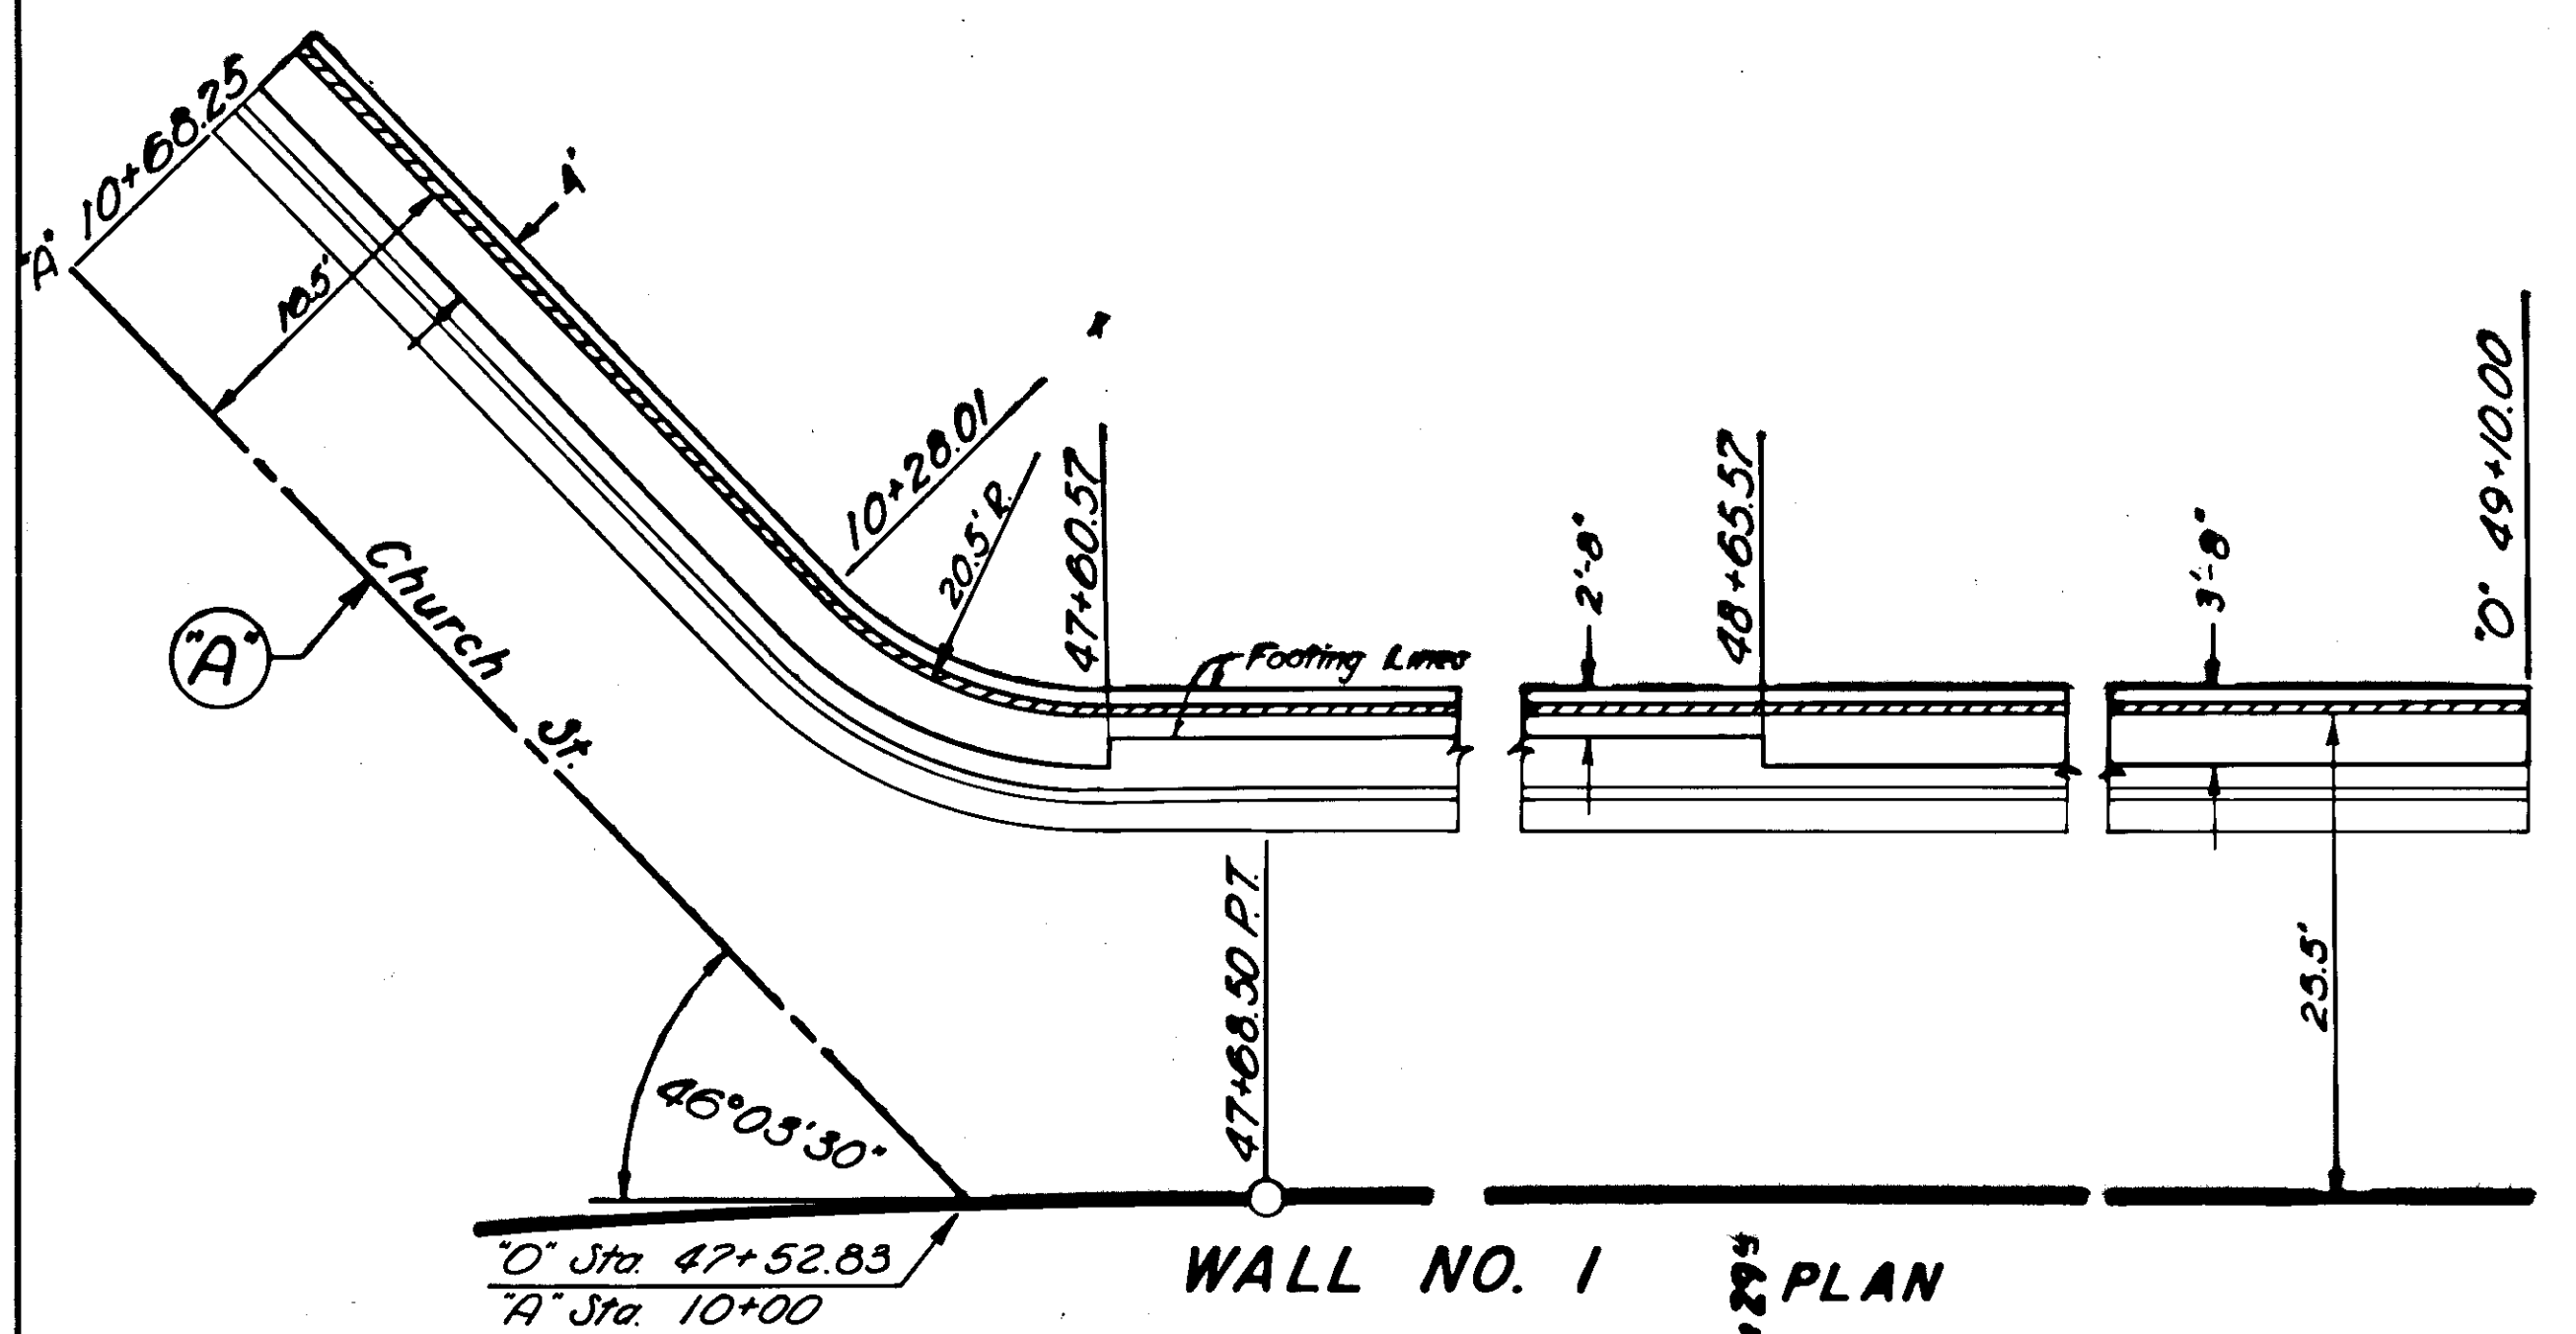


WALL NO. 1
PLAN

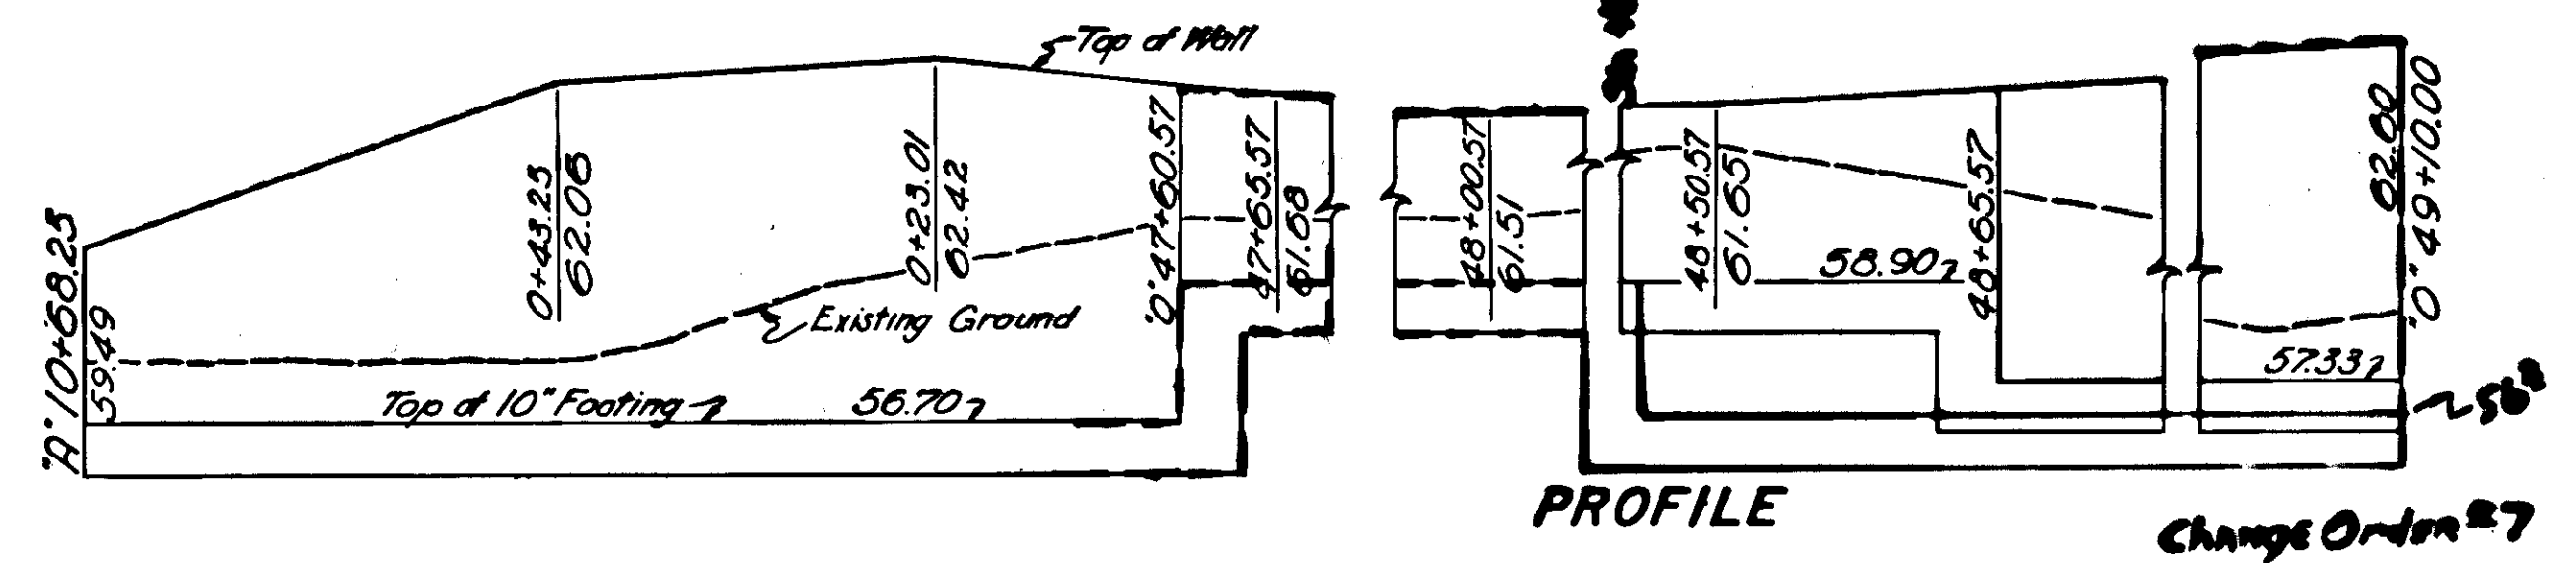


PROFILE
Change Order 27

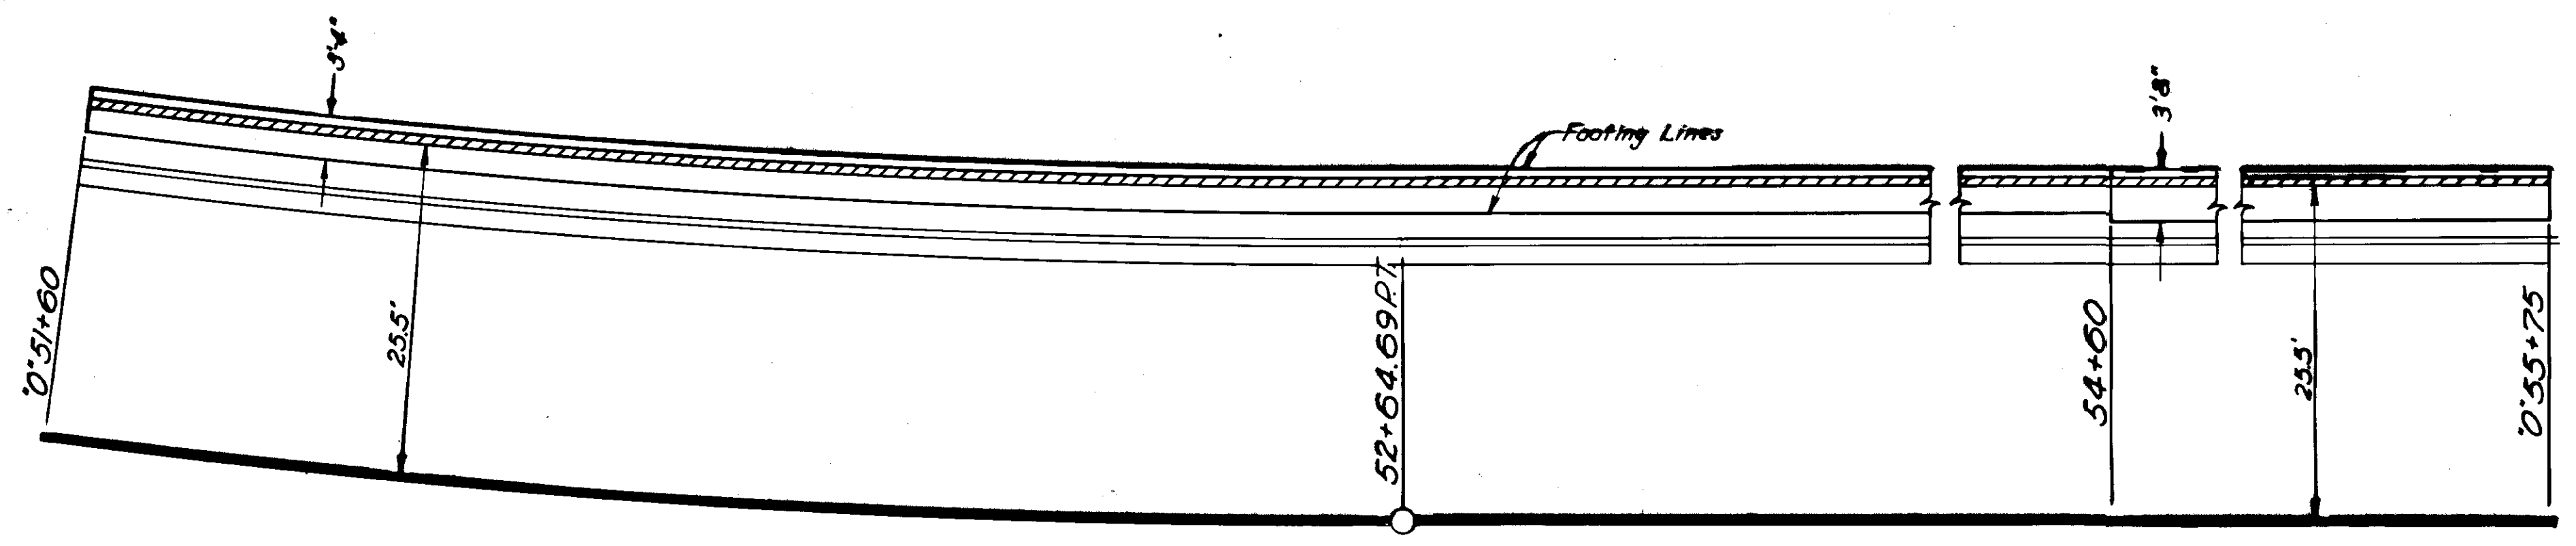


WALL NO. 4
PLAN

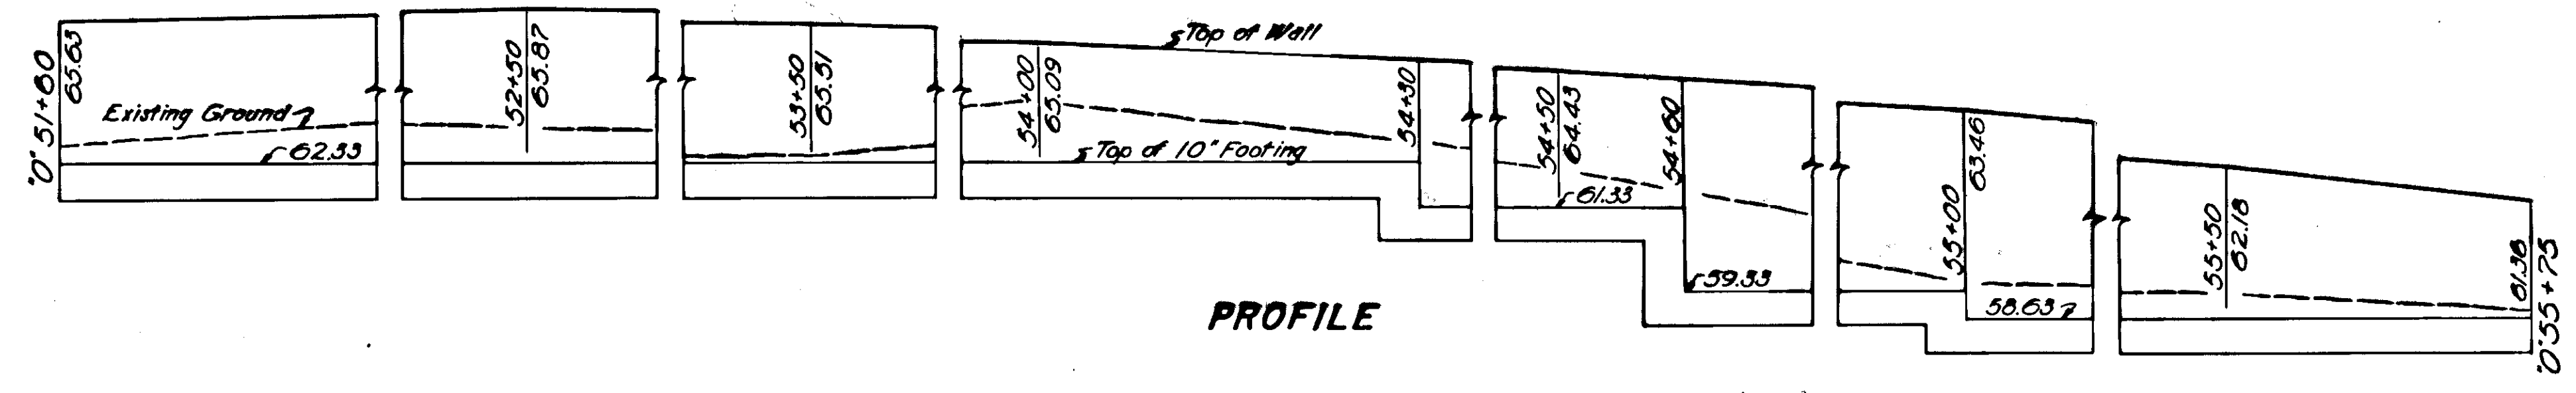


PROFILE
Change Order 27

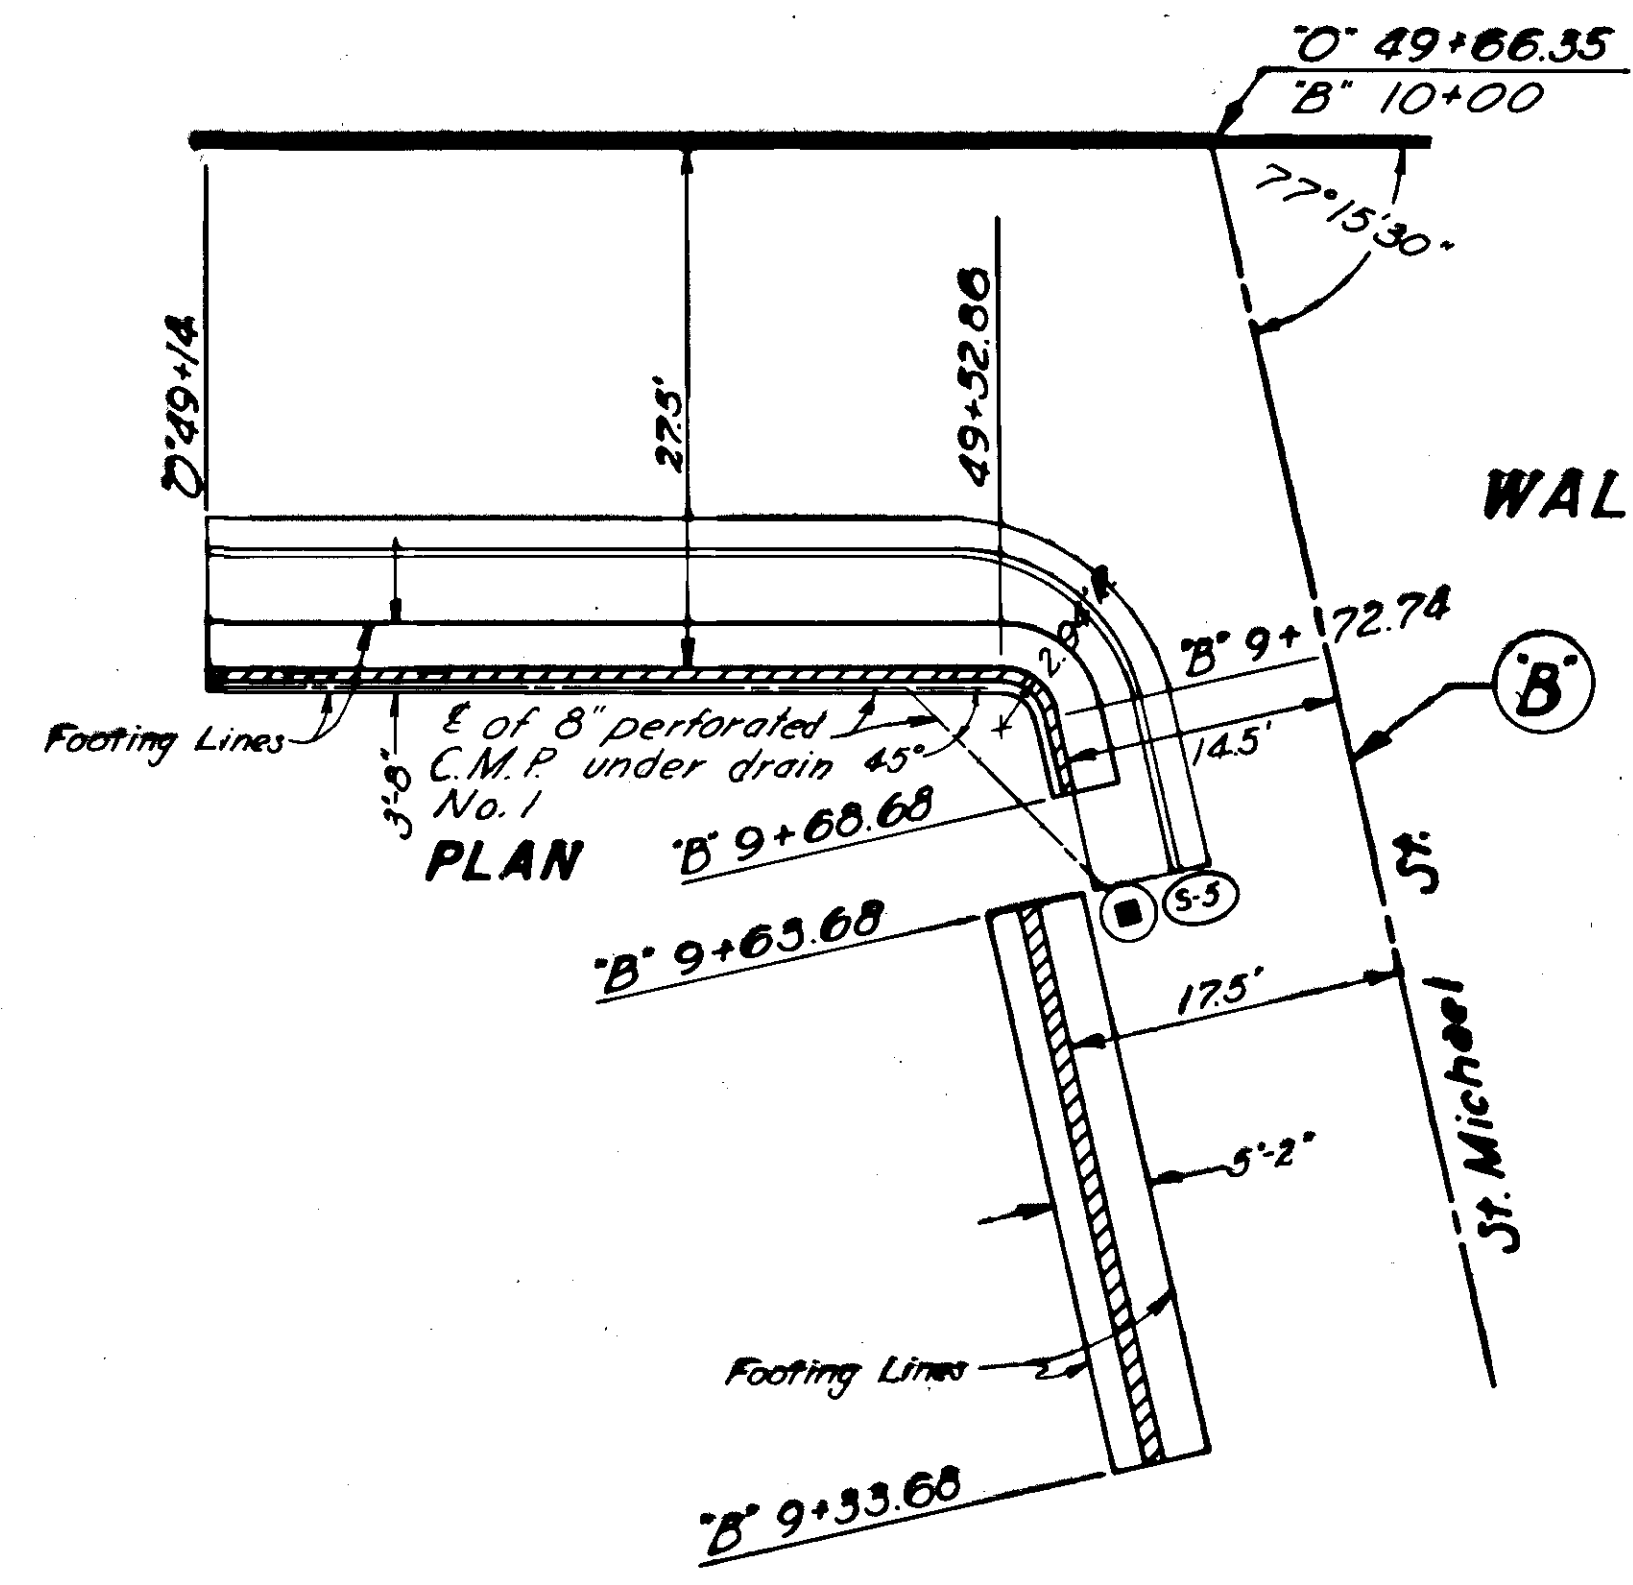


WALL NO. 2
PLAN

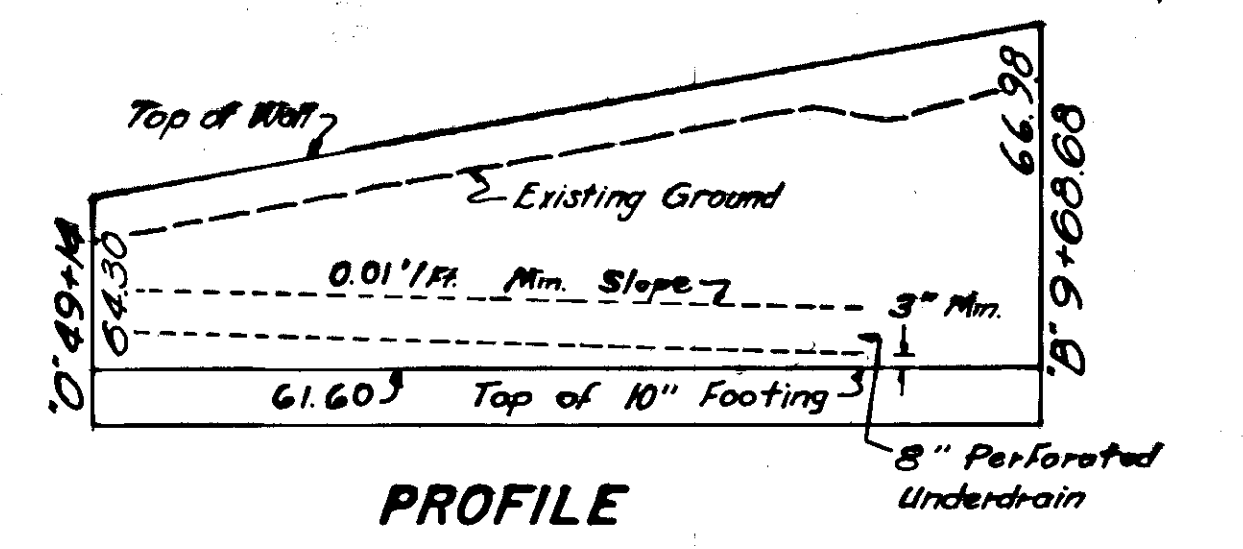


PROFILE

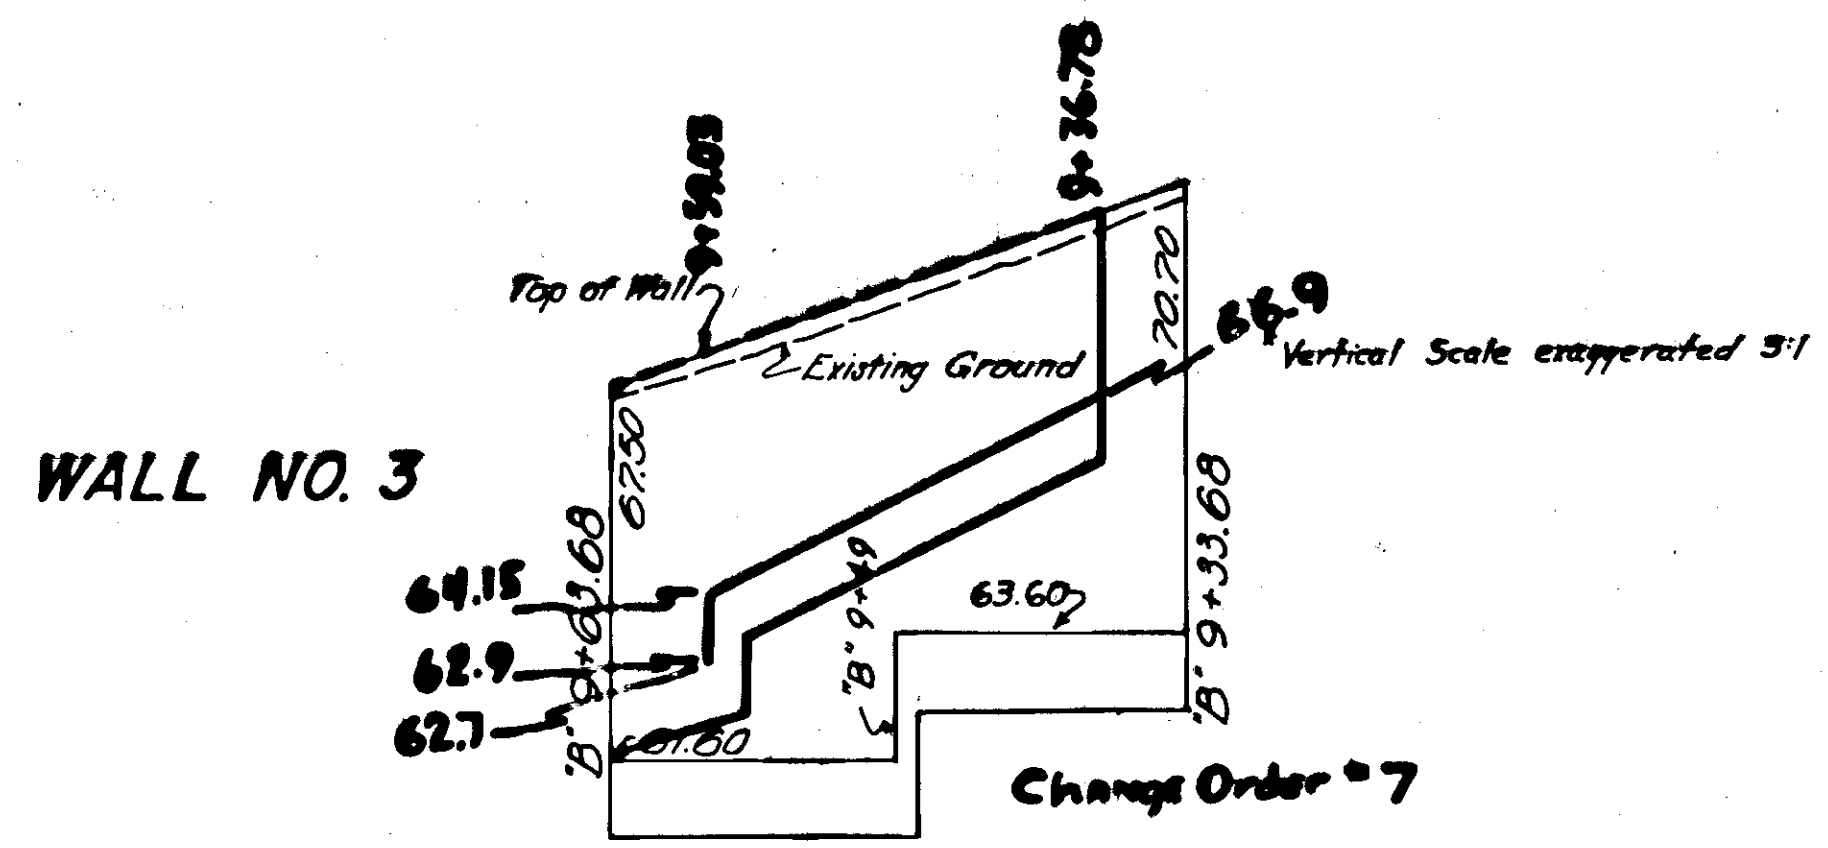


WALL NO. 3
PLAN

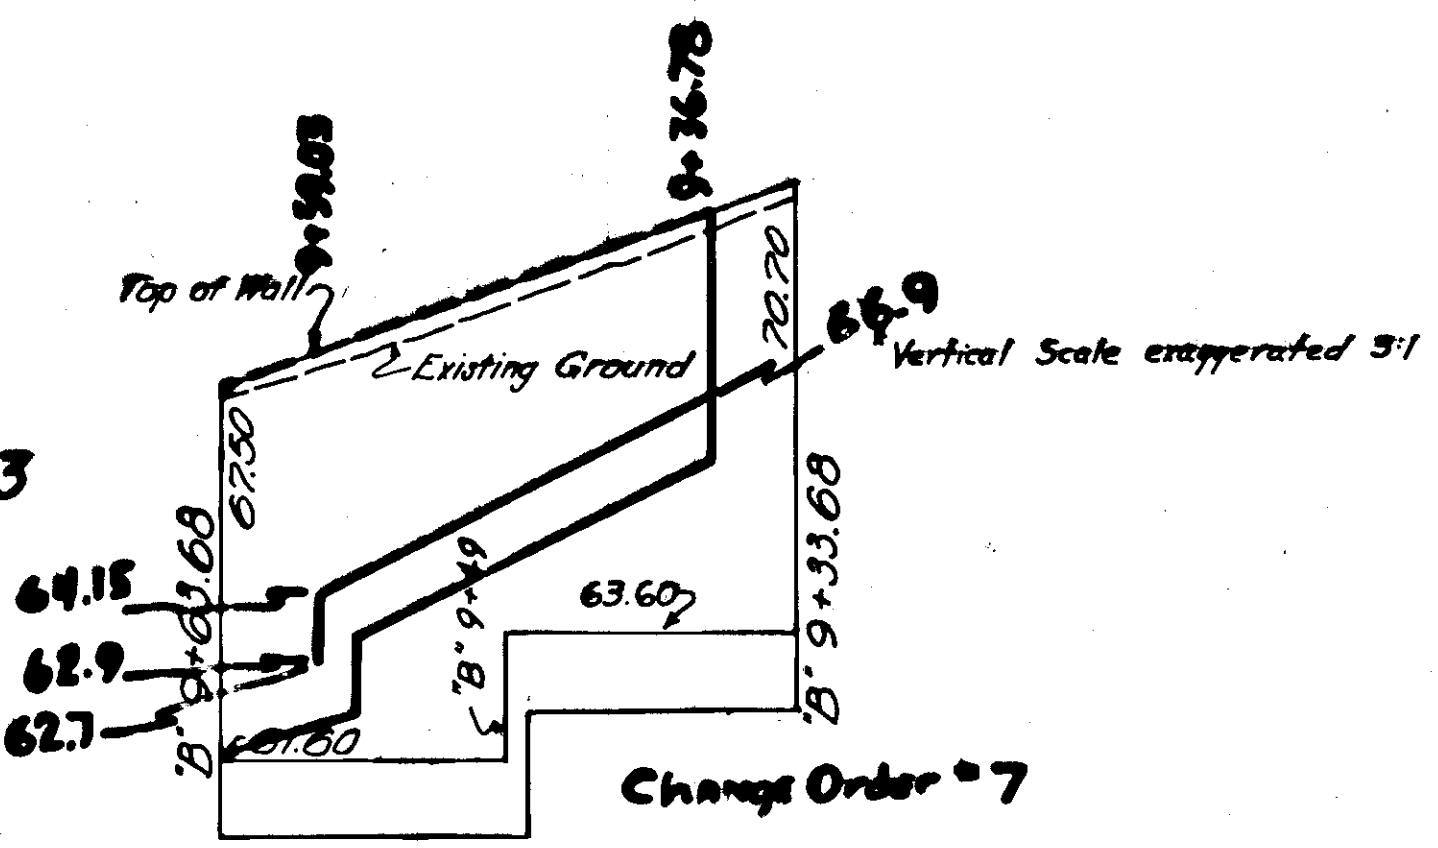

PROFILE

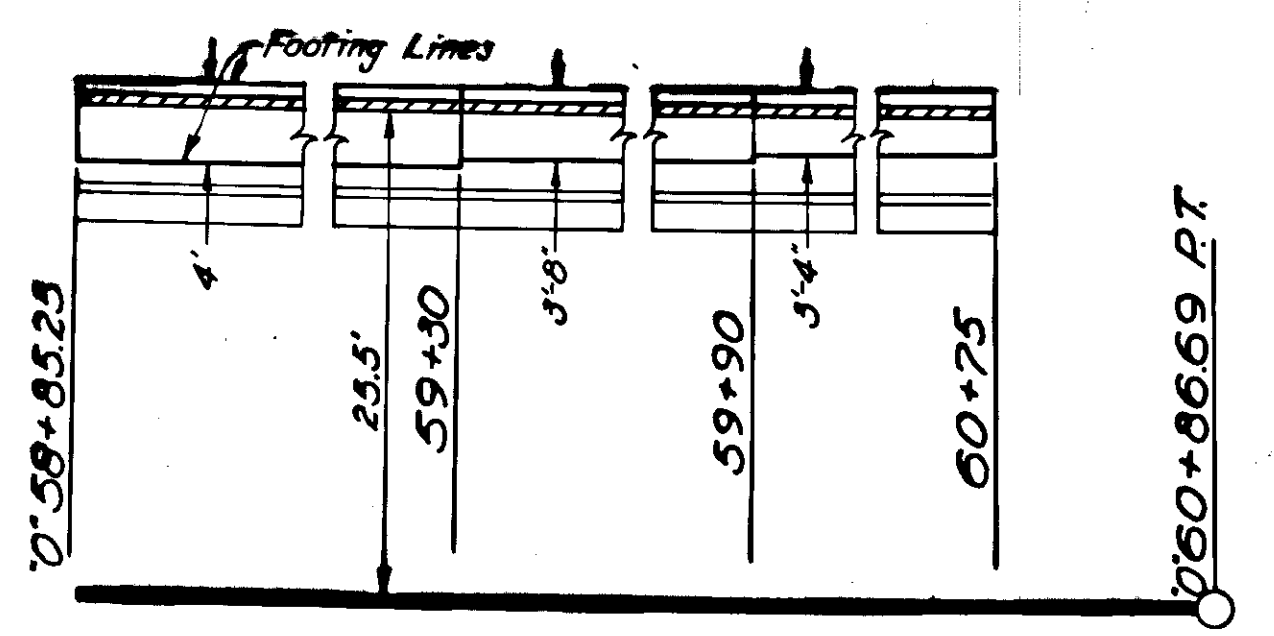


WALL NO. 5
PLAN

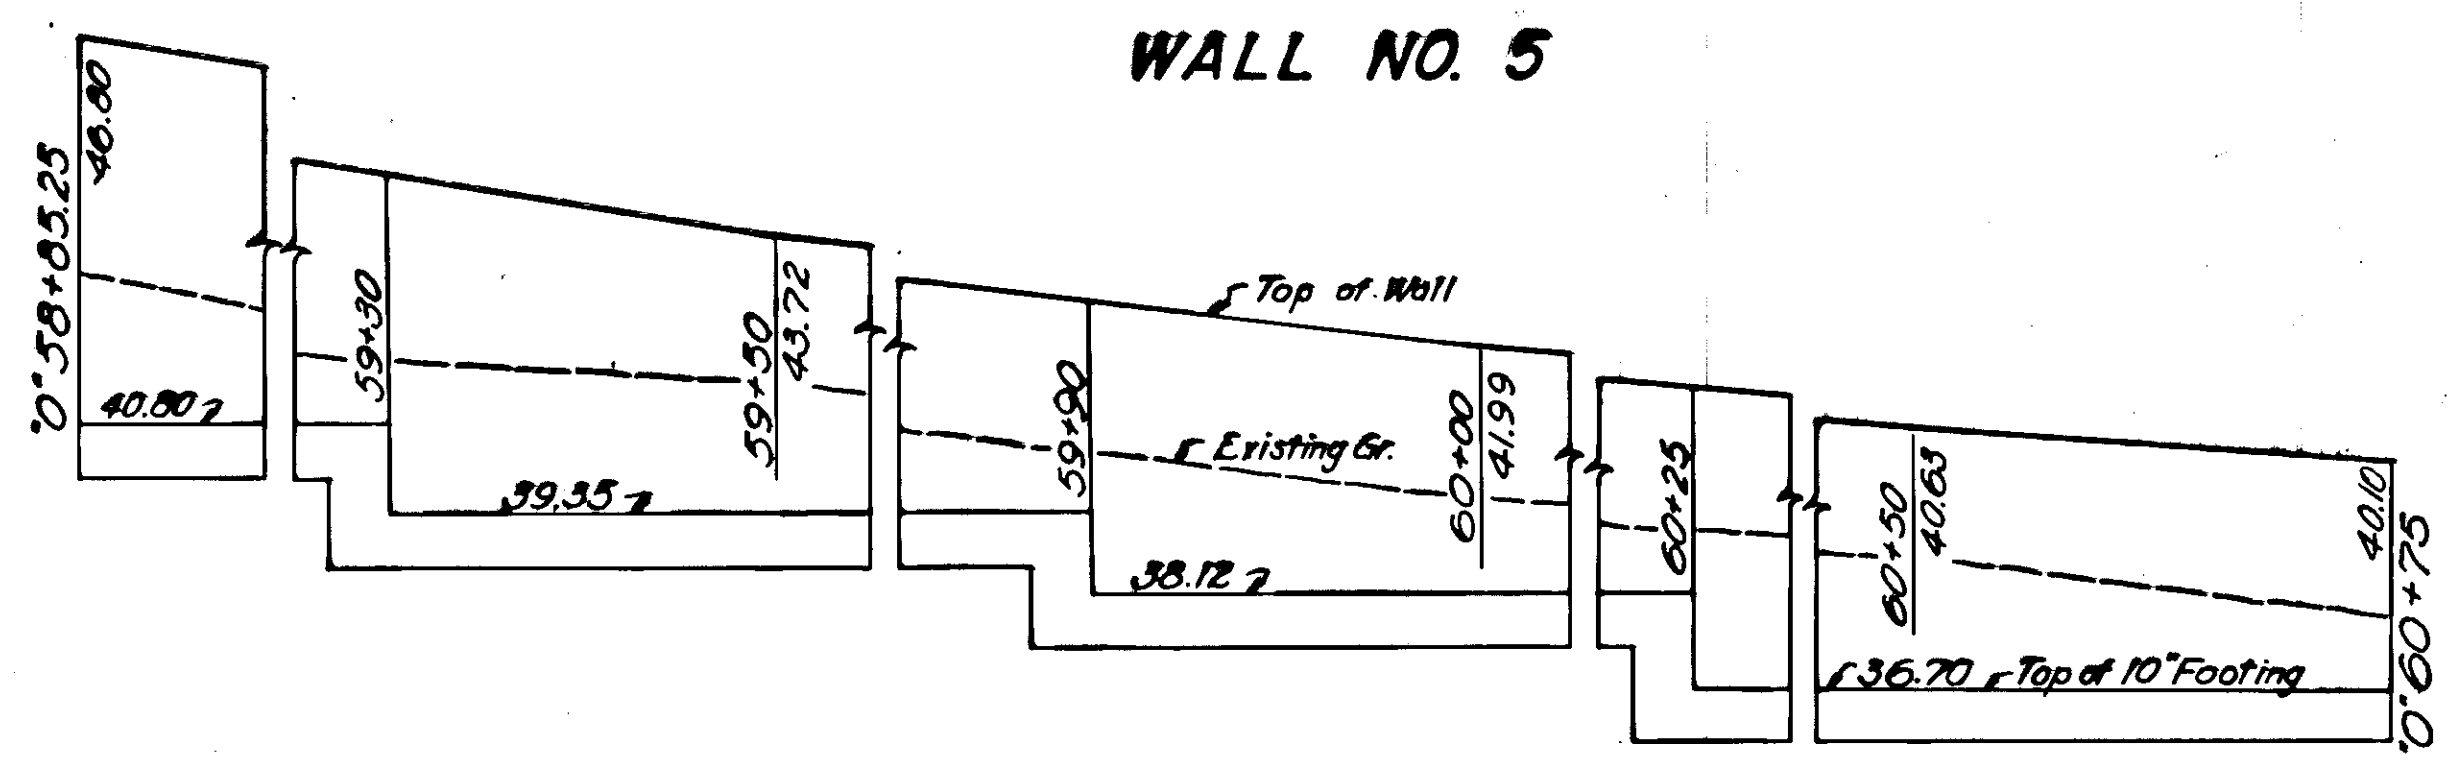


PROFILE


RETAINING WALLS AS-BUILT

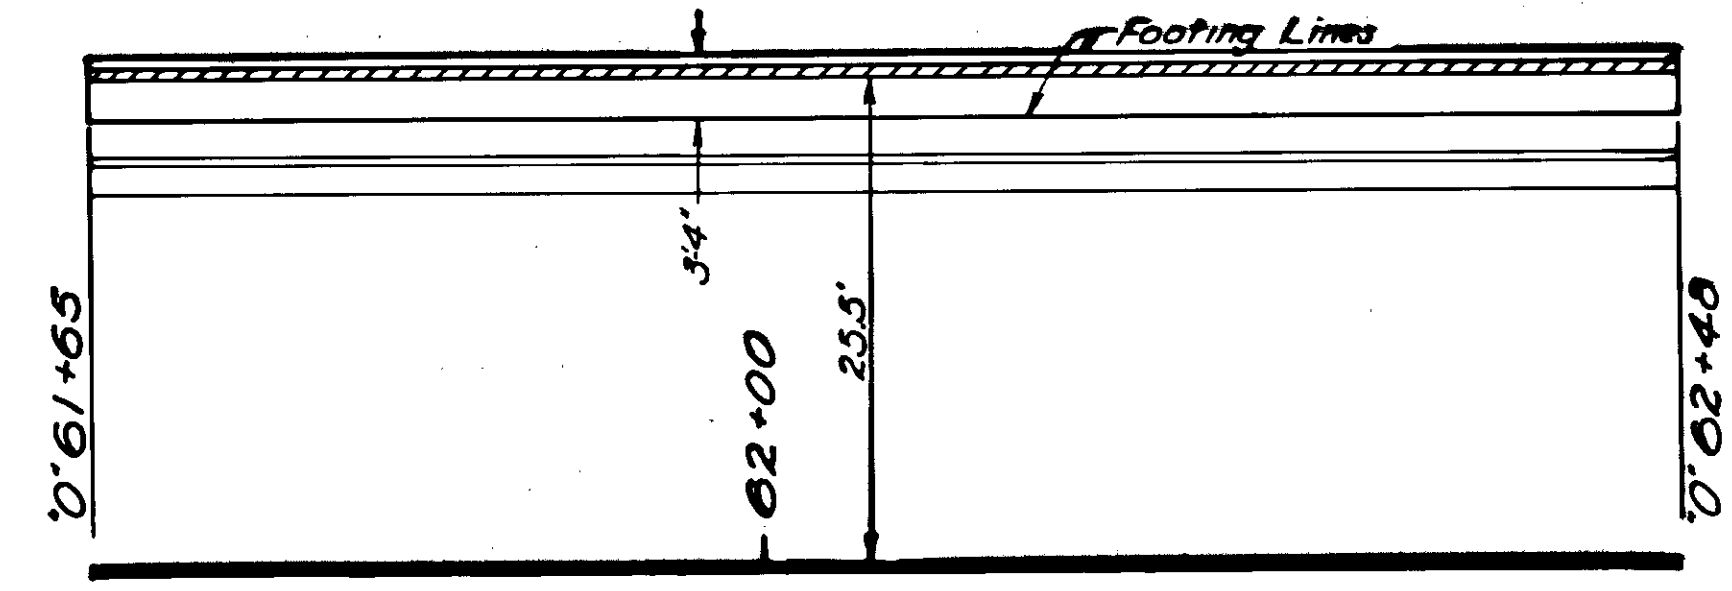


PLAN
WALL NO. 6

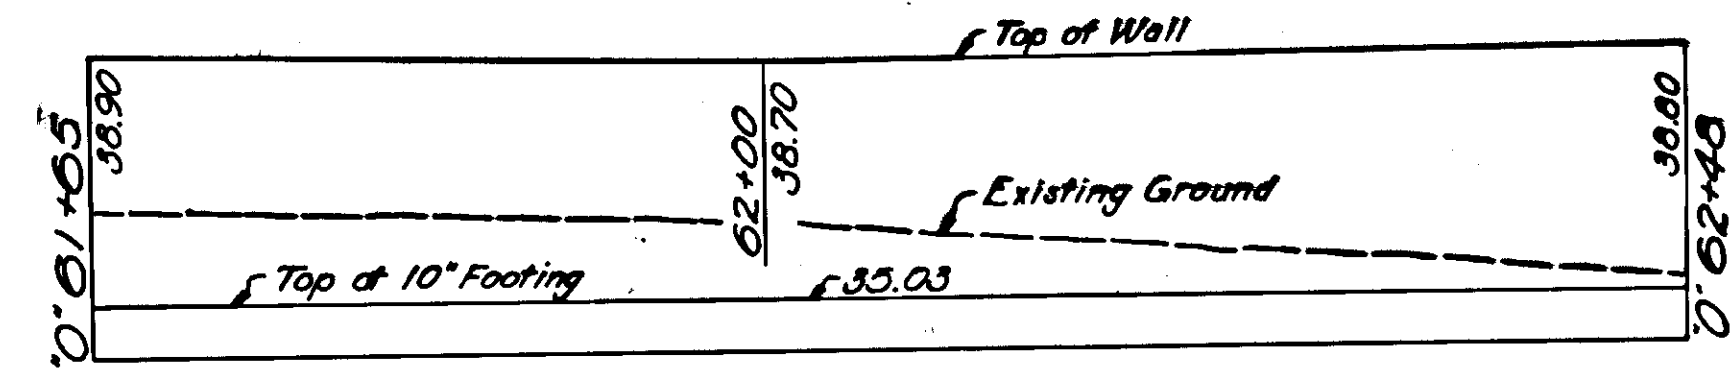


PROFILE

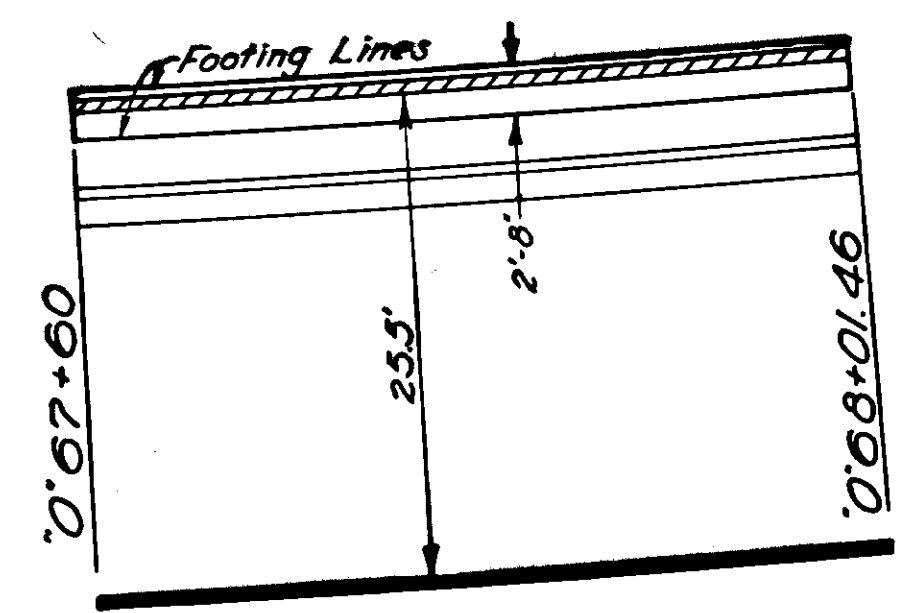


PLAN
WALL NO. 8

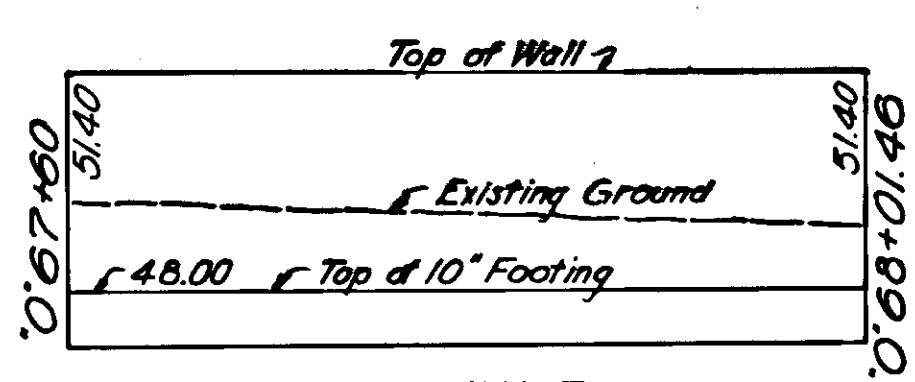


PROFILE

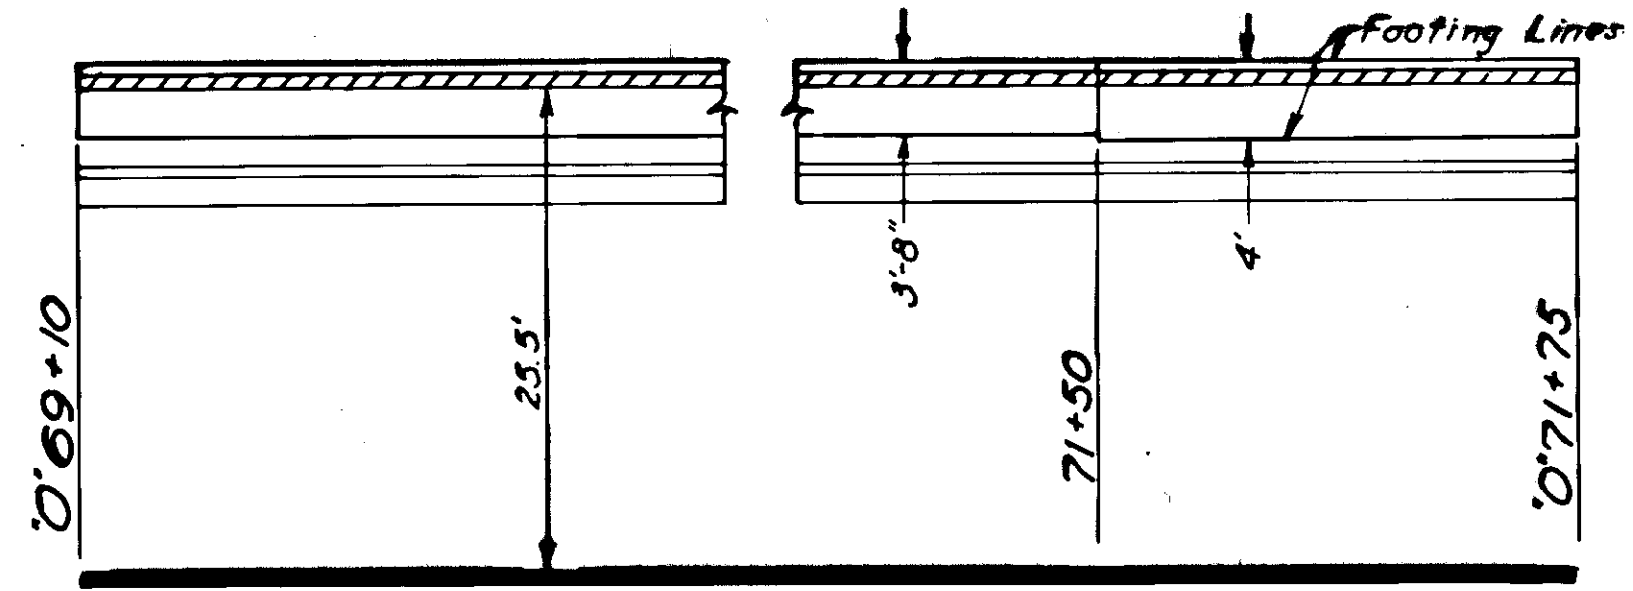


PLAN

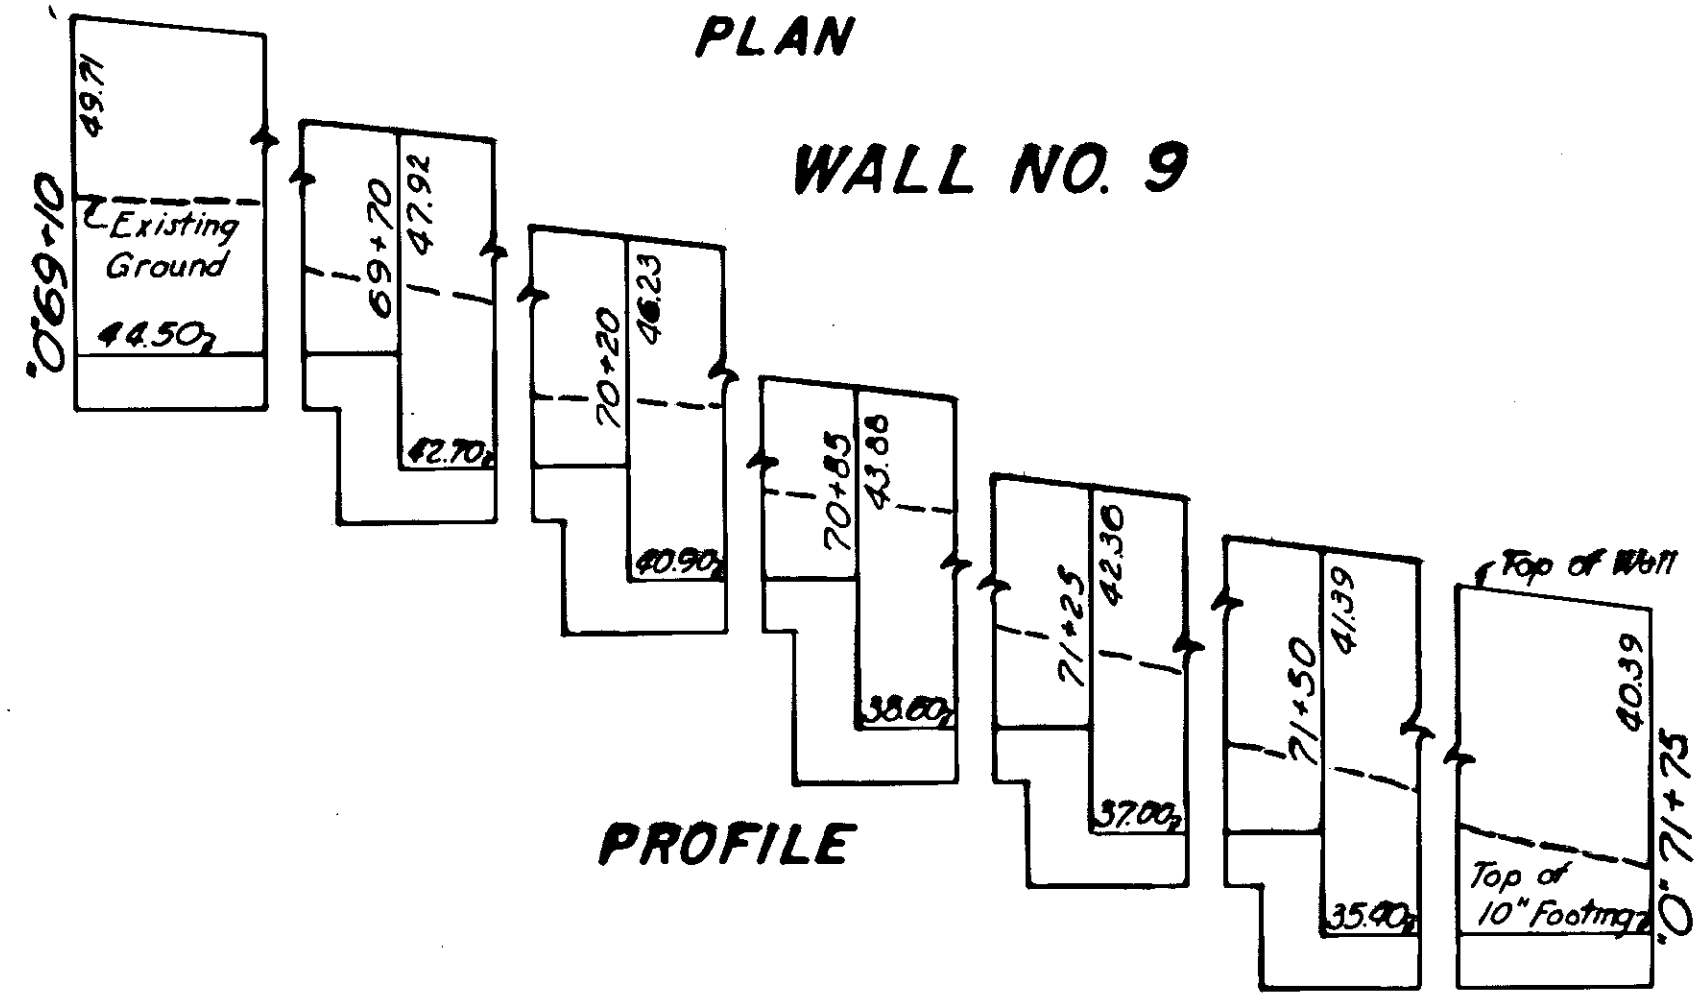


PROFILE

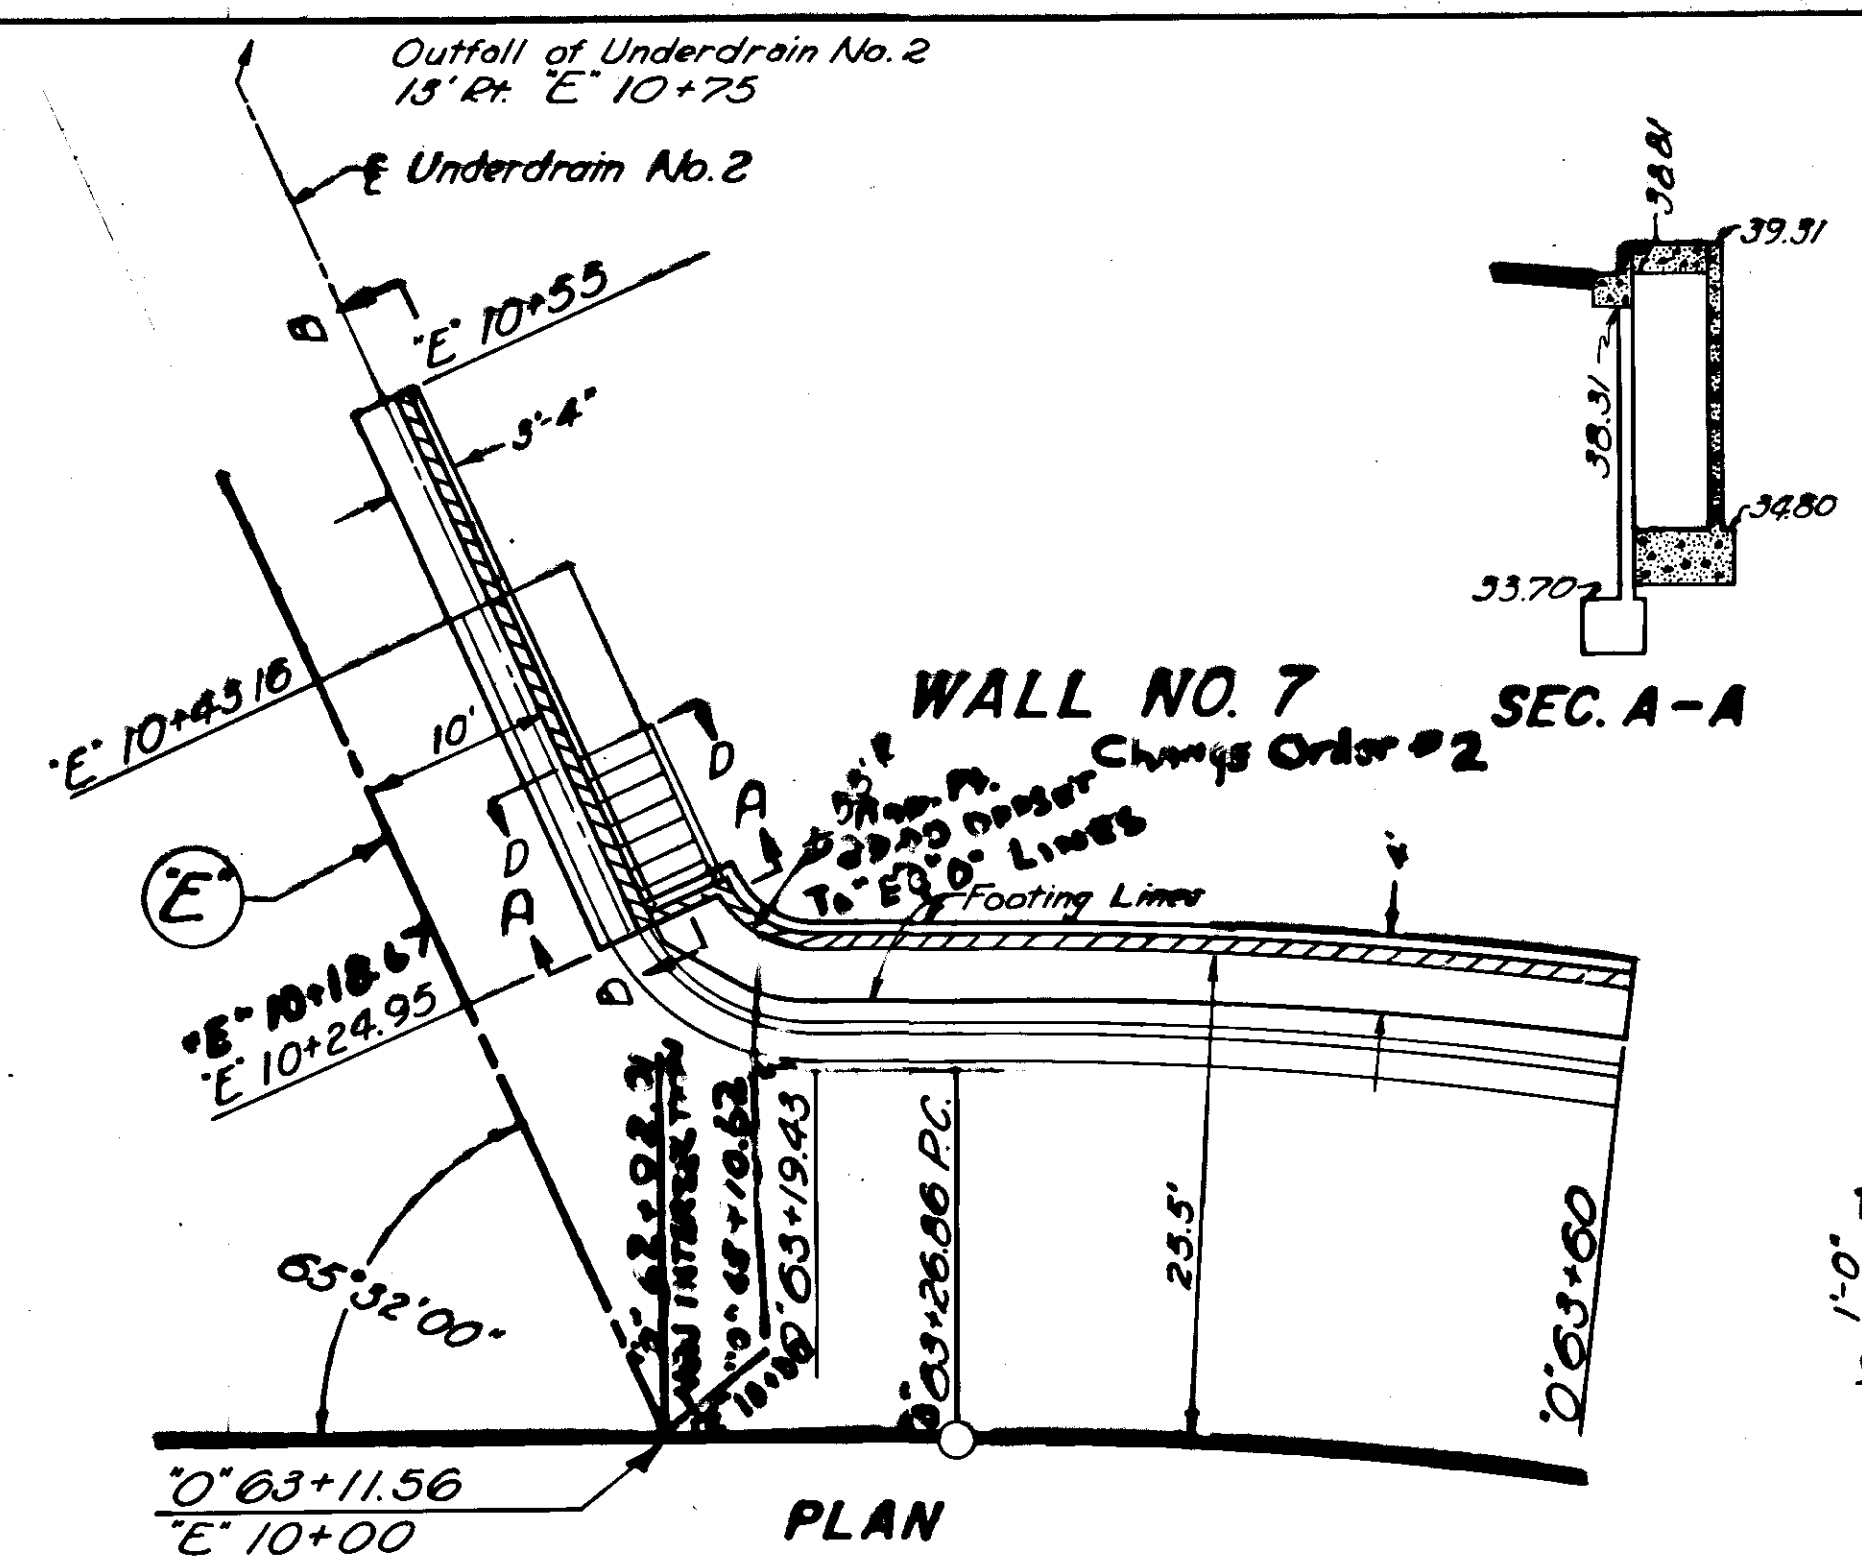


PLAN

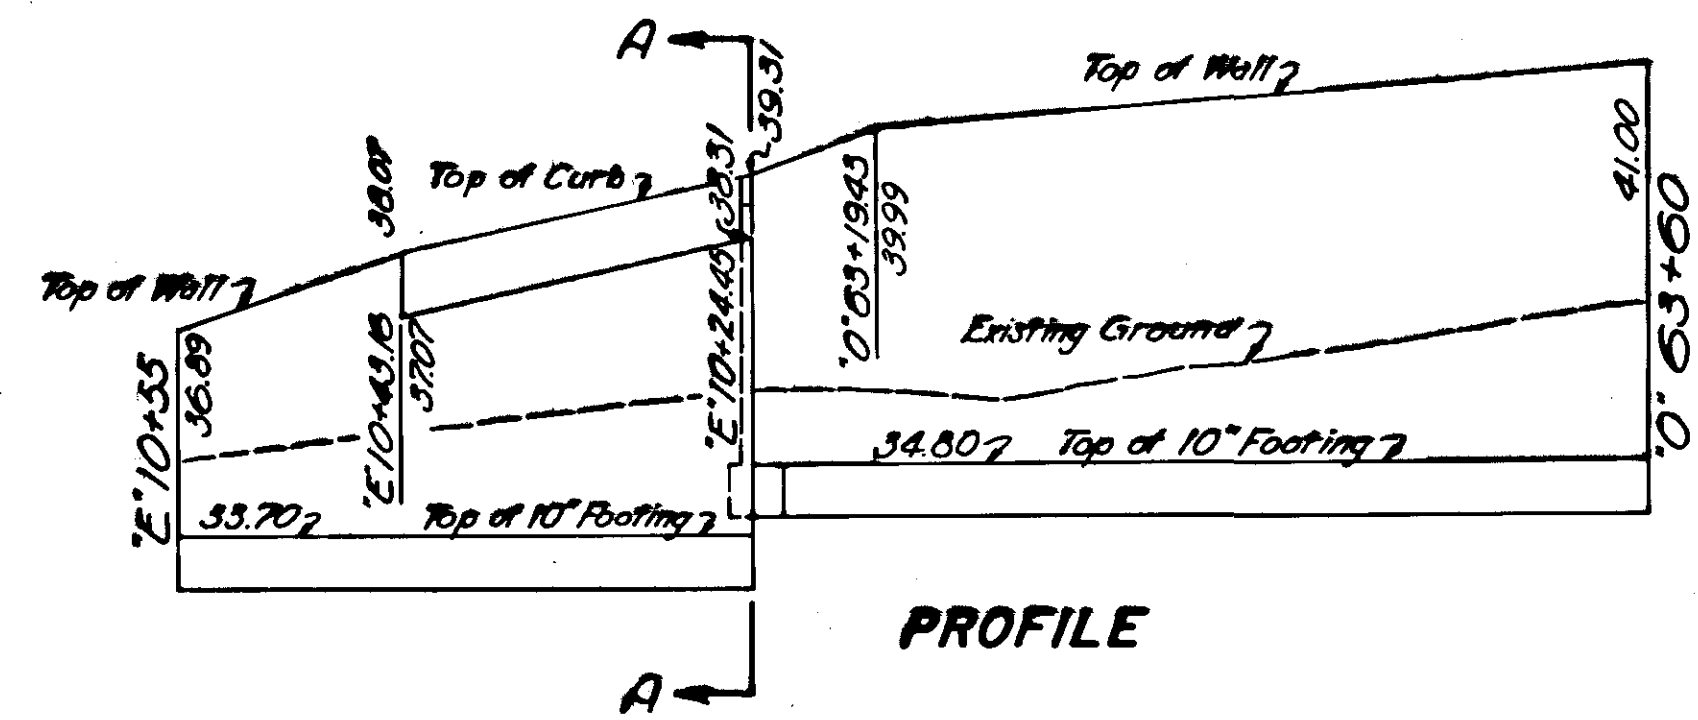


PROFILE

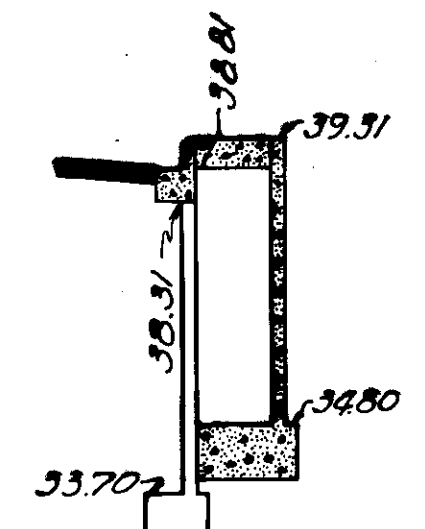


SEC. A-A

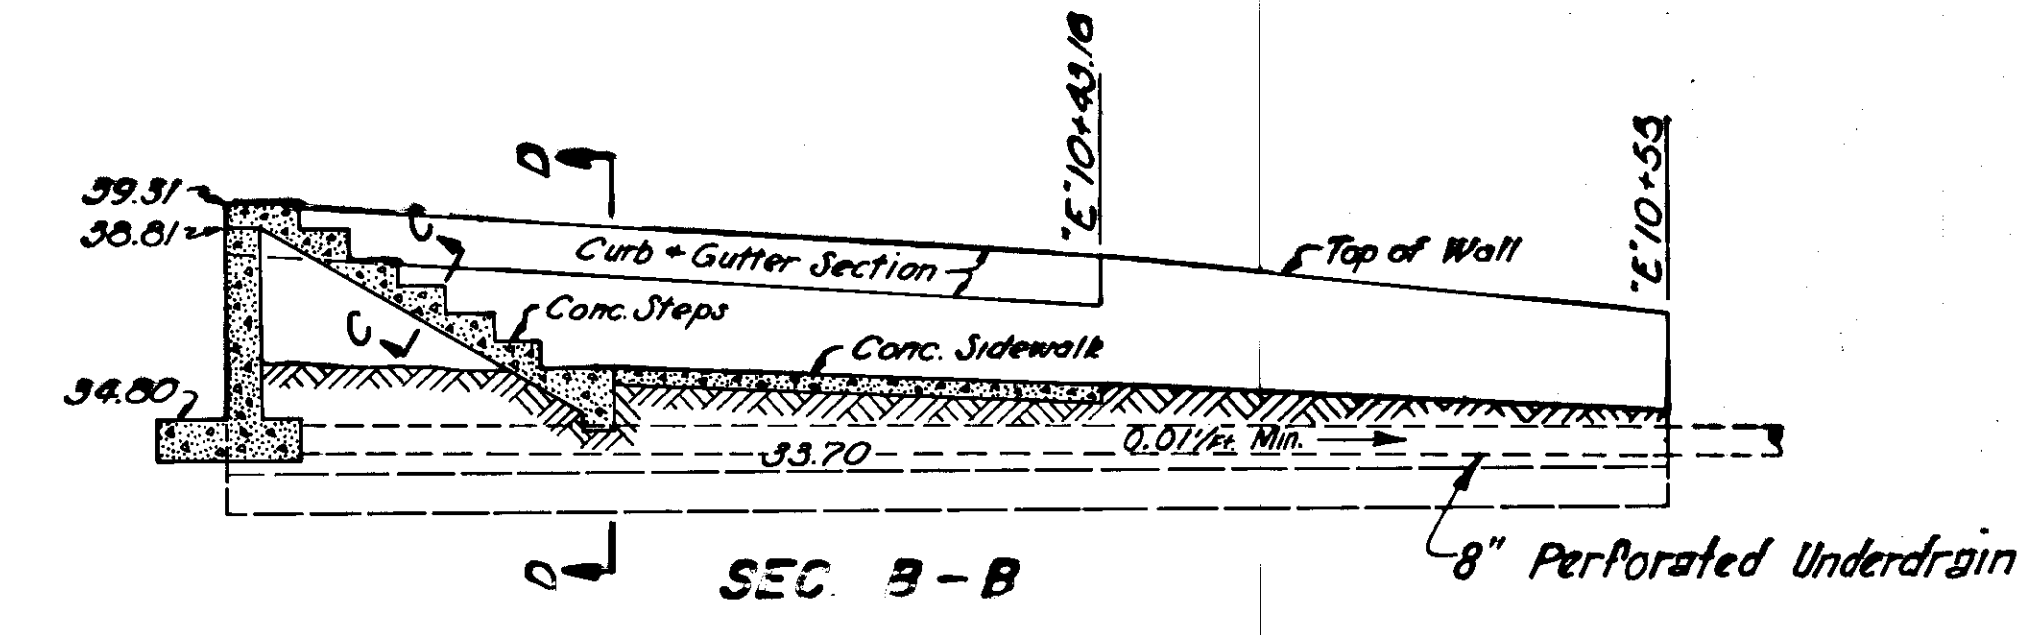

SEC. B-B

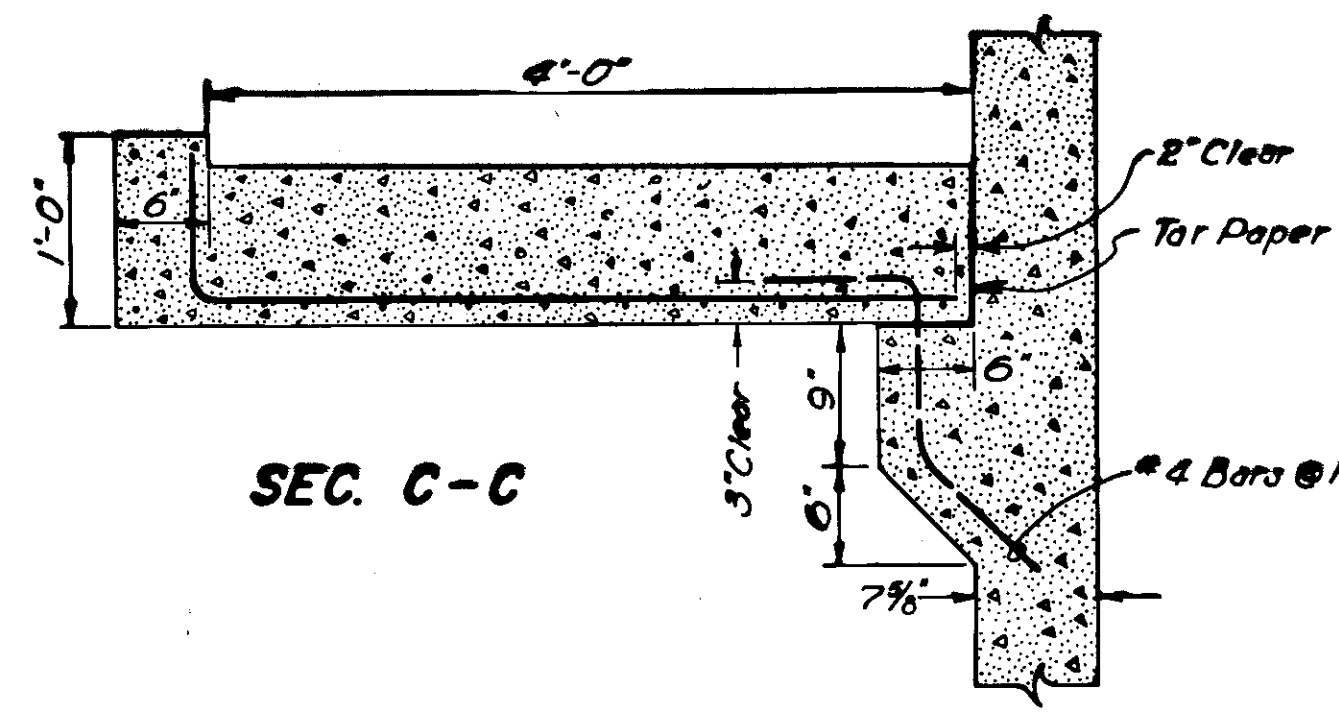


SEC. C-C

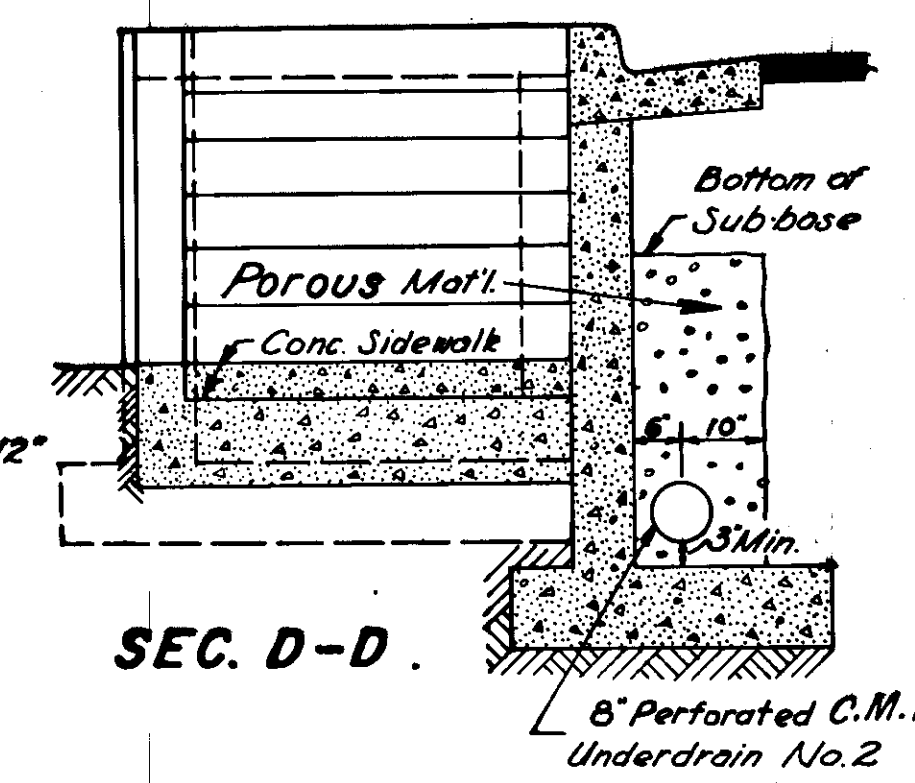


SEC. D-D

See Sheet No. 14 for Standard Stair Details.

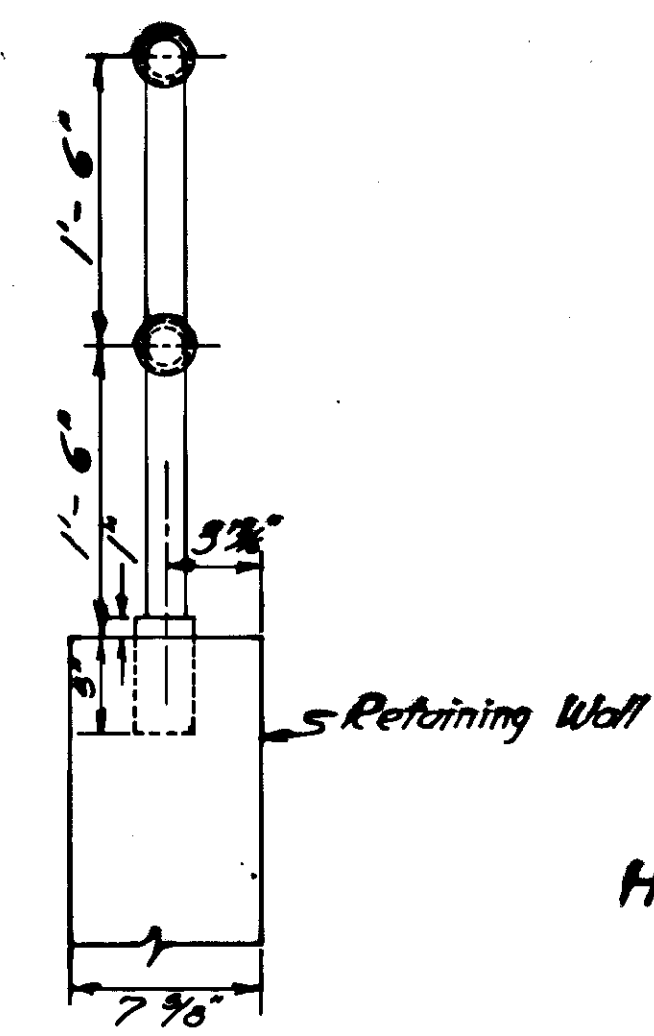

HAND RAIL DETAILS

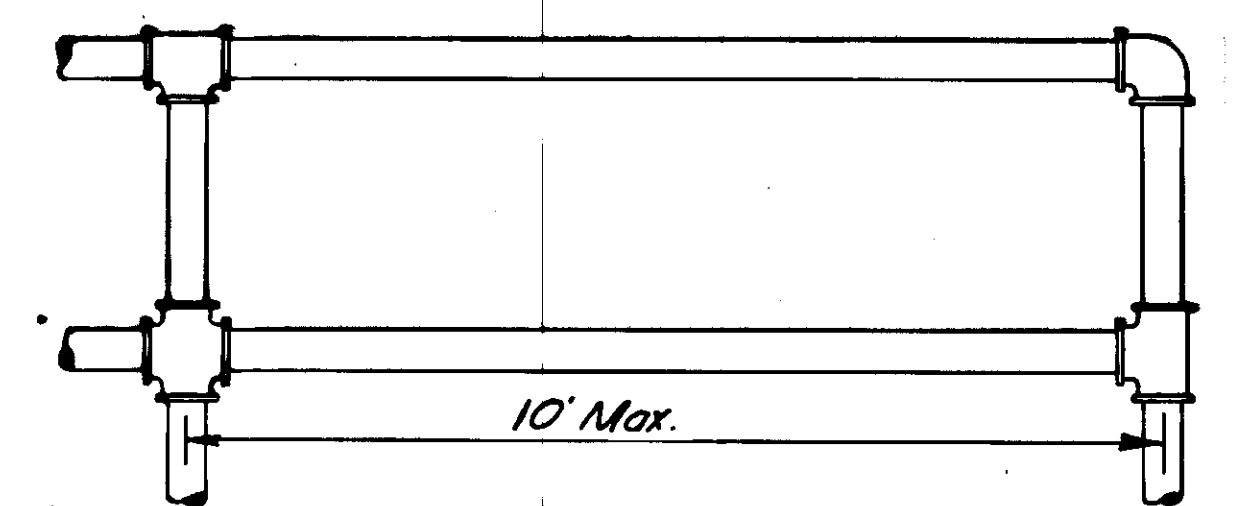


HAND RAIL LOCATIONS

Wall No.	From Station	To Station	Lineal Feet of Rail
1	0+10+08.25	0+49+10	192.9
4	0+51+60	0+55+75	373.0
5	0+58+85.25	0+60+75	177.0
6	0+61+65	0+62+48	74.0
7	0+10+24.95	0+63+60	45.6
8	0+67+60	0+68+01.46	40.5
9	0+69+10	0+71+15	196.0


GENERAL NOTES:

1. One and one half inch diameter Galvanized Steel Pipe shall be used for railing and posts.
2. Adjustable type galvanized fittings may be substituted for the welded joints.
3. Posts shall be set in 2 1/2" galvanized iron pipe sockets and calked or poured with lead.


CONCRETE STAIRWAYS AS-BUILT

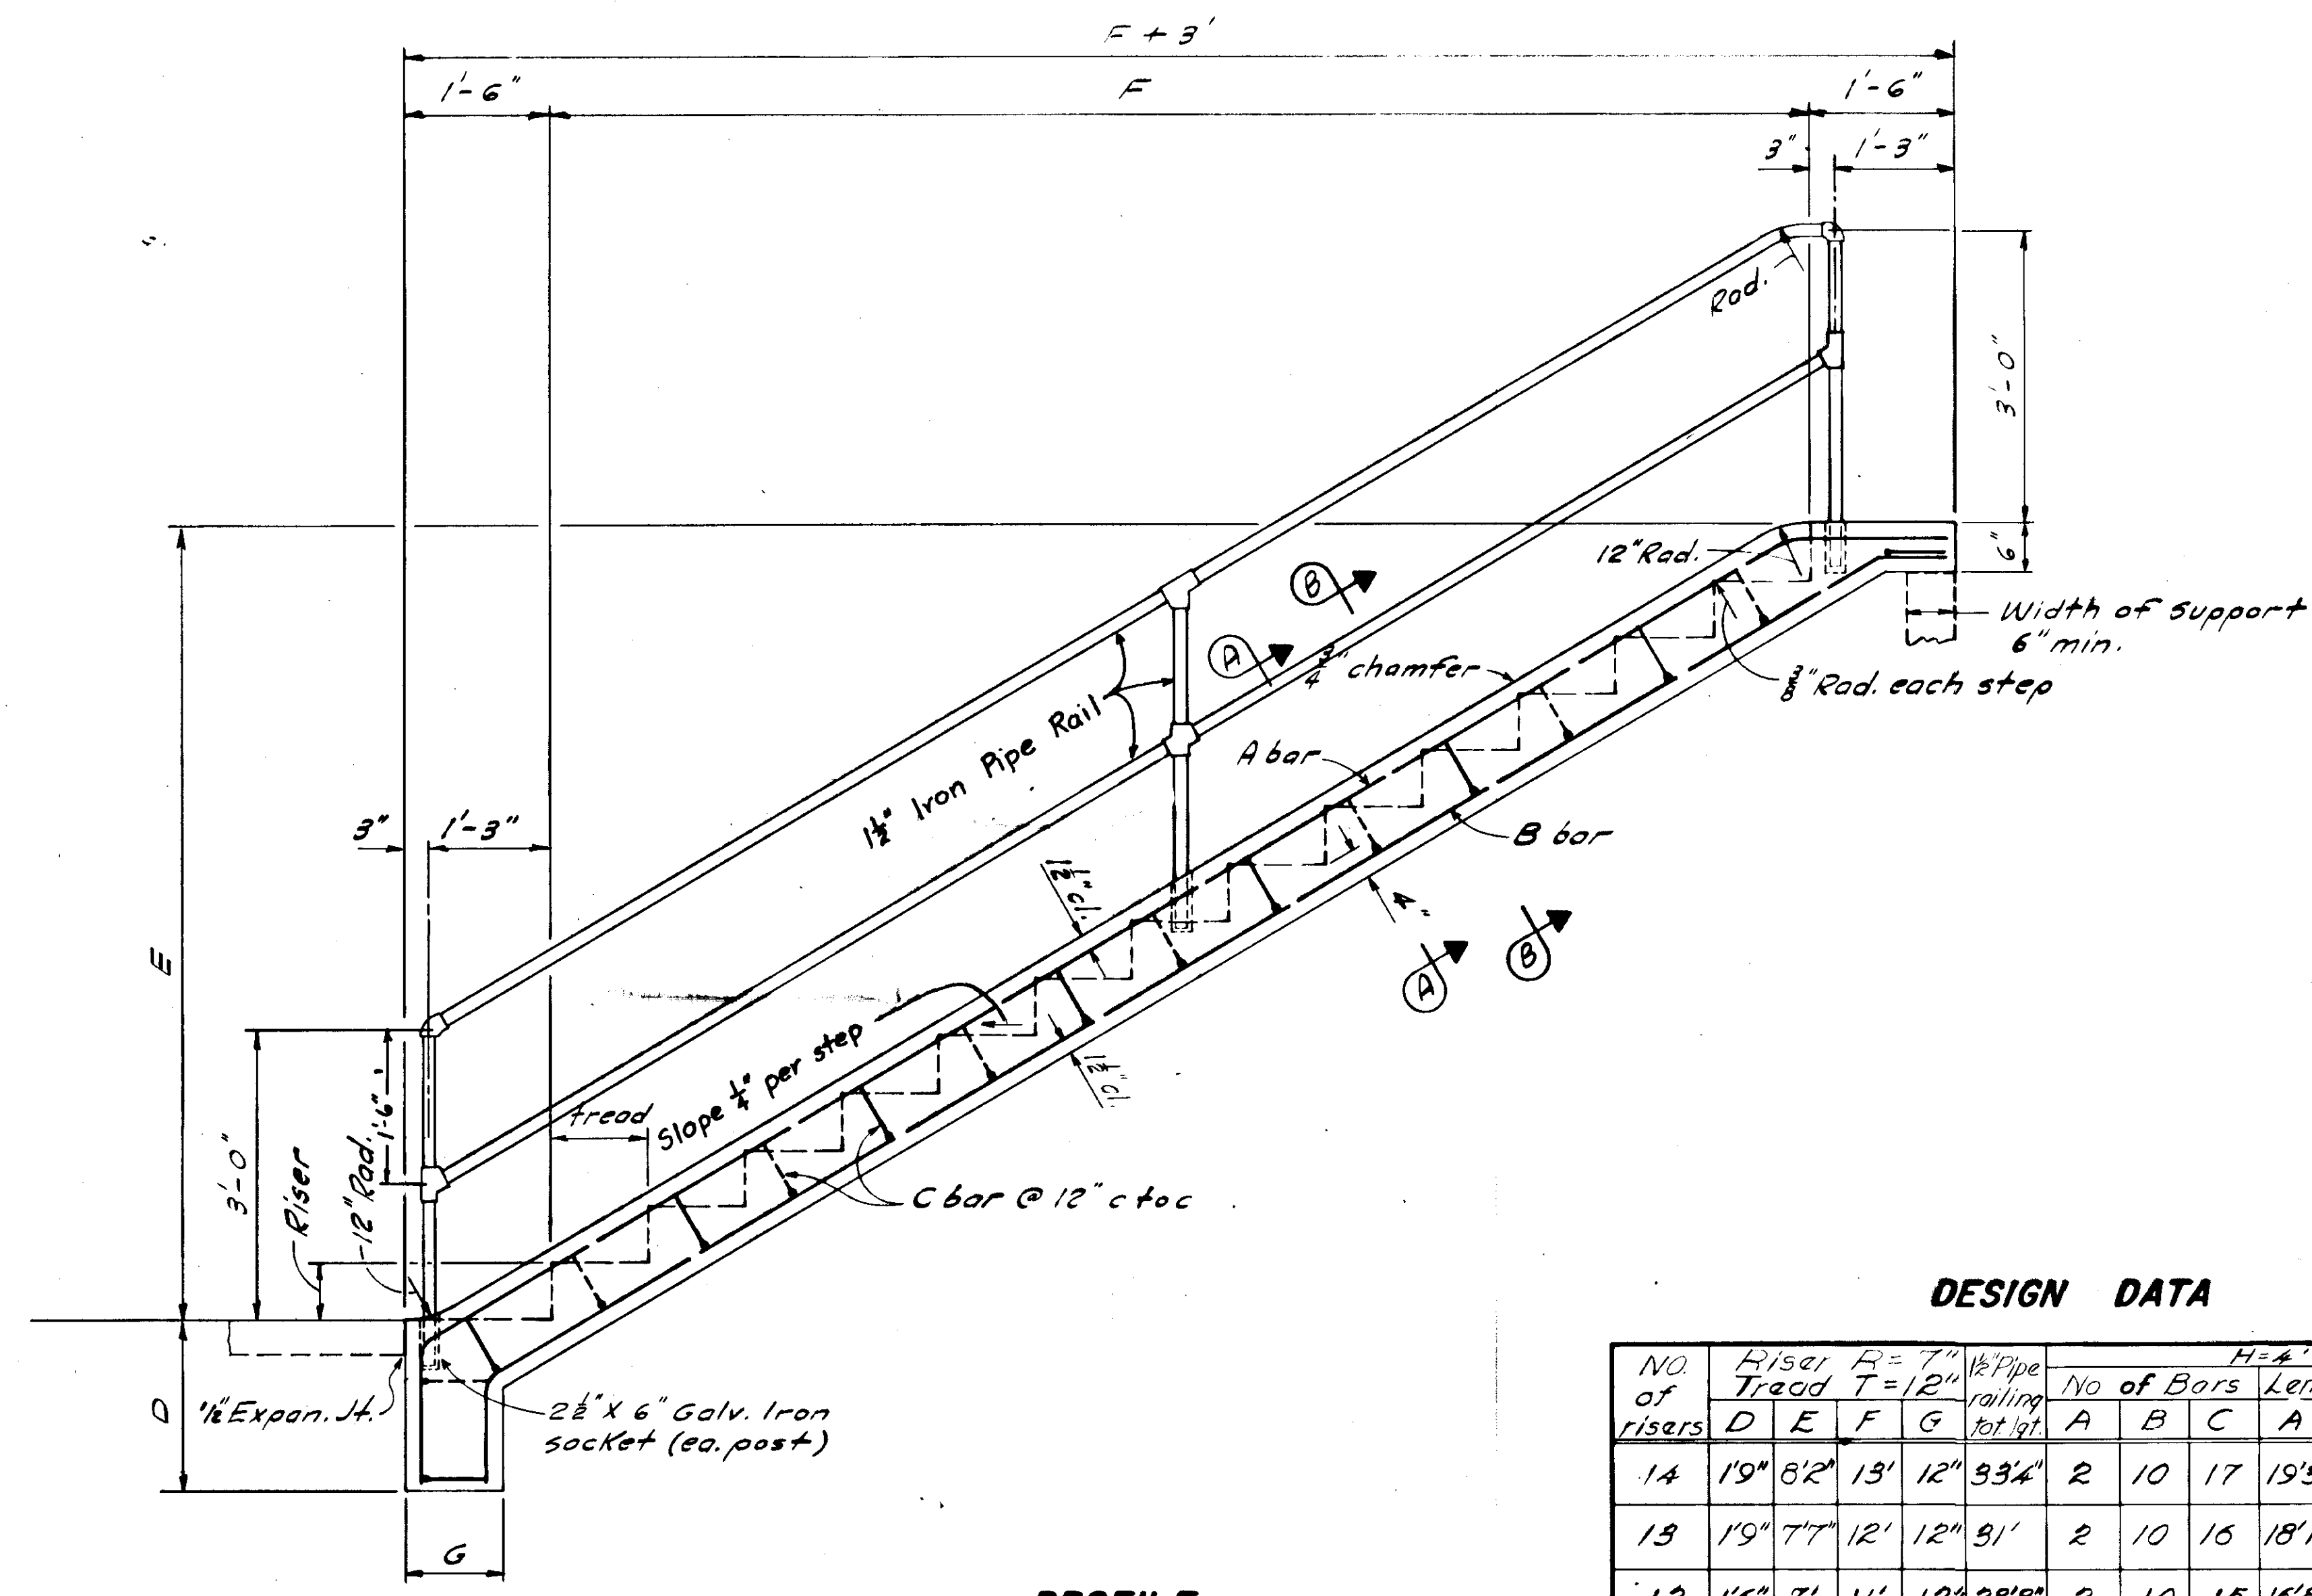

PROFILE

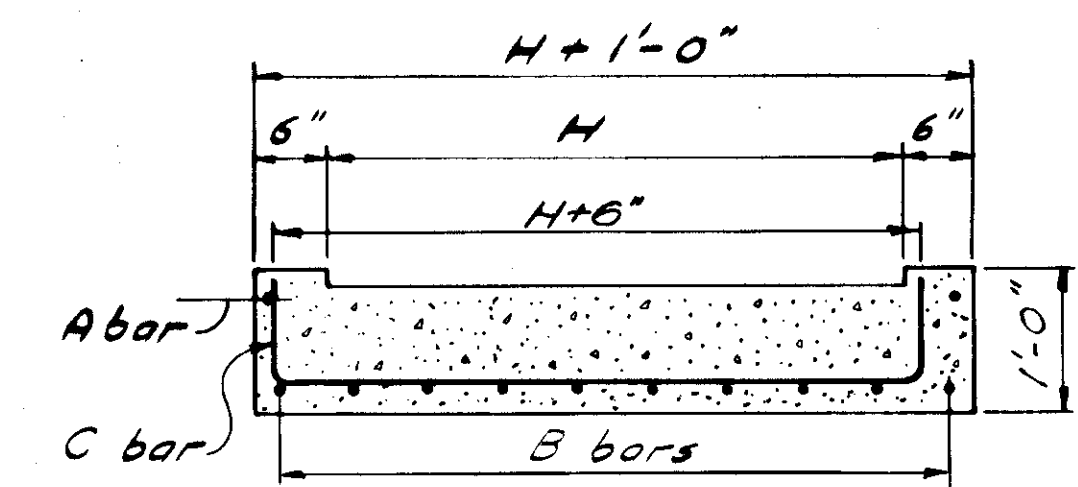

SECTION A-A

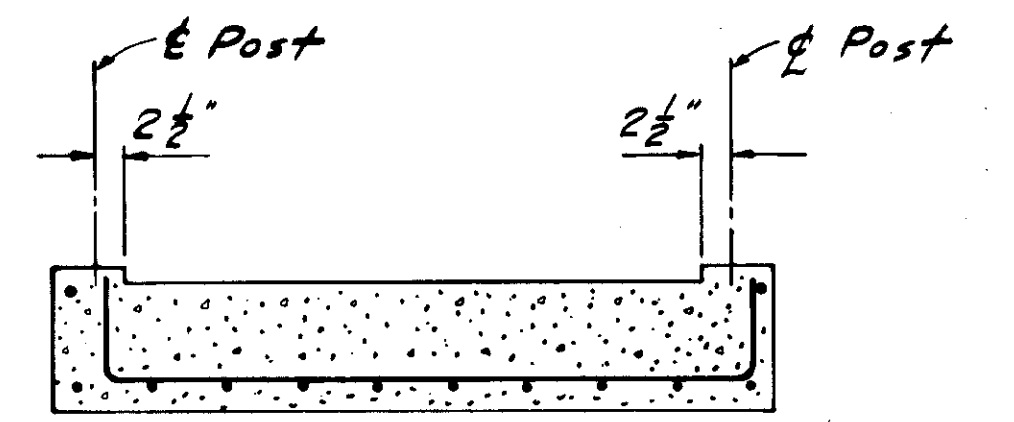

SECTION B-B

DESIGN DATA


NO. of risers	Riser R=7" Tread T=12"				1/2" Pipe railing tot. ht.	No. of Bars			Length of Bars			Total steel pounds	Total conc. cu. yds.
	D	E	F	G		A	B	C	A	B	C		
14	19"	8'2"	13'	12"	33'4"	2	10	17	19'3"	18'3"	6'	216	2.4
13	19"	7'7"	12'	12"	31'	2	10	16	18'1"	17'2"	6'	203	2.3
12	16"	7'	11'	12"	28'8"	2	10	15	16'8"	15'9"	6'	188	2.1
11	16"	6'5"	10'	12"	26'6"	2	10	14	15'6"	14'7"	6'	174	2.0
10	16"	5'10"	9'	10"	24'2"	2	10	13	14'4"	13'6"	6'	161	1.8
9	16"	5'3"	8'	10"	21'10"	2	10	12	13'2"	12'4"	6'	148	1.6
8	13"	4'8"	7'	10"	19'6"	2	10	10	11'9"	10'11"	6'	129	1.5
7	13"	4'1"	6'	8"	17'2"	2	10	9	10'7"	9'11"	6'	116	1.3
6	15"	3'6"	5'	8"	14'10"	2	10	8	9'6"	8'9"	6'	103	1.2
5	13"	2'11"	4'	8"	12'6"	2	10	7	8'4"	7'7"	6'	90	1.0
4	13"	2'4"	3'	6"	10'4"	2	10	6	7'2"	6'6"	6'	77	.9
3	13"	1'9"	2'	6"	—	2	10	5	6'5'4"	6'	64	.7	
2	13"	1'2"	1'	6"	—	2	10	4	4'10"	4'2"	6'	50	.6

NOTES:


- All edges shall be chamfered 3/4".
- 1/2 inch expansion joint shall be placed at the end of the steps where steps abut proposed or existing concrete sidewalk.
- All steel reinforcement shall be #4 Deformed Bars. Splices in reinforcing steel shall overlap a minimum length of 40 diameters.
- Railings and posts shall be of the same type as used on retaining walls.
- All steel shall have a minimum clear distance of 1 1/2" to face of concrete.
- All expansion joints shall be sealed with a hot poured elastic type joint seal conforming with AASHTO Designation M 173-60.

STATE	PROJECT NO.	YEAR	SHEET NO.	TOTAL SHEETS
ALASKA	S-0943(7)	1967	15	34


TREATED TIMBER STAIRWAY &
WALKWAY
AS-BUILT

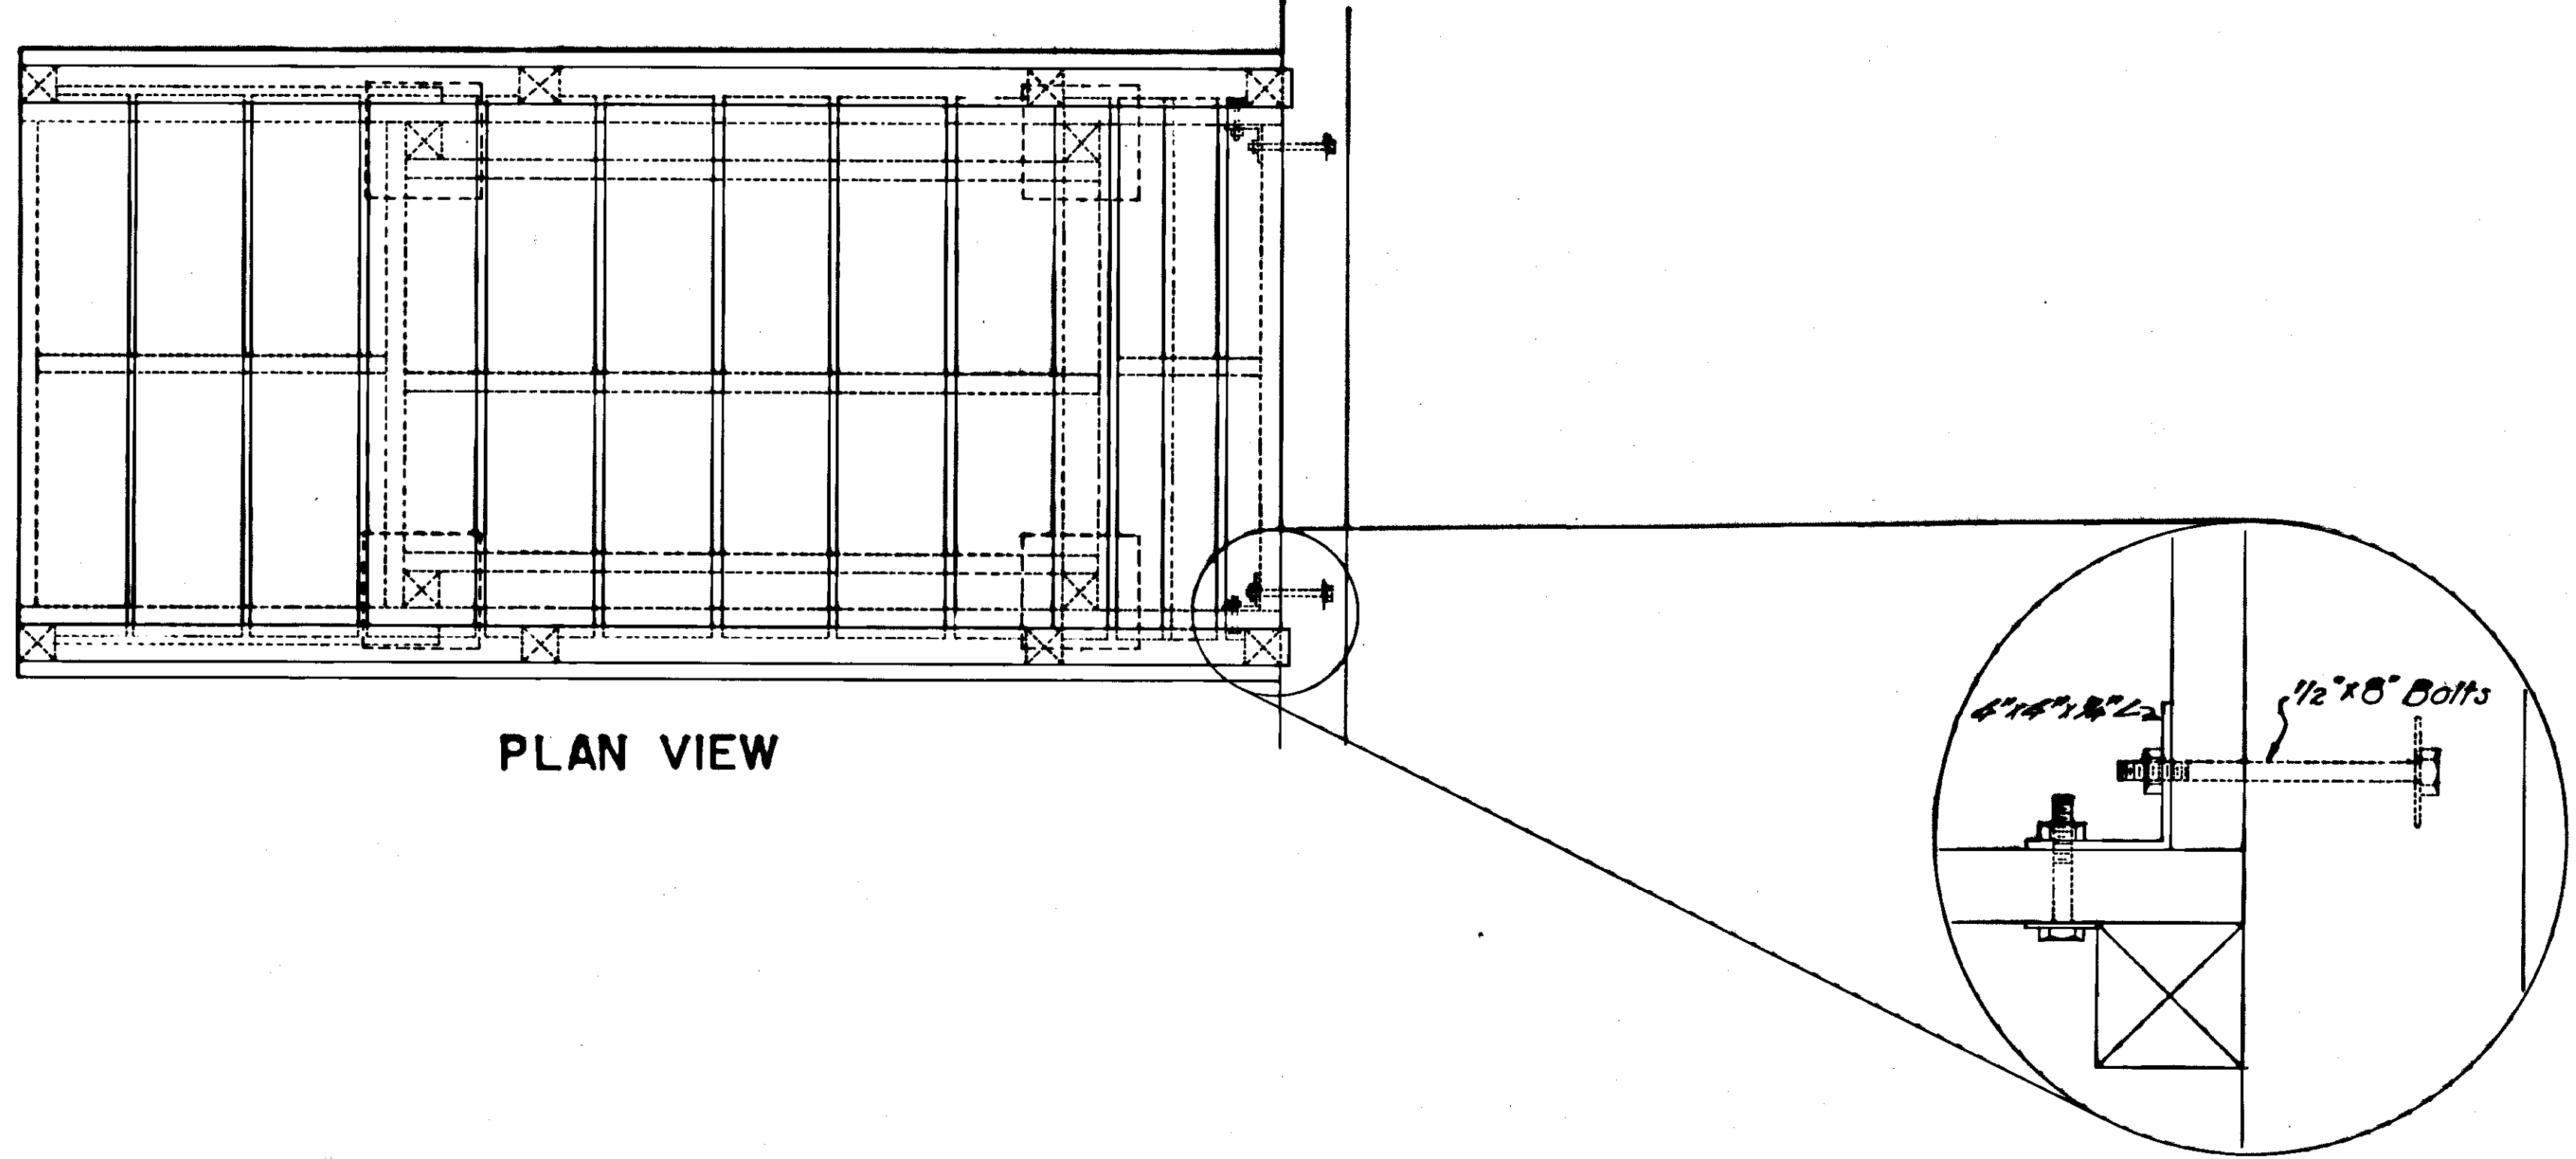

PLAN VIEW

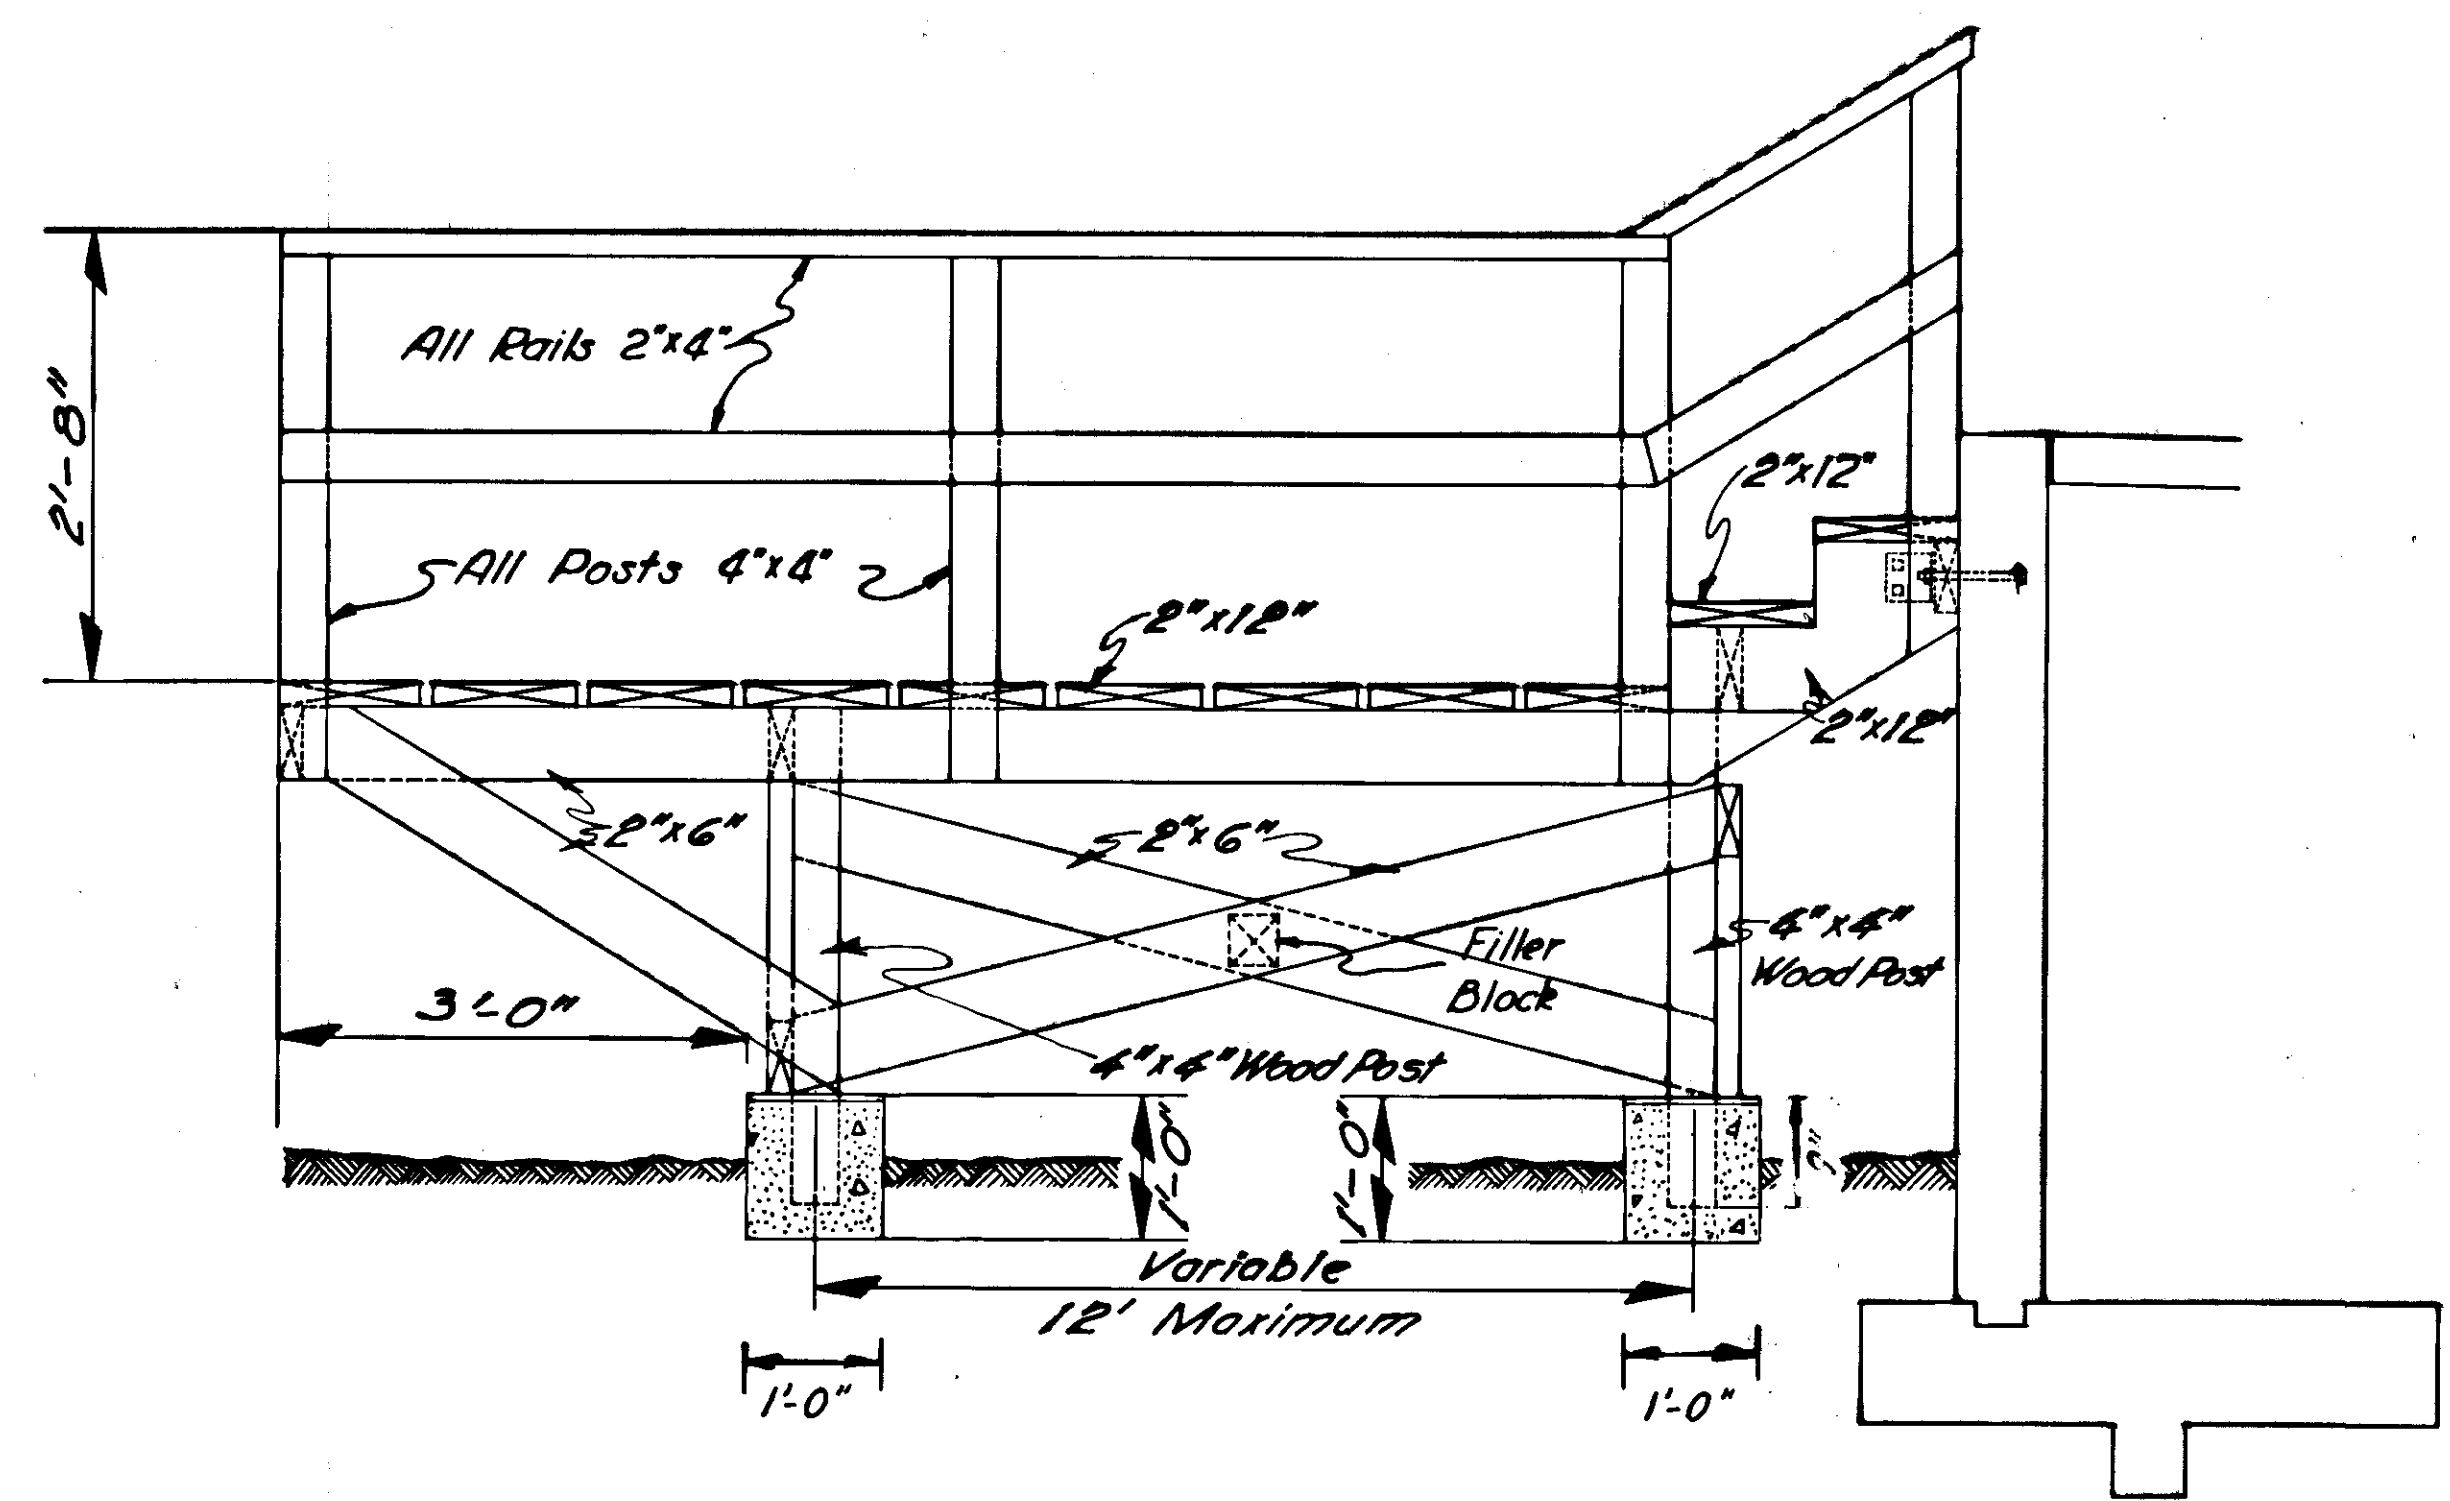

SIDE VIEW

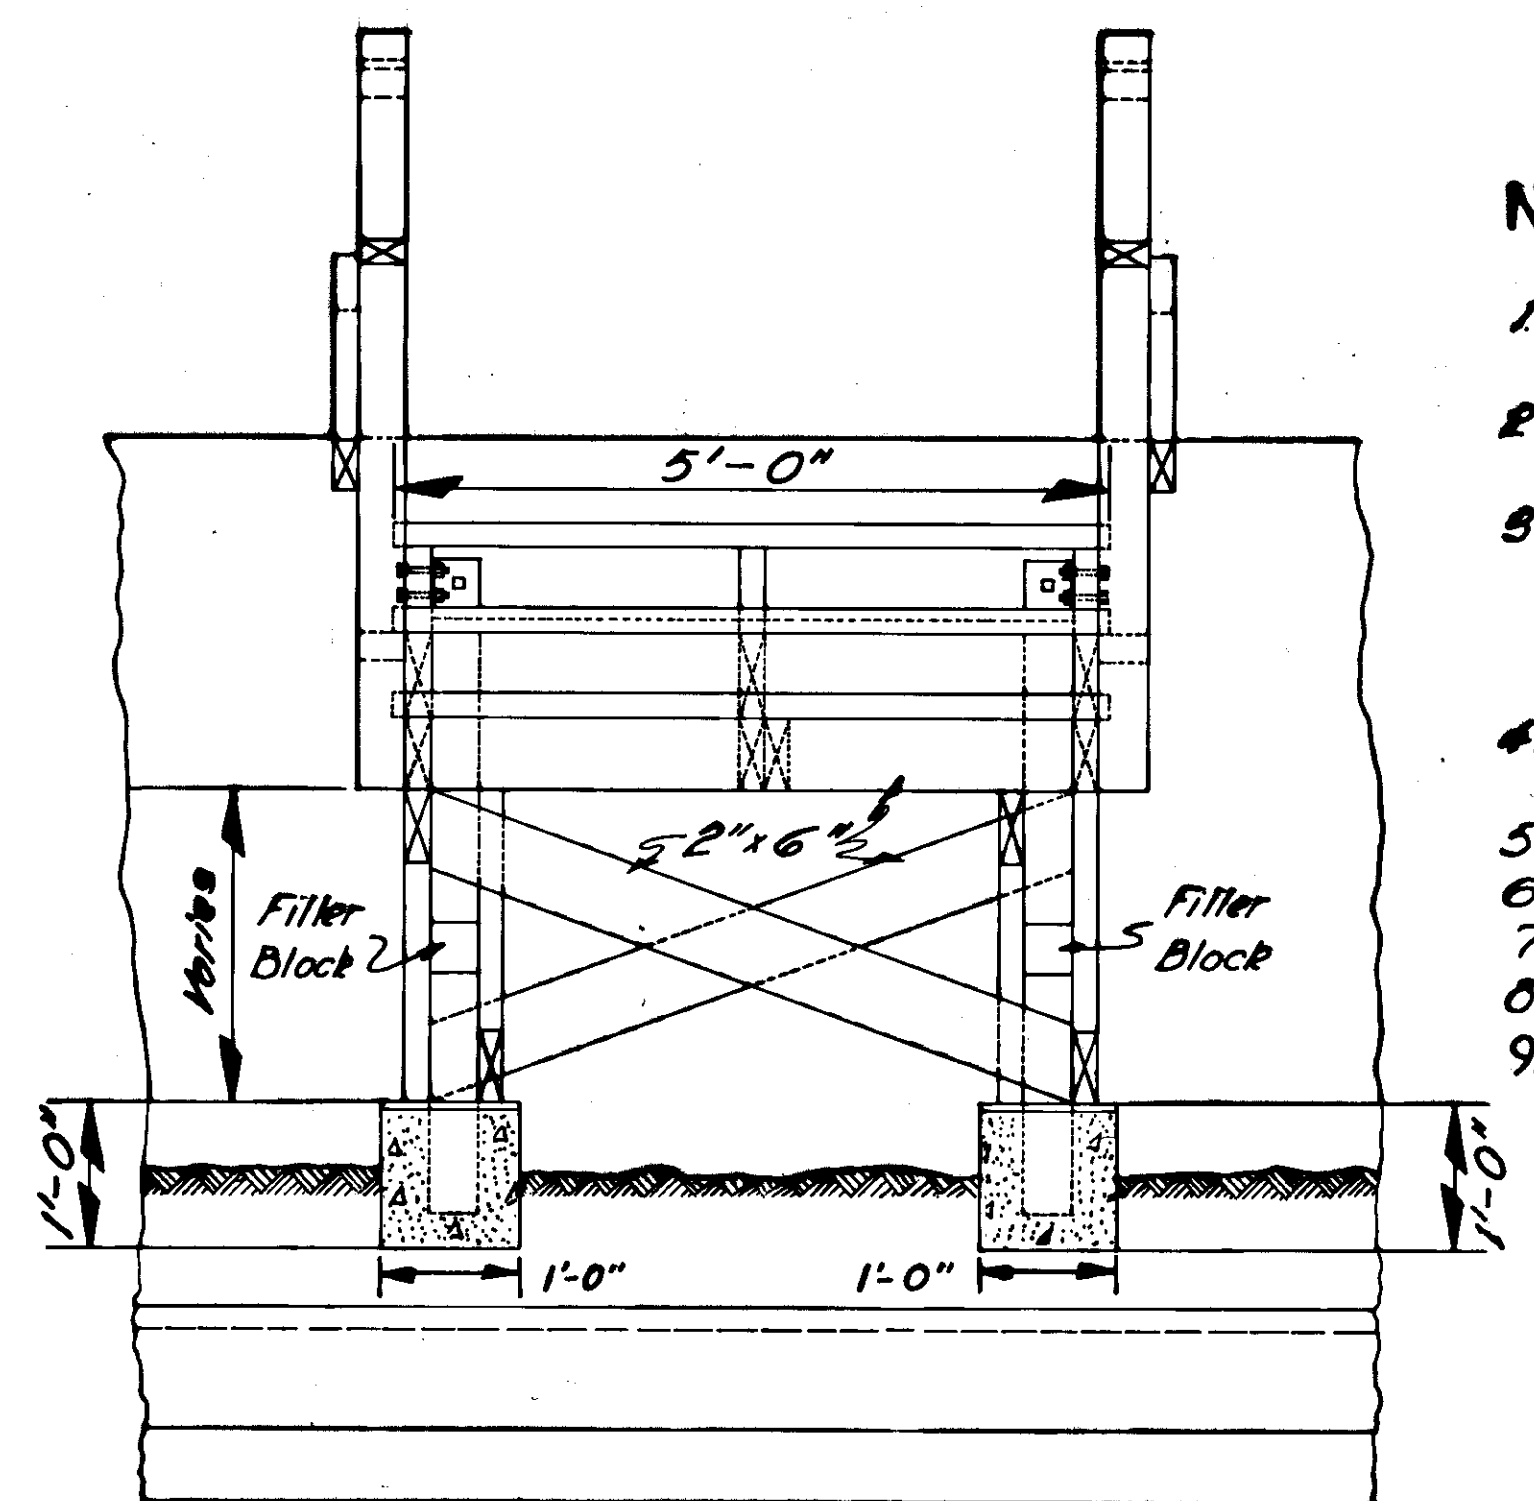


FRONT VIEW

NOTES:

1. All Bolts, washers, nails and other hardware shall be galvanized.
2. All Wood except railing, railing posts, and treads shall be of creosoted, pressure treated lumber.
3. All Railing, railing posts, and treads shall be No. 1 common Sitka Spruce or Douglas Fir, and shall be treated in accordance with 615.02(f) of the Special Provisions.
4. Locations of wood stairways is approximate only and is subject to change by the project engineer.
5. All wood shall be surfaced on four sides.
6. Footings shall have a 3/4" chamfer on all edges.
7. Nailing shall be as directed by the engineer.
8. Deck member spacing shall be one nail width.
9. Footings shall be class "A" concrete. Payment will be under item 601(1).

TYPICAL EXPANSION & CONTRACTION JOINT DETAILS

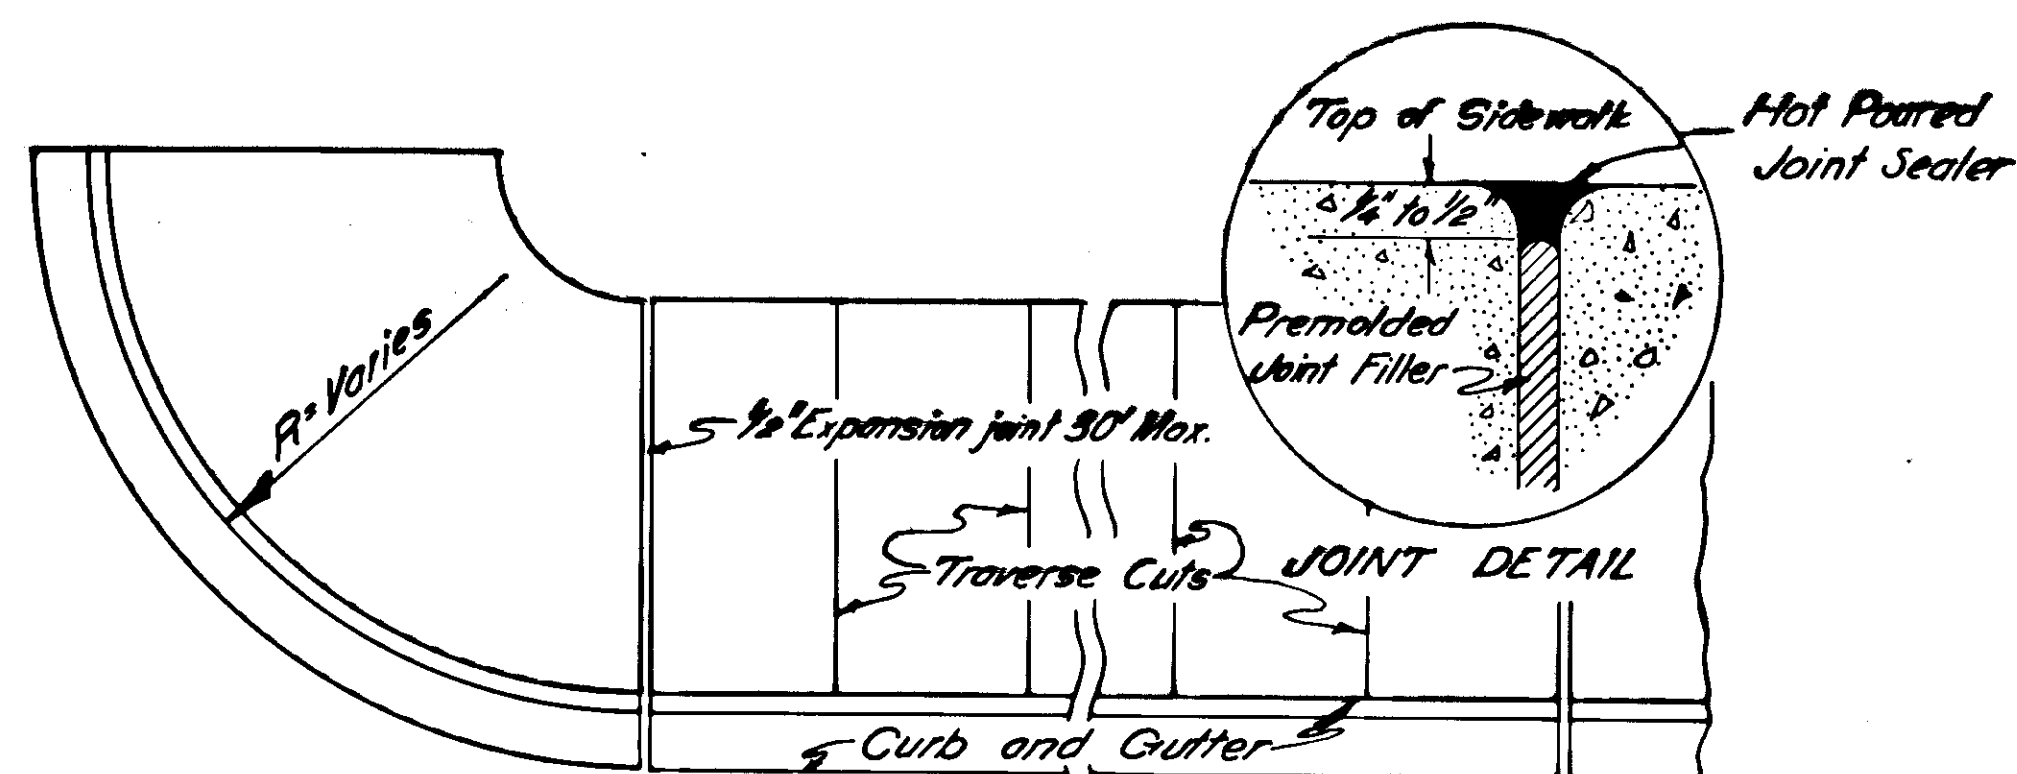


Expansion Joint: Premolded expansion joint filler 1/2" thick complying with AASHTO designation M153, type I shall be used at all expansion joints. Joints shall be located as follows:


Curb and Gutter: Expansion joints shall be at the end of the curb return and immediately following and preceding curb cuts. Thereafter expansion joints shall be spaced intermediately at intervals of 30' except where shorter sections are needed for closure.

Sidewalks: Expansion joints shall be opposite expansion joints in adjoining curb and gutter. Traverse plane weakness joints shall be at uniform intervals of 6' except where shorter sections are necessary for closures.


All expansion joints shall be sealed with a hot-poured elastic type joint seal conforming with AASHTO designation M173-60. This joint seal material will be considered incidental to Item 608(1), Concrete Sidewalk, and no separate payment will be made therefore.

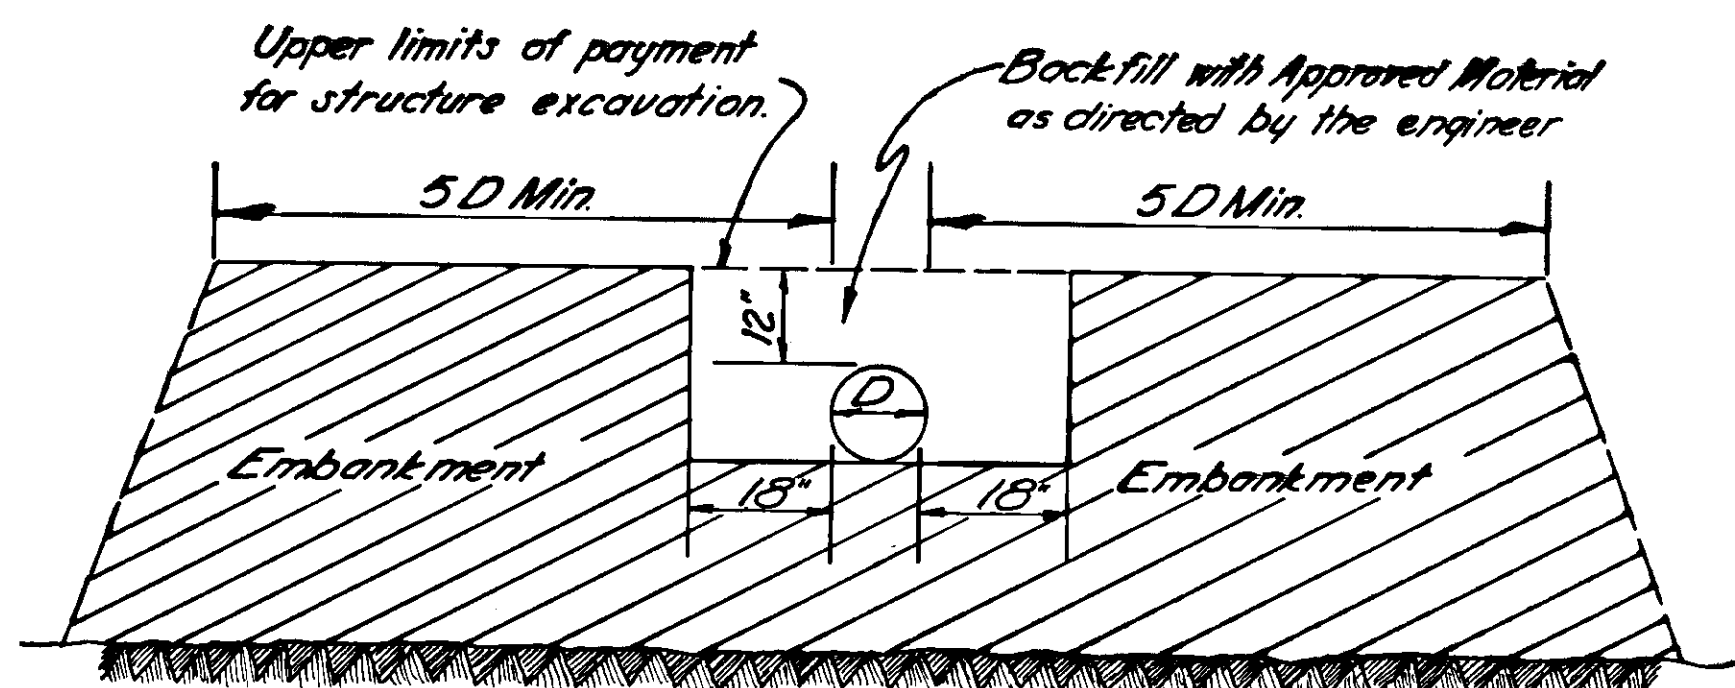


STRUCTURE EXCAVATION DETAIL

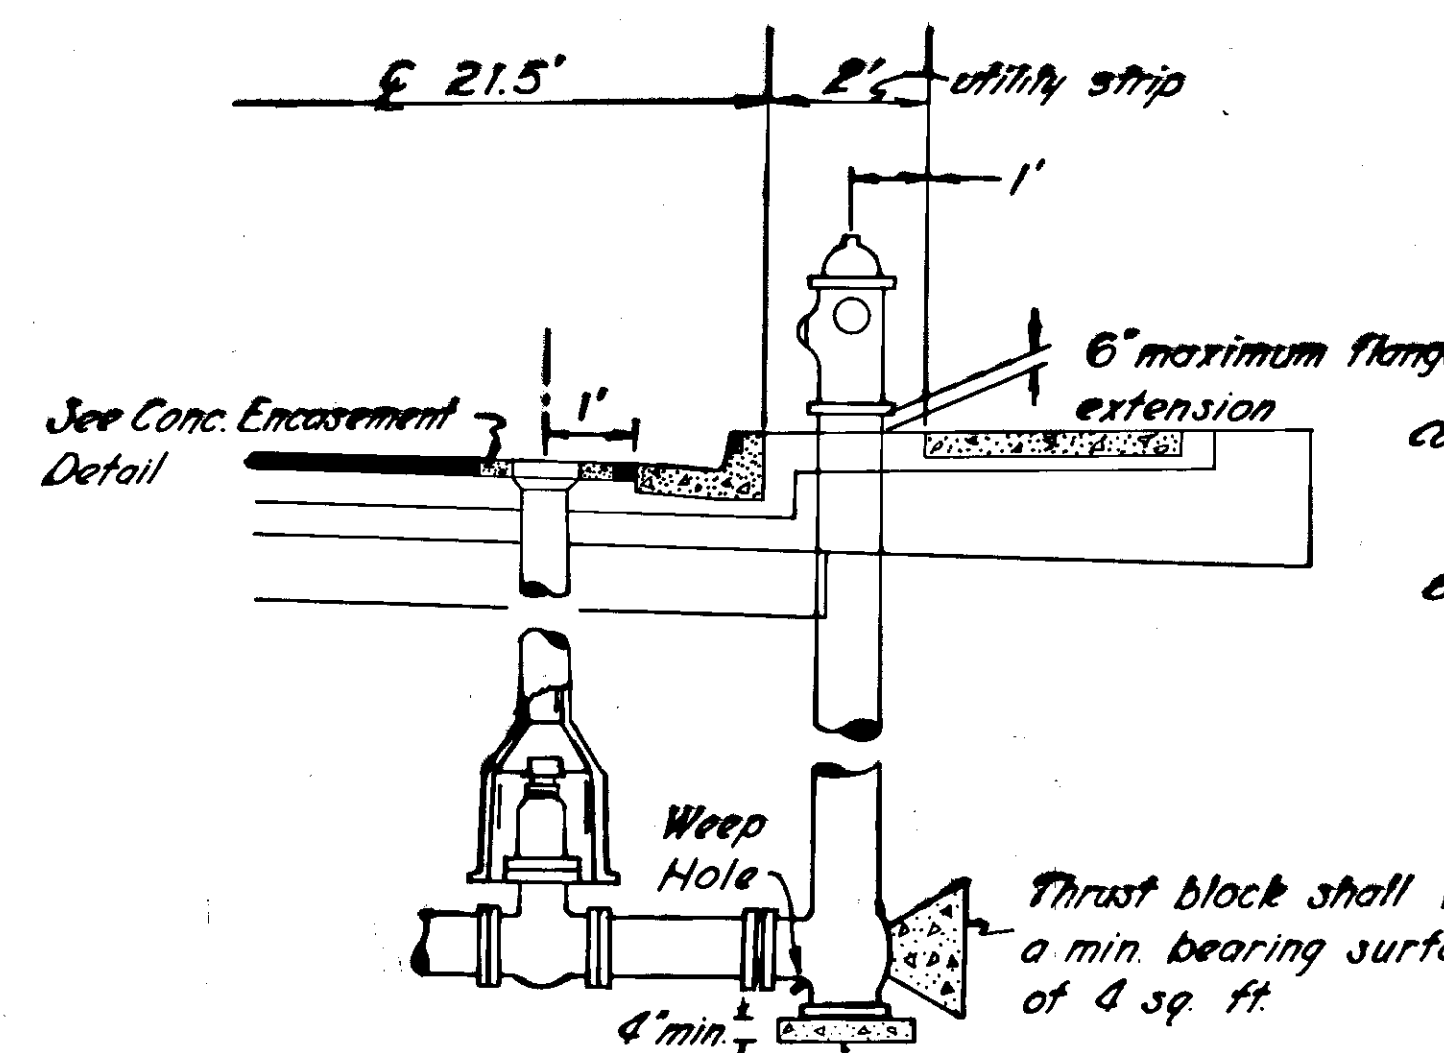


FIRE HYDRANT RELOCATION DETAIL
See Sheet No. 4 For Locations

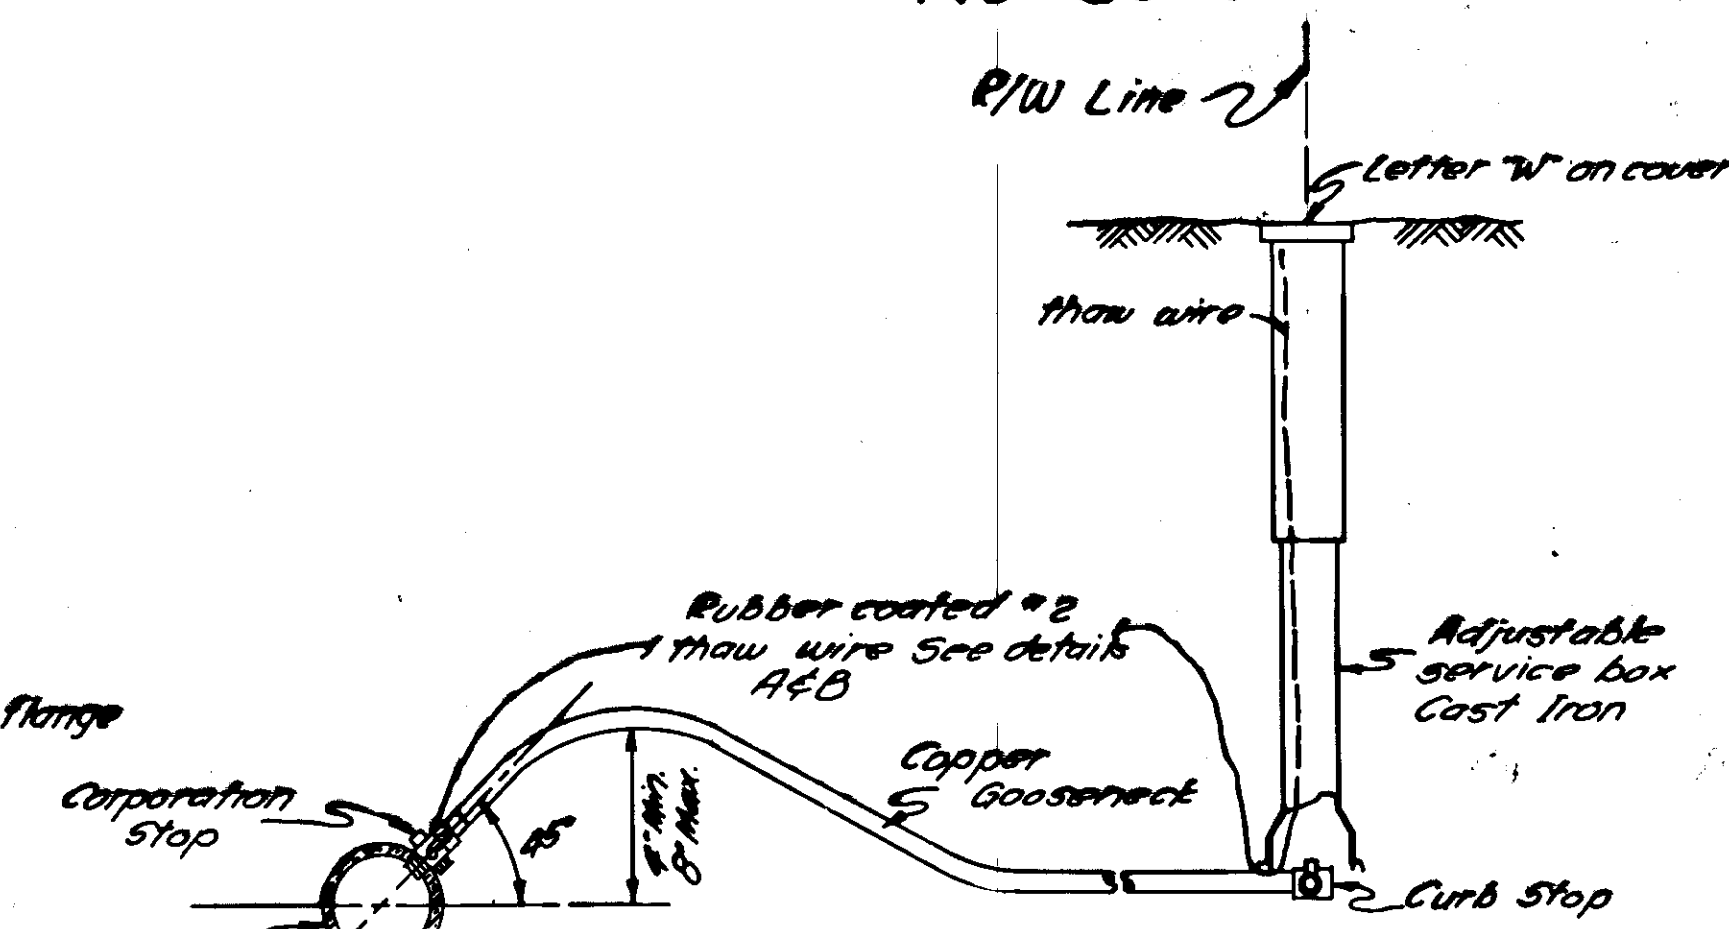


WATER SERVICE CONNECTION DETAIL

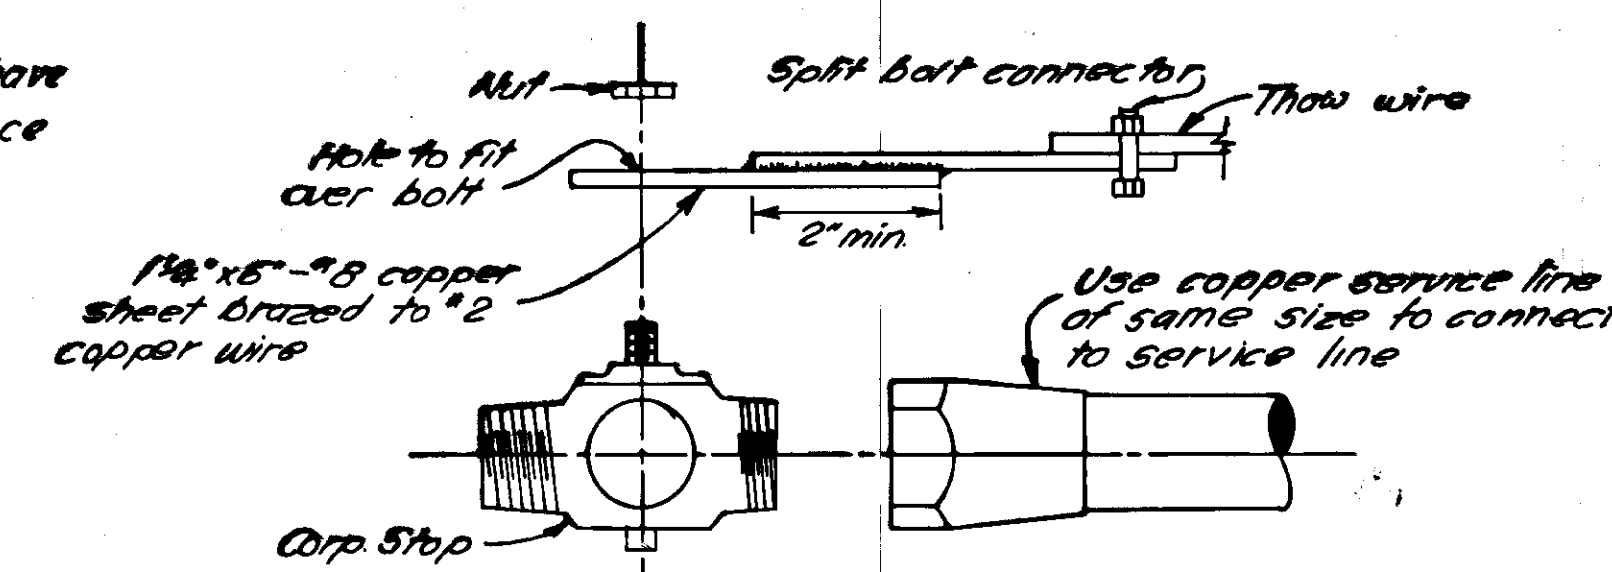

THAW WIRE CONNECTION - DETAIL 'A'

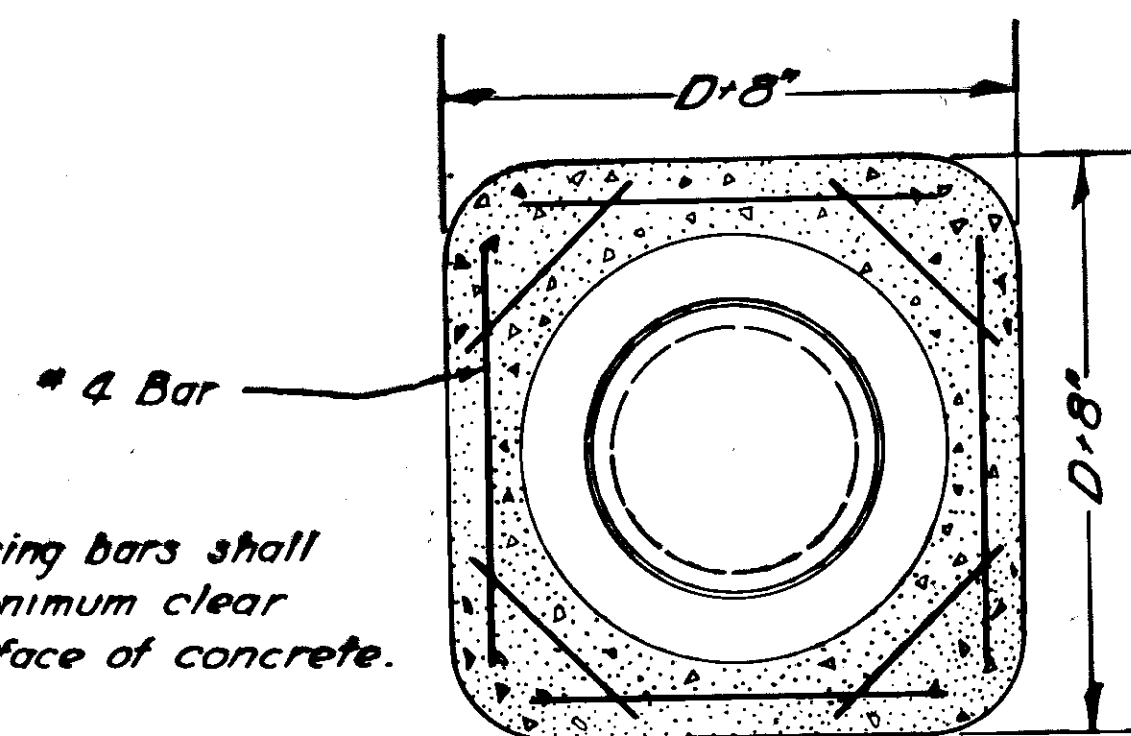

NOTE:
All reinforcing bars shall have a 2" minimum clear distance to face of concrete.

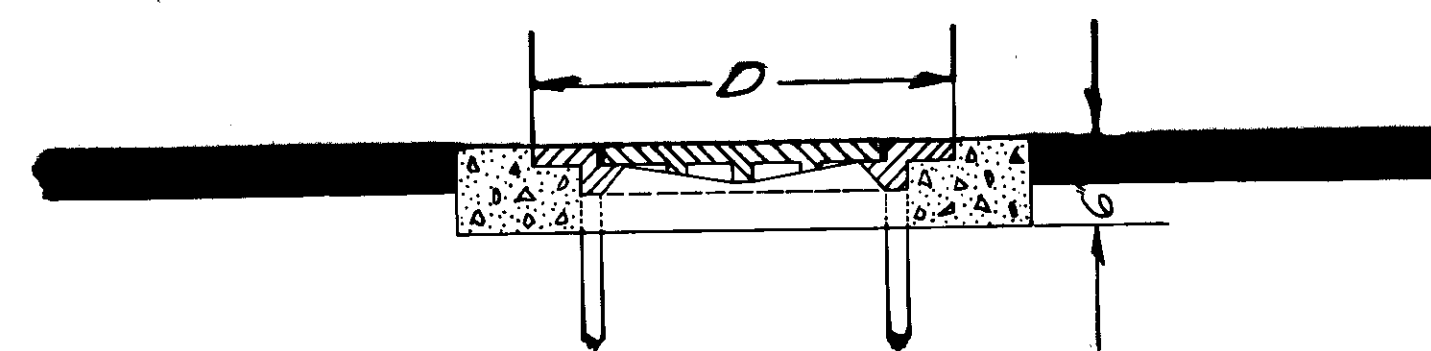


CONCRETE ENCASEMENT DETAIL

All valve box and cleanout covers falling within the pavement limits shall be adjusted to grade and encased in class 'A' concrete as directed by the engineer.

Concrete Encasements are incidental to the particular structure and item involved.

See Sheet No. 4 for Locations.

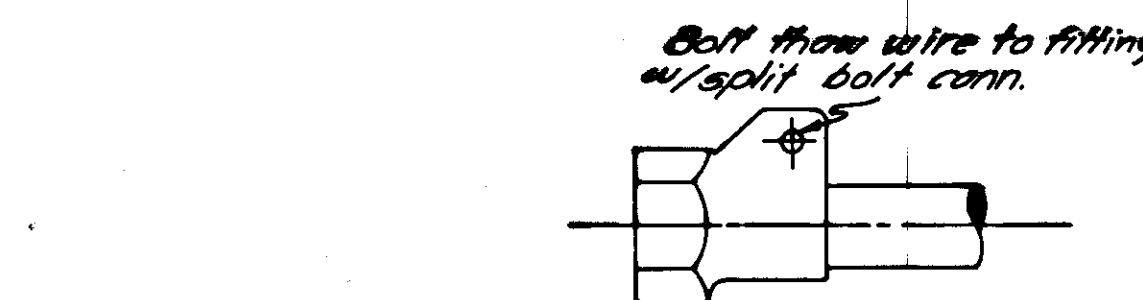


ALT. THAW WIRE CONNECTION DETAIL 'B'

UTILITY NOTES:

- All new water services to be installed will be 3/4" type 'K' copper service pipe, soft drawn, conforming to the requirements outlined in the special provisions. The attachment to the main will consist of a double strap iron pipe thread service clamp and a No. H 15035 Mueller corporation stop, 3/4", or the equivalent. At the Right-Of-Way line the service shall terminate with a No. H 15210 Mueller 3/4" stop and drain in a No. H 10306 extension type arch pattern base curb box or the equivalent.
- All new water services are to be placed at a min. depth of 4 feet.
- All water services shall have a thaw wire as shown.
- Sewer service lines shall be four (4) inch asbestos cement sewer pipe conforming to the requirements in the special provisions, and placed and connected as specified in the special provisions and as directed by the engineer.

STATE	PROJECT DESIGNATION	YEAR	SHEET NO.	TOTAL SHEETS
ALASKA	S-0943(7)	1967	17	34


AS-BUILT

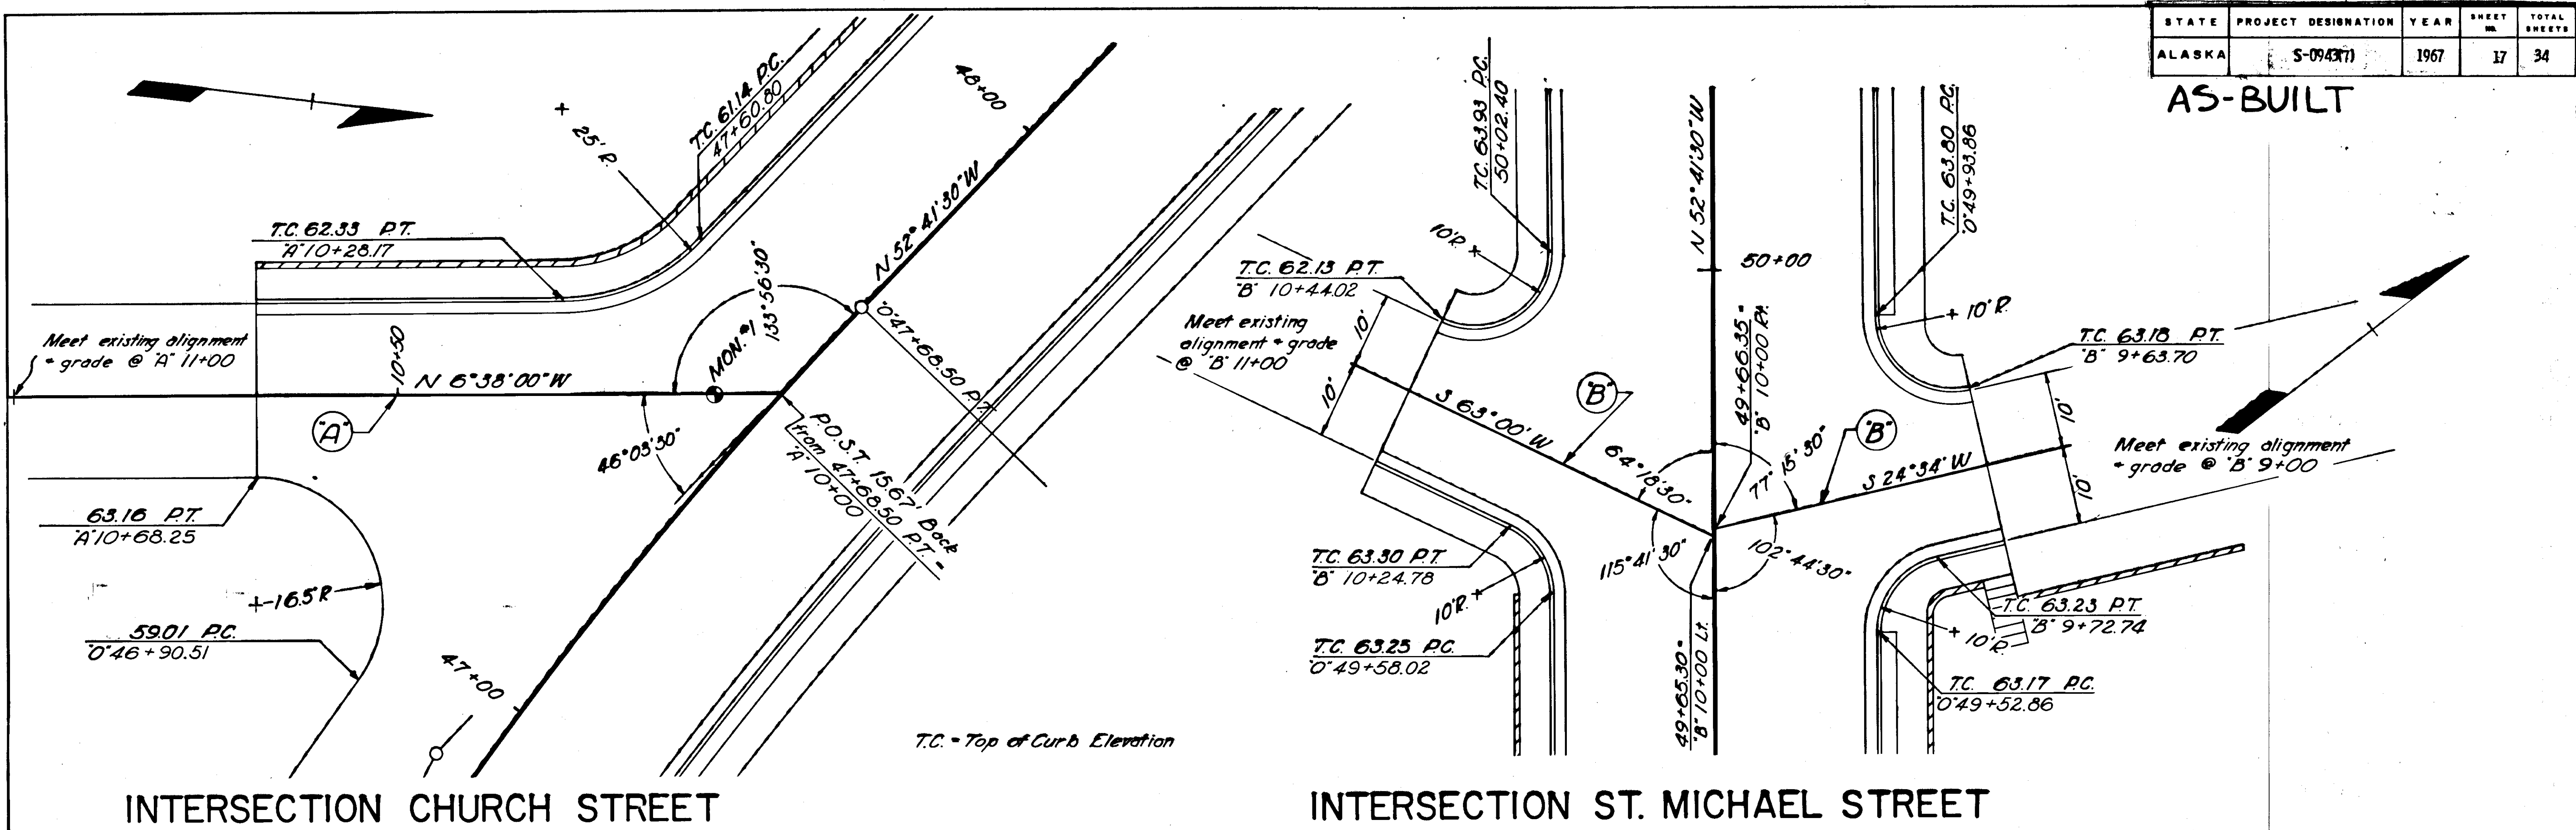

T.C. = Top of Curb Elevation


INTERSECTION CHURCH STREET

INTERSECTION ST. MICHAEL STREET

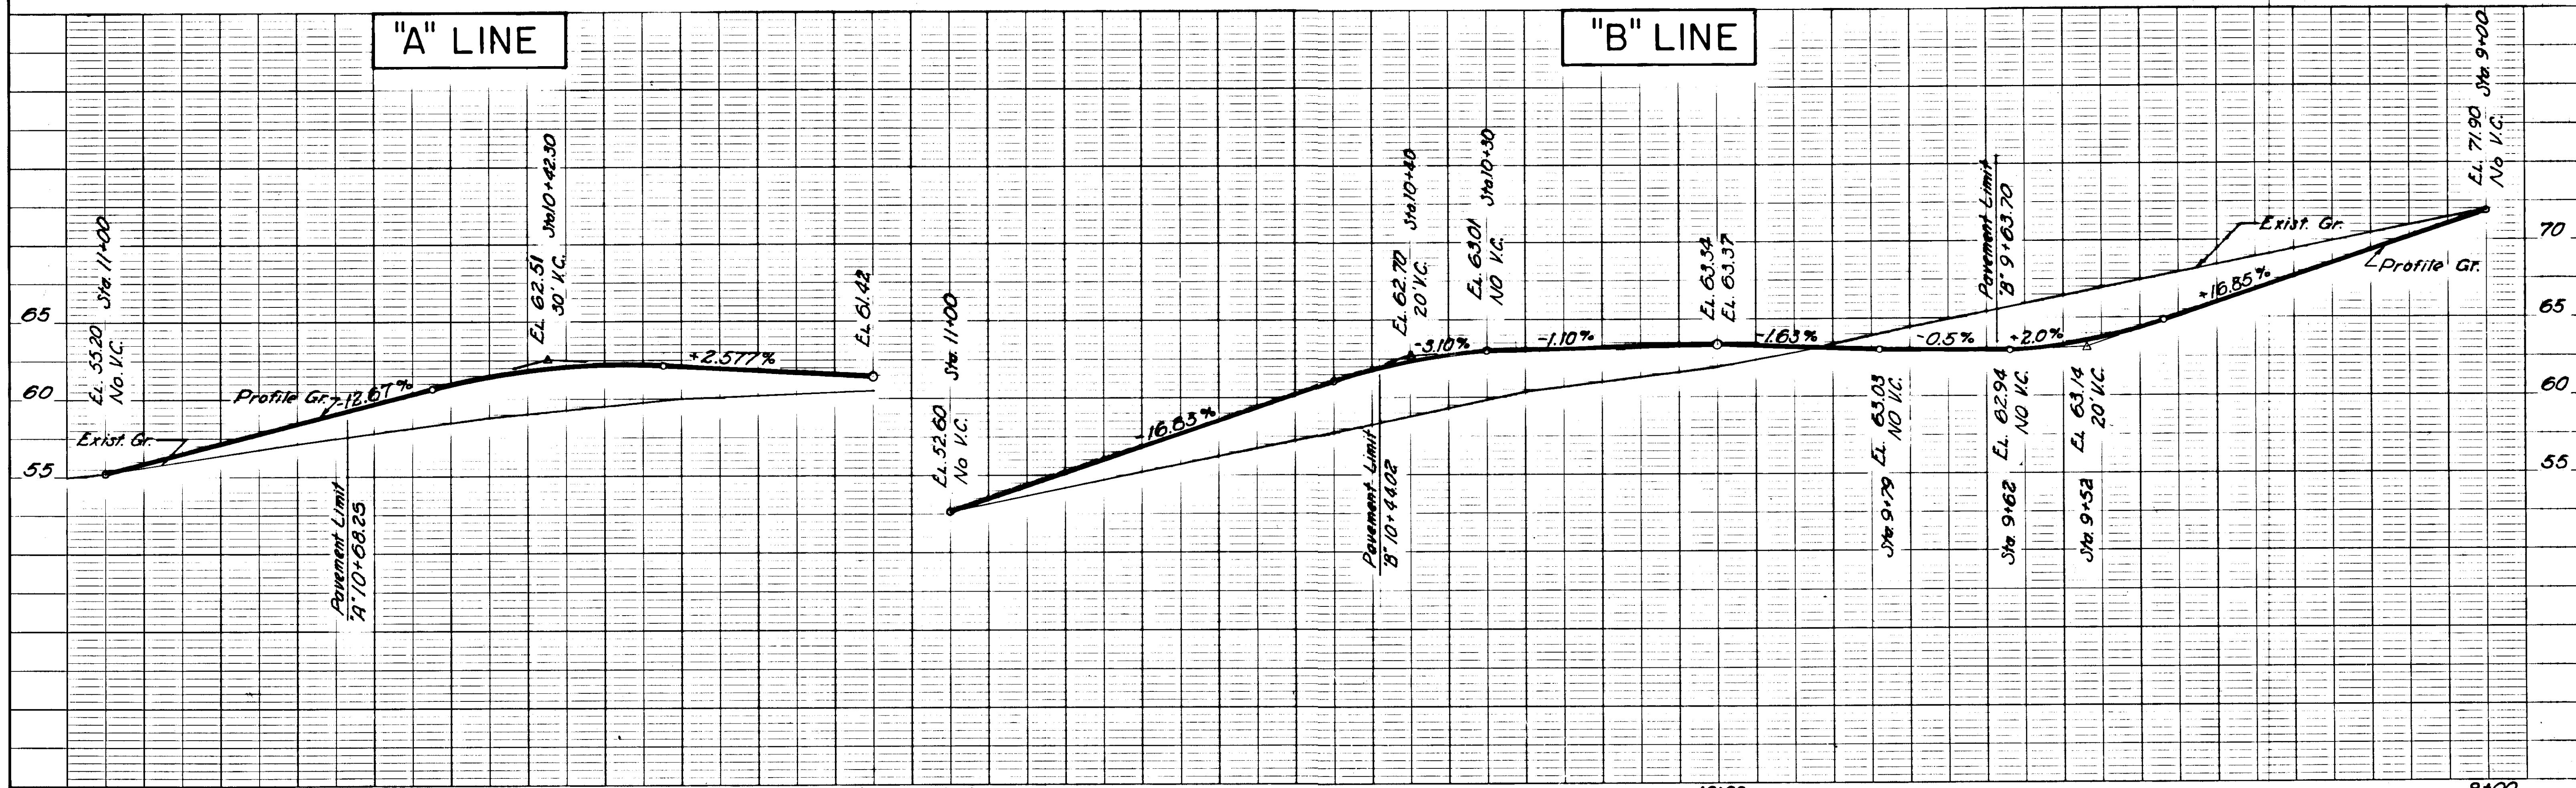


STATE	PROJECT DESIGNATION	YEAR	SHEET NO.	TOTAL SHEETS
ALASKA	S-0943(1)	1967	18	34

AS-BUILT

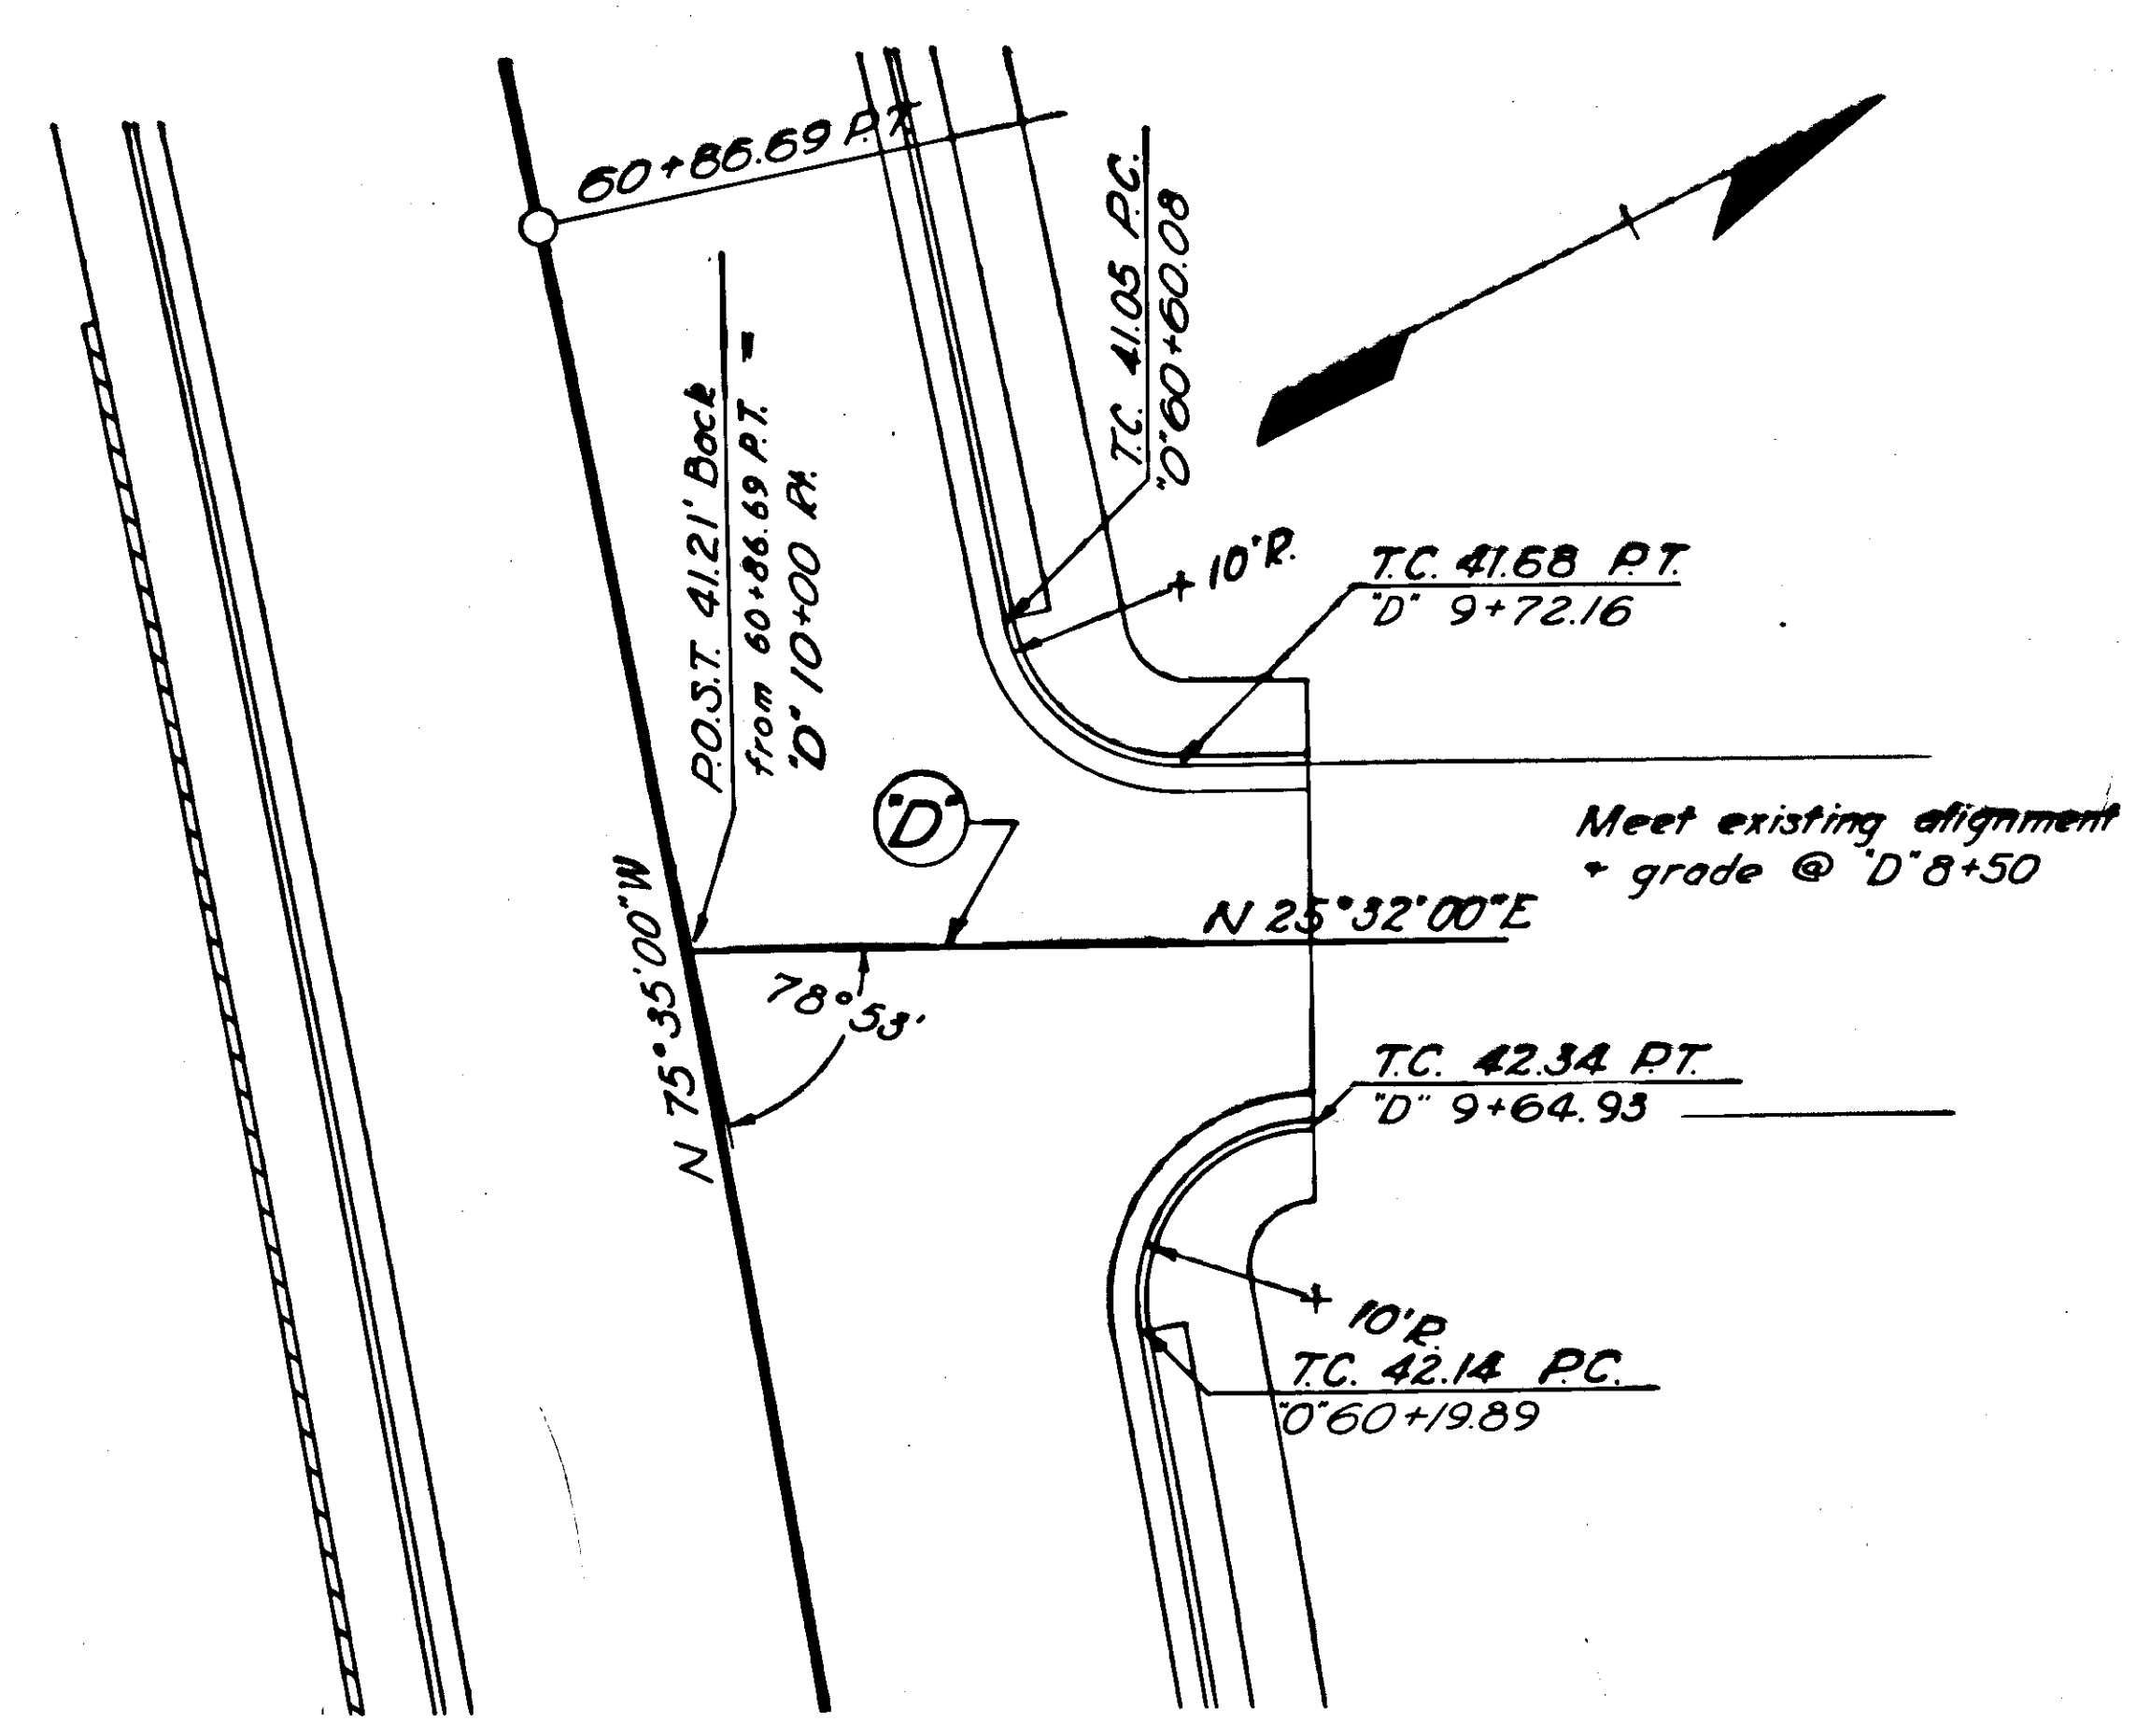

INTERSECTION GRIEF STREET


T.C. = Top of Curb Elevation

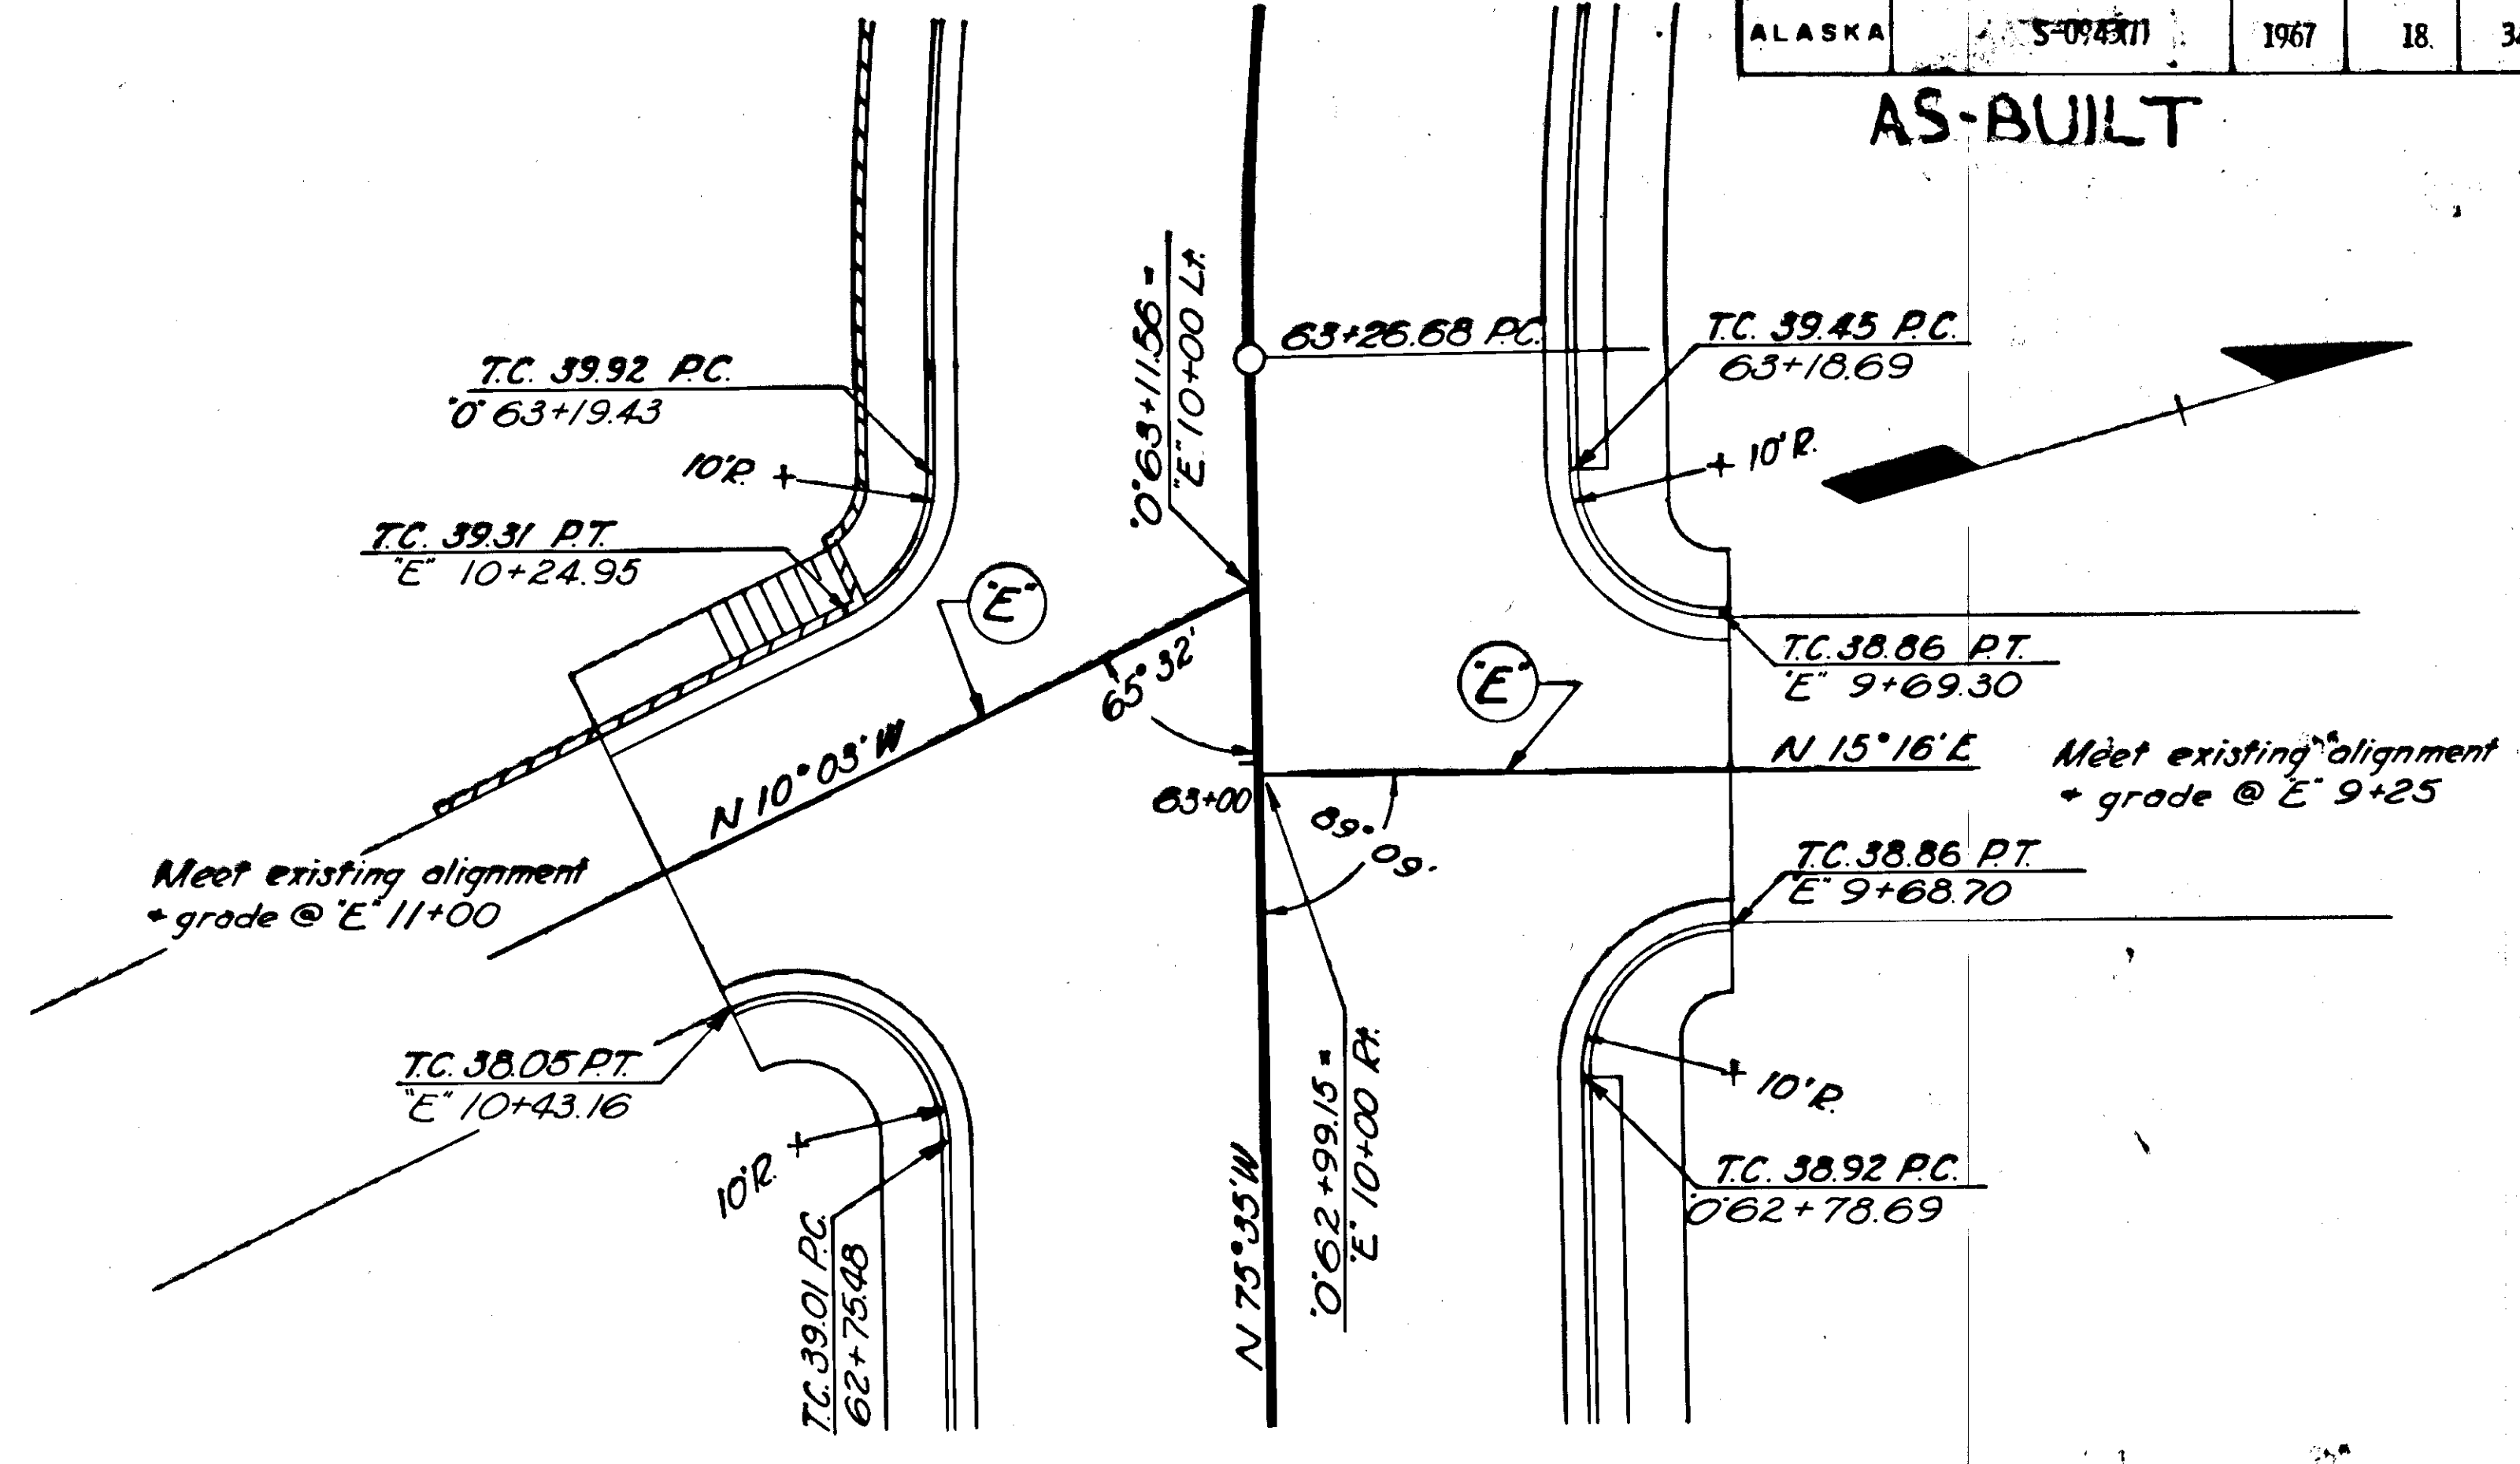

INTERSECTION MC KINNON STREET


"D" LINE

"E" LINE

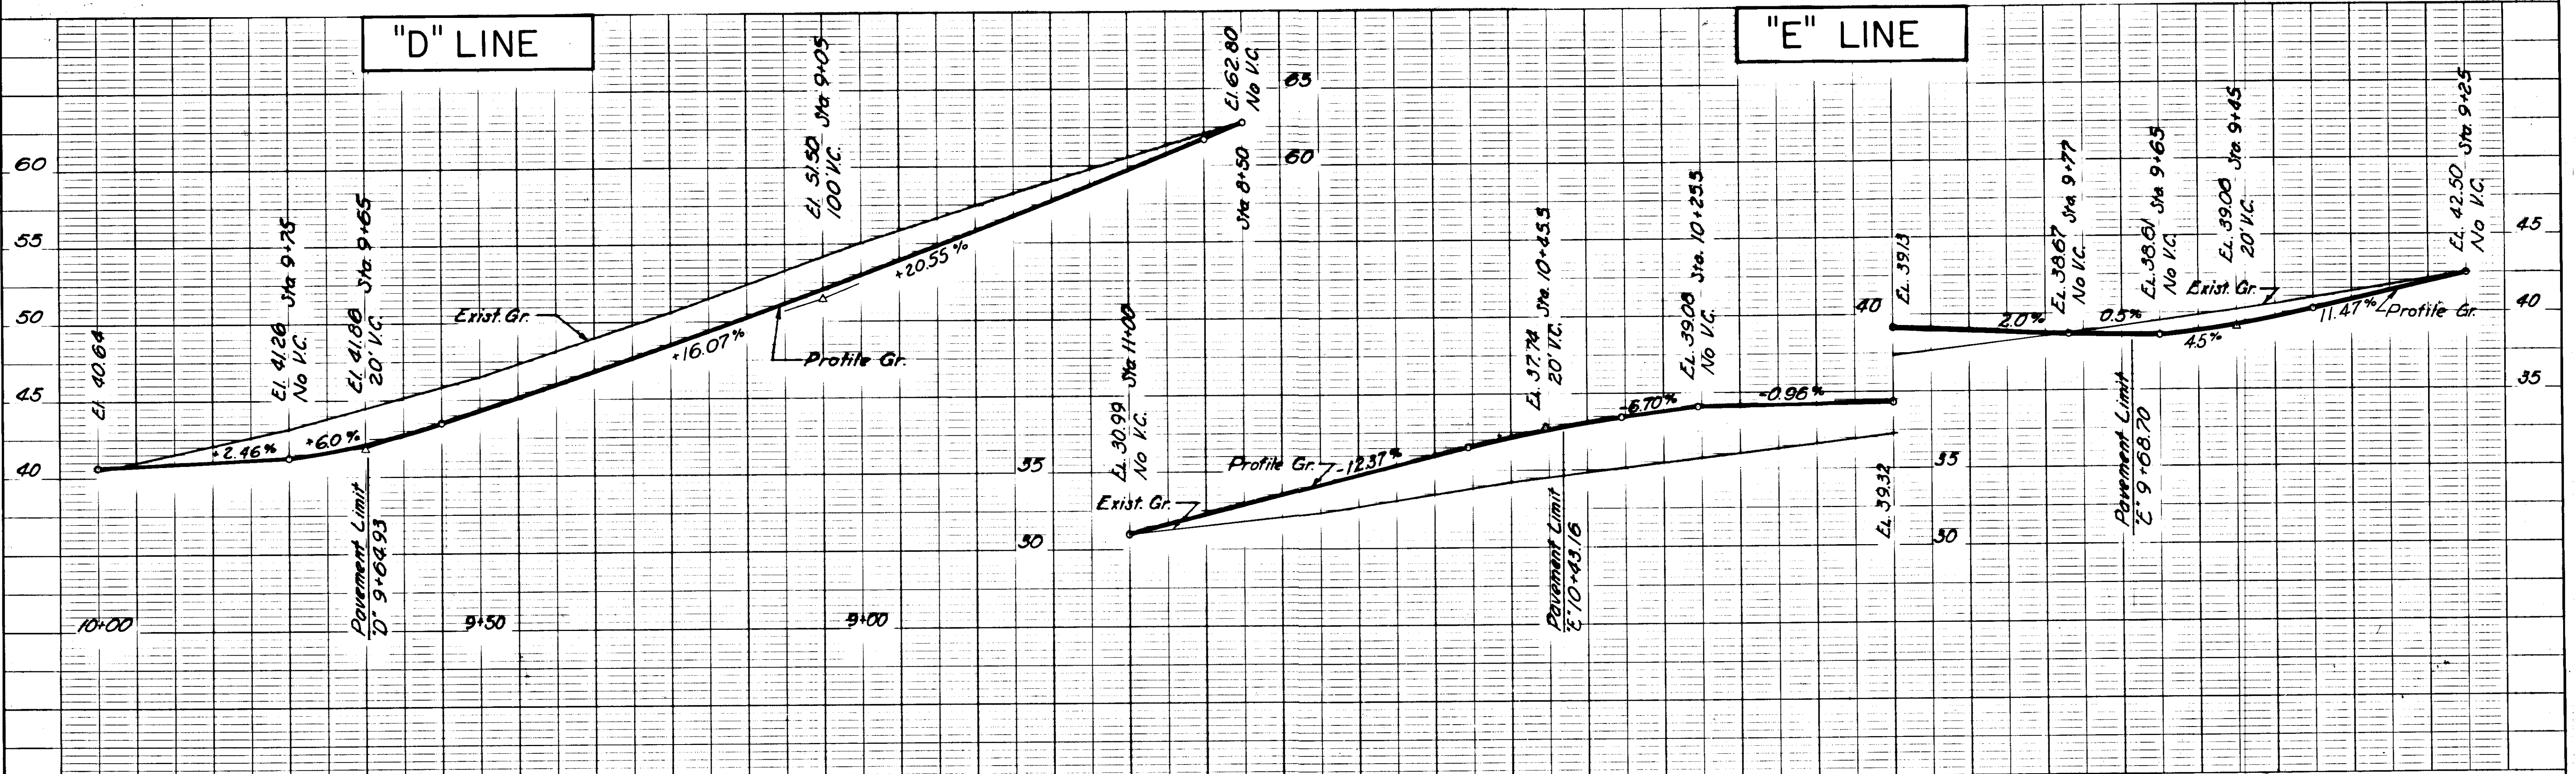

STATE	PROJECT DESIGNATION	YEAR	SHEET NO.	TOTAL SHEETS
ALASKA	S-094371	1967	19	34


AS-BUILT

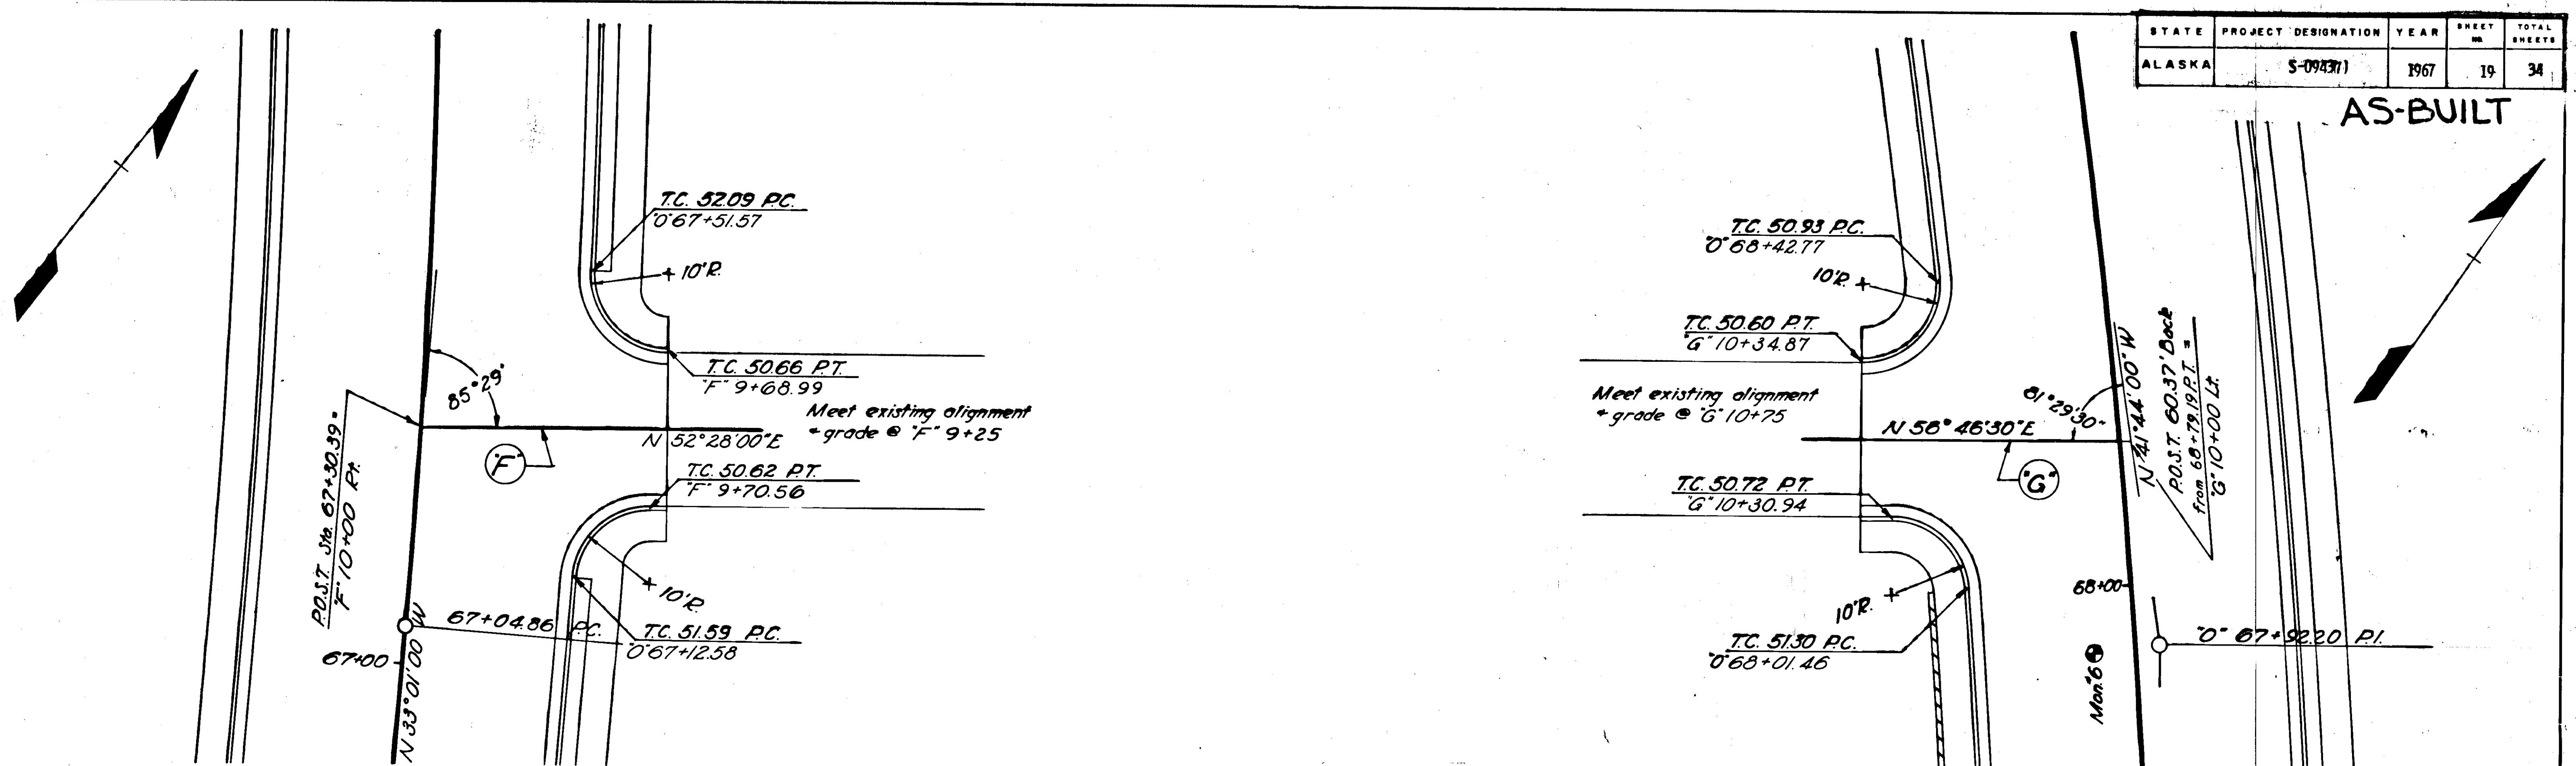



T.C. = Top of Curb Elevation

INTERSECTION BEVIER STREET

INTERSECTION CRITTENDEN STREET

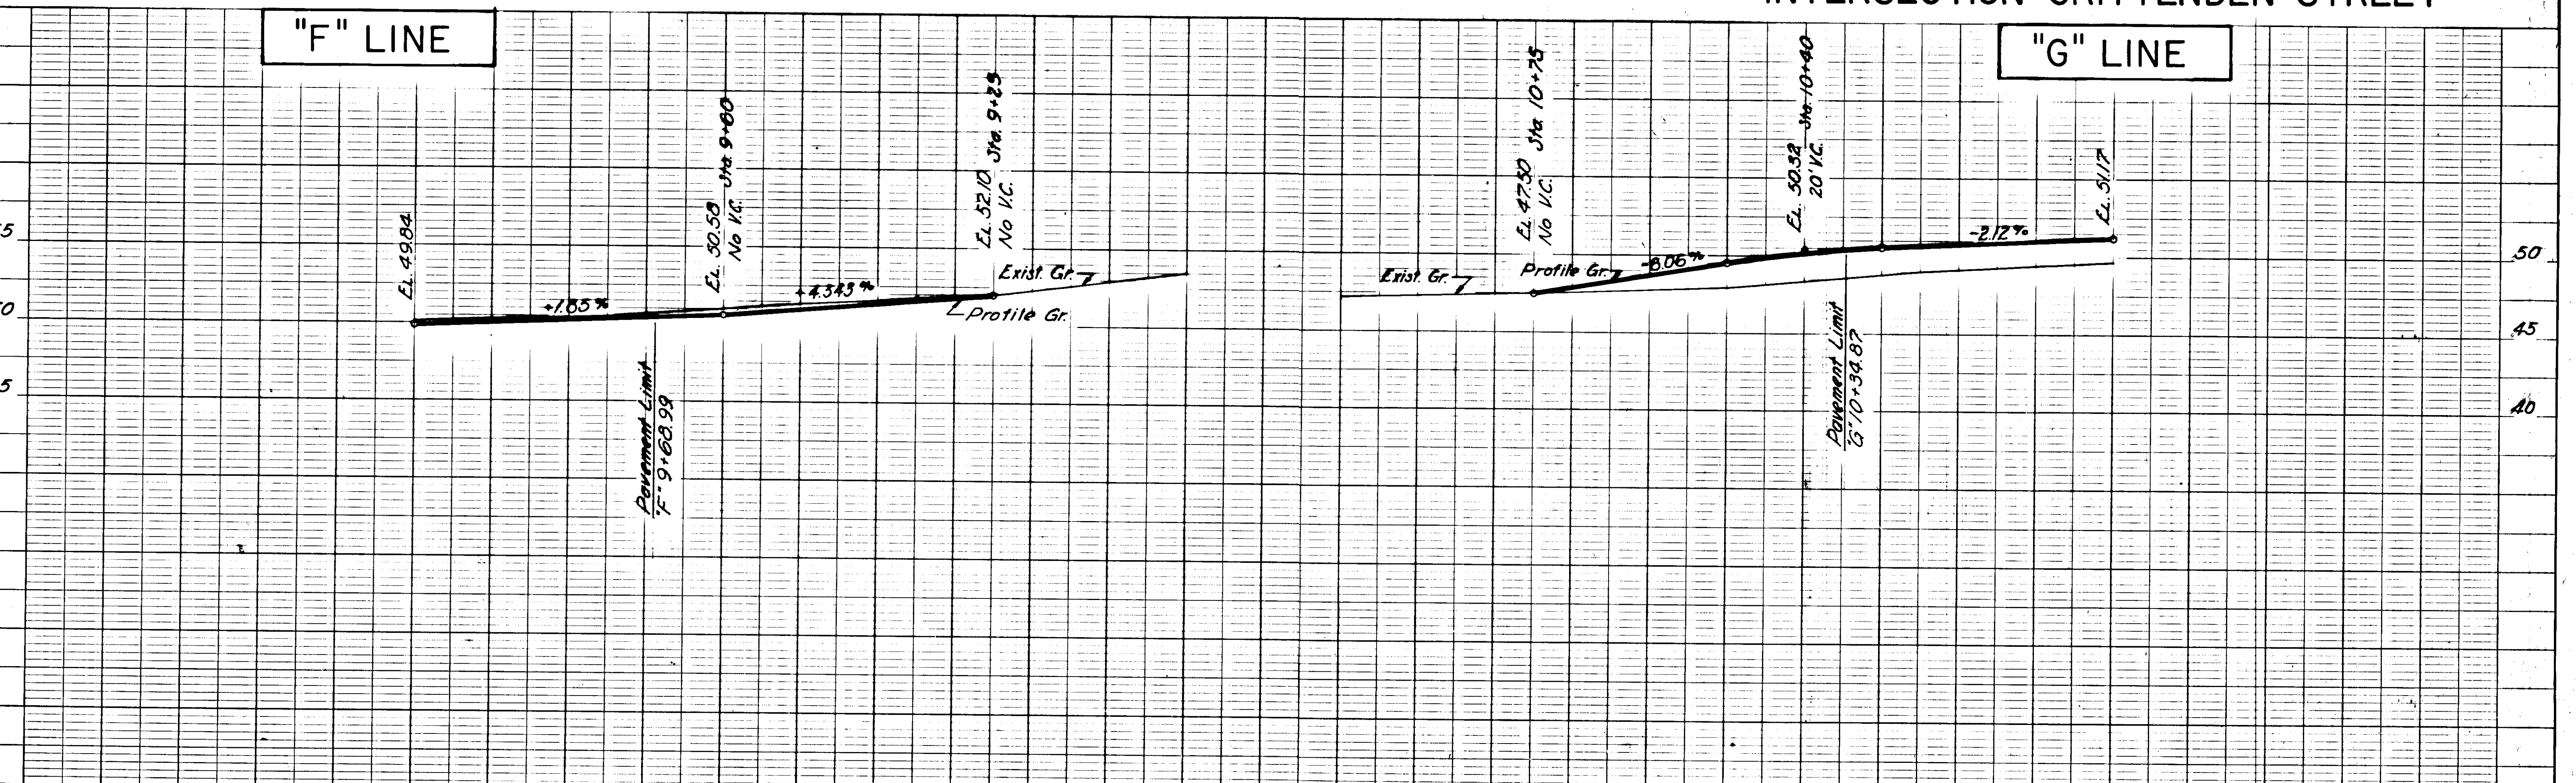


STATE	PROJECT DESIGNATION	YEAR	SHEET NO.	TOTAL SHEETS
ALASKA	S-0943(1)	1967	20	34

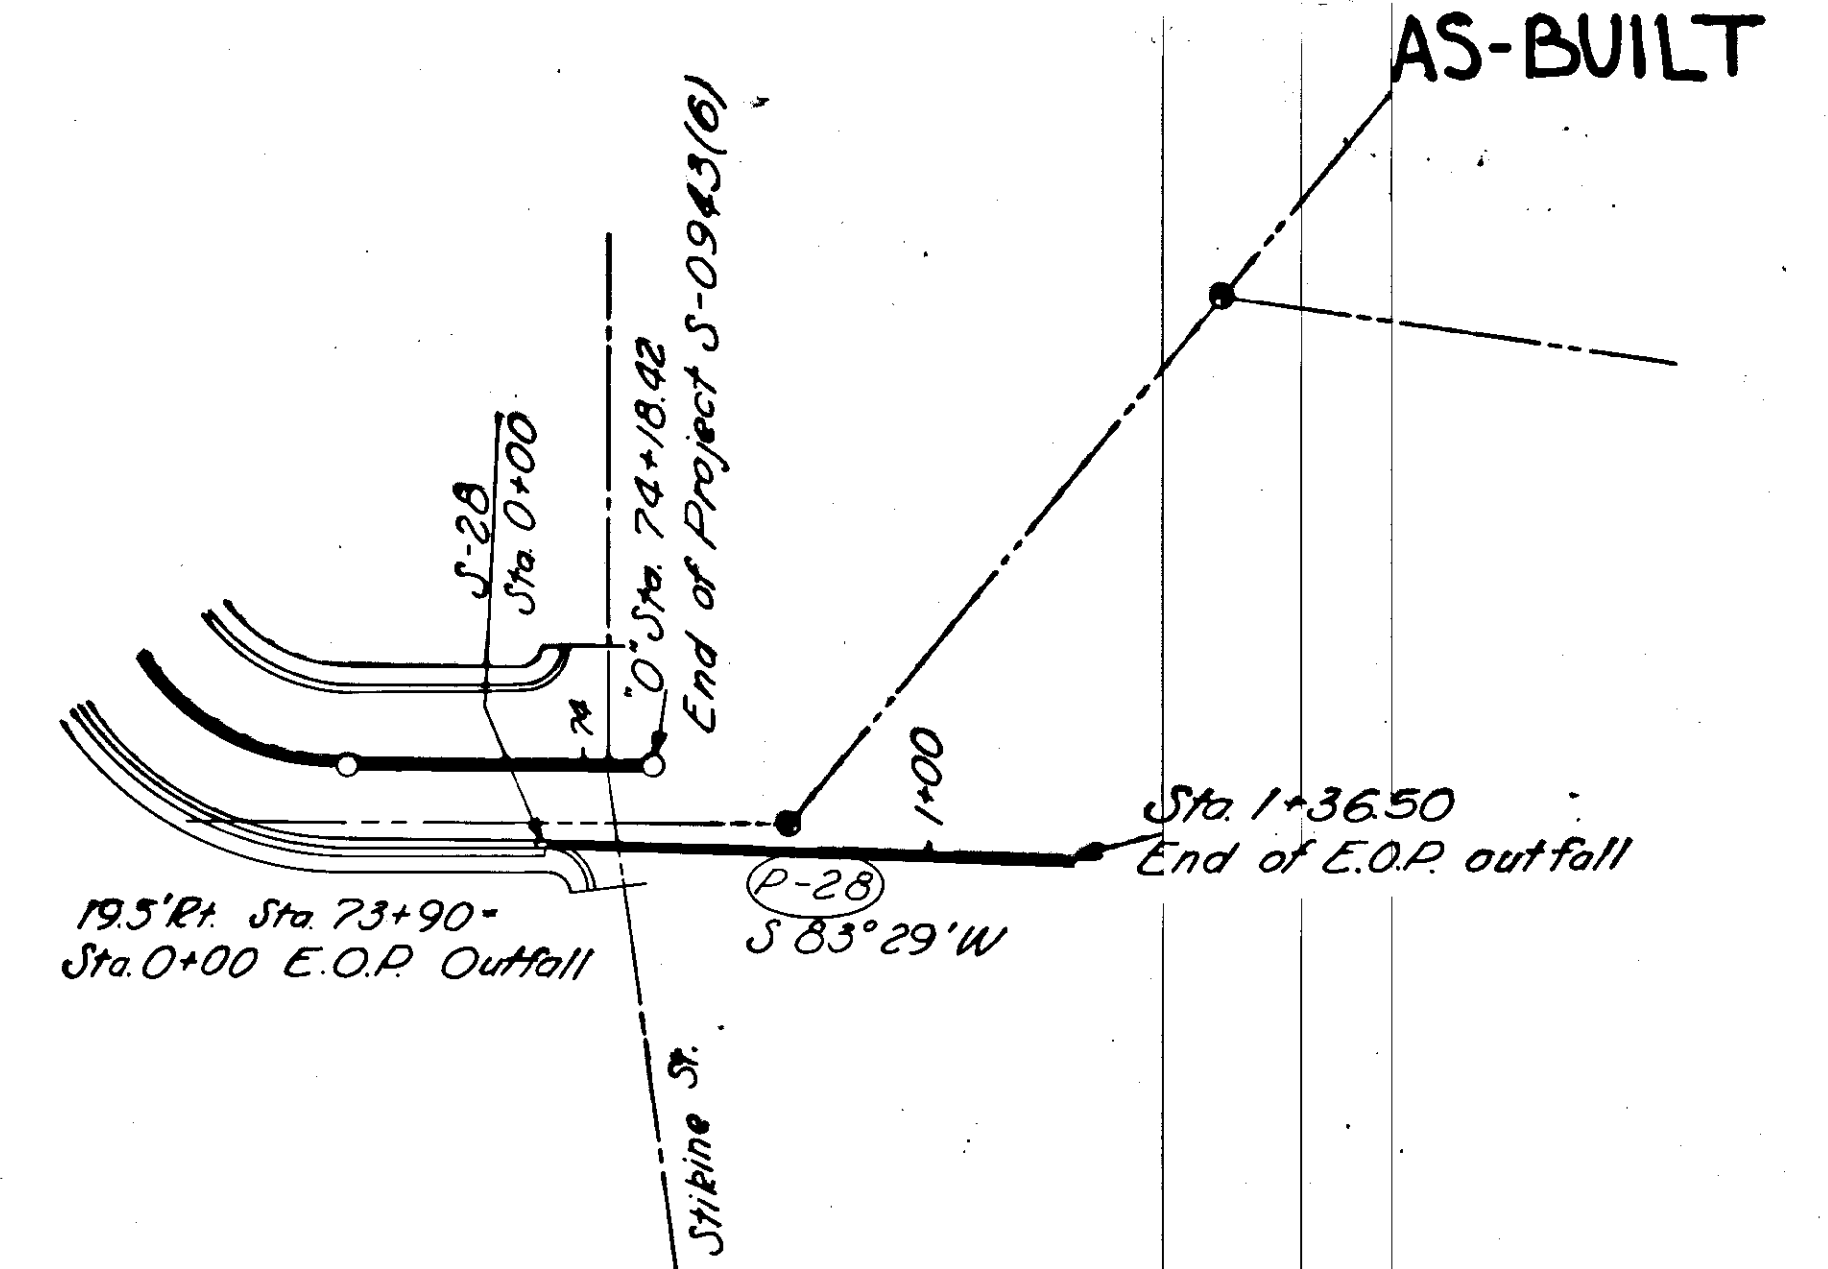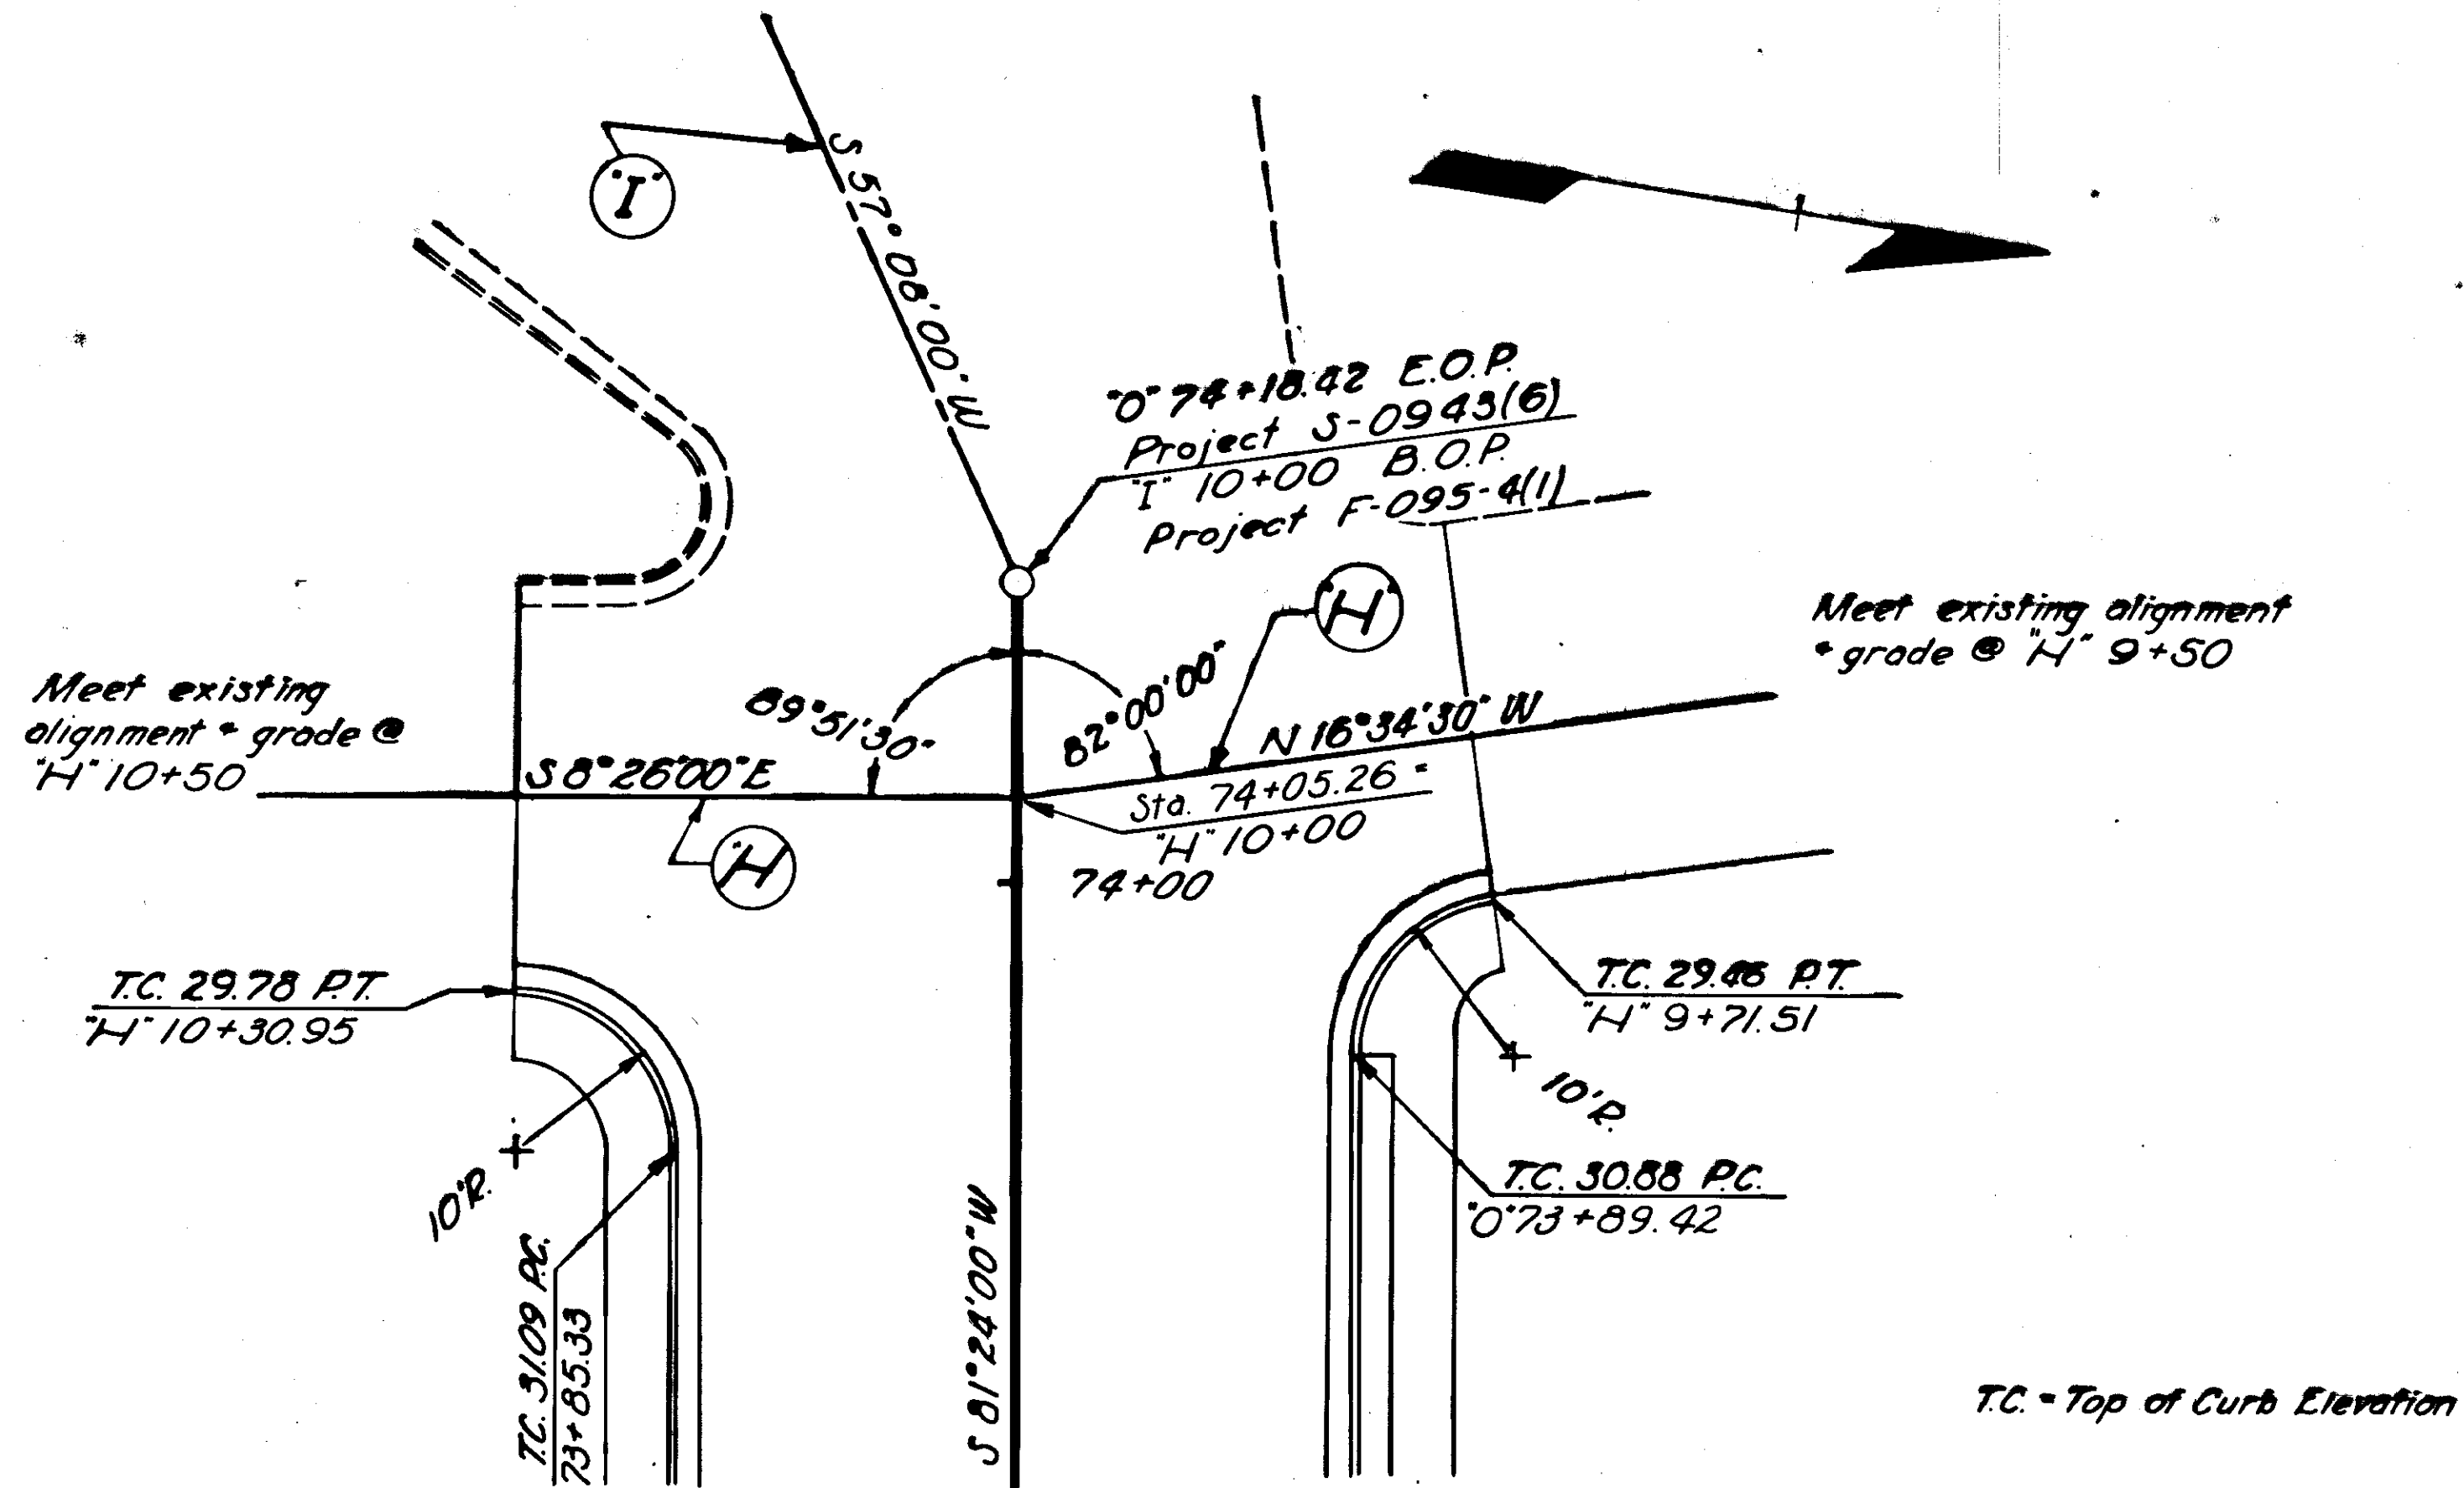

STIKINE STREET & FERRY TERMINAL


"H" AND "I" LINES

OUTFALL AT E.O.P.

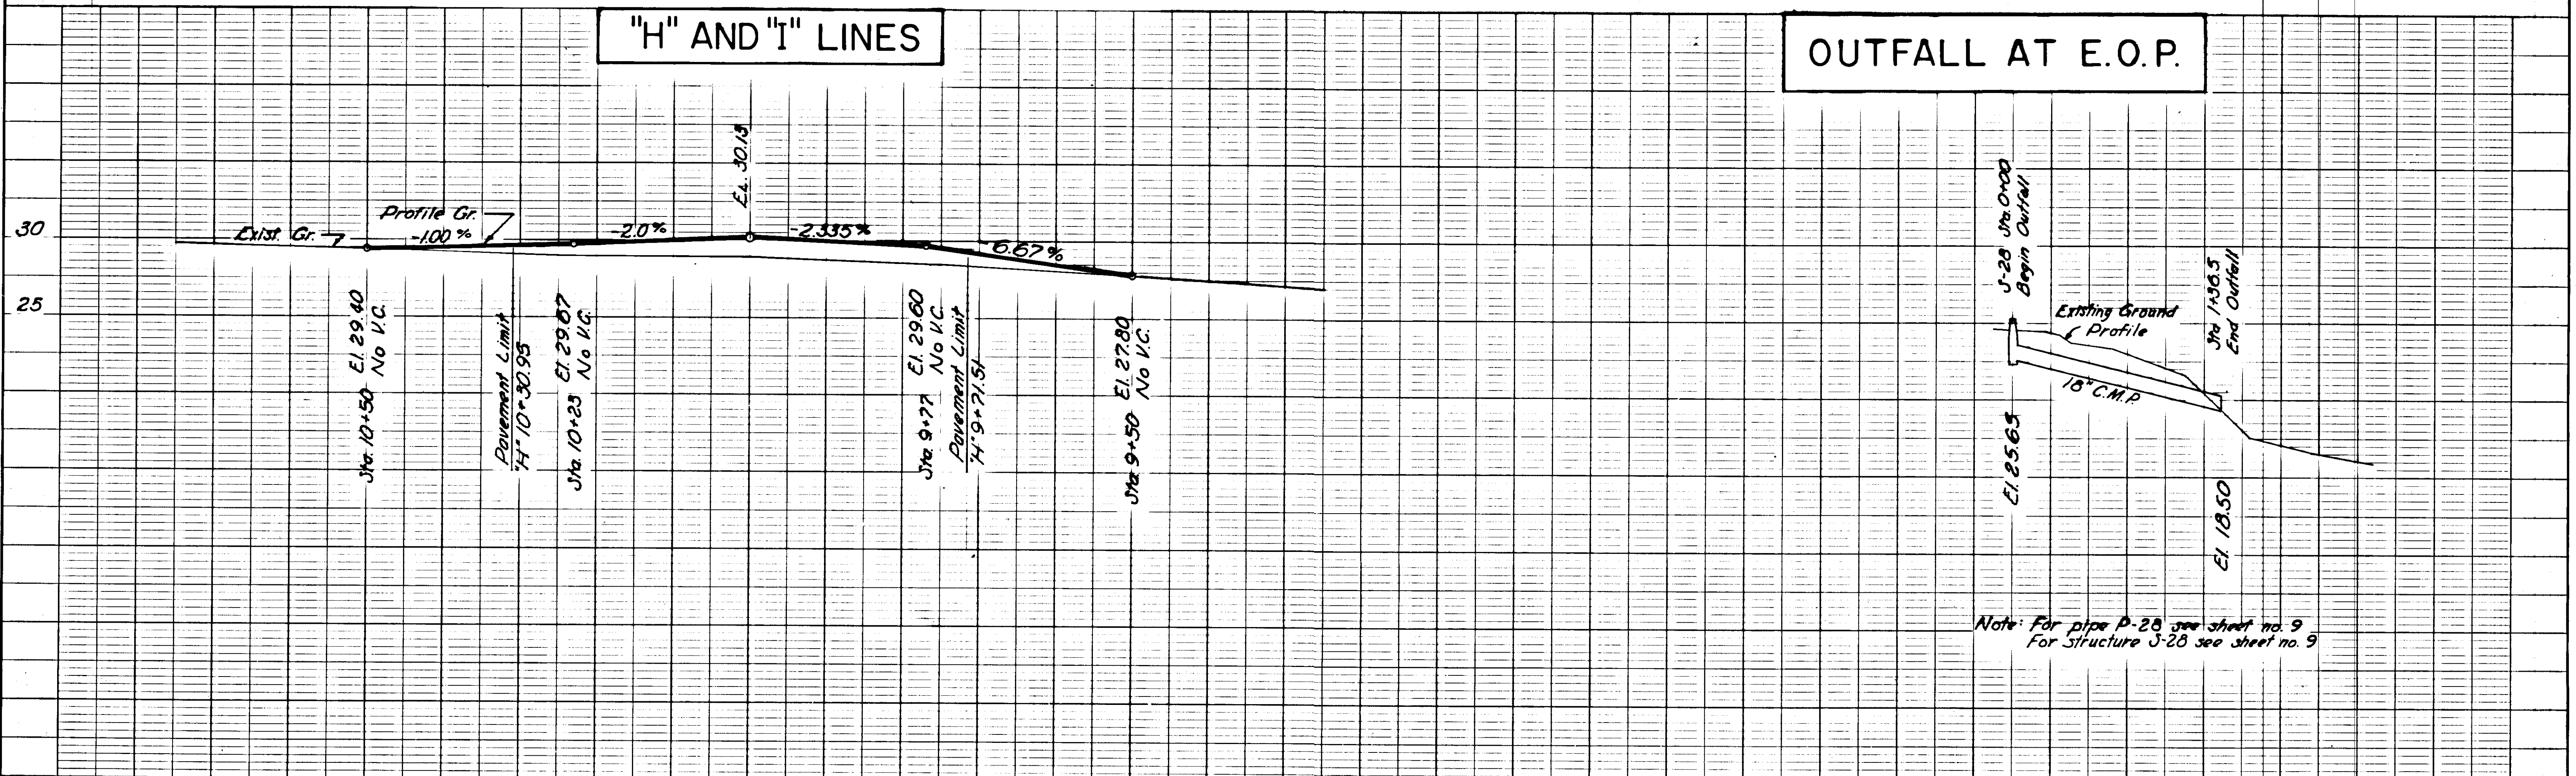



Note: For pipe P-28 see sheet no. 9
For structure S-28 see sheet no. 9

CONSTRUCTION PLAN
AS-BUILT

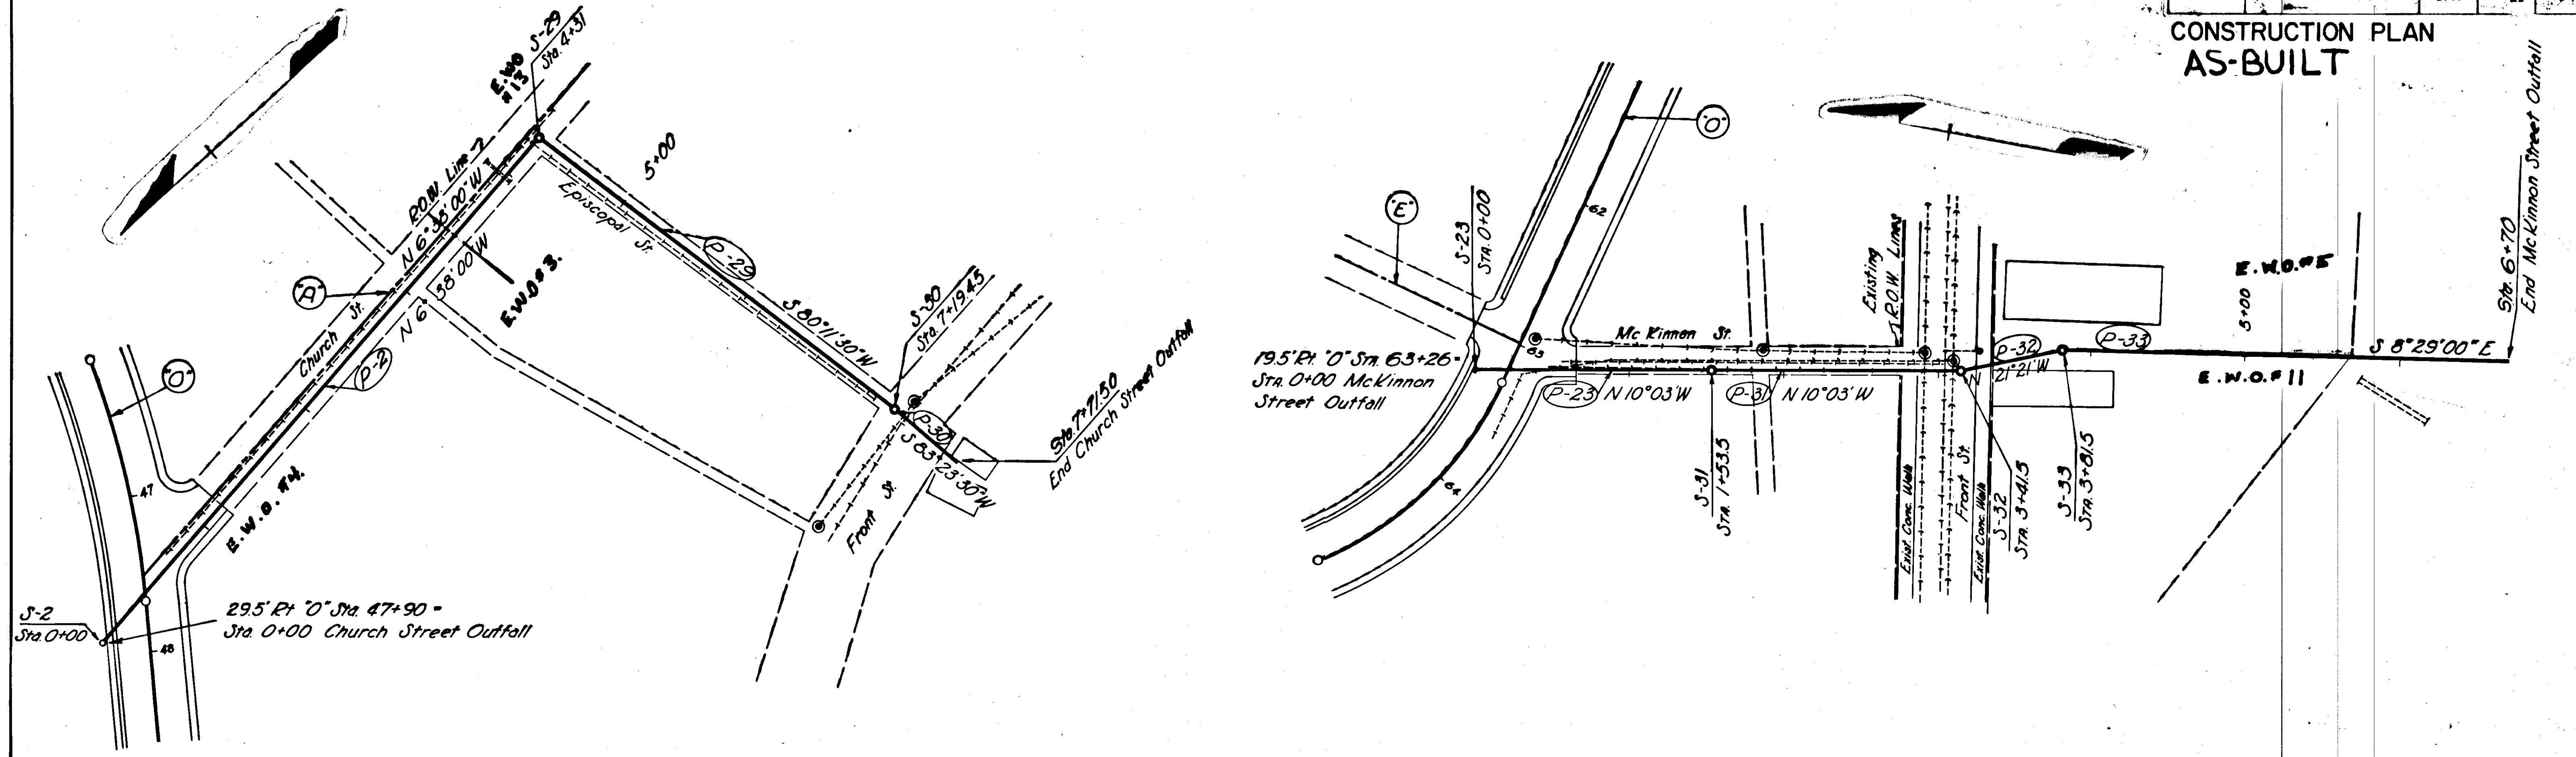

CHURCH STREET OUTFALL

MC KINNON STREET OUTFALL

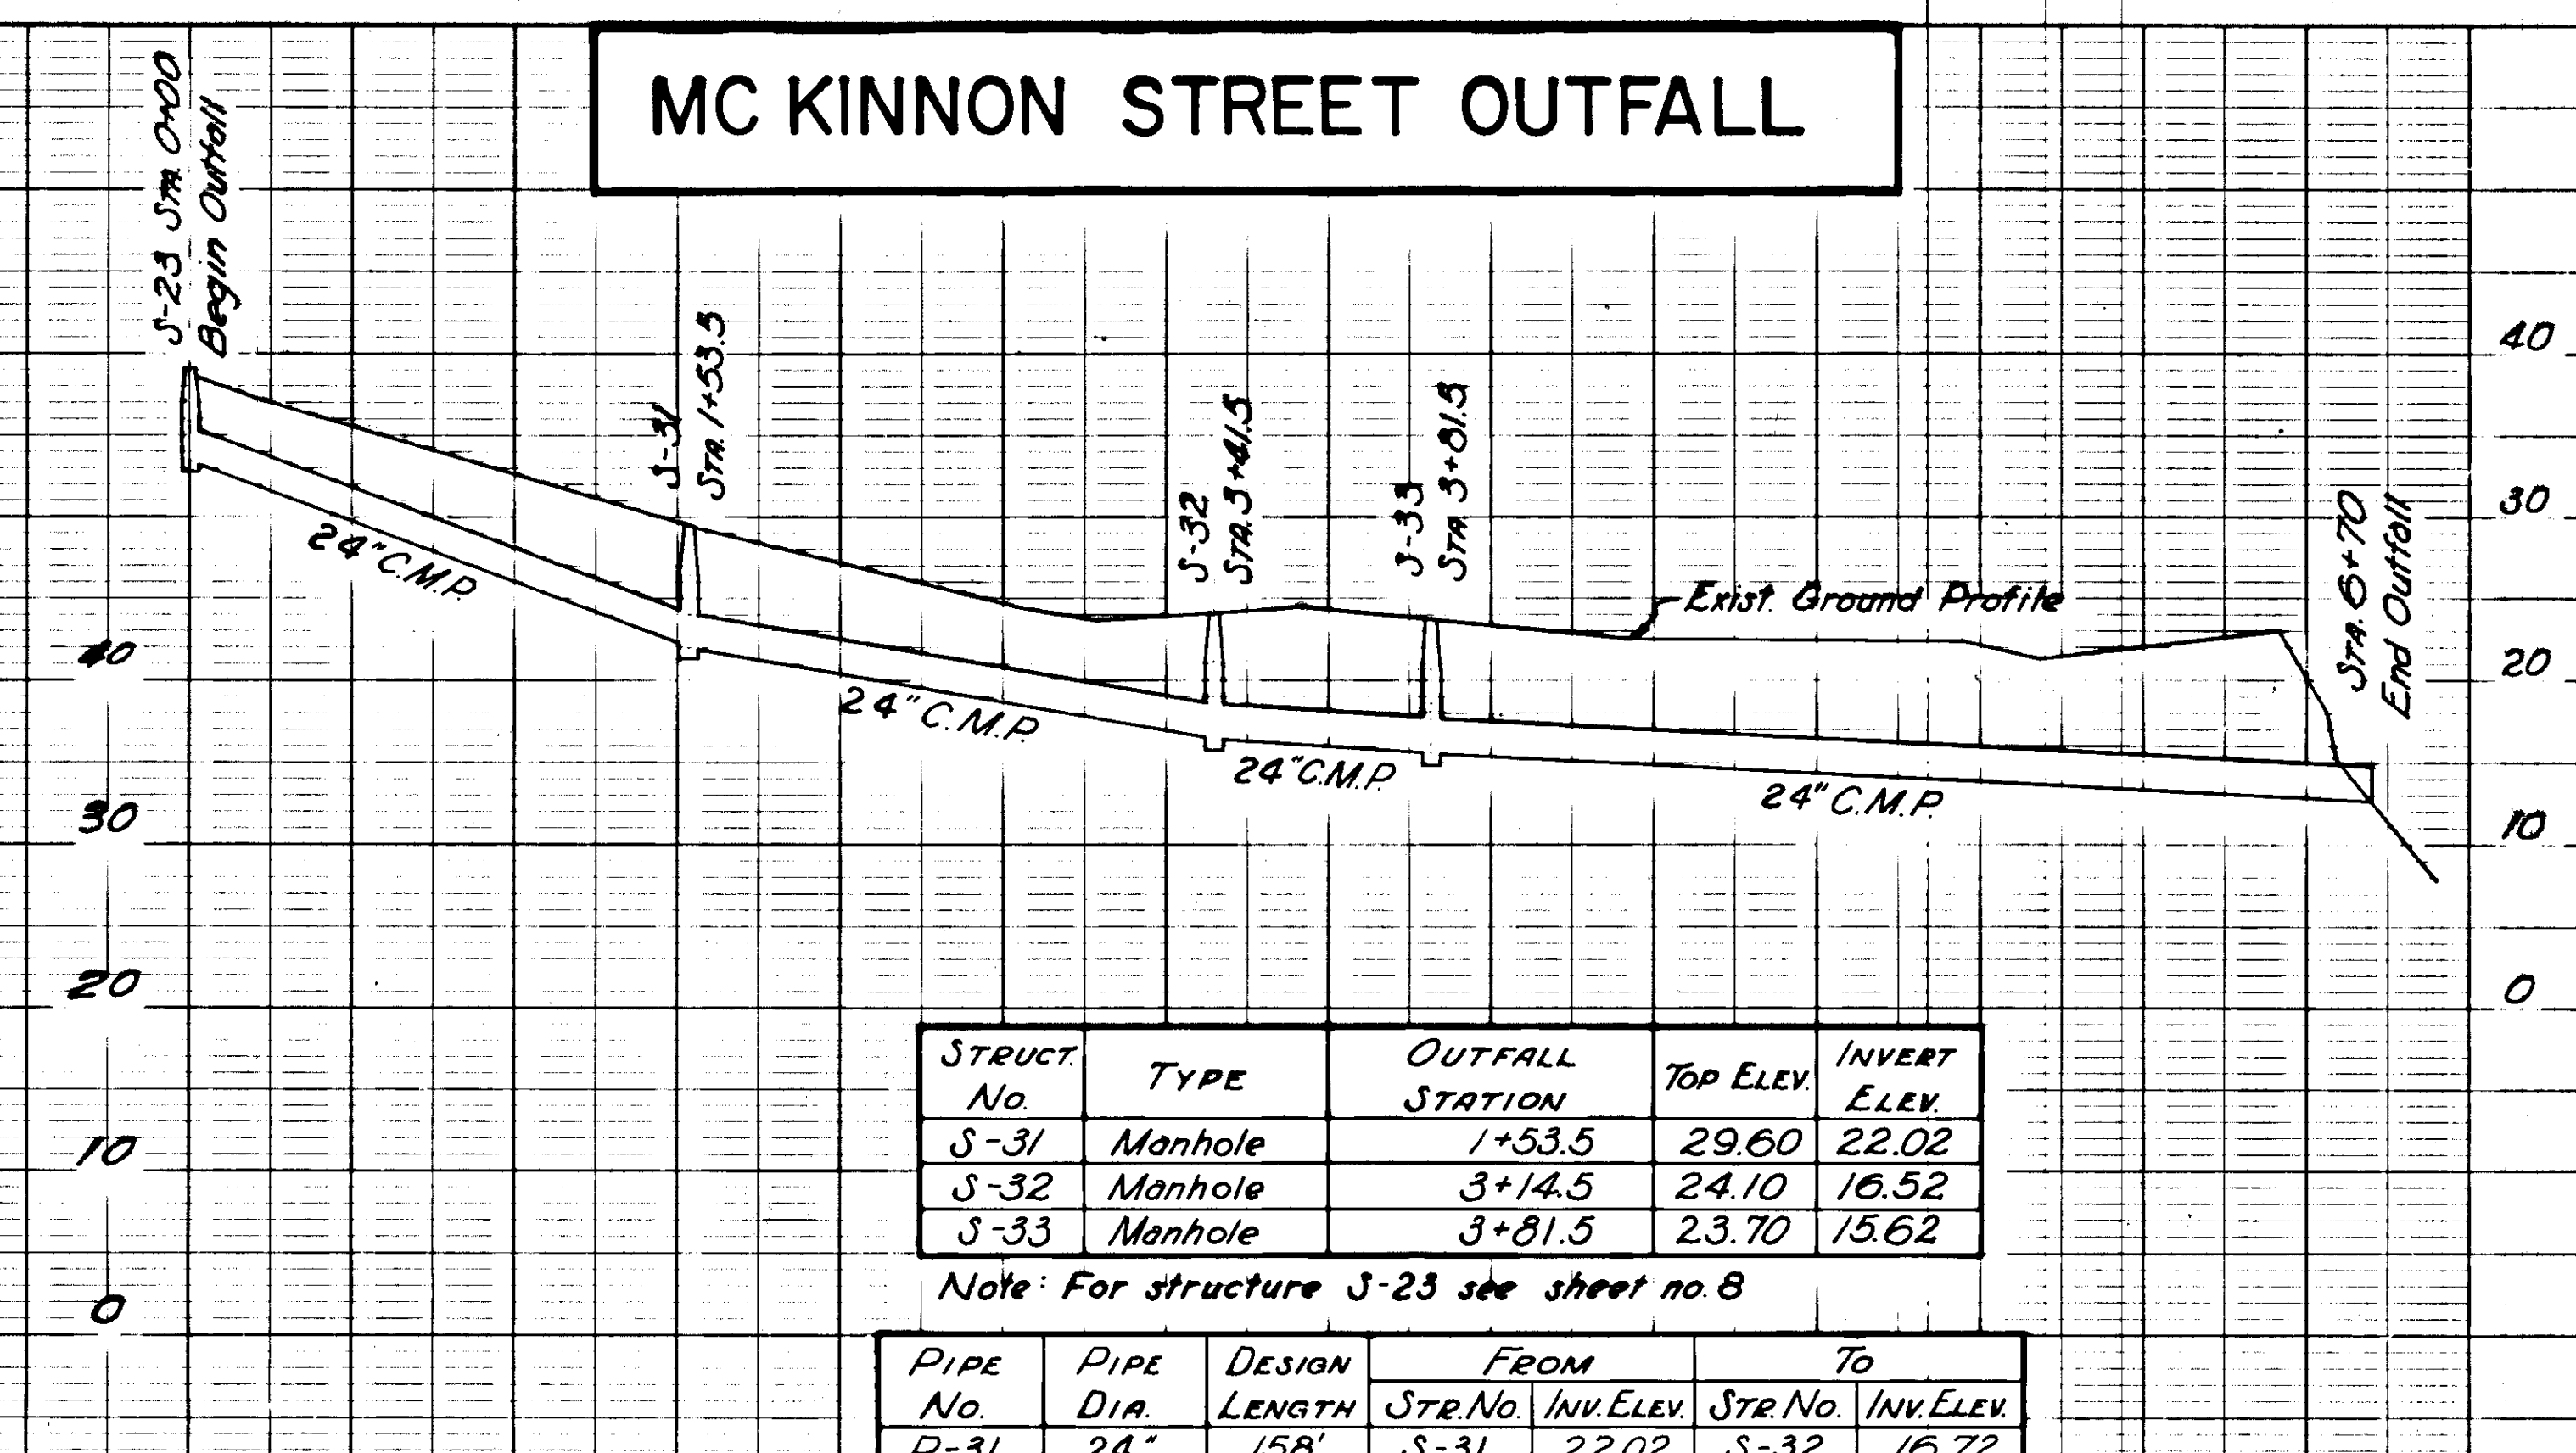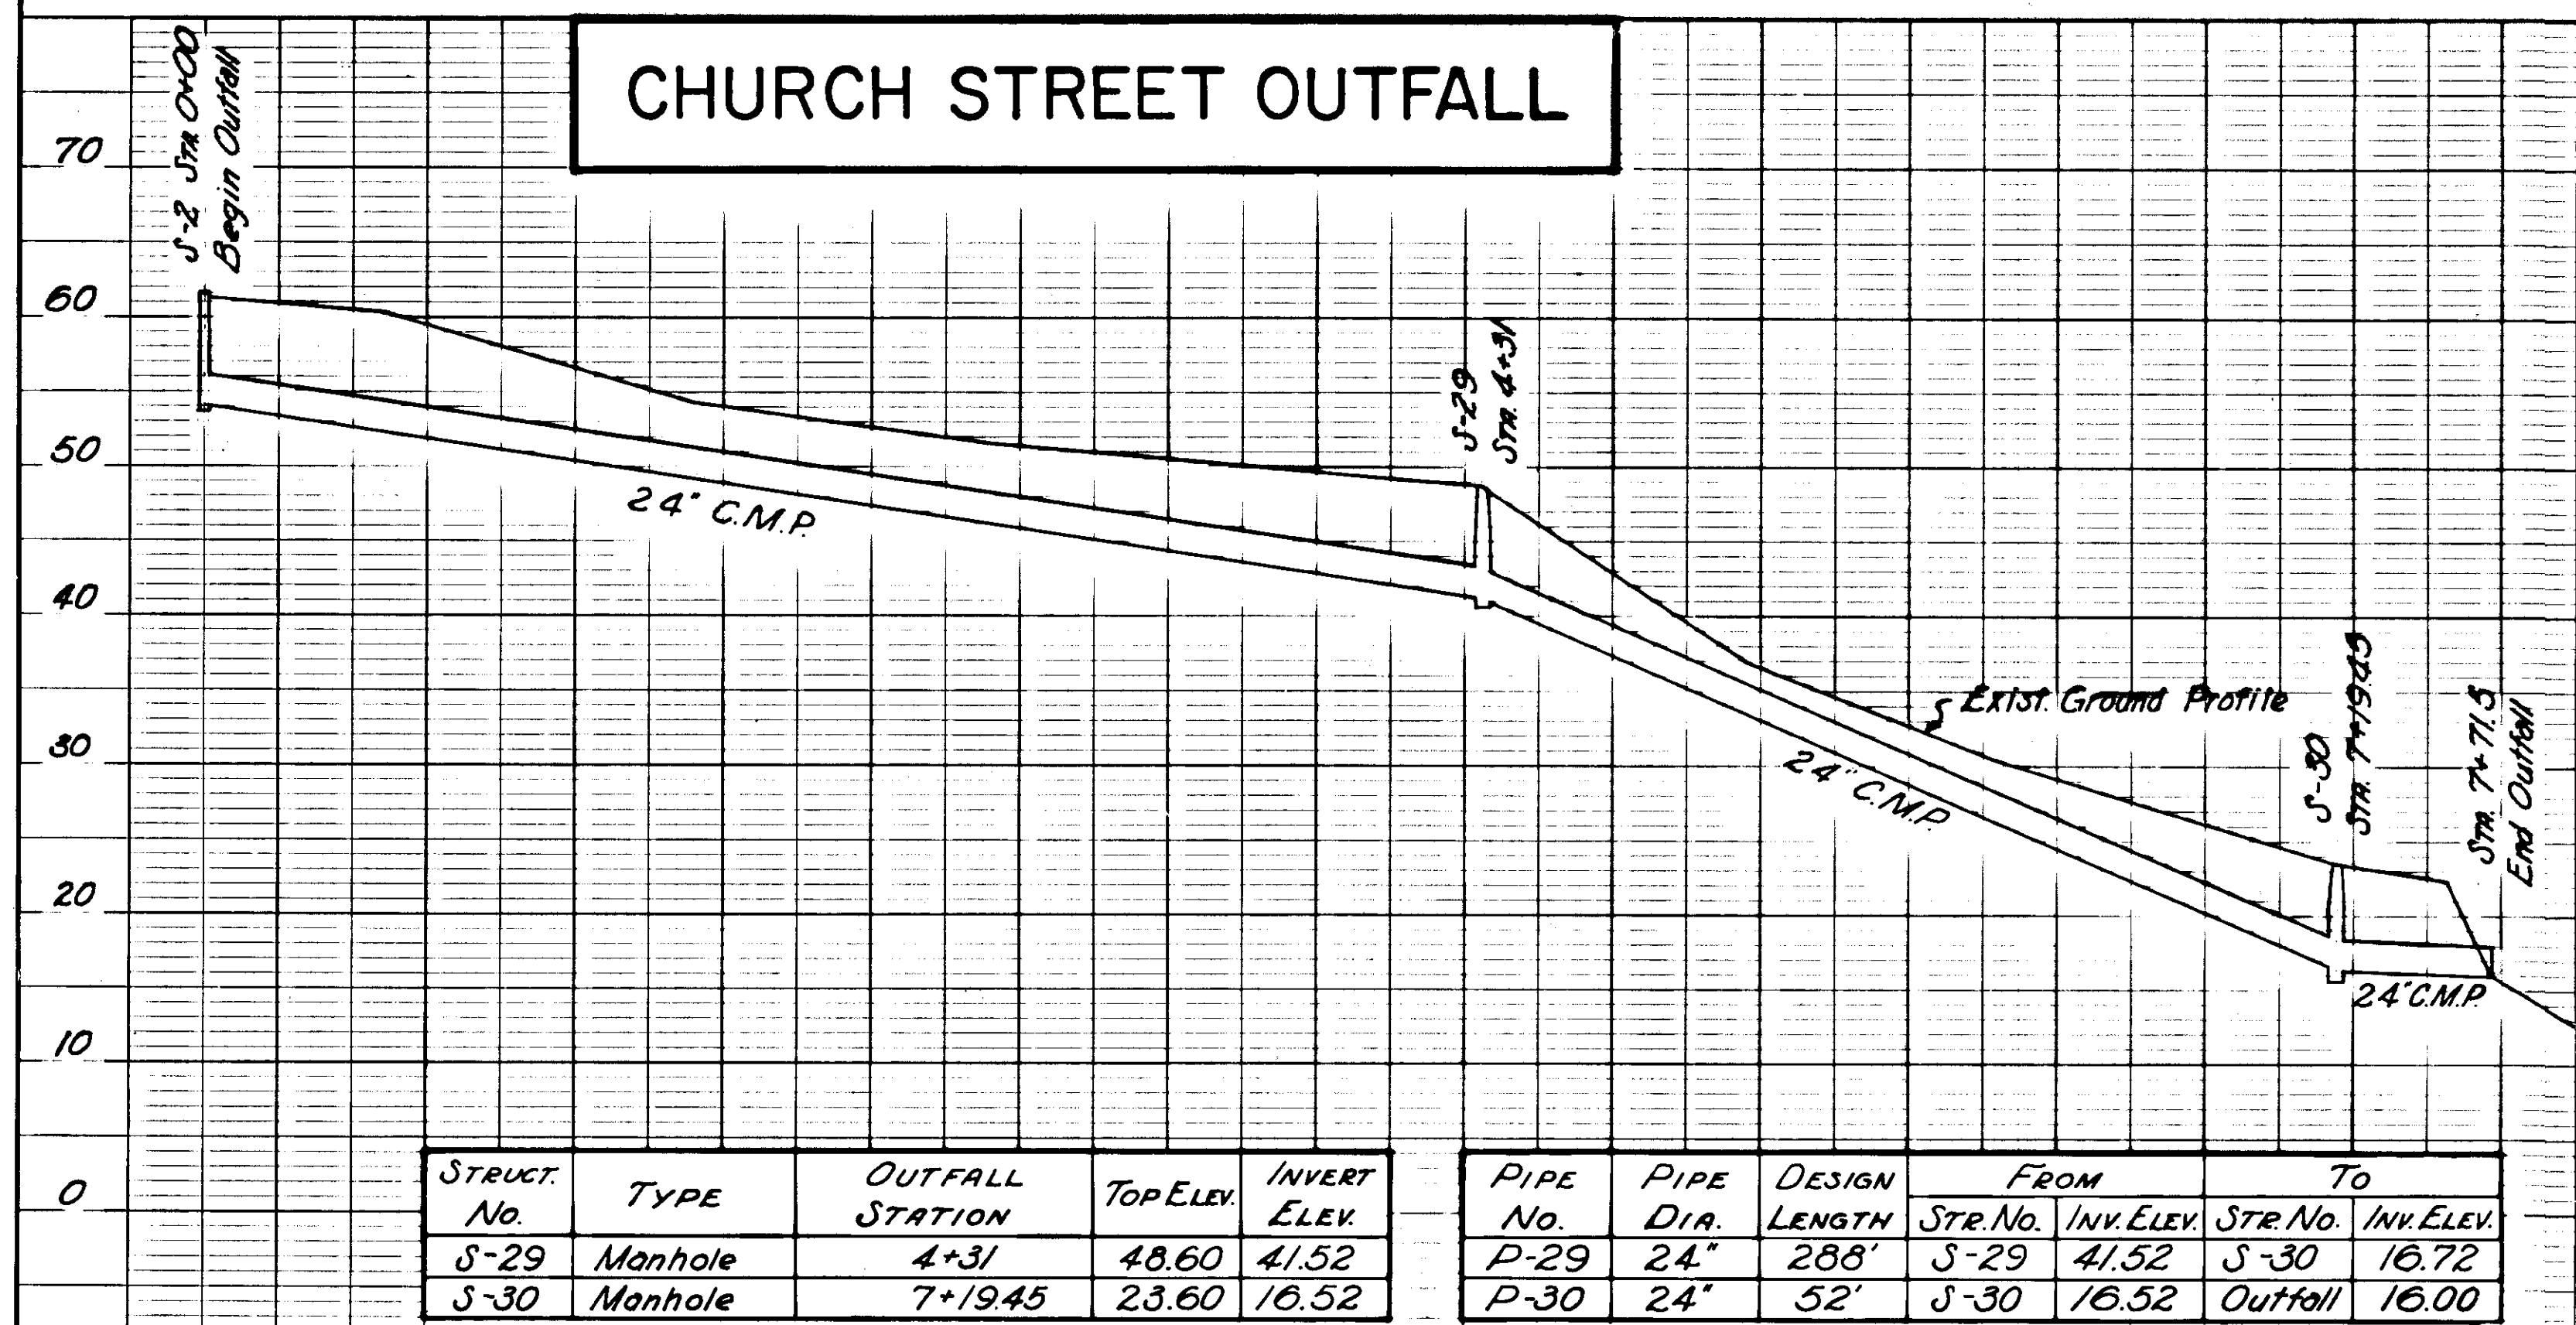

STRUCT. No.	TYPE	OUTFALL STATION	TOP ELEV.	INVERT ELEV.
S-29	Manhole	4+31	48.60	41.52
S-30	Manhole	7+19.45	23.60	16.52

Note: For structure S-2 see sheet no. 5

PIPE No.	PIPE DIA.	DESIGN LENGTH	FROM		TO	
			STR. No.	INV. ELEV.	STR. No.	INV. ELEV.
P-29	24"	288'	S-29	41.52	S-30	16.72
P-30	24"	52'	S-30	16.52	Outfall	16.00

Note: For pipe P-2 see sheet no. 5


STRUCT. No.	TYPE	OUTFALL STATION	TOP ELEV.	INVERT ELEV.
S-31	Manhole	1+53.5	29.60	22.02
S-32	Manhole	3+14.5	24.10	16.52
S-33	Manhole	3+81.5	23.70	15.62

Note: For structure S-23 see sheet no. 8


PIPE No.	PIPE DIA.	DESIGN LENGTH	FROM		TO	
			STR. No.	INV. ELEV.	STR. No.	INV. ELEV.
P-31	24"	158'	S-31	22.02	S-32	16.72
P-32	24"	66'	S-32	16.52	S-33	15.82
P-33	24"	288'	S-33	15.62	Outfall	12.60

Note: For pipe P-23 see sheet no. 8


AS-BUILT

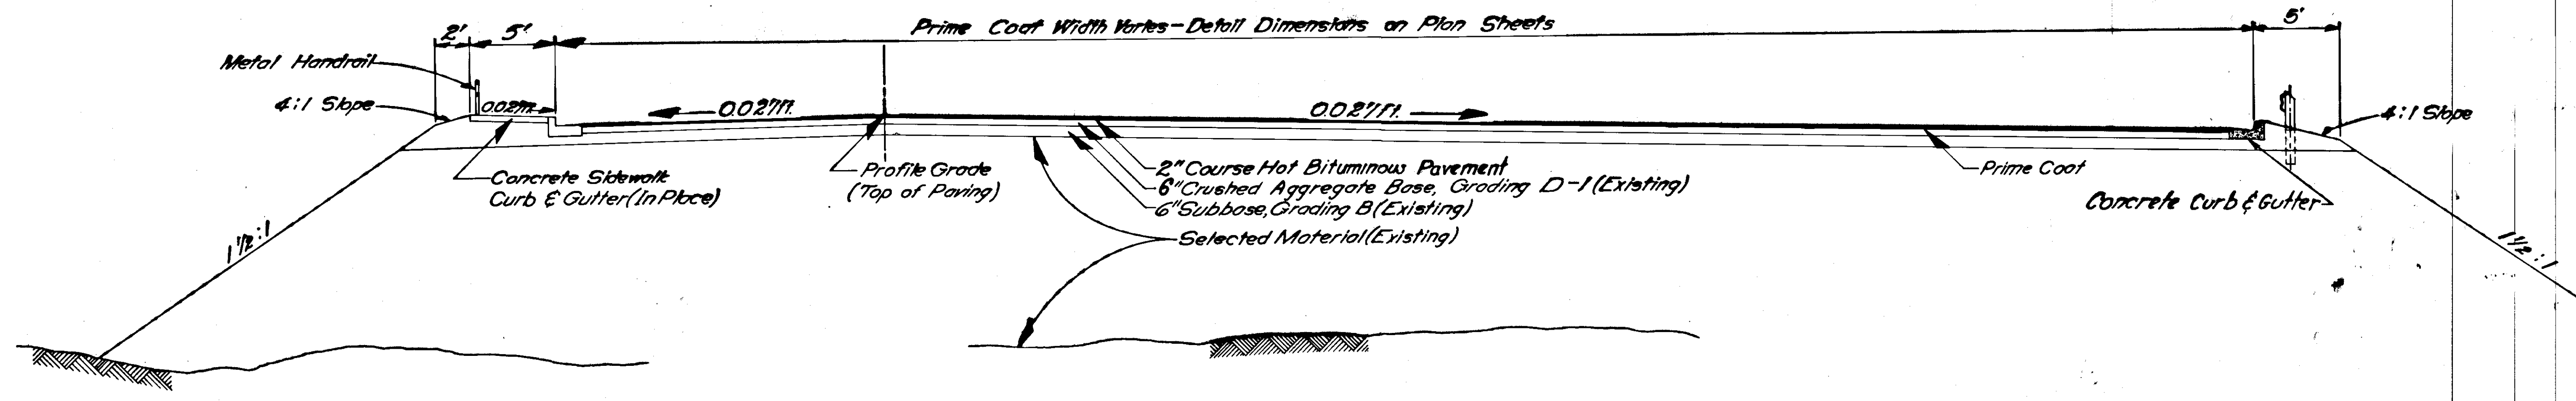


TYPICAL SECTION OF IMPROVEMENT
 F-095-4(1) FERRY TERMINAL
 "I" 10+00 TO "I" 12+93.73

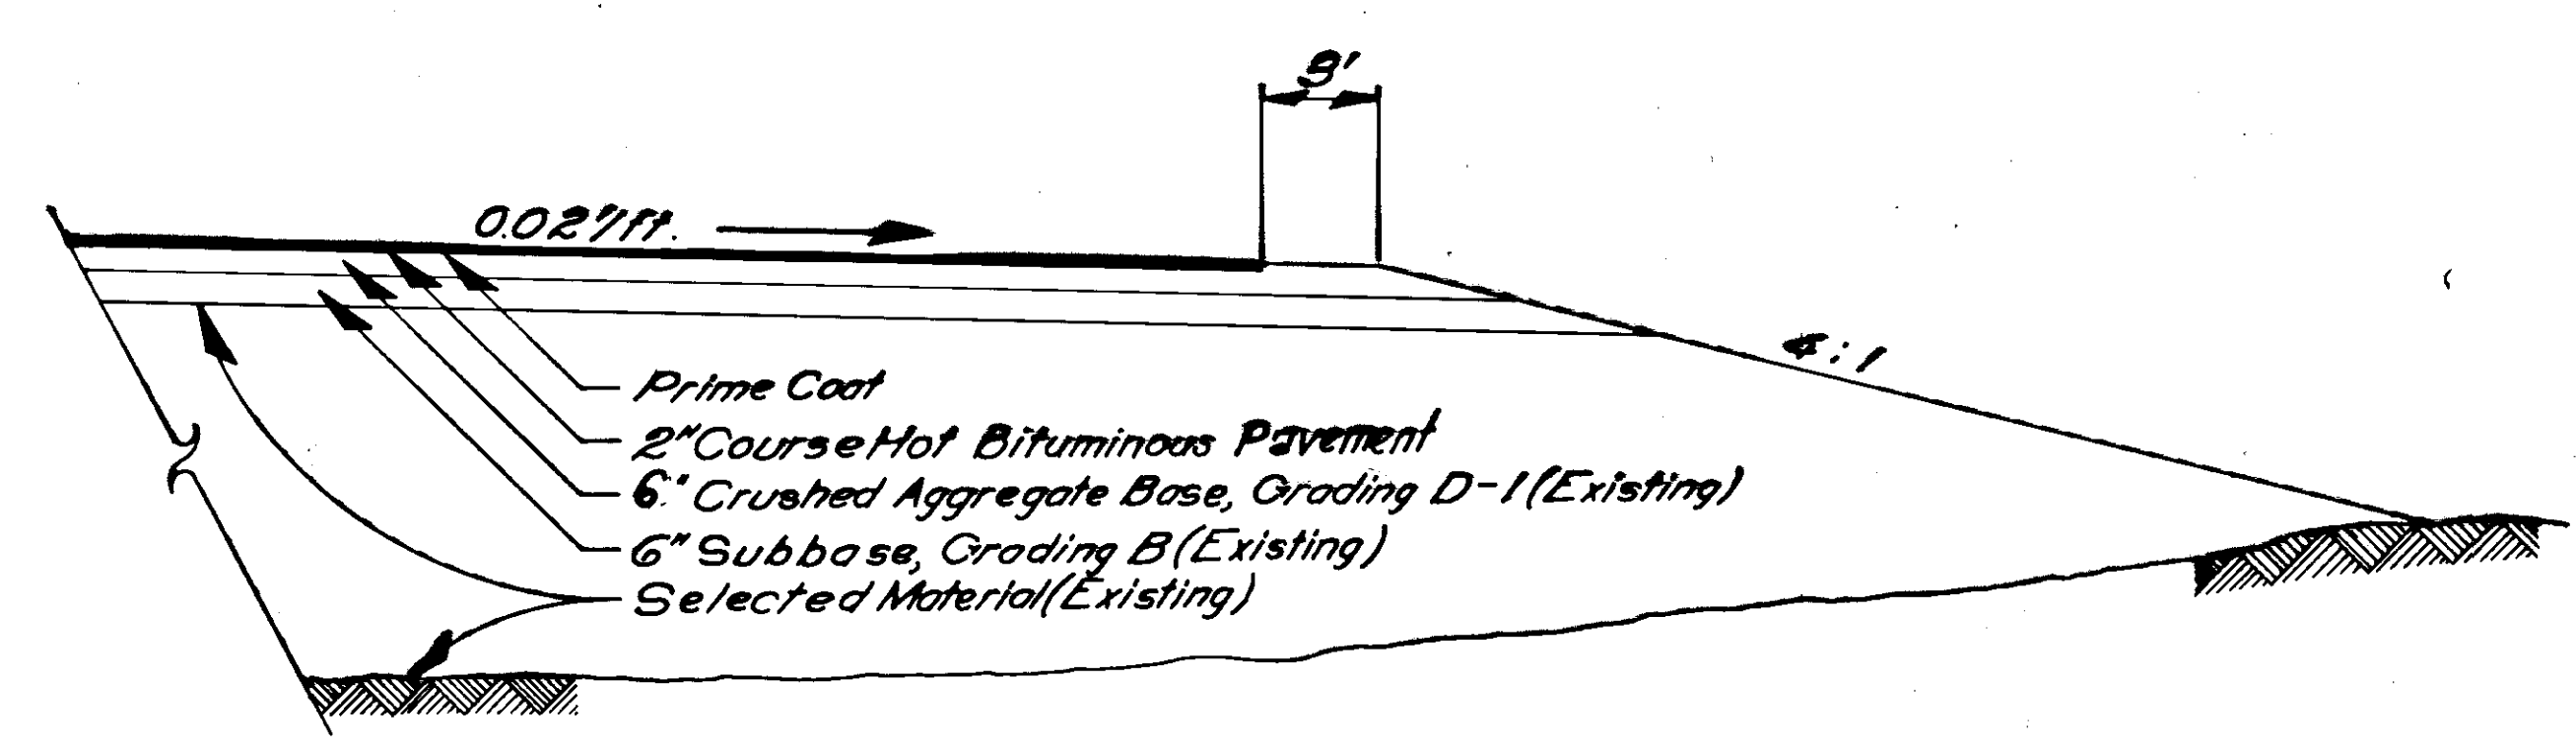

TYPICAL SHOULDER WITHOUT SIDEWALK OR CURB
 F-095-4(1) FERRY TERMINAL
 "I" 10+00 TO "I" 10+79.12

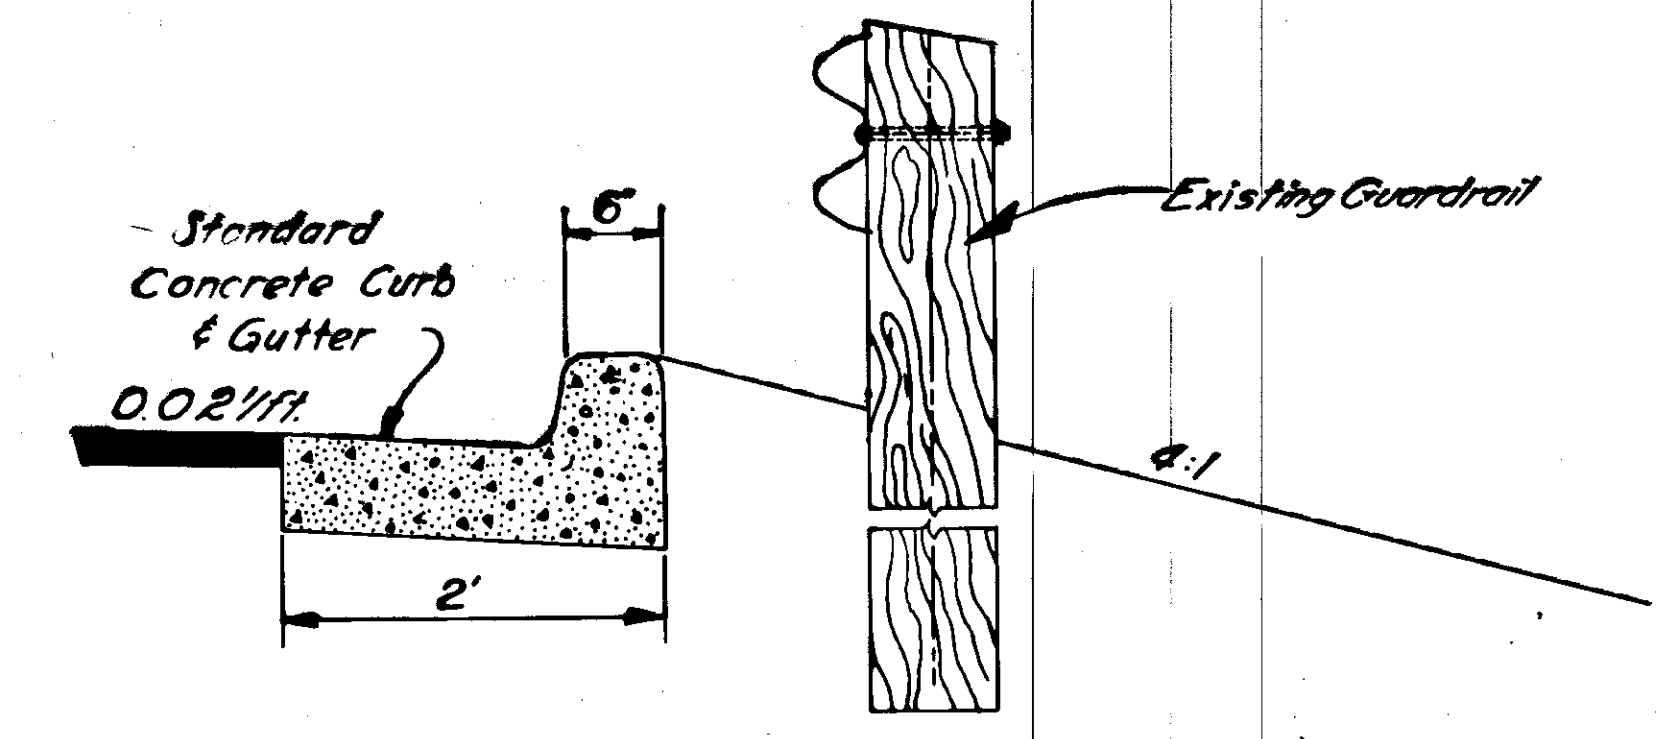

TYPICAL CURB & GUTTER DETAIL

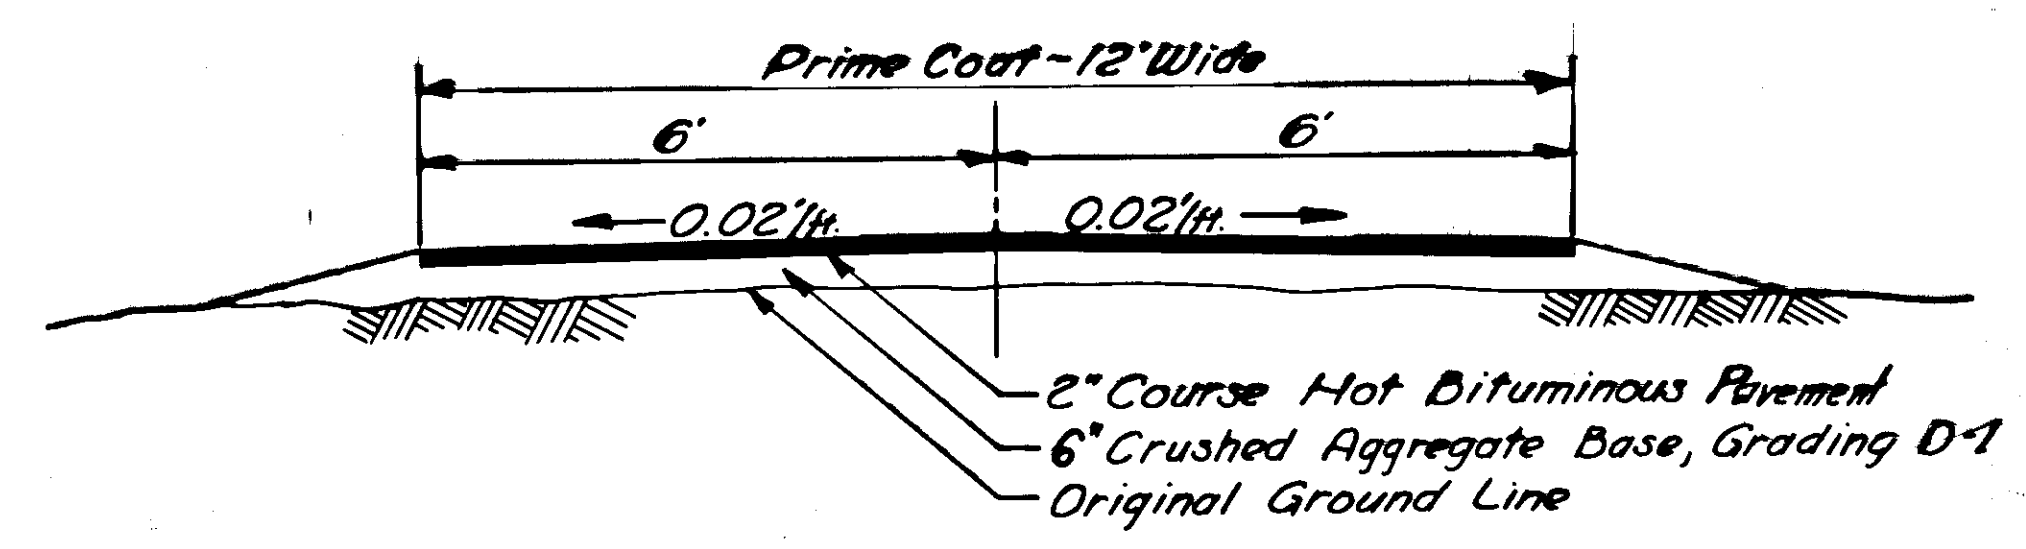


TYPICAL SECTION - MUNICIPAL BOAT RAMP
 S-0943(7)
 "R" 0+50 TO "R" 2+00

NOTE:

The contractor shall take adequate precautions to insure that none of the existing improvements, including guardrails, inlets, sidewalks and building, in the Ferry Terminal area are coated or discolored by the application of the prime coat. Existing base to be scarified 2" depth & retaid.

2-00243(1) 1734902

CONSTRUCTION PLAN

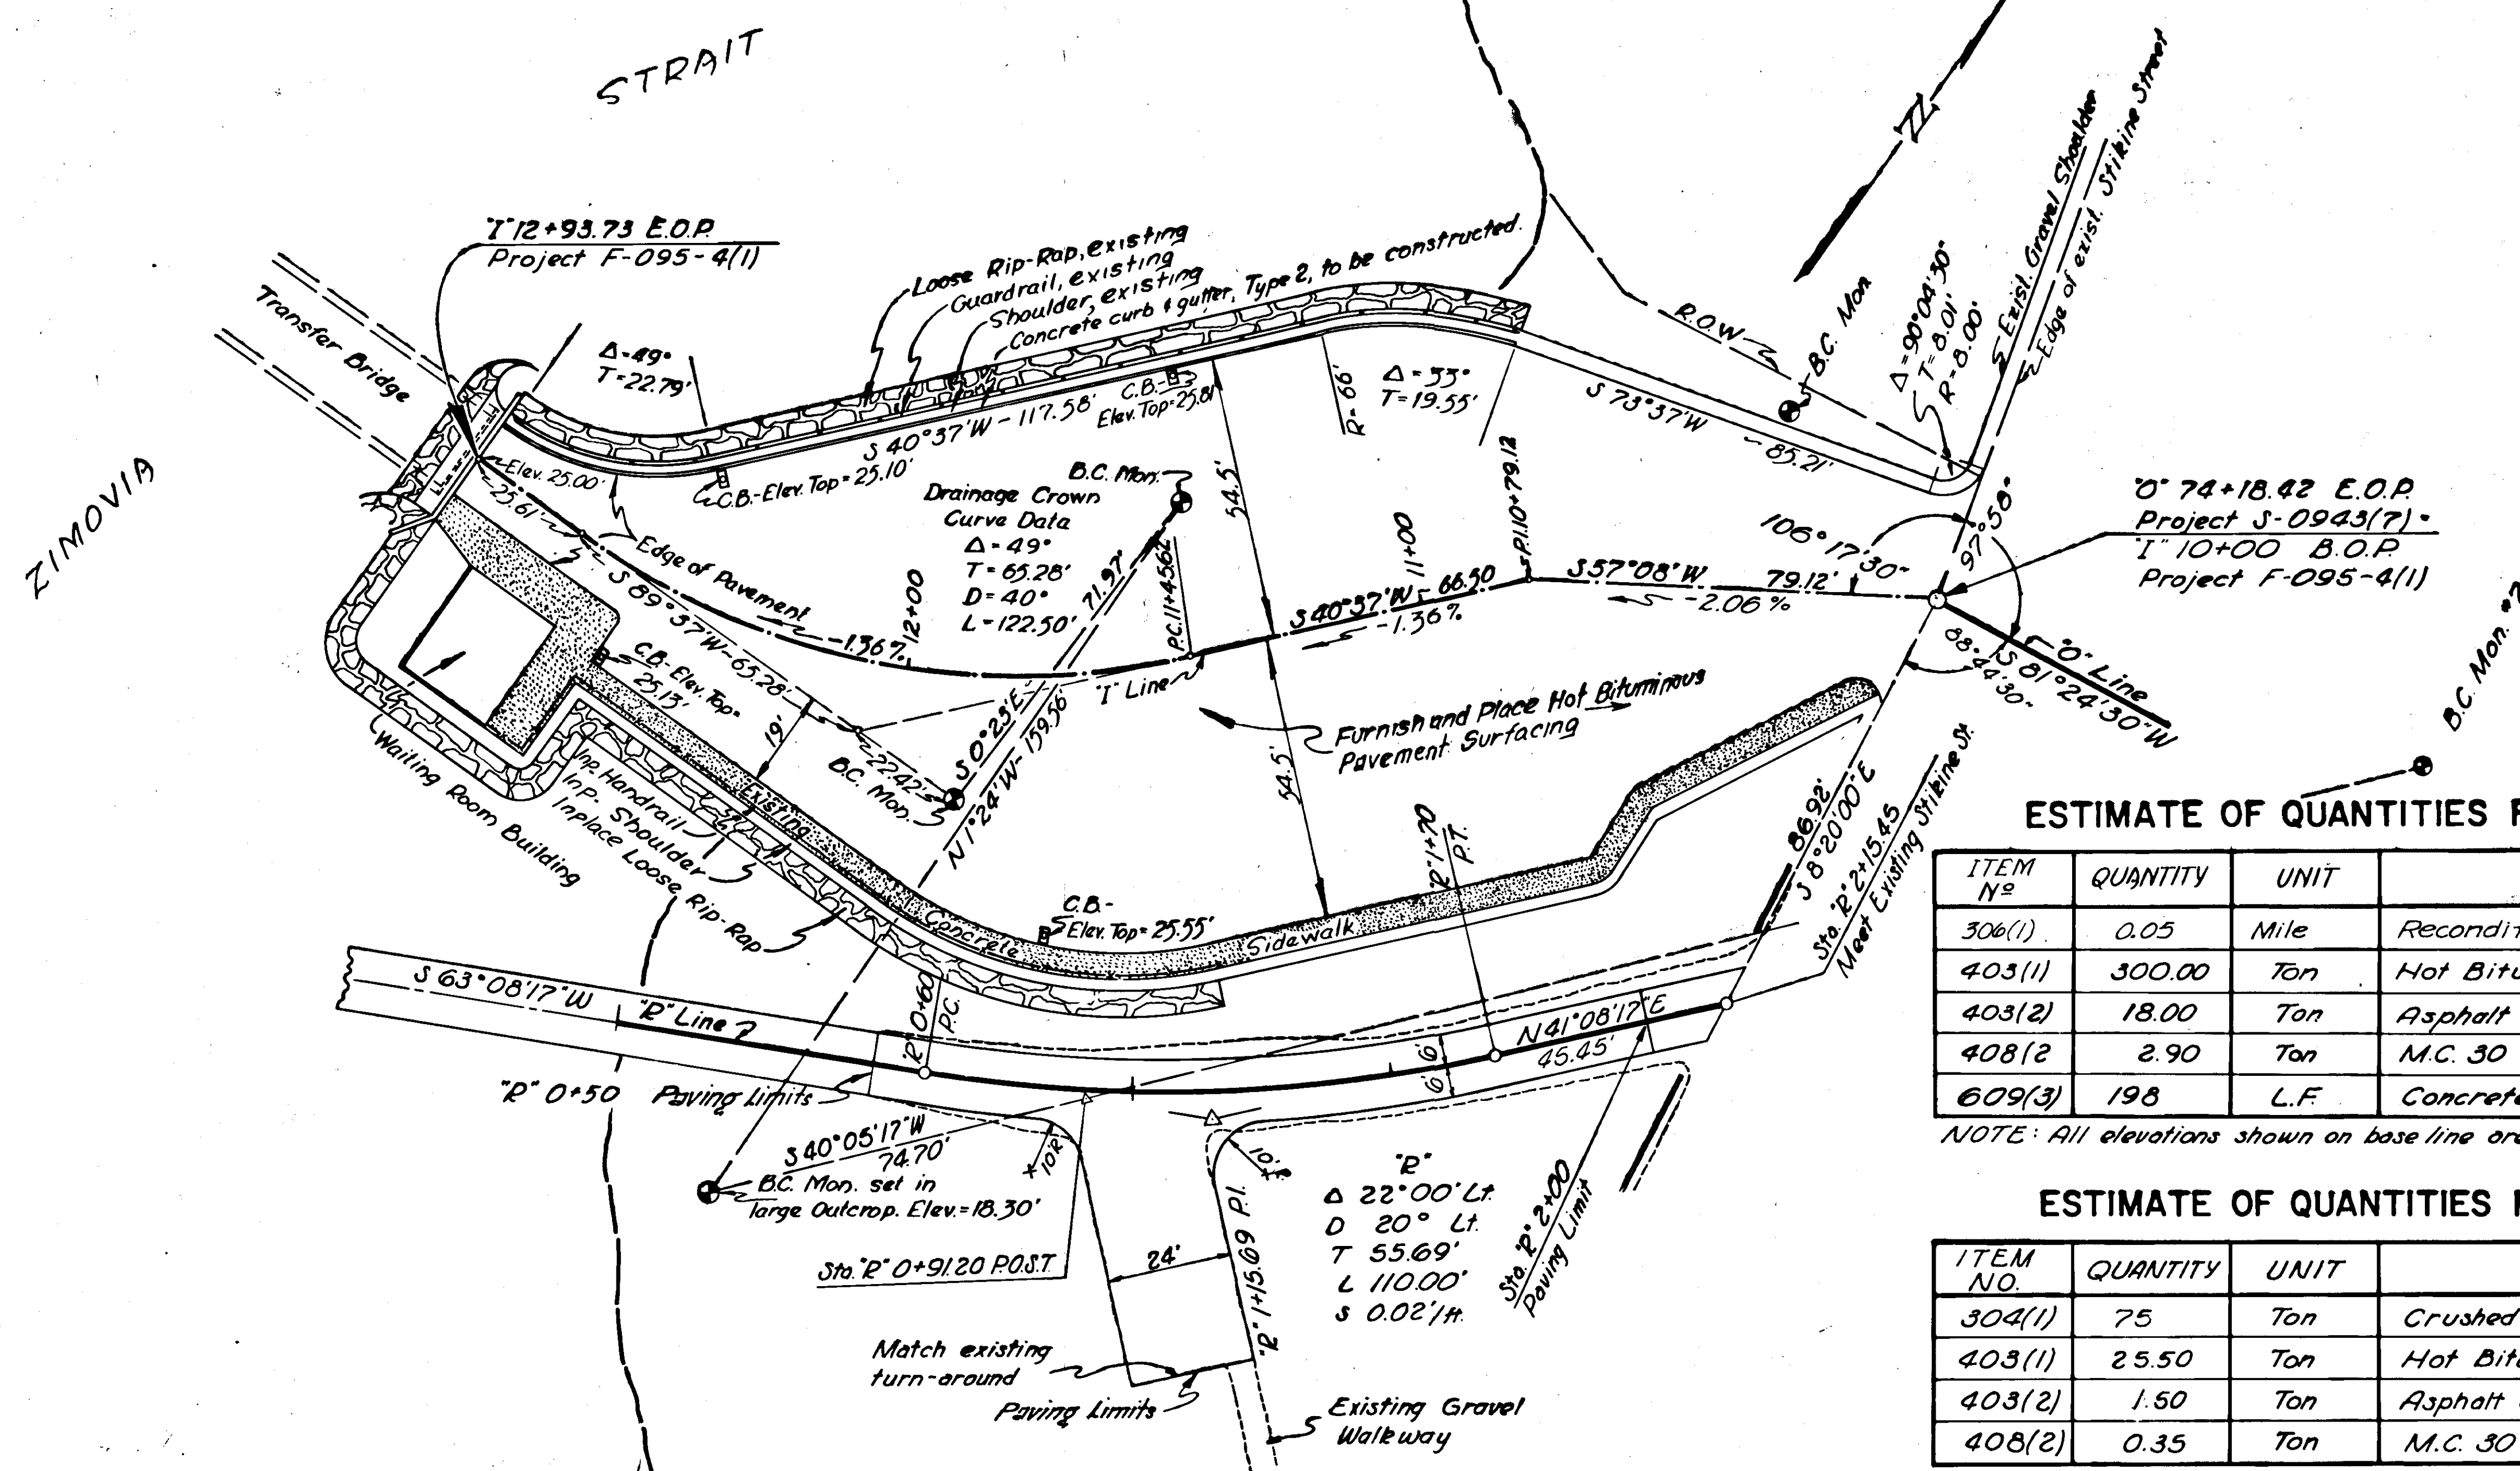

WRANGELL FERRY TERMINAL & BOAT RAMP PAVING PLAN

ESTIMATE OF QUANTITIES FOR F-095-4(1)


ITEM No	QUANTITY	UNIT	ITEM
306(1)	0.05	Mile	Reconditioning
403(1)	300.00	Ton	Hot Bituminous Pavement
403(2)	18.00	Ton	Asphalt Cement 120-150 Penetration
408(2)	2.90	Ton	M.C. 30 Prime Coat
609(3)	198	L.F.	Concrete Curb & Gutter, Type 2

NOTE: All elevations shown on base line are top of Bituminous Pavement.

ESTIMATE OF QUANTITIES FOR BOAT RAMP *

ITEM NO.	QUANTITY	UNIT	ITEM
304(1)	75	Ton	Crushed Aggregate Base Grading D-1
403(1)	25.50	Ton	Hot Bituminous Pavement
403(2)	1.50	Ton	Asphalt Cement 120-150 Penetration
408(2)	0.35	Ton	M.C. 30 Prime Coat


* S-0943(7) Non-Participating

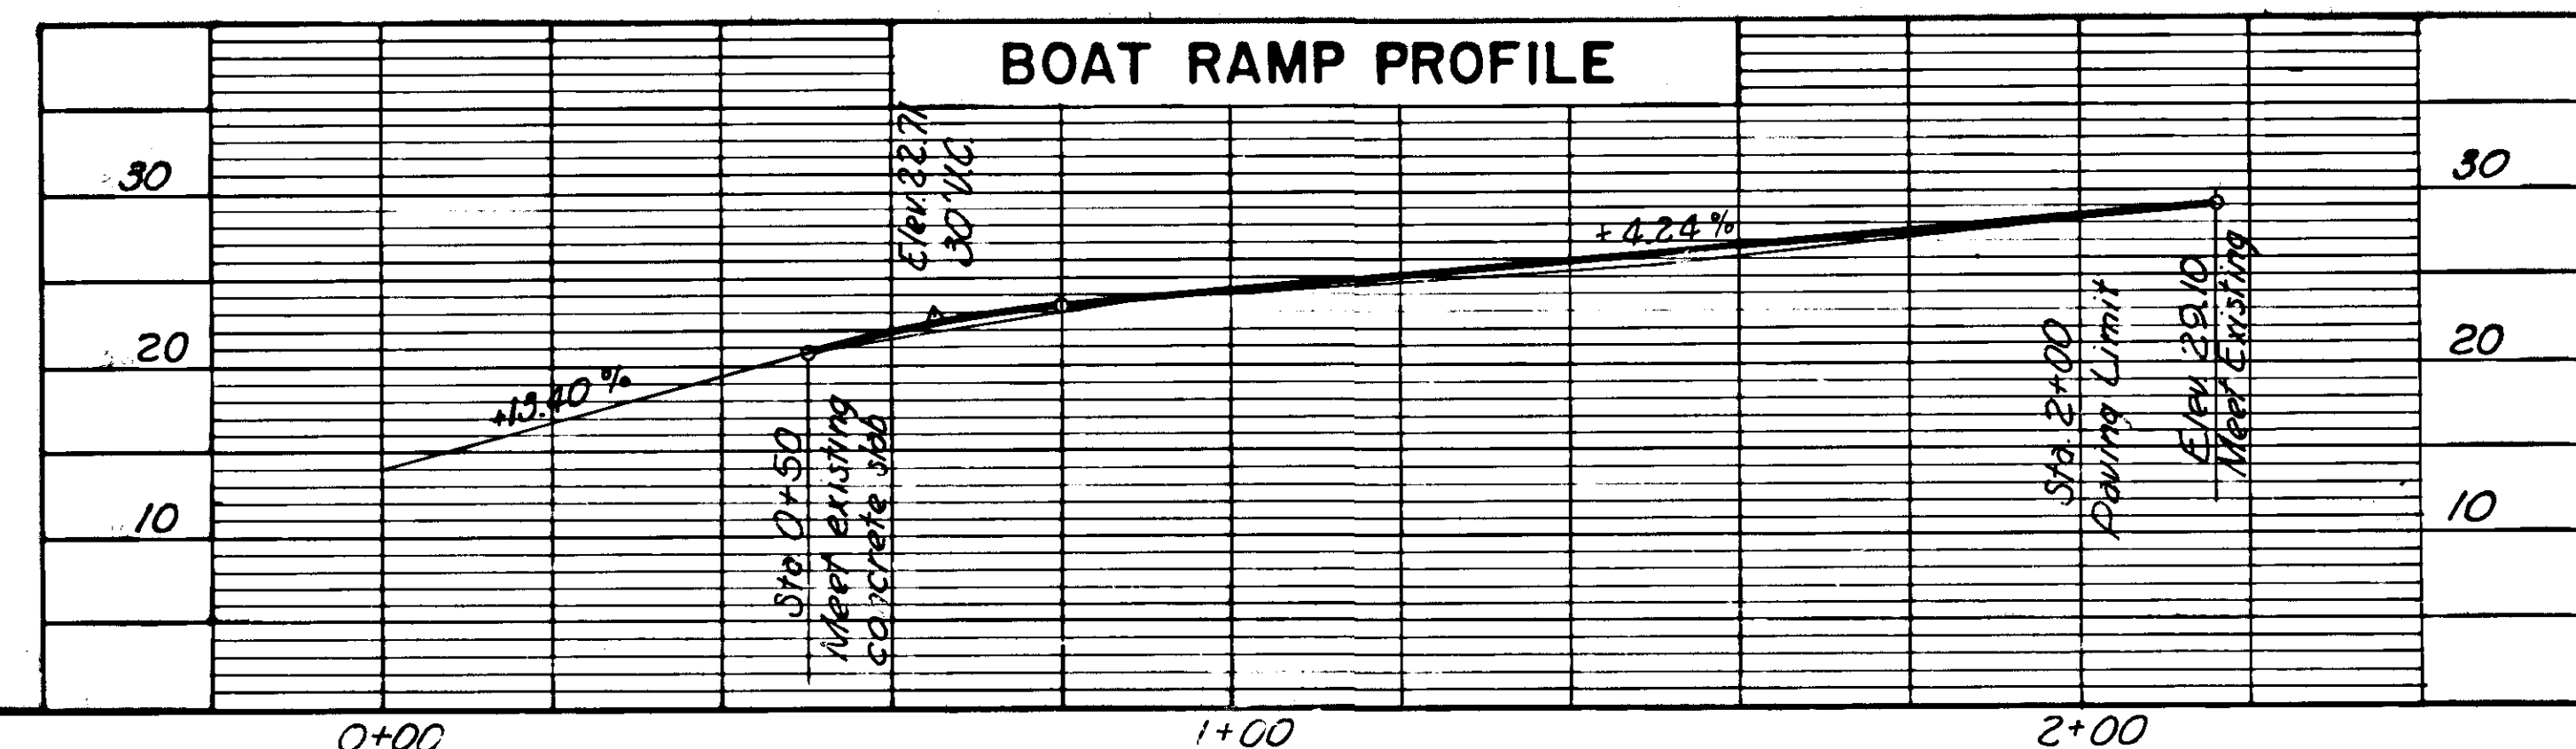

ZIMOVIA HIGHWAY PAVING S-0943(7)

STATE	PROJECT NO.	YEAR	SHEET NO.	TOTAL SHEETS
ALASKA	S-0943(7) F-095-A(1)	1967	24	34


Miscellaneous Clearing and Grubbing: The Removal of Trees, Trash Piles, Lumber, or Wood Piles, Abandoned or Junked Vehicles, Cutting Stumps Flush With The Ground, and Removing Stairways as Shown Below or as Directed by The Engineer.
3 Type 1 and 102 Type 2 approaches shall be surfaced as shown on Standard R-1(Modified). The necessary materials are included in the Estimate Of Quantities.

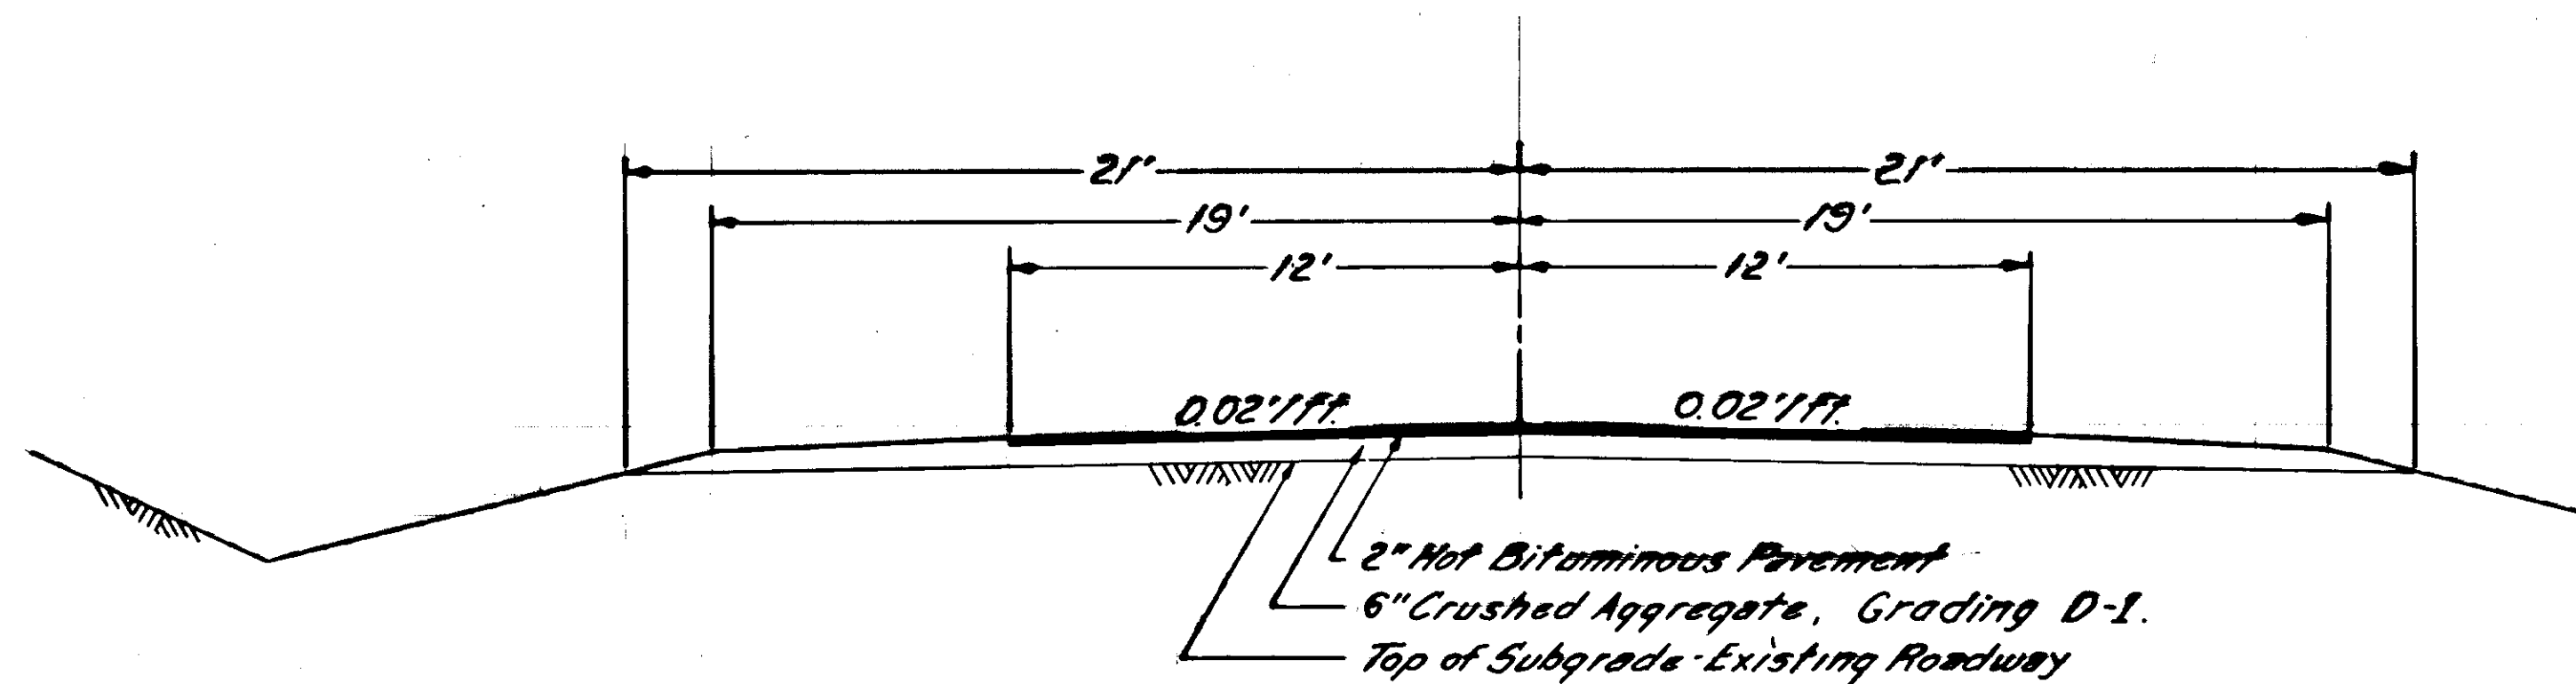


**CHURCH STREET TO SOUTH CITY LIMITS
MILE POINT 10.351 TO MILE POINT 9.478**

CLEARING AND GRUBBING

Station	Location	Description
M.P. 5.56	Left	Flush Cut Six Stumps
M.P. 5.61	Left	Flush Cut Stump
M.P. 6.56	Left	Remove Stump
M.P. 6.81		Remove Trash Pile
M.P. 7.21	Left	Remove Tree
M.P. 7.56	Right	Remove Lumber and Logs
M.P. 7.66	Left	Remove Lumber Pile
M.P. 7.71	Left	Remove Tree
M.P. 7.81	Left	Remove Two Trees
M.P. 7.86	Right	Remove Stairway
M.P. 8.21	Right	Remove Stump
M.P. 8.26	Left	Remove Tree
M.P. 9.01	Right	Remove Trash
M.P. 9.06	Left	Remove Lumber
M.P. 9.26	Left	Remove Stump
M.P. 9.86	Left	Remove Wood Pile

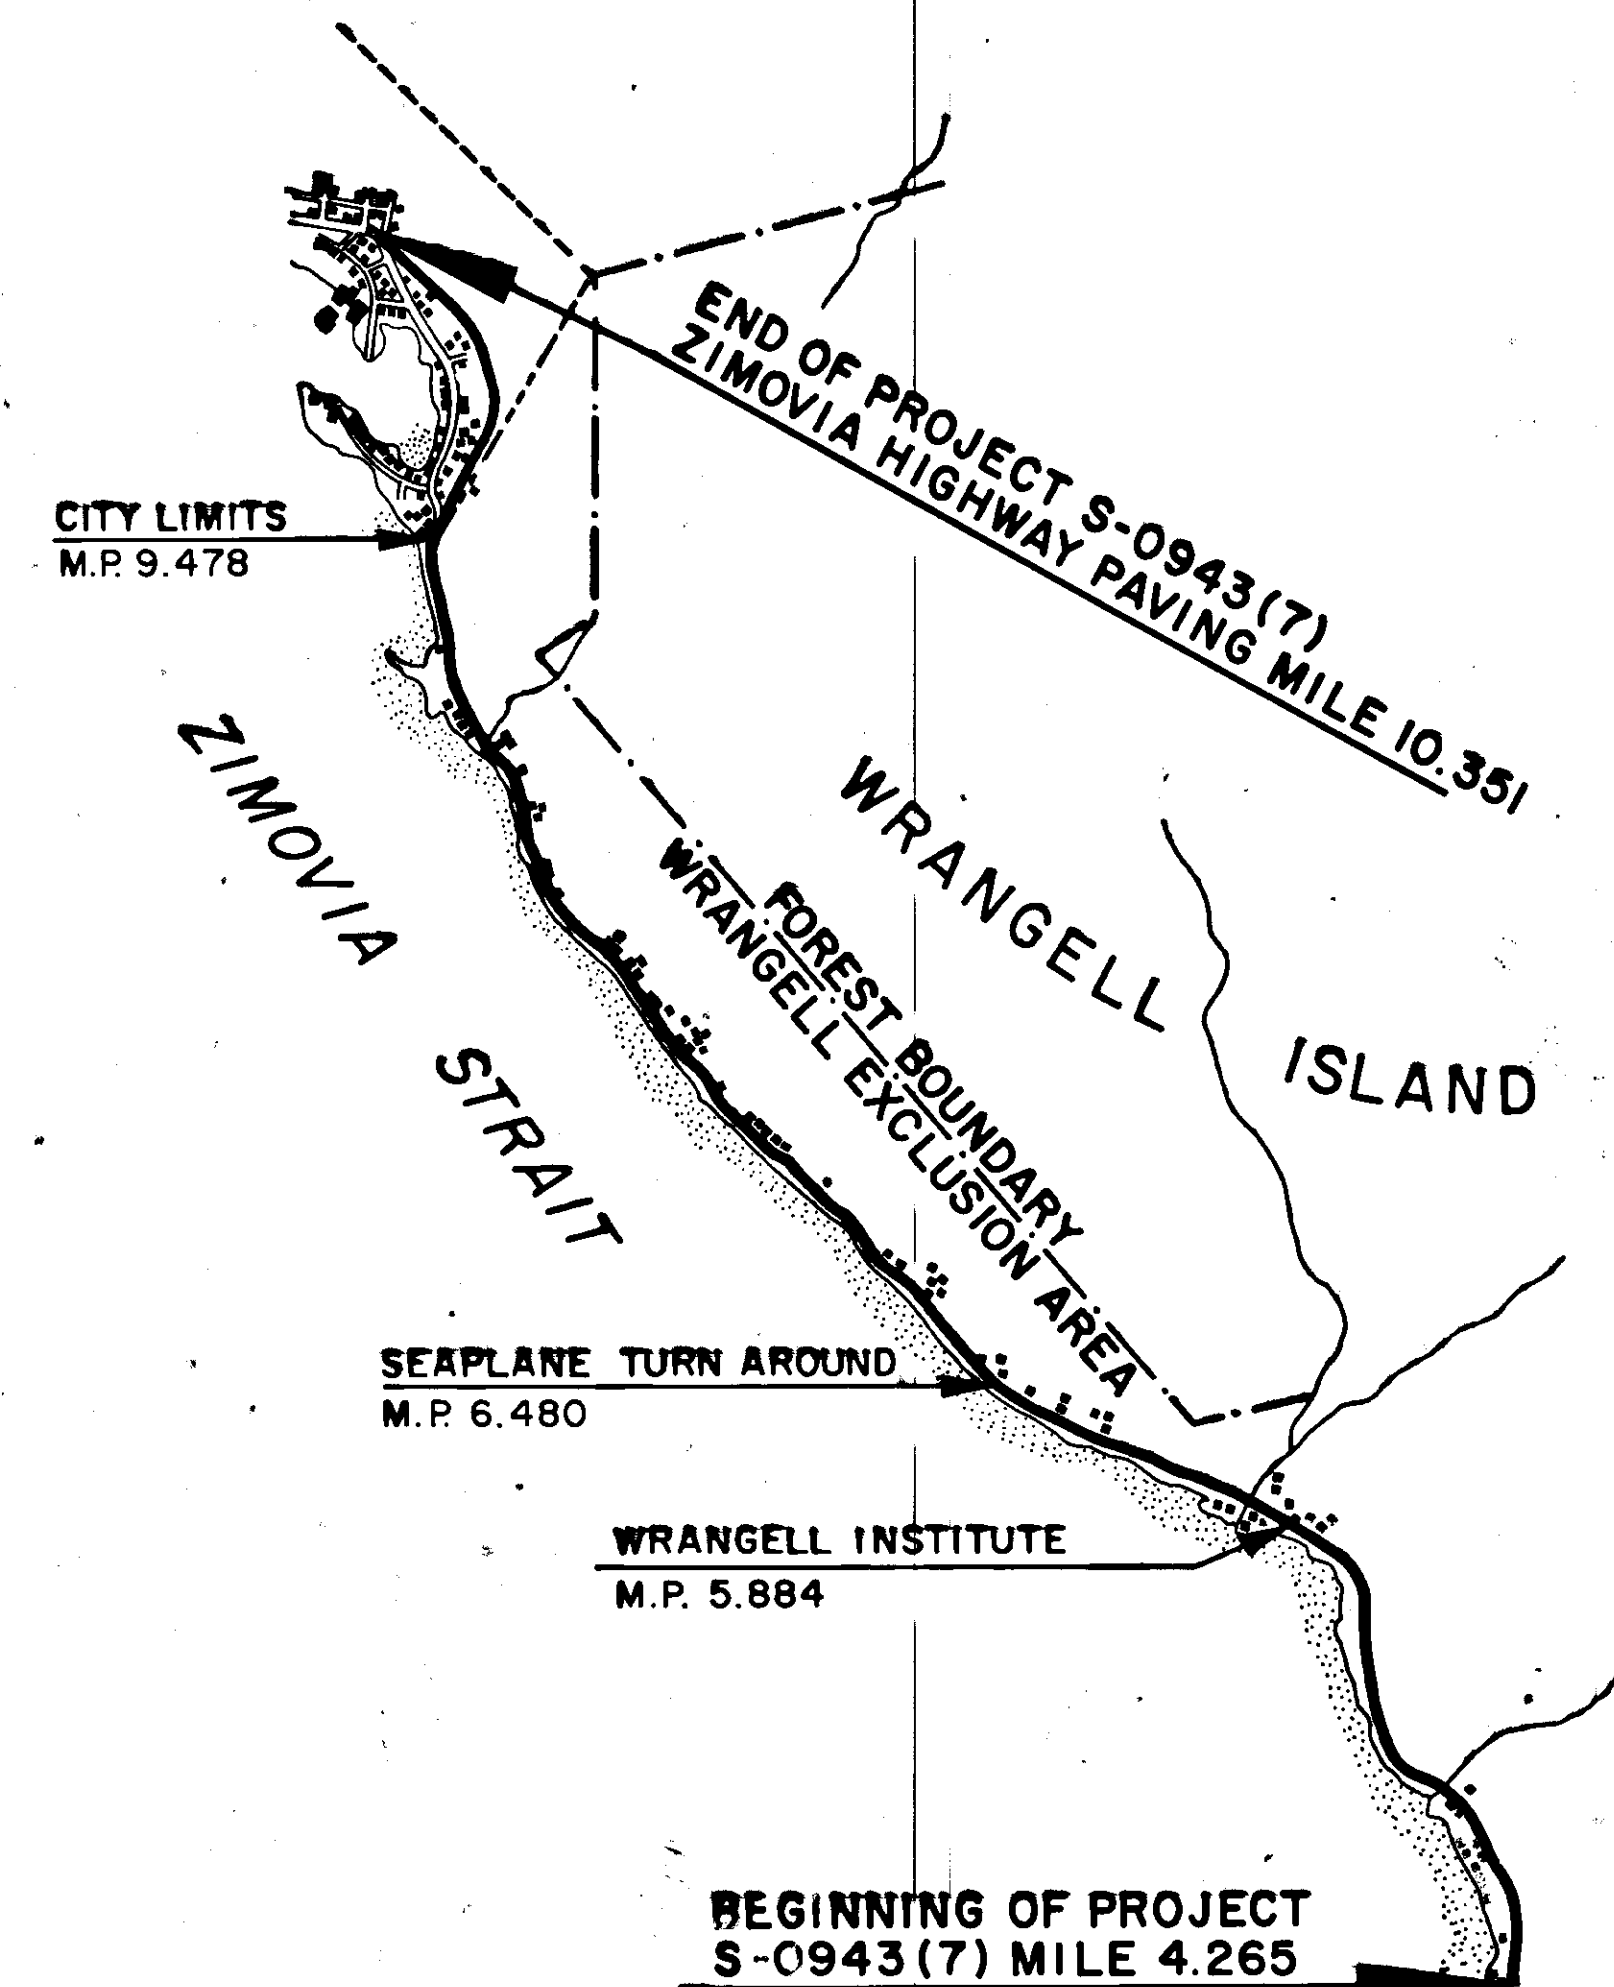

Note: Excavated Material to be wasted along fill slopes in a neat and orderly manner.

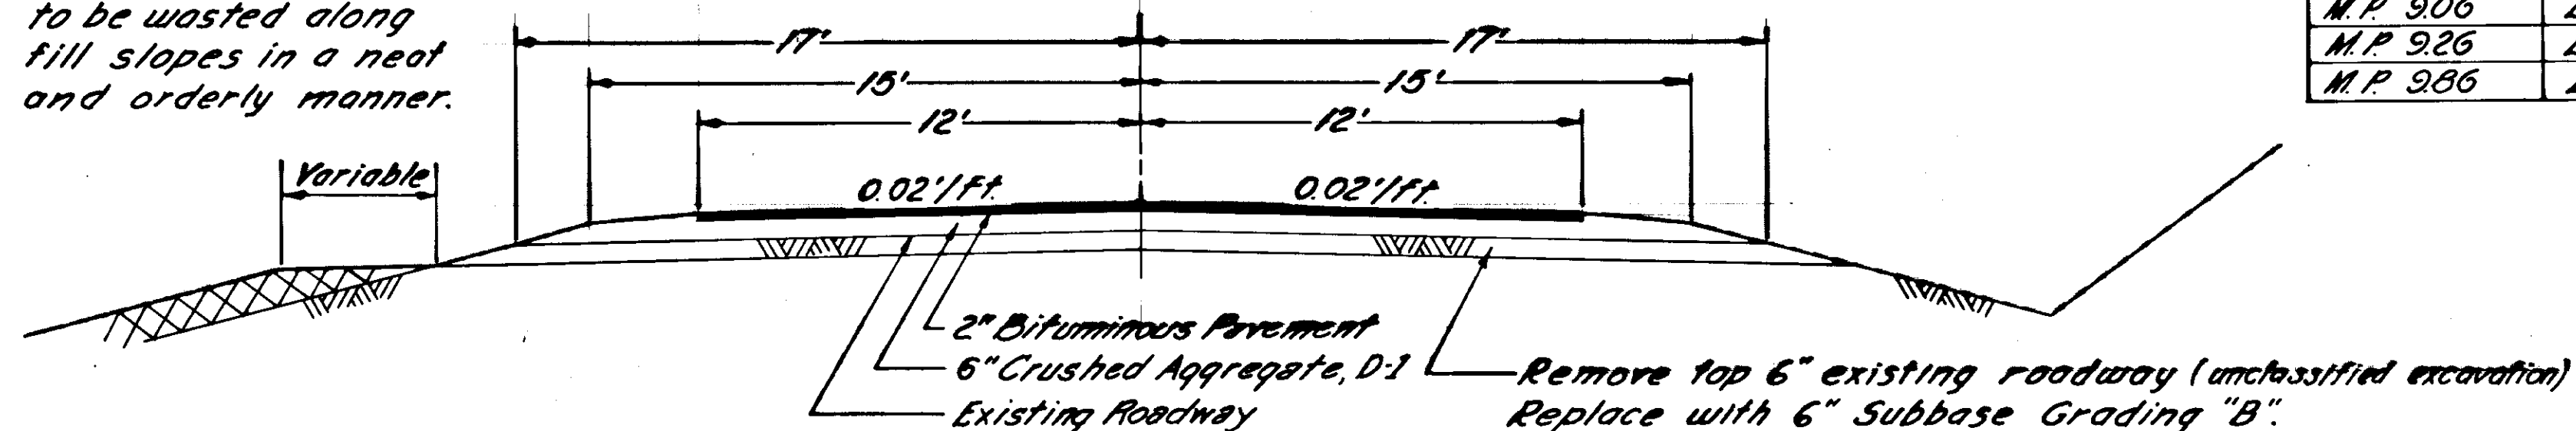

**SOUTH CITY LIMITS TO SAWMILL
MILE POINT 9.478 TO MILE POINT 4.265**

BEAM TYPE GUARDRAIL

Station	Left	Right
M.P. 4.795	75'	
M.P. 5.108	200'	200'
M.P. 5.998	200'	200'

MONUMENTS & CASES

Station	Location
M.P. 9.478 P.C.	Adjust
M.P. 9.517 P.T.	Adjust
M.P. 9.617 P.C.	Adjust
M.P. 9.659 P.T.	Adjust
M.P. 9.781 P.C.	Adjust
M.P. 9.902 P.T.	Adjust
M.P. 10.101 P.C.	Adjust
M.P. 10.159 P.T.	Adjust
M.P. 10.307 P.C.	Adjust
M.P. 10.343 P.T.	Adjust

CULVERT SUMMARY

Station	Structure Excavation	24" Pipe Conduit	36" Pipe Conduit	Removal of Culvert Pipe
	205(1)	603(26G)	603(26I)	202(4)
	Cu. Yds.	Lin. Ft.	Lin. Ft.	Lin. Ft.
M.P. 6.397	32.4	50		46
M.P. 7.466	57.2		56	50
M.P. 9.171	38.9	60		50
Total	128.5	110	56	146

ESTIMATE OF QUANTITIES FOR S-0943(7)

Item No.	Quantity	Unit	Item
202(4)	146	Lin. Ft.	Removal and Disposal of Culvert Pipe
206(1)	129	Cu. Yds.	Structure Excavation
304(1)	48,536	Ton	Crushed Aggregate, Base Course, Grading D-1
403(1)	9,944	Ton	Hot Bituminous Pavement
403(2)	596.7	Ton	Asphalt Cement 120-150 Penetration
408(2)	104.4	Ton	M.C. 30 Liquid Asphalt for Prime Coat
603(26G)	110	Lin. Ft.	24" Pipe Conduit
603(26I)	56	Lin. Ft.	36" Pipe Conduit
606(2)	875	Lin. Ft.	Beam Type Guardrail, Type II Posts
614(3)	10	Each	Adjust Existing Monument and Cases
201(3)	All Required	Lump Sum	Clearing and Grubbing
203(3)	18,350	Cu. Yds.	Unclassified Excavation
307(1)	35,833	Ton	Subbase, Grading B
306(1)	6.09	Mile	Reconditioning

Missing pages 25-34