
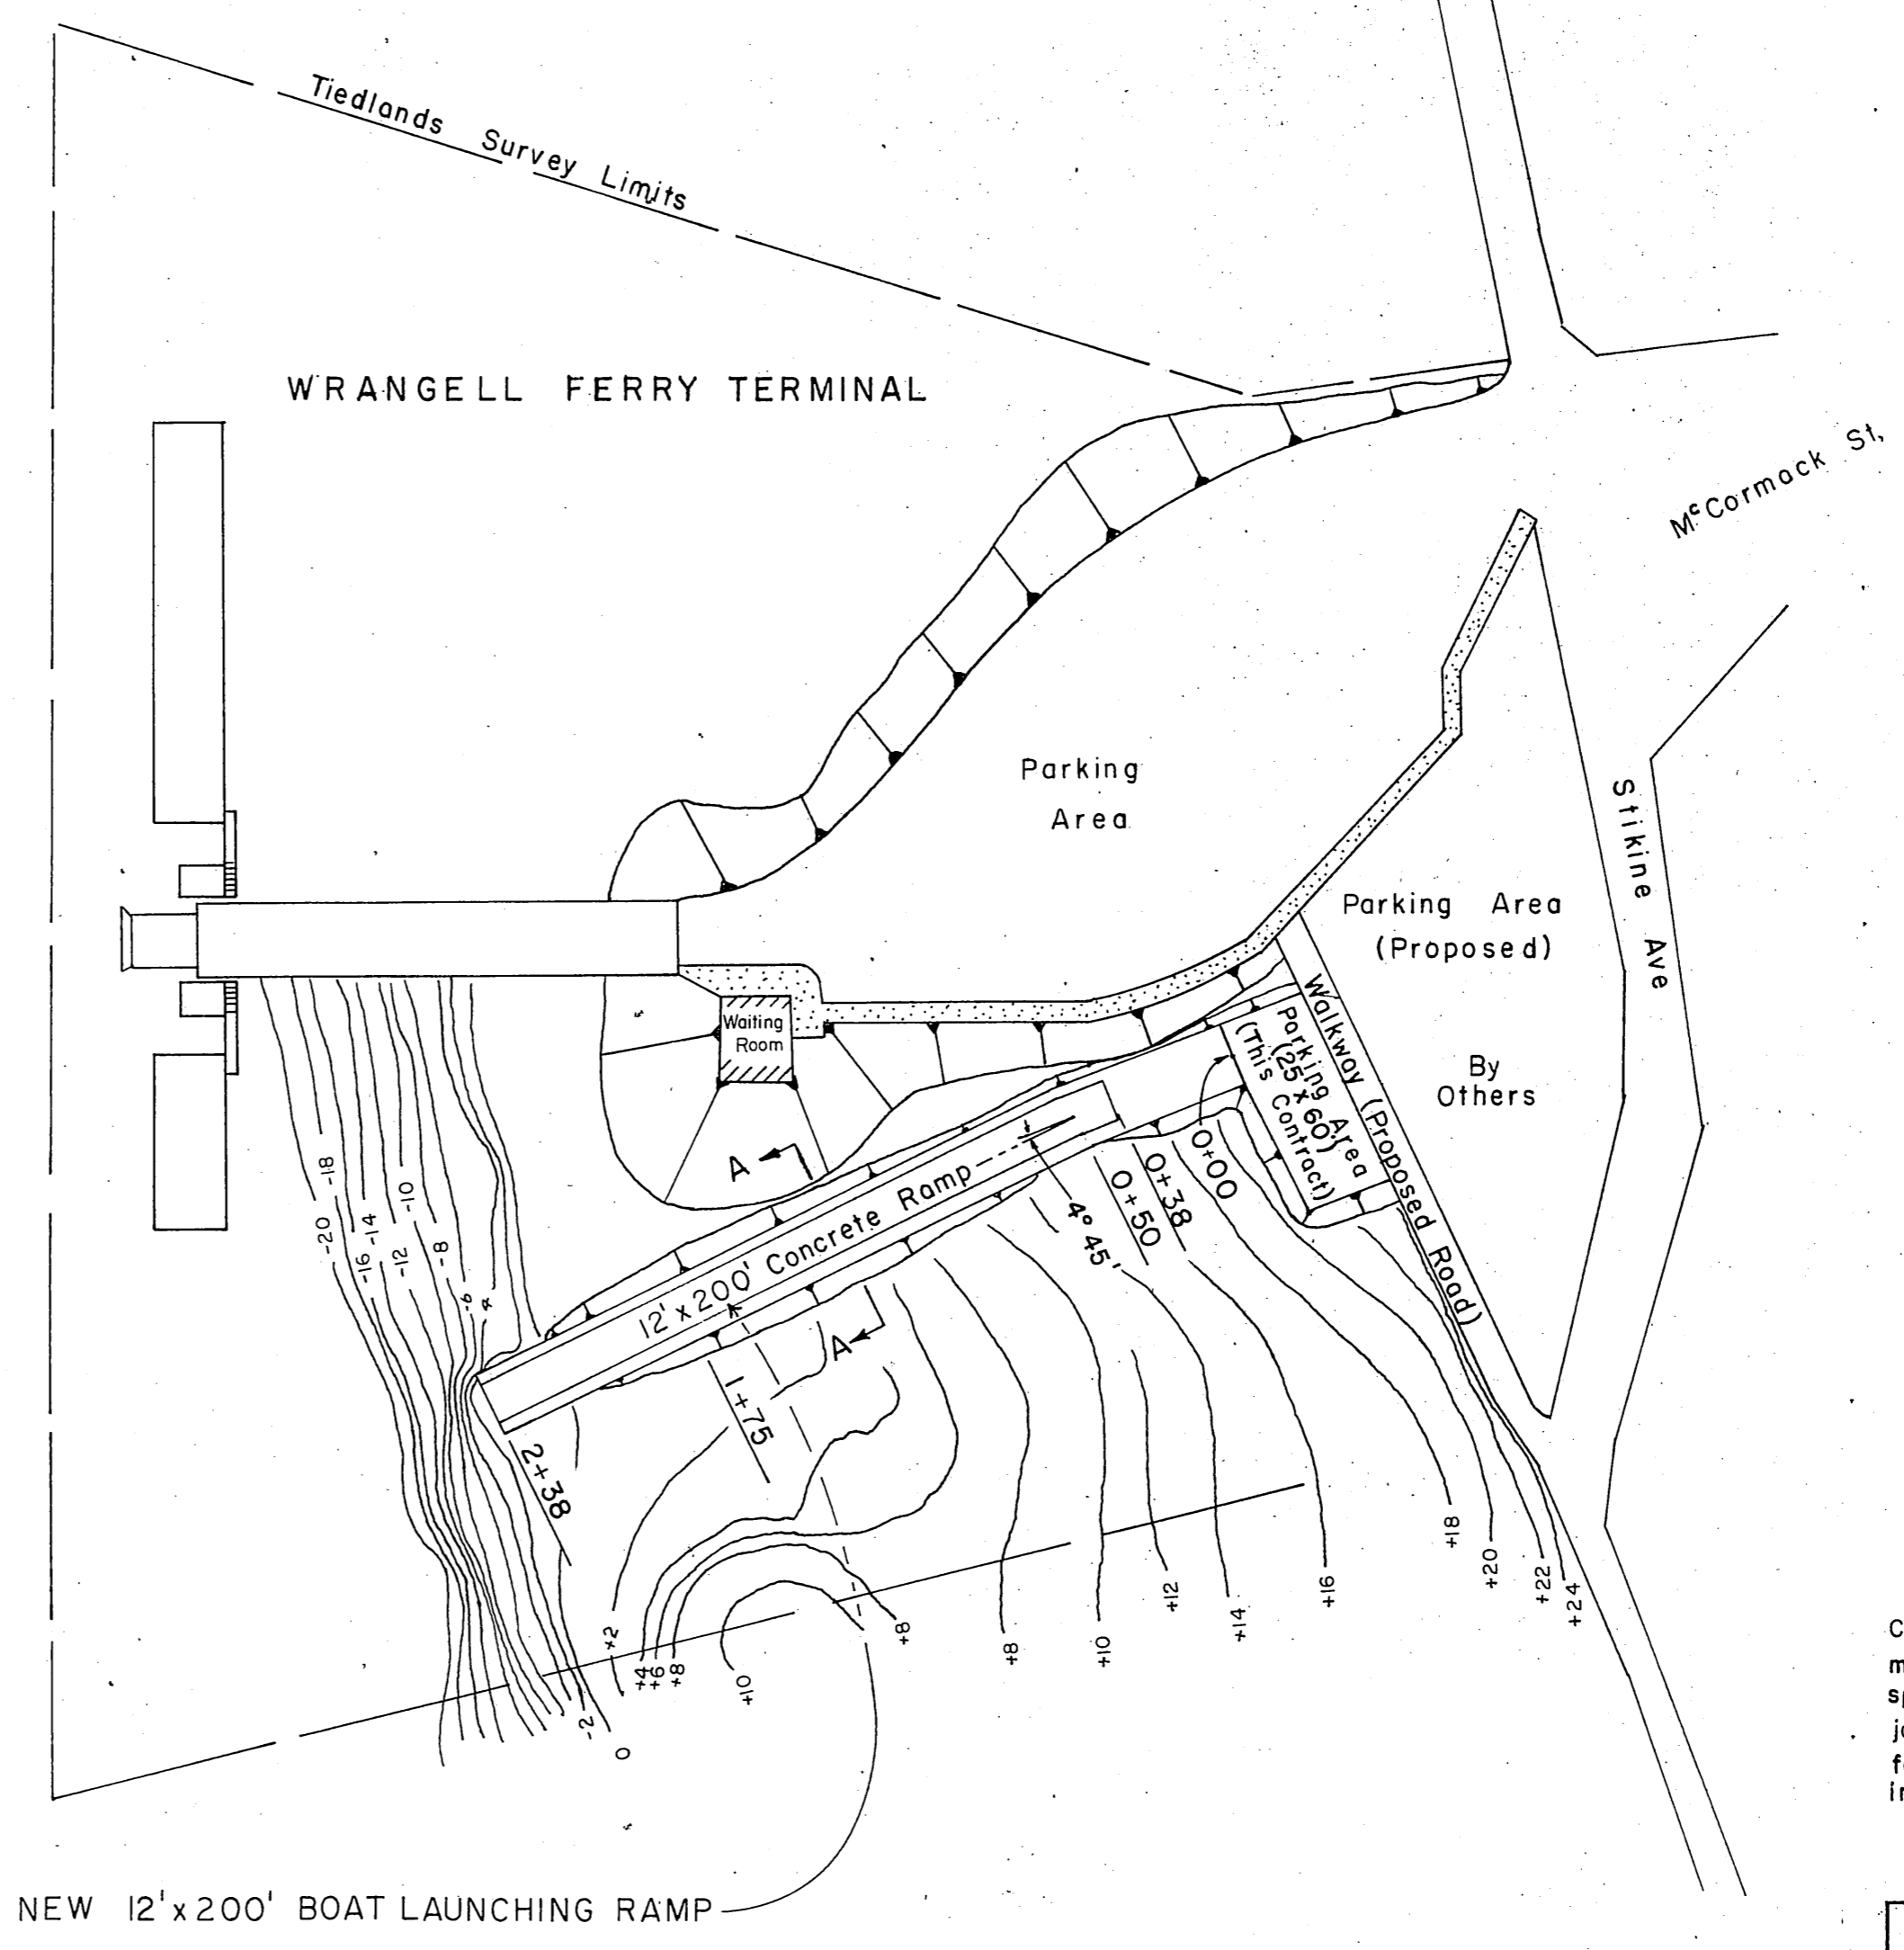
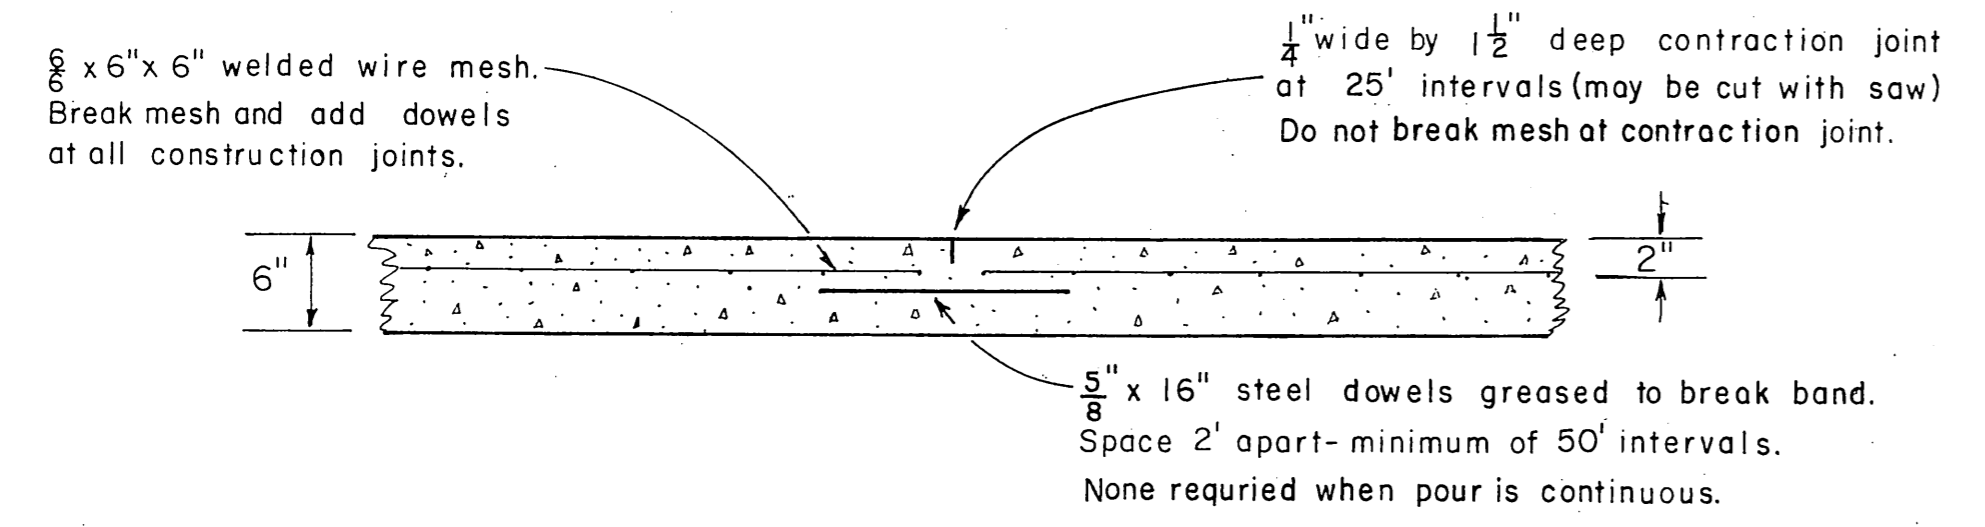
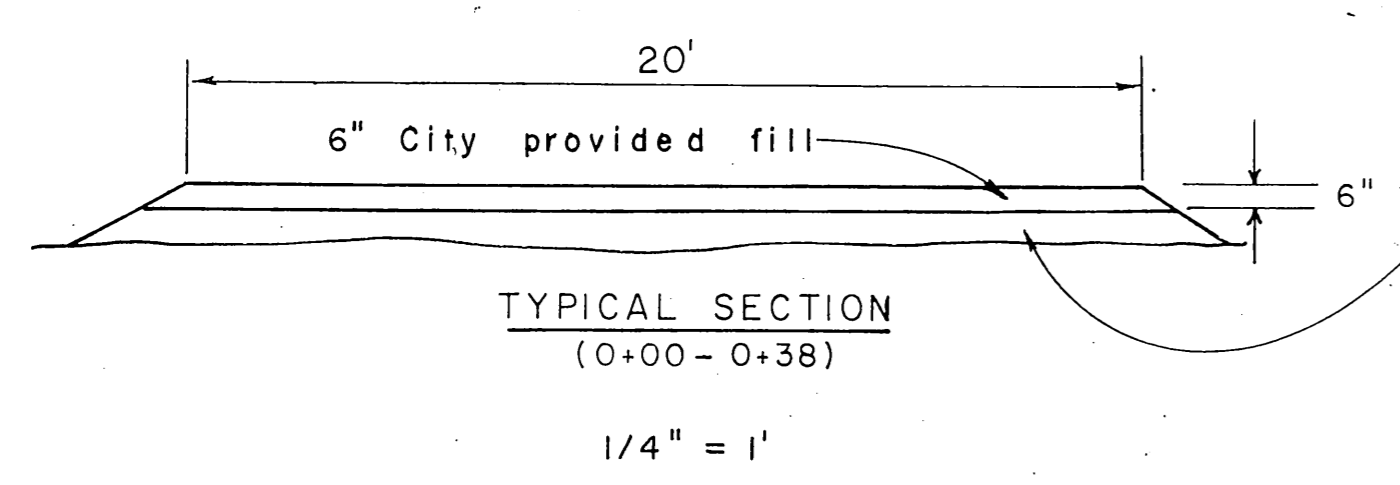
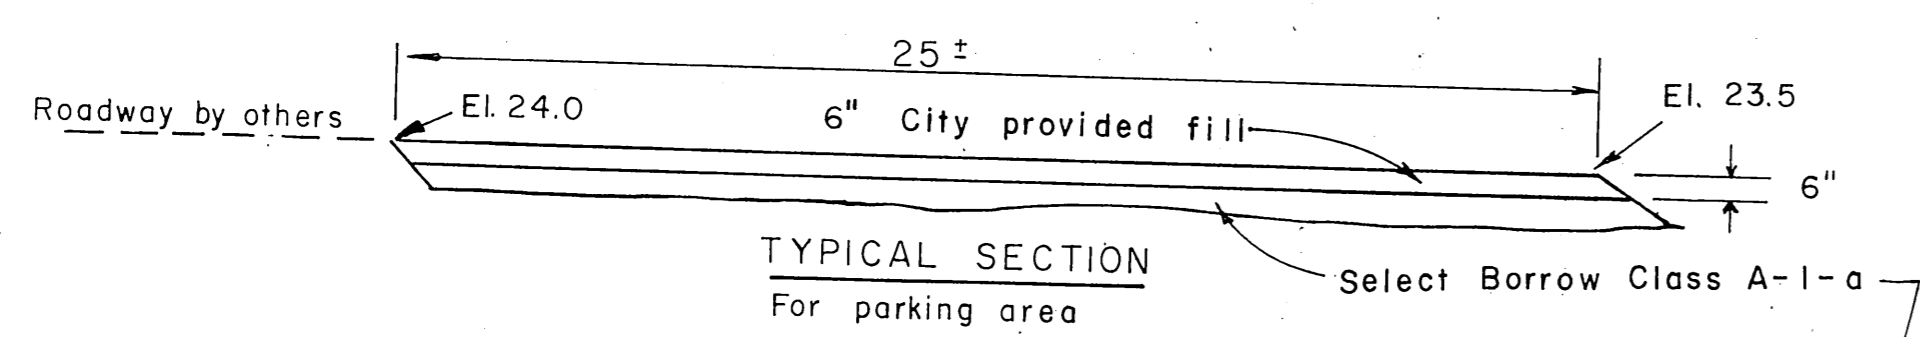
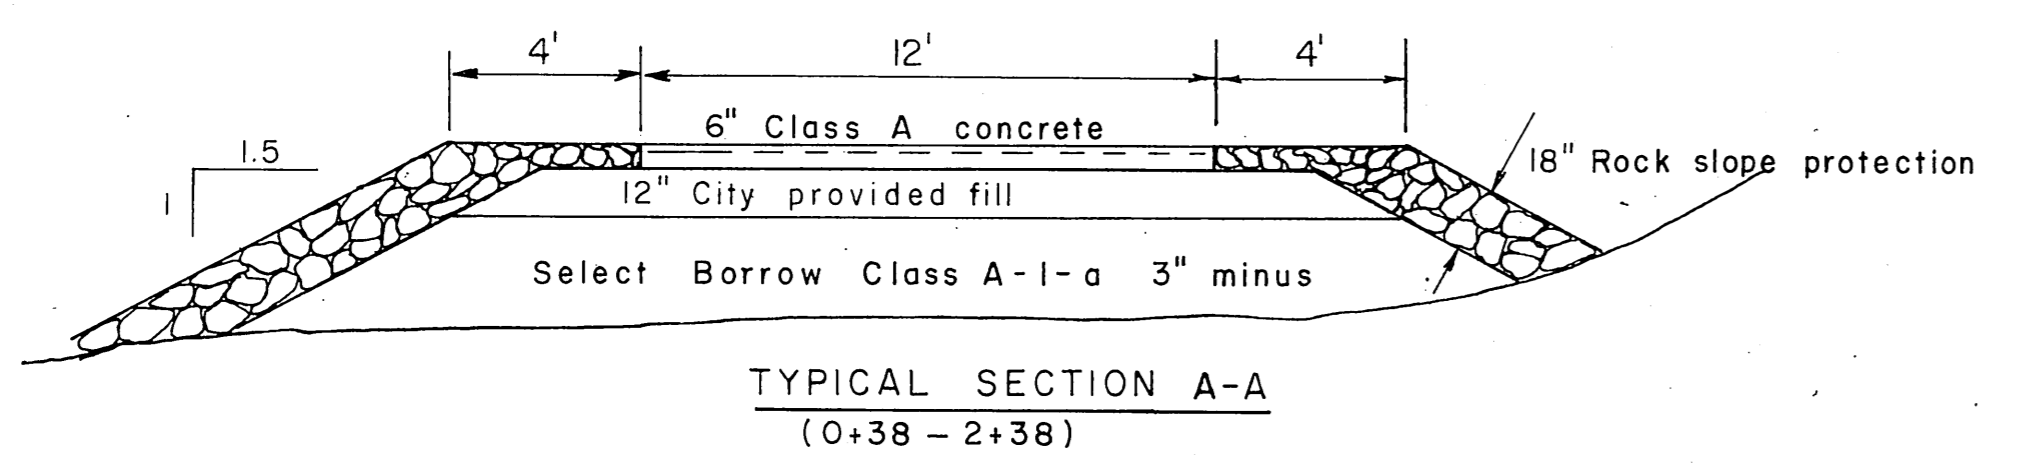


Wrangell Boat Launching Ramp A-4-82

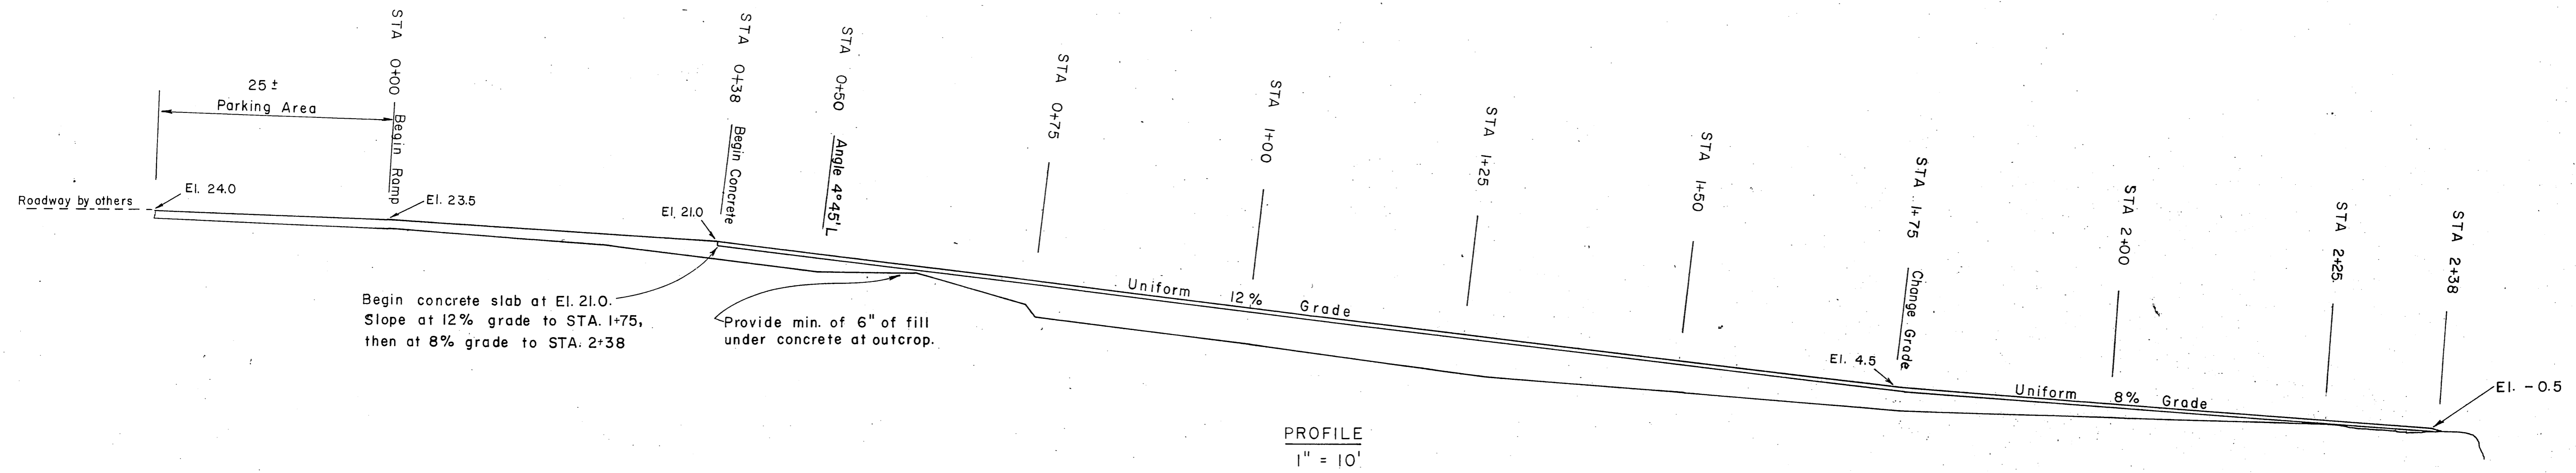

NOTES

Concrete shall consist of a 6 1/2 sack Class A concrete mix of the approx. proportions as listed in the specifications and approved by the Engr. Construction joints shall be located in such a manner as to fall at contraction joints, but shall not be at intervals of less than 50'.

STATE OF ALASKA DEPARTMENT OF PUBLIC WORKS DIVISION OF WATER AND HARBORS	
WRANGELL BOAT LAUNCHING RAMP	
SCALE As shown	DATE July 1965
PROJ. NO. W 66156	APPROVED <i>[Signature]</i> COMMISSIONER
SURVEYED BY WE DW DRAWN BY WE DW CHECKED BY DW	