


BRACE PILE TO TOWER CONNECTION DETAILS

NOTES:
 All new timber materials are treated, see specs.
 All new steel materials are galvanized, see specs.

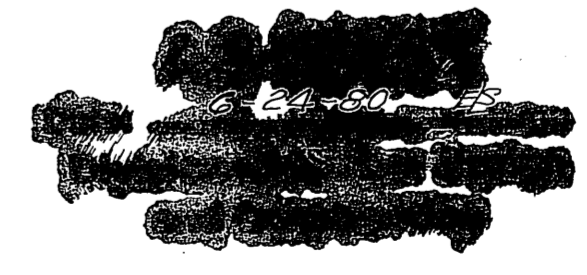

DO NOT SCALE THIS DRAWING - USE DIMENSIONS		
STATE OF ALASKA DEPARTMENT OF TRANSPORTATION AND PUBLIC FACILITIES DIVISION OF HARBOR DESIGN AND CONSTRUCTION		
WRANGELL FERRY TERMINAL IMPROVEMENTS		
SCALE As Shown	SURVEYED DCW	APPROVED
DESIGNED DCW	DRAWN ELS	Don Statter
CHECKED RPB	DATE 8-1-79	DIRECTOR
PROJECT NUMBER X30100	SHEET 1 OF 1	