



LOCATION MAP

NO SCALE

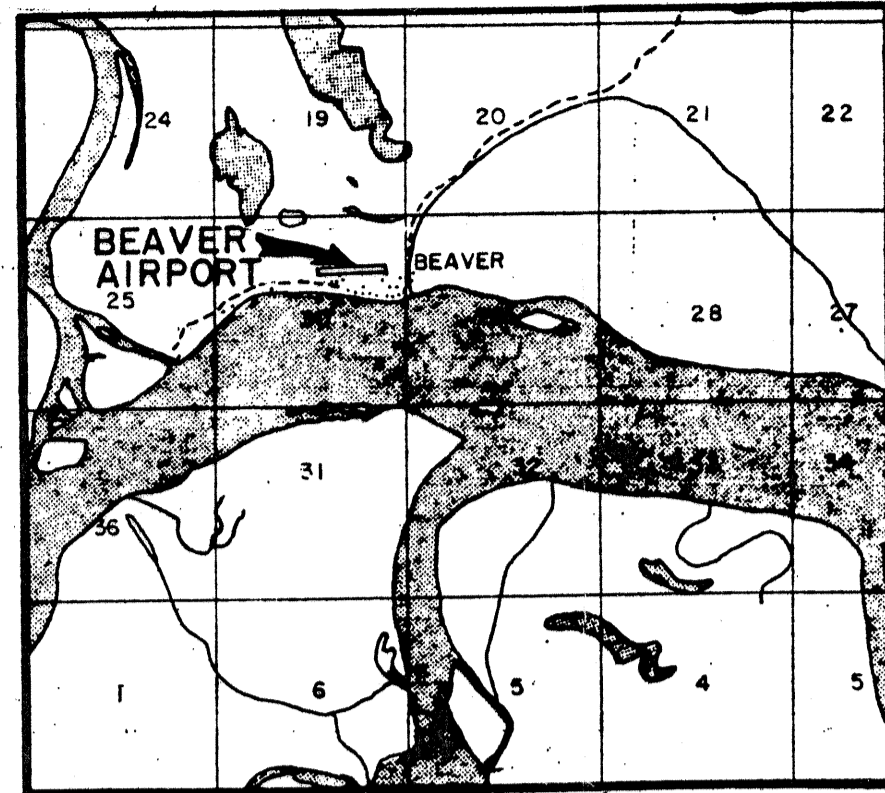

VICINITY MAP

SCALE: 1" = 1 MILE
SEC. 30, T18N, R2E
FAIRBANKS MERIDIAN
QUAD. MAP BEAVER (B-1)

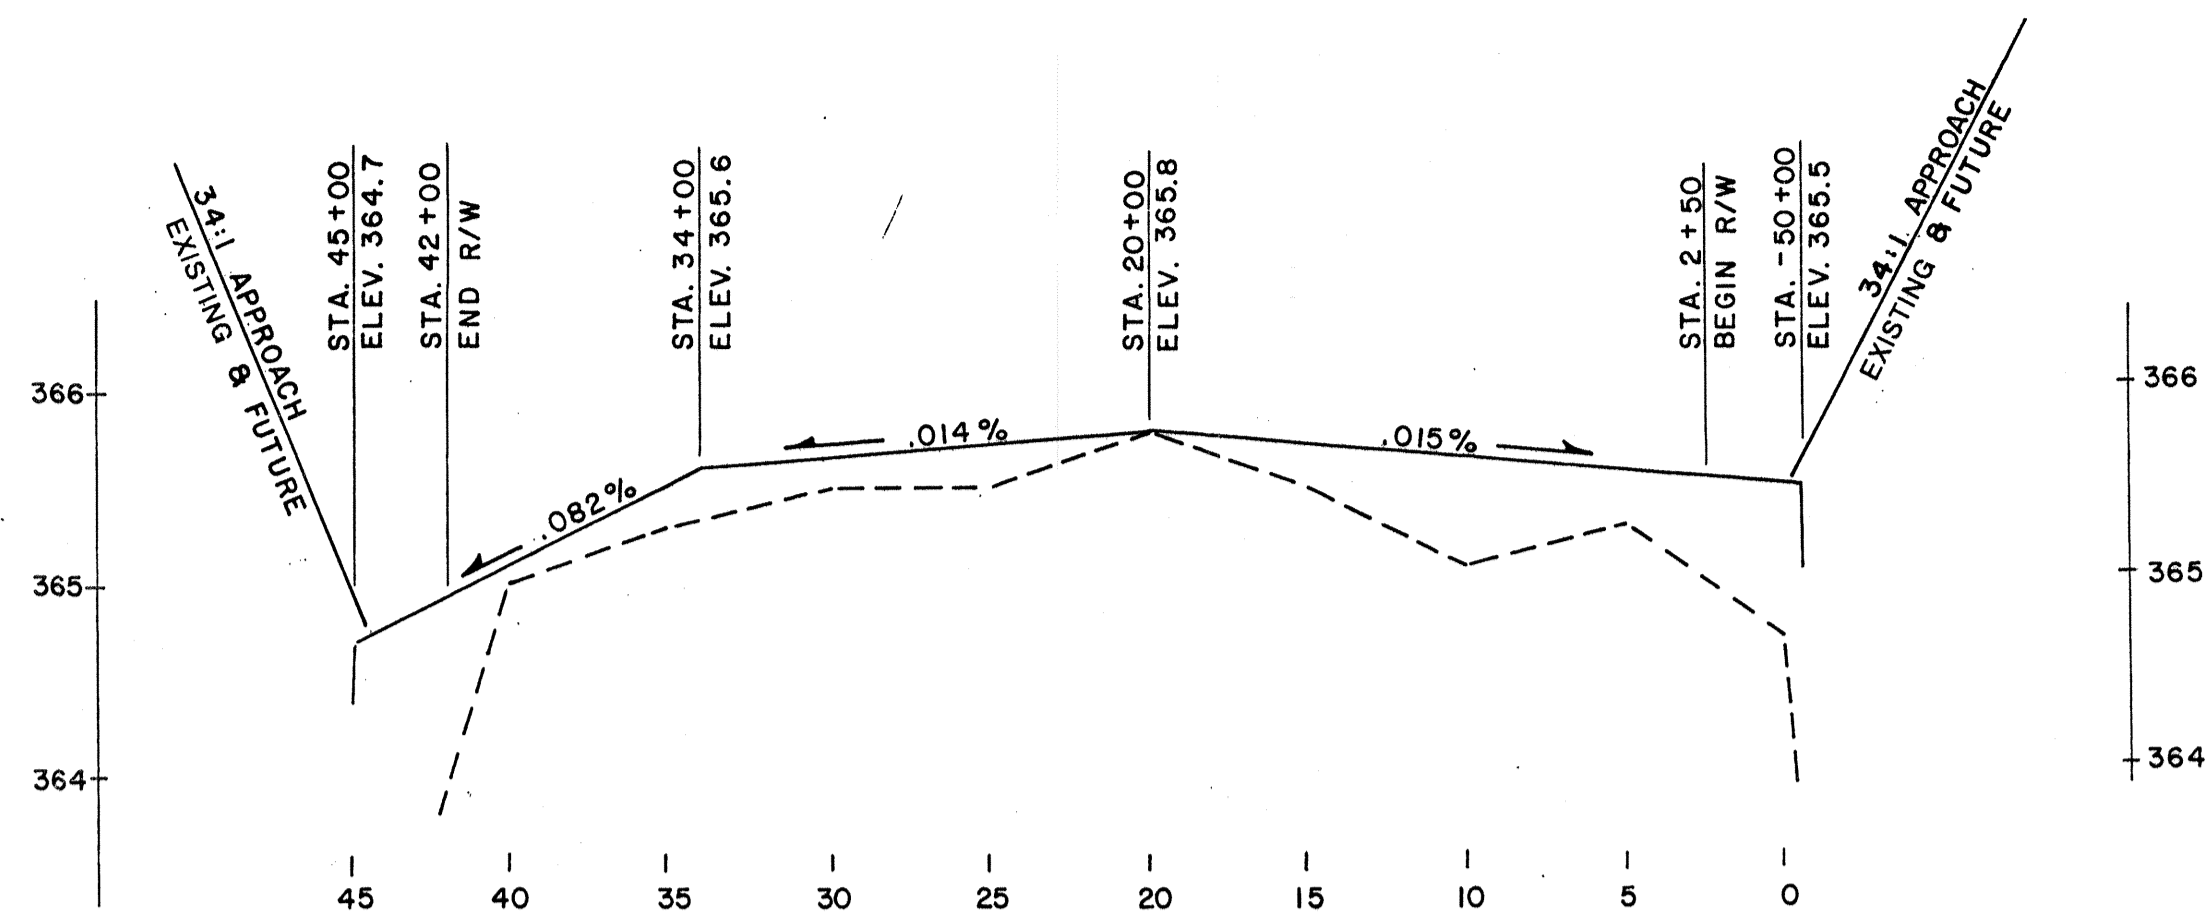


RUNWAY PROFILE

SCALE: HORZ. 1" = 600'
VERT. 1" = 1'



NOTE: PROFILE IS APPROXIMATE

NO WIND DATA AVAILABLE.

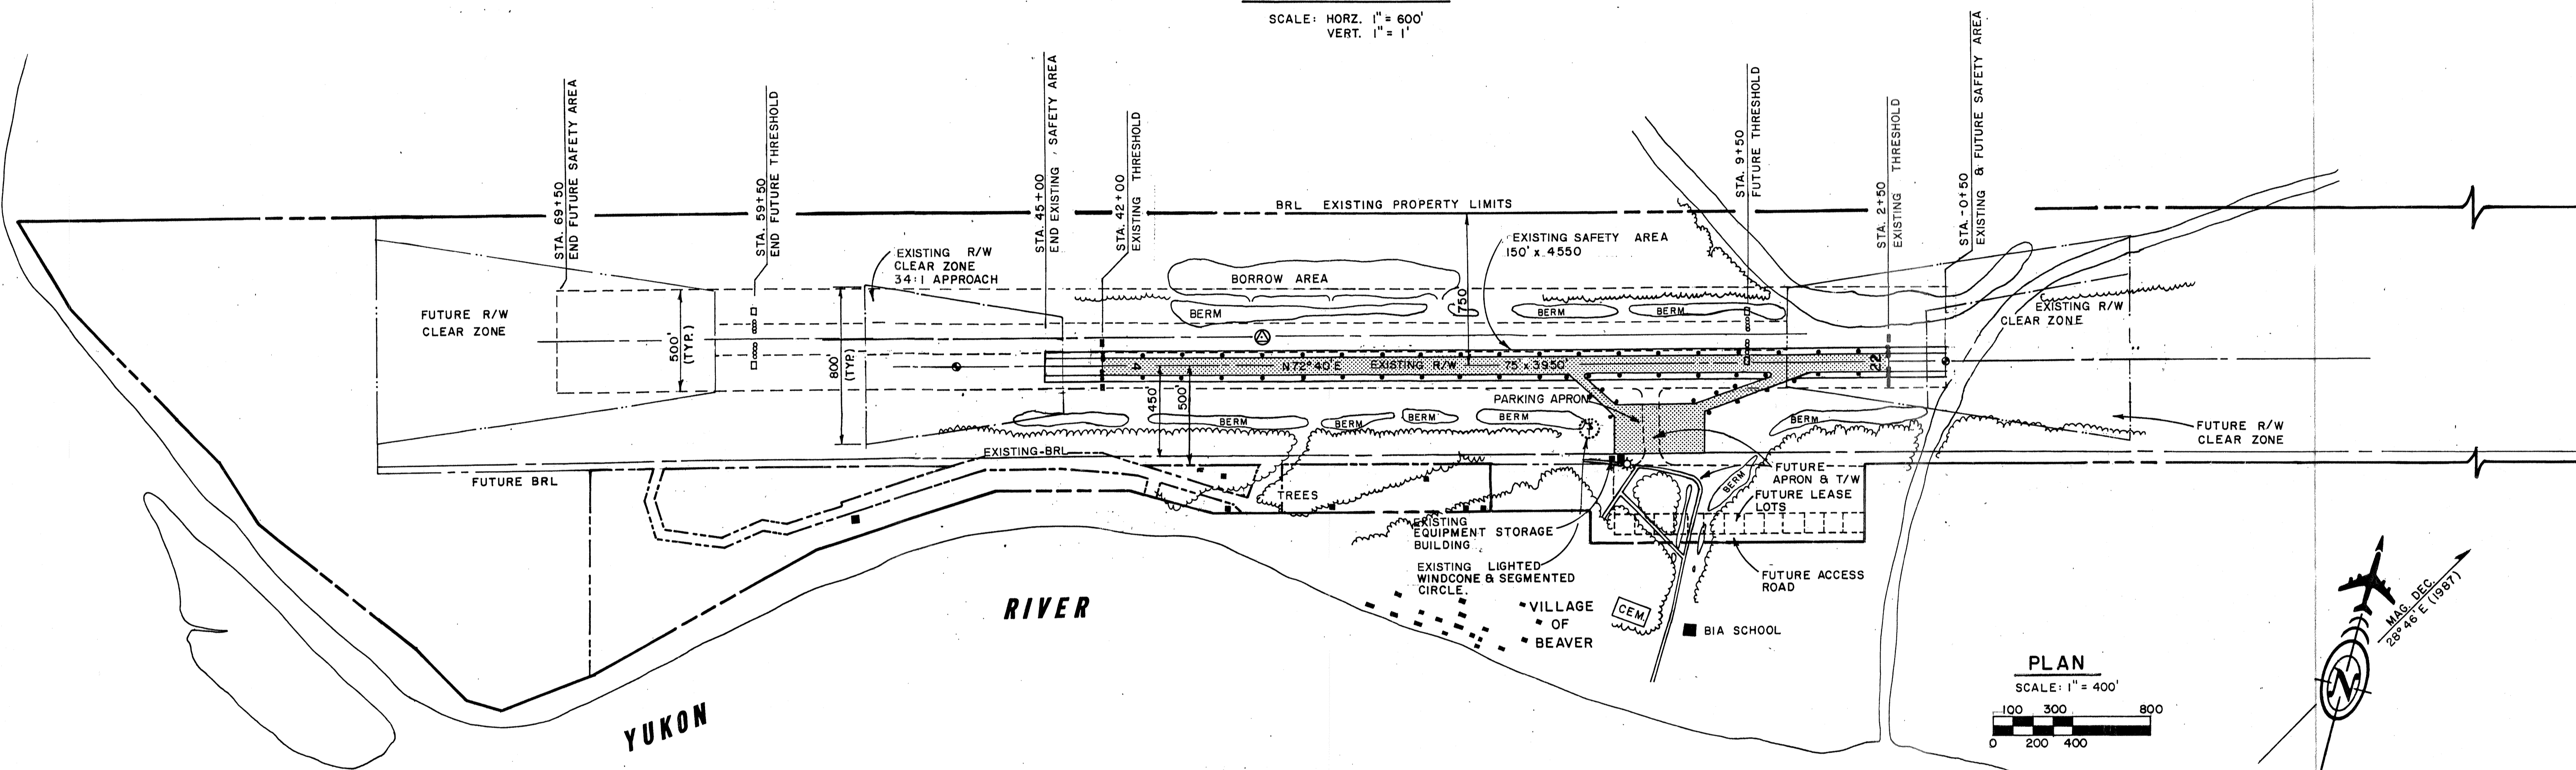

PLAN

SCALE: 1" = 400'

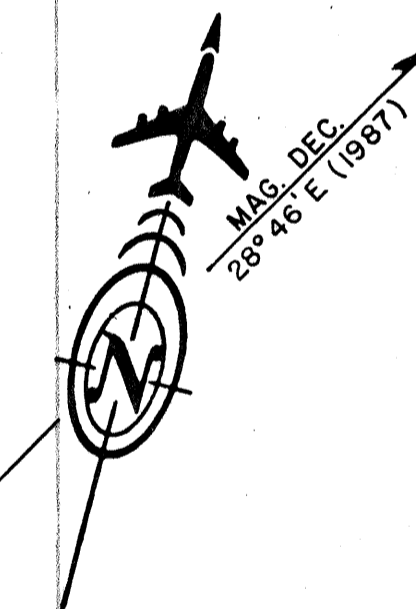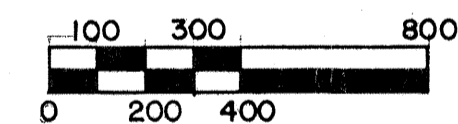

RUNWAY DATA	4/22		RUNWAY	
	EXISTING	FUTURE	PROPOSED	FUTURE
EFFECTIVE GRADIENT	.01	.01		
% WIND COVERAGE				
INSTRUMENT RUNWAY	N/A	N/A		
PAVEMENT SURFACE	GRAVEL	GRAVEL		
PAVEMENT STRENGTH	NONE	NONE		
APPROACH SURFACES	34:1	34:1		
RUNWAY LIGHTING	M1	M1		
RUNWAY MARKING				
NAVIGATION AIDS	NONE	NONE		
RUNWAY SAFETY AREA	150' x 4550'	500' x 7000'		
RUNWAY DIMENSION	75' x 3950'	150' x 5000'		
AIRPORT CATEGORY	UTILITY	TRANSPORT		

AIRPORT DATA	EXISTING		FUTURE	
	AIRPORT ELEVATION MSL	365.8	365.8	
MEAN TEMP HOTTEST MONTH	72.1/JULY	72.1/JULY		
AIRPORT & TERMINAL NAVAIDS	NONE	NONE		
RUNWAY/TAXIWAY LIGHTING	M1	M1		
RAMP LIGHTING	NONE	NONE		
AIRPORT REFERENCE PT.(ARP) LAT.	N66°22'			
DESIGN TYPE	LONG.		II	III
SERVICE LEVEL				

LEGEND	EXISTING		FUTURE	
	PROPERTY LINE	---	---	---
BUILDING RESTRICTION LINE (B.R.L.)	---	---	---	---
CLEAR ZONE	---	---	---	---
M.I. RUNWAY & TAXIWAY LIGHTS	•	•	•	•
SURVEY MONUMENTS	⊕	⊕	⊕	⊕
WIND CONE (LIGHTED)	⊕	⊕	⊕	⊕
WIND CONE (UNLIGHTED)	⊕	⊕	⊕	⊕
ROTATING BEACON	⊕	⊕	⊕	⊕
BUILDINGS	▭	▭	▭	▭
ROADWAYS	---	---	---	---
VASI	---	---	---	---
FACILITIES	---	---	---	---
AIRPORT REFERENCE POINT	⊕	⊕	⊕	⊕
RUNWAY BOUNDARY MARKERS	---	---	---	---

DEVIATION FROM DESIGN STANDARDS	EXISTING		FUTURE	
	ITEM			
BUILDING RESTRICTION LINE	450' LT.		625'	

APPROVED
By: *Paul W. ...*
AIRPORTS DIVISION, ALASKAN REGION
Date: 10/31/02

DESIGN	DATE	BY	REVISIONS
EMS			
7/24/02	AS-BUILT		
5/3/88	FAA APPROVED		

STATE OF ALASKA
DEPARTMENT OF TRANSPORTATION AND PUBLIC FACILITIES
NORTHERN REGION - DESIGN AND CONSTRUCTION - AVIATION

APPROVED
Daniel D. Urbach
DANIEL D. URBACH, P.E. CHIEF AVIATION DESIGN GROUP

DATE: 10/15/02

SUPERCEDS ALP DATED 4/21/83, REV. THRU 10/81.

BEAVER AIRPORT
AIRPORT LAYOUT PLAN

SHEET
1 OF 1