PROJECT DESIGNATION	SHEET NO.	TOTAL SHEETS
STP-0551(3)	R14	R39

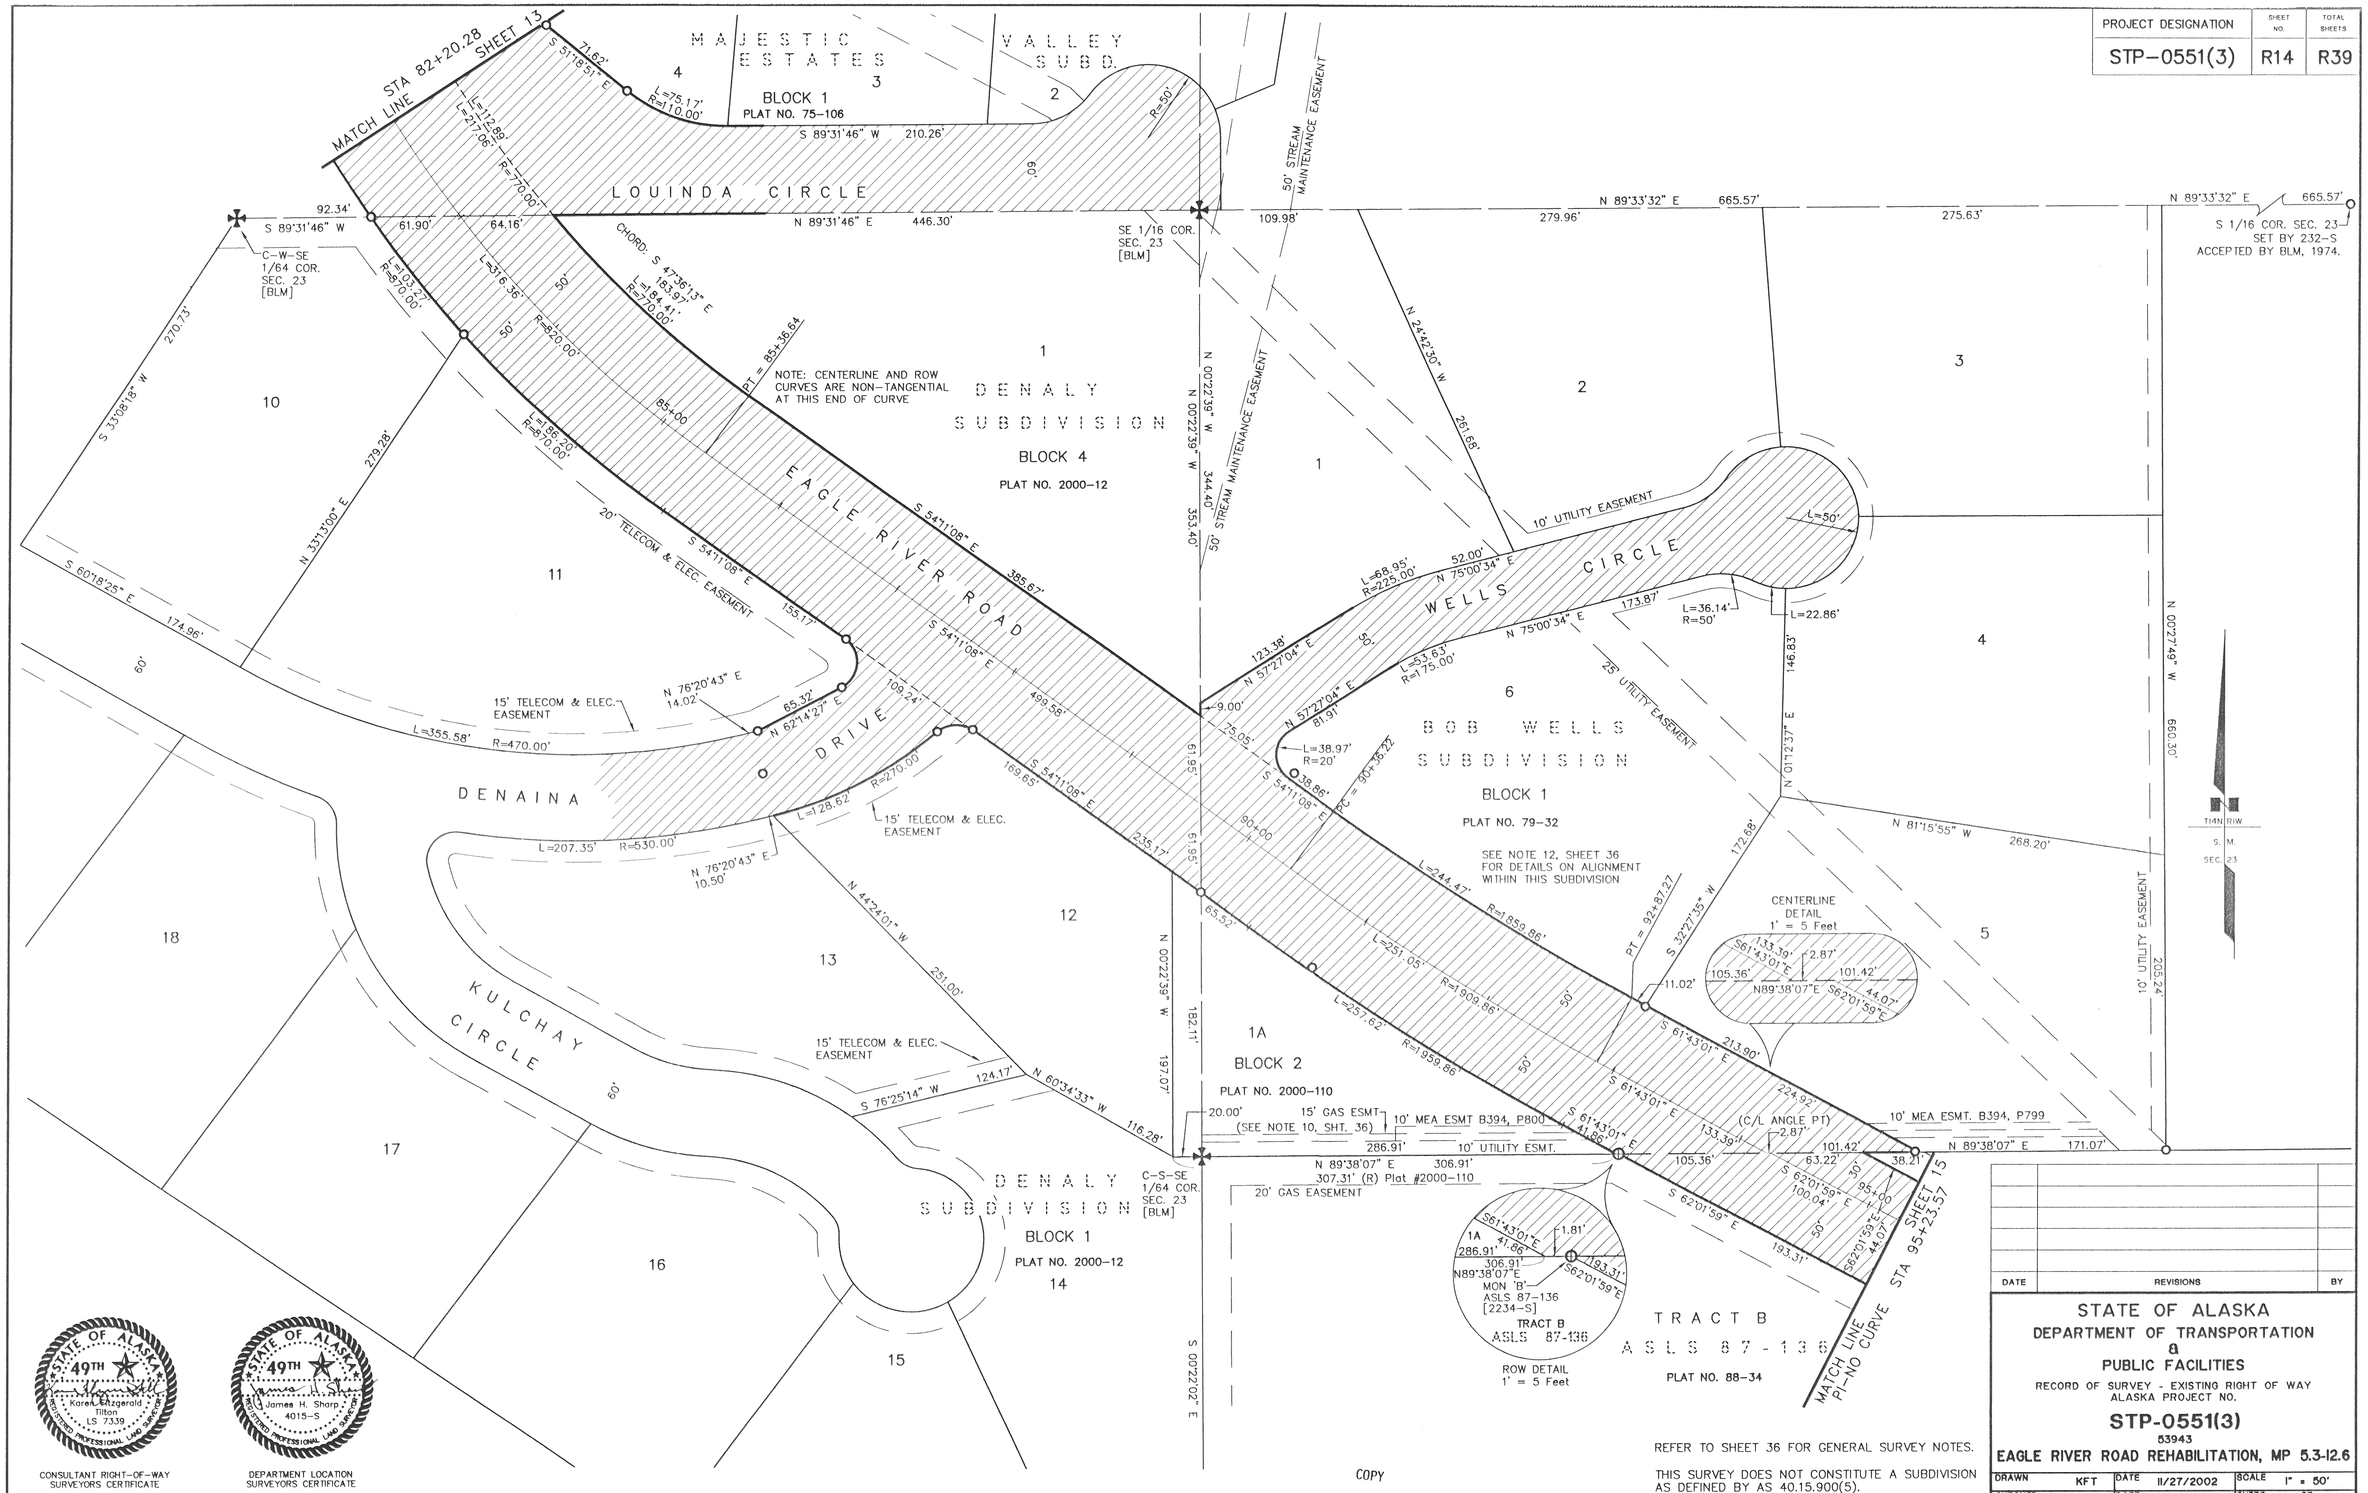

DATE	REVISIONS	BY

STATE OF ALASKA
DEPARTMENT OF TRANSPORTATION & PUBLIC FACILITIES

RECORD OF SURVEY - EXISTING RIGHT OF WAY
ALASKA PROJECT NO.

STP-0551(3)

53943

EAGLE RIVER ROAD REHABILITATION, MP 5.3-12.6

DRAWN	KFT	DATE	11/27/2002	SCALE	1" = 50'
CHECKED	MHS/ADOT	DATE	11/19/2002	SHEET	14 OF 39

STATE OF ALASKA 49TH
Karen Fitzgerald Tilton
LS 7339
REGISTERED PROFESSIONAL LAND SURVEYOR
CONSULTANT RIGHT-OF-WAY SURVEYORS CERTIFICATE

STATE OF ALASKA 49TH
James H. Sharp
4015-S
REGISTERED PROFESSIONAL LAND SURVEYOR
DEPARTMENT LOCATION SURVEYORS CERTIFICATE

COPY

REFER TO SHEET 36 FOR GENERAL SURVEY NOTES.

THIS SURVEY DOES NOT CONSTITUTE A SUBDIVISION AS DEFINED BY AS 40.15.900(5).

ANCHORAGE RECORDING DISTRICT 2002-157