


PROJECT DESIGNATION	SHEET NO.	TOTAL SHEETS
STP-0551(3)	R16	R39

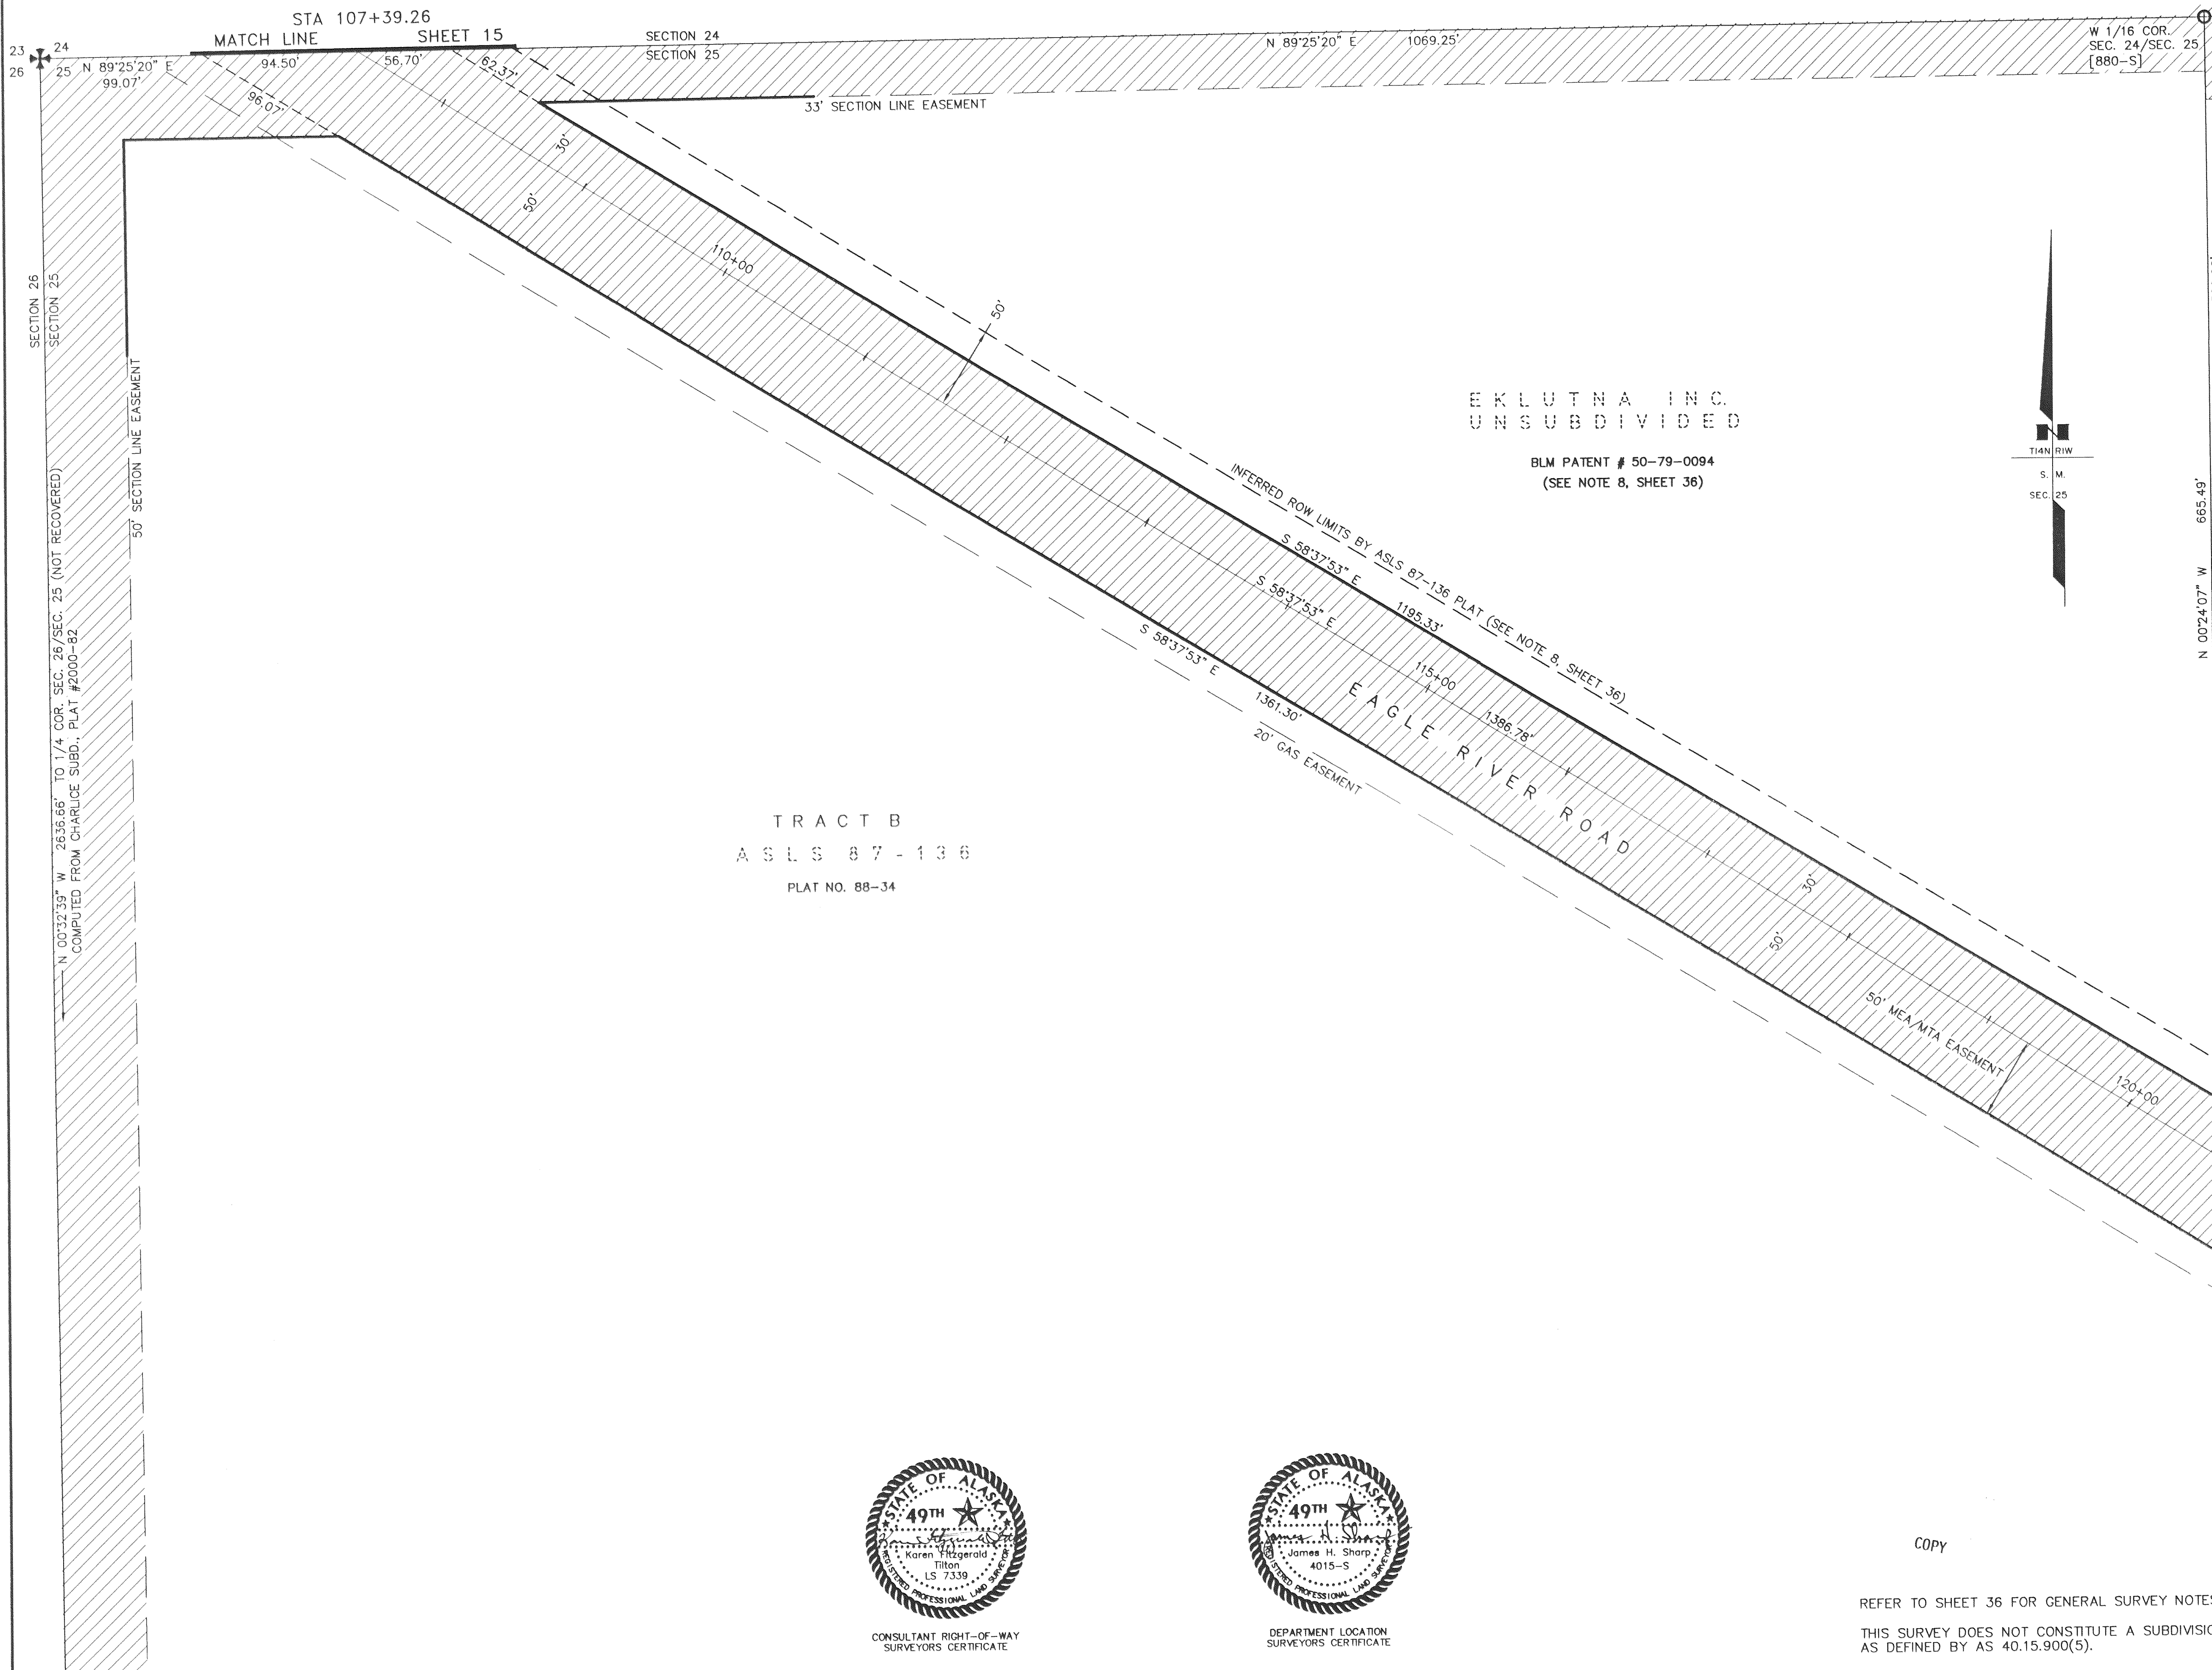

50' SECTION LINE EASEMENT
PER PLAT OF CHARLICE
SUBDIVISION

TRACT C-1A1
CHARLICE
SUBDIVISION


PLAT NO. 2000-82

EKLUTNA INC.
UNSUBDIVIDED

BLM PATENT # 50-79-0149

S 58°37'53" E
26.01'

MATCH LINE
PI-NO CURVE
STA 121+26.04

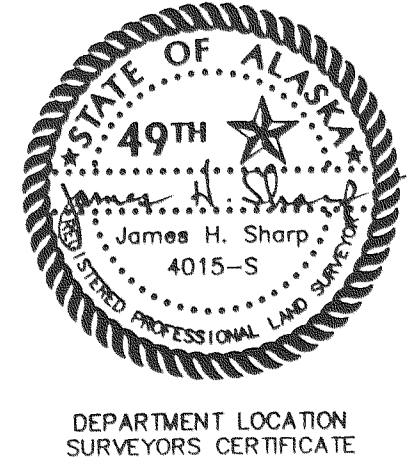

REFER TO SHEET 36 FOR GENERAL SURVEY NOTES.
THIS SURVEY DOES NOT CONSTITUTE A SUBDIVISION
AS DEFINED BY AS 40.15.900(5).

DATE		REVISIONS		BY
STATE OF ALASKA DEPARTMENT OF TRANSPORTATION & PUBLIC FACILITIES RECORD OF SURVEY - EXISTING RIGHT OF WAY ALASKA PROJECT NO. STP-0551(3) 53943 EAGLE RIVER ROAD REHABILITATION, MP 5.3-12.6				
DRAWN	KFT	DATE	11/27/2002	SCALE 1" = 50'
CHECKED	MHS/ADOT	DATE	11/19/2002	SHEET 16 OF 39

ANCHORAGE RECORDING DISTRICT 2002-157