PROJECT DESIGNATION	SHEET NO.	TOTAL SHEETS
STP-0551(3)	R25	R39

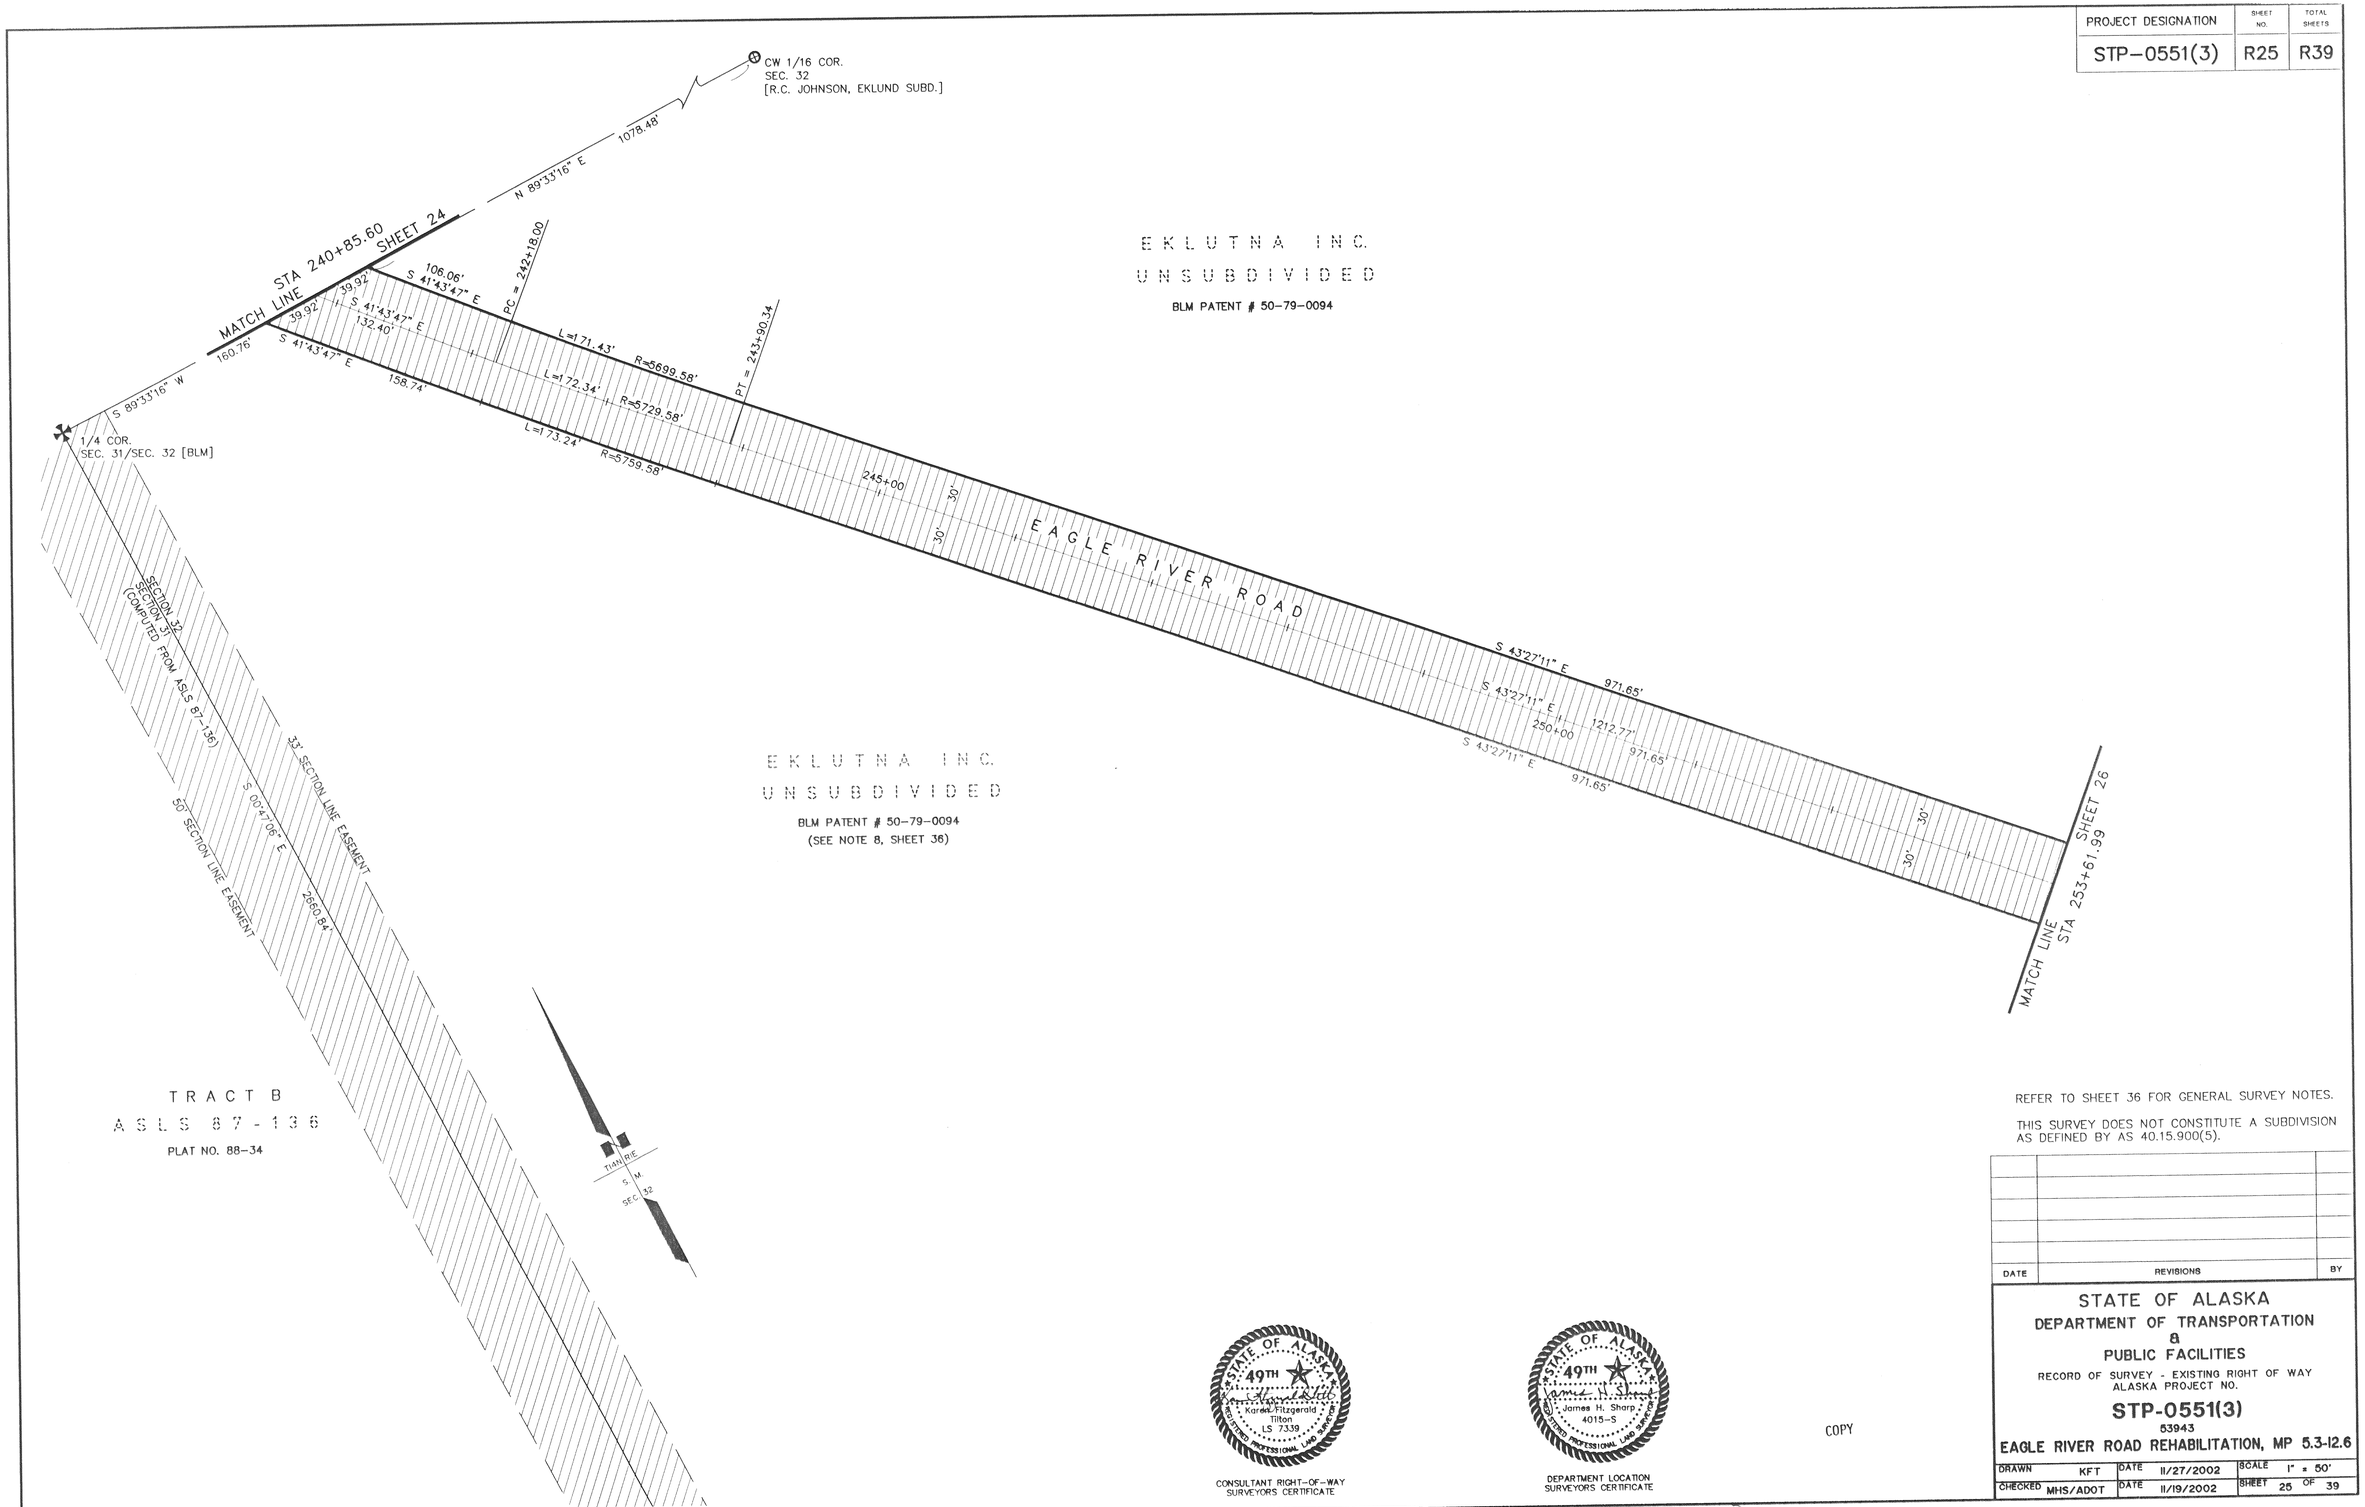

REFER TO SHEET 36 FOR GENERAL SURVEY NOTES.

THIS SURVEY DOES NOT CONSTITUTE A SUBDIVISION AS DEFINED BY AS 40.15.900(5).

DATE	REVISIONS	BY

STATE OF ALASKA 49TH Karen K. Fitzgerald Tilton LS 7339 REGISTERED PROFESSIONAL LAND SURVEYOR

CONSULTANT RIGHT-OF-WAY SURVEYORS CERTIFICATE

STATE OF ALASKA 49TH James H. Sharp 4015-S REGISTERED PROFESSIONAL LAND SURVEYOR

DEPARTMENT LOCATION SURVEYORS CERTIFICATE

COPY

STATE OF ALASKA
DEPARTMENT OF TRANSPORTATION
&
PUBLIC FACILITIES

RECORD OF SURVEY - EXISTING RIGHT OF WAY
ALASKA PROJECT NO.

STP-0551(3)

53943

EAGLE RIVER ROAD REHABILITATION, MP 5.3-12.6

DRAWN	KFT	DATE	11/27/2002	SCALE	1" = 50'
CHECKED	MHS/ADOT	DATE	11/19/2002	SHEET	25 OF 39

