



PROJECT DESIGNATION	SHEET NO.	TOTAL SHEETS
STP-0551(3)	R30	R39

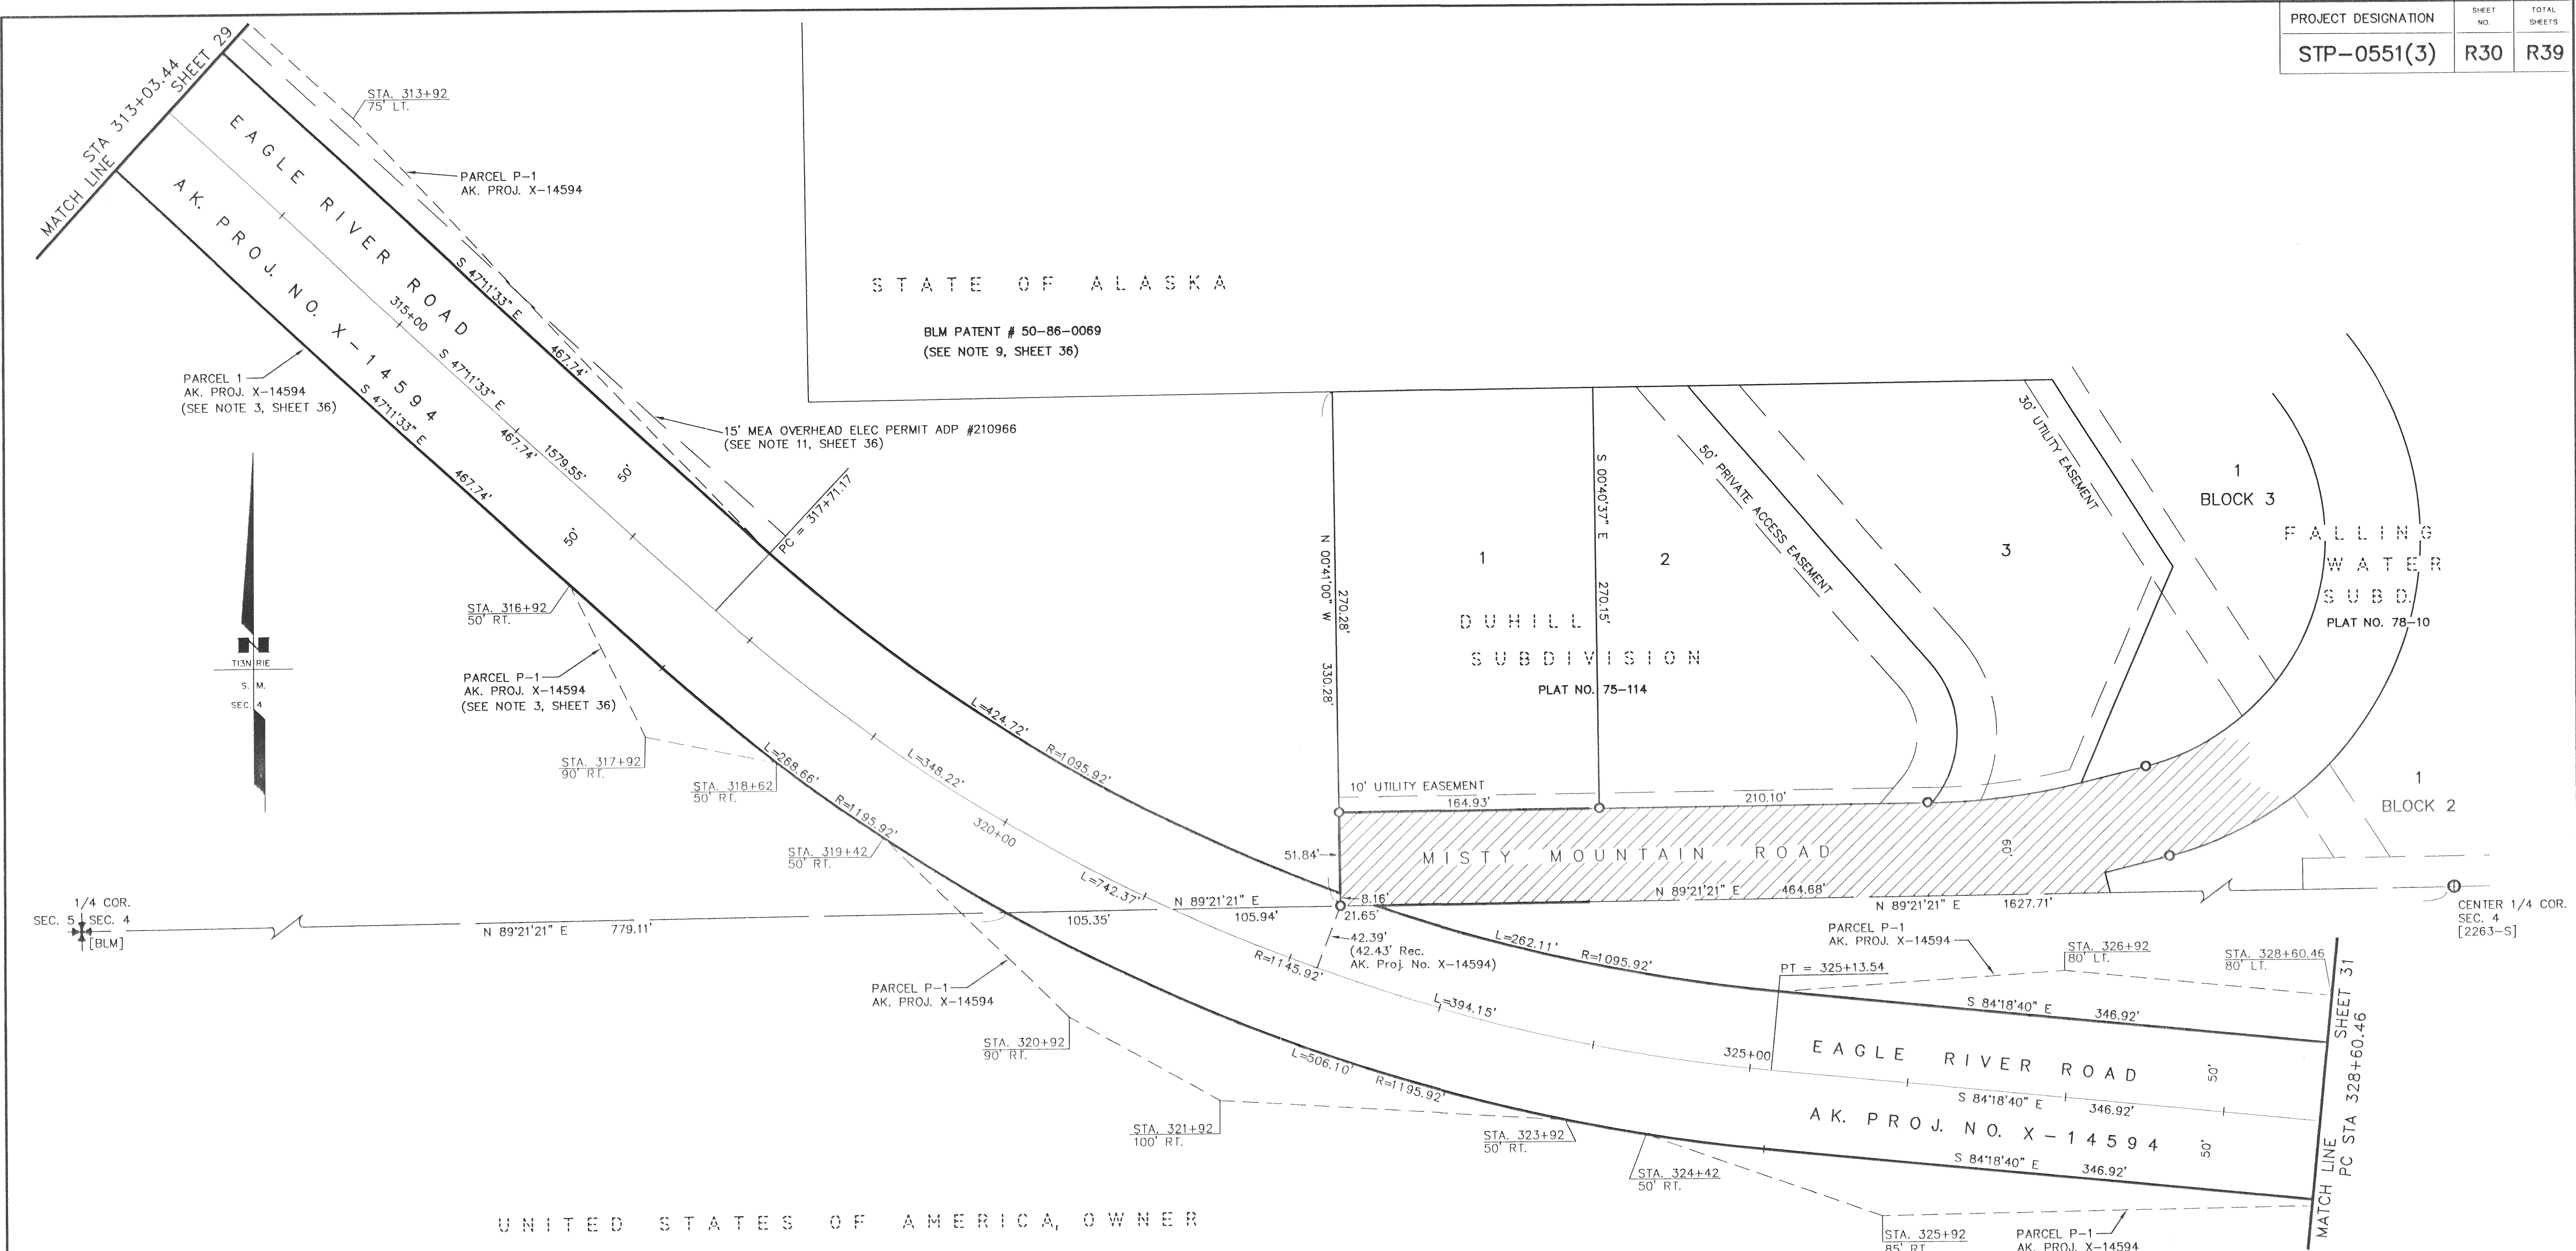

UNITED STATES OF AMERICA, OWNER
 MANAGED BY STATE OF ALASKA, DIVISION OF PARKS



CONSULTANT RIGHT-OF-WAY
 SURVEYORS CERTIFICATE

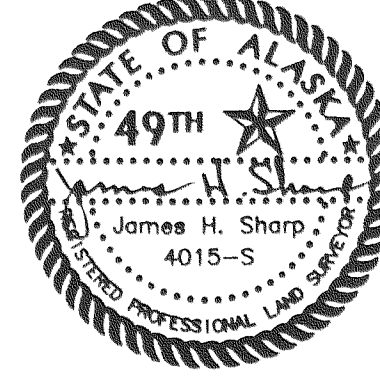

DEPARTMENT LOCATION
 SURVEYORS CERTIFICATE

REFER TO SHEET 36 FOR GENERAL SURVEY NOTES.
 THIS SURVEY DOES NOT CONSTITUTE A SUBDIVISION
 AS DEFINED BY AS 40.15.900(5).

DATE	REVISIONS	BY

STATE OF ALASKA
 DEPARTMENT OF TRANSPORTATION
 a
 PUBLIC FACILITIES
 RECORD OF SURVEY - EXISTING RIGHT OF WAY
 ALASKA PROJECT NO.
STP-0551(3)
 53943
EAGLE RIVER ROAD REHABILITATION, MP 5.3-12.6

DRAWN	KFT	DATE	11/27/2002	SCALE	1" = 50'
CHECKED	MHS/ADOT	DATE	11/19/2002	SHEET	30 OF 39

Anchorage Recording District 2002-157