PROJECT DESIGNATION	SHEET NO.	TOTAL SHEETS
STP-0551(3)	R32	R39

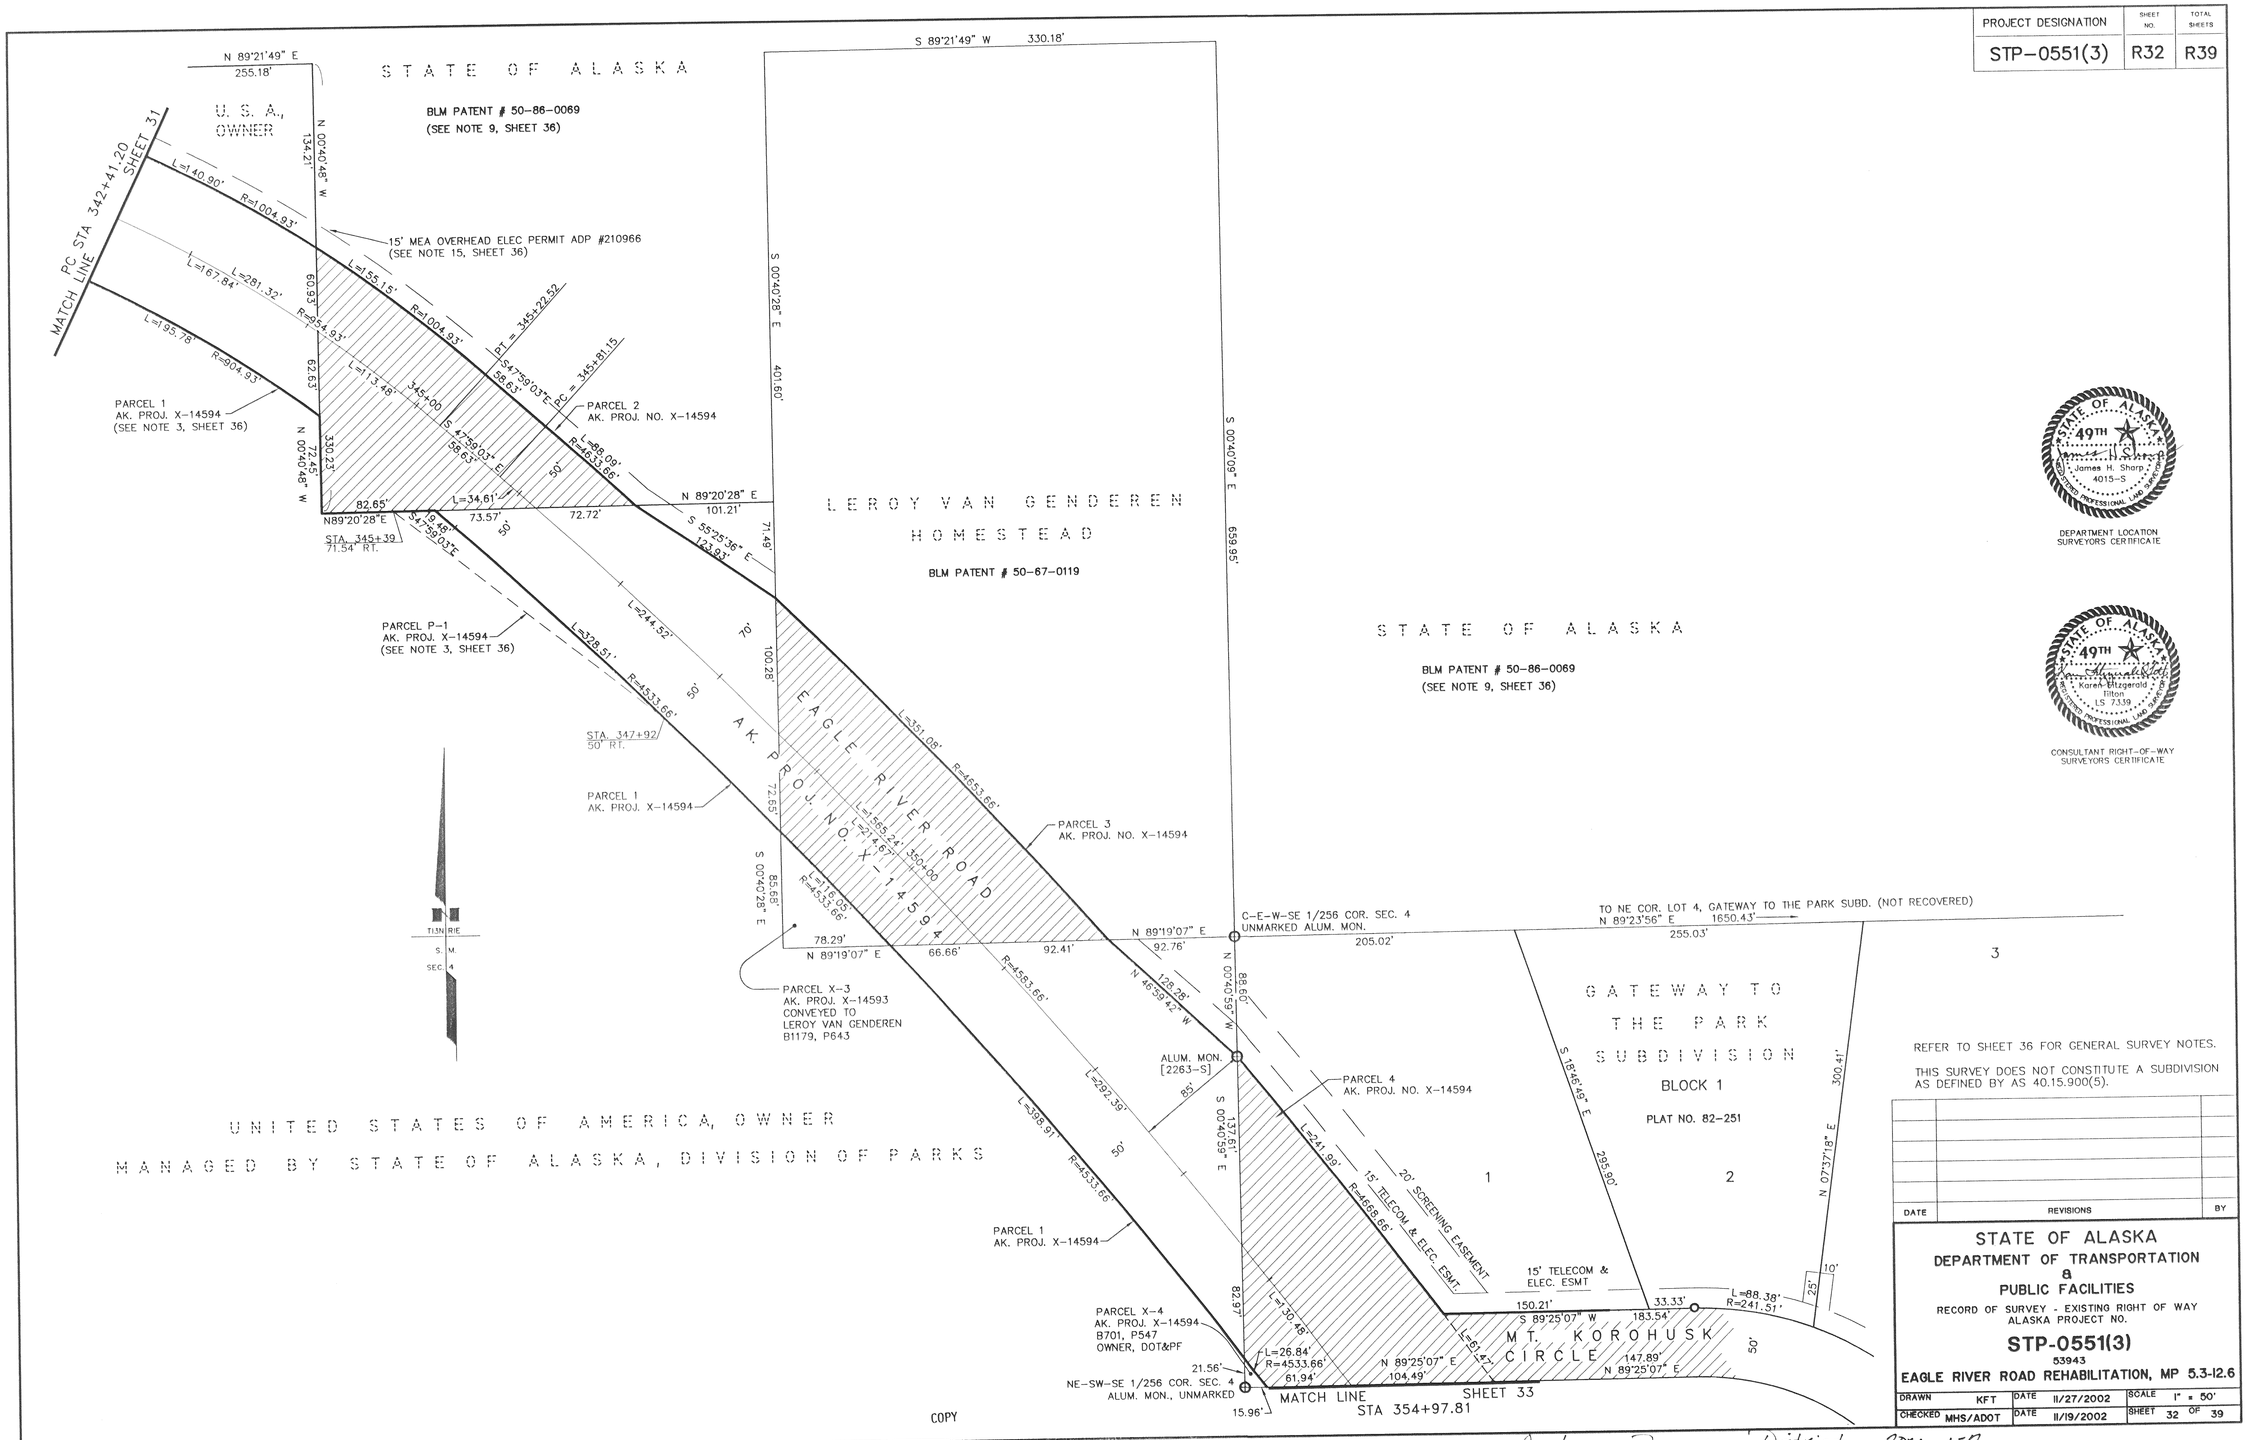

STATE OF ALASKA 49TH James H. Sharp 4015-S PROFESSIONAL LAND SURVEYOR

DEPARTMENT LOCATION SURVEYORS CERTIFICATE

STATE OF ALASKA 49TH Karen Fitzgerald Tilton LS 7139 PROFESSIONAL LAND SURVEYOR

CONSULTANT RIGHT-OF-WAY SURVEYORS CERTIFICATE

REFER TO SHEET 36 FOR GENERAL SURVEY NOTES.

THIS SURVEY DOES NOT CONSTITUTE A SUBDIVISION AS DEFINED BY AS 40.15.900(5).

DATE	REVISIONS	BY

STATE OF ALASKA
DEPARTMENT OF TRANSPORTATION
&
PUBLIC FACILITIES

RECORD OF SURVEY - EXISTING RIGHT OF WAY
ALASKA PROJECT NO.

STP-0551(3)

53943

EAGLE RIVER ROAD REHABILITATION, MP 5.3-12.6

DRAWN KFT	DATE 11/27/2002	SCALE 1" = 50'	
CHECKED MHS/ADOT	DATE 11/19/2002	SHEET 32 OF 39	

COPY

Anchorage Recording District 2002-157