




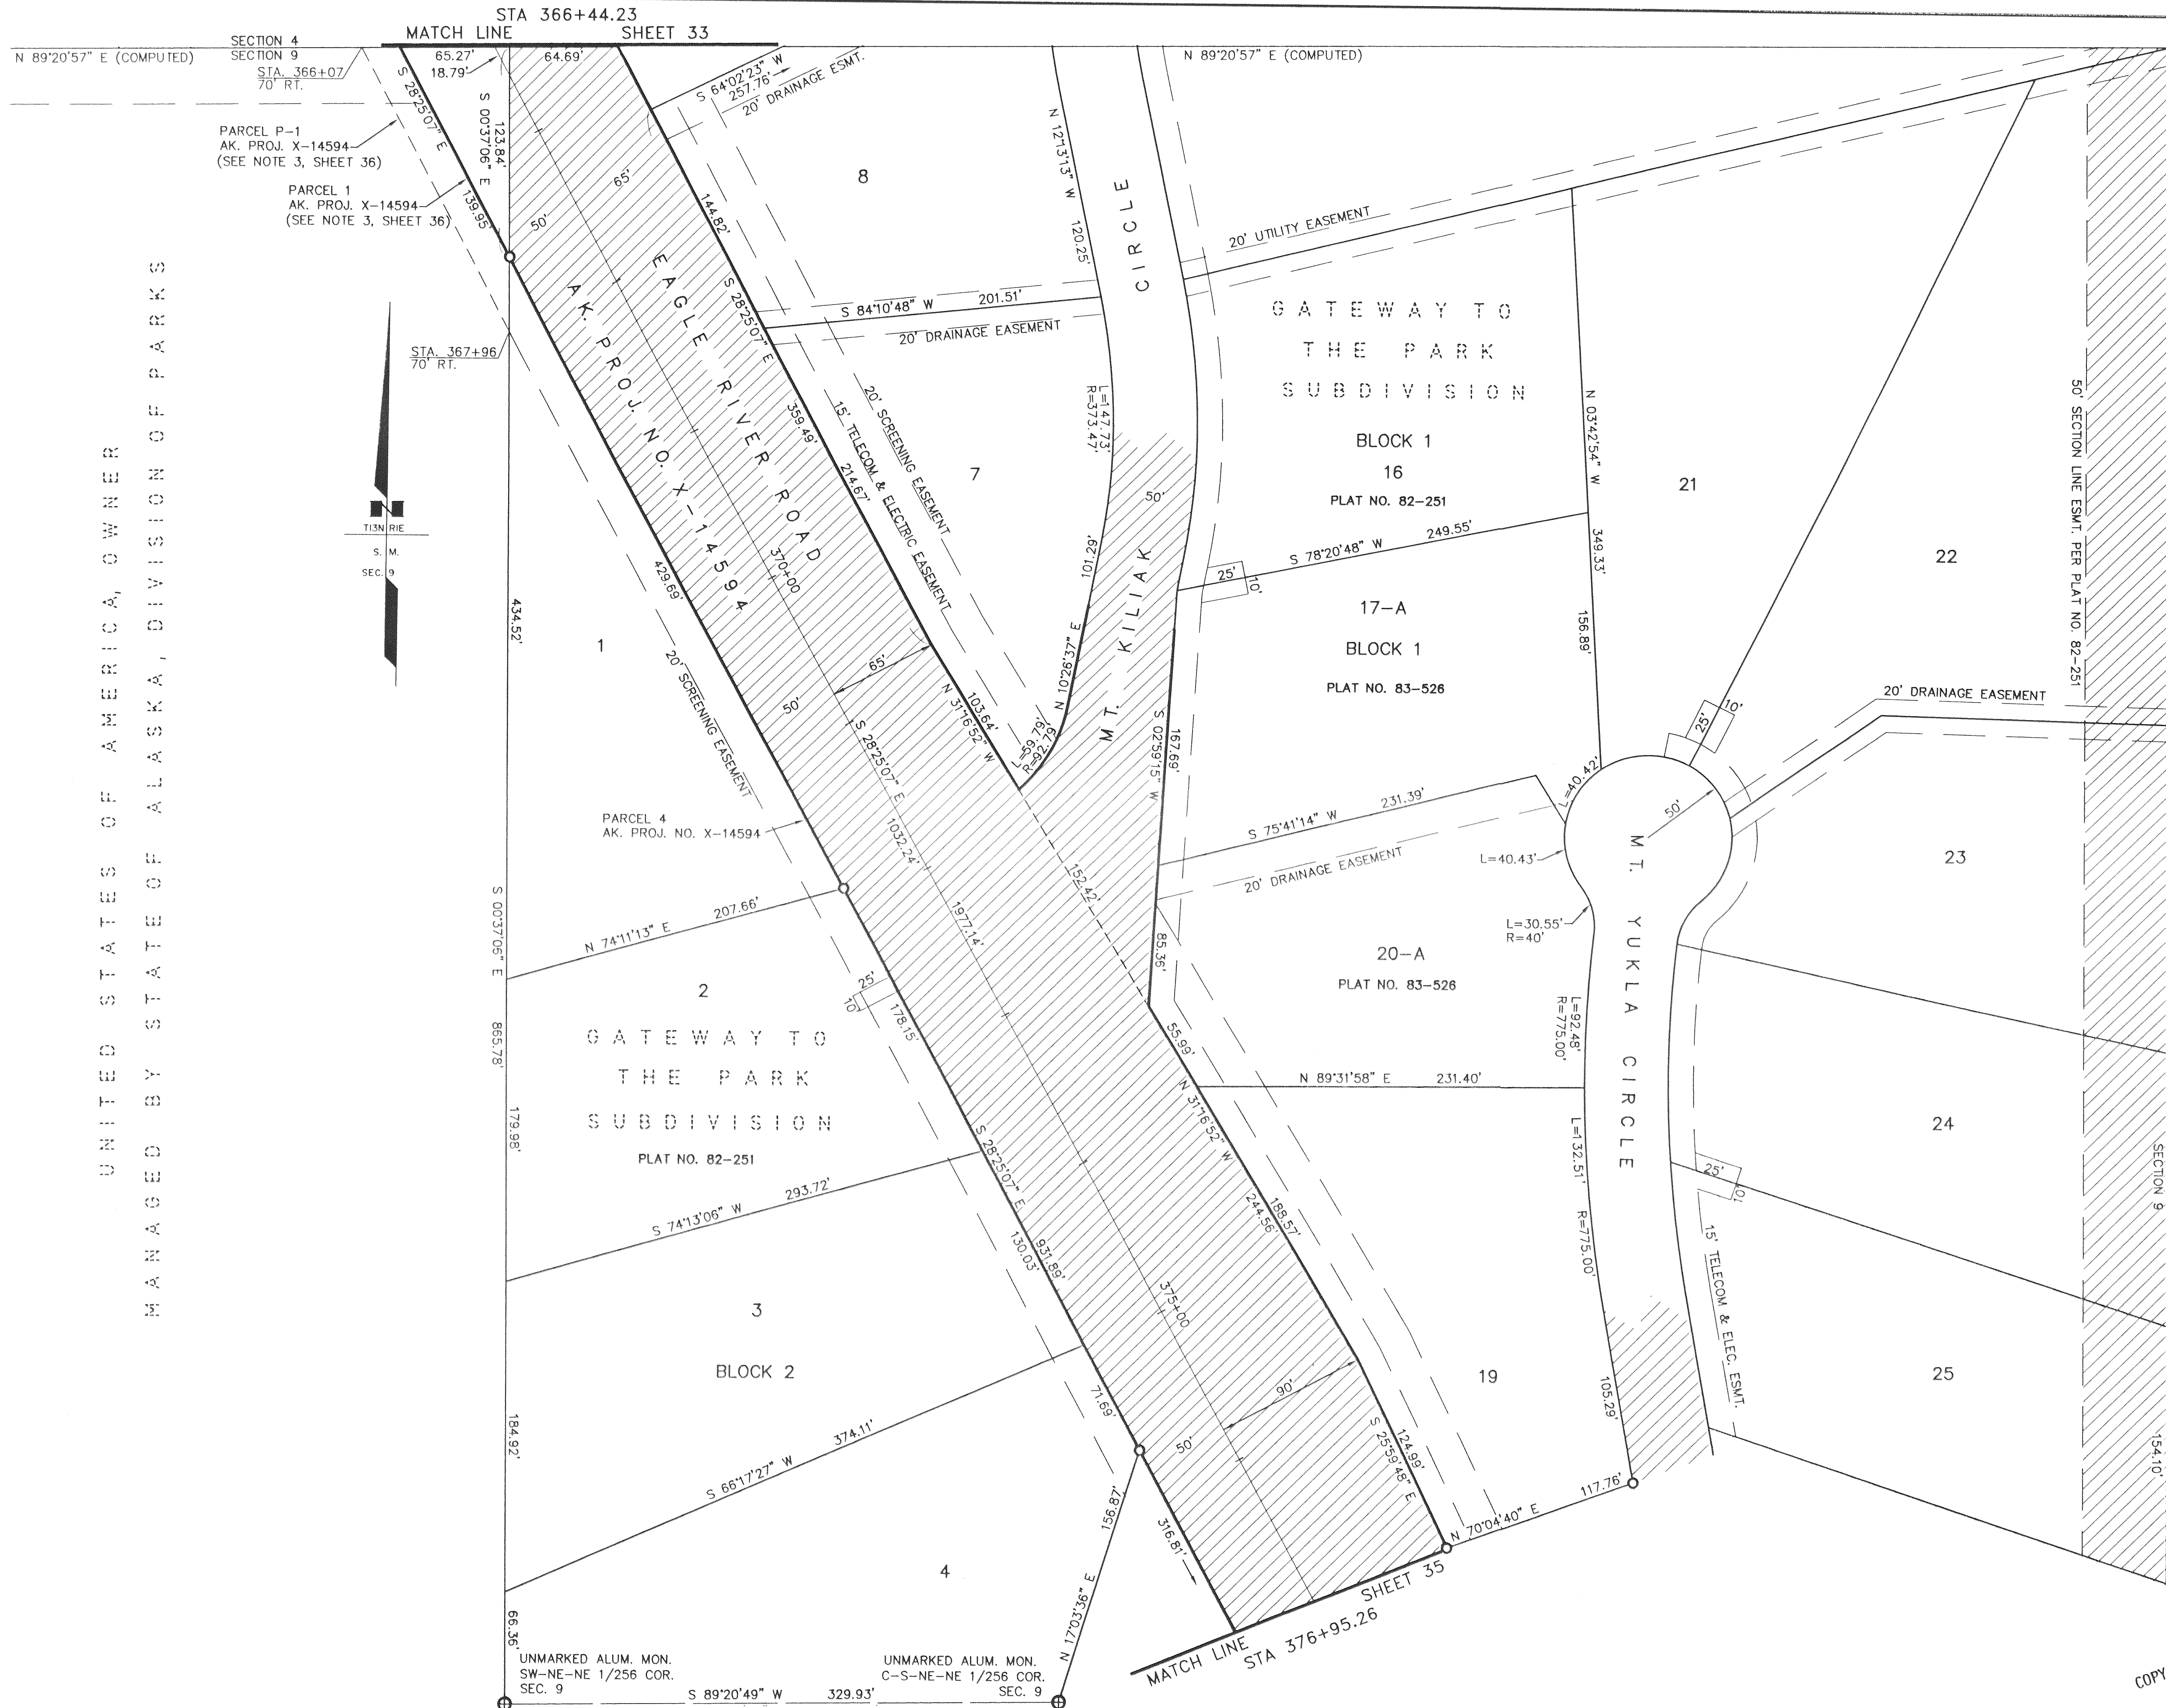

| PROJECT DESIGNATION | SHEET NO. | TOTAL SHEETS |
|---------------------|-----------|--------------|
| STP-0551(3)         | R34       | R39          |

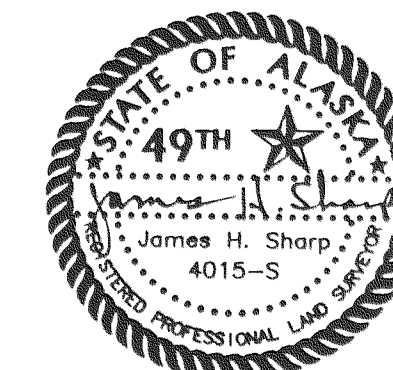

DEPARTMENT LOCATION  
SURVEYORS' CERTIFICATE

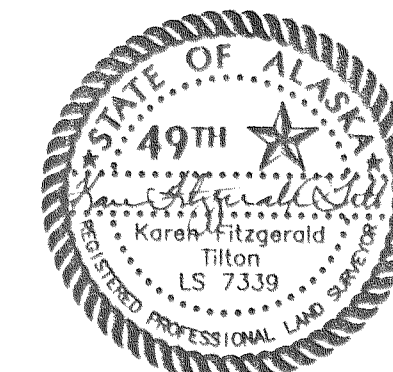

CONSULTANT RIGHT-OF-WAY  
SURVEYORS' CERTIFICATE

REFER TO SHEET 36 FOR GENERAL SURVEY NOTES.  
THIS SURVEY DOES NOT CONSTITUTE A SUBDIVISION  
AS DEFINED BY AS 40.15.900(5).

| DATE | REVISIONS | BY |
|------|-----------|----|
|      |           |    |
|      |           |    |
|      |           |    |
|      |           |    |
|      |           |    |

|   |          |          |            |
|---|----------|----------|------------|
| STATE OF ALASKA<br>DEPARTMENT OF TRANSPORTATION<br>&<br>PUBLIC FACILITIES<br>RECORD OF SURVEY - EXISTING RIGHT OF WAY<br>ALASKA PROJECT NO.<br><b>STP-0551(3)</b><br>53943<br><b>EAGLE RIVER ROAD REHABILITATION, MP 5.3-12.6</b> |          |          |            |
| DRAWN   | KFT      | DATE     | 11/27/2002 |
| CHECKED   | MHS/ADOT | DATE     | 11/19/2002 |
| SCALE   |          | 1" = 50' |            |
| SHEET   |          | 34       | OF 39      |

Anchorage Recording District 2002-157