



RECOVERED CORNERS - SHEET 8						
LOCATION	MONUMENT TYPE	NORTHING	EASTING	STATION	OFFSET	WORK ITEM
POL Lot 1 Bl D.C. Schroeder No. 3	Rebar	370930.436	427488.526			
NW Lot 1A Hamann	Rebar	370710.577	427490.417	+35.01	79.99 RT	
SE Lot 1 Bl D.C. Schroeder No. 3	Rebar	370864.413	427680.987	1+50.12	136.18 LT	
SE Lot 1A Hamann	Brass Cap [1822-S]	370312.163	427573.466	2+67.44	414.07 RT	
NE Lot 1A Hamann	Brass Cap [1822-S]	370603.363	427736.864	3+03.76	82.14 RT	
NW Lot 2 Baumer	Rebar	370858.039	427876.048	3+32.10	206.70 LT	
NE Lot 1B Hamann	Rebar	370578.797	427794.992	3+66.86	81.98 RT	
1/4 Cor. S15\S22 T14N RIW SM	Brass Cap [BLM]	369550.550	427501.731	4+99.67	1142.95 RT	
NE L2 Baumer	Rebar	370810.606	428077.767	5+36.28	242.05 LT	
PC Lot 4 Bl D.C. Schroeder No. 3	Rebar	370917.108	428231.463	6+36.00	400.23 LT	
PC N. Line Lot 1 Baumer	Rebar	370869.231	428228.956	6+52.44	355.20 LT	
PT Lot 4 Bl D.C. Schroeder No. 3	Rebar	370916.436	428255.453	6+58.33	409.01 LT	
PT N. Line Lot 1 Baumer	Rebar	370865.790	428248.820	6+72.06	359.81 LT	
NE Lot 3 Baumer	Rebar	370699.079	428266.352	7+53.48	213.28 LT	
PC Lot 4 Bl D.C. Schroeder No. 3	Rebar	370907.408	428387.583	7+83.45	452.44 LT	
SW Lot 4A Hamann	Rebar	370377.510	428232.268	8+48.04	95.96 RT	
NW Lot 4A Hamann	Rebar	370390.942	428241.415	8+51.20	80.02 RT	
NE Lot 1 Baumer	Brass Cap [609-S]	370837.149	428478.825	8+94.91	423.52 LT	
PC Lot 4A Hamann	Rebar	370312.182	428308.868	9+44.10	126.07 RT	
NE Lot 4 Baumer	Rebar	370635.877	428478.930	9+73.83	238.37 LT	
NE Lot 4A Hamann	Rebar	370176.280	428746.536	14+00.04	79.73 RT	

RECOVERED CORNERS - SHEET 9						
LOCATION	MONUMENT TYPE	NORTHING	EASTING	STATION	OFFSET	WORK ITEM
SW Lot 1 Bl Hamann	Rebar	370298.194	428812.781	14+13.25	58.39 LT	
NE Lot 4B Hamann	Alum. Mon [880-S]	370146.657	428815.123	14+74.75	80.13 RT	
Ang Pt ROW Lot 1 Bl Hamann No. 1	Rebar	370279.254	428988.478	15+82.33	109.76 LT	
SE Lot 4B Hamann	Alum. Mon [880-S]	369775.250	428818.059	16+22.89	420.73 RT	
E 1/16 Cor. S15\S22 T14N RIW SM	Rebar	369561.856	428820.221	17+08.44	616.24 RT	
NE Lot 8 Hamann	Rebar	370015.679	429116.620	18+03.49	82.68 RT	
SE Lot 1 Bl Hamann	Rebar	370175.568	429232.331	18+47.31	109.84 LT	
PC Lot 2 Bl Hamann	Rebar	370105.790	429396.557	20+25.72	109.95 LT	
PC Lot 9 Hamann	Rebar	369929.129	429326.377	20+30.44	80.08 RT	
NE Lot 9 Hamann	Rebar	369884.919	429426.860	21+41.78	80.23 RT	
SW Lot 3 Bl Hamann	Rebar	369990.057	429651.607	23+00.55	110.12 LT	
S 1/16 Cor S15\S14 T14N RIW SM	Alum Mon [609-S]	370893.371	430128.126	23+30.27	1130.89 LT	
SE Lot 3 Bl Hamann	Rebar	369724.870	430139.051	28+45.21	110.03 LT	
Sec. Cor 15\14\22\23 T14N RIW SM	Alum Mon	369573.901	430140.546	29+25.08	17.68 RT	

RECOVERED CORNERS - SHEET 10						
LOCATION	MONUMENT TYPE	NORTHING	EASTING	STATION	OFFSET	WORK ITEM
PT Lot 1 Sandhill	Rebar w\ Plastic Cap	369477.955	430178.310	30+09.15	78.34 RT	
NW Lot 3 Sandhill	Rebar w\ Plastic Cap	369404.396	430291.422	31+44.08	78.69 RT	
SW Tr.2 Schroeder No.3	Hub & Tack	369613.668	430797.707	34+56.57	371.98 LT	
NE Lot 3 Sandhill	Rebar w\ Plastic Cap	369192.425	430617.436	35+32.94	79.64 RT	
NE Tr.5 Schroeder No.2	Rebar	369552.718	430934.020	36+03.13	394.82 LT	
NE Lot 5 Sandhill	Rebar w\ Plastic Cap	368903.315	431062.554	40+63.71	80.69 RT	
SE Tract 6-B D.C. Schroeder No. 2	Rebar	368996.041	431216.238	41+42.41	80.63 LT	
Angle Point ROW Lot 6 Sandhill	Rebar	368850.852	431143.045	41+59.79	81.03 RT	
Angle Point ROW Lot 6 Sandhill	Rebar w\ Plastic Cap	368876.057	431160.841	41+61.05	50.20 RT	
SW Lot 7B D.C. Schroeder No. 2	Rebar	368961.213	431216.371			
NW Tract 8B Magnificent Min Slopes	Rebar	368847.272	431202.982	42+14.45	51.24 RT	
NE Lot 6 Sandhill	Rebar w\ Plastic Cap	368843.213	431209.015	42+21.72	51.19 RT	

RECOVERED CORNERS - SHEET 11						
LOCATION	MONUMENT TYPE	NORTHING	EASTING	STATION	OFFSET	WORK ITEM
N 1/16 Cor. S22\N23 T14N RIW SM	Brass Cap [BLM]	368254.302	430153.181			
SE Lot 7B Schroeder No.2	Rebar	368891.959	431467.877	43+82.99	151.00 LT	
PT Tract 8B-1 Magnificent Mtn Slopes	Rebar	368734.283	431341.188	44+03.01	50.18 RT	
NW Lot 1 B1 Groll	Rebar	368819.626	431467.836	44+30.30	100.13 LT	
SE Lot 7B Schroeder No.2	Rebar	368746.486	431469.895	44+84.27	50.72 LT	
NE Tract 8B-1 Magnificent Mtn Slopes	Rebar	368675.015	431399.101	44+86.34	49.86 RT	
Angle Point N. Line LI B1 Groll	Rebar	368689.179	431850.398	47+90.19	284.12 LT	
NW 1/16 Cor. S23 T14N RIW SM	Brass Cap [232-S]	368268.419	431473.673	48+30.25	279.22 RT	
NE Lot 1 B1 Groll	Rebar	368629.573	432001.837	49+38.37	351.41 LT	
NW Tract 4C D.C. Schroeder No. 1	Rebar	368159.091	431846.776	51+89.41	49.75 RT	
PT Lot 2 Groll	Rebar	368186.637	431943.894	52+04.05	50.14 LT	
PT Tract 4C D.C. Schroeder No. 1	Rebar	368146.373	431853.095	52+04.65	49.18 RT	
SE Lot 2 Groll No. 1	Rebar	368065.974	431995.807	53+35.21	49.93 LT	
C-N 1/16 Cor. S23 T14N RIW SM	Brass Cap [232-S]	368281.745	432797.445	54+55.10	871.40 LT	
PT Tract A Groll No. 1	Rebar	367937.854	432051.395	54+74.87	50.14 LT	
NE Lot 2A B2 Groll	Rebar with Alum. Cap	367842.380	431988.085	55+36.13	46.14 RT	
PC Tract A Groll No. 1	Rebar	367879.972	432121.685	55+61.66	90.45 LT	
SE Lot 2A B2 Groll	Rebar	367705.083	432067.295	56+84.98	48.81 RT	
C-W 1/16 Cor. S23 T14N RIW SM	Brass Cap [232-S]	366947.700	431489.405	58+67.44	980.80 RT	

RECOVERED CORNERS - SHEET 12						
LOCATION	MONUMENT TYPE	NORTHING	EASTING	STATION	OFFSET	WORK ITEM
SE Lot 2A B2 Groll	Rebar	367705.083	432067.295	56+84.98	48.81 RT	
C-W 1/16 Cor. S23 T14N RIW SM	Brass Cap [232-S]	366947.700	431489.405	58+67.44	980.80 RT	
NW Lot 1 B3B Loye	Brass Cap [609-S]	367725.882	432524.218	59+67.72	310.07 LT	
NE Lot 4 B2 Groll	Rebar	367358.761	432368.538	61+40.24	49.44 RT	
SE Tract A Groll No. 1	Alum. Mon [2263-S]	367730.151	432803.890	61+49.41	522.73 LT	
NE Lot 1 B3B Loye	Brass Cap [609-S]	367664.636	432804.713	61+99.11	480.03 LT	
PC Lot 6 B2 Groll	Rebar	367059.885	432631.896	65+38.59	49.44 RT	
PC Lot 2 B3B Loye	Rebar	367125.220	432706.124	65+38.65	49.44 LT	
SE Lot 6 B2 Groll	Rebar w/ Plastic Cap	366960.474	432713.875	66+72.00	47.66 RT	
SE Lot 2 B3B Loye	Rebar	366989.645	432812.674	67+05.40	49.79 LT	
C 1/4 Cor. S23 T14N RIW SM	Brass Cap [232-S]	366961.561	432813.106	67+28.28	34.33 LT	
NW Tract D H & H	Rebar	366961.727	432834.765	67+40.25	52.39 LT	

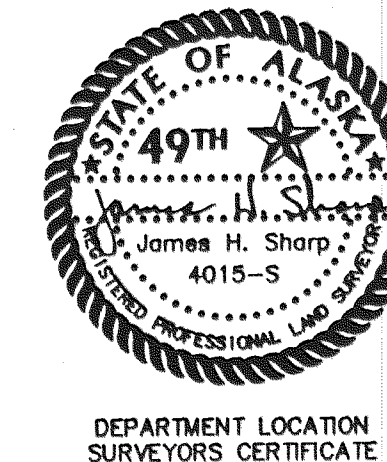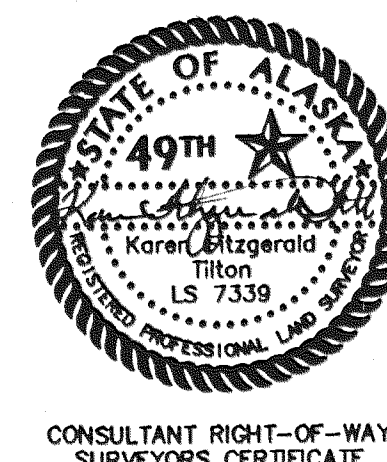

THIS SURVEY DOES NOT CONSTITUTE A SUBDIVISION
AS DEFINED BY AS 40.15.900(5).

DATE	REVISIONS	BY
STATE OF ALASKA DEPARTMENT OF TRANSPORTATION a PUBLIC FACILITIES RECORD OF SURVEY - EXISTING RIGHT OF WAY ALASKA PROJECT NO. STP-0551(3) 53943 EAGLE RIVER ROAD REHABILITATION, MP 5.3-12.6		
DRAWN	KFT	DATE II/27/2002
CHECKED	MHS/ADOT	DATE II/19/2002
		SCALE N/A
		SHEET 37 OF 39

COPY

Anchorage Recording District 2002-157