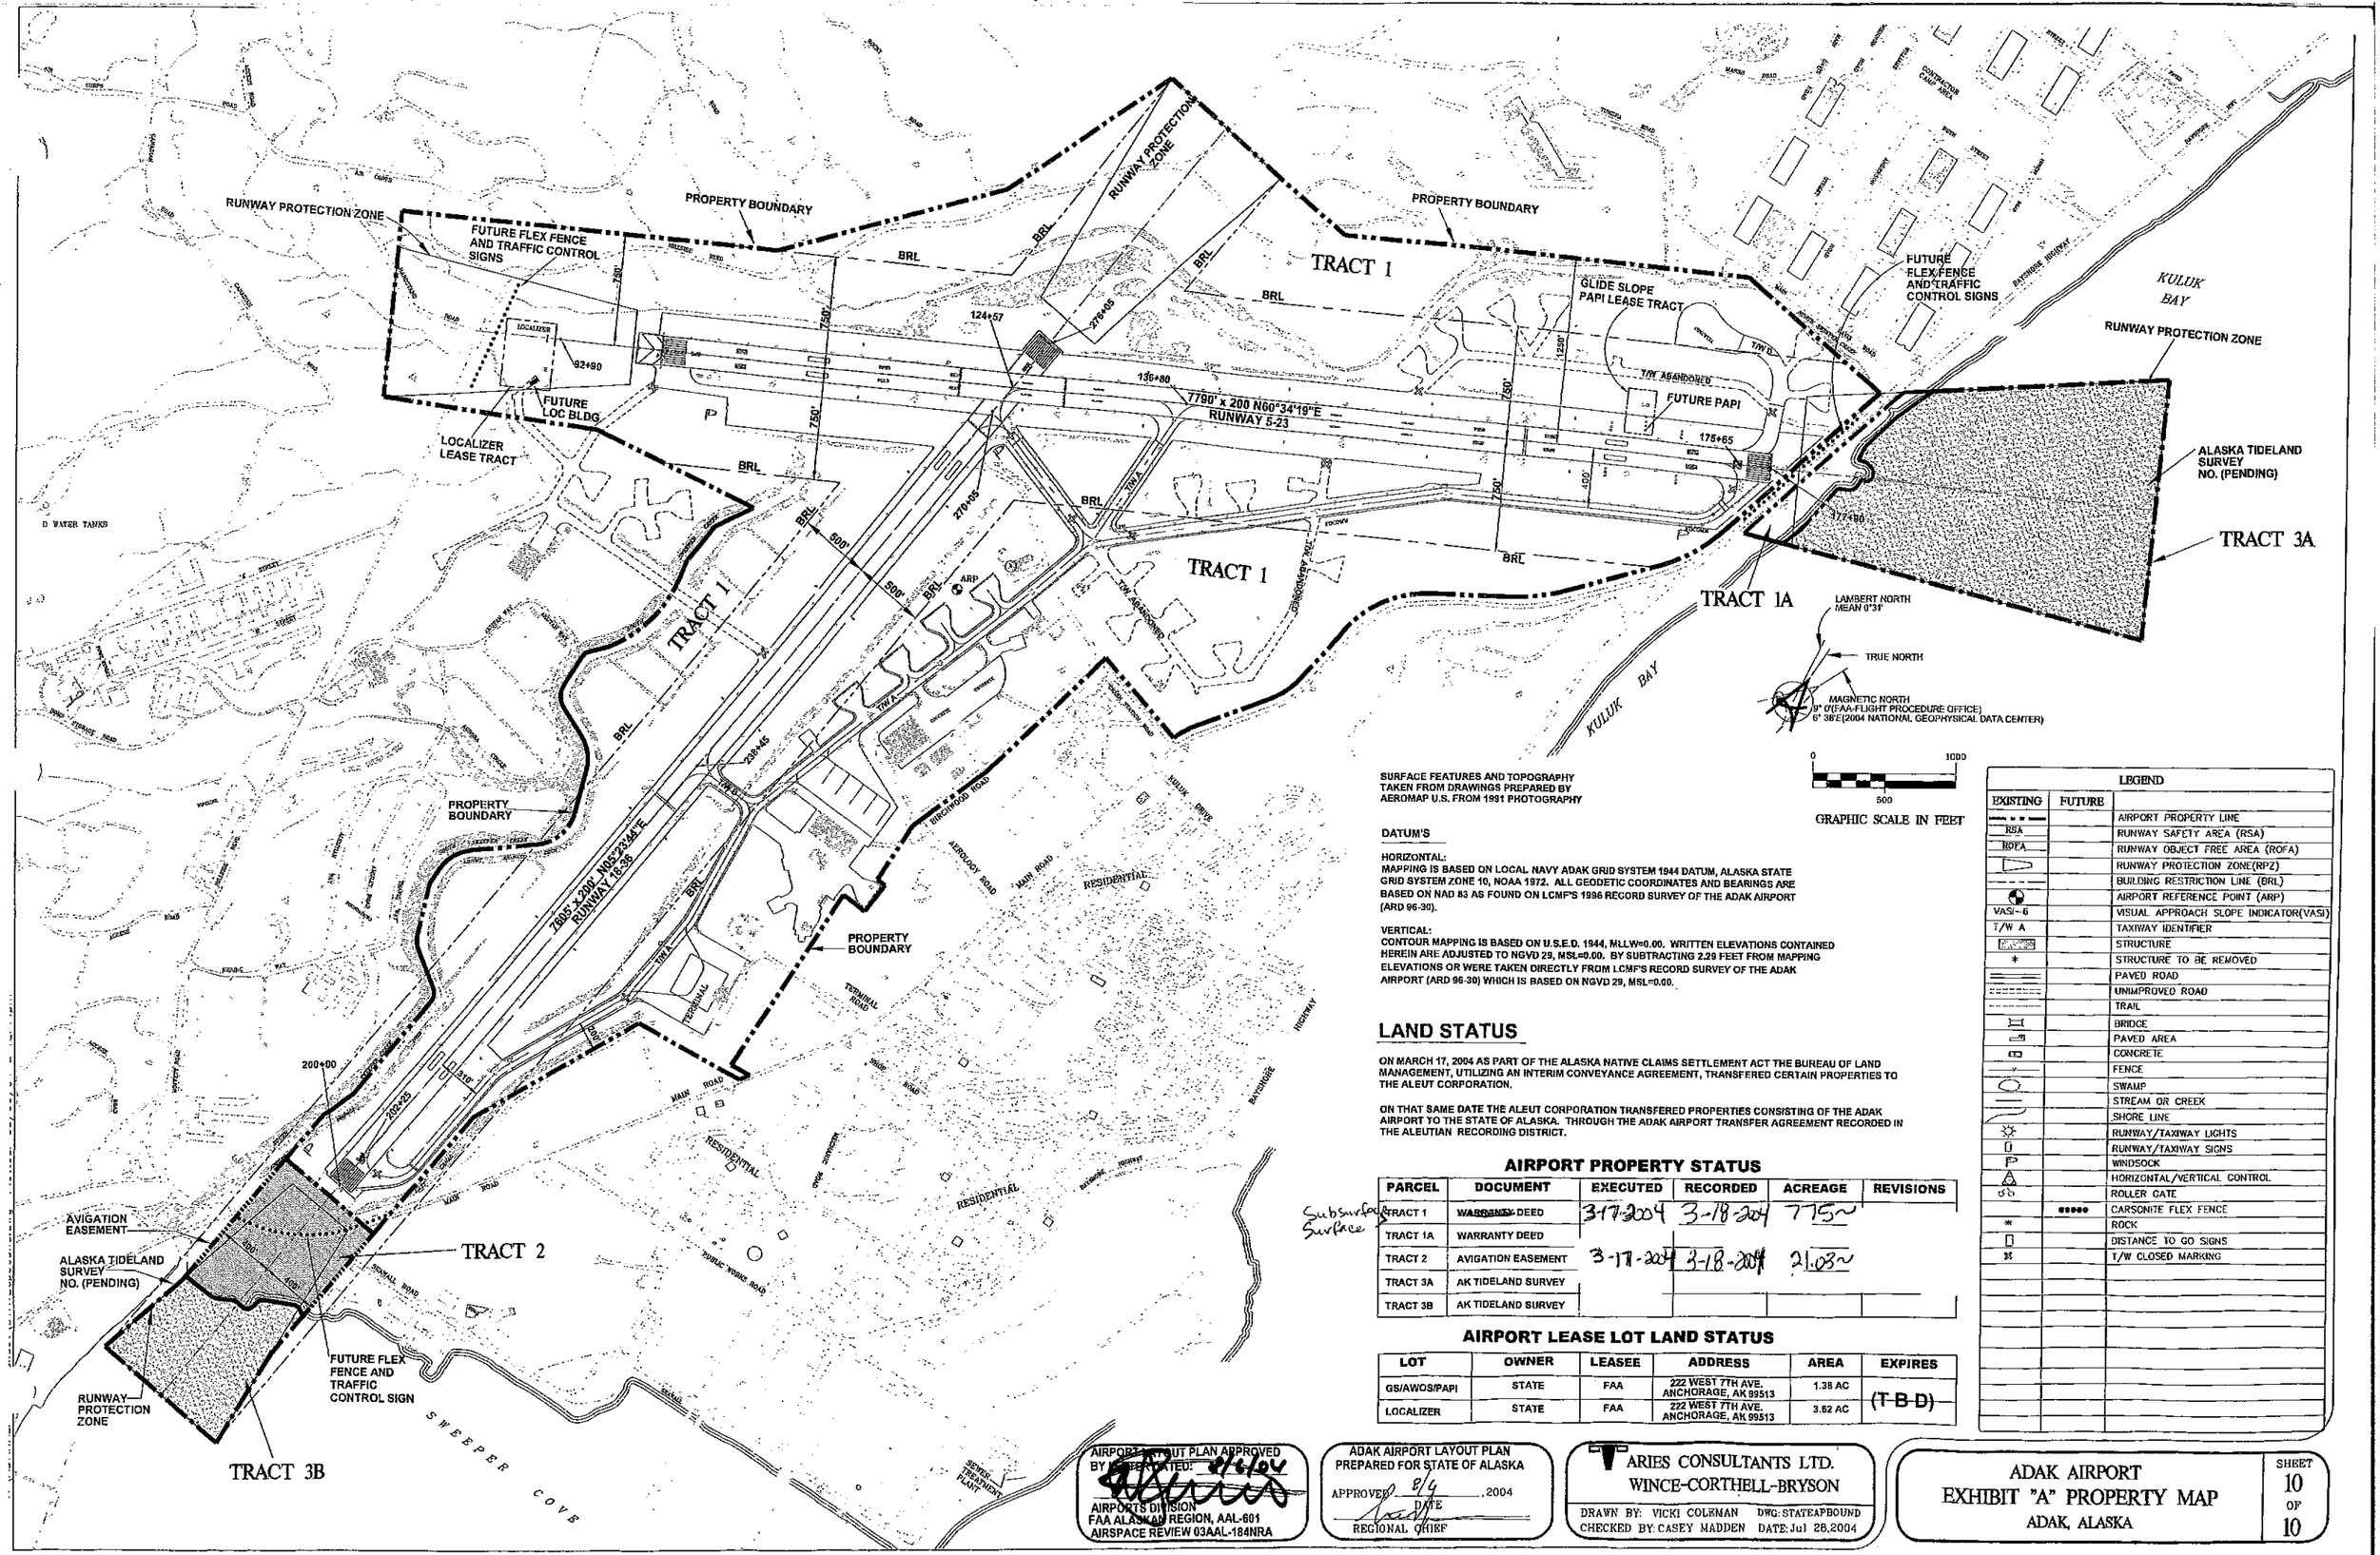

SURFACE FEATURES AND TOPOGRAPHY TAKEN FROM DRAWINGS PREPARED BY AEROMAP U.S. FROM 1991 PHOTOGRAPHY

0 1000
500
GRAPHIC SCALE IN FEET

DATUM'S

HORIZONTAL:
MAPPING IS BASED ON LOCAL NAVY ADAK GRID SYSTEM 1944 DATUM, ALASKA STATE GRID SYSTEM ZONE 10, NOAA 1972. ALL GEODETIC COORDINATES AND BEARINGS ARE BASED ON NAD 83 AS FOUND ON LCMF'S 1996 RECORD SURVEY OF THE ADAK AIRPORT (ARD 96-30).

VERTICAL:
CONTOUR MAPPING IS BASED ON U.S.E.D. 1944, MLLW=0.00. WRITTEN ELEVATIONS CONTAINED HEREIN ARE ADJUSTED TO NGVD 29, MSL=0.00. BY SUBTRACTING 2.29 FEET FROM MAPPING ELEVATIONS OR WERE TAKEN DIRECTLY FROM LCMF'S RECORD SURVEY OF THE ADAK AIRPORT (ARD 96-30) WHICH IS BASED ON NGVD 29, MSL=0.00.

LAND STATUS

ON MARCH 17, 2004 AS PART OF THE ALASKA NATIVE CLAIMS SETTLEMENT ACT THE BUREAU OF LAND MANAGEMENT, UTILIZING AN INTERIM CONVEYANCE AGREEMENT, TRANSFERED CERTAIN PROPERTIES TO THE ALEUT CORPORATION.

ON THAT SAME DATE THE ALEUT CORPORATION TRANSFERED PROPERTIES CONSISTING OF THE ADAK AIRPORT TO THE STATE OF ALASKA. THROUGH THE ADAK AIRPORT TRANSFER AGREEMENT RECORDED IN THE ALEUTIAN RECORDING DISTRICT.

AIRPORT PROPERTY STATUS

PARCEL	DOCUMENT	EXECUTED	RECORDED	ACREAGE	REVISIONS
TRACT 1	~~WARRANTY~~ DEED	3-17-2004	3-18-2004	775~	
TRACT 1A	WARRANTY DEED				
TRACT 2	AVIGATION EASEMENT	3-17-2004	3-18-2004	21.03~	
TRACT 3A	AK TIDELAND SURVEY				
TRACT 3B	AK TIDELAND SURVEY				

Subsurface Surface

AIRPORT LEASE LOT LAND STATUS

LOT	OWNER	LEASEE	ADDRESS	AREA	EXPIRES
GS/AWOS/PAPI	STATE	FAA	222 WEST 7TH AVE. ANCHORAGE, AK 99513	1.38 AC	~~(T-B-D)~~
LOCALIZER	STATE	FAA	222 WEST 7TH AVE. ANCHORAGE, AK 99513	3.62 AC	

LEGEND		
EXISTING	FUTURE	
		AIRPORT PROPERTY LINE
RSA		RUNWAY SAFETY AREA (RSA)
ROFA		RUNWAY OBJECT FREE AREA (ROFA)
		RUNWAY PROTECTION ZONE(RPZ)
		BUILDING RESTRICTION LINE (BRL)
		AIRPORT REFERENCE POINT (ARP)
VASI-6		VISUAL APPROACH SLOPE INDICATOR(VASI)
T/W A		TAXIWAY IDENTIFIER
		STRUCTURE
*		STRUCTURE TO BE REMOVED
		PAVED ROAD
		UNIMPROVED ROAD
		TRAIL
		BRIDGE
		PAVED AREA
		CONCRETE
		FENCE
		SWAMP
		STREAM OR CREEK
		SHORE LINE
		RUNWAY/TAXIWAY LIGHTS
		RUNWAY/TAXIWAY SIGNS
		WINDSOCK
		HORIZONTAL/VERTICAL CONTROL
		ROLLER GATE
		CARSONITE FLEX FENCE
*		ROCK
		DISTANCE TO GO SIGNS
		T/W CLOSED MARKING

AIRPORT LAYOUT PLAN APPROVED BY DELEGATED: 8/4/04
AIRPORTS DIVISION
FAA ALASKAN REGION, AAL-601
AIRSPACE REVIEW 03AAL-184NRA

ADAK AIRPORT LAYOUT PLAN PREPARED FOR STATE OF ALASKA
APPROVED 8/4, 2004
DATE
REGIONAL CHIEF

ARIES CONSULTANTS LTD.
WINCE-CORTHELL-BRYSON
DRAWN BY: VICKI COLEMAN DWG: STATEAPBOUND
CHECKED BY: CASEY MADDEN DATE: Jul 28,2004

ADAK AIRPORT
EXHIBIT "A" PROPERTY MAP
ADAK, ALASKA

SHEET 10 OF 10