

65.01.01 STERLING HWY: COOPER LANDING to SKILAK LAKE RD

Transit Notes¹ ERFO-2 (1)

Kenai River Bridge to Forest Boundary

April - June 65

DISTANCES FROM SIDE STAKES FOR CROSS-SECTIONING Roadway of any Width. Side Slopes $1\frac{1}{2}$ to 1.													
In the figure below: opposite 7 under "Cut or Fill" and under .3 read 11.0, the distance out from the side stake at left. Also, opposite 11 under "Cut or Fill" and under .1 read 16.7, the distance out from the side stake at right.													
Cut or Fill	0	.1	.2	.3	.4	.5	.6	.7	.8	.9	Cut or Fill	Distance out from Side or Shoulder Stake	
0	0.0	0.2	0.3	0.5	0.6	0.8	0.9	1.1	1.2	1.4	0	0	0.0
1	1.5	1.7	1.8	2.0	2.1	2.3	2.4	2.6	2.7	2.9	1	1	1.5
2	3.0	3.2	3.3	3.5	3.6	3.8	3.9	4.1	4.2	4.4	2	2	3.0
3	4.5	4.7	4.8	5.0	5.1	5.3	5.4	5.6	5.7	5.9	3	3	4.5
4	6.0	6.2	6.3	6.5	6.6	6.8	6.9	7.1	7.2	7.4	4	4	6.0
5	7.5	7.7	7.8	8.0	8.1	8.3	8.4	8.6	8.7	8.9	5	5	7.5
6	9.0	9.2	9.3	9.5	9.6	9.8	9.9	10.1	10.2	10.4	6	6	9.0
7	10.5	10.7	10.8	11.0	11.1	11.3	11.4	11.6	11.7	11.9	7	7	10.5
8	12.0	12.2	12.3	12.5	12.6	12.8	12.9	13.1	13.2	13.4	8	8	12.0
9	13.5	13.7	13.8	14.0	14.1	14.3	14.4	14.6	14.7	14.9	9	9	13.5
10	15.0	15.2	15.3	15.5	15.6	15.8	15.9	16.1	16.2	16.4	10	10	15.0
11	16.5	16.7	16.8	17.0	17.1	17.3	17.4	17.6	17.7	17.9	11	11	16.5
12	18.0	18.2	18.3	18.5	18.6	18.8	18.9	19.1	19.2	19.4	12	12	18.0
13	19.5	19.7	19.8	20.0	20.1	20.3	20.4	20.6	20.7	20.9	13	13	19.5
14	21.0	21.2	21.3	21.5	21.6	21.8	21.9	22.1	22.2	22.4	14	14	21.0
15	22.5	22.7	22.8	23.0	23.1	23.3	23.4	23.6	23.7	23.9	15	15	22.5
16	24.0	24.2	24.3	24.5	24.6	24.8	24.9	25.1	25.2	25.4	16	16	24.0
17	25.5	25.7	25.8	26.0	26.1	26.3	26.4	26.6	26.7	26.9	17	17	25.5
18	27.0	27.2	27.3	27.5	27.6	27.8	27.9	28.1	28.2	28.4	18	18	27.0
19	28.5	28.7	28.8	29.0	29.1	29.3	29.4	29.6	29.7	29.9	19	19	28.5
20	30.0	30.2	30.3	30.5	30.6	30.8	30.9	31.1	31.2	31.4	20	20	30.0
21	31.5	31.7	31.8	32.0	32.1	32.3	32.4	32.6	32.7	32.9	21	21	31.5
22	33.0	33.2	33.3	33.5	33.6	33.8	33.9	34.1	34.2	34.4	22	22	33.0
23	34.5	34.7	34.8	35.0	35.1	35.3	35.4	35.6	35.7	35.9	23	23	34.5
24	36.0	36.2	36.3	36.5	36.6	36.8	36.9	37.1	37.2	37.4	24	24	36.0
25	37.5	37.7	37.8	38.0	38.1	38.3	38.4	38.6	38.7	38.9	25	25	37.5
26	39.0	39.2	39.3	39.5	39.6	39.8	39.9	40.1	40.2	40.4	26	26	39.0
27	40.5	40.7	40.8	41.0	41.1	41.3	41.4	41.6	41.7	41.9	27	27	40.5
28	42.0	42.2	42.3	42.5	42.6	42.8	42.9	43.1	43.2	43.4	28	28	42.0
29	43.5	43.7	43.8	44.0	44.1	44.3	44.4	44.6	44.7	44.9	29	29	43.5
30	45.0	45.2	45.3	45.5	45.6	45.8	45.9	46.1	46.2	46.4	30	30	45.0
31	46.5	46.7	46.8	47.0	47.1	47.3	47.4	47.6	47.7	47.9	31	31	46.5
32	48.0	48.2	48.3	48.5	48.6	48.8	48.9	49.1	49.2	49.4	32	32	48.0
33	49.5	49.7	49.8	50.0	50.1	50.3	50.4	50.6	50.7	50.9	33	33	49.5
34	51.0	51.2	51.3	51.5	51.6	51.8	51.9	52.1	52.2	52.4	34	34	51.0
35	52.5	52.7	52.8	53.0	53.1	53.3	53.4	53.6	53.7	53.9	35	35	52.5
36	54.0	54.2	54.3	54.5	54.6	54.8	54.9	55.1	55.2	55.4	36	36	54.0
37	55.5	55.7	55.8	56.0	56.1	56.3	56.4	56.6	56.7	56.9	37	37	55.5
38	57.0	57.2	57.3	57.5	57.6	57.8	57.9	58.1	58.2	58.4	38	38	57.0
39	58.5	58.7	58.8	59.0	59.1	59.3	59.4	59.6	59.7	59.9	39	39	58.5
40	60.0	60.2	60.3	60.5	60.6	60.8	60.9	61.1	61.2	61.4	40	40	60.0

KEUFFEL & ESSER CO., N. Y.

RETURN TO
DEPT. OF HIGHWAYS
1306 E. 4th AVE., ANCHORAGE

Date _____
Project No. ERFO-2 (1)
Project Title Kenai Bridge - Forest Bound.
Gen. Local Cooper Landing - Hentons
Sta 601+23.0 to Sta. 976+00.30
Project Engr. _____
Party Chief P. Gallamore
Instrument Man R. Banks & Freer
Note Keeper Gallamore & Banks
Rodman R. Freer
Chairman H. Huling
Chairman D. Ogren

The paper in this book is made
of 50% high grade rag stock with
a WATER RESISTING surface sizing.

Page

INDEX

- 2-37 "L" Line Alignment 601+23.00 to 976+00.30
- 39-40 Traverse 672+43.77 - 694+20.38 for
Base Line to be used for X-sectioning
- 42-47 Tie to USCS&GS triangulation points and
centerline traverse closure information
- 48-49 Electrotape Check

Note - Beginning of project is station
601+23.00. This is the south end of
the bridge presently under construction.
This sta. was obtained from notes made
by "location" personnel and presently in
the hands of Bill Clark bridge inspector.

Sta. Temp. Cam.
Chain. Dist.
Foresight P.O.S.T. AHEAD.

Note: Tan forward from P.I. is offset 9.0'
Lt. of exist centerline.

P.O.T. 602+00

P.I. (New) 606+94.36

P.O.T. Forward

11.40'

Original P.I. 606+82.96

Az. X
D- 00° 03' 15" 2"
R- 180° 03' 08" 2"

232° 06' 22"


D- 232° 03' 37" 34"
R- 52° 03' 30" 34"

D- 00° 00' 24" 22"
R- 180° 00' 20" 22"
Mn. = 232° 06' 11"

D- 232° 06' 32" 33"
R- 52° 06' 34"

Note: Sta. of P.I. is that established
by location survey for new Kenai River
bridge, not the sta. used for previous const.
of the highway. Dist. from P.I. back to P.K.
at sta. 602+00 checks out fine.

4-22-65
Cloudy 3/4 40°

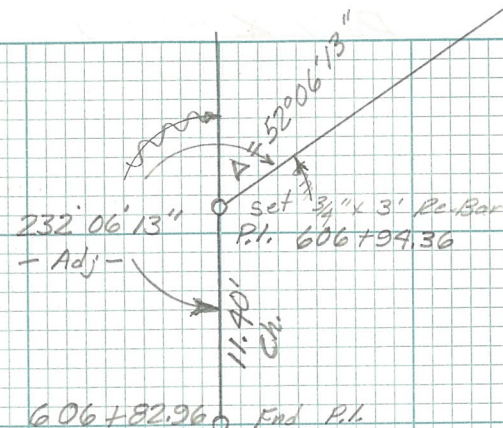

Gallamore (2)
Banks
Ch. Piece
Ch. Hiding H.
Ogren
Inst. K&E 2E 1 sec.
Theodolite
Standard checked
Chain.

End P.I.
H&T Probably is original P.I.

Horizon X

D- 232° 06' 37"
R- 52° 06' 34"

D- 00° 00' 24" 22"
R- 180° 00' 20"

D- 00° 00' 35" 40"
R- 180° 01' 46" 40"

127° 53' 44"

D- 127° 55' 21" 24"
R- 307° 55' 28" 24"

127 53 44
232 06 11
359° 59' 55"
= 232° 06' 13" Adj. X

602+000 End P.K. in Pavement
Presently being used for control
point in const. of bridge.

Kenai
River
Bridge
Under
Const.

Sta Dist. Defl. $\angle$

616-

615-

614-

613-

612-

611-

61.93'

+38.57 P.T.

610

+50

609

+50

608

+50 P.O.C.

607

+50

606

+50

605

+50

604

+50

603

602+94.23 P.C.

26° 03.1' ✓

24° 42.1' ✓

22° 57.1' ✓

21° 12.1' ✓

19° 27.1' ✓

17° 42.1' ✓

15° 57.1' ✓

14° 12.1' ✓

12° 27.1' ✓

10° 42.1' ✓

08° 57.1' ✓

07° 12.1' ✓

05° 27.1' ✓

03° 42.1' ✓

01° 57.1' ✓

0° 12.1' ✓

0° 00'

$\Delta = 52^\circ 06' 13''$

$D = 7^\circ 00' \text{ RT.}$

$T = 400.13'$


$L = 749.34'$

$R = 818.51$

$\frac{\Delta}{2} = 26^\circ 03.1'$

4-22-65
Cloudy $\frac{1}{2}$ 90°

Some ③
Crew

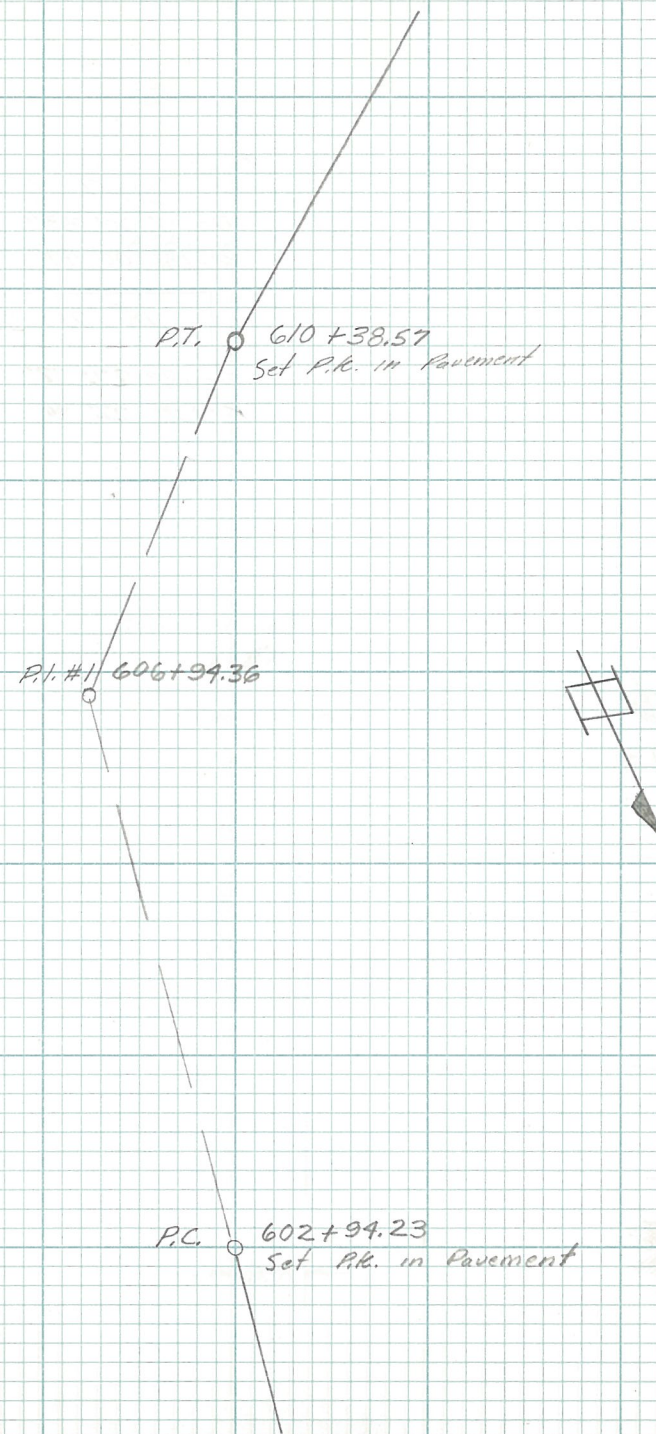

Sta. Chain.
Dist.

Hor. Rdg.

P.I. #2

Defl. Δ
D- 0° 00' 33" 38"
R- 180° 00' 44" 29"

18° 21' 58"

D- 18° 22' 32" 36"
R- 198° 22' 40" 36"

631-
630-
629-
628-
627-
626-
625-
624-
623-
622-
621-
620-
619-
618-
617-

Sa 4-23-65

Snow Flurries § 36°

Gallamore (4)

A Banks
Ch. Helling
Ch. Ogren

Horizon Δ

D- 00° 00' 28" 29"
R- 180° 00' 30" 29"

341° 38' 06"

D- 341° 38' 32" 35"
R- 161° 38' 37" 35"

341° 38' 06"
18 21 58

359° 00' 04"

P.O.S.T.

$\Delta = 18^\circ 21' 56''$
Adj.


P.I. #2 Set. P.K. in Pavement

P.O.S.T. 631+57.33
P.K. in Pavement

9.0'

"L" Line
Exist. Rd.

9.0'

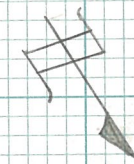

Sta. Chain.
Dist.

Defl. &

641+59.03 P.O.T.
59.03'

641

640+28.03 P.T.
28.03' Calc.
- 27.98 Ch.

640 -

639 -

638 -

637 -

636 -

635 -

634 -

633 -

632 -

90.25'

631+09.75 P.C.

09.75'

631 -

9° 10.9' ✓

8° 54.1' -

7° 54.1' -

6° 54.1' -

5° 54.1' -

4° 54.1' -

3° 54.1' -

2° 54.1' -

1° 54.1' -

0° 54.1' -

0° 00'

$\Delta = 18^\circ 21' 56''$
 $D = 2^\circ 00' \text{ LH}$
 $T = 463.12'$

$L = 918.28'$

$R = 2864.79'$

$\frac{\Delta}{2} = 09^\circ 10' 58''$

4-23-65

SAWZ (5)
CREW

P.O.T. 641+59.03
Set 2" x 2" H&T - Flush -

P.T. 640+28.03
Set 3/4" x 3' Re-Bar - 0.3' above ground -

P.I. #2
635+72.87
- Calc. -

P.C. 631+09.75
Set PK. in Pavement

Sta.

Az. $\times$

D-0° 09' 07" 05"
R-180° 09' 03" 05"

Horizon $\times$

D-0° 08' 19" 18"
R-180° 08' 17" 18"

P.I. #3

Mm.

186-42-35

D-186° 51' 41" 40"
R-06° 51' 40" 40"

Mm.

173-17-21

D-173° 25' 38" 38"
R-353° 25' 40" 38"

4-29-65


186-42-35
173-17-21
359° 59' 56"

P.I. #3 Set P.K. in Pavement

P.O.T. 641+59.03

Same Crew
Note - Line forward of P.I. is 9.0' ft. of exist. centerline

Adjusted
4° 06' 42' 37"

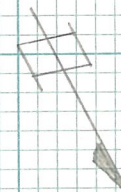

Sta. Chain
Dist.
Temp. Corr.

Defl.
X

655 -

654 -

653 -

90.57'

652+09.43 P.T.

652 -

651 -

650 -

649 -

648 -

647 -

646 -

61.60'

645+38.40 P.C.
38.40'

645 -

644 -

643 -

642 -

43.97'
~~43.97'~~ 0.00'

54.03
641+54.03 P.O.T.

3° 21.3' ✓ $\Delta = 06^\circ 42' 37''$
D = 1° 00' Rt. ~~90°~~ ~~90°~~
3° 18.5' - T = 335.94' ~~52'~~
L = 671.03'
R = 5729.58'

2° 48.5' -

2° 18.5' -

1° 48.5' -

1° 18.5' -

0° 48.5' -

0° 18.5' -

0° 00'

4-24-65


Same (7)
Crew

P.T. Set 652+09.43
P.K. in Pavement

P.I.#3 648+74.30

P.C. Set 645+38.40
3/4" x 3' Rebar in
backslope - Flush -

645+38.40
3 35.90
P.I. = 648+74.30

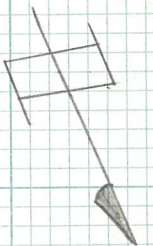

Sta.

P.I. #4

Az. $\times$
 $D = 00^{\circ}00'48''$
 $R = 180^{\circ}00'51''$
 $Mn. = 192^{\circ}00'05''$
 $D = 192^{\circ}00'55''$
 $R = 12^{\circ}00'59''$

$$\begin{array}{r} 192\ 00\ 05 \\ 167\ 59\ 54.5 \\ \hline 359^{\circ}59'59.5 \end{array}$$
Horizon $\times$
 $D = 00^{\circ}00'17''$
 $R = 180^{\circ}00'12''$
 $167^{\circ}59'54.5$
 $D = 168^{\circ}00'08''$
 $R = 348^{\circ}00'10''$
 $\Delta = 12^{\circ}00'05''$

661 -

660 -

659 -

658 -

657 -

656 -

5-7-65

Cloudy, Wind $\frac{1}{2}$ 30'Same (8)
Crew

$12^{\circ}00'05''$
 - Adj. -
 P.I. 4
 Set $\frac{3}{4}" \times 3'$ Rebar - Buried 0.5' -

 $\rightarrow 9.0' \leftarrow$

"L" Line

Ed. Exst.

 $\rightarrow 0.0' \leftarrow$

P.I. #30

Sta. Chain. Dist. Defl.

672 -

50.78

671+49.22 P.O.T. (No. 1 on Electrolite sheets)

671 -

670 -

669 -

668 -

47.56'

667+52.44 P.T.

667 -

P.I. 664+53.50 (Calc.)

666 -

 $\Delta = 12^\circ 00' 05''$

665 -

 $D = 2^\circ 00' R\&$

664 -

 $T = 301.13'$

663 -

 $L = 600.07$

662 -

 $R = 2864.79$ $E = 15.78 \pm'$

661+52.37 P.C.

 $\frac{\Delta}{2} = 06^\circ 00' 02''$ $\Delta = 12.0013888^\circ$

5-7-65

ERFO 2 (1)

Same (9)

Crew

P.O.T. 671+49.22

Set $\frac{3}{4}" \times 3'$ Re-Bar - Up 0.2' -

P.T. 667+52.44

Set $\frac{3}{4}" \times 3'$ Re-Bar - Flush -

P.I. #4 664+53.50 (Calc. Sta.)

Set $\frac{3}{4}" \times 3'$ Re-Bar - Buried 0.5' -

P.C. 661+52.37

Set P.R. in pavement

Sta. Chain.
Dist.
Temp. Corr.

688 -

686 & 687 Not set, Fall in river.

685 + 23.05 P.O.T. (No. 4 on Electrotape sheets)

685 -

684 -

683 -

682 -

43.87'

681 + 50.13 P.O.T. (No. 3 on Electrotape sheets) E. Tape Dist.
P.O.T. # 2 to # 3 = 464.94, Chained Dist.

681 - = 465.12'. E. Tape data used to station
P.O.T. # 3

679 & 680 Not set, Fall in river.

678 -

677 -

14.81

676 + 85.19 P.O.T. (No 2 on Electrotape sheets)

676 - E. Tape Dist. P.O.T. # 1 to # 2

675 - = 535.97. Distance chained = 536.17.

674 - E. Tape Dist. used to station # 2.

674 -

673 -

5-7-65

cloudy & 33°

EKTU 2 (1)

Same 10
Crew

P.O.T. Set 2"x2" H&T
685 + 23.05

P.O.T. Tack in 8" Spruce Stump
681 + 50.13

Kenai
River

P.O.T. Tack in 7" Birch Stump
676 + 85.19

Sta

Chain.

Dist

Defl.

Az. $\angle$ Horizon $\times$ D - 0° 00' 41" 36^E

R - 180-00-32

D - 0-00-39 38

R - 180-00-37

P.I. #5

690+95.35

175-08-27^E184-51-33^ED - 175-⁰⁹08-05

R - 355-09-03 09

D - 184-52-11 11^E

R - 09-52-12

175-08-27^E184-51-33^E

360-00-01

 $\Delta = 04^{\circ}51'33''$ 572.30'
- E. Tape Dist.

685+23.05

688+52

P.O.T. (#4)

5-7-65

Same (11)

Crew

P.O.S.T.

04°51'33"
- Adj.

P.I. #5

690+95.35


Set 3/4" x 3 Re-Bar in fill slope - Flush -

Note - Sta. of P.I. obtained using
E. Tape Dist. from P.O.T. #4

River

P.O.T. #4
(#4) 685+23.05

Sta.	Chain. Dist.	Decl. X		
702 -				
701 -				
700 -				
699 -				
698 -				
697 -				
696 -				
695 -				
694 -				
	61.82			
693+38.18 P.T.		02° 25.8' ✓	P.I. = 690+95.35	
693 -		02° 14.3' -	$\Delta = 04° 51' 38''$	
			$D = 1° 00' LA$	
692 -		01° 49.3' -	$T = 243.09'$	
			$L = 485.92'$	
691 -		01° 14.3' -	$R = 5,729.58$	
690 -		0° 49.3' -	$\frac{\Delta}{2} = 02° 25' 46''$	
689 -		0° 14.3' -	$\Delta = 4.859166°$	
	47.74			
688+52.26 P.C.		0° 00'		

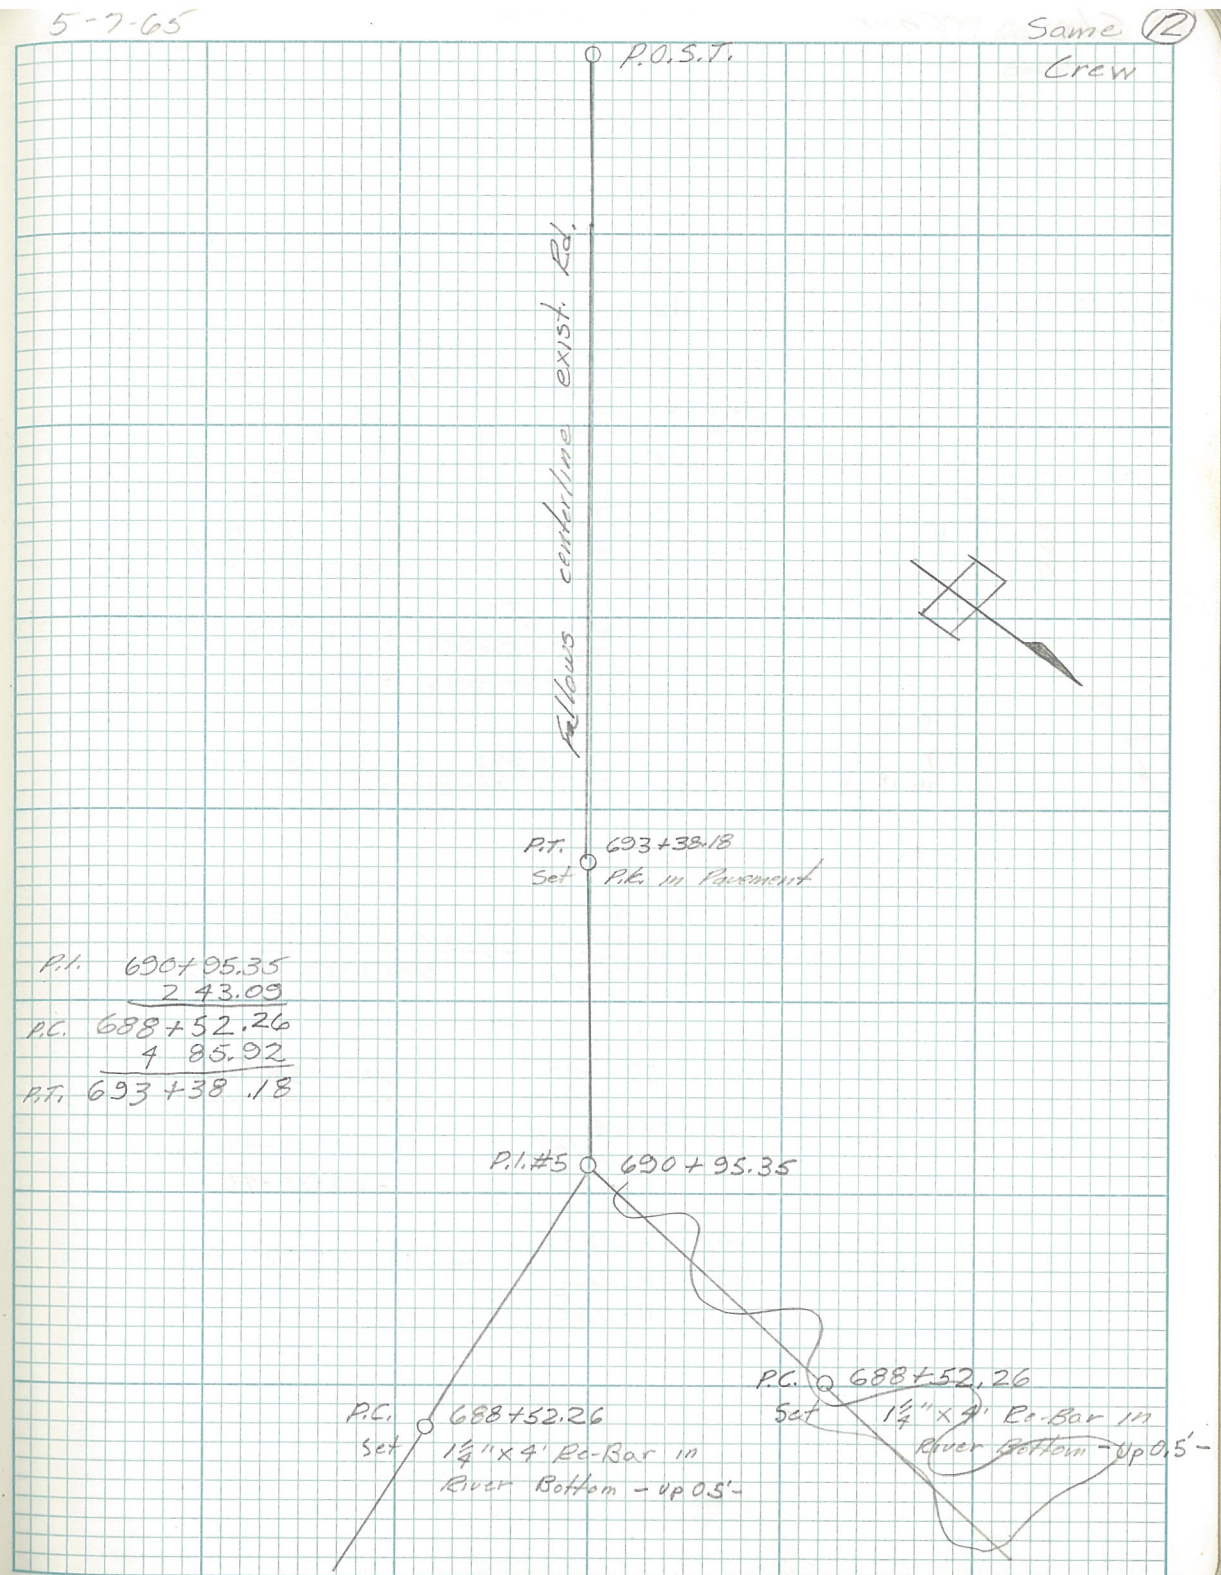

Sta Chain
Dist

P.I. #6 - Inaccessible -

Az. X

Horizon X

D - 0-04-28 25.5"
R - 180-04-23

D - 0-02-53 49"
R - 180-02-45

Mn. = 201-34-21

158-25-36.5

D - 201-38-47 46.5"
R - 21-38-46

D - 158-28-23 25.5"
R - 338-28-28

201-34-21
158-25-36.5
359-59-57.5

Adj. X = 21° 34' 23"

639.95'
Ch. (Double)

P.O.S.T. #1

Az. X

Horizon X

D - 0-02-12 10"
R - 180-02-08

D - 0-00-43 43"
R - 180-00-43

Mn. = 191-22-02.5

Mn. = 168-38-01

D - 191-24-14 12.5"
R - 11-24-11

D - 168-38-45 49"
R - 348-38-43

191-22-02.5
168-38-01
360-00-03.5

Adj. X = 11° 22' 01"

5-8-65
Clear 36"
21-34-23
11-22-01
32-56-24


179 59 60
32 56 24
147-03-36

CK+U - 2 (1)

Callamore (13)

Banks
Freer
Ch. Huling H.
Ch. Ogren

Inst. KSE #159098
S KSE 2 Thredell
used to turn angle.

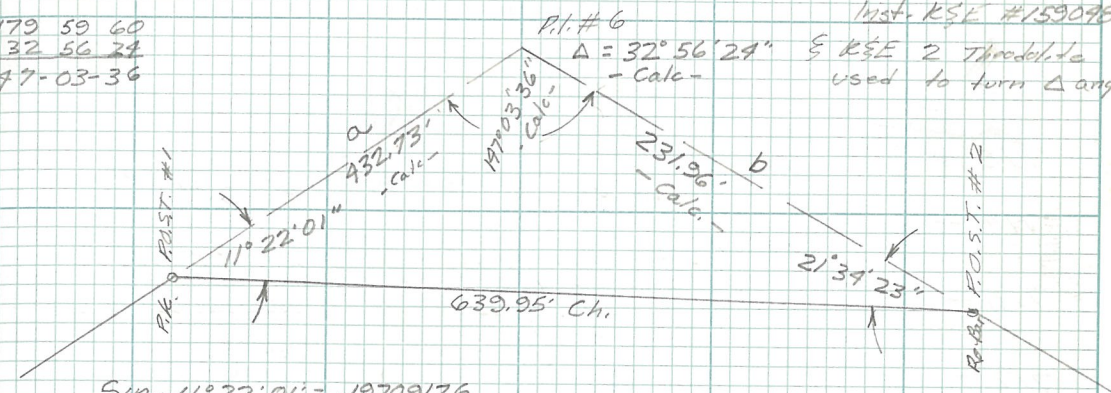

$\sin 11^\circ 22' 01" = .19709176$
 $21^\circ 34' 23" = .36768727$
 $147^\circ 03' 36" = .54376098$

$a = \frac{.36768727 \times 639.95}{.54376098} = \frac{23530147}{.54376098} = 432.73$

$b = \frac{.19709176 \times 639.95}{.54376098} = \frac{12612887}{.54376098} = 231.96'$

Sta

Chain.
Dist.

Defl. &

715 -

714 -

713 -

712 -

75.82'

711+29.18 P.T.

711 -

710 -

709 -

708 -

707 -

706 -

705 -

704 -

703 -

702+45.78 P.C.

P.O.S.T.
#1

54.22'

219.75'
Ch.

P.O.S.T. #2

18.98'
Ch.

16° 28.2' ✓

16° 01' ✓

14° 08.5' ✓

12° 16' ✓

10° 23.5' ✓

8° 31' ✓

6° 38.5' ✓

4° 46' ✓

2° 53.5' ✓

1° 01' ✓

0° 00' ✓

 $\Delta = 32^\circ 56' 24''$ $D = 3^\circ 45' B \pm$ $T = 451.71'$ $L = 878.40'$ $R = 1527.89'$ $\frac{\Delta}{2} = 16^\circ 28' 12''$ $\Delta = 32.970^\circ$

5-8-65

L.R.V. - 2 (1)

Same (19)
Crew451.71
231.96
219.75'

P.T. 711+24.18

Set P.K. in Pavement

219.75'
Ch.P.O.S.T. #2
3/4" x 3' Re-Bar
+UP 0.31'

231.96' Calc.

P.I. #6
- Not Set -432.73'
Calc.P.O.S.T. #1
P.K. in Pav.18.98'
Ch.

P.C. 702+45.78

Set P.K. in Pavement

451.71
432.73
18.98'

Sta.

P.I. # 7

AZ. Δ

Horizon Δ

D-0-08-92 41E
R-180-08-41

D-0-08-90 37E
R-180-08-35

109-09-06

255-51-00


D-109-17-99 47E
R-284-17-96

D-255-59-37 37S
R-75-59-38

109-09-06
255-51-00 Adj. $\Delta = 75^{\circ} 50' 57''$
360-00-06

5-8-65
Clear 360

Same (15)
Crew

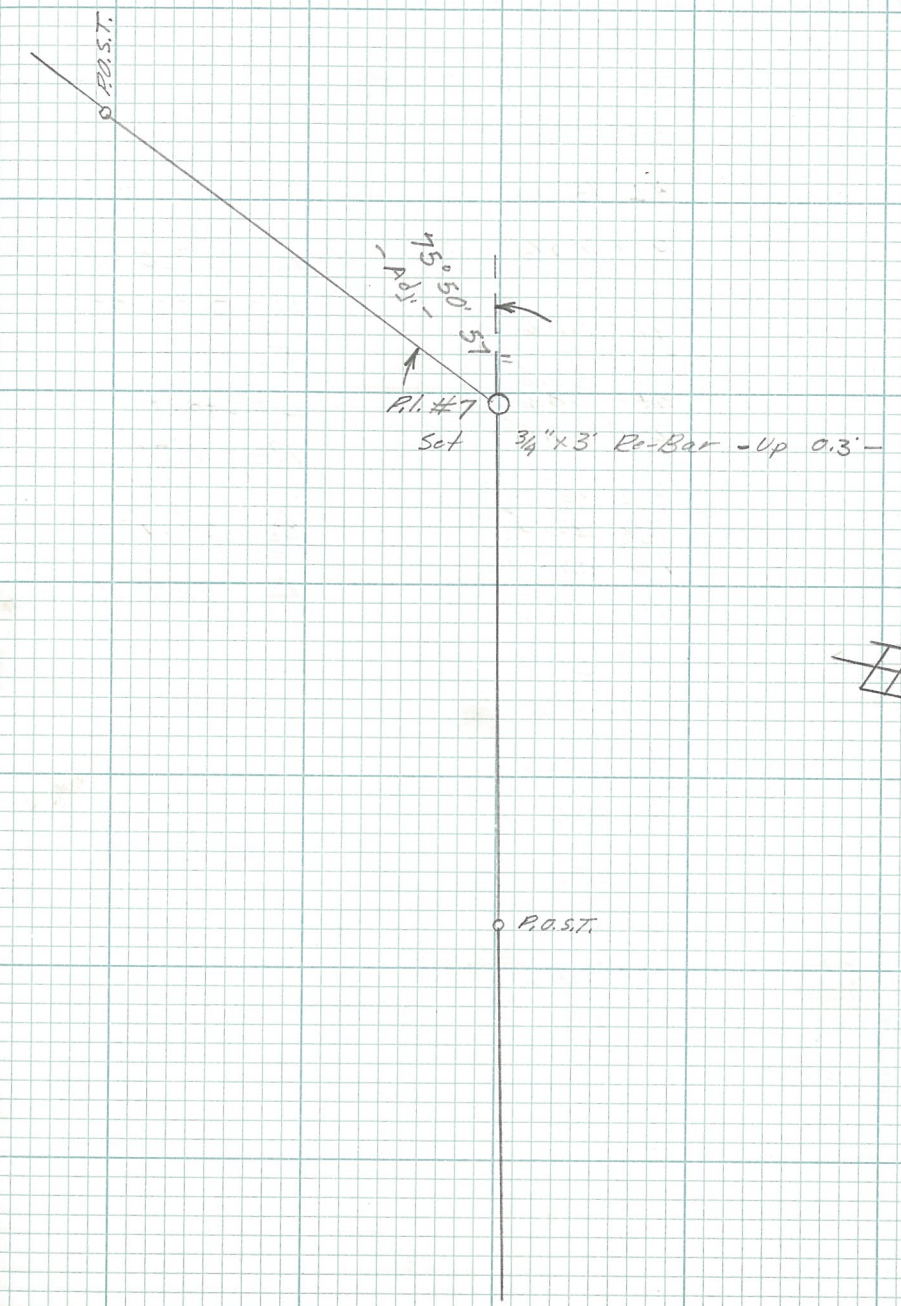

Sta Chain. Defl. 4
Dist.

724+77.04	P.T.	37° 55.5' ✓
+50		36° 50.6'
724-		34° 50.6'
+50		32° 50.6'
723 -		30° 50.6'
+50		28° 50.6'
722 -		26° 50.6'
+70 P.O.C		25° 38.6'
+50		24° 50.6'
721 -		22° 50.6'
+50		20° 50.6'
720 -		18° 50.6'
+50		16° 50.6'
719 -		14° 50.6'
+50		12° 50.6'
718 -		10° 50.6'
+50		8° 50.6'
717 -		6° 50.6'
+50		4° 50.6'
716 -		2° 50.6'
+50		0° 50.6'
715+28.93	P.C.	

$$\Delta = 75^{\circ} 50' 57''$$

$$D = 8^{\circ} 00' 41''$$

$$T = 558.04'$$

$$L = 948.11$$

$$R = 716.20$$

$$\frac{\Delta}{2} = 37^{\circ} 55' 28''$$

$$\Delta = 75.8491666^{\circ}$$

5-8-65

ERFO-2 (1)

Same 16
Crew

P.T. 724+77.04
Set P.K. in Pavement

720+86.97 P.I. #7
3/4" x 3" Re-Bar

P.C. 715+28.93
Set P.K. in Pavement

$$\begin{array}{r} 715+28.93 \\ 5 \quad 58.04 \\ \hline P.I. = 720+86.97 \end{array}$$

Sta

Chain
DistAz. $\angle$ Horizon $\angle$

D-0°06-47 46"

D-0°05-55 58"

R-180-06-95 46"

R-180-06-01 58"

P.O.S.T. #2

Mn.

193-43-10

Mn.

166-16-18^E193-43-10
166-16-18^E
359-59-58^E

D-193-49-55 56"

R-13-49-57

D-166-22-45 46^E

R-346-22-48

Adj. $\angle = 13^{\circ}43'11''$

- P.I. # 8

Inaccessible -

D-0°05-11 10.5"

R-180-05-10

D-0°06-59 01.2"

R-180-07-09

P.O.S.T. #1

213-41-41

196-18-18^E

D-213-46-51 51.5"

R-33-46-52

D-196-25-19 20"

R-326-25-21

213-41-41
196-18-18^E
359-59-59^EAdj. $\angle = 33^{\circ}41'41''$

730 -

729 -

728 -

727 -

726 -

725 -

5-10-65

Clear $\angle 40^{\circ}$

33-41-41

13-43-11

47-24-52


179 59 60

47 24 52

132-35-08

Same (17)

Crew

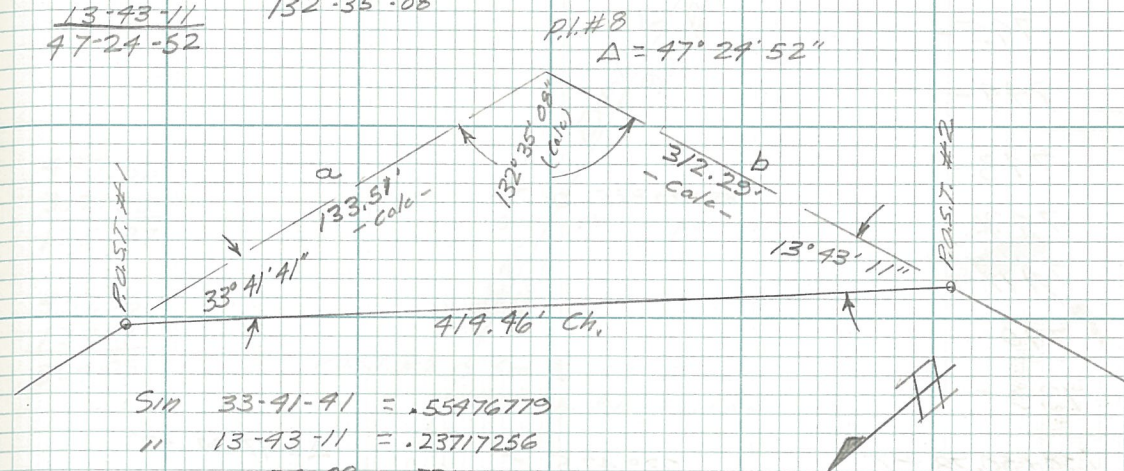

$$\sin 33-41-41 = .55476779$$

$$'' 13-43-11 = .23717256$$

$$'' 132-35-08 = .73626771$$

$$a = \frac{.23717256 \times 419.46}{.73626771} = \frac{98298539}{.73626771} = 133.51'$$

$$b = \frac{.55476779 \times 419.46}{.73626771} = \frac{22982906}{.73626771} = \frac{31066}{.73626771} = 3/2.29'$$

S/a. Chain. Defl. &
Dist.

745-

744-

743-

742-

741-

740-

739-

738+50.78 P.T.

23° 42.5' ✓

$\Delta = 47^{\circ} 24' 52''$

738 -

22° 14.9' ✓

$D = 5^{\circ} 45' R.L.$

+50

20° 48.6' ✓

$T = 437.56'$

737 -

19° 22.4' ✓

$L = 824.60'$

+50

17° 56.1' ✓

$R = 936.45'$

736 -

16° 29.9' ✓

$\frac{\Delta}{2} = 23^{\circ} 42' 26''$

+50

15° 03.6' ✓

$\Delta = 47.44444^{\circ}$

735 -

13° 37.4' ✓

+50

12° 11.1' ✓

734 -

10° 44.9' ✓

730+26.18

+50

9° 18.6' ✓

+ 37.56

733 -

7° 52.4' ✓

P.I. = 734+63.74

+50

6° 26.1' ✓

730+26.18

732 -

4° 59.9' ✓

+ 24.60

+50

3° 33.6' ✓

P.T. = 738+50.78

731 -

2° 07.4' ✓

+50

0° 41.1' ✓

730+26.18 P.C.

0° 00'

5-10-65

Same (18)
Crew

437.56

312.29

125.27

437.56

133.51

304.05

P.O.S.T. #2 Set $\frac{3}{4}$ " x 3' Re-Bar
in Sh. Rd. - Flush -

P.I. #8

- Inaccessible -

P.O.S.T. #1 Set $\frac{3}{4}$ " x 3' Re-Bar
733+30.23 on hillside - Up 0.4' -

P.C. 730+26.18
Set Pk. in pavement

730+26.18

3 04.05

733+30.23

Sta Chain.
Dist.

766-

765-

764-

763-

762-

761-

31.42'

760+68.58 P.O.T.

760-

759-

758-

757-

756-

755-

754-

753-

752-

84.31'

751+15.69 P.O.T.

751-

750-

749-


748-

747-

746-

5-10-65

Same (19)
Crew

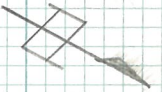

P.O.T. 760+68.58

Set P.K. in Pavement

Exist. & 90' RT

P.O.T. 751+15.69

Set P.K. in Pavement

Sta. Chain. Defl.
Dist. Δ

777 -
776 -
775 -
774 -
773 -

01.72

772+98.28 P.T.

772 -

771 -

770 -

769 -

768 -

767 -

766+50.69 P.C.

05° 40.0' ✓

04° 48.4' ✓

03° 55.9' ✓

03° 03.4' ✓

02° 10.9' ✓

01° 18.4' ✓

0° 25.9' ✓

$\Delta = 11^{\circ} 19' 58''$
 $D = 01^{\circ} 45' Rk$
 $T = 324.85'$
 $L = 647.59'$
 $R = 3274.06'$

$\frac{\Delta}{2} = 05^{\circ} 39' 59''$

$\Delta = 11.332777^{\circ}$

49.31'

5-10-65
Clear $\frac{1}{2}$ 60'

Same (20)
Crew

Az. Δ

D-0-07-06 01"
R-180-06-56 01"

P.I. #9

191-19-55.5 Mn.

D-191-26-57 56.5"
R-11-26-56

P.T. 772+98.28

Set P.E. in Pavement

P.I. #9
Set

769+75.54

3/4" x 3' Re-bar
in Sh. - Flush -

Horizon Δ

D-0-06-30 29"
R-180-06-28

Mn. 168-40-01

D-168-46-27 30"
R-348-46-33

168-40-01
191-19-55.5
359-59-56.5

Adj. $\Delta = 11-19-58$

P.C. 766+50.69

Set P.E. in Pavement

Sta. Chain. D+H. &
Dist.

790-

789-

788-

09.82

787+95.12 P.O.T.

787-

786-

785-

784-

20.14'

783+79.86 P.T.

05° 30.1' -

783-

04° 48.2' -

782-

03° 55.7' -

781-

03° 03.2' -

780- P.O.C.

02° 10.7' -

779-

01° 18.2' -

778-

0° 25.7' -

48.87'

777+51.13 P.C.

0° 00'

$$\Delta = 11^{\circ}00'10''$$

$$D = 1^{\circ}45'41''$$

$$T = 315.39'$$

$$L = 628.73$$

$$R = 3,274.05$$

$$\frac{\Delta}{2} = 05^{\circ}30'05''$$

$$\Delta = 11.002777^{\circ}$$

5-10-65

Same (21)
Crew

P.O.T. 787+95.18
Set P.K. in pavement

Az. &
D-0-06-04 09.5"
R-180-06-05
P.I. #10
Mn. 168-59-51.5

D-169-05-54
R-349-05-58 56"


Exist. &
9.0' P.K.

P.T. 783+79.86
Set P.K. in pavement

Horizon &
D-0-07-46 45"
R-180-07-44
191-00-11.5

D-191-07-55
R-01-07-58 56"

191-00-11.5
168-59-51.5
350-00-03.9

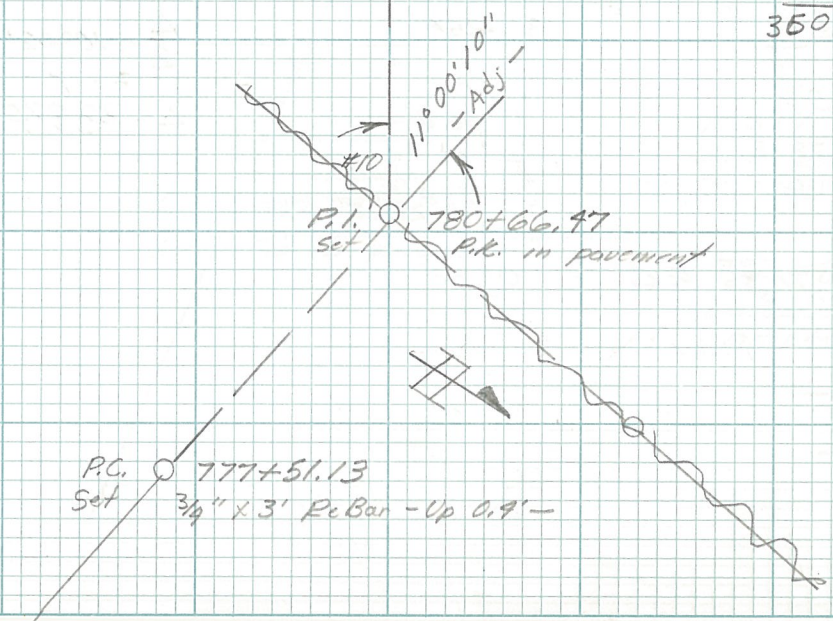

Sta

Chain.
Dist.Defl. $\times$

804-

803-

802-

801-

59.46'

800+40.54 P.T.

10° 02.3' ✓

800-

9° 25.8'

799-

7° 55.8'

 $\Delta = 20^\circ 04' 31''$ D = 3° 00' L_A

798- P.O.C.

6° 25.8'

T = 338.06'

L = 669.19'

797-

4° 55.8'

R = 1909.86'

796-

3° 25.8'

 $\frac{\Delta}{2} = 10^\circ 02' 16''$

795-

1° 55.8'

 $\Delta = 20.0752777^\circ$

794-

0° 25.8'

793+71.35 P.C.

0° 00'

793-

792-

791-

5-10-65

Same (22)
CrewAz. $\times$

D-0-00-31 30"

R-180-00-29 30"

P.I. #11

Mn.

159-55-31

D-159-56-02 01"

R-339-56-00 01"

159-55-31

200-04-33

360-00-04

Horizon $\times$

D-0-00-46 42"

R-180-00-38 42"

Mn.

200-04-33

D-200-05-18 15"

R-20-05-12 15"

P.T. 800+40.54

Set Pk. in pavement

P.I. #11 797+09.41

Set 3/4" x 3' ReBar in Fill slope -- Up 0.1' --

P.C. 793+71.35

Set Pk. in pavement

793+71.35

3 38.06

P.I. = 797+09.41

793+71.35

6 69.19

P.T. = 800+40.54

Sta

Chain.

Dist

Defl.

Temp Corr.

X

819 -

818 -

817 -

816 -

815 -

814 -

813 -

812 -

811 -

17.28'

810+82.72 P.T.

7° 19.9'

810 -

6° 17.9' ✓

809 -

5° 02.9' ✓

808 -

3° 47.9' ✓

807 -

2° 32.9' ✓

806 -

1° 17.9' ✓

805 -

0° 02.9' ✓

804+96.12 P.C.

0° 00'

$$\Delta = 17^{\circ} 39' 54''$$

$$D = 2^{\circ} 30' \text{ RT}$$

$$L = 586.60'$$

$$T = 294.91'$$

$$R = 2291.83'$$

$$\frac{\Delta}{2} = 07^{\circ} 19' 57''$$

$$\Delta = 14.66500^{\circ}$$

5-10-64

Same (23)

Crown

Exist.
0.0' Ch.

P.T. 810+82.72

Set P.K. in pavement

Az. X
D-0-07-13 195"
R-180-07-16

194-39-525

D-194-47-05 07"
R-14-47-09

P.I. # 12 807+91.03

Set 3/4" x 3' Re-Bar in Sh. - Flush -

Horizon X

D-0-09-03 04.5"
R-180-09-06

165-20-045

D-165-29-08 00"
R-345-29-10

165-20-04.5
194-39-52.5
359-59-57.0

P.C. - 804+96.12

586.60

P.T. - 810+82.72

804+96.12

294.91

P.I. - 807+91.03

P.C. 804+96.12

Set P.K. in pavement

Exist.
9.0' Ch.

Sta. Chain. Defl. & s

833+11.14 P.O.T.

833 -

+50

832 -

+50

831 -

+50

830 -

29.34

829+70.66 P.T.

20° 20.3' ✓

+50

19° 43.1' ✓

829 -

18° 13.1' ✓

+50

P.O.C.

16° 43.1' ✓

828 -

15° 13.1' ✓

+50

13° 43.1' ✓

827 -

12° 13.1' ✓

+50

10° 43.1' ✓

826 -

P.O.C.

9° 13.1' ✓

+50

7° 43.1' ✓

825 -

6° 13.1' ✓

+50

4° 43.1' ✓

824 -

3° 13.1' ✓

+50

1° 43.1' ✓

823 -

0° 13.1' ✓

+92.74

07.26'

822+92.74 P.C.

0° 00'

822 -

821 -

820 -

$\Delta = 40^\circ 40' 30''$

D = 6° 00' Rt.

T = 353.95'

L = 677.92'

R = 954.93'

$\frac{\Delta}{2} = 20^\circ 20' 15''$

$\Delta = 40.6750^\circ$

5-11-65

Partly Cloudy & 45°

LKT 0-2 (1)

Same (24)

Az. K

D = 0-08-42 44"

R = 180-08-46 44"

Mm. = 220-40-29

D = 220-49-12" 13"

R = 40-49-14" 13"

P.I. #13

826+46.69

Set 3/4" x 3' Re-Bar in Sh.

-Buried 0.5'-

822+92.74 P.C.

3 53.95

829+70.66 P.T.

822+92.74

3 53.95

826+46.69 P.I.

P.C. 822+92.74

Set P.B. in Pavement

P.O.T. 833+11.14

Set 3/4" x 3' Re-Bar in cut slope: Up 0.4'-

P.T. 829+70.66

Set 12" Spike in Sh. - Flush -

Horizon K

D = 0-09-27 26.5"

R = 180-09-26 26.5"

Mm. = 139-19-29E

D = 139-28-56 56"

R = 319-28-56 56"

139-19-29E

220-40-29

359-59-58E

Adj. K = 40° 40' 30"

Sta

Chain.
Dist.

Defl. & 's

849 -

848 -

847 -

846 -

845 -

844 -

843 -

842 -

841 -

38.93

840+61.07 P.T.

8° 21.5' ✓

840 -

7° 35.7' ✓

839 -

6° 20.7' ✓

838 -

5° 05.7' ✓

837 -

3° 50.7' ✓

836 -

2° 35.7' ✓

835 -

1° 20.7' ✓

834 -

07.54'

0° 05.7' ✓

833+92.46 P.C.

0° 00'

$$\Delta = 16^{\circ} 42' 55''$$

$$D = \Delta 2^{\circ} 30' \text{ LA}$$

$$T = 336.70'$$

$$L = 668.61'$$

$$R = 2291.83'$$

$$\frac{\Delta}{2} =$$

$$\Delta =$$

5-11-60

Snow Flurries $\pm 35^{\circ}$

Az. &

D-0-03-08 135"

R-180-03-19

163-17-055

D-163-20-13 19"

R-393-20-25

Horizon &

D-0-06-01 05.5"

R-180-06-10

196-42-555

D-196-48-57

R-16-49-05 01"

196-42-555

163-17-055

360-00-019

Adj. & = 16° 42' 55"

P.C. 833+92.46

6 68.61

P.T. 840+61.07


833+92.46

3 36.70

P.I. 837+29.16

Same (25)

Crew

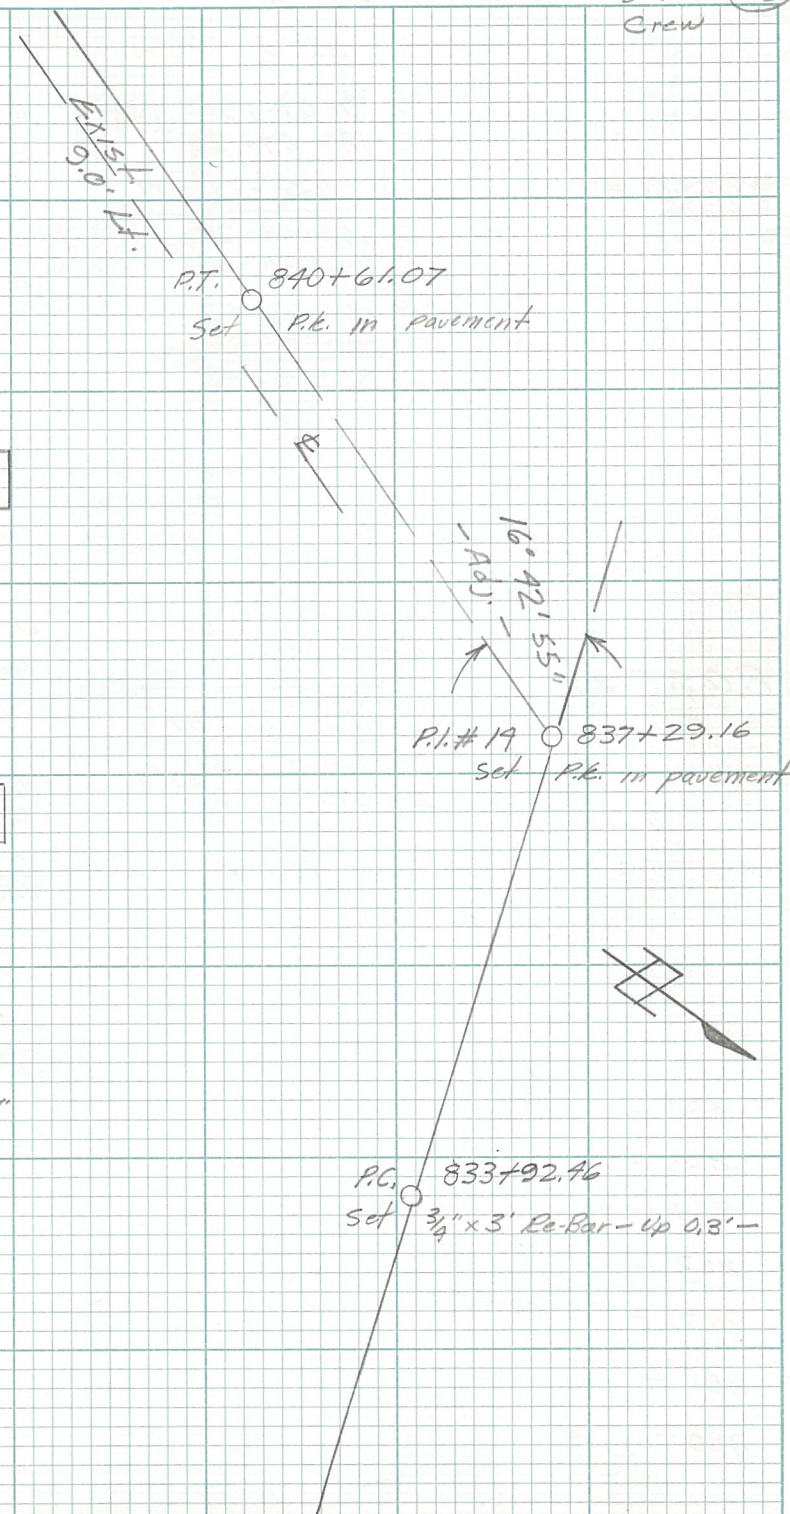

Sta Dist Defl. $\angle$

Az. $\angle$

Horizon $\angle$

D-0-07-19 235
R-180-07-28

D-0-07-03
R-180-07-00 015"

P.O.S.T. #2

165-37-07

194-22-52

D-165-44-27
R-345-44-34 305"

D-194-29-51 535"
R-19-29-56

194-22-52
165-37-07
359-59-59

$\angle = 14^{\circ} 22' 52''$

Az. $\angle$

Horizon $\angle$

D-0-04-02
R-180-04-12 07"

D-0-04-41 45"
R-180-04-49

P.O.S.T. #1

169-27-50.5

190-32-08.5

D-169-31-55
R-349-32-00 575-

D-190-36-54 535-
R-10-36-53

190-32-08.5
169-27-50.5
359-59-59.0

Adj. $\angle = 10^{\circ} 32' 09''$

856-

855-

854-

853-

852-

851-

850-


5-11-65

Snow Flurries $\angle 34^{\circ}$

(26)

10-32-09
19-22-52
24-55-01"

179-59-60
24-55-01
155-04-59

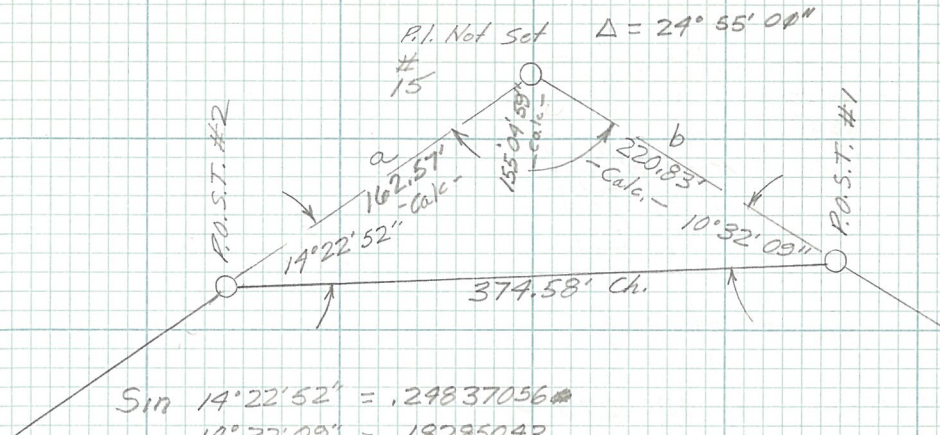

Sin $14^{\circ} 22' 52'' = .24837056$
" $10^{\circ} 32' 09'' = .18285043$
" $155^{\circ} 04' 59'' = .42130404$

$$a = \frac{.18285043 \times 374.58}{.42130404} = 162.57'$$


$$b = \frac{.24837056 \times 374.58}{.42130404} = 220.83'$$

$$T_s = \frac{316.96}{153.89} \quad \frac{316.96}{220.83} = 95.63$$


Sta.	Chain Dist	Defl.'s	
866 -			
865 -	75.33'		
864 + 29.67	P.O.T.	Begin Bridge	
864 -			
863 -			
	10.32'		
862 + 80.68	P.T.	12° 27.5' ✓	
+ 50		11° 50.7' ✓	
862 -		10° 50.7' ✓	
+ 50		9° 50.7' ✓	$\Delta = 29^{\circ} 55' 01''$
861 -		8° 50.7' ✓	$D = 4^{\circ} 00' 14''$
+ 50		7° 50.7' ✓	$T = 316.46'$
860 -		6° 50.7' ✓	$L = 622.92'$
+ 50		5° 50.7' ✓	$R = 1432.40'$
859 -		4° 50.7' ✓	$\frac{\Delta}{2} = 12^{\circ} 27' 30''$
+ 50		3° 50.7' ✓	$\Delta = 24.916944$
858 -		2° 50.7' ✓	
+ 50		1° 50.7' ✓	
857 -	42.24'	0° 50.7' ✓	
856 + 57.76	P.C.		

5-12-65
P. Cloudy & 42

Same (27)
Crew

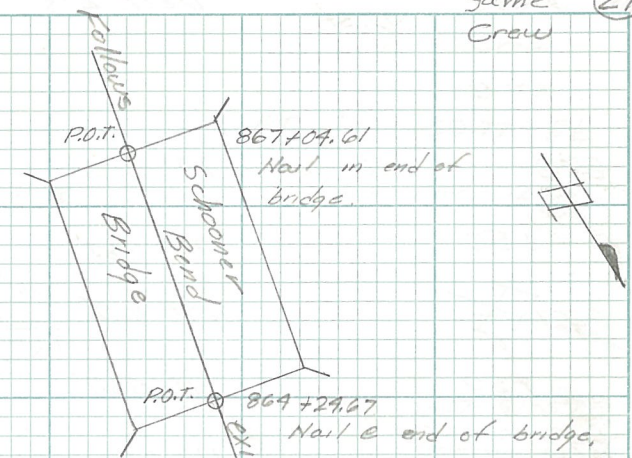

856 + 57.76
~~3 16~~
6 22.92
862 + 80.68 P.T.

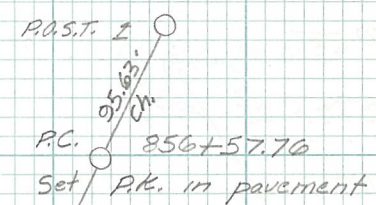

Sta.

Chain.

Dell. & S

Dist.

5-12-65

Same (29)

Crew

889 -

888 -

887 -

886 -

885 -

90.23'

884 + 09.77 A.P. =

Bk 884 + 59.77 P.T.

26° 03.0' -

+50

~~25° 46.2'~~ 25° 53.7'

884 -

25° 01.2'

+50

24° 08.7'

883 -

23° 16.2'

+50

22° 23.7'

882 -

21° 31.2'

+50

P.O.C.

20° 38.7'

881 -

19° 46.2'

+50

18° 53.7'

880 -

18° 01.2'

+50

17° 08.7'

879 -

16° 16.2'

+50

15° 23.7'

Sta. Chain Dist. Defl. Δ 's

903 -

902 -

901 -

900 -

899 -

898 -

07.89'

897+92.11 P.T. 12° 55.3' ✓

897 - 11° 32.4' -

896 - 10° 02.4' -

895 - 8° 32.4' -

894 - 7° 02.4' -

893 - 5° 32.4' -

892 - 4° 02.4' -

891 - 2° 32.4' -

890 - 1° 02.4' -

69.36'

889+30.64 P.C.

$$\Delta = 25^{\circ} 50' 39''$$

$$D = 3^{\circ} 00' \text{ Lt.}$$

$$T = 438.20'$$

$$L = 861.47'$$

$$R = 1909.86'$$

$$\frac{\Delta}{2} = 12^{\circ} 55' 20''$$

$$\Delta = 25.849166^{\circ}$$

5-12-65

P. Cloudy $\pm 50^{\circ}$

LRU-241

Same (30)

Clear

AZ. Δ

HORIZON Δ

D - 0-01-59 58°

E - 180-01-58

D - 0-02-31 30°

E - 180-02-30

154-09-185

205-50-365

D - 154-11-15 17°

E - 359-11-19

D - 205-53-05 07°

E - 25-53-09

154-09-185

205-50-365

359-59-55.0

Adj. $\Delta = 25^{\circ} 50' 39''$

P.I. #17 803+68.84

Set 3/4" x 3' Re-Bar
- up 0.3' -

889+30.64

8 61.97



P.T. 897+92.11

889+30.64

4 38.20

P.I. 893+68.84

P.C. 889+30.64
P.E. in pavement

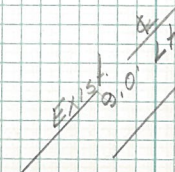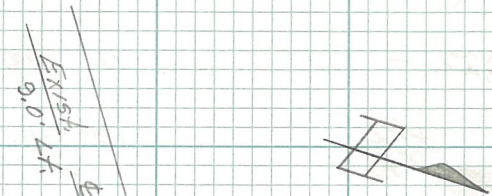

Sta. Chain.
Dist.

922 - 11° 38.4' ✓

+50 10° 34.7' ✓

921 - 09° 30.9' ✓

+50 08° 27.2' ✓

920 - 07° 23.4' ✓

+50 06° 19.7' ✓

919 - 05° 15.9' ✓

+50 04° 12.2' ✓

918 - 03° 08.4' ✓

+50 02° 04.7' ✓

917 - 01° 00.9' ✓

916+52.26 P.C. 0° 00' ✓

916 -

915 -

914 -

913 -

912 -

911 -

910 -

909 -

908 -

907 -

906 -

905 -

904 -

$\Delta = 32^\circ 33' 53''$
 $D = 9^\circ 15' 14''$
 $T = 393.77'$
 $L = 766.23'$
 $R = 1348.19'$

$\frac{\Delta}{2} = 16^\circ 16' 56''$
 $\Delta = 32.564722^\circ$

5-12-65

P. Cloudy 50°

Some (31)
Party

Az X

D-00-00-37 375"
E-180-00-38

147-26-07

D-197-26-42 495"
E-327-26-47

916+52.26
3 93.77
920+46.03 P.I.

916+52.26
7 66.23
924+18.49 P.T.

P.I. #18 920+46.03
Set 3/4" x 3' ReBar - Flush -

Horizon X

D-00-00-28 25"
E-180-00-22

212-33-53

D-212-34-18 18"
E-32-34-18

P.C. 916+52.26
Set P.R. in pavement

212-33-53
147-26-07
360-00-00

Exist. 4
9.0' Lx

Sta.

Chann.
DistDefl.
X

5-13-65

P. Cloudy & 75°

Same (32)
Crew

928 —

927 —

926 —

925 —

81.51

924+18.49 P.T. 16° 17.0' ✓

924 — 15° 53.4' —


+50 14° 49.7' —

923 — 13° 45.9' —

+50 12° 42.2' ✓

P.T. 924+18.49

Set Pk. in pavement

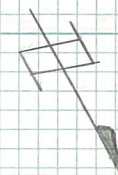

Sta.

Az. $\angle$ Horizon $\angle$

P.O.S.T. #2

D-00-00-12 09"
R-180-00-06

190-37-21

D-00-00-20 18"
R-180-00-17

169-22-40.5

D-190-37-32 30"
R-10-37-28

190-37-21
169-22-40.5
360-00-01.5

D-169-22-58 59"
R-349-23-00

Adj. $\angle$ = 10° 37' 20"Az. $\angle$ Horizon $\angle$

P.O.S.T. #1

D-00-00-29 30"
R-180-00-31

193-22-22

D-00-00-39 39.5"
R-180-00-40

166-37-35

D-193-22-52 52"
R-13-22-52

Adj. $\angle$ = 13-22-29

D-166-38-13 14.5"
R-346-38-16

166-37-35
193-22-22
359-59-57

5-13-65

Same (33)


Crew

10-37-20
13-22-24
23-59-44

P.I. #19

-Inaccessible-

$\Delta = 23^{\circ}59'44''$
-Calc-

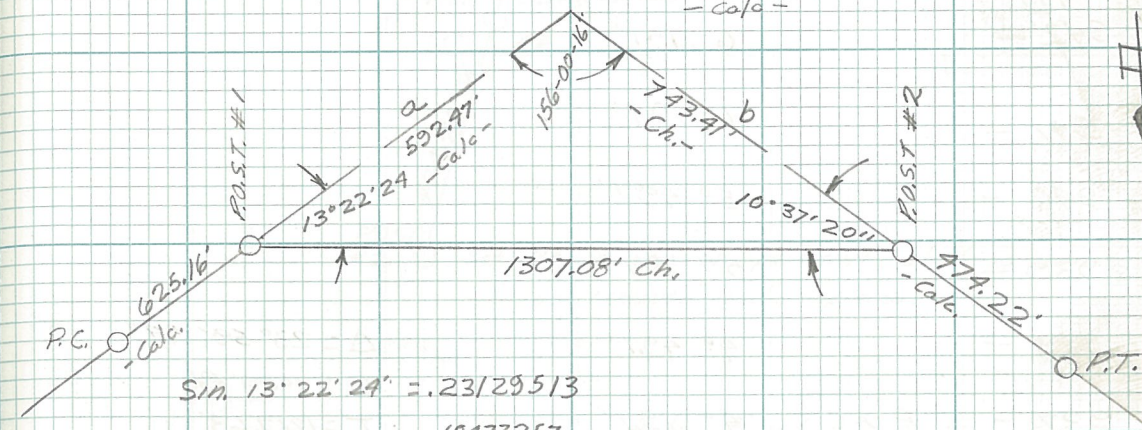Sim. $13^{\circ}22'24'' = .23129513$ " $10^{\circ}37'20'' = .18433257$ " $156.00.16 = .40666578$


$$a = \frac{.18433257 \times 1307.08}{.40666578} = \frac{24093742}{.40666578} = 592.47'$$

$$b = \frac{.23129513 \times 1307.08}{.40666578} = \frac{30232124}{.40666578} = 743.91'$$

T = 1217.63
592.47
625.16

1217.63
743.91
474.22

Sta	Chain Dist	Defl. Δ	
942 -		6° 49.1' -	
941 -		6° 19.1' -	
940 -		5° 49.1' -	
939 -		5° 19.1' -	
938 -		4° 49.1' -	$\Delta = 23^{\circ} 59' 44''$
937 -	P.O.C.	4° 19.1' -	$D = 1000' R.H.$
936 -		3° 49.1' -	$T = 1217.63'$
935 -		3° 19.1' -	$L = 2399.56'$
934 -		2° 49.1' -	$E = 5729.58'$
933 -		2° 19.1' -	$\frac{\Delta}{2} = 11^{\circ} 59' 52''$
932 -		1° 49.1' -	$\Delta = 23.99555^{\circ}$
931 -		1° 19.1' -	
930 -		0° 49.1' -	
929 -		0° 19.1' -	
928 + 36.42	63.58 P.C.		

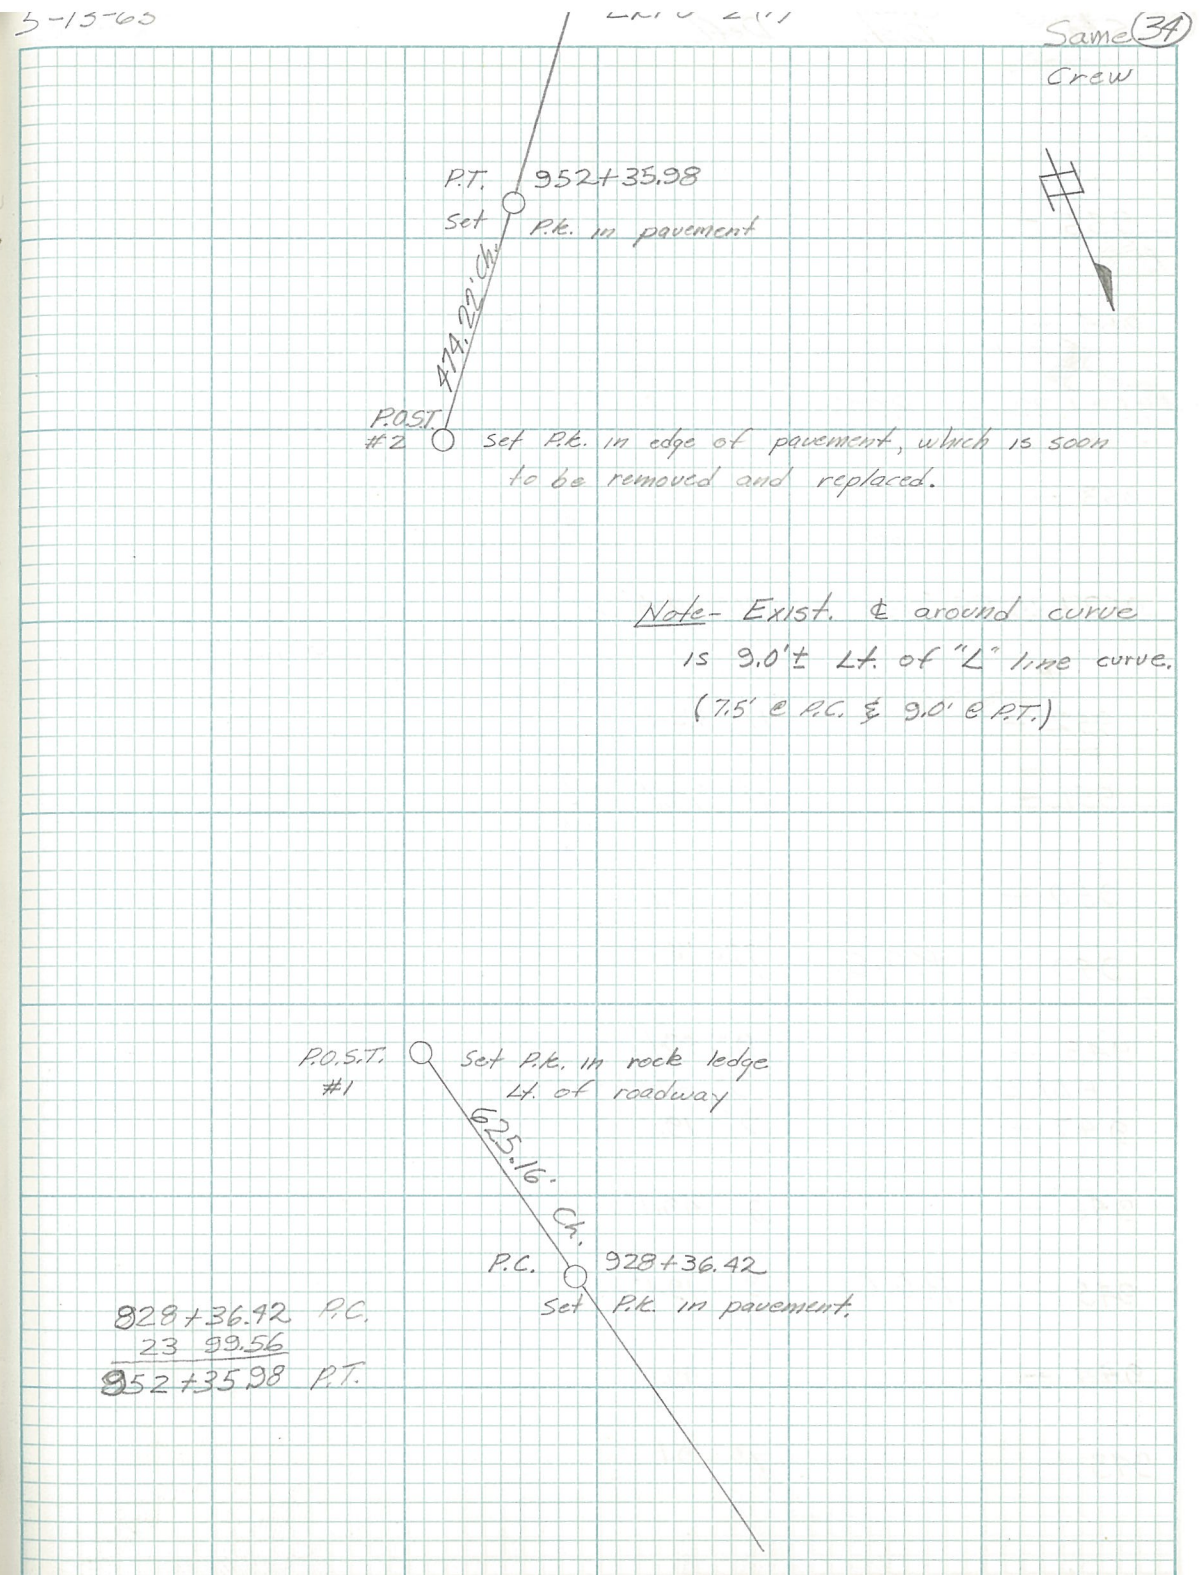

Sta. ^{Curv.} Dist. Defl.

955 -

954 -

67.87'

953+32.13 P.O.T.

953 -

64.02'

952+35.98 P.T. $11^{\circ} 59.9'$ ✓

952 -

$11^{\circ} 49.1'$

951 -

$11^{\circ} 19.1'$

950 -

$10^{\circ} 49.1'$

949 - P.O.C.

$10^{\circ} 19.1'$

948 -

$9^{\circ} 49.1'$

+ 61.21

$9^{\circ} 37.5'$ ✓

947 -

$9^{\circ} 19.1'$

946 -

$8^{\circ} 49.1'$

945 - P.O.C.

$8^{\circ} 19.1'$

944 -

$7^{\circ} 49.1'$

943 -

$7^{\circ} 19.1'$


5-14-65

Same (35)

Curve

P.O.T. 953+32.13
P.K.

EXIST. & 9.0' H.

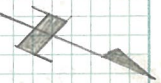

Sta. ^{chain} Dist. Defl. &

971-

970-

969-

968-

967-

28.51'

966+71.49 P.T. 3° 08.4' ✓

966- 2° 46.9' ✓

965- 2° 16.9' ✓

964- 1° 46.9' ✓

963- 1° 16.9' ✓

962- ~~1° 16.9'~~ 0° 46.9' ✓

961- ~~0° 46.9'~~ 0° 16.9' ✓

56.20

960+43.80 P.C. 0° 00'

960-

959-

958-

957-

956-


$\Delta = 06^\circ 16' 37''$
 $D = 1^\circ 00' 21''$
 $T = 314.15'$
 $L = 627.69'$
 $R = 5729.58'$

5-14-65
 P. Cloudy & 50

Same (36)

Crew

P.T. 966+71.49
 Set Pk. in pavement

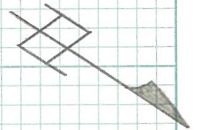

Az. &
 D-0-02-59 59°
 R-180-03-00 59°

173-43-21°

D-173-46-21 21"
 R-353-46-21 21"

173-43-21°
 186-16-35°
 359-59-57°

Horizon &
 D-0-01-04 04°
 R-180-01-04

186-16-35°

P.I. #20 963+57.35
 Pk. in edge
 of pavement

D-186-17-40 39°
 R-06-17-39 39°

Adj. & = 06° 16' 37"

960+43.80
 6 27.69
 966+71.49 P.T.

P.C. 960+43.80
 Pk. in pavement

Sta

Chain.

Dist.

Same (37)

Crew

5-15-65

976+00.30 E.O.P. = 26+68.35 of Location earthquake
repair survey.

976 -

975 -

974 -

973 -


972 -

E.O.P. 976+00.30

Exist. P.K. in pavement
(Set by Location in July 64
Sta. 26+68.35)

On exist.

It

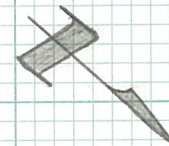

P.I. # 4 to P.I. #5

687 + 68.20 T.S. #2

I - $34^{\circ} 31' 30''$
II - $69^{\circ} 03' 15''$
III - $34^{\circ} 31' 38''$ Rt.

684+35.07 T.S. #1

I - $44^{\circ} 33' 30''$
II - $89^{\circ} 07' 15''$
Mn - $44^{\circ} 33' 38''$ RA

$672 + 43.77$ Beg. of Traverse

$I - 26^{\circ} 31' 45''$
 $II - 53^{\circ} 03' 45''$
 $Mn - 26^{\circ} 31' 52''$

5-17-65


ERTU = 11/

Same (39)


Party

Note - Stationing for Traverse

Line carried forward from "L" line
sta. 672+93.77.

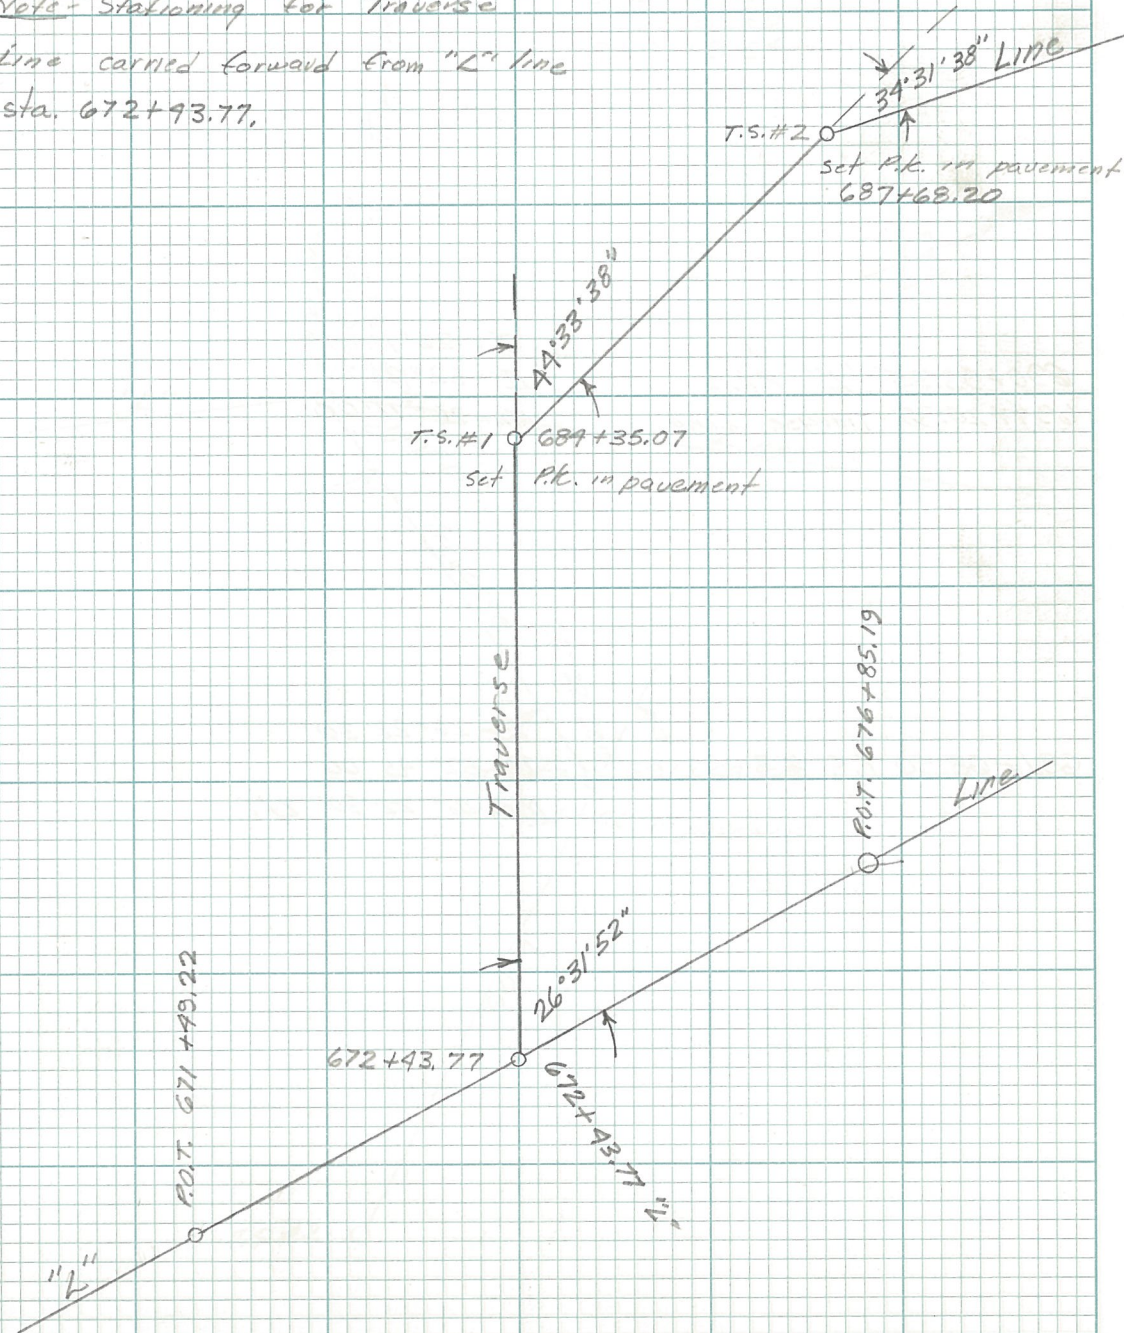

I - $26^{\circ} 22' 30''$
II - $52^{\circ} 45' 00''$
III - $26^{\circ} 22' 30''$ 4.

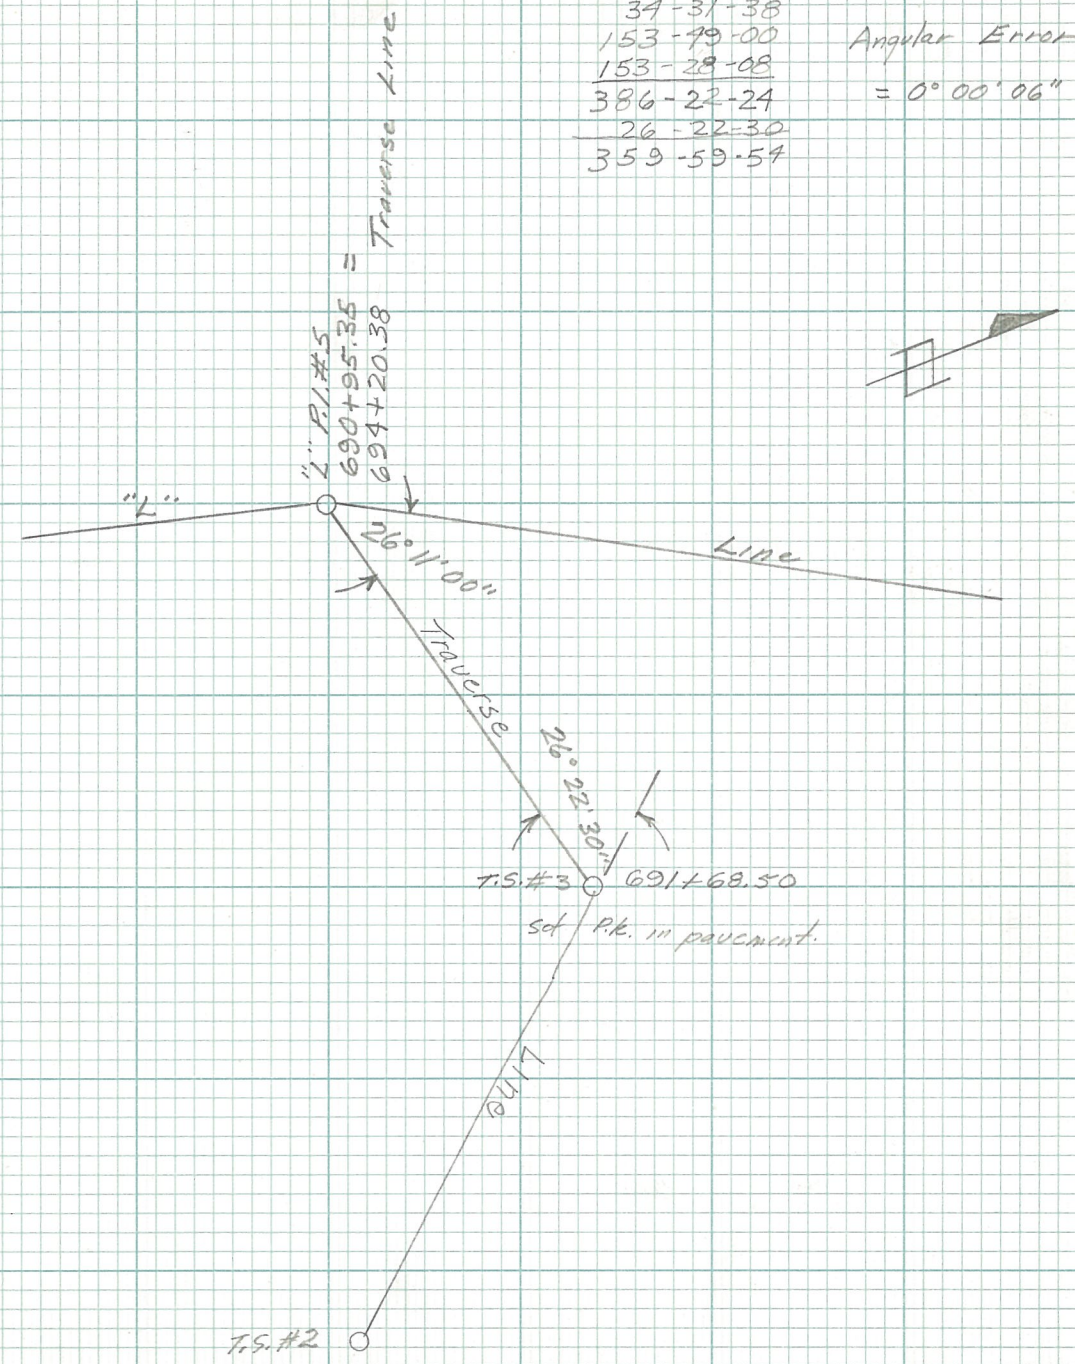

Sta.

Layout of Triangulation Ties to project.

Computed Traverse Closure of centerline alignment

Angular = $0^{\circ} 00' 32''$


$$\text{Dist.} = 5.33'$$

Accuracy Ratio = 1:18,800 *PJL* 6-29-65


$G = 22.65$

ERFO-2 (1)

(42)

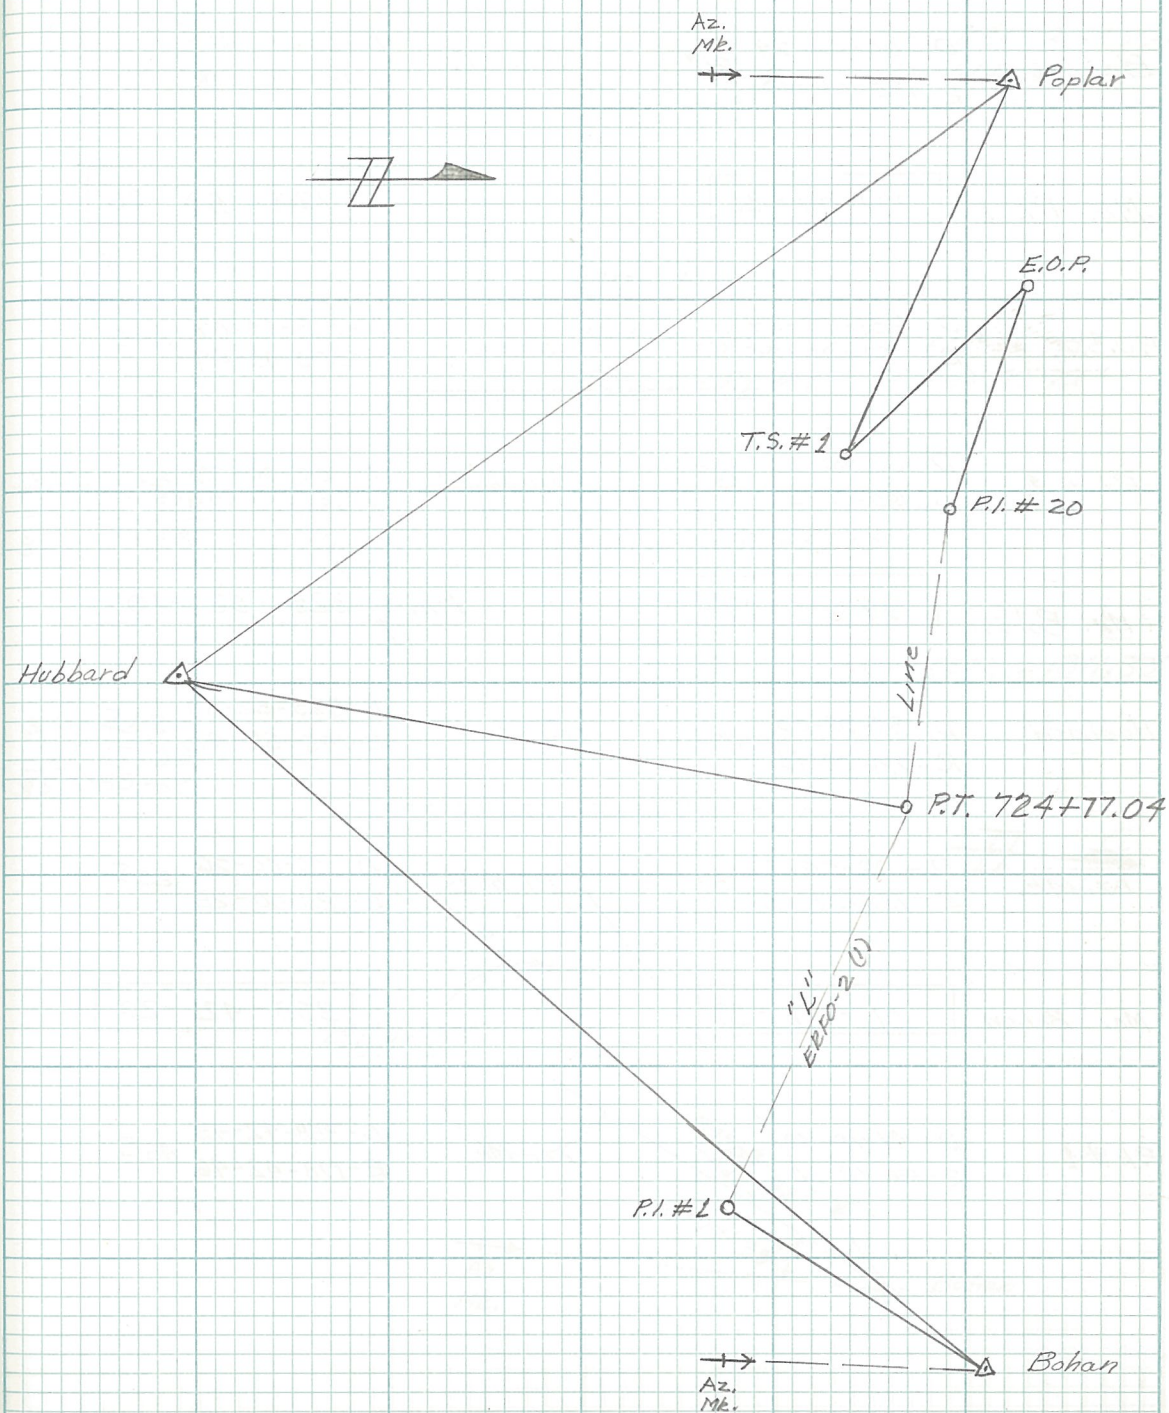

Sta.	Hor. Rdg.	Horizon	X
Bohan	D-00-00-29 21" R-180-00-18	P.O.S.T.	D-00-00-41 39° R-180-00-38
Mn. P.I. 1	231-00-31		128-59-26
P.O.S.T.	D-231-00-54 52" R-51-00-50	Bohan	D-129-00-07 05° R-309-00-04
P.I. # 1	D-00-00-23 23° R-180-00-24	Hubbard	D-00-00-29 29° R-180-00-29
Mn. Bohan	34-07-47°	Mn.	325-52-10°
Hubbard	D-34-08-09 11" R-214-08-13	P.I. # 1	D-325-52-38 39° R-145-52-41
Az. Mk.	D-00-00-52 51" R-180-00-50	P.I. # 2	D-00-00-26 25° R-180-00-25
Mn. Bohan	01-17-39		358-42-20
P.I. # 1	D-01-18-30 30" R-181-18-30	Az. Mk.	D-358-42-45 45° R-178-42-46

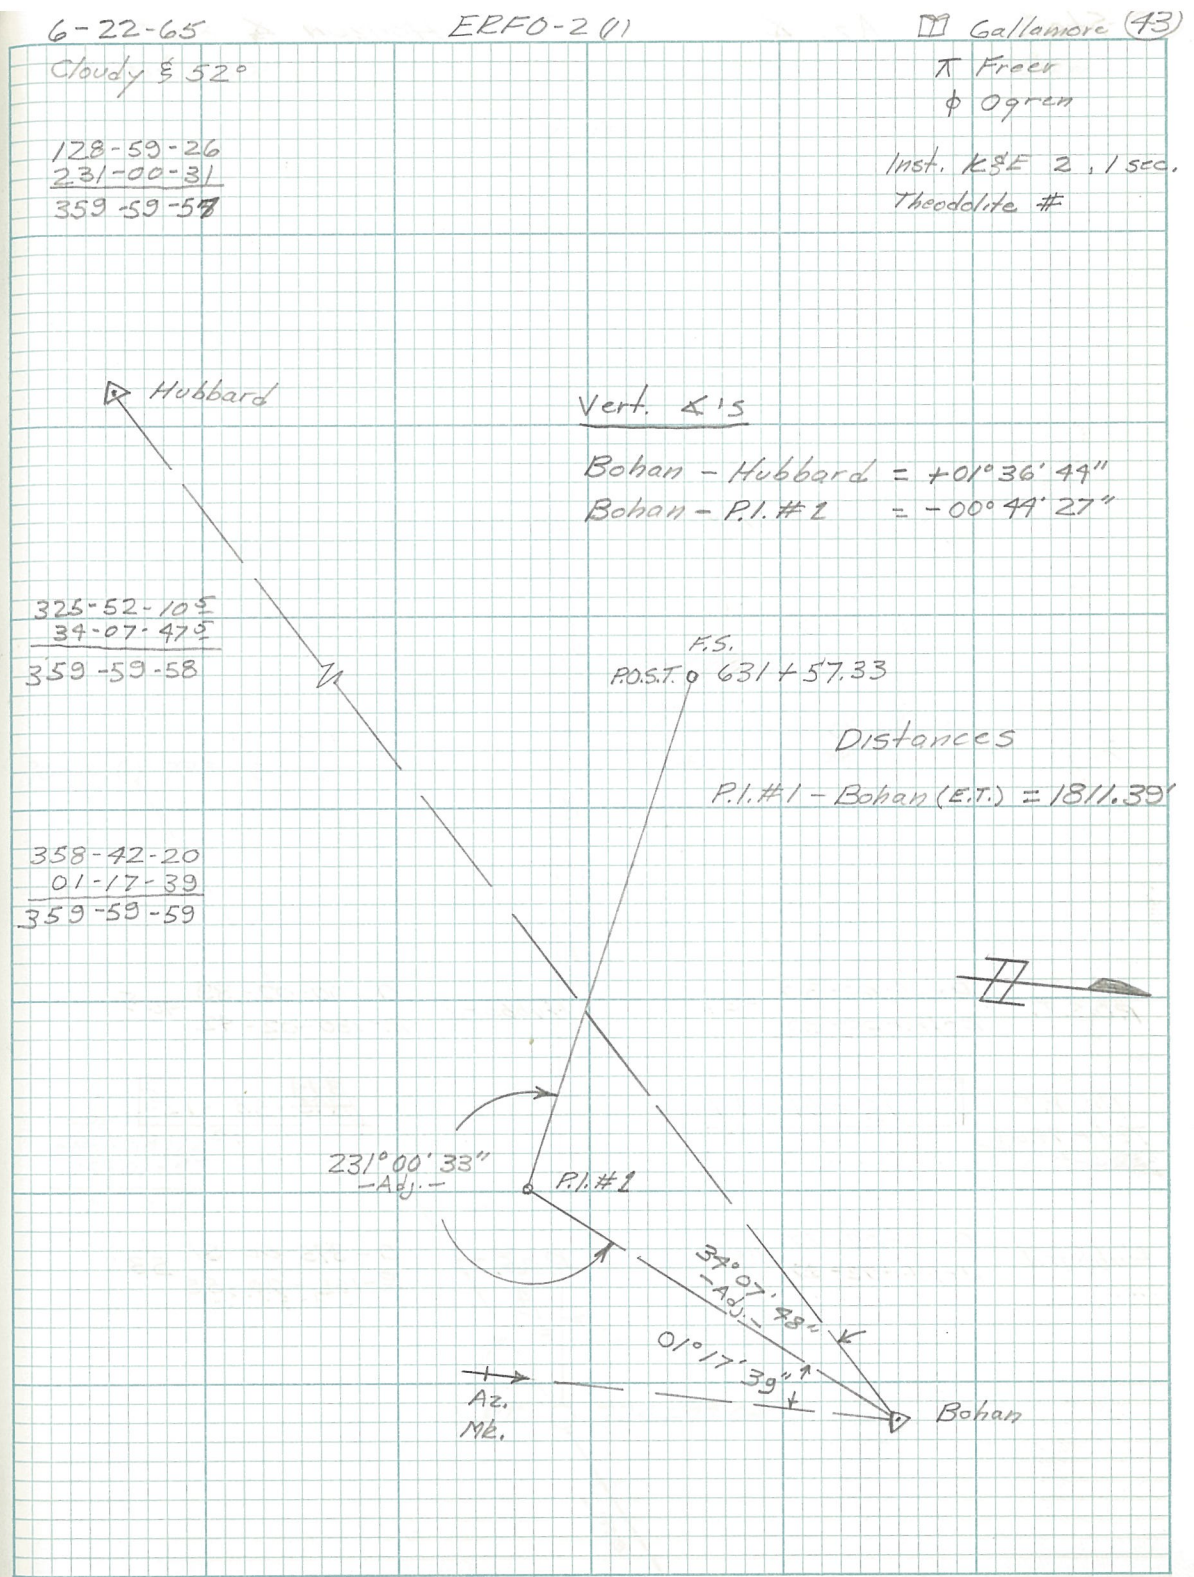

Sta.

Az. &

Horizon &

Same (77)

Crew

P.O.S.T. D-00-00-30 325"
R-180-00-35

Mn. P.T.
724+77.04

15-01-47

Hubbard D-15-02-17 195
R-195-02-22

Hubbard D-00-02-39 405
R-180-02-42

344
345-58-125

P.O.S.T. D-345-00-51 53"
R-165-00-55

6-29-65

Overcast & 50°

▽ Hubbard

6,704.89' E. Tape

Vert. &

P.T. to Hubbard
= +5° 03' 34"

P.O.S.T. ○ 733+30.23

344
345-58-125
15-01-47
350-59-595

P.T. ○ 724+77.04

Line



Sta.

Az. Δ Horizon Δ

E.O.P. D-00-00-15 15"
 976+00.30 R-180-00-15

Mn. T.S. #

358-43-36

Poplar

D-358-43-50 51"
 R-178-43-52

Poplar

D-00-00-47 48"
 R-180-00-49

01-16-21 $\frac{5}{5}$

E.O.P.

D-01-17-09 09 $\frac{5}{5}$
 R-181-17-10

P.I. # 20

D-00-00-20 22"
 R-180-00-24

Mn. E.O.P.

00-07-53

T.S. # 1

D-00-08-15 15"
 R-180-08-15

P.I. # 20

D-359-52-35 36"
 R-179-52-37

6-23-65

ERFO-2 (1)

(45)

P. Cloudy $\frac{5}{54}$
 Cloudy $\frac{5}{52}$


01-16-21 $\frac{5}{5}$
 358-43-36
 359-59-57 $\frac{5}{5}$

Vert. Δ 's

E.O.P. to T.S. #1
 = +01°19'06"

T.S. #1 to Poplar
 = +01°15'46"

359-52-12 $\frac{5}{5}$
 00-07-53
 359-59-05 $\frac{5}{5}$

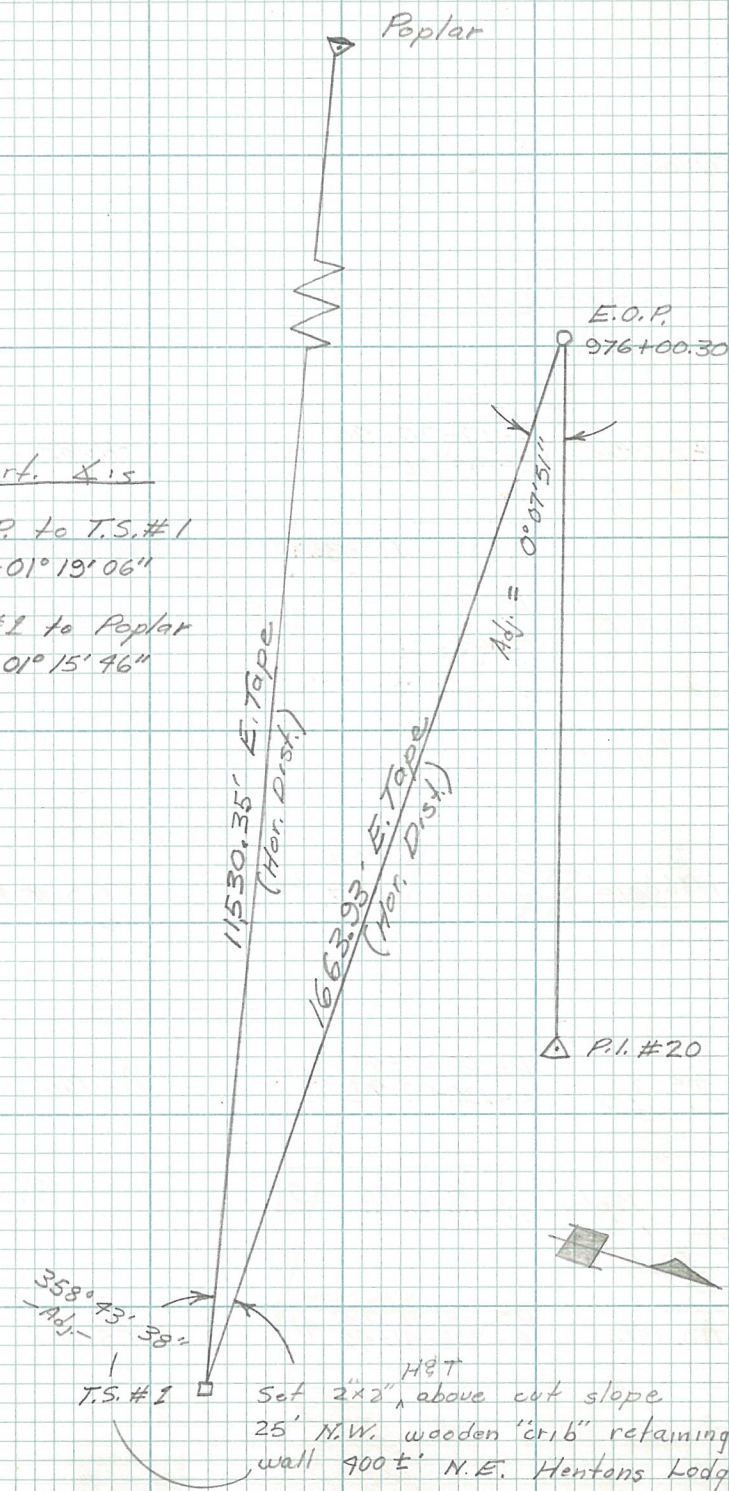

Sta.

Az. X

Horizon X

Hubbard D-00-00-28 30"
R-180-00-32

Az. Mk. D-00-00-38 30"
R-180-00-40

Poplar 17-20-16

Mn. = 342-39-41^E

Az. Mk. D-17-20-45 46"
R-197-20-47

Hubbard D-342-40-18 20^E"
R-162-40-23

T.S. #2 D-00-00-48 49^E"
R-180-00-51

Hubbard D-00-00-33 35^E"
R-180-00-38

Poplar 09-20-36

Mn. = 350-39-25^E

Hubbard D-09-21-24 25^E"
R-189-21-27

T.S. #1 D-350-³⁹42-59 01"
R-170-40-03

T.S. #1 D-00-00-44 46"
R-180-00-48

Az. Mk. D-00-00-48 45^E"
R-180-00-43

Poplar 26-40-55

Mn. = 333-19-07^E

Az. Mk. D-26-41-40 41"
R-206-41-42

T.S. #2 D-333-19-54 53"
R-153-19-52


6-23-65

Poplar

Same (46)

Partly Cloudy & 52

Crew

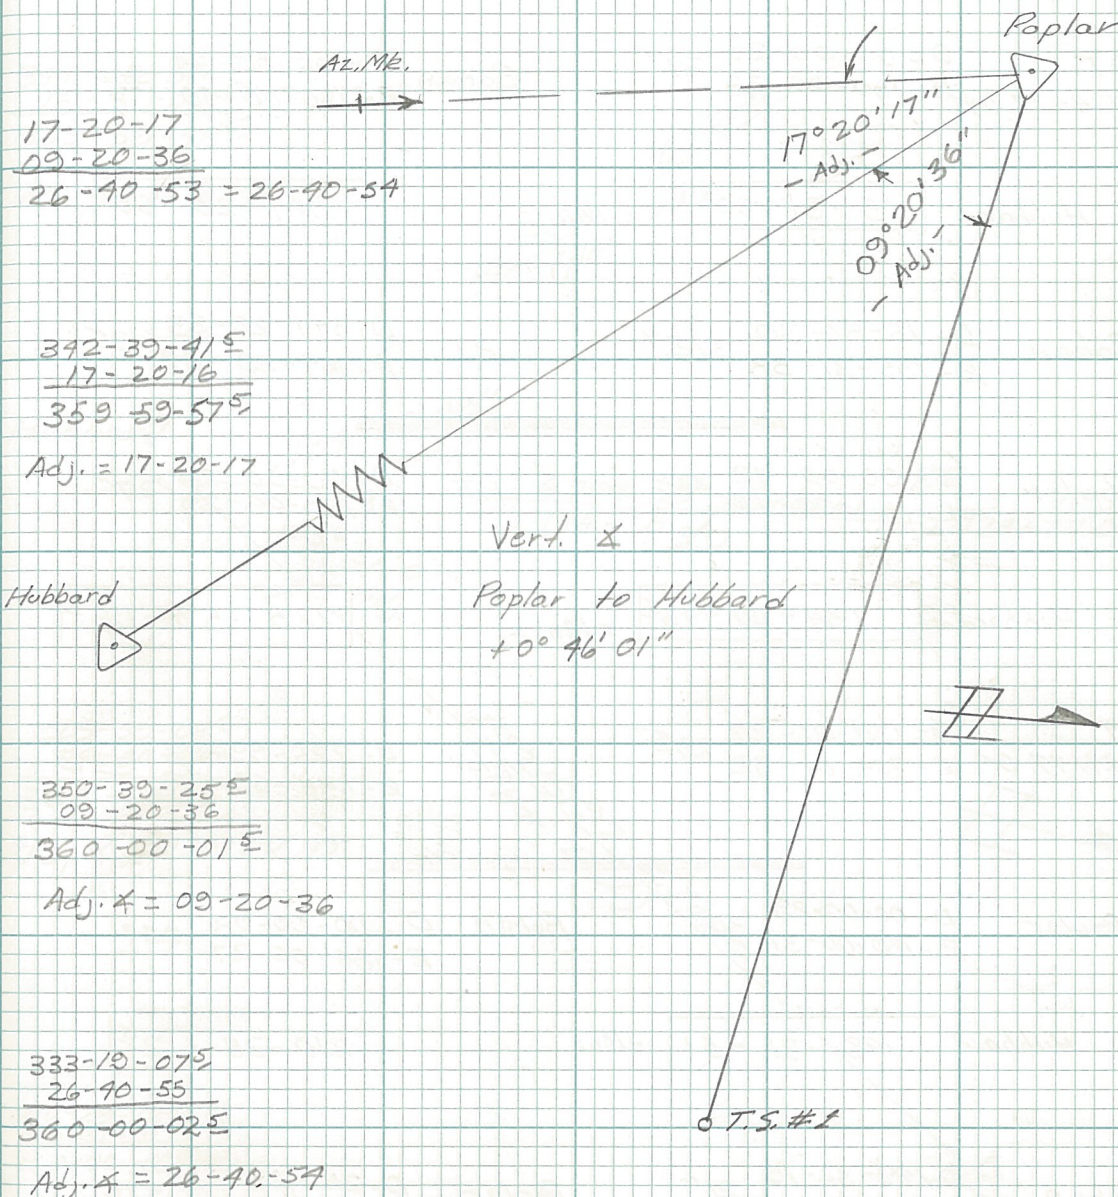

Sta.

Az. &

Horizon &

P.T. D-00-00-29 31"
 724+77.04 R-180-00-33

Bohan D-00-00-34 37"
 R-180-00-40

Hubbard 15-31-00^s = Mn. =

344-28-58

Bohan D-15-31-30 31^s"
 R-195-31-33

P.T. D-344-29-33 35"
 R-164-29-37

Poplar D-00-00-42 43"
 R-180-00-44

P.T. D-00-00-25 27"
 R-180-00-29

Hubbard 134-00-46^s = Mn. =

225-59-08^s

P.T. D-134-01-27 29^s"
 724+77.04 R-314-01-32

Poplar D-225-59-33 35^s"
 R-45-59-38

Poplar D-00-00-29 30"
 R-180-00-31

Bohan D-00-00-23 25"
 R-180-00-27

Hubbard 149-31-51 = Mn. =

210-28-12^s

Bohan D-149-32-19 21"
 R-329-32-23

Poplar D-210-28-35 37^s"
 R-30-28-40

6-24-65
 Partly Cloudy & 50°

Hubbard

Same
 Crew (47)

15° 31' 01"
 134 00 49
 149° 31' 50" ✓

344-28-58
 15-31-00^s
 359-59-58^s

Adj. & = 15° 31' 01"

Hubbard

134° 00' 49"
 - Adj. -

15° 31' 01"
 - Adj. -

6,704.89' E. Tape
 (Hor. Dist.) P.T. 0 724+77.04

225-59-08^s
 134-00-46^s
 359-59-55

Adj. & = 134° 00' 49"

29,215.97' E. Tape
 (Hor. Dist.)

210-28-12^s
 149-31-51
 360-00-03^s

Adj. & = 149° 31' 50"

Poplar

Bohan

Sta.	Chain. Dist.	Temp. Temp.	Temp. Corr.	True Dist.
------	-----------------	----------------	----------------	---------------

Note- As a check on the Electrotape calibration three points were set in line, and the distance double chained between them. The first distance was measured then the total of the two. Chaining was done with a chain that had been checked with Locations "standard" chain. Calibrated 10000' at 68° & 23 lbs. pull. Chain pull scale used for the check distance.

Total Dist., chained = 1450.55', E. Tape = 1450.28'

First Dist., chained = 838.45', E. Tape = 838.10'


Electrotape distances above are without using any fixed correction.

1450', E. Tape + 0.27' = Chain. Dist.

838', E. Tape + 0.26' = Chain. Dist.

From this information it was assumed the difference is not proportional to the distance involved. A

fixed correction of + 0.08 M. would balance the E. Tape to the chain. As another check distances from "Peplar" to "Hubbard" & "Hubbard" to "Boham" were measured with the Tapes.

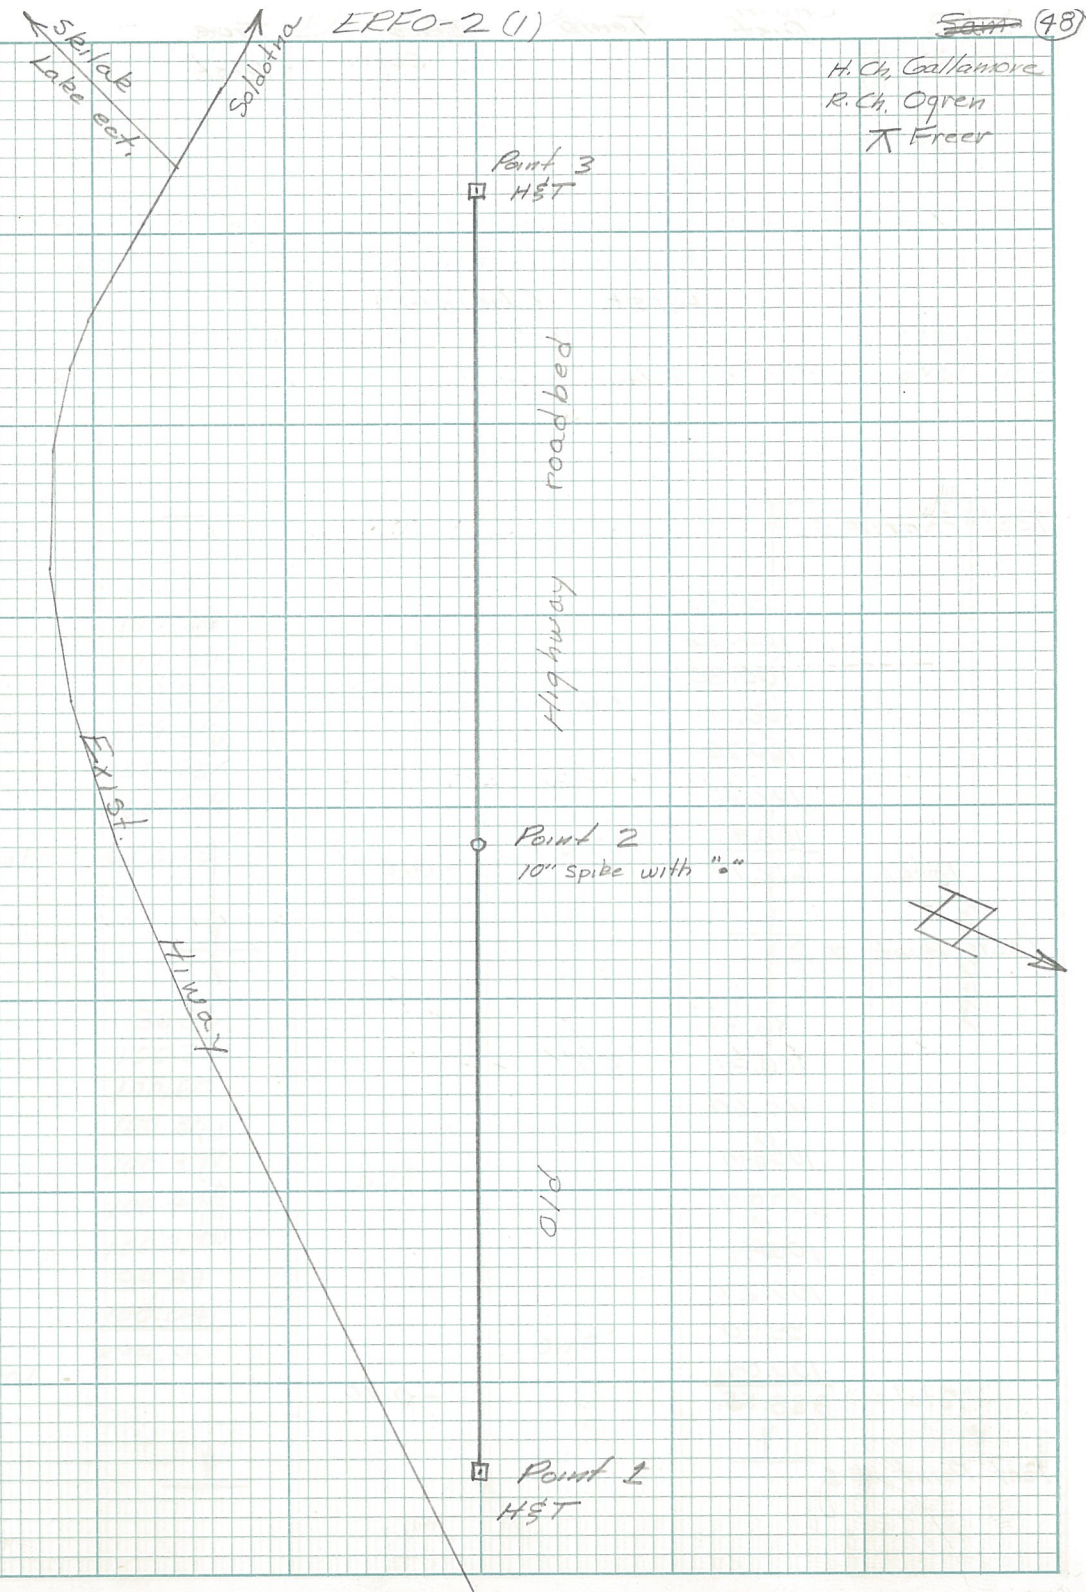

Sta

Chain
Dist.

Temp.

Temp.
Corr.True
Dist.

Electrotape Check

Same (49)
Grew

First Chaining

Test Point #3

	10.23	
	100.26	
	100.30	
	100.00	50°
	100.26	
	100.65	
	<u>100.47</u>	
Total	612.17	-0.07'

Test Point #2

	36.31	
	100.31	50°
	100.60	
	100.34	
	100.37	
	100.41	
	100.27	
	99.90	
	<u>100.04</u>	
Total =	838.55	-0.10'


Test Point #1

Second Chaining

Total
Dist. Mn.

	10.23	
	100.27	
	100.30	
	99.99	50°
	100.25	
	100.65	
	<u>100.47</u>	
Total	612.16	-0.07'

	36.32	
	100.31	
	100.60	
	100.35	
	100.37	50°
	100.40	
	100.27	
	99.89	
	<u>100.04</u>	
Total	838.55	-0.10'

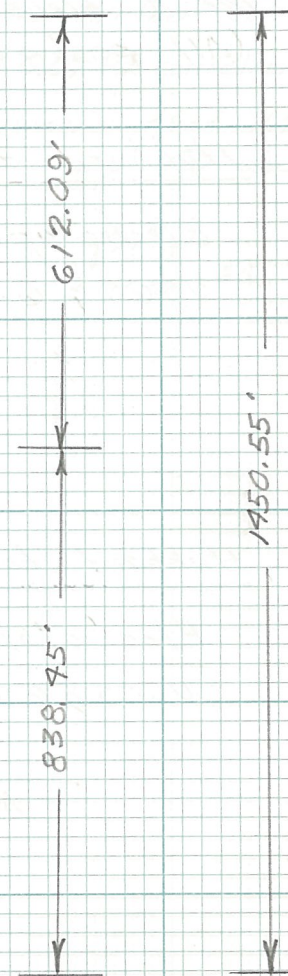

The distances from "Hubbard" to "Paplar" and from Hubbard to "Bohan" were measured with the electrotapes. The USCS & GS distances were later obtained. The results are below.

USCS & GS distances have been corrected to mean elevations from sea level information, (All post quake)

Hubbard to Paplar

Electrotape Measurement = 28,898.90'

USCS & GS Distances = 28,898.63'

Difference = 0.27'

Accuracy Ratio 1:107,000

Hubbard to Bohan

Electrotape Measurement = 19,215.97'

USCS & GS Distance = 19,215.49'

Difference = 0.48'

Accuracy Ratio = 1:40,000

7-20-65

Callamore (50)

Note: When making the electrotape measurement from "Hubbard" to "Bohan" some variation was noticed in the settings. The line of sight passed through some trees on another ridge. This may account for the wider spread on this "shot." Calculations on the electrotape sheets were made using a fixed correction of + 0.08. (see page 48) Another check at a later date arrived at a +0.07 M. correction.

From this information it appears that the electrotapes have a potential accuracy far above that necessary for our work.

pdg
1-20-65


83.56

83.54 -13° 13' P.C. 833+92.46

83.54 -13 15 .07344589

833+11.14
81.32

TRIGONOMETRIC FORMULÆ

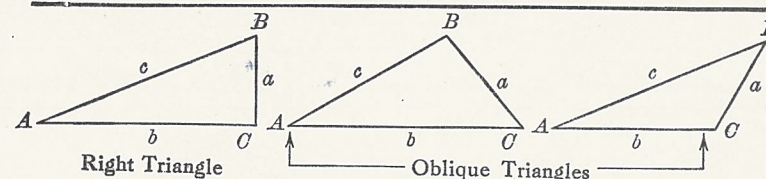

Solution of Right Triangles


For Angle A. $\sin = \frac{a}{c}$, $\cos = \frac{b}{c}$, $\tan = \frac{a}{b}$, $\cot = \frac{b}{a}$, $\sec = \frac{c}{b}$, $\csc = \frac{c}{a}$

Given	Required	
a, b	A, B, c	$\tan A = \frac{a}{b} = \cot B, c = \sqrt{a^2 + b^2} = a \sqrt{1 + \frac{b^2}{a^2}}$
a, c	A, B, b	$\sin A = \frac{a}{c} = \cos B, b = \sqrt{(c+a)(c-a)} = c \sqrt{1 - \frac{a^2}{c^2}}$
A, a	B, b, c	$B = 90^\circ - A, b = a \cot A, c = \frac{a}{\sin A}$
A, b	B, a, c	$B = 90^\circ - A, a = b \tan A, c = \frac{b}{\cos A}$
A, c	B, a, b	$B = 90^\circ - A, a = c \sin A, b = c \cos A$

Solution of Oblique Triangles

Given	Required	
A, B, a	b, c, C	$b = \frac{a \sin B}{\sin A}, C = 180^\circ - (A + B), c = \frac{a \sin C}{\sin A}$
A, a, b	B, c, C	$\sin B = \frac{b \sin A}{a}, C = 180^\circ - (A + B), c = \frac{a \sin C}{\sin A}$
a, b, C	A, B, c	$A + B = 180^\circ - C, \tan \frac{1}{2}(A - B) = \frac{(a - b) \tan \frac{1}{2}(A + B)}{a + b}$ $c = \frac{a \sin C}{\sin A}$
a, b, c	A, B, C	$s = \frac{a + b + c}{2}, \sin \frac{1}{2}A = \sqrt{\frac{(s - b)(s - c)}{bc}}$ $\sin \frac{1}{2}B = \sqrt{\frac{(s - a)(s - c)}{ac}}, C = 180^\circ - (A + B)$
a, b, c	Area	$s = \frac{a + b + c}{2}, \text{area} = \sqrt{s(s - a)(s - b)(s - c)}$
A, b, c	Area	$\text{area} = \frac{b c \sin A}{2}$
A, B, C, a	Area	$\text{area} = \frac{a^2 \sin B \sin C}{2 \sin A}$

REDUCTION TO HORIZONTAL

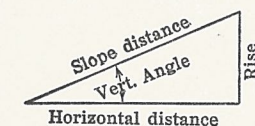

Horizontal distance = Slope distance multiplied by the cosine of the vertical angle. Thus: slope distance = 319.4 ft. Vert. angle = 5° 10'. From Table, Page IX, $\cos 5^\circ 10' = .9959$. Horizontal distance = $319.4 \times .9959 = 318.09$ ft. Horizontal distance also = Slope distance minus slope distance times (1 - cosine of vertical angle). With the same figures as in the preceding example, the following result is obtained. $\text{Cosine } 5^\circ 10' = .9959, 1 - .9959 = .0041, 319.4 \times .0041 = 1.31, 319.4 - 1.31 = 318.09$ ft.

When the rise is known, the horizontal distance is approximately: —the slope distance less the square of the rise divided by twice the slope distance. Thus: rise = 14 ft., slope distance = 302.6 ft. Horizontal distance = $302.6 - \frac{14 \times 14}{2 \times 302.6} = 302.6 - 0.32 = 302.28$ ft.